

O.D.O.T. DISTRICT 2 SURVEY OFFICE (USE ONLY)

PERSONNEL

REFERENCE NO. 25 AA

SHEET 3 OF 21

NOTES NIESE

DATE 12/4/19

ROUTE SR 582

H.C. LEU

WEATHER CLOUDY

COUNTY WOOD

R.C. NASON

TEMP. 38°

TOWNSHIP MIDDLETON

SECTION 28

DWG BY BALBAUGH

PID 81000

T 6 N R 11 E

TYPE MONUMENT MONBOX W/ 1" IPIN

ON SURFACE - ~~BELOW~~ ON

OFFSET 6.8 ± : RT

— TO — EDGE PAVEMENT


STATION: 402+47.43

HORIZ.DATUM: NAD83 (2011)


GEOID: 2012A

GRID: NORTHING: 654460.728

EASTING: 1665074.851

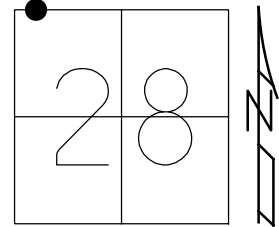


RECORD:  
 STA. 402+47.43  
 PER WOO-582-6.48  
 PID #81000  
 FD MONBOX  
 W/ 1" IPIN  
 REFAA25  
 11/14/19, JLL

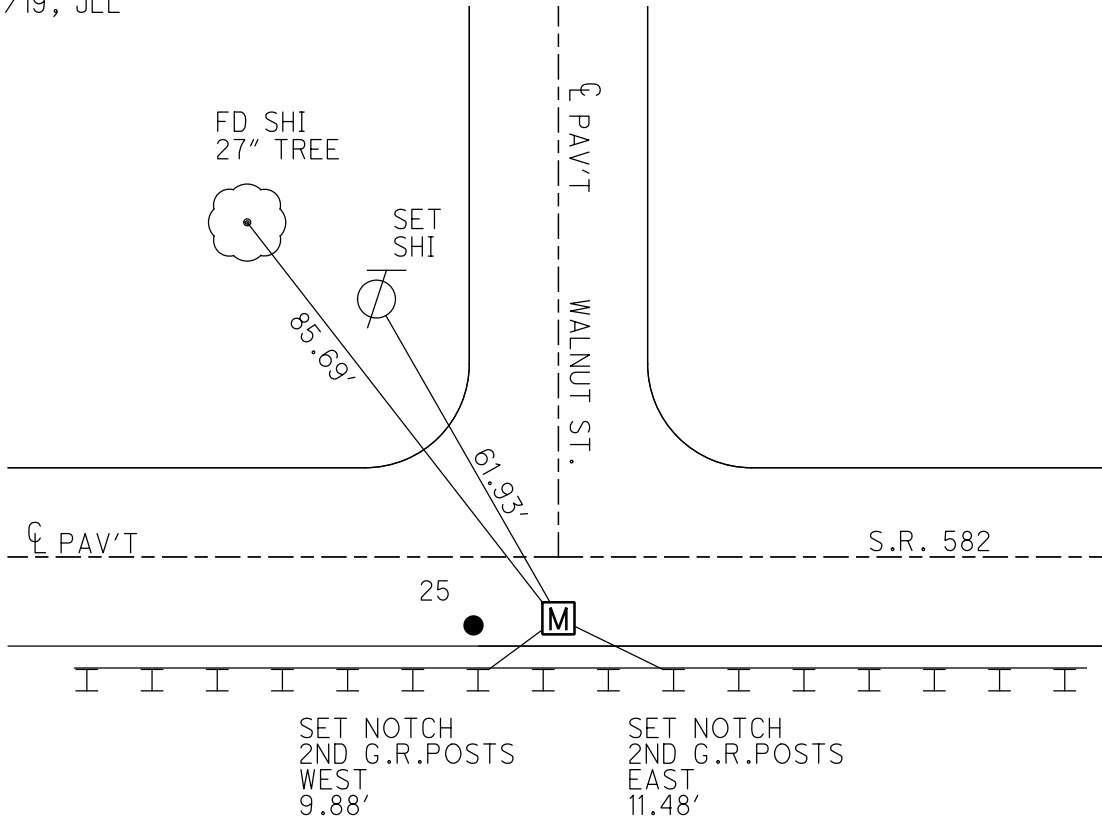

PERSONNEL TITLE PERSONNEL TITLE  
 Morrison \_\_\_\_\_  
 Holcombe \_\_\_\_\_  
 Smith \_\_\_\_\_  
 Burnside \_\_\_\_\_

COUNTY Wood DATE April, 17, 1969  
 S. R. #582 WEATHER Pt. Cloudy & Windy  
 SEC. From I-75 to SR#199 TEMP. +75°

DESCRIPTION Ties to Control points. JOB NO. 027300

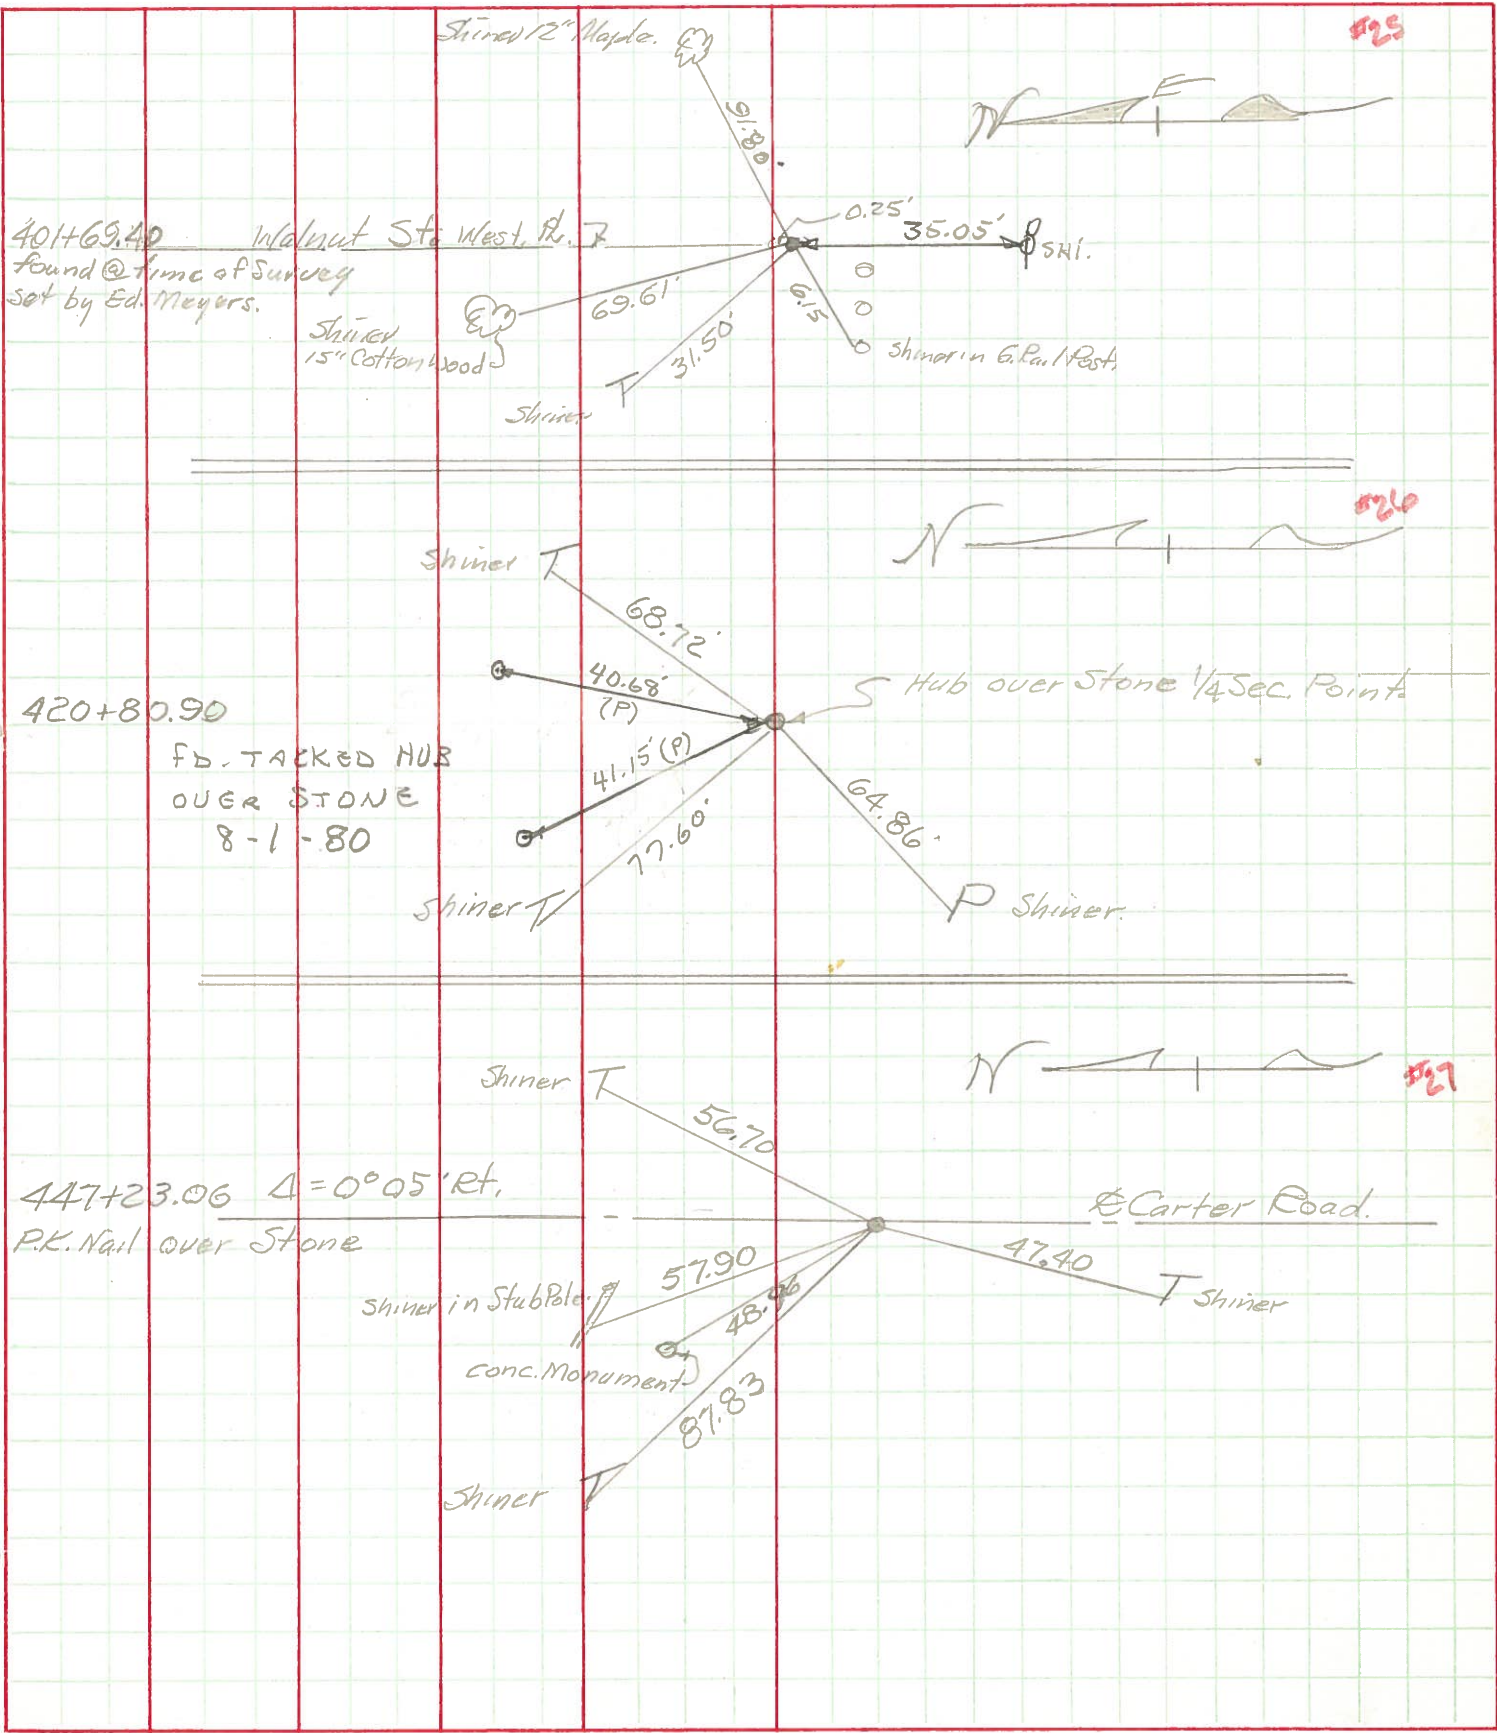

PERSONNEL	TITLE	PERSONNEL	TITLE
<i>Morrison</i>			
<i>Holcombe</i>			
<i>Smith</i>			
<i>Burnside</i>			

COUNTY Wood DATE April 17, 1980  
 S. R. # 582 WEATHER Pt. Cloudy 64°F  
 SEC. From T-75 to SP# 100 TEMP 47.5°

DESCRIPTION Trac to Central station JOB NO. 027500

