

O.D.O.T. DISTRICT 2 SURVEY OFFICE (USE ONLY)

PERSONNEL

REFERENCE NO. 25 A

SHEET 4 OF 21

NOTES LEU DATE 4/8/20
 H.C. LEU WEATHER SUNNY
 R.C. BALBAUGH TEMP. 66°

ROUTE SR 582
 COUNTY WOOD
 TOWNSHIP MIDDLETON
 SECTION 28

DWG BY BALBAUGH PID 81000

T 6 N R 11 E

TYPE MONUMENT MAG/WASHER

ON SURFACE - ~~BELOW~~ ON

OFFSET C PAVEMENT 7.0' ~~ET~~ : RT

2.5' TO RT EDGE PAVEMENT


STATION: 416+02.26

HORZ.DATUM: NAD83 (2011)

GEOID: 2012A


GRID: NORTHING: 654421.675

EASTING: 1666429.089

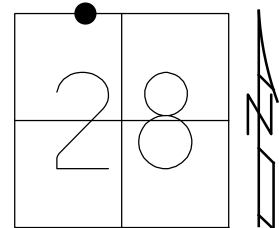

RECORD:
 FD P.K./WASHER
 4/15/05, MC
 SET MAG/WASHER
 8/23/05, MDB
 FD MAG/WASHER
 REFA25
 4/14/15, JLL
 D.N.F.
 4/23/19, JLL
 SET MAG/WASHER
 FROM COORDINATES
 4/8/20, JLL


RES. #10626

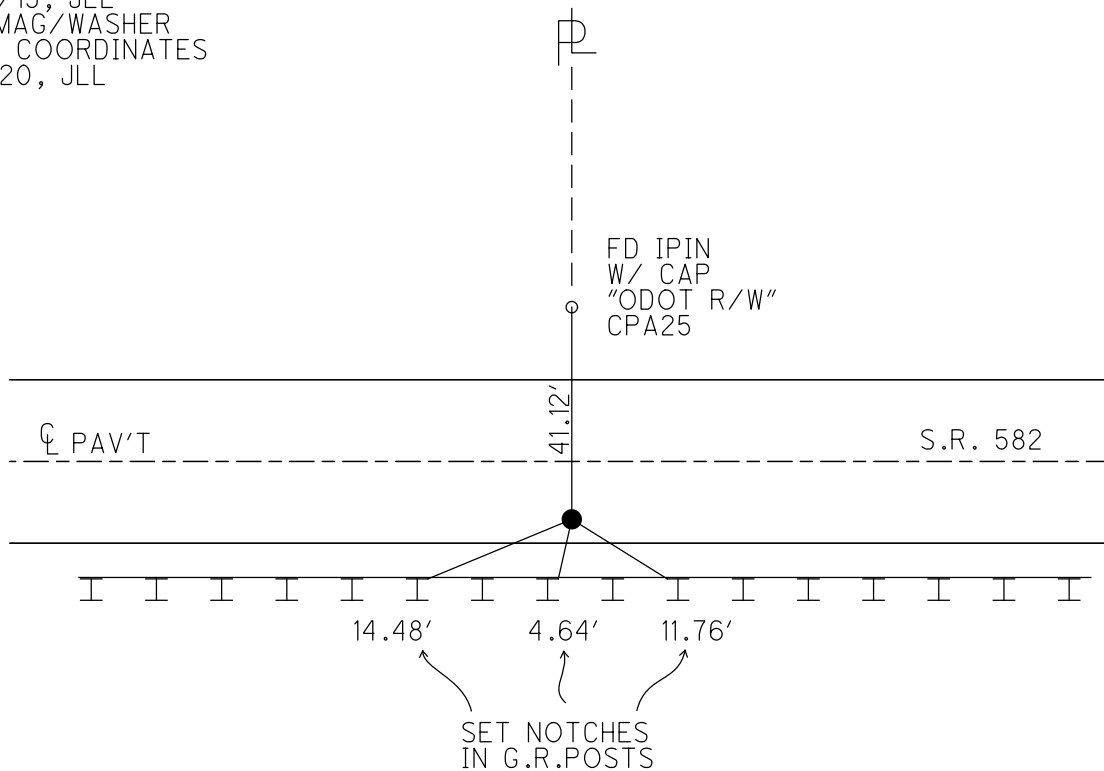

O.D.O.T. DISTRICT 2 SURVEY OFFICE


PERSONNEL	REFERENCE NO. <u>25-A</u>	SHEET <u>3</u> OF <u>20</u>
NOTES <u>BARNHISEL</u>	DATE <u>04/15/05</u>	ROUTE <u>582</u>
H.C. <u>CANTERBURY</u>	WEATHER <u>CLEAR</u>	COUNTY <u>WOOD</u>
R.C. <u>BARNHISEL</u>	TEMP. <u>+50°</u>	TOWNSHIP <u>MIDDLETON</u>
		SECTION <u>28</u>
		T <u>6</u> N R <u>11</u> E

TYPE MONUMENT PK NAIL/WASHER
 ON SURFACE - ~~BELOW~~ YES
~~LEFT~~ - Q PAV'T - RIGHT 7.0'
2.5' TO RT EDGE PAVEMENT
 S.L.M. 416+16
 GRID: NORTHING: EASTING:

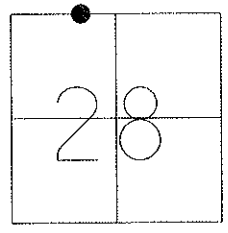

RESET MAG NAIL & WASHER
 08/23/05
 MDB

RES. #10626

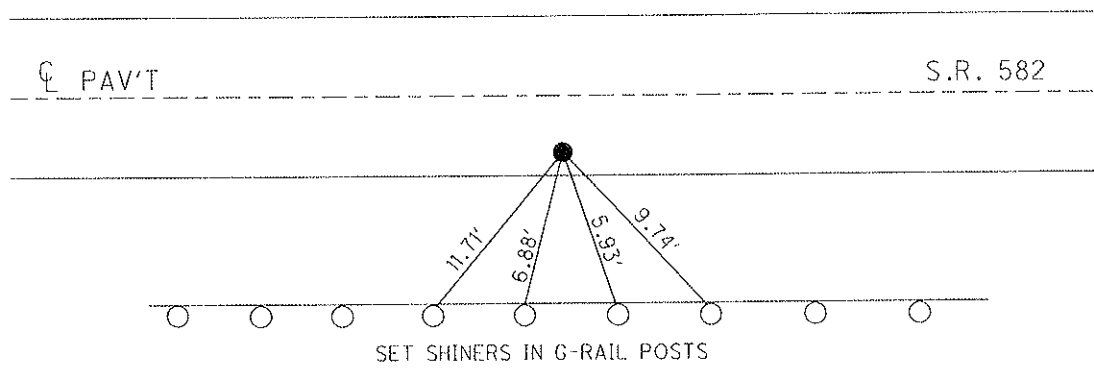

O.D.O.T. DISTRICT 2 SURVEY OFFICE

PERSONNEL

REFERENCE NO. 25-A

SHEET 3 OF 21

NOTES BARNHISEL

DATE 04/15/05

ROUTE 582

H.C. CANTERBURY

WEATHER CLEAR

COUNTY WOOD

R.C. BARNHISEL

TEMP. +50°

TOWNSHIP MIDDLETON

SECTION 28

T 6 N R 11 E


TYPE MONUMENT PK NAIL/WASHER

ON SURFACE ~~-BELOW~~ YES

~~LEFT~~ - Q PAV'T - RIGHT 7.0'


2.5' TO RT EDGE PAVEMENT

S.L.M. 416+16

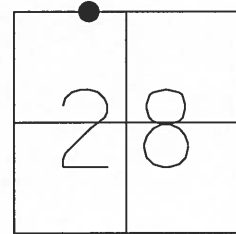

RESET MAG NAIL & WASHER
08/23/05
MDB

RES. #10626

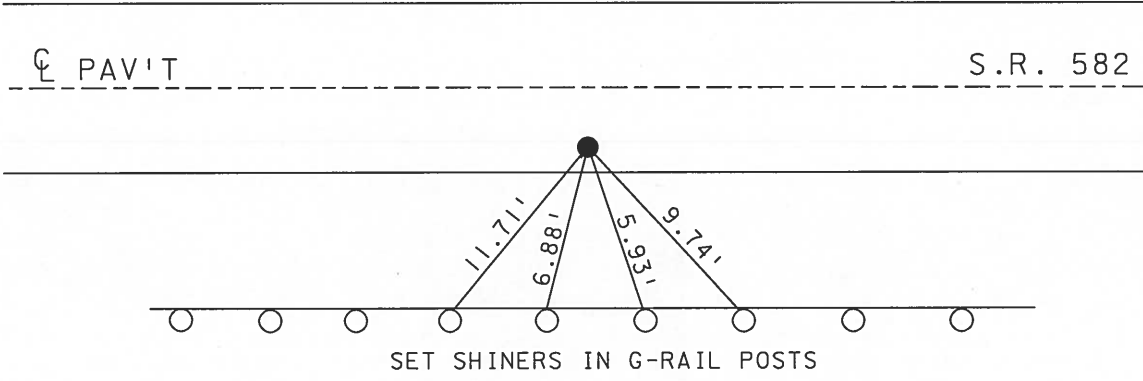

O.D.O.T. DISTRICT 2 SURVEY OFFICE

PERSONNEL _____

REFERENCE NO. 25-A

SHEET _____ OF _____

NOTES LOEHRKE

H.C. HOFFMAN

R.C. BARNHISEL

DATE 7-12-90

WEATHER Cloudy

TEMP. +85

ROUTE 582

COUNTY WOOD

TOWNSHIP MIDDLETON

SECTION 28

T 6 N R 11 E


TYPE MONUMENT P.K.

ON SURFACE - ~~BELOW~~ Yes

~~LEFT~~ - € PAV'T. - RIGHT 6.7

2.8 TO Rt EDGE PAVEMENT

S.L.M. 416+12

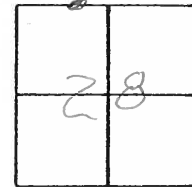

Set P.K./Washer
10-25-90
mB

