


O.D.O.T. DISTRICT 2 SURVEY OFFICE

PERSONNEL	REFERENCE NO. <u>38 A</u>	SHEET <u>2</u> OF <u>29</u>
NOTES <u>HOMAN</u>	DATE <u>4/27/10</u>	ROUTE <u>SR 582</u>
H.C. <u>HOMAN</u>	WEATHER <u>SUNNY</u>	COUNTY <u>WOOD</u>
R.C. <u>ROUSOS</u>	TEMP. <u>40°</u>	TOWNSHIP <u>TROY</u>
		SECTION <u>28</u>
		T <u>6</u> N R <u>12</u> E


TYPE MONUMENT SM. R.R. SPK.
~~ON SURFACE~~ - BELOW 2"
~~LEFT~~ - Q PAV'T - RIGHT 3' RIGHT / 4' EAST OF Q MAPLE
12.4' TO RT EDGE PAVEMENT
 S.L.M. 744+81.22 REC
 GRID: NORTHING: 651462.247 EASTING: 1696966.224

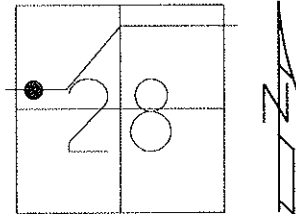

SET PK/WASHER
 11-06-90 MB

RESET MAG & WASHER
 NEWREFA38 7-8-10 DCH

NOTE: FILE 84803 CTNL

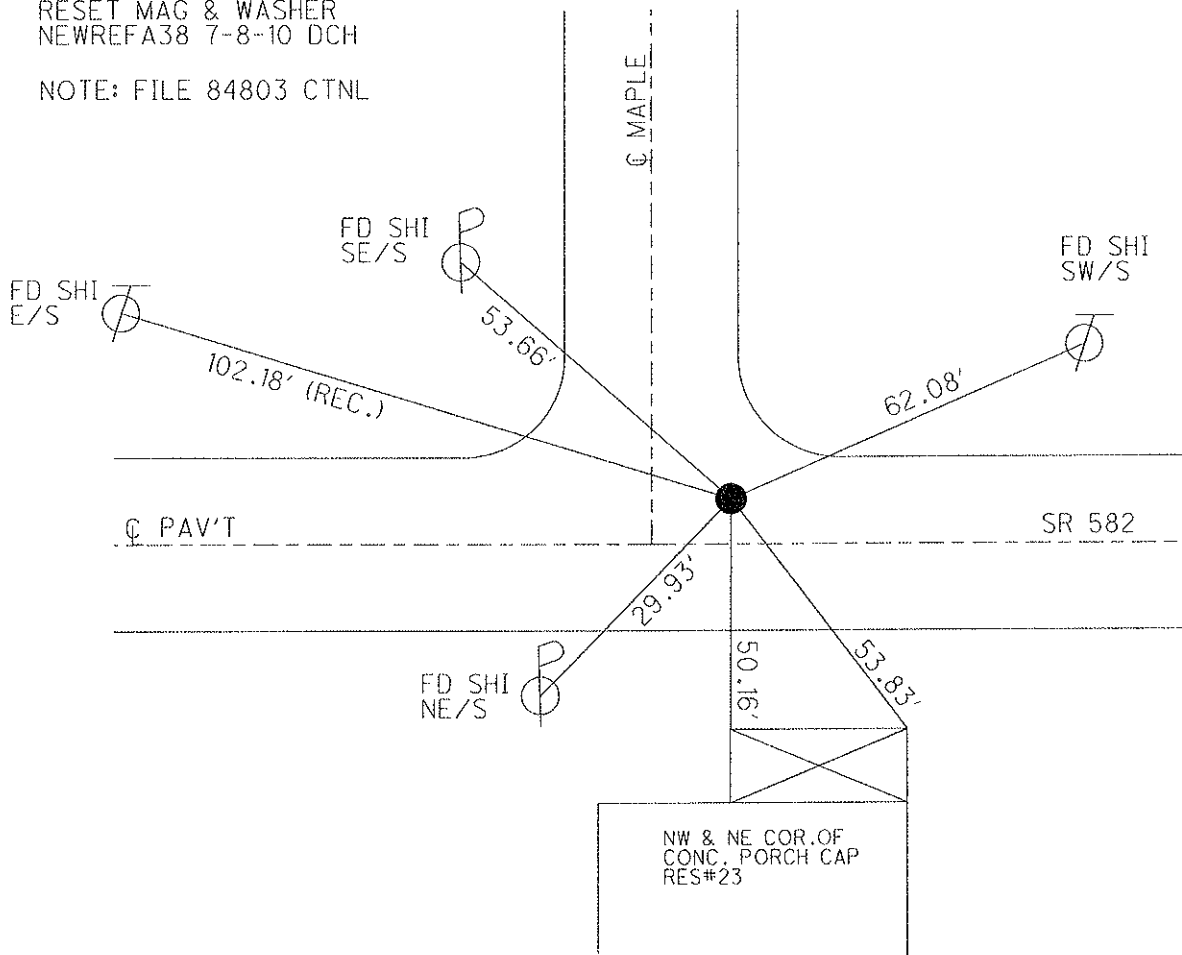

O.D.O.T. DISTRICT 2 SURVEY OFFICE

PERSONNEL

REFERENCE NO. 38-A

SHEET _____ OF _____

NOTES LOGHRKE

H.C. Hoffman

R.C. Steinhausner

DATE 7-13-90

WEATHER Cloudy - Windy

TEMP. +65

ROUTE S.R. 582

COUNTY Woods

TOWNSHIP TRO 4

SECTION 28

T. 6 N. R. 12 E.


TYPE MONUMENT Sm. R.R. spike

ON SURFACE - BELOW Yes


LEFT - PAV'T. - RIGHT 3.0' / 4.0' East of Maple

12.4 TO RT EDGE PAVEMENT

S.L.M. 745 + 71

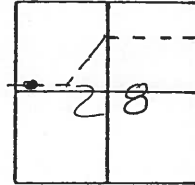

Set P.K. / Washes
11-6-90
MB

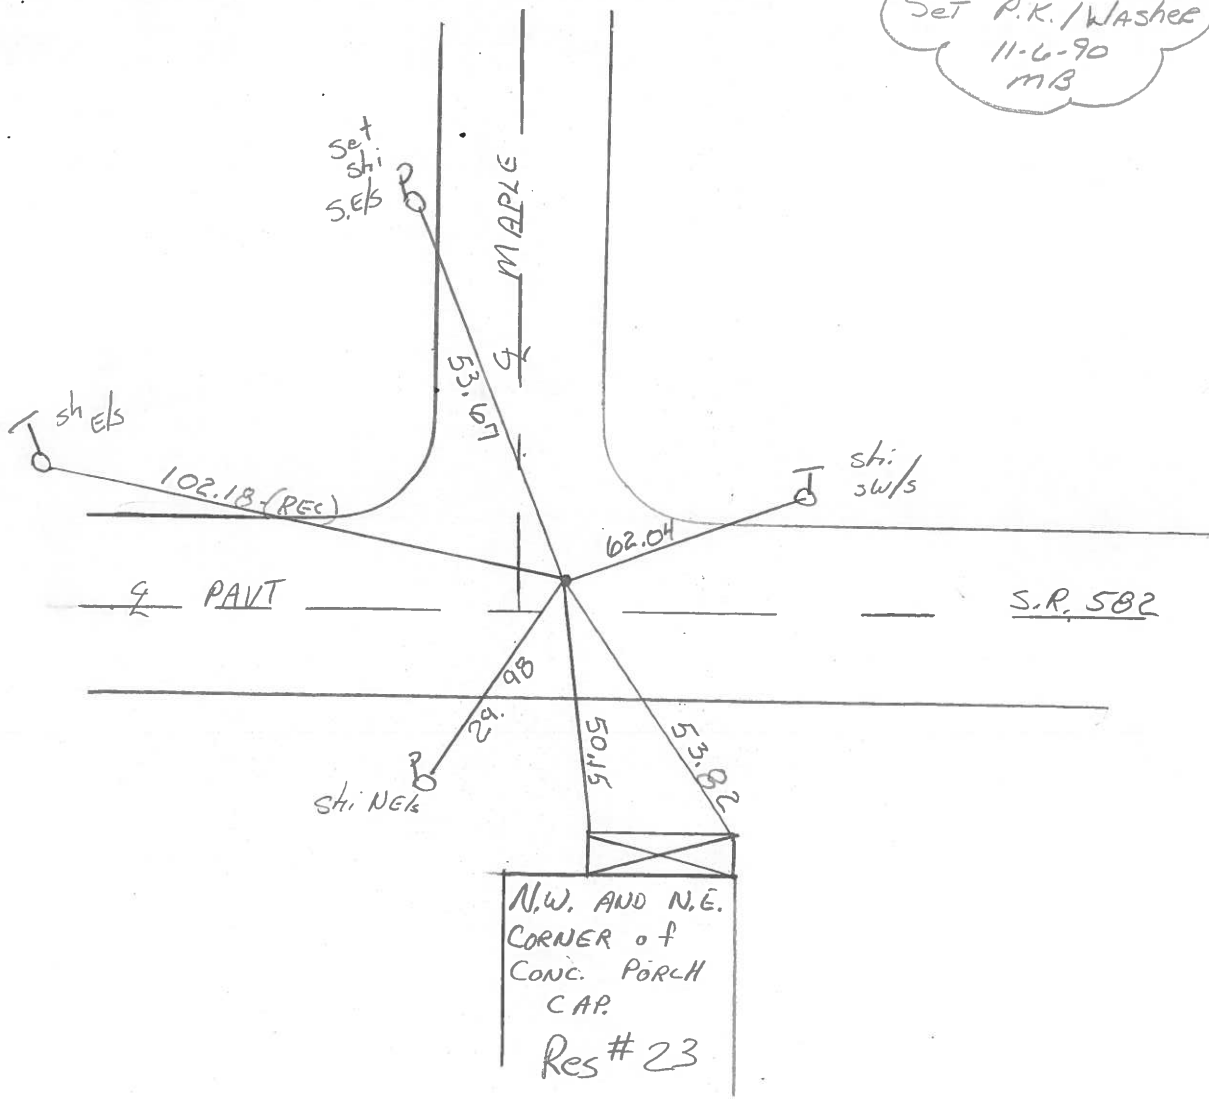

ODOT DISTRICT 2 SURVEY OFFICE

SHEET 19 OF

County Wood S.R. 582

Date 12 July 83

Township Troy

Weather Warm

Section 28

Temp. 91°


T N, R E

Personnel I. Stone

P. Newson


R. Michalak

D. Curtis

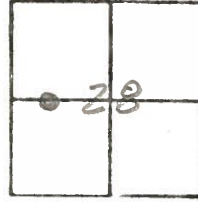

SLM Sta.

REF. NO. 38A

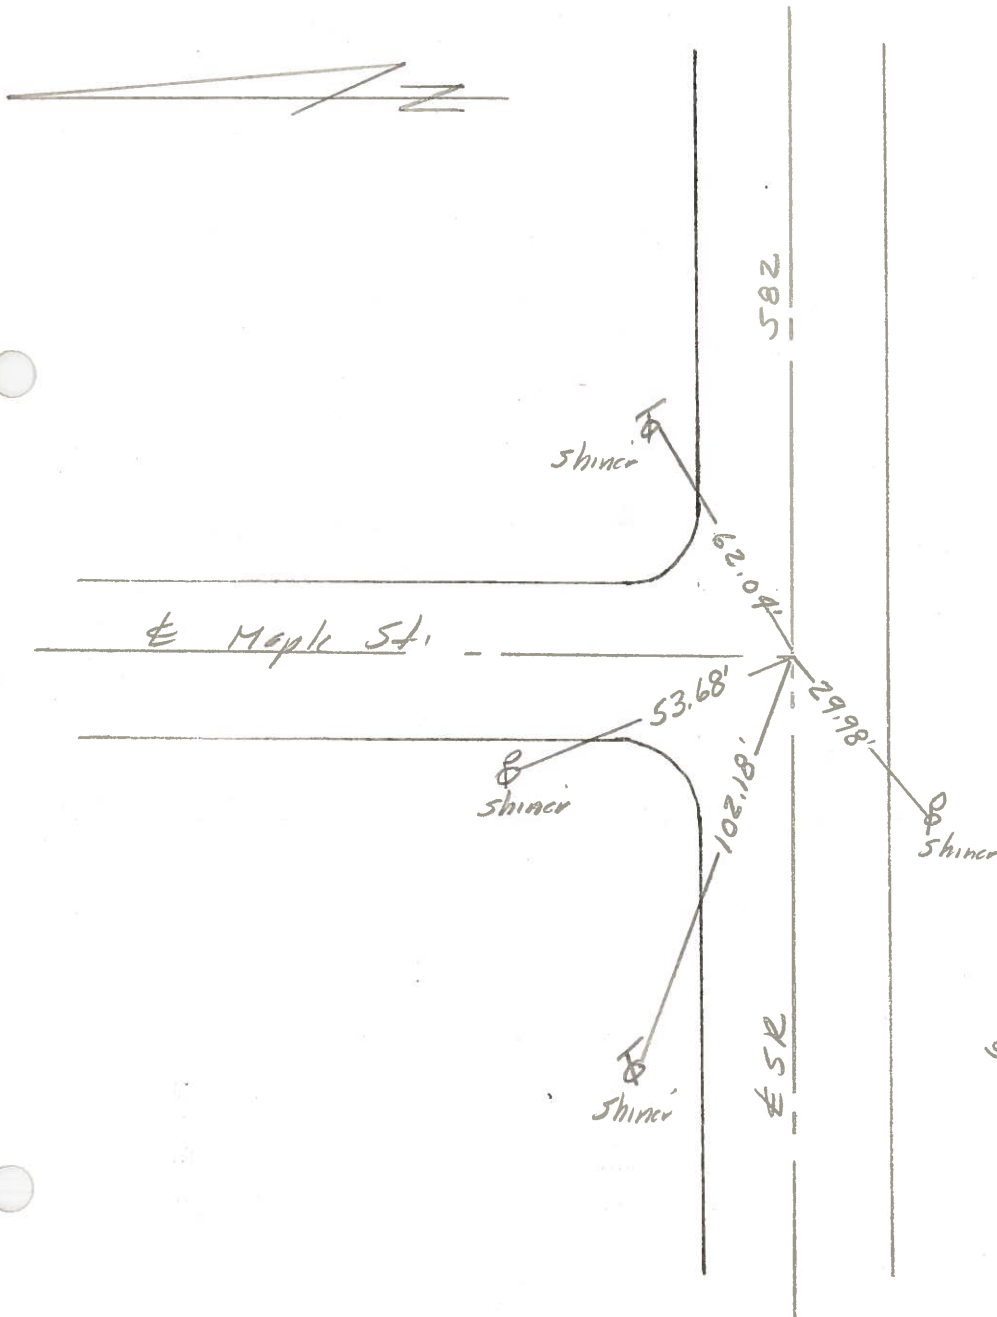

Fd. 1" I. pin 4" deep
12.5' to S. edge put.
set 5m. R-R. Spk.

PERSONNEL TITLE PERSONNEL TITLE

Morrison
Bowers
Holcombe

COUNTY Wood.

DATE April 11, 1968

S. R. #582


WEATHER Clear.

SEC. Lucky

TEMP. +50°

DESCRIPTION Ties to Control Points.

JOB NO. _____

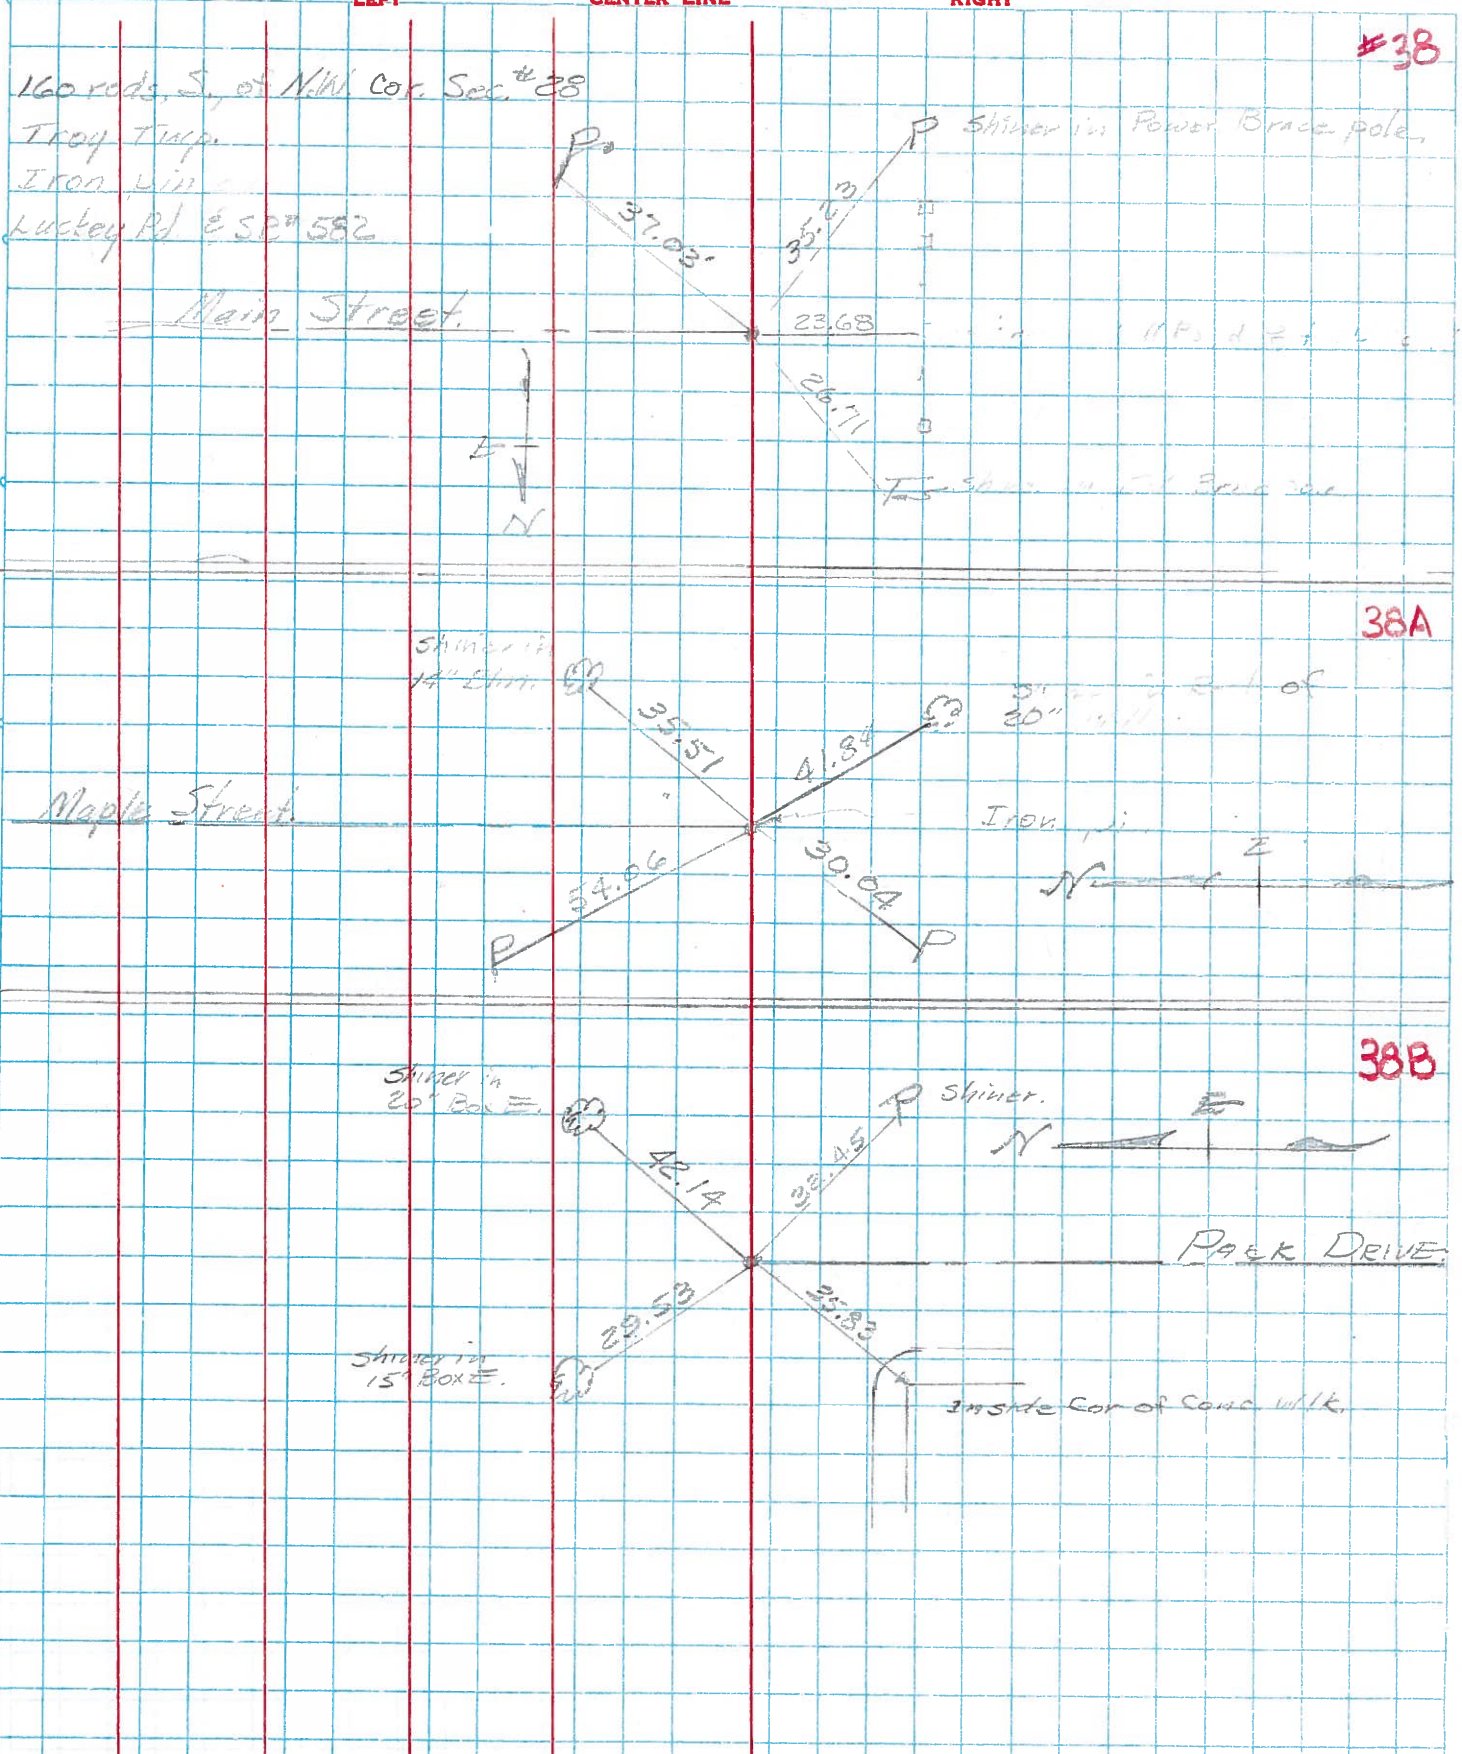

#38

38A

38B