

O.D.O.T. DISTRICT 2 SURVEY OFFICE

PERSONNEL

REFERENCE NO. 38 C

SHEET 4 OF 29

NOTES HOMAN

DATE 4-27-10

ROUTE SR 582

H.C. HOMAN

WEATHER SUNNY

COUNTY WOOD

R.C. ROUSOS

TEMP. 40°

TOWNSHIP TROY

SECTION 28

T 6 N R 12 E

TYPE MONUMENT _____ PK _____



ON SURFACE - ~~BELOW~~ _____ On Surface _____

LEFT - ☉ PAV'T - ~~RIGHT~~ _____ 1.1' _____

9.5' TO LT. EDGE PAVEMENT

S.L.M. 752+50

GRID: NORTHING: 651459.844 EASTING: 1697644.001

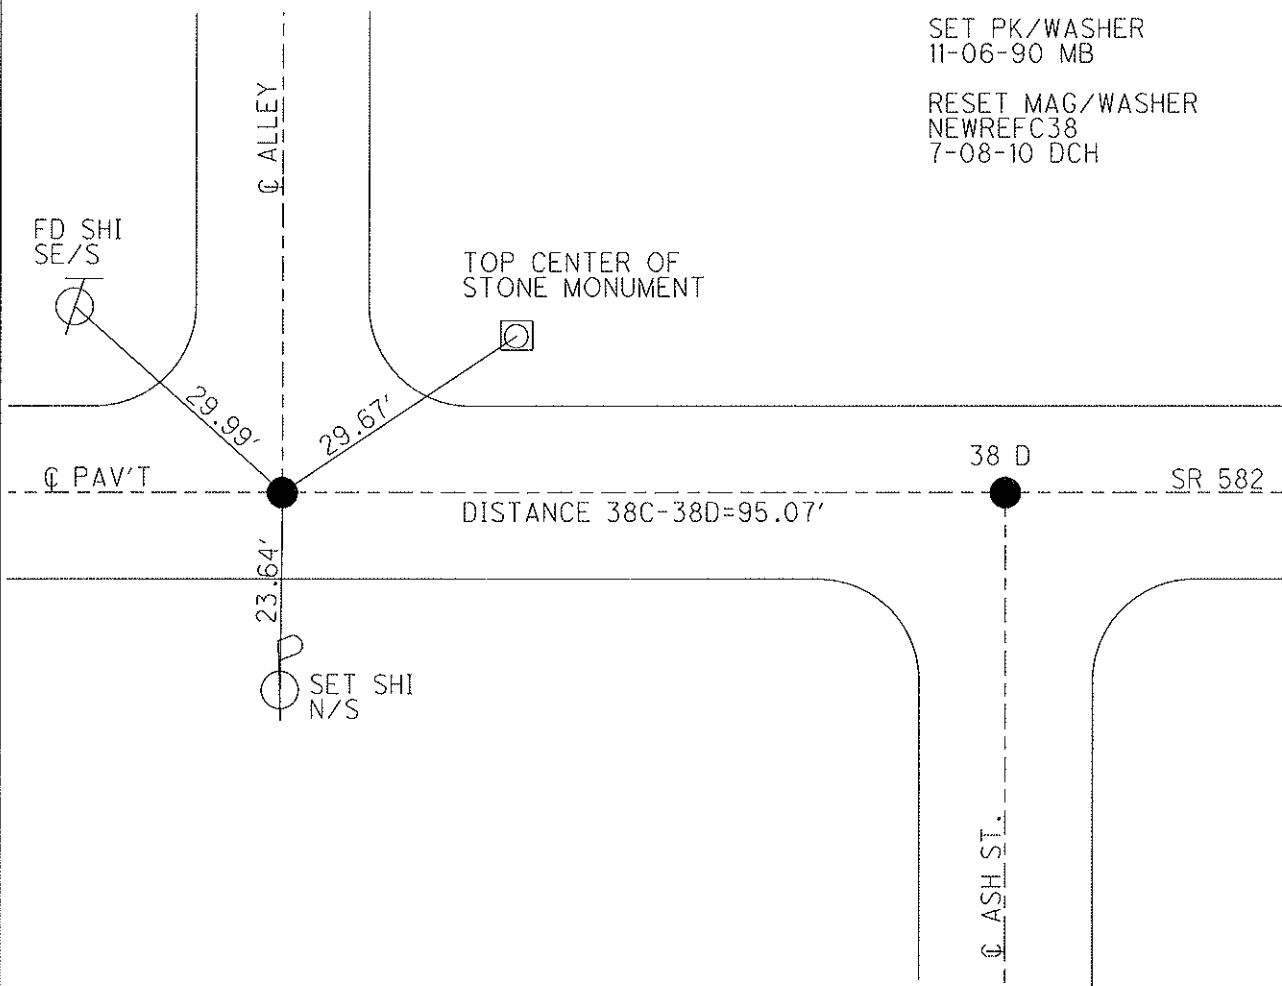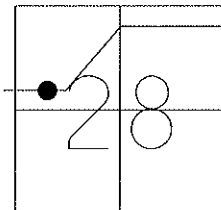

O.D.O.T. DISTRICT 2 SURVEY OFFICE

PERSONNEL

REFERENCE NO. 38C-38P SHEET OF

NOTES LOEHRKE

H.C. Hoffman

R.C. Steinhauser

DATE 7-13-90

WEATHER CLOUDY - WINDY

TEMP. 40.5

ROUTE S.R. 582

COUNTY WOOD

TOWNSHIP TROY

SECTION 28

T. 6 N. R. 12 E.


TYPE MONUMENT PK & PK

ON SURFACE - BELOW Yes


LEFT - PAV'T. - RIGHT LI

9.5 TO LT EDGE PAVEMENT

S.L.M. 752+50 & 753+45

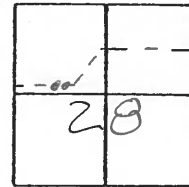

Set P.K. / Washer
11-6-90
MB

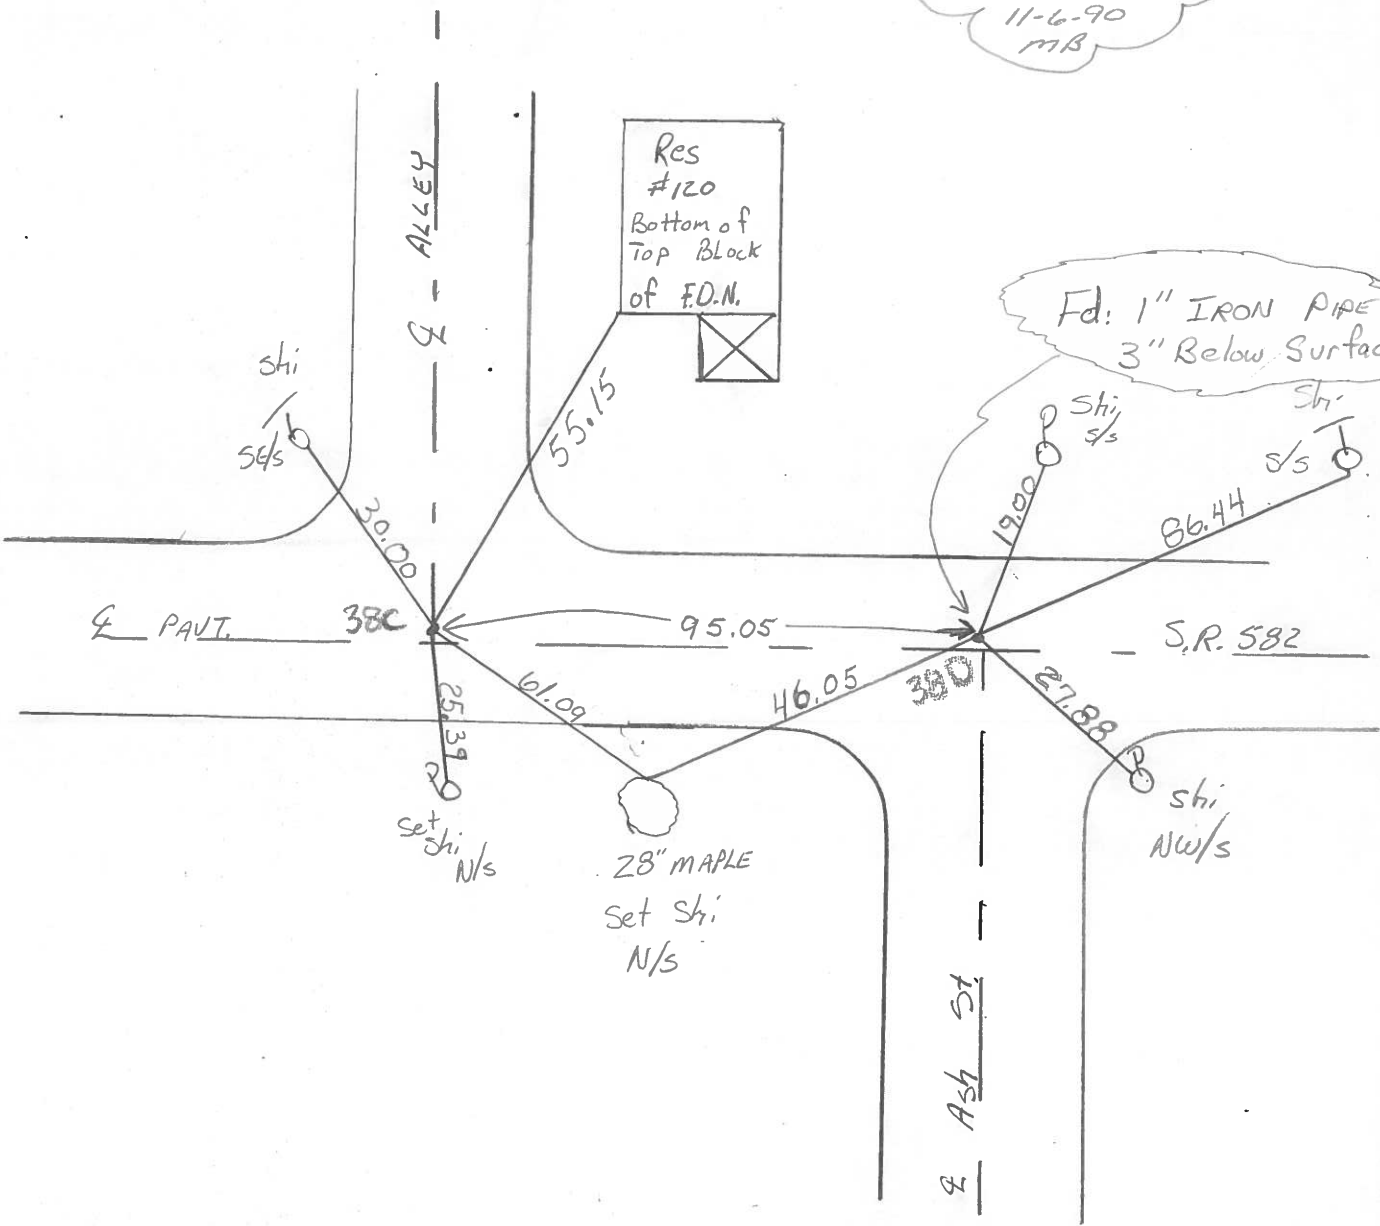

County Wood S.R. 582

Date 12 July 83

Township Troy

Weather Warm

Section 28

Temp. 90°


T N, R E

Personnel J. Stone

P. Neuser

R. Michalak

D. Curtis

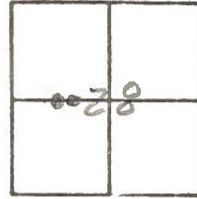


SLM STA.

REF. NO. 38C & 38D

#38D

Fd. 1" I. pin
10.9' to N. edge put.
SLM STA. 753+38

Set P.K. nail

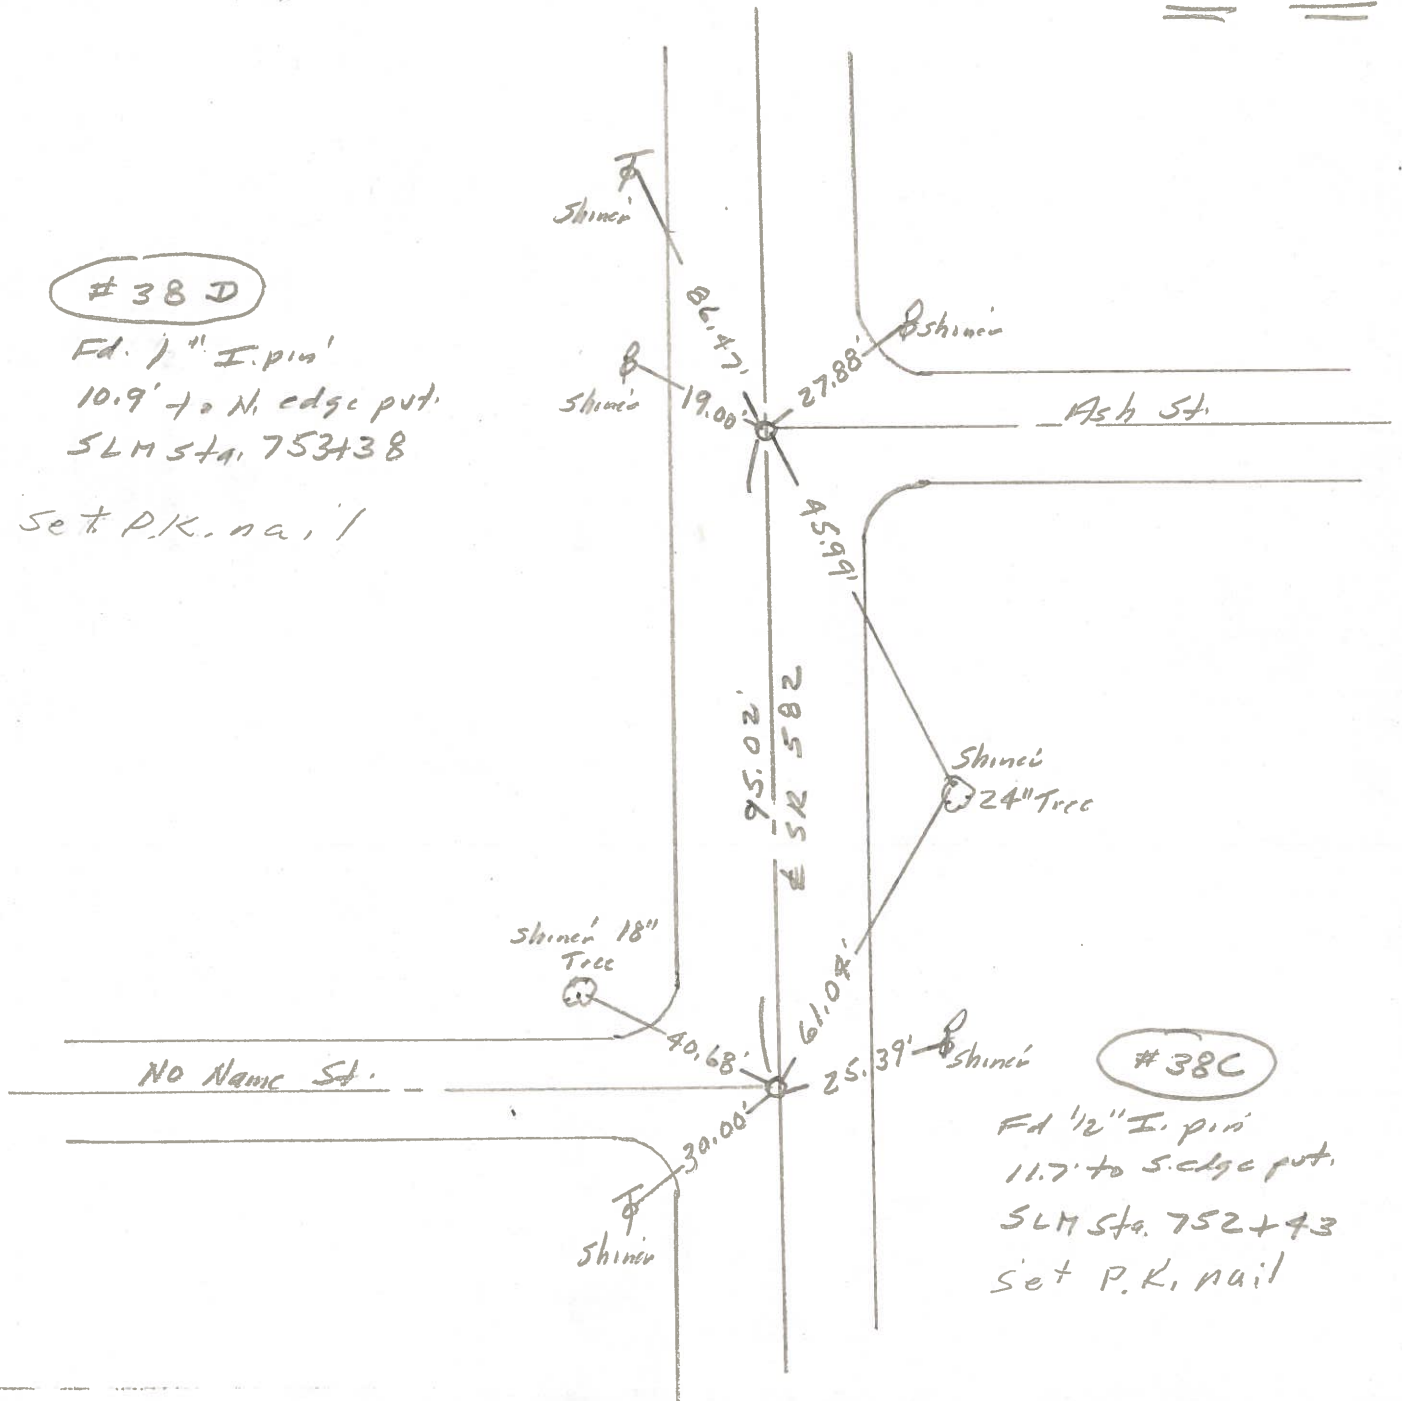

#38C

Fd. 1/2" I. pin
11.7' to S. edge put.
SLM STA. 752+43
Set P.K. nail

PERSONNEL TITLE PERSONNEL TITLE

Morrison
Bowers
Holcombe

COUNTY Wood. DATE April 11, 1968

S. R. #582 WEATHER Clear.

SEC. Luckey TEMP. +50°

DESCRIPTION Ties to Control Points JOB NO. _____

