
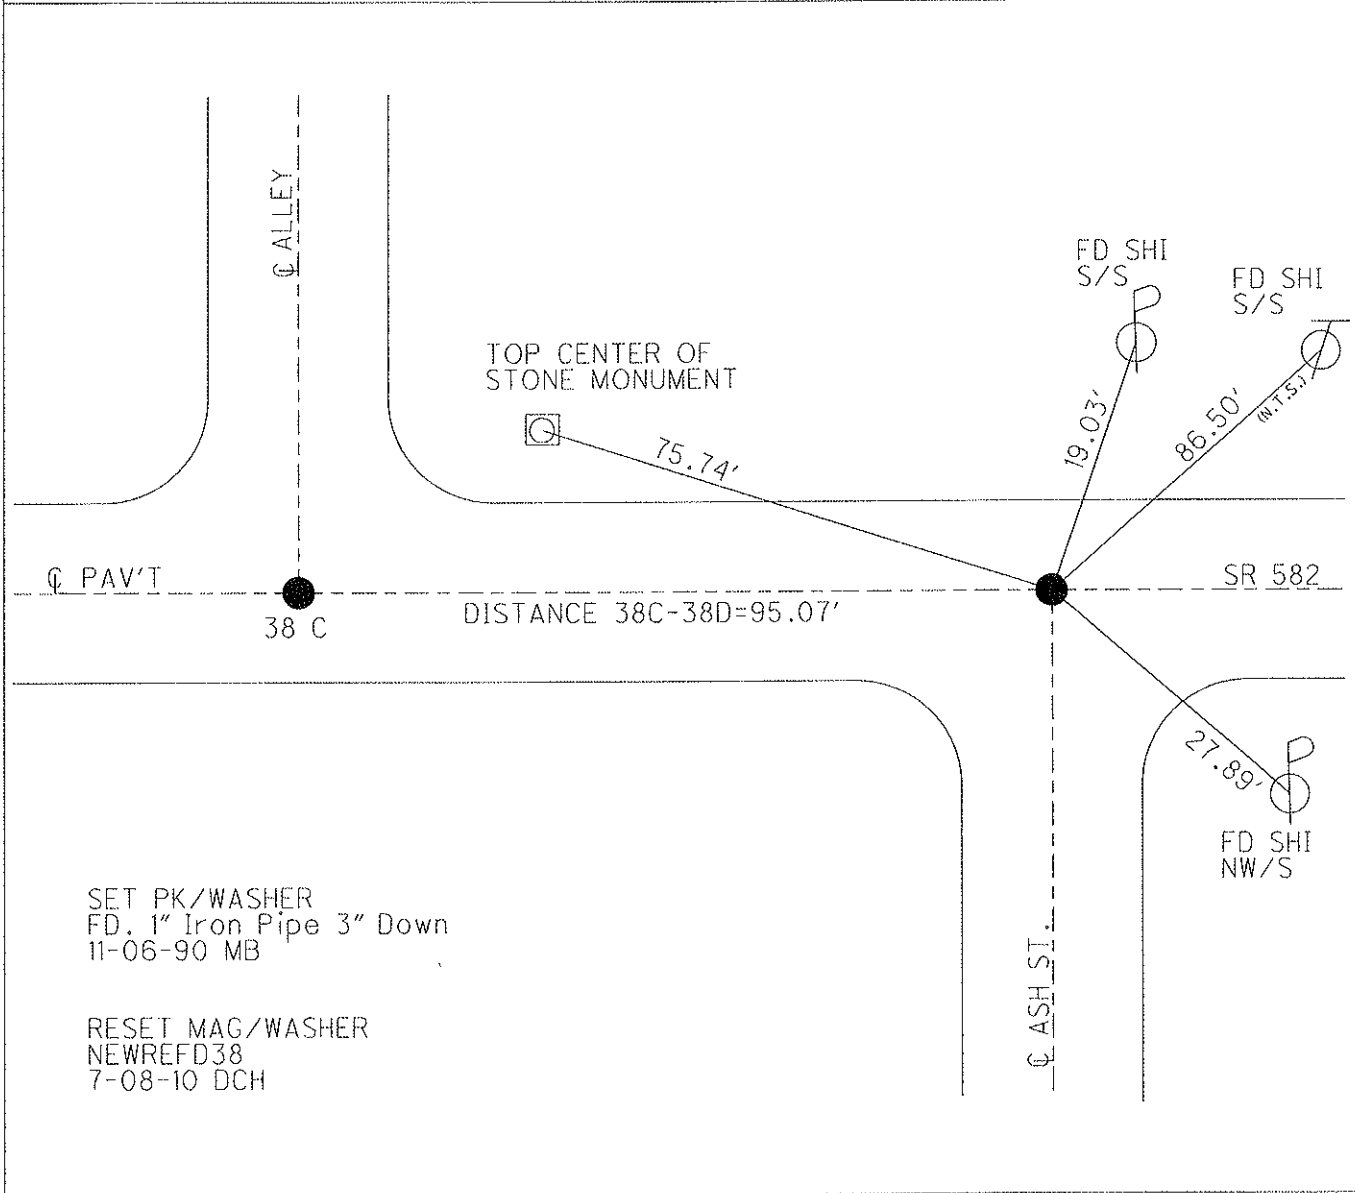


O.D.O.T. DISTRICT 2 SURVEY OFFICE

PERSONNEL _____	REFERENCE NO. <u>38 D</u>	SHEET <u>5</u> OF <u>29</u>
NOTES _____	DATE <u>4-27-10</u>	ROUTE <u>SR 582</u>
H.C. <u>HOMAN</u>	WEATHER <u>SUNNY</u>	COUNTY <u>WOOD</u>
R.C. <u>ROUSOS</u>	TEMP. <u>40°</u>	TOWNSHIP <u>TROY</u>
_____	_____	SECTION <u>28</u>
_____	_____	T. <u>6</u> N R. <u>12</u> E

TYPE MONUMENT _____ PK _____
 ON SURFACE - ~~BELOW~~ On Surface
 LEFT - ☉ PAV'T - ~~RIGHT~~ 1.1'
9.5' TO LT. EDGE PAVEMENT
 S.L.M. 753+45
 GRID: NORTHING: 651459.421 EASTING: 1697739.049

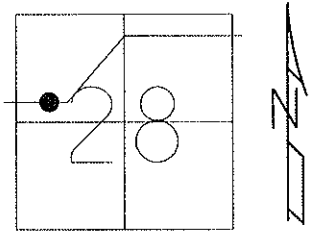

O.D.O.T. DISTRICT 2 SURVEY OFFICE

PERSONNEL _____

REFERENCE NO. 38C-38P SHEET _____ OF _____

NOTES LOHRKE

H.C. Hoffman

R.C. Steinhause

DATE 7-13-90

WEATHER CLOUDY - WINDY

TEMP. 40s

ROUTE S.R. 582

COUNTY WOOD

TOWNSHIP TROY

SECTION 28

T 6 N R 12 E


TYPE MONUMENT RK & PK _____

ON SURFACE - BELOW yes


LEFT- & PAVT. - RIGHT L.I

9.5 TO Lt EDGE PAVEMENT

S.L.M. 752150 & 753+45

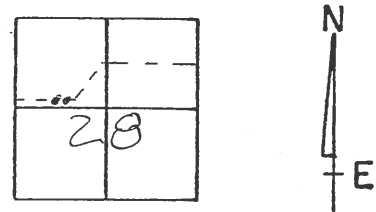

Set P.K. / Washer
11-6-90
MB

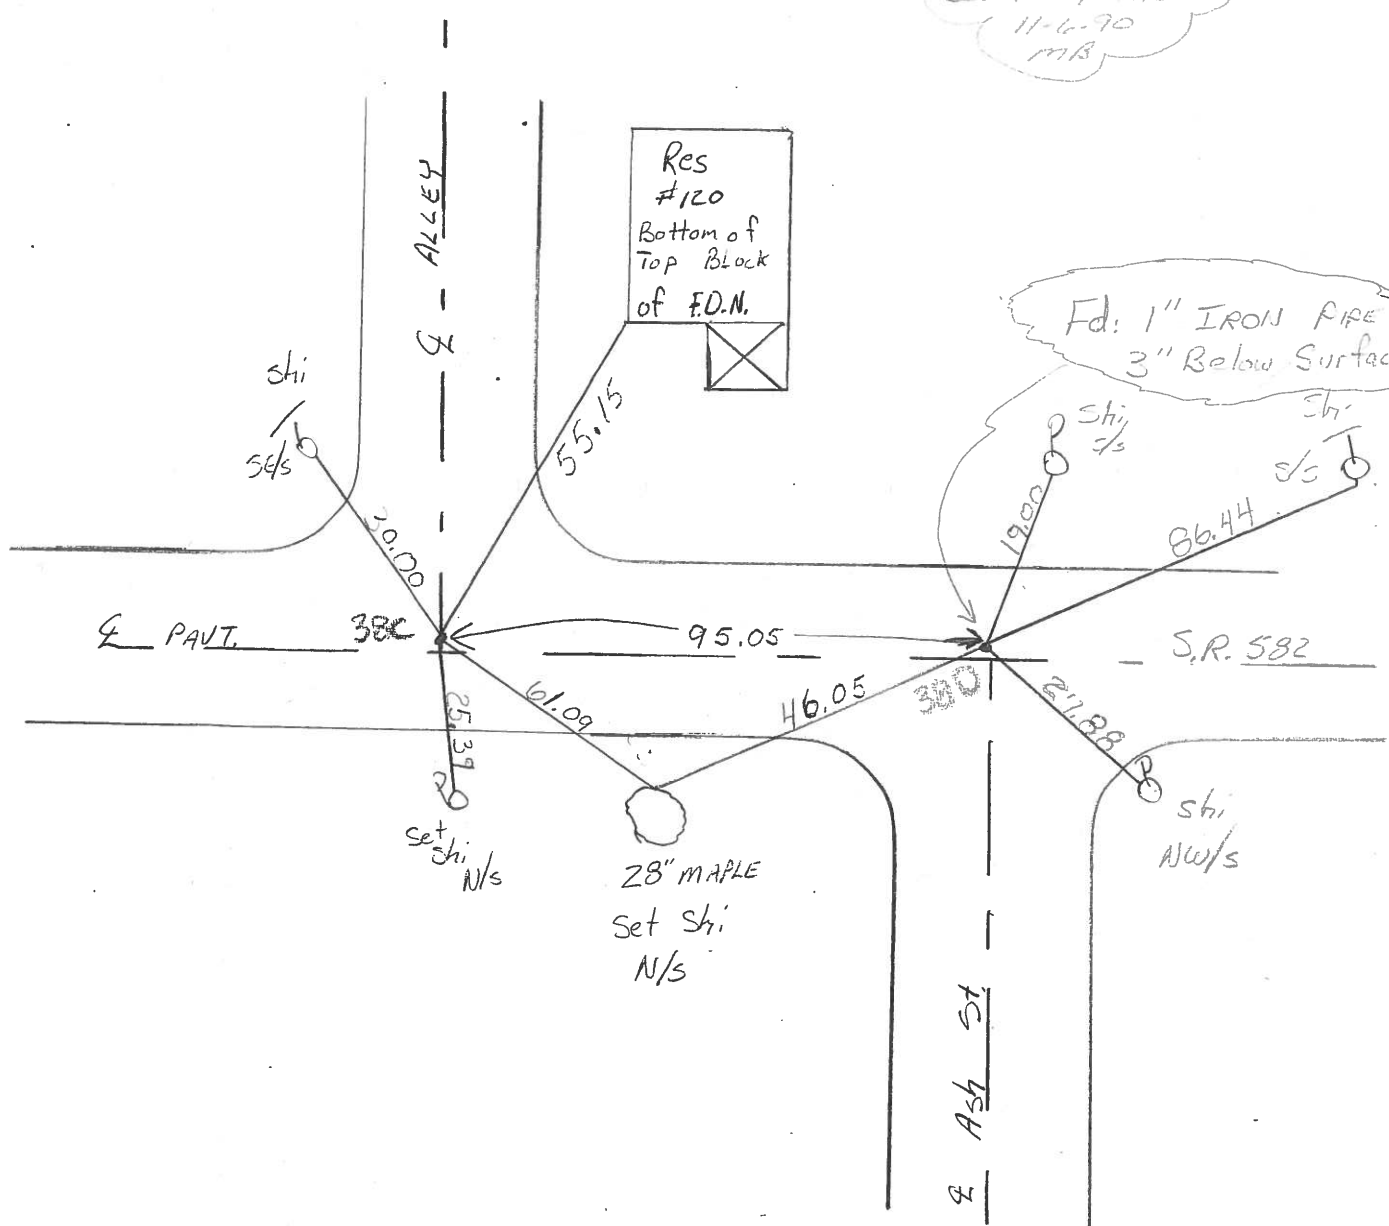

County Wood S.R. 582

Date 12 July 83

Township Troy

Weather Warm

Section 28

Temp. 90°


T N, R E

Personnel 1. Stone

P. Neuser

R. Michaelak

D. Curtis

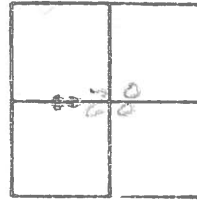

SLM STA.

REF. NO. 38C & 38D


38 D

FD. 1" I. pin

10.9' to N. edge pt.

SLM Sta. 753438

Set P.K. nail

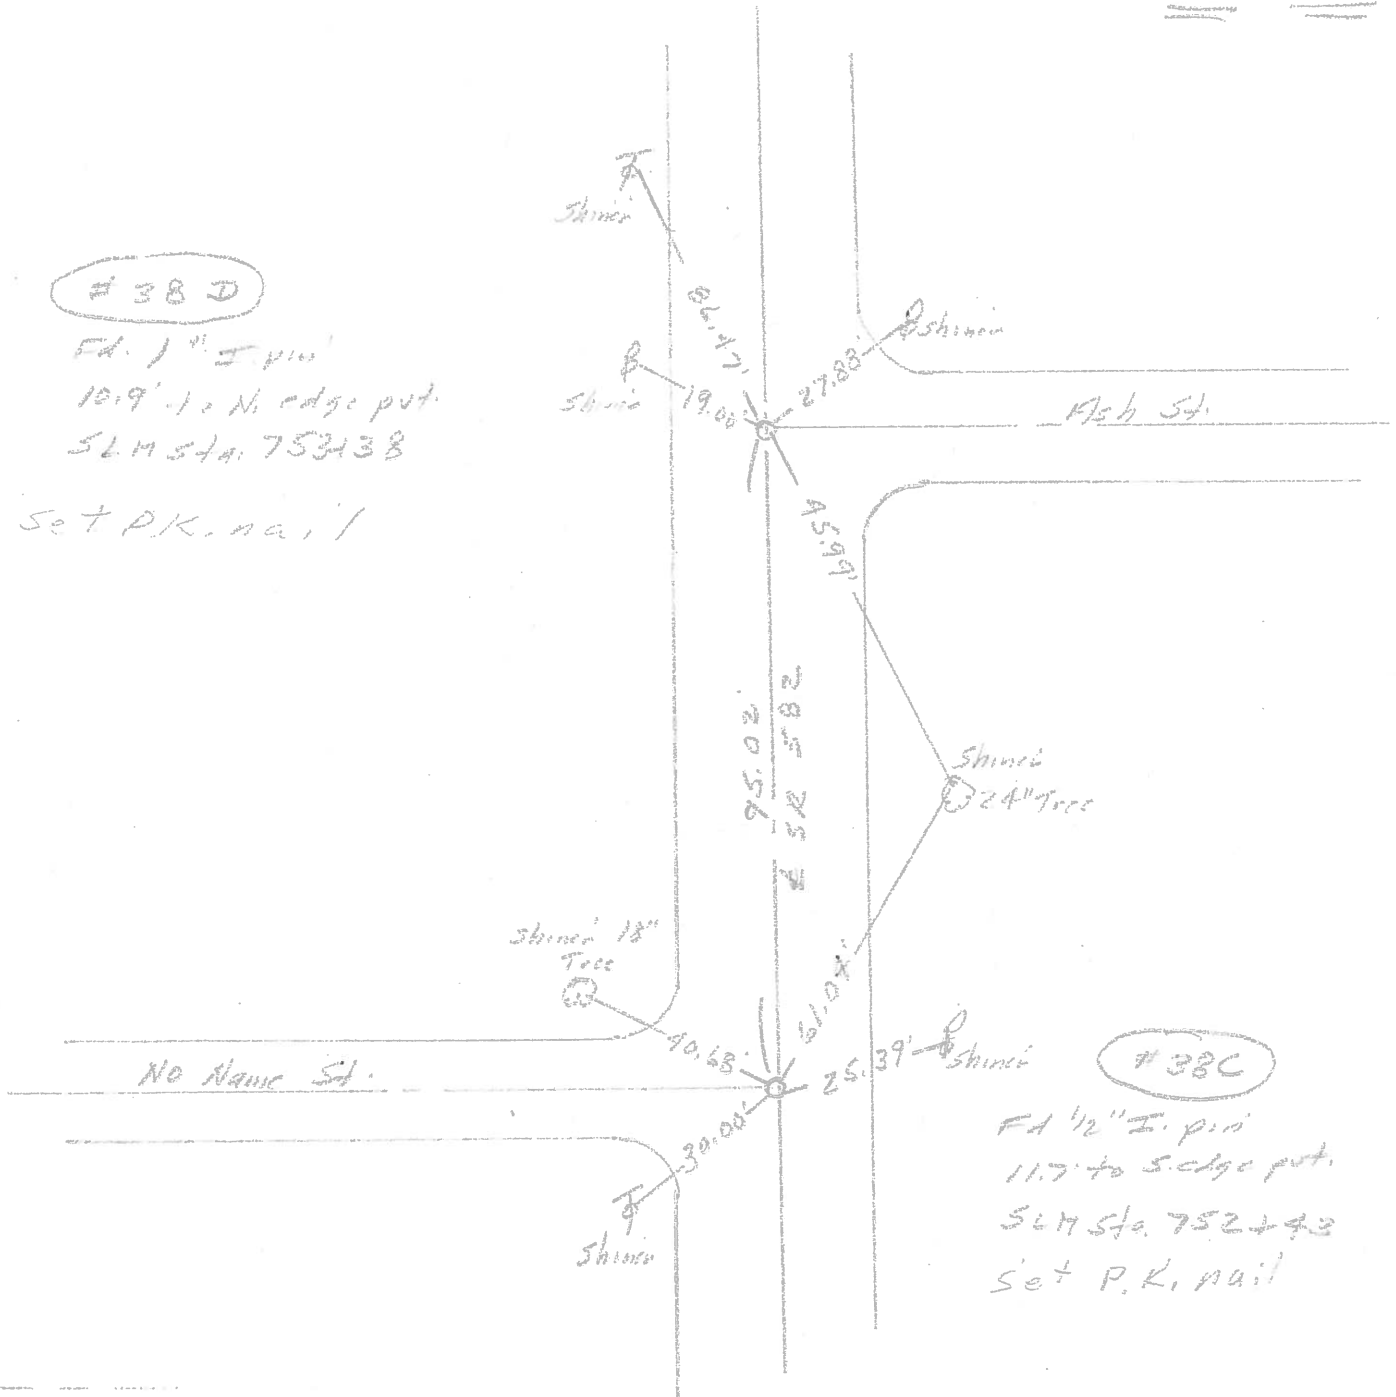

38 C

FD 1/2" I. pin

11.7' to S. edge pt.

SLM Sta. 752442

Set P.K. nail

PERSONNEL TITLE PERSONNEL TITLE
 Morrison _____
 Bowers _____
 Holcombe _____

COUNTY Wood. DATE April 11, 1968
 S. R. # 582 WEATHER Clear.
 SEC. Luckey TEMP. +50°

DESCRIPTION Ties to Control Points JOB NO. _____

