

O.D.O.T. DISTRICT 2 SURVEY OFFICE

PERSONNEL _____

REFERENCE NO. 39 A

SHEET 7 OF 29

NOTES HOMAN

DATE 4-27-10

ROUTE SR 582

H.C. HOMAN

WEATHER SUNNY

COUNTY WOOD

R.C. ROUSOS

TEMP. 40°

TOWNSHIP TROY

SECTION 28

T 6 N R 12 E

TYPE MONUMENT _____ P.K.NAIL _____


ON SURFACE - ~~BELOW~~ On Surface

~~LEFT~~ - Q PAV'T - ~~RIGHT~~ ON

TO EDGE PAVEMENT

S.L.M. 758+05.62


GRID: NORTHING: 651756.179 EASTING: 1698175.129

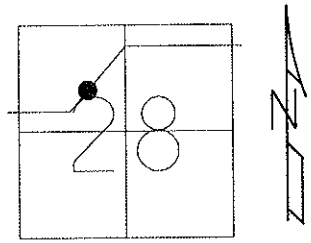

SET PK/WASHER
11-06-90 MB

RESET MAG/WASHER
NEWREFA39
7-08-10 DCH

DISTANCE BETWEEN
39A-39B= 27.62'

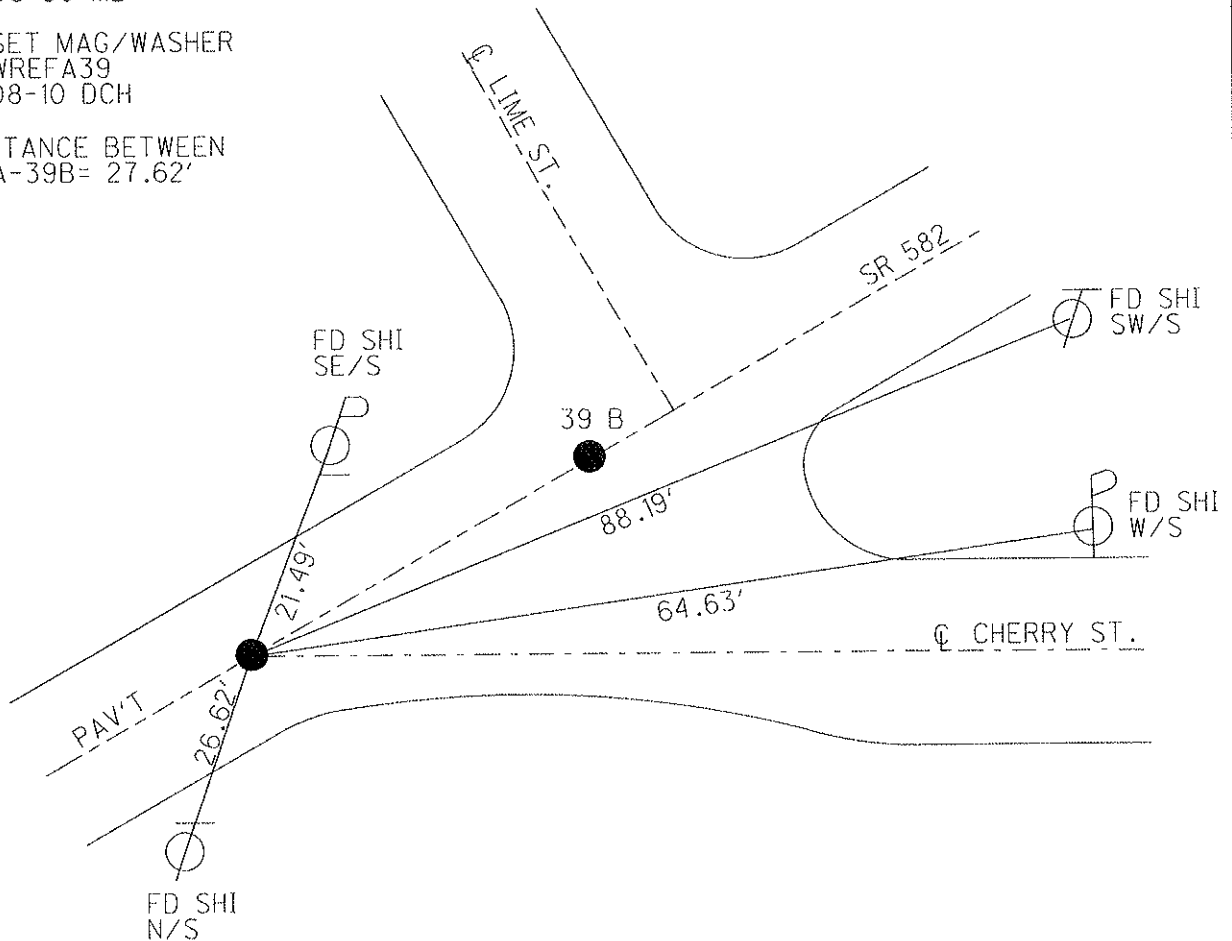

O.D.O.T. DISTRICT 2 SURVEY OFFICE

PERSONNEL _____

REFERENCE NO. 39A & 39B

SHEET _____ OF _____

NOTES LOEHRKE

H.C. Hoffman

DATE 7-13-90

ROUTE S.R. 582

R.C. Steinhauser

WEATHER CLOUDY-WINDY

COUNTY WOOD

TEMP. +68

TOWNSHIP TROY

SECTION 28

T 6 N R 12 E


TYPE MONUMENT P.K Nails

ON SURFACE - BELOW Yes

~~LEFT~~ - PAV'T. - RIGHT Yes


TO EDGE PAVEMENT

S.L.M. 758+98 759+26

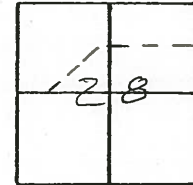

DISTANCE BETWEEN 27.60

Set P.K. / Washers
11-6-90
MB

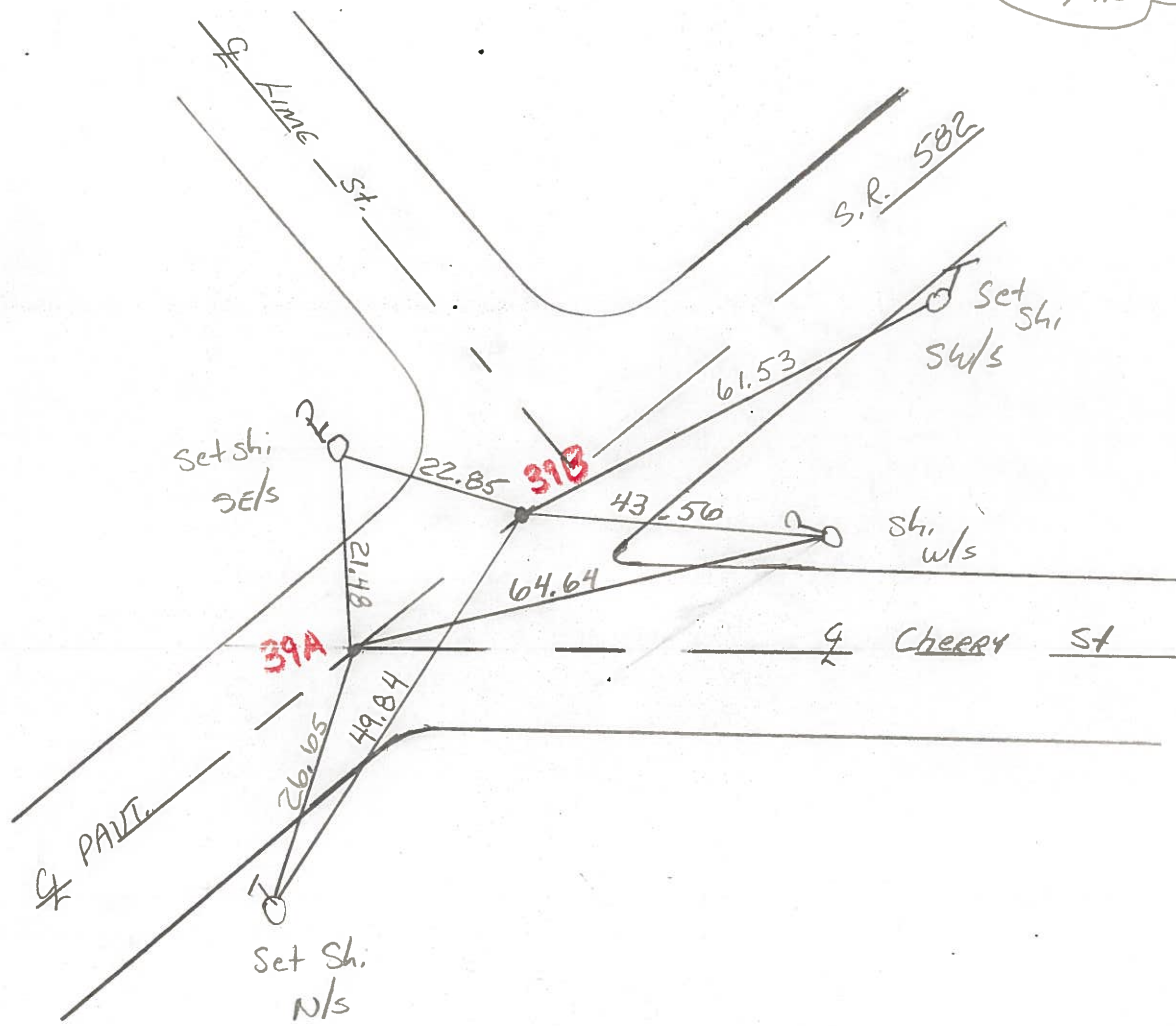

County Wood S.R. 582

Date 12 July 83

Township TROY

Weather Warm

Section 28

Temp. 90°


T N, R E

Personnel J. Stone

P. Neuser

R. Michalak

D. Curtis

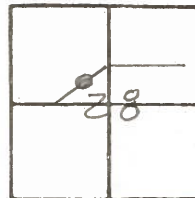

REF. No. 39A & 39B

#39B

Fd. 1" I. pin 3" deep
SLM Sta. 759 + 17

Set PK Nail

← Lime St.

582
Kratzer St.

Shiner
Shiner

← Cherry St.

#39A

Fd. 1" I. pin 3" deep
to w. edge put.


SLM Sta. 758 + 89

Set PK nail

Shiner

← 5R

Shiner

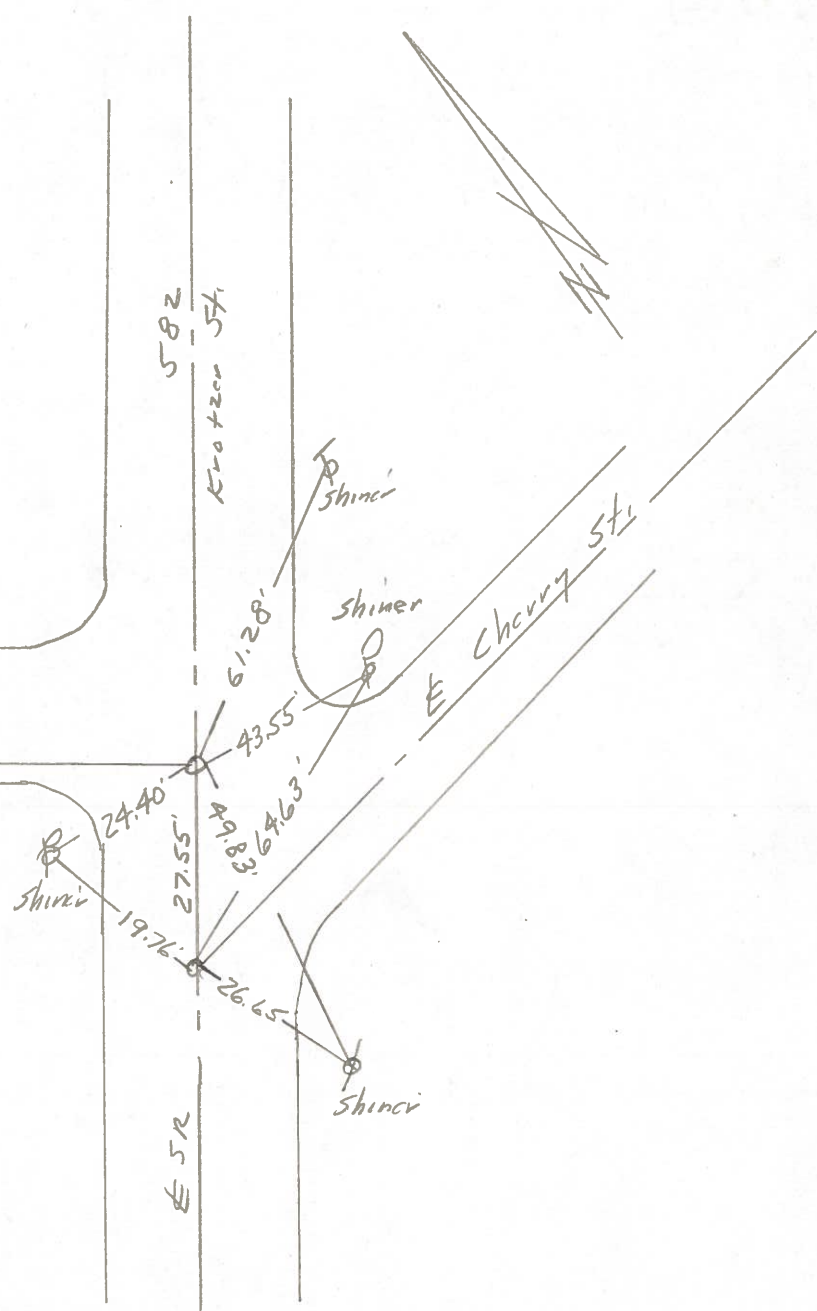

PERSONNEL TITLE PERSONNEL TITLE

COUNTY Wood

DATE April 11, 1968

S. R. # 582

WEATHER Clear

SEC. Luckey

TEMP. +55°

DESCRIPTION

Ties to Control Points

JOB NO. _____

LEFT

CENTER LINE

RIGHT

