


O.D.O.T. DISTRICT 2 SURVEY OFFICE

PERSONNEL	REFERENCE NO. <u>39 B</u>	SHEET <u>8</u> OF <u>29</u>
NOTES <u>HOMAN</u>	DATE <u>4-27-10</u>	ROUTE <u>SR 582</u>
H.C. <u>HOMAN</u>	WEATHER <u>SUNNY</u>	COUNTY <u>WOOD</u>
R.C. <u>ROUSOS</u>	TEMP. <u>40°</u>	TOWNSHIP <u>TROY</u>
		SECTION <u>28</u>
		T <u>6</u> N R <u>12</u> E

TYPE MONUMENT P.K.NAIL
 ON SURFACE - ~~BELOW~~ On Surface
~~LEFT - C PAV'T~~ - ~~RIGHT~~ On
TO EDGE PAVEMENT
 S.L.M. 758+33.23


GRID: NORTHING: 651774.786 EASTING: 1698195.524

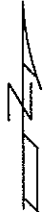

SET PK/WASHER
11-06-90 MB

RESET MAG/WASHER
NEWREFB39
7-08-10 DCH

DISTANCE BETWEEN
39A-39B = 27.62'

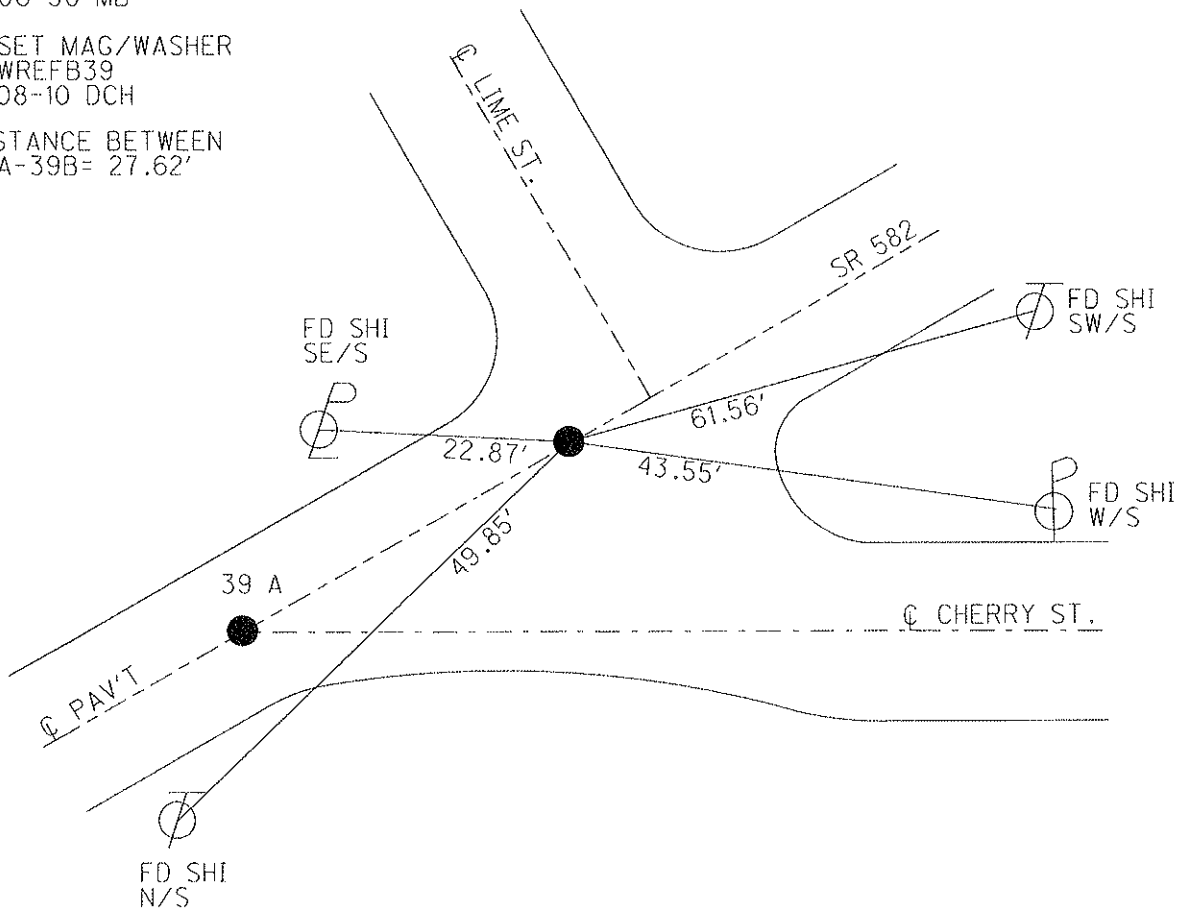

O.D.O.T. DISTRICT 2 SURVEY OFFICE

PERSONNEL _____

REFERENCE NO. 39A & 39B

SHEET _____ OF _____

NOTES LOEHRKE

H.C. Hoffman

DATE 7-13-90

ROUTE S.R. 582

R.C. Stenhouse

WEATHER CLOUDY - WINDY

COUNTY WOOD

TEMP. +68

TOWNSHIP TROY

SECTION 28

T. 6 N. R. 12 E


TYPE MONUMENT P.K. Nails

ON SURFACE - BELOW YES

LEFT - & PAV'T. - RIGHT YES


TO EDGE PAVEMENT

S.L.M. 758+98 759+26

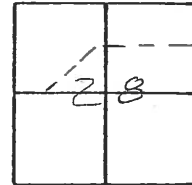

DISTANCE BETWEEN 21.60

SET P.K. / WASHERS
 11-6-90
 MIB

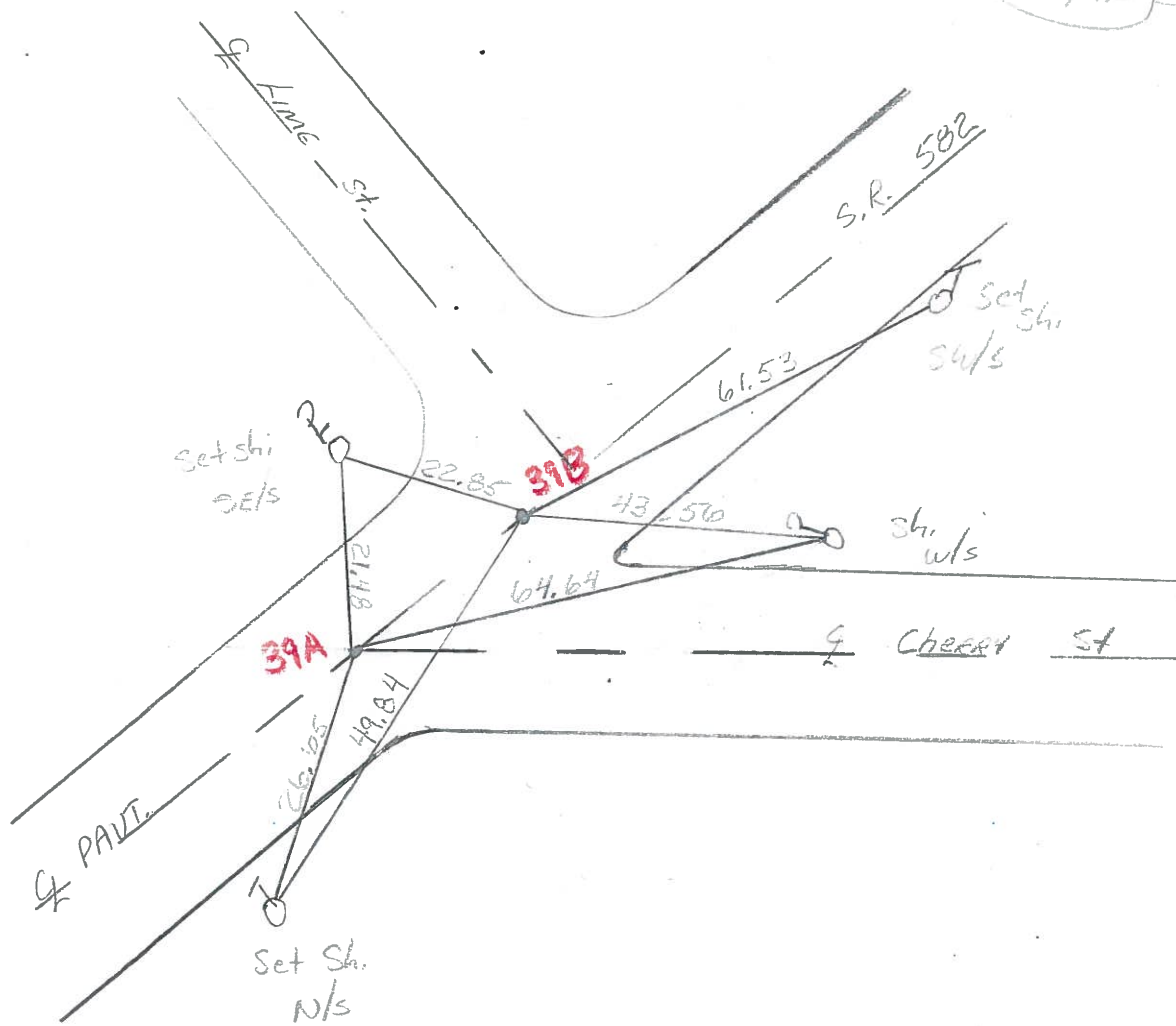

ODOT. DISTRICT 2 SURVEY OFFICE

SHEET 23 OF

County Wood S.R. 582

Date 12 July 83

Township TROY

Weather Warm

Section 28

Temp. 90°


T N, R E

Personnel J. Stone

P. Neuser

R. Michalski

D. Curtis

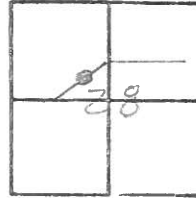

REF. No. 39A & 39B

#39B

Fd. 1" I. pin 3" deep
SLM Sta. 759 + 17

Set PK Nail


E Lime St.

#39A

Fd. 1" I. pin 3" deep
to W. edge put.

SLM Sta. 758 + 89

Set PK nail

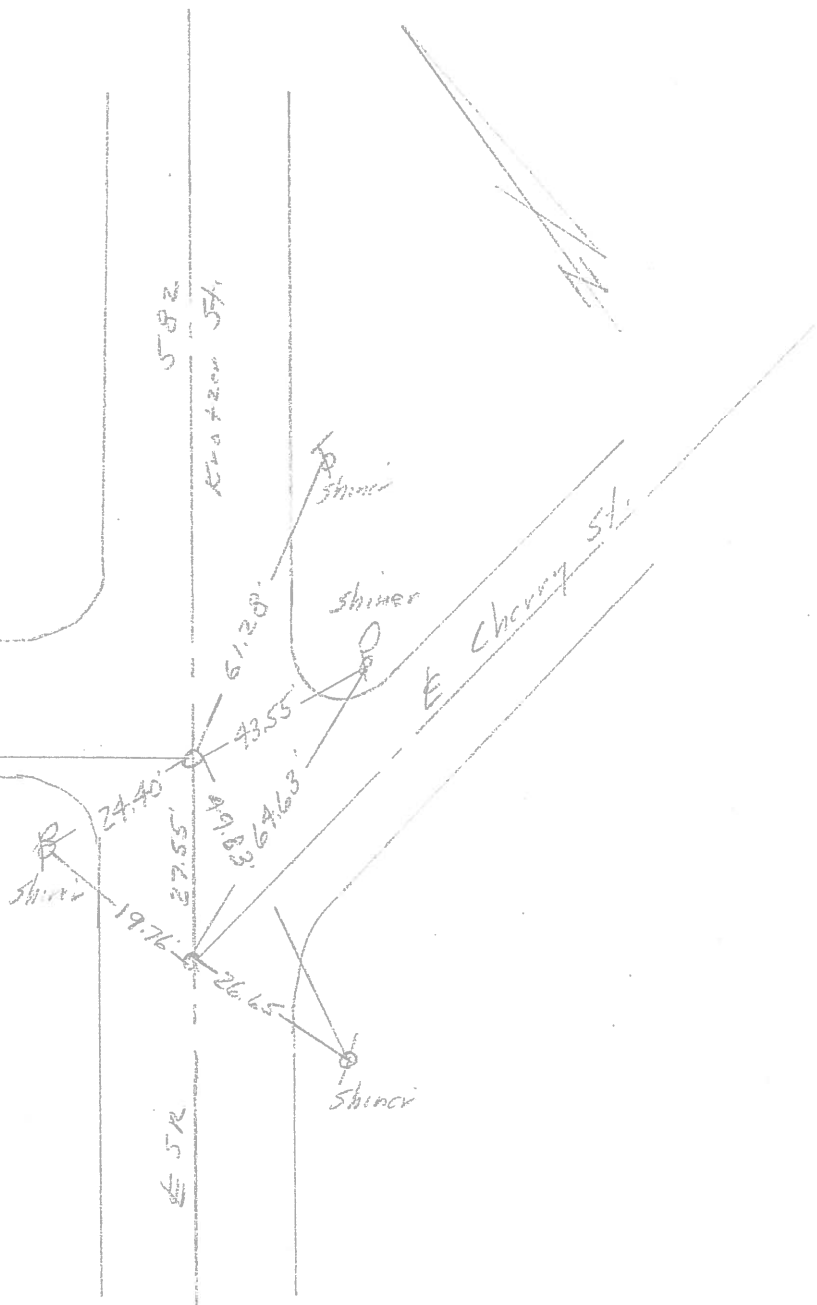

PERSONNEL TITLE PERSONNEL TITLE

COUNTY Wood

DATE April 11, 1968

S. R. # 582

WEATHER Clear

SEC. Luckey

TEMP. +55°

DESCRIPTION Ties to Control Points.

JOB NO. _____

