

O.D.O.T. DISTRICT 2 SURVEY OFFICE

PERSONNEL _____

REFERENCE NO. 40 A

SHEET 11 OF 29

NOTES HOMAN

DATE 4-27-10

ROUTE SR 582

H.C. HOMAN

WEATHER SUNNY

COUNTY WOOD

R.C. ROUSOS

TEMP. 40°

TOWNSHIP TROY

SECTION 28

T 6 N R 12 E

TYPE MONUMENT 1" IRON PIN


~~ON SURFACE~~ - BELOW 5"

~~LEFT - C PAV'T~~ - RIGHT 11.5'

1.2' TO RT EDGE PAVEMENT


S.L.M. 770+98 (PT. IS SOUTH OF S.E.P.)

GRID: NORTHING: 6652453.808 EASTING: 1699104.548

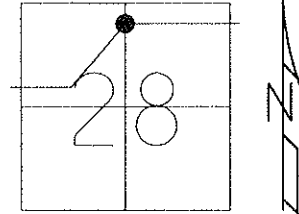

DID NOT COVER
11-06-90 MB

DID NOT COVER
7-08-10 DCH

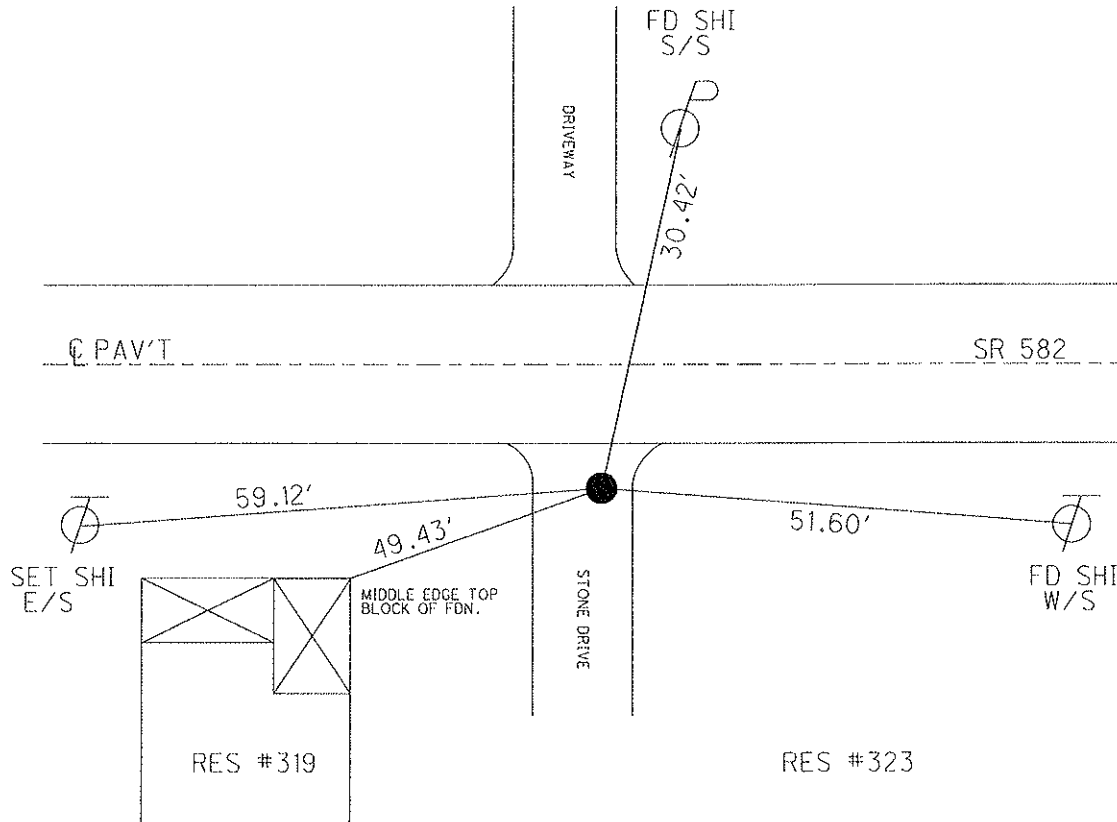

O.D.O.T. DISTRICT 2 SURVEY OFFICE

PERSONNEL

REFERENCE NO. 40-A

SHEET _____ OF _____

NOTES LOEHRKE

H.C. Hoffman

R.C. BARNHISEL

DATE 7-23-90

WEATHER pt Cloudy

TEMP. +75

ROUTE S.R. 582

COUNTY WOOD

TOWNSHIP TROY

SECTION 28

T6 N R 12 E


TYPE MONUMENT 1" IRON ROD

~~ON SURFACE~~ - BELOW 5" Below


~~LEFT - & PAV'T.~~ - RIGHT 11.5

1.2 TO R+ EDGE PAVEMENT 15 south of S.E.P.

S.L.M. 770 + 98

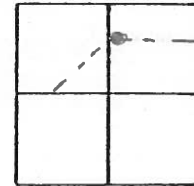

Did NOT COVER
11-6-90
MB

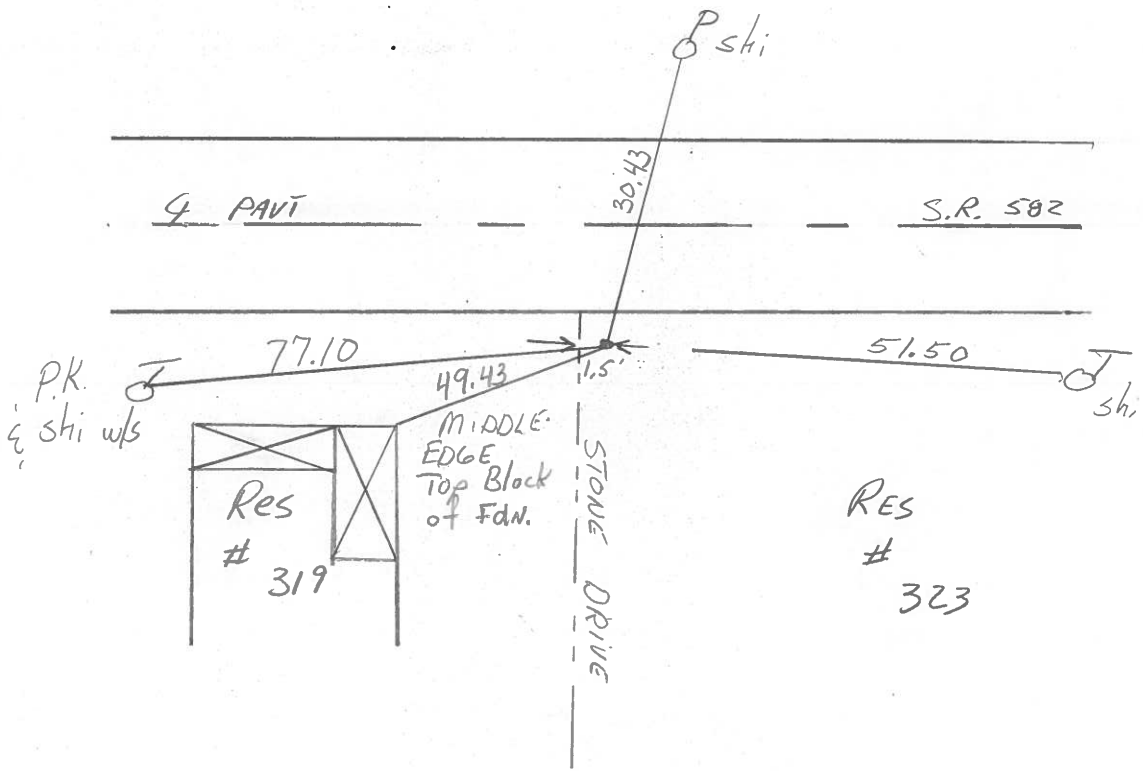

County Wood S.R. 582

Date 13 July 83

Township Troy

Weather Warm

Section 28

Temp. 86°


T N, R E

Personnel I. Stone

P. Neusser


R. Michalak

D. Curtis

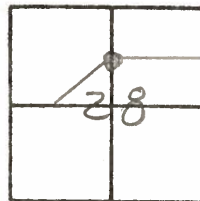

SLM STA. 770+91

REF NO. 40 A

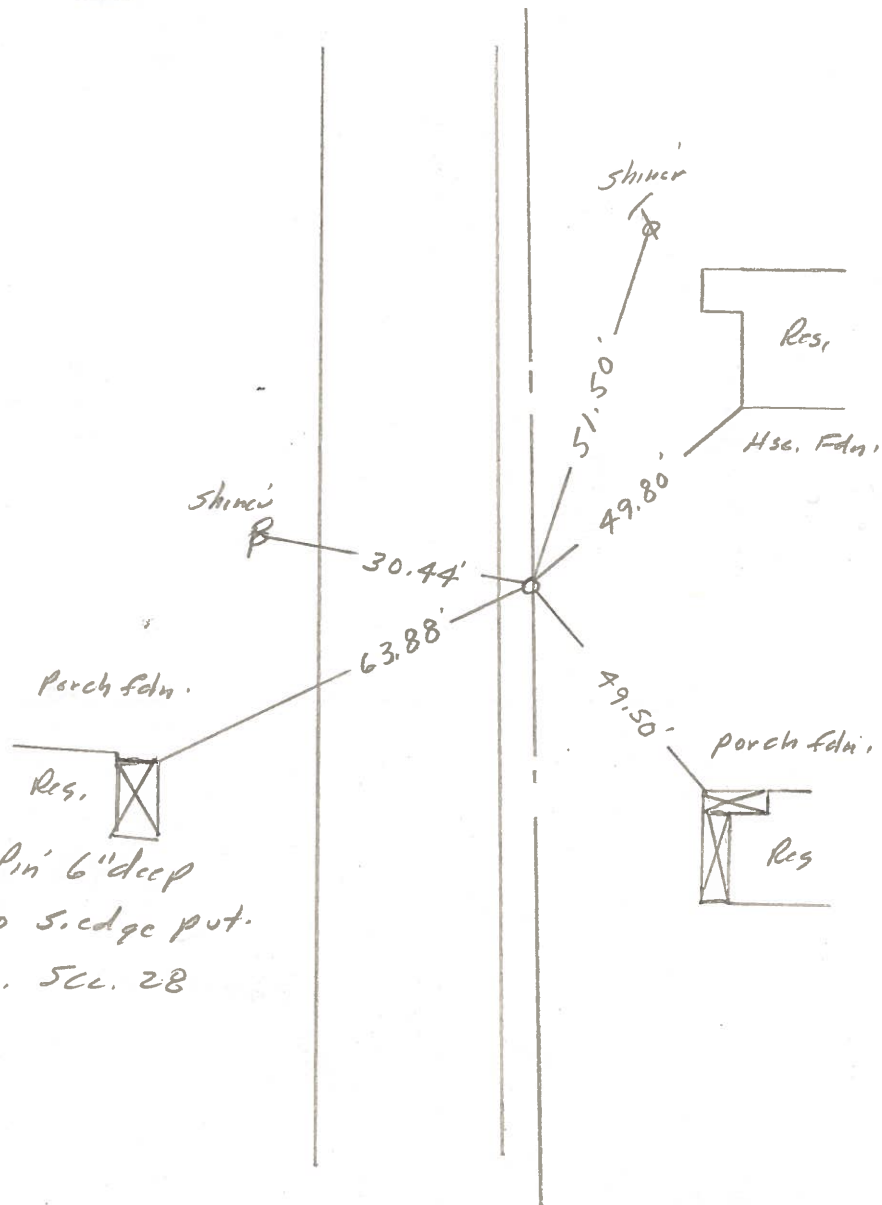

Fd. 1" I. Pin 6" deep
2.7' N. to S. edge put.
1/16 Cor. S.C. 28