

O.D.O.T. DISTRICT 2 SURVEY OFFICE

PERSONNEL \_\_\_\_\_

REFERENCE NO. 40 D

SHEET 14 OF 29

NOTES HOMAN

DATE 4-27-10

ROUTE SR 582

H.C. HOMAN

WEATHER SUNNY

COUNTY WOOD

R.C. ROUSOS

TEMP. 40°

TOWNSHIP TROY

SECTION 28

T 6 N R 12 E

TYPE MONUMENT \_\_\_\_\_ Shank \_\_\_\_\_


ON SURFACE - ~~BELOW~~ \_\_\_\_\_ On Surface \_\_\_\_\_

~~LEFT~~ - ~~Q~~ PAV'T - RIGHT 6.5'

16.0' TO LT. EDGE PAVEMENT

S.L.M. 779+06.46, ON ~~Q~~ PAV'T AT RUCH ST.


GRID: NORTHING: 652449.102 EASTING: 1700003.863

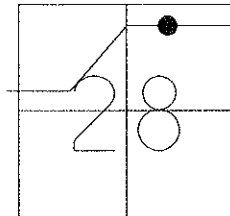


SET PK/WASHER  
11-06-90 MB

RESET MAG/WASHER  
NEWREFD40 7-08-10 DCH

FD SHI  
SE/S

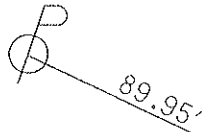

89.95'

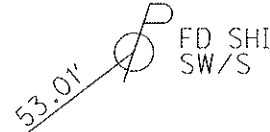

53.01'

FD SHI  
SW/S

~~Q~~ PAV'T

SR 582

SET SHI  
NE/S




23.65'

27.65'

FD. N/SHI  
ON ~~Q~~ PAV'T

RUCH ST

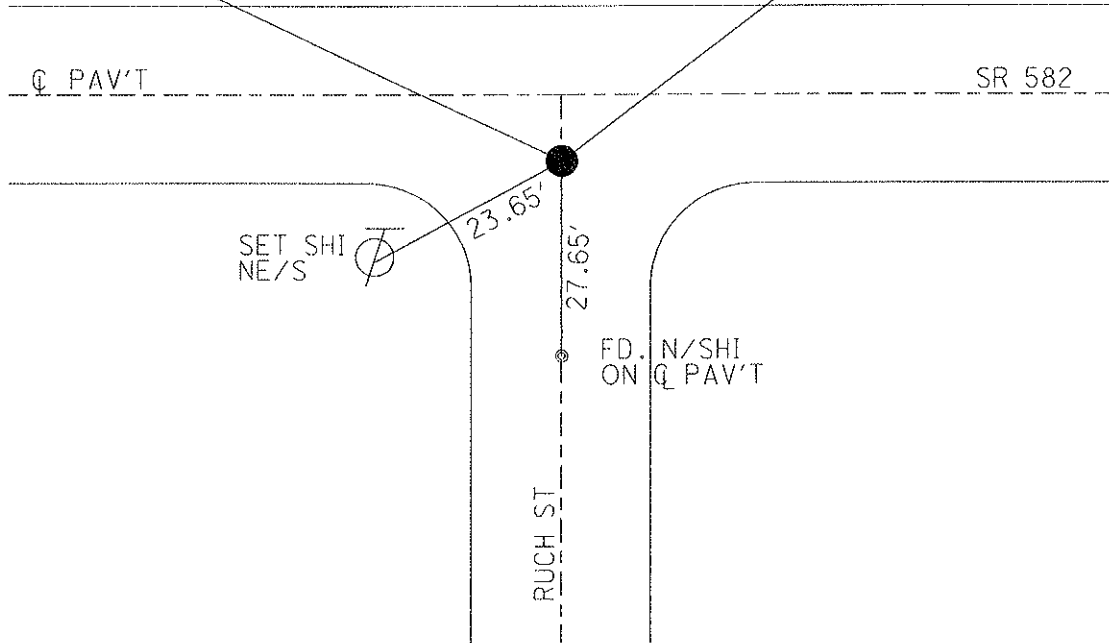

# O.D.O.T. DISTRICT 2 SURVEY OFFICE

PERSONNEL \_\_\_\_\_ REFERENCE NO. 40 D SHEET \_\_\_\_\_ OF \_\_\_\_\_

NOTES LOHRKE

H.C. HOFFMAN

R.C. BAENHSEL

DATE 7-23-90

WEATHER cloudy

TEMP. +75°

ROUTE S.R. 582

COUNTY WOOD

TOWNSHIP TROY

SECTION 28

T6 NR 12 E


TYPE MONUMENT P.K. NAIL

ON SURFACE - BELOW YES


~~LEFT~~ - & PAV'T. - RIGHT 6.5

160 TO Lt EDGE PAVEMENT ON & PAVT Ruch st.

S.L.M. 779 +98

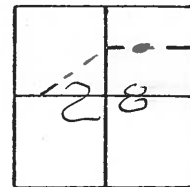

Set P.K. / Washer  
11-6-90  
MB

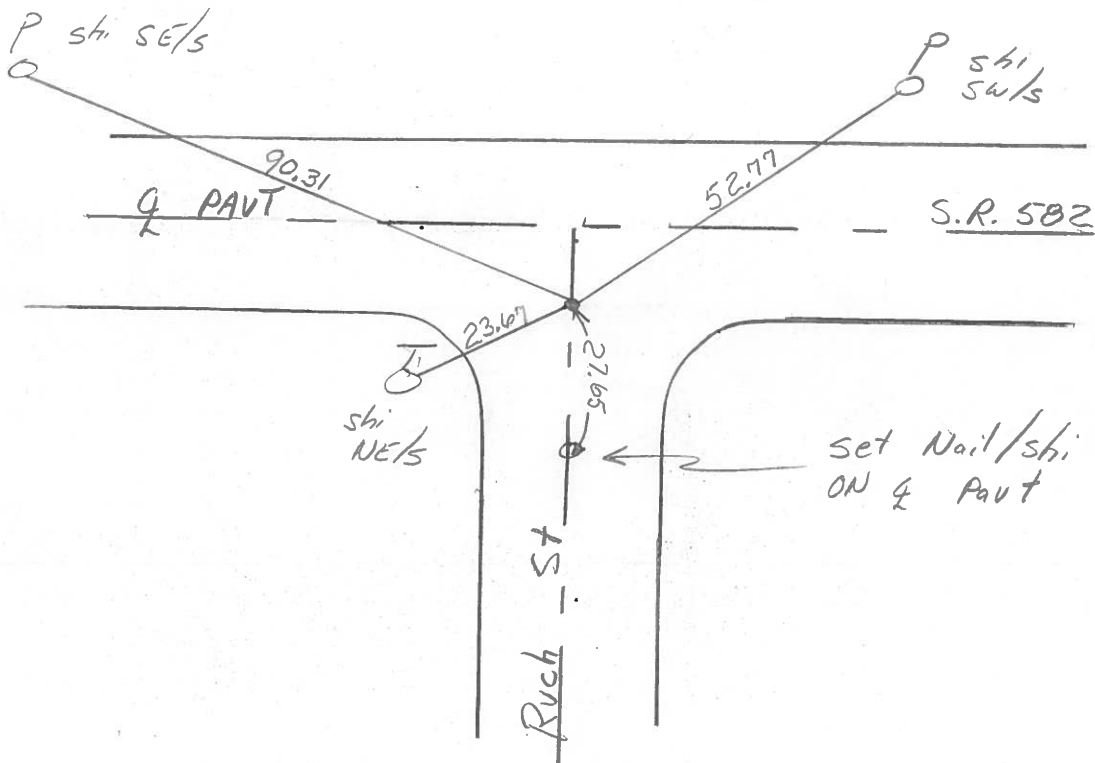

County Wood S.R. 582

Date 13 July 83

Township Troy

Weather Warm

Section 28

Temp. 88°


T N, R E

Personnel L. Stone

P. Neuser


R. Michalak

D. Curtis

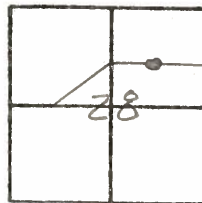

SLM Sta. 779+92

REF. NO. 40D

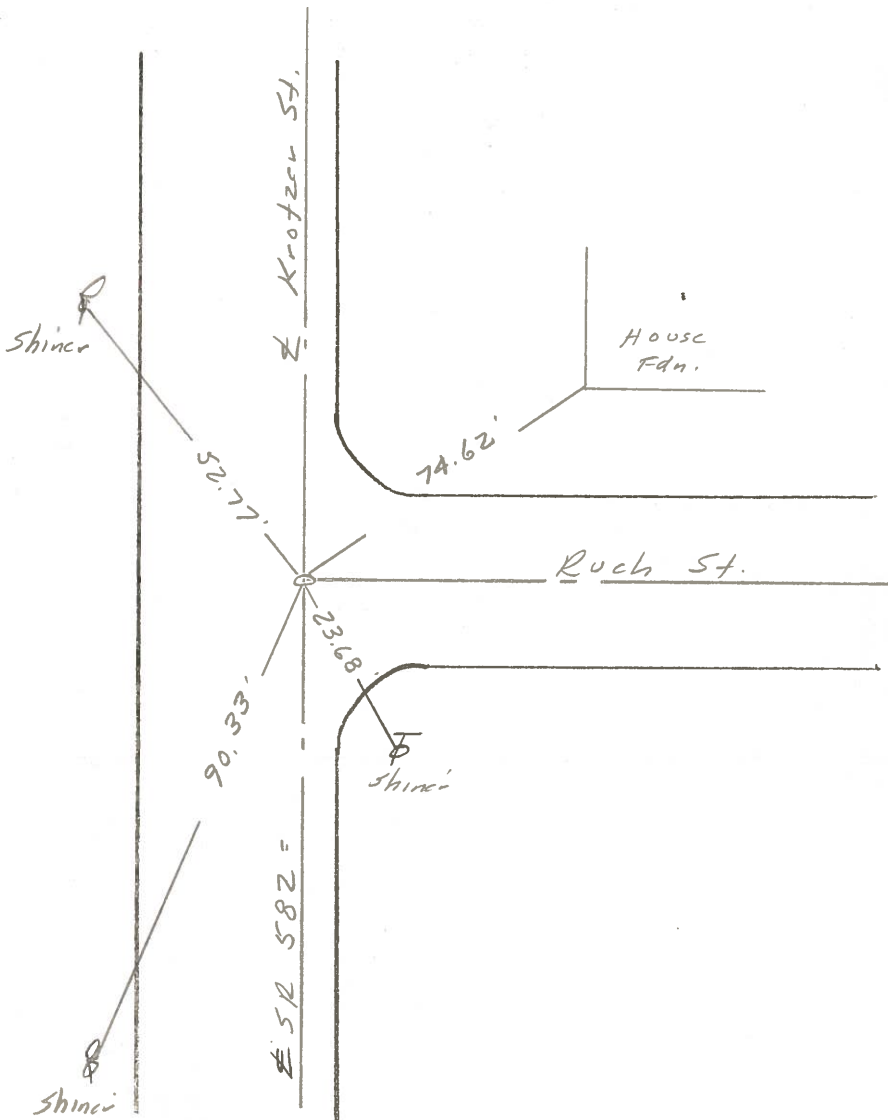

Fd. 1" I. Pin 3" deep  
16.7' to N. edge put.

set PK nail

PERSONNEL	TITLE	PERSONNEL	TITLE	COUNTY	Wood	DATE	April, 12, 1968
<u>Norrison</u>	_____	_____	_____	S. R.	# 582	WEATHER	Clear
<u>Bowers</u>	_____	_____	_____	SEC.	Lucky.	TEMP.	+60°
<u>Halcombe</u>	_____	_____	_____	DESCRIPTION	Ties to Control Points.		JOB NO.
<u>Kern</u>	_____	_____	_____				

