

O.D.O.T. DISTRICT 2 SURVEY OFFICE

PERSONNEL

REFERENCE NO. 40 F

SHEET 16 OF 29

NOTES HOMAN

DATE 4-27-10

ROUTE SR 582

H.C. HOMAN

WEATHER SUNNY

COUNTY WOOD

R.C. ROUSOS

TEMP. 45°

TOWNSHIP TROY

SECTION 28

T 6 N R 12 E


TYPE MONUMENT MAG/WASHER

ON SURFACE - ~~BELOW~~ On Surface

~~LEFT - C PAV'T - RIGHT~~ 5.8'

3.5' TO RT EDGE PAVEMENT


S.L.M. 784+22 REC

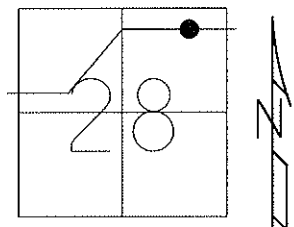

GRID: NORTHING: 652446.240 EASTING: 1700427.183

SET PK/WASHER
11-06-90 MB

RESET MAG/WASHER
NEWREFF 40
7-08-10 DCH

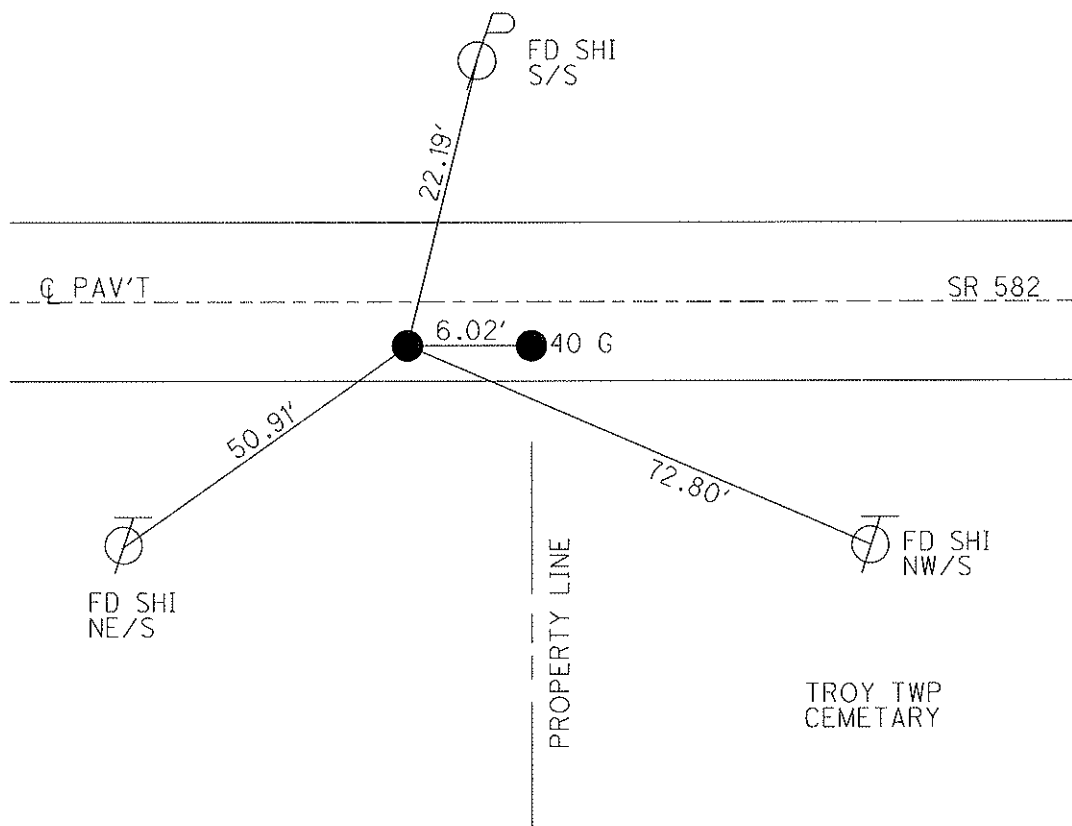

TROY TWP
CEMETARY

O.D.O.T. DISTRICT 2 SURVEY OFFICE

PERSONNEL

REFERENCE NO. 40 F

SHEET _____ OF _____

NOTES LOEHRKE

H.C. Hoffman

R.C. BARNHISEL

DATE 7-23-90

WEATHER Pt Cloudy

TEMP. +78

ROUTE 582

COUNTY WOOD

TOWNSHIP TROY

SECTION 28

T 6 N R 12 E


TYPE MONUMENT P.K. Nails

ON SURFACE - ~~BELOW~~ yes


~~LEFT - &~~ PAV'T. - RIGHT S.8

35 TO Rt EDGE PAVEMENT

S.L.M. 784+22 784+28

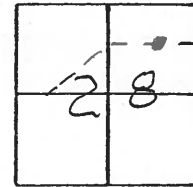

Set P.K. / Washer
11-6-90
MB

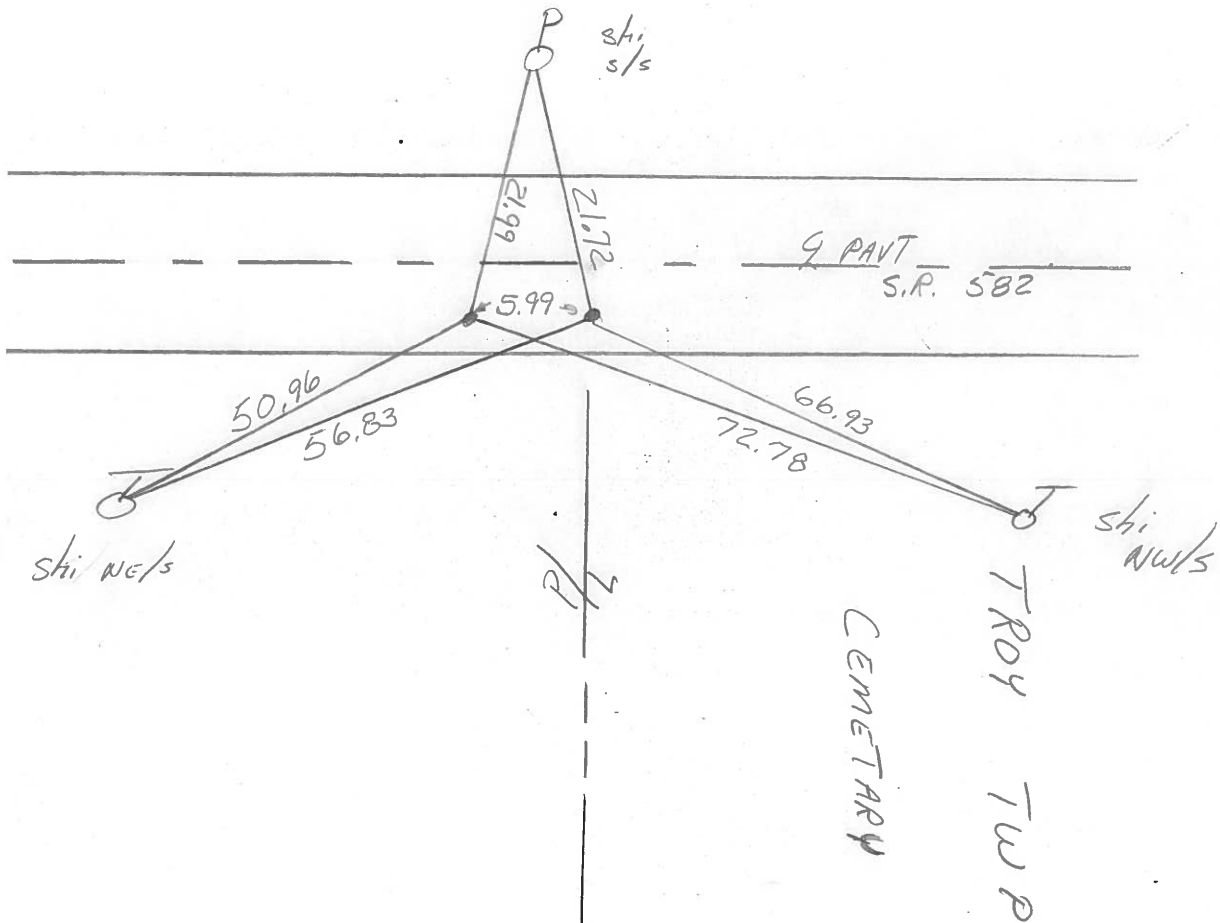

County Wood S.R. 582

Date 13 July 83

Township Troy

Weather Wcsm

Section 28

Temp. 88°


T N, R E

Personnel I. Stone

P. Neuser


R. Michalak

D. Curtis

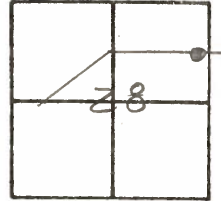

SLM STA. 784+14 & +20

REF. NO. 40F

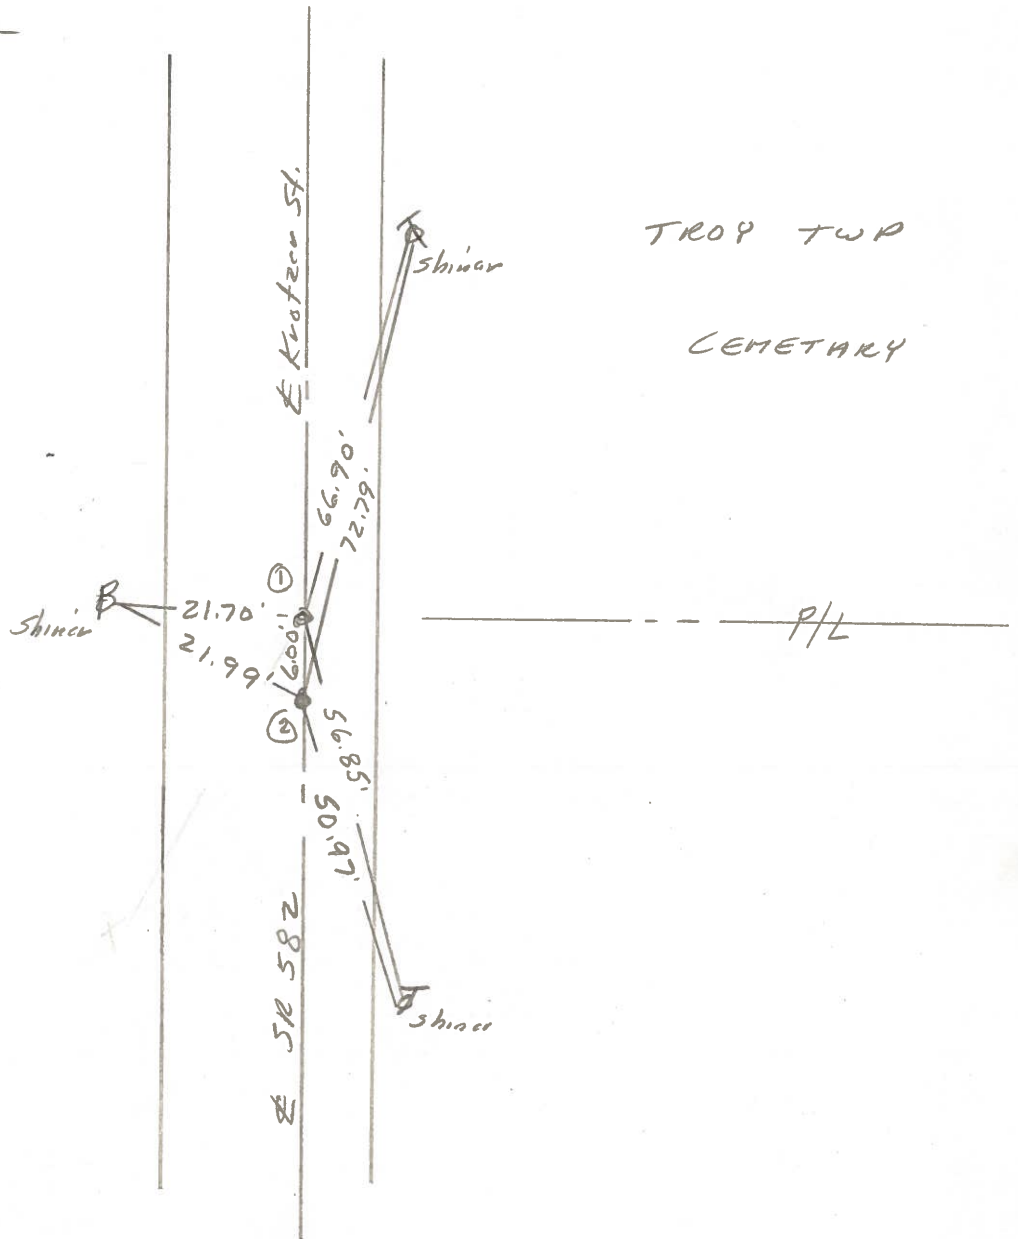

Set PK Nail

- ① Fd 1" I. Pin 3" deep
15.6' to N. edge put.
3.2' to S. edge put.

- ② Fd RR Spk 6" deep
15.2' to N. edge put.
3.5' to S. edge put.

Set PK Nail

PERSONNEL TITLE PERSONNEL TITLE
 Morrison _____
 Bowers _____
 Holcombe _____
 Kern _____

COUNTY Wood DATE April, 12, 1968
 S. R. # 582 WEATHER Clear
 SEC. Lucky. TEMP. 160°

DESCRIPTION Ties to Control Points. JOB NO. _____

