

O.D.O.T. DISTRICT 2 SURVEY OFFICE

PERSONNEL _____

REFERENCE NO. 41 A

SHEET 19 OF 29

NOTES HOMAN

DATE 4-27-10

ROUTE SR 582

H.C. HOMAN

WEATHER SUNNY

COUNTY WOOD

R.C. ROUSOS

TEMP. 45°

TOWNSHIP TROY

SECTION 28

T 6 N R 12 E


TYPE MONUMENT SM R.R. SPIKE

~~ON SURFACE~~ - BELOW 2"

~~LEFT~~ - Q PAV'T - RIGHT 6.6'

TO EDGE PAVEMENT

S.L.M. 13.6' W. Q LEMOYNE RD.

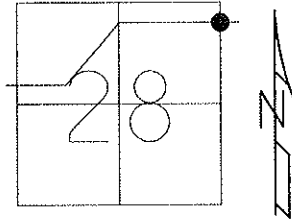


GRID: NORTHING: 652439.525 EASTING: 1701730.020

NOTE: ORIGIN UNKNOWN
SET PK/WASHER
11-07-90 MB

RESET MAG/WASHER
NEWREFA41,7-08-10 DCH

DIST .41-41A=53.00'

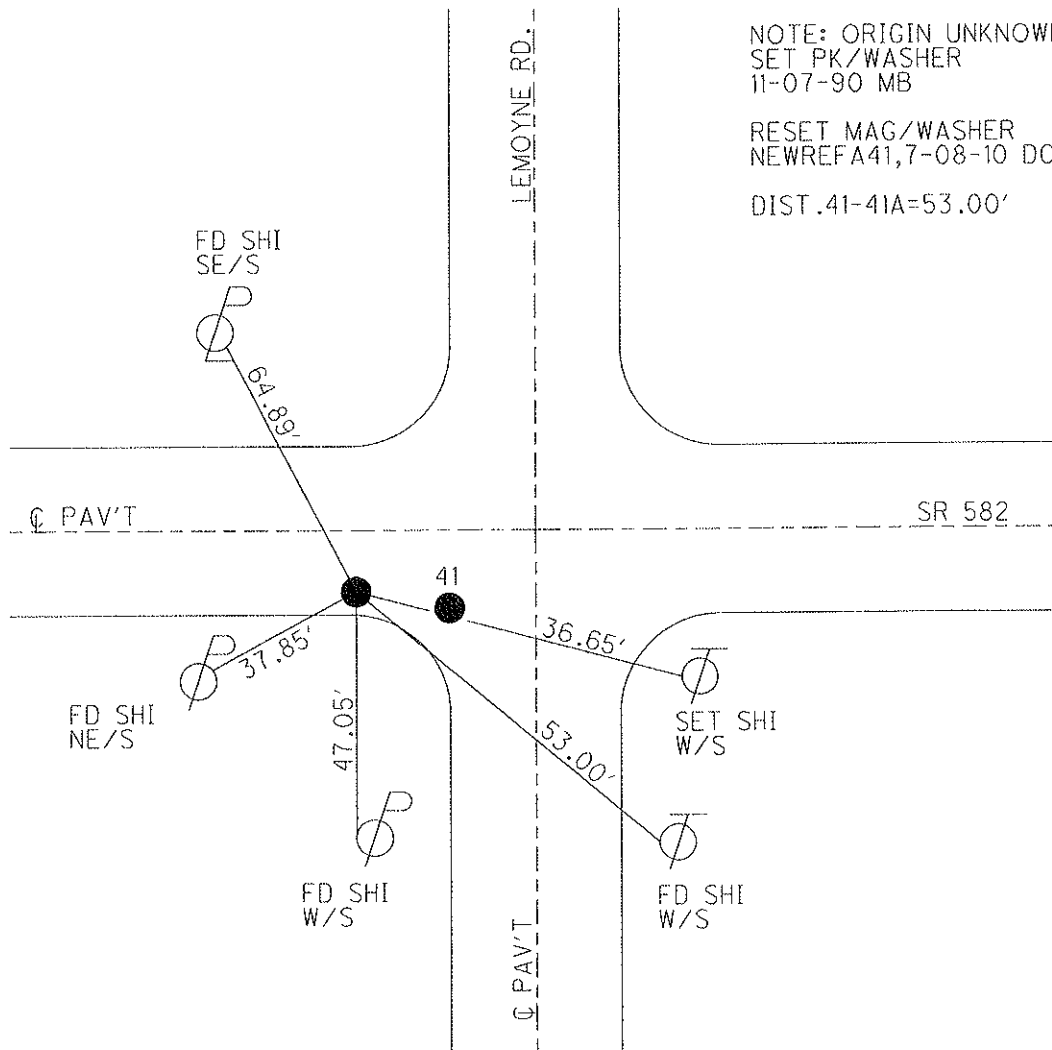

O.D.O.T. DISTRICT 2 SURVEY OFFICE

PERSONNEL

REFERENCE NO. 41

SHEET OF

NOTES LOEHRKE

H.C. Hoffman

DATE 7-26-90

ROUTE 582

R.C. BARNHISEL

WEATHER PT. CLOUDY

COUNTY WOOD

TEMP. 77.5

TOWNSHIP TROY

SECTION 28

T 6 N R 12 E


TYPE MONUMENT Sm R.R Spike

ON SURFACE - BELOW yes

~~LEFT~~ - C PAVT. - RIGHT 6.6'


TO EDGE PAVEMENT 13.6 W & Lem. Rd

S.L.M. 797 + 25

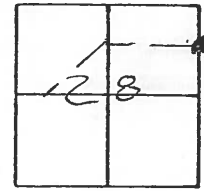

NOTE: ORIGIN UNKNOWN

Set P.K/Washer
11-7-90
YMB

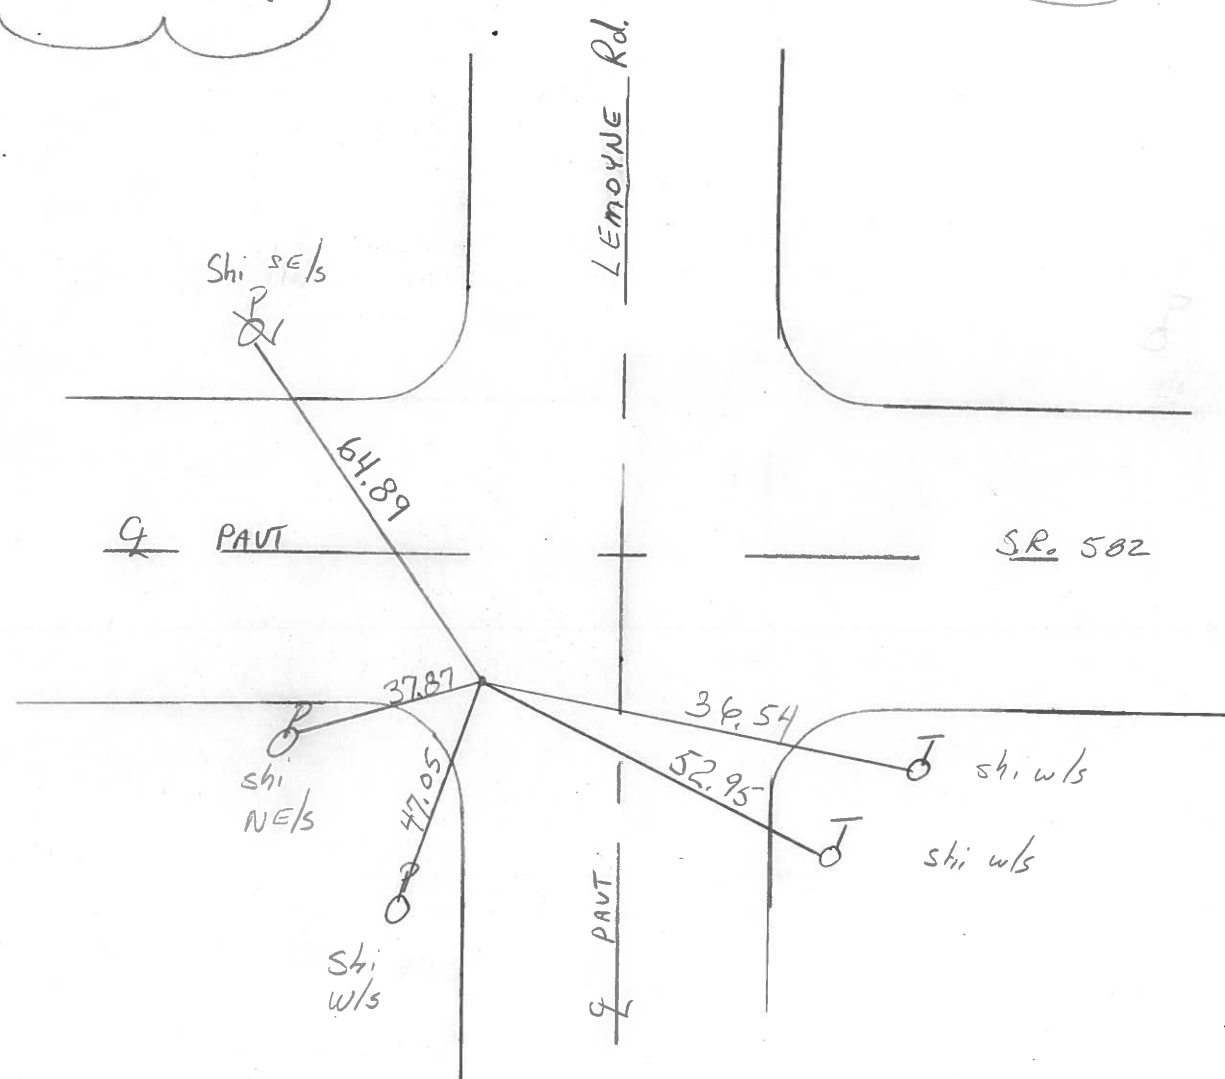

County Wood S.R. 582

Date 13 July 83

Township Troy

Weather Warm

Section 28

Temp. 88°


T N, R E

Personnel I. Stone

P. Neusev

R. Michalak

D. Curtis

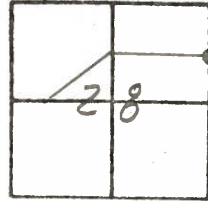

SLM STA. 797+81

REF. NO. 41

