



O.D.O.T. DISTRICT 2 SURVEY OFFICE

PERSONNEL \_\_\_\_\_

REFERENCE NO. 44

SHEET 25 OF 29

NOTES HOMAN

DATE 4-28-10

ROUTE SR 582

H.C. HOMAN

WEATHER SUNNY

COUNTY WOOD

R.C. ROUSOS

TEMP. 35°

TOWNSHIP TROY

SECTION 27

T 6 N R 12 E

TYPE MONUMENT MAG NAIL

ON SURFACE - ~~BELOW~~ On Surface


~~LEFT~~ - PAV'T - RIGHT 9.0' Q EAST

TO EDGE PAVEMENT

S.L.M. 862+90.02, 14.9' LT. Q SOUTH


GRID: NORTHING: 651121.050

EASTING: 1707039.203

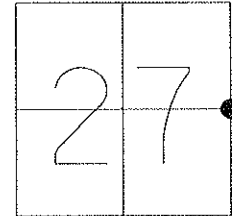

SET PK/WASHER  
11-07-90 MB

SET MAG/WASHER  
NEWREF44 7-09-10 DCH

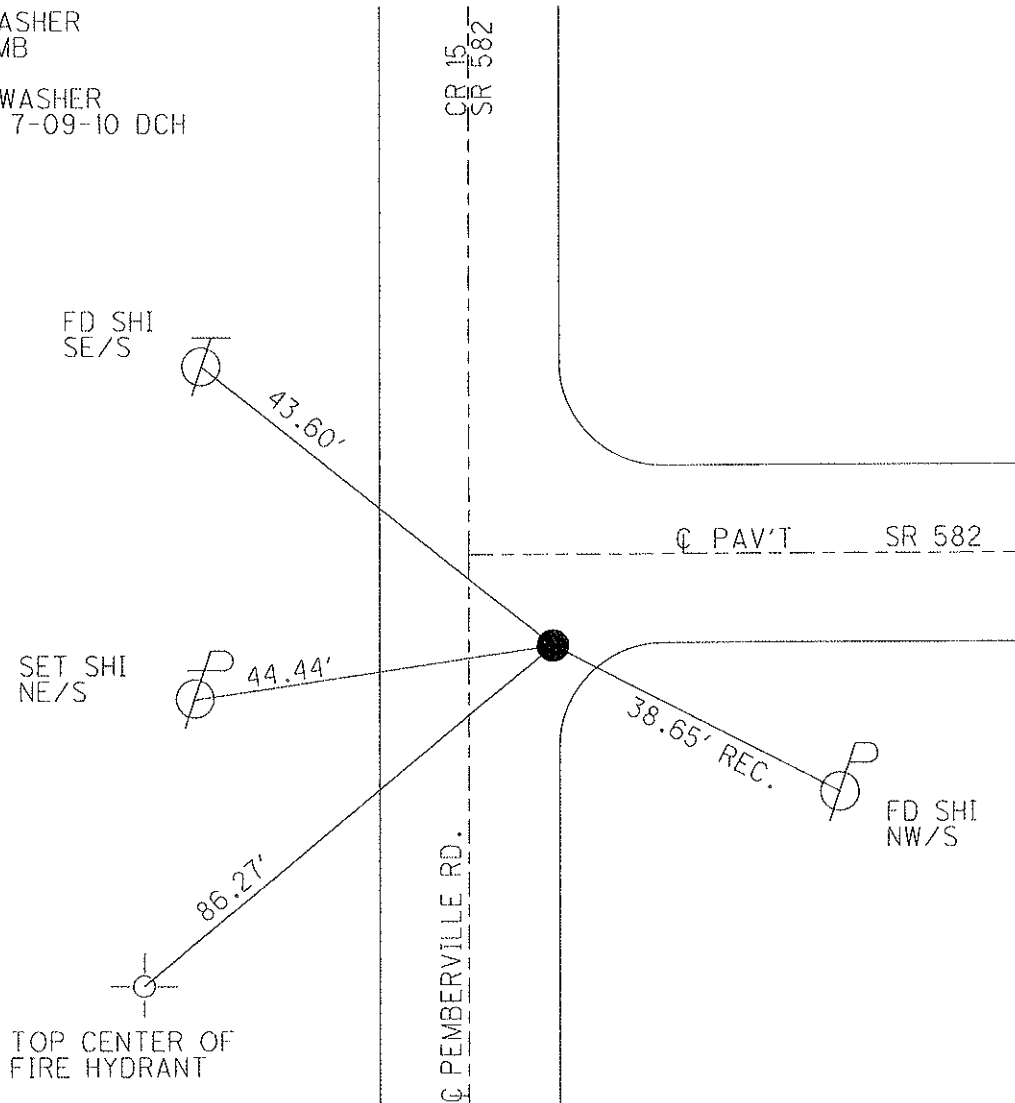

# O.D.O.T. DISTRICT 2 SURVEY OFFICE

PERSONNEL \_\_\_\_\_

REFERENCE NO. 44

SHEET \_\_\_\_\_ OF \_\_\_\_\_

NOTES LOEHRKE

H.C. LOEHRKE

DATE 7-26-90

ROUTE 582

R.C. BARNHISEL

WEATHER CLOUDY

COUNTY WOOD

TEMP. +85

TOWNSHIP TROY

SECTION 27

T 6 & R 12 E


TYPE MONUMENT 1/2" IRON PIN

ON SURFACE - BELOW 1 1/2"


LEFT - & PAV'T. - RIGHT 9.0° EAST

TO EDGE PAVEMENT 14.9 L~~E~~ South

S.L.M. 864105

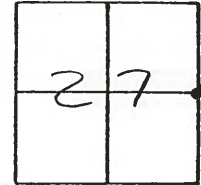

Set P.K. / Washer  
11-7-90  
MB

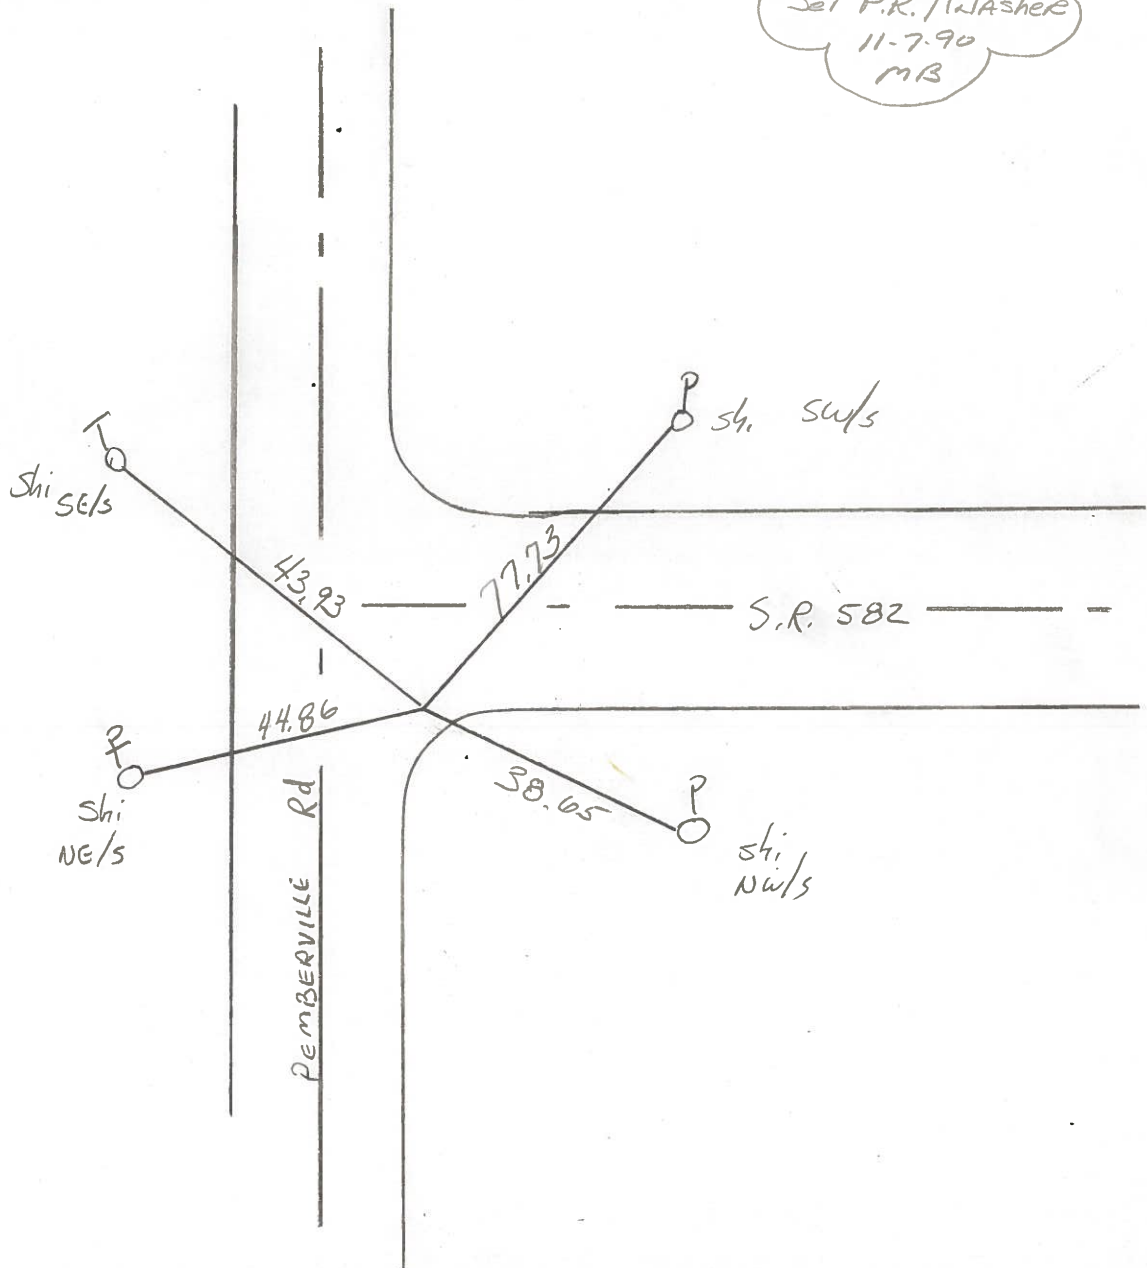

ODOT. DISTRICT 2 SURVEY OFFICE

SHEET 34 OF

County Wood S.R. 582

Date 13 July 83

Township Troy


Weather Warm

Section 27

Temp. 89°

T N, R E

Personnel I. Stone

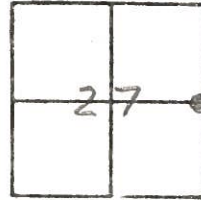


P. Neuse

R. Michalak

D. Curtis

SLM STA. 863+91

REF. No. 44

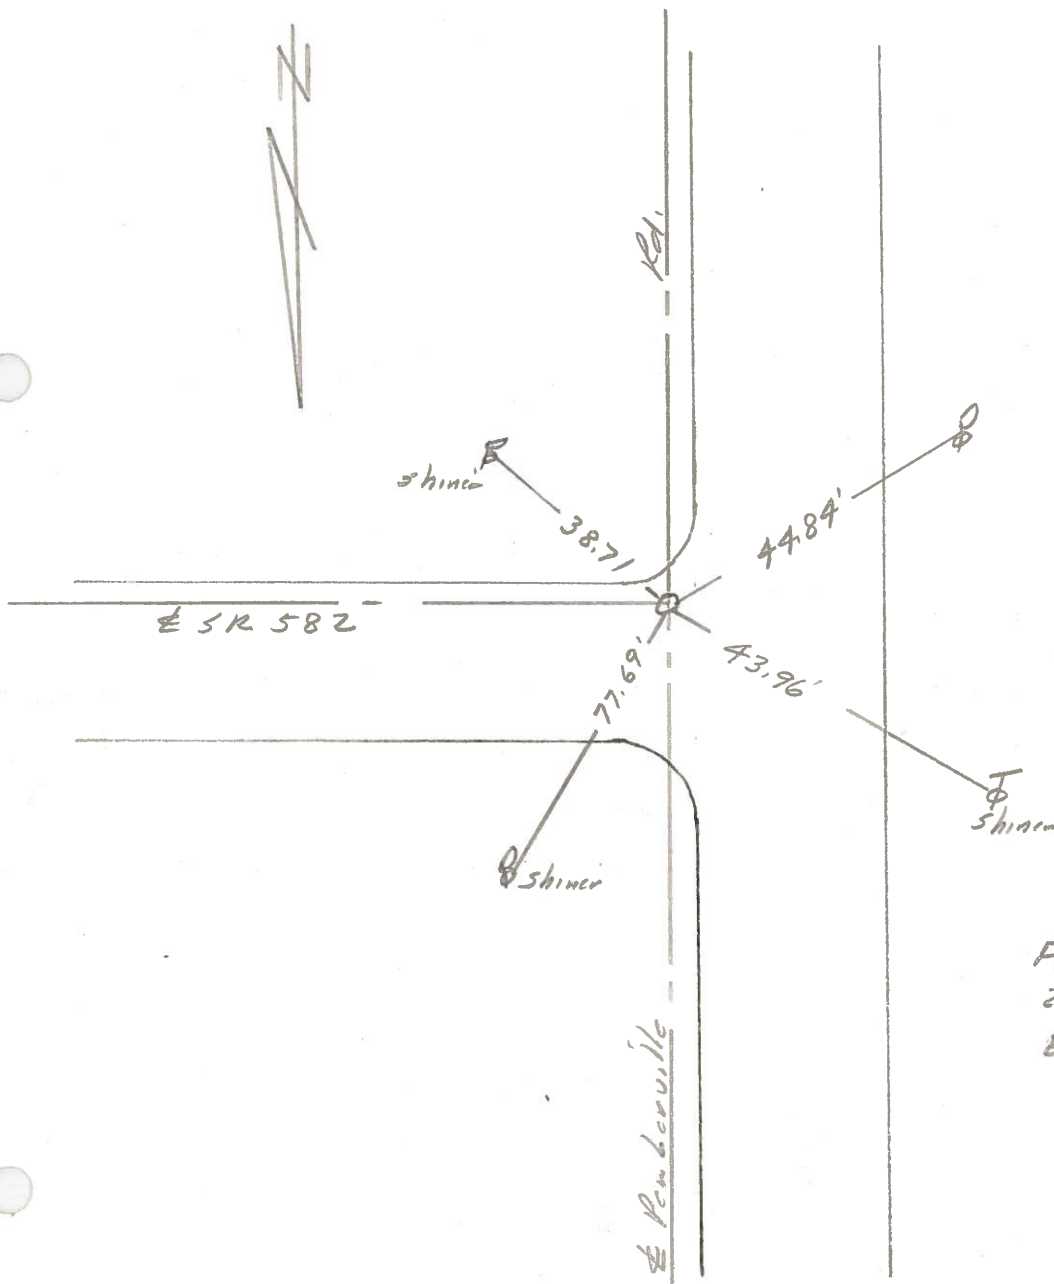

Fd. Small Iron pin 1/2"  
25.9' to W. edge pvt.  
E 1/4 cor. sec. 27

County Wood S.R. 582

Date 5-6-82

Township Troy

Weather clear - Windy

Section 26


Temp. +80°

T6N, R12E

Personnel HOFFMAN



Loehrke

#44 Householder

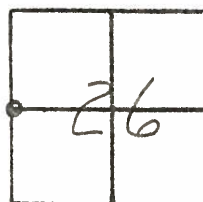

Fd. I. Rod @ surface  
1/2" DIA.

15.0' E. of & PAUT Pemberville Rd  
7.9' S. of & PAUT S.R. 582

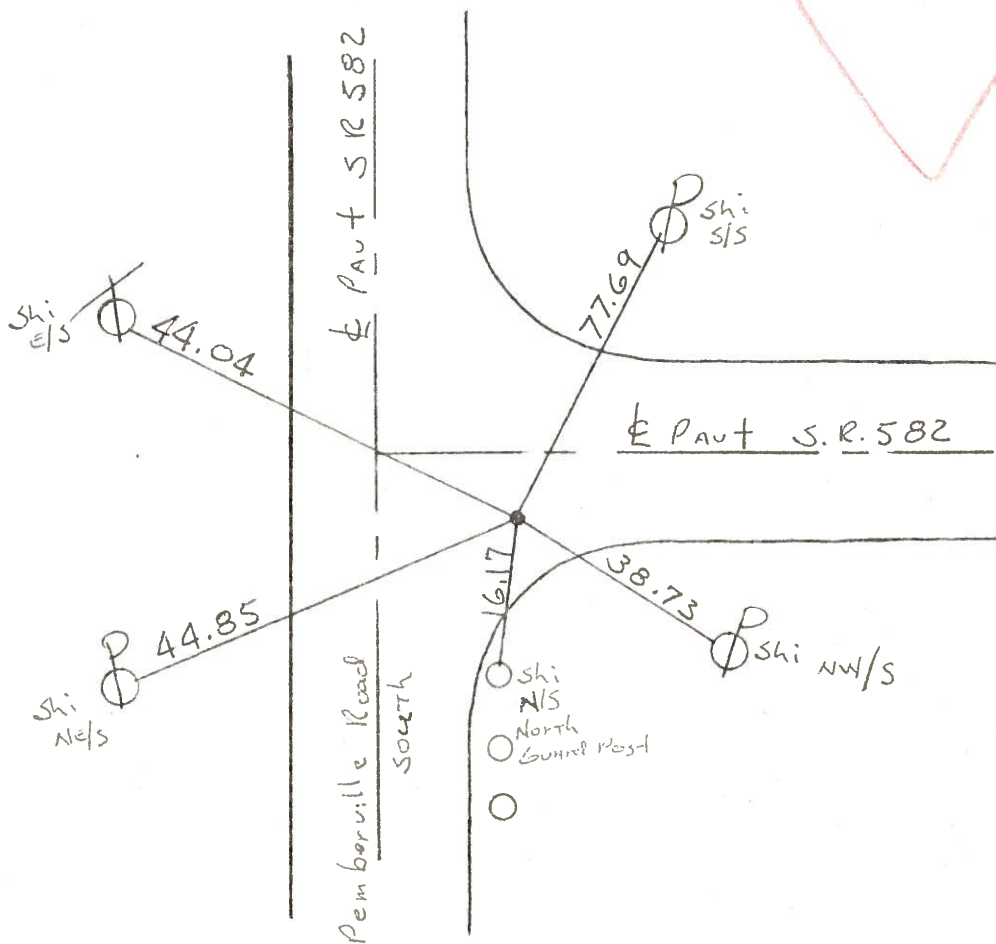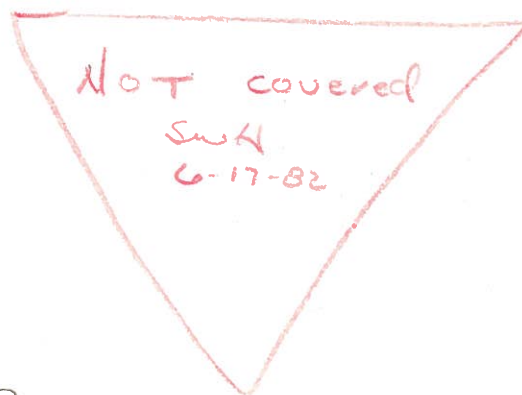

County Wood S.R. 582

Date 5-6-82

Township Troy


Weather clear - windy

Section 26

Temp. +80°

T6N, R12E

Personnel HOFFMAN

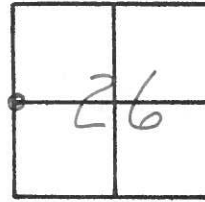


Loehrke

#44 Householder

Fd. I. Rod @ surface  
1/2" DIA.

15.0' E. of & PAUT Pemberville Rd

7.9' S. of & PAUT S.R. 582

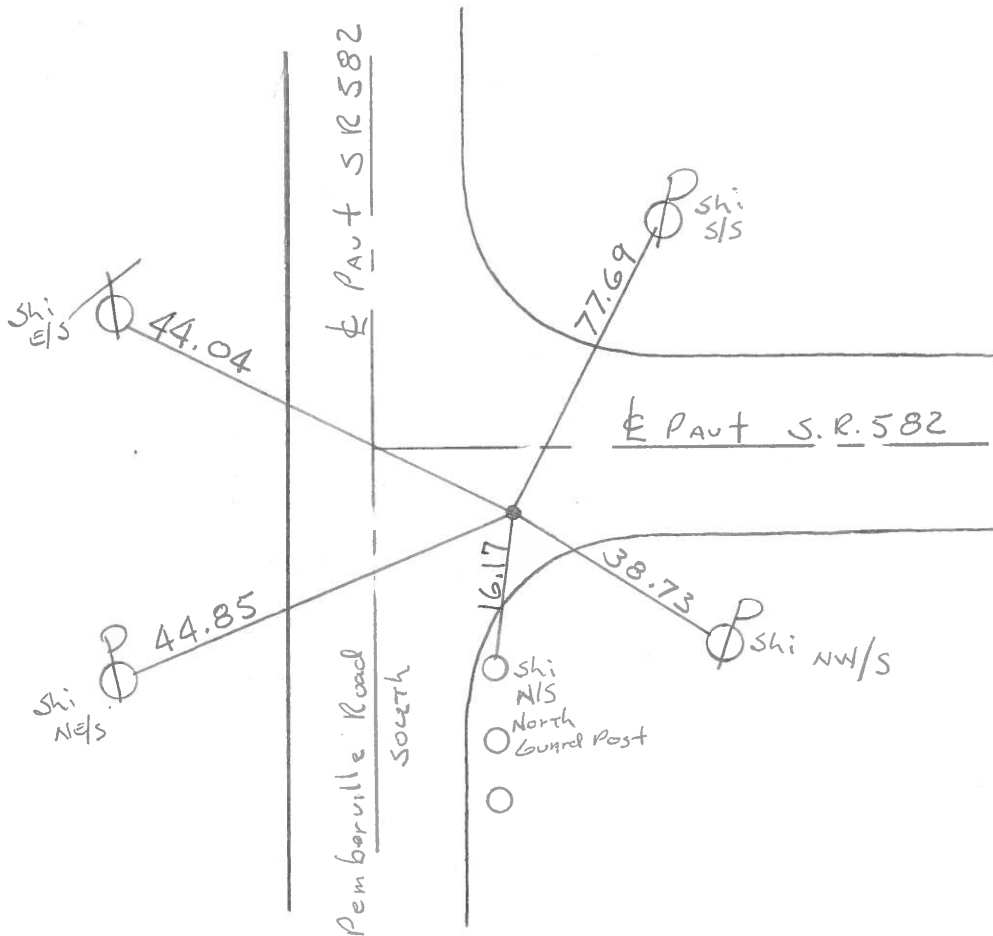

Town 6 N. Range 12 E.

1/4 Corner of Sections 26, 27 TRAY TWP.

Kind of Monument R.R. SPR. Remarks \_\_\_\_\_

FOUND SET 12-23-1968 BY COUNTY

N. & S. Road PEMBERVILLE F. B. \_\_\_\_\_ P. \_\_\_\_\_


E. & W. Road ST. RT. 582 F. B. \_\_\_\_\_ P. \_\_\_\_\_

**44**

N



Date Checked: \_\_\_\_\_

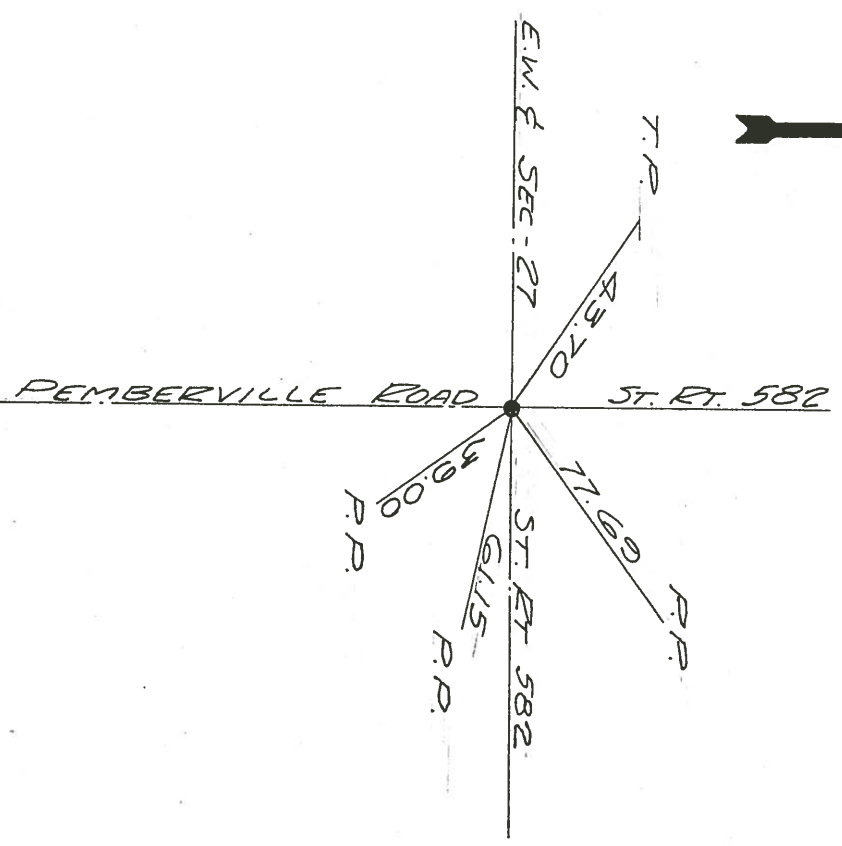

Town 6 N Range 12 E.

INT. Corner of Sections 26 TRAY

Kind of Monument BOLT <sup>1/2" diam</sup> Remarks \_\_\_\_\_

FOUND SET 12-14-1970 BY \_\_\_\_\_

N. & S. Road \_\_\_\_\_ F. B. \_\_\_\_\_ P. \_\_\_\_\_

E. & W. Road ST. RT. 582 F. B. \_\_\_\_\_ P. \_\_\_\_\_

**45**

N



Date Checked: \_\_\_\_\_

