

O.D.O.T. DISTRICT 2 SURVEY OFFICE

PERSONNEL

REFERENCE NO. 1

SHEET 1 OF 13

NOTES J. HARBAUGH

DATE 06/28/11

ROUTE US 20 & SR 795

H.C. R. LUMBREZER

WEATHER SUNNY

COUNTY WOOD

R.C. K. MOSER

TEMP. 80° F

TOWNSHIP PERRYSBURG

SECTION 6

T 4 N R 11 E

TYPE MONUMENT MAG NAIL & WASHER SET



~~ON SURFACE~~ - BELOW 4"

~~LEFT~~ - Q PAV'T - ~~RIGHT~~ BOTH

TO EDGE PAVEMENT

S.L.M. 0+00

Grid: Northing: 690737.122 Easting: 1659830.954

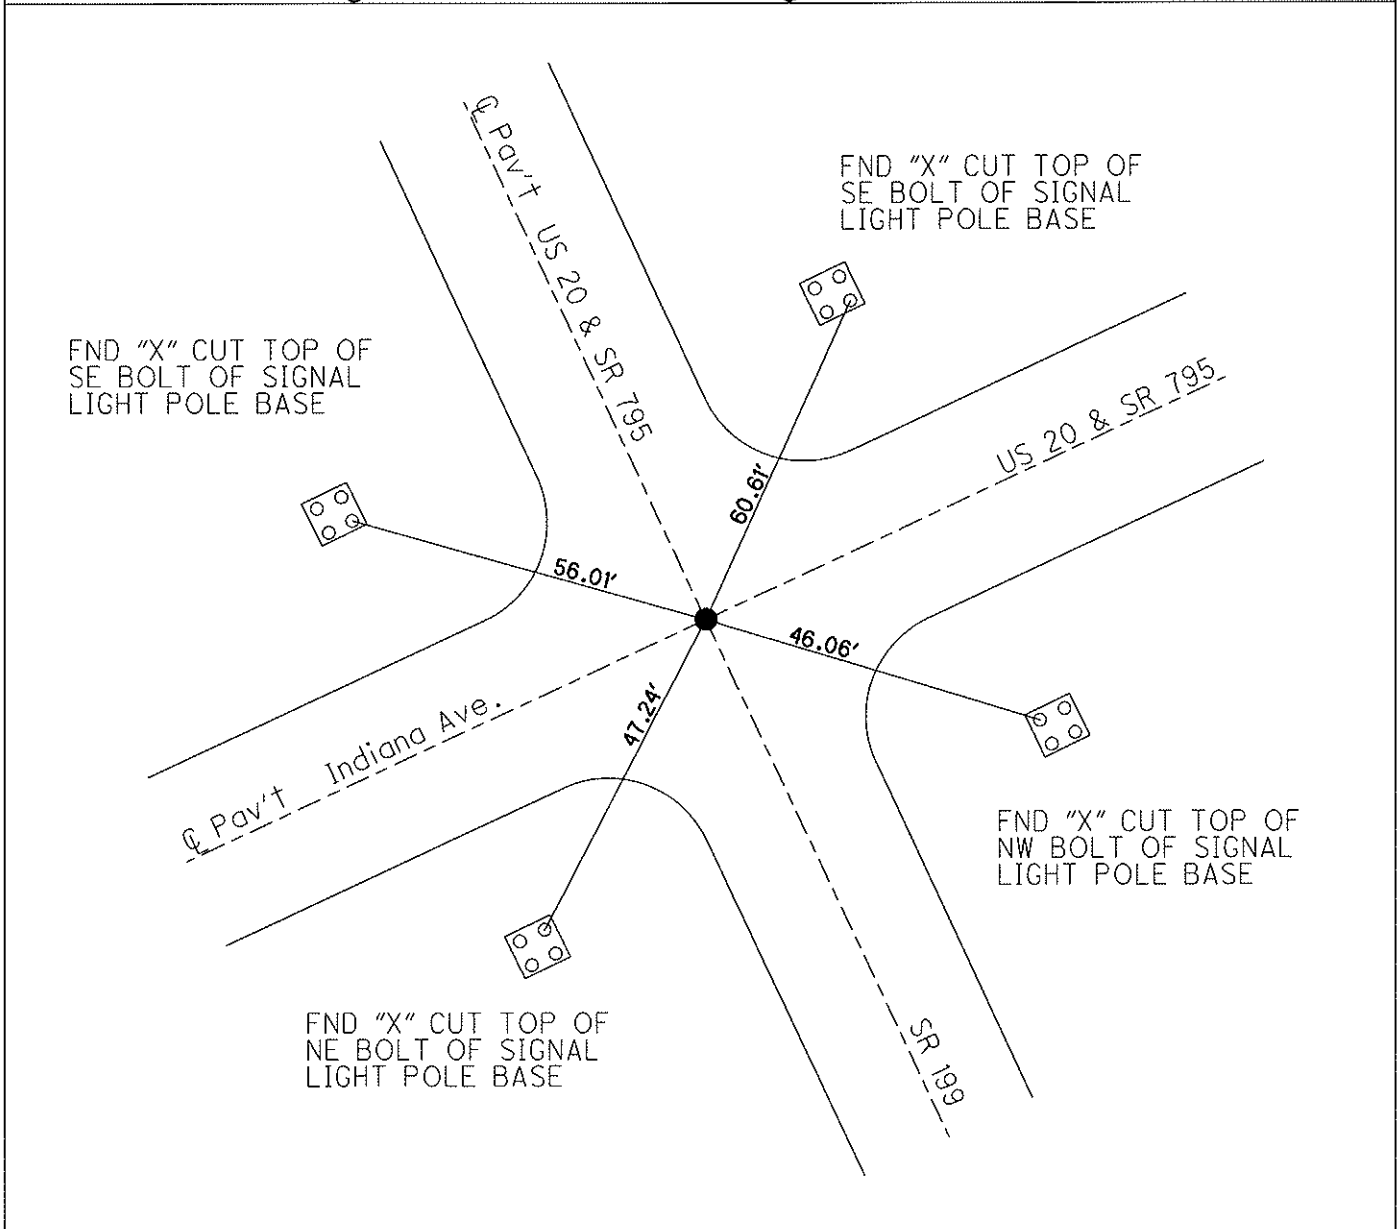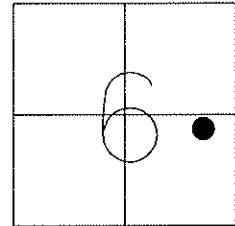

O.D.O.T. DISTRICT 2 SURVEY OFFICE

PERSONNEL

REFERENCE NO. _____

SHEET _____ OF _____

NOTES BARNHISEL

H.C. REED

R.C. Loehrke

HOFFMAN

DATE 5-4-88

WEATHER SUNNY

TEMP. +55°

ROUTE U.S. 20 - SE 199 & 795

COUNTY WOOD

TOWNSHIP Peerysburg

SECTION _____

T _____ R _____



TYPE MONUMENT 1" Iron Rod

ON SURFACE - BELOW 3"

~~LEFT - & PAV'T. - RIGHT~~ Both

TO EDGE PAVEMENT

S.L.M. 73+79

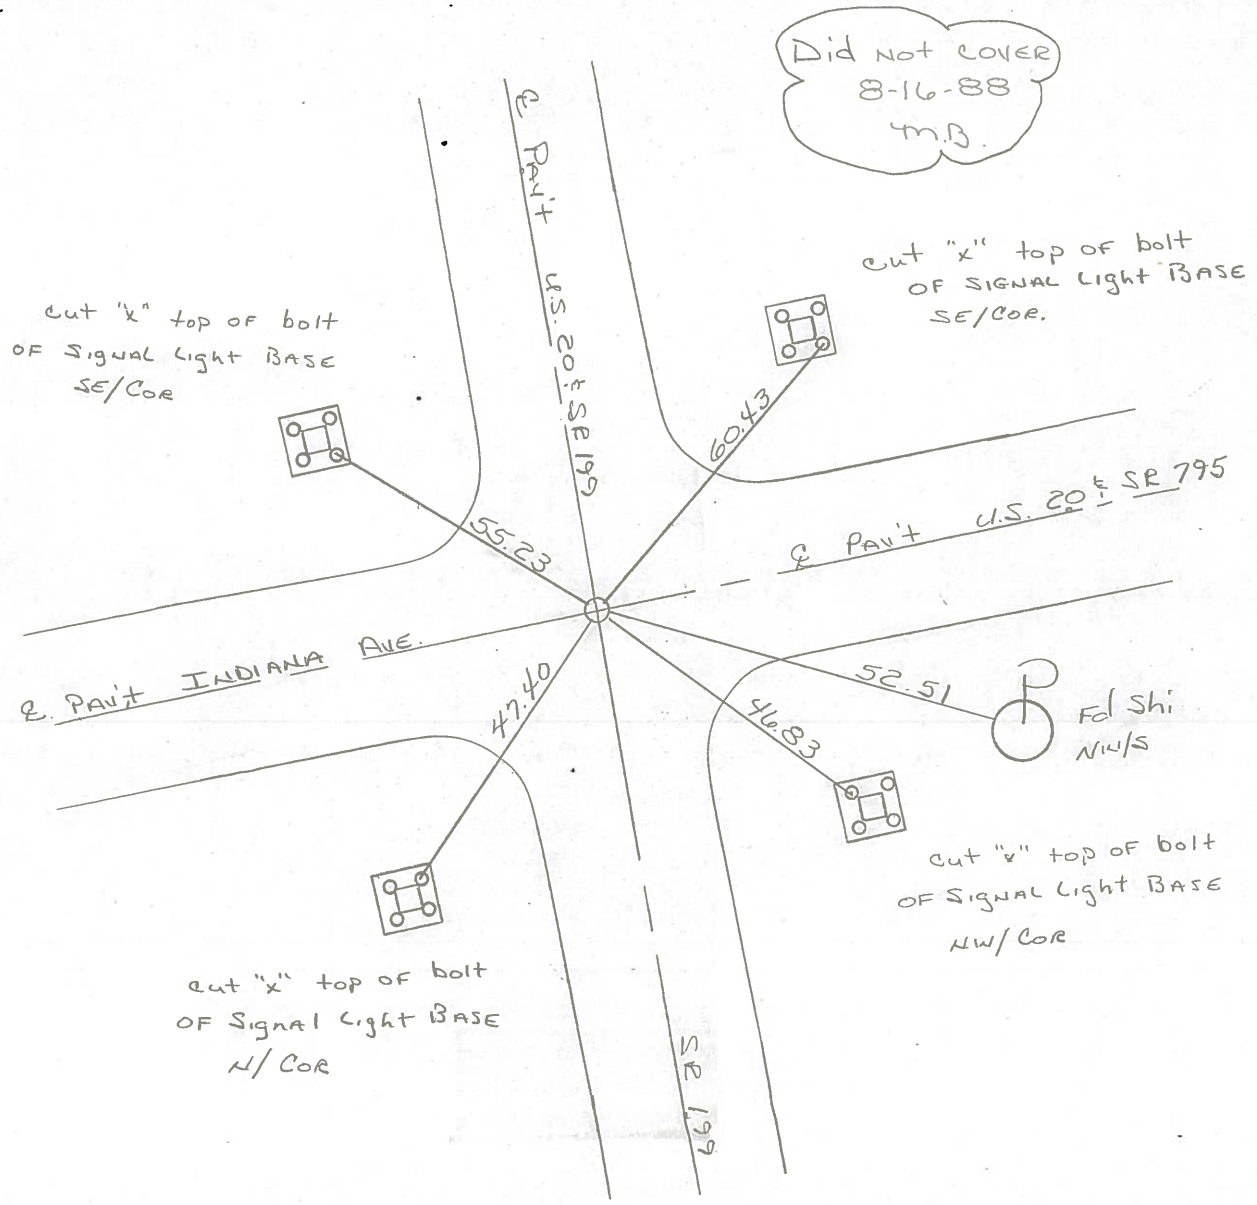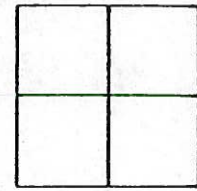

PERSONNEL TITLE PERSONNEL TITLE

BURNSIDE
SMITH
HOFFMAN

COUNTY WOOD DATE 2-26-70

S. R. 795 WEATHER CLEAR

SEC. PERRYSBURG CORP. TEMP. +20°

DESCRIPTION CONTROL TIES (INDIANA AVE) JOB NO.

