


O.D.O.T. DISTRICT 2 SURVEY OFFICE (USE ONLY)


PERSONNEL	REFERENCE NO.	13	SHEET	7	OF	19
NOTES	HUSS	DATE	5/24/12	ROUTE	SR 795	
H.C.	HUSS	WEATHER	FAIR	COUNTY	WOOD	
R.C.	CANTERBURY	TEMP.	82°	TOWNSHIP	LAKE	
				SECTION	18	
				T	7	N
				R	12	E

TYPE MONUMENT MON.BOX _____
 ON SURFACE - ~~BELOW~~ ON _____
 LEFT - Q PAV'T - RIGHT ON _____
 - TO - EDGE PAVEMENT _____
 S.L.M. 280+89 ± _____

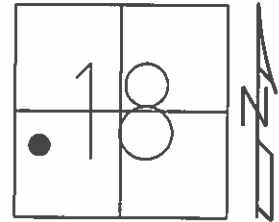

GRID: NORTHING: 692855.079 EASTING: 1687256.967

RECORD:
 STA. 281+02.86=
 10+00 TRACEY RD
 $\Delta = 4^{\circ} 02' 15''$ LT
 FD STONE 36" BELOW
 SET 3/8" IPIN
 OVER STONE
 1/22/71, BURNSIDE
 FD MON.BOX
 8/17/71, I.S.
 FD MONBOX
 W/IPIN, MC
 GPS, REF13

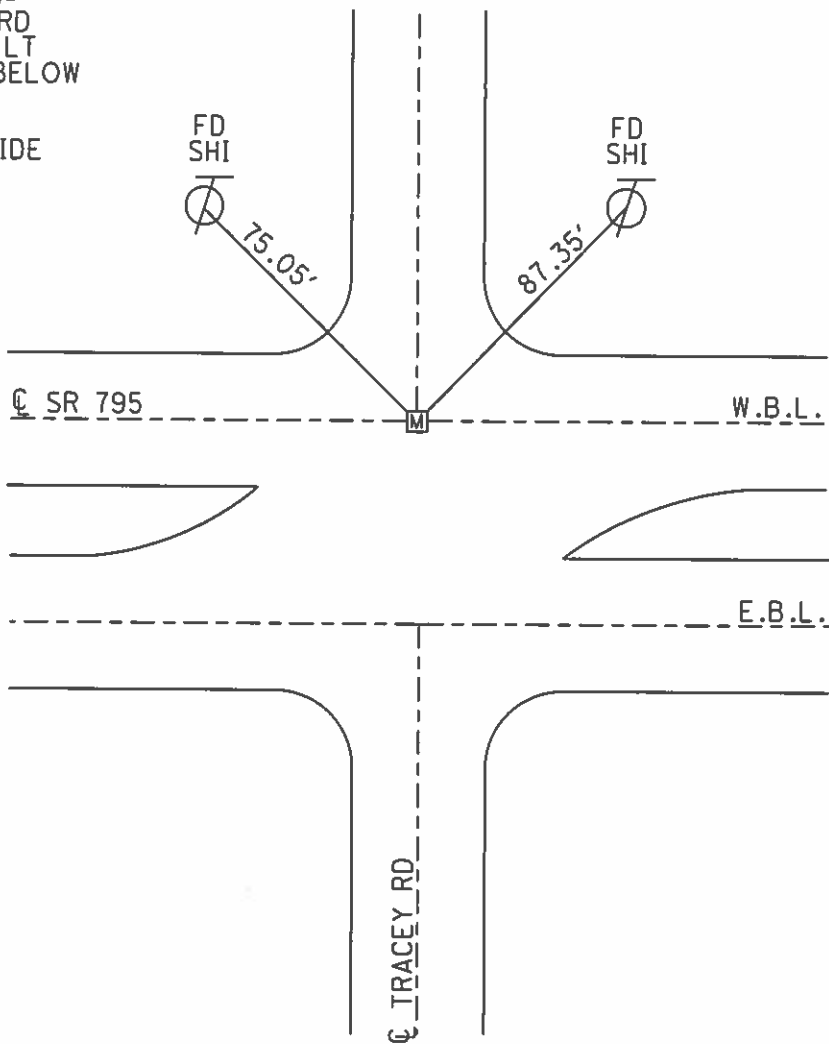

PERSONNEL TITLE PERSONNEL TITLE

COUNTY Wood

DATE 8-15-58

Sworden.

S. R. #795

WEATHER

SEC.

TEMP.

DESCRIPTION

LEFT

CENTER LINE

RIGHT

JOB NO.

Tracy Rd.		N.W.	SE. cor. N. coping,	23.64'
Fd. Stone (Ed. Meyers Private Eng)		N.W.	S.W. cor. N. coping,	31.02' 30.94'
N.E. cor. Sec. #1		S.W.	N.W. cor. S. Hdwl.	29.03' 28.09'
T4. U.S. Res.		S.W.	S.E. cor. S. Hdwl.	16.67' 16.47'
Found Iron Pipe.		S.W.	Conc. mon.	21.57' 21.22'

#536