

PERSONNEL TITLE PERSONNEL TITLE

COUNTY Wood

DATE

S. R. #795

WEATHER

SEC.

TEMP.

DESCRIPTION


Moline Over-head

JOB NO.

LEFT

CENTER LINE

RIGHT

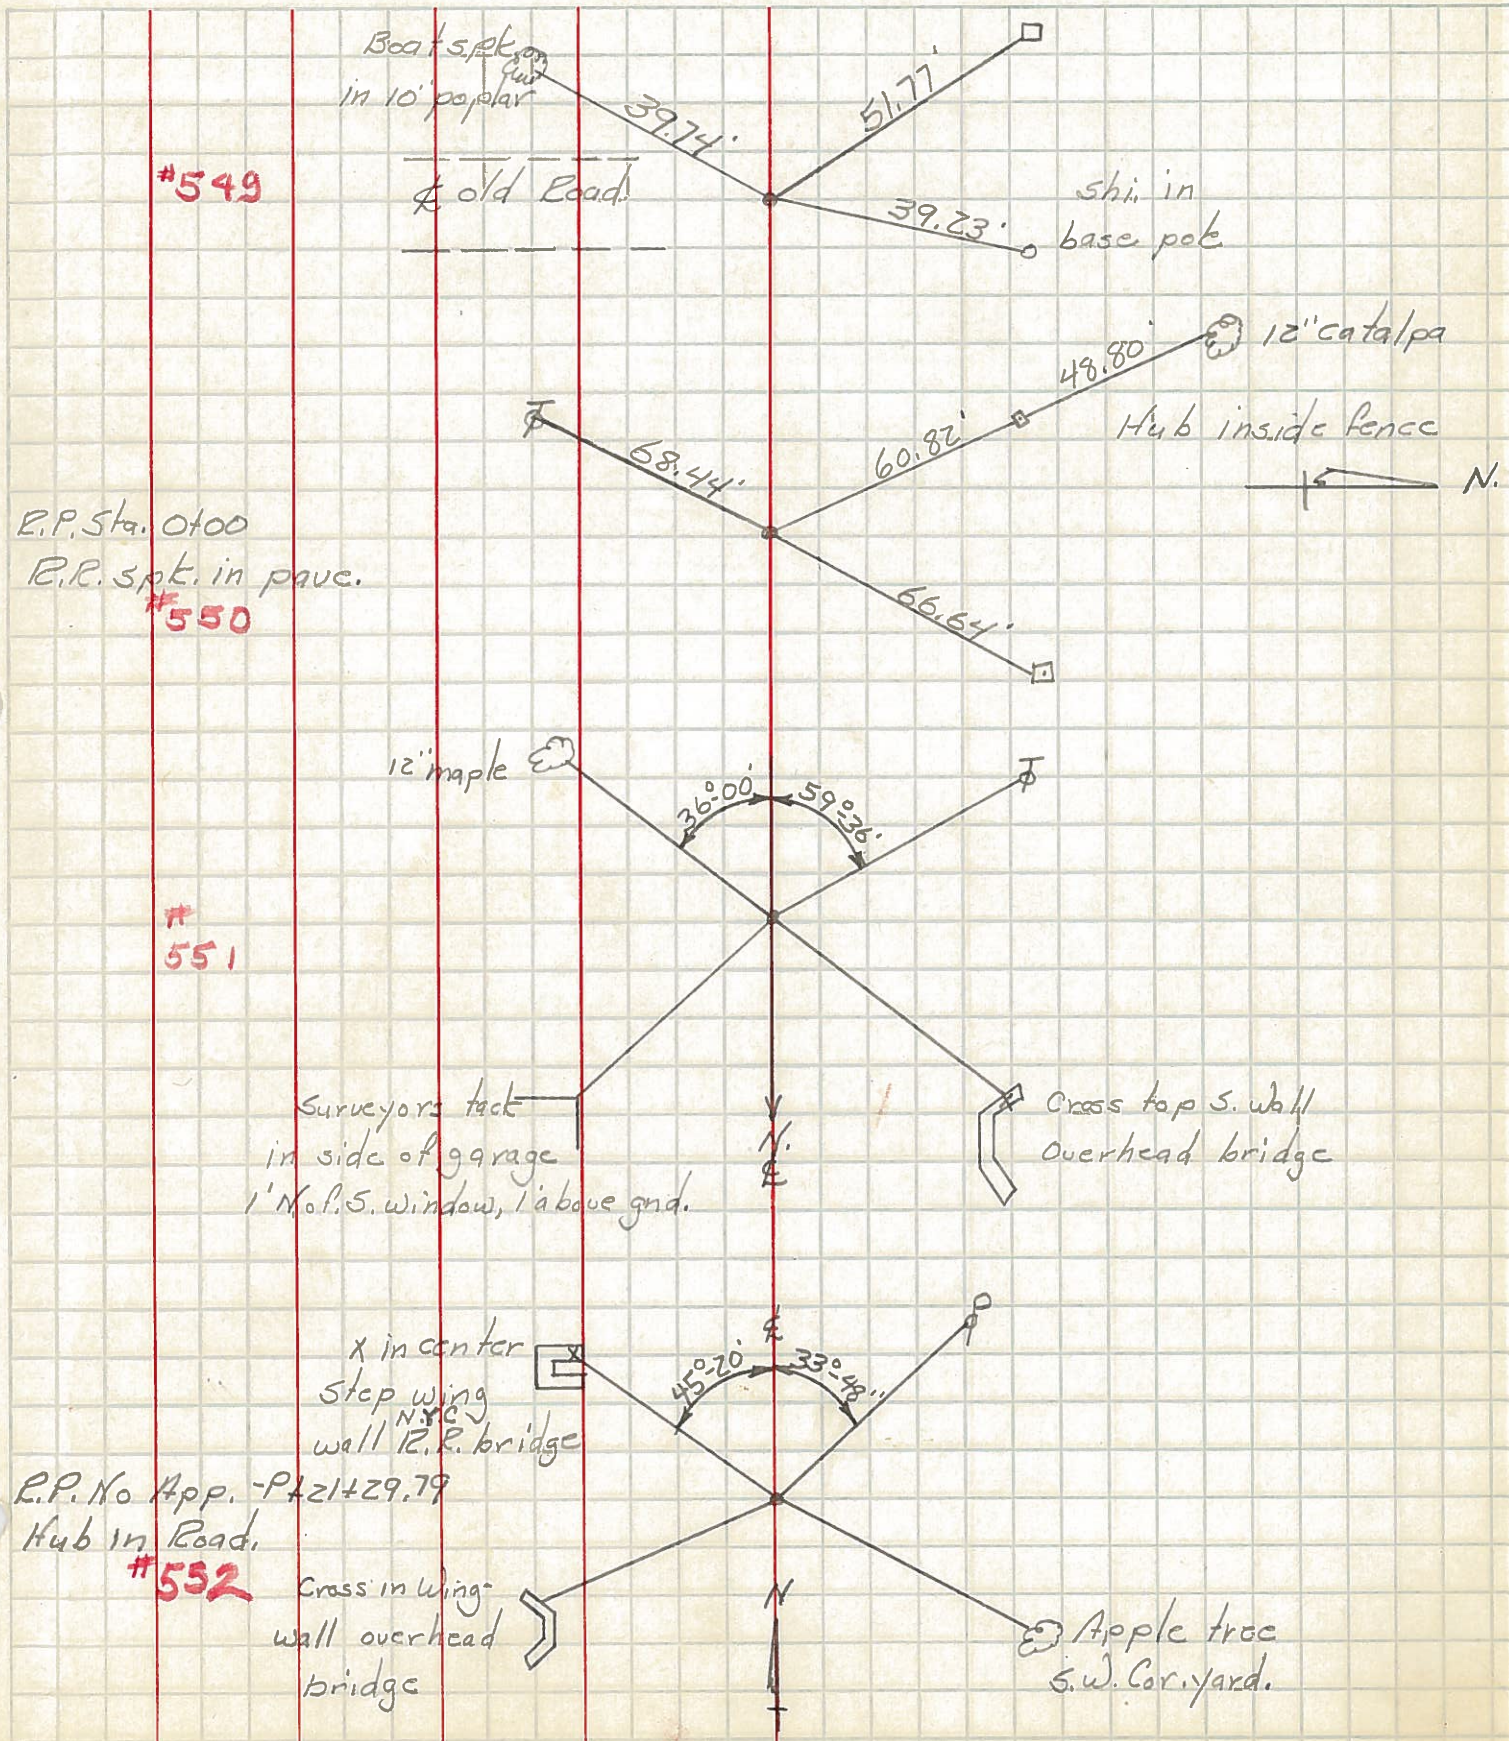



PERSONNEL TITLE PERSONNEL TITLE

COUNTY Wood

DATE

S. R. #795

WEATHER

SEC.

TEMP.

DESCRIPTION Moline Over-head


LEFT

CENTER LINE

RIGHT


JOB NO.

R.P. - P.I. 27+85.84 N app  
#553

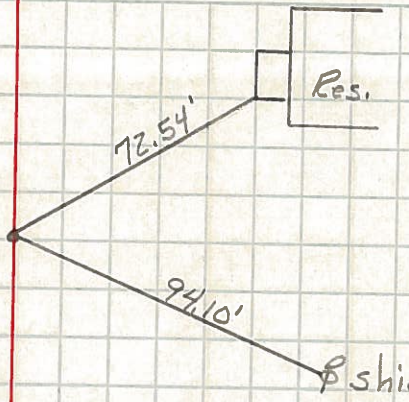

P.I. 27+87.56  
#554

R/W Sta. 28+43.75-  
30' Lt & N app.  
#555

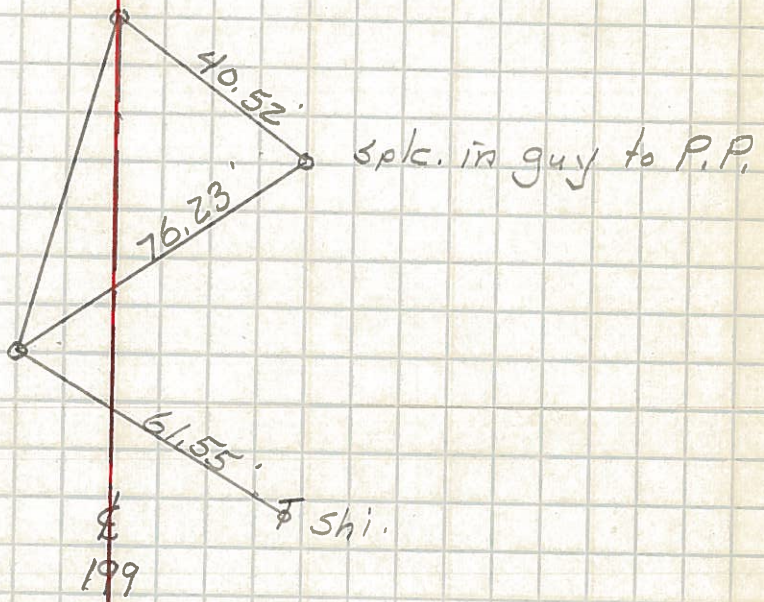

P.I. 25+80.44  
#556