


PERSONNEL TITLE PERSONNEL TITLE

COUNTY Henry DATE 3-11, 12-82

S. R. 65 WEATHER Fair

SEC. \_\_\_\_\_ TEMP. +34°

DESCRIPTION Marina @ Mary Lane Thurston Park - Asphalt Resurface JOB NO. \_\_\_\_\_

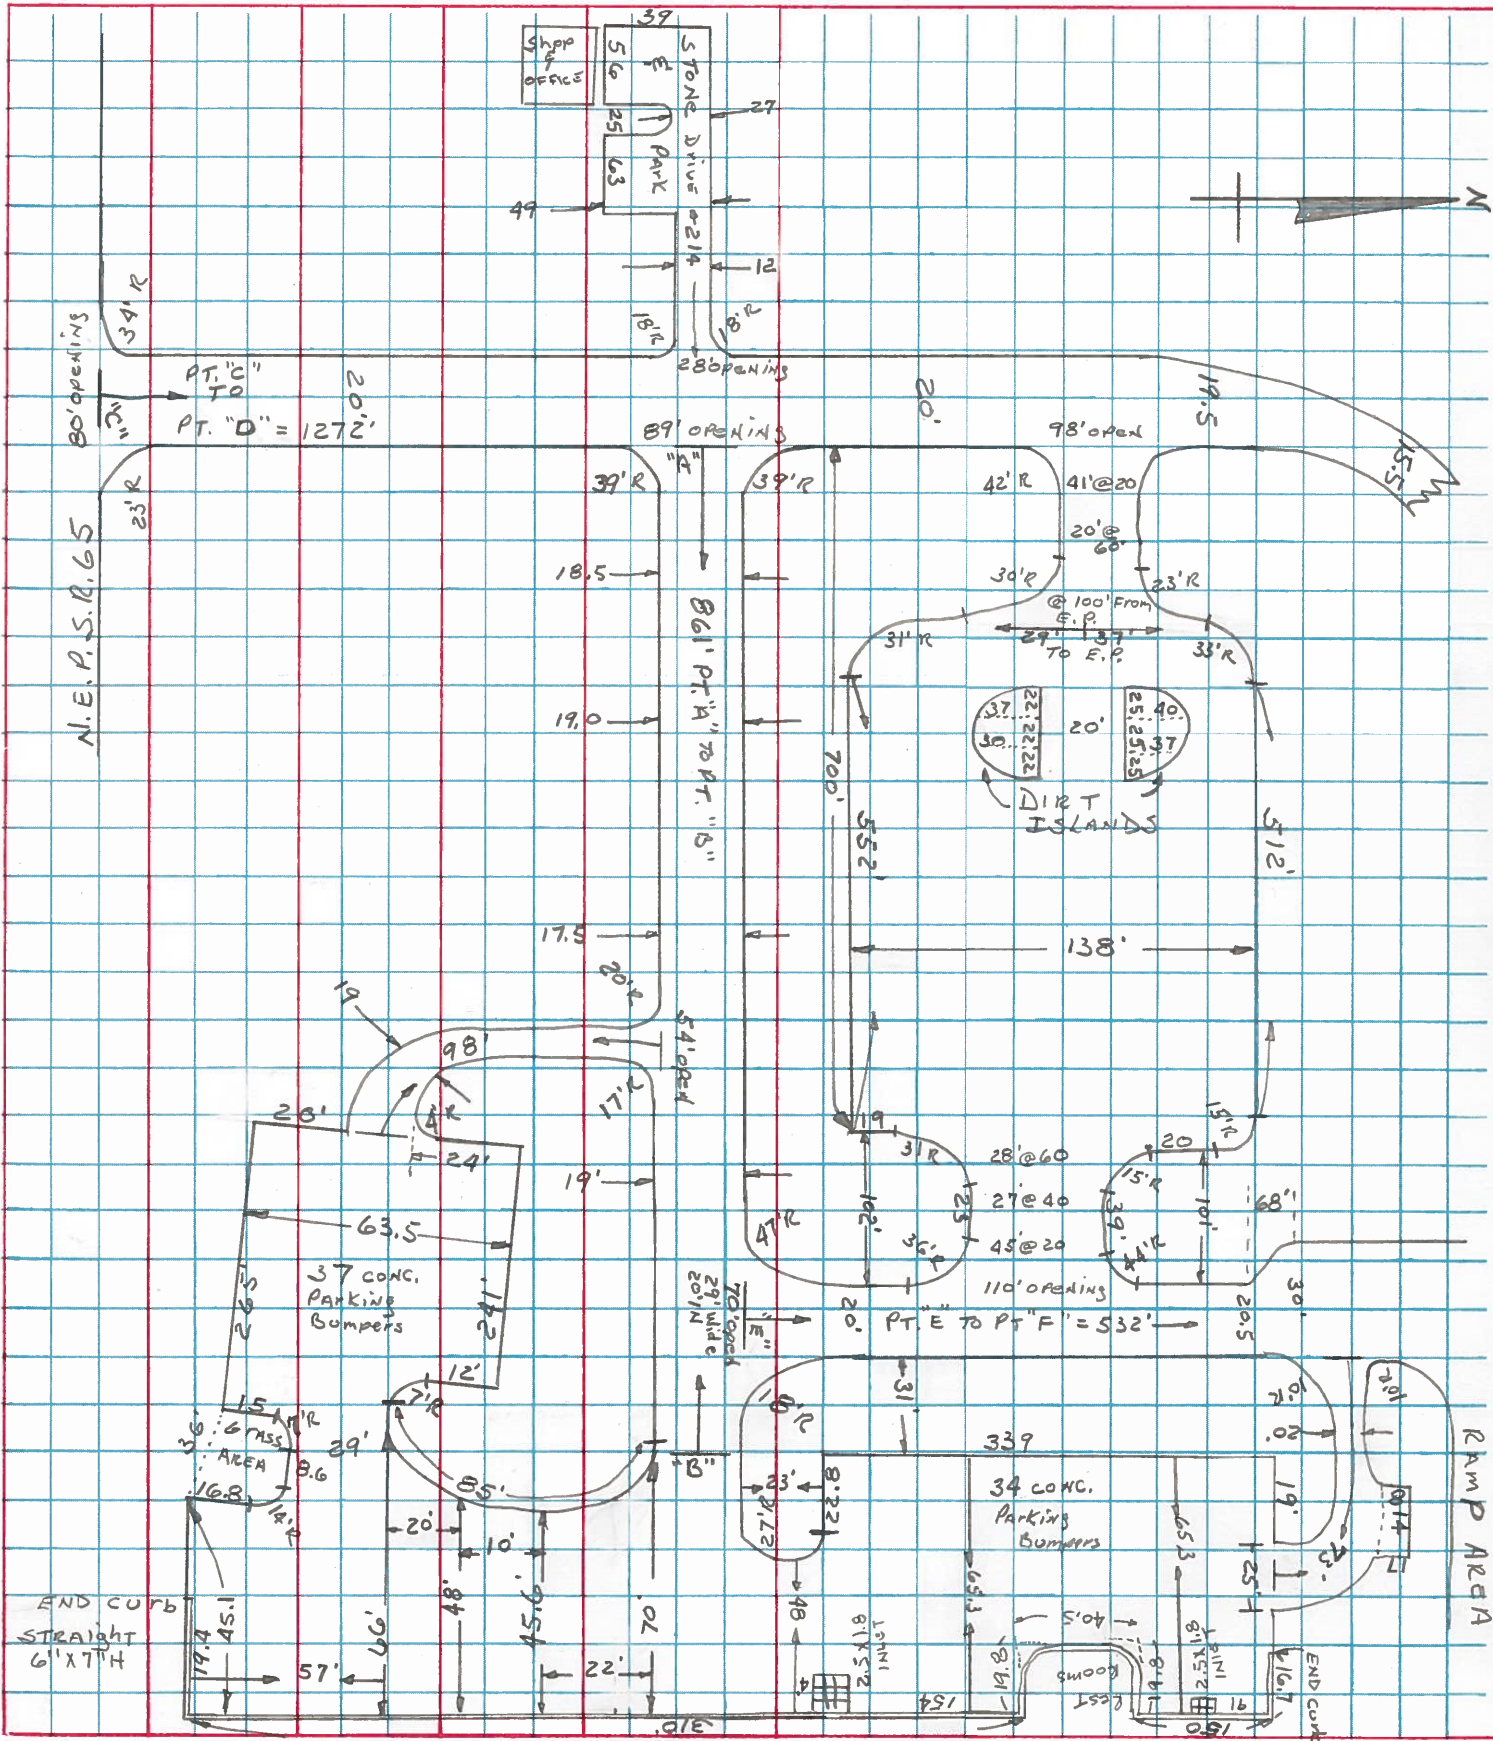

PERSONNEL	TITLE	PERSONNEL	TITLE
Hoffman			
+			
Crew			


COUNTY Henry DATE 3-11, 12-82

S. R. 65 WEATHER Fair

SEC. TEMP. 43.4°

DESCRIPTION MARINA @ Mary Lane Thurston Park - Resurfacing Proj. JOB NO.

LEFT CENTER LINE RIGHT

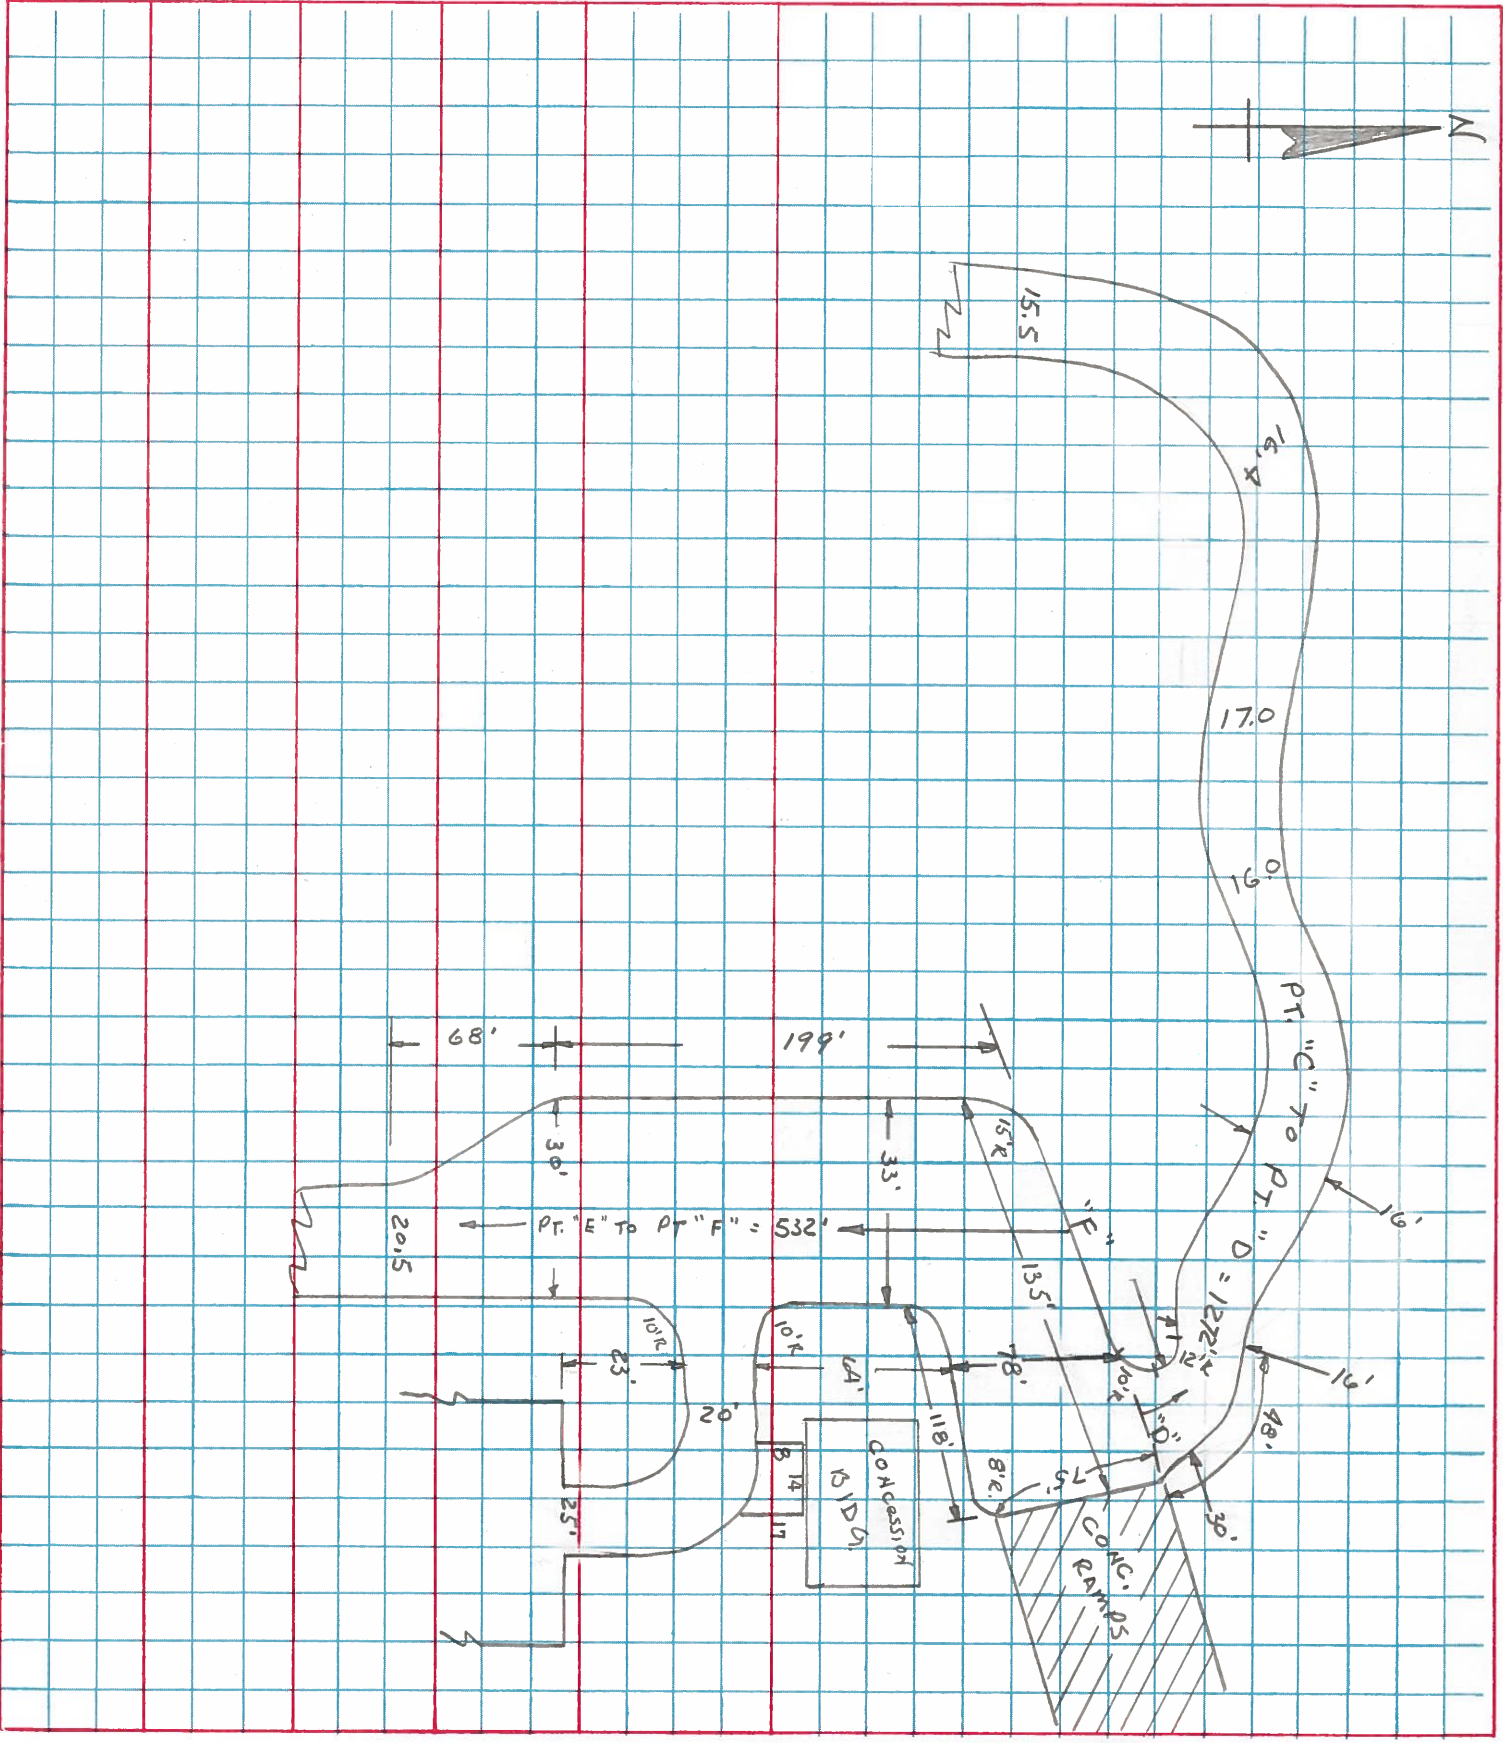




PERSONNEL	TITLE	PERSONNEL	TITLE
Hoffman			
Crew			

COUNTY Wood DATE 3-30-82  
 S. R. 65 WEATHER cloudy  
 SEC. M.L. Thurston Park TEMP. +45°

DESCRIPTION Measure drives for blacktop JOB NO. \_\_\_\_\_  
 LEFT CENTER LINE RIGHT

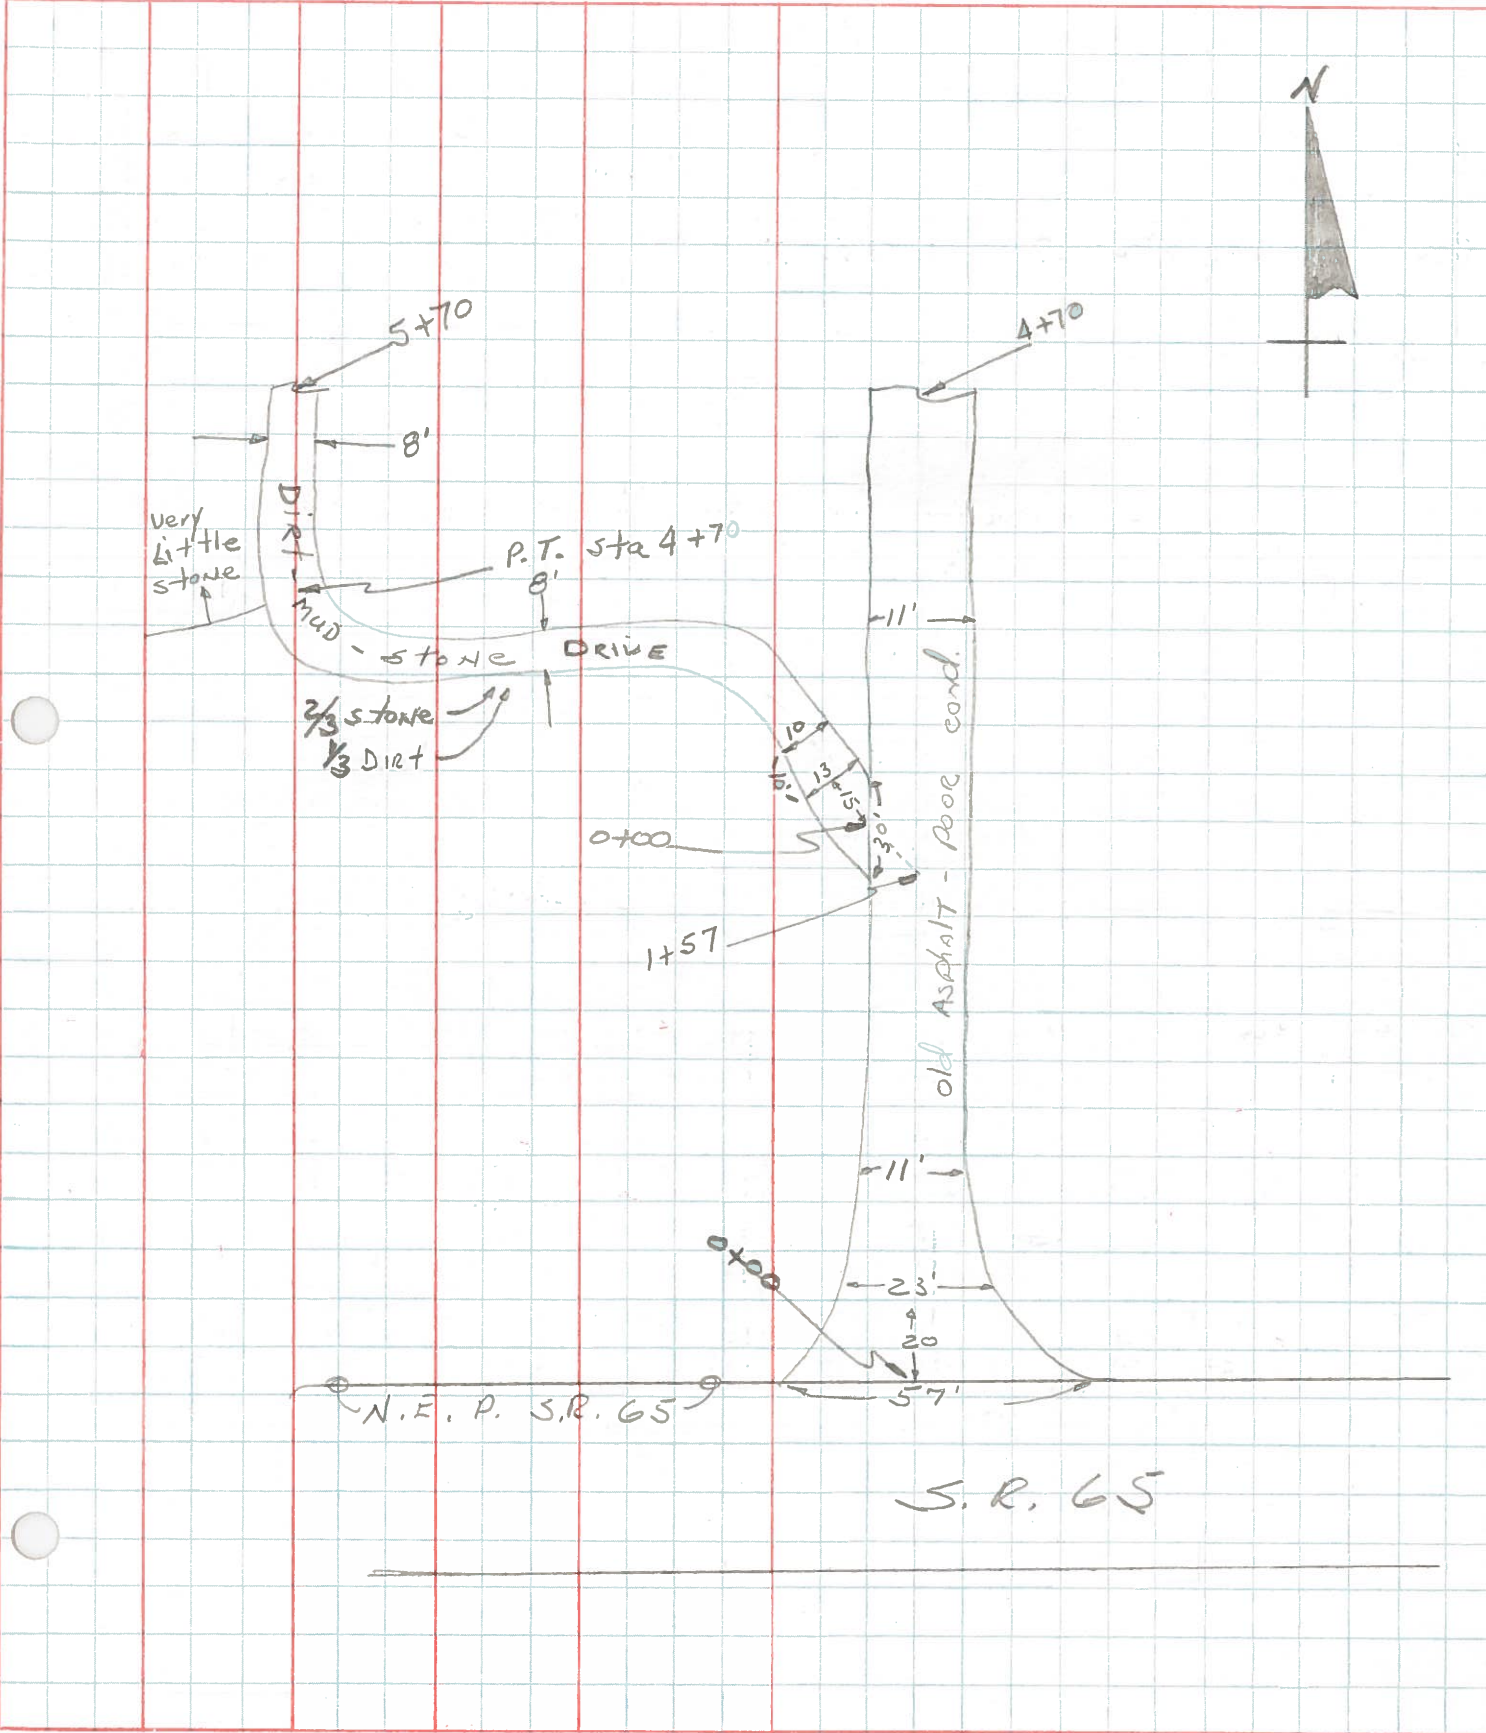

PERSONNEL TITLE PERSONNEL TITLE  
 Hoffman  
 &  
 crew

COUNTY Wood DATE 3-30-82  
 S. R. 65 WEATHER Cloudy  
 SEC. m. J. Thurston Park TEMP. +45°

DESCRIPTION Measure Drives & Parking For Blacktop  
 LEFT CENTER LINE RIGHT JOB NO.

