


O.D.O.T. DISTRICT 2 SURVEY OFFICE (USE ONLY)


PERSONNEL _____ REFERENCE NO. 1 SHEET 1 OF 50
NOTES NIESE _____ DATE 4/27/22 ROUTE SR 120
H.C. O'DONNELL _____ WEATHER BREEZY COUNTY FULTON
R.C. AUBLE _____ TEMP. 37° TOWNSHIP CHESTERFIELD
PARADYSZ _____ SECTION 9
DWG BY RHOADES _____ PID 99582 T 9 N R 2 E

TYPE MONUMENT MAG/WASHER
ON SURFACE - ~~BELOW~~ ON
OFFSET Q PAVEMENT 2.0' LT : RT
8.4' TO RT EDGE PAVEMENT
STATION: 0+00

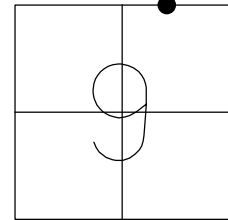

HORIZ. DATUM: NAD83 2011 GEOID: NAVD88 2012A
GRID: NORTHING: 749435.590 EASTING: 1510950.832


RECORD:
1926 PLAN
FD R.R.SPIKE
8/19/02, DCH
FD MAG/WASHER
REF1
5/12/17
5/7/19, JLL
FD MAG/WASHER
REF1
9/22/20, JFO
2/26/21, JMR
4/27/22, JFO
SET MAG/WASHER
7/26/22, TDN

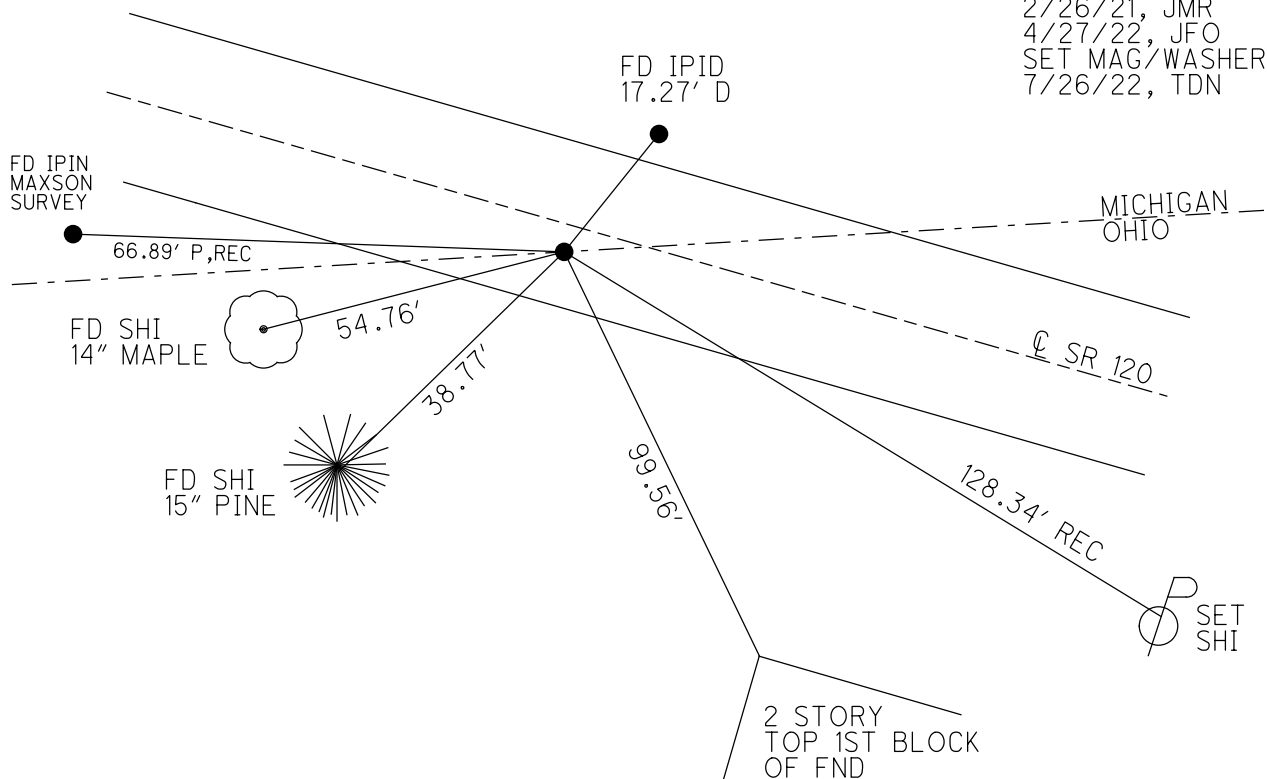

O.D.O.T. DISTRICT 2 SURVEY OFFICE (USE ONLY)


PERSONNEL	REFERENCE NO. <u>1 A</u>	SHEET <u>2</u> OF <u>50</u>
NOTES NIESE	DATE <u>4/27/22</u>	ROUTE <u>SR 120</u>
H.C. O'DONNELL	WEATHER <u>BREEZY</u>	COUNTY <u>FULTON</u>
R.C. AUBLE	TEMP. <u>37°</u>	TOWNSHIP <u>CHESTERFIELD</u>
PARADYSZ		SECTION <u>9</u>
DWG BY RHOADES	PID <u>99582</u>	T <u>9</u> N R <u>2</u> E

TYPE MONUMENT 1/2" SMOOTH METAL SHAFT
~~ON SURFACE~~ - BELOW 3/4"
 OFFSET Q PAVEMENT 1.5' LT : ~~RT~~
- TO - EDGE PAVEMENT
 STATION: 7+86

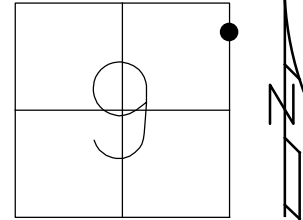

HORZ. DATUM: NAD83 2011 GEOID: NAVD88 2012A
 GRID: NORTHING: 749196.580 EASTING: 1511697.078

RECORD:
 1926 PLAN
 SET P.K.NAIL
 11/17/03, DCH
 FD 1/2" SMOOTH
 METAL SHAFT
 3/4" DOWN
 REFA1
 5/12/17
 5/7/19, JLL
 9/22/20, JFO
 2/26/21, JMR
 SET MAG/WASHER
 7/26/22, TDN

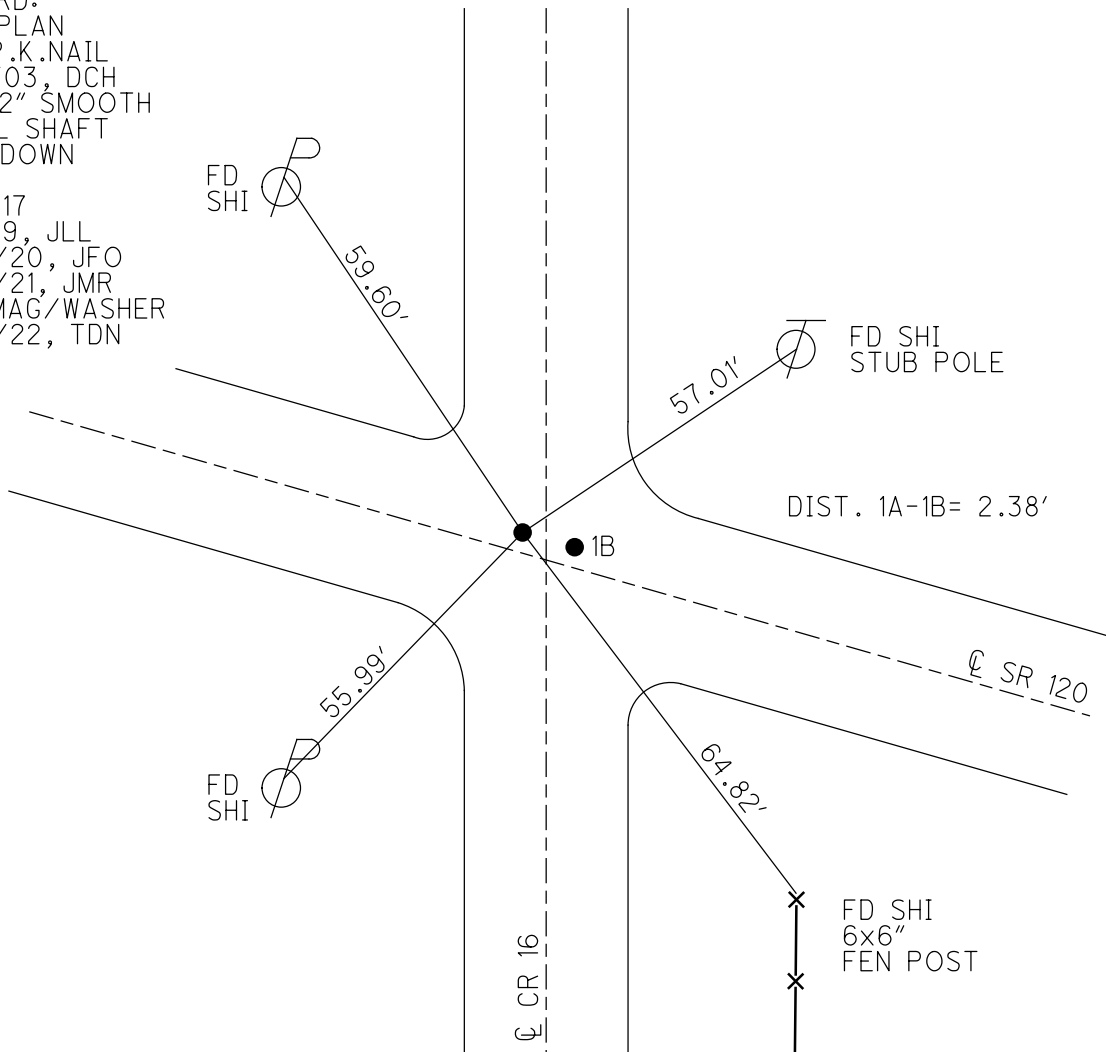


O.D.O.T. DISTRICT 2 SURVEY OFFICE (USE ONLY)


PERSONNEL _____ REFERENCE NO. 1 B SHEET 3 OF 50
NOTES NIESE DATE 4/27/22 ROUTE SR 120
H.C. O'DONNELL WEATHER BREEZY COUNTY FULTON
R.C. AUBLE TEMP. 37° TOWNSHIP CHESTERFIELD
PARADYSZ SECTION 9
DWG BY RHOADES PID 99582 T 9 N R 2 E

TYPE MONUMENT MAG/WASHER
ON SURFACE - ~~BELOW~~ ON
OFFSET Q PAVEMENT 1.5' LT : ~~RT~~
- TO - EDGE PAVEMENT
STATION: 7+86

HORZ. DATUM: NAD83 2011 GEOID: NAVD88 2012A
GRID: NORTHING: 749195.872 EASTING: 1511699.384

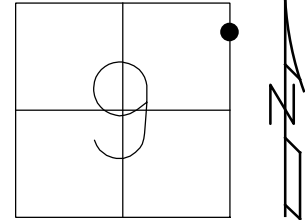

RECORD: P.I.
1926 PLAN
SET MAG/WASHER
11/17/03, DCH
FD MAG/WASHER
REFB1
5/12/17
4/26/19, JLL
FD MAG/WASHER
REFB1
9/22/20, JFO
2/26/21, JMR
SET MAG/WASHER
7/26/22, TDN

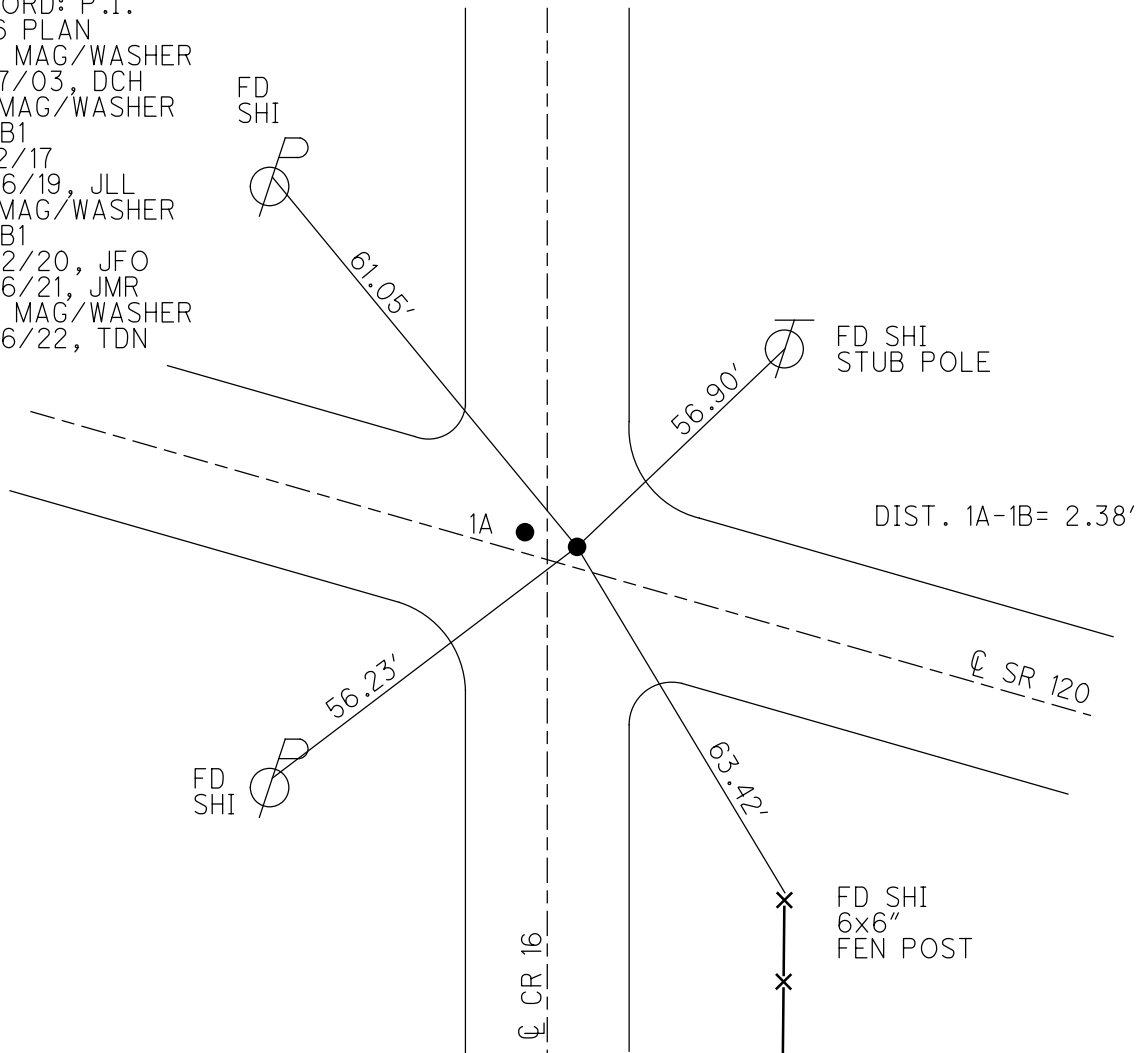


O.D.O.T. DISTRICT 2 SURVEY OFFICE (USE ONLY)


PERSONNEL _____ REFERENCE NO. 2 SHEET 4 OF 50
 NOTES NIESE _____ DATE 4/27/22 ROUTE SR 120
 H.C. O'DONNELL _____ WEATHER BREEZY COUNTY FULTON
 R.C. PARADYSZ _____ TEMP. 37° TOWNSHIP CHESTERFIELD
 AUBLE _____ SECTION 10
 DWG BY RHOADES PID 99582 T 9 N R 2 E

TYPE MONUMENT MAG/WASHER
 ON SURFACE - ~~BELOW~~ ON
 OFFSET Q PAVEMENT 0.5' ~~LT~~ : RT
9.5' TO RT EDGE PAVEMENT
 STATION: 25+00

HORZ. DATUM: NAD83 2011 GEOID: NAVD88 2012A
 GRID: NORTHING: 748665.810 EASTING: 1513329.417

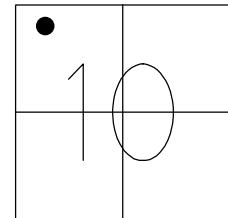


RECORD:
 1926 PLAN
 SET MAG/WASHER
 12/22/03, DCH
 FD MAG/WASHER
 REF2
 5/12/17
 4/26/19, JLL
 FD MAG/WASHER
 REF2
 9/22/20, JFO
 2/26/21, JMR
 SET MAG/WASHER
 7/26/22, TDN

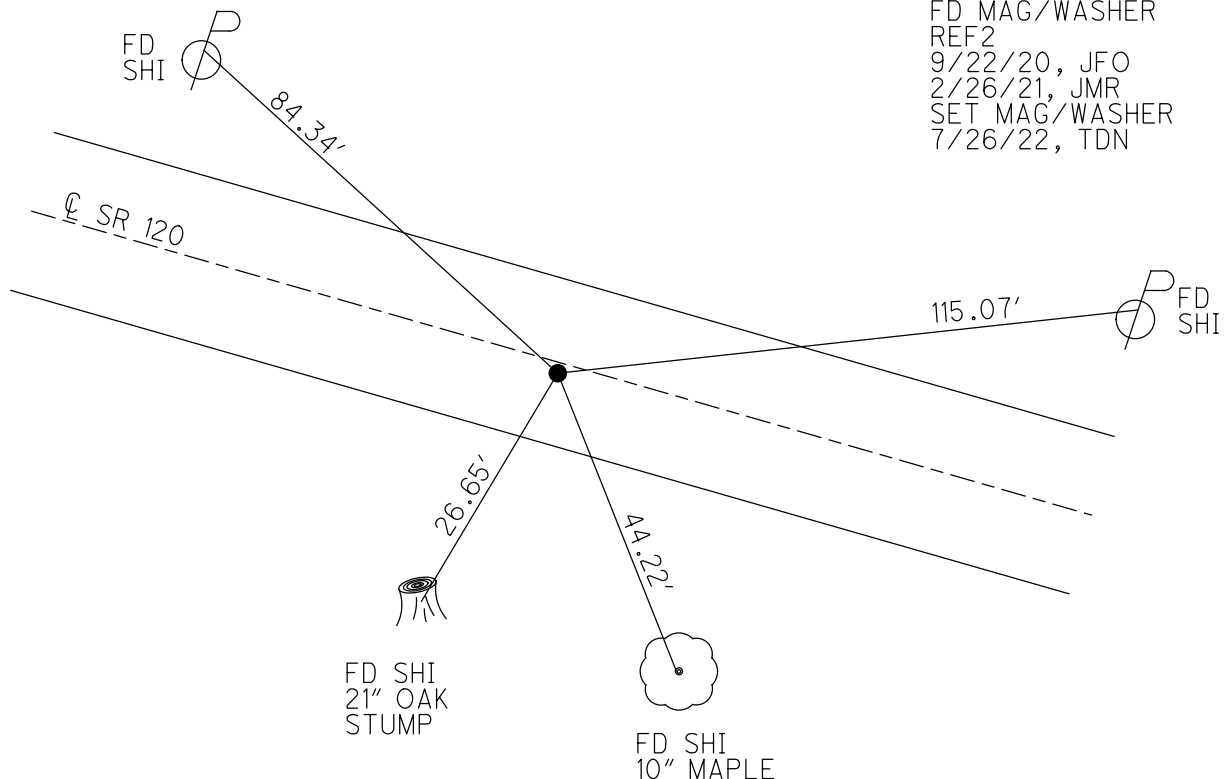

O.D.O.T. DISTRICT 2 SURVEY OFFICE (USE ONLY)


PERSONNEL	REFERENCE NO.	<u>2 A</u>	SHEET	<u>5</u>	OF	<u>50</u>
NOTES	<u>NIESE</u>	DATE	<u>2/26/21</u>	ROUTE	<u>SR 120</u>	
H.C.	<u>O'DONNELL</u>	WEATHER	<u>FAIR</u>	COUNTY	<u>FULTON</u>	
R.C.	<u>PARADYSZ</u>	TEMP.	<u>30°</u>	TOWNSHIP	<u>CHESTERFIELD</u>	
	<u>AUBLE</u>			SECTION	<u>10</u>	
DWG BY	<u>RHOADES</u>	PID	<u>99582</u>	T	<u>9</u>	N
				R	<u>2</u>	E

TYPE MONUMENT MAG NAIL
ON SURFACE - ~~BELOW~~ ON
OFFSET Q PAVEMENT ON LT : RT
10' TO LT EDGE PAVEMENT
STATION: 44+00

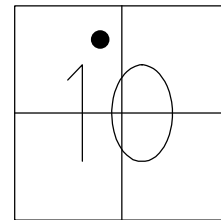

HORZ. DATUM: NAD83 2011 GEOID: NAVD88 2012A
GRID: NORTHING: 748088.784 EASTING: 1515139.676

RECORD:
1926 PLAN
SET MAG/WASHER
12/22/03, DCH
SET MAG/WASHER
5/23/11, RJL
FD MAG/WASHER
REFA2
5/12/17
4/26/19, JLL
FD MAG NAIL
REFA2
9/22/20, JFO
2/26/21, JMR
SET MAG/WASHER
7/26/22, TDN


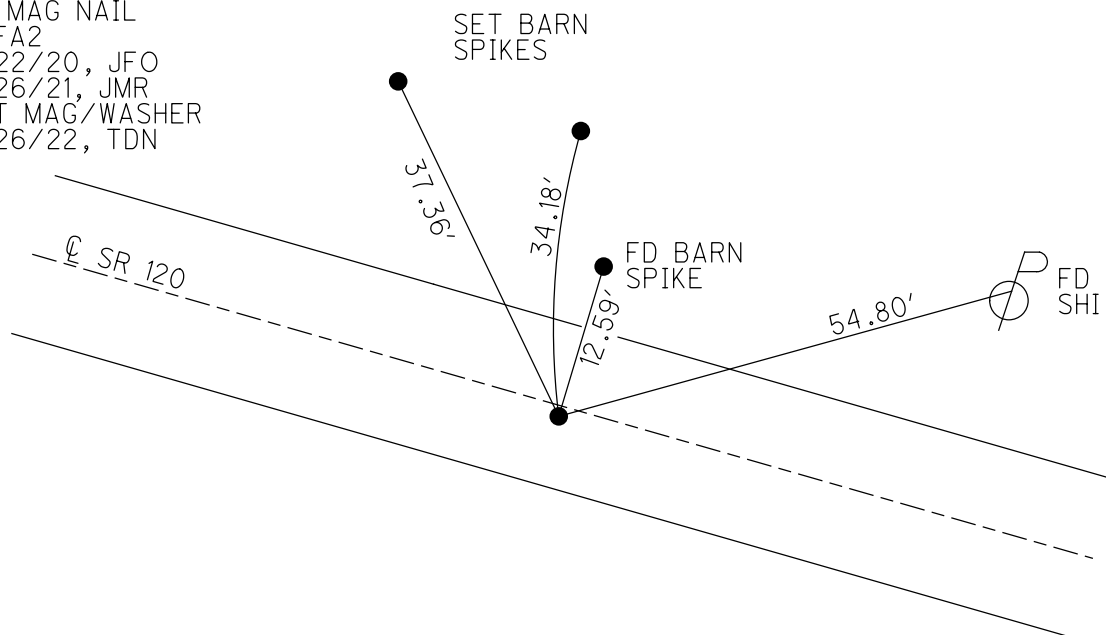


O.D.O.T. DISTRICT 2 SURVEY OFFICE (USE ONLY)

PERSONNEL _____ REFERENCE NO. 2 B SHEET 6 OF 50
NOTES NIESE DATE 4/27/22 ROUTE SR 120
H.C. O'DONNELL WEATHER BREEZY COUNTY FULTON
R.C. PARADYSZ TEMP. 37° TOWNSHIP CHESTERFIELD
AUBLE SECTION 11
DWG BY RHOADES PID 99582 T 9 N R 2 E

TYPE MONUMENT MAG/WASHER
ON SURFACE - ~~BELOW~~ ON
OFFSET CL PAVEMENT 3' LT : RT
- TO - EDGE PAVEMENT
STATION: 77+50



HORZ. DATUM: NAD83 2011 GEOID: NAVD88 2012A
GRID: NORTHING: 747062.126 EASTING: 1518328.534

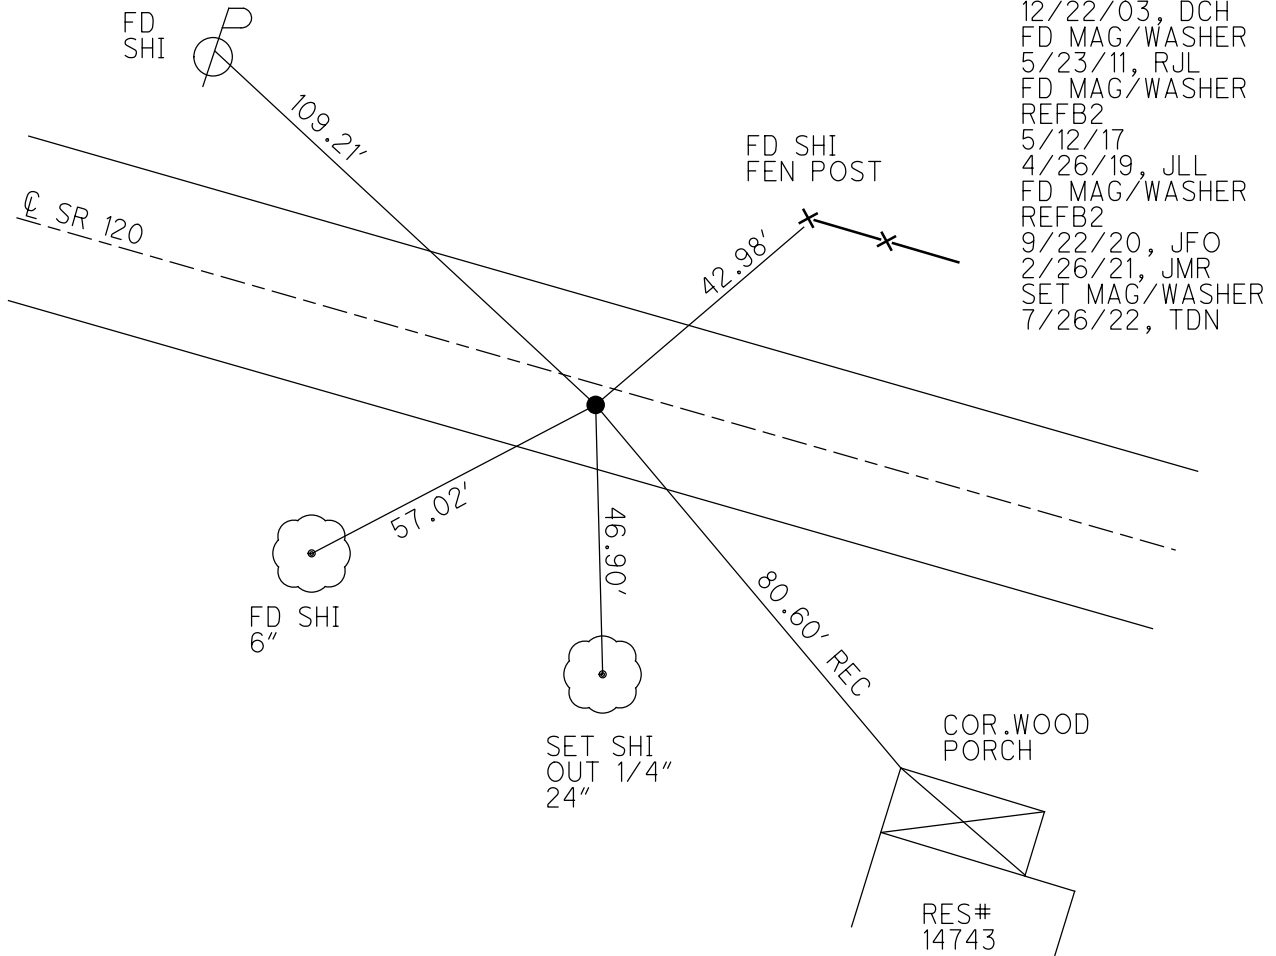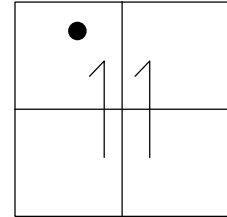

O.D.O.T. DISTRICT 2 SURVEY OFFICE (USE ONLY)


PERSONNEL _____ REFERENCE NO. 2 BA SHEET 7 OF 50
NOTES NIESE DATE 2/26/21 ROUTE SR 120
H.C. O'DONNELL WEATHER FAIR COUNTY FULTON
R.C. PARADYSZ TEMP. 30° TOWNSHIP CHESTERFIELD
AUBLE SECTION 11
DWG BY RHOADES PID PAVETRAIN T 9 N R 2 E

TYPE MONUMENT MAG NAIL
ON SURFACE - ~~BELOW~~ ON
OFFSET 0 PAVEMENT ON LT : RT
- TO - EDGE PAVEMENT
STATION: 78+83

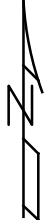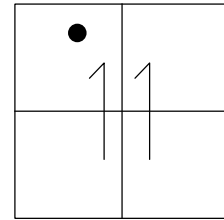

HORZ. DATUM: NAD83 2011 GEOID: NAVD88 2012A
GRID: NORTHING: 747023.824 EASTING: 1518469.708

RECORD:
ORIGIN UNKNOWN
FD MAG NAIL
REFBA2
4/27/22, JFO
SET MAG/WASHER
7/26/22, TDN

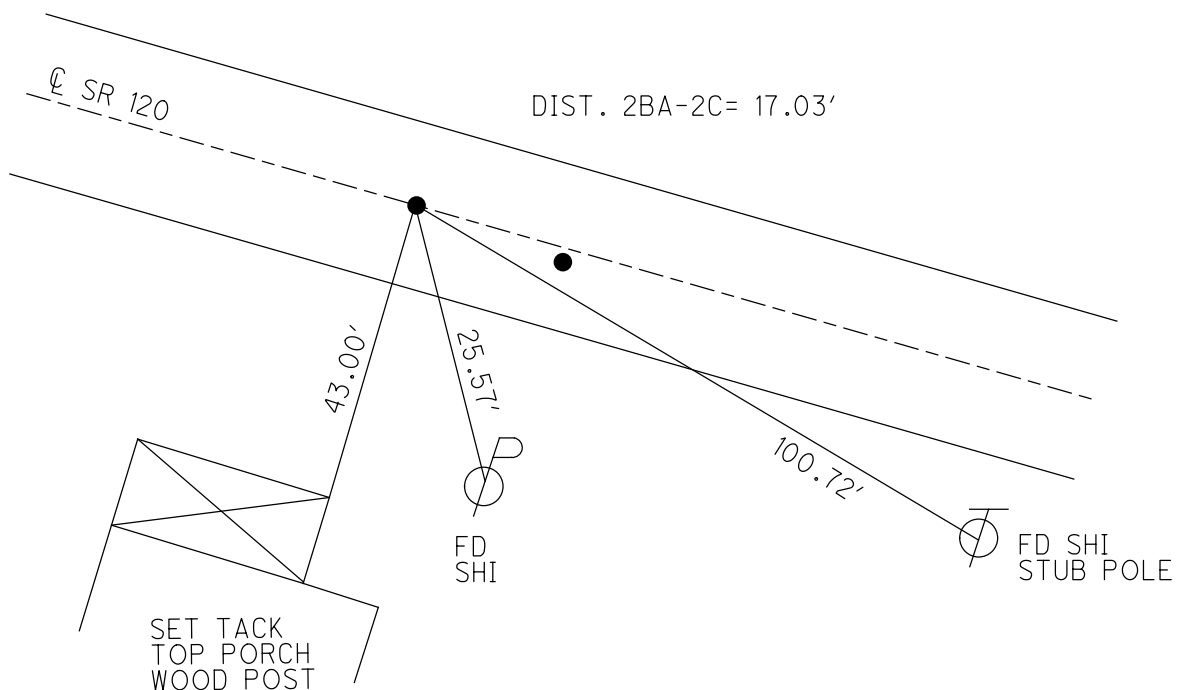


O.D.O.T. DISTRICT 2 SURVEY OFFICE (USE ONLY)


PERSONNEL _____ REFERENCE NO. 2 C SHEET 8 OF 50
 NOTES NIESE DATE 4/27/22 ROUTE SR 120
 H.C. O'DONNELL WEATHER BREEZY COUNTY FULTON
 R.C. PARADYSZ TEMP. 37° TOWNSHIP CHESTERFIELD
AUBLE SECTION 11
 DWG BY NIESE PID 99582 T 9 N R 2 E

TYPE MONUMENT MAG/WASHER
 ON SURFACE - ~~BELOW~~ ON
 OFFSET Q PAVEMENT ON LT : RT
- TO - EDGE PAVEMENT
 STATION: 79+00

HORZ. DATUM: NAD83 2011 GEOID: NAVD88 2012A
 GRID: NORTHING: 747022.844 EASTING: 1518473.323

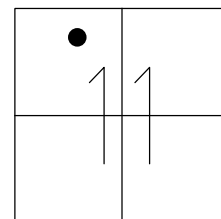

RECORD:
 1926 PLAN
 SET MAG/WASHER
 12/22/03, DCH
 FD MAG/WASHER
 5/23/11, RJL
 FD MAG/WASHER
 REFC2
 5/12/17, JLL
 SET MAG/WASHER
 REFC2
 6/14/17
 4/26/19, JLL
 FD MAG/WASHER
 REFC2
 9/22/20, JFO
 2/26/21, JMR
 SET MAG/WASHER
 7/26/22, TDN

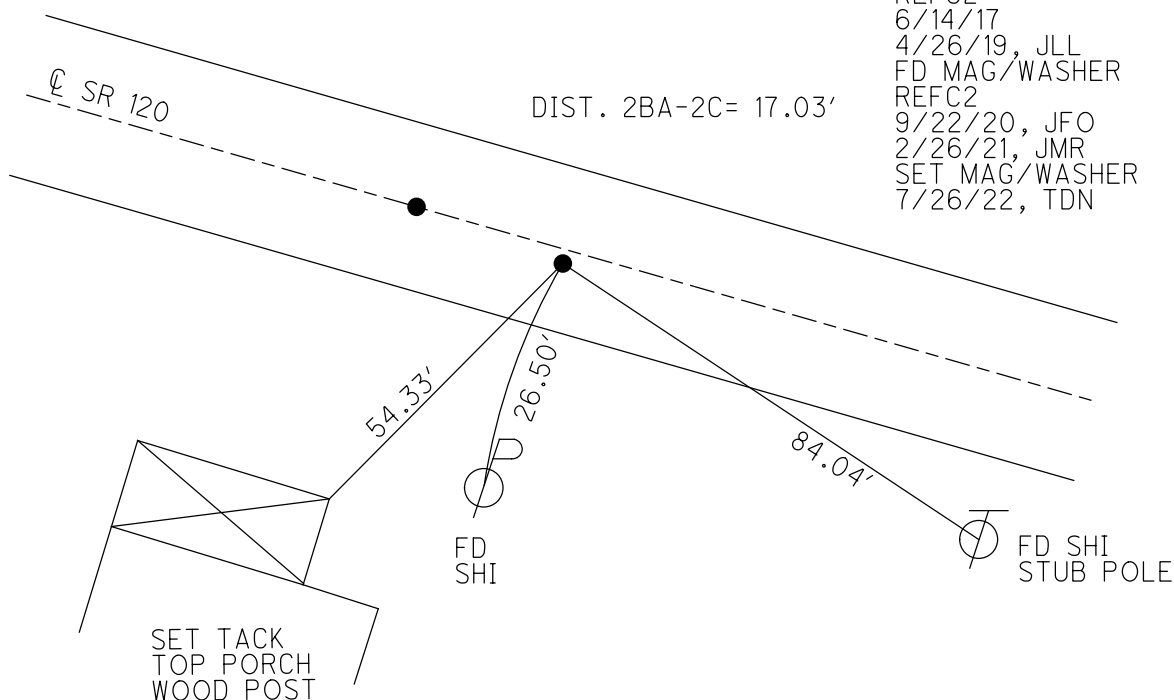


O.D.O.T. DISTRICT 2 SURVEY OFFICE (USE ONLY)


PERSONNEL	REFERENCE NO.	<u>3</u>	SHEET	<u>9</u>	OF	<u>50</u>
NOTES	<u>NIESE</u>	DATE	<u>4/27/22</u>	ROUTE	<u>SR 120</u>	
H.C.	<u>O'DONNELL</u>	WEATHER	<u>BREEZY</u>	COUNTY	<u>FULTON</u>	
R.C.	<u>PARADYSZ</u>	TEMP.	<u>37°</u>	TOWNSHIP	<u>CHESTERFIELD</u>	
	<u>AUBLE</u>			SECTION	<u>11</u>	
DWG BY	<u>RHOADES</u>	PID	<u>99582</u>	<u>T 9 N R 2 E</u>		

TYPE MONUMENT MAG/WASHER
ON SURFACE - ~~BELOW~~ ON
OFFSET Q PAVEMENT 0.7' LT : ~~RT~~
10.8' TO LT EDGE PAVEMENT
STATION: 91+00

HORZ. DATUM: NAD83 2011 GEOID: NAVD88 2012A
GRID: NORTHING: 746674.268 EASTING: 1519621.676

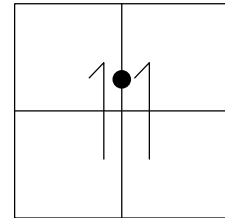

RECORD:
1926 PLAN
SET MAG/WASHER
12/22/03, DCH
FD MAG/WASHER
5/23/11, RJL
FD MAG/WASHER
REF3
5/12/17
4/26/19, JLL
FD MAG/WASHER
REF3
9/22/20, JFO
2/26/21, JMR
SET MAG/WASHER
7/26/22, TDN

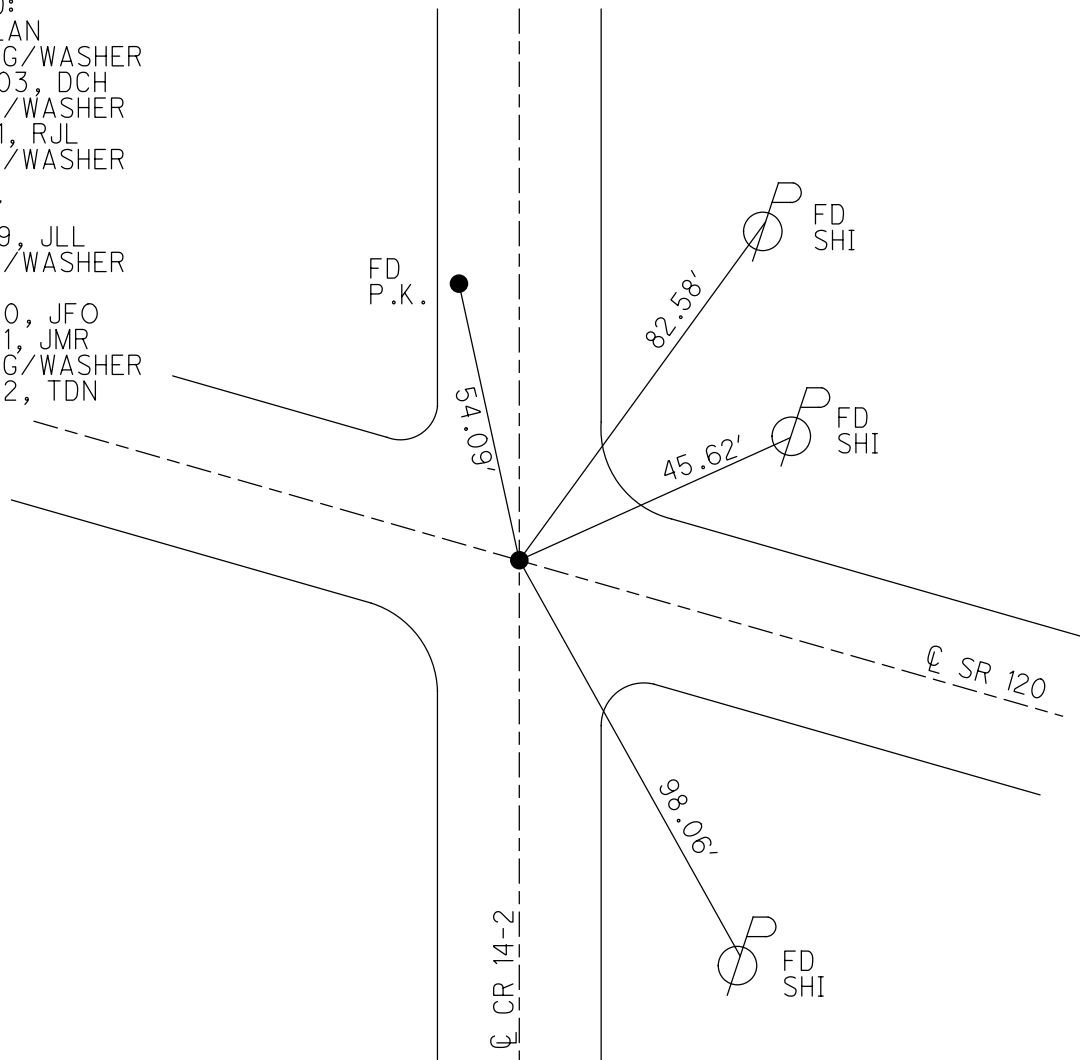


O.D.O.T. DISTRICT 2 SURVEY OFFICE (USE ONLY)


PERSONNEL _____ REFERENCE NO. 4 SHEET 10 OF 50
NOTES NIESE _____ DATE 4/27/22 ROUTE SR 120
H.C. O'DONNELL _____ WEATHER BREEZY COUNTY FULTON
R.C. PARADYSZ _____ TEMP. 37° TOWNSHIP CHESTERFIELD
AUBLE _____ SECTION 11
DWG BY RHOADES PID 99582 T 9 N R 2 E

TYPE MONUMENT MAG/WASHER
ON SURFACE - ~~BELOW~~ ON
OFFSET Q PAVEMENT 0.6' LT : RT
9.4' TO RT EDGE PAVEMENT
STATION: 118+53

HORZ. DATUM: NAD83 2011 GEOID: NAVD88 2012A
GRID: NORTHING: 745858.574 EASTING: 1522250.897

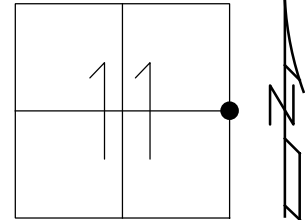

RECORD:
1926 PLAN
SET MAG/WASHER
12/22/03, DCH
FD MAG/WASHER
5/23/11, RJL
FD MAG/WASHER
REF4
5/12/17
4/26/19, JLL
FD MAG/WASHER
REF4
9/22/20, JFO
2/26/21, JMR
SET MAG/WASHER
7/26/22, TDN



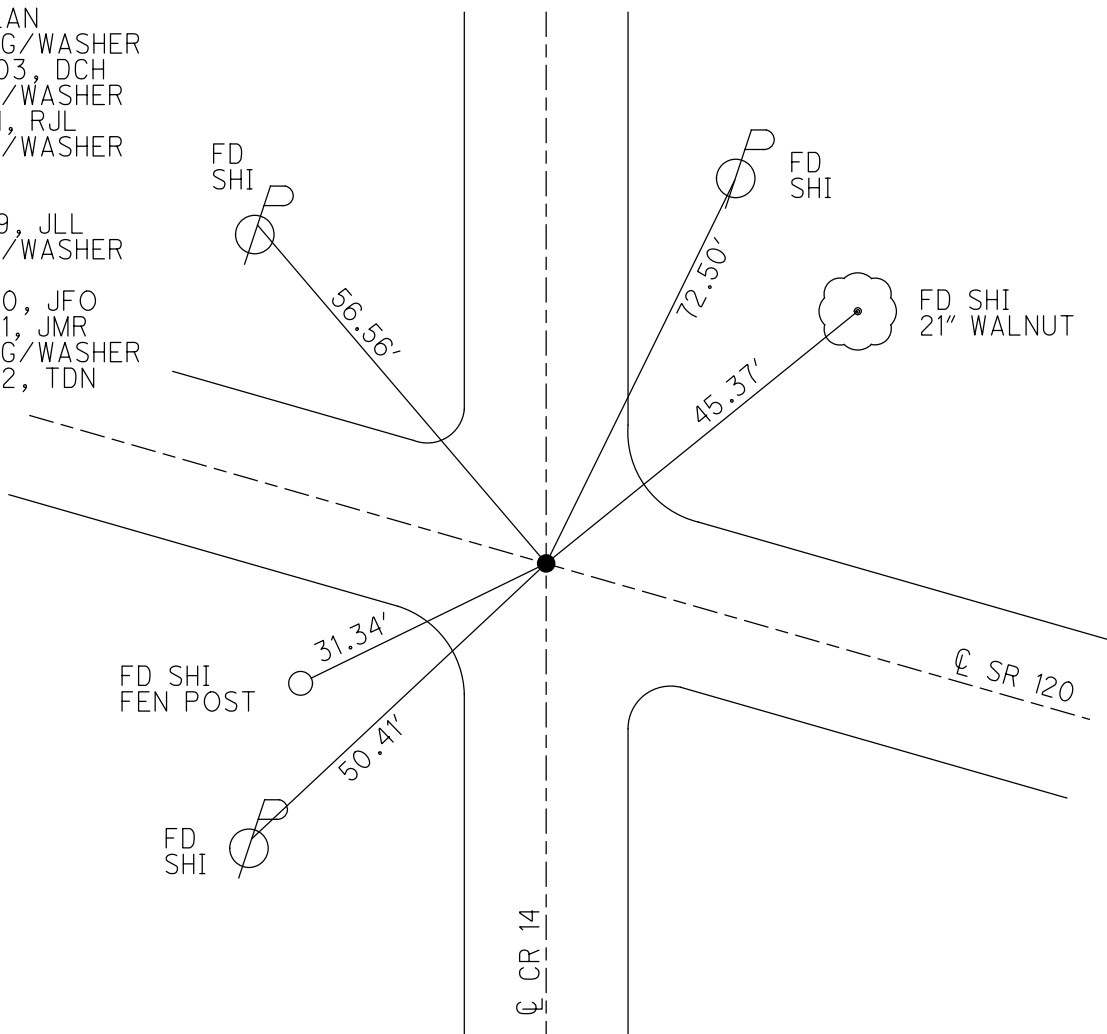


O.D.O.T. DISTRICT 2 SURVEY OFFICE (USE ONLY)

PERSONNEL _____ REFERENCE NO. 4 A SHEET 11 OF 50
NOTES NIESE DATE 4/27/22 ROUTE SR 120
H.C. O'DONNELL WEATHER CALM COUNTY FULTON
R.C. PARADYSZ TEMP. 37° TOWNSHIP CHESTERFIELD
AUBLE SECTION 12
DWG BY RHOADES PID 99582 T 9 N R 2 E

TYPE MONUMENT MAG/WASHER
ON SURFACE - ~~BELOW~~ ON
OFFSET Q PAVEMENT 1.1' ~~LT~~ : RT
9.1' TO ~~RT~~ EDGE PAVEMENT
STATION: 132+66

HORZ. DATUM: NAD83 2011 GEOID: NAVD88 2012A
GRID: NORTHING: 745439.932 EASTING: 1523600.761

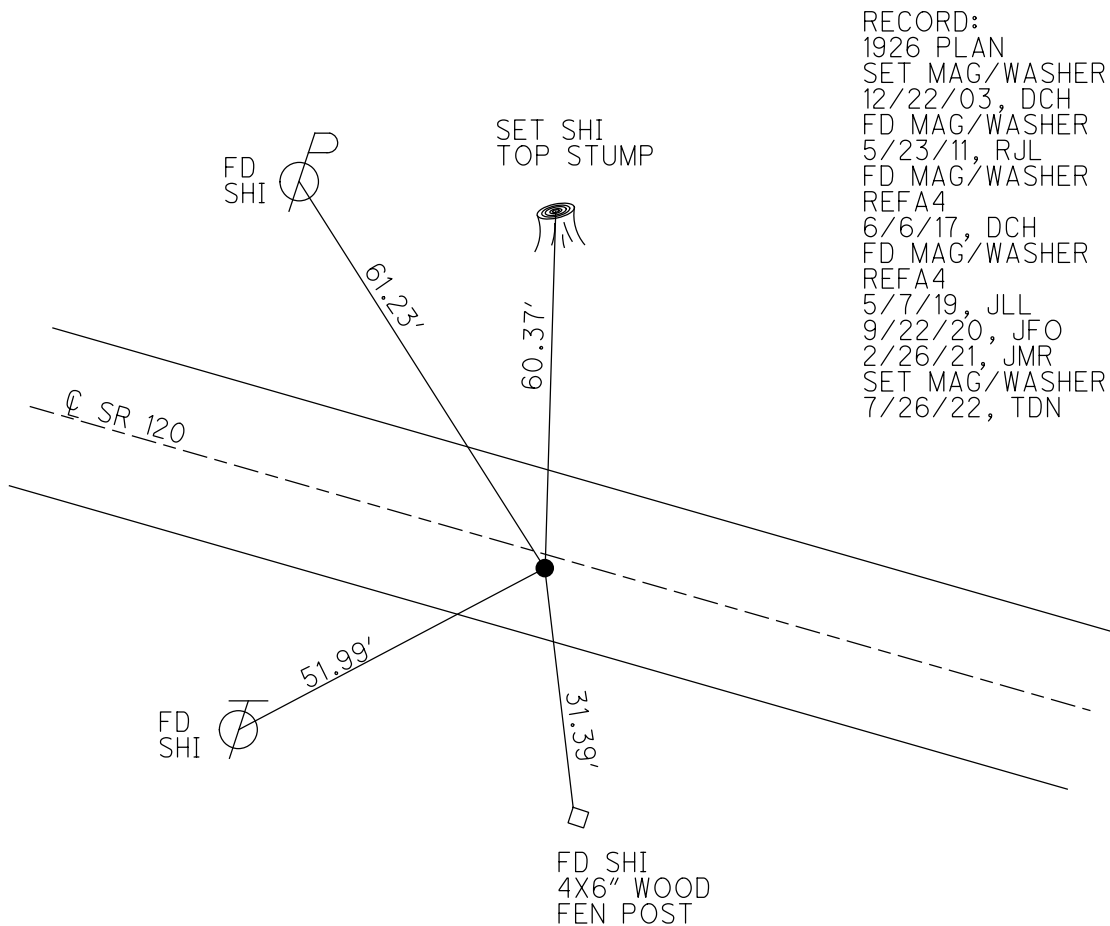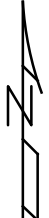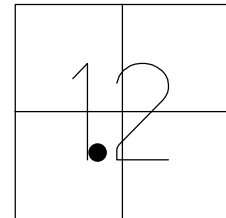


O.D.O.T. DISTRICT 2 SURVEY OFFICE (USE ONLY)

PERSONNEL _____ REFERENCE NO. 5 SHEET 12 OF 50
 NOTES ASTON _____ DATE 6/5/24 ROUTE SR 120
 H.C. NIESE _____ WEATHER WINDY COUNTY FULTON
 R.C. PRESTON-COLVIN _____ TEMP. 75° TOWNSHIP CHESTERFIELD
 SECTION 12
 DWG BY _____ PID PAVETRAIN T 9 N R 2 E

TYPE MONUMENT MAG/WASHER
 ON SURFACE - ~~BELOW~~ ON
 OFFSET Q PAVEMENT 1.2' LT : ~~RT~~
- TO - EDGE PAVEMENT
 STATION: 161+00

HORZ. DATUM: NAD83 2011 GEOID: NAVD88 2012A
 GRID: NORTHING: 744595.936 EASTING: 1526305.380

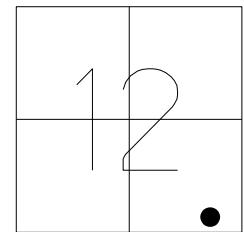

FD NOTCH
1' UP SR 120
SIGN POST

FD SHI
63.20'

101.29'

FD 3" PIPE
OLD USGS BM
N.EDGE

FD MAG

Q CR 13-1

33.66'

48.78'

56.79'

FD SHI
BEHIND
CONDUIT
COVER

RECORD:
1926 PLAN
SET MAG/WASHER
12/22/03, DCH
FD MAG/WASHER
5/23/11, RJL
FD MAG/WASHER
REF5
5/12/17
4/26/19, JLL
9/22/20, JFO
2/26/21, JMR
SET MAG/WASHER
7/26/22, TDN
FD MAG/W
NEW REF 5
6/5/24, TDN
FD MAG/W
6/23/25, TDN


Q SR 120

O.D.O.T. DISTRICT 2 SURVEY OFFICE (USE ONLY)


PERSONNEL _____ REFERENCE NO. 6 SHEET 13 OF 50
 NOTES NIESE DATE 4/27/22 ROUTE SR 120
 H.C. O'DONNELL WEATHER WINDY COUNTY FULTON
 R.C. PARADYSZ TEMP. 42° TOWNSHIP ROYALTON
AUBLE SECTION 7
 DWG BY RHOADES PID 99582 T 9 N R 3 E

TYPE MONUMENT MAG/WASHER
 ON SURFACE - ~~BELOW~~ ON
 OFFSET Q PAVEMENT 0.4' ~~LT~~ : RT
10.3' TO LT EDGE PAVEMENT
 STATION: 174+73

HORZ. DATUM: NAD83 2011 GEOID: NAVD88 2012A
 GRID: NORTHING: 744417.613 EASTING: 1527654.291

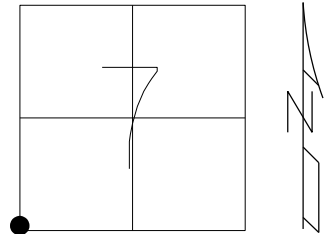

RECORD: 1926 PLAN
 STA. 174+73.15
 FD IPIN
 SET MAG/WASHER
 12/22/03, DCH
 FD MAG/WASHER
 5/23/11, RJL
 FD MAG/WASHER
 REF6
 5/7/19, JLL
 9/23/20, JFO
 2/26/21, JMR
 SET MAG/WASHER
 7/27/22, TDN
 FD MAG/W
 6/23/25, TDN

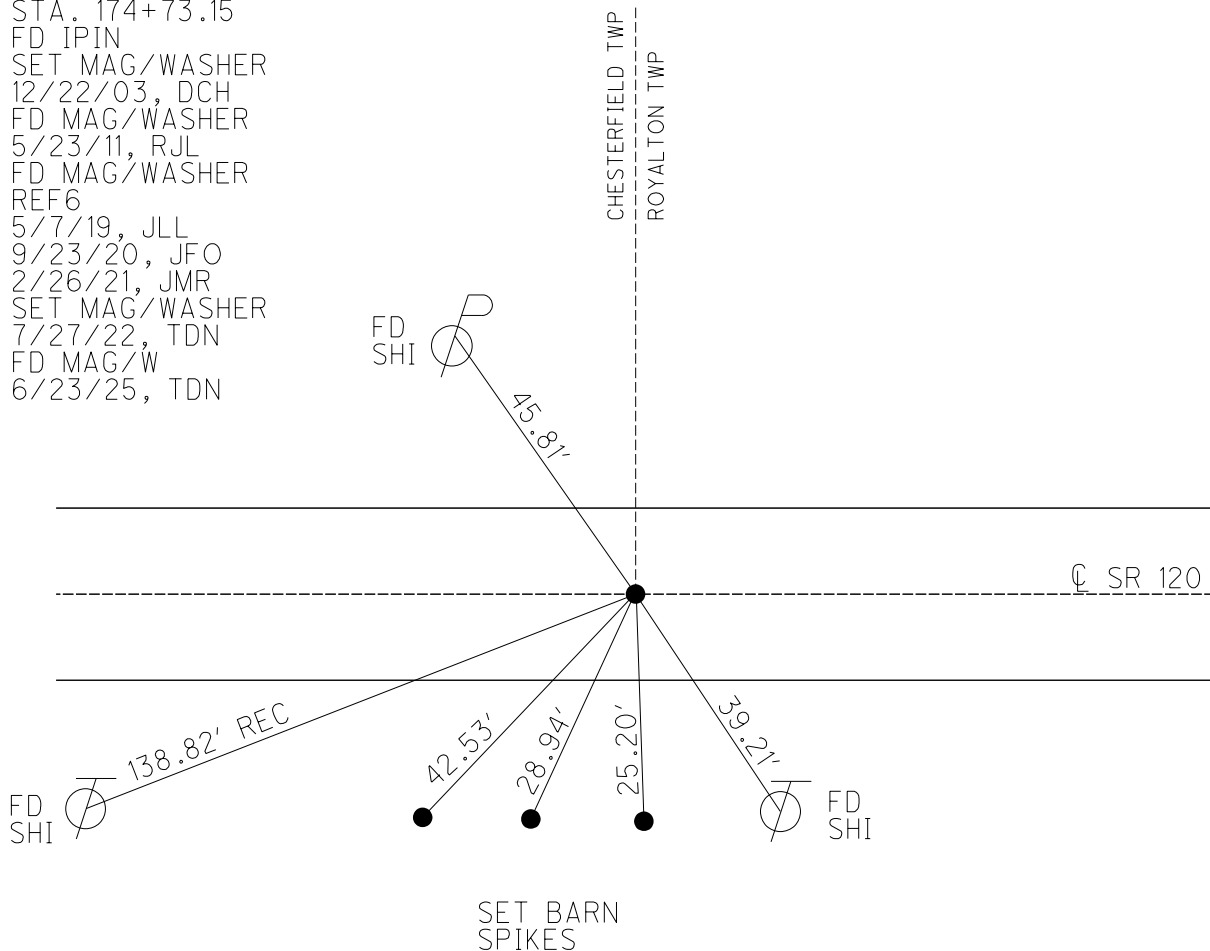

O.D.O.T. DISTRICT 2 SURVEY OFFICE (USE ONLY)

PERSONNEL	REFERENCE NO.	<u>7</u>	SHEET	<u>14</u>	OF	<u>50</u>
NOTES	NIESE	DATE	<u>4/27/22</u>	ROUTE	<u>SR 120</u>	
H.C.	O'DONNELL	WEATHER	<u>WINDY</u>	COUNTY	<u>FULTON</u>	
R.C.	PARADYSZ	TEMP.	<u>42°</u>	TOWNSHIP	<u>ROYALTON</u>	
	AUBLE			SECTION	<u>7</u>	
DWG BY	<u>RHOADES</u>	PID	<u>99582</u>	T <u>9</u> N R <u>3</u> E		

TYPE MONUMENT MAG/WASHER

ON SURFACE - ~~BELOW~~ ON


OFFSET CL PAVEMENT ON LT : RT

10.4' TO RT EDGE PAVEMENT


STATION: 200+77

HORZ. DATUM: NAD83 2011 GEOID: NAVD88 2012A

GRID: NORTHING: 744425.931 EASTING: 1530257.613

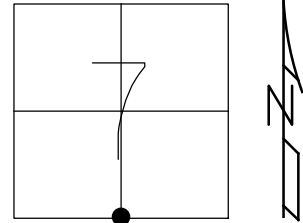

RECORD: 1926 PLAN
STA. 200+76.8
FD IPIPE
FD R.R.SPIKE
6" DOWN
SET MAG/WASHER
9/9/03, DCH
FD MAG/WASHER
5/23/11, RJL
FD MAG/WASHER
REF7
5/17/19, JLL
9/23/20, JFO
2/26/21, JMR
SET MAG/WASHER
7/27/22, TDN

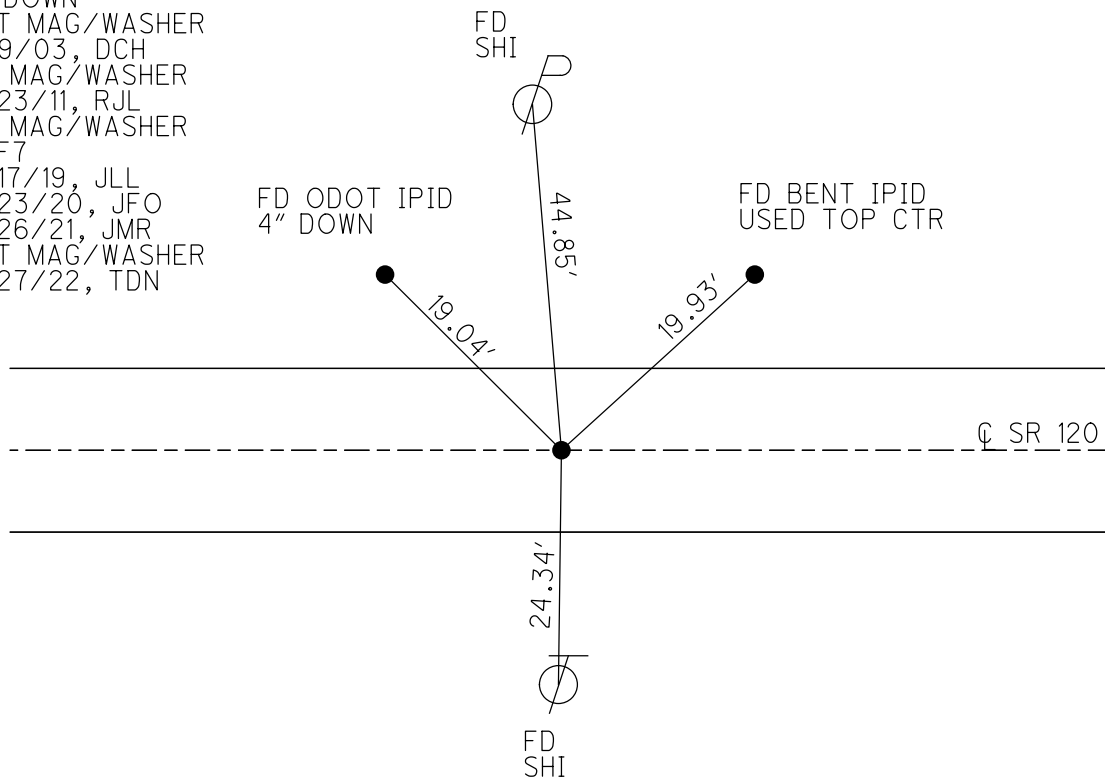

O.D.O.T. DISTRICT 2 SURVEY OFFICE (USE ONLY)

PERSONNEL _____ REFERENCE NO. 8 SHEET 15 OF 50
NOTES NIESE _____ DATE 4/27/22 ROUTE SR 120
H.C. O'DONNELL _____ WEATHER WINDY COUNTY FULTON
R.C. PARADYSZ _____ TEMP. 45° TOWNSHIP ROYALTON
AUBLE _____ SECTION 7
DWG BY RHOADES _____ PID 99582 T 9 N R 3 E

TYPE MONUMENT MAG/WASHER

ON SURFACE - ~~BELOW~~ ON


OFFSET ¢ PAVEMENT 1.3' LT : ~~RT~~

8.6' TO LT EDGE PAVEMENT


STATION: 227+35

HORIZ. DATUM: NAD83 2011 GEOID: NAVD88 2012A

GRID: NORTHING: 744436.911 EASTING: 1532913.104

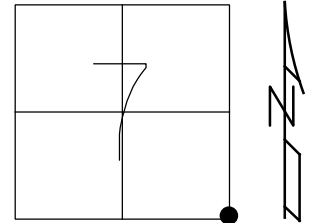

RECORD: 1926 PLAN
STA. 227+33.2
FD IPIPE
SET MAG/WASHER
9/8/03, DCH
FD MAG/WASHER
5/23/11, RJL
FD MAG/WASHER
REF8
5/7/19, JLL
9/23/20, JFO
2/26/21, JMR
SET MAG/WASHER
7/27/22, TDN

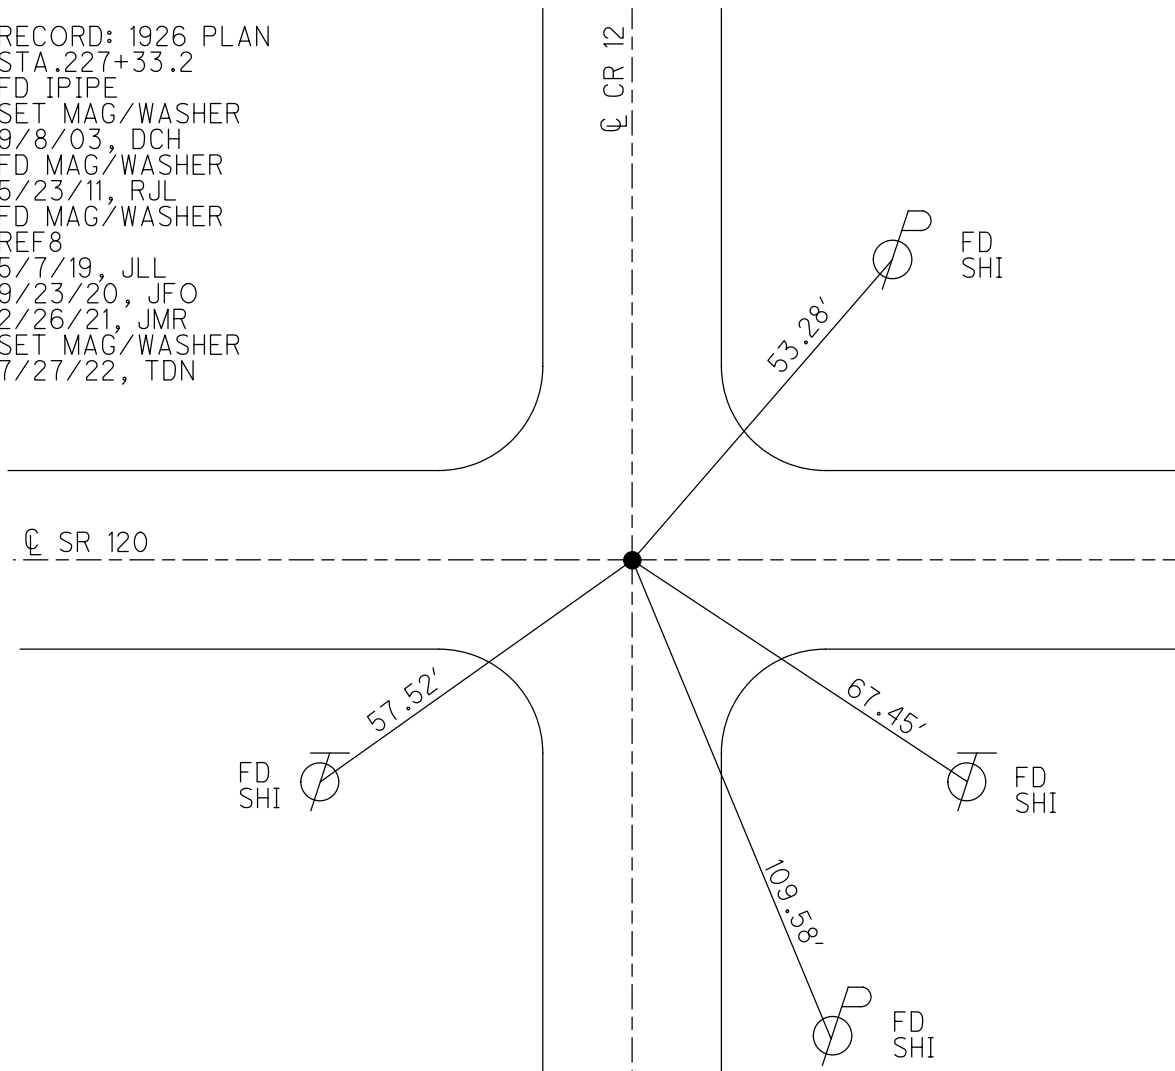

O.D.O.T. DISTRICT 2 SURVEY OFFICE (USE ONLY)

PERSONNEL

REFERENCE NO.

8 AA

SHEET

16 OF 50

NOTES RHOADES

DATE 4/28/22

ROUTE SR 120

H.C. O'DONNELL

WEATHER SUNNY

COUNTY FULTON

R.C. RHOADES

TEMP. 40°

TOWNSHIP ROYALTON

SECTION 8

DWG BY RHOADES

PID 99582

T 9 N R 3 E

TYPE MONUMENT MAG NAIL

ON SURFACE - ~~BELOW~~ ON

OFFSET CL PAVEMENT 1.1' ~~LT~~ : RT

8.8' TO RT EDGE PAVEMENT


STATION: 253+92

HORZ. DATUM: NAD83 2011


GEOID: NAVD88 2018

GRID: NORTHING: 744437.702

EASTING: 1535570.648

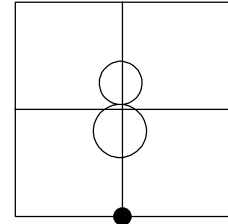

RECORD:
FD MAG/WASHER
5/23/11, RJL
FD MAG NAIL
REFAA8
5/7/19, JLL
4/28/22, JFO
SET MAG/WASHER
7/27/22, TDN

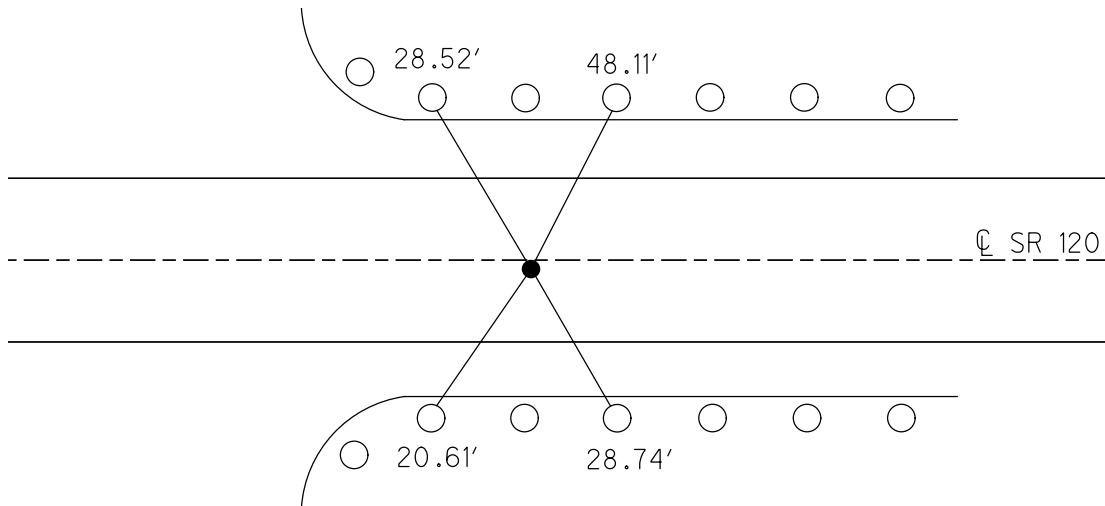

FD SHI'S IN
G.R.POSTS

O.D.O.T. DISTRICT 2 SURVEY OFFICE (USE ONLY)

PERSONNEL _____ REFERENCE NO. 8 A SHEET 17 OF 50

NOTES RHOADES DATE 4/28/22 ROUTE SR 120
H.C. O'DONNELL WEATHER SUNNY COUNTY FULTON
R.C. RHOADES TEMP. 40° TOWNSHIP ROYALTON

SECTION 8
T 9 N R 3 E

DWG BY RHOADES PID 99582

TYPE MONUMENT MAG/WASHER

ON SURFACE - ~~BELOW~~ ON


OFFSET CL PAVEMENT 0.8' ~~LT~~ : RT

9.5' TO RT EDGE PAVEMENT


STATION: 268+55

HORZ. DATUM: NAD83 2011 GEOID: NAVD88 2018

GRID: NORTHING: 744439.075 EASTING: 1537033.706

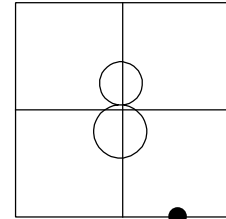

RECORD:
SET MAG/WASHER
12/26/03, DCH
FD MAG/WASHER
5/23/11, RJL
REFA8
5/7/19, JLL
SET MAG/WASHER
7/28/22, TDN

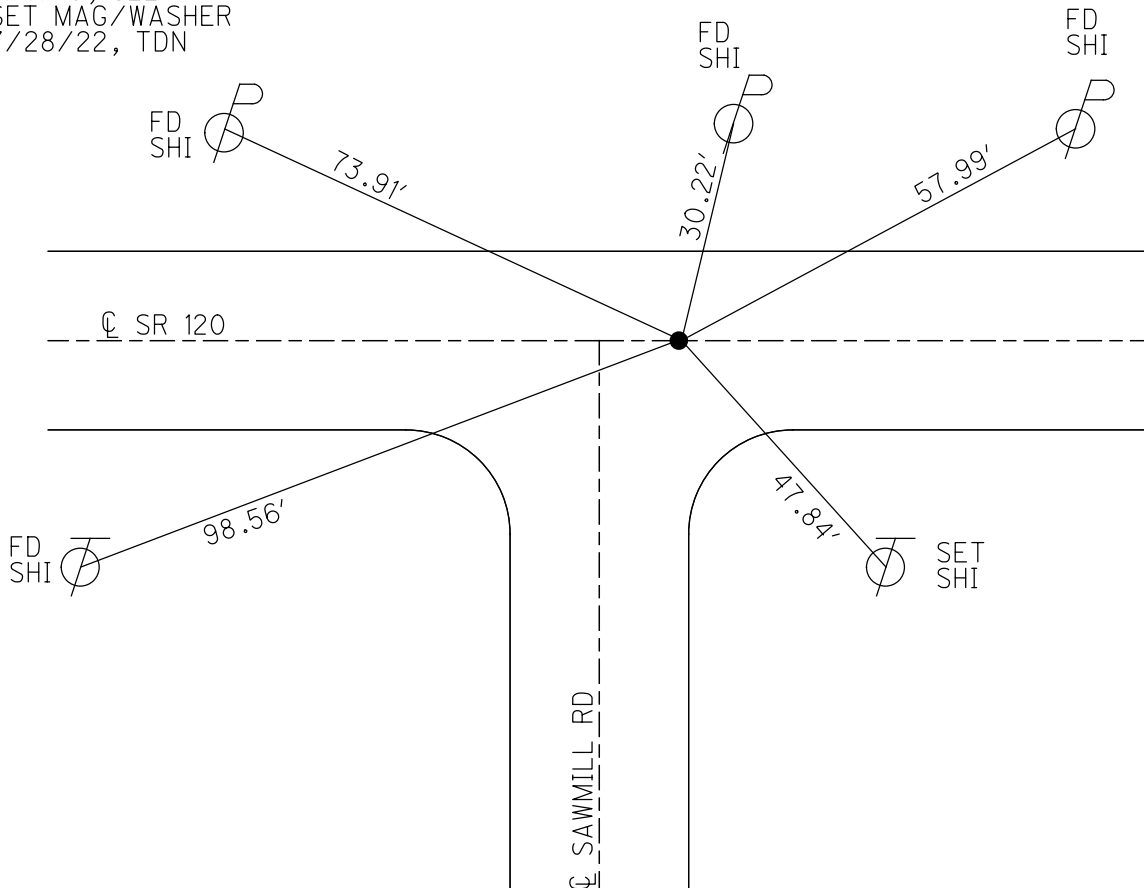


O.D.O.T. DISTRICT 2 SURVEY OFFICE (USE ONLY)


PERSONNEL	REFERENCE NO.	<u>8 B</u>	SHEET	<u>18</u>	OF	<u>50</u>
NOTES	<u>RHOADES</u>	DATE	<u>4/28/22</u>	ROUTE	<u>SR 120</u>	
H.C.	<u>O'DONNELL</u>	WEATHER	<u>SUNNY</u>	COUNTY	<u>FULTON</u>	
R.C.	<u>RHOADES</u>	TEMP.	<u>40°</u>	TOWNSHIP	<u>ROYALTON</u>	
DWG BY	<u>RHOADES</u>	PID	<u>99582</u>	SECTION	<u>8</u>	
				<u>T 9 N</u>	<u>R 3 E</u>	

TYPE MONUMENT MAG/WASHER
ON SURFACE - ~~BELOW~~ ON
OFFSET CL PAVEMENT ON LT : RT
- TO - EDGE PAVEMENT
STATION: 271+85

HORZ. DATUM: NAD83 2011 GEOID: NAVD88 2018
GRID: NORTHING: 744439.374 EASTING: 1537363.760

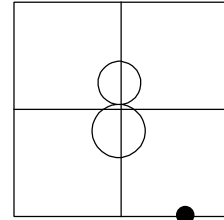

RECORD:
FD SM.R.R.SPIKE
8/15/03, DCH
SET MAG/WASHER
12/26/03, DCH
FD MAG/WASHER
REFB8
5/7/19, JLL
SET MAG/WASHER
7/27/22, TDN

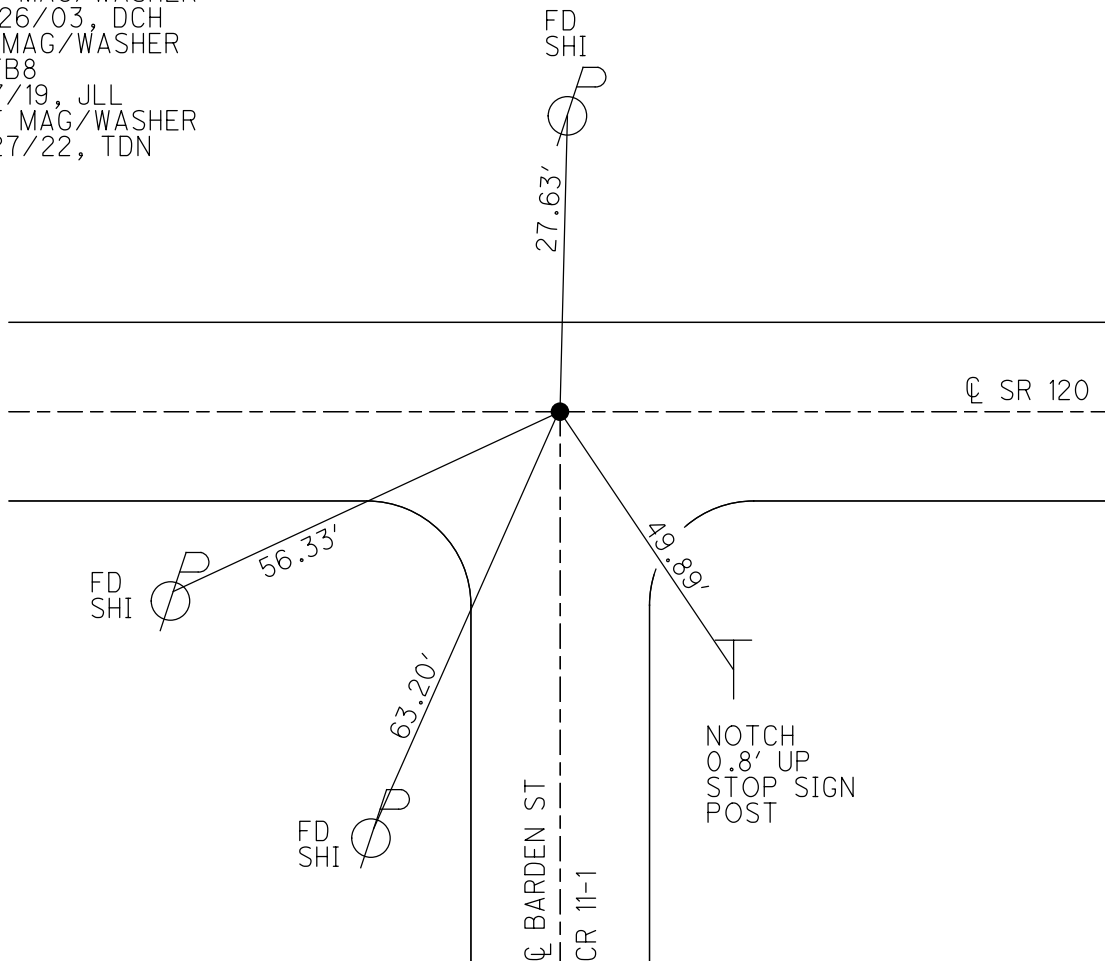

O.D.O.T. DISTRICT 2 SURVEY OFFICE (USE ONLY)

PERSONNEL _____ REFERENCE NO. 9 SHEET 19 OF 50
NOTES RHOADES DATE 4/28/22 ROUTE SR 120
H.C. O'DONNELL WEATHER SUNNY COUNTY FULTON
R.C. RHOADES TEMP. 40° TOWNSHIP ROYALTON
SECTION 8
DWG BY RHOADES PID 99582 T 9 N R 3 E

TYPE MONUMENT SM.R.R.SPIKE

~~ON SURFACE~~ - BELOW 3 1/2"


OFFSET Q PAVEMENT 1.5' LT : ~~RT~~

- TO - EDGE PAVEMENT


STATION: 280+50

HORIZ. DATUM: NAD83 2011 GEOID: NAVD88 2018

GRID: NORTHING: 744439.765 EASTING: 1538228.606

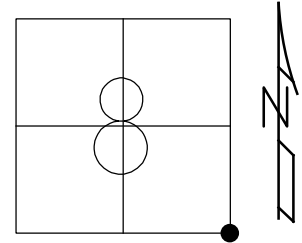

RECORD:
FD P.K.NAIL
8/15/03, DCH
SET MAG/WASHER
12/26/03, DCH
FD MAG/WASHER
REF9
5/7/19, JLL
FD SM.R.R.SPIKE
3 1/2" DOWN
REF9
4/28/22, JFO
SET MAG/WASHER
7/29/22, TDN

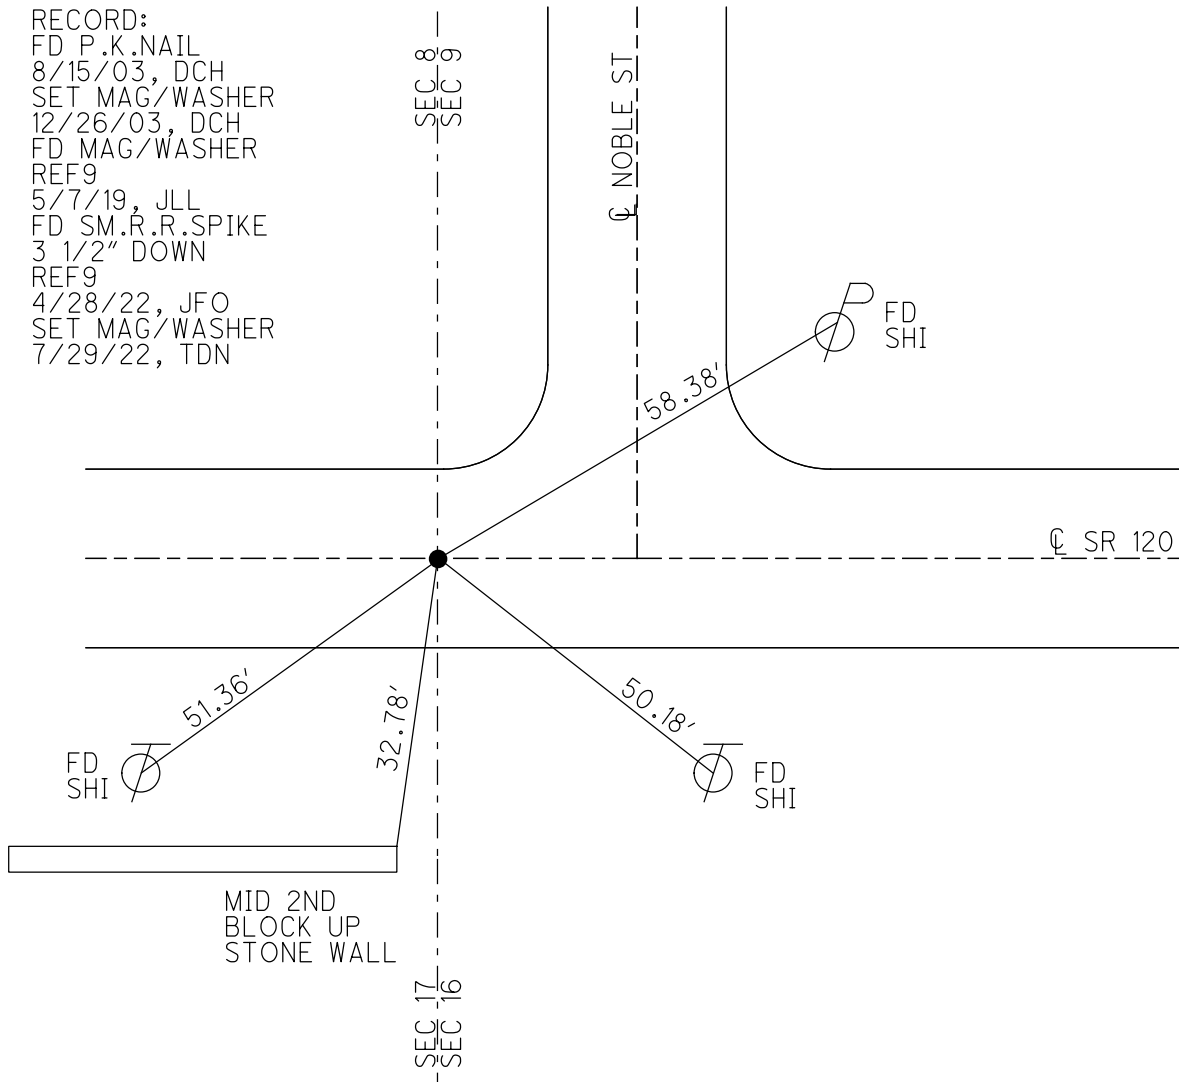

O.D.O.T. DISTRICT 2 SURVEY OFFICE (USE ONLY)

PERSONNEL _____ REFERENCE NO. 9 AA SHEET 20 OF 50

NOTES RHOADES DATE 4/28/22 ROUTE SR 120
H.C. O'DONNELL WEATHER SUNNY COUNTY FULTON
R.C. RHOADES TEMP. 40° TOWNSHIP ROYALTON
SECTION 9

DWG BY RHOADES PID 99582

T 9 N R 3 E

TYPE MONUMENT NAIL

~~ON SURFACE~~ - BELOW 2"


OFFSET $\odot$ PAVEMENT 0.6' $\pm$: RT

- TO - EDGE PAVEMENT


STATION: 288+62

HORZ. DATUM: NAD83 2011 GEOID: NAVD88 2018

GRID: NORTHING: 744439.742 EASTING: 1539040.193

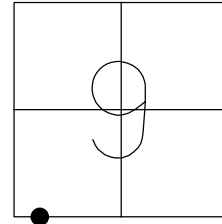

RECORD:
POINT UNKNOWN
FD NAIL
2" DOWN
4/28/22, JFO
SET MAG/WASHER
REFAA9
7/29/22, TDN

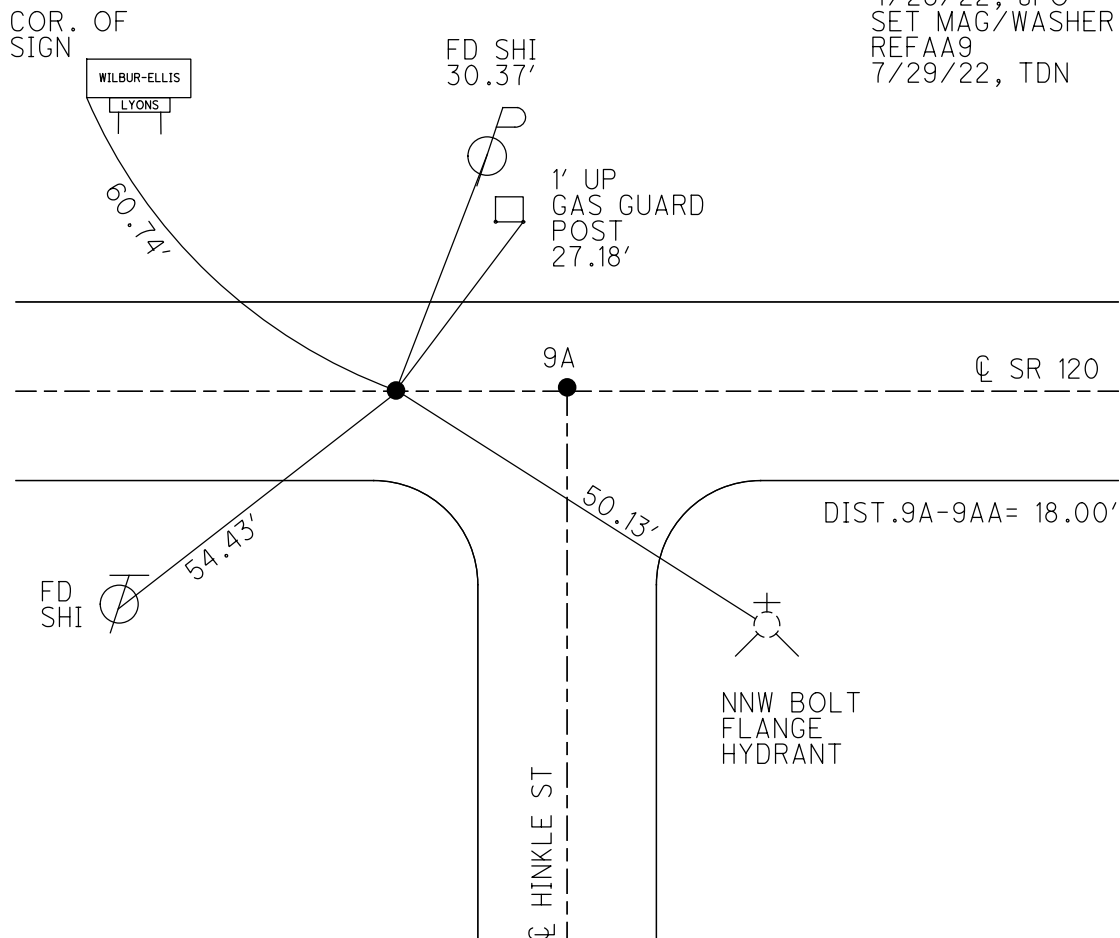

O.D.O.T. DISTRICT 2 SURVEY OFFICE (USE ONLY)

PERSONNEL _____ REFERENCE NO. 9 A SHEET 21 OF 50

NOTES RHOADES DATE 4/28/22 ROUTE SR 120
H.C. O'DONNELL WEATHER SUNNY COUNTY FULTON
R.C. RHOADES TEMP. 40° TOWNSHIP ROYALTON

DWG BY RHOADES PID 99582 SECTION 9
T 9 N R 3 E

TYPE MONUMENT MAG SHANK

ON SURFACE - ~~BELOW~~ ON


OFFSET Q PAVEMENT 1.0' LT : ~~RT~~

- TO - EDGE PAVEMENT


STATION: 288+80

HORIZ. DATUM: NAD83 2011 GEOID: NAVD88 2018

GRID: NORTHING: 744441.367 EASTING: 1539058.091

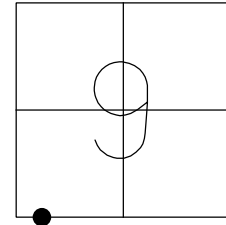

COR. OF
SIGN


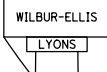


FD SHI
32.44' REC



1' UP
GAS GUARD
POST
26.16'

RECORD:
DNF
8/15/03, DCH
MAG NAIL SET
BY OTHERS
12/29/03, DCH
FD MAG NAIL
REFA9
5/7/19, JLL
FD MAG SHANK
4/28/22, JFO
SET MAG/WASHER
7/29/22, TDN

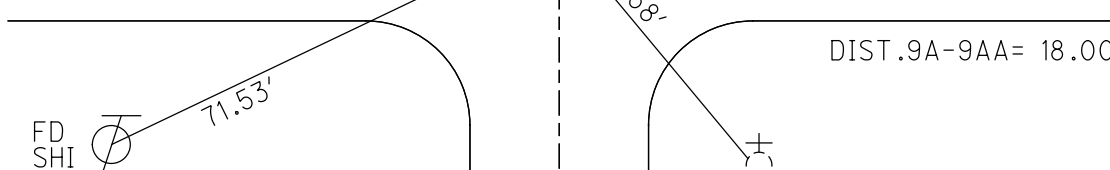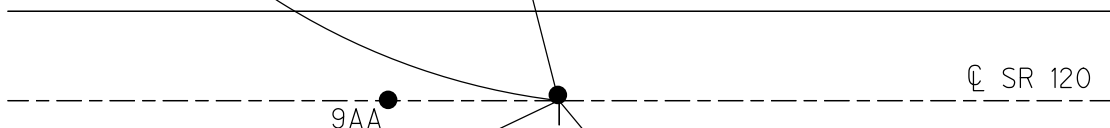

Q HINKLE ST

NNW BOLT
FLANGE
HYDRANT


DIST. 9A-9AA= 18.00'

O.D.O.T. DISTRICT 2 SURVEY OFFICE (USE ONLY)


PERSONNEL _____ REFERENCE NO. 9 B SHEET 22 OF 50
NOTES MILLER DATE 8/29/22 ROUTE SR 120
H.C. NIESE WEATHER SUNNY COUNTY FULTON
R.C. AUBLE TEMP. 82° TOWNSHIP ROYALTON
SECTION 9
DWG BY RHOADES PID 99582 T 9 N R 3 E

TYPE MONUMENT MAG/WASHER
ON SURFACE - ~~BELOW~~ ON
OFFSET ℄ PAVEMENT ON LT : ~~RT~~
- TO - EDGE PAVEMENT
STATION: 293+72

HORZ. DATUM: NAD83 2011 GEOID: NAVD88 2018
GRID: NORTHING: 744442.365 EASTING: 1539550.277

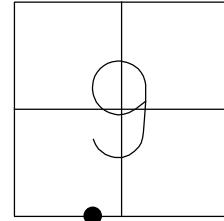

RECORD:
FD P.K.NAIL
8/15/03, DCH
MAG NAIL SET
BY OTHERS
12/29/03, DCH
SET MAG/WASHER
7/29/22, TDN

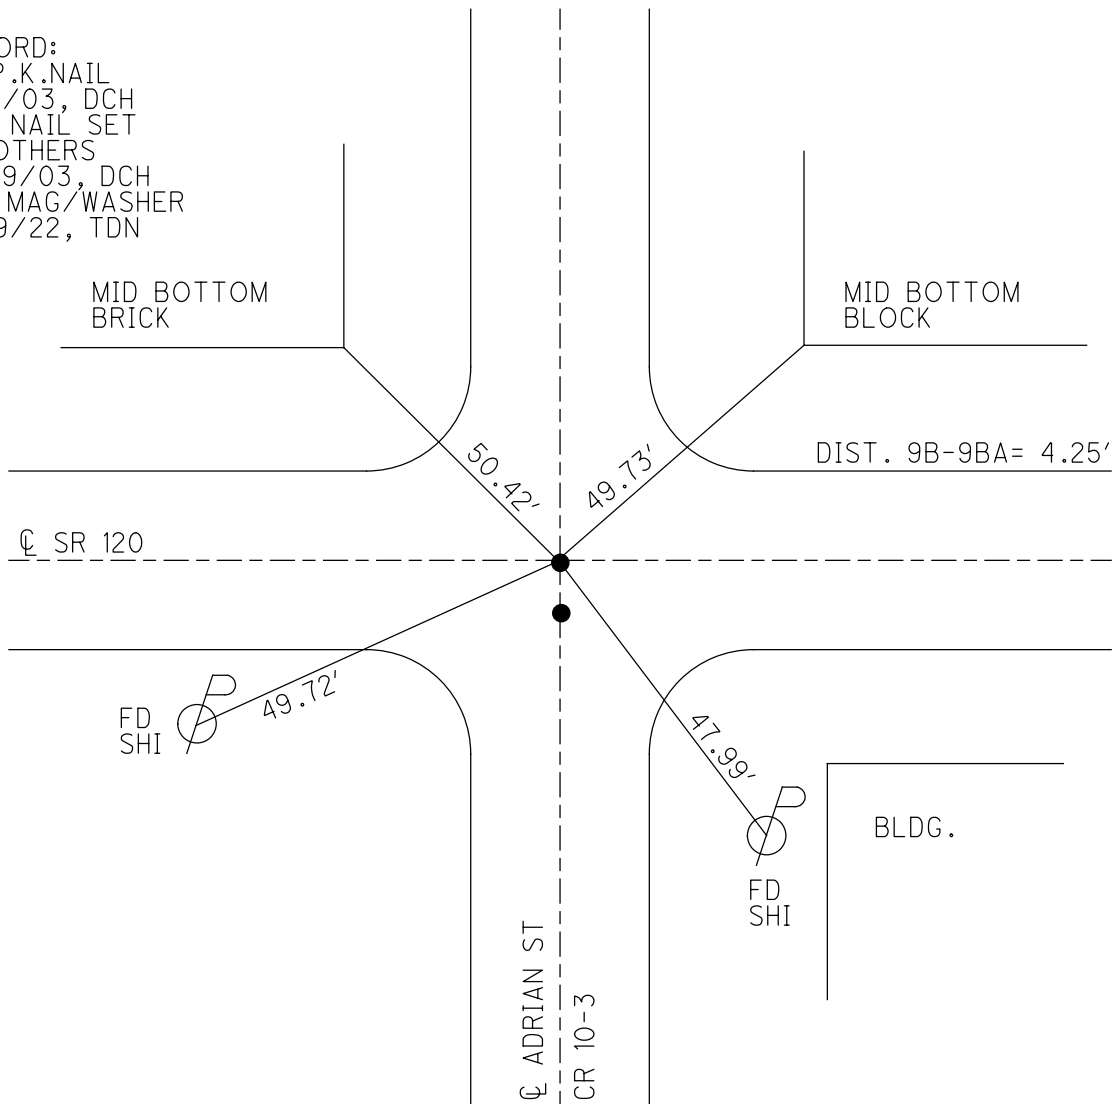


O.D.O.T. DISTRICT 2 SURVEY OFFICE (USE ONLY)


PERSONNEL _____ REFERENCE NO. 9 BA SHEET 23 OF 50
NOTES RHOADES DATE 4/28/22 ROUTE SR 120
H.C. O'DONNELL WEATHER SUNNY COUNTY FULTON
R.C. RHOADES TEMP. 40° TOWNSHIP ROYALTON
SECTION 9
DWG BY RHOADES PID 99582 T 9 N R 3 E

TYPE MONUMENT MAG NAIL
ON SURFACE - ~~BELOW~~ ON
OFFSET CL PAVEMENT 4.2' LT : ~~RT~~
- TO - EDGE PAVEMENT
STATION: 293+72

HORZ. DATUM: NAD83 2011 GEOID: NAVD88 2018
GRID: NORTHING: 744438.114 EASTING: 1539550.301

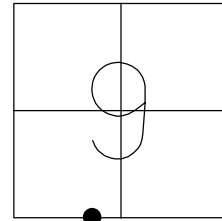

RECORD:
FD SM.MAG NAIL
REFB9
5/7/19, JLL
4/28/22, JFO
SET MAG/WASHER
7/29/22, TDN

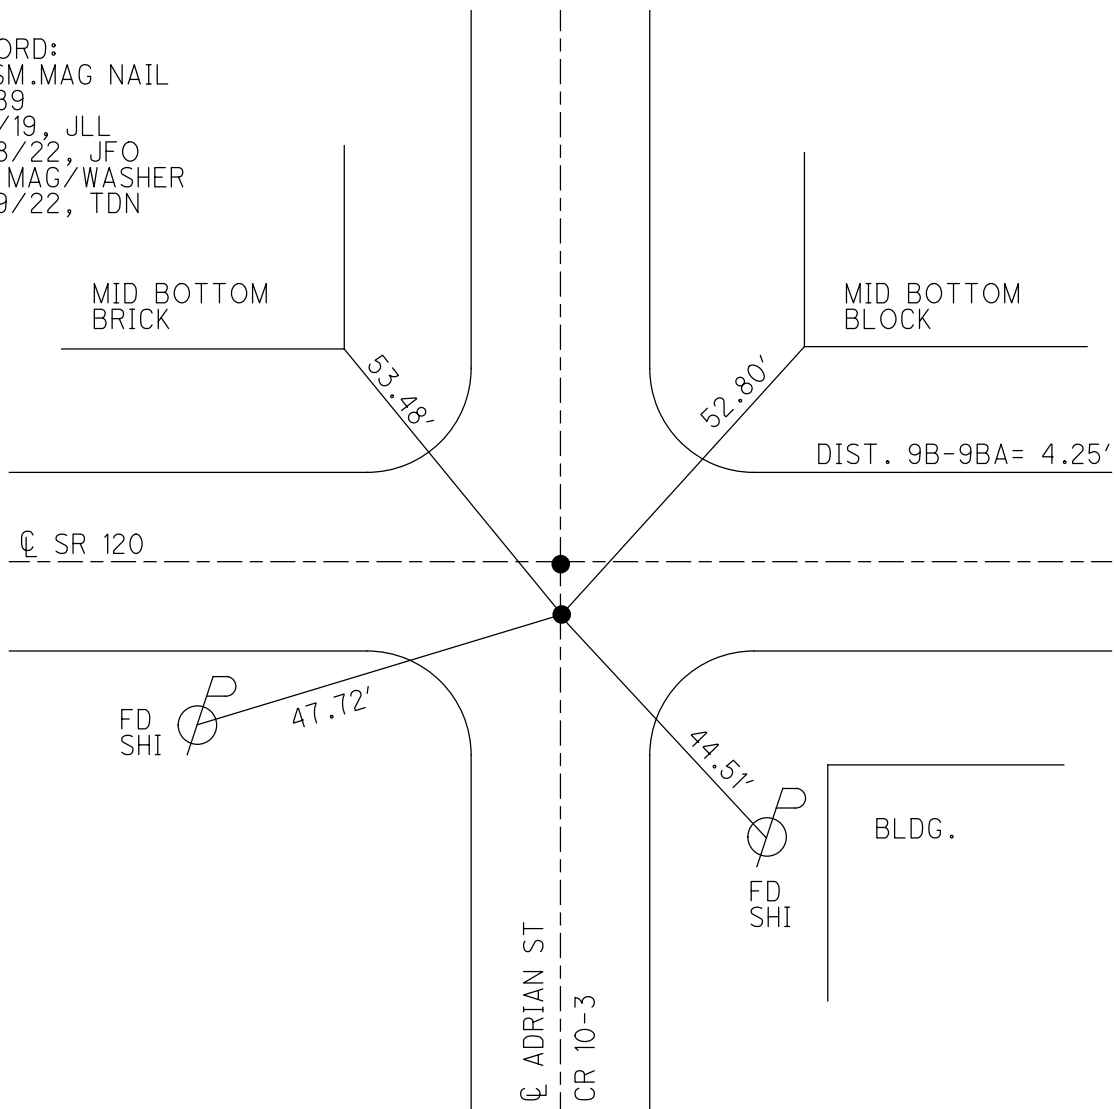


O.D.O.T. DISTRICT 2 SURVEY OFFICE (USE ONLY)


PERSONNEL _____ REFERENCE NO. 9 C SHEET 24 OF 50
 NOTES RHOADES _____ DATE 4/28/22 ROUTE SR 120
 H.C. O'DONNELL _____ WEATHER SUNNY COUNTY FULTON
 R.C. RHOADES _____ TEMP. 40° TOWNSHIP ROYALTON
 DWG BY RHOADES PID 99582 SECTION 9
 T 9 N R 3 E

TYPE MONUMENT MAG SHANK
 ON SURFACE - ~~BELOW~~ ON
 OFFSET Q PAVEMENT ON LT : RT
- TO - EDGE PAVEMENT
 STATION: 298+96

HORZ. DATUM: NAD83 2011 GEOID: NAVD88 2018
 GRID: NORTHING: 744443.341 EASTING: 1540068.766

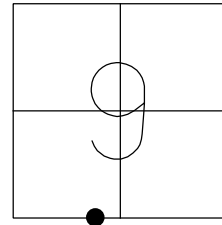

RECORD:
 FD MAG NAIL
 8/15/03, DCH
 SET MAG/WASHER
 12/29/03, DCH
 FD MAG/WASHER
 REFC9
 5/7/19, JLL
 FD MAG SHANK
 4/28/22, JFO
 SET MAG/WASHER
 7/29/22, TDN

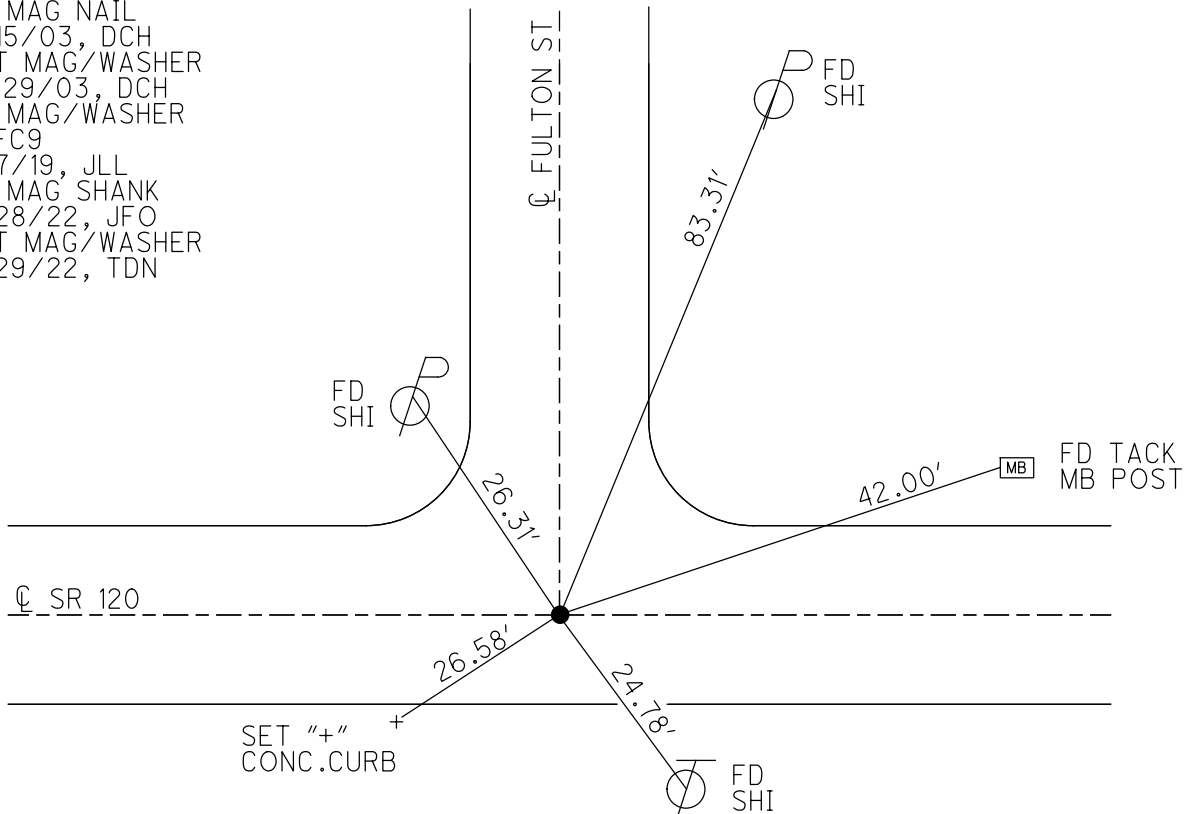

O.D.O.T. DISTRICT 2 SURVEY OFFICE (USE ONLY)

PERSONNEL _____ REFERENCE NO. 9 D SHEET 25 OF 50

NOTES RHOADES DATE 4/28/22 ROUTE SR 120

H.C. O'DONNELL WEATHER SUNNY COUNTY FULTON

R.C. RHOADES TEMP. 45° TOWNSHIP ROYALTON

SECTION 9

DWG BY RHOADES PID 99582

T 9 N R 3 E

TYPE MONUMENT MAG/WASHER

ON SURFACE - ~~BELOW~~ ON


OFFSET ℄ PAVEMENT 1.5' LT : ~~RT~~

- TO - EDGE PAVEMENT


STATION: 306+93

HORIZ. DATUM: NAD83 2011 GEOID: NAVD88 2018

GRID: NORTHING: 744445.086 EASTING: 1540872.727

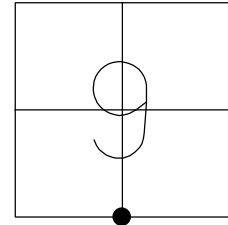

RECORD:
FD SM.R.R.SPIKE
8/15/03, DCH
SET MAG/WASHER
12/29/03, DCH
FD MAG/WASHER
REFD9
5/7/19, JLL
SET MAG/WASHER
7/29/22, TDN


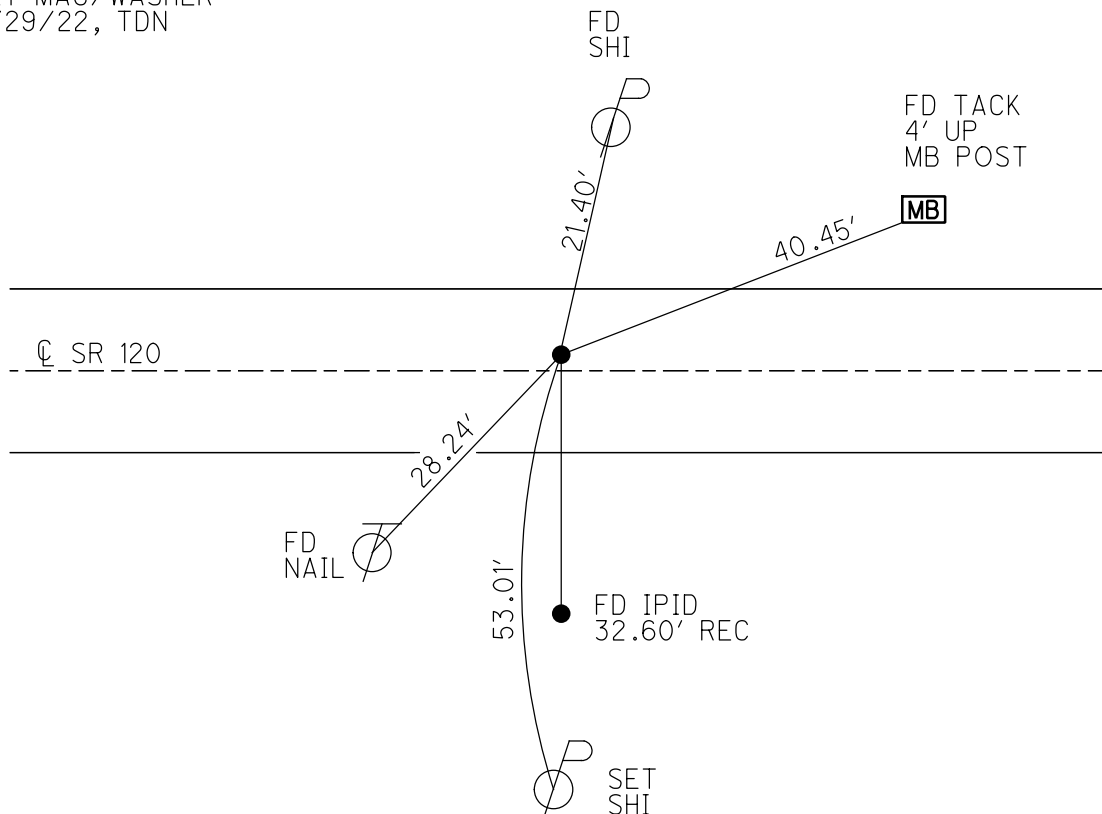


O.D.O.T. DISTRICT 2 SURVEY OFFICE (USE ONLY)

PERSONNEL _____ REFERENCE NO. 9 E SHEET 26 OF 50
NOTES RHOADES DATE 4/28/22 ROUTE SR 120
H.C. O'DONNELL WEATHER SUNNY COUNTY FULTON
R.C. RHOADES TEMP. 45° TOWNSHIP ROYALTON
DWG BY RHOADES PID 99582 SECTION 9
T 9 N R 3 E


TYPE MONUMENT MAG NAIL
ON SURFACE - ~~BELOW~~ ON
OFFSET Q PAVEMENT 3.5' LT : ~~RT~~
- TO - EDGE PAVEMENT
STATION: 310+09

HORZ. DATUM: NAD83 2011 GEOID: NAVD88 2018
GRID: NORTHING: 744447.282 EASTING: 1541188.196

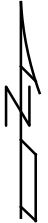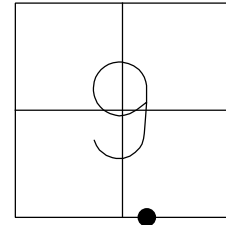

RECORD:
FD MAG/WASHER
8/15/03, DCH
SET MAG/WASHER
12/29/03, DCH
FD MAG/WASHER
REFE9
5/7/19, JLL
SET MAG/WASHER
7/29/22, TDN

NOTE: 1 " SQ.BOLT WAS REMOVED,
DUE TO SANITARY SEWER PROJECT.
8/15/03, DCH

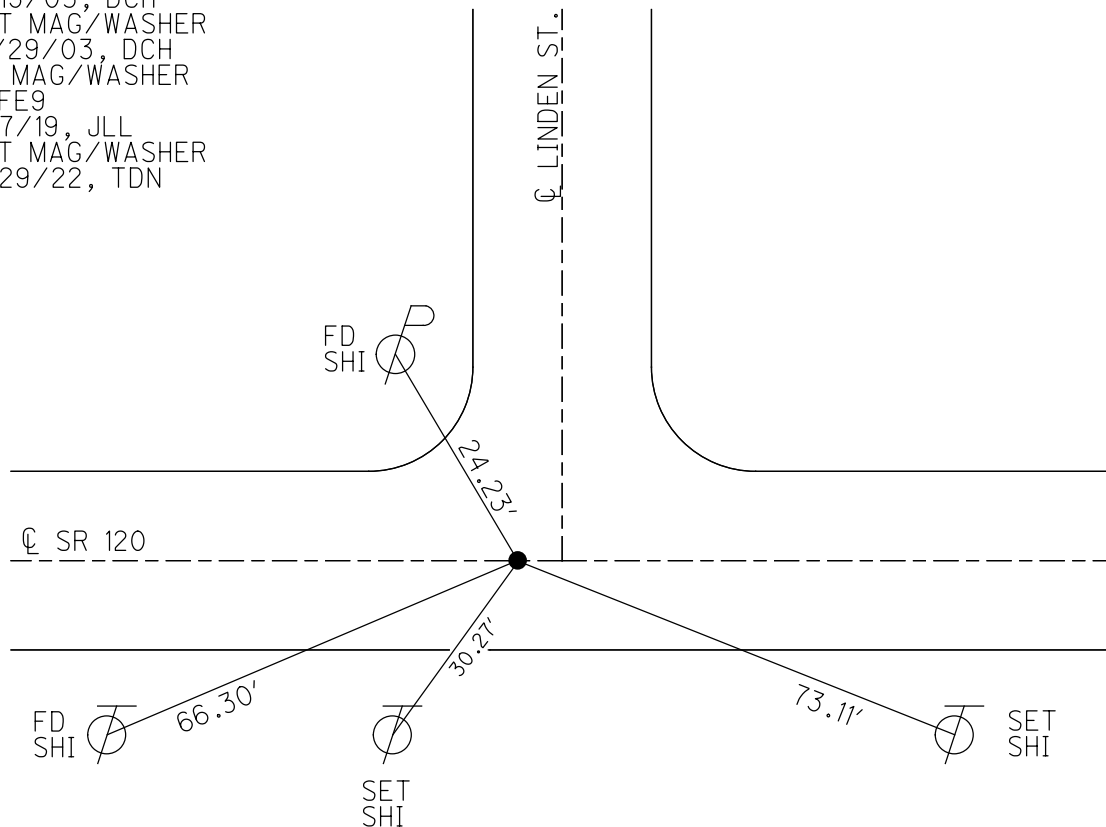


O.D.O.T. DISTRICT 2 SURVEY OFFICE (USE ONLY)


PERSONNEL _____ REFERENCE NO. 10 SHEET 27 OF 50
NOTES RHOADES DATE 4/28/22 ROUTE SR 120
H.C. O'DONNELL WEATHER SUNNY COUNTY FULTON
R.C. RHOADES TEMP. 45° TOWNSHIP ROYALTON
DWG BY RHOADES PID 99582 SECTION 9
T 9 N R 3 E

TYPE MONUMENT MAG/WASHER
ON SURFACE - ~~BELOW~~ ON
OFFSET CL PAVEMENT 0.6' ~~LT~~ : RT
- TO - EDGE PAVEMENT
STATION: 320+42.64

HORZ. DATUM: NAD83 2011 GEOID: NAVD88 2018
GRID: NORTHING: 744452.147 EASTING: 1542184.386

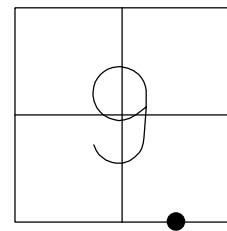

RECORD:
FD R.R.SPIKE
8/15/03, DCH
SET MAG/WASHER
12/29/03, DCH
FD MAG NAIL
REF23
6/8/10, DCH
FD MAG/WASHER
REF10
5/7/19, JLL
4/28/22, JFO
SET MAG/WASHER
7/29/22, TDN

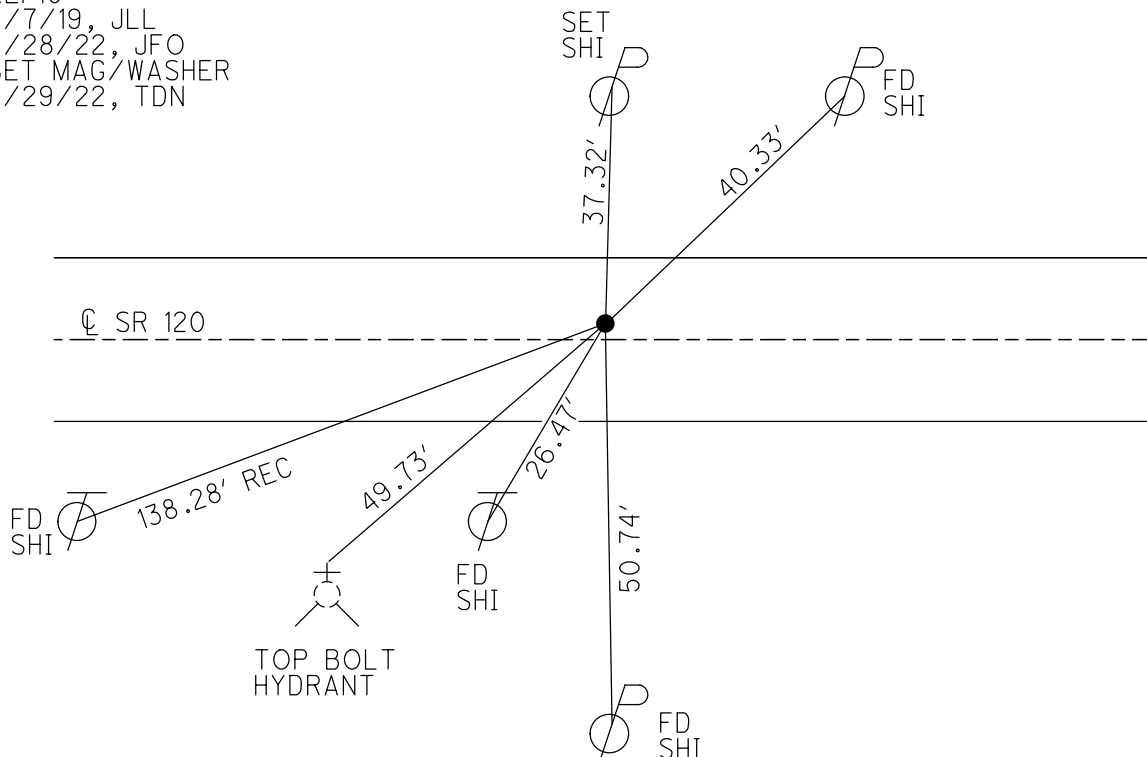

O.D.O.T. DISTRICT 2 SURVEY OFFICE (USE ONLY)

PERSONNEL

REFERENCE NO. 11

SHEET 28 OF 50

NOTES

HOMAN

DATE 5/11/12

ROUTE SR 120

H.C.

ROUSOS

WEATHER SUNNY

COUNTY FULTON

R.C.

HOMAN

TEMP. 55°

TOWNSHIP ROYALTON

SECTION 9

DWG BY RHOADES

PID PAVETRAIN

T 9 N R 3 E

TYPE MONUMENT R.R.SPIKE

ON SURFACE - ~~BELOW~~ ON

OFFSET Q PAVEMENT 2.5' LT : ~~RT~~

- TO - EDGE PAVEMENT


STATION: 333+58.27

HORIZ. DATUM: NAD83 2011

GEOID: NAVD88 2018

GRID: NORTHING: 744464.689

EASTING: 1543499.941

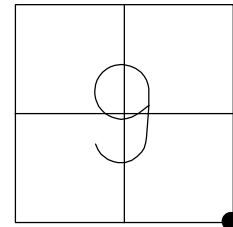

RECORD:

FD 1" IPIPE

2" DOWN

6/14/90, IRS

FD R.R.SPIKE

8/15/03, DCH

SET MAG/WASHER

12/29/03, DCH

FD R.R.SPIKE

REF24

6/8/10, DCH

SET P.K./WASHER

NEWREF24

8/9/12, DCH

FD MAG/WASHER

REF11

5/7/19, JLL

FD P.K./WASHER

REF11

7/1/22, DSA

4/12/23, JMR

FD
SHI



57.64'



FD
SHI

60.88'



FD
SHI

41.78'

44.30'

TOP BOLT
HYDRANT

Q CR 10

Q SR 120

O.D.O.T. DISTRICT 2 SURVEY OFFICE (USE ONLY)

PERSONNEL _____ **REFERENCE NO.** 11 A **SHEET** 29 **OF** 50
NOTES HOMAN **DATE** 5/11/12 **ROUTE** SR 120
H.C. ROUSOS **WEATHER** SUNNY **COUNTY** FULTON
R.C. HOMAN **TEMP.** 55° **TOWNSHIP** ROYALTON
DWG BY RHOADES **PID** PAVETRAIN **SECTION** 10
T 9 **N** **R** 3 **E**

TYPE MONUMENT SM.R.R.SPIKE

ON SURFACE - ~~BELOW~~ ON


OFFSET $\odot$ PAVEMENT 0.8' **LT : RT**

9.5' **TO LT** **EDGE PAVEMENT**


STATION: 360+32.08

HORIZ. DATUM: NAD83 2011 **GEOID:** NAVD88 2018

GRID: NORTHING: 744471.855 **EASTING:** 1546173.833

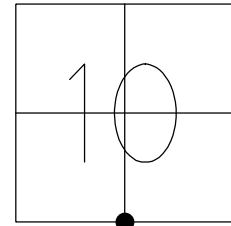

RECORD:
 FD SM.R.R.SPIKE
 6/14/90, IRS
 SET R.R.SPIKE
 9/20/90, DC
 FD R.R.SPIKE
 REF25
 6/8/10, DCH
 SET P.K./WASHER
 NEWREF25
 8/9/12, DCH
 FD P.K./WASHER
 REFA11
 7/1/22, DSA
 4/12/23, JMR

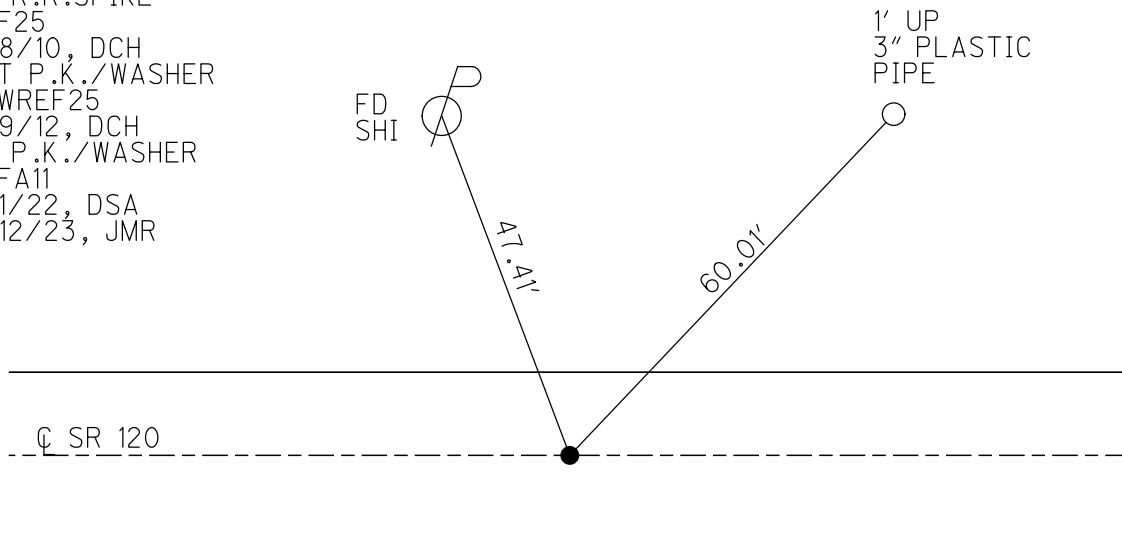


O.D.O.T. DISTRICT 2 SURVEY OFFICE (USE ONLY)


PERSONNEL _____ REFERENCE NO. 12 SHEET 30 OF 50
NOTES HOMAN DATE 5/11/12 ROUTE SR 120
H.C. ROUSOS WEATHER SUNNY COUNTY FULTON
R.C. HOMAN TEMP. 60° TOWNSHIP ROYALTON
DWG BY RHOADES PID PAVETRAIN SECTION 10
T 9 N R 3 E

TYPE MONUMENT MONBOX W/1" IPIN
ON SURFACE - ~~BELOW~~ ON
OFFSET Q PAVEMENT ON LT : RT
- TO - EDGE PAVEMENT
STATION: 386+92.17

HORZ. DATUM: NAD83 2011 GEOID: NAVD88 2018
GRID: NORTHING: 744462.159 EASTING: 1548833.793

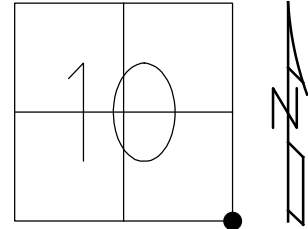

RECORD:
FD MONBOX
9/19/84, DC
FD MONBOX
REF26
6/8/10, DCH
FD MONBOX
W/1" IPIN
REF12
7/1/22, DSA
4/12/23, JMR

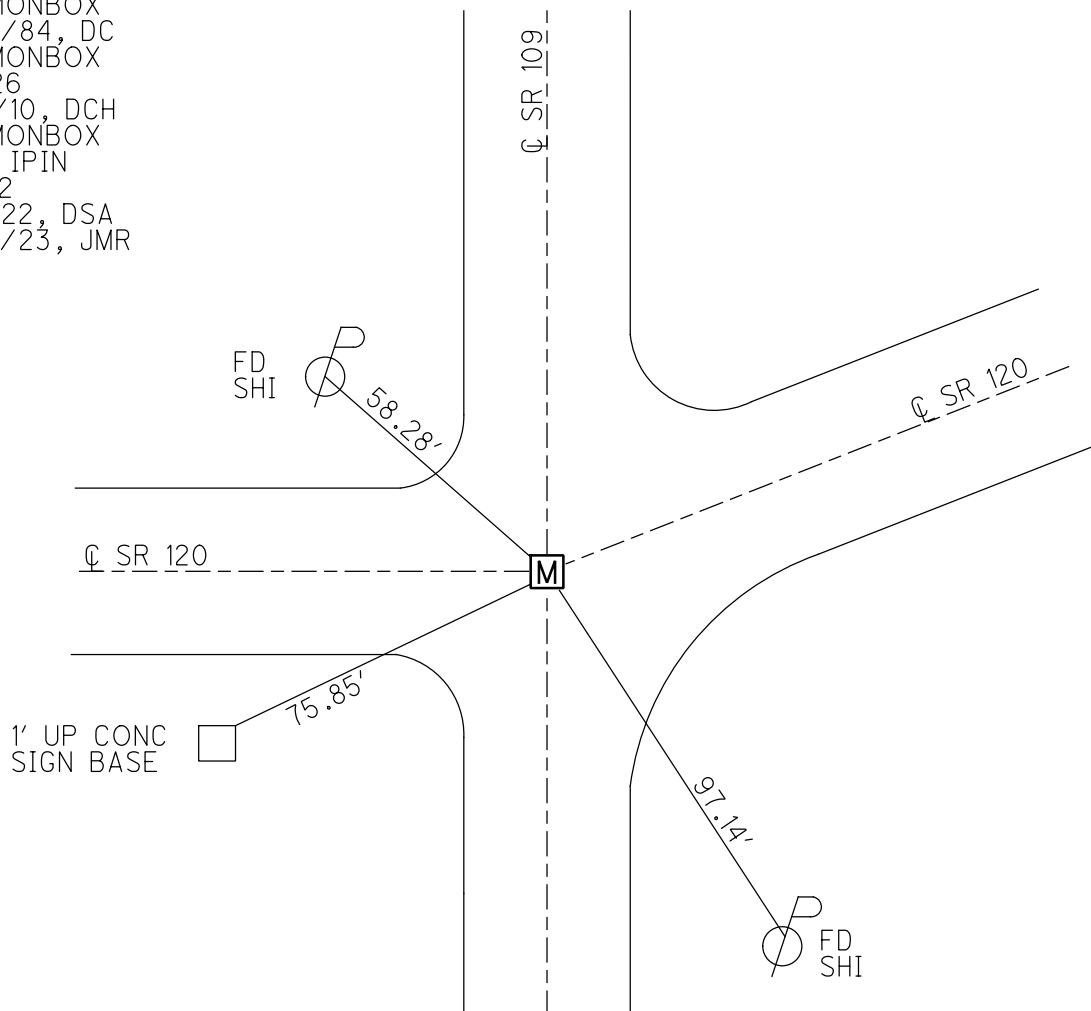

O.D.O.T. DISTRICT 2 SURVEY OFFICE (USE ONLY)

PERSONNEL _____ REFERENCE NO. 12 A SHEET 31 OF 50

NOTES HOMAN DATE 5/11/12 ROUTE SR 120

H.C. ROUSOS WEATHER SUNNY COUNTY FULTON

R.C. HOMAN TEMP. 60° TOWNSHIP ROYALTON

SECTION 11

DWG BY RHOADES PID PAVETRAIN

T 9 N R 3 E

TYPE MONUMENT MONBOX W/1" IPIN

ON SURFACE - ~~BELOW~~ ON


OFFSET Q PAVEMENT 10' ~~LT~~ : RT

23.4' TO LT EDGE PAVEMENT


STATION: 388+66.95

HORZ. DATUM: NAD83 2011 GEOID: NAVD88 2018

GRID: NORTHING: 744520.563 EASTING: 1548998.514

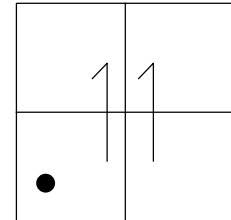

RECORD: P.I.
FD MONBOX
5/12/81, DC
FD MONBOX
REF27
6/8/10, DCH
FD NEW MONBOX
NO IPIN INSIDE
5/11/12, DCH
FD MONBOX
W/1" IPIN
REFA12
7/1/22, DSA
4/12/23, JMR

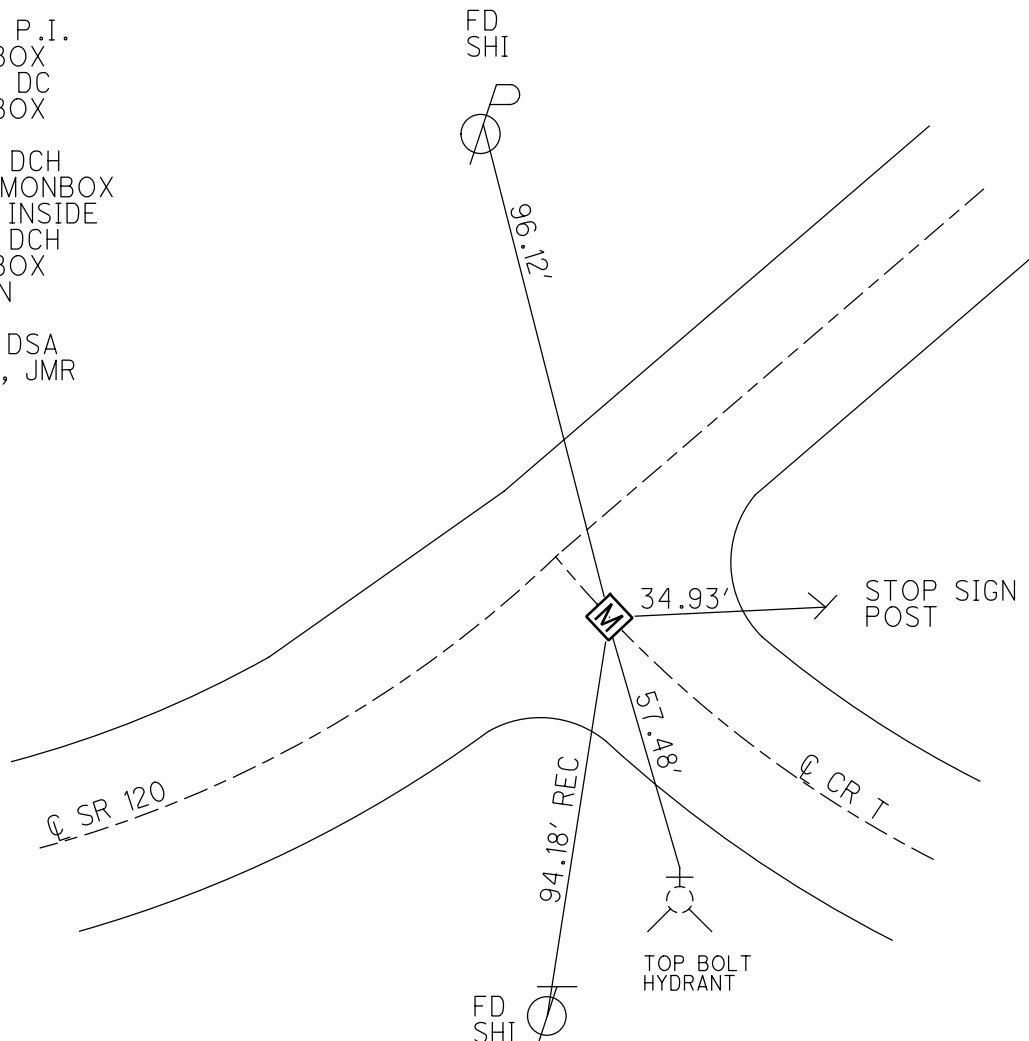


O.D.O.T. DISTRICT 2 SURVEY OFFICE (USE ONLY)


PERSONNEL _____ REFERENCE NO. 12 B SHEET 32 OF 50
 NOTES HOMAN DATE 5/11/12 ROUTE SR 120
 H.C. ROUSOS WEATHER SUNNY COUNTY FULTON
 R.C. HOMAN TEMP. 60° TOWNSHIP ROYALTON
 DWG BY RHOADES PID PAVETRAIN SECTION 11
 T 9 N R 3 E

TYPE MONUMENT MONBOX W/1" IPIN
 ON SURFACE - ~~BELOW~~ ON
 OFFSET Q PAVEMENT 3' LT : ~~RT~~
7.3' TO LT EDGE PAVEMENT
 STATION: 391+23.05

HORZ. DATUM: NAD83 2011 GEOID: NAVD88 2018
 GRID: NORTHING: 744695.209 EASTING: 1549185.185

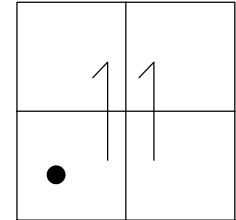

RECORD: P.I.
 FD MONBOX
 5/12/81, DC
 FD MONBOX
 REF28
 6/8/10, DCH
 FD NEW MONBOX
 NEWREF28
 5/11/12, DCH
 FD MONBOX
 W/1" IPIN
 REFB12
 7/1/22, DSA
 4/12/23, JMR

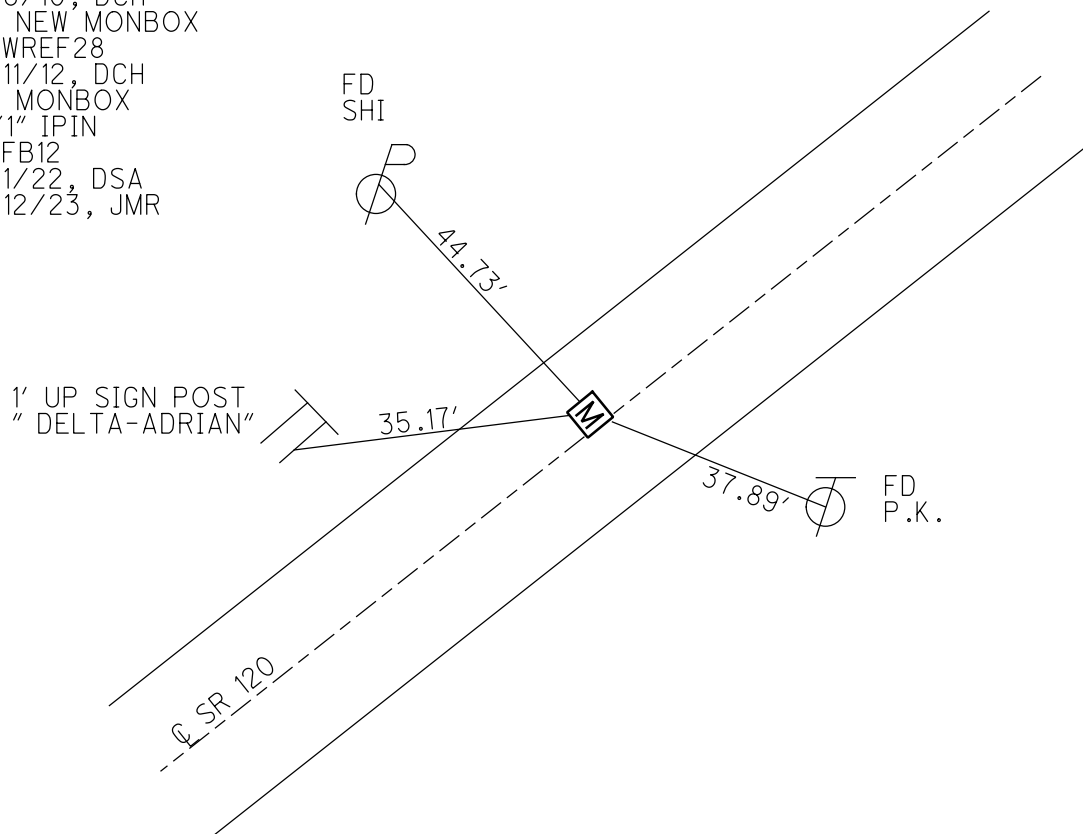

O.D.O.T. DISTRICT 2 SURVEY OFFICE (USE ONLY)

PERSONNEL REFERENCE NO. 12 C SHEET 33 OF 50

NOTES	HOMAN	DATE	5/11/12	ROUTE	SR 120
H.C.	ROUSOS	WEATHER	SUNNY	COUNTY	FULTON
R.C.	HOMAN	TEMP.	60°	TOWNSHIP	ROYALTON

DWG BY RHOADES PID PAVETRAIN

SECTION 11
T9N R3E

TYPE MONUMENT MAG NAIL

ON SURFACE - ~~BELOW~~ ON


OFFSET C PAVEMENT 0.6' LT : RT

10' TO LT EDGE PAVEMENT

STATION: 394+41.34

HORZ. DATUM: NAD83 2011 GEOID: NAVD88 2018

GRID: NORTHING: 744870.817 EASTING: 1549451.367

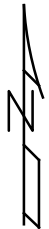

RECORD:

1928 PLAN

$$\Delta = 0^{\circ} 13' 20''$$

SET P.K.NAIL

4/17/91, IRS

FD P.K.NAIL

1991

SET P.K./WASHER

3/18/92

FD MAG NAIL

REF 29

6/8/10, DCH

SET MAG/WASHER

NEWREF29


8/29/12, DCH

FD MAG/WASHER

REFC12

7/1/22, DSA


4/12/23, JMR

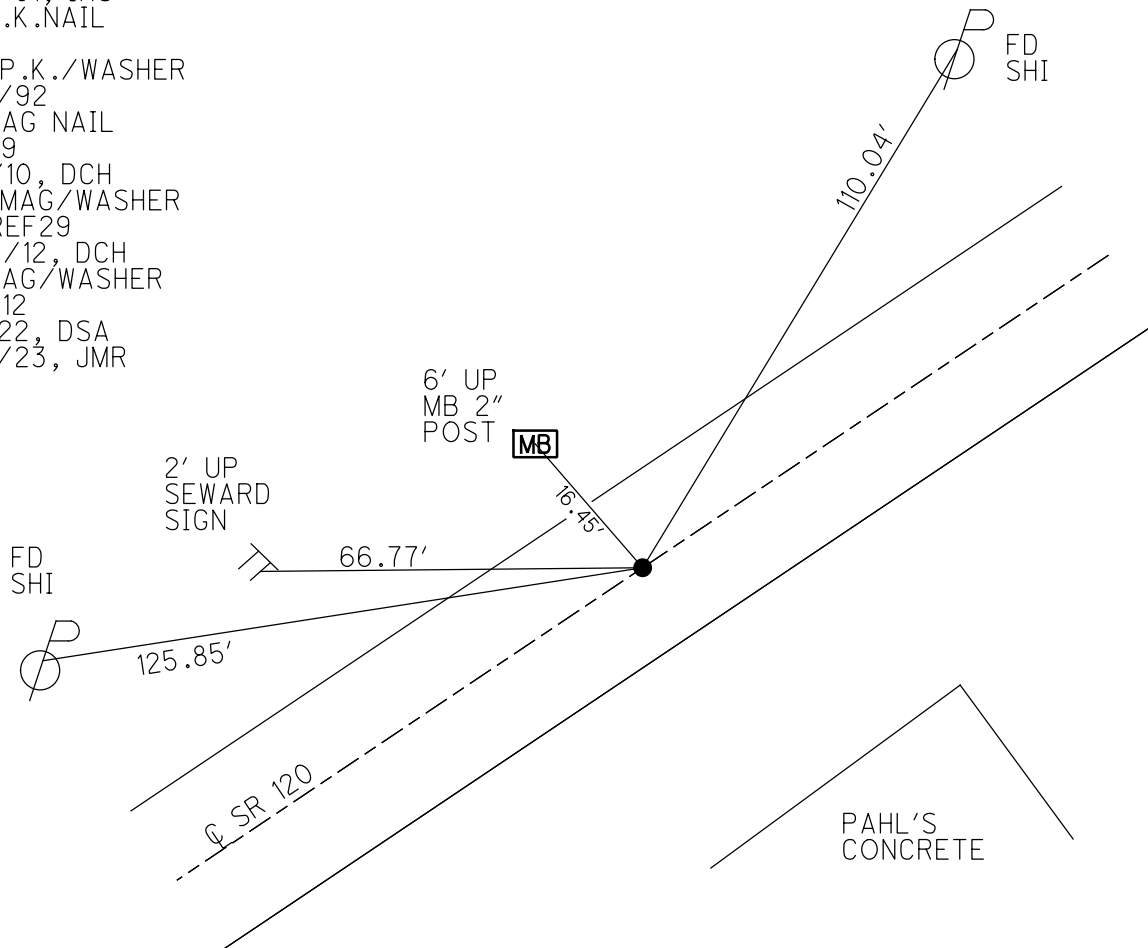

O.D.O.T. DISTRICT 2 SURVEY OFFICE (USE ONLY)


PERSONNEL _____ REFERENCE NO. 13 SHEET 34 OF 50
NOTES HOMAN DATE 5/11/12 ROUTE SR 120
H.C. ROUSOS WEATHER SUNNY COUNTY FULTON
R.C. HOMAN TEMP. 60° TOWNSHIP ROYALTON
DWG BY RHOADES PID PAVETRAIN SECTION 11
T 9 N R 3 E

TYPE MONUMENT P.K.NAIL
ON SURFACE - ~~BELOW~~ ON
OFFSET Q PAVEMENT ON LT : RT
- TO - EDGE PAVEMENT
STATION: 448+98.32

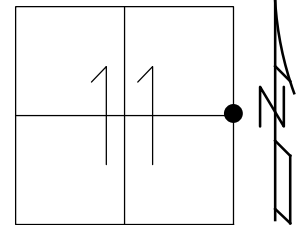

HORIZ. DATUM: NAD83 2011 GEOID: NAVD88 2018
GRID: NORTHING: 747481.874 EASTING: 1554108.960

RECORD:
FD P.K.NAIL
4/17/91, IRS
SET P.K./WASHER
3/18/92
FD P.K. NAIL
REF30
6/8/10, DCH
SET MAG/WASHER
NEWREF30
DCH
FD P.K./WASHER
REF13
3-5-8,
4-29-19, JFO
7/1/22, DSA
4/12/23, JMR

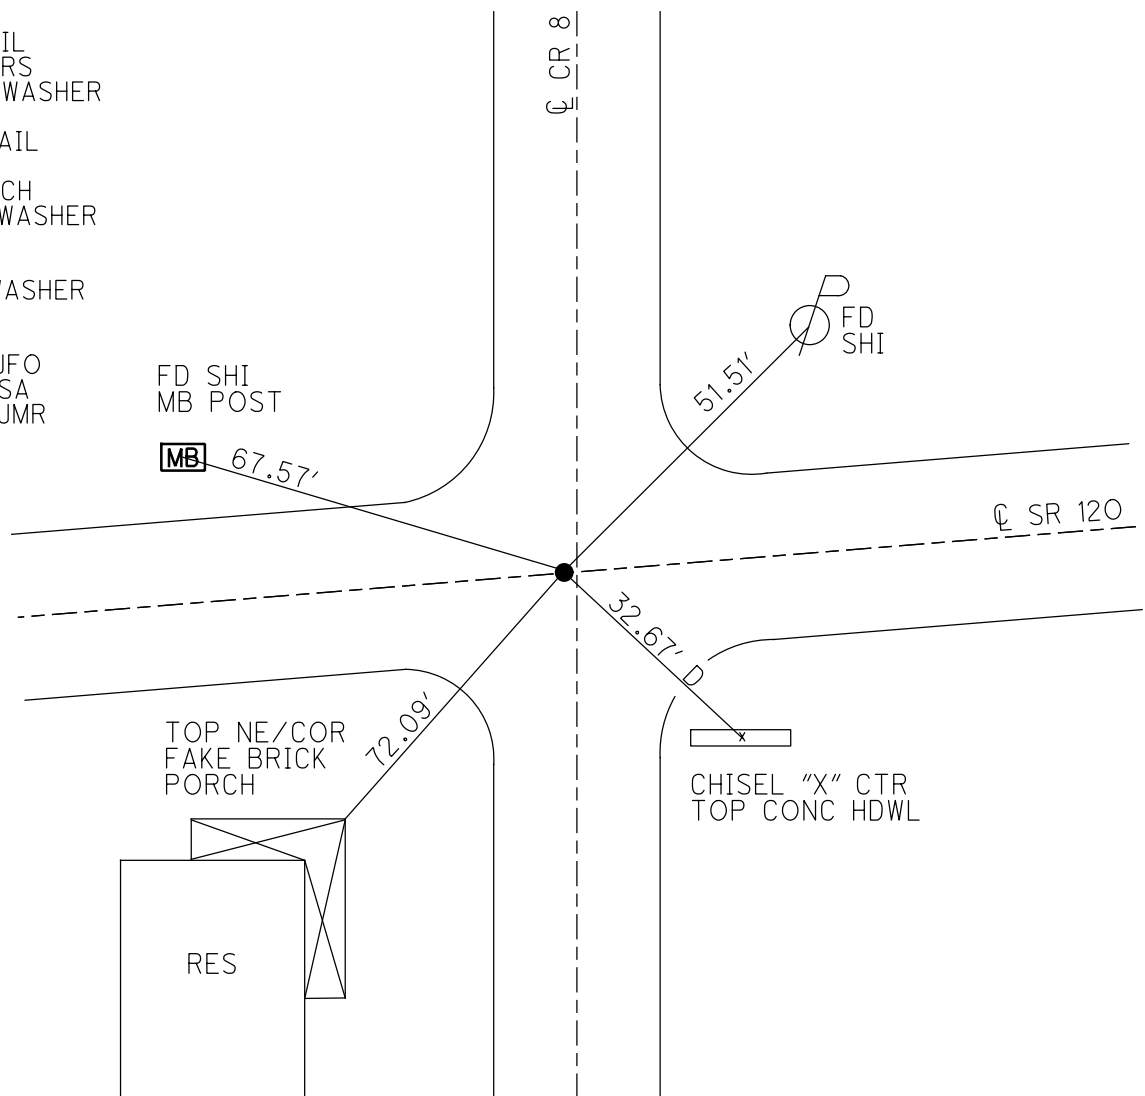

O.D.O.T. DISTRICT 2 SURVEY OFFICE (USE ONLY)

PERSONNEL

REFERENCE NO. 14

SHEET 32 OF 47

NOTES RHOADES

DATE 4/29/19

ROUTE SR 120

H.C. O'DONNELL

WEATHER RAIN

COUNTY FULTON

R.C. O'DONNELL

TEMP. 46°

TOWNSHIP ROYALTON

SECTION 12

DWG BY NASON PID 101243

T 9 N R 3 E

TYPE MONUMENT MAG/WASHER

ON SURFACE - ~~BELOW~~ ON

OFFSET Q PAVEMENT ON LT : RT

10' TO LT EDGE PAVEMENT


STATION: 501+60

HORZ.DATUM: NAD83 (2011)


GEOID: 2012A

GRID: NORTHING: 747941.840

EASTING: 1559350.479

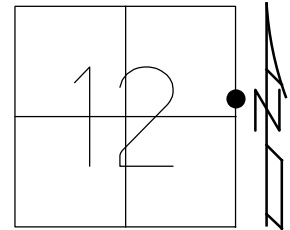

RECORD:
FD P.K./WASHER
3" DOWN
8/15/03, DCH
SET MAG/WASHER
8/15/03, DCH
FD MAG NAIL
REF31
6/8/10, DCH
FD MAG/WASHER
REF14
3/5/18, JFO
SET MAG/WASHER
7/26/19, JFO

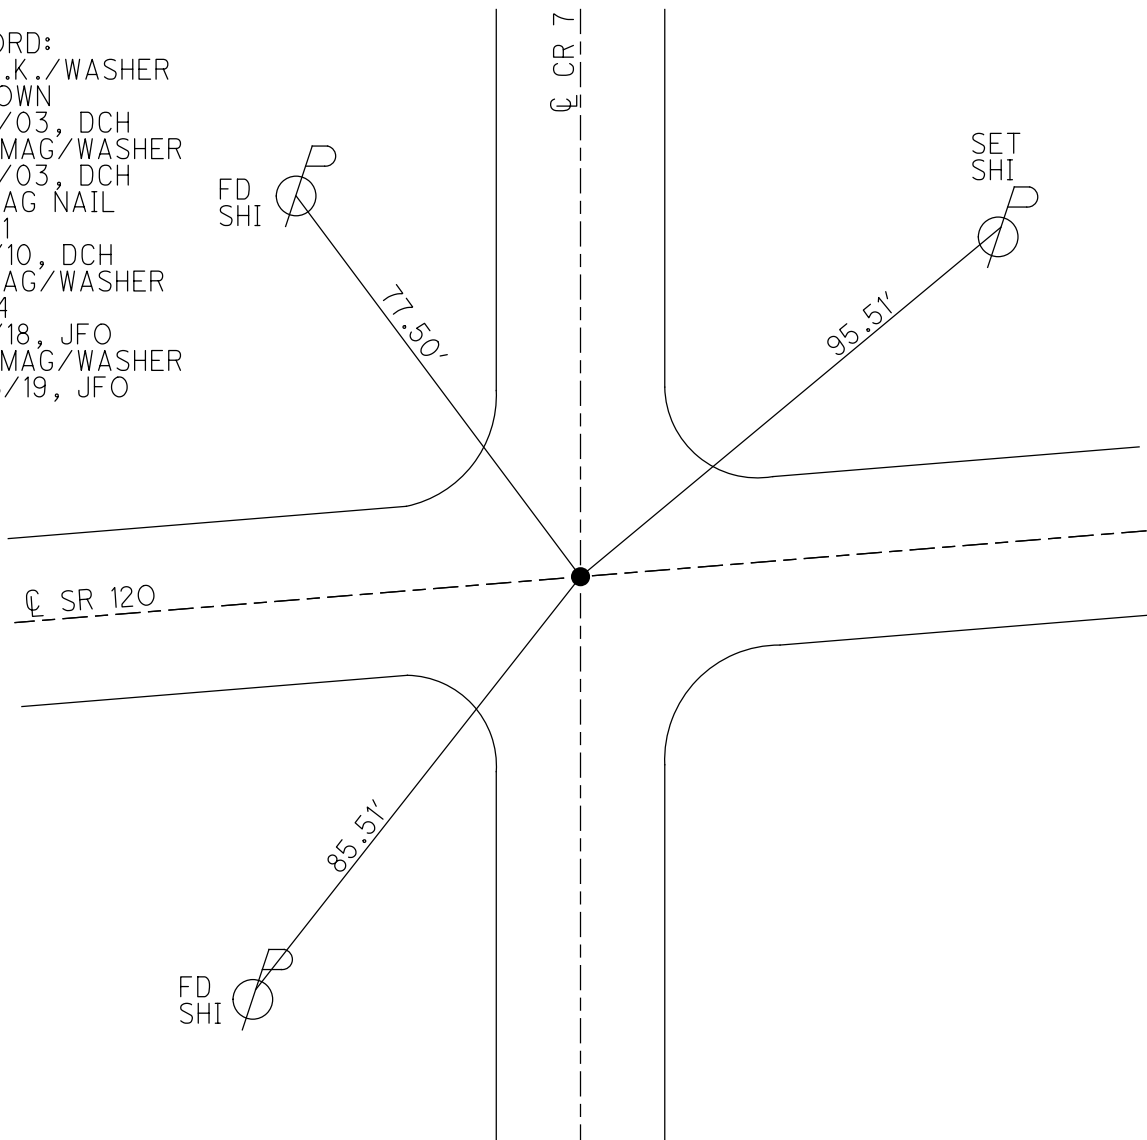

O.D.O.T. DISTRICT 2 SURVEY OFFICE (USE ONLY)

PERSONNEL

REFERENCE NO. 14 A

SHEET 33 OF 47

NOTES RHOADES

DATE 4/29/2019

ROUTE SR 120

H.C. O'DONNELL

WEATHER RAIN

COUNTY FULTON

R.C. RHOADES

TEMP. 46°

TOWNSHIP AMBOY

DWG BY NASON PID 101243

SECTION 7

T 9 N R 4 E

TYPE MONUMENT MAG/WASHER

ON SURFACE - ~~BELOW~~ ON

OFFSET CL PAVEMENT 1.6' LT : RT

8.9' TO RT EDGE PAVEMENT


STATION: 525+96.70

HORIZ.DATUM: NAD83 (2011)


GEOID: 2012A

GRID: NORTHING: 748156.407

EASTING: 1561777.717

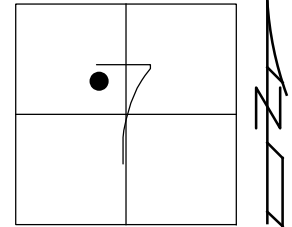

SET MAG/WASHER
8/18/03, DCH
FD MAG/WASHER
5/20/11, RJL
REF A14
5/23/11, RJL
FD MAG/WASHER
REF A14
3/5/18, JFO
SET MAG/WASHER
7/26/19, JFO

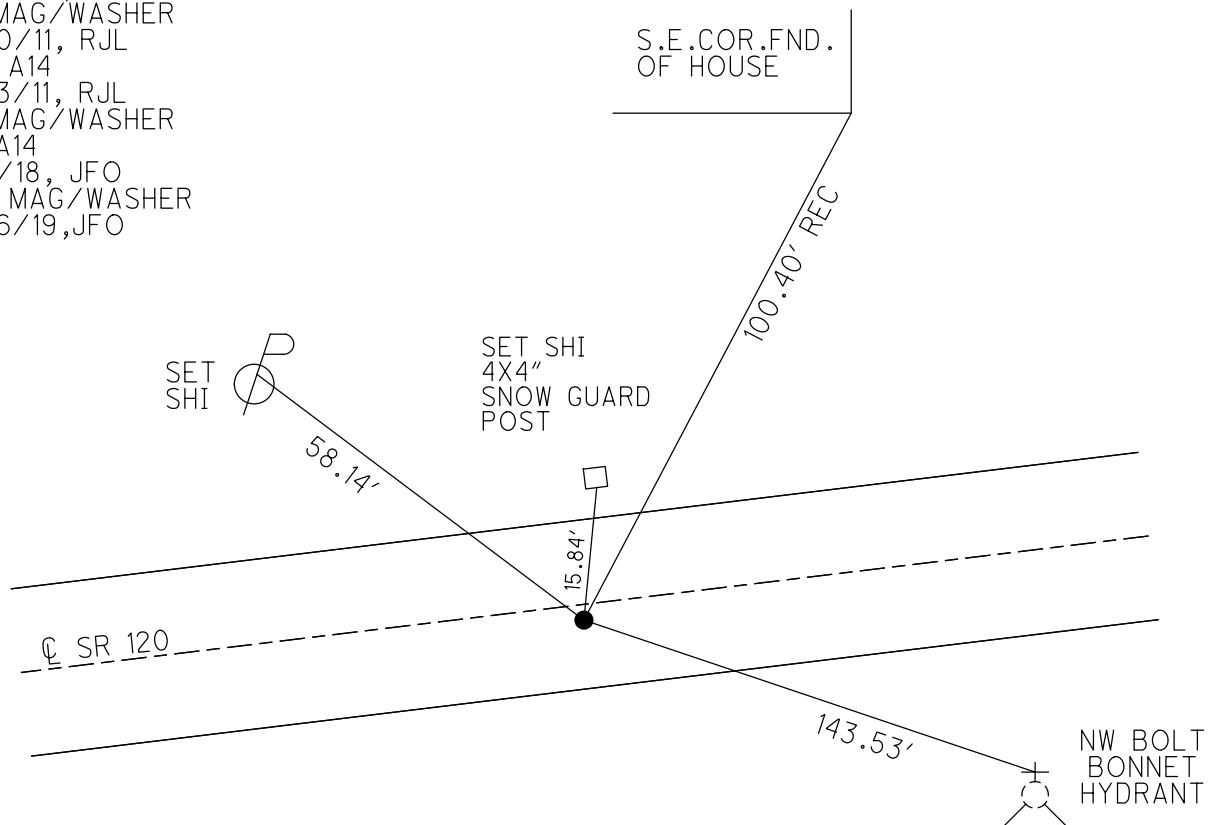

O.D.O.T. DISTRICT 2 SURVEY OFFICE (USE ONLY)

PERSONNEL

REFERENCE NO. 14 B

SHEET 34 OF 47

NOTES RHOADES

DATE 4/29/19

ROUTE SR 120

H.C. O'DONNELL

WEATHER RAIN

COUNTY FULTON

R.C. RHOADES

TEMP. 46°

TOWNSHIP AMBOY

DWG BY NASON PID 101243

SECTION 7

T 9 N R 4 E

TYPE MONUMENT MAG/WASHER

ON SURFACE - ~~BELOW~~ ON

OFFSET Q PAVEMENT ON LT : RT

10' TO LT EDGE PAVEMENT


STATION: 535+66.79

HORZ.DATUM: NAD83 (2011)


GEOID: 2012A

GRID: NORTHING: 748241.762

EASTING: 1562744.041

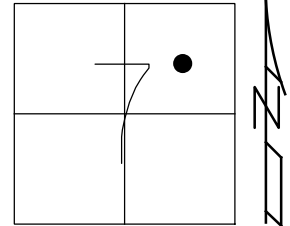

SET MAG/WASHER
8/18/03, DCH
FD MAG/WASHER
5/20/11, RJL
REF B14
5/23/11, RJL
FD MAG/WASHER
REFB14
3/5/18, JFO
SET MAG/WASHER
7/26/19, JFO

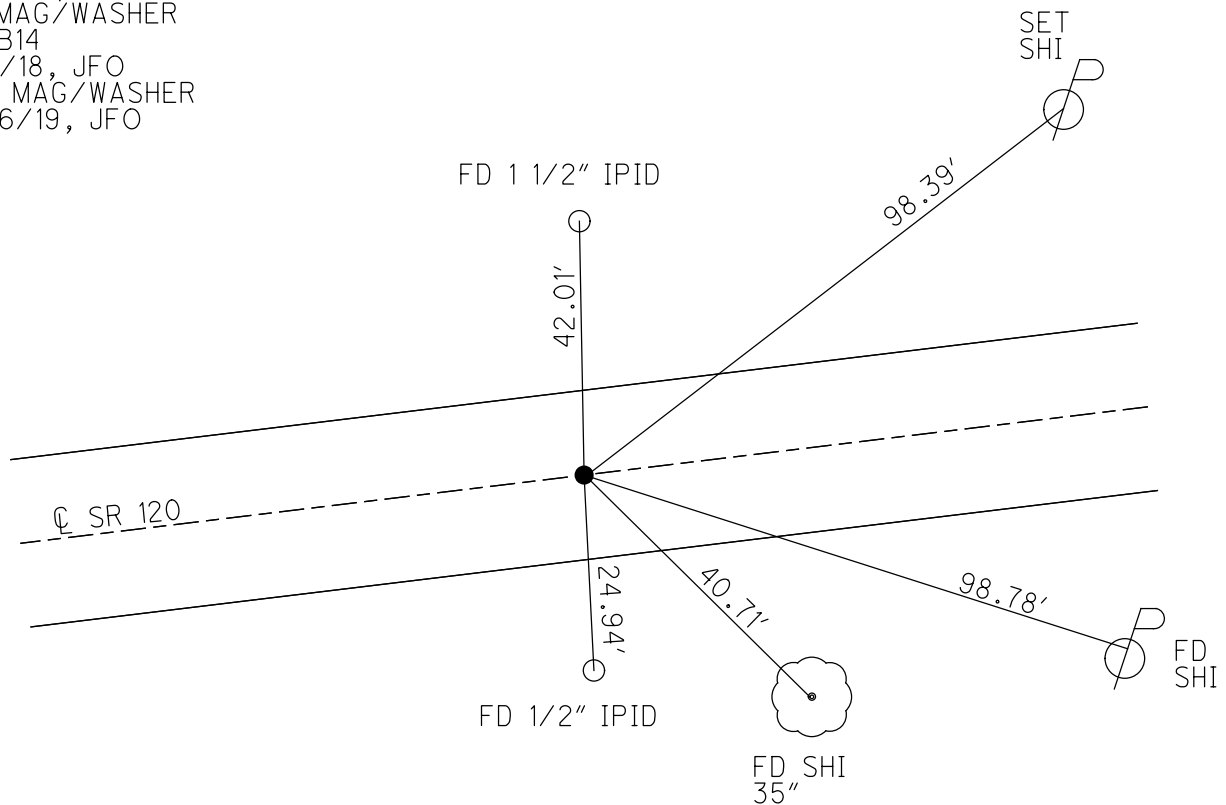

O.D.O.T. DISTRICT 2 SURVEY OFFICE (USE ONLY)

PERSONNEL

REFERENCE NO. 15

SHEET 35 OF 45

NOTES RHOADES

DATE 4/29/19

ROUTE SR 120

H.C. O'DONNELL

WEATHER CLOUDY

COUNTY FULTON

R.C. RHOADES

TEMP. 42°

TOWNSHIP AMBOY

DWG BY NASON

PID 101243

SECTION 7

T 9 N R 4 E

TYPE MONUMENT MAG/WASHER

ON SURFACE - ~~BELOW~~ ON

OFFSET CL PAVEMENT 1' LT : RT

8.8' TO LT EDGE PAVEMENT



STATION: 561+68.88

HORIZ.DATUM: NAD83 (2011)

GEOID: 2012A

GRID: NORTHING: 748474.811

EASTING: 1565335.672

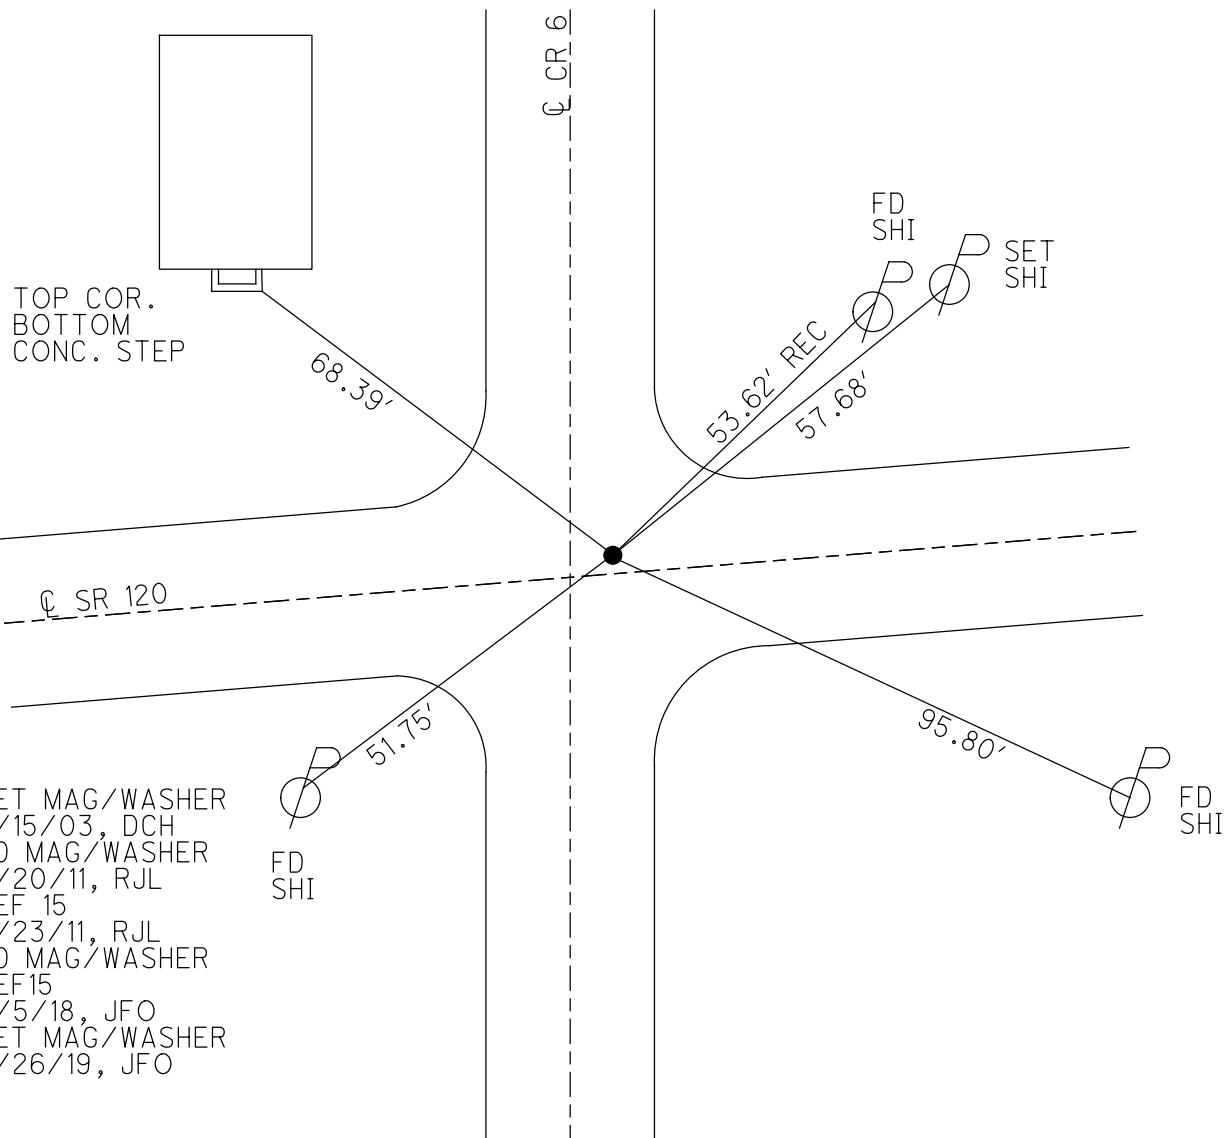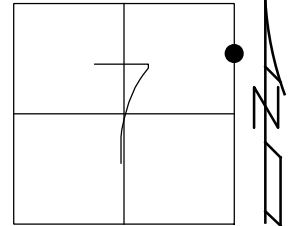

O.D.O.T. DISTRICT 2 SURVEY OFFICE (USE ONLY)

PERSONNEL

REFERENCE NO. 15 A

SHEET 36 OF 47

NOTES RHOADES

DATE 4/29/19

ROUTE SR 120

H.C. O'DONNELL

WEATHER CLOUDY

COUNTY FULTON

R.C. RHOADES

TEMP. 42°

TOWNSHIP AMBOY

DWG BY NASON

PID 101243

SECTION 8

T 9 N R 4 E

TYPE MONUMENT MAG/WASHER

ON SURFACE - ~~BELOW~~ ON

OFFSET 0.4' LT : ~~RT~~

10' TO LT EDGE PAVEMENT



STATION: 574+83.2

HORZ.DATUM: NAD83 (2011)

GEOID: 2012A

GRID: NORTHING: 74859.333

EASTING: 1566644.668

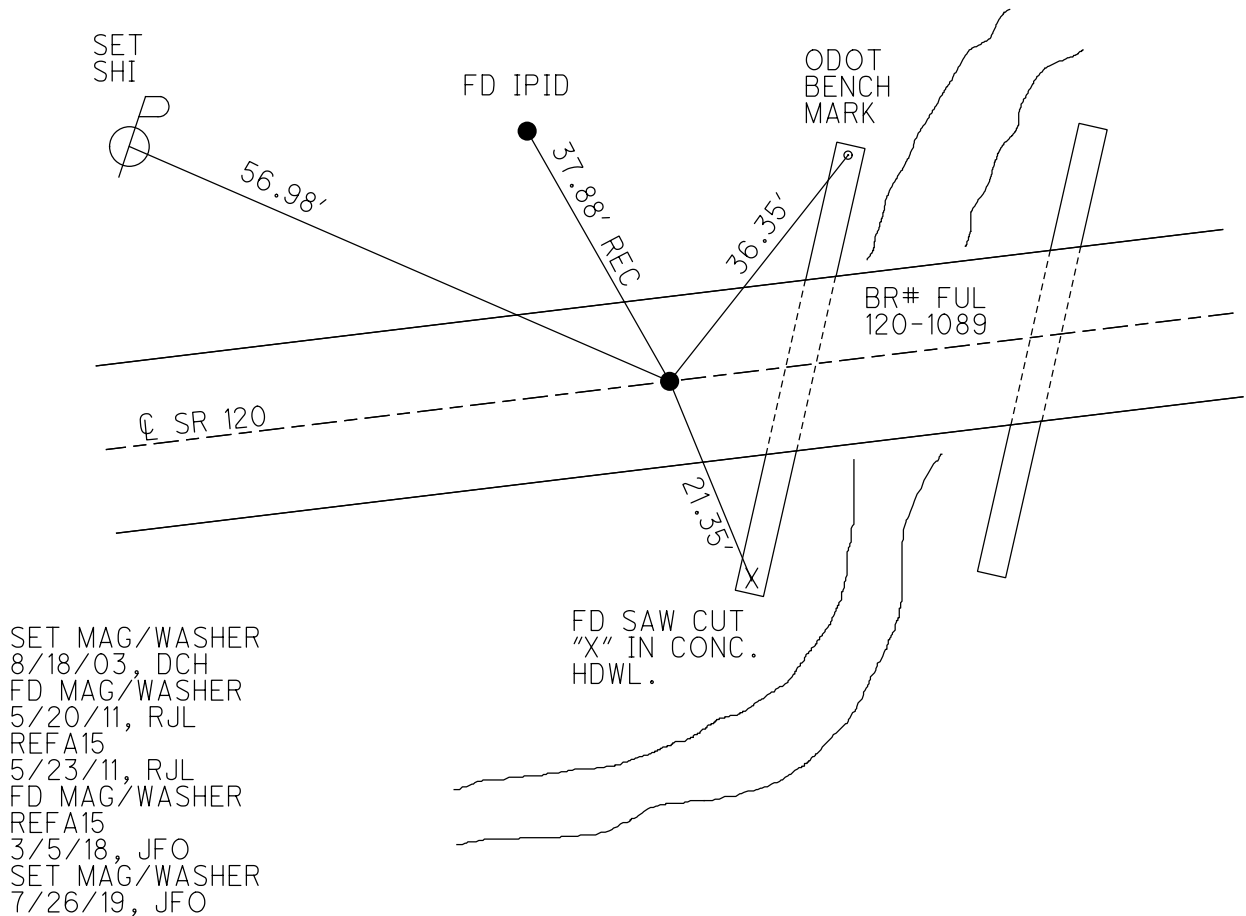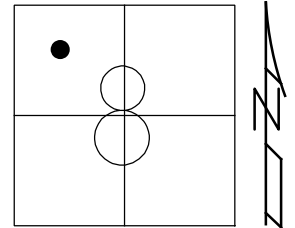

SET MAG/WASHER
8/18/03, DCH
FD MAG/WASHER
5/20/11, RJL
REFA15
5/23/11, RJL
FD MAG/WASHER
REFA15
3/5/18, JFO
SET MAG/WASHER
7/26/19, JFO

O.D.O.T. DISTRICT 2 SURVEY OFFICE (USE ONLY)

PERSONNEL

REFERENCE NO. 15 B

SHEET 37 OF 47

NOTES RHOADES

DATE 4/29/19

ROUTE SR 120

H.C. O'DONNELL

WEATHER CLOUDY

COUNTY FULTON

R.C. RHOADES

TEMP. 42°

TOWNSHIP AMBOY

DWG BY NASON

PID 101243

SECTION 8

T 9 N R 4 E

TYPE MONUMENT MAG/WASHER

ON SURFACE - ~~BELOW~~ ON

OFFSET CL PAVEMENT 1.2' ~~LT~~ : RT

8.9' TO RT EDGE PAVEMENT


STATION: 586+09.99

HORIZ.DATUM: NAD83(2011)


GEOID: 2012A

GRID: NORTHING: 748692.913

EASTING: 1567767.024

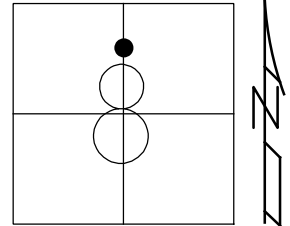

FD MAG/WASHER
5/20/11, RJL
REFB15
5/23/11, RJL
FD MAG/WASHER
REFB15
3/5/19, JFO
SET MAG/WASHER
7/26/19

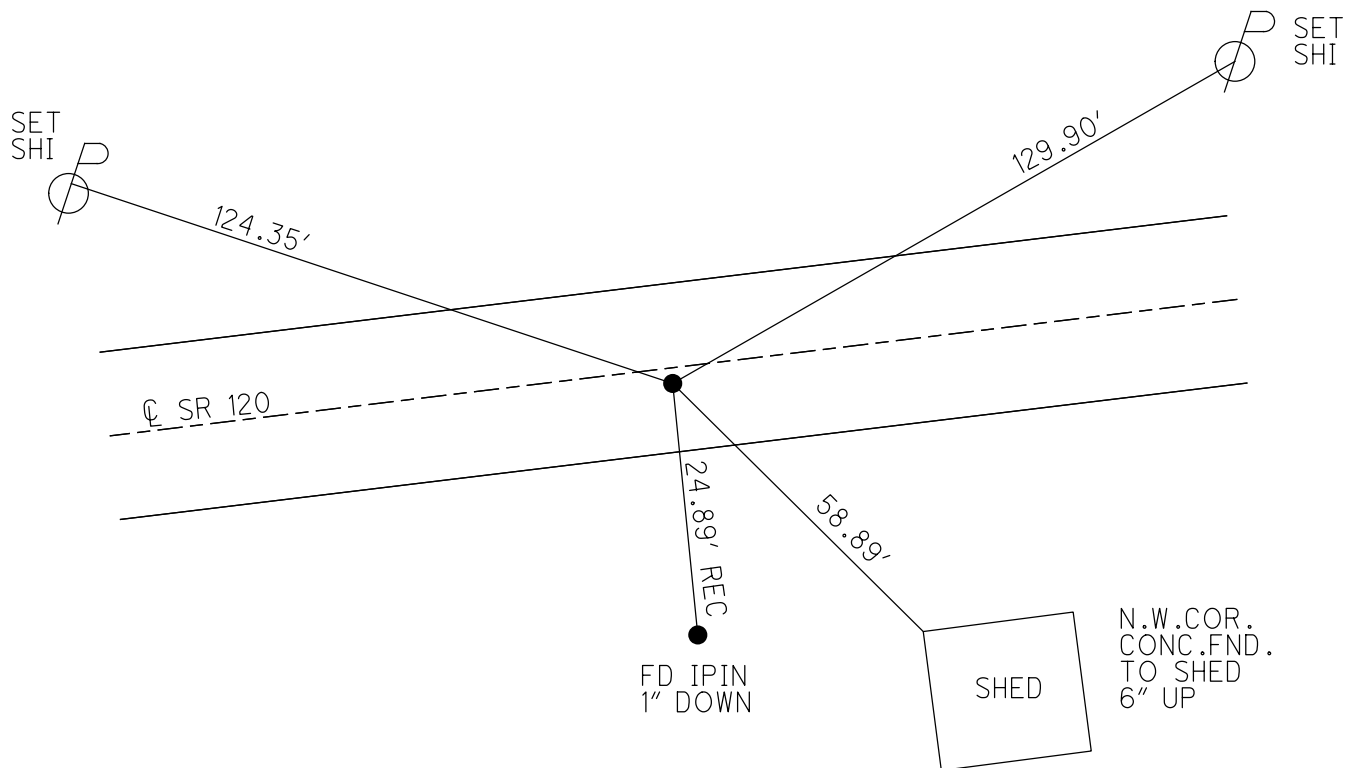

O.D.O.T. DISTRICT 2 SURVEY OFFICE (USE ONLY)

PERSONNEL

REFERENCE NO. 15 C

SHEET 38 OF 47

NOTES RHOADES
H.C. O'DONNELL
R.C. RHOADES

DATE 5/2/19
WEATHER CLOUDY
TEMP. 53°

ROUTE SR 120
COUNTY FULTON
TOWNSHIP AMBOY
SECTION 8
T 9 N R 4 E

DWG BY NASON PID 101243

TYPE MONUMENT MAG/WASHER


ON SURFACE - ~~BELOW~~ ON

OFFSET CL PAVEMENT 3.4' LT : ~~RT~~
6.8' TO LT EDGE PAVEMENT


STATION: 604+17.08

HORZ.DATUM: NAD83 (2011) GEOID: 2012A

GRID: NORTHING: 748854.745 EASTING: 1569566.852

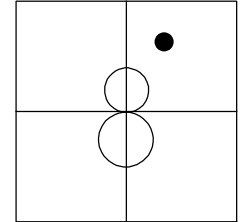

SET MAG/WASHER
8/18/03, DCH
FD MAG/WASHER
5/20/11, RJL
REFC15
5/23/11, RJL
FD MAG/WASHER
REFC15
3/5/18, JFO

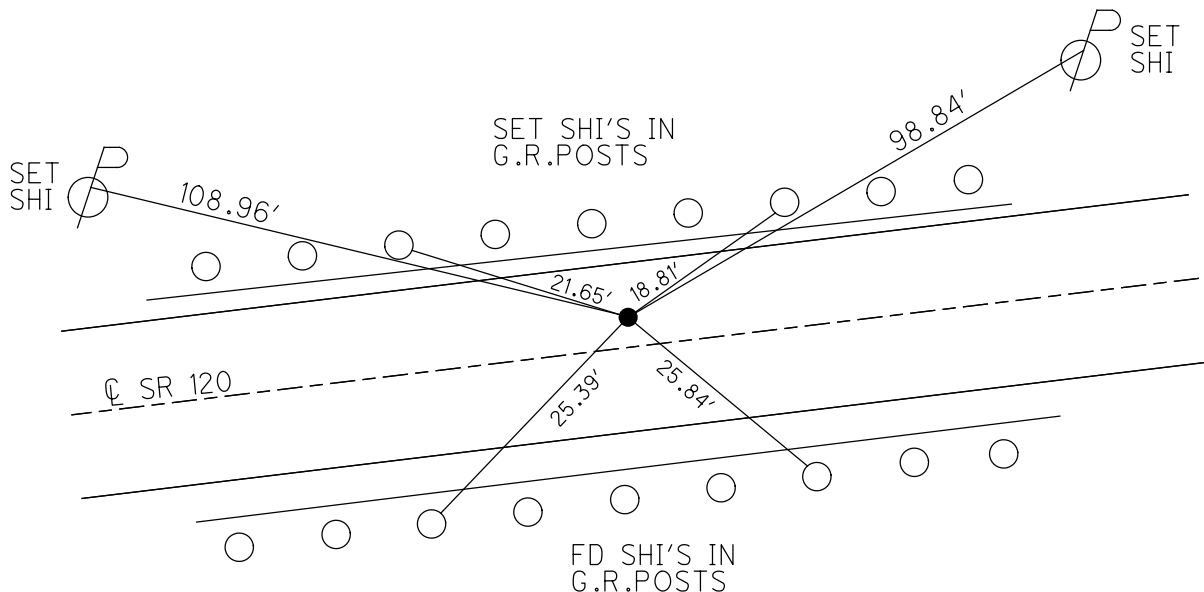

O.D.O.T. DISTRICT 2 SURVEY OFFICE (USE ONLY)

PERSONNEL

REFERENCE NO. 15 D

SHEET 39 OF 47

NOTES FINGER

DATE 5/20/11

ROUTE SR 120

H.C. LUMBREZER

WEATHER CLOUDY

COUNTY FULTON

R.C. MOSER

TEMP. 65°

TOWNSHIP AMBOY

DWG BY NASON PID 101243

SECTION 8

T 9 N R 4 E

TYPE MONUMENT D.N.F. R.R.SPIKE

~~ON SURFACE~~ - BELOW 6"

OFFSET $\varnothing$ PAVEMENT _____ LT : RT

_____ TO _____ EDGE PAVEMENT


STATION: 608+76.84

HORZ.DATUM: NAD83 (2011)


GEOID: 2012A

GRID: NORTHING: 748907.472

EASTING: 1570026.547

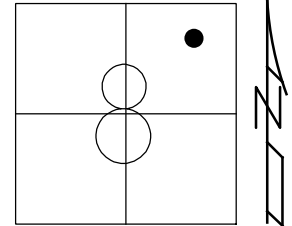

RECORD: 1991
FD R.R.SPIKE
6" DOWN
459.76' TO REF 15B
D.N.F.
CALC.POINT USED
3/5/18, JFO

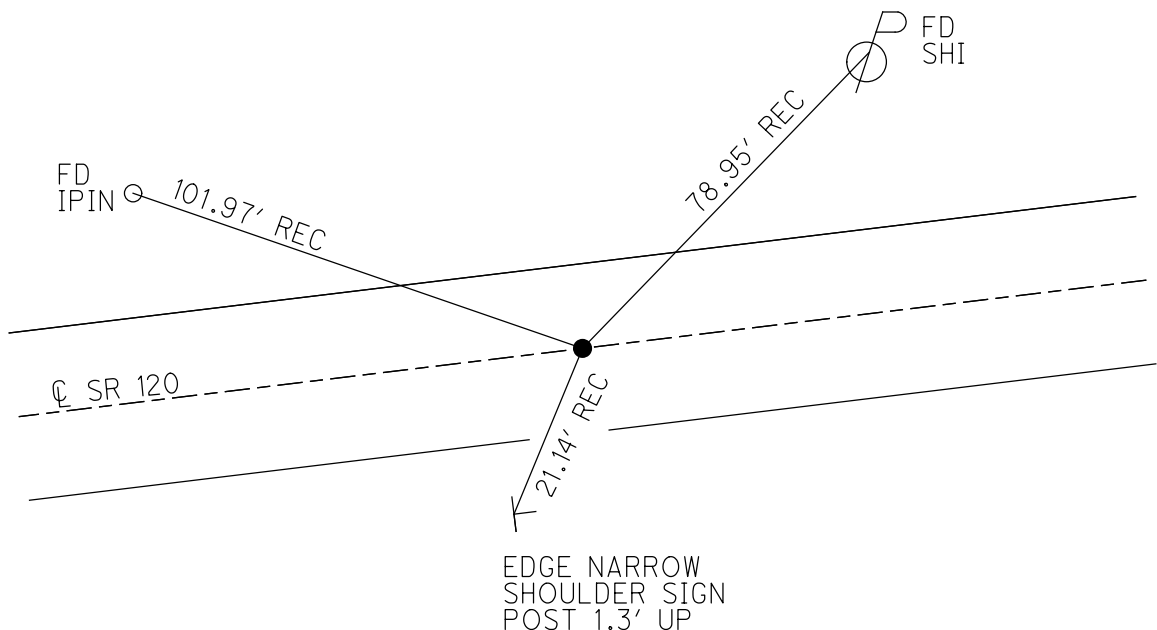

O.D.O.T. DISTRICT 2 SURVEY OFFICE (USE ONLY)

PERSONNEL

REFERENCE NO. 16

SHEET 40 OF 47

NOTES RHOADES

DATE 5/2/19

ROUTE SR 120

H.C. O'DONNELL

WEATHER CLOUDY

COUNTY FULTONR.C. RHOADES

TEMP. 54°

TOWNSHIP AMBOYSECTION 8

T_9_N R_4_E

DWG BY NASON

PID 101243

TYPE MONUMENT MAG/WASHER

ON SURFACE - ~~BELOW~~ ON

OFFSET C PAVEMENT 1.0' LT : RT


11.2" TO RT EDGE PAVEMENT

STATION: 614+08.91


HORZ.DATUM: NAD83 (2011)

GEOID: 2012A

GRID: NORTHING: 748907.864

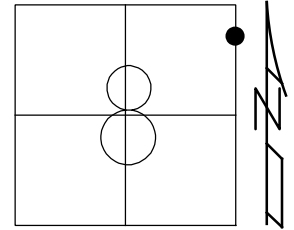EASTING:1570556.673

SET MAG/WASHER
8/18/03, DCH
FD MAG/WASHER
5/20/11, RJL
REF 16
5/23/11, RJL
FD MAG/WASHER
REF 16
3/5/18, JFO
SET MAG/WASHER
7/26/19

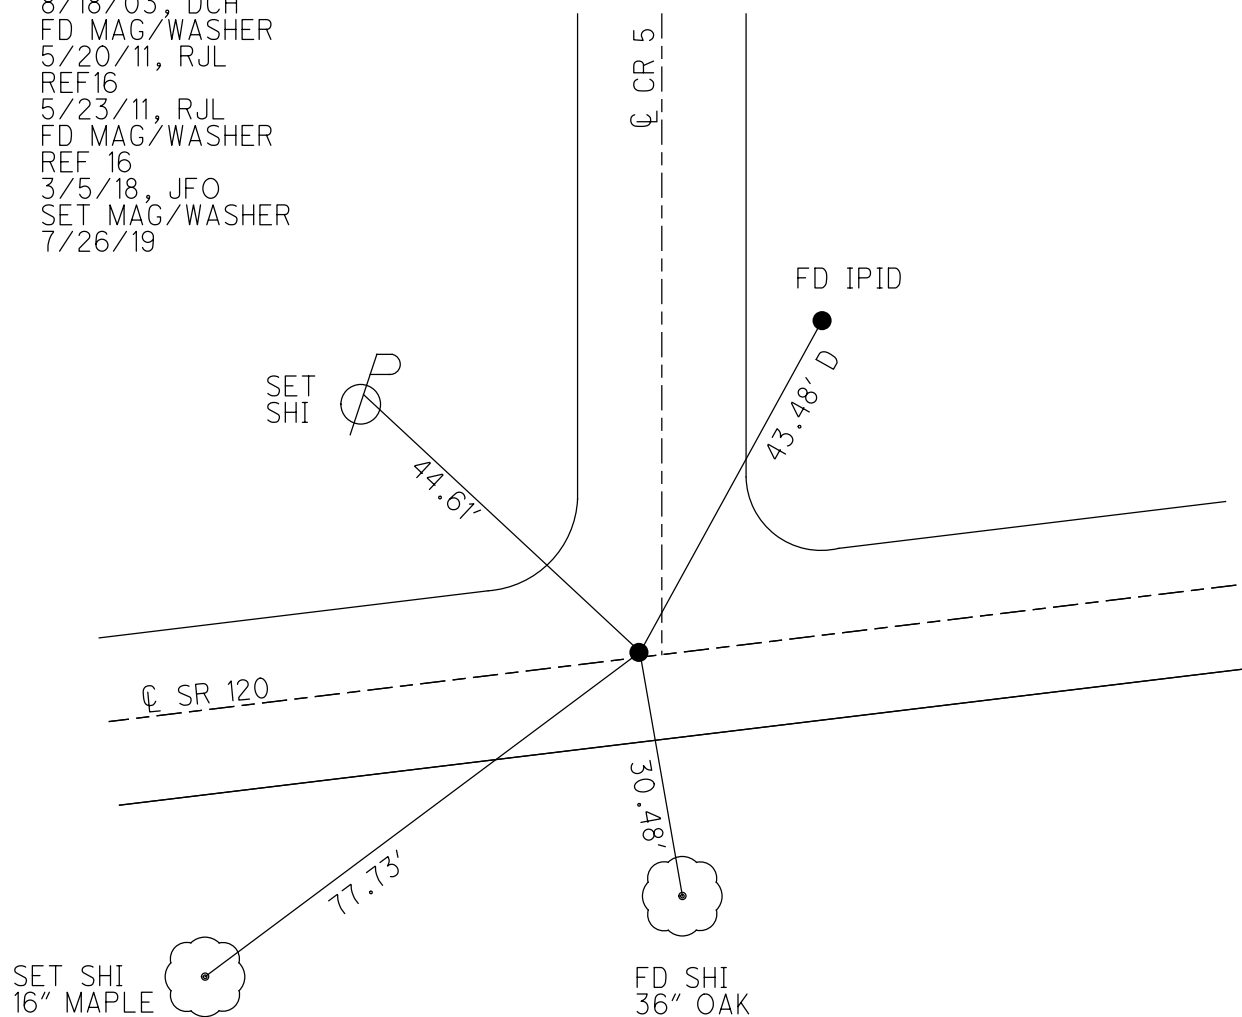

O.D.O.T. DISTRICT 2 SURVEY OFFICE (USE ONLY)

PERSONNEL

REFERENCE NO. 16 A

SHEET 41 OF 47

NOTES O'DONNELL

DATE 4/29/19

ROUTE SR 120

H.C. RHOADES

WEATHER CLOUDY

COUNTY FULTON

R.C. O'DONNELL

TEMP. 47°

TOWNSHIP AMBOY

DWG BY NASON PID 101243

SECTION 9

T 9 N R 4 E

TYPE MONUMENT P.K. NAIL

ON SURFACE - ~~BELOW~~ ON

OFFSET CL PAVEMENT 0.8' LT : ~~RT~~

9.4' TO LT EDGE PAVEMENT


STATION: 641+01.17

HORZ.DATUM: NAD83 (2011)


GEOID: 2012A

GRID: NORTHING: 749146.674

EASTING: 1573238.326

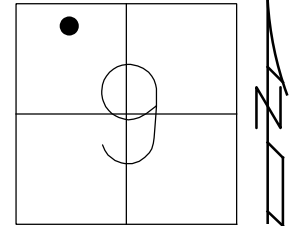

FD P.K.NAIL
5/20/11, RJL
REF A17
5/23/11, RJL
FD P.K. NAIL
REFA16
3/5/18, JFO
SET MAG/WASHER
8/7/19, JFO

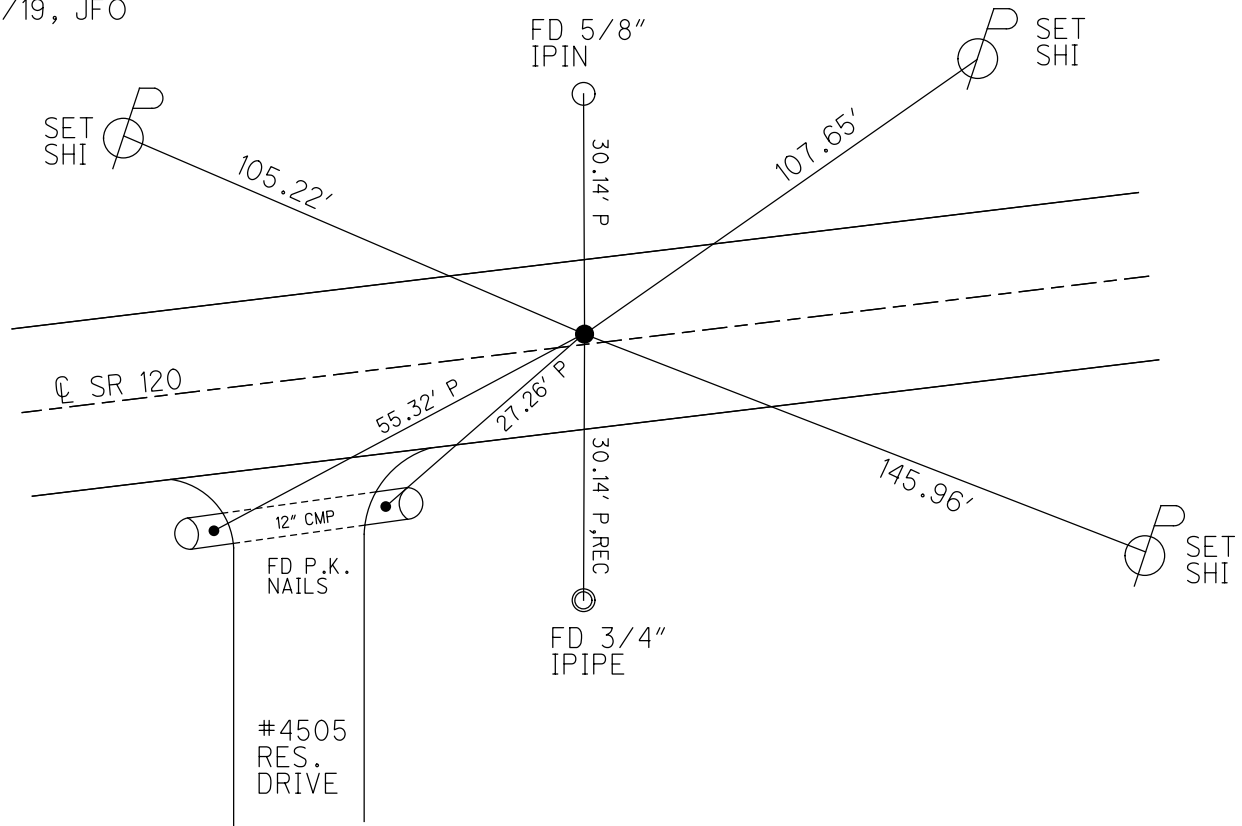

O.D.O.T. DISTRICT 2 SURVEY OFFICE (USE ONLY)

PERSONNEL

REFERENCE NO. 17

SHEET 45 OF 50

NOTES PRESTON-COLVIN

DATE 6/5/24

ROUTE SR 120

H.C. ASTON

WEATHER WINDY

COUNTY FULTON

R.C. NIESE

TEMP. 75°

TOWNSHIP AMBOY

SECTION 9

DWG BY PID PAVETRAIN

T 9 N R 4 E

TYPE MONUMENT MAG/WASHER

ON SURFACE - ~~BELOW~~ ON

OFFSET Q PAVEMENT ON LT : RT

10.1' TO LT EDGE PAVEMENT


STATION: 654+46.89

HORZ.DATUM: NAD83 (2011)


GEOID: 2012A

GRID: NORTHING: 749264.529

EASTING: 1574578.869

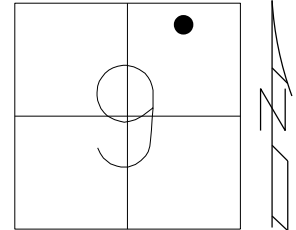

SET MAG/WASHER
8/18/03, DCH
FD MAG/WASHER
5/20/11, RJL
REF 17
5/20/11, RJL
FD MAG/WASHER
REF17
3/5/18, JFO
SET MAG/WASHER
8/7/19, JFO
FD MAG/W
NEW REF 17
6/5/24, TDN
FD MAG/W
6/23/25, TDN

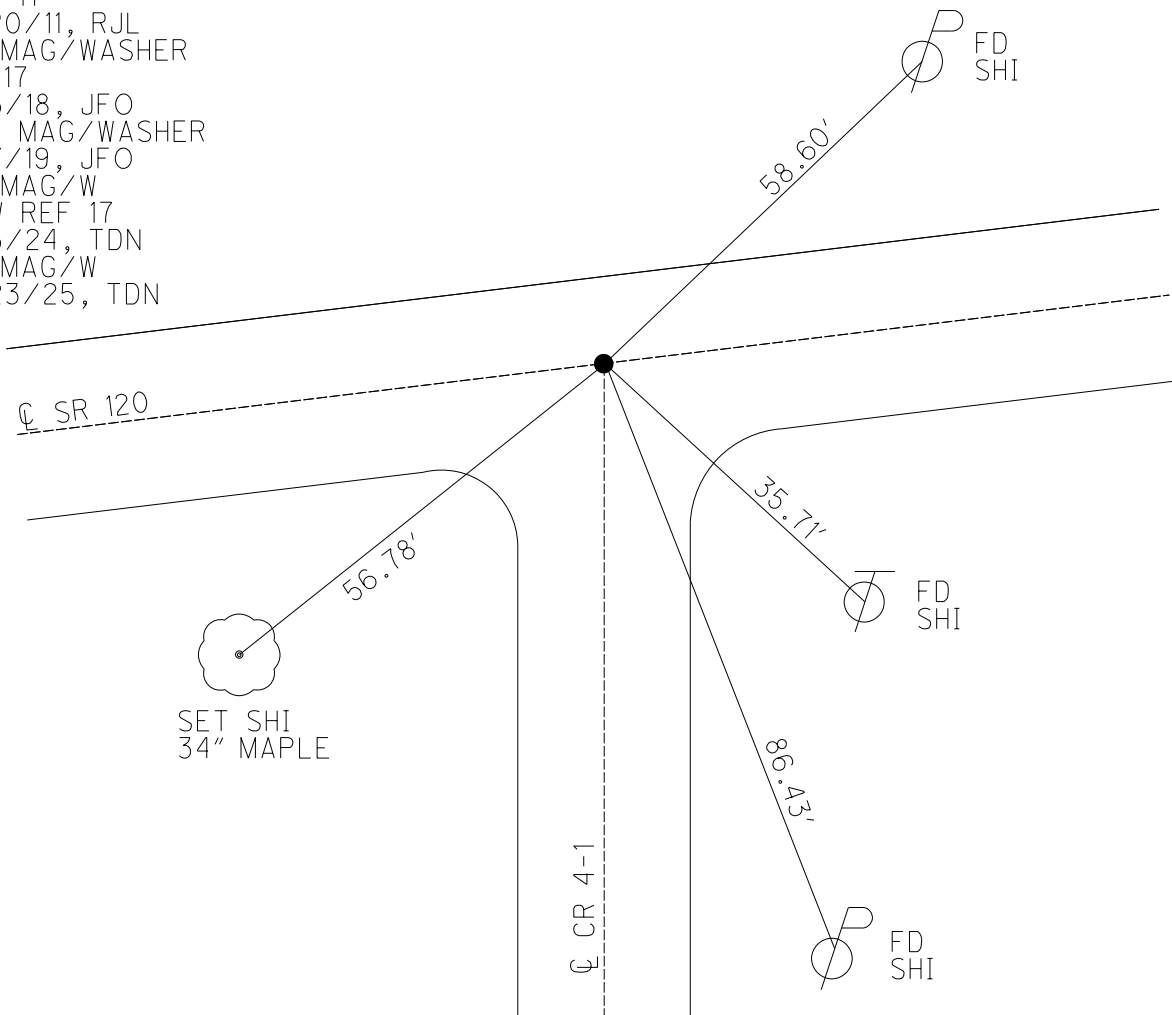

O.D.O.T. DISTRICT 2 SURVEY OFFICE (USE ONLY)

PERSONNEL

REFERENCE NO. 17 A

SHEET 43 OF 47

NOTES RHOADES

DATE 3/5/18

ROUTE SR 120

H.C. O'DONNELL

WEATHER

COUNTY FULTON

R.C. SEAMAN

TEMP.

TOWNSHIP AMBOY

DWG BY NASON

PID 101234

SECTION 9

T 9 N R 4 E

TYPE MONUMENT MONBOX

ON SURFACE - ~~BELOW~~ ON

OFFSET Q PAVEMENT 1.5' LT : ~~RT~~

TO EDGE PAVEMENT


STATION: 663+44.89

HORIZ.DATUM: NAD83 (2011)


GEOID: 2012A

GRID: NORTHING: 749266.182

EASTING: 1575470.228

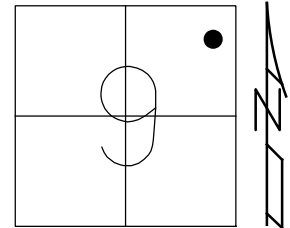

RECORD:
POINT USED IN PROJECT
"PUMP STATION" PID 88419
BY: NORTHWEST CONSULTANTS
5/2/12
FD EMPTY MONBOX
SHOT CENTER
REFA17
3/6/18
FD MONBOX COVERED
W/3" ASPHALT
8/7/19, JFO
STAKED OUT CALC.
PNT SET MAG NAIL
CALCA17
8/17/19, JFO

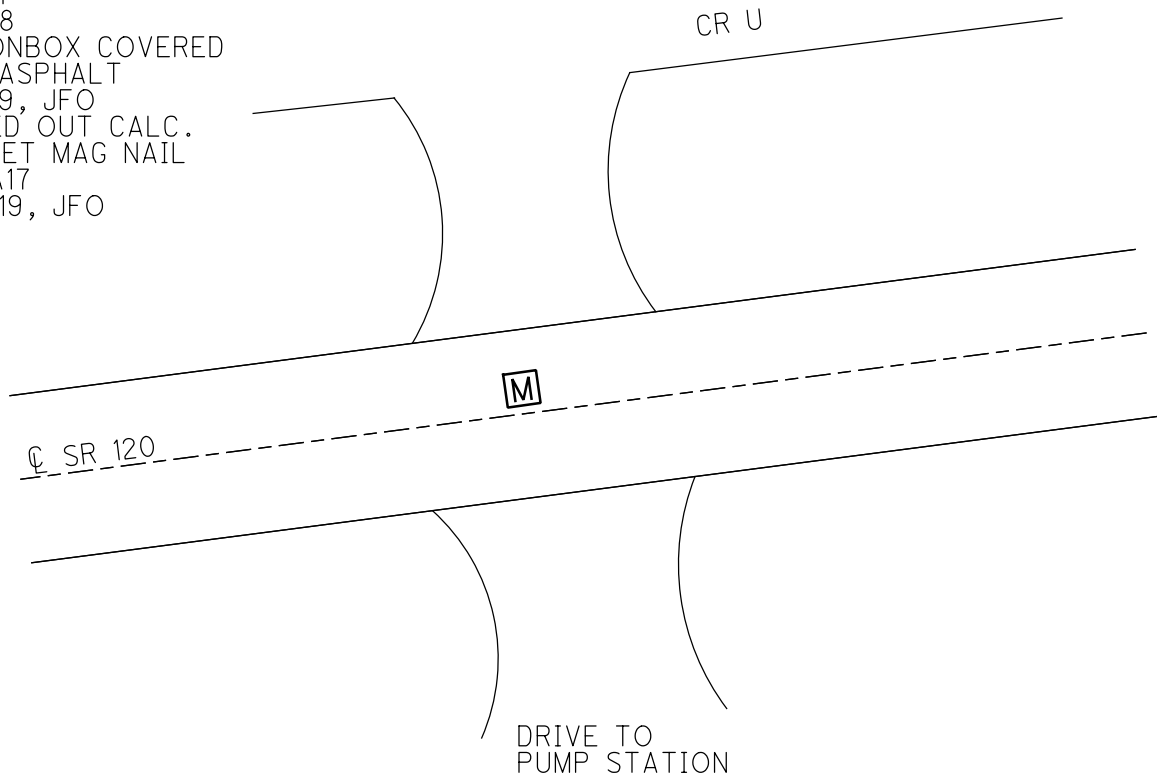

O.D.O.T. DISTRICT 2 SURVEY OFFICE (USE ONLY)

PERSONNEL

REFERENCE NO. 17 B

SHEET 44 OF 47

NOTES RHOADES
H.C. O'DONNELL
R.C. SEAMAN

DATE 3/5/18
WEATHER _____
TEMP. _____

ROUTE SR 120
COUNTY FULTON
TOWNSHIP AMBOY
SECTION 10
T 9 N R 4 E

DWG BY NASON PID 101243

TYPE MONUMENT MONBOX


ON SURFACE - ~~BELOW~~ ON

OFFSET $\varnothing$ PAVEMENT 3' LT : ~~RT~~
TO EDGE PAVEMENT


STATION: 668+05.25

HORZ.DATUM: NAD83 (2011) GEOID: 2012A

GRID: NORTHING: 749306.737 EASTING: 1575928.838

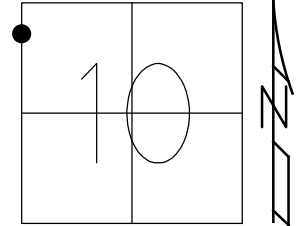

RECORD:
POINT USED IN PROJECT
"PUMP STATION" PID 88419
BY: NORTHWEST CONSULTANTS
5/2/12
FD EMPTY MONBOX
SHOT CENTER
REF B17
3/6/18, JFO
FD MONBOX
8/7/19, JFO

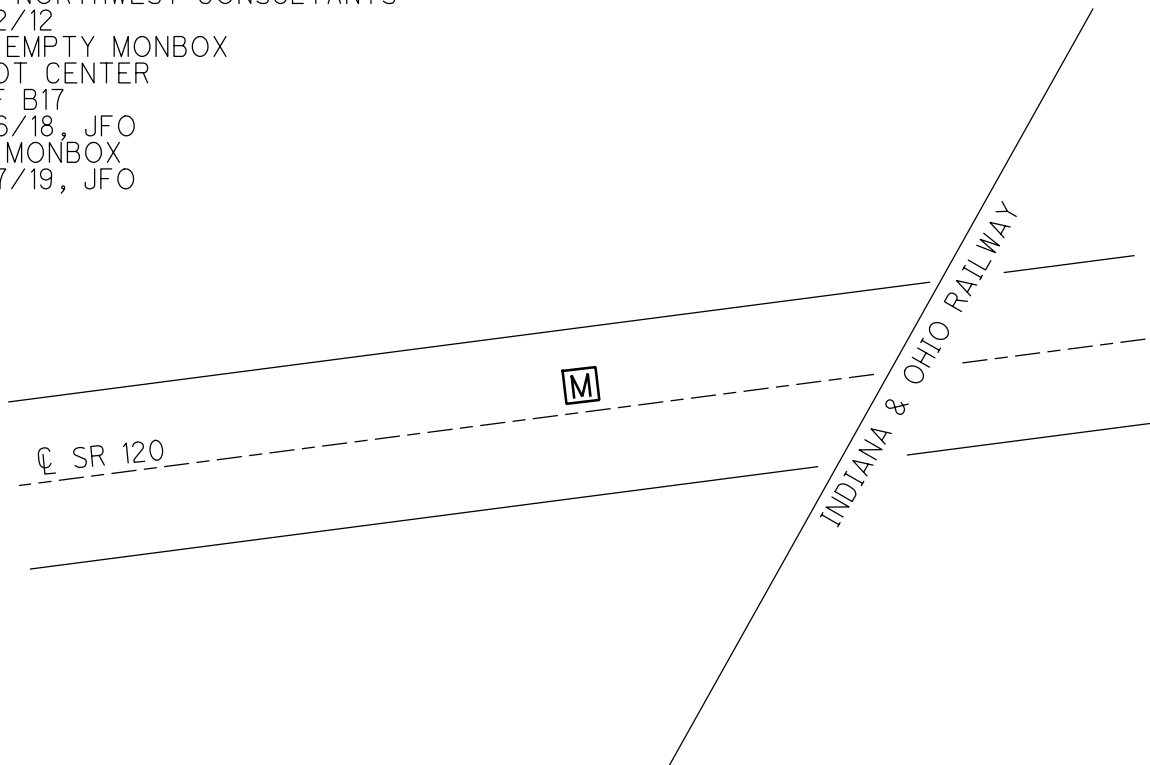

O.D.O.T. DISTRICT 2 SURVEY OFFICE (USE ONLY)

PERSONNEL

REFERENCE NO. 18

SHEET 45 OF 47

NOTES RHOADES

DATE 4/29/19

ROUTE SR 120

H.C. O'DONNELL

WEATHER CLOUDY

COUNTY FULTON

R.C. RHOADES

TEMP. 47°

TOWNSHIP AMBOY

SECTION 10

DWG BY NASON PID 101243

T 9 N R 4 E

TYPE MONUMENT MAG/WASHER

ON SURFACE - ~~BELOW~~ ON

OFFSET Q PAVEMENT 3' LT : ~~RT~~

7.4' TO LT EDGE PAVEMENT


STATION: 694+39.04

HORZ.DATUM: NAD83(2011)


GEOID: 2012A

GRID: NORTHING: 749505.684

EASTING: 1578544.312

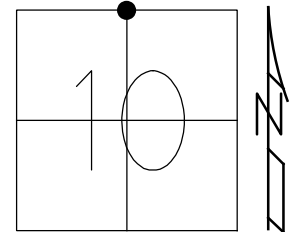

SET MAG/WASHER
8/18/03, DCH
FD MAG/WASHER
5/20/11, RJL
REF 18
5/20/11, RJL
FD MAG/WASHER
REF18
3/5/18, JFO
SET MAG/WASHER
8/7/19, JFO

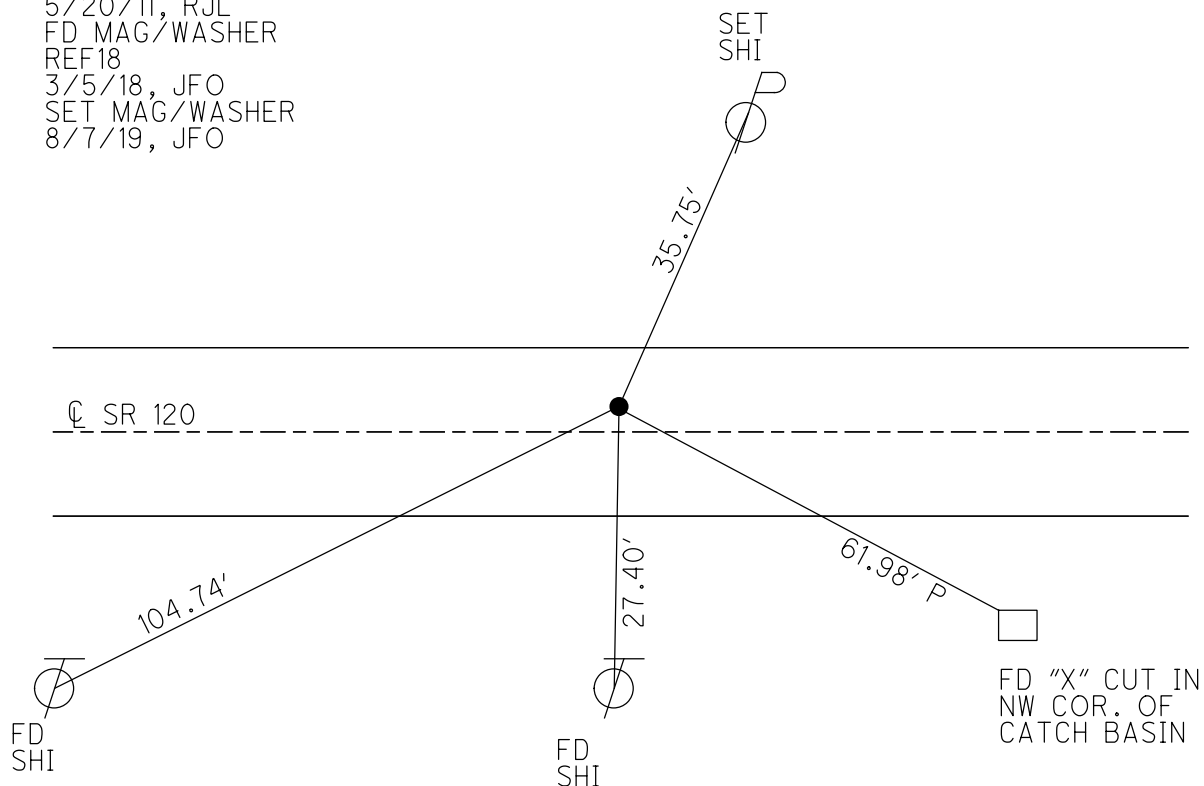

O.D.O.T. DISTRICT 2 SURVEY OFFICE (USE ONLY)

PERSONNEL

REFERENCE NO. 19

SHEET 46 OF 47

NOTES RHOADES

DATE 6/23/21

ROUTE SR 120

H.C. AUBLE

WEATHER CLOUDY

COUNTY FULTON

R.C. NIESH

TEMP. 63°

TOWNSHIP AMBOY

DWG BY RHOADES

PID 101213

SECTION 11

T 9 N R 4 E

TYPE MONUMENT MONBOX W/ 1" IPIN

ON SURFACE - ~~BELOW~~ ON

OFFSET Q PAVEMENT 2' ~~LT~~ : RT

- TO - EDGE PAVEMENT


STATION: 721+28.80

HORIZ.DATUM: NAD83 (2011)


GEOID: 2012A

GRID: NORTHING: 749064.958

EASTING: 1581163.965

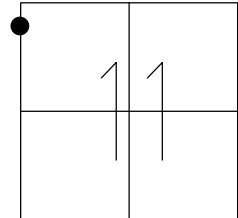

FD MONBOX
W/"X" ON LID
REF19
3/5/18, JFO
FD MONBOX
W/1" IPIN
REF19
6/23/21, DSA

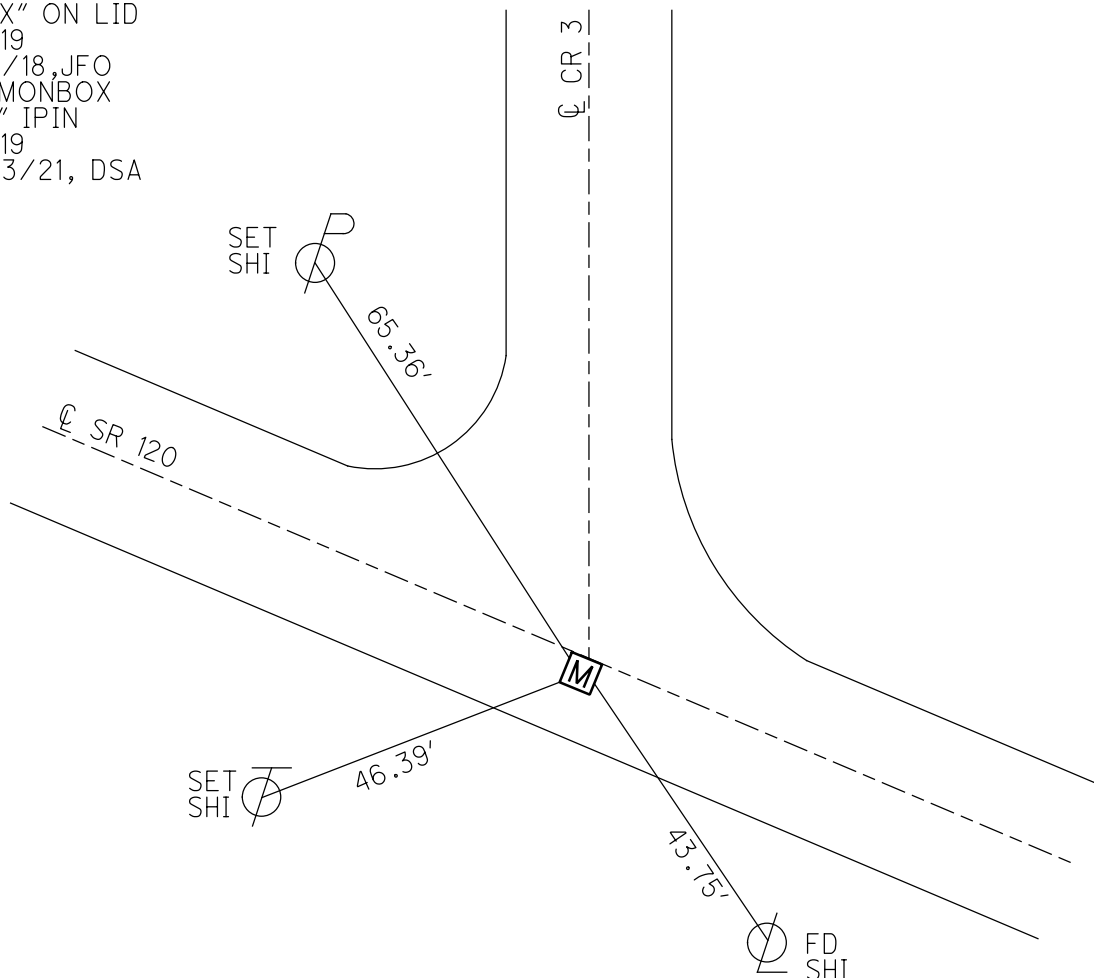

O.D.O.T. DISTRICT 2 SURVEY OFFICE (USE ONLY)

PERSONNEL

REFERENCE NO. 20

SHEET 47 OF 47

NOTES RHOADES

DATE 6/23/21

ROUTE SR 120

H.C. AUBLE

WEATHER CLOUDY

COUNTY FULTON

R.C. NIESH

TEMP. 63°

TOWNSHIP AMBOY

DWG BY RHOADES PID 101213

SECTION 11

T 9 N R 4 E

TYPE MONUMENT MONBOX W/ 1" IPIN

ON SURFACE - ~~BELOW~~ ON

OFFSET Q PAVEMENT 2.6' ~~LT~~ : RT

- TO - EDGE PAVEMENT



STATION: 735+33.37

HORZ.DATUM: NAD83 (2011)

GEOID: 2012A


GRID: NORTHING: 748569.372

EASTING: 1582478.112

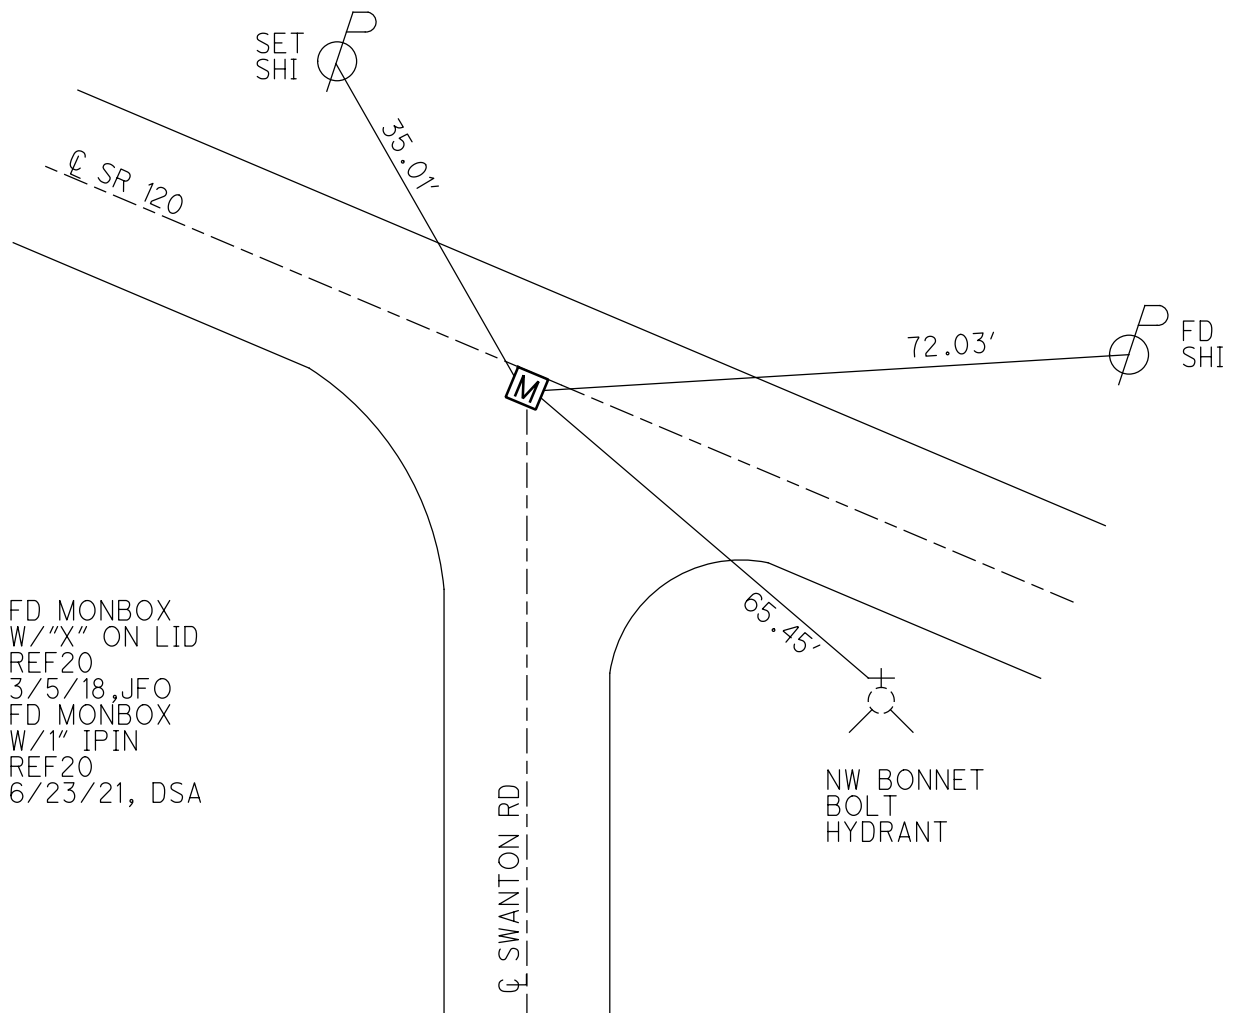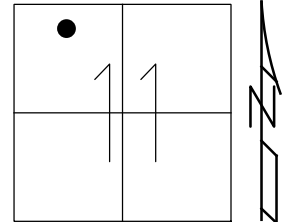

PERSONNEL	TITLE	PERSONNEL	TITLE	COUNTY	DATE	WEATHER	TEMP.
W. Denno				Fulton	Aug. 26, 1968	cool	68°F
D. Curtis				S. R. 120			
J. Brindley				SEC.			
A. Vanel							

DESCRIPTION Alignment-S.R. 120 in Metamora JOB NO. 02816(0)

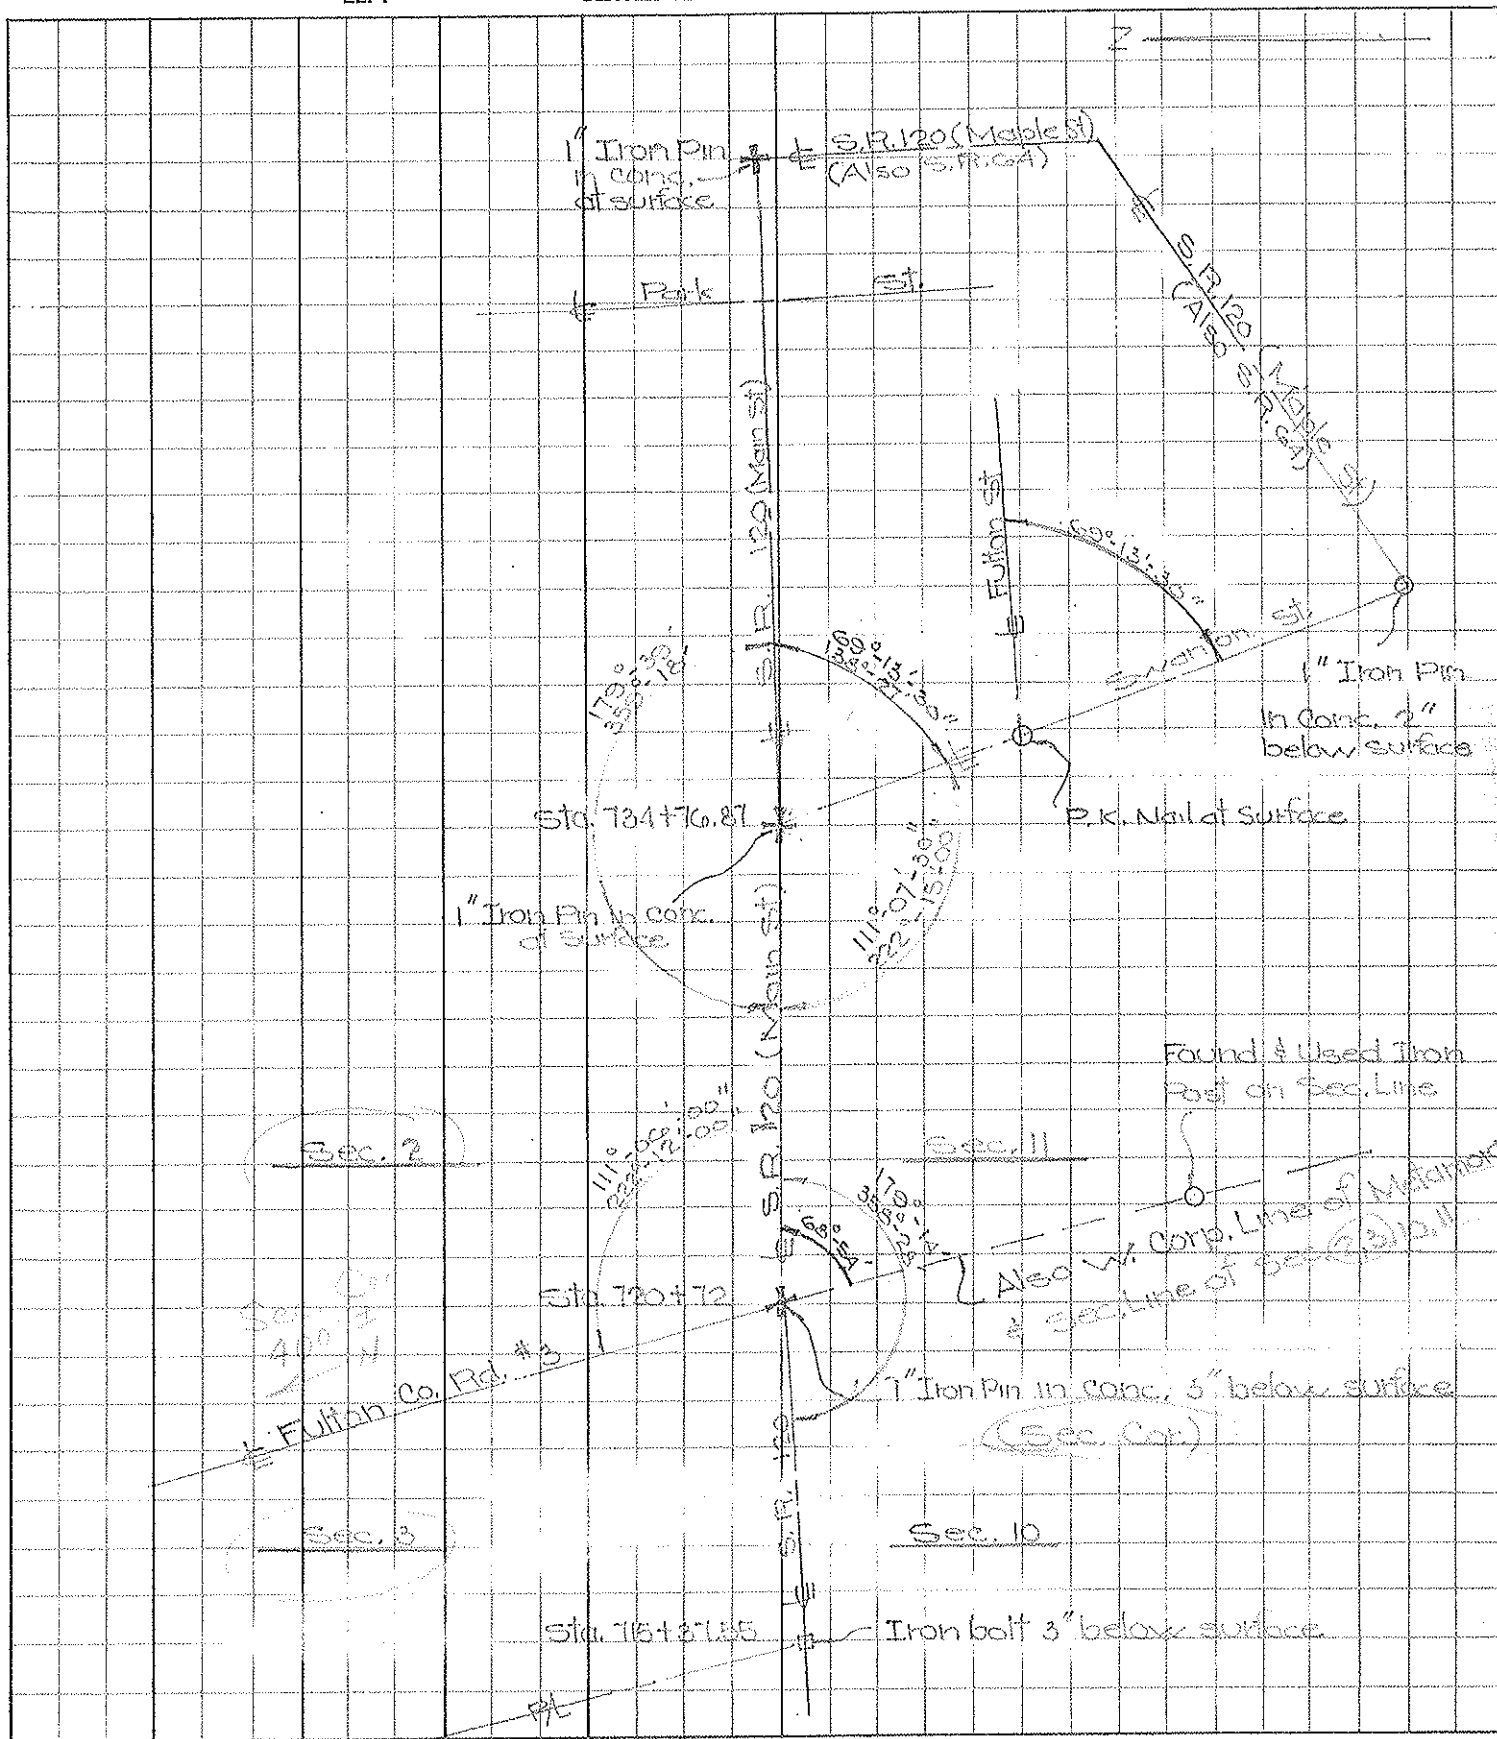

PERSONNEL	TITLE	PERSONNEL	TITLE	COUNTY	DATE	WEATHER	TEMP.
W. Denno		J. Teal		Fulton	Sept. 25, 1968	mild	70°±
D. Curtis				S. R.	120		
D. Granata				SEC.			
J. Brinley							

DESCRIPTION References To Control Points JOB NO. 02816 (C)

