



PERSONNEL	TITLE	PERSONNEL	TITLE	COUNTY	DATE
Red Beach				Fulton	Jan 1972
Newcomb				S. R. US 20-A	WEATHER
Knape				SEC. 12, Clinton Twp. T-7-N	TEMP.
Eriksen					

DESCRIPTION ALIGNMENT & CONTROLS JOB NO. _____

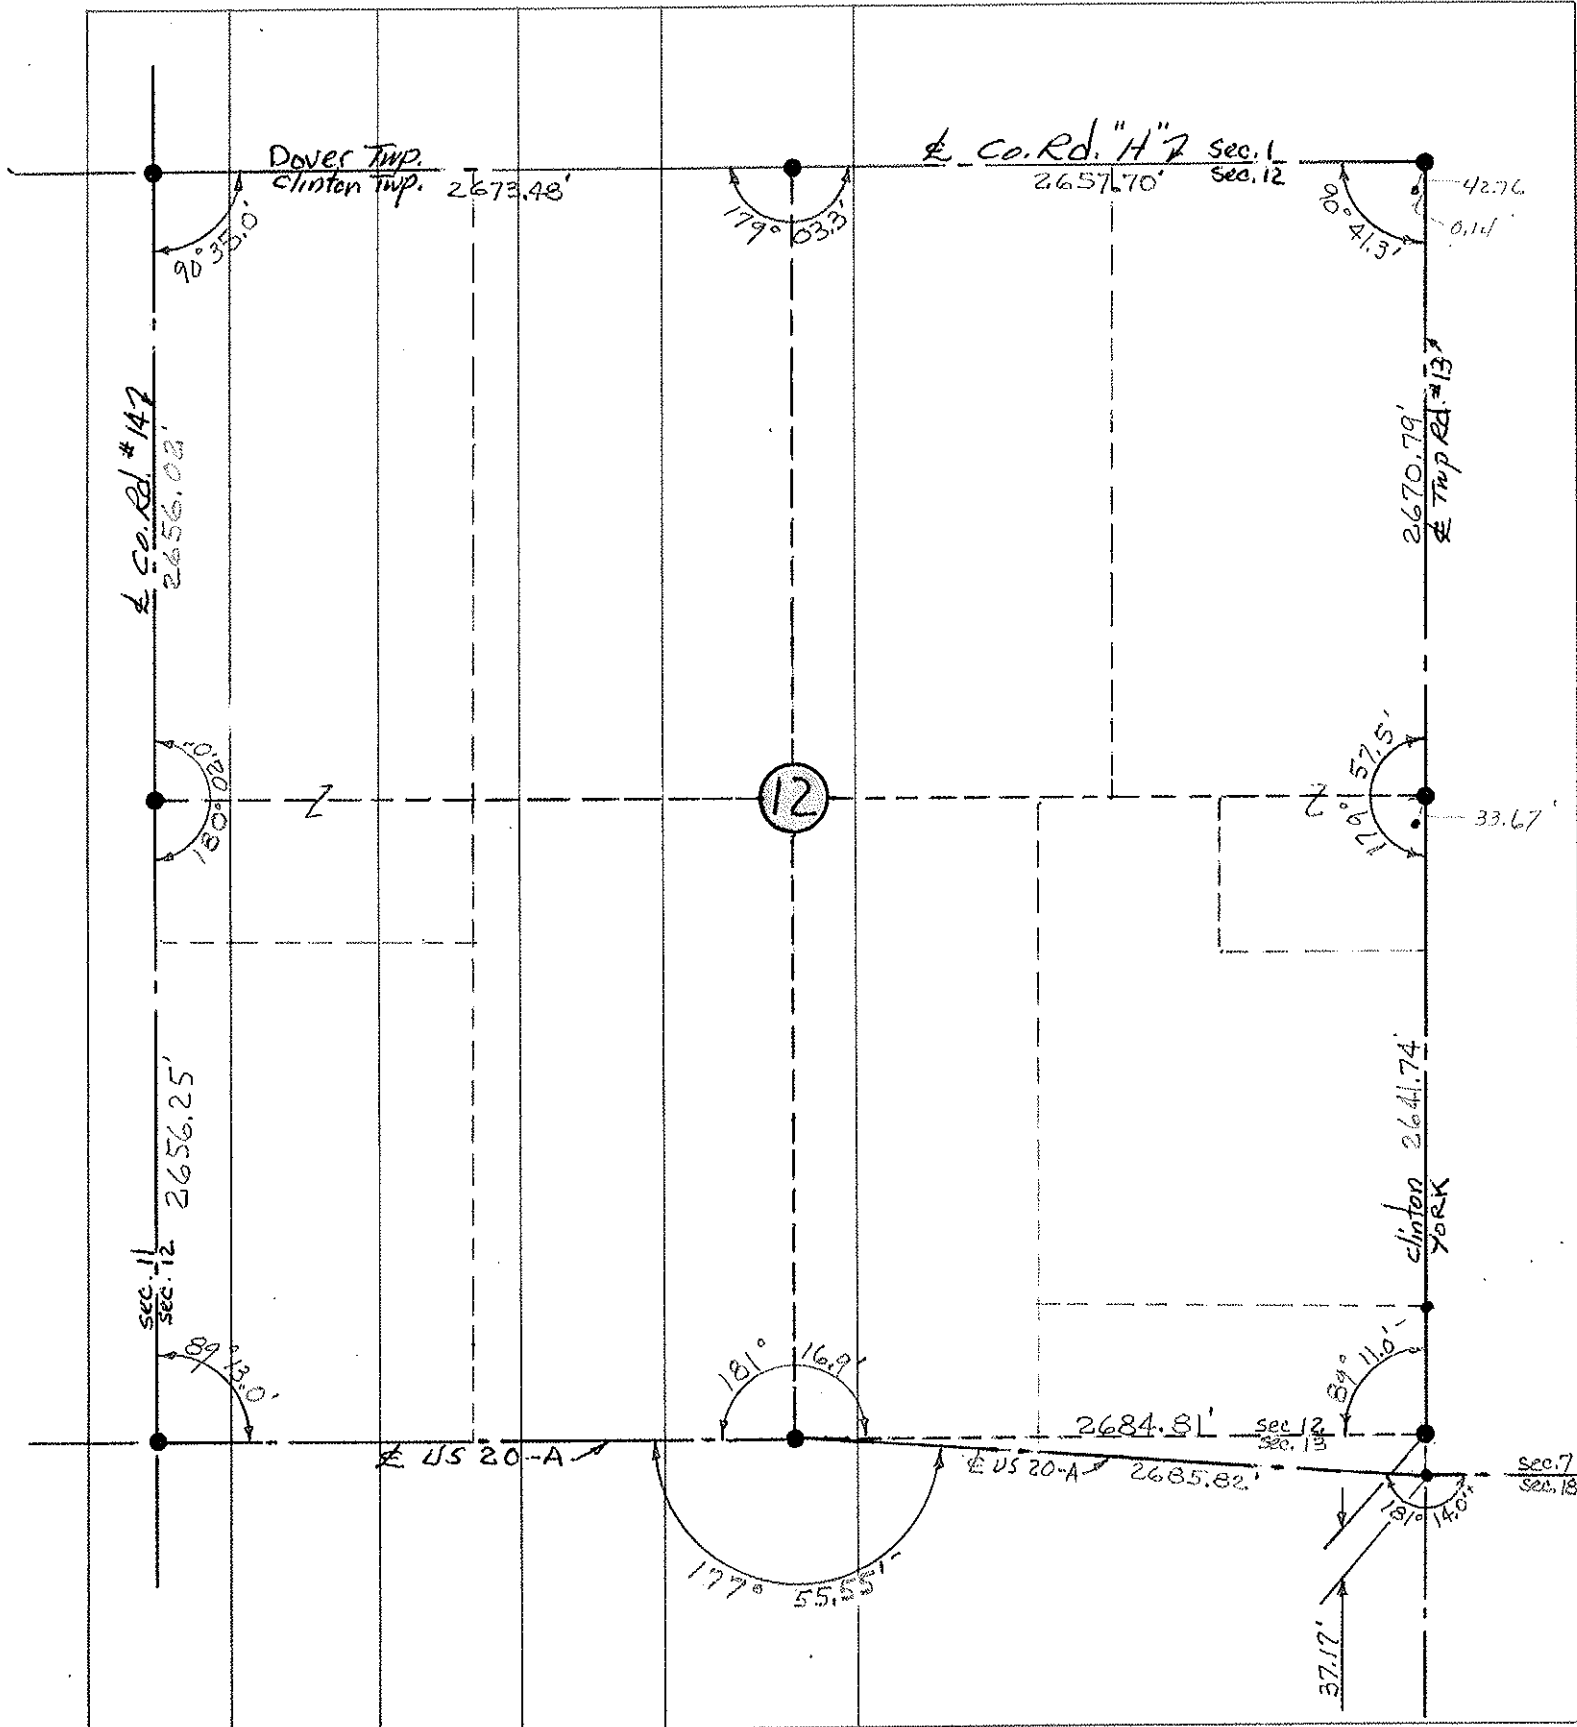

PERSONNEL	TITLE	PERSONNEL	TITLE	COUNTY	DATE
Red Beach				FULTON	Jan 1972
Newcomb				US 20-A	
Knappe					
Eriksen				SEC. 13 Clinton Twp. T-7-N	TEMP.


DESCRIPTION ALIGNMENT & CONTROLS JOB NO. _____

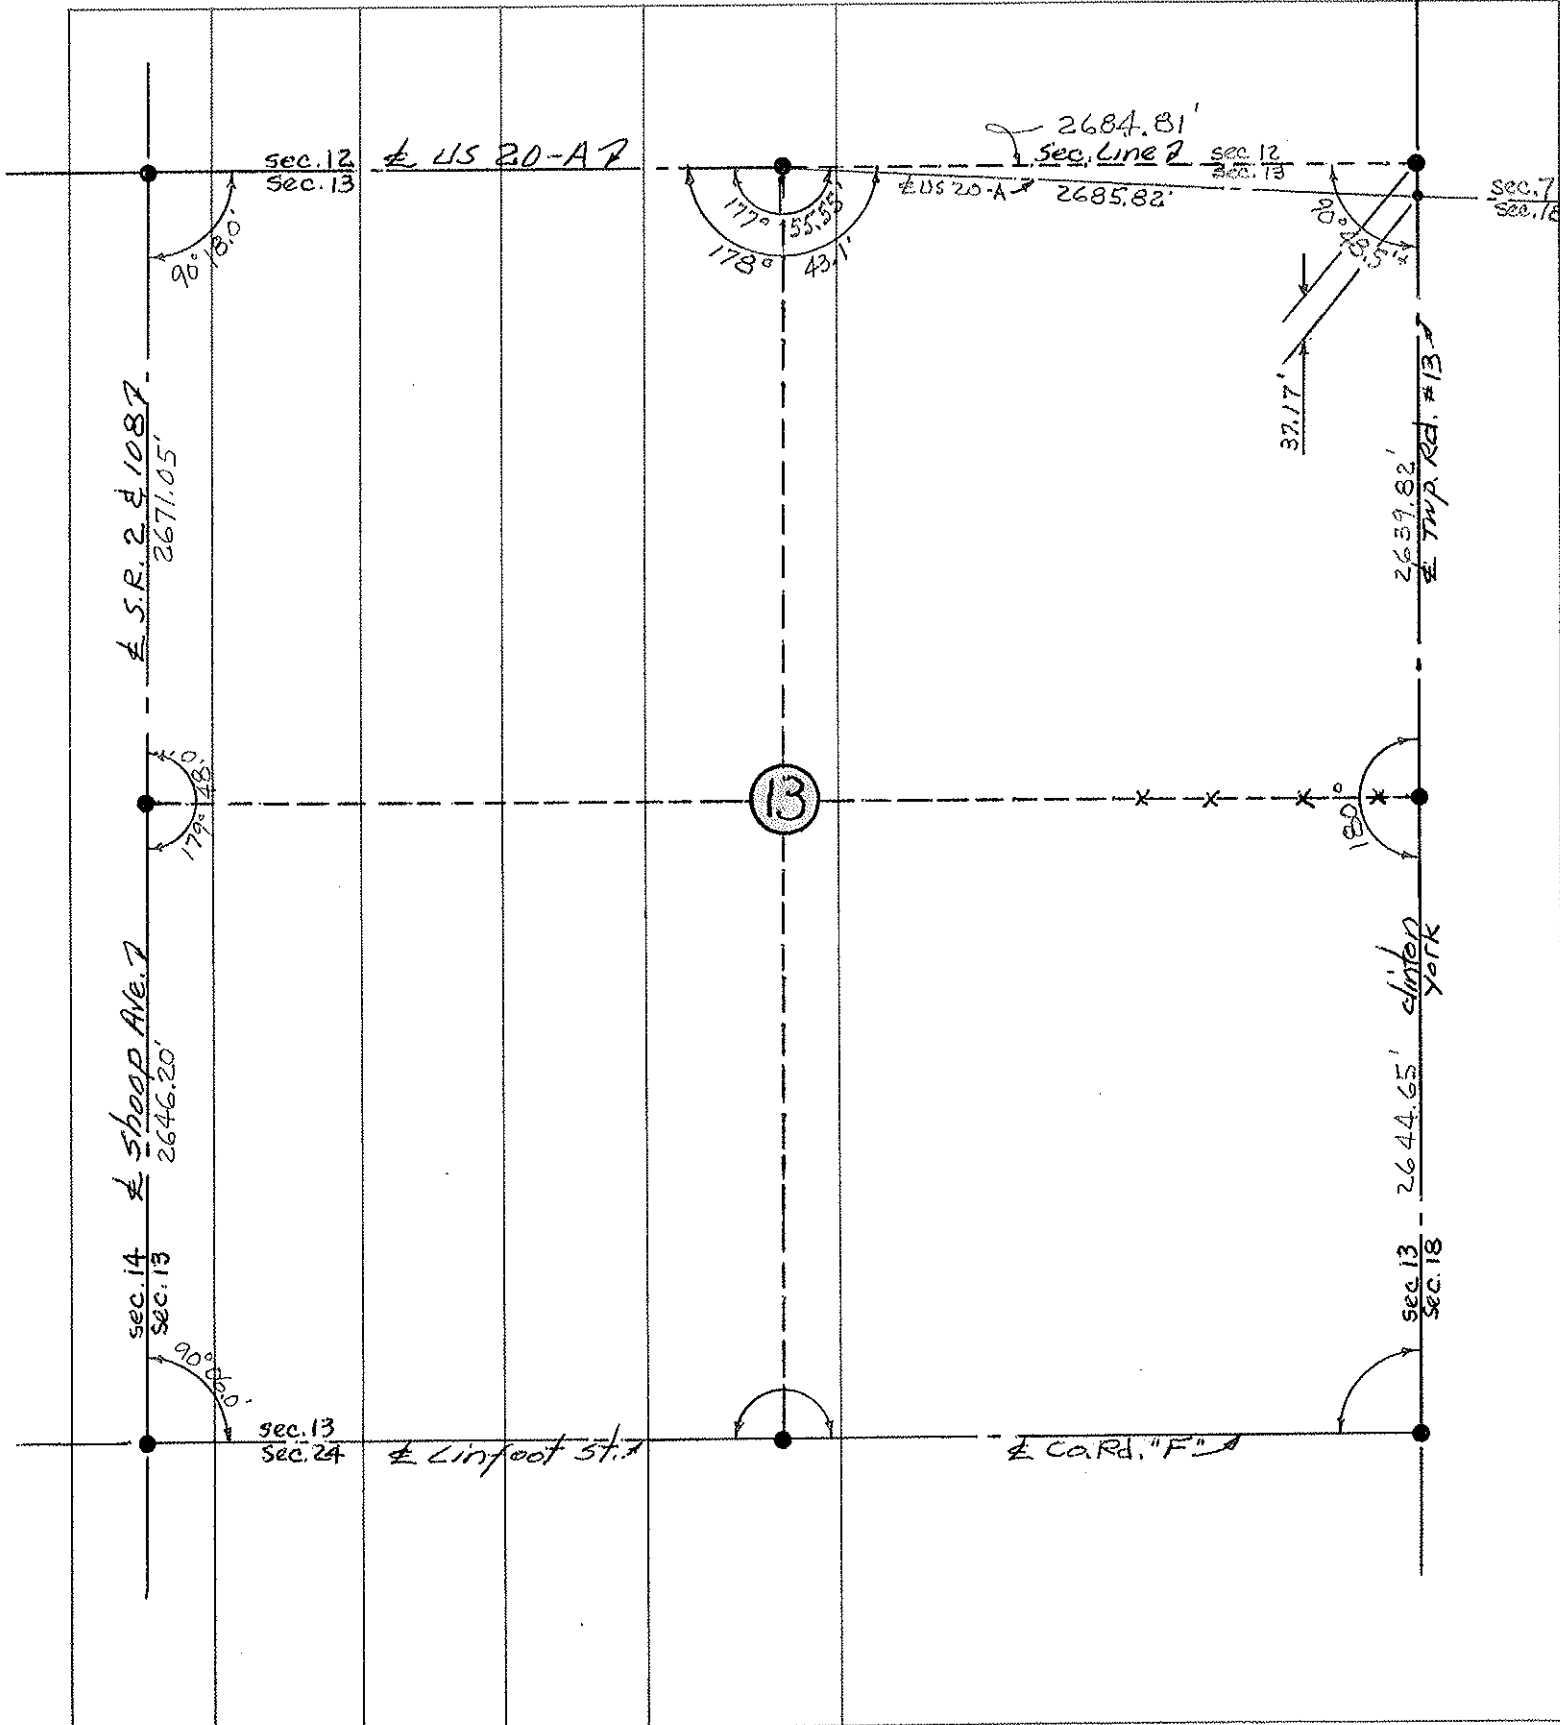

PERSONNEL	TITLE	PERSONNEL	TITLE	COUNTY	DATE
Red Beach				Fulton	Jan 1972
Newcomb				S. R.	US 20-A
Knappe				SEC. 7 YORK TWP. T-7-N	WEATHER
Eriksen					TEMP.

DESCRIPTION ALIGNMENT & CONTROLS JOB NO. _____

LEFT CENTER LINE RIGHT

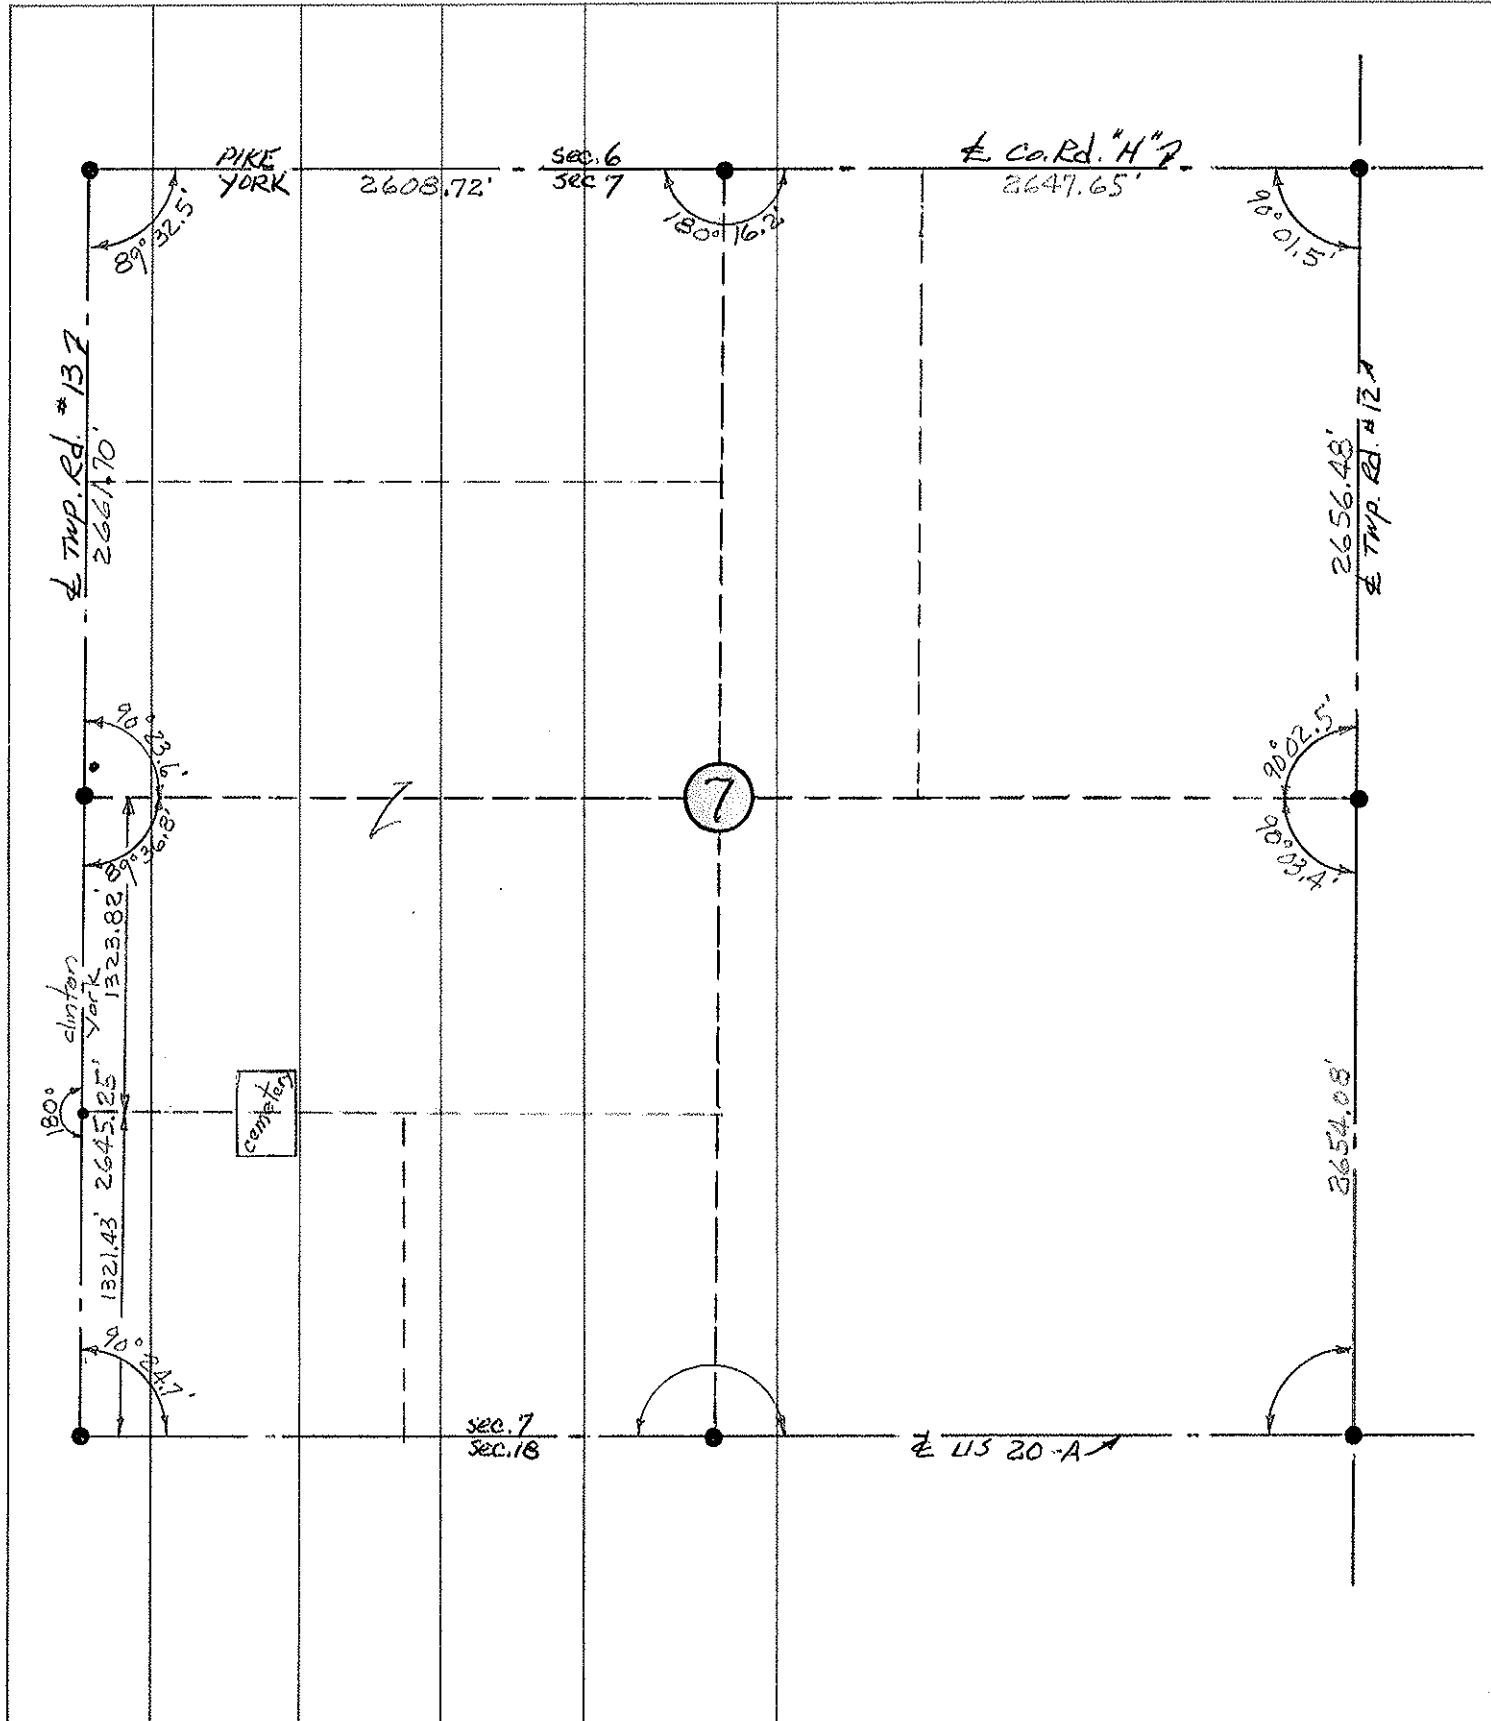

PERSONNEL TITLE PERSONNEL TITLE

Red Beach
Newcomb
Knappe

COUNTY FULTON

DATE Dec. 1971

S. R. US 20-A

WEATHER _____

SEC. 8 YORK TWP T-7-N

TEMP. _____

DESCRIPTION


ALIGNMENT & CONTROLS

JOB NO. _____

LEFT

CENTER LINE

RIGHT

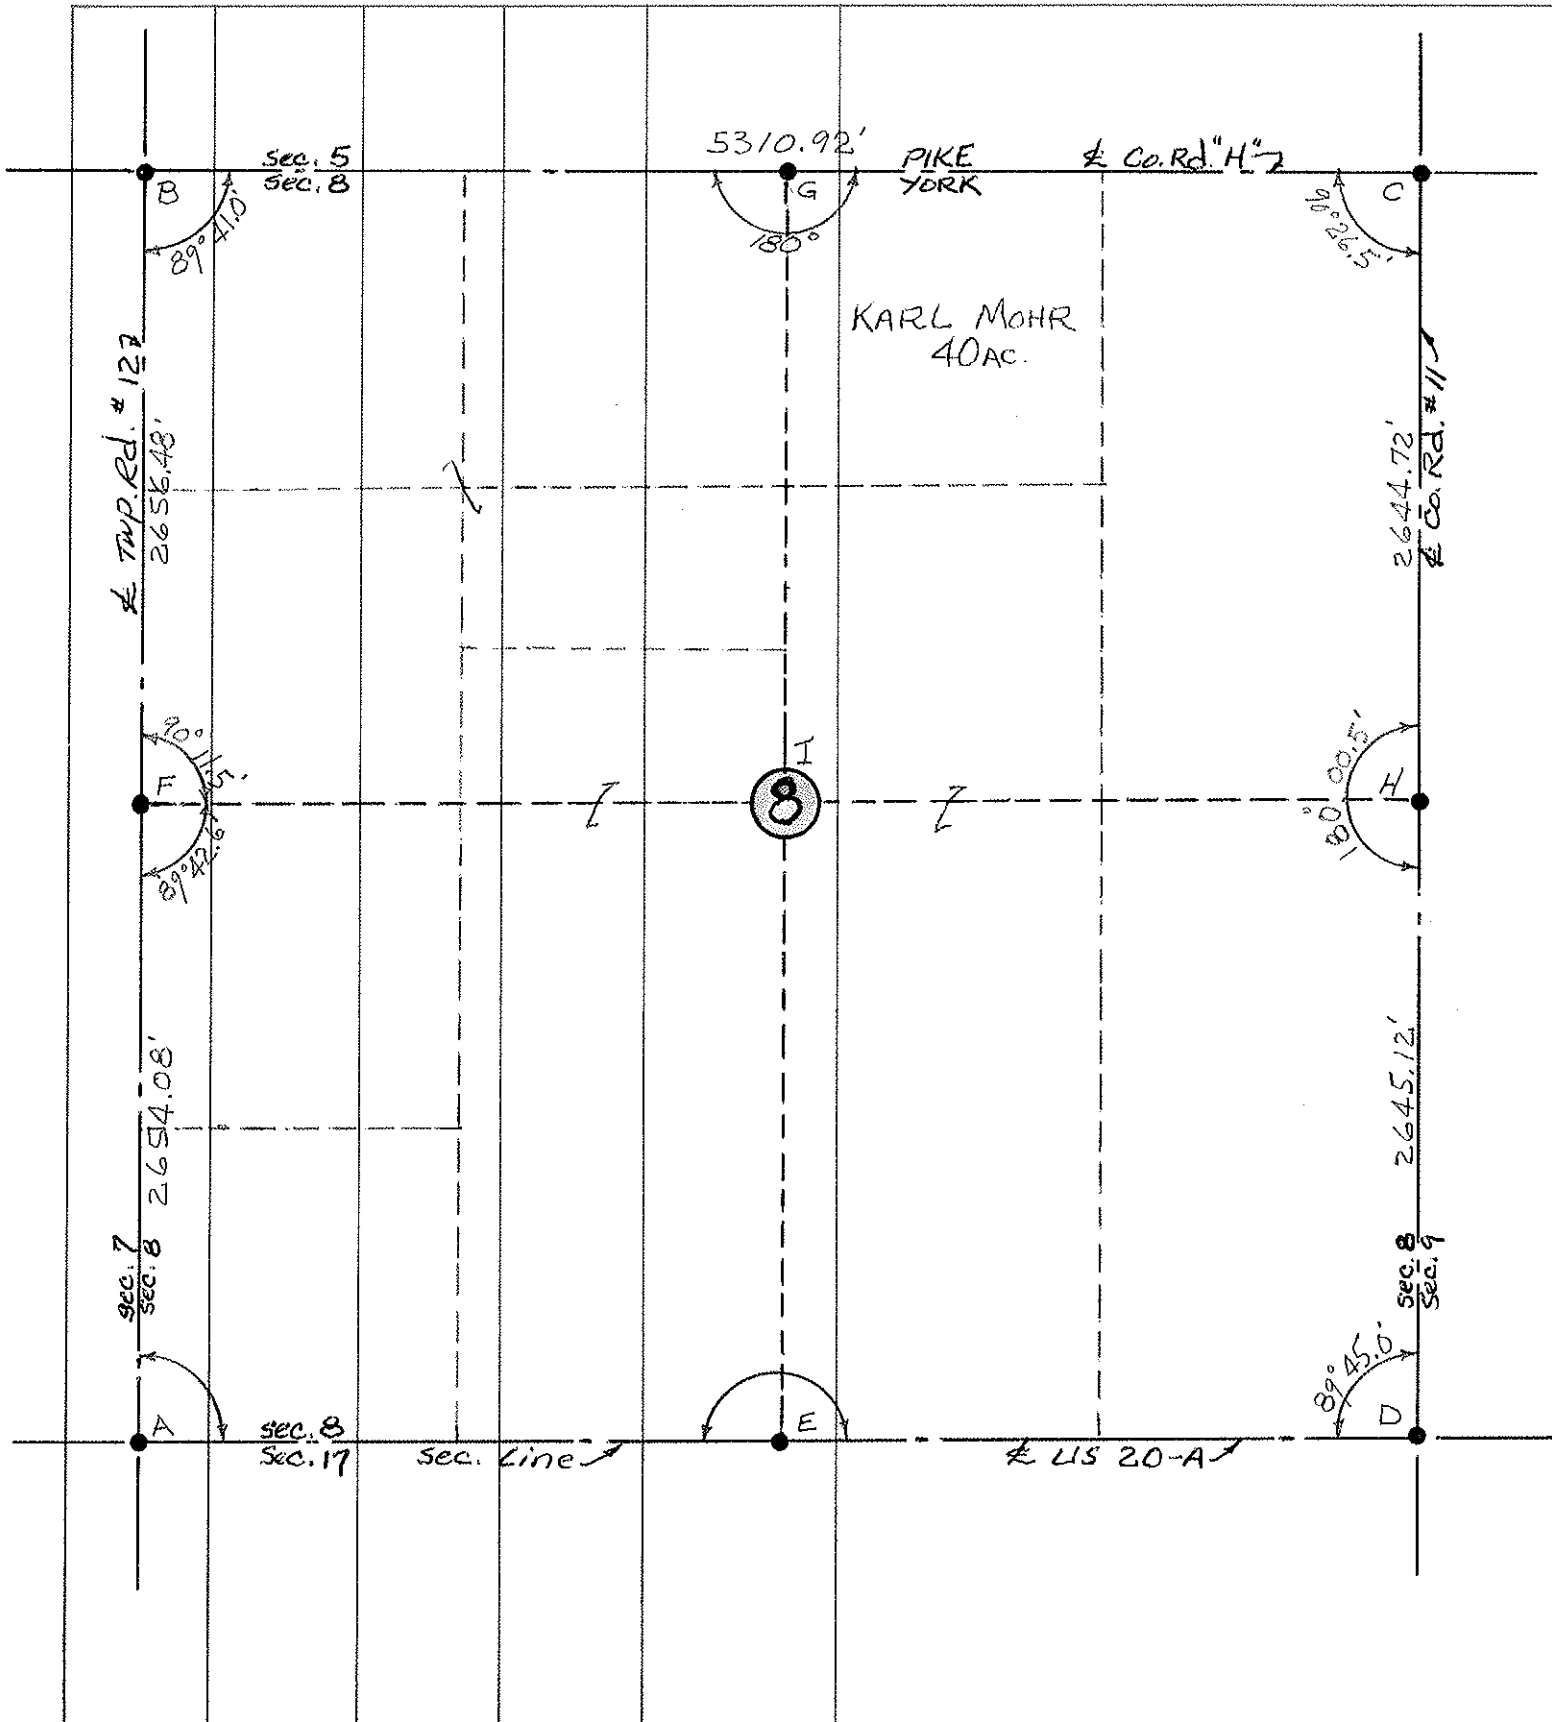

PERSONNEL TITLE PERSONNEL TITLE

Red Beach
Newcomb
KnapeCOUNTY FultonDATE Nov-Dec 1971S. R. US 20-A

WEATHER _____

SEC. 9 YORK TWP T-7-N TEMP. _____

DESCRIPTION


ALIGNMENT & CONTROLS

JOB NO. _____

LEFT

CENTER LINE

RIGHT

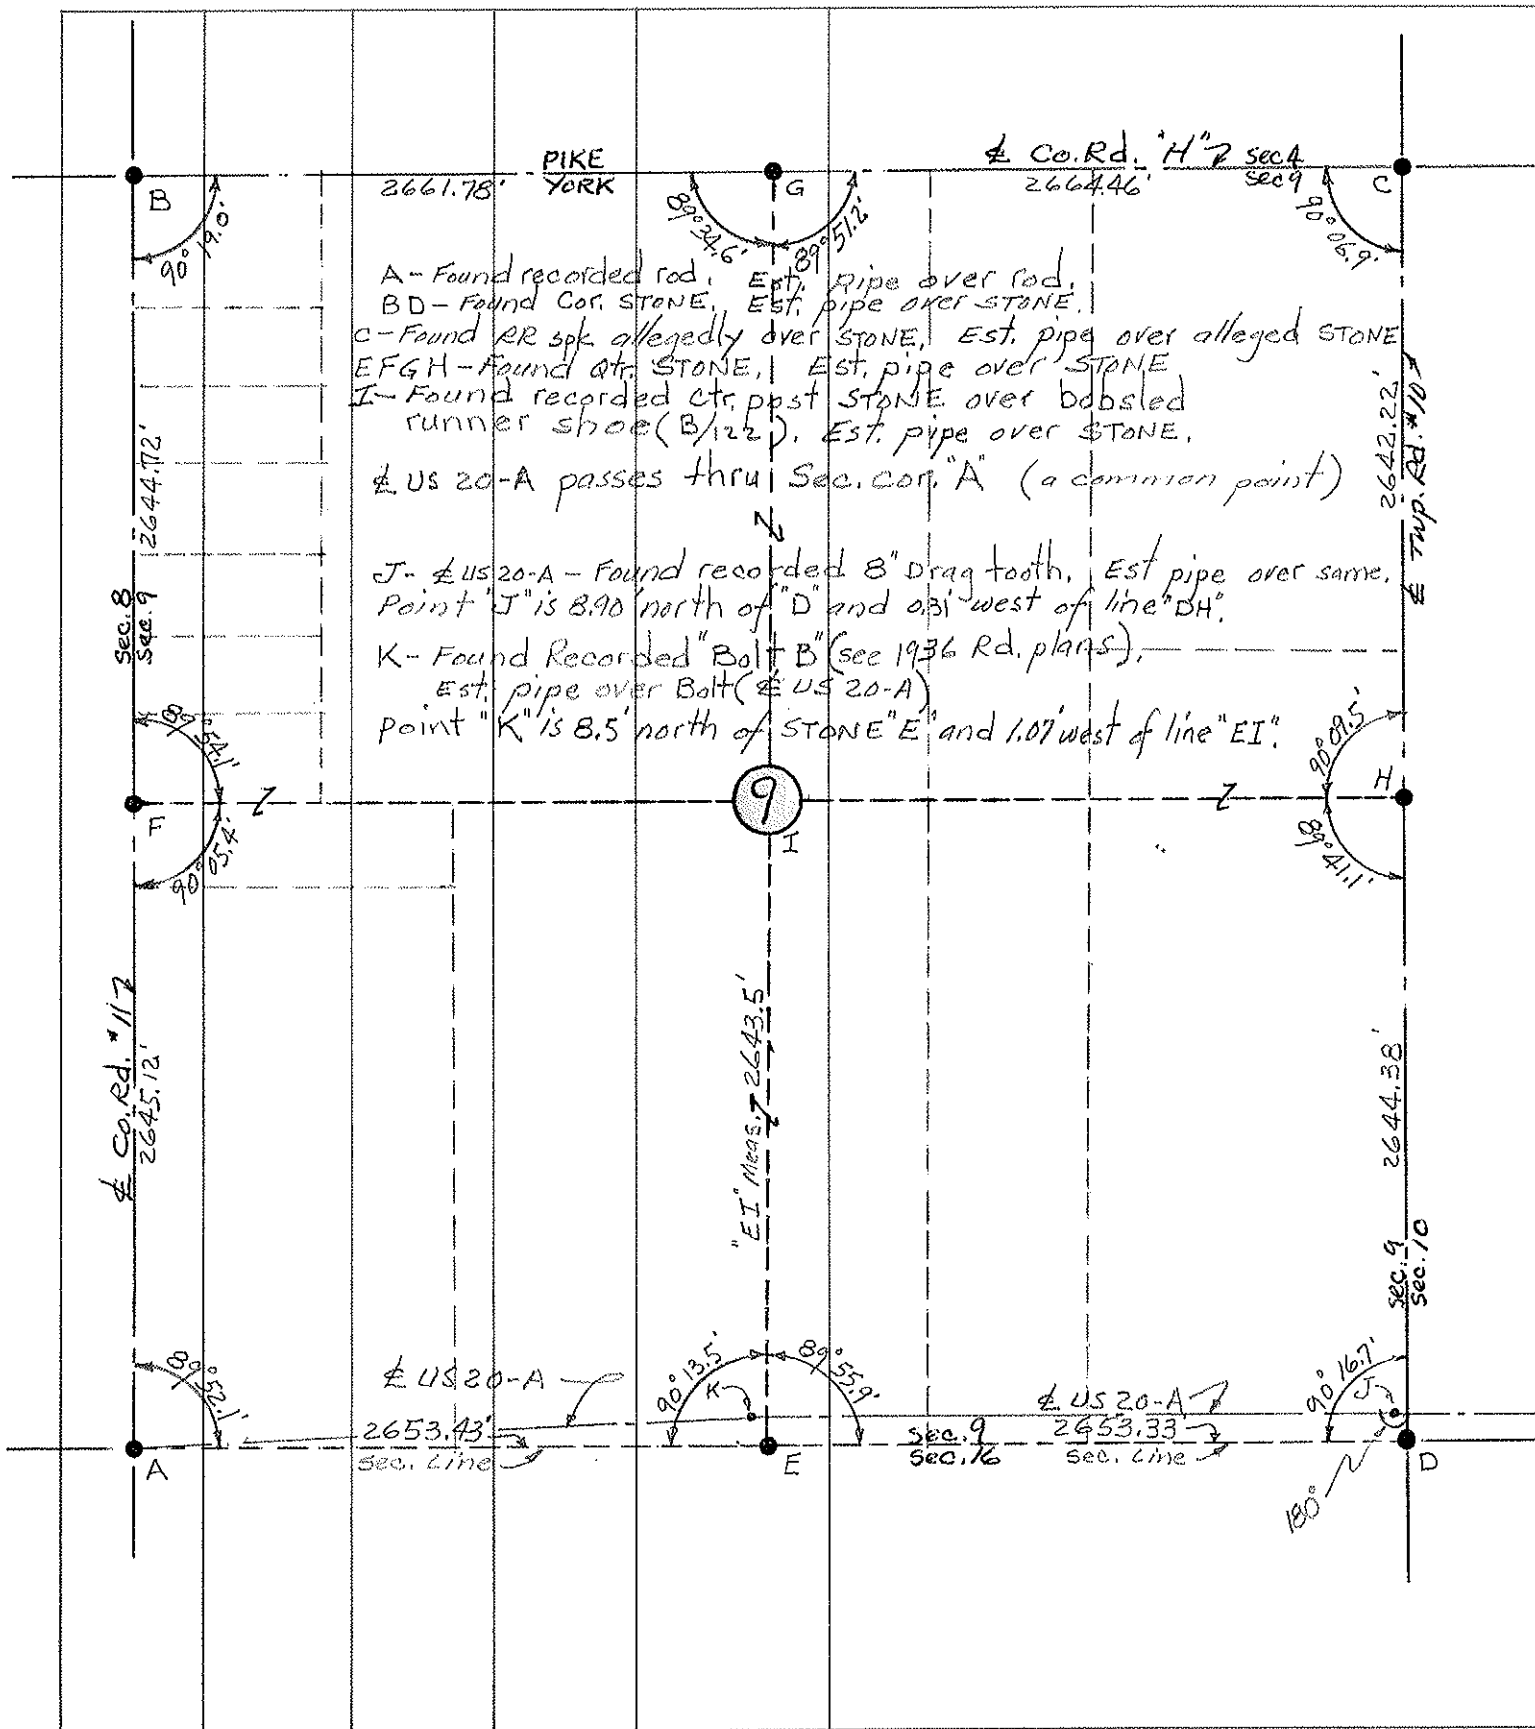

PERSONNEL TITLE PERSONNEL TITLE

Red Beach
Newcomb
KnappeCOUNTY FULTON DATE SEPT. '71S. R. US 20-A WEATHER _____SEC. 10, YORK TWP., T-7-N TEMP. _____

DESCRIPTION


ALIGNMENT & CONTROLS

JOB NO. _____

LEFT

CENTER LINE

RIGHT

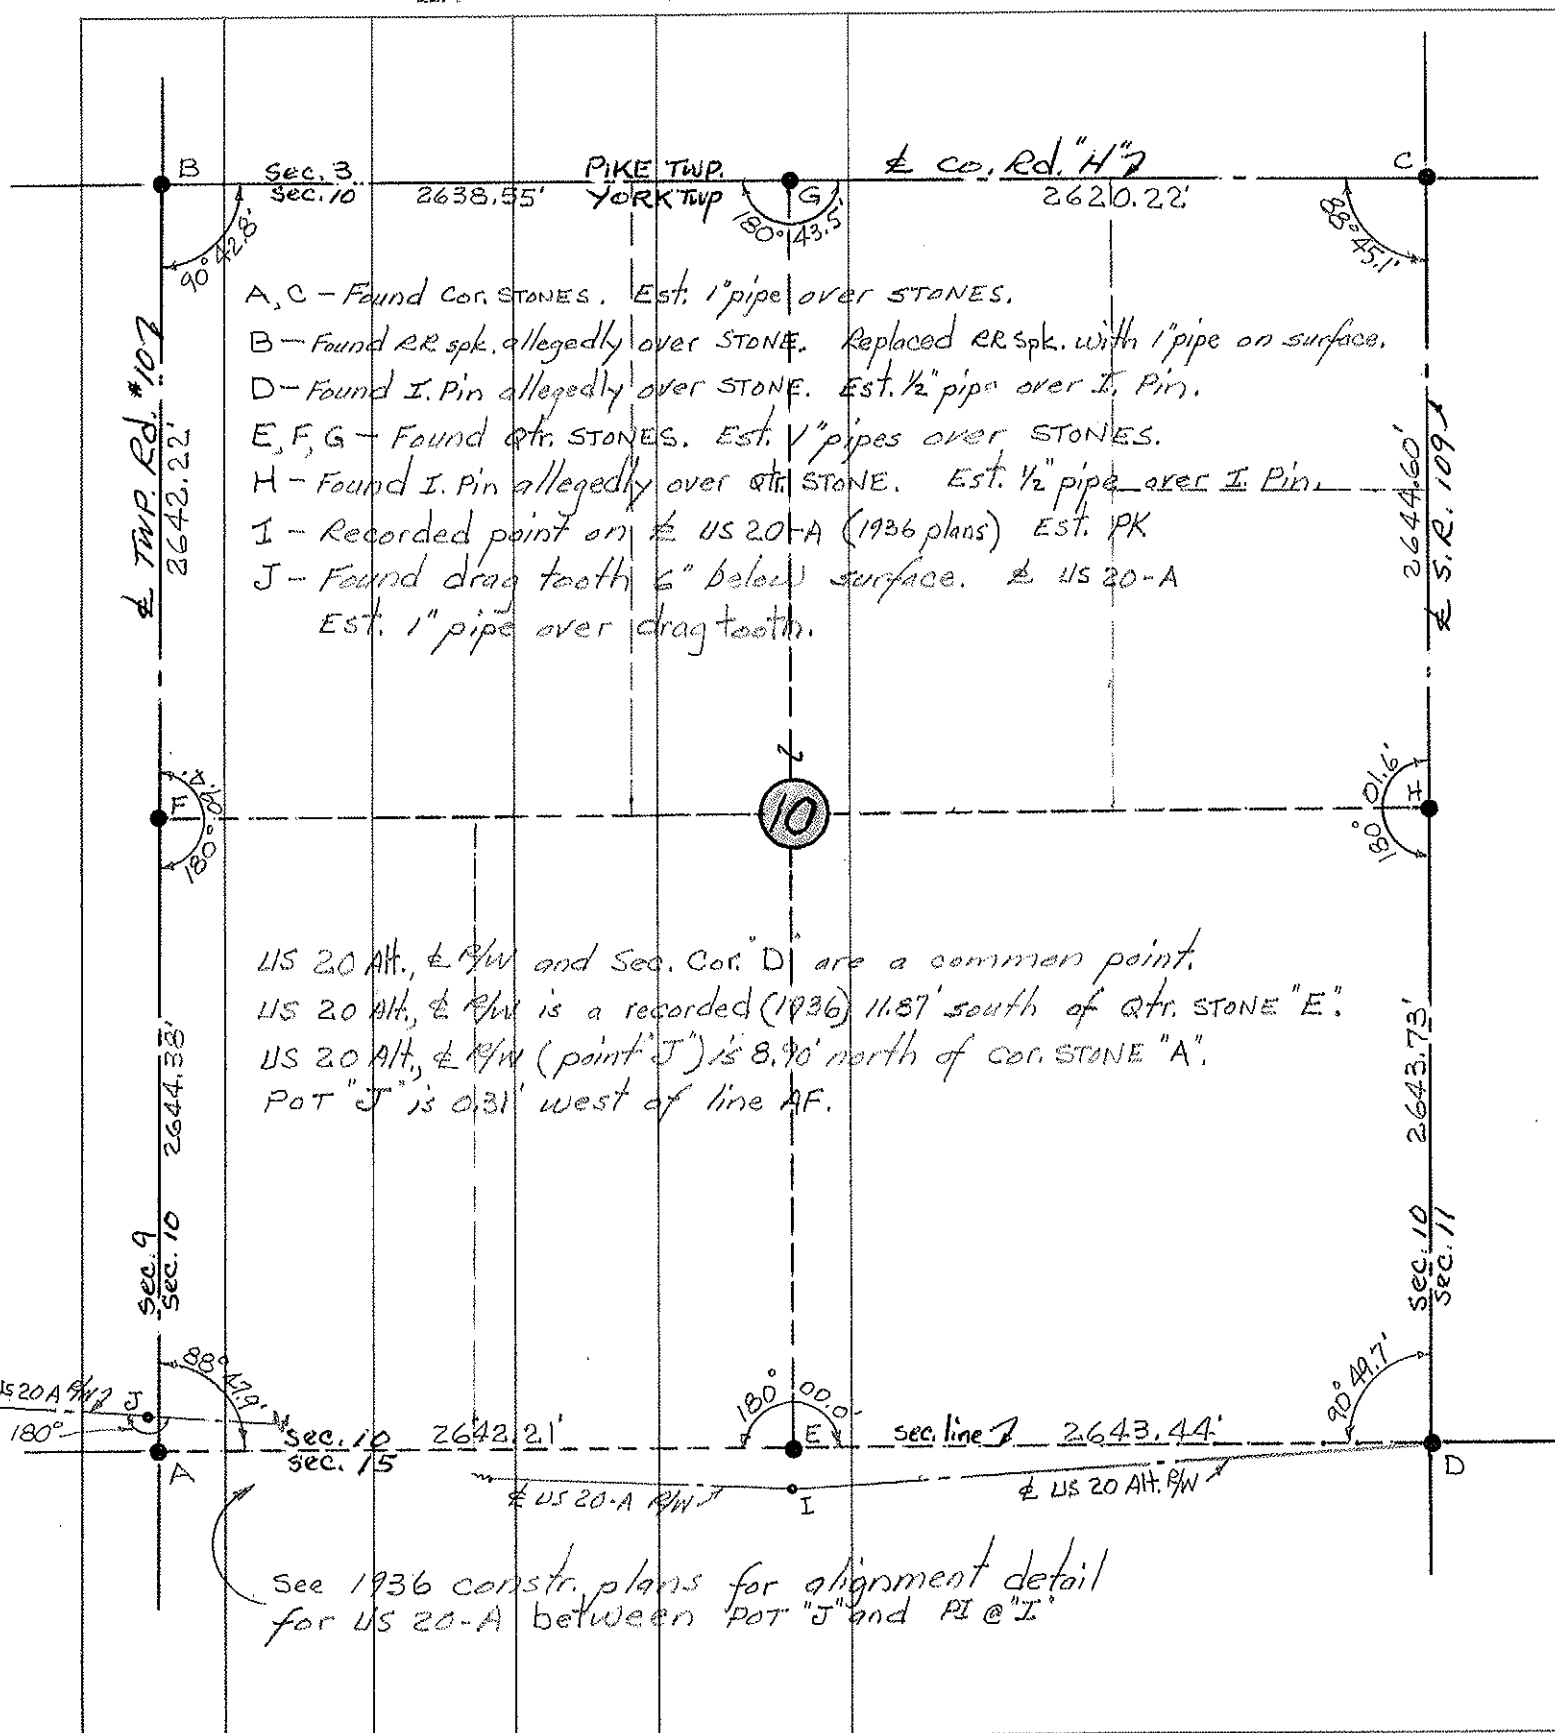

PERSONNEL	TITLE	PERSONNEL	TITLE
1	2	3	4
5	6	7	8
9	10	11	12
13	14	15	16
17	18	19	20
21	22	23	24
25	26	27	28
29	30	31	32
33	34	35	36
37	38	39	40
41	42	43	44
45	46	47	48
49	50	51	52
53	54	55	56
57	58	59	60
61	62	63	64
65	66	67	68
69	70	71	72
73	74	75	76
77	78	79	80
81	82	83	84
85	86	87	88
89	90	91	92
93	94	95	96
97	98	99	100

Red Beach

Newcomb

Кнаре

K-2 W. QTC. STONE, Sec. 10

COUNTY FULTON

DATE Nov. 1971

E. qtr STONE Sec. 10

S. R. US 20-A

WEATHER

SEC. 15, YORK TWP T-7-N

TEMP

DESCRIPTION


ALIGNMENT & CONTROLS

JOB NO

LEFT

CENTER LINE

RIGHT

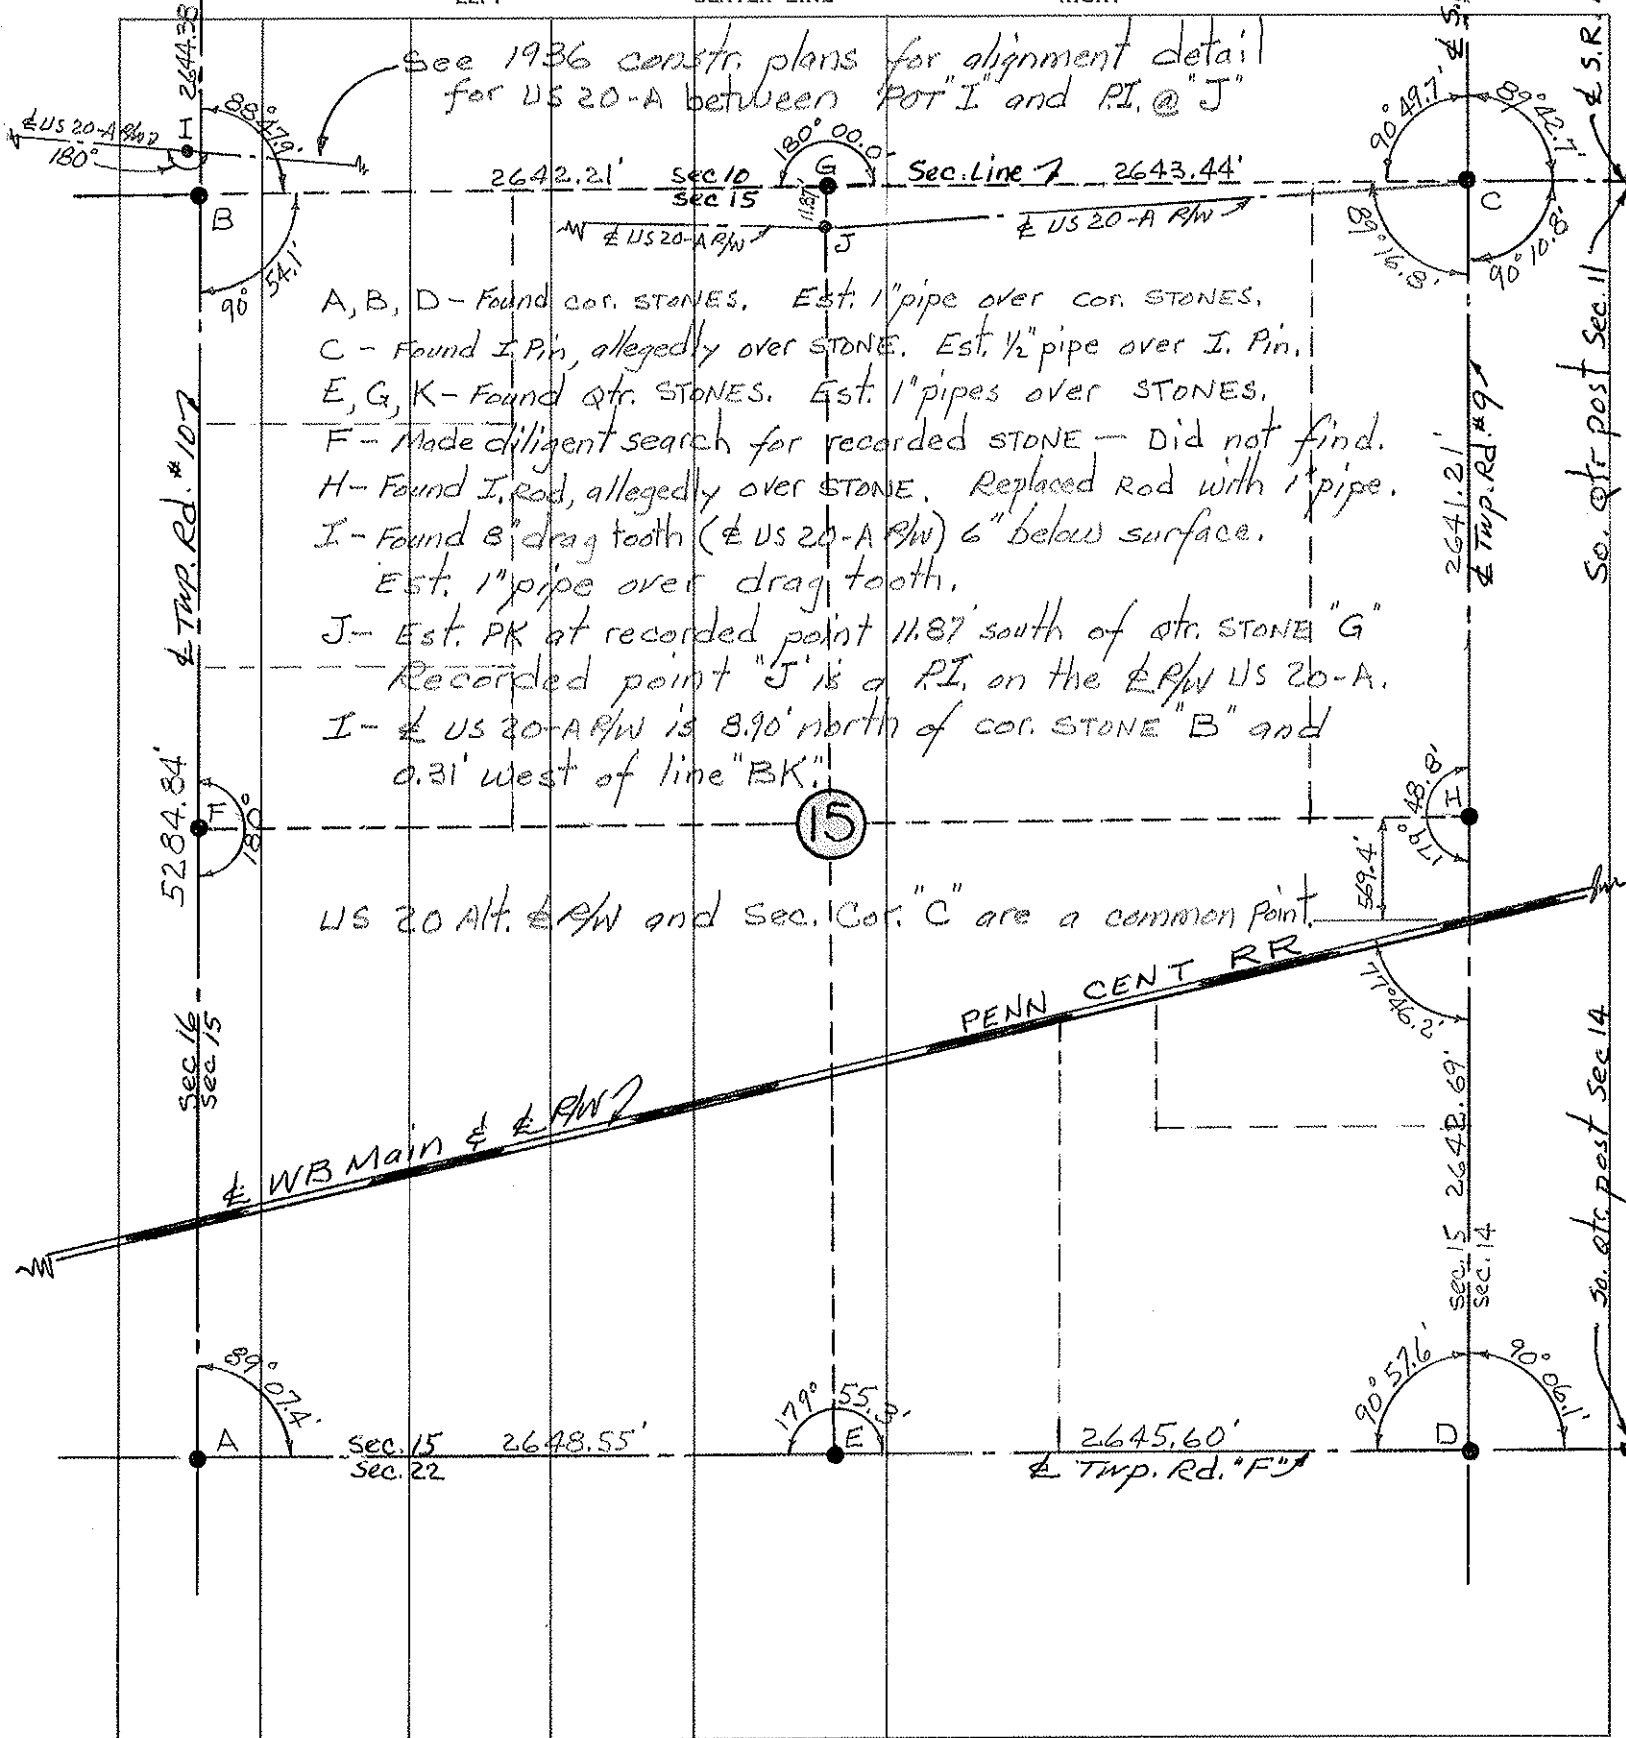

COUNTY FULTON DATE Nov. 1971


S. R. US 20-A WEATHER

SEC. 16 YORK TWP T-7-N TEMP

DESCRIPTION	ALIGNMENT	CONTROLS	JOB NO.
	CENTER LINE	RIGHT	

ALIGNMENT & CONTROLS

LEFT	CENTER LINE	RIGHT
1	2	3
4	5	6
7	8	9
364	365	366
367		

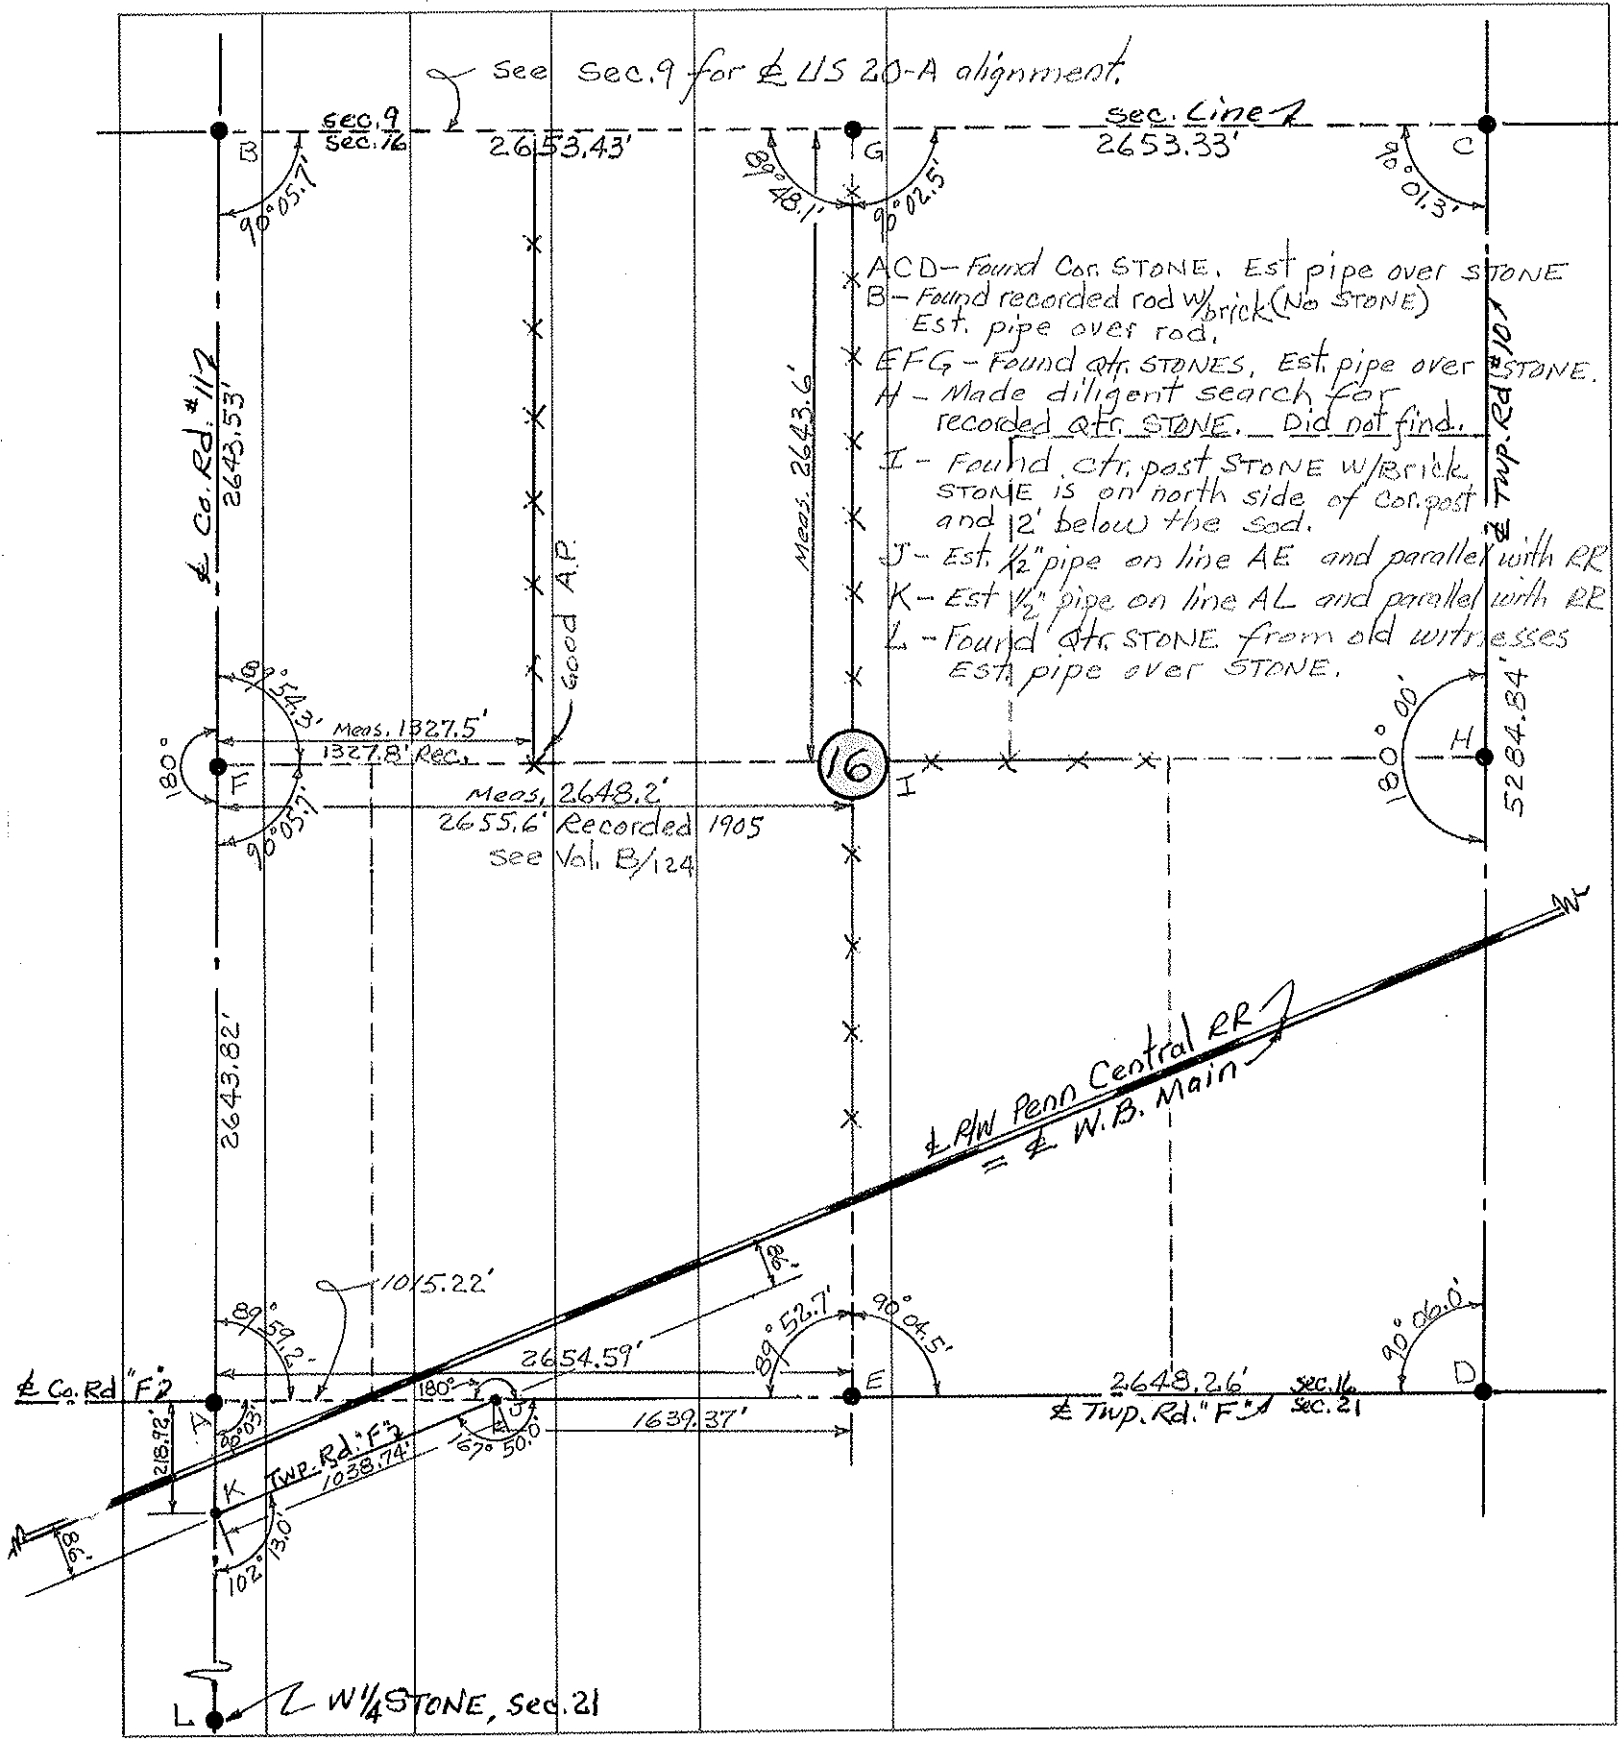

O.D.O.T. DISTRICT 2 SURVEY OFFICE (USE ONLY)

PERSONNEL

REFERENCE NO. 1

SHEET 1 OF 63

NOTES NIESE

DATE 2/26/21

ROUTE US 20 A

H.C. RHOADES

WEATHER CLOUDY

COUNTY FULTON

R.C. _____

TEMP. 31°

TOWNSHIP GERMAN

DWG BY NIESE

PID PAVING TRAIN

SECTION 11

T 7 N R 4 E

TYPE MONUMENT P.K./WASHER

~~ON SURFACE~~ - BELOW 1"

OFFSET CL PAVEMENT 1.5' ~~LT~~ : RT

- TO - EDGE PAVEMENT


STATION: 0+00

HORZ.DATUM: -

GEOID: -


GRID: NORTHING: 704996.127

EASTING: 1453954.198

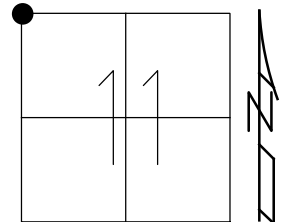

RECORD:
FD BENT IPIPE
3" DOWN
SET P.K./WASHER
9/73, BEACH
FD P.K./WASHER
5/29/02, MB
SET P.K./WASHER
9/24/02, MB
FD P.K./WASHER
7/9/04, DCH
SET MAG/WASHER
8/24/04, MB
FD MAG/WASHER
REF27
5/17/16, JFO
FD P.K./WASHER
1" DOWN
4/19/17, JFO
SET MAG/WASHER
11/20/17, JFO
FD MAG/WASHER
9/23/20, JFO
2/26/21, JMR

NOTE: REF 27 WILLIAMS CO.

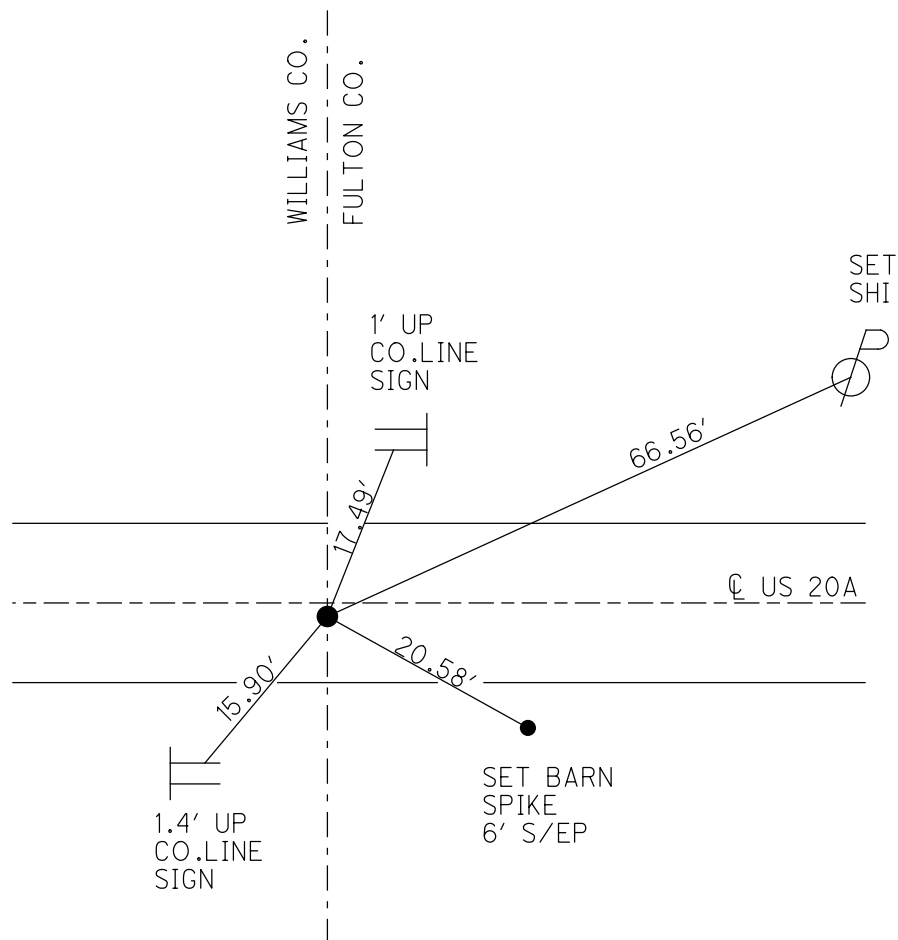

O.D.O.T. DISTRICT 2 SURVEY OFFICE (USE ONLY)

PERSONNEL

REFERENCE NO. 2

SHEET 2 OF 63

NOTES NIESE

DATE 2/26/21

ROUTE US 20A

H.C. RHOADES

WEATHER CLOUDY

COUNTY FULTON

R.C.

TEMP. 31°

TOWNSHIP GERMAN

DWG BY NIESE

PID PAVETRAIN

SECTION 11

T 7 N R 4 E

TYPE MONUMENT MAG/WASHER

ON SURFACE - ~~BELOW~~ ON

OFFSET CL PAVEMENT 0.9' LT : ~~RT~~

11.4' TO RT EDGE PAVEMENT


STATION: 26+34

HORIZ.DATUM: NAD83 2011


GEOID: NAVD88 2012A

GRID: NORTHING: 704971.221

EASTING: 1456581.416

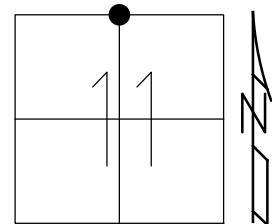

RECORD: 2004
FD 1" PIPE
2004
FD P.K./WASHER
7/9/04, DCH
SET MAG/WASHER
8/24/04, MB
FD MAG/WASHER
REF2
9/23/20, JFO
2/26/21, JMR

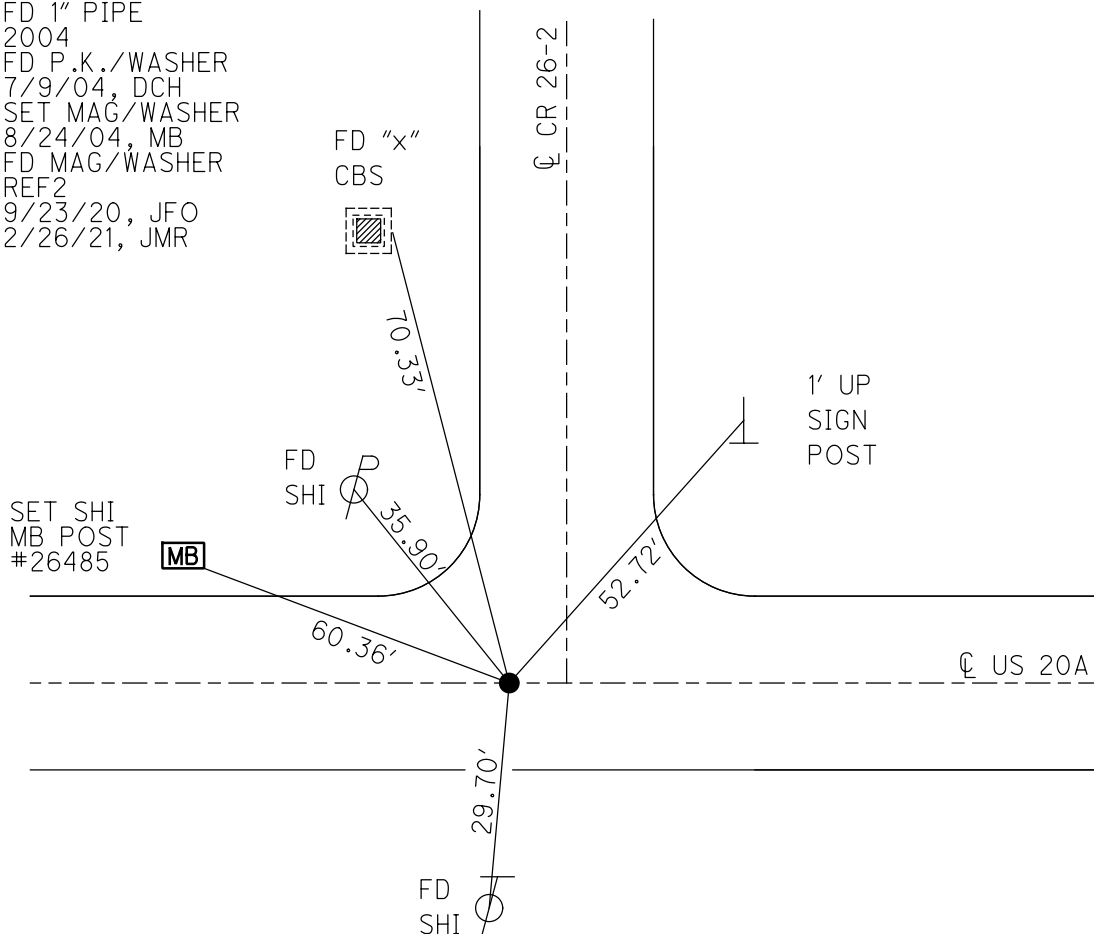

O.D.O.T. DISTRICT 2 SURVEY OFFICE (USE ONLY)

PERSONNEL

REFERENCE NO. 3

SHEET 3 OF 63

NOTES NIESE

DATE 2/26/21

ROUTE US 20A

H.C. RHOADES

WEATHER CLOUDY

COUNTY FULTON

R.C.

TEMP. 31°

TOWNSHIP GERMAN

DWG BY NIESE

PID PAVETRAIN

SECTION 12

T 7 N R 4 E

TYPE MONUMENT MAG/WASHER

ON SURFACE - ~~BELOW~~ ON

OFFSET CL PAVEMENT 5.1' ~~LT~~ : RT

4.9' TO RT EDGE PAVEMENT


STATION: 52+73

HORZ.DATUM: NAD83 2011


GEOID: NAVD88 2012A

GRID: NORTHING: 704912.479

EASTING: 1459212.894

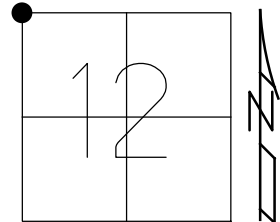

RECORD:
FD 1" IPIPE
1" DOWN
2004
FD P.K./WASHER
7/9/04, DCH
SET MAG/WASHER
8/24/04, MB
FD MAG/WASHER
REF3
9/23/20, JFO
2/26/21, JMR

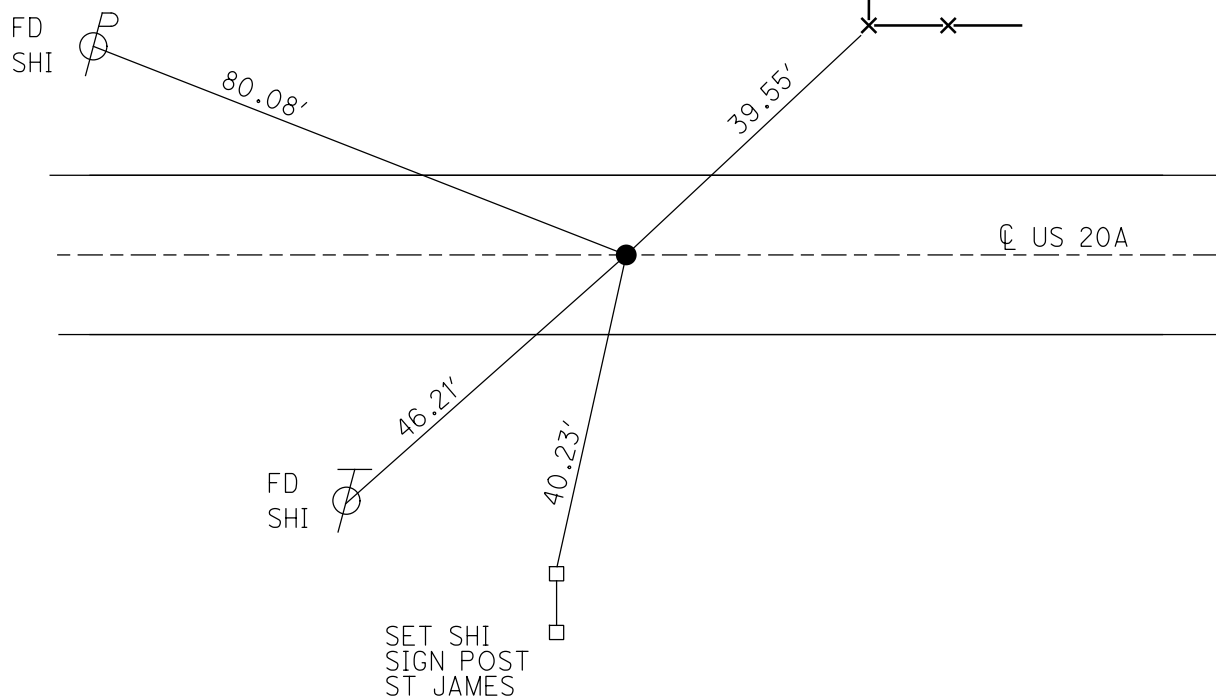

O.D.O.T. DISTRICT 2 SURVEY OFFICE (USE ONLY)

PERSONNEL

REFERENCE NO. 4

SHEET 4 OF 63

NOTES NIESE

DATE 2/26/21

ROUTE US 20A

H.C. RHOADES

WEATHER CLOUDY

COUNTY FULTON

R.C.

TEMP. 31°

TOWNSHIP GERMAN

DWG BY NIESE

PID PAVETRAIN

SECTION 12

T 7 N R 4 E

TYPE MONUMENT MAG/WASHER

ON SURFACE - ~~BELOW~~ ON

OFFSET CL PAVEMENT 1.1' LT : RT

- TO - EDGE PAVEMENT


STATION: 79+06.84

HORZ.DATUM: NAD83 2011


GEOID: NAVD88 2012A

GRID: NORTHING: 704911.960

EASTING: 1461849.258

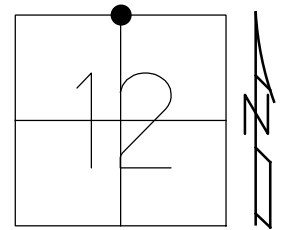

RECORD: C.P.O.C.
FD P.K./WASHER
7/9/04, DCH
SET P.K./WASHER
8/24/04, MB
FD MAG/WASHER
REF4
9/23/20, JFO
2/26/21, JMR

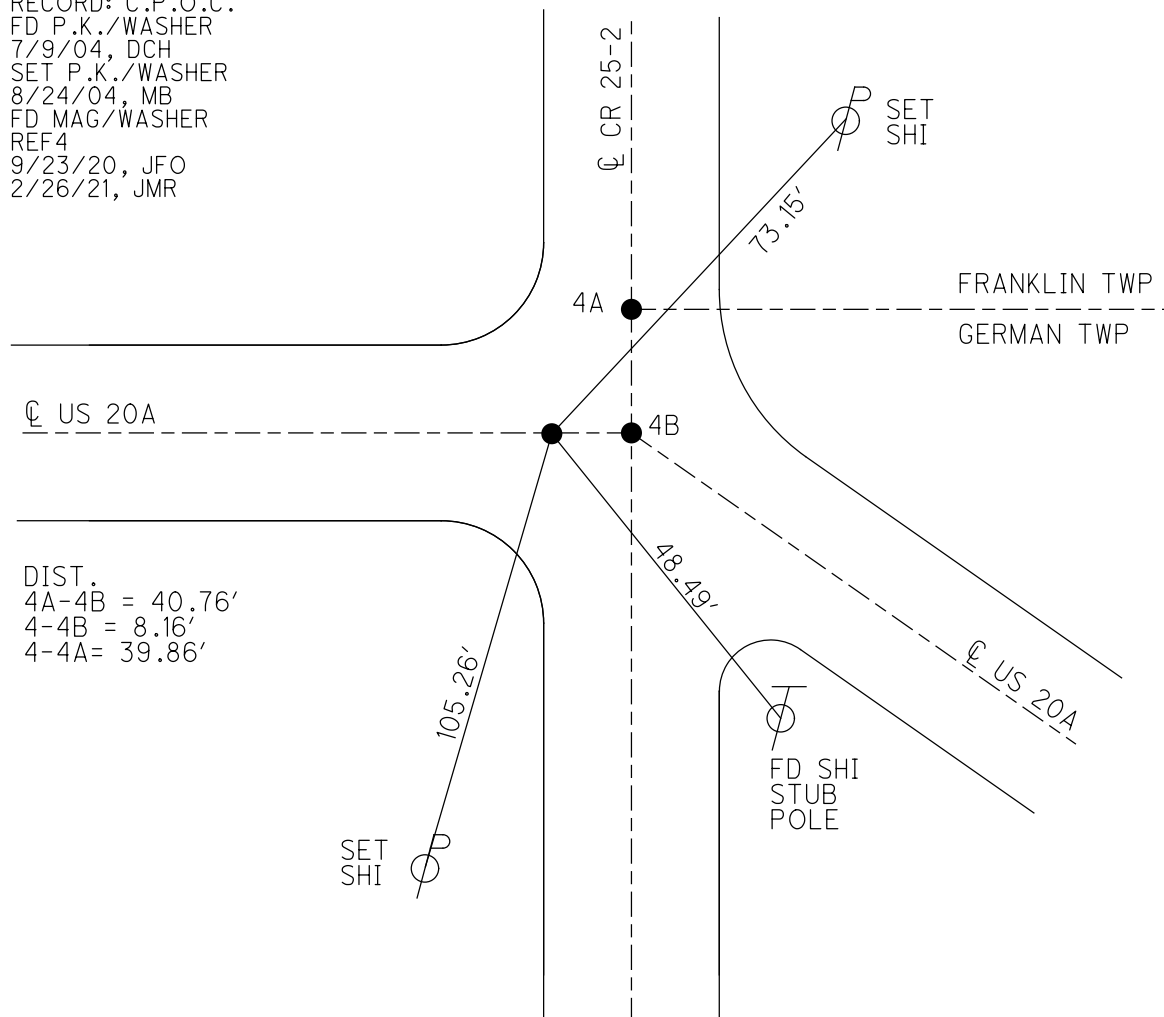

DIST.
4A-4B = 40.76'
4-4B = 8.16'
4-4A = 39.86'

PERSONNEL

REFERENCE NO. 4 A

SHEET 5 OF 63

NOTES _____ NIESE

DATE 2/26/21

ROUTE US 20A

H.C. RHOADES

WEATHER CLOUDY

COUNTY FULTON

R.C. _____

TEMP. 31°

TOWNSHIP GERMANDWG BY NIESE PID PAVETRAINSECTION 12

T_7_N R_4_E

TYPE MONUMENT MAG NAIL

ON SURFACE - ~~BELOW~~ ON _____

OFFSET C PAVEMENT 39.76' LT : RT


_____TO_____EDGE PAVEMENT

STATION: 79+15


HORZ.DATUM: NAD83 2011

GEOID: NAVD88 2012A

GRID: NORTHING: 704950.856

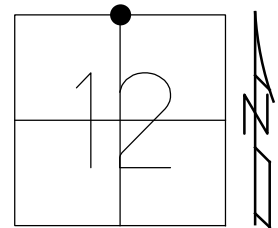EASTING: 1461857.855

RECORD:
FD IPIPE
2004
FD LG.R.R.SPIKE
7/9/04, DCH
FD MAG/WASHER
REFA4
9/23/20, JFO
2/26/21, JMR

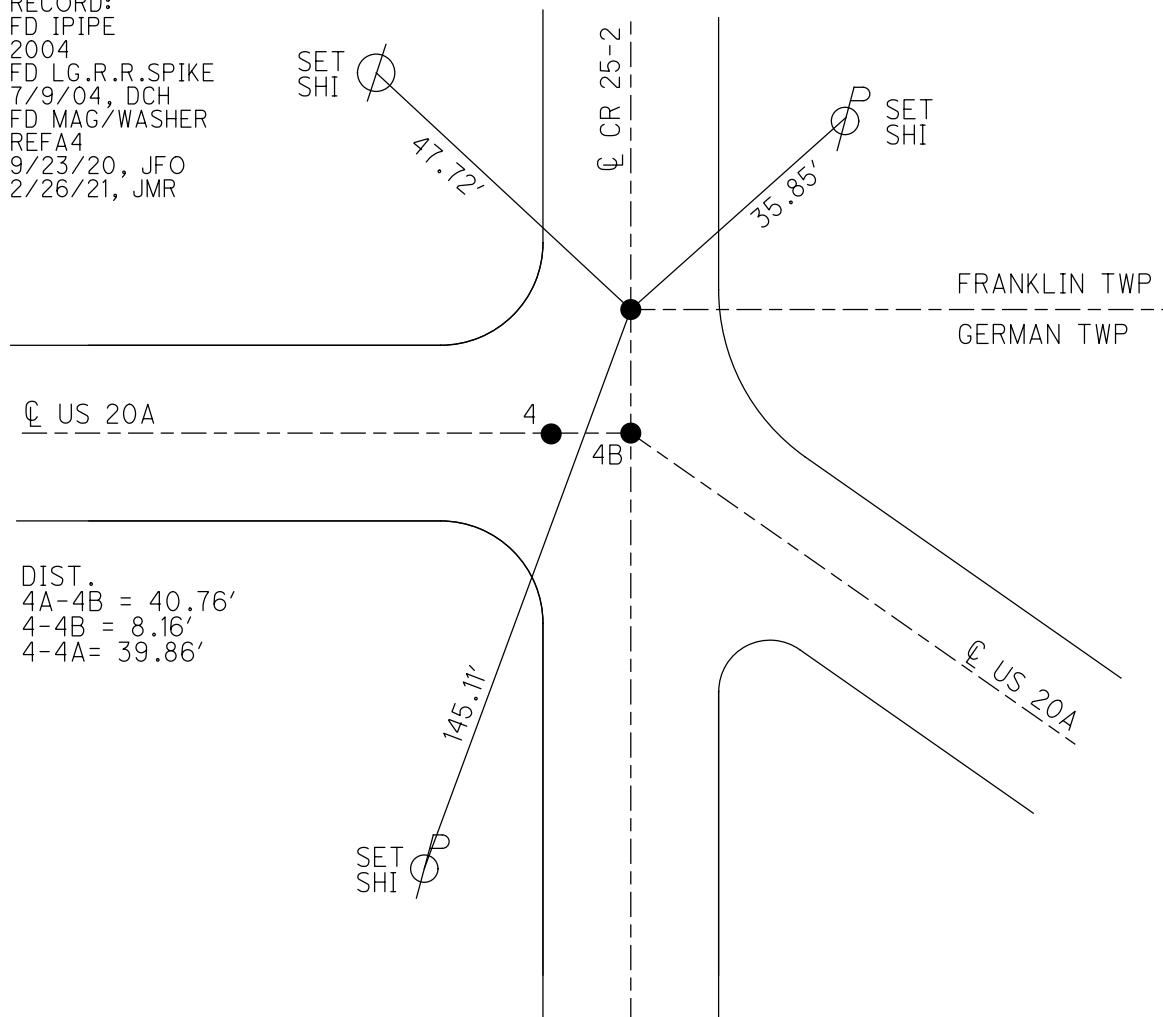

PERSONNEL _____ REFERENCE NO. 4 B SHEET 6 OF 63
NOTES NIESE DATE 2/26/21 ROUTE US 20A
H.C. RHOADES WEATHER CLOUDY COUNTY FULTON
R.C. _____ TEMP. 31° TOWNSHIP GERMAN
_____ SECTION 12
DWG BY NIESE PID PAVETRAIN T 7 N R 4 E
TYPE MONUMENT MAG/WASHER
ON SURFACE - ~~BELOW~~ ON
OFFSET C PAVEMENT 1.1' ~~LT~~ : RT
- TO - EDGE PAVEMENT
STATION: 79+15
HORZ.DATUM: NAD83 2011 GEOID: NAVD88 2012A
GRID: NORTHING: 704910.134 EASTING: 1461857.214

€ US 20A

O.D.O.T. DISTRICT 2 SURVEY OFFICE (USE ONLY)

PERSONNEL

REFERENCE NO. 5

SHEET 7 OF 63

NOTES NIESE

DATE 2/26/21

ROUTE US 20A

H.C. RHOADES

WEATHER CLOUDY

COUNTY FULTON

R.C.

TEMP. 31°

TOWNSHIP GERMAN

DWG BY NIESE

PID PAVETRAIN

SECTION 12

T 7 N R 4 E

TYPE MONUMENT MAG/WASHER

ON SURFACE - ~~BELOW~~ ON

OFFSET Q PAVEMENT ON LT : RT

9.3' TO LT EDGE PAVEMENT


STATION: 92+32

HORZ.DATUM: NAD83 2011


GEOID: NAVD88 2012A

GRID: NORTHING: 704323.066

EASTING: 1463150.062

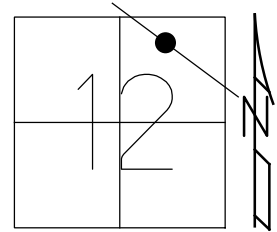

RECORD: P.I.
STA. 93+34.9
 $\Delta = 0^\circ 18' 01''$ RT
4/17/74, BEACH
FD P.K./WASHER
7/9/04, DCH
SET MAG/WASHER
8/24/04, MB
FD MAG/WASHER
REF5
9/23/20, JFO
2/26/21, JMR
8/26/21, JFO

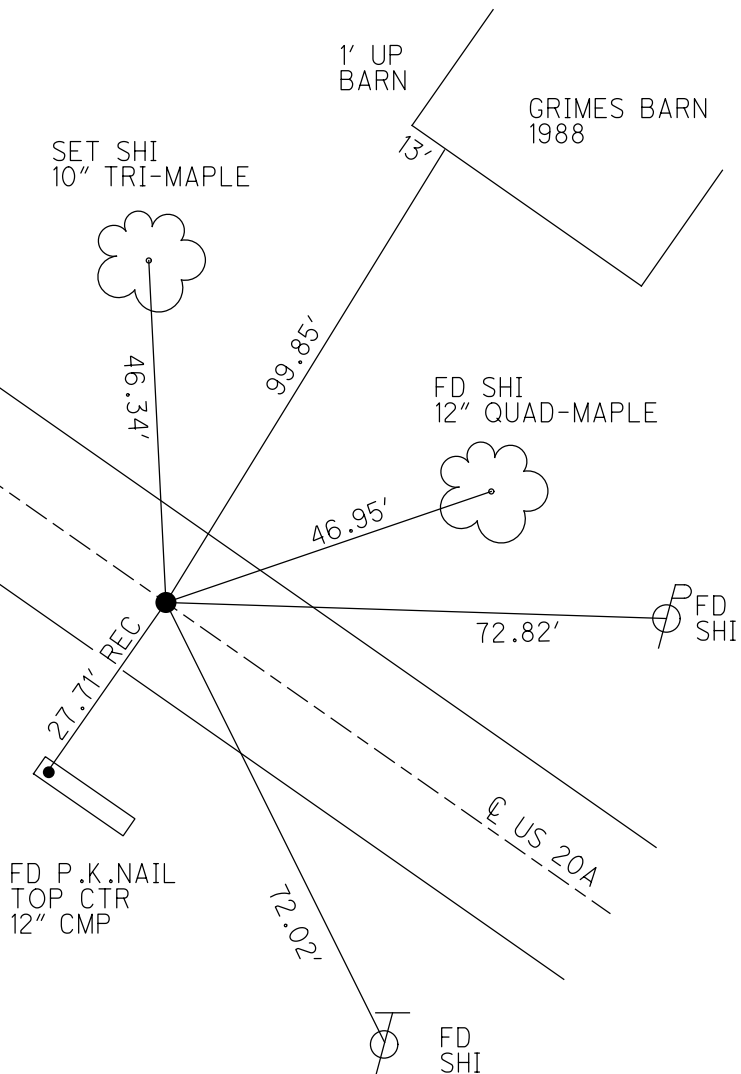

O.D.O.T. DISTRICT 2 SURVEY OFFICE (USE ONLY)

PERSONNEL

REFERENCE NO. 5 A

SHEET 8 OF 63

NOTES NIESE

DATE 2/26/21

ROUTE US 20A

H.C. RHOADES

WEATHER CLOUDY

COUNTY FULTON

R.C. _____

TEMP. 31°

TOWNSHIP GERMAN

SECTION 7

DWG BY NIESE

PID PAVETRAIN

T 7 N R 5 E

TYPE MONUMENT MAG/WASHER

ON SURFACE - ~~BELOW~~ ON

OFFSET Q PAVEMENT ON LT : RT

9.9' TO RT EDGE PAVEMENT


STATION: 108+20

HORZ.DATUM: NAD83 2011

GEOID: NAVD88 2012A


GRID: NORTHING: 703668.131

EASTING: 1464480.011

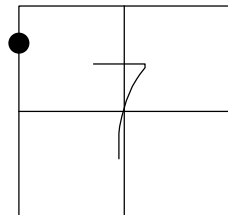

RECORD:

FD P.K.NAIL
7/9/04, DCH
SET MAG/WASHER
8/24/04, MB
FD MAG/WASHER
REFA5
9/23/20, JFO
2/26/21, JMR
8/26/21, JFO

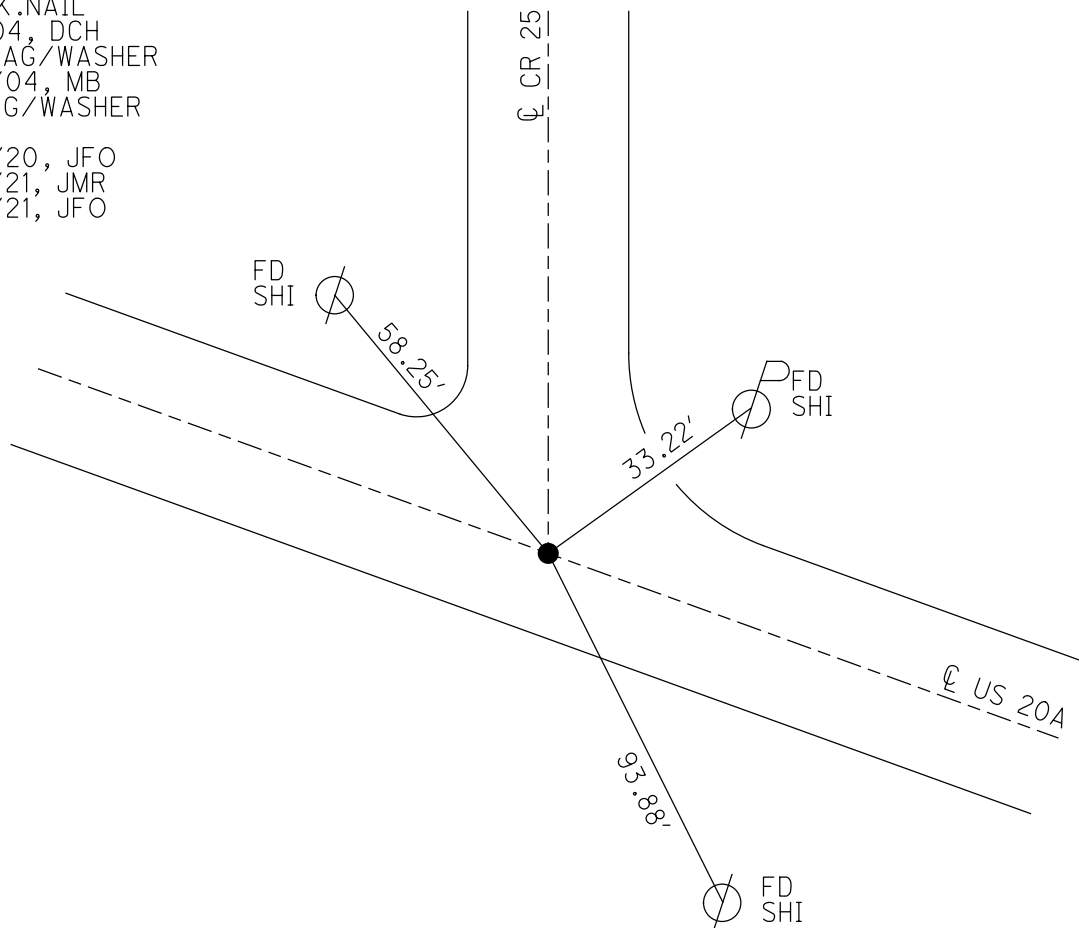

O.D.O.T. DISTRICT 2 SURVEY OFFICE (USE ONLY)

PERSONNEL

REFERENCE NO. 6

SHEET 9 OF 63

NOTES NIESE

DATE 2/26/21

ROUTE US 20A

H.C. RHOADES

WEATHER CLOUDY

COUNTY FULTON

R.C.

TEMP. 31°

TOWNSHIP GERMAN

DWG BY NIESE

PID PAVETRAIN

SECTION 7

T 7 N R 5 E

TYPE MONUMENT MAG/WASHER

ON SURFACE - ~~BELOW~~ ON

OFFSET CL PAVEMENT 1.4' LT : ~~RT~~

8.8' TO LT EDGE PAVEMENT



STATION: 110+33

HORZ.DATUM: NAD83 2011

GEOID: NAVD88 2012A

GRID: NORTHING: 703574.360

EASTING: 1464670.653

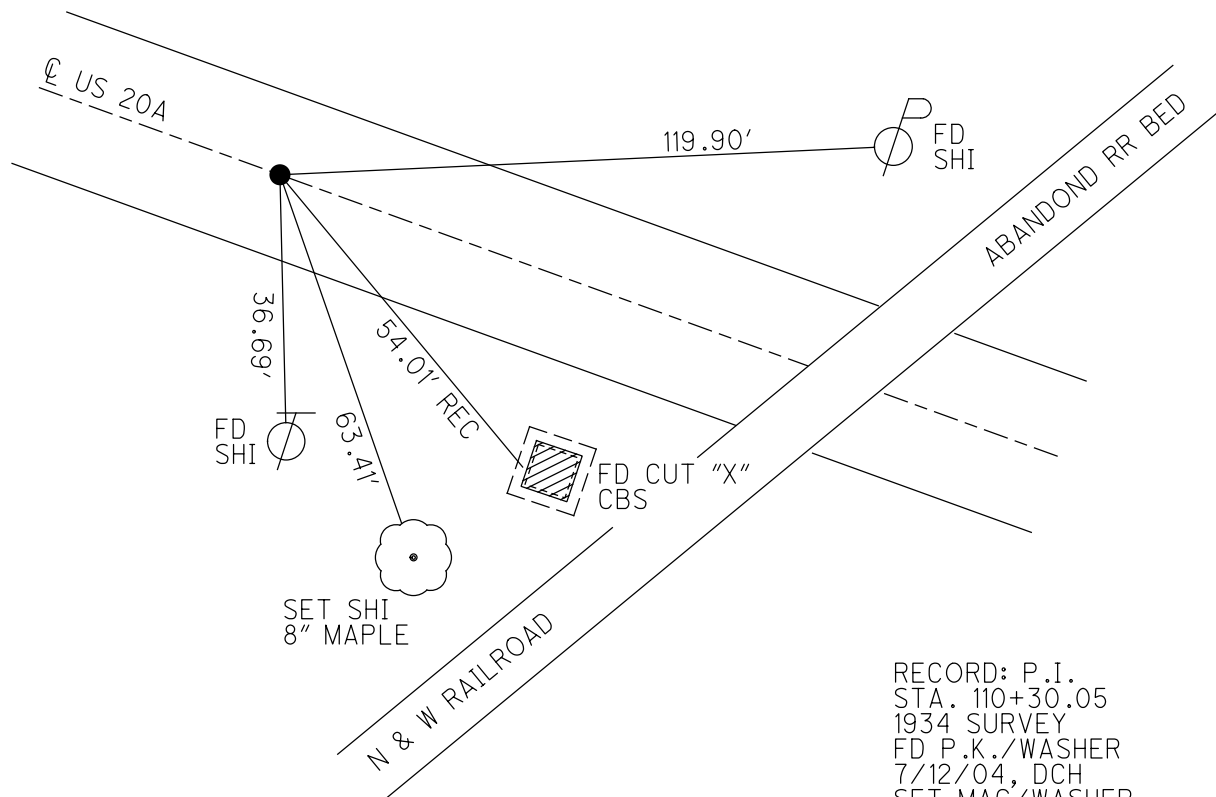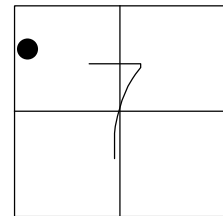

RECORD: P.I.
STA. 110+30.05
1934 SURVEY
FD P.K./WASHER
7/12/04, DCH
SET MAG/WASHER
8/24/04, MB
FD MAG/WASHER
REF6
9/23/20, JFO
2/26/21, JMR
8/26/21, JFO

O.D.O.T. DISTRICT 2 SURVEY OFFICE (USE ONLY)

PERSONNEL

REFERENCE NO. 6 A

SHEET 10 OF 63

NOTES NIESE

DATE 2/26/21

ROUTE US 20A

H.C. RHOADES

WEATHER CLOUDY

COUNTY FULTON

R.C. _____

TEMP. 31°

TOWNSHIP GERMAN

DWG BY NIESE

PID PAVETRAIN

SECTION 7

T 7 N R 5 E

TYPE MONUMENT MAG/WASHER

ON SURFACE - ~~BELOW~~ ON

OFFSET Q PAVEMENT ON LT : RT

10.77' TO LT EDGE PAVEMENT


STATION: 125+09

HORZ.DATUM: NAD83 2011


GEOID: NAVD88 2012A

GRID: NORTHING: 702906.525

EASTING: 1465988.559

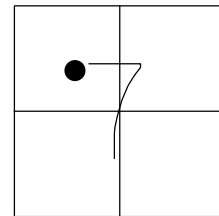

RECORD: P.O.T.
STA. 125+07.57
PRE 1934
FD P.K./WASHER
7/12/04, MB
SET MAG/WASHER
8/24/04, MB
FD MAG/WASHER
REF A6
9/24/20, JFO
2/26/21, JMR
8/26/21, JFO

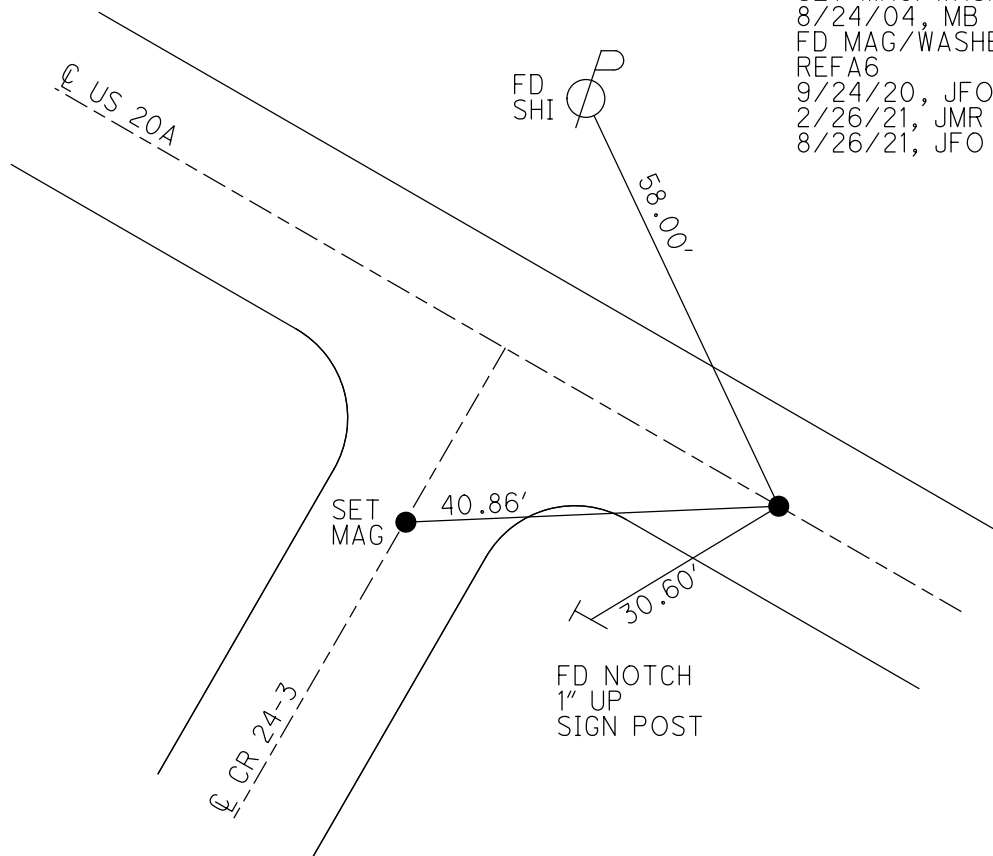

O.D.O.T. DISTRICT 2 SURVEY OFFICE (USE ONLY)

PERSONNEL

REFERENCE NO. 6 B

SHEET 11 OF 63

NOTES NIESE

DATE 2/26/21

ROUTE US 20A

H.C. RHOADES

WEATHER CLOUDY

COUNTY FULTON

R.C. _____

TEMP. 31°

TOWNSHIP GERMAN

DWG BY NIESE

PID PAVETRAIN

SECTION 7

T 7 N R 5 E

TYPE MONUMENT 1" IPIPE

~~ON SURFACE~~ - BELOW 6"

OFFSET CL PAVEMENT 31.8' ~~LT~~ : RT


21.8' TO RT EDGE PAVEMENT

STATION: 130+11



HORZ.DATUM: NAD83 2011

GEOID: NAVD88 2012A

GRID: NORTHING: _____ EASTING: _____

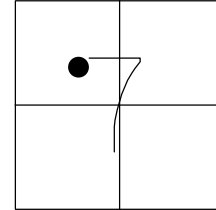

RECORD: P.I.
FD 1" IPIPE
6" DOWN
5/18/94, CL
D.N.F.
9/24/20, JFO
2/26/21, JMR

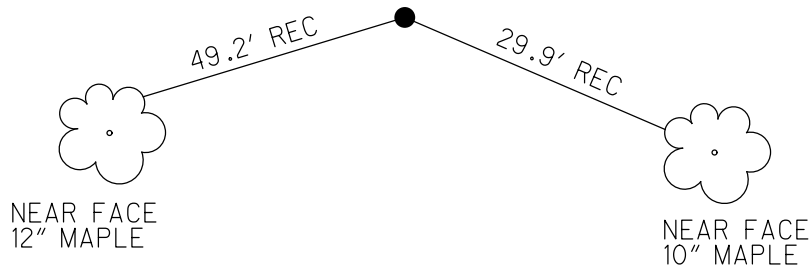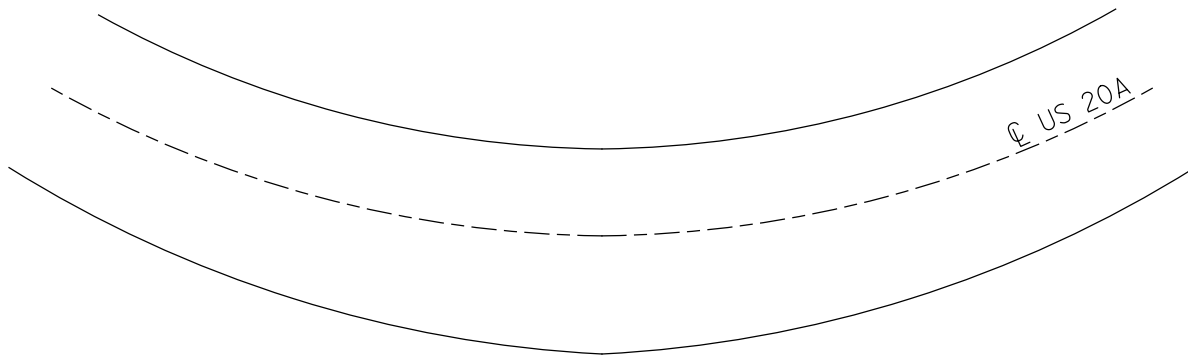

O.D.O.T. DISTRICT 2 SURVEY OFFICE (USE ONLY)

PERSONNEL

REFERENCE NO. 6 BB

SHEET 12 OF 63

NOTES NIESE

DATE 2/26/21

ROUTE US 20A

H.C. RHOADES

WEATHER CLOUDY

COUNTY FULTON

R.C.

TEMP. 31°

TOWNSHIP GERMAN

SECTION 7

DWG BY NIESE

PID PAVETRAIN

T 7 N R 5 E

TYPE MONUMENT MAG/WASHER

ON SURFACE - ~~BELOW~~ ON

OFFSET CL PAVEMENT 1.7' ~~LT~~ : RT

9.2' TO RT EDGE PAVEMENT


STATION: 132+72

HORIZ.DATUM: NAD83 2011

GEOID: NAVD88 2012A


GRID: NORTHING: 702670.729

EASTING: 1466709.324

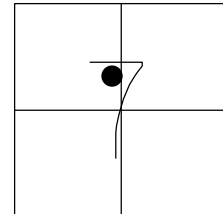

RECORD: P.T.
STA. 132+45.53
FD P.K./WASHER
7/12/04, MB
SET MAG/WASHER
8/24/04, MB
FD MAG/WASHER
REFBB6
9/24/20, JFO
2/26/21, JMR
SET MAG/WASHER
REFBB6
11/8/21, JFO

SET NOTCHES
GR POSTS

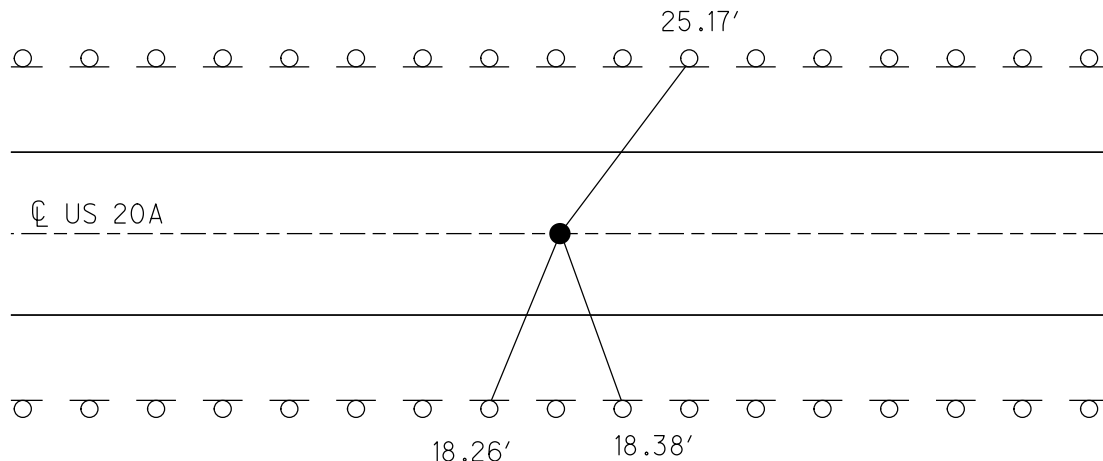

O.D.O.T. DISTRICT 2 SURVEY OFFICE (USE ONLY)

PERSONNEL

REFERENCE NO. 6 BBB

SHEET 13 OF 63

NOTES NIESE

DATE 2/26/21

ROUTE US 20A

H.C. RHOADES

WEATHER CLOUDY

COUNTY FULTON

R.C. _____

TEMP. 31°

TOWNSHIP GERMAN

DWG BY NIESE

PID PAVETRAIN

SECTION 7

T 7 N R 5 E

TYPE MONUMENT P.K./WASHER

ON SURFACE - ~~BELOW~~ ON

OFFSET CL PAVEMENT ON LT : RT

9.0' TO LT EDGE PAVEMENT


STATION: 132+17

HORIZ.DATUM: NAD83 2011


GEOID: NAVD88 2012A

GRID: NORTHING: _____

EASTING: _____

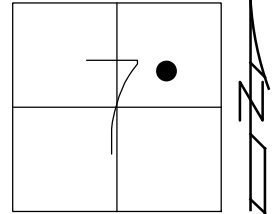

RECORD: P.C.
FD P.K./WASHER
3/3/83, IRS
SET P.K./WASHER
8/9/83, SWH
SET P.K.NAIL
STA. 156+89.37
3/3/85, IRS
D.N.F.
7/12/04, MB
9/24/20, JFO
2/26/21, JMR

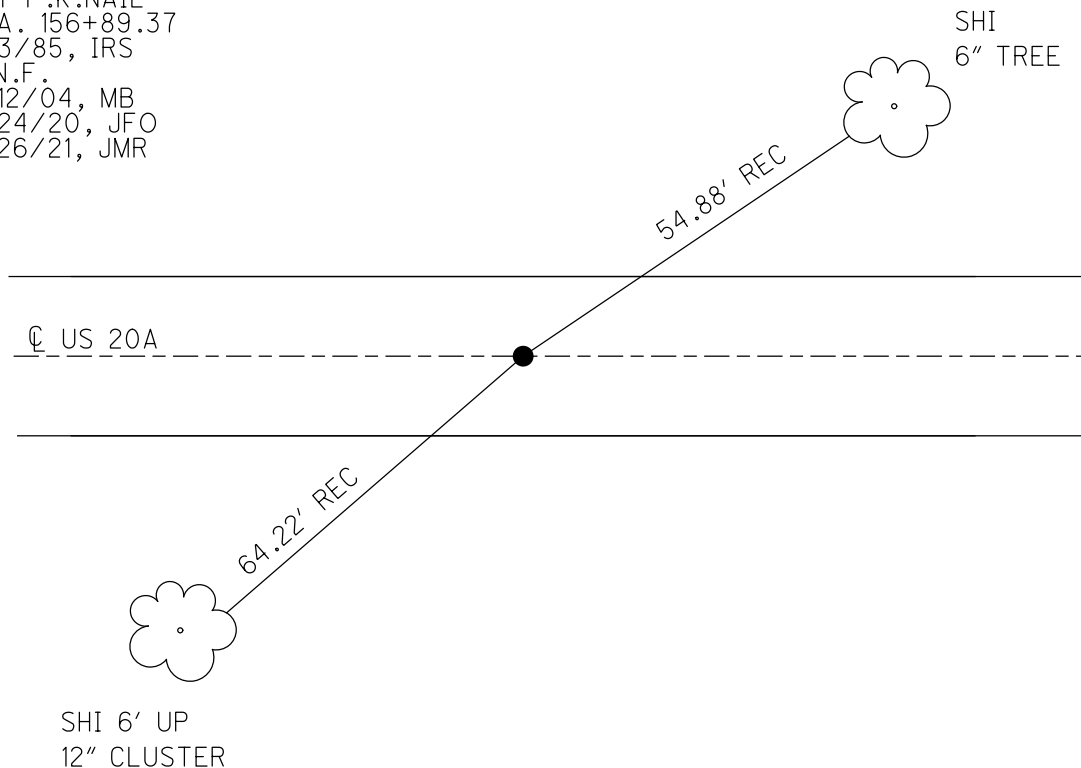

O.D.O.T. DISTRICT 2 SURVEY OFFICE (USE ONLY)

PERSONNEL

REFERENCE NO. 6 C

SHEET 14 OF 63

NOTES RHOADES

DATE 9/24/20

ROUTE US 20A

H.C. O'DONNELL

WEATHER SUNNY

COUNTY FULTON

R.C. AUBLE

TEMP. 56°

TOWNSHIP GERMAN

SECTION 7

DWG BY RHOADES

PID PAVETRAIN

T 7 N R 5 E

TYPE MONUMENT 1" IPIPE

~~ON SURFACE~~ - BELOW 1"

OFFSET CL PAVEMENT - LT : RT

68.1' TO LT EDGE PAVEMENT



STATION: 141+66

HORZ.DATUM: NAD83 2011

GEOID: NAVD88 2012A

GRID: NORTHING: 702655.909

EASTING: 1467608.395

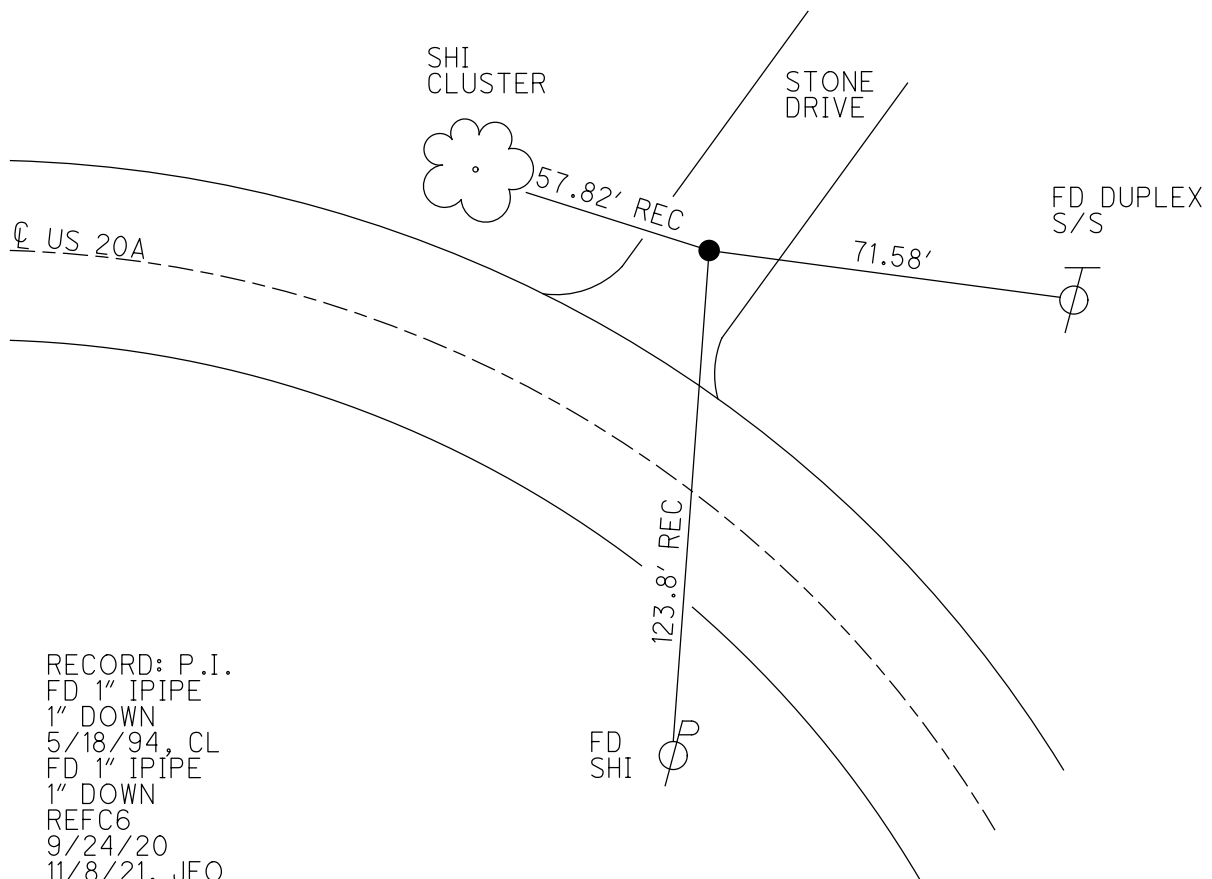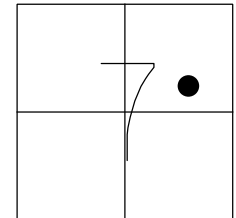

O.D.O.T. DISTRICT 2 SURVEY OFFICE (USE ONLY)

PERSONNEL

REFERENCE NO. 6 D

SHEET 15 OF 63

NOTES NIESE

DATE 2/26/21

ROUTE US 20A

H.C. RHOADES

WEATHER CLOUDY

COUNTY FULTON

R.C. _____

TEMP. 31°

TOWNSHIP GERMAN

DWG BY NIESE

PID PAVETRAIN

SECTION 7

T 7 N R 5 E

TYPE MONUMENT SM.R.R.SPIKE

~~ON SURFACE~~ - BELOW 5"

OFFSET CL PAVEMENT ON LT : RT

10.1' TO LT EDGE PAVEMENT


STATION: 149+28.94

HORZ.DATUM: NAD83 2011


GEOID: NAVD88 2012A

GRID: NORTHING: 702148.026

EASTING: 1468207.178

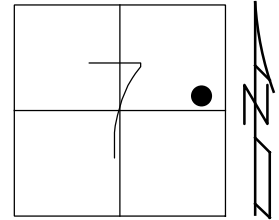

RECORD:
ORIGIN UNKNOWN
FD R.R.SPIKE
7/6/83, CL
SET P.K./WASHER
8/9/83, SWH
FD SM.R.R.SPIKE
5" DOWN
REFD6
8/25/17, DCH
10/15/19, JFO
9/21/20, JFO
2/26/21, JMR
11/8/21, JFO

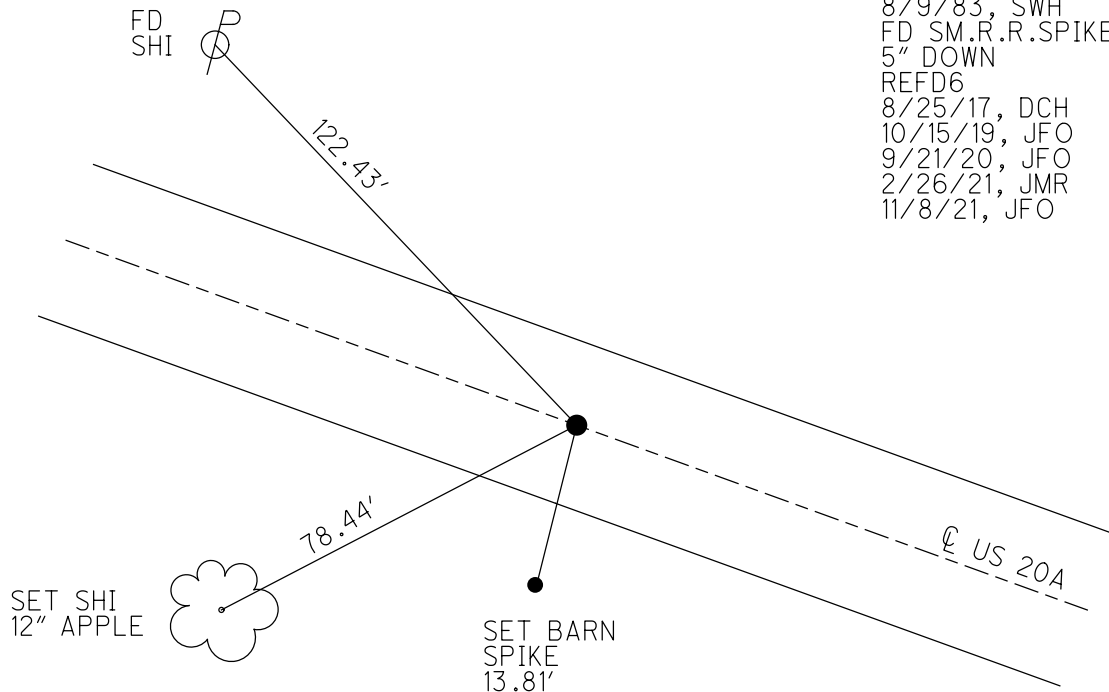

O.D.O.T. DISTRICT 2 SURVEY OFFICE (USE ONLY)

PERSONNEL

REFERENCE NO. 7


NOTES LEU
H.C. LEU
R.C. HOMAN

DATE 8/25/17
WEATHER CLR
TEMP. 61°

ROUTE US 20A
COUNTY FULTON
TOWNSHIP GERMAN
SECTION 8
T 7 N R 5 E

DWG BY NIESE PID 92126

TYPE MONUMENT MAG NAIL/WASHER
ON SURFACE - BELOW ON
OFFSET $\varnothing$ PAVEMENT ON

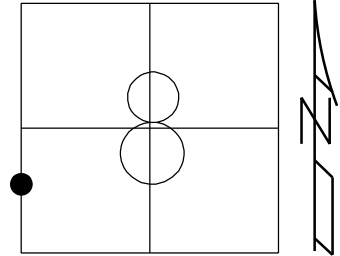

STATION: 158+24.00


HORIZ.DATUM: NAD83/FUL OCCS GEOID: 18

GRID: NORTHING: 701558.928 EASTING: 1468901.548

LDP: NORTHING: 356525.476 EASTING: 115848.741

RECORD:
SET P.K.NAIL
9/9/73, BENCH
FD P.K.NAIL
4/9/92, STANLEY
FD P.K./WASHER
1 1/2" DOWN
7/12/04, MB
SET MAG/WASHER
8/24/04, MB
FD MAG/WASHER
REF7
8/21/17, JLL
SET MAG/WASHER
NEWREF7
10/15/19, JFO
FD MAG/WASHER
CKREF7
9/16/20, JFO
FD MAG/WASH
REF7
8/25/25, TDN

NOTE:
SR 66 REF102

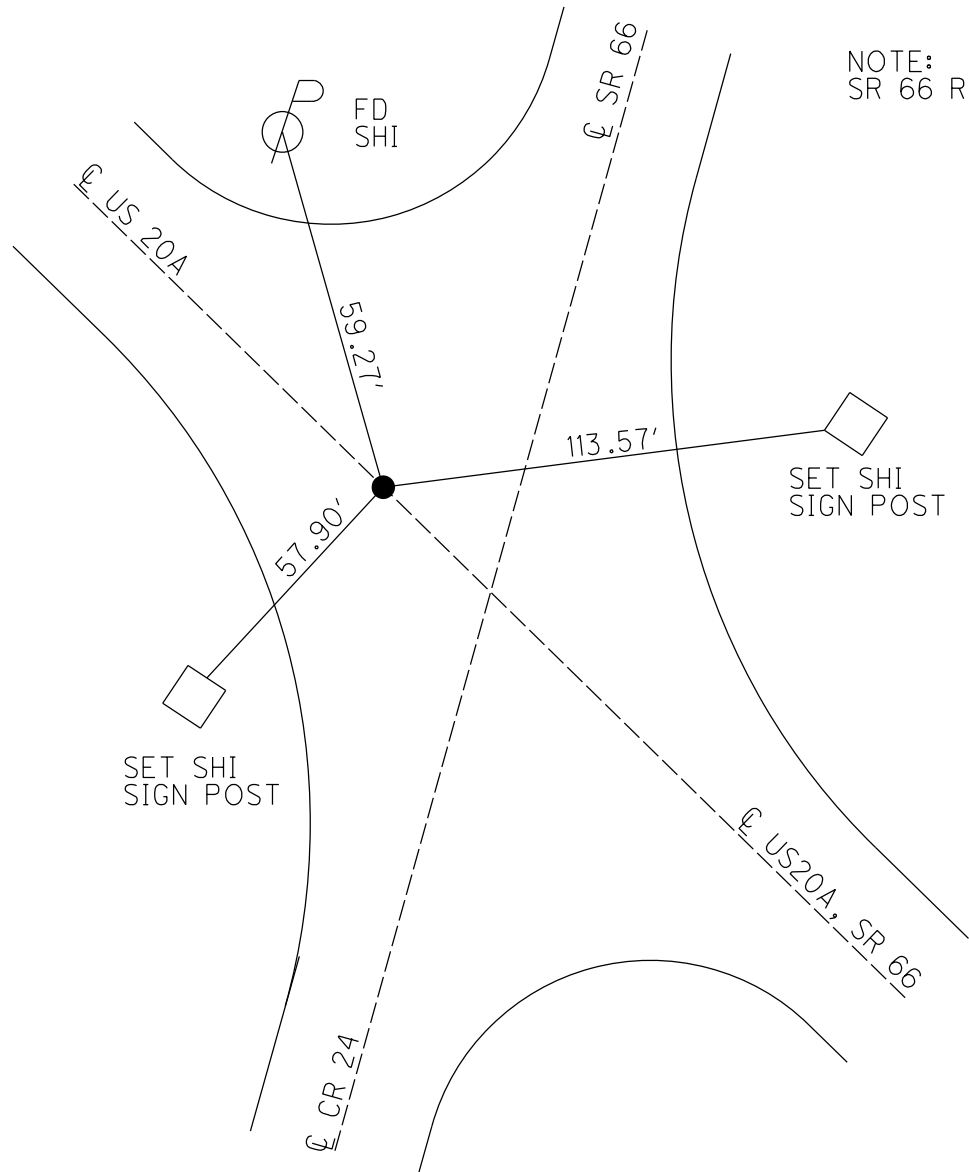

O.D.O.T. DISTRICT 2 SURVEY OFFICE (USE ONLY)

PERSONNEL

REFERENCE NO. 7A

NOTES PRESTON-COLVIN

DATE 8/25/25

ROUTE US 20A

H.C. NIESE

WEATHER CLR

COUNTY FULTON

R.C. PRESTON-COLVIN

TEMP. 70°

TOWNSHIP GERMAN

DWG BY BARRIERE

PID NO PID (R/W)

SECTION 8

T 7 N R 5 E

TYPE MONUMENT MAG NAIL/WASHER

ON SURFACE - BELOW ON

OFFSET Q PAVEMENT ON

STATION: 190+90.04

HORIZ. DATUM: NAD83/FUL OCCS


GEOID: 18

GRID: NORTHING: 699456.222

EASTING: 1471380.402

LDP: NORTHING: 354469.900


EASTING: 118367.014

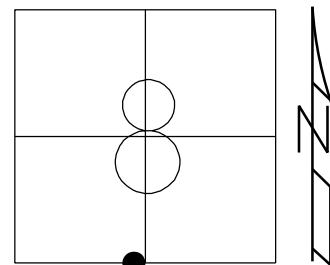


RECORD: 7A

P.I.
STA 191+05.27
 $\Delta=39^{\circ}16'LT$
1984
FD HARROW TOOTH
3" DOWN
REFA7
8/25/17, JLL
FD HARROW TOOTH
3" DOWN
CKREFA7
9/16/20, JFO
SET MAG/WASHER
NEWREF7A
8/25/25, TDN

RECORD: 7B
FD RSPK 3" DOWN
REF7B
8/25/25, TDN

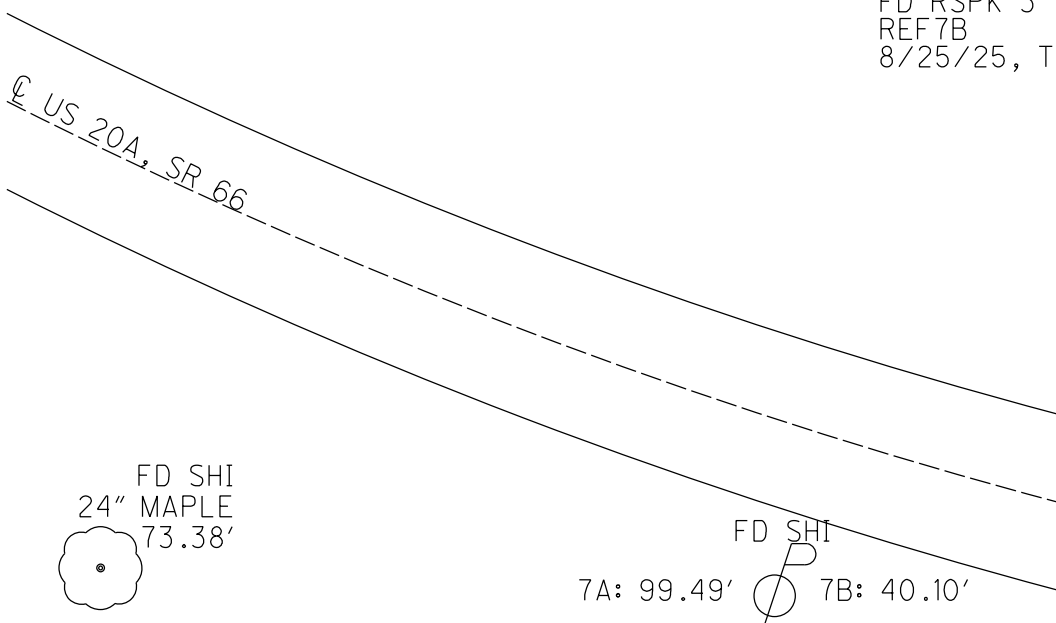

FD SHI
125.79'

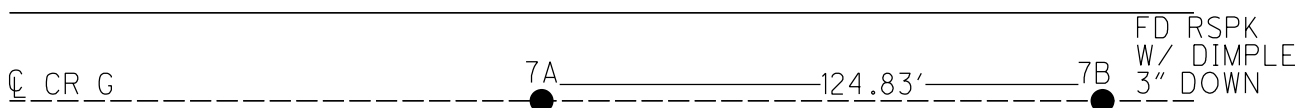

SET SHI
53.74'

SET SHI
47.58'

O.D.O.T. DISTRICT 2 SURVEY OFFICE (USE ONLY)

PERSONNEL

REFERENCE NO. 8

SHEET 18 OF 62

NOTES O'DONNELL

DATE 7/10/19

ROUTE US 20A

H.C. LEU

WEATHER FAIR

COUNTY FULTON

R.C. AUBLE

TEMP. 76°

TOWNSHIP GERMAN

MILLER

SECTION 8

DWG BY NIESE

PID 92126

T 7 N R 5 E

TYPE MONUMENT MAG/WASHER

ON SURFACE - ~~BELOW~~ ON

OFFSET Q PAVEMENT 0.5' ~~LT~~ : RT

9.6' TO RT EDGE PAVEMENT


STATION: 204+88

HORZ.DATUM: NAD83(2011)

GEOID: 2012A


GRID: NORTHING: 669430.560

EASTING: 1472818.498

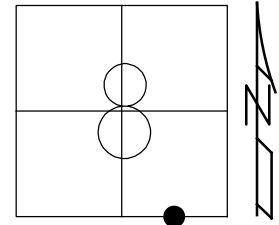

RECORD:
FD PK/WASHER
7/12/04, MB
SET MAG/WASHER
8/24/04, MB
FD MAG/WASHER
9/24/14
US 20A REF8
9/29/14, EBW
SET MAG/WASHER
US 20A NEWREF8
10/15/19, JFO

NOTE:
SR 66 REF 101

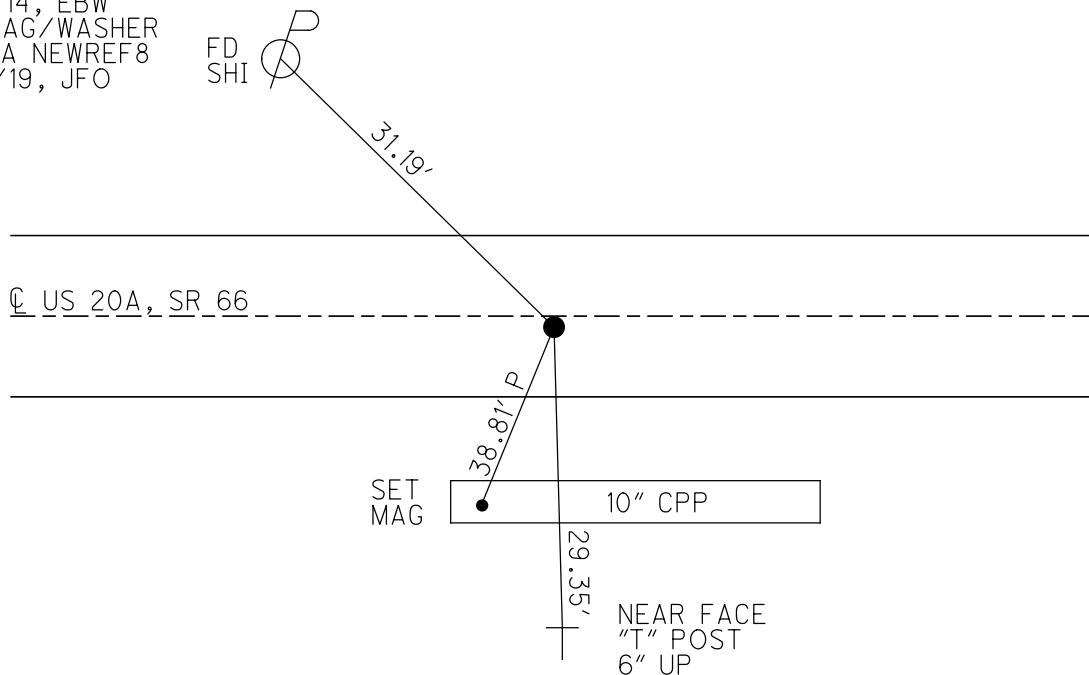

O.D.O.T. DISTRICT 2 SURVEY OFFICE (USE ONLY)

PERSONNEL

REFERENCE NO. 9

SHEET 19 OF 62

NOTES O'DONNELL

DATE 7/10/19

ROUTE US 20A

H.C. LEU

WEATHER SUNNY

COUNTY FULTON

R.C. AUBLE

TEMP. 76°

TOWNSHIP GERMAN

MILLER

SECTION 9

DWG BY NIESE

PID 92126

T 7 N R 5 E

TYPE MONUMENT MONBOX W/ 1" IPIN

ON SURFACE - ~~BELOW~~ ON

OFFSET $\varnothing$ PAVEMENT 1.2' ~~LT~~ : RT

- TO - EDGE PAVEMENT


STATION: 218+04.5

HORZ.DATUM: NAD83(2011)

GEOID: 2012A


GRID: NORTHING: 699406.988

EASTING: 1474134.806

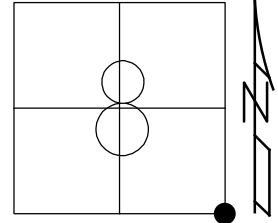

RECORD:
STA 315+32
FD PK/WASHER
10/13/93, CL
6/5/02, TMR
FD 1" IPIN IN CONC
7" BELOW
SET MONBOX
9/17/02, TMR
FD MONBOX
2002
FD 1" IPIN IN
MONBOX
REF9
7/24/14, EBW
SR66
REF13A
7/10/19, JFO

NOTE:
SR 66 REF 13A

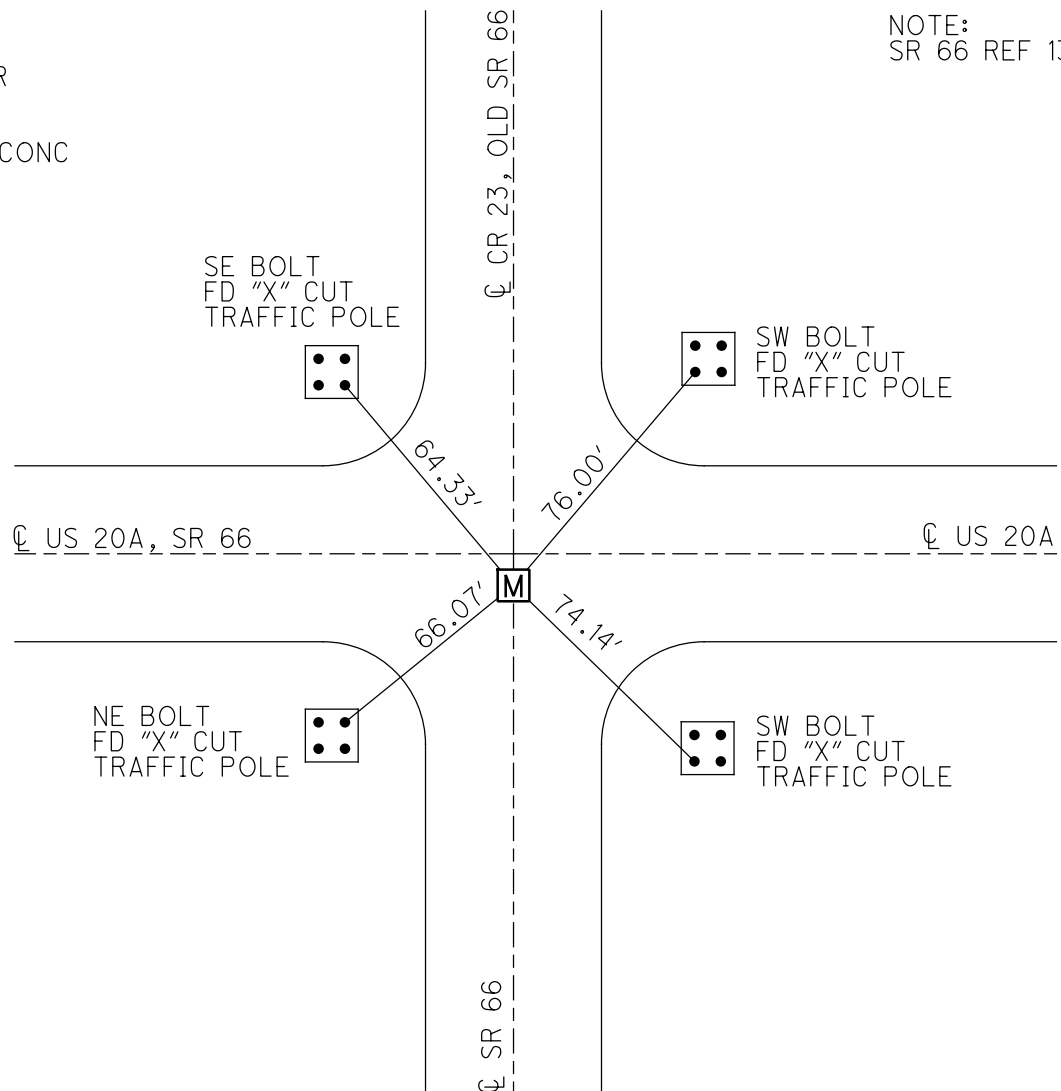

O.D.O.T. DISTRICT 2 SURVEY OFFICE (USE ONLY)

PERSONNEL

REFERENCE NO. 9 A

SHEET 20 OF 62

NOTES LEU

DATE 7/12/18

ROUTE US 20A

H.C. LEU

WEATHER SUNNY

COUNTY FULTON

R.C. HAGEMEYER

TEMP. 83°

TOWNSHIP GERMAN

SECTION 9

DWG BY NASON

PID 101232

T 7 N R 5 E

TYPE MONUMENT P.K.SHANK

ON ~~SURFACE~~ - BELOW 3"

OFFSET Q PAVEMENT 0.4' ~~LT~~ : RT

10.1' TO RT EDGE PAVEMENT


STATION: 231+22.76

HORZ.DATUM: NAD83(2011)


GEOID: 2012A

GRID: NORTHING: 699384.147

EASTING: 1475452.847

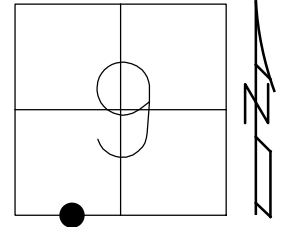

RECORD:
FD P.K./WASHER
6/6/02, TMR
SET MAG/WASHER
4/22/03, DCH
FD P.K.SHANK
3" DOWN
REFA9
9/24/14, EBW
SET MAG/WASHER
10/15/19, JFO

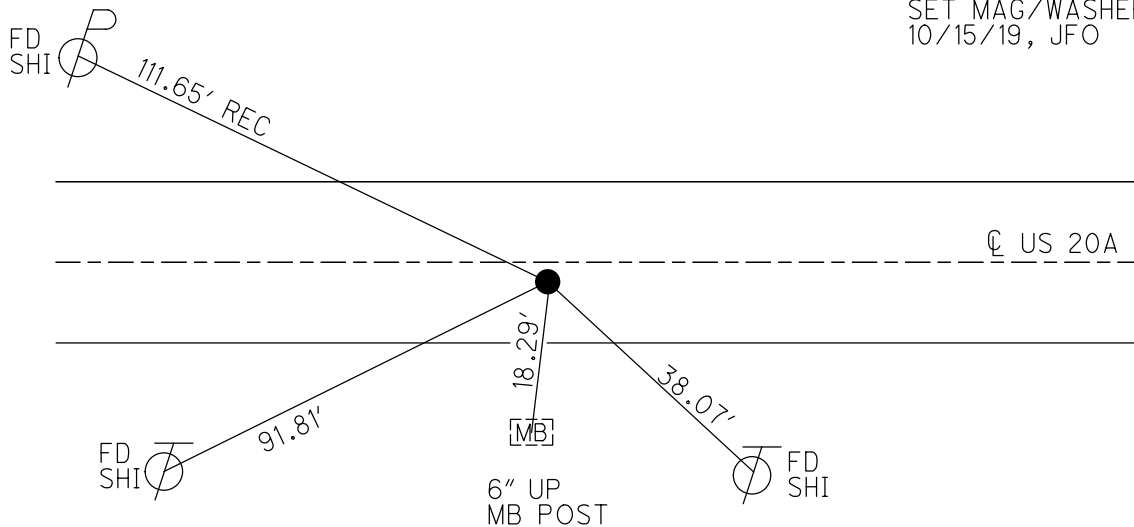

O.D.O.T. DISTRICT 2 SURVEY OFFICE (USE ONLY)

PERSONNEL

REFERENCE NO. 10

SHEET 21 OF 62

NOTES LEU

DATE 7/12/18

ROUTE US 20A

H.C. LEU

WEATHER SUNNY

COUNTY FULTON

R.C. HAGEMEYER

TEMP. 83°

TOWNSHIP GERMAN

DWG BY NASON

PID 101232

SECTION 9

T 7 N R 5 E

TYPE MONUMENT P.K.NAIL

~~ON SURFACE~~ - BELOW 1"

OFFSET CL PAVEMENT 1.1' ~~LT~~ : RT

9.9' TO RT EDGE PAVEMENT


STATION: 244+40.76

HORZ.DATUM: NAD83(2011)


GEOID: 2012A

GRID: NORTHING: 699360.948

EASTING: 1476770.643

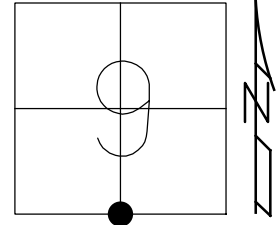

RECORD:
FD P.K./WASHER
6/6/02, TMR
SET MAG/WASHER
4/22/03, DCH
FD MAG/WASHER
REF10
9/24/14, EBW
SET MAG/WASHER
10/15/19, JFO

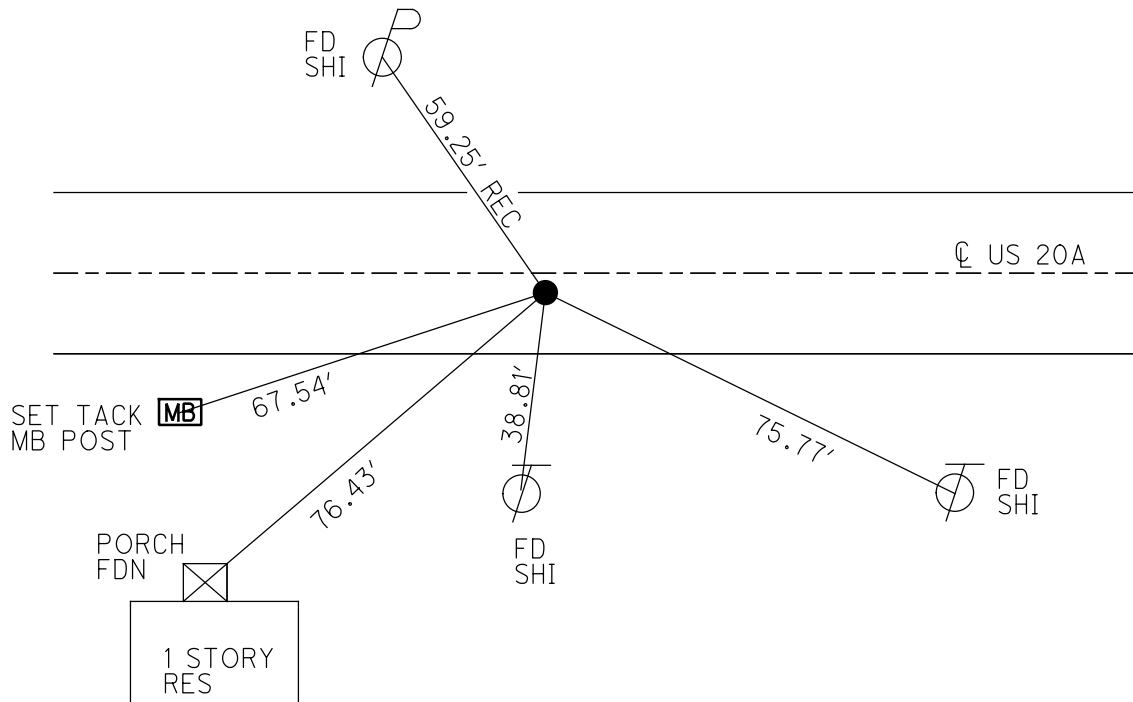

O.D.O.T. DISTRICT 2 SURVEY OFFICE (USE ONLY)

PERSONNEL

REFERENCE NO. 10 A

SHEET 22 OF 62

NOTES LEU

DATE 7/12/18

ROUTE US 20A

H.C. LEU

WEATHER SUNNY

COUNTY FULTON

R.C. HAGEMEYER

TEMP. 84°

TOWNSHIP GERMAN

SECTION 9

DWG BY NASON

PID 101232

T 7 N R 5 E

TYPE MONUMENT P.K./WASHER

~~ON SURFACE~~ - BELOW 1"

OFFSET CL PAVEMENT 0.8" ~~LT~~ : RT

9.8' TO RT EDGE PAVEMENT


STATION: 257+59.52

HORZ.DATUM: NAD83(2011)

GEOID: 2012A

GRID: NORTHING: 699337.938

EASTING: 1478089.202

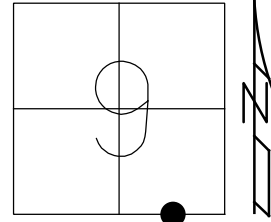

RECORD:

FD P.K./WASHER

6/6/02, TMR

SET MAG/WASHER

4/22/03, DCH

FD P.K./WASHER


1" DOWN

REFA10

9/29/14, EBW

SET MAG/WASHER

10/15/19, JFO

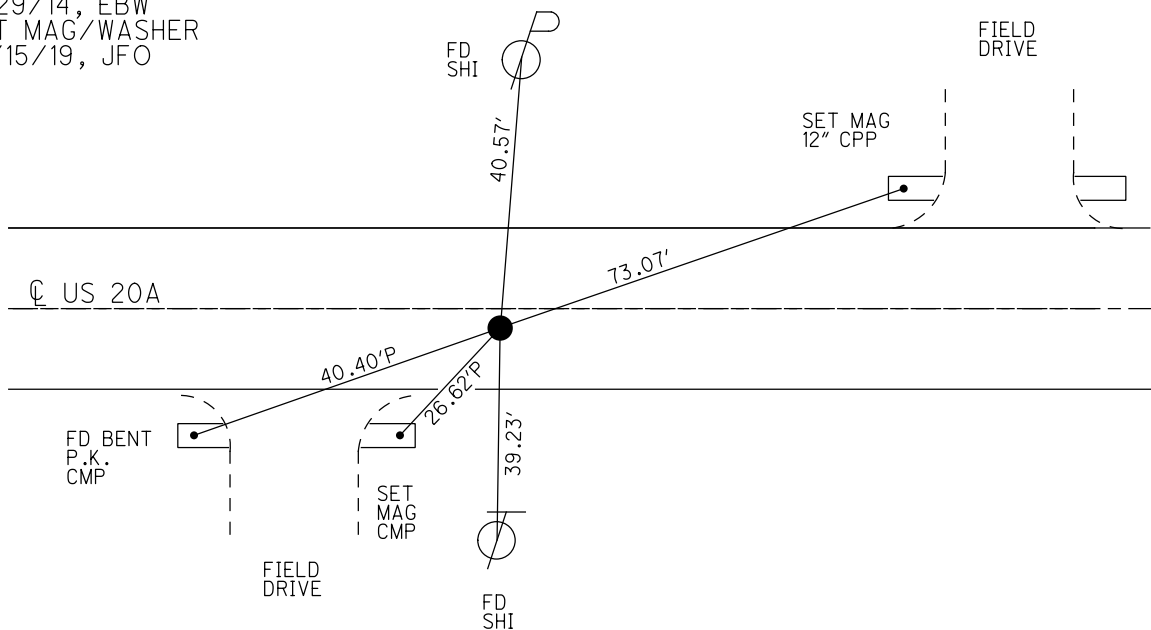

O.D.O.T. DISTRICT 2 SURVEY OFFICE (USE ONLY)

PERSONNEL

REFERENCE NO. 11

SHEET 23 OF 62

NOTES LEU

DATE 7/12/18

ROUTE US 20A

H.C. LEU

WEATHER SUNNY

COUNTY FULTON

R.C. HAGEMeyer

TEMP. 84°

TOWNSHIP GERMAN

DWG BY NASON

PID 101232

SECTION 9

T 7 N R 5 E

TYPE MONUMENT P.K./WASHER

~~ON SURFACE~~ - BELOW 1"

OFFSET Q PAVEMENT 0.6" ~~LT~~ : RT

- TO - EDGE PAVEMENT



STATION: 270+77.25

HORZ.DATUM: NAD83(2011)

GEOID: 2012A

GRID: NORTHING: 699315.053

EASTING: 1479406.734

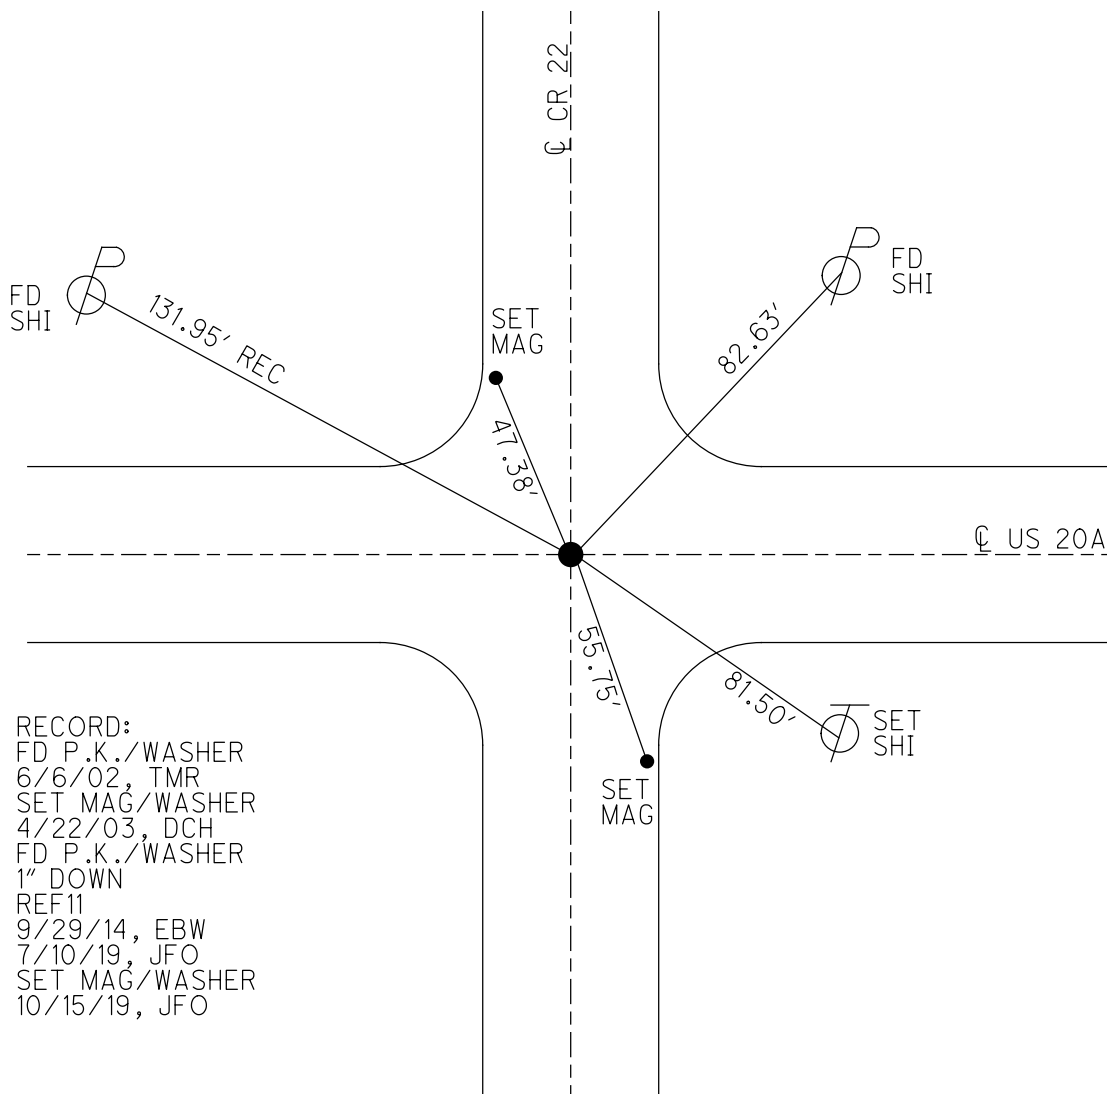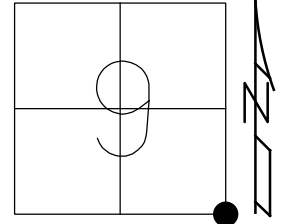

RECORD:
FD P.K./WASHER
6/6/02, TMR
SET MAG/WASHER
4/22/03, DCH
FD P.K./WASHER
1" DOWN
REF11
9/29/14, EBW
7/10/19, JFO
SET MAG/WASHER
10/15/19, JFO

O.D.O.T. DISTRICT 2 SURVEY OFFICE (USE ONLY)

PERSONNEL

REFERENCE NO. 11 A

SHEET 24 OF 62

NOTES MICHALAK

DATE 6/6/02

ROUTE US 20A

H.C. ROUSOS

WEATHER RAIN

COUNTY FULTON

R.C. MALINSKY

TEMP. 70°

TOWNSHIP GERMAN

DWG BY NASON

PID 101232

SECTION 10

T 7 N R 5 E

TYPE MONUMENT P.K./WASHER

ON SURFACE - ~~BELOW~~ ON

OFFSET CL PAVEMENT 0.5" LT : ~~RT~~

9.7' TO LT EDGE PAVEMENT


STATION: 283+92

HORIZ.DATUM: _____


GEOID: _____

GRID: NORTHING: _____

EASTING: _____

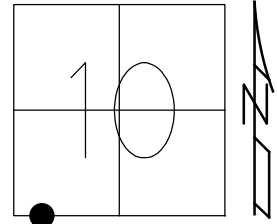

RECORD:
FD P.K./WASHER
6/6/02, TMR
DNF
7/10/19, JFO

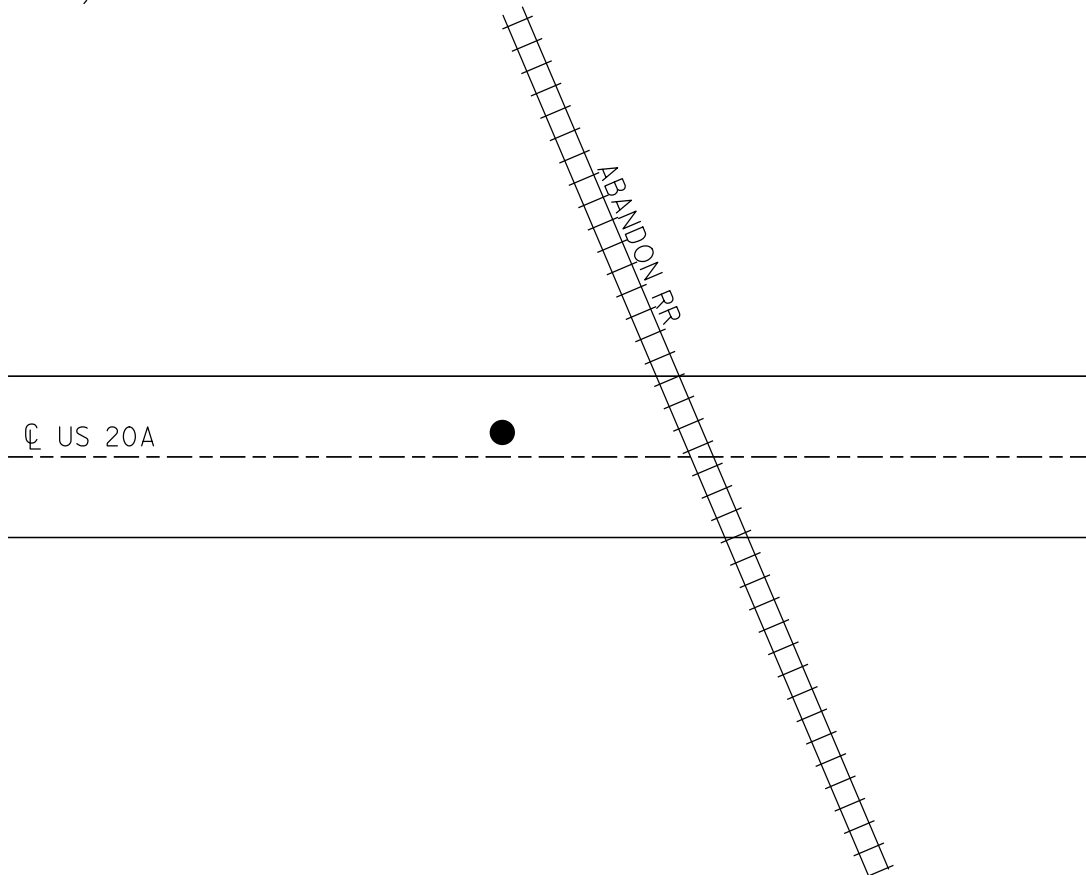

O.D.O.T. DISTRICT 2 SURVEY OFFICE (USE ONLY)

PERSONNEL

REFERENCE NO. 12

SHEET 25 OF 62

NOTES WESTFALL

DATE 6/6/02

ROUTE US 20A

H.C. HOMAN

WEATHER RAIN

COUNTY FULTON

R.C. LEU

TEMP. 65°

TOWNSHIP GERMAN

SECTION 10

DWG BY NASON

PID 101232

T 7 N R 5 E

TYPE MONUMENT P.K./WASHER

ON SURFACE - ~~BELOW~~ ON

OFFSET 0.4' ~~LT~~ : RT

10.0 TO RT EDGE PAVEMENT


STATION: 297+07.18

HORZ.DATUM: NAD83(2011)


GEOID: 2012A

GRID: NORTHING: 699262.594

EASTING: 1482036.143

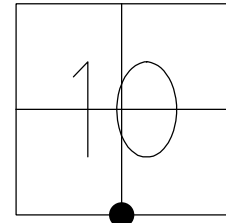

RECORD:
STA 297+09.8
FD P.K./WASHER
6/6/02, TMR
SET MAG/WASHER
4/22/03, DCH
FD MAG/WASHER
REF12
9/29/14, EBW
7/10/19, JFO
SET MAG/WASHER
NEWREF12
10/15/19, JFO

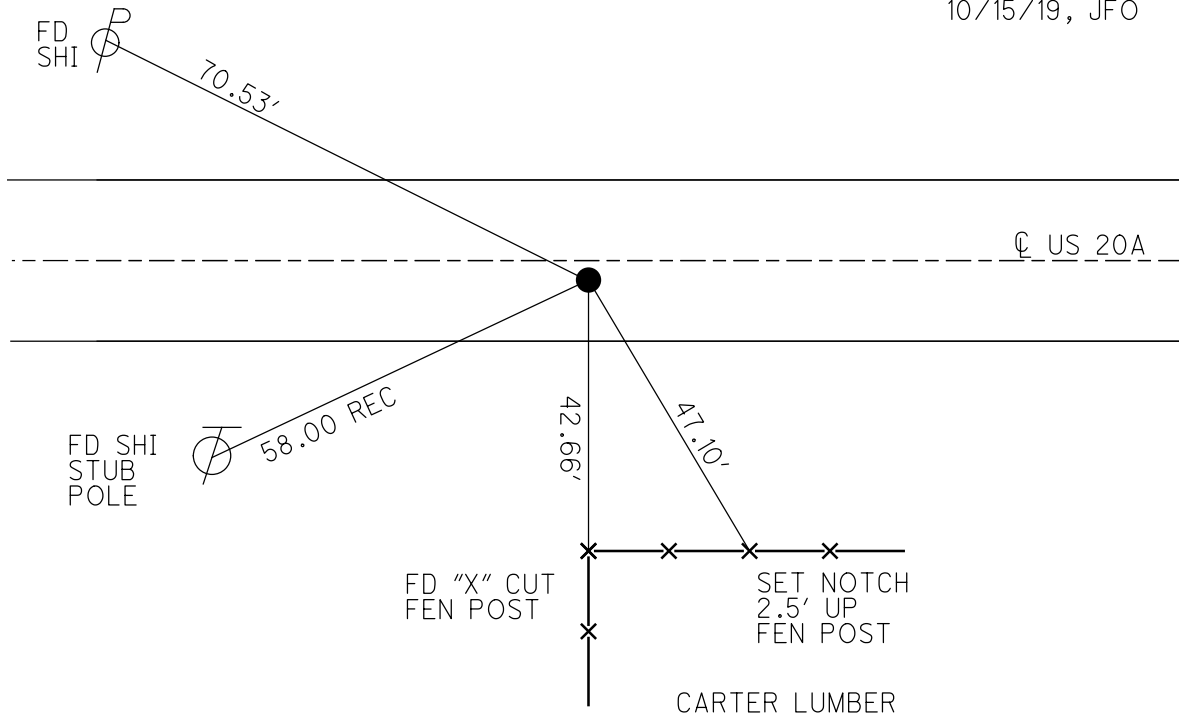

O.D.O.T. DISTRICT 2 SURVEY OFFICE (USE ONLY)

PERSONNEL

REFERENCE NO. 12 A

SHEET 26 OF 62

NOTES MICHALAK

DATE 6/6/02

ROUTE US 20A

H.C. ROUSOS

WEATHER RAIN

COUNTY FULTON

R.C. MALINSKY

TEMP. 65°

TOWNSHIP GERMAN

SECTION 10

DWG BY NASON

PID 101232

T 7 N R 5 E

MAG/WASHER

ON SURFACE - ~~BELOW~~ YES

OFFSET CL PAVEMENT 0.3' ~~LT~~ : RT

10.2 TO RT EDGE PAVEMENT


STATION: 313+54.09

HORIZ.DATUM: NAD83(2011)

GEOID: 2012A

GRID: NORTHING: 699230.529

EASTING: 1483682.736

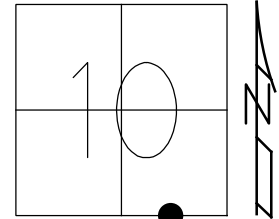

RECORD:

STA 313+57.9

FD P.K./WASHER

6/6/02, TMR

SET MAG/WASHER

9/19/02, DCH


REFA12

9/29/19, EBW

7/10/19, JFO

SET MAG/WASHER

10/15/19, JFO

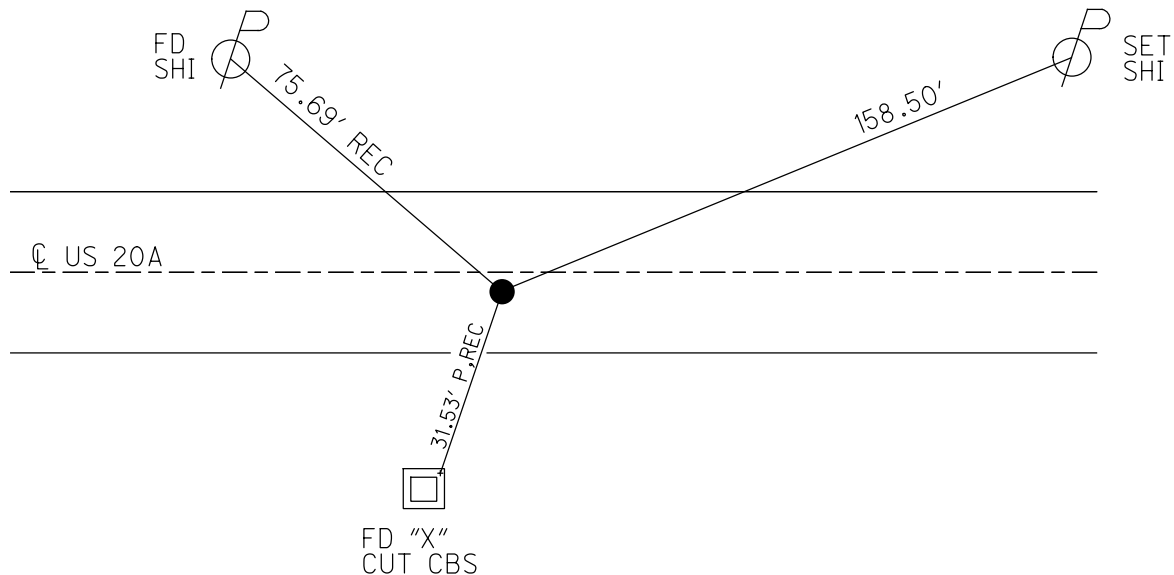

O.D.O.T. DISTRICT 2 SURVEY OFFICE (USE ONLY)

PERSONNEL

REFERENCE NO. 13

SHEET 27 OF 62

NOTES O'DONNELL

DATE 7/10/19

ROUTE US 20A

H.C. LEU

WEATHER SUNNY

COUNTY FULTON

R.C. AUBLE

TEMP. 76°

TOWNSHIP GERMAN

MILLER

SECTION 10

DWG BY NASON

PID 101232

T 7 N R 5 E

TYPE MONUMENT MAG/WASHER

ON ~~SURFACE~~ - BELOW 3"

OFFSET Q PAVEMENT 0.3' ~~LT~~ : RT

- TO - EDGE PAVEMENT



STATION: 323+35.12

HORIZ.DATUM: NAD83(2011)

GEOID: 2012A

GRID: NORTHING: 699211.643

EASTING: 1484663.585

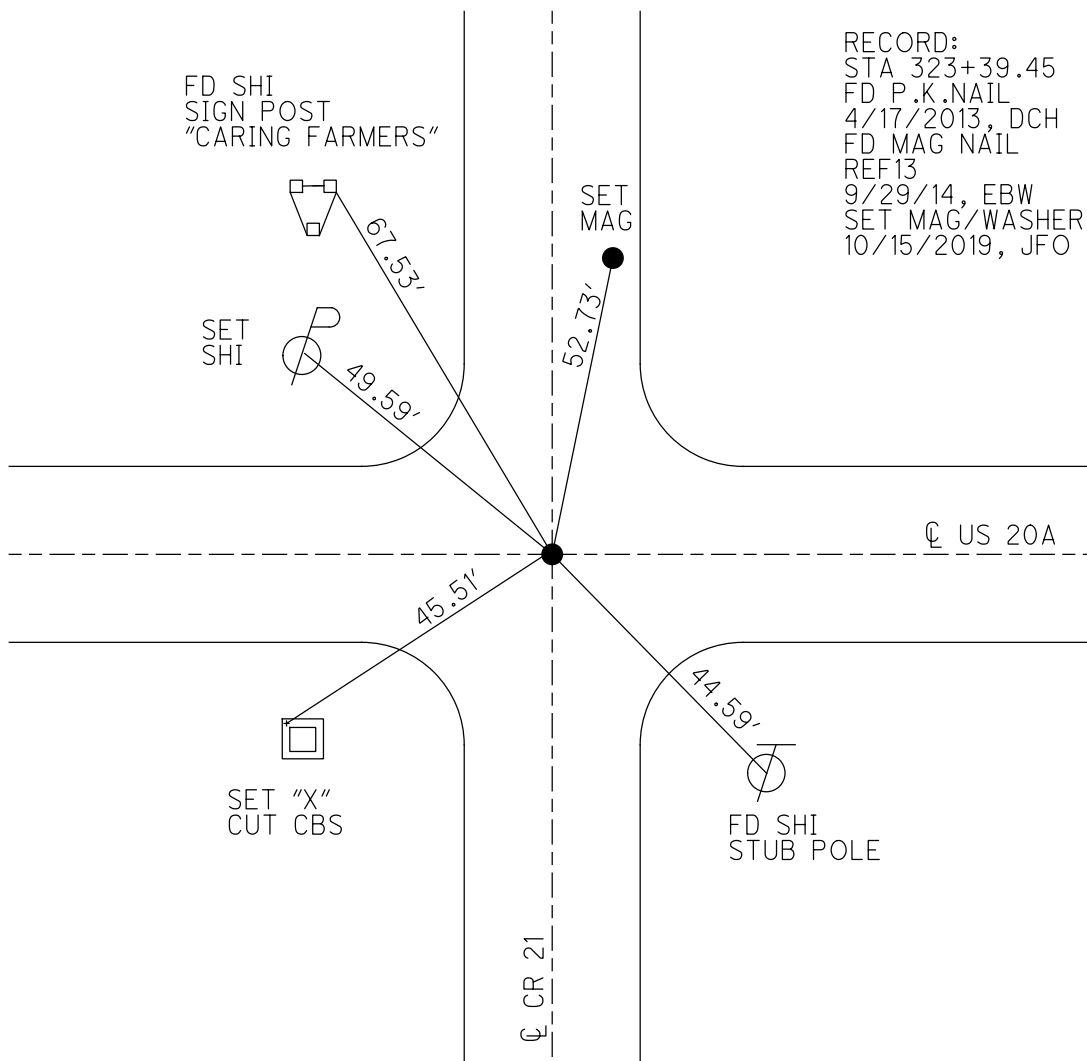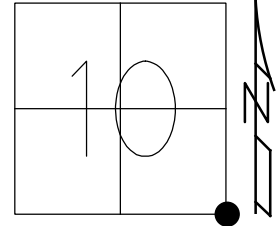

RECORD:
STA 323+39.45
FD P.K.NAIL
4/17/2013, DCH
FD MAG NAIL
REF13
9/29/14, EBW
SET MAG/WASHER
10/15/2019, JFO

O.D.O.T. DISTRICT 2 SURVEY OFFICE (USE ONLY)

PERSONNEL

REFERENCE NO. 14

SHEET 28 OF 62

NOTES O'DONNELL

DATE 7/10/19

ROUTE US 20A

H.C. LEU

WEATHER SUNNY

COUNTY FULTON

R.C. AUBLE

TEMP. 67°

TOWNSHIP GERMAN

MILLER

SECTION 11

DWG BY NASON

PID 101232

T 7 N R 5 E

TYPE MONUMENT MAG/WASHER

ON SURFACE - ~~BELOW~~ YES

OFFSET CL PAVEMENT 0.8' ~~LT~~ : RT

9.5 TO RT EDGE PAVEMENT


STATION: 349+84.98

HORIZ.DATUM: NAD83(2011)

GEOID: 2012A

GRID: NORTHING: 699173.752

EASTING: 1487313.172

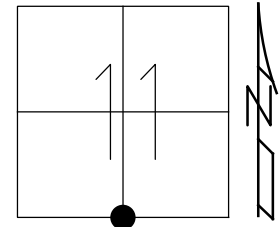

RECORD:

STA 349+89.31

FD P.K./WASHER

6/6/02, TMR

SET MAG/WASHER

4/22/03, DCH


FD MAG/WASHER

REF14

9/24/2014, EBW

SET MAG/WASHER

10/16/19, JFO

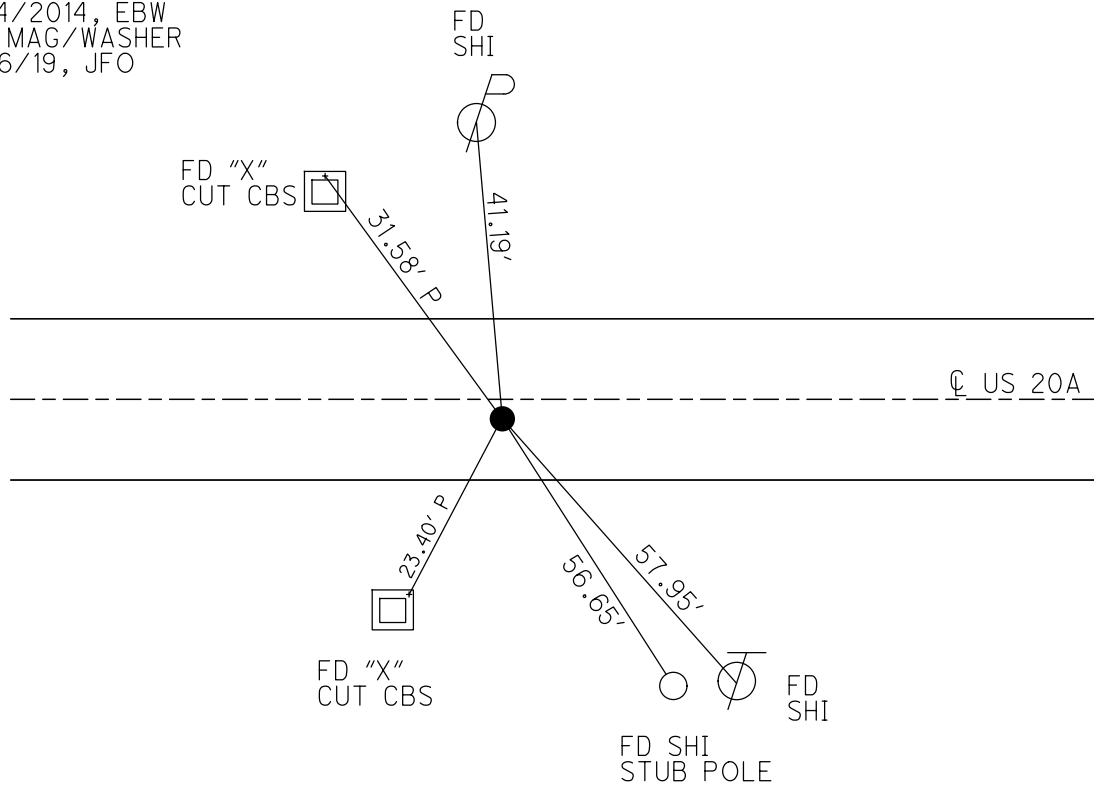

O.D.O.T. DISTRICT 2 SURVEY OFFICE (USE ONLY)

PERSONNEL

REFERENCE NO. 15

SHEET 29 OF 62

NOTES WESTFALL

DATE 7/24/14

ROUTE US 20A

H.C. WESTFALL

WEATHER SUNNY

COUNTY FULTON

R.C. THOMAS

TEMP. 65°

TOWNSHIP GERMAN

SECTION 11

DWG BY NASON

PID 101232

T 7 N R 5 E

TYPE MONUMENT P.K./WASHER

ON SURFACE - ~~BELOW~~ ON

OFFSET Q PAVEMENT 0.5' LT : ~~RT~~

- TO - EDGE PAVEMENT


STATION: 376+25.30

HORZ.DATUM: NAD83(2011)


GEOID: 2012A

GRID: NORTHING: 699158.660

EASTING: 1489953.450

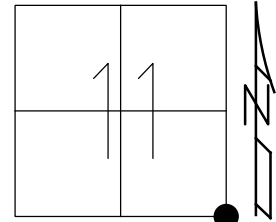

RECORD:
STA 376+30.25
FD P.K./WASHER
6/6/02, TMR
SET MAG/WASHER
4/22/03, DCH
FD BRASS MON.
4" DOWN
9/24/14, EBW
7/10/19, JFO
SET MAG/WASHER
10/16/19, JFO

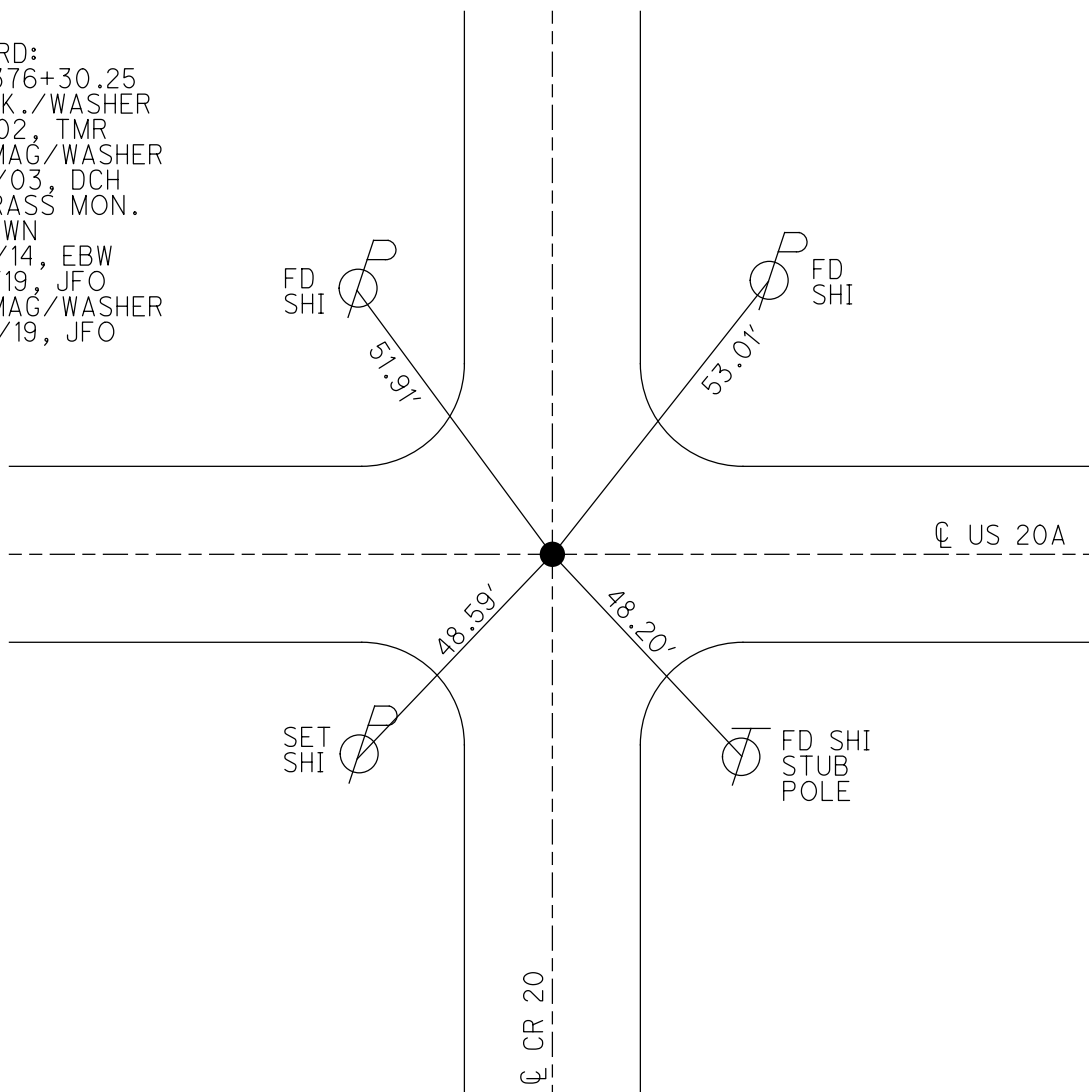

O.D.O.T. DISTRICT 2 SURVEY OFFICE (USE ONLY)

PERSONNEL

REFERENCE NO. 16

SHEET 30 OF 62

NOTES RHOADES

DATE 7/18/18

ROUTE US 20A

H.C. LEU

WEATHER SUNNY

COUNTY FULTON

R.C. HAGEMEYER

TEMP. 68°

TOWNSHIP GERMAN

TRENKA

SECTION 12

DWG BY NASON

PID 101232

T 7 N R 5 E

TYPE MONUMENT MAG/WASHER

ON SURFACE - ~~BELOW~~ ON

OFFSET Q PAVEMENT 0.6' LT : ~~RT~~

9.8' TO LT EDGE PAVEMENT


STATION: 402+74.30

HORZ.DATUM: NAD83(2011)


GEOID: 2012A

GRID: NORTHING: 699118.302

EASTING: 1492602.148

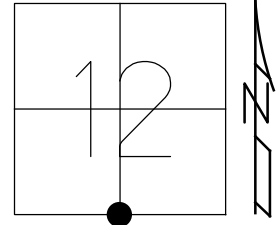

RECORD:
STA. 402+80.49
FD P.K./WASHER
6/6/02, DCH
SET MAG/WASHER
4/22/03, DCH
FD MAG/WASHER
REF16
9/29/14, EBW
7/10/19, JFO
SET MAG/WASHER
10/16/19, JFO

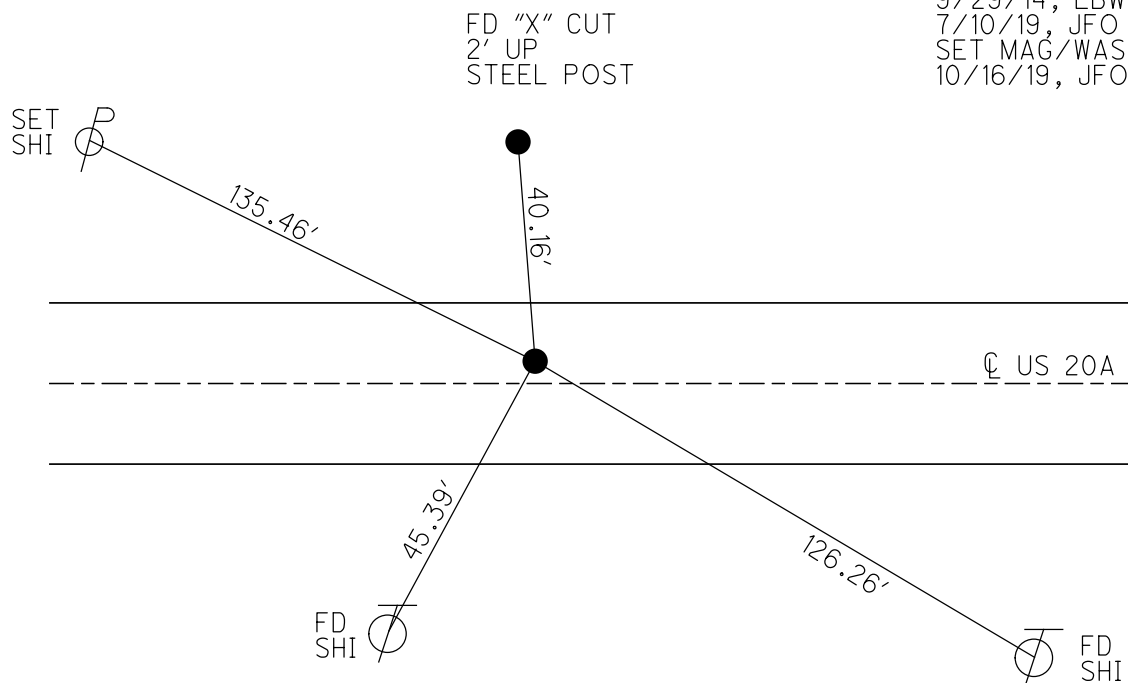

O.D.O.T. DISTRICT 2 SURVEY OFFICE (USE ONLY)

PERSONNEL

REFERENCE NO. 16 A

SHEET 31 OF 62

NOTES MILLER

DATE 7/12/19

ROUTE US 20A

H.C. LEU

WEATHER SUNNY

COUNTY FULTON

R.C. AUBLE

TEMP. 72°

TOWNSHIP GERMAN

SECTION 12

DWG BY NASON

PID 101232

T 7 N R 5 E

TYPE MONUMENT MONBOX

ON SURFACE - ~~BELOW~~ ON

OFFSET 0.6' ~~LT~~ : RT

10.1' TO RT EDGE PAVEMENT


STATION: 424+24.14

HORZ.DATUM: NAD83(2011)


GEOID: 2012A

GRID: NORTHING: 699076.665

EASTING: 1494751.585

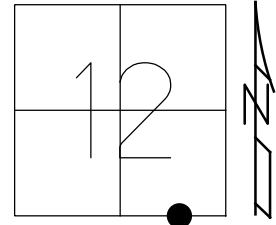

RECORD:
STA. 424+29.9
FD MONBOX
6/6/02, DCH
REFA116
7/24/14, EBW
FD MONBOX
W/1" IPIN
REFA16
7/12/19, JLL
REFA16
10/16/19, JFO

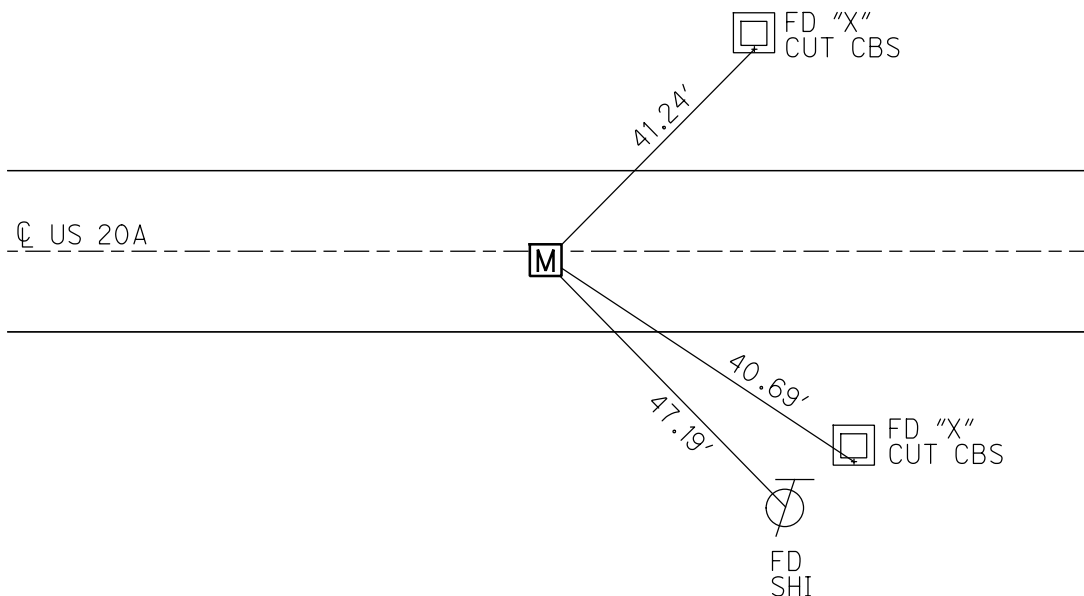

O.D.O.T. DISTRICT 2 SURVEY OFFICE (USE ONLY)

PERSONNEL

REFERENCE NO. 17

SHEET 32 OF 62

NOTES MILLER

DATE 7/12/19

ROUTE US 20A

H.C. LEU

WEATHER SUNNY

COUNTY FULTON

R.C. AUBLE

TEMP. 72°

TOWNSHIP CLINTON

SECTION 7

DWG BY RHOADES

PID 92126

T 7 N R 6 E

TYPE MONUMENT MAG/WASHER

ON SURFACE - ~~BELOW~~ ON

OFFSET Q PAVEMENT 11' LT : ~~RT~~

- TO - EDGE PAVEMENT


STATION: 429+23.86

HORIZ.DATUM: NAD83 2011


GEOID: 2012A

GRID: NORTHING: 699089.332

EASTING: 1495251.567

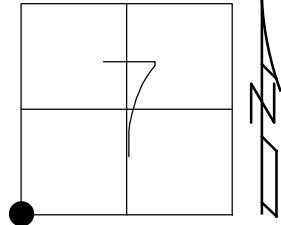

RECORD:
STA. 429+29.6
FD P.K.NAIL
6/6/02, TMR
SET MAG/WASHER
4/22/03, DCH
FD MAG/WASHER
REF17
7/24/14, EBW
REF17
7/12/19, JLL
SET MAG/WASHER
NEWREF17
10/16/19, JFO

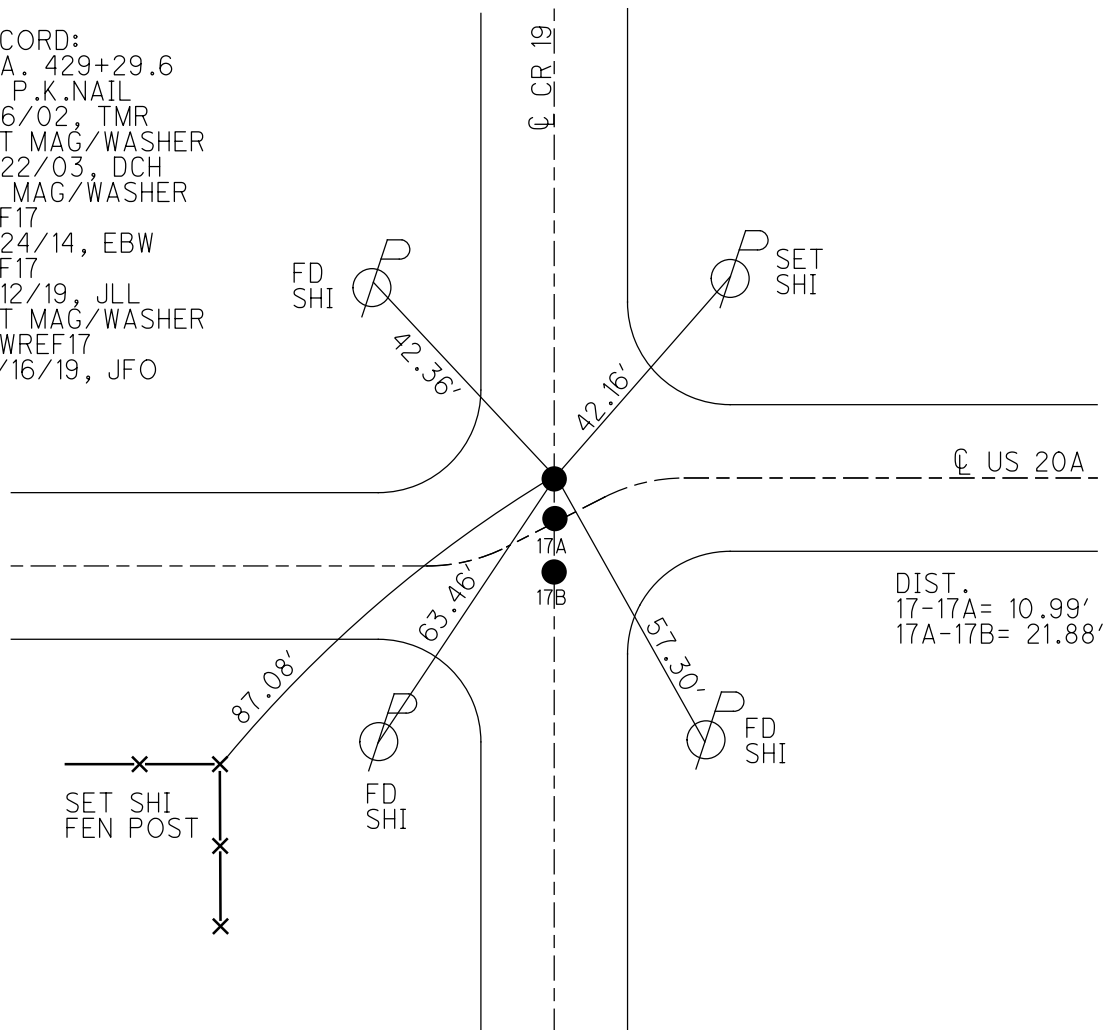

O.D.O.T. DISTRICT 2 SURVEY OFFICE (USE ONLY)

PERSONNEL

REFERENCE NO. 17 A

SHEET 33 OF 62

NOTES MILLER

DATE 7/12/19

ROUTE US 20A

H.C. LEU

WEATHER SUNNY

COUNTY FULTON

R.C. AUBLE

TEMP. 72°

TOWNSHIP CLINTON

DWG BY RHOADES PID 92126

SECTION 7

T 7 N R 6 E

TYPE MONUMENT MAG/WASHER

ON SURFACE - ~~BELOW~~ ON

OFFSET Q PAVEMENT ON LT : RT

- TO - EDGE PAVEMENT


STATION: 429+23.86

HORZ.DATUM: NAD83 2011


GEOID: 2012A

GRID: NORTHING: 699078.349

EASTING: 1495251.303

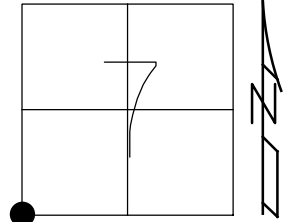

RECORD:
STA. 429+29.6
FD P.K./WASHER
6/6/02, TMR
SET MAG/WASHER
4/22/03, DCH
FD MAG NAIL
REFA17
7/24/14, EBW
REFA17
7/12/19, JLL
FD MAG/WASHER
REFA17
10/16/19, JFO

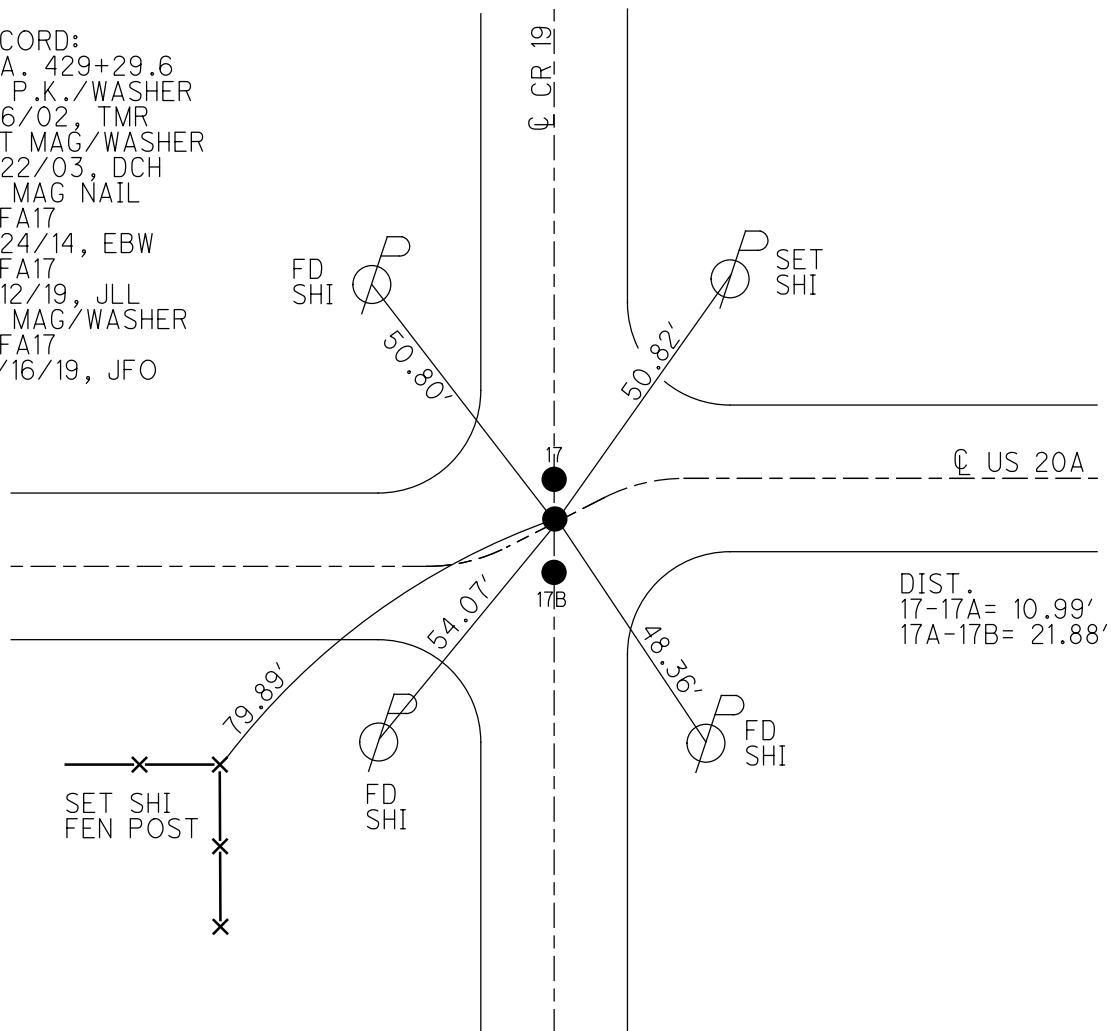

O.D.O.T. DISTRICT 2 SURVEY OFFICE (USE ONLY)

PERSONNEL

REFERENCE NO. 17 B

SHEET 34 OF 62

NOTES MILLER

DATE 7/12/19

ROUTE US 20A

H.C. LEU

WEATHER SUNNY

COUNTY FULTON

R.C. AUBLE

TEMP. 72°

TOWNSHIP CLINTON

SECTION 7

DWG BY RHOADES

PID 92126

T 7 N R 6 E

TYPE MONUMENT MAG SPIKE

ON SURFACE - ~~BELOW~~ ON

OFFSET CL PAVEMENT 22' ~~LT~~ : RT

- TO - EDGE PAVEMENT


STATION: 429+23.86

HORIZ.DATUM: NAD83 2011

GEOID: 2012A


GRID: NORTHING: 699056.470

EASTING: 1495250.937

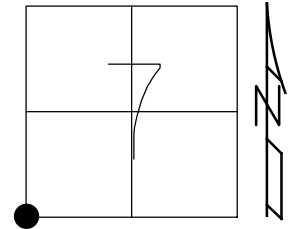

RECORD:

STA. 429+29.6
FD P.K./WASHER
6/6/02, TMR
SET MAG/WASHER
4/22/03, DCH
FD MAG SPIKE
REFB17
7/24/14, EBW
REFB17
7/12/19, JLL
SET MAG/WASHER
NEWREFB17
10/16/19, JFO

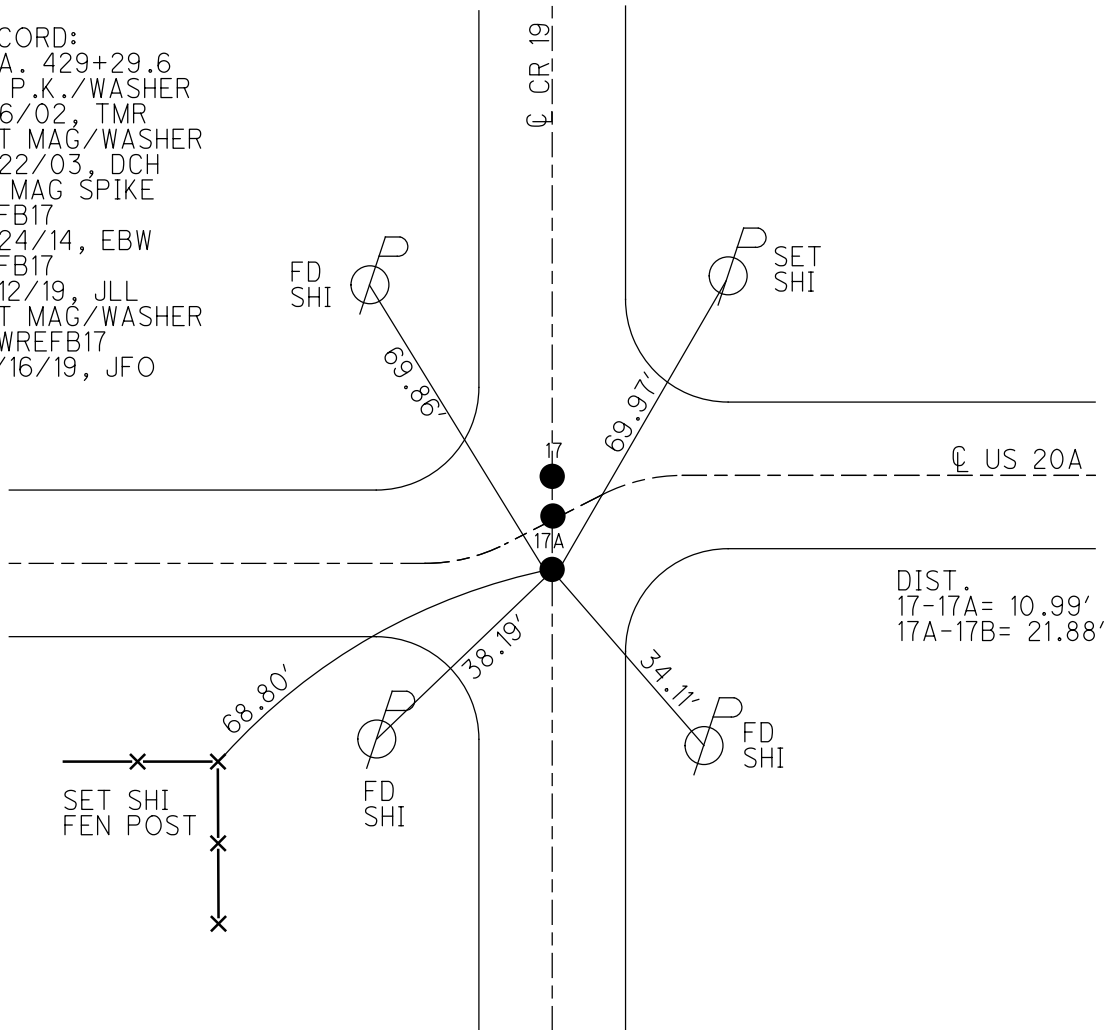

O.D.O.T. DISTRICT 2 SURVEY OFFICE (USE ONLY)

PERSONNEL

REFERENCE NO. 17 C

SHEET 35 OF 62

NOTES MICHALAK

DATE 6/6/02

ROUTE US 20A

H.C. HOMAN

WEATHER SUNNY

COUNTY FULTON

R.C. MALINSKY

TEMP. 56°

TOWNSHIP CLINTON

SECTION 7

DWG BY RHOADES

PID 92126

T 7 N R 6 E

TYPE MONUMENT P.K./WASHER

ON SURFACE - BELOW ON

OFFSET $\oslash$ PAVEMENT 2.5' LT : RT

8.2' TO LT EDGE PAVEMENT


STATION: 434+24.16

HORIZ.DATUM: NAD83 2011


GEOID: 2012A

GRID: NORTHING: 699080.005

EASTING: 1495751.606

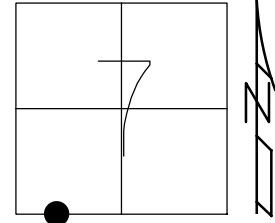

RECORD:
STA. 434+29.91
FD P.K./WASHER
6/6/02, DCH
SET MAG/WASHER
4/26/03, DCH
FD MAG/WASHER
REFC17
9/29/14, EBW
7/12/19, JLL
SET MAG/WASHER
10/16/19, JFO

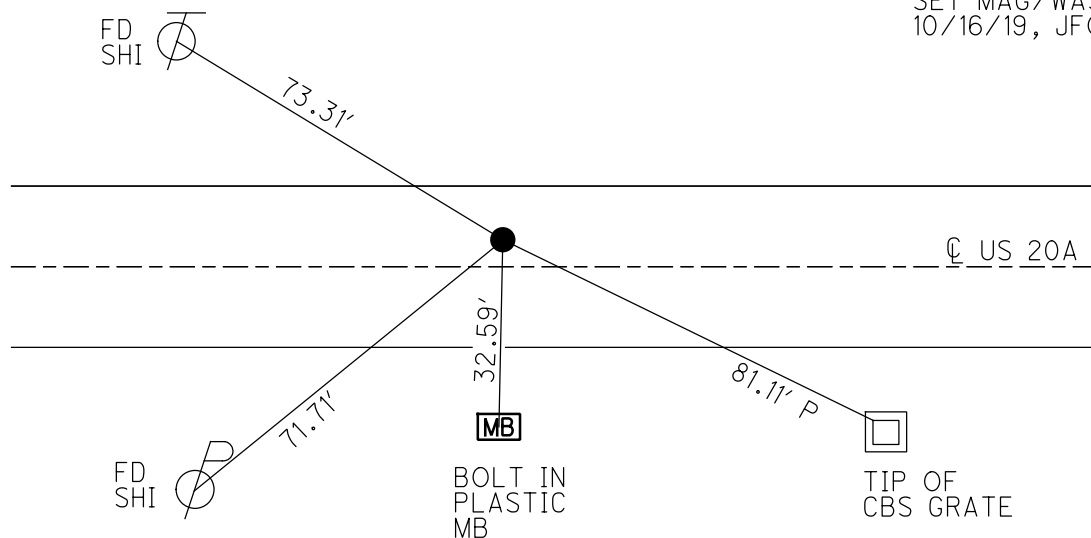

O.D.O.T. DISTRICT 2 SURVEY OFFICE (USE ONLY)

PERSONNEL

REFERENCE NO. 18

SHEET 36 OF 62

NOTES MILLER

DATE 7/12/19

ROUTE US 20A

H.C. LEU

WEATHER SUNNY

COUNTY FULTON

R.C. AUBLE

TEMP. 71°

TOWNSHIP GERMAN

DWG BY NASON

PID 101232

SECTION 7

T 7 N R 6 E

TYPE MONUMENT MAG/WASHER

ON SURFACE - ~~BELOW~~ ON

OFFSET CL PAVEMENT 1.4' ~~LT~~ : RT

8.8' TO RT EDGE PAVEMENT


STATION: 452+05.91

HORZ.DATUM: NAD83(2011)

GEOID: 2012A

GRID: NORTHING: 699046.447


EASTING: 1497533.039

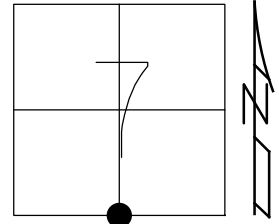


RECORD:

STA. 452+11.65
FD P.K./WASHER
6/6/02 DCH
SET MAG/WASHER
4/26/03, DCH
FD MAG/WASHER
REF18
9/29/14, EBW
7/12/19, JFO
SET MAG/WASHER
10/16/19, JFO

RES#18502

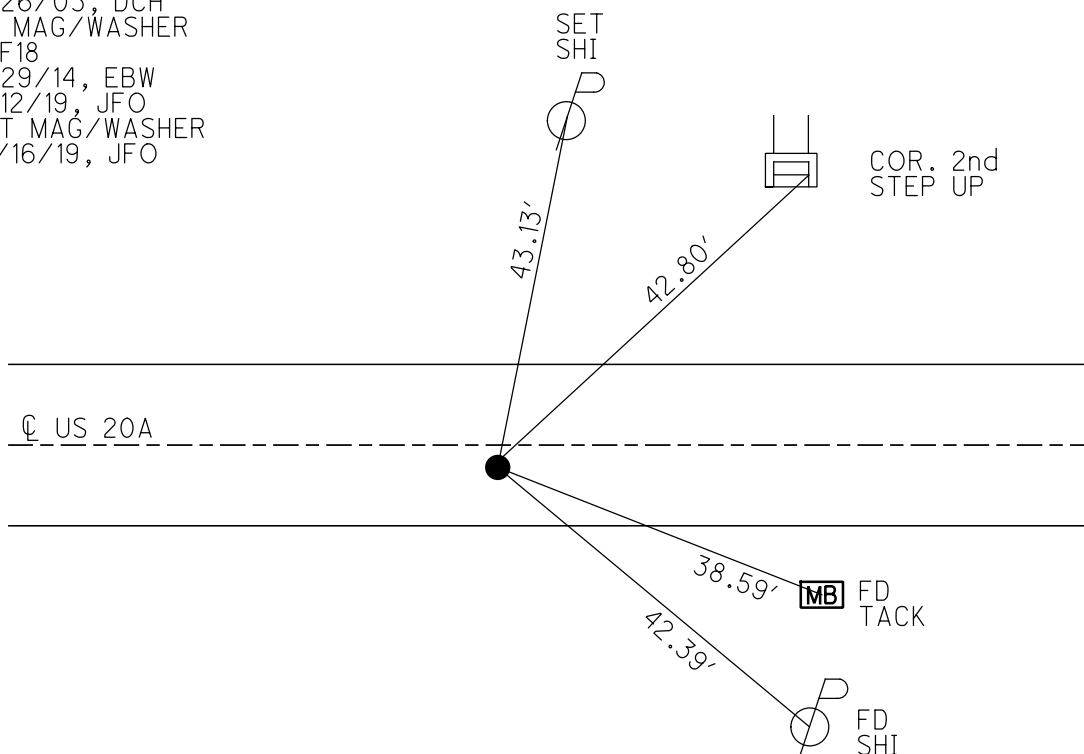

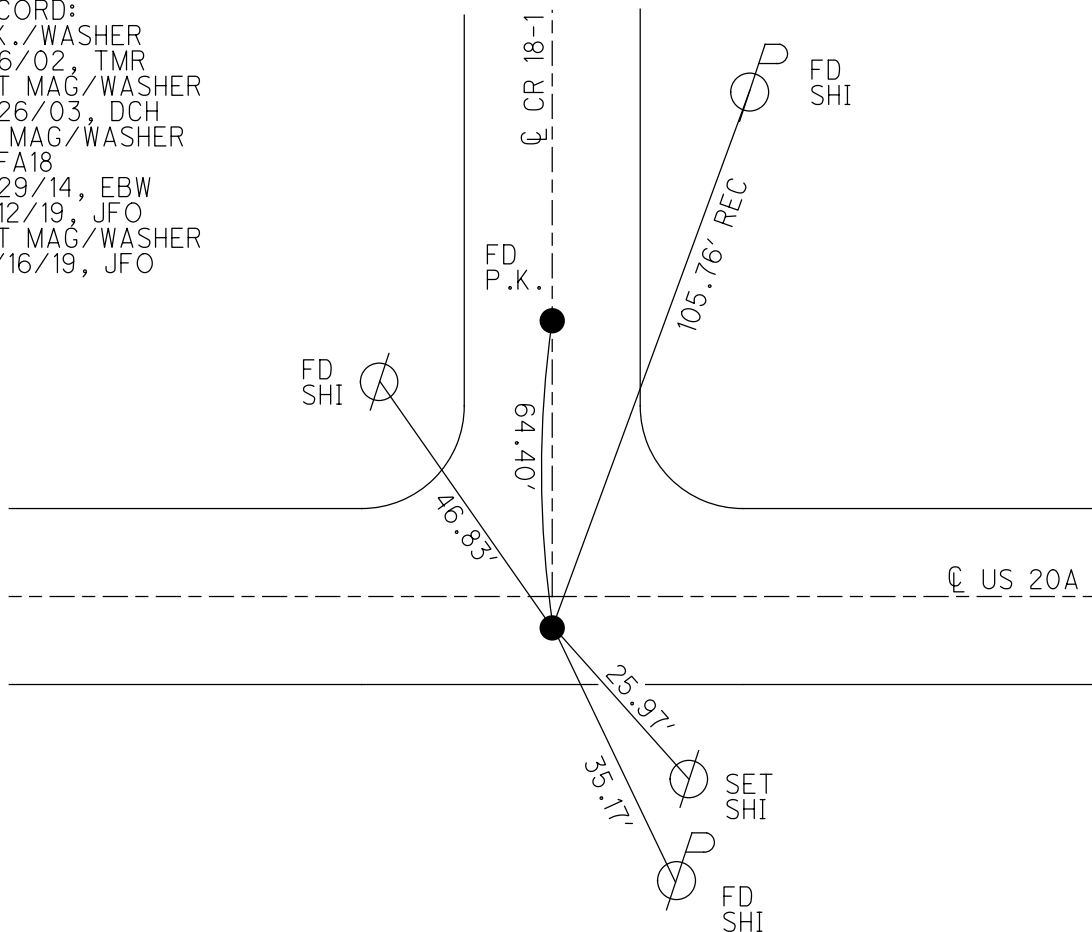

O.D.O.T. DISTRICT 2 SURVEY OFFICE (USE ONLY)

PERSONNEL

REFERENCE NO. 19 A

SHEET 38 OF 62

NOTES RHOADES

DATE 7/18/18

ROUTE US 20A

H.C. LEU

WEATHER SUNNY

COUNTY FULTON

R.C. MALINSKY

TEMP. 70°

TOWNSHIP CLINTON

HAGEMEYER

SECTION 7

DWG BY NASON

PID 101232

T 7 N R 6 E

TYPE MONUMENT P.K./WASHER

ON SURFACE - ~~BELOW~~ ON

OFFSET CL PAVEMENT 4' LT : ~~RT~~

7' TO LT EDGE PAVEMENT



STATION: 478+63.48

HORIZ.DATUM: NAD83(2011)

GEOID: 2012A

GRID: NORTHING: 699071.895

EASTING: 1500190.047

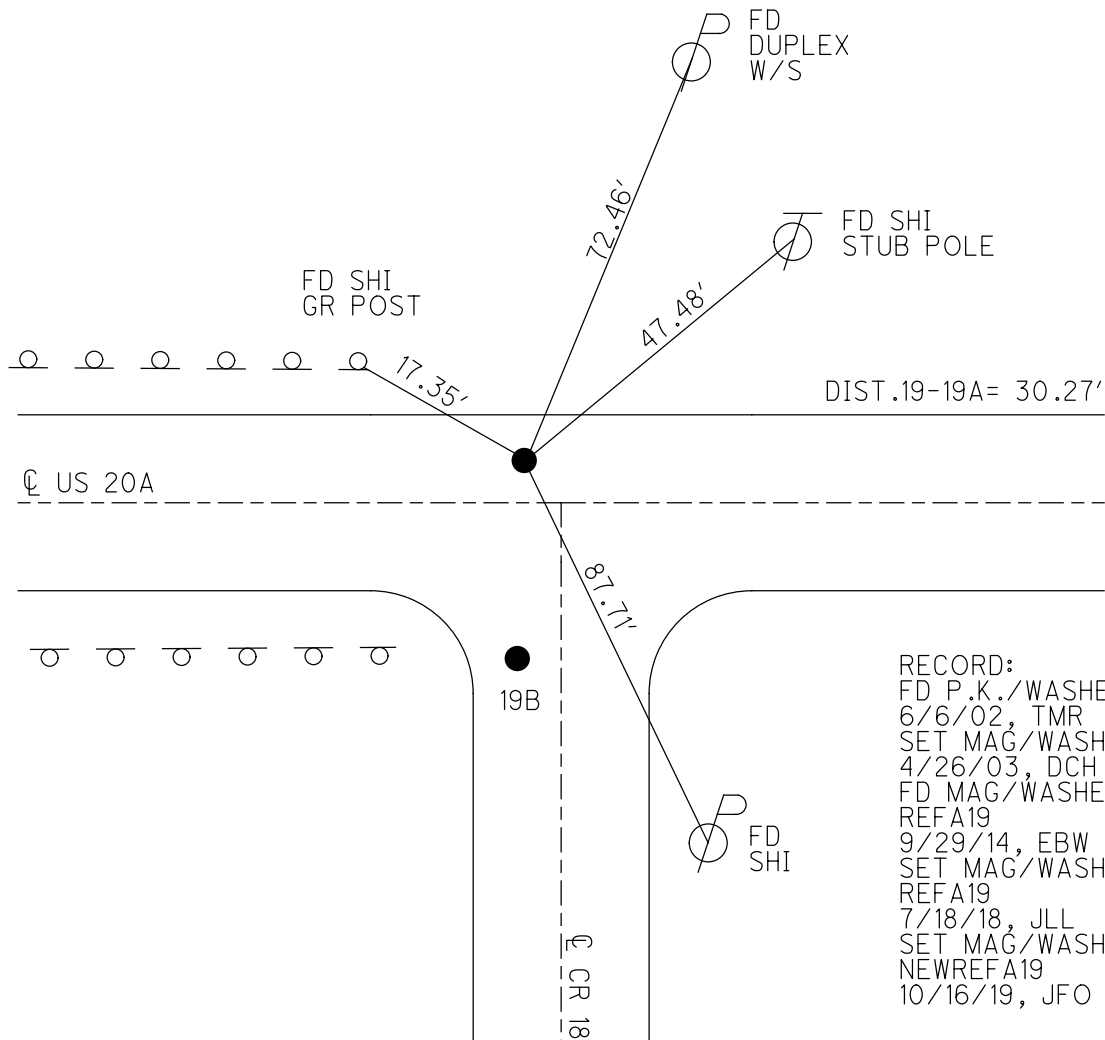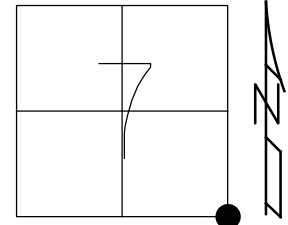

RECORD:
FD P.K./WASHER
6/6/02, TMR
SET MAG/WASHER
4/26/03, DCH
FD MAG/WASHER
REFA19
9/29/14, EBW
SET MAG/WASHER
REFA19
7/18/18, JLL
SET MAG/WASHER
NEWREFA19
10/16/19, JFO

O.D.O.T. DISTRICT 2 SURVEY OFFICE (USE ONLY)

PERSONNEL

REFERENCE NO. 19 B

SHEET 39 OF 62

NOTES RHOADES

DATE 7/18/18

ROUTE US 20A

H.C. LEU

WEATHER SUNNY

COUNTY FULTON

R.C. MALINSKY

TEMP. 70°

TOWNSHIP CLINTON

HAGEMEYER

SECTION 7

DWG BY NASON

PID 101232

T 7 N R 6 E

TYPE MONUMENT P.K./WASHER

ON SURFACE - ~~BELOW~~ ON

OFFSET CL PAVEMENT 9.4' LT : RT

- TO - EDGE PAVEMENT



STATION: 478+63.48

HORZ.DATUM: NAD83(2011)

GEOID: 2012A

GRID: NORTHING: 699041.624

EASTING: 1500190.409

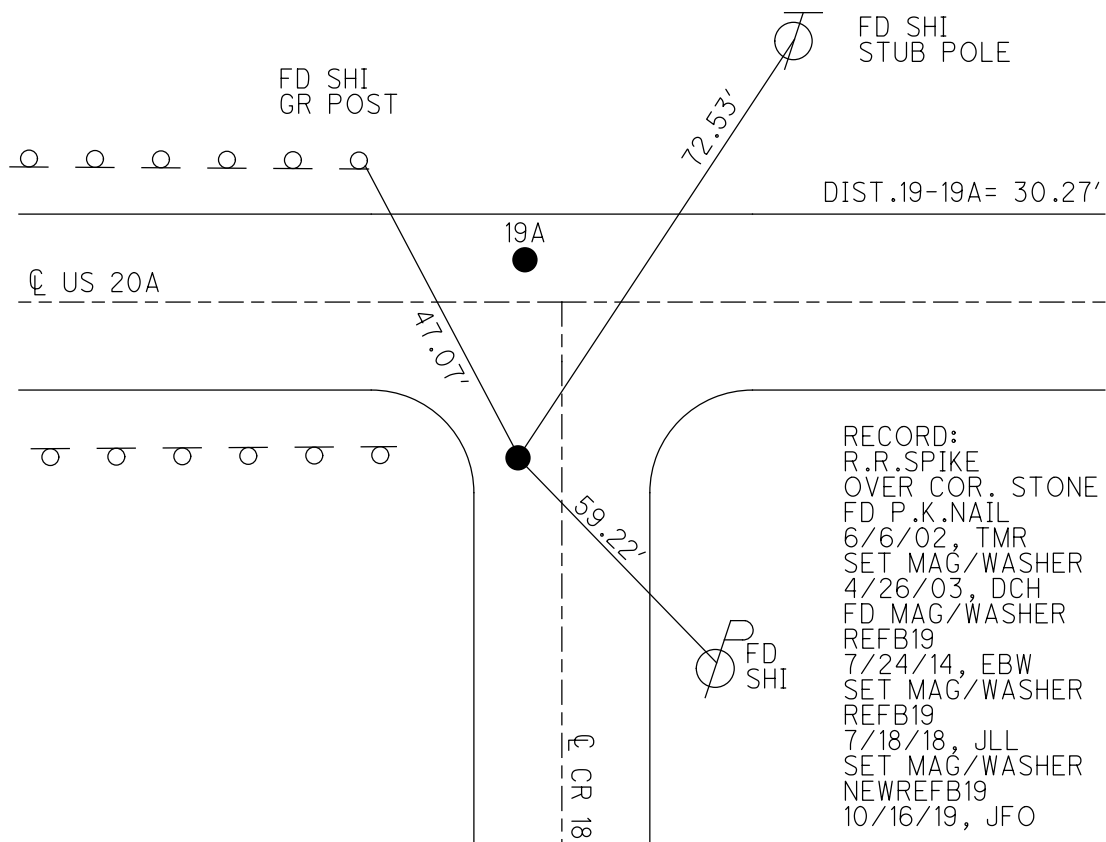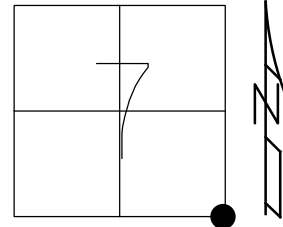

O.D.O.T. DISTRICT 2 SURVEY OFFICE (USE ONLY)

PERSONNEL

REFERENCE NO. 20

SHEET 40 OF 62

NOTES MILLER

DATE 7/12/19

ROUTE US 20A

H.C. O'DONNELL

WEATHER SUNNY

COUNTY FULTON

R.C. AUBLE

TEMP. 71°

TOWNSHIP CLINTON

RHOADES

SECTION 8

DWG BY NASON

PID 101232

T 7 N R 6 E

TYPE MONUMENT MAG/WASHER

~~ON SURFACE~~ - BELOW 2"

OFFSET Q PAVEMENT 2.1' LT : ~~RT~~

8.5' TO LT EDGE PAVEMENT


STATION: 505+12.77

HORZ.DATUM: NAD83(2011)

GEOID: 2012A

GRID: NORTHING: 699033.854

EASTING: 1502839.061

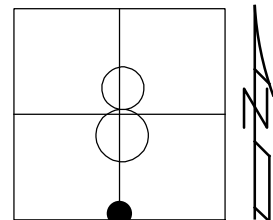

RECORD:

FD P.K./WASHER

6/6/02, DCH

FD P.K./WASHER

2" DOWN

REF20


9/25/14, EBW

FD MAG/WASHER

7/12/19, JFO

SET MAG/WASHER

10/16/19, JFO

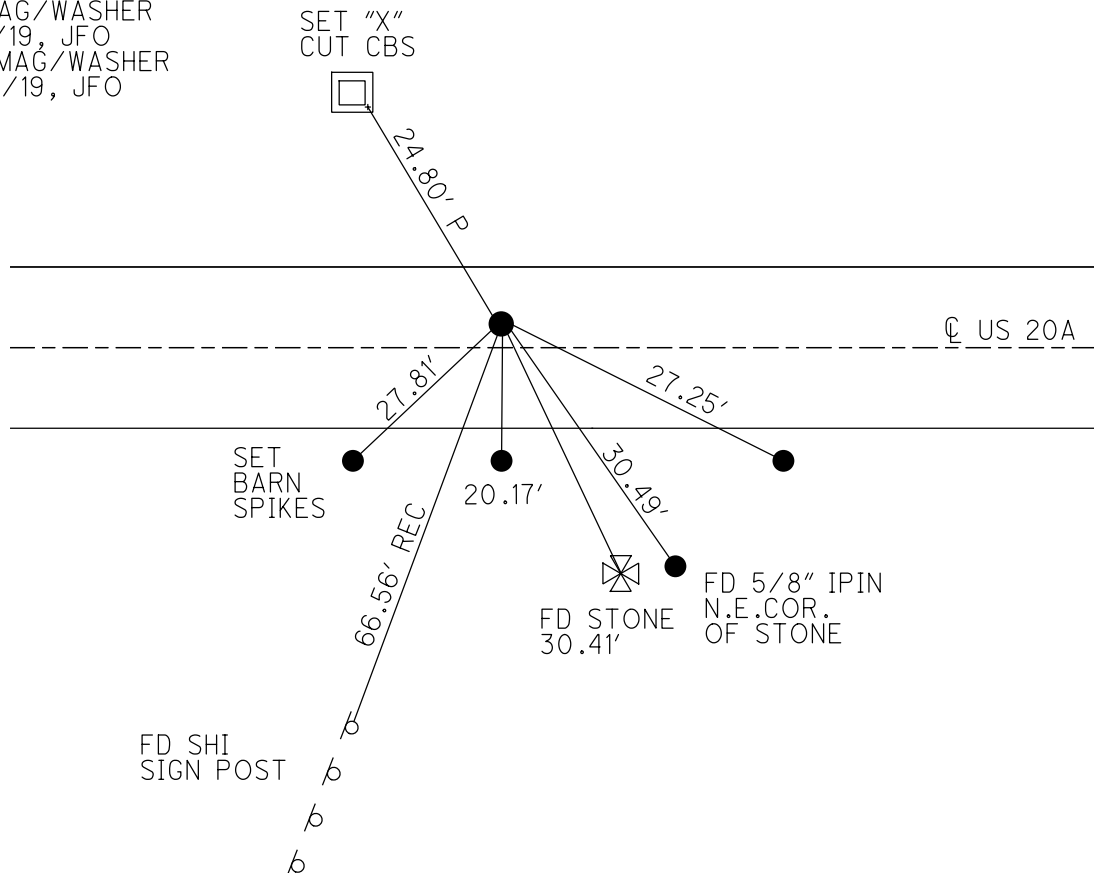

O.D.O.T. DISTRICT 2 SURVEY OFFICE (USE ONLY)

PERSONNEL

REFERENCE NO. 20 A

SHEET 41 OF 62

NOTES RHOADES

DATE 7/18/18

ROUTE US 20A

H.C. LEU

WEATHER SUNNY

COUNTY FULTON

R.C. TRENKA

TEMP. 70°

TOWNSHIP CLINTON

HAGEMEYER

SECTION 8

DWG BY NASON

PID 101232

T 7 N R 6 E

TYPE MONUMENT MAG/WASHER

ON SURFACE - ~~BELOW~~ ON

OFFSET CL PAVEMENT 3.6' ~~LT~~ : RT

6.6 TO RT EDGE PAVEMENT



STATION: 513+17.17

HORIZ.DATUM: NAD83(2011)

GEOID: 2012A

GRID: NORTHING: 698992.223

EASTING: 1503642.433

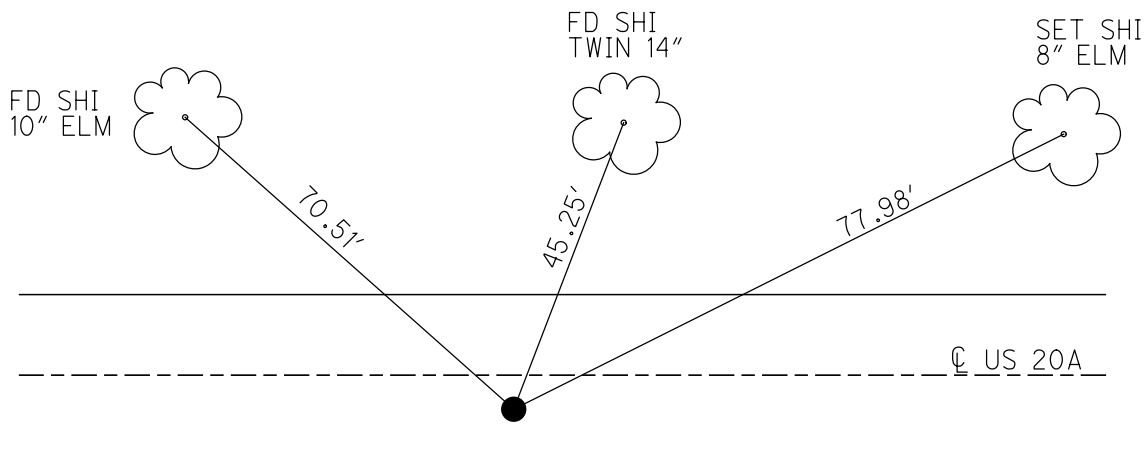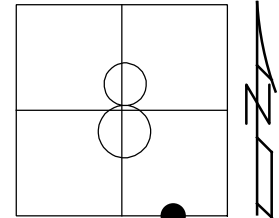

RECORD:
STA 513+22.08
FD P.K./WASHER
6/6/02, DCH
SET MAG NAIL
4/26/03, DCH
FD MAG SHANK
REF20A
7/24/14, EBW
SET MAG/WASHER
REFA20
7/18/18, JLL
FD MAG/WASHER
7/12/19, JFO
SET MAG/WASHER
NEWREFA20
10/21/19, JFO

O.D.O.T. DISTRICT 2 SURVEY OFFICE (USE ONLY)

PERSONNEL

REFERENCE NO. 21

SHEET 42 OF 62

NOTES MILLER
H.C. O'DONNELL
R.C. AUBLE
RHOADES

DATE 7/12/19
WEATHER SUNNY
TEMP. 72°

ROUTE US 20A
COUNTY FULTON
TOWNSHIP CLINTON
SECTION 8

DWG BY NASON PID 101232

T 7 N R 6 E

TYPE MONUMENT MAG/WASHER

ON SURFACE - ~~BELOW~~ ON

OFFSET 0.7' RT

TO EDGE PAVEMENT 1.5' E OF C S


STATION: 531+62.21

HORZ.DATUM: NAD83(2011)


GEOID: 2012A

GRID: NORTHING: 698966.085

EASTING: 1505487.334

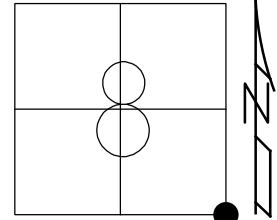

RECORD:
STA. 531+67.27
SET MAG/WASHER
4/26/03, DCH
FD MAG/WASHER
1/29/13, TMR
SET MAG/WASHER
1/29/13, DCH
FD MAG/WASHER
REF21
9/30/14, EBW
FD MAG/WASHER
REF21
7/12/19, JFO
SET MAG/WASHER
10/21/19, JFO

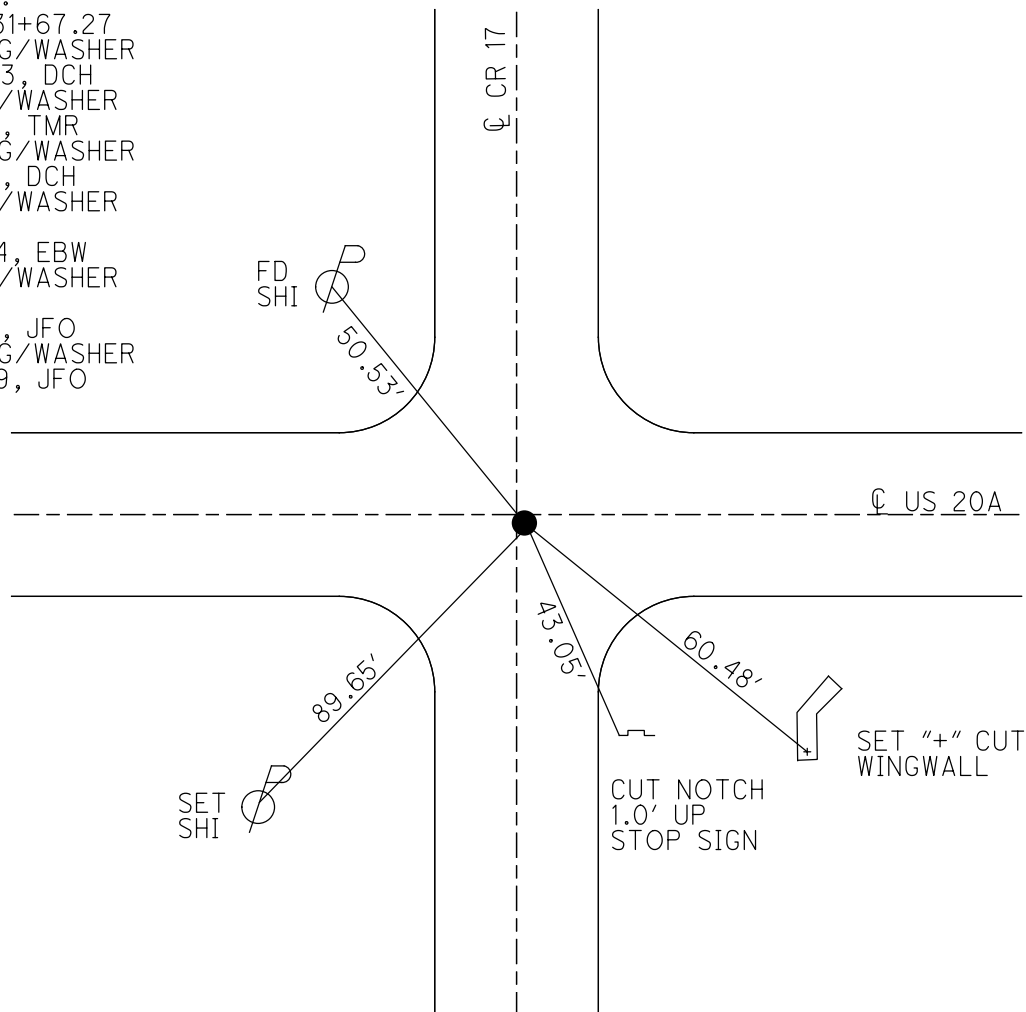

O.D.O.T. DISTRICT 2 SURVEY OFFICE (USE ONLY)

PERSONNEL

REFERENCE NO. 22

SHEET 43 OF 62

NOTES LEU

DATE 4/22/19

ROUTE US 20A

H.C. LEU

WEATHER SUNNY

COUNTY FULTON

R.C. JAMES

TEMP. 57°

TOWNSHIP CLINTON

SECTION 9

DWG BY NASON

PID 101232

T 7 N R 6 E

TYPE MONUMENT P.K.NAIL

~~ON SURFACE~~ - BELOW 3"

OFFSET CL PAVEMENT 0.7' ~~LT~~ : RT

9.8' TO RT EDGE PAVEMENT


STATION: 557+91.32

HORIZ.DATUM: NAD83(2011)


GEOID: 2012A

GRID: NORTHING: 698937.429

EASTING: 1508116.286

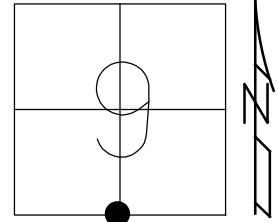

RECORD:
STA. 557+96.7
SET MAG/WASHER
9/19/02, DCH
FD P.K.NAIL
3" DOWN
REF22
9/30/14, EBW
FD P.K.NAIL
3" DOWN
REF22
7/16/19, JFO
SET MAG/WASHER
10/21/19, JFO

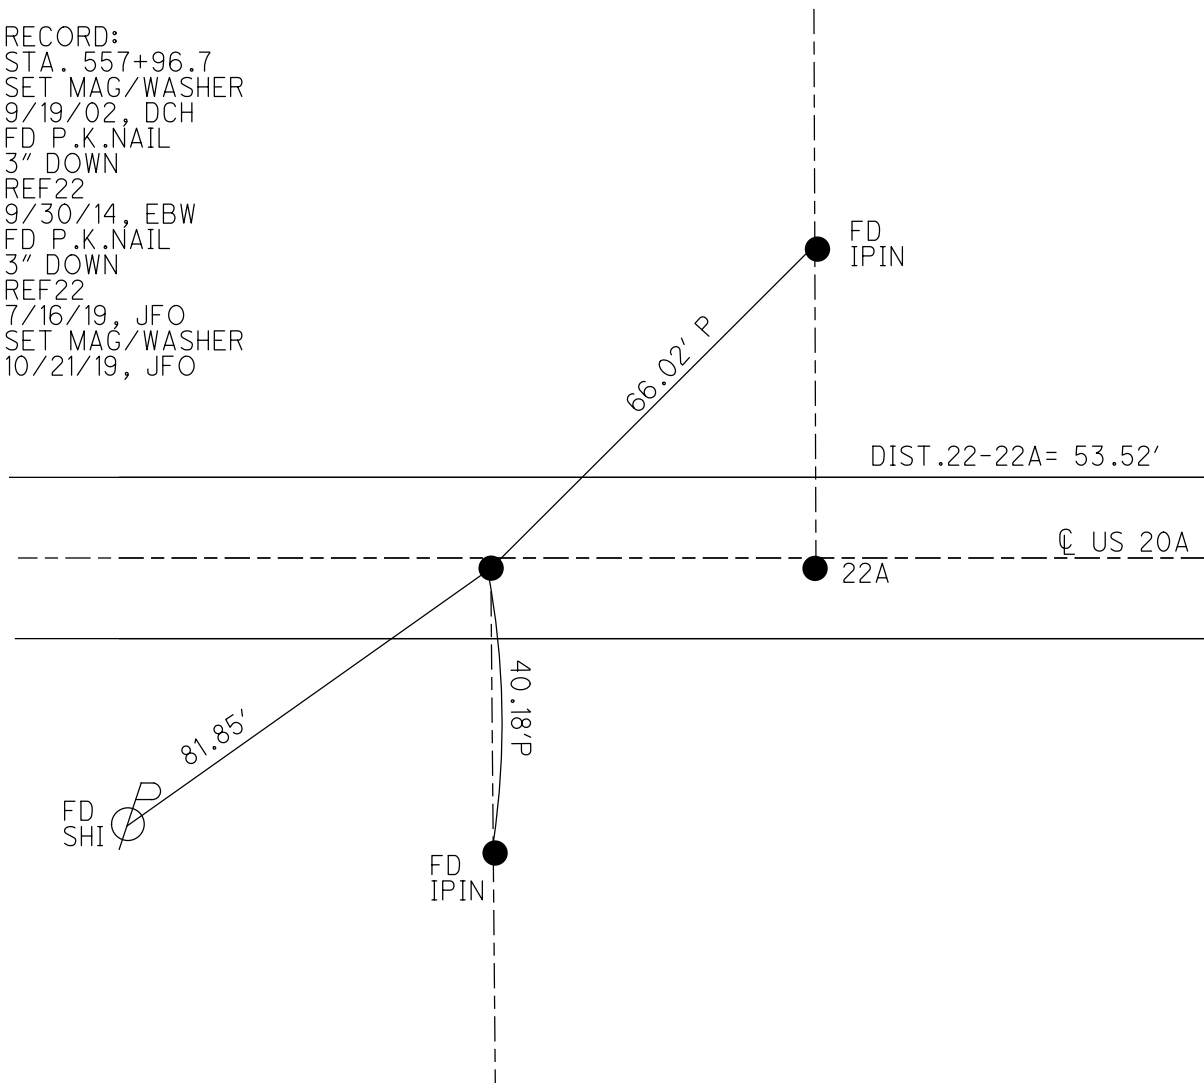

O.D.O.T. DISTRICT 2 SURVEY OFFICE (USE ONLY)

PERSONNEL

REFERENCE NO. 22 A

SHEET 44 OF 62

NOTES LEU

DATE 4/22/19

ROUTE US 20A

H.C. LEU

WEATHER SUNNY

COUNTY FULTON

R.C. JAMES

TEMP. 57°

TOWNSHIP CLINTON

DWG BY ---
NASON

PID 101232

SECTION 9

T 7 N R 6 E

TYPE MONUMENT MAG/WASHER

ON SURFACE - ~~BELOW~~ ON

OFFSET Q PAVEMENT 0.7' ~~LT~~ : RT

- TO - EDGE PAVEMENT


STATION: 558+44.84

HORZ.DATUM: NAD83(2011)

GEOID: 2012A

GRID: NORTHING: 698936.810


EASTING: 1508169.804

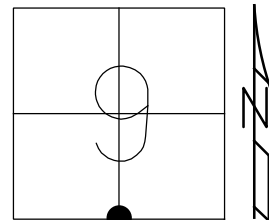

RECORD:
STA. 558+42
FD P.K./WASHER
6/6/02, DCH
SET MAG/WASHER
9/19/02, DCH
FD MAG/WASHER
REFA22
9/30/14, EBW
REFA22
7/16/19, JFO
SET MAG/WASHER
10/21/19, JFO

DIST.22-22A= 53.52'

Q US 20A

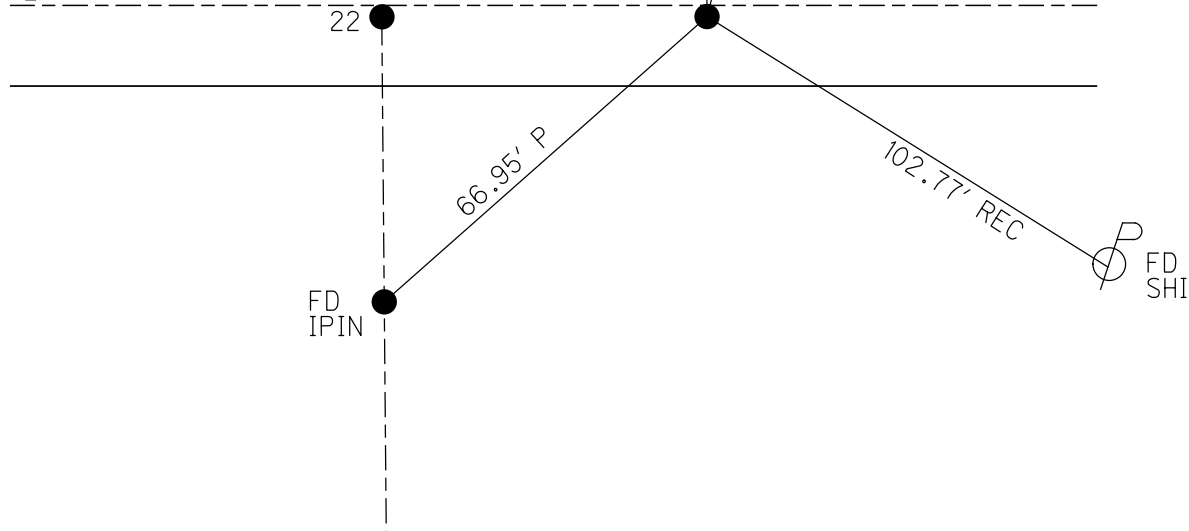

O.D.O.T. DISTRICT 2 SURVEY OFFICE (USE ONLY)

PERSONNEL

REFERENCE NO. 23

SHEET 45 OF 62

NOTES RHOADES

DATE 7/18/18

ROUTE US 20A

H.C. LEU

WEATHER CLOUDY

COUNTY FULTON

R.C. TRENKA

TEMP. 77°

TOWNSHIP CLINTON

SECTION 9

DWG BY NASON

PID 101232

T 7 N R 6 E

TYPE MONUMENT MAG/WASHER

ON SURFACE - ~~BELOW~~ ON

OFFSET Q PAVEMENT 1.0' LT : RT

- TO - EDGE PAVEMENT


STATION: 584+20.37

HORIZ.DATUM: NAD83(2011)


GEOID: 2012A

GRID: NORTHING: 698907.884

EASTING: 1510745.170

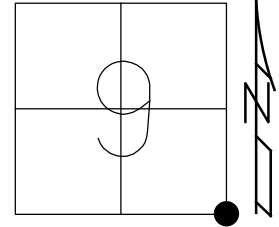

RECORD:
STA. 584+25.76
FD P.K./WASHER
6/6/02, TMR
SET MAG/WASHER
4/26/03, DCH
FD MAG/WASHER
REF23
9/30/14, EBW
7/16/19, JFO
SET MAG/WASHER
10/21/19, JFO

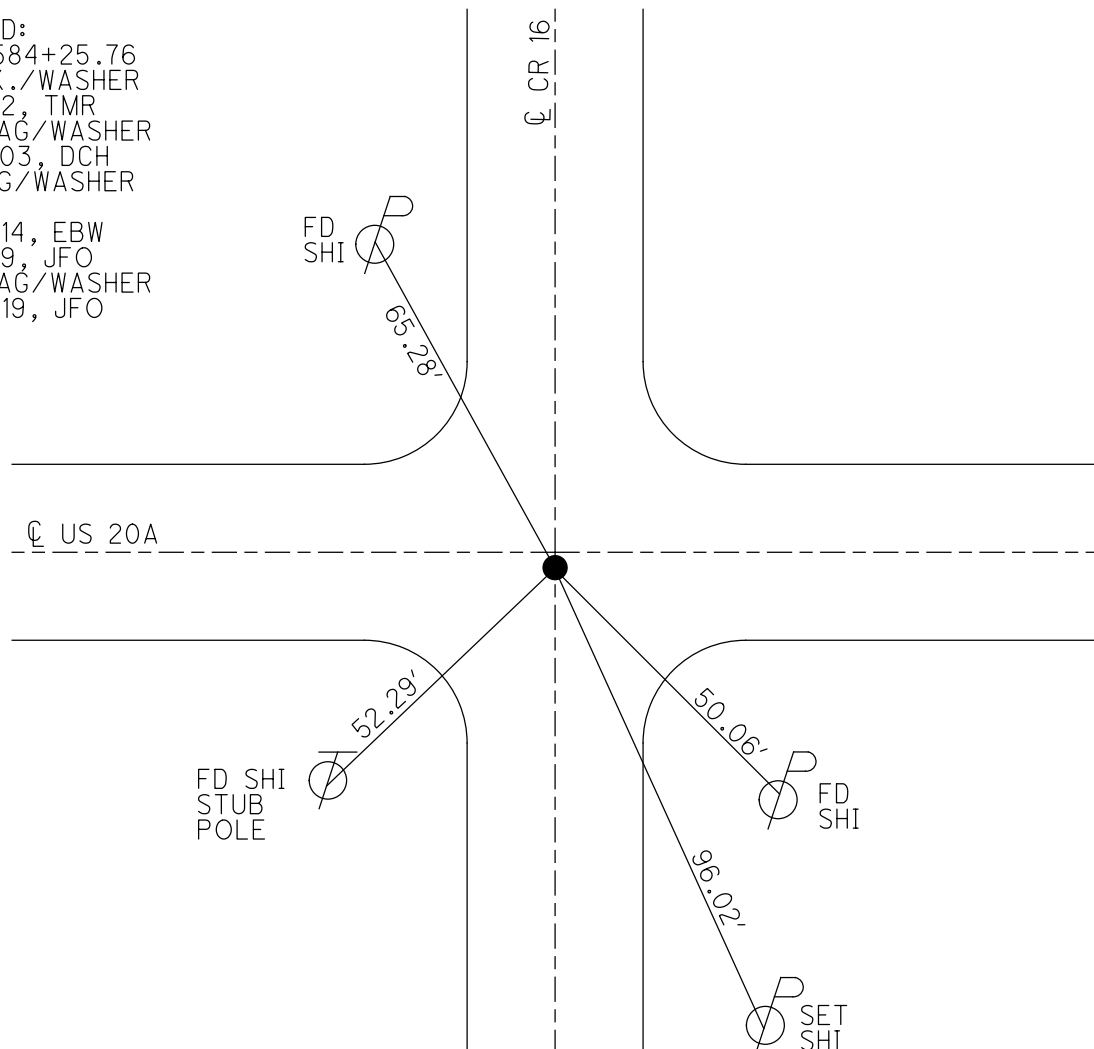

O.D.O.T. DISTRICT 2 SURVEY OFFICE (USE ONLY)

PERSONNEL

REFERENCE NO. 24

SHEET 46 OF 62

NOTES RHOADES

DATE 7/18/18

ROUTE US 20A

H.C. LEU

WEATHER CLOUDY

COUNTY FULTON

R.C. TRENKA

TEMP. 77°

TOWNSHIP CLINTON

DWG BY NASON

PID 101232

SECTION 10

T 7 N R 6 E

TYPE MONUMENT P.K.NAIL

ON SURFACE - ~~BELOW~~ ON

OFFSET Q PAVEMENT 0.2' LT : ~~RT~~

10.3' TO LT EDGE PAVEMENT


STATION: 610+42.02

HORZ.DATUM: NAD83(2011)

GEOID: 2012A

GRID: NORTHING: 698896.393


EASTING: 1513366.796

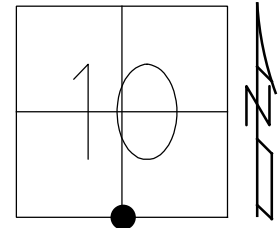

RECORD:

STA. 610+47.88
FD P.K./WASHER
6/6/02, DCH
SET MAG/WASHER
9/19/02, DCH
FD P.K.NAIL
BENT NORTHERLY
REF24
9/30/14, EBW
SET MAG/WASHER
7/18/18, JLL
10/21/19, JFO

BRICK COLUMN
TOP 17TH BRICK UP
CHURCH SIGN

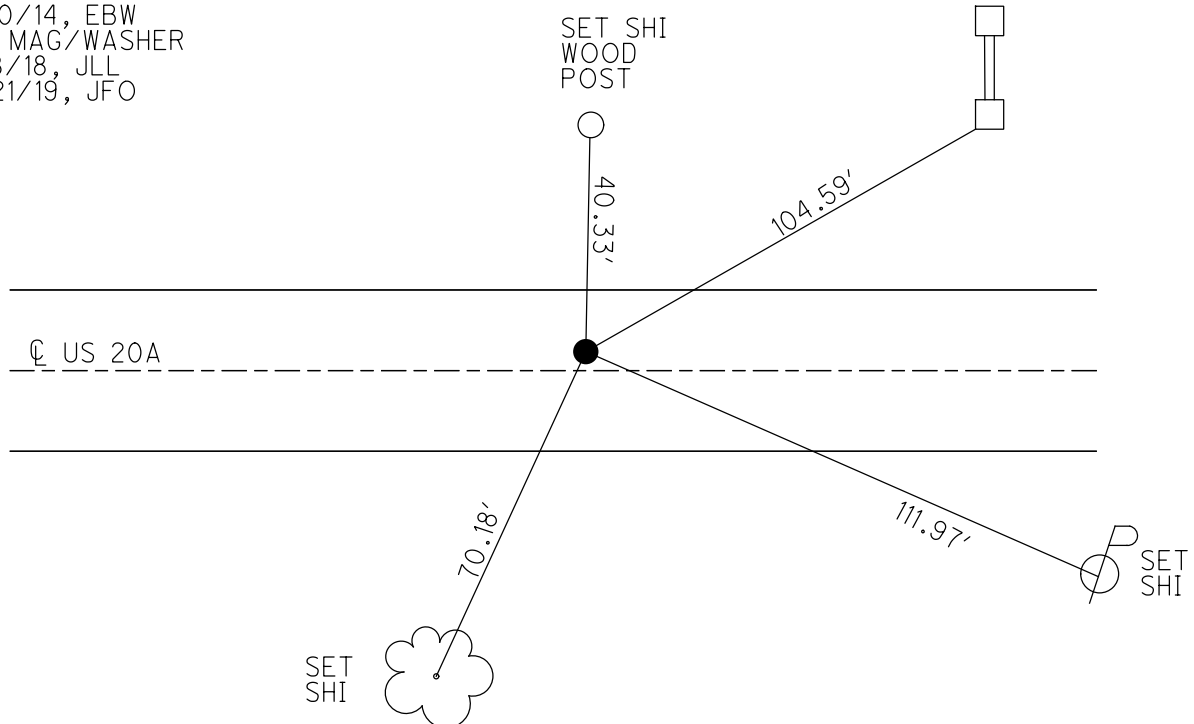

O.D.O.T. DISTRICT 2 SURVEY OFFICE (USE ONLY)

PERSONNEL

REFERENCE NO. 24 A

SHEET 47 OF 62

NOTES RHOADES

DATE 7/18/18

ROUTE US 20A

H.C. RHOADES

WEATHER CLOUDY

COUNTY FULTON

R.C. TRENKA

TEMP. 77°

TOWNSHIP CLINTON

LEU HAGEMEYER

SECTION 10

DWG BY NASON

PID 101232

T 7 N R 6 E

TYPE MONUMENT P.K./WASHER

ON SURFACE - ~~BELOW~~ ON

OFFSET Q PAVEMENT ON LT : RT

10.1' TO LT EDGE PAVEMENT


STATION: 623+57.93

HORIZ.DATUM: NAD83(2011)

GEOID: 2012A

GRID: NORTHING: 698891.139

EASTING: 1514682.702

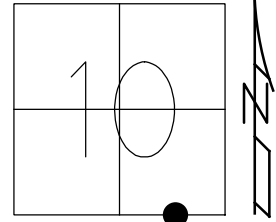

RECORD:

FD P.K./WASHER

6/6/02, DCH

SET MAG/WASHER

9/19/02, DCH

DNF

7/24/14, EBW


7/16/19, JFO

SET MAG/WASHER

7/18/18, JLL

NEWREFA24

10/21/19, JFO

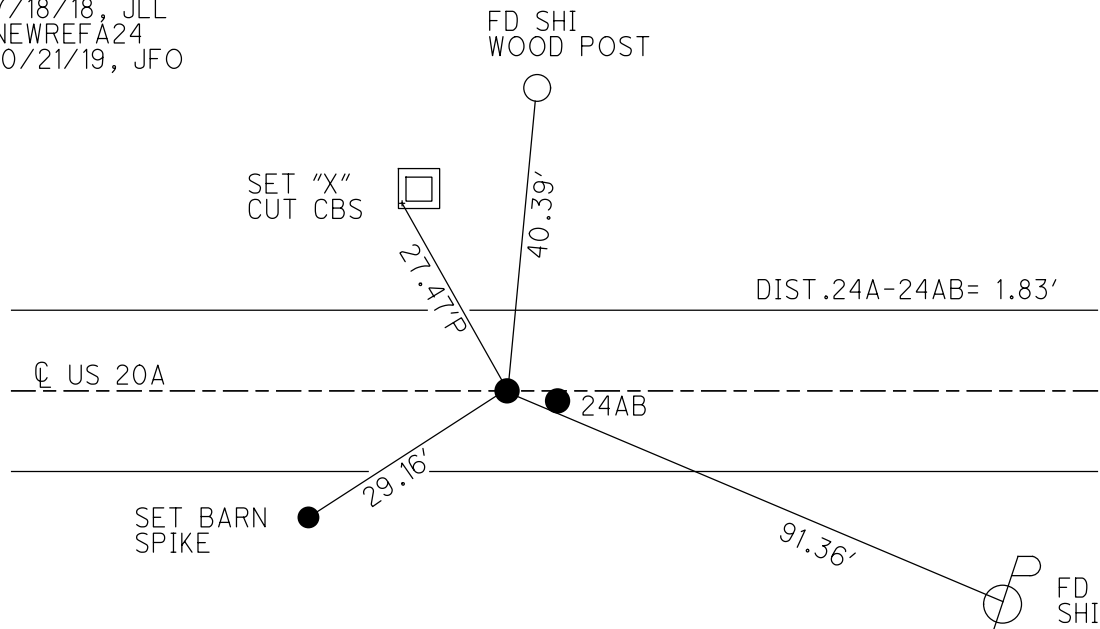

O.D.O.T. DISTRICT 2 SURVEY OFFICE (USE ONLY)

PERSONNEL

REFERENCE NO. 24 AB

SHEET 48 OF 62

NOTES RHOADES

DATE 7/18/18

ROUTE US 20A

H.C. RHOADES

WEATHER CLOUDY

COUNTY FUTLON

R.C. TRENKA

TEMP. 77°

TOWNSHIP CLINTON

LEU HAGEMEYER

SECTION 10

DWG BY NASON

PID 101232

T 7 N R 6 E

TYPE MONUMENT P.K./WASHER

ON SURFACE - ~~BELOW~~ ON

OFFSET Q PAVEMENT 0.3' ~~LT~~ : RT

10.1' TO LT EDGE PAVEMENT


STATION: 623+59.76

HORIZ.DATUM: NAD83(2011)

GEOID: 2012A

GRID: NORTHING: 698890.820

EASTING: 1514684.495

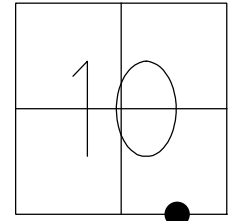

RECORD:

FD P.K./WASHER

6/6/02, DCH

SET MAG/WASHER

9/19/02, DCH


FD MAG/WASHER

7/16/19, JFO

SET MAG/WASHER

NEWREFAB24

10/21/19, JFO

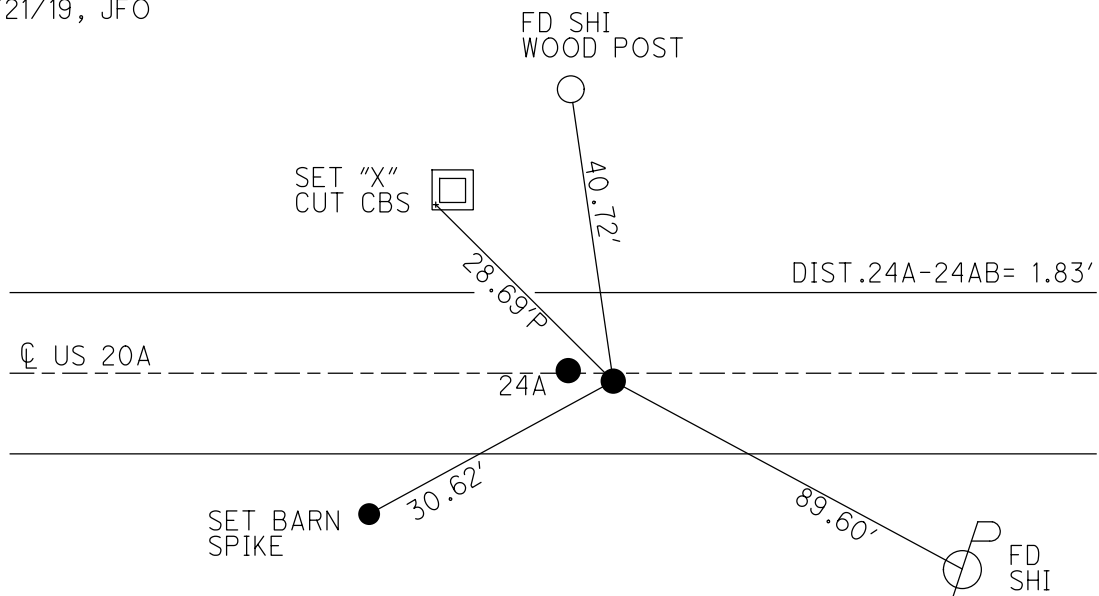

O.D.O.T. DISTRICT 2 SURVEY OFFICE (USE ONLY)

PERSONNEL

REFERENCE NO. 24 B

SHEET 49 OF 62

NOTES MICHALAK

DATE 6/6/02

ROUTE US 20A

H.C. HOMAN

WEATHER CLOUDY

COUNTY FULTON

R.C. MALINSKY

TEMP. 56°

TOWNSHIP CLINTON

SECTION 10

DWG BY NASON

PID 101232

T 7 N R 6 E

TYPE MONUMENT P.K.NAIL

ON SURFACE - ~~BELOW~~ ON

OFFSET CL PAVEMENT ON LT : RT

10.1' TO LT EDGE PAVEMENT


STATION: 625+67

HORZ.DATUM: _____


GEOID: _____

GRID: NORTHING: _____

EASTING: _____

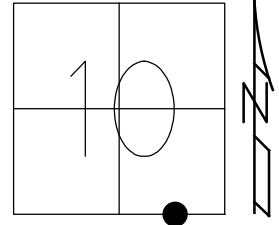

RECORD:
FD P.K. NAIL
7/24/14, EBW
DNF
7/18/18, JLL

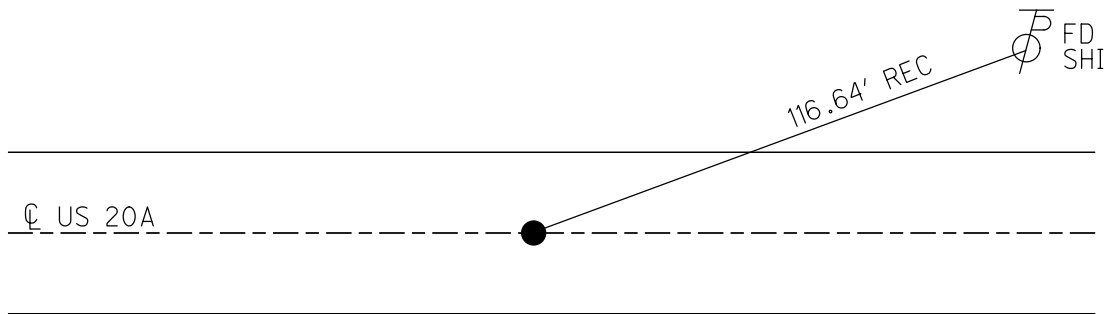

O.D.O.T. DISTRICT 2 SURVEY OFFICE (USE ONLY)

PERSONNEL

REFERENCE NO. 25

SHEET 50 OF 62

NOTES MICHALAK

DATE 6/6/02

ROUTE US 20A

H.C. HOMAN

WEATHER CLOUDY

COUNTY FULTON

R.C. MALINSKY

TEMP. 56°

TOWNSHIP CLINTON

SECTION 10

DWG BY NASON

PID 101232

T 7 N R 6 E

TYPE MONUMENT MAG/WASHER

ON SURFACE - ~~BELOW~~ ON

OFFSET 0 PAVEMENT ON LT : RT

- TO - EDGE PAVEMENT


STATION: 636+73.82

HORZ.DATUM: NAD83(2011)


GEOID: 2012A

GRID: NORTHING: 698885.890

EASTING: 1515998.582

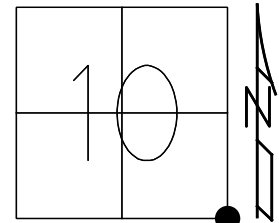

RECORD:
FD P.K./WASHER
6/6/02, DCH
SET MAG/WASHER
4-26-03, DCH
FD MAG/WASHER
REF25
9/30/14, EBW
7/16/19, JFO
SET MAG/WASHER
10/21/19, JFO

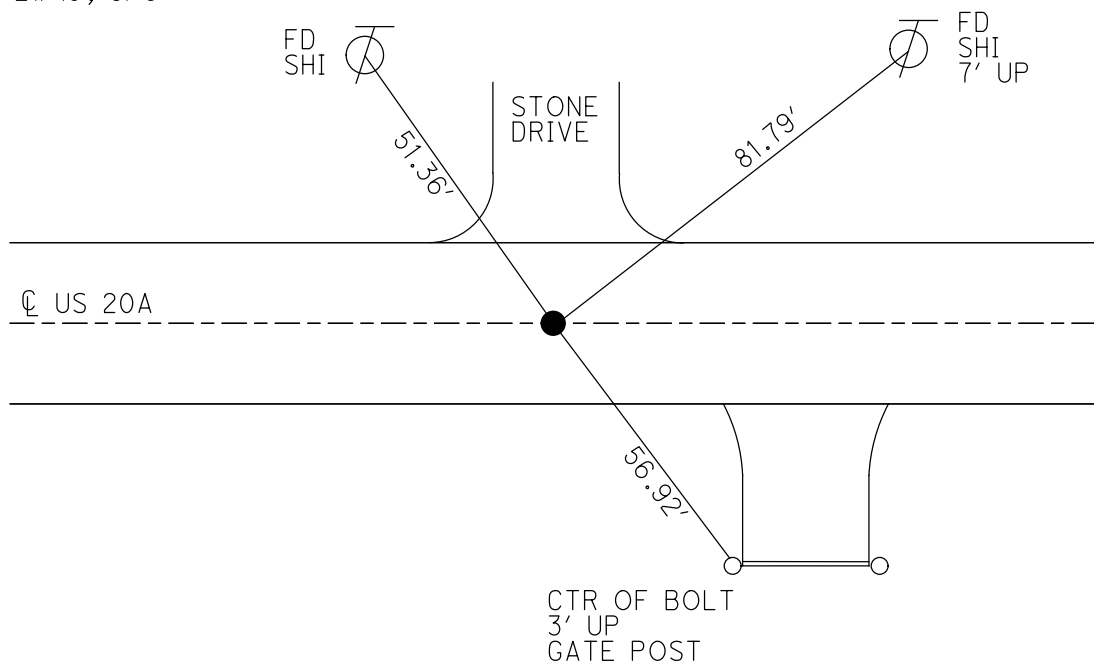

O.D.O.T. DISTRICT 2 SURVEY OFFICE (USE ONLY)

PERSONNEL

REFERENCE NO. 26

SHEET 51 OF 62

NOTES MILLER

DATE 7/16/19

ROUTE US 20A

H.C. O'DONNELL

WEATHER CLOUDY

COUNTY FULTON

R.C. AUBLE

TEMP. 78°

TOWNSHIP CLINTON

RHOADES

SECTION 11

DWG BY NASON

PID 101232

T 7 N R 6 E

TYPE MONUMENT MAG/WASHER

ON SURFACE - ~~BELOW~~ ON

OFFSET Q PAVEMENT 1' LT : ~~RT~~

- TO - EDGE PAVEMENT


STATION: 651+08.75

HORZ.DATUM: NAD83(2011)


GEOID: 2012A

GRID: NORTHING: 698881.519

EASTING: 1517433.498

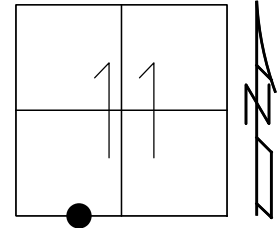

RECORD:
FD SM.R.R.SPIKE
6/6/02, DCH
SET MAG/WASHER
7-18-03, DCH
FD MAG/WASHER
REF26
9/30/14, EBW
FD MAG/WASHER
7/16/19, JFO
SET MAG/WASHER
10/22/19, JFO

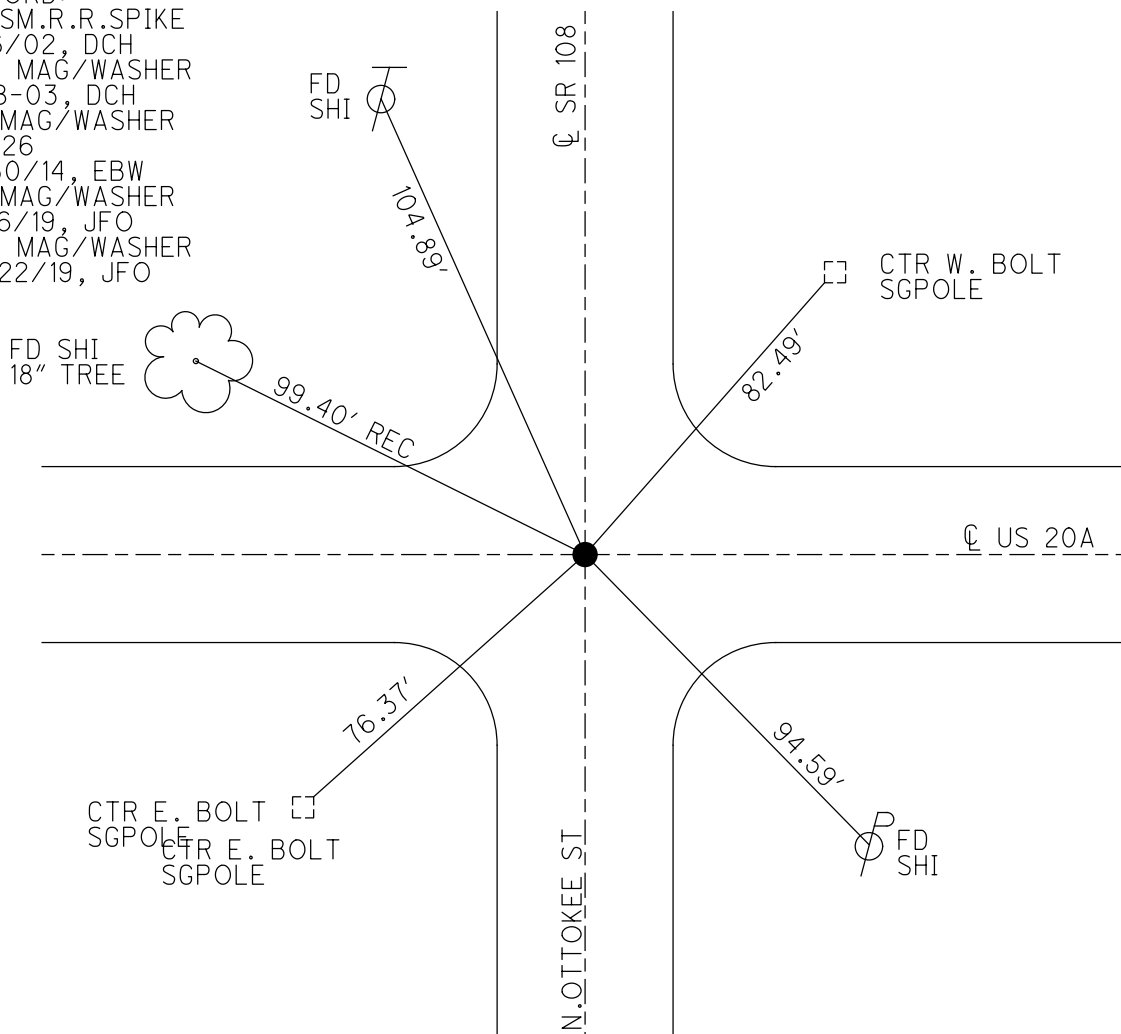

O.D.O.T. DISTRICT 2 SURVEY OFFICE (USE ONLY)

PERSONNEL

REFERENCE NO. 26 A

SHEET 52 OF 62

NOTES MILLER

DATE 7/16/19

ROUTE US 20A

H.C. O'DONNELL

WEATHER CLOUDY

COUNTY FULTON

R.C. AUBLE

TEMP. 78°

TOWNSHIP CLINTON

RHOADES

SECTION 11

DWG BY NASON

PID 101232

T 7 N R 6 E

TYPE MONUMENT P.K.SHANK

ON SURFACE - ~~BELOW~~ ON

OFFSET Q PAVEMENT ON LT : RT

- TO - EDGE PAVEMENT


STATION: 662+99.35

HORZ.DATUM: NAD83(2011)


GEOID: 2012A

GRID: NORTHING: 698878.807

EASTING: 1518624.102

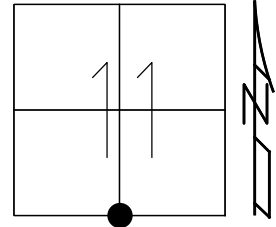

RECORD:
FD P.K.NAIL
6/6/02, DCH
SET MAG/WASHER
7-18-03, DCH
FD P.K.SHANK
REFA26
7/24/14, EBW
7/16/19, JFO
SET MAG/WASHER
10/22/19, JFO

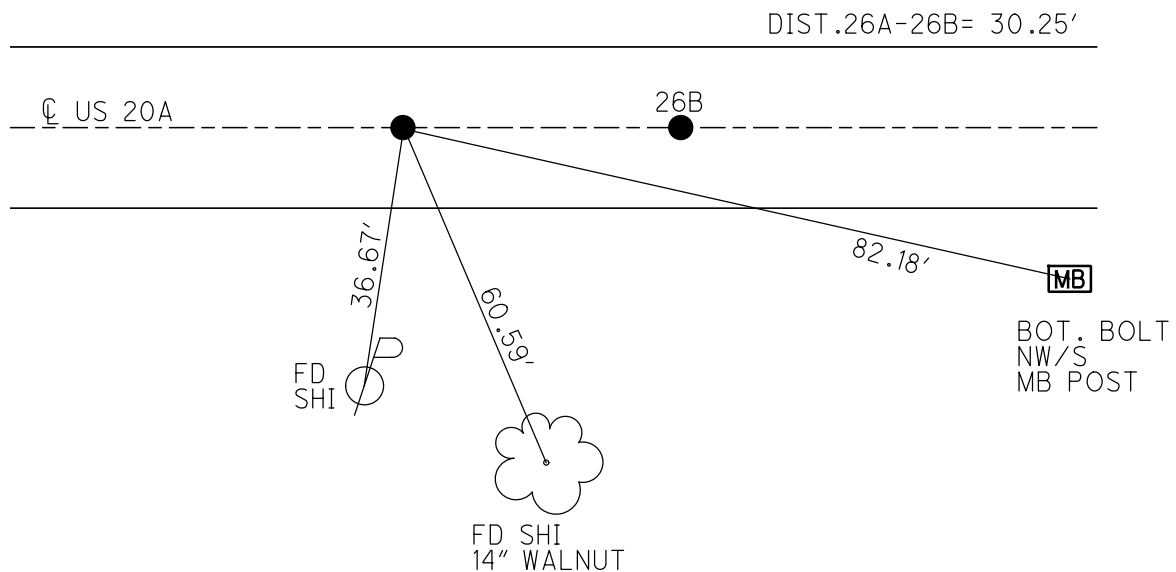

O.D.O.T. DISTRICT 2 SURVEY OFFICE (USE ONLY)

PERSONNEL

REFERENCE NO. 26 B

SHEET 53 OF 62

NOTES MILLER

DATE 7/16/19

ROUTE US 20A

H.C. O'DONNELL

WEATHER CLOUDY

COUNTY FULTON

R.C. AUBLE
RHOADES

TEMP. 78°

TOWNSHIP CLINTON

DWG BY NASON

PID 101232

SECTION 11

T 7 N R 6 E

TYPE MONUMENT MAG/WASHER

ON SURFACE - ~~BELOW~~ ON

OFFSET Q PAVEMENT ON LT : RT

- TO - EDGE PAVEMENT


STATION: 663+29.61

HORIZ.DATUM: NAD83(2011)


GEOID: 2012A

GRID: NORTHING: 698878.692

EASTING: 1518654.357

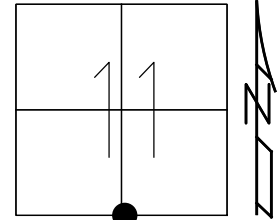

RECORD:
FD SM.R.R.SPIKE
6/6/02, DCH
SET MAG/WASHER
7-18-03, DCH
FD MAG/WASHER
REFB26
7/24/14, EBW
7/16/19, JFO
SET MAG/WASHER
10/22/19, JFO

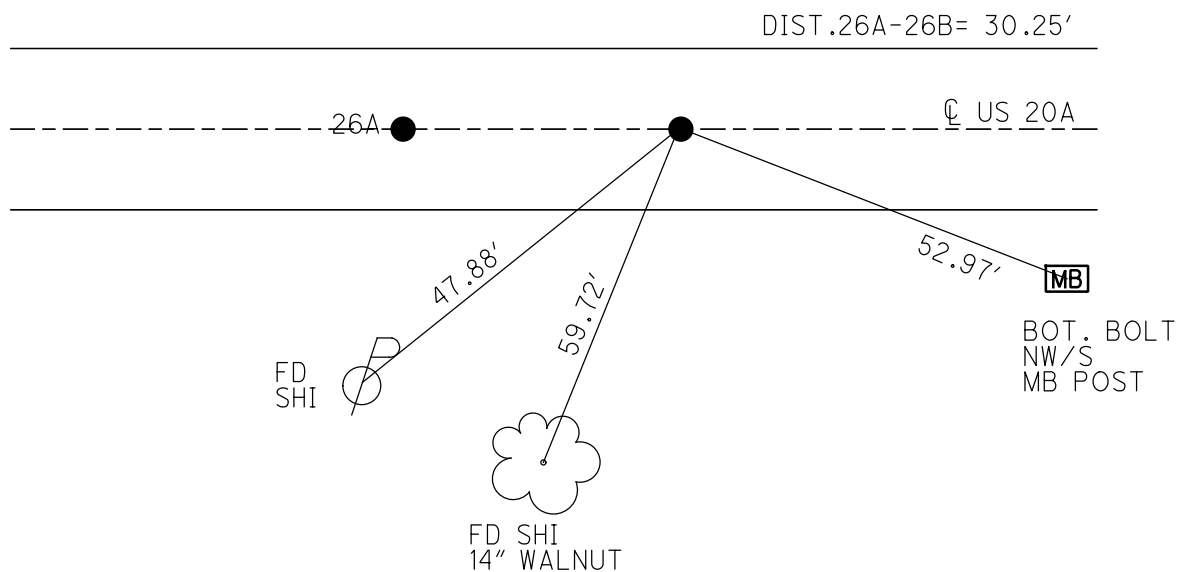

O.D.O.T. DISTRICT 2 SURVEY OFFICE (USE ONLY)

PERSONNEL

REFERENCE NO. 27

SHEET 54 OF 62

NOTES MILLER

DATE 7/16/19

ROUTE US 20A

H.C. O'DONNELL

WEATHER RAINING

COUNTY FULTON

R.C. AUBLE

TEMP. 78°

TOWNSHIP CLINTON

RHOADES

SECTION 11

DWG BY NASON PID 101232

T 7 N R 6 E

TYPE MONUMENT MAG/WASHER

ON SURFACE - ~~BELOW~~ ON

OFFSET ℄ PAVEMENT ON LT : RT

- TO - EDGE PAVEMENT


STATION: 689+70.19

HORZ.DATUM: NAD83(2011)


GEOID: 2012A

GRID: NORTHING: 698927.092

EASTING: 1521294.497

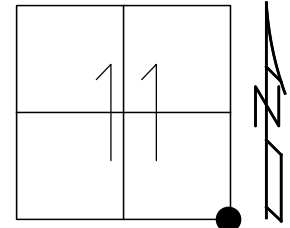

RECORD:
FD SM.R.R.SPIKE
6/6/02, DCH
SET MAG/WASHER
7-18-03, DCH
FD MAG/WASHER
REF27
9/30/14, EBW
7/16/19, JFO
SET MAG/WASHER
10/22/19, JFO

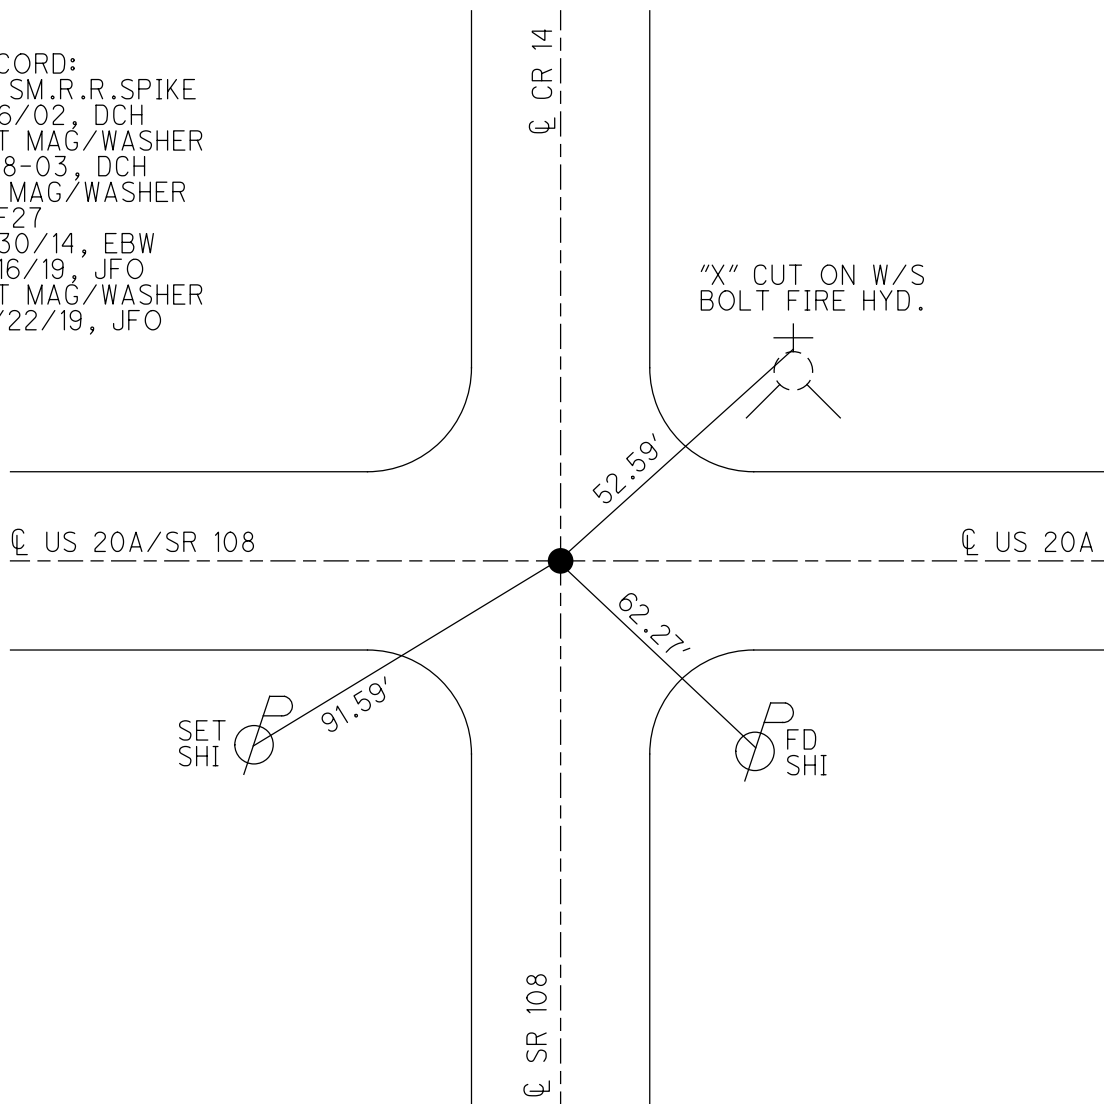

O.D.O.T. DISTRICT 2 SURVEY OFFICE (USE ONLY)

PERSONNEL

REFERENCE NO. 28

SHEET 55 OF 62

NOTES MILLER

DATE 7/16/19

ROUTE US 20A

H.C. O'DONNELL

WEATHER CLOUDY

COUNTY FULTON

R.C. AUBLE

TEMP. 78°

TOWNSHIP CLINTON

RHOADES

SECTION 1

DWG BY NASON PID 101232

T 7 N R 6 E

TYPE MONUMENT P.K.SHANK

ON SURFACE - ~~BELOW~~ ON

OFFSET CL PAVEMENT 2.4' LT : ~~RT~~

9.6' TO LT EDGE PAVEMENT


STATION: 716+46.27

HORZ.DATUM: NAD83(2011)


GEOID: 2012A

GRID: NORTHING: 698900.760

EASTING: 1523970.448

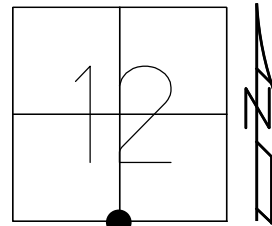

RECORD:
FD P.K.NAIL
9/16/04, MB
SET MAG/WASHER
10-13-04, DCH
FD P.K.SHANK
REF28
9/30/14, EBW
REF28
12/21/17, JFO
SET MAG/WASHER
10/22/19, JFO

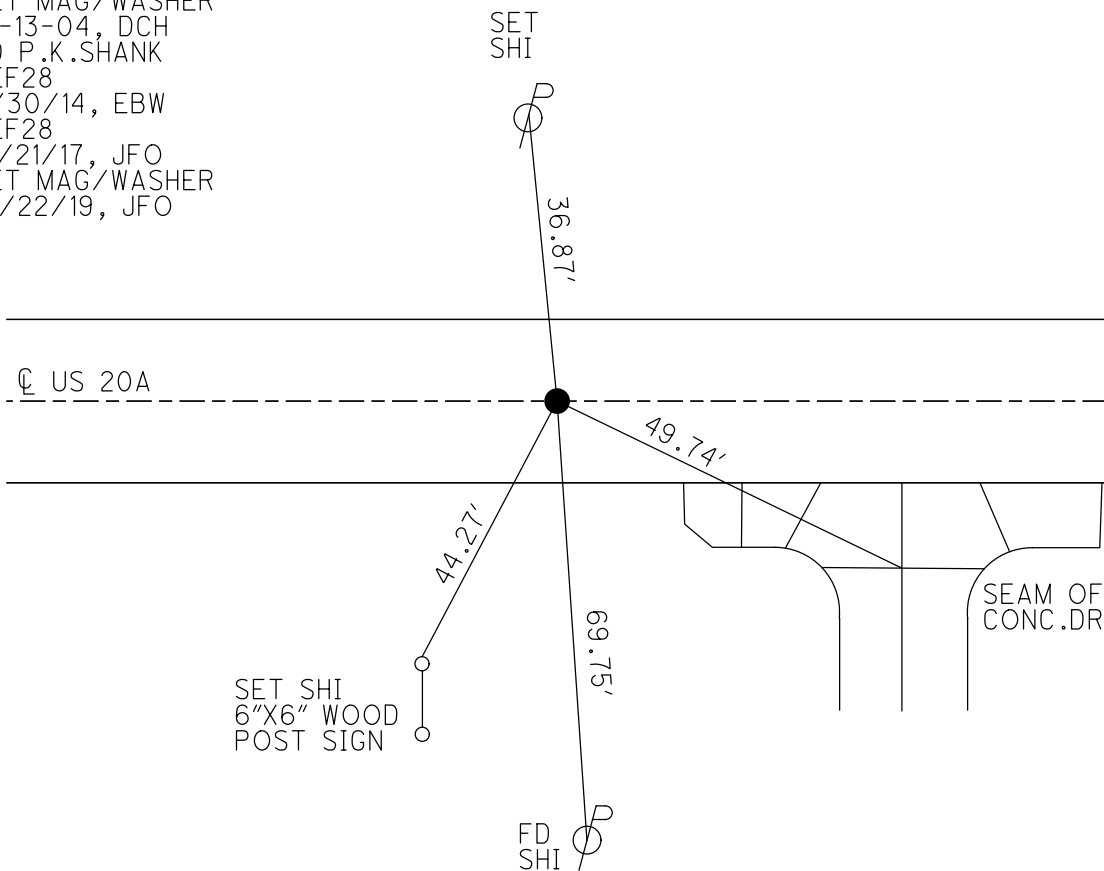

O.D.O.T. DISTRICT 2 SURVEY OFFICE (USE ONLY)

PERSONNEL

REFERENCE NO. 29

SHEET 56 OF 63

NOTES RHOADES DATE 6/11/19
H.C. O'DONNELL WEATHER SUNNY
R.C. MILLER TEMP. 62°

ROUTE US 20A
COUNTY FULTON
TOWNSHIP CLINTON
SECTION 13
T 7 N R 6 E

DWG BY BALBAUGH PID 101232

TYPE MONUMENT MAG NAIL

ON SURFACE - ~~BELOW~~ ON

OFFSET Q PAVEMENT 1.5' ~~LT~~ : RT

TO EDGE PAVEMENT


STATION: 743+31.58

HORIZ.DATUM: NAD83 (2011)


GEOID: 2012A

GRID: NORTHING: 698777.438

EASTING: 1526652.805

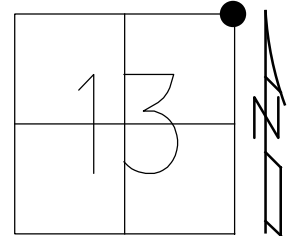

NOTE:
DIST. 29-29A = 37.13'

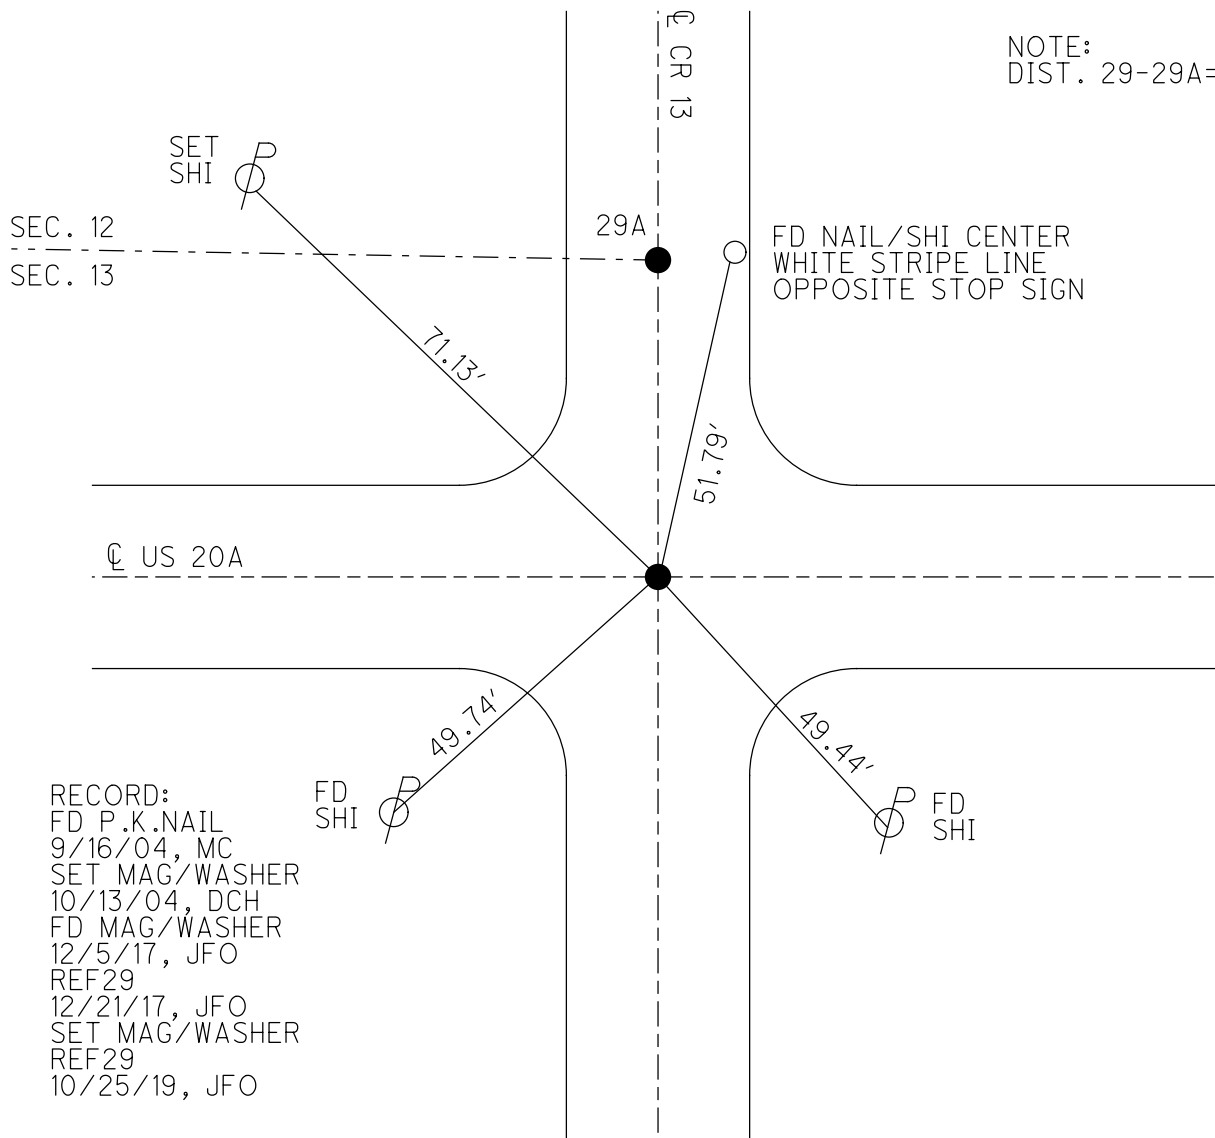

RECORD:
FD P.K.NAIL
9/16/04, MC
SET MAG/WASHER
10/13/04, DCH
FD MAG/WASHER
12/5/17, JFO
REF29
12/21/17, JFO
SET MAG/WASHER
REF29
10/25/19, JFO

O.D.O.T. DISTRICT 2 SURVEY OFFICE (USE ONLY)

PERSONNEL

REFERENCE NO. 29 A

SHEET 57 OF 63

NOTES RHOADES DATE 6/11/19

H.C. O'DONNELL WEATHER SUNNY

R.C. MILLER TEMP. 62°

ROUTE US 20A

COUNTY FULTON

TOWNSHIP CLINTON

SECTION 13

DWG BY BALBAUGH PID 101232

T 7 N R 6 E

TYPE MONUMENT MAG NAIL

ON SURFACE - ~~BELOW~~ ON

OFFSET CL PAVEMENT ON LT : RT

TO EDGE PAVEMENT


STATION: 743+31.58

HORIZ.DATUM: NAD83 (2011)


GEOID: 2012A

GRID: NORTHING: 698814.540

EASTING: 1526653.552

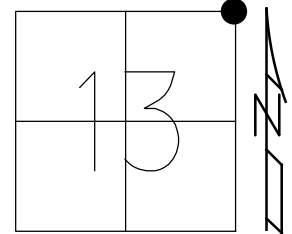

NOTE:
DIST. 29-29A= 37.13'

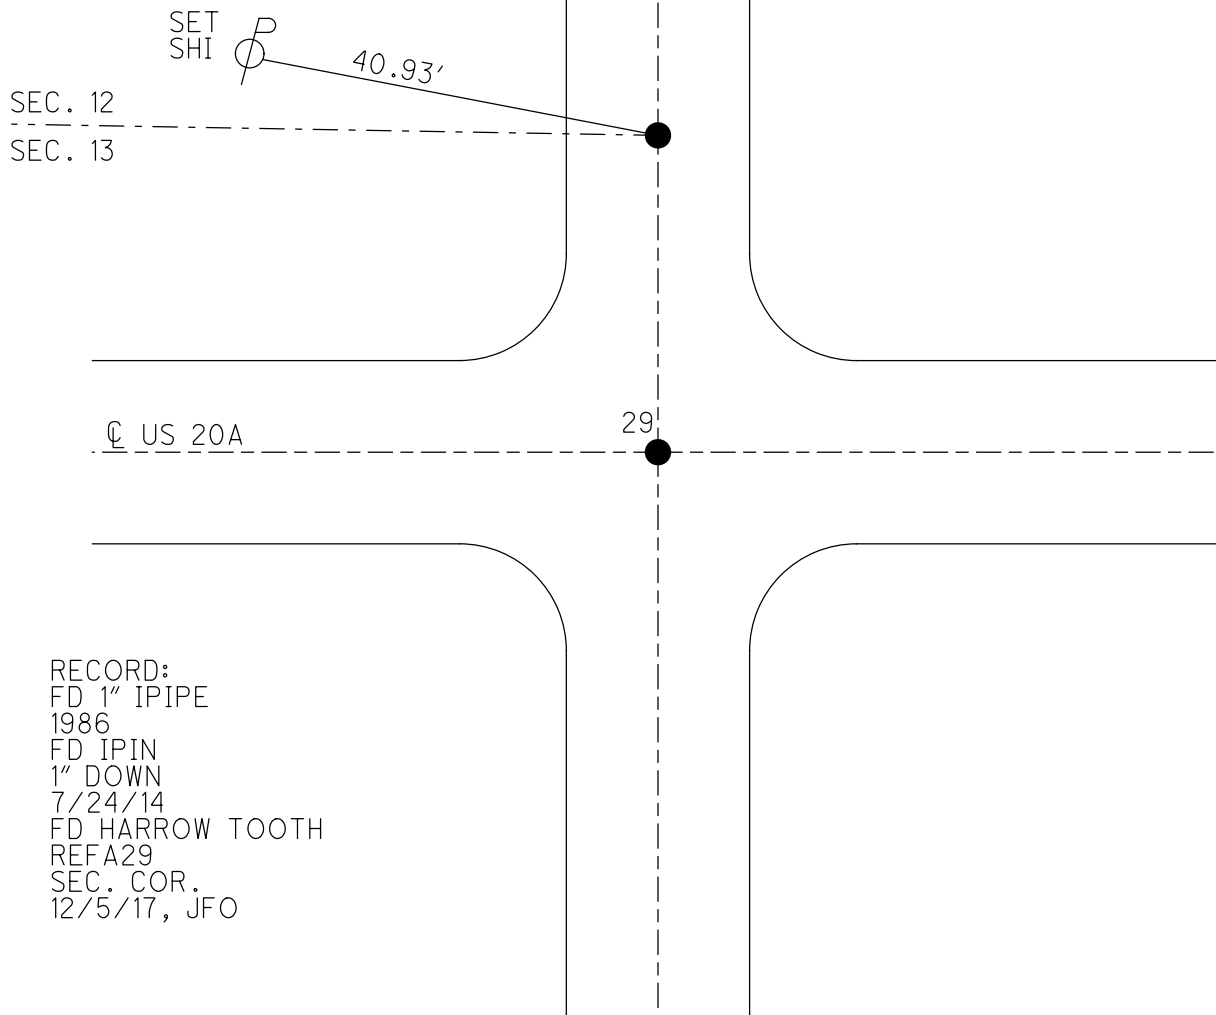

O.D.O.T. DISTRICT 2 SURVEY OFFICE (USE ONLY)

PERSONNEL

REFERENCE NO. 30

SHEET 58 OF 63

NOTES RHOADES

DATE 6/11/19

ROUTE US 20A

H.C. O'DONNELL

WEATHER SUNNY

COUNTY FULTON

R.C. MILLER

TEMP. 62°

TOWNSHIP YORK

SECTION 18

DWG BY BALBAUGH

PID 101232

T 7 N R 7 E

TYPE MONUMENT MAG/WASHER

ON SURFACE - ~~BELOW~~ ON

OFFSET CL PAVEMENT ON ~~LT~~ : ~~RT~~

13.1' TO RT EDGE PAVEMENT


STATION: 769+47.43

HORIZ.DATUM: NAD83 (2011)

GEOID: 2012A


GRID: NORTHING: 698713.590

EASTING: 1529267.935

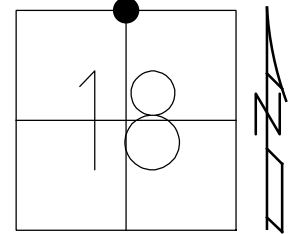

RECORD:

FD P.K.NAIL
9/16/04, MC
SET MAG/WASHER
10/13/04, DH
FD MAG/WASHER
12/5/17, JFO
REF30
12/21/17, JFO
REF30
6/13/19, JFO
FD MONBOX
W/ 1 1/2" IPIPE
NEWREF30
10/25/19, JFO

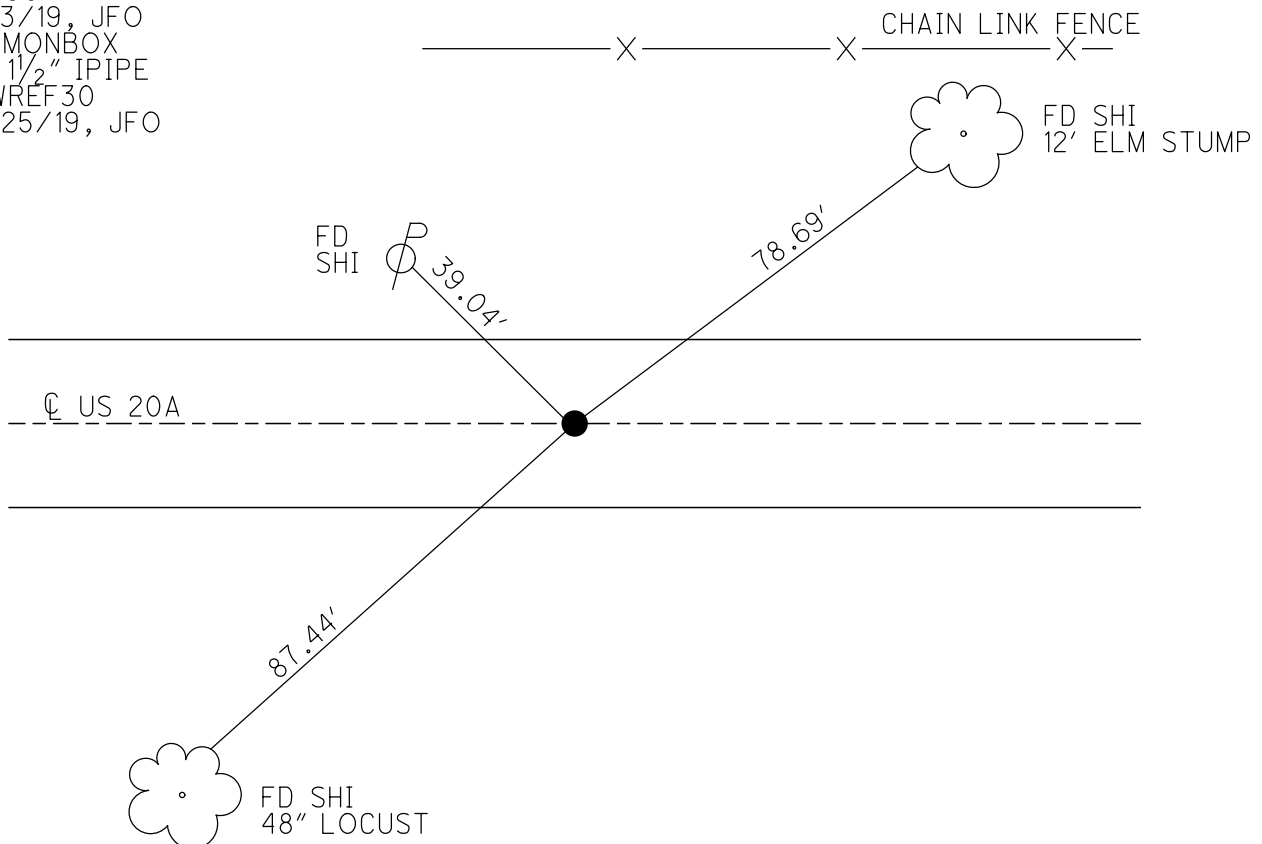

O.D.O.T. DISTRICT 2 SURVEY OFFICE (USE ONLY)

PERSONNEL

REFERENCE NO. 31

SHEET 59 OF 63

NOTES RHOADES

DATE 6/11/19

ROUTE US 20A

H.C. O'DONNELL

WEATHER SUNNY

COUNTY FULTON

R.C. MILLER

TEMP. 62°

TOWNSHIP YORK

SECTION 18

DWG BY BALBAUGH PID 101232

T 7 N R 7 E

TYPE MONUMENT MAG/WASHER

ON SURFACE - ~~BELOW~~ ON

OFFSET Q PAVEMENT ON LT : RT

TO EDGE PAVEMENT


STATION: 795+77.04

HORIZ.DATUM: NAD83 (2011)


GEOID: 2012A

GRID: NORTHING: 698652.834

EASTING: 1531896.829

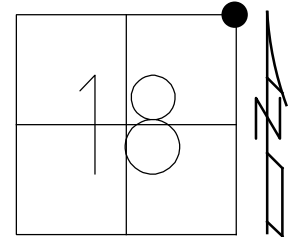

RECORD:
FD P.K.NAIL
9/16/04, MC
SET MAG/WASHER
10/13/04, DCH
FD MAG/WASHER
12/5/17, JFO
REF31
12/21/17, JFO
REF31
6/13/19, JFO
FD MONBOX
W/ 1 1/2" IPIPE
NEWREF31
10/25/19, JFO

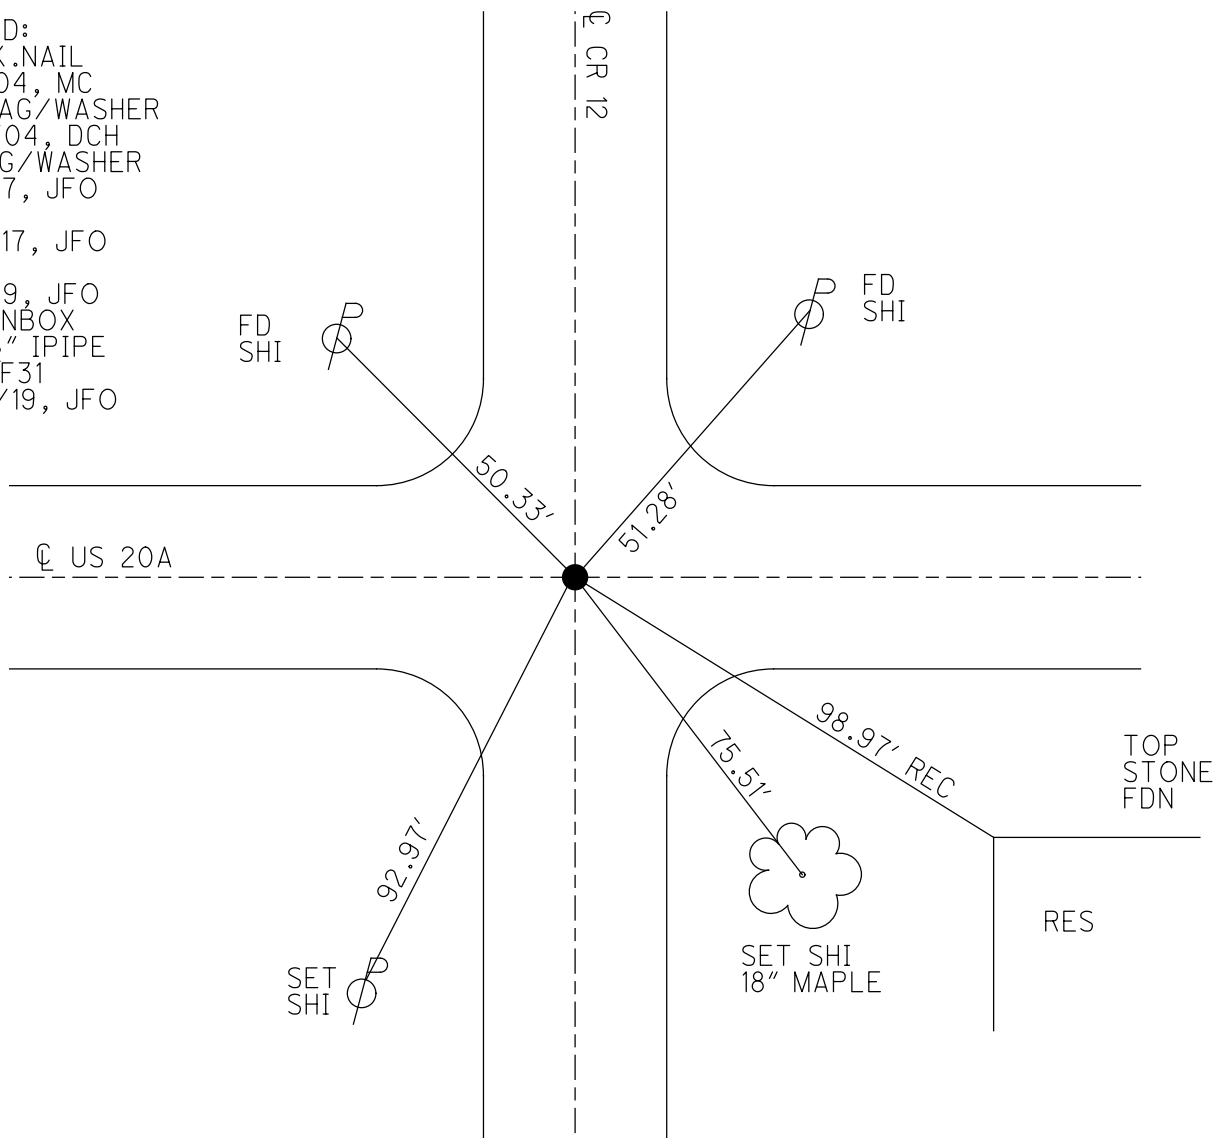

O.D.O.T. DISTRICT 2 SURVEY OFFICE (USE ONLY)

PERSONNEL

REFERENCE NO. 32

SHEET 60 OF 63

NOTES RHOADES

DATE 6/11/19

ROUTE US 20A

H.C. O'DONNELL

WEATHER SUNNY

COUNTY FULTON

R.C. MILLER

TEMP. 62°

TOWNSHIP YORK

DWG BY BALBAUGH

PID 101232

SECTION 17

T 7 N R 7 E

TYPE MONUMENT MAG/WASHER

ON SURFACE - ~~BELOW~~ ON

OFFSET CL PAVEMENT ON ~~LT~~ : ~~RT~~

13.1' TO RT EDGE PAVEMENT


STATION: 822+36.27

HORZ.DATUM: NAD83 (2011)


GEOID: 2012A

GRID: NORTHING: 698594.692

EASTING: 1534555.360

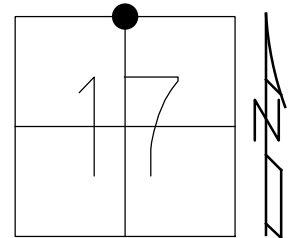

RECORD:
FD R.R.SPIKE
9/16/04, MC
SET MAG/WASHER
10/13/04, DCH
FD MAG/WASHER
12/5/17, JFO
REF32
12/21/17, JFO
SET MAG/WASHER
10/25/19, JFO

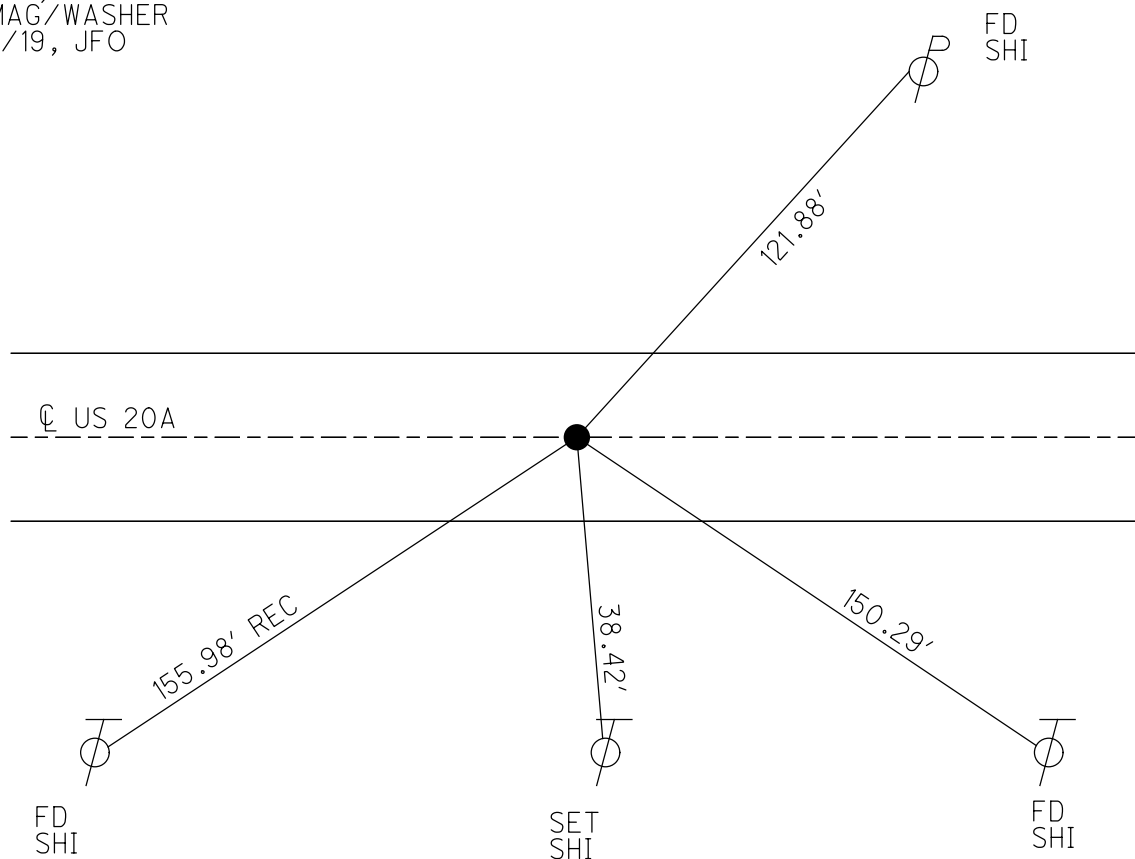

O.D.O.T. DISTRICT 2 SURVEY OFFICE (USE ONLY)

PERSONNEL

REFERENCE NO. 33

SHEET 61 OF 63

NOTES RHOADES

DATE 6/11/19

ROUTE US 20A

H.C. O'DONNELL

WEATHER SUNNY

COUNTY FULTON

R.C. MILLER

TEMP. 62°

TOWNSHIP YORK

DWG BY BALBAUGH PID 101232

SECTION 17

T 7 N R 7 E

TYPE MONUMENT MAG/WASHER

ON SURFACE - ~~BELOW~~ ON

OFFSET CL PAVEMENT 0.7' ~~LT~~ : RT

TO EDGE PAVEMENT


STATION: 848+95.23

HORZ.DATUM: NAD83 (2011)


GEOID: 2012A

GRID: NORTHING: 698536.250

EASTING: 1537213.675

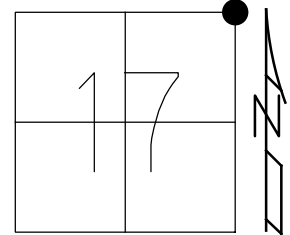

RECORD:
FD P.K.NAIL
9/16/04, MC
SET MAG/WASHER
10/13/04, DCH
FD MAG/WASHER
12/5/17, JFO
REF33
12/21/17, JFO
SET MAG/WASHER
10/25/19, JFO

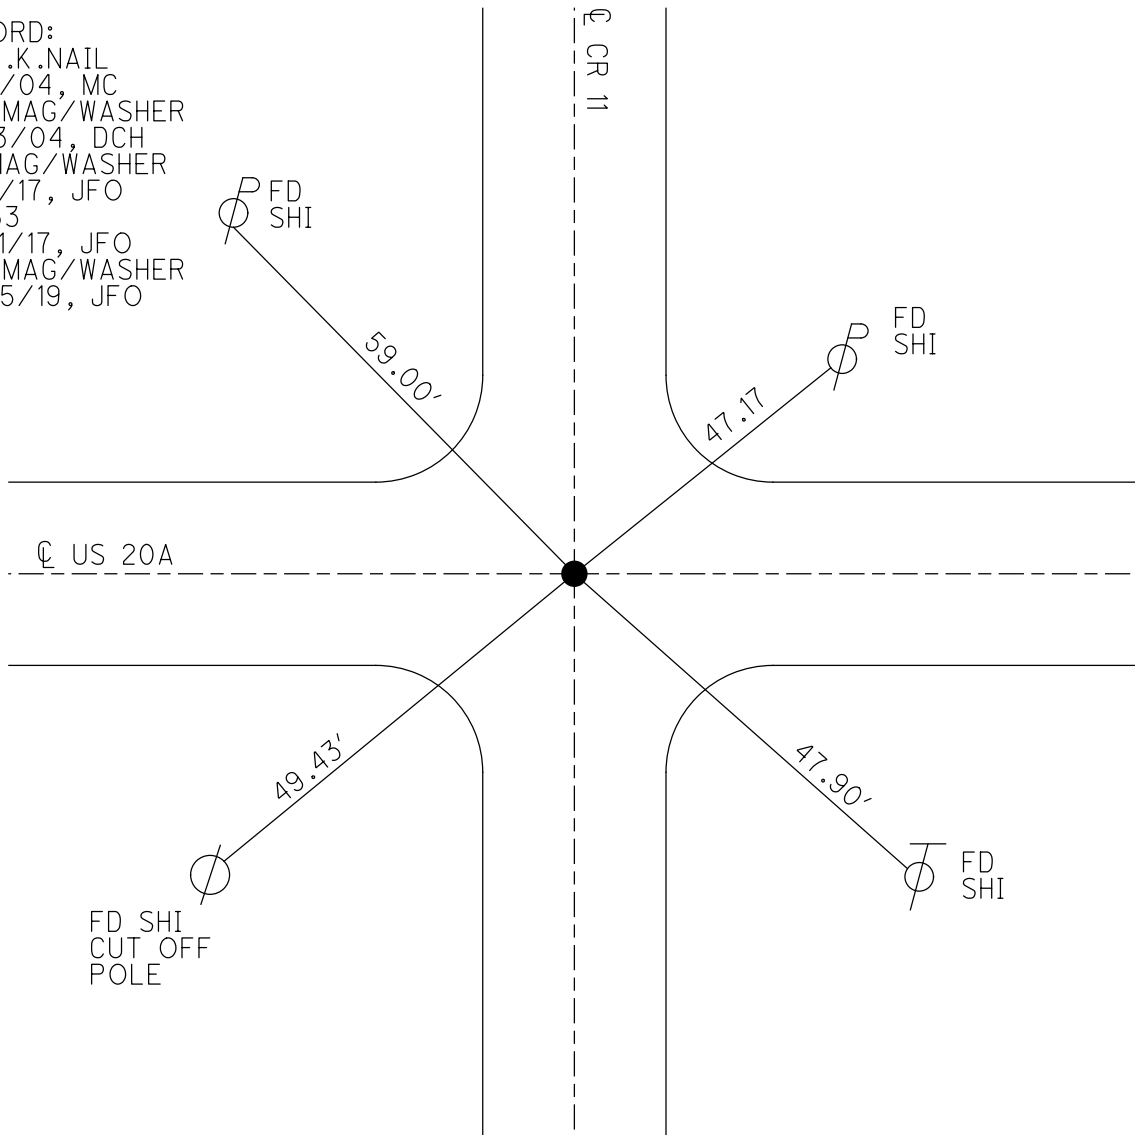

O.D.O.T. DISTRICT 2 SURVEY OFFICE (USE ONLY)

PERSONNEL

REFERENCE NO. 34

SHEET 62 OF 63

NOTES RHOADES

DATE 6/11/19

ROUTE US 20A

H.C. O'DONNELL

WEATHER SUNNY

COUNTY FULTON

R.C. MILLER

TEMP. 62°

TOWNSHIP YORK

SECTION 16

DWG BY BALBAUGH PID 101232

T 7 N R 7 E

TYPE MONUMENT MAG/WASHER

ON SURFACE - ~~BELOW~~ ON

OFFSET 0.6' LT : ~~RT~~

14.0' TO RT EDGE PAVEMENT


STATION: 875+46.85

HORIZ.DATUM: NAD83 (2011)

GEOID: 2012A

GRID: NORTHING: 698504.367


EASTING: 1539865.102

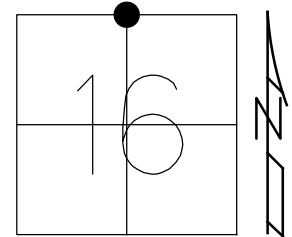

RECORD:

FD P.K.NAIL
9/16/04, MC
SET MAG/WASHER
10/13/04, DCH
FD MAG/WASHER
12/5/17, JFO
REF34
12/21/17, JFO
SET MAG/WASHER
10/25/19, JFO

DIST. 34-34A=8.62'

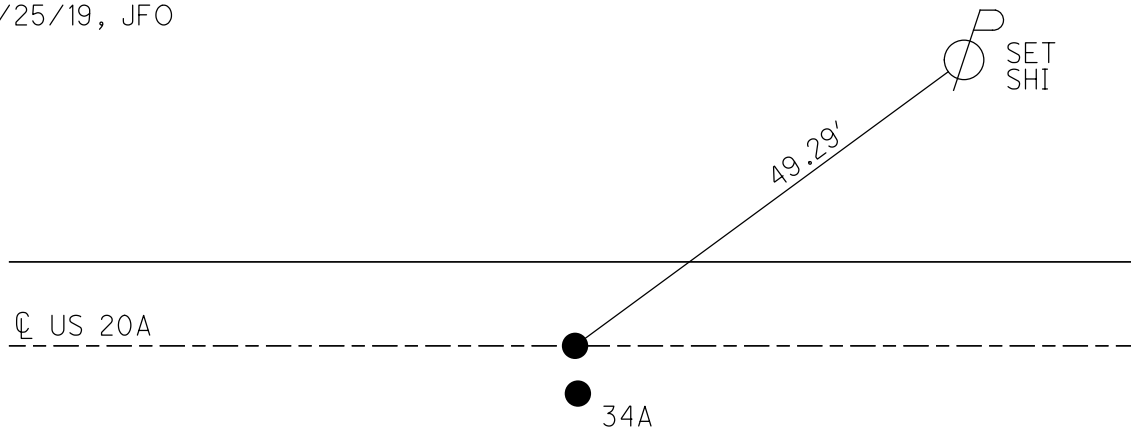

O.D.O.T. DISTRICT 2 SURVEY OFFICE (USE ONLY)

PERSONNEL

REFERENCE NO. 34 A

SHEET 63 OF 63

NOTES RHOADES

DATE 6/11/19

ROUTE US 20A

H.C. O'DONNELL

WEATHER SUNNY

COUNTY FULTON

R.C. MILLER

TEMP. 62°

TOWNSHIP YORK

SECTION 16

DWG BY BALBAUGH PID 101232

T 7 N R 7 E

TYPE MONUMENT MAG/WASHER

ON SURFACE - ~~BELOW~~ ON

OFFSET Q PAVEMENT 8.0' ~~LT~~ : RT

5.5' TO RT EDGE PAVEMENT


STATION: 875+47.98

HORIZ.DATUM: NAD83 (2011)

GEOID: 2012A

GRID: NORTHING: 698495.795


EASTING: 1539866.130

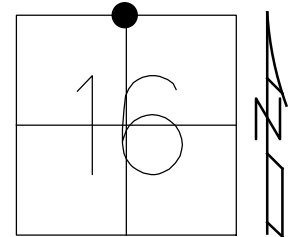

RECORD:

FD P.K.NAIL
9/16/04, MC
SET MAG/WASHER
10/13/04, DCH
FD MAG/WASHER
12/5/17, JFO
REFA34
12/21/17, JFO
SET MAG/WASHER
10/25/19, JFO

DIST. 34-34A=8.62'

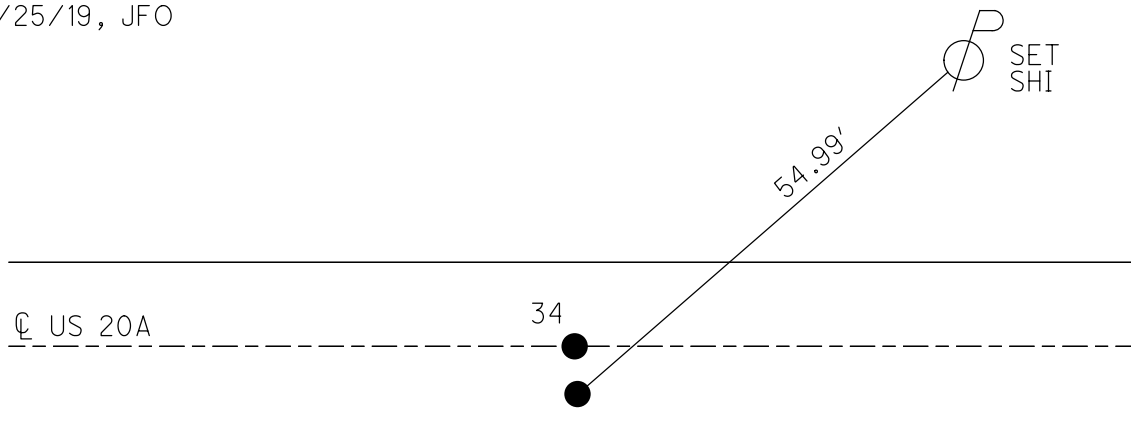

O.D.O.T. DISTRICT 2 SURVEY OFFICE (USE ONLY)

PERSONNEL

REFERENCE NO. 35

SHEET 1 OF 6

NOTES RHOADES

DATE 6/13/19

ROUTE US 20A

H.C. O'DONNELL

WEATHER CLOUDY

COUNTY FULTON

R.C. MILLER

TEMP. 59°

TOWNSHIP YORK

DWG BY BALBAUGH PID 101232

SECTION 16

T 7 N R 7 E

TYPE MONUMENT P.K.NAIL

ON SURFACE - ~~BELOW~~ ON

OFFSET CL PAVEMENT ON ~~LT~~ : ~~RT~~

TO EDGE PAVEMENT


STATION: 902+00.67

HORIZ.DATUM: NAD83 (2011)

GEOID: 2012A


GRID: NORTHING: 698456.845

EASTING: 1542518.499

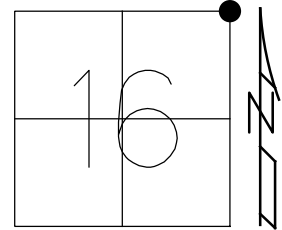

RECORD:
PLAN STA. 27+503.740
FD P.K./WASHER
9/2/98, CL
FD P.K.NAIL
3" DOWN
REF35
12/21/17, JFO
SET MAG/WASHER
10/25/19, JFO

NOTE:
DIST. 35-35A= 8.88'

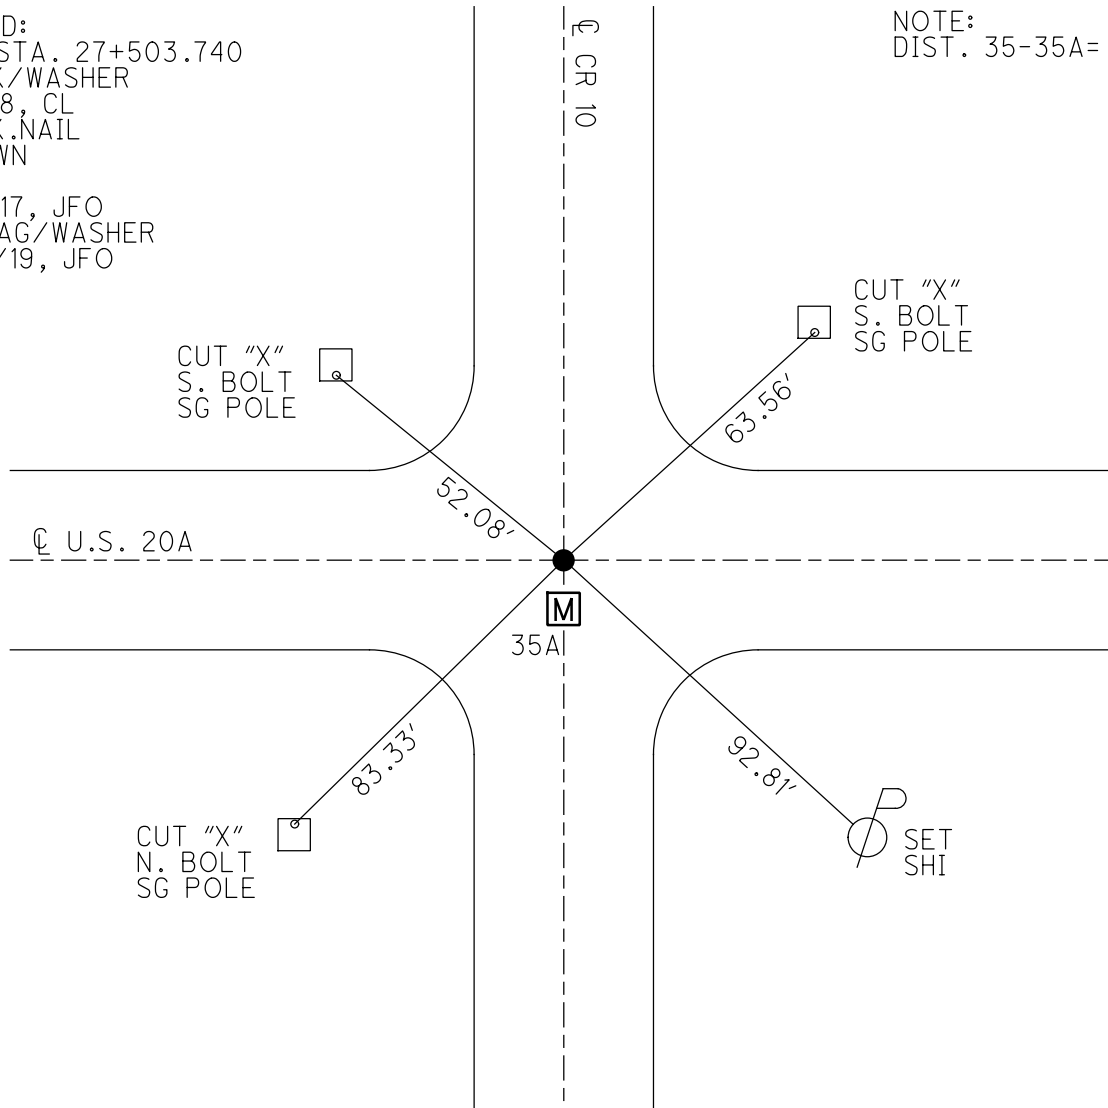

O.D.O.T. DISTRICT 2 SURVEY OFFICE (USE ONLY)

PERSONNEL

REFERENCE NO. 35 A

SHEET 2 OF 6

NOTES RHOADES
H.C. O'DONNELL
R.C. MILLER

DATE 6/13/19
WEATHER CLOUDY
TEMP. 59°

ROUTE US 20A
COUNTY FULTON
TOWNSHIP YORK
SECTION 16
T 7 N R 7 E

DWG BY BALBAUGH PID 101232

TYPE MONUMENT MONBOX W/ 3/4" IPIPE

ON SURFACE - ~~BELOW~~ ON

OFFSET CL PAVEMENT ±8.88' ~~LT~~ : RT
TO EDGE PAVEMENT


STATION: 902+00.67

HORZ.DATUM: NAD83 (2011)

GEOID: 2012A


GRID: NORTHING: 698447.978

EASTING: 1542518.640

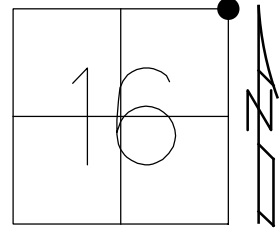

RECORD:
FD IPIPE
6" DOWN
FD STONE
24" DOWN
SET MONBOX
W/ 1 1/2" IPIPE
9/2/98, CL
FD MONBOX
W/ 3/4" IPIPE
REFA35
12/21/17, JFO
FD MONBOX
W/ 3/4" IPIPE
10/25/19, JFO

NOTE:
DIST. 35-35A= 8.88'

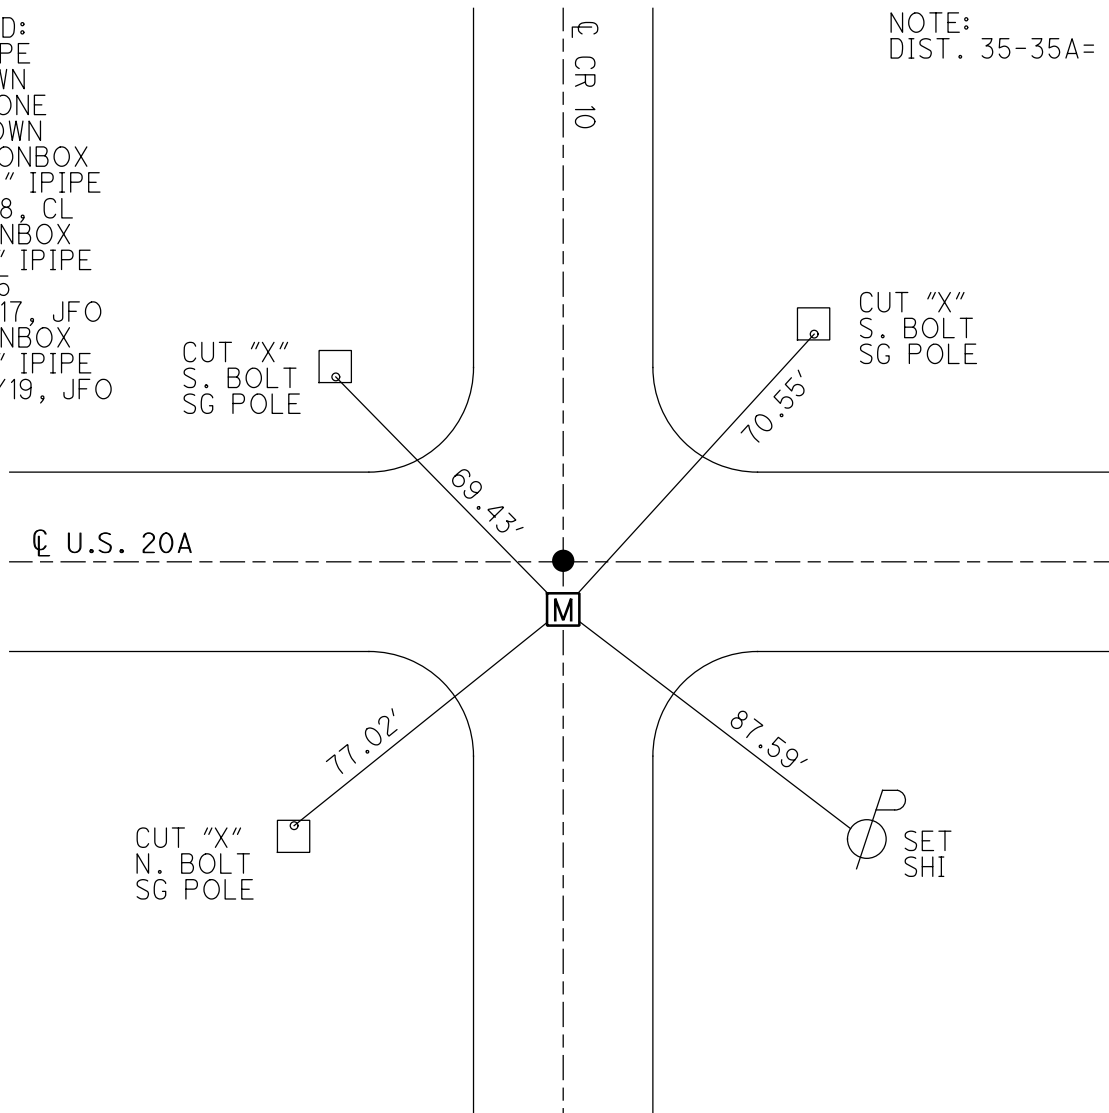

O.D.O.T. DISTRICT 2 SURVEY OFFICE (USE ONLY)

PERSONNEL

REFERENCE NO. 36

SHEET 3 OF 6

NOTES RHOADES

DATE 6/13/19

ROUTE US 20A

H.C. O'DONNELL

WEATHER CLOUDY

COUNTY FULTON

R.C. MILLER

TEMP. 60°

TOWNSHIP YORK

SECTION 15

DWG BY BALBAUGH PID 101232

T 7 N R 7 E

TYPE MONUMENT P.K.NAIL

ON SURFACE - ~~BELOW~~ ON

OFFSET CL PAVEMENT ON ~~LEFT~~ : ~~RIGHT~~

TO EDGE PAVEMENT


STATION: 928+42.66

HORIZ.DATUM: NAD83 (2011)

GEOID: 2012A


GRID: NORTHING: 698431.237


EASTING: 1545160.363

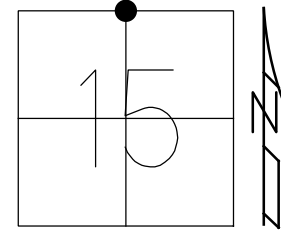

RECORD:
FD P.K./WASHER
9/3/98, CL
FD P.K.NAIL
4" DOWN
REF36
12/21/17, JFO
SET MAG/WASHER
10/25/19, JFO

NOTE:
DIST. 36-36A = 11.88'

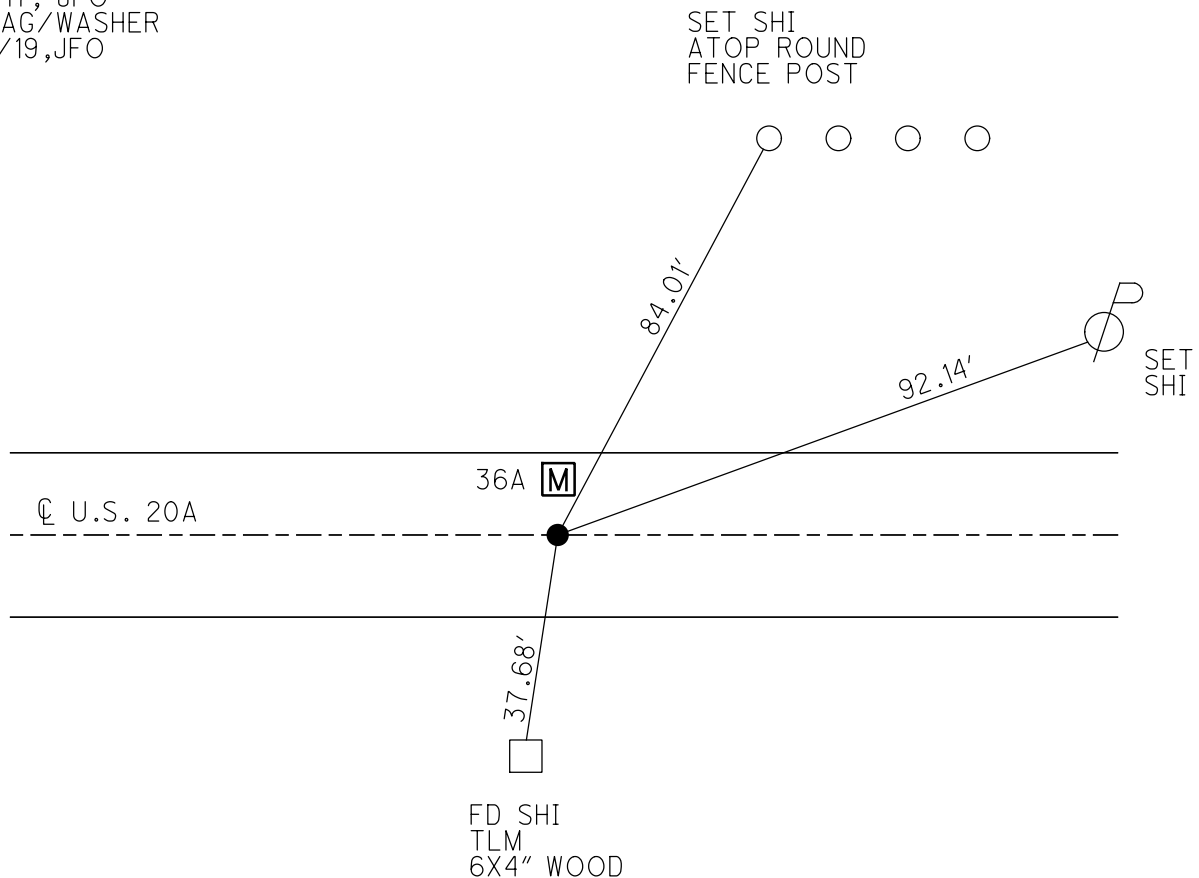

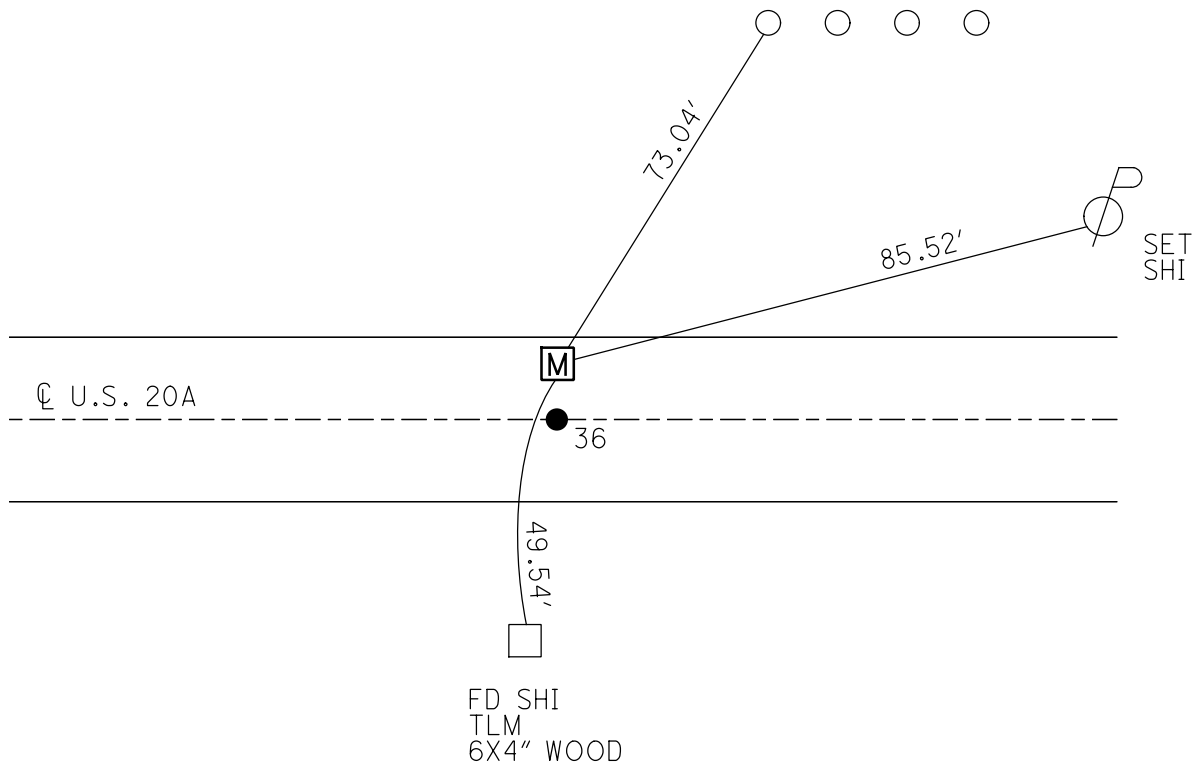

O.D.O.T. DISTRICT 2 SURVEY OFFICE (USE ONLY)

PERSONNEL

REFERENCE NO. 37

SHEET 5 OF 6

NOTES RHOADES

DATE 6/13/19

ROUTE US 20A

H.C. O'DONNELL

WEATHER CLOUDY

COUNTY FULTON

R.C. MILLER

TEMP. 60°

TOWNSHIP YORK

DWG BY BALBAUGH PID 101232

SECTION 15

T 7 N R 7 E

TYPE MONUMENT MONBOX W/ 2 1/2" DOMED HEAD IPIN

ON SURFACE - ~~BELOW~~ ON

OFFSET Q PAVEMENT ON ~~LT~~ : ~~RT~~

TO EDGE PAVEMENT


STATION: 954+86.02

HORZ.DATUM: NAD83 (2011)

GEOID: 2012A


GRID: NORTHING: 698438.220

EASTING: 1547803.702

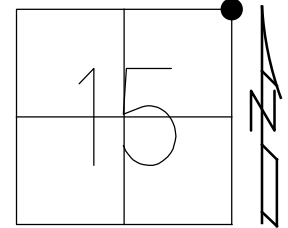

RECORD:
FD DOMED IPIN
5' DOWN
FD STONE
UNDISTURBED
22" DOWN
SET MONBOX
W/ IPIN
9/2/98
FD MONBOX
W/ IPIN
REFA22
6/8/12, MC
FD 2 1/2" IPIN
W/ DOMED HEAD
REF37
12/21/17, JFO

NOTE: SR 109 REFA22

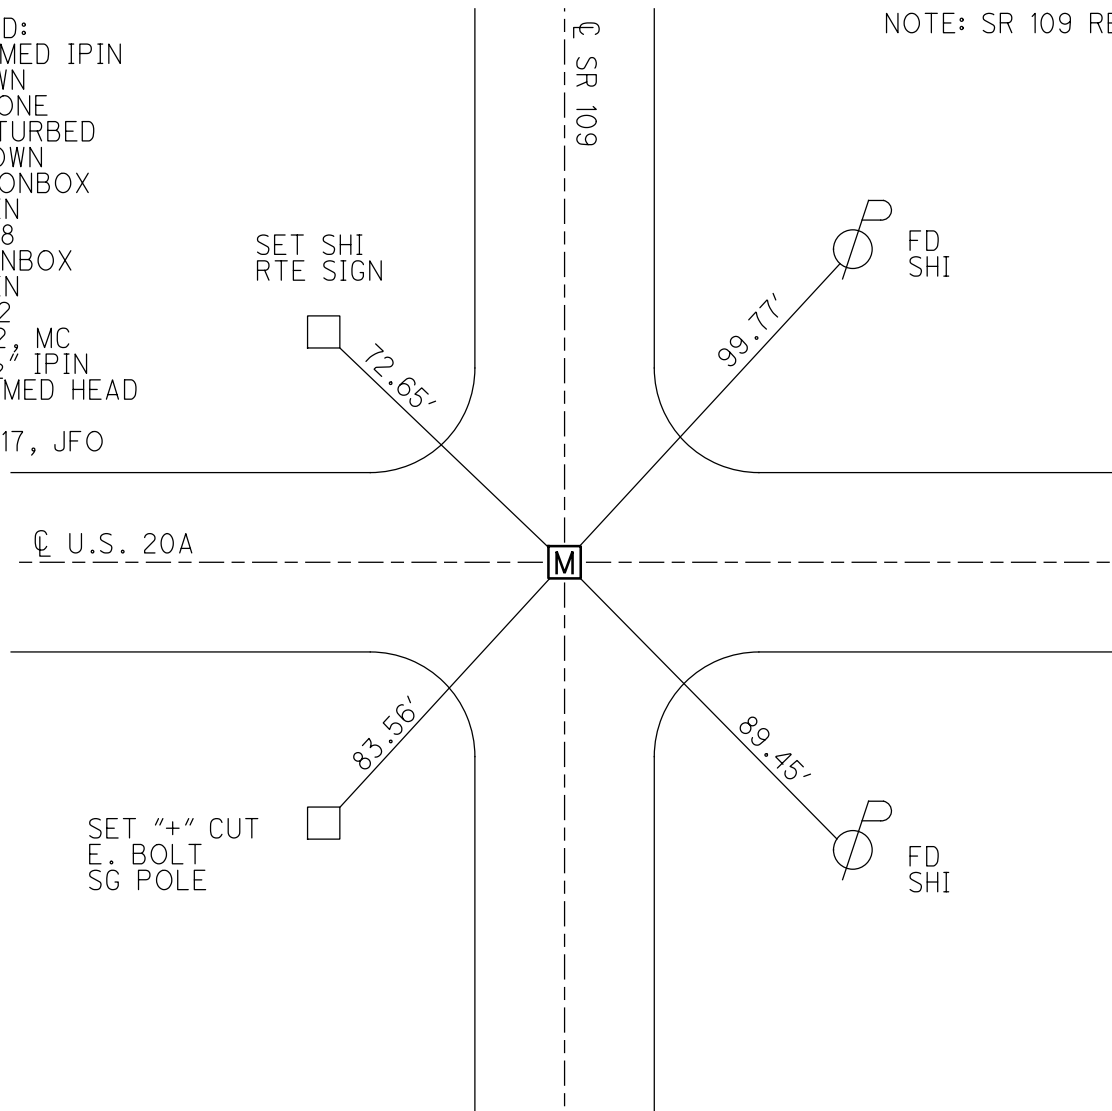

O.D.O.T. DISTRICT 2 SURVEY OFFICE (USE ONLY)

PERSONNEL

REFERENCE NO. 39

SHEET 6 OF 6

NOTES NIESE

DATE 4-23-21

ROUTE US 20A

H.C. AUBLE

WEATHER CLOUDY

COUNTY FULTON

R.C. NIESE

TEMP. 41°

TOWNSHIP YORK

SECTION 14

DWG BY AUBLE

PID 101295

T 7 N R 7 E

TYPE MONUMENT MAG NAIL

ON SURFACE - ~~BELOW~~ ON

OFFSET CL PAVEMENT ON LT : RT

12.4' TO RT EDGE PAVEMENT


STATION: 981+28.99

HORZ.DATUM: NAD83 (2011)

GEOID: 2012A


GRID: NORTHING: 698408.703

EASTING: 1550446.486

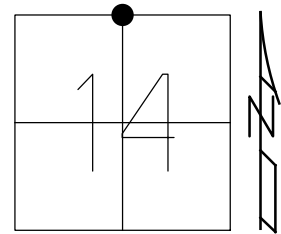

RECORD:

FD SM.R.R.SPIKE
8/14/03, RGN
SET MAG/WASHER
12/29/03, RGN
FD MAG/WASHER
12/5/17, JFO
REF39
12/21/17, JFO
SET MAG/WASHER
10-6-21, DSA

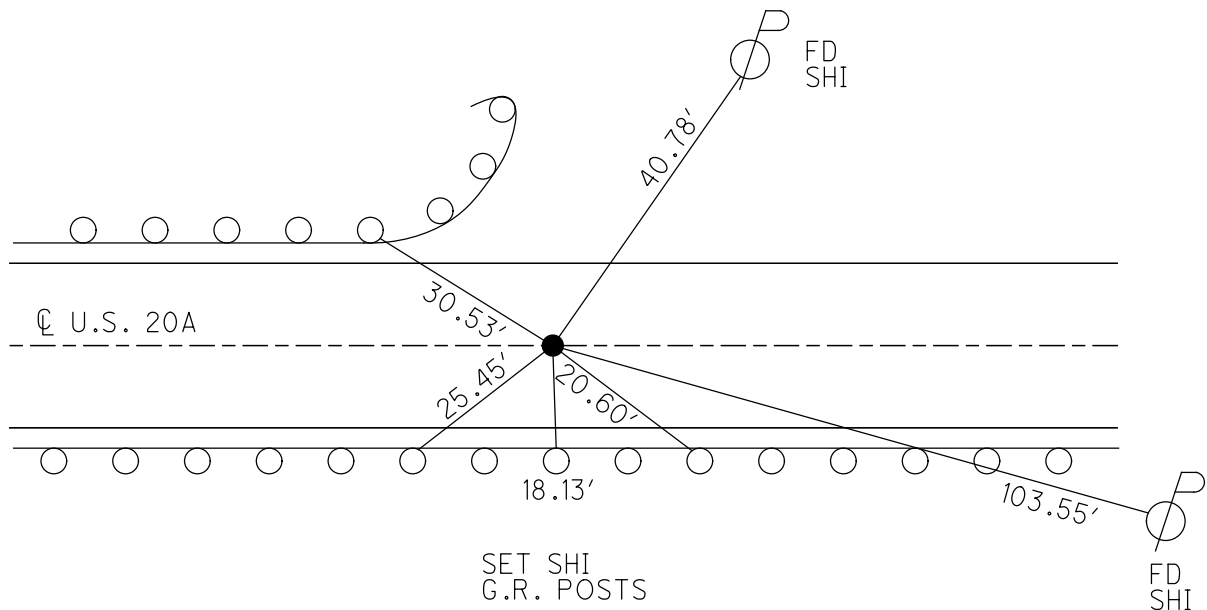

O.D.O.T. DISTRICT 2 SURVEY OFFICE (USE ONLY)

PERSONNEL

REFERENCE NO. 39 A

SHEET 1 OF 14

NOTES NIESE

DATE 4-23-21

ROUTE US 20 A

H.C. AUBLE

WEATHER WINDY

COUNTY FULTON

R.C. NIESE

TEMP. 50°

TOWNSHIP YORK

SECTION 14

DWG BY AUBLE

PID 101295

T 7 N R 7 E

TYPE MONUMENT MAG NAIL

ON SURFACE - ~~BELOW~~ ON

OFFSET Q PAVEMENT ON LT : RT

12.2' TO LT EDGE PAVEMENT


STATION: 1008+18

HORZ.DATUM: NAD83(2011)


GEOID: 12A

GRID: NORTHING: 698378.296

EASTING: 1553087.009

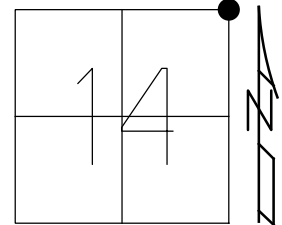

RECORD:
SET MAG/WASHER
12/29/03, RGN
FD MAG NAIL
REFA39
1-9-20, JLL
SET MAG/WASHER
10-6-21, DSA

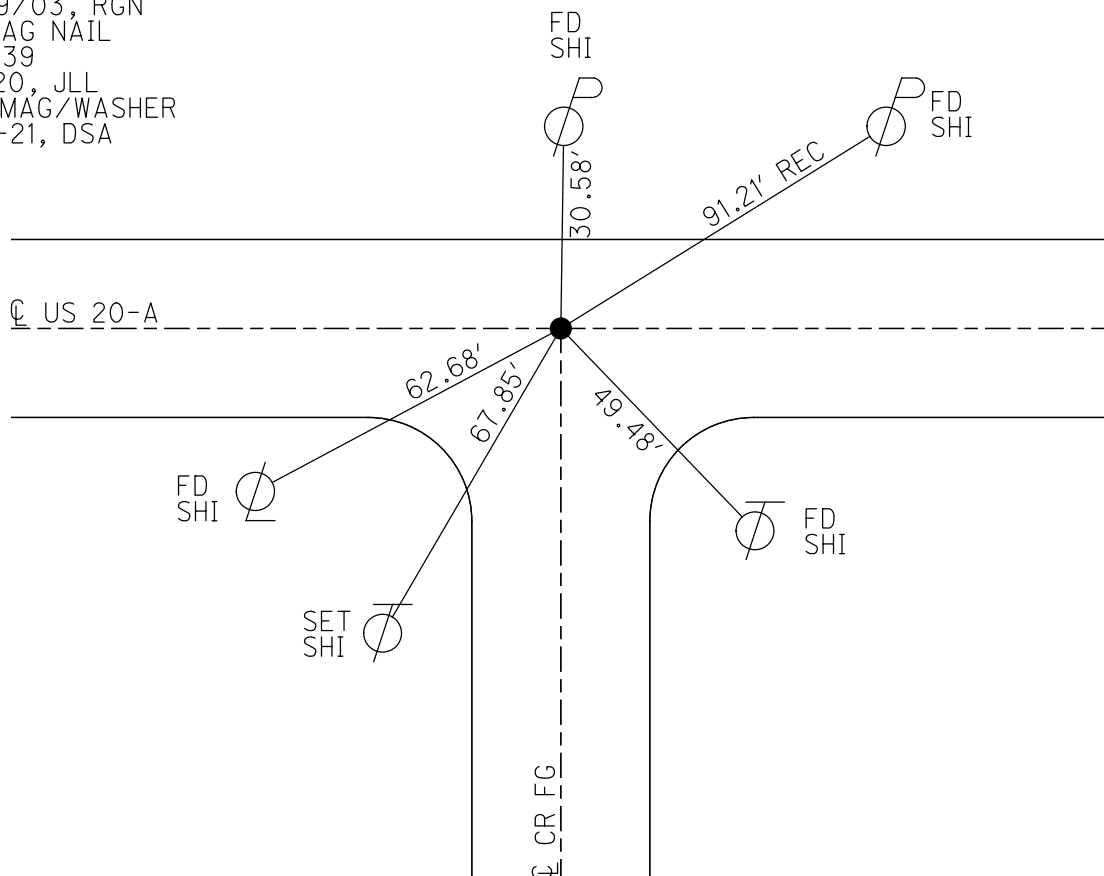

O.D.O.T. DISTRICT 2 SURVEY OFFICE (USE ONLY)

PERSONNEL

REFERENCE NO. 39 B

SHEET 2 OF 14

NOTES NIESE

DATE 4-23-21

ROUTE US 20 A

H.C. AUBLE

WEATHER CLOUDY

COUNTY FULTON

R.C. NIESE

TEMP. 50°

TOWNSHIP YORK

SECTION 13

DWG BY AUBLE

PID 101295

T 7 N R 7 E

TYPE MONUMENT MAG/WASHER

ON SURFACE - ~~BELOW~~ ON

OFFSET Q PAVEMENT ON LT : RT

- TO - EDGE PAVEMENT


STATION: 1026+58

HORZ.DATUM: NAD83(2011)


GEOID: 12A

GRID: NORTHING: 698391.517

EASTING: 1554925.957

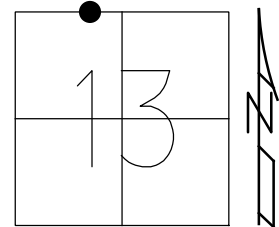

RECORD:
SET MAG/WASHER
12/29/03, RGN
FD MAG/WASHER
REFB39
1-9-20, JLL
SET MAG/WASHER
10-6-21, DSA

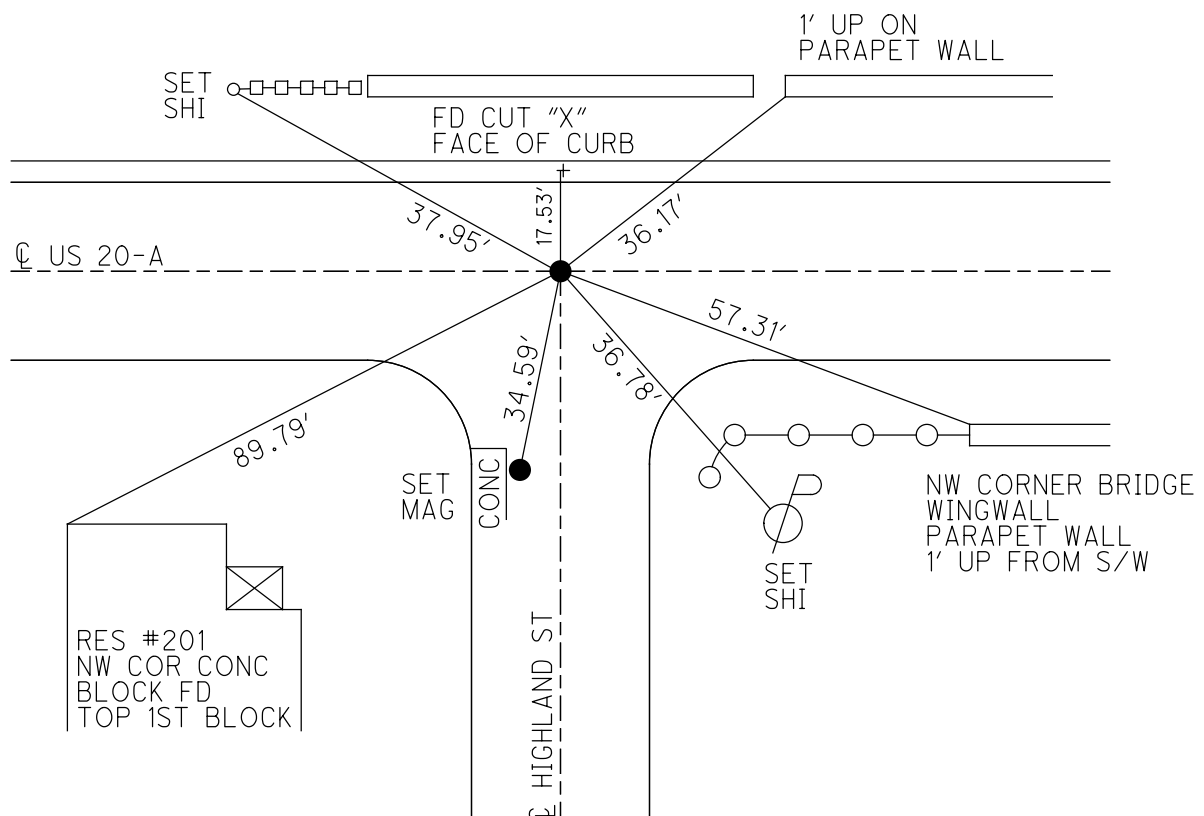

O.D.O.T. DISTRICT 2 SURVEY OFFICE (USE ONLY)

PERSONNEL

REFERENCE NO. 39 C

SHEET 3 OF 14

NOTES NIESE

DATE 4-23-21

ROUTE US 20 A

H.C. AUBLE

WEATHER CLOUDY

COUNTY FULTON

R.C. NIESE

TEMP. 50°

TOWNSHIP YORK

SECTION 13

DWG BY AUBLE

PID 101295

T 7 N R 7 E

TYPE MONUMENT MAG SHANK

~~ON SURFACE~~ - BELOW 1"

OFFSET CL PAVEMENT 1.0' LT : RT

- TO - EDGE PAVEMENT


STATION: 1032+49

HORIZ.DATUM: NAD83(2011)


GEOID: 12A

GRID: NORTHING: 698395.671

EASTING: 155517.712

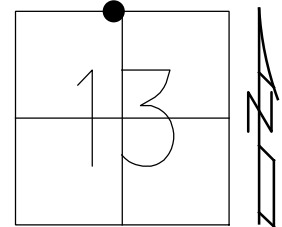

RECORD:
SET MAG/WASHER
12/29/03, RGN
FD MAG SHANK
REFC39
1/9/20, JLL
SET MAG/WASHER
10-6-21, DSA

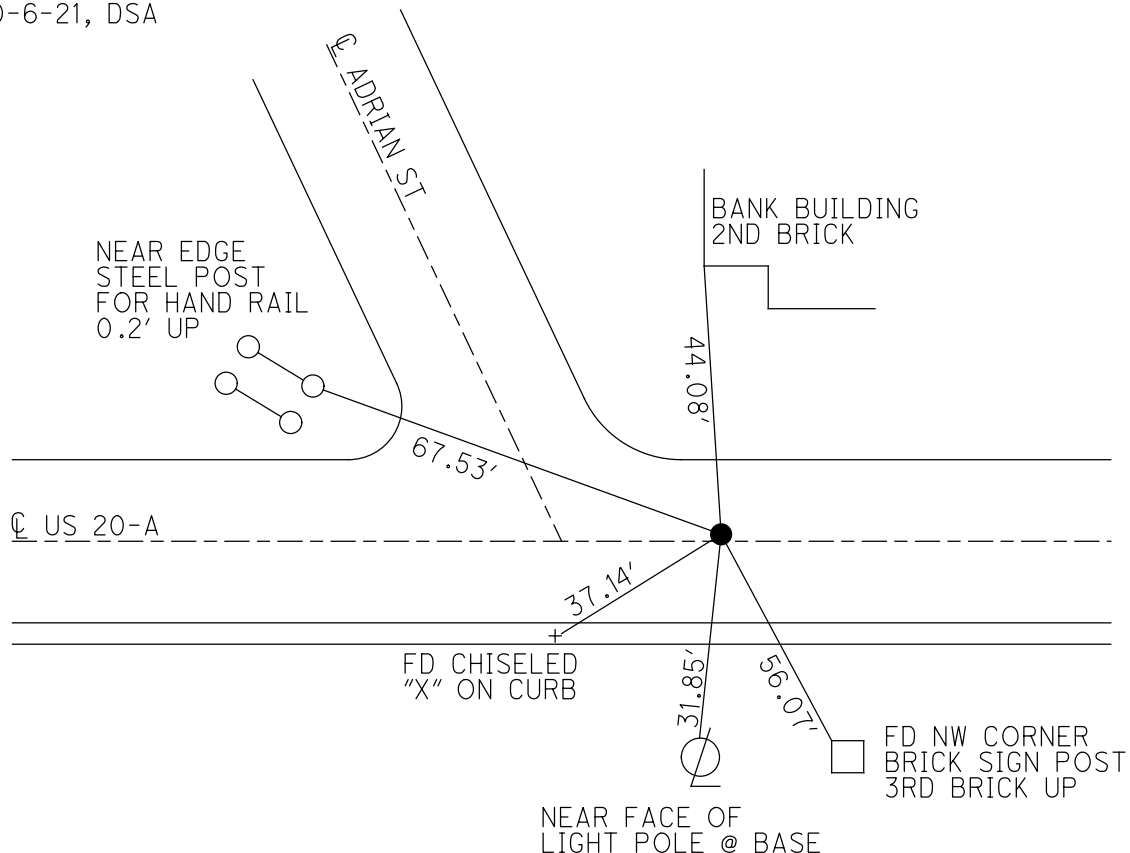

O.D.O.T. DISTRICT 2 SURVEY OFFICE (USE ONLY)

PERSONNEL

REFERENCE NO. 39 D

SHEET 4 OF 14

NOTES NIESE

DATE 4-23-21

ROUTE US 20 A

H.C. AUBLE

WEATHER WINDY

COUNTY FULTON

R.C. NIESE

TEMP. 50°

TOWNSHIP YORK

SECTION 13

DWG BY AUBLE

PID 101295

T 7 N R 7 E

TYPE MONUMENT MAG NAIL

ON SURFACE - ~~BELOW~~ ON

OFFSET CL PAVEMENT 1.4' LT : ~~RT~~

- TO - EDGE PAVEMENT


STATION: 1034+81

HORZ.DATUM: NAD83(2011)


GEOID: 12A

GRID: NORTHING: 698397.399

EASTING: 1555749.754

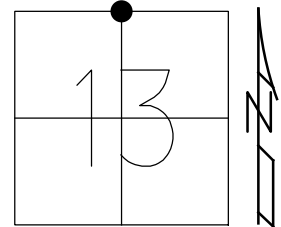

RECORD:
SET MAG/WASHER
12/29/03, RGN
FD MAG NAIL
REFD39
1-21-20, JLL
SET MAG/WASHER
10-7-21, DSA

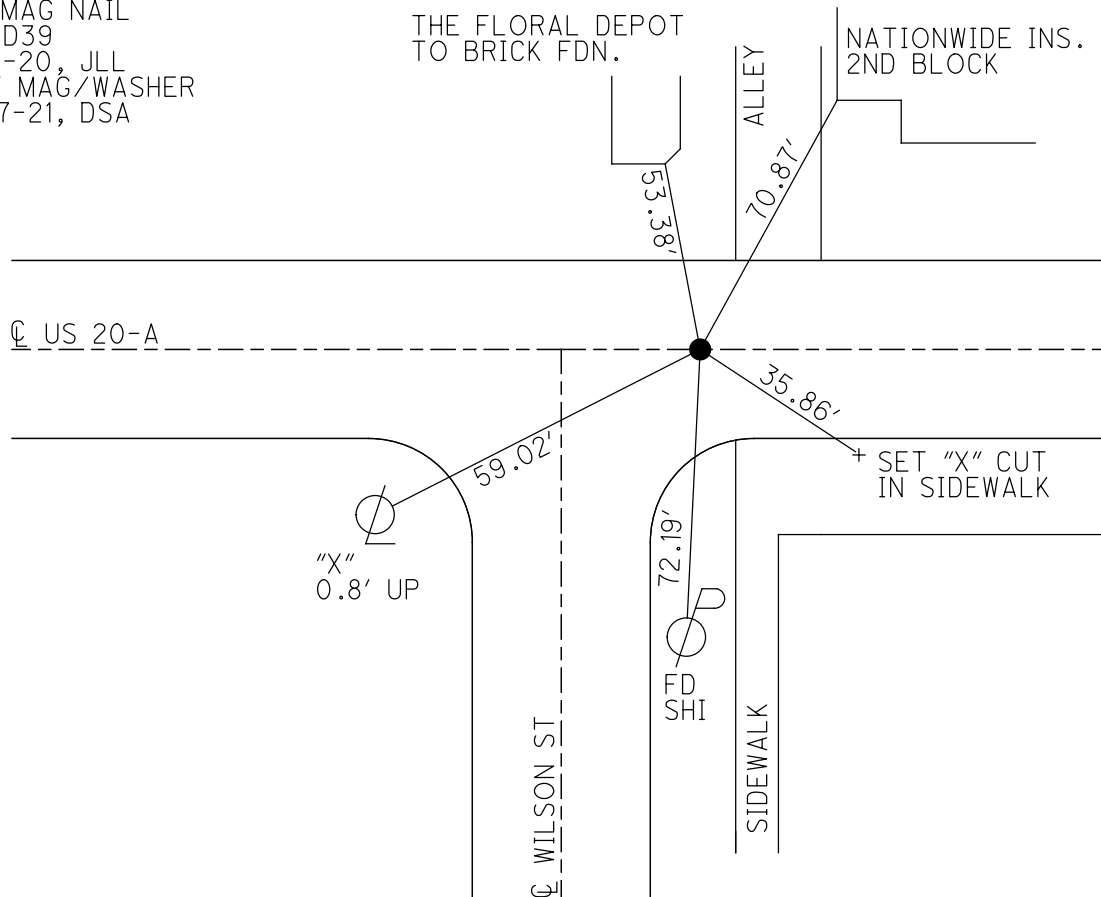

O.D.O.T. DISTRICT 2 SURVEY OFFICE (USE ONLY)

PERSONNEL

REFERENCE NO. 39 E

SHEET 5 OF 14

NOTES NIESE

DATE 4-23-21

ROUTE US 20 A

H.C. AUBLE

WEATHER CLOUDY

COUNTY FULTON

R.C. NIESE

TEMP. 55°

TOWNSHIP YORK

SECTION 13

DWG BY AUBLE PID 101295

T 7 N R 7 E

TYPE MONUMENT MAG/WASHER

ON SURFACE - ~~BELOW~~ ON

OFFSET Q PAVEMENT ON LT : RT

- TO - EDGE PAVEMENT


STATION: 1038+12

HORZ.DATUM: NAD83(2011)


GEOID: 12A

GRID: NORTHING: 698400.577

EASTING: 1556081.890

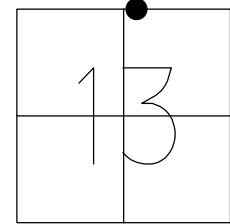

RECORD:
SET P.K. NAIL
5/13/88
SET MAG/WASHER
1/12/04, RGN
FD MAG/WASHER
REFE39
1-21-20, JLL
FD MAG/WASHER
4-23-21, DSA
FD MONBOX
W/1" IPIPE
NEWREFE39
10-7-21, DSA

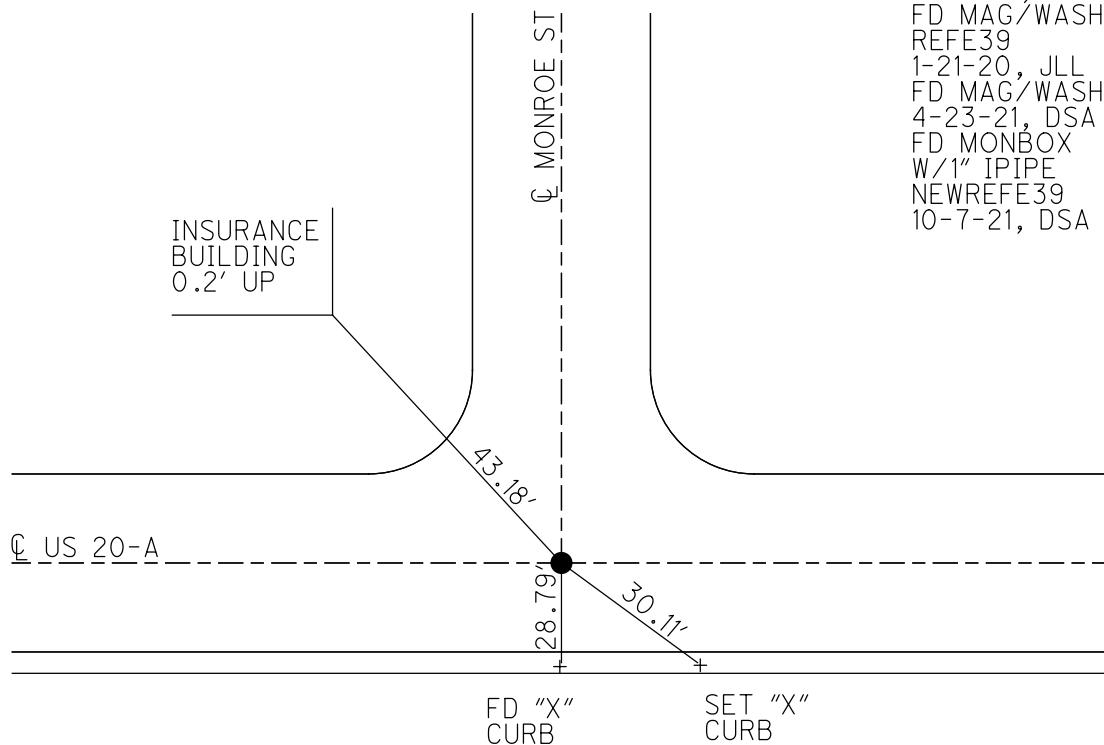

O.D.O.T. DISTRICT 2 SURVEY OFFICE (USE ONLY)

PERSONNEL

REFERENCE NO. 39 F

SHEET 6 OF 14

NOTES RHOADES

DATE 1-27-20

ROUTE US 20 A

H.C. LEU

WEATHER CLOUDY

COUNTY FULTON

R.C. O'DONNELL

TEMP. 34°

TOWNSHIP YORK

BALBAUGH

SECTION 13

DWG BY AUBLE

PID 101295

T 7 N R 7 E

TYPE MONUMENT 1" IPIN BENT EASTERLY

~~ON SURFACE~~ - BELOW 4"

OFFSET Q PAVEMENT 5.0' ~~LT~~ : RT

- TO - EDGE PAVEMENT


STATION: 1048+25

HORIZ.DATUM: NAD83(2011)


GEOID: 12A

GRID: NORTHING: 698410.405

EASTING: 1557091.581

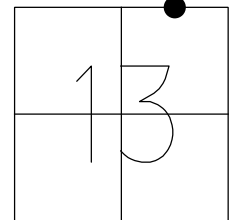

RECORD:
SET SM.R.R.SPIKE
5/13/88
SET MAG/WASHER
1/12/04, RGN
FD 1" IPIN
4" DOWN
REFF39
1-27-20, JLL
SET MAG/WASHER
10-7-21, DSA

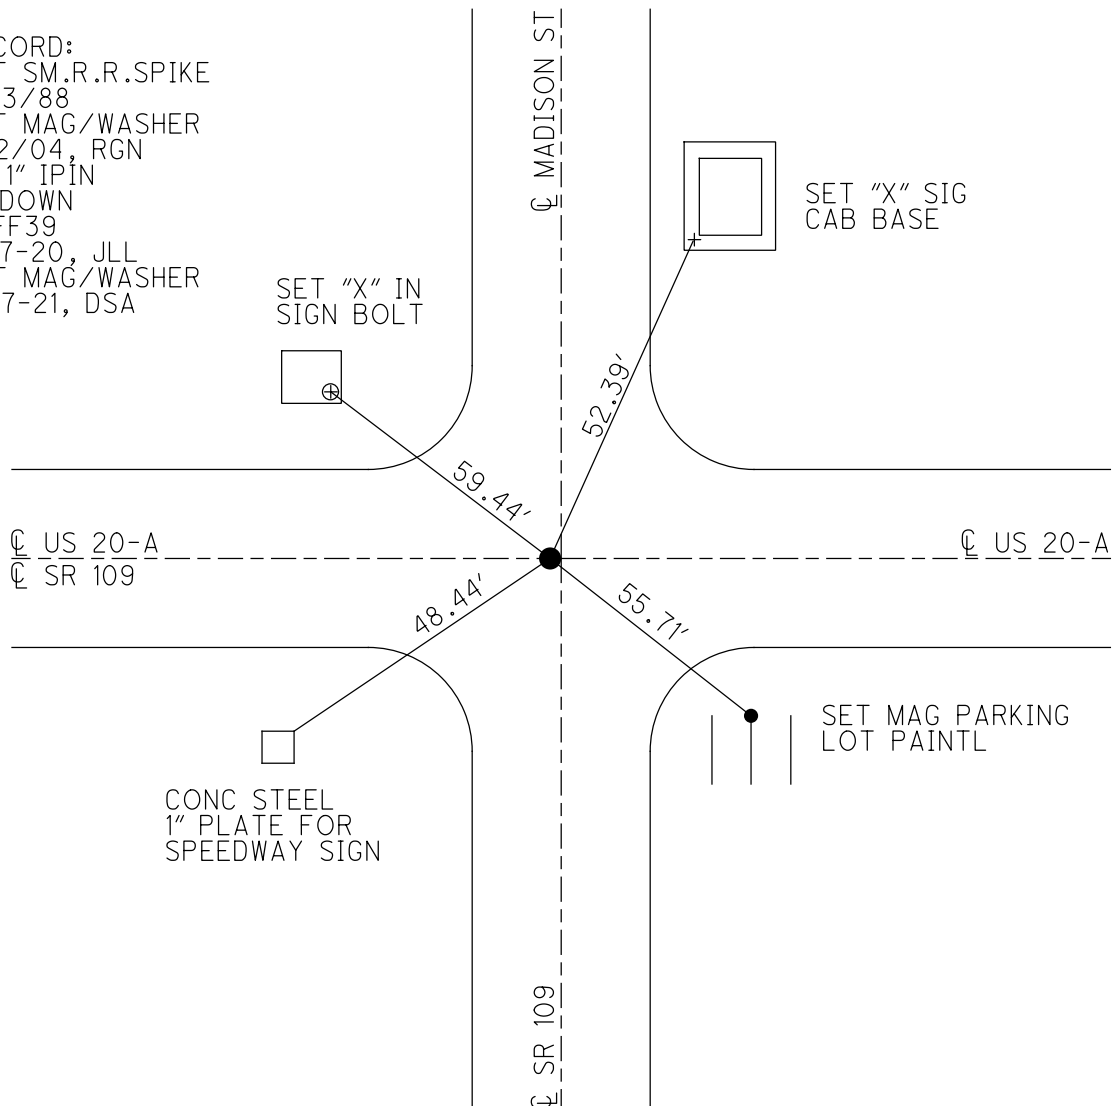

O.D.O.T. DISTRICT 2 SURVEY OFFICE (USE ONLY)

PERSONNEL

REFERENCE NO. 39 G

SHEET 7 OF 14

NOTES NIESE

DATE 4-27-21

ROUTE US 20 A

H.C. AUBLE

WEATHER CLOUDY

COUNTY FULTON

R.C. NIESE

TEMP. 60°

TOWNSHIP YORK

SECTION 13

DWG BY AUBLE

PID 101295

T 7 N R 7 E

TYPE MONUMENT MAG/WASHER

ON SURFACE - ~~BELOW~~ ON

OFFSET CL PAVEMENT 4.1' ~~LT~~ : RT

- TO - EDGE PAVEMENT


STATION:

HORIZ.DATUM: NAD83(2011)


GEOID: 12A

GRID: NORTHING: 698414.869

EASTING: 1557582.477

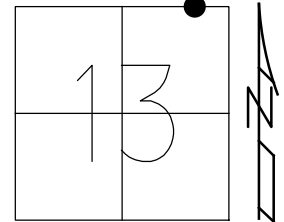

RECORD:
SET P.K. NAIL
5/13/88
SET MAG/WASHER
1/12/04, RGN
FD MAG/WASHER
REFG39
1/27/20, JLL
SET MAG/WASHER
10/7/21, DSA

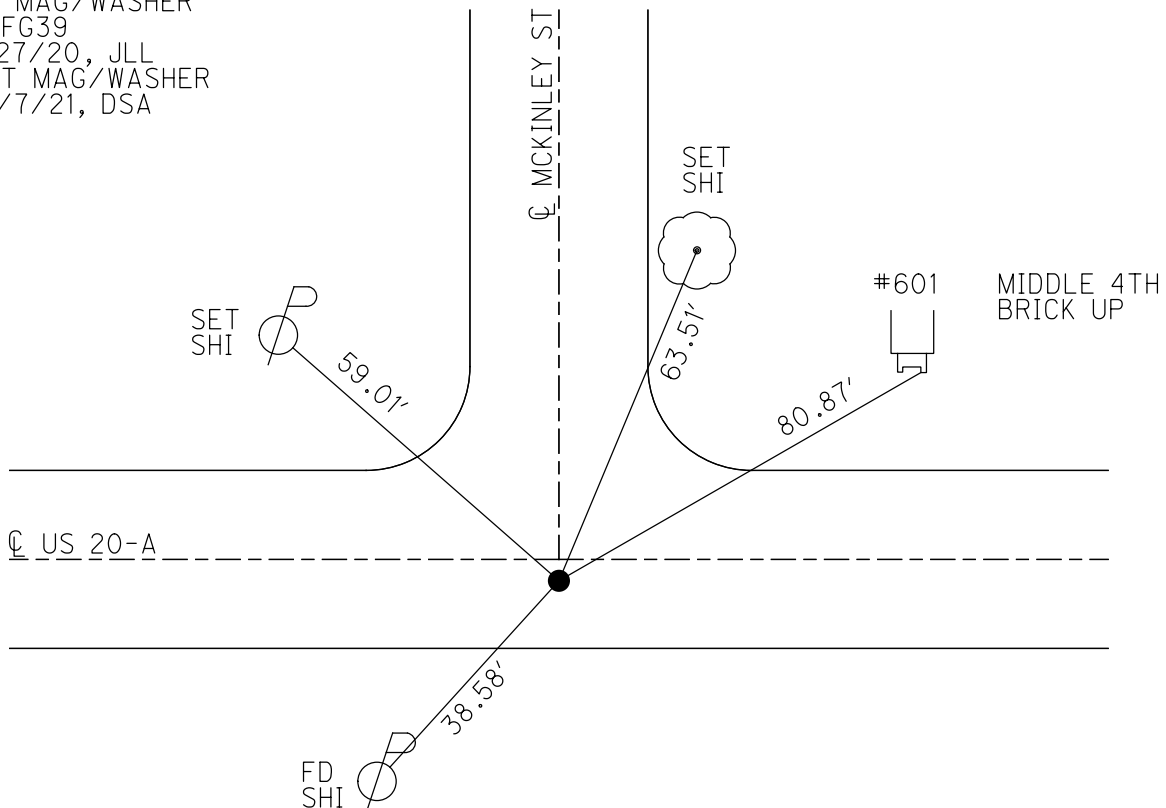

O.D.O.T. DISTRICT 2 SURVEY OFFICE (USE ONLY)

PERSONNEL

REFERENCE NO. 39 H

SHEET 8 OF 14

NOTES NIESE

DATE 4/27/21

ROUTE US 20 A

H.C. AUBLE

WEATHER CLOUDY

COUNTY FULTON

R.C. NIESE

TEMP. 60°

TOWNSHIP YORK

SECTION 13

DWG BY AUBLE

PID 101295

T 7 N R 7 E

TYPE MONUMENT 1" IPIN

~~ON SURFACE~~ - BELOW 2.5"

OFFSET $\angle$ PAVEMENT 2.7' ~~LT~~ : RT

- TO - EDGE PAVEMENT


STATION: 1061+51

HORIZ.DATUM: NAD83(2011)


GEOID: 12A

GRID: NORTHING: 698423.093

EASTING: 1558418.788

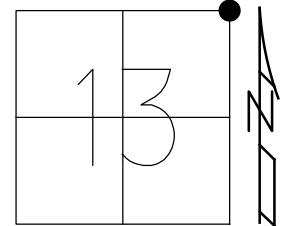

RECORD:
SET MAG/WASHER
1/12/04, RGN
FD MAG/WASHER
REFH39
1-21-20, JLL
FD 1" IPIN
2.5" DOWN
4-27-21, DSA
SET MAG/WASHER
10-7-21, DSA

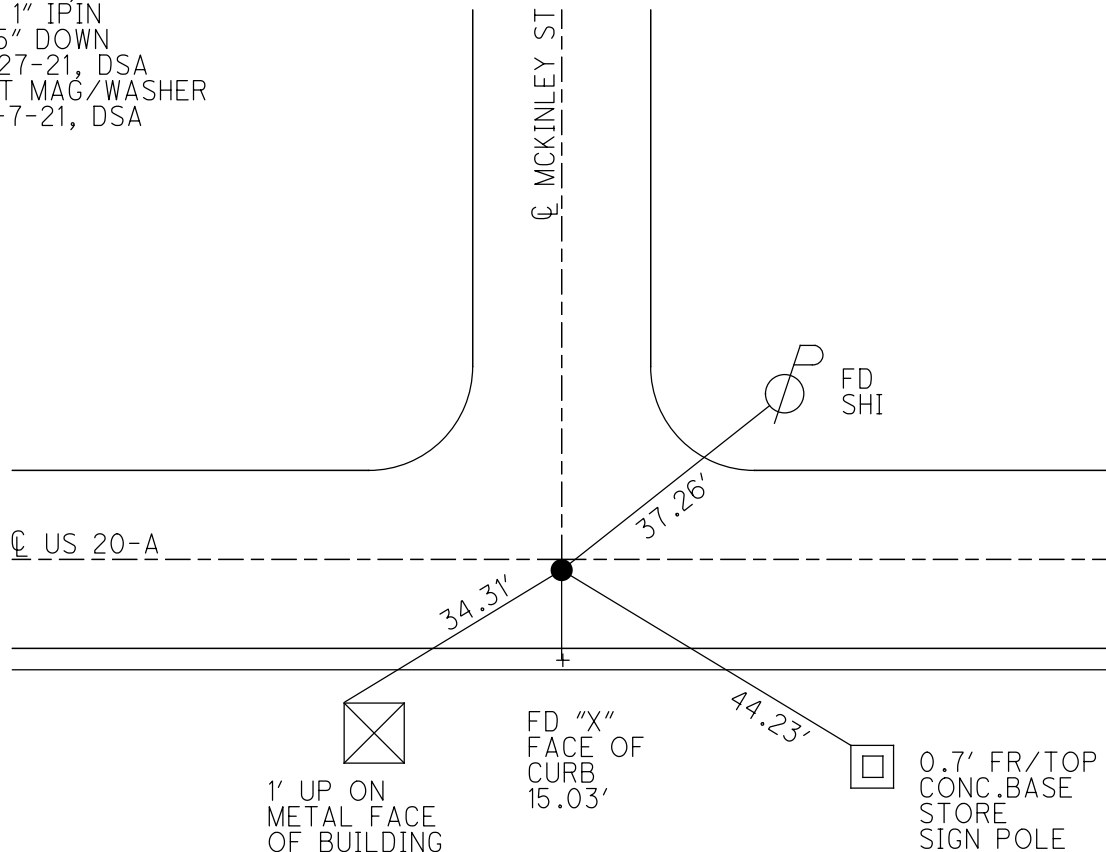

O.D.O.T. DISTRICT 2 SURVEY OFFICE (USE ONLY)

PERSONNEL

REFERENCE NO. 39 I

SHEET 9 OF 14

NOTES O'DONNELL

DATE 1-27-20

ROUTE US 20 A

H.C. LEU

WEATHER CLOUDY

COUNTY FULTON

R.C. BALBAUGH

TEMP. 33°

TOWNSHIP SWAN CREEK

SECTION 18

DWG BY AUBLE

PID 101295

T 7 N R 8 E

TYPE MONUMENT P.K.SHANK

~~ON SURFACE~~ - BELOW 4"

OFFSET CL PAVEMENT ON LT : RT

13.0' TO RT EDGE PAVEMENT


STATION: 1083+13

HORZ.DATUM: NAD83(2011)


GEOID: 12A

GRID: NORTHING: 698388.161

EASTING: 1560579.498

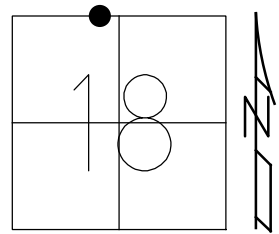

RECORD:
SET MAG/WASHER
1/12/04, RGN
FD P.K.SHANK
REFI39
1/27/20, JFO
SET MAG/WASHER
11-1-21, DSA

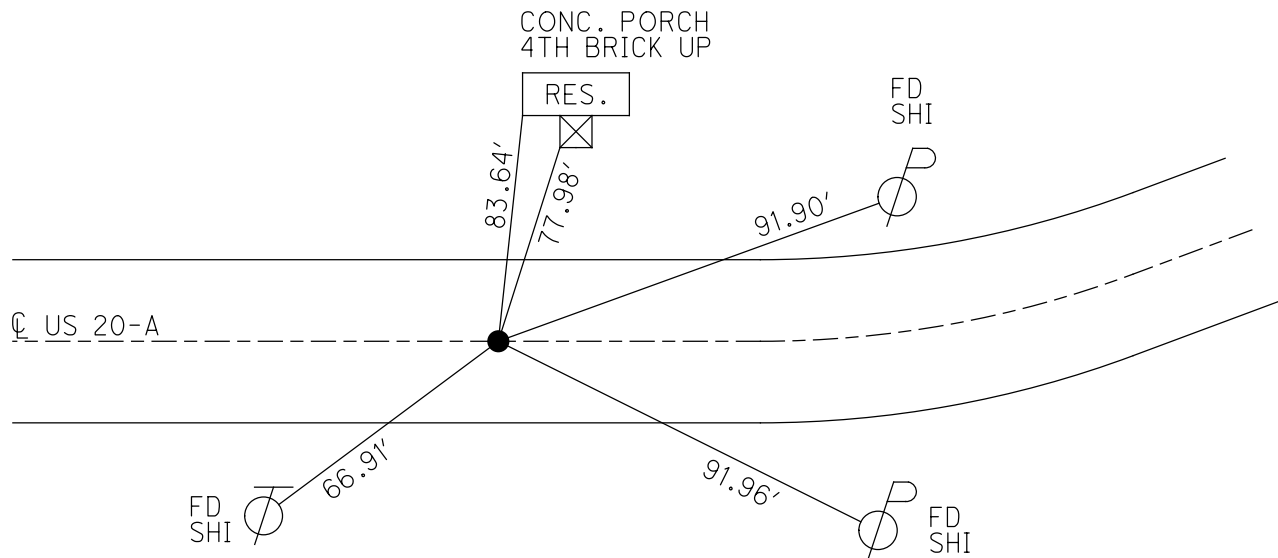

O.D.O.T. DISTRICT 2 SURVEY OFFICE (USE ONLY)

PERSONNEL

REFERENCE NO. 39 HH

SHEET 10 OF 14

NOTES LEU

DATE 1-27-20

ROUTE US 20 A

H.C. LEU

WEATHER CLOUDY

COUNTY FULTON

R.C. BALBAUGH

TEMP. 33°

TOWNSHIP SWAN CREEK

DWG BY AUBLE

PID 101295

SECTION 18

T 7 N R 8 E

TYPE MONUMENT 1 1/2" IPIPE

~~ON SURFACE~~ - BELOW 9"

OFFSET CL PAVEMENT 27.8' ~~LT~~ : RT

12.4' TO RT EDGE PAVEMENT


STATION: 1087+02

HORZ.DATUM: NAD83(2011)


GEOID: 12A

GRID: NORTHING: 698378.778

EASTING: 1560968.280

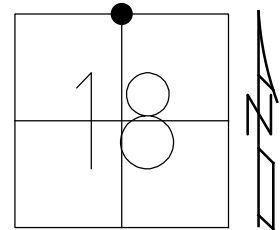

RECORD:
FD 1 1/2" IPIPE
4" DOWN
3/21/01, DCH
9" DOWN
REFHH39
11-1-21, DSA

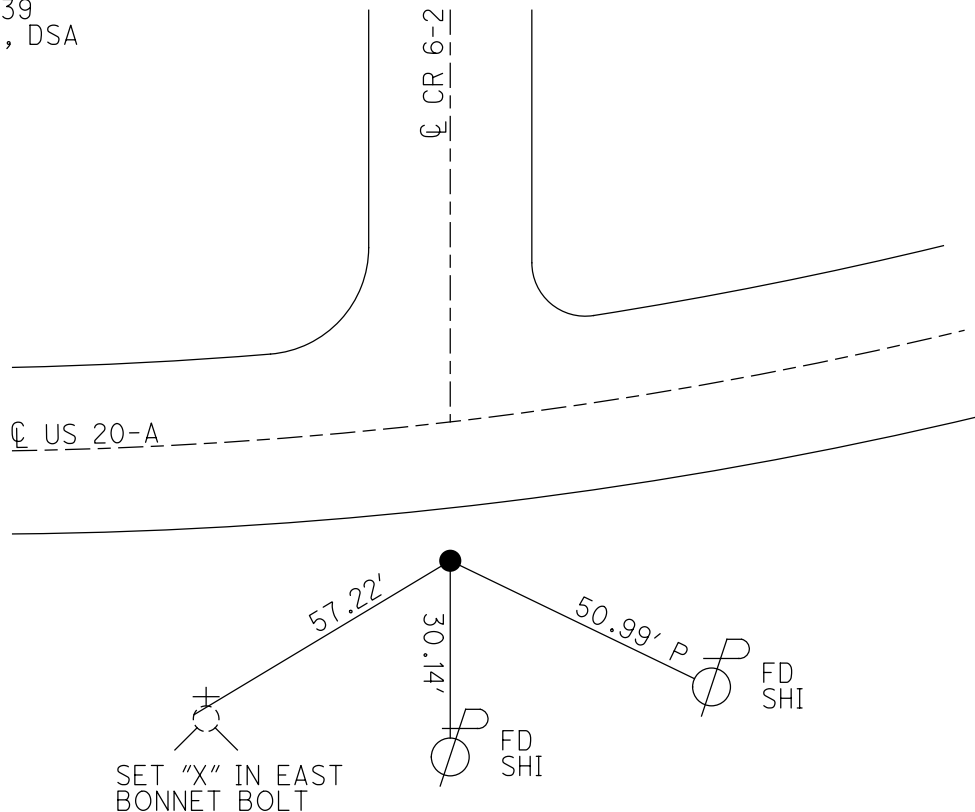

O.D.O.T. DISTRICT 2 SURVEY OFFICE (USE ONLY)

PERSONNEL

REFERENCE NO. 40

SHEET 11 OF 14

NOTES NIESE

DATE 4-27-21

ROUTE US 20 A

H.C. AUBLE

WEATHER CLOUDY

COUNTY FULTON

R.C. NIESE

TEMP. 65°

TOWNSHIP SWAN CREEK

SECTION 17

DWG BY AUBLE PID 101295

T 7 N R 8 E

TYPE MONUMENT P.K. NAIL

ON SURFACE - ~~BELOW~~ ON

OFFSET Q PAVEMENT ON LT : RT

- TO - EDGE PAVEMENT


STATION: 1132+27

HORIZ.DATUM: NAD83(2011)


GEOID: 12A

GRID: NORTHING: 698112.181

EASTING: 1564973.884

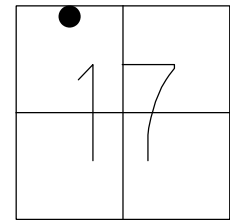

RECORD:
ON DELTA EAST
CORP LINE
SET P.K. NAIL
9/15/86, IRS
FD P.K.NAIL
REF40
1-23-20, JLL
FD P.K.NAIL
4-27-21, DSA
SET MAG/WASHER
11-1-21, DSA

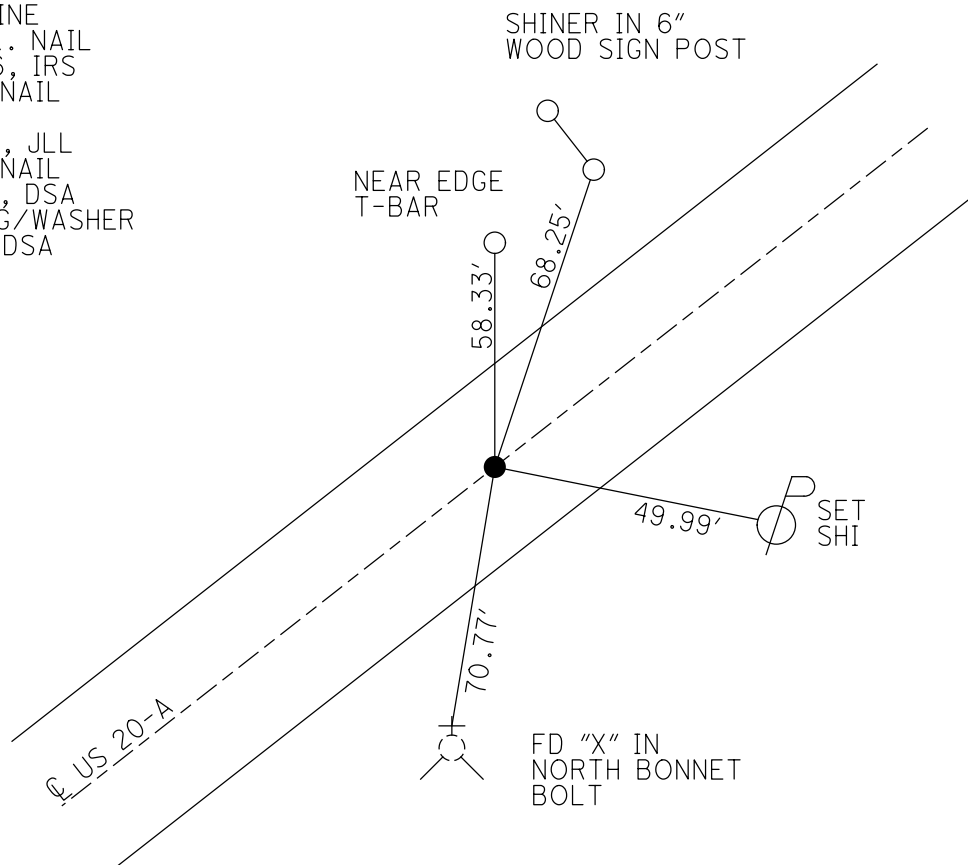

O.D.O.T. DISTRICT 2 SURVEY OFFICE (USE ONLY)

PERSONNEL

REFERENCE NO. 41

SHEET 12 OF 14

NOTES NIESE

DATE 4-27-21

ROUTE US 20 A

H.C. AUBLE

WEATHER WINDY

COUNTY FULTON

R.C. NIESE

TEMP. 65°

TOWNSHIP SWAN CREEK

SECTION 17

DWG BY AUBLE PID 101295

T 7 N R 8 E

TYPE MONUMENT SM.R.R.SPIKE

ON SURFACE - ~~BELOW~~ ON


OFFSET Q PAVEMENT ON LT : RT

- TO - EDGE PAVEMENT


STATION: 1146+07

HORZ.DATUM: NAD83(2011) GEOID: 12A

GRID: NORTHING: 698333.882 EASTING: 1566313.614

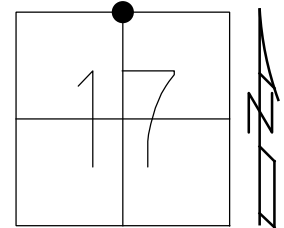

RECORD:
SET SM.SPIKE
9/15/86, IRS
FD SM.R.R.SPIKE
REF41
1-23-20, JLL
FD SM.R.R.SPIKE
4-27-21, DSA
SET MAG/WASHER
11-1-21, DSA

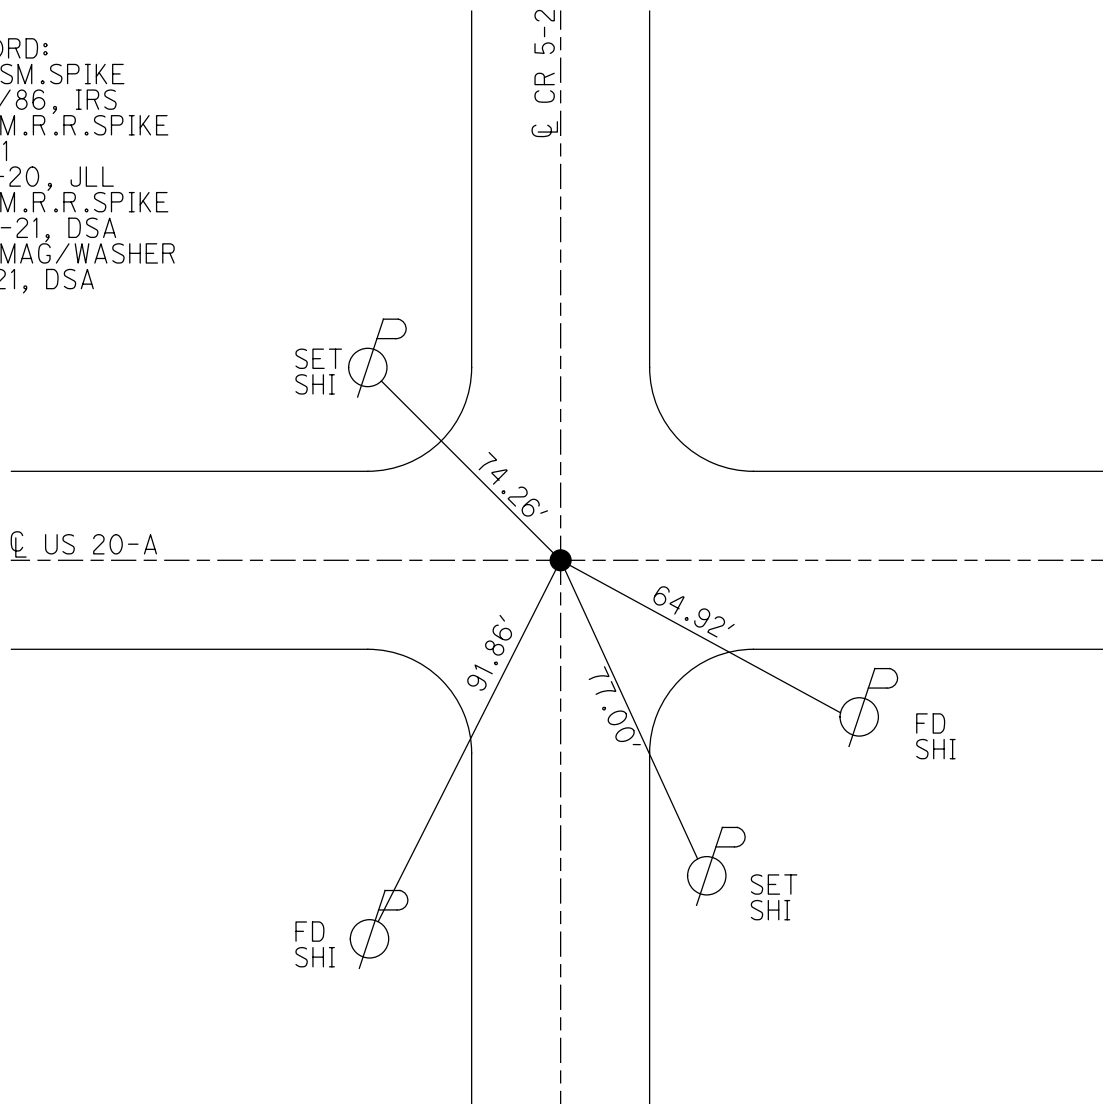

O.D.O.T. DISTRICT 2 SURVEY OFFICE (USE ONLY)

PERSONNEL

REFERENCE NO. 42

SHEET 13 OF 14

NOTES NIESE

DATE 4-27-21

ROUTE US 20 A

H.C. AUBLE

WEATHER WINDY

COUNTY FULTON

R.C. NIESE

TEMP. 65°

TOWNSHIP SWAN CREEK

SECTION 16

DWG BY AUBLE

PID 101295

T 7 N R 8 E

TYPE MONUMENT R.R.SPIKE

ON SURFACE - ~~BELOW~~ ON

OFFSET Q PAVEMENT ON LT : RT

- TO - EDGE PAVEMENT


STATION: 1172+80

HORIZ.DATUM: NAD83(2011)


GEOID: 12A

GRID: NORTHING: 698262.131

EASTING: 1568985.100

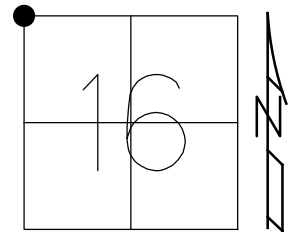

RECORD:
SET SM.R.R.SPIKE
9/15/86, IRS
FD SM.R.R.SPIKE
REF42
1-23-20, JLL
4-27-21, DSA
SET MAG/WASHER
11-1-21, DSA

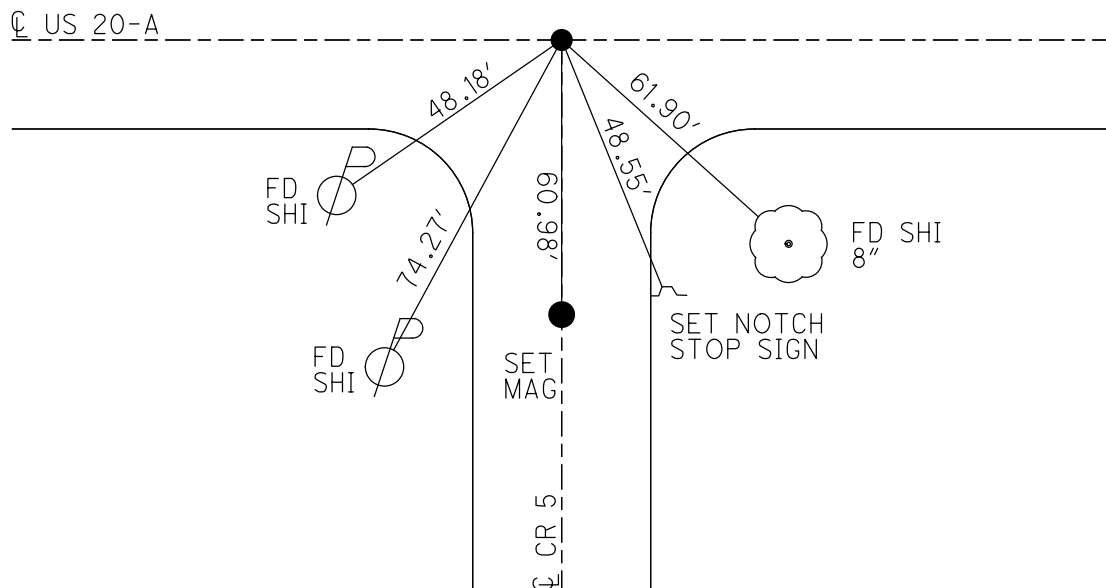

O.D.O.T. DISTRICT 2 SURVEY OFFICE (USE ONLY)

PERSONNEL

REFERENCE NO. 42 A

SHEET 14 OF 14

NOTES LEU

DATE 1-23-20

ROUTE US 20 A

H.C. LEU

WEATHER CLOUDY

COUNTY FULTON

R.C. BALBAUGH

TEMP. 33°

TOWNSHIP SWAN CREEK

SECTION 16

DWG BY AUBLE PID 101295

T 7 N R 8 E

TYPE MONUMENT P.K.NAIL

~~ON SURFACE~~ - BELOW 2.5"

OFFSET Q PAVEMENT ON LT : RT

- TO - EDGE PAVEMENT


STATION: 1199+42

HORIZ.DATUM: NAD83(2011)


GEOID: 12A

GRID: NORTHING: 698215.824

EASTING: 1571645.929

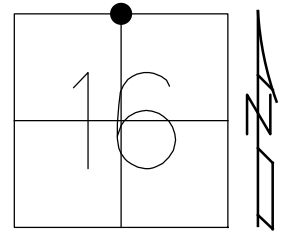

RECORD:
SET P.K. NAIL
9/15/86, IRS
FD P.K.NAIL
REFA42
1-23-20, JLL
SET MAG/WASHER
11-1-21, DSA

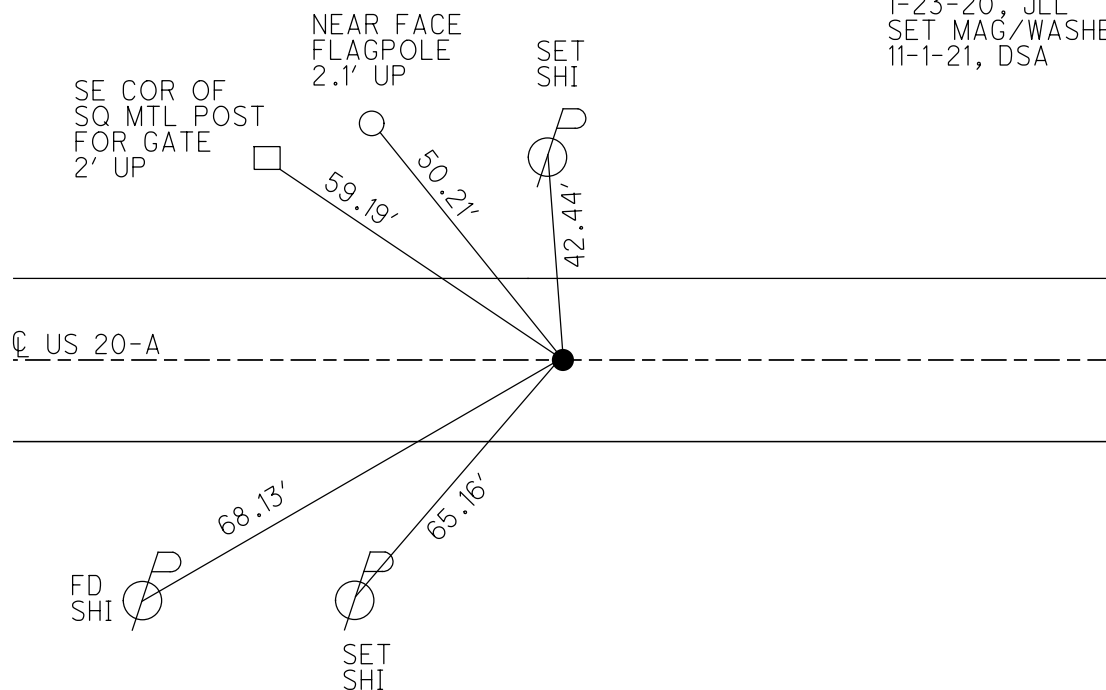

O.D.O.T. DISTRICT 2 SURVEY OFFICE (USE ONLY)

PERSONNEL

REFERENCE NO. 43

SHEET 1 OF 10

NOTES NIESE

DATE 4-27-21

ROUTE US 20-A

H.C. AUBLE

WEATHER WINDY

COUNTY FULTON

R.C. NIESE

TEMP. 65°

TOWNSHIP SWAN CREEK

SECTION 9

DWG BY AUBLE

PID 101295

T 7 N R 8 E

TYPE MONUMENT R.R.SPIKE

ON SURFACE - ~~BELOW~~ ON

OFFSET Q PAVEMENT ON LT : RT

- TO - EDGE PAVEMENT


STATION: 1225+94.12

HORZ.DATUM: NAD83(2011)


GEOID: 12A

GRID: NORTHING: 698186.708

EASTING: 1574302.170

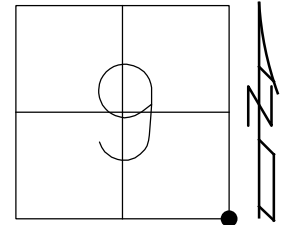

RECORD:
SET SM.R.R.SPIKE
9/15/86, IRS
FD R.R.SPIKE
REF43
7/31/12, SDC
FD SM.R.R.SPIKE
REF43
1-23-20, JLL
4-27-21, DSA
SET MAG/WASHER
11-1-21, DSA

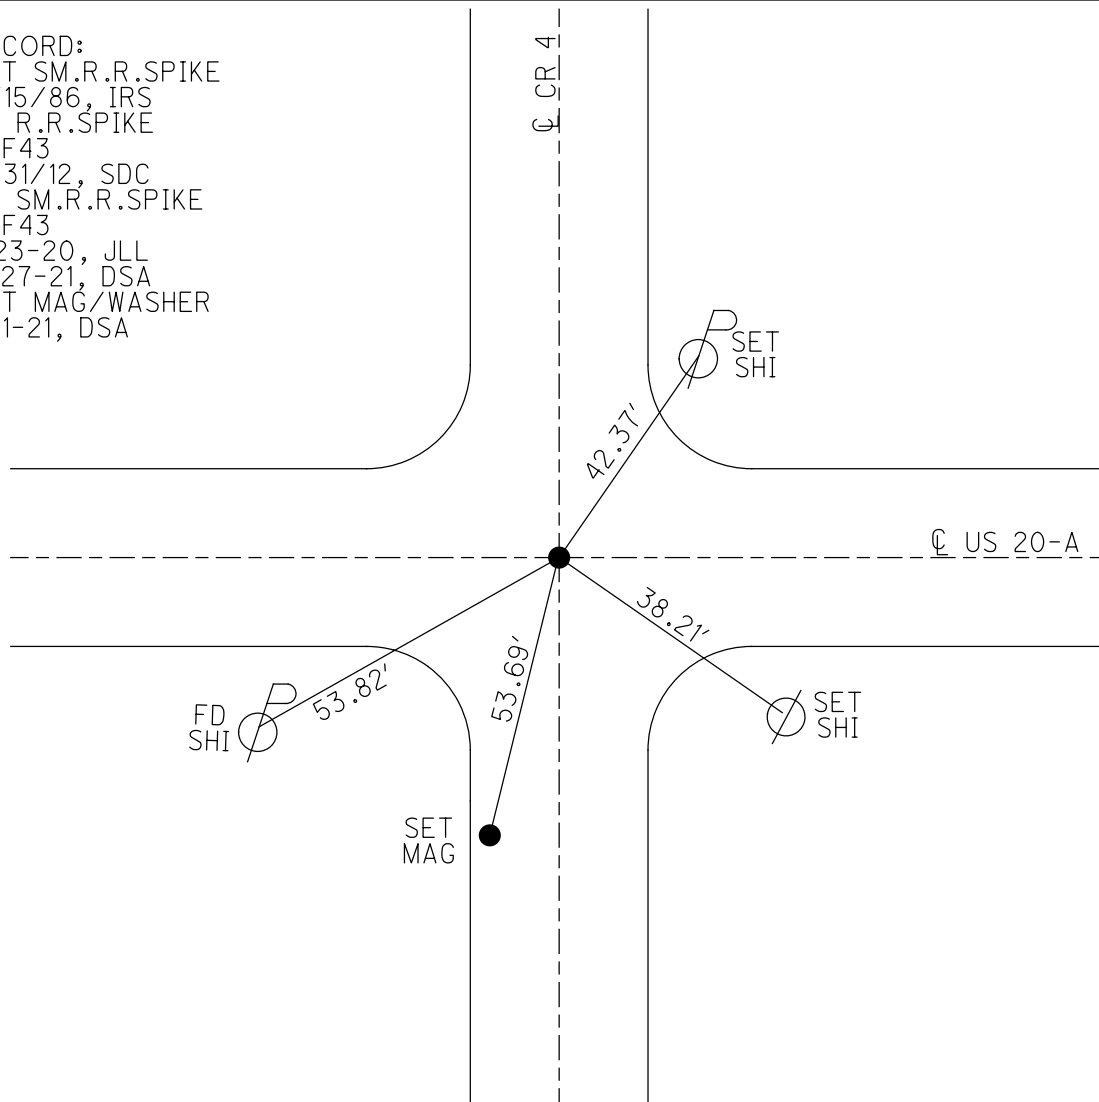

O.D.O.T. DISTRICT 2 SURVEY OFFICE (USE ONLY)

PERSONNEL

REFERENCE NO. 44

SHEET 2 OF 10

NOTES NIESE

DATE 4-27-21

ROUTE US 20-A

H.C. AUBLE

WEATHER WINDY

COUNTY FULTON

R.C. NIESE

TEMP. 70°

TOWNSHIP SWAN CREEK

-

SECTION 10

DWG BY AUBLE

PID 101295

T 7 N R 8 E

TYPE MONUMENT P.K.NAIL

ON SURFACE - ~~BELOW~~ ON

OFFSET Q PAVEMENT ON LT : RT

- TO - EDGE PAVEMENT


STATION: 1252+53.53

HORZ.DATUM: NAD83(2011)


GEOID: 12A

GRID: NORTHING: 698155.151

EASTING: 1576961.457

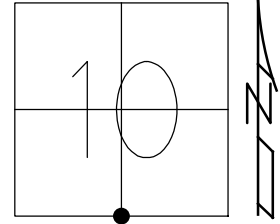

RECORD:
SET P.K.NAIL
9/15/86, IRS
FD P.K.NAIL
REF44
7/31/12, SDC
FD P.K.NAIL
REF44
1-23-20, JLL
4-27-21, DSA
SET MAG/WASHER
11-1-21, DSA

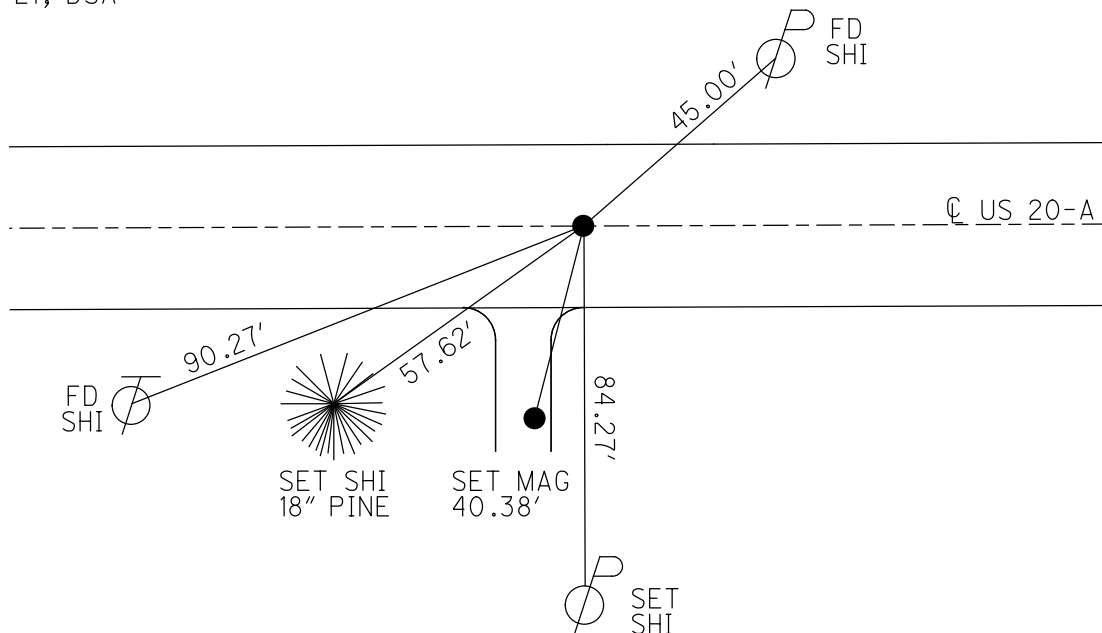

O.D.O.T. DISTRICT 2 SURVEY OFFICE (USE ONLY)

PERSONNEL

REFERENCE NO. 44 A

SHEET 3 OF 10

NOTES O'DONNELL

DATE 1-27-20

ROUTE US 20-A

H.C. LEU

WEATHER CLOUDY

COUNTY FULTON

R.C. O'DONNELL

TEMP. 35°

TOWNSHIP SWAN CREEK

BALBAUGH

SECTION 10

DWG BY AUBLE

PID 101295

T 7 N R 8 E

TYPE MONUMENT 3/4" IPIN

~~ON SURFACE~~ - BELOW 6"

OFFSET CL PAVEMENT 6" ~~LEFT~~ : RT

- TO - EDGE PAVEMENT


STATION: 1265+78

HORZ.DATUM: NAD83(2011)


GEOID: 12A

GRID: NORTHING: 698131.910

EASTING: 1578319.455

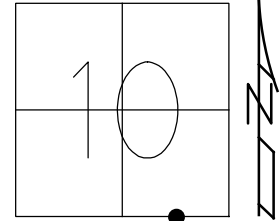

RECORD:
FD 3/4" IPIN
6" DOWN
3/4/86, IRS
SET SM.R.R.SPIKE
9/15/86
FD 3/4" IPIN
6" DOWN
1/27/20, JLL
SET MAG/WASHER
11-1-21, DSA

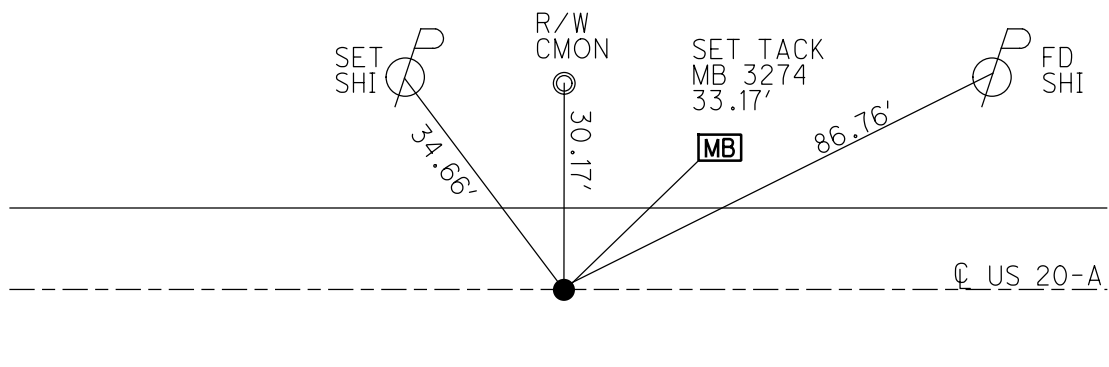

O.D.O.T. DISTRICT 2 SURVEY OFFICE (USE ONLY)

PERSONNEL

REFERENCE NO. 44 B

SHEET 4 OF 10

NOTES LEU

DATE 1-23-20

ROUTE US 20-A

H.C. LEU

WEATHER CLOUDY

COUNTY FULTON

R.C. BALBAUGH

TEMP. 35°

TOWNSHIP SWAN CREEK

DWG BY AUBLE

PID 101295

SECTION 10

T 7 N R 8 E

TYPE MONUMENT 5/8" IPID

~~ON SURFACE~~ - BELOW 2"

OFFSET CL PAVEMENT 23.2' ~~LT~~ : RT

11.3' TO RT EDGE PAVEMENT


STATION: 1274+14.47

HORZ.DATUM: NAD83(2011)


GEOID: 12A

GRID: NORTHING: 698118.046

EASTING: 1579098.304

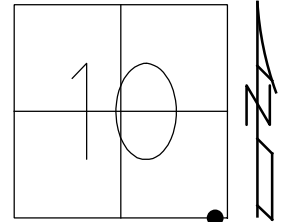

RECORD:
FD R.R.SPIKE
4" DOWN
2/4/86
9/15/86, IRS
FD R.R.SPIKE
DISTURBED
7/31/12, SDC
SET 5/8" IPID
5/2/13, SDC
FD 5/8" IPID
2" DOWN
REFB44
1/23/20, JLL

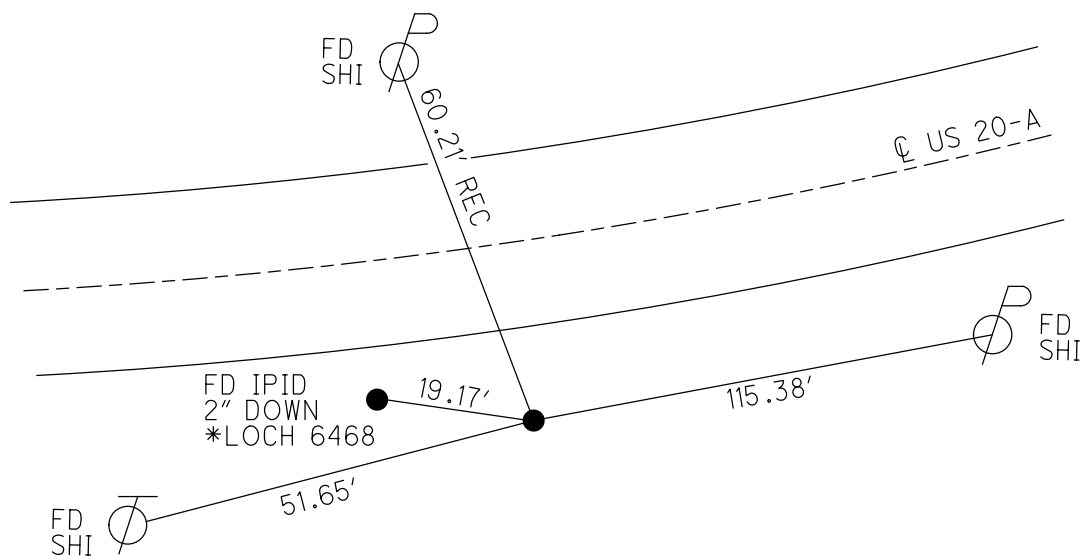


O.D.O.T. DISTRICT 2 SURVEY OFFICE (USE ONLY)


PERSONNEL	REFERENCE NO. <u>45</u>	SHEET <u>5</u> OF <u>10</u>
NOTES <u>RHOADES</u>	DATE <u>7/27/16</u>	ROUTE <u>US 20-A</u>
H.C. <u>O'DONNELL</u>	WEATHER <u>SUNNY</u>	COUNTY <u>FULTON</u>
R.C. <u>KEFFER</u>	TEMP. <u>72°</u>	TOWNSHIP <u>SWAN CREEK</u>
		SECTION <u>10</u>
		T <u>7</u> N R <u>8</u> E

TYPE MONUMENT SM.R.R.SPIKE
 ON SURFACE - ~~BELOW~~ ON
 LEFT - Q PAV'T - RIGHT ON
- TO - EDGE PAVEMENT
 S.L.M. 1279+65.48

Grid: Northing: 698360.745 Easting: 1579622.420

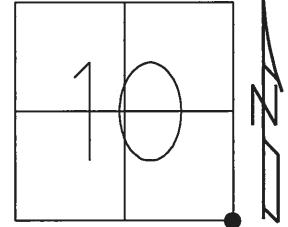

RECORD:
 SET SM.SPIKE
 9/15/86, IRS
 FD SM.SPIKE
 GPS, REF45
 7/31/12, SDC
 SET MAG/WASHER
 NEWREF45
 11/18/16, JFO

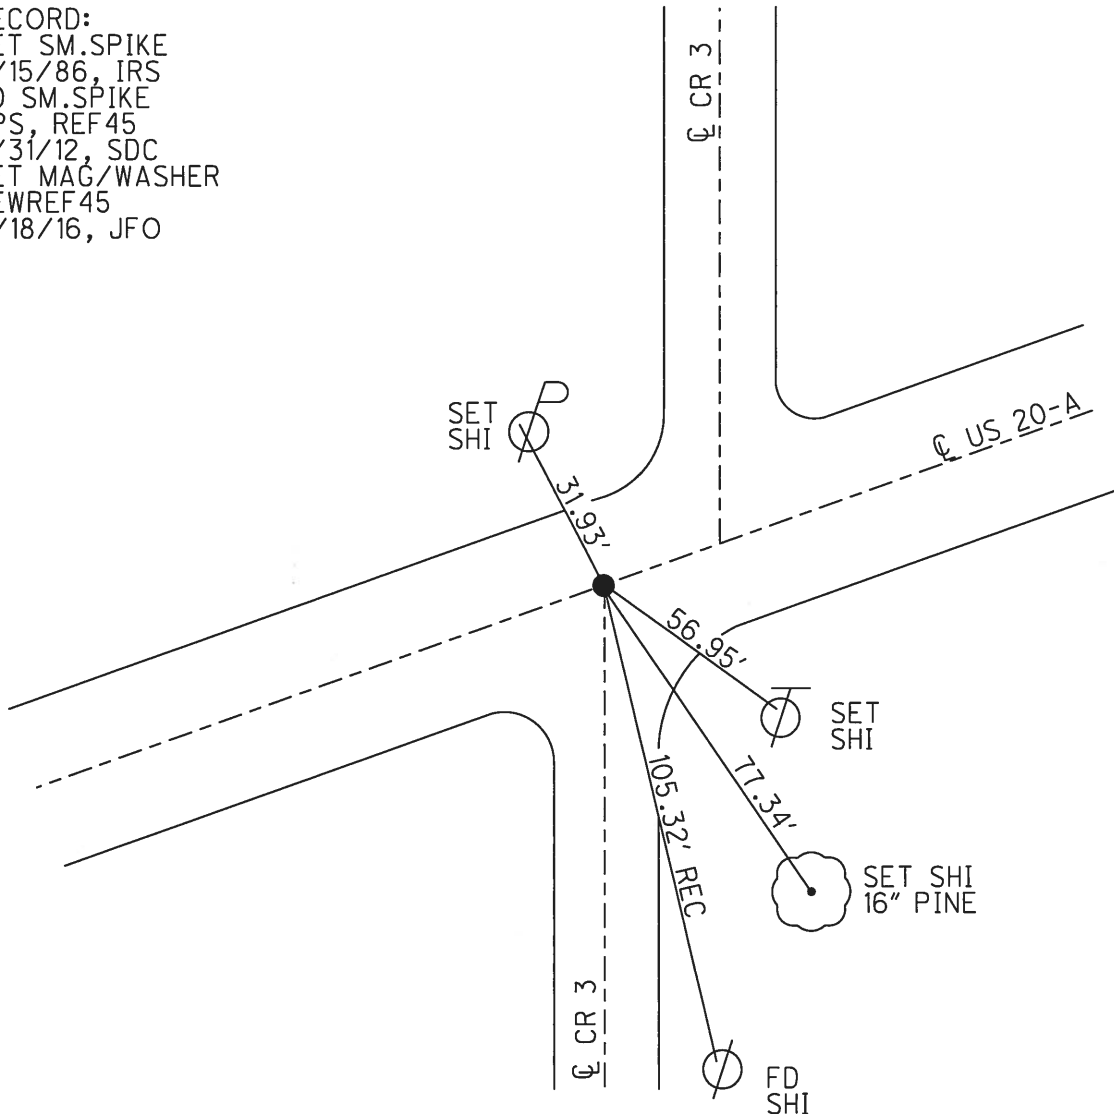

O.D.O.T. DISTRICT 2 SURVEY OFFICE (USE ONLY)

PERSONNEL _____ REFERENCE NO. 46 SHEET 6 OF 10
NOTES RHOADES DATE 7/27/16 ROUTE US 20-A
H.C. O'DONNELL WEATHER SUNNY COUNTY FULTON
R.C. KEFFER TEMP. 74° TOWNSHIP SWAN CREEK
SECTION 11
T 7 N R 8 E

TYPE MONUMENT R.R.SPIKE


~~ON SURFACE~~ - BELOW 6"

LEFT - ℄ PAV'T - RIGHT -


0.4' TO LT EDGE PAVEMENT

S.L.M. 1315+82.89

Grid: Northing: 699879.082 Easting: 1582905.733

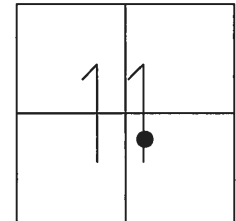

RECORD:
SET LG.R.R.SPIKE
9/15/86, IRS
FD BOLT
W/PUNCH HOLE
REF46
7/31/12, SDC
SET MAG/WASHER
NEWREF46
11/18/16, JFO

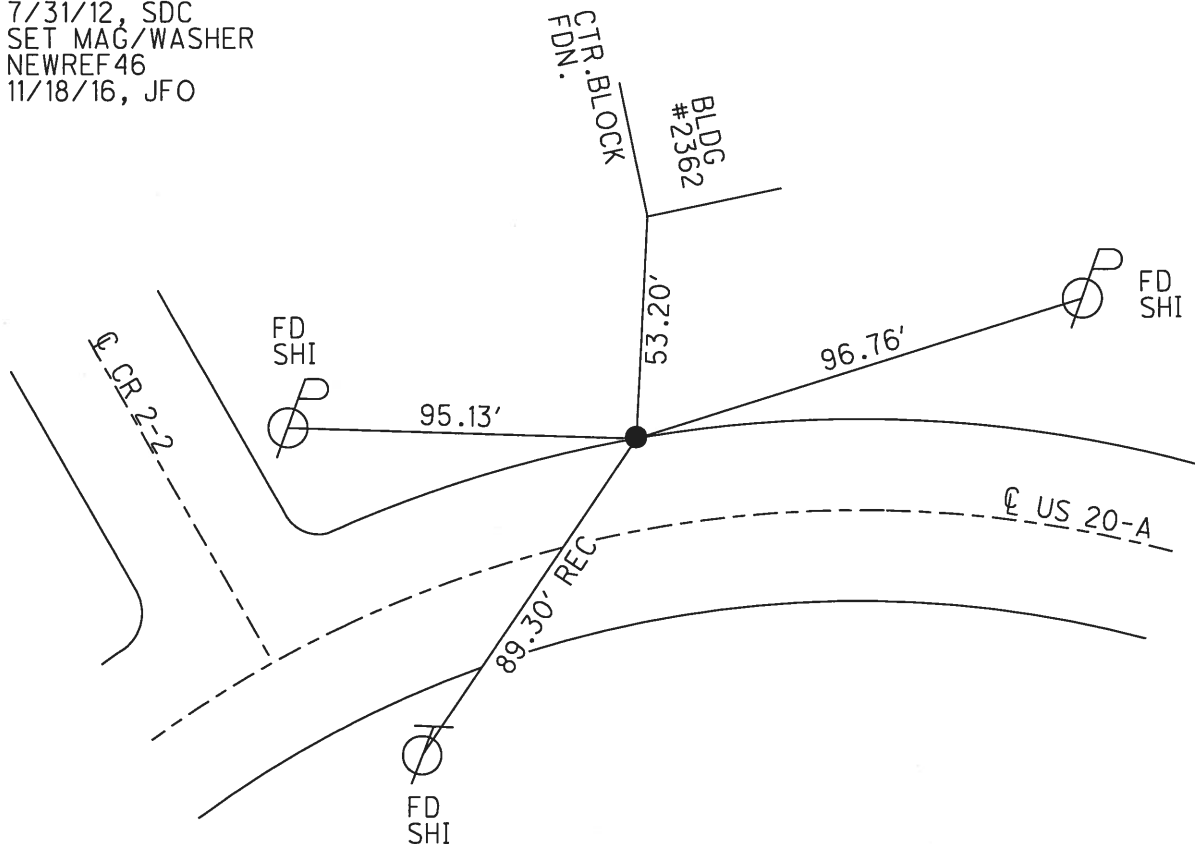

O.D.O.T. DISTRICT 2 SURVEY OFFICE (USE ONLY)

PERSONNEL

REFERENCE NO. 47

SHEET 7 OF 10

NOTES RHOADES

DATE 7/27/16

ROUTE US 20-A

H.C. O'DONNELL

WEATHER SUNNY

COUNTY FULTON

R.C. KEFFER

TEMP. 74°

TOWNSHIP SWAN CREEK

SECTION 11

T 7 N R 8 E

TYPE MONUMENT R.R.SPIKE


~~ON SURFACE~~ - BELOW 2"

LEFT - Q PAV'T - RIGHT ON


- TO - EDGE PAVEMENT

S.L.M. 1336+25.66

Grid: Northing: 700051.642 Easting: 1584944.112

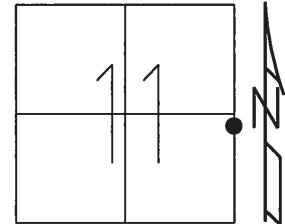

RECORD:
SET SM.SPIKE
9/15/86, IRS
FD SPIKE SHANK
REF47
7/31/12, SDC
SET MAG/WASHER
NEWREF47
11/18/16, JFO

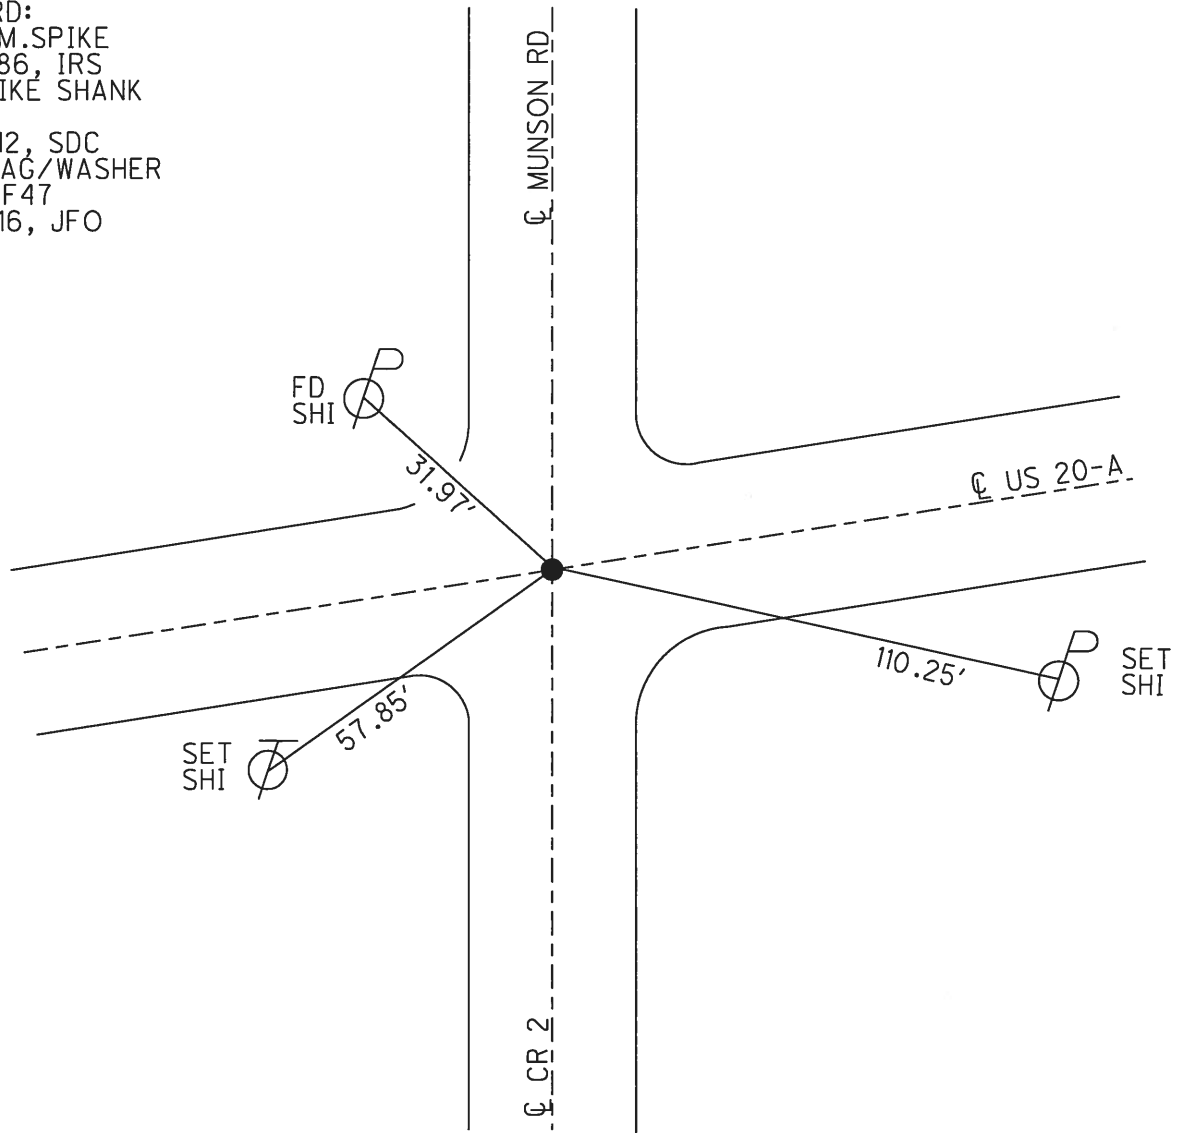

O.D.O.T. DISTRICT 2 SURVEY OFFICE (USE ONLY)

PERSONNEL _____ REFERENCE NO. 47 A SHEET 8 OF 10
NOTES RHOADES DATE 7/27/16 ROUTE US 20-A
H.C. O'DONNELL WEATHER SUNNY COUNTY FULTON
R.C. KEFFER TEMP. 74° TOWNSHIP SWAN CREEK
SECTION 12
T 7 N R 8 E

TYPE MONUMENT _____ P.K.NAIL _____


~~ON SURFACE~~ - BELOW 3"

LEFT - ℄ PAV'T - RIGHT ON


- TO - EDGE PAVEMENT

S.L.M. 1347+90.43

Grid: Northing: 700140.750 Easting: 1586105.519

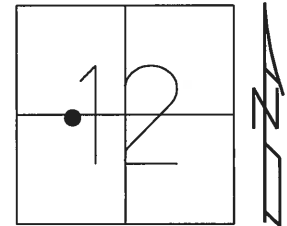

RECORD:
SET P.K.NAIL
9/15/86, IRS
FD P.K.NAIL
REFA47
7/31/12, SDC
SET MAG/WASHER
NEWREFA47
11/18/16, JFO

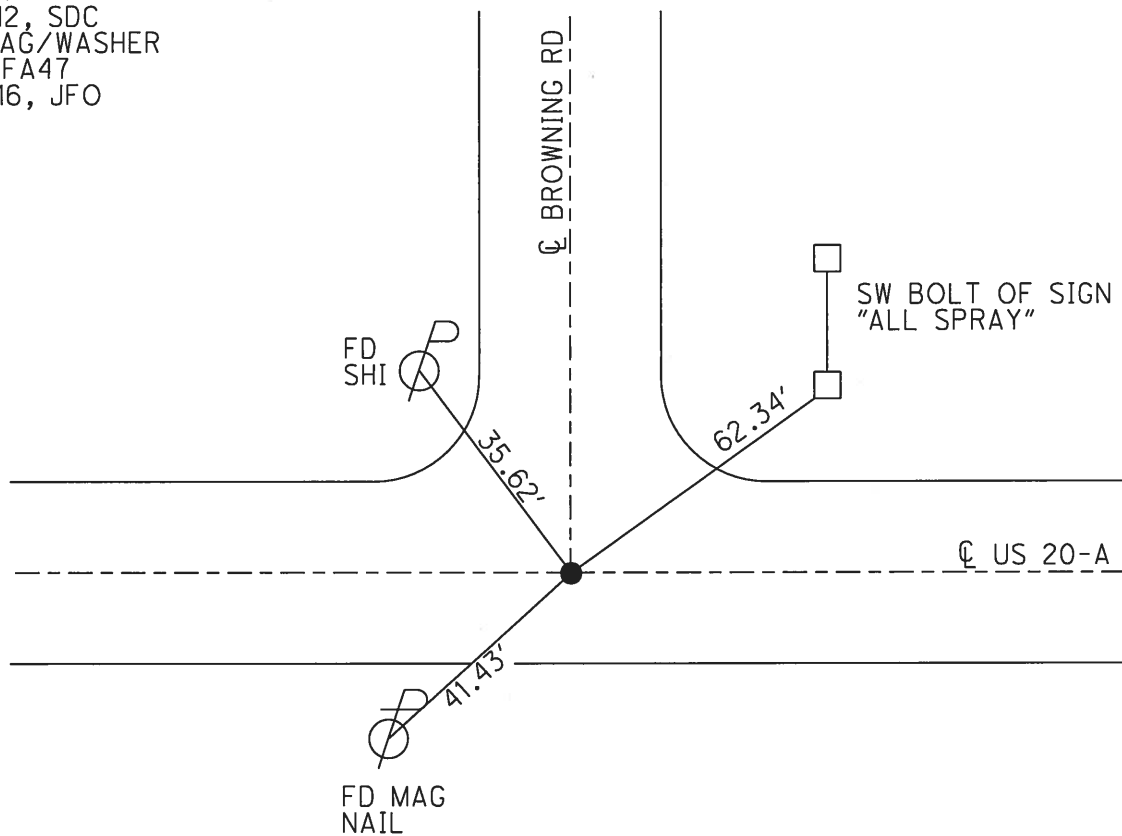

O.D.O.T. DISTRICT 2 SURVEY OFFICE (USE ONLY)

PERSONNEL _____ REFERENCE NO. 48 SHEET 9 OF 10
NOTES STONE DATE 3/05/86 ROUTE US 20-A
H.C. CURTIS WEATHER CLOUDY COUNTY FULTON
R.C. HOUSEHOLDER TEMP. 35° TOWNSHIP SWAN CREEK
MICHALAK SECTION 12
T 7 N R 8 E

TYPE MONUMENT BRASS PLATE


~~ON SURFACE~~ - BELOW 3"

LEFT - ℄ PAV'T - RIGHT ON


- TO - EDGE PAVEMENT

S.L.M. 1376+50.99

Grid: Northing: 700364.714 Easting: 1588957.177

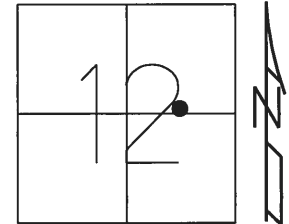

RECORD:
FD BRASS PLATE
9/15/86, IRS
FD MONBOX
W/1" IPIN
REF48
7/31/12, SDC
FD MONBOX
W/ 1" IPIN
NEWREF48
12/22/16, JFO

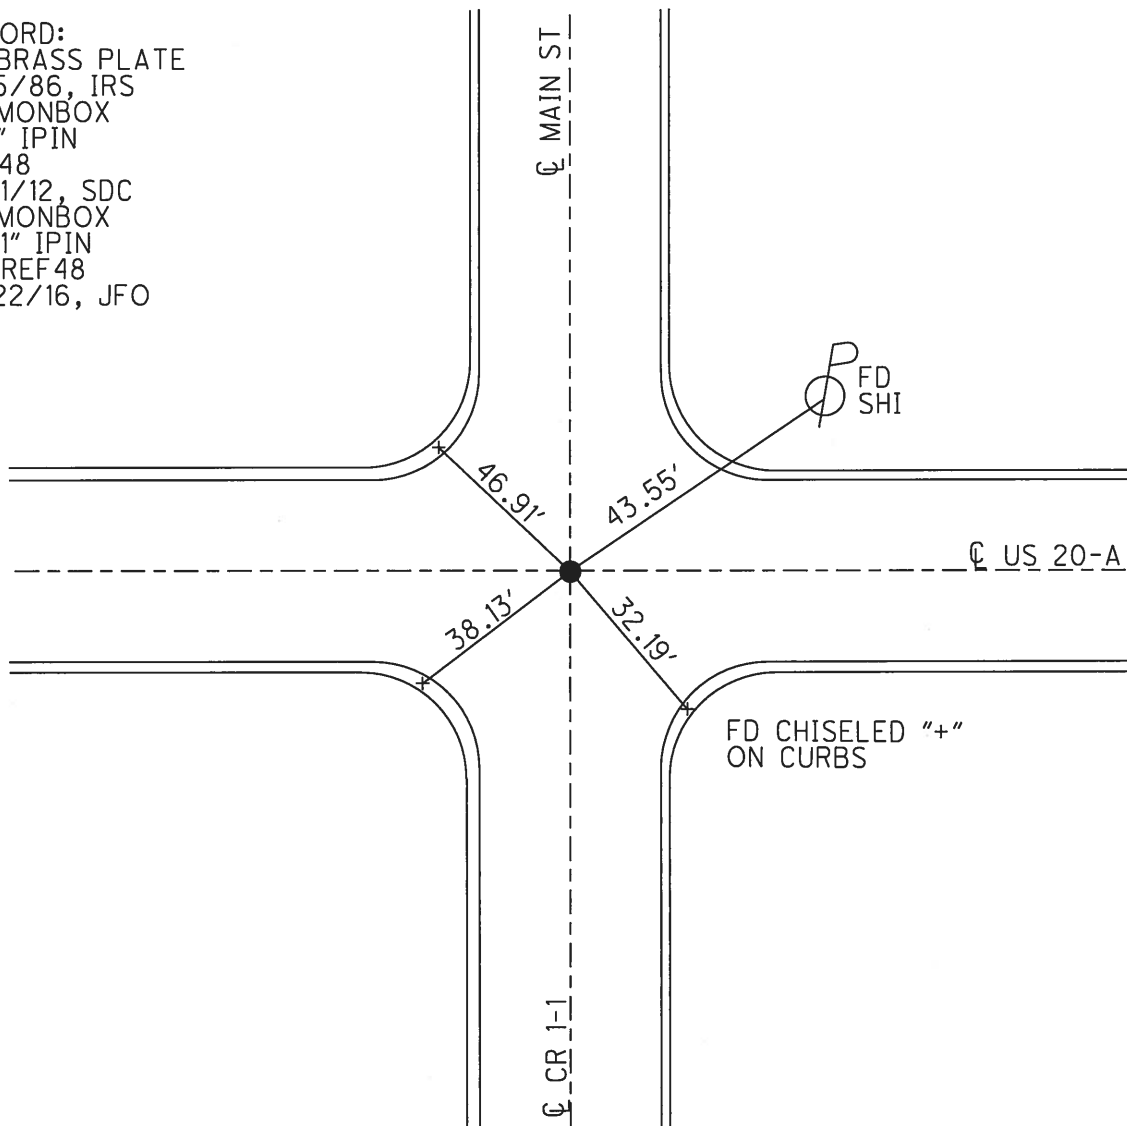

O.D.O.T. DISTRICT 2 SURVEY OFFICE (USE ONLY)

PERSONNEL

REFERENCE NO. 49

SHEET 10 OF 10

NOTES STONE

DATE 3/5/86

ROUTE US 20 A

H.C. CURTIS

WEATHER CLOUDY

COUNTY FULTON

R.C. HOUSEHOLDER

TEMP. 35°

TOWNSHIP SWAN CREEK

MICHALAK

SECTION 12

T 7 N R 8 E

TYPE MONUMENT MONBOX


~~ON SURFACE~~ - BELOW 2"

LEFT - ℄ PAV'T - RIGHT ON


- TO - EDGE PAVEMENT

S.L.M. 1389+69.40

Grid: Northing: 700472.785 Easting: 1590271.213

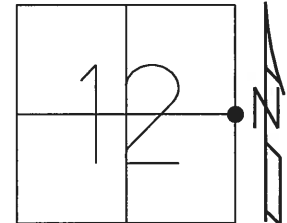

RECORD:
FD MONBOX
9/15/86, IRS
FD MONBOX
W/1" IPIN
REF49
7/31/12, SDC
FD MONBOX
W/1" IPIN &
6-SIDED METAL CAP
NEWREF49
12/22/16, JFO

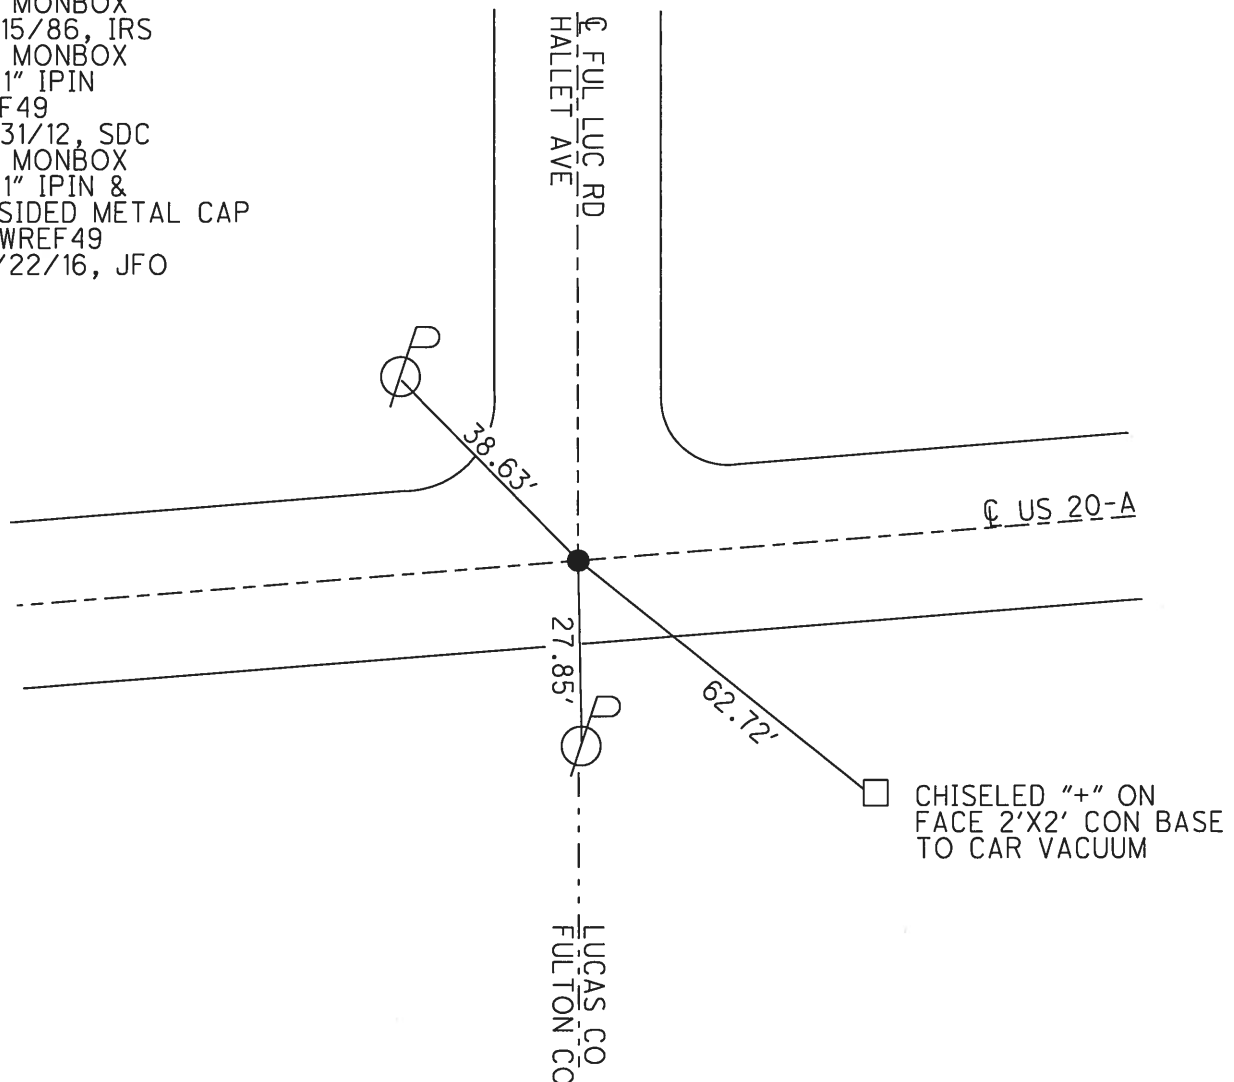


PERSONNEL TITLE PERSONNEL TITLE

COUNTY Fulton DATE 1-17-61


S R 20.71 WEATHER Fair

SEC. 1 TEMP. 20

DESCRIPTION LEFT CENTER LINE RIGHT JOB NO.

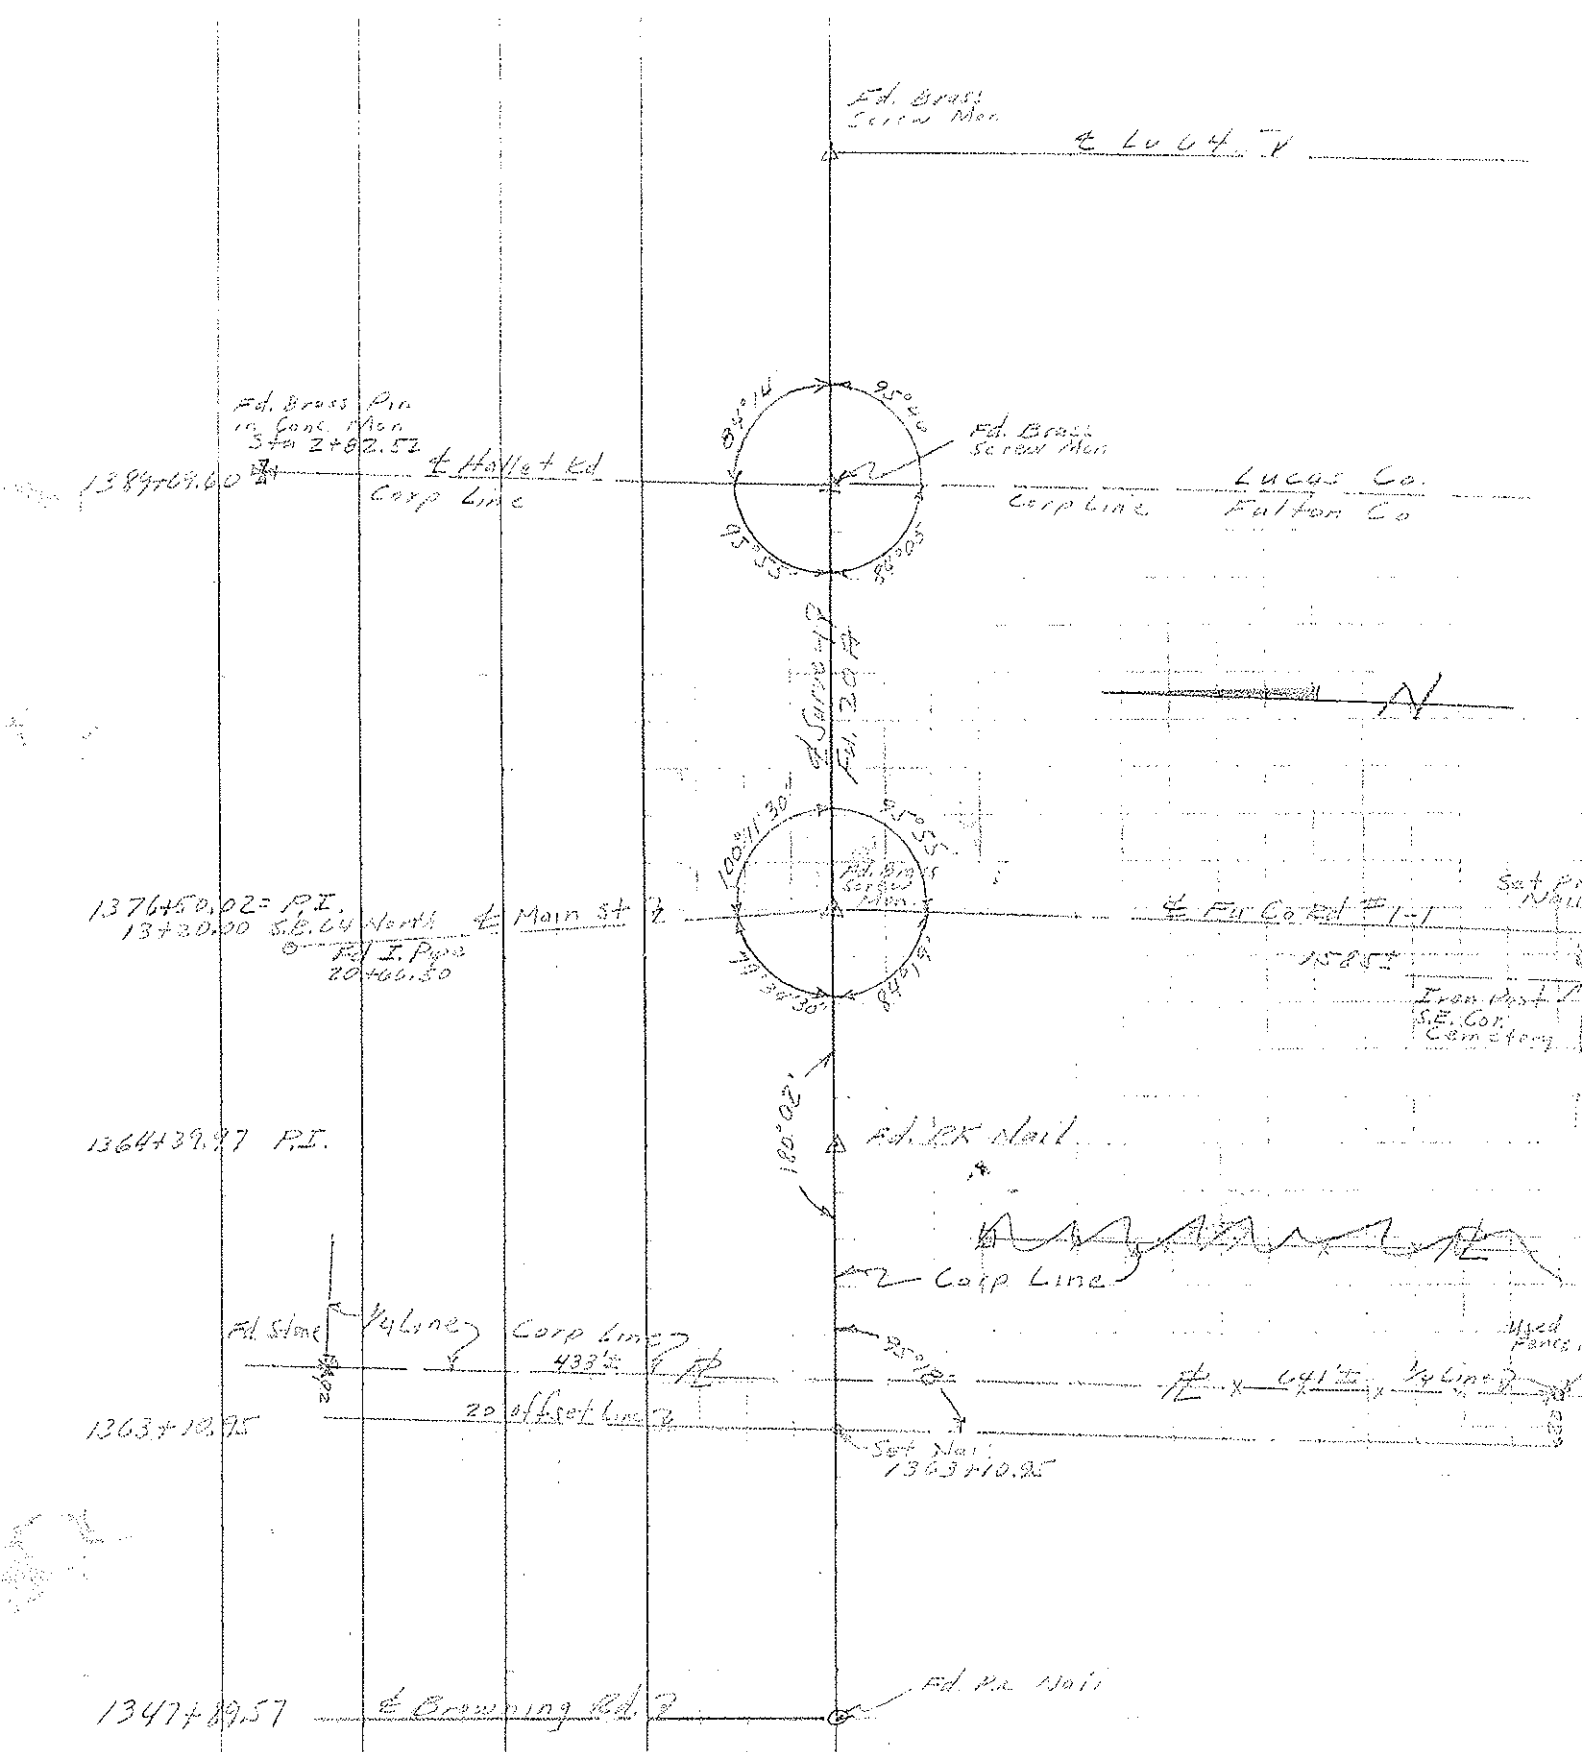

PERSONNEL	TITLE	PERSONNEL	TITLE	COUNTY	DATE
<u>Mason</u>				<u>San Diego</u>	<u>Aug 10 - 61</u>
<u>Surveyor</u>				S. R. <u>26-16</u>	WEATHER <u>cloudy</u>
<u>Tracer</u>				SEC. <u>10-20-20</u>	TEMP. <u>76°</u>
<u>Driver</u>					
DESCRIPTION <u>Reference to former plat</u>				JOB NO. _____	
LEFT		CENTER LINE		RIGHT	

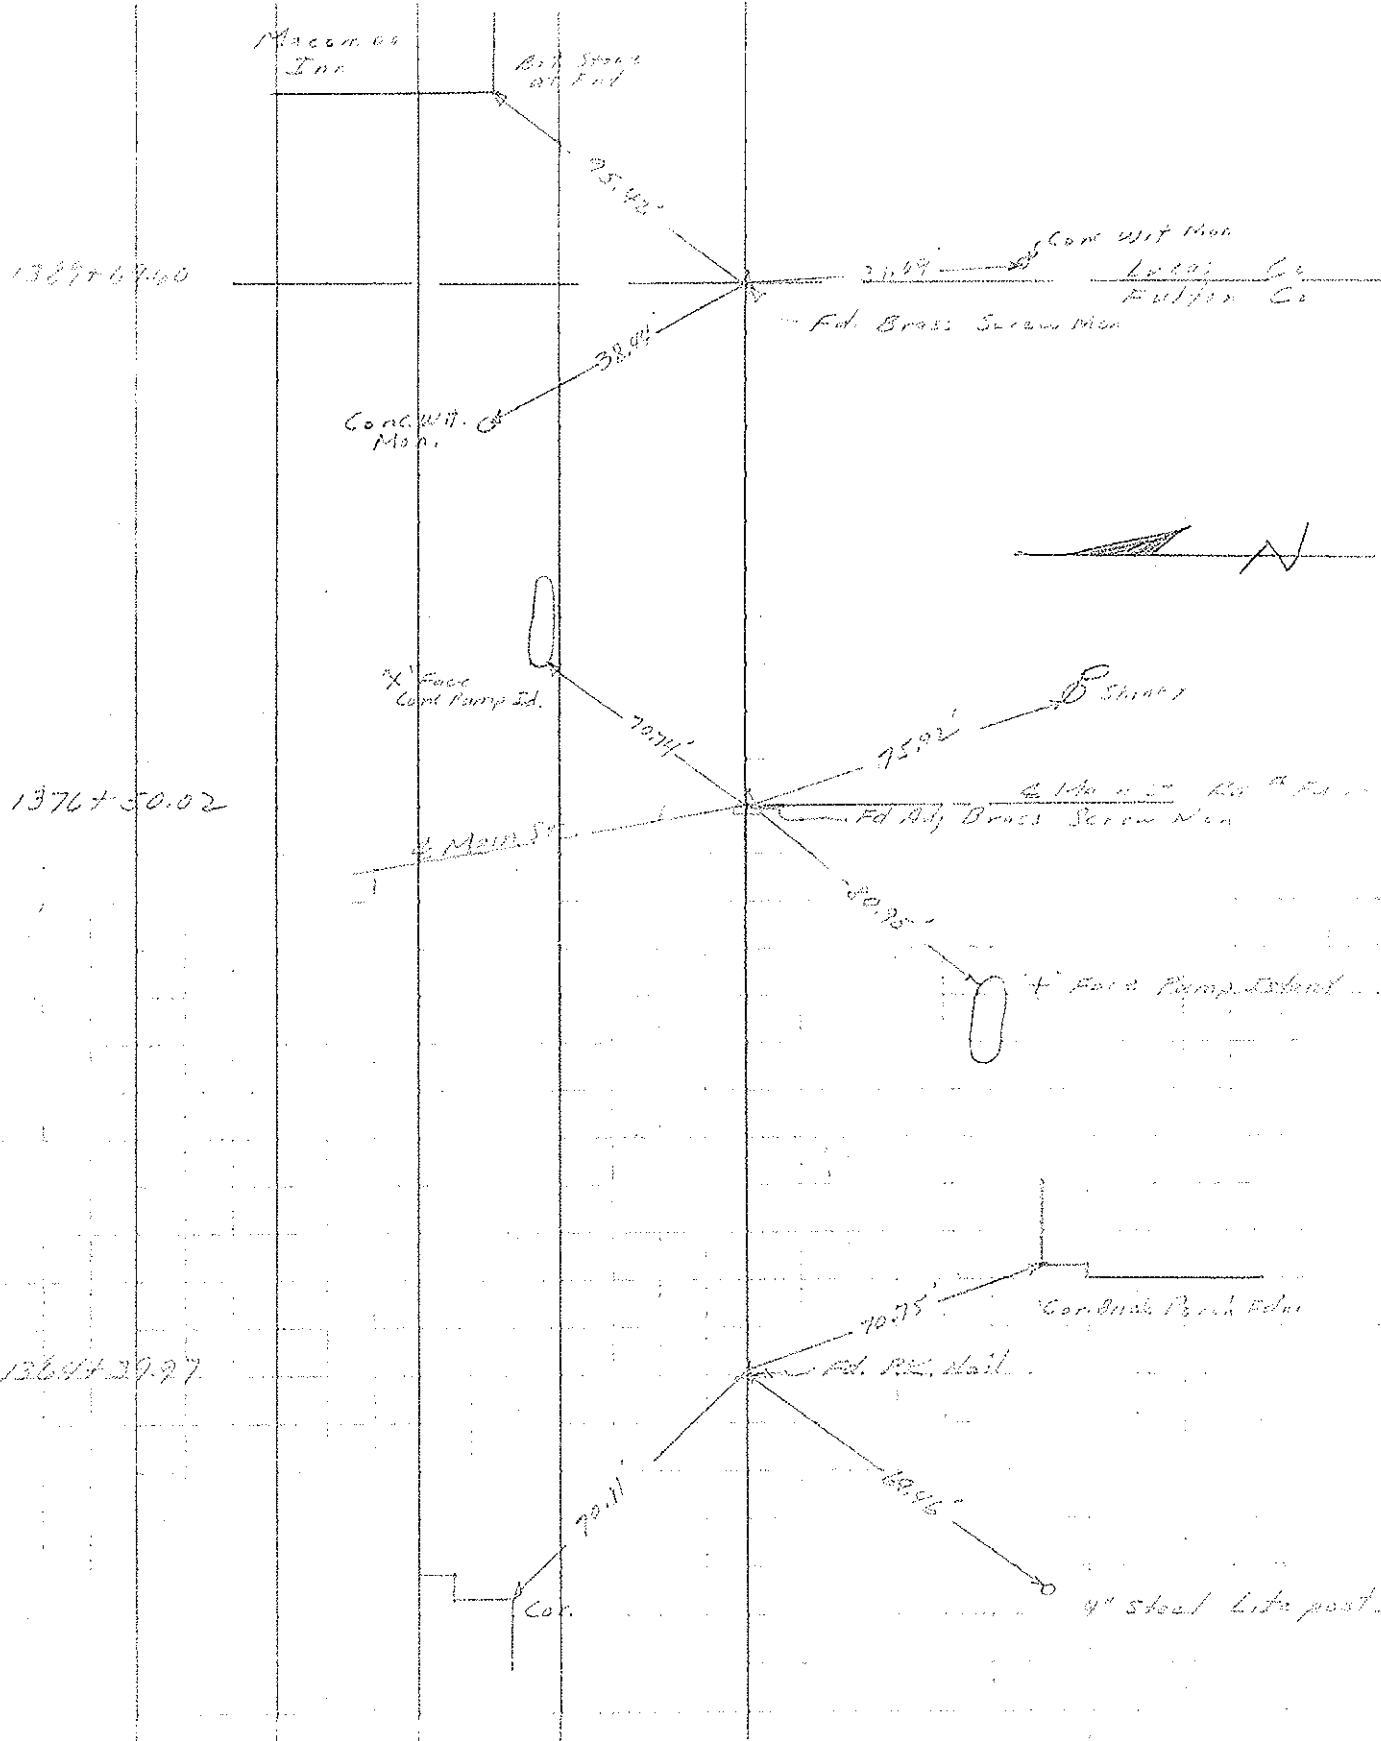


COUNTY Fuller DATE 5-17-67

S. R. 207 WEATHER Clear

SEC. Extraction TEMP. 60

LEFT	CENTER LINE	RIGHT
1	2	3
4	5	6
7	8	9
364	365	366
367		

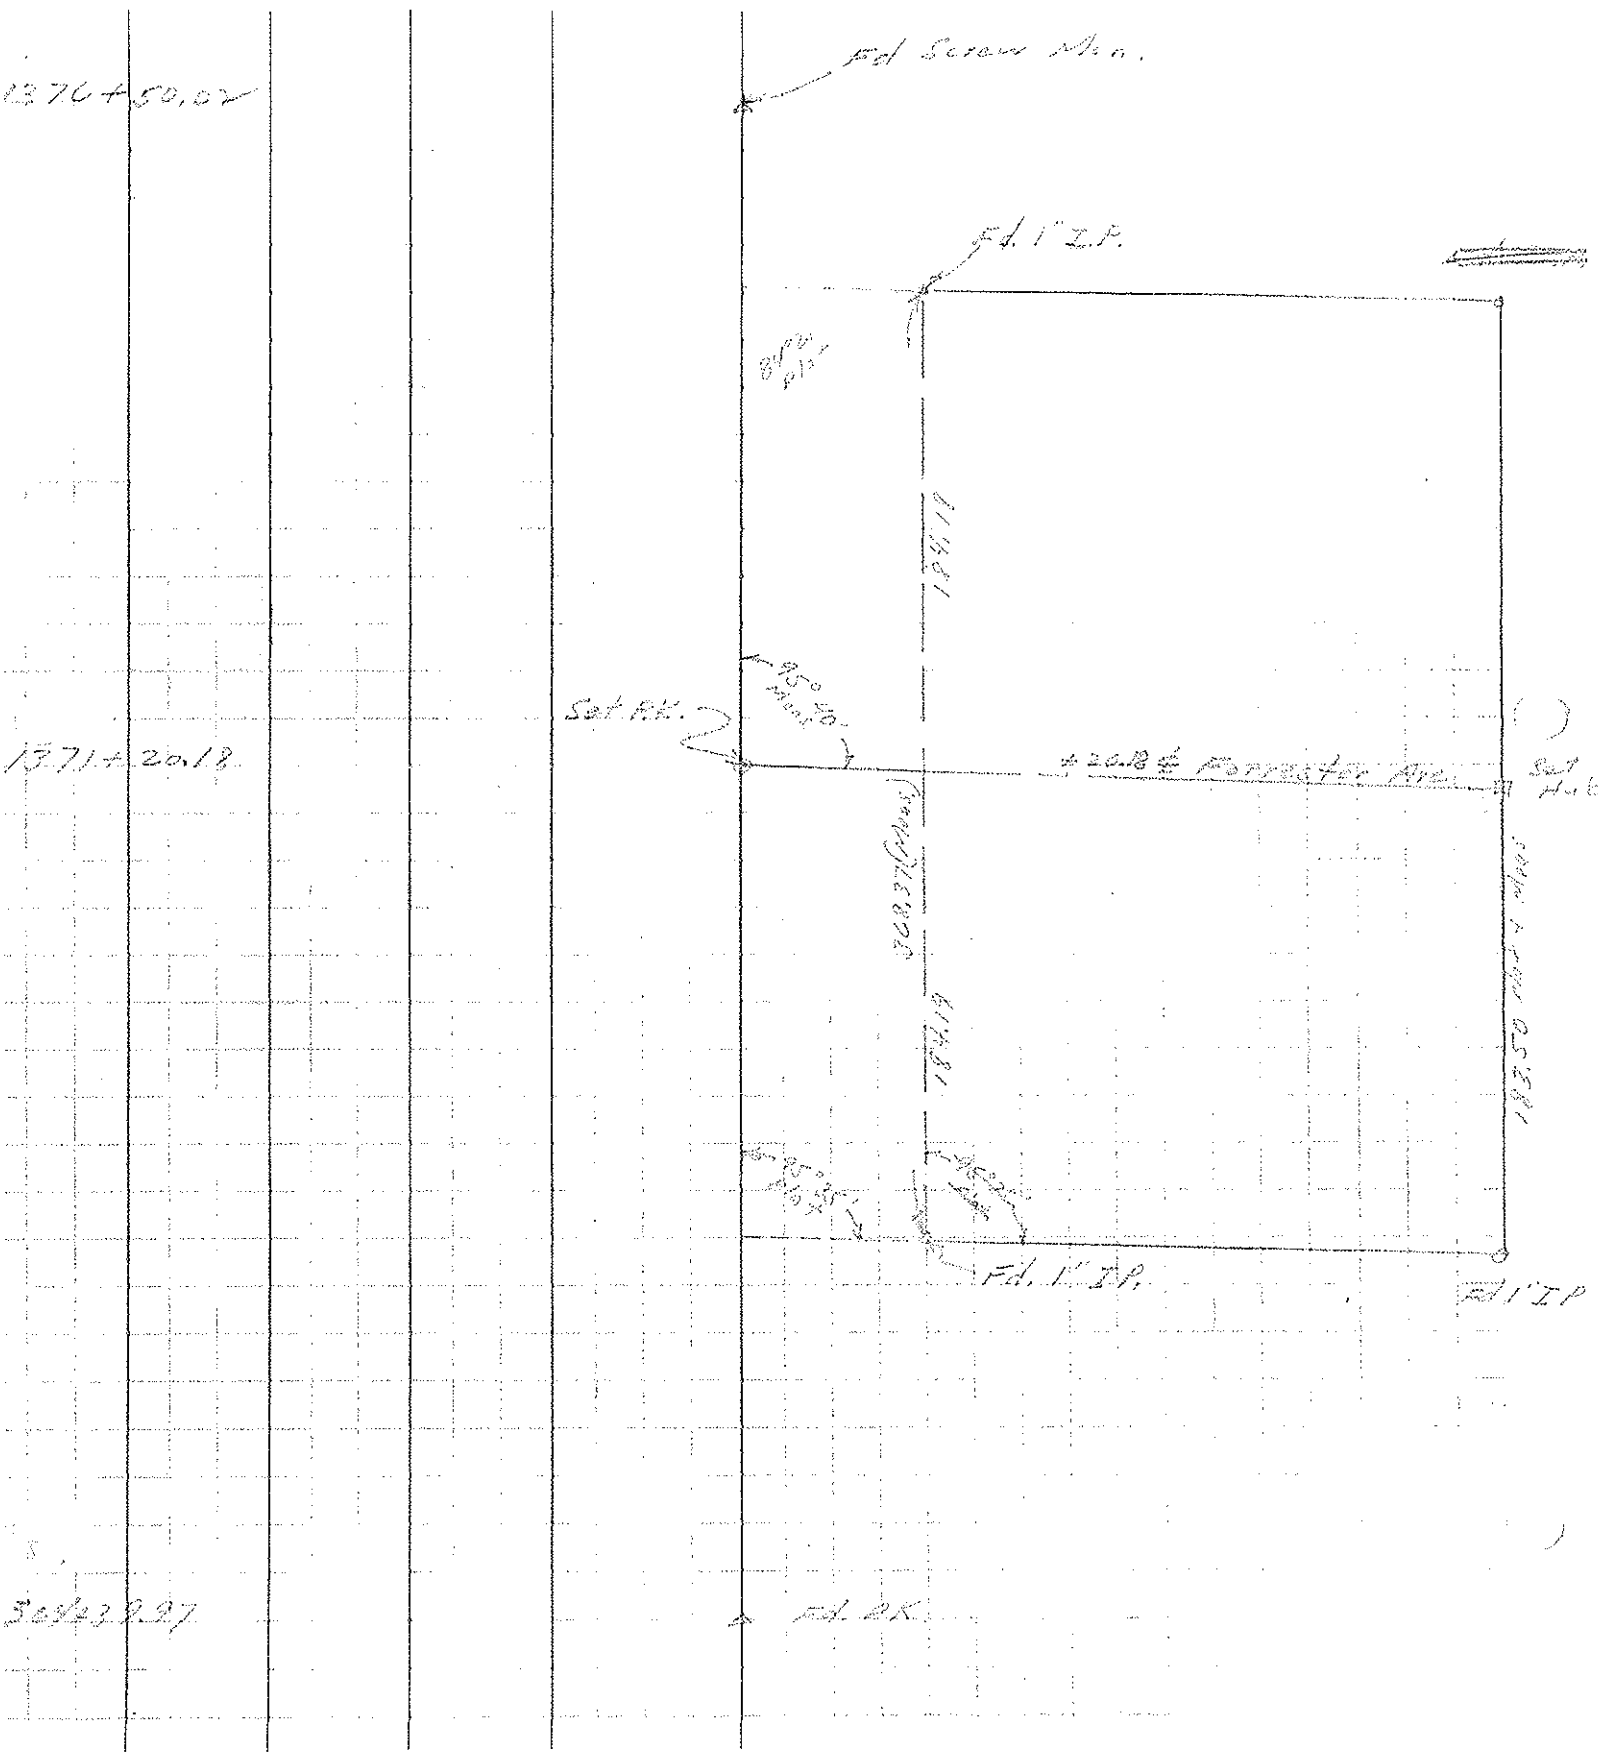

PERSONNEL	TITLE	PERSONNEL	TITLE	COUNTY	DATE
Tolson				Butler	May 16, 1978
Waller				S. R. U.S. 20A	WEATHER
Van D				SEC.	TEMP.
Gravala					

DESCRIPTION	JOB NO.
-------------	---------

