

O.D.O.T. DISTRICT 2 SURVEY OFFICE (USE ONLY)

PERSONNEL

REFERENCE NO. 67

SHEET 50 OF 58

NOTES STONE DATE 9/3/76
 H.C. NEUSER WEATHER FAIR
 R.C. CURTIS TEMP. 65°

ROUTE SR 184
 COUNTY LUCAS
 TOWNSHIP CITY OF TOLEDO
 SECTION 7
 T 9 S R 8 E

DWG BY NIESE PID _____

TYPE MONUMENT UNKNOWN

ON SURFACE - ~~BELOW~~ ON


OFFSET ☉ PAVEMENT ON _____ LT : RT

- TO - EDGE PAVEMENT


STATION: 1090+16.92

HORZ. DATUM: _____ GEOID: _____

GRID: NORTHING: _____ EASTING: _____

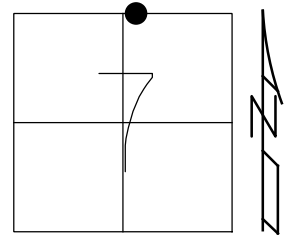

RECORD: P.O.T.
 9/3/76, STONE

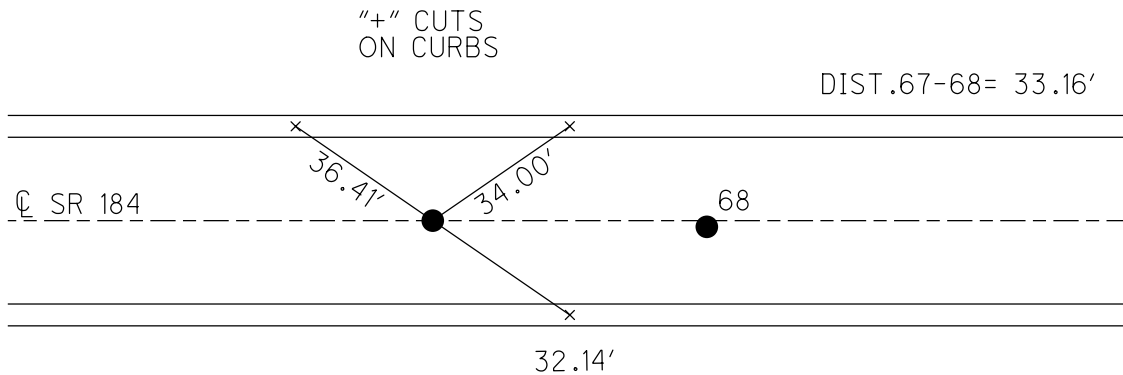

PERSONNEL	TITLE	PERSONNEL	TITLE
Stanc			
Nease			
Curtis			

COUNTY Lucas DATE 3 Sept. 76
 S. R. 187 WEATHER Fair
 SEC. Alexis Rd. (New) TEMP. 65°

DESCRIPTION References to Control Points JOB NO.

LEFT CENTER LINE RIGHT

