

O.D.O.T. DISTRICT 2 SURVEY OFFICE (USE ONLY)

PERSONNEL

REFERENCE NO. 75

SHEET 58 OF 58

NOTES STONE DATE 9/3/76

H.C. NEUSER WEATHER FAIR

R.C. CURTIS TEMP. 65°

ROUTE SR 184

COUNTY LUCAS

TOWNSHIP CITY OF TOLEDO

SECTION 8

DWG BY NIESE PID _____

T 9 S R 8 E

TYPE MONUMENT UNKNOWN

ON SURFACE - ~~BELOW~~ ON

OFFSET Q PAVEMENT ON _____ LT : RT

- TO - EDGE PAVEMENT


STATION: _____

HORIZ.DATUM: _____


GEOID: _____

GRID: NORTHING: _____

EASTING: _____

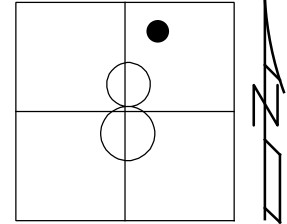

RECORD:
FD MONBOX
9/3/76, STONE

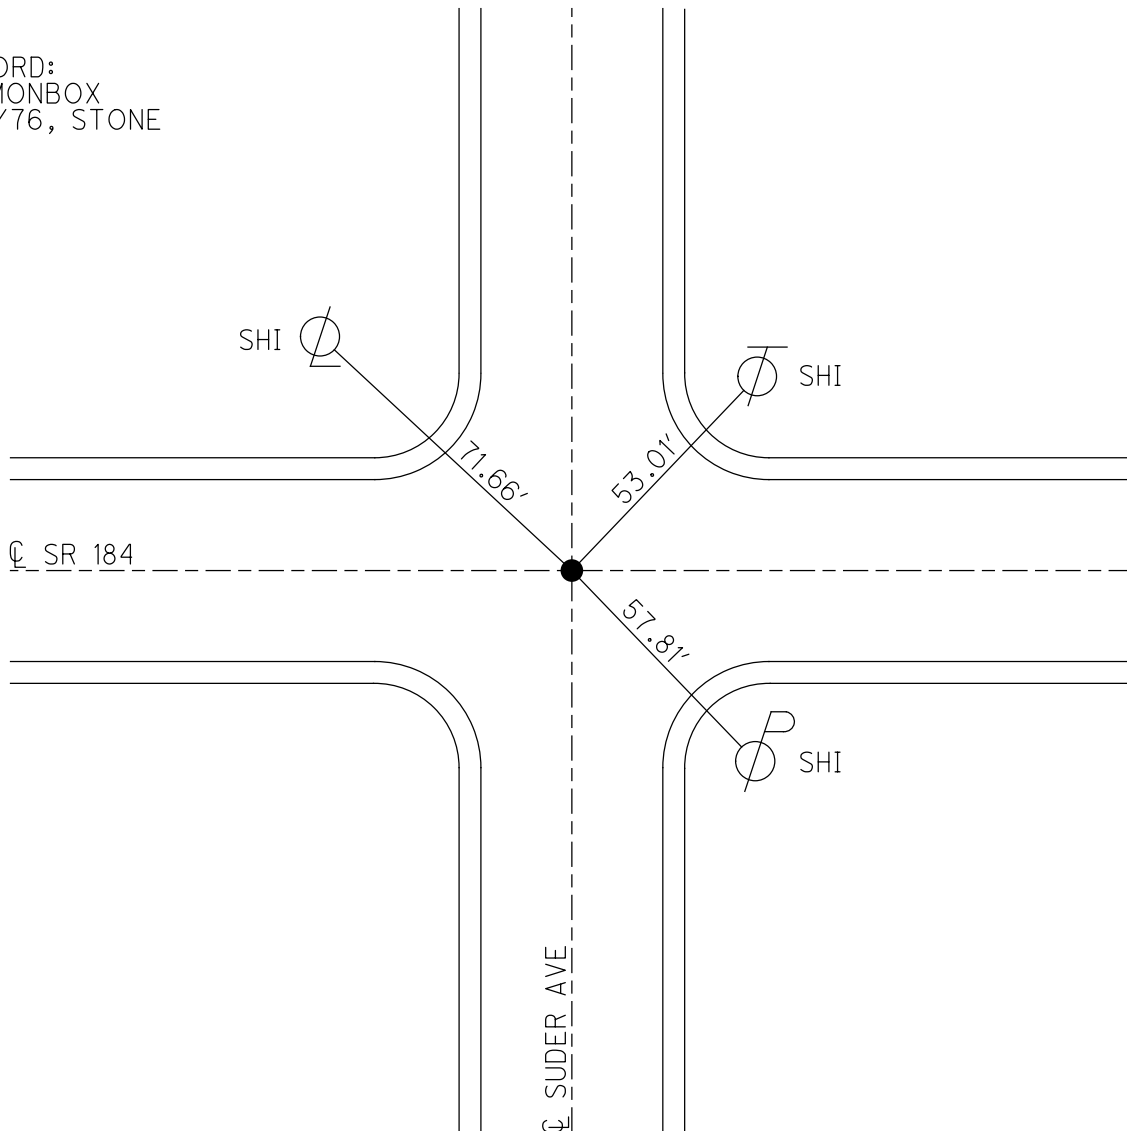

PERSONNEL TITLE PERSONNEL TITLE

COUNTY Lucas DATE 3 Sept. 76

Shaver
Nease
Curtis

S. R. 189 WEATHER Fair

SEC. Alexis Rd. (Old) TEMP. 72°

DESCRIPTION *Reference to Central Points* LEFT CENTER LINE RIGHT JOB NO.

