


PLAN
BY: _____
DATE: _____
SURVEYED: _____
NOTED: _____
CHECKED: _____
BY: _____
DATE: _____

PROFILE
BY: _____
DATE: _____
SURVEYED: _____
NOTED: _____
CHECKED: _____
BY: _____
DATE: _____

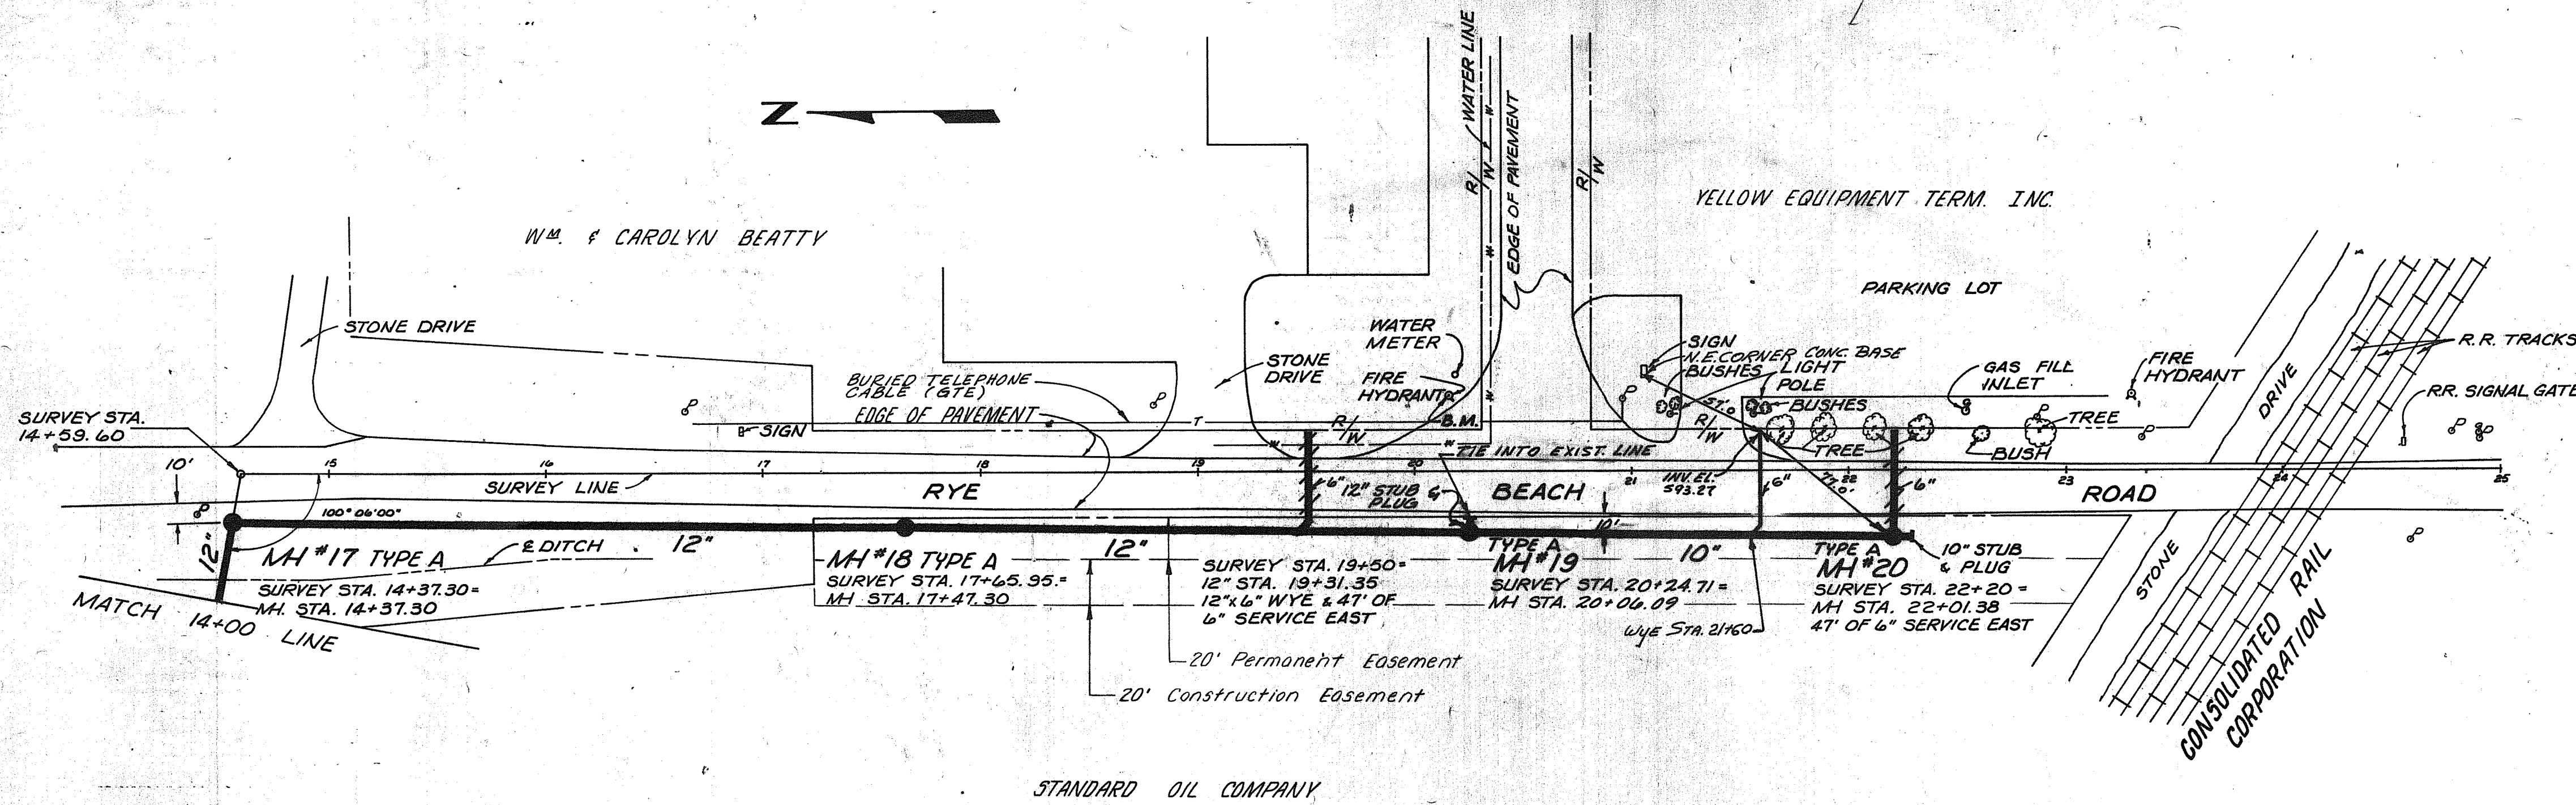

BENCH MARK
R.R. SPIKE IN P. POLE,
1st. POLE S. RYE BEACH RD.
EXIT RAMP S. SIDE BY-PASS,
E. SIDE RYE BEACH RD.
ELEV. 604.65


BENCH MARK
T.S.F.H. IN FRONT
NORTH BUILDING
ELEV. 602.86

CONSULTING ENGINEERS
BURGESS & NIPLE, LIMITED
COLUMBUS, OHIO

ERIE COUNTY, OHIO
EAST ERIE COUNTY SEWER AND WATER DISTRICT
SAWMILL CREEK
RYE BEACH ROAD
SANITARY TRUNK SEWER

SCALE: VERT. 1" = 5'
HOR. 1" = 50'

DATE: MAR. 1973
CONTRACT 3A
SHEET 5 OF 10

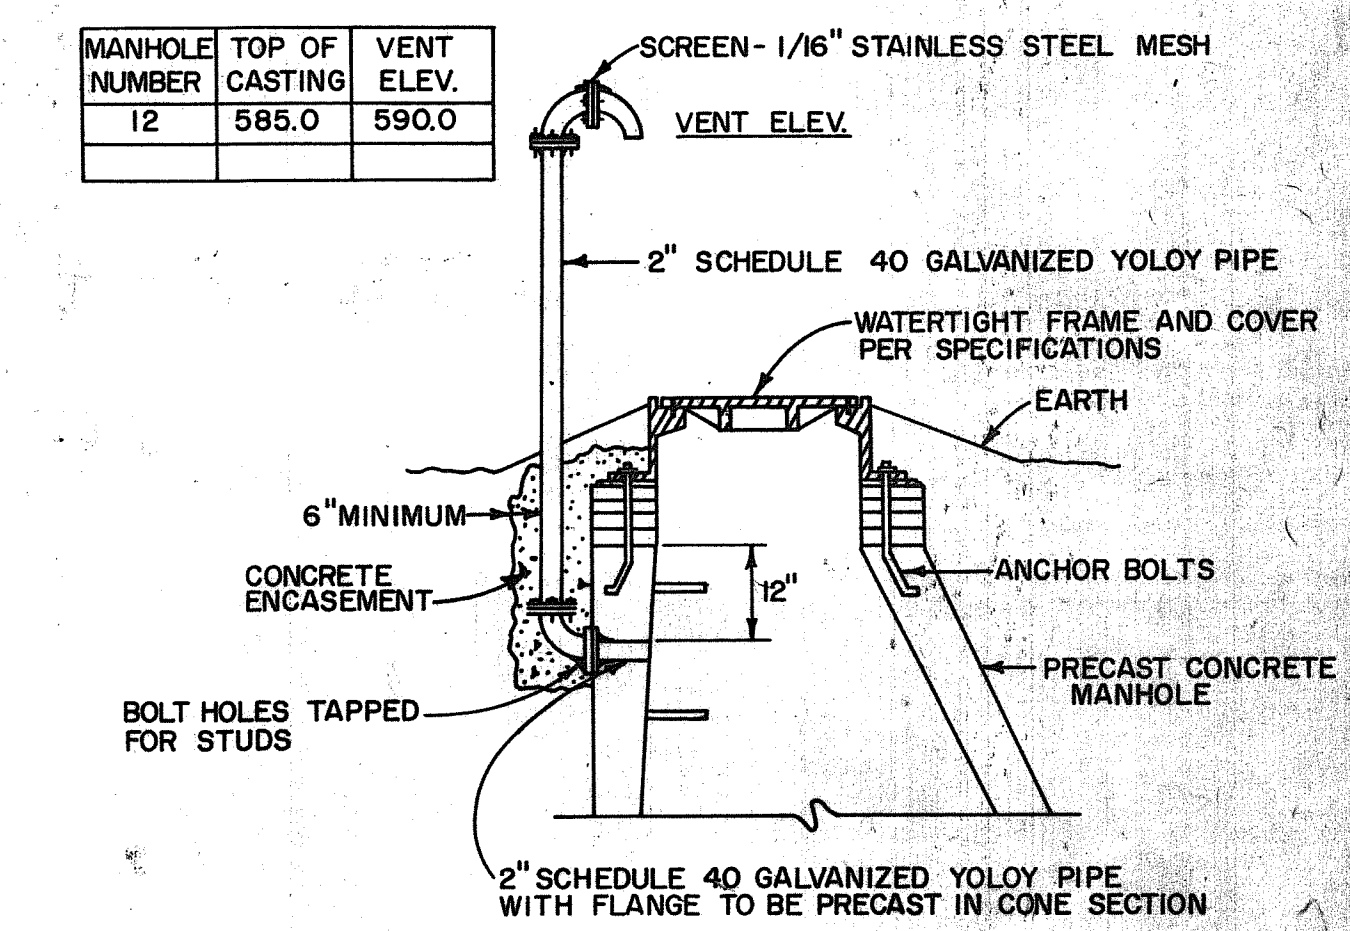

MANHOLE VENT
NO SCALE



REVISED 3/21/78 AS CONSTRUCTED
THE INFORMATION SHOWN HEREON IS INTENDED TO BE
COMPLETE AND CORRECT, HOWEVER, ALL PERSONS SHALL
VERIFY INFORMATION TAKEN FROM THIS DRAWING.