

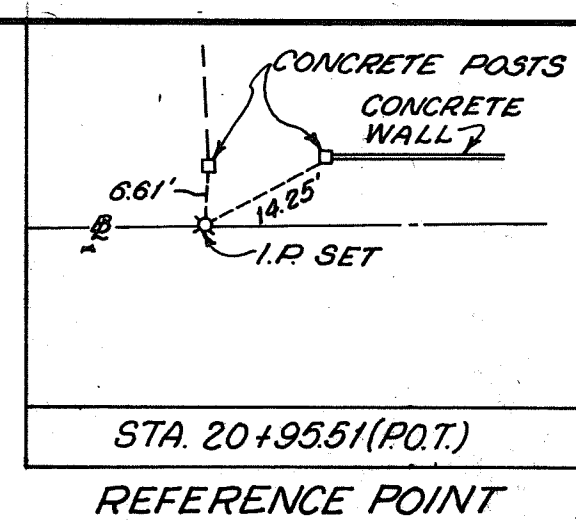


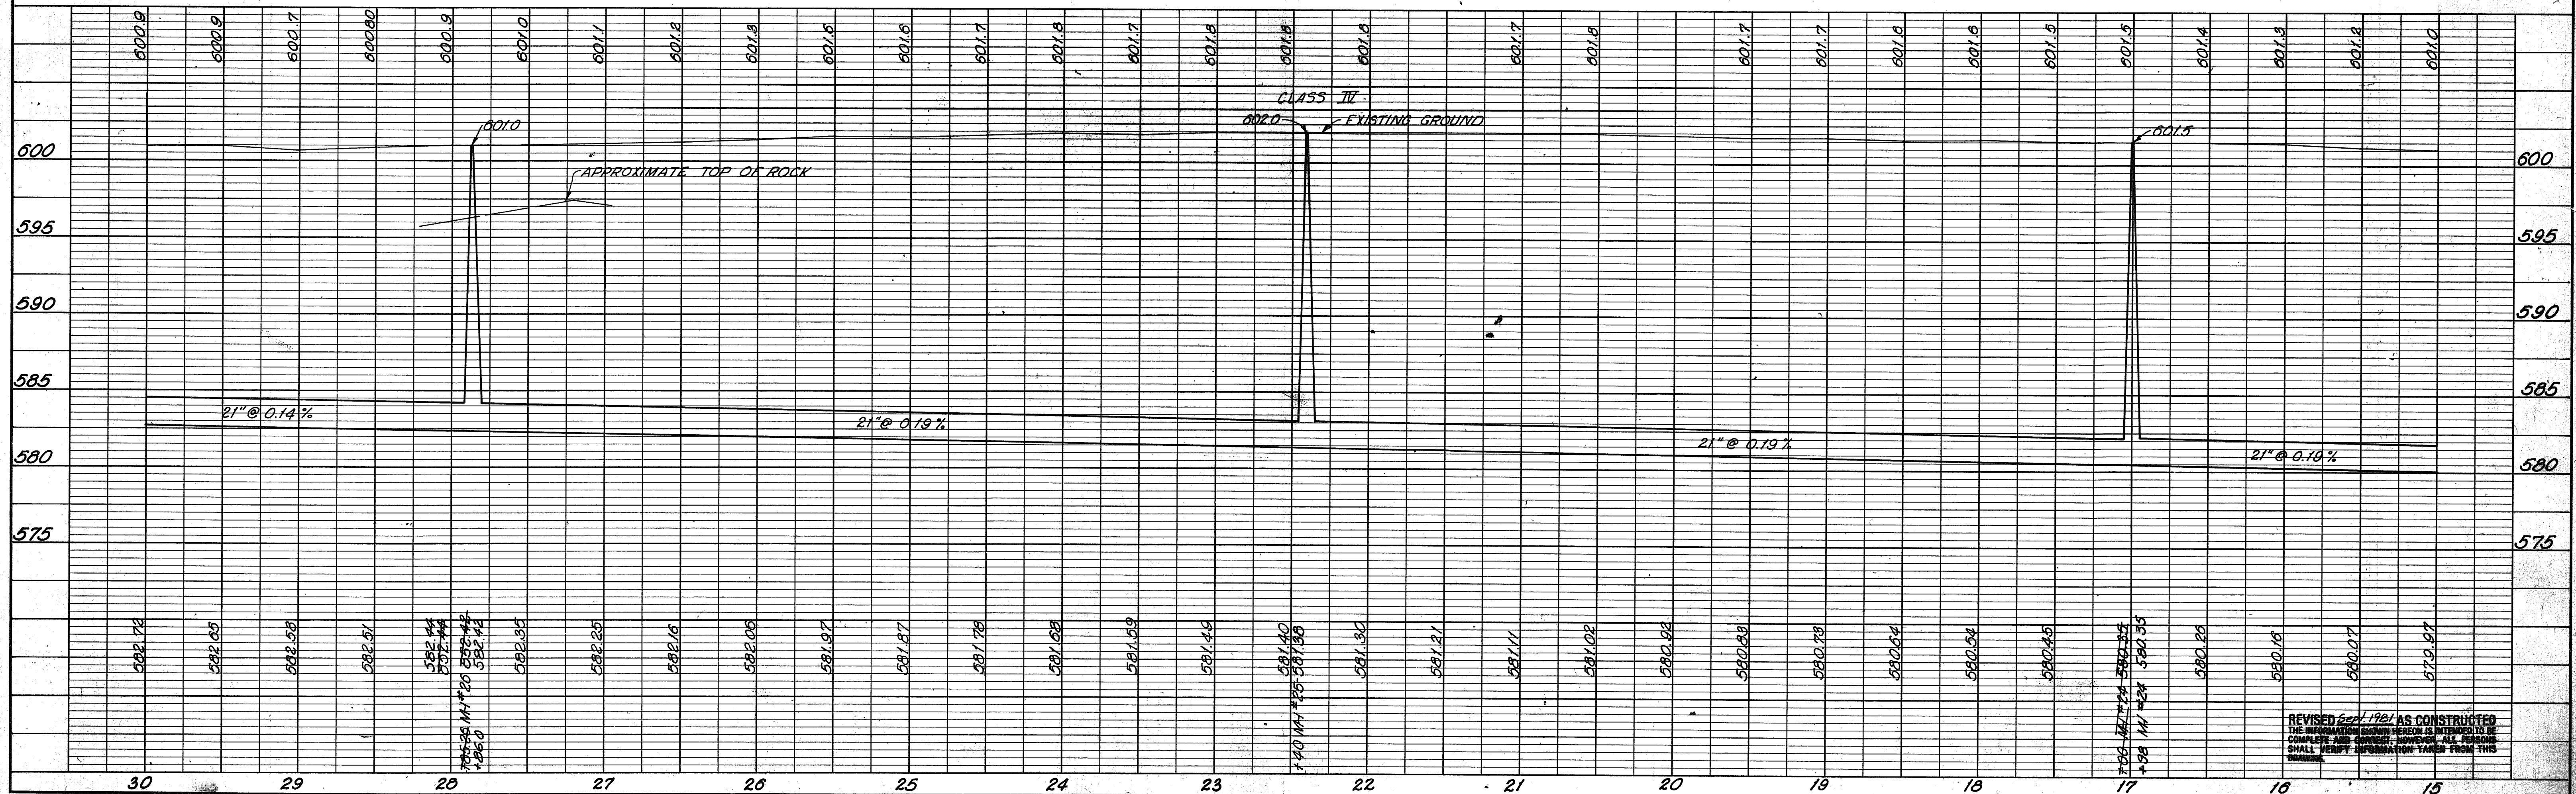

PLAN	SURVEYED	BY	DATE
	PLOTTED		
	ALIGNMENT CHECKED		
	RT. OF WAY CHECKED		
No. _____			

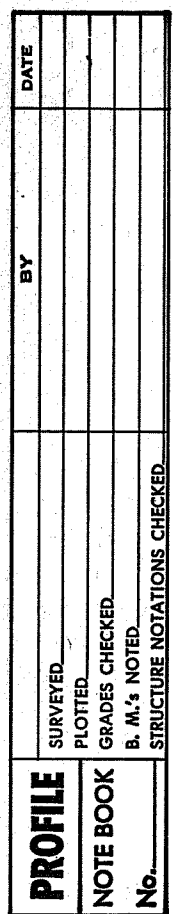

REVISED Sept. 1981 AS CONSTRUCTED
THE INFORMATION SHOWN HEREON IS INTENDED TO BE
COMPLETE AND CORRECT, HOWEVER, ALL PERSONS
SHALL VERIFY INFORMATION TAKEN FROM THIS
DRAWING.