


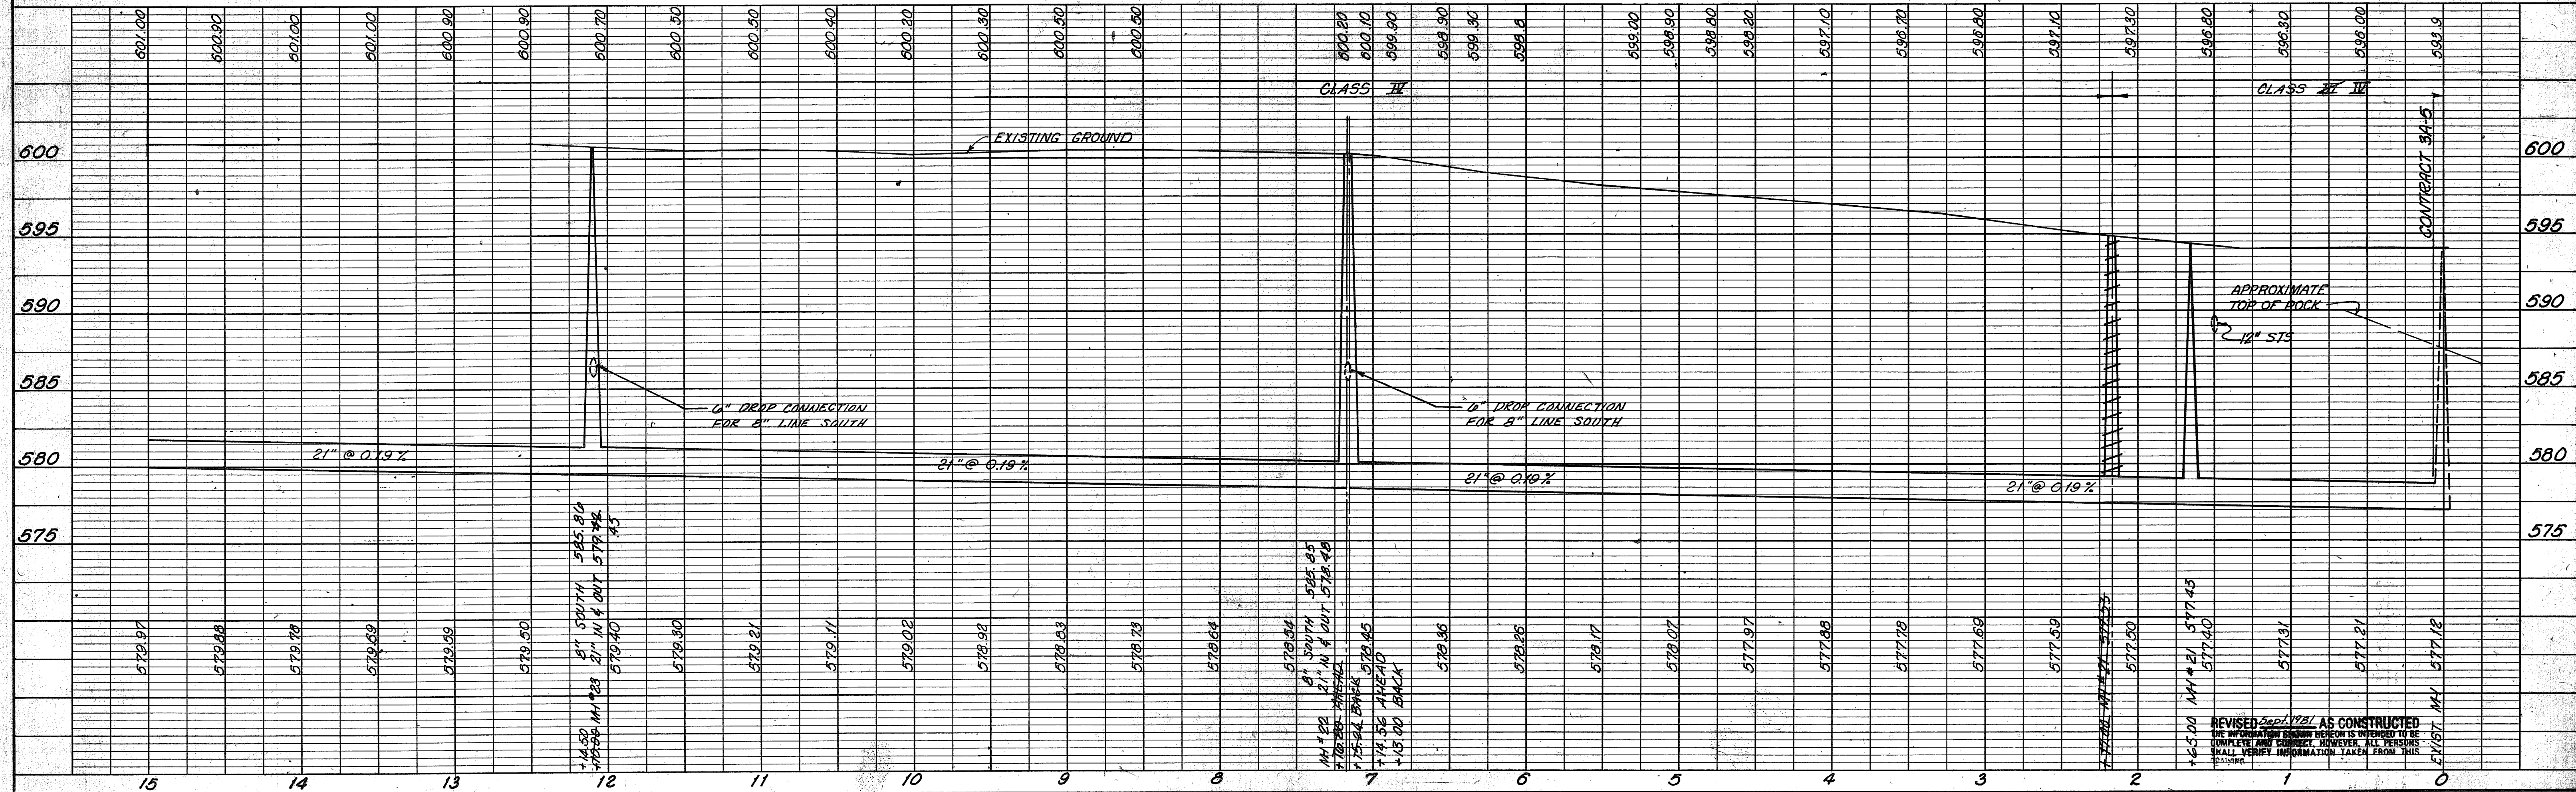


PROFILE	SURVEYED	BY	DATE
	PLOTTED		
	GRADES CHECKED		
	B. M.'s NOTED		
NOTE BOOK	ELECTRICITY NOTATIONS CHECKED		
No. _____			

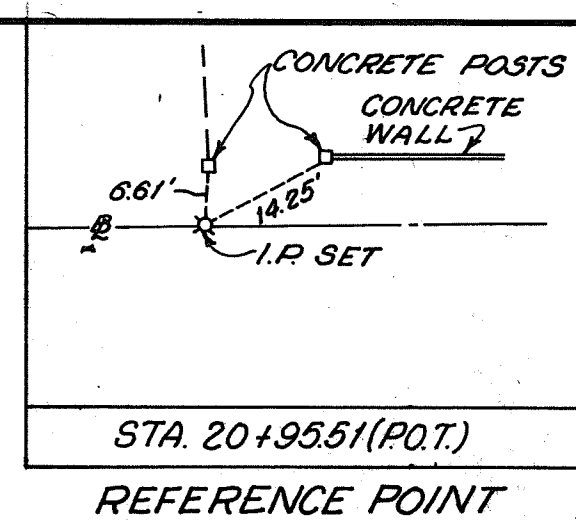

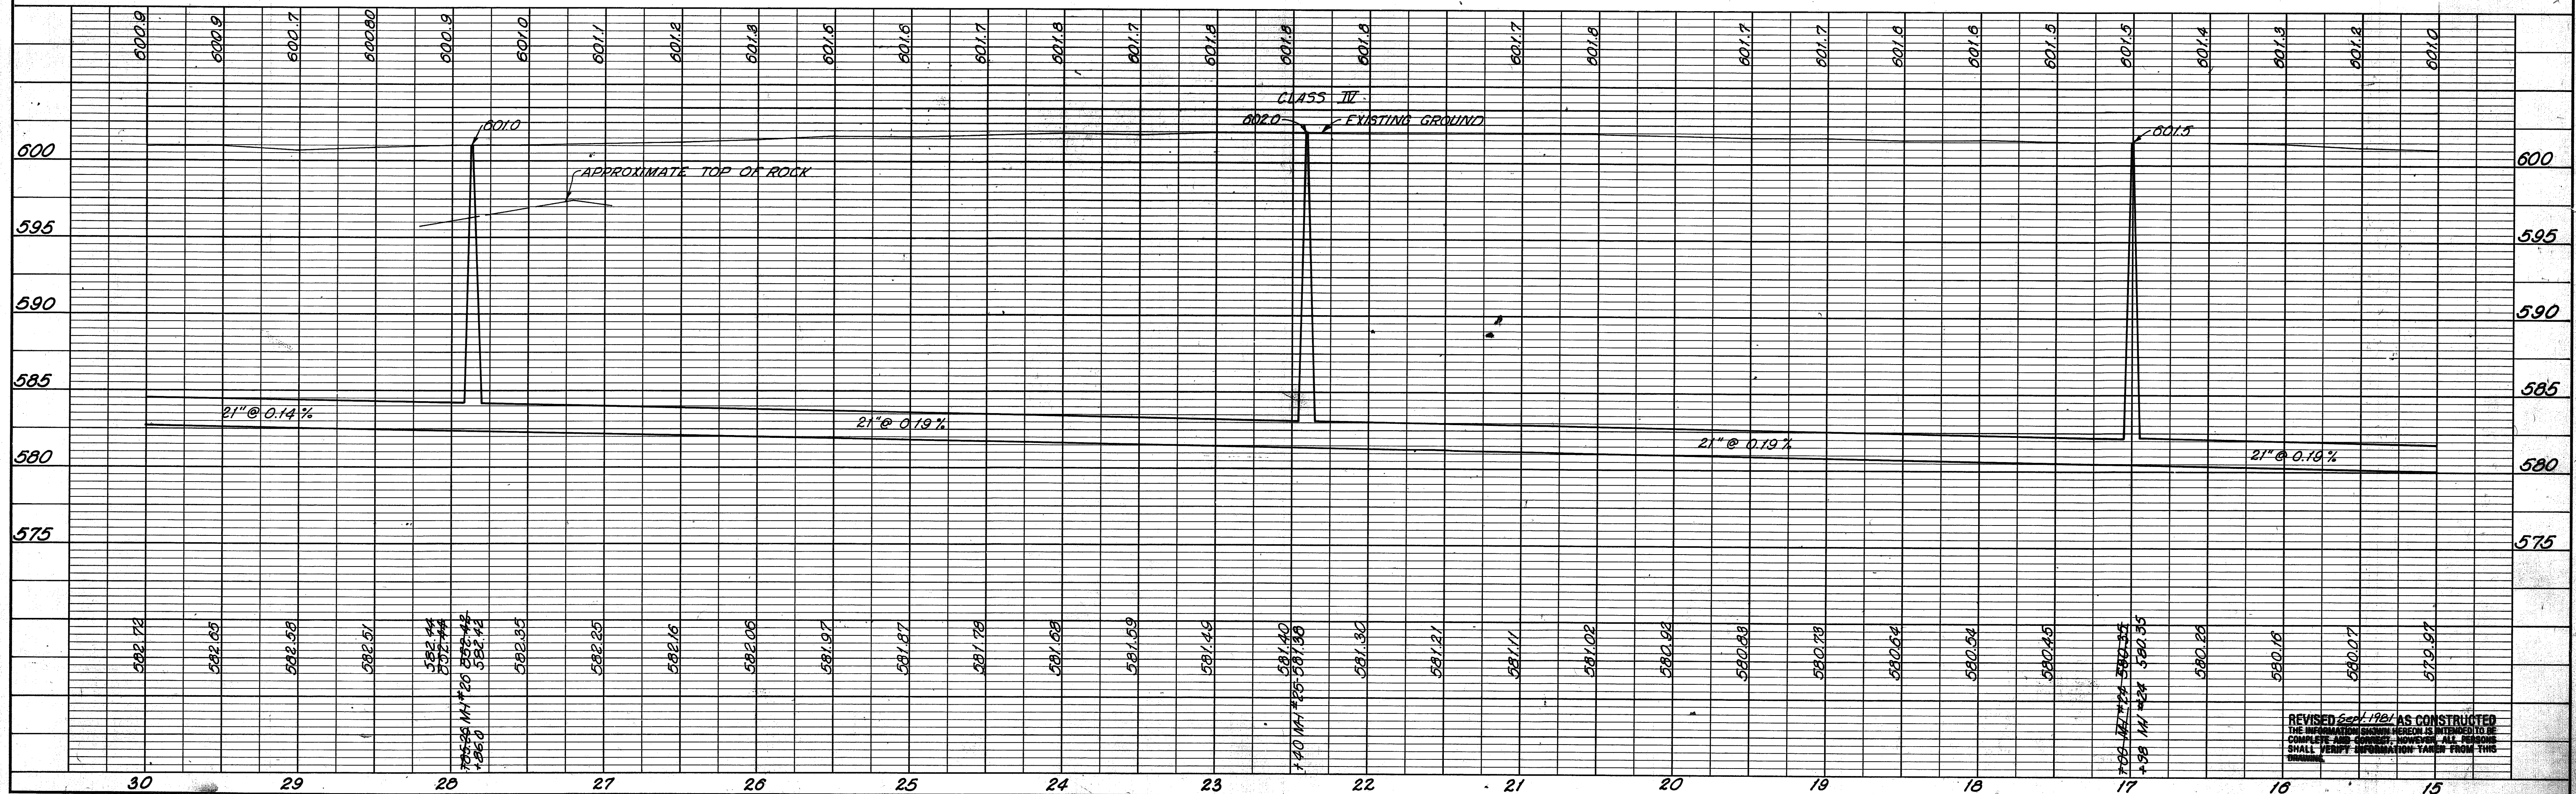

PLAN	SURVEYED	BY	DATE
	PLOTTED		
	NOTE BOOK		
No.	ALIGNMENT CHECKED		
	RT. OF WAY CHECKED		

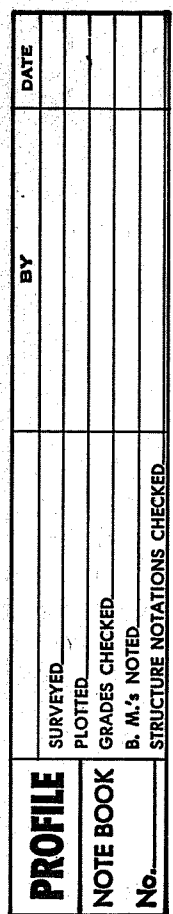

REVISED Sept. 1981 AS CONSTRUCTED
THE INFORMATION SHOWN HEREON IS INTENDED TO BE
COMPLETE AND CORRECT, HOWEVER, ALL PERSONS
SHALL VERIFY INFORMATION TAKEN FROM THIS
DRAWING.

DATE	
BY	
REVISION	
NO.	
PLAN	
NOTE BOOK	
NO.	

DATE	
BY	
REVISION	
NO.	
PROFILE	
NOTE BOOK	
NO.	

CONSULTING ENGINEERS

BURGESS & NIPLE, LIMITED

COLUMBUS, OHIO

ERIE COUNTY, OHIO

EAST ERIE COUNTY SEWER AND WATER DISTRICT

SAWMILL CREEK

CLEVELAND SANDUSKY ROAD

SCALE: VERT. 1"=5'

HOR. 1"=50'

DRAWN BY P.E.M.

CHECKED BY F.J.E.

DATE: AUG. 1976

CONTRACT 3A

SHEET 8 OF 10



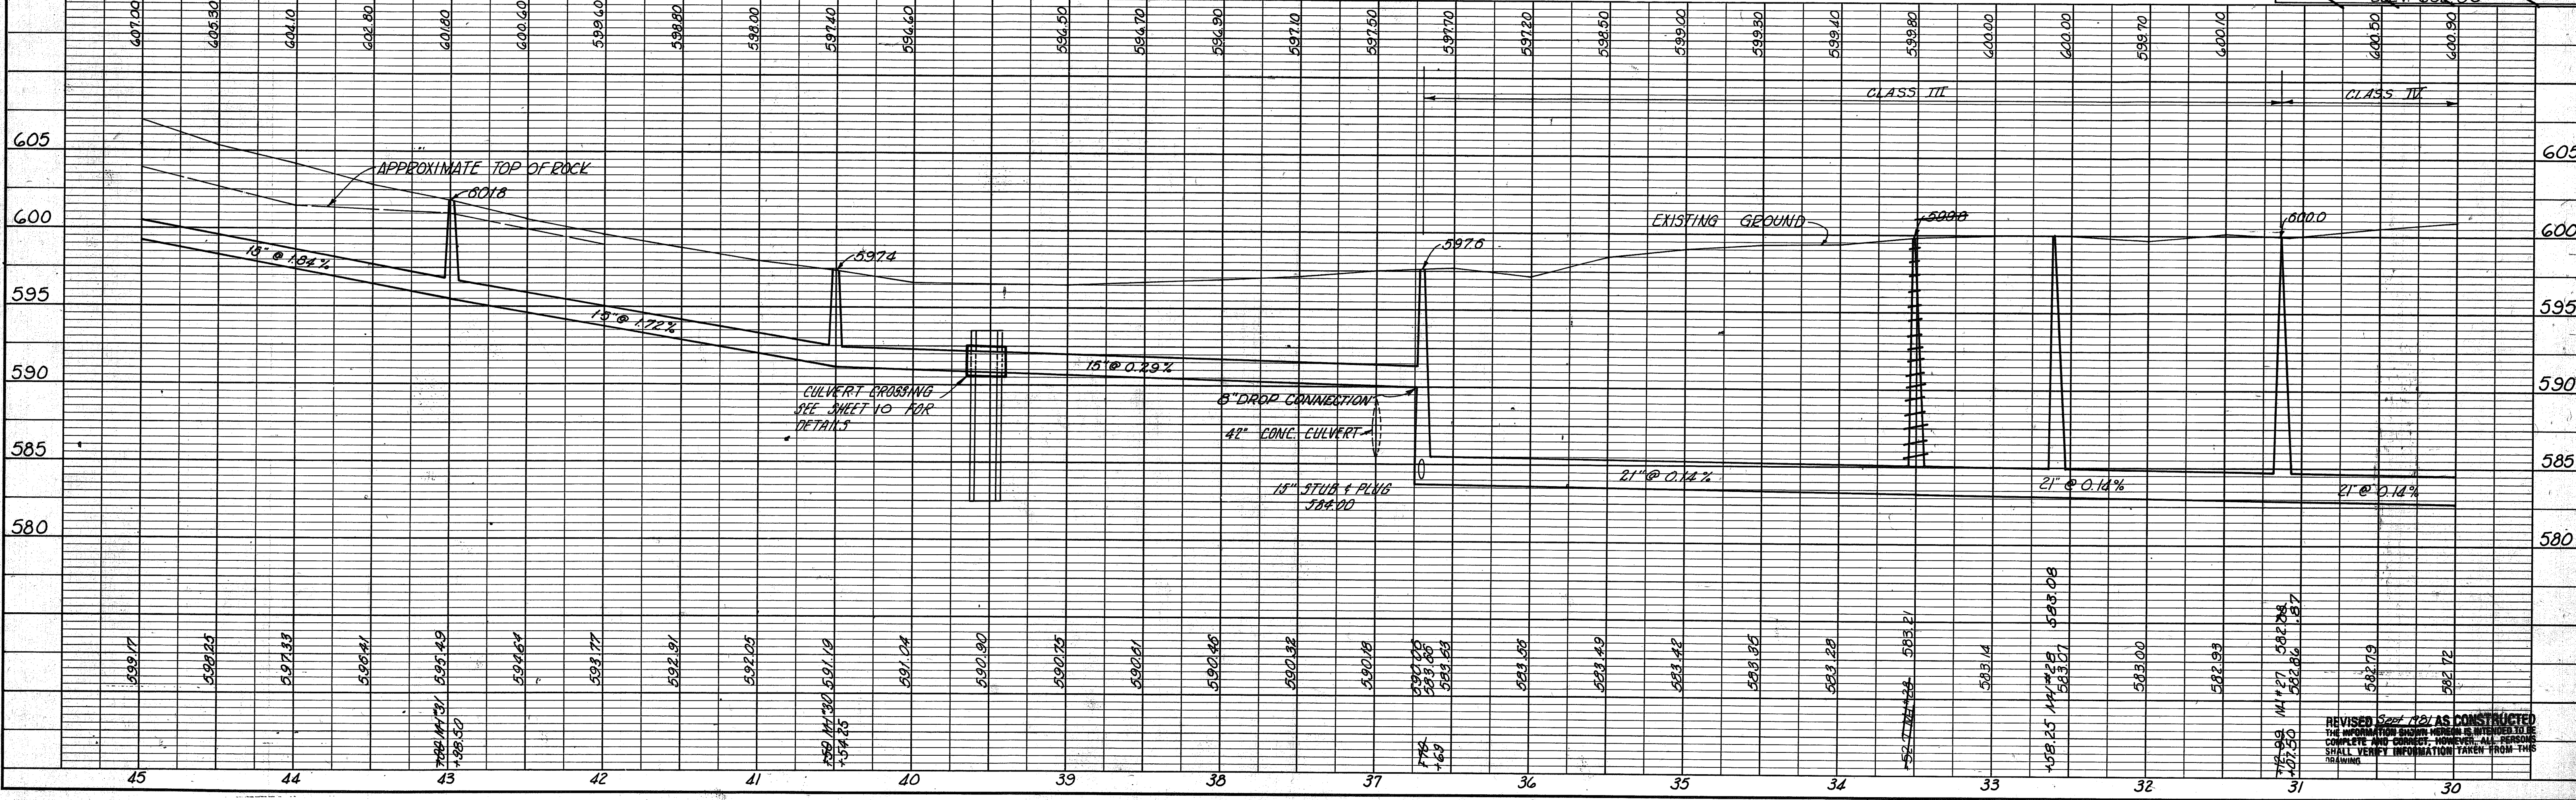


PLATE 1 (PLAN - PROFILE) BPR STANDARD
 Eriks Design Co., Chicago - New York

PROFILE	SURVEYED	BY	DATE
	PLOTTED		
	GRADES CHECKED		
	B. M.'s NOTED		
	EXISTING MONUMENTS CHECKED		

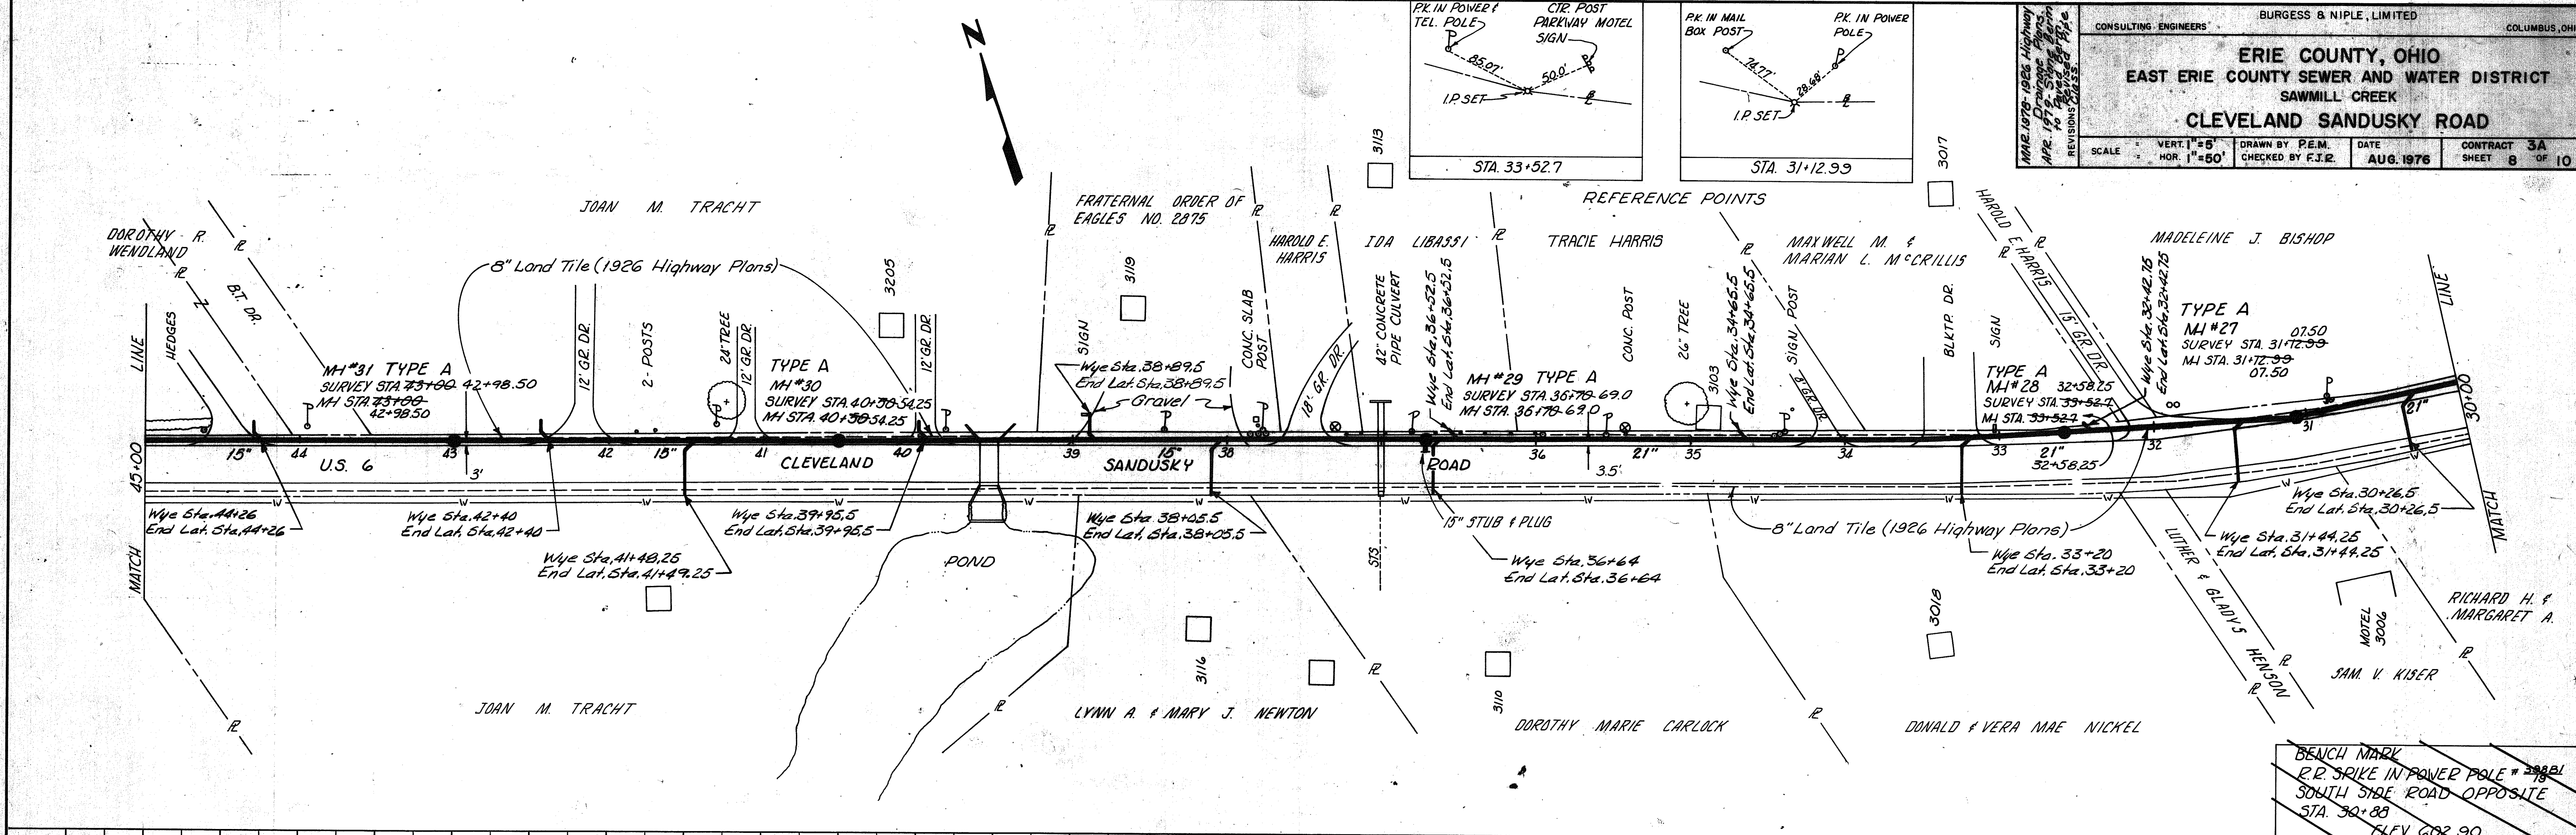

PROFILE			BY	DATE
NOTE BOOK	SURVEYED			
	PLOTTED			
	GRADES CHECKED			
	B./M./I. NOTED			
No.	STRUCTURE MOVATIONS CHECKED			

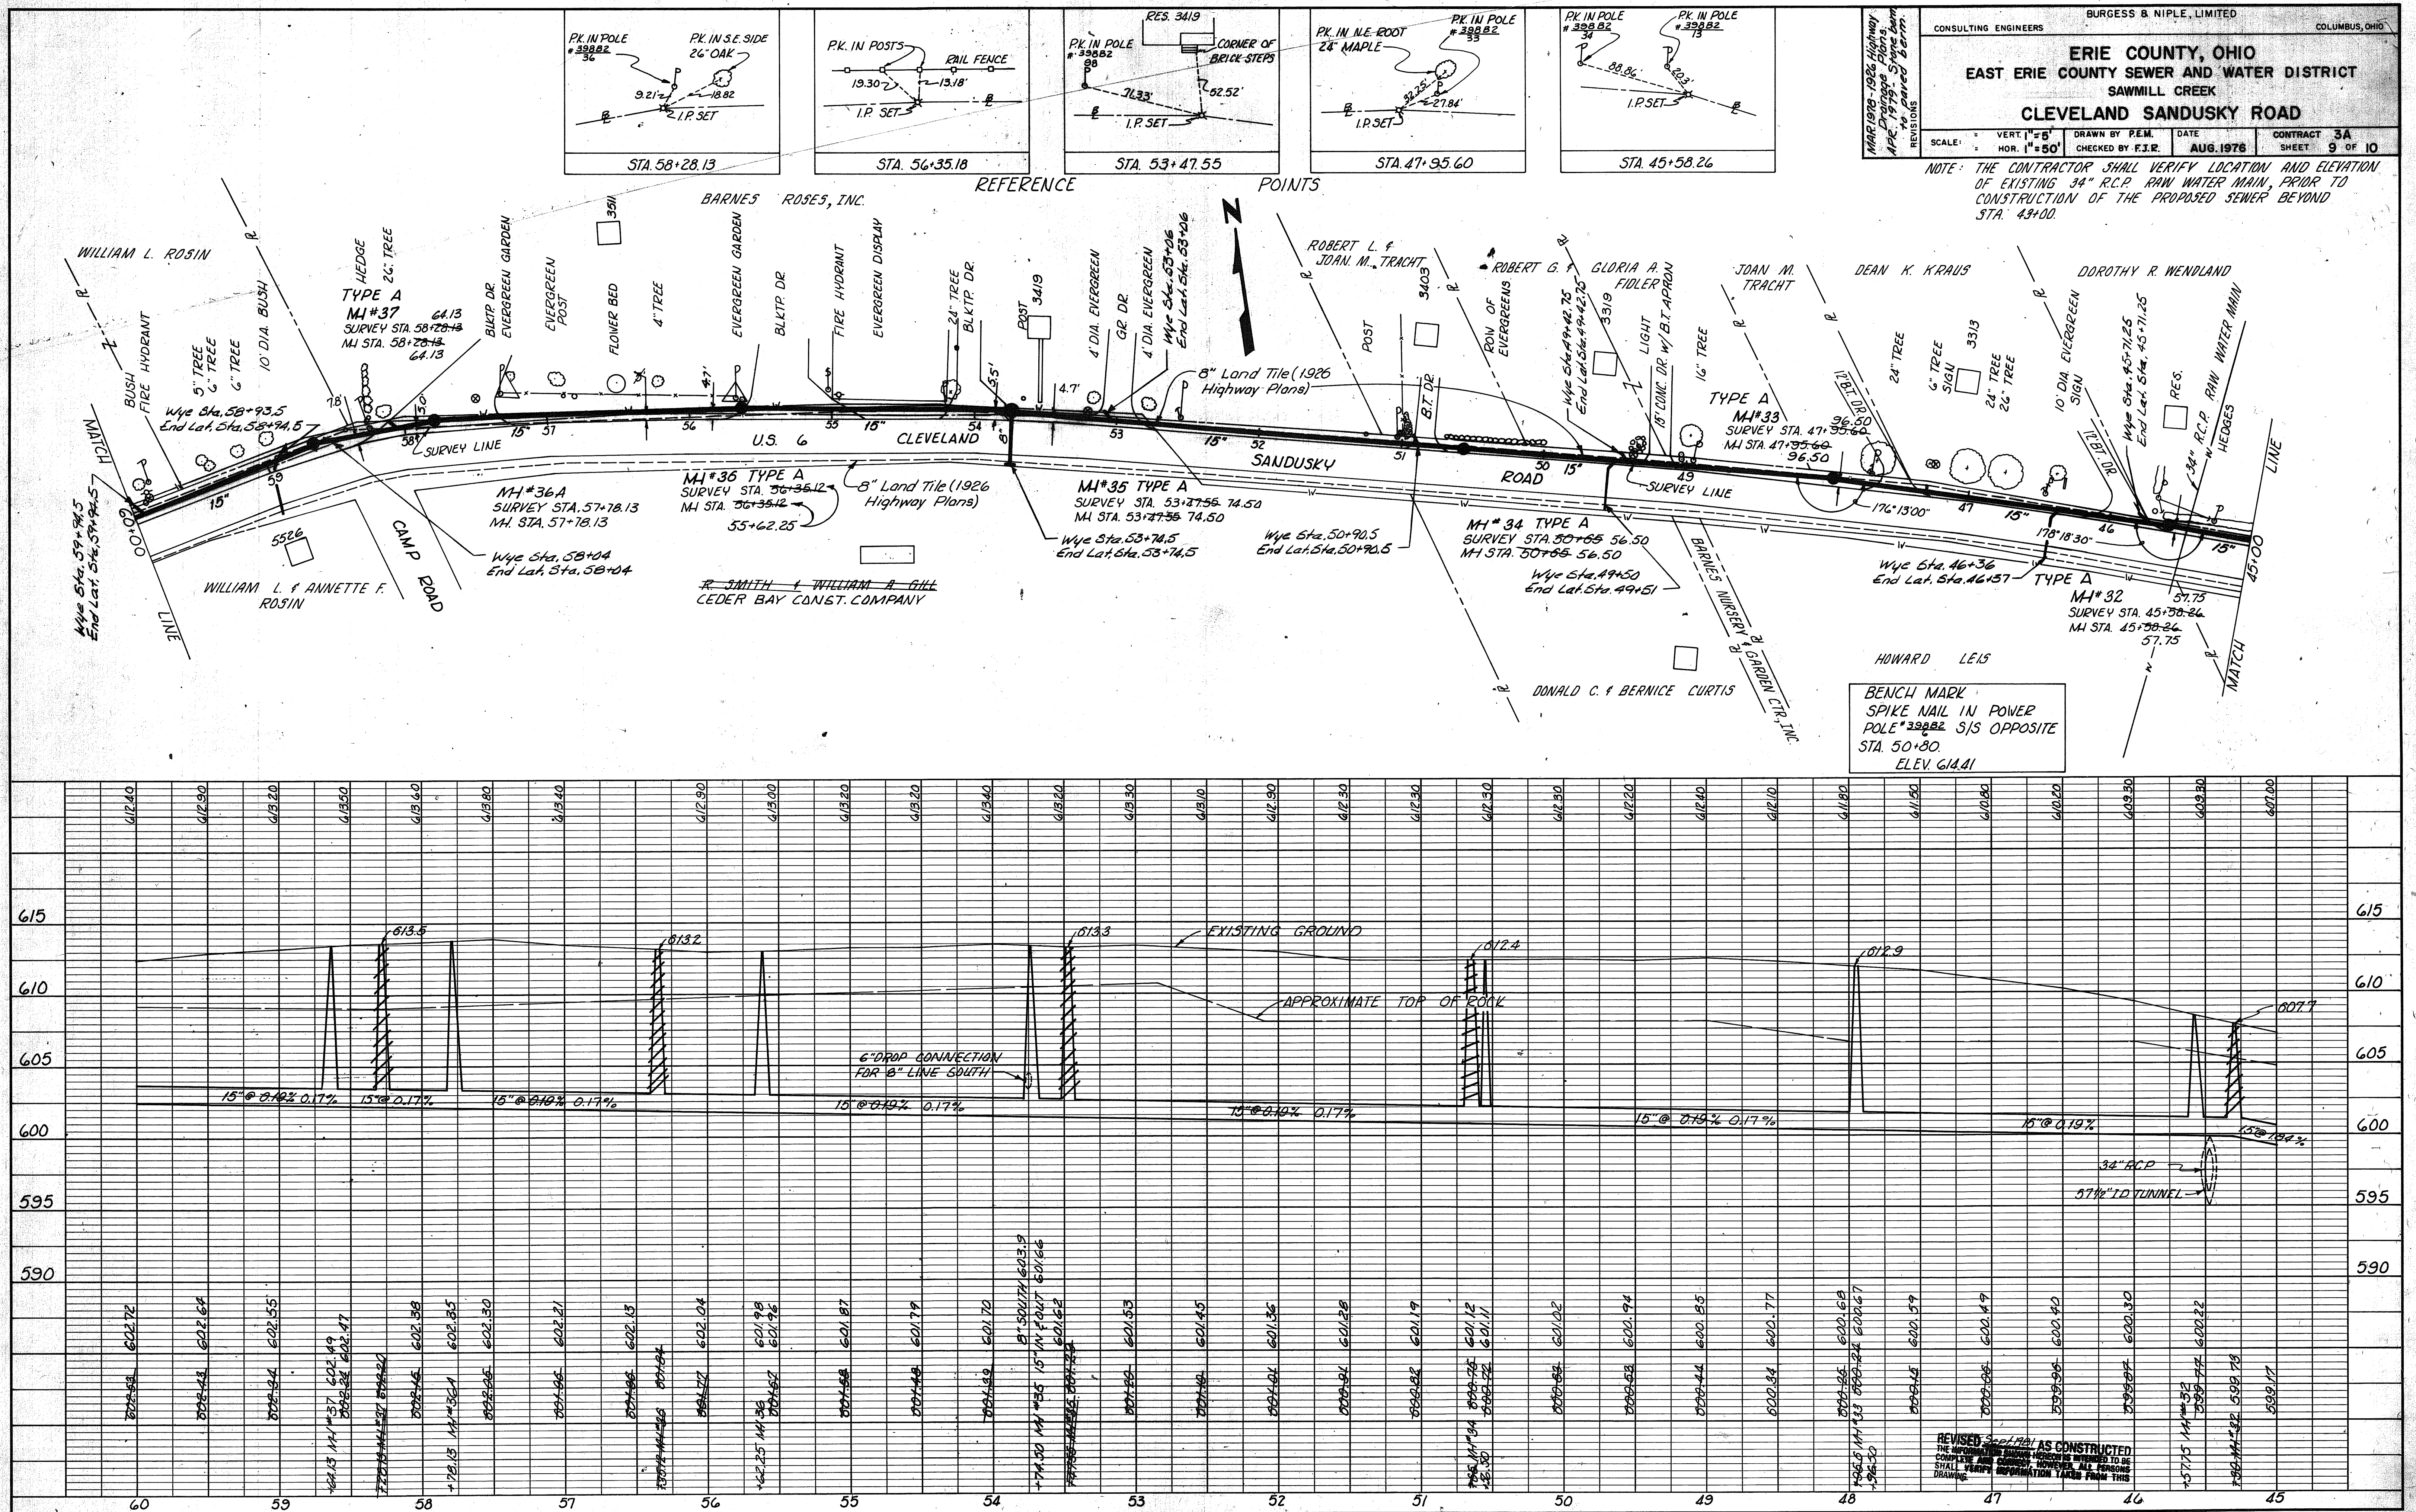