

ATTACHMENT A

VERTICAL CLEARANCE


15' 11"

SUBWAY NUMBER SUM-77-0958L

DATE MEASURED JULY 8, 2014


BY BOLTZ - COOPER

IR 77 SB ONLY

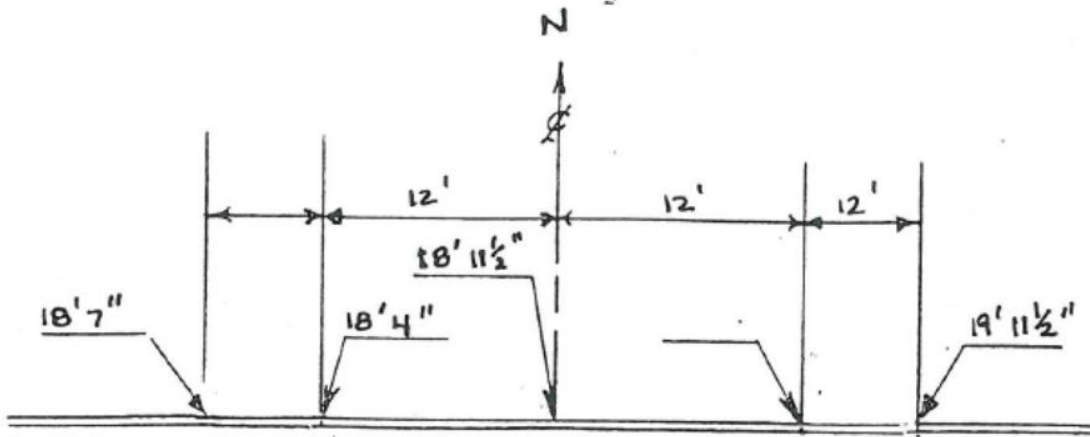

IR 277 WB

IR 77 NB OFF RAMP BRIDGE
OVER IR 77 SB TO IR 277 WB

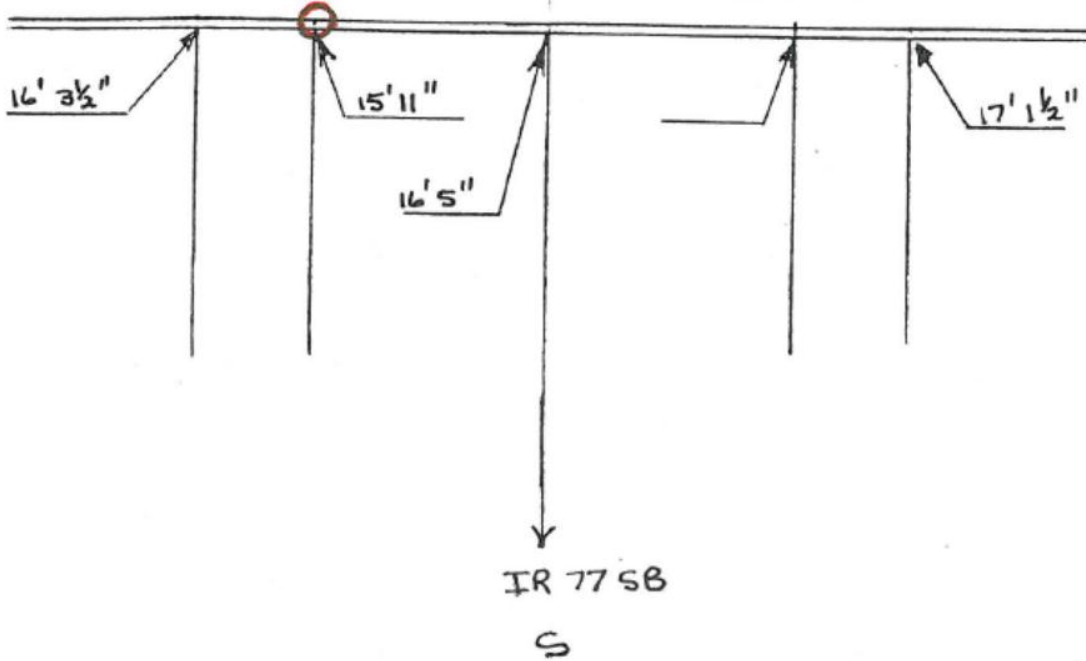

VERTICAL CLEARANCE

18'8" EB
17'0" WB

BRIDGE NO. SUM-76-0758

DATE MEASURED JULY 8, 2014

\neq
IR 76

BY BOLTZ - COOPER

