


FED. RD.	STATE	PROJECT
2	OHIO	

1
7

SUM-18-9.23

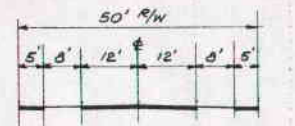

TYPICAL SECTION EXISTING HILLCREST ST.

AKRON EXP'WAY & CURVE DATA



PI STA. 252+03.64
 $\Delta = 17^{\circ}36'26''$ LT.
 $D_c = 1^{\circ}15'$
 $R = 4583.66'$
 $L = 1408.58'$
 $T = 709.88'$
 $E = 54.65'$
 P.C. STA. 244+93.76
 P.T. STA. 259+02.34

FOUNDATION SOUNDINGS

FOUNDATION DESIGN AND FOUNDATION QUANTITIES ARE BASED ON A STUDY OF SOIL BORINGS TAKEN BY THE STATE HIGHWAY DEPARTMENT FOR SUM-18-9.23. THIS BORING INFORMATION APPEARS ON THE CONTRACT DRAWINGS FOR SUM-18-9.23, BUT THE STATE DOES NOT GUARANTEE THE ACCURACY THEREOF.

PROPOSED STRUCTURE

TYPE: CONTINUOUS STEEL BEAM WITH REINFORCED CONCRETE DECK AND SUBSTRUCTURE.
 SKEW: $14^{\circ}31'15''$ RF. TO LOCAL TANGENT
 SPANS: 51'-0" - 85'-0" - 76'-0" - 46'-0" $\frac{1}{4}$ BEARINGS
 ALIGNMENT: STRAIGHT
 LOADING: 85 PSF LIVE LOAD
 SUPERELEVATION: NONE
 SLOPE PROTECTION: 1-10 CRUSHED AGGREGATE

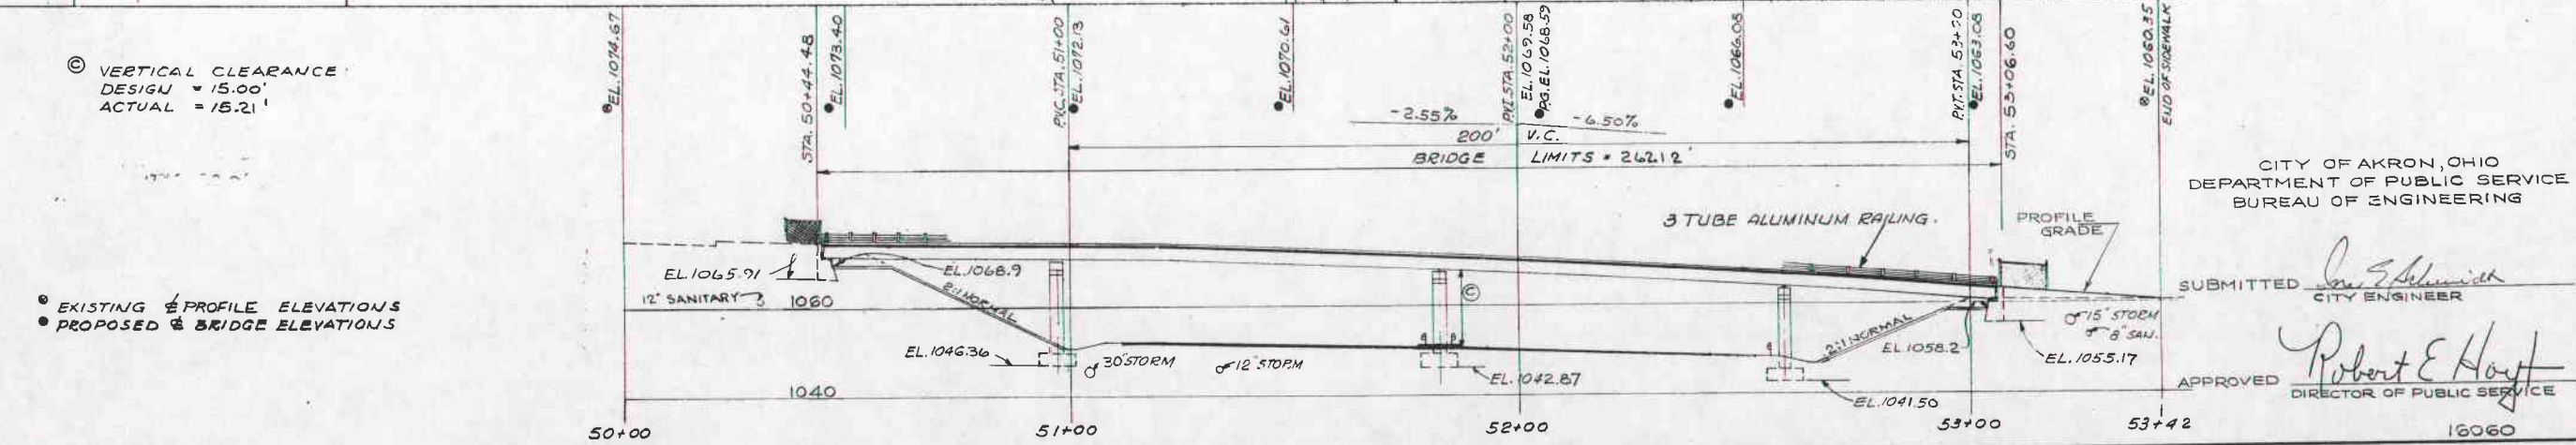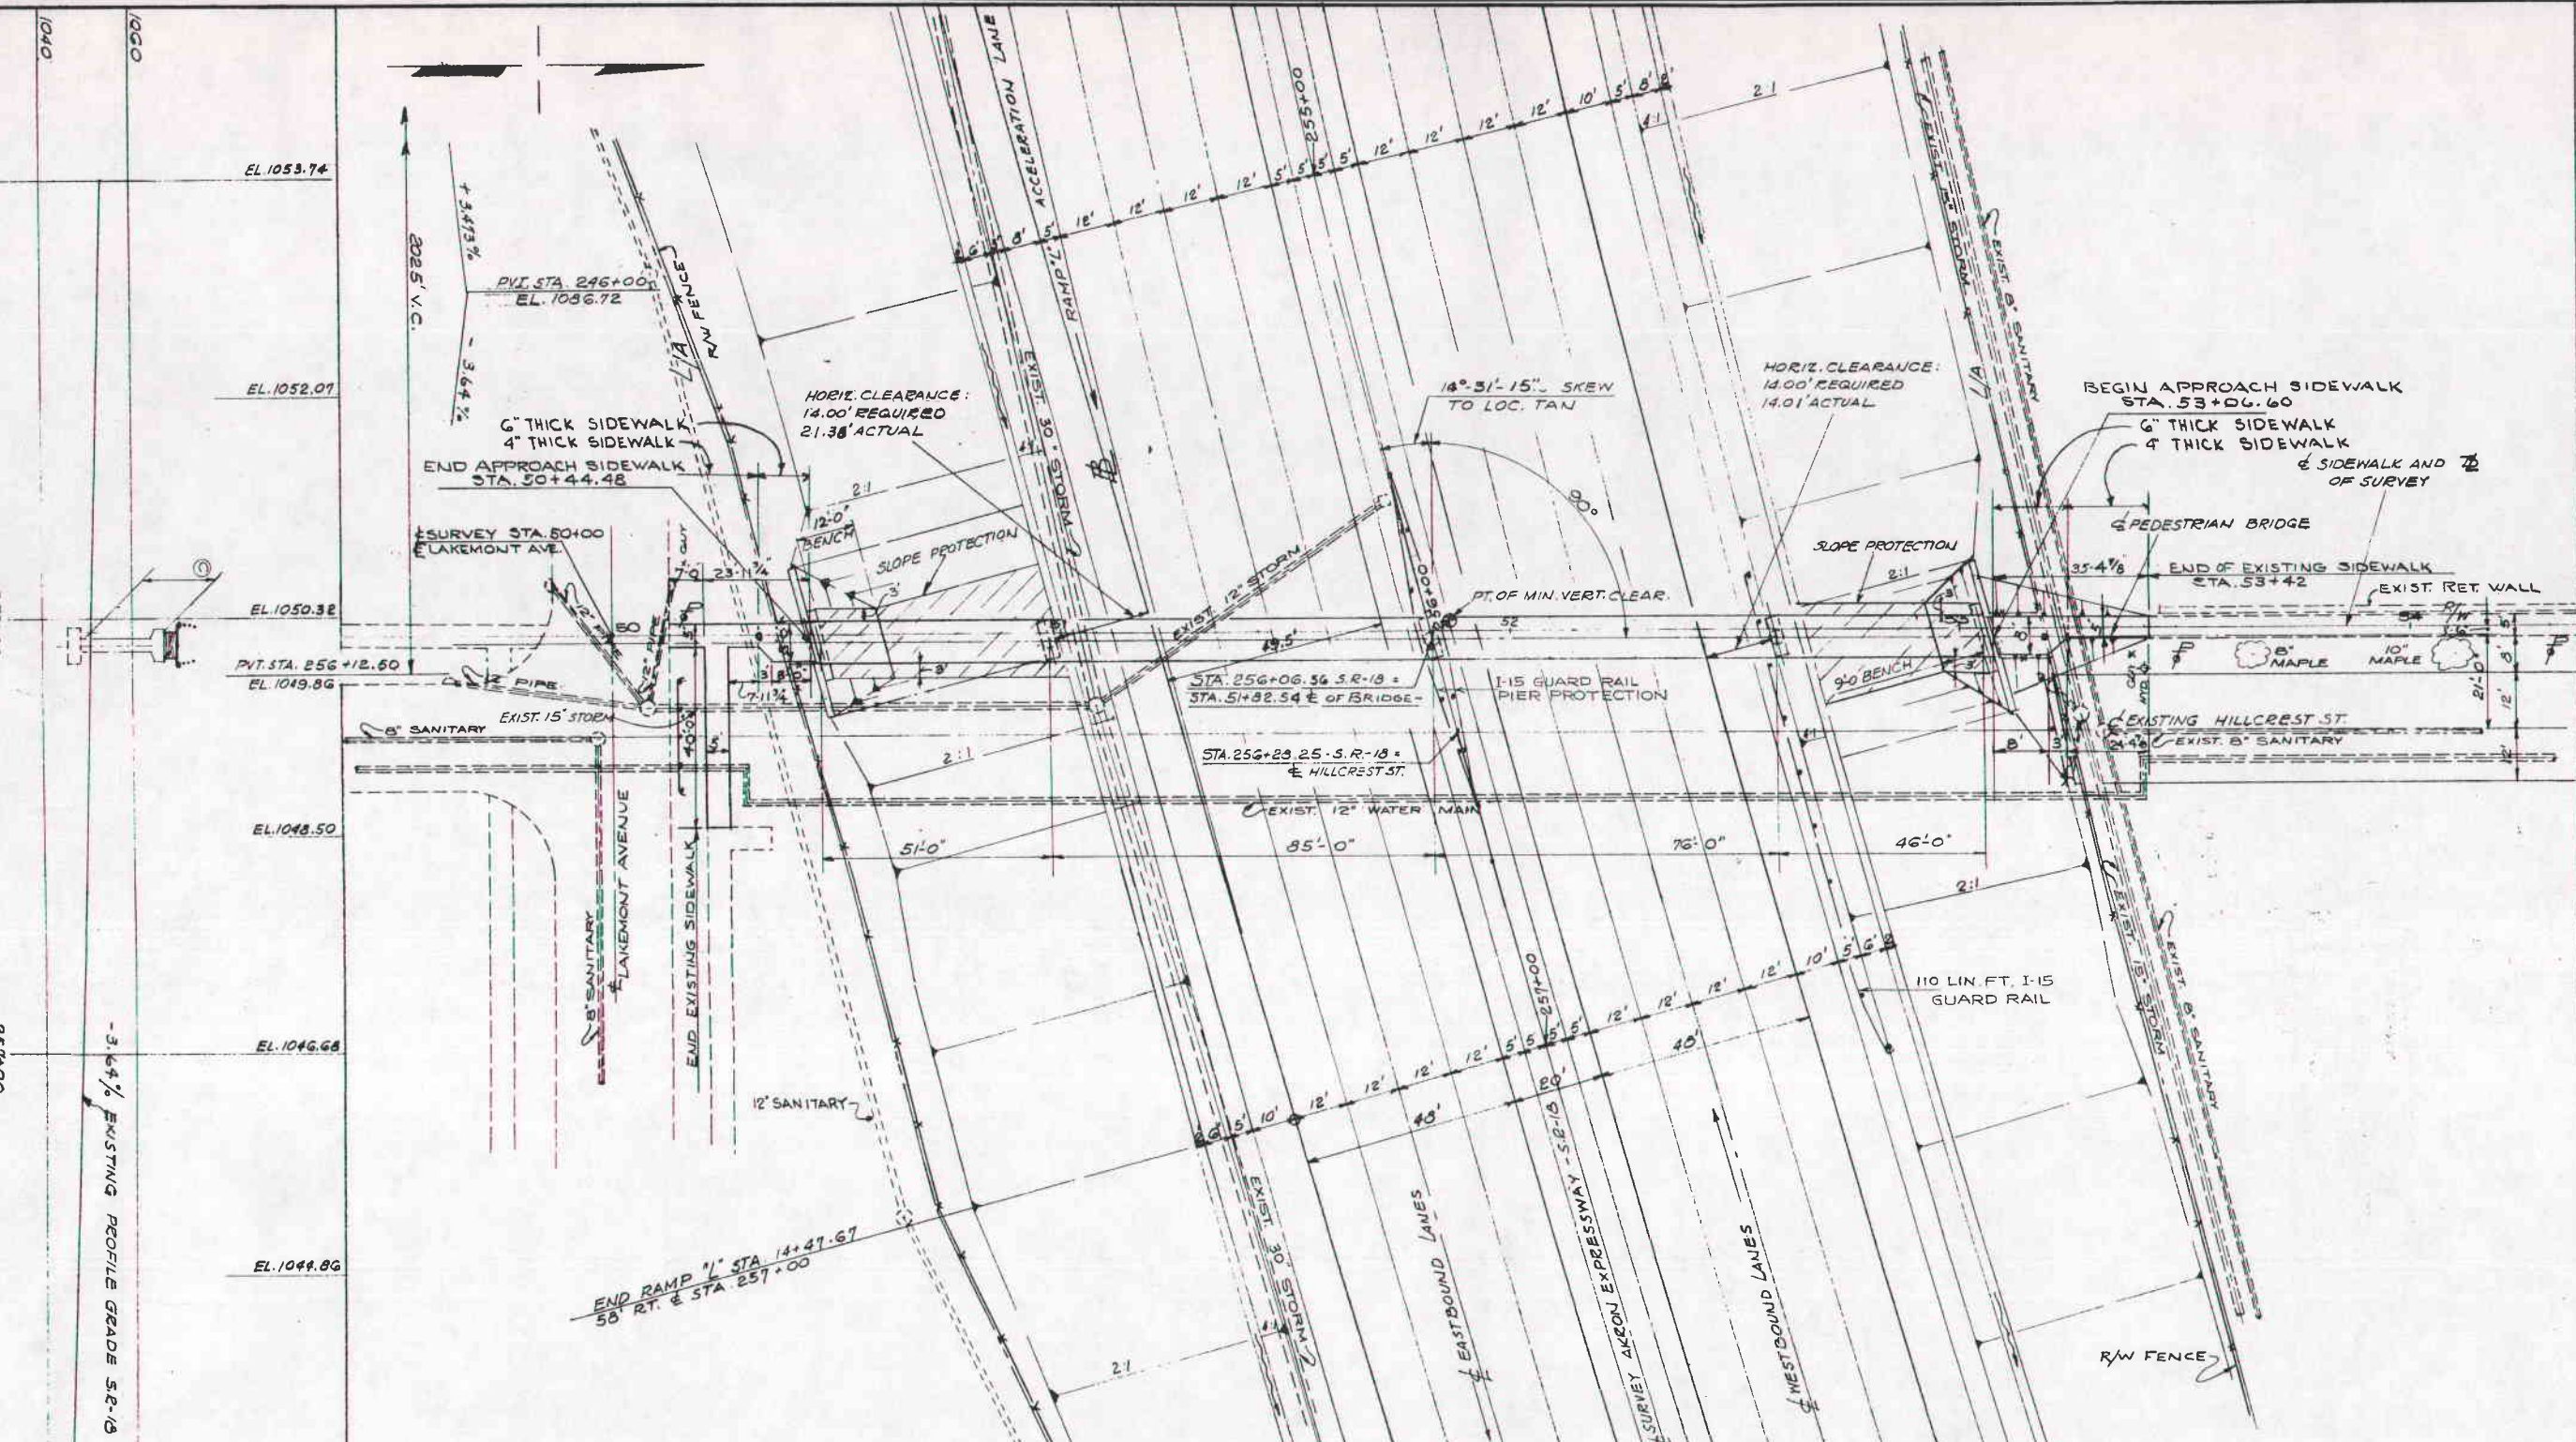

CITY OF AKRON, OHIO
 DEPARTMENT OF PUBLIC SERVICE
 BUREAU OF ENGINEERING

SUBMITTED *James S. Schumaker*
 CITY ENGINEER

APPROVED *Robert E. Hoyt*
 DIRECTOR OF PUBLIC SERVICE

STATE OF OHIO
 DEPARTMENT OF HIGHWAYS
 BUREAU OF BRIDGES

BEISWENGER & HOCH, Consulting Engineers
 AKRON, OHIO

SITE PLAN
 BRIDGE NO. SUM-18-0939
 PEDESTRIAN BRIDGE
 UNDER HILLCREST STREET
 AKRON EXP'WAY PART 13 SUMMIT COUNTY
 STA. 256+06.56

DESIGNED	DRAWN	TRACED	CHECKED	REVIEWED	DATE	REVISED
RDH	ADNESSY		RDH	RDH	8/3/63	10-29-63


A-7200

SUM-18-9.23


GENERAL NOTES

DESIGN SPECIFICATIONS: THIS STRUCTURE CONFORMS TO THE REQUIREMENTS OF "DESIGN SPECIFICATIONS FOR HIGHWAY STRUCTURES" OF THE STATE OF OHIO, DEPARTMENT OF HIGHWAYS, DATED 9-1-57, TOGETHER WITH CURRENT REVISIONS THEREOF.


EXCAVATION QUANTITY: FOR THE ABUTMENTS, IN ADDITION TO THAT OUTLINED IN SEC. E-2.09, INCLUDES THE REMOVAL OF MATERIAL BOUNDED BY THE PROPOSED BENCH, BY THE FRONT VERTICAL PLANE DESCRIBED IN SEC. E-2.09 AND BY THE FINISHED SLOPE OF THE CUT.

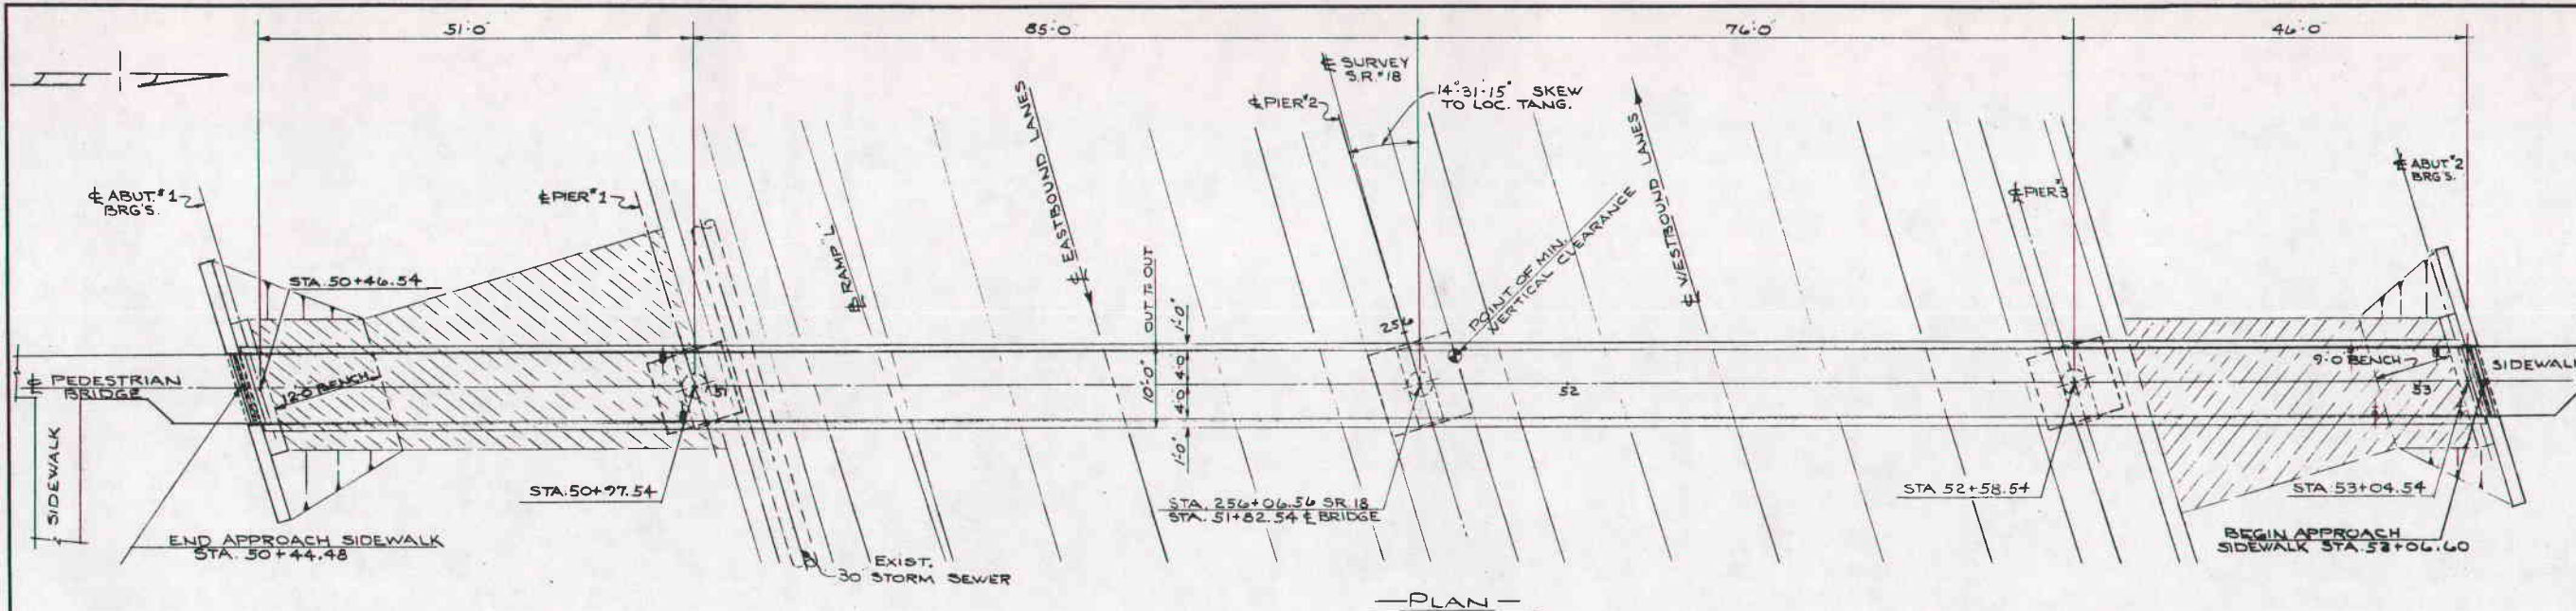

- PLAN -

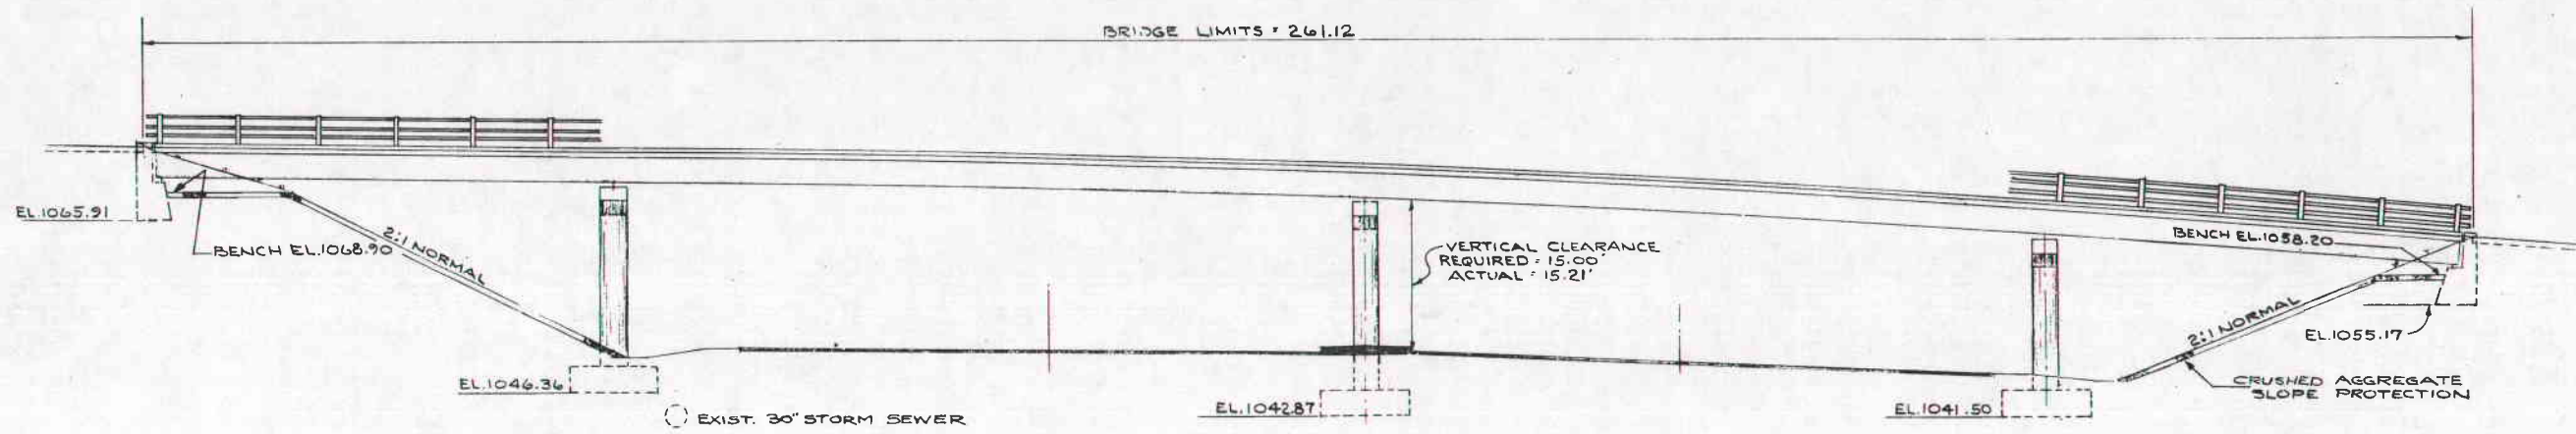

- ELEVATION -

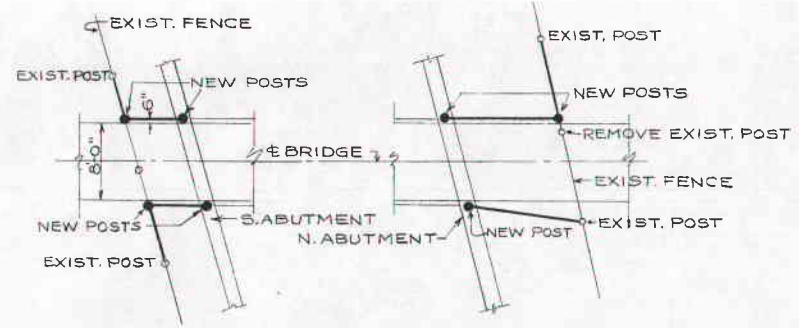

REVISION TO RIGHT OF WAY FENCE
ITEM 173
SCALE 1" = 10'

GENERAL NOTES - CONTD.

THE REQUIREMENTS OF SEC. 5-1.22, RUBBED FINISHED SHALL APPLY TO THE FOLLOWING EXPOSED CONCRETE SURFACES: THE ENTIRE SUPERSTRUCTURE EXCEPT THE TOP AND BOTTOM SURFACES OF SLAB, THE ENTIRE SURFACE OF PIERS AND ABUTMENTS EXCEPT BRIDGE SEATS, BACKWALLS AND THE FACE OF SPILL THROUGH ABUTMENTS BETWEEN OUTSIDE BEAMS

POROUS BACKFILL: 2 FT. THICK, FULL LENGTH OF ABUTMENT AND WINGS SHALL EXTEND UP TO THE UNDERSIDE OF THE SIDEWALK OR TO THE FINISHED GROUND SURFACE.

BRIDGE SEAT REINFORCING: SPECIAL CARE SHALL BE TAKEN IN PLACING REINFORCING STEEL IN THE VICINITY OF THE BRIDGE SEAT SO AS TO AVOID INTERFERENCE WITH THE DRILLING OF ANCHOR BAR HOLES

PIER #1 FOOTING: EXTREME CARE MUST BE TAKEN DURING THE CONSTRUCTION OF PIER #1 FOOTING IN ORDER NOT TO DISTURB THE EXISTING 30" STORM SEWER

CONTINUOUS BEAM SHOP ASSEMBLY: REFERENCE PARAGRAPH 4, SEC. 5-7.12 OF THE CONSTRUCTION AND MATERIAL SPECIFICATIONS, IF ROLLED BEAMS ARE FIELD SPICED ONLY AT SUPPORTS, FOR THE PURPOSE OF CHECKING THE FIT-UP OF WELD JOINT PREPARATION, ONLY TWO ADJACENT BEAMS NEED BE SHOP ASSEMBLED AT A TIME IN THEIR CORRECT, UNLOADED POSITIONS. ALL BEAMS SHALL BE ASSEMBLED AND MATCH MARKED.

BEAM WEB WELDS: BUTT-WELDS IN WEBS OF BEAMS MAY HAVE CONVEX REINFORCEMENT IN ACCORDANCE WITH SECT. 5-7.22. FINISHING FLUSH BY GRINDING IS NOT NECESSARY.

FINANCING FOR BRIDGE: IS TO BE BORNE 100% BY THE CITY OF AKRON

FOUNDATION BEARING PRESSURE: PIER FOOTINGS ARE DESIGNED FOR A MAXIMUM BEARING PRESSURE OF 2.5 TONS PER SQ. FT. AND ABUT. FOOTINGS FOR 1 TON PER SQ. FT.

CONTINUOUS BEAM SPLICES: IF BEAMS HAVING DEPTHS DIFFERING BY MORE THAN 1/8 ARE TO BE SPICED BY BUTT WELDING, THE DEPTH OF THE SMALLER-DEPTH BEAM SHALL BE INCREASED BY SPLITTING THE WEB LONGITUDINALLY AT A DISTANCE OF 1/2 BELOW THE BOTTOM OF THE TOP FLANGE AND FOR A DISTANCE SUFFICIENT TO ALLOW THE FLANGE TO BE BENT UP AT A SLOPE OF NOT MORE THAN 3/8 PER FOOT, AFTER WHICH THE SPLIT IN THE WEB SHALL BE COMPLETELY WELDED WITH FULL DEPTH PENETRATION AND GROUND FLUSH.

CONCRETE DECK PLACING: IN ORDER TO FACILITATE WATER CURING OF THE CONCRETE OF THE DECK SLAB, THE PLACING OF CONCRETE SHALL PROGRESS UPGRADE. THE SLAB MAY BE PLACED IN SECTIONS, BETWEEN TRANSVERSE CONSTRUCTION JOINTS WHICH ARE PARALLEL TO TRANSVERSE REINFORCING STEEL AND ARE LOCATED NEAR THE CENTER OF ANY SPAN.

REFERENCE SHALL BE MADE TO STANDARD DRAWINGS:
CSB: 2-56 SHT. #2 REVISED 2-2-59
FSB: 1-62 REVISED 1-15-63

ESTIMATED QUANTITIES

□ INCLUDES 6x6-1/4 MESH REINFORCING & INCIDENTALS TO CONSTRUCTING NEW SIDEWALK TO MATCH WITH EXISTING SIDEWALK

ITEM	TOTAL	UNIT	DESCRIPTION	SUPER.	ABUTS.	PIERS	GEN.	ITEM	TOTAL	UNIT	DESCRIPTION	SUPER.	ABUTS.	PIERS	GEN.	ITEM	TOTAL	UNIT	DESCRIPTION	SUPER.	ABUTS.	PIERS	GEN.
E-2	176	CU.YDS.	UNCLASSIFIED EXCAVATION		103	73		S-7	67,091	LBS.	STRUCTURAL STEEL	67,091				S-29	21	CU.YDS.	POROUS BACKFILL		21		
								S-8	67,091	LBS.	FIELD PAINTING OF STRUCTURAL STL.	67,091				S-29	6	EACH	SCUPPERS	6			
S-1	46	CU.YDS.	CLASS 'C' CONC. SUPERSTRUCTURE	46											I-10	210	SONDS	CRUSHED AGGREGATE SLOPE PROTECTION		210			
S-1	39	CU.YDS.	CLASS 'E' CONC. ABUTMENTS		39										I-13	188	SQ.FT.	6 THK CONCRETE SIDEWALK				188	
S-1	20	CU.YDS.	CLASS 'C' CONC. PIERS ABOVE FOOTINGS			20		S-14	521.46	LIN.FT.	3 TUBE ALUMINUM RAILING, SUPPORT AND ANCHOR BOLTS.	521.46				I-13	419	SQ.FT.	4 THK CONCRETE SIDEWALK				419
S-1	29	CU.YDS.	CLASS 'E' CONC. PIER FOOTINGS			29									I-15	110	LIN.FT.	GUARD RAIL, STEEL BEAM STANDARD TYPE (DEEP)				110	
S-4	13,828	LBS.	REINFORCING STEEL	4,428	2,121	7,279									I-15	100	LIN.FT.	GUARD RAIL PIER PROTECTION				100	
															172	LUMP	REMOVE AND REPLACE MEDIAN STRIP					LUMP	
															173	LUMP	REVISION TO RIGHT OF WAY FENCE					LUMP	

STATE OF OHIO
DEPARTMENT OF HIGHWAYS
BUREAU OF BRIDGES




BEISWENGER & HOCH, Consulting Engineers
AKRON, OHIO

GENERAL PLAN & ELEVATION
BRIDGE NO. SUM-18-0939
PEDESTRIAN BRIDGE
UNDER HILLCREST STREET
AKRON EXP'WAY, PART-13 SUMMIT COUNTY
STA. 256+06.56

DESIGNED	DRAWN	TRACED	CHECKED	REVIEWED	DATE	REVISED
RDH	JP		RDH	R.D.H.	4/3/63	10-29-63




12080

SUM-18-923

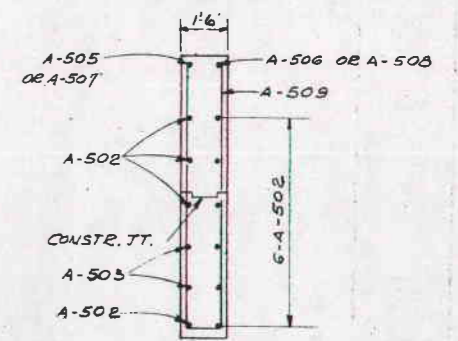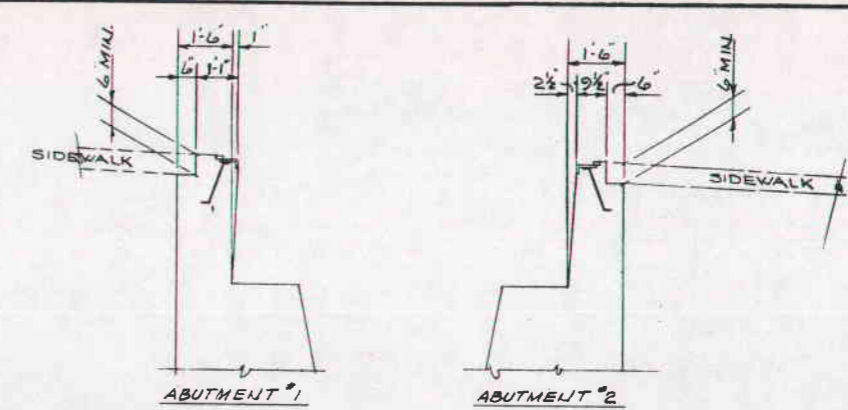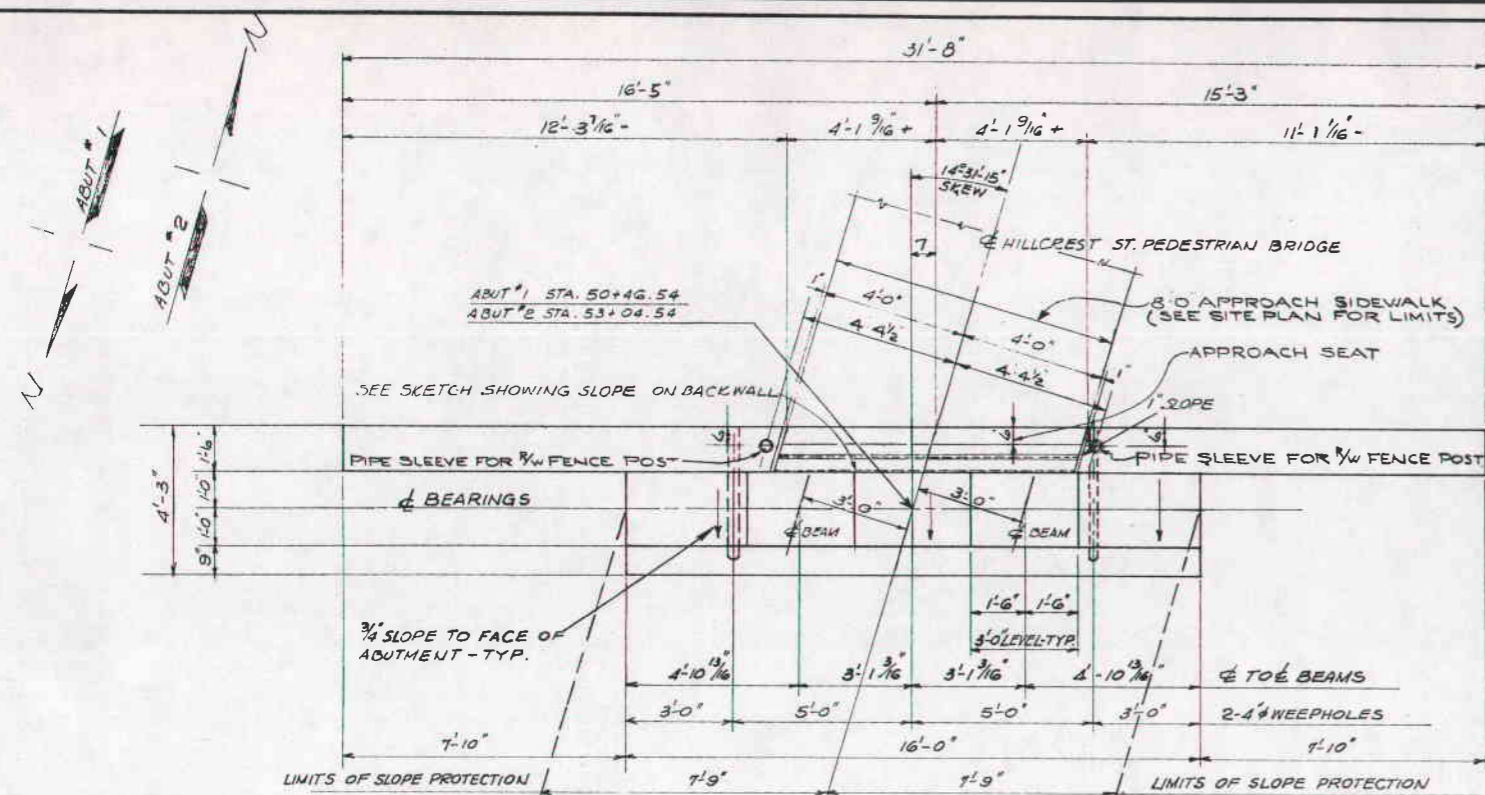

EAST ABUT. #1
WEST ABUT. #2

WEST ABUT. #1
EAST ABUT. #2

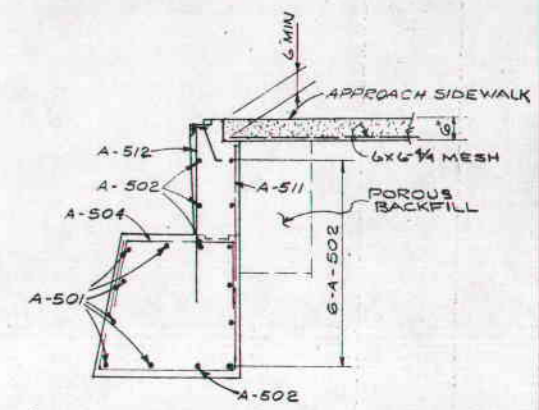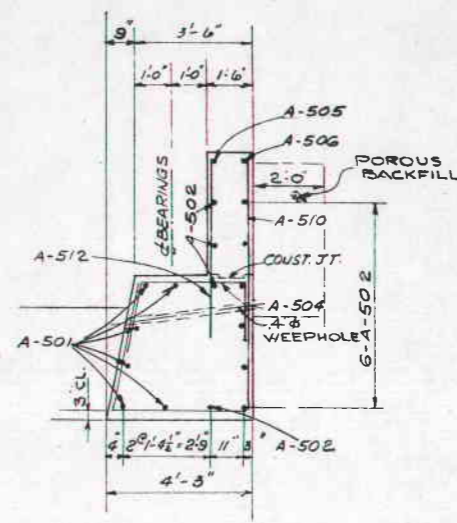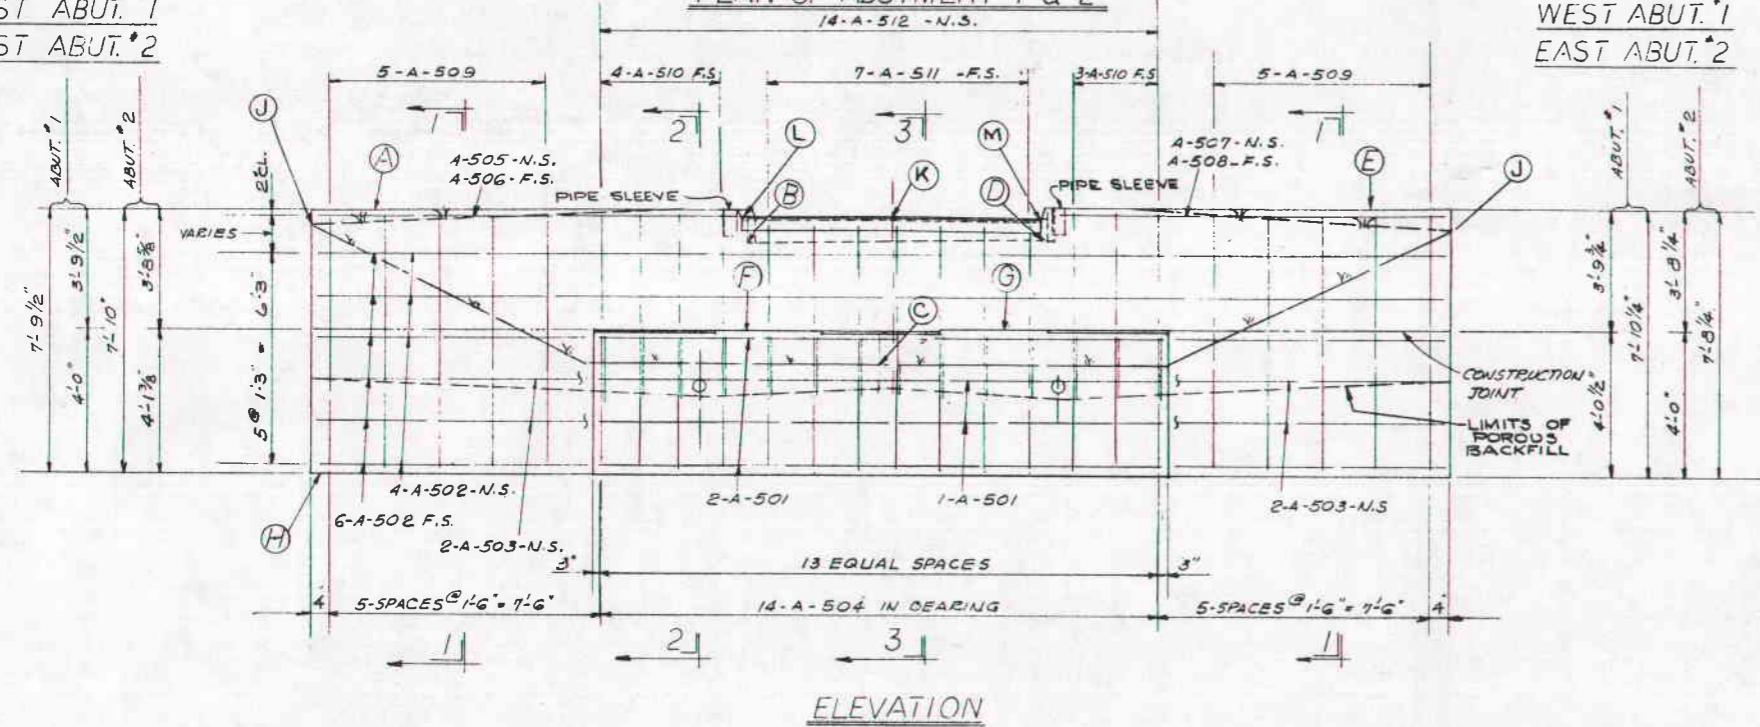

FOR DIMENSIONS AND DETAILS NOT SHOWN SEE SECTION 2-2

ELEVATION TABLE

	A	B	C	D	E	F	G	H	J	L*	M*	K*
ABUTMENT #1	1073.70	1072.95	1068.90	1073.01	1073.76	1069.91	1069.95	1065.91	1073.20	1073.38	1073.44	1073.45
ABUTMENT #2	1063.00	1062.25	1058.20	1062.11	1062.86	1059.28	1059.17	1055.17	1062.40	1062.68	1062.54	1062.65


* INDICATES ELEVATIONS GIVEN TO HEEL OF L

STATE OF OHIO
DEPARTMENT OF HIGHWAYS
BUREAU OF BRIDGES

BEISWENGER & HOCH, Consulting Engineers
AKRON, OHIO

ABUTMENT DETAILS
BRIDGE # SUM-18-0939
PEDESTRIAN BRIDGE
UNDER HILLCREST STREET
AKRON EXP'WAY, PART-13- SUMMIT COUNTY
STA. 256+06.56

DESIGNED	DRAWN	TRACED	CHECKED	REVIEWED	DATE	REVISED
RDH.	JK		RDH	R.D.H.	8/9/63	10-29-63




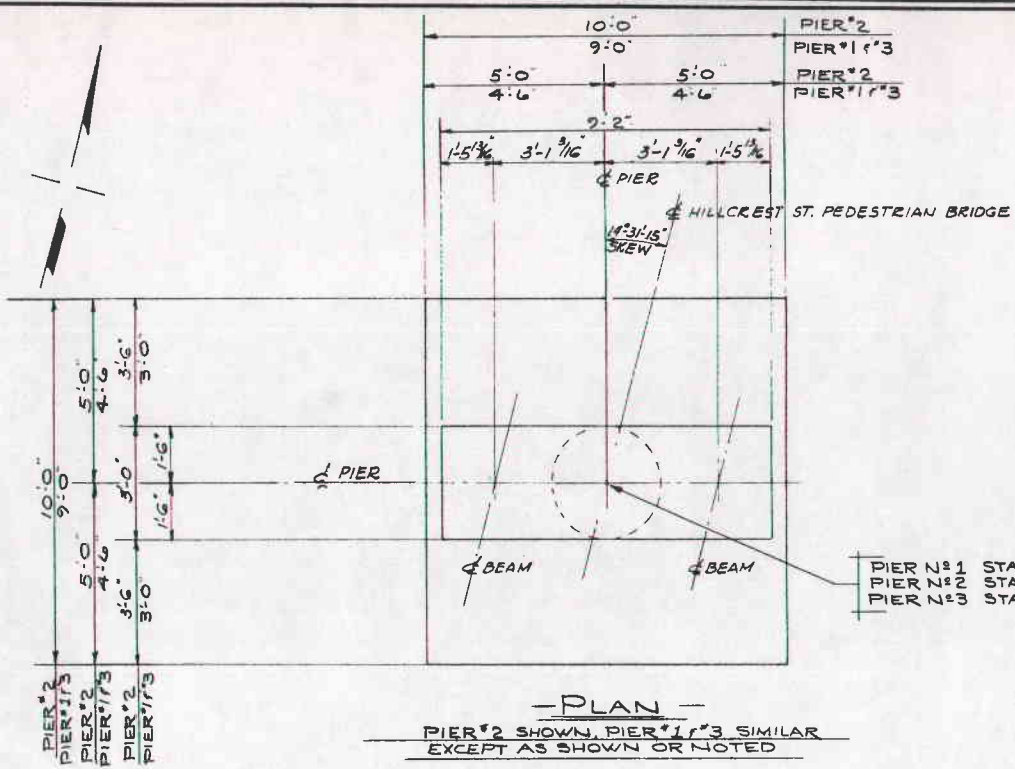


ELEVATION TABLE

	A	B	C
PIER #1	1068.65	1068.61	1044.36
PIER #2	1065.69	1065.62	1042.87
PIER #3	1062.09	1062.00	1041.50



PIER #1 STA. 50+97.54
 PIER #2 STA. 51+82.54
 PIER #3 STA. 52+58.54

- PLAN -
 PIER #2 SHOWN, PIER #1 & #3 SIMILAR EXCEPT AS SHOWN OR NOTED

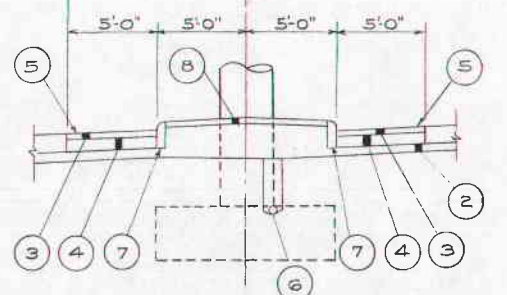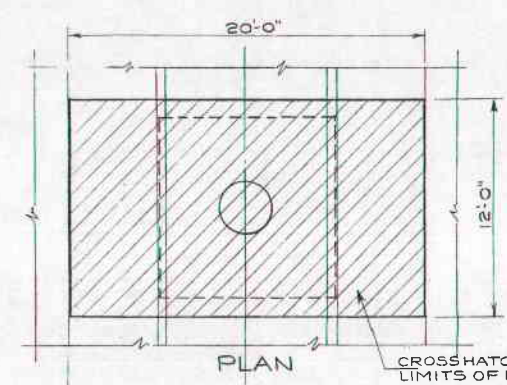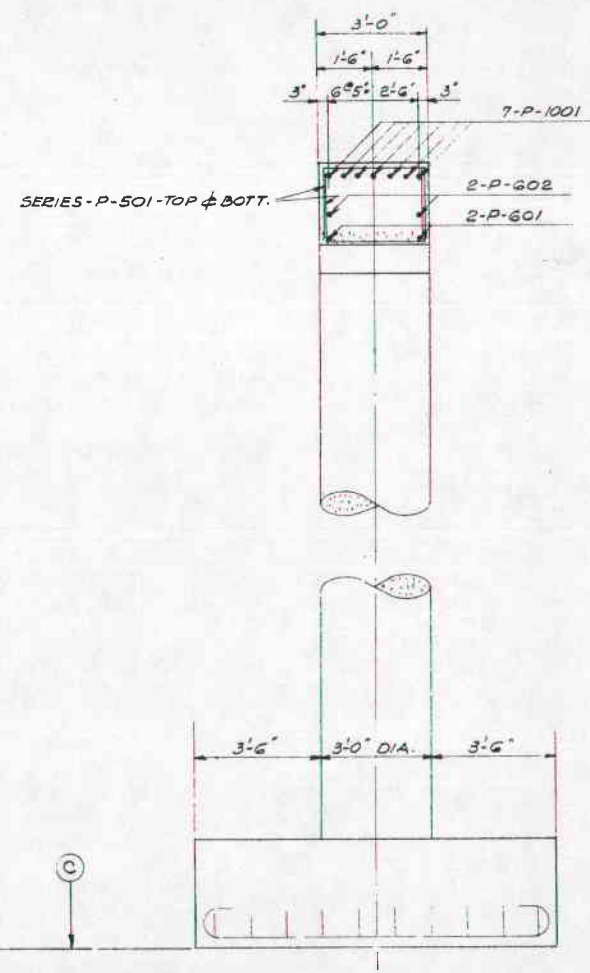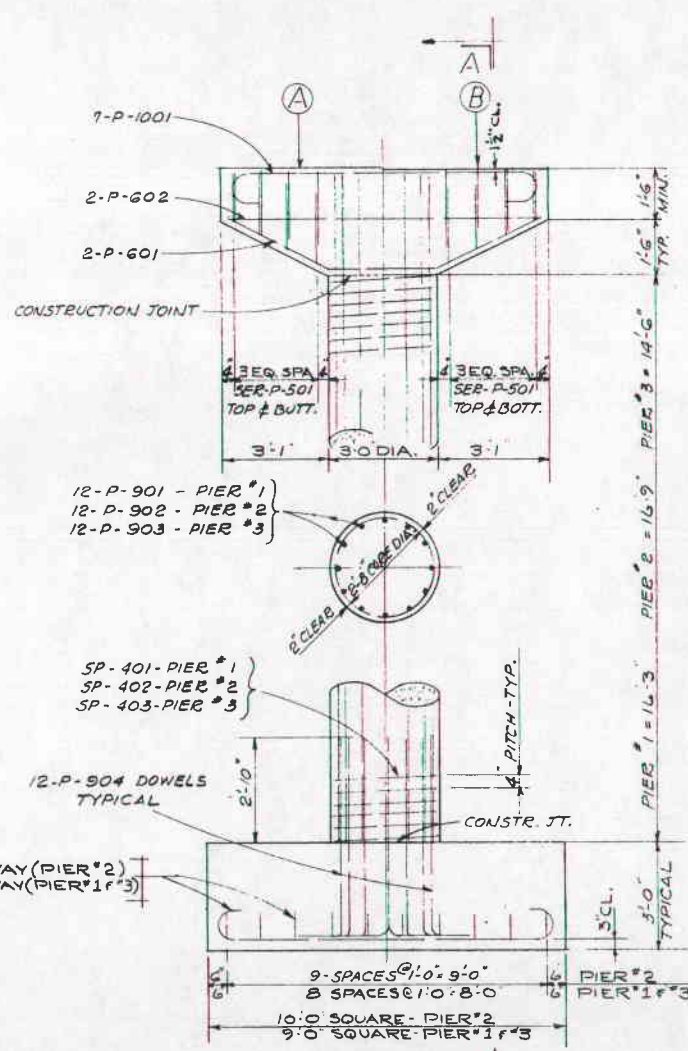

- 2 I-22 SUBBASE (VARIABLE DEPTH) GRADING "A" OR "B"
- 3 B-21 3" WATERPROOFED AGGREGATE BASE COURSE
- 4 B-112 5" POROUS BASE COURSE
- 5 T-31 BITUMINOUS SURFACE TREATMENT, ONE APPLICATION, SEC. M 5.2 RC-3 OR M 5.3 MC-5
- 6 I-1 6" PIPE CLASS I-3
- 7 I-12 STANDARD TYPE 6 CONCRETE CURB
- 8 I-21 4" STANDARD TYPE I PORTLAND CEMENT CONCRETE MEDIAN PAVEMENT, CLASS C CONCRETE



NOTE: THESE ITEMS ARE TO BE REMOVED WITHIN THE LIMITS SHOWN ON THE PLAN, DURING CONSTRUCTION OF PIER NO. 2. AFTER THE PIER IS COMPLETED THEY SHALL BE REPLACED AS ORIGINALLY CONSTRUCTED. PAYMENT FOR REMOVAL AND REPLACEMENT SHALL BE MADE UNDER ITEM 172, REMOVE AND REPLACE MEDIAN PAVEMENT.

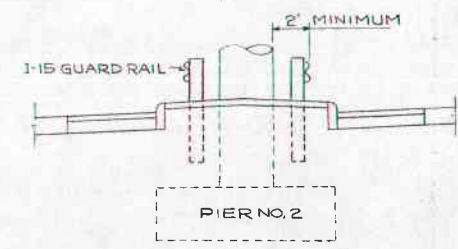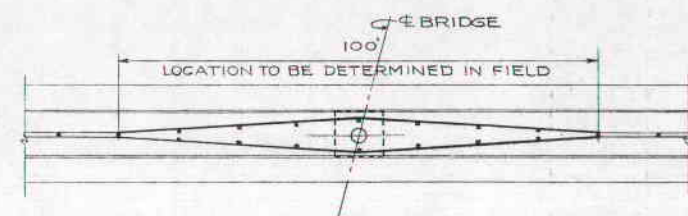




PIER PROTECTION DETAILS

NOTE: ALL REINFORCING STEEL SHALL HAVE A MIN. COVER OF 2" CONCRETE UNLESS OTHERWISE NOTED.

STATE OF OHIO DEPARTMENT OF HIGHWAYS BUREAU OF BRIDGES						
BEISWENGER & HOCH, Consulting Engineers AKRON, OHIO						
PIER DETAILS						
BRIDGE NO SUM-18-0939 PEDESTRIAN BRIDGE UNDER HILLCREST STREET AKRON EXP'WAY, PART-13 SUMMIT COUNTY STA. 256+06.56						
DESIGNED	DRAWN	TRACED	CHECKED	REVIEWED	DATE	REVISED
RDH	JK		RDH	R.B.H.	9/63	

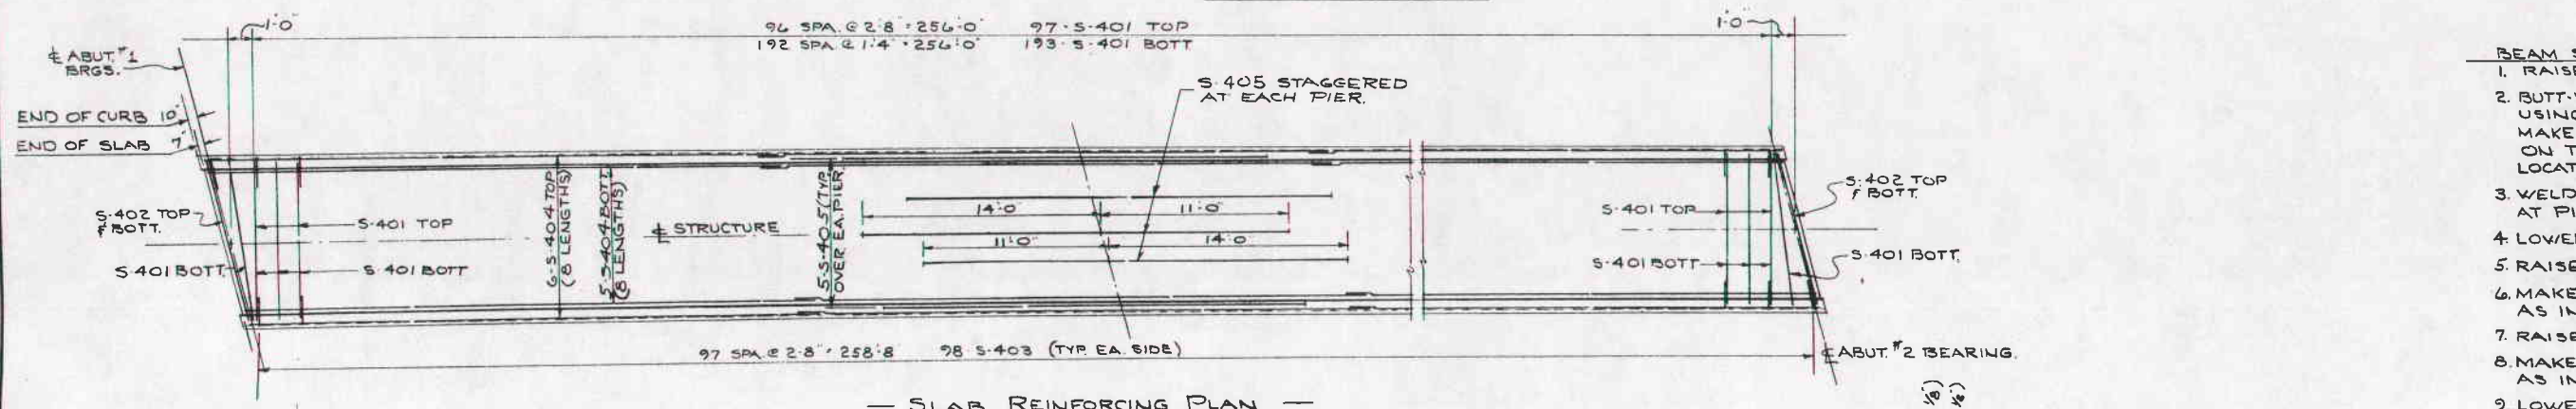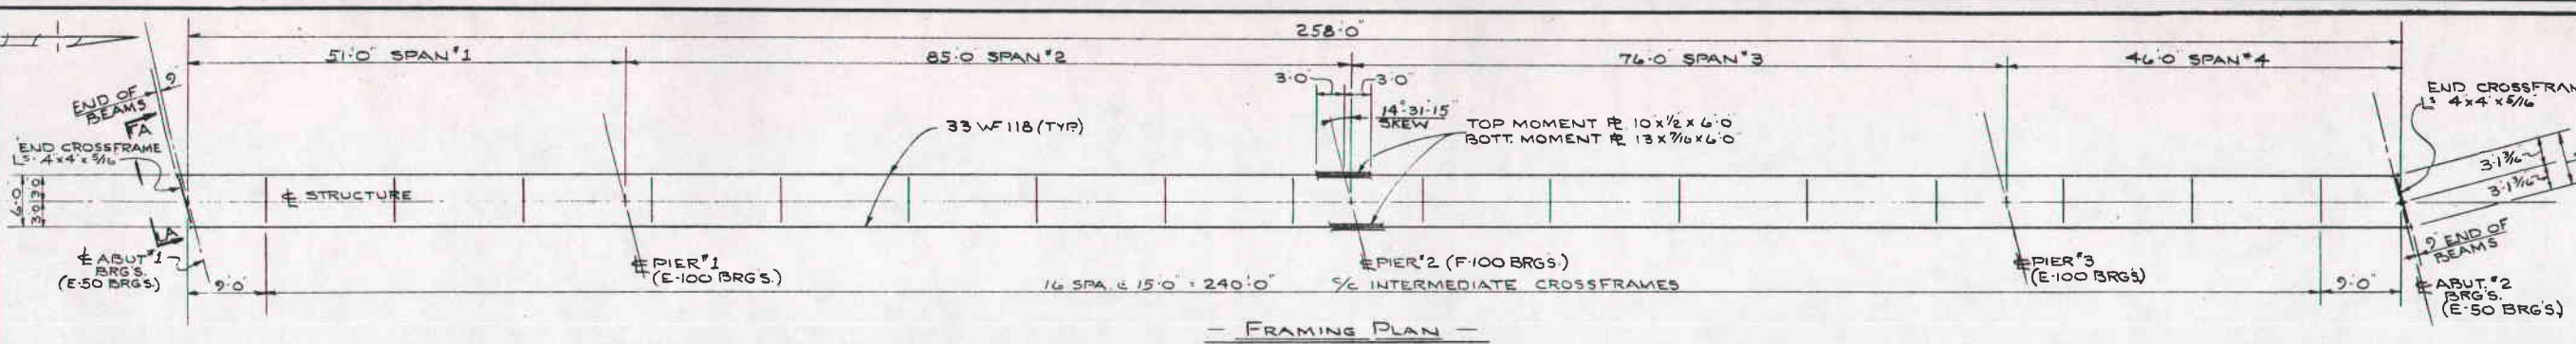

- BEAM SPLICE WELDING PROCEDURE:**
1. RAISE BEAMS AT PIER #3 - 3 3/8"
 2. BUTT-WELD BEAM FLANGES AND WEB AT PIER #2 USING THE FOLLOWING SEQUENCE: MAKE ONE PASS ON EACH FLANGE, THEN TWO ON THE WEB; REPEAT, USING ONE PASS AT EACH LOCATION, UNTILL WELDS ARE COMPLETED.
 3. WELD TOP & BOTTOM FLANGE MOMENT PLATES AT PIER #2
 4. LOWER BEAMS AT PIER #3
 5. RAISE BEAMS 1" AT ABUTMENT #1
 6. MAKE SPLICE AT PIER #1 USING SAME PROCEDURE AS IN STEP #2.
 7. RAISE BEAMS 5/8" AT ABUTMENT #2
 8. MAKE SPLICE AT PIER #3 USING SAME PROCEDURE AS IN STEP #2
 9. LOWER BEAM ENDS AT ABUT. #1 AND ABUT. #2 INTO FINAL POSITION

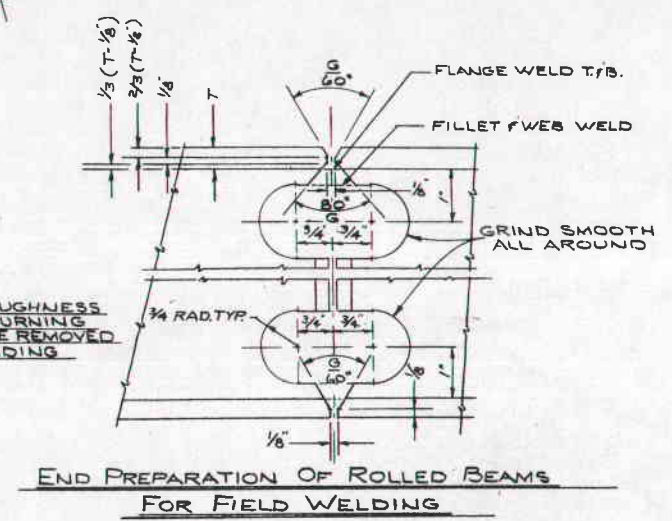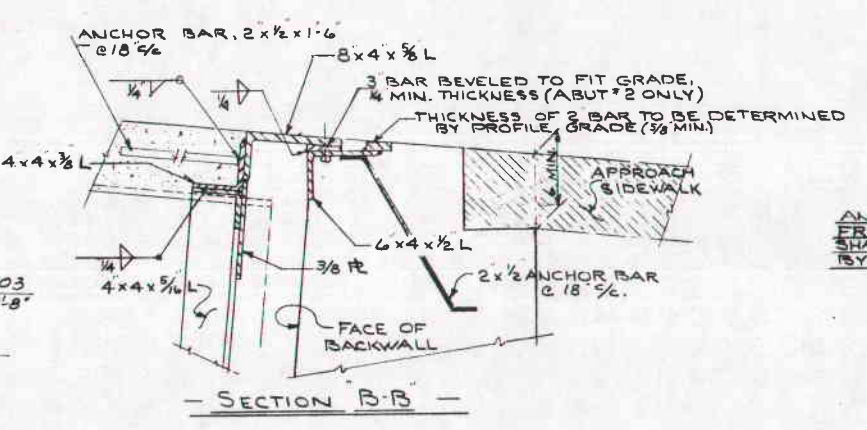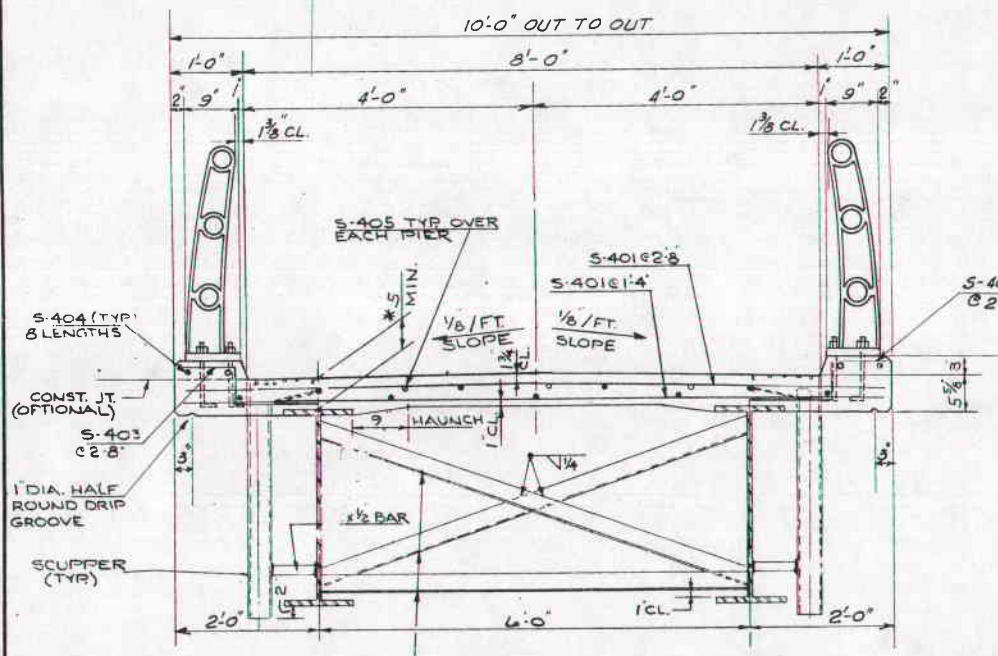


*** SLAB THICKNESS:** THIS IS A NOMINAL DIMENSION INCLUDING 1/4" MONOLITHIC WEARING SURFACE. THE QUANTITY OF DECK CONCRETE TO BE PAID FOR SHALL BE BASED ON THIS DIMENSION, EVEN THOUGH DEVIATION FROM IT MAY BE NECESSARY BECAUSE THE TOP FLANGE OF THE BEAM MAY NOT HAVE THE EXACT CAMBER OR CONFORMATION REQUIRED TO PLACE IT PARALLEL TO THE FINISHED GRADE.

DECK SLAB HAUNCH: THE HAUNCH IN THE DECK SLAB ADJACENT TO THE TOP OF STEEL BEAMS, WHICH IS SHOWN AS 9" WIDE, MAY VARY FROM THIS DIMENSION BETWEEN THE LIMITS OF 6" AND 12", EXCEPT THAT THE MAXIMUM SLOPE SHALL NOT EXCEED 3 INCHES PER FOOT. PAYMENT FOR DECK SLAB CONCRETE SHALL BE BASED ON THE 9" WIDTH.

WELDING: WELDING OF STRUCTURAL STEEL SHALL BE CLASS "A" EXCEPT AS OTHERWISE SHOWN. WELDS SHOWN AS FIELD WELDS MAY, AT THE OPTION OF THE CONTRACTOR, BE MADE IN THE SHOP.

INTERMEDIATE CROSSFRAME ANGLES 3x3x3/8" WELD BOTH SIDES OF VERTICAL LEG AND TOP SIDE OF HORIZONTAL LEG TO BEAM WITH 1/4" CONTINUOUS FILLET WELD

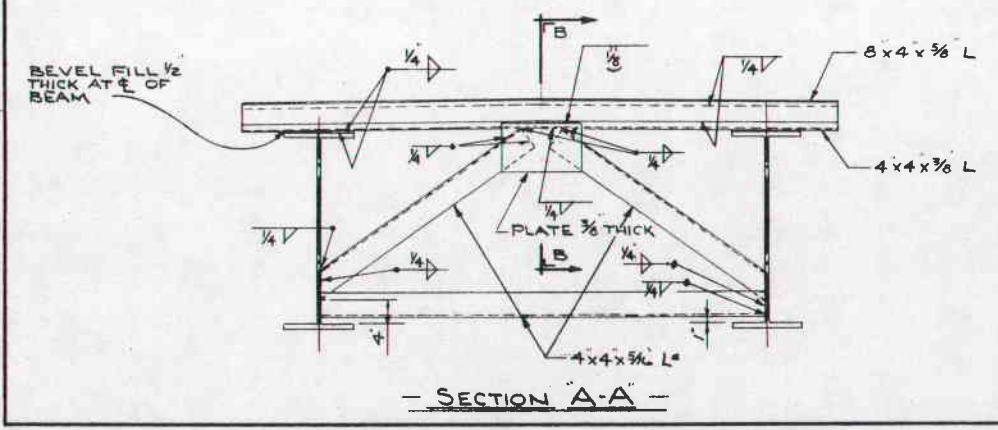

DEFLECTION AND CAMBER

LOCATION	SPAN #1	SPAN #2	SPAN #3	SPAN #4
DEFLECTION DUE TO WEIGHT OF STEEL	0.018"	0.256"	0.146"	0.015"
DEFLECTION DUE TO REMAINING DEAD LOAD	0.059"	0.826"	0.470"	0.048"
CONVEXITY REQUIRED FOR VERTICAL CURVE	0.000"	2.140"	1.740"	0.620"
SUM OF DEFLECTION AND CONVEXITY	0.077"	3.222"	2.356"	0.683"
REQUIRED CAMBER	0	3 1/4"	2 3/8"	0

STATE OF OHIO
DEPARTMENT OF HIGHWAYS
BUREAU OF BRIDGES

BEISWENGER & HOCH, Consulting Engineers
AKRON, OHIO

FRAMING PLAN & SLAB DETAILS
BRIDGE NO SUM 18 0939
PEDESTRIAN BRIDGE
UNDER HILLCREST STREET
AKRON EXPWAY PART 13 SUMMIT COUNT
STA. 256+06.56


DESIGNED	DRAWN	TRACED	CHECKED	REVIEWED	DATE	REVISE
RDH	JNF		RDH	R.O.H.	8/2/23	10-29-

10660
A-7204


FED. RD.	STATE	PROJECT
2	OHIO	

6
7


SUM-18-923

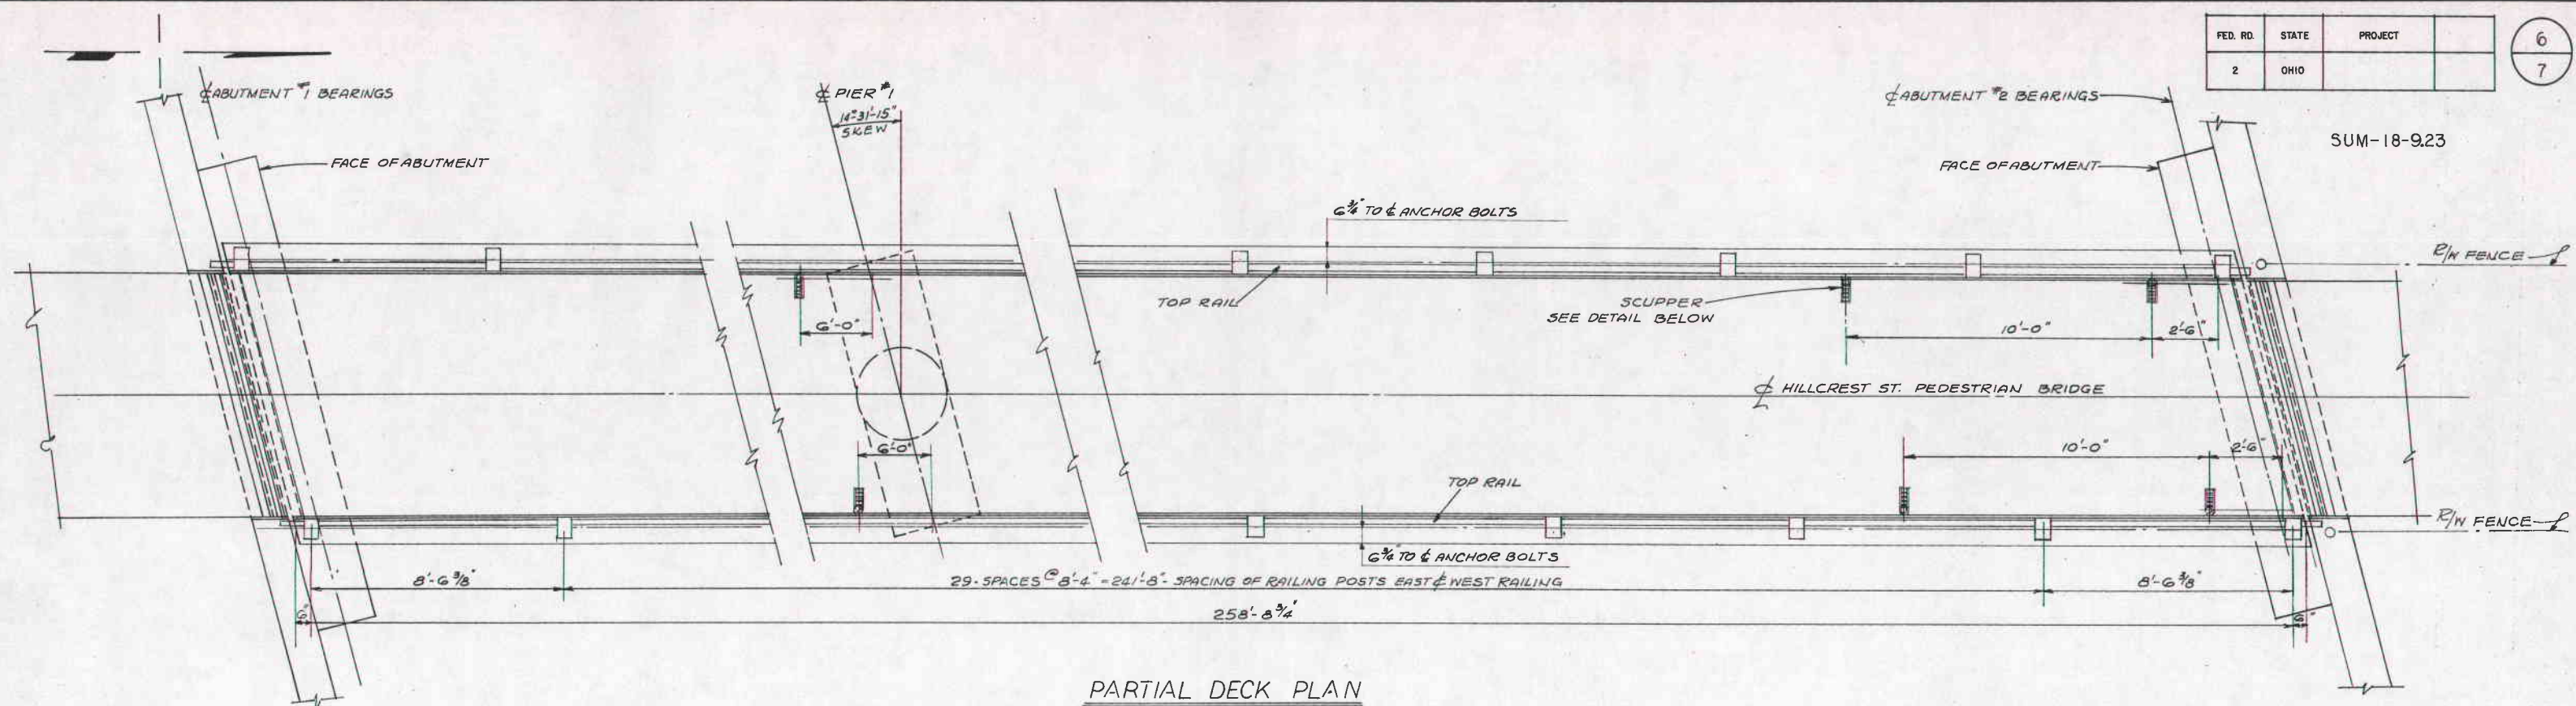

PARTIAL DECK PLAN

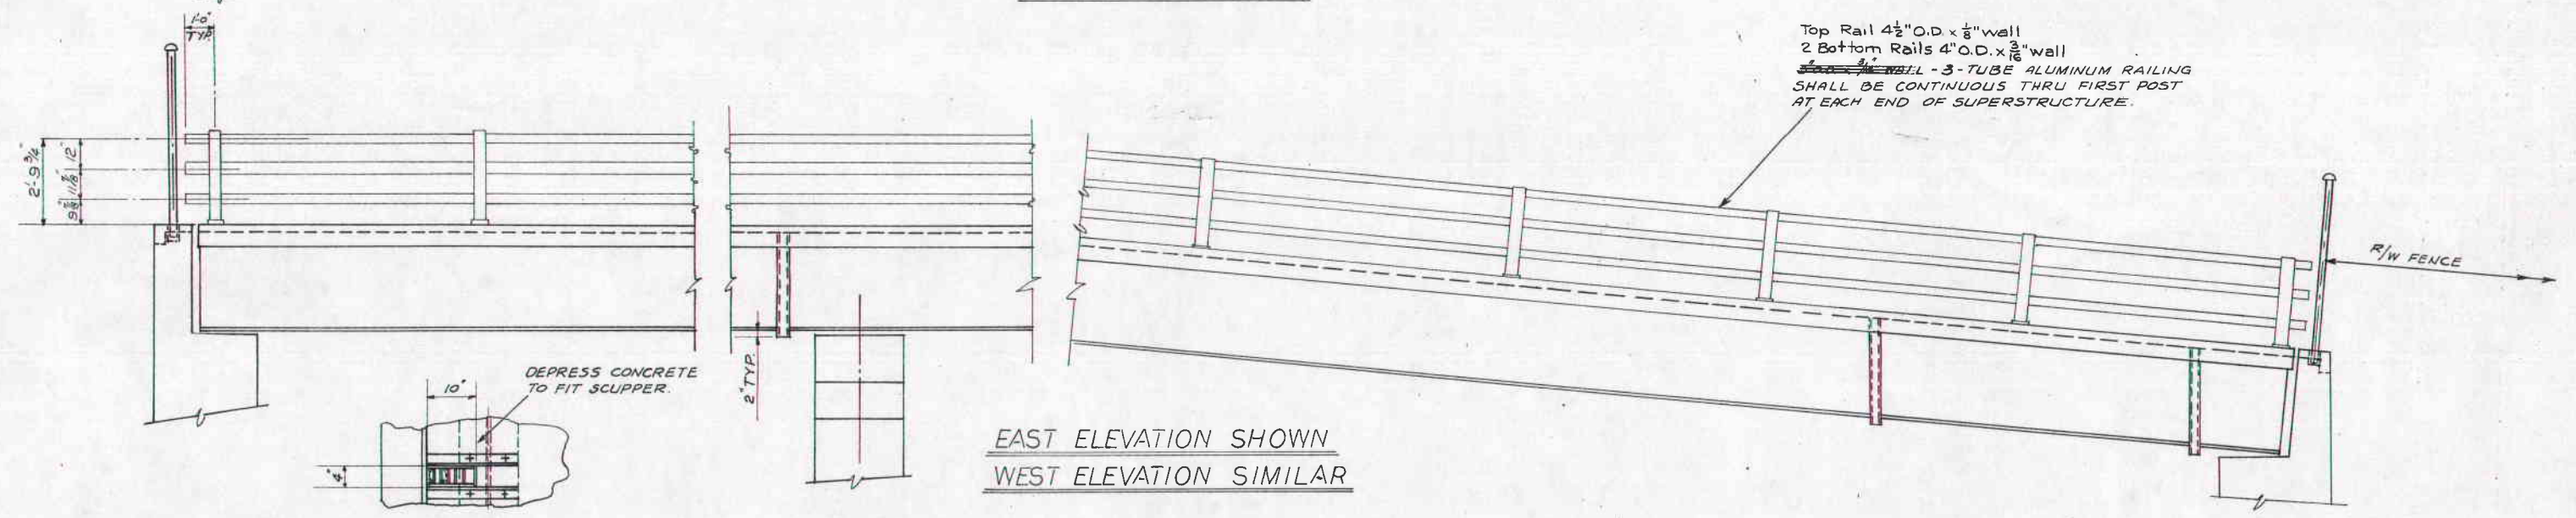

EAST ELEVATION SHOWN
WEST ELEVATION SIMILAR

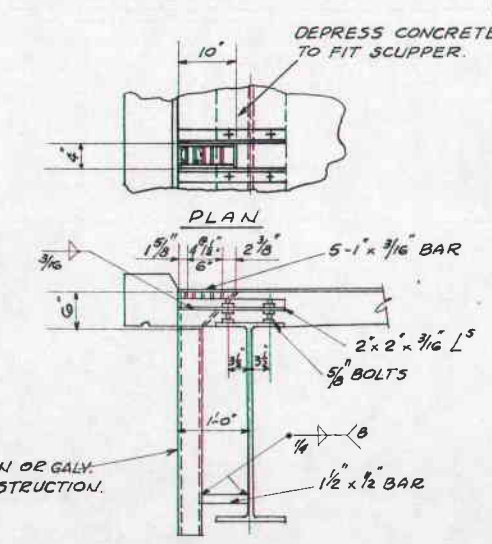

SCUPPER DETAIL
FABRICATE FROM 3/16" THICK STEEL.
ALL WELDED CONSTRUCTION.

STATE OF OHIO DEPARTMENT OF HIGHWAYS BUREAU OF BRIDGES					
BEISWENGER & HOCH, Consulting Engineers AKRON, OHIO					
RAILING & DRAINAGE DETAILS					
BRIDGE NO SUM-18-0939					
PEDESTRIAN BRIDGE					
UNDER HILLCREST STREET					
AKRON EXP'WAY, PART-13. SUMMIT COUNTY					
STA. 256+06.56.					
DESIGNED	DRAWN	TRACED	CHECKED	REVIEWED	DATE
R.D.H.	JK		R.D.H.	R.D.H.	8/9/63
					10/29/65

16060
A-7205