

Vertical Clearance


Min. Clearance 14' 9"

Bridge No. SOM-76-0914

Route MANCHESTER

Date Measured 1-7-2020

BY K. COOPER / S. MACADAM

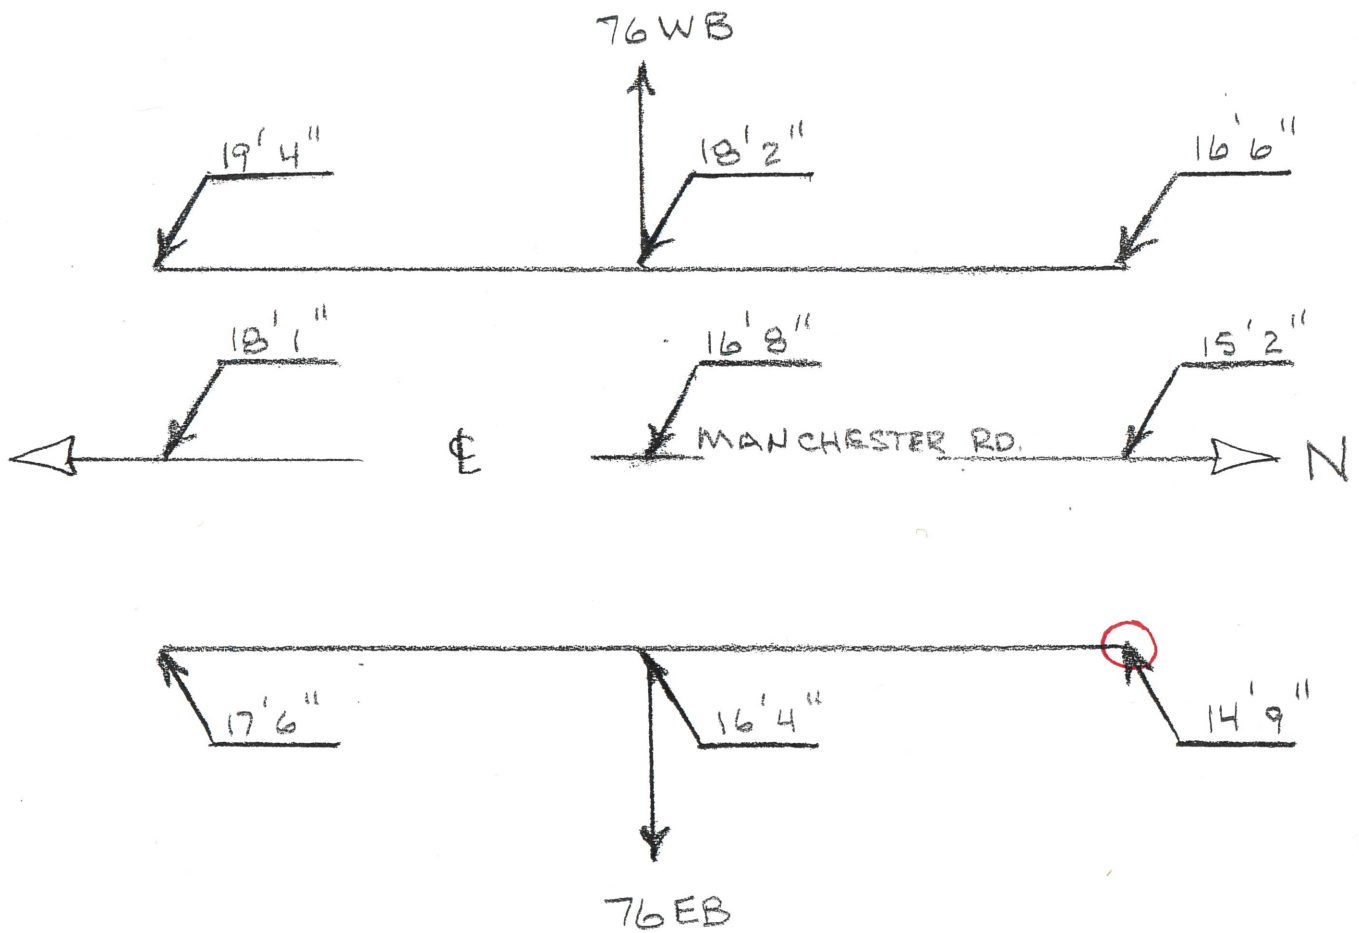

Vertical Clearance


Min. Clearance 15' 1" SB

Bridge No. SUM-76-0954

Route BOWERY ST. + ERIE
CANAL

Date Measured 1-7-2020

BY K. COOPER / S. MACADAM

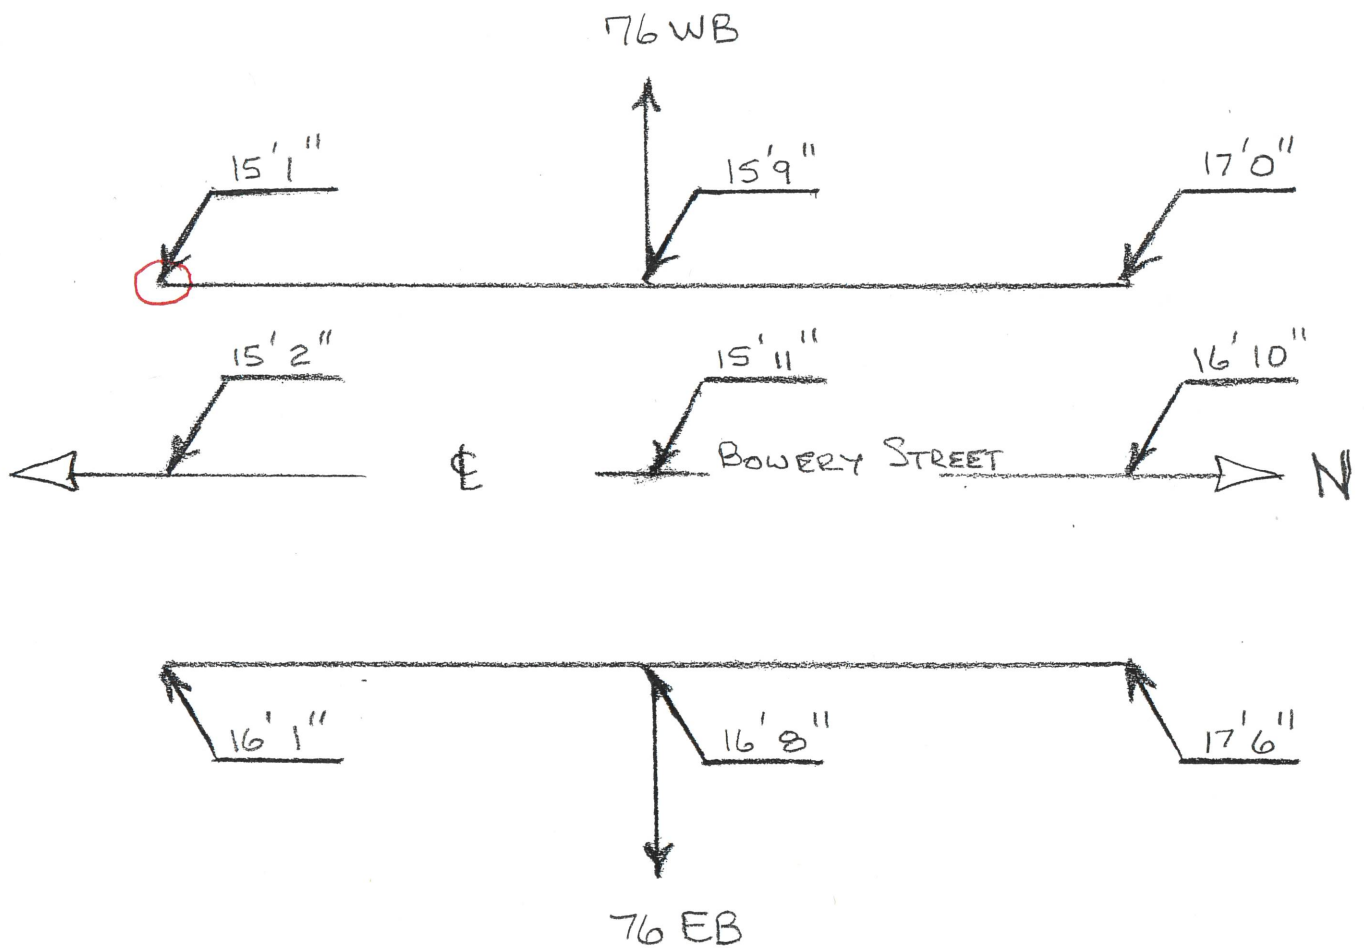

Vertical Clearance


Min. Clearance 16' 8"

Bridge No. SUM-76-0964

Route LAKESHORE

Date Measured 1-7-2020

BY K. COOPER / S. MACADAM

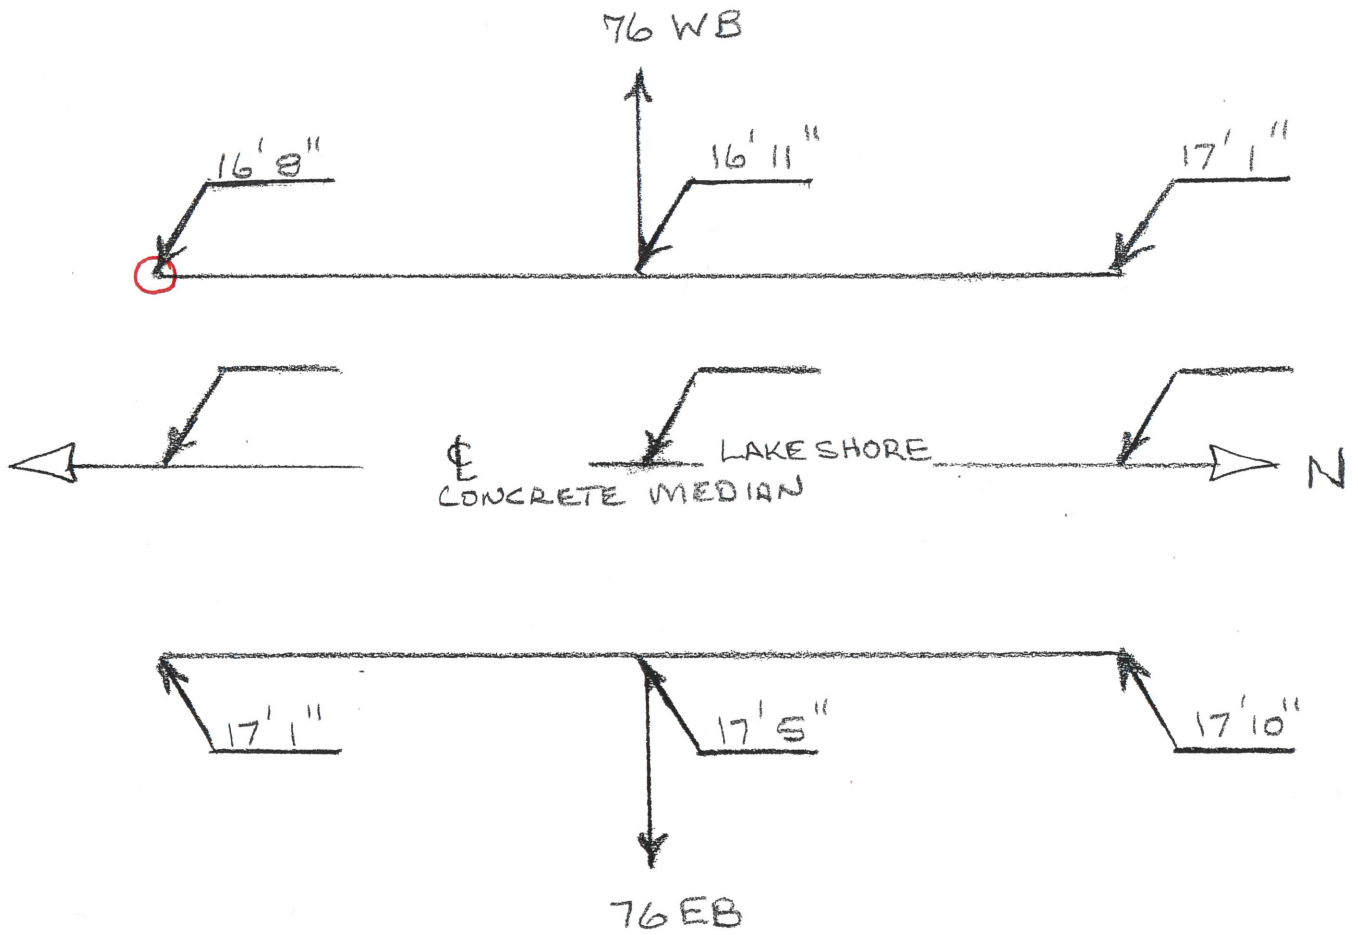




Ohio Department of Transportation
Vertical Clearance Survey Form

County: SUMMIT Route: 77 Date: 10-26-18

Structure No. ~~10.20~~ 10.22 By: MS MH

(CATAWBA AVE)

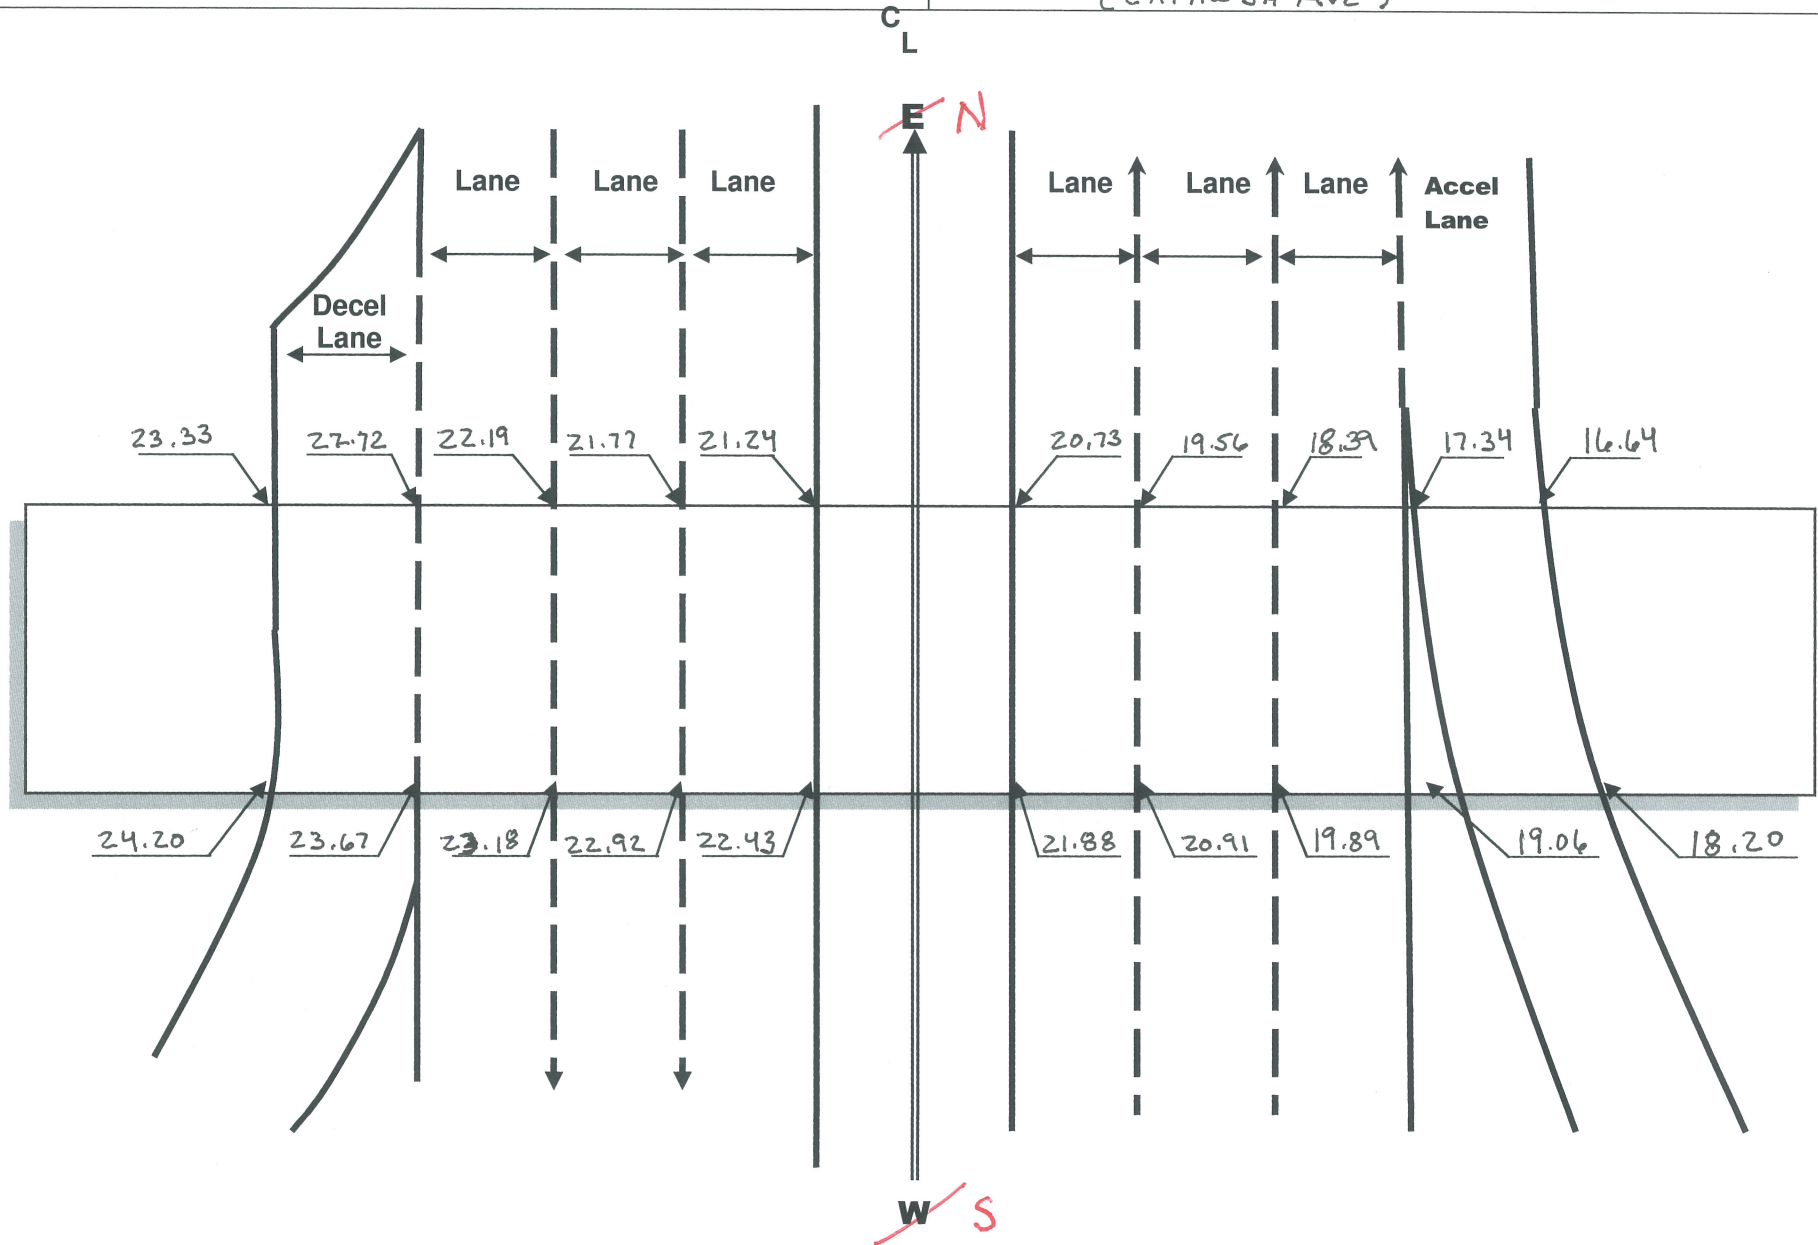



Ohio Department of Transportation
Vertical Clearance Survey Form


County: SUMMIT Route: 77

Date: 10-26-18

Structure No. * SEE BELOW

By: MS MH

(WILBETH RD)

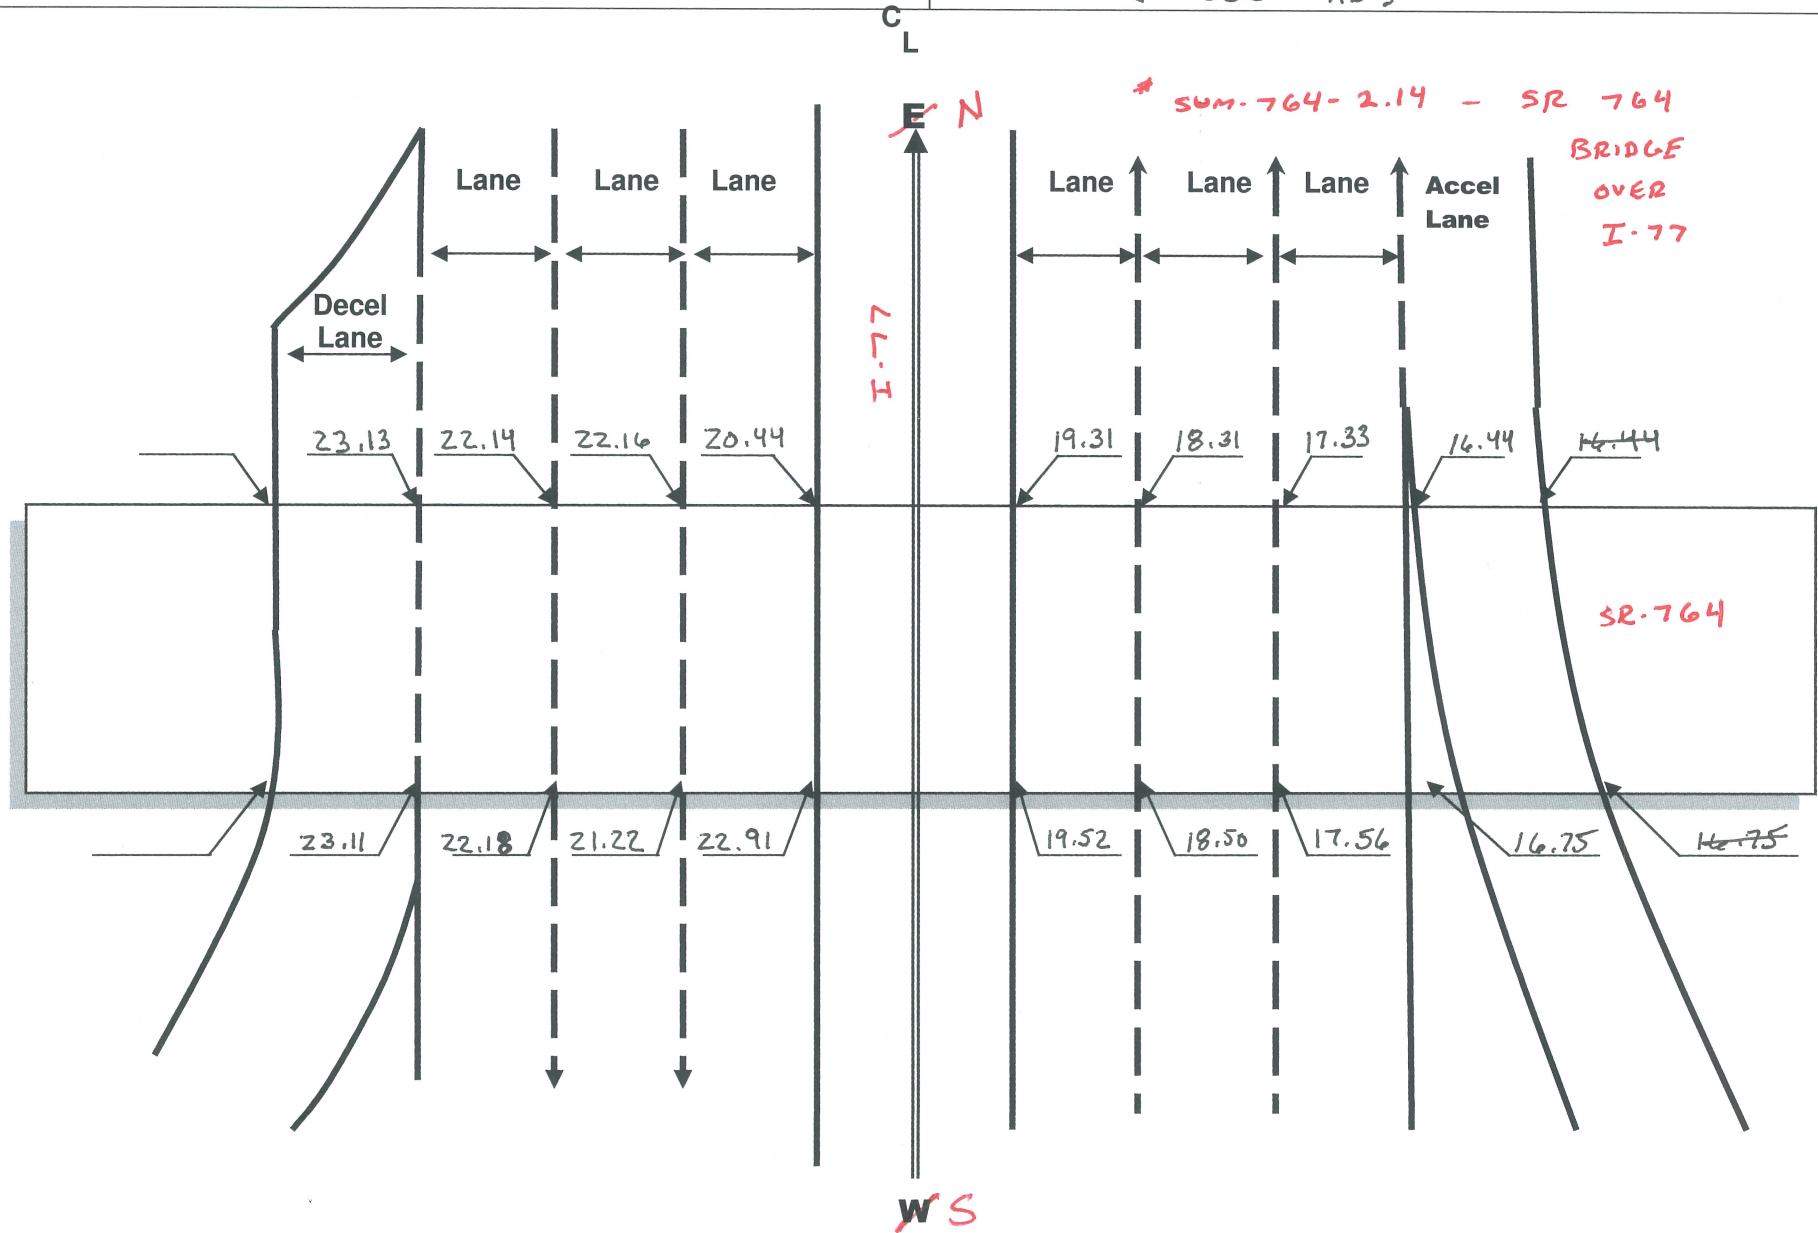



Ohio Department of Transportation
Vertical Clearance Survey Form


County: SUMMIT Route: 77

Date: 10-26-18

Structure No. ~~1128~~ 11.32

By: MS MH

COLE AVE

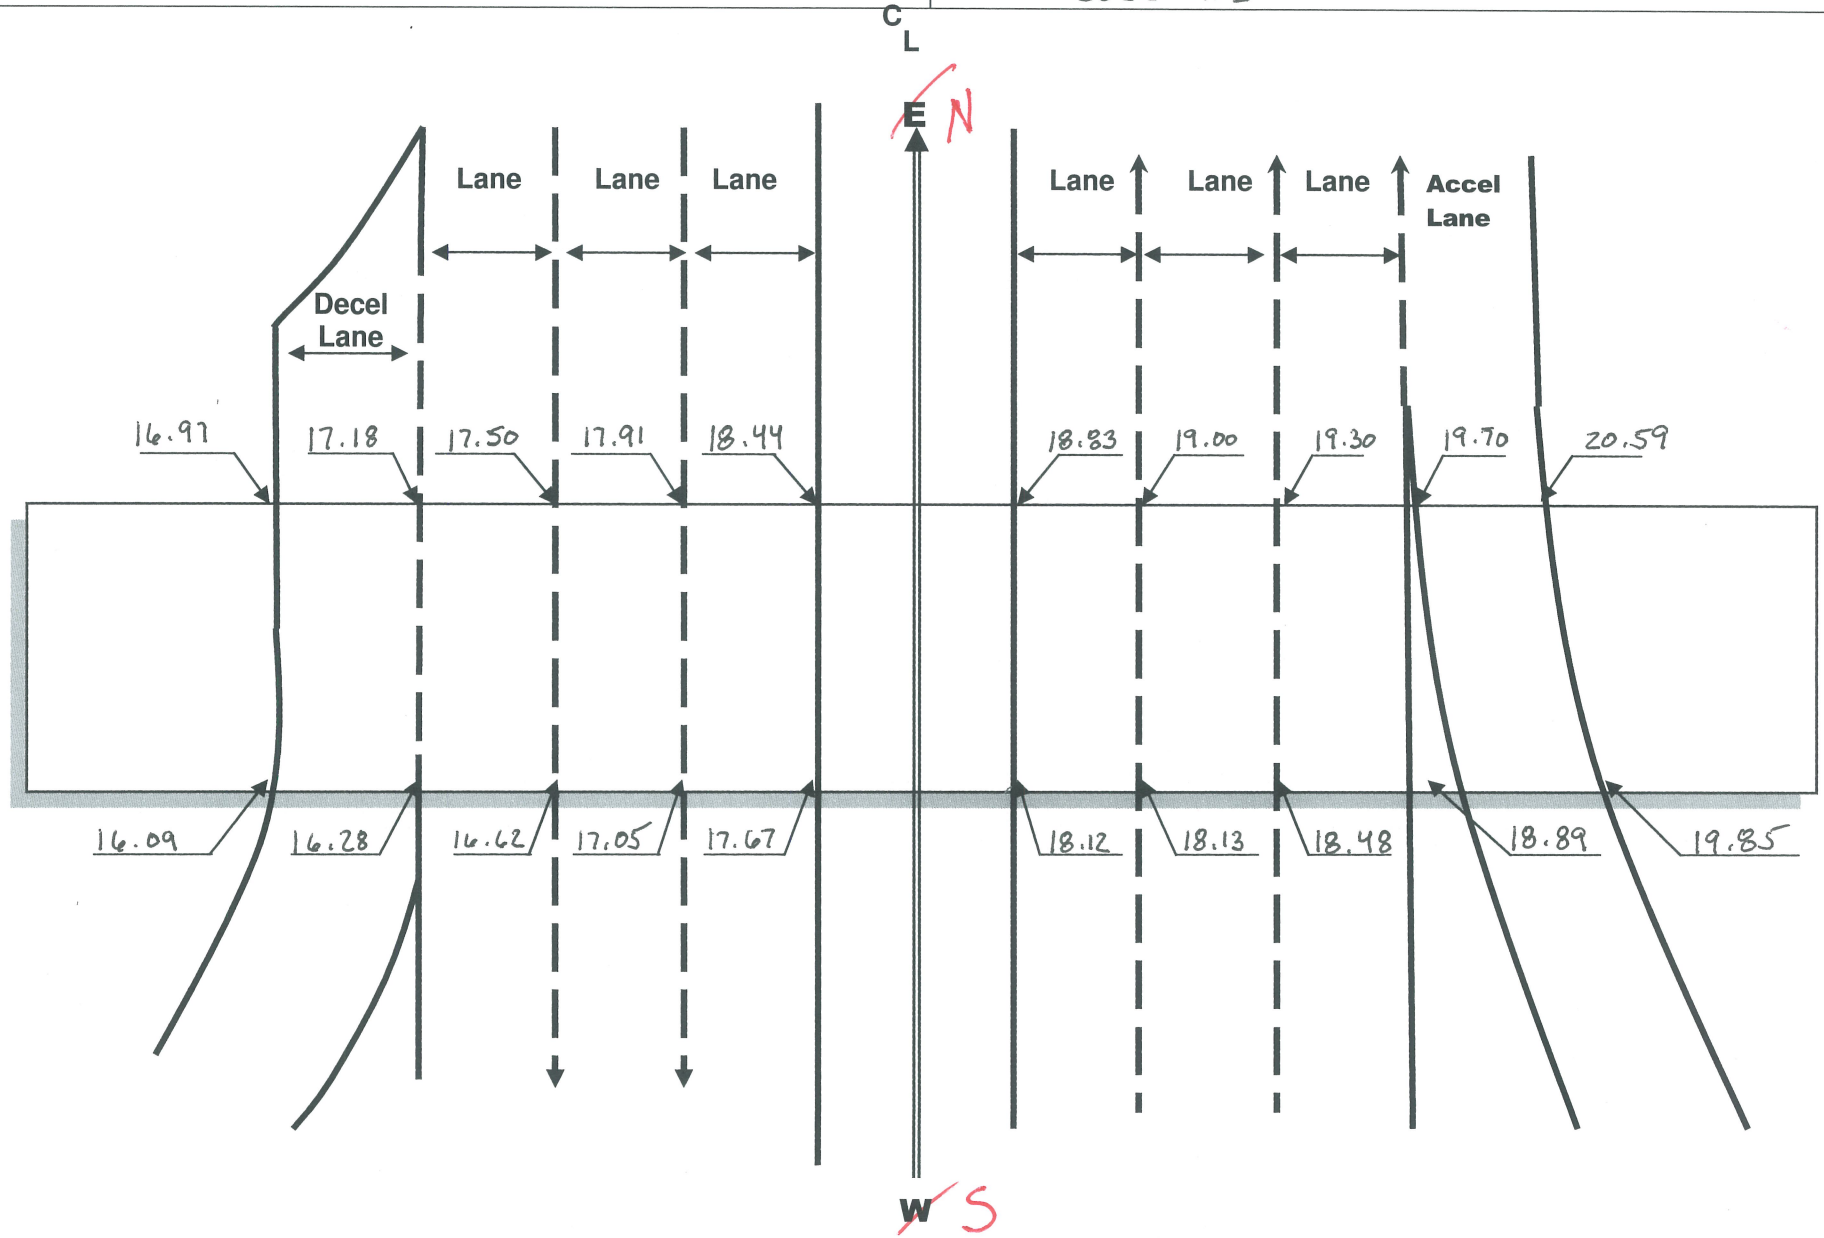



Ohio Department of Transportation
Vertical Clearance Survey Form


County: SUMMIT Route: 77

Date: 10-26-18

Structure No. ~~11.50~~ 11.52

By: MS MH


(LOVERS LANE)

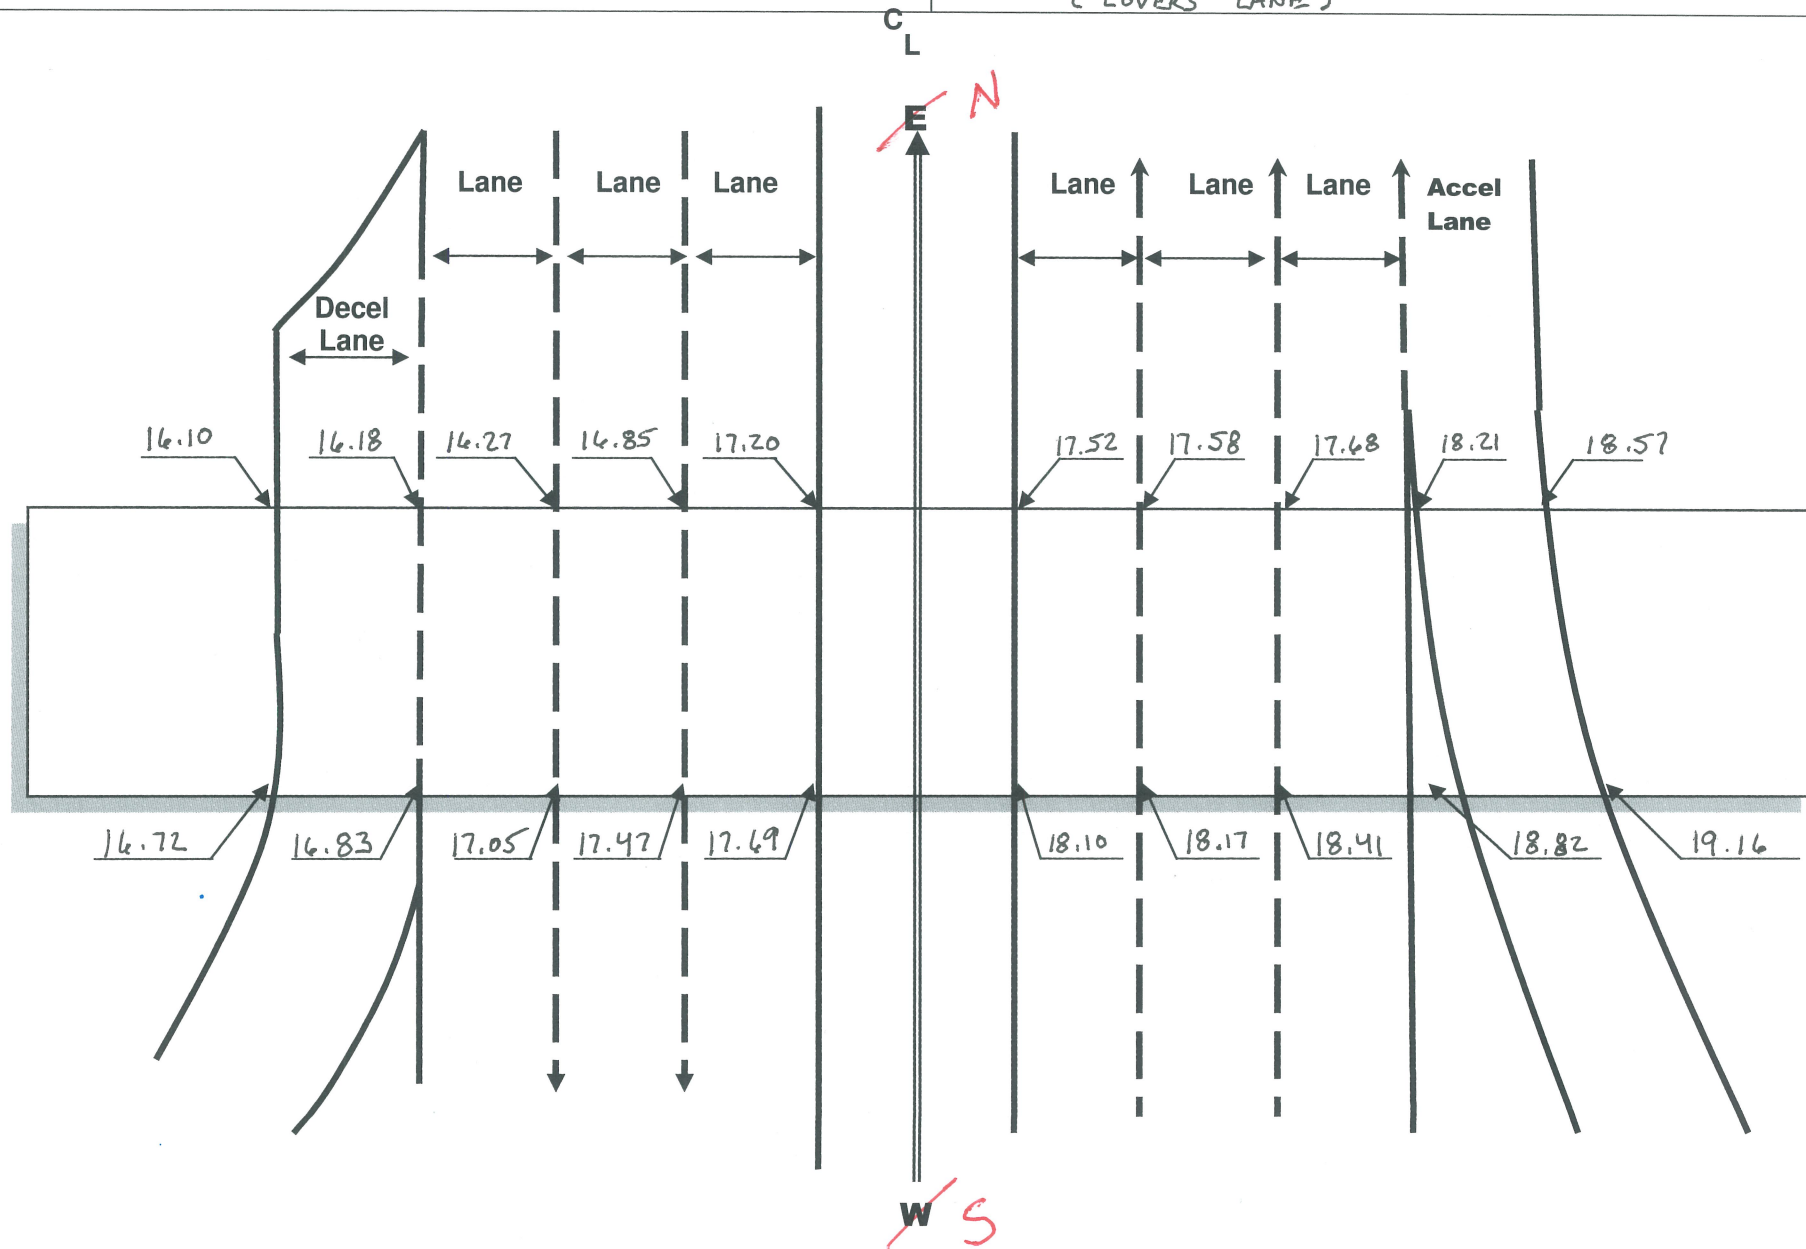



Ohio Department of Transportation
Vertical Clearance Survey Form

County: Summit Route: 77 76 Date: 10-30-18
Structure No. 1483 8.76 By: SA MH
EAST ST

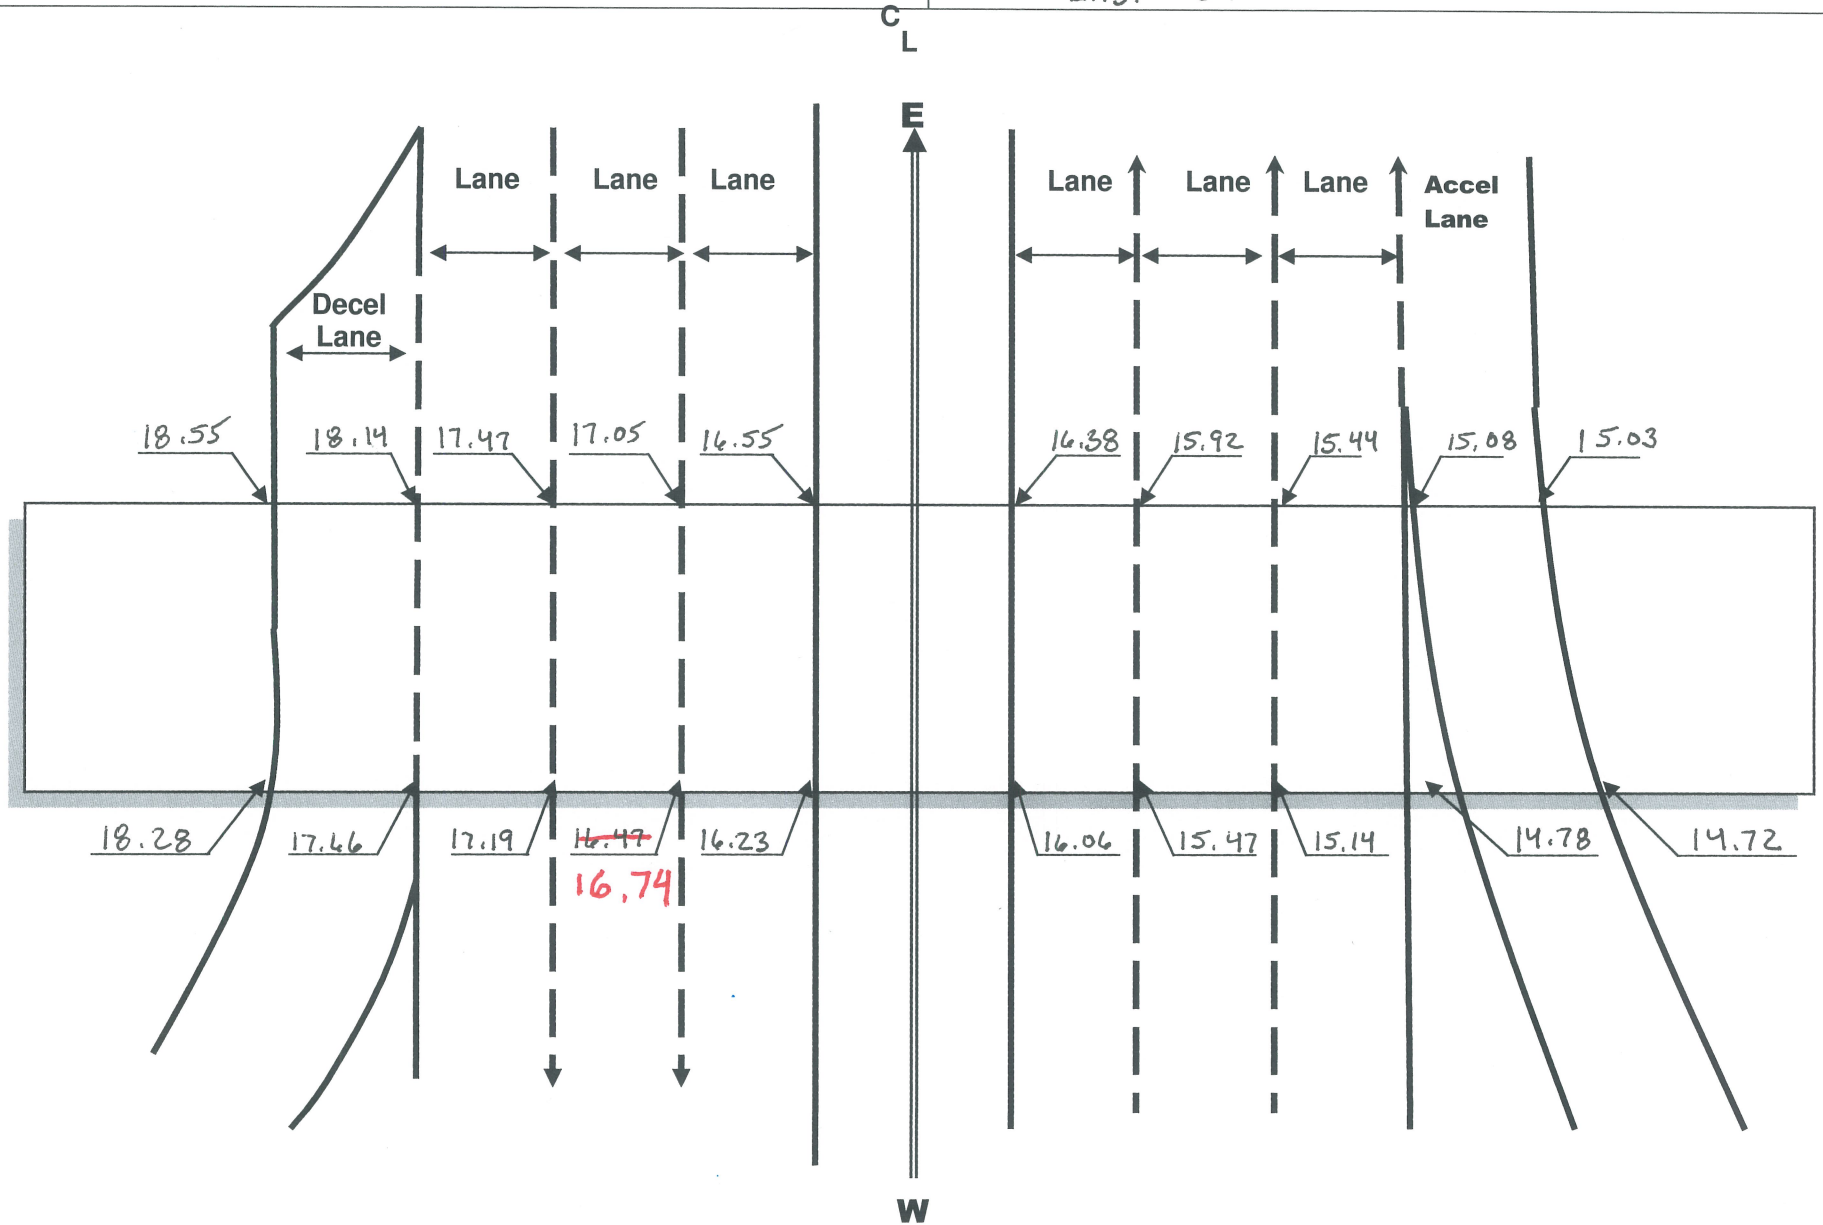




Ohio Department of Transportation
Vertical Clearance Survey Form

County: Summit Route: ~~77~~ 76 Date: 10-30-18

Structure No. ~~14.63~~ 8.94 By: JO MH

PED. BRIDGE

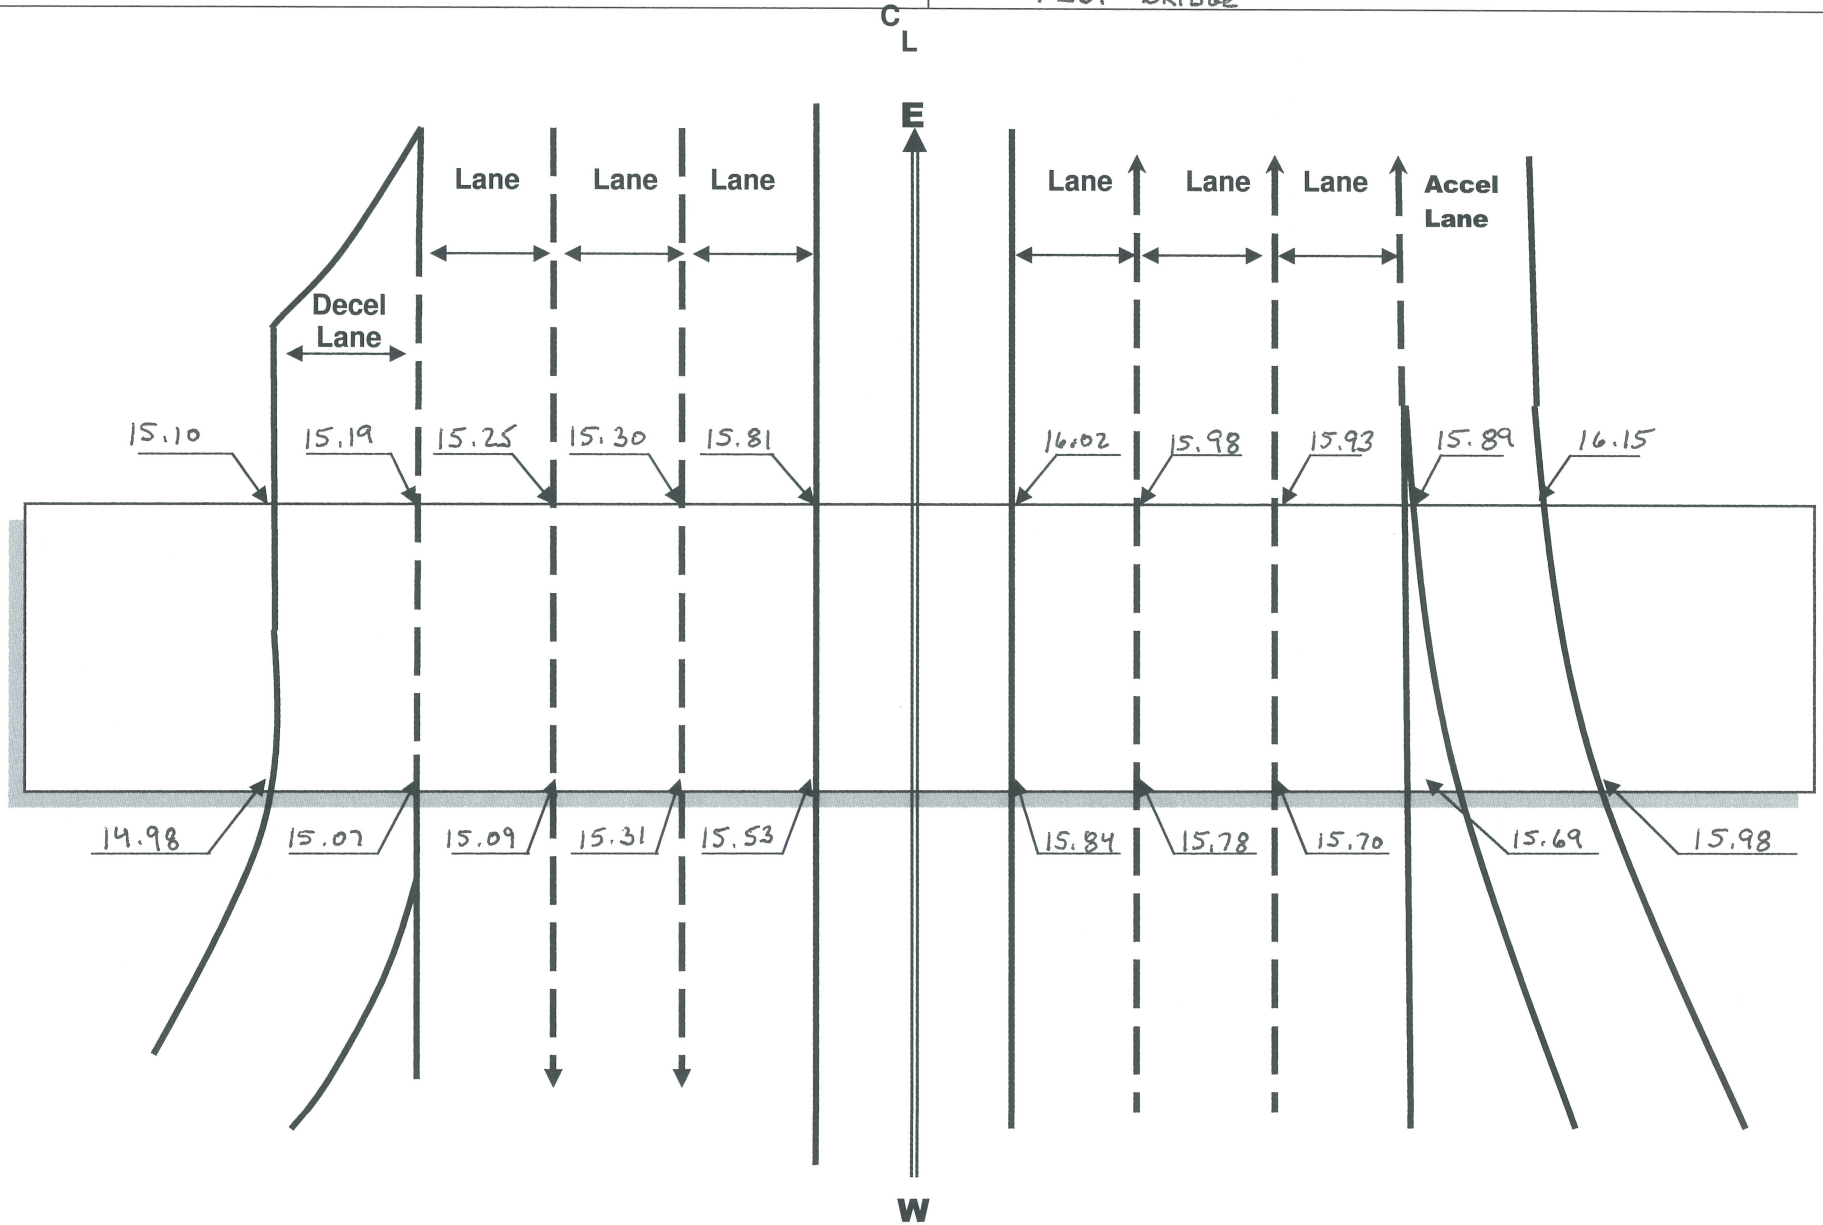




Ohio Department of Transportation
Vertical Clearance Survey Form

County: SUMMIT Route: ~~77~~ 76 Date: 10-30-18

Structure No. UNKNOWN* By: J.O. M.H.

(INNERBELT BRIDGE)

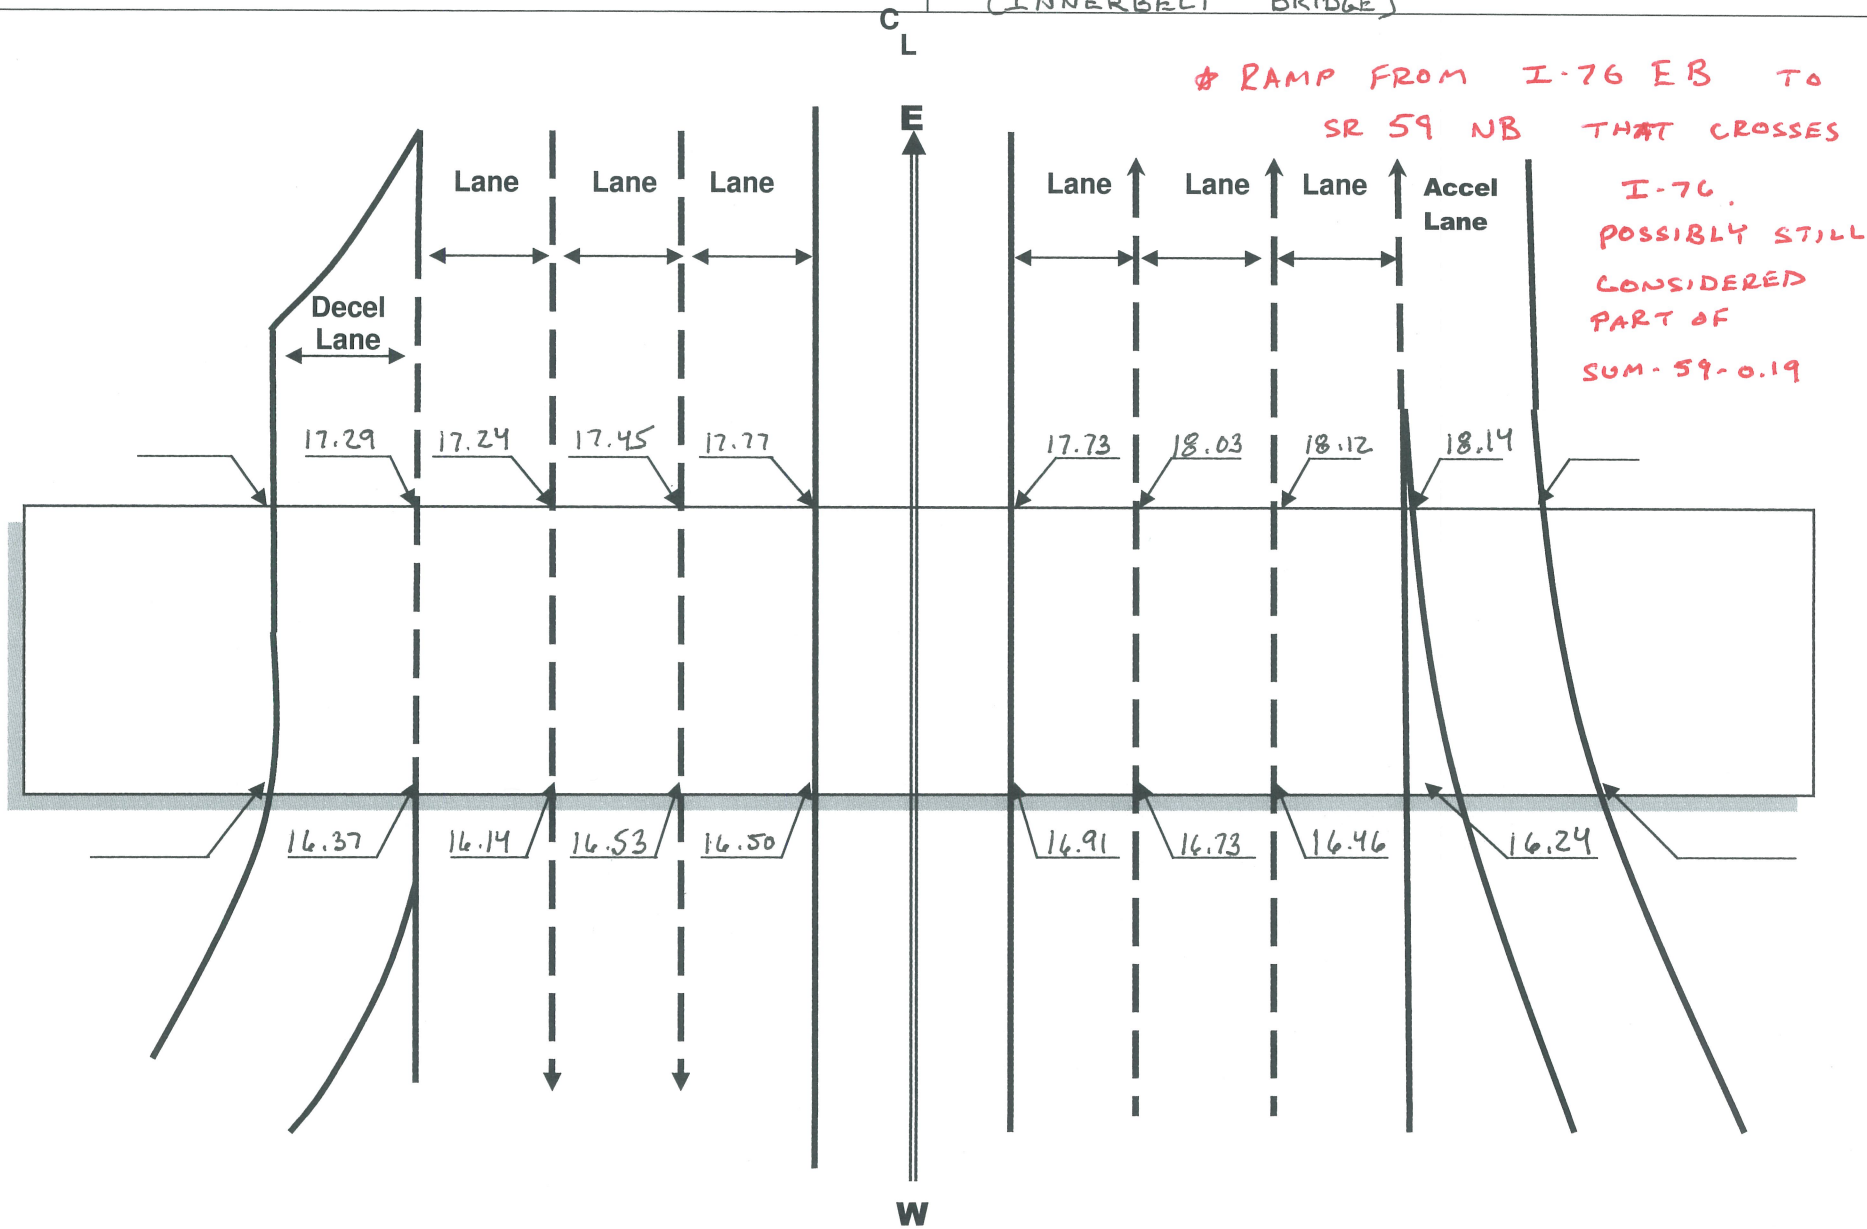



Ohio Department of Transportation
Vertical Clearance Survey Form

County: SUMMIT Route: 76 Date: 10-30-18
Structure No. 09.94 By: JO MH
PRINCETON ST BRIDGE

