


MICROFILMED
JUL 10 1979
REPRODUCTION

MAH-711-0.17

NOTE:
TRACK MAY BE TAKEN OUT OF SERVICE DURING CONSTRUCTION OF PIER 2. ALL COSTS OF REMOVAL AND REPLACEMENT OF TRACK TO BE AT THE CONTRACTOR'S OWN EXPENSE.

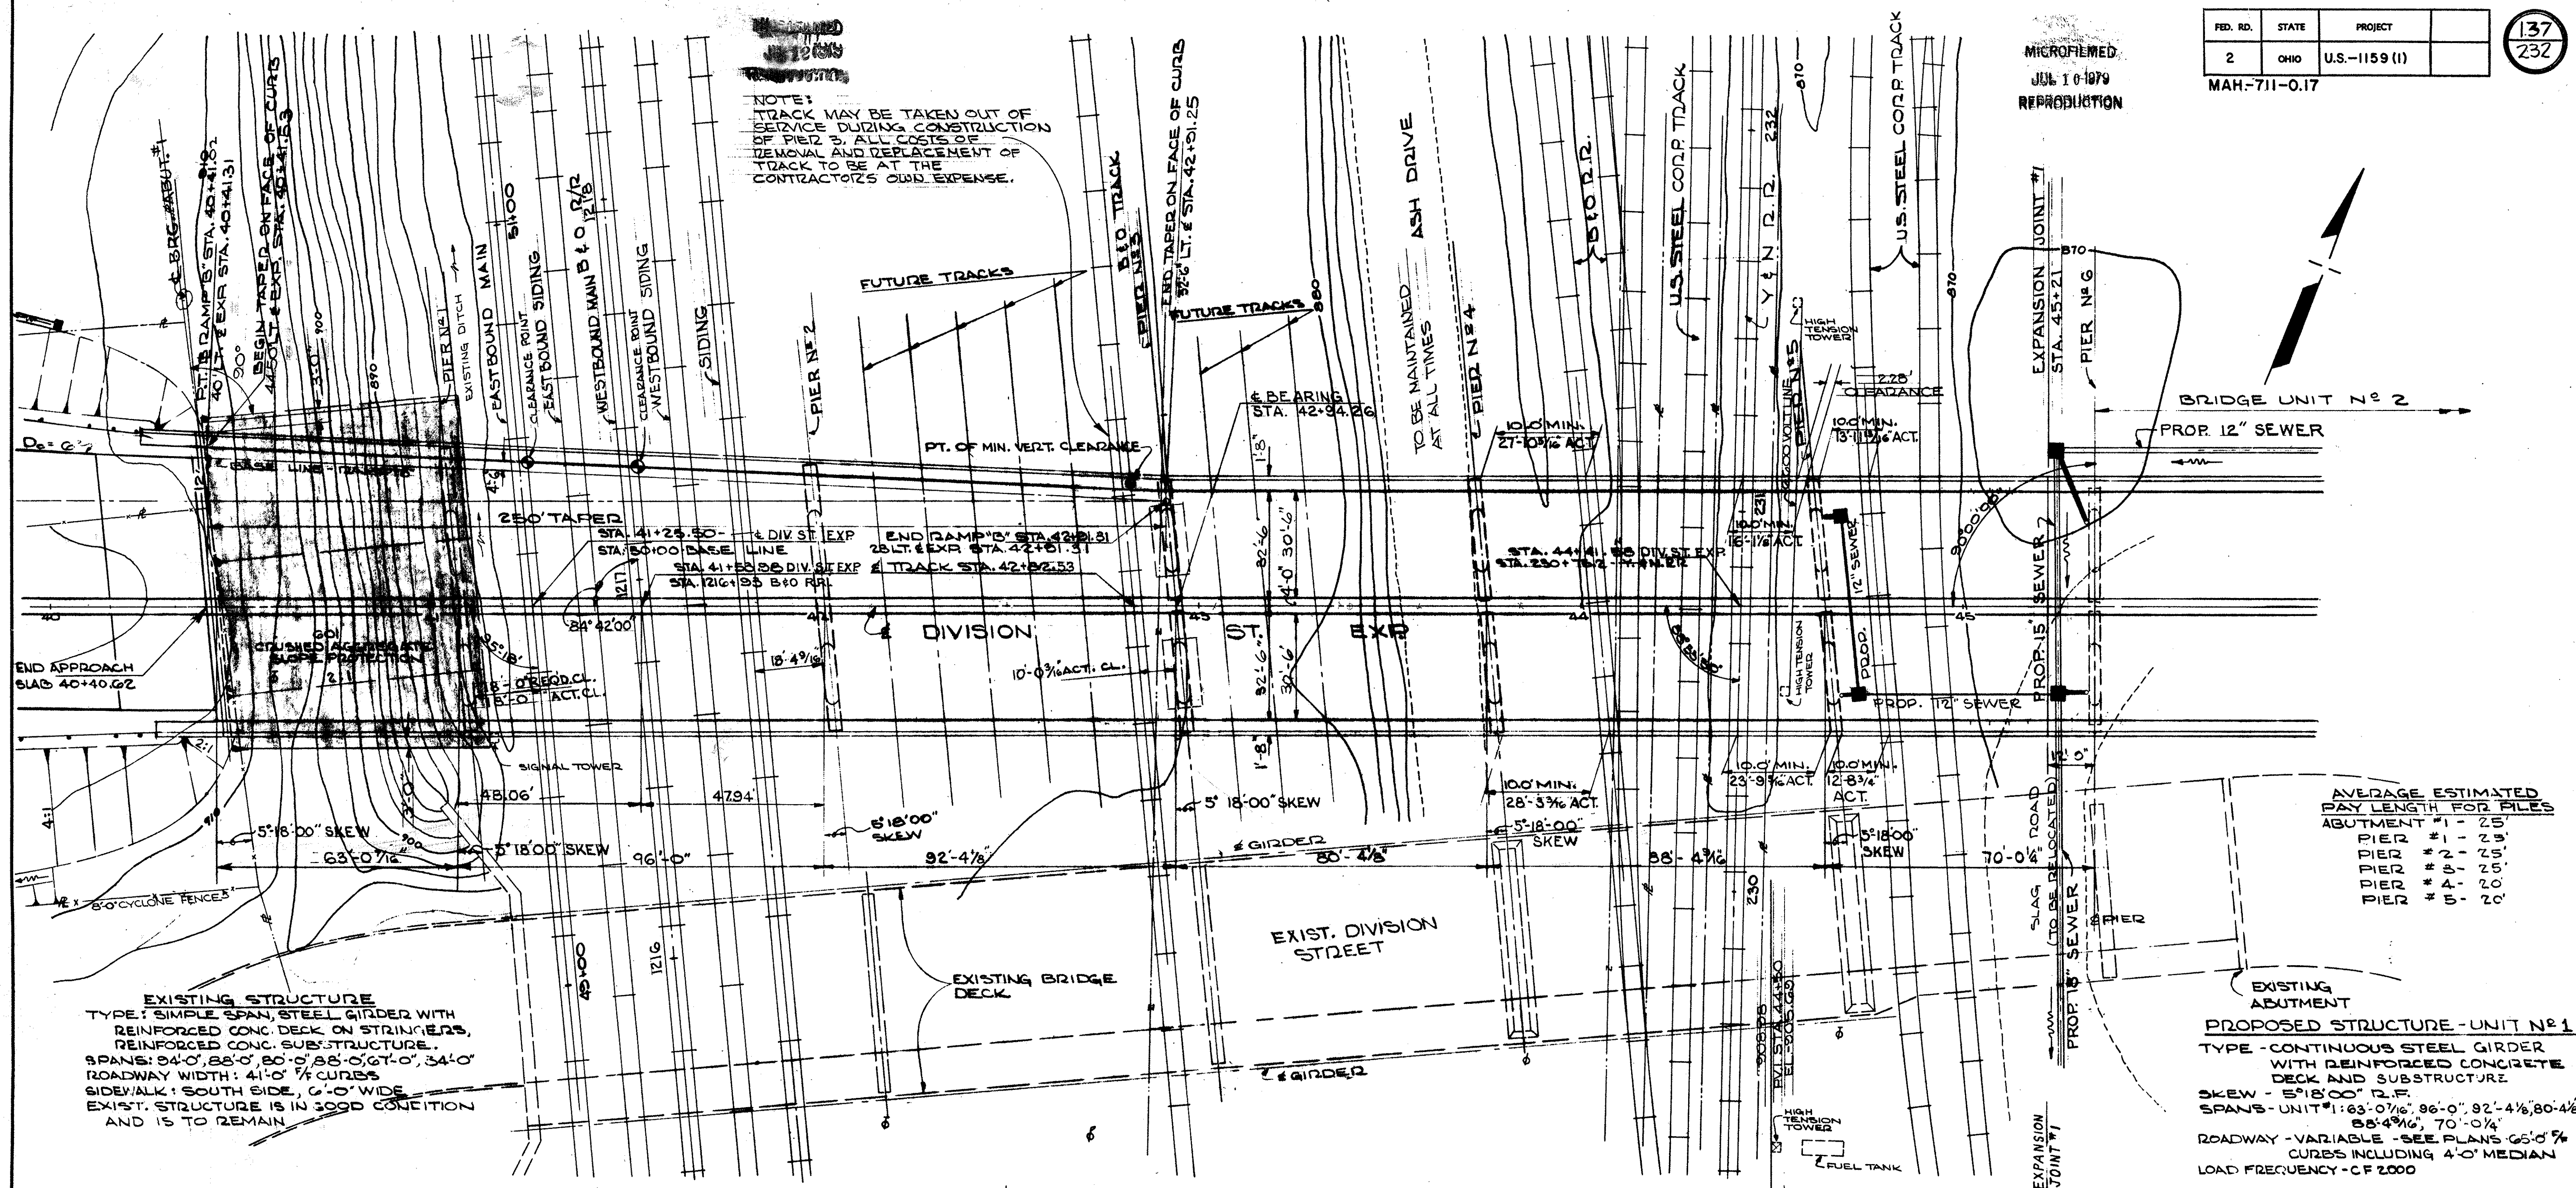


AVERAGE ESTIMATED PAY LENGTH FOR FILES

ABUTMENT #1 - 25'
PIER #1 - 23'
PIER #2 - 25'
PIER #3 - 26'
PIER #4 - 20'
PIER #5 - 20'

EXISTING STRUCTURE
TYPE - SIMPLE SPAN, STEEL GIRDER WITH REINFORCED CONC. DECK ON STRINGERS, REINFORCED CONC. SUBSTRUCTURE.
SPANS - 34'-0", 38'-0", 30'-0", 38'-0", 34'-0"
ROADWAY WIDTH - 41'-0" W/ CURBS
SIDEWALK - SOUTH SIDE, 6'-0" WIDE
EXIST. STRUCTURE IS IN GOOD CONDITION AND IS TO REMAIN

EXISTING ABUTMENT
PROPOSED STRUCTURE - UNIT NO. 1
TYPE - CONTINUOUS STEEL GIRDER WITH REINFORCED CONCRETE DECK AND SUBSTRUCTURE
SKEW - 5'-18'-00" R.F.
SPANS - UNIT #1: 63'-0 1/2", 96'-0", 92'-4 1/8", 80'-4 1/8"
ROADWAY - VARIABLE - SEE PLANS G5'-0 1/2" CURBS INCLUDING 4'-0" MEDIAN
LOAD FREQUENCY - CF 2000

WEARING SURFACE - 1" MONOLITHIC APPROACH SLAB - 25' LONG (AS-1-27)
ALIGNMENT - TANGENT
SUPERELEVATION - NONE
TRAFFIC COUNT: 14,500 ADT 1980
SLOPE PROTECTION - ITEM 601 CRUSHED AGGREGATE SLOPE PROTECTION

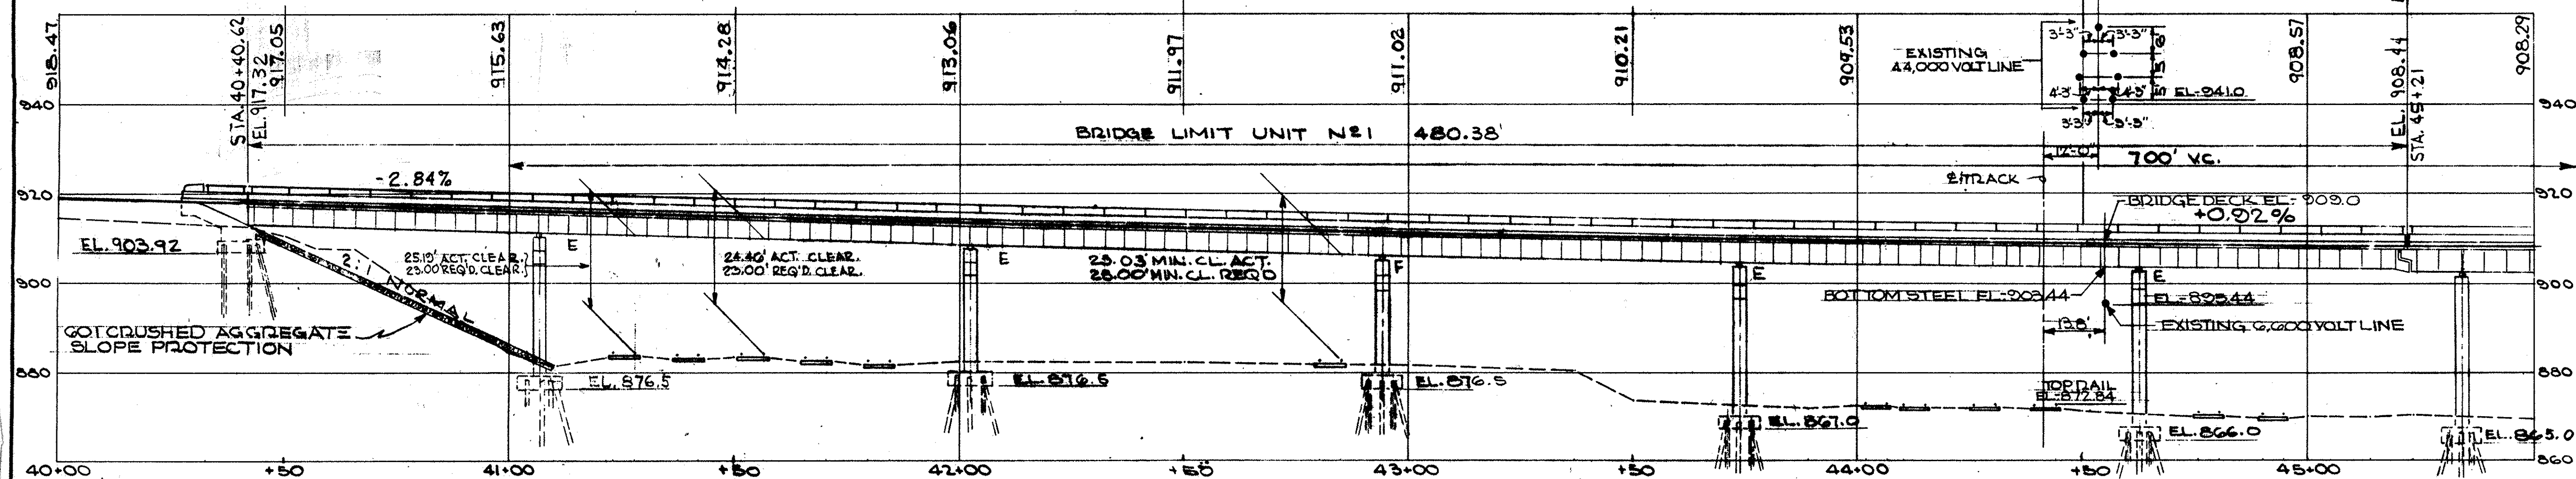

STATE OF OHIO
DEPARTMENT OF HIGHWAYS
BUREAU OF BRIDGES

AKRON, OHIO GLAUS, PYLE & SCHOMER YOUNGSTOWN, OHIO

SITE PLAN
BRIDGE NO. MAH-711-0116
OVER MAHONING RIVER
YOUNGSTOWN MAHONING COUNTY


UNIT NO. 1

DESIGNED	DRAWN	TRACED	CHECKED	REVIEWED	DATE	REVISED
W.K.D.	D.S.		W.K.D.	W.K.L.	6-22-68	




FED. RD.	STATE	PROJECT
2	OHIO	U.S.-1159 (1)

138
232


MAH.-711-0.17

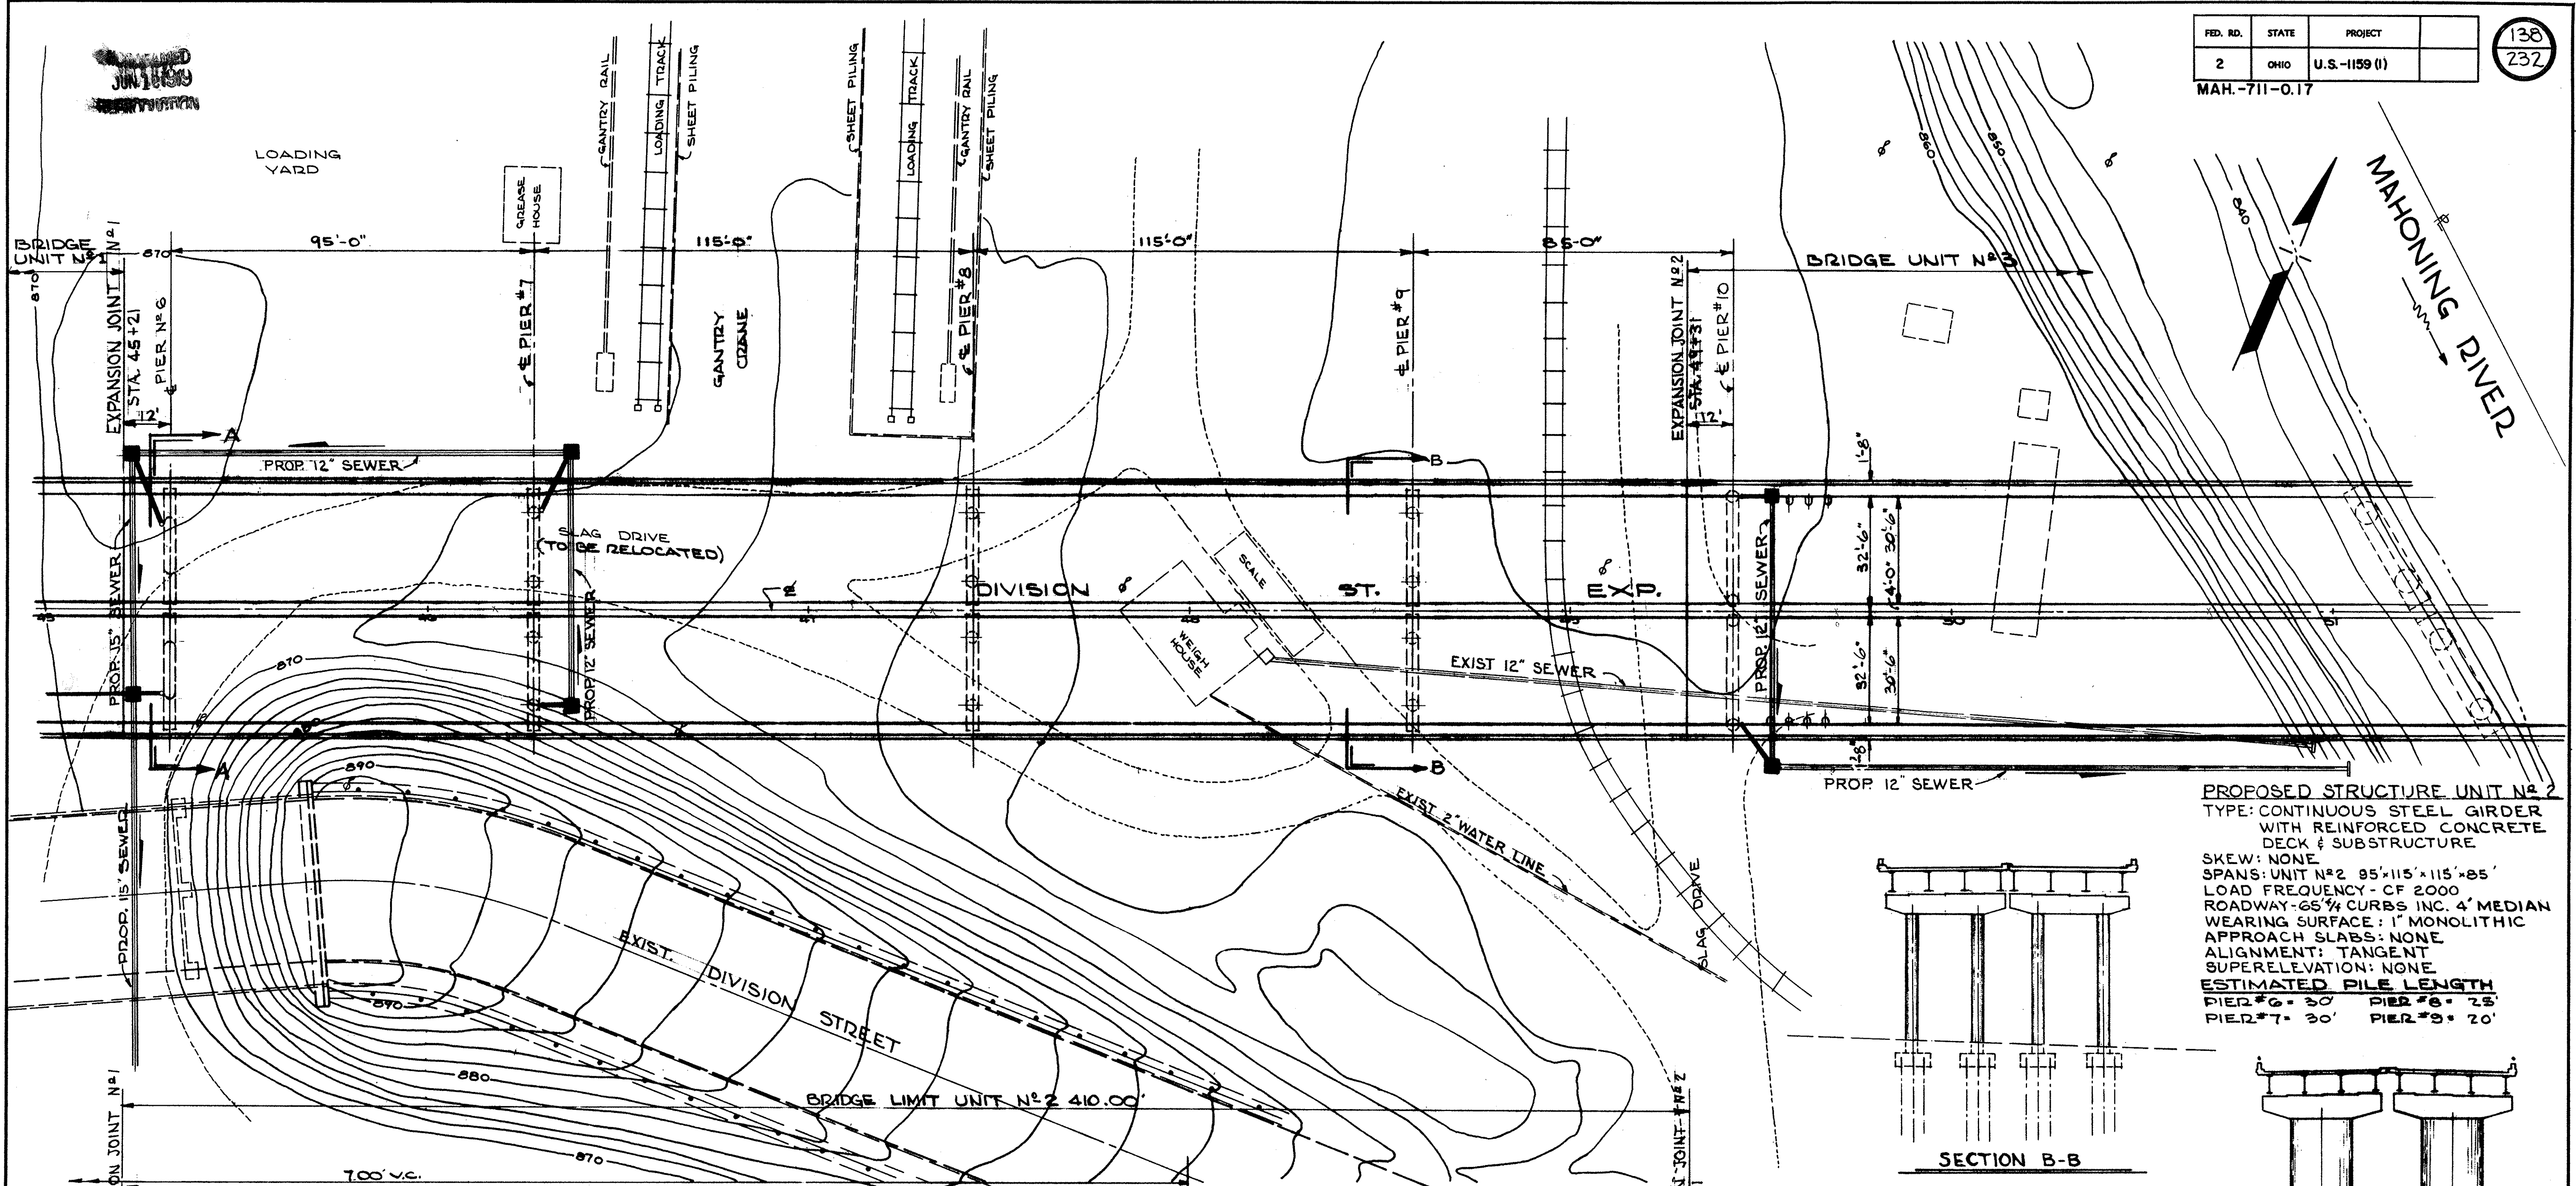

PROPOSED STRUCTURE UNIT No. 2
 TYPE: CONTINUOUS STEEL GIRDER WITH REINFORCED CONCRETE DECK & SUBSTRUCTURE
 SKEW: NONE
 SPANS: UNIT No. 2 85'-115'-115'-85'
 LOAD FREQUENCY - CF 2000
 ROADWAY - 65' CURBS INC. 4' MEDIAN
 WEARING SURFACE: 1" MONOLITHIC
 APPROACH SLABS: NONE
 ALIGNMENT: TANGENT
 SUPERELEVATION: NONE
ESTIMATED PILE LENGTH
 PIER #6 - 30' PIER #8 - 23'
 PIER #7 - 30' PIER #9 - 20'

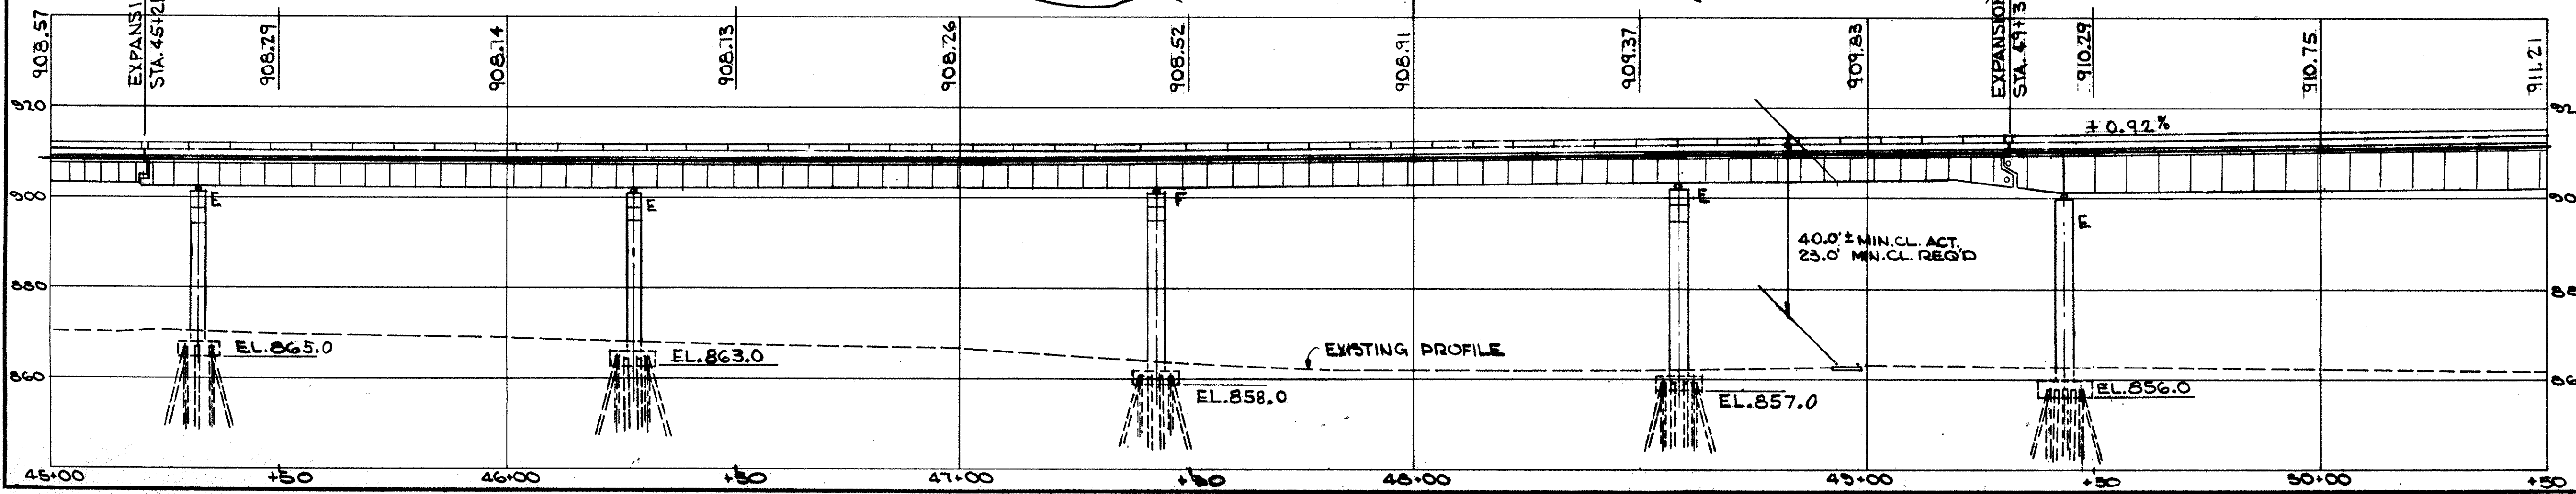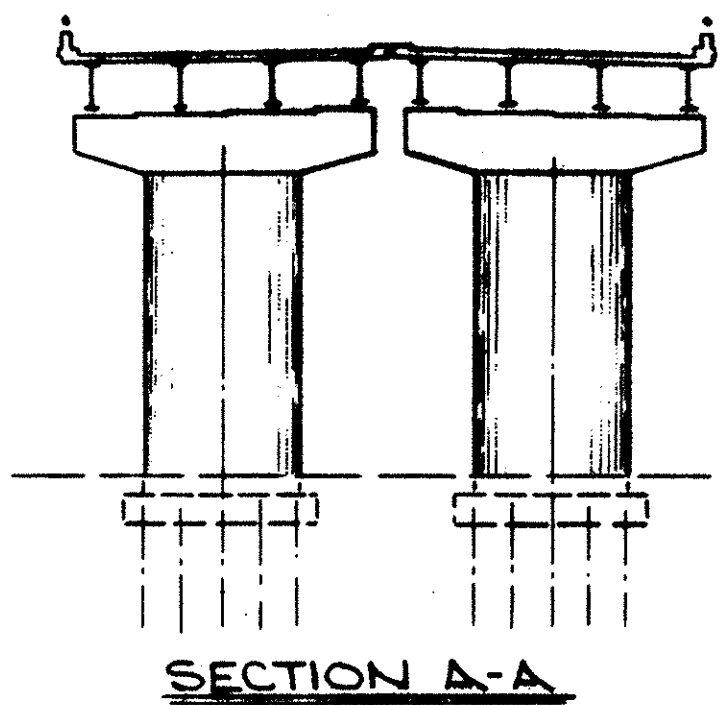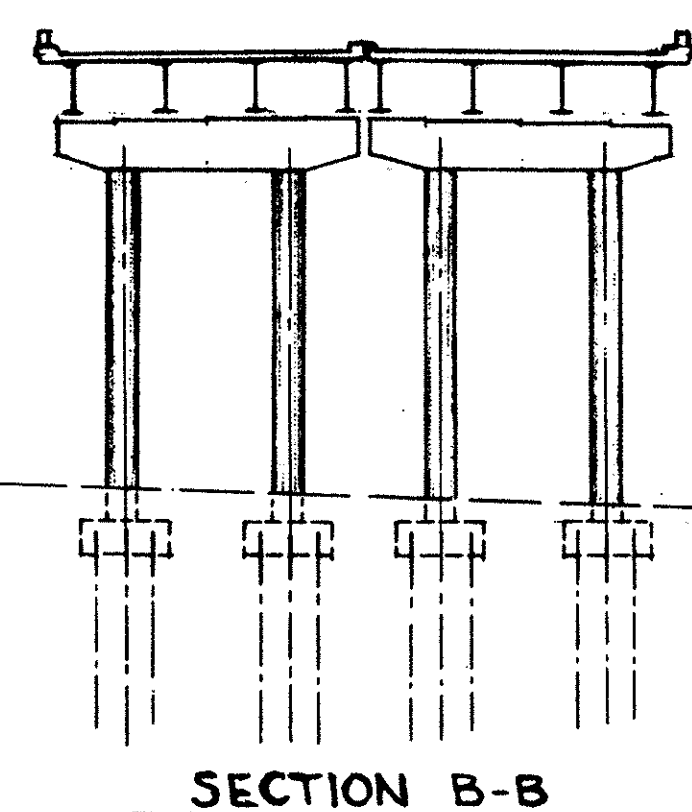

STATE OF OHIO DEPARTMENT OF HIGHWAYS BUREAU OF BRIDGES					
AKRON, OHIO			GLAUS, PYLE & SCHOMER YOUNGSTOWN, OHIO		
SITE PLAN					
BRIDGE No. MAH-711-0116					
OVER MAHONING RIVER					
YOUNGSTOWN MAHONING COUNTY					
UNIT: No. 2					
DESIGNED	DRAWN	TRACED	CHECKED	REVIEWED	DATE
W.K.D.	D.S.		W.K.D.	W.K.D.	6-22-68

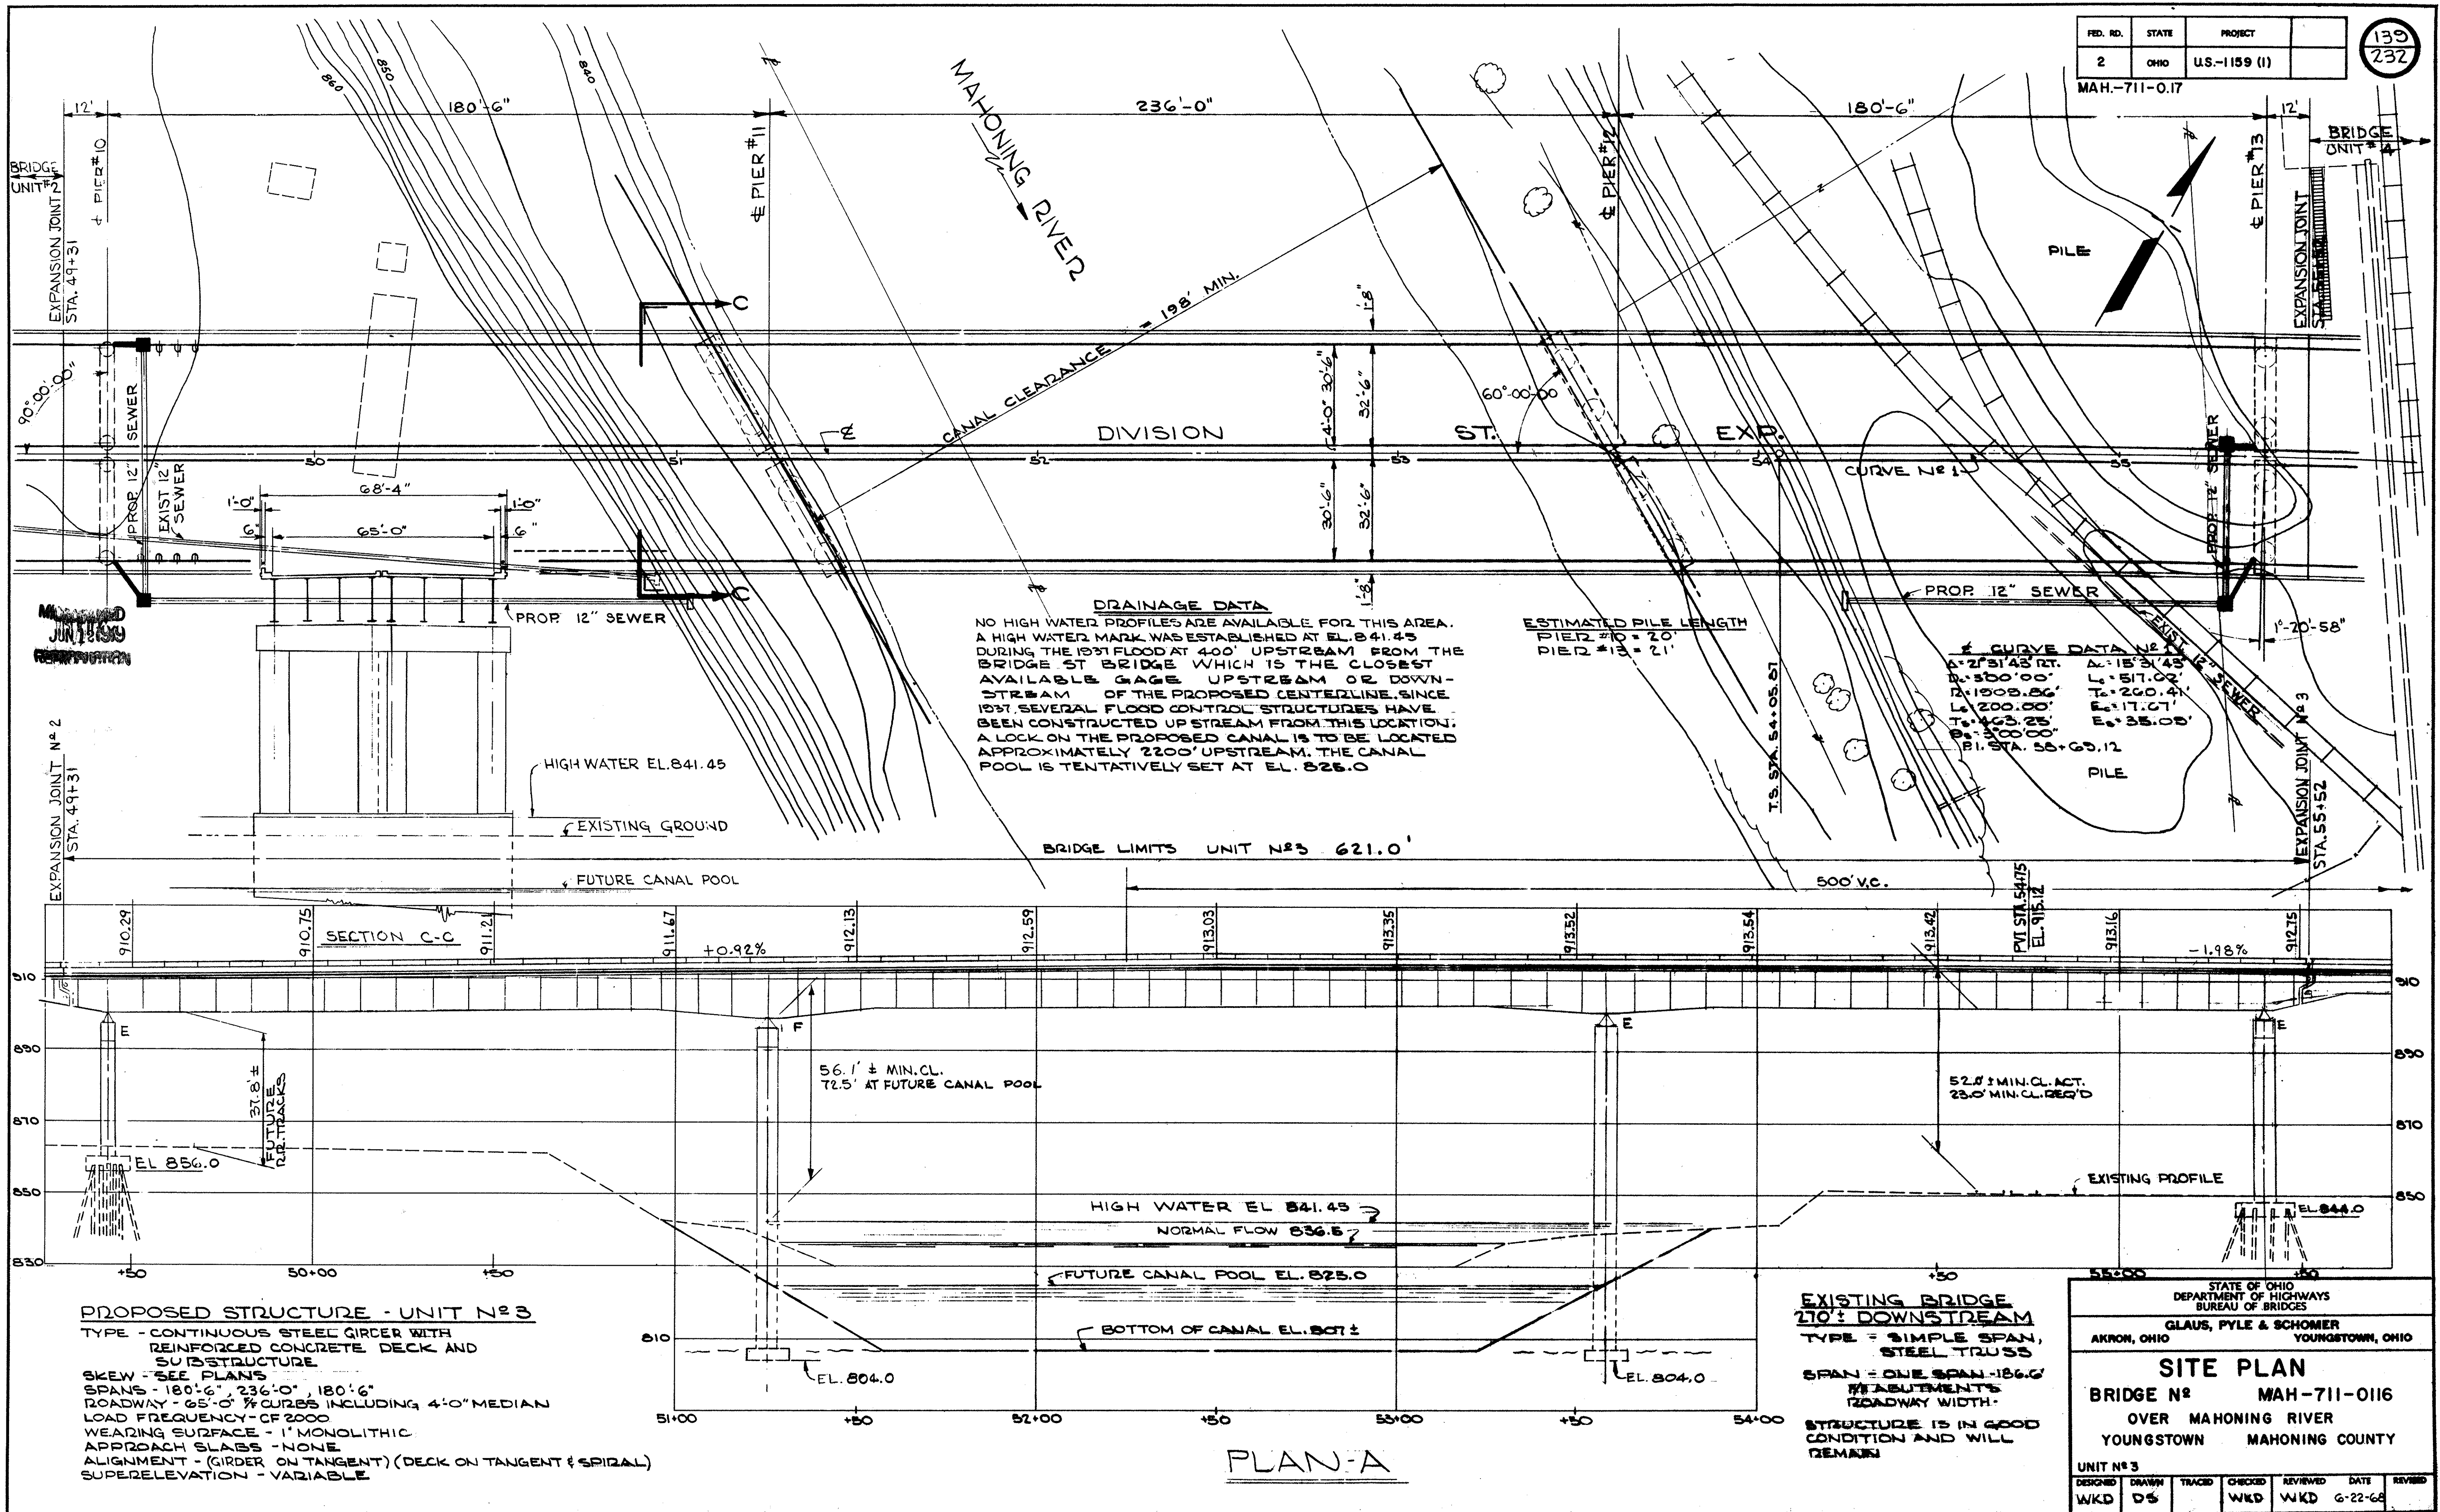

DRAINAGE DATA
 NO HIGH WATER PROFILES ARE AVAILABLE FOR THIS AREA. A HIGH WATER MARK WAS ESTABLISHED AT EL. 841.45 DURING THE 1937 FLOOD AT 400' UPSTREAM FROM THE BRIDGE ST BRIDGE WHICH IS THE CLOSEST AVAILABLE GAGE UPSTREAM OR DOWNSTREAM OF THE PROPOSED CENTERLINE. SINCE 1937 SEVERAL FLOOD CONTROL STRUCTURES HAVE BEEN CONSTRUCTED UPSTREAM FROM THIS LOCATION. A LOCK ON THE PROPOSED CANAL IS TO BE LOCATED APPROXIMATELY 2200' UPSTREAM. THE CANAL POOL IS TENTATIVELY SET AT EL. 825.0

ESTIMATED PILE LENGTH
 PIER #10 = 20'
 PIER #13 = 21'

CURVE DATA
 A = 2731.43 RT. Δ = 15° 31' 48"
 B = 500.00' L = 517.00'
 R = 1908.86' T = 200.41'
 L = 200.00' E = 17.67'
 T = 463.26' E₂ = 35.08'
 B = 400.00' B1 STA. 56+65.12

PROPOSED STRUCTURE - UNIT N° 3
 TYPE - CONTINUOUS STEEL GIRDER WITH REINFORCED CONCRETE DECK AND SUBSTRUCTURE
 SKEW - SEE PLANS
 SPANS - 180'-6", 236'-0", 180'-6"
 ROADWAY - 65'-0" CURBS INCLUDING 4'-0" MEDIAN
 LOAD FREQUENCY - CF 2000
 WEARING SURFACE - 1" MONOLITHIC
 APPROACH SLABS - NONE
 ALIGNMENT - (GIRDER ON TANGENT) (DECK ON TANGENT & SPIRAL)
 SUPERELEVATION - VARIABLE

EXISTING BRIDGE 270'± DOWNSTREAM
 TYPE - SIMPLE SPAN, STEEL TRUSS
 SPAN - ONE SPAN - 186'-0"
 REABUTMENTS ROADWAY WIDTH -
 STRUCTURE IS IN GOOD CONDITION AND WILL REMAIN


STATE OF OHIO
 DEPARTMENT OF HIGHWAYS
 BUREAU OF BRIDGES
 GLAUS, PYLE & SCHOMER
 AKRON, OHIO YOUNGSTOWN, OHIO

SITE PLAN
 BRIDGE N° MAH-711-016
 OVER MAHONING RIVER
 YOUNGSTOWN MAHONING COUNTY

DESIGNED	DRAWN	TRACED	CHECKED	REVIEWED	DATE	REVISION
WKD	DS		WKD	WKD	6-22-68	

PLAN-A

REVISION
JUN 2 1969

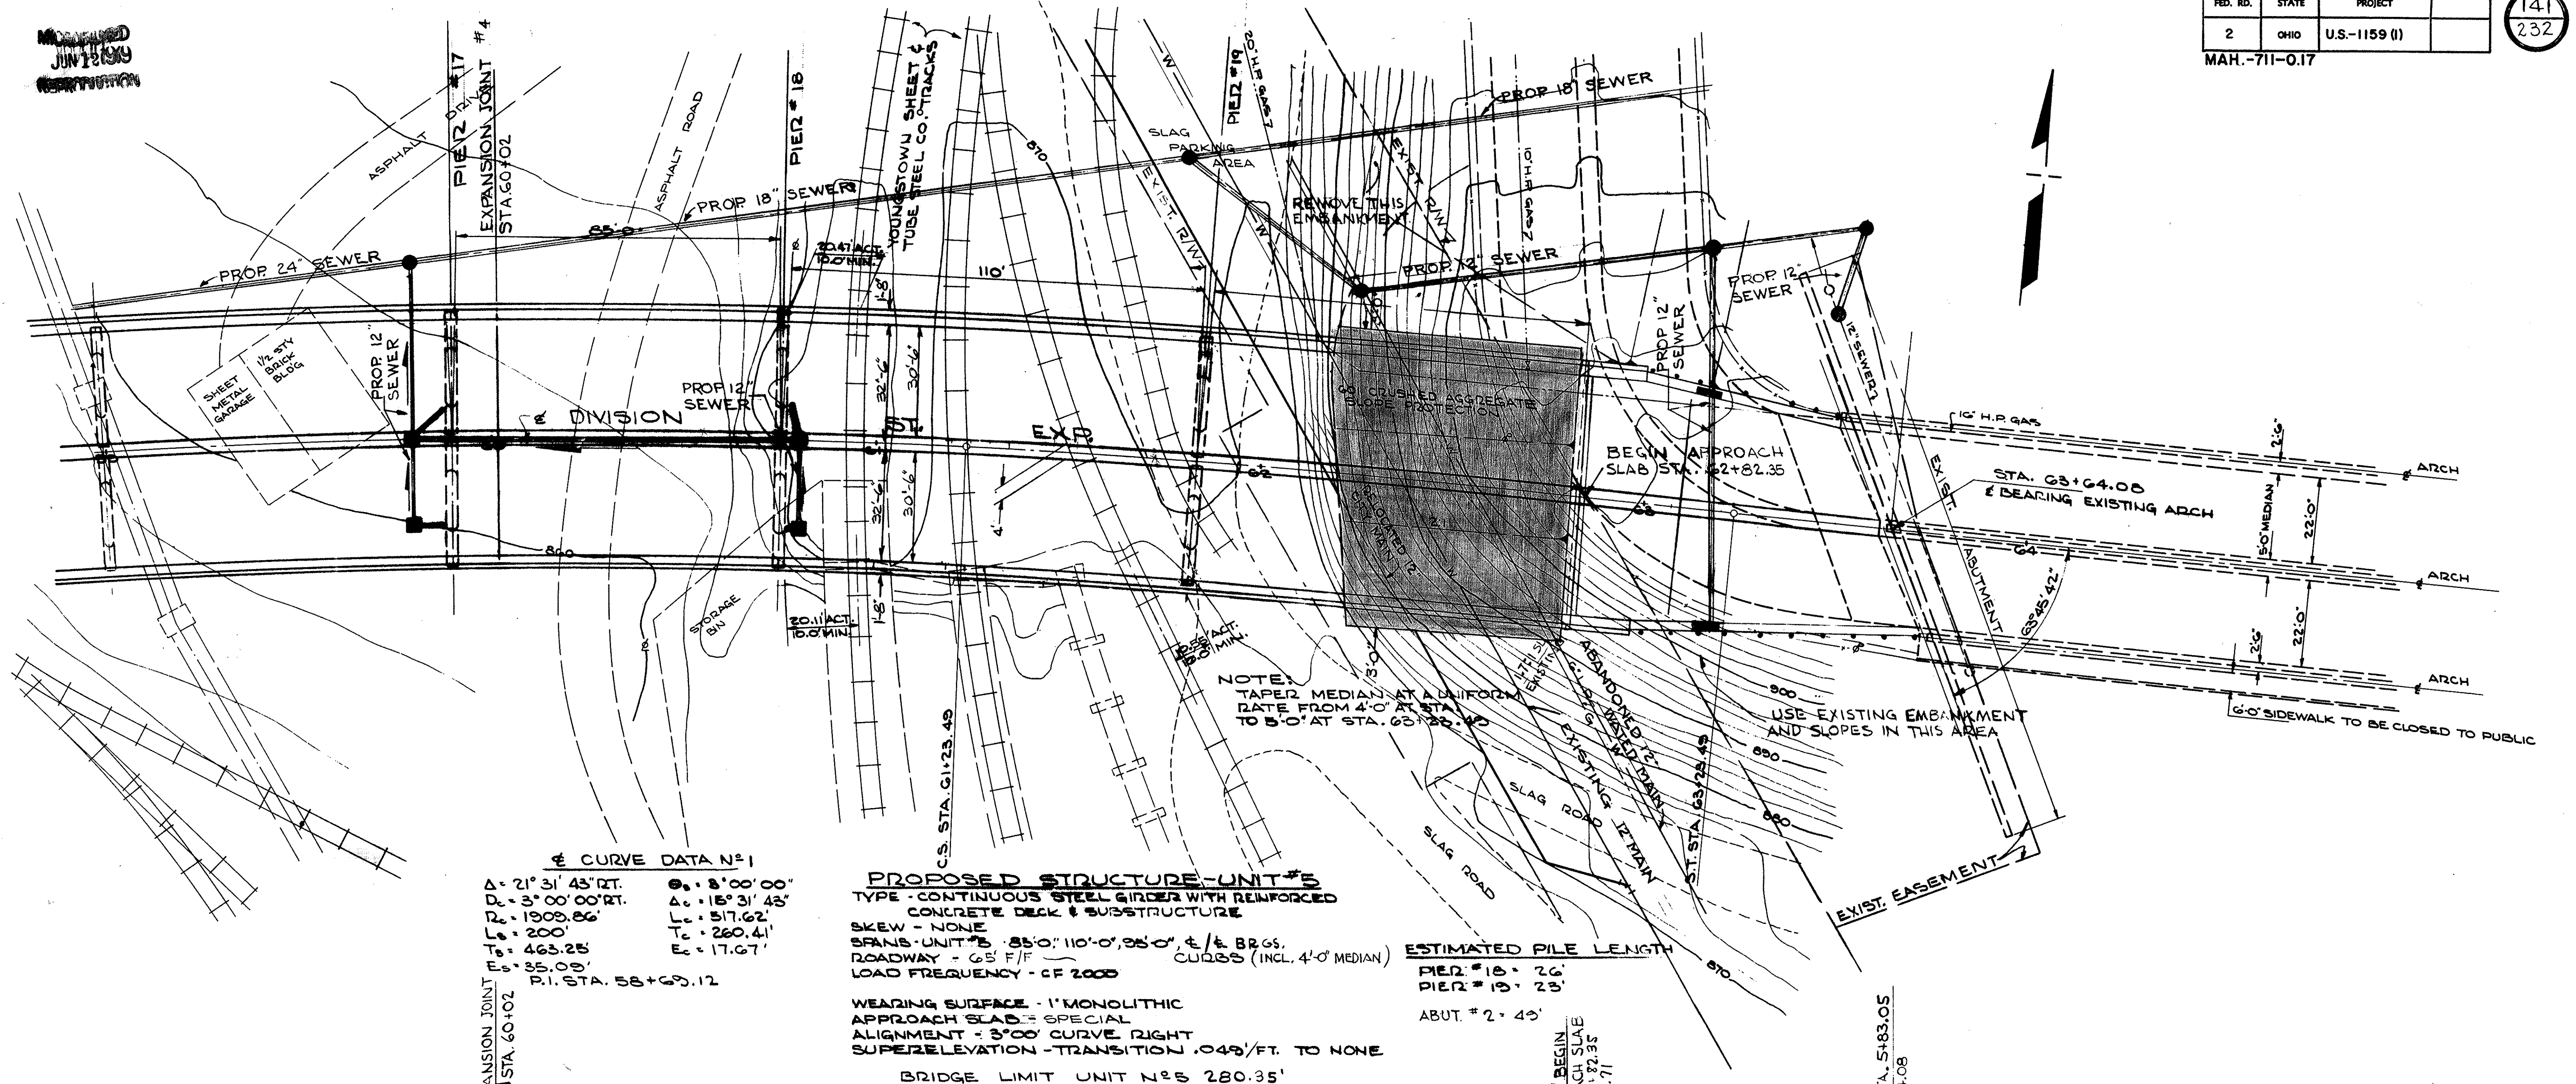


Curve Data No. 1

$\Delta = 21^{\circ} 31' 43''$ RT.	$\Delta_c = 3^{\circ} 00' 00''$
$D_c = 3^{\circ} 00' 00''$ RT.	$\Delta_c = 15^{\circ} 31' 43''$
$P_c = 1909.86'$	$L_c = 517.62'$
$T_c = 200'$	$T_c = 260.41'$
$E_c = 463.25'$	$E_c = 17.67'$
$P.I. STA. 58+69.12$	

PROPOSED STRUCTURE - UNIT #5
 TYPE - CONTINUOUS STEEL GIRDER WITH REINFORCED CONCRETE DECK & SUBSTRUCTURE
 SKEW - NONE
 SPANS - UNIT #5 - 85'-0" 110'-0" 98'-0" & 1/2 BRGS.
 ROADWAY - 65' F/F CROSS (INCL. 4'-0" MEDIAN)
 LOAD FREQUENCY - CF 2000
 WEARING SURFACE - 1" MONOLITHIC
 APPROACH SLAB - SPECIAL ALIGNMENT - 3'-00" CURVE RIGHT
 SUPERELEVATION - TRANSITION .04%/FT. TO NONE
 BRIDGE LIMIT UNIT NO. 5 280.35'

ESTIMATED PILE LENGTH
 PIER #18 - 26'
 PIER #19 - 23'
 ABUT. #2 - 40'

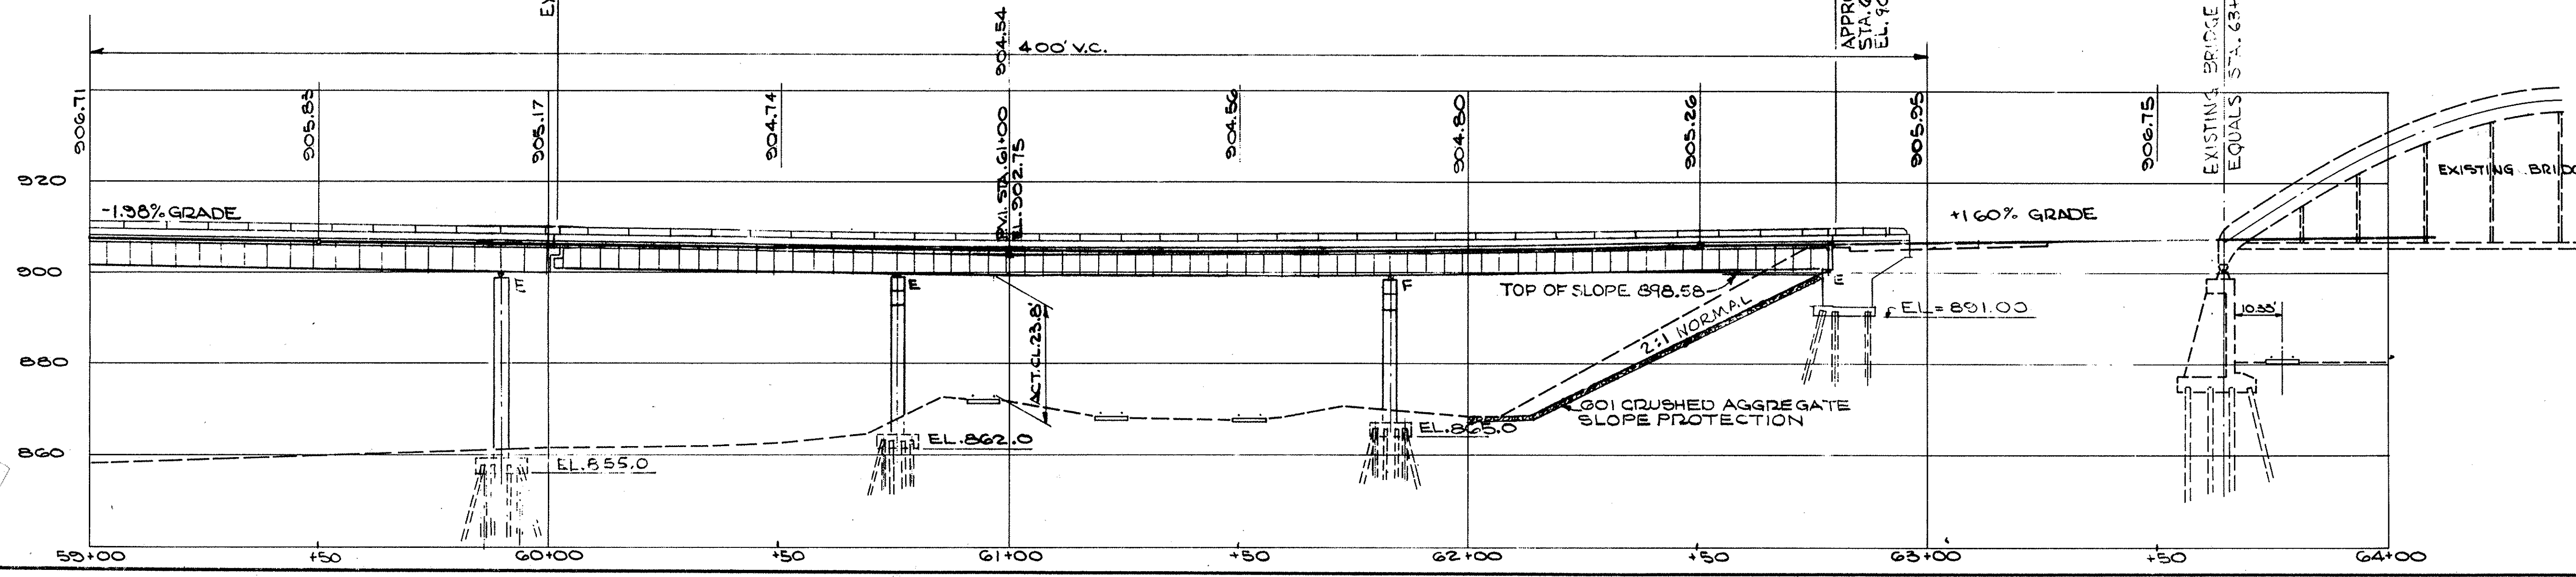

STATE OF OHIO
 DEPARTMENT OF HIGHWAYS
 BUREAU OF BRIDGES

AKRON, OHIO
 YOUNGSTOWN, OHIO

GLAUS, PYLE & SCHOMER

SITE PLAN
 BRIDGE NO. MAH-711-0116
 OVER MAHONING RIVER
 YOUNGSTOWN MAHONING COUNTY

UNIT NO. 5

DESIGNED	DRAWN	TRACED	CHECKED	REVIEWED	DATE	REVISED
W/KD	D/S		W/KD	W/KD	6-22-68	

MAHONGON
JUN 1969
REVISIONS

FED. RD.	STATE	PROJECT
2	OHIO	U.S.-1159 (I)

142
232

MAH-711-0.17

GENERAL NOTES

REFERENCE SHALL BE MADE TO STANDARD DRAWINGS:

AS-1-47	REVISED	1-11-68
BR-1-45	REVISED	1-19-64-65
SD-1-45	DATED	11-8-65
GR-2A	REVISED	1-1-67

AND TO SUPPLEMENTAL SPECIFICATIONS:

808	DATED	1-1-69
811	DATED	1-1-69
825	DATED	1-1-69
927	DATED	1-1-69

DESIGN SPECIFICATIONS: THIS STRUCTURE CONFORMS TO THE REQUIREMENTS OF "DESIGN SPECIFICATIONS FOR HIGHWAY STRUCTURE" OF THE STATE OF OHIO, DEPARTMENT OF HIGHWAYS, DATED 9-1-57, TOGETHER WITH CURRENT REVISIONS THEREOF.

DESIGN DATA:

DESIGN LOADING - CF 2000

CONCRETE CLASS C - BASIC UNIT STRESS 1,333 P.S.I. (SUPERSTRUCTURE & PIER)
CONCRETE CLASS C - BASIC UNIT STRESS 1,133 P.S.I. (ABUTMENT & FOOTINGS)

STRUCTURAL STEEL - ASTM A36 - BASIC UNIT STRESS 20,000 P.S.I. AND
ASTM A441 - BASIC UNIT STRESS 23,000 P.S.I.

REINFORCING STEEL - ASTM A615, A616, A617, DEFORMED, INTERMEDIATE
OR HARD GRADE. BASIC UNIT STRESS 20,000 P.S.I.
EXCEPT, SPIRAL REINFORCEMENT SHALL BE PLAIN,
A306 OR A499 WITH BASIC UNIT STRESS OF
18,000 P.S.I.

SHEETING AND BRACING: BEFORE CONSTRUCTION IS STARTED, EIGHT SETS OF PRINTS SHOWING DETAILS OF THE SHEETING AND BRACING TO BE USED FOR EXCAVATION ADJACENT TO THE RAILROAD TRACKS SHALL BE SUBMITTED TO THE DIRECTOR FOR APPROVAL BY THE DEPARTMENT OF HIGHWAYS AND FIVE SETS OF PRINTS FOR EACH RAILROAD COMPANY FOR APPROVAL.

ALIGNING RAILROAD TRACKS: AFTER THE CONTRACTOR HAS COMPLETED ALL EXCAVATION AND BACKFILL ADJACENT TO THE RAILROAD TRACKS IN COMPLIANCE WITH SEC. 503.04 AND 503.09 OF THE CONSTRUCTION AND MATERIAL SPECIFICATIONS, SUBJECT TO THE SUPERVISION OF THE RAILROAD COMPANY, NOTHING IN SEC. 503.04, 503.09, 108.04 OF THE SPECIFICATIONS SHALL BE CONSTRUED TO HOLD THE CONTRACTOR LIABLE FOR ALIGNING AND RESURFACING THE RAILROAD TRACKS.

RAILROAD AERIAL LINES WILL BE RELOCATED BY THE RAILROAD. THE CONTRACTOR SHALL USE ALL PRECAUTIONS NECESSARY TO SEE THAT THE LINES ARE NOT DISTURBED DURING THE CONSTRUCTION STAGE AND SHALL COOPERATE WITH THE RAILROAD IN THE RELOCATION OF THESE LINES. THE COST OF THE RELOCATION SHALL BE INCLUDED IN THE RAILROAD FORCE ACCOUNT WORK.

FOUNDATION BEARING PRESSURE: FOOTINGS ARE DESIGNED FOR A MAXIMUM BEARING PRESSURE OF:

PIER 11 & 12	9 T.S.F.
PIER 15	9 T.S.F.
PIER 16	9 T.S.F.

ALL REMAINING PIERS AND ABUTMENTS ARE SUPPORTED ON PILES.

PILES SHALL BE DRIVEN TO FIRM CONTACT WITH ROCK. IF THE LENGTH OF PENETRATION IS APPROXIMATELY EQUAL TO THE DEPTH TO ROCK ACCORDING TO THE BRIDGE FOUNDATION INVESTIGATION REPORT, THE FIRM CONTACT SHALL BE CONSIDERED AS ATTAINED WHEN THE CAPACITY ACCORDING TO THE FORMULA IN SEC. 507.05 IS NOT LESS THAN THE FOLLOWING VALUE FOR A PILE HAMMER OF THE INDICATED ENERGY RATING.

FOR ABUTMENT NO. 1 PILES
52 TONS PER PILE USING A 7000 FT. LB. HAMMER
40 TONS PER PILE USING AN 11000 FT. LB. HAMMER
40 TONS PER PILE USING A 15000 FT. LB. OR GREATER HAMMER
40 TONS DESIGN LOAD

FOR ABUTMENT NO. 2 PILES
48 TONS PER PILE USING AN 11000 FT. LB. HAMMER
48 TONS PER PILE USING A 15000 FT. LB. OR GREATER HAMMER
48 TONS DESIGN LOAD

FOR PIERS NO. 1, 2, 3, 8
62 TONS PER PILE USING AN 11000 FT. LB. HAMMER
50 TONS PER PILE USING A 15000 FT. LB. OR GREATER HAMMER
50 TONS DESIGN LOAD

FOR PIERS NO. 4, 5, 9, 13, 17
70 TONS PER PILE USING AN 11000 FT. LB. HAMMER
52 TONS PER PILE USING A 15000 FT. LB. OR GREATER HAMMER
50 TONS DESIGN LOAD

FOR PIERS NO. 6 & 7
56 TONS PER PILE USING AN 11000 FT. LB. HAMMER
50 TONS PER PILE USING A 15000 FT. LB. OR GREATER HAMMER
50 TONS DESIGN LOAD

FOR PIER NO. 10
45 TONS PER PILE USING AN 11000 FT. LB. HAMMER
45 TONS PER PILE USING A 15000 FT. LB. OR GREATER HAMMER
45 TONS DESIGN LOAD

FOR PIER NO. 14
67 TONS PER PILE USING AN 11000 FT. LB. HAMMER
50 TONS PER PILE USING A 15000 FT. LB. OR GREATER HAMMER
50 TONS DESIGN LOAD

FOR PIERS NO. 18 & 19
45 TONS PER PILE USING AN 11000 FT. LB. HAMMER
45 TONS PER PILE USING A 15000 FT. LB. OR GREATER HAMMER
45 TONS DESIGN LOAD

THE FOLLOWING FOOTINGS ARE IN ROCK. PIER 11, PIER 12, PIER 15, AND PIER 16. THEY SHALL EXTEND A MINIMUM OF 3" INTO UNDISTURBED ROCK OR TO THE ELEVATION SHOWN, WHICHEVER IS LOWER.

WELDS ON SECONDARY STRESS CARRYING MEMBERS ARE SHOWN THIS 

FIELD WELDED ATTACHMENTS: NO ATTACHMENTS SHALL BE MADE BY WELDING TO THE TOP FLANGES OF THE BEAMS OR GIRDERS WITHIN A DISTANCE OF 0.10 OF THE SPAN LENGTH ON EITHER SIDE OF THE INTERIOR SUPPORTS. WELDING FOR ATTACHMENTS TO THE TOP FLANGES AT OTHER PARTS OF THE SPANS SHALL BE KEPT AT LEAST 2" FROM EDGE OF FLANGE.

MACHINE FINISH: THE CONCRETE BRIDGE DECK SHALL BE FINISHED BY THE USE OF A FINISHING MACHINE.

THE CONTRACTOR SHALL FURNISH TO THE DIRECTOR, FOR APPROVAL, 3 PRINTS SHOWING THIS PROPOSED ERECTION PROCEDURE FOR THE PLATE GIRDERS.

THE CONCRETE DECK SLAB SHALL BE POURED IN THE FOLLOWING SEQUENCE:

FIRST	UNIT 1
SECOND	UNIT 2
THIRD	UNIT 5
FOURTH	UNIT 4
FIFTH	UNIT 3


EACH DECK SEGMENT SHALL BE POURED CONTINUOUSLY FROM EXPANSION JOINT TO EXPANSION JOINT.

EXCAVATION QUANTITY INCLUDES THE REMOVAL OF FILL MATERIAL REQUIRED FOR CONSTRUCTION OF THE ABUTMENTS.

CONSTRUCTION CLEARANCE OF 20' VERTICALLY ABOVE THE TOP OF THE RAILROAD RAILS AND 8' HORIZONTALLY FROM THE CENTER OF TRACKS SHALL BE MAINTAINED AT ALL TIMES.

GUARD RAIL EXPANSION JOINTS: EXPAND THE SLOTTED HOLES SHOWN ON THE RAIL SPLICE DETAIL ON STANDARD DRAWING GR-2A TO 3/4" x 6-1/2" FOR ALL END POST CONNECTIONS OF THE MEDIAN GUARD RAIL ADJACENT TO THE EXPANSION JOINTS AT THE ABUTMENTS AS WELL AS EACH UNIT. PAYMENT TO BE INCLUDED IN THE UNIT BID PRICE FOR ITEM 517, RAILING (DOUBLE-FACED, DEEP BEAM RAIL WITH STEEL POSTS AND BOLTS). SEE DETAIL OF RAIL SPLICE SHEET 143, and this sheet.

PAINTING OF STRUCTURAL STEEL SHALL CONFORM TO ITEM 514 EXCEPT THAT THE FINAL TWO COATS OF FINISH PAINT SHALL CONFORM TO ITEM 708.05 INSTEAD OF 708.12. COLOR OF FINAL TWO COATS TO BE APPROVED BY THE STATE OF OHIO AND THE CITY OF YOUNGSTOWN.

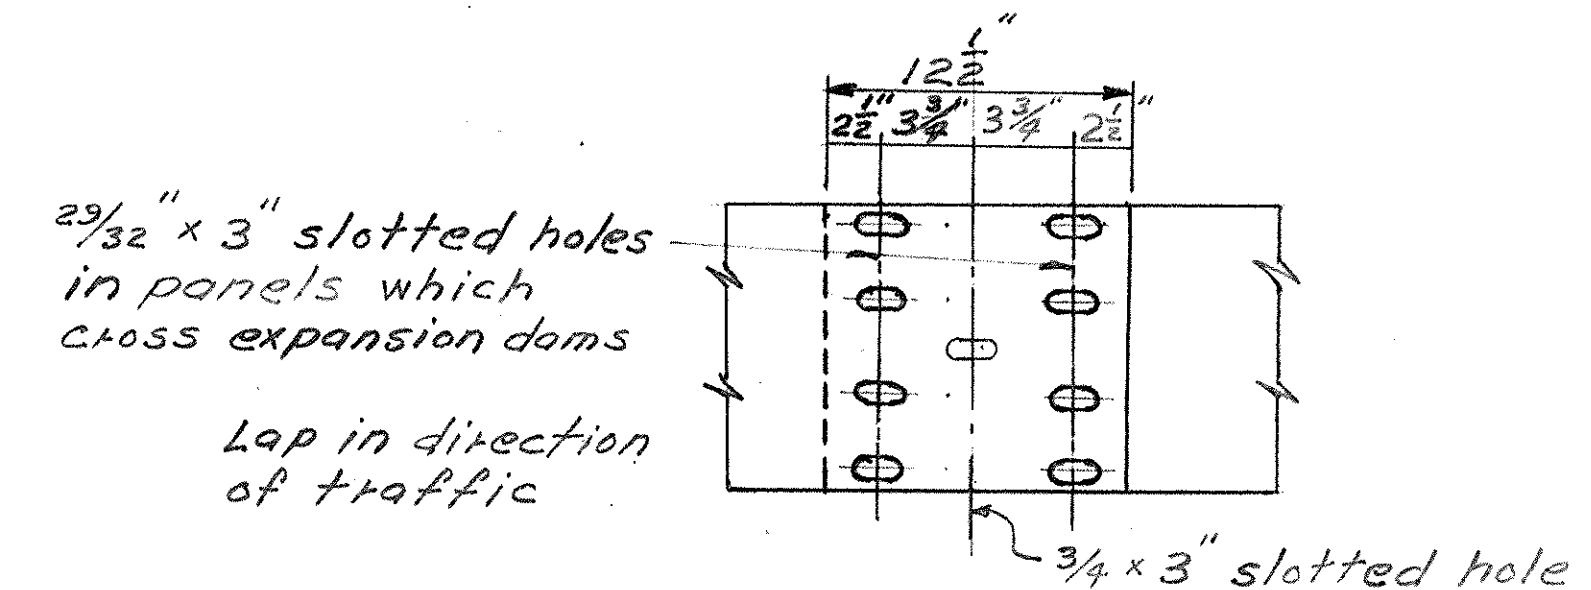

DETAIL OF SPICE IN MEDIAN GUARD RAIL ADJACENT TO EXPANSION JOINTS

ESTIMATED QUANTITIES

D.M. 10-7-67
R.A.H. 6-21-68

ITEM	TOTAL	UNIT	DESCRIPTION	SUPER STRUCT.	ABUT'S	PIERS	GEN.		
503	4,414	CU. YD.	UNCLASSIFIED EXCAVATION		497	3,917			
503	LUMP	SUM.	COFFERDAMS, CRIBS, SHEETING				LUMP		
503	1,398	CU. YD.	DOCK EXCAVATION			1,398		+126	1,524
505	LUMP	SUM.	FIRST TEST PILE				LUMP		
506	LUMP	SUM.	FIRST PILE TEST LOAD				LUMP		
506	1	EACH	SUBSEQUENT PILE TEST LOAD				1		
507	19,657	LIN. FT.	PILES - STEEL 12 5P 53	1,382,288	1,212	18,425			
509	240,936	LBS.	REINFORCING STEEL	149,592	21,151	102,414	1,025,955		
511	4,791	CU. YD.	CLASS "C" CONCRETE - SUPERSTRUCTURE	4,791	20,270	10,254,994			
511	3,934	CU. YD.	CLASS "C" CONCRETE - PIERS ABOVE FTNG.			3,934			
511	219	CU. YD.	CLASS "C" CONCRETE - ABUT. ABOVE FTNG.			219			
511	1,427	CU. YD.	CLASS "C" CONCRETE - FOOTINGS			1,427			
513	5,919,920	LBS.	STRUCTURAL STEEL	5,866,754		107,175		+21,739	5,995,668
514	5,919,920	LBS.	Field Painting of Structural Steel	5,866,754		107,175		+21,739	5,995,668
517	2,250	LIN. FT.	RAILING (DOUBLE-FACED, DEEP BEAM RAIL WITH STEEL POSTS AND BOLTS)	2,241.73					
517	4,553.41	LIN. FT.	RAILING - TYPE - I	4,481.09	72.32				

ITEM	TOTAL	UNIT	DESCRIPTION	SUPER STRUCT.	ABUT'S	PIERS	GEN.		
518	75	CU. YD.	POROUS BACKFILL			75			
518	130	LIN. FT.	6" PERFORATED, HELICAL CMP, INCLUDING SPECIALS, 707.01			130			
518	132	LIN. FT.	6" NON PERFORATED HELICAL CMP, 707.01			132			
518	119	EACH	SCUPPERS, INCLUDING SUPPORTS, TYPE-2	119					
518	2414	LIN. FT.	8" STD. PIPE HORIZONTAL CONDUCTORS, WROUGHT IRON, ALLOY STEEL (707.11) OR HOT DIPPED GALVANIZED STEEL, INCLUDING SPECIAL.			2414			
518	488	LIN. FT.	8" STD. PIPE DOWNSPOUT, WROUGHT IRON, ALLOY STEEL (707.11) OR HOT DIPPED GALVANIZED STEEL, INCLUDING SPECIALS.			488			
601	1,363	SQ. YD.	CRUSHED AGGREGATE SLOPE PROTECTION						1,363
625			SEE SHEET 83 FOR LIGHTING SUMMARY						
808	4,791	UNITS	WATER-REDUCING, SET-RETARDING ADMIXTURE	4,791					
825	18,710	SQ. YD.	CONCRETE SURFACE TREATMENT	18,666	44				

Revised
1-26-70

STATE OF OHIO
DEPARTMENT OF HIGHWAYS
BUREAU OF BRIDGES

AKRON, OHIO

GLAUS, PYLE & SCHOMER
YOUNGSTOWN, OHIO

GEN. NOTES & EST. QUANTITIES
BRIDGE N^o MAH-711-0116
OVER MAHONING RIVER
YOUNGSTOWN MAHONING COUNTY



DESIGNED	DRAWN	TRACED	CHECKED	REVIEWED	DATE	REVISED
RAH.	J.D.P.		D.M.	WKD	6-22-68	3-28-69 7-11-69

MODIFIED
JUN 12 1960

FED. RD.	STATE	PROJECT
7	OHIO	U.S.-1150(1)

143
232

MAH-711-017

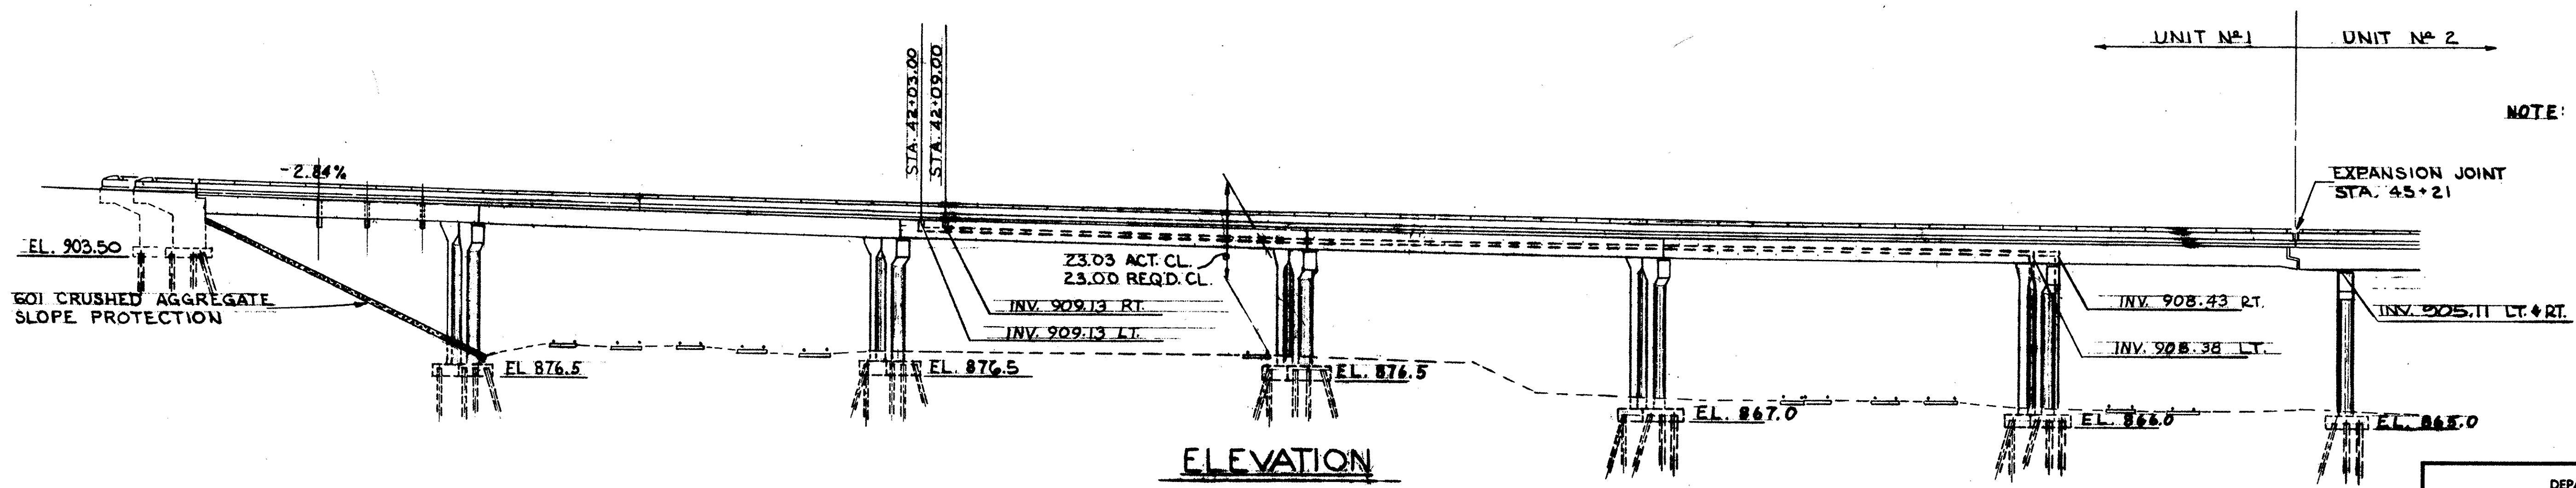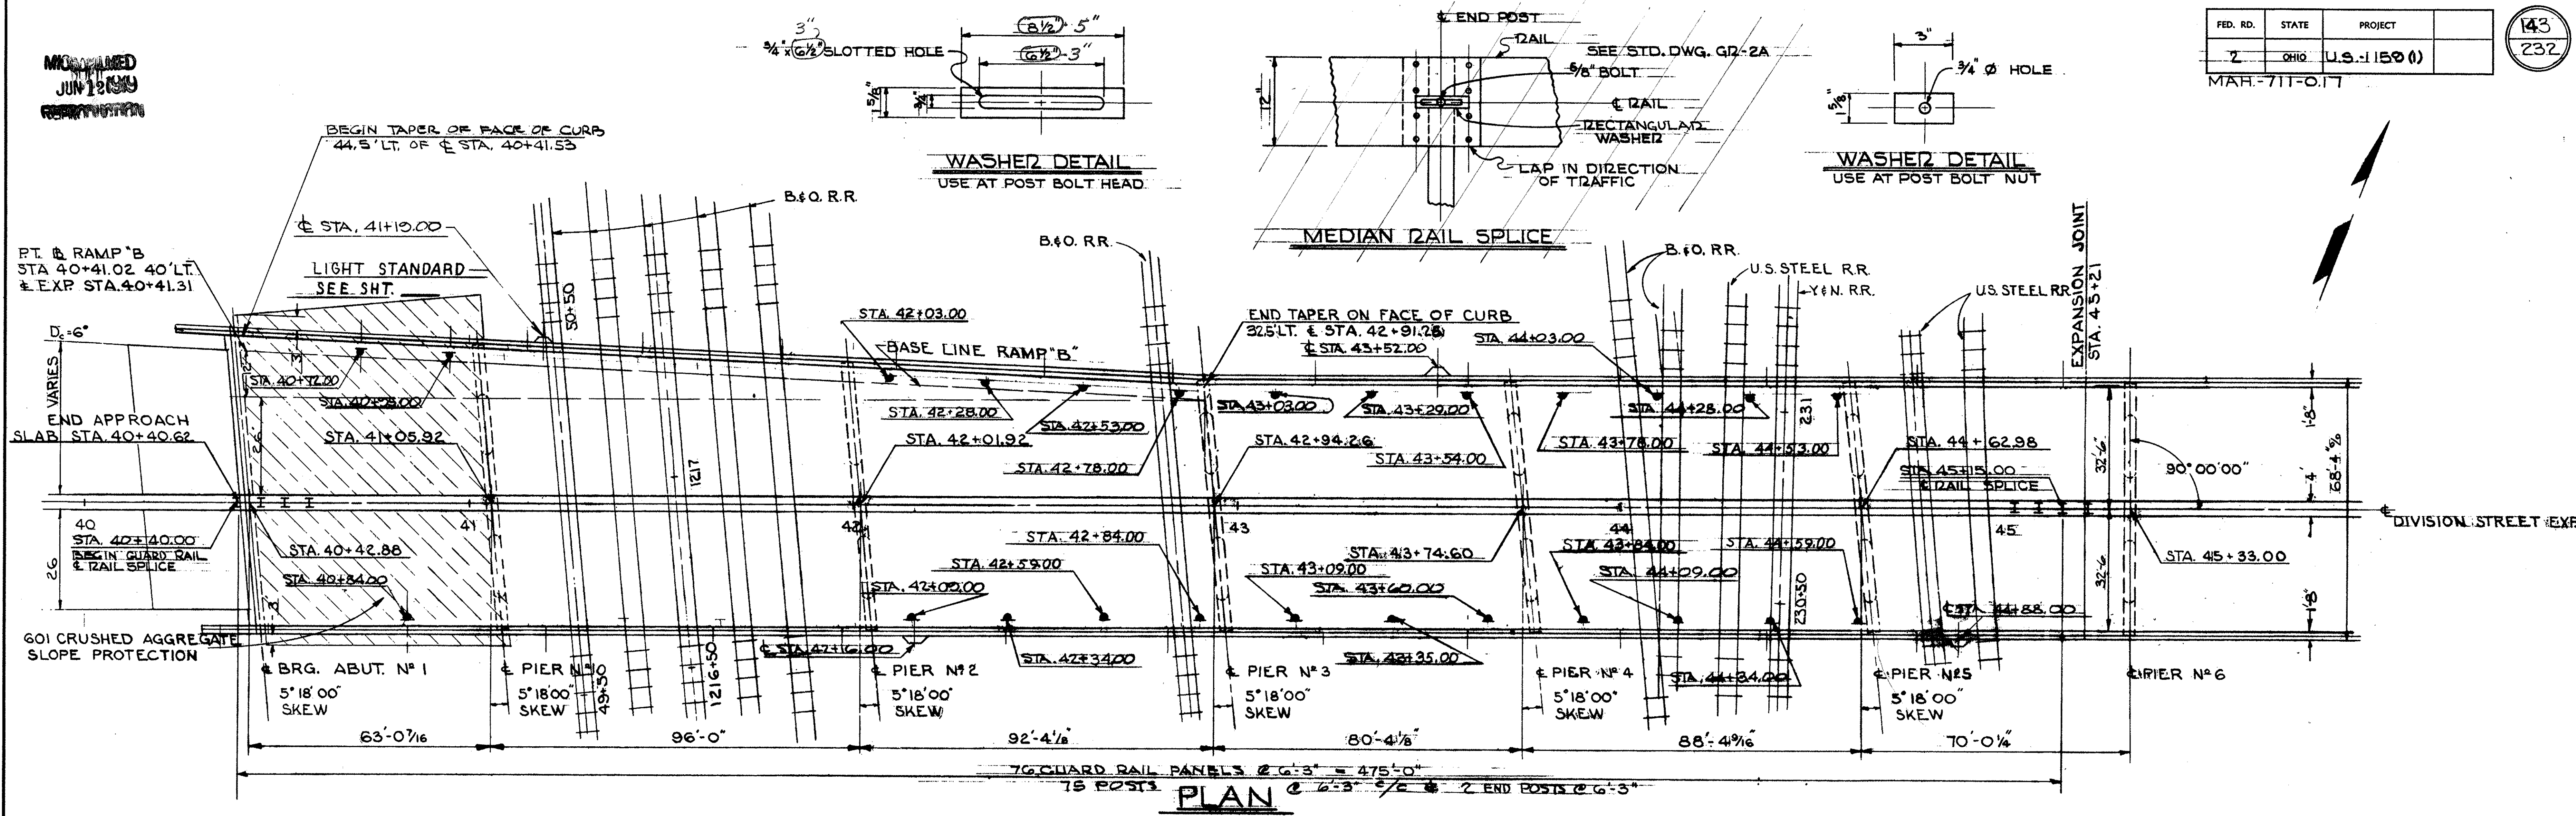

STATE OF OHIO
DEPARTMENT OF HIGHWAYS
BUREAU OF BRIDGES

AKRON, OHIO YOUNGSTOWN, OHIO

GLAUS, PYLE & SCHOMER

GENERAL PLAN & ELEVATION
BRIDGE NO. MAH-711-0116
OVER MAHONING RIVER
YOUNGSTOWN MAHONING COUNTY

UNIT #1



DESIGNED	DRAWN	TRACED	CHECKED	REVIEWED	DATE	REVISED
D.M.	WP		RH	WKD	6-22-60	3-25-69

MAH-711-0116


FED. RD.	STATE	PROJECT	
2	OHIO	U.S.-170 (1)	

MAH-711-0.17


144
232

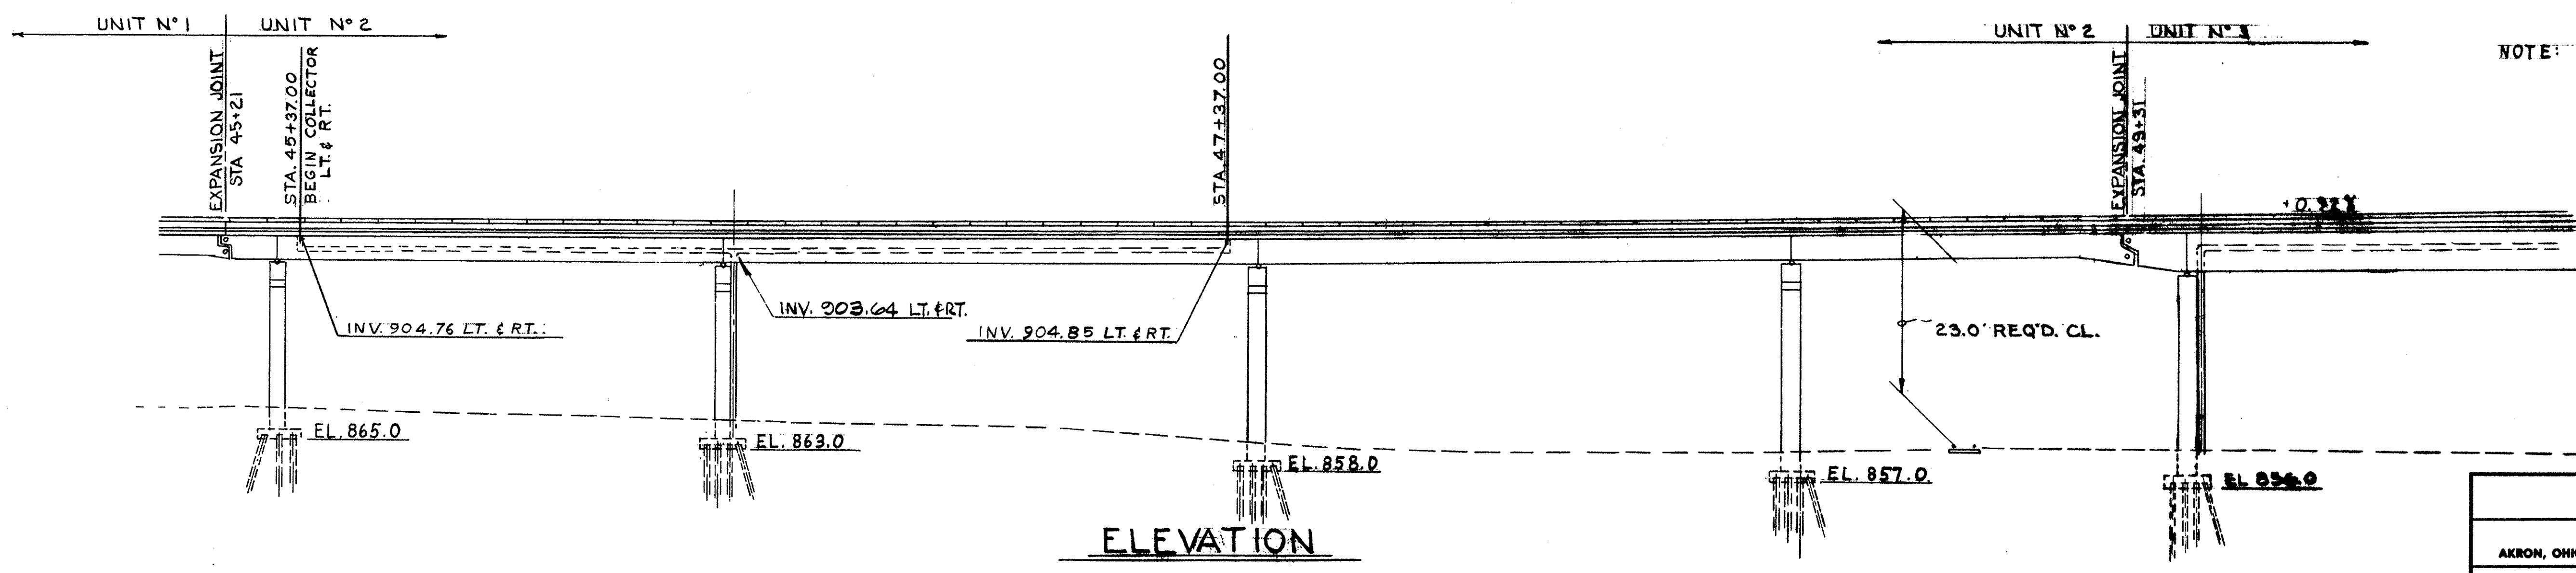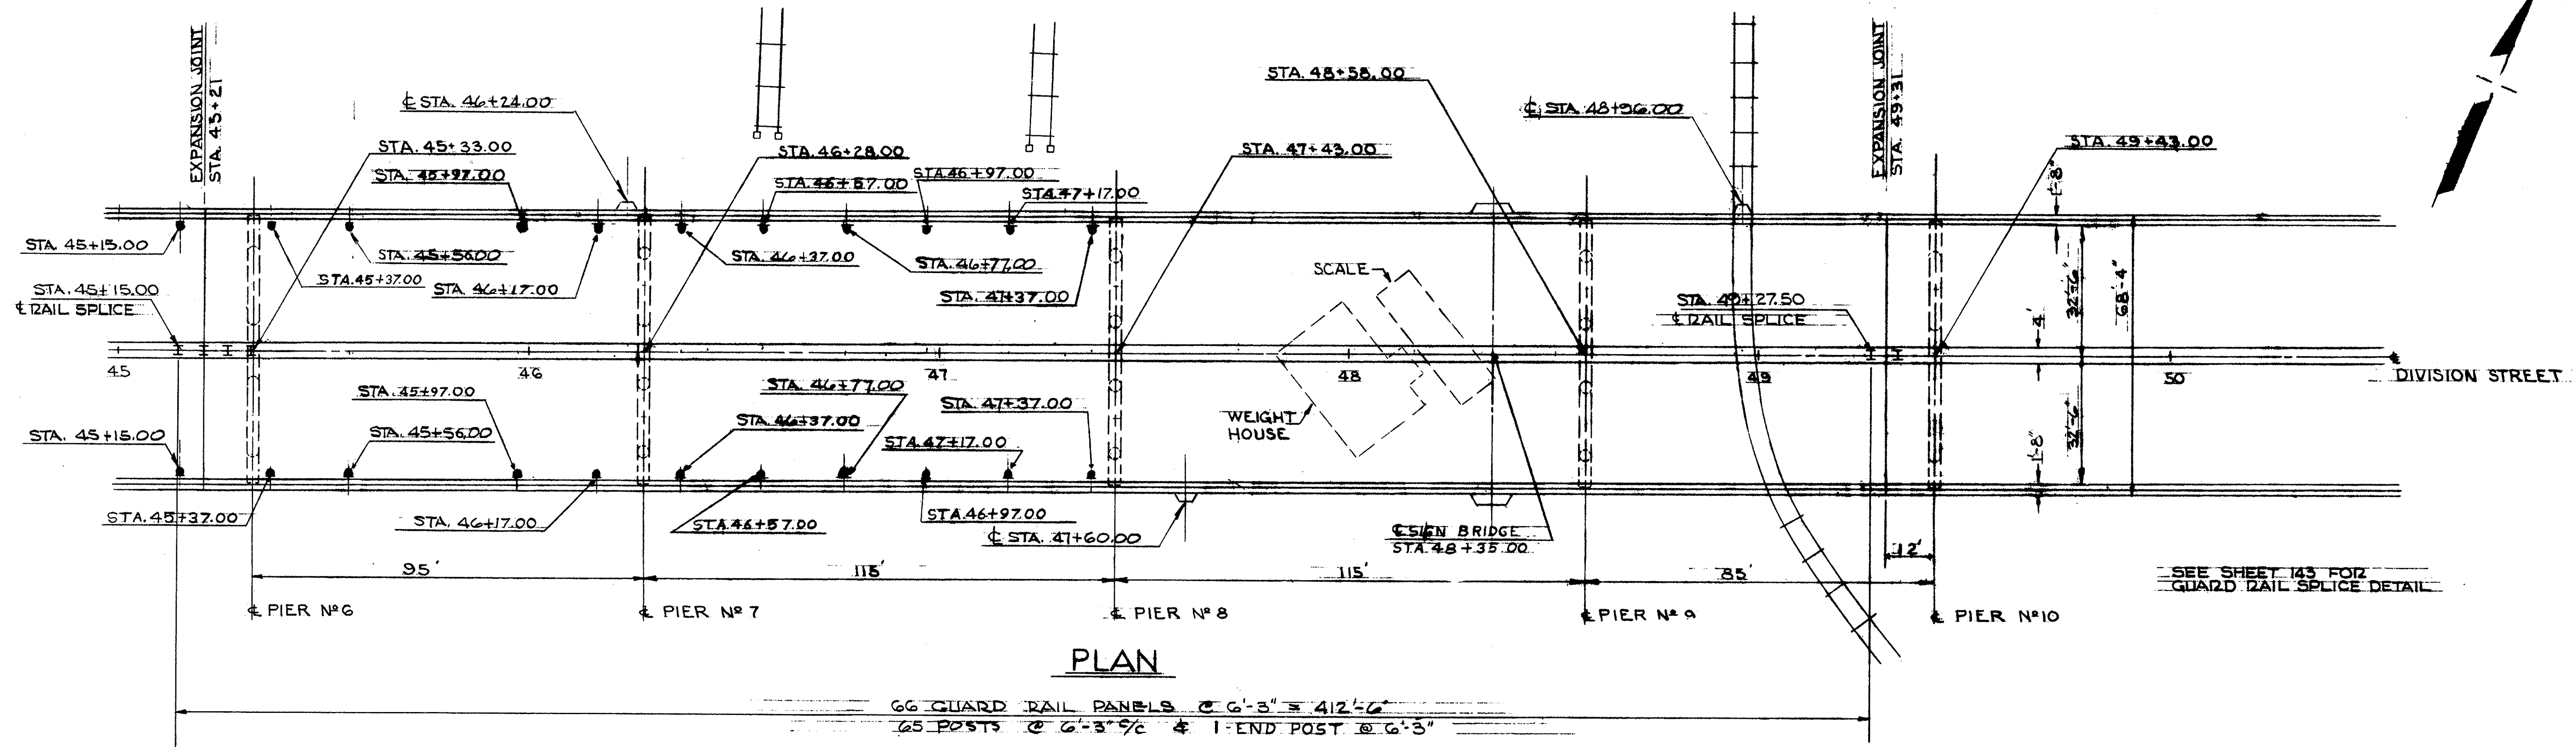

STATE OF OHIO DEPARTMENT OF HIGHWAYS BUREAU OF BRIDGES					
GLAUS, PYLE & SCHOMER AKRON, OHIO			YOUNGSTOWN, OHIO		
GENERAL PLAN & ELEVATION					
BRIDGE N°			MAH-711-0116		
OVER MAHONING RIVER					
YOUNGSTOWN			MAHONING COUNTY		
UNIT N° 2					
DESIGNED	DRAWN	TRACED	CHECKED	REVIEWED	DATE
WKB	DS		WKB	WKB	6-22-68

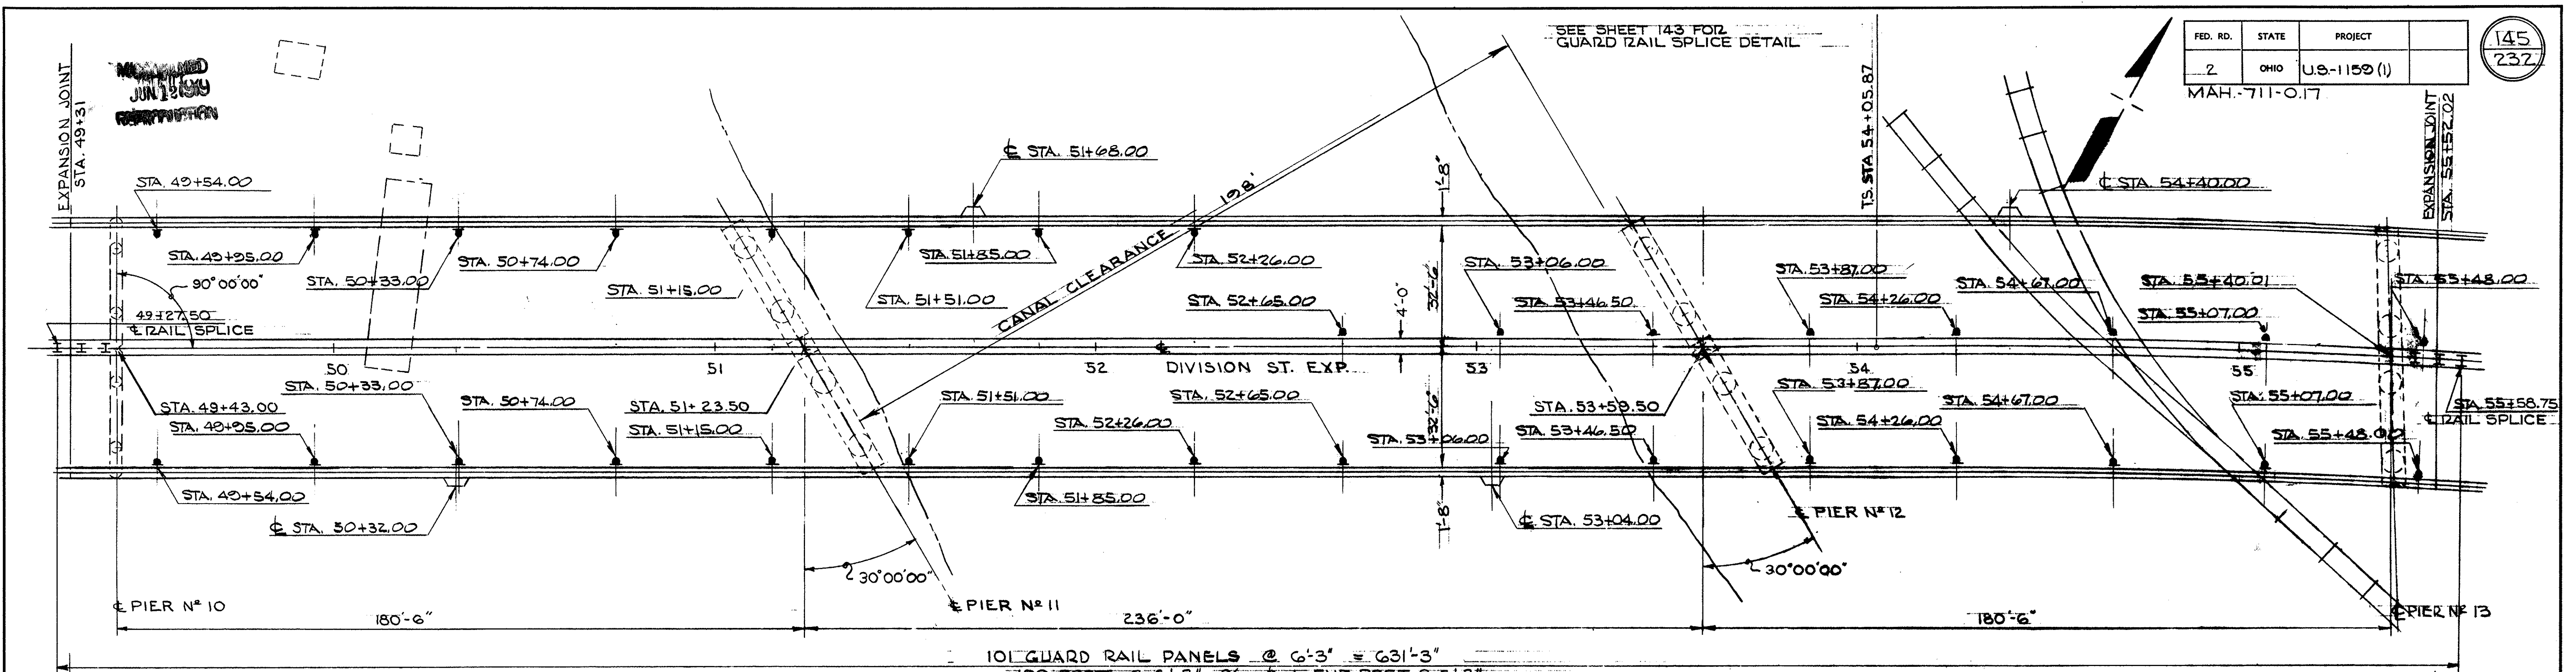

PLAN

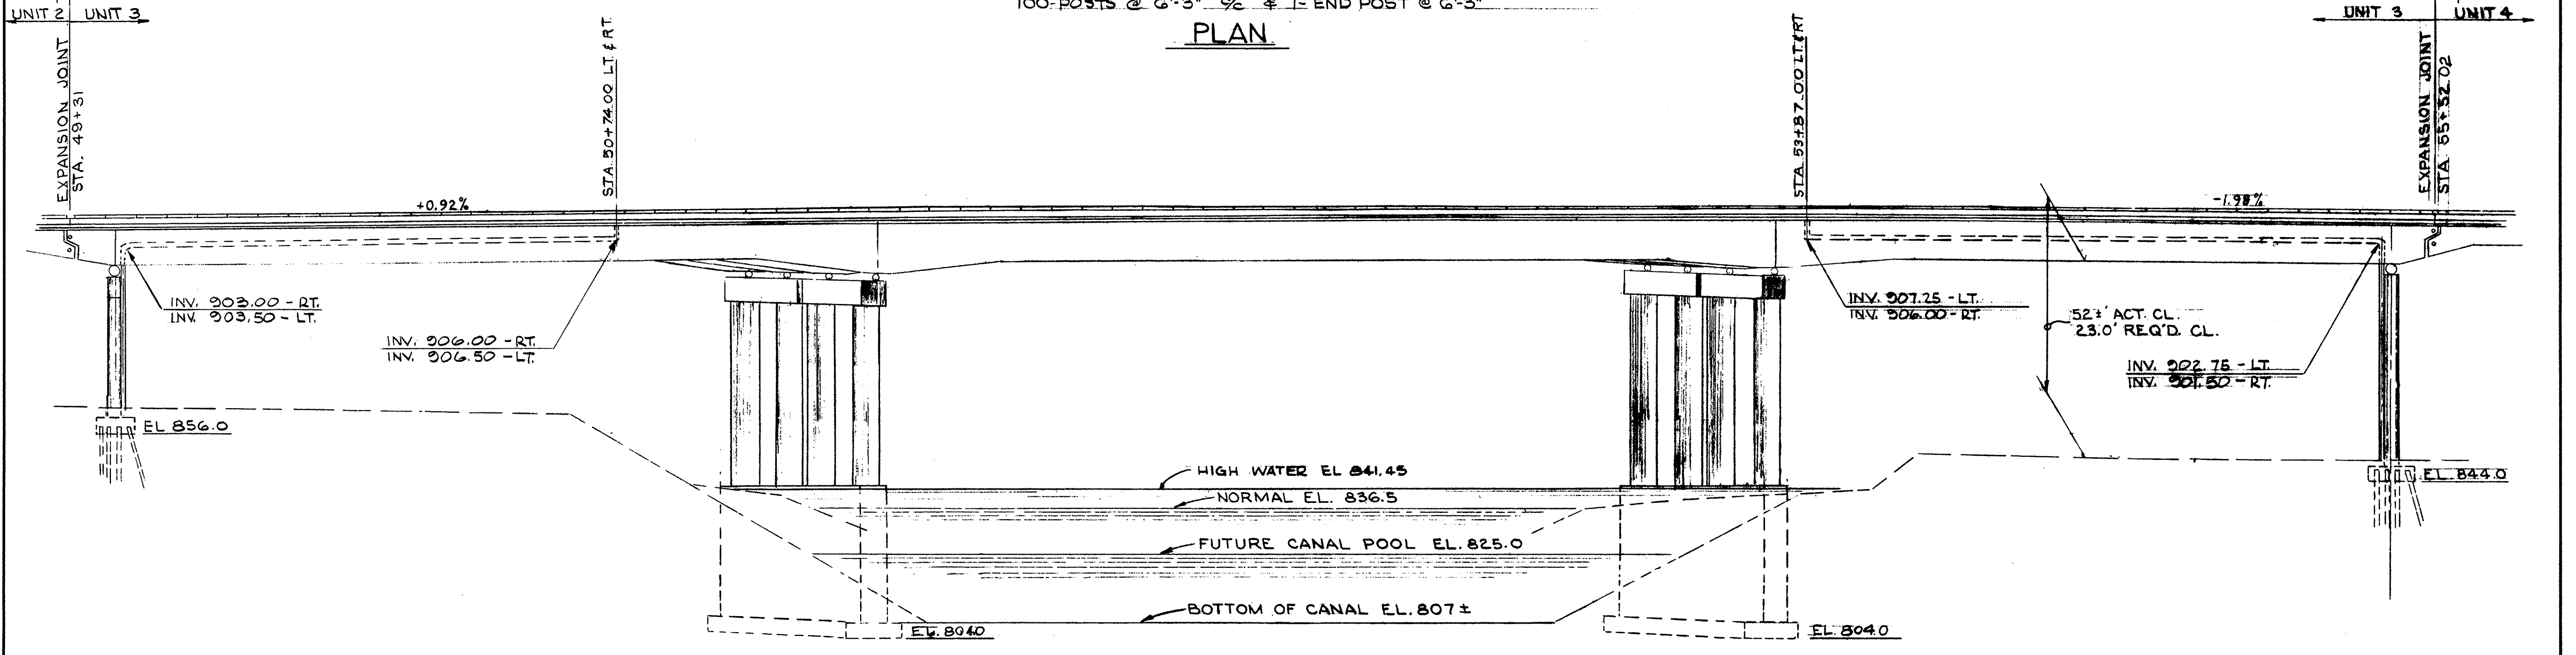

ELEVATION



STATE OF OHIO DEPARTMENT OF HIGHWAYS BUREAU OF BRIDGES					
GLAUS, PYLE & SCHOMER			YOUNGSTOWN, OHIO		
AKRON, OHIO					
GENERAL PLAN & ELEVATION					
BRIDGE N° MAH-711-016					
OVER MAHONING RIVER					
YOUNGSTOWN MAHONING COUNTY					
UNIT N° 3					
DESIGNED	DRAWN	TRACED	CHECKED	REVIEWED	DATE
WKB	D.S.		WKB	WKB	6-22-68
					REVISED

JUN 19 1968

FED. RD.	STATE	PROJECT
2	OHIO	U.S.-11100 (1)

146
232

MAH-711-011

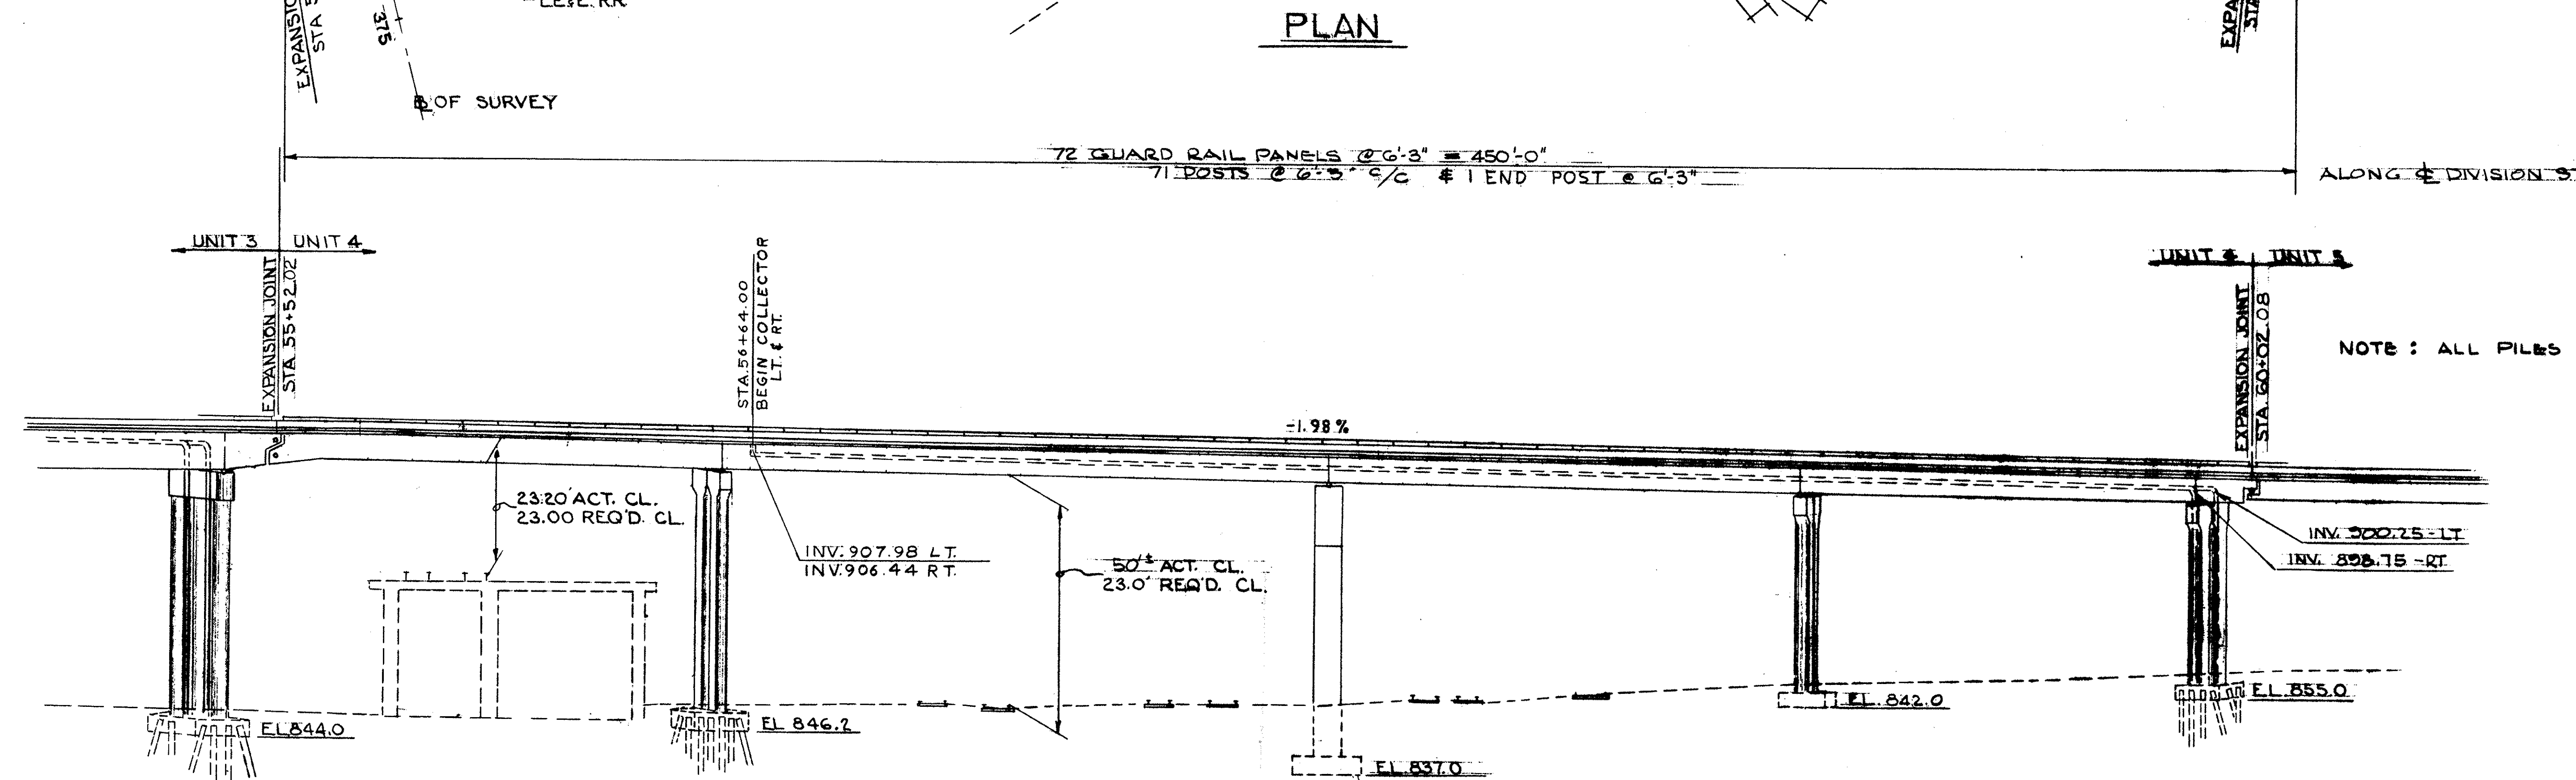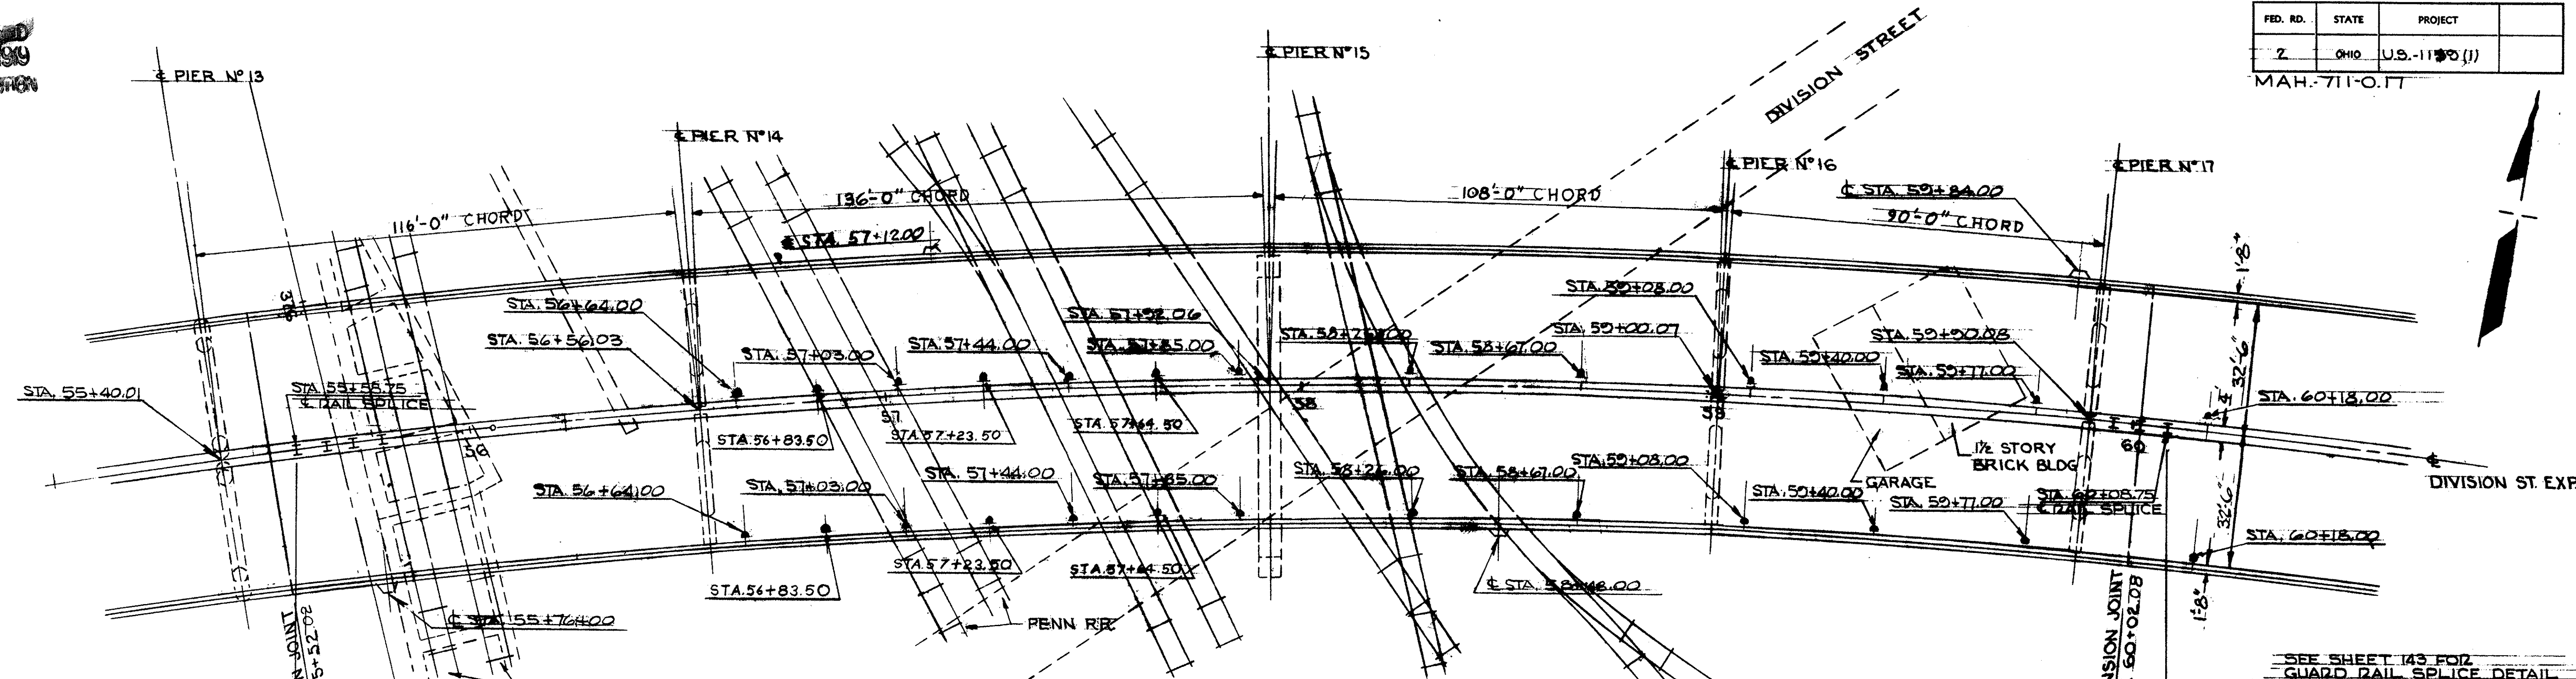

STATE OF OHIO
DEPARTMENT OF HIGHWAYS
BUREAU OF BRIDGES

AKRON, OHIO YOUNGSTOWN, OHIO

GLAUS, PYLE & SCHOMER

GENERAL PLAN & ELEVATION
BRIDGE N^o MAH-711-0116
OVER MAHONING RIVER
YOUNGSTOWN MAHONING COUNTY

UNIT #4

DESIGNED	DRAWN	TRACED	CHECKED	REVIEWED	DATE	REVISED
WKO	DS		WKO	WKO	6-22-68	


MAHONGONING
JUN 13 1969
REVISION

SEE SHEET 143 FOR
GUARD RAIL SPLICE DETAIL


FED. RD.	STATE	PROJECT
2	OHIO	U.S.-1159 (1)

147
232

MAH-711-0.17

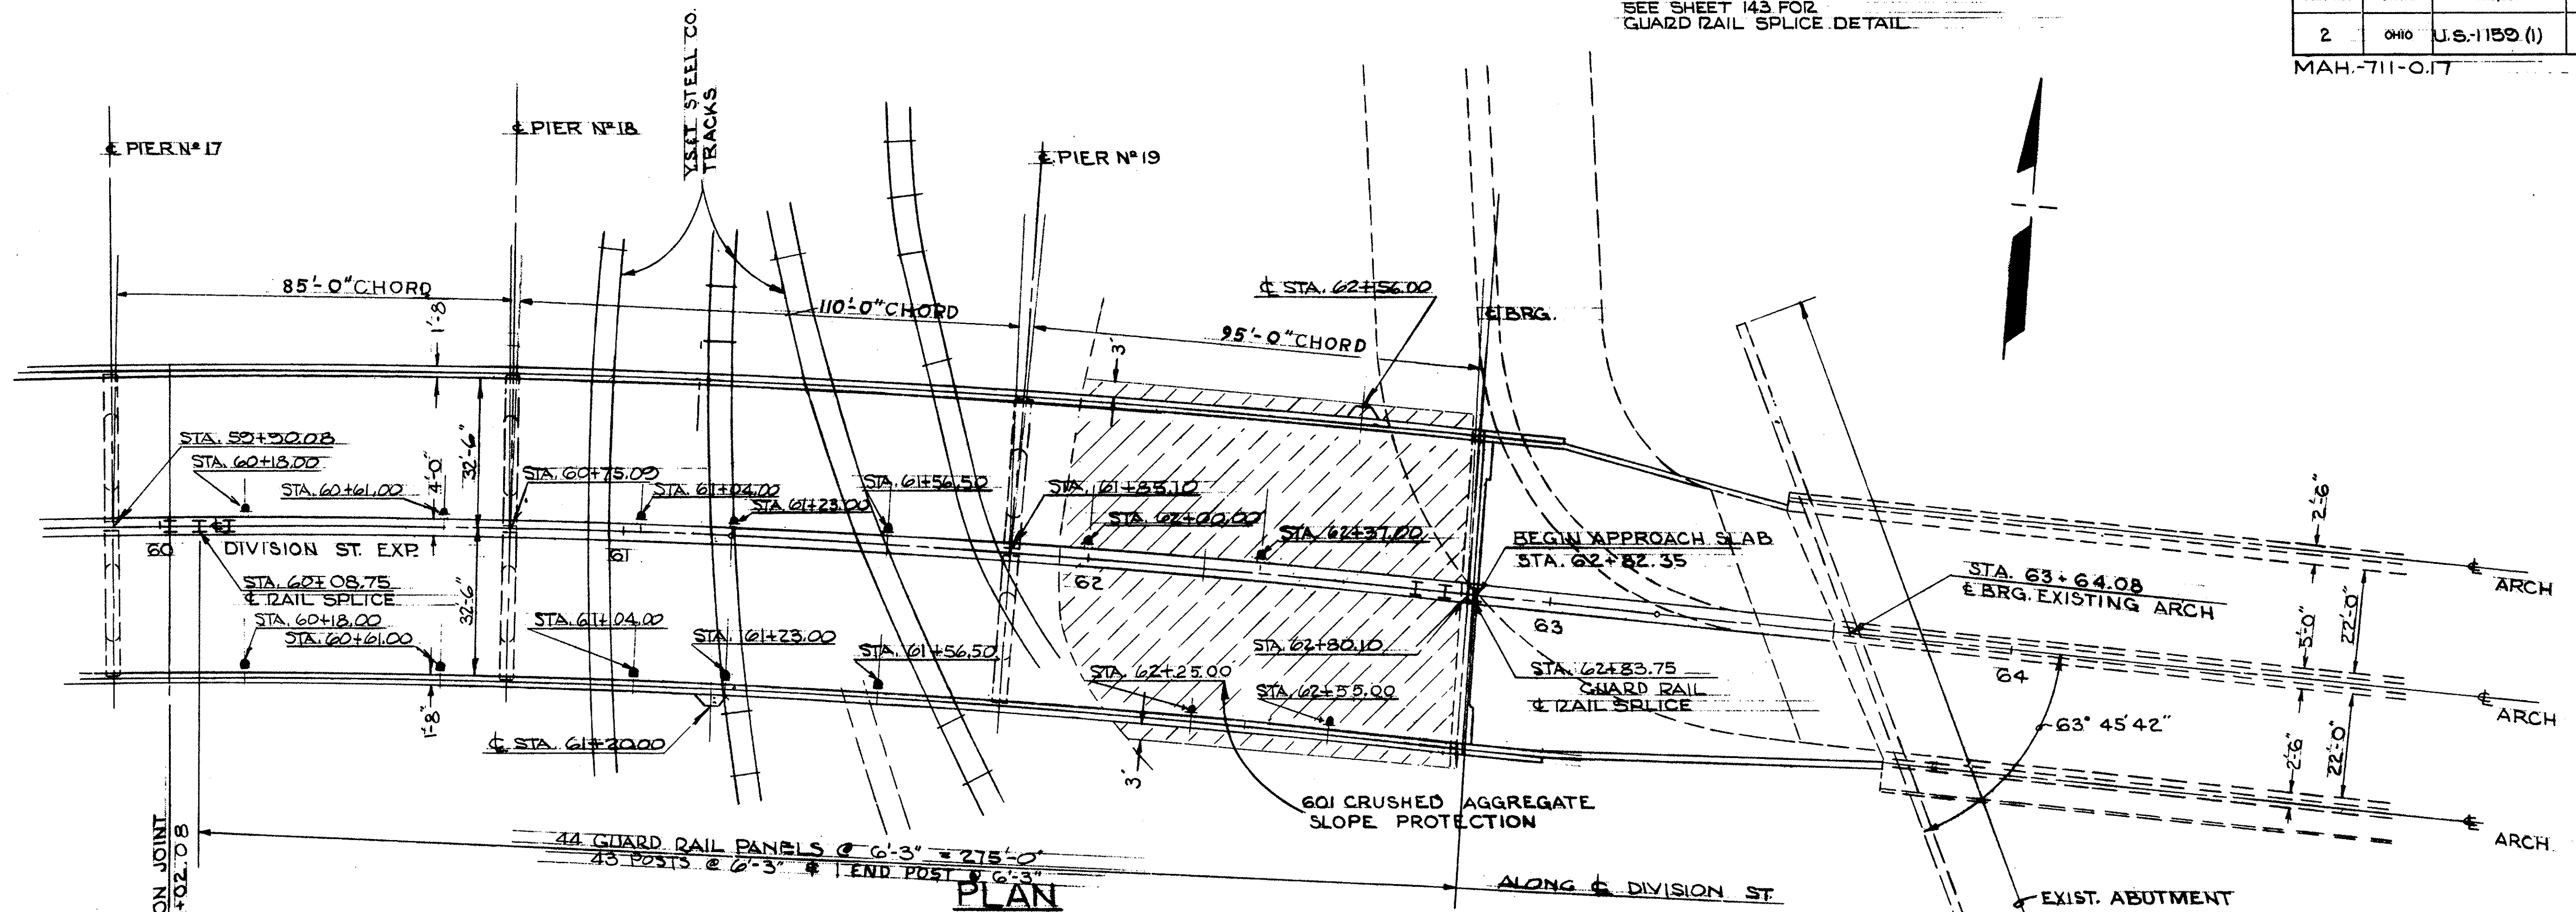

PLAN

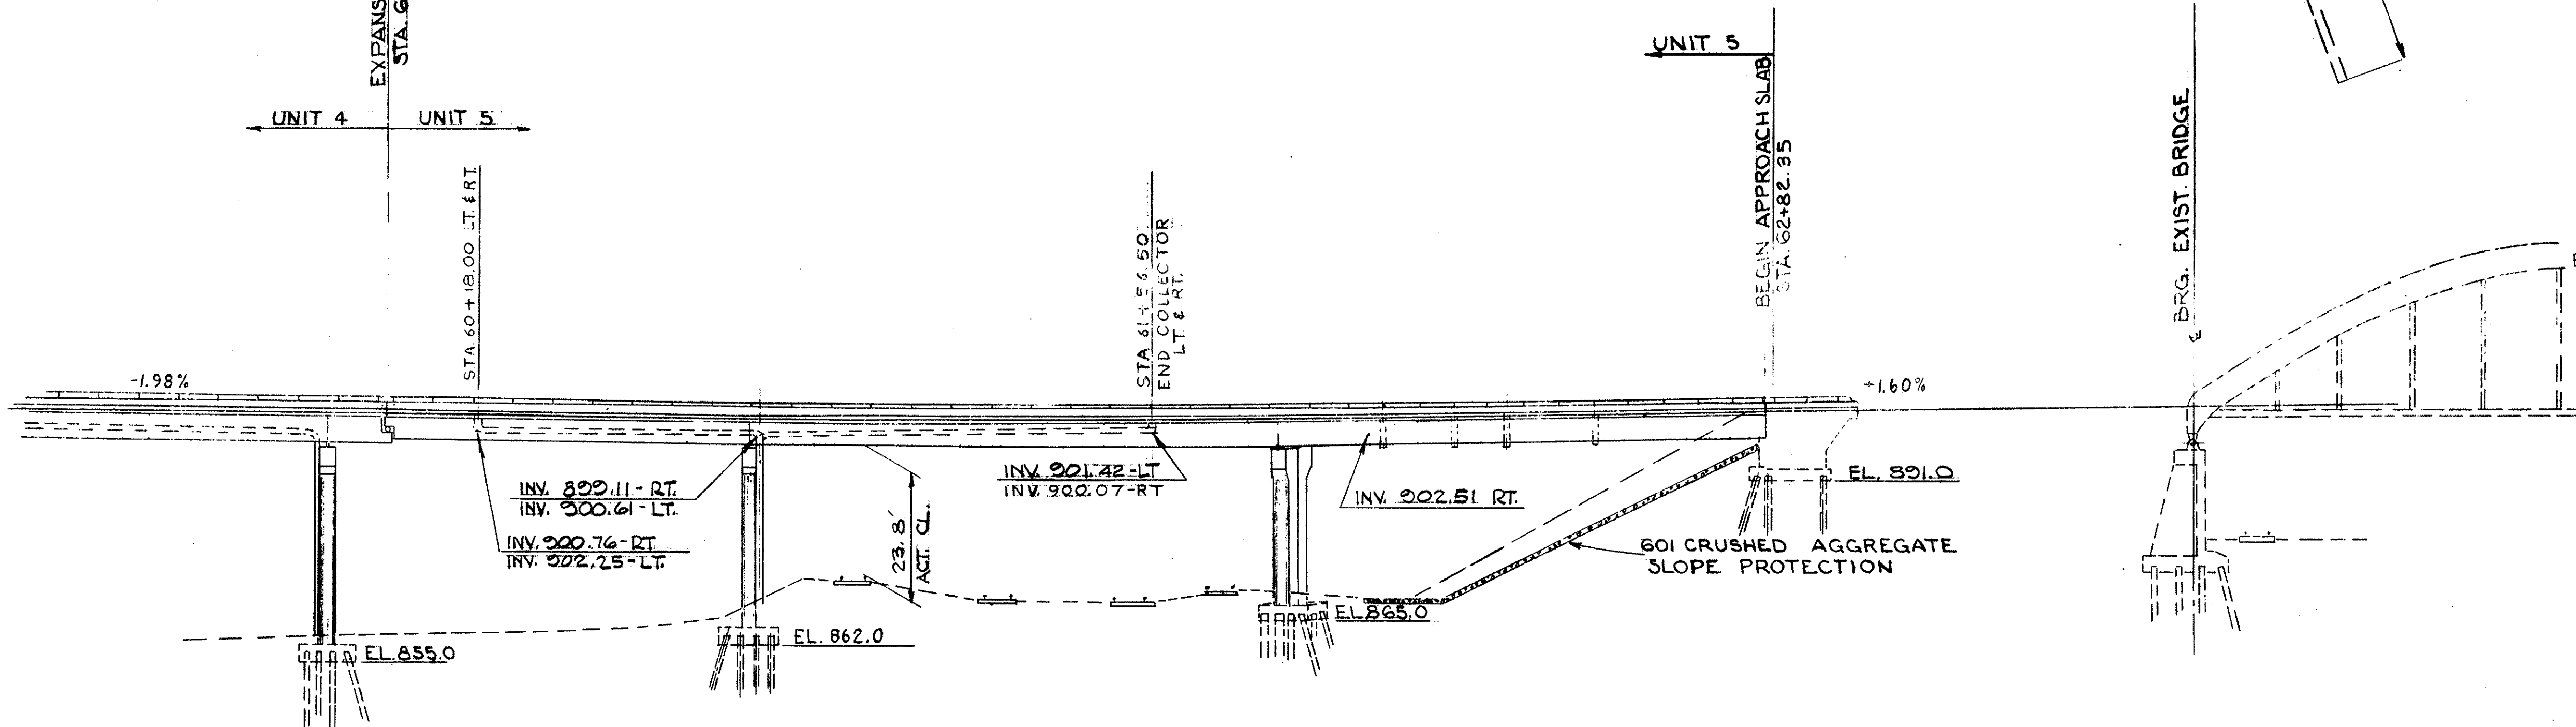

ELEVATION

NOTE: ALL PILES 12 BP 53


STATE OF OHIO DEPARTMENT OF HIGHWAYS BUREAU OF BRIDGES					
AKRON, OHIO			YOUNGSTOWN, OHIO		
GLAUS, PYLE & SCHOMER					
GENERAL PLAN & ELEVATION					
BRIDGE N°			MAH-711-0116		
OVER MAHONING RIVER			YOUNGSTOWN MAHONING COUNTY		
UNIT N° 5					
DESIGNED	DRAWN	TRACED	CHECKED	REVIEWED	DATE
D.M.	WP		RH	WKD	6-22-68

MAHONING
JUN 13 1968

FED. RD.	STATE	PROJECT
2	OHIO	U.S.-1159 (1)

148
232

MAH-711-017
UNIT No 1 UNIT No 2

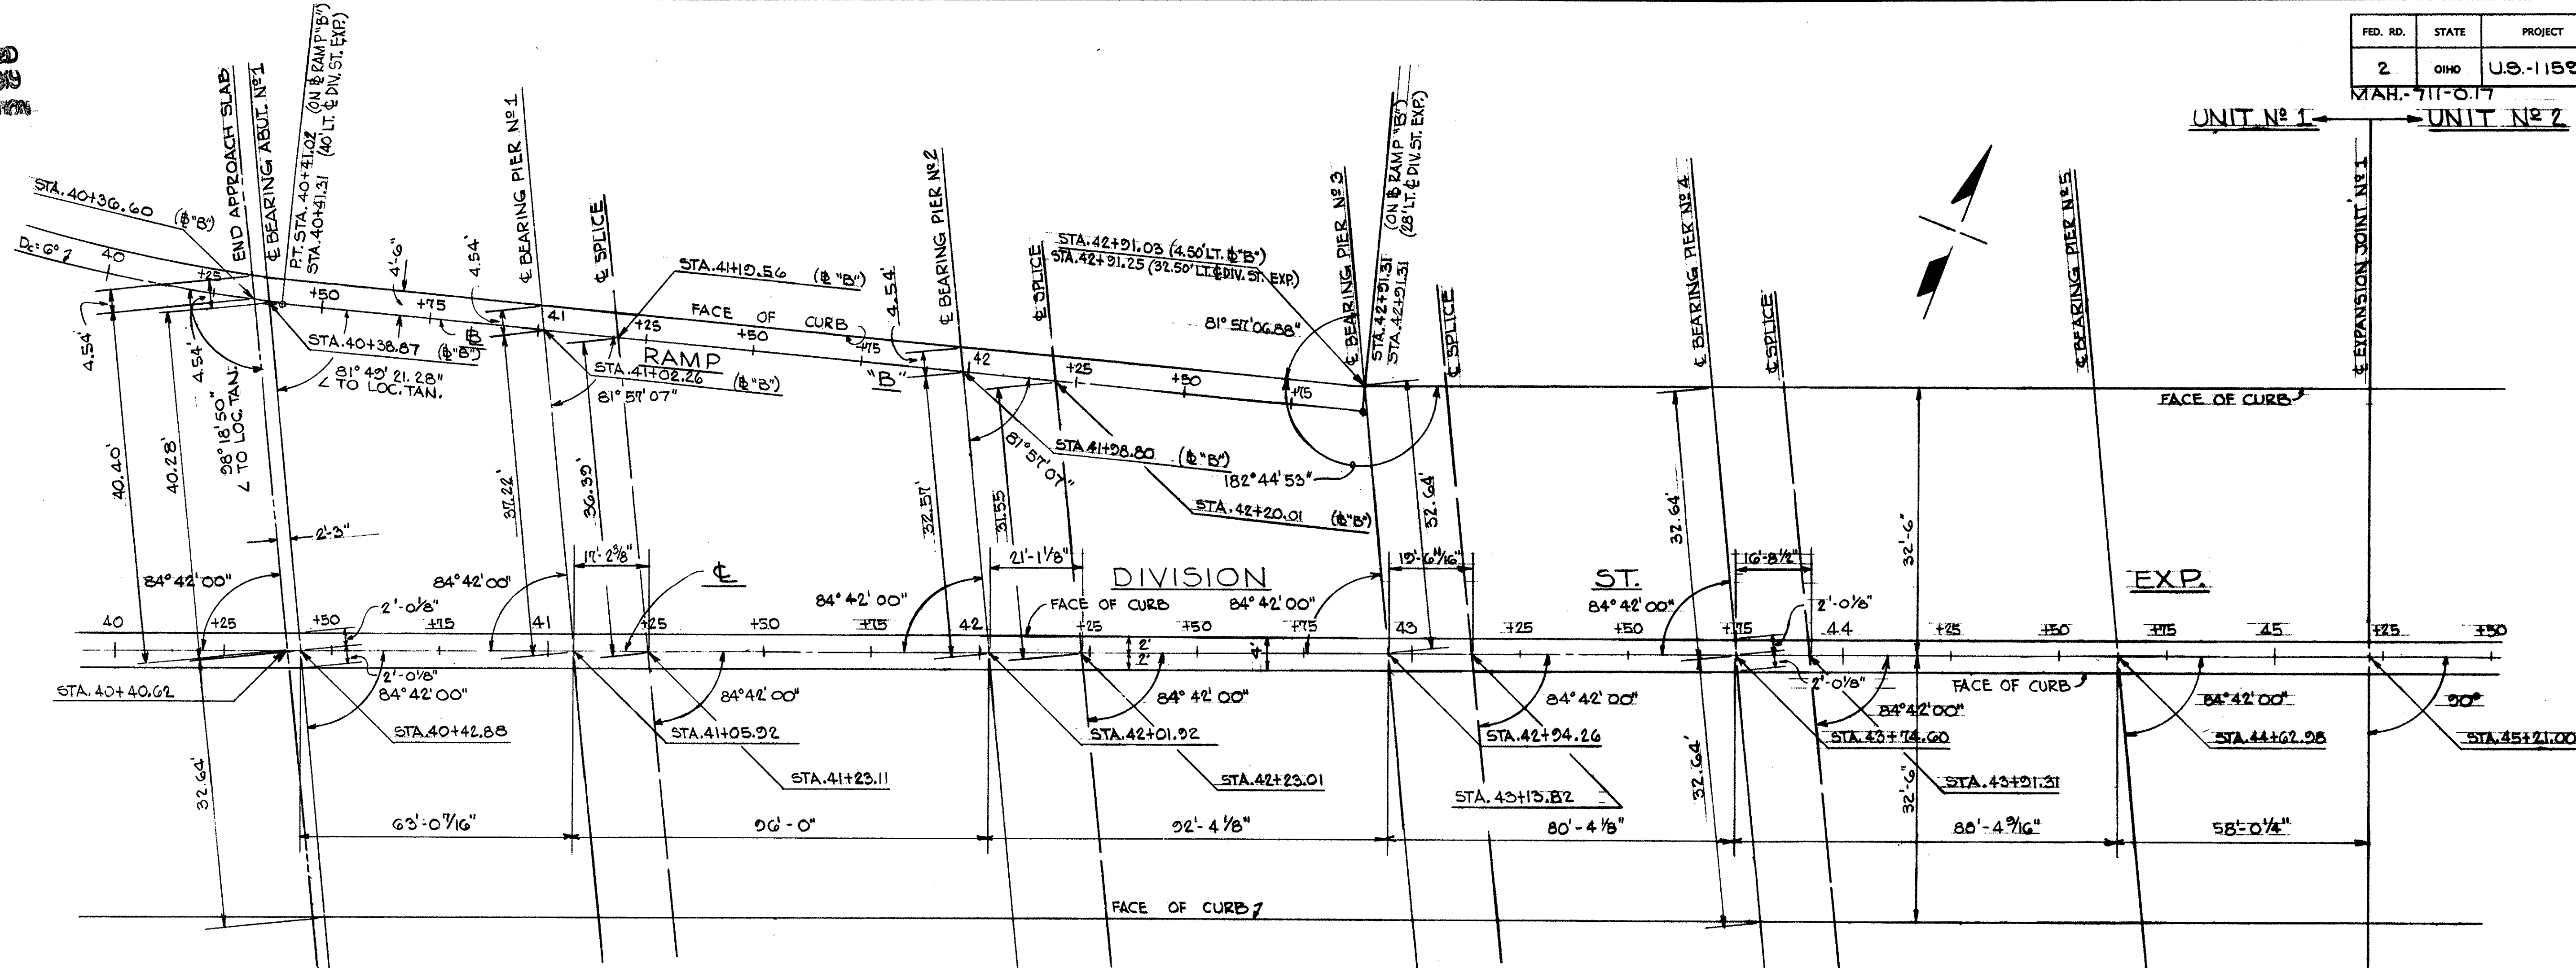

RAMP 'B' CURVE DATA
 P.C. STA. 38+74.99
 P.I. STA. 39+57.92
 P.T. STA. 40+41.02
 $\Delta = 91^{\circ} 50' 52''$ $L = 166.63'$
 $D = 6^{\circ}$ $CH = 166.42'$
 $R = 954.23'$ $E = 3.65'$
 $T = 83.53'$ $M = 3.63'$


STATE OF OHIO DEPARTMENT OF HIGHWAYS BUREAU OF BRIDGES						
AKRON, OHIO YOUNGSTOWN, OHIO						
GLAUS, PYLE & SCHOMER						
GEOMETRIC PLAN						
BRIDGE No MAH-711-016						
OVER MAHONING RIVER						
YOUNGSTOWN MAHONING COUNTY						
UNIT No 1						
DESIGNED	DRAWN	TRACED	CHECKED	REVIEWED	DATE	REVISED
R.W.S.	R.W.S.		R.W.S.	W.K.D.	6-22-68	

JUN 13 1969
REVISION

FED. RD.	STATE	PROJECT	
Z	OHIO	US-150 (1)	

149
232

MAH-711-0.17

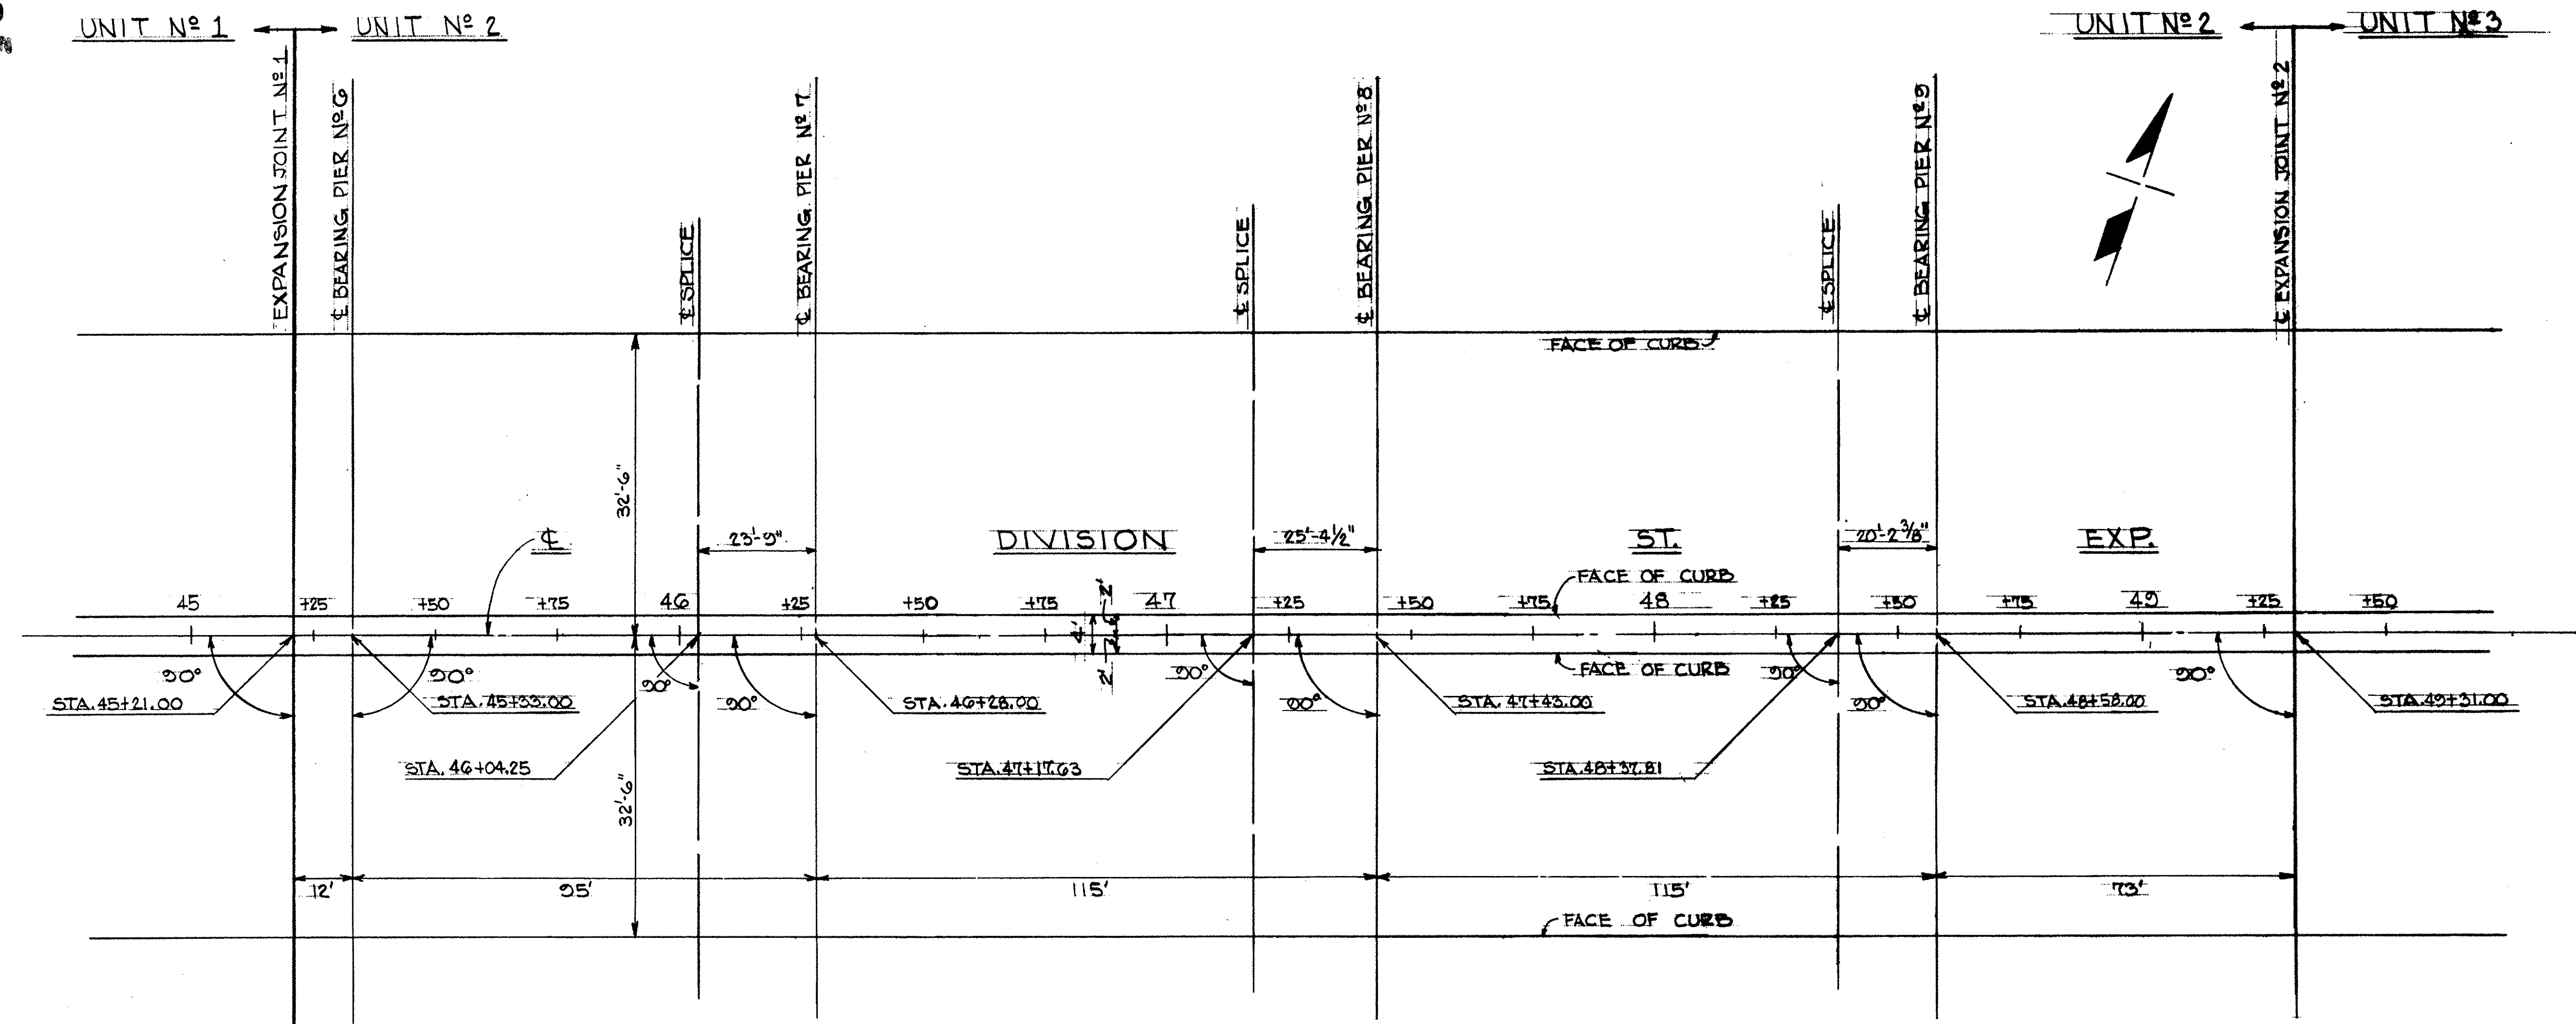


STATE OF OHIO DEPARTMENT OF HIGHWAYS BUREAU OF BRIDGES					
AKRON, OHIO			GLAUS, PYLE & SCHOMER YOUNGSTOWN, OHIO		
GEOMETRIC PLAN					
BRIDGE No MAH-711-0116					
OVER MAHONING RIVER					
YOUNGSTOWN MAHONING COUNTY					
UNIT No 2					
DESIGNED	DRAWN	TRACED	CHECKED	REVIEWED	DATE
RWS	RWS		RWS	WKB	6-22-68

MAHONING
JUN 1968
REVISION

FED. RD.	STATE	PROJECT
2	OHIO	U.S.-1150 (1)

MAH-711-0.17

150
232

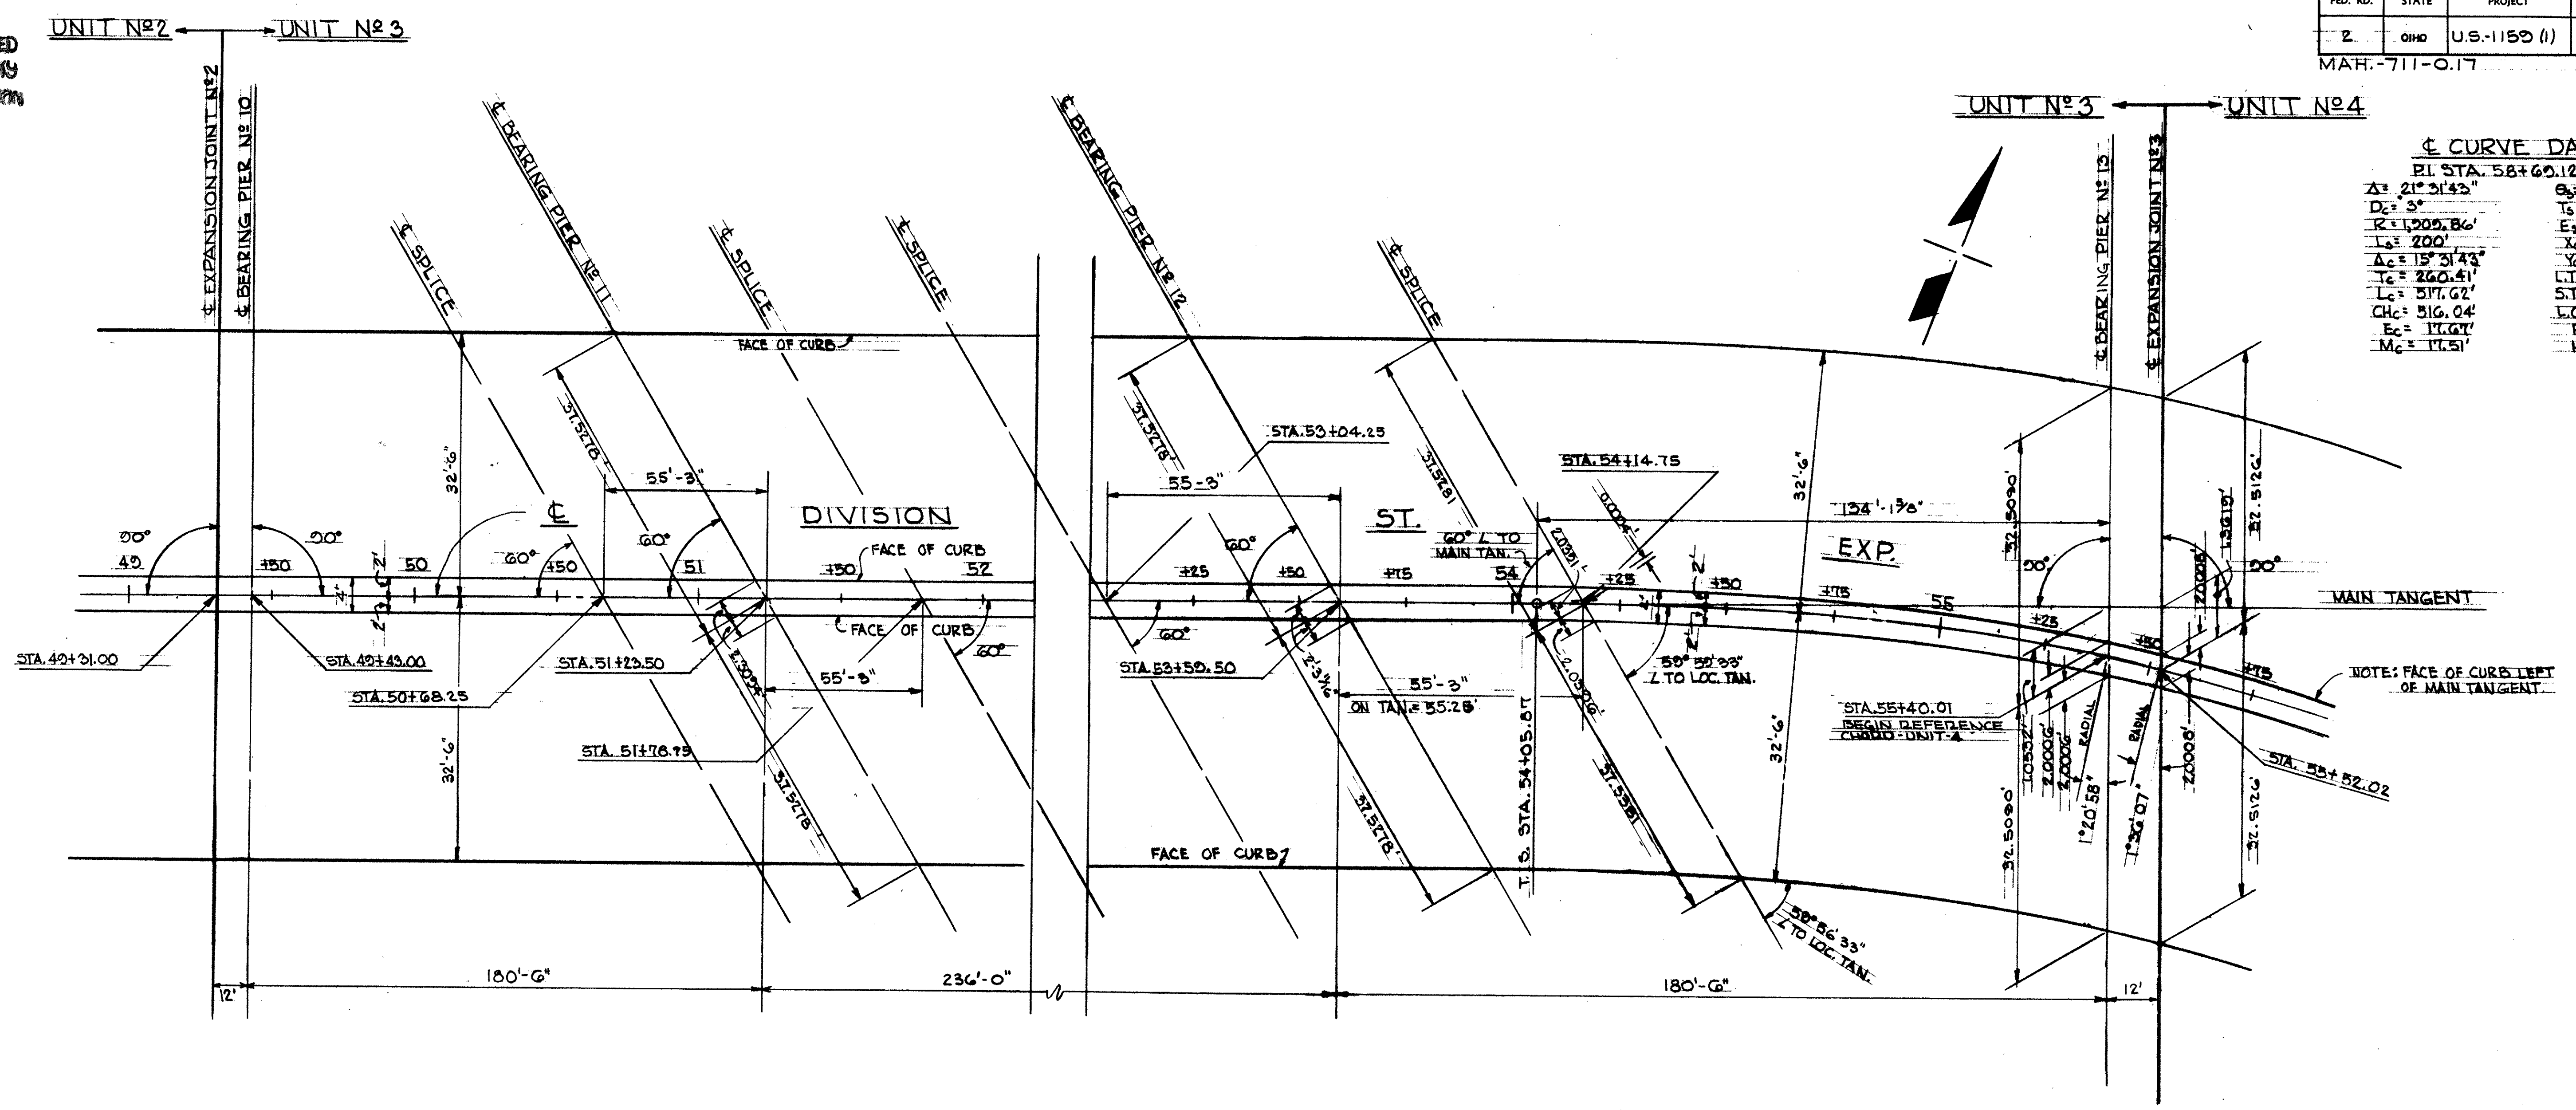


◊ CURVE DATA
PI STA. 58+60.12

$\Delta = 21^\circ 31' 43''$	$\theta = 3^\circ$
$D = 9'$	$L_s = 463.25'$
$R = 1,009.86'$	$E_s = 55.10'$
$L_c = 200'$	$X_c = 199.95'$
$\Delta_c = 15^\circ 31' 43''$	$Y_c = 3.49'$
$L_c = 260.41'$	$L.T. = 133.35'$
$Chc = 517.62'$	$S.T. = 66.68'$
$Ec = 11.64'$	$L.C. = 199.95'$
$M_c = 11.51'$	$P = 0.87'$
	$K = 99.99'$

NOTE: FACE OF CURB LEFT OF MAIN TANGENT.


STATE OF OHIO DEPARTMENT OF HIGHWAYS BUREAU OF BRIDGES					
GLAUS, PYLE & SCHOMER			AKRON, OHIO YOUNGSTOWN, OHIO		
GEOMETRIC PLAN					
BRIDGE NO		MAH - 711 - 0116			
OVER MAHONING RIVER					
YOUNGSTOWN			MAHONING COUNTY		
UNIT NO 3					
DESIGNED	DRAWN	TRACED	CHECKED	REVIEWED	DATE
RWS	RWS		RWS	WKO	6-22-68
					REVISION

MAH-711-0.17

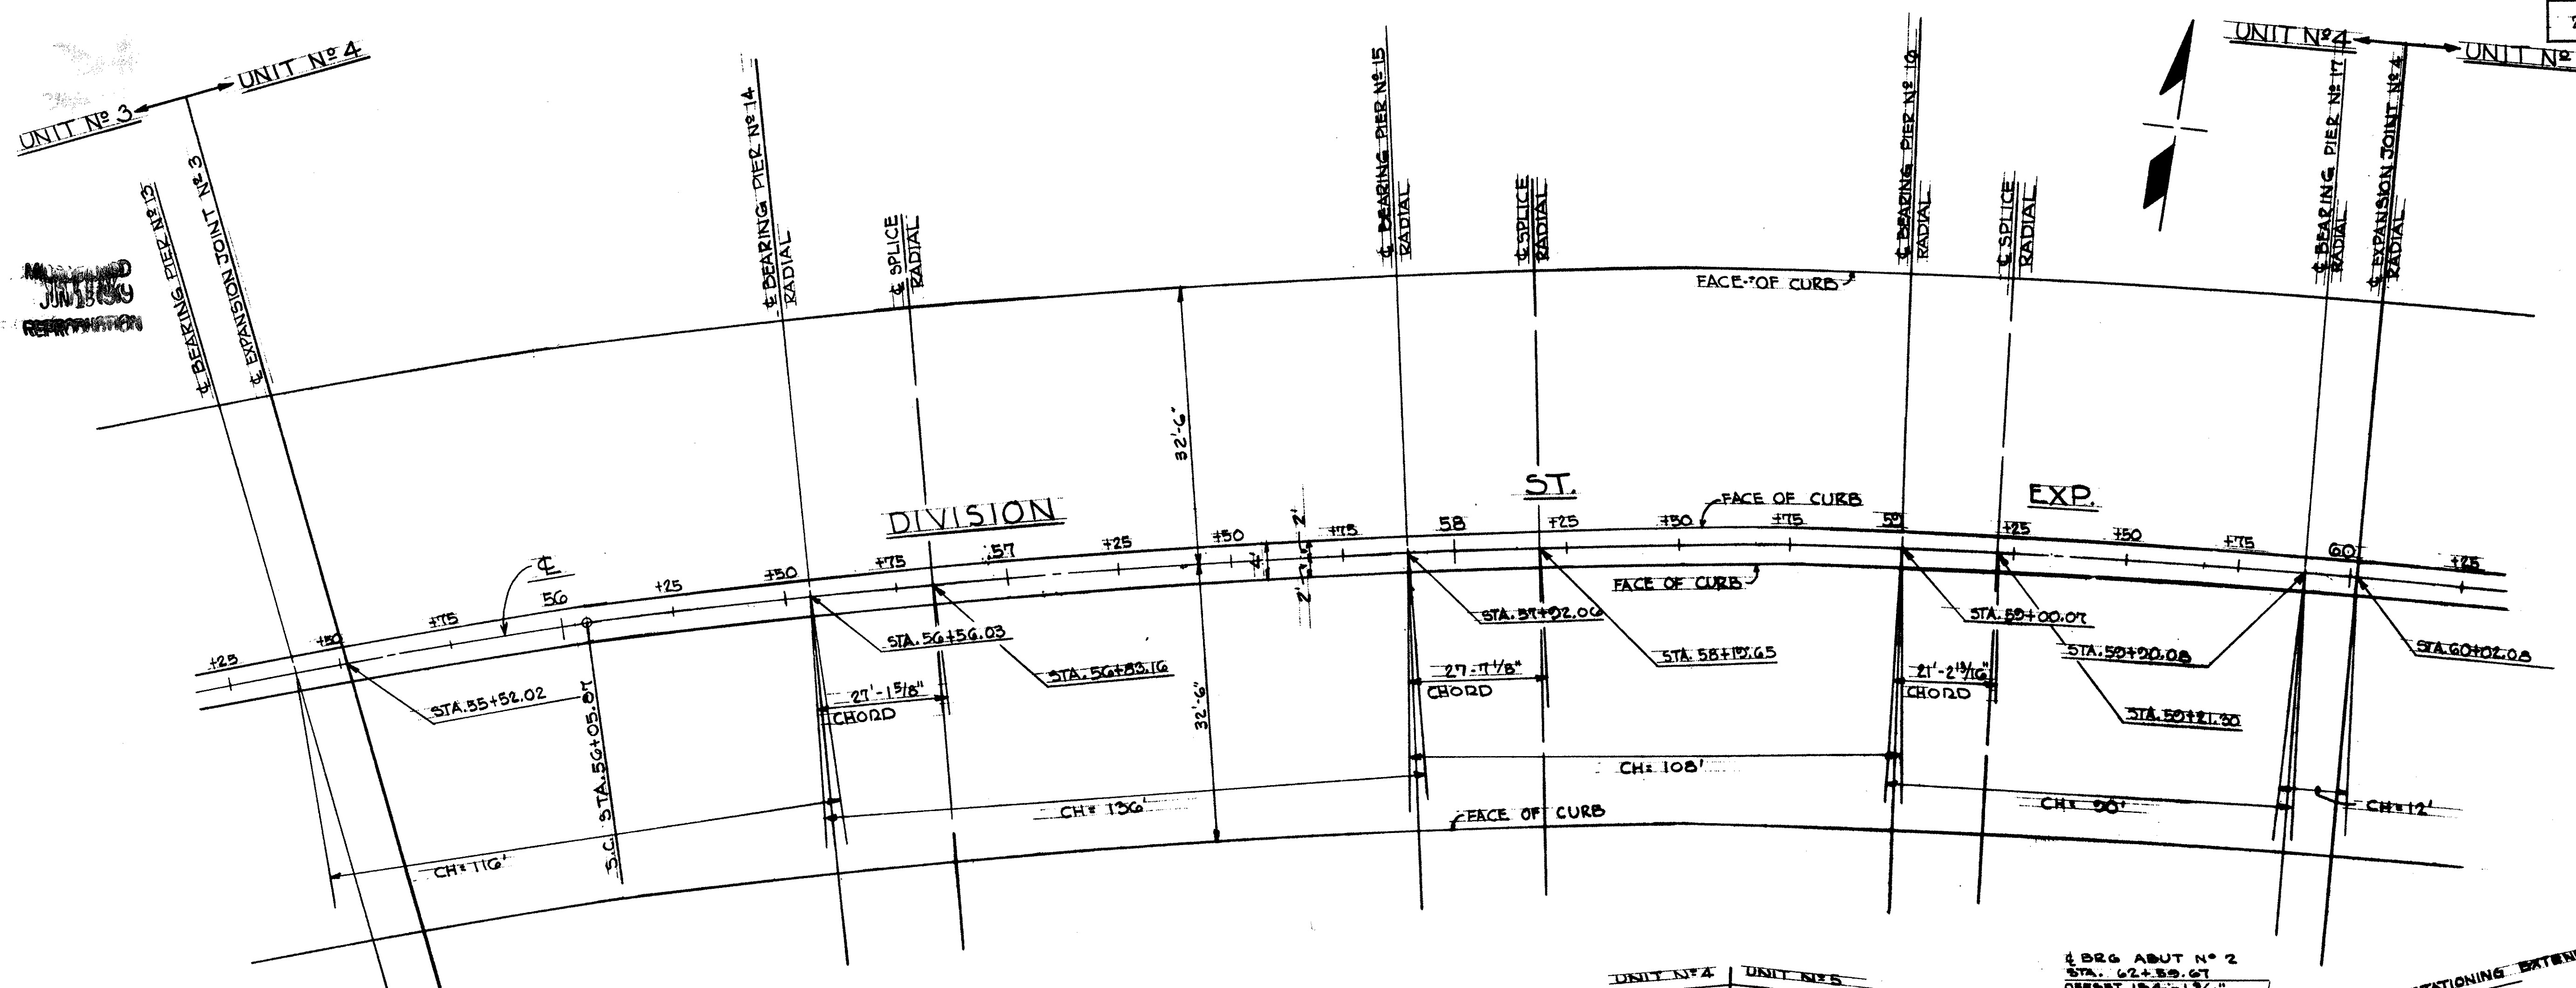

C CURVE DATA
 B1. STA. 58+62.12

$\Delta = 21^\circ 31' 43''$	$\theta = 3^\circ$
$D = 3'$	$T_b = 463.25'$
$R = 1,905.86'$	$E_s = 35.10'$
$L_s = 200'$	$X_c = 199.95'$
$\Delta_c = 15^\circ 31' 43''$	$V_c = 3.49'$
$T_c = 240.41'$	$L.T. = 153.35'$
$L_c = 517.62'$	$S.T. = 66.68'$
$CH_c = 516.04'$	$L.C. = 102.98'$
$E_c = 17.01'$	$P.E. = 0.87'$
$M_c = 17.51'$	$K = 59.99'$

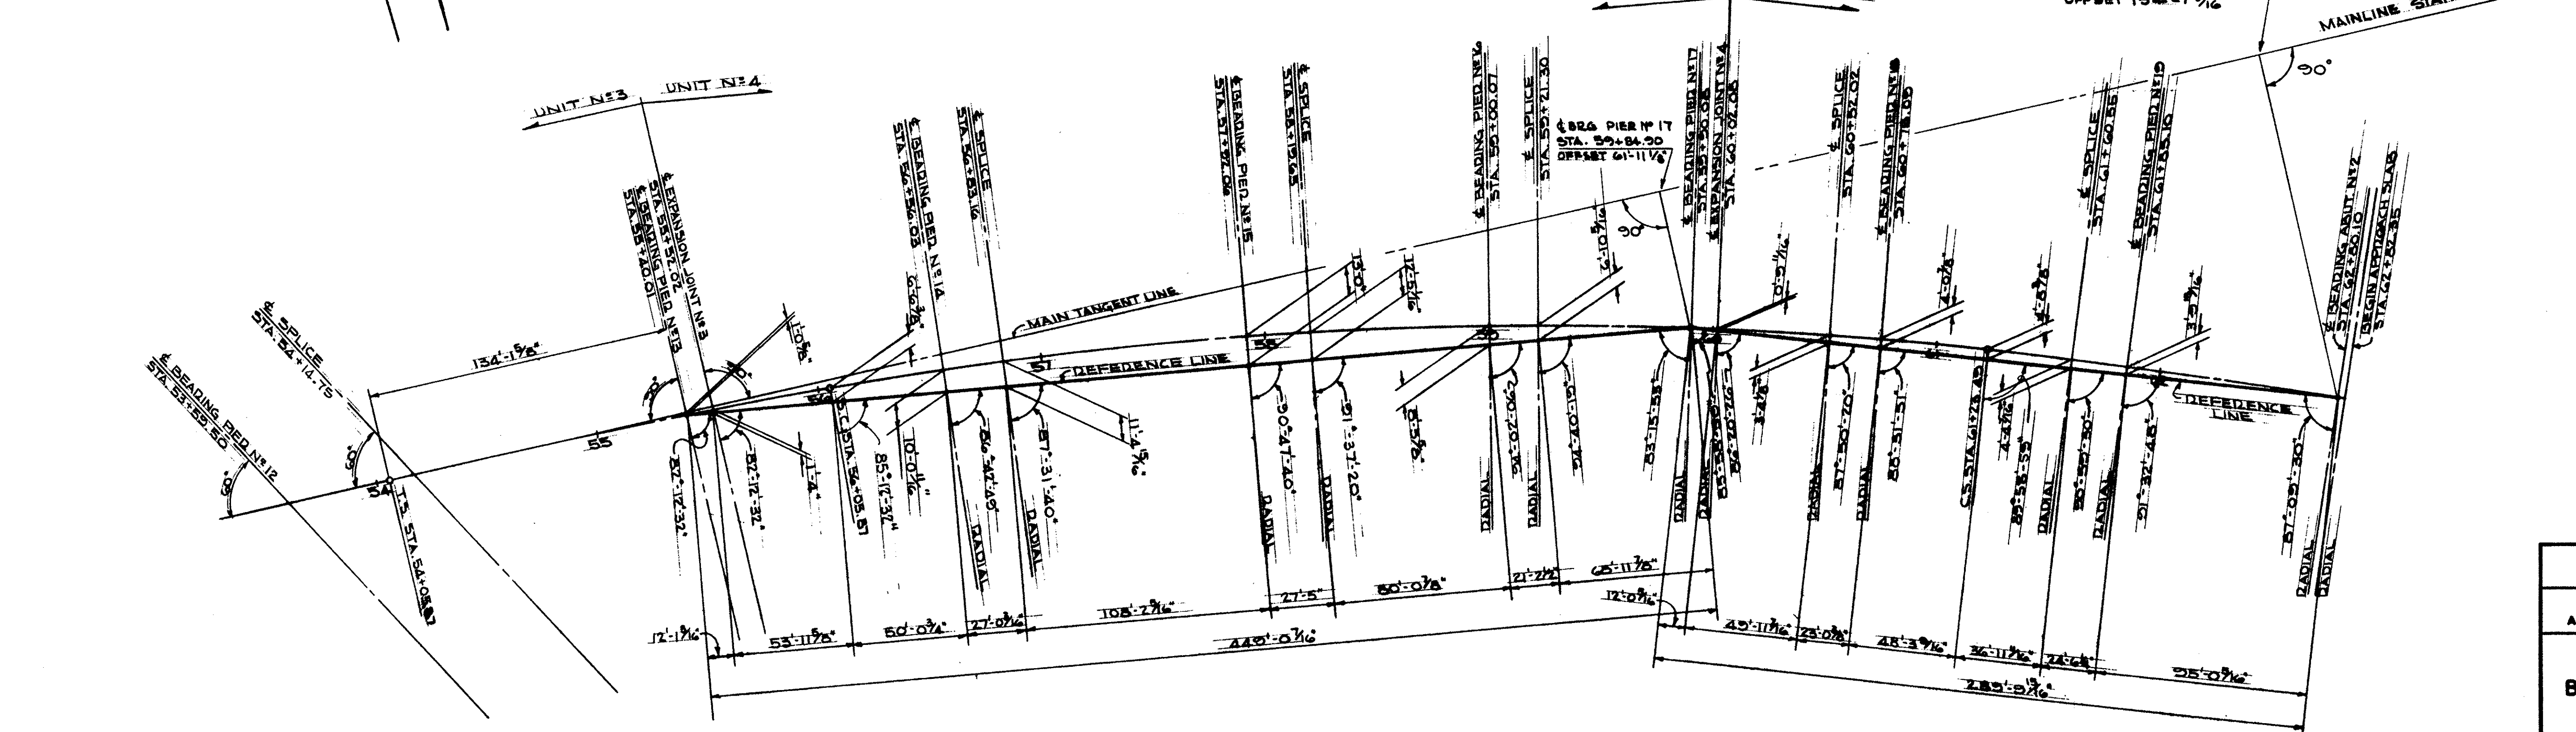

REFERENCE LINE DATA


STATE OF OHIO DEPARTMENT OF HIGHWAYS BUREAU OF BRIDGES					
GLAUS, PYLE & SCHOMER			AKRON, OHIO YOUNGSTOWN, OHIO		
GEOMETRIC PLAN					
BRIDGE NO. MAH-711-016			OVER MAHONING RIVER		
YOUNGSTOWN			MAHONING COUNTY		
UNIT NO. 4					
DESIGNED RWS	DRAWN RWS	TRACED	CHECKED P. K.	REVIEWED WKB	DATE 6-22-68

MAHONING
JUN 13 1968
RESURFACING

FED. RD.	STATE	PROJECT
2	OHIO	U.S.-1150 (1)

152
232

MAH-711-017

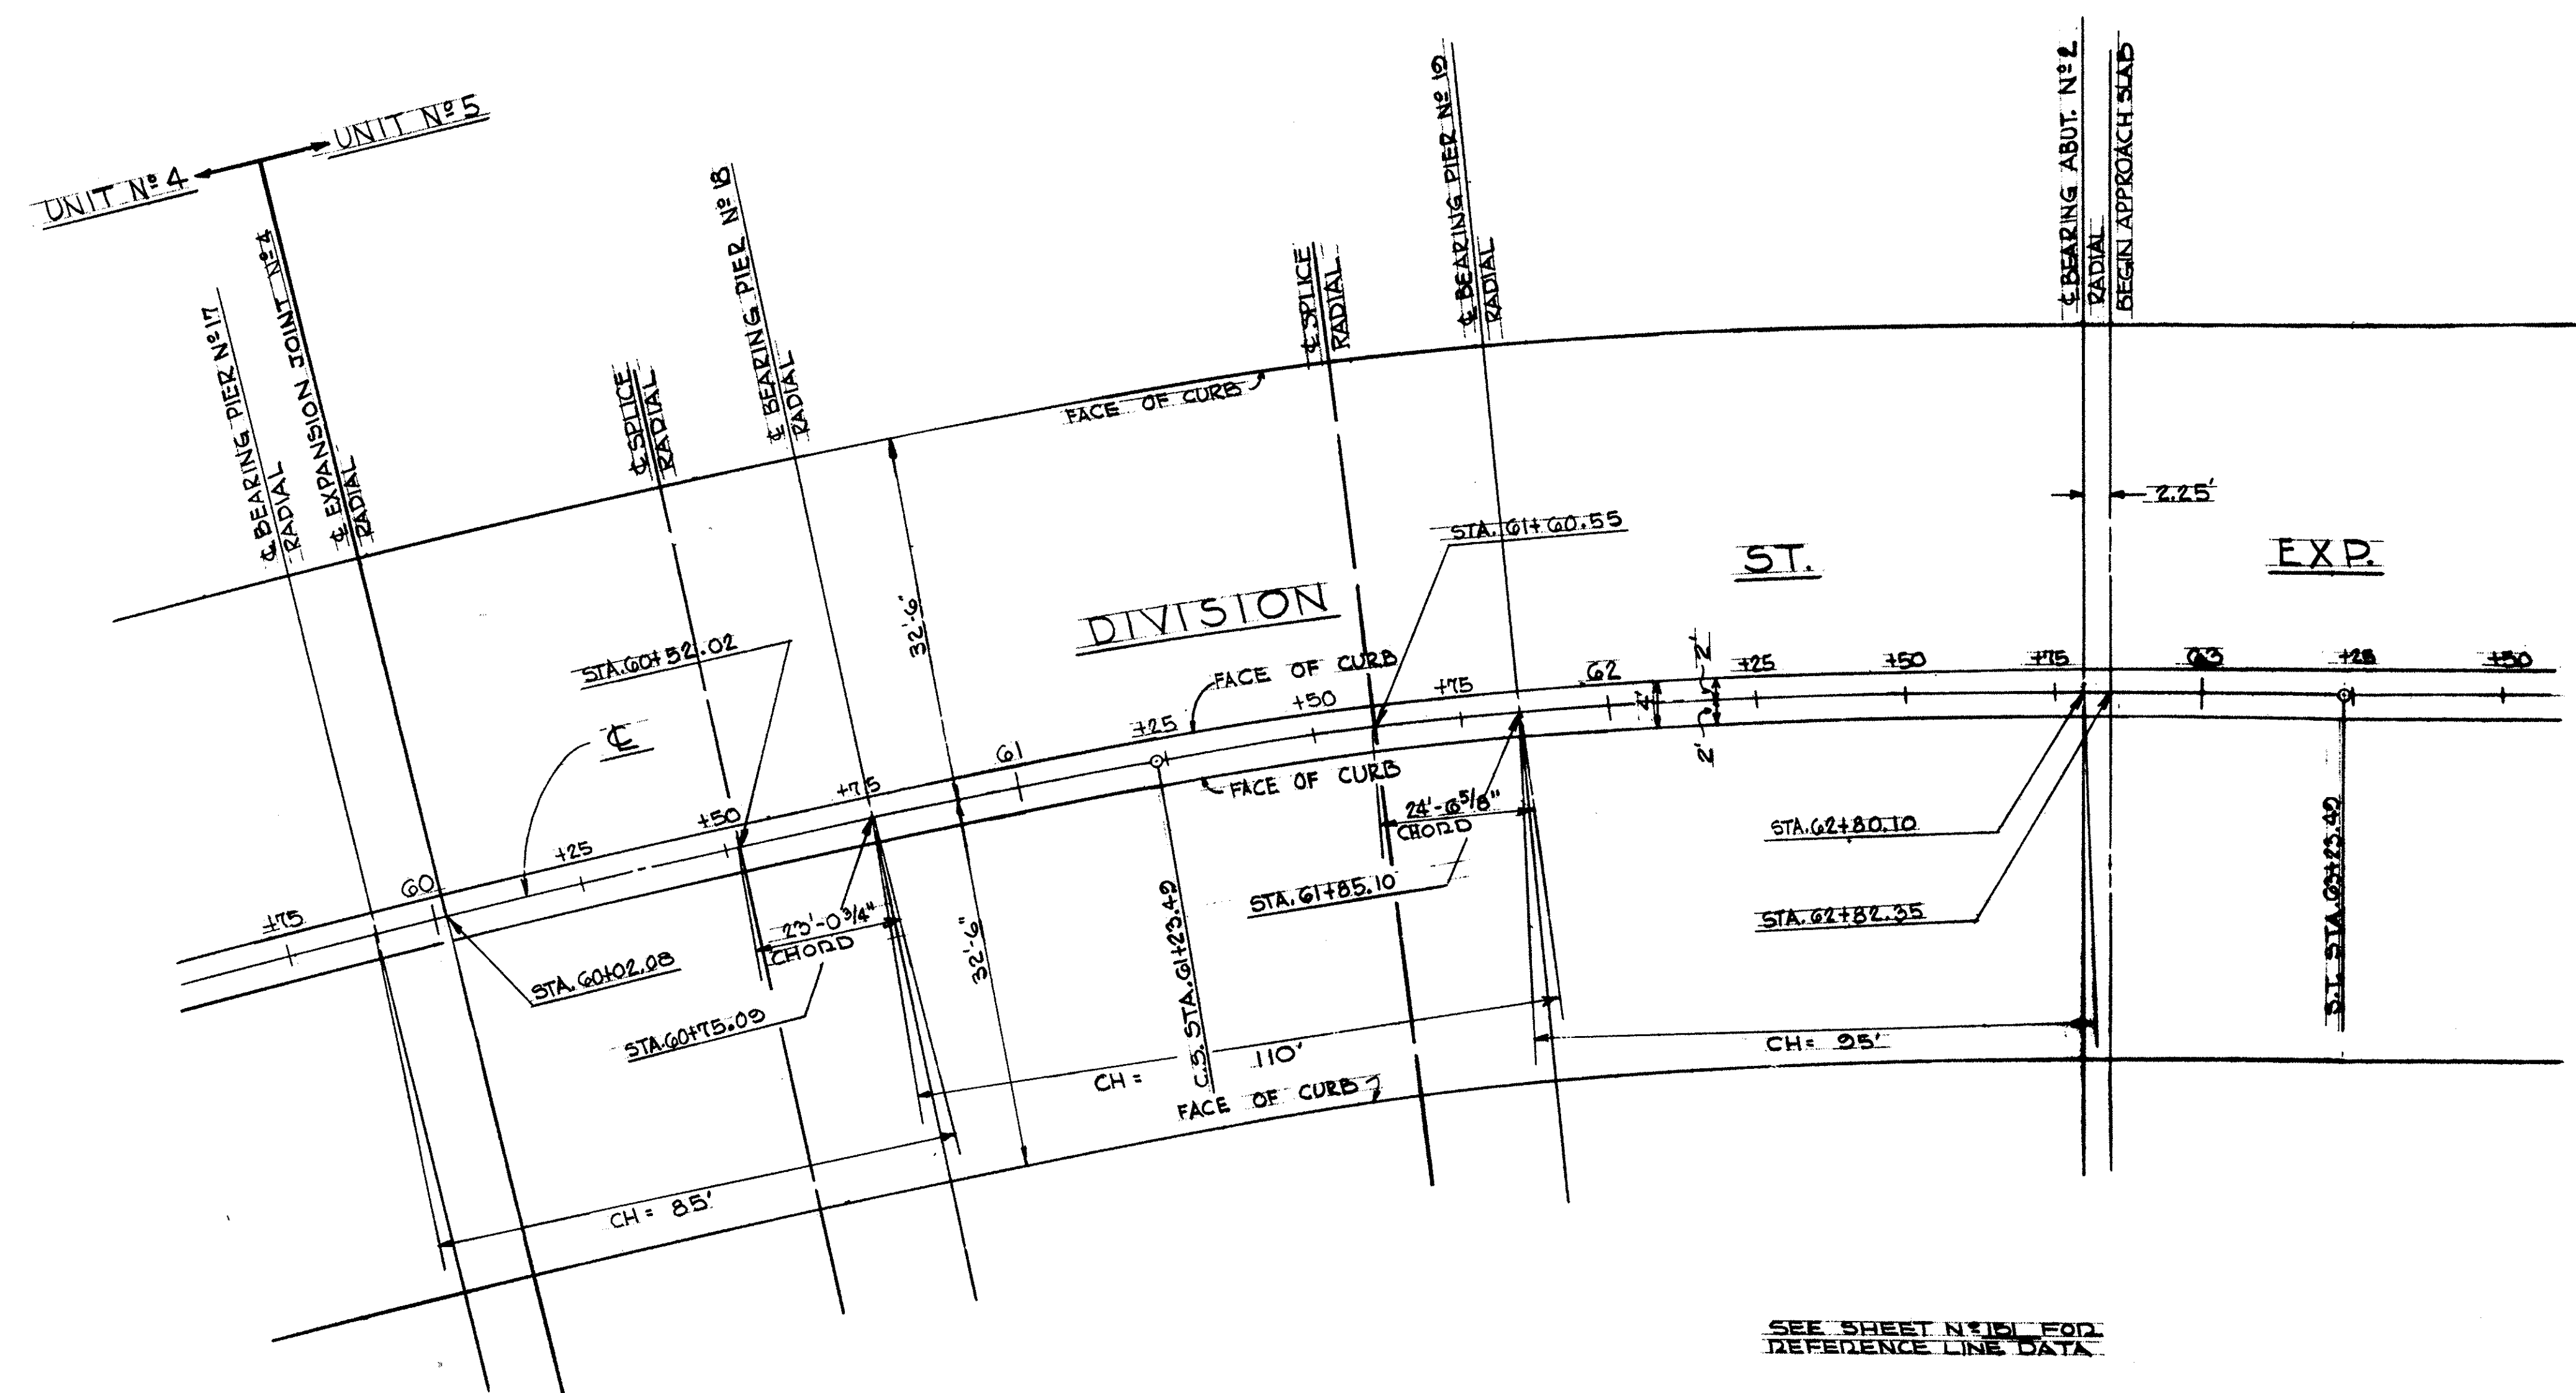

SEE SHEET N 151 FOR
REFERENCE LINE DATA

CURVE DATA

PI. STA. 58+60.12	$\Delta_c = 2^\circ$
$\Delta = 21^\circ 21' 45''$	$L_s = 465.25'$
$R = 1,000.66'$	$E_s = 35.10'$
$L_c = 200'$	$L_s = 192.95'$
$\Delta_c = 15^\circ 21' 45''$	$\Delta_c = 3.45'$
$L_c = 260.31'$	$L_s = 192.95'$
$L_s = 517.62'$	$S.T. = 66.68'$
$CH = 516.04'$	$L_c = 1155.08'$
$E_c = 17.67'$	$P.T. = 611'$
$M_c = 17.51'$	$K = 99.22'$


STATE OF OHIO DEPARTMENT OF HIGHWAYS BUREAU OF BRIDGES					
GLAUS, PYLE & SCHOMER AKRON, OHIO			YOUNGSTOWN, OHIO		
GEOMETRIC PLAN					
BRIDGE No		MAH-711-016			
OVER MAHONING RIVER					
YOUNGSTOWN			MAHONING COUNTY		
UNIT No 5					
DESIGNED	DRAWN	TRACED	CHECKED	REVIEWED	DATE
RWS	RWS		P.K.	WKB	6-22-68

MAHONGON
JUN 13 1968
REPRODUCTION

FED. RD.	STATE	PROJECT
2	OHIO	U.S.-1159 (I)

153
232

MAH-711-0-17

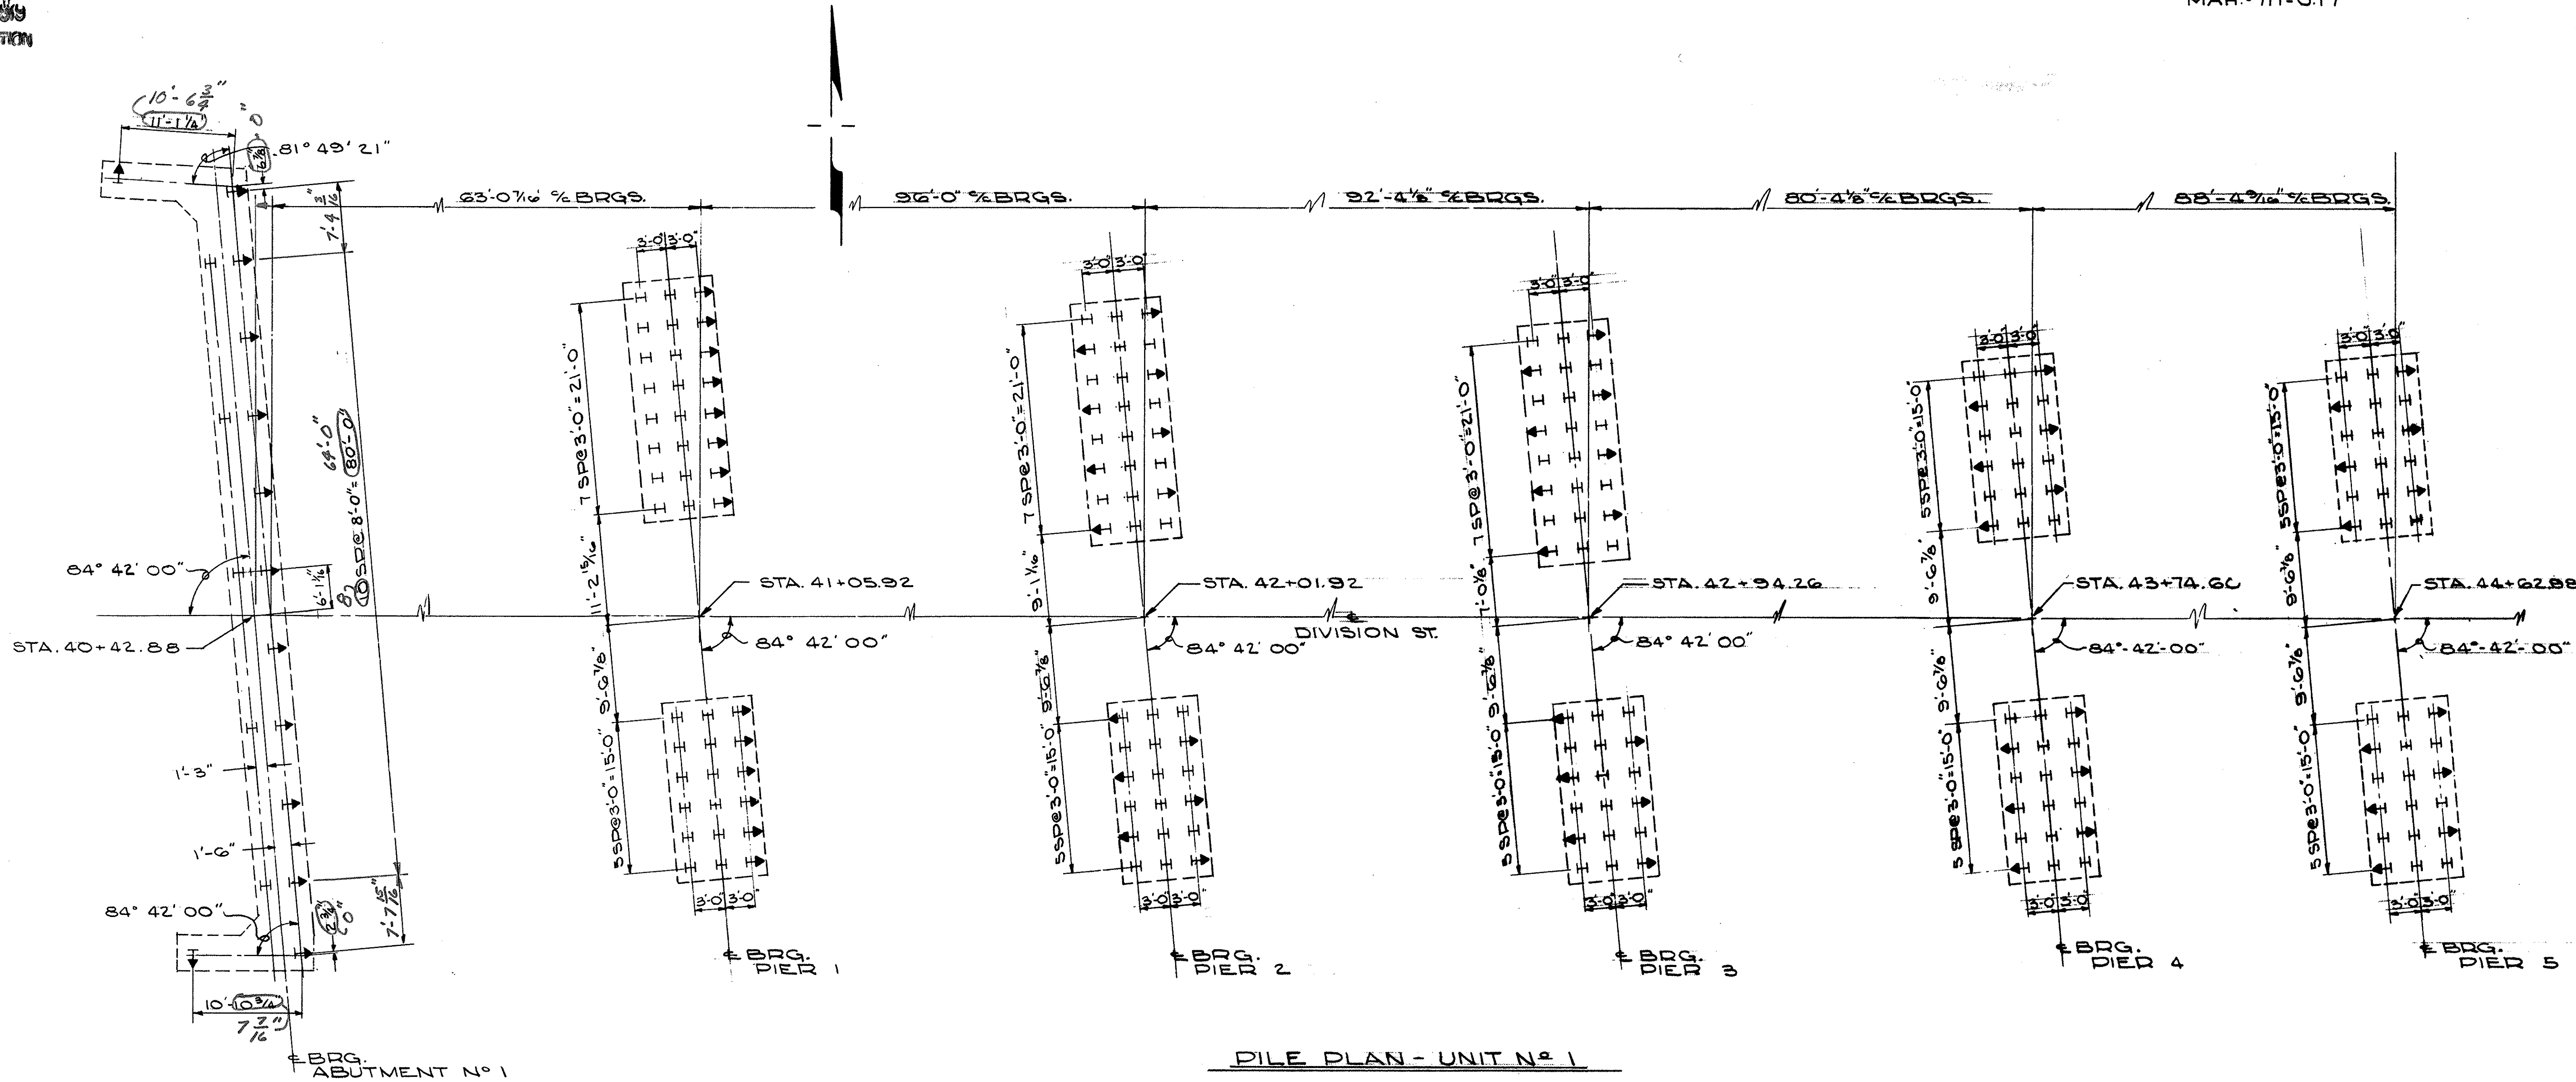


PILE PLAN - UNIT N° 1

NOTES:
 ALL PILES 12 BP 53
 → INDICATES DIRECTION OF 1:4 BATTER ON PILES

STATE OF OHIO DEPARTMENT OF HIGHWAYS BUREAU OF BRIDGES					
GLAUS, PYLE & SCHOMER			AKRON, OHIO		
YOUNGSTOWN, OHIO					
PILE PLAN					
BRIDGE N° MAH-711-016					
OVER MAHONING RIVER					
YOUNGSTOWN MAHONING COUNTY					
UNIT N° 1					
DESIGNED	DRAWN	TRACED	CHECKED	REVIEWED	DATE
JWC	JWC		JM	WLD	6-22-68
					7-1-68

MAH-711-0.17

APPROVED
JUN 15 1968
REVISION

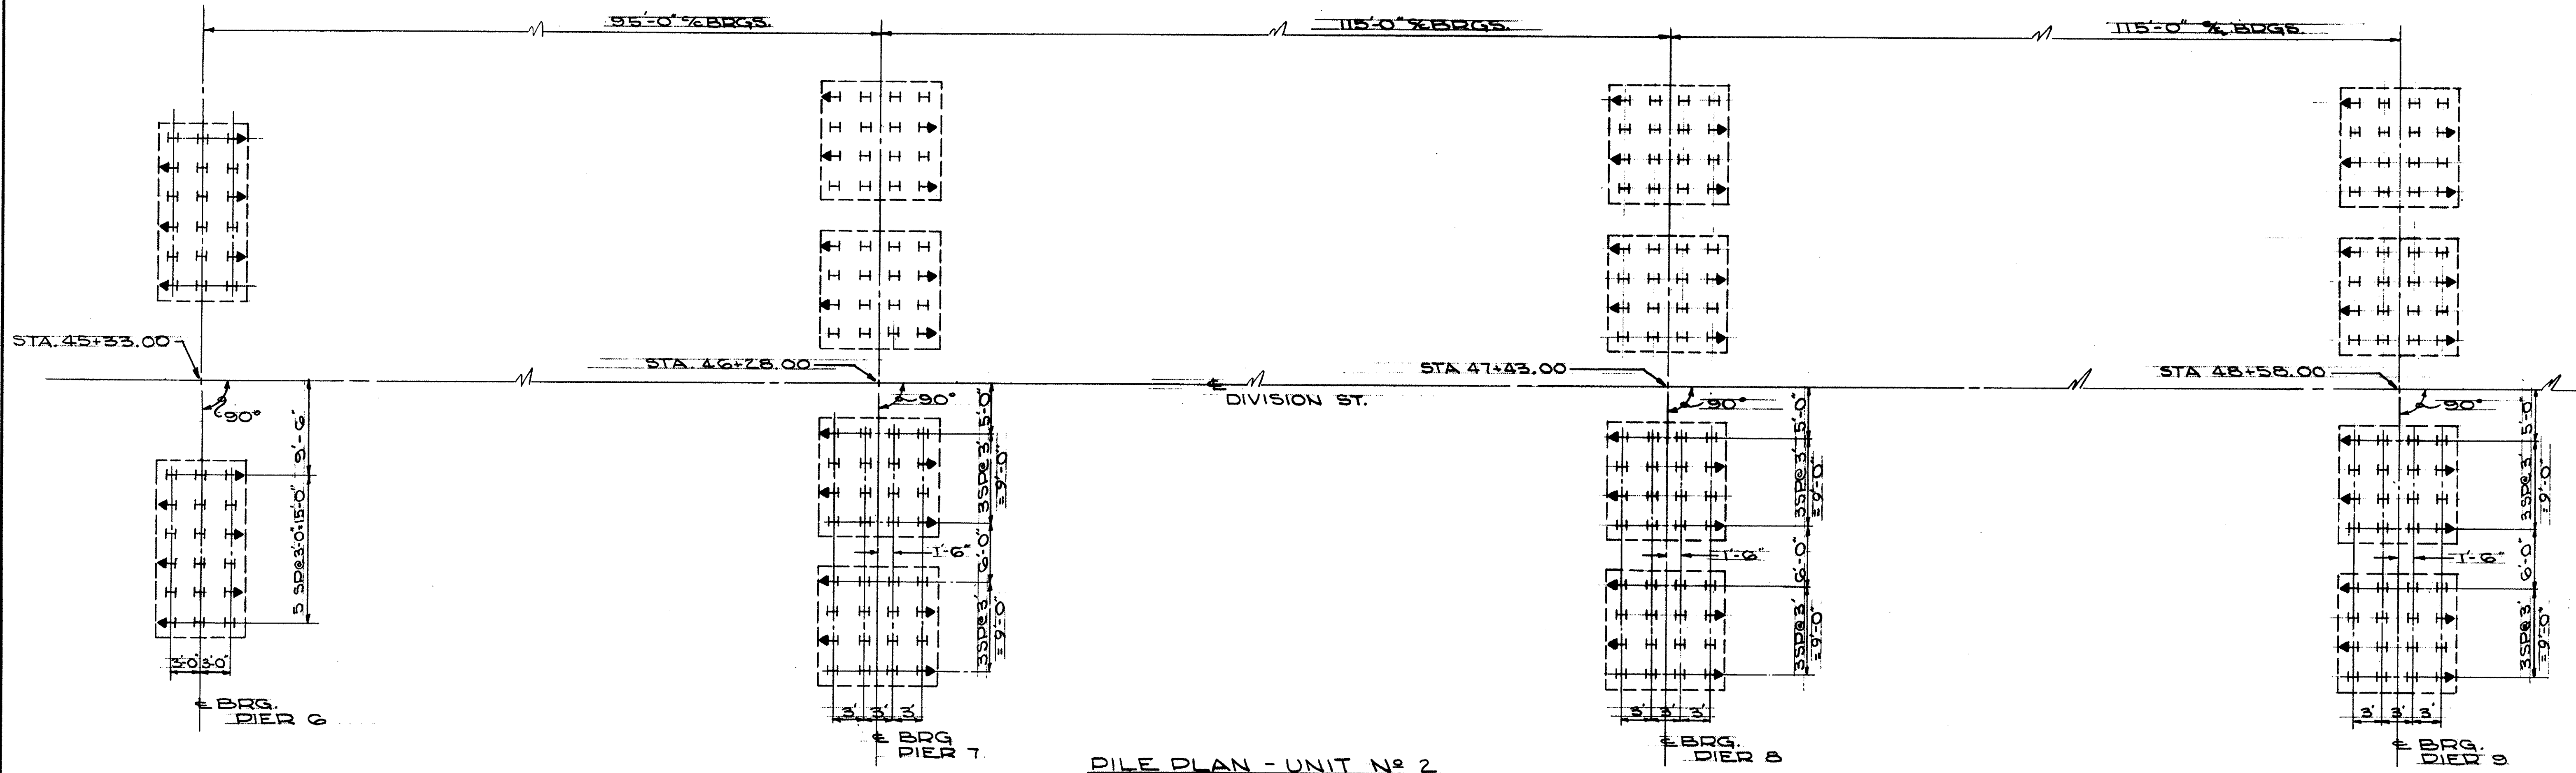

PILE PLAN - UNIT No 2

NOTE:
ALL PILES 12 BP 53
PILE SPACING SYMMETRICAL
ABOUT & DIVISION ST.


STATE OF OHIO DEPARTMENT OF HIGHWAYS BUREAU OF BRIDGES						
AKRON, OHIO						
GLAUS, PYLE & SCHOMER YOUNGSTOWN, OHIO						
PILE PLAN						
BRIDGE No			MAH-711-0116			
OVER MAHONING RIVER YOUNGSTOWN MAHONING COUNTY						
UNIT No 2						
DESIGNED	DRAWN	TRACED	CHECKED	REVIEWED	DATE	REVISED
JWC	JWC		JM	WLD	6-22-68	

MAHONING
COUNTY

FED. RD.	STATE	PROJECT
2	OHIO	U.S.-1189 (1)

155
232

MAH-711-O.17

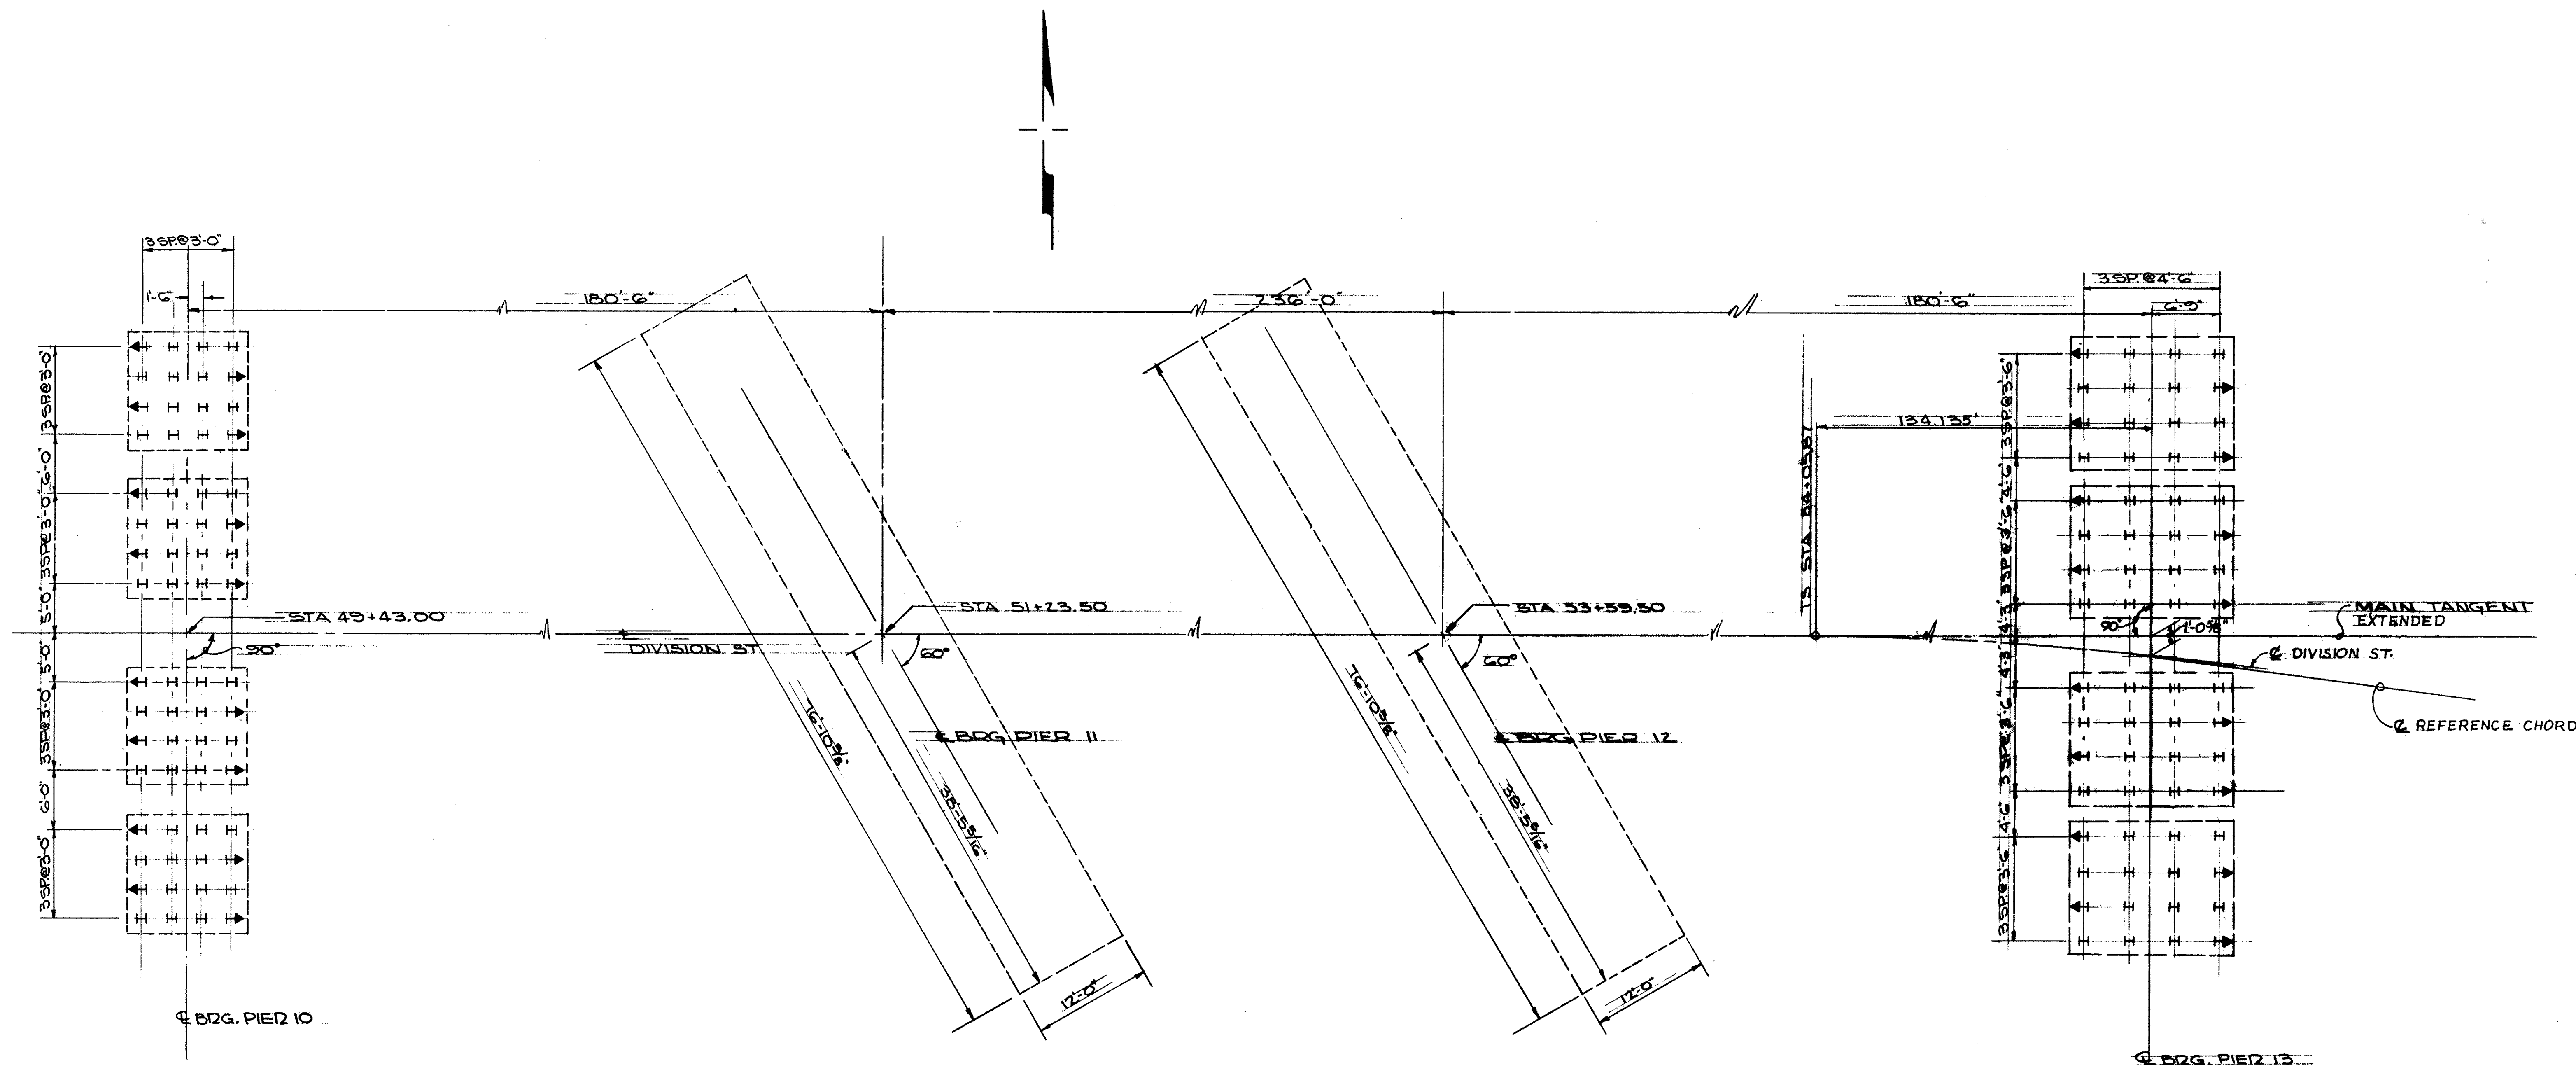

PILE PLAN UNIT N°3

ALL PILES 12 DP53


STATE OF OHIO DEPARTMENT OF HIGHWAYS BUREAU OF BRIDGES						
AKRON, OHIO			GLAUS, PYLE & SCHOMER YOUNGSTOWN, OHIO			
PILE PLAN						
BRIDGE N° MAH-711-0116						
OVER MAHONING RIVER						
YOUNGSTOWN MAHONING COUNTY						
UNIT N° 3						
DESIGNED	DRAWN	TRACED	CHECKED	REVIEWED	DATE	REVISED
JWC	JWC		JJM	WKB	6-22-68	

APPROVED
JUN 13 1968
REVISION

FED. RD.	STATE	PROJECT
2	OHIO	MAH-1159 (1)

156
232

MAH-711-0.17

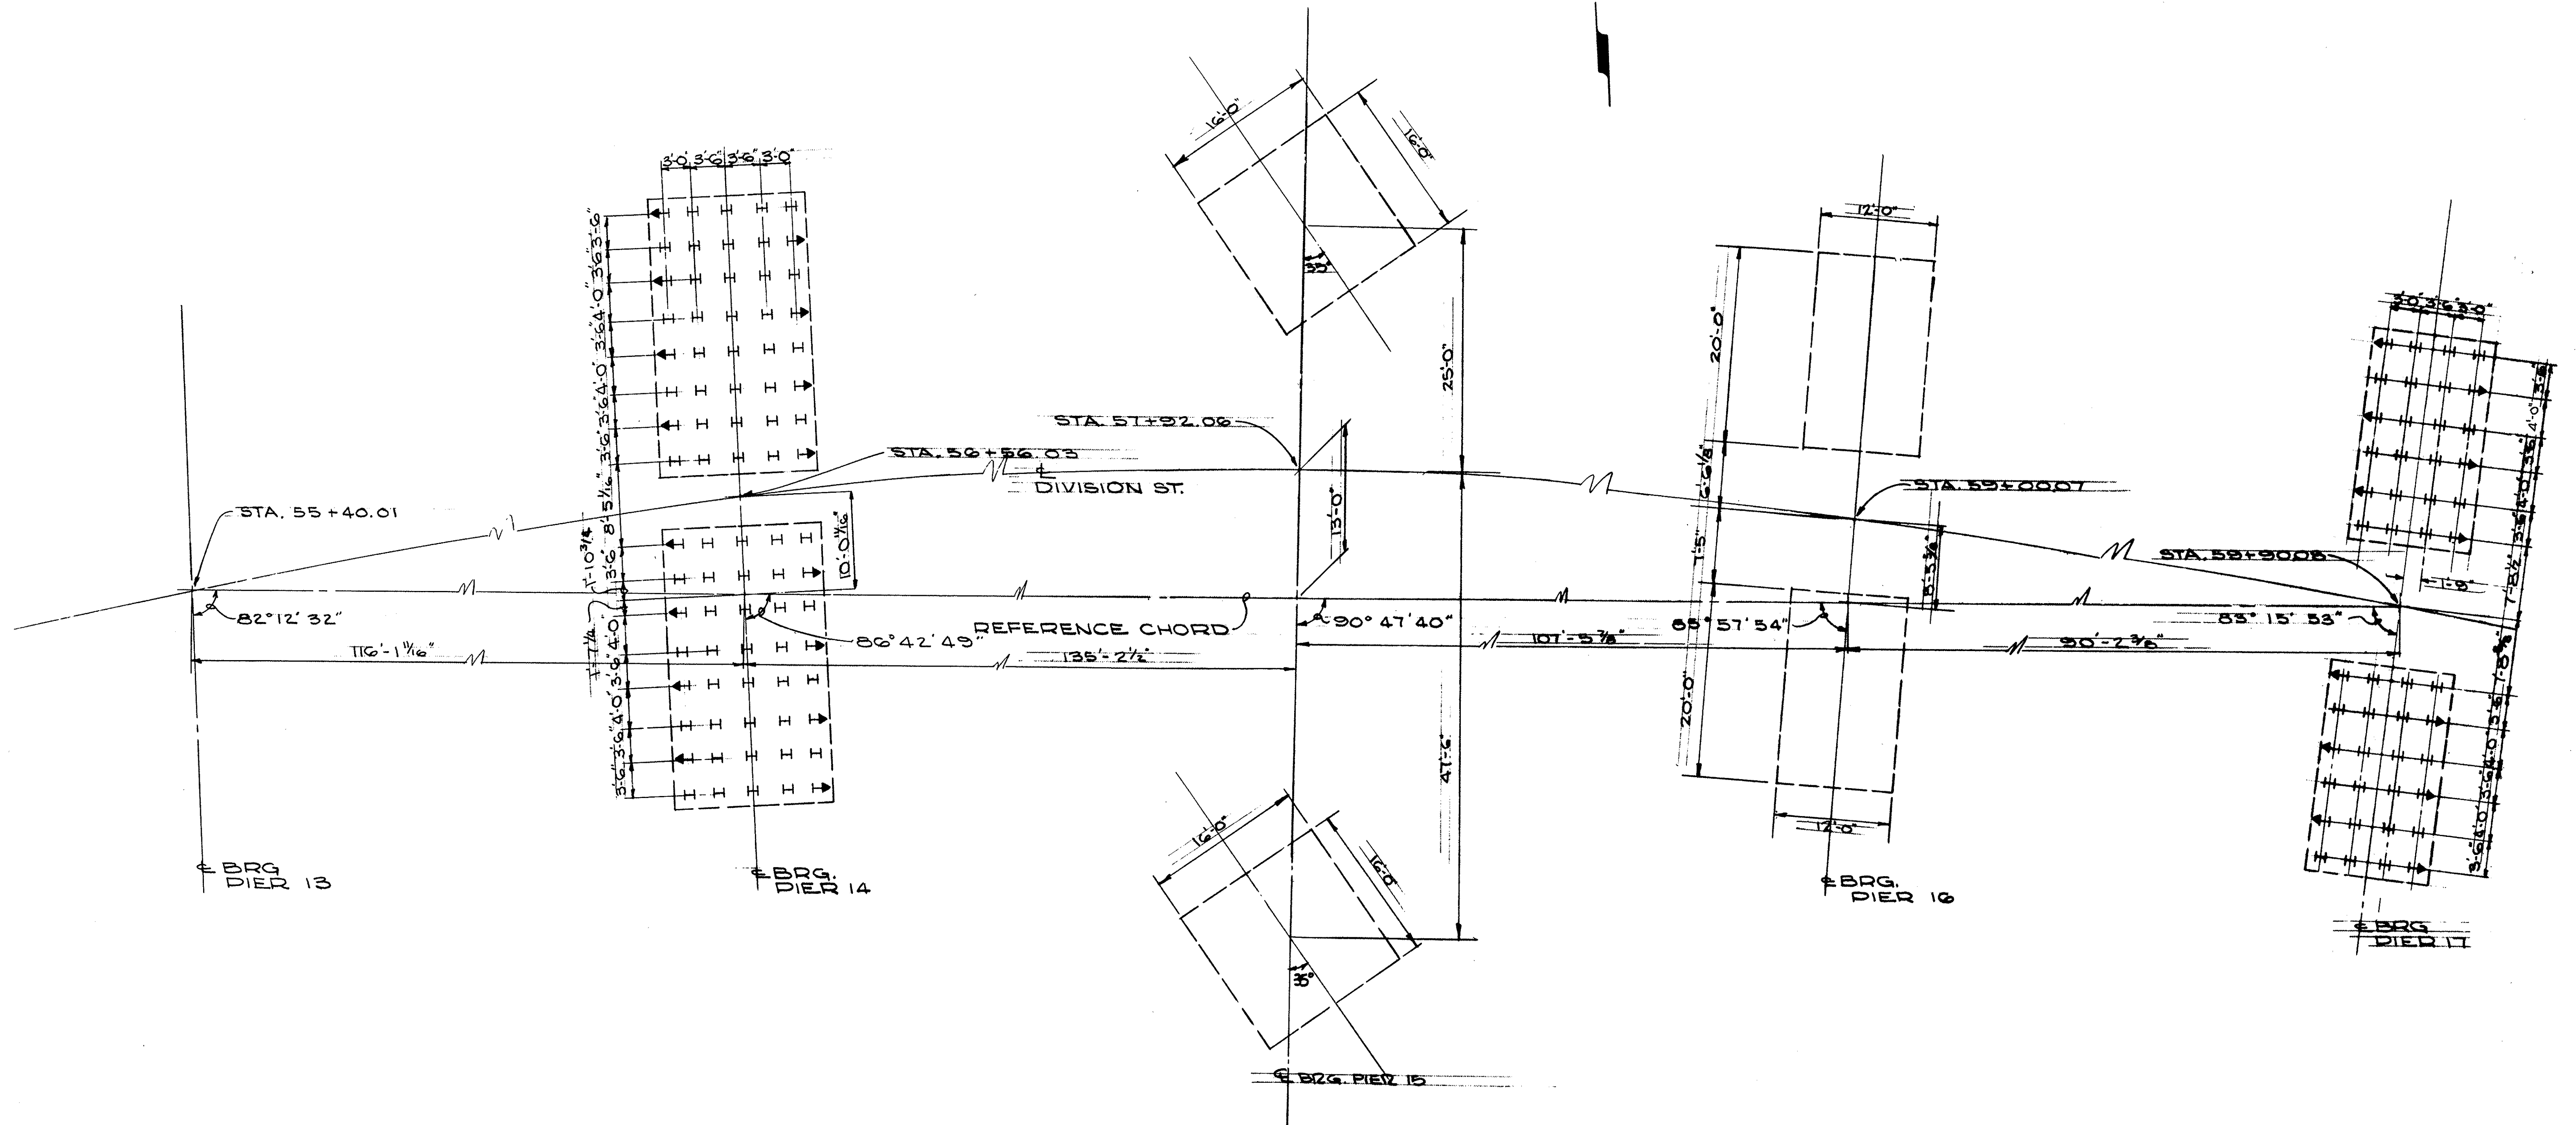

PILE PLAN-UNIT N°4

SEE SHEET 151 FOR REFERENCE CHORD


STATE OF OHIO DEPARTMENT OF HIGHWAYS BUREAU OF BRIDGES						
GLAUS, PYLE & SCHOMER AKRON, OHIO			YOUNGSTOWN, OHIO			
PILE PLAN						
BRIDGE N°			MAH-711-0116			
OVER MAHONING RIVER YOUNGSTOWN MAHONING COUNTY						
UNIT N°4						
DESIGNED	DRAWN	TRACED	CHECKED	REVIEWED	DATE	REVISED
JWC	JWC		JKA	WLD	6-22-68	

MAHONING
JUN 13 1968
RESTRICTION

FED. RD.	STATE	PROJECT
2	OHIO	U.S.-1159 (1)

157
232

MAH-711-0.17

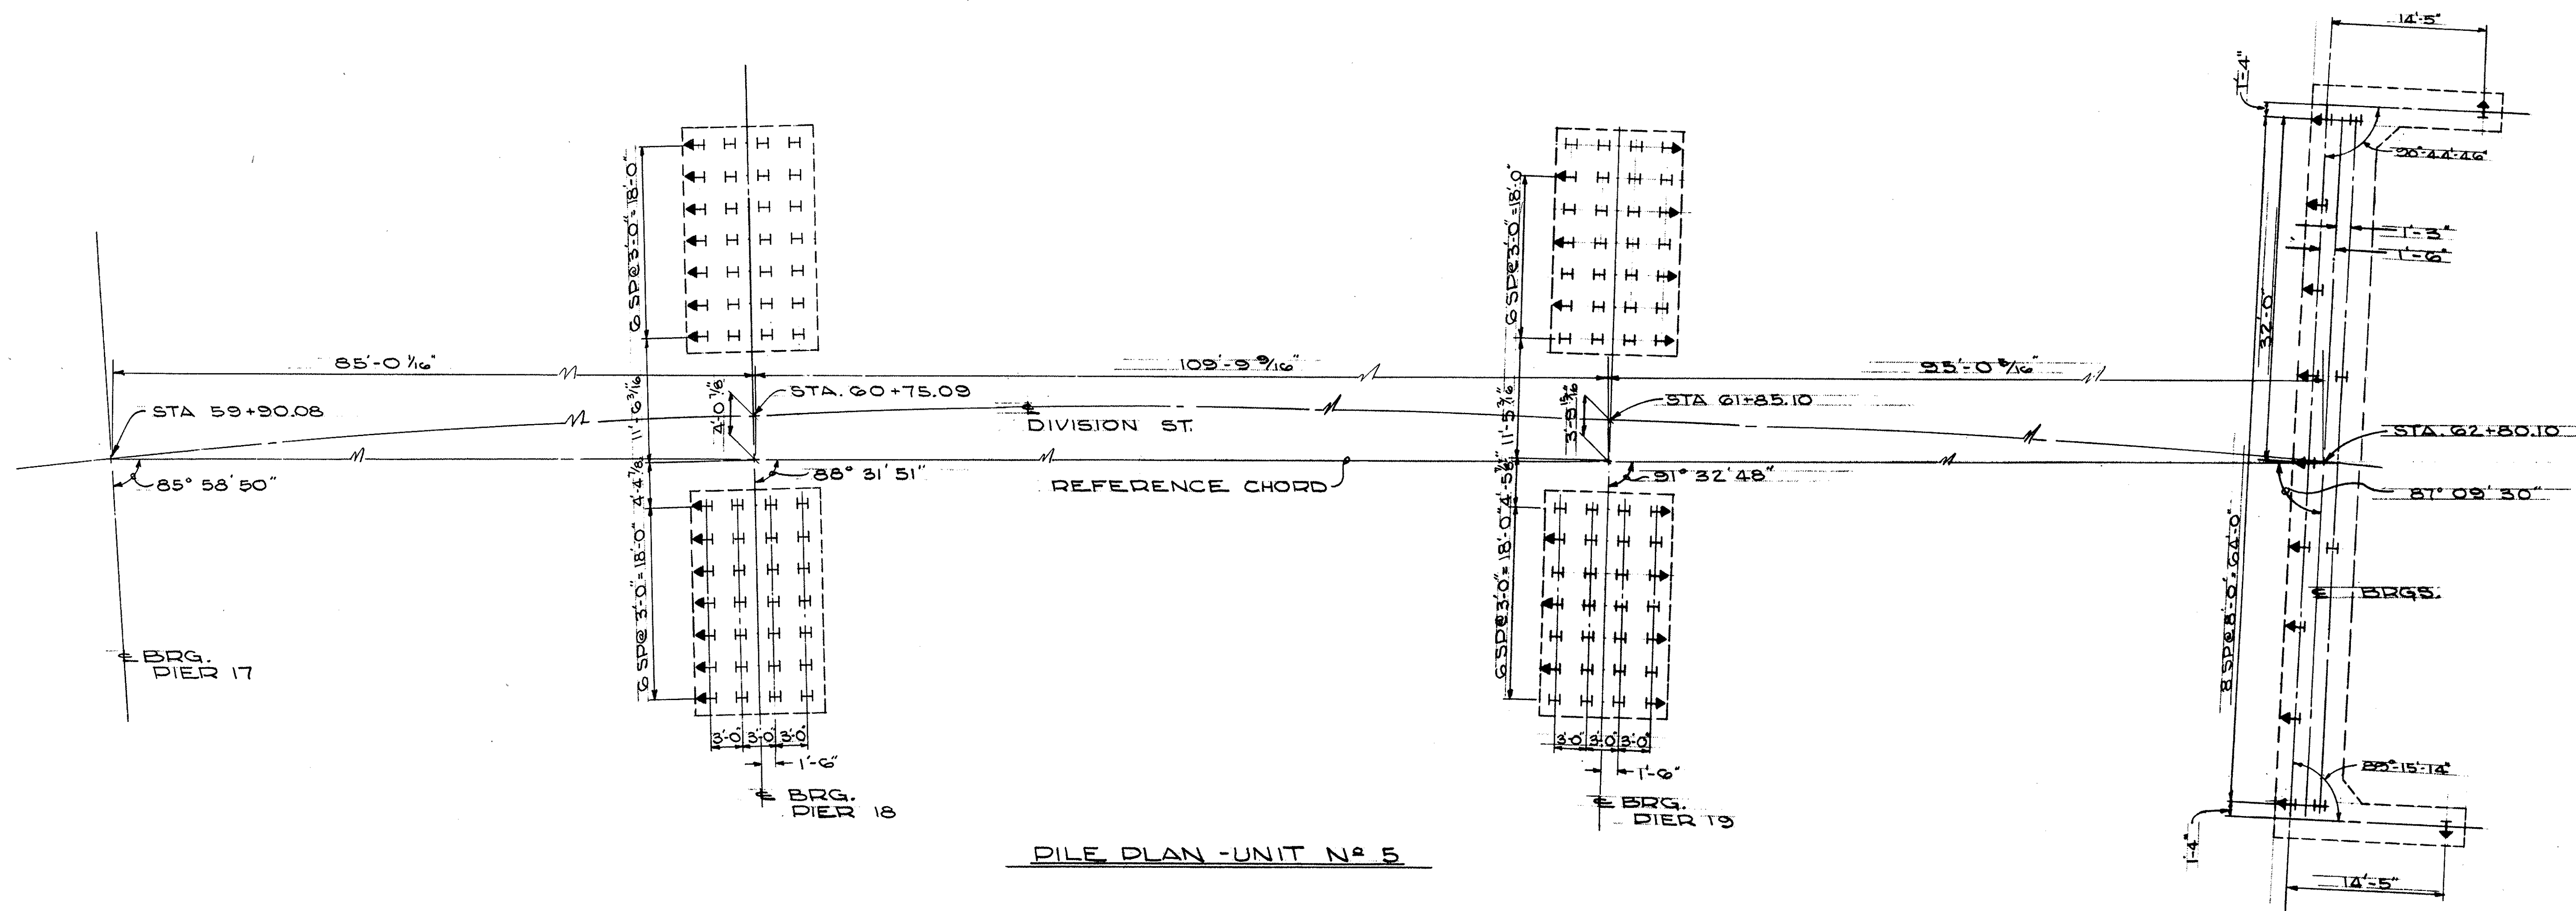

PILE PLAN - UNIT N^o 5

NOTE:
 ALL PILES 12 BSPB3
 H INDICATES DIRECTION OF 1/4 BATTER ON PILES
 SEE SHEET 151 FOR REFERENCE CHORD






STATE OF OHIO DEPARTMENT OF HIGHWAYS BUREAU OF BRIDGES					
GLAUS, PYLE & SCHOMER AKRON, OHIO YOUNGSTOWN, OHIO					
PILE PLAN					
BRIDGE N ^o MAH-711-0116					
OVER MAHONING RIVER					
YOUNGSTOWN MAHONING COUNTY					
UNIT N ^o 5					
DESIGNED	DRAWN	TRACED	CHECKED	REVIEWED	DATE
JWC	JWC		JM	WKB	6-22-68

REVISIONS
 JUN 13 1969
 REVISION

FED. RD.	STATE	PROJECT	
2	OHIO	U.S.-1150 (U)	

MAH-711-0.17

158-A
 232

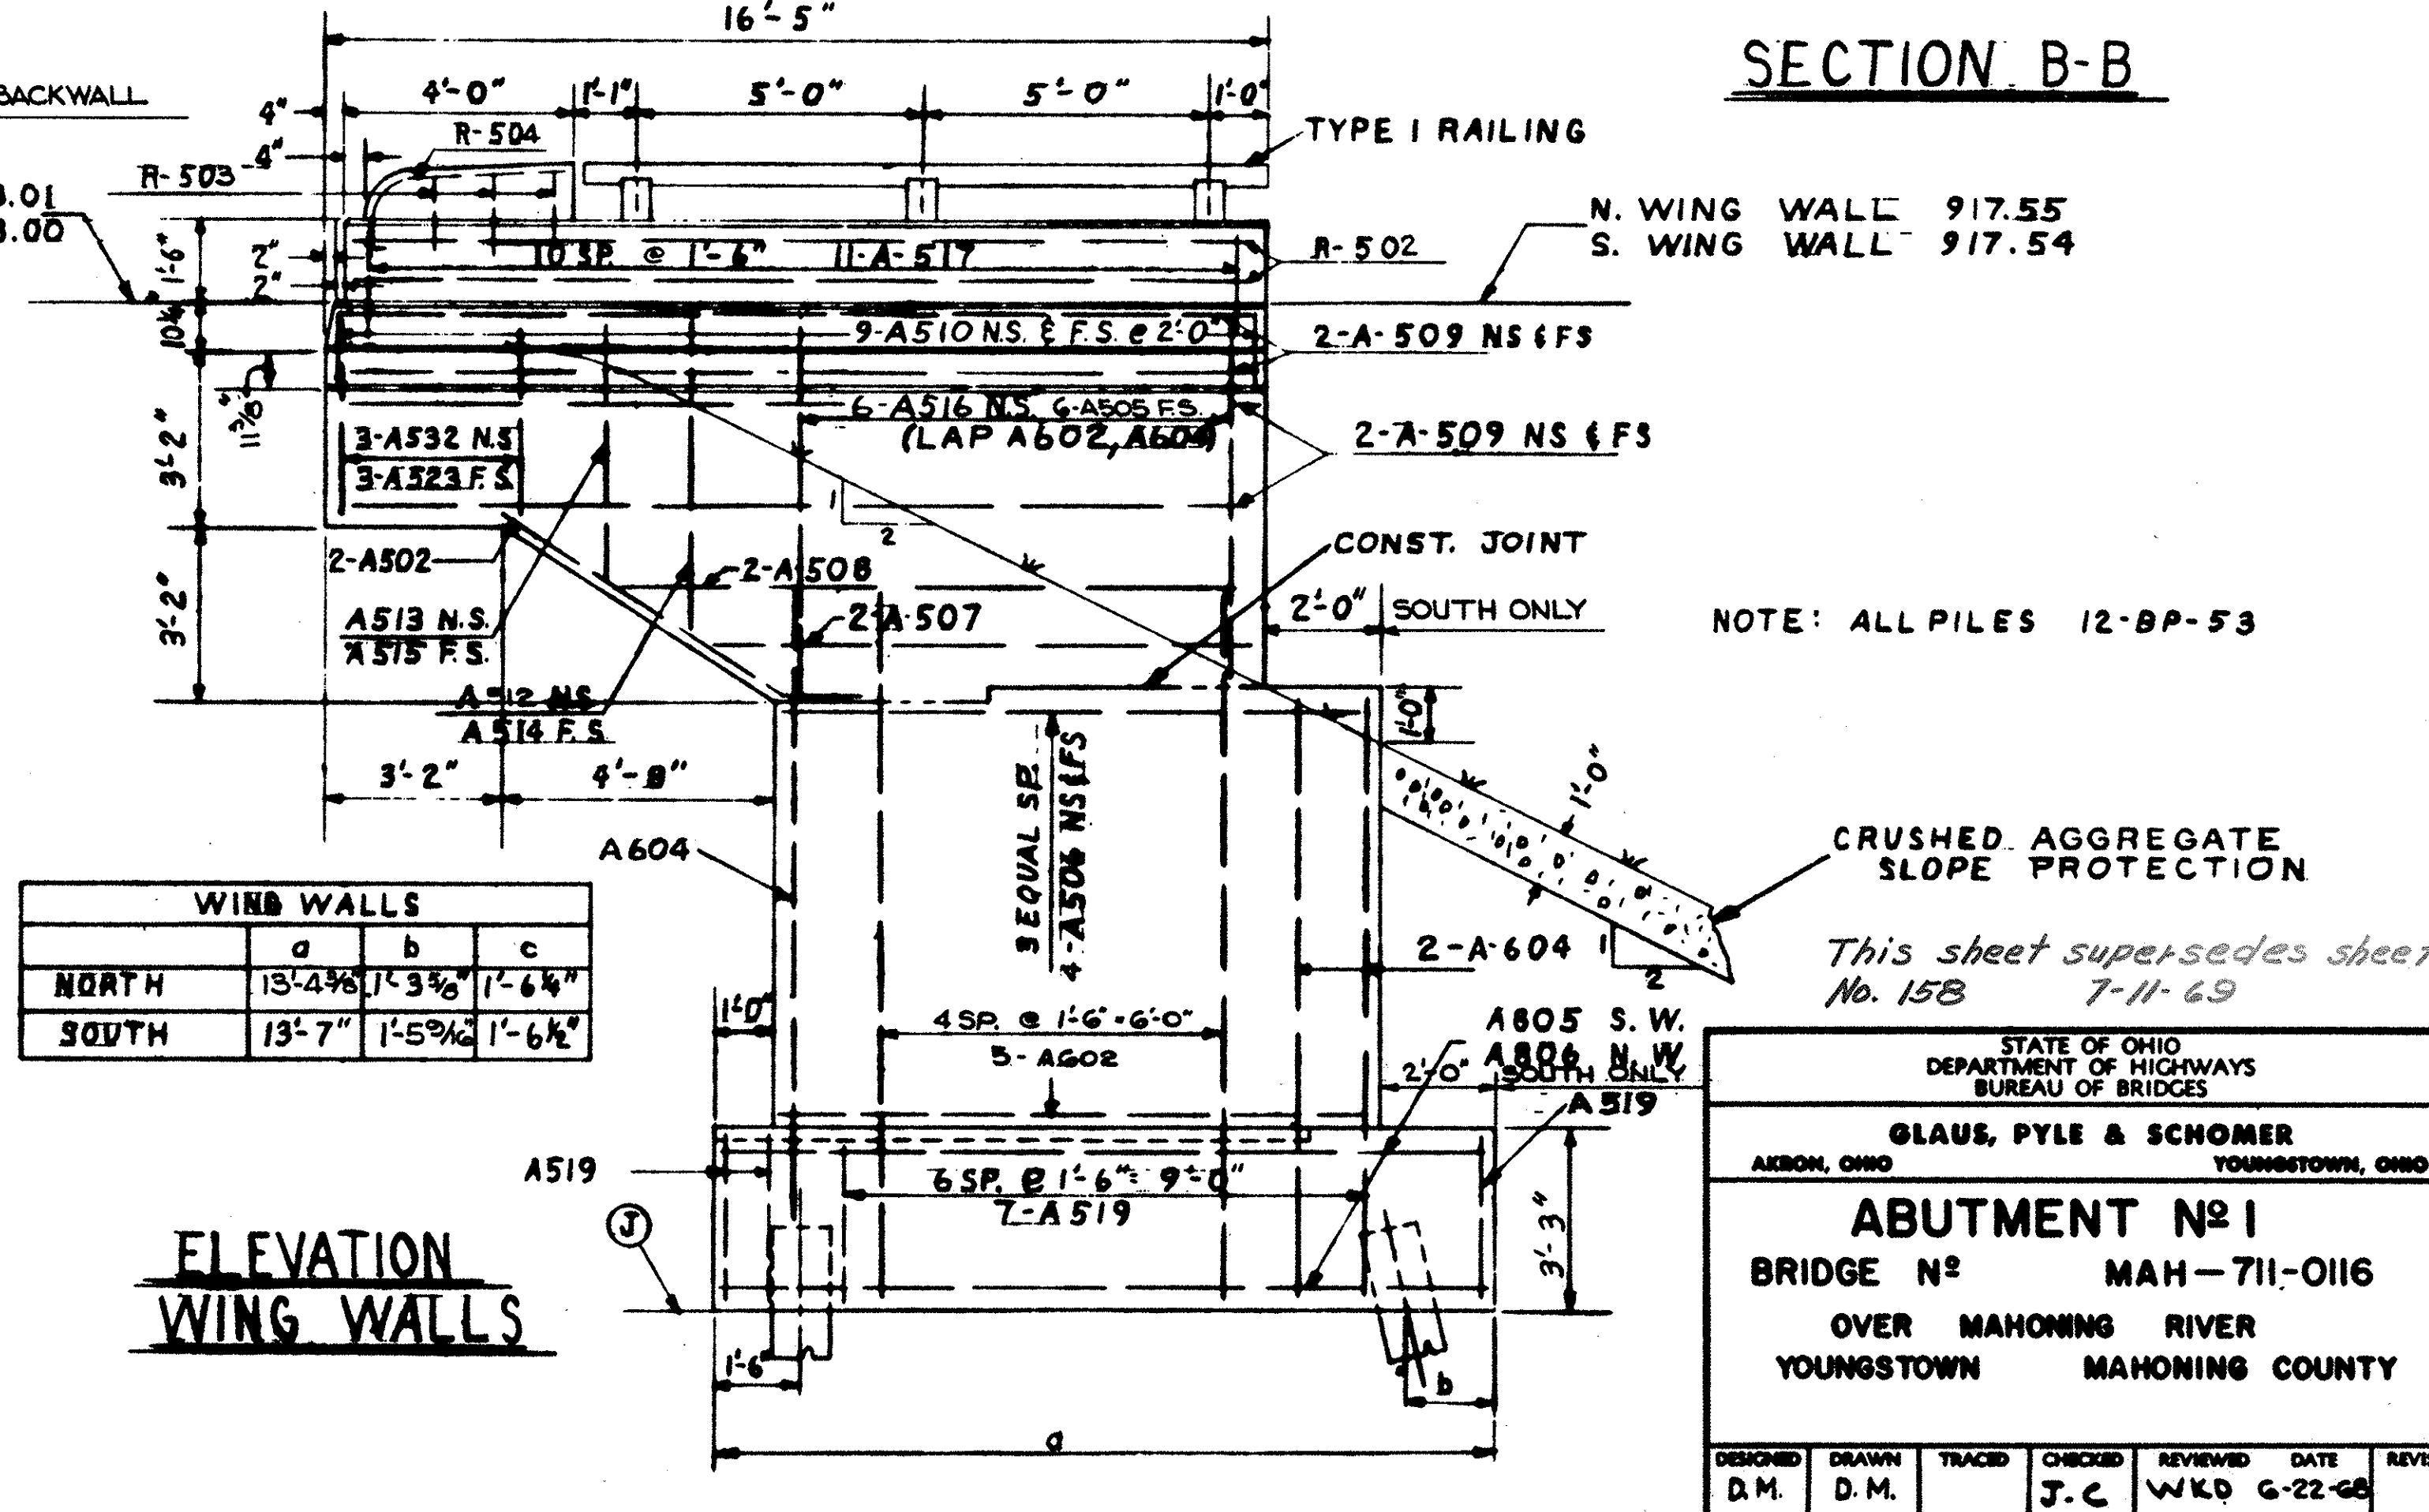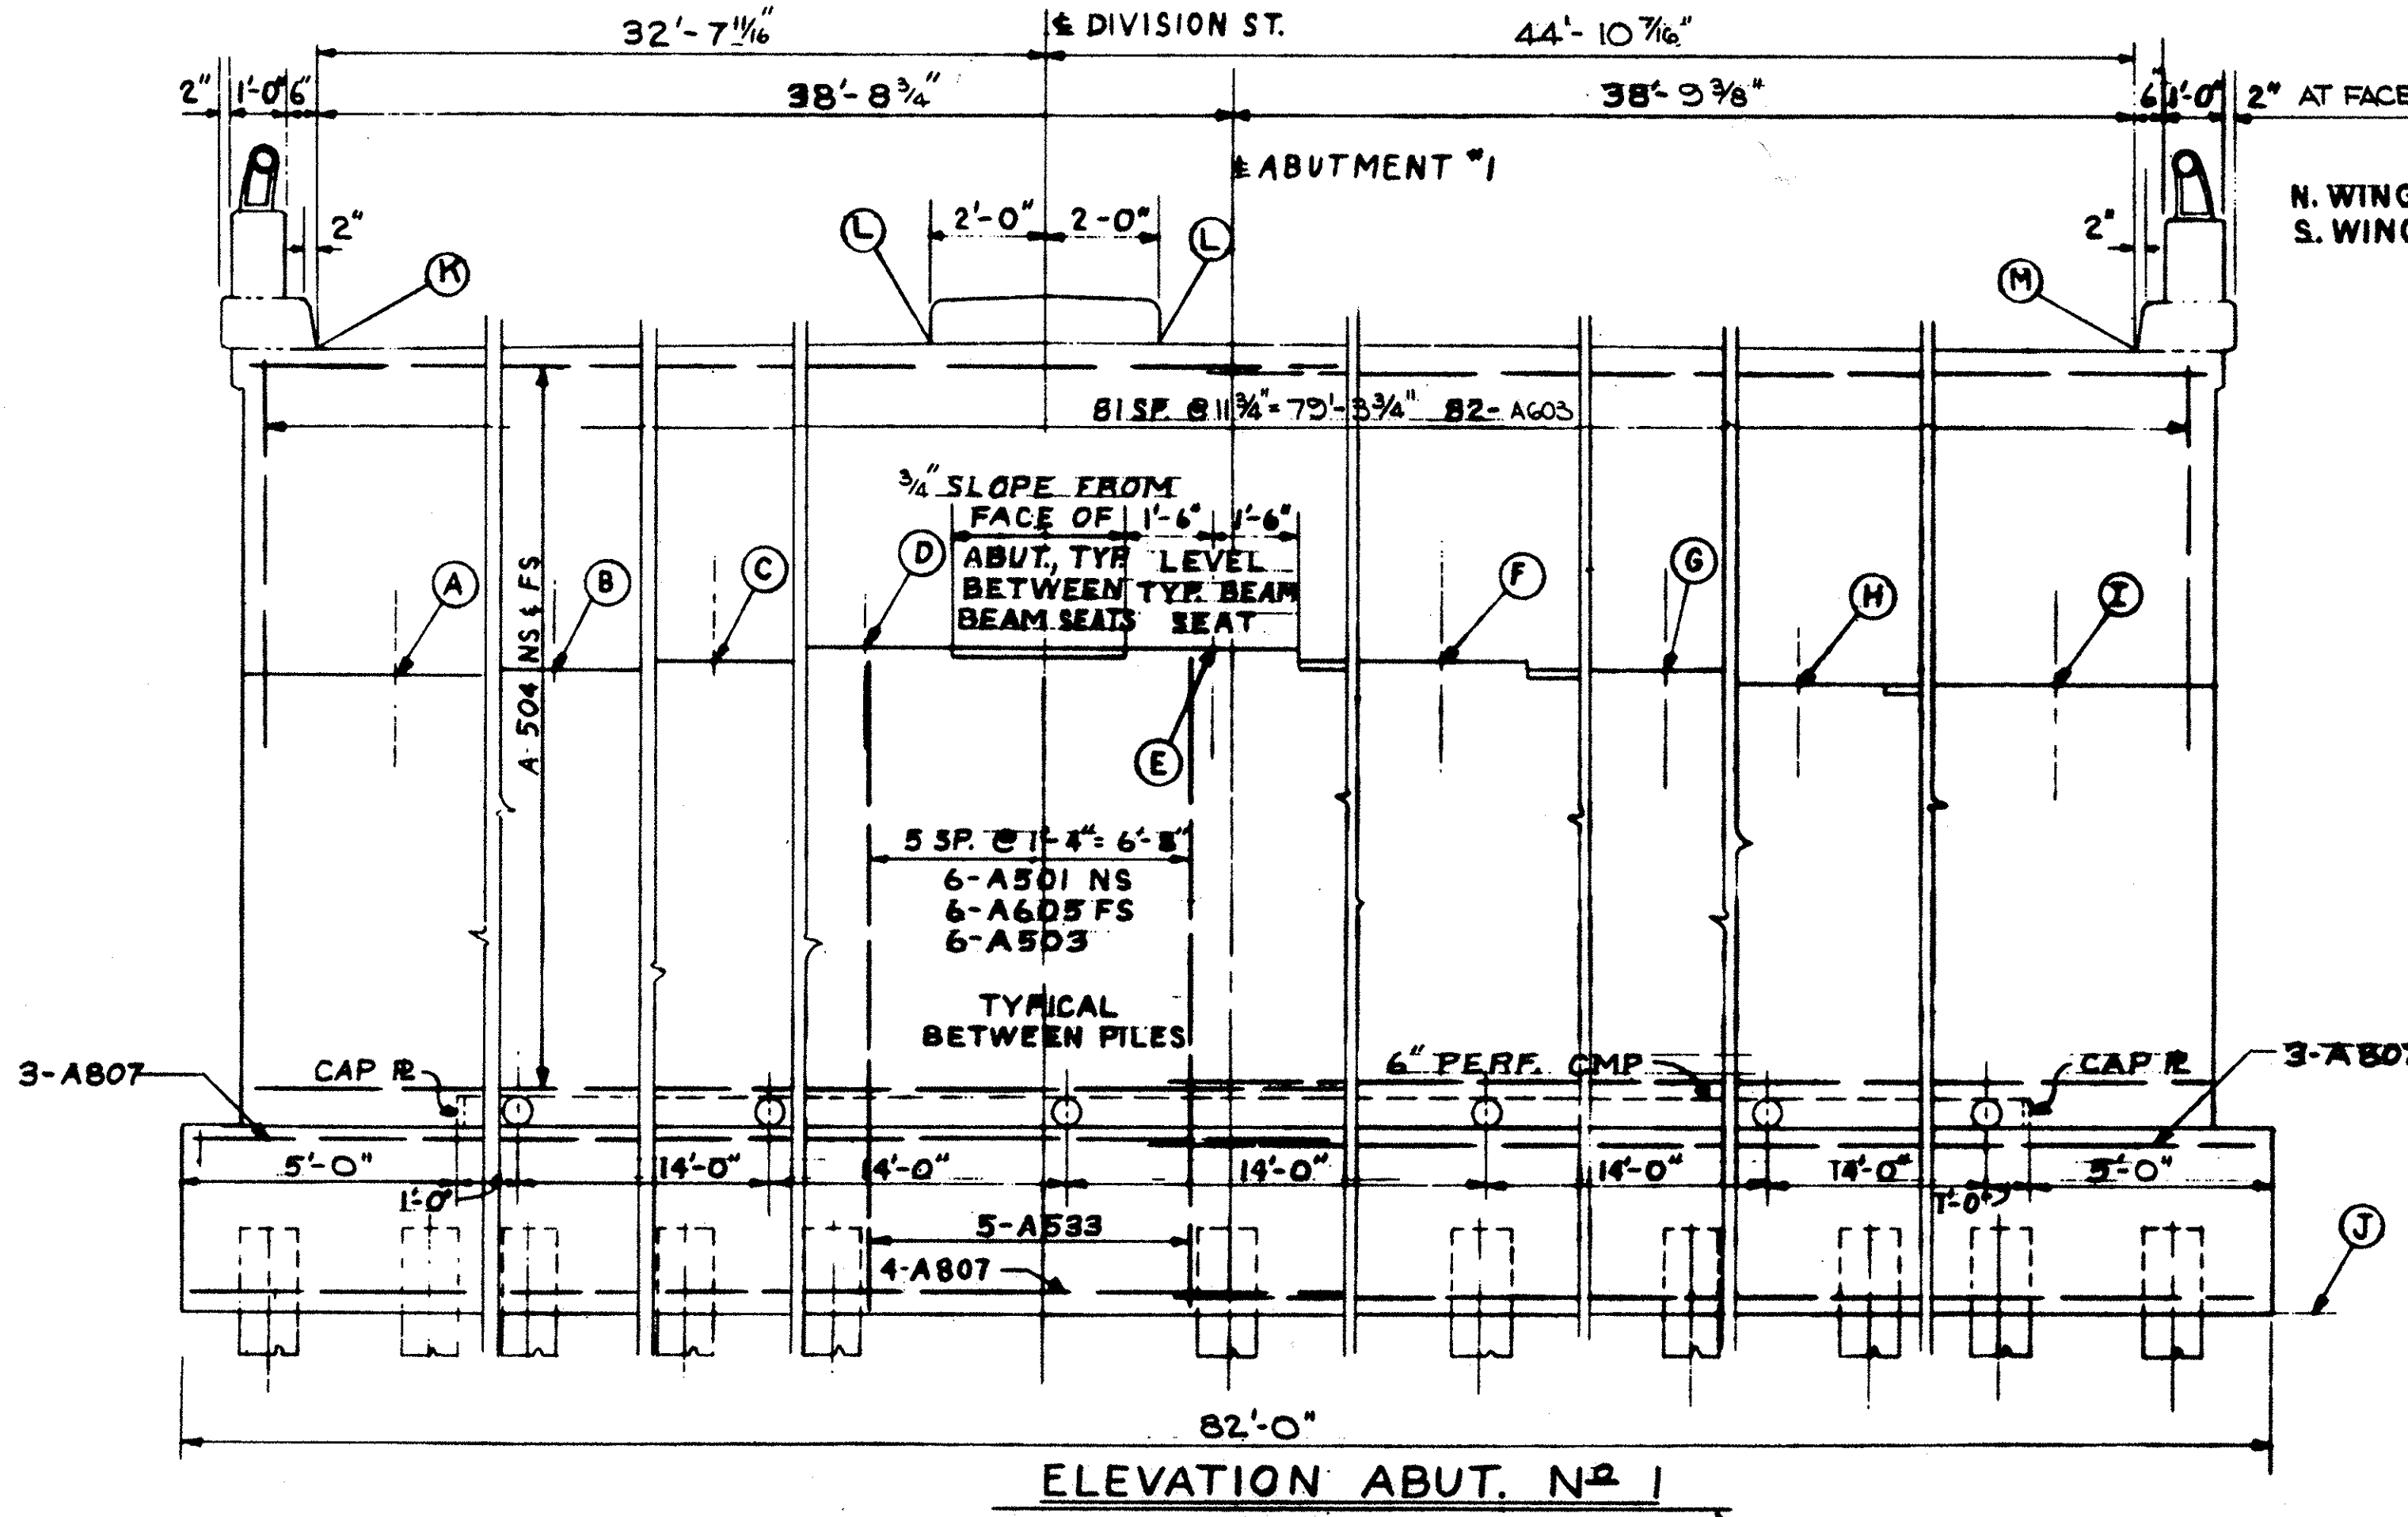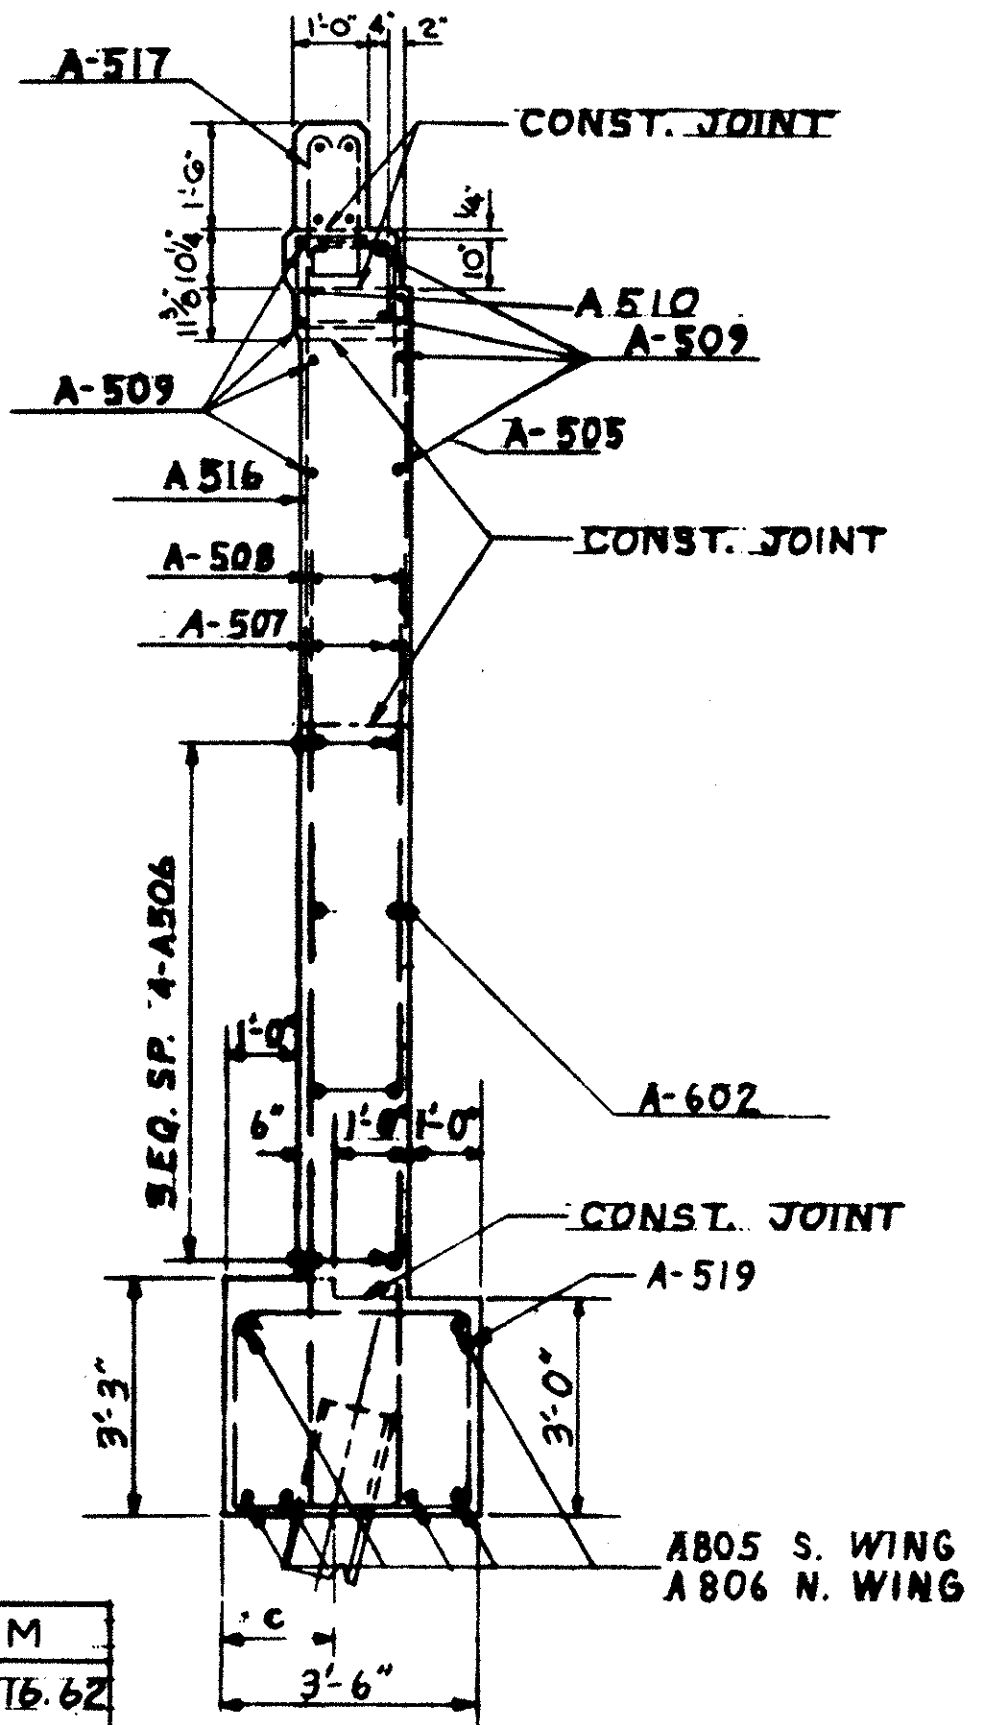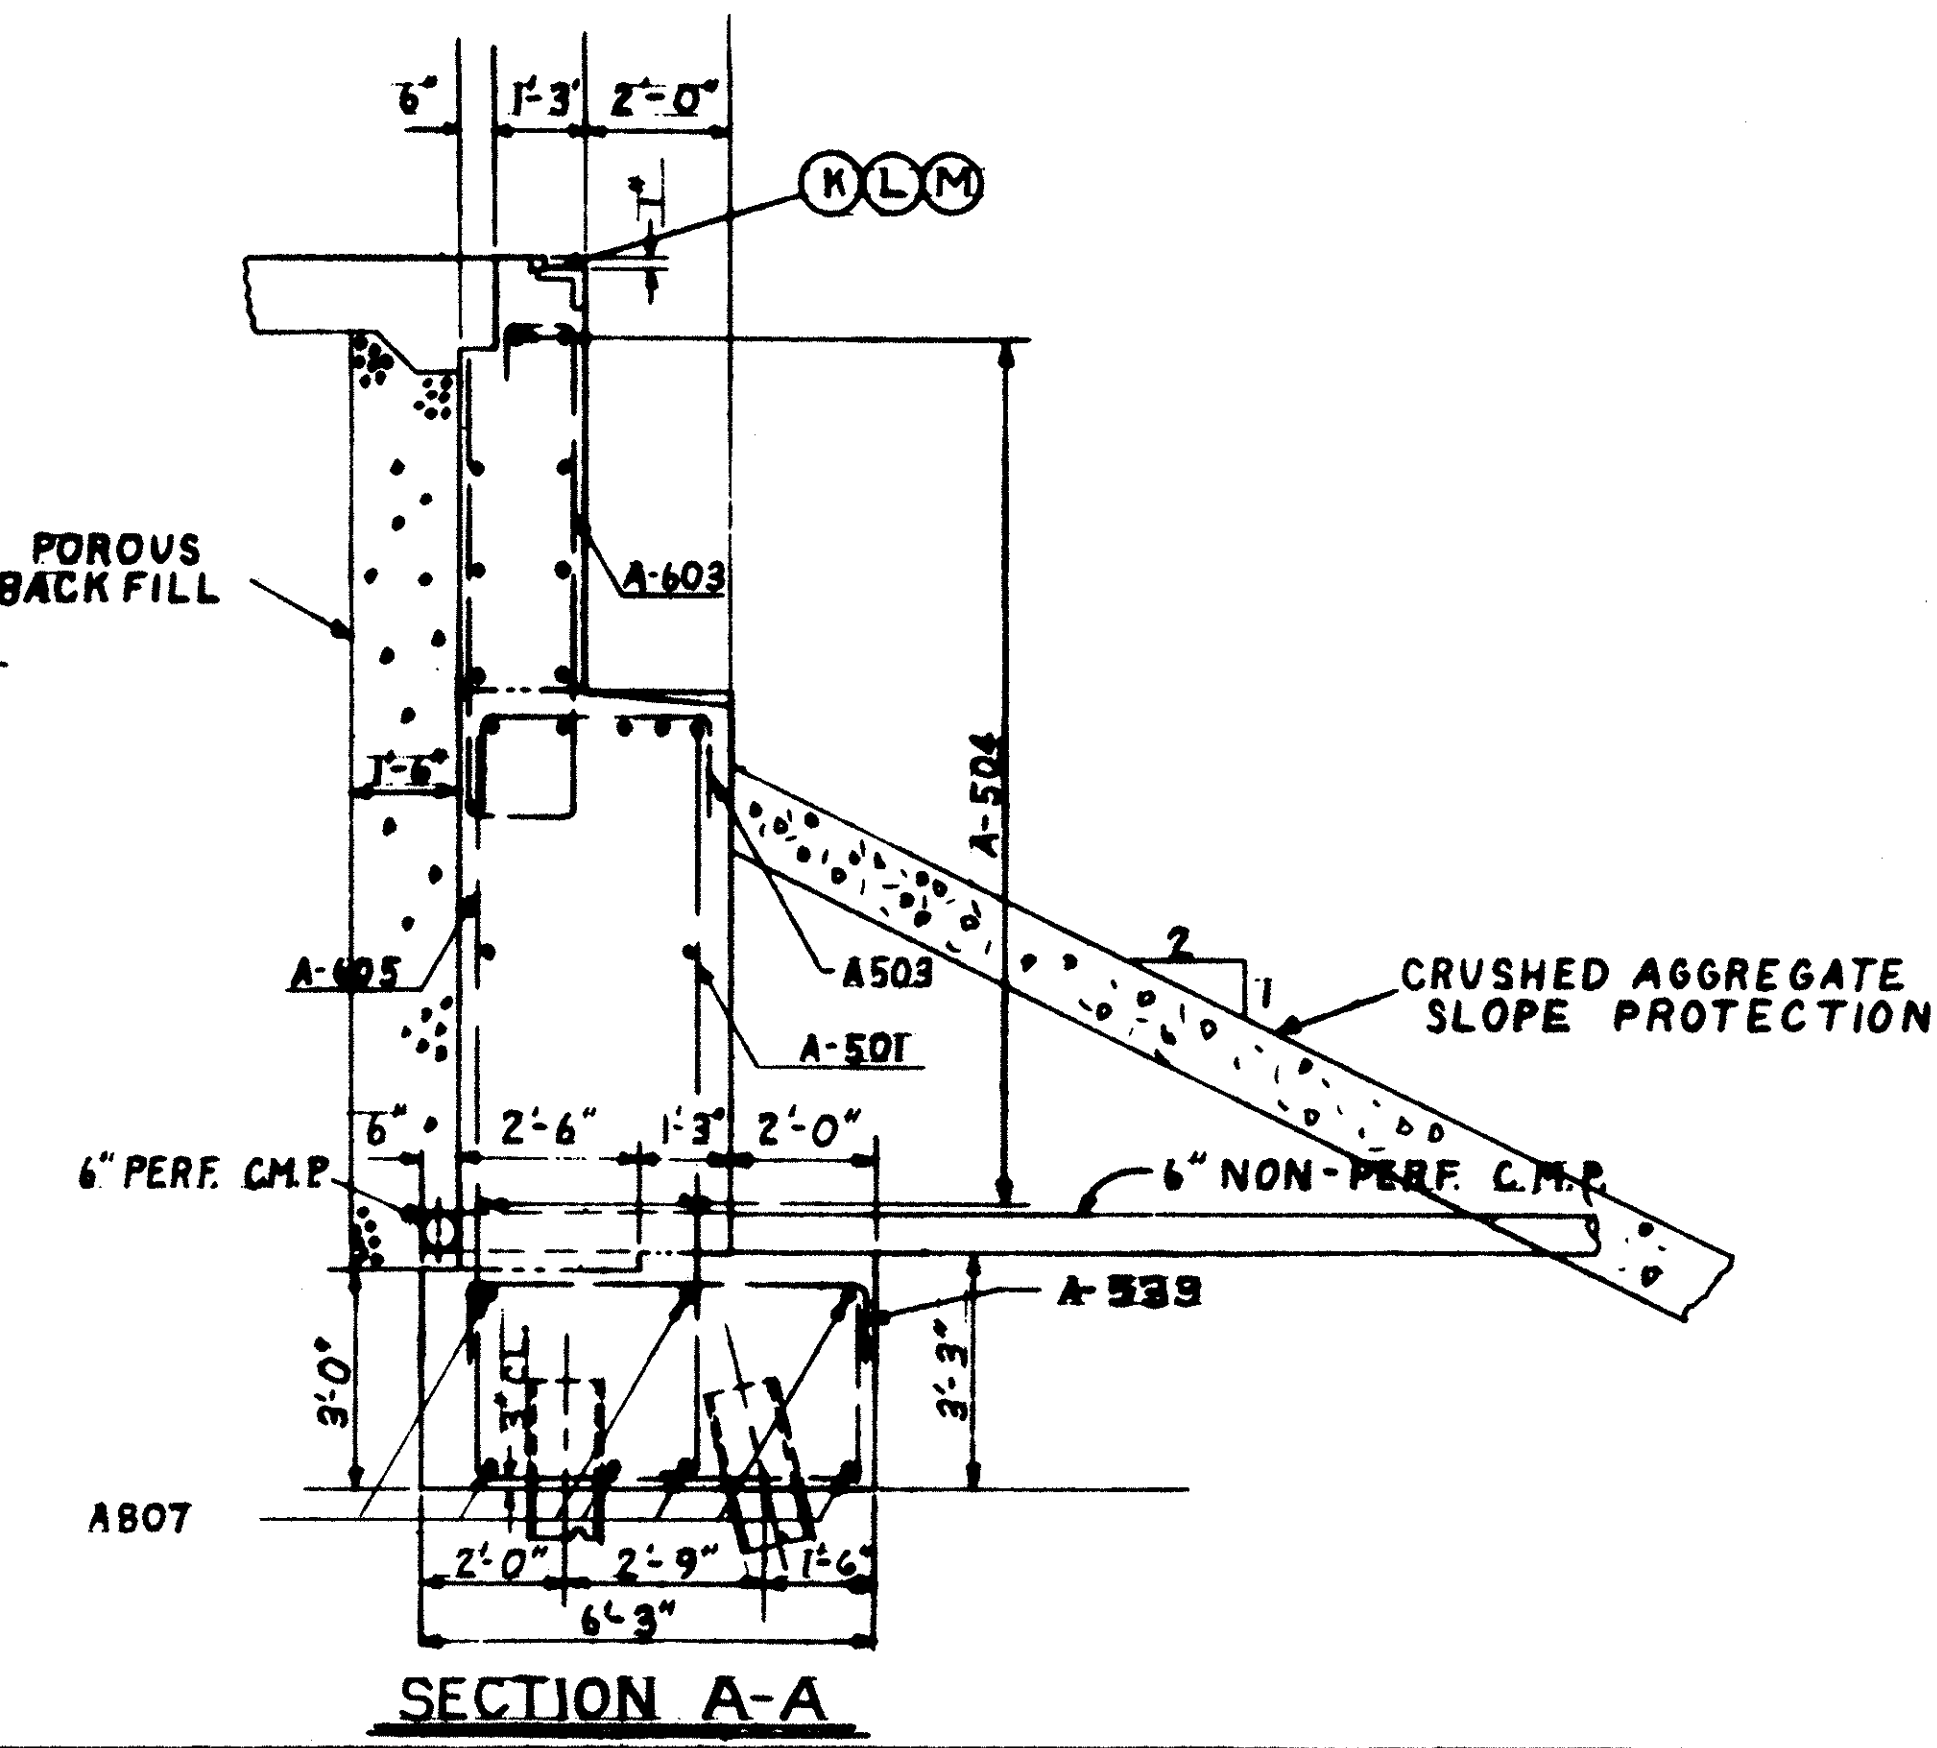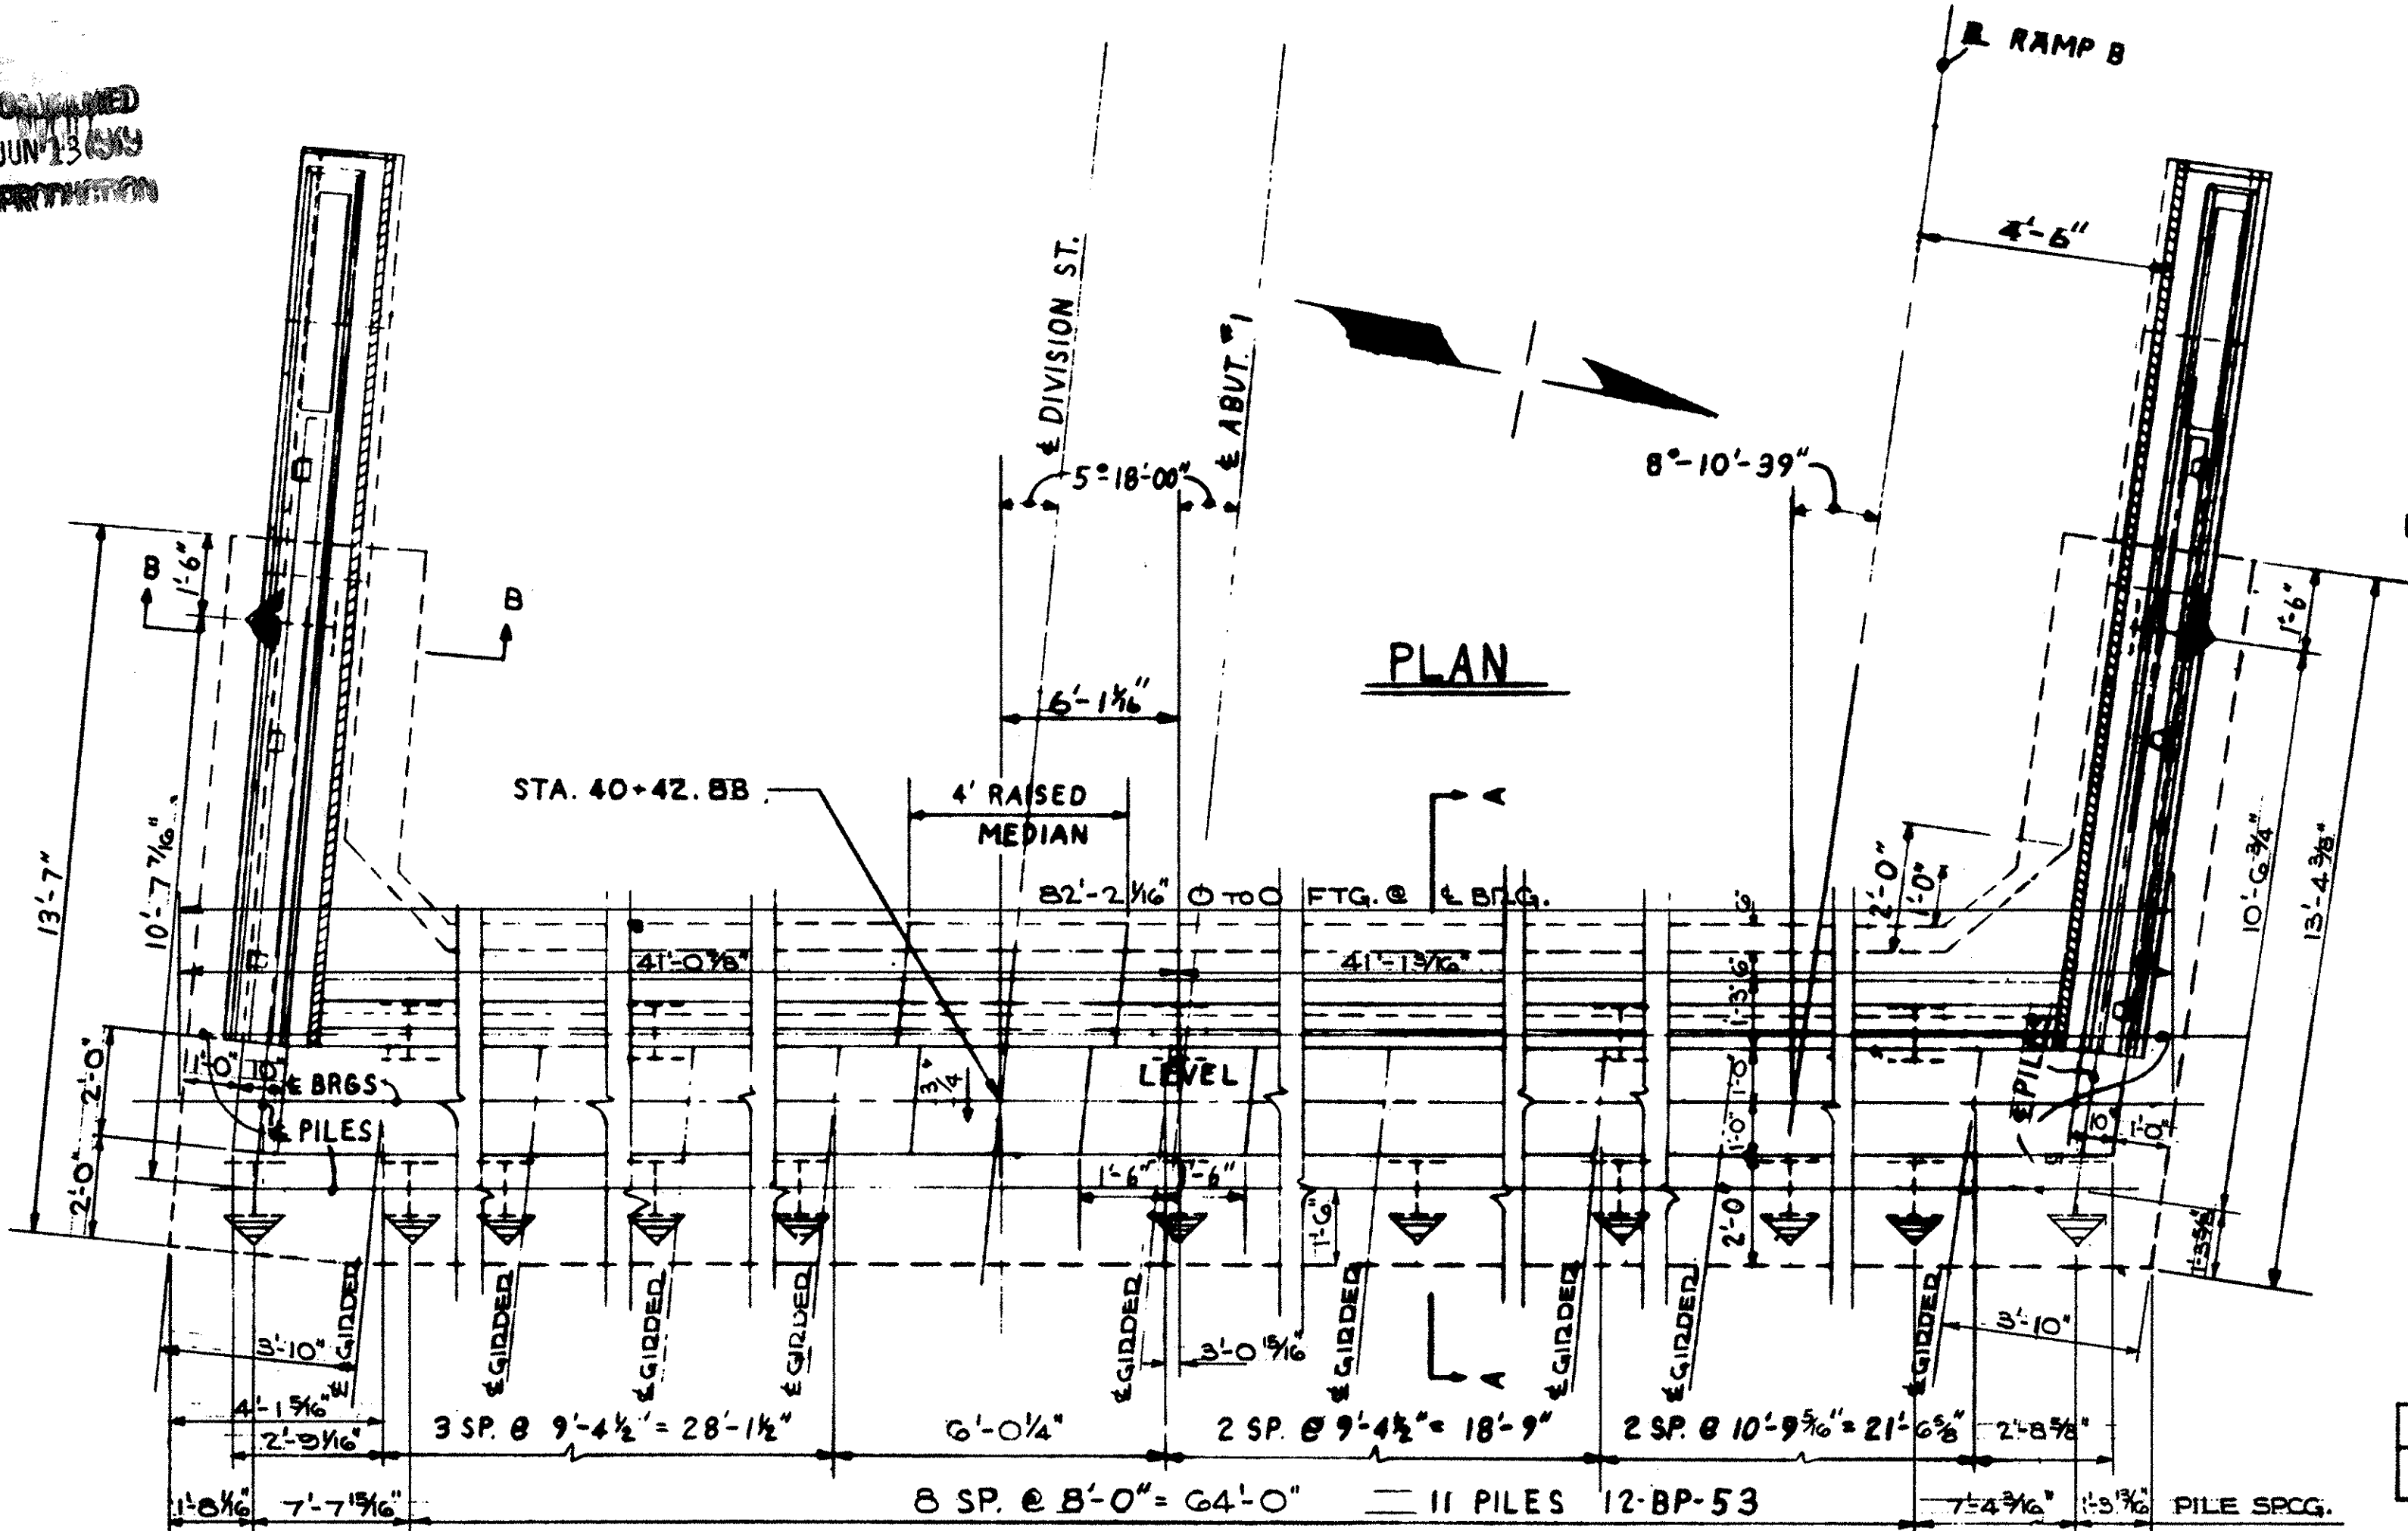

WIND WALLS

	a	b	c
NORTH	13'-4 3/8"	1'-3 3/8"	1'-6 3/8"
SOUTH	13'-7"	1'-5 3/8"	1'-6 3/8"

STATE OF OHIO
 DEPARTMENT OF HIGHWAYS
 BUREAU OF BRIDGES

GLAUS, PYLE & SCHOMER
 ABRON, OHIO

ABUTMENT N#1
 BRIDGE N# MAH-711-0116
 OVER MAHONING RIVER
 YOUNGSTOWN MAHONING COUNTY




DESIGNED	D.M.	DRAWN	D.M.	TRACED	J.C.	CHECKED	J.C.	REVIEWED	W.K.D.	DATE	6-22-68
----------	------	-------	------	--------	------	---------	------	----------	--------	------	---------

MICROFILMED
JUN 13 1978

FED. RD.	STATE	PROJECT
2	OHIO	U.S.-1150 (1)


159
232

MAH-711-O.17

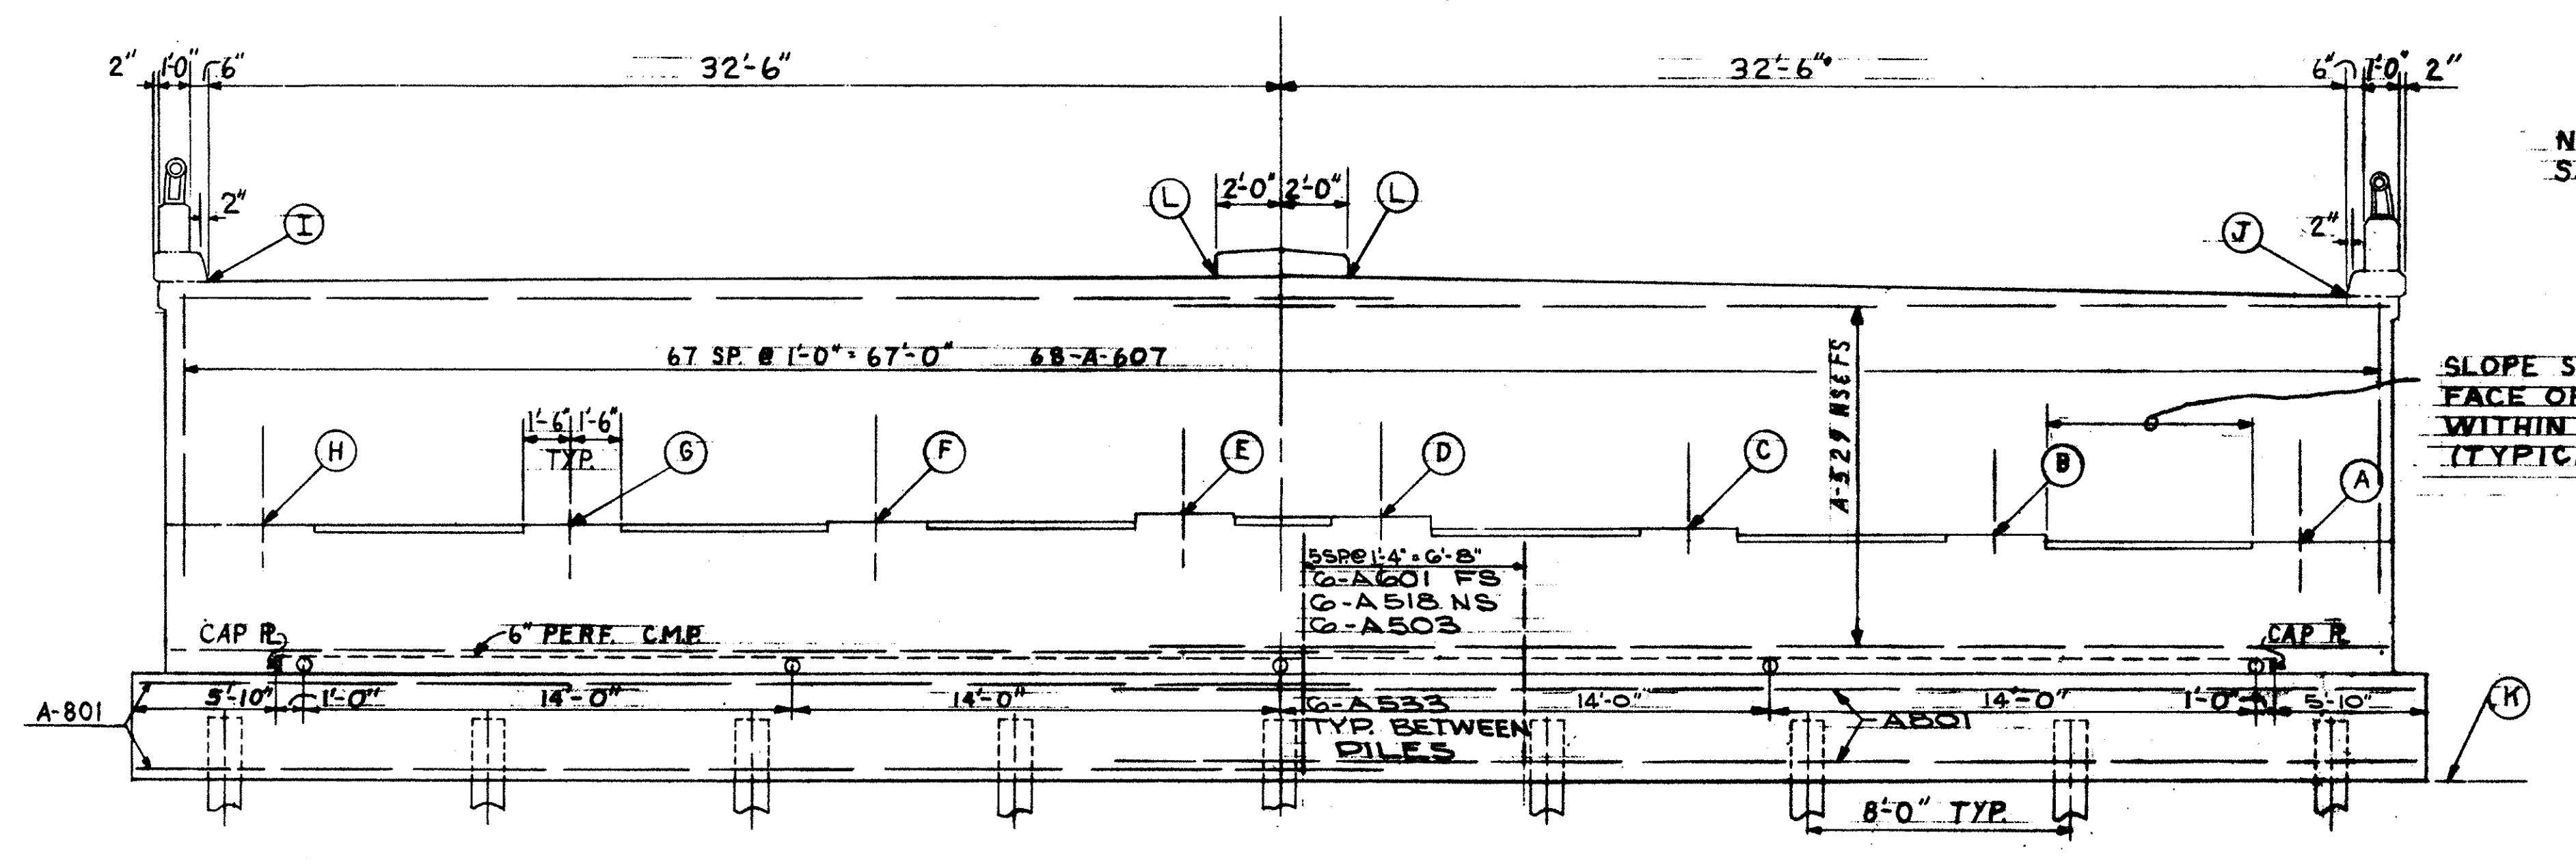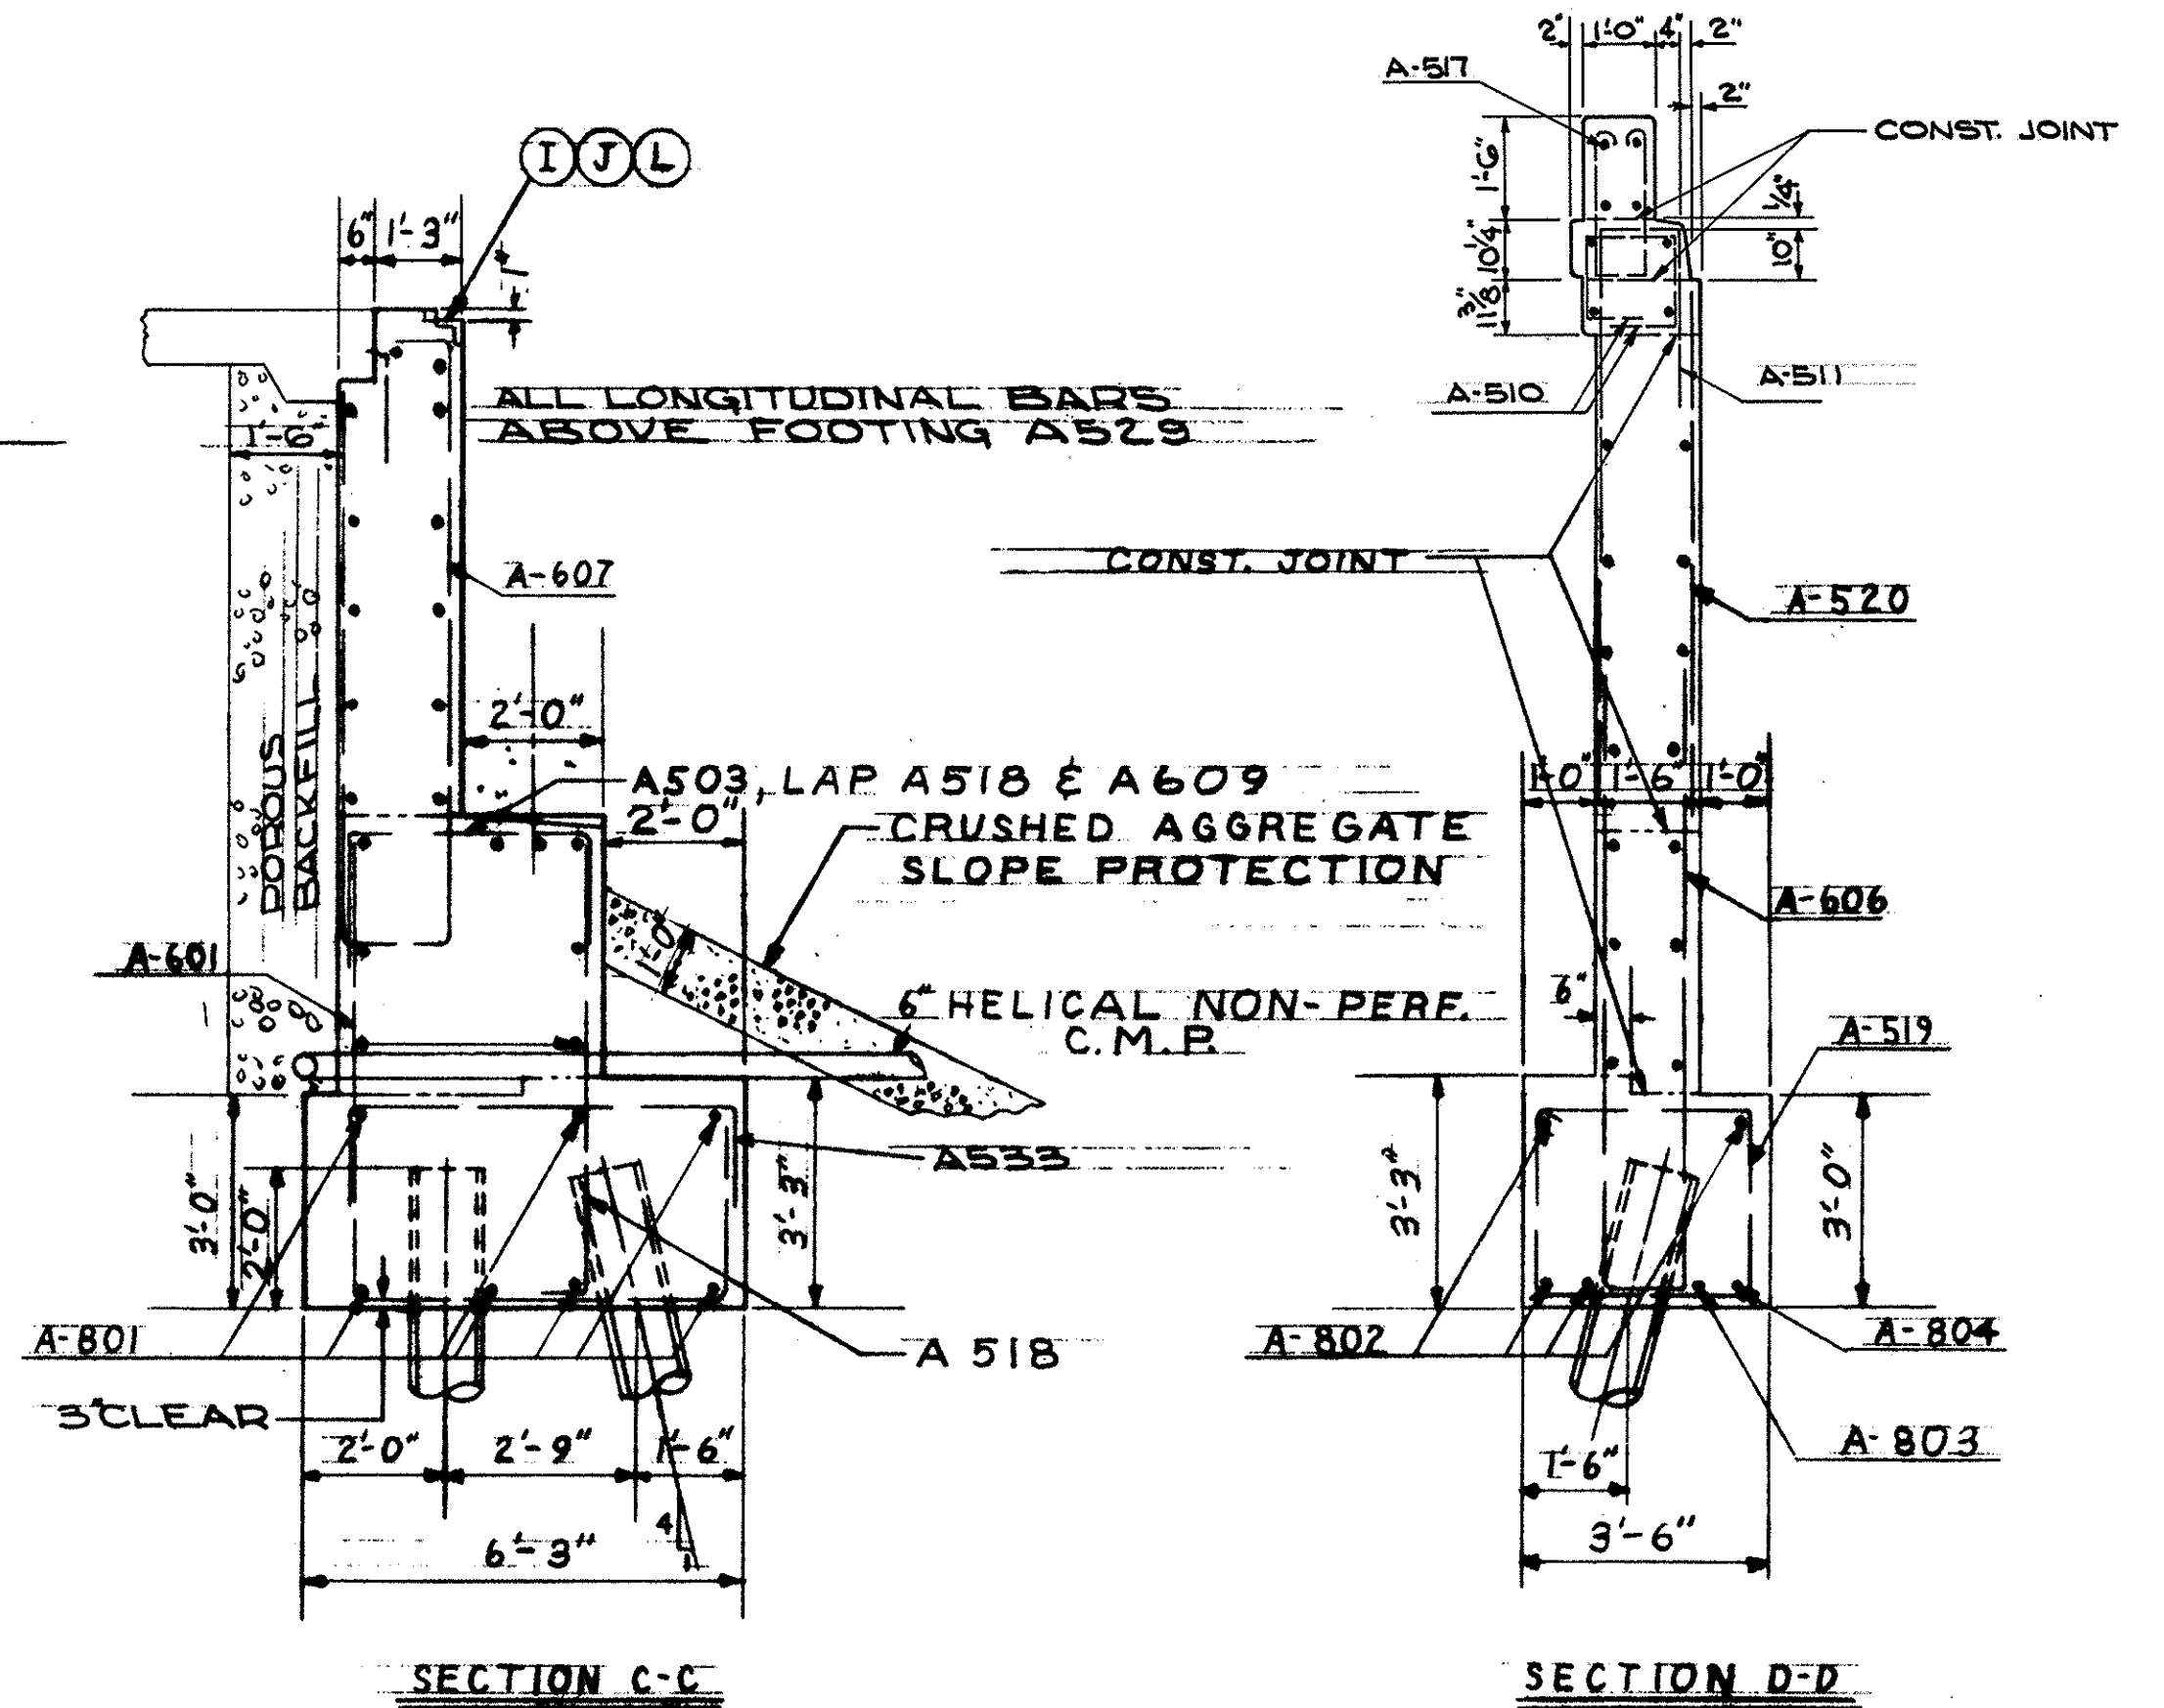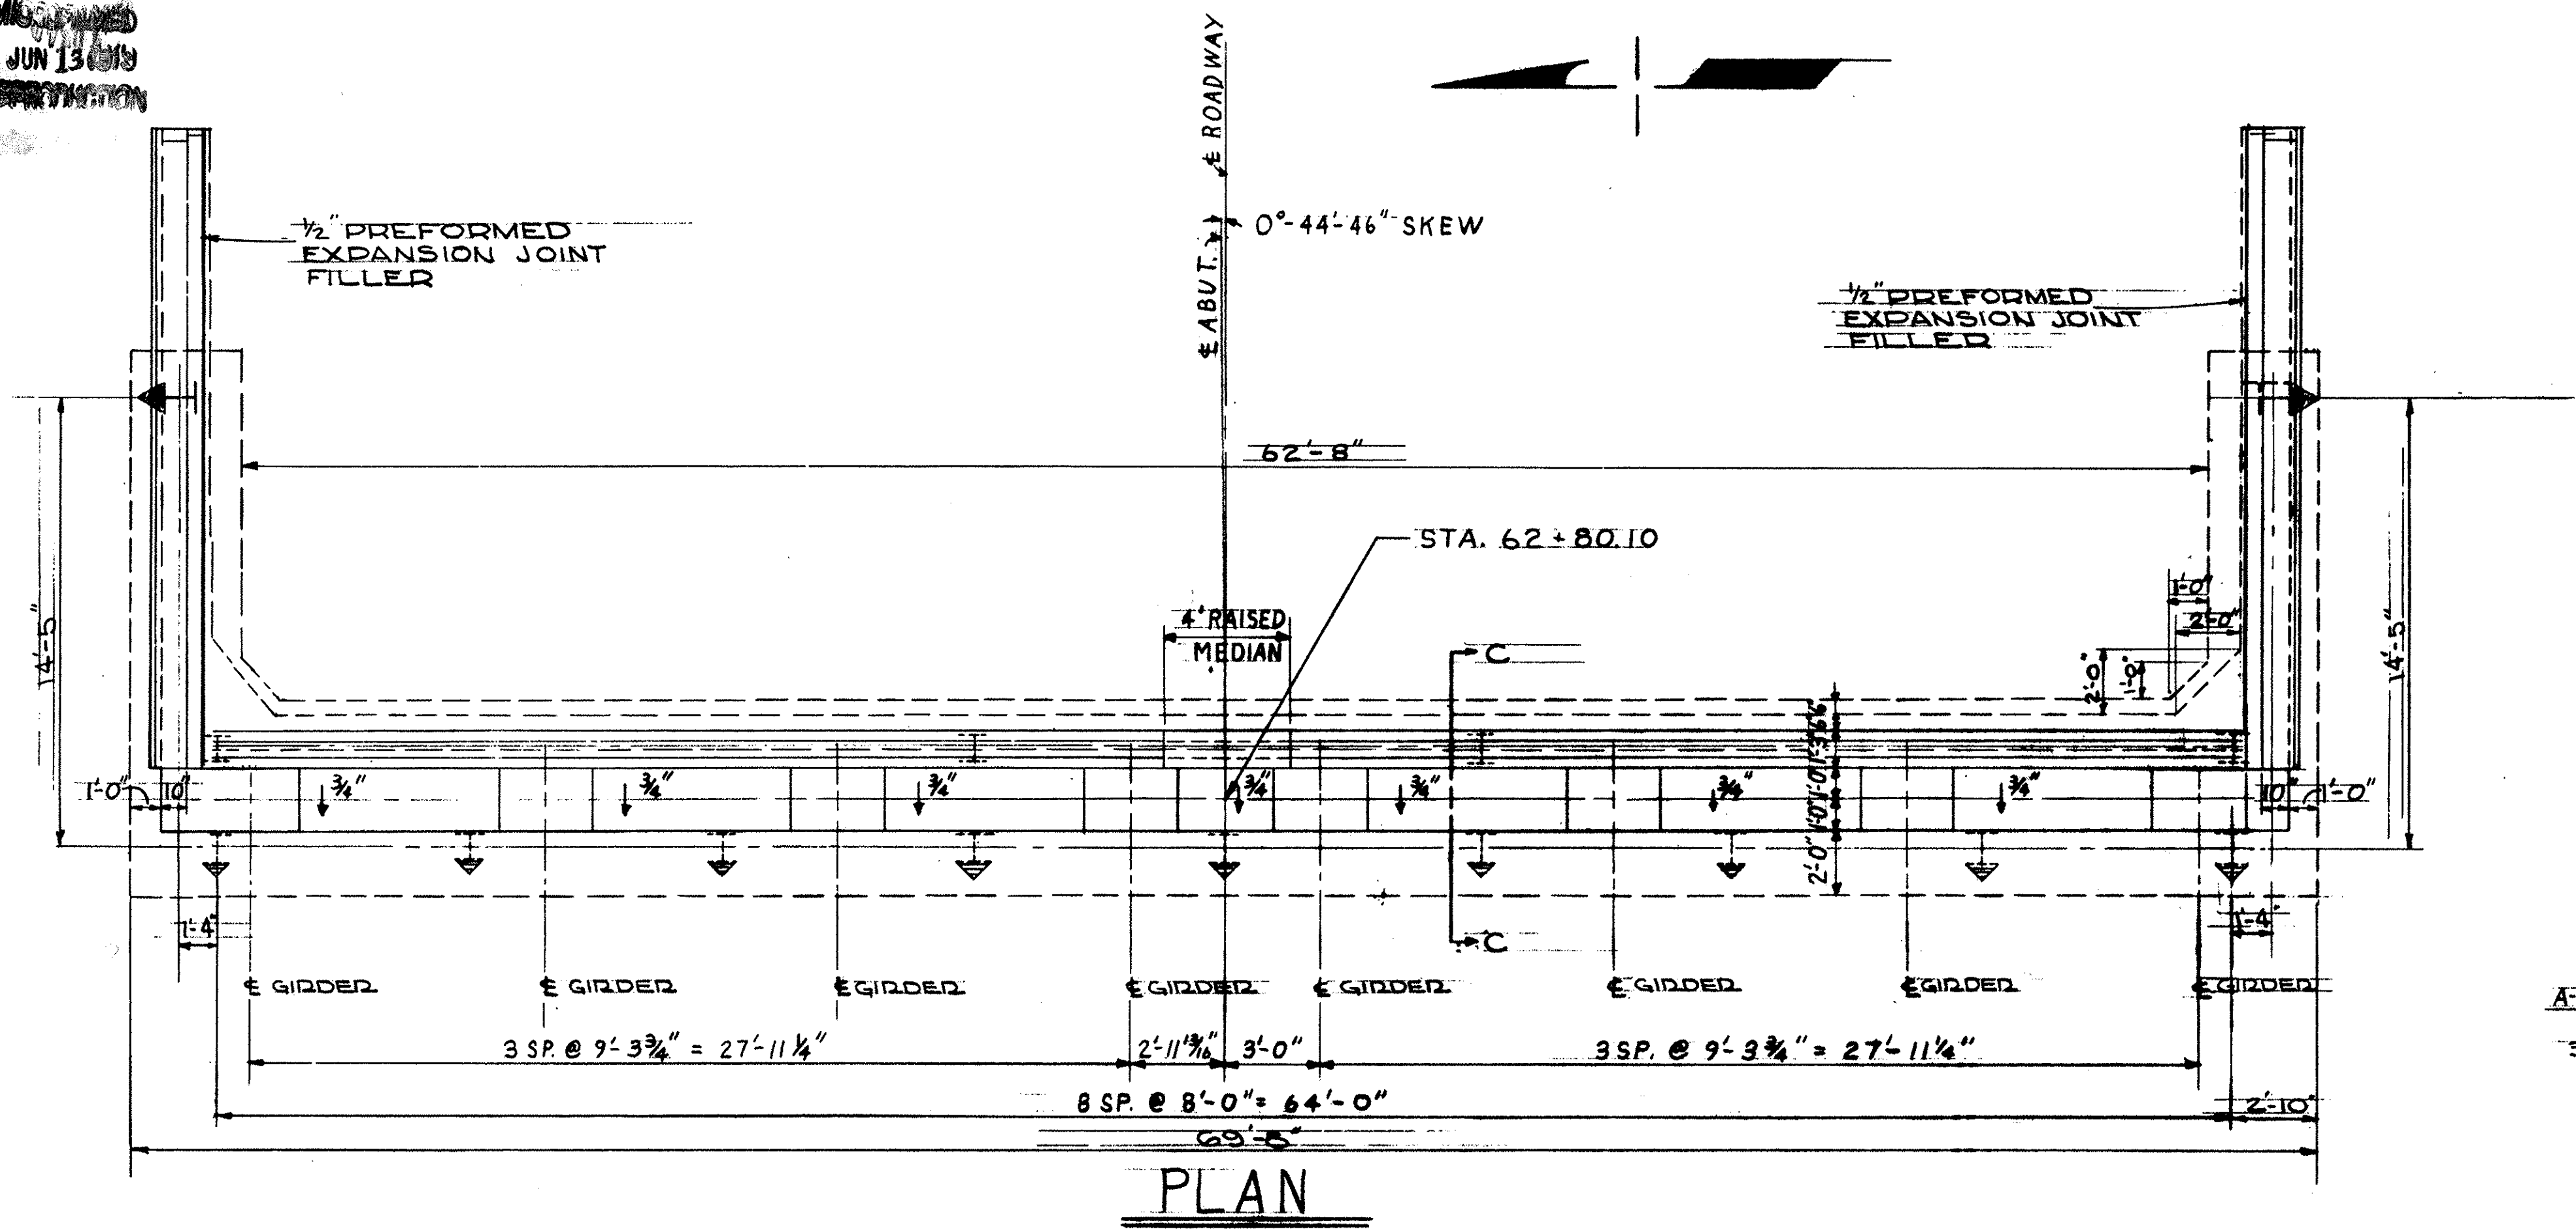

N. WING WALL 906.76
S. WING WALL 905.21

SLOPE SEAT 3/4" FROM FACE OF ABUTMENT WITHIN THIS AREA (TYPICAL)

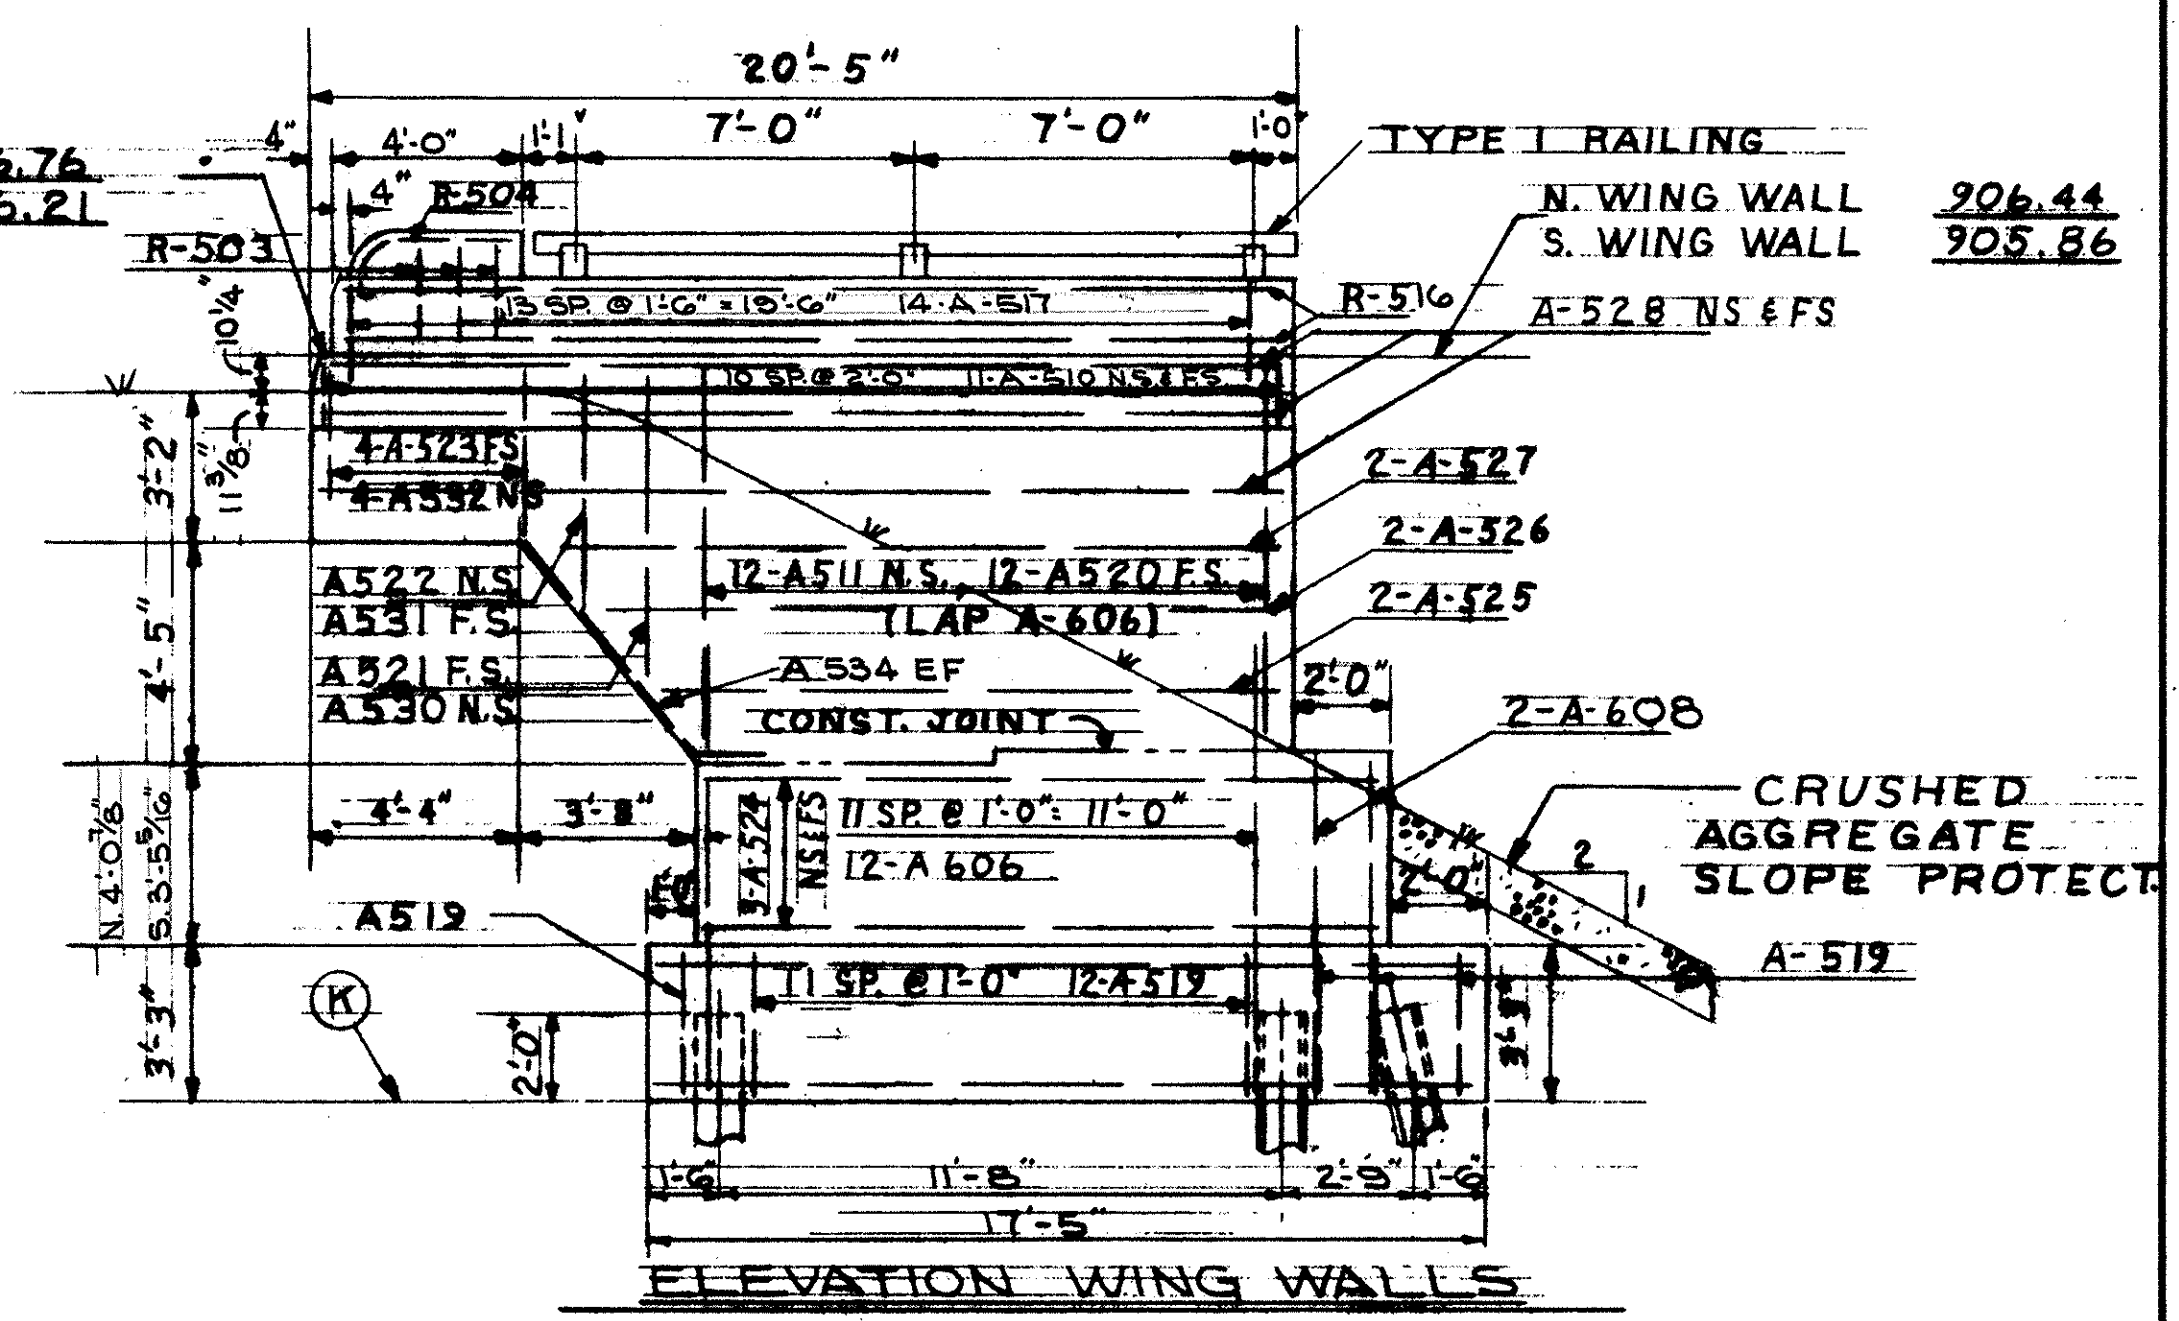

ELEVATION ABUT. N° 2

NOTE:
ADJUSTABLE TYPE ELBOWS MEETING SPECIFICATIONS REQUIREMENTS FOR GAGE AND COATING ARE ACCEPTABLE FOR MAKING BENDS IN PERFORATED CORRUGATED METAL PIPE. ELBOWS AND THE STEM OF TEES NEED NOT BE PERFORATED.

ELEVATION TABLE												
	A	B	C	D	E	F	G	H	I	J	K	L
ABUT. # 2	897.99	898.19	898.40	898.73	898.75	898.58	898.57	898.56	905.52	904.96	891.00	905.51

STATE OF OHIO
DEPARTMENT OF HIGHWAYS
BUREAU OF BRIDGES

AKRON, OHIO






GLAUS, PYLE & SCHOMER
YOUNGSTOWN, OHIO

ABUTMENT N° 2

BRIDGE N° MAH-711-O116
OVER MAHONING RIVER
YOUNGSTOWN MAHONING COUNTY


DESIGNED	DRAWN	TRACED	CHECKED	REVIEWED	DATE	REVISED
D.M.	D.M.		J.C.	W.K.D.	6-22-68	

MAH-711-017

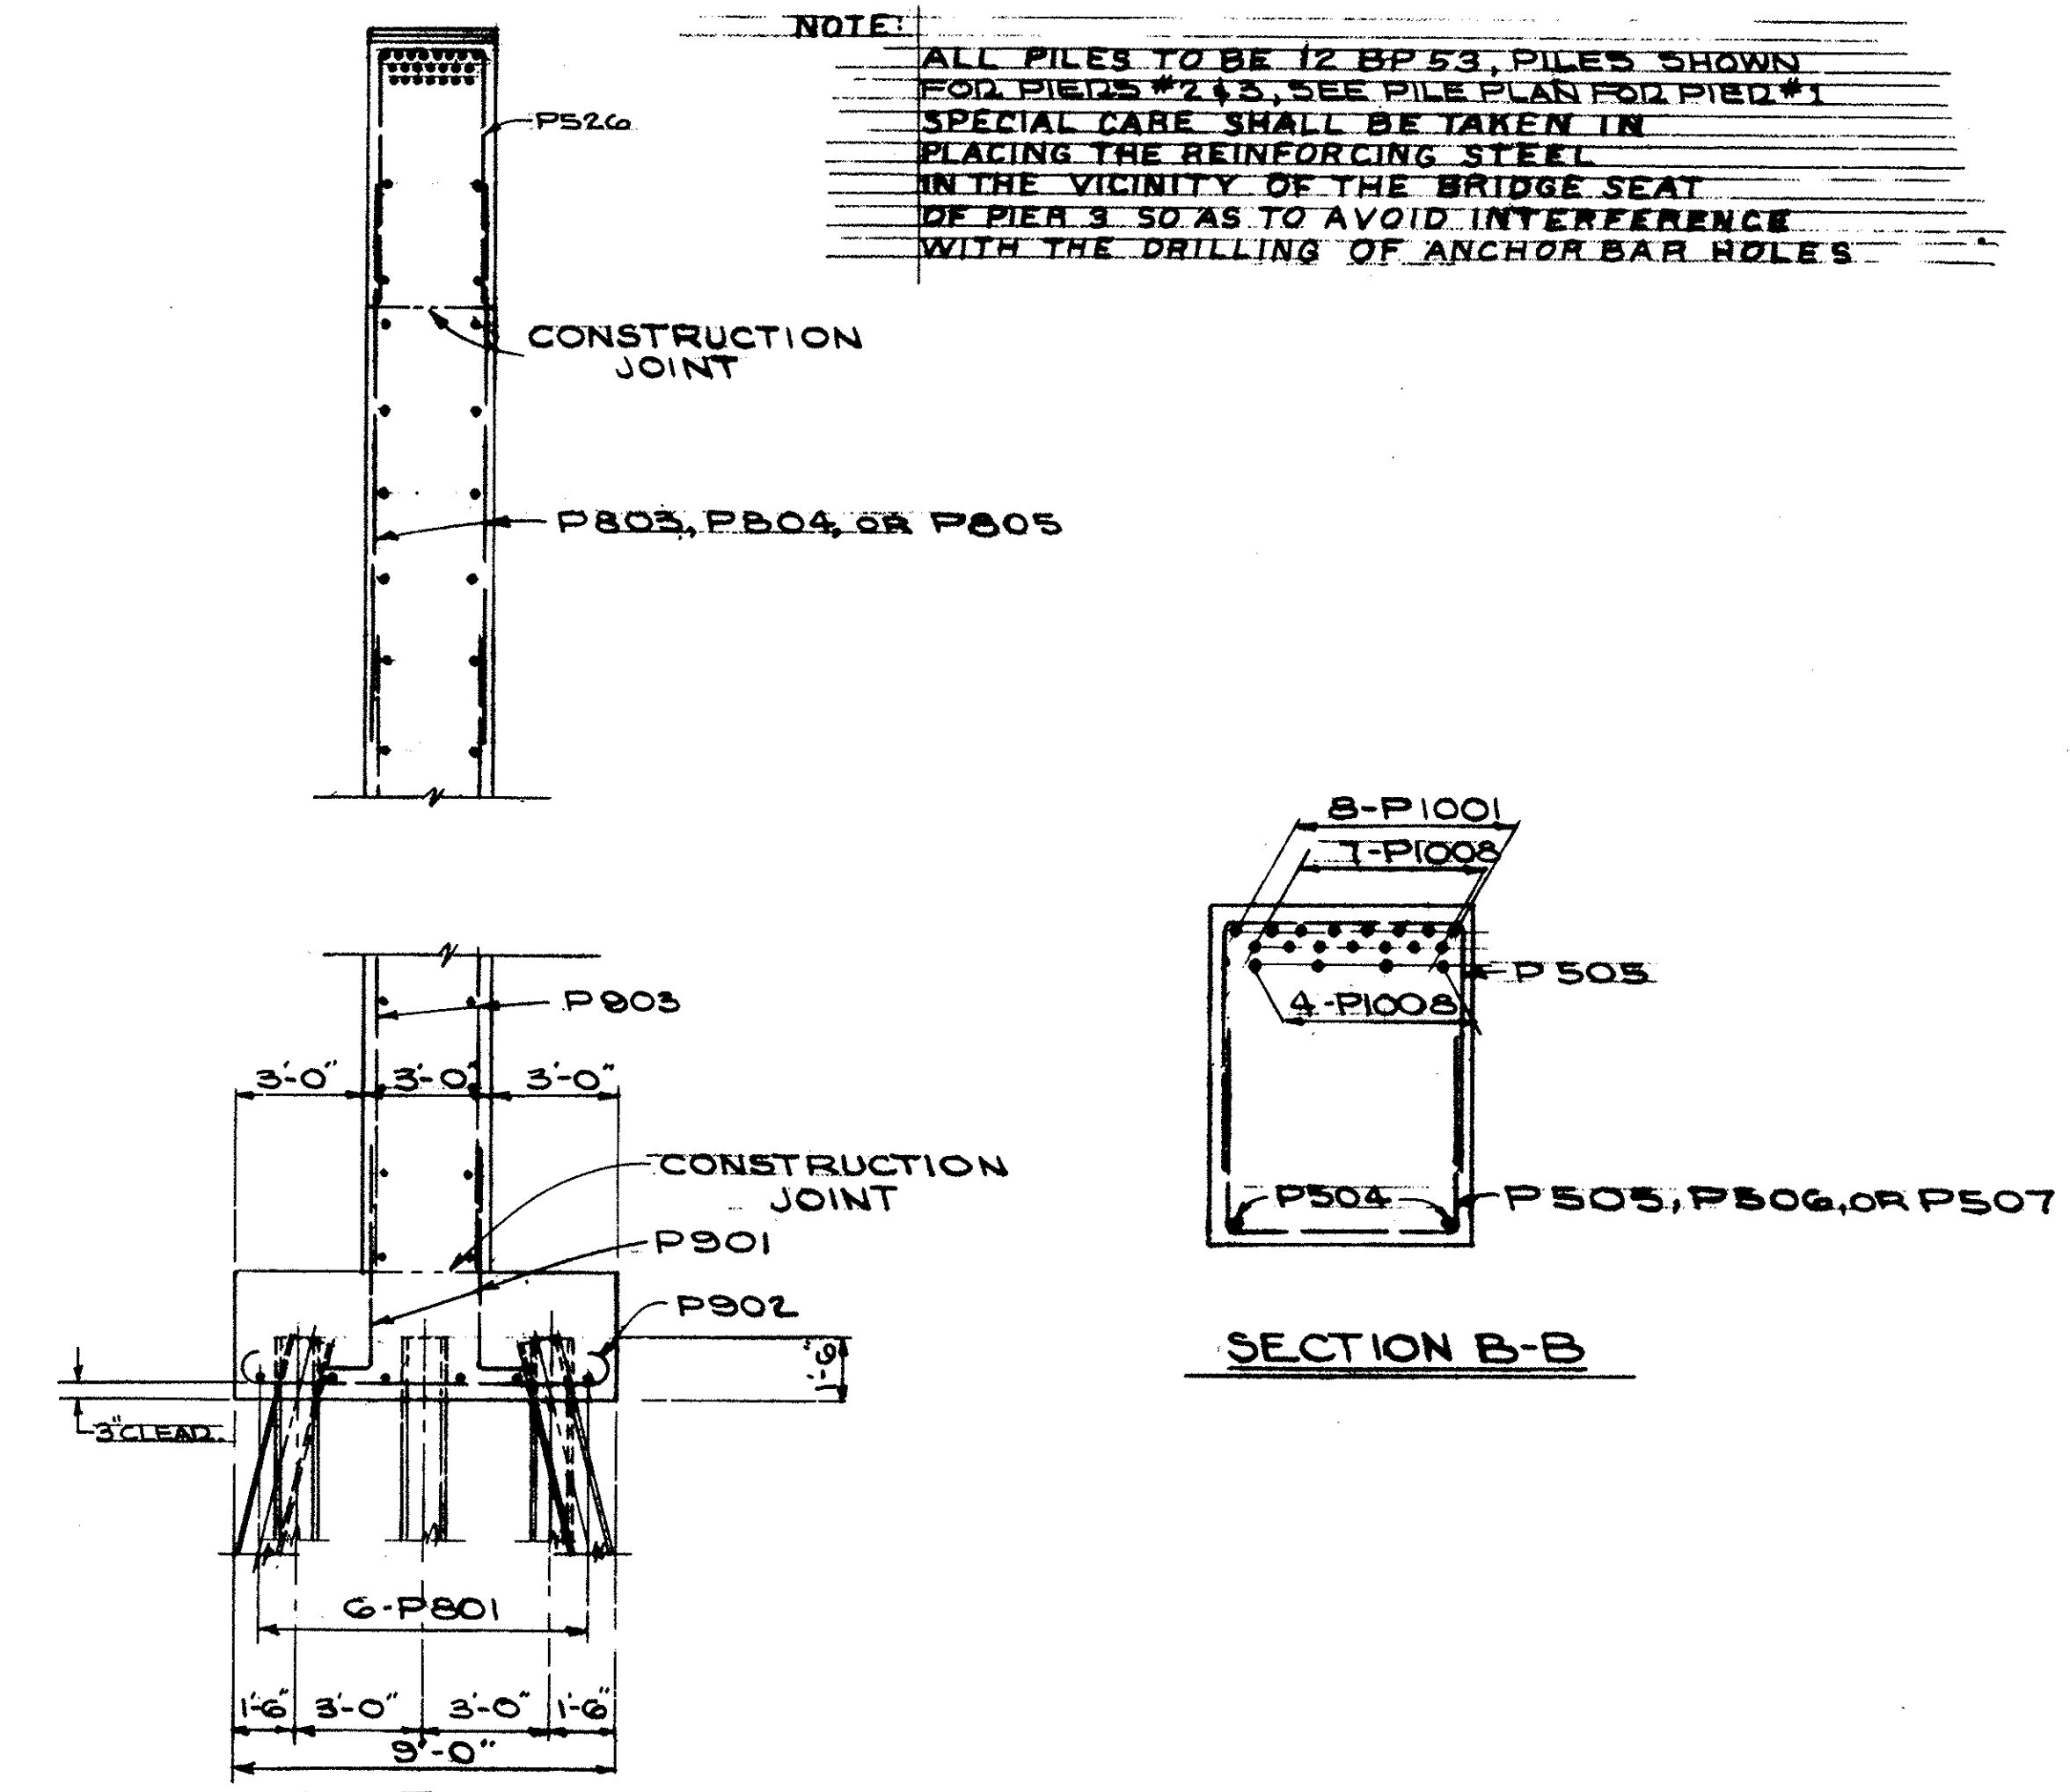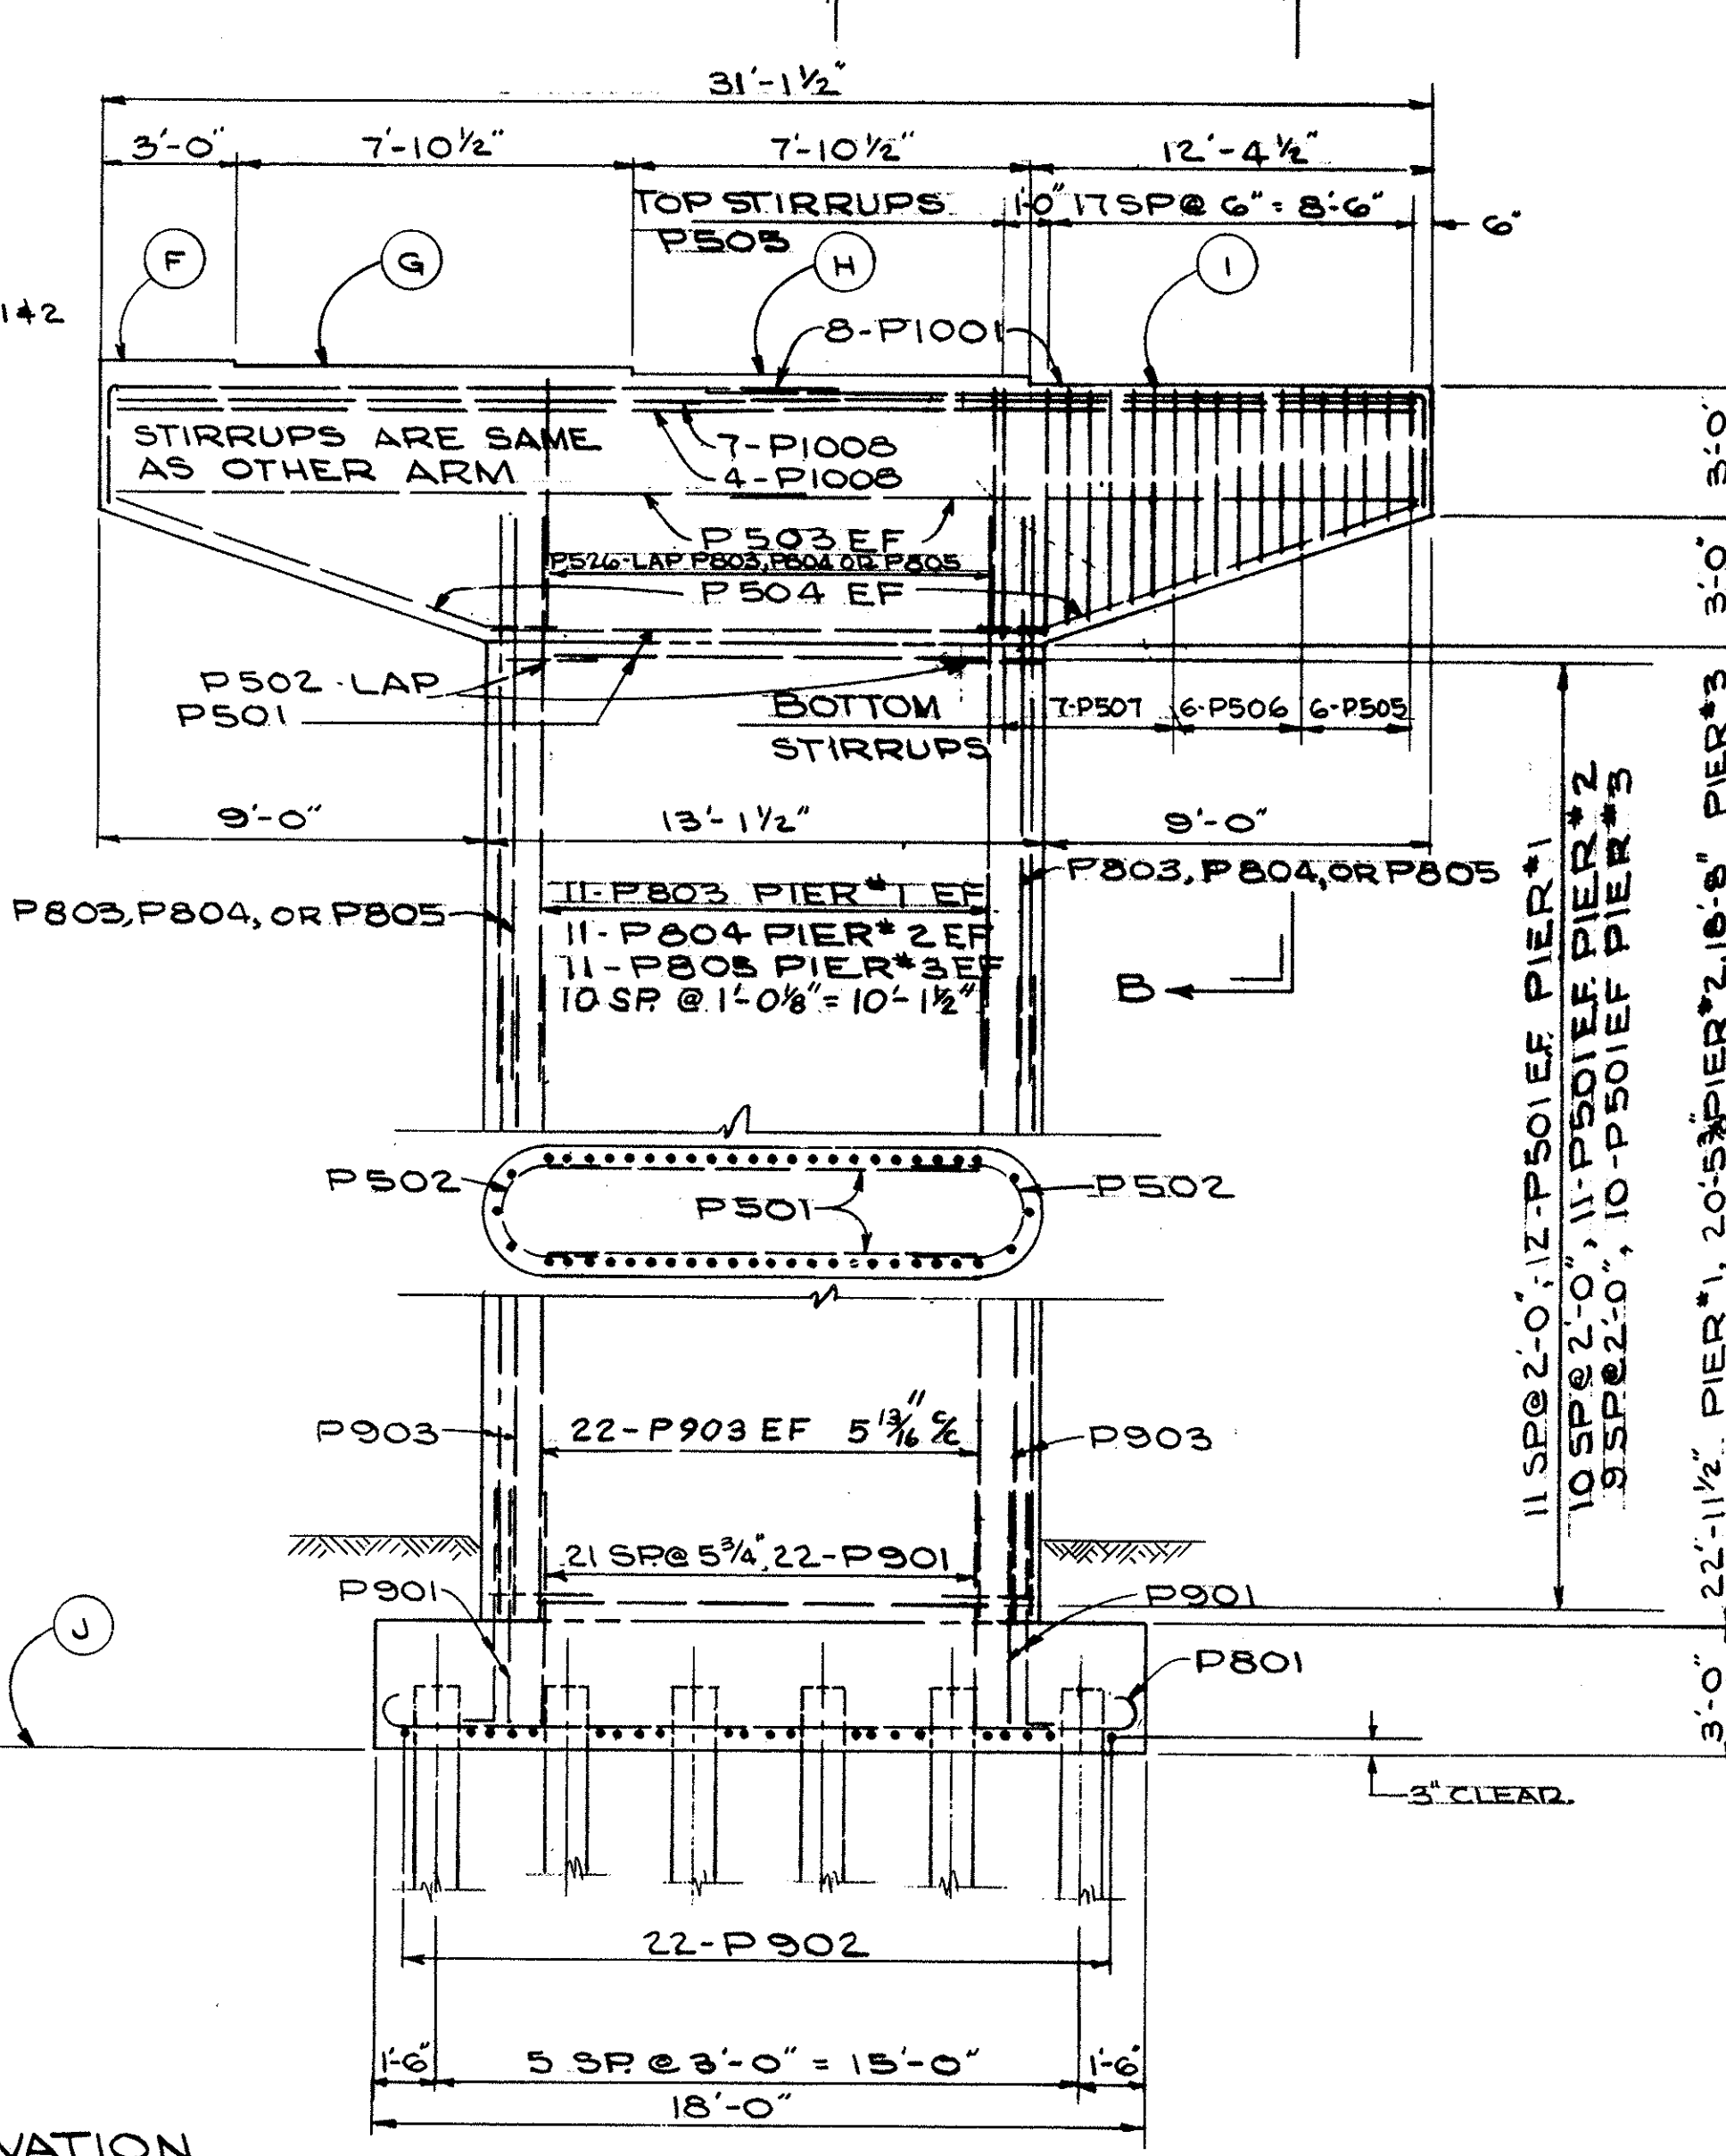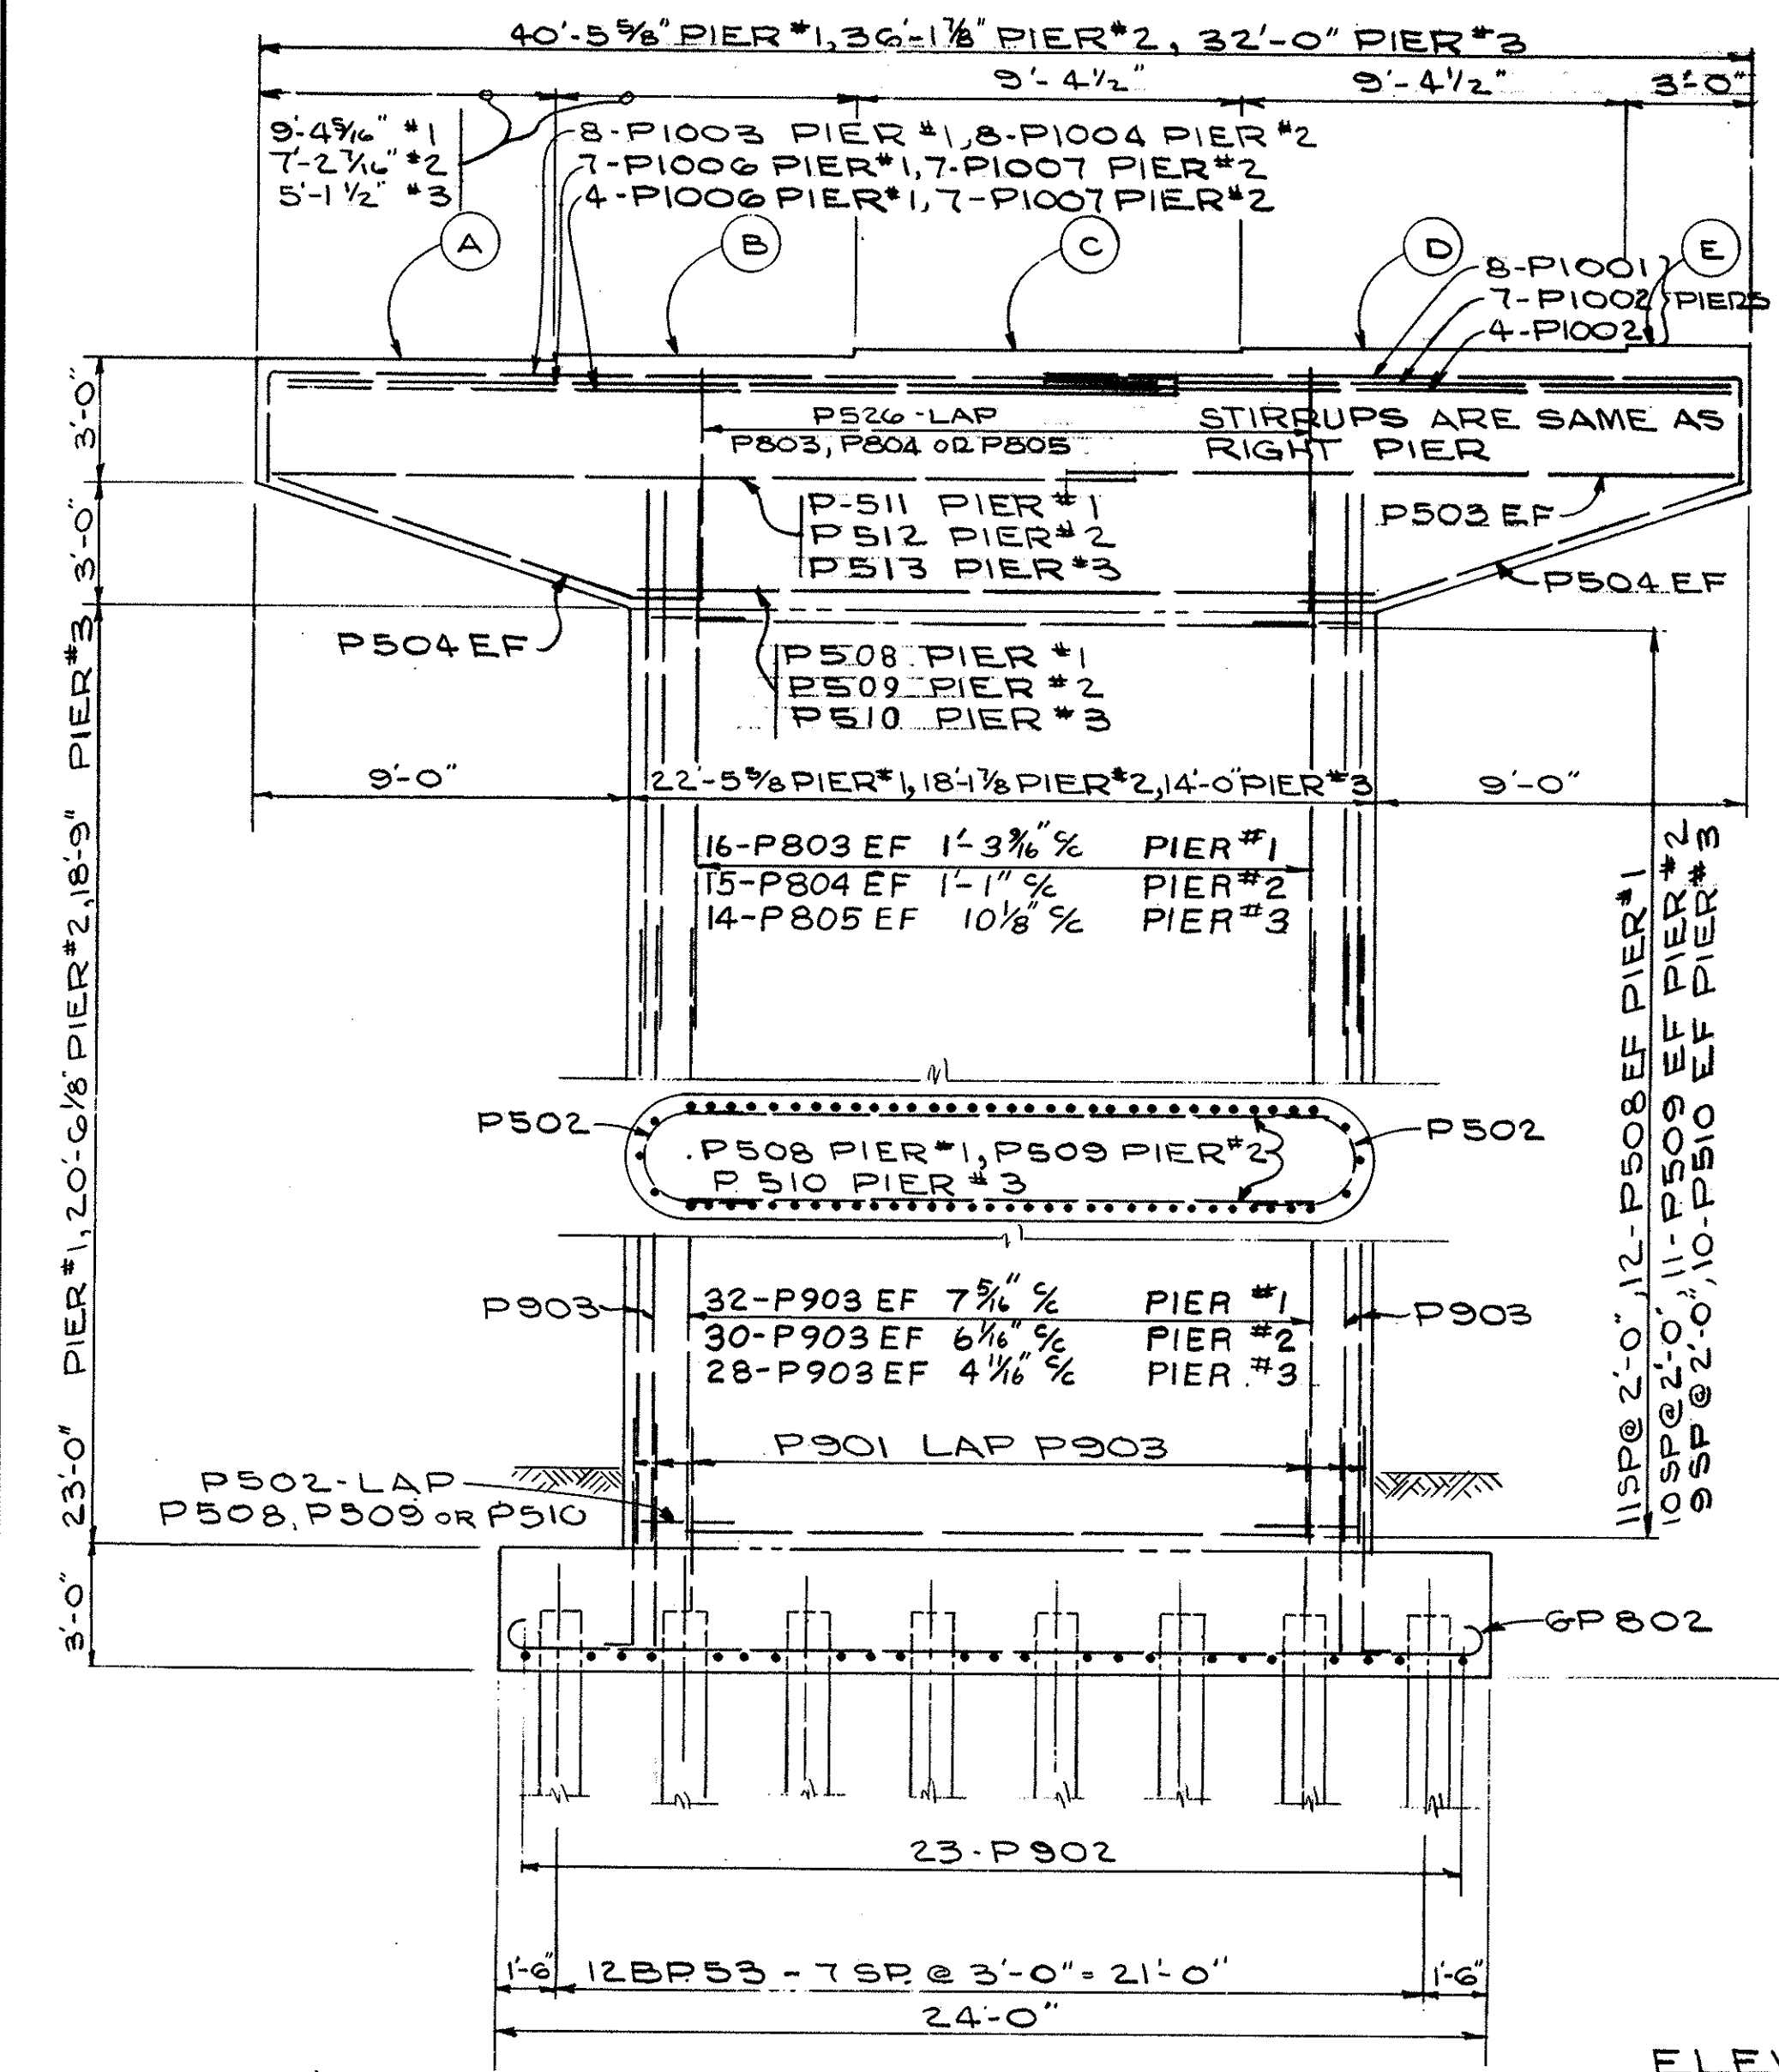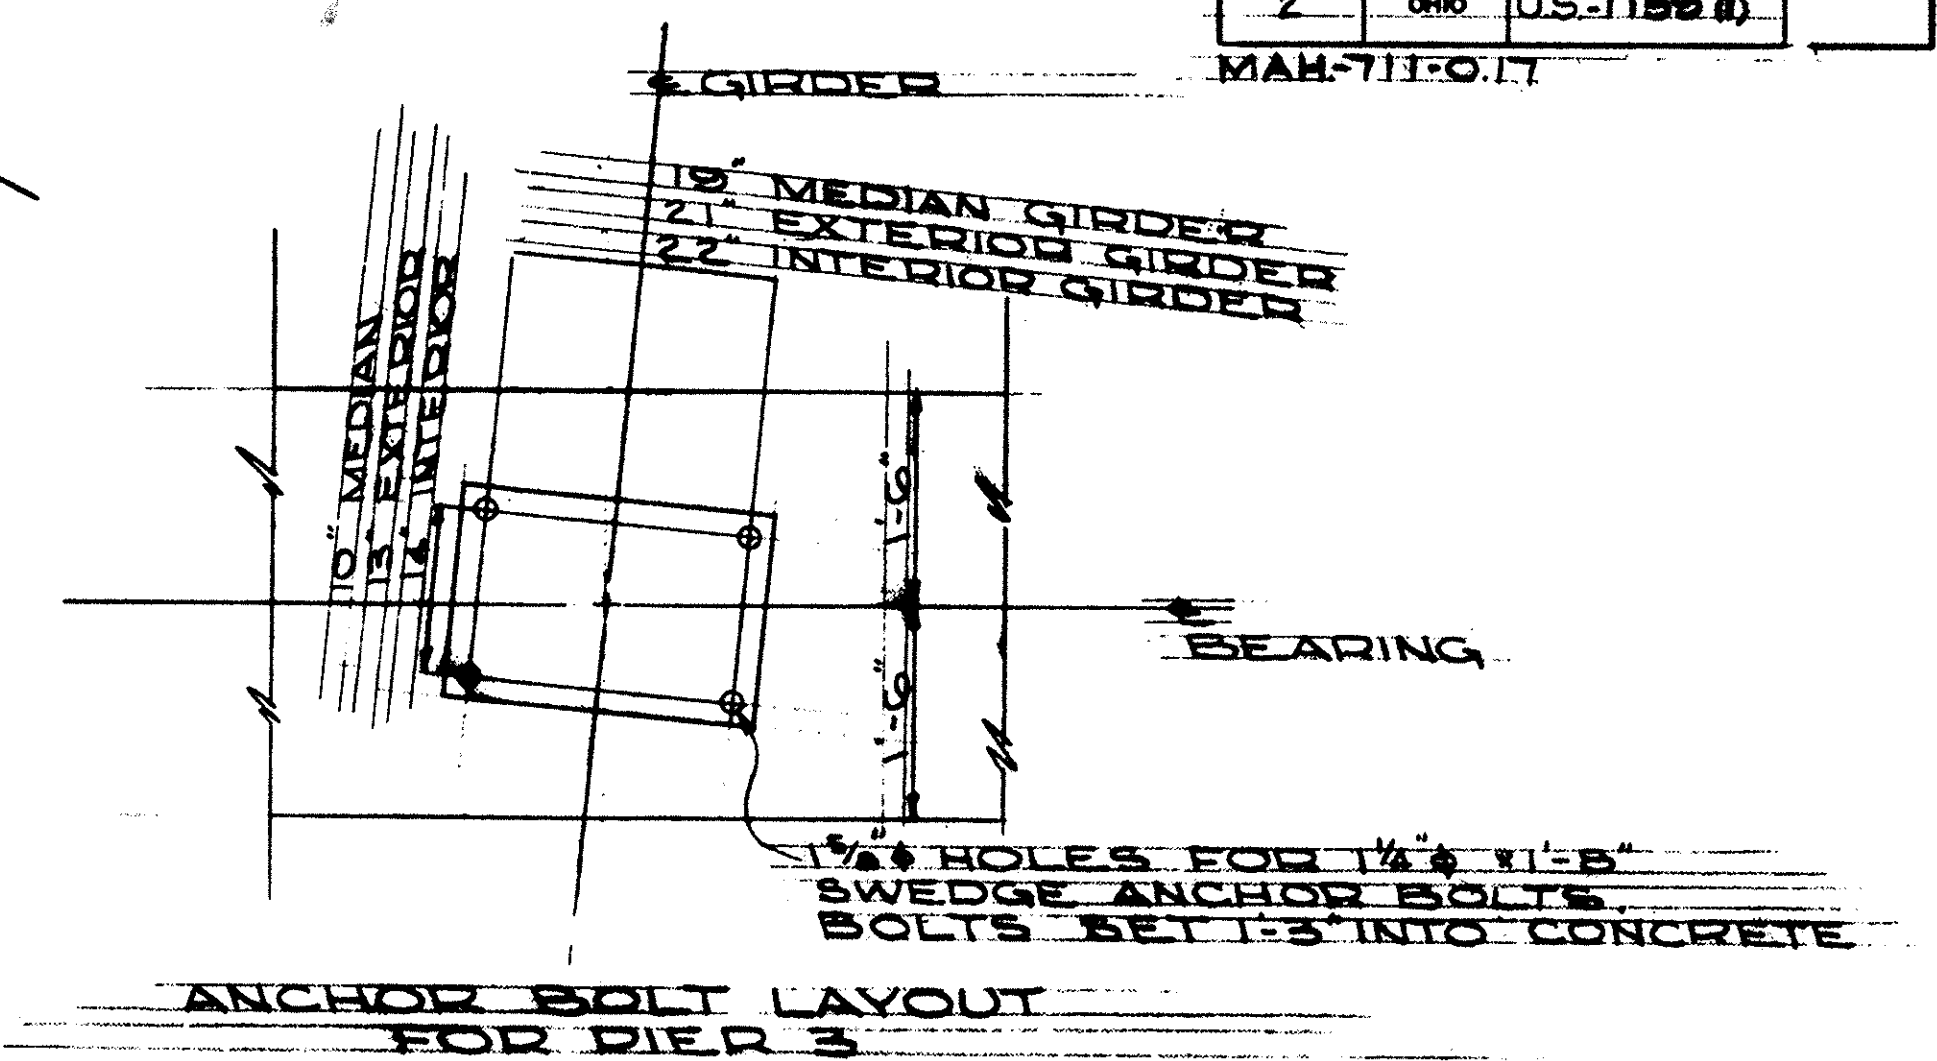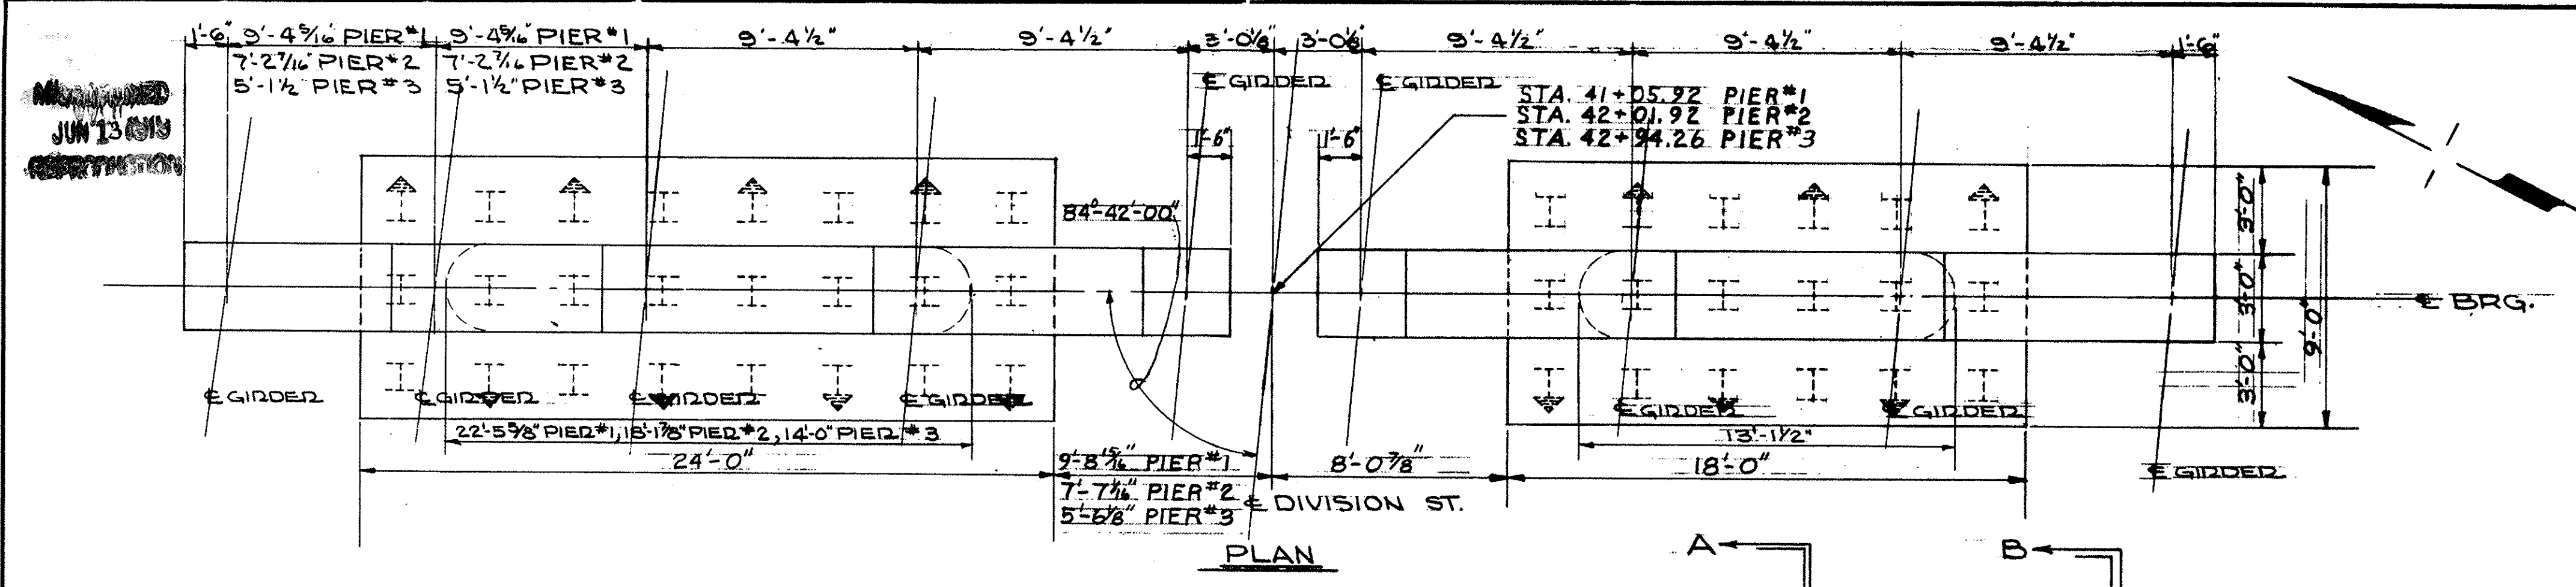

PIER ELEVATION TABLE

	A	B	C	D	E	F	G	H	I	J
PIER 1	908.50	908.32	908.24	908.76	909.05	909.03	908.70	908.53	908.46	876.50
PIER 2	906.01	906.08	906.09	906.22	906.58	906.56	906.17	906.00	905.95	876.50
PIER 3	904.25	904.84	904.31	904.44	904.82	904.81	904.39	904.23	904.16	876.50

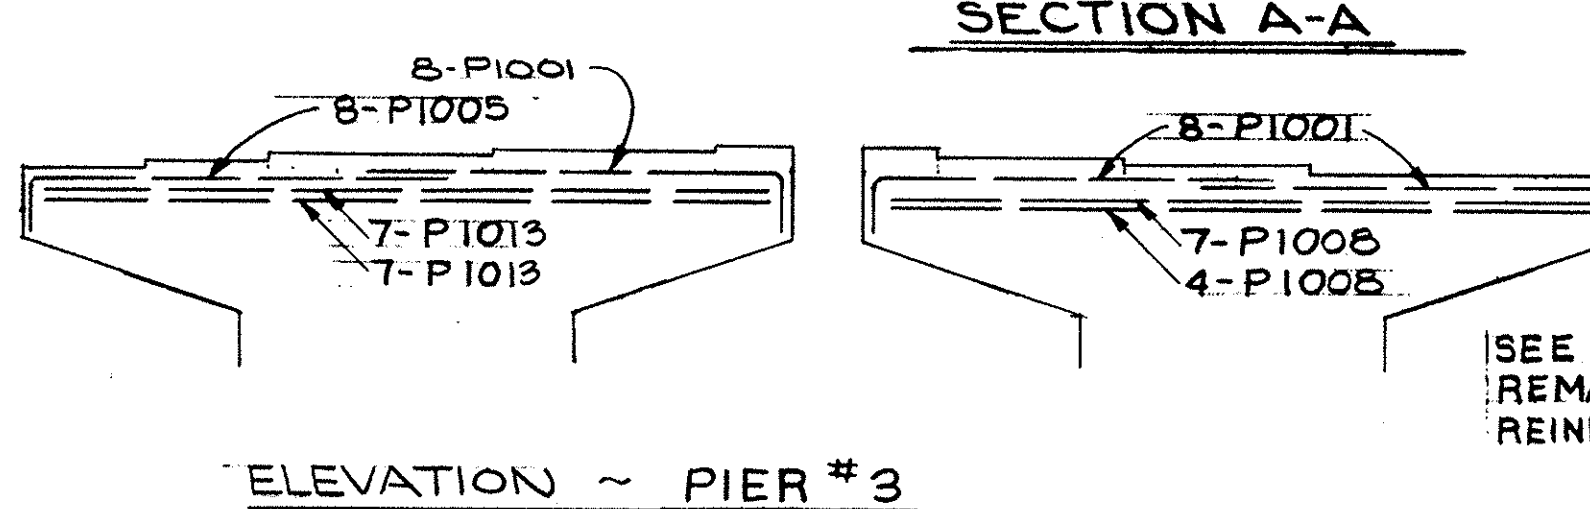

SEE ELEVATION FOR REMAINDER OF REINFORCING IN PIER #3

STATE OF OHIO
DEPARTMENT OF HIGHWAYS
BUREAU OF BRIDGES


AKRON, OHIO

GLAUS, PYLE & SCHOMER
YOUNGSTOWN, OHIO

PIERS 1, 2, & 3
BRIDGE N^o MAH-711-0116
OVER MAHONING RIVER
YOUNGSTOWN MAHONING COUNTY

DESIGNED	DRAWN	TRACED	CHECKED	REVIEWED	DATE	REVISED
JWC	JWC		JM	WKD	6-22-68	





MAH-711-0.17

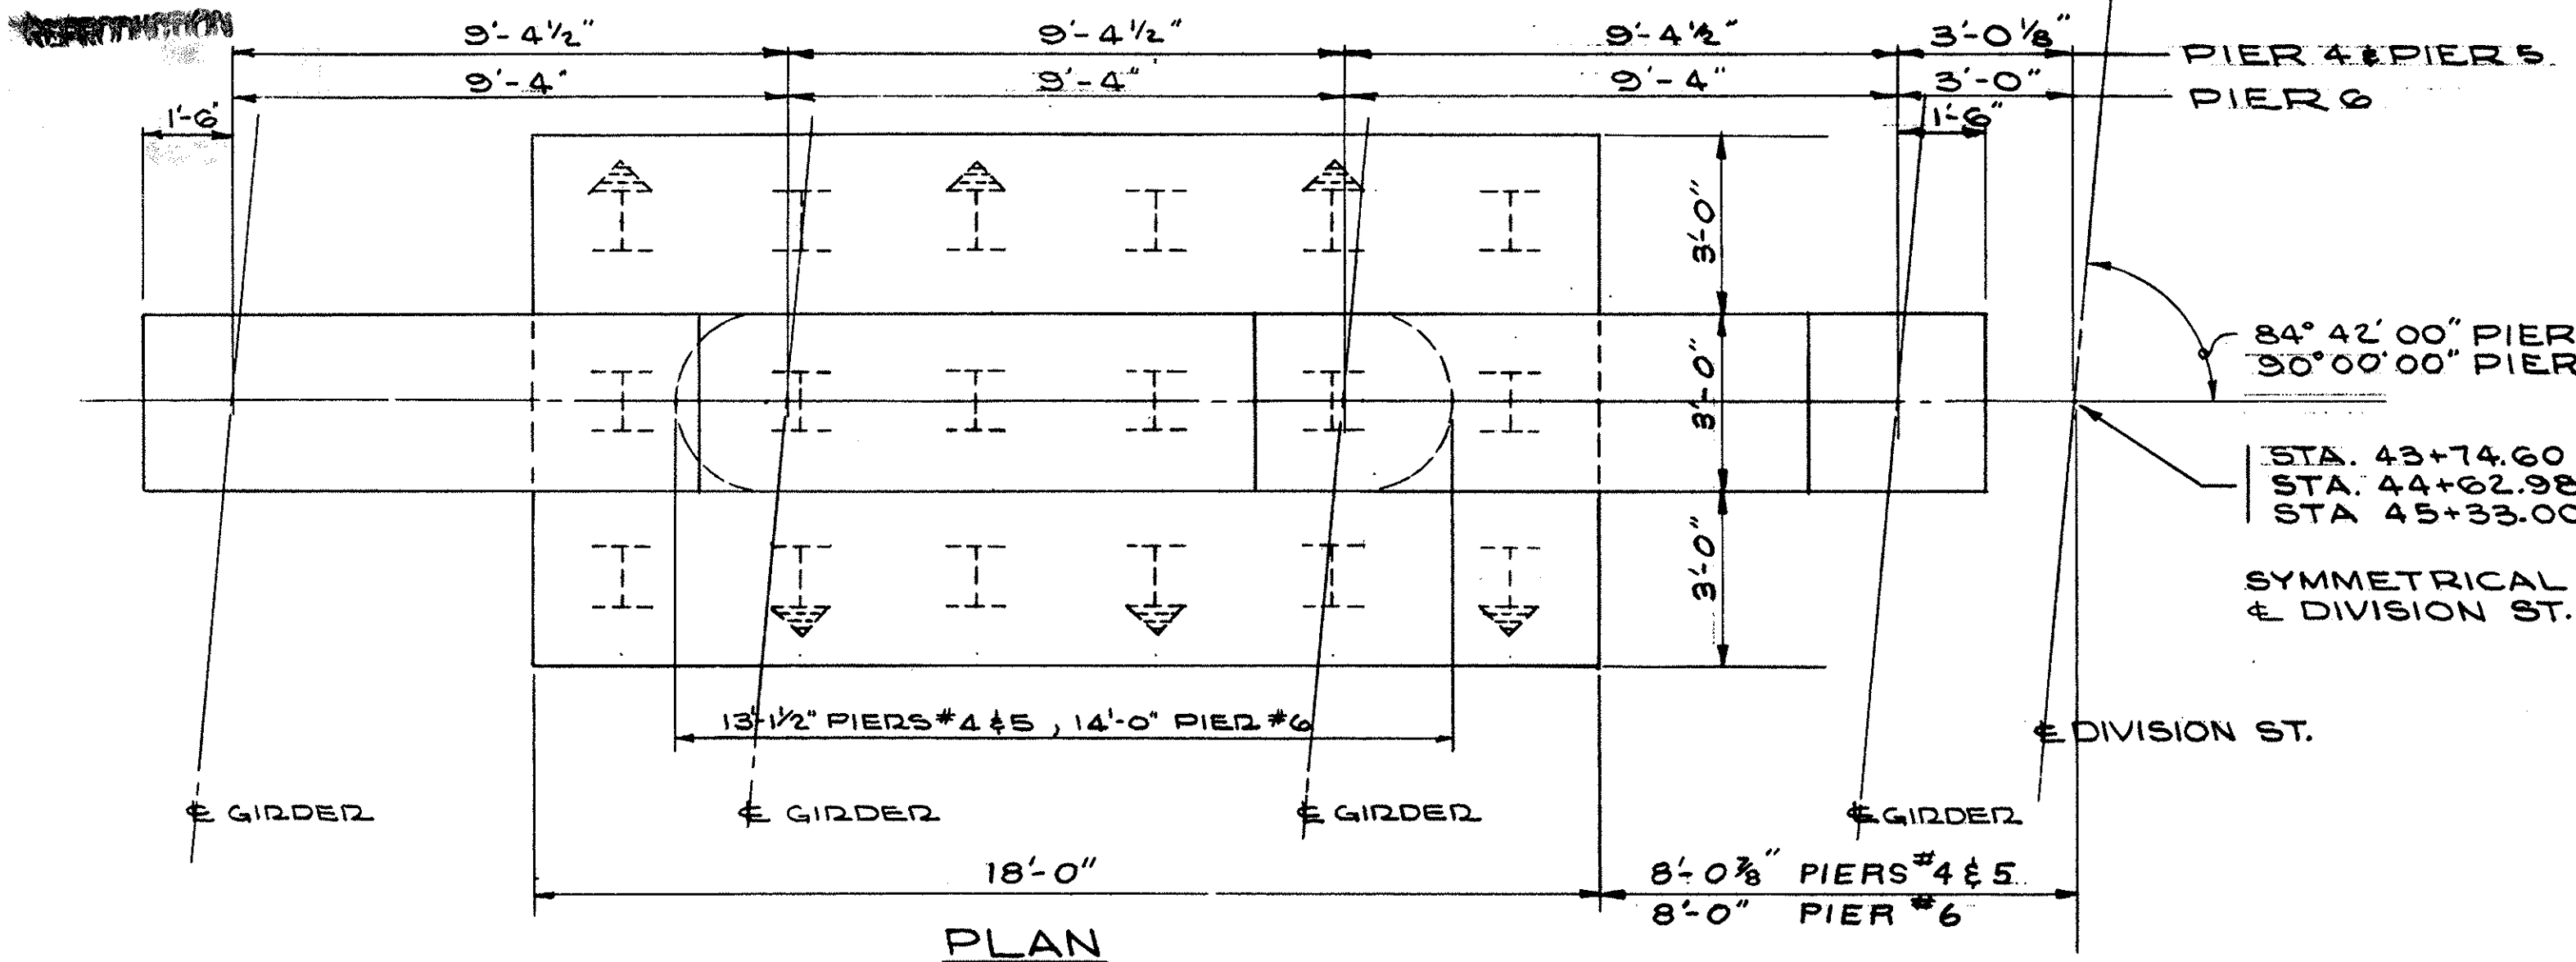

84° 42' 00" PIER 4 & PIER 5
30° 00' 00" PIER 6

STA. 43+74.60 PIER 4
STA. 44+62.98 PIER 5
STA. 45+33.00 PIER 6

SYMMETRICAL ABOUT
÷ DIVISION ST.

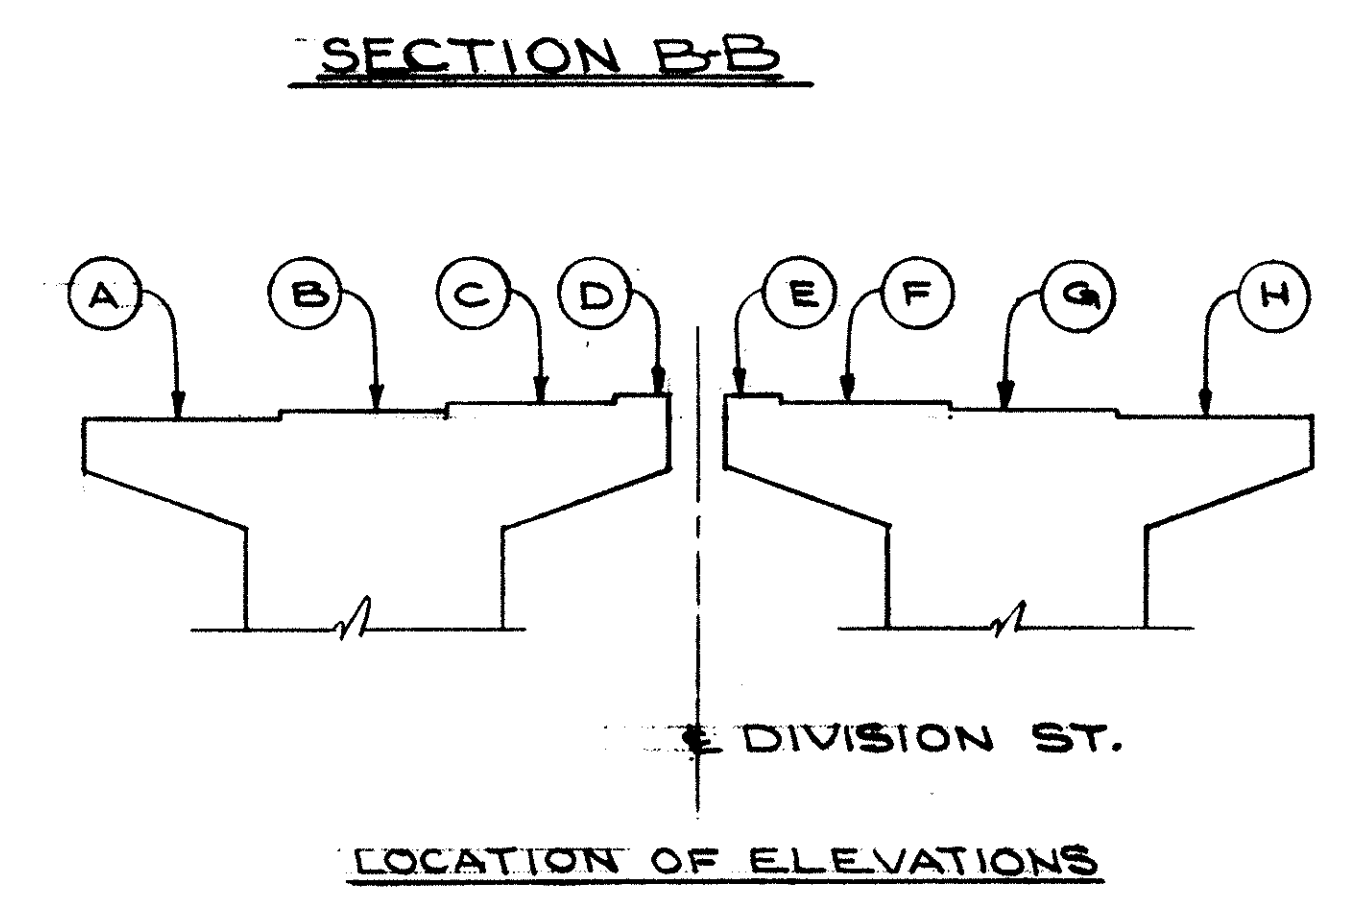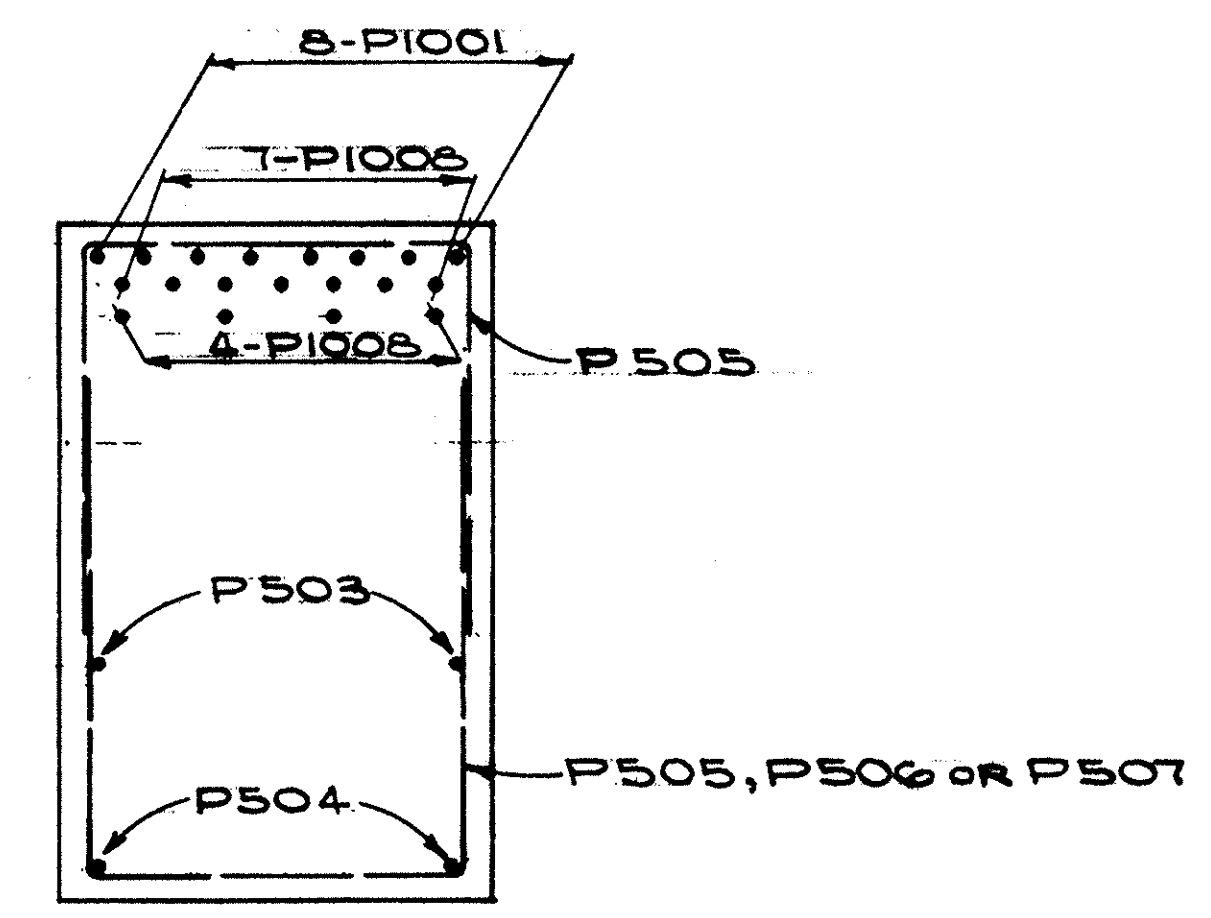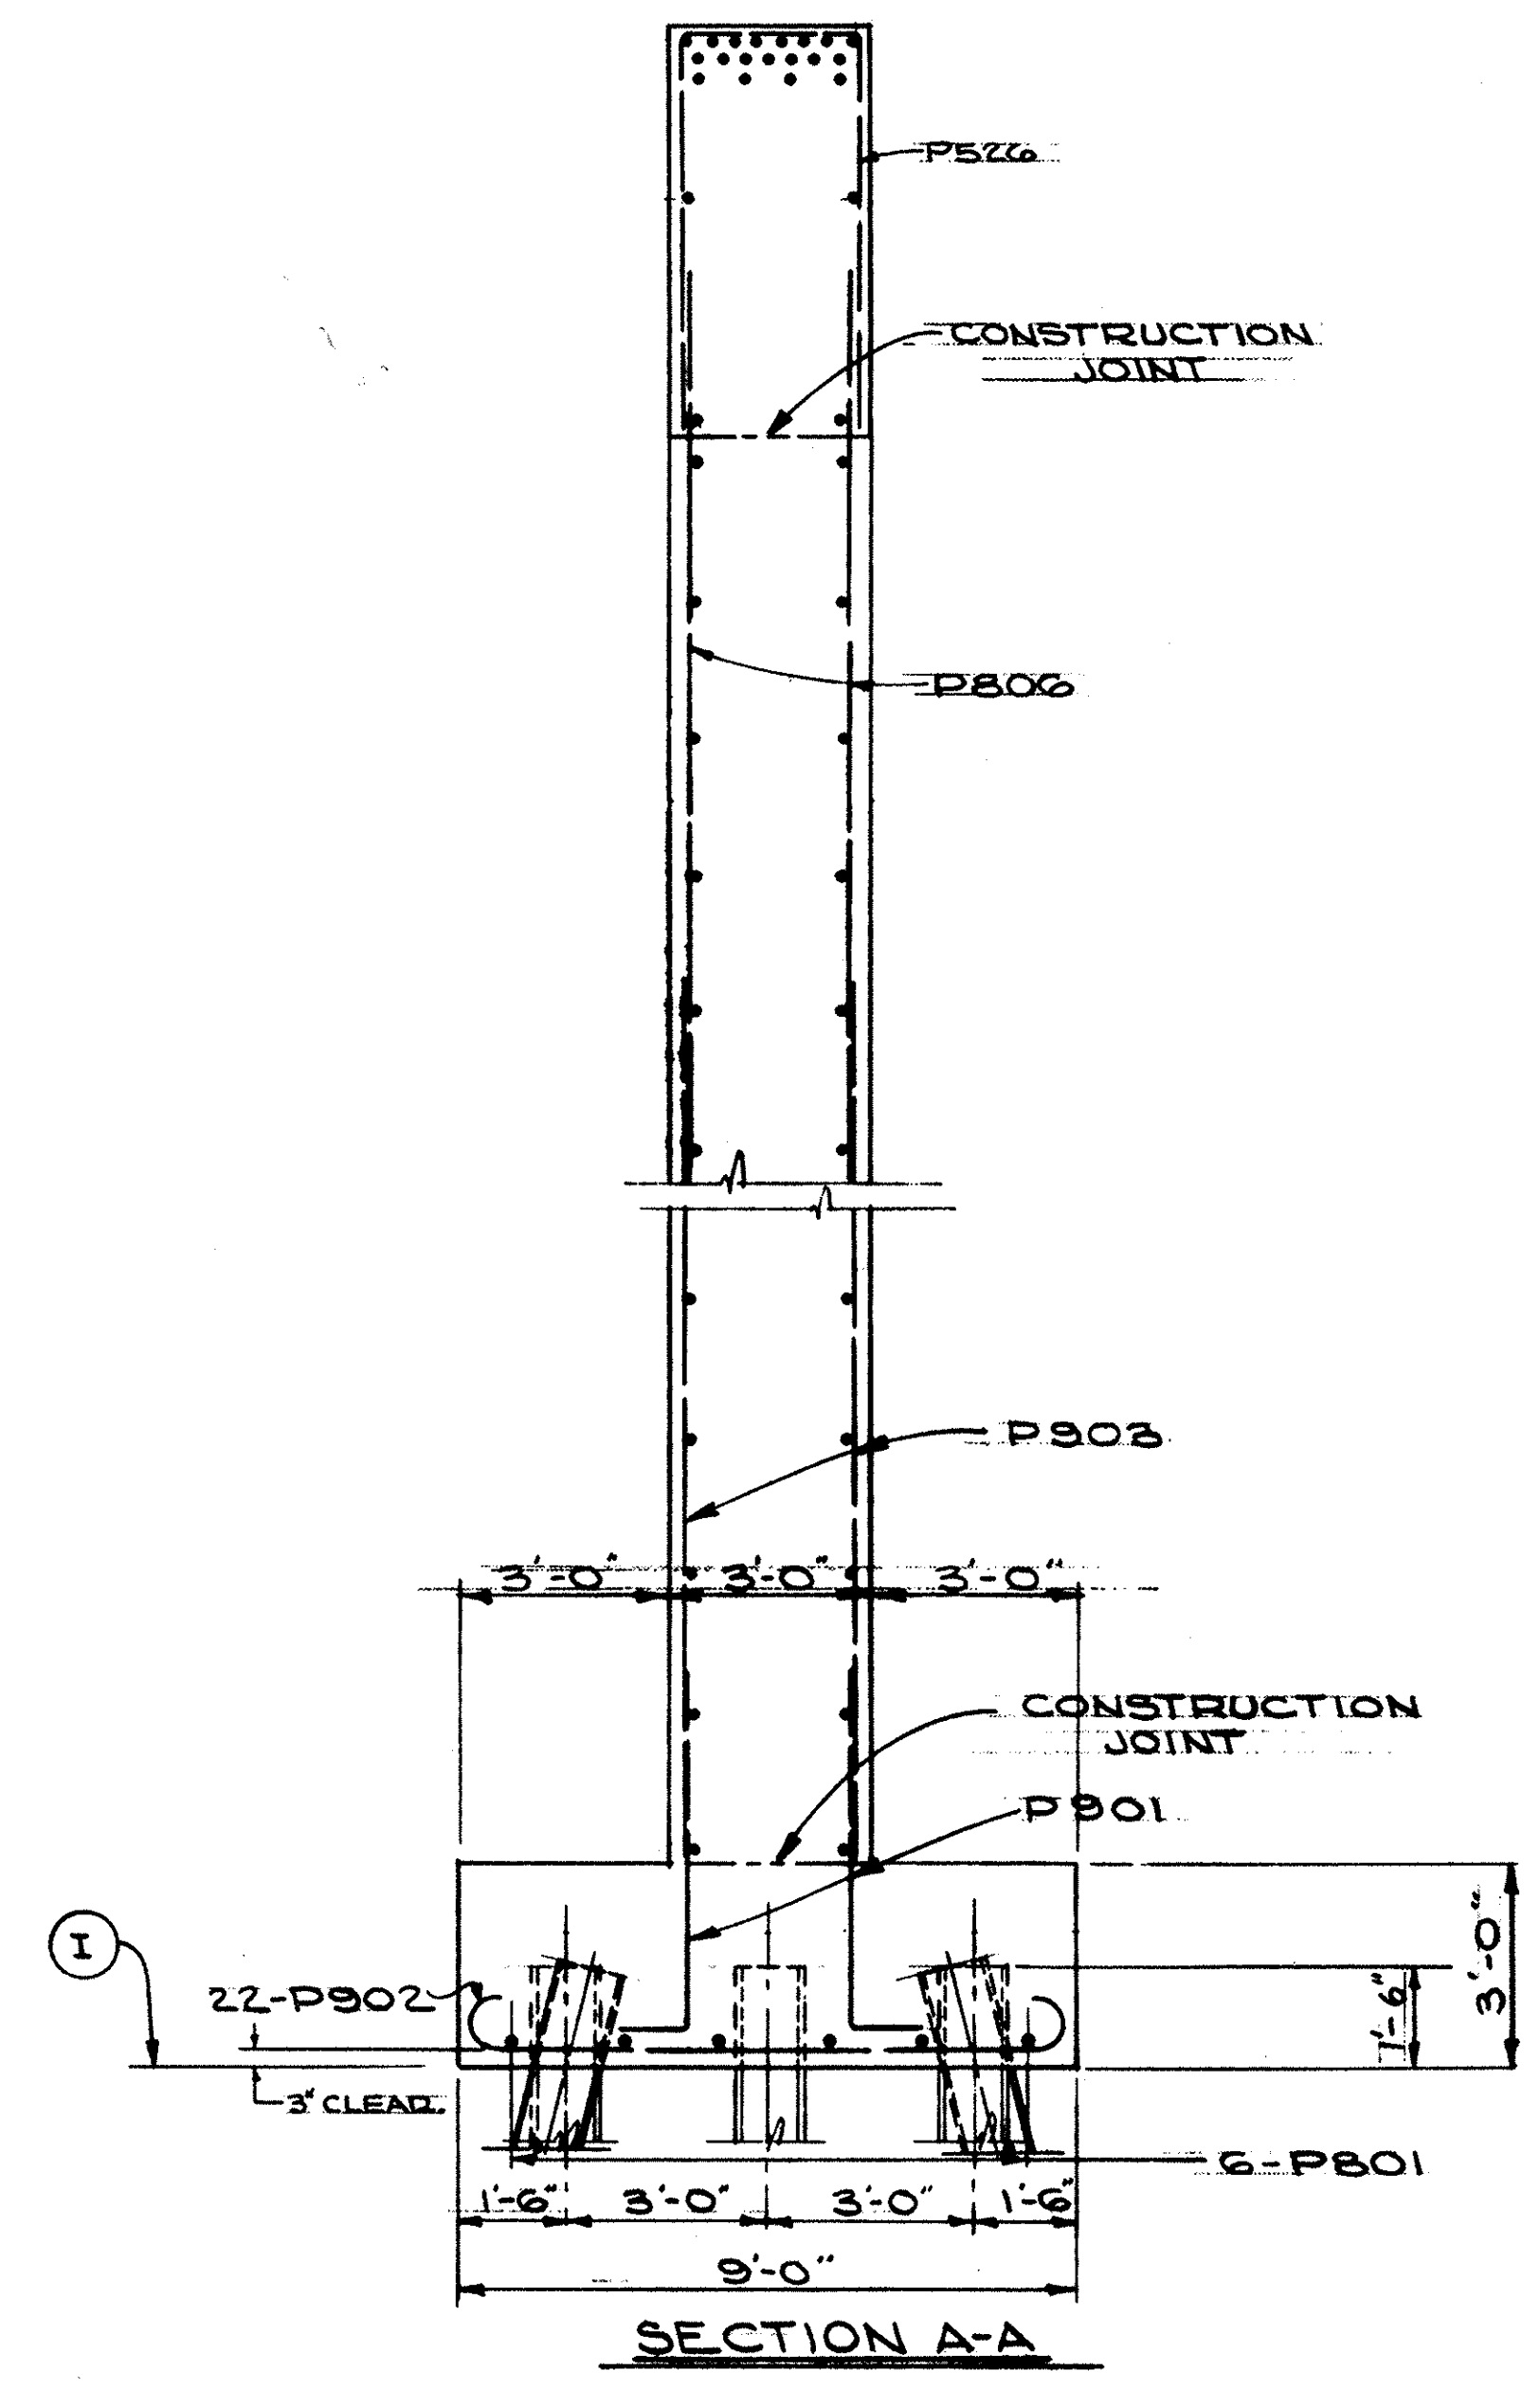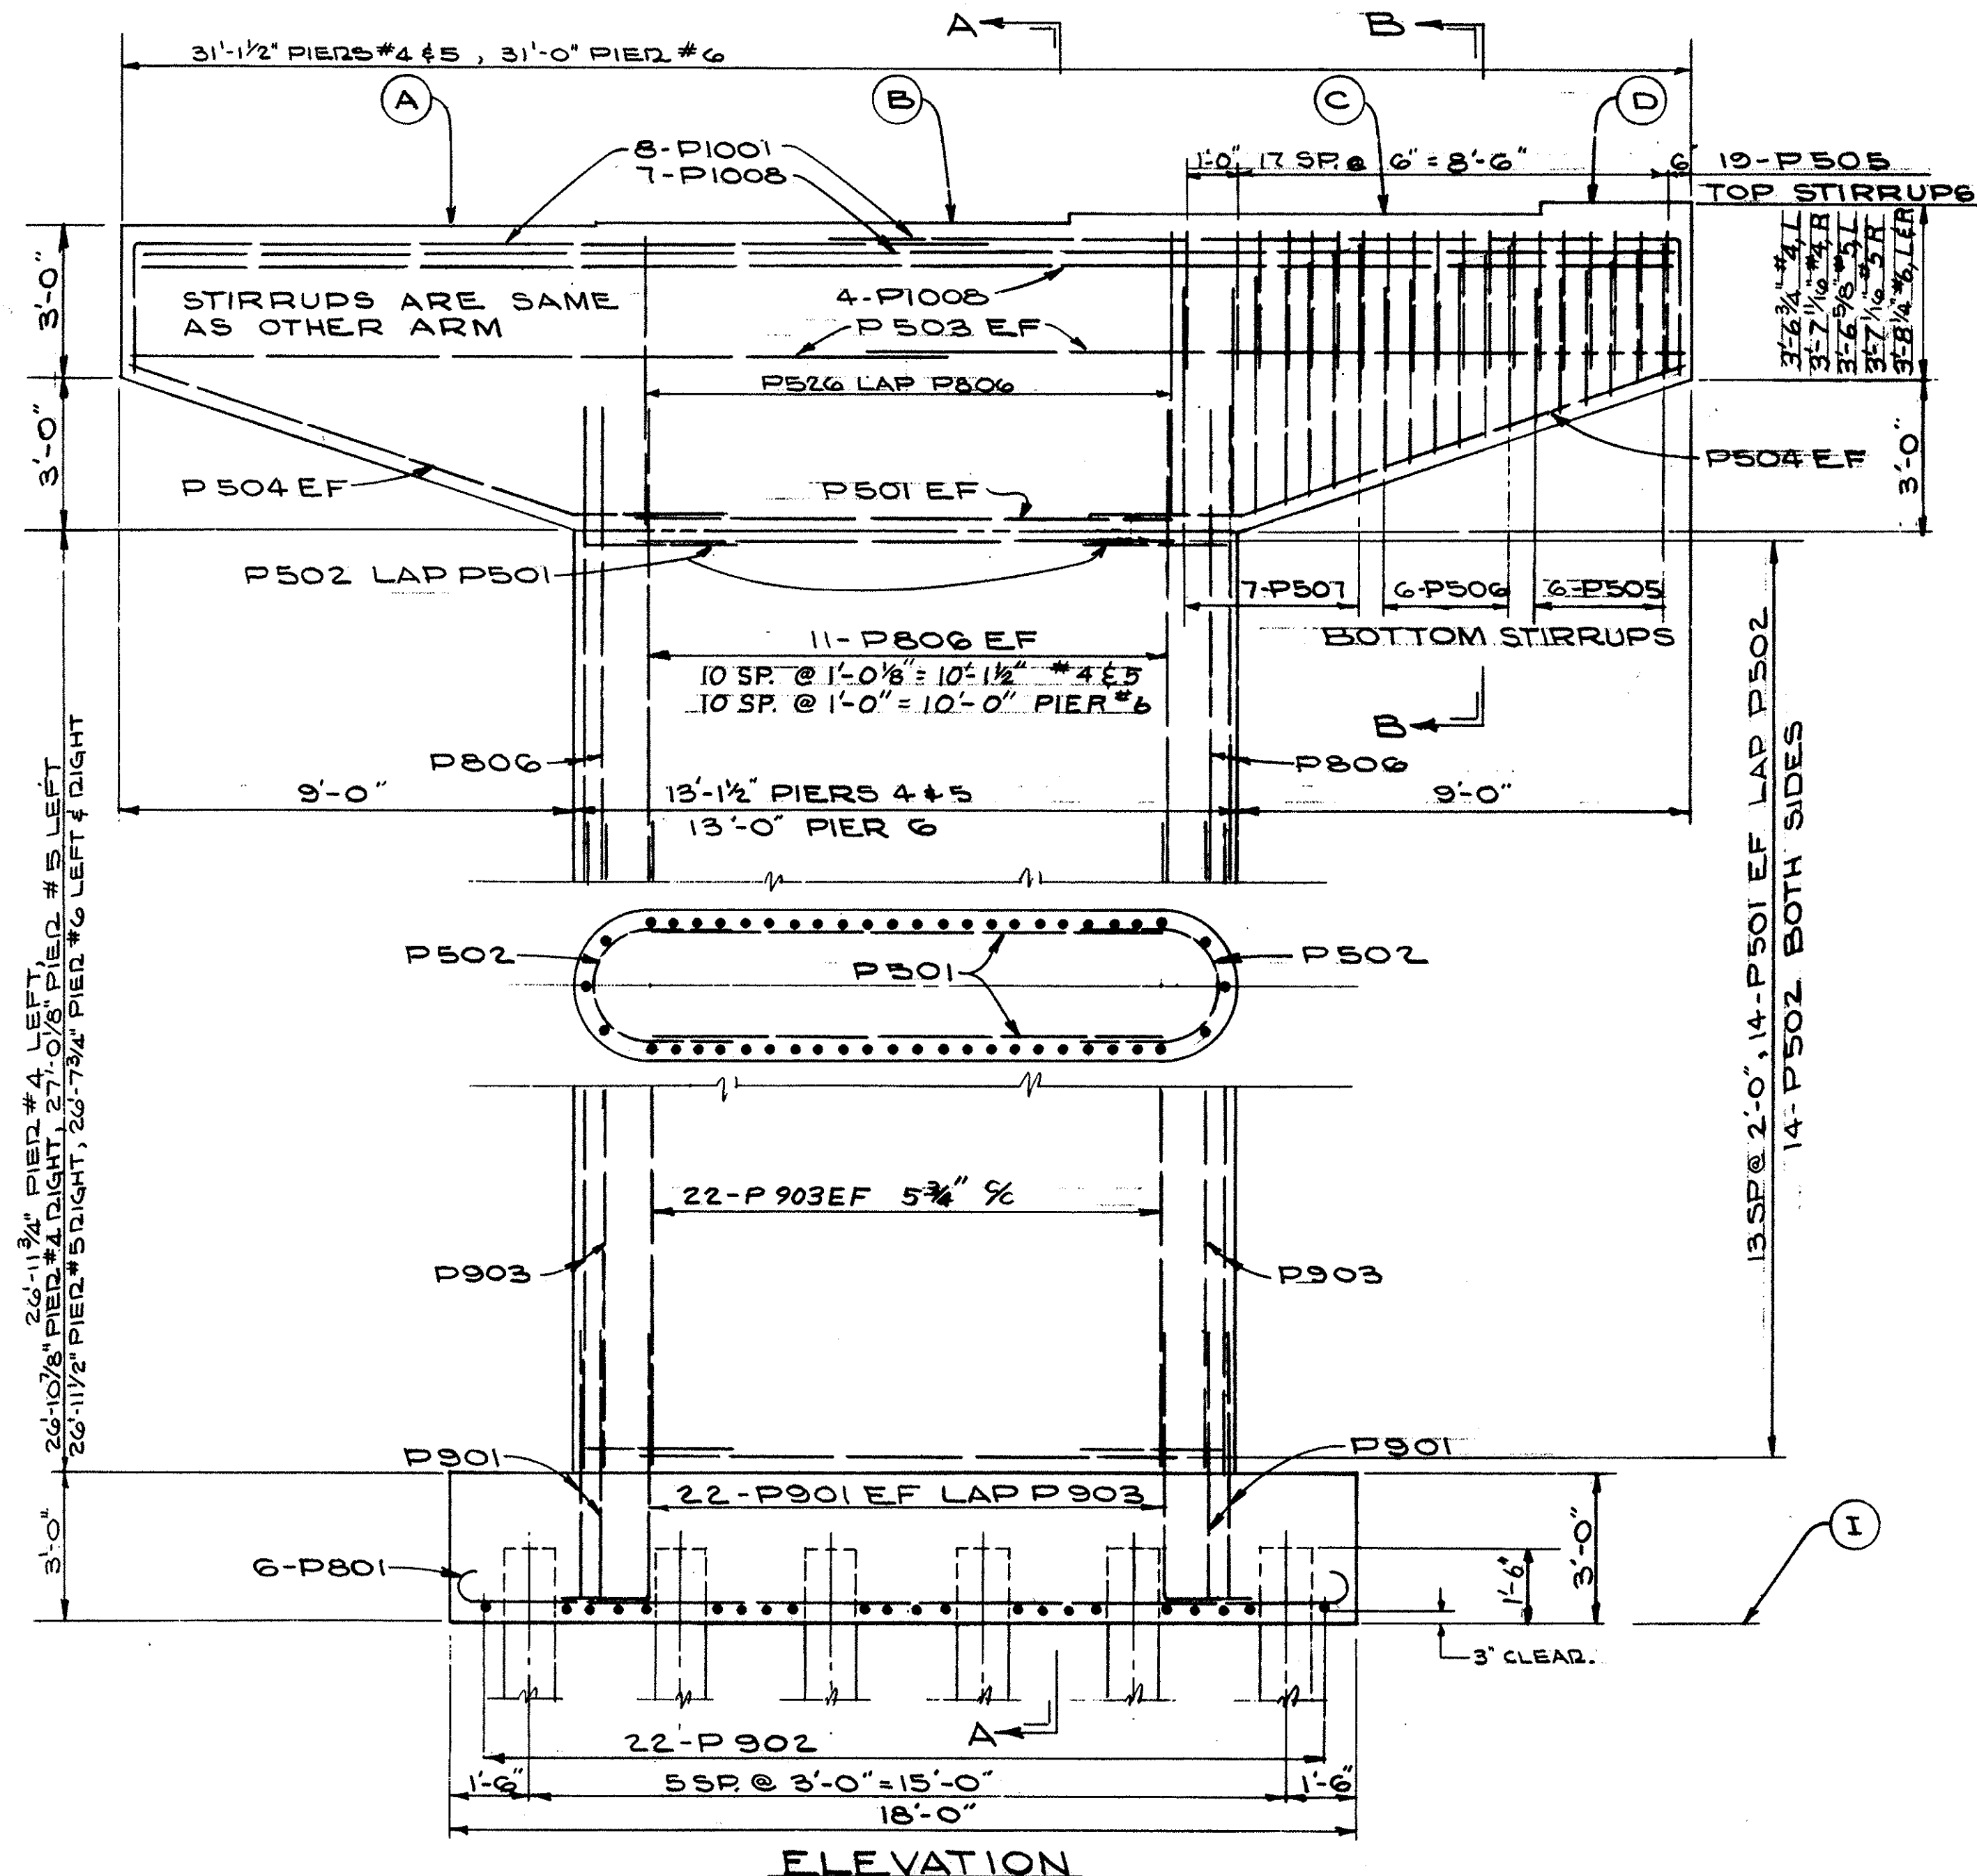

NOTE: ALL PILES TO BE 12BP53

PIER ELEVATION TABLE

	A	B	C	D	E	F	G	H	I
PIER 4	902.98	903.03	903.16	903.54	903.54	903.13	902.27	902.90	867.00
PIER 5	902.01	902.09	902.23	902.56	902.55	902.21	902.05	901.96	866.00
PIER 6	900.64	900.66	900.81	901.07	901.07	900.81	900.66	900.64	865.00

STATE OF OHIO
DEPARTMENT OF HIGHWAYS
BUREAU OF BRIDGES

AKRON, OHIO


GLAUS, PYLE & SCHOMER
YOUNGSTOWN, OHIO

PIERS 4, 5, & 6
BRIDGE N^o MAH-711-0116
OVER MAHONING RIVER
YOUNGSTOWN MAHONING COUNTY


DESIGNED	DRAWN	TRACED	CHECKED	REVIEWED	DATE	REVISED
JWC	JWC		JM	WKE	6-22-68	

MAHONING
JUN 13 1968
BRIDGE

STA. 46+28.00 PIER 7
STA. 47+43.00 PIER 8
STA. 48+58.00 PIER 9


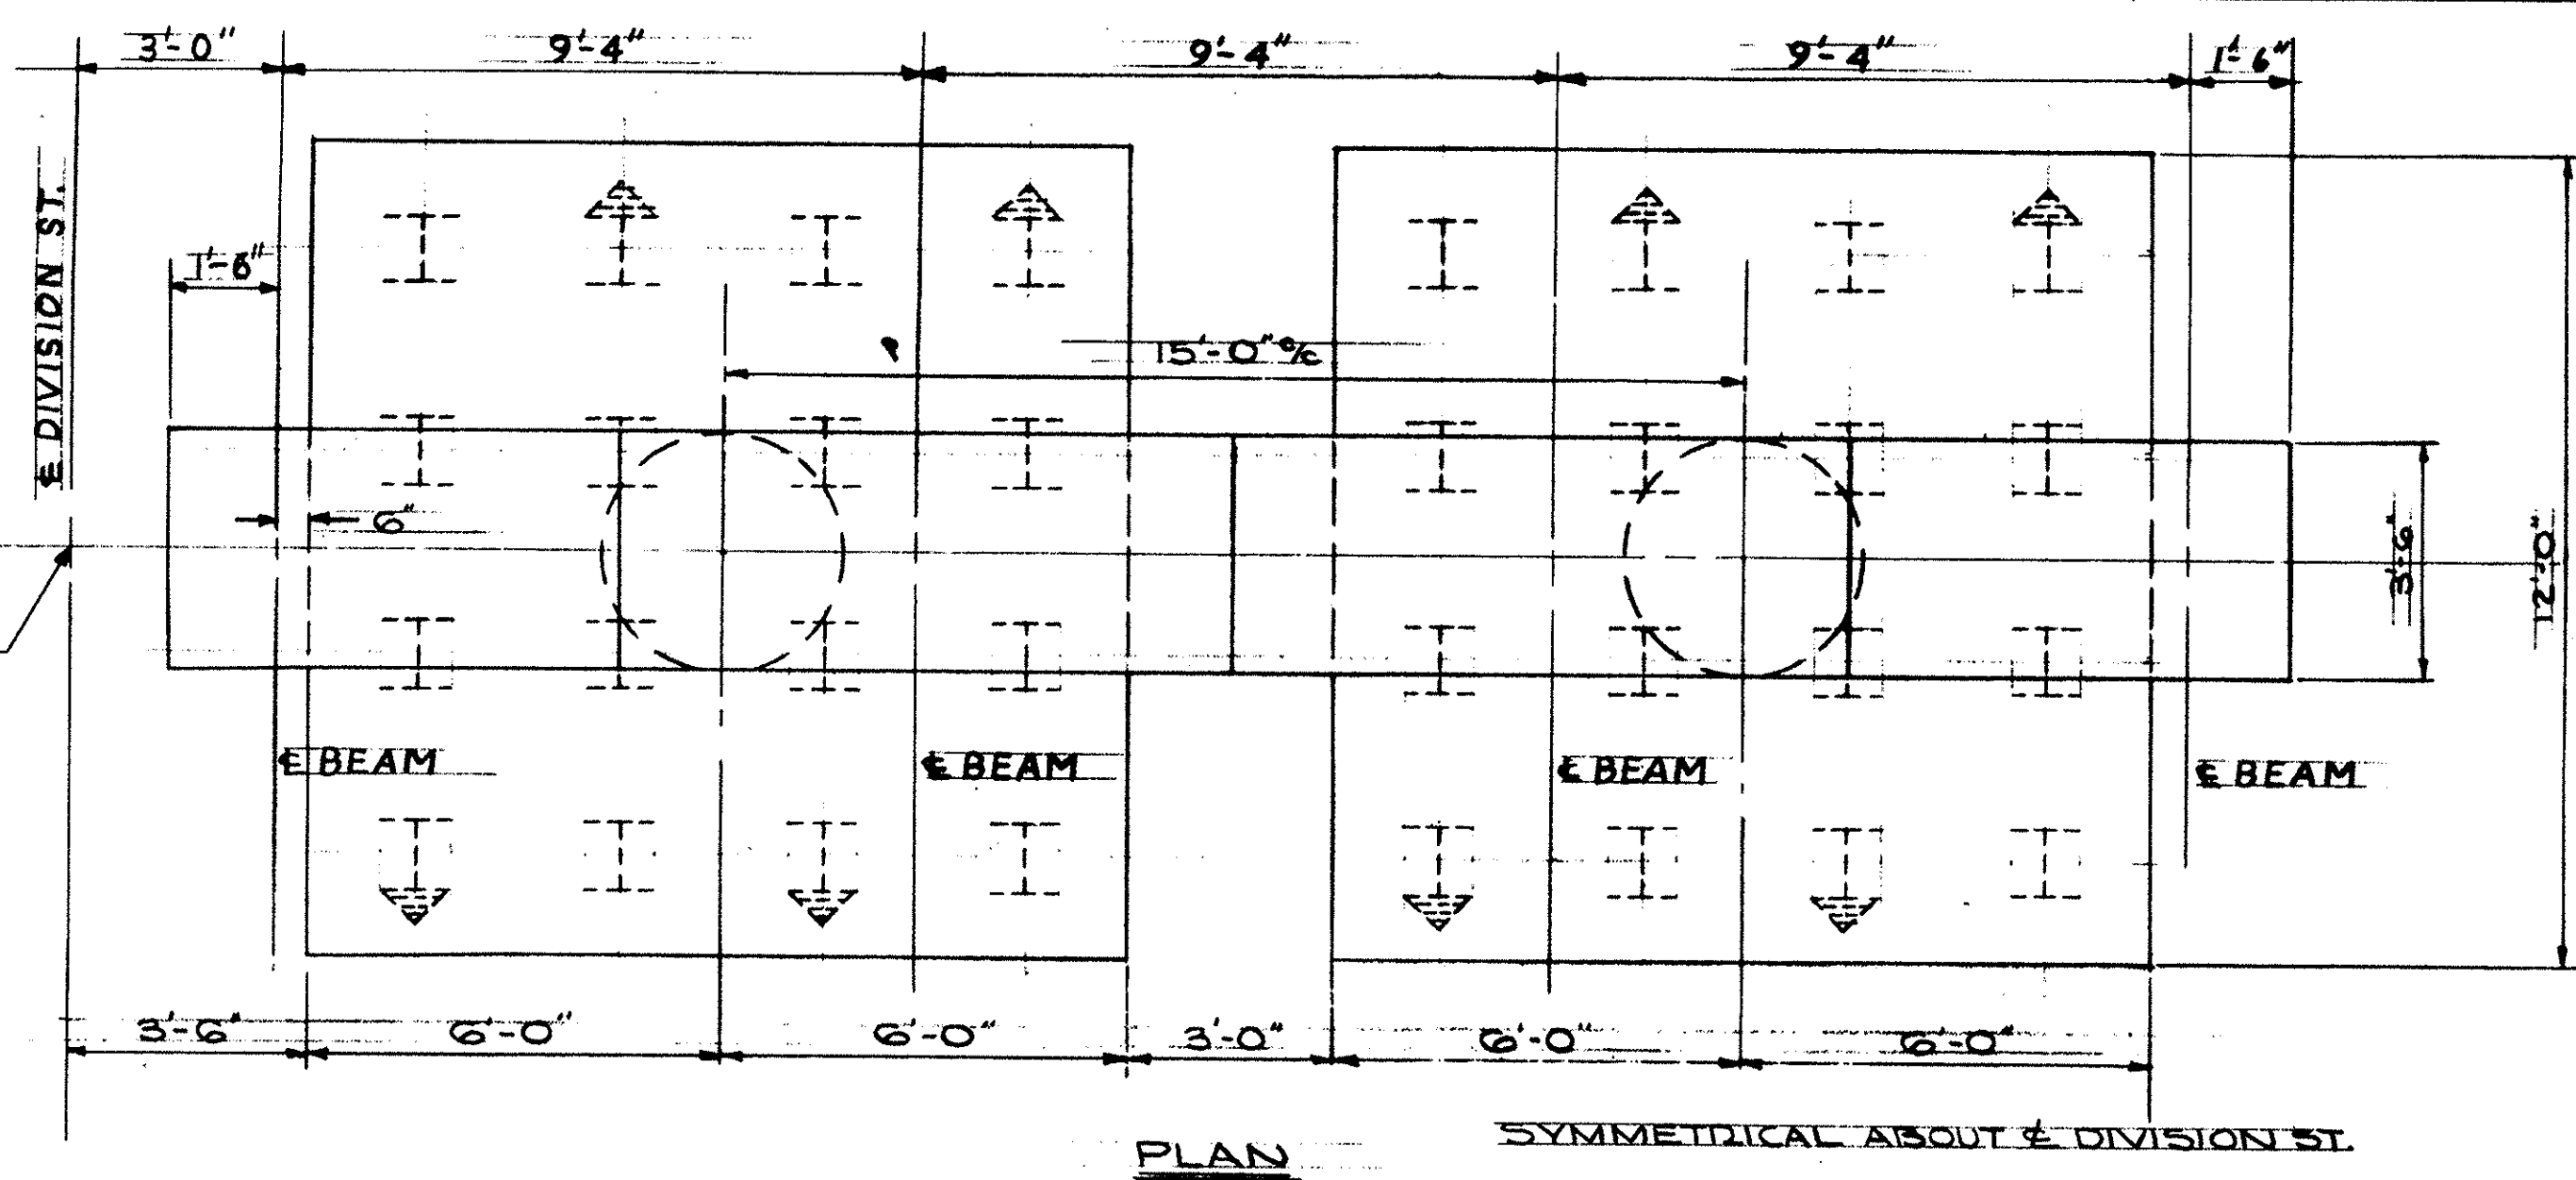


	A	B	C	D	E	F	G	H	I
PIER 7	900.07	900.10	900.25	900.53	900.53	900.25	900.10	900.07	863.00
PIER 8	900.39	900.45	900.59	900.87	900.87	900.59	900.45	900.39	855.00
PIER 9	901.46	901.47	901.61	901.92	901.92	901.61	901.47	901.46	857.00

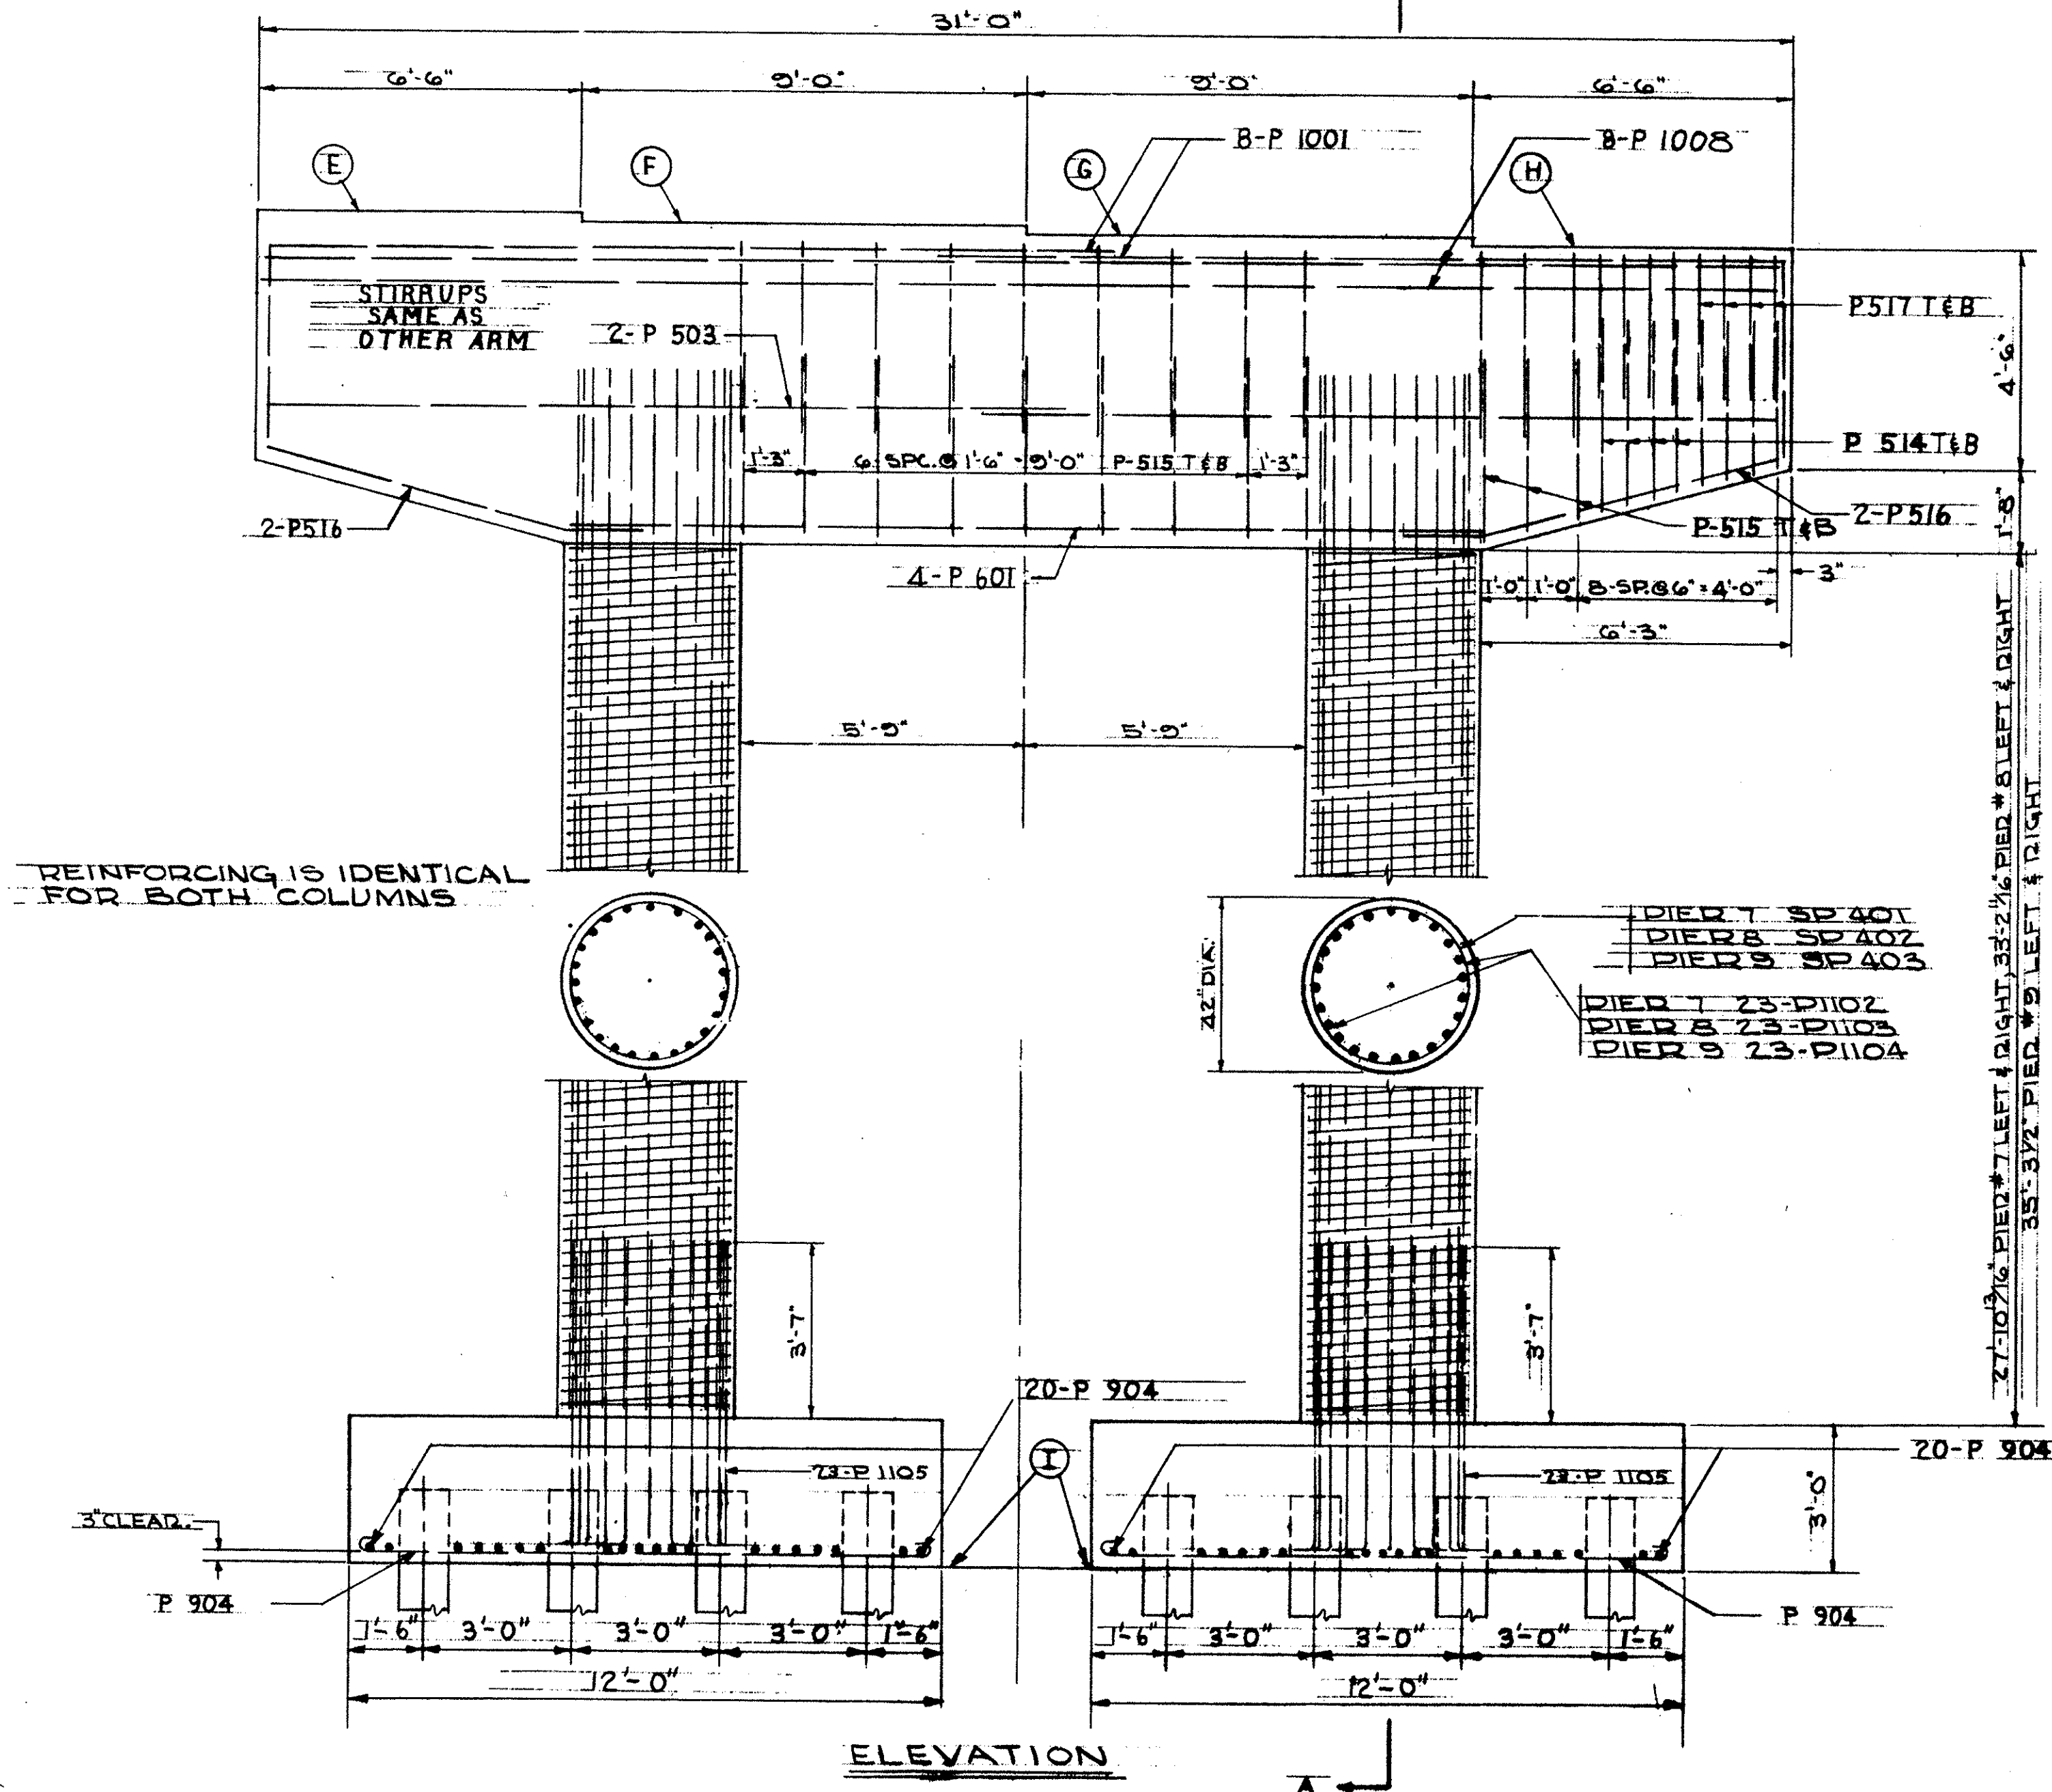

REINFORCING IS IDENTICAL FOR BOTH COLUMNS

PIER 7 SP 401
PIER 8 SP 402
PIER 9 SP 403
PIER 7 23-P1102
PIER 8 23-P1103
PIER 9 23-P1104


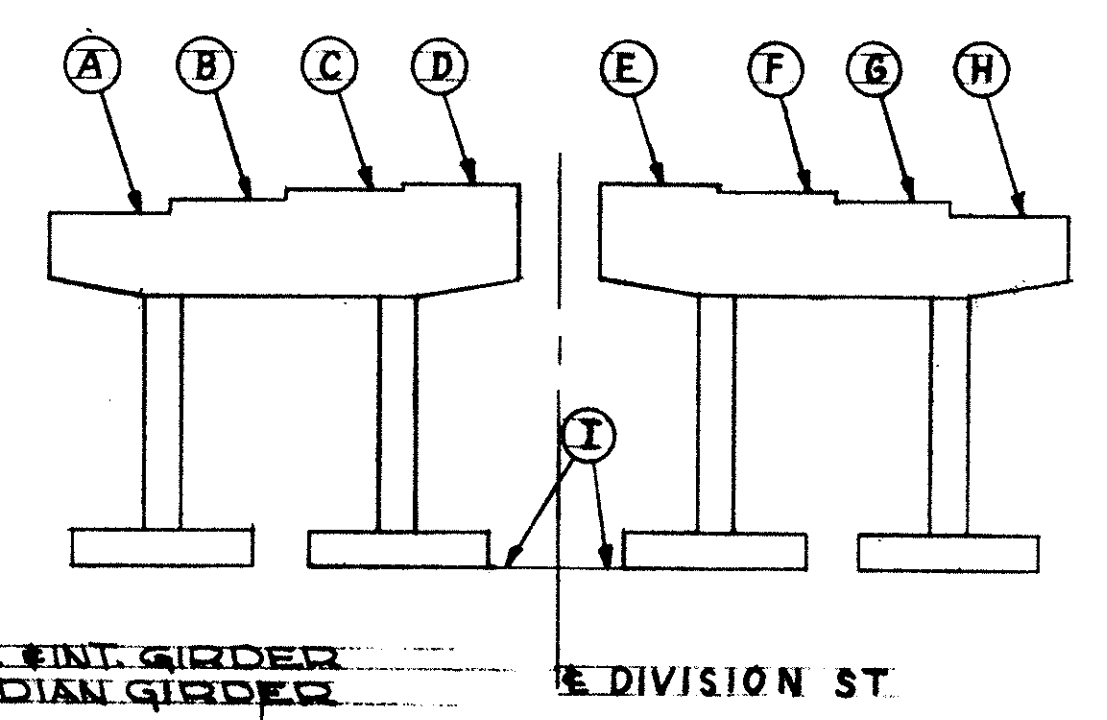
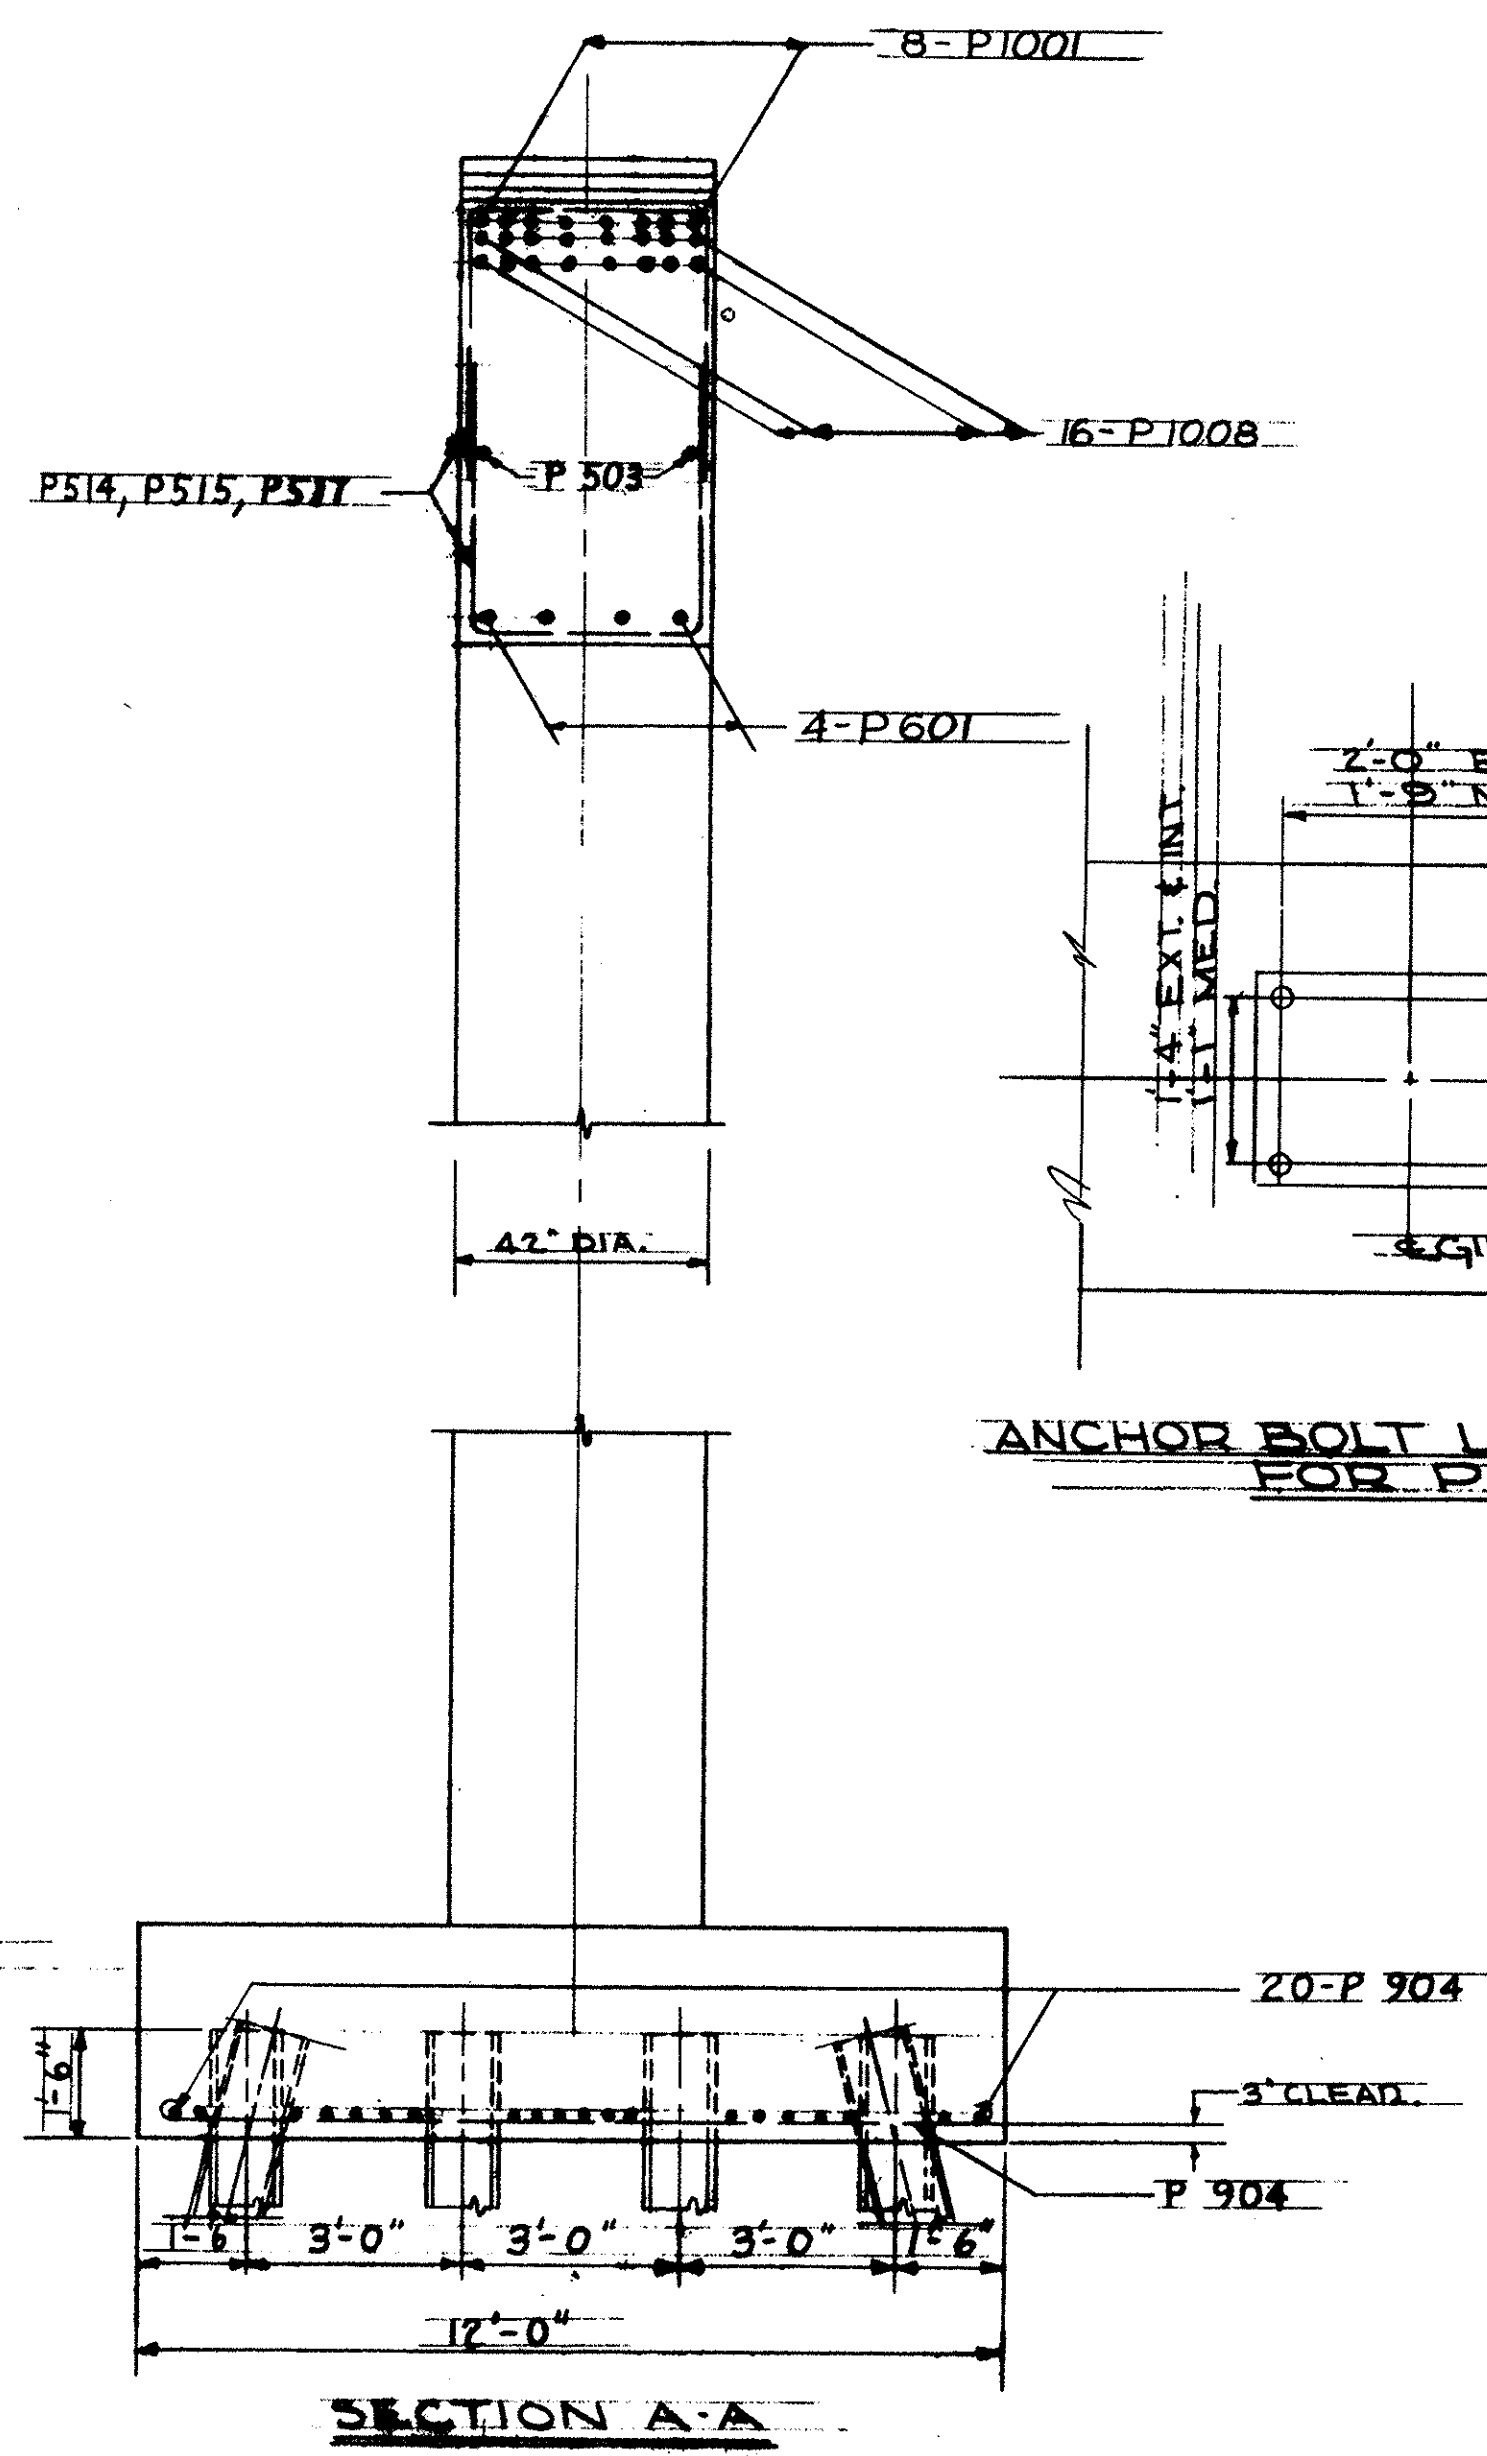


1/2" HOLES FOR 1/4" x 1-8" SWEDGE ANCHOR BOLTS. BOLTS SET 1/3" INTO CONCRETE.

NOTE:
ALL PILES TO BE 17.5 D53
SPECIAL CARE SHALL BE TAKEN IN PLACING THE REINFORCING STEEL IN THE VICINITY OF THE BRIDGE SEAT OF PIER 8 SO AS TO AVOID INTERFERENCE WITH THE DRILLING OF ANCHOR BAR HOLES.

STATE OF OHIO DEPARTMENT OF HIGHWAYS BUREAU OF BRIDGES						
AKRON, OHIO	GLAUS, PYLE & SCHOMER YOUNGSTOWN, OHIO					
PIERS 7, 8, & 9 BRIDGE N ^o MAH-711-0116 OVER MAHONING RIVER YOUNGSTOWN MAHONING COUNTY						
DESIGNED JWC	DRAWN JDP	TRACED	CHECKED JM	REVIEWED WKD	DATE 6-22-68	REVISED

MAHONING RIVER
JUN 13 1968

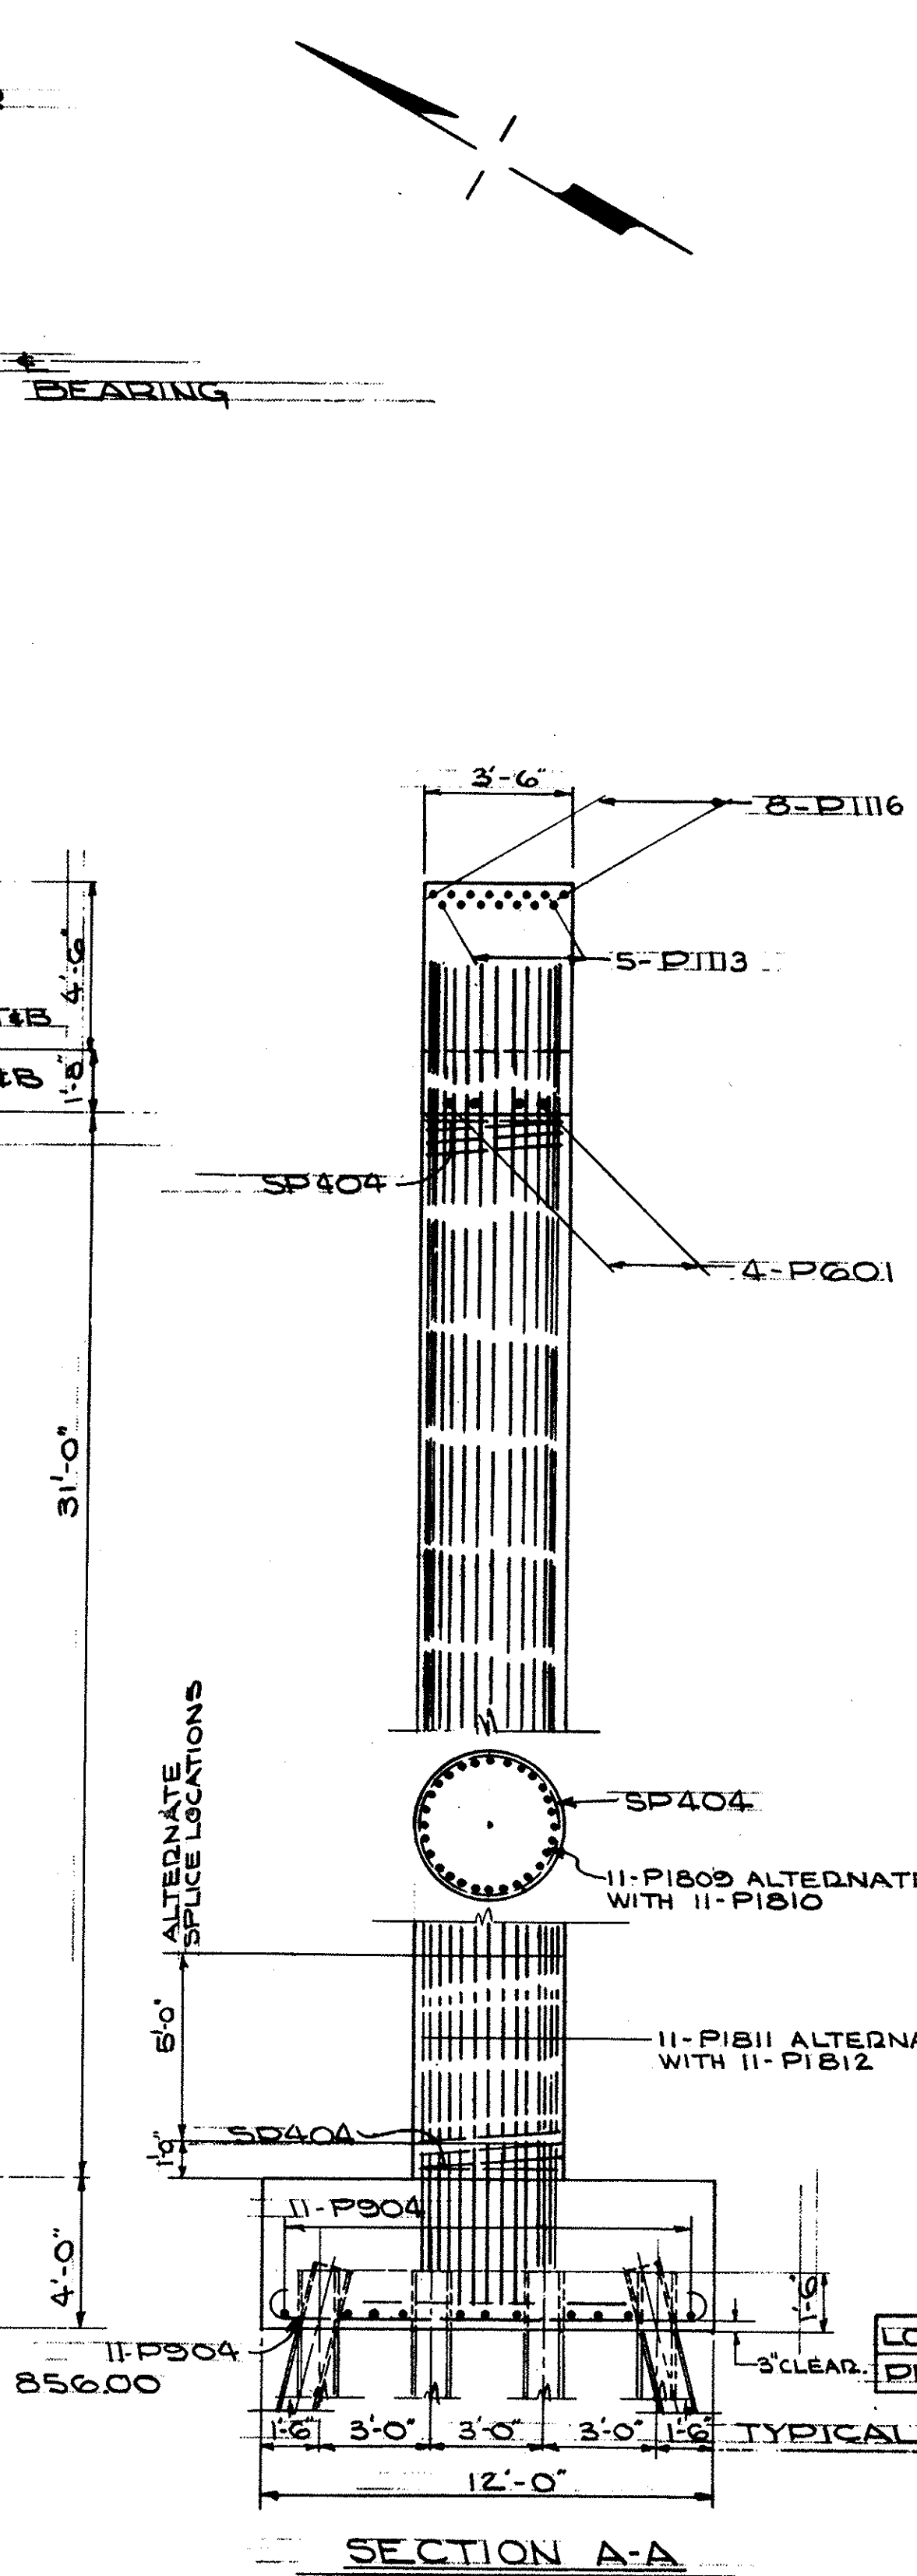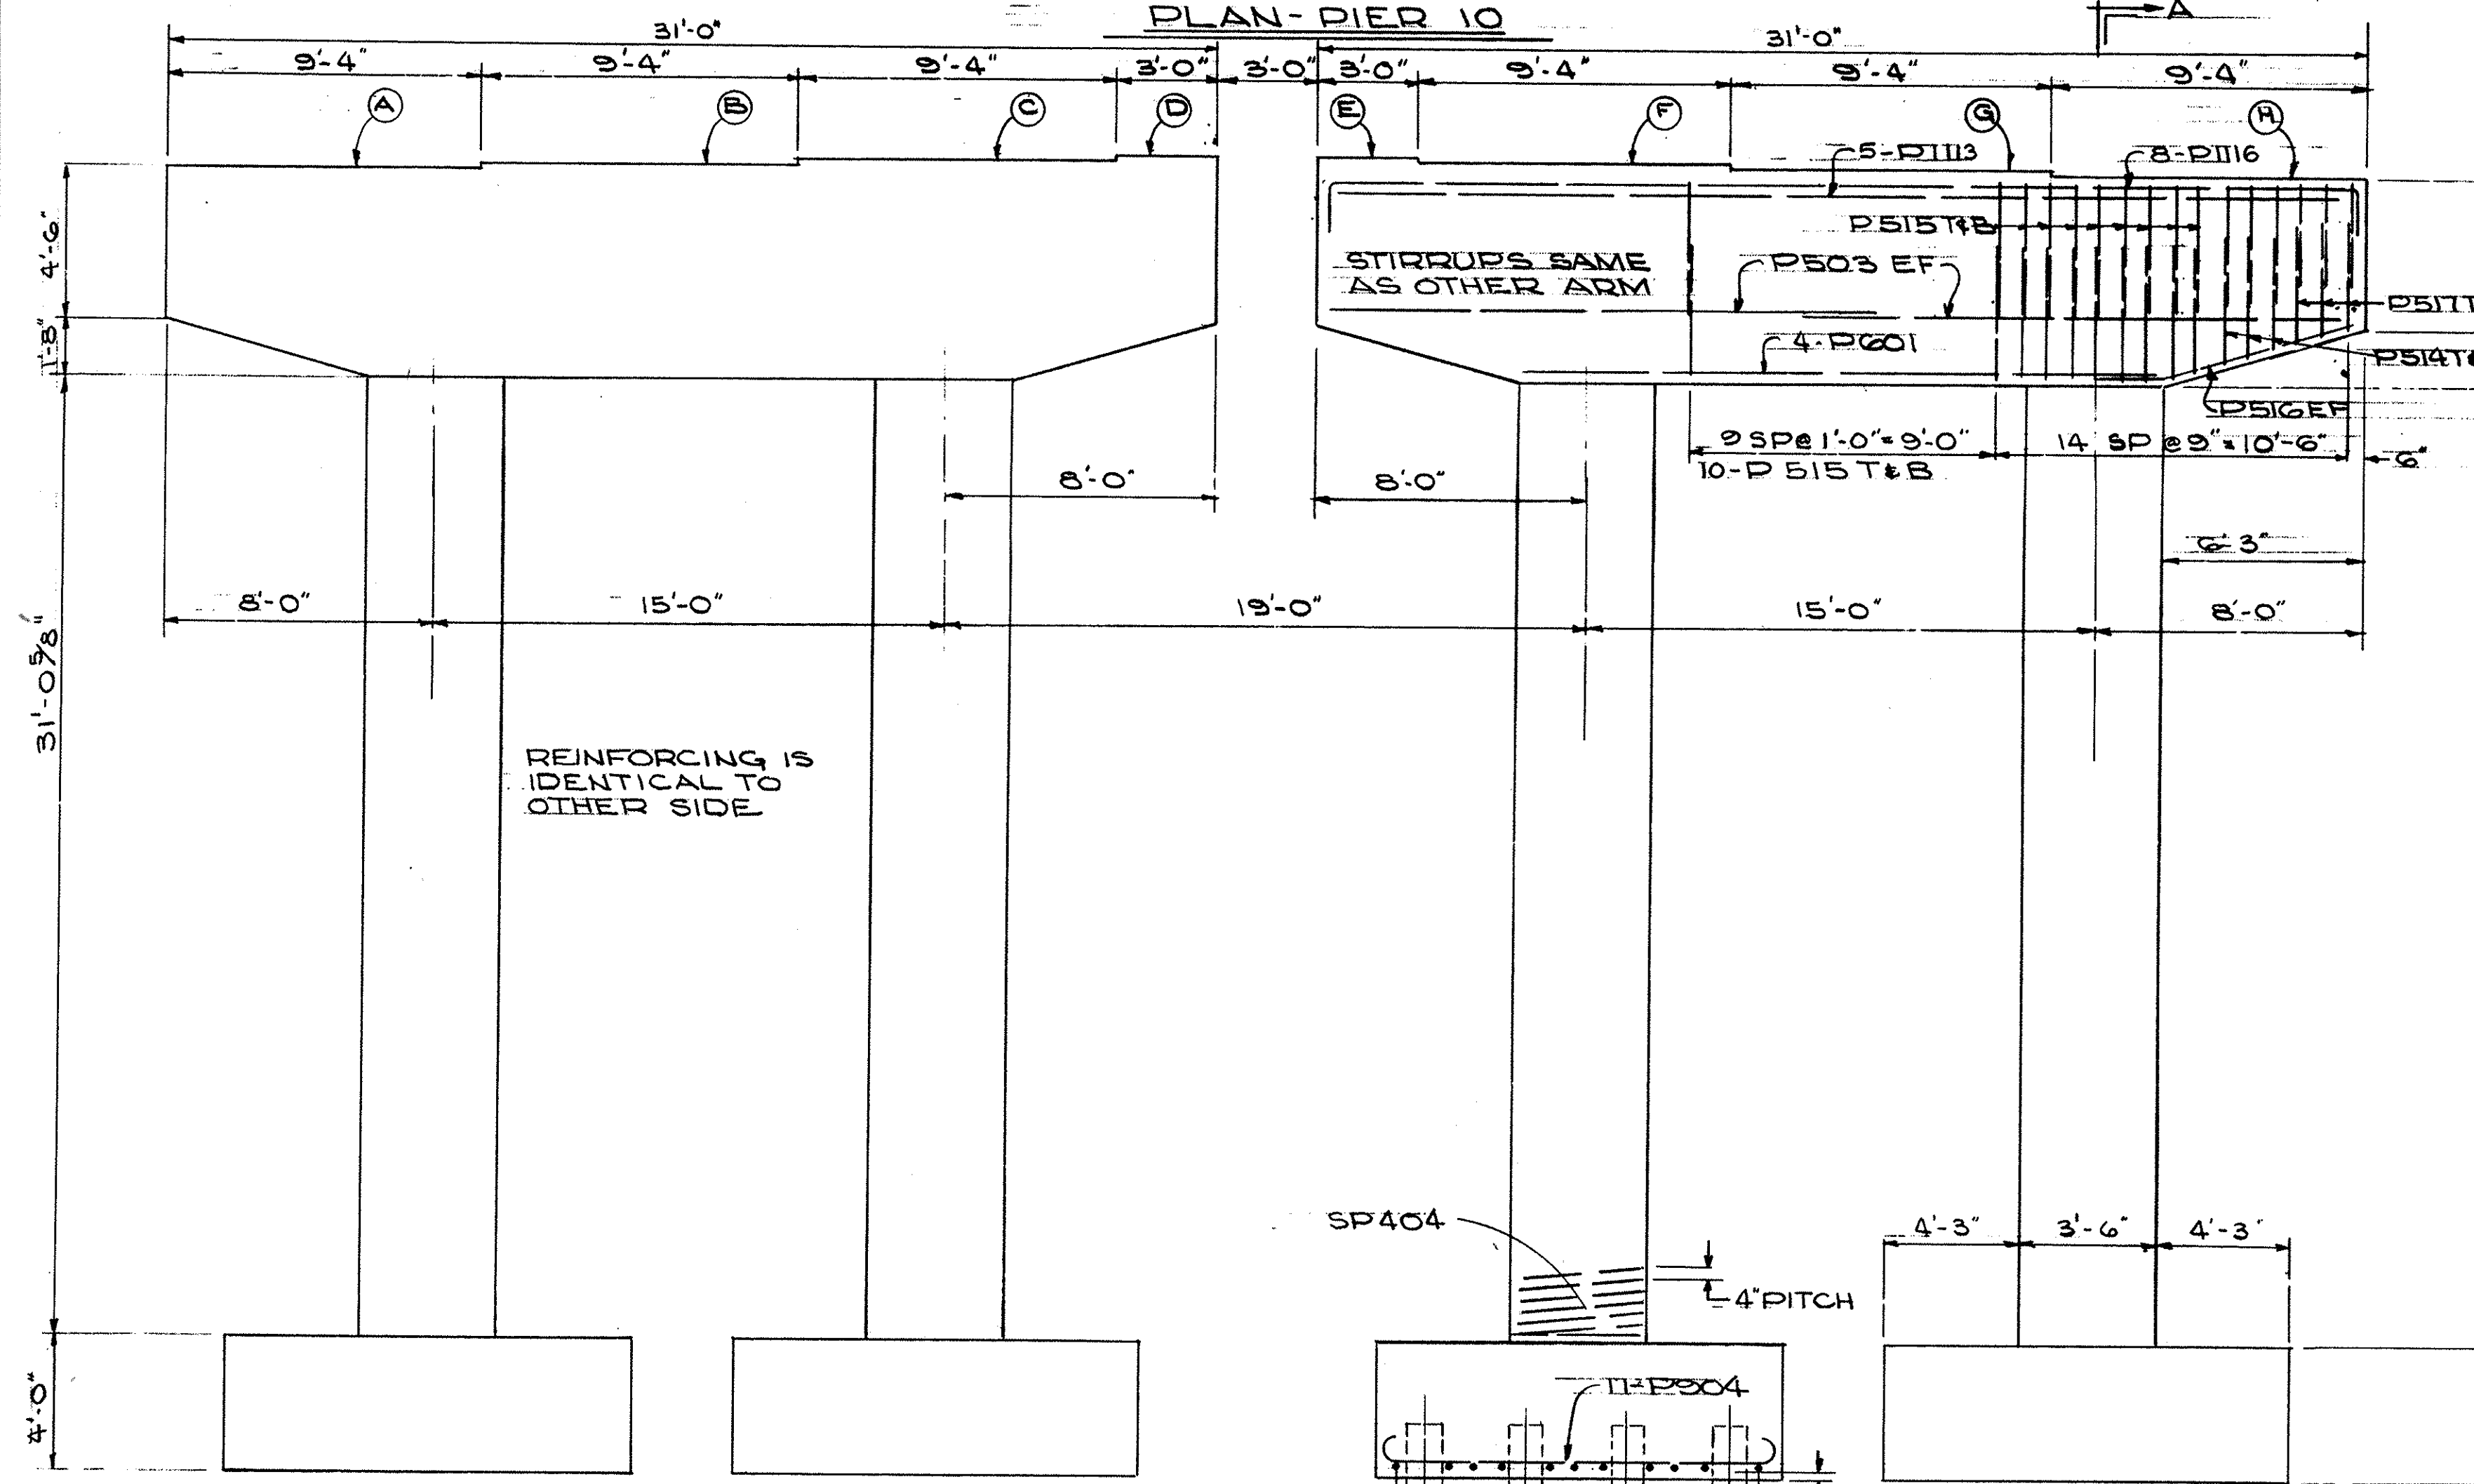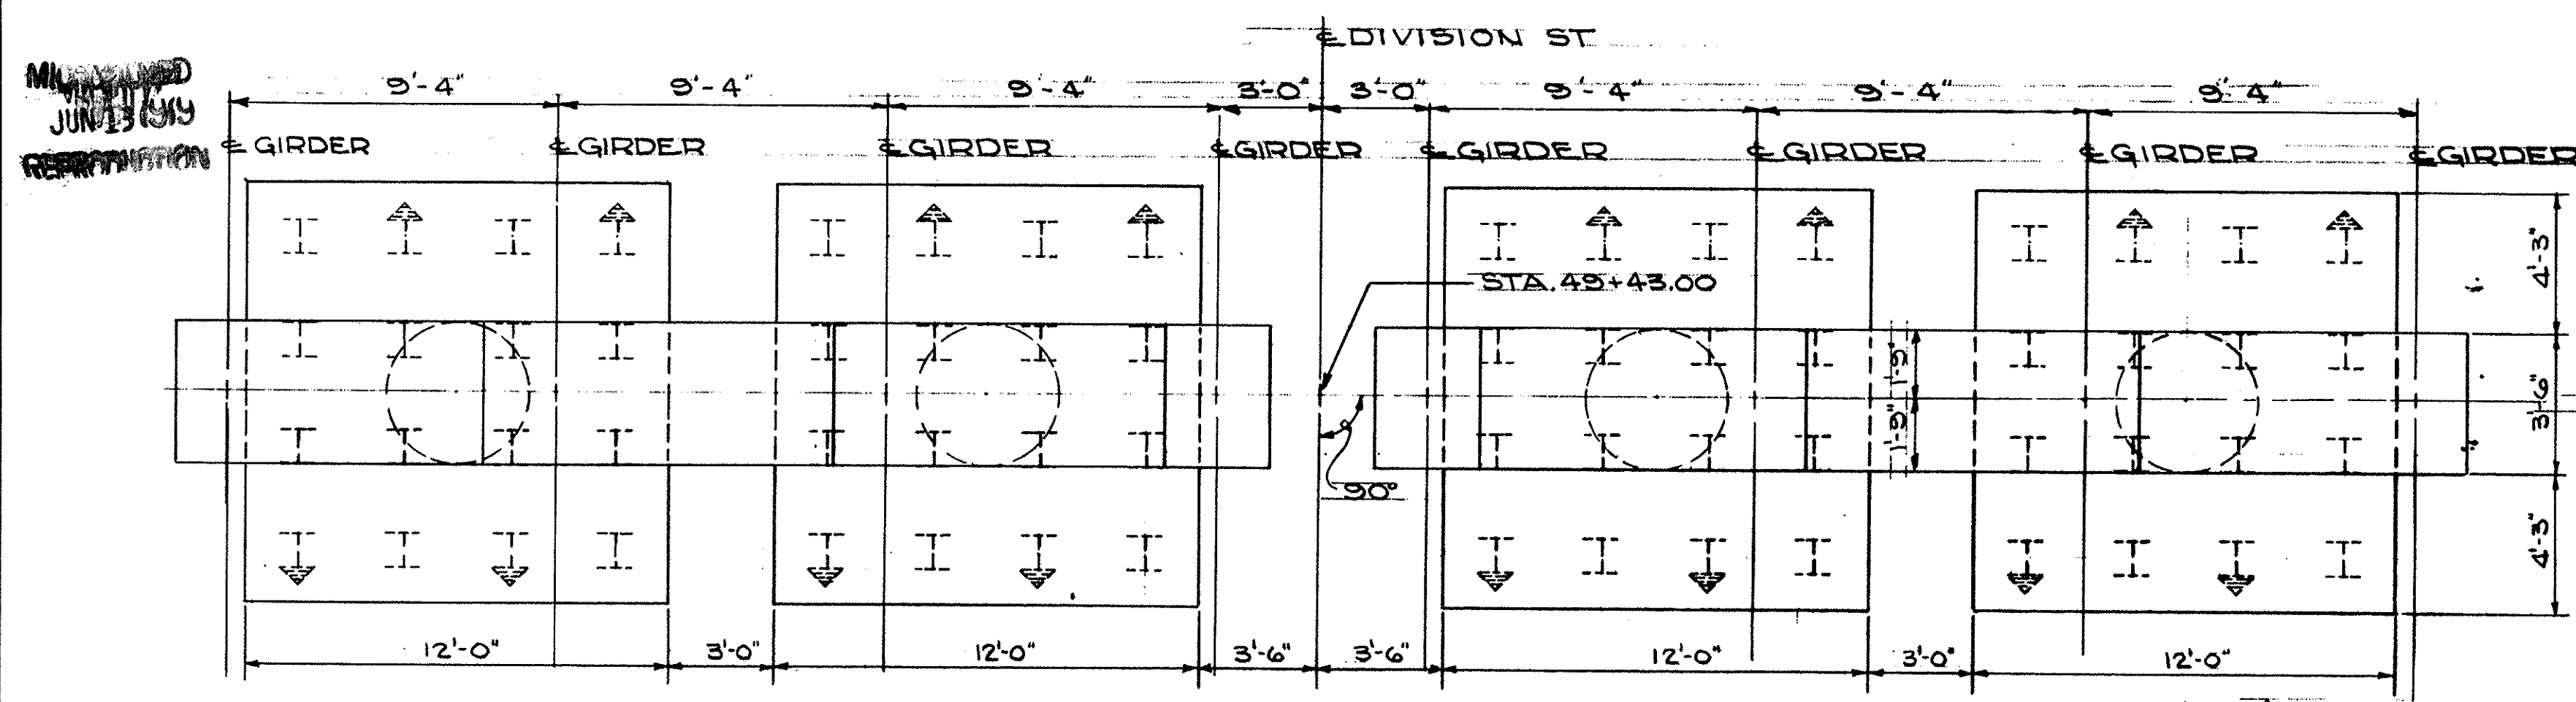

PERMISSION IS GRANTED TO ADD (1) No. 18 BAR TO EACH COLUMN OF PIER 10 TO COMPENSATE FOR DEFICIENCY IN YIELD STRENGTH.

LOCATION	A	B	C	D	E	F	G	H
PIER 10	897.22	897.31	897.45	897.72	897.72	897.39	897.25	897.16

ELEVATION PIER 10

SECTION A-A




NOTE:
WELDED SPLICES OF #18 BARS SHALL NOT BE USED. AN APPROVED POSITIVE CONNECTION FOR BARS DESIGNED TO DEVELOP 125% OF THE SPECIFIED YIELD STRENGTH OF THE BAR SHALL BE PROVIDED.

STATE OF OHIO DEPARTMENT OF HIGHWAYS BUREAU OF BRIDGES					
GLAUS, PYLE & SCHOMER			YOUNGSTOWN, OHIO		
PIER 10					
BRIDGE N ^o		MAH-711-0116			
OVER MAHONING RIVER			YOUNGSTOWN MAHONING COUNTY		
DESIGNED	DRAWN	TRACED	CHECKED	REVIEWED	DATE
JWC	JWC		JM	WLD	6-22-68

MAH-711-017
 JUN 18 1969
 REPRODUCTION


FED. RD.	STATE	PROJECT	164 232
2	OHIO	U.S.-1159 (1)	

MAH-711-017

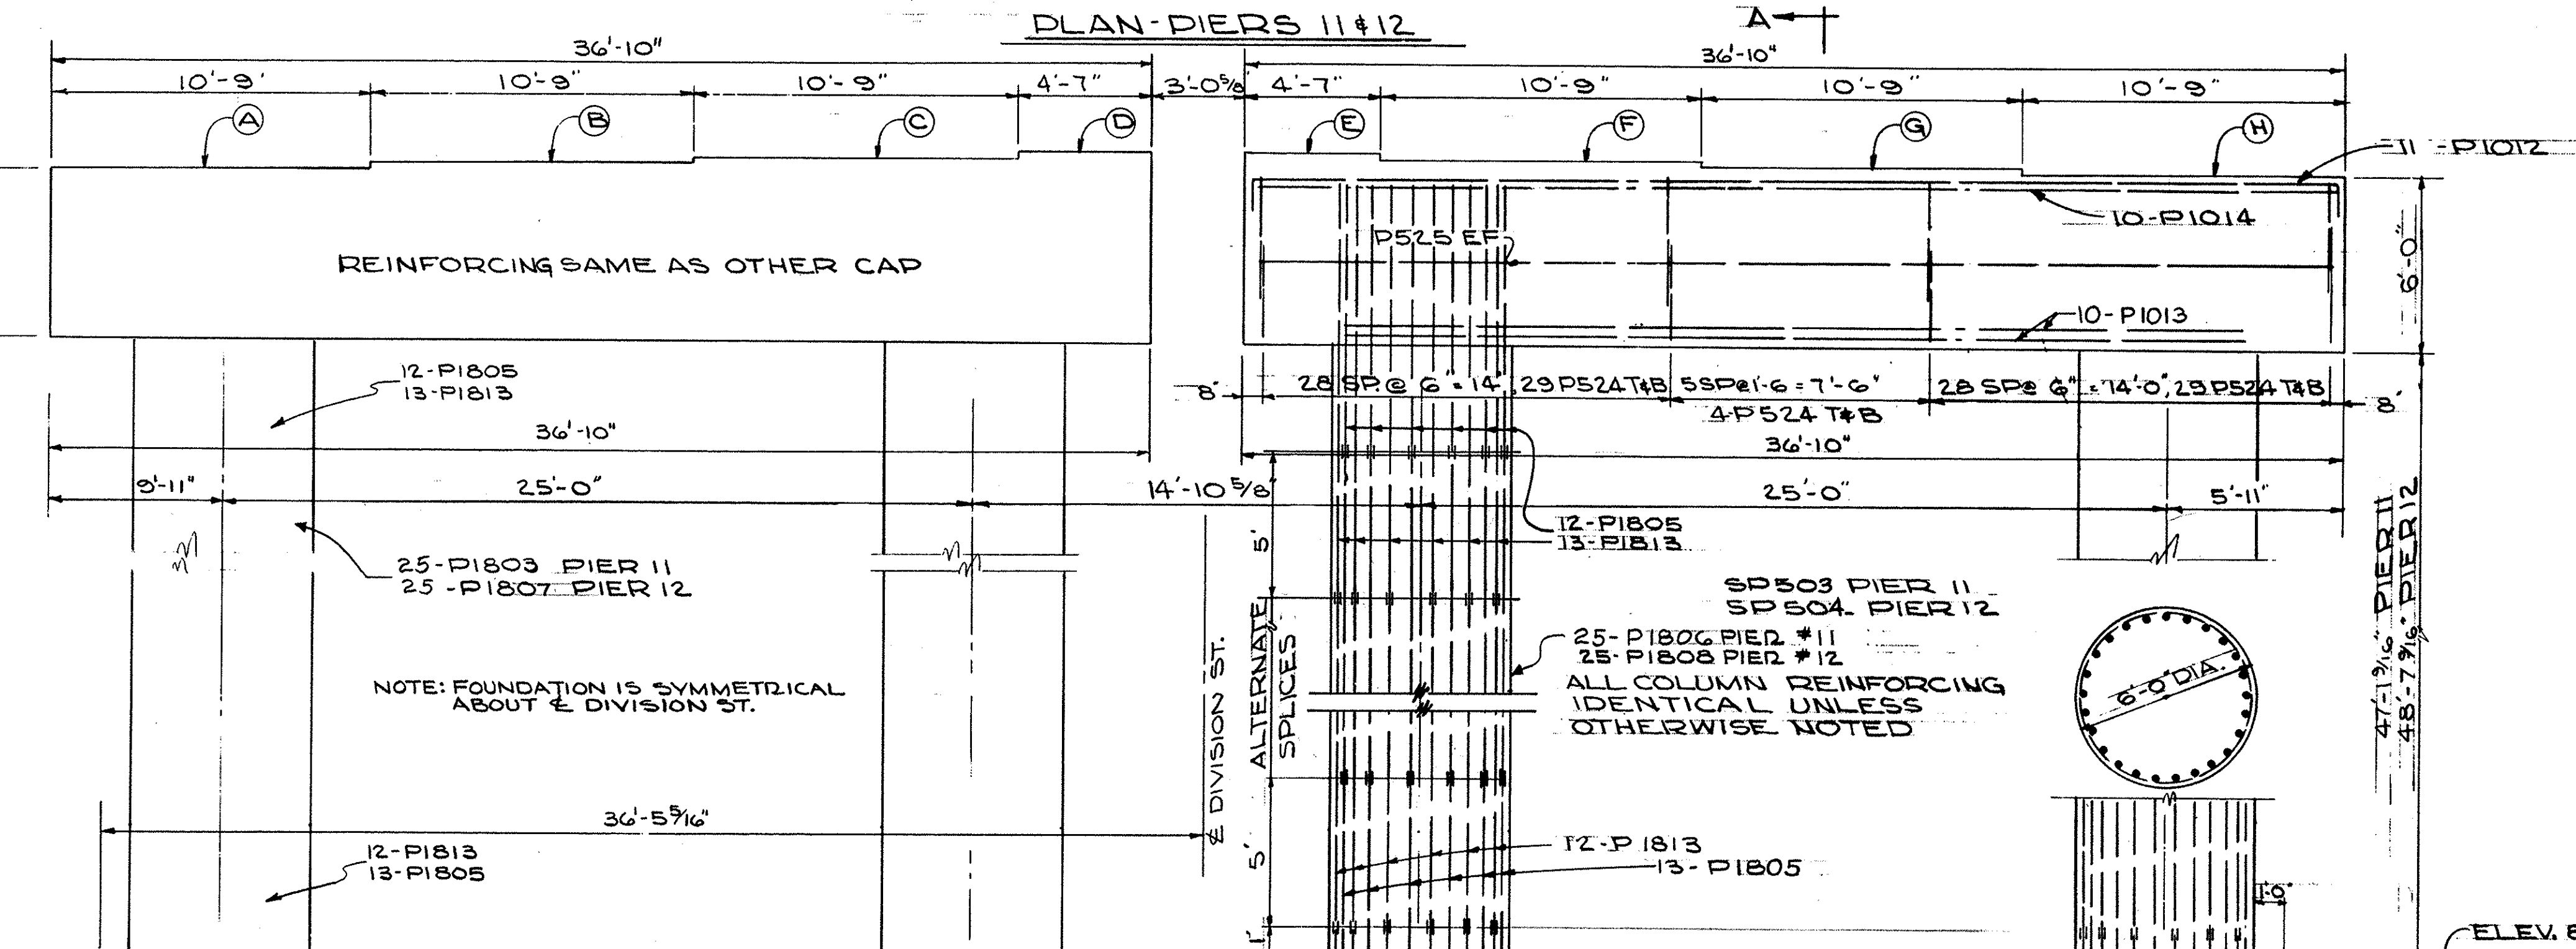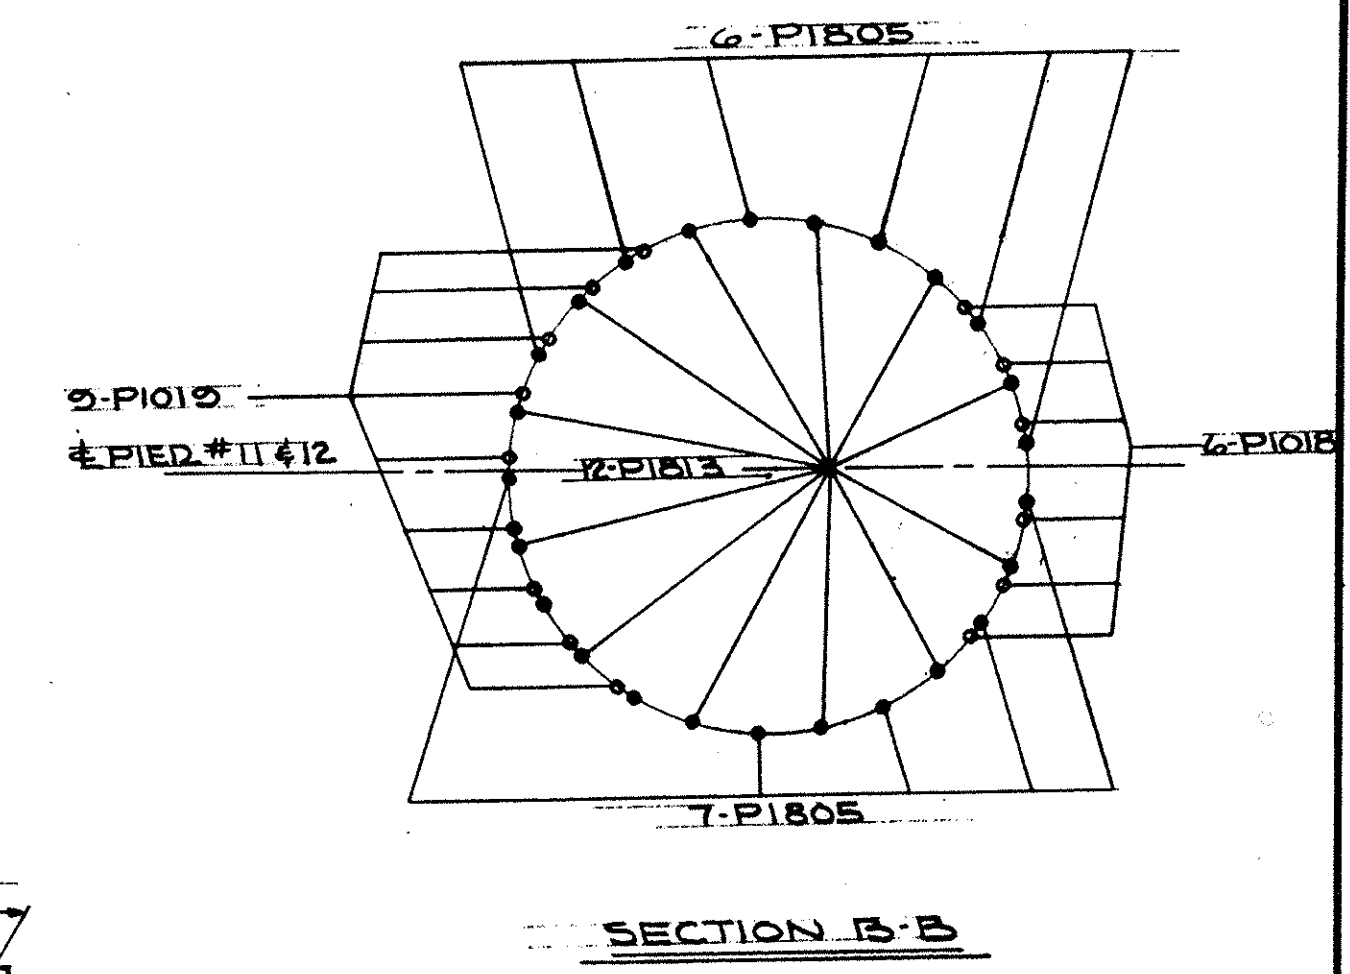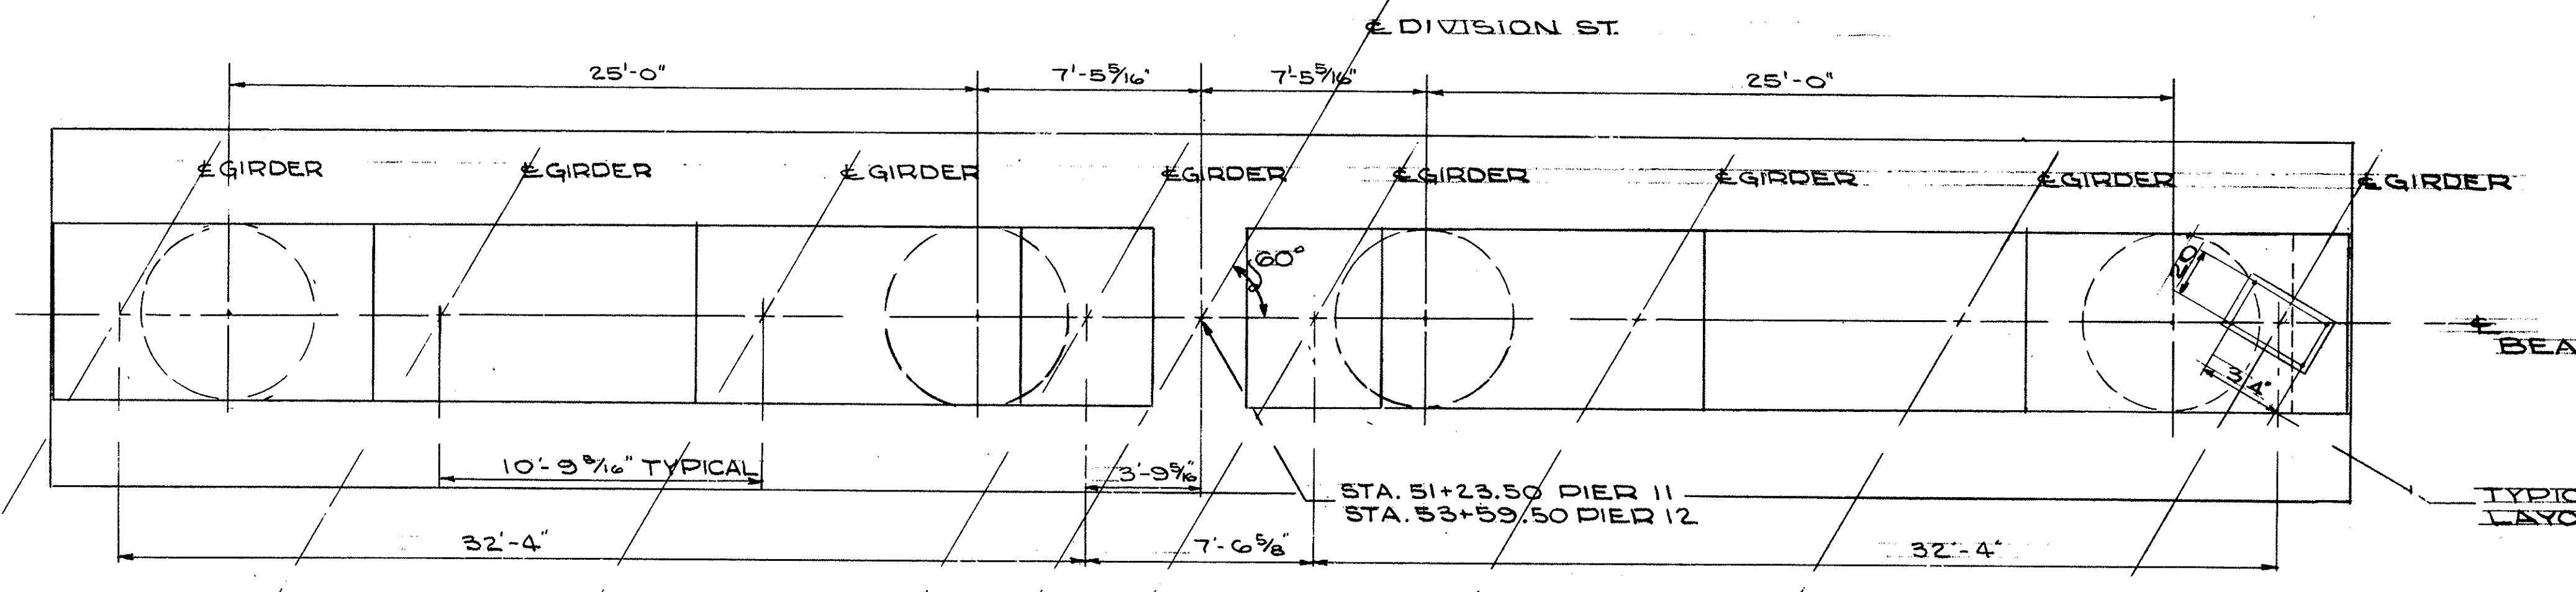

NOTE: SPECIAL CARE SHALL BE TAKEN IN PLACING REINFORCING STEEL IN THE VICINITY OF THE BRIDGE SEAT OF PIER 11 SO AS TO AVOID INTERFERENCE WITH THE DRILLING OF ANCHOR BAR HOLES.

WELDED SPLICES OF #18 BARS SHALL NOT BE USED. AN APPROVED POSITIVE CONNECTION FOR BARS DESIGNED TO DEVELOP 125% OF THE SPECIFIED YIELD STRENGTH OF THE BAR SHALL BE PROVIDED.

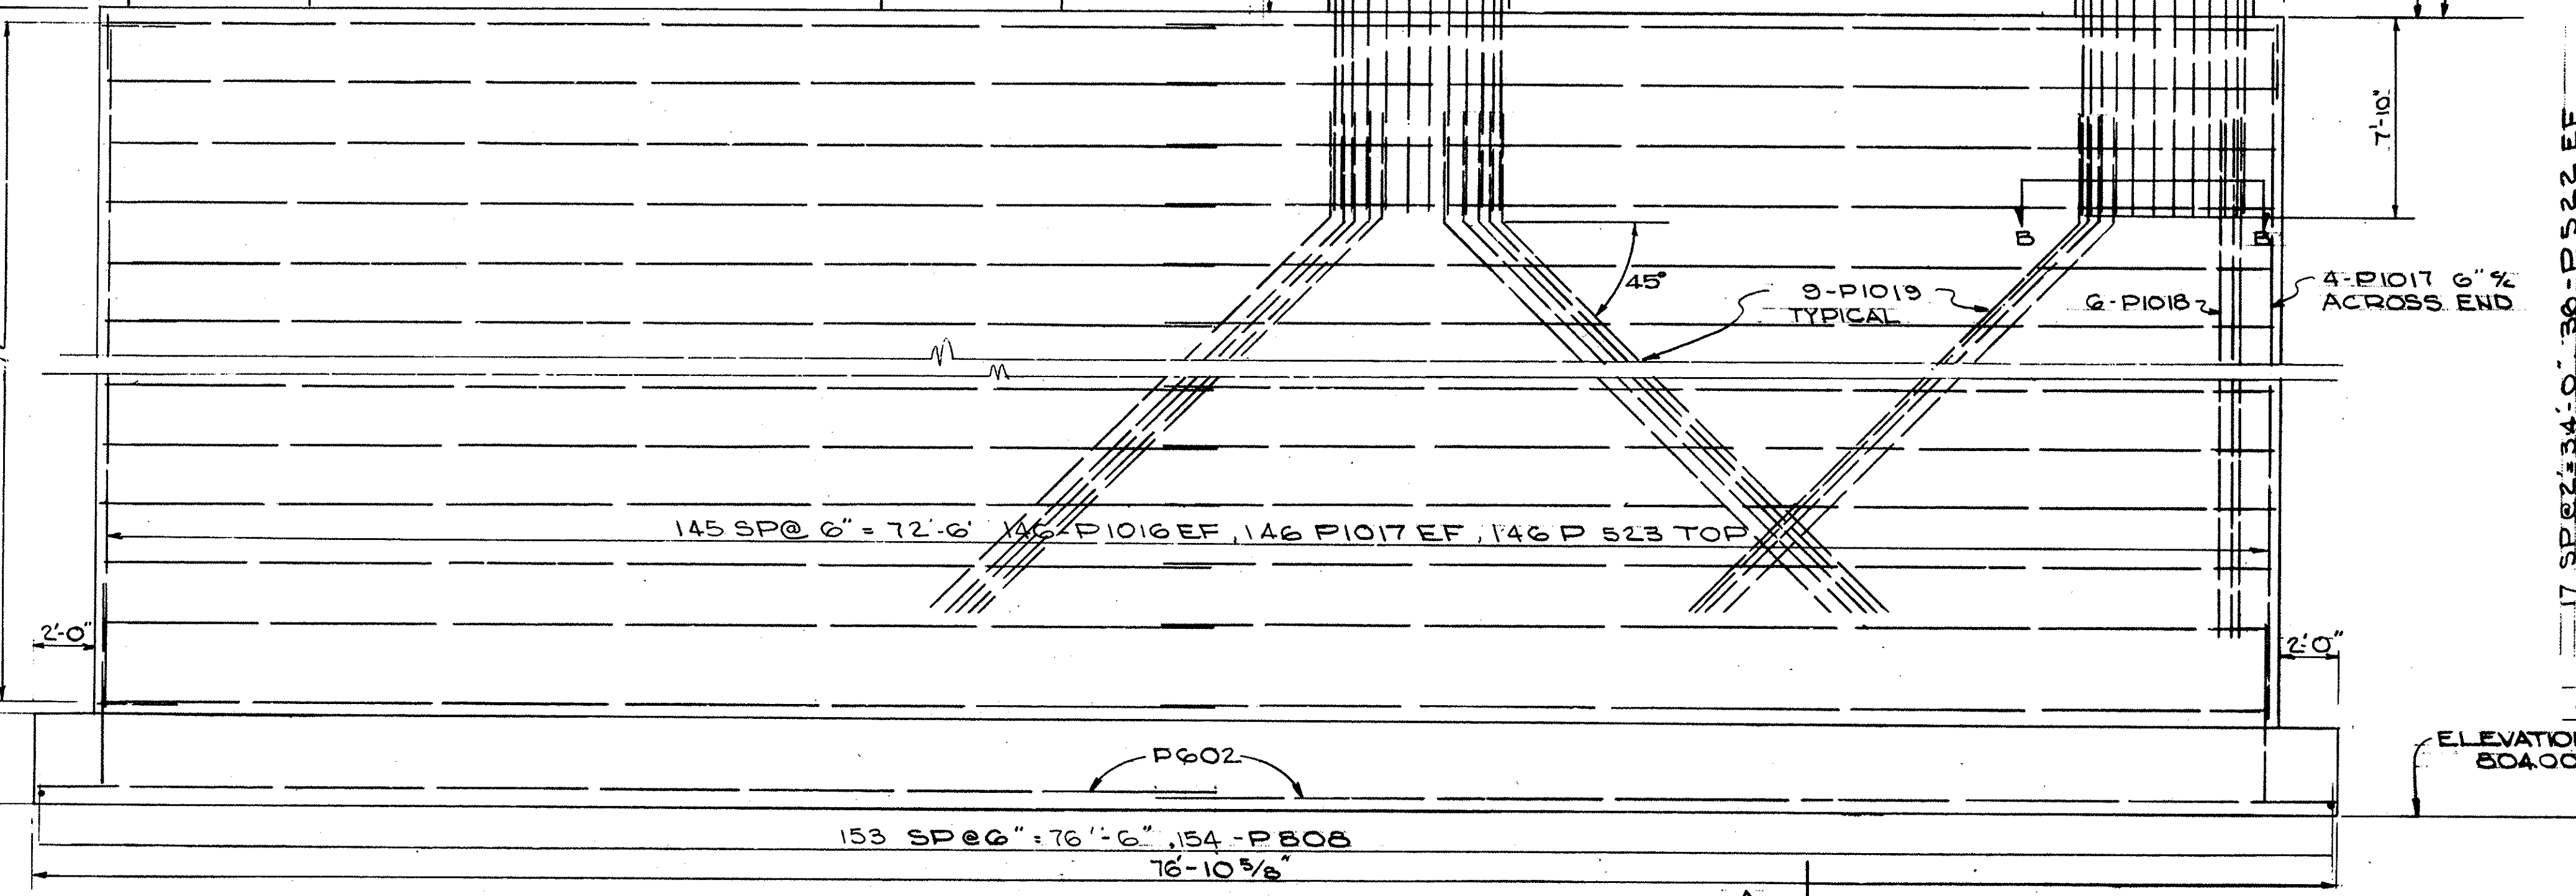

PIER ELEVATION TABLE				
LOCATION	A	B	C	D
PIER 11	894.80	895.00	895.20	895.39
PIER 12	897.79	897.23	897.15	897.07
LOCATION	E	F	G	H
PIER 11	895.47	895.32	895.27	895.13
PIER 12	897.05	896.91	896.77	896.63

This sheet is superseded by sheet No. 164A. 9-12-69

STATE OF OHIO
 DEPARTMENT OF HIGHWAYS
 BUREAU OF BRIDGES

AKRON, OHIO YOUNGSTOWN, OHIO

GLAUS, PYLE & SCHOMER

PIER 11 & 12
 BRIDGE No. MAH-711-016
 OVER MAHONING RIVER
 YOUNGSTOWN MAHONING COUNTY


DESIGNED	DRAWN	TRACED	CHECKED	REVIEWED	DATE	REVISED
JWC	JWC		J.M.	W.K.D.	6-22-68	

REVISION
JUN 18 1969

FED. RD.	STATE	PROJECT
2	OHIO	U.S.-1150 (I)

164A
232

MAH-711-0.17

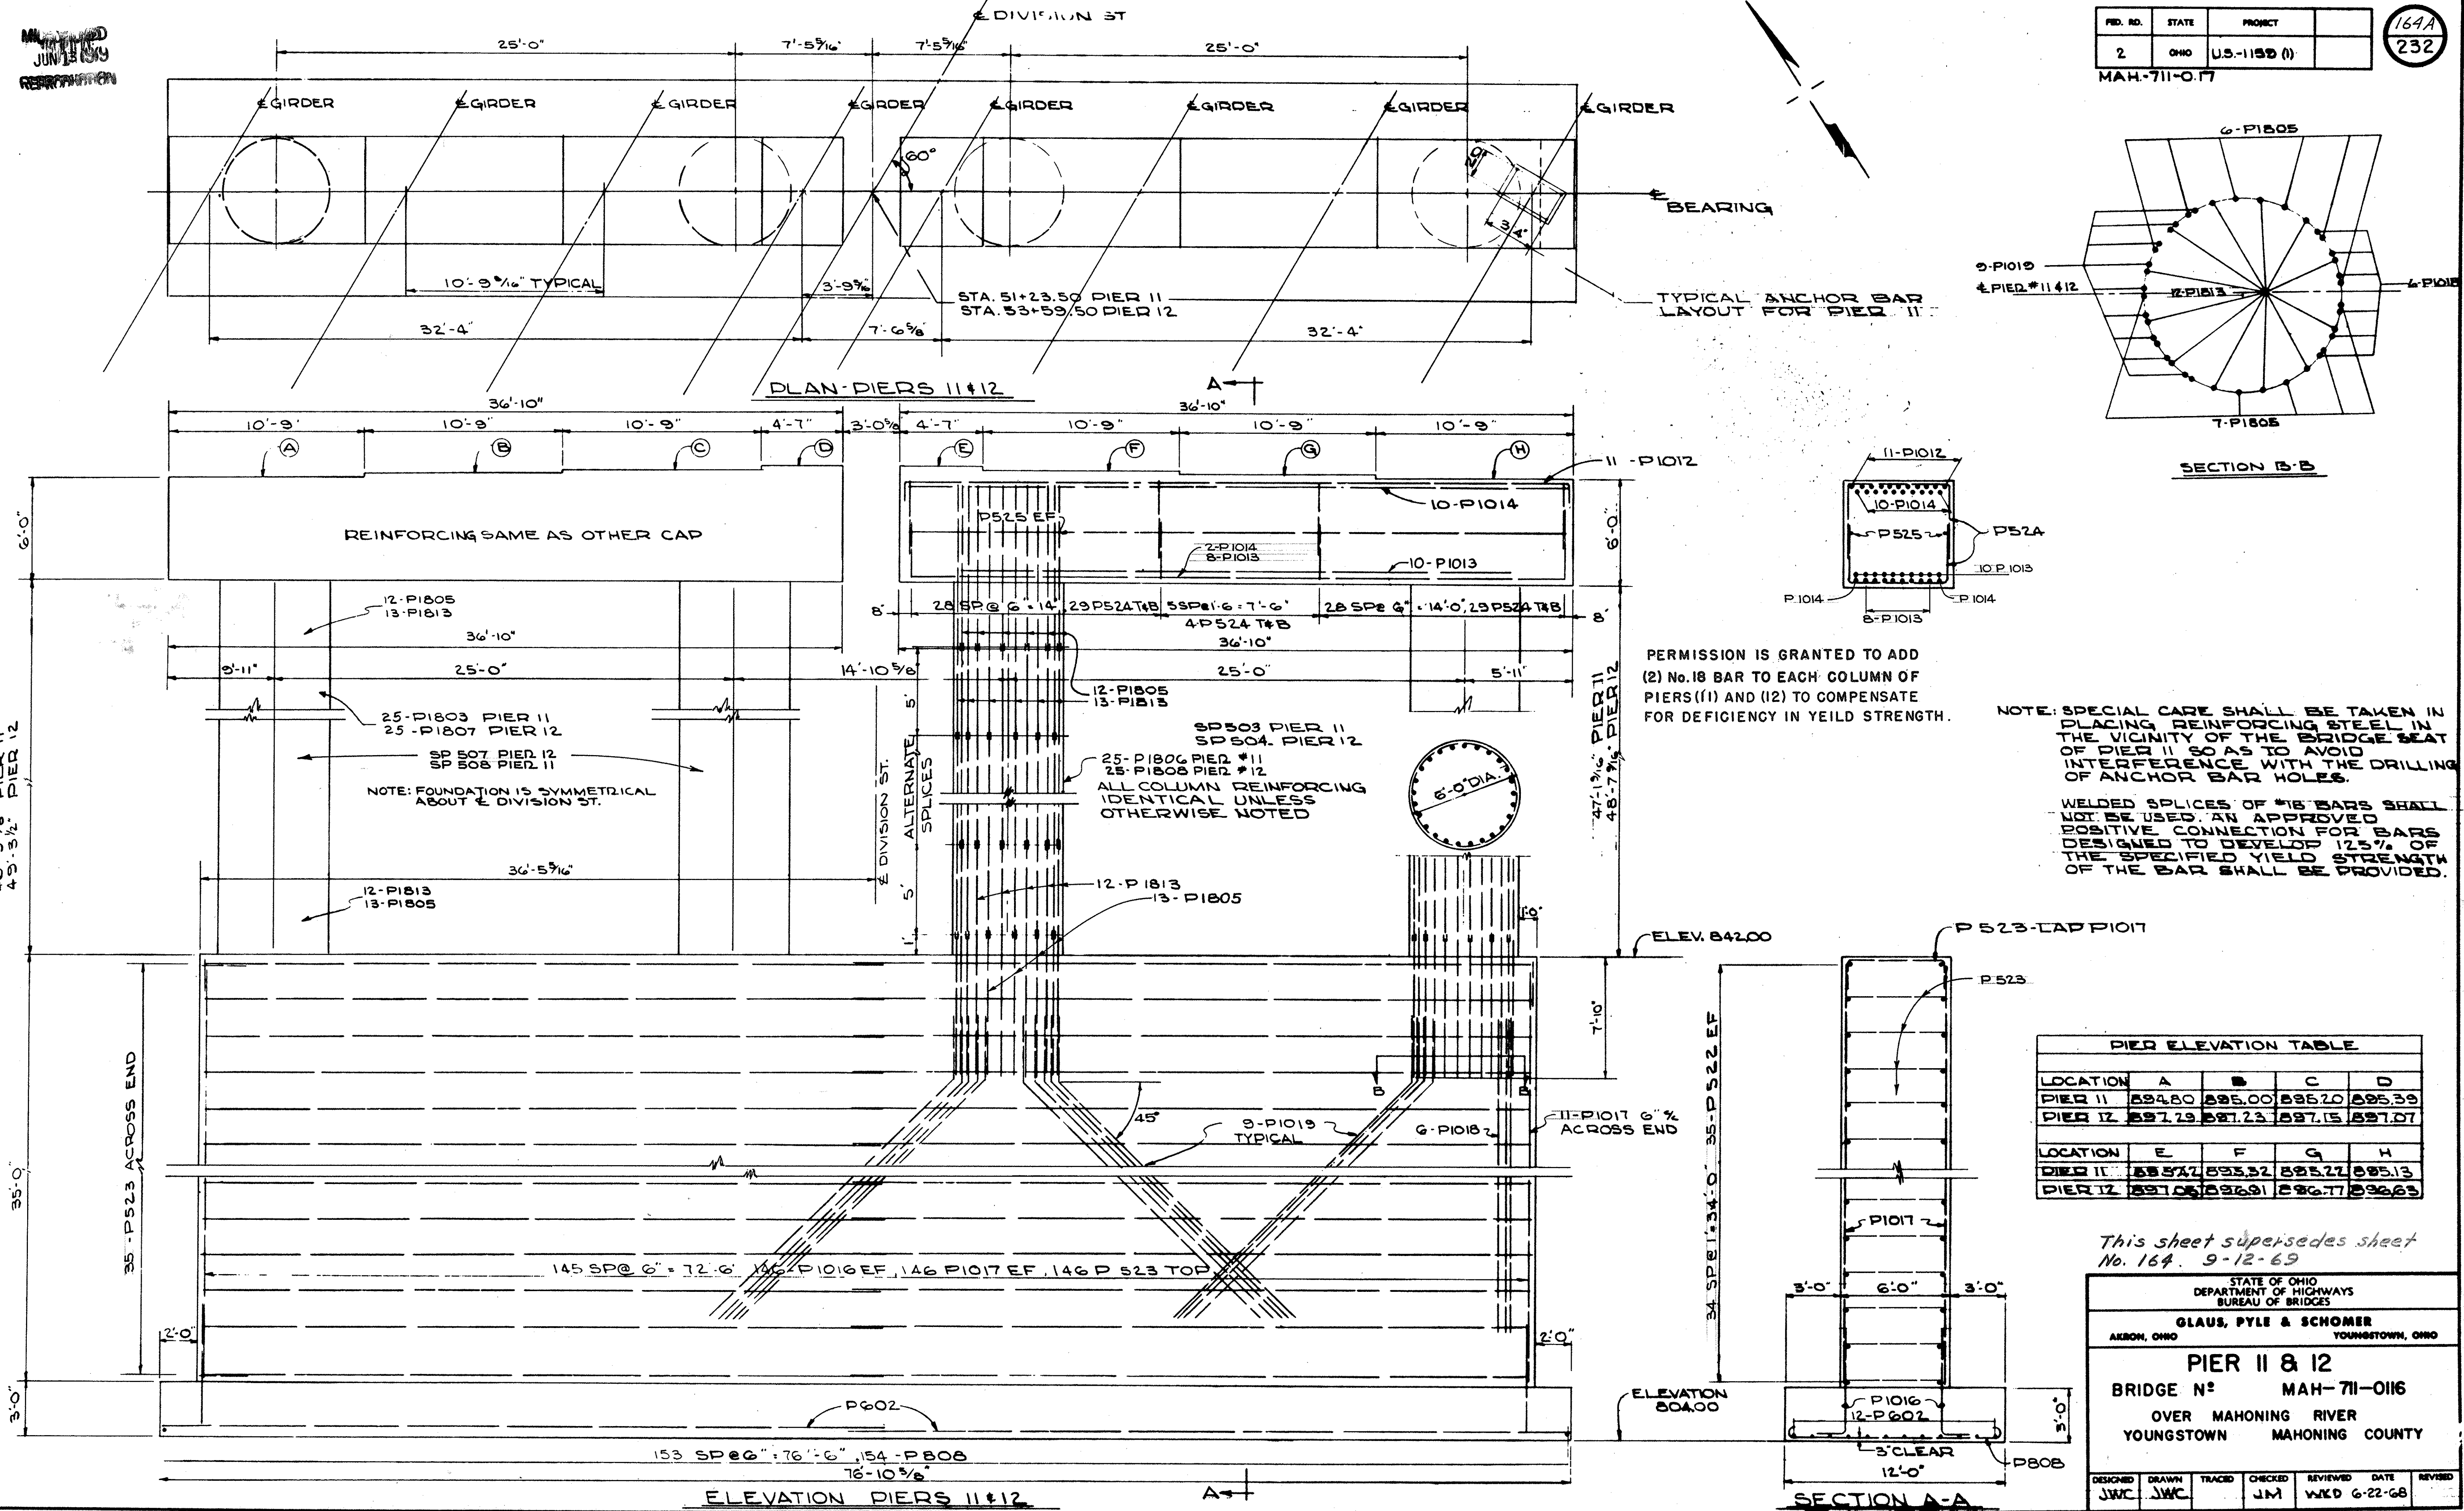

PERMISSION IS GRANTED TO ADD (2) No. 18 BAR TO EACH COLUMN OF PIERS (1) AND (2) TO COMPENSATE FOR DEFICIENCY IN YIELD STRENGTH.

NOTE: SPECIAL CARE SHALL BE TAKEN IN PLACING REINFORCING STEEL IN THE VICINITY OF THE BRIDGE SEAT OF PIER 11 SO AS TO AVOID INTERFERENCE WITH THE DRILLING OF ANCHOR BAR HOLES.

WELDED SPLICES OF #18 BARS SHALL NOT BE USED. AN APPROVED POSITIVE CONNECTION FOR BARS DESIGNED TO DEVELOP 125% OF THE SPECIFIED YIELD STRENGTH OF THE BAR SHALL BE PROVIDED.

PIER ELEVATION TABLE				
LOCATION	A	B	C	D
PIER 11	894.80	895.00	895.20	895.39
PIER 12	897.29	897.23	897.15	897.07
LOCATION	E	F	G	H
PIER 11	895.72	895.52	895.22	895.13
PIER 12	897.06	896.91	896.77	896.69

This sheet supersedes sheet No. 164, 9-12-69

STATE OF OHIO
DEPARTMENT OF HIGHWAYS
BUREAU OF BRIDGES

AKRON, OHIO YOUNGSTOWN, OHIO




GLAUS, PYLE & SCHOMER

PIER 11 & 12

BRIDGE NO. MAH-711-0116

OVER MAHONING RIVER
YOUNGSTOWN MAHONING COUNTY

DESIGNED	DRAWN	TRACED	CHECKED	REVIEWED	DATE	REVISED
JWC	JWC		JM	WKO	6-22-68	

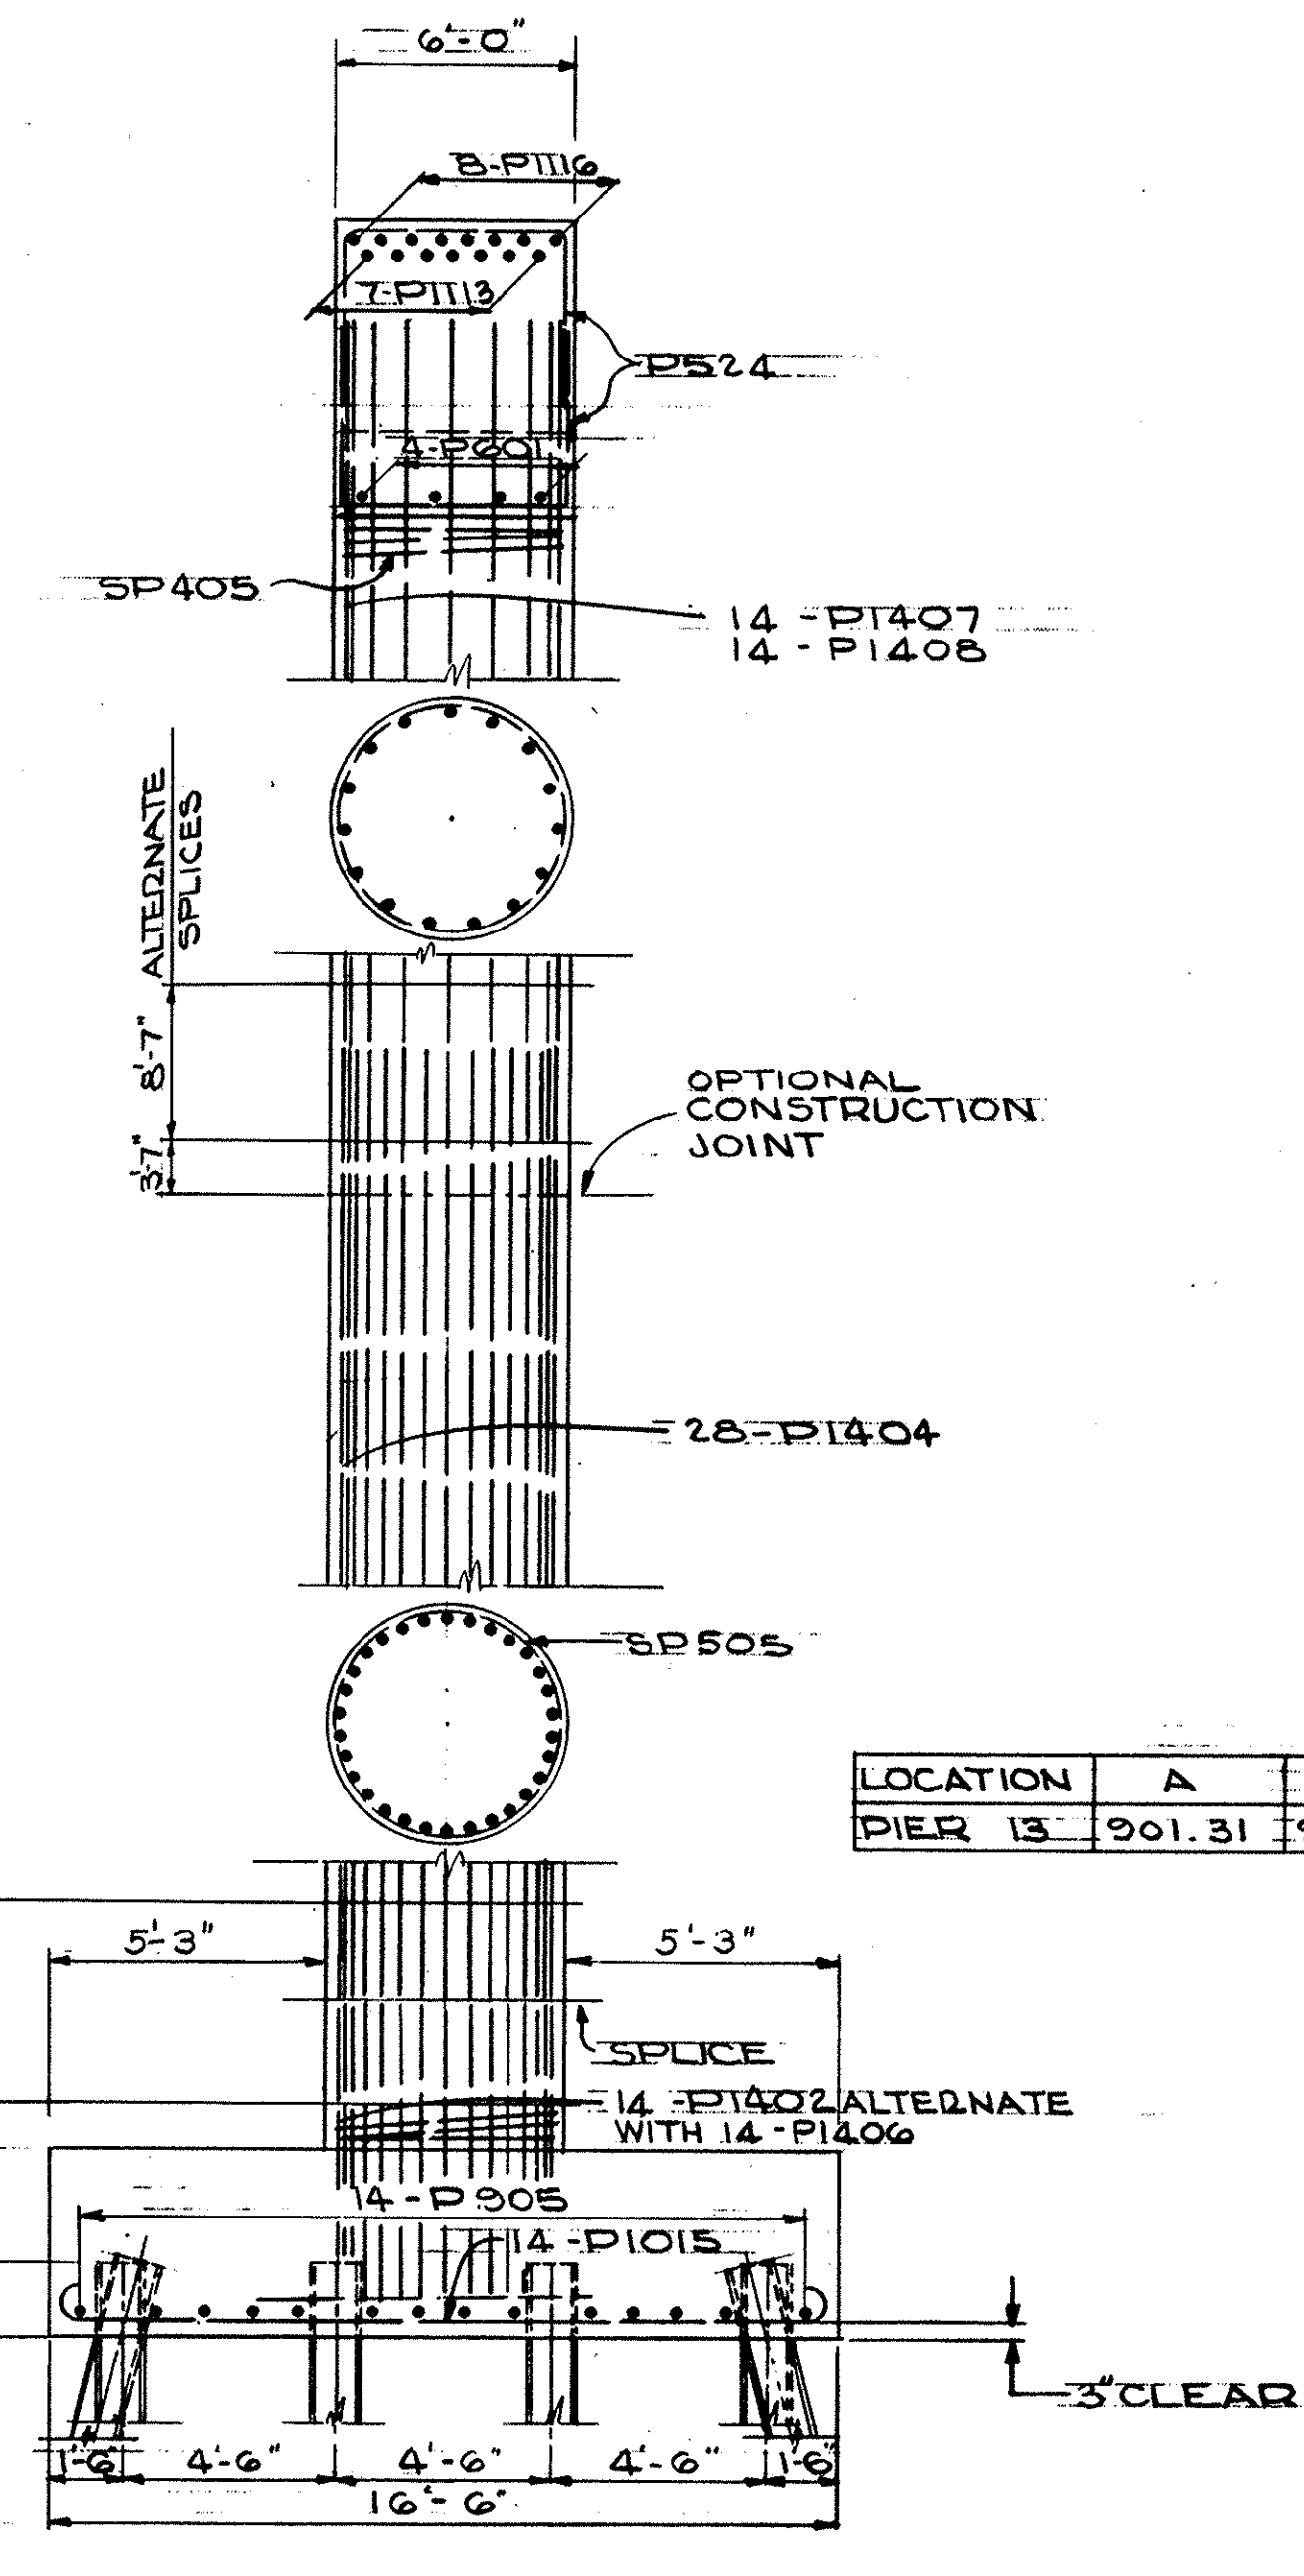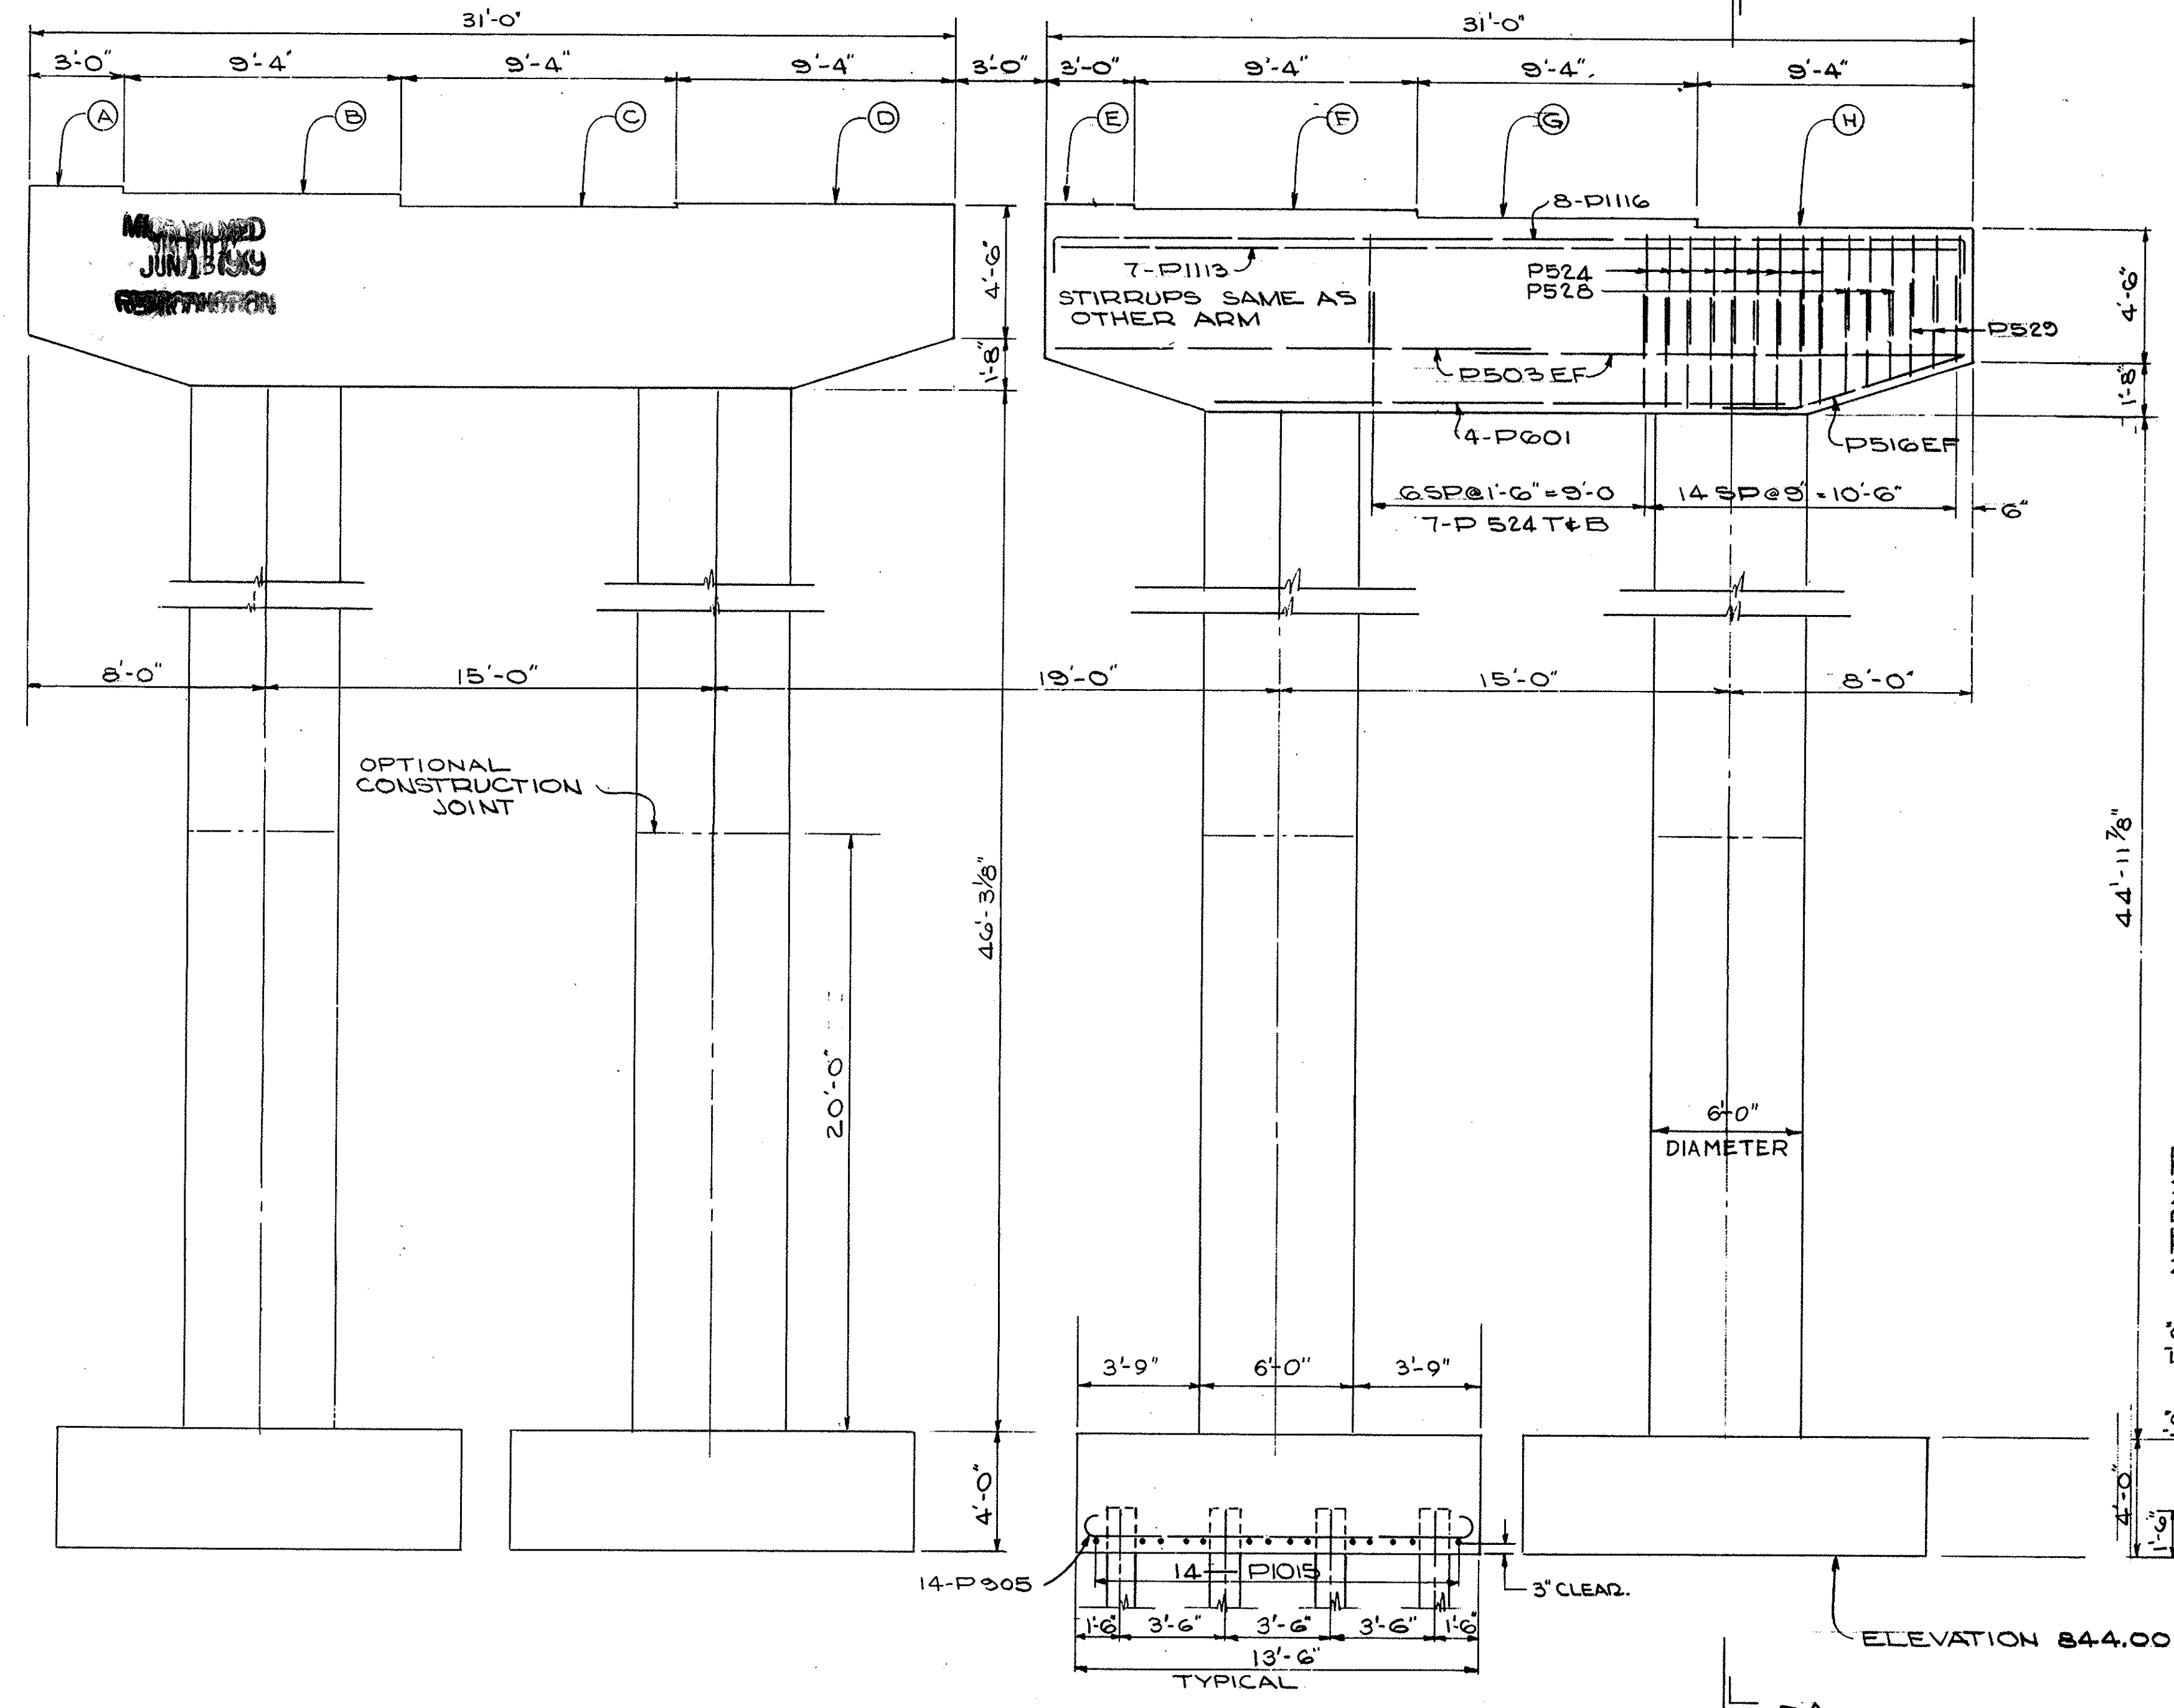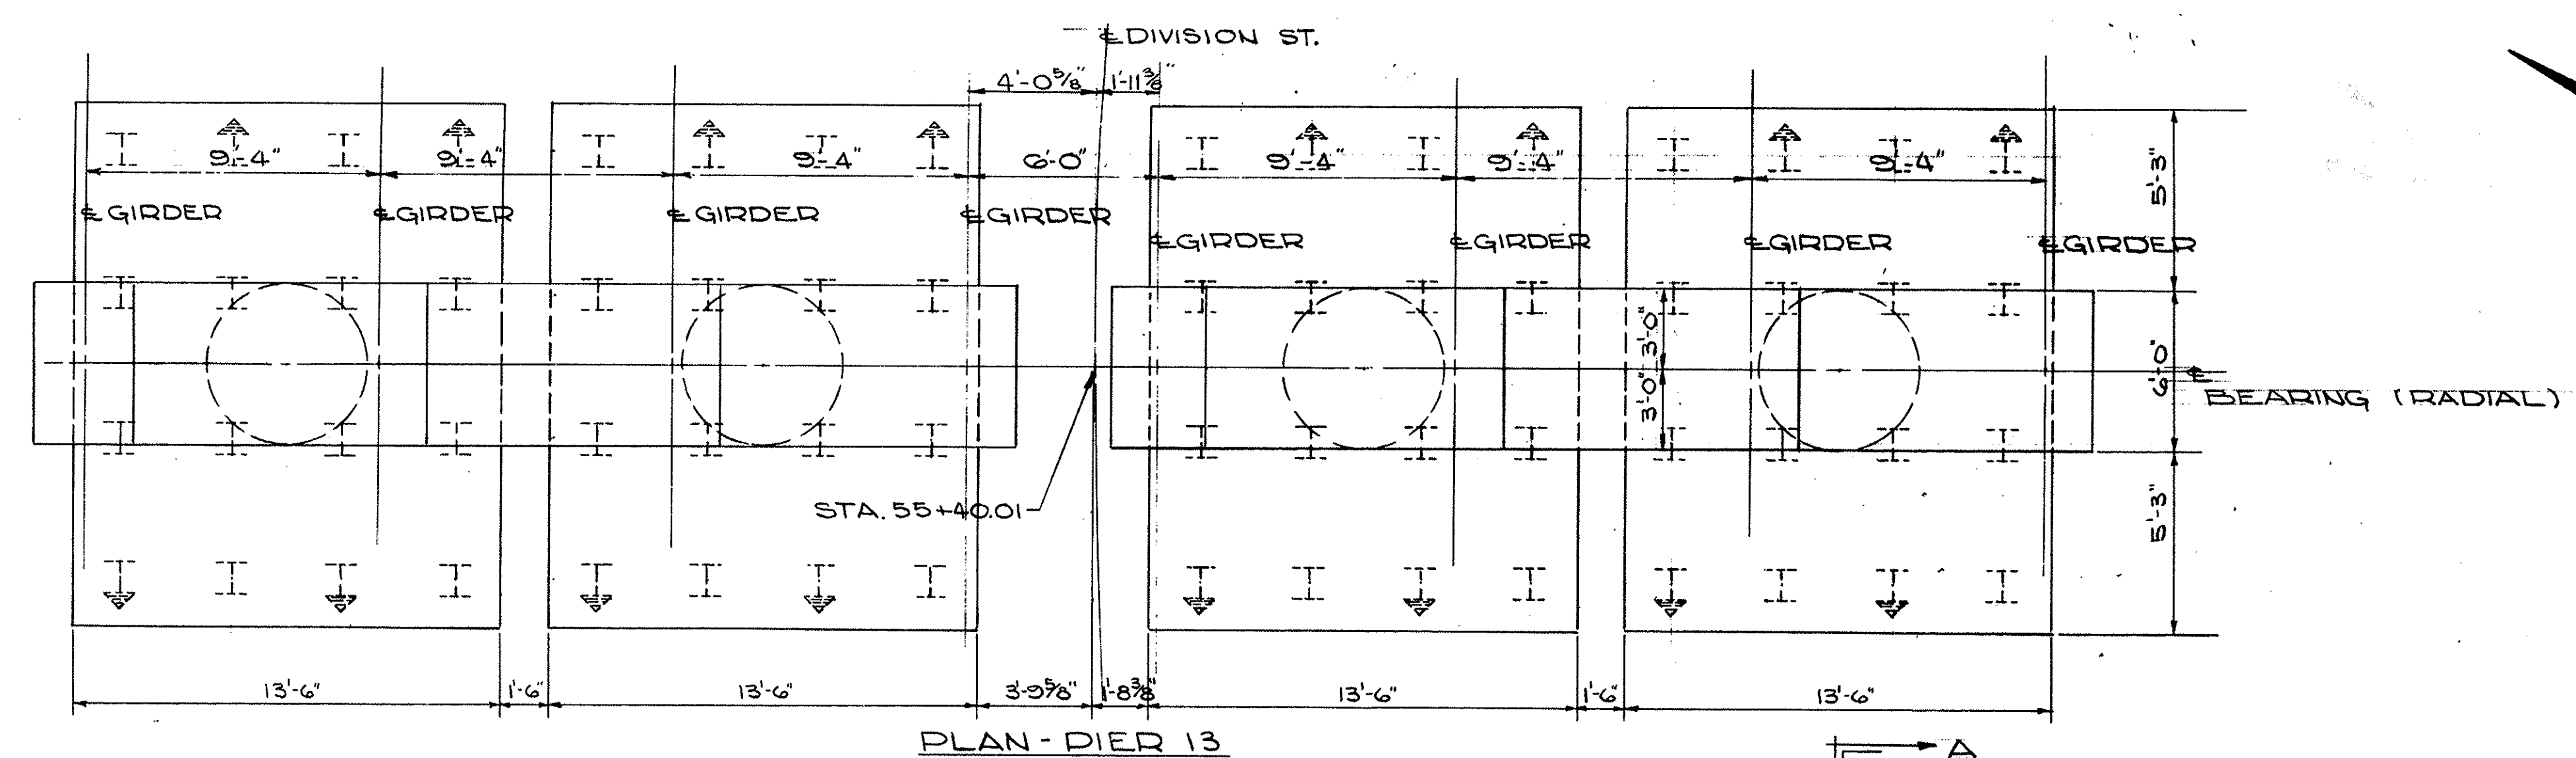

PIER ELEVATION TABLE

LOCATION	A	B	C	D	E	F	G	H
PIER 13	901.31	900.96	900.61	900.43	900.35	899.81	899.46	899.16

NOTE:
WELDED SPLICES OF #14 BARS SHALL NOT BE USED. AN APPROVED POSITIVE CONNECTION FOR BARS DESIGNED TO DEVELOP 125% OF THE SPECIFIED YIELD STRENGTH OF THE BAR SHALL BE PROVIDED.

This sheet is superseded by sheet No. 165A 9-12-69




STATE OF OHIO
DEPARTMENT OF HIGHWAYS
BUREAU OF BRIDGES

GLAUS, PYLE & SCHOMER
AKRON, OHIO YOUNGSTOWN, OHIO

PIER 13
BRIDGE N^o MAH-711-016
OVER MAHONING RIVER
YOUNGSTOWN MAHONING COUNTY

DESIGNED	DRAWN	TRACED	CHECKED	REVIEWED	DATE	REVISED
JWC	JWC		JM	WKD	6-22-68	

MAHONGON RIVER
JUN 15 1969

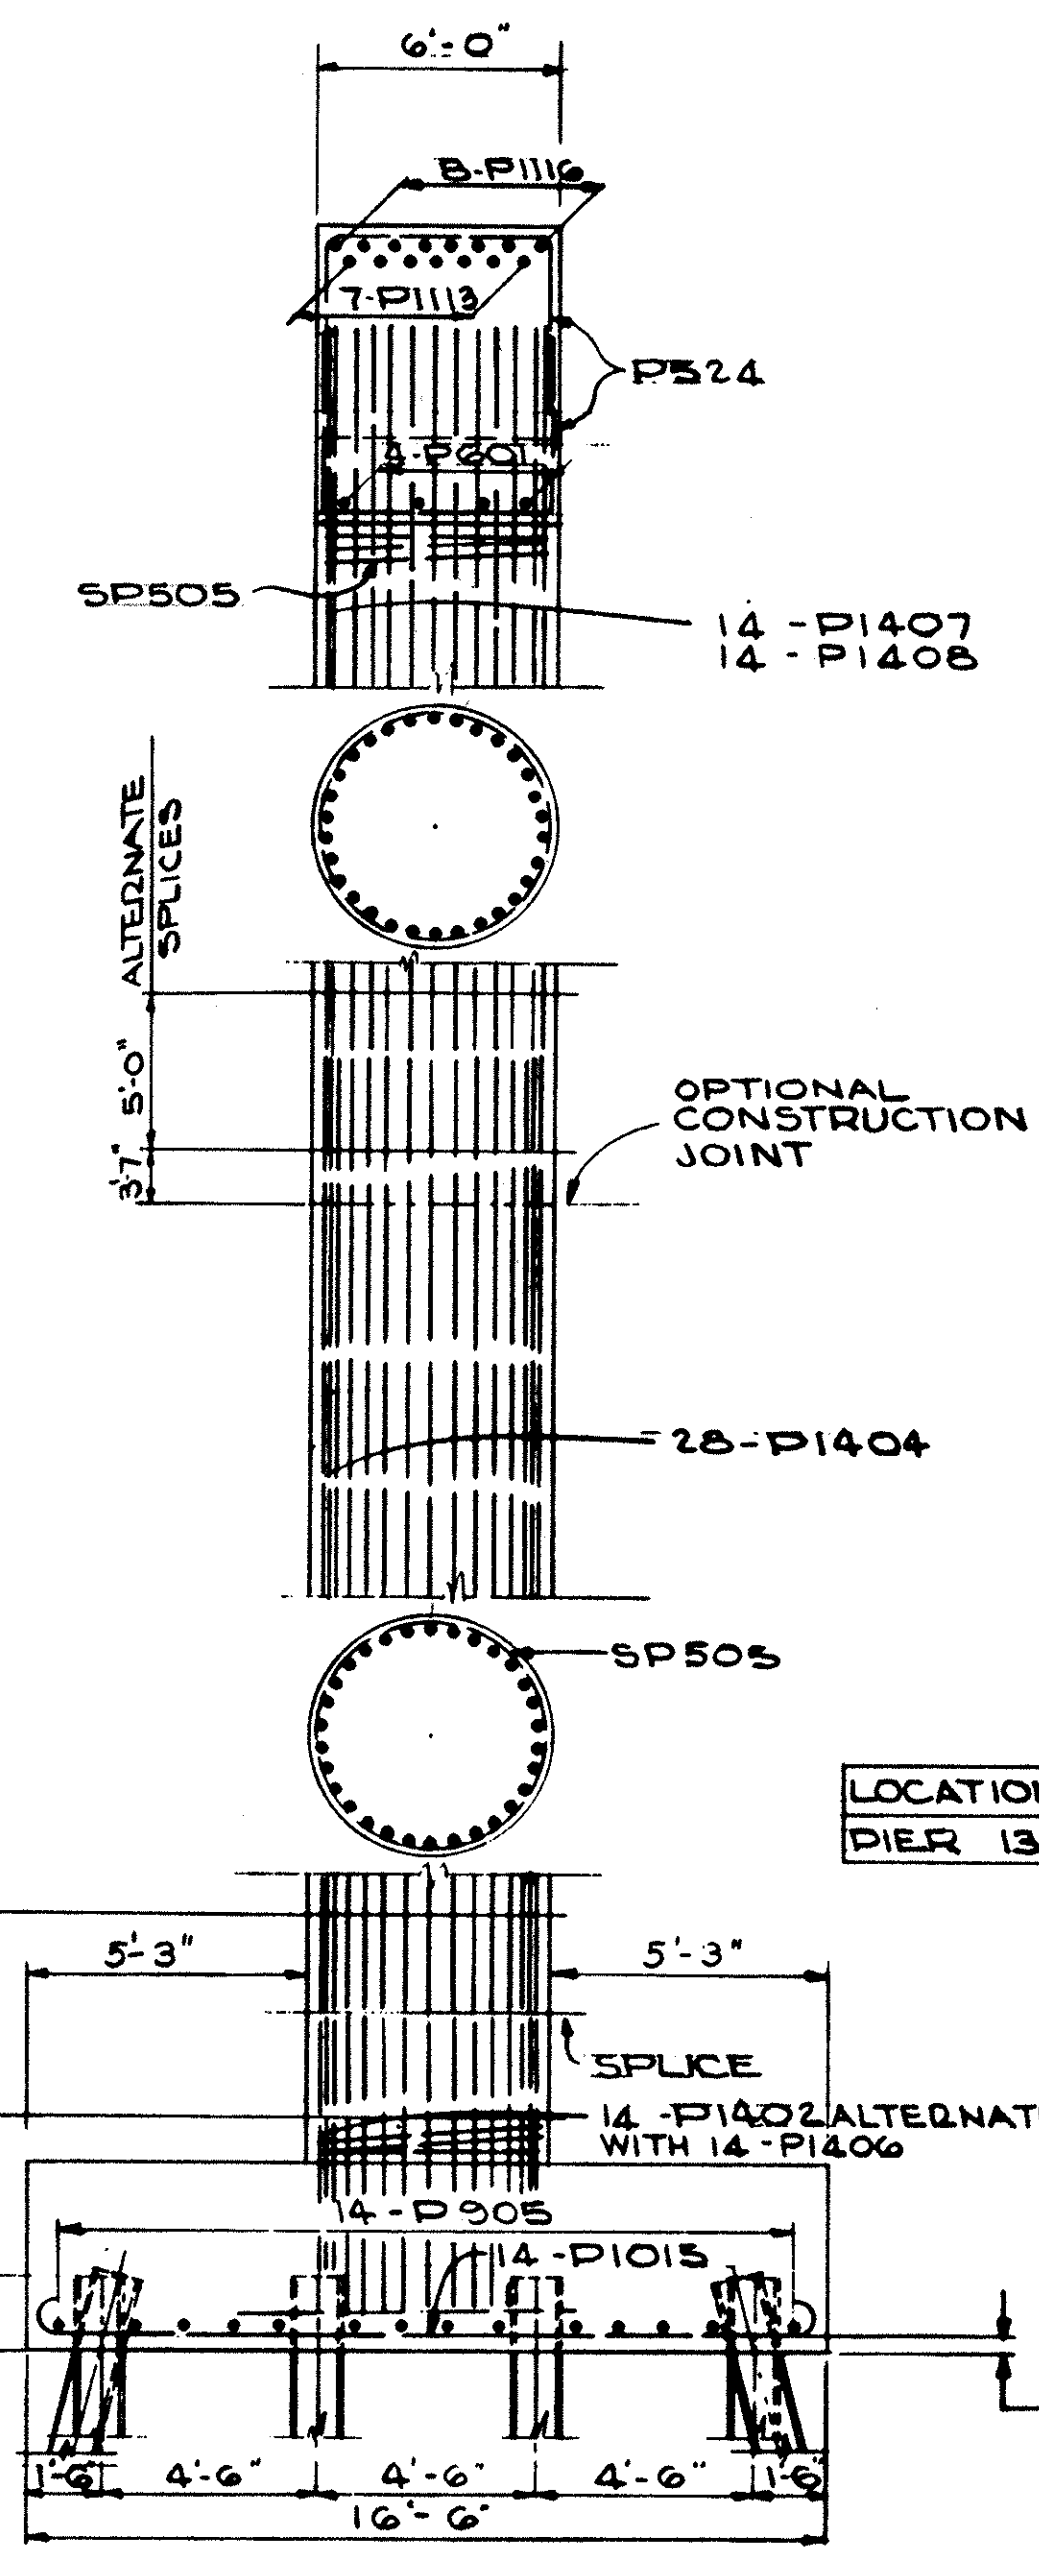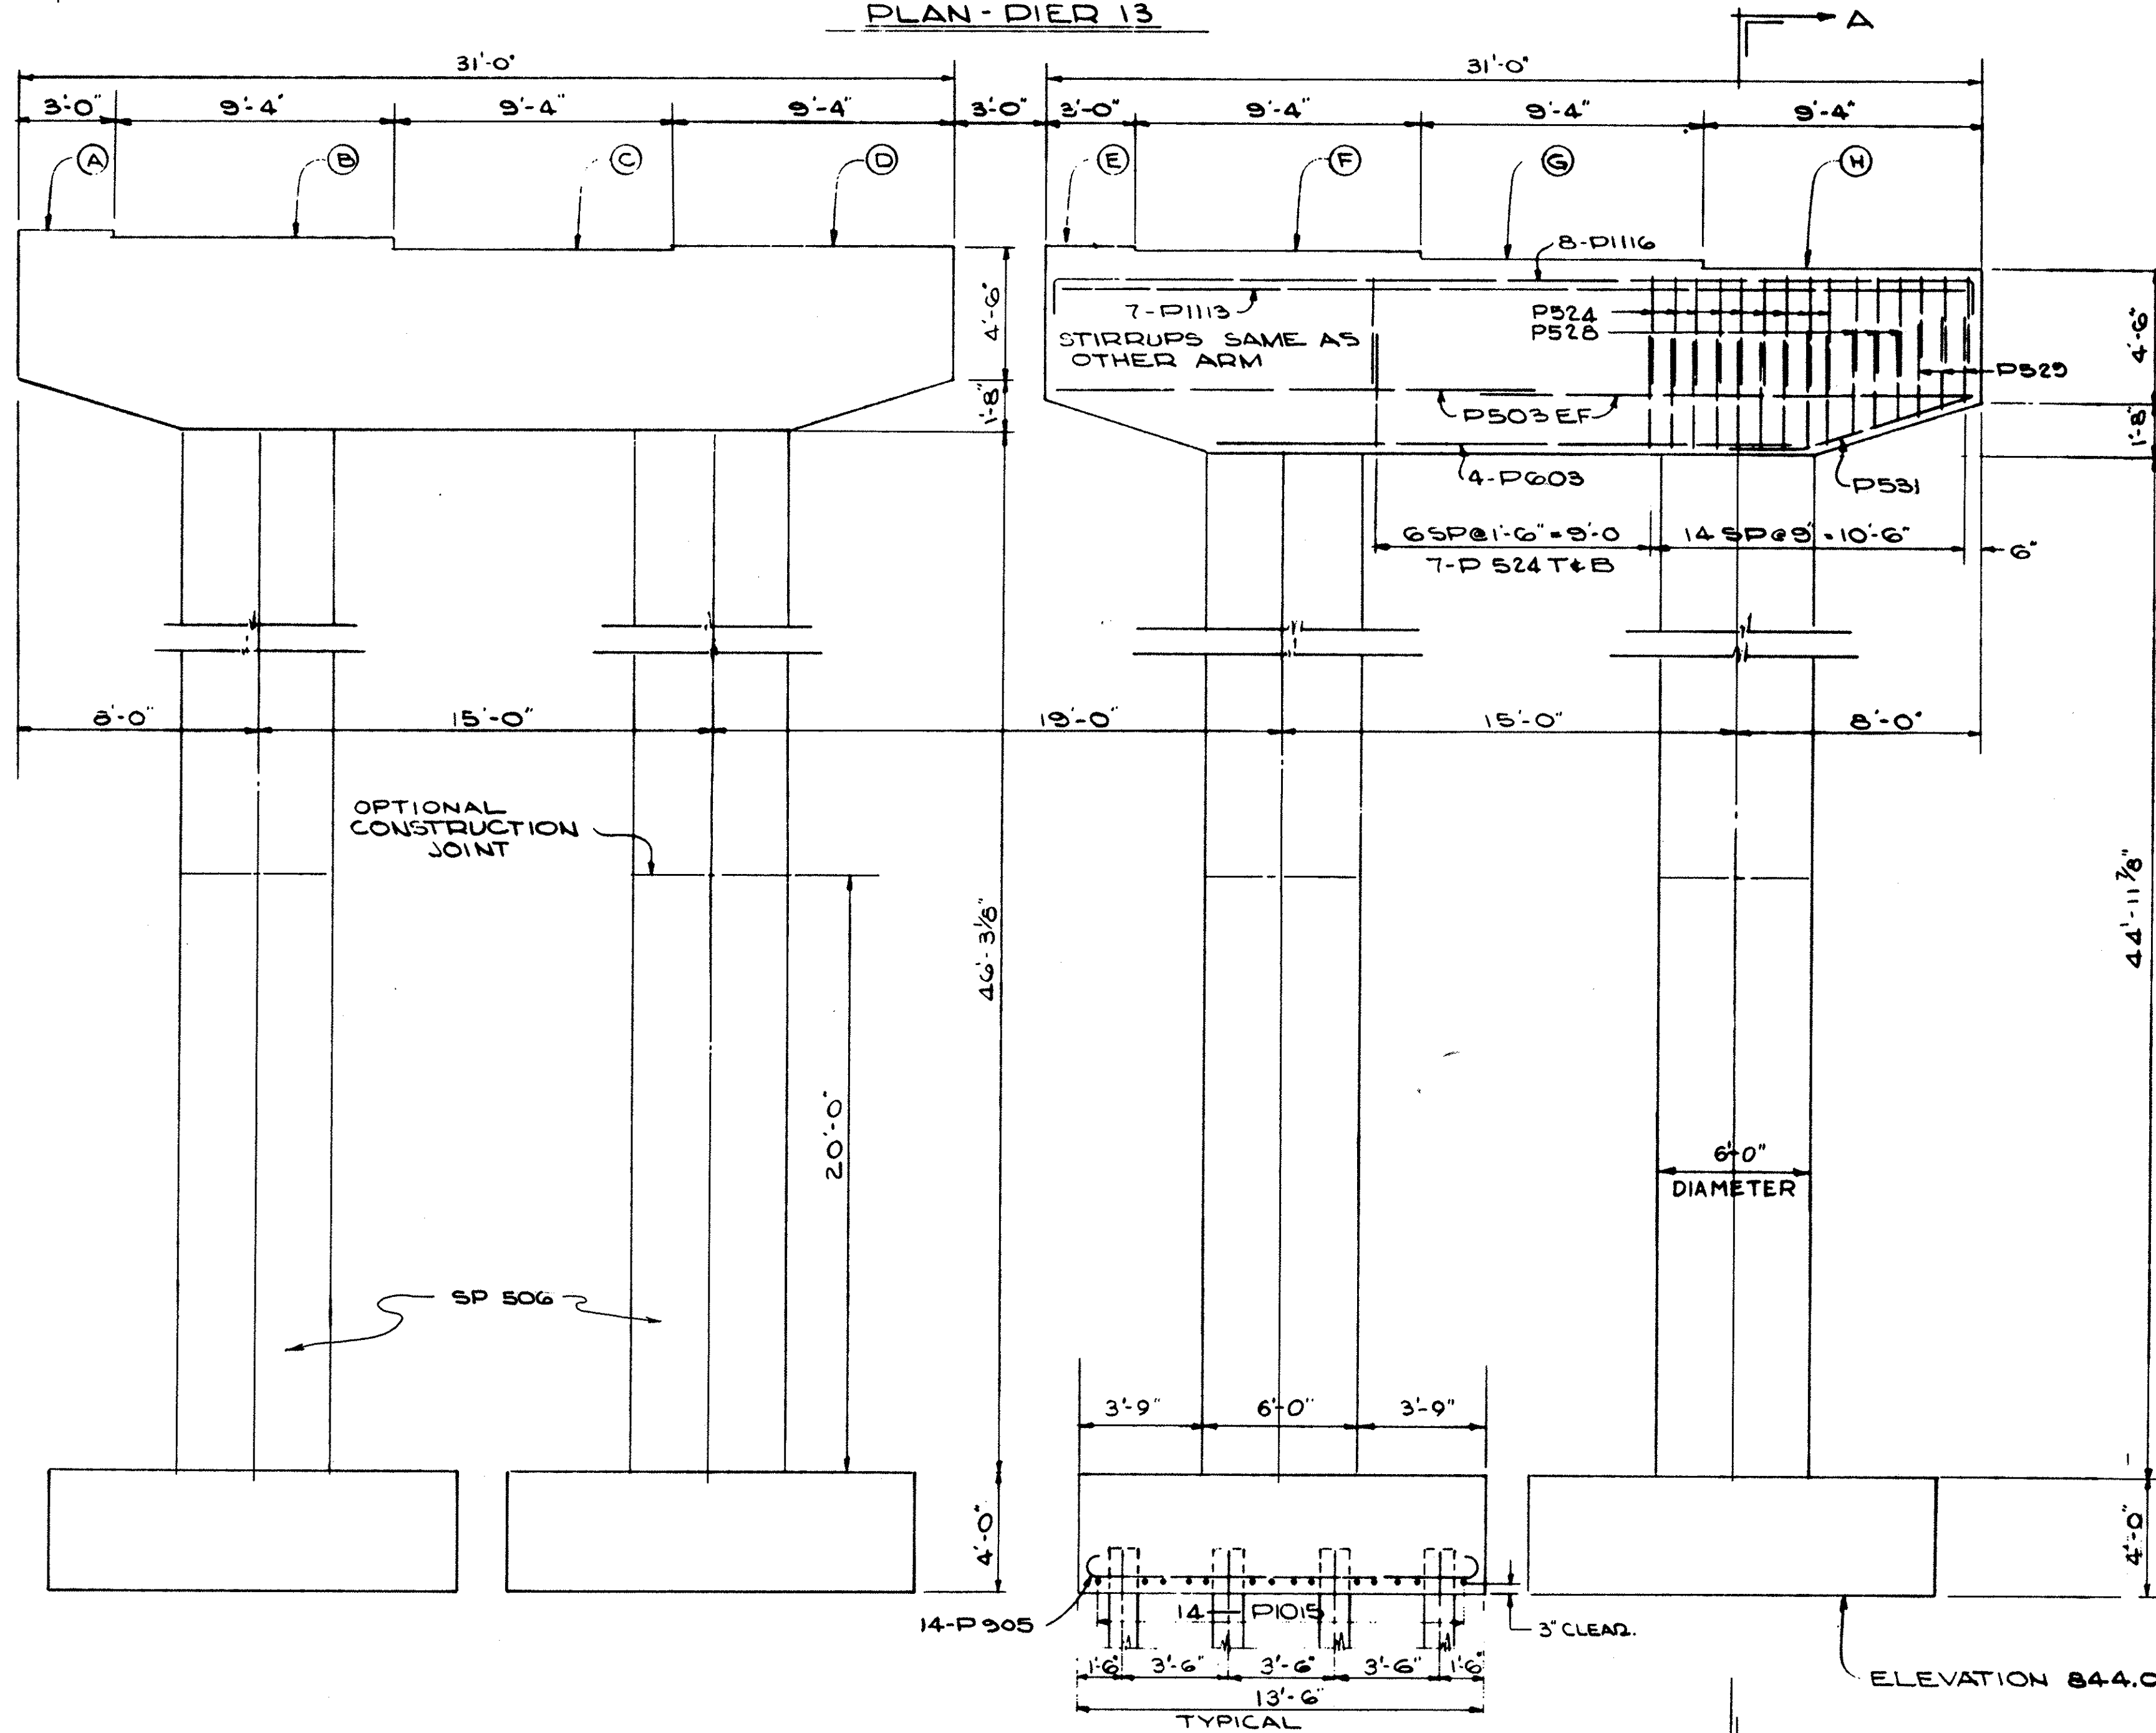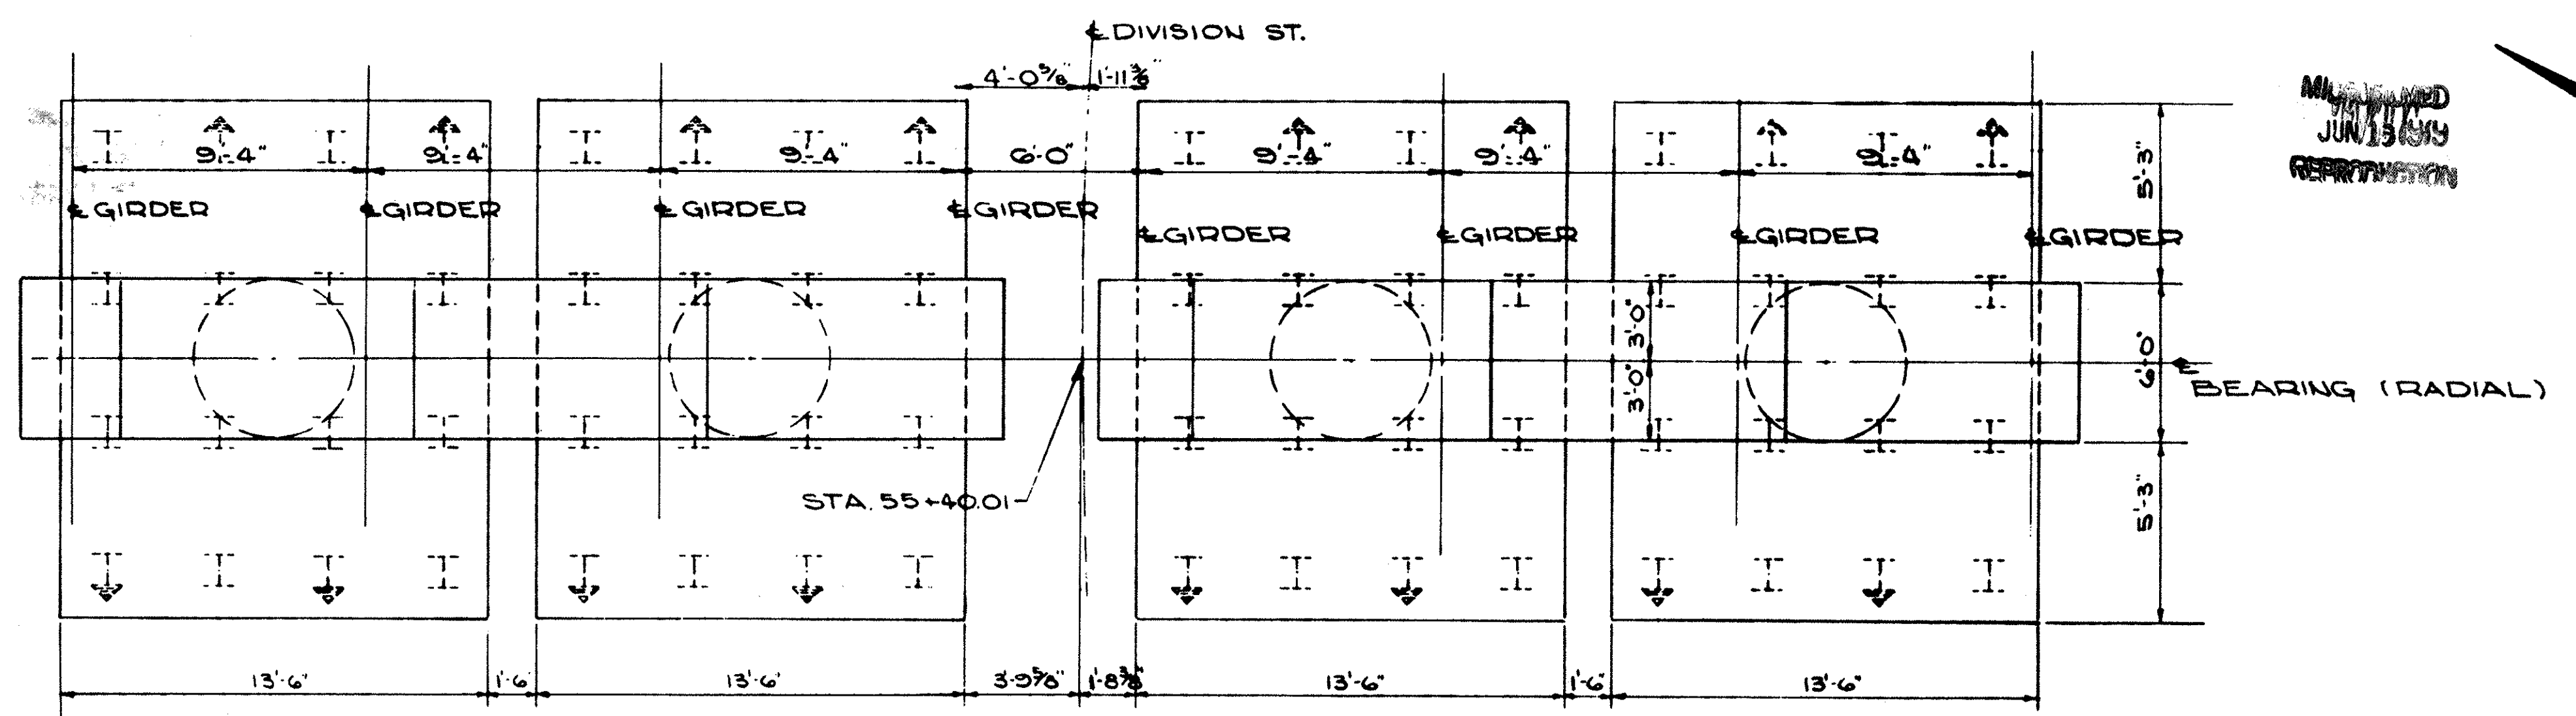

NOTE:
WELDED SPLICES OF #14 BARS SHALL NOT BE USED. AN APPROVED POSITIVE CONNECTION FOR BARS DESIGNED TO DEVELOP 125% OF THE SPECIFIED YIELD STRENGTH OF THE BAR SHALL BE PROVIDED.

LOCATION	A	B	C	D	E	F	G	H
PIER 13	901.31	900.96	900.61	900.43	900.35	899.81	899.46	899.16

This sheet supersedes sheet No. 165 9-12-69

STATE OF OHIO
DEPARTMENT OF HIGHWAYS
BUREAU OF BRIDGES

GLAUS, PYLE & SCHOMER
AKRON, OHIO YOUNGSTOWN, OHIO

PIER 13
BRIDGE N^o MAH-711-0116
OVER MAHONING RIVER
YOUNGSTOWN MAHONING COUNTY



DESIGNED	DRAWN	TRACED	CHECKED	REVIEWED	DATE	REVISED
JWC	JWC		JM	WKD	6-22-68	

REVISIONS
 JUN 13 1969
 REVISION

FED. RD.	STATE	PROJECT
2	OHIO	U.S.-1150(1)

166
 232

MAH-711-0.17

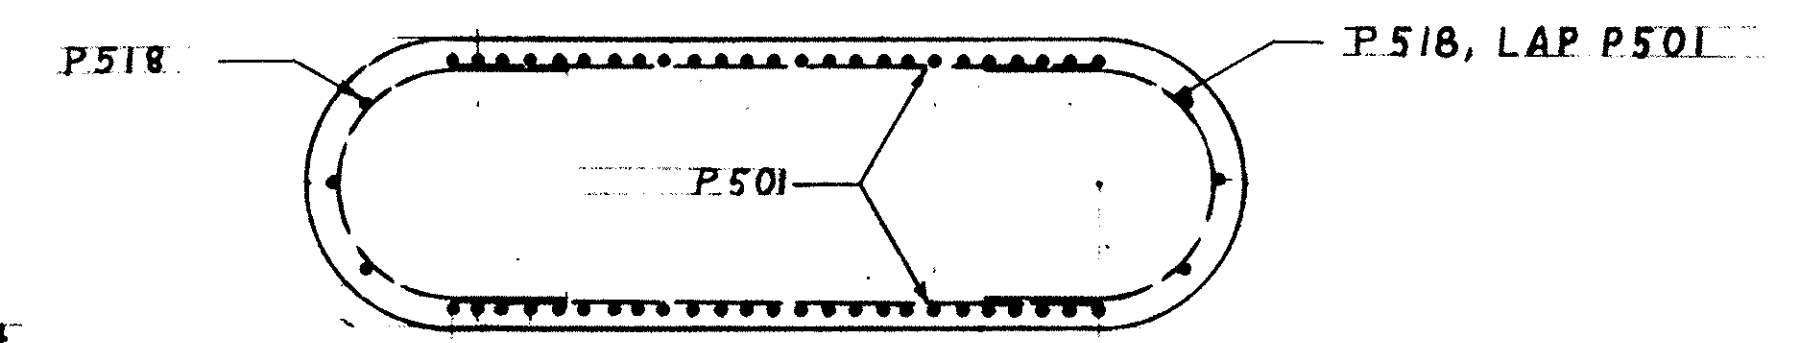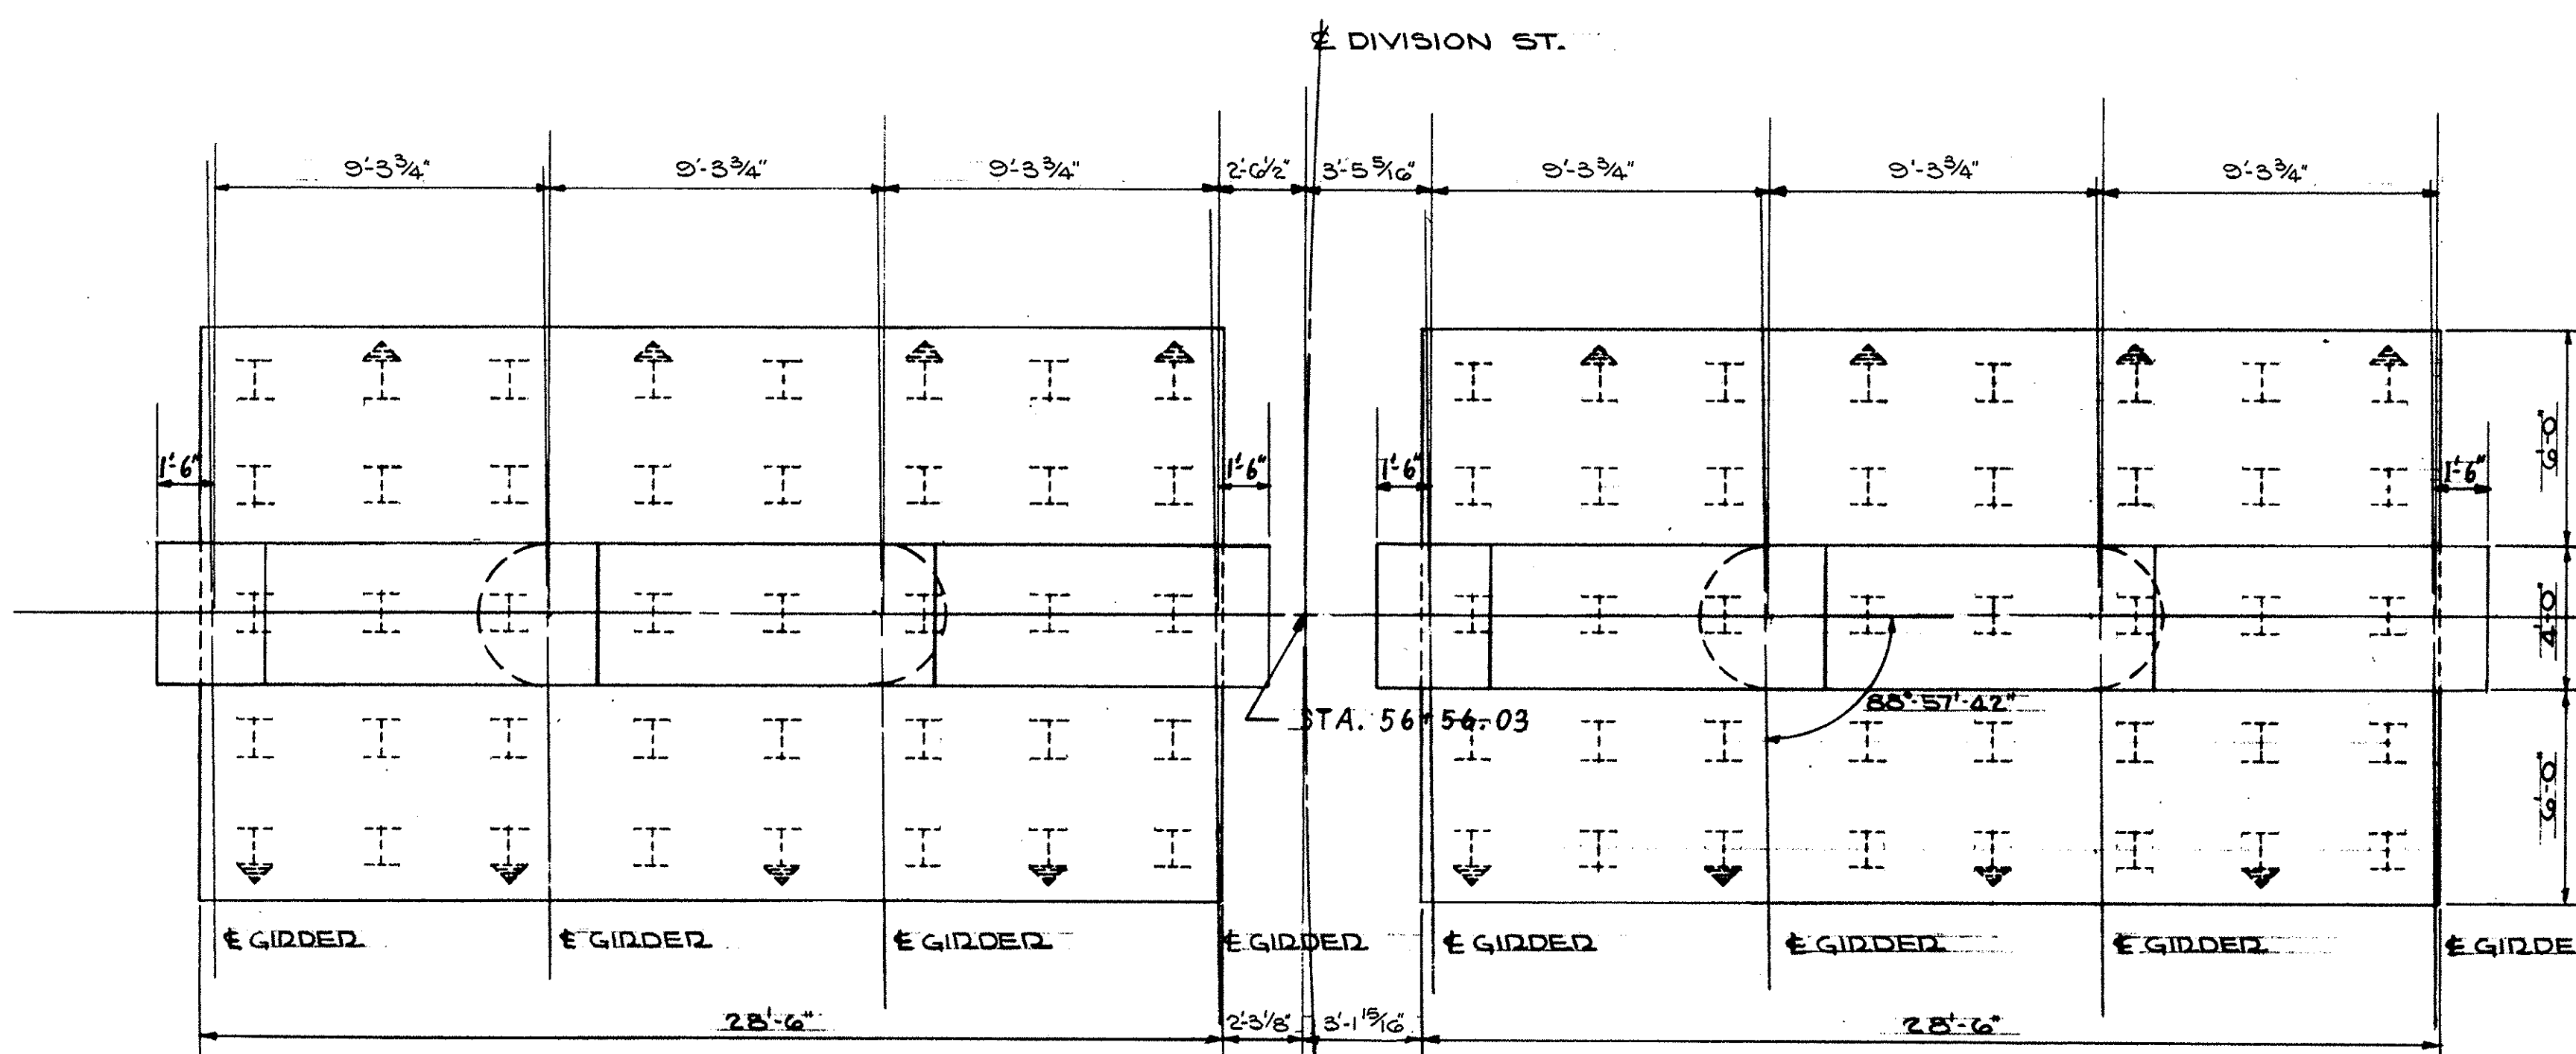


SECTION B-B


PIER #14 ELEVATION TABLE

	A	B	C	D	E	F	G	H	I
PIER 14	904.56	904.10	903.64	903.58	903.49	902.63	902.17	901.73	846.20


NOTE: ALL PILING 12 BP 53

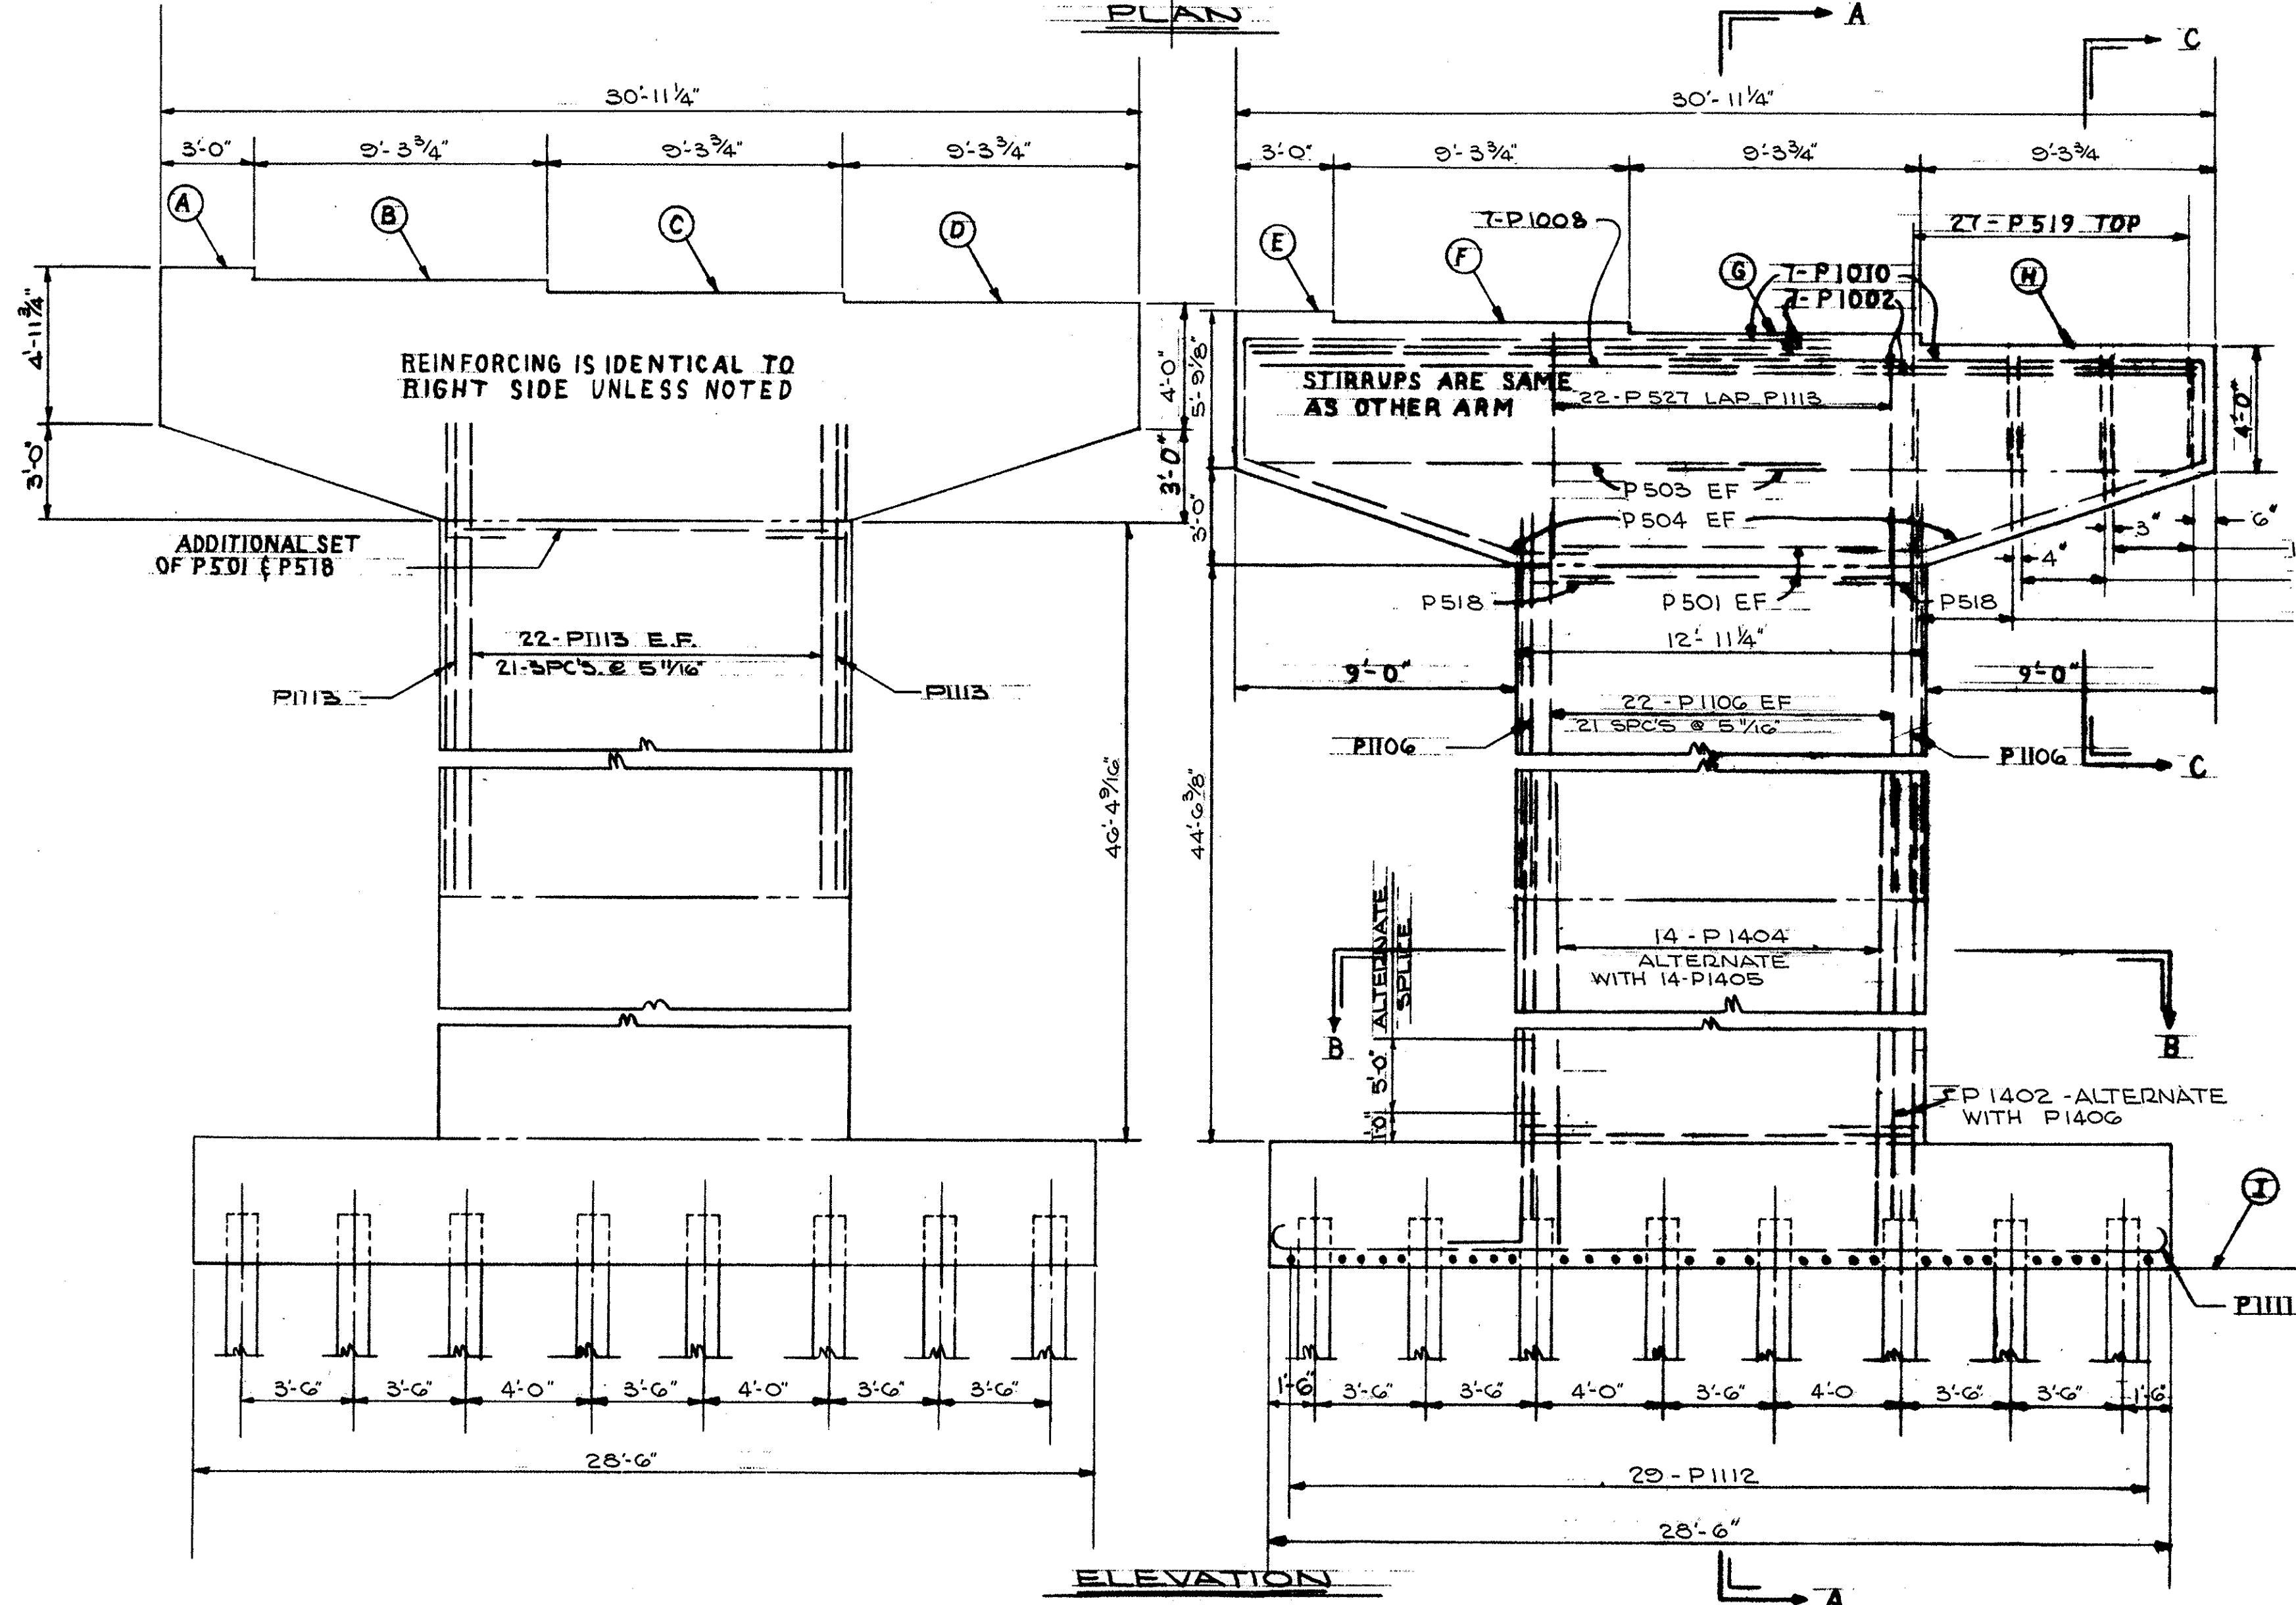

ELEVATION

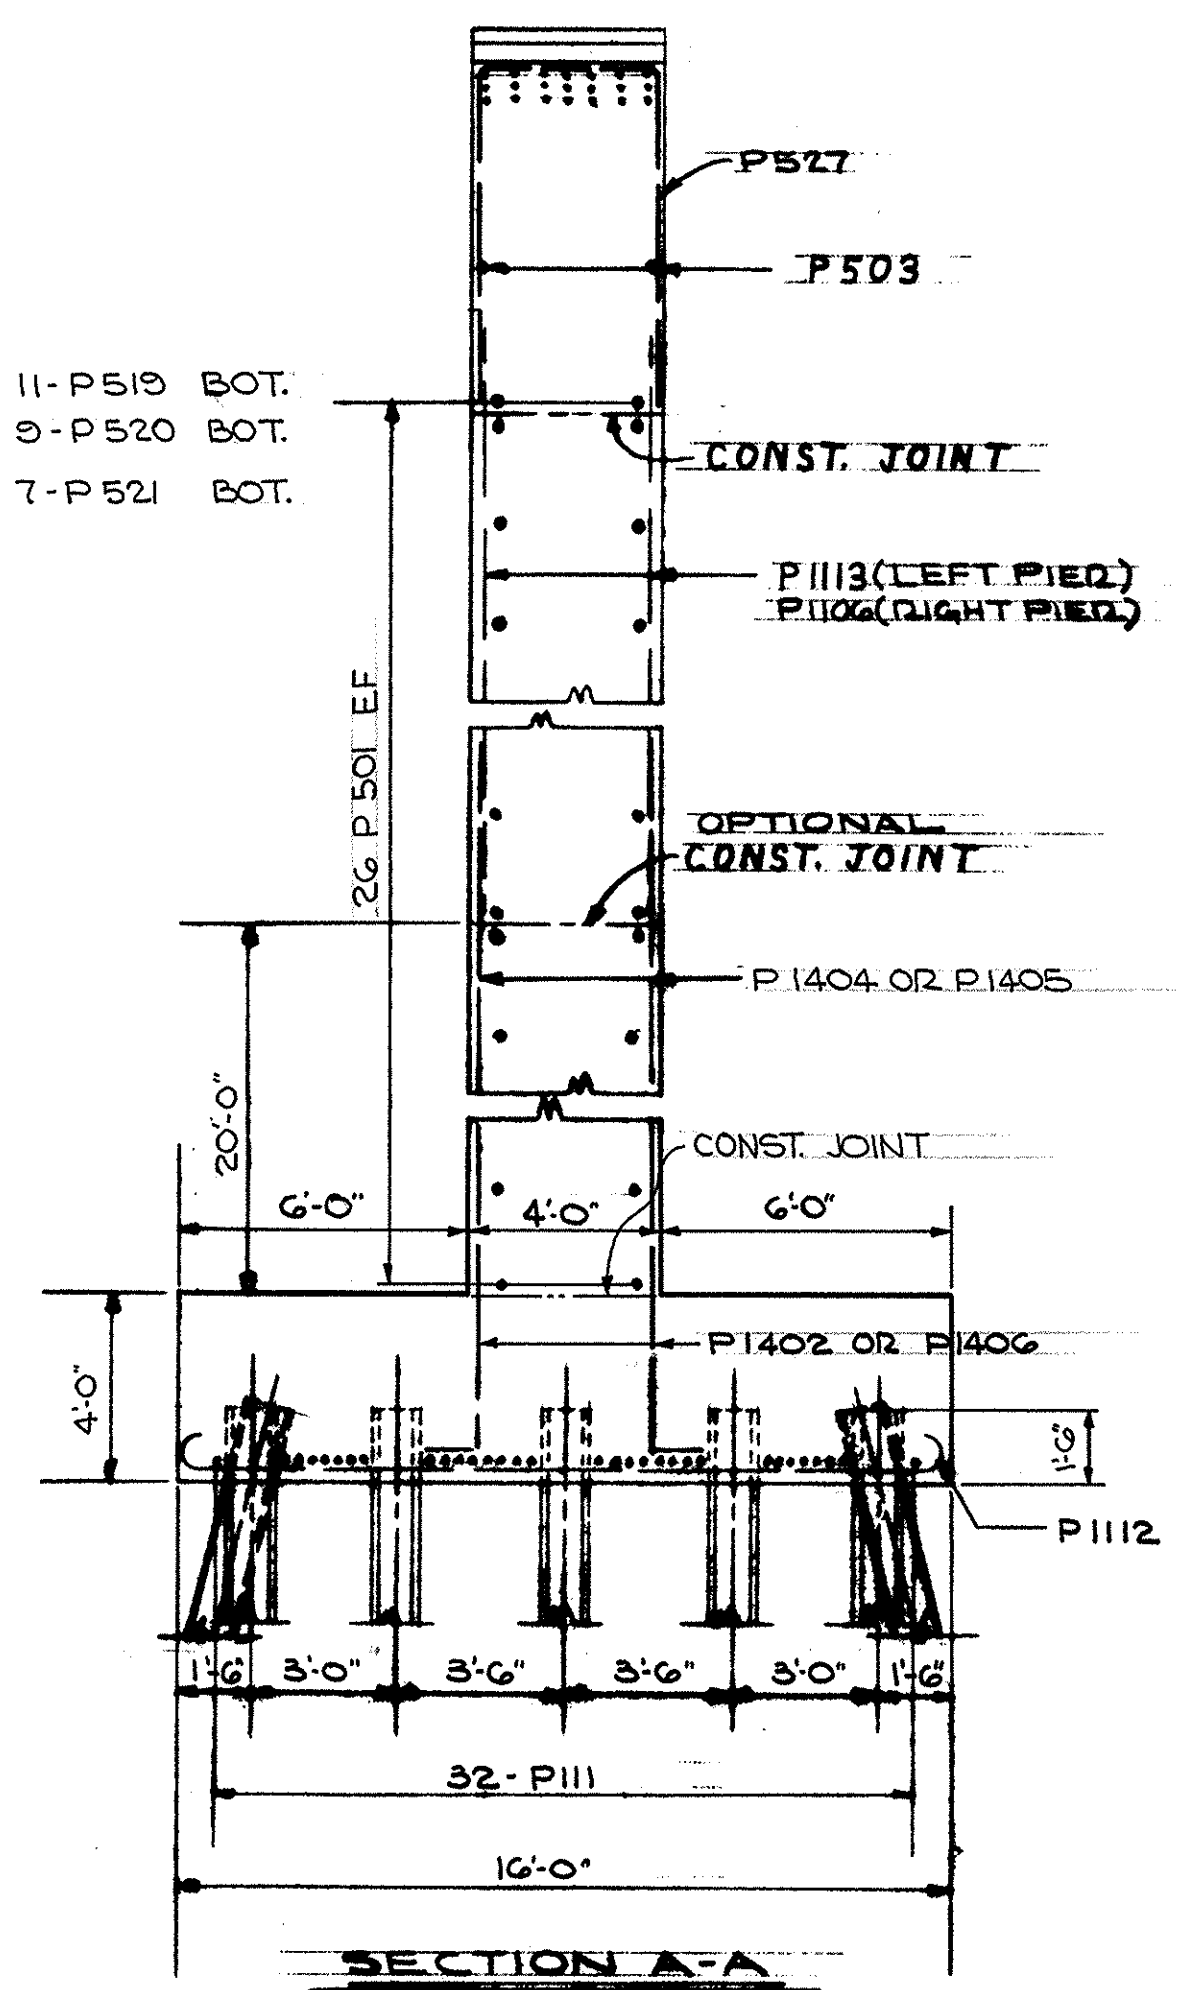

SECTION A-A

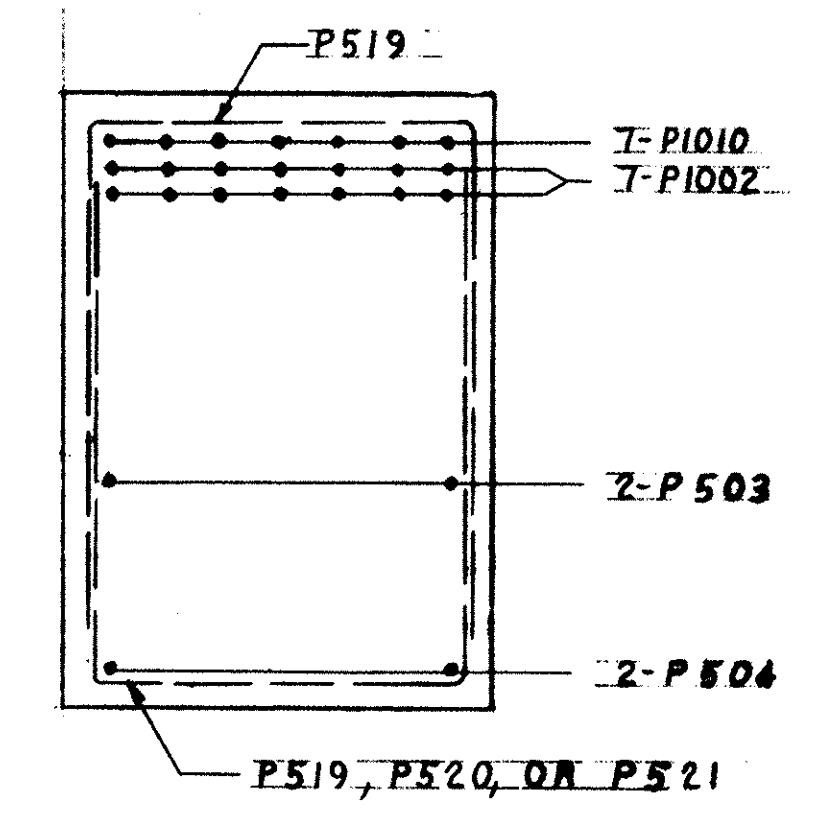

SECTION C-C

This sheet is superseded by sheet No. 166A. 9-12-69



STATE OF OHIO
 DEPARTMENT OF HIGHWAYS
 BUREAU OF BRIDGES

AKRON, OHIO GLAUS, PYLE & SCHOMER YOUNGSTOWN, OHIO

PIER 14
 BRIDGE N^o MAH-711-0116
 OVER MAHONING RIVER
 YOUNGSTOWN MAHONING COUNTY

DESIGNED	DRAWN	TRACED	CHECKED	REVIEWED	DATE	REVISED
J.W.C.	D.M.		J.M.	W.K.D.	6-22-68	


REVISIONS
 JUN 13 1969
 REVISION

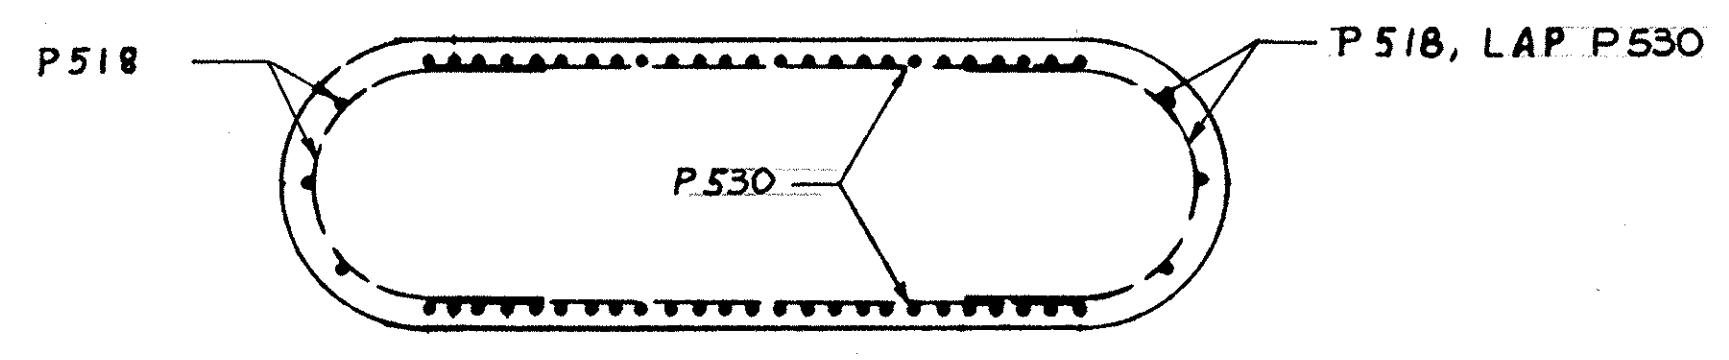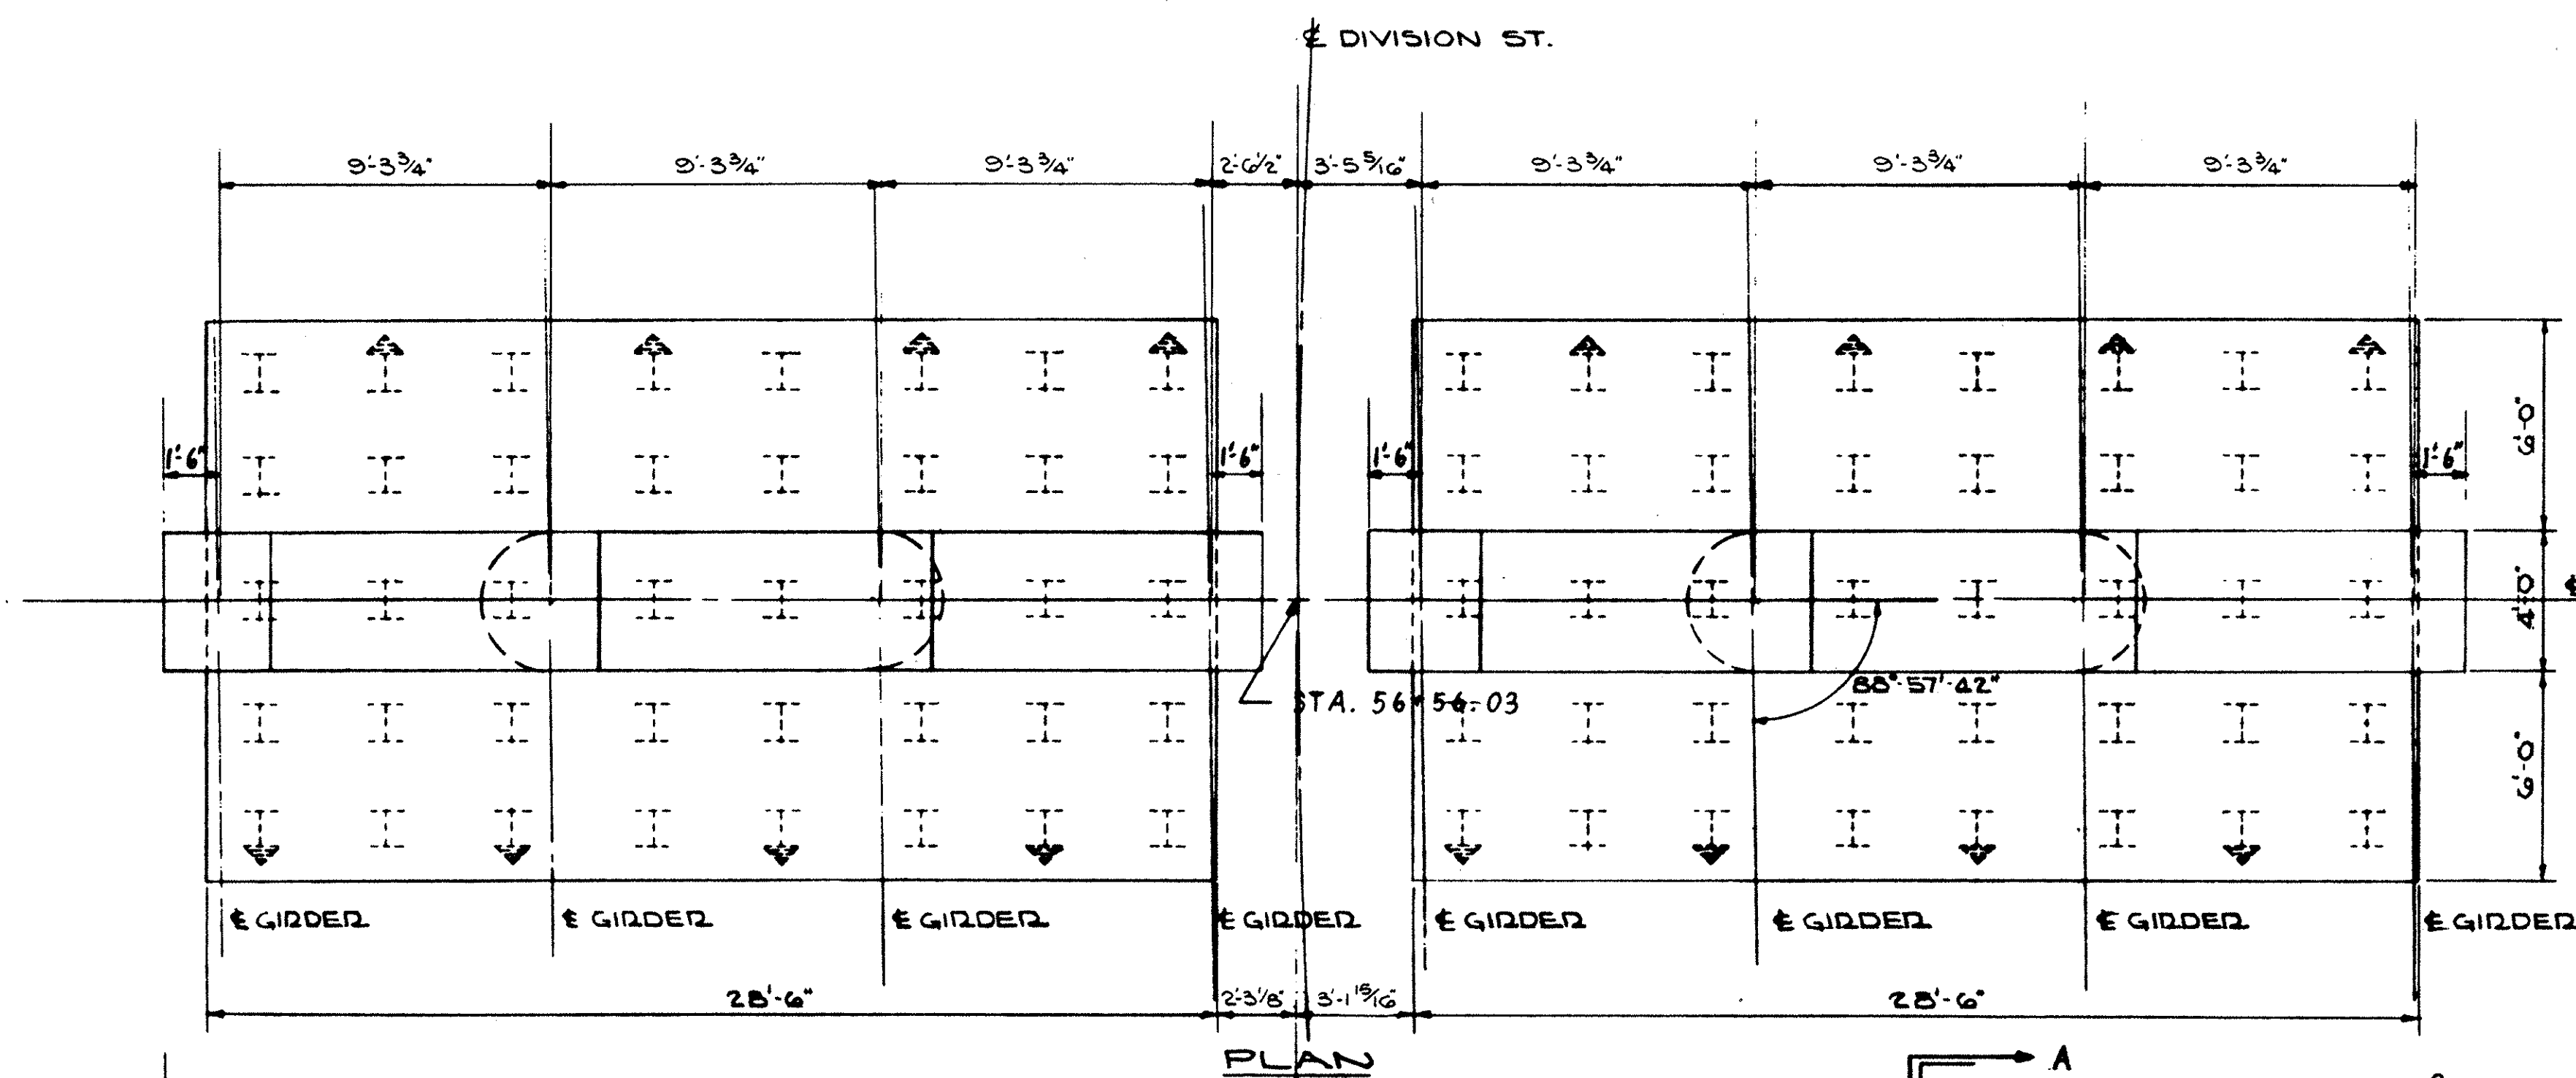


SECTION B-B

PIER #14 ELEVATION TABLE


	A	B	C	D	E	F	G	H	I
PIER 14	904.56	904.10	903.64	903.58	903.49	902.63	902.17	901.73	846.20

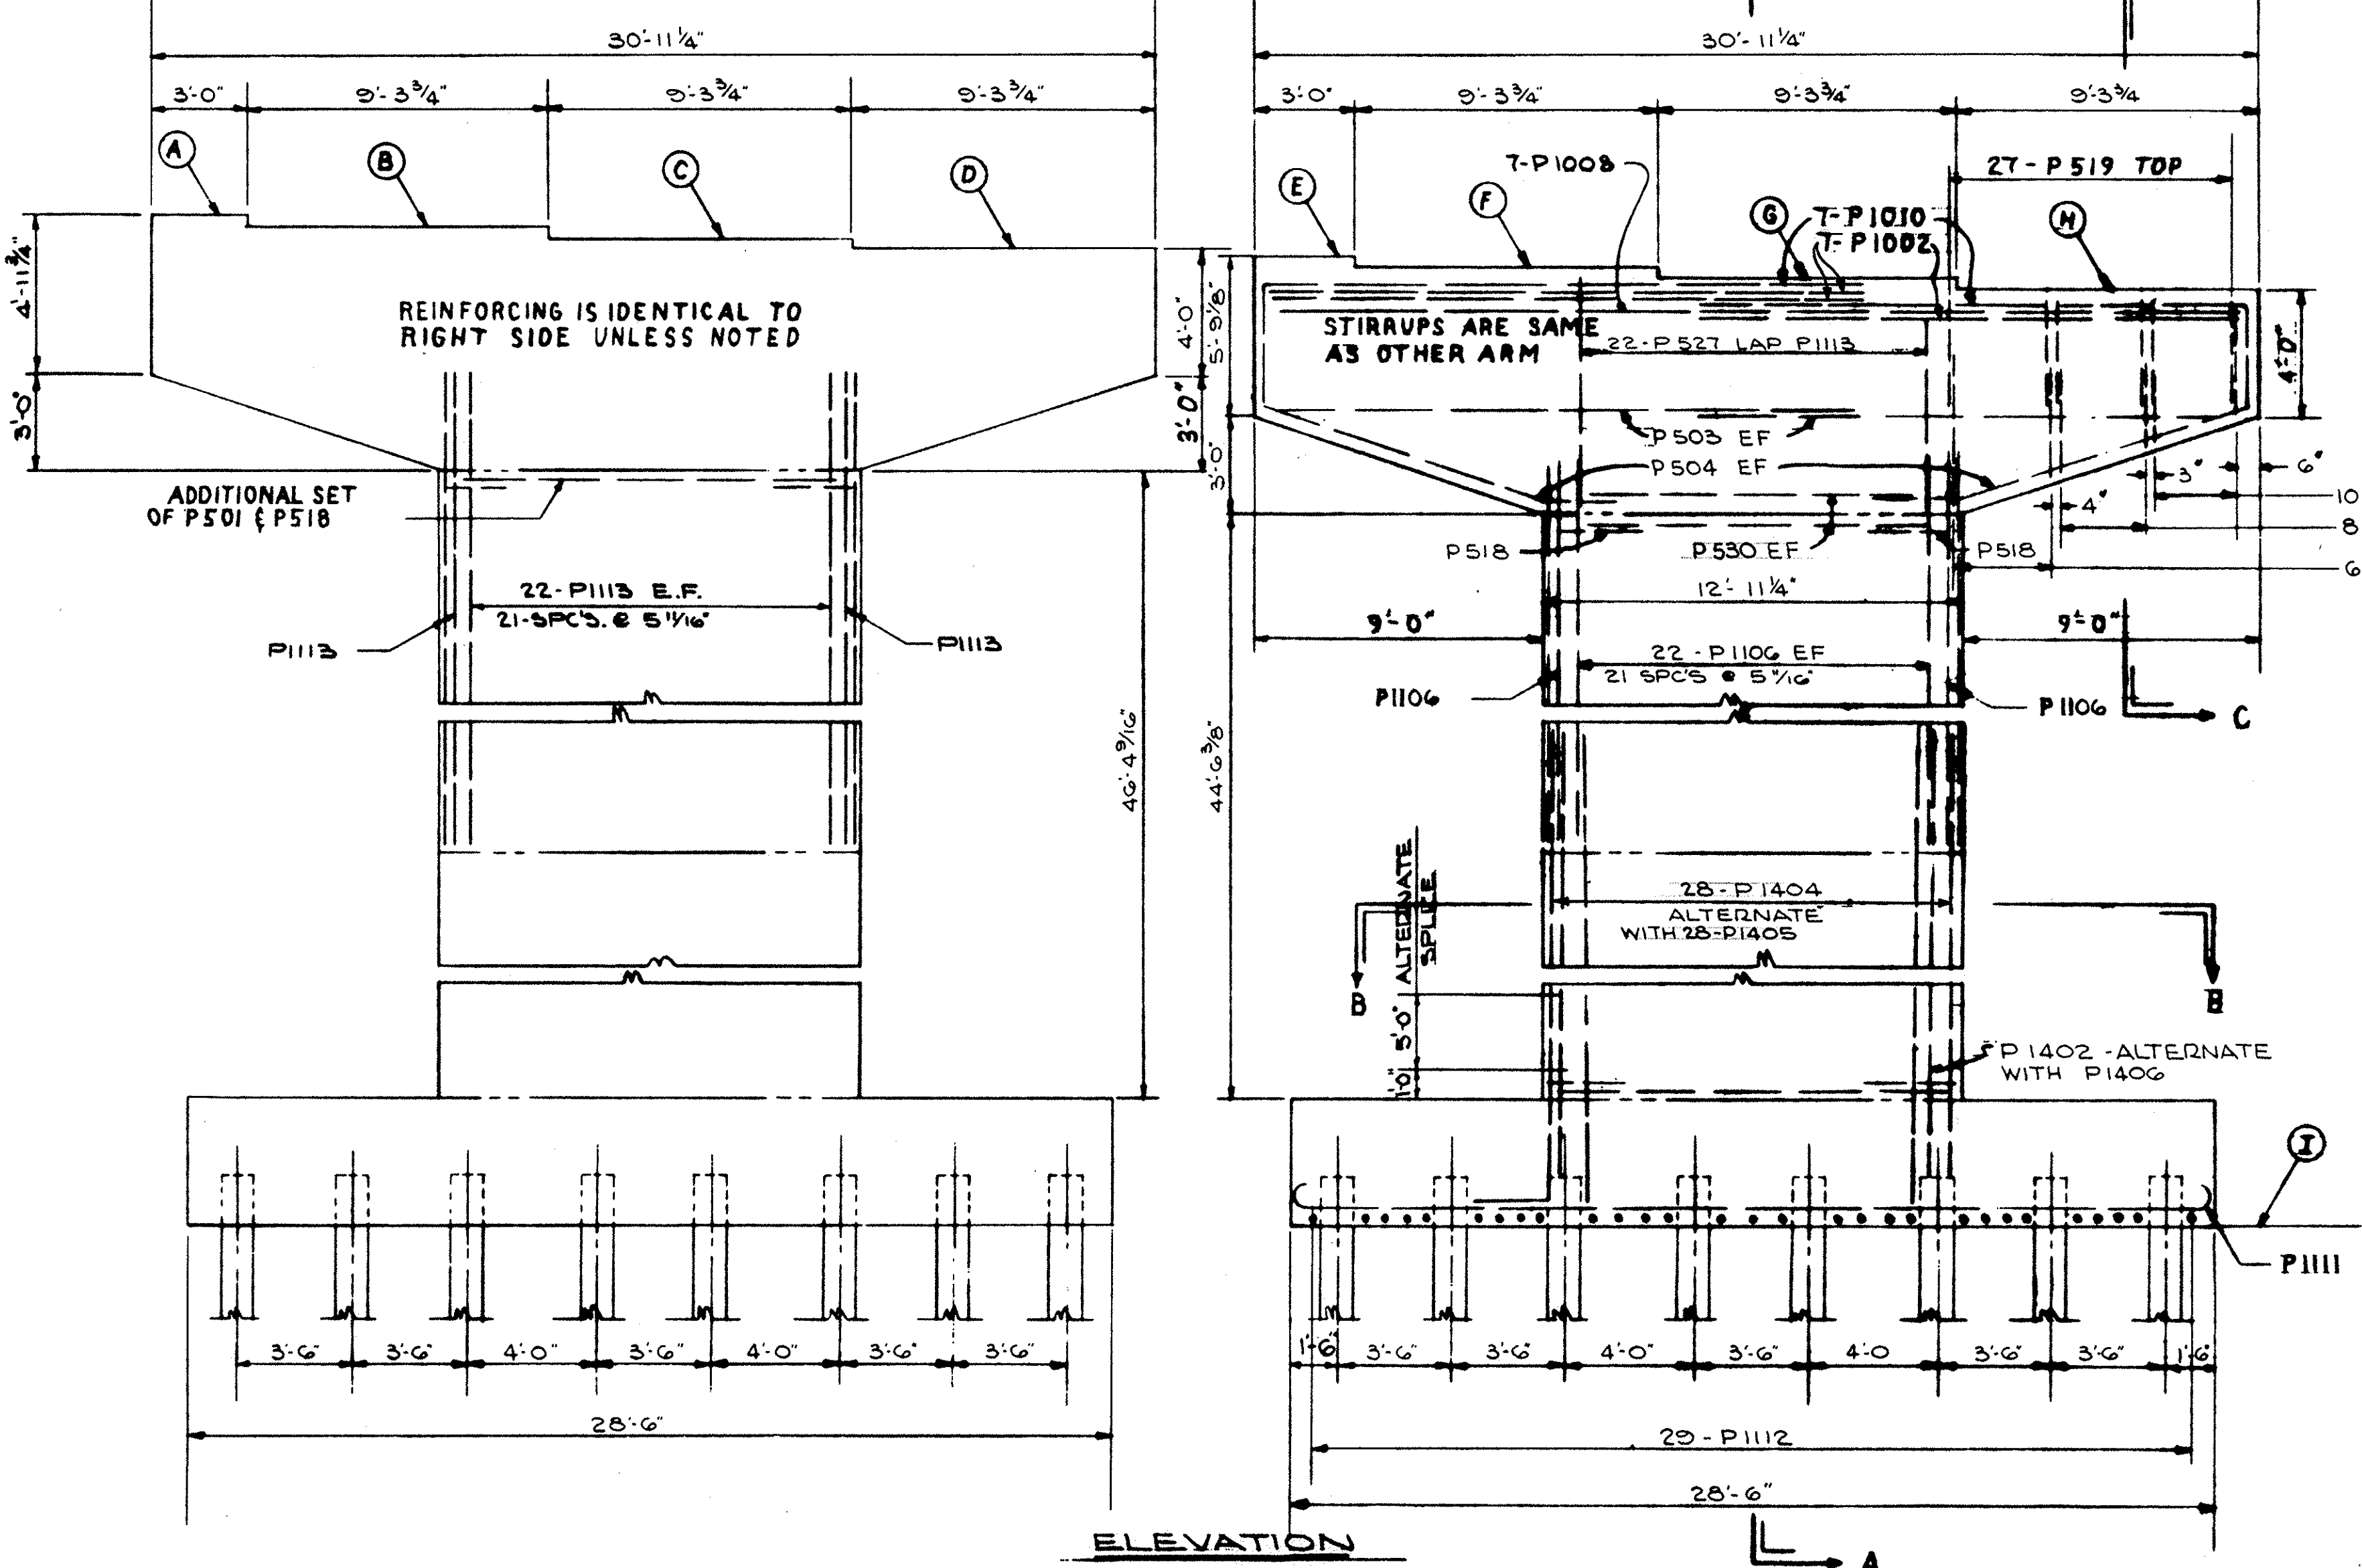

ELEVATION

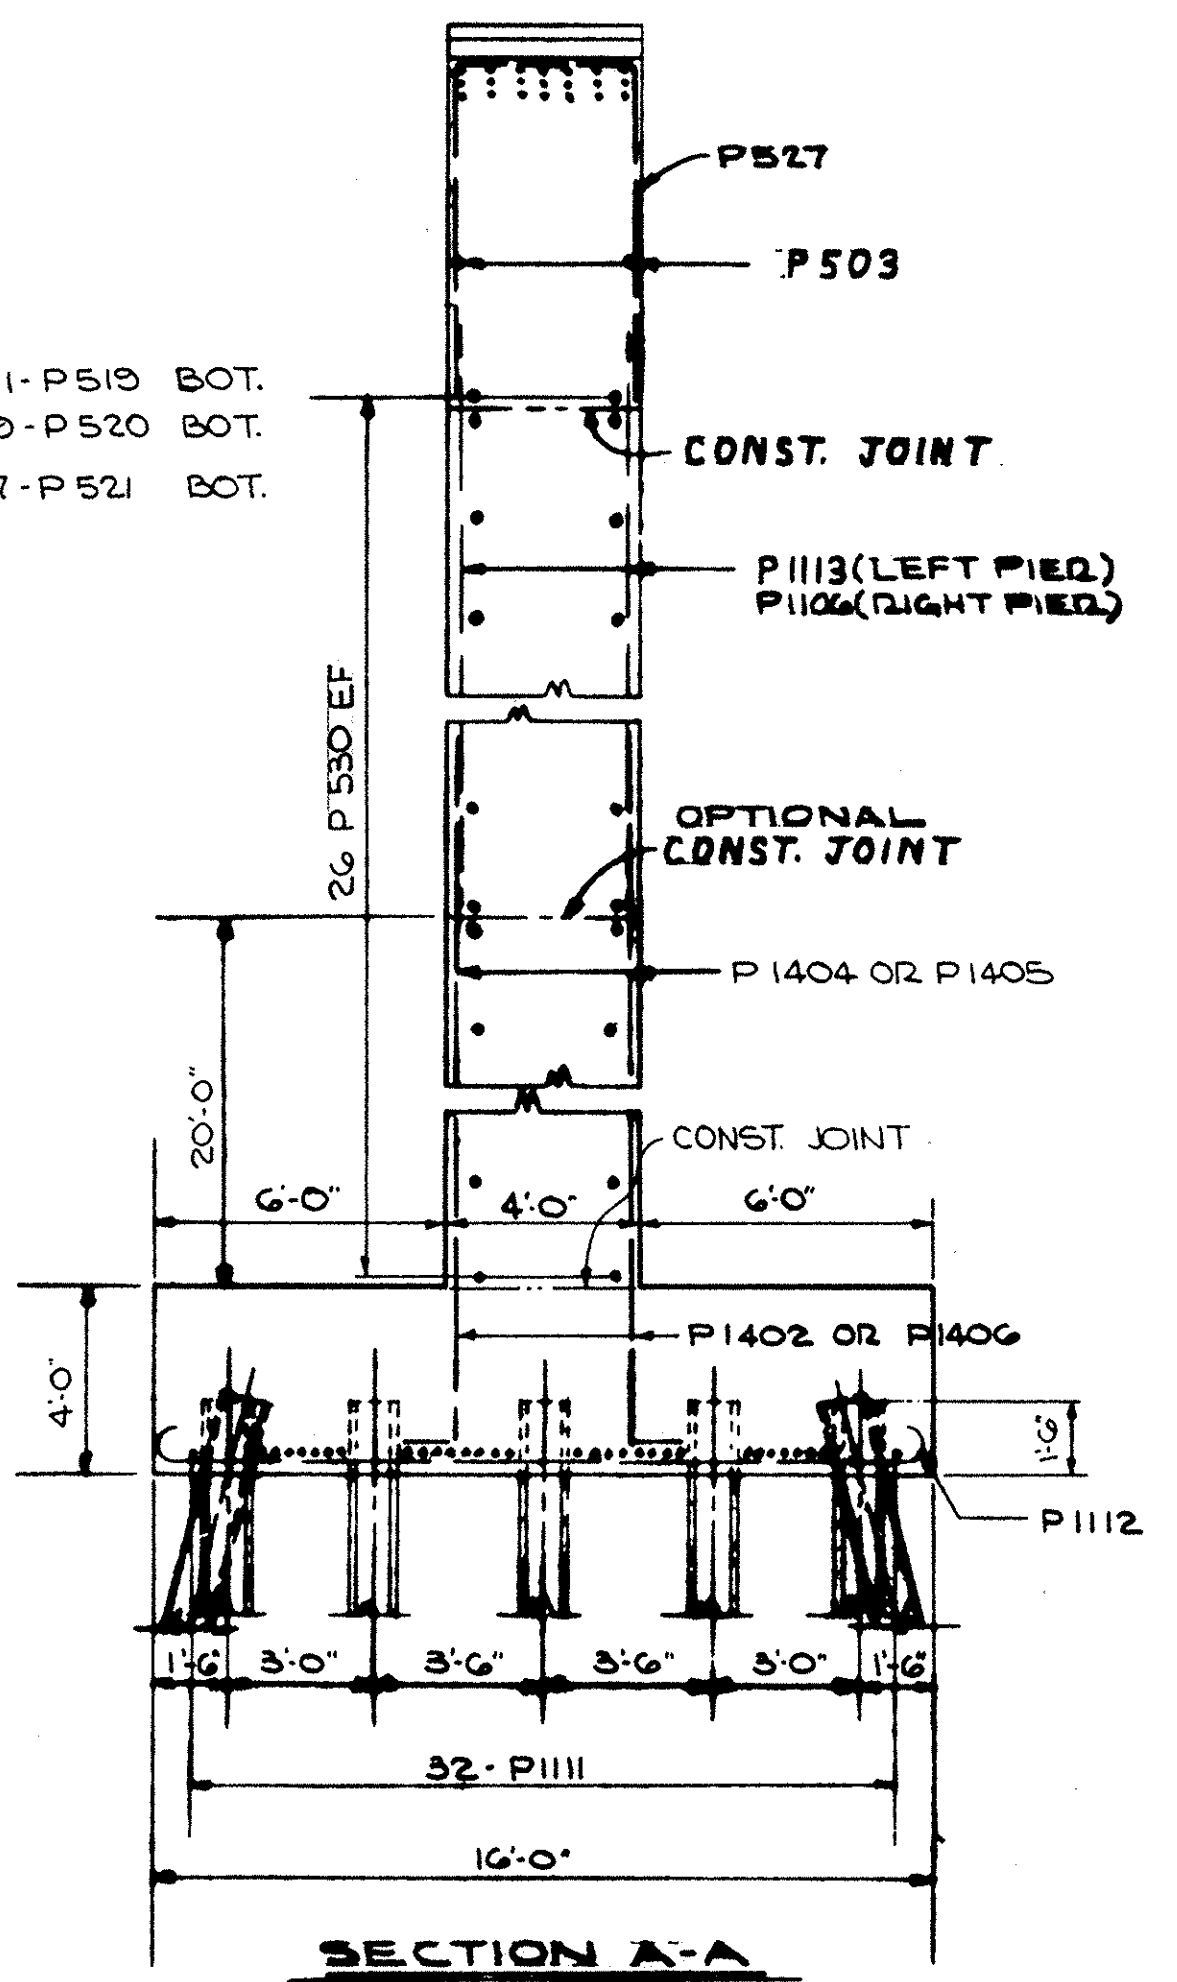

SECTION A-A

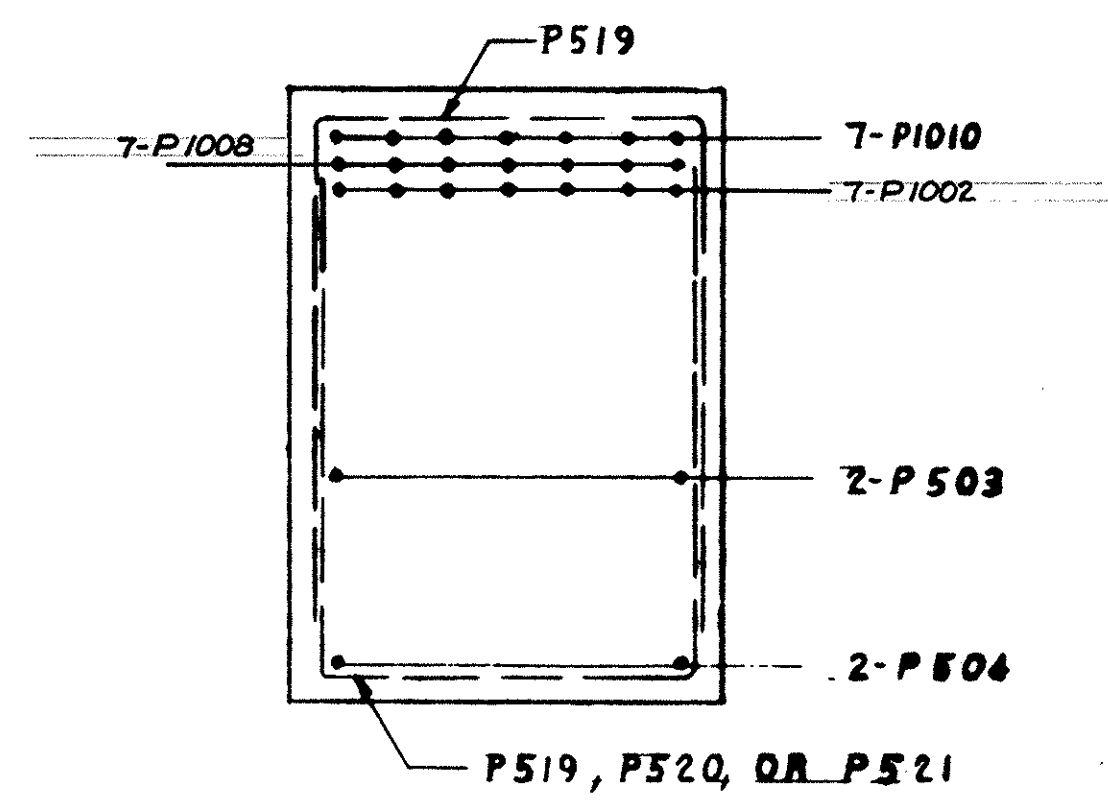

SECTION C-C

NOTE: ALL PILING 12 BP 53

This sheet supersedes sheet No. 166. 9-12-69

STATE OF OHIO
 DEPARTMENT OF HIGHWAYS
 BUREAU OF BRIDGES

AKRON, OHIO GLAUS, PYLE & SCHOMER YOUNGSTOWN, OHIO

PIER 14
 BRIDGE #2 MAH-711-016
 OVER MAHONING RIVER
 YOUNGSTOWN MAHONING COUNTY




DESIGNED	DRAWN	TRACED	CHECKED	REVIEWED	DATE	REVISED
J.W.C.	D.M.		J.M.	W.K.D.	6-22-68	

MAHONING
JUN 19 1968
REPRINTING

FED. RD.	STATE	PROJECT	
2	OHIO	U.S.-1150 (A)	

MAH-711-017

167
232

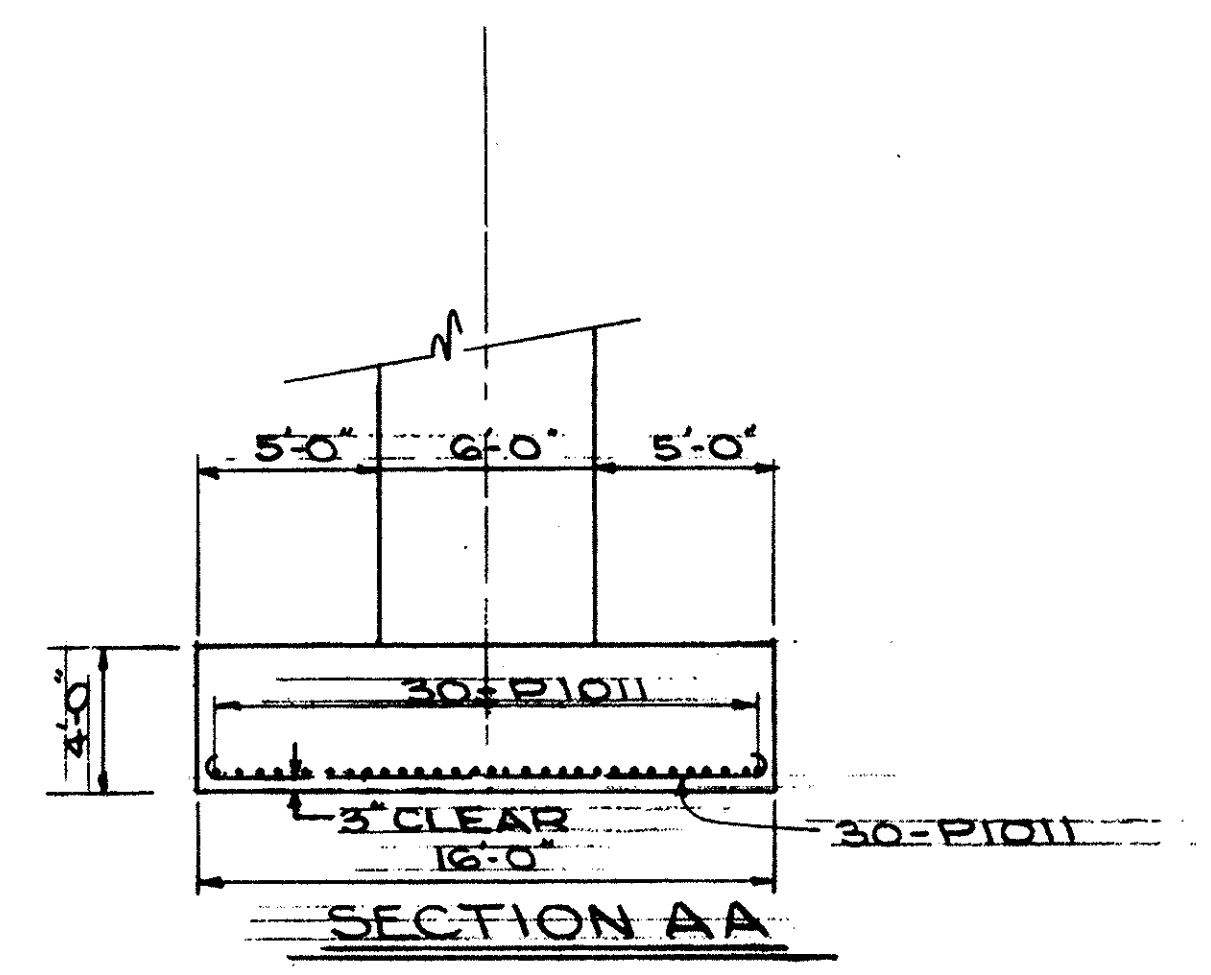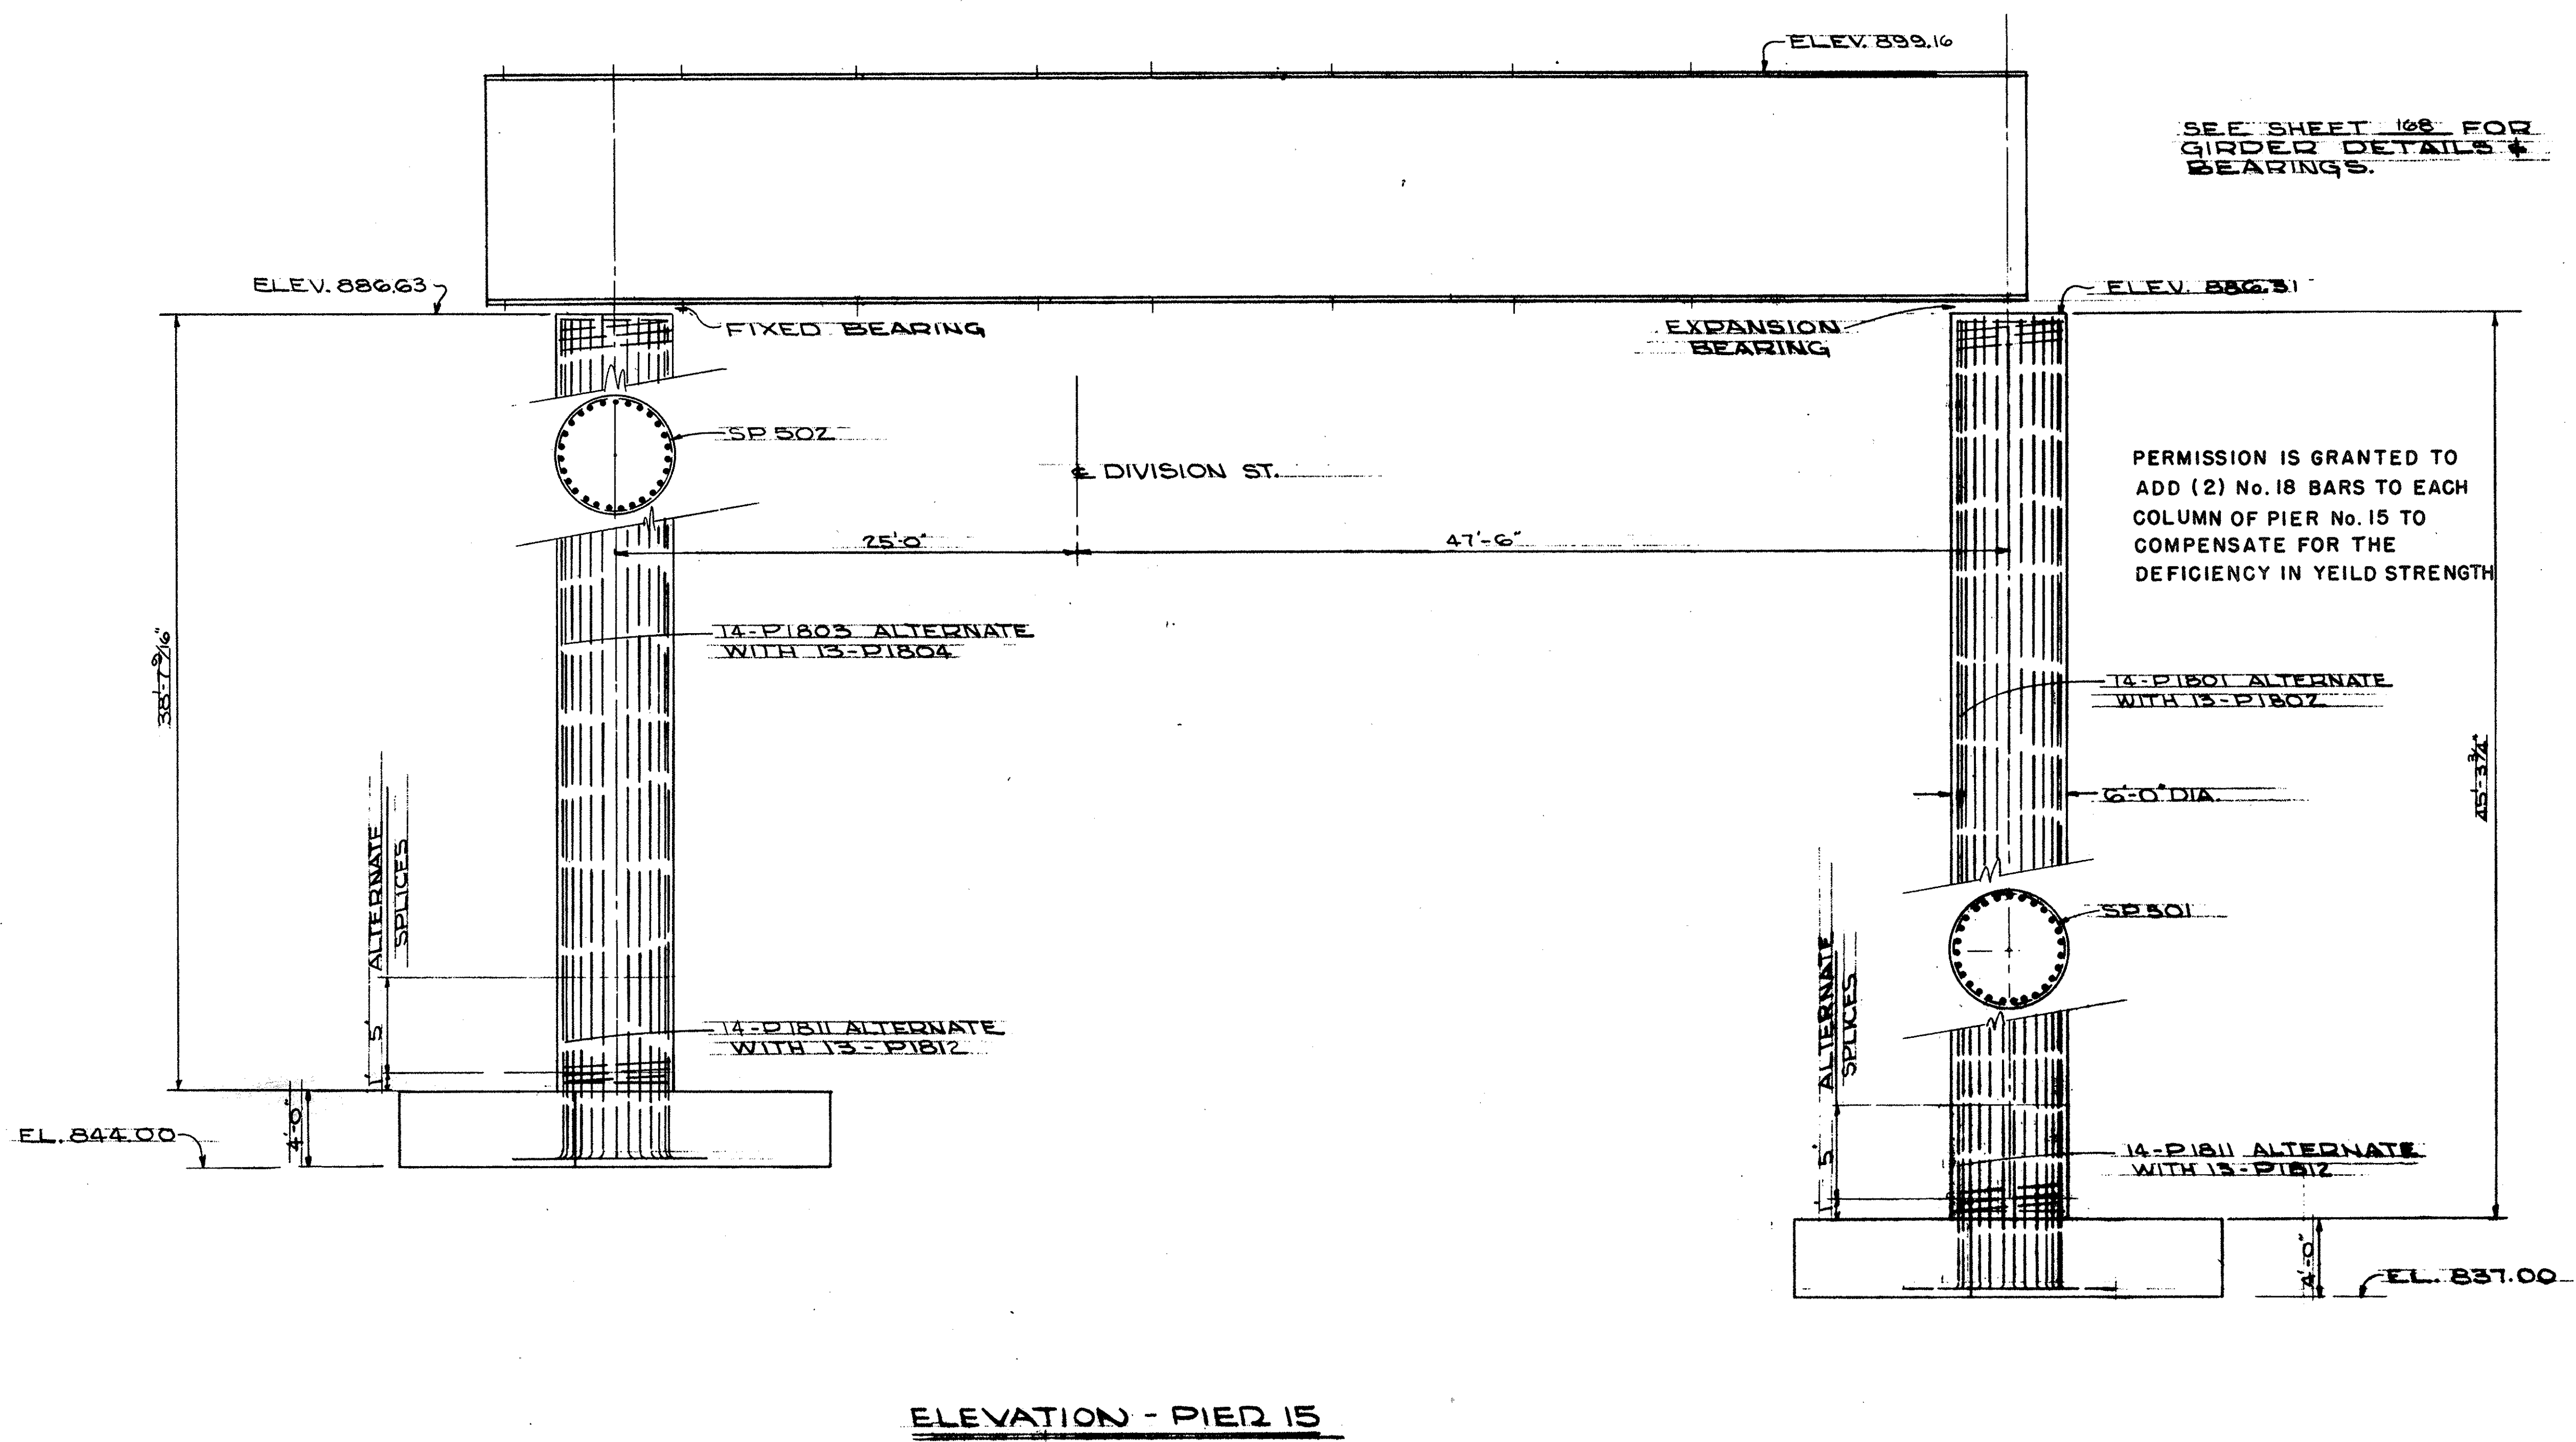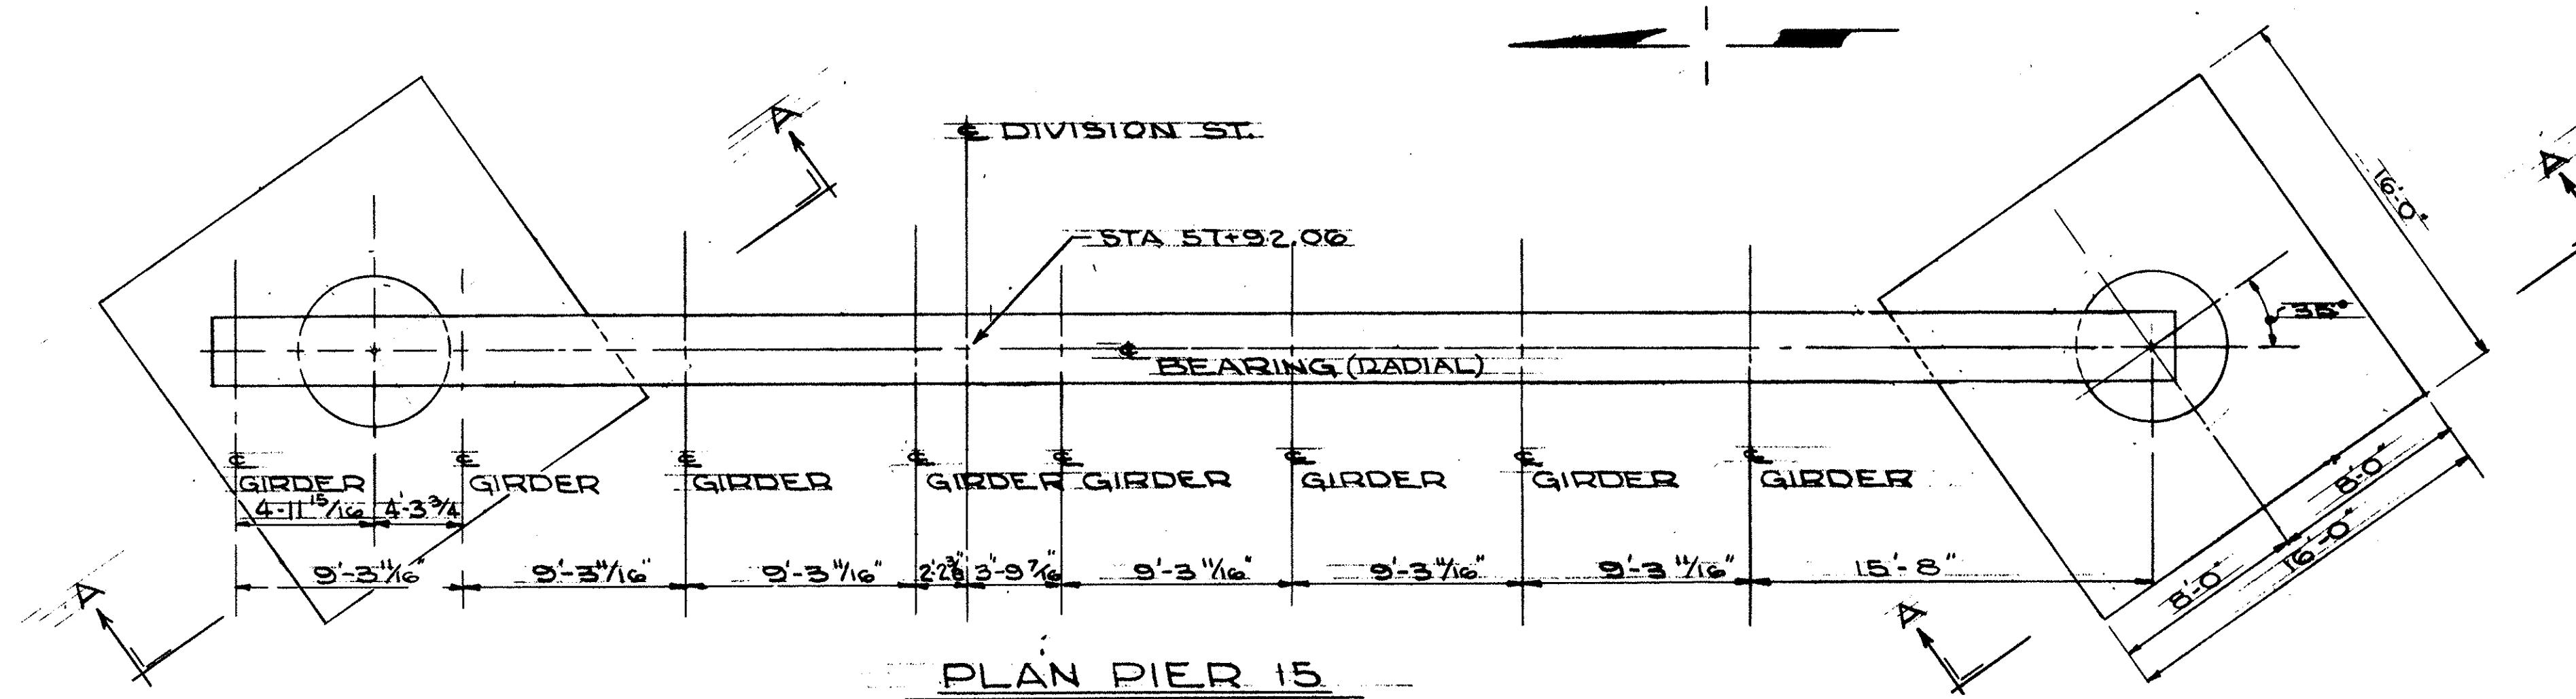

STATE OF OHIO DEPARTMENT OF HIGHWAYS BUREAU OF BRIDGES						
AKRON, OHIO			YOUNGSTOWN, OHIO			
GLAUS, PYLE & SCHOMER						
PIER 15						
BRIDGE No. MAH-711-0116			OVER MAHONING RIVER			
YOUNGSTOWN			MAHONING COUNTY			
DESIGNED	DRAWN	TRACED	CHECKED	REVIEWED	DATE	REVISED
JWC	JWC		JFA	WKS	6-22-68	



Printed As-Built

REVISION
JUN 11 1969




NO. 2	STATE	PROJECT
2	OHIO	U.S. HIGHWAY 11

168
237




MAH-711-017

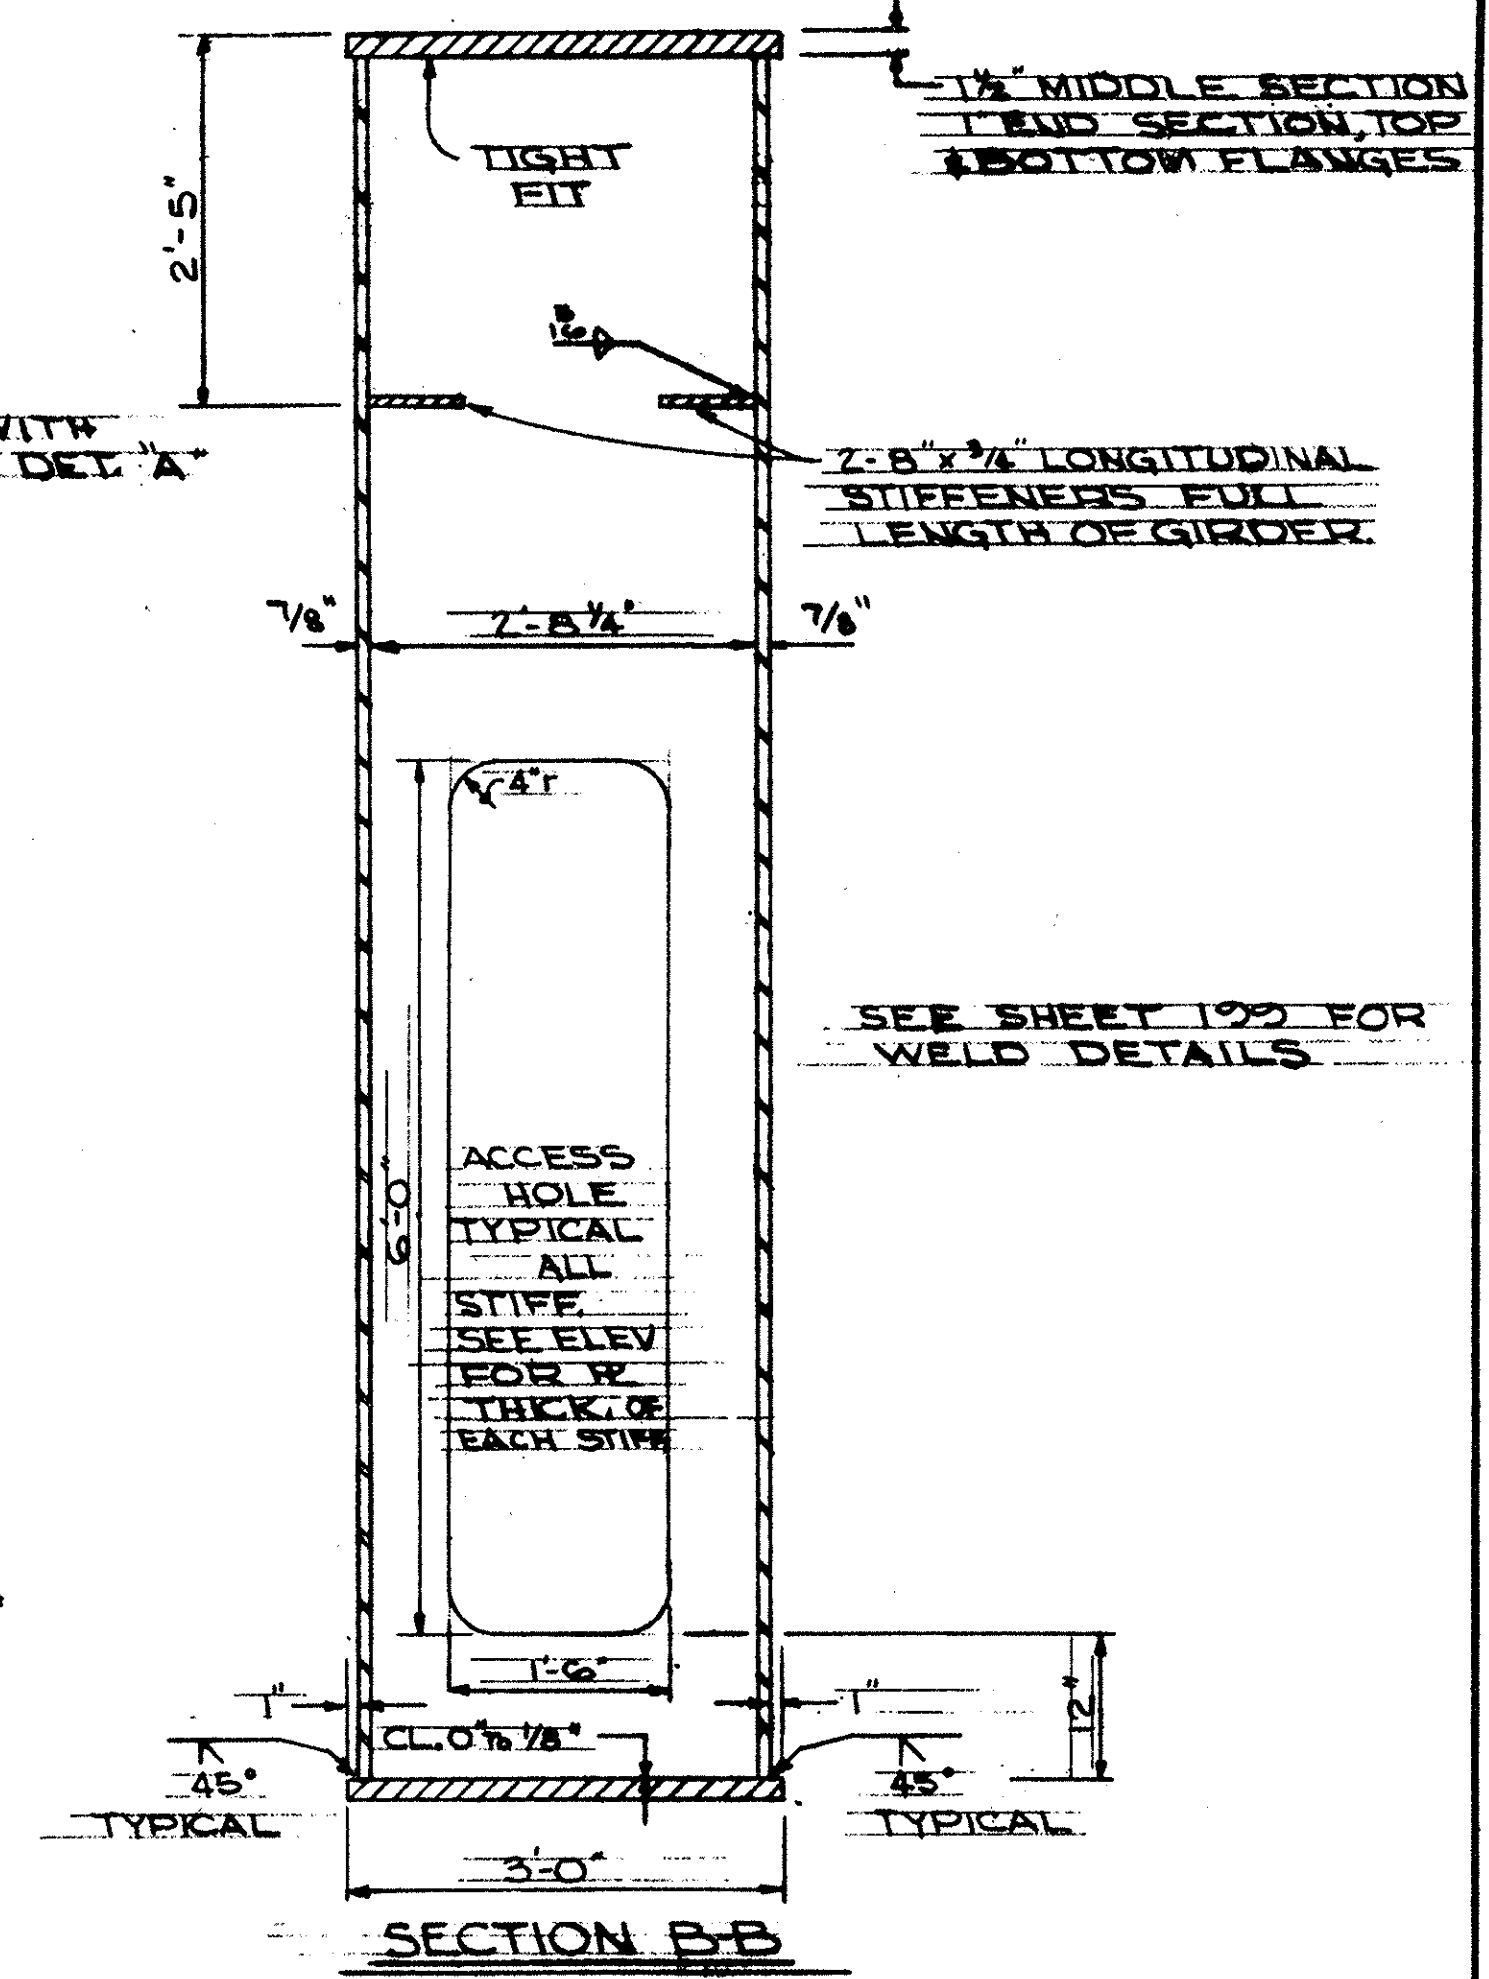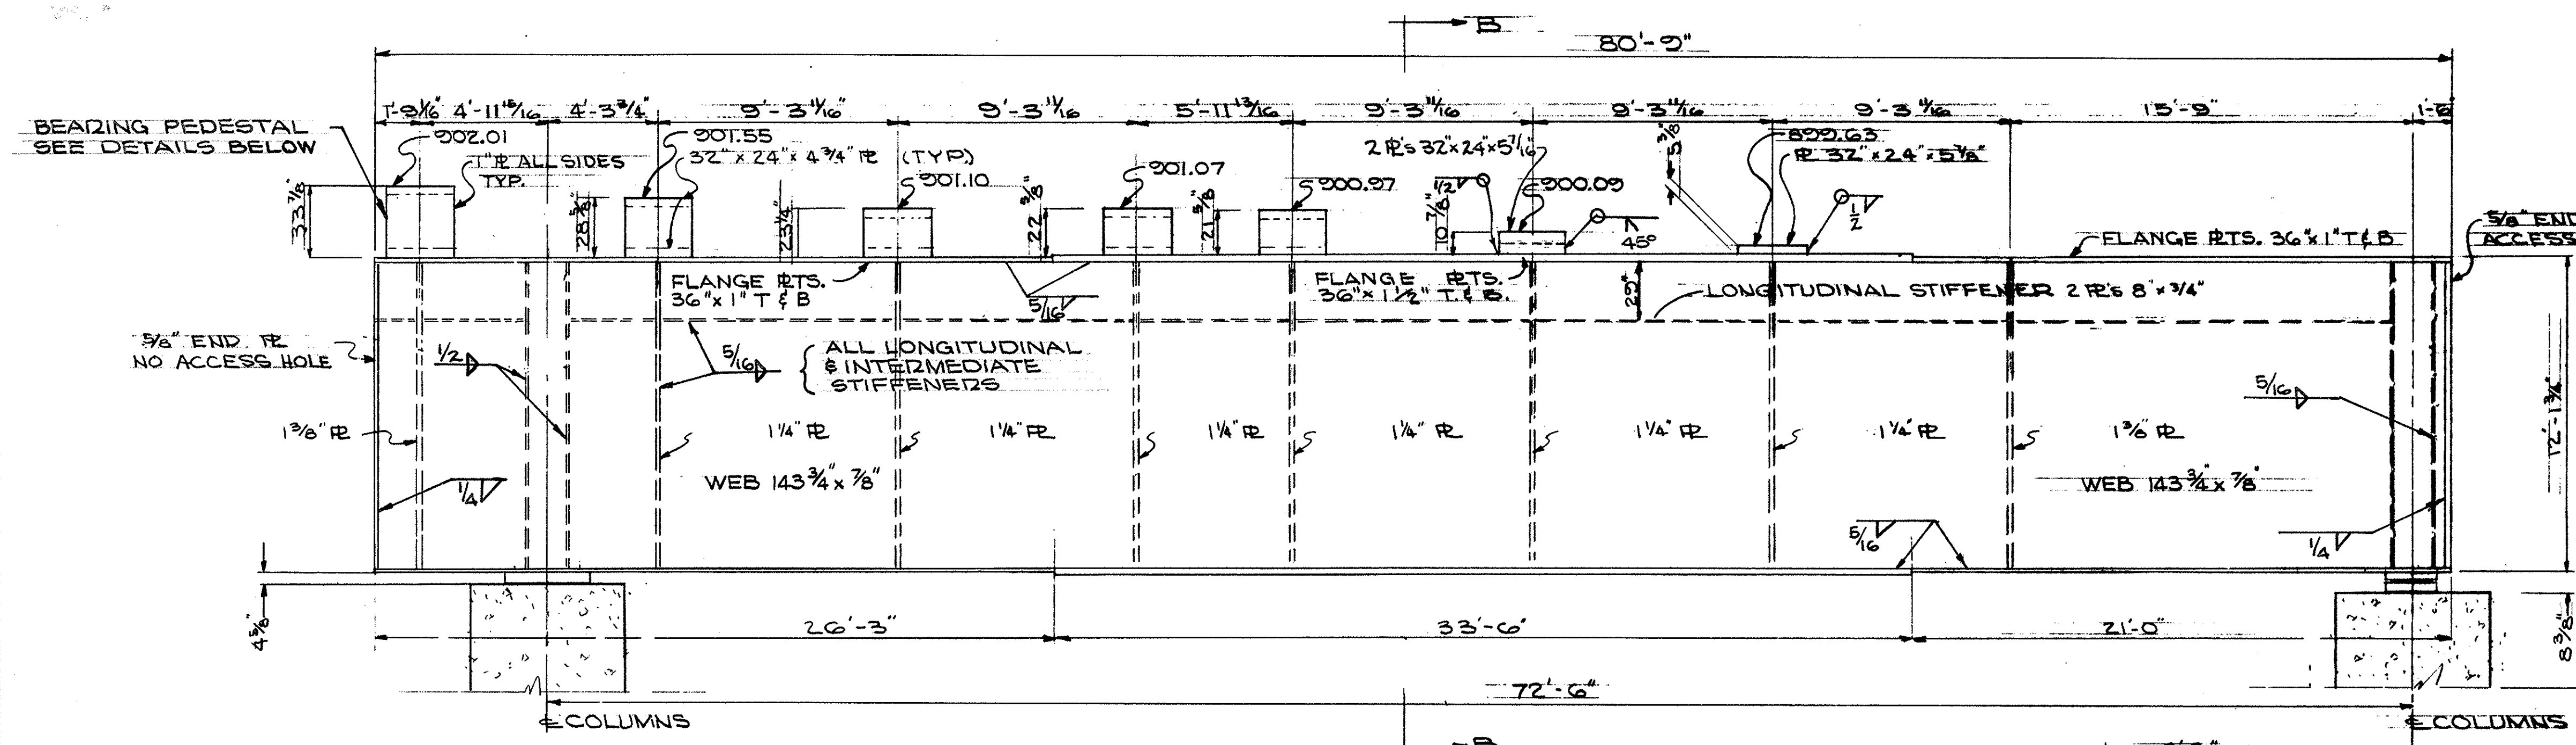

ELEVATION GIRDER CAP
(NO CAMBER REQ.)

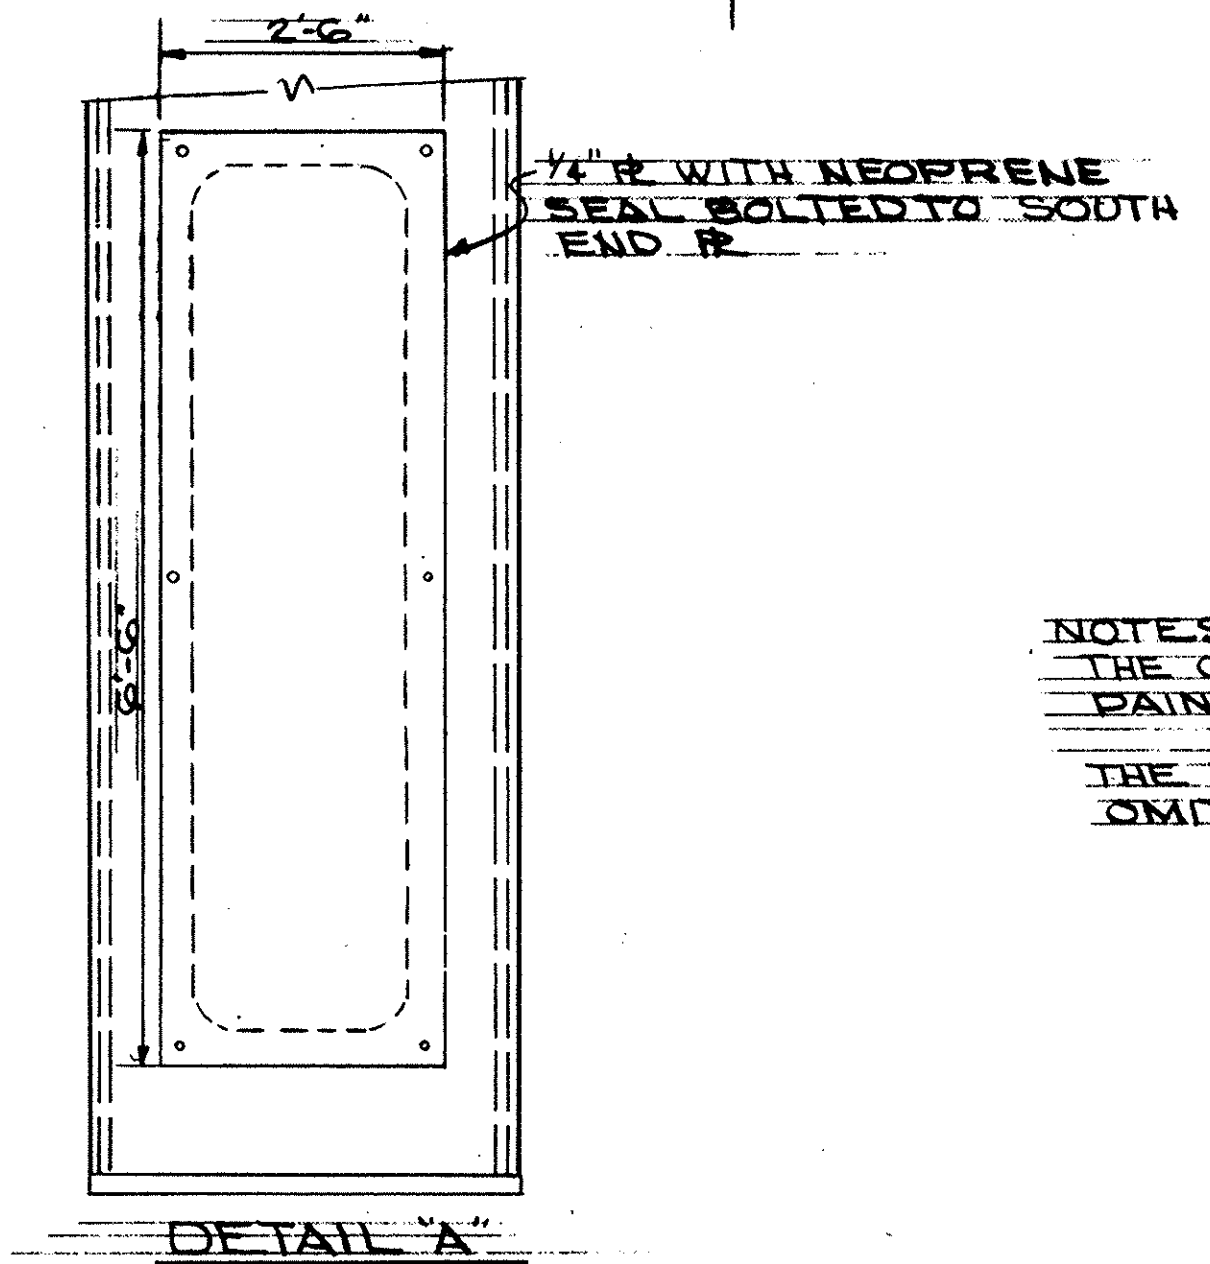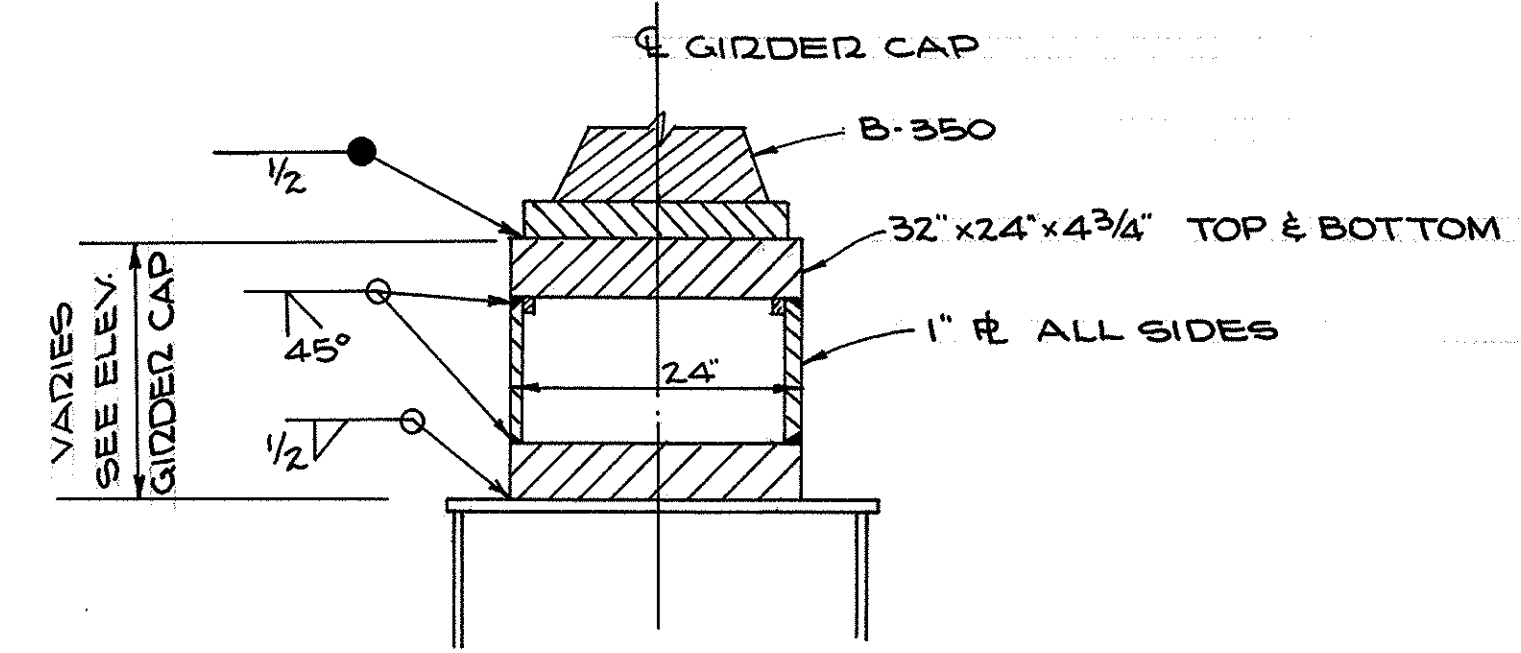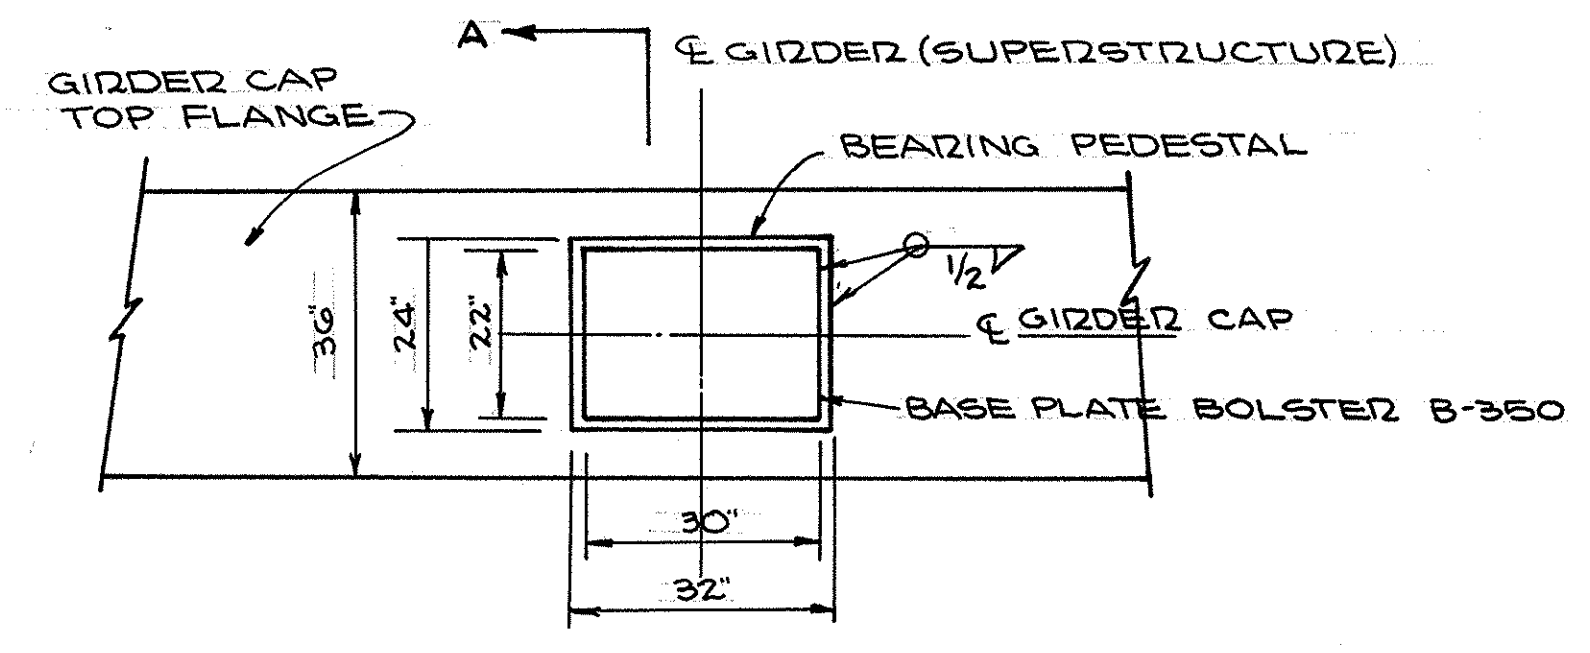


NOTES
THE GIRDER SHALL BE FABRICATED, INTERIOR PAINTED AND SEALED IN THE SHOP
THE THREE FIELD COATS OF PAINT SHALL BE OMITTED FROM THE INSIDE OF THE BOX GIRDER

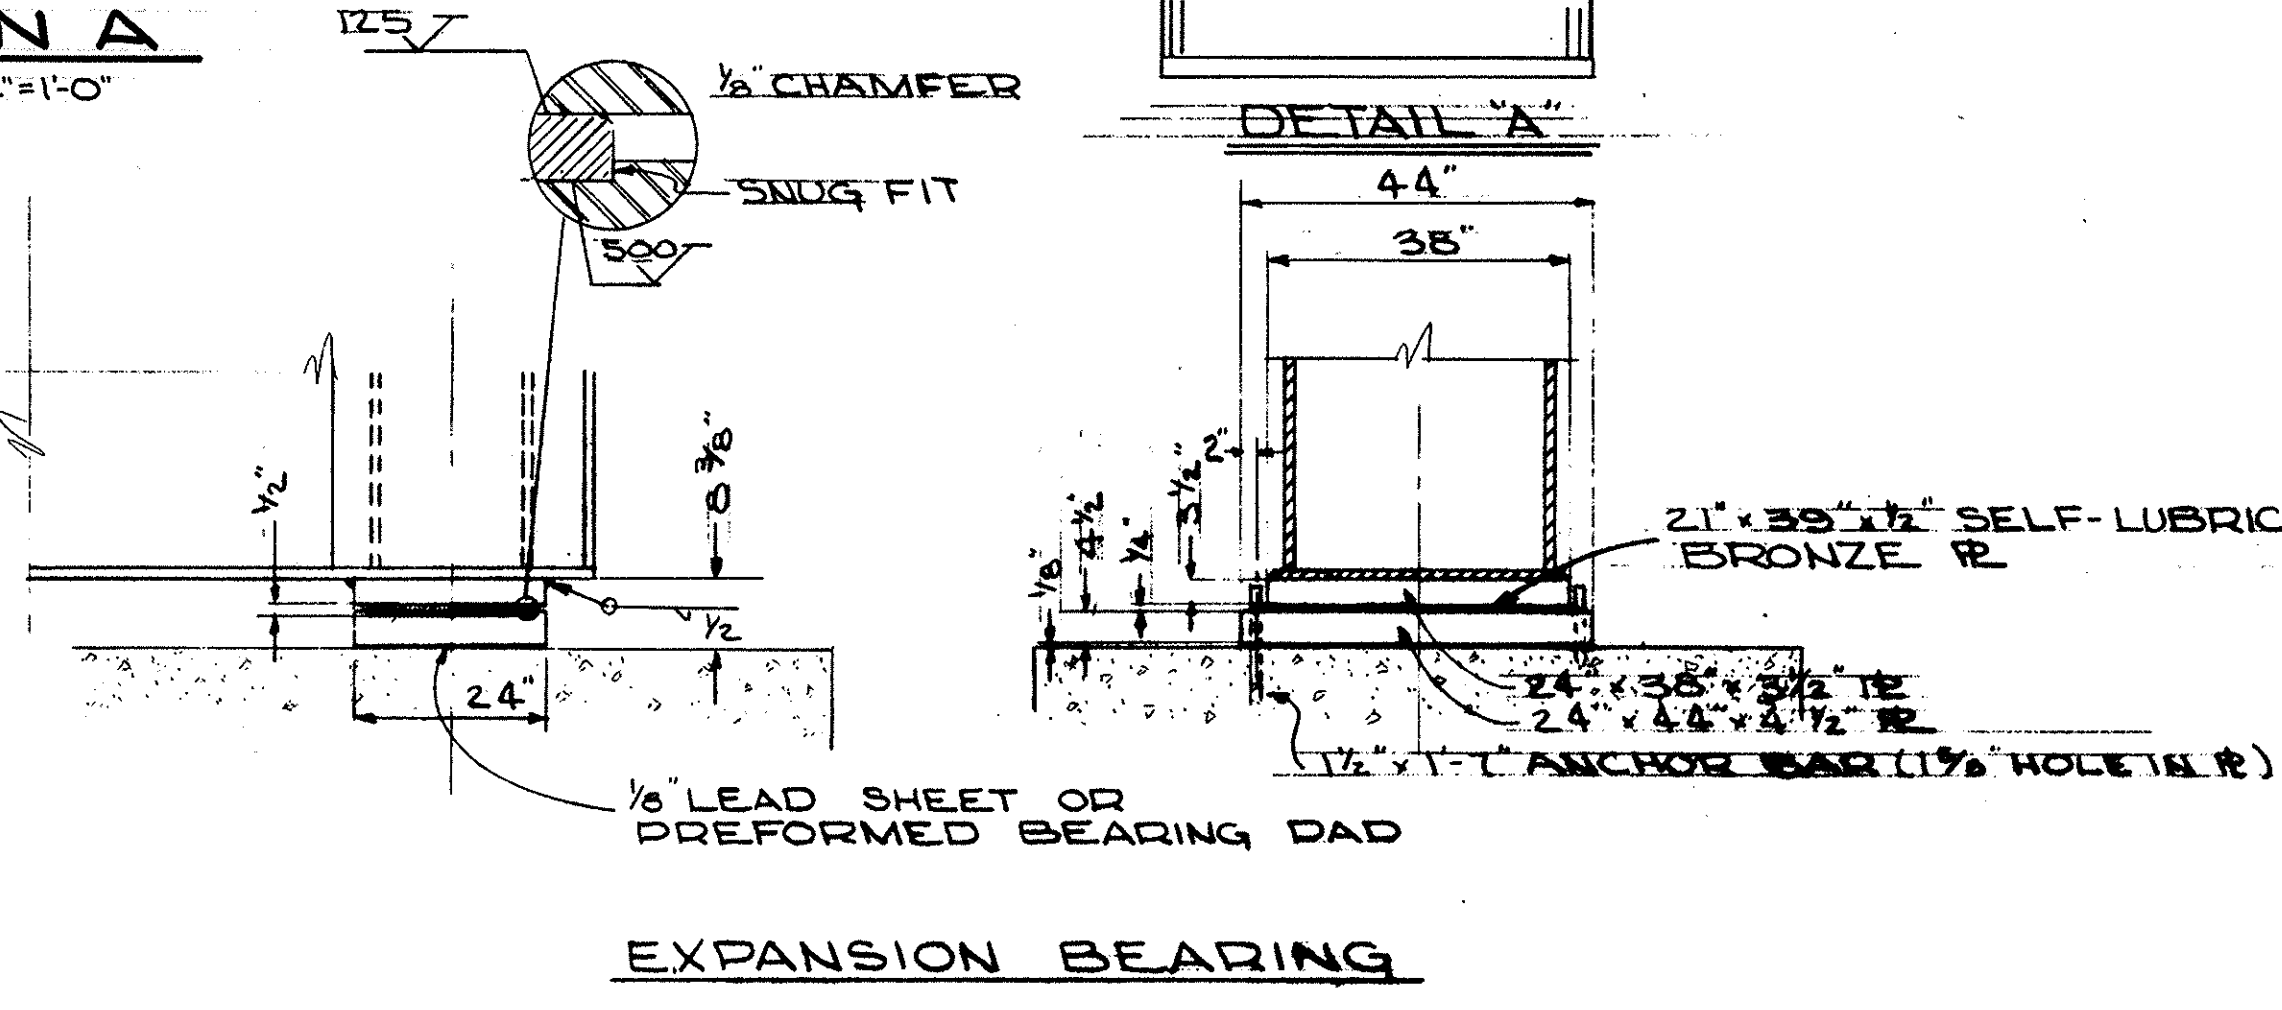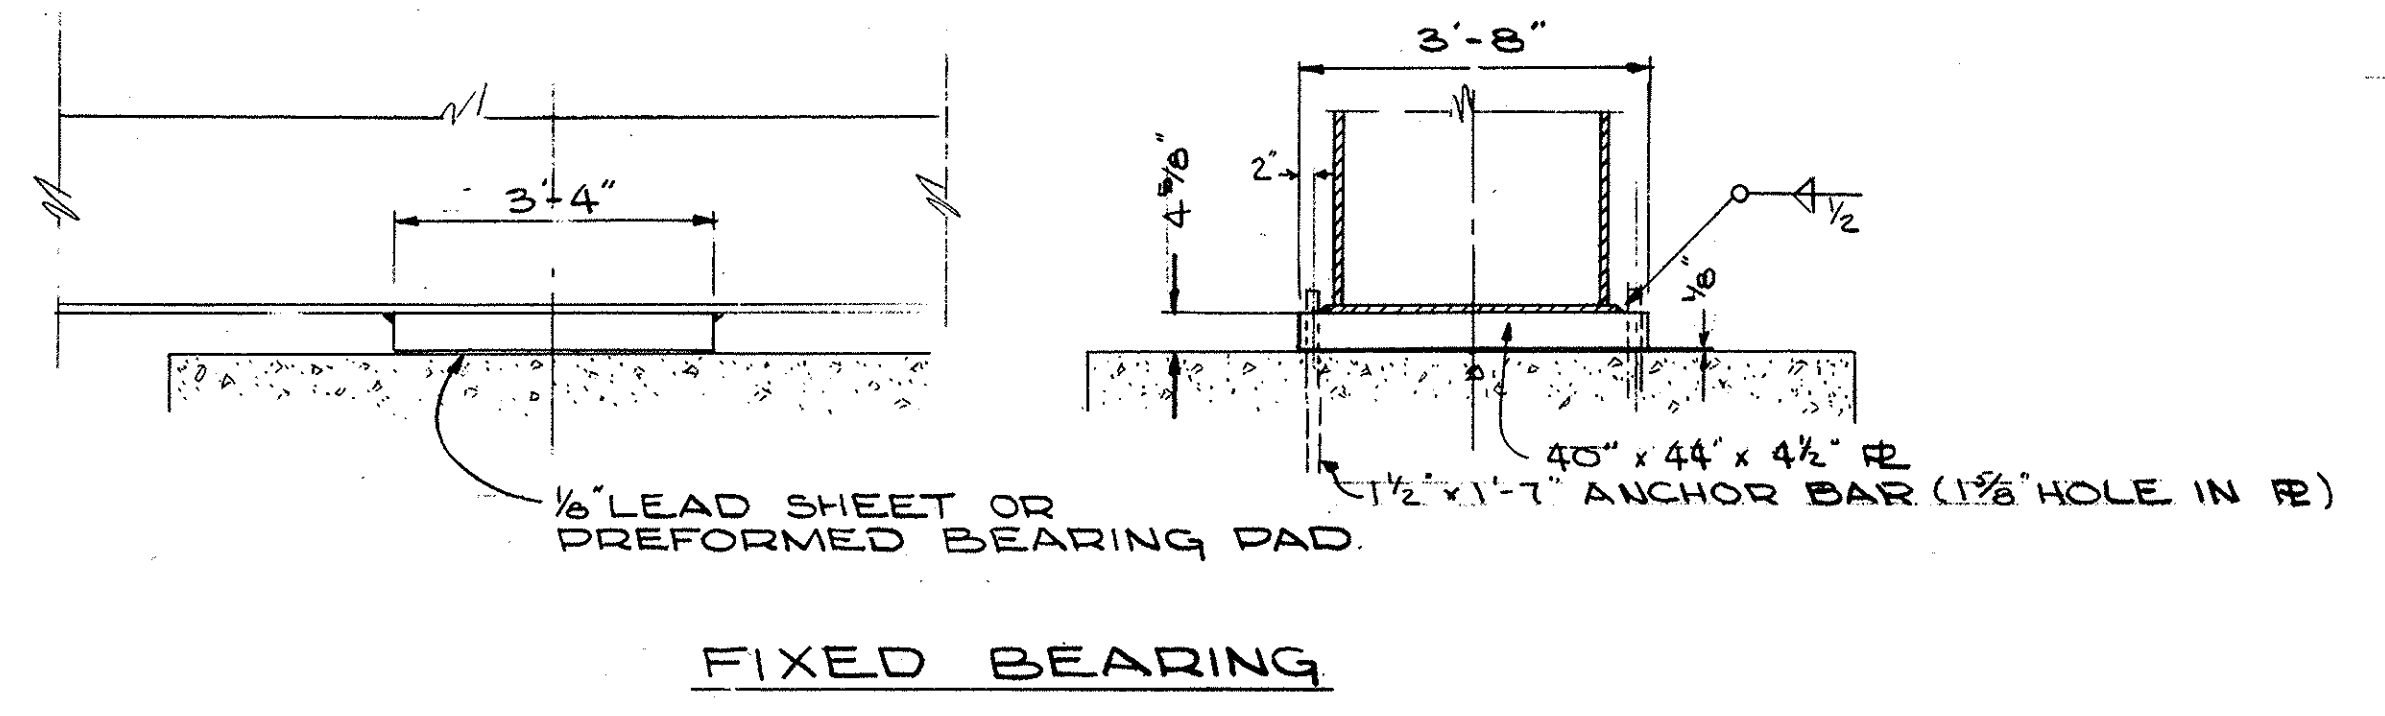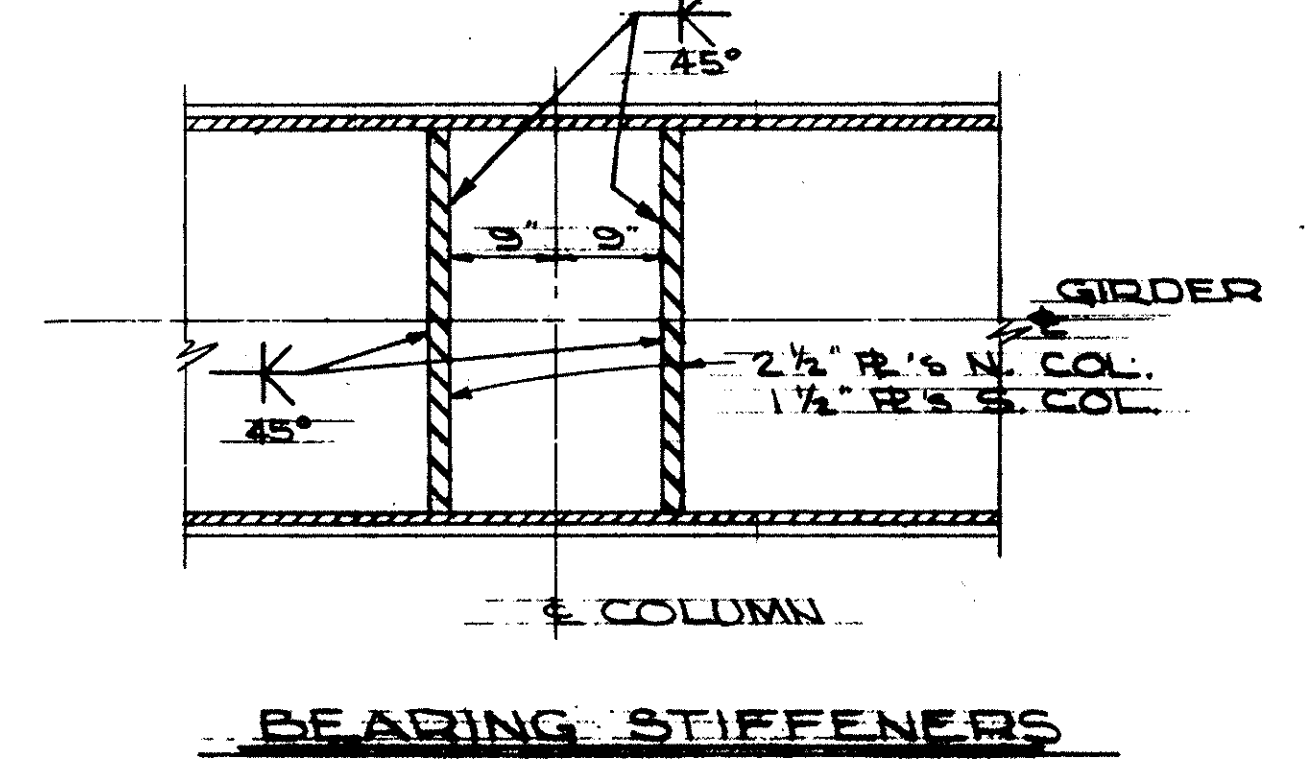


STATE OF OHIO DEPARTMENT OF HIGHWAYS BUREAU OF BRIDGES						
AKRON, OHIO			YOUNGSTOWN, OHIO			
GLAUS, PYLE & SCHOMER						
GIRDER CAP DETAILS FOR PIER 15						
BRIDGE NO. MAH-711-0116			OVER MAHONING RIVER			
YOUNGSTOWN			MAHONING COUNTY			
DESIGNED	DRAWN	TRACED	CHECKED	REVIEWED	DATE	REVISED
JWC	JWC		JM	WMB	6-22-68	

MAH-711-2.17

MINIMUM
JUN 15 1969
REVISION

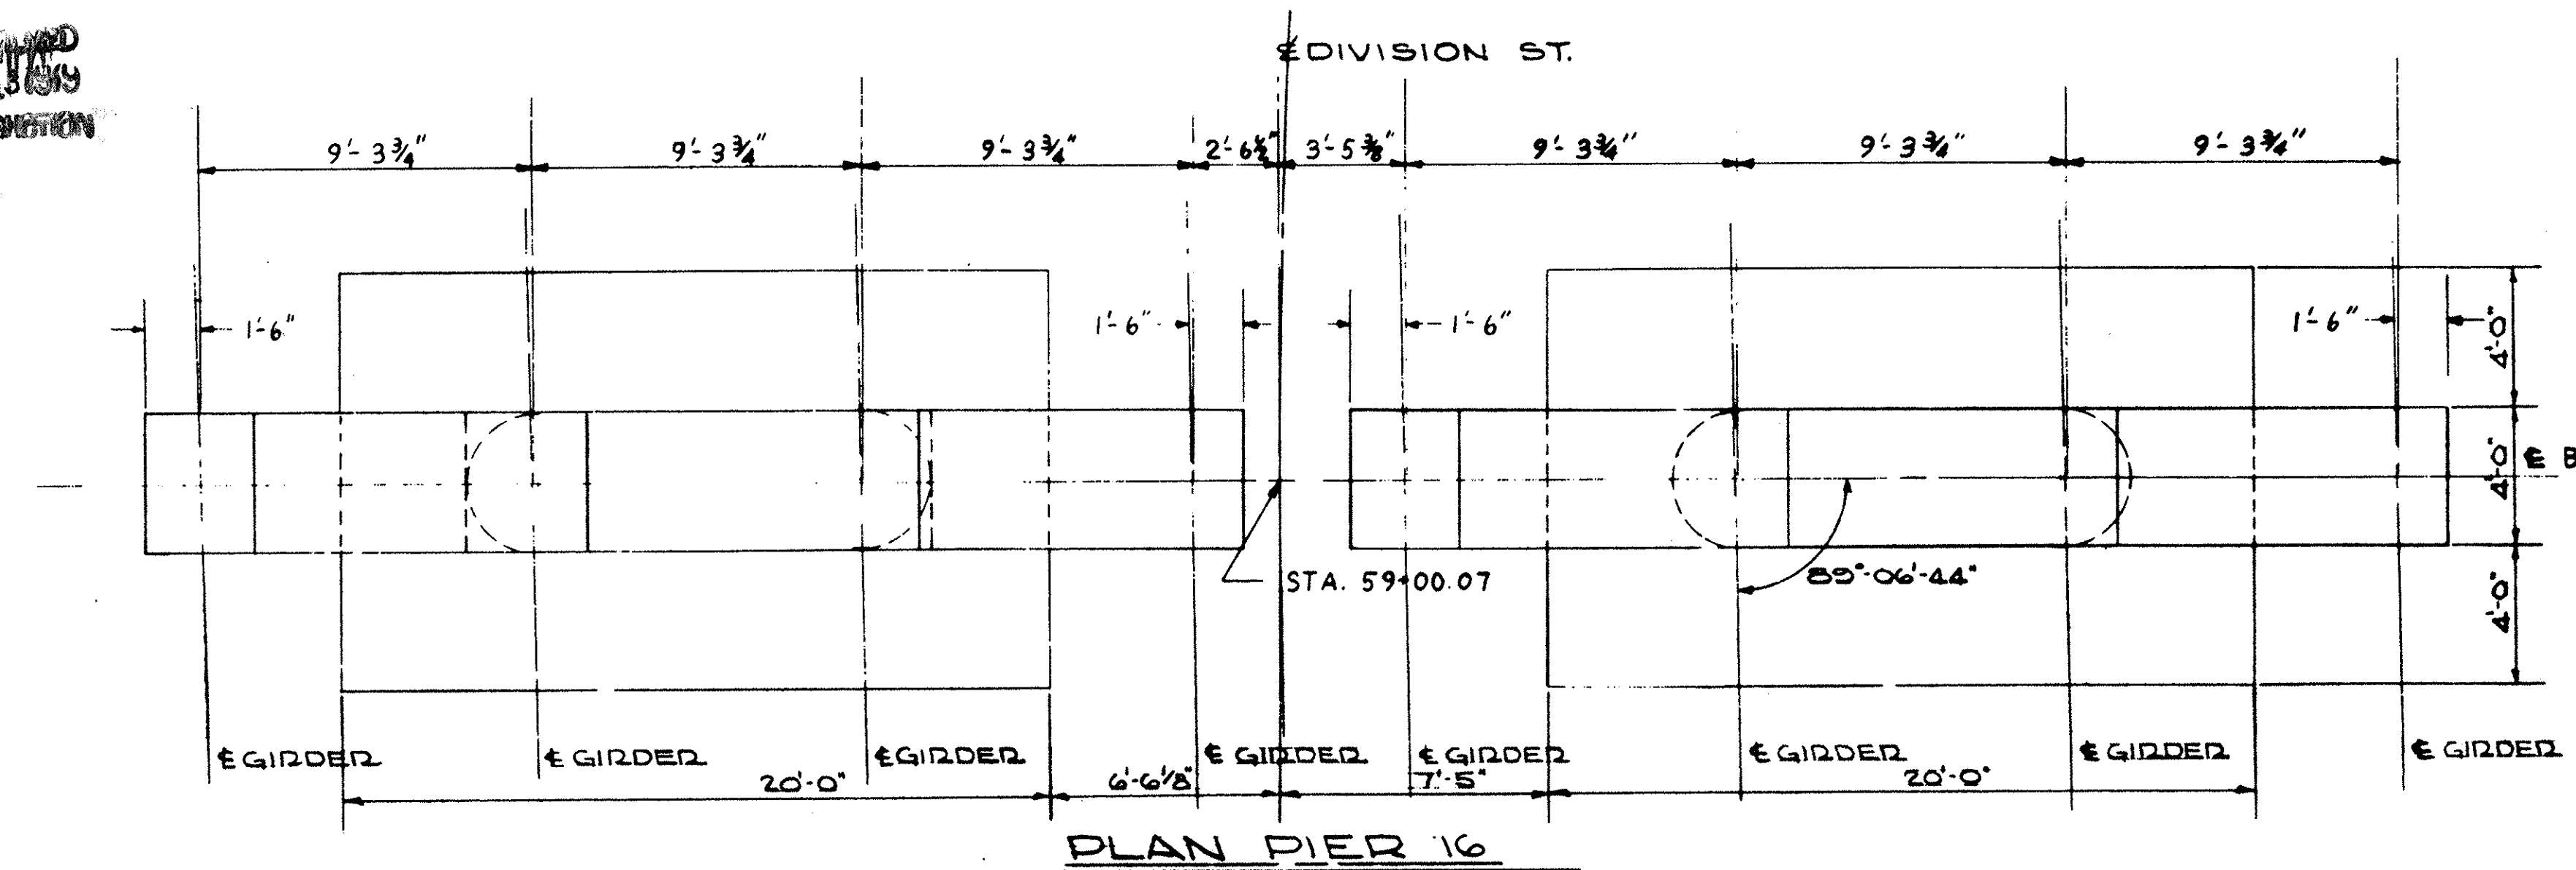

PLAN PIER 16

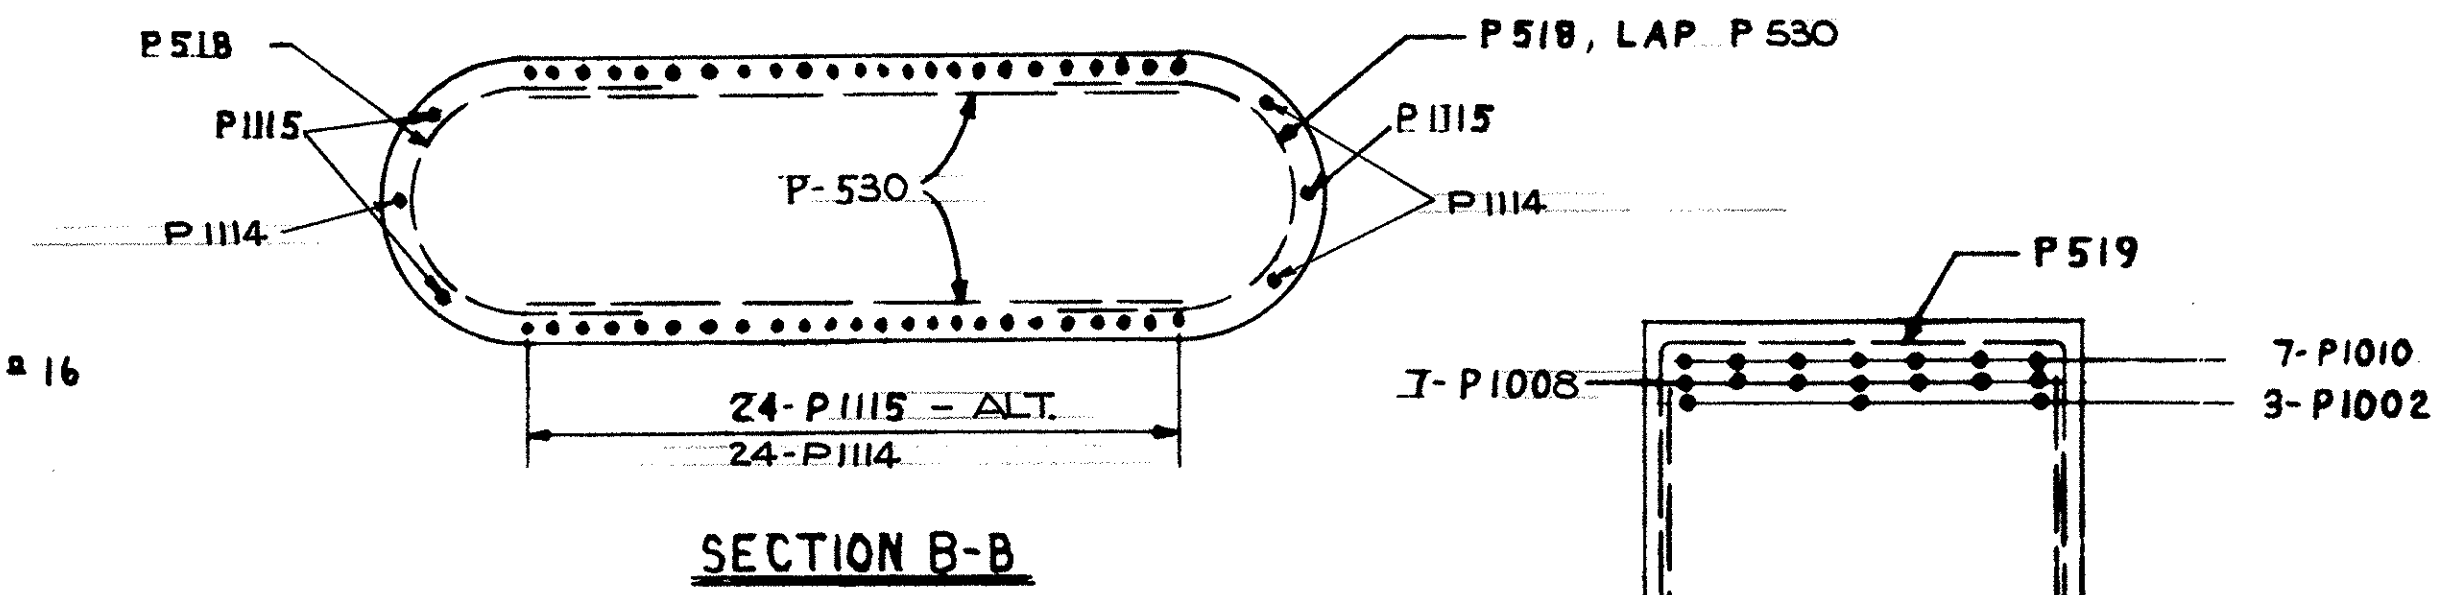


SECTION B-B

SECTION C-C


NOTE:
WELDED SPLICES OF #14 BARS SHALL NOT BE USED. AN APPROVED POSITIVE CONNECTION FOR BARS DESIGNED TO DEVELOP 125% OF THE SPECIFIED YIELD STRENGTH OF THE BAR SHALL BE PROVIDED.
THE LEFT STEM MAY HAVE TO BE REDESIGNED IF THE 30' ± WATER LINE IS NOT IN THE LOCATION SHOWN.

PIER ELEVATION TABLE


PIER 16	A	B	C	D	E	F	G	H	I
	900.14	899.68	899.23	898.99	898.89	898.22	897.76	897.30	842.00

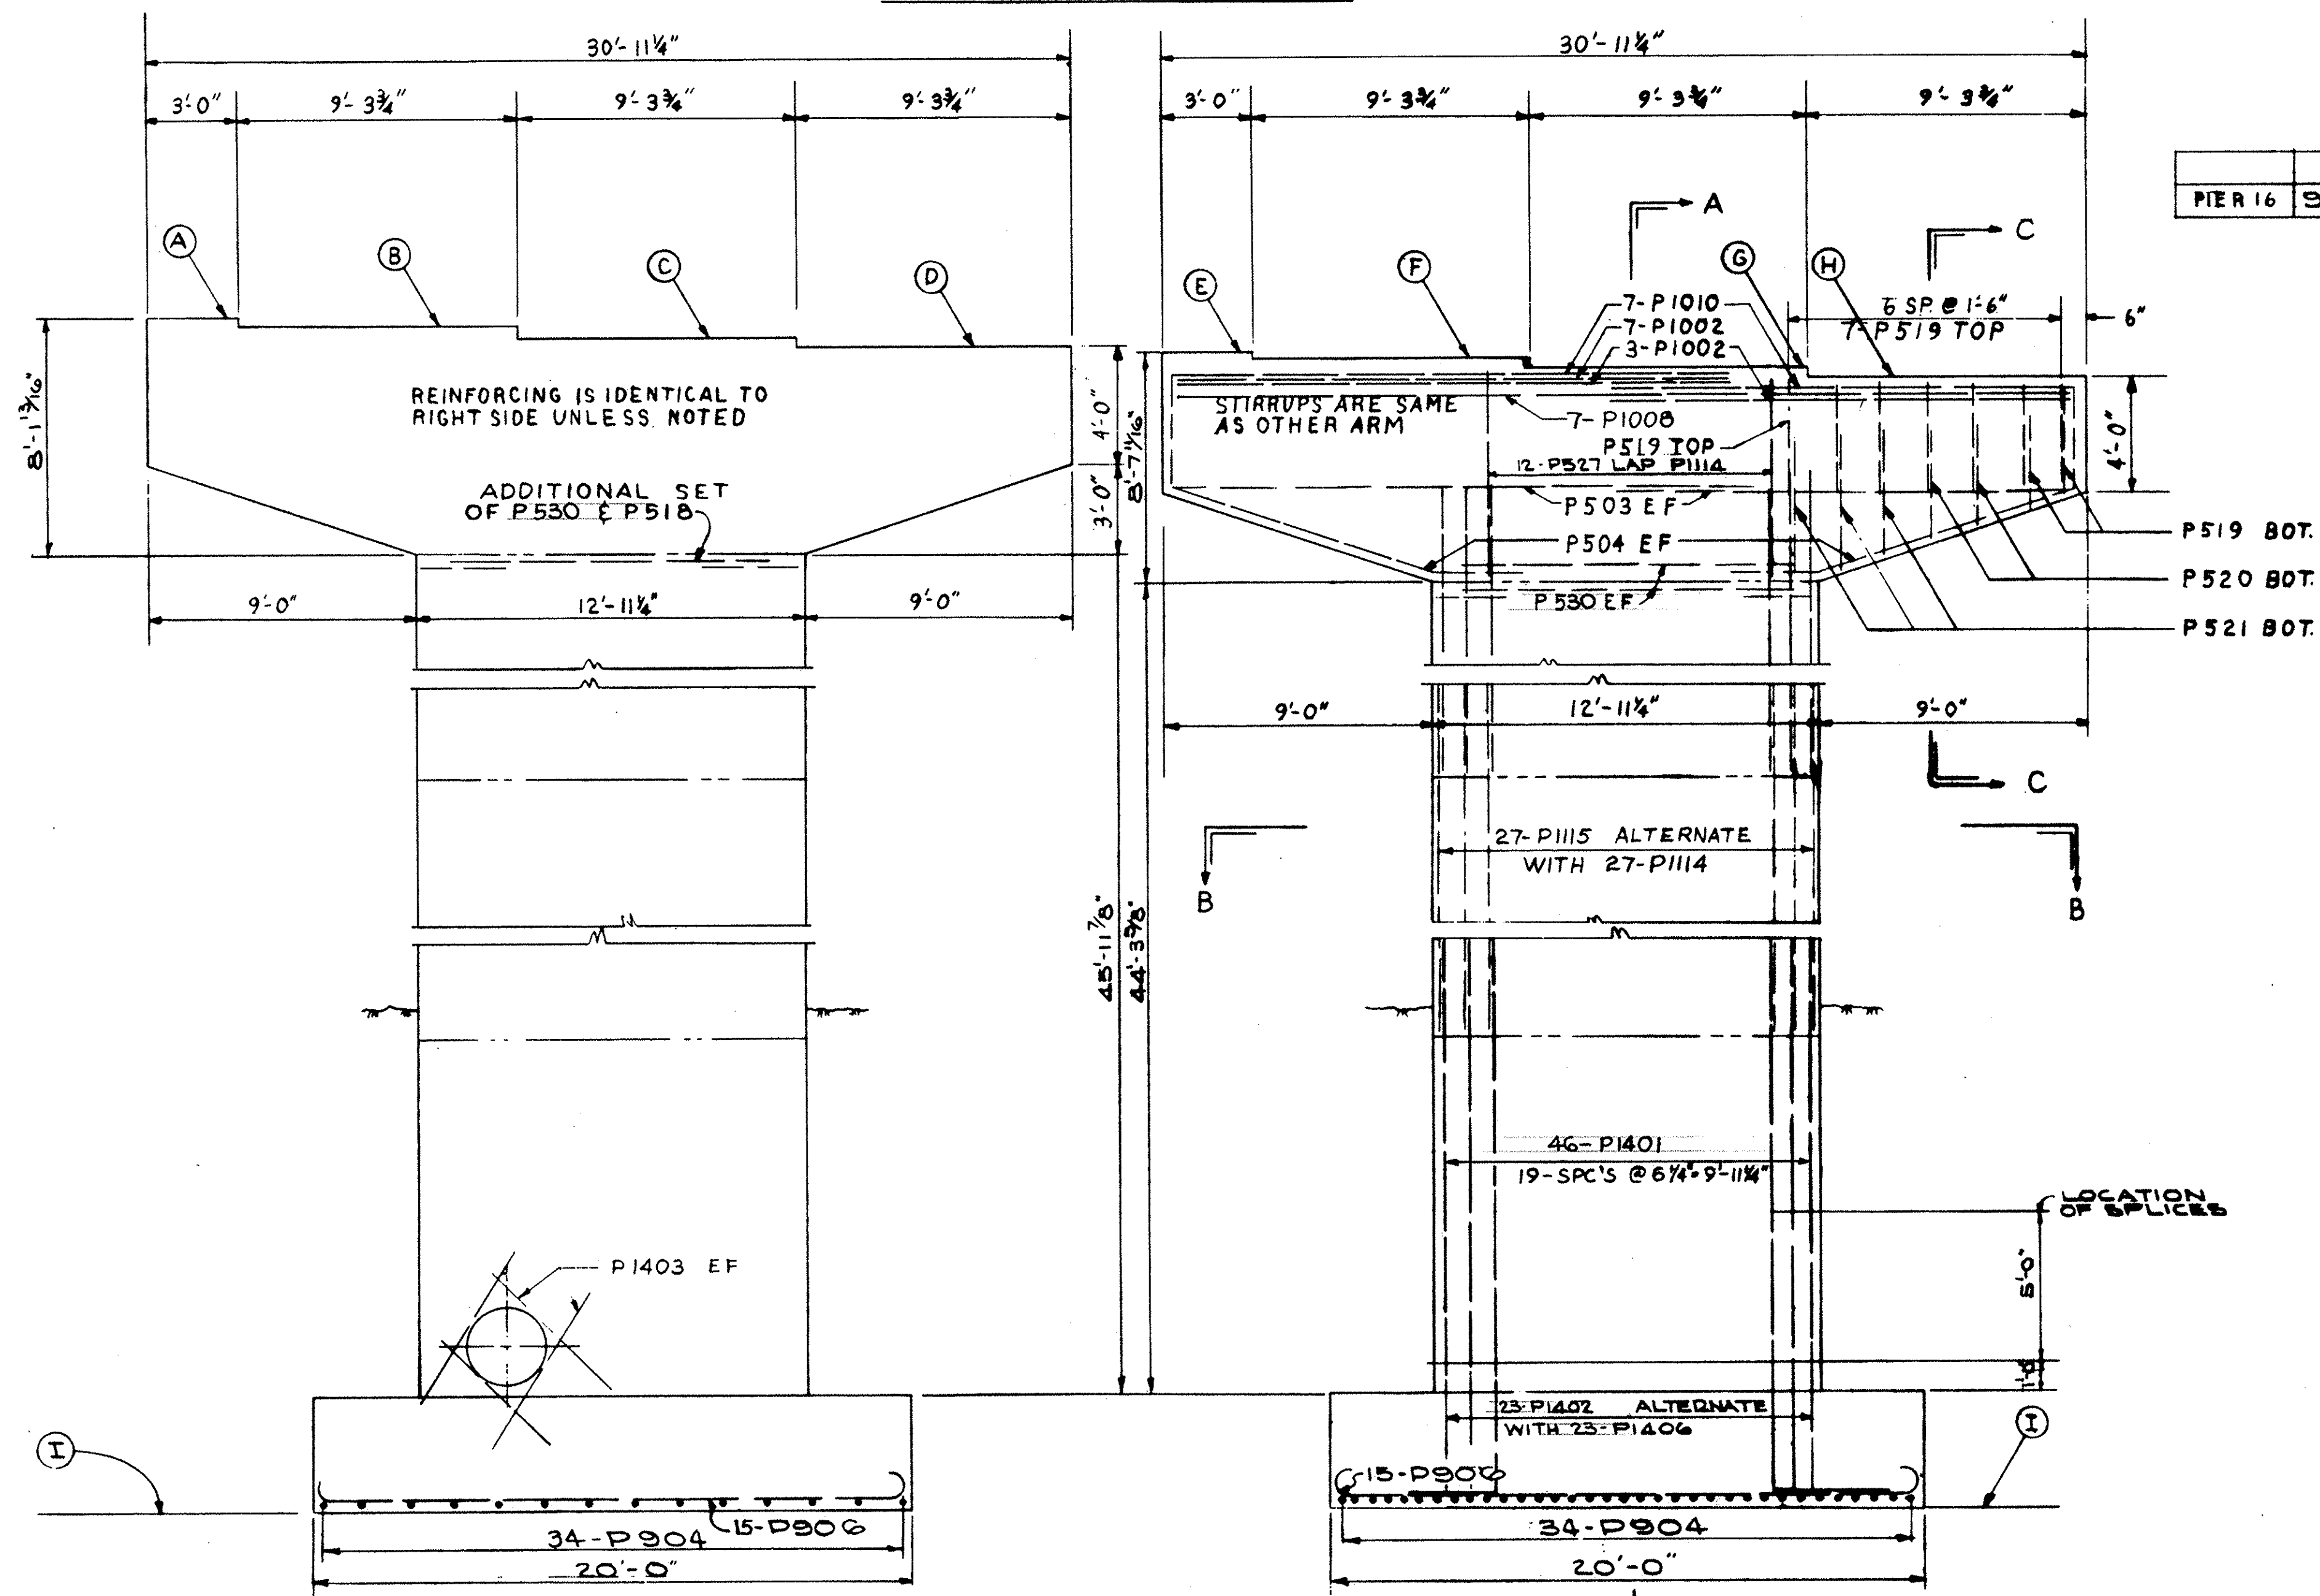

ELEVATION-PIER 16

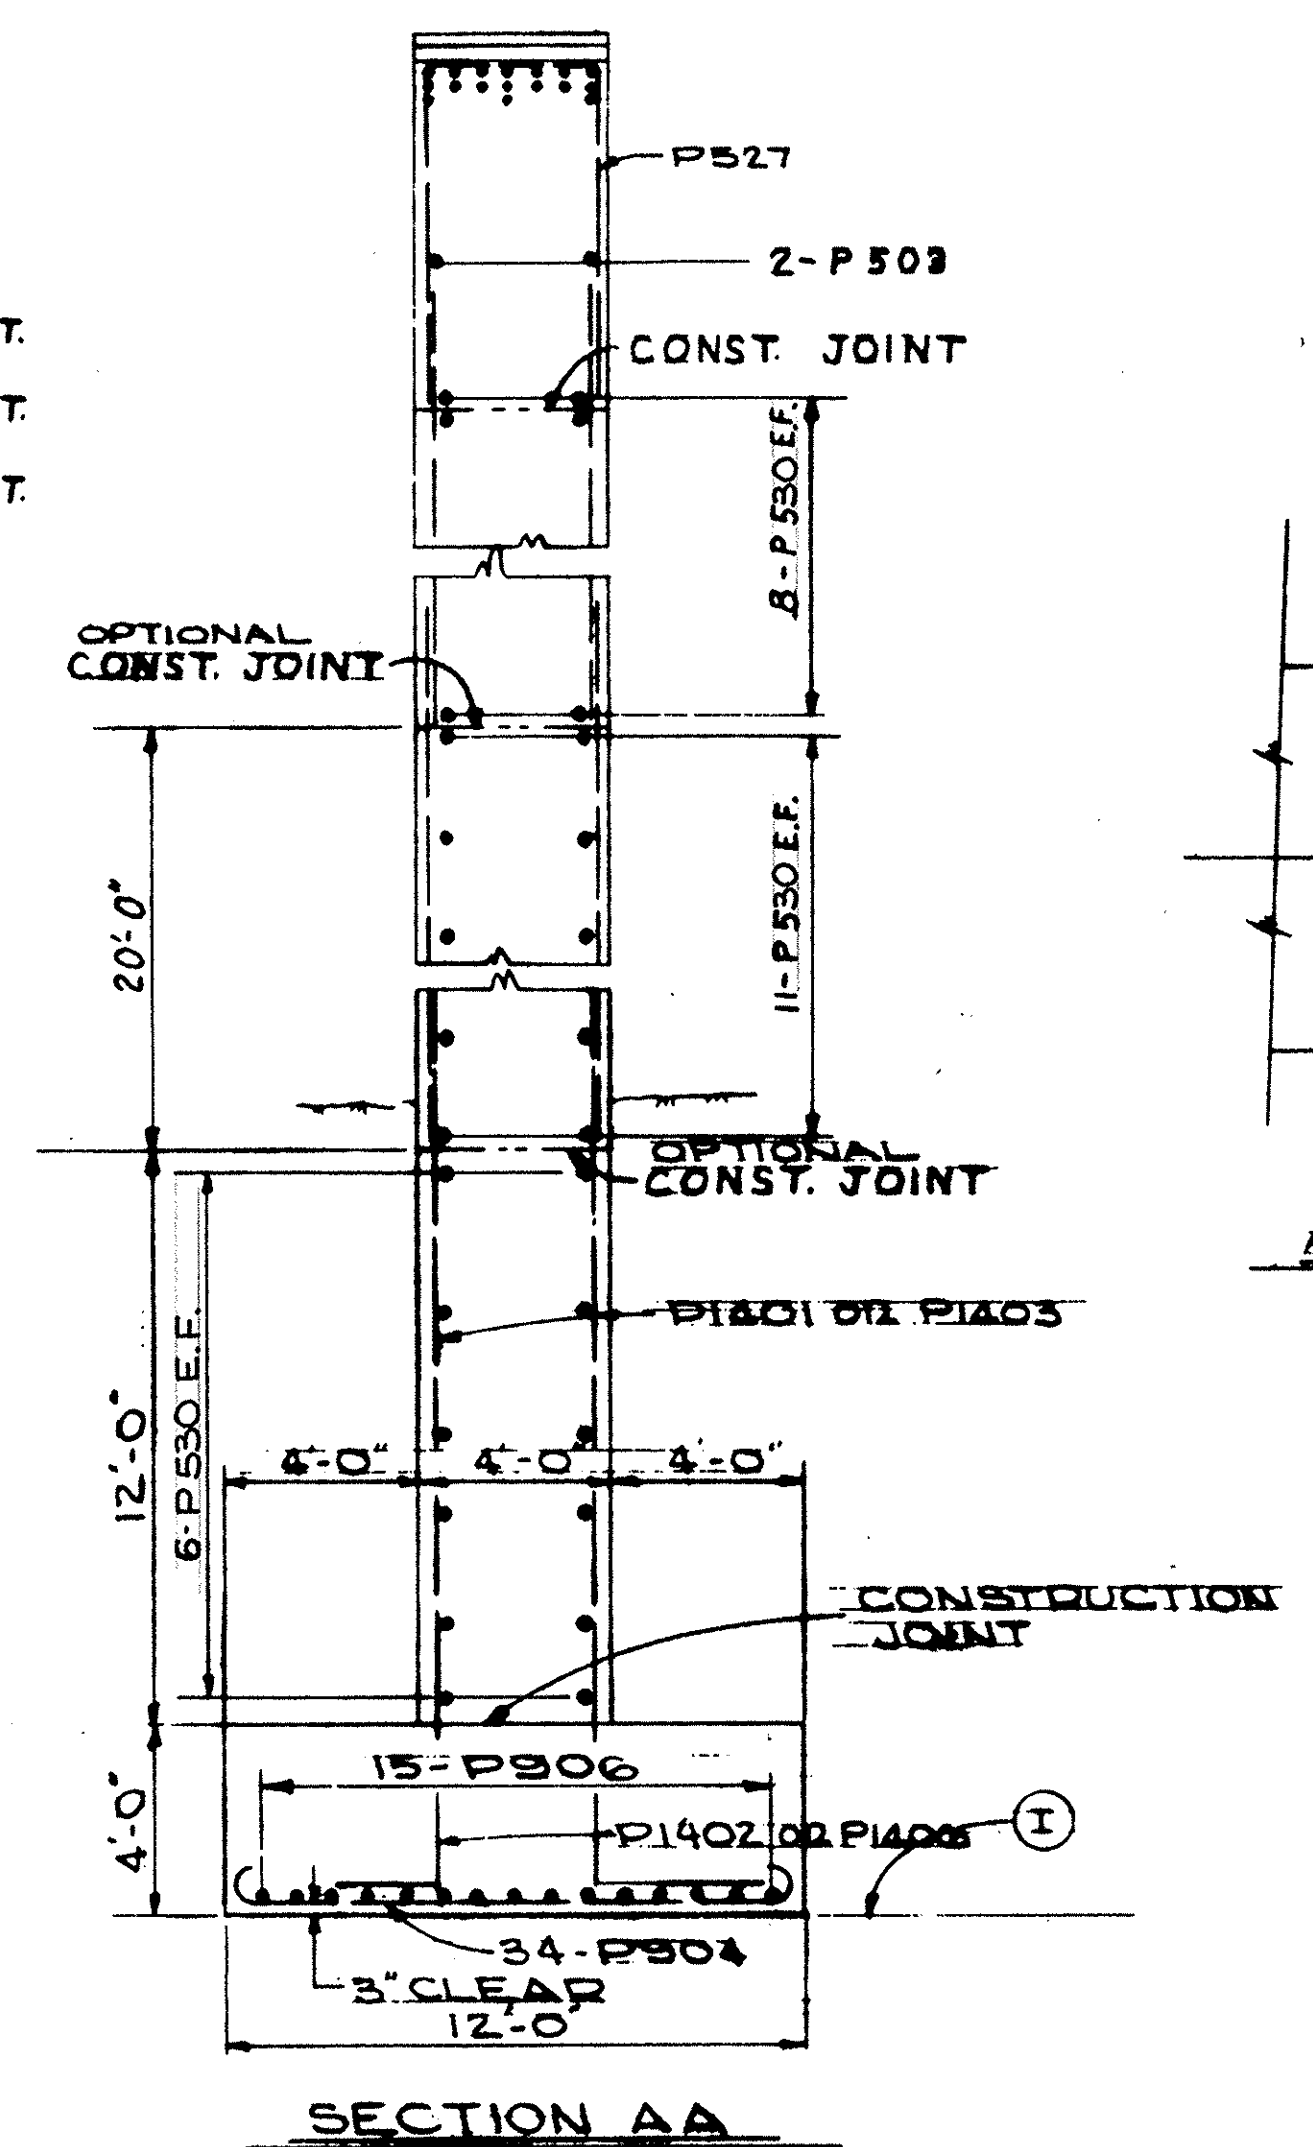

SECTION AA

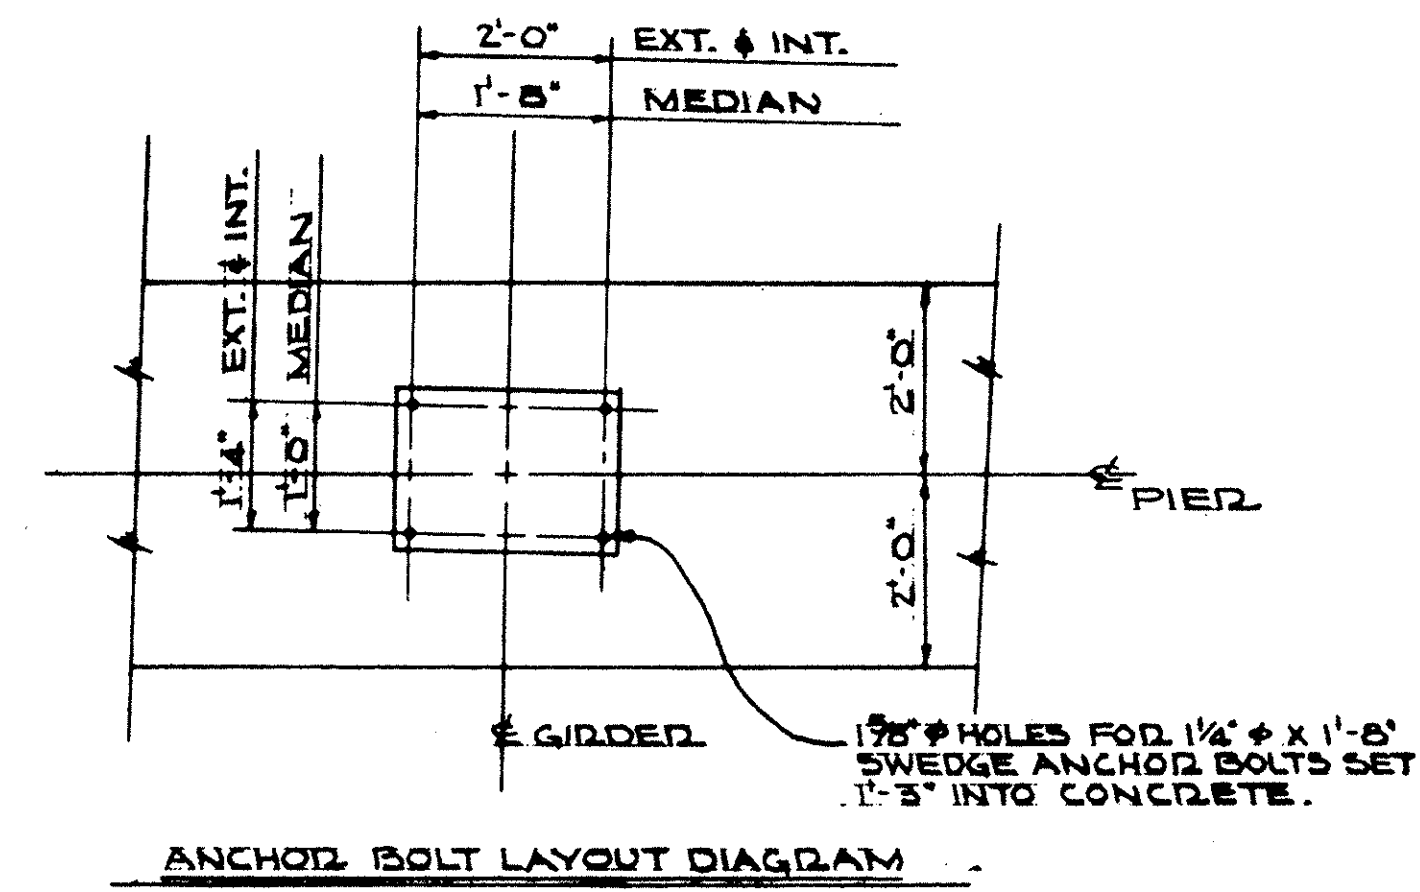





This sheet supersedes sheet No. 169. 9-12-69

STATE OF OHIO DEPARTMENT OF HIGHWAYS BUREAU OF BRIDGES						
GLAUS, PYLE & SCHOMER AKRON, OHIO YOUNGSTOWN, OHIO						
PIER 16						
BRIDGE N°			MAH-711-016			
OVER MAHONING RIVER						
YOUNGSTOWN			MAHONING COUNTY			
DESIGNED	DRAWN	TRACED	CHECKED	REVIEWED	DATE	REVISED
J.W.C.	D.M.		J.M.	W.K.D.	6-22-68	

MAHONING
JUN 13 1969
REPRODUCTION

FED. RD.	STATE	PROJECT	170 232
2	OHIO	U.S.-1150 (1)	

MAH-711-0.17

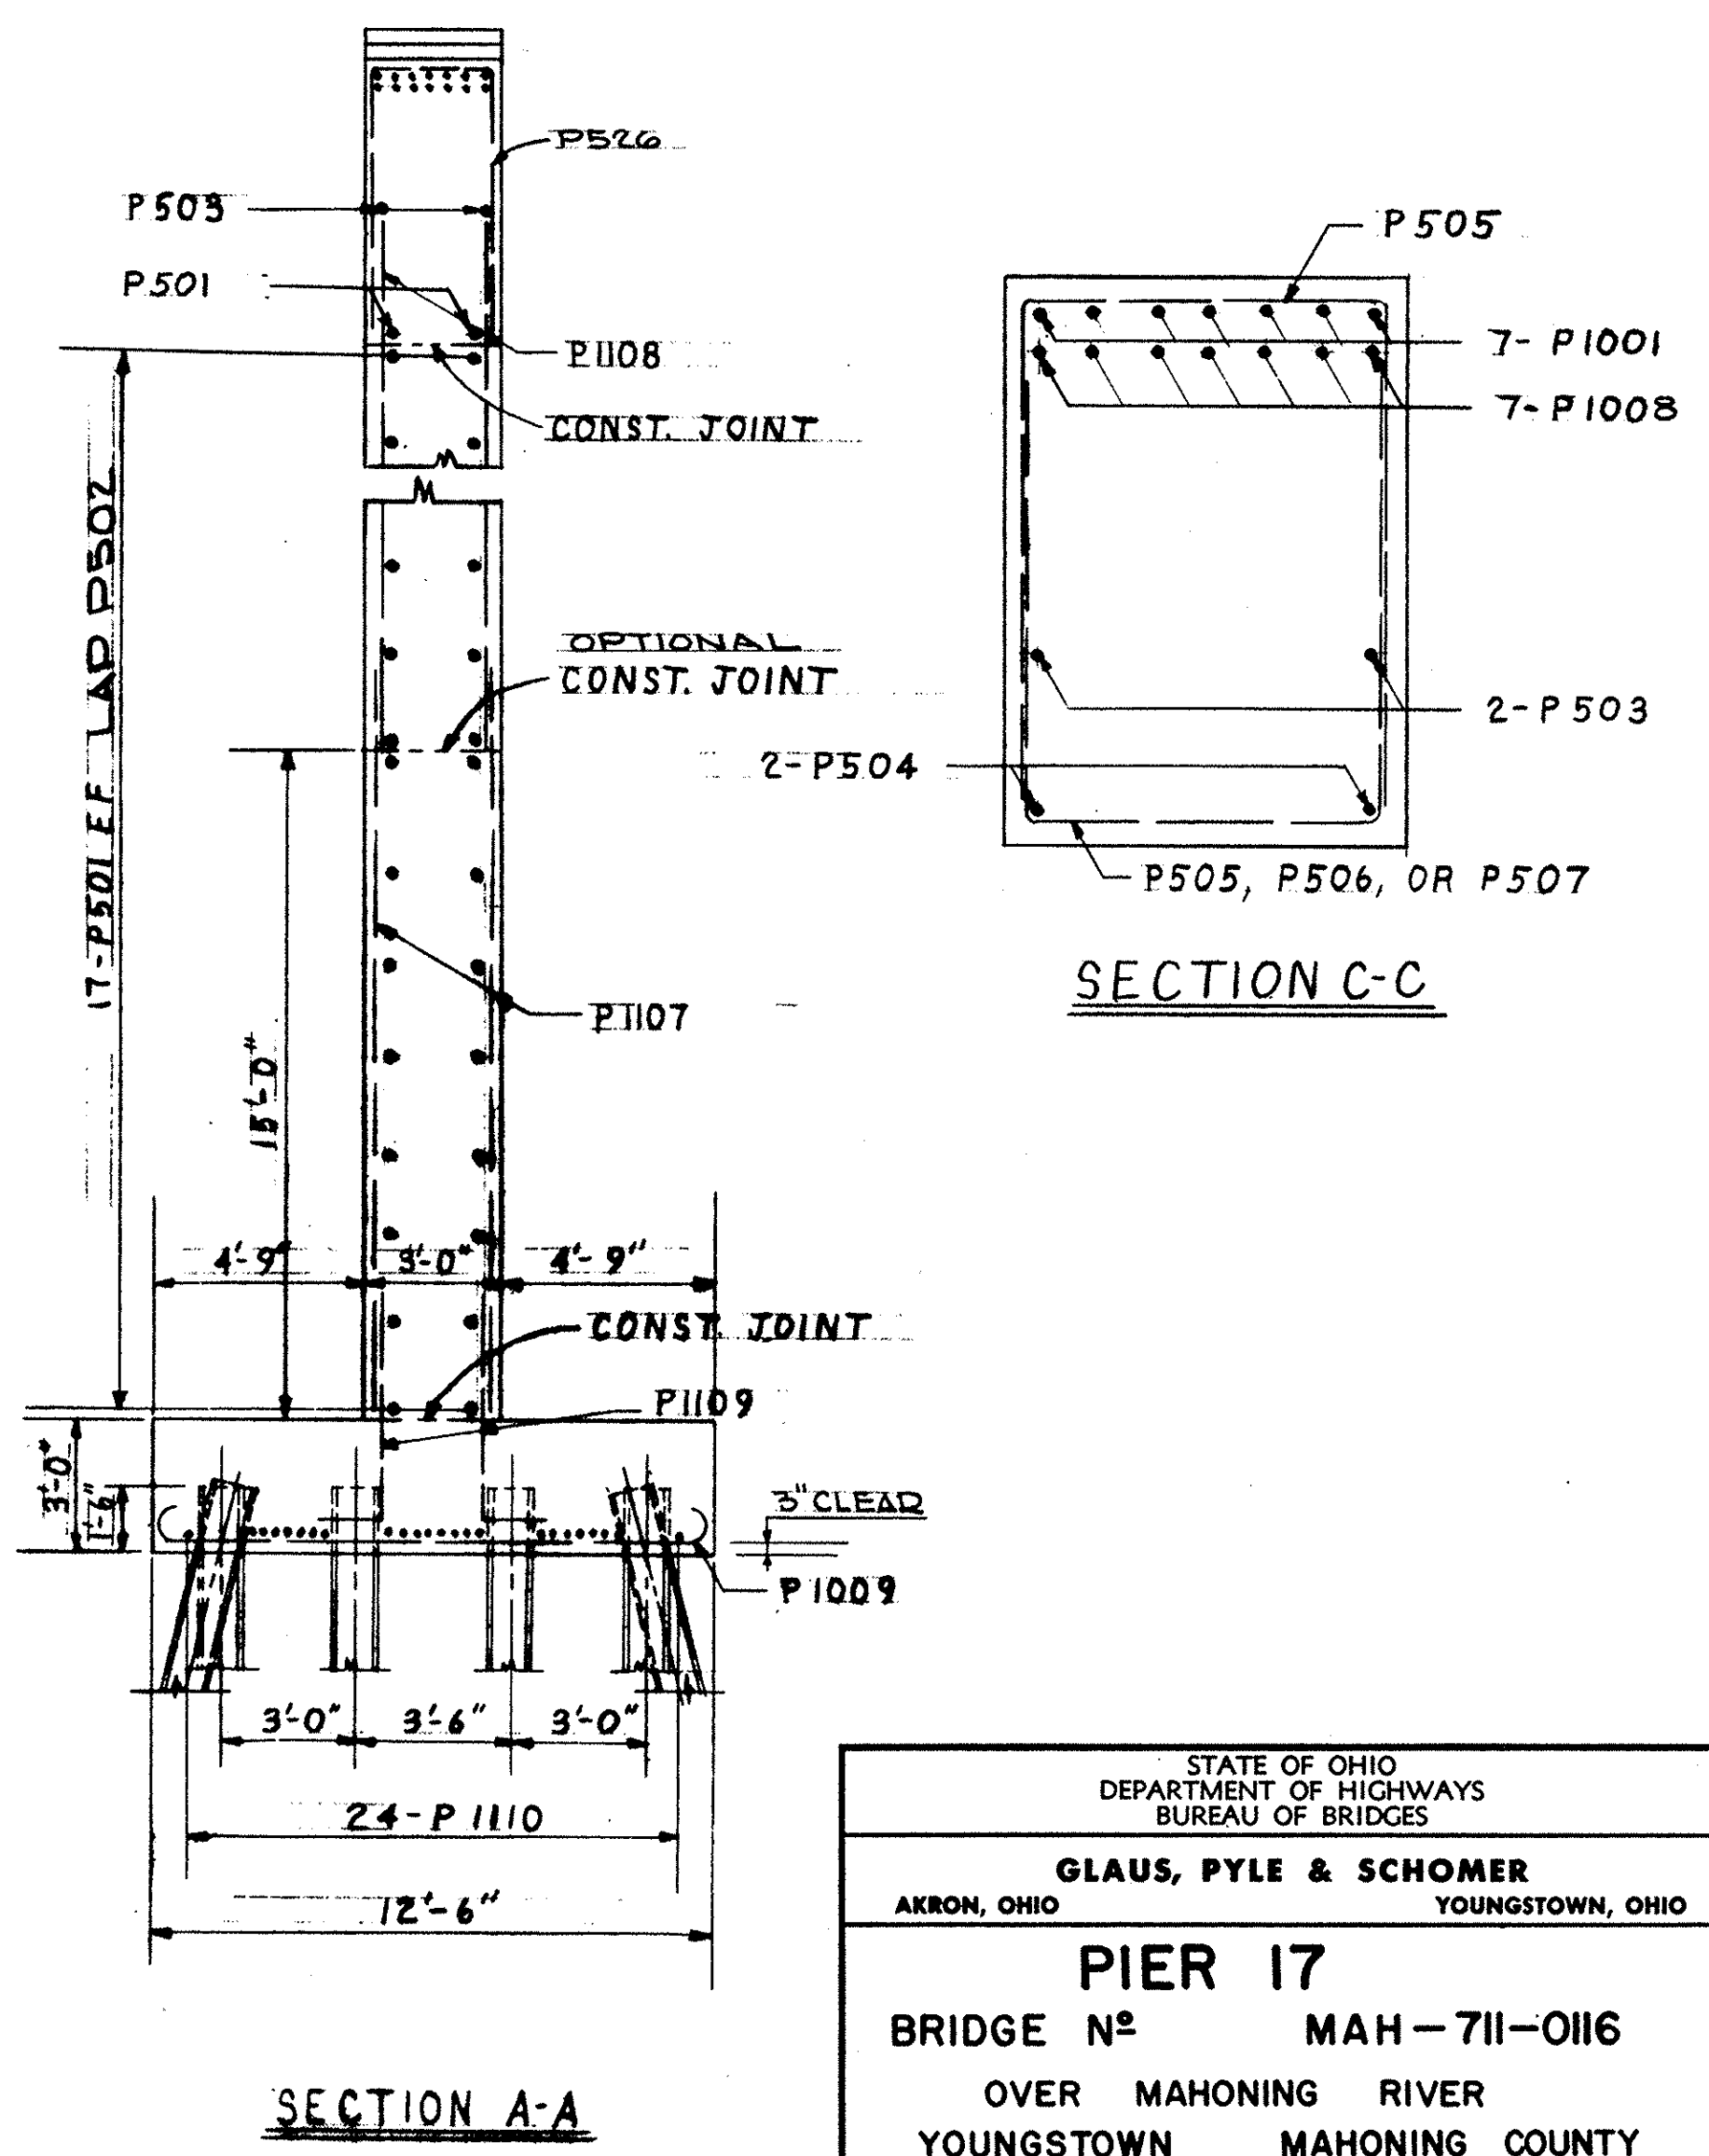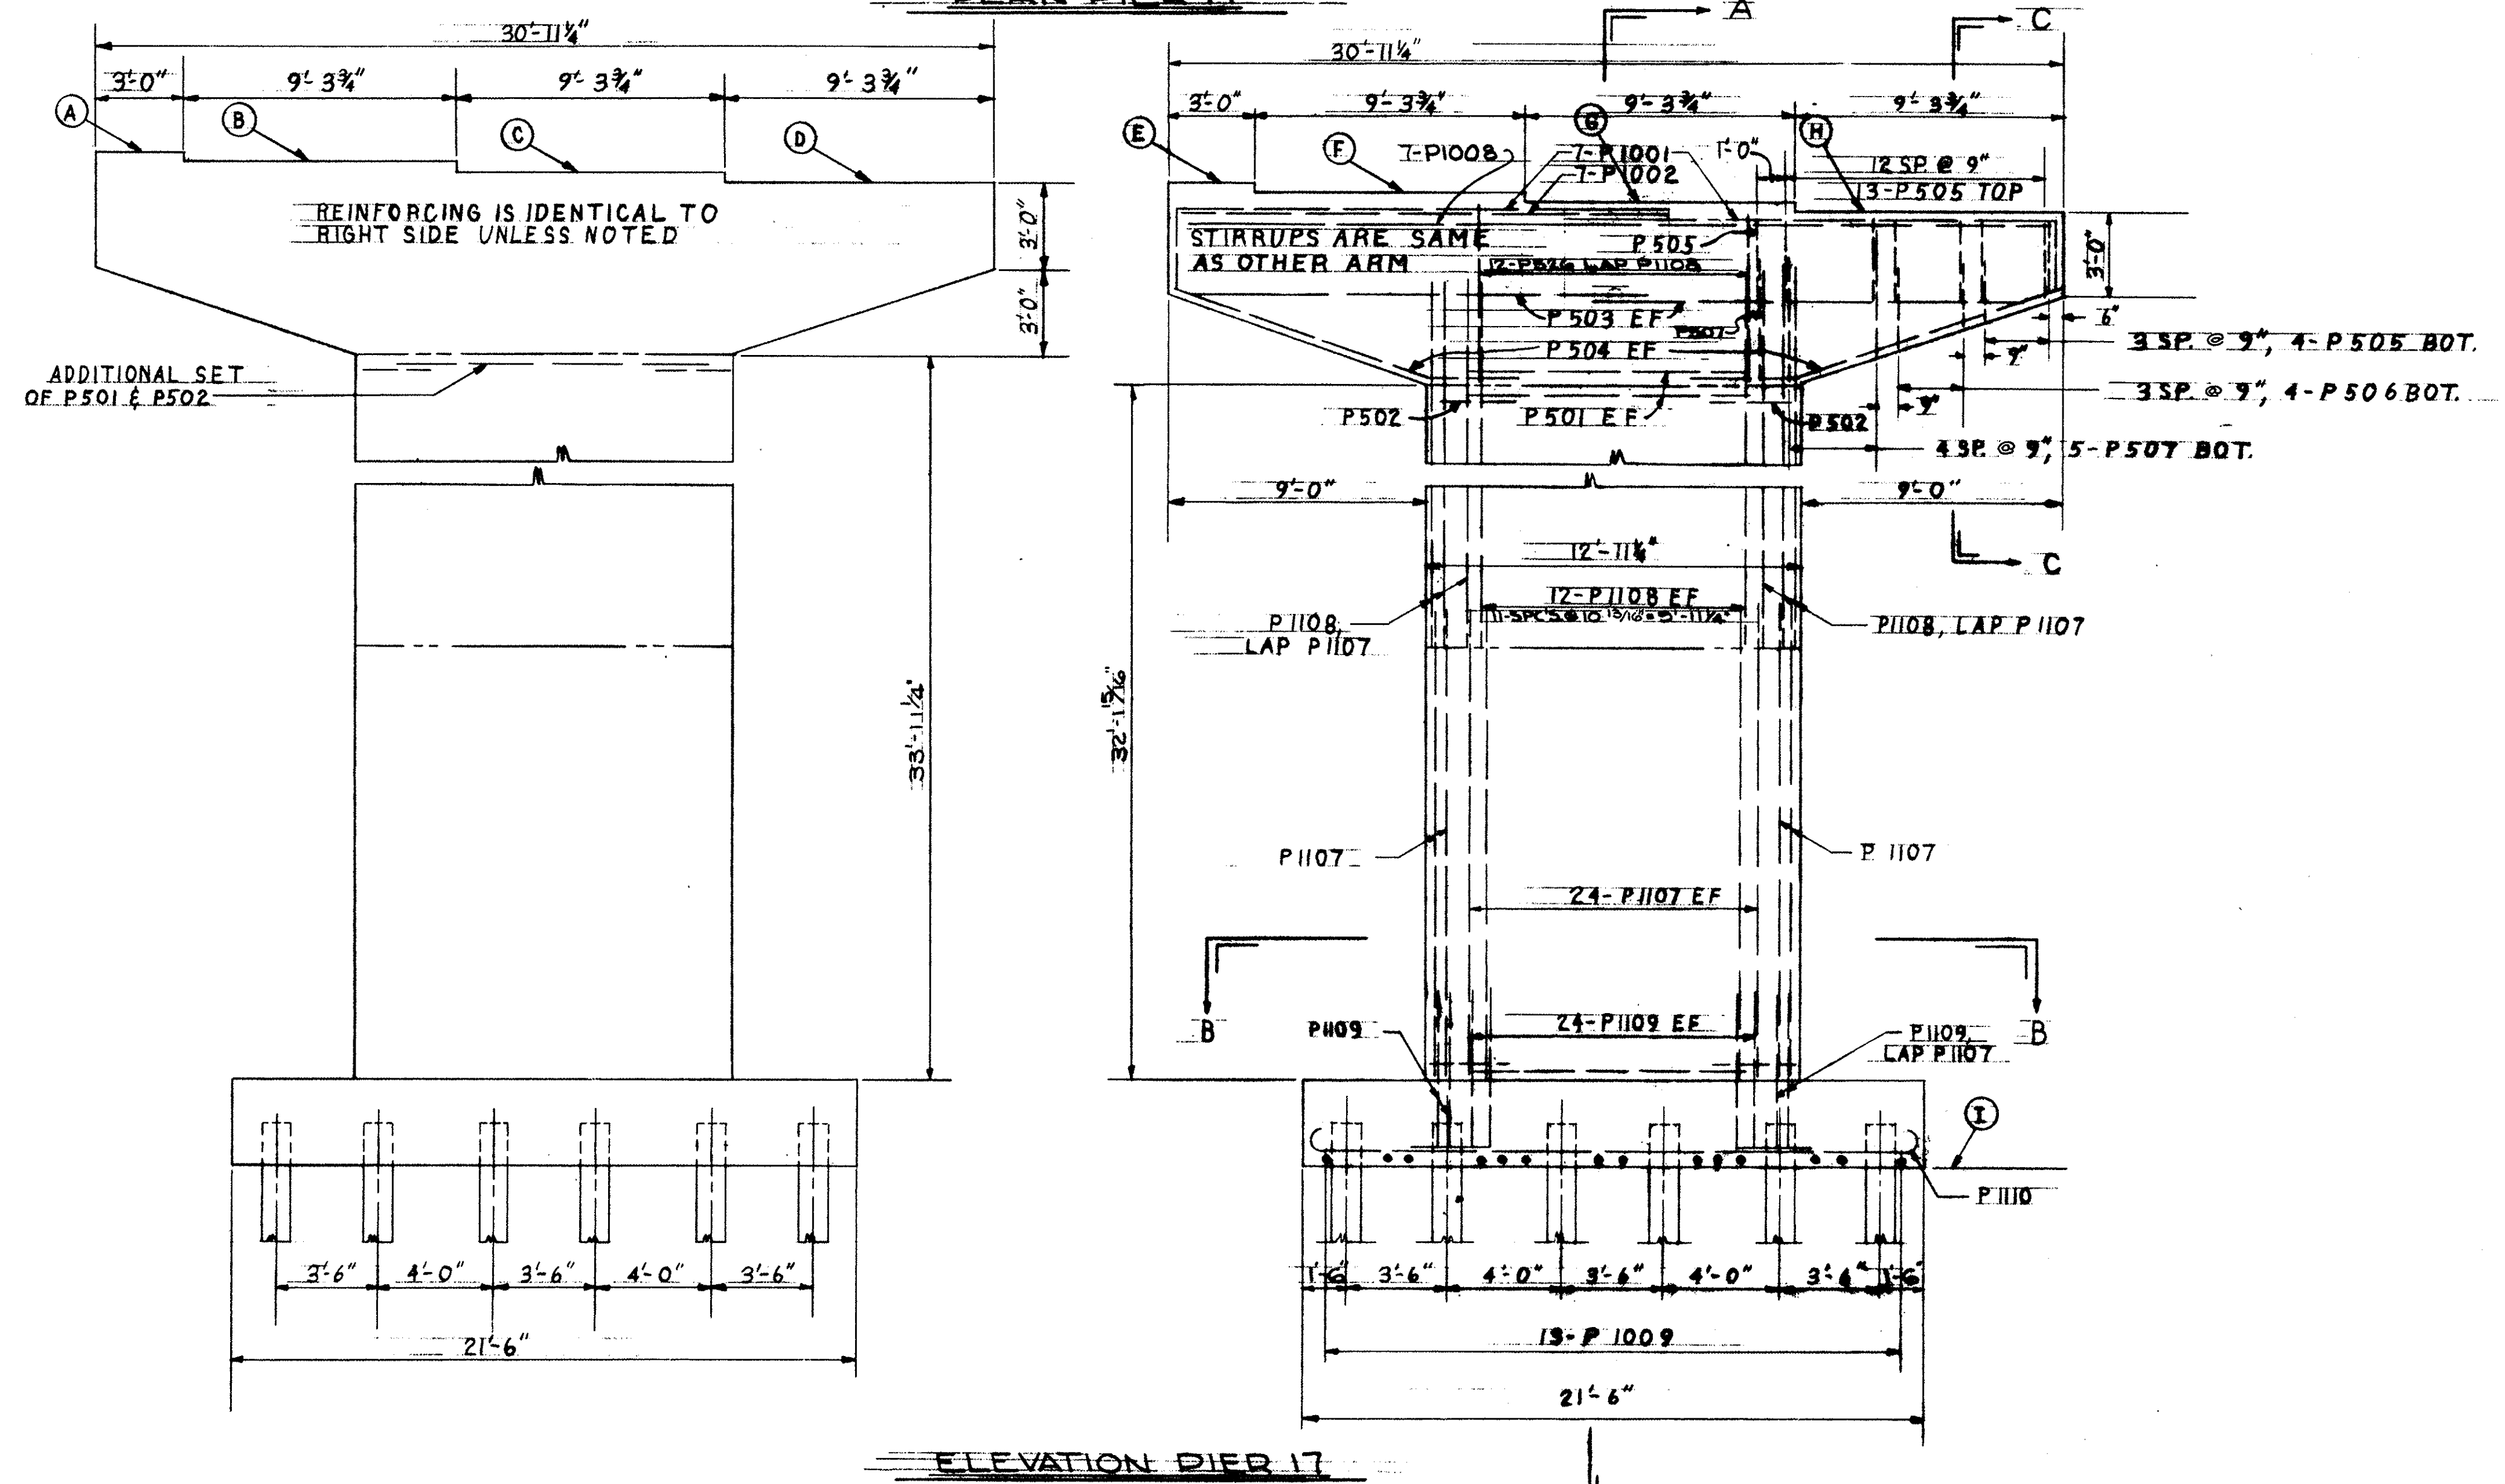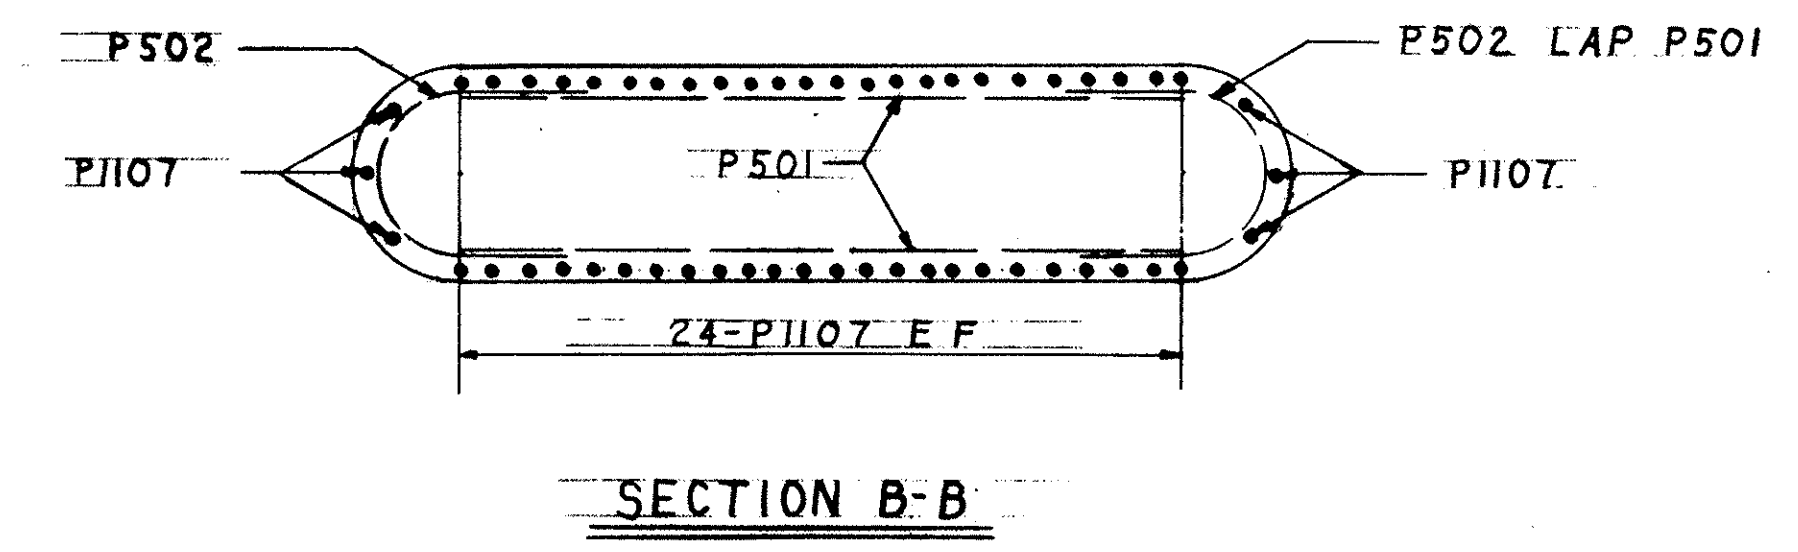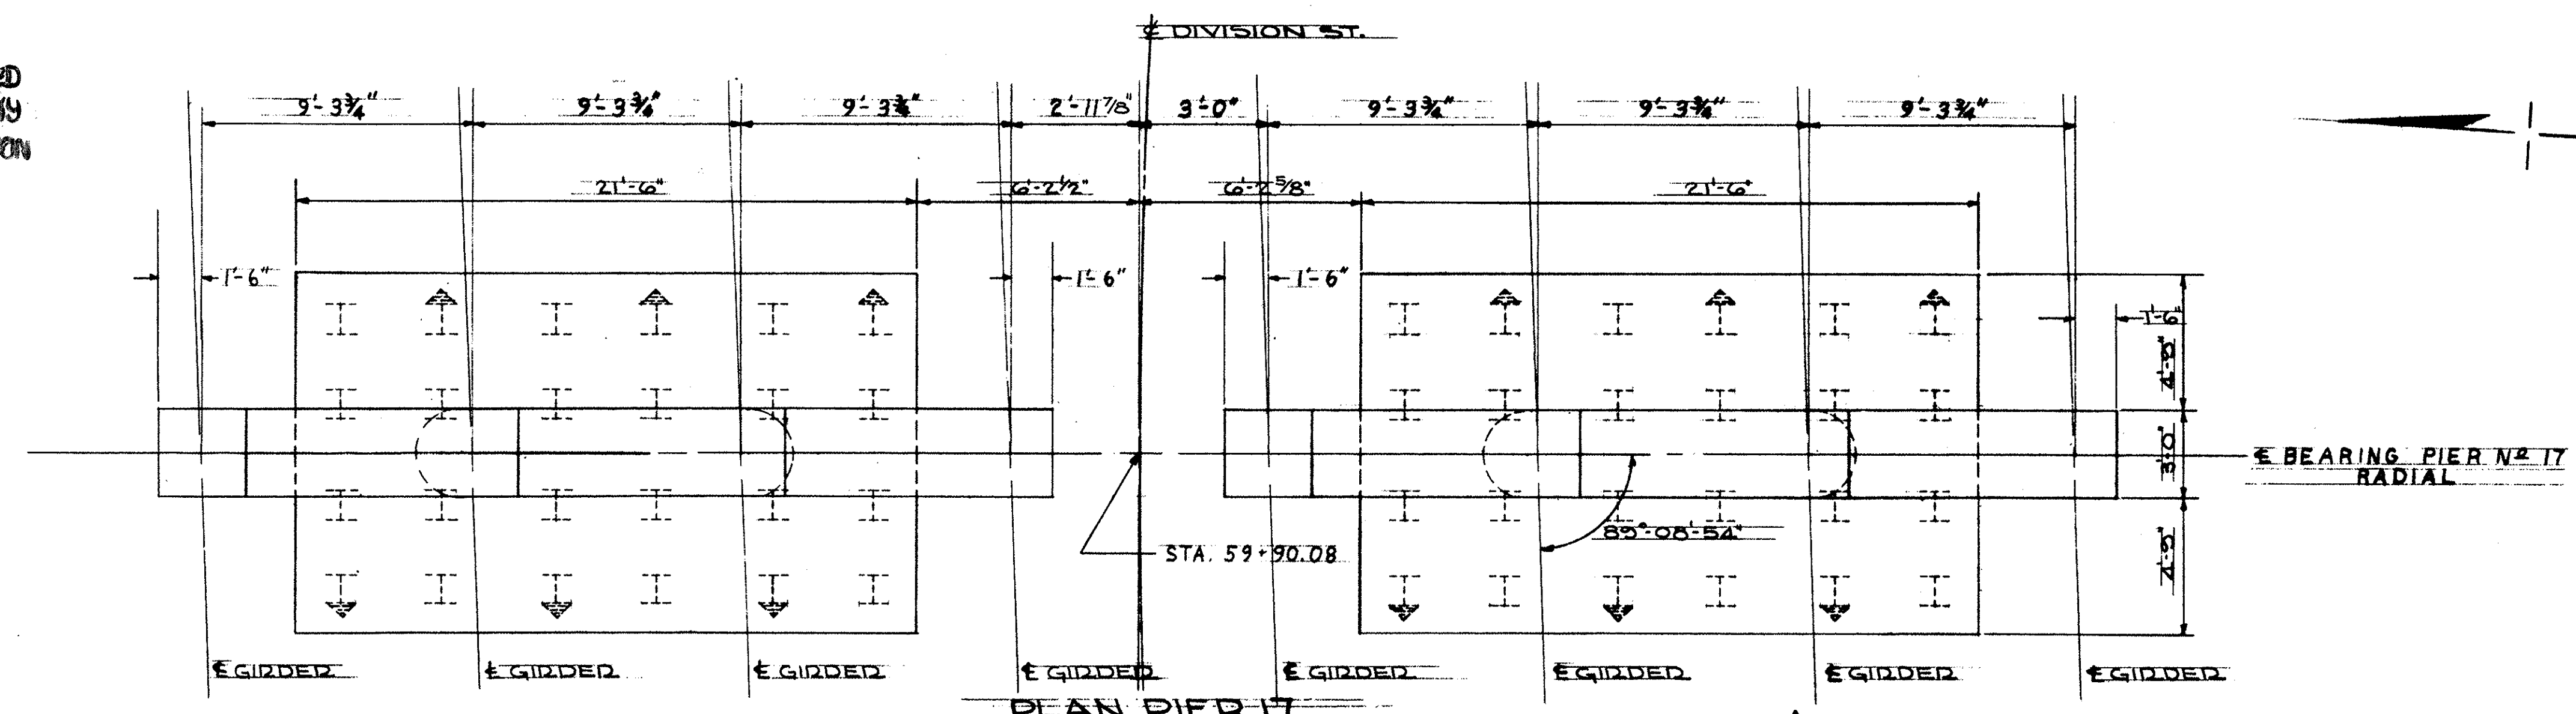

PIER ELEVATION TABLE

	A	B	C	D	E	F	G	H	I
PIER 17	898.95	898.60	898.15	897.94	897.85	897.14	896.68	896.12	855.00

NOTE: ALL PILING 12 BP 53




STATE OF OHIO
DEPARTMENT OF HIGHWAYS
BUREAU OF BRIDGES

AKRON, OHIO

GLAUS, PYLE & SCHOMER
YOUNGSTOWN, OHIO

PIER 17
BRIDGE NO MAH-711-016
OVER MAHONING RIVER
YOUNGSTOWN MAHONING COUNTY

DESIGNED	DRAWN	TRACED	CHECKED	REVIEWED	DATE	REVISED
JWC	DM		JM	WCB	6-22-68	

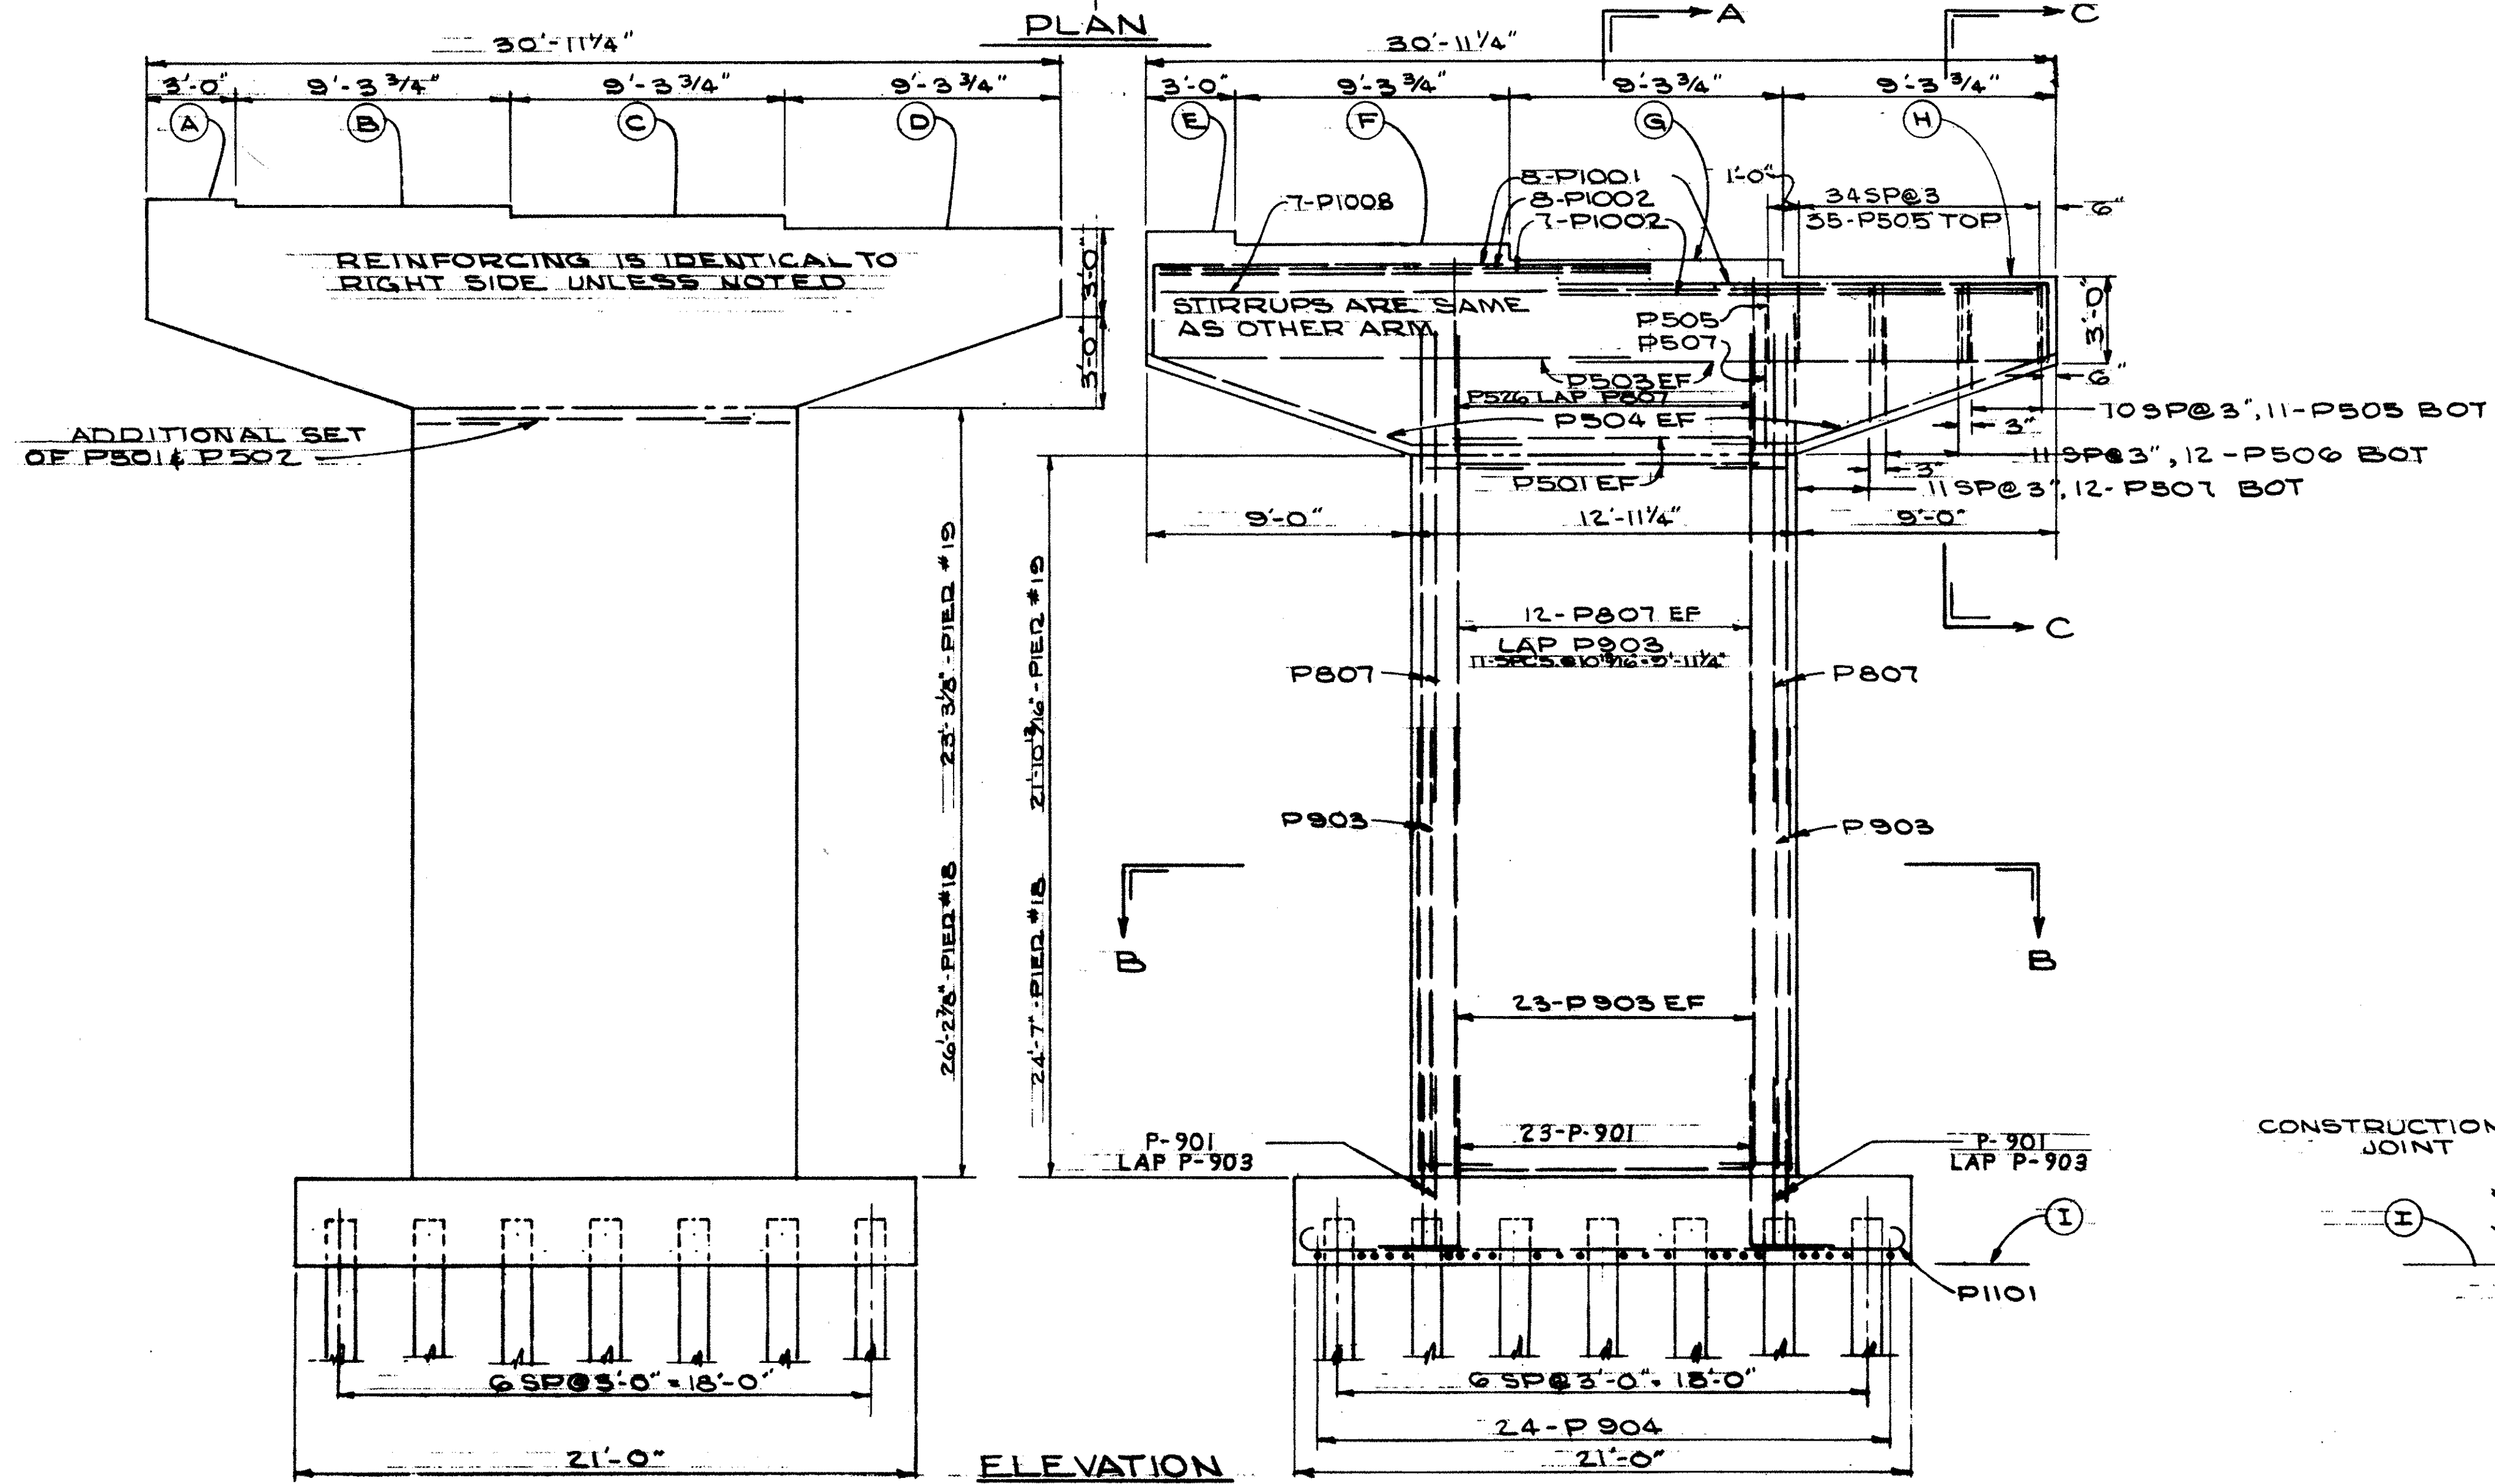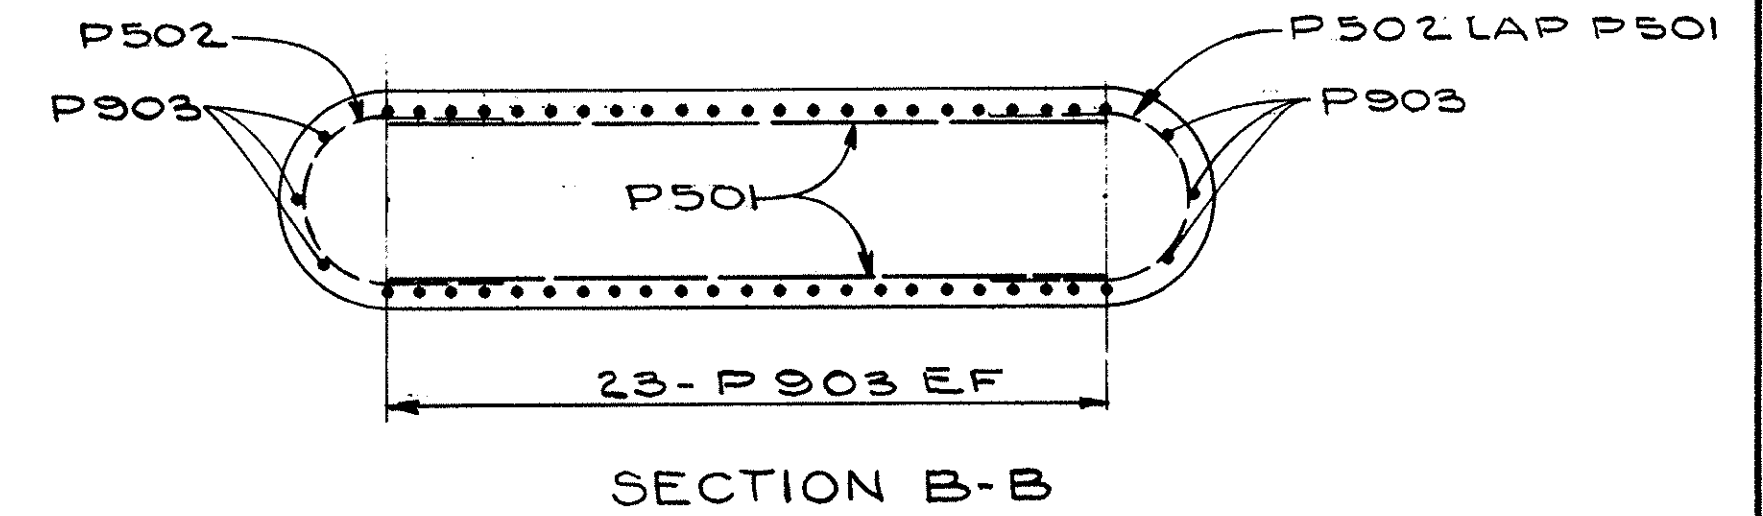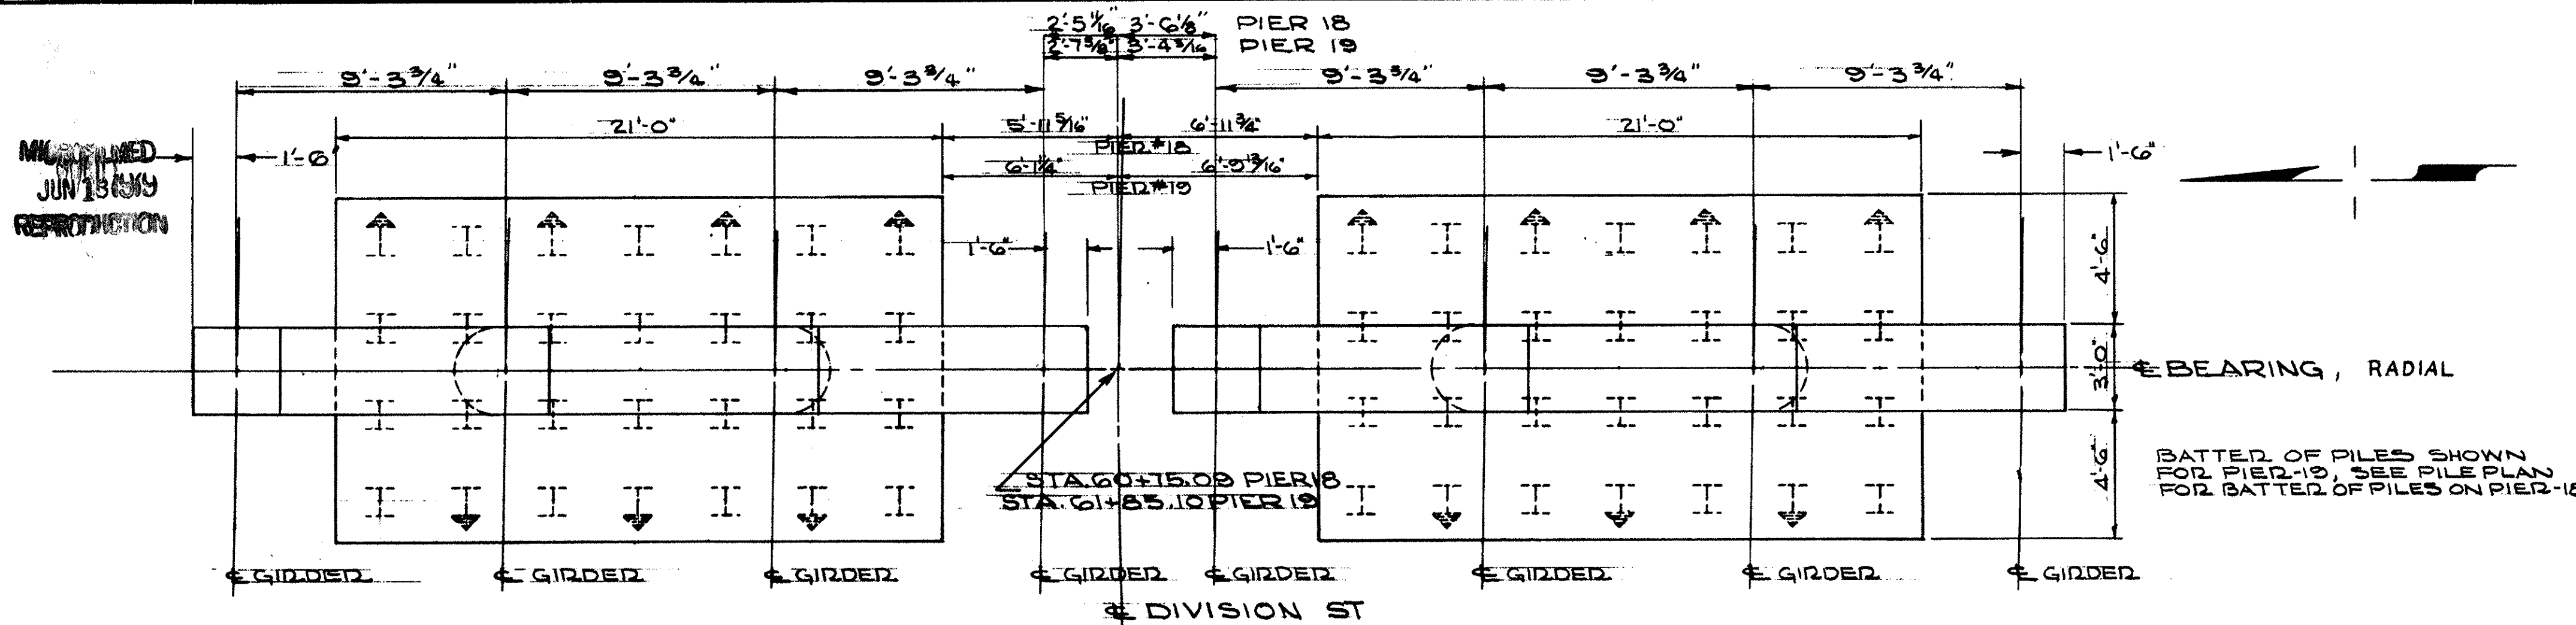

PIER ELEVATION TABLE

	A	B	C	D	E	F	G	H	I
PIER 18	896.19	897.80	897.41	897.24	897.15	896.48	896.02	895.58	862.00
PIER 19	897.53	897.34	897.17	897.26	897.20	896.59	896.23	895.90	865.00

NOTE: ALL PILING 12 BF 53

SPECIAL CARE SHALL BE TAKEN IN PLACING REINFORCING STEEL IN THE VICINITY OF THE BRIDGE SEAT OF PIER 19 SO AS TO AVOID INTERFERENCE WITH THE DRILLING OF ANCHOR BAR HOLES.


STATE OF OHIO
DEPARTMENT OF HIGHWAYS
BUREAU OF BRIDGES

AKRON, OHIO
GLAUS, PYLE & SCHOMER
YOUNGSTOWN, OHIO

PIERS 18, & 19
BRIDGE N^o MAH-711-0116
OVER MAHONING RIVER
YOUNGSTOWN MAHONING COUNTY

DESIGNED	DRAWN	TRACED	CHECKED	REVIEWED	DATE	REVISED
JWC	JWC		JM	WKD	6-22-68	

MAHONING
JUN 13 1968
REVISION

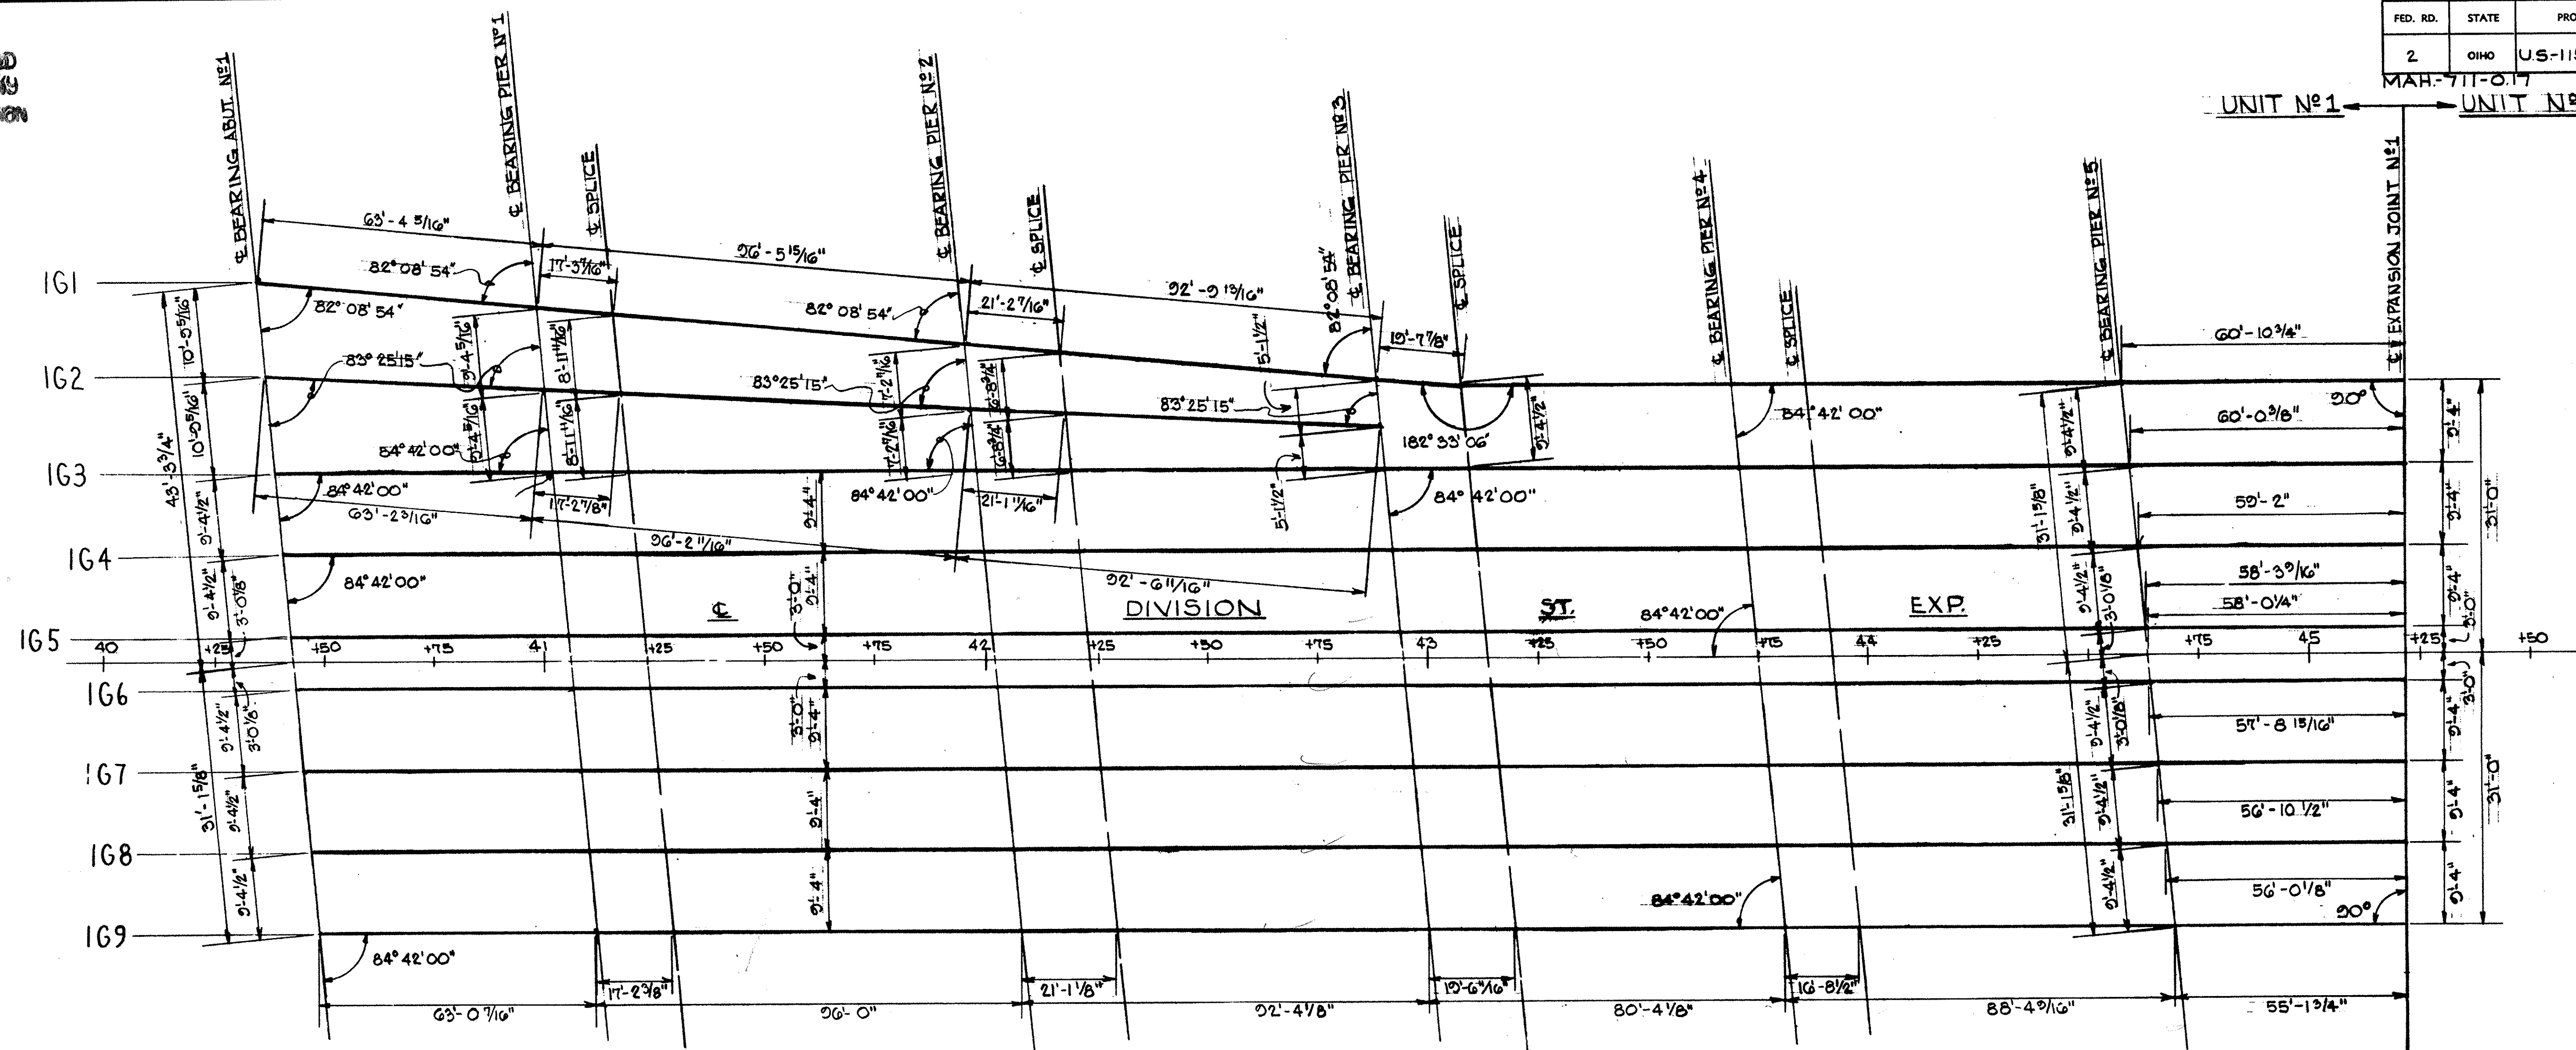

GIRDER	LOCATION					
	ABUT. 1	PIER 1	PIER 2	PIER 3	PIER 4	PIER 5
IG1, IG9	R-75	R-225	R-250	B-225	R-225	R-200
IG2	R-125	R-250	R-250	B-100		
IG3, IG4, IG7, IG8	R-100	R-250	R-275	B-250	R-250	R-225
IG5, IG6	R-75	R-200	R-200	B-175	R-175	R-175

ROCKER SETTING DATA						
+ INDICATES ROCKERS TILTED AWAY FROM PIER # 3						
TEMPERATURE AT TIME OF SETTING	ABUT. NO. 1	PIER 1	PIER 2	PIER 3	PIER 4	PIER 5
100°F	+3/4"	+3/16"	+1/4"	---	+1/4"	+1/2"
80°F	+3/8"	+1/4"	+1/8"	---	+1/8"	+1/4"
60°F	0"	0"	0"	---	0"	0"
30°F	-3/16"	-3/8"	-3/16"	---	-3/16"	-3/8"
-10°F	-1/4"	-1/16"	-7/16"	---	-3/8"	-7/8"

STATE OF OHIO
DEPARTMENT OF HIGHWAYS
BUREAU OF BRIDGES

GLAUS, PYLE & SCHOMER
AKRON, OHIO YOUNGSTOWN, OHIO

FRAMING PLAN
BRIDGE NO. MAH-711-0116
OVER MAHONING RIVER
YOUNGSTOWN MAHONING COUNTY

UNIT NO. 1


DESIGNED	DRAWN	TRACED	CHECKED	REVIEWED	DATE	REVISED
RWS	RWS		F.K.	WKB	6-22-68	

REPRODUCTION
JUN 13 1979

FED. RD.	STATE	PROJECT
2	OHIO	U.S.-1150 (1)

173
232

MAH-711-0.17

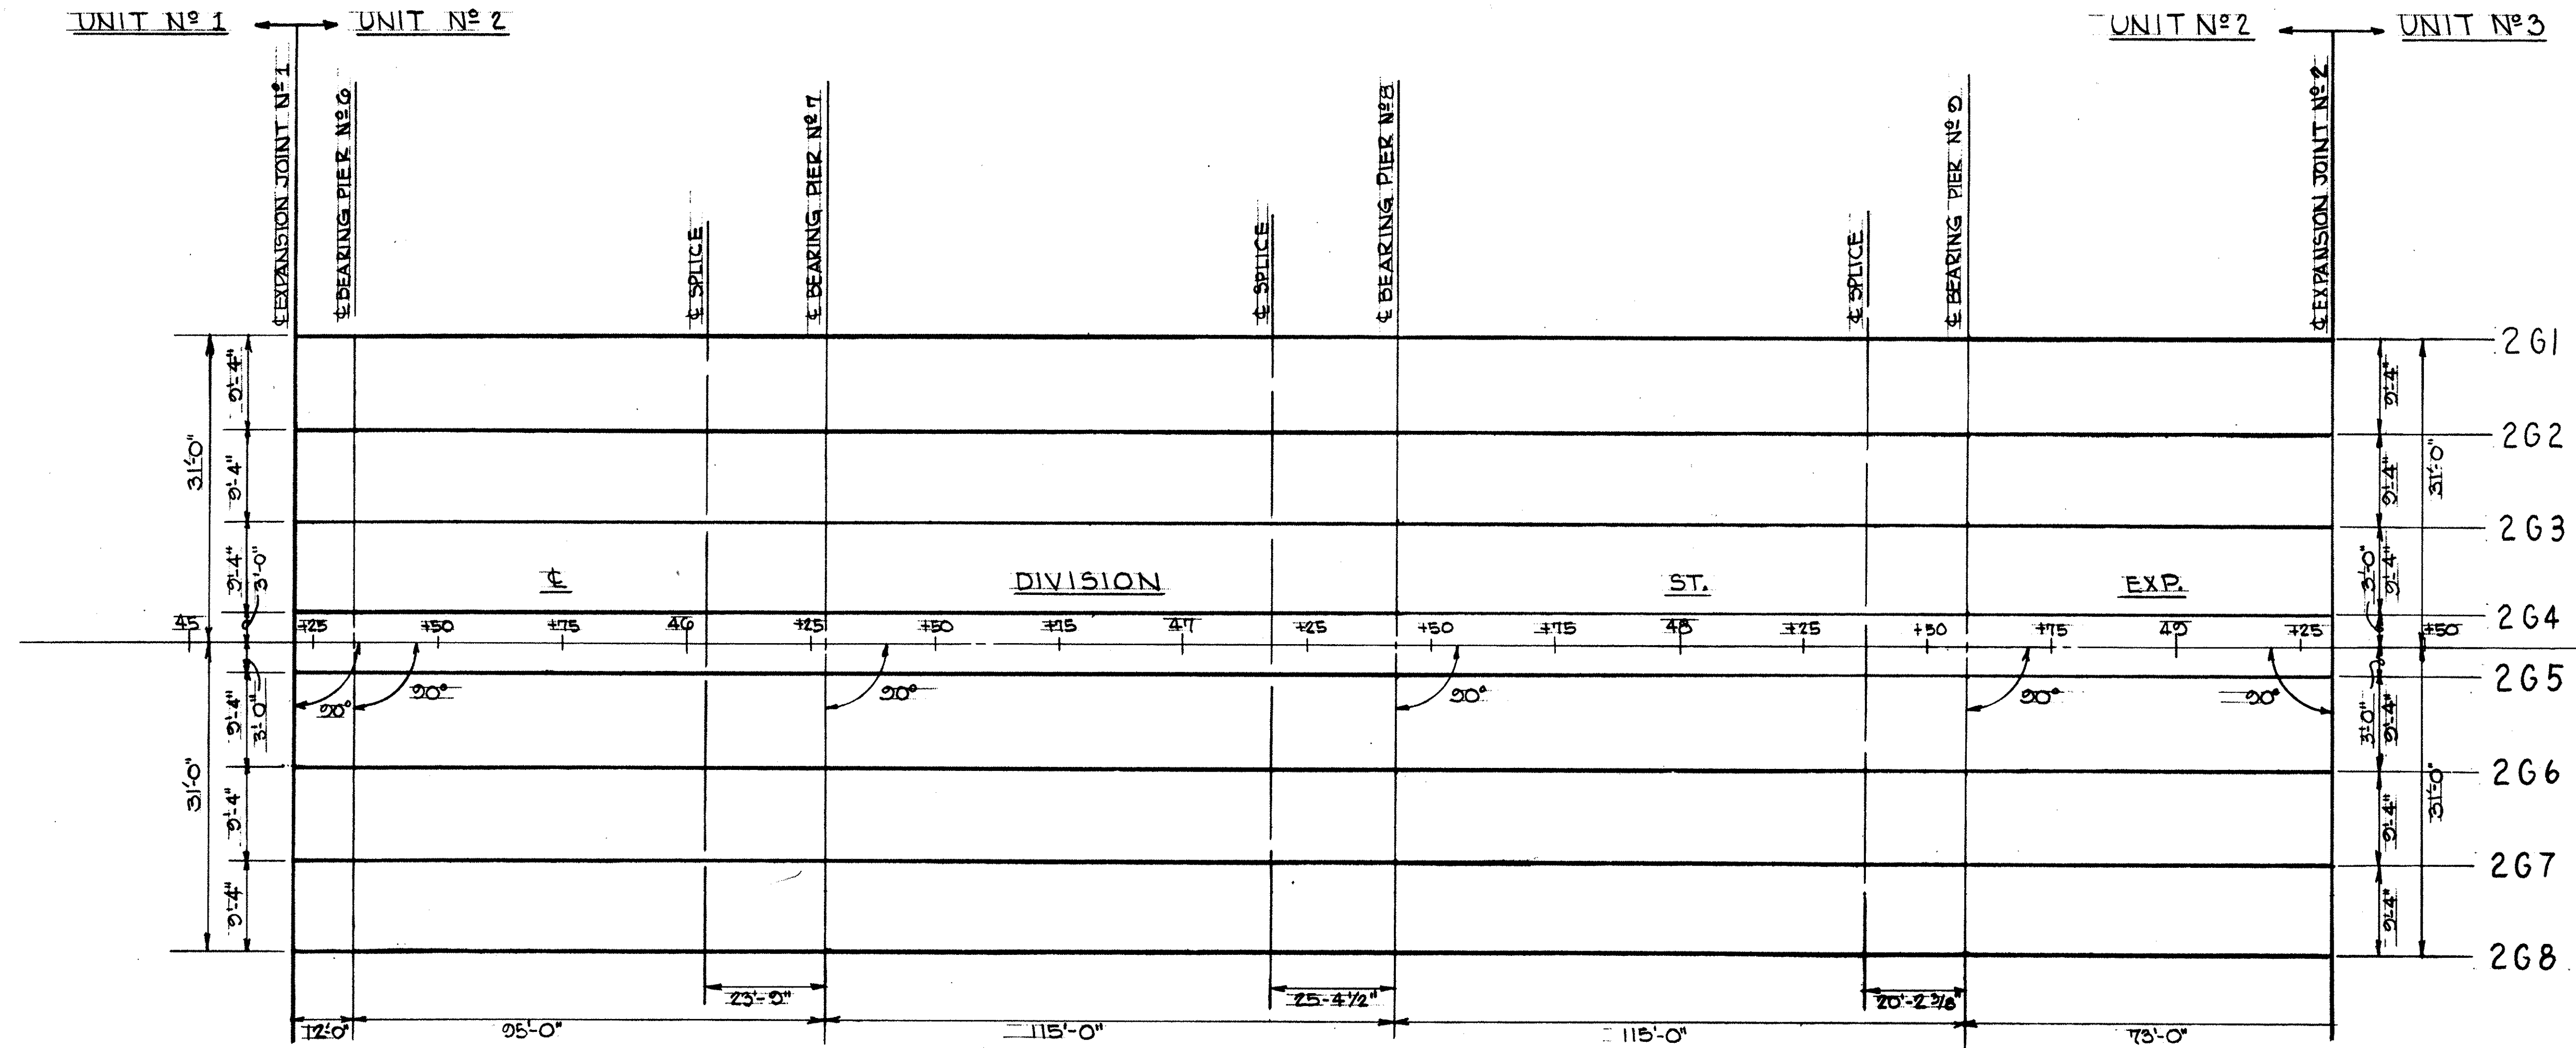

BEARING TABLE				
GIRDER	LOCATION			
	PIER 6	PIER 7	PIER 8	PIER 9
261, 268	R-175	R-275	B-275	R-250
262, 263, 266, 267	R-200	R-300	B-300	R-300
264, 265	R-175	R-250	B-275	R-250

ROCKER SETTING DATA				
+ INDICATES ROCKER TILTED AWAY FROM PIER # 8				
TEMPERATURE AT TIME OF SETTING	PIER 6	PIER 7	PIER 8	PIER 9
100°F	+5/8"	+5/16"	---	+5/16"
80°F	+5/16"	+3/8"	---	+3/8"
60°F	0"	0"	---	0"
30°F	-7/16"	-1/4"	---	-1/4"
-10°F	-1 1/16"	-3/16"	---	-3/16"

STATE OF OHIO
DEPARTMENT OF HIGHWAYS
BUREAU OF BRIDGES


AKRON, OHIO

GLAUS, PYLE & SCHOMER
YOUNGSTOWN, OHIO

FRAMING PLAN
BRIDGE No MAH-711-0116
OVER MAHONING RIVER
YOUNGSTOWN MAHONING COUNTY

UNIT No 2

DESIGNED	DRAWN	TRACED	CHECKED	REVIEWED	DATE	REVISED
P.K.	RWS		RWS	WLD	6-22-68	

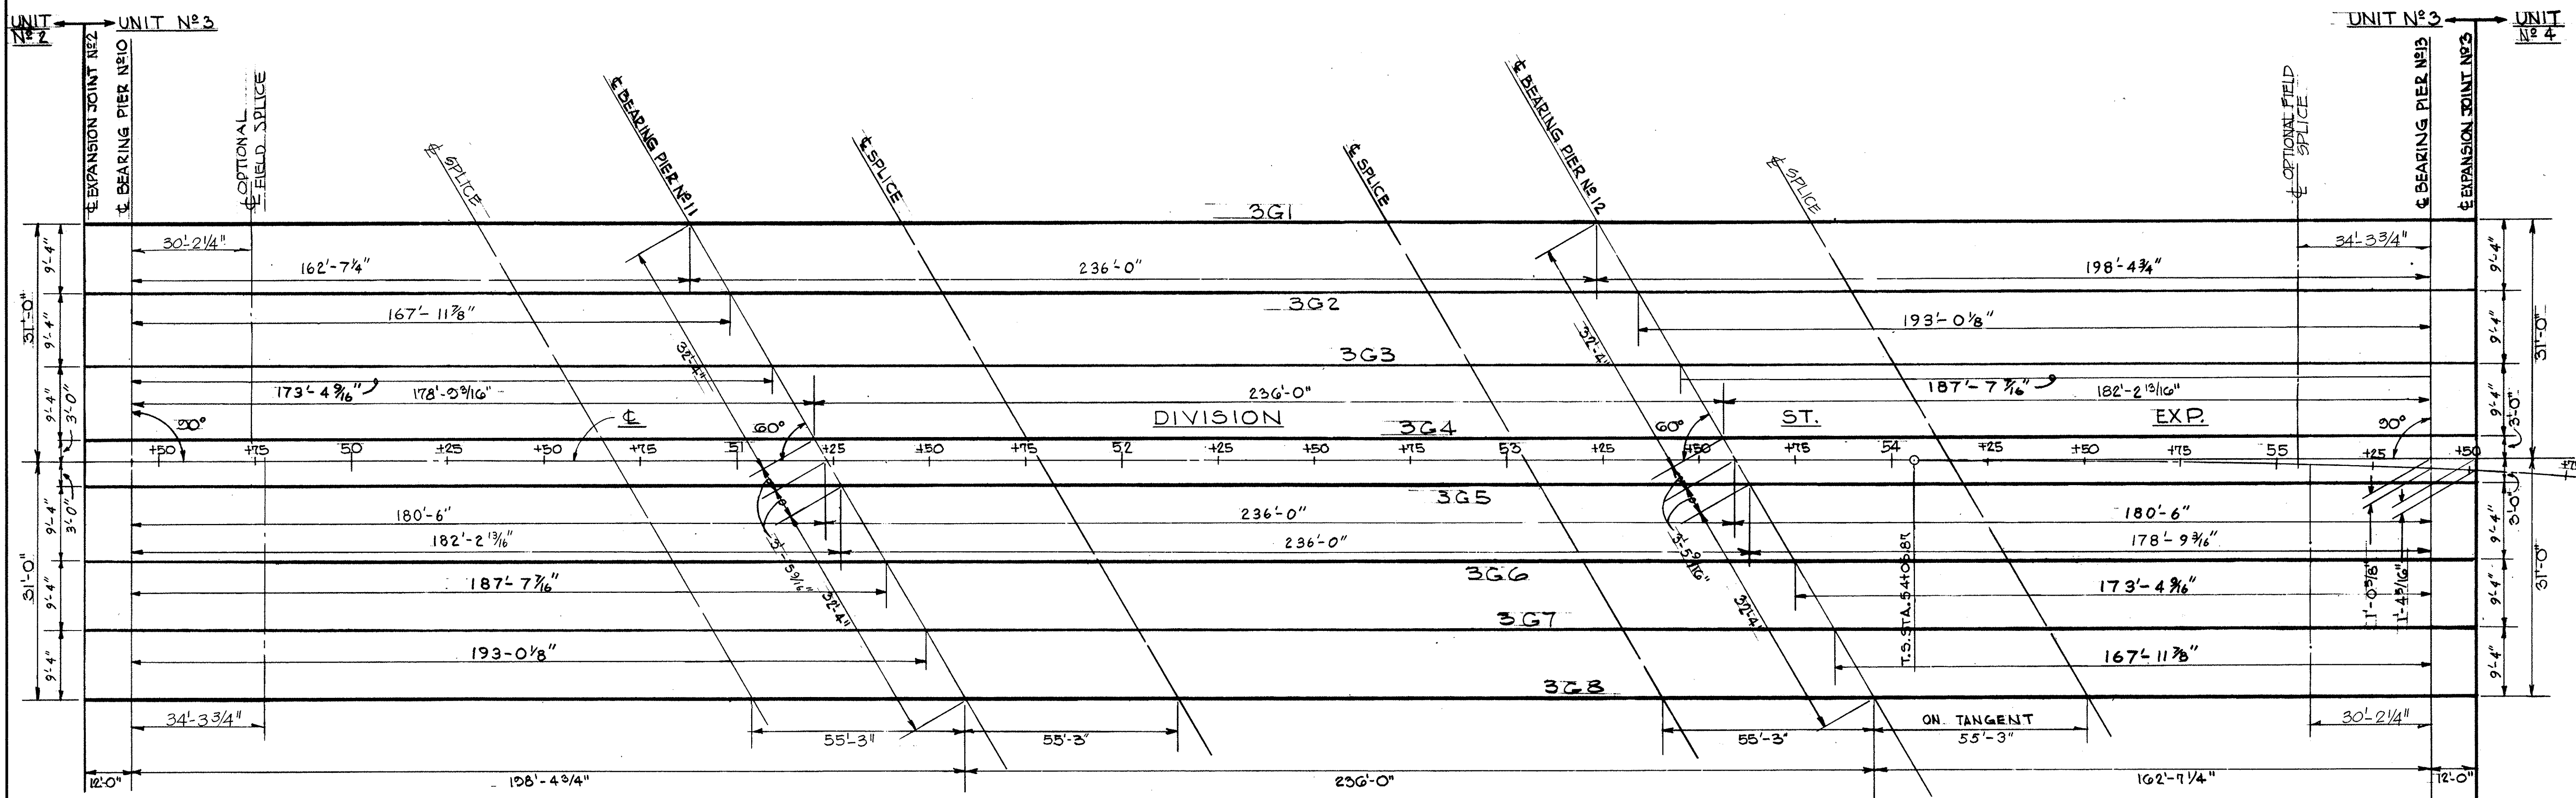

BEARING TABLE				
GIRDER	LOCATION			
	PIER 10	PIER 11	PIER 12	PIER 13
3G1	R-250	B-600	R-600	R-300
3G2	R-275	B-600	R-600	R-300
3G3	R-275	B-600	R-600	R-300
3G4	R-225	B-600	R-600	R-225
3G5	R-225	B-600	R-600	R-225
3G6	R-300	B-600	R-600	R-300
3G7	R-300	B-600	R-600	R-300
3G8	R-275	B-600	R-600	R-275

ROCKER SETTING DATA				
+ INDICATES ROCKER TILTED AWAY FROM PIER # 11				
TEMPERATURE AT TIME OF SETTING	PIER 10	PIER 11	PIER 12	PIER 13
100°F	+ 1/2"	—	+ 1/16"	+ 1 3/16"
80°F	+ 1/4"	—	+ 5/16"	+ 5/8"
60°F	0"	—	0"	0"
30°F	- 3/8"	—	- 1/2"	- 7/8"
-10°F	- 1 1/16"	—	- 1 3/16"	- 2 1/16"

STATE OF OHIO
DEPARTMENT OF HIGHWAYS
BUREAU OF BRIDGES

AKRON, OHIO

GLAUS, PYLE & SCHOMER
YOUNGSTOWN, OHIO

FRAMING PLAN
BRIDGE NO. MAH-711-0116
OVER MAHONING RIVER
YOUNGSTOWN MAHONING COUNTY

UNIT NO. 3


DESIGNED	DRAWN	TRACED	CHECKED	REVIEWED	DATE	REVISED
FK	RWS		RWS	WKO	6-22-68	

MAHONING COUNTY
RESERVATION

FED. RD.	STATE	PROJECT
2	OHIO	U.S.-1159 (I)

175
232

MAH-711-017

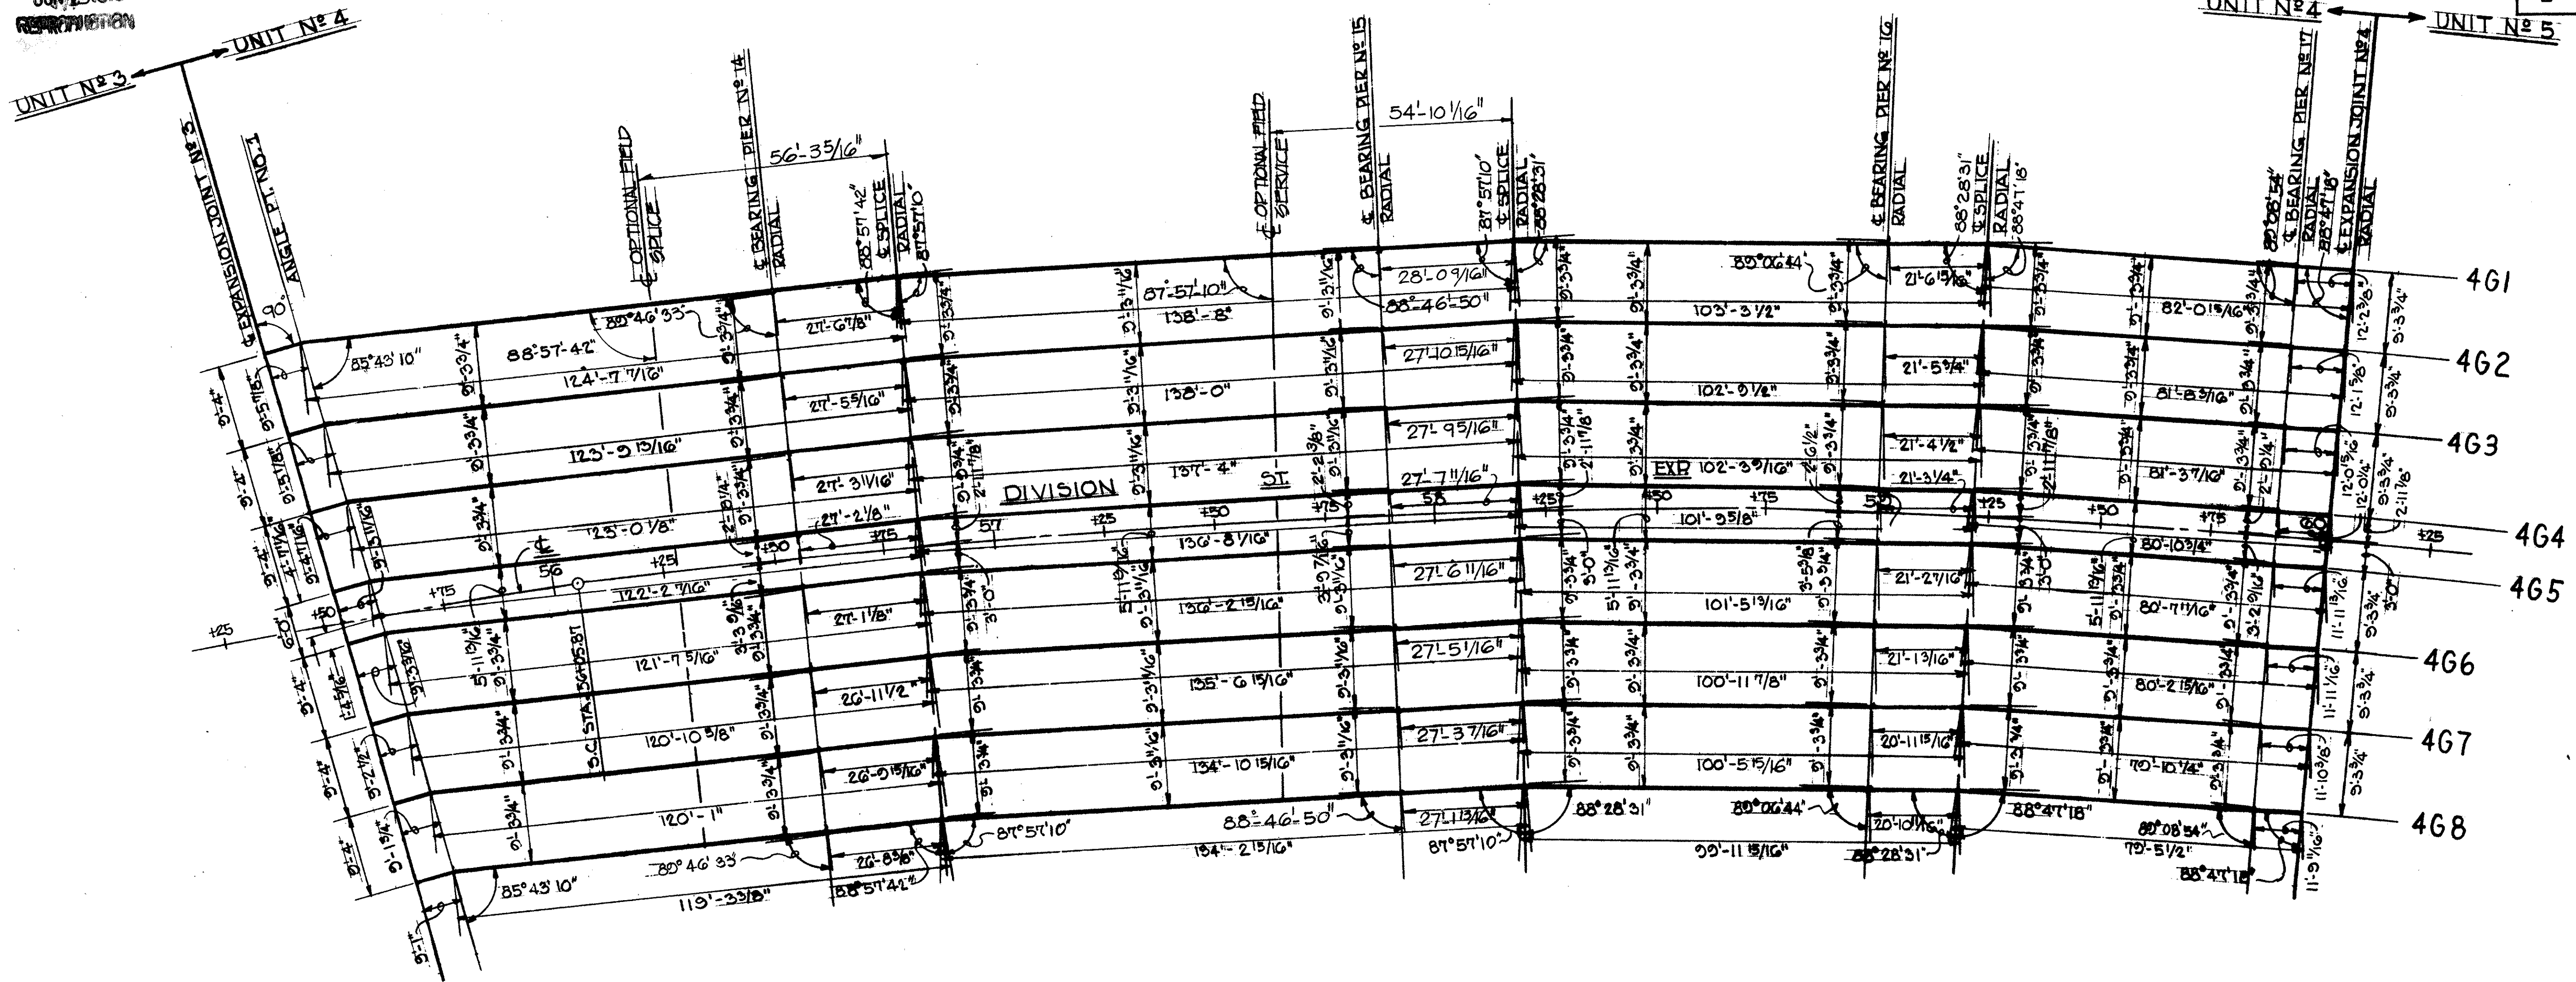

GIRDER	LOCATION			
	PIER 14	PIER 15	PIER 16	PIER 17
4G1	R-350	B-350	B-300	R-200
4G2, 4G3, 4G6, 4G7	R-350	B-350	B-300	R-175
4G4, 4G5	R-250	B-225	B-200	R-125
4G8	R-350	B-350 SPEC.	B-300	R-200

ROCKER SETTING DATA				
+ INDICATES ROCKER TILTED AWAY FROM PIER #15				
TEMPERATURE AT TIME OF SETTING	PIER 14	PIER 15	PIER 16	PIER 17
100° F	+3/8"	—	—	+3/8"
80° F	+3/16"	—	—	+1/8"
60° F	0"	—	—	0"
30° F	-3/16"	—	—	-3/16"
-10° F	-3/16"	—	—	-3/16"

STATE OF OHIO
DEPARTMENT OF HIGHWAYS
BUREAU OF BRIDGES

AKRON, OHIO

GLAUS, PYLE & SCHOMER
YOUNGSTOWN, OHIO

FRAMING PLAN
BRIDGE NO. MAH-711-016
OVER MAHONING RIVER
YOUNGSTOWN MAHONING COUNTY

UNIT NO. 4


DESIGNED	DRAWN	TRACED	CHECKED	REVIEWED	DATE	REVISED
F.K.	R.W.S.		R.W.S.	W.K.D.	6-22-68	

MAHONING
JUN 13 1968
REPRODUCTION

FED. RD.	STATE	PROJECT	
2	OHIO	U.S.-1159 (1)	

176
232

MAH-711-0.17

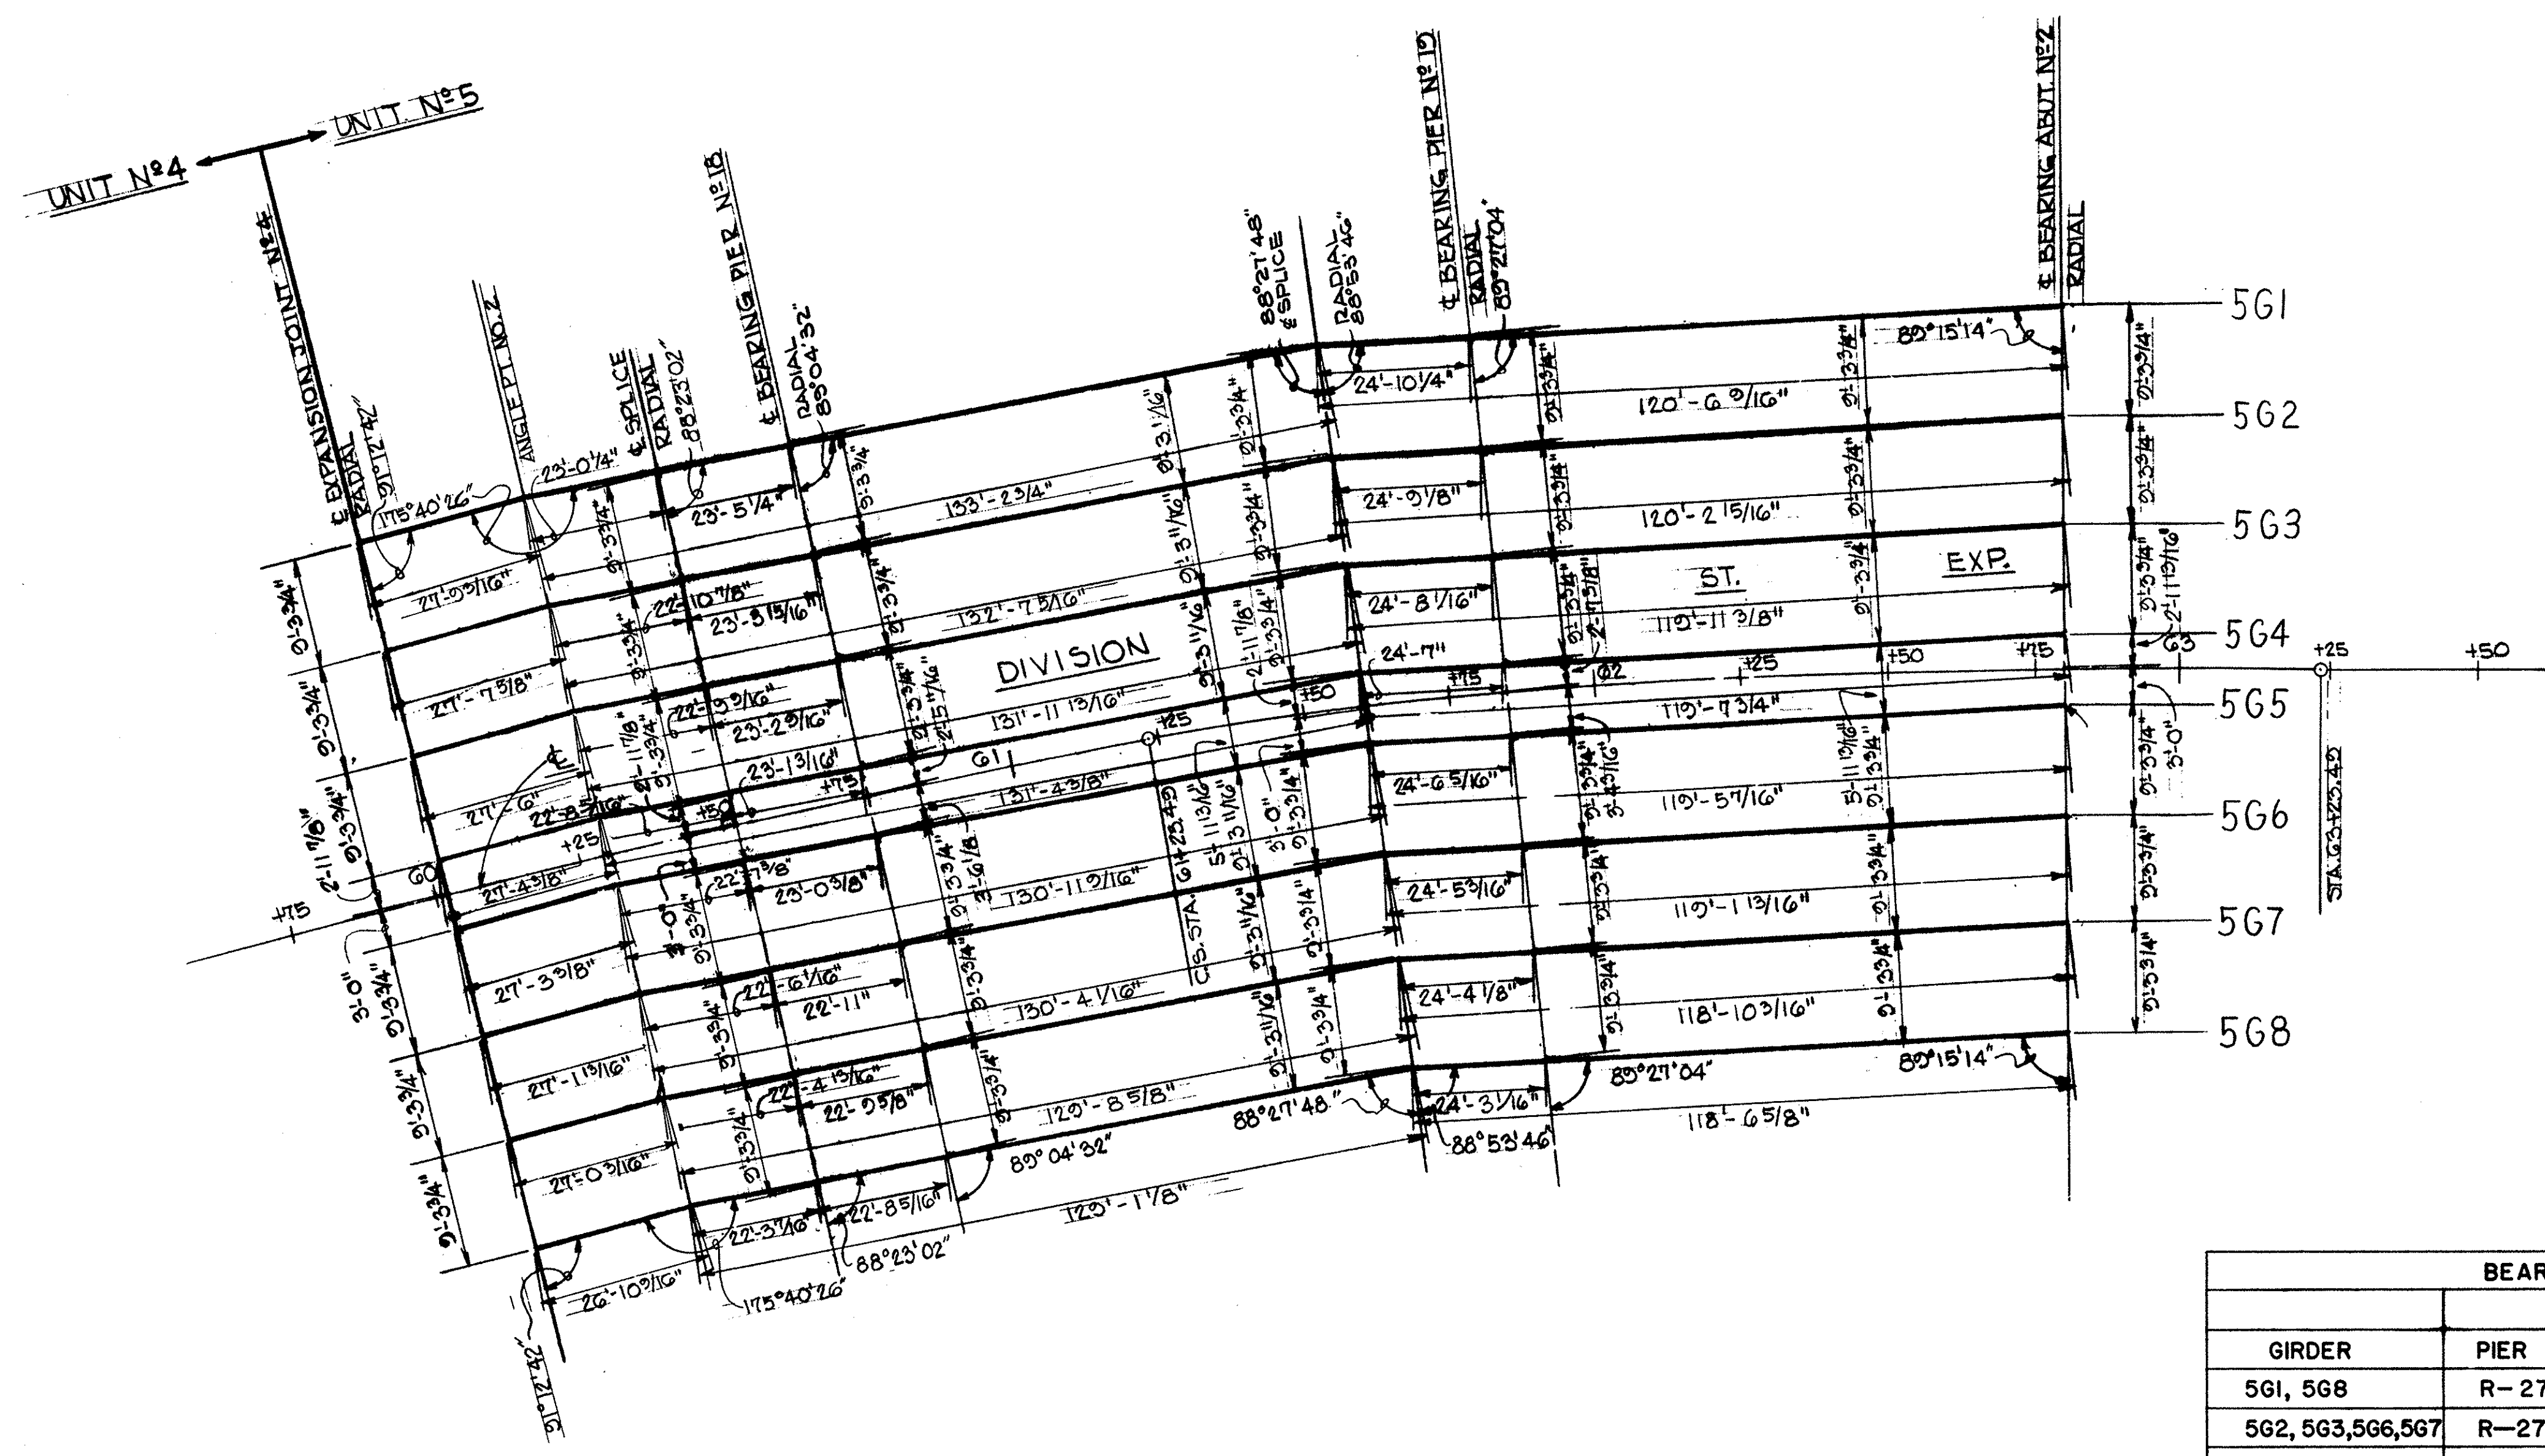

GIRDER	LOCATION		
	PIER 18	PIER 19	ABUT. 2
5G1, 5G8	R-275	B-300	R-125
5G2, 5G3, 5G6, 5G7	R-275	B-300	R-125
5G4, 5G5	R-200	B-225	R-100

ROCKED SETTING DATA			
TEMPERATURE AT TIME OF SETTING	PIER 18	PIER 19	ABUT. #2
100°F	+ 5/16"		+ 1/4"
80°F	+ 3/16"		+ 1/8"
60°F	0"		0"
30°F	+ 1/4"		+ 3/16"
-10°F	+ 9/16"		+ 1/2"

STATE OF OHIO
DEPARTMENT OF HIGHWAYS
BUREAU OF BRIDGES

AKRON, OHIO

GLAUS, PYLE & SCHOMER
YOUNGSTOWN, OHIO


FRAMING PLAN
BRIDGE N^o MAH-711-0116
OVER MAHONING RIVER
YOUNGSTOWN MAHONING COUNTY

UNIT N^o 5

DESIGNED P. K.	DRAWN RWS	TRACED	CHECKED RWS	REVIEWED WLD	DATE 6-22-68	REVISED
-------------------	--------------	--------	----------------	-----------------	-----------------	---------

MAHONING RIVER
BRIDGE

UNIT NO.1 ← UNIT NO.2

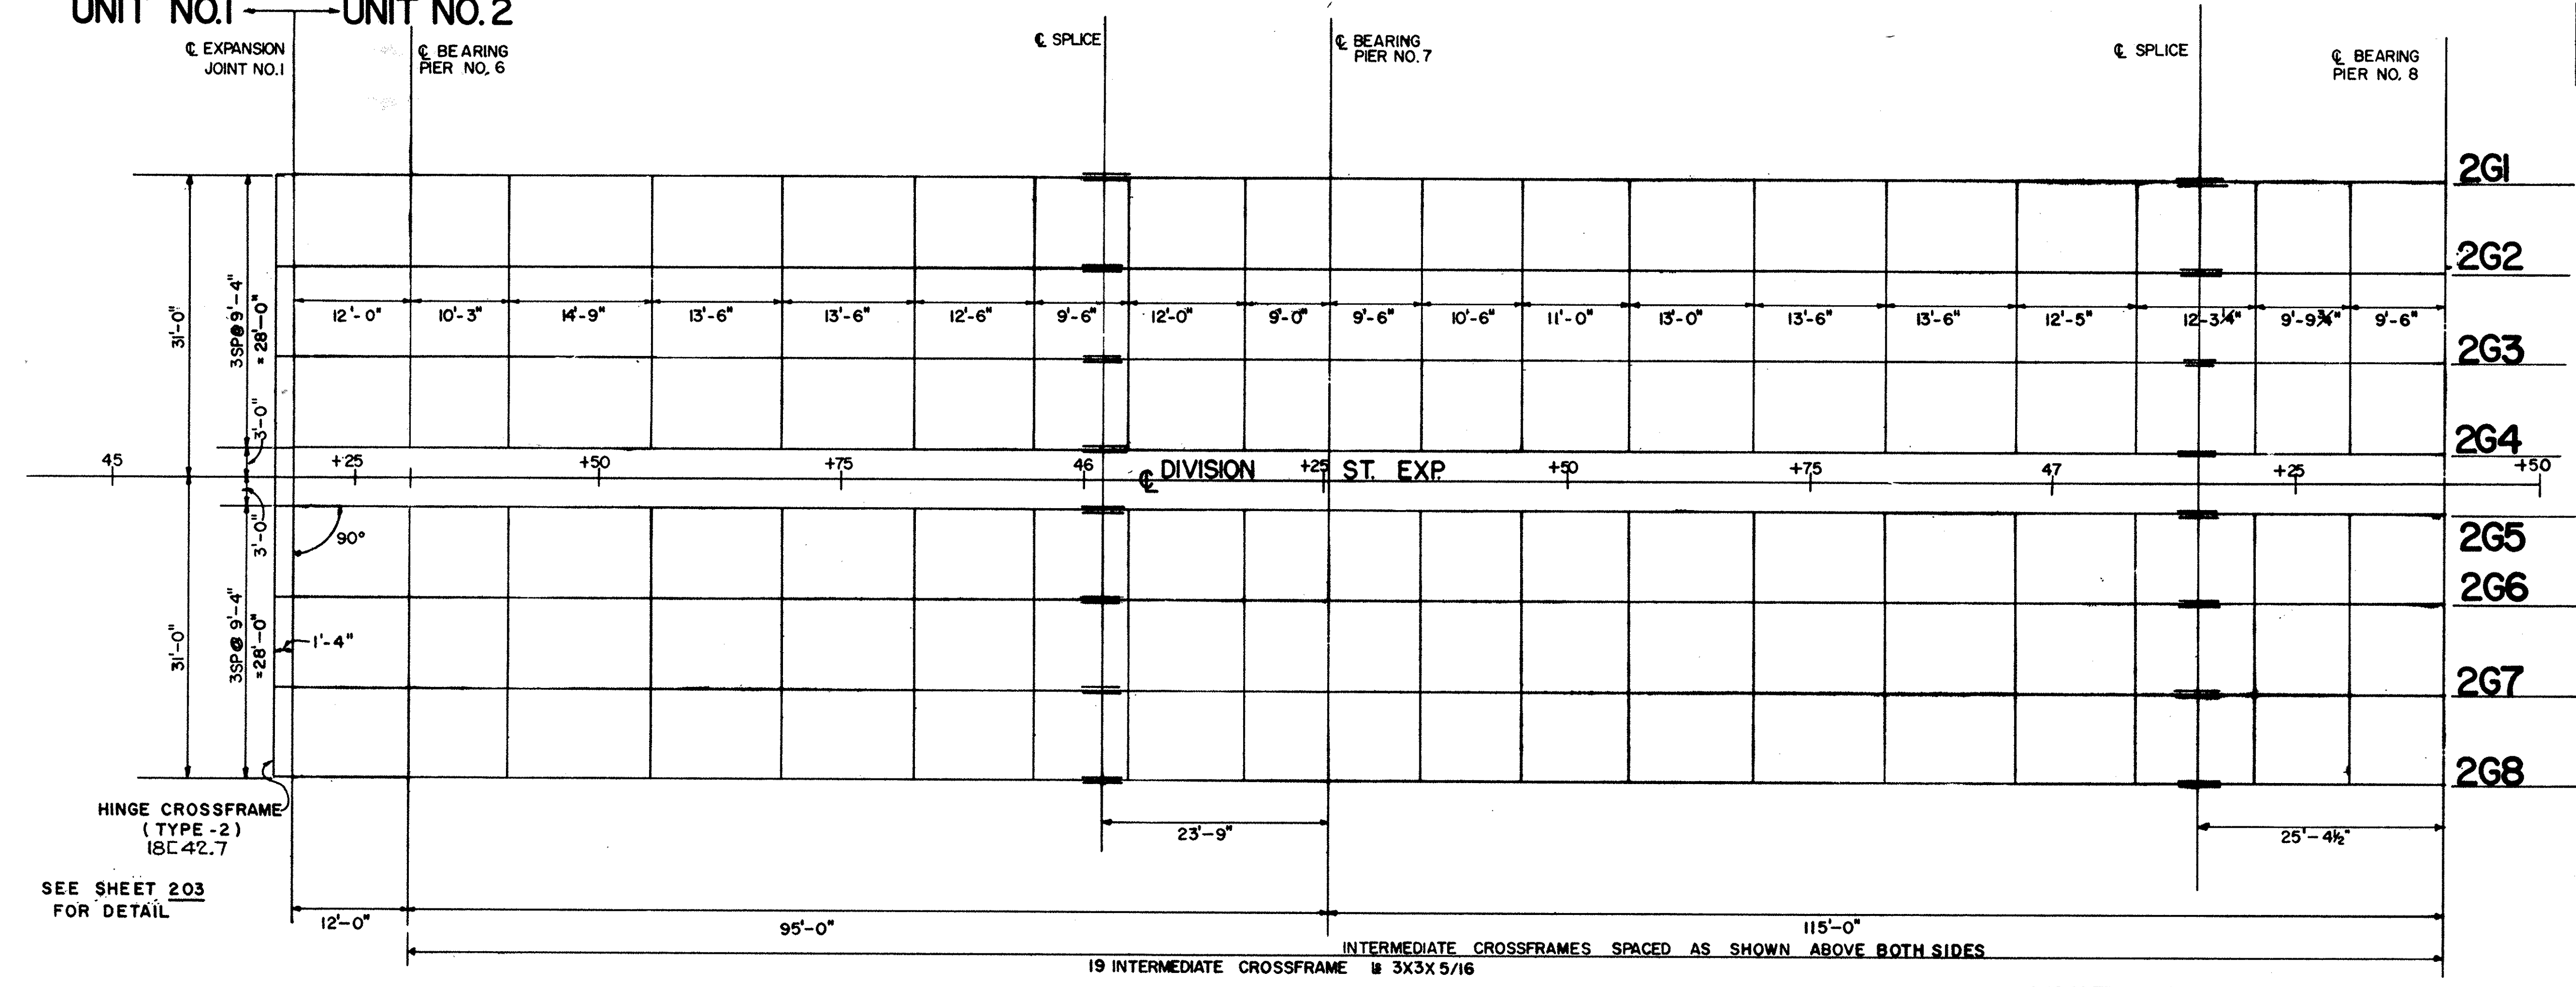


FED. RD.	STATE	PROJECT
2	OHIO	U.S.-1159 0

178
232

MAH.-711-0.17

SEE SHEET 186 FOR GIRDER DETAILS

UNIT NO. 2 ← UNIT NO. 3

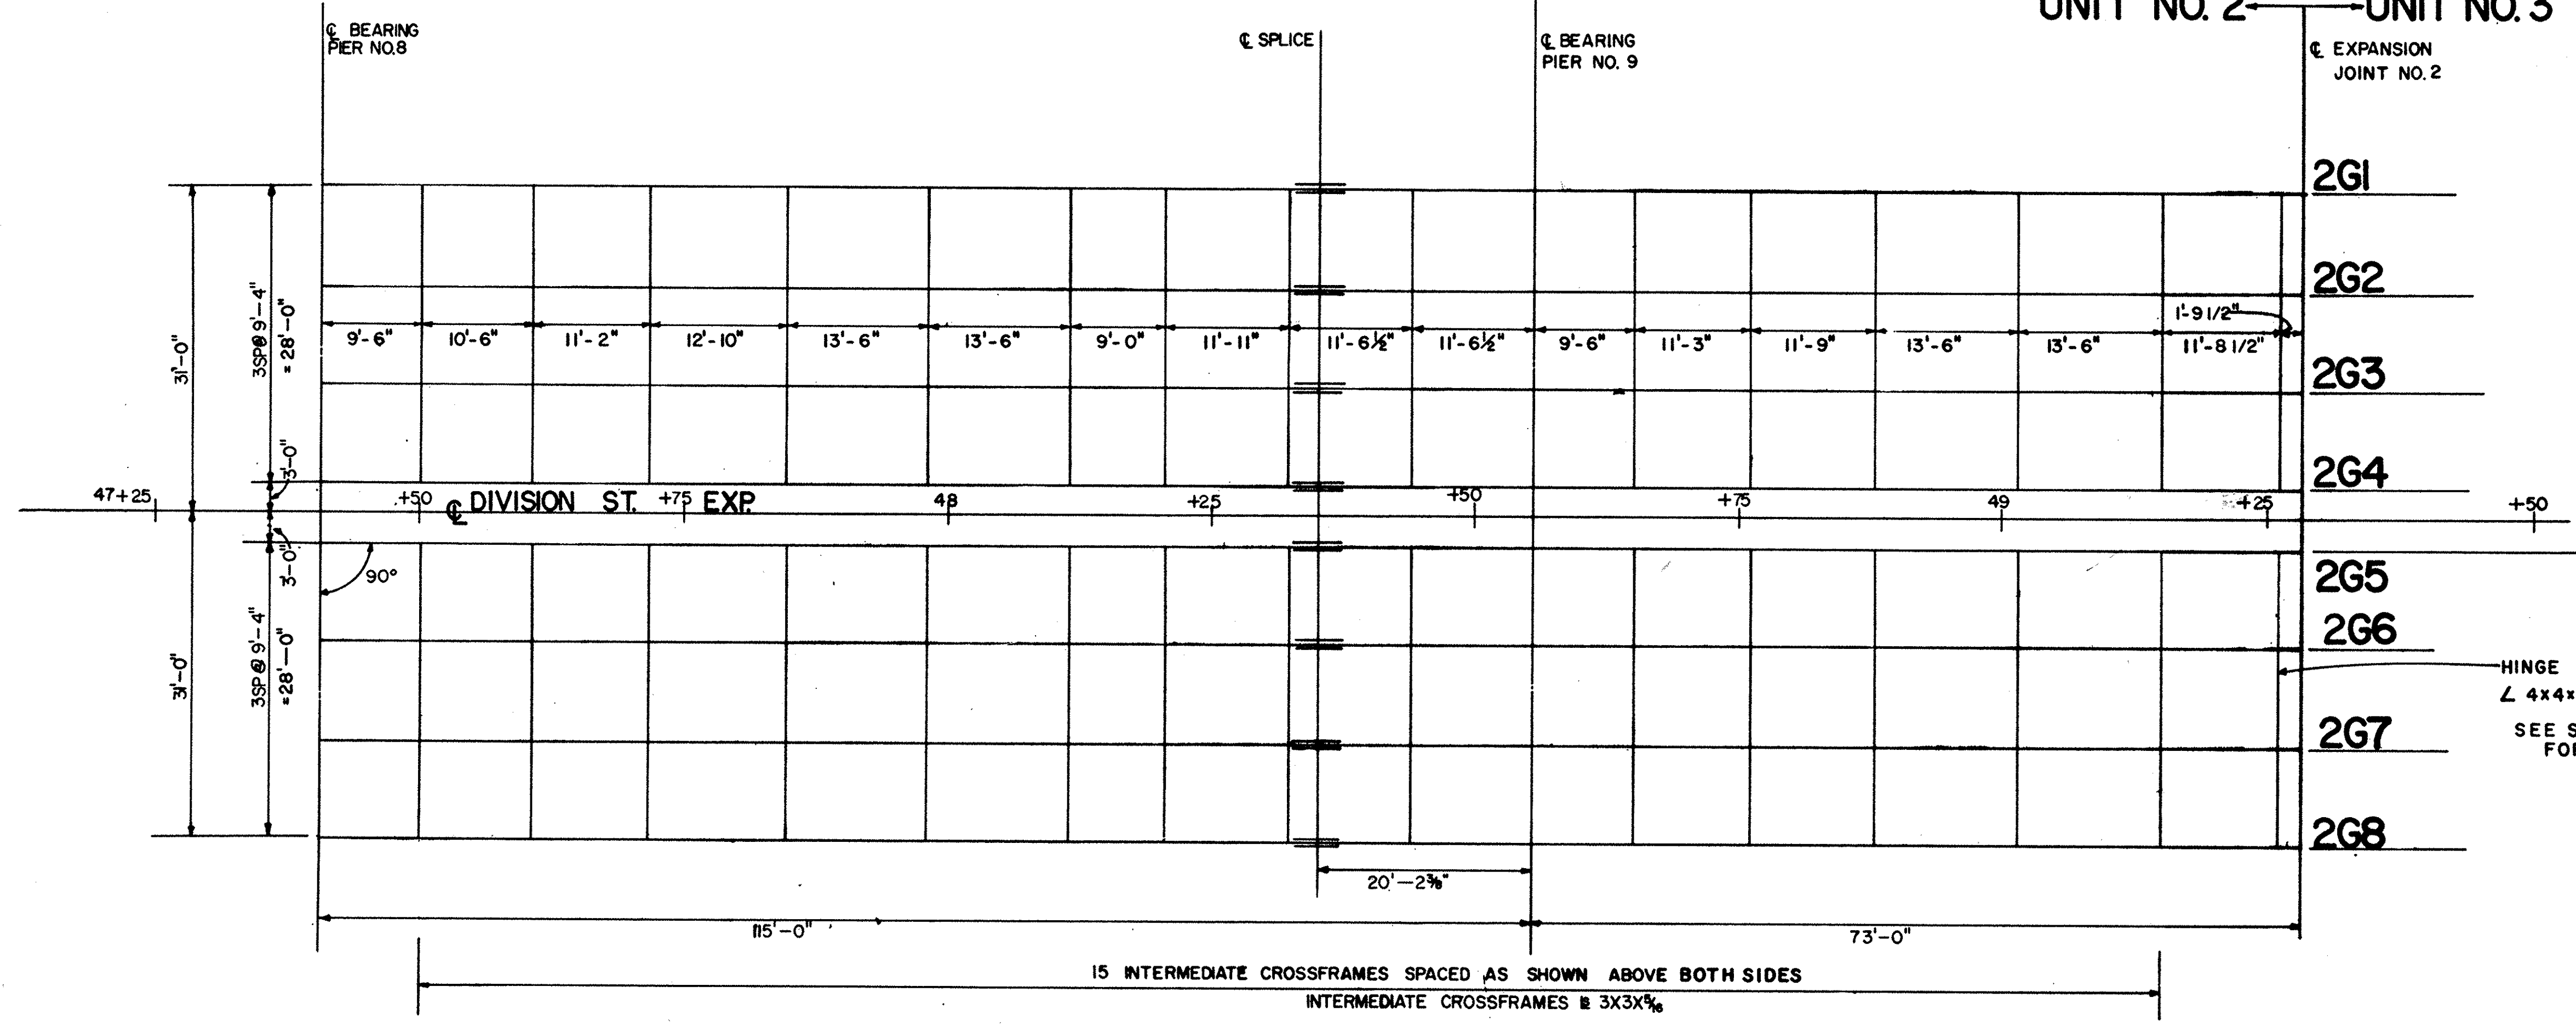



STATE OF OHIO
DEPARTMENT OF HIGHWAYS
BUREAU OF BRIDGES
AKRON, OHIO

GLAUS, PYLE & SCHOMER
YOUNGSTOWN, OHIO

CROSS FRAMES
BRIDGE N^o MAH-711-0116
OVER MAHONING RIVER
YOUNGSTOWN MAHONING COUNTY

DESIGNED	DRAWN	TRACED	CHECKED	REVIEWED	DATE	REVISED
J.M.	D.M.		R.H.	W.K.D.	6-22-68	

MAH-711-0.17

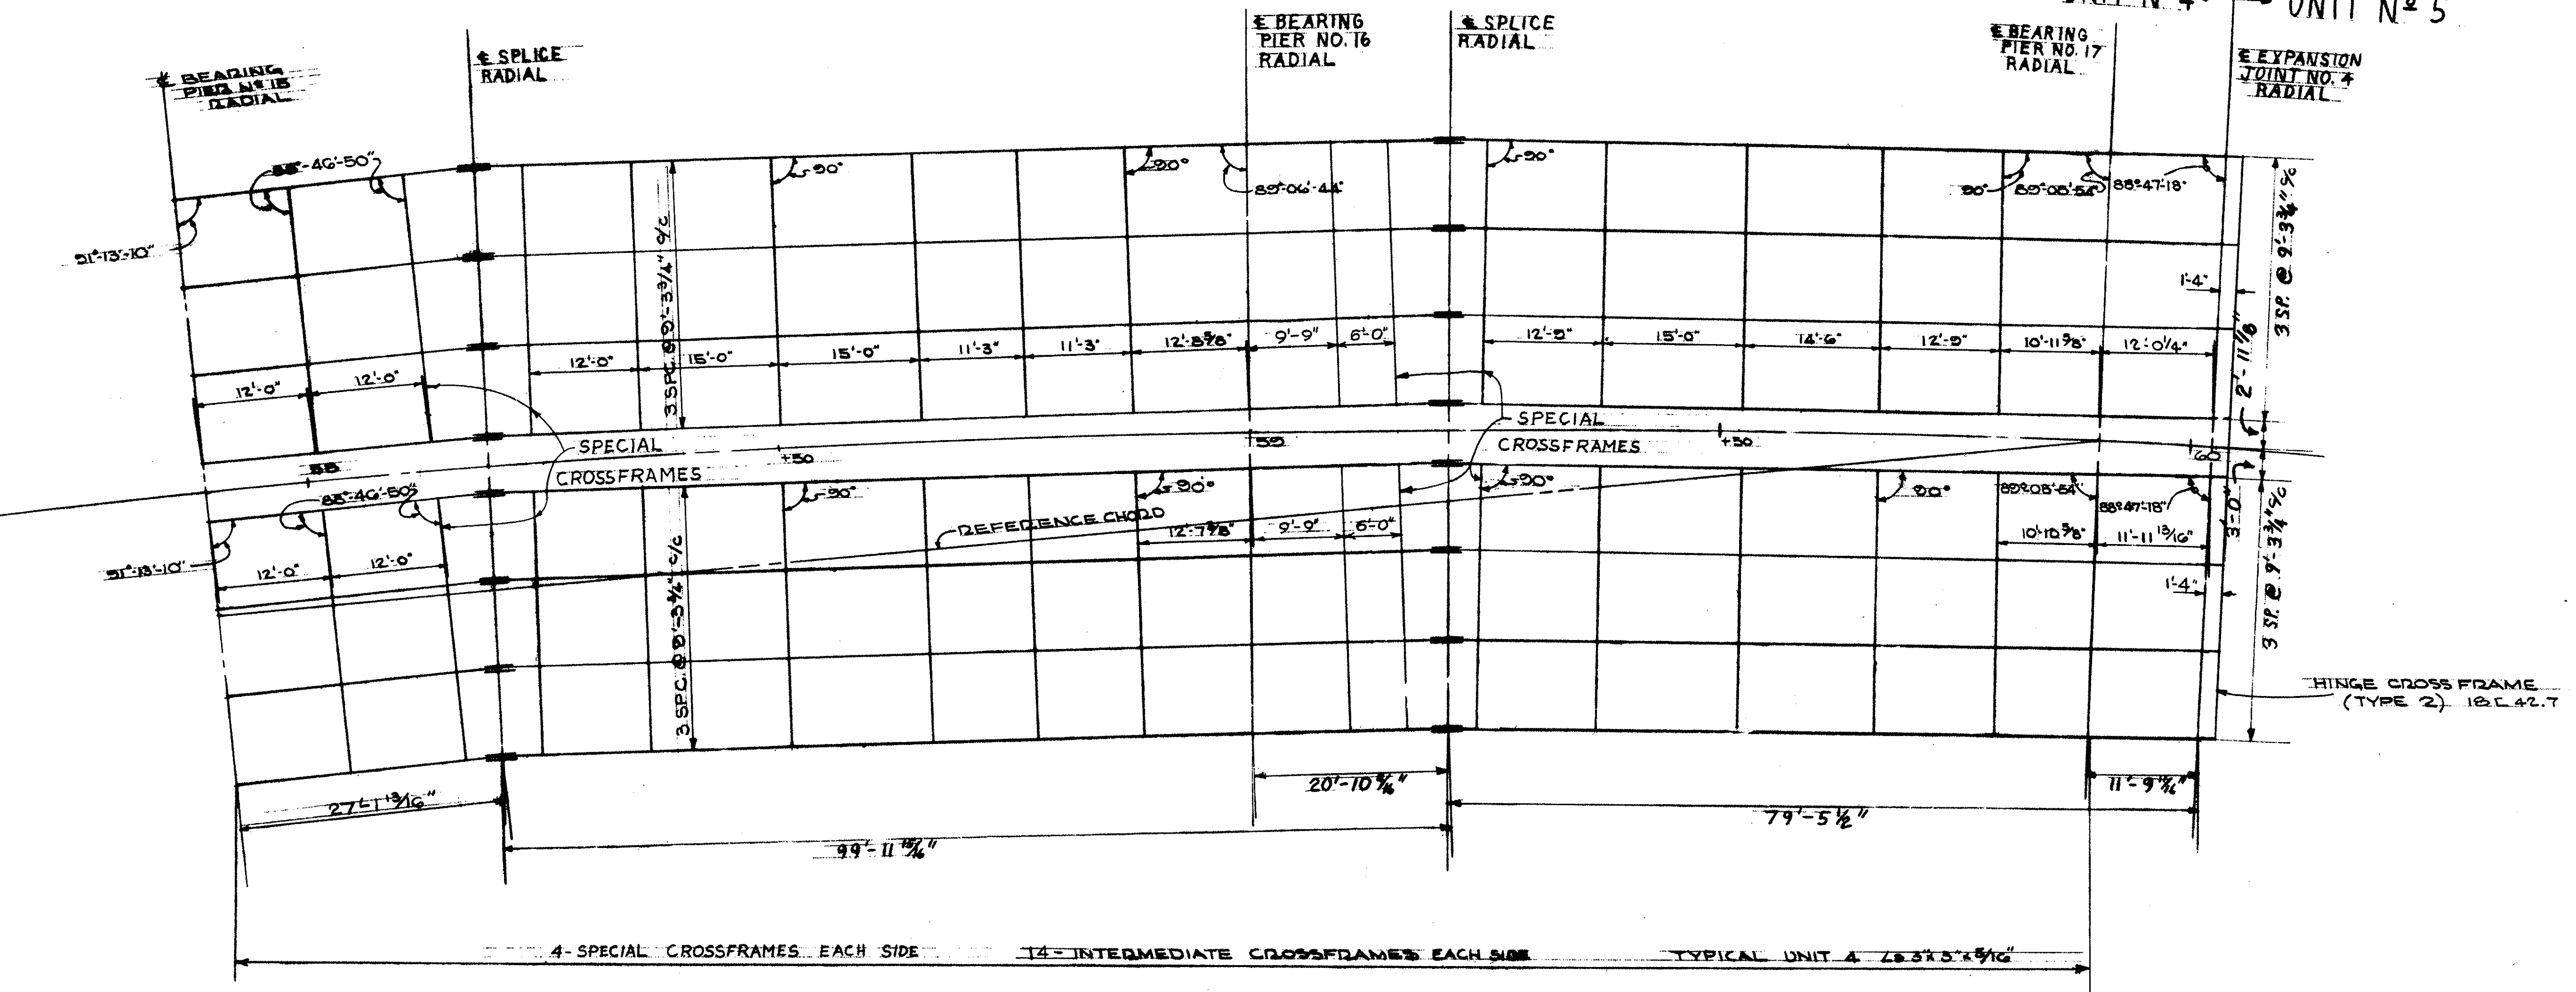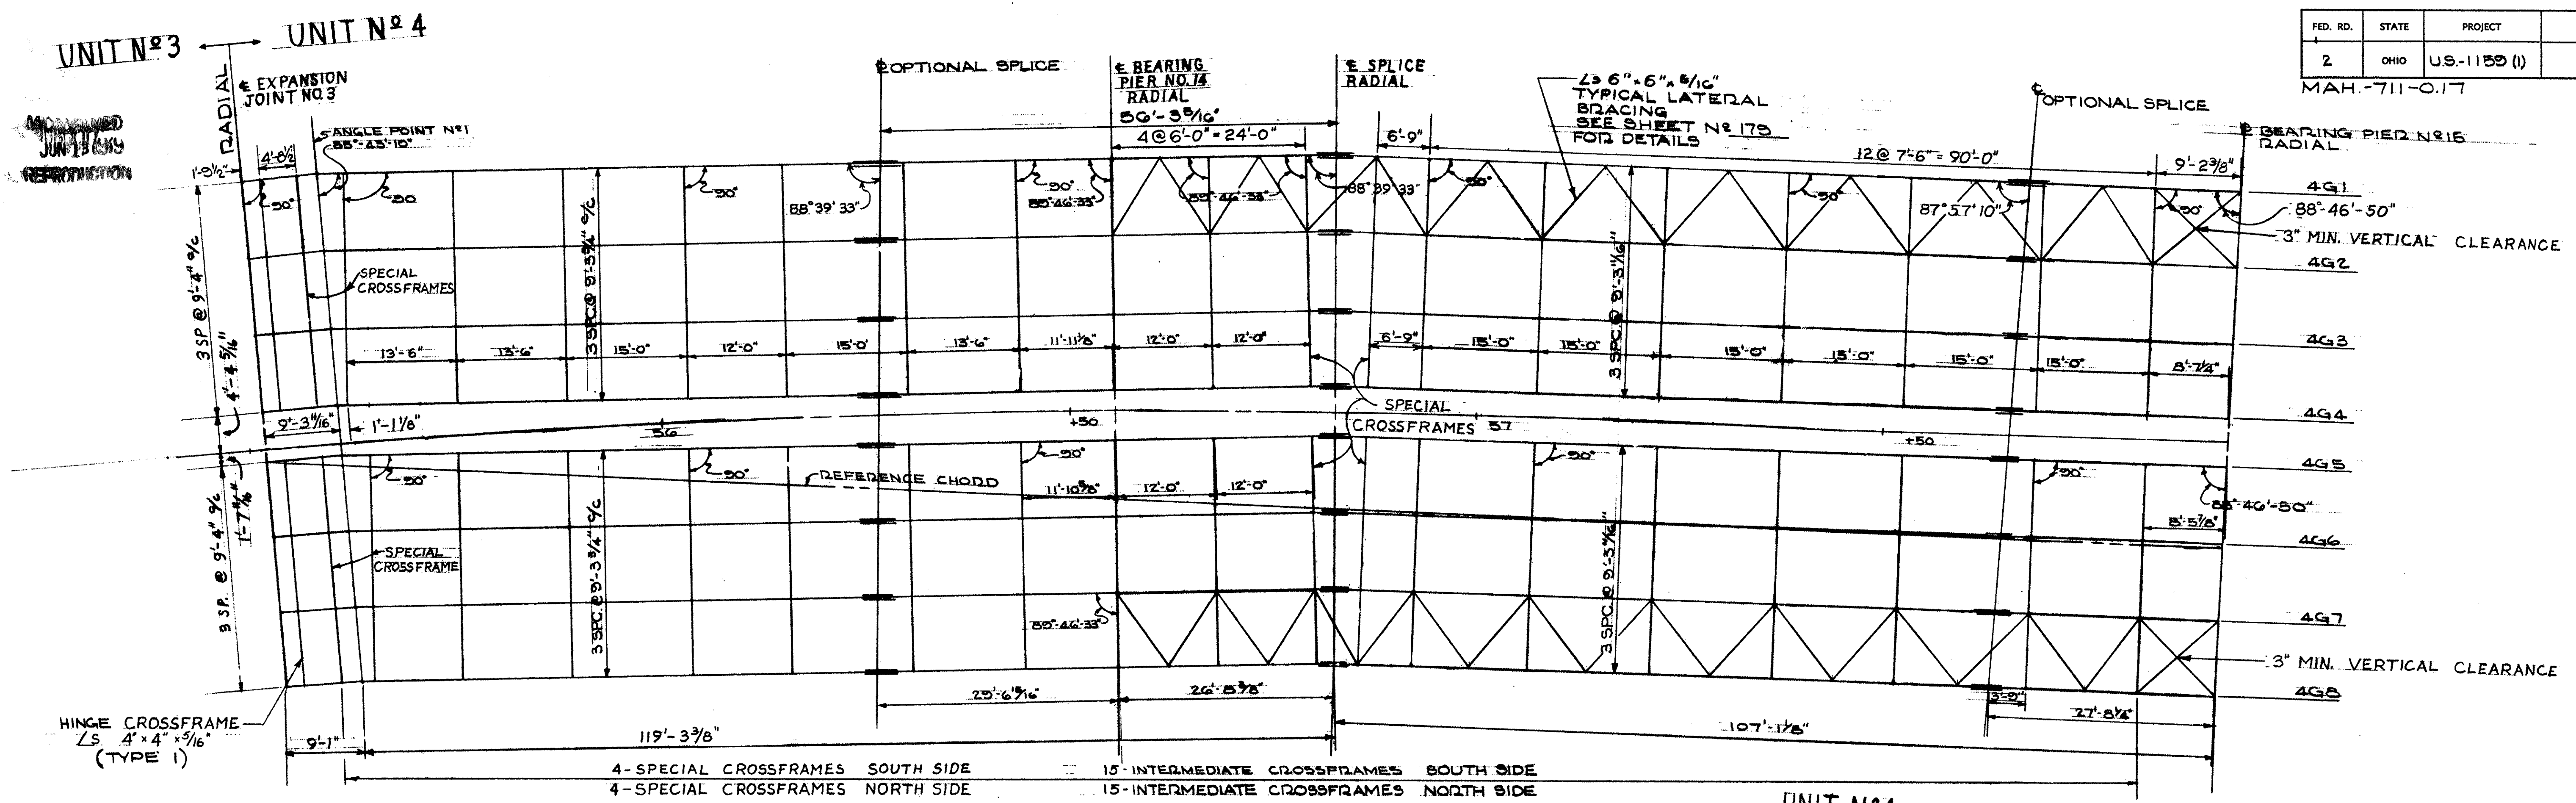

STATE OF OHIO DEPARTMENT OF HIGHWAYS BUREAU OF BRIDGES					
GLAUS, PYLE & SCHOMER AKRON, OHIO YOUNGSTOWN, OHIO					
CROSS FRAMES					
BRIDGE NO.			MAH-711-0116		
OVER MAHONING RIVER					
YOUNGSTOWN			MAHONING COUNTY		
UNIT NO. 4					
DESIGNED	DRAWN	TRACED	CHECKED	REVIEWED	DATE
R.H.	J.P.		D.M.	W.K.D.	6-22-68
REVISED					


MAHONING
JUNCTION
REPAIR/RECONSTRUCTION

FED. RD.	STATE	PROJECT
2	OHIO	U.S.-1160 (1)

MAH-711-0.17

181
232

UNIT N^o 4 UNIT N^o 5

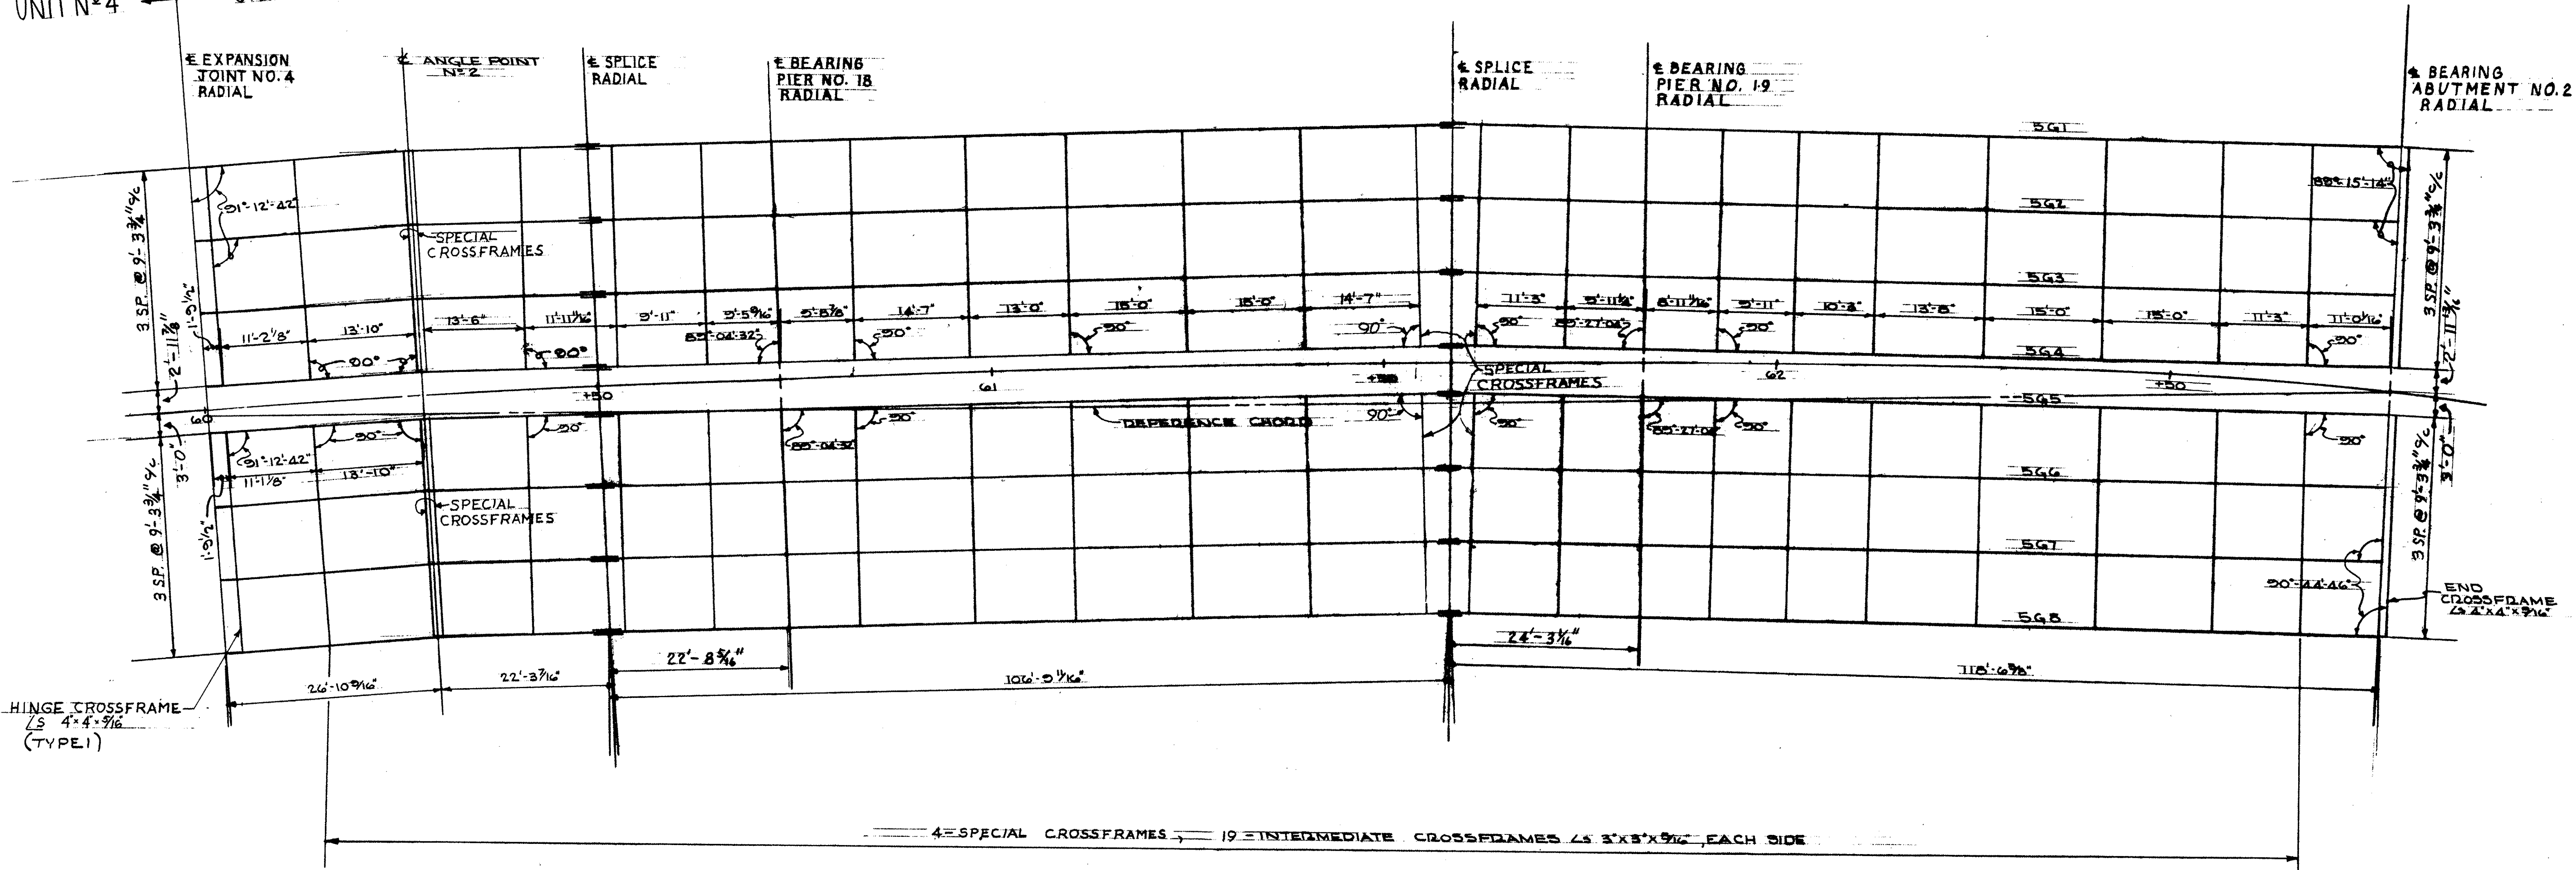

SEE SHEET N^o 205
FOR SPECIAL CROSSFRAME DETAIL


STATE OF OHIO DEPARTMENT OF HIGHWAYS BUREAU OF BRIDGES					
GLAUS, PYLE & SCHOMER AKRON, OHIO YOUNGSTOWN, OHIO					
CROSS FRAMES					
BRIDGE N ^o			MAH-711-0116		
OVER MAHONING RIVER					
YOUNGSTOWN			MAHONING COUNTY		
UNIT N ^o 5					
DESIGNED	DRAWN	TRACED	CHECKED	REVIEWED	DATE
R.H.	D.M.		R.H.	W.K.D.	6-22-68

FED. RD.	STATE	PROJECT
2	OHIO	U.S.-1159 (1)

182
232

MAHONING RIVER
BRIDGE

NOTE:
ALL WEB PLATES 48" x 3/8" EXCEPT @ HINGES
ALL BEARING STIFFENERS 71 1/2" x 4'-0"
IN PAIRS.
ALL INTERMEDIATE STIFFENERS
48" x 4'-0" IN PAIRS
ALL STIFFENERS MARKED THUS 'O' ARE
STIFFENERS TO WHICH CROSSFRAME
BRIDGING ANGLES ARE ATTACHED.
FLANGE PLATES ARE THE SAME ON
TOP & BOT.
ALL SPLICES NOTED SP. I-A THRU "E" ARE
FIELD SPLICES.

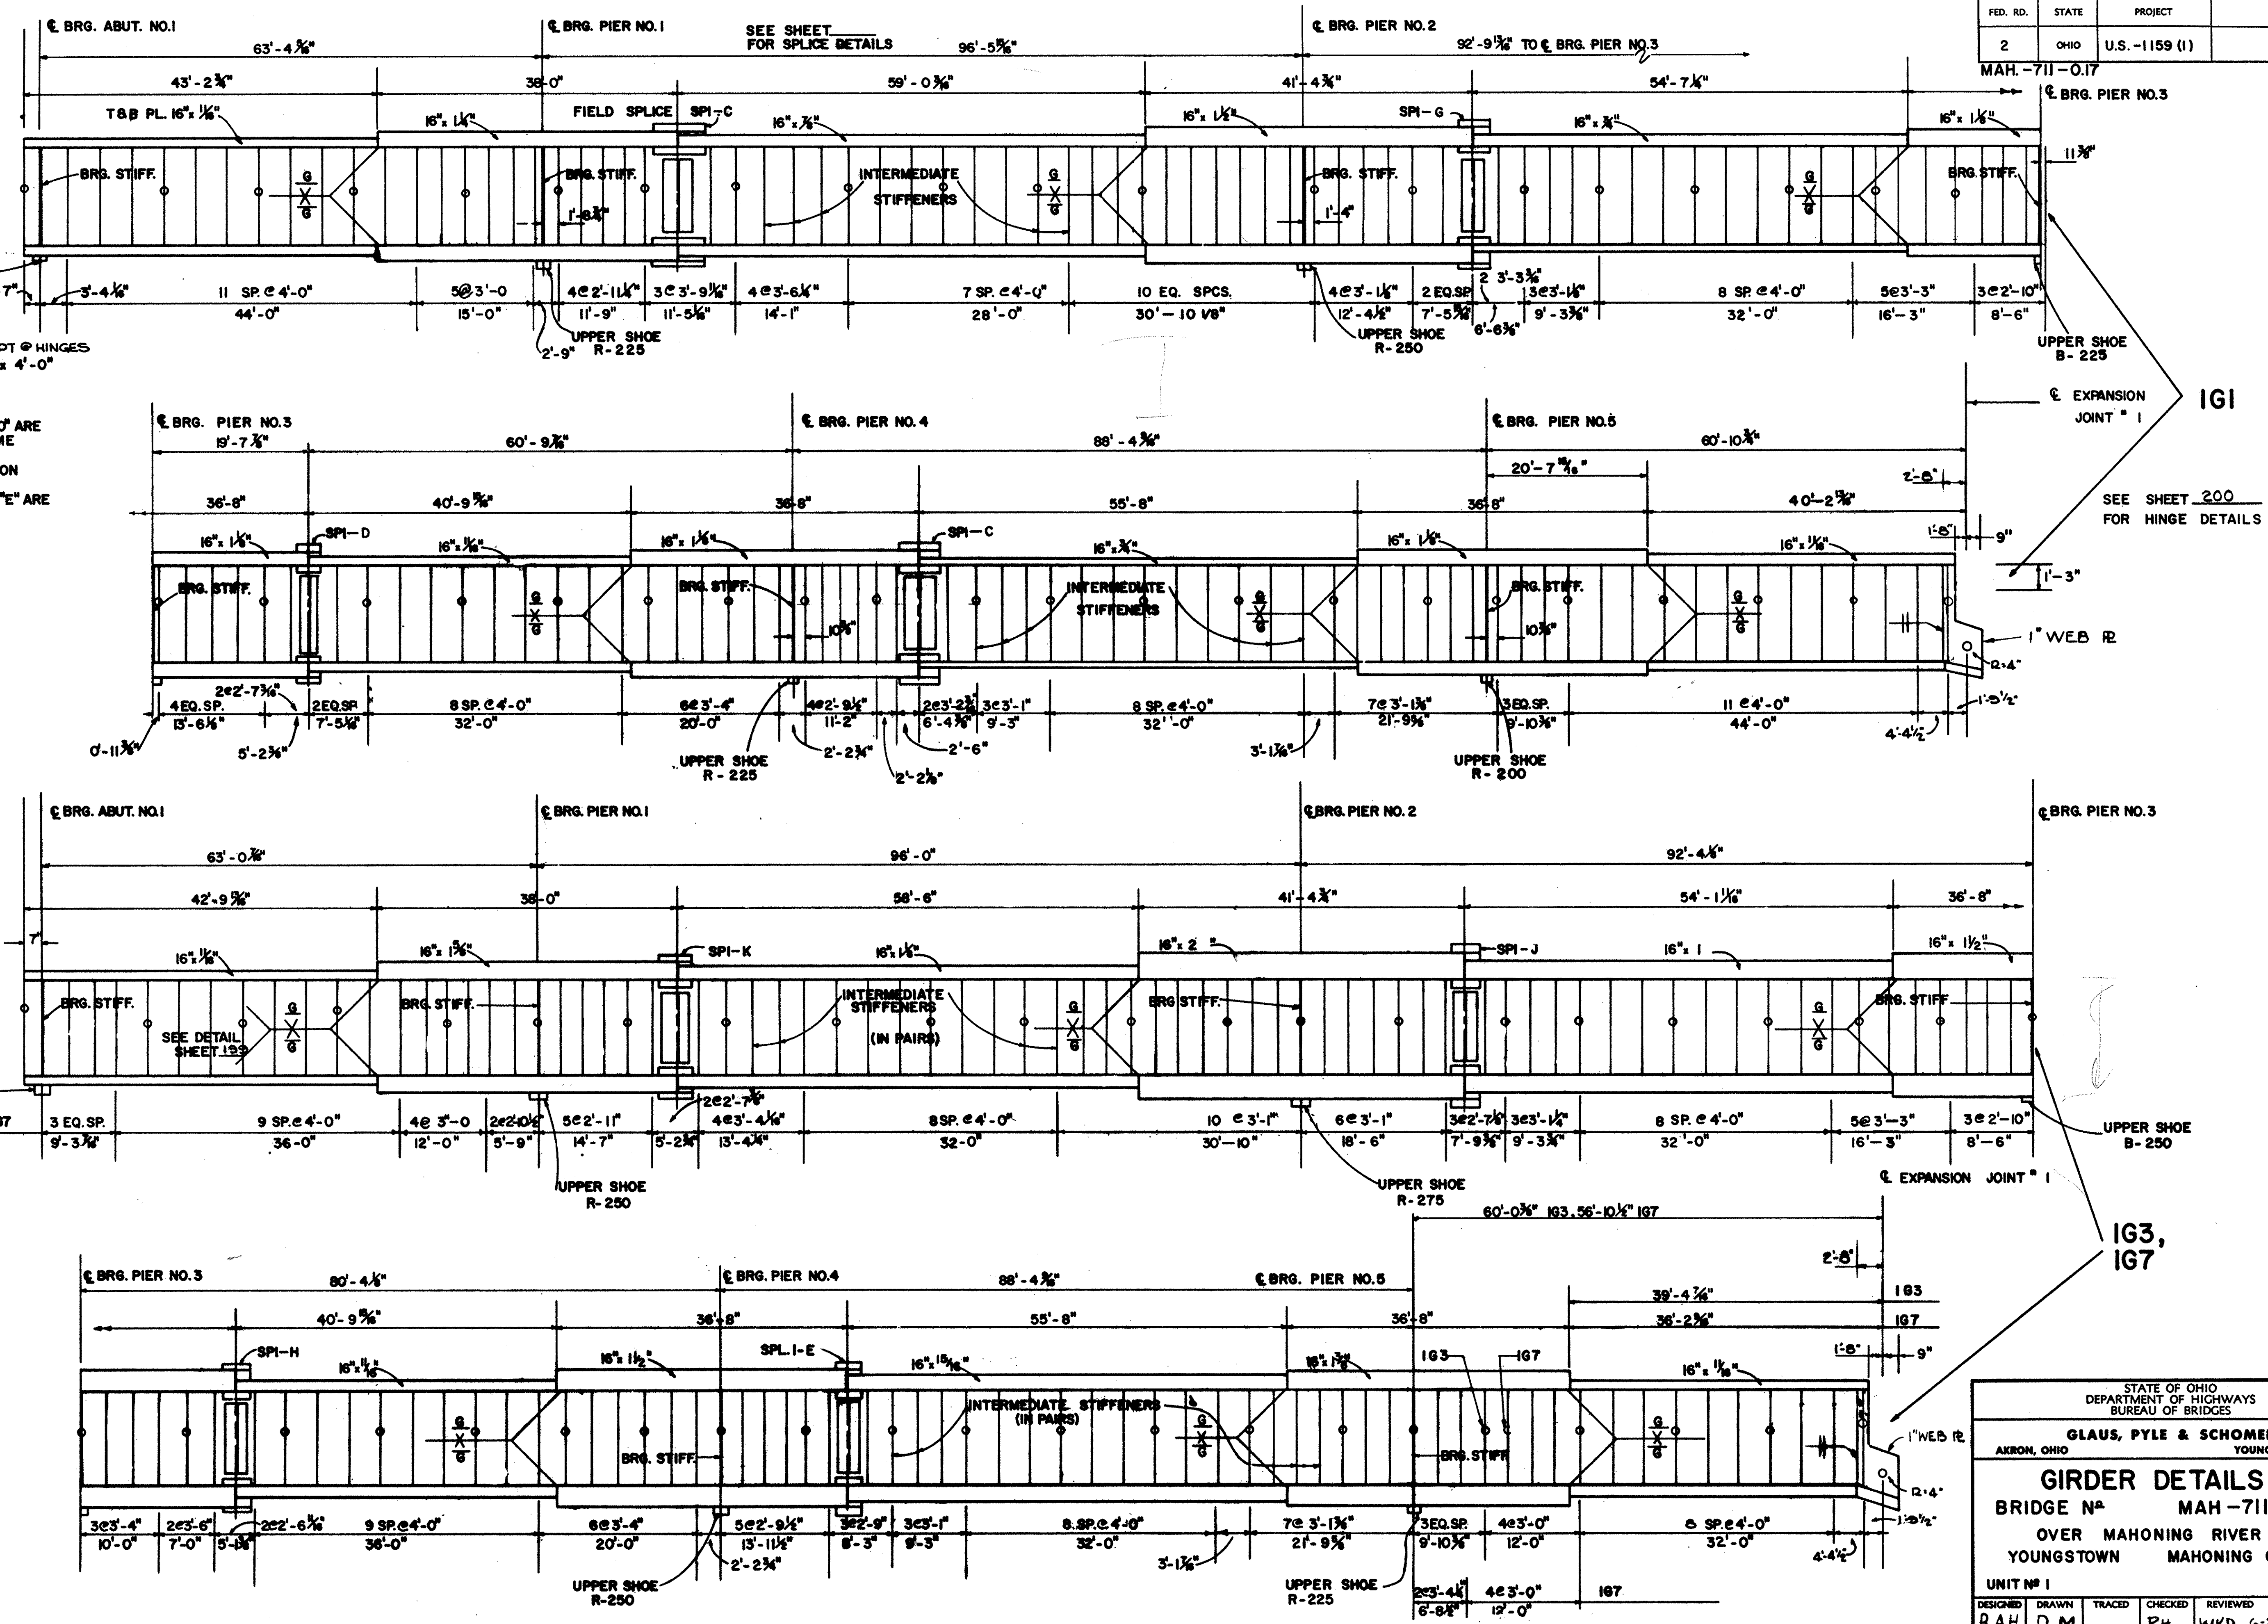


STATE OF OHIO DEPARTMENT OF HIGHWAYS BUREAU OF BRIDGES						
AKRON, OHIO		GLAUS, PYLE & SCHOMER YOUNGSTOWN, OHIO				
GIRDER DETAILS						
BRIDGE NO. MAH-711-0116			OVER MAHONING RIVER YOUNGSTOWN MAHONING COUNTY			
UNIT NO. 1						
DESIGNED	DRAWN	TRACED	CHECKED	REVIEWED	DATE	REVISED
RAH	D.M.		RH	WKD	6-22-68	

FED. RD.	STATE	PROJECT
2	OHIO	US.-1159 (I)

183
232


MAH-711-0.17

REVISION
JUN 19 1969

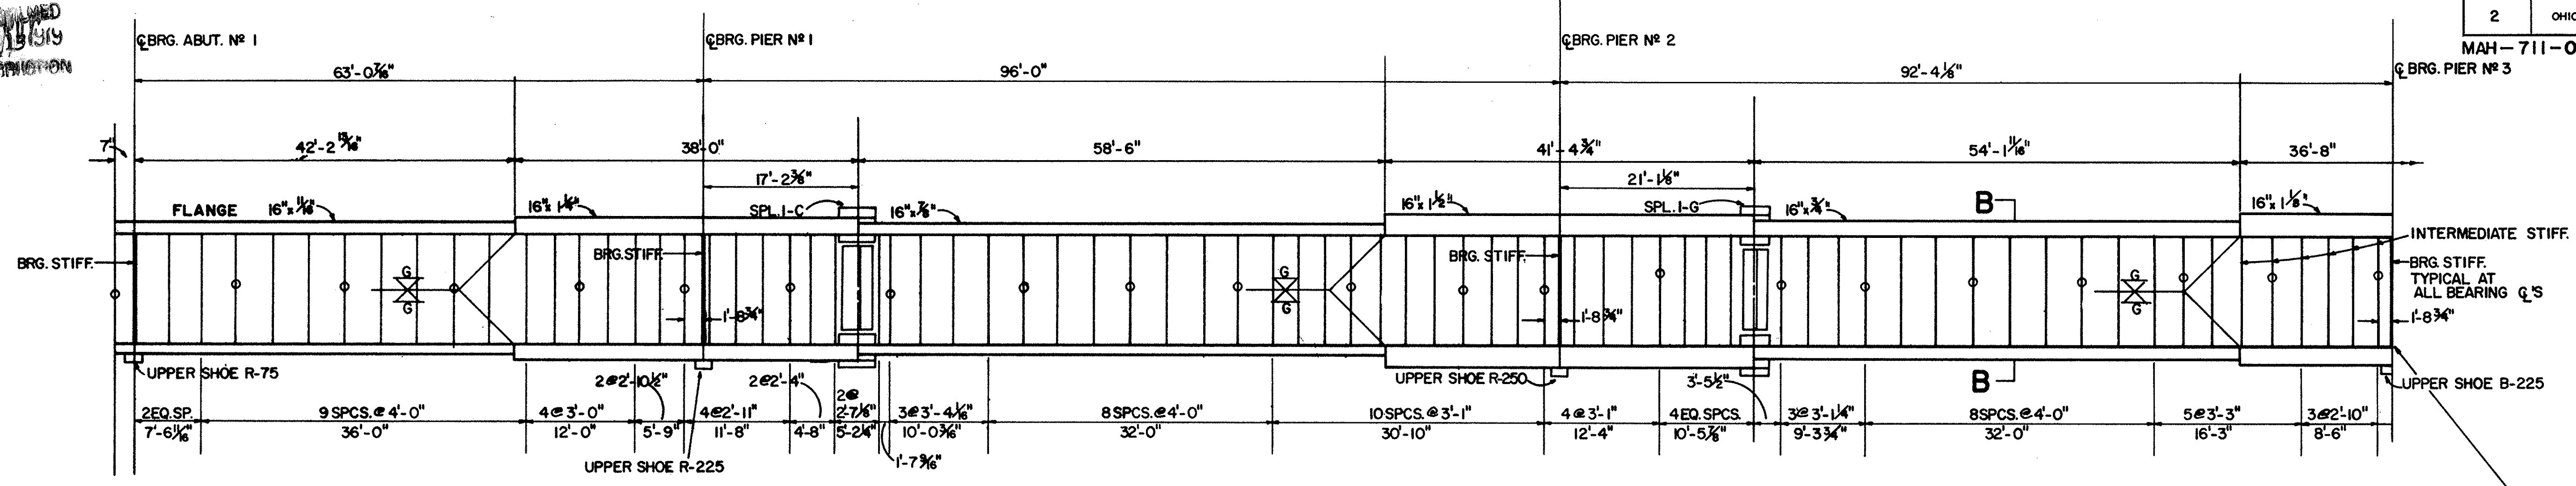


NOTE:
ALL WEB PLATE 48" x 3/8"
ALL BEARING STIFFENERS 7" x 5/8" x 4'-0"
IN PAIRS.
ALL INTERMEDIATE STIFFENERS
4" x 3/4" x 4'-0" IN PAIRS
ALL STIFFENERS MARKED THUS "O"
ARE STIFFENERS TO WHICH CROSS-
FRAME BRIDGING ANGLES ARE
ATTACHED.
FLANGE PLATES ARE THE SAME ON
TOP & BOTTOM
ALL SPLICES NOTED SP. I-A THRU "E"
ARE FIELD SPLICES.

IG9

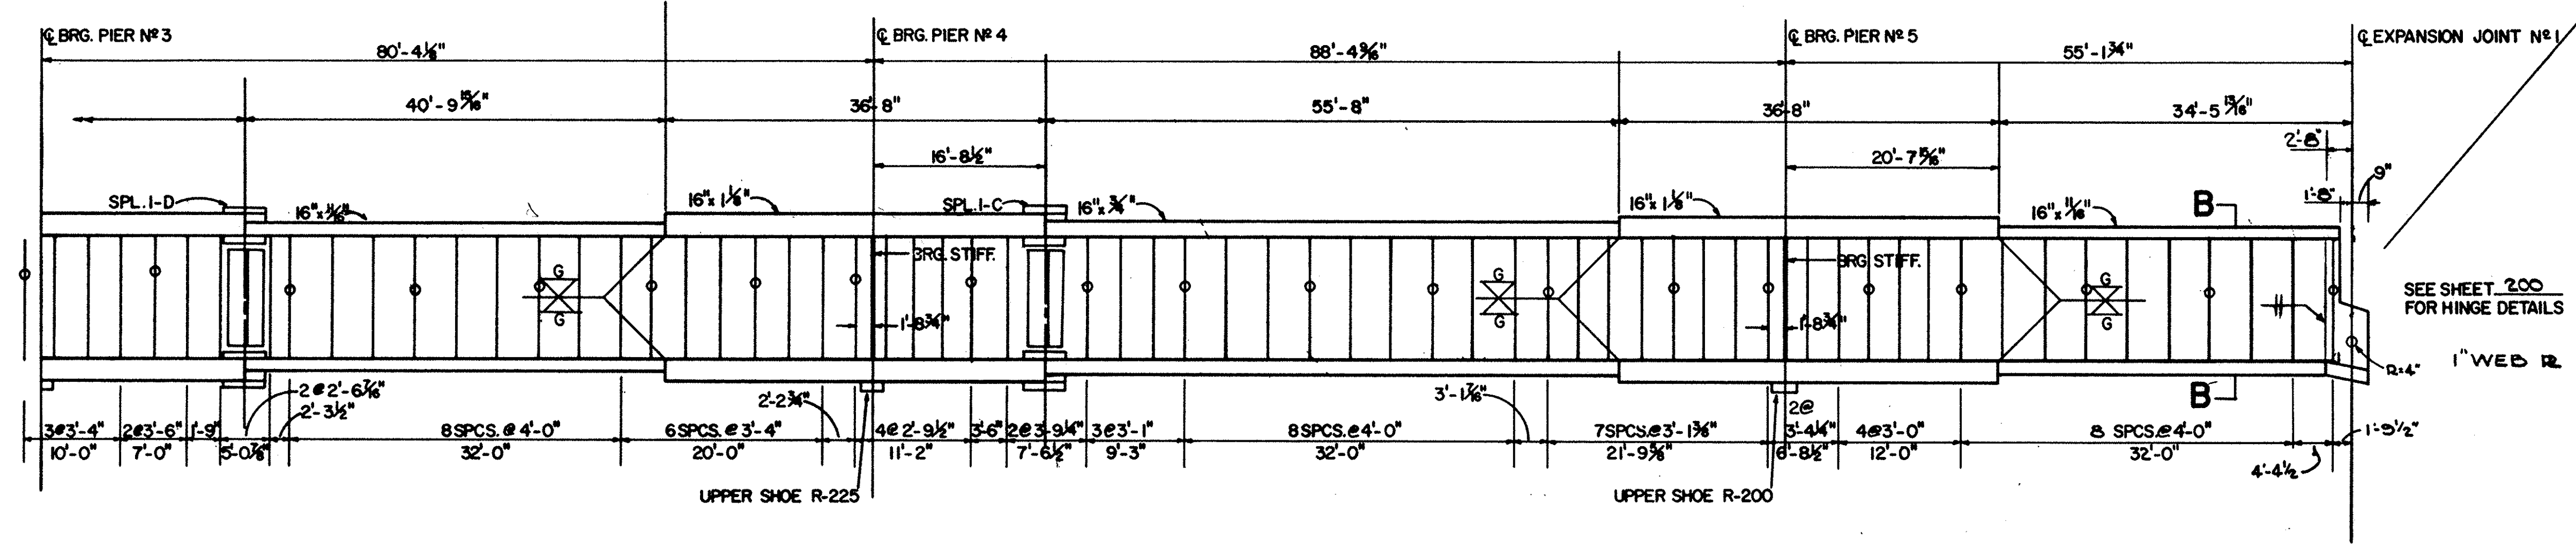

SEE SHEET 200
FOR HINGE DETAILS

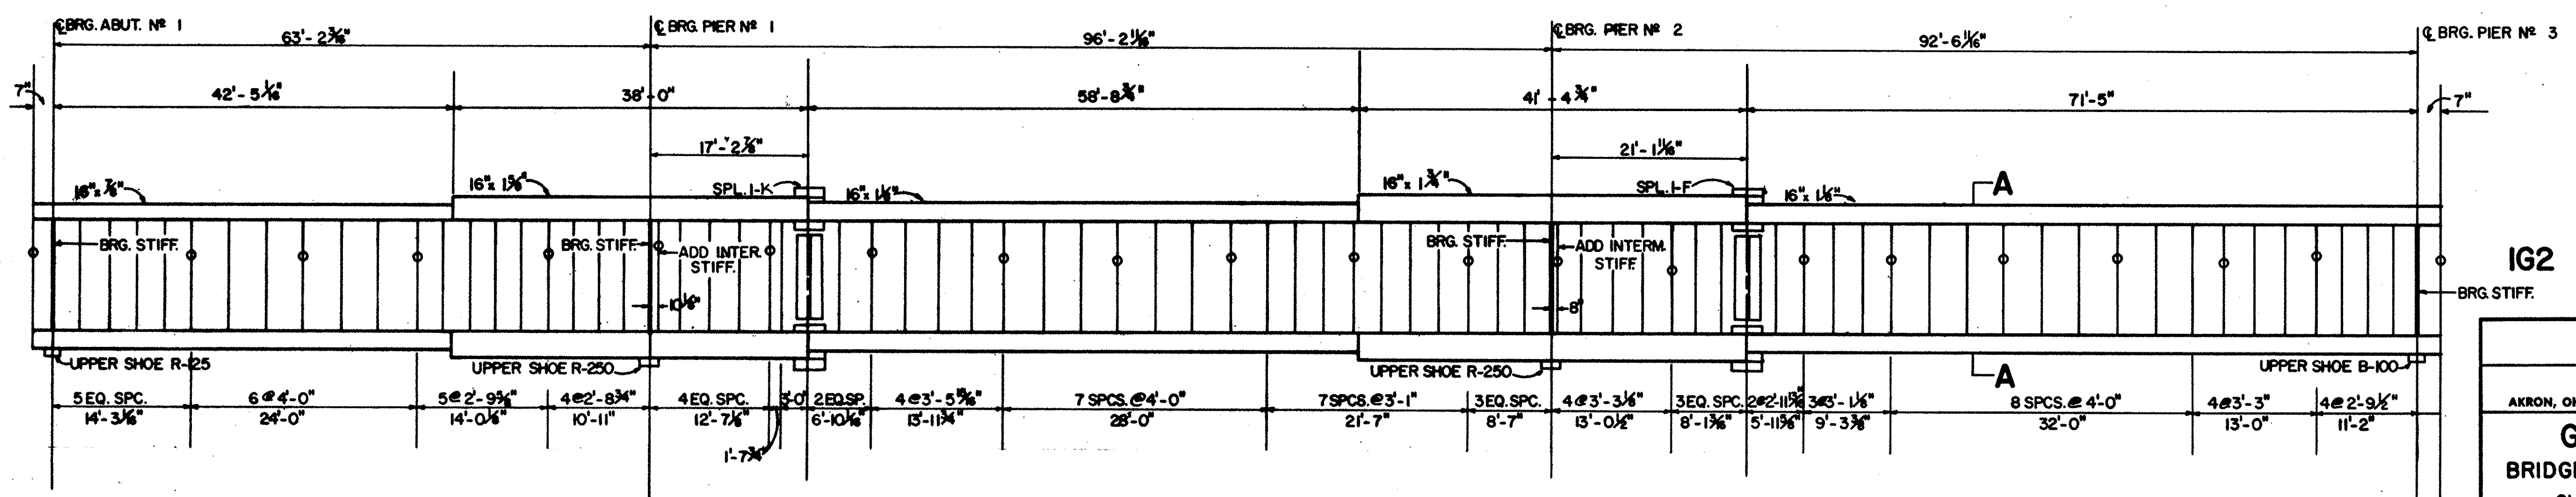

IG2


STATE OF OHIO DEPARTMENT OF HIGHWAYS BUREAU OF BRIDGES					
AKRON, OHIO					
GLAUS, PYLE & SCHOMER YOUNGSTOWN, OHIO					
GIRDER DETAILS					
BRIDGE NO. MAH-711-0116					
OVER MAHONING RIVER					
YOUNGSTOWN MAHONING COUNTY					
UNIT NO. 1					
DESIGNED RH	DRAWN D.M.	TRACED	CHECKED RH	REVIEWED WKO	DATE 6-22-68

MAHONING RIVER
 JUN 13 1968
 REPRODUCTION

FED. RD.	STATE	PROJECT
2	OHIO	U.S.-1159(1)

184
 232

MAH.-711-0.17

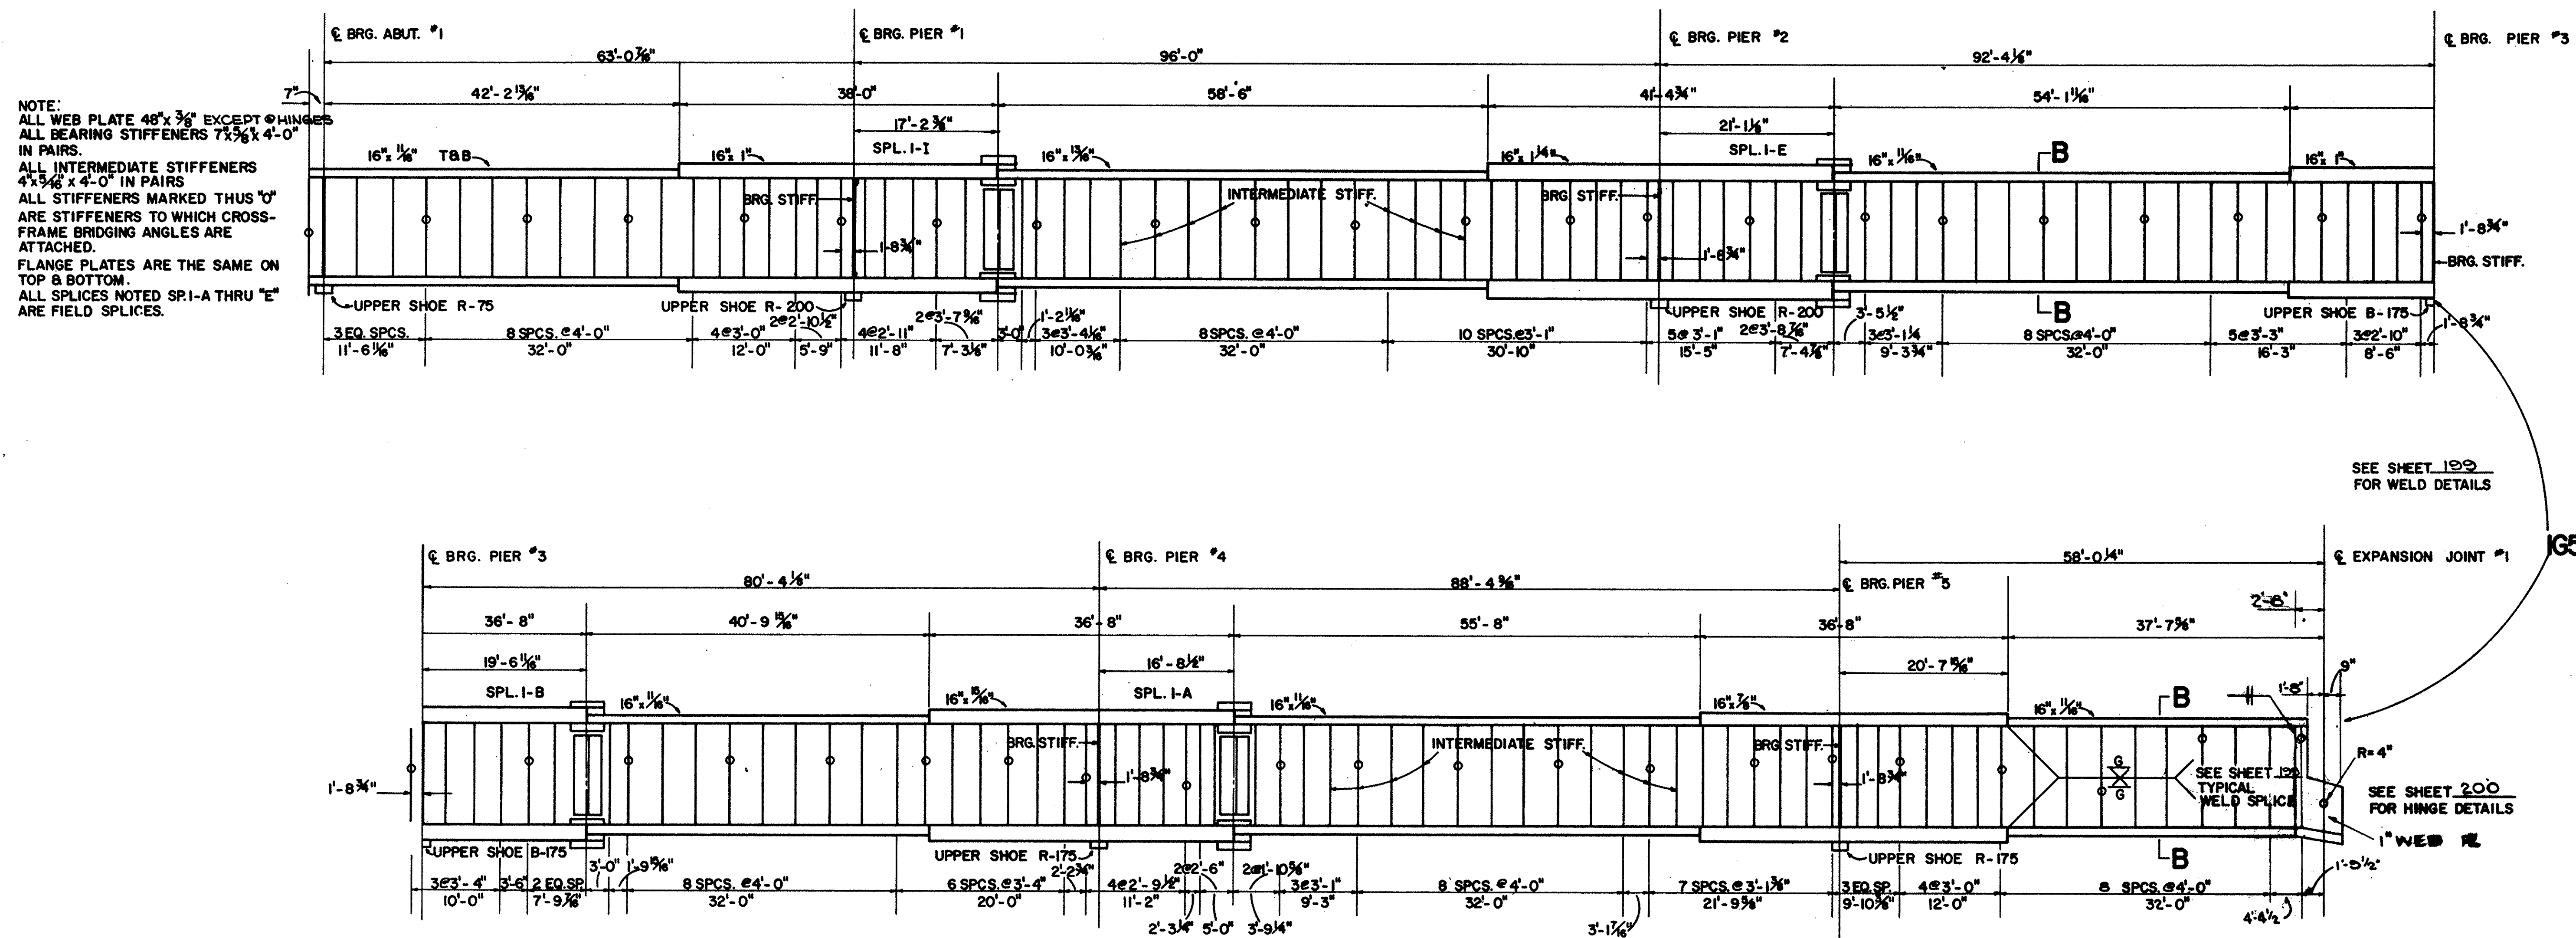

SEE SHEET 109 FOR WELD DETAILS

SEE SHEET 122 TYPICAL WELD SPLICE

SEE SHEET 200 FOR HINGE DETAILS


STATE OF OHIO DEPARTMENT OF HIGHWAYS BUREAU OF BRIDGES					
GLAUS, PYLE & SCHOMER AKRON, OHIO YOUNGSTOWN, OHIO					
GIRDER DETAILS					
BRIDGE NO. MAH.-711-0116					
OVER MAHONING RIVER					
YOUNGSTOWN MAHONING COUNTY					
UNIT NO. 1					
DESIGNED RH	DRAWN D.M.	TRACED	CHECKED RH	REVIEWED W.K.D.	DATE 6-22-68

MAHONING RIVER
JUN 13 1959
REPRINTED




FED. RD.	STATE	PROJECT
2	OHIO	U.S.-1159 (I)

185
232

MAH.-711-O.17

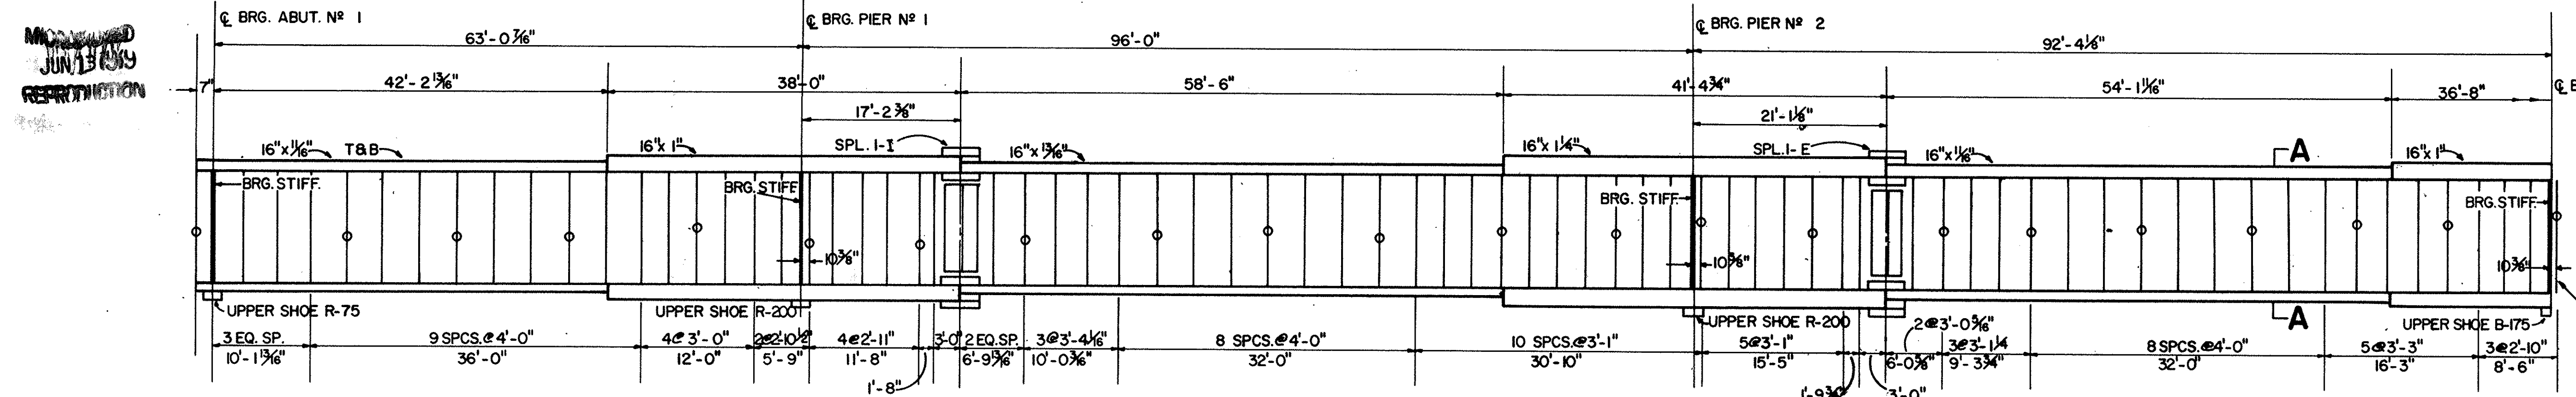

NOTE:
ALL WEB PLATE 48"x 3/8" EXCEPT @ HINGES
ALL BEARING STIFFENERS 7"x 9/16"x 4'-0"
IN PAIRS.
ALL INTERMEDIATE STIFFENERS
4"x 5/16"x 4'-0" IN PAIRS
ALL STIFFENERS MARKED THUS "O"
ARE STIFFENERS TO WHICH CROSS-
FRAME BRIDGING ANGLES ARE
ATTACHED
FLANGE PLATES ARE THE SAME ON
TOP & BOTTOM.
ALL SPLICES NOTED SP.1-A THRU "E"
ARE FIELD SPLICES.

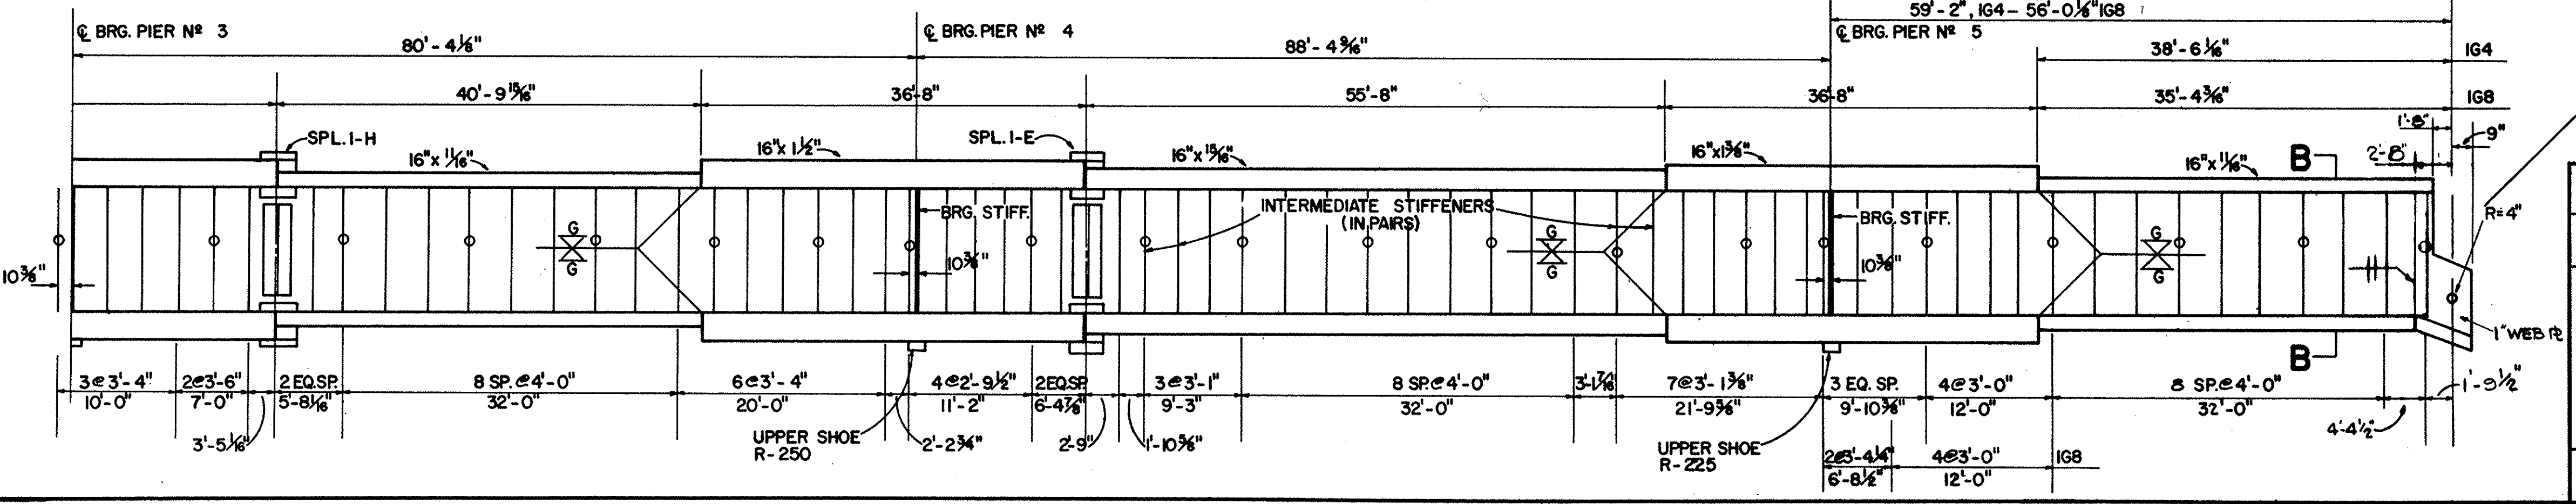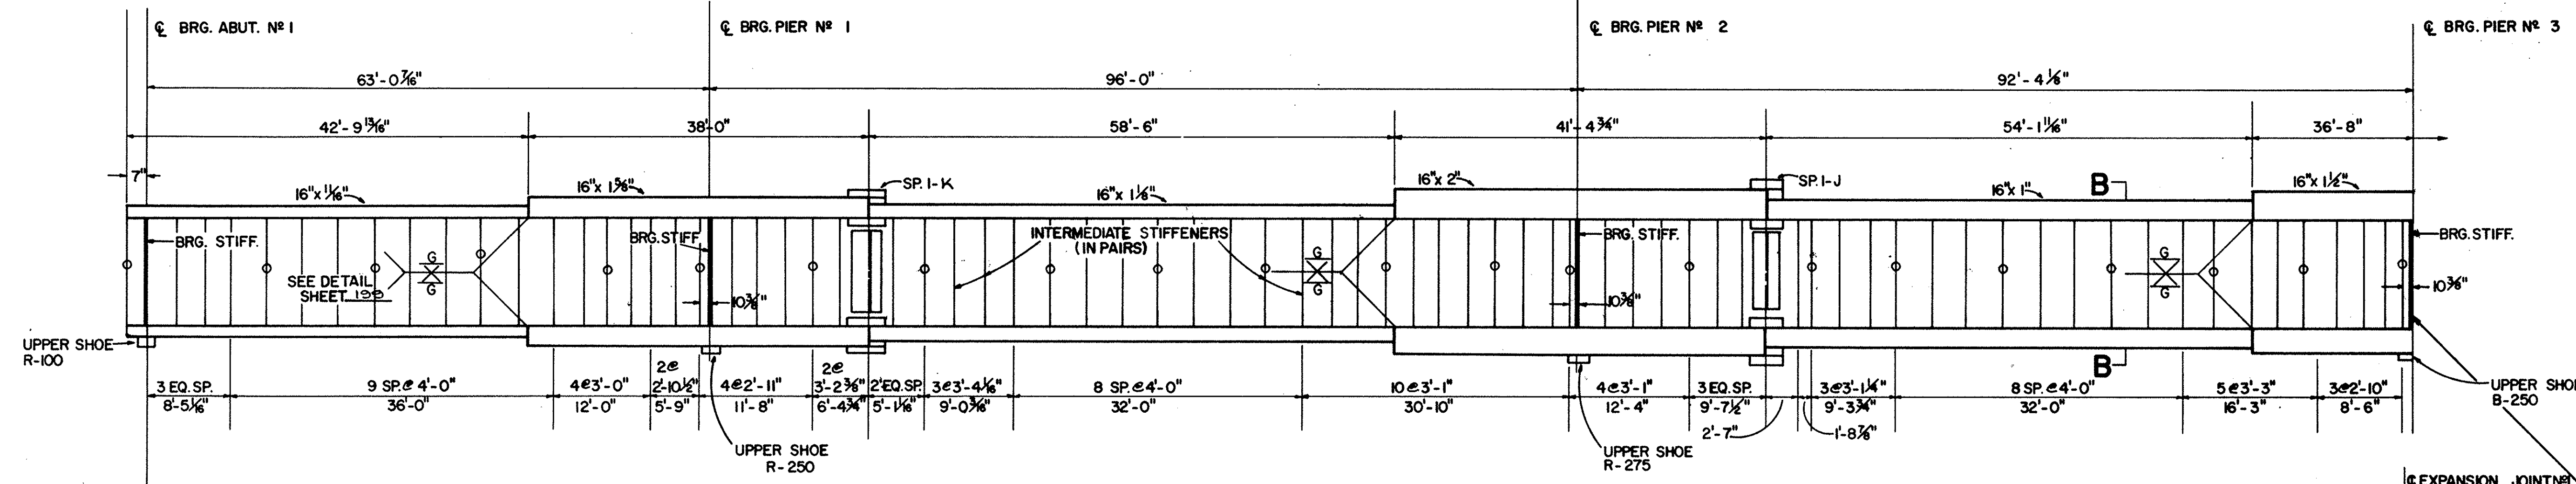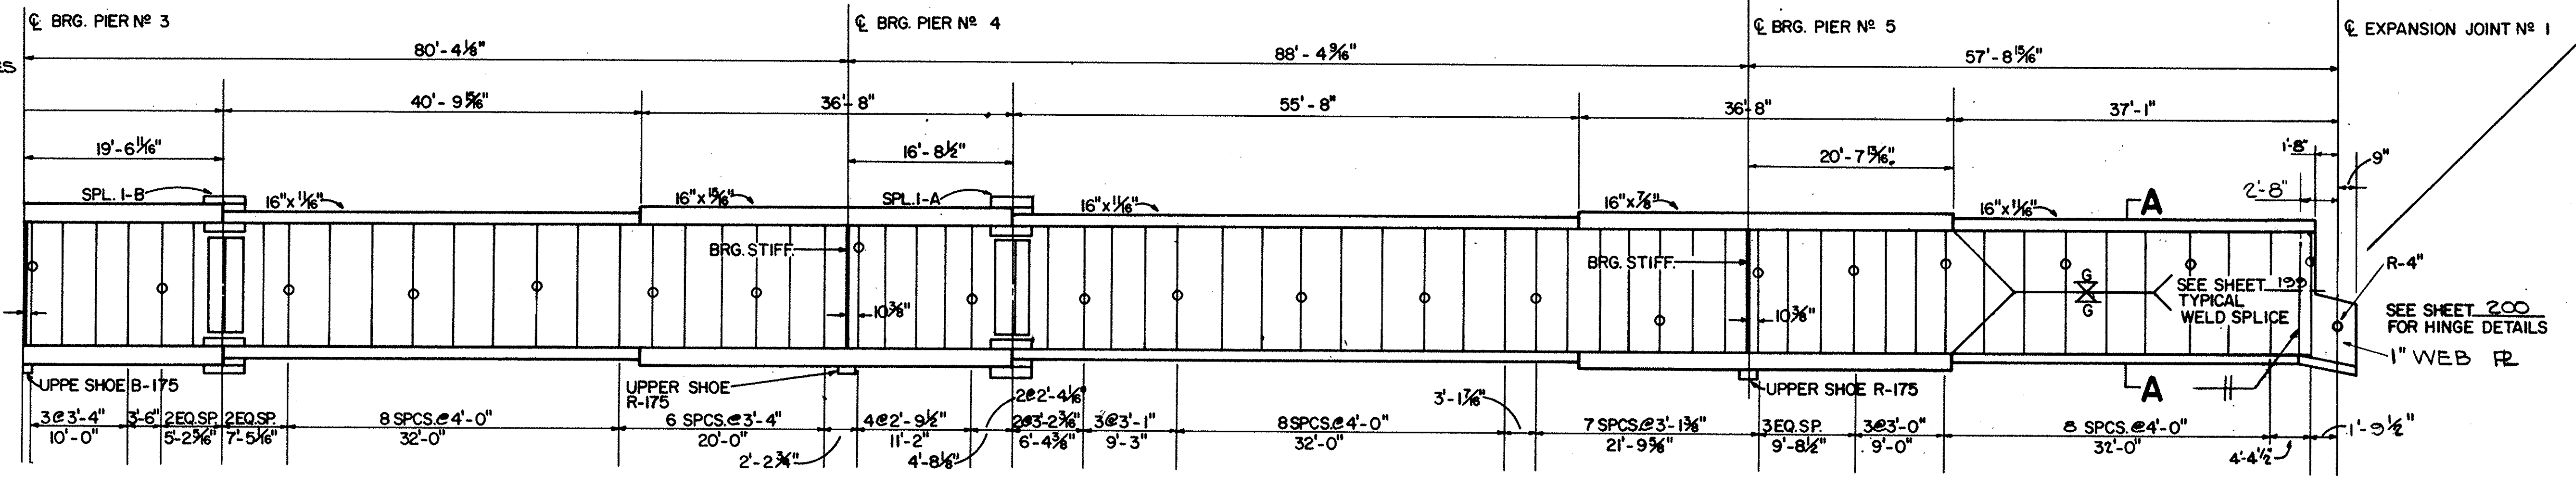

STATE OF OHIO
DEPARTMENT OF HIGHWAYS
BUREAU OF BRIDGES

AKRON, OHIO GLAUS, PYLE & SCHOMER YOUNGSTOWN, OHIO

GIRDER DETAILS
BRIDGE N° MAH.-711-O116
OVER MAHONING RIVER
YOUNGSTOWN MAHONING COUNTY

UNIT N° 1


DESIGNED	DRAWN	TRACED	CHECKED	REVIEWED	DATE	REVISED
RH	D.M.		RH	WKO	6-22-68	

REVISION
 JUN 15 1969

FED. RD.	STATE	PROJECT
2	OHIO	U.S.-1159 (1)

186
 232

MAH-711-0.17

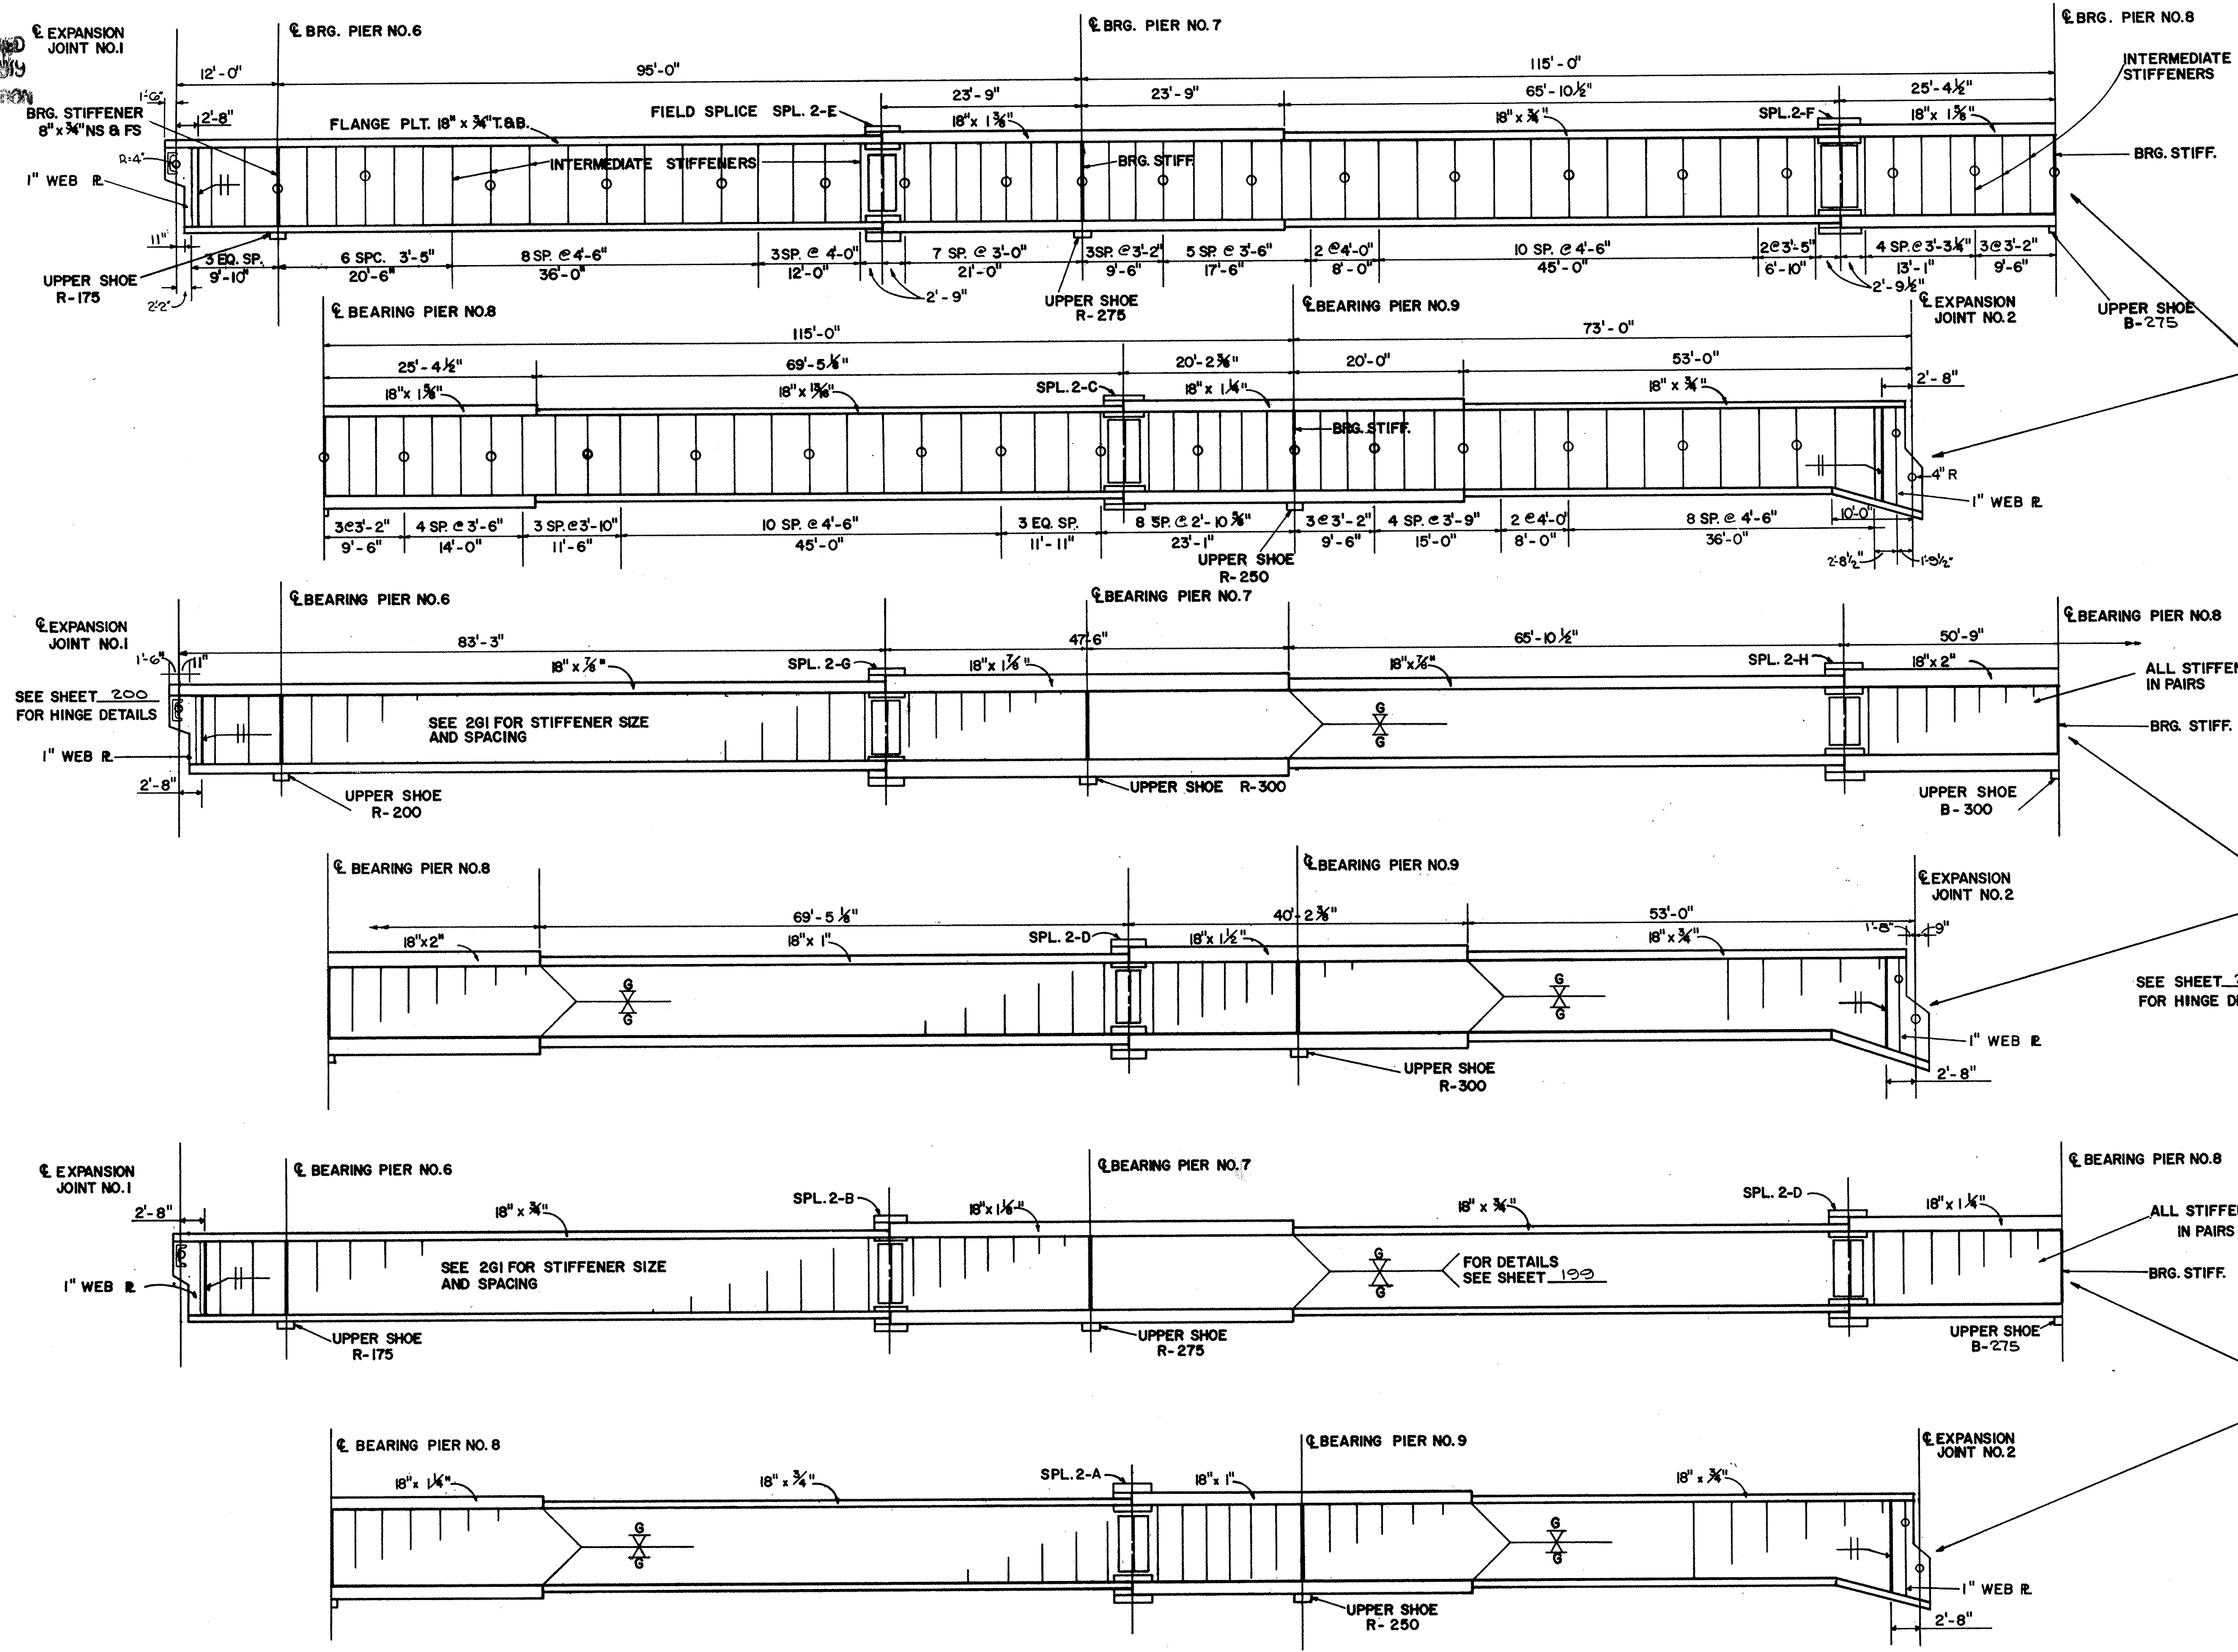

2 G1
 2 G8

NOTE: ALL WEB PLATES 60" x 3/8", EXCEPT @ HINGE EXCEPT AT EXPANSION JT. NO. 2
 ALL INTERMEDIATE STIFFENERS 6" x 3/8" x 5'-0" IN PAIRS
 ALL BEARING STIFFENERS IN PAIRS 8" x 3/4" x 5'-0"
 ALL SPLICES NOTED SP. 2-A THRU H ARE FIELD SPLICES. SEE SHEET 200 FOR DETAILS.
 CROSSFRAMES CONNECT TO ALL STIFFENERS MARKED φ

2G2, 2G3, 2G6, 2G7

SEE SHEET 200 FOR HINGE DETAILS

2G4, 2G5


STATE OF OHIO DEPARTMENT OF HIGHWAYS BUREAU OF BRIDGES					
GLAUS, PYLE & SCHOMER AKRON, OHIO			YOUNGSTOWN, OHIO		
GIRDER DETAILS					
BRIDGE NO. MAH-711-0116			OVER MAHONING RIVER		
YOUNGSTOWN			MAHONING COUNTY		
UNIT NO. 2					
DESIGNED	DRAWN	TRACED	CHECKED	REVIEWED	DATE
J. M.	D. M.		RH	WKO	6-22-68

REPRODUCTION
JUN 13 1969

FED. RD.	STATE	PROJECT
2	OHIO	U.S.-1159 (1)

187
232

MAH-711-0.17

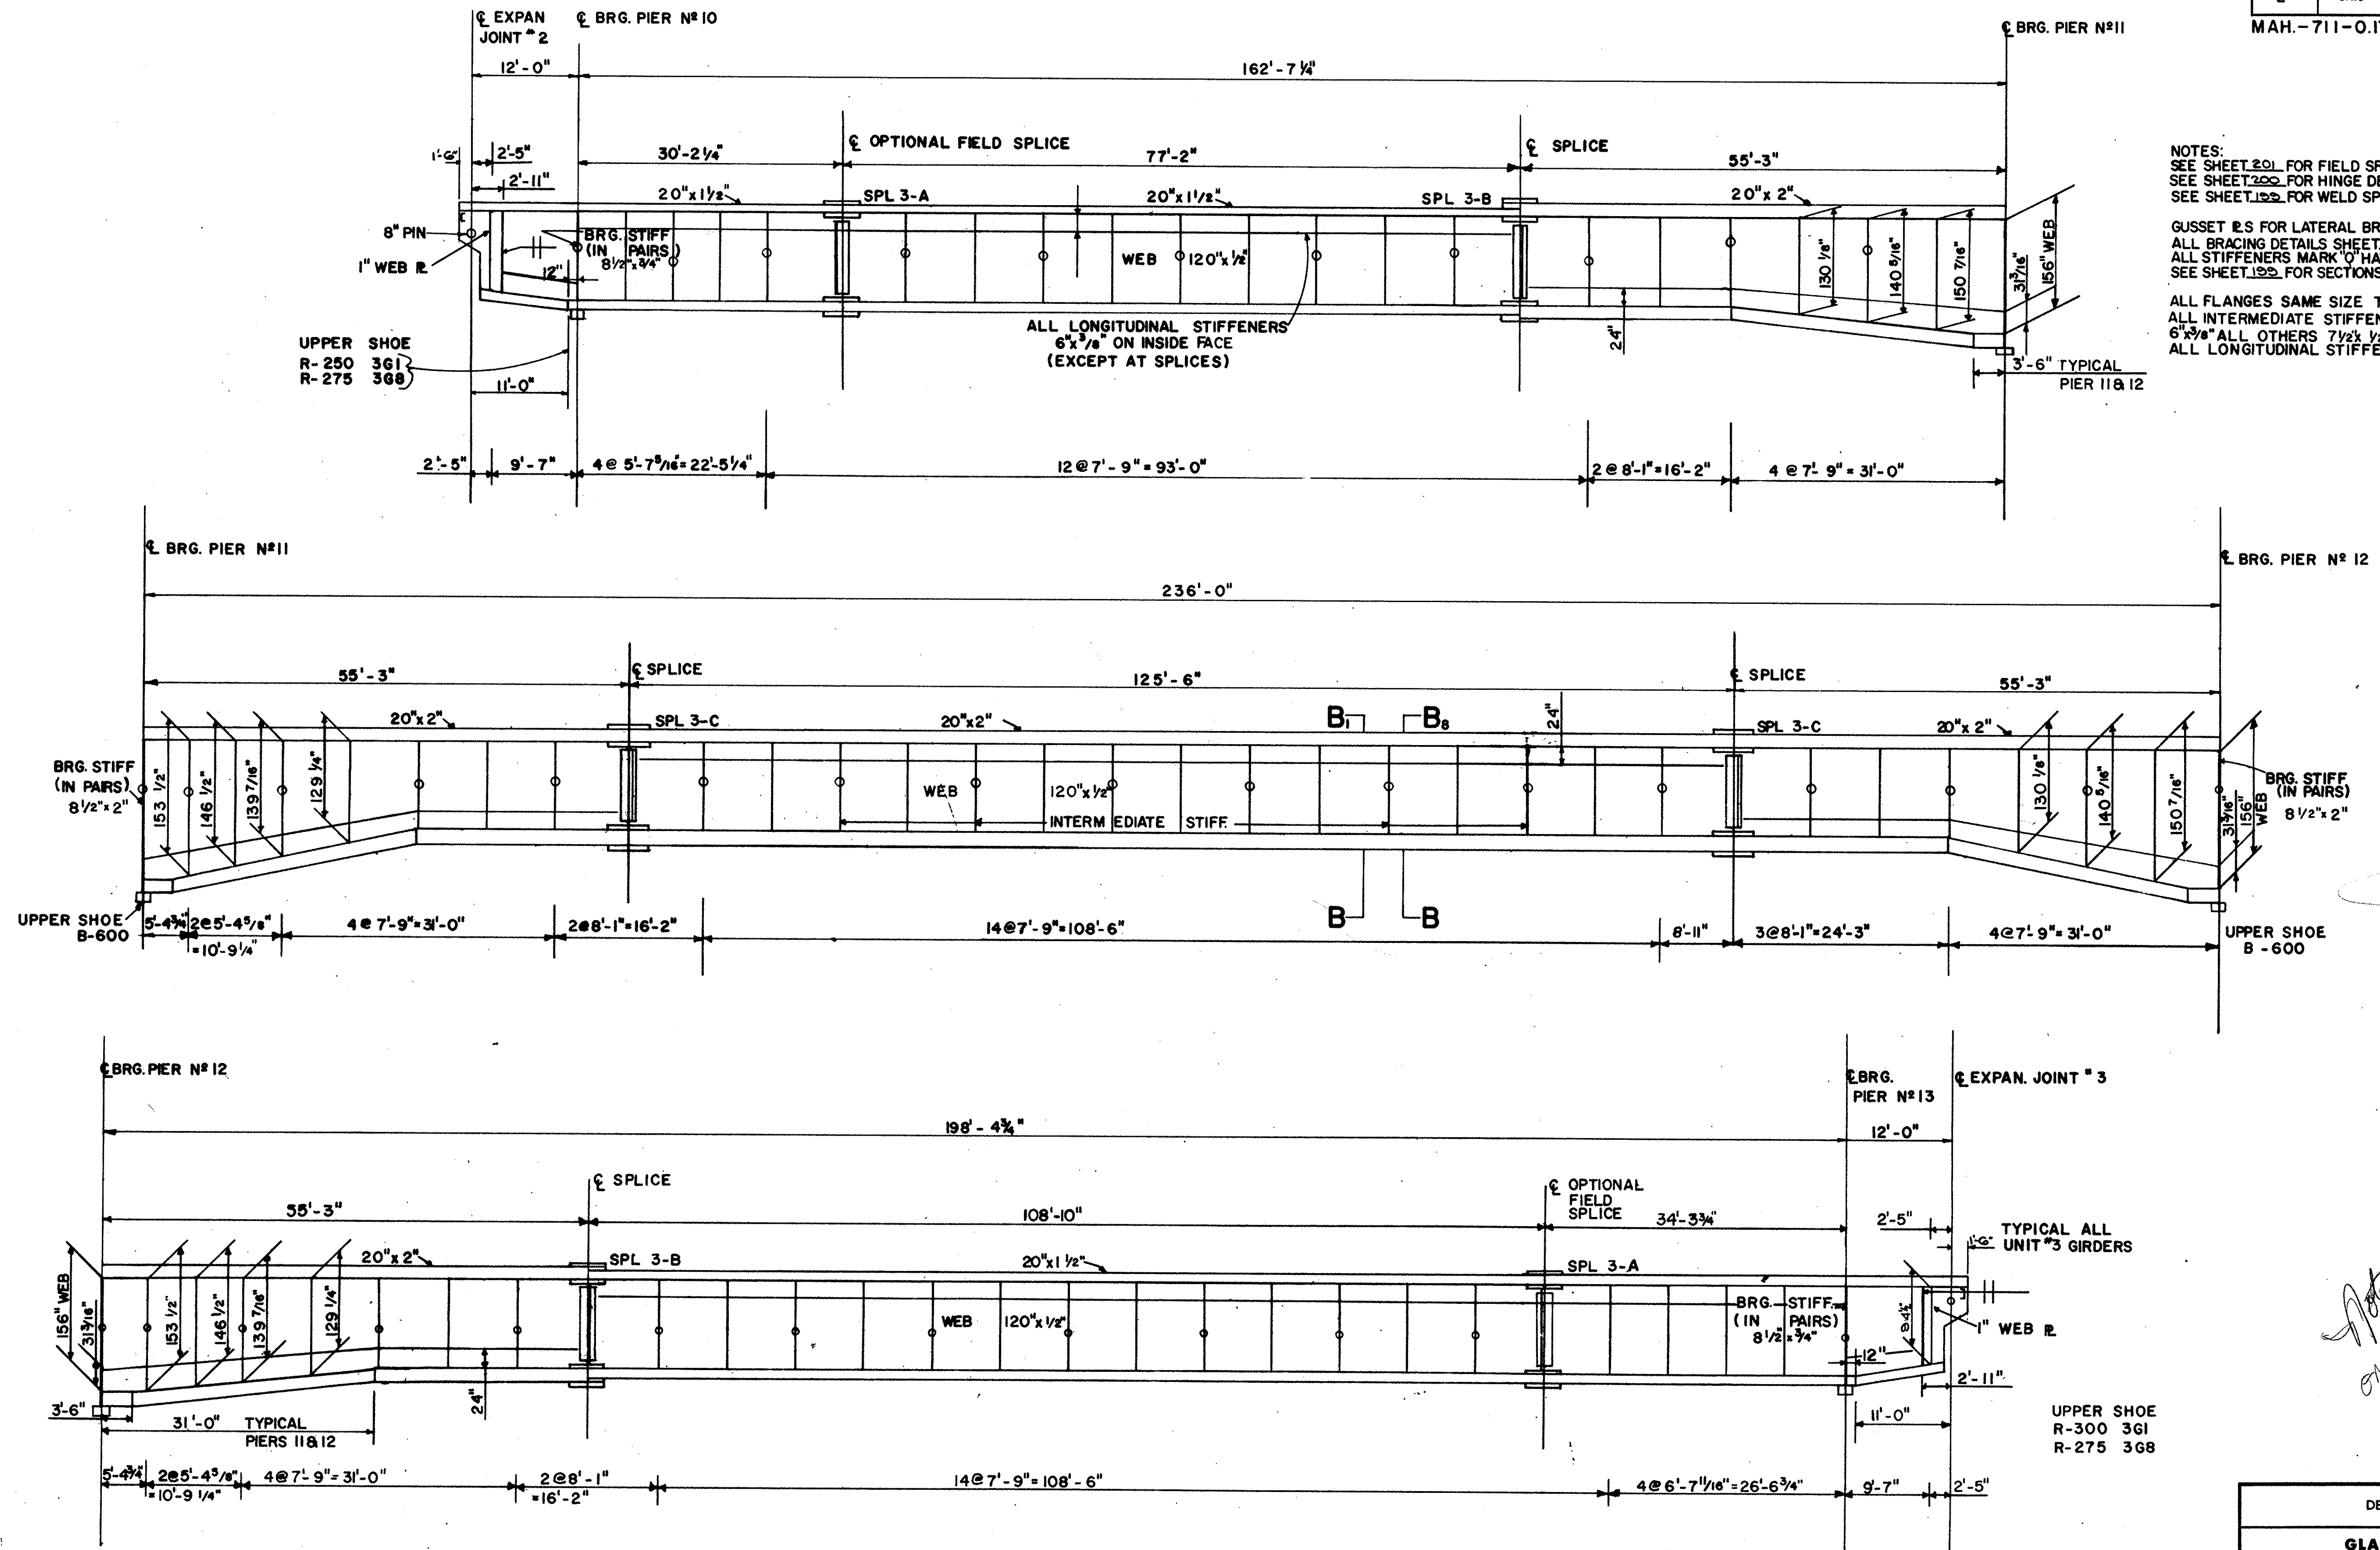

NOTES:
SEE SHEET 201 FOR FIELD SPLICE DETAILS.
SEE SHEET 200 FOR HINGE DETAILS.
SEE SHEET 199 FOR WELD SPLICE DETAILS
GUSSET B'S FOR LATERAL BRACING NOT SHOWN.
ALL BRACING DETAILS SHEET 199
ALL STIFFENERS MARK 'O' HAVE ATTACHING CROSSFRAMES.
SEE SHEET 199 FOR SECTIONS 'A-A', 'B-B'
ALL FLANGES SAME SIZE TOP AND BOTTOM.
ALL INTERMEDIATE STIFFENERS AT 120" WEB ARE 6" x 3/8" ALL OTHERS 7 1/2" x 1/2"
ALL LONGITUDINAL STIFFENERS 6" x 3/8"

3G1 SHOWN
3G8 OPP. HAND

*Note profile view 139/232
on site plan does not
show correct spacing
of stiffeners*

STATE OF OHIO DEPARTMENT OF HIGHWAYS BUREAU OF BRIDGES						
GLAUS, PYLE & SCHOMER AKRON, OHIO YOUNGSTOWN, OHIO						
GIRDER DETAILS						
BRIDGE N° MAH-711-0116						
OVER MAHONING RIVER						
YOUNGSTOWN MAHONING COUNTY						
UNIT N°3						
DESIGNED	DRAWN	TRACED	CHECKED	REVIEWED	DATE	REVISED
RH	B.P.		RH	WKO	6-22-68	



REPRODUCTION
JUN 13 1969

FED. RD.	STATE	PROJECT
2	OHIO	U.S.-1159 (1)


188
232

MAH-711-0.17

SEE NOTES SHEET 187

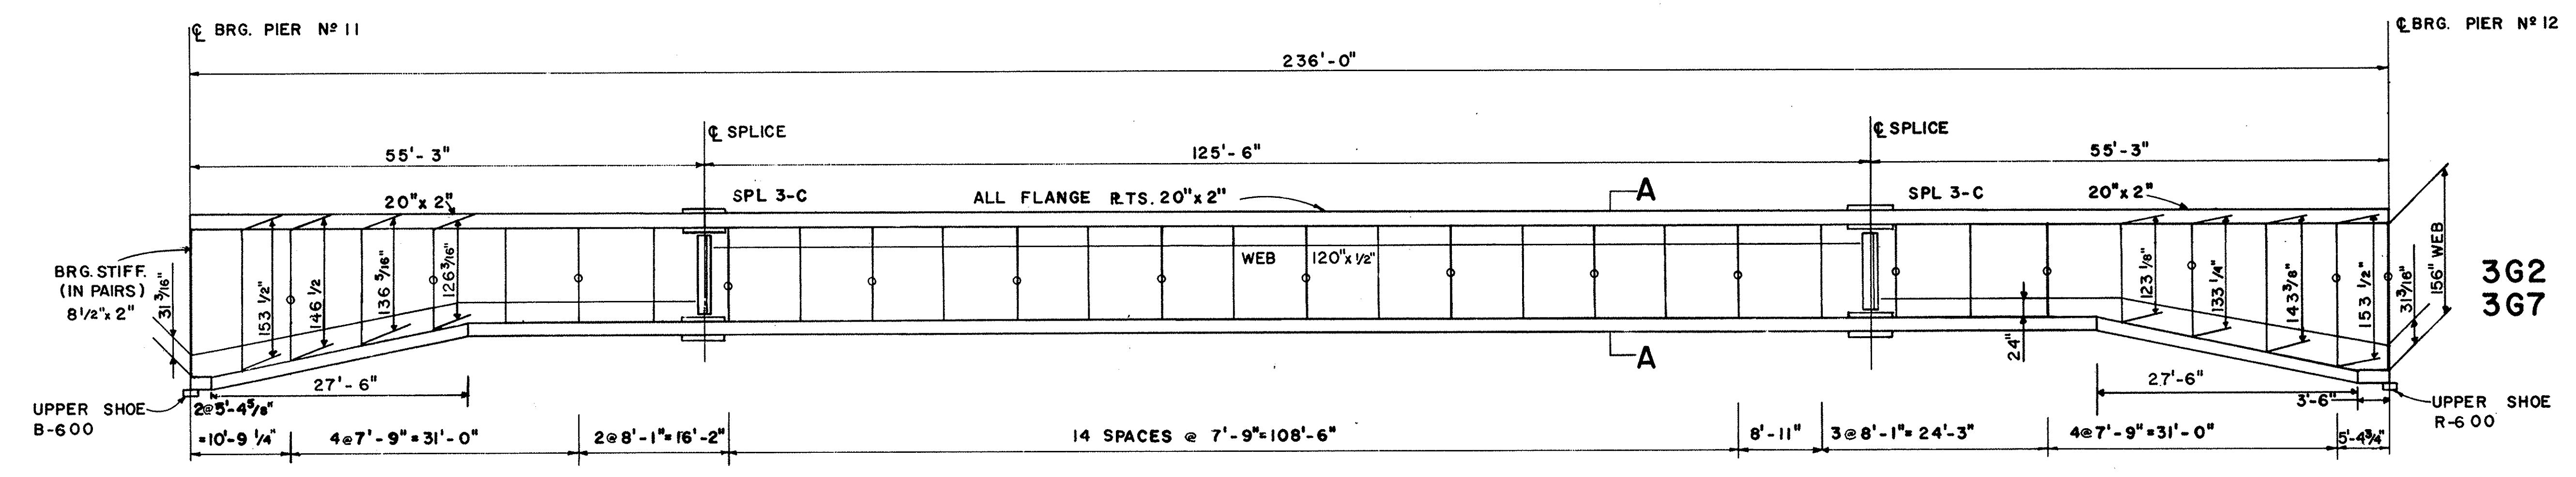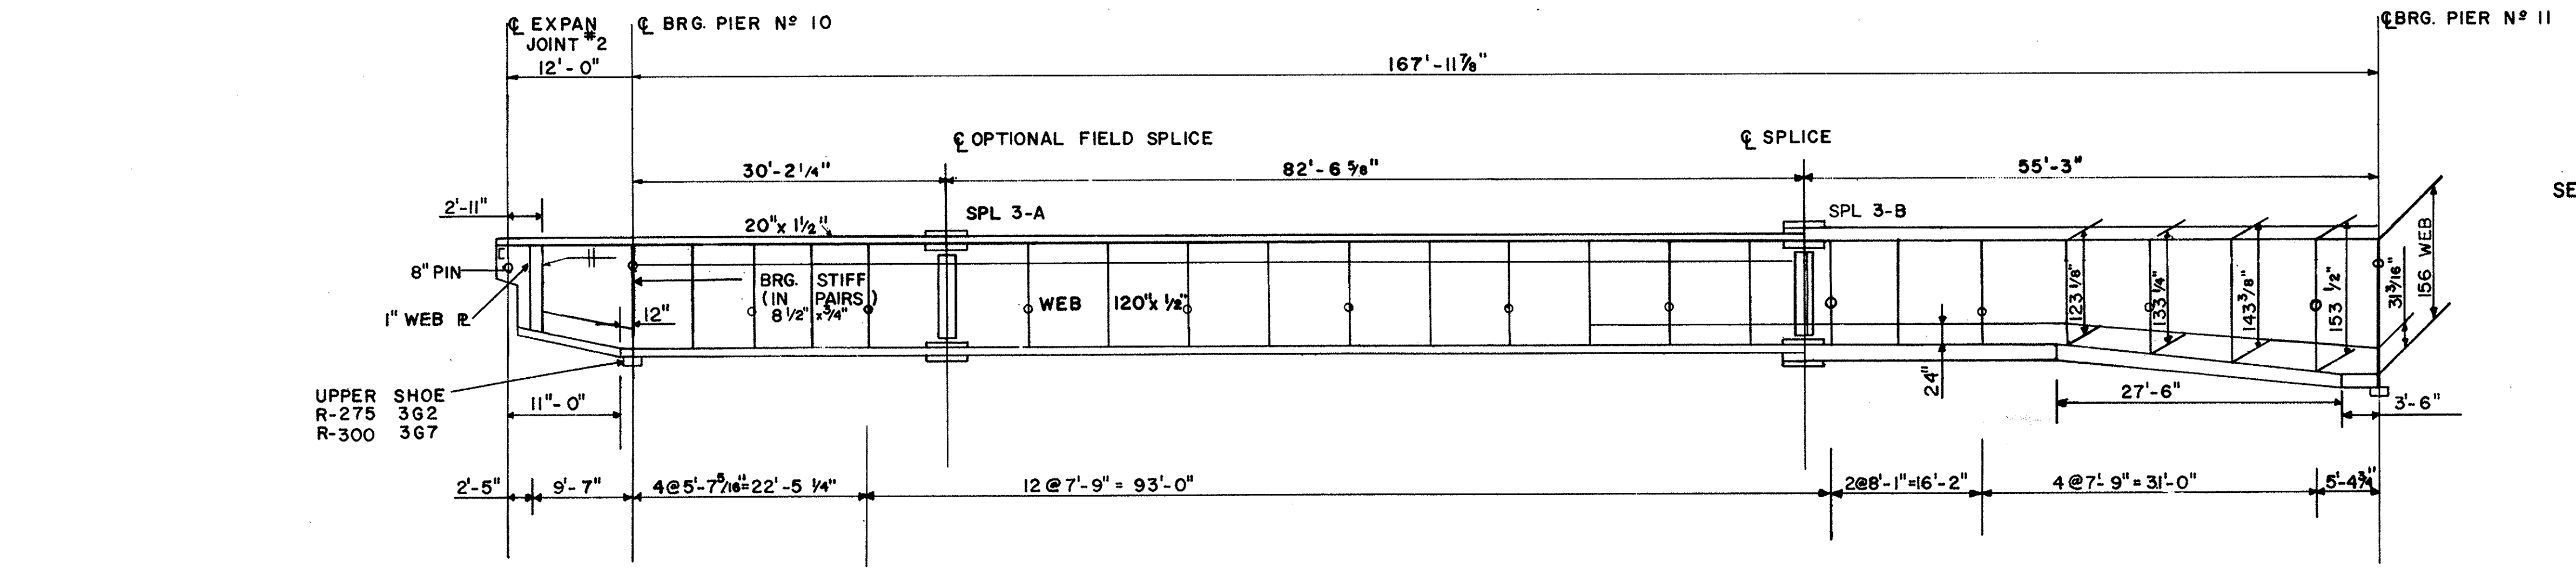

3G2 SHOWN
3G7 OPP. HAND

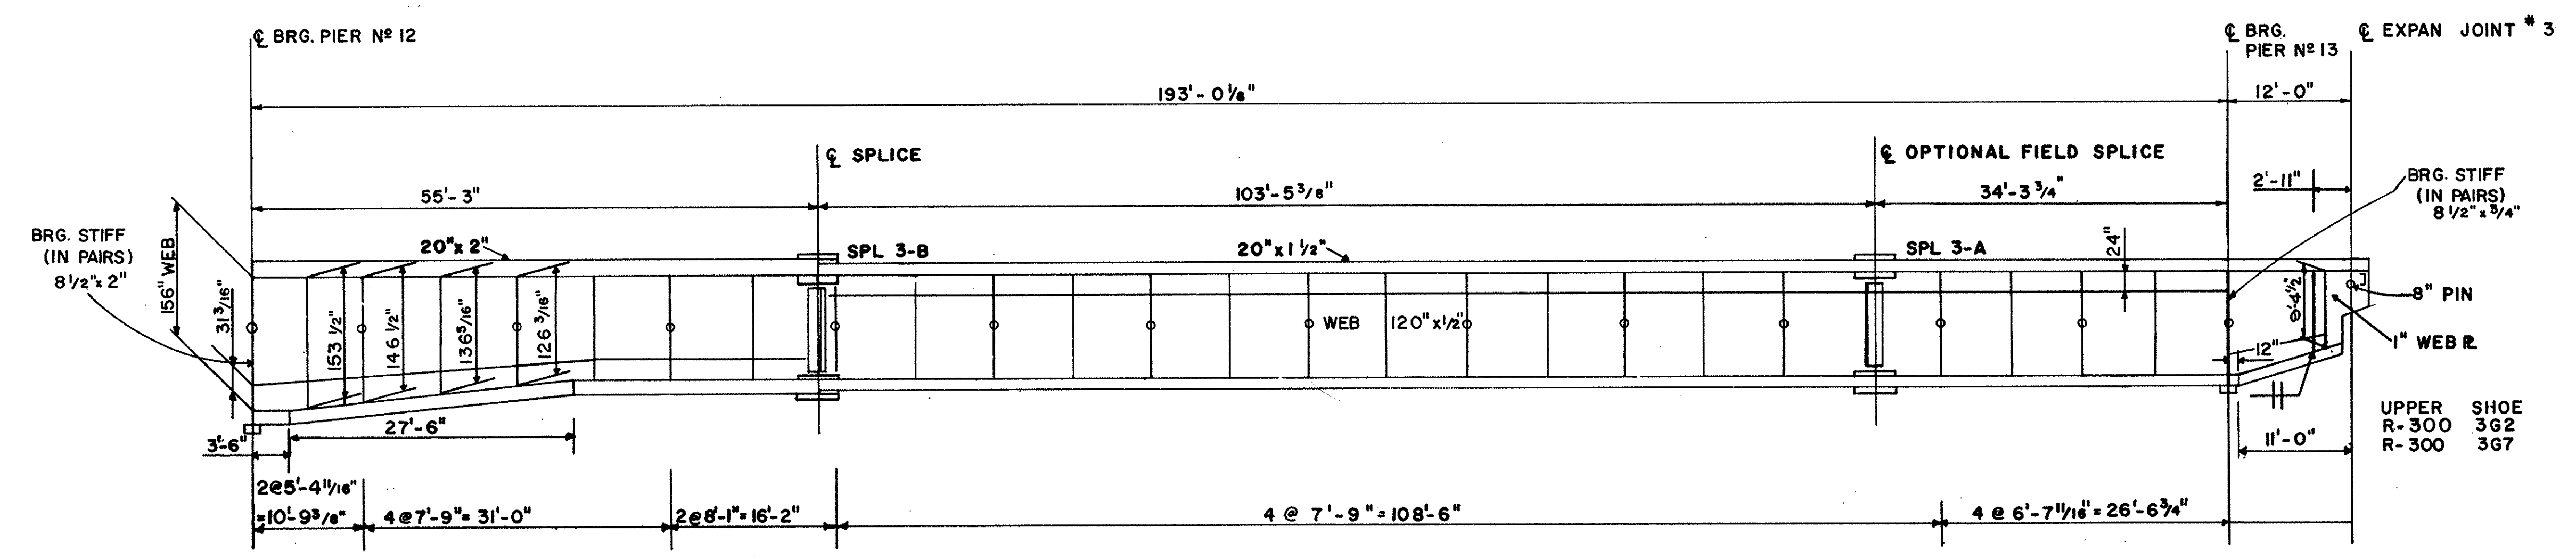


STATE OF OHIO DEPARTMENT OF HIGHWAYS BUREAU OF BRIDGES						
AKRON, OHIO			YOUNGSTOWN, OHIO			
GIRDER DETAILS						
BRIDGE N°			MAH-711-0116			
OVER MAHONING RIVER						
YOUNGSTOWN MAHONING COUNTY						
UNIT N° 3						
DESIGNED	DRAWN	TRACED	CHECKED	REVIEWED	DATE	REVISED
RH	B.P.		RH	WKO	6-22-68	

MAHONGON
JUN 15 1919
REPRODUCTION

FED. RD.	STATE	PROJECT
2	OHIO	U.S.-1159 (I)

189
232

MAH-711-0.17

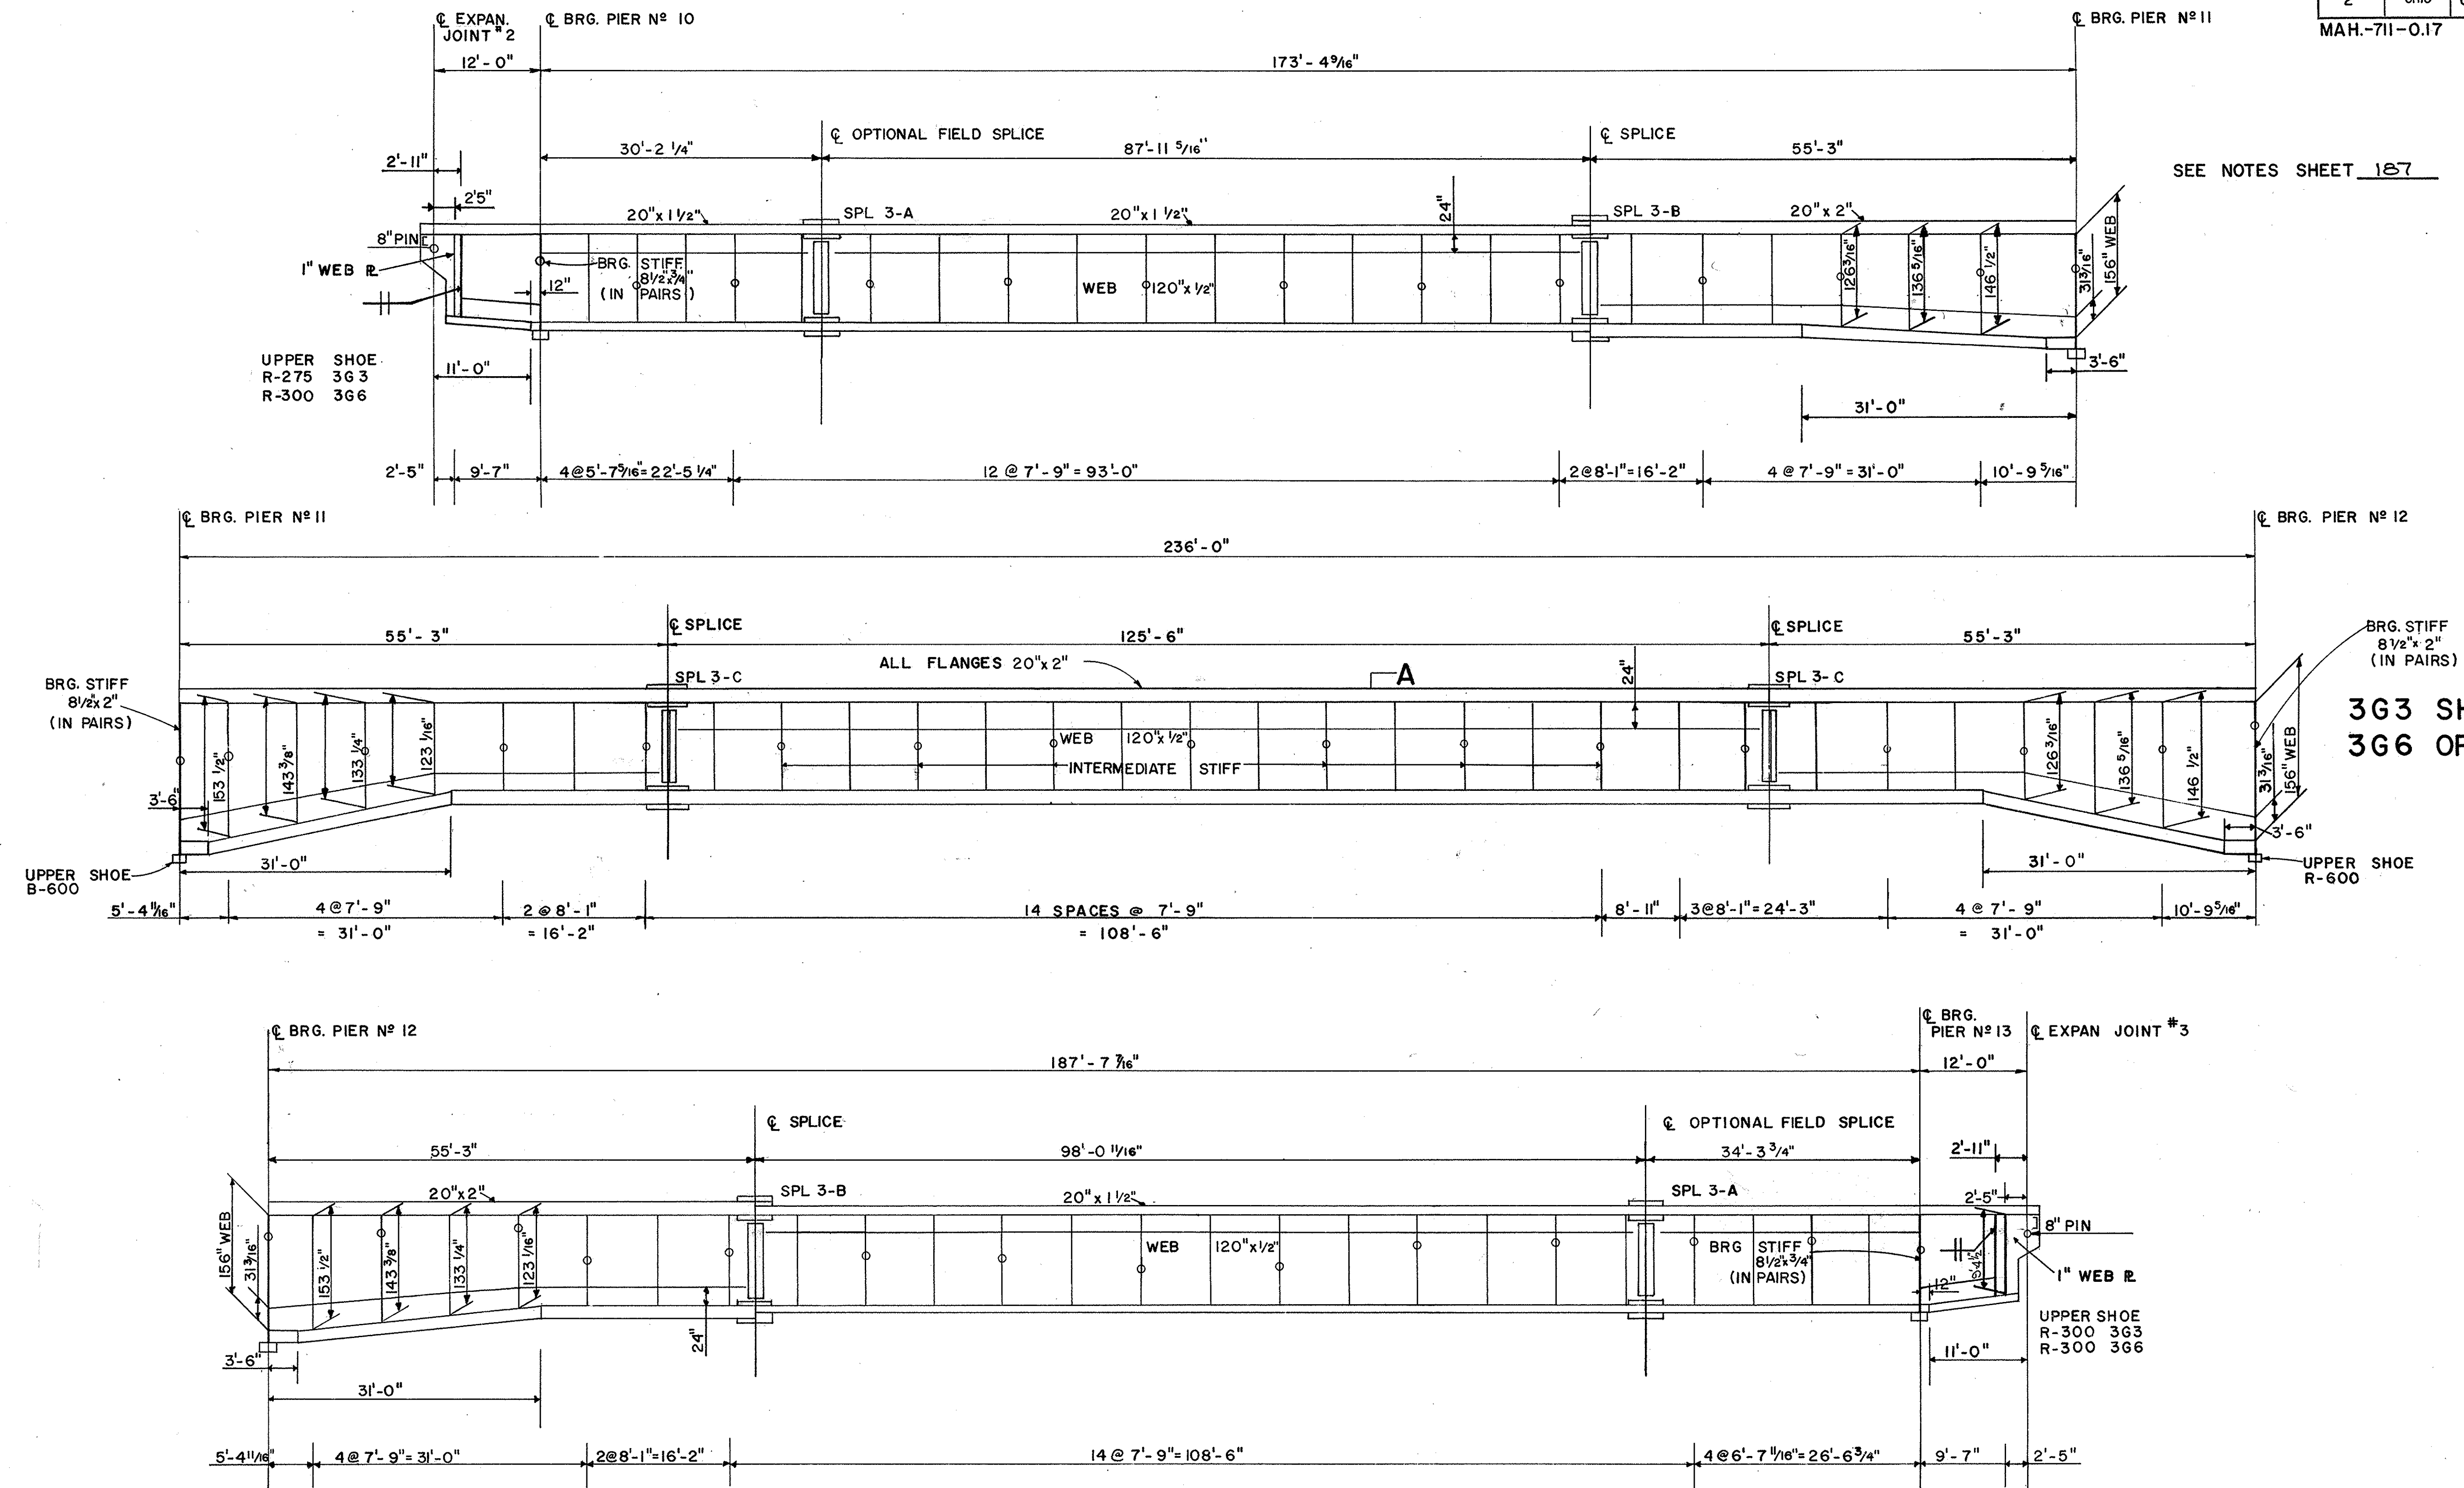

SEE NOTES SHEET 187

BRG. STIFF
8 1/2" x 2"
(IN PAIRS)
**3G3 SHOWN
3G6 OPP. HAND**

STATE OF OHIO
DEPARTMENT OF HIGHWAYS
BUREAU OF BRIDGES

AKRON, OHIO **GLAUS, PYLE & SCHOMER** YOUNGSTOWN, OHIO

GIRDER DETAILS
BRIDGE N^o MAH-711-0116
OVER MAHONING RIVER
YOUNGSTOWN MAHONING COUNTY

UNIT N^o 3


DESIGNED	DRAWN	TRACED	CHECKED	REVIEWED	DATE	REVISED
R.H.	B.P.		R.H.	W.K.D.	6-22-68	

MAHONING RIVER BRIDGE



FED. RD.	STATE	PROJECT
2	OHIO	U.S.-1159 (I)

190
232

MAH-711-0.17

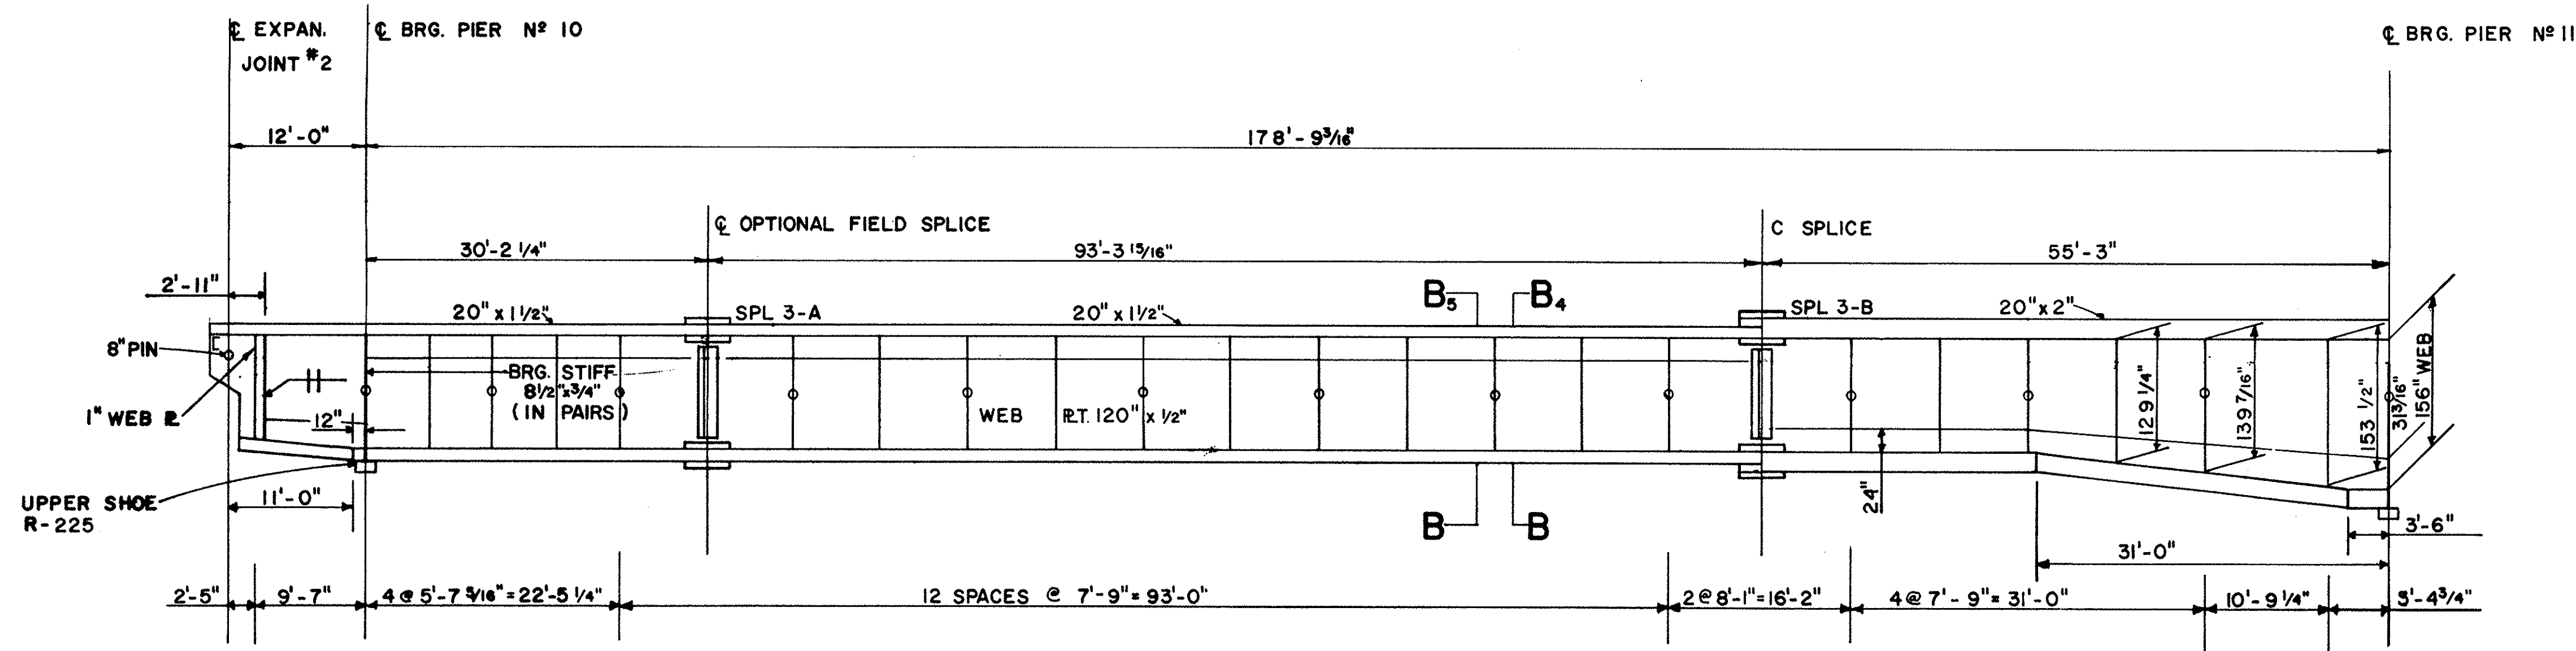

SEE NOTES SHEET 187

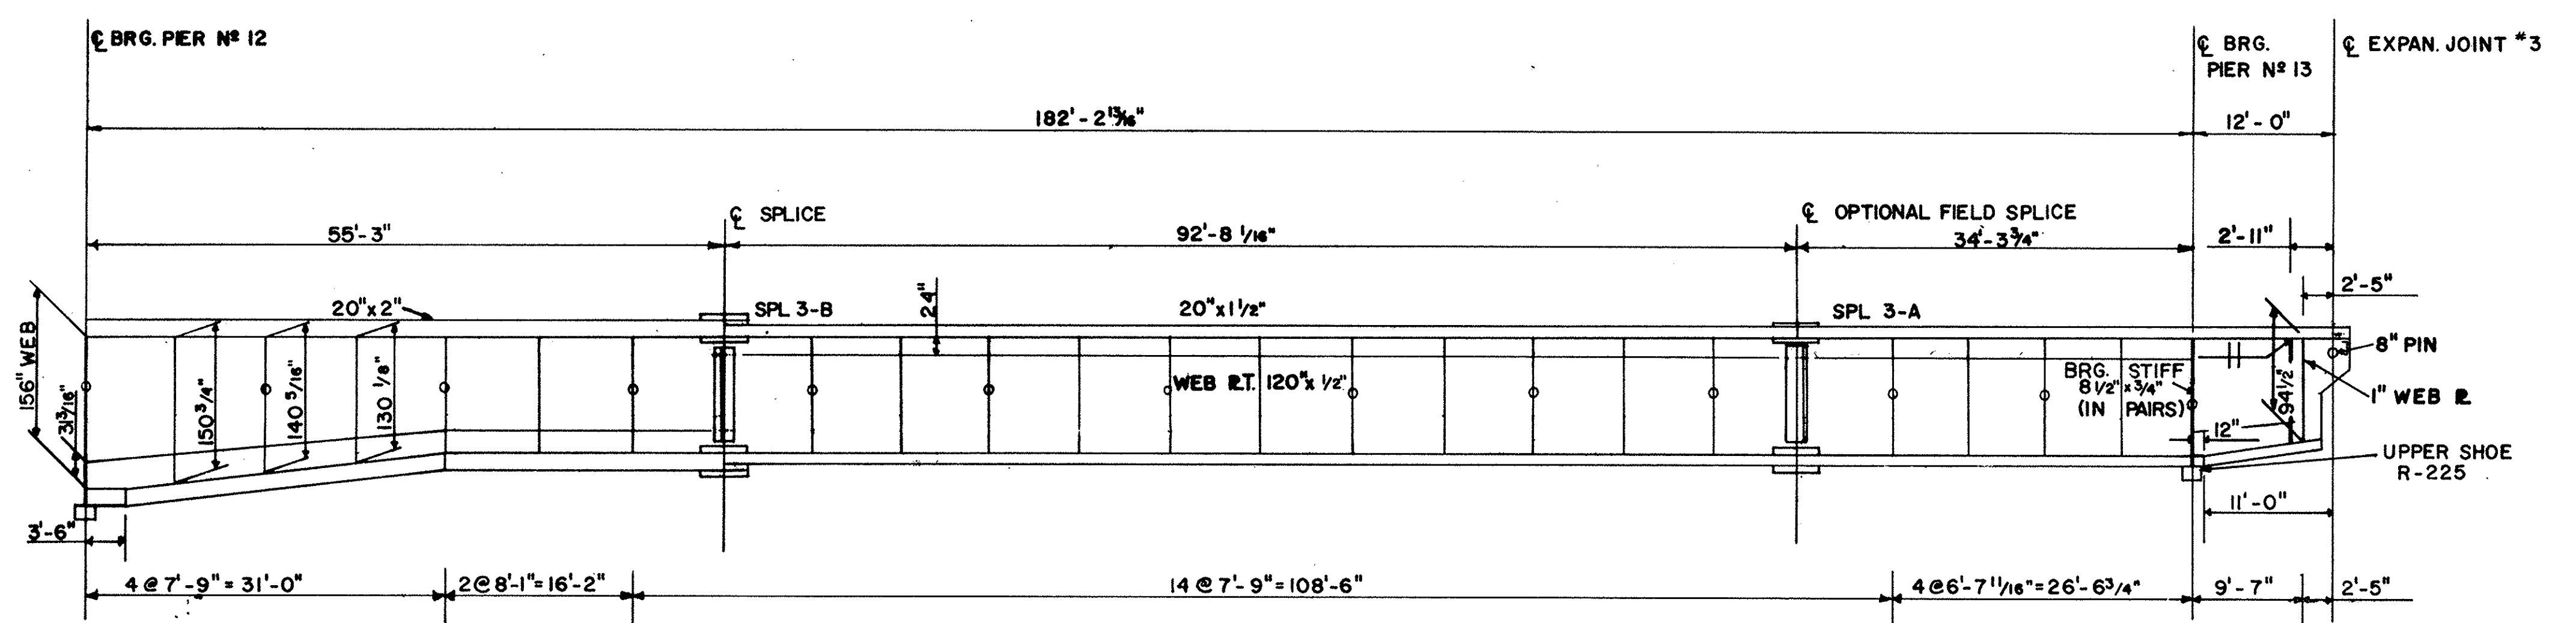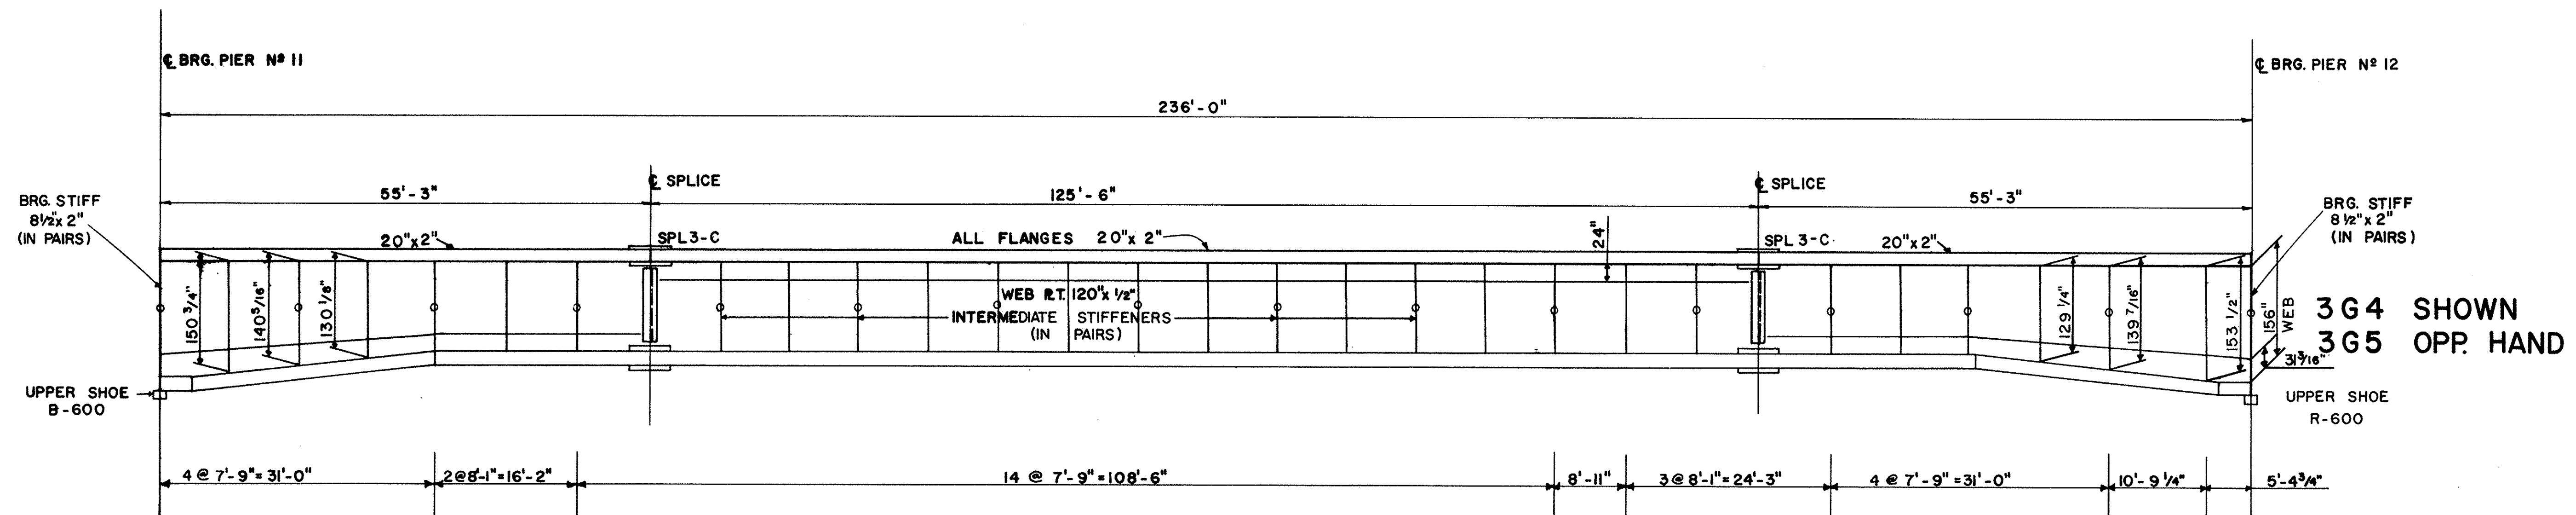


STATE OF OHIO DEPARTMENT OF HIGHWAYS BUREAU OF BRIDGES						
AKRON, OHIO			YOUNGSTOWN, OHIO			
GLAUS, PYLE & SCHOMER						
GIRDER DETAILS						
BRIDGE N° MAH-711-0116			OVER MAHONING RIVER			
YOUNGSTOWN			MAHONING COUNTY			
UNIT N° 3						
DESIGNED	DRAWN	TRACED	CHECKED	REVIEWED	DATE	REVISED
R.H.	B.P.		R.H.	WKD	6-22-68	


FED. RD.	STATE	PROJECT
2	OHIO	U.S.-1159(1)

101
232


MAH-711-0.17

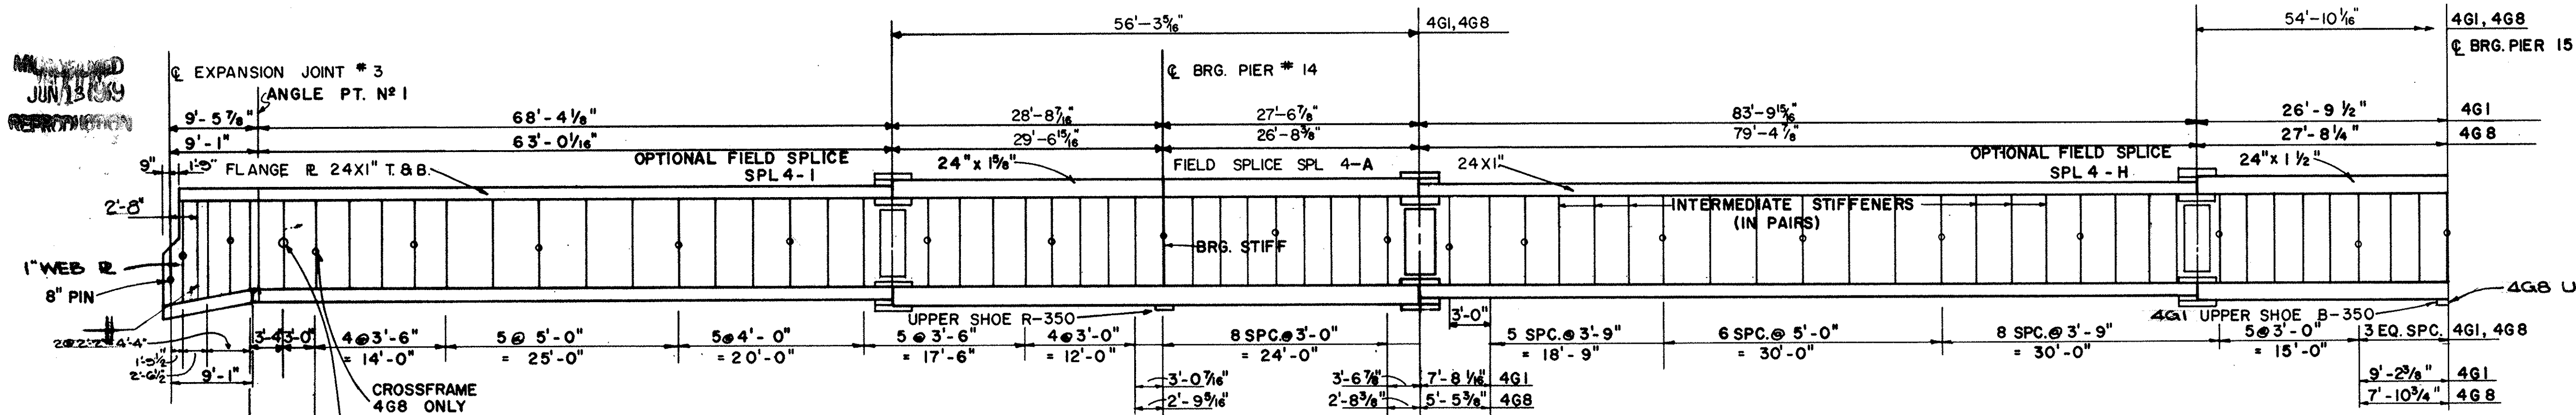


NOTE:
ALL WEB PLATES G4" x 3/8" EXCEPT AT
EXP JOINT #3 TO ANGLE POINT N#1
AND EXP JOINT #4

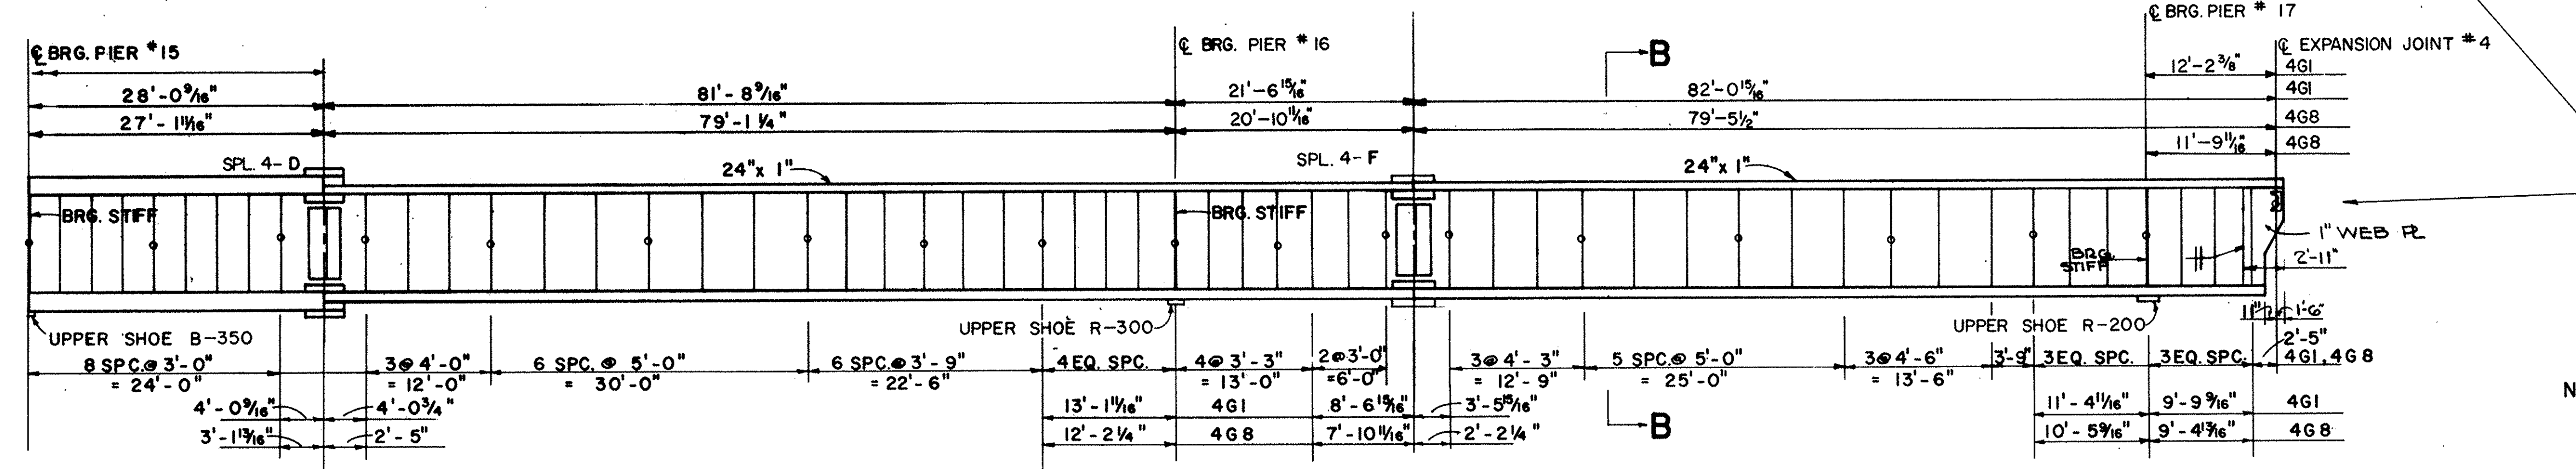

NOTE:
SEE SHEET 109 FOR SECT. B-B
SEE SHEET 102 FOR ADDITIONAL NOTES

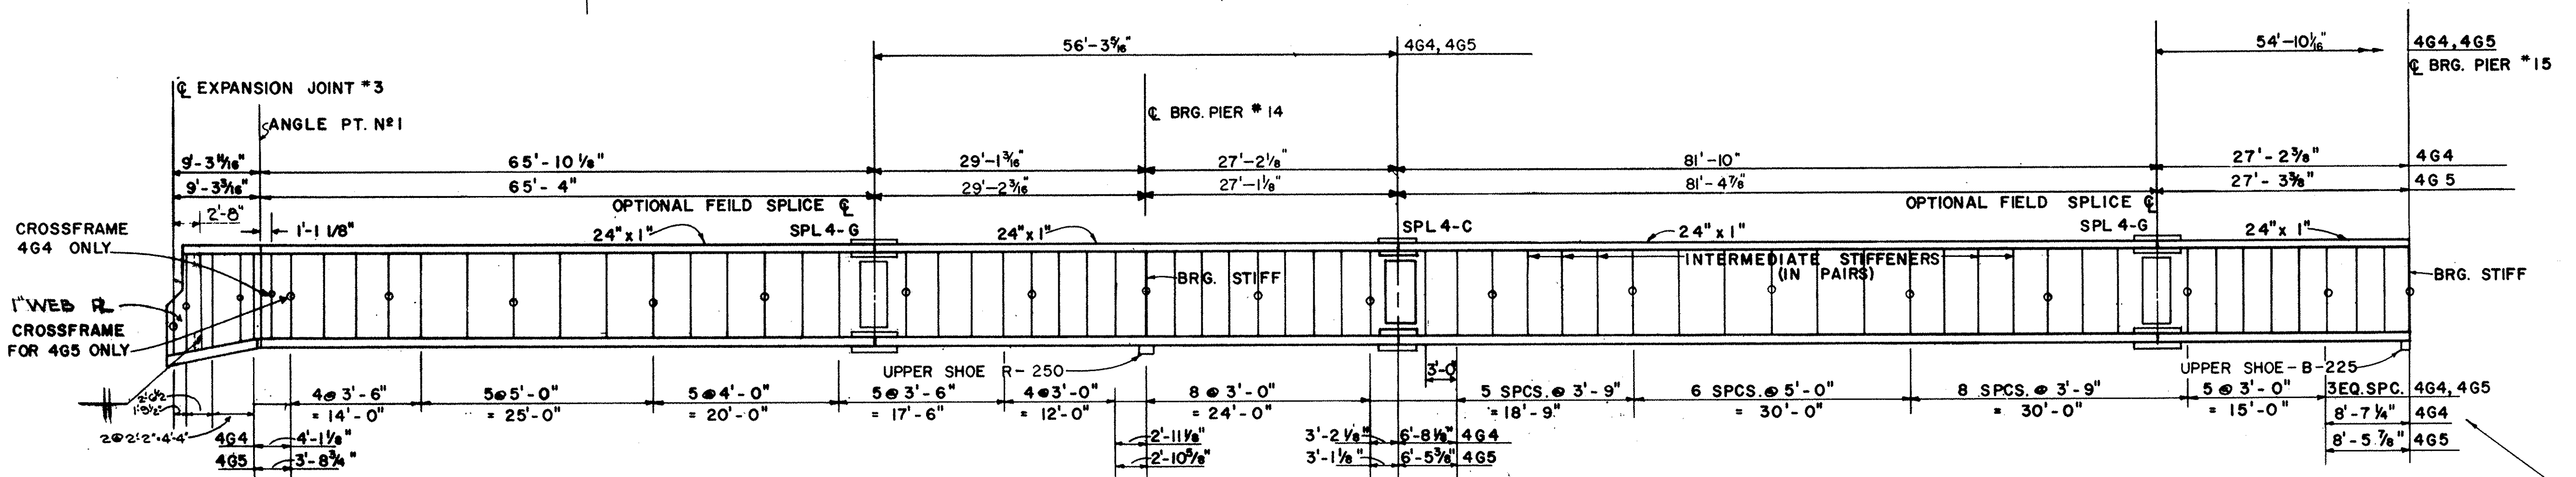

4G4, 4G5

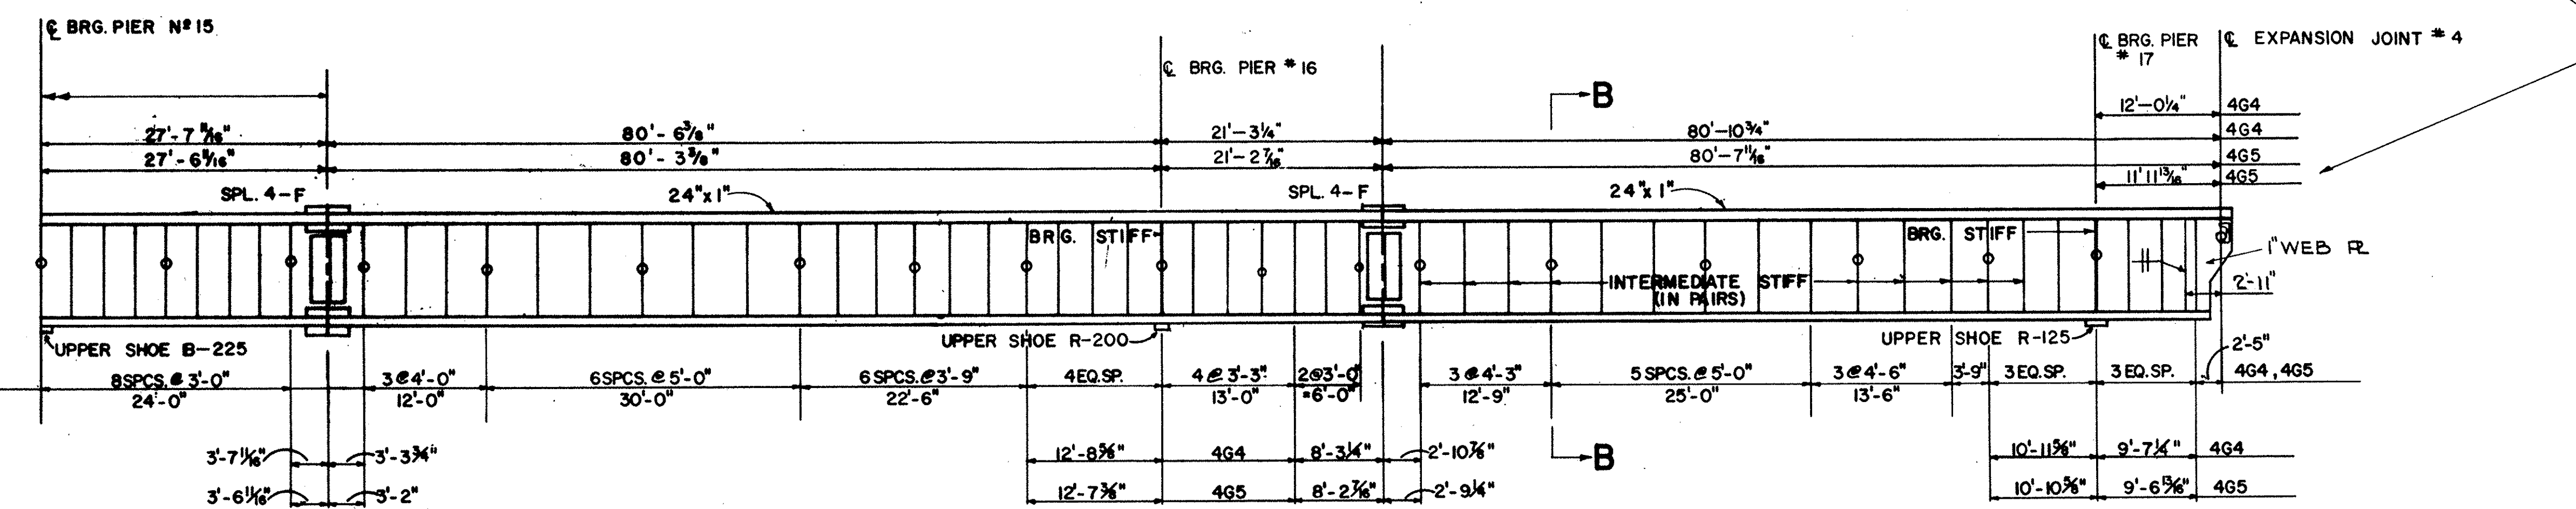


STATE OF OHIO DEPARTMENT OF HIGHWAYS BUREAU OF BRIDGES					
AKRON, OHIO					
GLAUS, PYLE & SCHOMER YOUNGSTOWN, OHIO					
GIRDER DETAILS					
BRIDGE N° MAH-711-0116					
OVER MAHONING RIVER					
YOUNGSTOWN MAHONING COUNTY					
UNIT N° 4					
DESIGNED RAH	DRAWN DM	TRACED RH	CHECKED WKD	REVIEWED G-22-68	DATE REVISD

MAHONING
JUN 13 1968
REVISION

FED. RD.	STATE	PROJECT
2	OHIO	US-1159 (I)

192
232


MAH-711-0.17

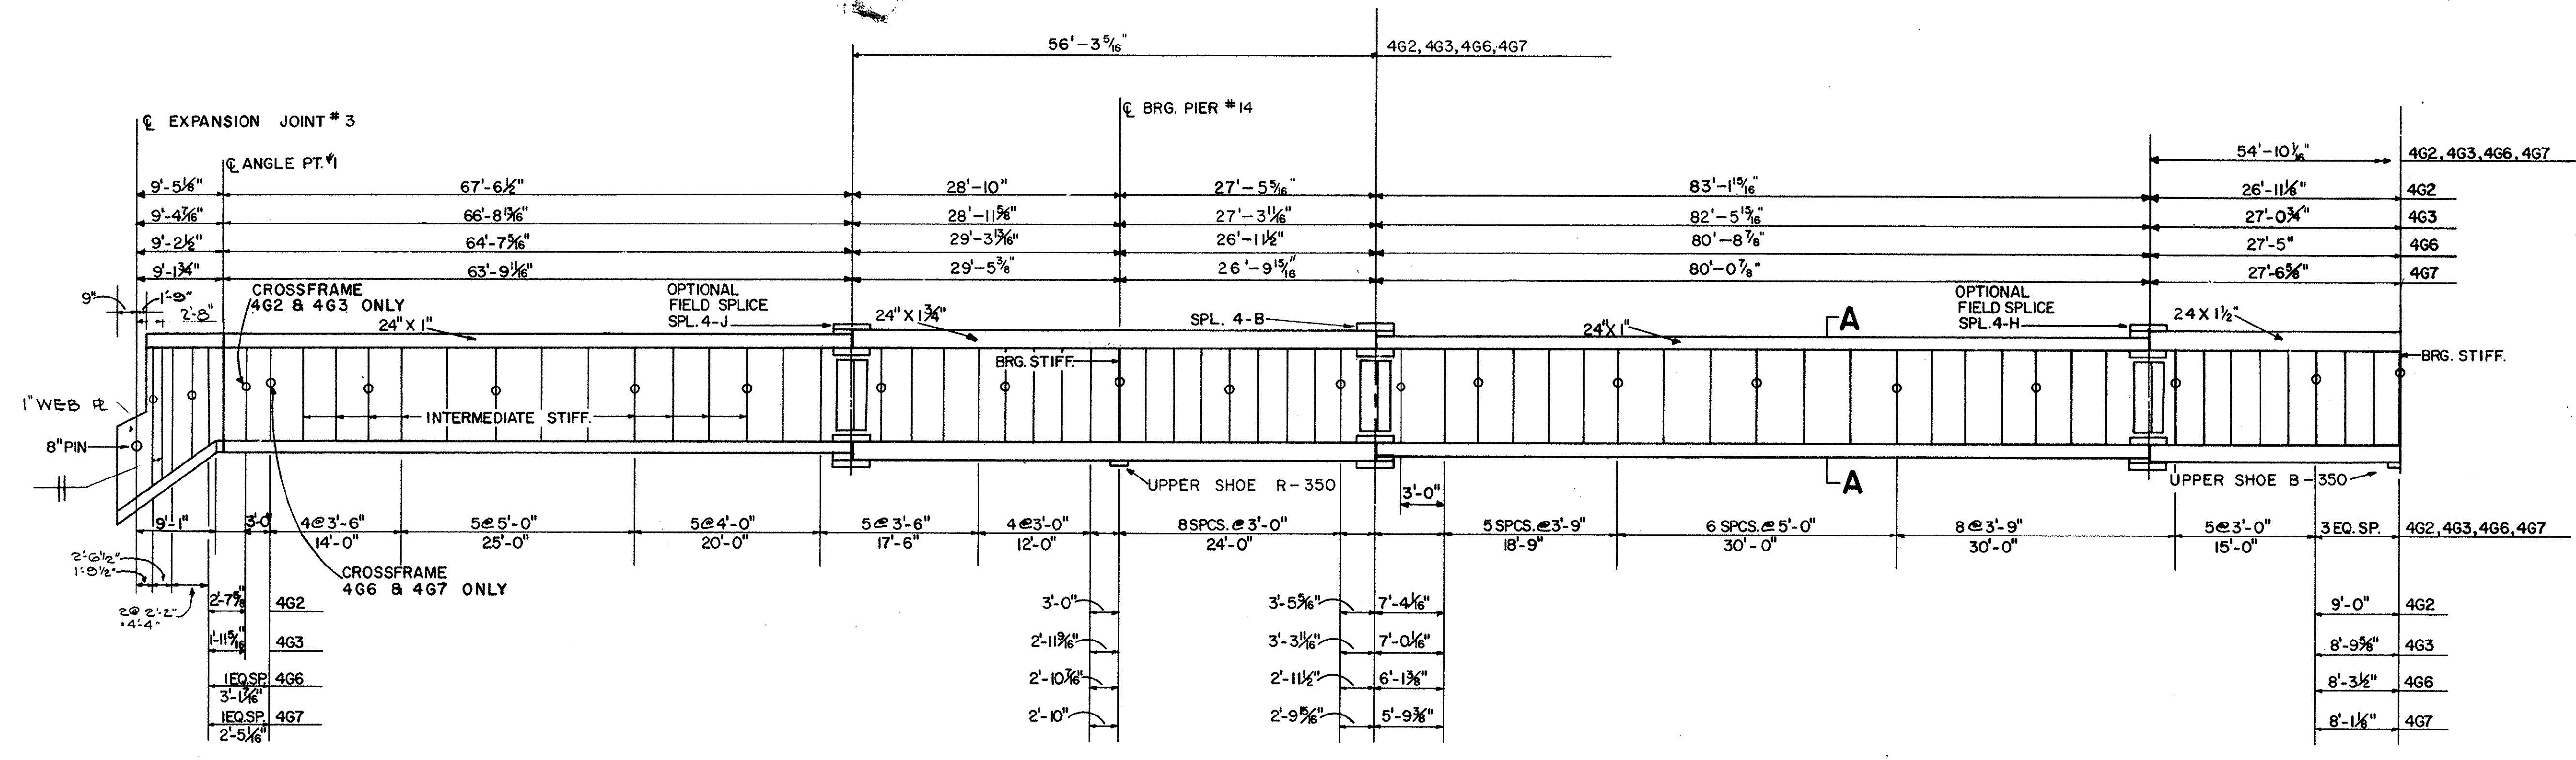

NOTE:
ALL WEB PLATES 64" x 3/8" EXCEPT AT EXP. JOINT 3. TO ANGLE PT. #1
ALL BEARING STIFFENERS 10" x 1" IN PAIRS.
ALL INTERMEDIATE STIFFENER 6" x 3/8" IN PAIRS.
SEE SHEET 201 FOR FIELD SPLICES DETAILS.
SEE SHEET 200 FOR HINGE DETAILS
SEE SHEET 199 FOR WELD SPLICE DETAILS

GUSSET R.S. FOR LATERAL BRACING NOT SHOWN SEE BRACING DETAILS SHEET 179
ALL STIFFENERS MARKED "O" ARE STIFFENERS TO WHICH THE CROSSFRAME BRIDGING ANGLES ARE WELDED. SEE SHEET 199 FOR SECTIONS "A-A".

462, 463
466, 467

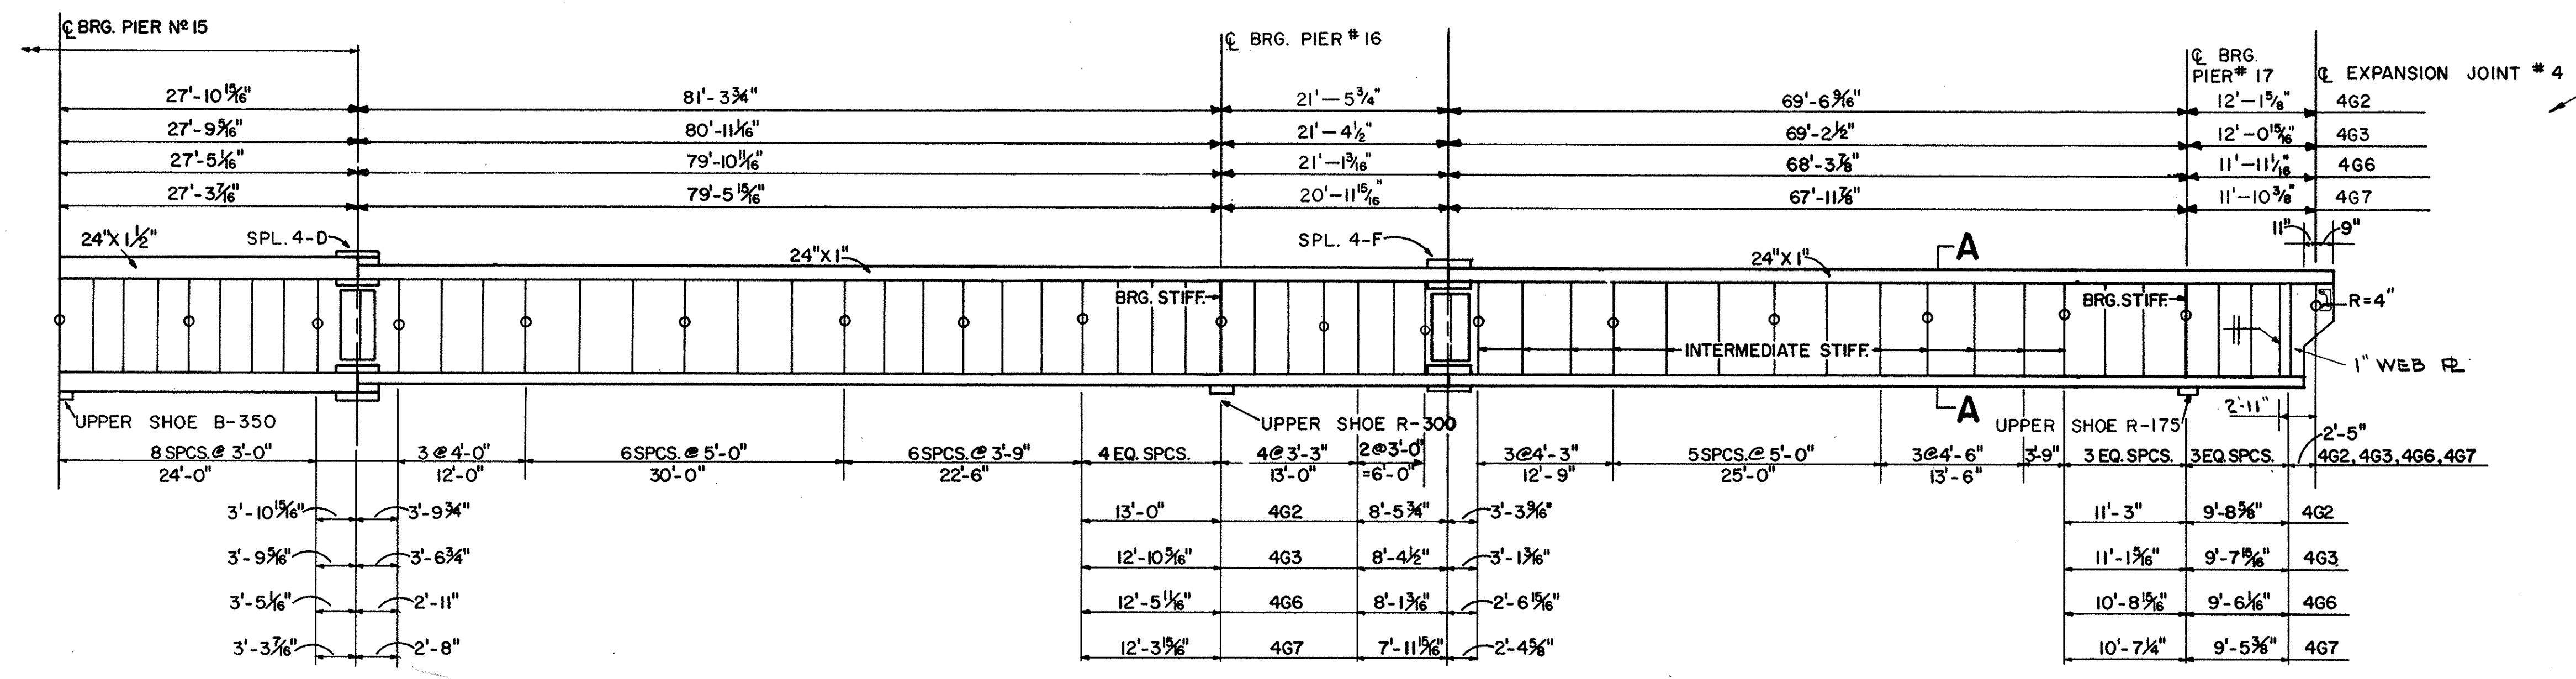

STATE OF OHIO
DEPARTMENT OF HIGHWAYS
BUREAU OF BRIDGES


GLAUS, PYLE & SCHOMER
AKRON, OHIO YOUNGSTOWN, OHIO

GIRDER DETAILS
BRIDGE N^o MAH-711-0116
OVER MAHONING RIVER
YOUNGSTOWN MAHONING COUNTY

UNIT N^o 4

DESIGNED	DRAWN	TRACED	CHECKED	REVIEWED	DATE	REVISED
RH	T.B.		D.M.	WLD	6-22-68	

MAHONING RIVER
JUN 13 1939
REVISION

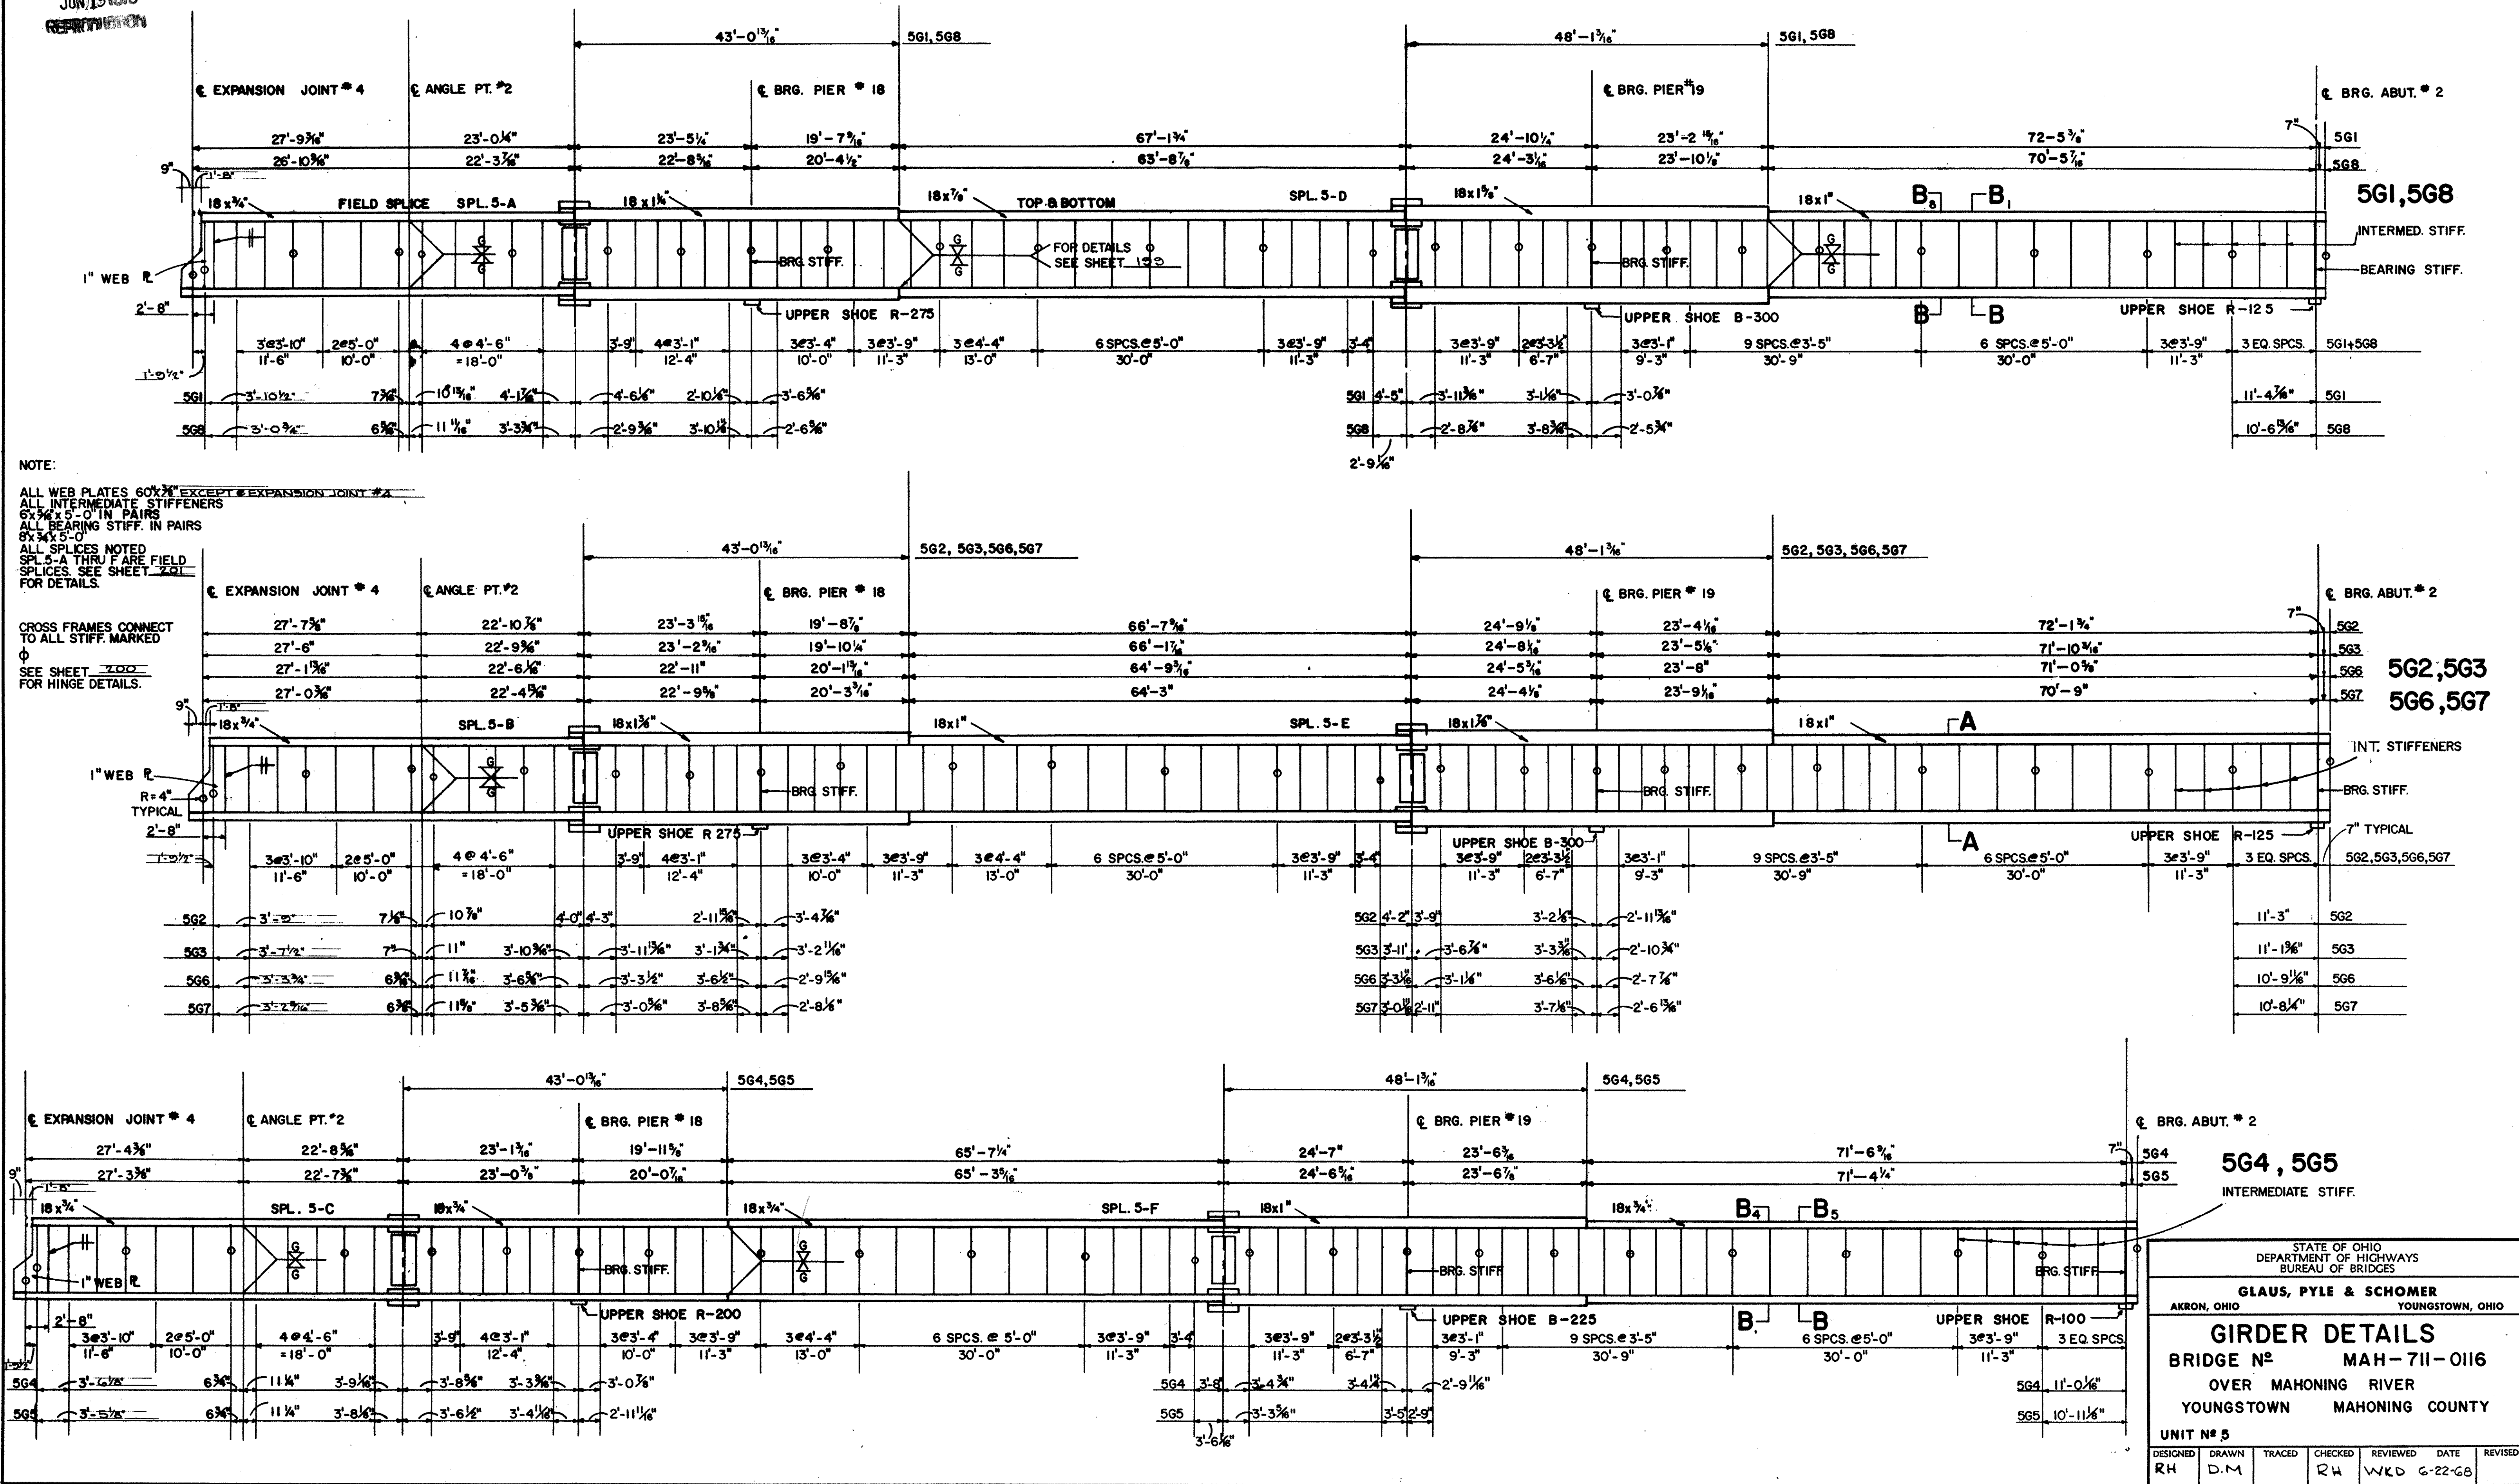

NOTE:
ALL WEB PLATES 60% EXCEPT EXPANSION JOINT #4
ALL INTERMEDIATE STIFFENERS
6x3/4x5'-0" IN PAIRS
ALL BEARING STIFF. IN PAIRS
8x3/4x5'-0"
ALL SPLICES NOTED
SPL 5-A THRU F ARE FIELD
SPLICES. SEE SHEET 201
FOR DETAILS.

CROSS FRAMES CONNECT
TO ALL STIFF. MARKED
Φ
SEE SHEET 200
FOR HINGE DETAILS.

STATE OF OHIO
DEPARTMENT OF HIGHWAYS
BUREAU OF BRIDGES

AKRON, OHIO

GLAUS, PYLE & SCHOMER
YOUNGSTOWN, OHIO

GIRDER DETAILS
BRIDGE NO. MAH-711-0116
OVER MAHONING RIVER
YOUNGSTOWN MAHONING COUNTY

UNIT NO. 5


DESIGNED	DRAWN	TRACED	CHECKED	REVIEWED	DATE	REVISED
RH	D.M.		RW	WLD	6-22-38	

DEFLECTION AND CAMBER

	SPAN 1		SPAN 2				SPAN 3				SPAN 4				SPAN 5				PARTIAL SPAN 6			E.J.#1				
	ABUT #1	1/4	1/2	3/4	PIER #1	SPLICE	1/4	1/2	3/4	PIER #2	SPLICE	1/2	3/4	PIER #3	SPLICE	1/2	3/4	PIER #4	SPLICE	1/4	1/2		3/4			
GIRDER 1G1																										
DEFLECTION DUE TO WT. OF STEEL	---	0.027	0.027	0.006		0.043	0.065	0.105	0.054		0.038	0.092	0.099	0.085	0.011	0.029	0.011		0.042	0.060	0.100	0.060	0.004	0.023	0.023	
DEFLECTION DUE TO REMAINING DEAD LOAD	---	0.185	0.181	0.041		0.291	0.441	0.707	0.364		0.256	0.620	0.397		0.074	0.194	0.072		0.284	0.402	0.677	0.401	0.030	0.153	0.157	
ADJUSTMENT REQUIRED FOR VERTICAL CURVE	---	-0.000	-0.006	-0.001		-0.440	-0.362	-0.342	-0.562		-0.488	-0.693	-0.520		-0.258	-0.437	-0.349		-0.386	-0.472	-0.629	-0.472	-0.224	-0.299	-0.224	
REQUIRED SHOP CAMBER INCHES	---	0.212	0.208	0.046		-0.106	-0.055	-0.063	-0.144		-0.195	0.020	-0.063		-0.172	-0.214	-0.266		-0.060	-0.011	0.148	-0.011	-0.190	-0.124	-0.044	
HEIGHT OF CHORD INCHES	---	-1.816	-3.631	-5.447	-7.262	-8.683	-9.245	-11.227	-13.211	-15.193	-15.644	-16.182	-16.676	-17.171	-16.620	-16.044	-15.481	-14.918	-13.577	-13.144	-11.370	-9.595	-7.820	-5.866	-3.911	-1.955
GIRDER 1G2																										
DEFLECTION DUE TO WT. OF STEEL	---	0.029	0.031	0.011		0.029	0.045	0.067	0.022		0.083	0.185	0.153													
DEFLECTION DUE TO REMAINING DEAD LOAD	---	0.158	0.167	0.057		0.155	0.239	0.358	0.116		0.445	0.989	0.821													
ADJUSTMENT REQUIRED FOR VERTICAL CURVE	---	-0.001	-0.001	-0.002		-0.439	-0.559	-0.746	-0.559		-0.486	-0.690	-0.517													
REQUIRED SHOP CAMBER INCHES	---	0.186	0.197	0.066		-0.254	-0.276	-0.321	-0.422		0.042	0.483	0.457													
HEIGHT OF CHORD INCHES	---	-0.743	-1.484	-2.227	-2.969	-3.212	-3.308	-3.647	-3.986	-4.325	-3.337	-2.162	-1.081													
GIRDER 1G3																										
DEFLECTION DUE TO WT. OF STEEL	---	0.029	0.028	0.008		0.034	0.053	0.086	0.044		0.030	0.074	0.047		0.012	0.029	0.011		0.036	0.051	0.087	0.052	0.005	0.023	0.023	
DEFLECTION DUE TO REMAINING DEAD LOAD	---	0.163	0.162	0.044		0.196	0.300	0.488	0.251		0.172	0.420	0.266		0.065	0.163	0.060		0.202	0.288	0.494	0.293	0.029	0.130	0.133	
ADJUSTMENT REQUIRED FOR VERTICAL CURVE	---	-0.001	-0.002	-0.004		-0.437	-0.557	-0.743	-0.557		-0.484	-0.687	-0.515		-0.383	-0.520	-0.390		-0.386	-0.472	-0.629	-0.472	-0.218	-0.290	-0.218	
REQUIRED SHOP CAMBER INCHES	---	0.191	0.188	0.048		-0.207	-0.205	-0.168	-0.262		-0.282	-0.193	-0.202		-0.306	-0.329	-0.319		-0.148	-0.133	-0.048	-0.127	-0.184	-0.138	-0.062	
HEIGHT OF CHORD INCHES	---	-1.873	-3.748	-5.621	-7.495	-8.965	-9.547	-11.599	-13.652	-15.704	-16.227	-16.850	-17.423	-17.996	-17.393	-16.757	-16.138	-15.518	-14.094	-13.636	-11.752	-9.870	-7.987	-5.990	-3.994	-1.997
GIRDER 1G4																										
DEFLECTION DUE TO WT. OF STEEL	---	0.029	0.029	0.008		0.034	0.053	0.086	0.044		0.030	0.074	0.047		0.011	0.028	0.010		0.036	0.051	0.088	0.053	0.004	0.020	0.021	
DEFLECTION DUE TO REMAINING DEAD LOAD	---	0.163	0.162	0.044		0.196	0.299	0.488	0.251		0.172	0.421	0.267		0.064	0.161	0.058		0.205	0.292	0.500	0.299	0.021	0.114	0.120	
ADJUSTMENT REQUIRED FOR VERTICAL CURVE	---	-0.002	-0.004	-0.006		-0.437	-0.557	-0.743	-0.557		-0.484	-0.687	-0.515		-0.383	-0.520	-0.390		-0.386	-0.472	-0.629	-0.472	-0.212	-0.282	-0.212	
REQUIRED SHOP CAMBER INCHES	---	0.190	0.187	0.046		-0.207	-0.205	-0.169	-0.262		-0.282	-0.192	-0.201		-0.307	-0.331	-0.321		-0.145	-0.129	-0.042	-0.121	-0.187	-0.148	-0.071	
HEIGHT OF CHORD INCHES	---	-1.877	-3.752	-5.629	-7.506	-8.971	-9.550	-11.594	-13.638	-15.683	-16.199	-16.812	-17.377	-17.942	-17.333	-16.690	-16.063	-15.437	-14.008	-13.547	-11.657	-9.766	-7.876	-5.906	-3.937	-1.969
GIRDER 1G5																										
DEFLECTION DUE TO WT. OF STEEL	---	0.027	0.027	0.006		0.048	0.072	0.113	0.059		0.040	0.096	0.062		0.010	0.028	0.009		0.048	0.068	0.114	0.070	0.000	0.015	0.017	
DEFLECTION DUE TO REMAINING DEAD LOAD	---	0.159	0.158	0.034		0.284	0.426	0.674	0.353		0.237	0.571	0.366		0.062	0.165	0.056		0.288	0.405	0.679	0.417	0.000	0.090	0.101	
ADJUSTMENT REQUIRED FOR VERTICAL CURVE	---	-0.003	-0.005	-0.008		-0.437	-0.557	-0.743	-0.557		-0.484	-0.687	-0.515		-0.383	-0.520	-0.390		-0.386	-0.472	-0.629	-0.472	-0.205	-0.274	-0.205	
REQUIRED SHOP CAMBER INCHES	---	0.183	0.180	0.032		-0.105	-0.059	0.045	-0.145		-0.207	-0.020	-0.087		-0.311	-0.328	-0.325		-0.050	0.001	0.164	0.015	-0.205	-0.169	-0.088	
HEIGHT OF CHORD INCHES	---	-1.879	-3.758	-5.638	-7.517	-8.976	-9.552	-11.588	-13.624	-15.660	-16.169	-16.775	-17.332	-17.888	-17.272	-16.622	-15.989	-15.356	-13.921	-13.458	-11.560	-9.662	-7.764	-5.882	-3.882	-1.940
GIRDER 1G6																										
DEFLECTION DUE TO WT. OF STEEL	---	0.027	0.027	0.006		0.048	0.072	0.113	0.059		0.040	0.096	0.062		0.010	0.028	0.009		0.049	0.068	0.115	0.071	-0.001	-0.014	0.016	
DEFLECTION DUE TO REMAINING DEAD LOAD	---	0.159	0.158	0.034		0.284	0.426	0.674	0.353		0.238	0.571	0.367		0.061	0.164	0.055		0.289	0.407	0.683	0.420	-0.005	0.081	0.093	
ADJUSTMENT REQUIRED FOR VERTICAL CURVE	---	-0.003	-0.006	-0.009		-0.437	-0.557	-0.743	-0.557		-0.484	-0.687	-0.515		-0.383	-0.520	-0.390		-0.386	-0.472	-0.629	-0.472	-0.201	-0.269	-0.201	
REQUIRED SHOP CAMBER INCHES	---	0.183	0.179	0.030		-0.105	-0.059	0.045	-0.145		-0.207	-0.020	-0.087		-0.312	-0.329	-0.326		-0.048	0.003	0.169	0.019	-0.207	-0.174	-0.093	
HEIGHT OF CHORD INCHES	---	-1.880	-3.762	-5.642	-7.523	-8.978	-9.554	-11.585	-13.615	-15.646	-16.151	-16.750	-17.302	-17.854	-17.233	-16.579	-15.941	-15.304	-13.865	-13.400	-11.498	-9.595	-7.692	-5.770	-3.846	-1.924
GIRDER 1G7																										
DEFLECTION DUE TO WT. OF STEEL	---	0.029	0.029	0.008		0.034	0.053	0.086	0.044		0.031	0.074	0.047		0.011	0.028	0.010		0.037	0.053	0.091	0.055	0.000	0.014	0.016	
DEFLECTION DUE TO REMAINING DEAD LOAD	---	0.163	0.162	0.044		0.195	0.299	0.487	0.250		0.173	0.422	0.268		0.062	0.157	0.055		0.210	0.299	0.514	0.312	0.002	0.077	0.089	
ADJUSTMENT REQUIRED FOR VERTICAL CURVE	---	-0.004	-0.008	-0.012		-0.437	-0.557	-0.743	-0.557		-0.484	-0.687	-0.515		-0.383	-0.520	-0.390		-0.386	-0.472	-0.629	-0.472	-0.195	-0.261	-0.195	
REQUIRED SHOP CAMBER INCHES	---	0.188	0.182	0.039		-0.207	-0.205	-0.169	-0.262		-0.281	-0.190	-0.200		-0.310	-0.336	-0.326		-0.139	-0.120	-0.025	-0.105	-0.193	-0.170	-0.091	
HEIGHT OF CHORD INCHES	---	-1.883	-3.767	-5.650	-7.534	-8.982	-9.556	-11.578	-13.601	-15.623	-16.121	-16.711	-17.256	-17.800	-17.172	-16.511	-15.866	-15.222	-13.777	-13.312	-11.401	-9.491	-7.580	-5.686	-3.789	-1.895
GIRDER 1G8																										
DEFLECTION DUE TO WT. OF STEEL	---	0.029	0.029	0.008		0.034	0.053	0.086	0.044		0.031	0.075	0.047		0.011	0.027	0.009		0.037	0.053	0.091	0.056	-0.001	0.011	0.014	
DEFLECTION DUE TO REMAINING DEAD LOAD	---	0.163	0.162	0.044		0.195	0.299	0.487	0.250		0.173	0.423	0.269		0.062	0.155	0.053		0.212	0.302	0.519	0.317	-0.004	0.064	0.079	
ADJUSTMENT REQUIRED FOR VERTICAL CURVE	---	-0.005	-0.010	-0.015		-0.437	-0.557	-0.743	-0.557		-0.484	-0.687	-0.515		-0.383	-0.520	-0.390		-0.386	-0.472	-0.629	-0.472	-0.190	-0.253	-0.190	
REQUIRED SHOP CAMBER INCHES	---	0.187	0.180	0.036		-0.207	-0.205	-0.169	-0.262		-0.280	-0.190	-0.199		-0.311	-0.337	-0.327		-0.137	-0.117	-0.019	-0.099	-0.195	-0.177	-0.097	
HEIGHT OF CHORD INCHES	---	-1.885	-3.771	-5.657	-7.543	-8.986	-9.557	-11.572	-13.585	-15.600	-16.099	-16.623	-17.209	-17.746	-17.111	-16.442	-15.791	-15.142	-13.690	-13.222	-11.304	-9.386	-7.469	-5.602	-3.734	-1.867
GIRDER 1G9																										
DEFLECTION DUE TO WT. OF STEEL	---	0.027	0.026	0.006		0.042	0.064	0.103	0.053		0.037	0.090	0.058		0.010	0.027	0.009		0.044	0.063	0.107	0.065	-0.004	0.007	0.010	
DEFLECTION DUE TO REMAINING DEAD LOAD	---	0.181	0.178	0.040		0.285	0.432	0.692	0.386		0.251	0.609	0.391		0.070	0.184	0.062		0.299	0.423	0.718	0.441	-0.025	0.047	0.070	
ADJUSTMENT REQUIRED FOR VERTICAL CURVE	---	-0.006	-0.012	-0.019		-0.437	-0.557	-0.743	-0.557		-0.484	-0.687	-0.515		-0.383	-0.520	-0.390		-0.386	-0.472	-0.629	-0.472	-0.184	-0.245	-0.184	
REQUIRED SHOP CAMBER INCHES	---	0.202	0.192	0.027		-0.110	-0.061	0.052	-0.148		-0.196	0.013	-0.066		-0.303	-0.308	-0.319		-0.042	0.014	0.195	0.035	-0.212	-0.191	-0.104	
HEIGHT OF CHORD INCHES	---	-1.888	-3.776	-5.664	-7.552	-8.989	-9.558	-11.564	-13.571																	

MAH-711-017
JUN 15 1969
REPRODUCTION

	DEFLECTION AND CAMBER TABLE																			
	SPAN 7					SPAN 8					SPAN 9					PARTIAL SPAN 10				
	E.J.#1	PIER #6	1/4	1/2	SPLICE	PIER #7	1/5	2/5	3/5	SPLICE	PIER #8	1/4	2/5	3/5	SPLICE	PIER #9	1/4	1/2	3/4	E.J.#2
GIRDER 2G1																				
DEFLECTION DUE TO WEIGHT OF STEEL	-0.03	----	0.107	0.126	0.059	----	0.032	0.084	0.082	0.035	----	0.055	0.127	0.135	0.058	----	0.000	0.021	0.024	----
DEFLECTION DUE TO REMAINING DEAD LOAD	-0.16	----	0.460	0.577	0.258	----	0.261	0.607	0.577	0.253	----	0.317	0.757	0.816	0.353	----	0.006	0.133	0.149	----
ADJUSTMENT REQUIRED FOR VERTICAL CURVE	0.32	----	-0.545	-0.727	-0.545	----	-0.682	-1.023	-1.023	-0.733	----	-0.465	-0.589	-0.419	-0.184	----	0.000	0.000	0.000	----
REQUIRED SHOP CAMBER - INCHES	0.13	----	0.022	-0.024	-0.228	----	-0.389	-0.331	-0.364	-0.445	----	-0.093	0.295	0.532	0.227	----	0.006	0.154	0.173	----
GIRDER 2G2																				
DEFLECTION DUE TO WEIGHT OF STEEL	-0.03	----	0.102	0.119	0.055	----	0.027	0.075	0.074	0.031	----	0.052	0.120	0.128	0.055	----	0.002	0.024	0.027	----
DEFLECTION DUE TO REMAINING DEAD LOAD	-0.12	----	0.355	0.440	0.192	----	0.185	0.445	0.426	0.184	----	0.244	0.580	0.622	0.267	----	0.014	0.125	0.138	----
ADJUSTMENT REQUIRED FOR VERTICAL CURVE	0.32	----	-0.545	-0.727	-0.545	----	-0.682	-1.023	-1.023	-0.733	----	-0.465	-0.589	-0.419	-0.184	----	0.000	0.000	0.000	----
REQUIRED SHOP CAMBER - INCHES	0.17	----	-0.088	-0.168	-0.299	----	-0.470	-0.502	-0.522	-0.518	----	-0.169	0.111	0.332	0.138	----	0.015	0.149	0.165	----
GIRDER 2G3																				
DEFLECTION DUE TO WEIGHT OF STEEL	-0.03	----	0.102	0.119	0.055	----	0.027	0.075	0.074	0.031	----	0.052	0.120	0.128	0.055	----	0.002	0.024	0.027	----
DEFLECTION DUE TO REMAINING DEAD LOAD	-0.12	----	0.359	0.444	0.194	----	0.184	0.444	0.425	0.183	----	0.244	0.580	0.623	0.267	----	0.013	0.125	0.138	----
ADJUSTMENT REQUIRED FOR VERTICAL CURVE	0.32	----	-0.545	-0.727	-0.545	----	-0.682	-1.023	-1.023	-0.733	----	-0.465	-0.589	-0.419	-0.184	----	0.000	0.000	0.000	----
REQUIRED SHOP CAMBER - INCHES	0.17	----	-0.084	-0.164	-0.297	----	-0.472	-0.504	-0.523	-0.519	----	-0.169	0.111	0.332	0.138	----	0.015	0.149	0.164	----
GIRDER 2G4																				
DEFLECTION DUE TO WEIGHT OF STEEL	-0.03	----	0.111	0.132	0.062	----	0.040	0.101	0.098	0.043	----	0.065	0.149	0.158	0.069	----	-0.001	0.021	0.024	----
DEFLECTION DUE TO REMAINING DEAD LOAD	-0.15	----	0.414	0.520	0.236	----	0.263	0.590	0.563	0.255	----	0.324	0.755	0.807	0.354	----	0.000	0.114	0.128	----
ADJUSTMENT REQUIRED FOR VERTICAL CURVE	0.32	----	-0.545	-0.727	-0.545	----	-0.682	-1.023	-1.023	-0.733	----	-0.465	-0.589	-0.419	-0.184	----	0.000	0.000	0.000	----
REQUIRED SHOP CAMBER - INCHES	0.14	----	-0.021	-0.075	-0.248	----	-0.328	-0.332	-0.362	-0.435	----	-0.076	0.315	0.546	0.240	----	-0.000	0.135	0.152	----
GIRDER 2G5																				
DEFLECTION DUE TO WEIGHT OF STEEL	-0.03	----	0.111	0.132	0.062	----	0.040	0.101	0.098	0.043	----	0.065	0.149	0.158	0.069	----	-0.001	0.021	0.024	----
DEFLECTION DUE TO REMAINING DEAD LOAD	-0.15	----	0.417	0.523	0.237	----	0.262	0.589	0.562	0.254	----	0.324	0.755	0.807	0.354	----	0.000	0.114	0.128	----
ADJUSTMENT REQUIRED FOR VERTICAL CURVE	0.32	----	-0.545	-0.727	-0.545	----	-0.682	-1.023	-1.023	-0.733	----	-0.465	-0.589	-0.419	-0.184	----	0.000	0.000	0.000	----
REQUIRED SHOP CAMBER - INCHES	0.14	----	-0.018	-0.072	-0.246	----	-0.329	-0.333	-0.363	-0.435	----	-0.076	0.315	0.547	0.240	----	0.000	0.135	0.152	----
GIRDER 2G6																				
DEFLECTION DUE TO WEIGHT OF STEEL	-0.03	----	0.102	0.119	0.055	----	0.027	0.075	0.074	0.031	----	0.052	0.120	0.128	0.055	----	0.002	0.024	0.027	----
DEFLECTION DUE TO REMAINING DEAD LOAD	-0.13	----	0.370	0.454	0.199	----	0.180	0.439	0.421	0.181	----	0.245	0.582	0.624	0.267	----	0.013	0.125	0.137	----
ADJUSTMENT REQUIRED FOR VERTICAL CURVE	0.32	----	-0.545	-0.727	-0.545	----	-0.682	-1.023	-1.023	-0.733	----	-0.465	-0.589	-0.419	-0.184	----	0.000	0.000	0.000	----
REQUIRED SHOP CAMBER - INCHES	0.16	----	-0.074	-0.153	-0.291	----	-0.475	-0.509	-0.527	-0.521	----	-0.168	0.113	0.333	0.138	----	0.015	0.149	0.164	----
GIRDER 2G7																				
DEFLECTION DUE TO WEIGHT OF STEEL	-0.03	----	0.102	0.119	0.055	----	0.027	0.075	0.074	0.031	----	0.052	0.120	0.128	0.055	----	0.002	0.024	0.027	----
DEFLECTION DUE TO REMAINING DEAD LOAD	-0.14	----	0.374	0.458	0.202	----	0.179	0.437	0.420	0.180	----	0.246	0.582	0.624	0.268	----	0.013	0.125	0.137	----
ADJUSTMENT REQUIRED FOR VERTICAL CURVE	0.32	----	-0.545	-0.727	-0.545	----	-0.682	-1.023	-1.023	-0.733	----	-0.465	-0.589	-0.419	-0.184	----	0.000	0.000	0.000	----
REQUIRED SHOP CAMBER - INCHES	0.15	----	-0.070	-0.149	-0.289	----	-0.477	-0.510	-0.528	-0.522	----	-0.167	0.113	0.334	0.138	----	0.015	0.149	0.164	----
GIRDER 2G8																				
DEFLECTION DUE TO WEIGHT OF STEEL	-0.03	----	0.107	0.126	0.059	----	0.032	0.084	0.082	0.035	----	0.055	0.127	0.135	0.058	----	0.000	0.021	0.024	----
DEFLECTION DUE TO REMAINING DEAD LOAD	-0.20	----	0.494	0.612	0.276	----	0.250	0.593	0.565	0.247	----	0.321	0.762	0.819	0.354	----	0.005	0.132	0.148	----
ADJUSTMENT REQUIRED FOR VERTICAL CURVE	0.32	----	-0.545	-0.727	-0.545	----	-0.682	-1.023	-1.023	-0.733	----	-0.465	-0.589	-0.419	-0.184	----	0.000	0.000	0.000	----
REQUIRED SHOP CAMBER - INCHES	0.09	----	0.055	0.011	-0.210	----	-0.400	-0.346	-0.375	-0.451	----	-0.090	0.299	0.535	0.228	----	0.005	0.153	0.172	----
GIRDER 2G1, 2G2, 2G3, 2G4, 2G5, 2G6, 2G7, 2G8																				
HEIGHT OF CHORD	1.005	----	-1.990	-3.978	-5.968	-7.952	-9.327	-8.696	-9.066	-9.397	-9.805	-8.687	-7.568	-6.450	-5.196	-4.214	-3.161	-2.107	-1.054	----

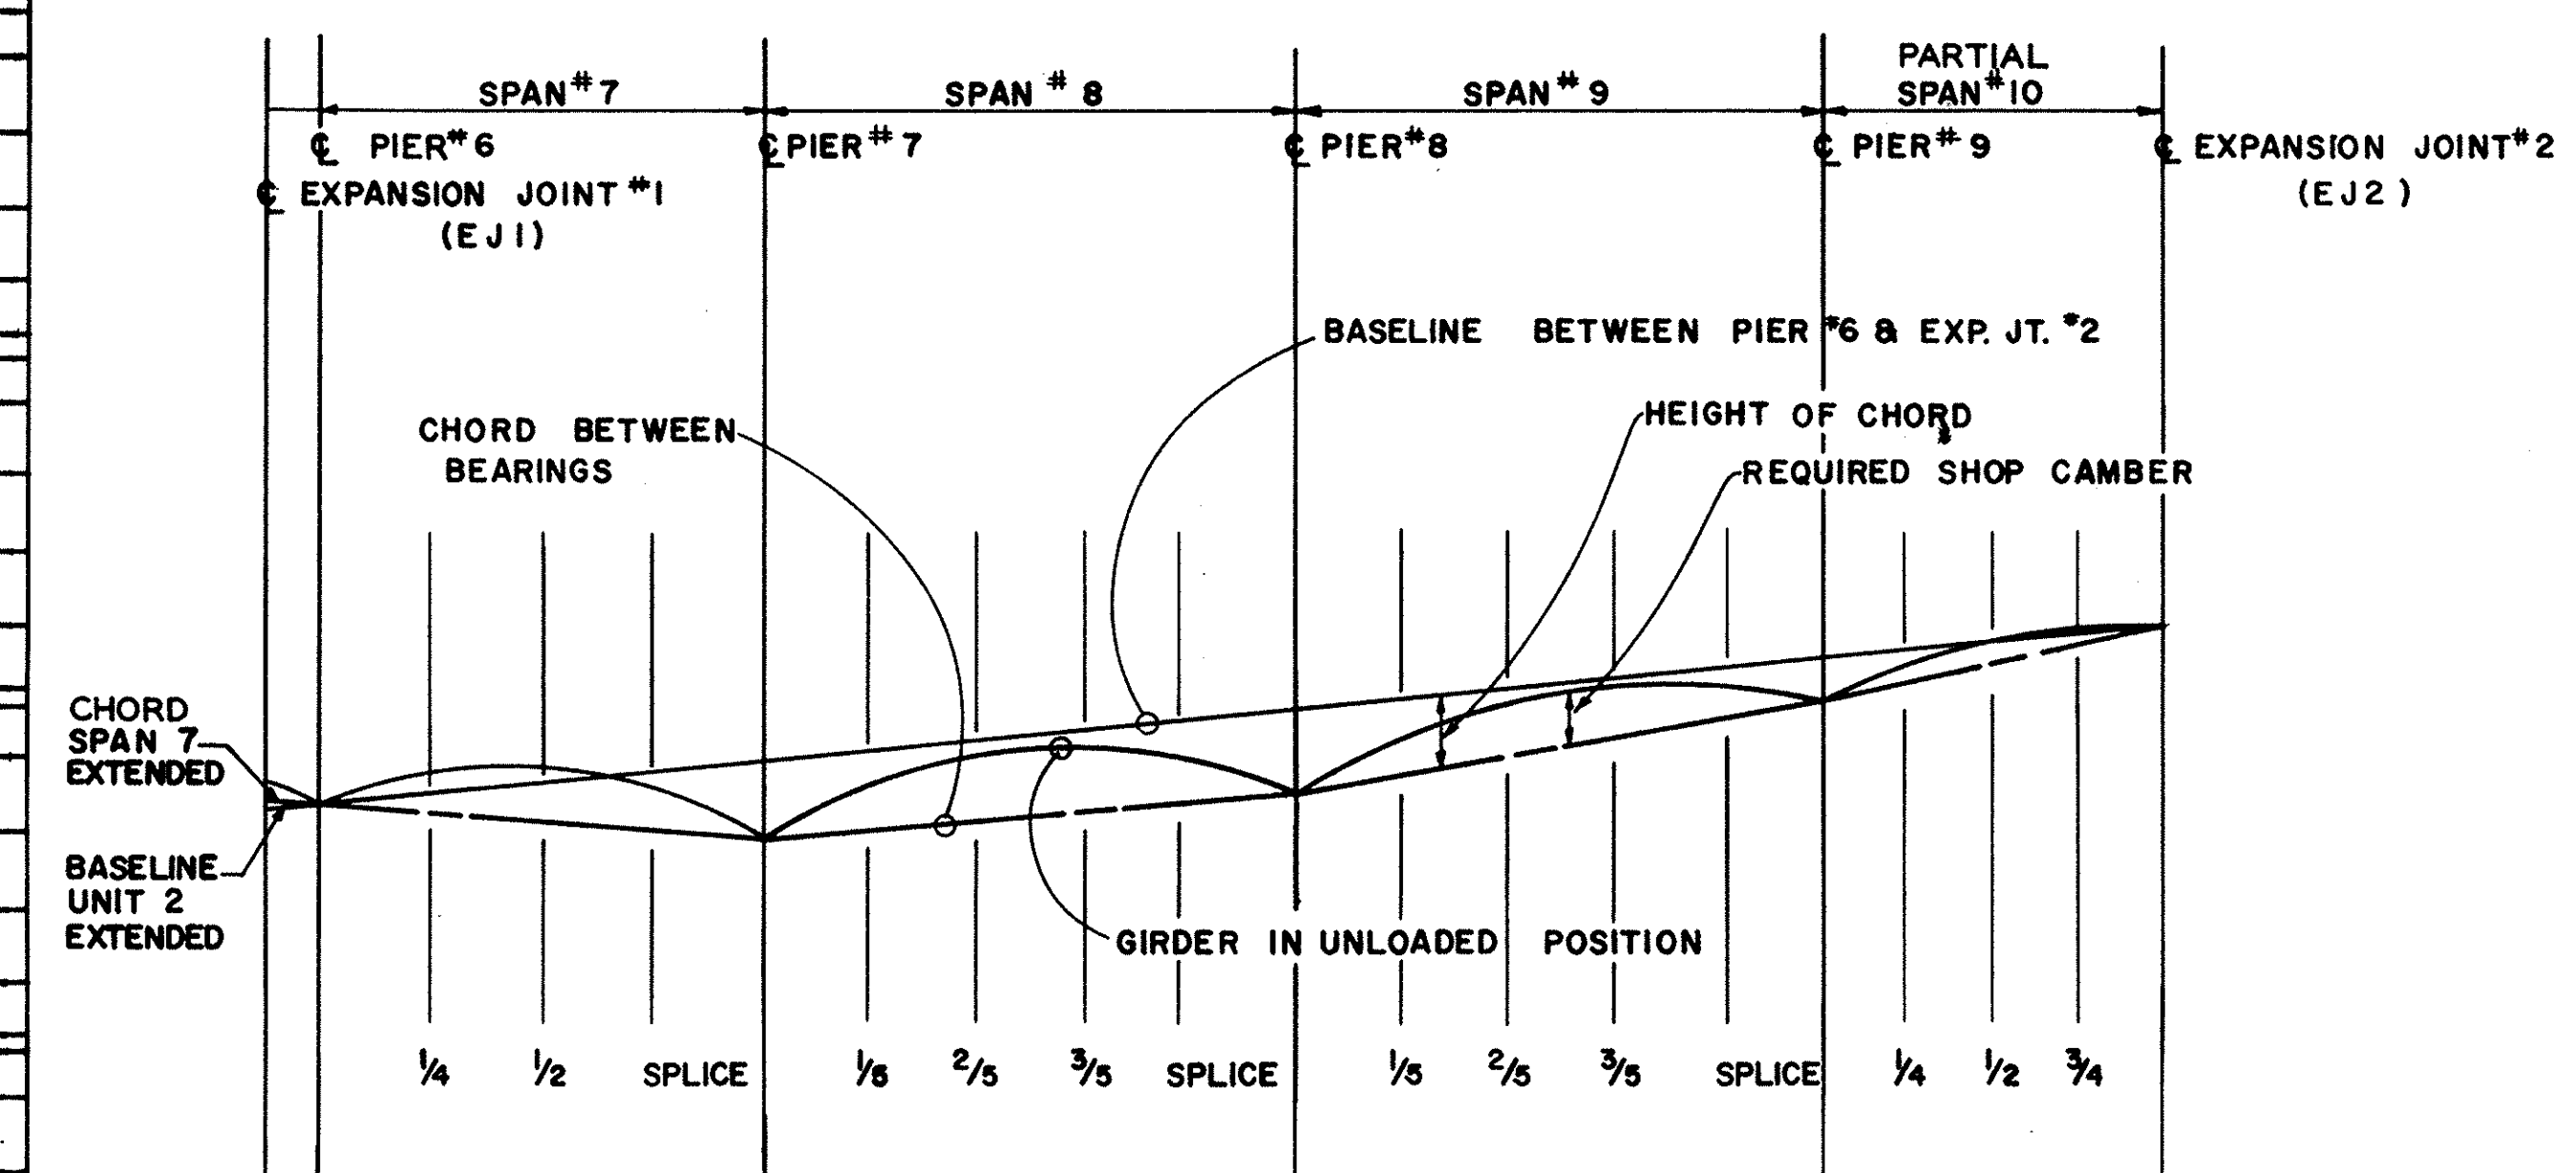

LAYOUT DIAGRAM

SEE SHEET 186 FOR GIRDER DIMENSIONS.

NOTE:
NEGATIVE VALUES INDICATE DIMENSION IS BELOW BASELINE OR CHORD.

STATE OF OHIO
DEPARTMENT OF HIGHWAYS
BUREAU OF BRIDGES

AKRON, OHIO YOUNGSTOWN, OHIO

GLAUS, PYLE & SCHOMER

LAYOUT DIAGRAMS
BRIDGE N° MAH-711-0116
OVER MAHONING RIVER
YOUNGSTOWN MAHONING COUNTY

UNIT N° 2

DESIGNED F.K.	DRAWN H.P.	TRACED	CHECKED D.M.	REVIEWED W.K.D.	DATE 6-22-68	REVISED
------------------	---------------	--------	-----------------	--------------------	-----------------	---------

DEFLECTION AND CAMBER TABLE

FED. RD.	STATE	PROJECT
2	OHIO	U.S.-1159 (I)

196
232

MAH-711-017

GIRDER	E.J.#2	PIER #10	SPAN 11							PIER #11	SPAN 12							PIER #12	SPAN 13							PIER #13	E.J.#3		
			1/8	1/4	3/8	1/2	SPLICE	3/4	7/8		1/10	1/5	3/10	2/5	1/2	3/5	7/10		4/5	9/10	1/8	1/4	SPLICE	1/2	5/8			3/4	7/8
GIRDER 3G1																													
DEFLECTION DUE TO WT. OF STEEL	-0.050		0.081	0.134	0.146	0.114	0.056	-0.008	-0.035		0.127	0.217	0.305	0.633	0.668	0.601	0.449	0.254	0.082		0.039	0.185	0.275	0.507	0.546	0.462	0.266		-0.180
DEFLECTION DUE TO REMAINING DEAD LOAD	-0.140		0.255	0.447	0.519	0.458	0.302	0.101	-0.024		0.250	0.667	1.092	1.381	1.452	1.285	0.925	0.479	0.115		0.208	0.680	0.948	1.581	1.644	1.353	0.756		-0.330
ADJUSTMENT REQUIRED FOR VERTICAL CURVE	0.000		0.000	0.000	0.000	0.000	0.000	0.000	0.000		0.465	0.939	1.413	1.887	2.361	2.664	2.579	2.107	1.247		1.068	1.709	1.866	2.471	2.393	1.932	1.121		-0.587
REQUIRED SHOP CAMBER INCHES	-0.190		0.335	0.581	0.665	0.573	0.358	0.093	-0.059		0.841	1.923	3.010	3.901	4.481	4.550	3.954	2.840	1.444		1.316	2.574	3.089	4.559	4.582	3.747	2.143		-1.067
HEIGHT OF CHORD INCHES	-0.308	0.000	0.523	1.045	1.568	2.092	2.594	3.137	3.659	4.182	5.171	6.158	7.147	8.136	9.124	10.112	11.100	12.089	13.078	14.065	12.307	10.549	9.688	7.033	5.274	3.516	1.758	0.000	-0.850
GIRDER 3G2																													
DEFLECTION DUE TO WT. OF STEEL	-0.060		0.100	0.169	0.188	0.155	0.081	0.011	-0.028		0.123	0.312	0.503	0.635	0.675	0.613	0.463	0.268	0.091		0.023	0.145	0.234	0.427	0.466	0.397	0.229		-0.120
DEFLECTION DUE TO REMAINING DEAD LOAD	-0.160		0.290	0.510	0.598	0.540	0.353	0.151	-0.000		0.217	0.600	0.999	1.279	1.359	1.218	0.894	0.481	0.132		0.146	0.517	0.762	1.250	1.308	1.080	0.605		-0.280
ADJUSTMENT REQUIRED FOR VERTICAL CURVE	0.009		-0.016	-0.031	-0.047	-0.063	-0.080	-0.094	-0.110		0.518	1.036	1.554	2.072	2.584	2.843	2.713	2.197	1.292		1.106	1.806	2.064	2.555	2.425	1.935	1.114		-0.554
REQUIRED SHOP CAMBER INCHES	-0.111		0.374	0.647	0.739	0.632	0.354	0.067	-0.139		0.858	1.948	3.056	3.986	4.618	4.673	4.071	2.945	1.515		1.275	2.468	3.069	4.232	4.199	3.412	1.948		-0.954
HEIGHT OF CHORD INCHES	-0.439	0.000	0.767	1.535	2.302	3.068	3.881	4.603	5.370	6.137	7.044	7.950	8.857	9.763	10.670	11.576	12.484	13.390	14.297	15.204	13.303	11.402	10.339	7.602	5.701	3.800	1.901	0.000	-0.945
GIRDER 3G3																													
DEFLECTION DUE TO WT. OF STEEL	-0.070		0.123	0.209	0.236	0.202	0.108	0.033	-0.020		0.118	0.306	0.498	0.635	0.680	0.622	0.476	0.280	0.100		0.009	0.109	0.195	0.356	0.393	0.338	0.196		-0.100
DEFLECTION DUE TO REMAINING DEAD LOAD	-0.180		0.350	0.618	0.731	0.671	0.434	0.216	0.025		0.201	0.579	0.984	1.276	1.370	1.243	0.928	0.516	0.155		0.104	0.415	0.654	1.056	1.115	0.924	0.517		-0.250
ADJUSTMENT REQUIRED FOR VERTICAL CURVE	0.009		-0.017	-0.034	-0.051	-0.068	-0.087	-0.102	-0.119		0.565	1.129	1.694	2.259	2.793	3.010	2.839	2.280	1.334		1.146	1.910	2.260	2.610	2.438	1.926	1.102		-0.564
REQUIRED SHOP CAMBER INCHES	-0.141		0.456	0.793	0.916	0.805	0.454	0.147	-0.114		0.884	2.015	3.177	4.170	4.843	4.875	4.242	3.076	1.589		1.259	2.434	3.109	4.023	3.946	3.187	1.815		-0.914
HEIGHT OF CHORD INCHES	-0.546	0.000	1.010	2.022	3.032	4.043	5.207	6.065	7.075	8.087	8.909	9.731	10.553	11.376	12.198	13.020	13.842	14.665	15.487	16.309	14.270	12.232	10.942	8.155	6.116	4.078	2.039	0.000	-1.026
GIRDER 3G4																													
DEFLECTION DUE TO WT. OF STEEL	-0.080		0.148	0.253	0.290	0.254	0.139	0.058	-0.011		0.112	0.297	0.492	0.632	0.682	0.629	0.486	0.291	0.107		-0.004	0.077	0.160	0.292	0.328	0.284	0.166		-0.090
DEFLECTION DUE TO REMAINING DEAD LOAD	-0.200		0.387	0.684	0.815	0.758	0.483	0.269	0.050		0.171	0.516	0.896	1.176	1.277	1.172	0.889	0.508	0.165		0.061	0.298	0.510	0.812	0.865	0.720	0.403		-0.190
ADJUSTMENT REQUIRED FOR VERTICAL CURVE	0.000		-0.002	-0.005	-0.007	-0.010	-0.013	-0.015	-0.017		0.613	1.227	1.840	2.454	2.991	3.168	2.958	2.360	1.374		1.190	2.019	2.400	2.636	2.430	1.904	1.084		-0.571
REQUIRED SHOP CAMBER INCHES	-0.280		0.533	0.932	1.097	1.002	0.608	0.312	0.022		0.896	2.040	3.228	4.262	4.951	4.970	4.333	3.159	1.646		1.248	2.394	3.069	3.740	3.623	2.908	1.652		-0.851
HEIGHT OF CHORD INCHES	-0.675	0.000	1.253	2.506	3.758	5.010	6.559	7.516	8.768	10.021	10.757	11.494	12.230	12.966	13.703	14.438	15.175	15.911	16.648	17.384	15.211	13.038	11.494	8.692	6.520	4.346	2.173	0.000	-1.143
GIRDER 3G5																													
DEFLECTION DUE TO WT. OF STEEL	-0.090		0.166	0.284	0.328	0.292	0.160	0.077	-0.004		0.107	0.291	0.486	0.629	0.682	0.632	0.492	0.297	0.112		-0.011	0.058	0.139	0.254	0.290	0.253	0.148		-0.080
DEFLECTION DUE TO REMAINING DEAD LOAD	-0.220		0.432	0.763	0.912	0.854	0.539	0.318	0.070		0.159	0.499	0.881	1.167	1.277	1.180	0.903	0.524	0.177		0.042	0.250	0.454	0.718	0.770	0.643	0.360		-0.170
ADJUSTMENT REQUIRED FOR VERTICAL CURVE	0.000		0.000	0.000	0.000	0.000	0.000	0.000	0.000		0.646	1.292	1.938	2.584	3.114	3.266	3.031	2.408	1.398		1.194	2.040	2.418	2.610	2.400	1.882	1.080		-0.481
REQUIRED SHOP CAMBER INCHES	-0.310		0.597	1.048	1.240	1.146	0.699	0.395	0.067		0.912	2.082	3.305	4.380	5.073	5.079	4.426	3.230	1.686		1.225	2.348	3.011	3.583	3.460	2.778	1.588		-0.831
HEIGHT OF CHORD INCHES	-0.690	0.000	1.310	2.621	3.932	5.243	6.932	7.864	9.174	10.486	11.197	11.909	12.622	13.333	14.045	14.756	15.469	16.181	16.892	17.605	15.404	13.204	11.524	8.802	6.602	4.402	2.201	0.000	-1.184
GIRDER 3G6																													
DEFLECTION DUE TO WT. OF STEEL	-0.100		0.196	0.338	0.393	0.356	0.195	0.109	0.009		0.100	0.280	0.476	0.622	0.680	0.635	0.498	0.306	0.118		-0.020	0.033	0.108	0.202	0.236	0.209	0.123		-0.070
DEFLECTION DUE TO REMAINING DEAD LOAD	-0.270		0.547	0.969	1.164	1.101	0.684	0.437	0.114		0.149	0.506	0.919	1.237	1.369	1.278	0.991	0.587	0.207		0.018	0.199	0.408	0.636	0.692	0.582	0.326		-0.160
ADJUSTMENT REQUIRED FOR VERTICAL CURVE	0.000		0.000	0.000	0.000	0.000	0.000	0.000	0.000		0.698	1.396	2.094	2.792	3.296	3.412	3.140	2.481	1.434		1.435	2.459	2.763	2.809	2.518	1.937	1.089		-0.600
REQUIRED SHOP CAMBER INCHES	-0.370		0.743	1.307	1.557	1.457	0.879	0.545	0.122		0.946	2.183	3.489	4.652	5.344	5.325	4.629	3.374	1.759		1.432	2.691	3.279	3.646	3.445	2.728	1.538		-0.830
HEIGHT OF CHORD INCHES	-0.740	0.000	1.448	2.896	4.344	5.792	7.771	8.688	10.136	11.584	12.343	13.103	13.861	14.621	15.379	16.139	16.898	17.657	18.416	19.175	16.778	14.381	12.346	9.588	7.190	4.794	2.396	0.000	-1.321
GIRDER 3G7																													
DEFLECTION DUE TO WT. OF STEEL	-0.120		0.229	0.397	0.466	0.427	0.234	0.145	0.023		0.091	0.268	0.463	0.613	0.675	0.635	0.503	0.312	0.123		-0.028	0.011	0.081	0.155	0.188	0.169	0.100		-0.060
DEFLECTION DUE TO REMAINING DEAD LOAD	-0.310		0.637	1.130	1.362	1.298	0.793	0.540	0.156		0.125	0.471	0.884	1.211	1.356	1.280	1.004	0.606	0.222		-0.007	0.135	0.329	0.508	0.563	0.477	0.268		-0.130
ADJUSTMENT REQUIRED FOR VERTICAL CURVE	0.000		0.000	0.000	0.000	0.000	0.000	0.000	0.000		0.752	1.504	2.256	2.998	3.468	3.549	3.244	2.550	1.469		1.683	2.739	2.976	2.926	2.582	1.966	1.097		-0.626
REQUIRED SHOP CAMBER INCHES	-0.530		0.866	1.526	1.827	1.725	1.027	0.685	0.179		0.968	2.243	3.604	4.822	5.499	5.465	4.751	3.468	1.814		1.648	2.885	3.386	3.589	3.333	2.612	1.465		-0.816
HEIGHT OF CHORD INCHES	-0.792	0.000	1.592	3.185	4.777	6.370	8.664	9.554	11.147	12.739	13.544	14.350	15.156	15.961	16.766	17.573	18.378	19.183	19.988	20.795	18.196	15.595	13.151	10.397	7.798	5.198	2.599	0.000	-1.481
GIRDER 3G8																													
DEFLECTION DUE TO WT. OF STEEL	-0.130		0.266	0.462	0.546	0.507																							

DEFLECTION AND CAMBER TABLE

FED. RD.	STATE	PROJECT
2	OHIO	U.S.-1159 (I)


198
232

MAH-711-0.17

MAHONING
JUN 13 1968
REVISION

	PARTIAL SPAN 18				SPAN 19				SPAN 20						
	E.J.#4	1/4	1/2	SPLICE	1/5	2/5	3/5	SPLICE	PIER #19	1/4	1/2	3/4	ABUT#2		
GIRDER 5G1															
DEFLECTION DUE TO WT. OF STEEL	----	0.034	0.035	0.017	----	0.054	0.109	0.100	0.046	----	0.049	0.111	0.097	----	
DEFLECTION DUE TO REMAINING DEAD LOAD	----	0.197	0.202	0.097	----	0.315	0.630	0.577	0.266	----	0.285	0.642	0.559	----	
ADJUSTMENT REQUIRED FOR VERTICAL CURVE	----	0.489	0.951	0.369	----	-1.158	-1.614	-1.530	-0.992	----	-0.930	-1.222	-0.905	----	
REQUIRED SHOP CAMBER - INCHES	----	0.720	1.187	0.482	----	-0.789	-0.874	-0.853	-0.680	----	-0.596	-0.469	-0.250	----	
HEIGHT OF CHORD - INCHES	----	-1.602	-3.203	-4.384	-6.407	----	-6.824	-7.243	-7.661	-8.032	-8.497	-6.373	-4.248	-2.124	----
GIRDER 5G2															
DEFLECTION DUE TO WT. OF STEEL	----	0.034	0.036	0.018	----	0.045	0.091	0.082	0.037	----	0.048	0.108	0.094	----	
DEFLECTION DUE TO REMAINING DEAD LOAD	----	0.182	0.189	0.096	----	0.241	0.484	0.437	0.194	----	0.254	0.571	0.498	----	
ADJUSTMENT REQUIRED FOR VERTICAL CURVE	----	0.269	0.536	0.107	----	-1.159	-1.615	-1.532	-0.995	----	-0.930	-1.222	-0.905	----	
REQUIRED SHOP CAMBER - INCHES	----	0.485	0.761	0.221	----	-0.873	-1.039	-1.012	-0.764	----	-0.629	-0.544	-0.313	----	
HEIGHT OF CHORD - INCHES	----	-1.756	-3.554	-4.805	-7.021	----	-7.376	-7.730	-8.084	-8.398	-8.792	-6.594	-4.396	-2.198	----
GIRDER 5G3															
DEFLECTION DUE TO WT. OF STEEL	----	0.034	0.035	0.018	----	0.044	0.089	0.081	0.036	----	0.048	0.107	0.093	----	
DEFLECTION DUE TO REMAINING DEAD LOAD	----	0.178	0.186	0.095	----	0.236	0.474	0.427	0.189	----	0.254	0.568	0.495	----	
ADJUSTMENT REQUIRED FOR VERTICAL CURVE	----	0.049	0.121	-0.155	----	-1.159	-1.616	-1.533	-0.996	----	-0.930	-1.221	-0.904	----	
REQUIRED SHOP CAMBER - INCHES	----	0.261	0.342	-0.043	----	-0.879	-1.052	-1.025	-0.771	----	-0.629	-0.546	-0.315	----	
HEIGHT OF CHORD - INCHES	----	-1.908	-3.817	-5.224	-7.634	----	-7.924	-8.213	-8.502	-8.759	-9.082	-6.811	-4.541	-2.270	----
GIRDER 5G4															
DEFLECTION DUE TO WT. OF STEEL	----	0.033	0.034	0.016	----	0.070	0.134	0.123	0.059	----	0.064	0.139	0.119	----	
DEFLECTION DUE TO REMAINING DEAD LOAD	----	0.170	0.177	0.084	----	0.362	0.695	0.638	0.306	----	0.333	0.723	0.618	----	
ADJUSTMENT REQUIRED FOR VERTICAL CURVE	----	-0.172	-0.294	-0.417	----	-1.159	-1.616	-1.533	-0.997	----	-0.929	-1.218	-0.901	----	
REQUIRED SHOP CAMBER - INCHES	----	0.031	-0.083	-0.316	----	-0.728	-0.787	-0.772	-0.632	----	-0.532	-0.357	-0.165	----	
HEIGHT OF CHORD - INCHES	----	-2.060	-4.122	-5.640	-8.243	----	-8.467	-8.692	-8.916	-9.114	-9.365	-7.024	-4.682	-2.341	----
GIRDER 5G5															
DEFLECTION DUE TO WT. OF STEEL	----	0.032	0.034	0.016	----	0.069	0.132	0.121	0.058	----	0.064	0.138	0.118	----	
DEFLECTION DUE TO REMAINING DEAD LOAD	----	0.168	0.175	0.083	----	0.357	0.686	0.630	0.302	----	0.332	0.720	0.615	----	
ADJUSTMENT REQUIRED FOR VERTICAL CURVE	----	-0.184	-0.314	-0.412	----	-1.241	-1.752	-1.601	-0.945	----	-0.983	-1.287	-0.950	----	
REQUIRED SHOP CAMBER - INCHES	----	0.016	-0.105	-0.313	----	-0.815	-0.934	-0.851	-0.586	----	-0.587	-0.428	-0.216	----	
HEIGHT OF CHORD - INCHES	----	-2.111	-4.222	-5.777	-8.442	----	-8.666	-8.890	-9.115	-9.314	-9.564	-7.174	-4.782	-2.392	----
GIRDER 5G6															
DEFLECTION DUE TO WT. OF STEEL	----	0.032	0.033	0.017	----	0.042	0.084	0.076	0.033	----	0.048	0.106	0.092	----	
DEFLECTION DUE TO REMAINING DEAD LOAD	----	0.170	0.177	0.091	----	0.223	0.448	0.402	0.176	----	0.252	0.560	0.487	----	
ADJUSTMENT REQUIRED FOR VERTICAL CURVE	----	-0.186	-0.316	-0.413	----	-1.487	-2.244	-1.987	-1.162	----	-0.980	-1.283	-0.946	----	
REQUIRED SHOP CAMBER - INCHES	----	0.016	-0.105	-0.306	----	-1.221	-1.712	-1.510	-0.952	----	-0.680	-0.617	-0.367	----	
HEIGHT OF CHORD - INCHES	----	-2.315	-4.631	-6.337	-9.262	----	-9.487	-9.712	-9.937	-10.136	-10.388	-7.791	-5.195	-2.597	----
GIRDER 5G7															
DEFLECTION DUE TO WT. OF STEEL	----	0.031	0.033	0.017	----	0.041	0.083	0.074	0.032	----	0.048	0.105	0.091	----	
DEFLECTION DUE TO REMAINING DEAD LOAD	----	0.167	0.174	0.089	----	0.218	0.438	0.392	0.171	----	0.252	0.557	0.484	----	
ADJUSTMENT REQUIRED FOR VERTICAL CURVE	----	-0.187	-0.318	-0.414	----	-1.733	-2.737	-2.372	-1.387	----	-0.977	-1.277	-0.941	----	
REQUIRED SHOP CAMBER - INCHES	----	0.011	-0.111	-0.308	----	-1.473	-2.216	-1.906	-1.174	----	-0.677	-0.615	-0.366	----	
HEIGHT OF CHORD - INCHES	----	-2.520	-5.039	-6.896	-10.079	----	-10.304	-10.531	-10.757	-10.956	-11.209	-8.407	-5.605	-2.802	----
GIRDER 5G8															
DEFLECTION DUE TO WT. OF STEEL	----	0.030	0.031	0.015	----	0.047	0.095	0.086	0.039	----	0.049	0.107	0.093	----	
DEFLECTION DUE TO REMAINING DEAD LOAD	----	0.174	0.179	0.087	----	0.275	0.548	0.496	0.225	----	0.282	0.621	0.536	----	
ADJUSTMENT REQUIRED FOR VERTICAL CURVE	----	-0.189	-0.320	-0.415	----	-1.999	-3.229	-2.756	-1.593	----	-0.972	-1.271	-0.938	----	
REQUIRED SHOP CAMBER - INCHES	----	0.015	-0.110	-0.314	----	-1.657	-2.587	-2.174	-1.329	----	-0.642	-0.542	-0.307	----	
HEIGHT OF CHORD - INCHES	----	-2.724	-5.447	-7.454	-10.894	----	-11.120	-11.347	-11.574	-11.773	-12.026	-9.020	-6.013	-3.007	----

SEE UNIT 4
FOR THIS SECTION



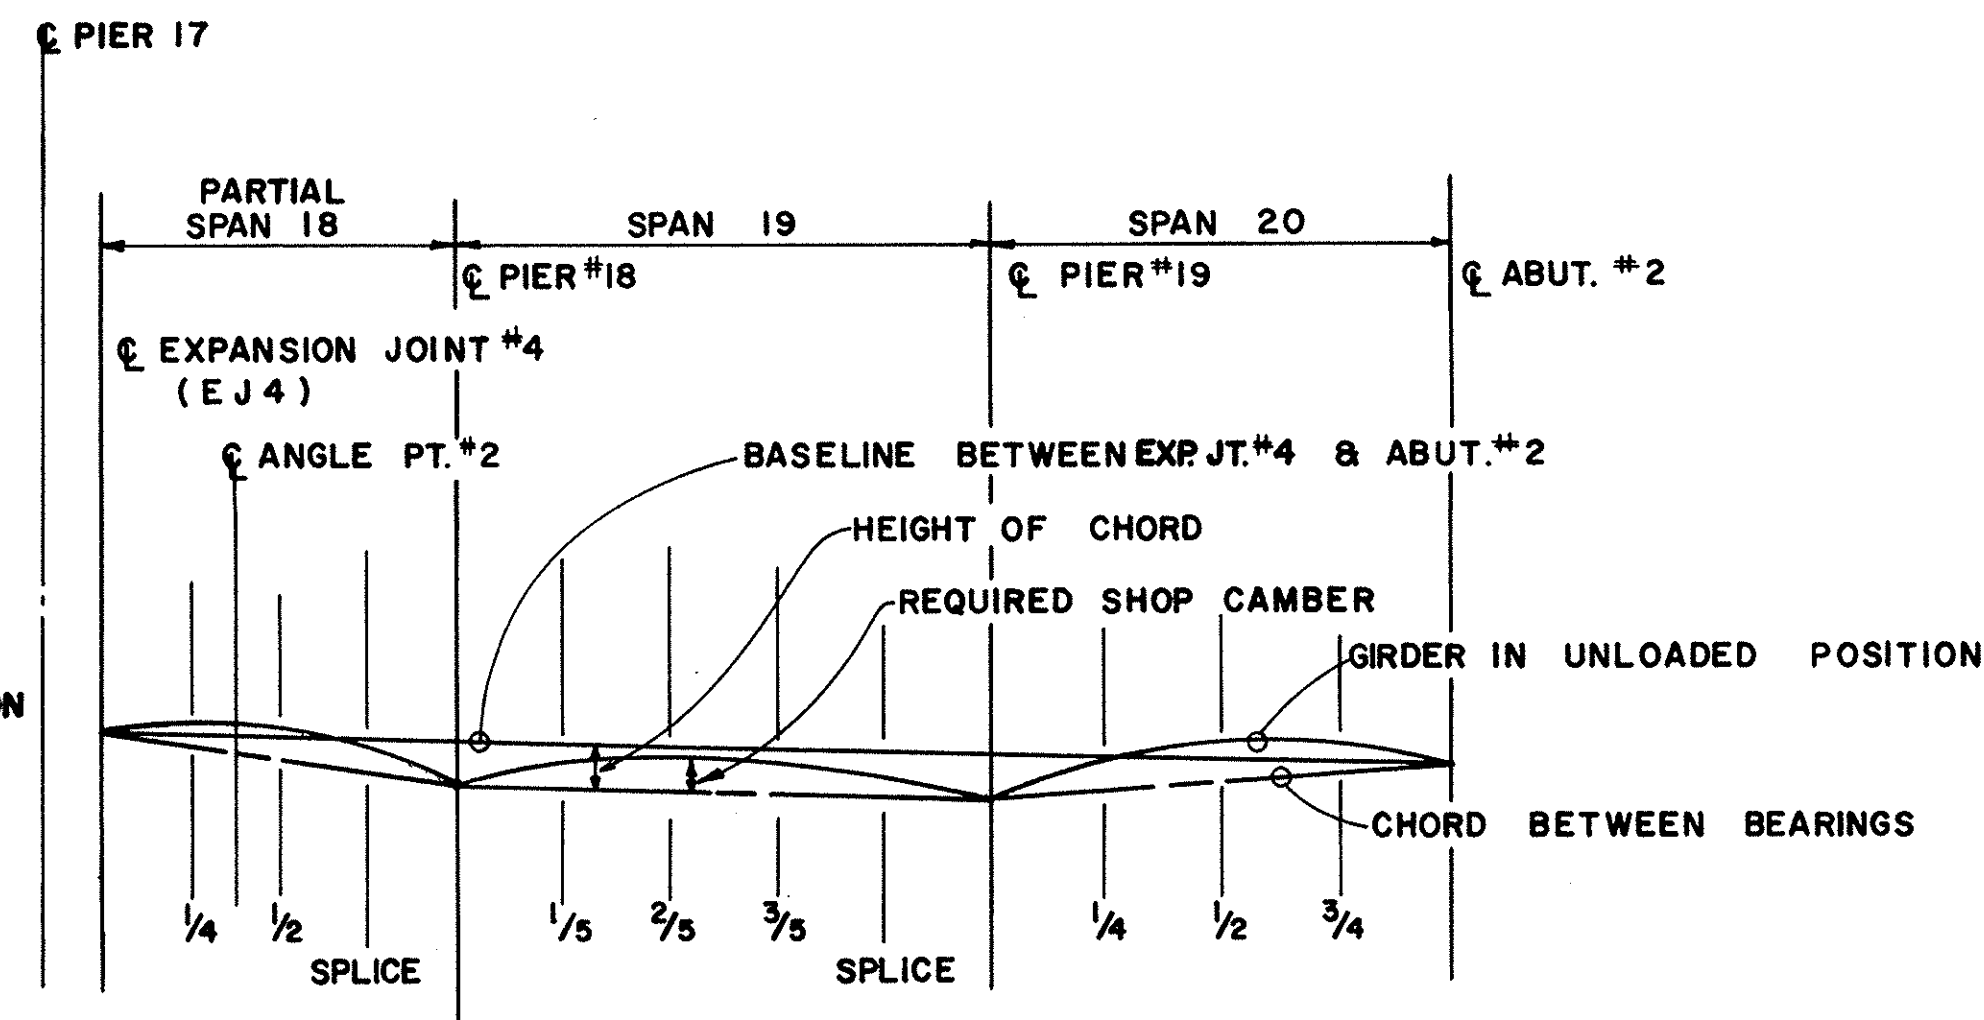


LAYOUT DIAGRAM

SEE SHEET 193
FOR GIRDER DIMENSIONS.

NOTE:
NEGATIVE VALUES INDICATE DIMENSION
IS BELOW BASELINE OR CHORD.

STATE OF OHIO DEPARTMENT OF HIGHWAYS BUREAU OF BRIDGES					
GLAUS, PYLE & SCHOMER			AKRON, OHIO YOUNGSTOWN, OHIO		
LAYOUT DIAGRAMS					
BRIDGE N ^o		MAH-711-0116			
OVER MAHONING RIVER					
YOUNGSTOWN			MAHONING COUNTY		
UNIT N ^o 5					
DESIGNED	DRAWN	TRACED	CHECKED	REVIEWED	DATE
F.K.	C.P.		R.H.	W.K.D.	6-22-68

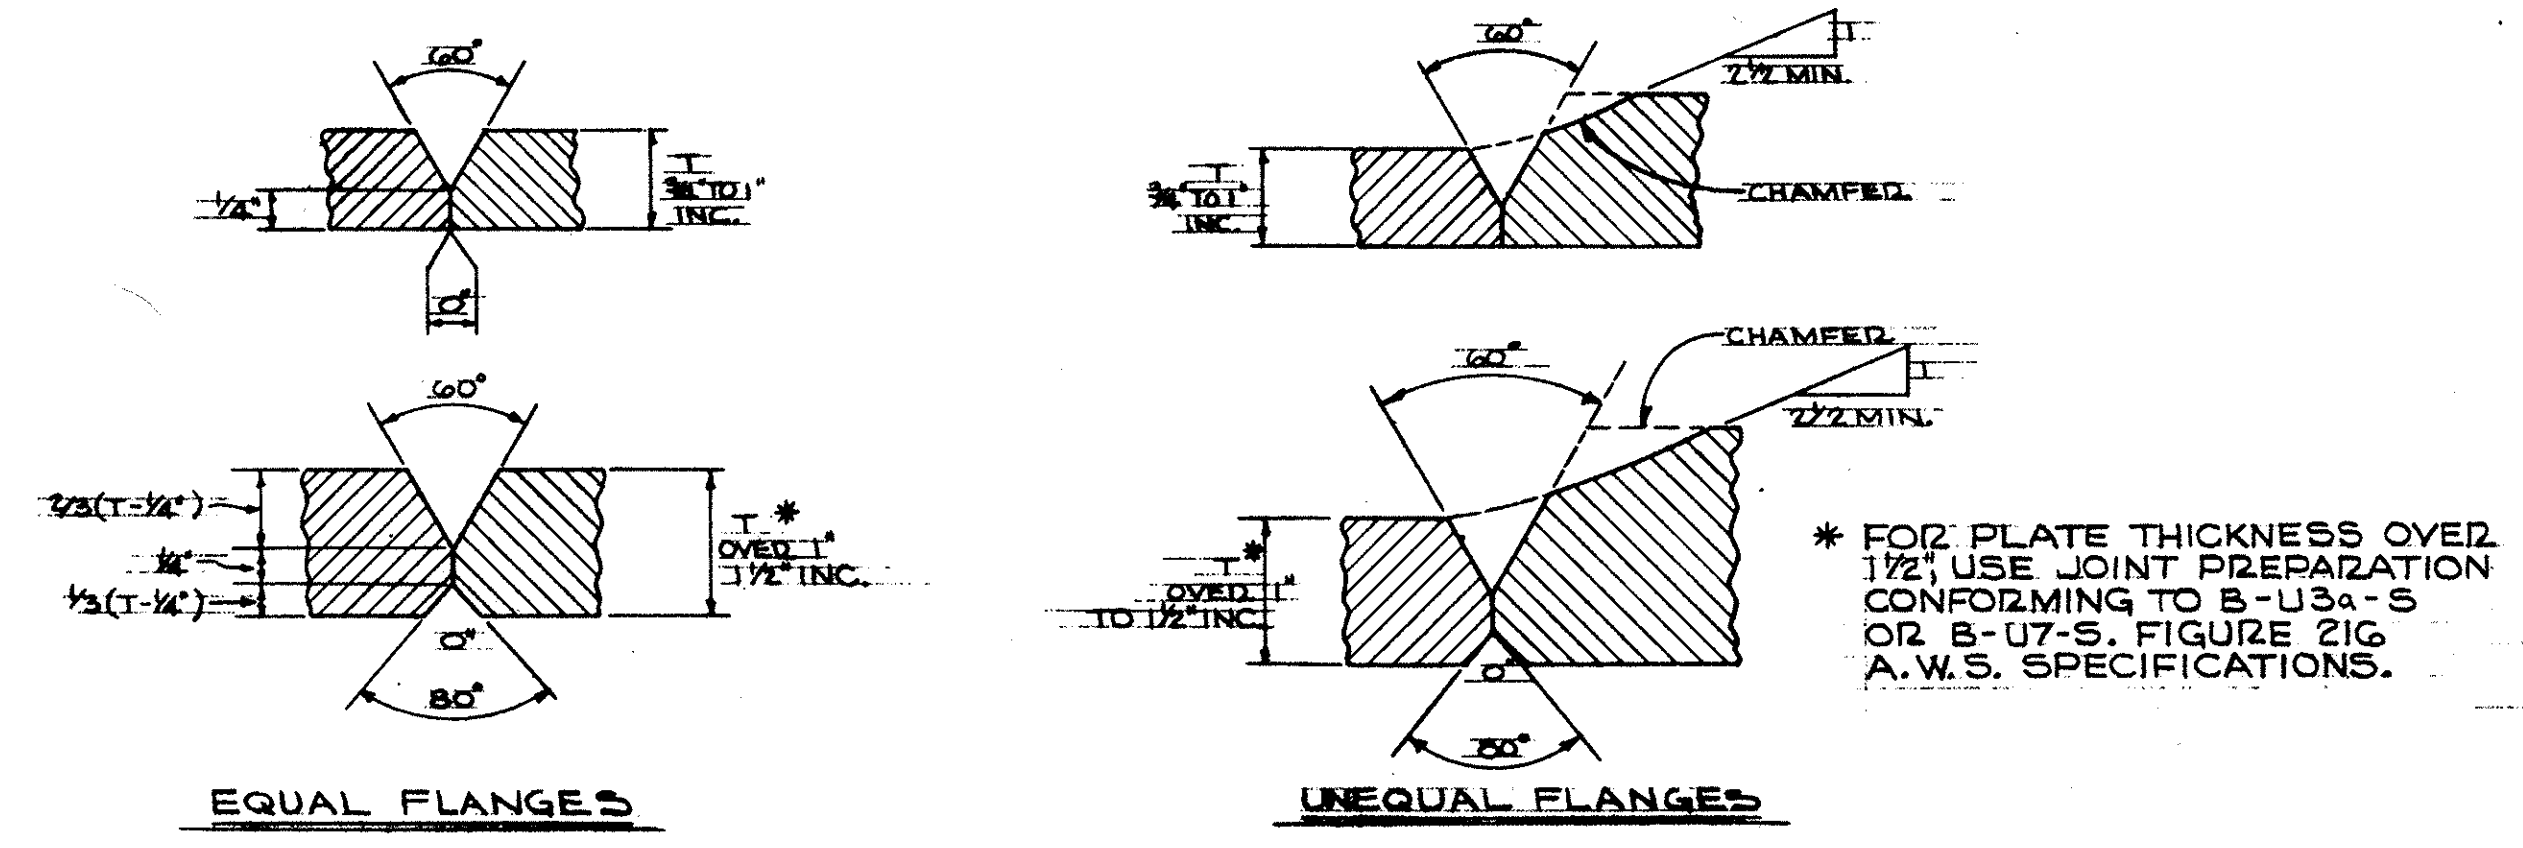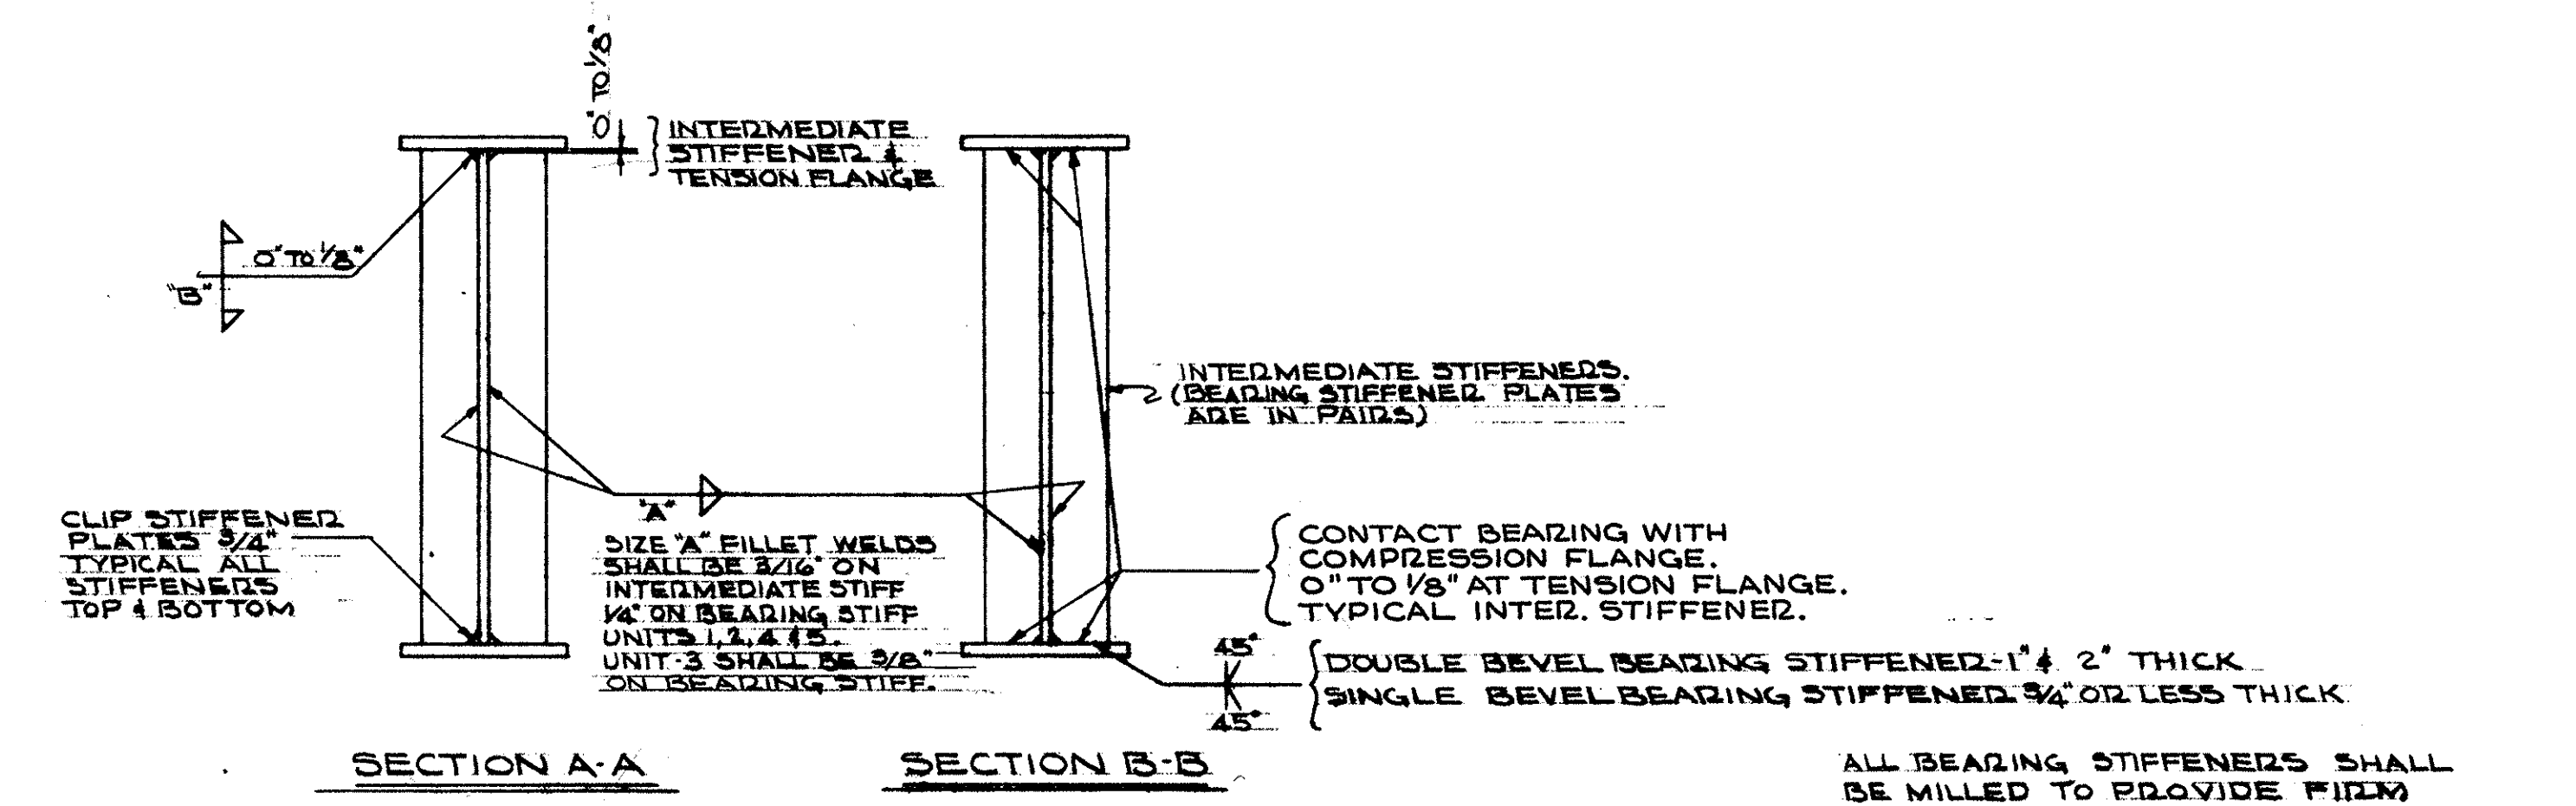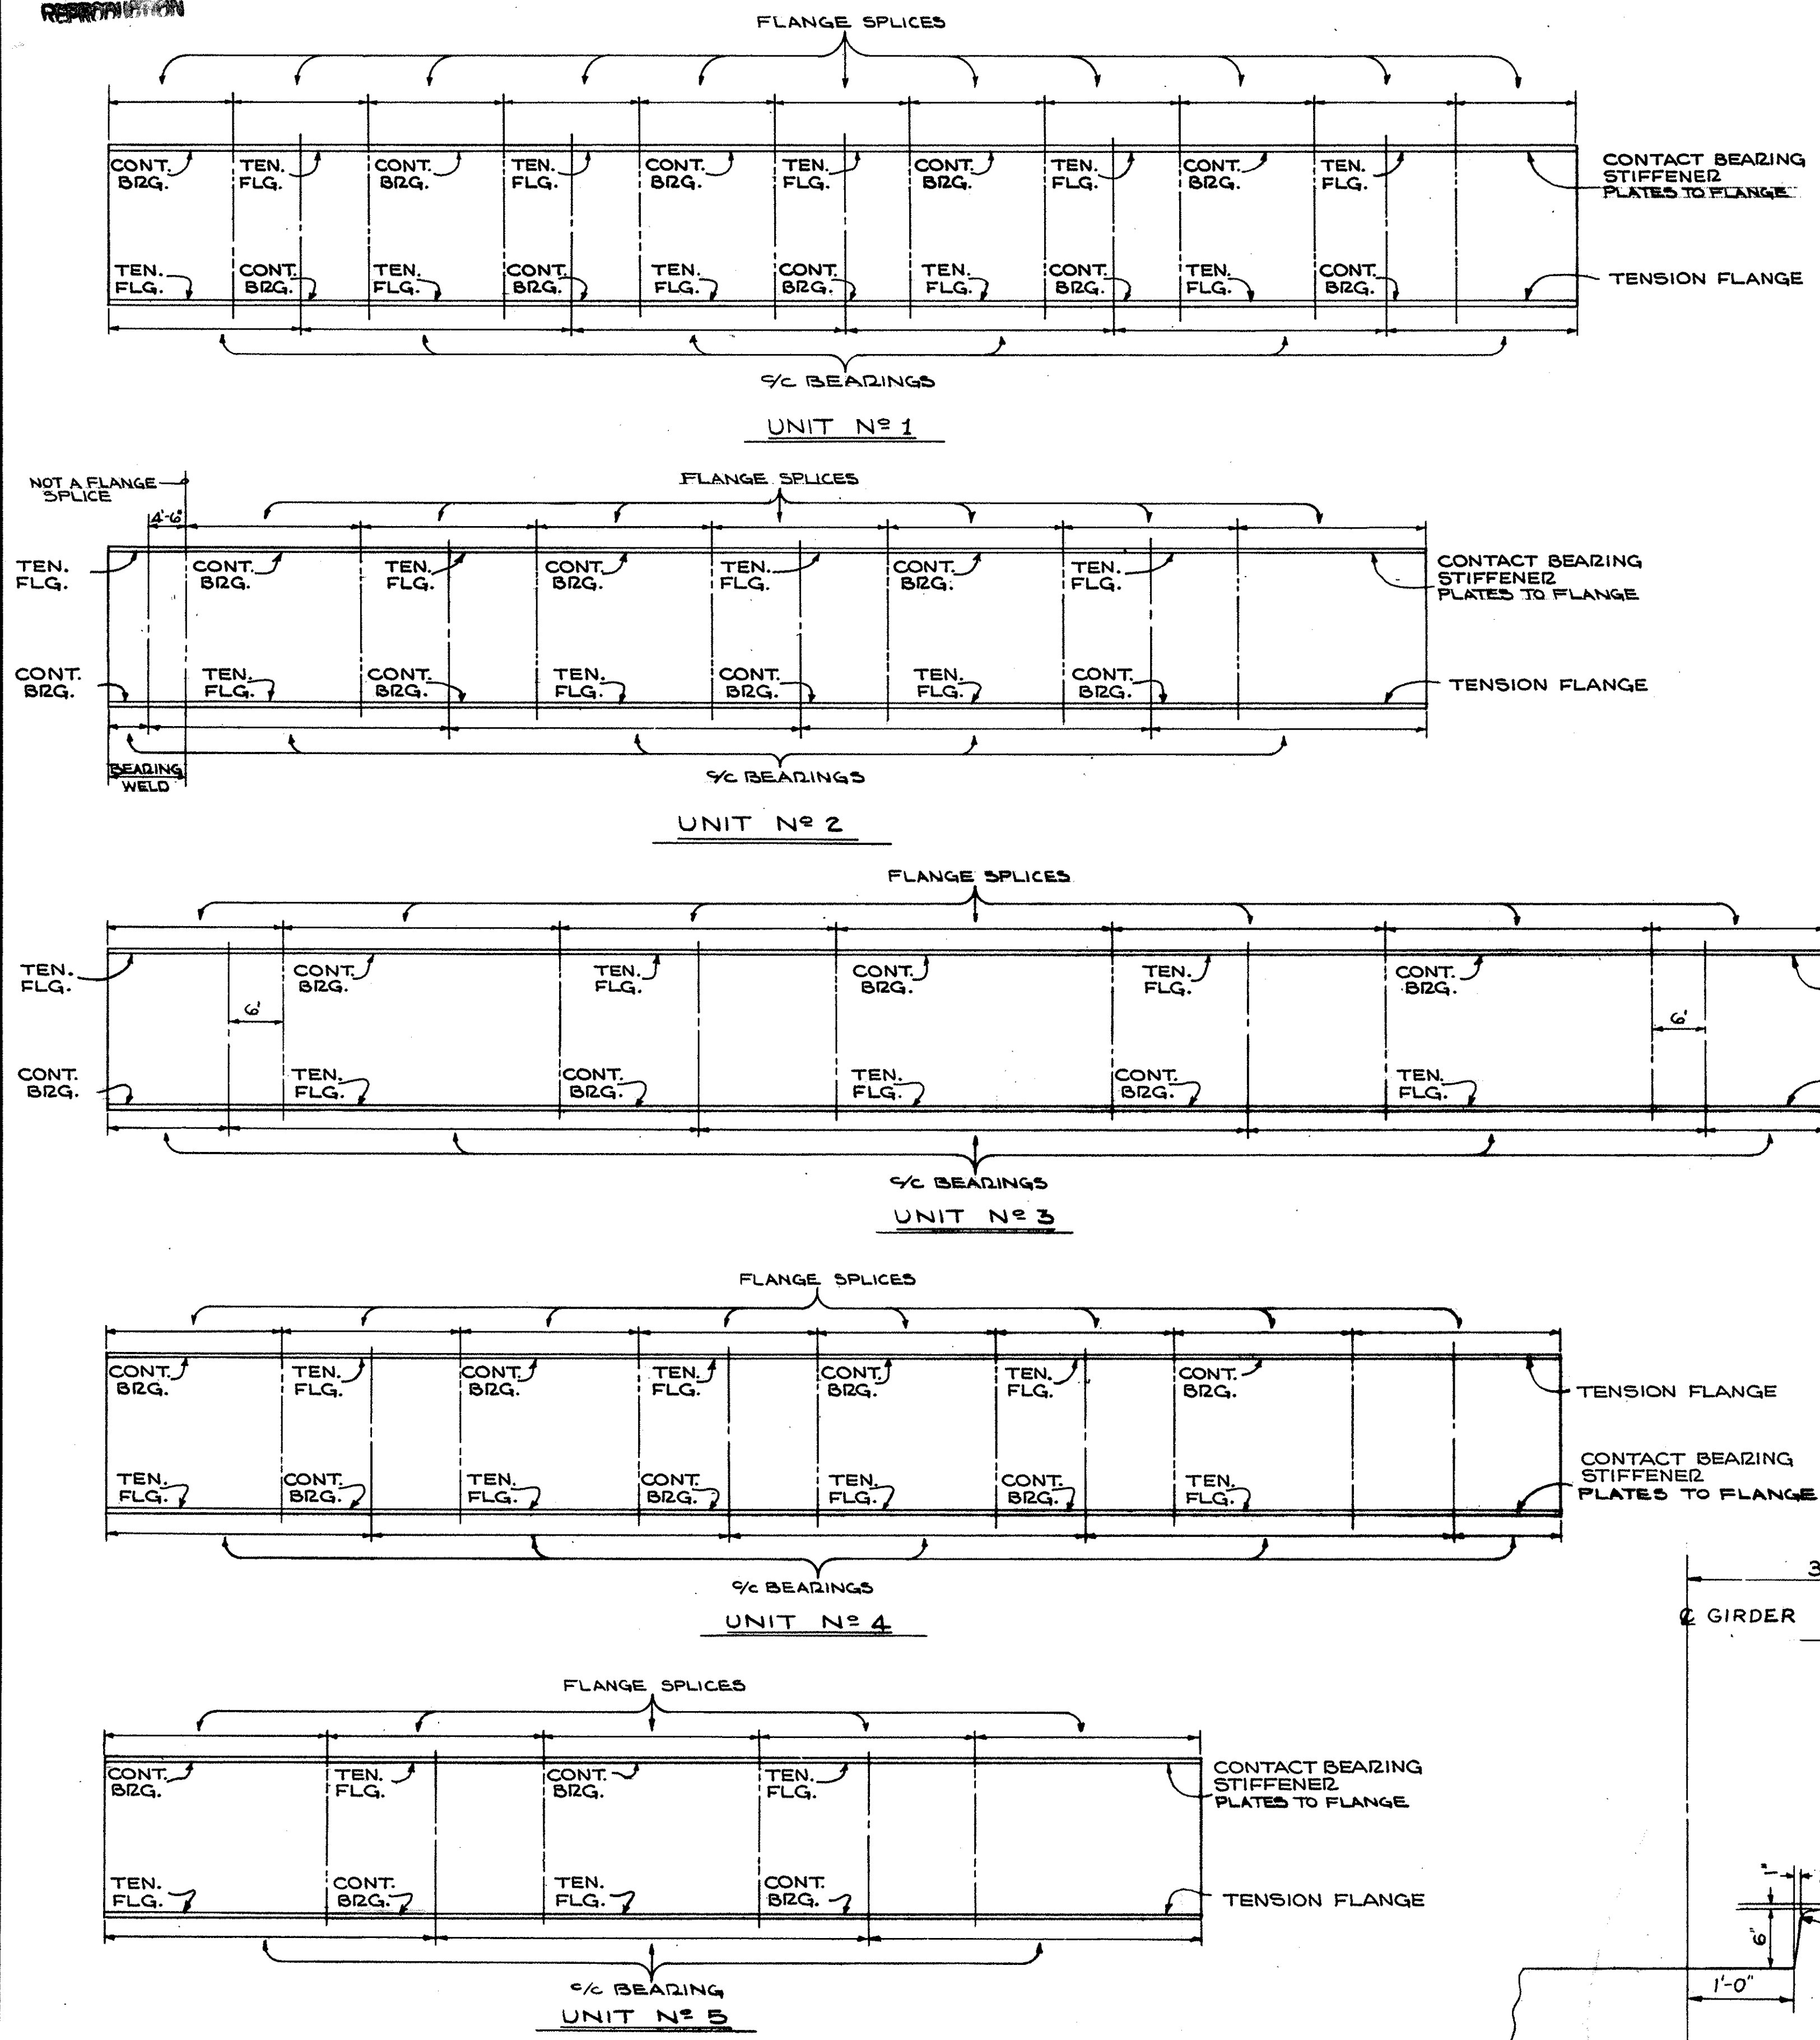

SIZE 'B' FILLET WELDS SHALL BE 3/16" FOR 1/2" OR LESS FLANGES AND 3/8" FOR THICKER FLANGES

ALL FULL PENETRATION WELDS SHALL BE BACK-GROUGED AND WELDED AFTER WELDING FAT SIDE. ALL GRINDING SHALL BE PARALLEL TO THE DIRECTION OF STRESS. ALL FLANGE TO FLANGE AND WEB TO WEB SPLICES ARE TO BE GROUND.

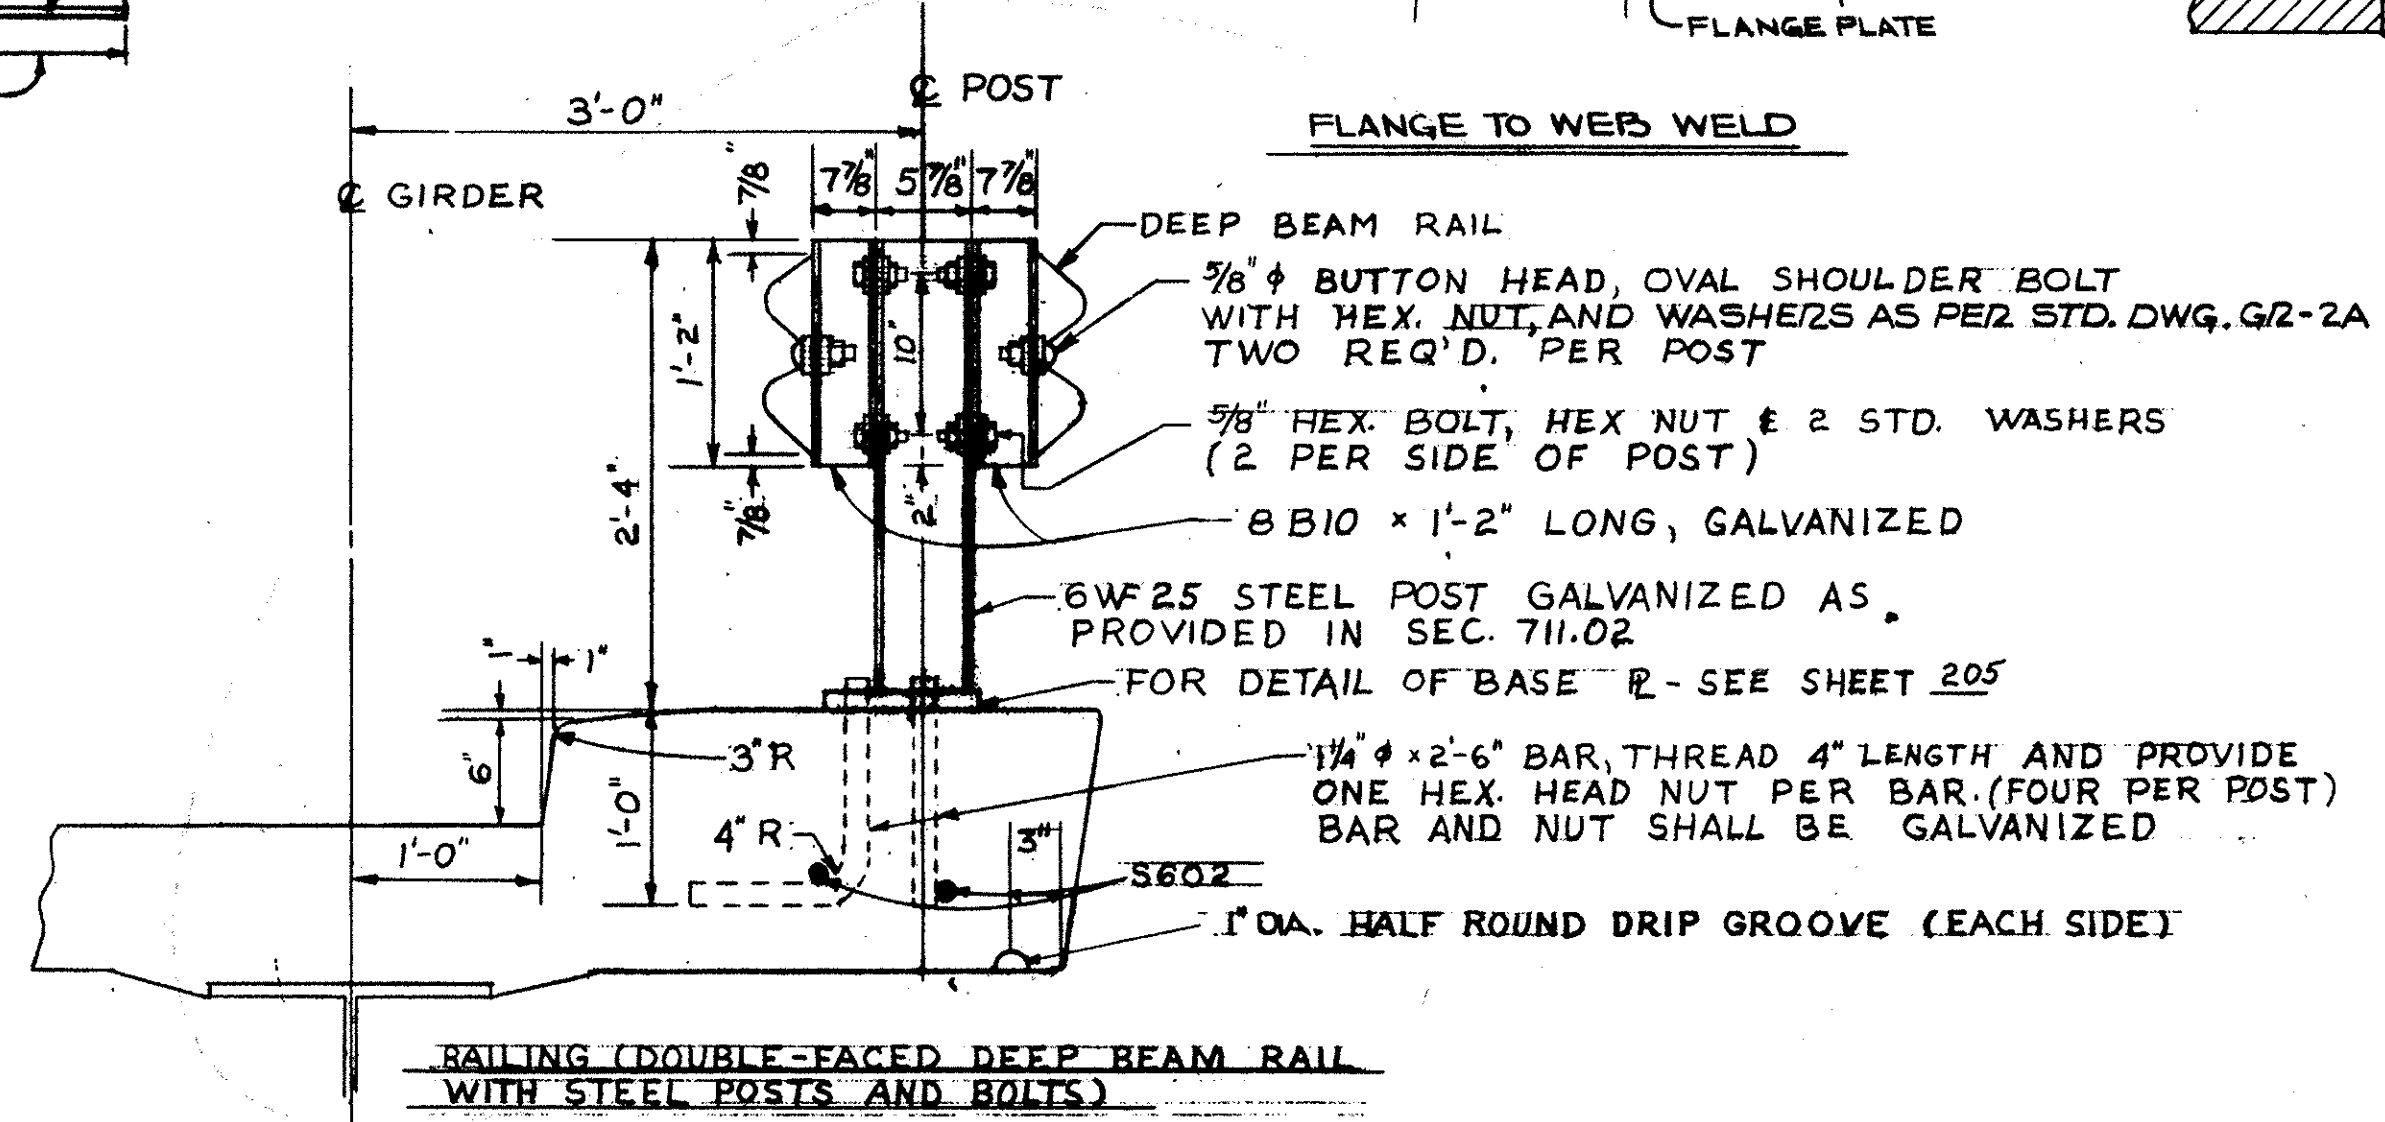
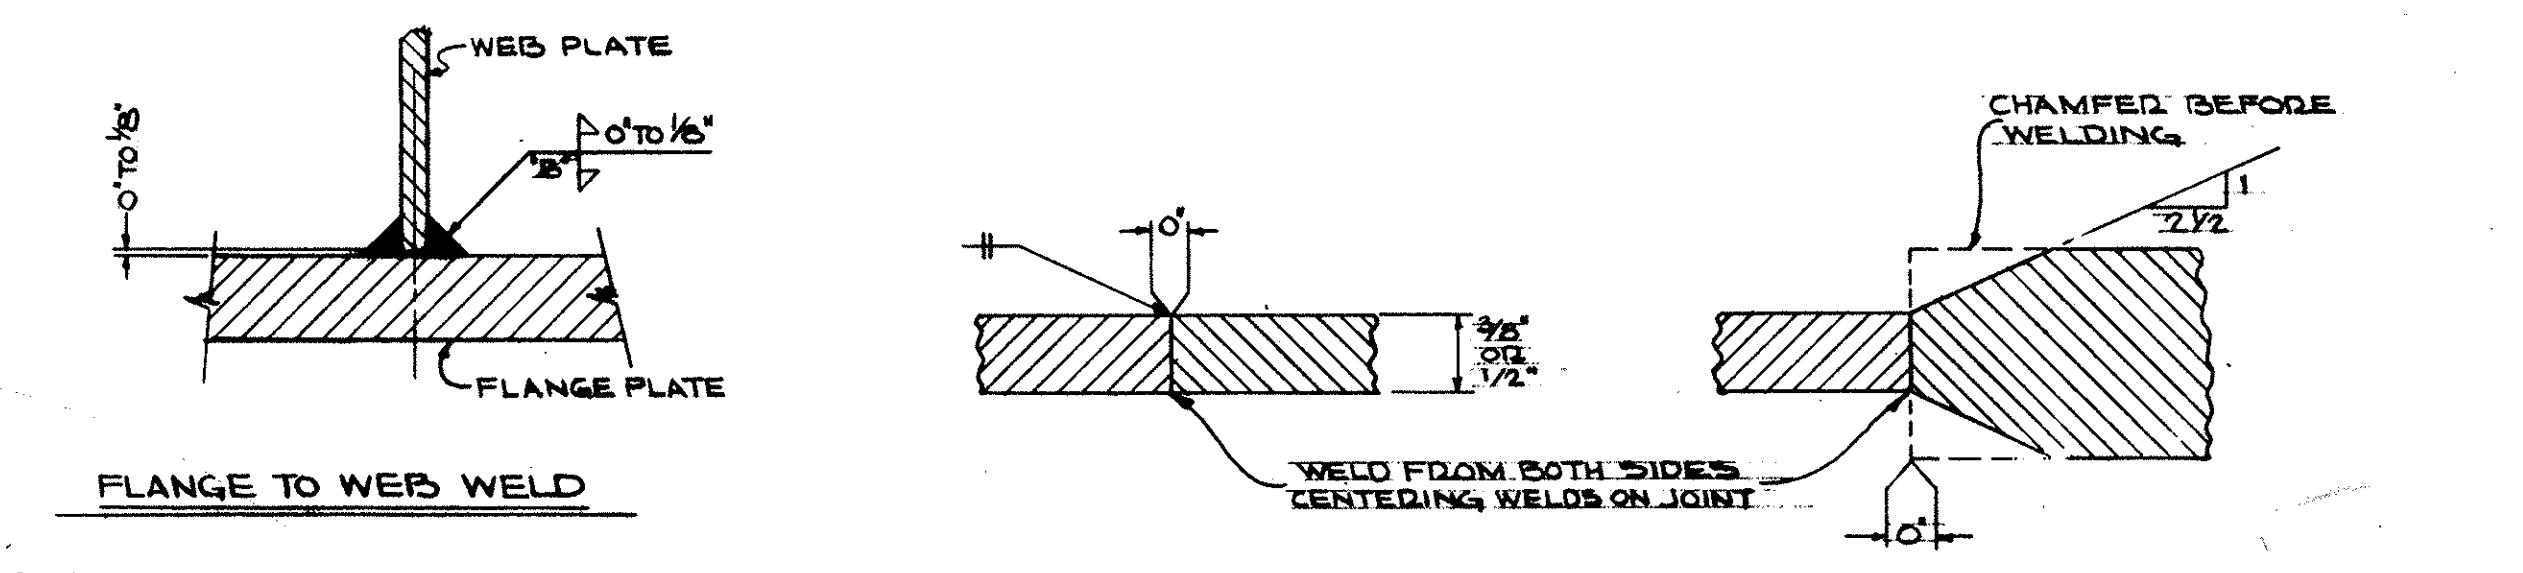


DIAGRAM FOR FIT & WELDING OF INTERMEDIATE STIFFENER PLATES TO GIRDER FLANGES




STATE OF OHIO DEPARTMENT OF HIGHWAYS BUREAU OF BRIDGES					
AKRON, OHIO					
GLAUS, PYLE & SCHOMER YOUNGSTOWN, OHIO					
WELD DETAILS					
BRIDGE N°		MAH-711-0116			
		OVER MAHONING RIVER			
		YOUNGSTOWN MAHONING COUNTY			
DESIGNED	DRAWN	TRACED	CHECKED	REVIEWED	DATE
D.A.H.	J.D.P.		R.W.	W.K.D.	6-22-68

MICROFILMED
JUN 19 1989



FED. RD.	STATE	PROJECT
2	OHIO	U.S.-1182 (1)

200
232

MAH-711-0.17

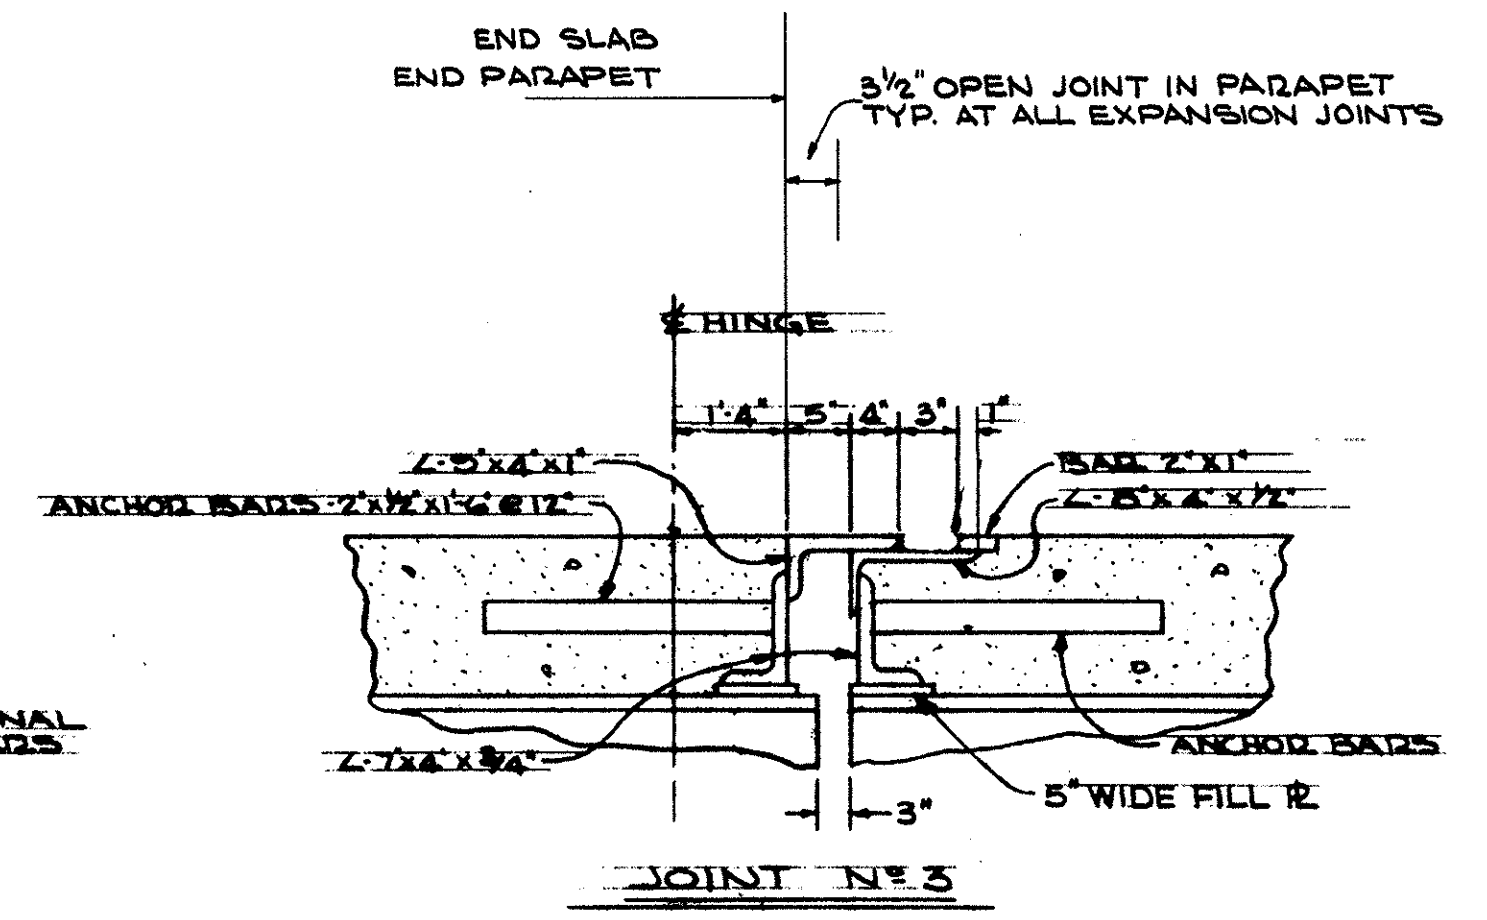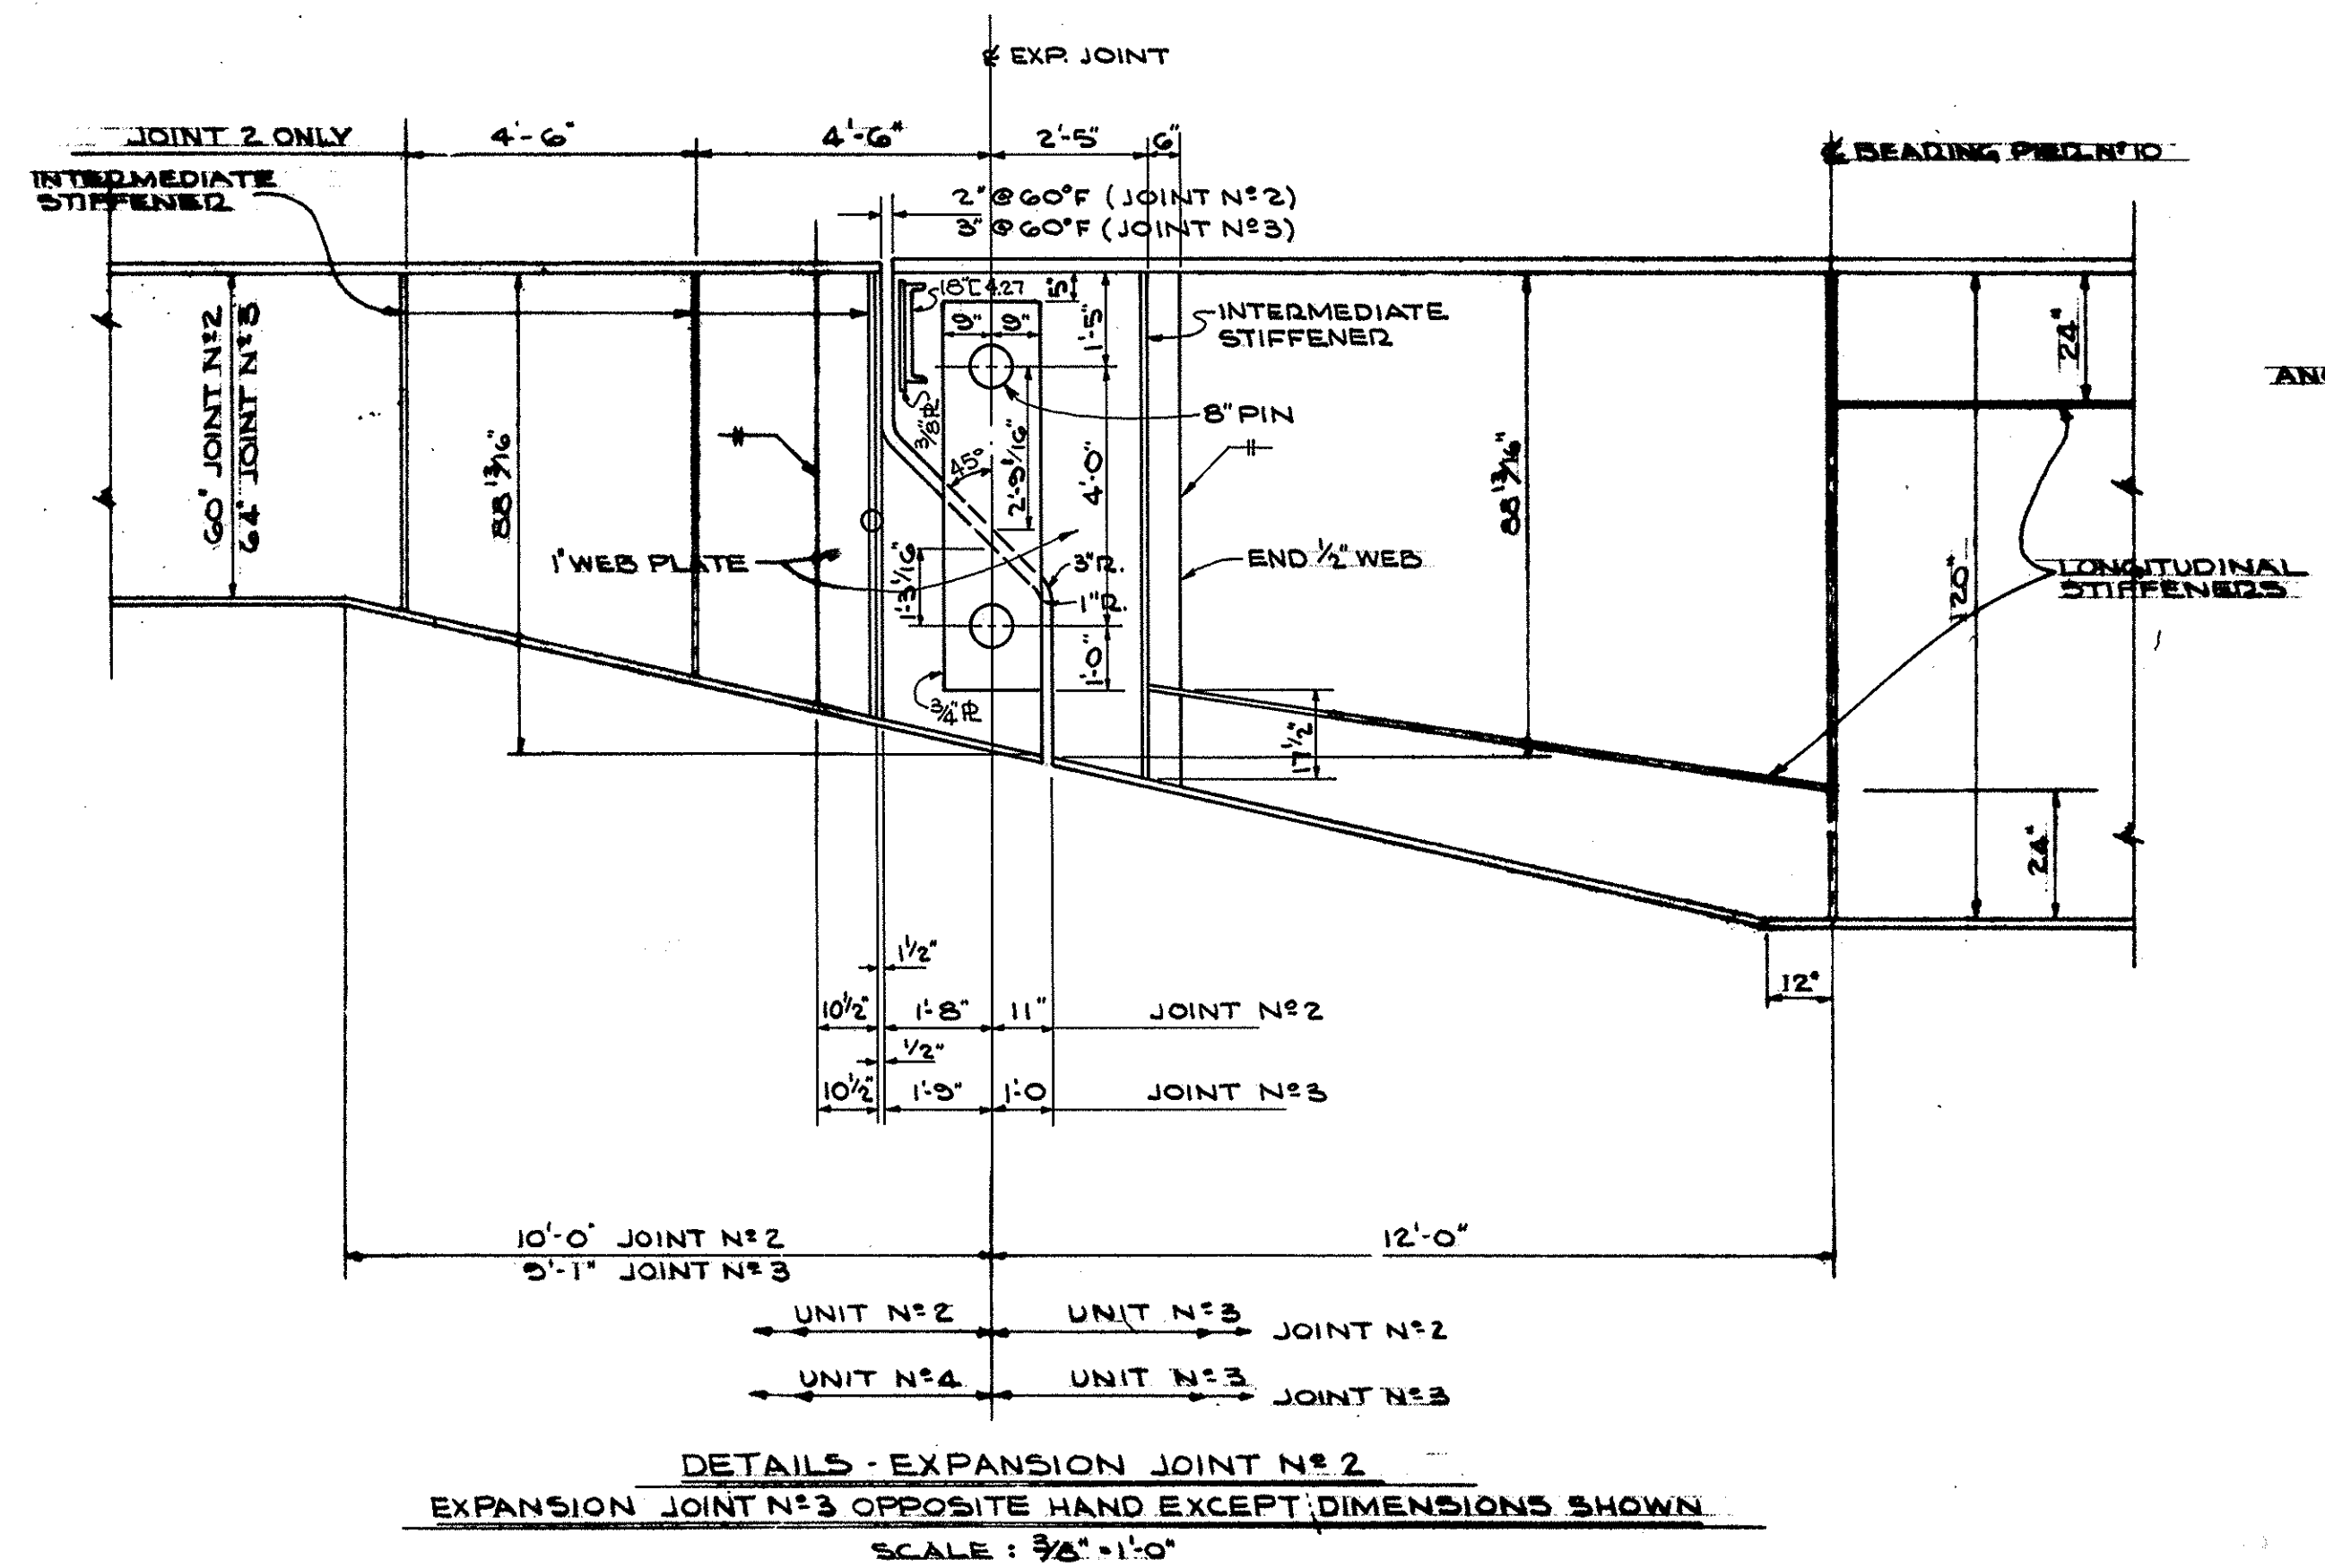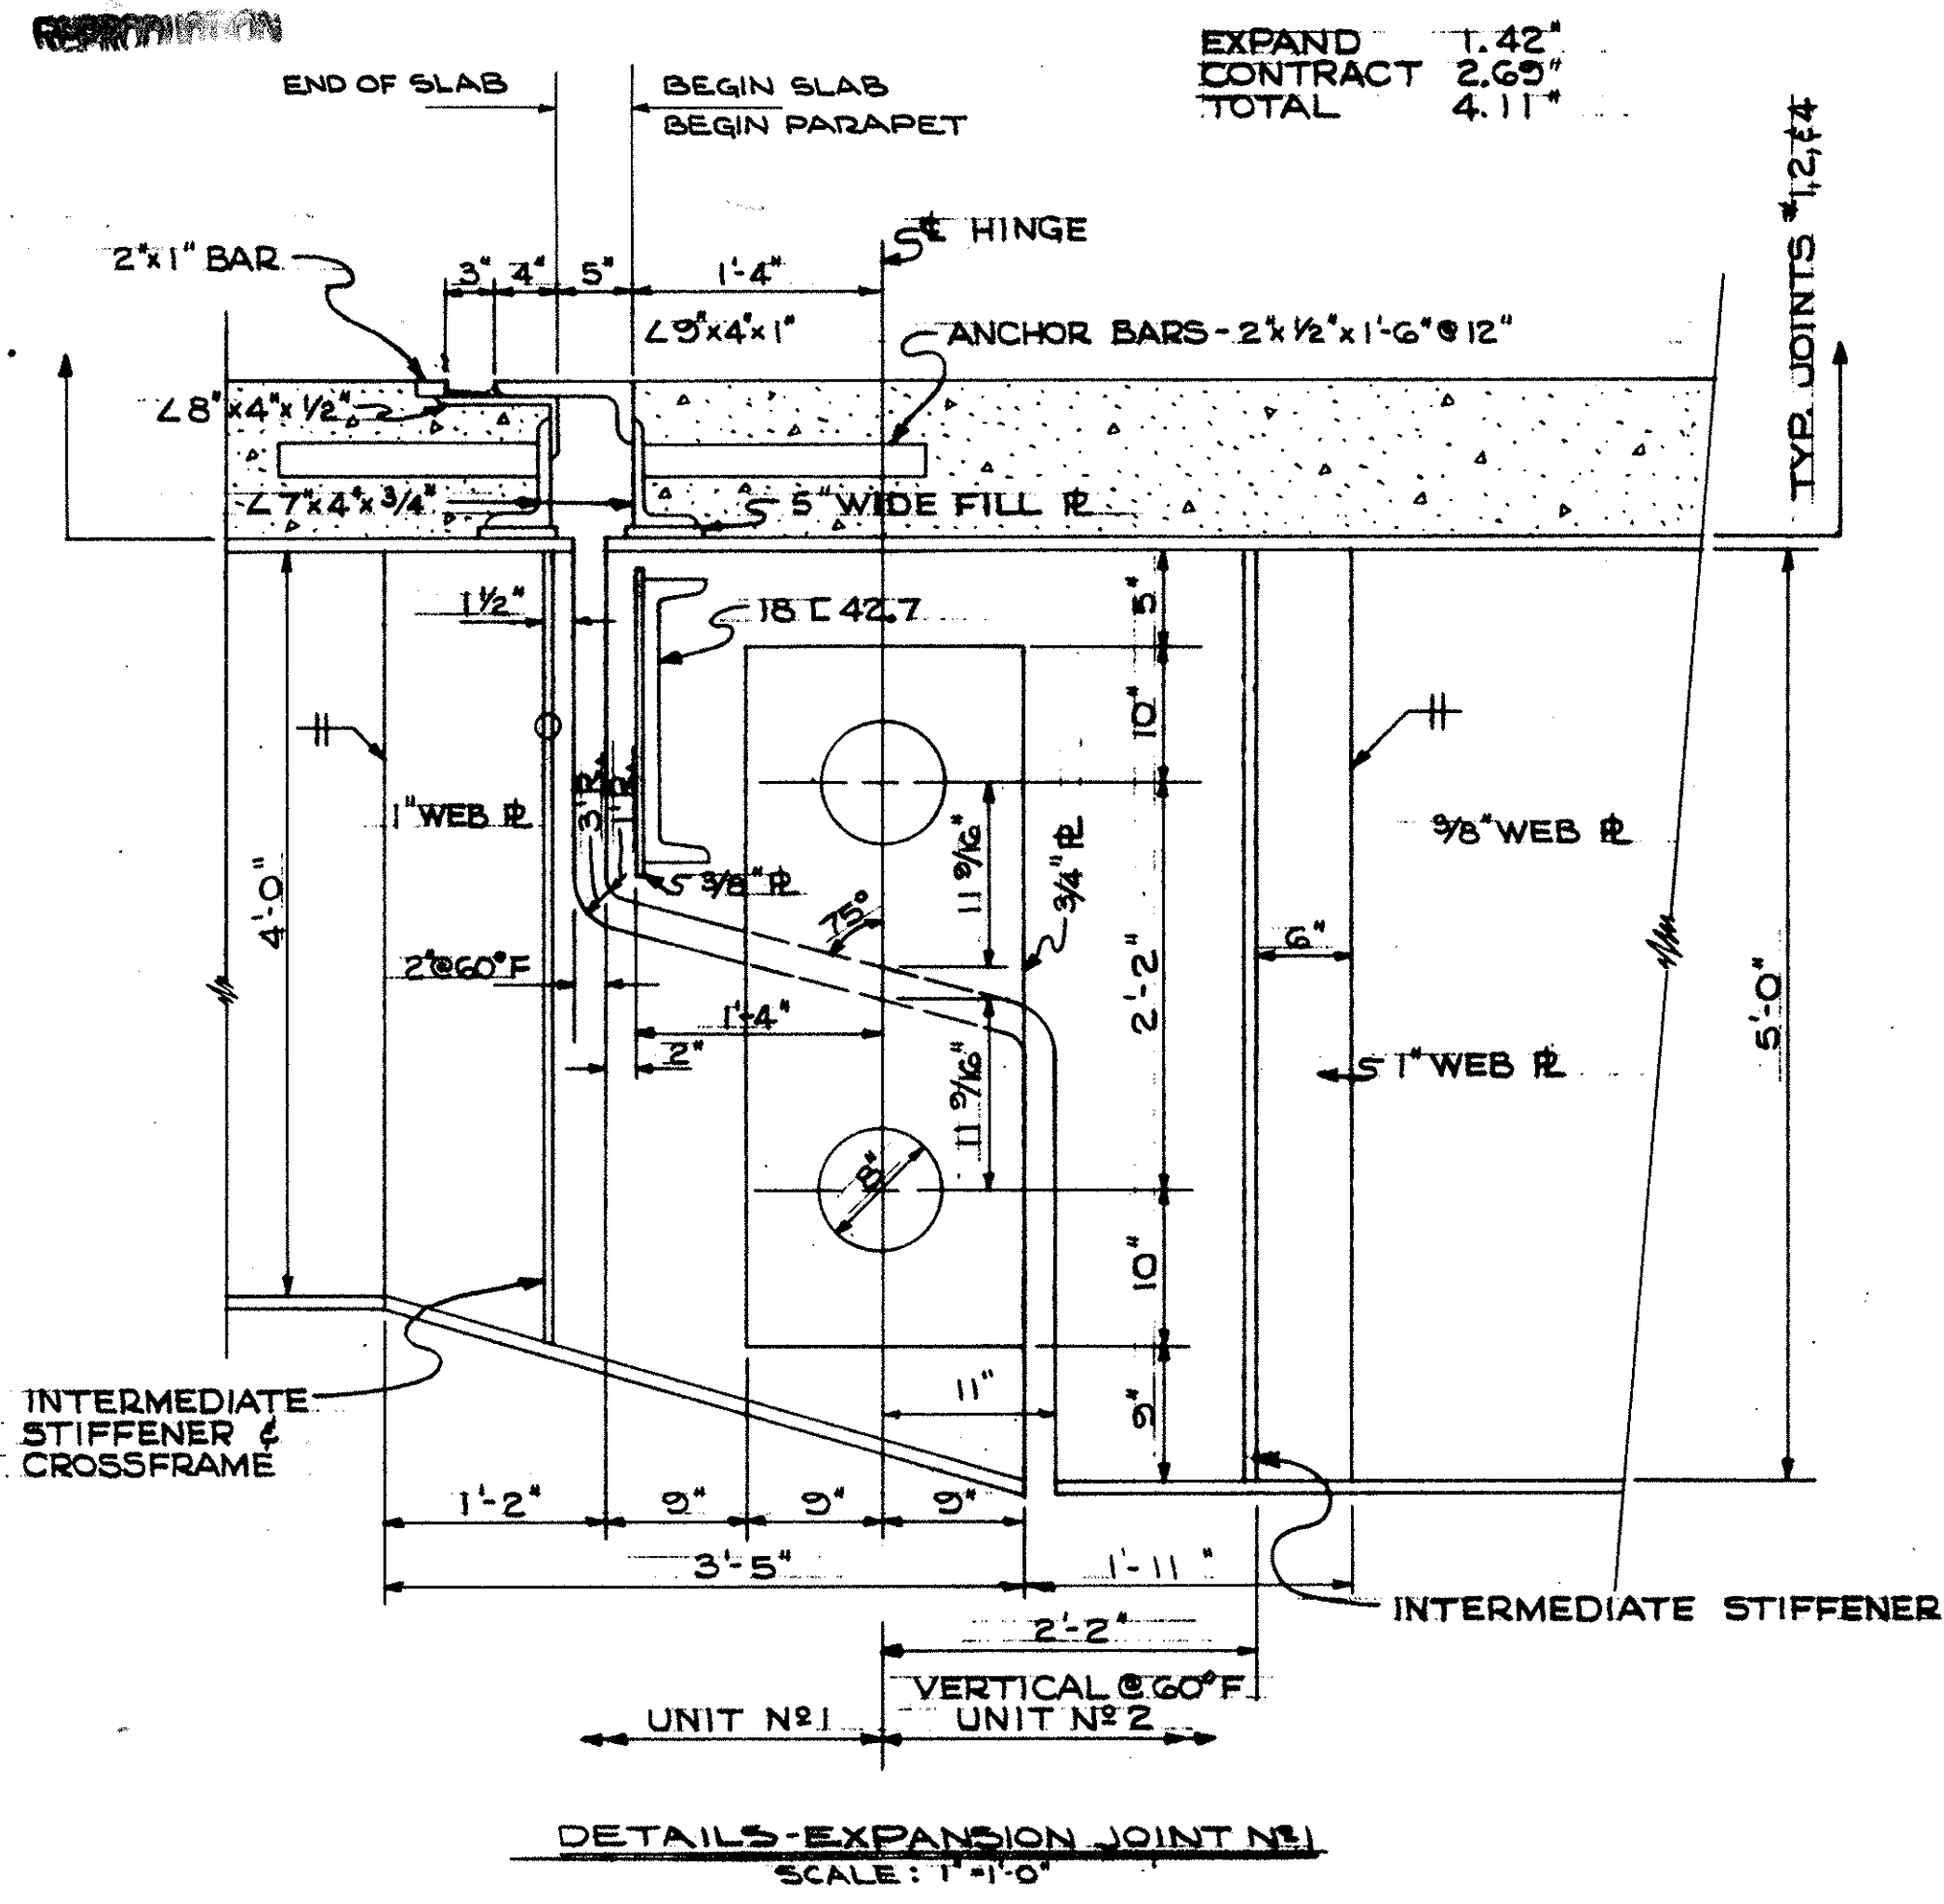


NOTE:
INNER FACE OF HINGE PLATES AND PORTIONS OF GIRDED COVERED BY HINGE PLATES SHALL BE PAINTED 2 COATS FINISH PAINT BEFORE ERECTION.

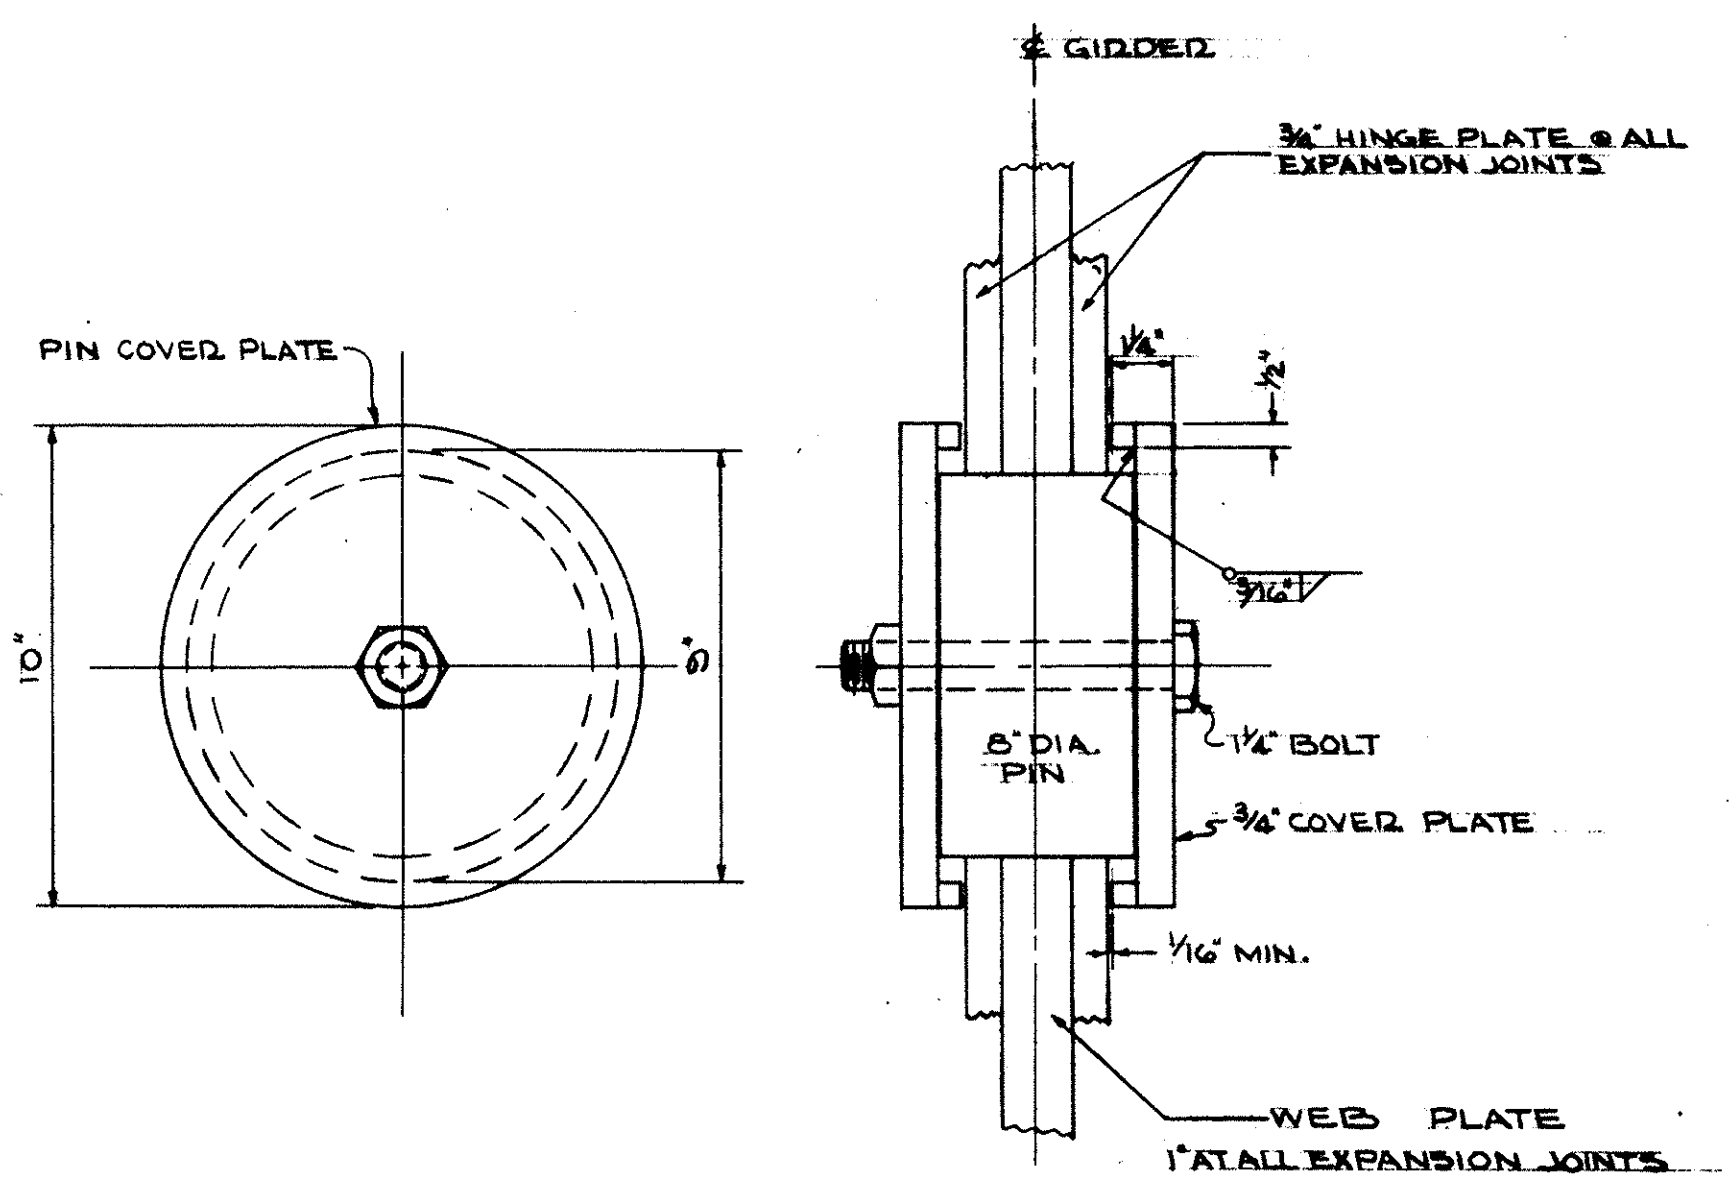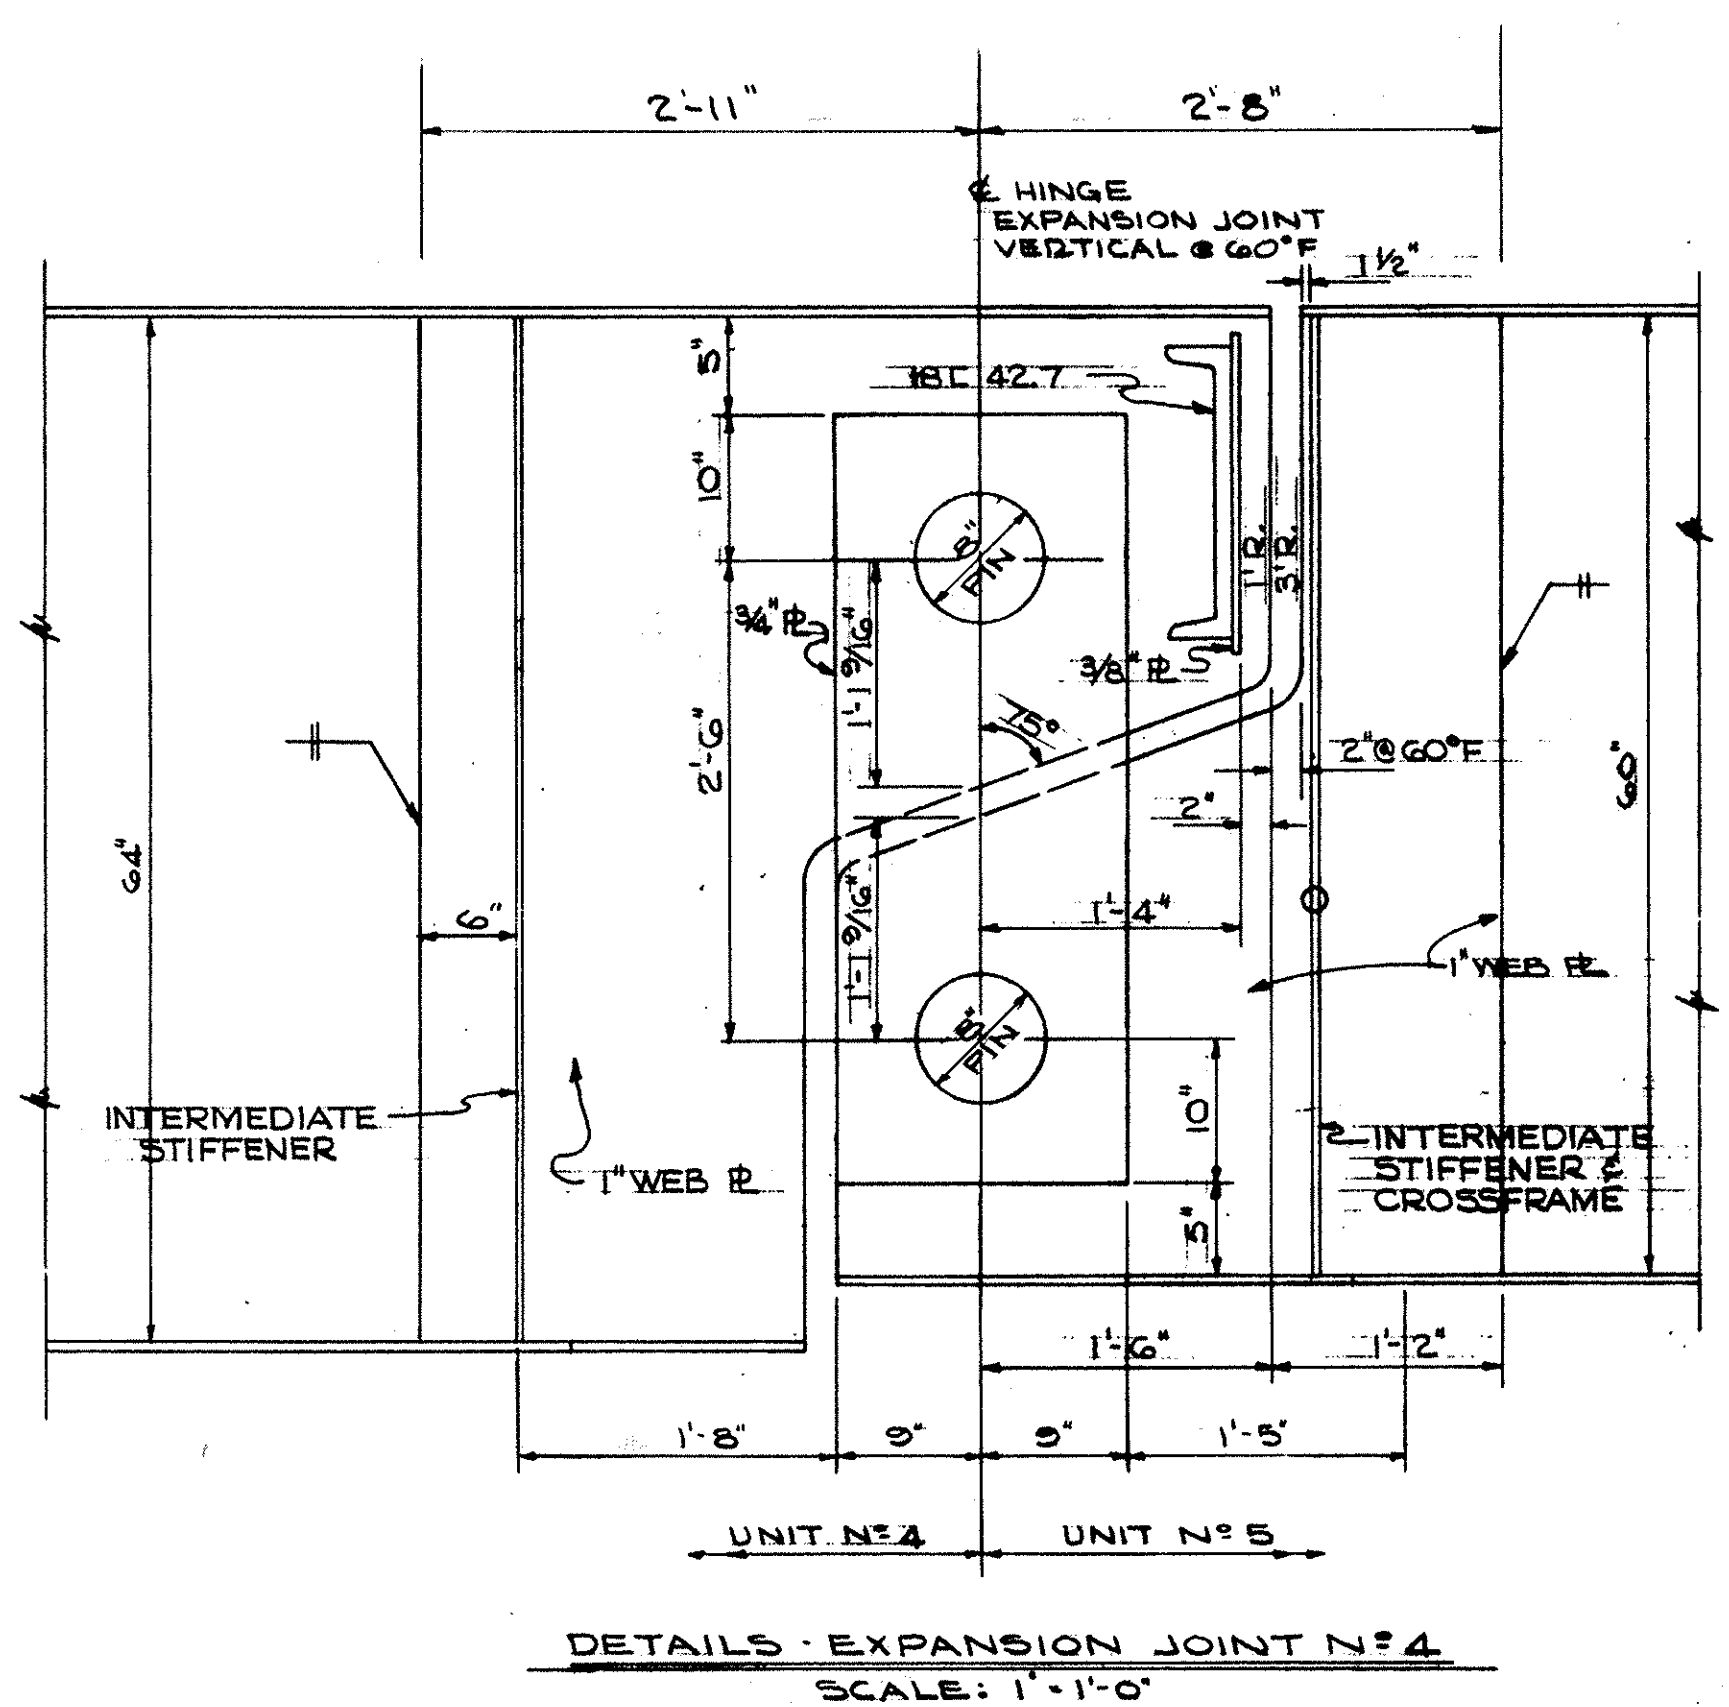


STATE OF OHIO DEPARTMENT OF HIGHWAYS BUREAU OF BRIDGES						
GLAUS, PYLE & SCHOMER AKRON, OHIO YOUNGSTOWN, OHIO						
HINGE DETAILS						
BRIDGE N° MAH-711-0116						
OVER MAHONING RIVER						
YOUNGSTOWN MAHONING COUNTY						
DESIGNED	DRAWN	TRACED	CHECKED	REVIEWED	DATE	REVISED
RH	J.D.P.		RH	W.K.D.	6-22-68	

NOT REPRODUCED
JUN 13 1969
REPRODUCTION

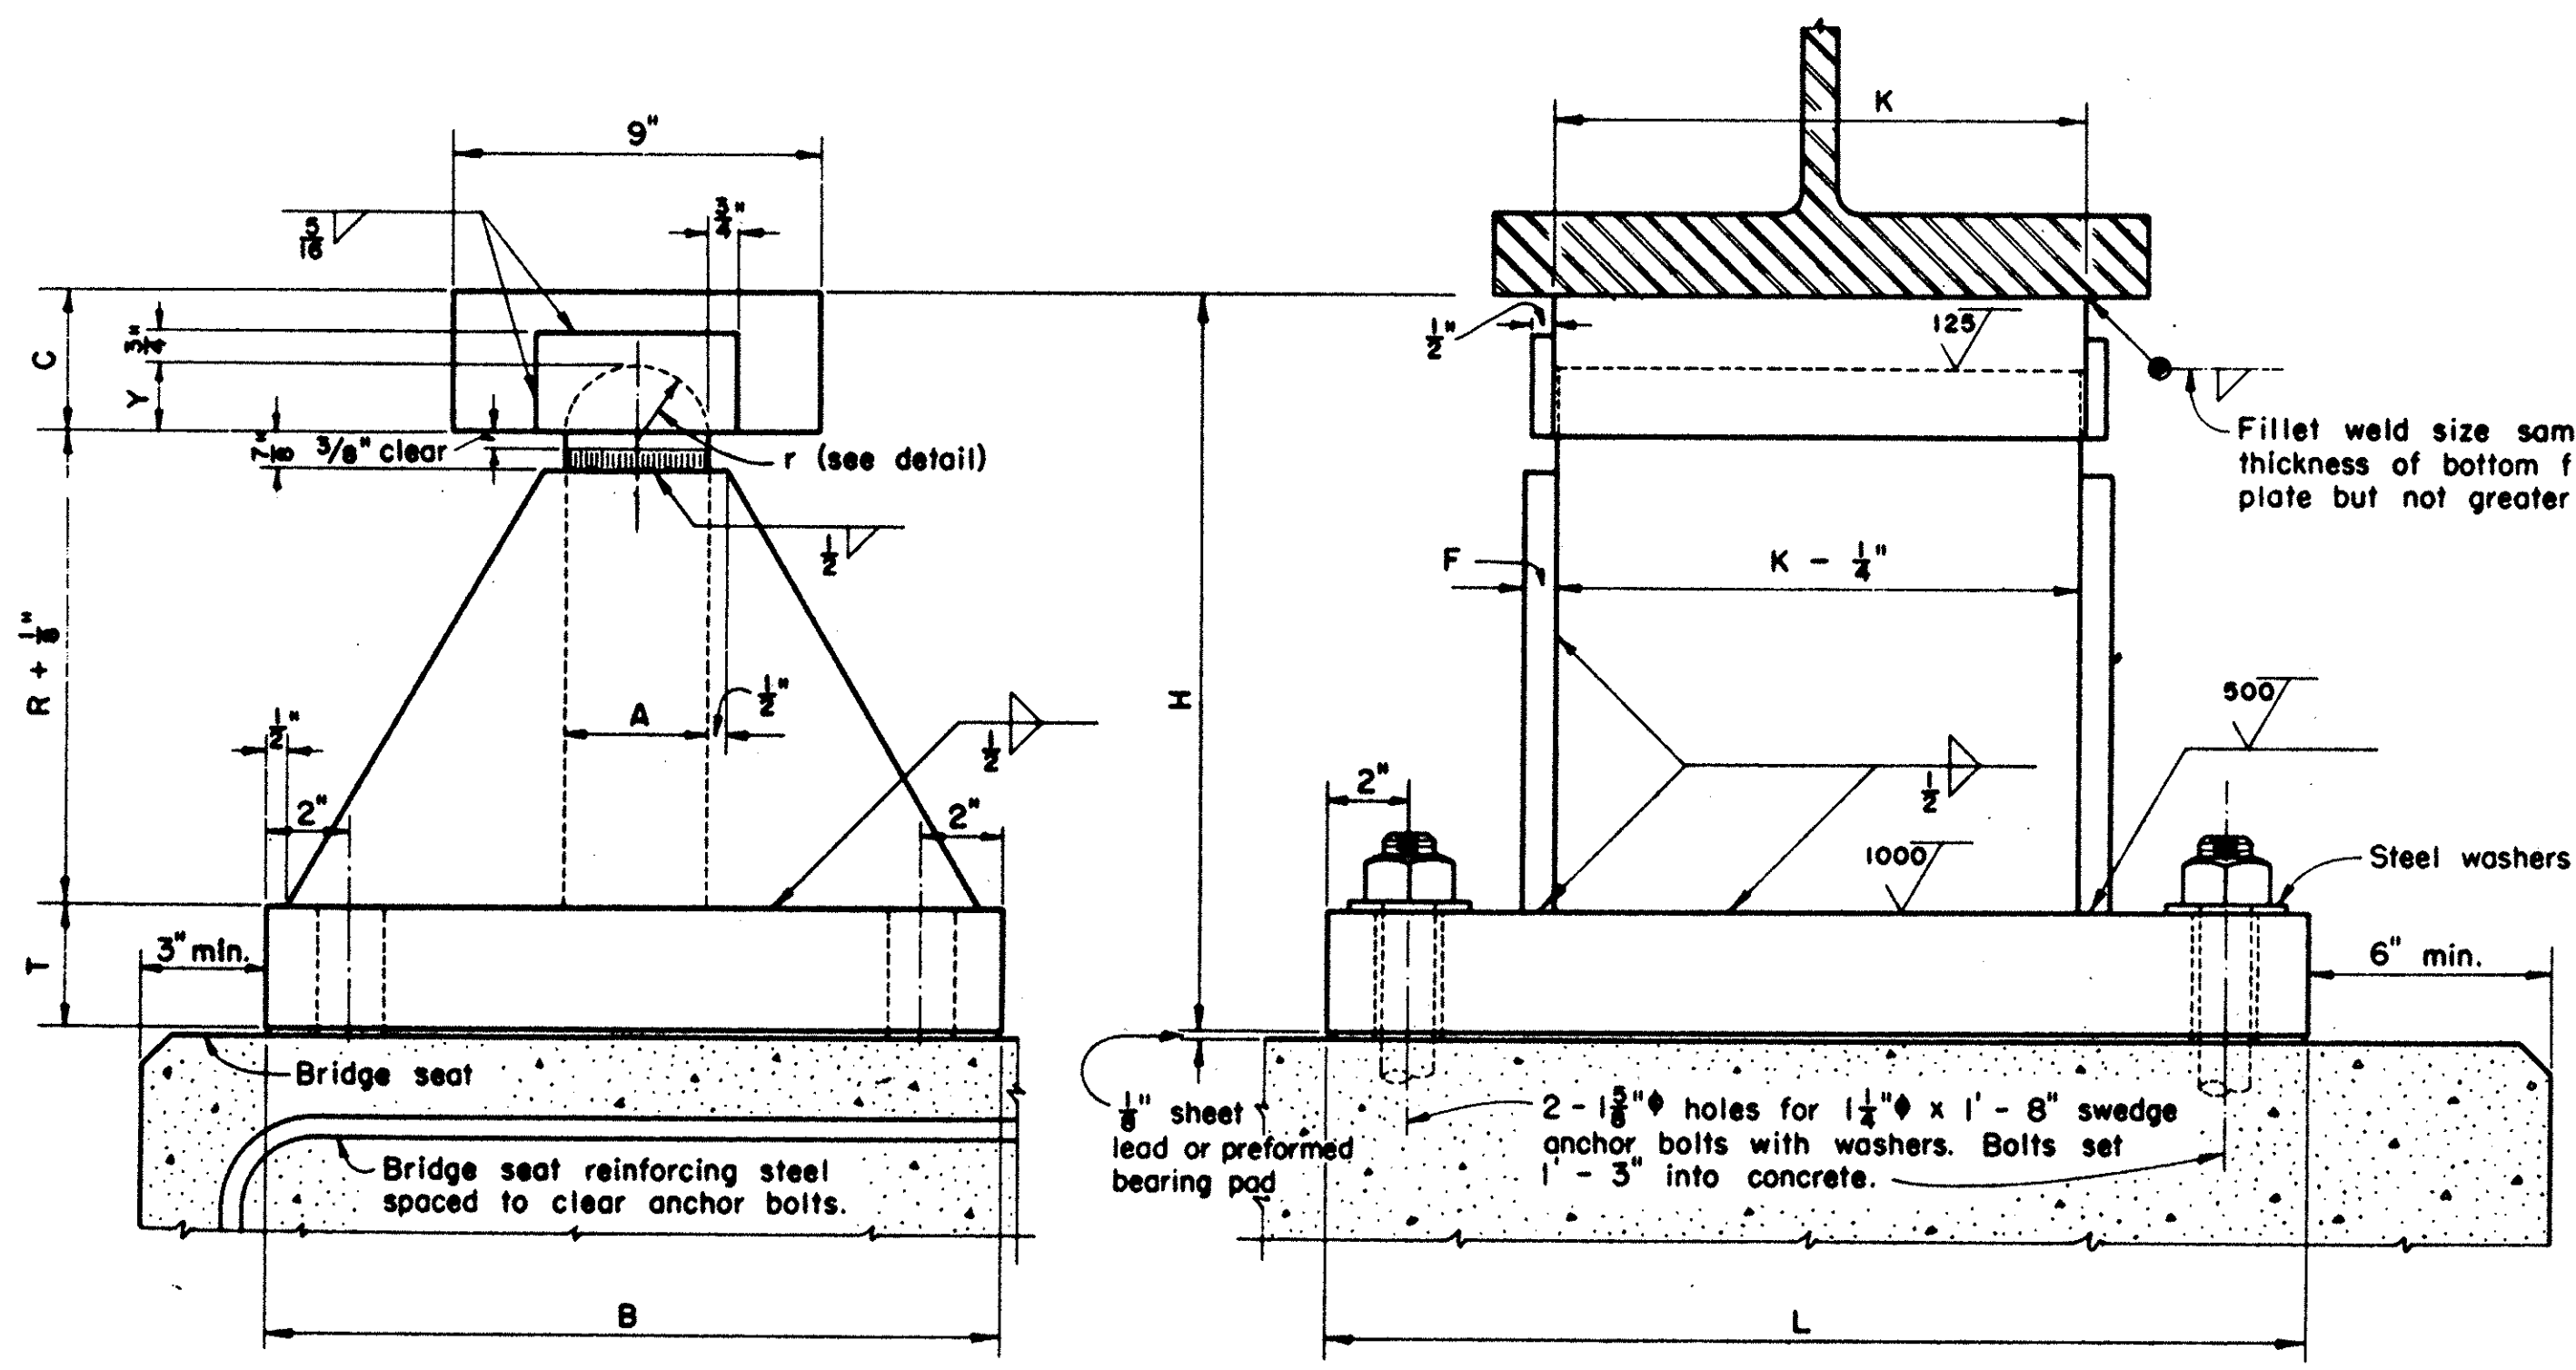


STRUCTURAL STEEL BOLSTER
See table below for additional dimensions.

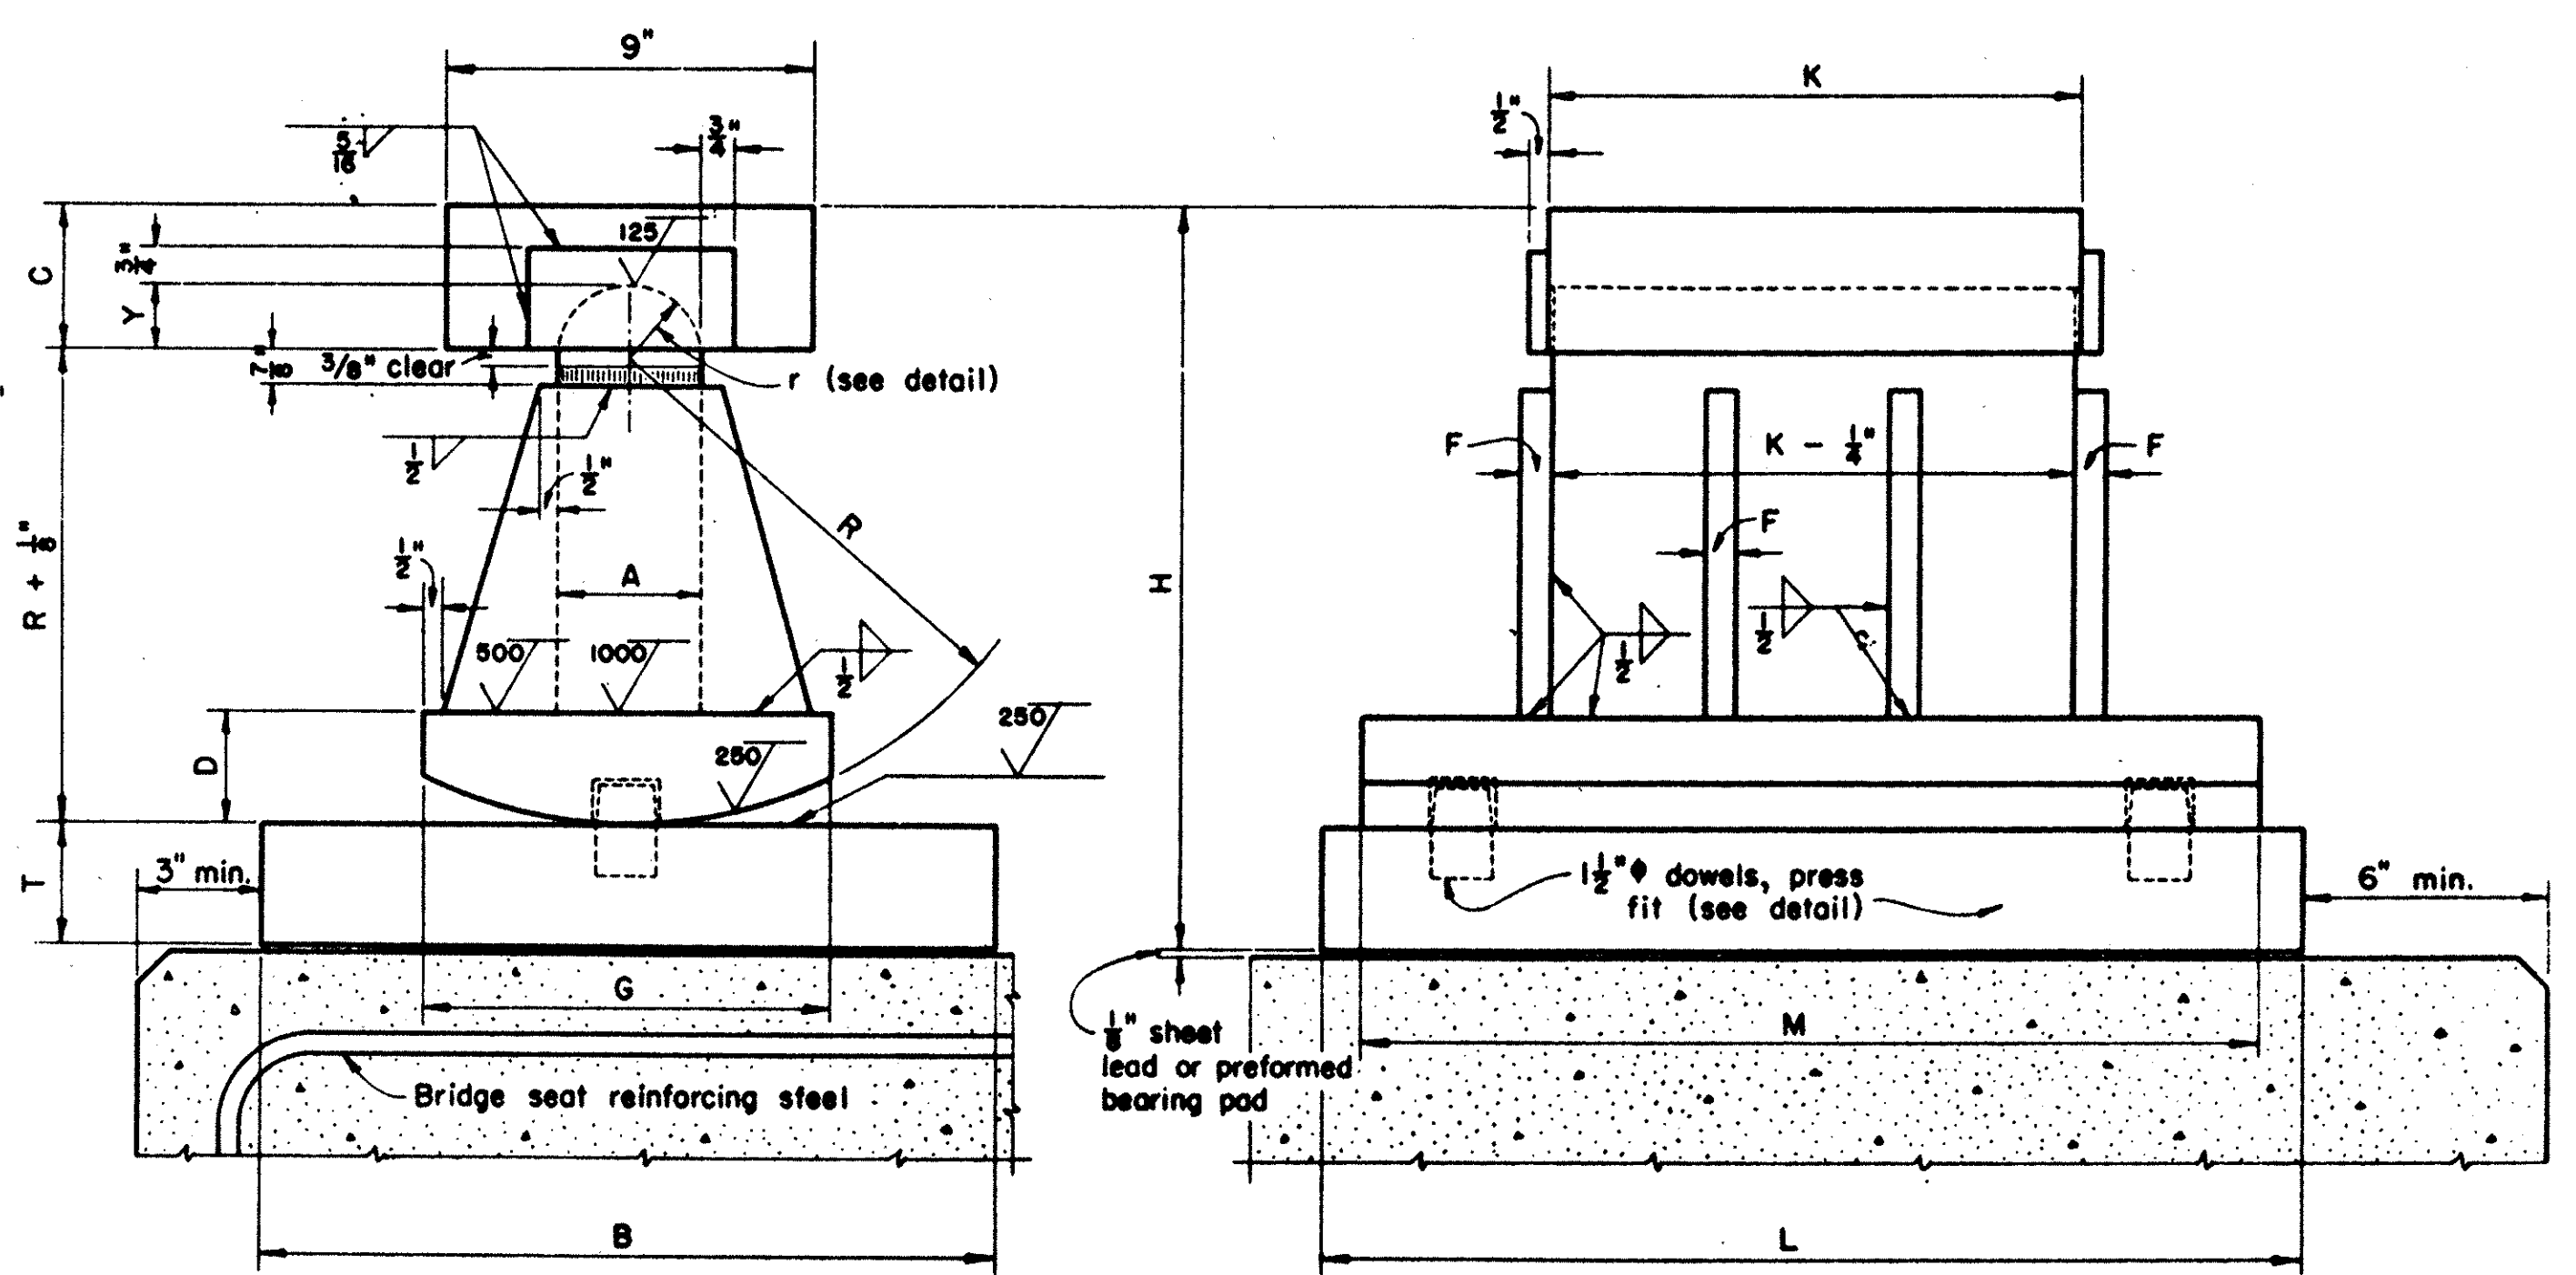


STRUCTURAL STEEL ROCKER
See table below for additional dimensions.

NR REQUIRED	NR REQUIRED	TYPE ROCKER	TYPE BOLSTER	DIMENSIONS (INCHES)													WEIGHT (LB)	
				A	B	C	D	F	G	H	K	L	M	R	T	Y	ROCKER	BOLSTER
4		R-75		2 1/2	8	2 1/2	1 3/4	1/2	7	9 1/2	9	15	16	5 1/2	1 1/2	3/16	205	
6		R-100	B-100	2 1/2	10	2 1/2	2	1/2	7 1/2	10 1/2	9	15	11	6 1/2	1 1/2	3/16	250	225
9		R-125		3	11	3	2	1/2	8	12 1/2	10 1/2	20	18	7 1/2	1 1/2	1/16	325	
12	2	R-175	B-175	3	14	3 1/2	2 1/2	1/2	9	15 1/2	12	23	20	9 1/2	2	1/16	505	455
14	2	R-200	B-200	3	16	3 1/2	2 1/2	1/2	9	16 1/2	12	24	21	10 1/2	2 1/2	1/16	605	540
12	6	R-225	B-225	3	17	3 1/2	2 1/2	1/2	9	16 1/2	13	25	22	11	2 1/2	1/16	665	590
21	4	R-250	B-250	3 1/2	18	3 1/2	2 1/2	1/2	10	17 1/2	13	26	23	11 1/2	2 1/2	1/16	775	695
16	4	R-275	B-275	3 1/2	19	3 1/2	3 1/4	3/4	12	18 1/2	14	27	24	12	2 3/4	1/16	945	800
15	16	R-300	B-300	3 1/2	20	3 1/2	3 1/4	3/4	12	19 1/2	14	28	25	12 1/2	3	1/16	1050	895
6	5	R-350	B-350	3 1/2	22	4	3 1/2	3/4	14	21 1/2	20	30	27	14	3 1/2	1/16	1325	1225
	1		B-350 SPECIAL	3 1/2	22	4	3 1/2	3/4	14	21 1/2	20	30	27	14	3 3/4	1/16		1230
8	8	R-600	B-600	4	24	4	3 3/4	1-1/4	16	28-1/8	1-1/4	38	34	20	4	1-15/16	2163	1728

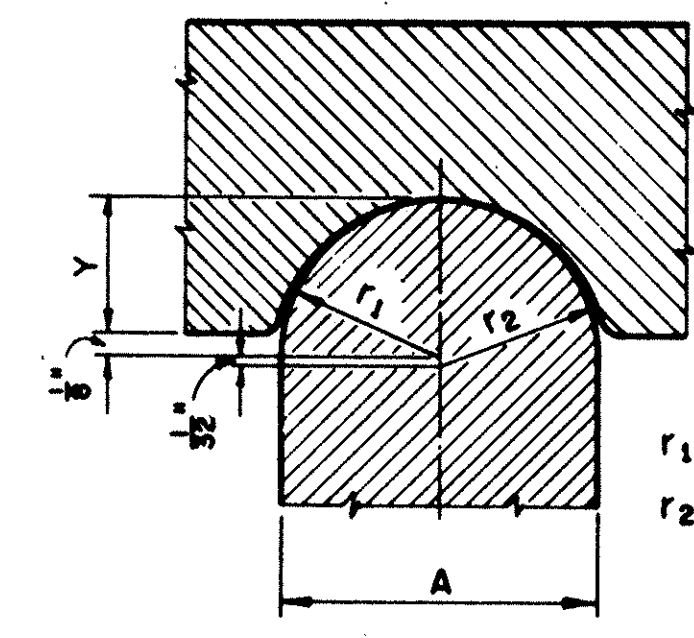

TOP BEARING DETAIL

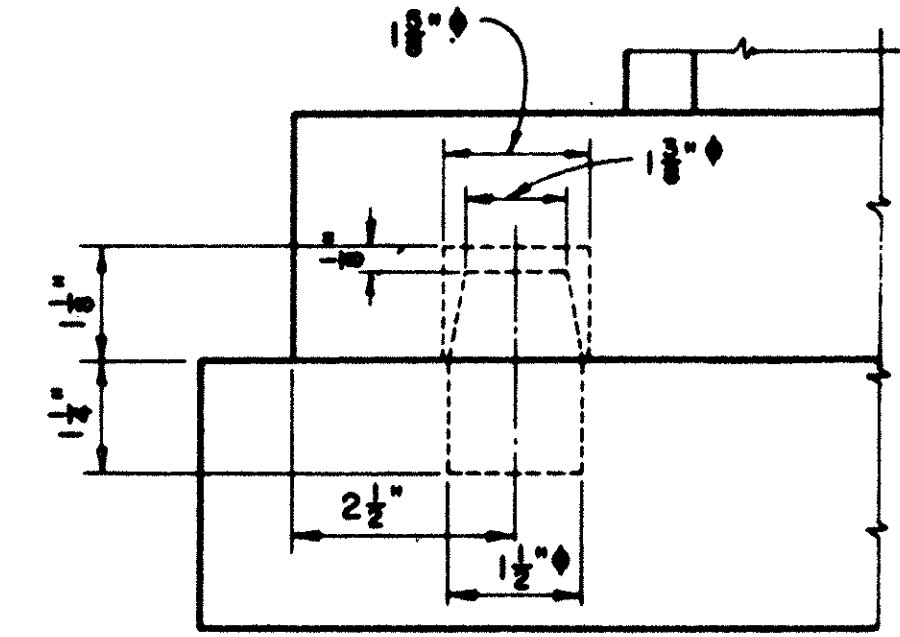

DOWEL DETAIL

USE A441 STRUCTURAL STEEL FOR R-600 AND B-600

STATE OF OHIO
DEPARTMENT OF HIGHWAYS
BUREAU OF BRIDGES


AXLSON, OHIO YOUNGSTOWN, OHIO

CLAUS, PYLE & SCHOMER

ROCKER & BOLSTER
BRIDGE N^o MAH-711-0116
OVER MAHONING RIVER
YOUNGSTOWN MAHONING COUNTY


DESIGNED	DRAWN	TRACED	CHECKED	REVIEWED	DATE	REVISED
LT	JP		RH	WKD	6-22-68	

MAHONING
JUN 1969
REVISION

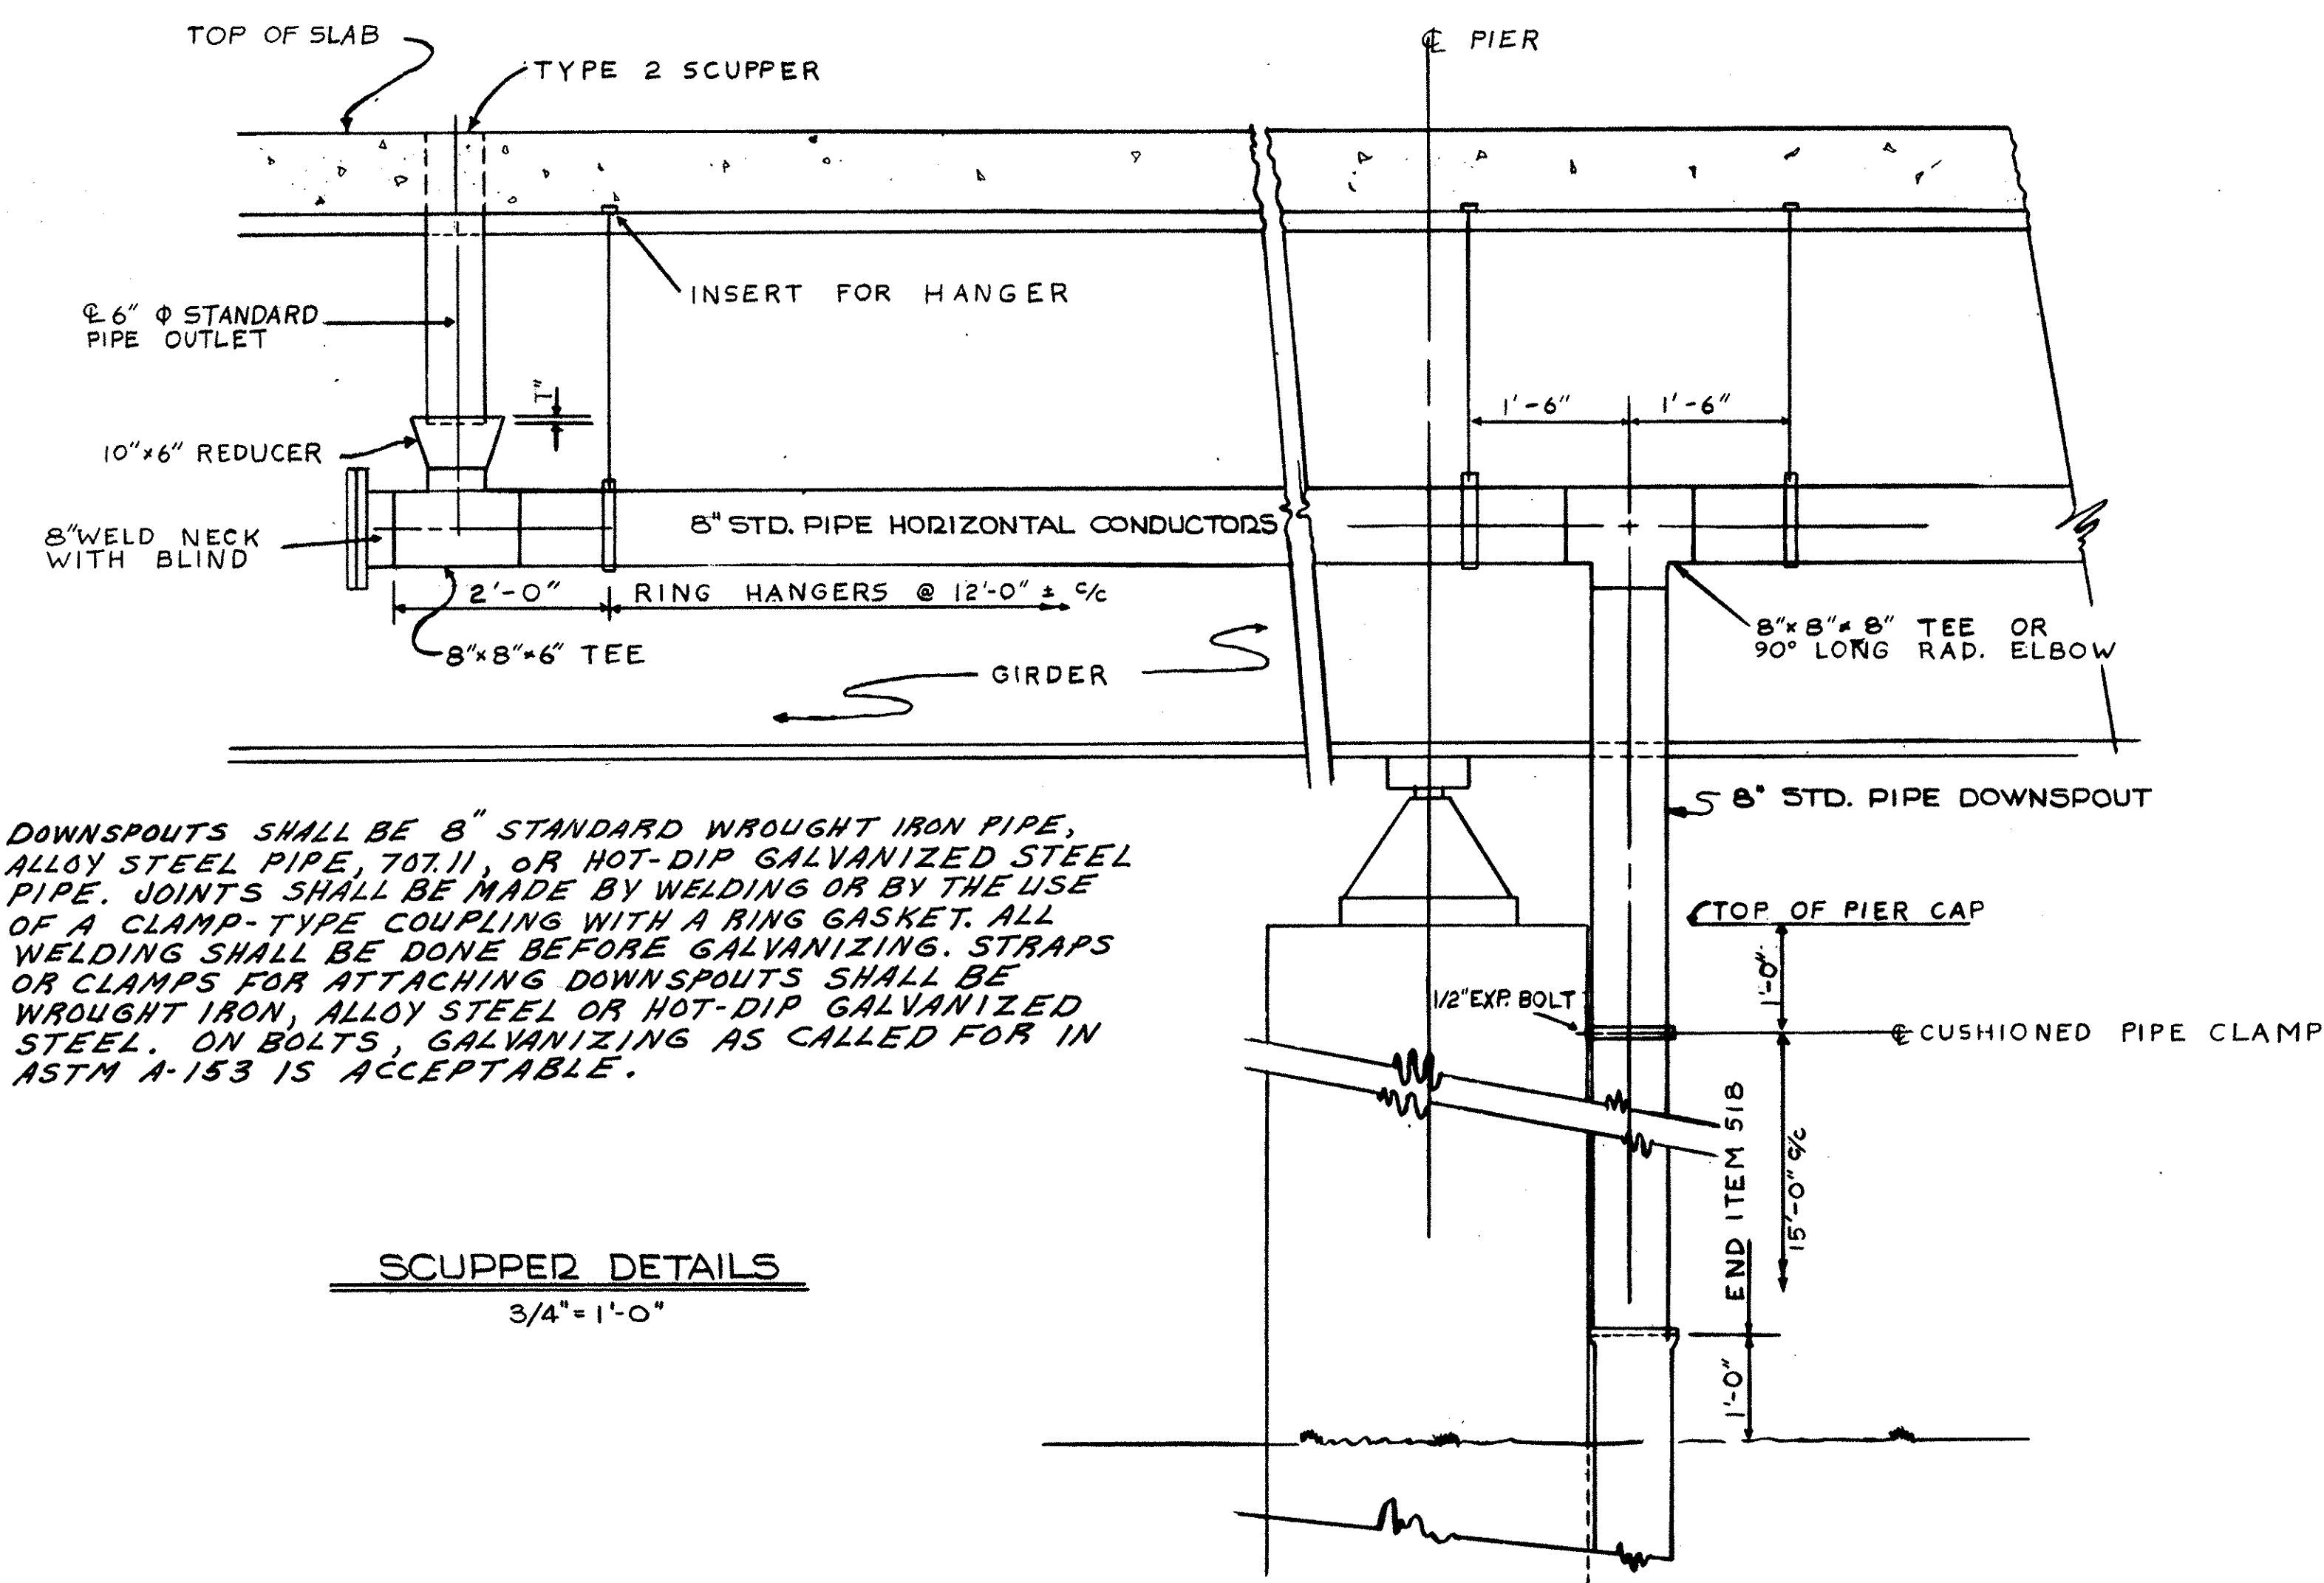


DOWNSPOUTS SHALL BE 8" STANDARD WROUGHT IRON PIPE, ALLOY STEEL PIPE, 70711, OR HOT-DIP GALVANIZED STEEL PIPE. JOINTS SHALL BE MADE BY WELDING OR BY THE USE OF A CLAMP-TYPE COUPLING WITH A RING GASKET. ALL WELDING SHALL BE DONE BEFORE GALVANIZING. STRAPS OR CLAMPS FOR ATTACHING DOWNSPOUTS SHALL BE WROUGHT IRON, ALLOY STEEL OR HOT-DIP GALVANIZED STEEL. ON BOLTS, GALVANIZING AS CALLED FOR IN ASTM A-153 IS ACCEPTABLE.


SCUPPER DETAILS
3/4" = 1'-0"

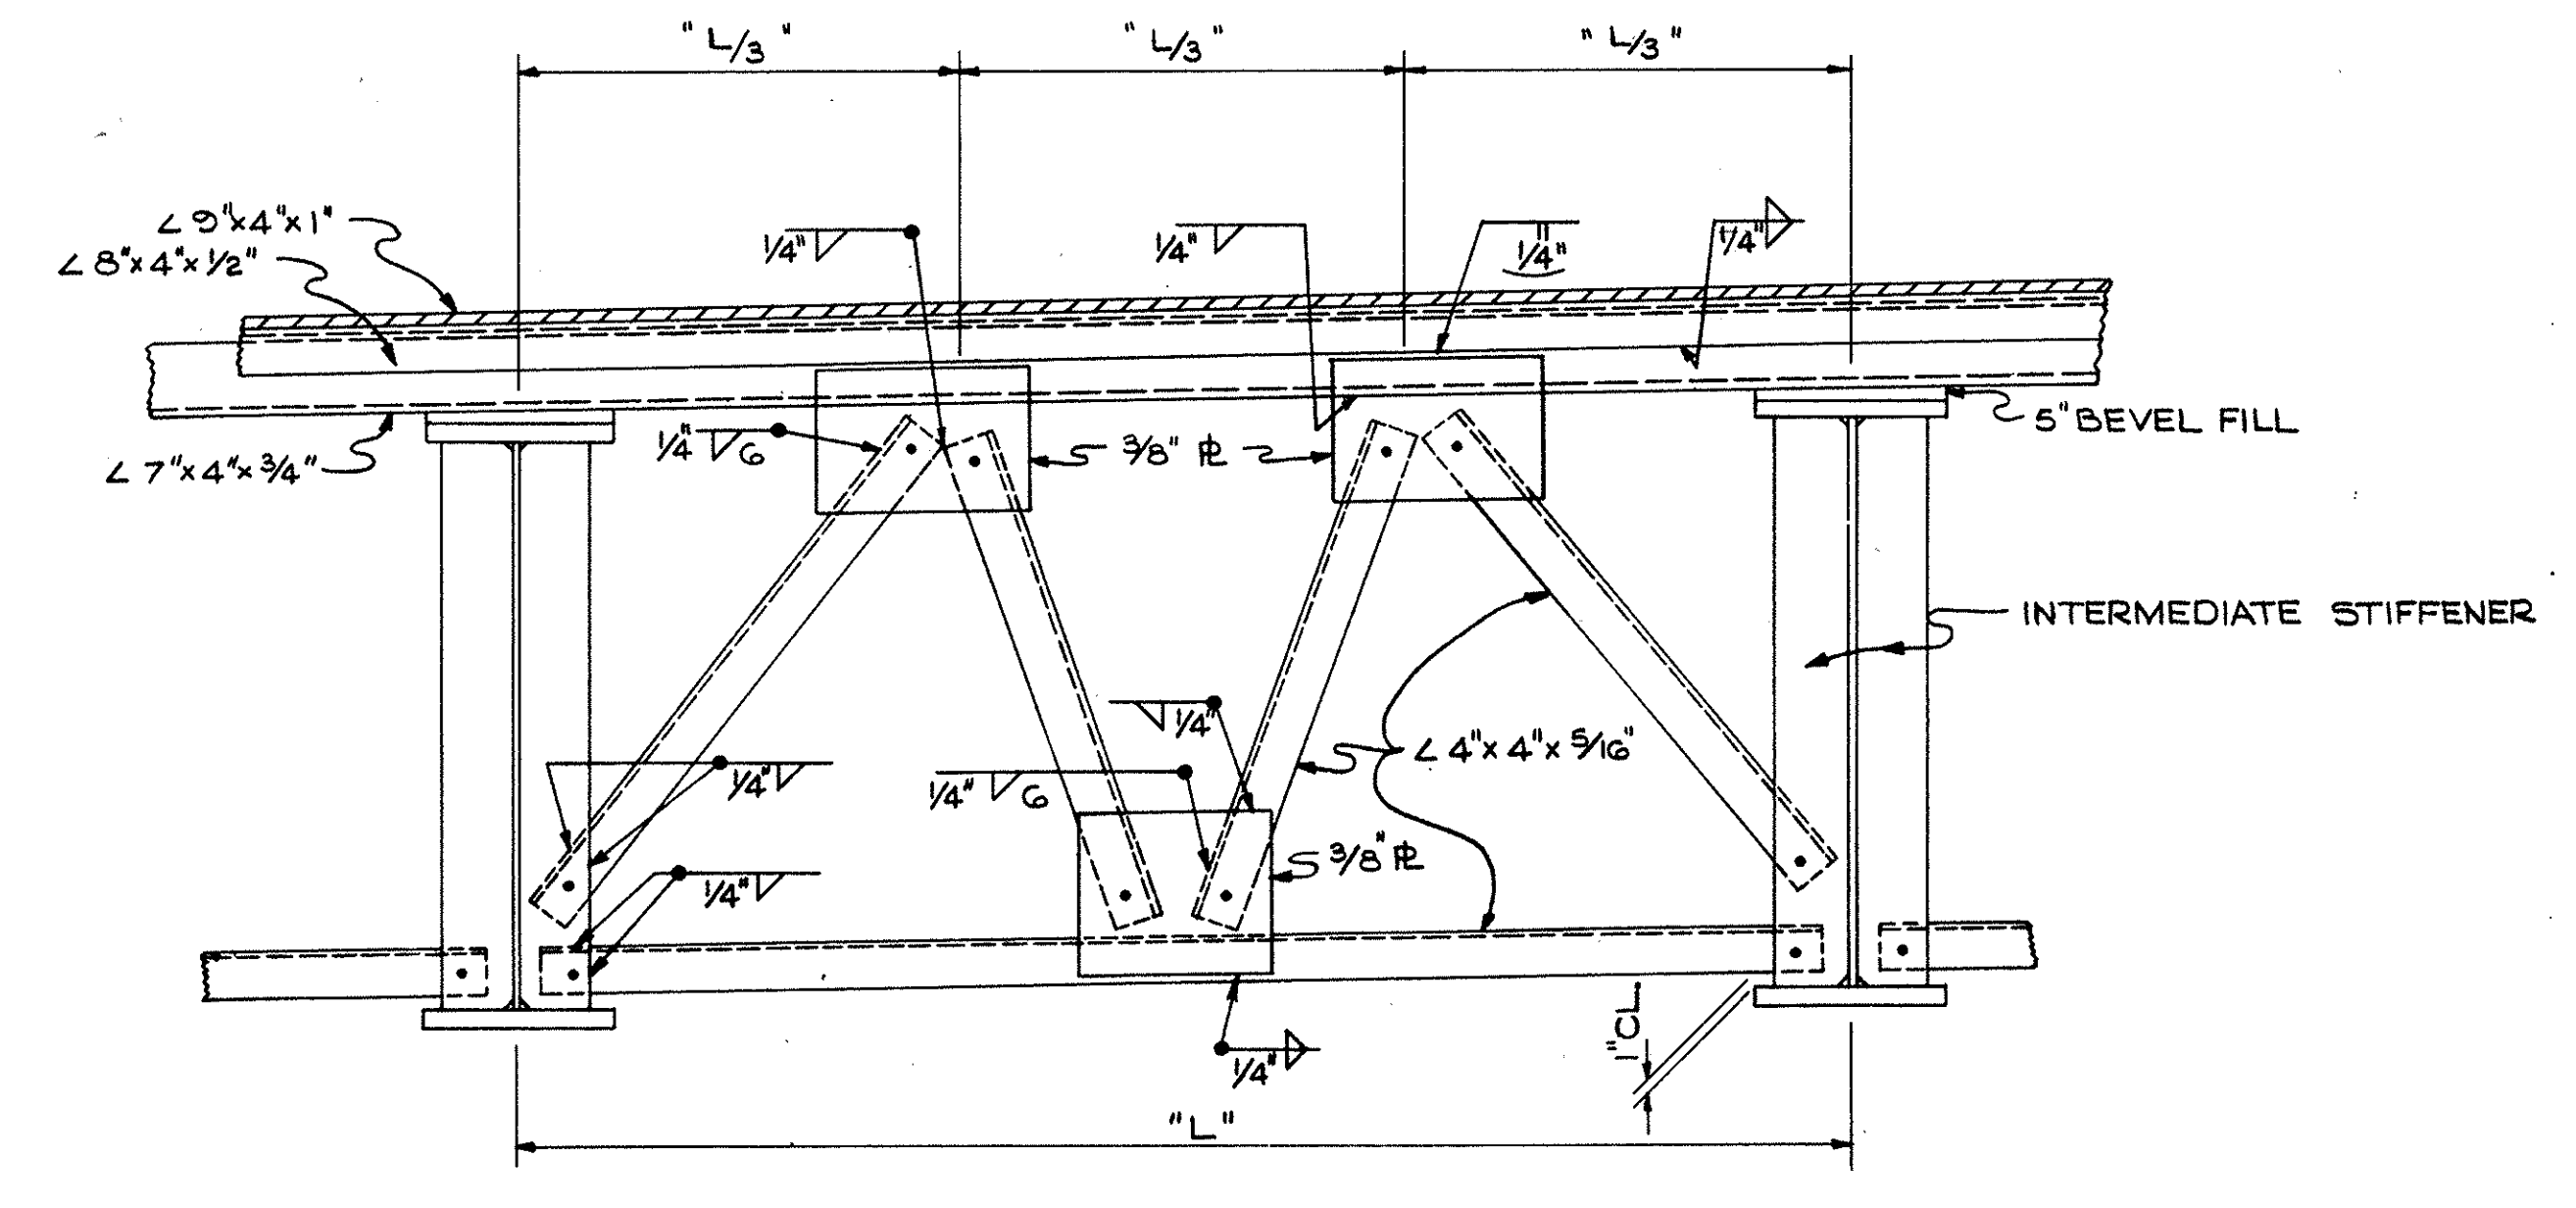


HINGE CROSSFRAME (TYPE-1)
3/4" = 1'-0"

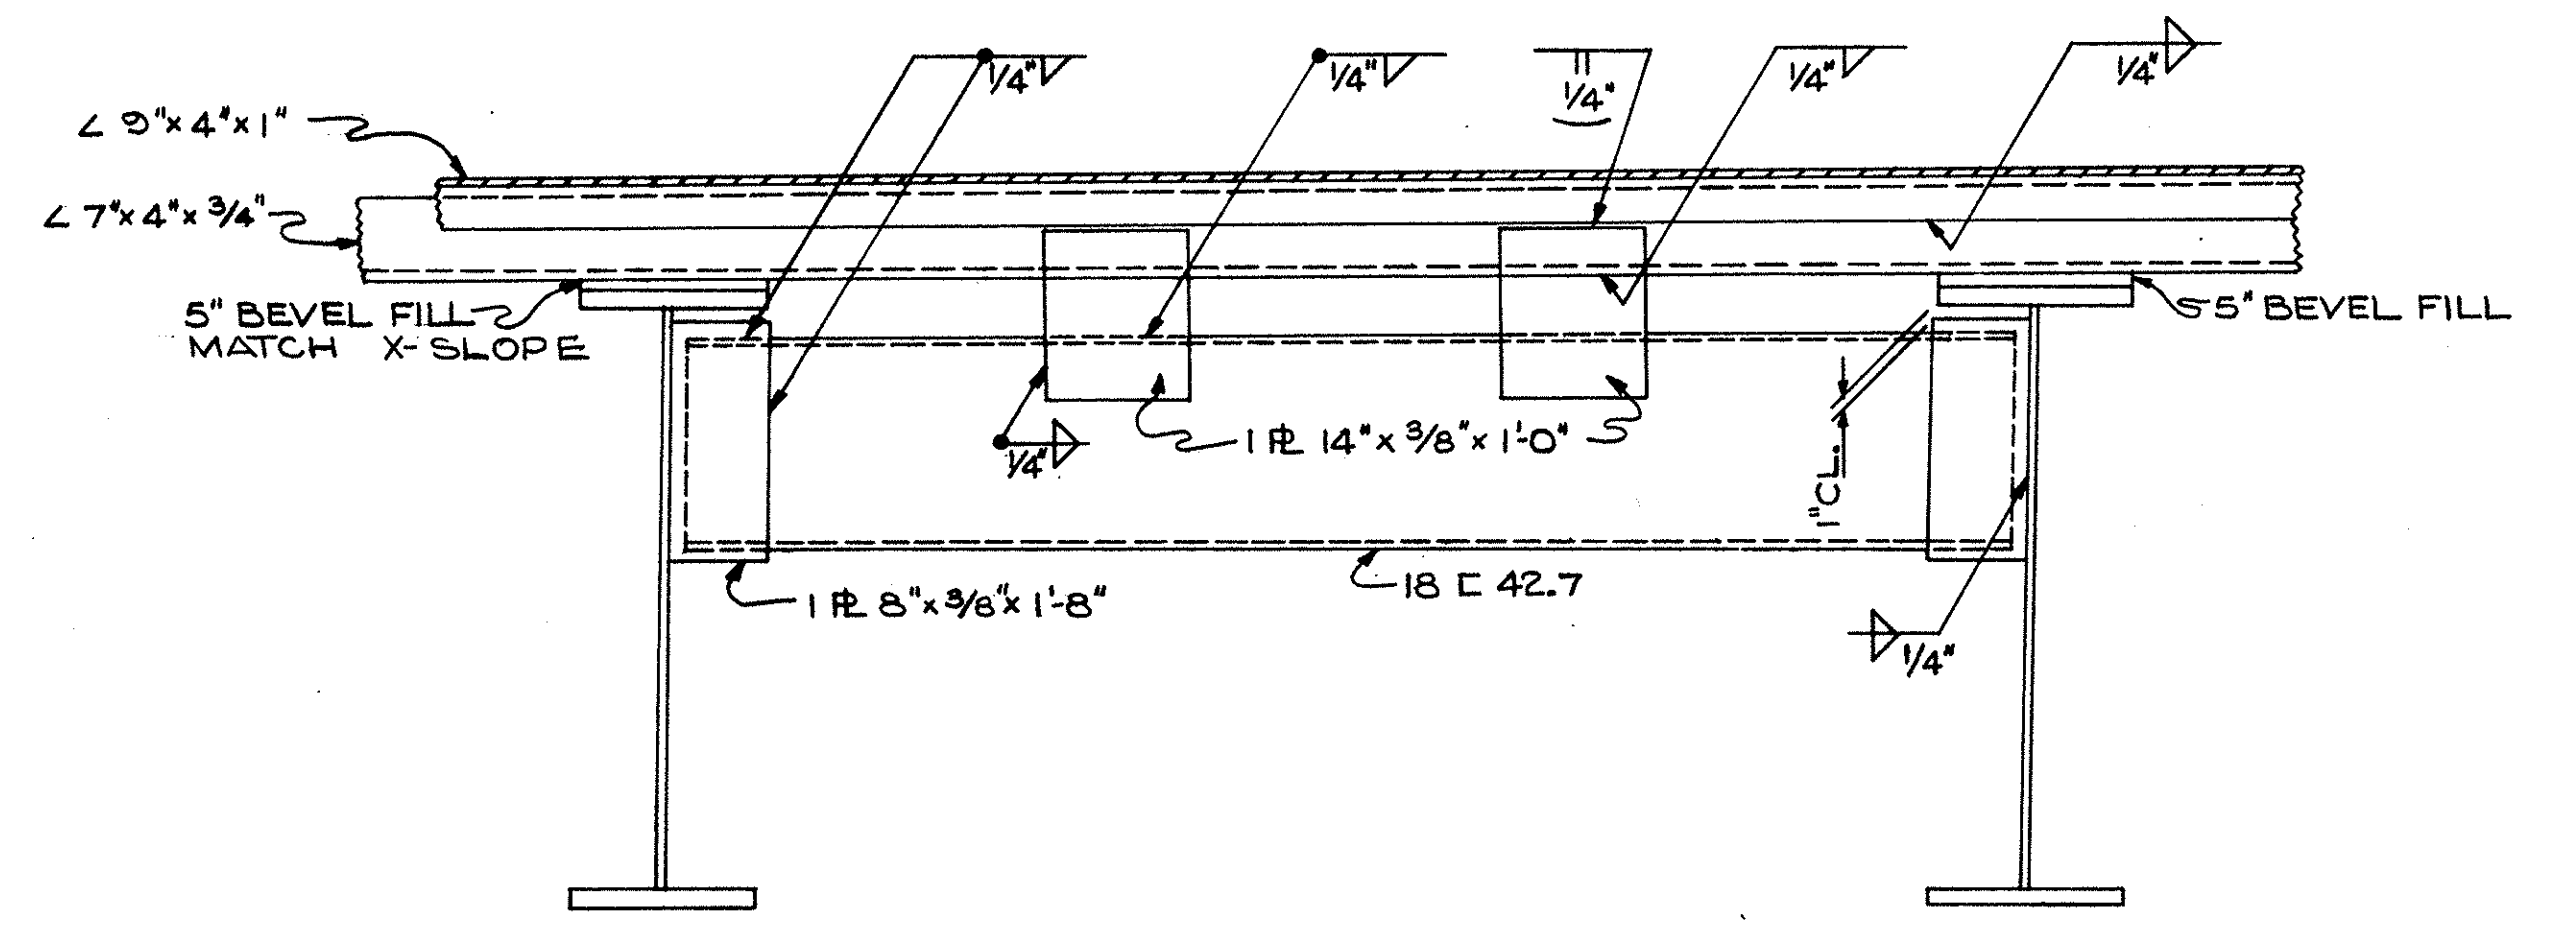

HINGE CROSSFRAME (TYPE-2)
3/4" = 1'-0"

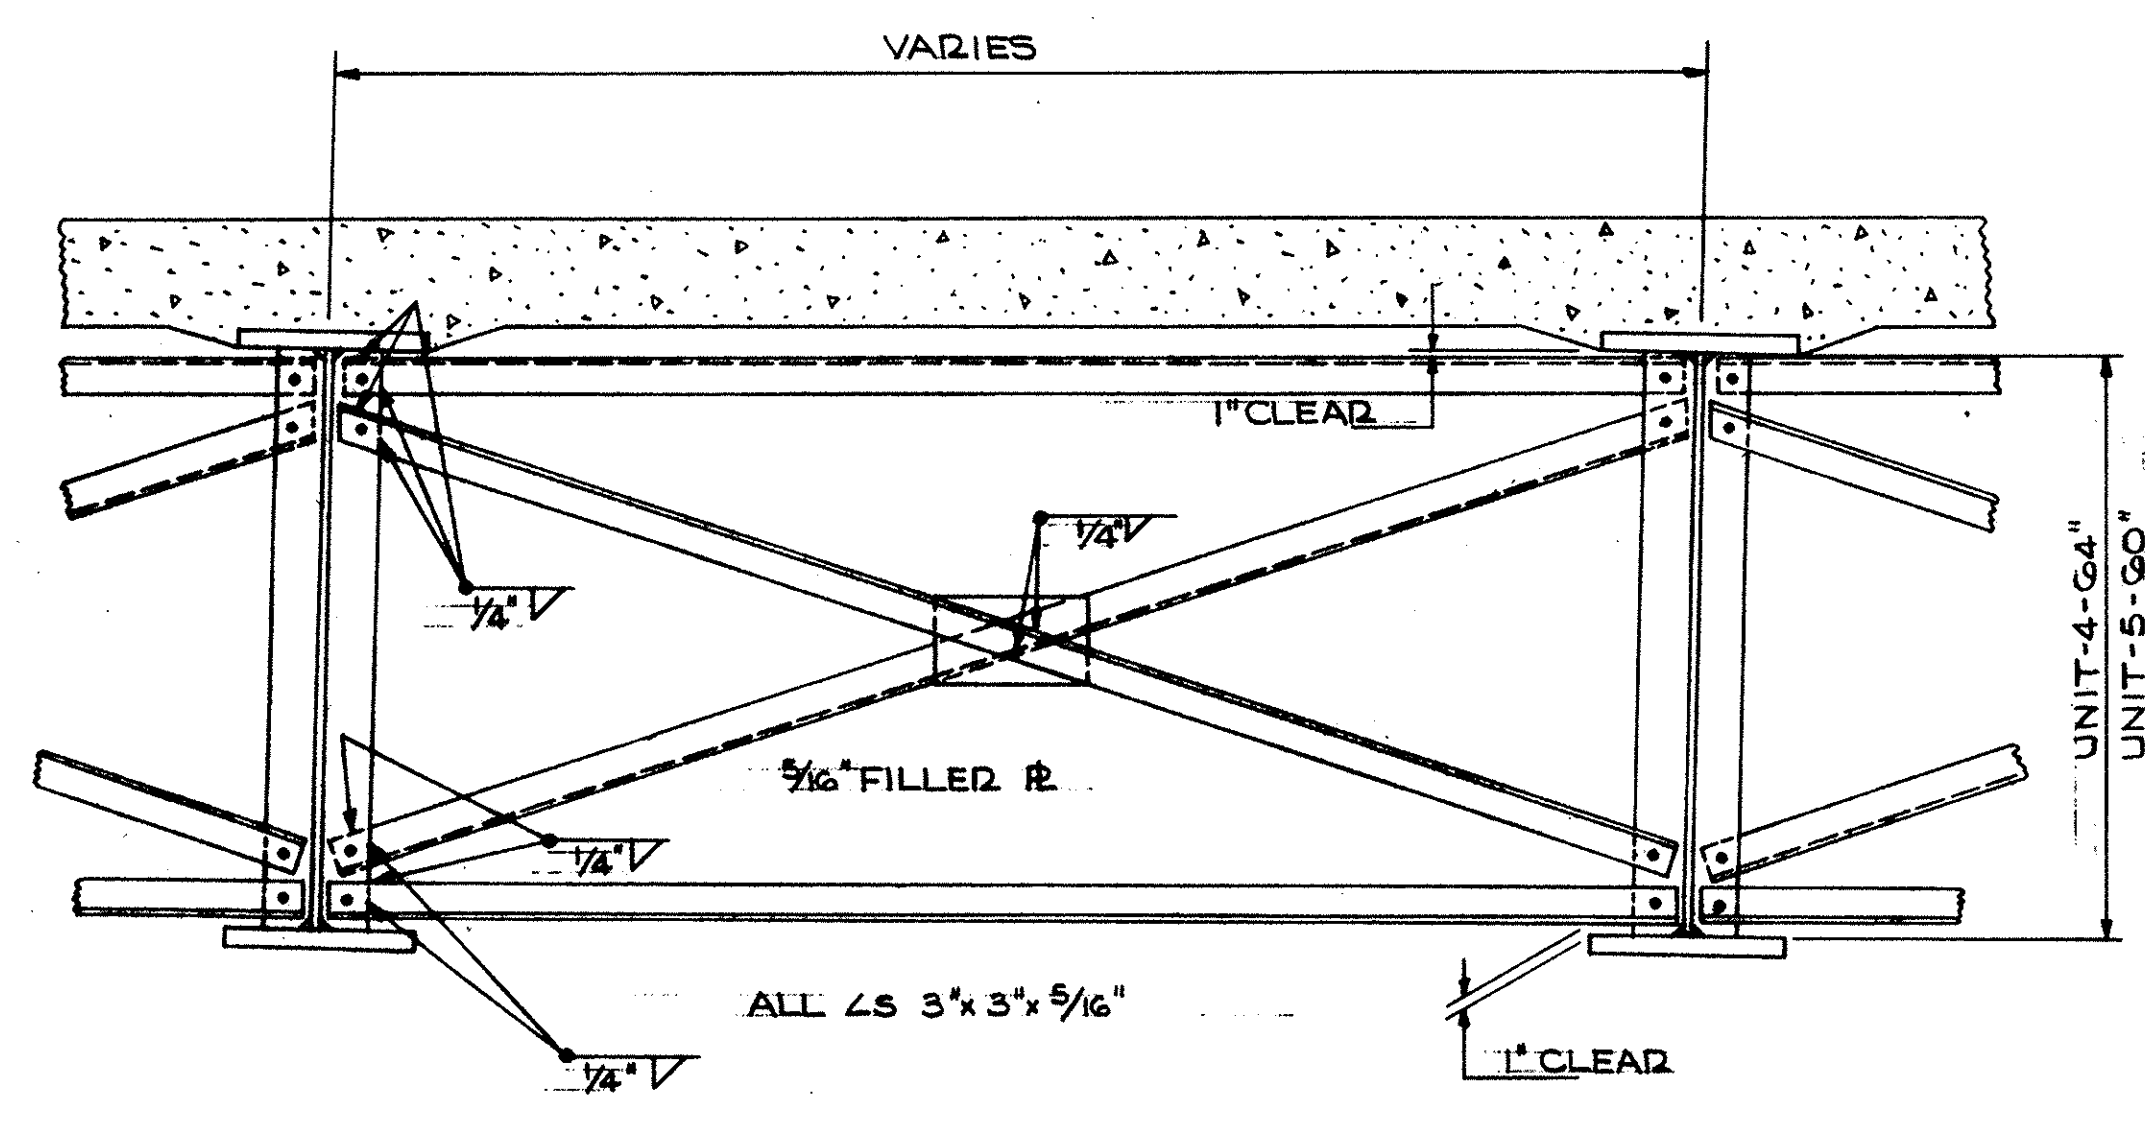

SPECIAL CROSSFRAME DETAIL
3/4" = 1'-0"

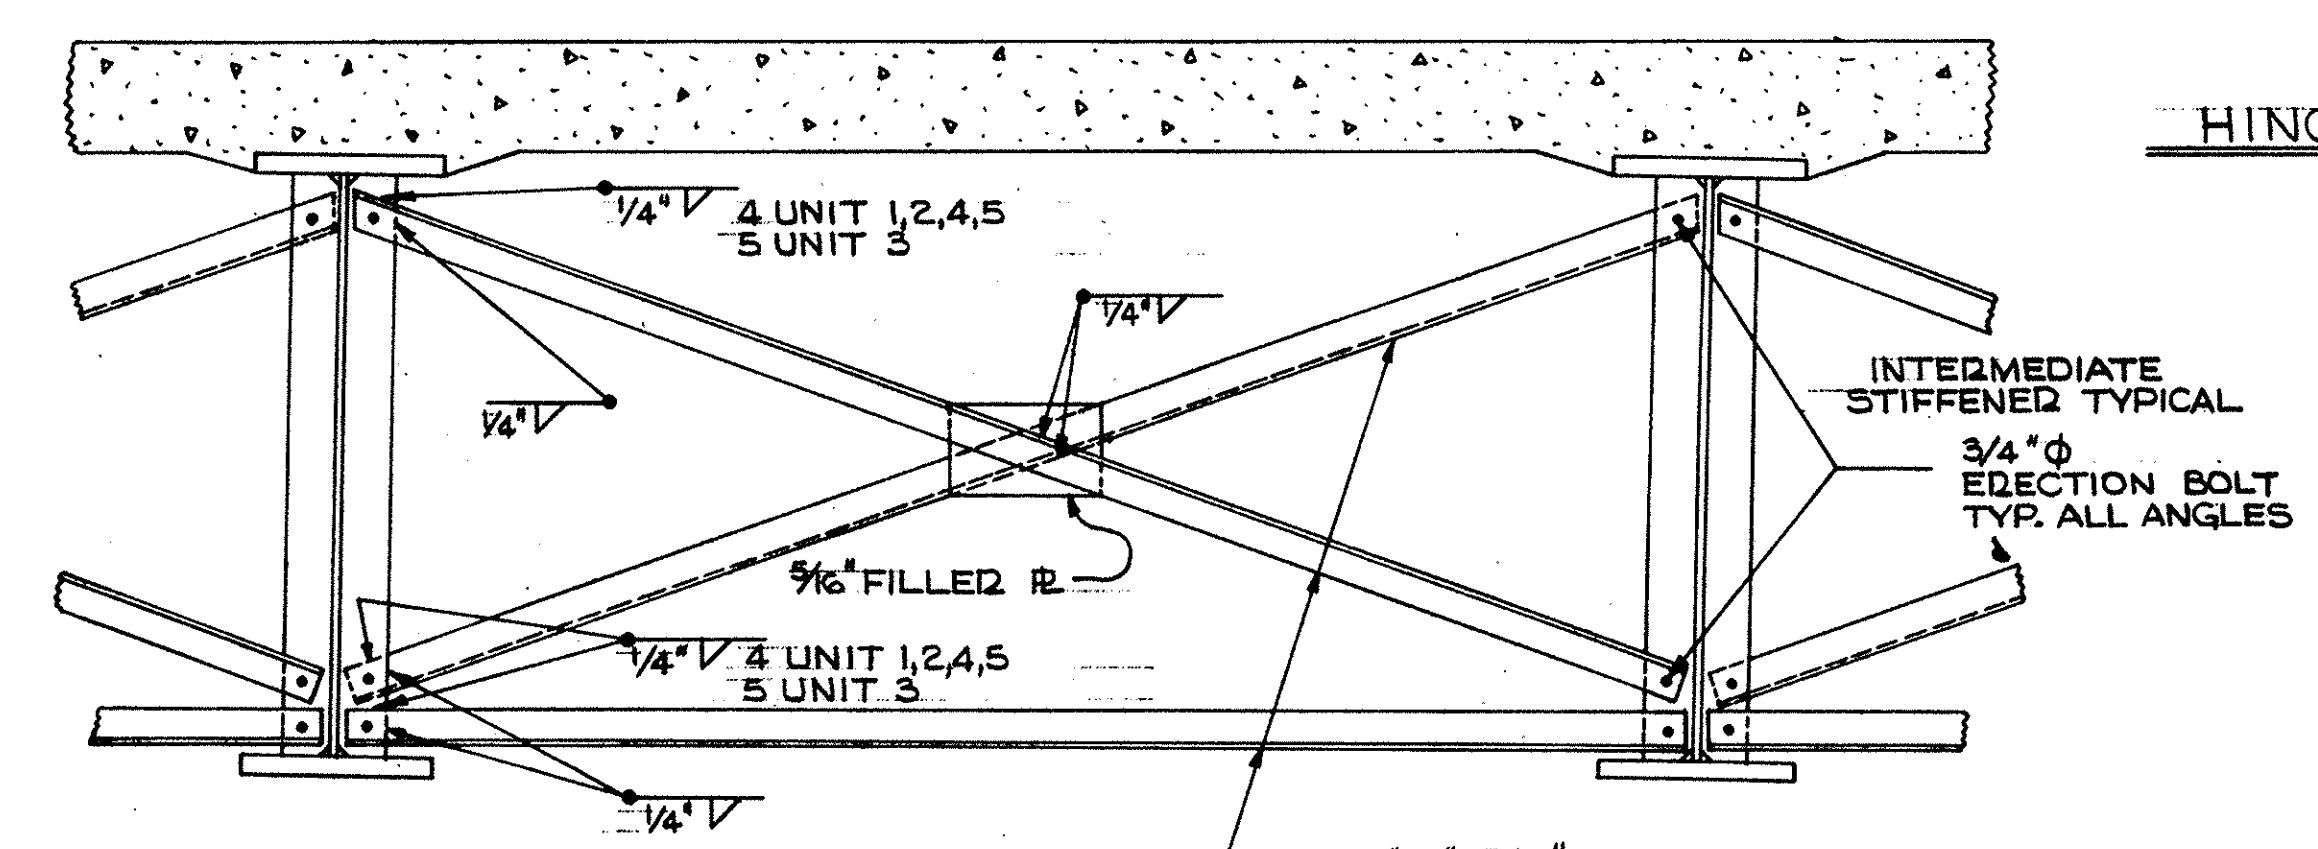



INTERMEDIATE CROSSFRAMES
3/4" = 1'-0"

STATE OF OHIO DEPARTMENT OF HIGHWAYS BUREAU OF BRIDGES						
AKRON, OHIO GLAUS, PYLE & SCHOMER YOUNGSTOWN, OHIO						
MISC. DETAILS						
BRIDGE No			MAH-711-0116			
OVER MAHONING RIVER						
YOUNGSTOWN MAHONING COUNTY						
UNIT No 5						
DESIGNED	DRAWN	TRACED	CHECKED	REVIEWED	DATE	REVISED
R.H.			R.H.	W.K.D.	6-22-68	

FED. RD.	STATE	PROJECT
2	OHIO	U.S.-1159 (I)

204A
232

MAH-711-011
341 - SPC'S @ 8" = 227' 4"
5601 (TOP)
5701 (BOTTOM)

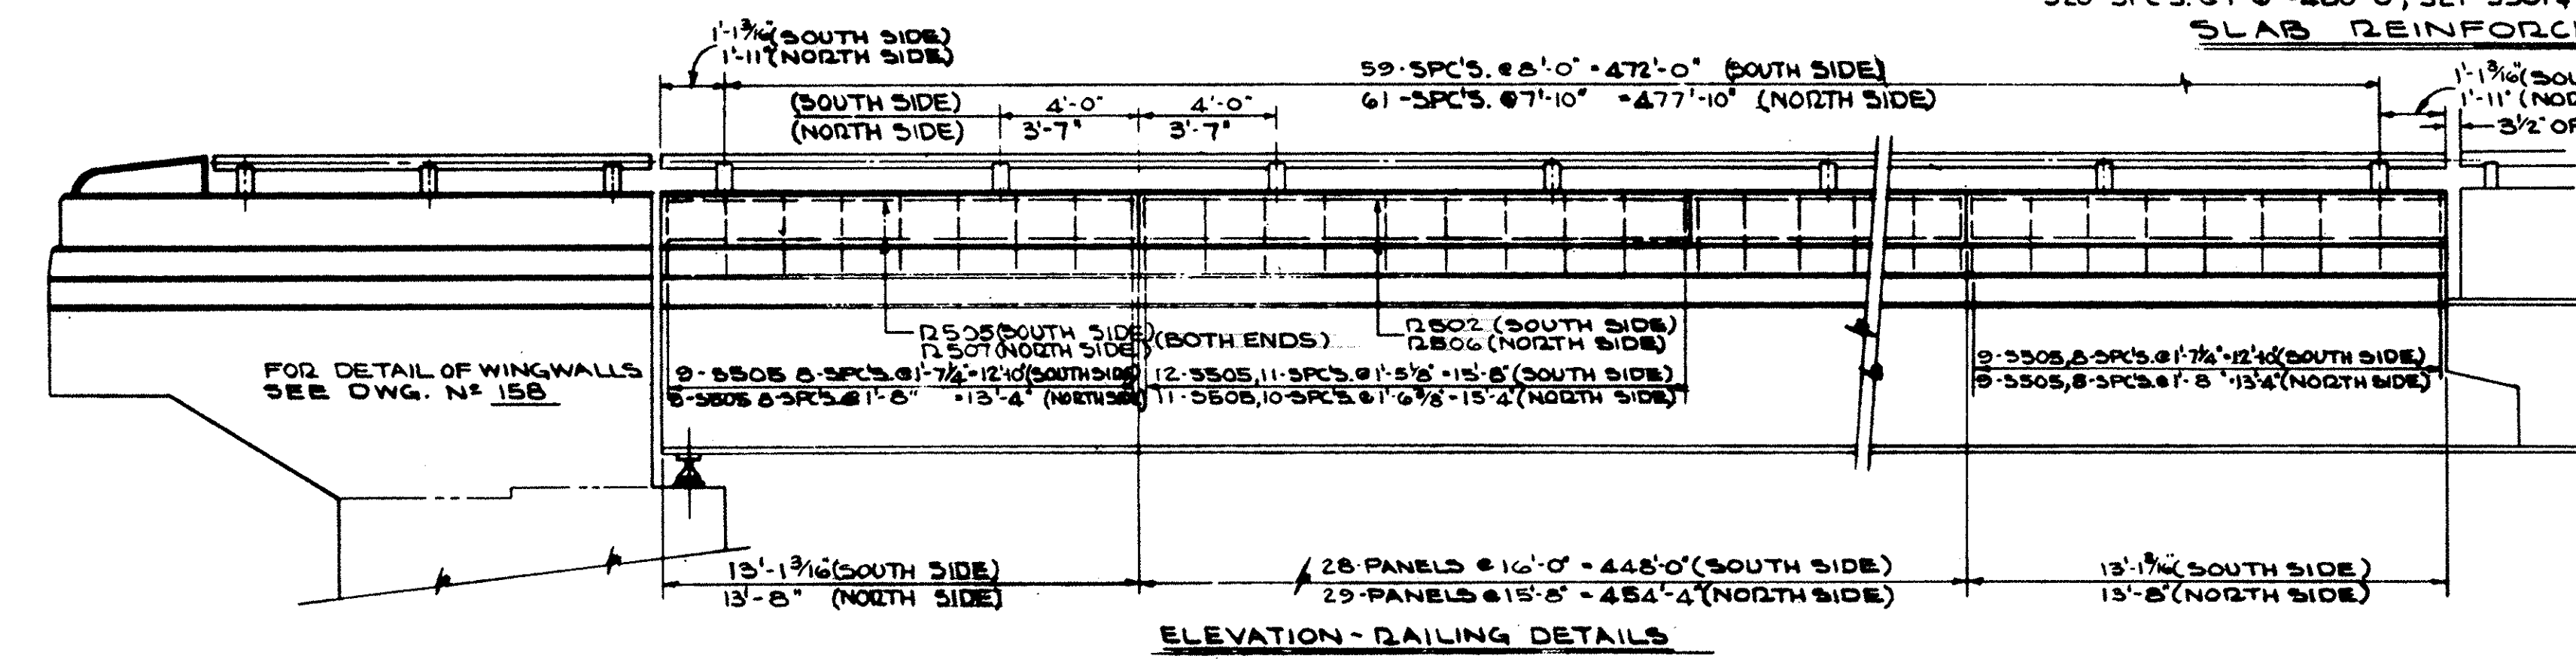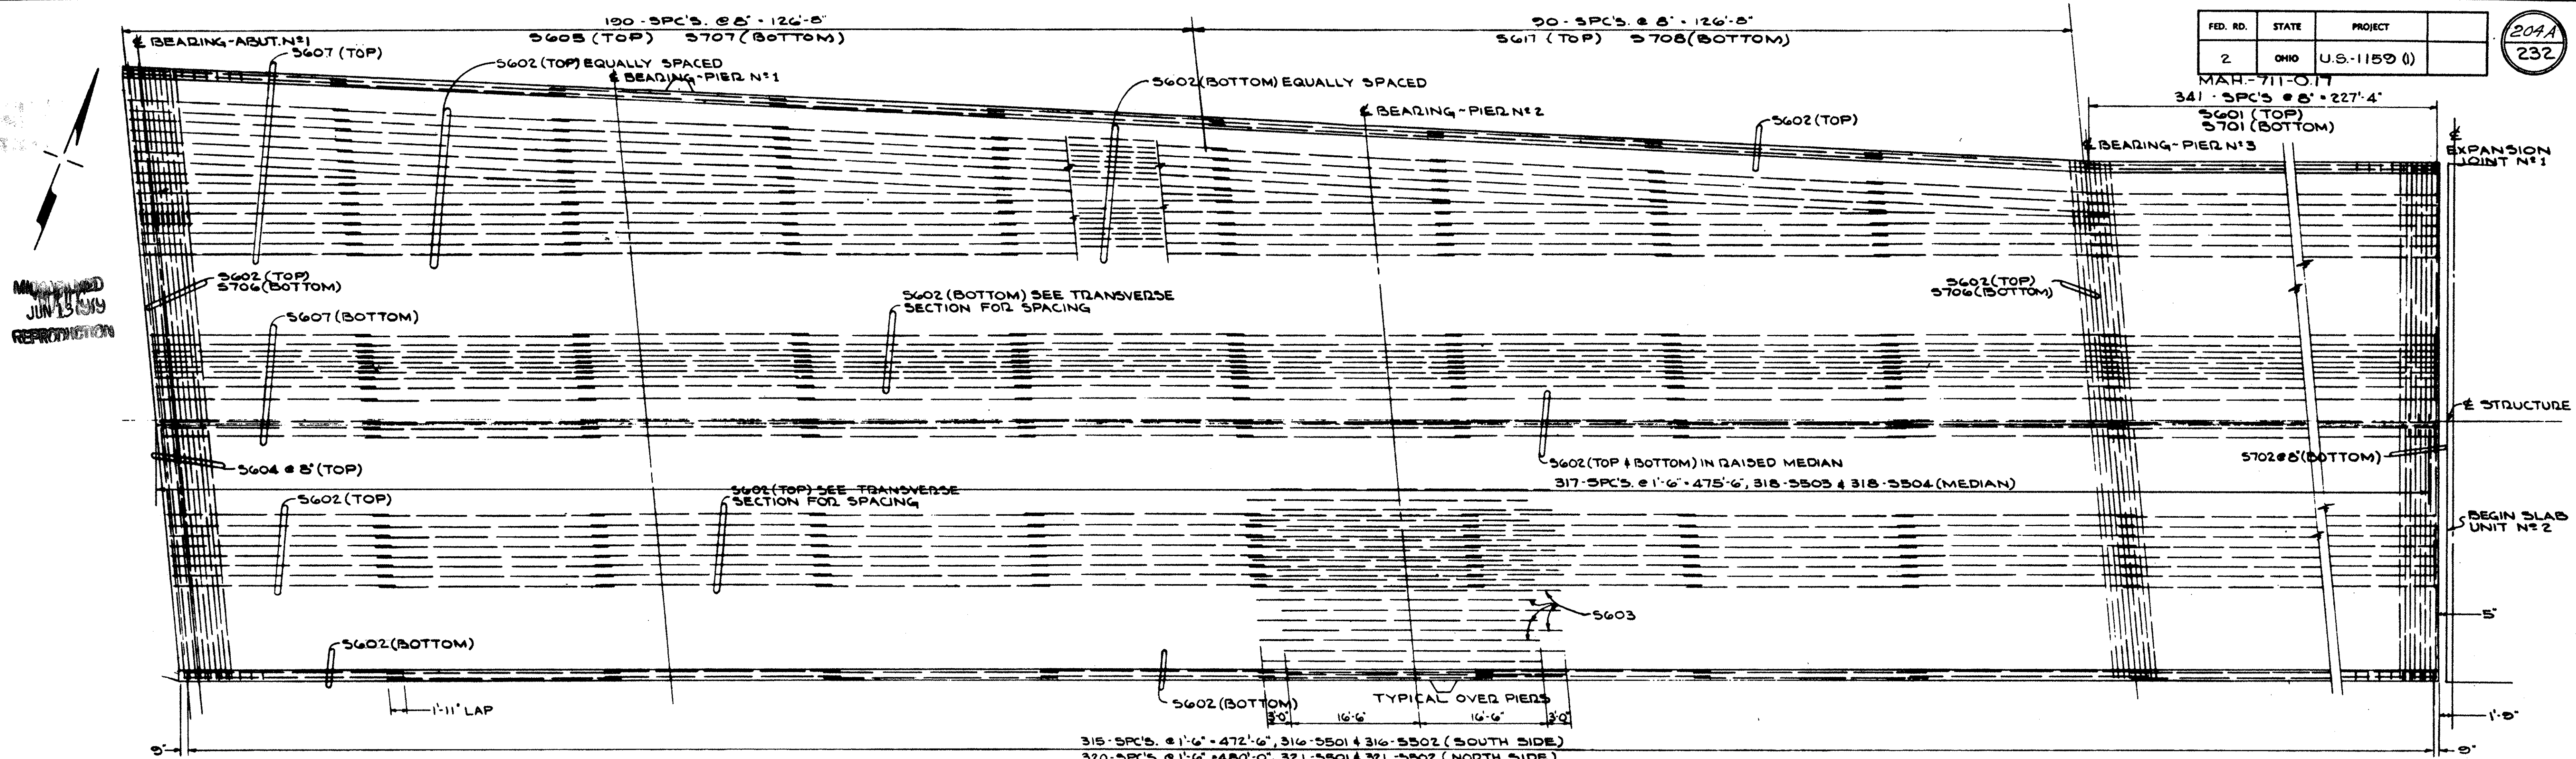

SLAB REINFORCING PLAN


315 - SPC'S @ 1'-6" = 472'-6", 316 - 5501 & 316 - 5502 (SOUTH SIDE)
320 - SPC'S @ 1'-6" = 480'-0", 321 - 5501 & 321 - 5502 (NORTH SIDE)

59 - SPC'S @ 8" = 472'-0" (SOUTH SIDE)
61 - SPC'S @ 7'-10" = 477'-10" (NORTH SIDE)

FACE OF CURB

916.70	916.25	915.64	915.39	914.95	914.34	913.75	913.13	912.55	912.07	911.62	911.16	910.70	910.36	910.04	909.72	909.42	909.16	908.92	908.66	908.41	908.20	908.16	908.05	907.94
916.69	916.26	915.81	915.35	914.90	914.26	913.66	913.06	912.47	911.96	911.53	911.05	910.60	910.26	909.94	909.63	909.34	909.09	908.86	908.60	908.36	908.24	908.15	908.04	907.94

DECK ELEVATIONS

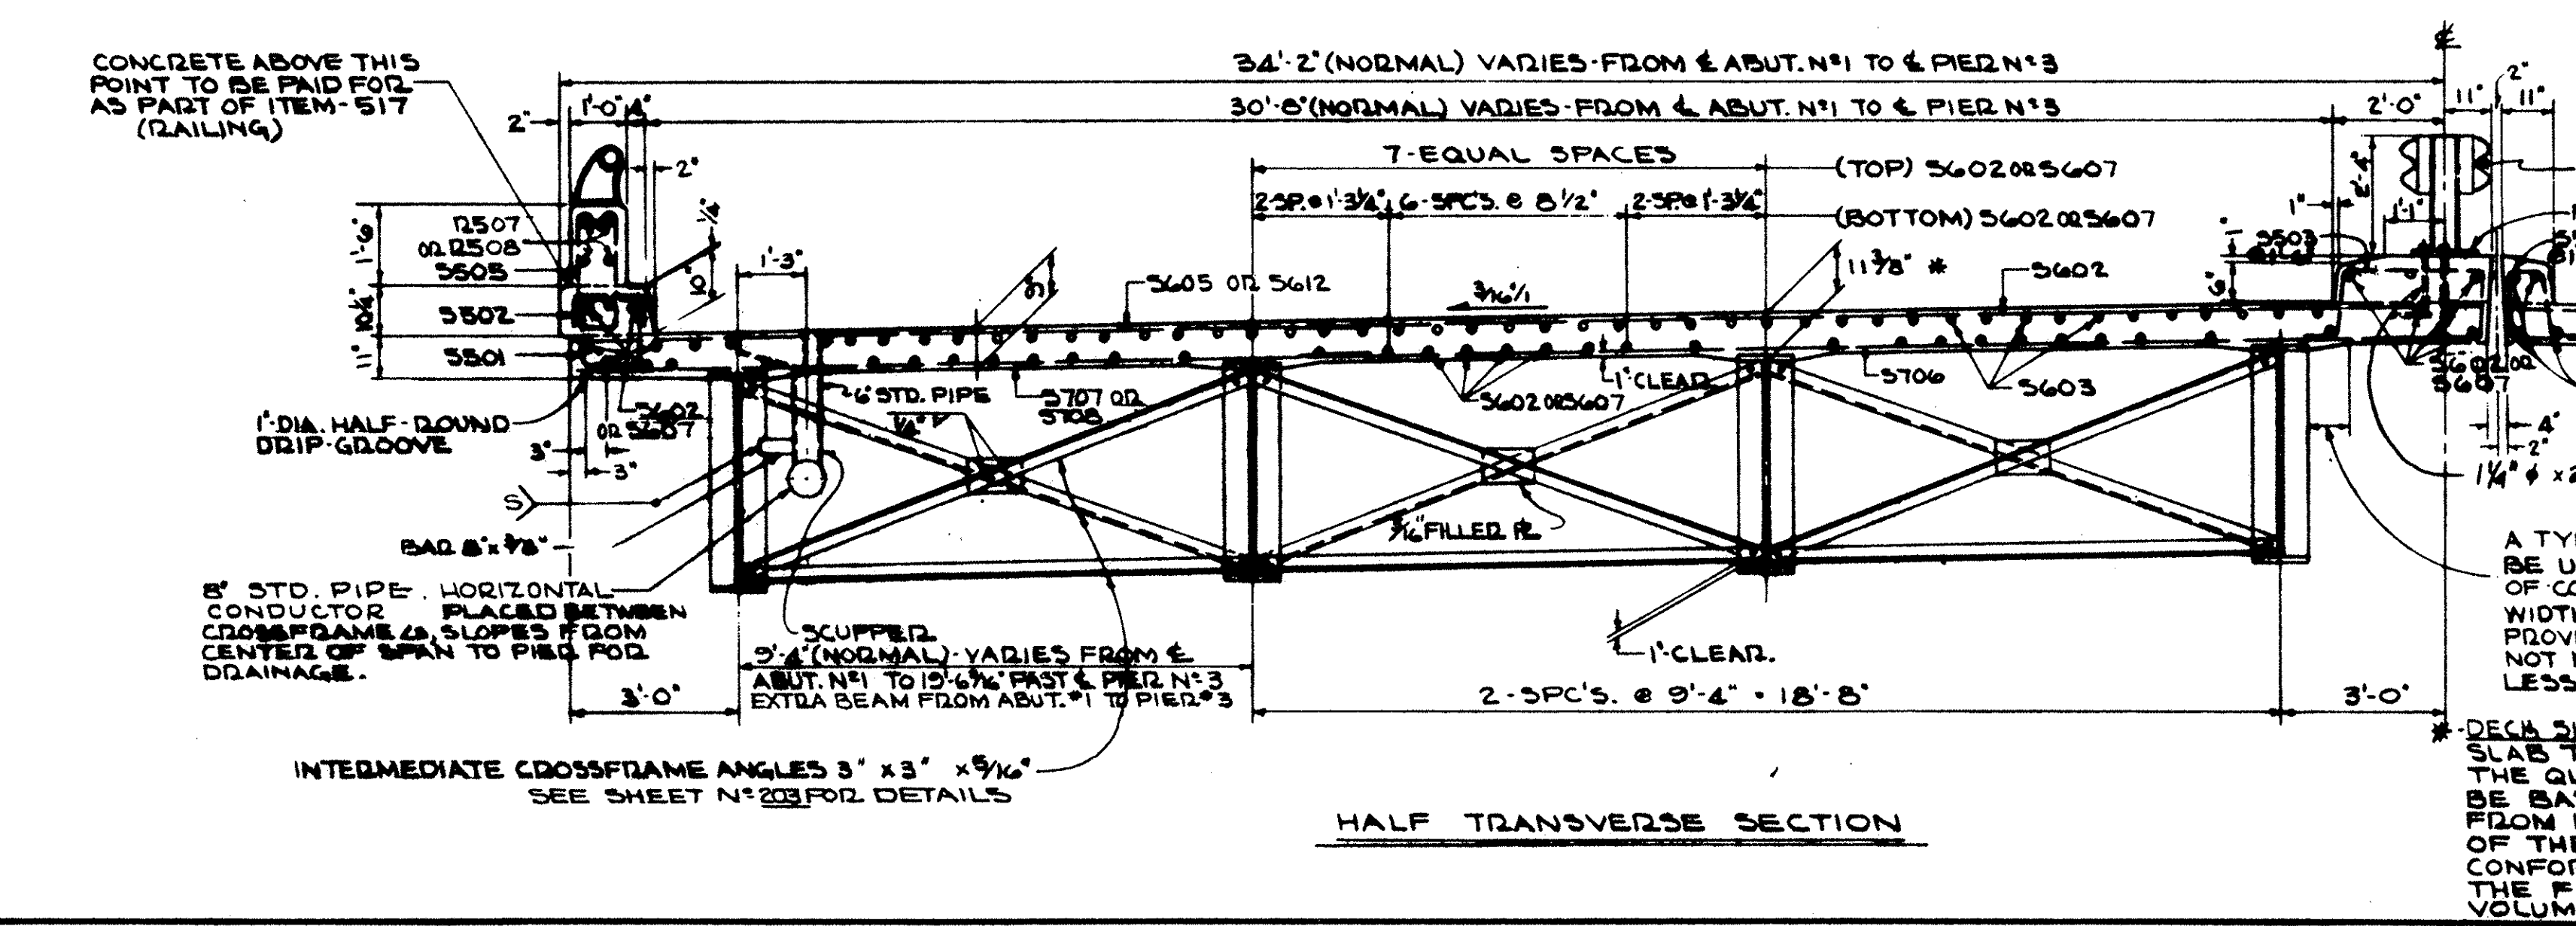

NOTE:
THE ELEVATIONS SHOWN AT THE FACE OF CURBS ARE THOSE WHICH ARE REQUIRED BEFORE THE CONCRETE DECK IS PLACED. PROPER ALLOWANCE HAS BEEN MADE FOR THE DEAD LOAD DEFLECTIONS CAUSED BY THE WEIGHT OF CONCRETE.

A TYPICAL HAUNCH WIDTH OF 9" SHALL BE USED FOR COMPUTING QUANTITY OF CONCRETE. HOWEVER, THE HAUNCH WIDTH MAY VARY BETWEEN 6" AND 12" PROVIDED THAT THE SLOPE SHALL BE NOT MORE THAN 1:4 FOR A HAUNCH LESS THAN 9" IN WIDTH.

DECK SLAB DEPTH: THE DISTANCE SHOWN FROM TOP OF THE DECK SLAB TO TOP OF THE WEB PLATE IS THE NOMINAL DIMENSION. THE QUANTITY OF DECK CONCRETE TO BE PAID FOR SHALL BE BASED ON THIS DIMENSION EVEN THOUGH DEVIATION FROM IT MAY BE NECESSARY BECAUSE THE TOP FLANGE OF THE BEAM MAY NOT HAVE THE EXACT CAMBER OR CONFORMATION REQUIRED TO PLACE IT PARALLEL TO THE FINISHED GRADE. DEDUCTION SHALL BE MADE FOR VOLUME OF ENCLOSED STEEL PLATES.

STATE OF OHIO
DEPARTMENT OF HIGHWAYS
BUREAU OF BRIDGES

GLAUS, PYLE & SCHOMER
AKRON, OHIO YOUNGSTOWN, OHIO

SLAB DETAILS
BRIDGE N° MAH-711-0116
OVER MAHONING RIVER
YOUNGSTOWN MAHONING COUNTY

UNIT N° 1

DESIGNED	DRAWN	TRACED	CHECKED	REVIEWED	DATE	REVISED
JP	J.D.P.		J.C.	W.K.D.	6-22-68	


This sheet supersedes sheet No. 204. 9-12-69

MAHONING
JUN 13 1965
REPRODUCTION

FED. RD.	STATE	PROJECT	
2	OHIO		

204B
232


MAH. 711-0.17

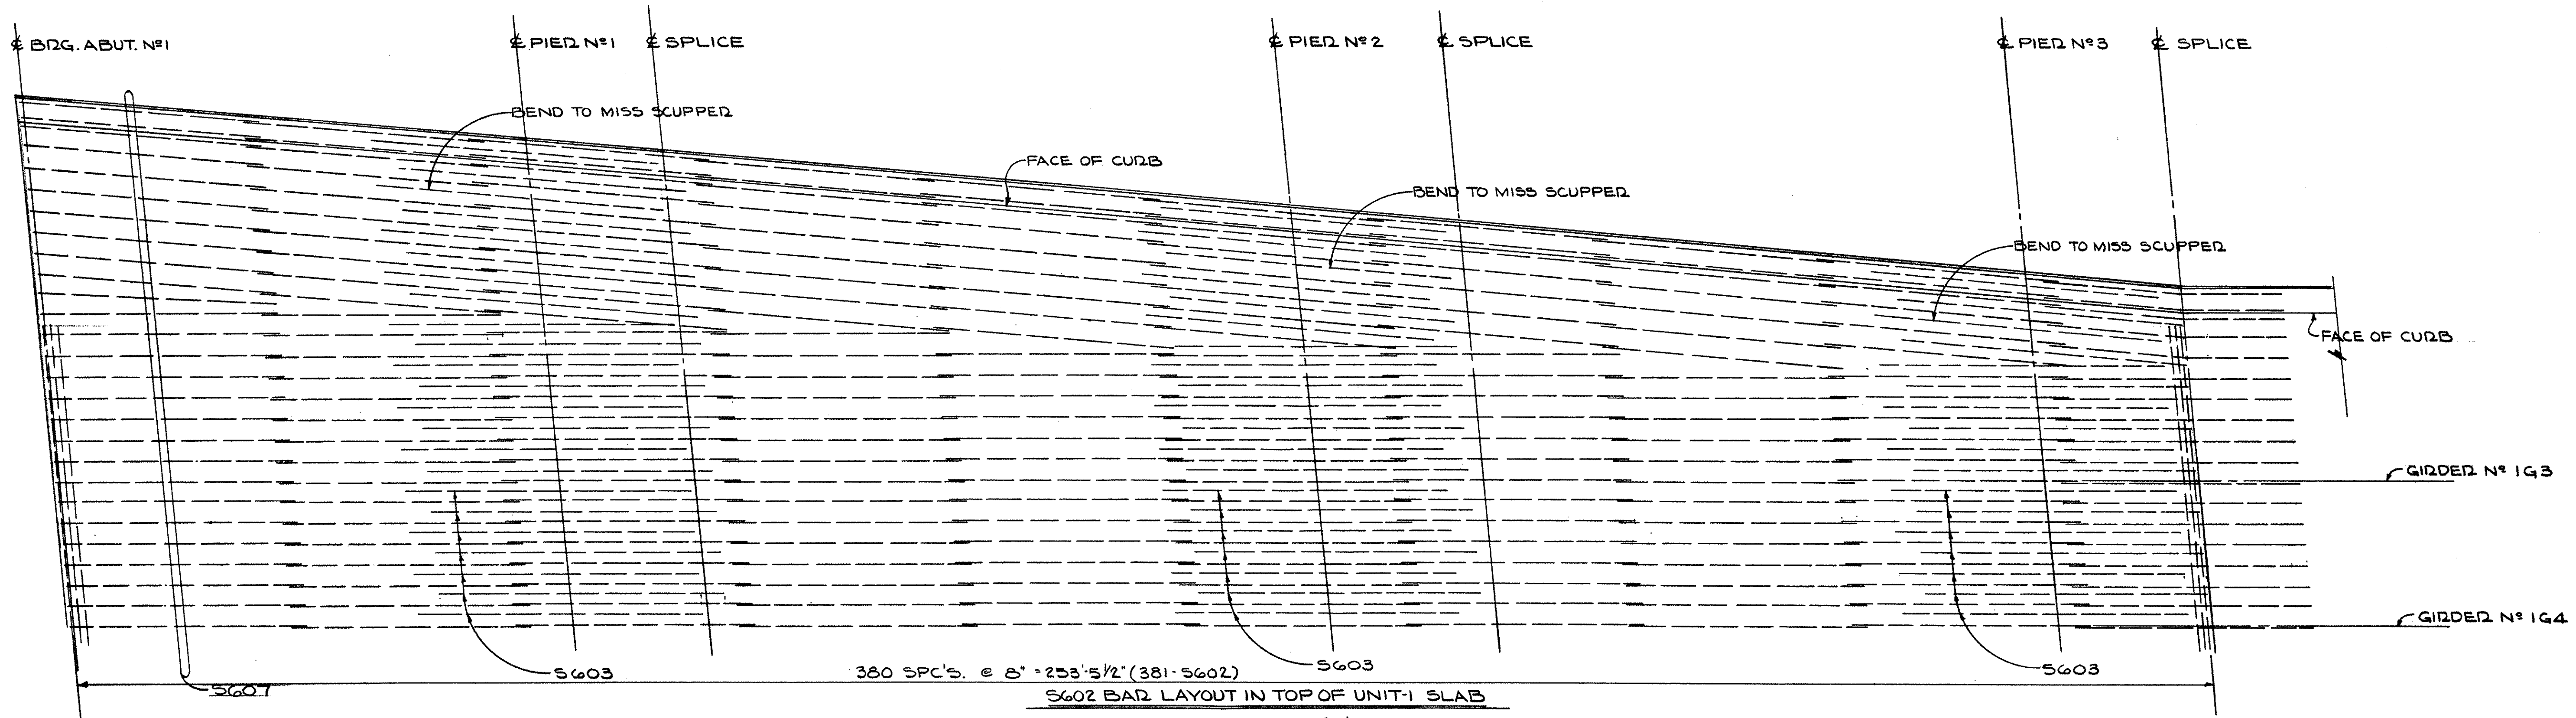

NOTE:
ALL BARS S602
EXCEPT WHERE NOTED.

SCALE: HORIZ. 3/32" = 1'-0"
VERT. 3/16" = 1'-0"

NOTE:
FOR ADDITIONAL DETAILS
SEE SHEET N° 204A

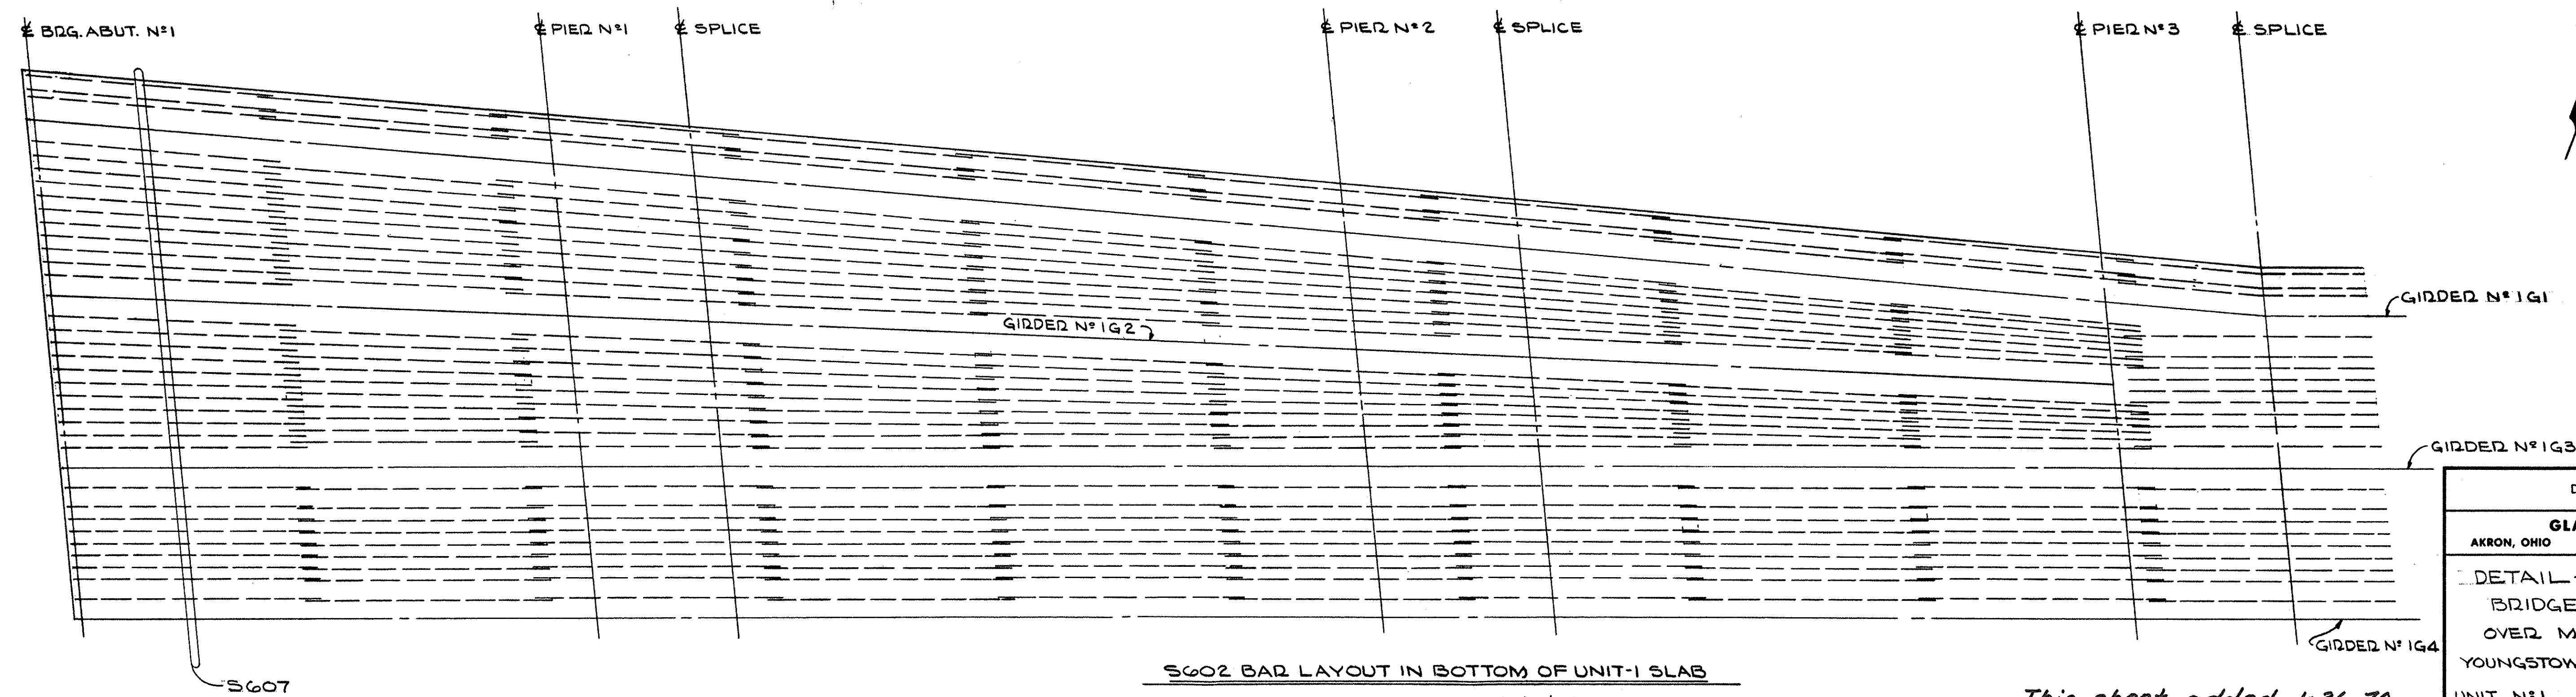

S602 BAR LAYOUT IN BOTTOM OF UNIT-1 SLAB



SCALE: HORIZ. 3/32" = 1'-0"
VERT. 3/16" = 1'-0"

This sheet added 1-26-70




STATE OF OHIO DEPARTMENT OF HIGHWAYS BUREAU OF BRIDGES						
AKRON, OHIO			YOUNGSTOWN, OHIO			
GLAUS, PYLE & SCHOMER						
DETAIL - SLAB REINFORCING						
BRIDGE N° MAH. 711-0116						
OVER MAHONING RIVER						
YOUNGSTOWN MAHONING COUNTY						
UNIT N° 1						
DESIGNED	DRAWN	TRACED	CHECKED	REVIEWED	DATE	REVISED
RAH	J.D.P.		J.M.	W.K.D.	1-21-70	

MAH-711-017

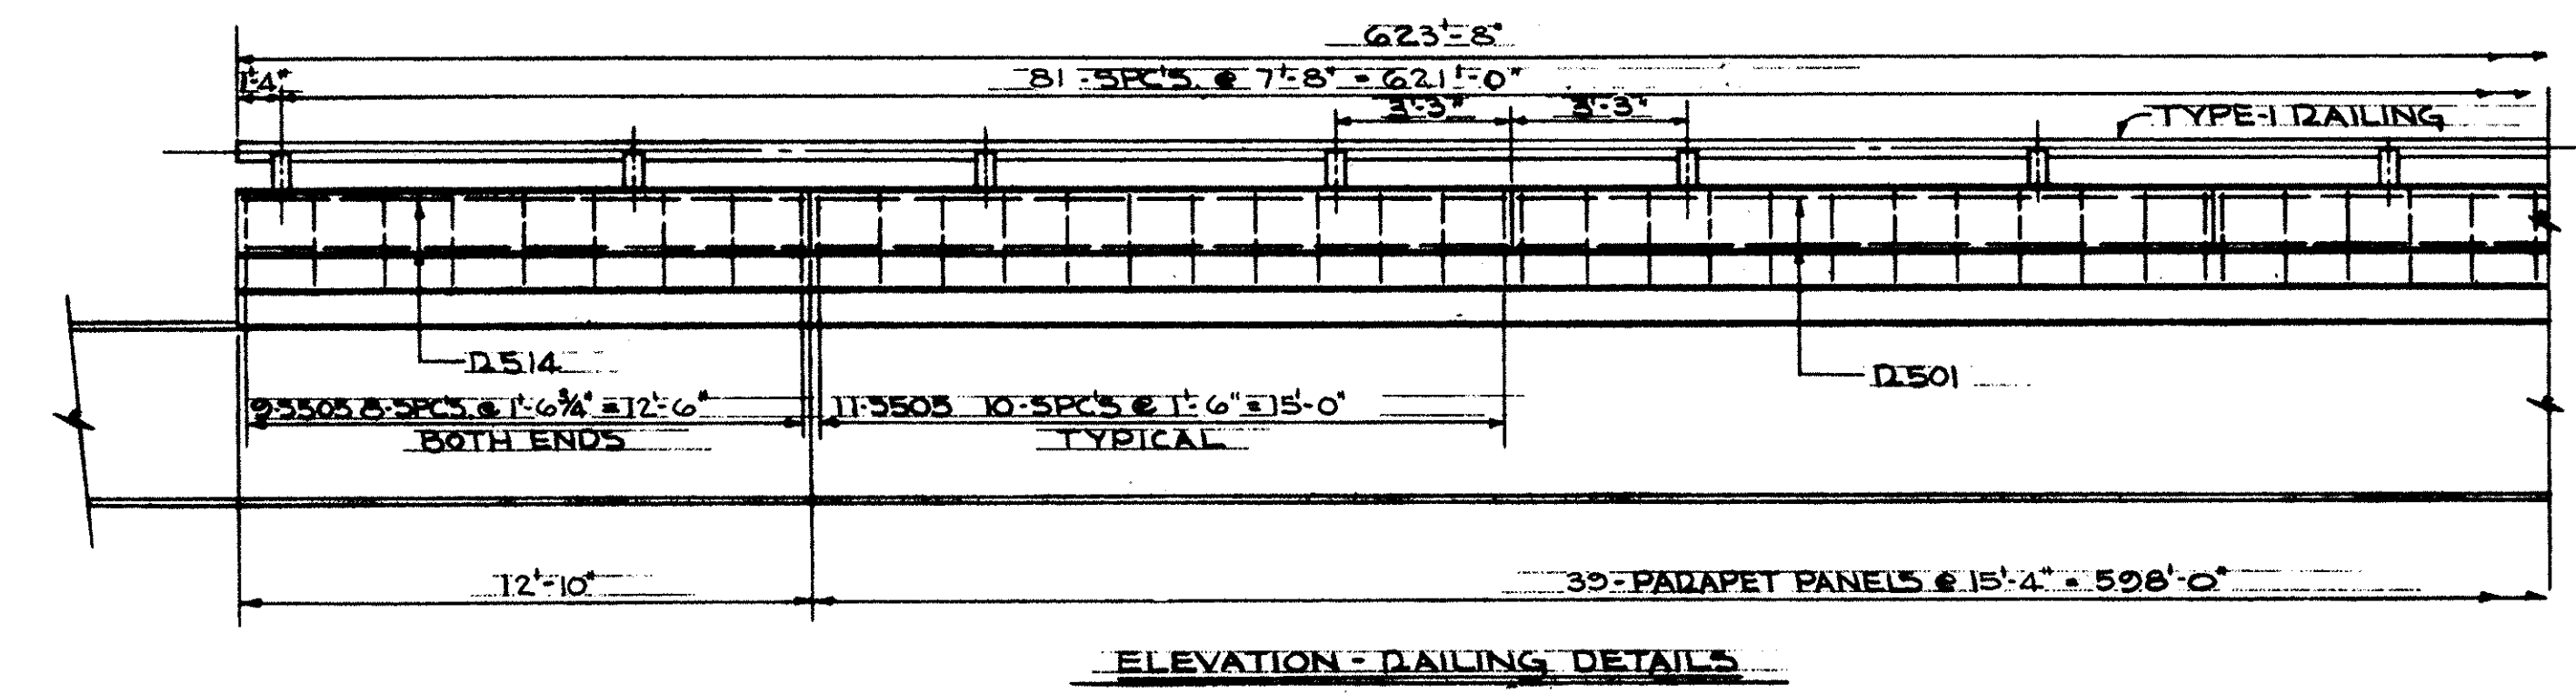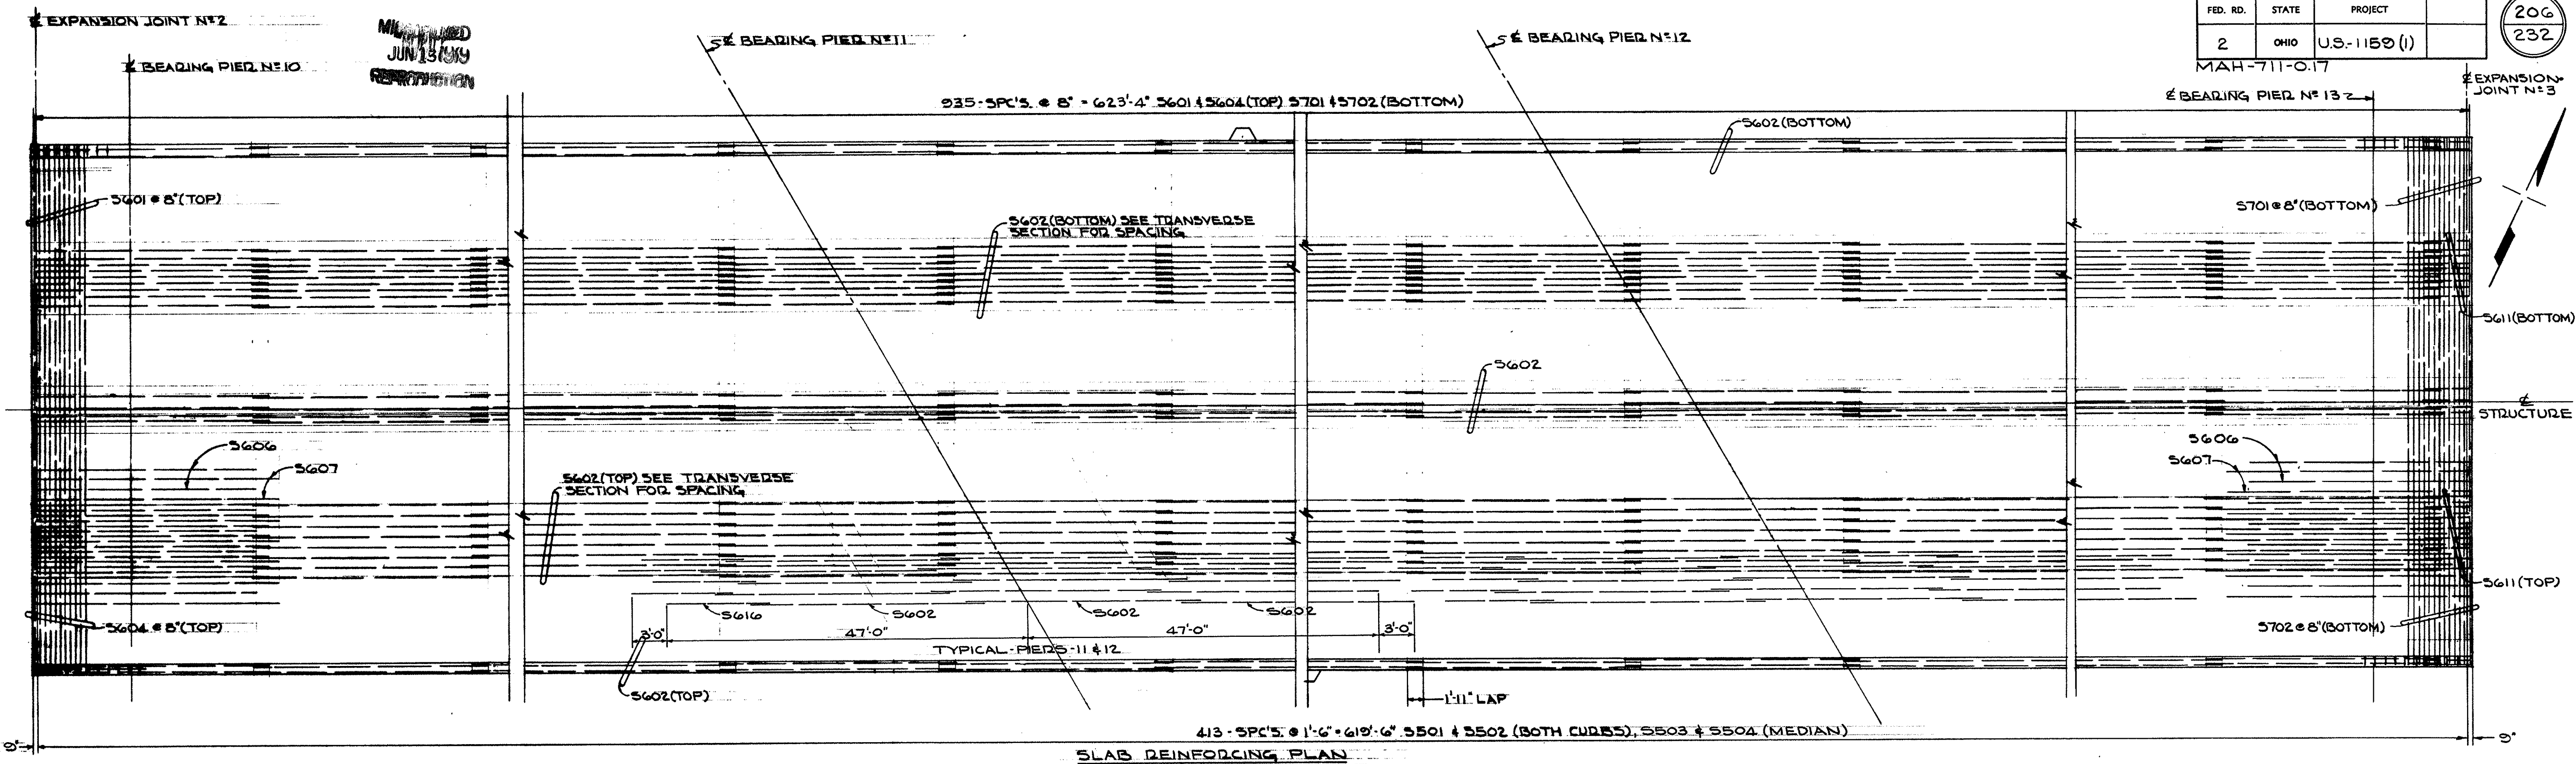

EXPANSION JOINT N°2	PIER N°10	PIER N°11	PIER N°12	PIER N°13	EXPANSION JOINT N°3
909.50	909.75	909.75	909.75	909.75	909.50
	909.26	910.16	910.35	910.53	910.70
	910.16	910.35	910.53	910.70	910.87
	911.05	911.24	911.55	911.87	912.20
	911.24	911.55	911.87	912.20	912.52
	912.20	912.52	912.82	913.08	913.30
	913.08	913.30	913.48	913.63	913.77
	913.63	913.77	913.91	914.05	914.14
	914.05	914.14	914.24	914.27	914.24
	914.14	914.24	914.27	914.24	914.15
	914.24	914.27	914.24	914.15	914.00
	914.27	914.24	914.15	914.00	913.65
	914.24	914.15	914.00	913.65	
	914.15	914.00	913.65		
	914.00	913.65			
	913.65				

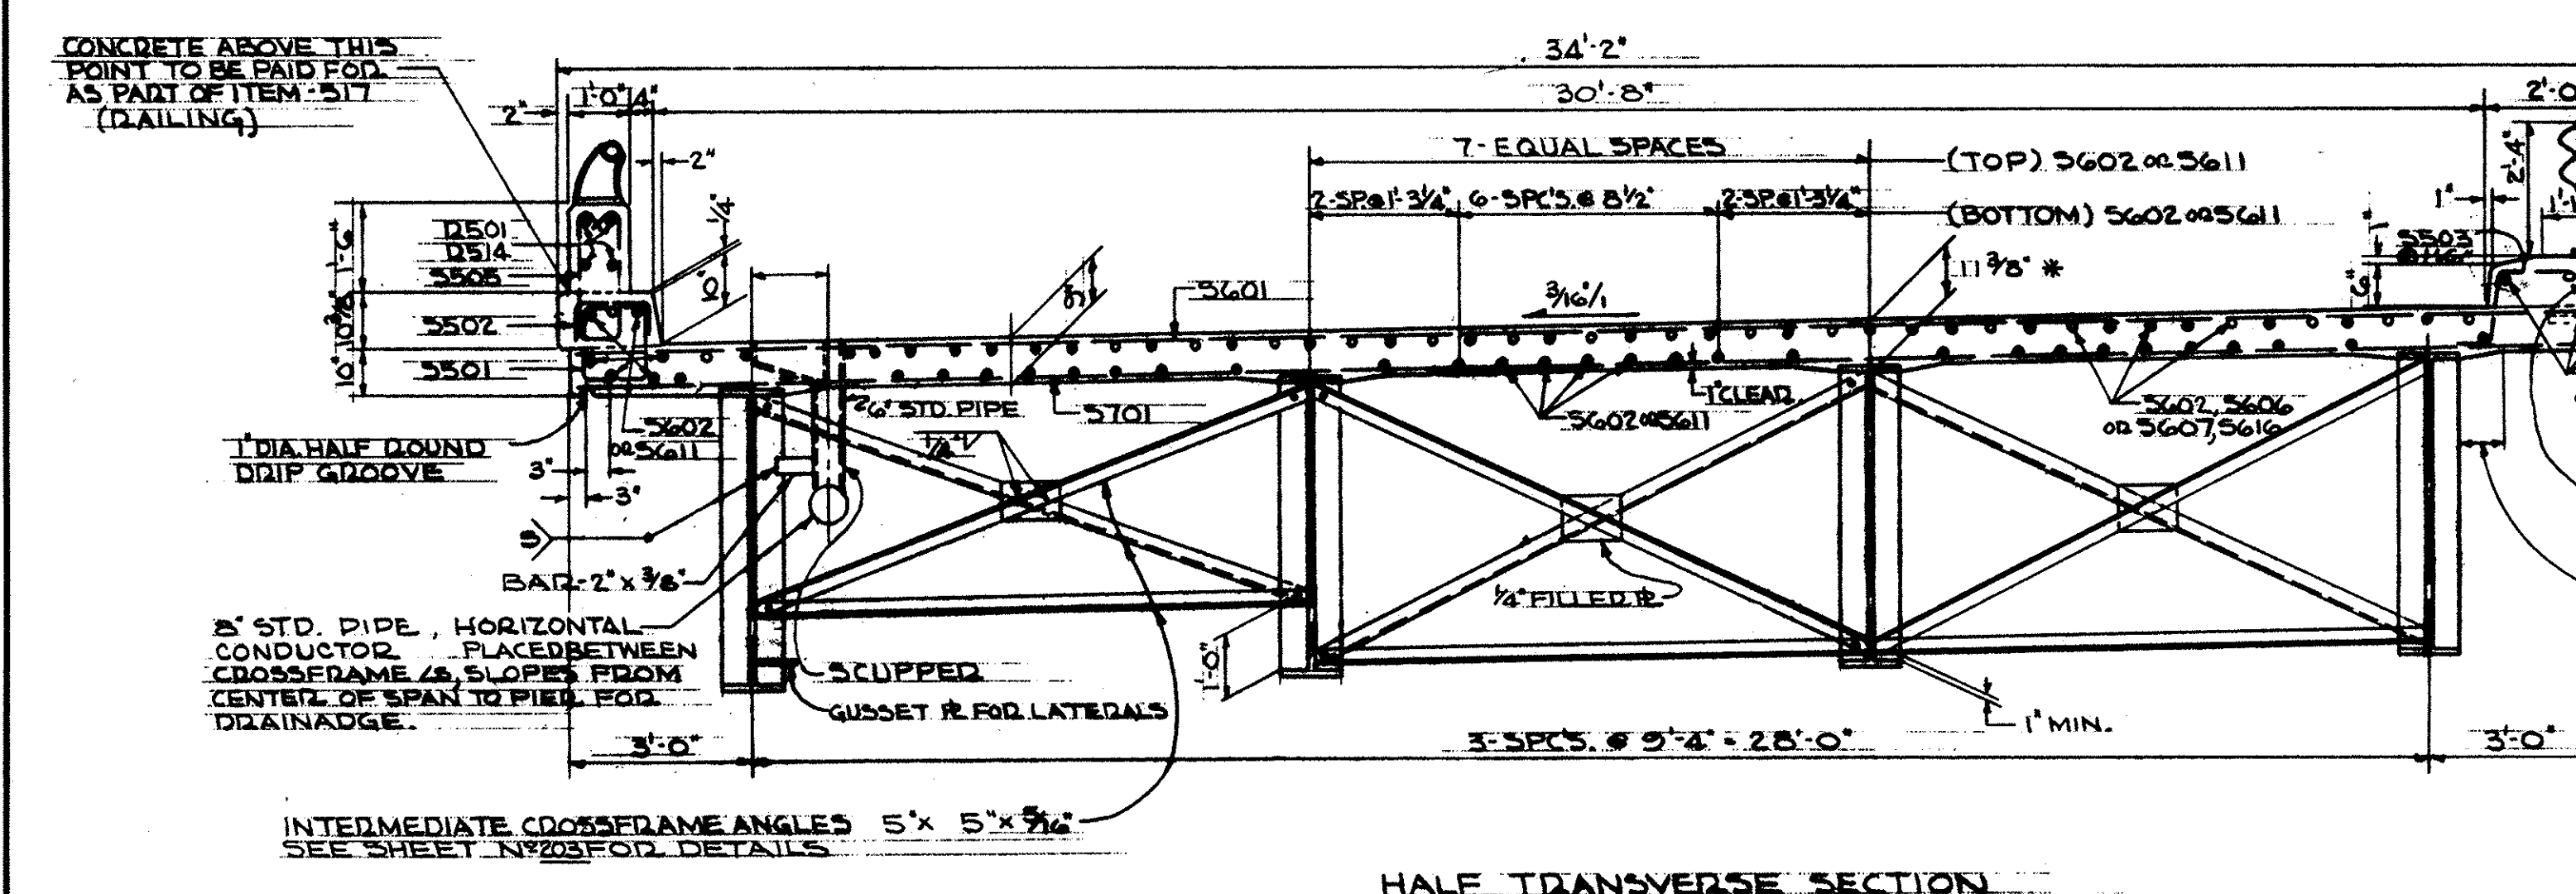

RAILING (DOUBLE-FACED DEEP BEAM RAIL WITH STEEL POSTS AND BOLTS) SEE SHEET N° 205 FOR DETAILS OF BASE PLATE. SEE SHEET N° 205

SYMMETRICAL ABOUT & EXCEPT AS SHOWN



A TYPICAL HAUNCH WIDTH OF 9" SHALL BE USED FOR COMPUTING QUANTITY OF CONCRETE. HOWEVER, THE HAUNCH WIDTH MAY VARY BETWEEN 6" AND 12" PROVIDED THAT THE SLOPE SHALL BE NOT MORE THAN 1:4 FOR A HAUNCH LESS THAN 9" IN WIDTH.

*DECK SLAB DEPTH: THE DISTANCE SHOWN FROM TOP OF THE DECK SLAB TO TOP OF THE WEB PLATE IS THE NOMINAL DIMENSION. THE QUANTITY OF DECK CONCRETE TO BE PAID FOR SHALL BE BASED ON THIS DIMENSION EVEN THOUGH DEVIATION FROM IT MAY BE NECESSARY BECAUSE THE TOP FLANGE OF THE GIRDED MAY NOT HAVE THE EXACT CAMBER OR CONFORMATION REQUIRED TO PLACE IT PARALLEL TO THE FINISHED GRADE. DEDUCTION SHALL BE MADE FOR VOLUME OF ENCASED STEEL PLATES.


NOTE:
THE ELEVATIONS SHOWN AT THE FACE OF CURBS ARE THOSE WHICH ARE REQUIRED BEFORE THE CONCRETE DECK IS PLACED. PROPER ALLOWANCE HAS BEEN MADE FOR THE DEAD LOAD DEFLECTIONS CAUSED BY THE WEIGHT OF THE CONCRETE.

This sheet is superseded by sheet No. 206A. 9-12-69

STATE OF OHIO DEPARTMENT OF HIGHWAYS BUREAU OF BRIDGES						
AKRON, OHIO	YOUNGSTOWN, OHIO					
GLAUS, PYLE & SCHOMER						
SLAB DETAILS						
BRIDGE N°	MAH-711-0116					
OVER MAHONING RIVER						
YOUNGSTOWN	MAHONING COUNTY					
UNIT N° 3						
DESIGNED	DRAWN	TRACED	CHECKED	REVIEWED	DATE	REVISED
JP	J.P.P.		J.C.	W.K.D.	6-22-68	

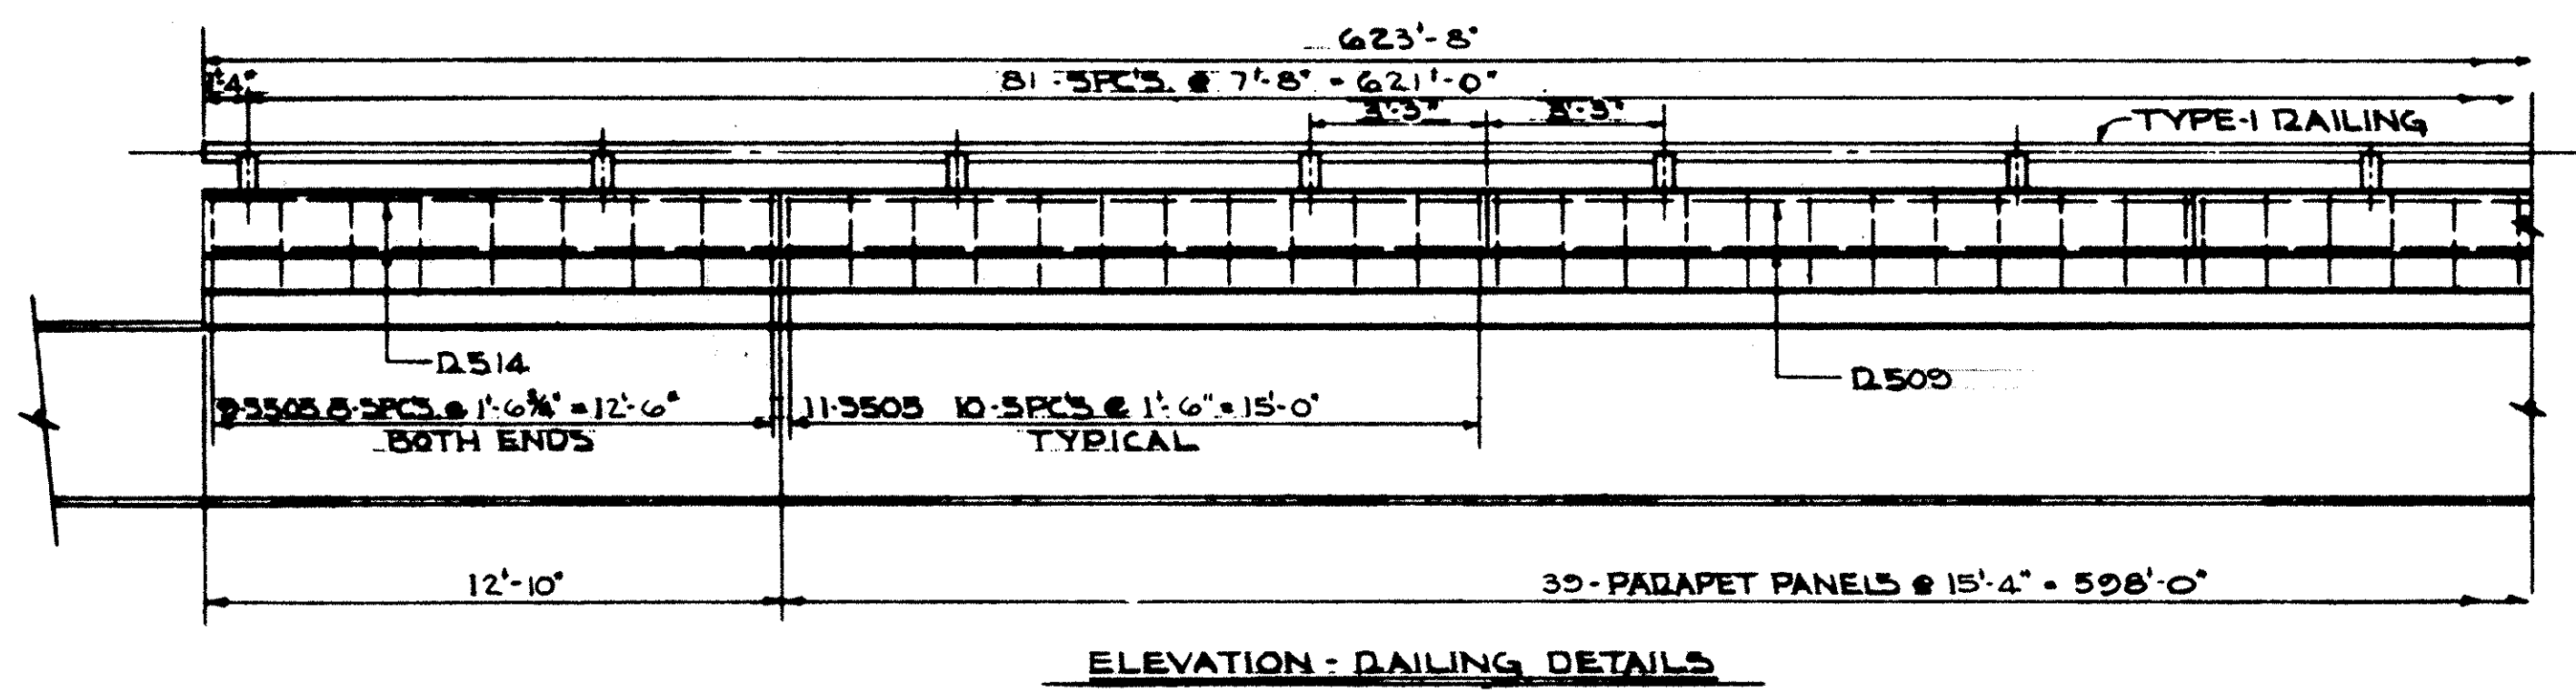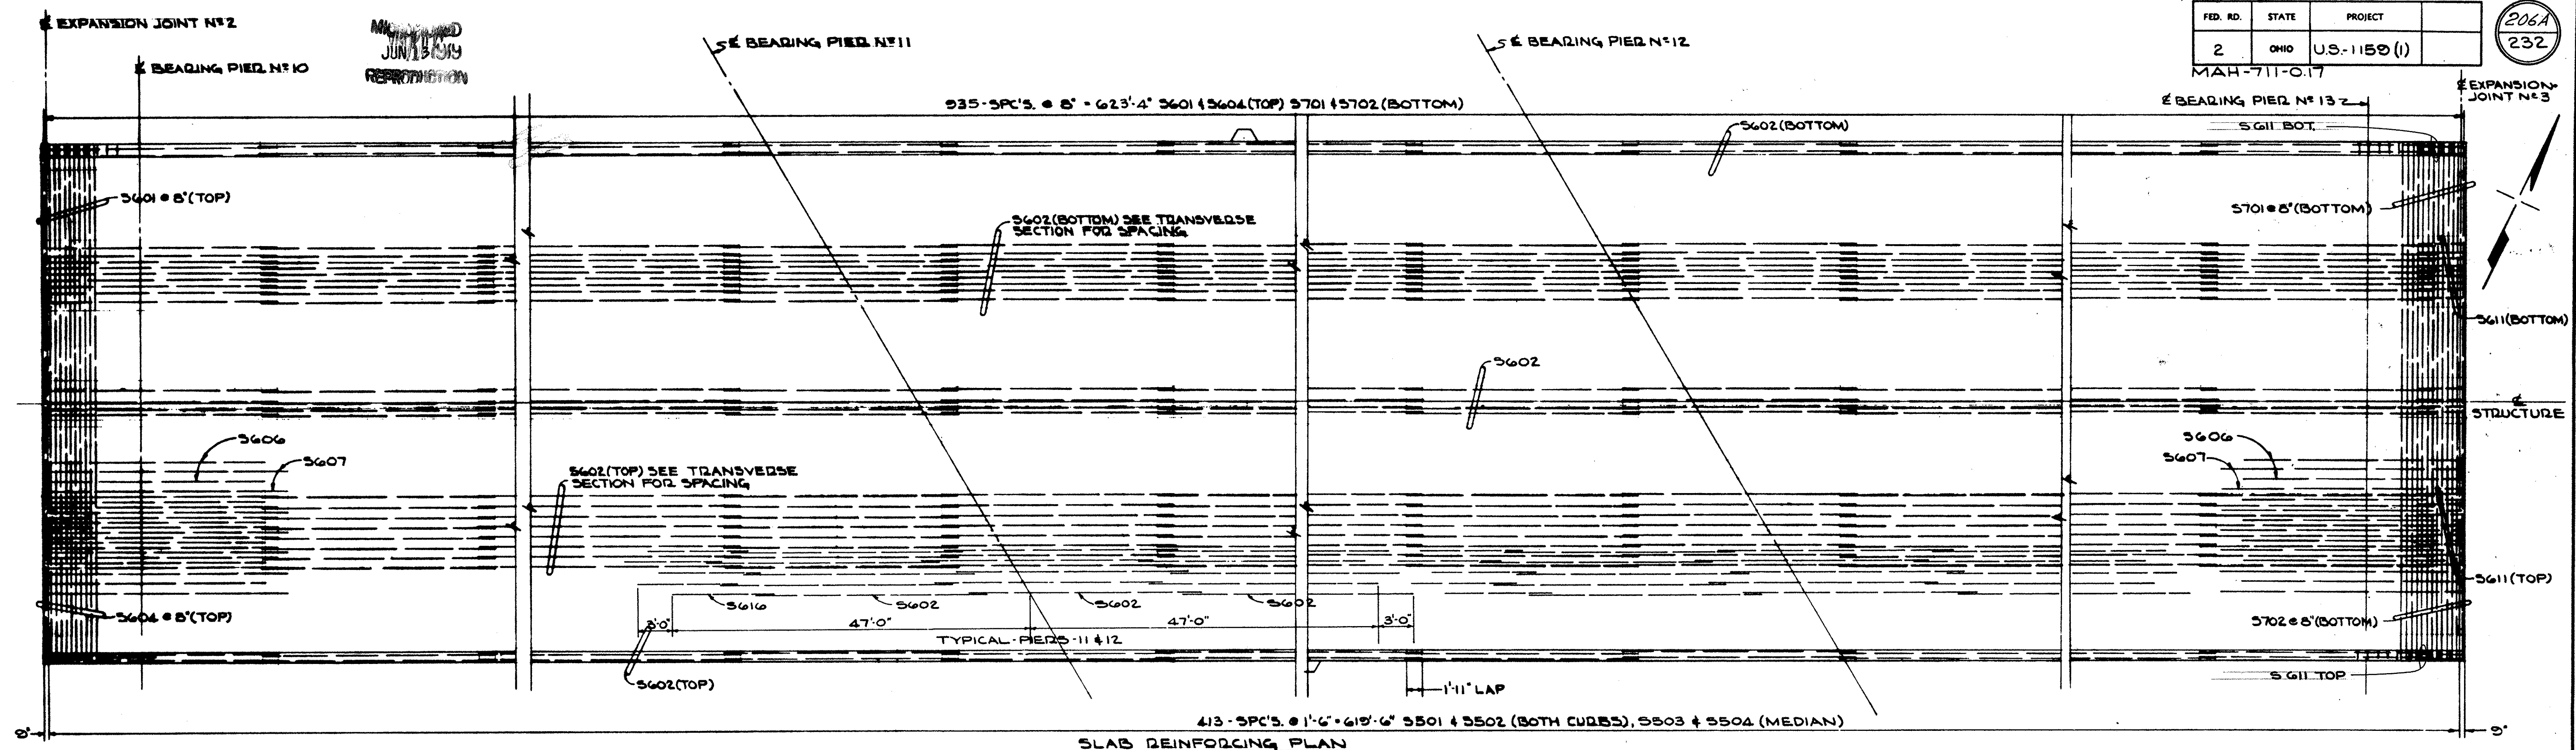

EXPANSION JOINT #2	PIER #10	PIER #11	PIER #12	PIER #13	EXPANSION JOINT #3
909.50	909.75	909.96	910.16	910.35	910.53
	910.16	910.35	910.53	910.70	910.87
	911.05	911.24	911.55	911.67	912.20
	912.52	912.82	913.08	913.30	913.48
	913.48	913.77	913.91	914.03	914.14
	914.14	914.24	914.24	914.27	914.24
	914.27	914.24	914.15	914.00	913.65
	913.75	913.56	913.33	913.05	912.75
	912.90	913.00	913.05	913.07	913.07
	913.06	912.98	912.84	912.67	912.47
	912.23	911.97	911.67	911.37	911.18
	911.18	911.00	910.80	910.56	910.33
	910.33	910.16	909.96	909.75	909.50

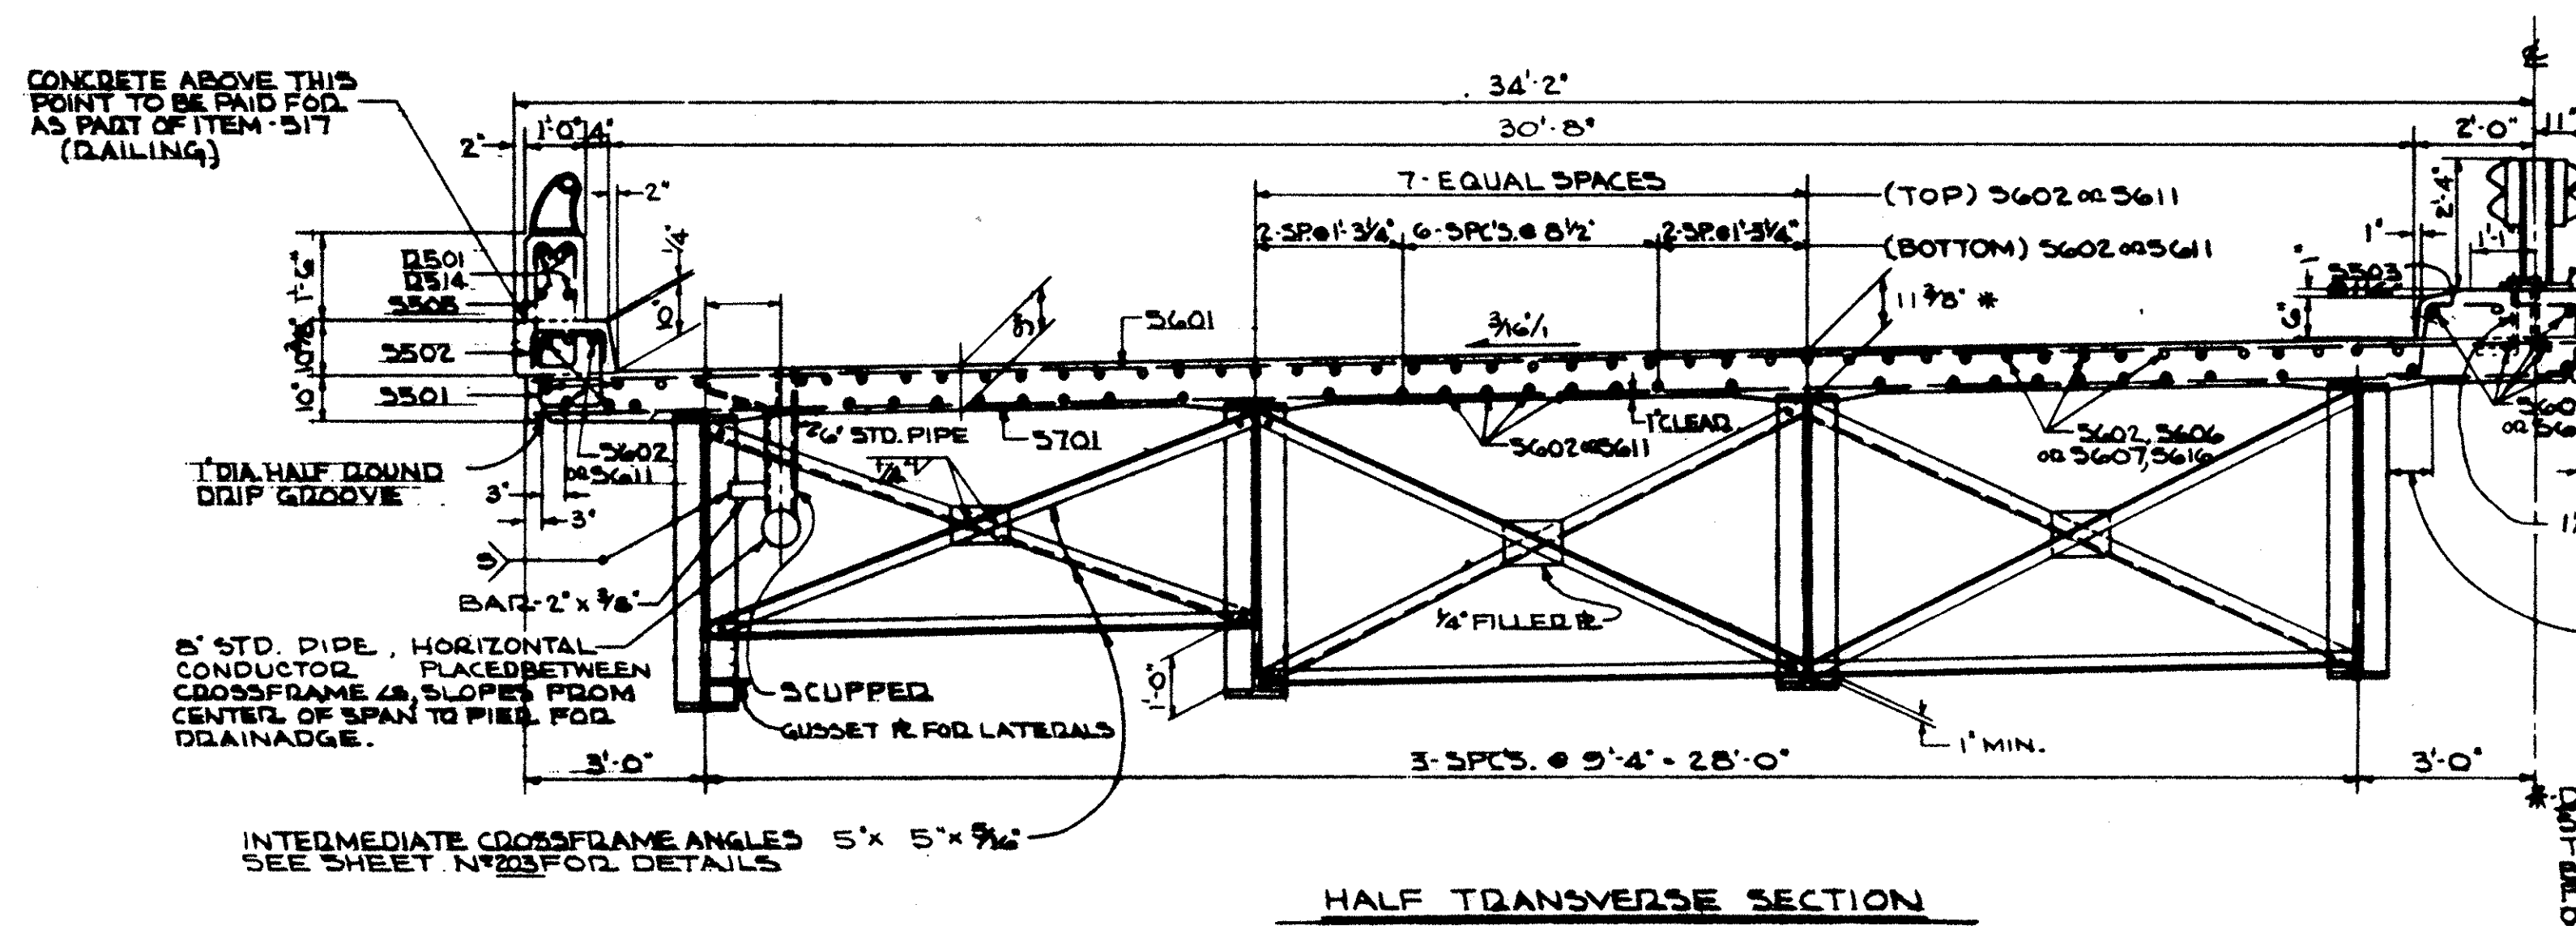

NOTE:
THE ELEVATIONS SHOWN AT THE FACE OF CURBS ARE THOSE WHICH ARE REQUIRED BEFORE THE CONCRETE DECK IS PLACED. PROPER ALLOWANCE HAS BEEN MADE FOR THE DEAD LOAD DEFLECTIONS CAUSED BY THE WEIGHT OF THE CONCRETE.

DECK SLAB DEPTH: THE DISTANCE SHOWN FROM TOP OF THE DECK SLAB TO TOP OF THE WEB PLATE IS THE NOMINAL DIMENSION. THE QUANTITY OF DECK CONCRETE TO BE PAID FOR SHALL BE BASED ON THIS DIMENSION EVEN THOUGH DEVIATION FROM IT MAY BE NECESSARY BECAUSE THE TOP FLANGE OF THE GIRDED MAY NOT HAVE THE EXACT CAMBER OR CONFORMATION REQUIRED TO PLACE IT PARALLEL TO THE FINISHED GRADE. DEDUCTION SHALL BE MADE FOR VOLUME OF ENCASED STEEL PLATES.

This sheet supersedes sheet No. 206 9-12-69

STATE OF OHIO
DEPARTMENT OF HIGHWAYS
BUREAU OF BRIDGES

GLAUS, PYLE & SCHOMER
AKRON, OHIO YOUNGSTOWN, OHIO

SLAB DETAILS
BRIDGE #2 MAH-711-016
OVER MAHONING RIVER
YOUNGSTOWN MAHONING COUNTY

UNIT # 3


DESIGNED	DRAWN	TRACED	CHECKED	REVIEWED	DATE	REVISED
JP	J.D.P.		J.C.	W.K.D.	6-22-68	

MODIFIED
JUN 13 1969
REPRODUCTION

FED. RD.	STATE	PROJECT	
2	OHIO	US 1155 M	

MAH. 711-017

2065
232

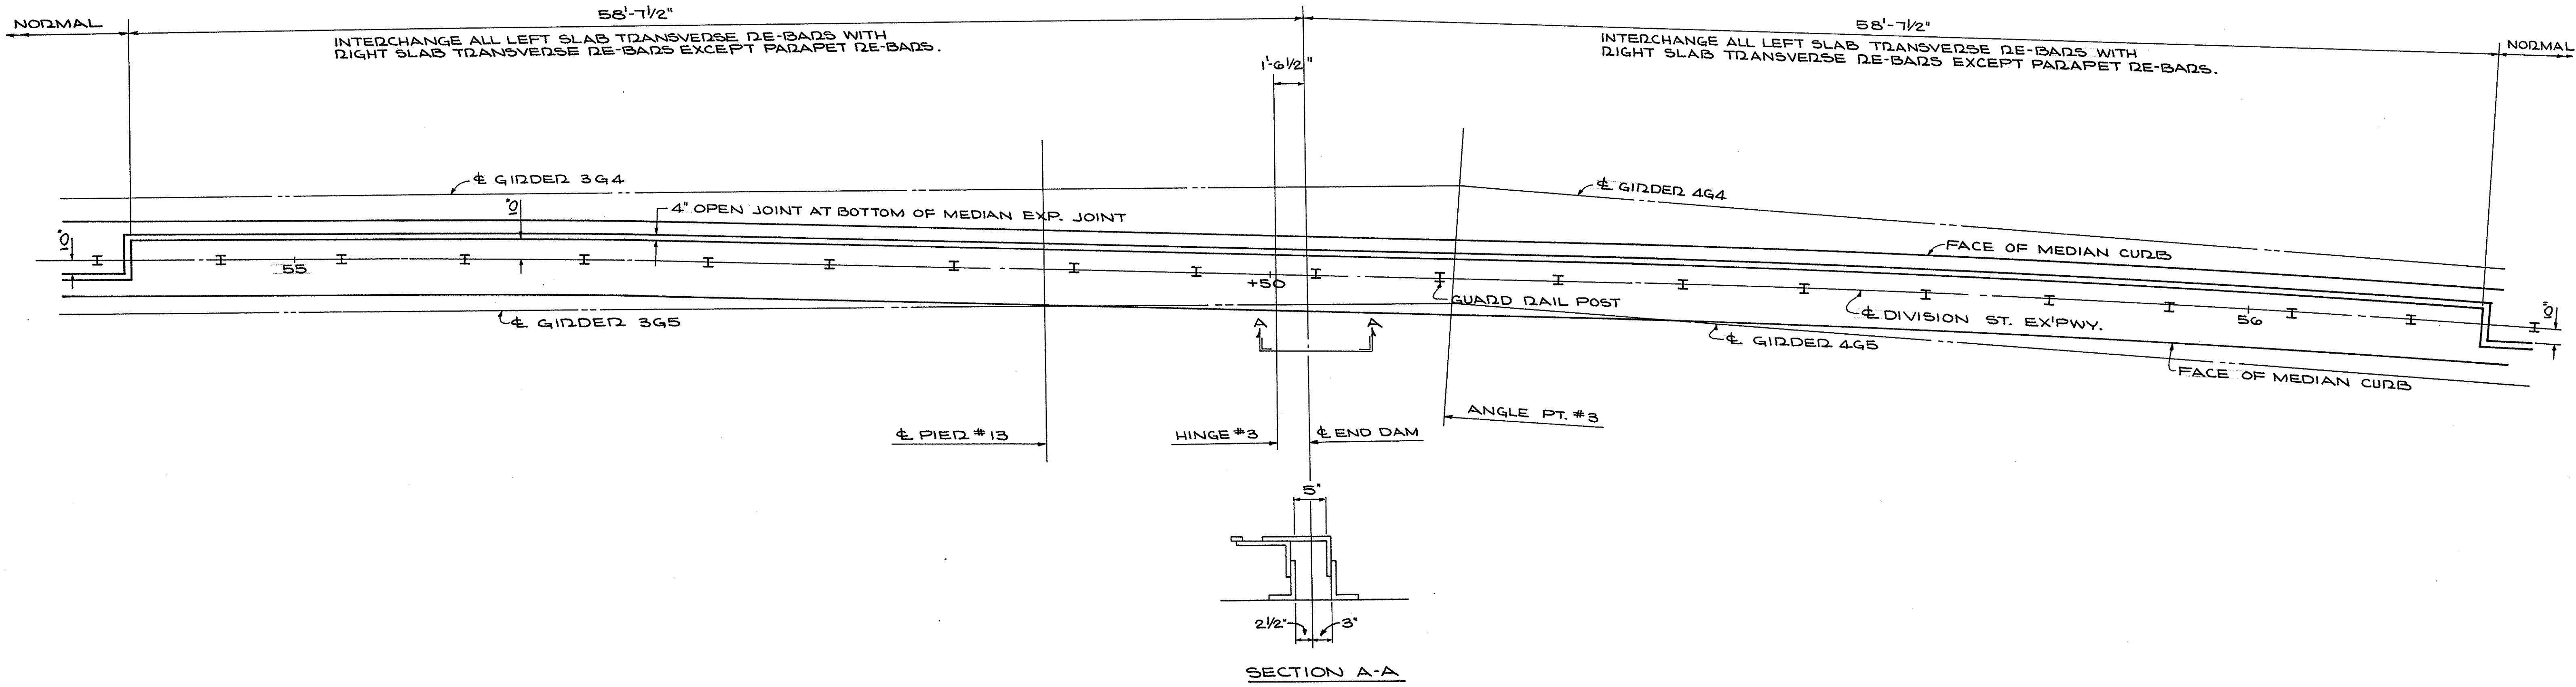

This sheet added 5-24-71


STATE OF OHIO DEPARTMENT OF HIGHWAYS BUREAU OF BRIDGES						
GLAUS, PYLE, SCHOMER, BURNS & DeHAVEN AKRON, OHIO YOUNGSTOWN, OHIO						
REVISED MEDIAN EXP. JT.						
BRIDGE N ^o MAH- 711- 0116						
OVER MAHONING RIVER						
YOUNGSTOWN MAHONING COUNTY						
UNIT 3 & 4						
DESIGNED	DRAWN	TRACED	CHECKED	REVIEWED	DATE	REVISED

MAH-711-016
JUN 13 1969
REVISION


FED. RD.	STATE	PROJECT
2	OHIO	U.S.-1150 (I)

207
232

MAH-711-0.17

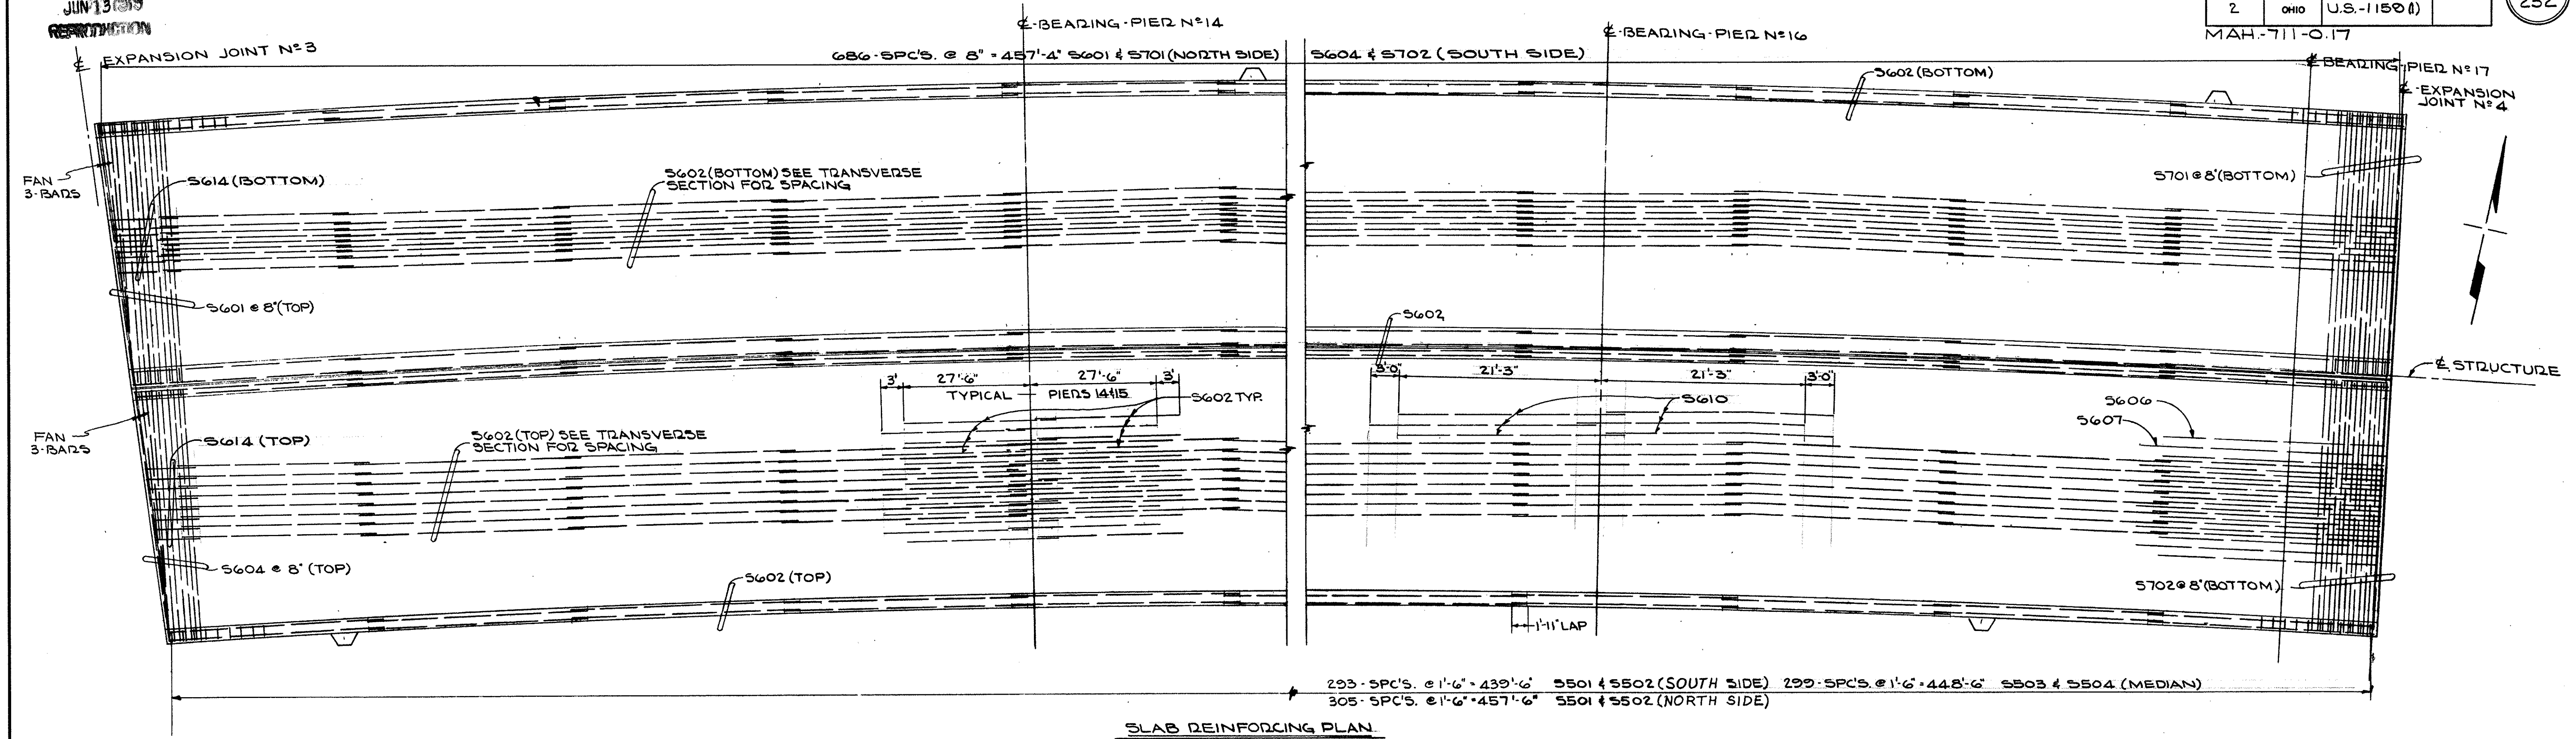

SLAB REINFORCING PLAN

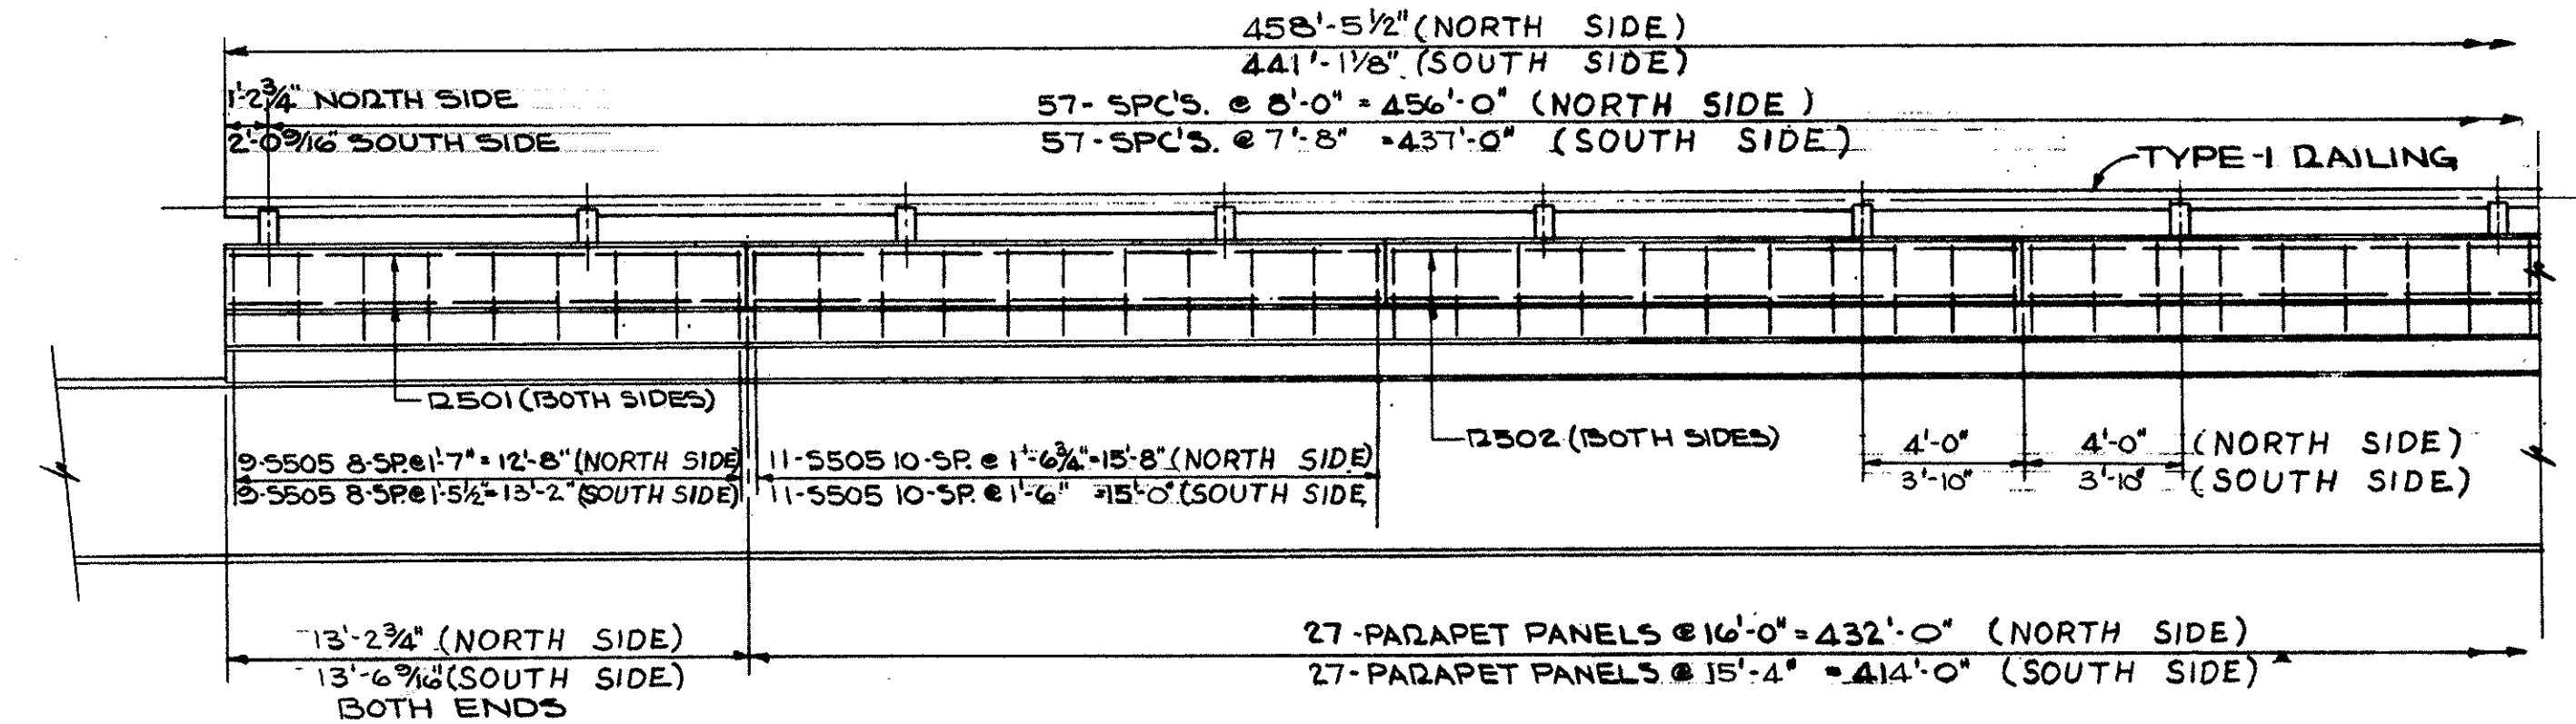


ELEVATION - RAILING DETAILS

EXPANSION JOINT N° 3	913.65	913.74	913.83	913.92	912.89	912.98	912.19	912.19	911.70	911.81	910.82	910.94	909.91	909.50	909.07	908.64	908.20	907.79	907.43	907.00	906.76	906.64		
	911.48	911.20	910.86	910.53	910.22	909.90	909.56	909.19	908.76	908.31	907.83	907.35	906.92	906.51	906.08	905.64	905.21	904.80	904.43	904.09	903.79	903.66	903.64	
	PIER N° 14												PIER N° 15				PIER N° 16				PIER N° 17		EXPANSION JOINT N° 4	

DECK ELEVATIONS

NOTE:
THE ELEVATIONS SHOWN AT THE FACE OF CURBS ARE THOSE WHICH ARE REQUIRED BEFORE THE CONCRETE DECK IS PLACED. PROPER ALLOWANCE HAS BEEN MADE FOR THE DEAD LOAD DEFLECTIONS CAUSED BY THE WEIGHT OF THE CONCRETE.

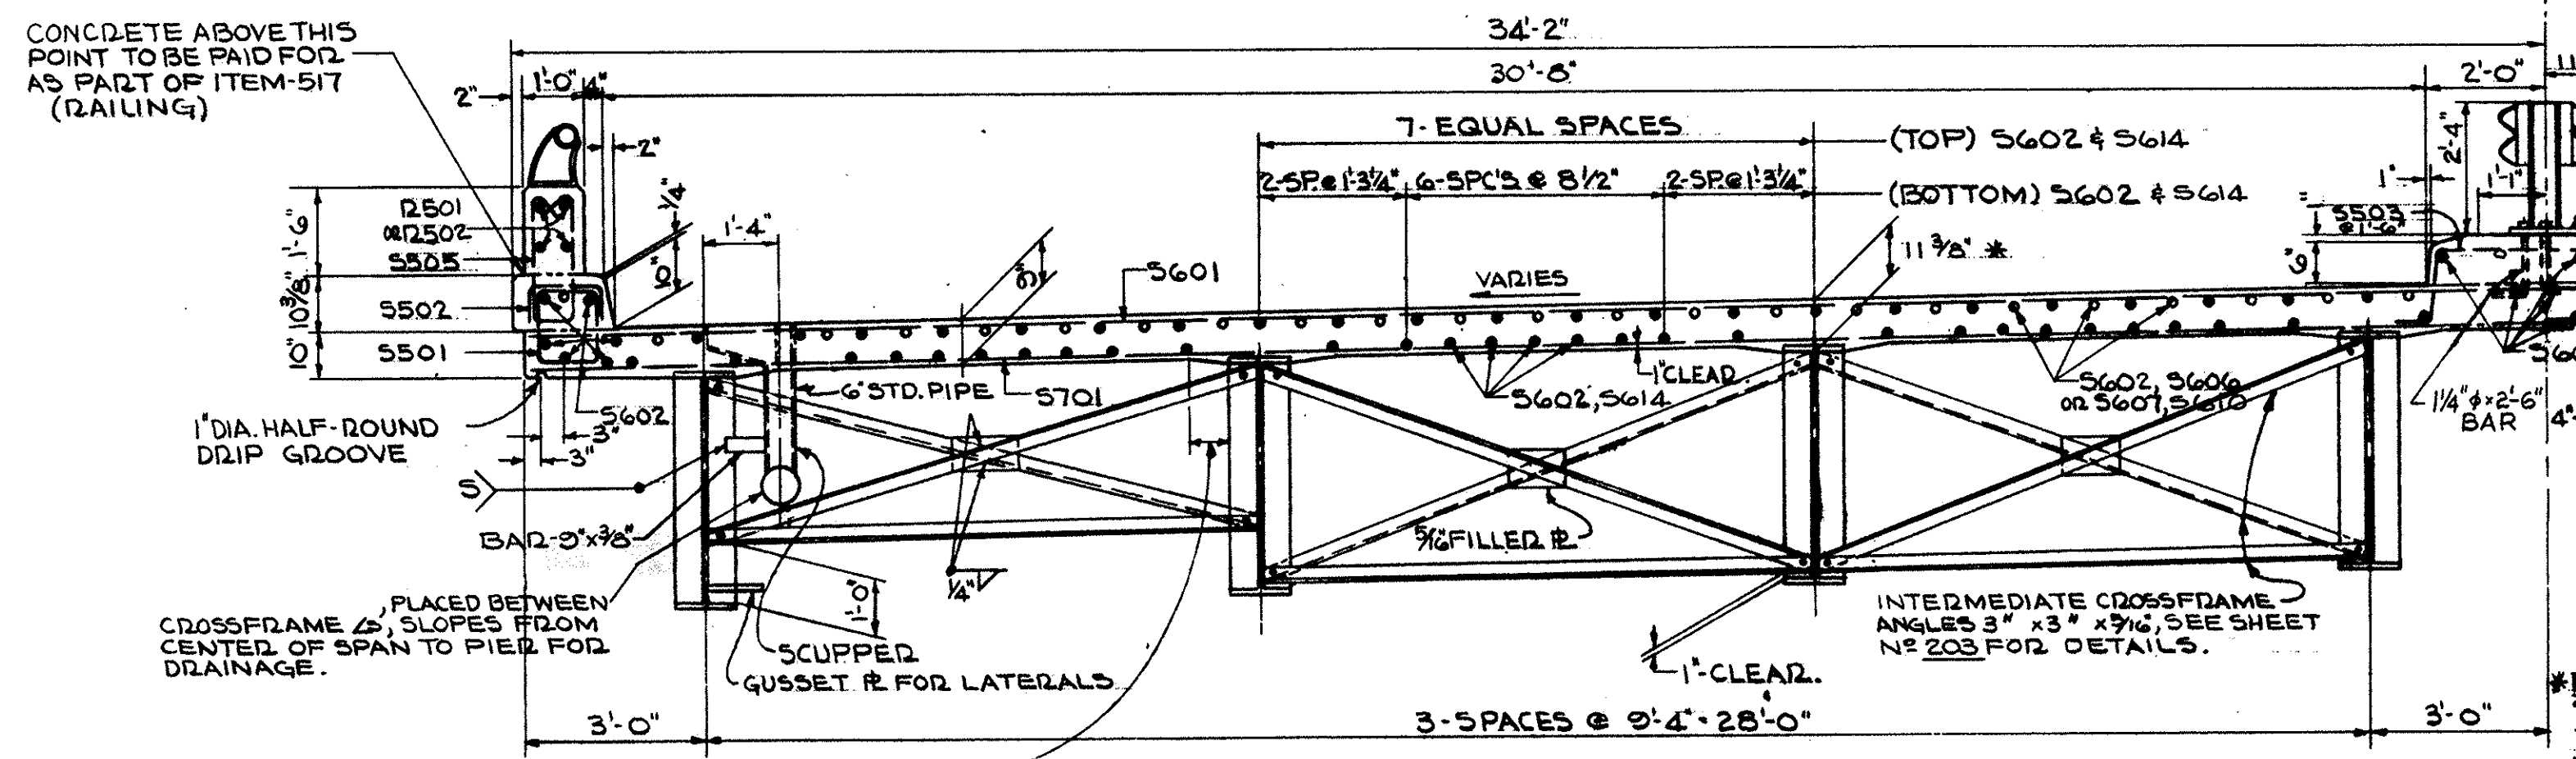

HALF TRANSVERSE SECTION

*DECK SLAB DEPTH: THE DISTANCE SHOWN FROM TOP OF THE DECK SLAB TO TOP OF THE WEB PLATE IS THE NOMINAL DIMENSION. THE QUANTITY OF DECK CONCRETE TO BE PAID FOR SHALL BE BASED ON THIS DIMENSION EVEN THOUGH DEVIATION FROM IT MAY BE NECESSARY BECAUSE THE TOP FLANGE OF THE GIRDED MAY NOT HAVE THE EXACT CAMBER OR CONFORMATION REQUIRED TO PLACE IT PARALLEL TO THE FINISHED GRADE, DEDUCT VOLUME OF ENCASED STEEL PLATES.

CONCRETE ABOVE THIS POINT TO BE PAID FOR AS PART OF ITEM-517 (RAILING)

PLACED BETWEEN CROSSFRAME & SLOPES FROM CENTER OF SPAN TO PIER FOR DRAINAGE.

A TYPICAL HAUNCH WIDTH OF 9" SHALL BE USED FOR COMPUTING QUANTITY OF CONCRETE. HOWEVER, THE HAUNCH WIDTH MAY VARY BETWEEN 6" AND 12" PROVIDED THAT THE SLOPE SHALL BE NOT MORE THAN 1:4 FOR A HAUNCH LESS THAN 9" IN WIDTH.

This sheet is superseded by sheet No. 207A. 9-12-69


STATE OF OHIO DEPARTMENT OF HIGHWAYS BUREAU OF BRIDGES					
GLAUS, PYLE & SCHOMER AKRON, OHIO YOUNGSTOWN, OHIO					
SLAB DETAILS					
BRIDGE N°		MAH-711-016			
OVER MAHONING RIVER					
YOUNGSTOWN		MAHONING COUNTY			
UNIT N° 4					
DESIGNED	DRAWN	TRACED	CHECKED	REVIEWED	DATE
J.P.	J.R.P.		J.C.	W.K.D.	6-22-68

MICROFILMED
JUNE 13, 1971
REPRODUCTION
G6.


FED. RD.	STATE	PROJECT
2	OHIO	U.S.-1150 (1)

208A
232


MAH-711-0.17

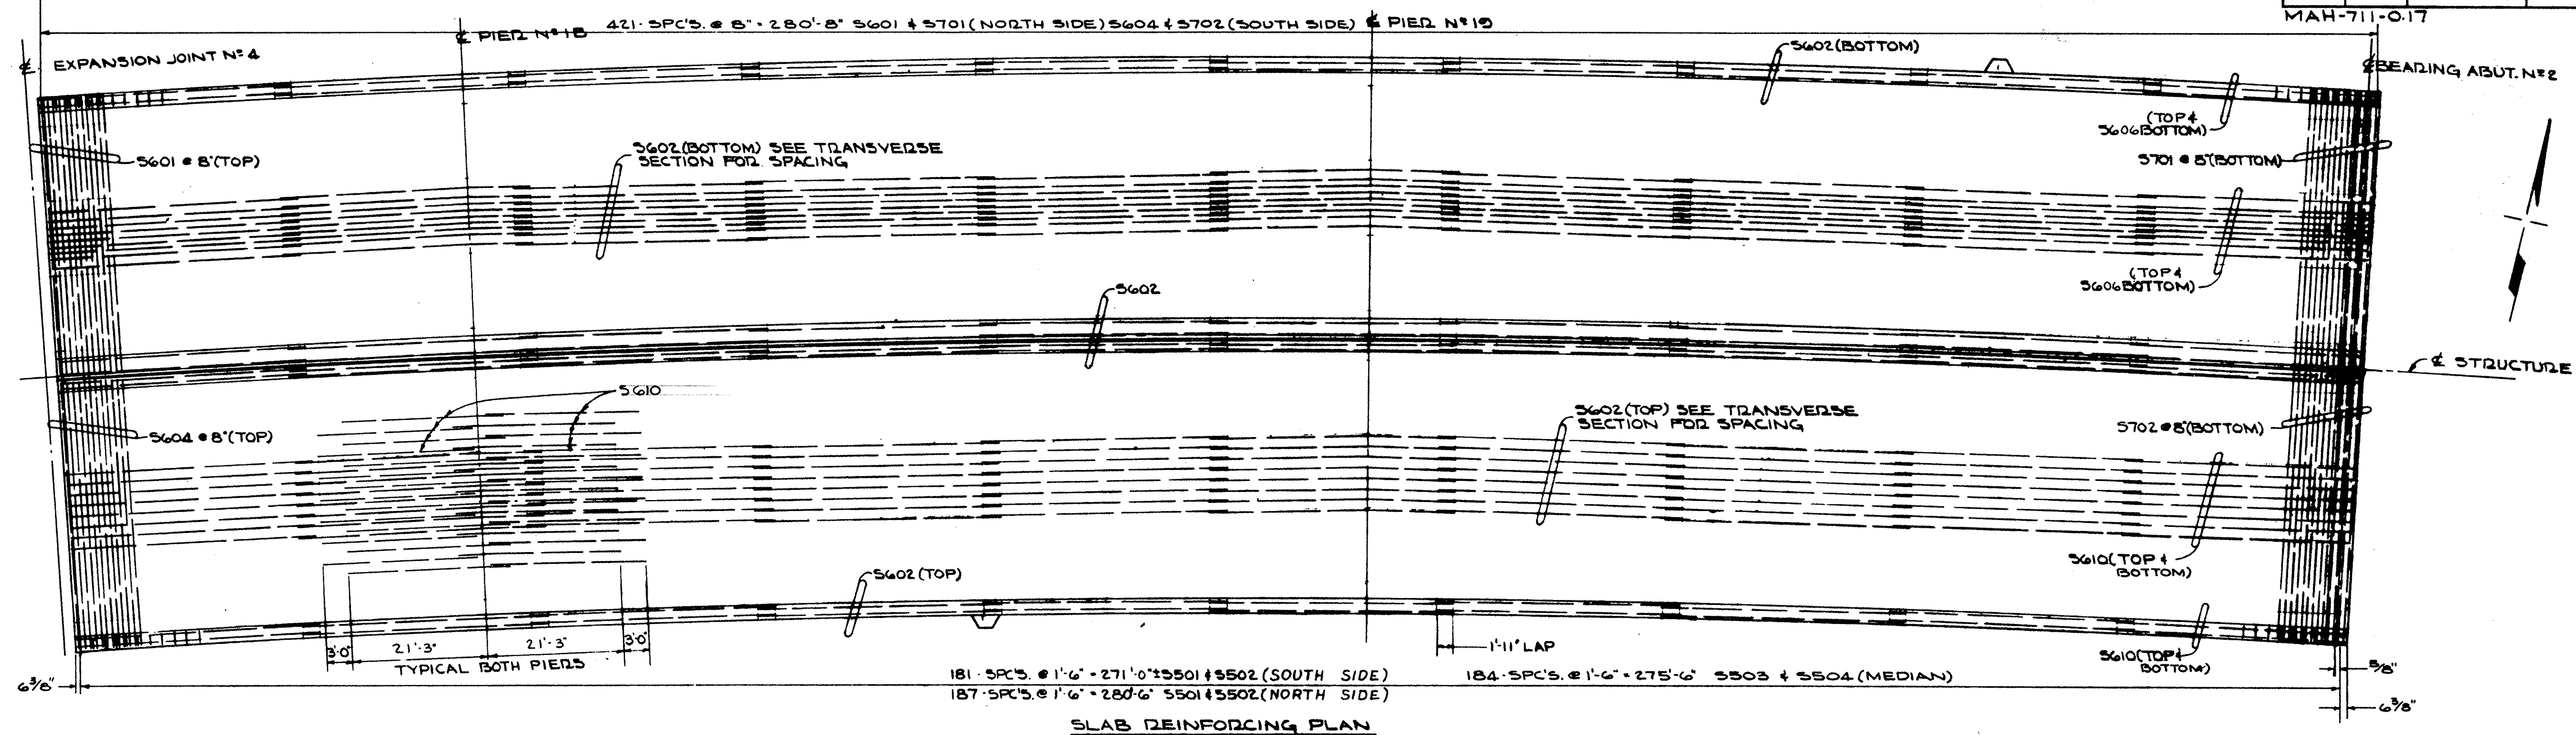

SLAB REINFORCING PLAN

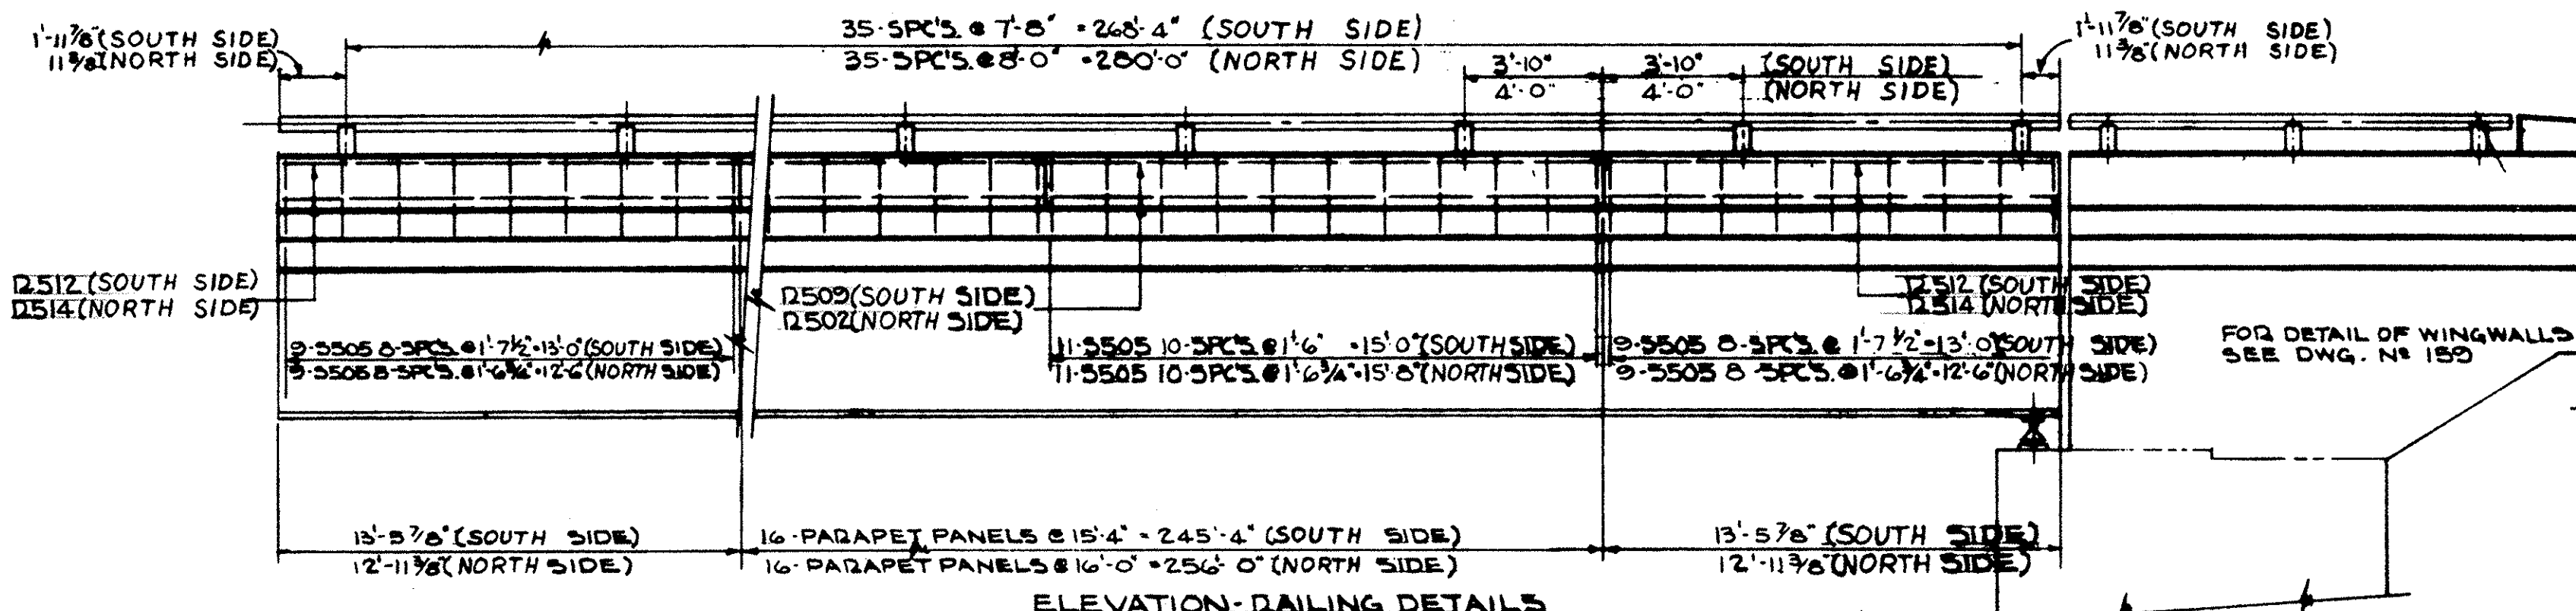

ELEVATION-RAILING DETAILS

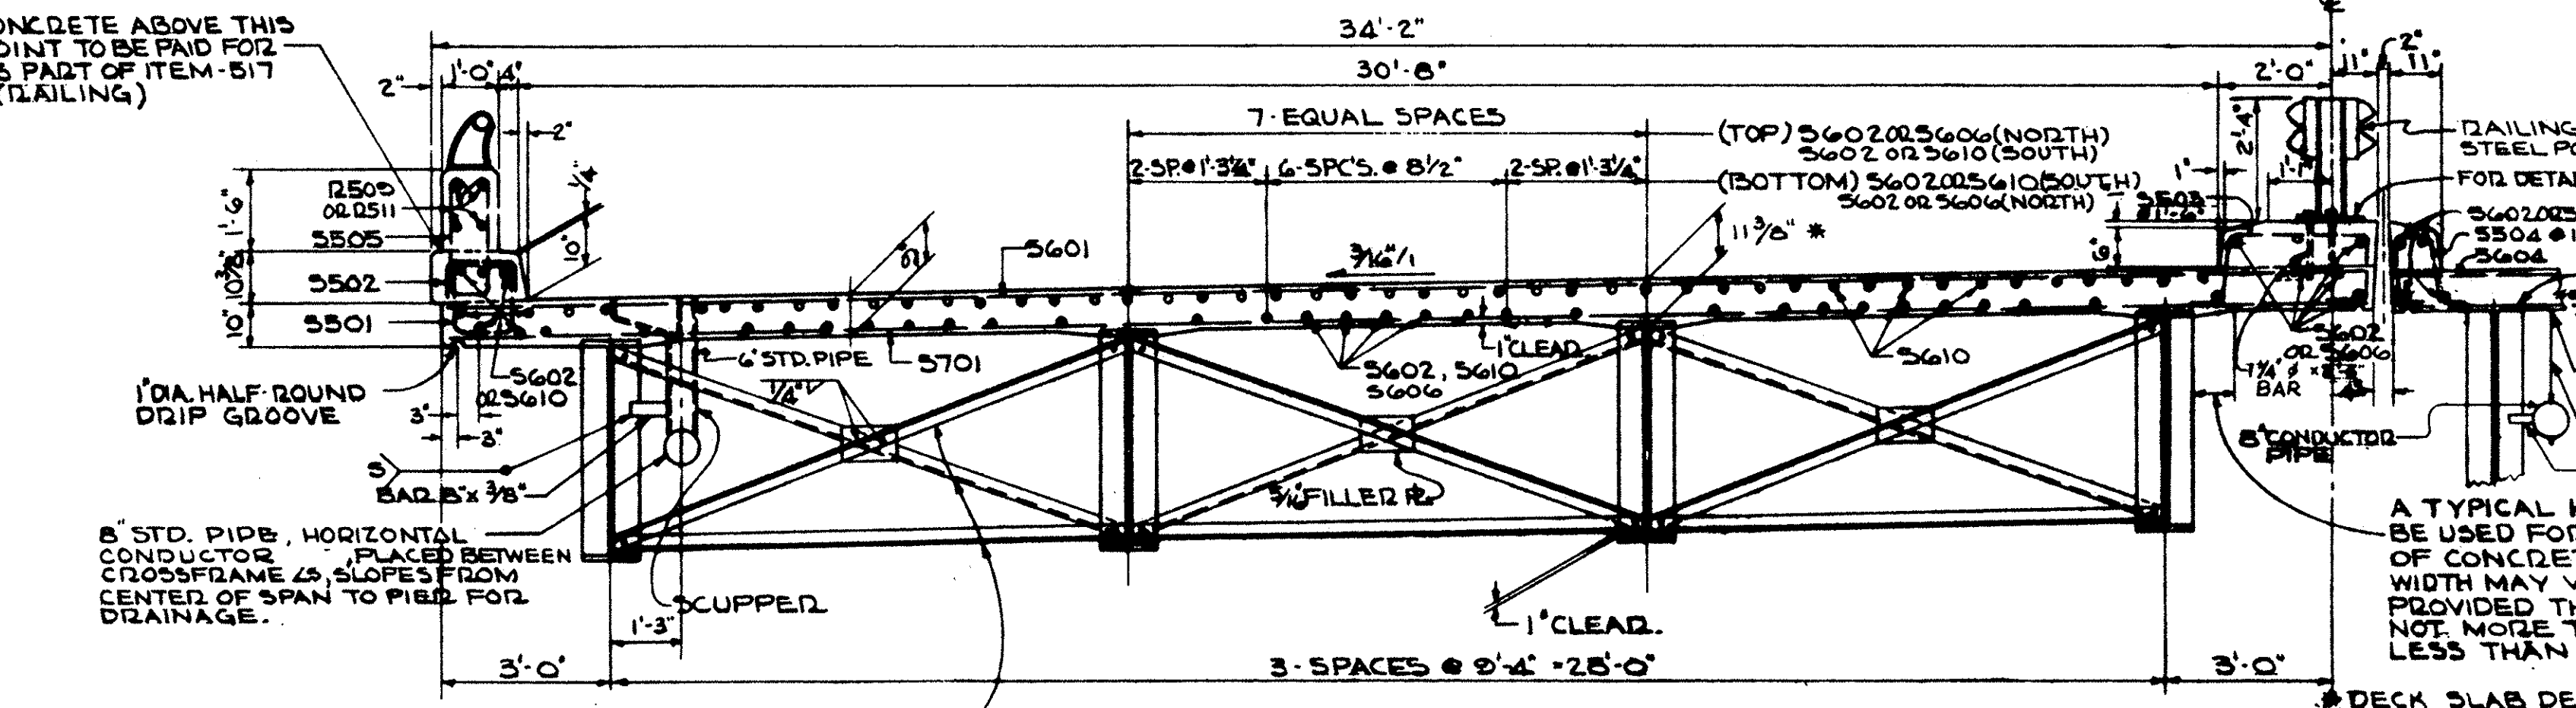

HALF TRANSVERSE SECTION

CONCRETE ABOVE THIS POINT TO BE PAID FOR AS PART OF ITEM-517 (RAILING)

6" STD. PIPE, HORIZONTAL CONDUCTOR PLACED BETWEEN CROSSFRAME AS SLOPES FROM CENTER OF SPAN TO PIER FOR DRAINAGE.

INTERMEDIATE CROSSFRAME ANGLES 3" x 3" x 9/16" SEE SHEET N° 203 FOR DETAILS

FOR DETAIL OF WINGWALLS SEE DWG. N° 153


A TYPICAL HAUNCH WIDTH OF 9" SHALL BE USED FOR COMPUTING QUANTITY OF CONCRETE. HOWEVER, THE HAUNCH WIDTH MAY VARY BETWEEN 6" AND 12" PROVIDED THAT THE SLOPE SHALL BE NOT MORE THAN 1:4 FOR A HAUNCH LESS THAN 9" IN WIDTH.

DECK SLAB DEPTH: THE DISTANCE SHOWN FROM TOP OF THE DECK SLAB TO TOP OF THE WEB PLATE IS THE NOMINAL DIMENSION. THE QUANTITY OF DECK CONCRETE TO BE PAID FOR SHALL BE BASED ON THIS DIMENSION, EVEN THOUGH DEVIATION FROM IT MAY BE NECESSARY BECAUSE THE TOP FLANGE OF THE GIRDED MAY NOT HAVE THE EXACT CAMBER OR CONFORMATION REQUIRED TO PLACE IT PARALLEL TO THE FINISHED GRADE. DEDUCTION SHALL BE MADE FOR VOLUME OF ENCASED STEEL PLATES.


FACE OF CURB	FACE OF CURB
906.45	905.45
906.53	903.34
906.08	903.21
906.87	903.12
905.48	903.07
905.55	903.07
905.42	903.18
905.31	903.34
905.26	903.54
905.29	903.86
905.38	904.23
905.49	904.61
905.60	905.01

NOTE: THE ELEVATIONS SHOWN AT THE FACE OF CURBS ARE THOSE WHICH ARE REQUIRED BEFORE THE CONCRETE DECK IS PLACED. PROPER ALLOWANCE HAS BEEN MADE FOR THE DEAD LOAD DEFLECTIONS CAUSED BY THE WEIGHT OF THE CONCRETE.


DECK ELEVATIONS

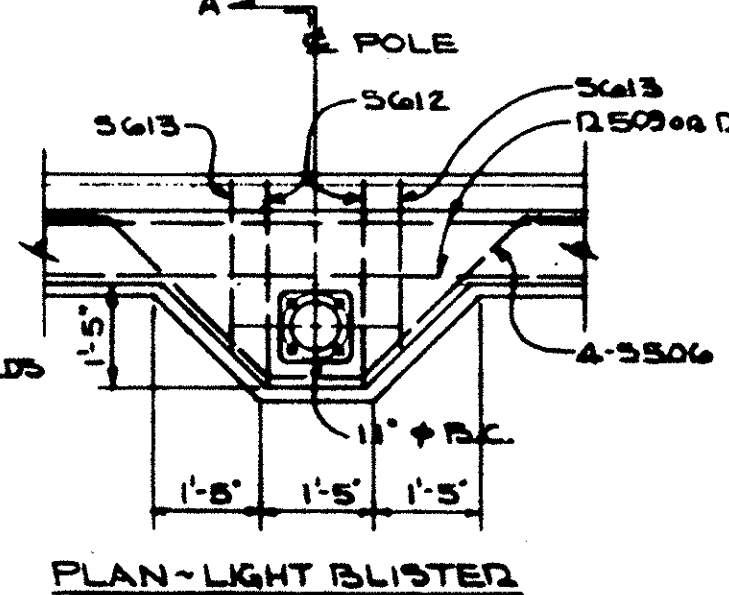

PLAN-LIGHT BLISTER

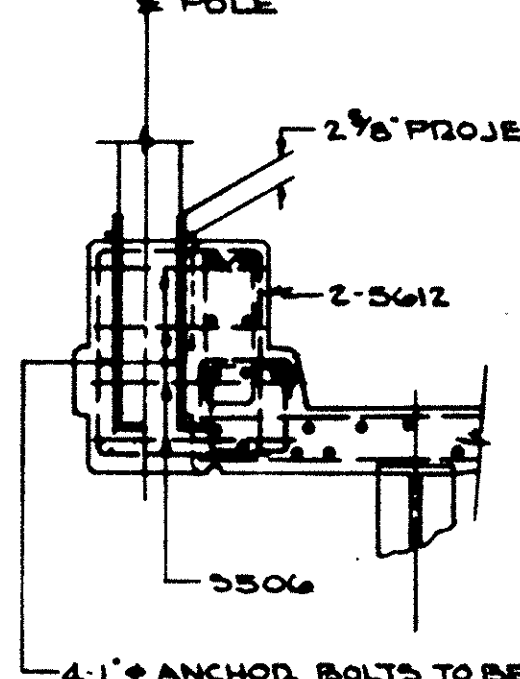

SECTION-A

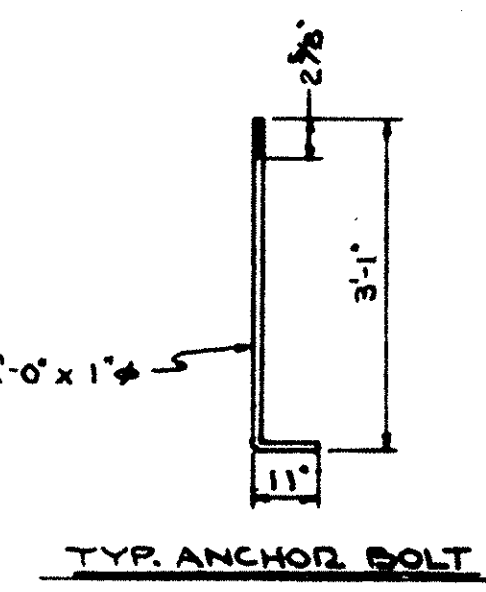

TYP. ANCHOR BOLT

STATE OF OHIO DEPARTMENT OF HIGHWAYS BUREAU OF BRIDGES	
AKRON, OHIO	YOUNGSTOWN, OHIO
GLAUS, PYLE & SCHOMER	
BRIDGE N° MAH-711-0116	
OVER MAHONING RIVER	
YOUNGSTOWN MAHONING COUNTY	
UNIT N° 5	
DESIGNED RH	DRAWN J.D.P.
TRACED J.C.	CHECKED J.C.
REVIEWED WKB	DATE 6-22-68
REVISED	

This sheet supersedes sheet No. 208. 9-12-69

SUPERSTRUCTURE				
MARK	NUMBER	LENGTH	WEIGHT	SHAPE
S501	2,981	4'-4"	13,463	BT
S502	2,981	2'-0"	6,218	BT
S503	1,490	5'-0"	7,770	BT
S504	1,490	3'-0"	4,662	BT
S505	2,985	5'-7"	17,373	BT
S506	68	9'-11"	704	BT
S601	3,002	34'-2"	154,073	ST
S602	11,534	30'-0"	519,722	ST
S603	241	36'-0"	13,031	ST
S604	3,398	32'-6"	165,873	ST
S605	191	18'-9"	5,379	ST
S606	179	28'-6"	7,662	ST
S607	188	31'-6"	8,895	ST
S609	150	26'-7"	5,988	ST
S610	155	23'-9"	5,529	ST
S611	122	5'-10"	1,068	ST
S612	58	10'-6"	915	BT
S613	38	9'-9"	556	BT
S614	89	9'-0"	1,203	ST
S615	122	16'-1"	2,947	ST
S616	84	12'-9"	1,800	ST
S617	191	11'-10"	3,402	ST
S701	3,002	34'-2"	209,670	ST
S702	3,374	32'-6"	224,135	ST
S704	4	39'-9"	325	ST
S705	8	13'-6"	221	BT
S706	382	30'-0"	23,424	ST
S707	191	18'-9"	7,320	ST
S708	191	11'-10"	4,630	ST
S801	68	9'-0"	1,634	ST
SUPERSTRUCTURE TOTAL		1,419,592		

ABUTMENTS				
MARK	NUMBER	LENGTH	WEIGHT	SHAPE
A501	5360	10'-0"	626,553	BT
A502	4	7'-6"	31	BT
A503	1088	6'-4"	713,680	BT
A504	42	40'-6"	395,317	ST
A505	12	5'-3"	66	ST
A506	2416	10'-3"	171,051	ST
A507	4	9'-6"	40	ST
A508	4	11'-3"	47	ST
A509	16	16'-0"	267	ST
A510	80	2'-3"	188	BT
A511	24	9'-9"	244	BT
A512	2	8'-0"	17	BT
A513	2	6'-11"	14	BT
A514	2	4'-8"	10	ST
A515	2	3'-8"	8	ST
A516	12	8'-4"	104	BT
A517	50	5'-8"	296	BT
A518	50	6'-10"	356	BT
A519	502	12'-3"	664,732	BT
A520	24	6'-8"	167	ST
A521	2	5'-7"	12	ST
A522	2	4'-3"	9	ST
A523	14	2'-8"	39	ST
A524	12	14'-1"	176	ST
A525	4	13'-0"	54	ST
A526	4	13'-11"	58	ST
A527	4	14'-10"	62	ST
A528	12	20'-1"	251	ST
A529	40	34'-6"	1439	ST
A530	2	8'-9"	18	BT
A531	2	7'-4"	15	BT
A532	14	5'-11"	86,439	BT
A533	105	6'-3"	684	BT
AG01	50	14'-7"	1095	BT
AG02	120	24'-2"	363,439	BT
AG03	1982	15'-9"	191,569	BT
AG04	4	14'-9"	20,500	BT
AG05	60	17'-6"	177,393	BT
AG06	24	18'-8"	709	BT
AG07	68	18'-8"	1907	BT
AG08	8	6'-7"	79	ST
A801	14	35'-2"	135,674	ST
A802	8	17'-1"	30,665	ST
A803	2	11'-10"	63,800	BT
A804	2	13'-10"	7,944	BT
A805	6	13'-3"	212,270	ST
A806	6	13'-6"	216,279	ST
A807	14	41'-3"	196,323	ST
ABUTMENTS TOTAL		2,115	20,299	

PIERS				
MARK	NUMBER	LENGTH	WEIGHT	SHAPE
P501	650	9'-11"	6,723	ST
P502	478	7'-6"	3,739	BT
P503	122	16'-3"	2,068	ST
P504	88	12'-4"	1,132	BT
P505	1084	7'-10"	8,856	BT
P506	256	8'-10"	2,625	BT
P507	300	11'-10"	3,515	BT
P508	26	19'-6"	529	ST
P509	24	15'-2"	380	ST
P510	22	11'-0"	252	ST
P511	2	25'-6"	53	ST
P512	2	21'-2"	44	ST
P513	2	17'-0"	35	ST
P514	120	9'-10"	1,231	BT
P515	284	10'-10"	3,209	BT
P516	40	7'-9"	323	BT
P517	120	8'-10"	1,106	BT
P518	202	8'-0"	1,685	BT
P519	188	10'-10"	2,124	BT
P520	44	12'-10"	589	BT
P521	52	14'-10"	804	BT
P522	288	37'-0"	11,114	ST
P523	436	8'-10"	405,330	BT
P524	588	12'-10"	7,870	BT
P525	8	36'-6"	305	ST
P526	216	13'-10"	3,117	BT
P527	68	16'-10"	1,194	BT
P528	24	12'-4"	309	BT
P529	24	11'-4"	284	BT
P601	40	18'-2"	1,091	ST
P602	48	39'-3"	2,830	ST
P801	54	19'-10"	2,860	BT
P802	18	25'-10"	1,242	BT
P803	66	13'-0"	229,222	ST
P804	64	10'-6"	1,794	ST
P805	62	8'-9"	1,448	ST
P806	168	16'-8"	7,476	ST
P807	120	16'-4"	5,233	ST
P808	308	13'-10"	11,376	BT
P901	856	6'-5"	18,676	BT
P902	267	11'-2"	10,137	BT
P903	856	15'-0"	43,656	ST
P904	732	14'-2"	35,259	BT
P905	56	15'-8"	2,983	BT
P906	30	22'-2"	2,261	BT
P1001	356	19'-6"	29,871	BT
P1002	148	17'-0"	10,826	ST
P1003	8	28'-10"	993	BT
P1004	8	24'-6"	843	BT
P1005	8	19'-4"	686	BT
P1006	11	26'-4"	1,246	ST
P1007	14	22'-4"	1,325	ST
P1008	265	30'-8"	34,969	ST
P1009	26	15'-0"	1,678	BT
P1010	56	21'-6"	5,181	BT
P1011	120	18'-6"	3,553	BT
P1012	44	38'-8"	7,321	BT
P1013	94	31'-4"	12,674	ST
P1014	40	36'-6"	6,282	ST
P1015	56	18'-0"	4,578	BT
P1016	584	6'-11"	17,380	BT
P1017	600	34'-8"	89,503	ST
P1018	24	32'-0"	3,305	ST
P1019	108	21'-10"	10,146	BT
P1101	80	23'-10"	10,130	BT
P1102	92	31'-7"	15,438	ST
P1103	92	36'-10"	18,002	ST
P1104	92	38'-9"	18,941	ST
P1105	276	7'-4"	10,753	BT


PIERS				
MARK	NUMBER	LENGTH	WEIGHT	SHAPE
P1106	50	28'-1"	7,459	ST
P1107	108	18'-7"	10,661	ST
P1108	60	22'-5"	7,147	ST
P1109	108	9'-8"	5,547	BT
P1110	48	24'-4"	6,205	BT
P1111	64	31'-4"	10,654	BT
P1112	68	18'-10"	5,803	BT
P1113	50	29'-11"	7,948	ST
P1114	54	37'-7"	10,783	ST
P1115	54	32'-7"	9,348	ST
P1116	32	33'-0"	5,811	BT
P1401	52	15'-7"	6,199	ST
P1402	138	6'-8"	7,042	BT
P1403	8	6'-0"	367	ST
P1404	168	22'-7"	29,024	ST
P1405	56	17'-7"	7,532	ST
P1406	138	11'-8"	12,320	BT
P1407	56	25'-8"	10,997	ST
P1408	56	26'-8"	8,855	ST
P1801	14	44'-2"	8,409	ST
P1802	13	39'-2"	6,925	ST
P1803	64	37'-6"	32,642	ST
P1804	18	32'-6"	5,746	ST
P1805	200	8'-10"	24,018	ST
P1806	50	38'-0"	25,840	ST
P1807	50	39'-11"	27,146	ST
P1808	50	39'-4"	26,744	ST
P1809	44	35'-7"	21,293	ST
P1810	44	36'-7"	18,301	ST
P1811	72	7'-4"	7,180	BT
P1812	70	12'-4"	11,741	BT
P1813	200	13'-10"	37,617	ST

SPIRAL REINFORCING LIST						
MARK	NUMBER	CORE DIA.	LENGTH OF SPIRAL	PITCH	NO OF TURNS	WEIGHT
SP401	4	3'-1"	27'-11"	4"	87	2,248
SP402	4	3'-1"	33'-3"	4"	103	2,661
SP403	4	3'-1"	35'-3"	4"	109	2,816
SP404	4	3'-1"	31'-0"	4"	96	2,491
SP501	1	5'-7"	45'-4"	3"	184	3,363
SP502	1	5'-7"	38'-7"	3"	157	2,869
SP503	4	5'-7"	47'-1"	3"	191	13,962
SP504	4	5'-7"	48'-7"	3"	198	14,473
SP505	4	5'-7"	45'-0"	3"	183	13,377
SPACERS						
						3,145
SPIRAL REINFORCING TOTAL						61,295
GRAND TOTAL PIERS						1,026,414

REPLACEMENT BARS				
MARK	NUMBER	LENGTH	SHAPE	
RE401	2	5'-3"		ST
RE501	9	6'-7"		ST
RE601	43	6'-11"		ST
RE701	24	7'-2"		ST
RE801	3	7'-6"		ST
RE901	9	7'-10"		ST
RE1001	7	8'-3"		ST
RE1101	15	8'-7"		ST
RE1401	6	2'-6"		ST
RE1801	12	2'-6"		ST

NOTE: REPLACEMENT BARS FOR #14 & #18 WILL BE SPLICES USING POSITIVE CONNECTION.

TOTAL REINFORCING	
ABUTMENT TOTAL	2,115
PIERS TOTAL	1,026,414
SUPERSTRUCTURE TOT.	1,419,592
GRAND TOTAL	2,465,121

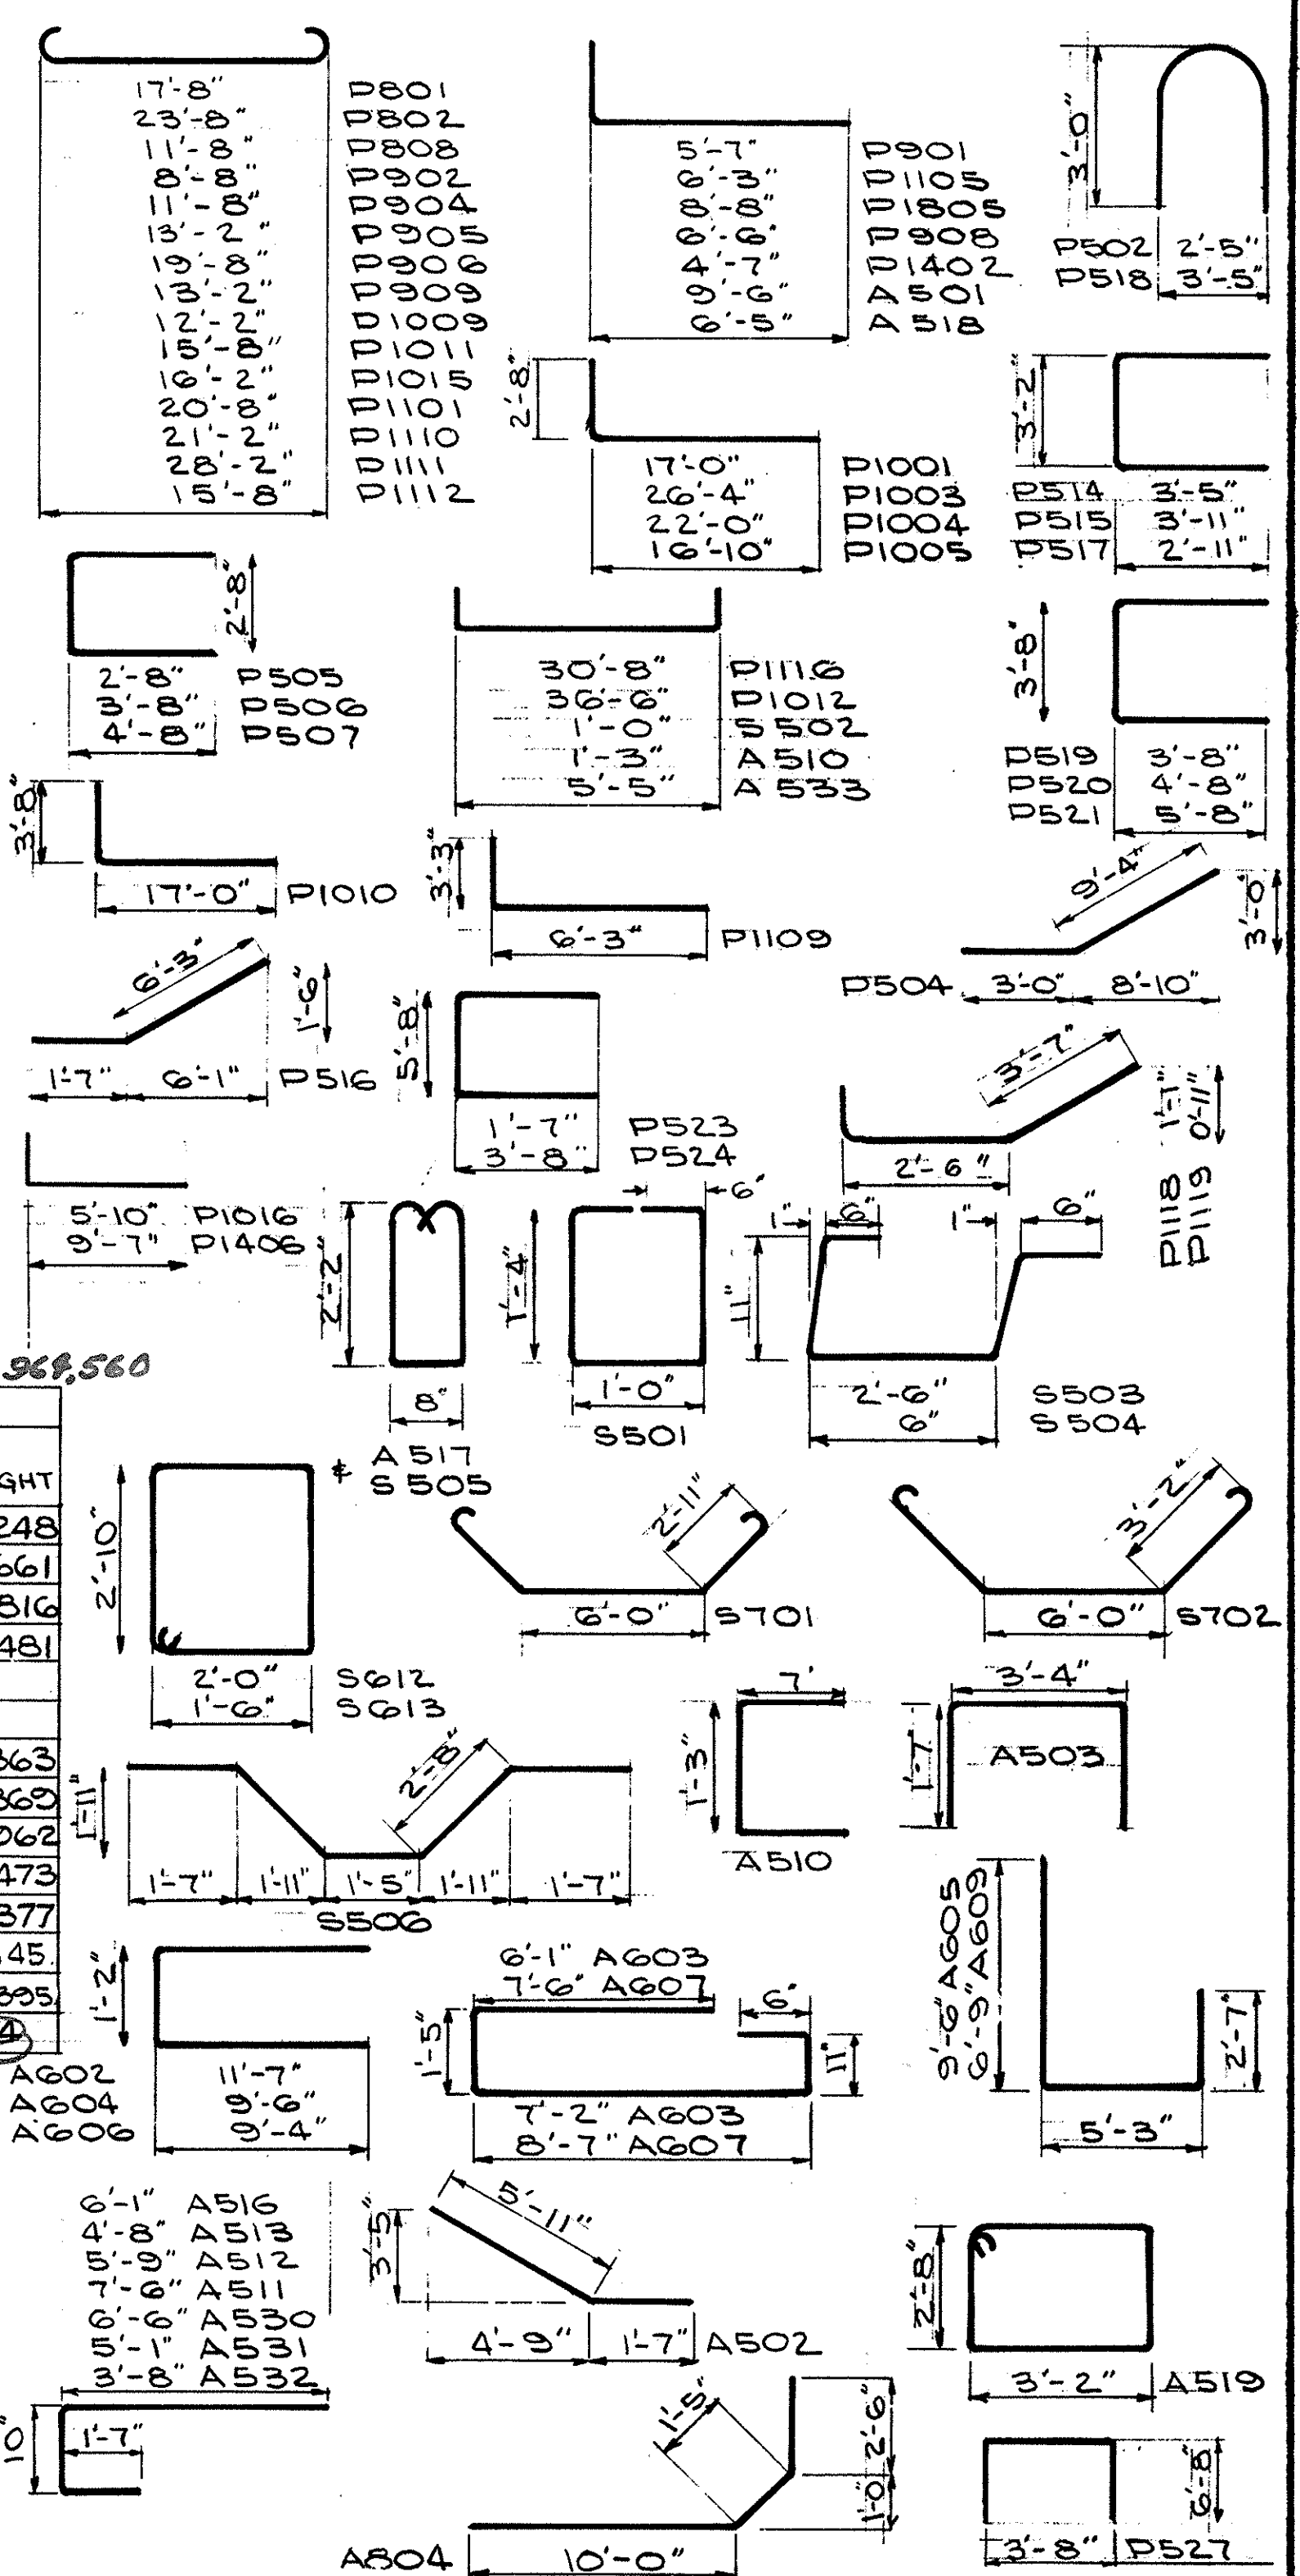

JWC 5-3-68
RAH 6-21-68

STATE OF OHIO
DEPARTMENT OF HIGHWAYS
BUREAU OF BRIDGES

GLAUS, PYLE & SCHOMER
AKRON, OHIO YOUNGSTOWN, OHIO


REINFORCING SCHEDULE

BRIDGE N^o MAH-711-0116
OVER MAHONING RIVER
YOUNGSTOWN MAHONING COUNTY

DESIGNED	DRAWN	TRACED	CHECKED	REVIEWED	DATE	REVISED
JWC	JWC		RH	WKP	6-22-68	7-11-68

RAILING-THESE REINFORCING BARS WILL BE INCLUDED AS PART OF SIT FOR PAYMENT				
MARK	NUMBER	LENGTH	SHAPE	
R501	400	12'-8"		ST
R502	412	15'-8"		ST
R503	12	4'-2"		BT
R504	8	5'-4"		BT
R505	8	12'-11"		ST
R506	120	14'-8"		ST
R507	8	13'-4"		ST
R508	128	12'-9"		ST
R509	68	15'-0"		ST
R510	4	16'-0"		ST
R511	8	12'-7"		ST
R512	4	13'-0"		ST
R513	8	11'-6"		ST
R514	16	12'-6"		ST
R515	72	13'-8"		ST
R516	8	19'-9"		ST
R701	6	13'-0"		BT
R702	2	39'-9"		ST

SPIRAL REINFORCING BARS: THE "LENGTH" SHOWN IN THE STEEL LIST FOR THE SPIRAL BARS IS THE DISTANCE FROM THE TOP OF THE FOOTING TO THE BOTTOM OF THE PIER CAP. THE "NO OF TURNS" SHOWN IS THE "LENGTH" DIVIDED BY THE PITCH, PLUS 3 TURNS (TOTAL NUMBER OF CLOSED COILS), EXPRESSED AS THE NUMBER WHOLE NUMBER. SPIRAL REINFORCING BARS SHALL NOT HAVE DEFORMATIONS BUT SHALL IN OTHER RESPECTS CONFORM TO ITEM 509. 1/2 CLOSED COILS SHALL BE PROVIDED AT THE ENDS OF EACH SPIRAL UNIT. FOUR STEEL CHANNEL, TEE OR ANGLE SPACERS, WEIGHING APPROXIMATELY 0.68 LB. PER LIN. FT. OF SPACER, SHALL BE PROVIDED FOR EACH SPIRAL UNIT. THEY SHALL BE EQUALLY SPACED ALONG THE PERIPHERY OF THE COIL. THE NUMBER OF POUNDS OF THESE SPACERS BASED ON 0.68 LB. PER LIN. FT., WILL BE PAID FOR AS REINFORCING STEEL AND IS INCLUDED IN THE TABULATED QUANTITY OF SPIRAL BARS.

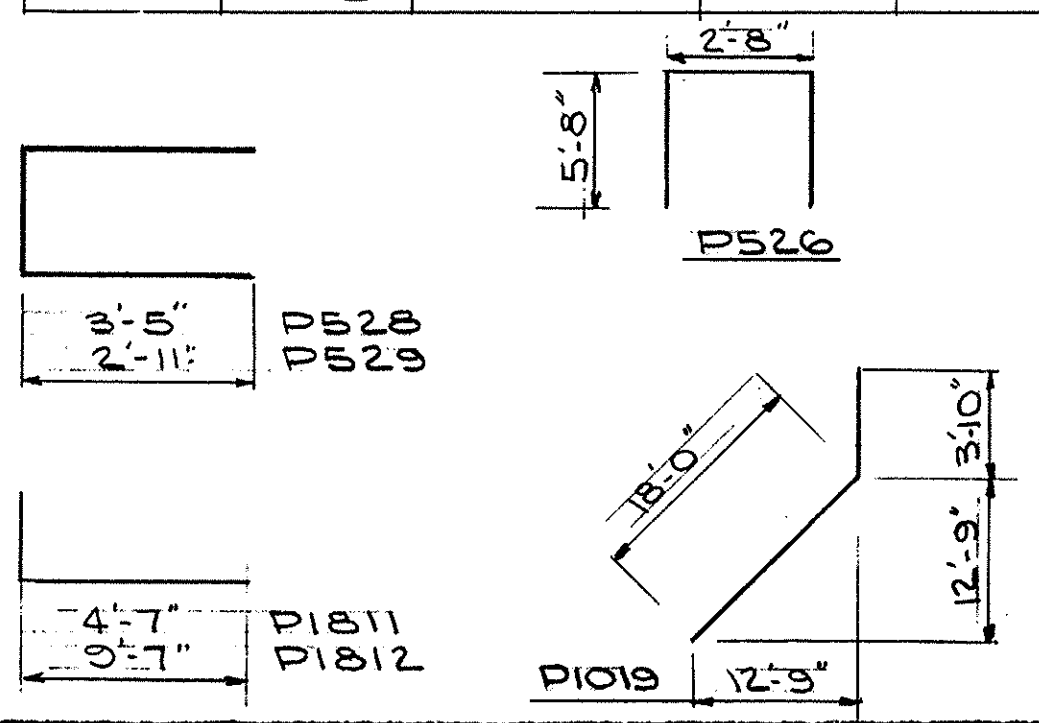

This sheet is superseded by sheet No. 209A, 9-12-69

SUPERSTRUCTURE				
MARK	NUMBER	LENGTH	WEIGHT	SHAPE
S 501	2,981	4'-4"	13,463	BT.
S 502	2,981	2'-0"	6,218	BT.
S 503	1,490	5'-0"	7,770	BT.
S 504	1,490	3'-0"	4,662	BT.
S 505	3,215	5'-7"	18,722	BT.
S 506	68	9'-11"	704	BT.
S 601	3,002	34'-6"	155,560	ST.
S 602	11,010	30'-0"	463,081	ST.
S 603	141,298	36'-0"	7,624	ST.
S 604	3,398	32'-6"	165,873	ST.
S 605	191	18'-9"	5,379	ST.
S 606	131	28'-6"	5,608	ST.
S 607	156,166	31'-6"	7,381	ST.
S 609	282	26'-7"	11,260	ST.
S 610	344	23'-9"	12,271	ST.
S 611	122	5'-10"	1,068	ST.
S 612	68,66	10'-6"	915	ST.
S 613	38	9'-9"	556	ST.
S 614	89,62	9'-0"	1,203	ST.
S 615	122	16'-1"	2,947	ST.
S 616	94	12'-9"	1,800	ST.
S 617	191	11'-10"	3,402	ST.
S 701	3,002	34'-2"	209,670	ST.
S 702	3,374	32'-6"	224,135	ST.
S 704	4	39'-9"	325	ST.
S 705	8	13'-6"	221	ST.
S 706	382	30'-0"	23,424	ST.
S 707	191	18'-9"	7,320	ST.
S 708	191	11'-10"	4,630	ST.
SUPERSTRUCTURE TOTAL			1,368,826	
			1,382,282	

ABUTMENTS				
MARK	NUMBER	LENGTH	WEIGHT	SHAPE
A 501	60	10'-0"	626	BT.
A 502	4	7'-6"	31	BT.
A 503	108	6'-4"	713	BT.
A 504	42	40'-6"	1,774	ST.
A 505	12	5'-3"	66	ST.
A 506	16	10'-3"	171	ST.
A 507	4	9'-6"	40	ST.
A 508	4	11'-3"	47	ST.
A 509	16	16'-0"	267	ST.
A 510	80	2'-3"	188	BT.
A 511	24	30'-9"	244	BT.
A 512	2	8'-0"	17	BT.
A 513	2	6'-11"	14	BT.
A 514	2	4'-9"	10	ST.
A 515	2	3'-8"	8	ST.
A 516	12	8'-4"	104	BT.
A 517	50	5'-8"	296	BT.
A 518	48	6'-11"	346	BT.
A 519	52	12'-3"	664	BT.
A 520	24	6'-8"	167	ST.
A 521	2	5'-7"	12	ST.
A 522	2	4'-3"	9	ST.
A 523	14	2'-8"	39	ST.
A 524	12	14'-1"	176	ST.
A 525	4	13'-0"	54	ST.
A 526	4	13'-11"	58	ST.
A 527	4	14'-10"	62	ST.
A 528	12	20'-11"	251	ST.
A 529	40	34'-6"	1,439	ST.
A 530	2	8'-9"	18	BT.
A 531	2	7'-4"	15	BT.
A 532	14	5'-11"	86	BT.
A 533	108	6'-5"	723	BT.
A 534	4	7'-7"	32	BT.
A 601	48	14'-3"	1,027	BT.
A 602	10	24'-2"	363	BT.
A 603	82	15'-9"	1,940	BT.
A 604	4	14'-4"	86	BT.
A 605	60	17'-6"	1,577	BT.
A 606	24	19'-8"	709	BT.
A 607	68	18'-8"	1,907	BT.
A 608	8	6'-7"	79	ST.
A 801	14	55'-11"	1,343	ST.
A 802	8	17'-1"	365	ST.
A 803	2	11'-10"	63	BT.
A 804	2	13'-10"	74	ST.
A 805	6	13'-3"	212	ST.
A 806	6	13'-6"	216	ST.
A 807	14	41'-3"	1,542	ST.
ABUTMENT TOTAL			20,270	

PIERS				
MARK	NUMBER	LENGTH	WEIGHT	SHAPE
P 601	32	18'-2"	1,934	ST.
P 602	48	39'-3"	2,830	ST.
P 603	8	20'-8"	248	ST.
P 801	54	19'-10"	2,860	BT.
P 802	18	25'-10"	1,242	BT.
P 803	66	13'-0"	2,290	ST.
P 804	64	10'-6"	1,794	ST.
P 805	62	8'-9"	1,448	ST.
P 806	168	16'-8"	7,476	ST.
P 807	120	16'-4"	5,233	ST.
P 808	308	13'-10"	11,376	BT.
P 901	856	6'-5"	18,676	BT.
P 902	267	11'-2"	10,137	BT.
P 903	856	15'-0"	43,656	ST.
P 904	732	14'-2"	35,259	BT.
P 905	56	15'-8"	2,983	BT.
P 906	30	22'-2"	2,261	BT.
P 1001	356	19'-6"	29,871	BT.
P 1002	192	17'-0"	14,045	ST.
P 1003	8	28'-10"	993	BT.
P 1004	8	24'-6"	843	BT.
P 1005	8	19'-4"	666	BT.
P 1006	11	26'-4"	1,246	ST.
P 1007	14	22'-4"	1,345	ST.
P 1008	265	30'-6"	34,779	ST.
P 1009	26	15'-0"	1,678	BT.
P 1010	56	20'-6"	4,940	BT.
P 1011	120	18'-6"	9,553	BT.
P 1012	44	38'-8"	7,321	BT.
P 1013	86	31'-4"	11,595	ST.
P 1014	48	36'-6"	7,539	ST.
P 1015	56	19'-0"	4,578	BT.
P 1016	584	6'-11"	17,380	BT.
P 1017	628	34'-8"	93,679	ST.
P 1018	24	32'-0"	3,305	ST.
P 1019	108	21'-10"	10,146	BT.
P 1101	80	23'-10"	10,130	BT.
P 1102	92	31'-7"	15,438	ST.
P 1103	92	36'-10"	18,002	ST.
P 1104	92	38'-9"	18,941	ST.
P 1105	276	7'-4"	10,753	BT.
P 1106	50	28'-1"	7,459	ST.
P 1107	108	18'-7"	10,661	ST.
P 1108	60	22'-5"	7,147	ST.
P 1109	108	9'-8"	5,547	BT.
P 1110	48	24'-4"	6,205	BT.
P 1111	64	31'-4"	10,654	BT.
P 1112	58	18'-10"	5,803	BT.
P 1113	74	29'-11"	11,762	ST.
P 1114	54	36'-7"	10,496	ST.
P 1115	54	31'-7"	9,061	ST.
P 1116	32	23'-0"	5,611	BT.
P 1401	92	15'-7"	10,968	ST.
P 1402	158	6'-8"	8,058	BT.
P 1403	8	6'-0"	367	ST.
P 1404	168	22'-7"	29,024	ST.
P 1405	56	17'-7"	7,532	ST.
P 1406	158	11'-8"	14,102	BT.
P 1407	56	26'-11"	11,531	ST.
P 1408	56	21'-11"	9,389	ST.
P 1801	14	44'-1"	8,393	ST.
P 1802	13	39'-1"	6,910	ST.
P 1803	64	37'-5"	32,567	ST.
P 1804	13	32'-5"	5,731	ST.
P 1805	200	8'-10"	24,018	ST.
P 1806	50	38'-0"	25,840	ST.
P 1807	50	39'-11"	27,146	ST.
P 1808	50	39'-4"	26,744	ST.
P 1809	44	35'-7"	21,293	ST.
P 1810	44	30'-7"	18,301	ST.
P 1811	72	7'-4"	7,180	BT.
P 1812	70	12'-4"	11,741	BT.
P 1813	200	13'-10"	37,617	ST.
PIERS TOTAL			983,838	

SPIRAL REINFORCING LIST						
MARK	NUMBER	CORE DIA.	LENGTH OF SPIRAL	PITCH	Nº OF TURNS	WEIGHT
SP 401	4	3'-1"	27'-11"	4"	87	2,248
SP 402	4	3'-1"	33'-3"	4"	103	2,661
SP 403	4	3'-1"	35'-3"	4"	109	2,816
SP 404	4	3'-1"	31'-0"	4"	96	2,481
SP 501	1	5'-7"	45'-2"	3"	184	3,363
SP 502	1	5'-7"	38'-5"	3"	157	2,869
SP 503	2	5'-7"	47'-1"	3"	191	6,988
SP 504	2	5'-7"	48'-7"	3"	198	7,244
SP 505	2	5'-7"	45'-0"	3"	183	6,685
SP 506	2	5'-7"	46'-3"	3"	188	6,878
SP 507	2	5'-7"	49'-4"	3"	200	7,317
SP 508	2	5'-7"	46'-9"	3"	190	6,951
SPACERS						3,145
SPIRAL REINFORCING TOTAL						61,656
GRAND TOTAL PIERS						1,045,494

TOTAL REINFORCING	
ABUTMENT TOTAL	20,270
PIERS TOTAL	1,045,494
SUPERSTRUCTURE TOTAL	1,368,826
GRAND TOTAL	2,434,590

2,448,096


RAILING-THESE REINFORCING BARS WILL BE INCLUDED AS PART OF 517 FOR PAYMENT				
MARK	NUMBER	LENGTH	SHAPE	
R 501	8	12'-8"		ST.
R 502	484	15'-8"		ST.
R 503	12	4'-2"		BT.
R 504	8	5'-4"		BT.
R 505	8	12'-11"		ST.
R 506	116	15'-4"		ST.
R 507	8	13'-4"		ST.
R 508	8	13'-2"		ST.
R 509	484	15'-0"		ST.
R 512	8	13'-0"		ST.
R 514	40	12'-6"		ST.
R 516	8	19'-9"		ST.
R 701	6	13'-0"		BT.
R 702	2	39'-9"		ST.

REPLACEMENT BARS				
MARK	NUMBER	LENGTH	SHAPE	
RE 401	2	5'-3"		ST.
RE 501	9	6'-7"		ST.
RE 601	43	6'-11"		ST.
RE 701	24	7'-2"		ST.
RE 801	3	7'-6"		ST.
RE 901	9	7'-10"		ST.
RE 1001	7	8'-3"		ST.
RE 1101	15	8'-7"		ST.
RE 1401	6	2'-6"		ST.
RE 1801	12	2'-6"		ST.

NOTE: REPLACEMENT BARS FOR #14 & #18 WILL BE SPLICES USING POSITIVE CONNECTION.

PIERS				
MARK	NUMBER	LENGTH	WEIGHT	SHAPE
P 501	442	9'-11"	4,572	ST.
P 502	478	7'-6"	3,739	BT.
P 503	122	16'-8"	2,068	ST.
P 504	88	12'-4"	1,132	BT.
P 505	1048	7'-10"	9,562	BT.
P 506	256	9'-10"	2,625	BT.
P 507	296	11'-10"	3,653	BT.
P 508	26	19'-6"	529	ST.
P 509	24	15'-2"	380	ST.
P 510	22	11'-0"	252	ST.
P 511	2	25'-6"	53	ST.
P 512	2	21'-2"	44	ST.
P 513	2	17'-0"	35	ST.
P 514	120	9'-10"	1,231	BT.
P 515	284	10'-10"	3,209	BT.
P 516	32	7'-9"	259	BT.
P 517	120	8'-10"	1,106	BT.
P 518	200	9'-0"	1,877	BT.
P 519	188	10'-10"	2,124	BT.
P 520	44	12'-10"	589	BT.
P 521	40	14'-10"	619	BT.
P 522	280	37'-0"	10,805	ST.
P 523	432	8'-10"	3,980	BT.
P 524	588	12'-10"	7,870	BT.
P 525	8	36'-6"	305	ST.
P 526	216	13'-10"	3,117	BT.
P 527	68	16'-10"	1,194	BT.
P 528	24	12'-4"	308	BT.
P 529	24	11'-4"	254	BT.
P 530	208	8'-11"	1,934	ST.
P 531	8	6'-7"	55	BT.

SPIRAL REINFORCING BARS: THE "LENGTH" SHOWN IN THE STEEL LIST FOR THE SPIRAL BARS IS THE DISTANCE FROM THE TOP OF THE FOOTING TO THE BOTTOM OF THE PIER CAP. THE "NO. OF TURNS" SHOWN IS THE "LENGTH" DIVIDED BY THE PITCH, PLUS 3 TURNS (TOTAL NUMBER OF CLOSED COILS), EXPRESSED AS THE NEAREST WHOLE NUMBER. SPIRAL REINFORCING BARS SHALL NOT HAVE DEFORMATIONS BUT SHALL IN OTHER RESPECTS CONFORM TO ITEM 509. 1/2 CLOSED COILS SHALL BE PROVIDED AT THE ENDS OF EACH SPIRAL UNIT. FOUR STEEL CHANNEL, TEE OR ANGLE SPACERS, WEIGHING APPROXIMATELY 0.68 LB. PER LIN. FT. OF SPACER, SHALL BE PROVIDED FOR EACH SPIRAL UNIT. THEY SHALL BE EQUALLY SPACED ALONG THE PERIPHERY OF THE COIL. THE NUMBER OF POUNDS OF THESE SPACERS BASED ON 0.68 LB. PER LIN. FT., WILL BE PAID FOR AS REINFORCING STEEL AND IS INCLUDED IN THE TABULATED QUANTITY OF SPIRAL BARS.

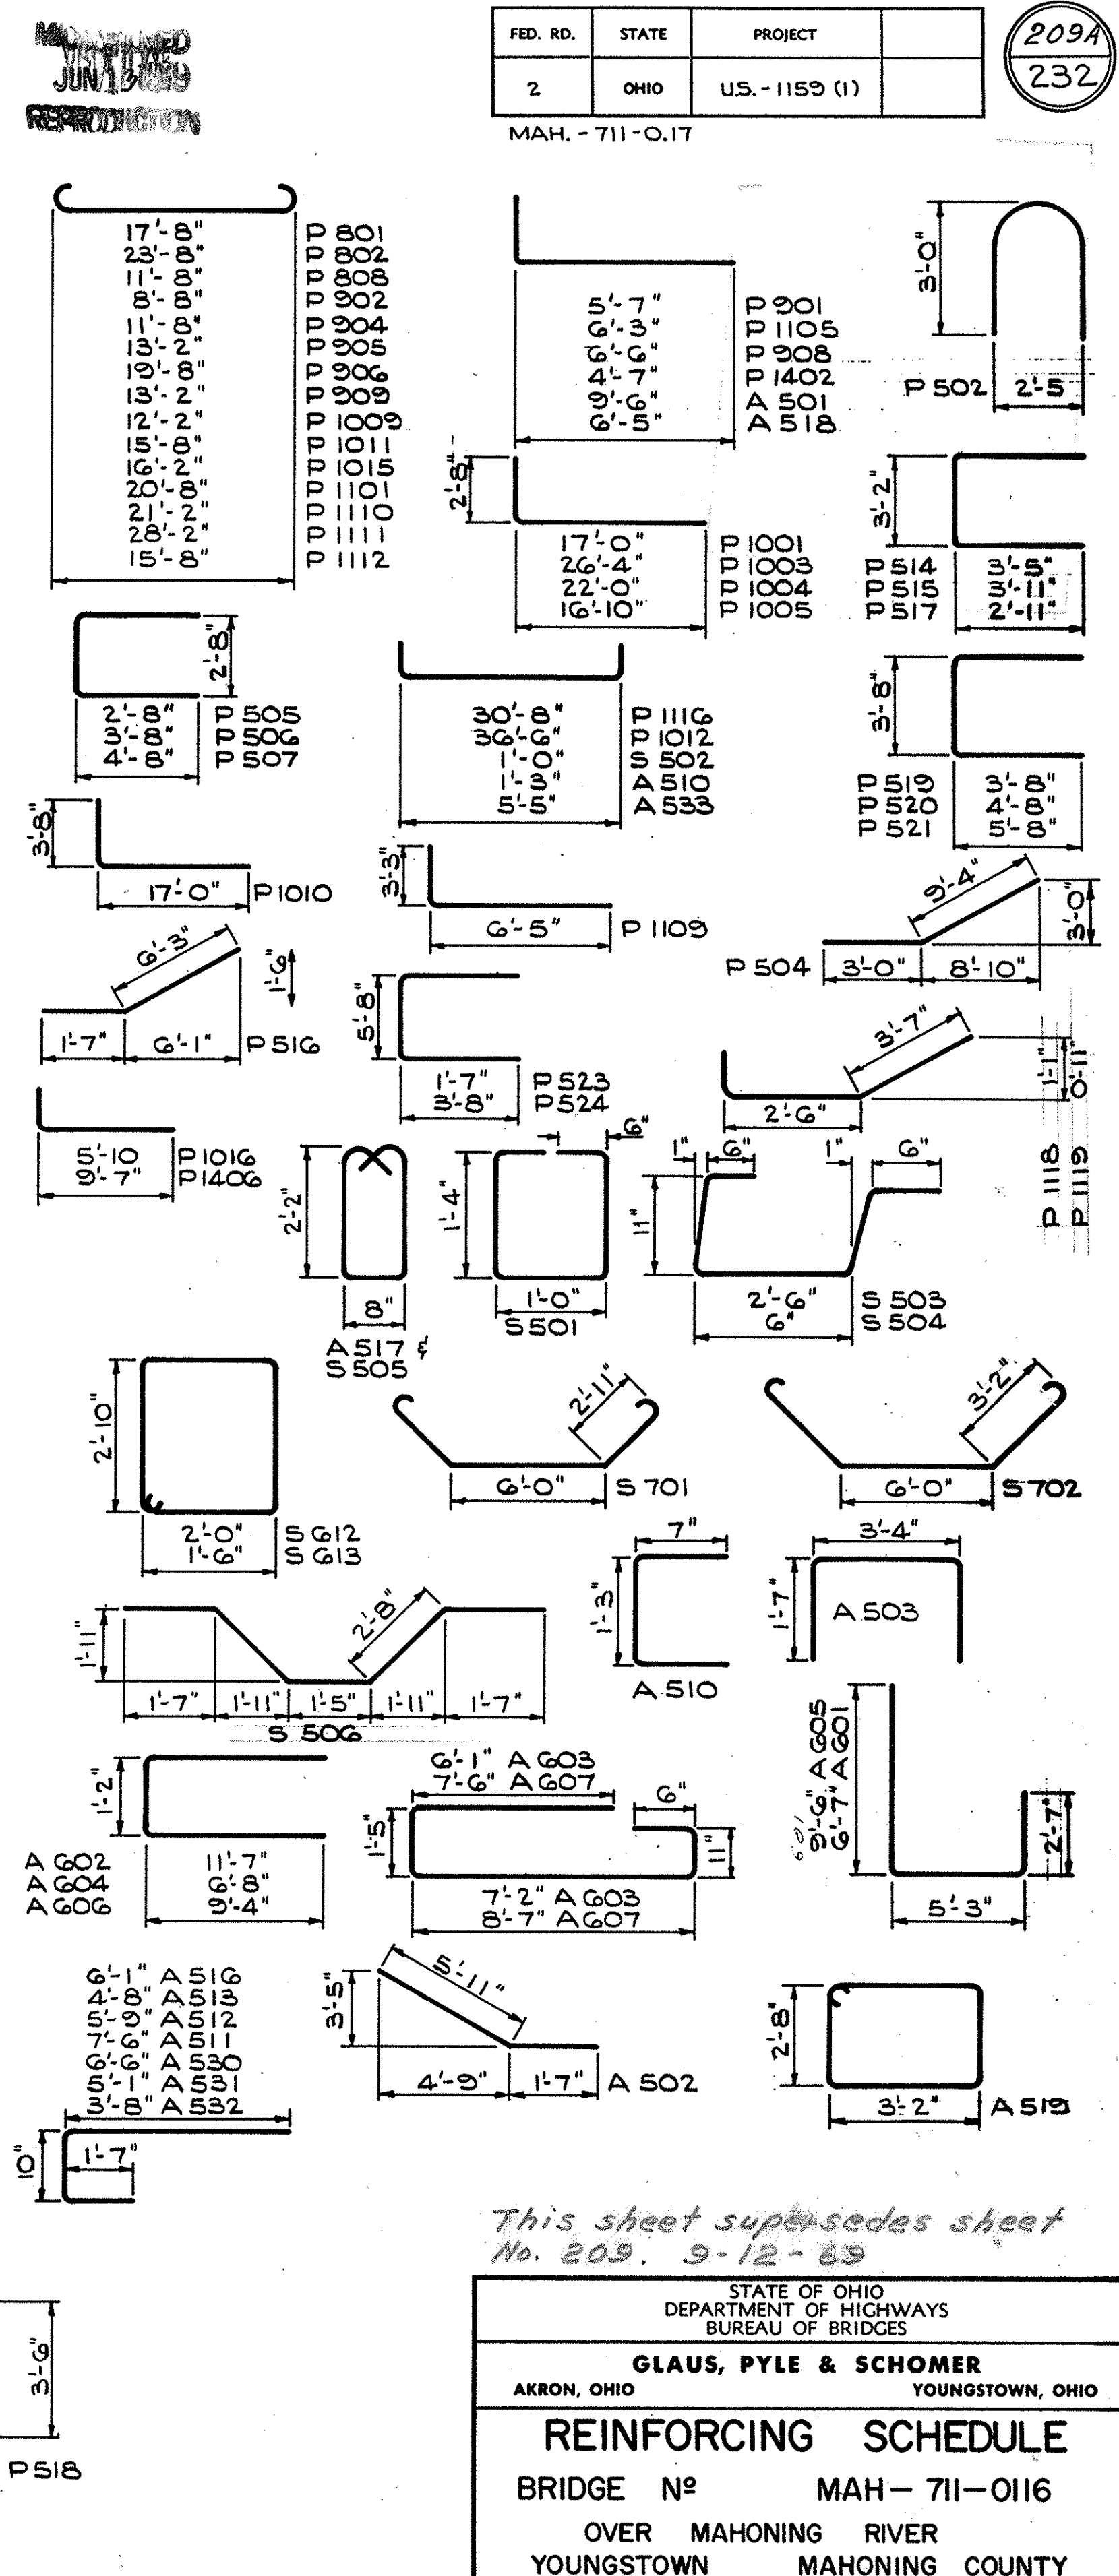

This sheet supersedes sheet No. 209, 9-12-63

DESIGNED	DRAWN	TRACED	CHECKED	REVIEWED	DATE	REVISED