


FED. ROAD DIV. NO.	STATE	FED. AID PROJ. NO.	TYPE FUNDS	57 123
2	OHIO			


SUMMIT COUNTY  
CITY OF AKRON  
EXPRESSWAY SYSTEM  
EXPRESSWAY - PART 7  
SUM - 18R - 12.90

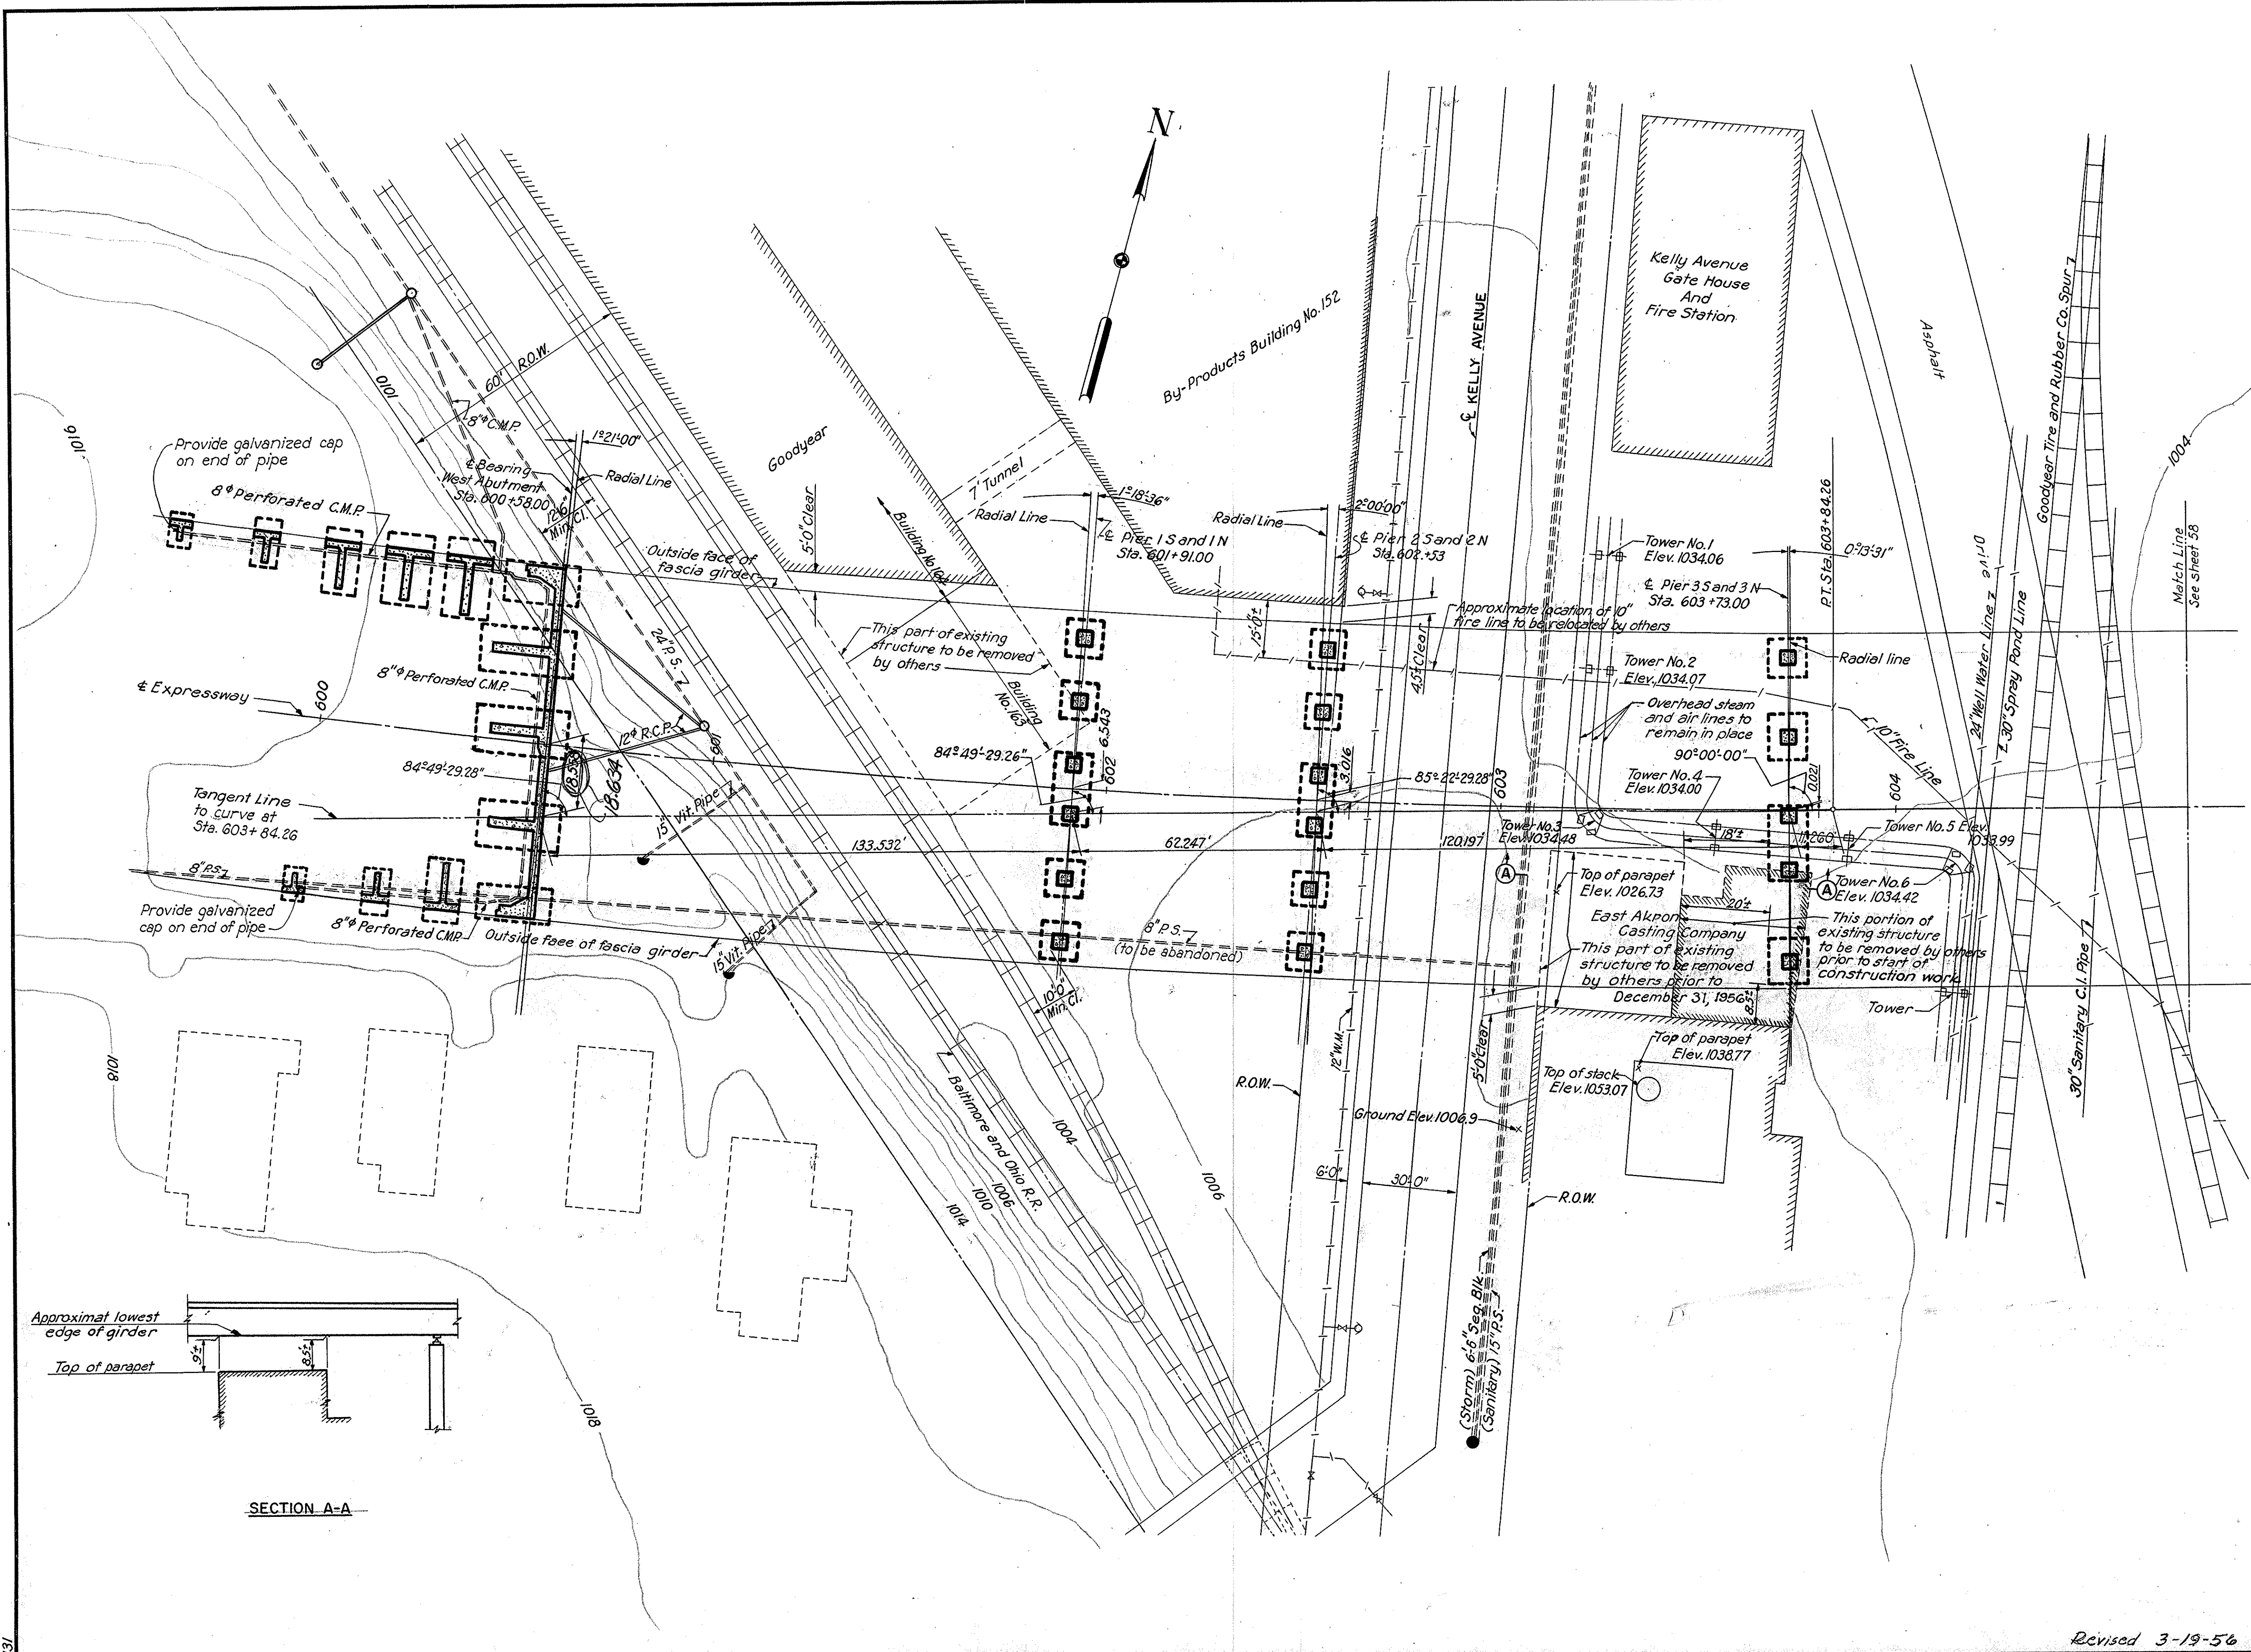

LEGEND

- Existing Water Main
- Existing Sewer
- New Sewer
- Existing Sewer Manhole
- Existing Sewer Inlet
- Water Valve
- Water Hydrant
- New Sewer Manhole

Notes:  
Existing buildings on the viaduct right-of-way will be removed, as indicated on the site plan, by others to existing ground level, and basements shall be filled by the contractor with compacted embankment material.  
Payment for filling of basements will be made under Items E-2.  
Elevations shown for towers carrying overhead steam and air lines are top of tower elevations.

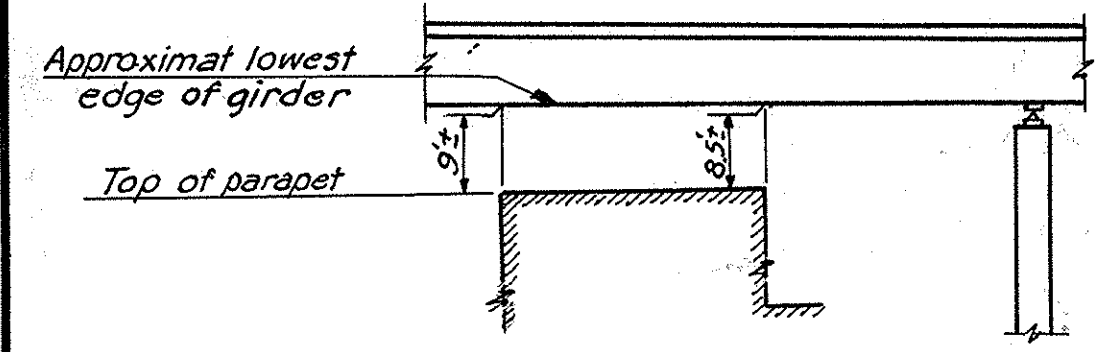

SECTION A-A

PART 7

**AKRON EXPRESSWAY SYSTEM**  
WEST VIADUCT  
BR. NO. SU-18R-135  
SITE PLAN

AKRON	SUMMIT COUNTY,	OHIO
-------	----------------	------

SCALE 1" = 20'-0"  
MADE S.M.A. DATE 8-3-55  
TRCD. S.M.A. DATE 8-5-55  
CRD. J.W.L. DATE 9-19-55

HOWARD, NEEDLES, TAMMEN & BERGENOFF  
CONSULTING ENGINEERS  
KANSAS CITY CLEVELAND NEW YORK  
901 SHEET - 57


Revised 3-19-56

FED. ROAD DIV. NO.	STATE	FED. AID PROJ. NO.	TYPE FUNDS	58 123
2	OHIO			

SUMMIT COUNTY  
CITY OF AKRON  
AKRON EXPRESSWAY SYSTEM  
EXPRESSWAY - PART 7  
SUM-18R-12.90

LEGEND

- Existing Water Main
- Existing Sewer
- New Sewer
- Existing Sewer Manhole
- Existing Sewer Inlet
- Water Valve
- Water Hydrant
- New Sewer Manhole

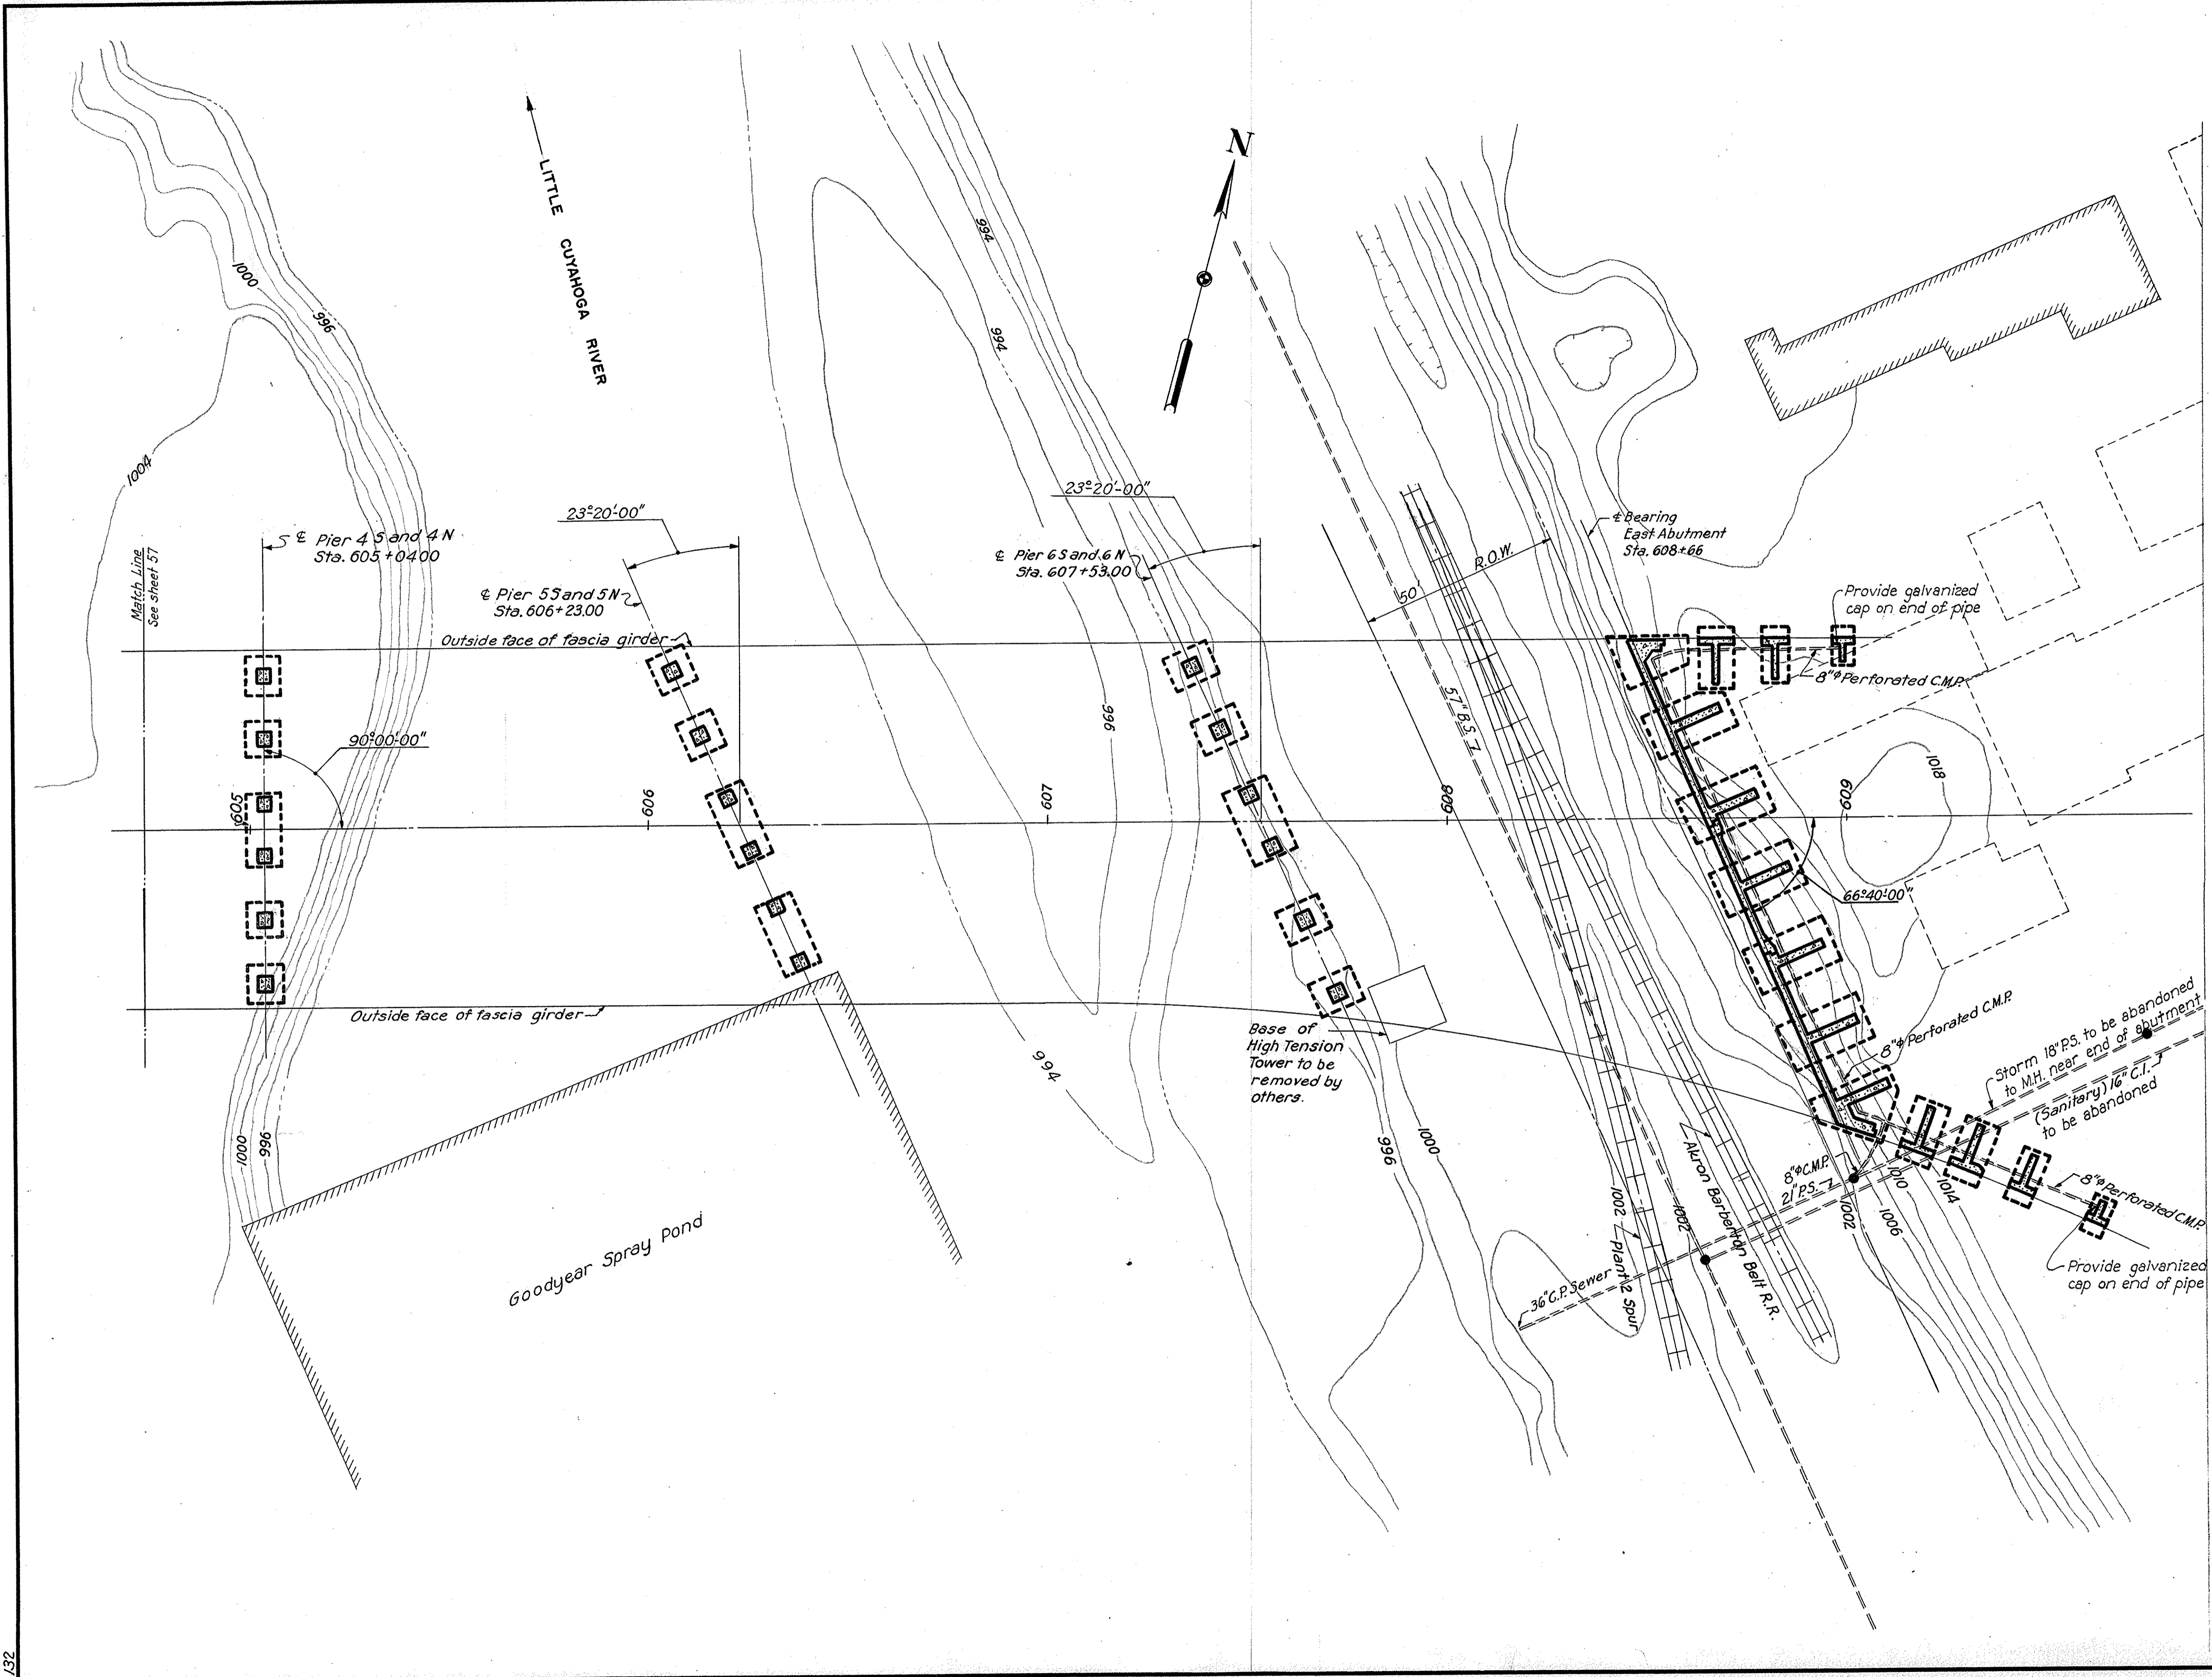

PART 7

**AKRON EXPRESSWAY SYSTEM**  
WEST VIADUCT  
BR. NO. SU-18R-135

SITE PLAN

AKRON      SUMMIT COUNTY      OHIO

SCALE 1" = 20'-0"  
MADE S.M.A. DATE 8-3-58  
TRCD. C.M.A. DATE 8-6-55  
CKD. L.L. DATE 9-20-55



HOWARD, NEEDLES, TAMMEN & BERGENDOFF  
CONSULTING ENGINEERS  
KANSAS CITY      CLEVELAND      NEW YORK  
901 SHEET 58

132

SUMMIT COUNTY  
CITY OF AKRON  
AKRON EXPRESSWAY SYSTEM

Ramp E-9 Curve Data  
 $D = 9^{\circ}00'00''$   
 $\Delta = 66^{\circ}40'11''$   
 $R = 636.32'$   
 $T = 418.73'$   
 $L = 740.76'$

Expressway Curve Data  
 $D = 2^{\circ}00'00''$   
 $\Delta = 21^{\circ}08'25''$   
 $R = 2864.79'$   
 $T = 534.59'$   
 $L = 1057.01'$

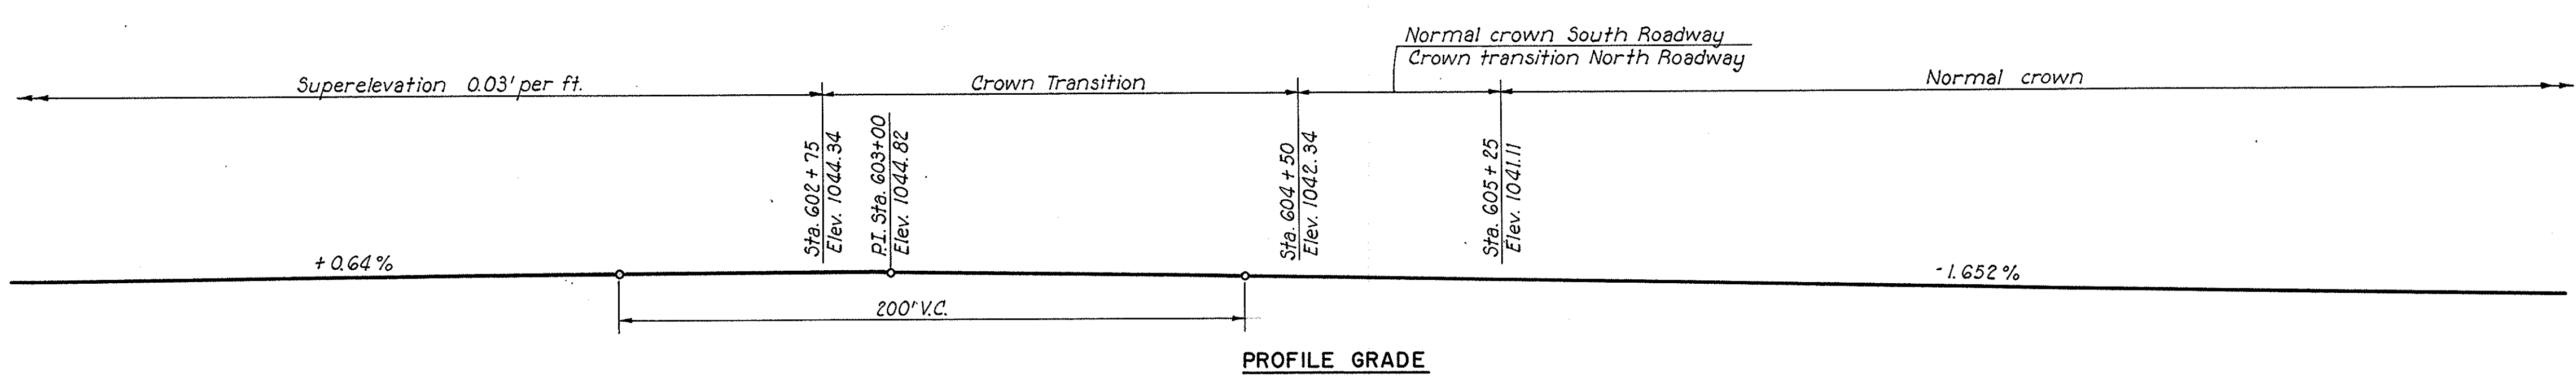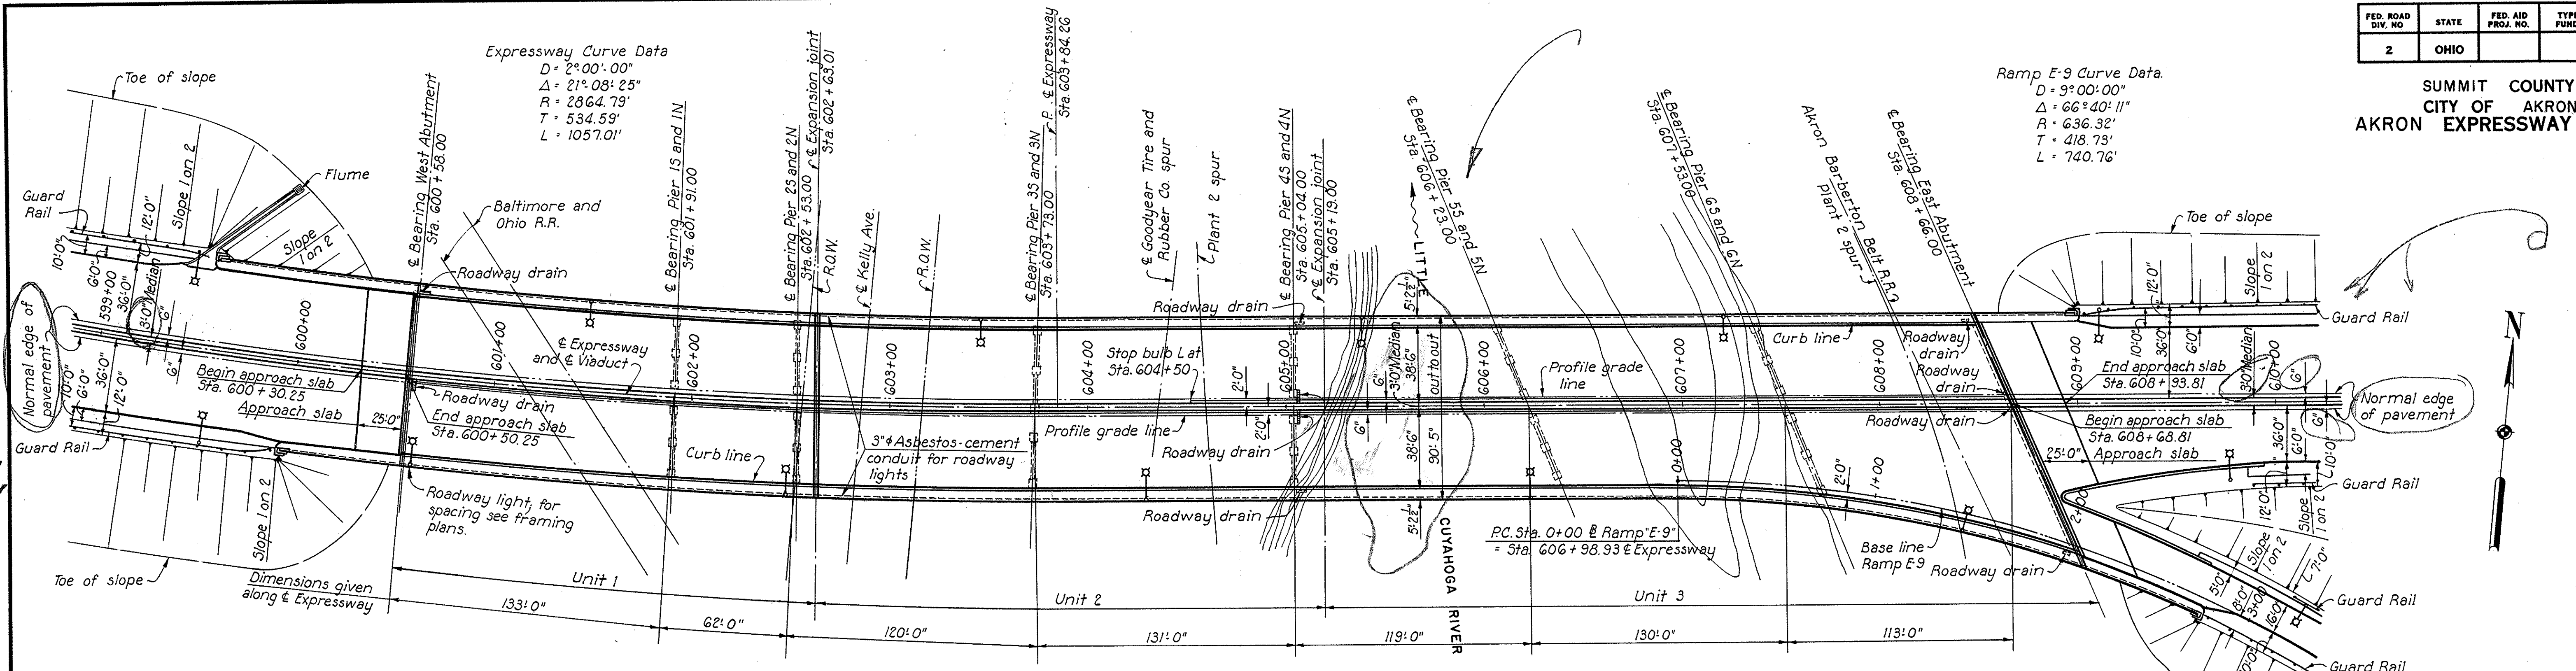

**PROPOSED STRUCTURE**

Type: 7-span continuous steel girder with concrete deck and sub-structure.


Spans: 133'-0", 62'-0", 120'-0", 131'-0", 119'-0", 130'-0" and 113'-0"  $\epsilon$  to  $\epsilon$  bearing.

Roadway: 2  $\times$  38'-0" each with 4'-0" median, 3'-0" sidewalk.

Loading: CF 2000

Skew: Varies

Surface Course: 2 1/2" Asphaltic concrete

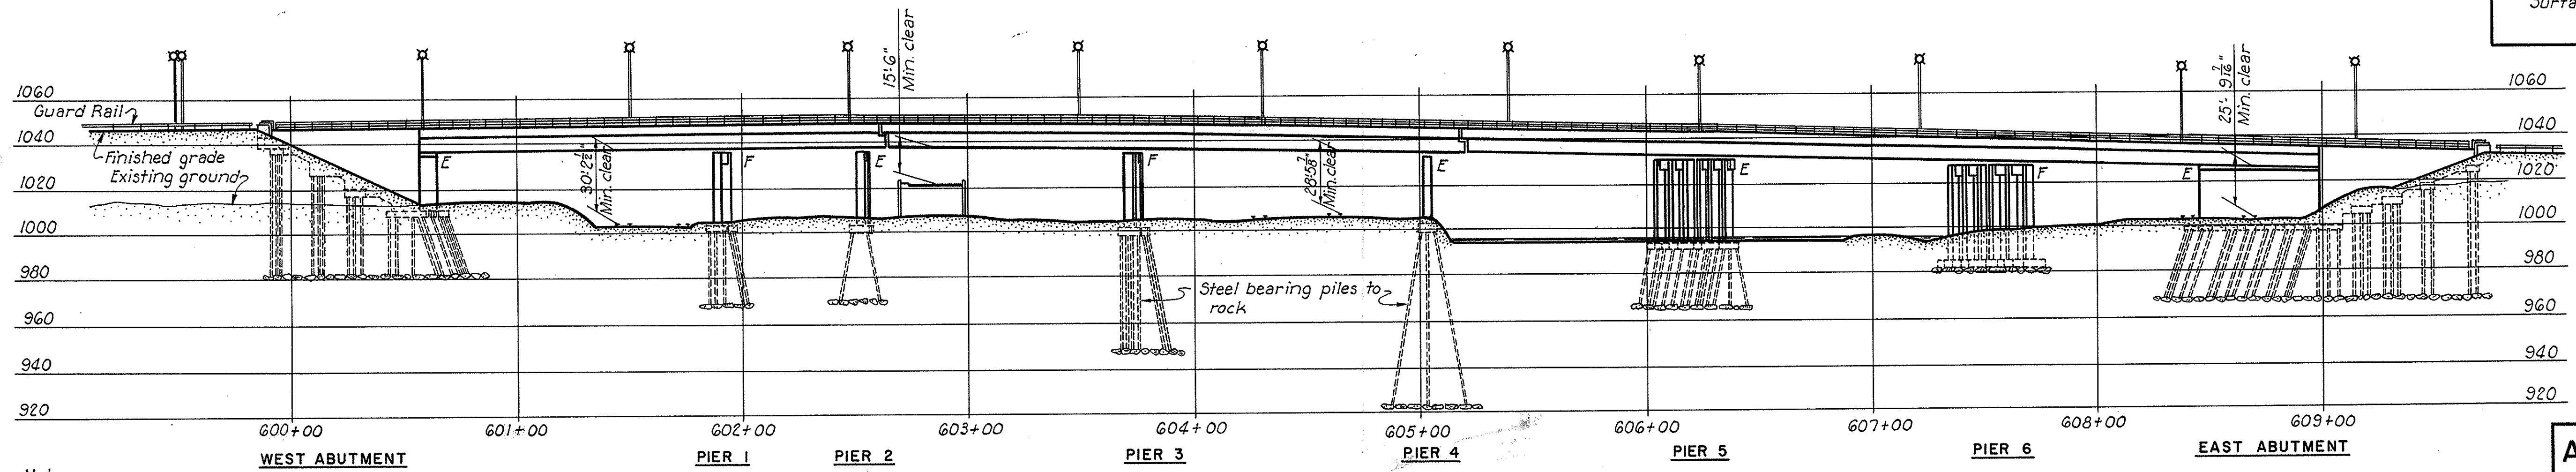

Note:  
 Minimum clearance of Baltimore and Ohio R.R. is at top of west rail of west track and  $\epsilon$  north exterior girder.  
 Minimum clearance of Kelly Avenue is at  $\epsilon$  of Kelly Avenue and  $\epsilon$  south exterior girder.  
 Minimum clearance of Goodyear Tire and Rubber Co. spur is at top of east rail of east track and  $\epsilon$  south exterior girder.  
 Minimum clearance of Akron Barberton Belt R.R. is at top of east rail of east track and  $\epsilon$  south exterior girder.

Note:  
 Approximate rock lines shown are determined by interpolation of borings and are approximate only.

*Changes or additions are being up.*

Revised 12-19-55

**AKRON EXPRESSWAY SYSTEM**  
 WEST VIADUCT  
 BR. NO. SU-18R-135  
 GENERAL PLAN AND ELEVATION

AKRON SUMMIT COUNTY, OHIO




SCALE: 1" = 40'

MADE S.M.A. DATE: 8-9-55  
 TRCD. CAL. DATE: 10-28-55  
 CKD. LWL. DATE: 10-4-55

HOWARD, NEEDLES, TAMMEN & BERGENDOFF  
 CONSULTING ENGINEERS  
 KANSAS CITY CLEVELAND NEW YORK

901 SHEET 59

**SUMMIT COUNTY  
CITY OF AKRON  
EXPRESSWAY SYSTEM**

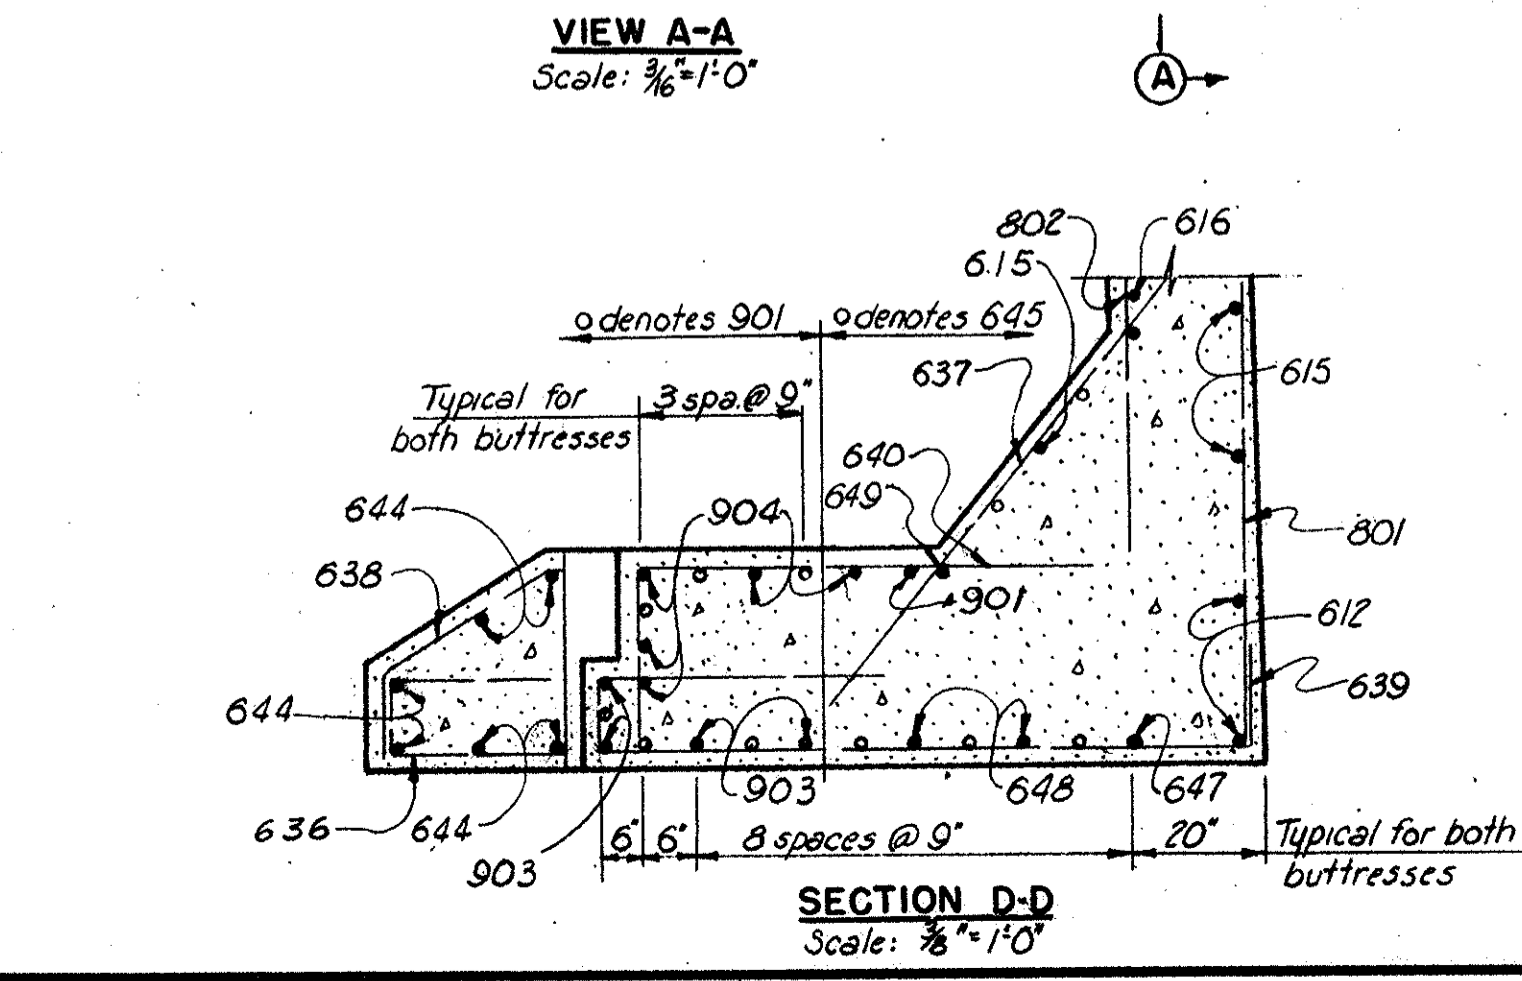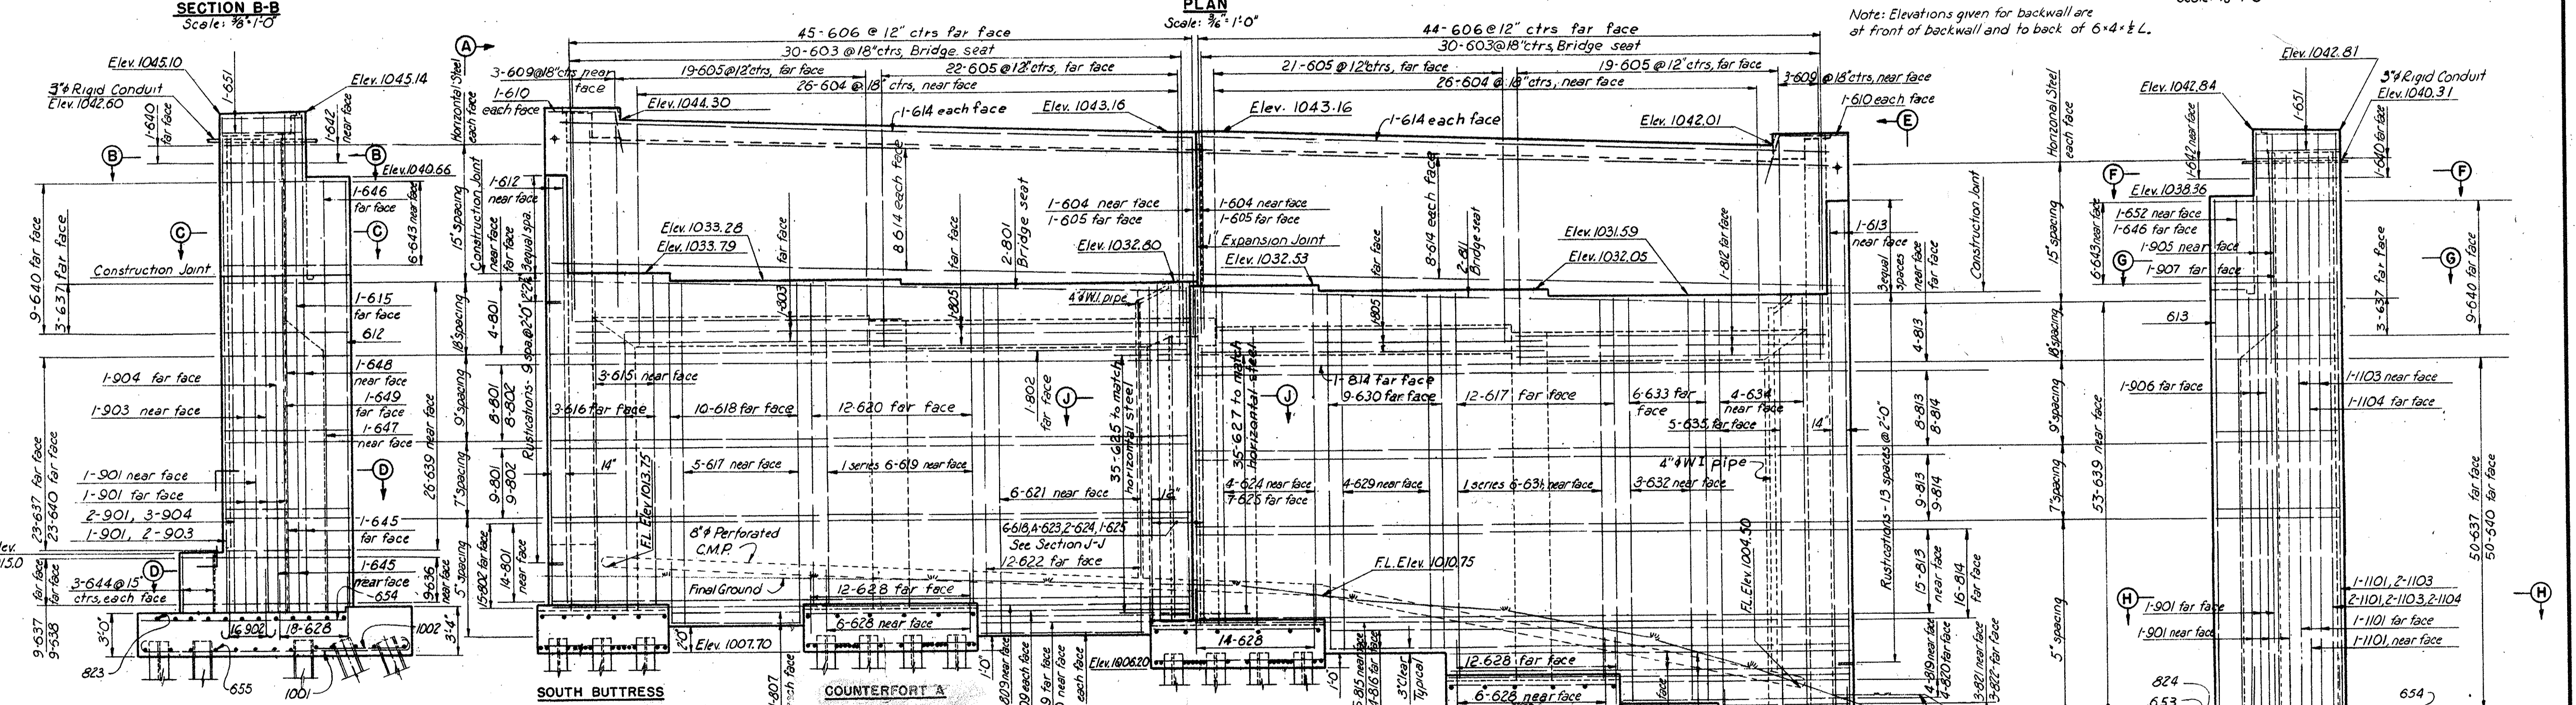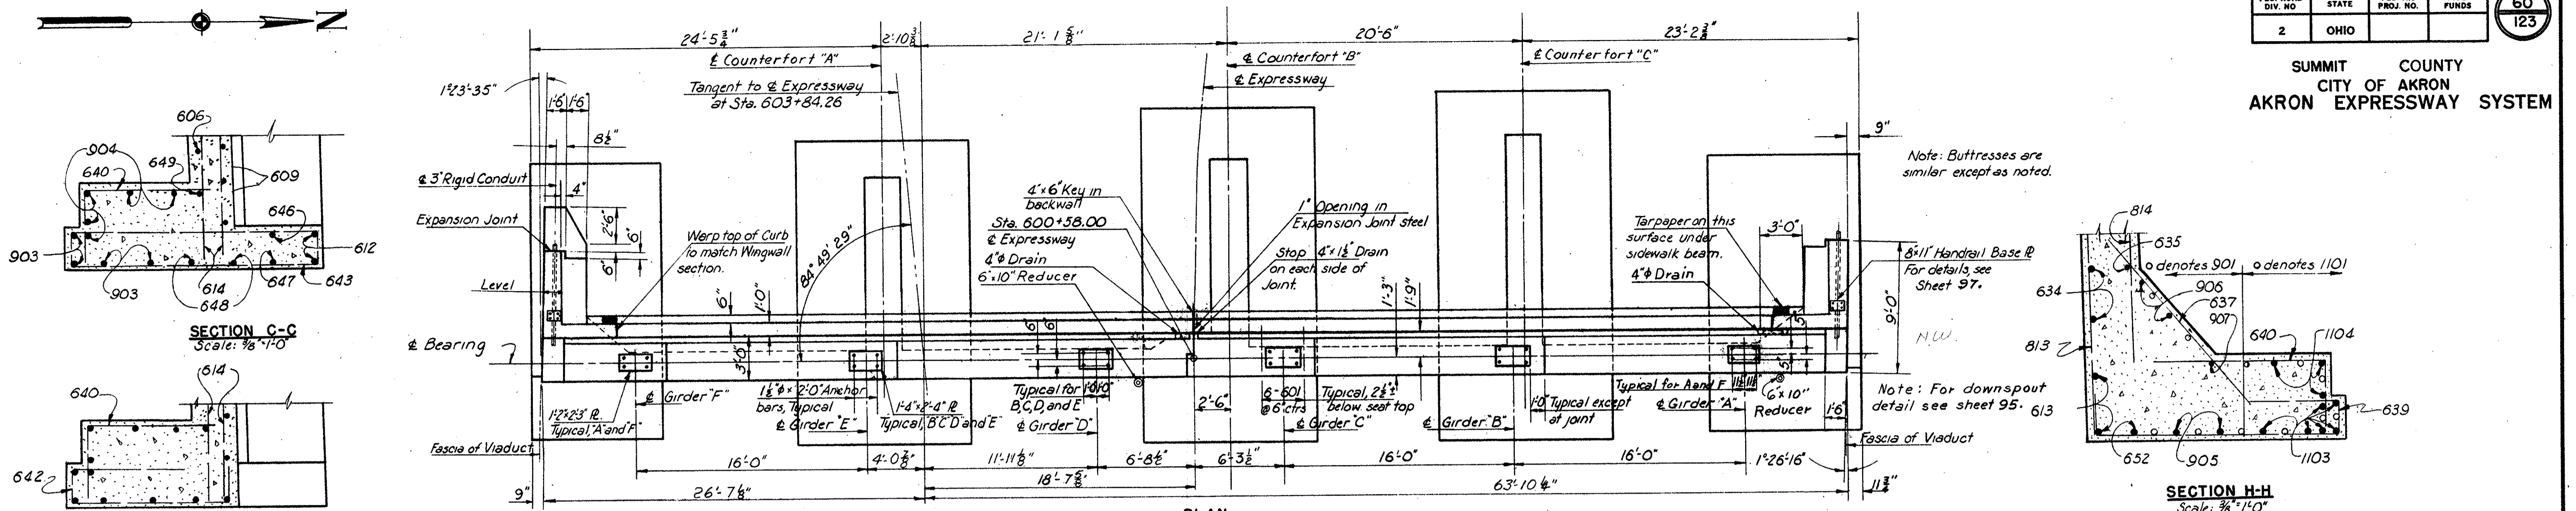

**AKRON EXPRESSWAY SYSTEM**

**WEST VIADUCT  
BR. NO. SU-18R-135**


**WEST ABUTMENT**

**AKRON SUMMIT COUNTY, OHIO**


SCALE As Shown  
MADE D.L.L. DATE 7-29-55  
TRCD. DATE  
CKD. D.F.B. DATE 10-17-55

HOWARD, NEEDLES, TAMMEN & BERGENDOFF  
CONSULTING ENGINEERS  
KANSAS CITY CLEVELAND NEW YORK  
901 SHEET 60


**SUMMIT COUNTY  
CITY OF AKRON  
AKRON EXPRESSWAY SYSTEM**

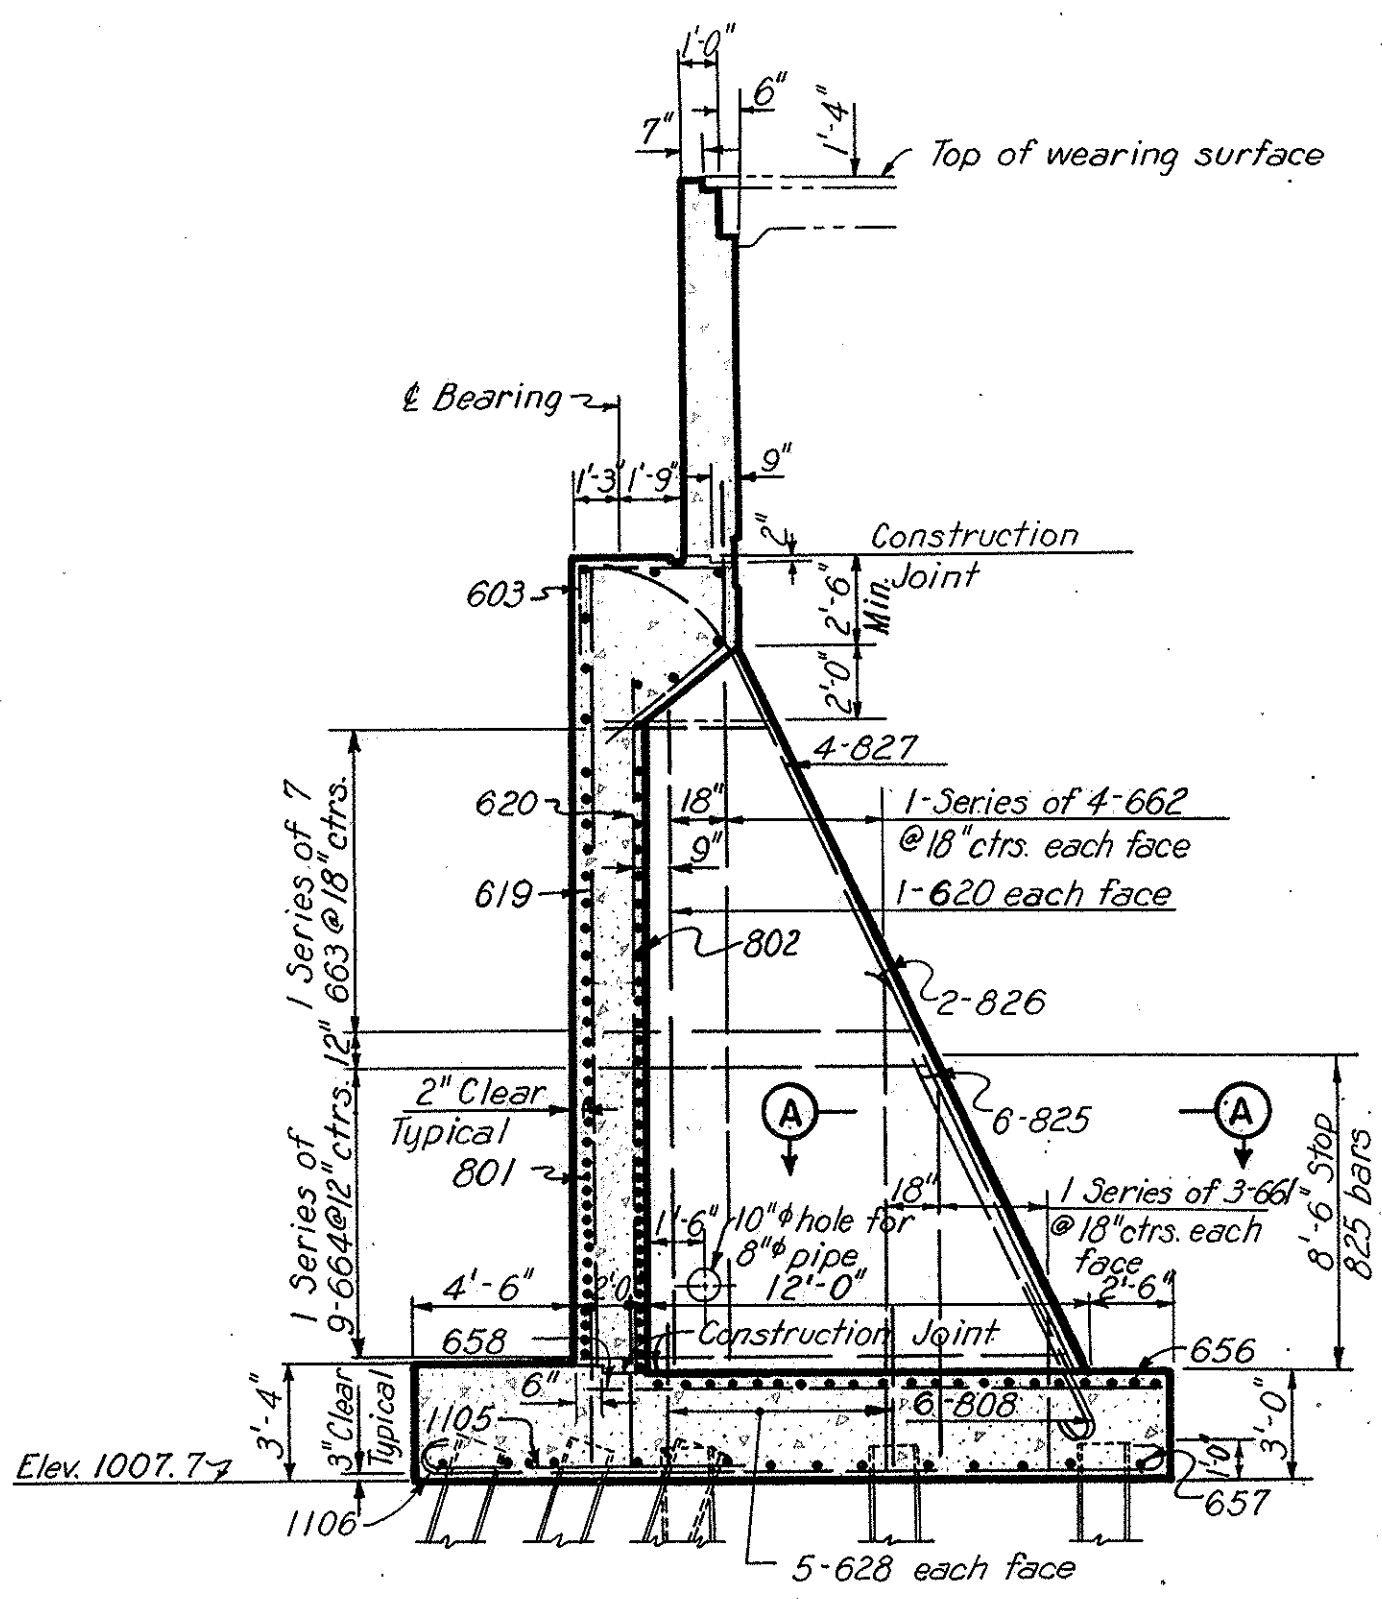



For steel in backwall see detail A  
**COUNTERFORT A**  
Scale:  $\frac{3}{8}'' = 1'-0''$

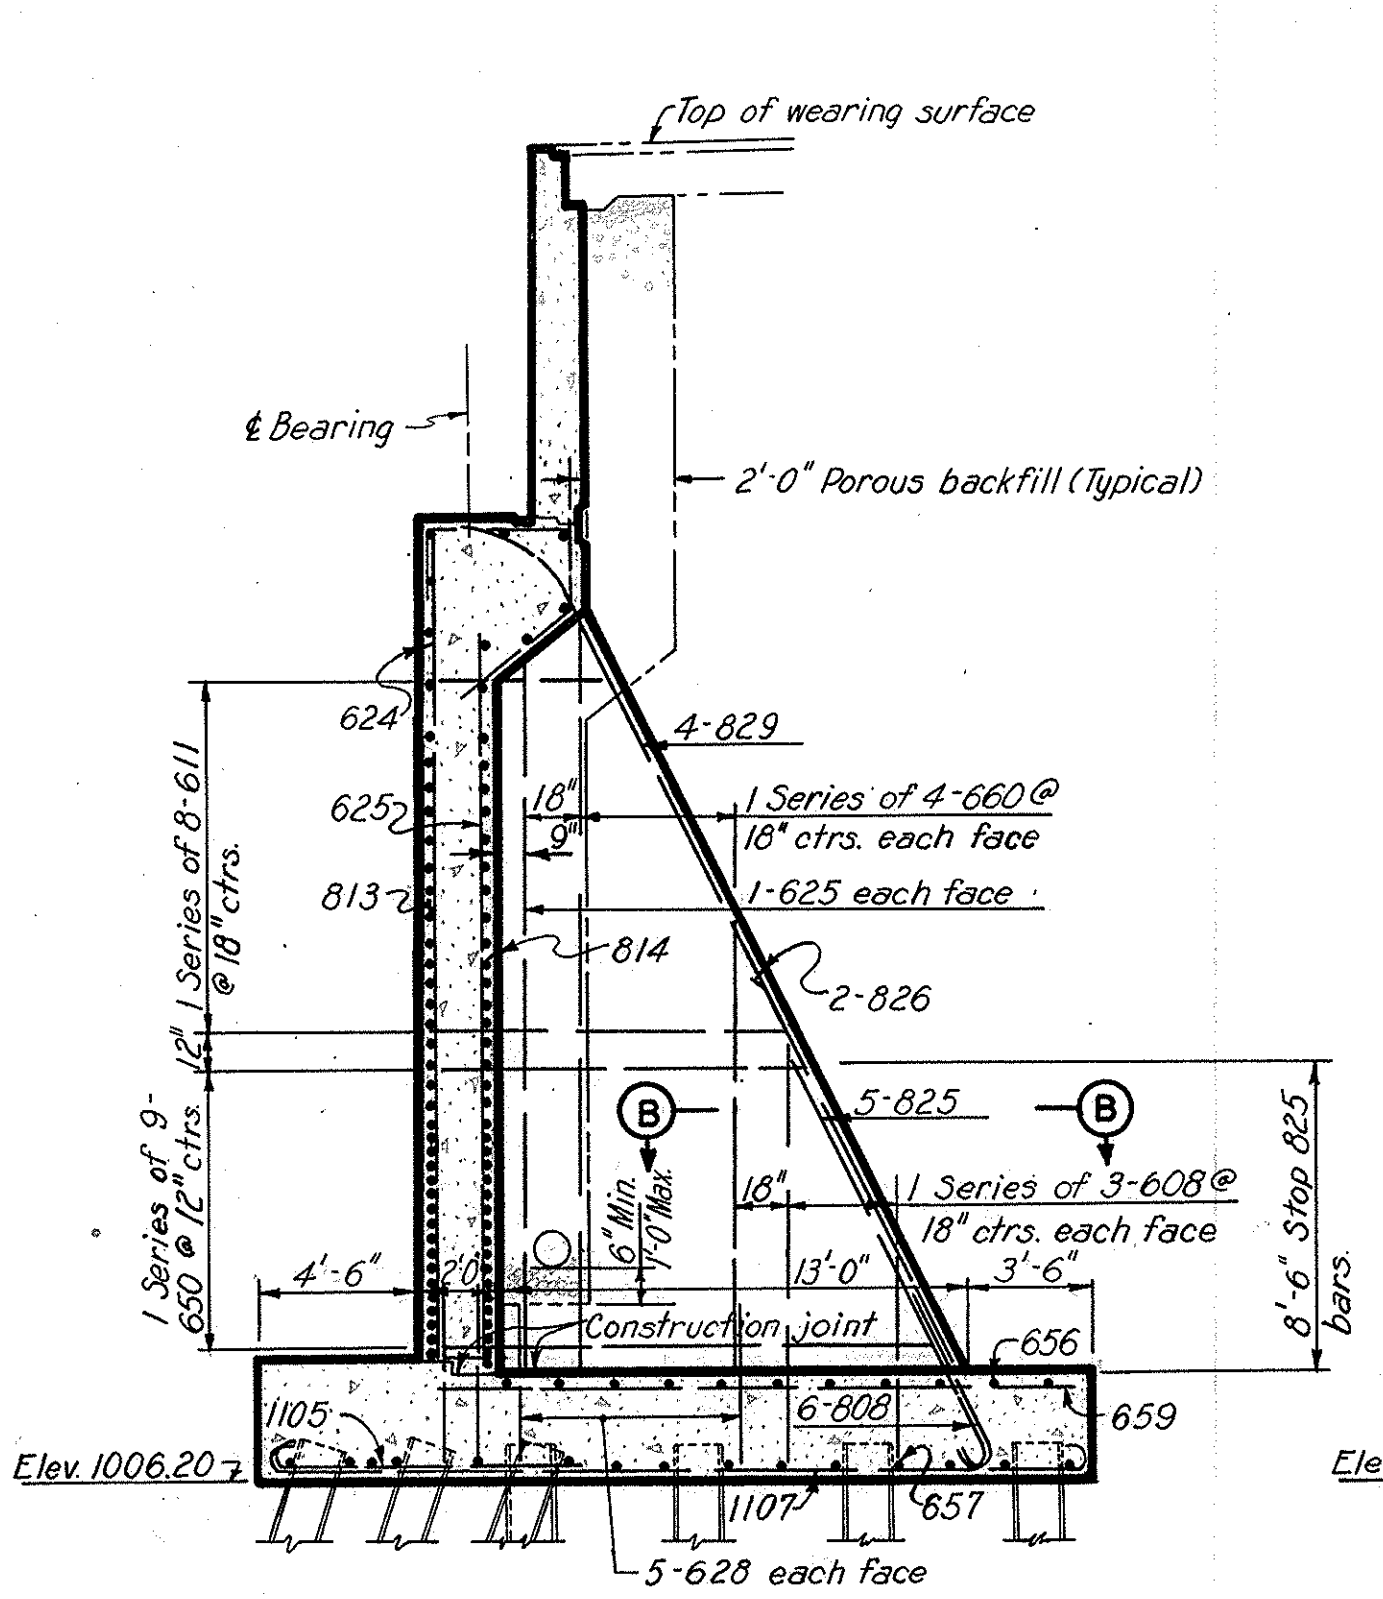




For steel in backwall see detail A  
**COUNTERFORT B**  
Scale:  $\frac{3}{8}'' = 1'-0''$

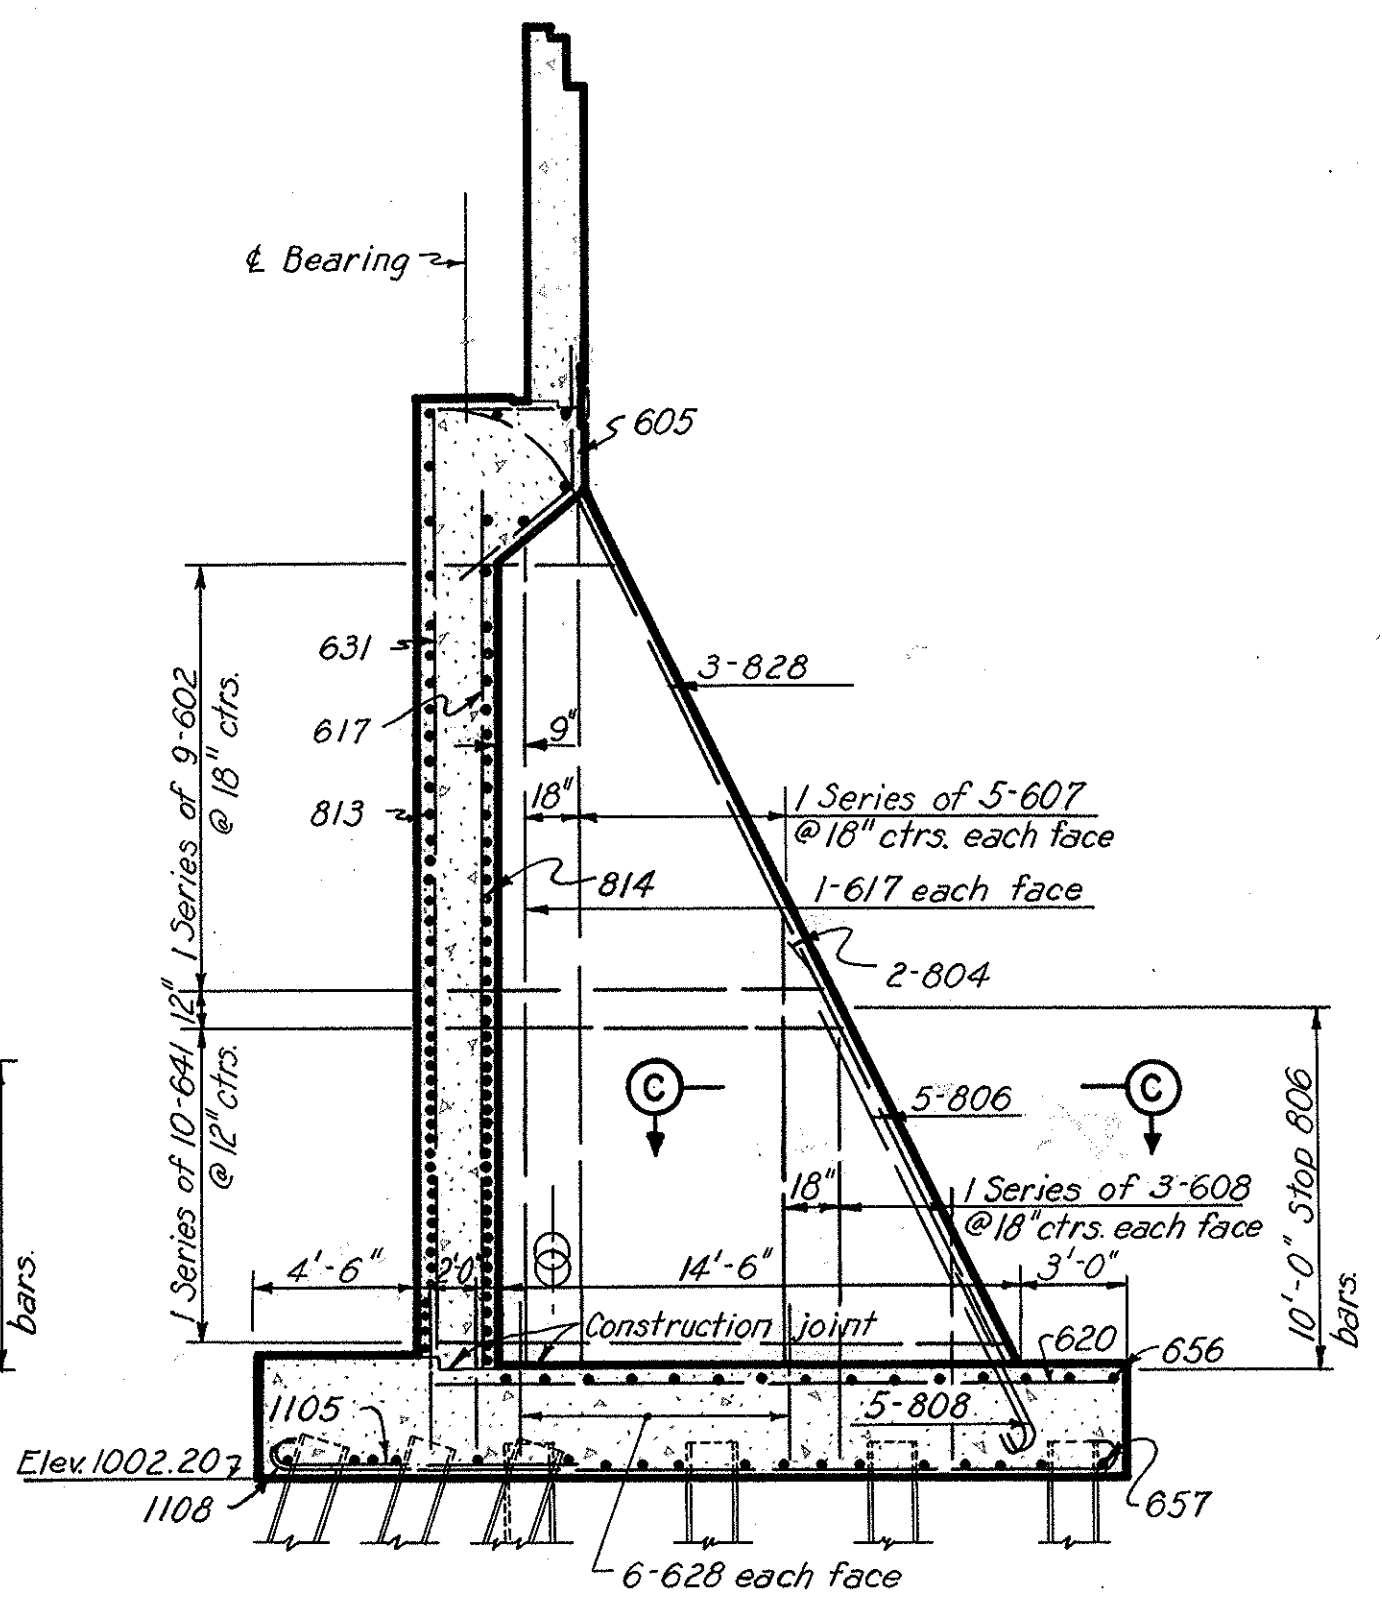

For steel in backwall see detail A  
**COUNTERFORT C**  
Scale:  $\frac{3}{8}'' = 1'-0''$

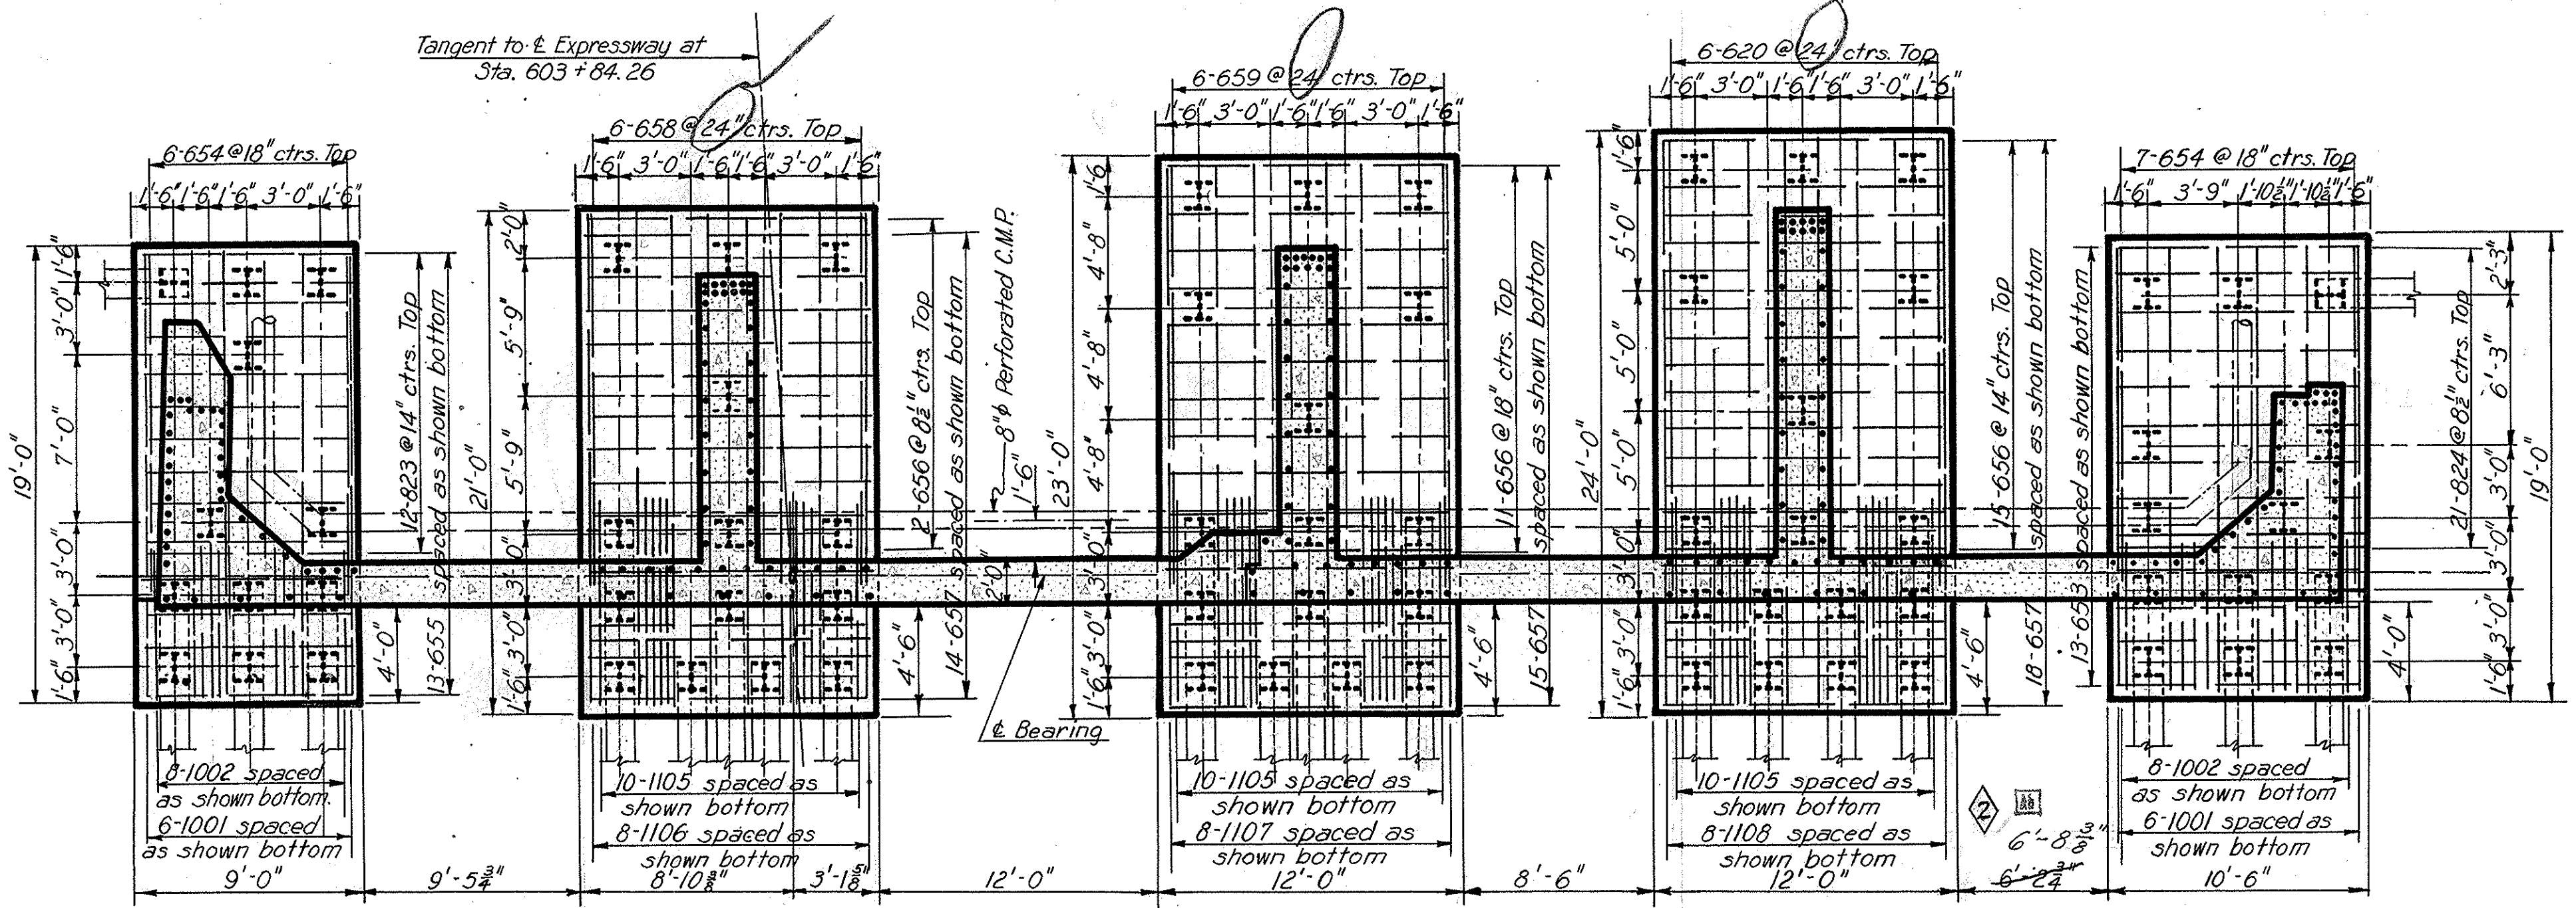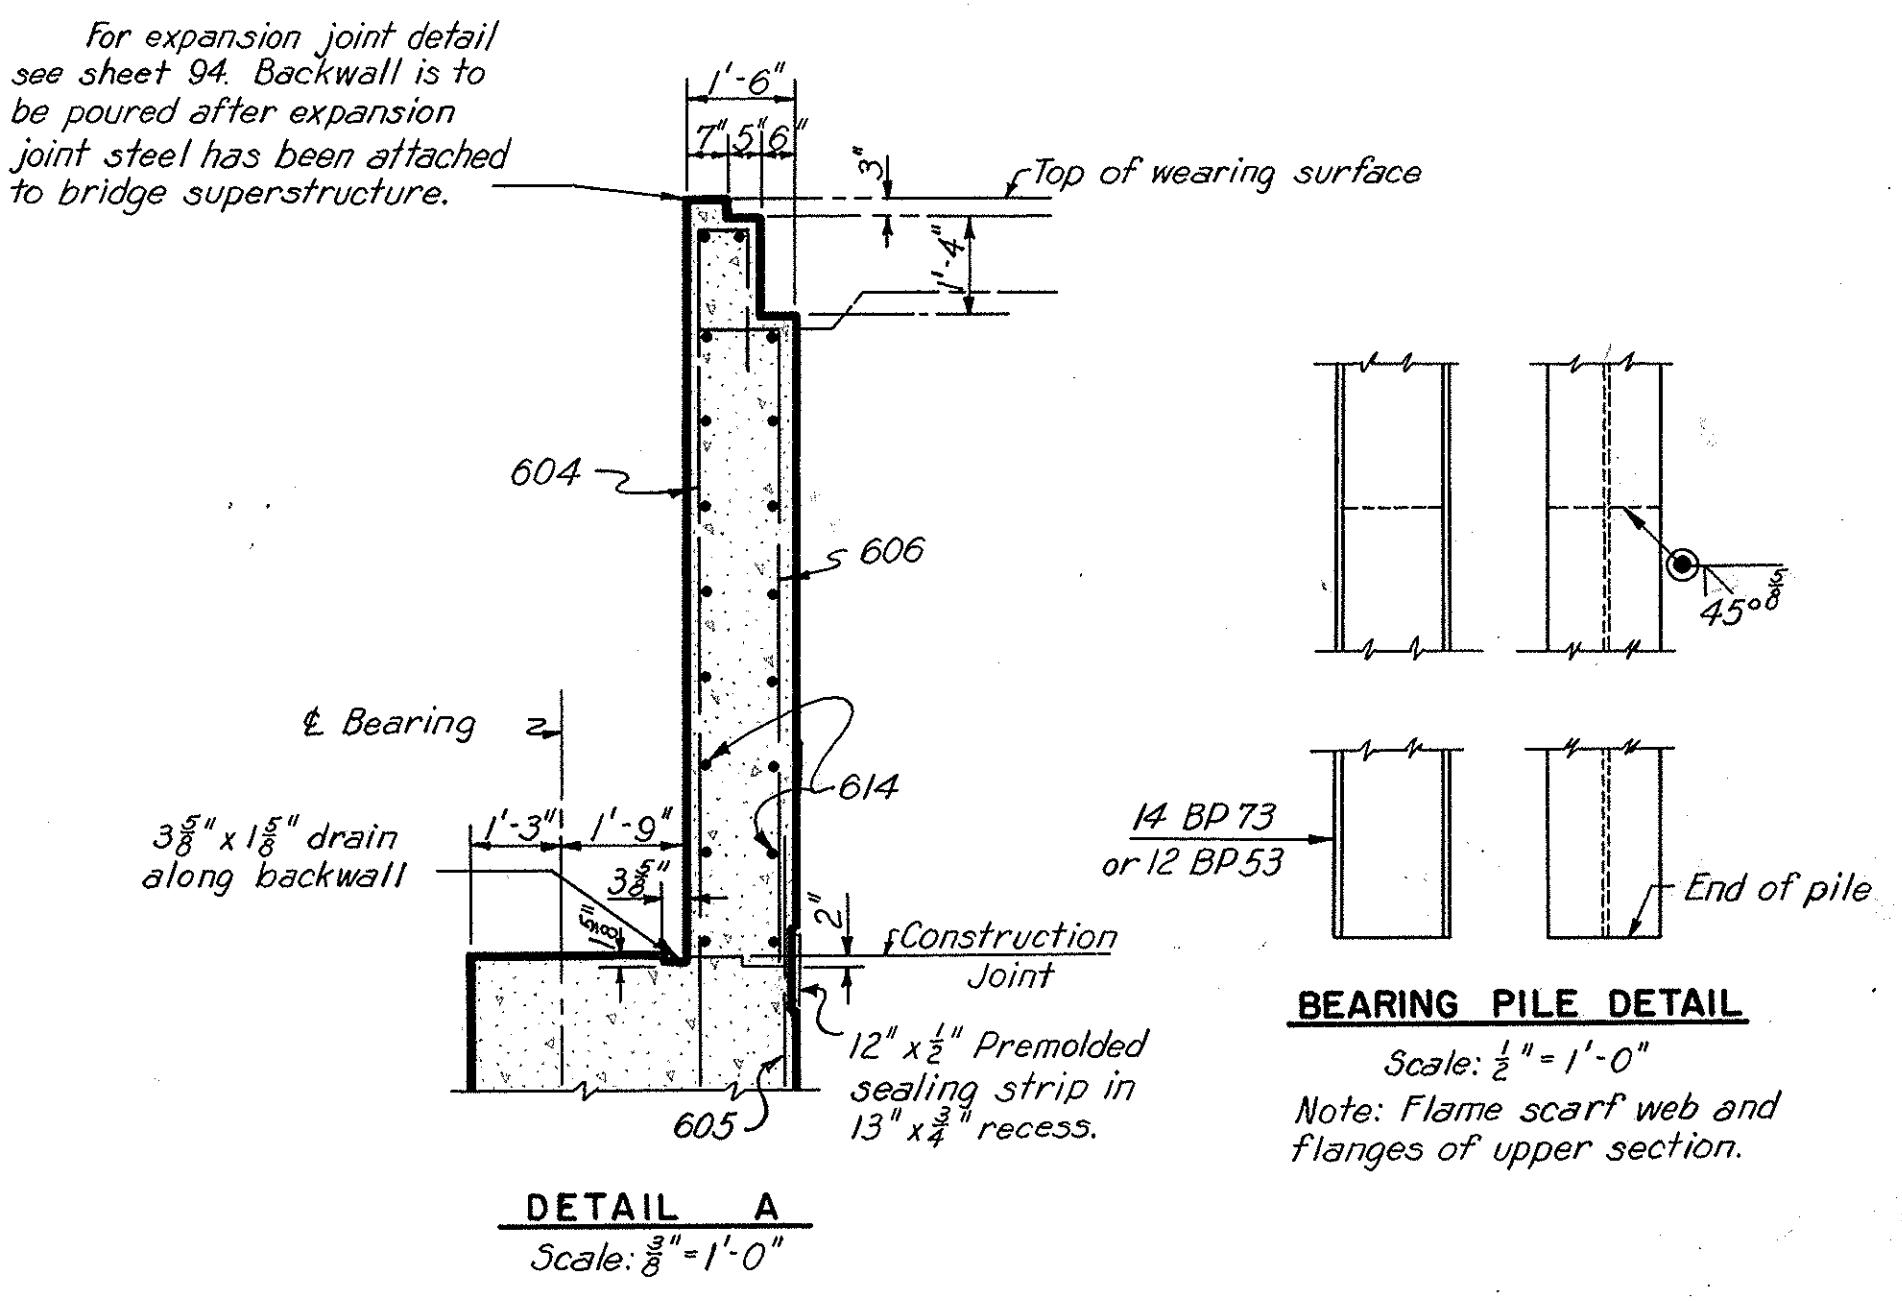

**FOOTING PLAN**  
Scale:  $\frac{3}{8}'' = 1'-0''$

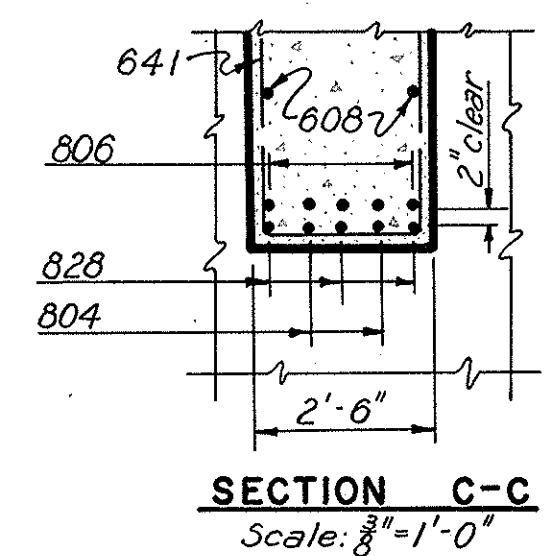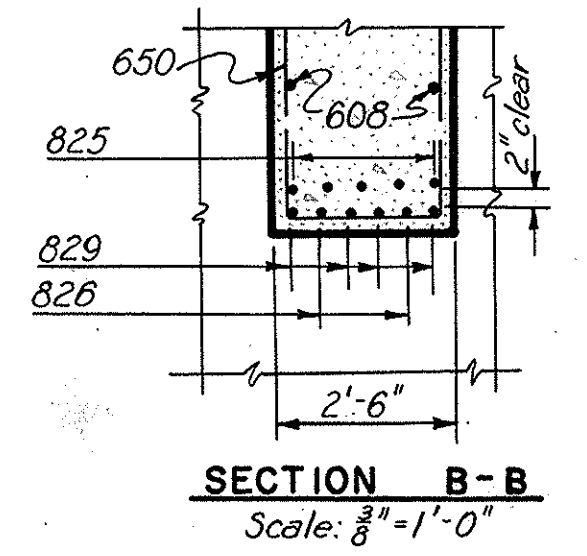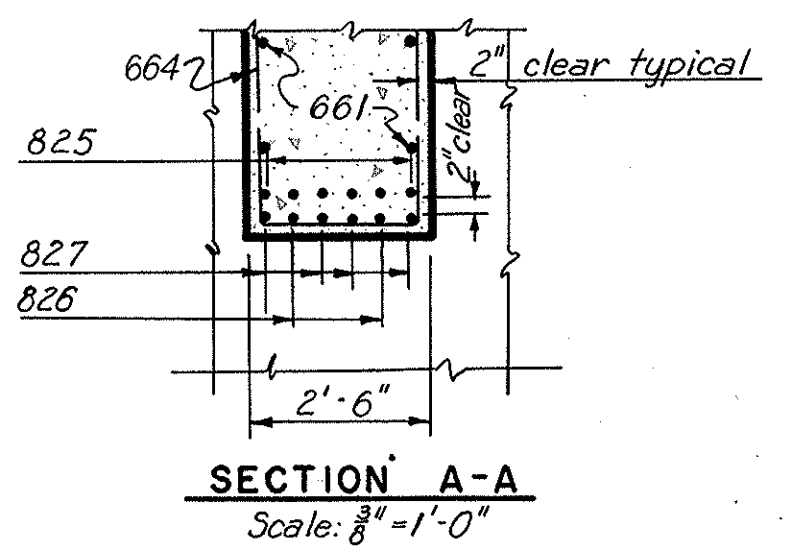

Notes:  
For reinforcement schedule see sheet 62.  
All piles to be 14 BP 73.  
For dimensions not shown see West Abutment plan and elevation, sheet 60.  
Dimensions shown on counterfort A are typical for counterforts B and C, except as noted.  
For rustication detail see sheet 76.  
All battered piles are battered 4 in 12.  
Average vertical length of piles is 26'.  
Pile spacings are given along bottom of footings.

**AKRON EXPRESSWAY SYSTEM  
WEST VIADUCT  
BR. NO. SU-18R-135  
WEST ABUTMENT DETAILS**


AKRON SUMMIT COUNTY, OHIO

SCALE AS SHOWN  
MADE W.L. DATE 2-6-55  
TRCD G.J.K. DATE 10-24-55  
CKD D.F.B. DATE 9-8-55

HOWARD, NEEDLES, TAMMEN & BERGENDOFF  
CONSULTING ENGINEERS  
KANSAS CITY CLEVELAND NEW YORK  
901 SHEET 61

Revised 3-3-56  
Revised 12-19-55

MARK	NUMBER	LENGTH	TYPE	DIMENSIONS				SERIES INCRE- MENT	WEIGHT POUNDS	MARK	NUMBER	LENGTH	TYPE	DIMENSIONS				SERIES INCRE- MENT	WEIGHT POUNDS
				A	B	C	D							A	B	C	D		
<b>WEST ABUTMENT</b>																			
601	36	3'-9"	Str.					203											
602	1 Ser. of 9	13'-8" to 25'-8"	122	1'-0"	4'-9" to 10'-9"	2'-2"		9-9-8"	265	801	37	44'-3"	Str.				4571		
603	60	6'-2"	104	4'-2"	2'-0"				556	802	33	42'-3"	Str.				3723		
604	54	16'-4"	119	12'-6"	0'-8"	3'-2"			1330	803	3	23'-0"	Str.				184		
605	83	12'-0"	108	7'-6"	4'-6"	9-8"			1495	804	2	13'-0"	Str.				70		
606	89	9'-8"	104	8'-6"	1'-2"				1314	805	6	22'-3"	Str.				357		
607	2 Ser. of 5	12'-6" to 24'-0"	Str.						273	806	5	14'-6"	101	13'-0"	1'-6"		194		
608	4 Ser. of 3	5'-6" to 11'-6"	Str.					3'-0"	153	807	4	9'-0"	Str.				96		
609	6	16'-10"	119	13'-0"	0'-8"	3'-2"			151	808	17	6'-0"	101	4'-6"	1'-6"		272		
610	4	7'-2"	108	4'-8"	2'-6"	1'			43	809	6	14'-6"	Str.				232		
611	1 Ser. of 8	13'-2" to 23'-2"	122	1'-0"	4'-6" to 9'-6"	2'-2"		8-1/2"	218	810	3	11'-6"	Str.				92		
612	2	29'-6"	Str.						89	811	2	44'-9"	Str.				279		
613	2	35'-9"	Str.						107	812	3	21'-6"	Str.				172		
614	36	44'-9"	Str.						2420	813	36	48'-11"	119	45'-3"	1'-2"	2'-6"	4702		
615	4	22'-6"	Str.						135	814	34	43'-3"	Str.				3930		
616	3	20'-3"	Str.						91	815	5	36'-0"	Str.				480		
617	19	23'-3"	Str.						664	816	4	34'-0"	Str.				365		
618	16	21'-0"	Str.						505	817	5	28'-0"	Str.				374		
619	1 Ser. of 6	21'-6" to 22'-0"	Str.					1-3/8"	196	818	5	26'-0"	Str.				348		
620	20	19'-3"	Str.						578	819	4	15'-9"	Str.				168		
621	6	23'-9"	Str.						214	820	4	13'-9"	Str.				147		
622	12	21'-3"	Str.						383	821	3	8'-9"	Str.				70		
623	4	23'-0"	Str.						138	822	3	6'-9"	Str.				54		
624	6	22'-9"	Str.						204	823	12	8'-6"	Str.				273		
625	10	20'-6"	Str.						308	824	21	10'-0"	Str.				561		
626	35	14'-3"	123						750	825	11	12'-6"	101	11'-0"	1'-6"		367		
627	35	5'-6"	104	2'-6"	3'-0"				288	826	4	12'-0"	Str.				128		
628	112	4'-0"	Str.						675	827	4	25'-6"	125	21'-6"	3'-0"	5-1/2"	282		
629	4	24'-6"	Str.						147	828	3	30'-9"	125	26'-9"	3'-0"	6"	247		
630	9	22'-0"	Str.						296	829	4	26'-9"	125	22'-9"	3'-0"	6-1/4"	287		
631	1 Ser. of 6	25'-9" to 26'-3"	Str.					1-3/8"	236										
632	3	27'-9"	Str.						125										
633	6	25'-0"	Str.						225										
634	4	29'-0"	Str.						174										
635	5	27'-0"	Str.						202										
636	9	16'-10"	120	2'-0"	11'-8"	1'-2"			227										
637	88	9'-0"	Str.						1190										
638	9	10'-6"	121	6'-5"	2'-11"	1'-2"			142										
639	79	14'-4"	120	2'-0"	8'-8"	1'-2"			1700										
640	95	7'-8"	104	5'-0"	2'-8"				1090										
641	1 Ser. of 10	26'-8" to 35'-8"	122	1'-0"	11'-3" to 15'-9"	2'-2"		6"	468	901	12	10'-0"	Str.				408		
642	4	11'-4"	120	2'-6"	5'-8"	1'-2"			68	902	26	6'-0"	101	4'-5"	1'-7"		530		
643	12	16'-10"	124	5'-0"	8'-8"	1'-2"			303	903	4	34'-0"	Str.				462		
644	6	4'-3"	Str.						38	904	5	33'-6"	Str.				571		
645	5	10'-0"	Str.						75	905	2	40'-6"	Str.				276		
646	2	8'-9"	Str.						26	906	2	29'-0"	Str.				197		
647	1	29'-9"	Str.						45	907	1	40'-0"	Str.				136		
648	2	34'-3"	104	34'-3"	1'-6"				102										
649	1	32'-3"	Str.						48										
650	1 Ser. of 9	24'-2" to 32'-8"	122	1'-0"	10'-0" to 14'-3"	2'-2"		6-3/8"	384										
651	4	13'-6"	109	10"	5'-8"				81										
652	1	36'-0"	Str.						54	1001	12	21'-0"	100	17'-6"	1'-9"		1084		
653	13	11'-4"	100	9'-6"	0'-11"				221	1002	16	7'-9"	101	6'-0"	1'-9"		534		
654	13	14'-6"	Str.						283										
655	13	9'-10"	100	8'-0"	0'-11"				191										
656	47	11'-6"	Str.						812										
657	47	12'-10"	100	11'-0"	0'-11"				905	1101	6	10'-0"	Str.				319		
658	6	16'-6"	Str.						148	1102	15	7'-0"	101	5'-1"	1'-11"		558		
659	6	18'-6"	Str.						167	1103	6	40'-6"	Str.				1290		
660	2 Ser. of 4	12'-0" to 21'-0"	Str.					3'-0"	200	1104	3	40'-0"	Str.				638		
661	2 Ser. of 3	4'-0" to 10'-0"	Str.					3'-0"	63	1105	30	10'-3"	101	8'-4"	1'-11"		1631		
662	2 Ser. of 4	10'-9" to 13'-9"	Str.					3'-0"	185	1106	8	23'-4"	100	19'-6"	1'-11"		992		
663	1 Ser. of 7	13'-8" to 22'-2"	122	1'-0"	4'-9" to 9'-0"	2'-2"		8-1/2"	189	1107	8	25'-4"	100	21'-6"	1'-11"		1078		
664	1 Ser. of 9	22'-8" to 30'-8"	122	1'-0"	9'-3" to 13'-3"	2'-2"		6"	359	1108	8	26'-4"	100	22'-6"	1'-11"		1123		
																	TOTAL 58,935		

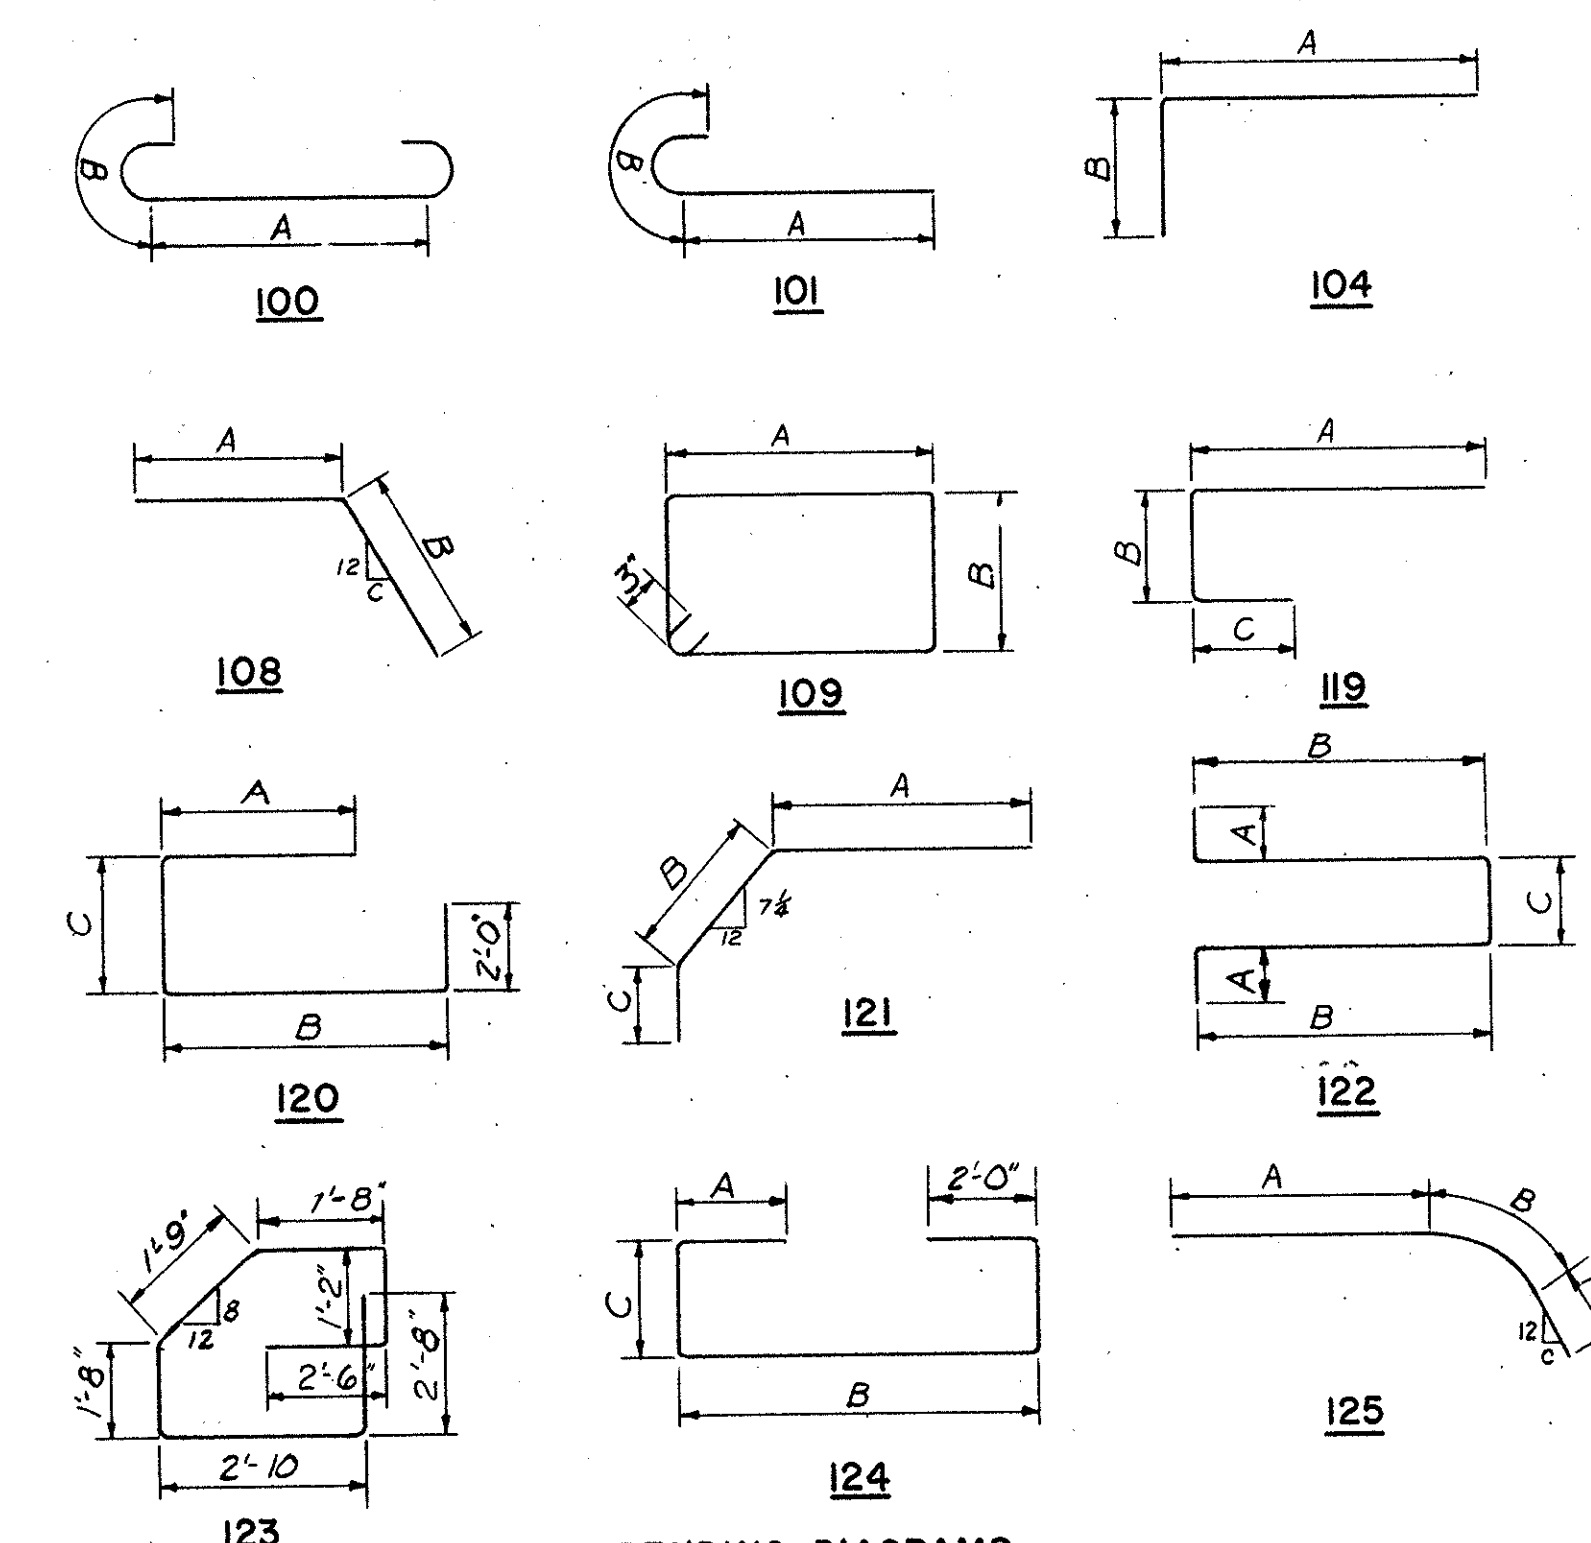

Note: Bar dimensions are given out to out.

SIZE	NUMBER	LENGTH	TYPE	WEIGHT
4	1	5'-3"	Str.	4
5	7	5'-7"	Str.	41
6	19	5'-11"	Str.	169
7	11	6'-3"	Str.	141
8	4	6'-6"	Str.	69
9	1	6'-10"	Str.	23
10	1	7'-2"	Str.	31
11	10	7'-6"	Str.	399
Total				877

Replacement bars are listed for entire structure.

PART 7

## AKRON EXPRESSWAY SYSTEM


WEST VIADUCT  
BR. NO. SU-18R-135  
WEST ABUTMENT

### REINFORCEMENT SCHEDULE

AKRON, SUMMIT COUNTY, OHIO

SCALE: None  
MADE: L.W.L. DATE: 7-30-55  
HOWARD, NEEDLES, TAMMEN & BERGENDOFF  
CONSULTING ENGINEERS  
TRC: DATE: 9-8-55  
KANSAS CITY CLEVELAND NEW YORK  
901 SHEET-62

SUMMIT COUNTY  
CITY OF AKRON  
ARKON EXPRESSWAY SYSTEM

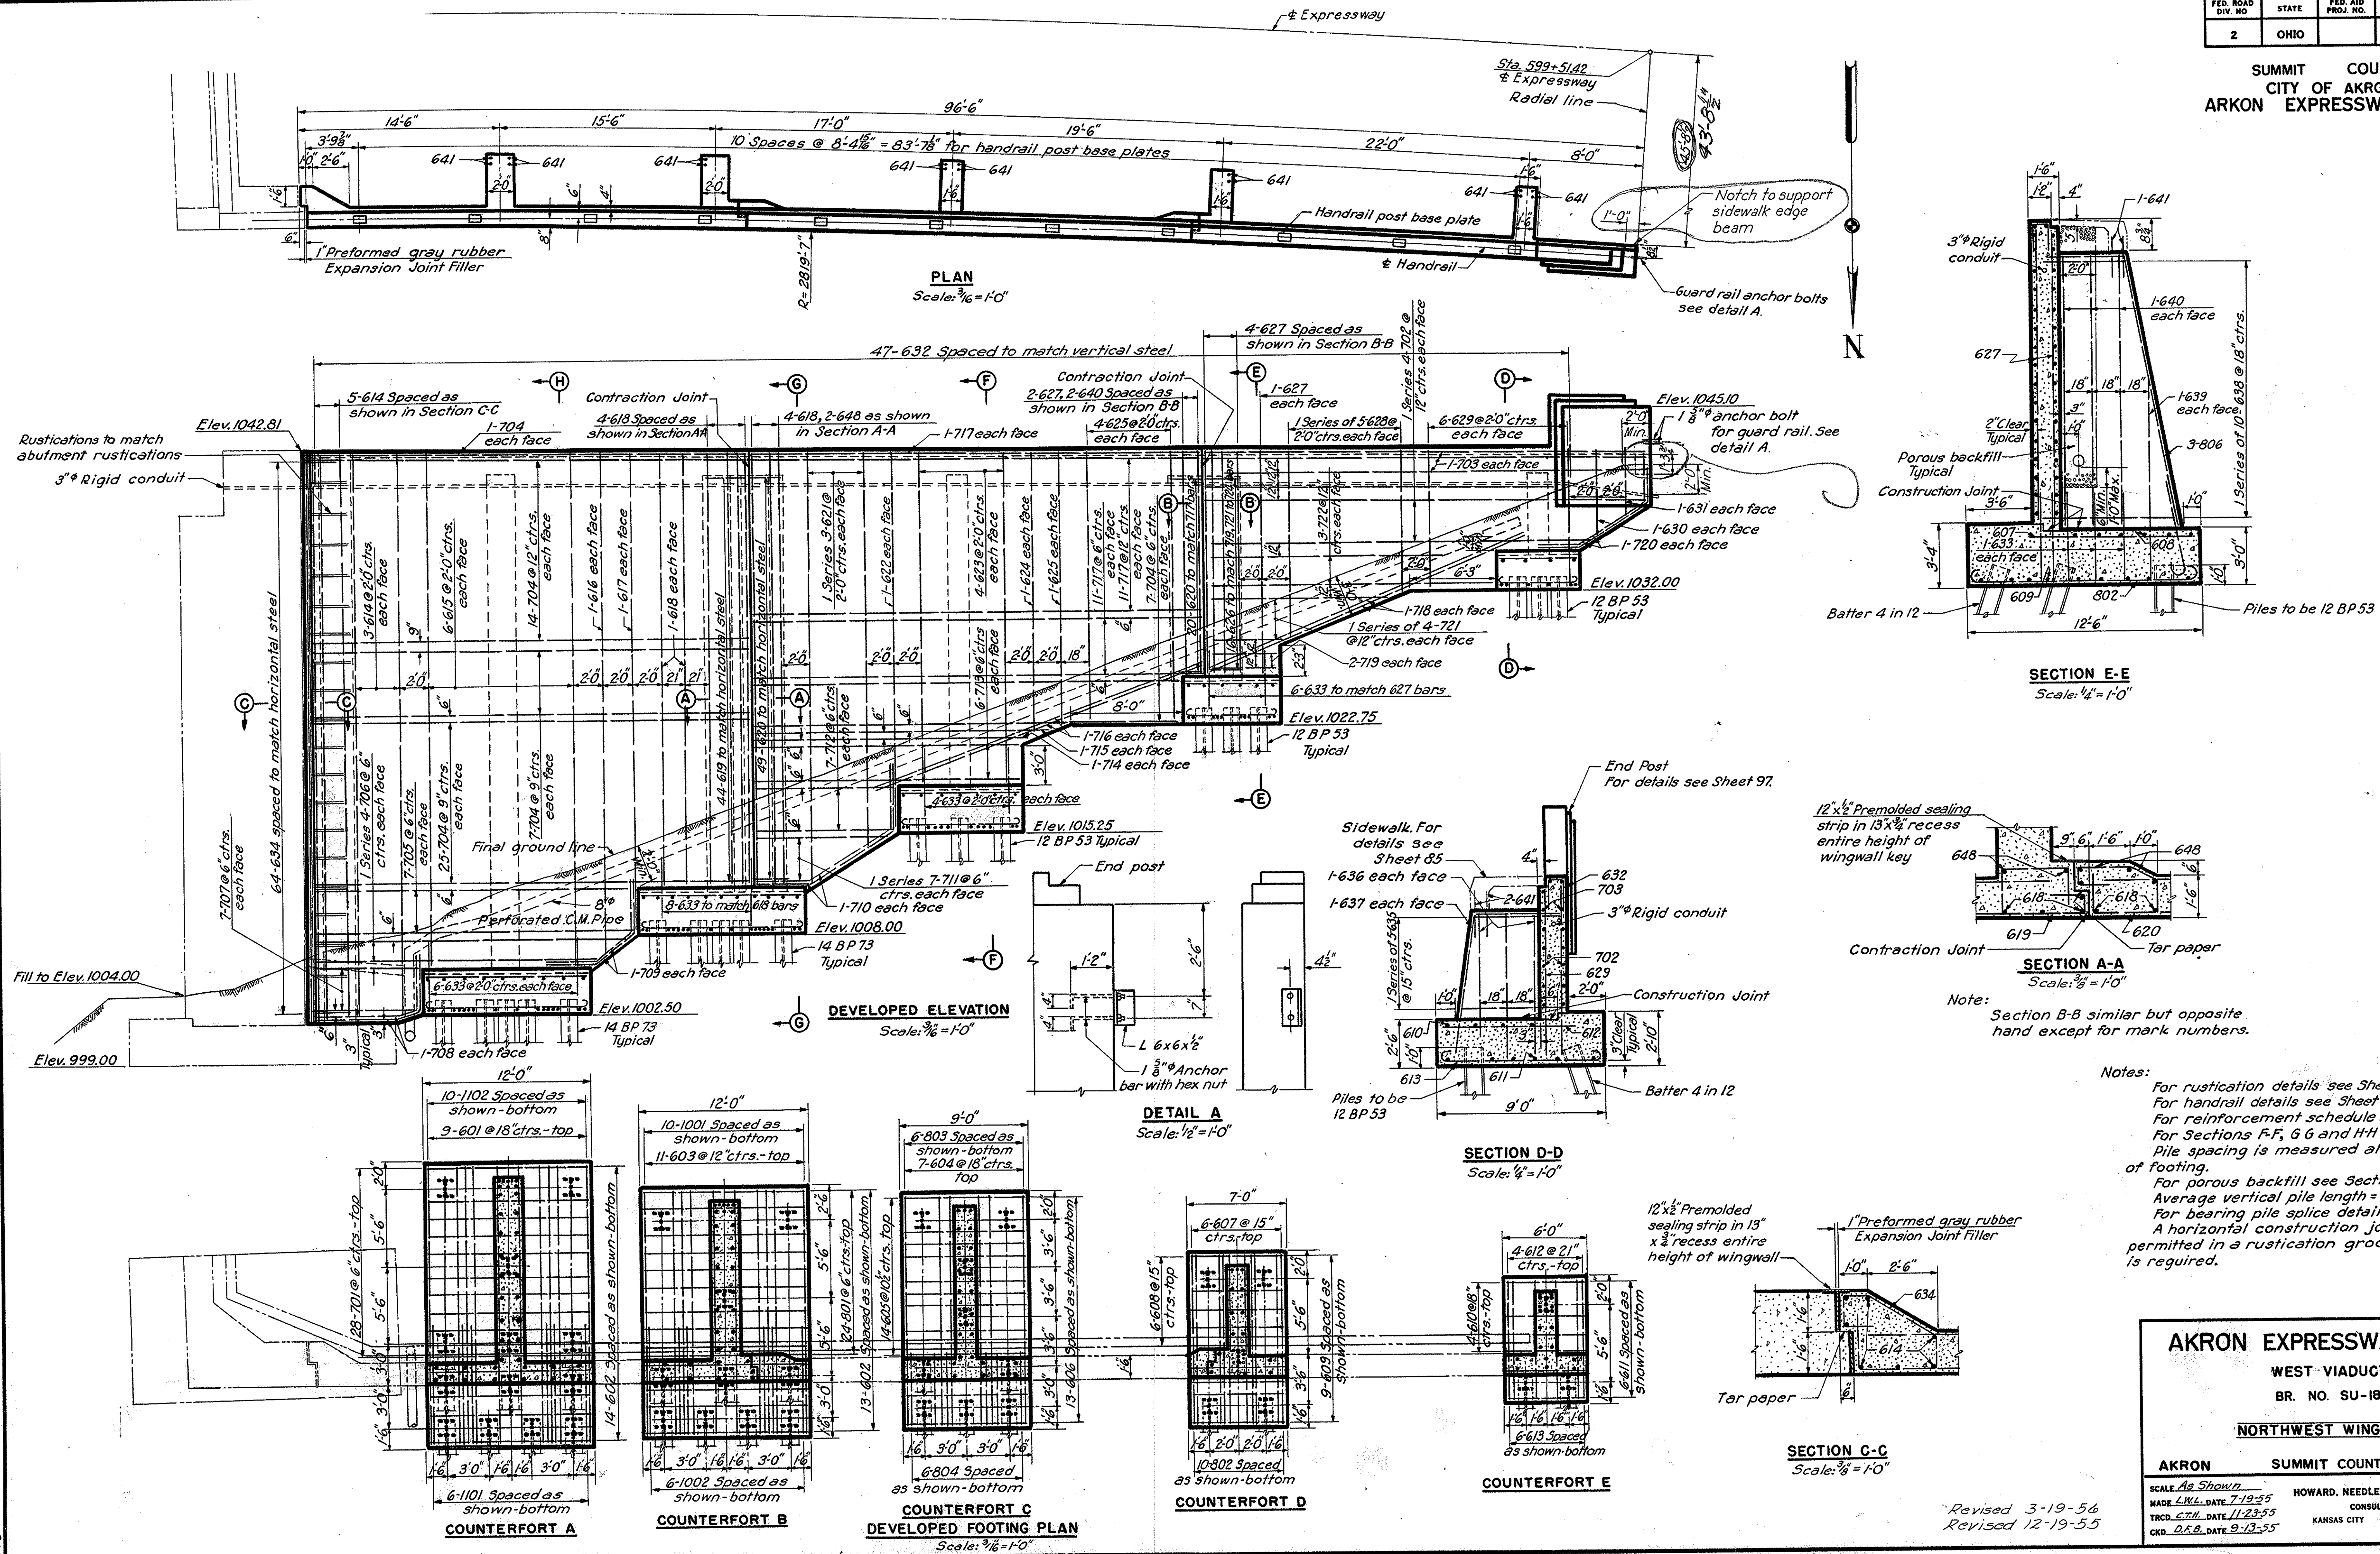

Note:  
Section B-B similar but opposite hand except for mark numbers.

- Notes:
- For rustication details see Sheet 78.
  - For handrail details see Sheet 97.
  - For reinforcement schedule see Sheet 64.
  - For Sections F-F, G-G and H-H see Sheet 64.
  - Pile spacing is measured along bottom of footing.
  - For porous backfill see Section E-E. Average vertical pile length = 39 feet.
  - For bearing pile splice details see Sheet 61.
  - A horizontal construction joint will be permitted in a rustication groove if a joint is required.

**PART 7**


**AKRON EXPRESSWAY SYSTEM**  
WEST VIADUCT  
BR. NO. SU-18R-135  
NORTHWEST WINGWALL

AKRON	SUMMIT COUNTY	OHIO
SCALE: As Shown	HOWARD, NEEDLES, TAMMEN & BERGENDOFF	
MADE L.W.L. DATE 7-19-55	CONSULTING ENGINEERS	
TRCD. DATE 11-23-55	KANSAS CITY CLEVELAND NEW YORK	
CKD. DATE 9-13-55		901 SHEET 63


Revised 3-19-56  
Revised 12-19-55

SUMMIT COUNTY  
CITY OF AKRON  
AKRON EXPRESSWAY SYSTEM


Note: Section K-K similar to section J-J except for mark numbers.

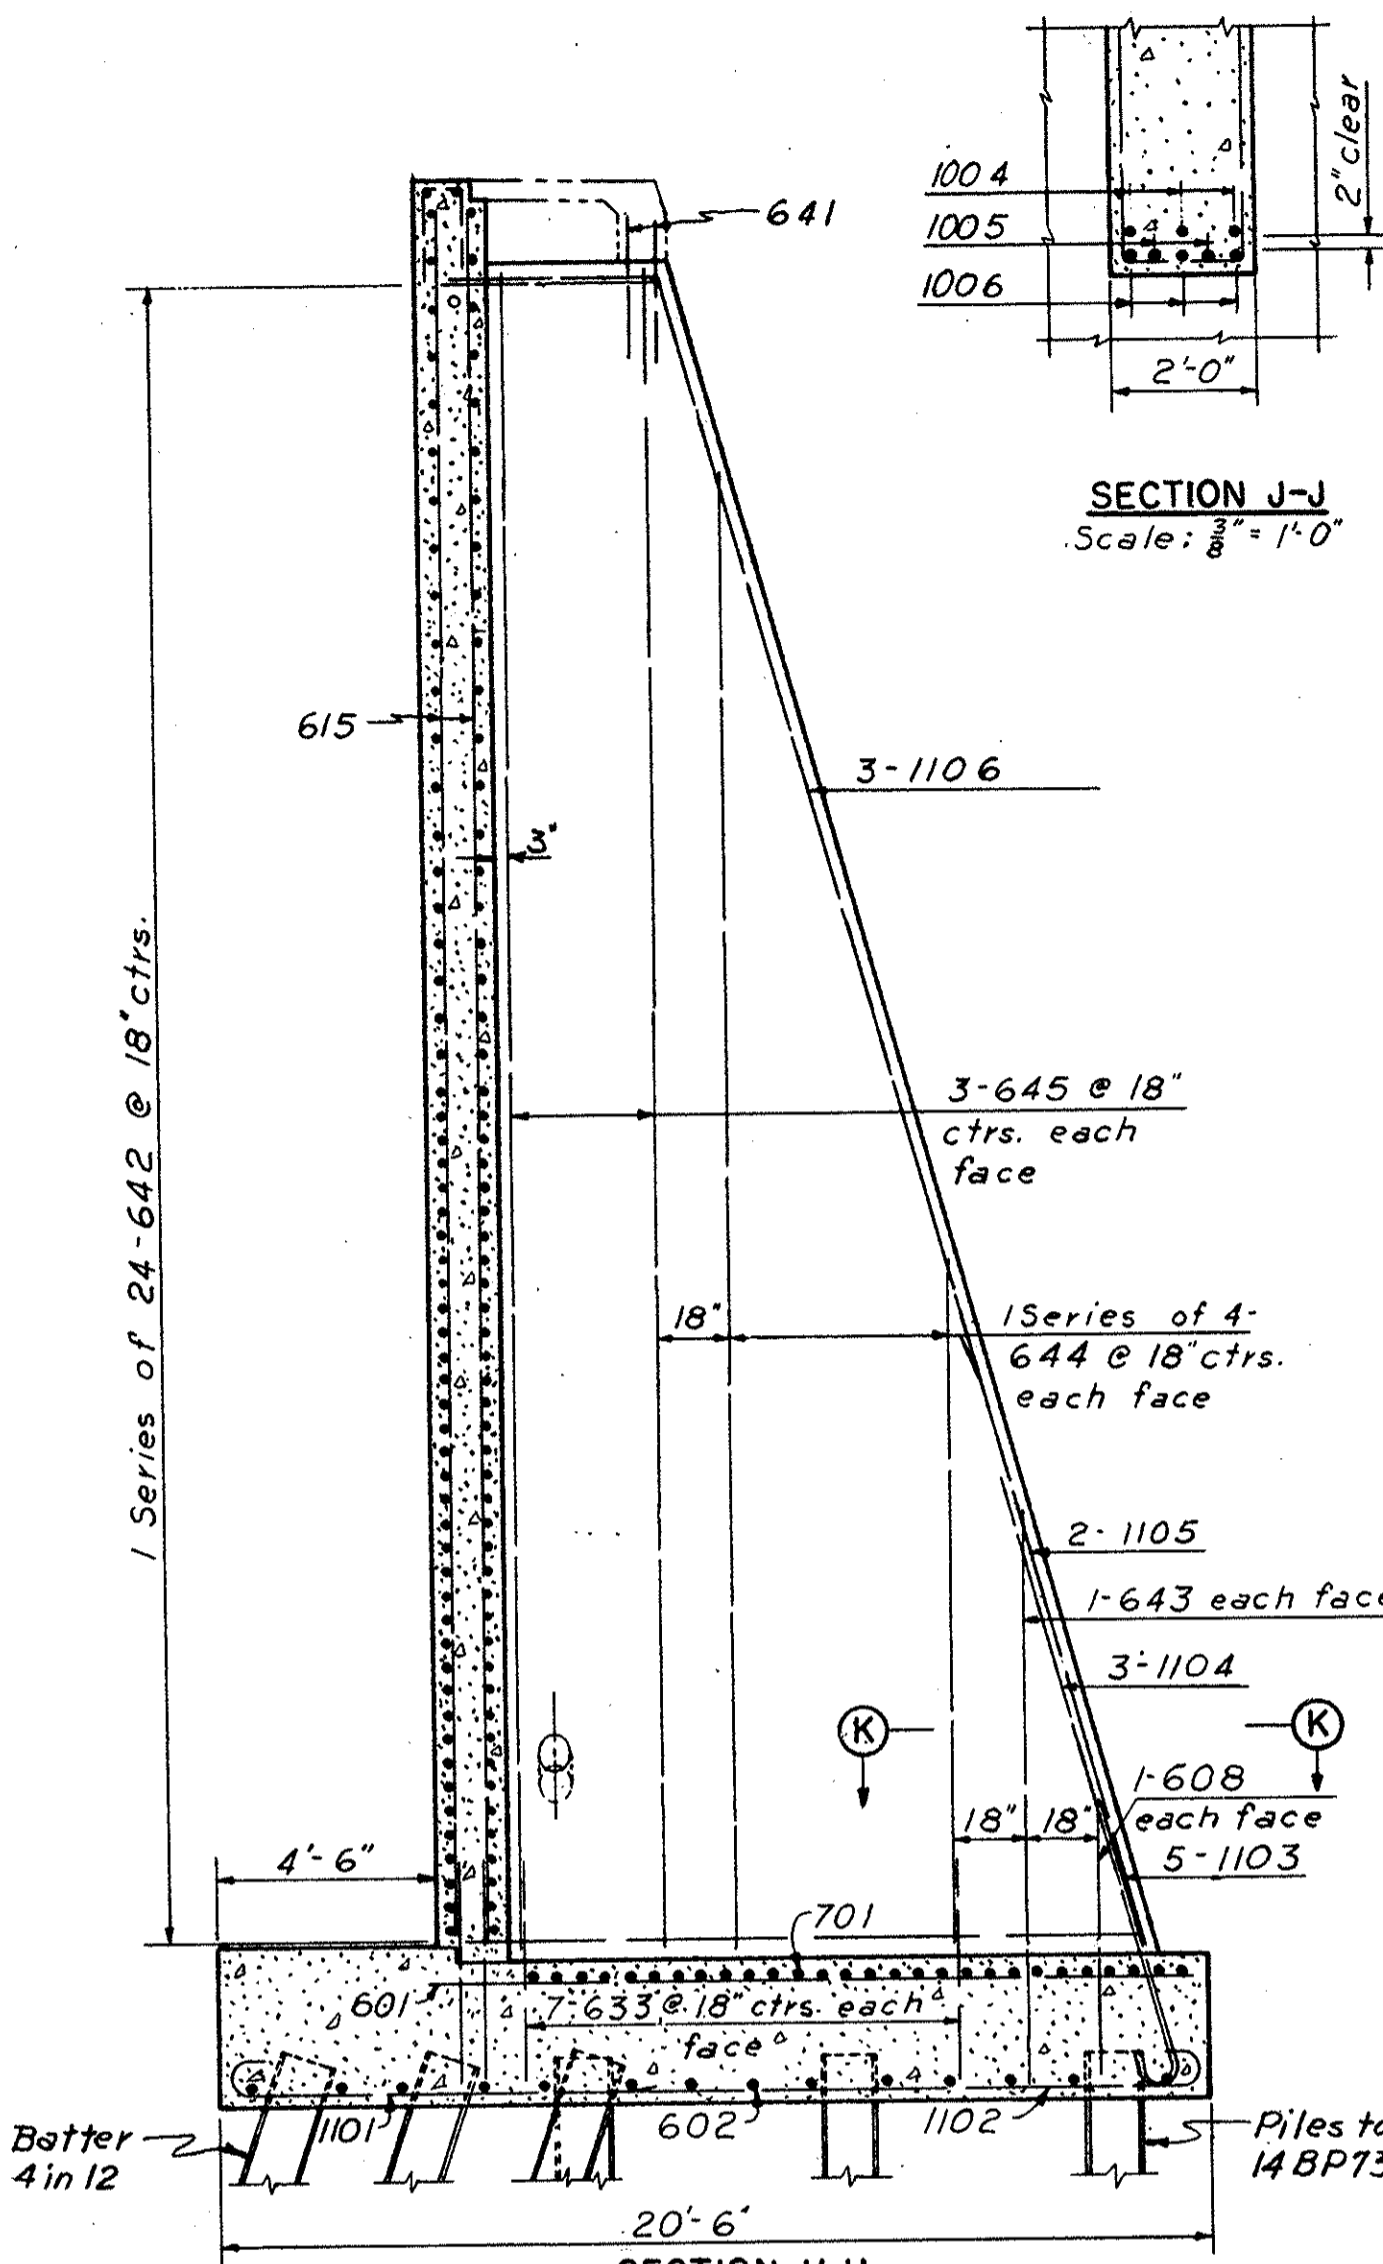


SECTION H-H Scale: 1/4" = 1'-0"

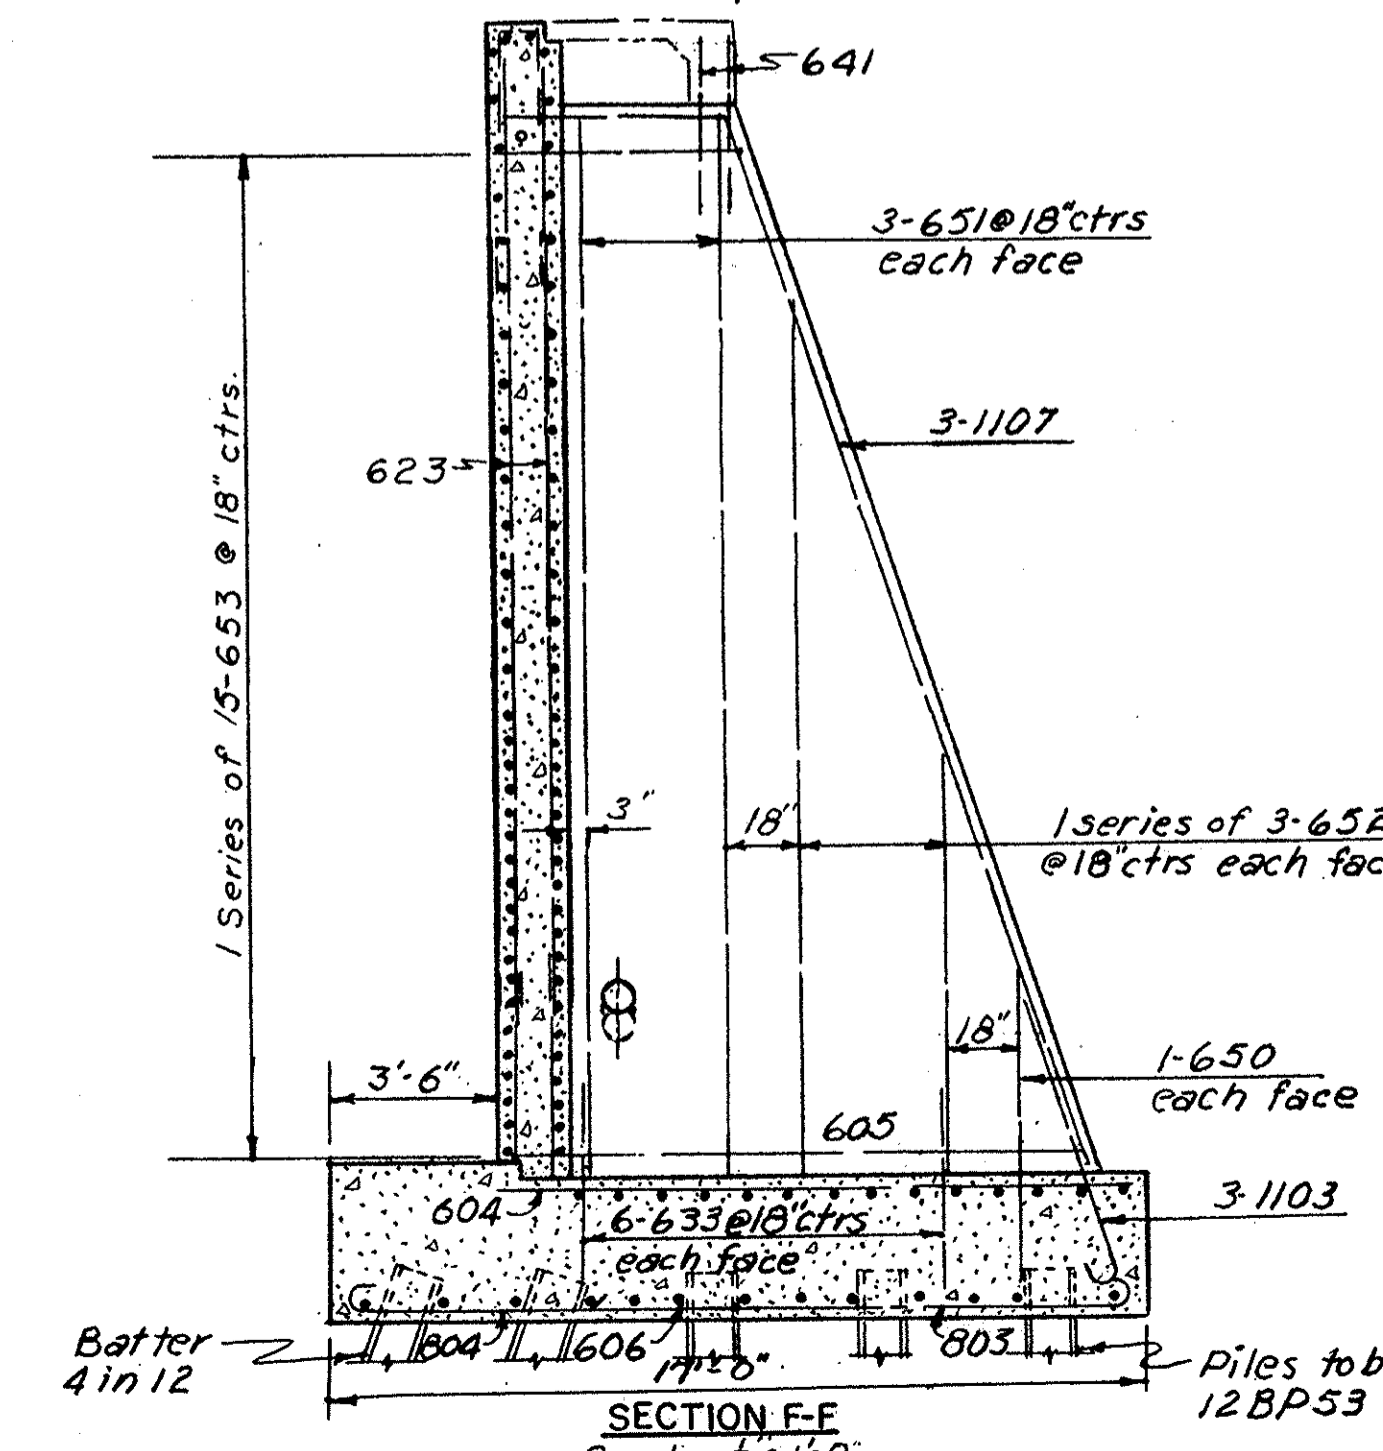

SECTION F-F Scale: 1/4" = 1'-0"

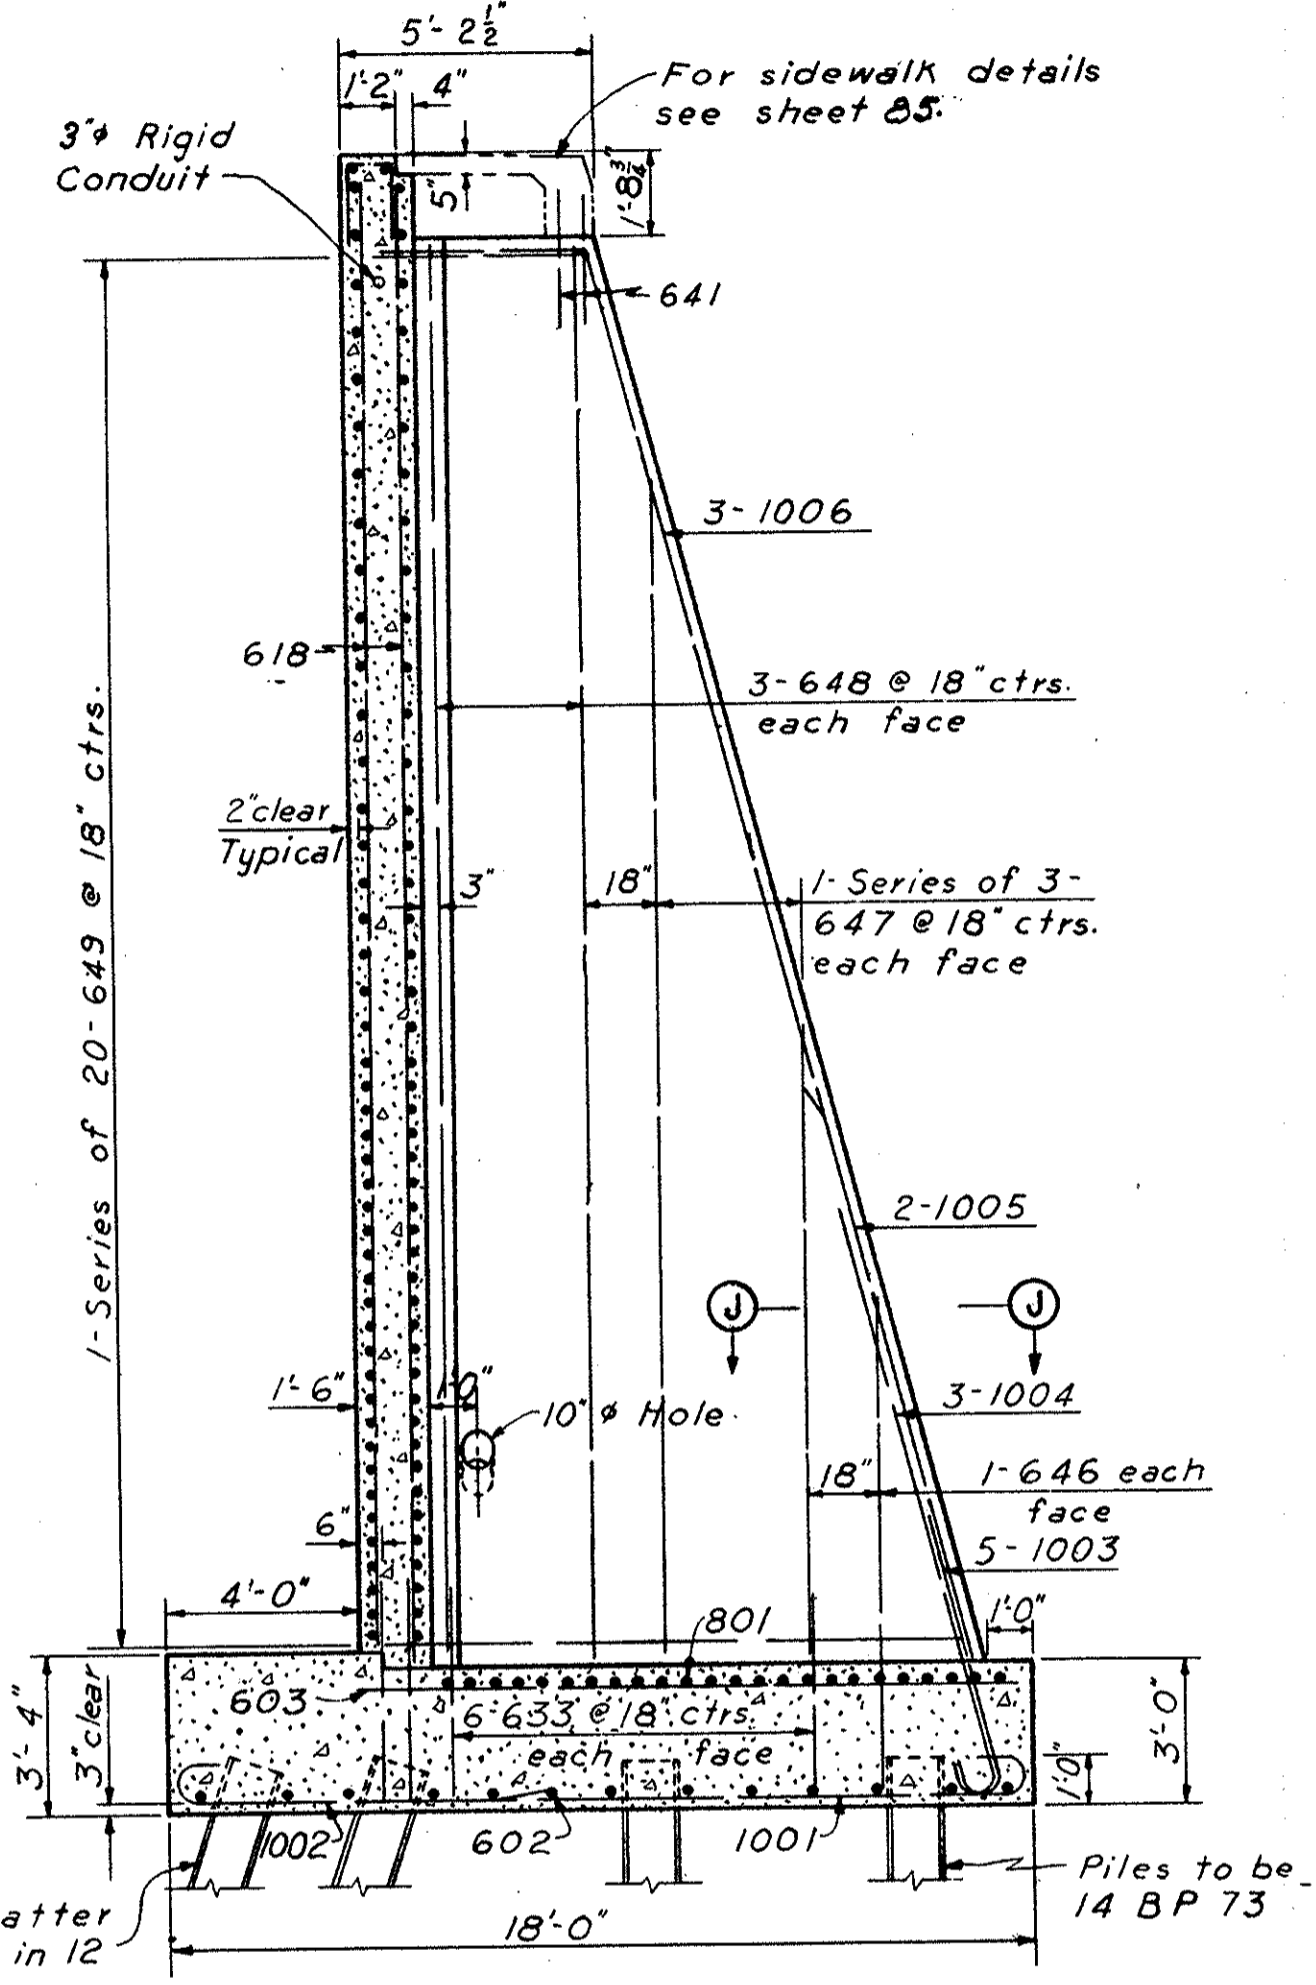

SECTION G-G Scale: 1/4" = 1'-0"

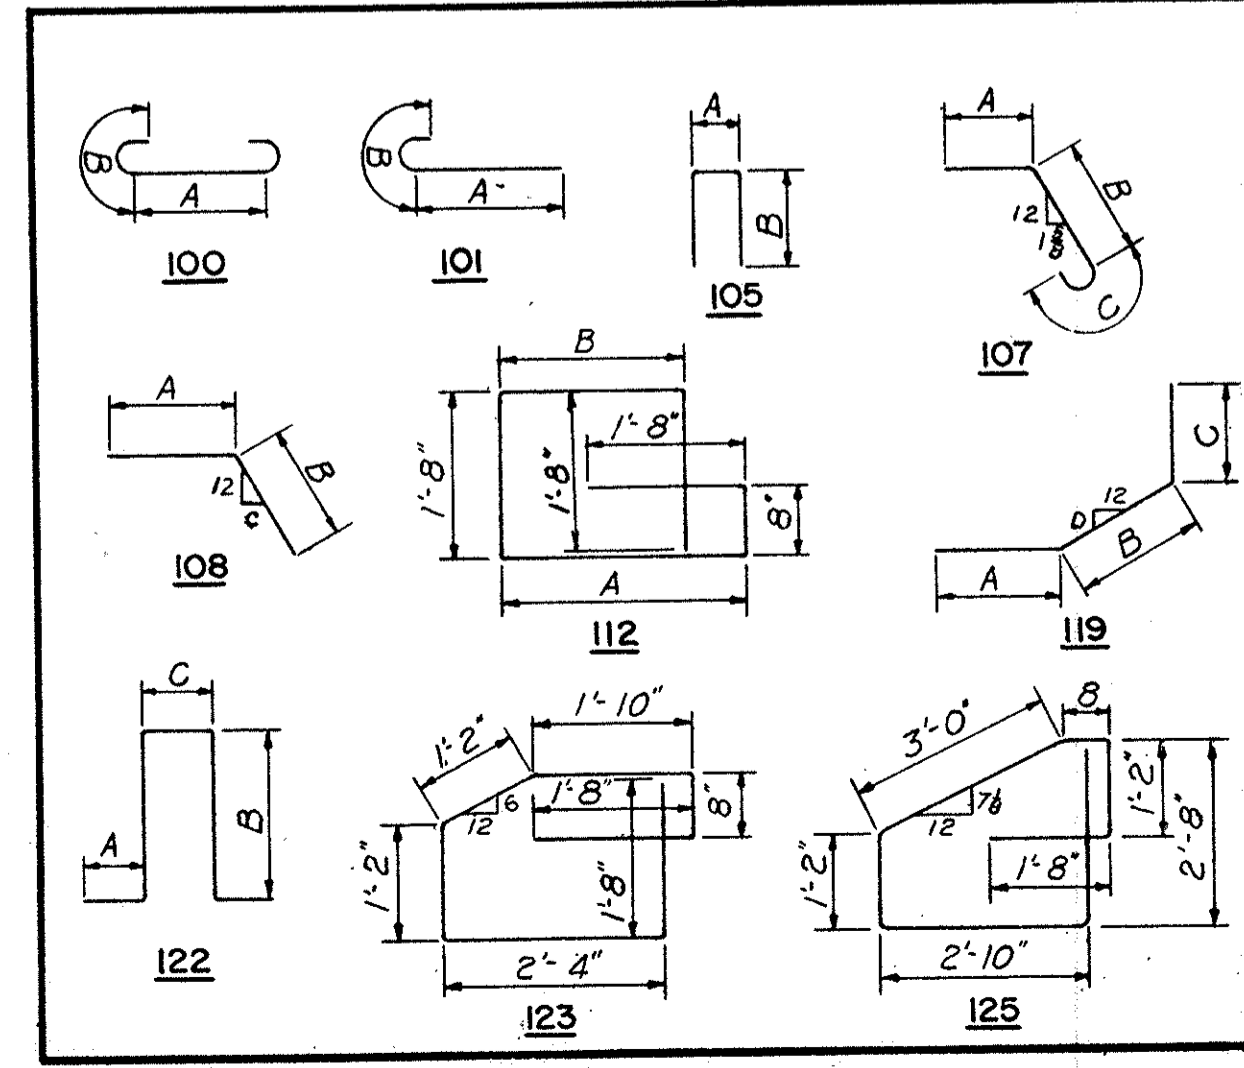

MARK	NUMBER	LENGTH	TYPE	DIMENSIONS				SERIES INCRE-MENT	WEIGHT POUNDS	
				A	B	C	D			
NORTHWEST WINGWALL										
601	9	16'-0"	Str.						216	
602	27	12'-10"	100	11'-0"	0'-11"				520	
603	11	14'-0"	Str.						231	
604	7	13'-6"	Str.						142	
605	14	8'-6"	Str.						179	
606	13	9'-10"	100	8'-0"	0'-11"				192	
607	6	9'-0"	Str.						81	
608	8	6'-6"	Str.						78	
609	9	7'-10"	100	6'-0"	0'-11"				106	
610	4	5'-6"	Str.						33	
611	6	6'-10"	100	5'-0"	0'-11"				62	
612	4	8'-0"	Str.						48	
613	6	9'-10"	100	8'-0"	0'-11"				89	
614	11	40'-0"	Str.						661	
615	12	36'-6"	Str.						656	
616	2	35'-6"	Str.						107	
617	2	34'-0"	Str.						102	
618	12	30'-9"	Str.						554	
619	44	11'-0"	112	2'-11"	2'-5"				727	
620	69	10'-6"	123						1088	
621	2 Ser. of 3	27'-9" to 30'-6"	Str.						264	
622	2	26'-6"	Str.						80	
623	8	23'-6"	Str.						282	
624	2	19'-9"	Str.						60	
625	10	19'-0"	Str.						285	
626	16	10'-2"	112	2'-5"	1'-11"				240	
627	8	16'-0"	Str.						192	
628	2 Ser. of 5	9'-6" to 12'-9"	Str.						169	
629	12	9'-3"	Str.						167	
630	2	5'-9"	Str.						17	
631	2	5'-0"	Str.						15	
632	47	5'-10"	105	0'-10"	2'-6"				412	
633	78	4'-9"	Str.						556	
634	64	13'-2"	125						1266	
635	1 Ser. of 5	12'-10" to 14'-2"	122	1'-0"	4'-10" to 5'-6"	1'-2"			101	
636	6	7'-6"	Str.						68	
637	2	12'-11"	107	4'-6"	7'-6"	0'-11"			39	
638	1 Ser. of 10	12'-8" to 18'-2"	12	1'-0"	4'-9" to 7'-6"	1'-2"			232	
639	2	10'-6"	Str.						31	
640	8	14'-6"	Str.						174	
641	16	3'-6"	Str.						84	
642	1 Ser. of 24	13'-2" to 32'-8"	122	1'-0"	4'-9" to 14'-6"	1'-8"			826	
643	2	11'-6"	Str.						35	
644	2 Ser. of 4	14'-6" to 31'-0"	Str.						273	
645	6	35'-0"	Str.						315	
646	2	10'-0"	Str.						30	
647	2 Ser. of 3	13'-6" to 25'-0"	Str.						173	
648	8	29'-3"	Str.						351	
649	1 Ser. of 20	13'-2" to 28'-8"	122	1'-0"	4'-9" to 12'-6"	1'-8"			63	
650	2	7'-6"	Str.						23	
651	6	22'-3"	Str.						200	
652	2 Ser. of 3	9'-0" to 18'-0"	Str.						122	
653	1 Ser. of 15	12'-8" to 27'-2"	122	1'-0"	4'-9" to 12'-0"	1'-2"			449	
END POST										
									79	
									33	
									101	
									15	
									72	
									8	
									9	
									Total	35,674
701	28	11'-6"	Str.						658	
702	2 Ser. of 4	27'-6" to 31'-0"	Str.						479	
703	8	28'-0"	Str.						458	
704	108	30'-6"	Str.						6733	
705	14	22'-6"	Str.						644	
706	2 Ser. of 4	20'-0" to 22'-3"	Str.						346	
707	14	7'-6"	Str.						215	
708	4	11'-0"	119	5'-6"	1'-6"	4'-0"	3		90	
709	4	11'-3"	119	3'-6"	3'-9"	4'-0"	8 1/2		92	
710	4	14'-6"	119	3'-0"	7'-0"	4'-6"	7 3/8		118	
711	2 Ser. of 7	4'-6" to 9'-3"	Str.						195	
712	14	9'-9"	Str.						279	
713	12	17'-9"	Str.						435	
714	2	18'-6"	Str.						75	
715	2	19'-9"	Str.						81	
716	4	24'-9"	Str.						202	
717	46	32'-0"	Str.						3009	
718	4	25'-0"	Str.						204	

Notes:  
For location of sections see elevation sheet 63.  
For dimensions not shown see sheet 63.  
Dimensions shown for section G-G are typical except as noted.  
For porous backfill details see sheet 63.  
For replacement bars see Sheet 62.

AKRON EXPRESSWAY SYSTEM  
WEST VIADUCT  
BR. NO. SU-18R-135









NORTHWEST WINGWALL DETAILS

AKRON SUMMIT COUNTY, OHIO  
SCALE As Shown  
MADE L.W.L. DATE 7-24-55  
TRCD. DATE 7-24-55  
CKD. D.F.B. DATE 9-13-55  
HOWARD, NEEDLES, TAMMEN & BERGENDOFF  
CONSULTING ENGINEERS  
KANSAS CITY CLEVELAND NEW YORK  
901 SHEET 64

PART 7




**SUMMIT COUNTY  
CITY OF AKRON  
AKRON EXPRESSWAY SYSTEM**

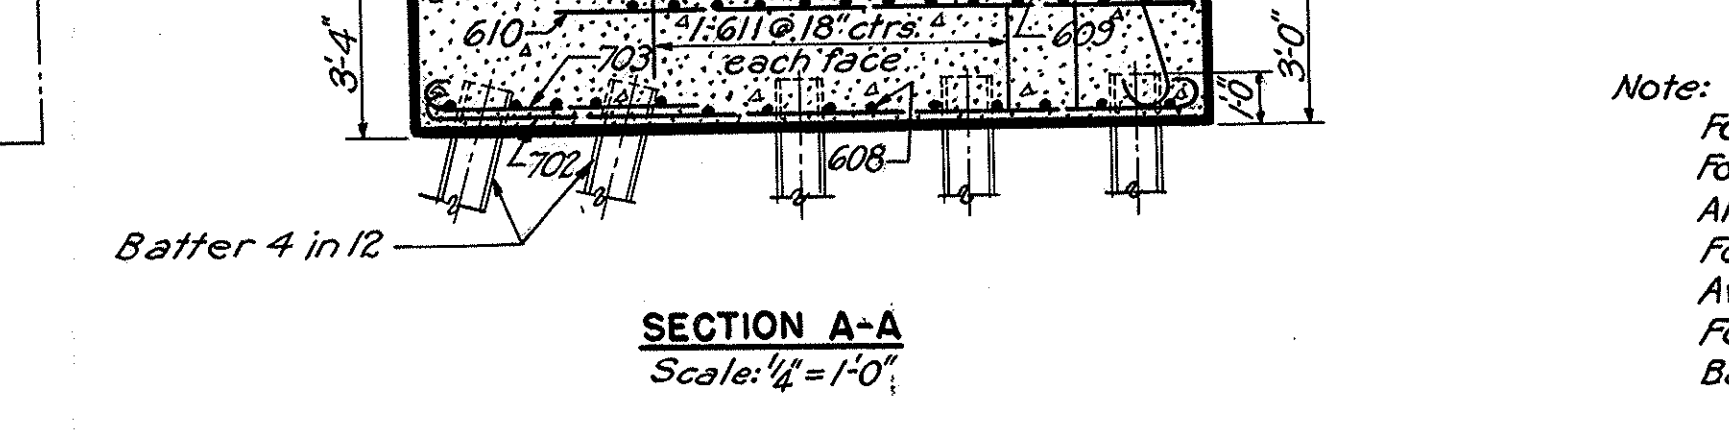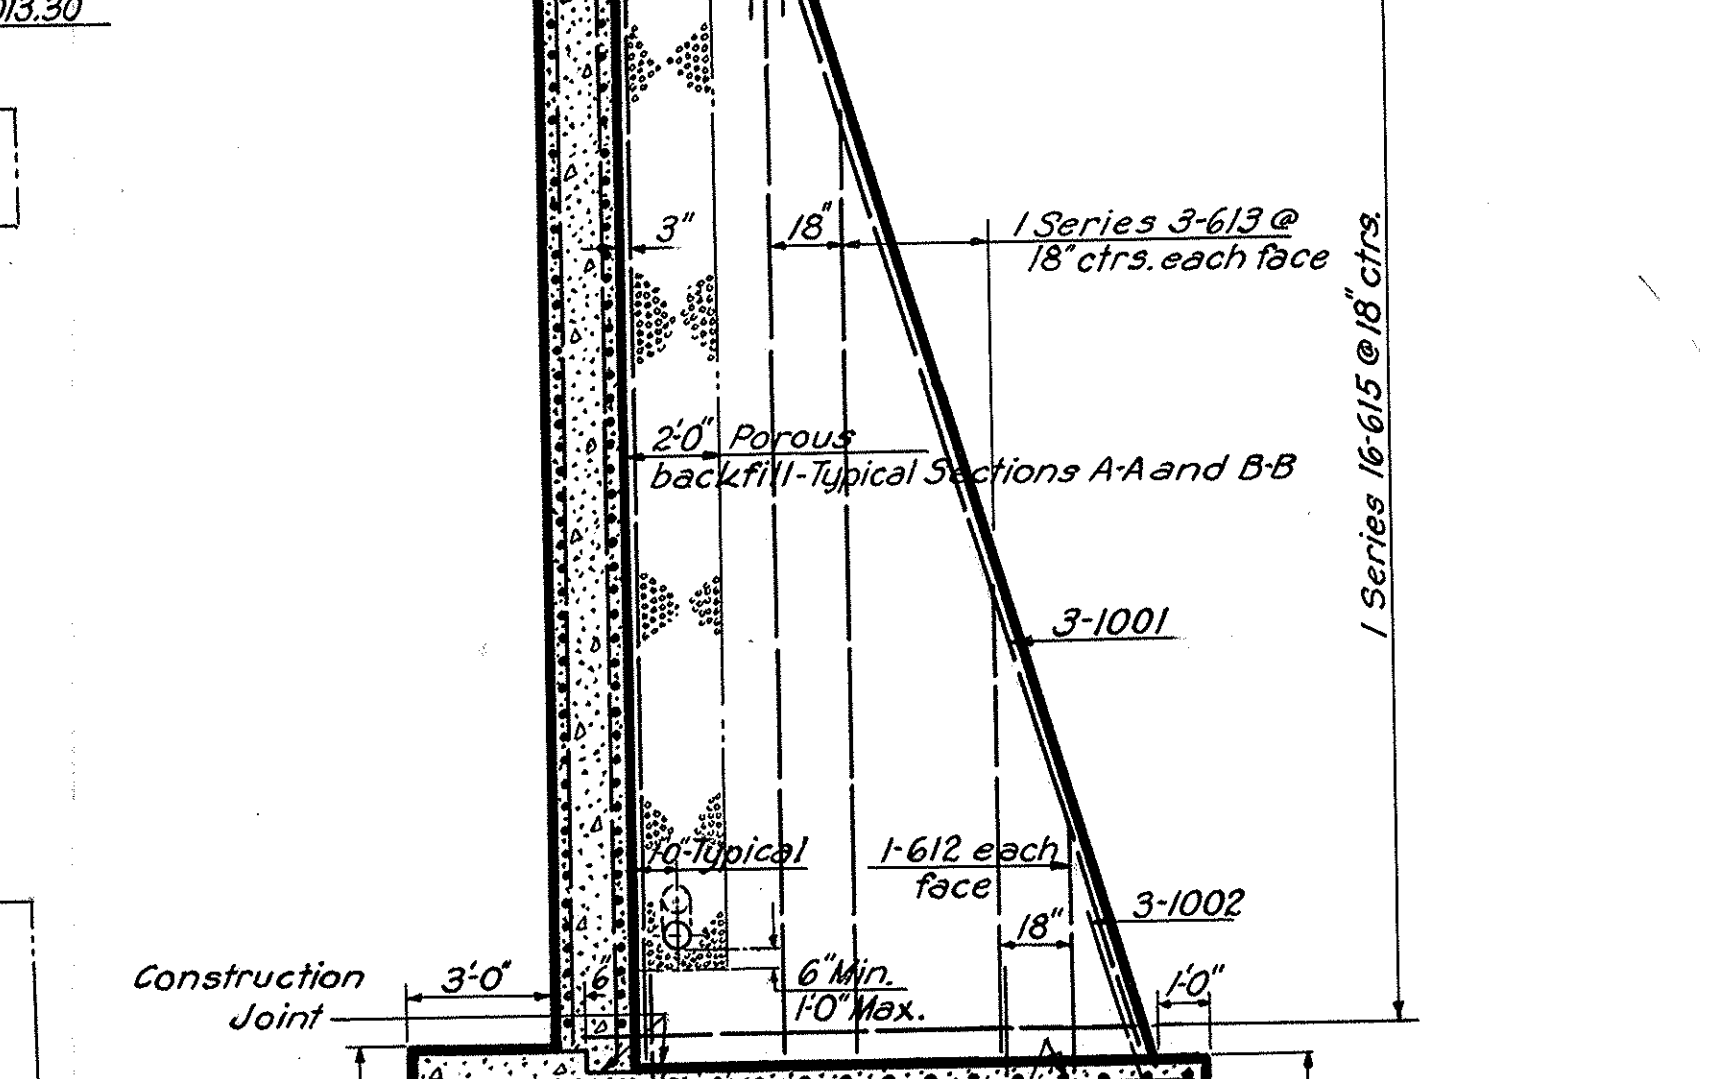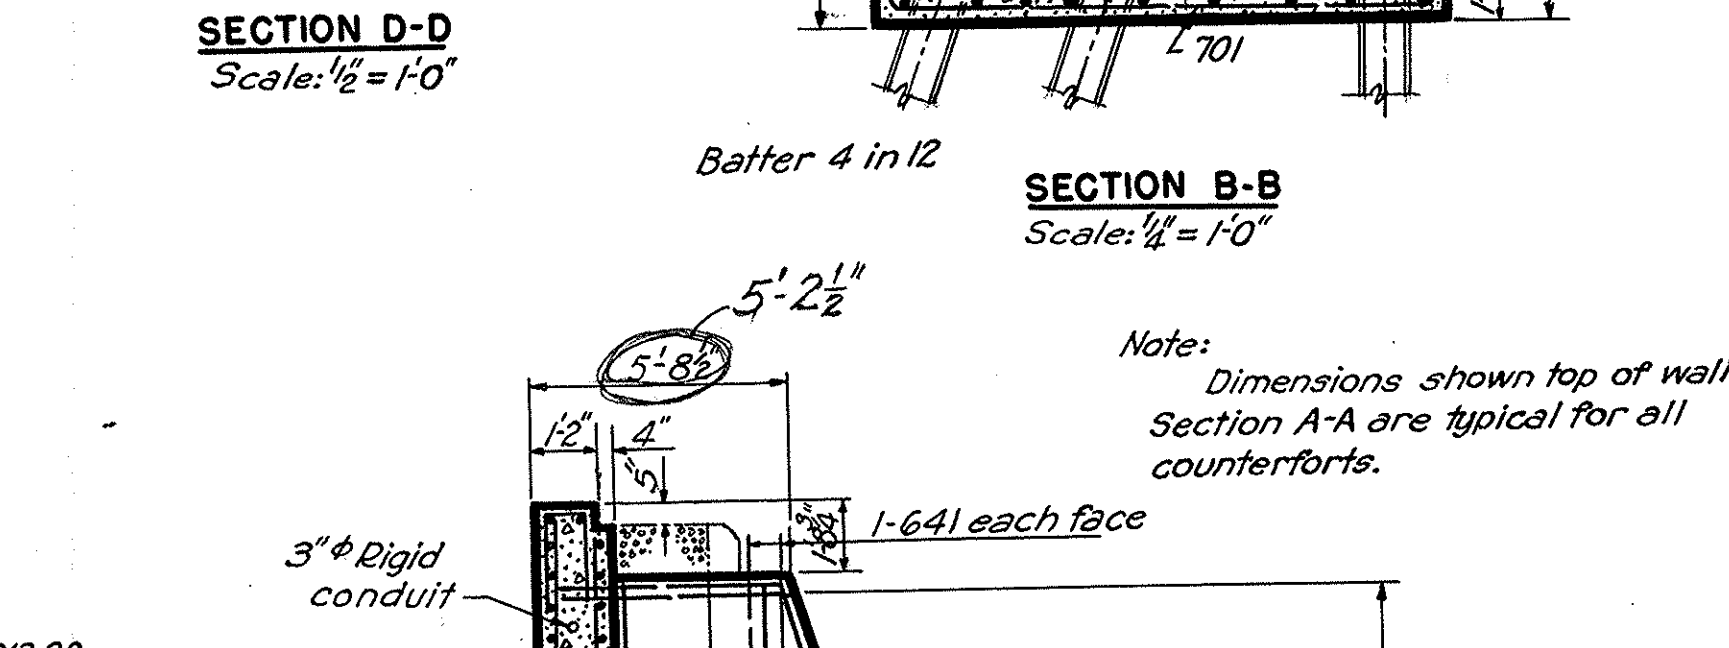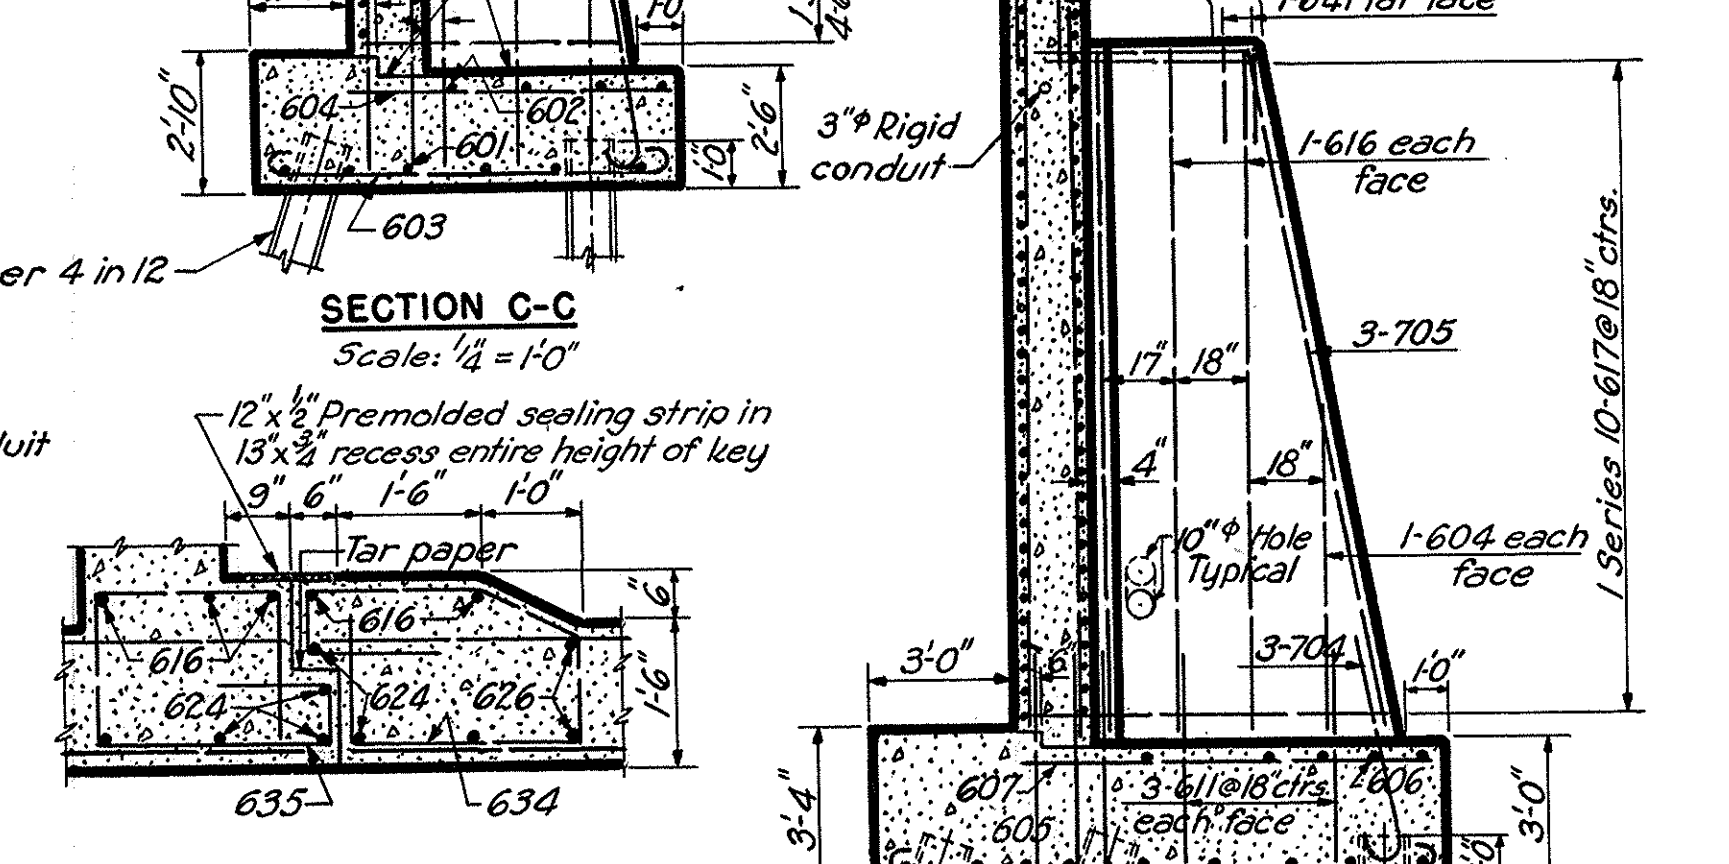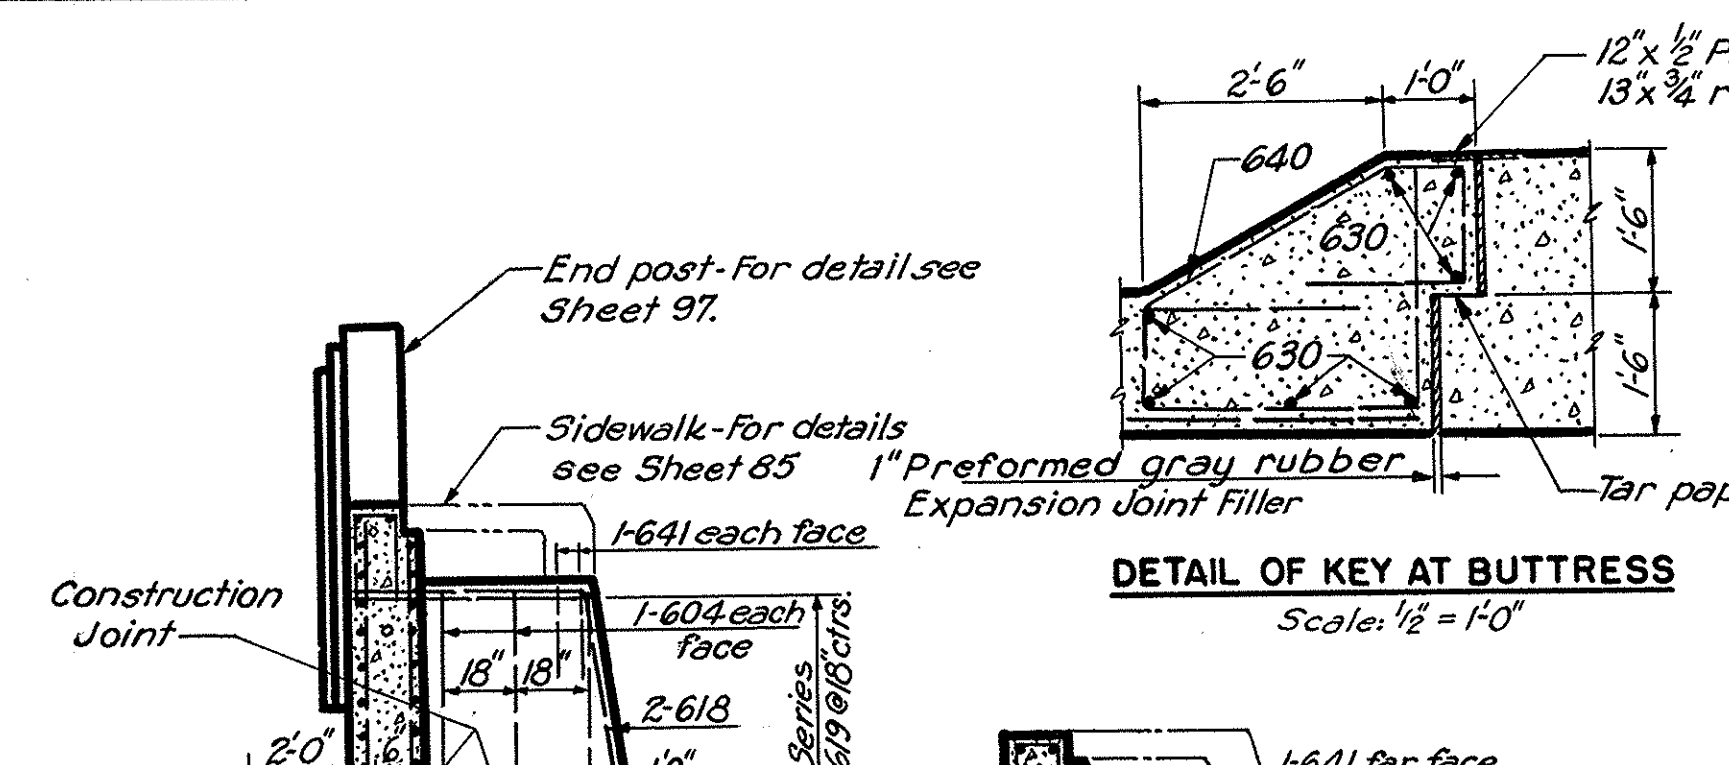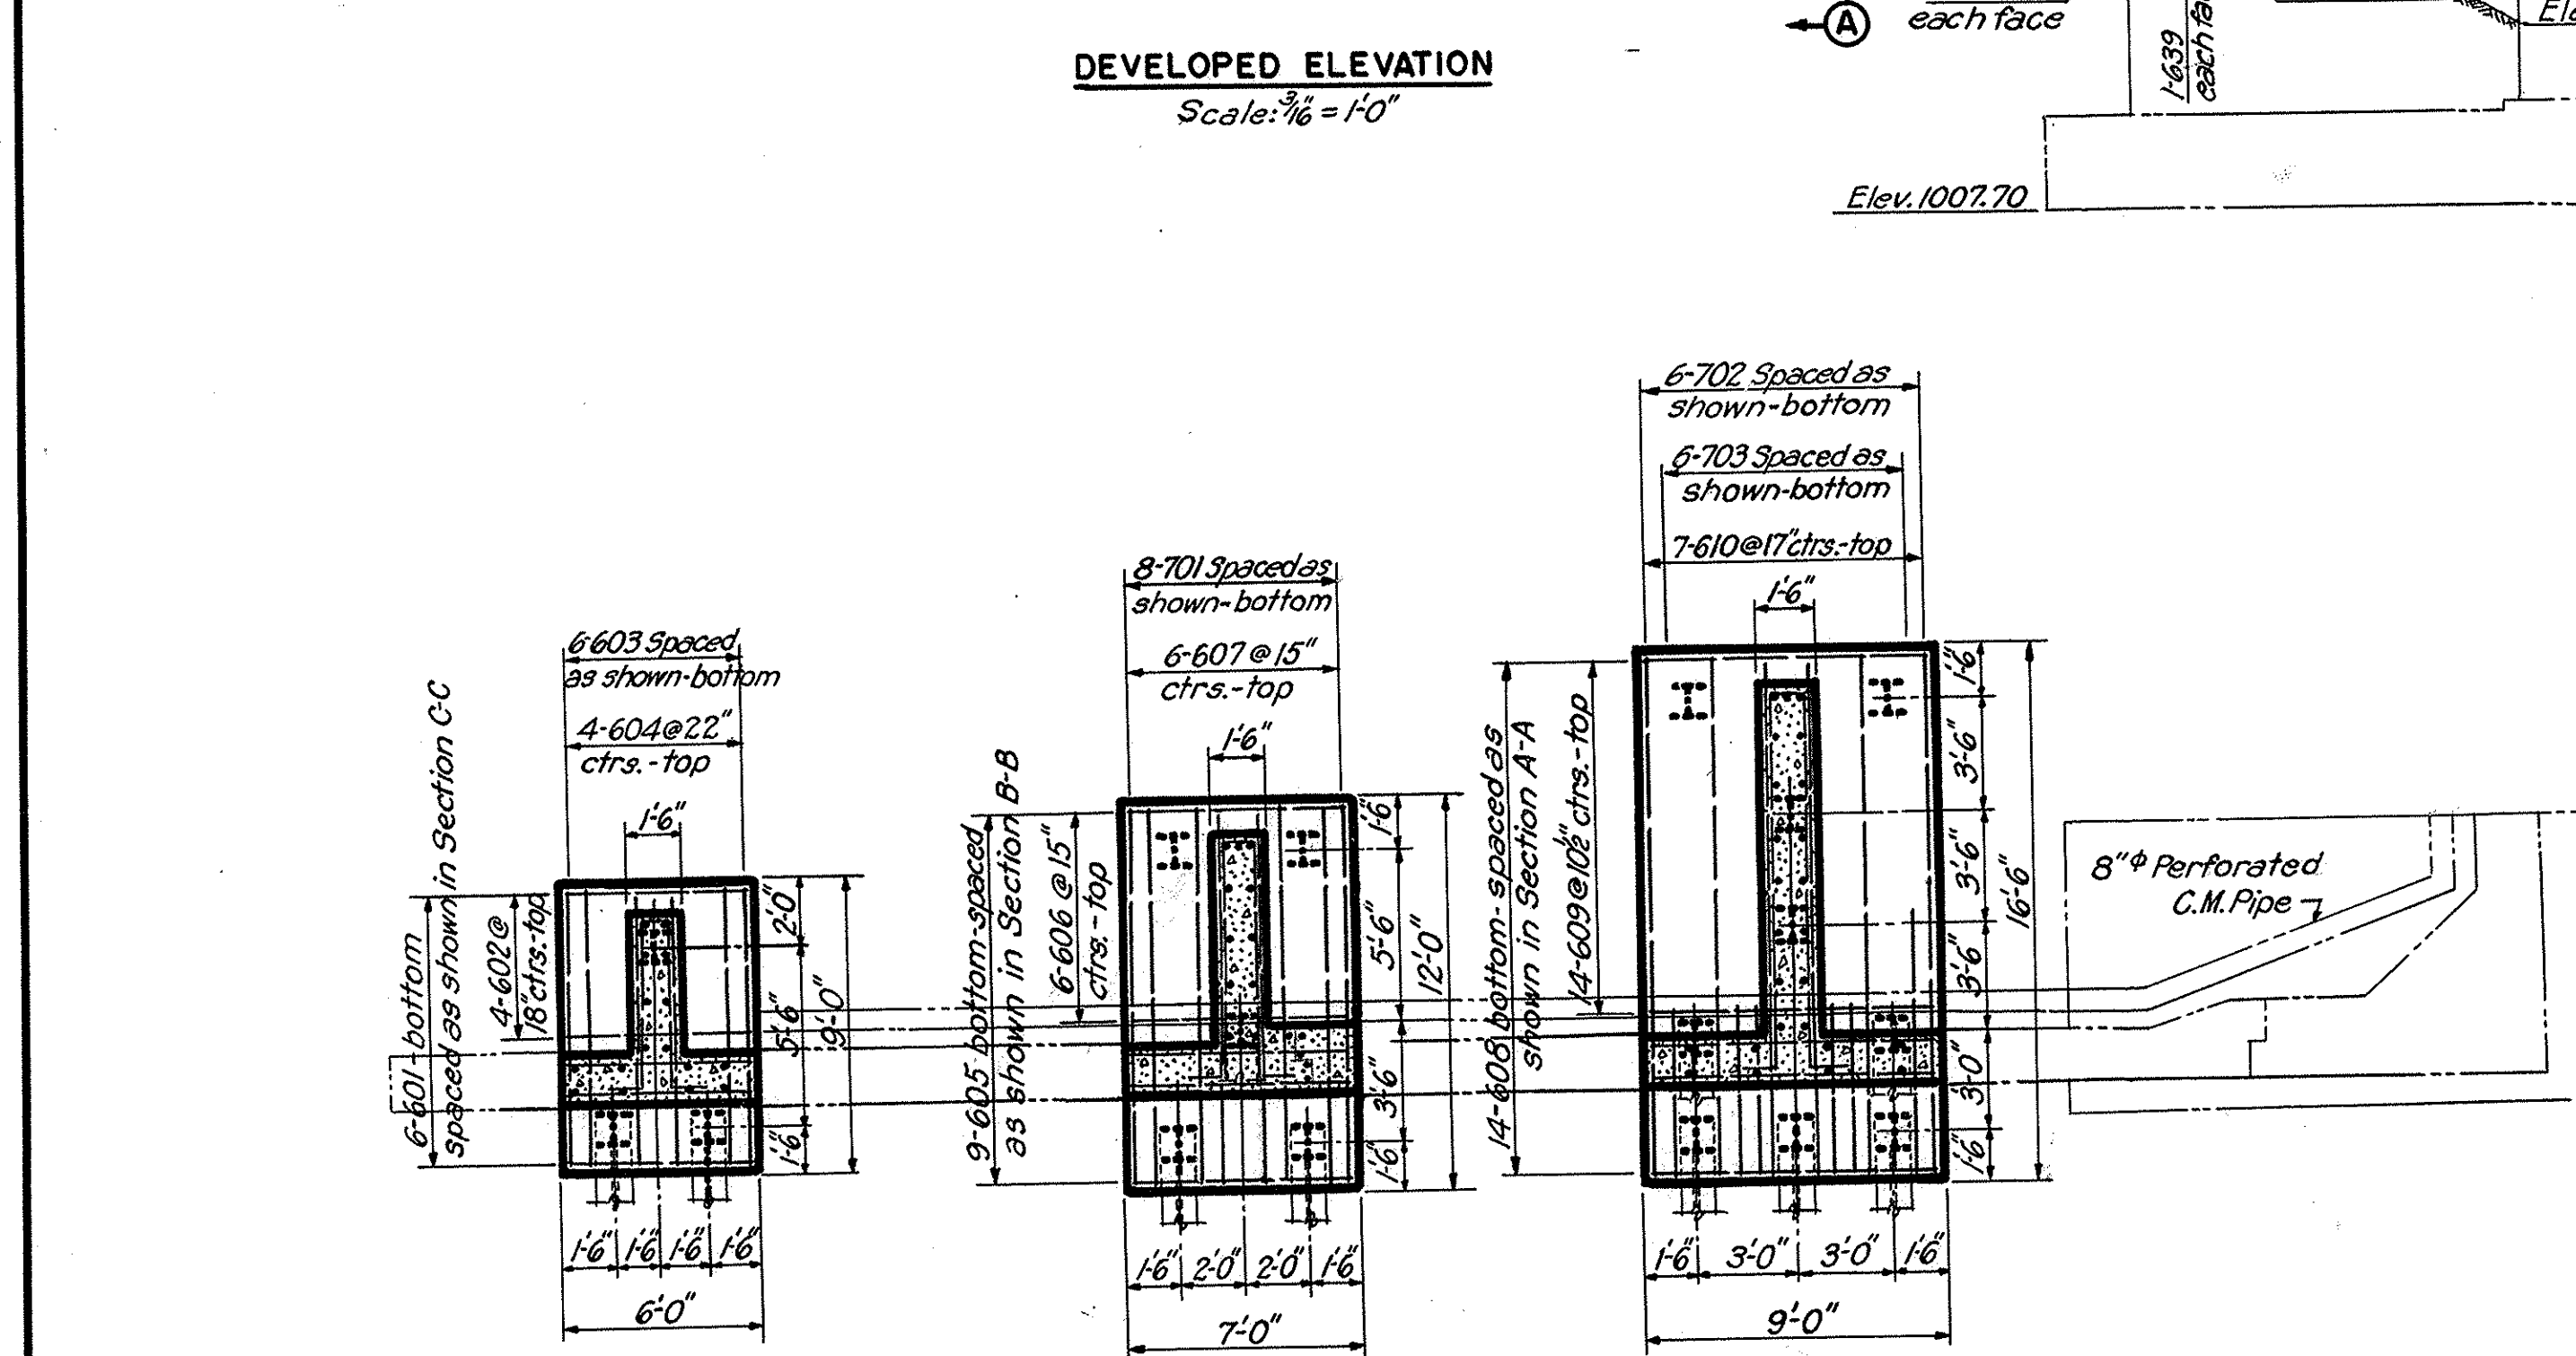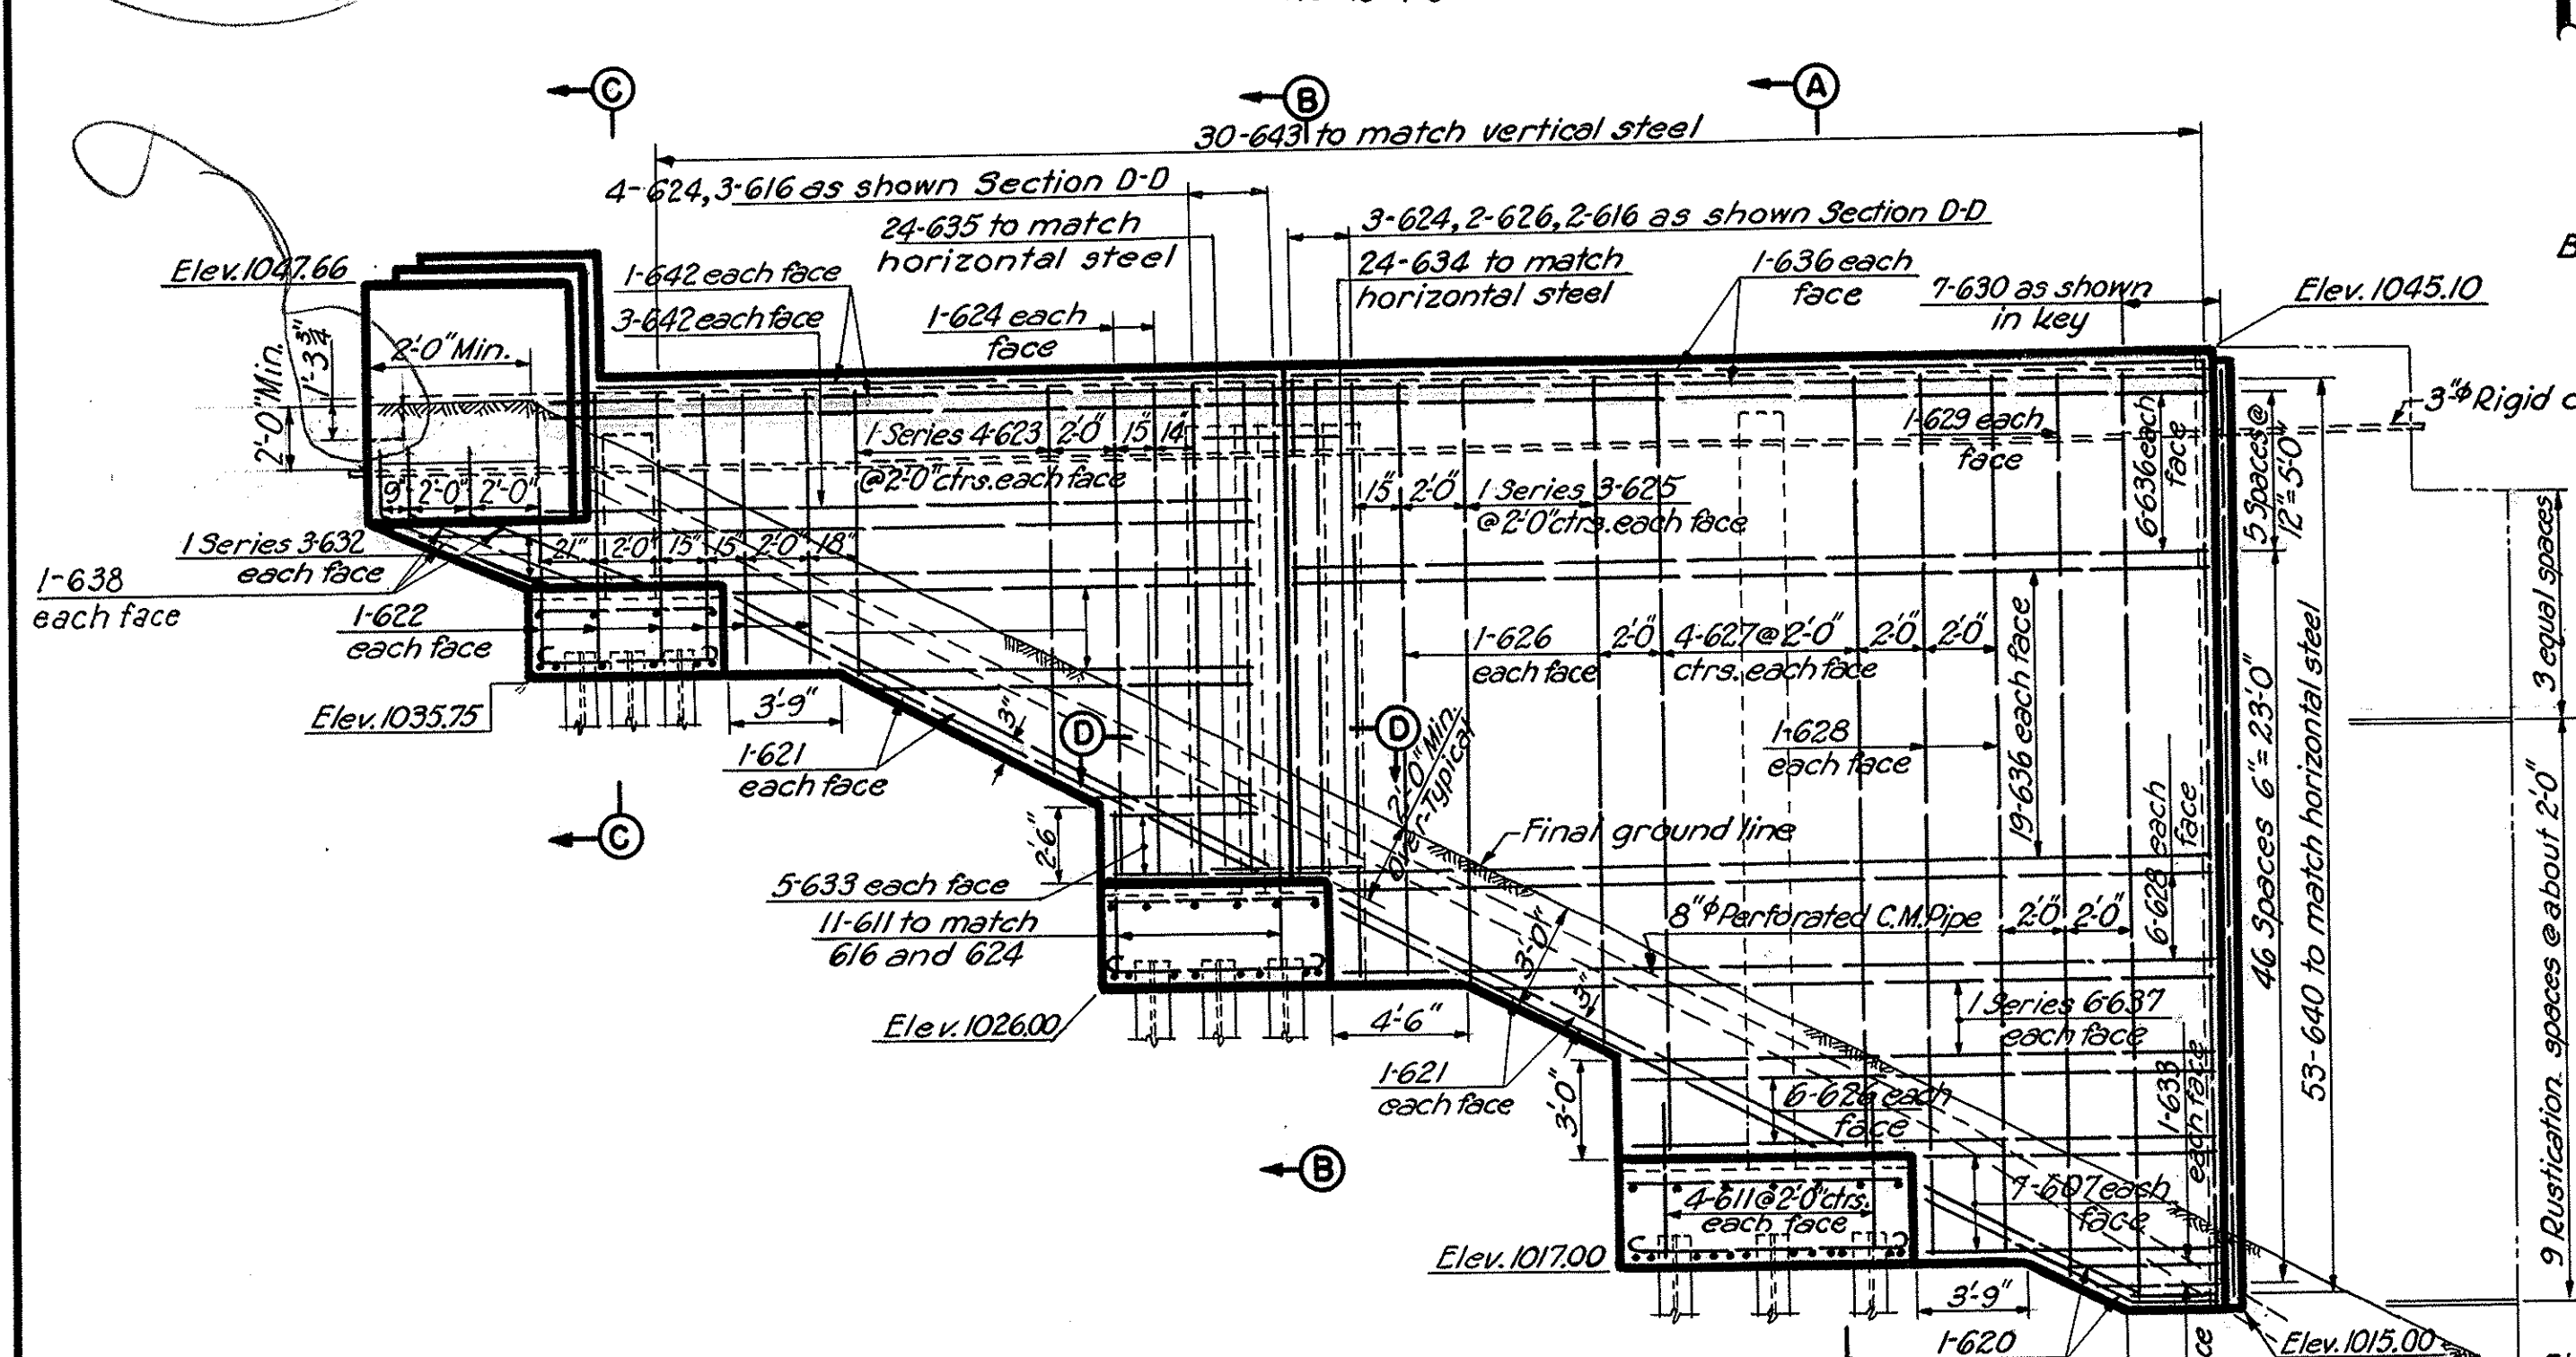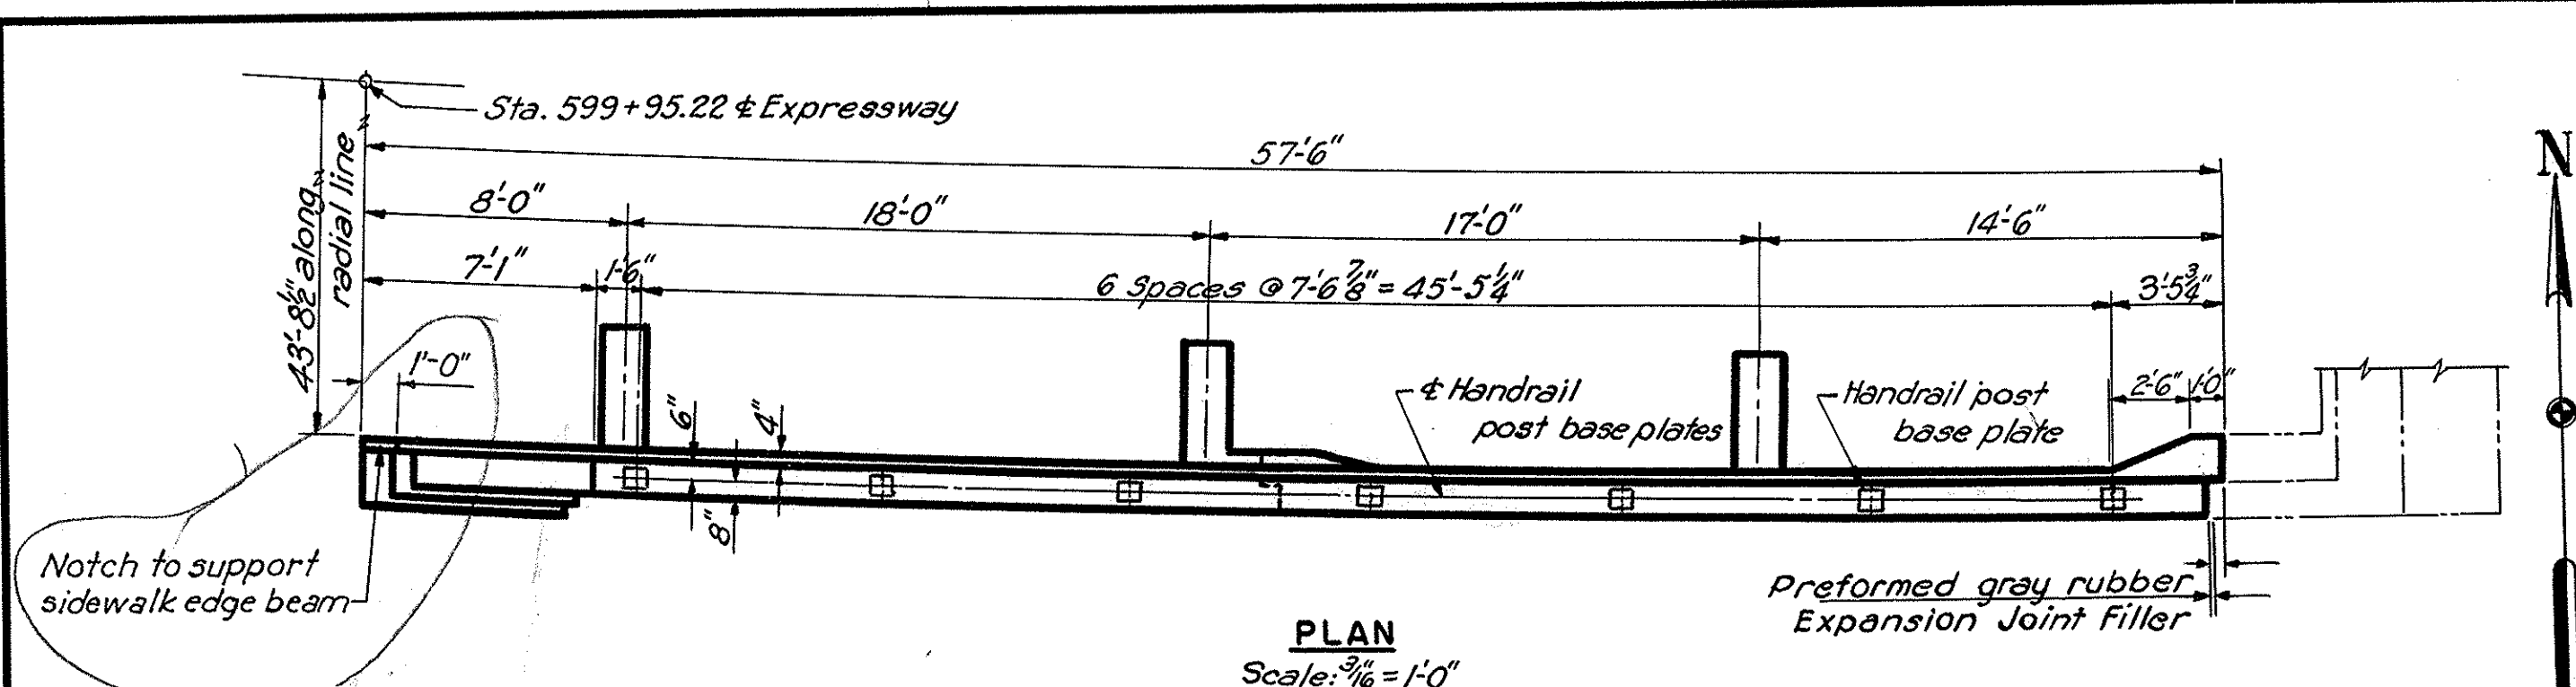

MARK	NUMBER	LENGTH	TYPE	DIMENSIONS				SERIES INCR. MENT	WEIGHT POUNDS
				A	B	C	D		
601	6	6'-10"	100	5'-0"	0'-11"				62
602	4	5'-6"	Str.						33
603	6	9'-10"	100	8'-0"	0'-11"				89
604	12	7'-0"	Str.						126
605	9	7'-10"	100	6'-0"	0'-11"				105
606	6	6'-6"	Str.						39
607	20	9'-0"	Str.						270
608	14	9'-10"	100	8'-0"	0'-11"				205
609	14	8'-6"	Str.						179
610	7	13'-6"	Str.						143
611	38	5'-0"	Str.						285
612	2	7'-3"	Str.						21
613	2 Series of 3	9'-9" to 19'-9"	Str.					5'-0"	134
614	6	23'-3"	Str.						210
615	1 Series of 16	12'-8" to 27'-2"	122	4'-9" to 12'-0"				5%	479
616	9	14'-0"	Str.						190
617	1 Series of 10	12'-8" to 18'-2"	122	4'-9" to 7'-6"				3%	232
618	2	12'-8"	107						38
619	1 Series of 4	12'-8" to 14'-2"	122	4'-9" to 5'-6"				3"	82
620	4	9'-10"	108	7'-0"	2'-10"	16 1/2"			59
621	20	16'-0"	Str.						481
622	12	8'-3"	Str.					1'-0"	120
623	2 Series of 4	8'-6" to 11'-6"	Str.						249
624	11	15'-0"	Str.					1'-9"	174
625	2 Series of 3	18'-0" to 20'-6"	Str.						434
626	16	18'-0"	Str.						288
627	8	23'-9"	Str.						162
628	4	27'-0"	Str.						336
629	2	27'-6"	Str.						306
630	7	29'-0"	Str.						201
631	2 Series of 8	4'-9" to 12'-0"	Str.					1'-0"	221
632	2 Series of 3	22'-6" to 26'-6"	Str.					2'-0"	86
633	12	4'-9"	Str.						379
634	24	10'-6"	123						361
635	24	10'-0"	112						2300
636	54	28'-3"	Str.					10 3/4"	370
637	2 Series of 6	18'-0" to 22'-6"	Str.	5'-6"	2'-0"	16 1/2"			68
638	6	7'-6"	108						12
639	2	3'-9"	Str.						1055
640	53	13'-2"	Str.						45
641	10	3'-0"	Str.						338
642	10	22'-6"	Str.						241
643	30	5'-4"	105						
701	8	13'-2"	100	10'-0"	1'-2"				214
702	6	17'-8"	100	15'-4"	1'-2"				98
703	6	7'-2"	101	6'-0"	1'-2"				35
704	3	5'-8"	101	4'-6"	1'-2"				116
705	3	19'-0"	108	14'-3"	4'-9"	2 3/4"			
1001	3	28'-9"	108	24'-0"	4'-9"	2 3/4"			370
1002	3	7'-3"	101	5'-6"	1'-9"				85

END POST									
686	7	7'-6"	Str.						80
687	3	7'-3"	Str.						33
688	10	6'-9"	Str.						100
689	2	5'-0"	Str.						15
690	8	6'-0"	Str.						76
691	1	5'-6"	Str.						8
692	1	5'-9"	Str.						9
<b>Total</b>									<b>12,575</b>

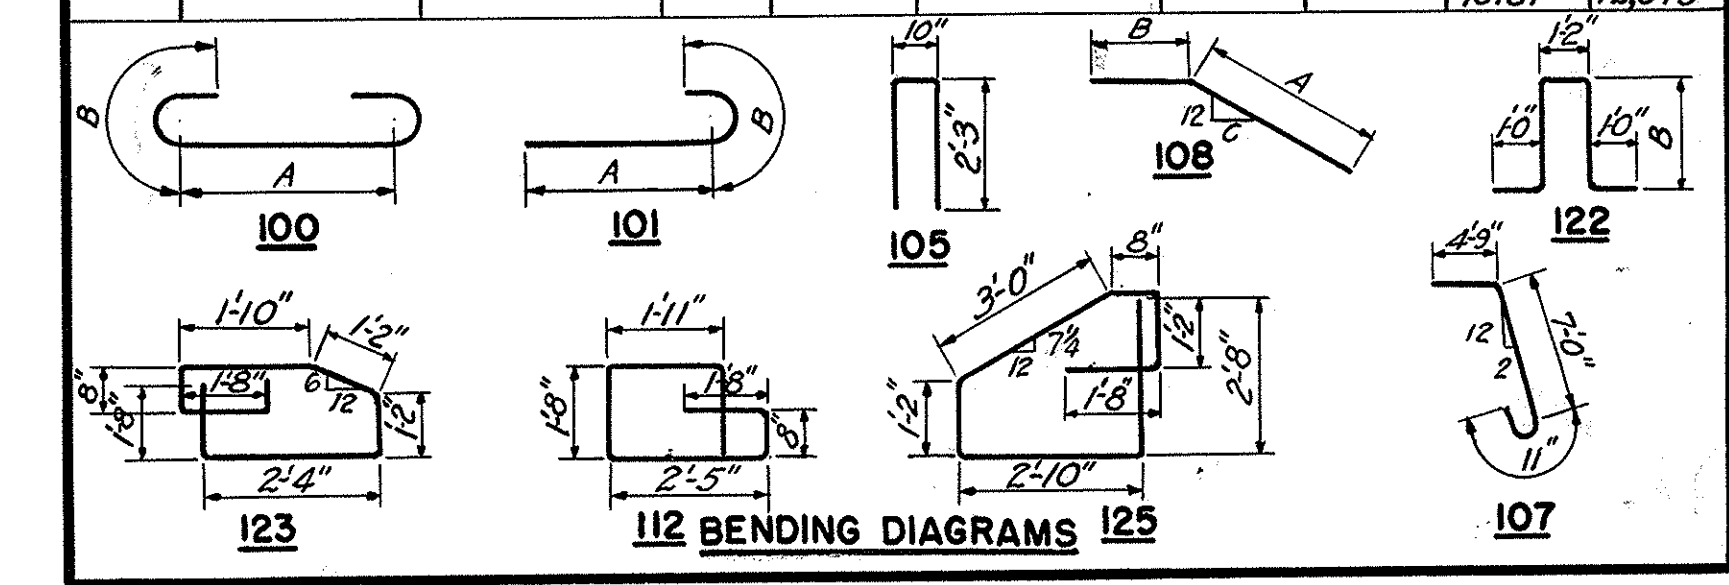

Note:  
For handrail details see Sheet 97.  
For rustication detail see Sheet 78.  
All piles to be 12 BP 53.  
For replacement bars see Sheet 62.  
Average vertical pile length = 47 feet.  
For bearing pile splice details see Sheet 61.  
Bar dimensions are given out to out.

**AKRON EXPRESSWAY SYSTEM**  
WEST VIADUCT  
BR. NO. SU-18R-135  
**SOUTHWEST WINGWALL**







AKRON SUMMIT COUNTY. OHIO

SCALE As Shown  
MADE B.S.S. DATE 8-12-55  
TRCD. C.T.H. DATE 11-29-55  
CKD. D.F.B. DATE 9-15-55


HOWARD, NEEDLES, TAMMEN & BERGENDOFF  
CONSULTING ENGINEERS  
KANSAS CITY CLEVELAND NEW YORK  
901 SHEET-65

Revised 3-19-58  
Revised 12-19-55

SUMMIT COUNTY  
CITY OF AKRON  
AKRON EXPRESSWAY SYSTEM

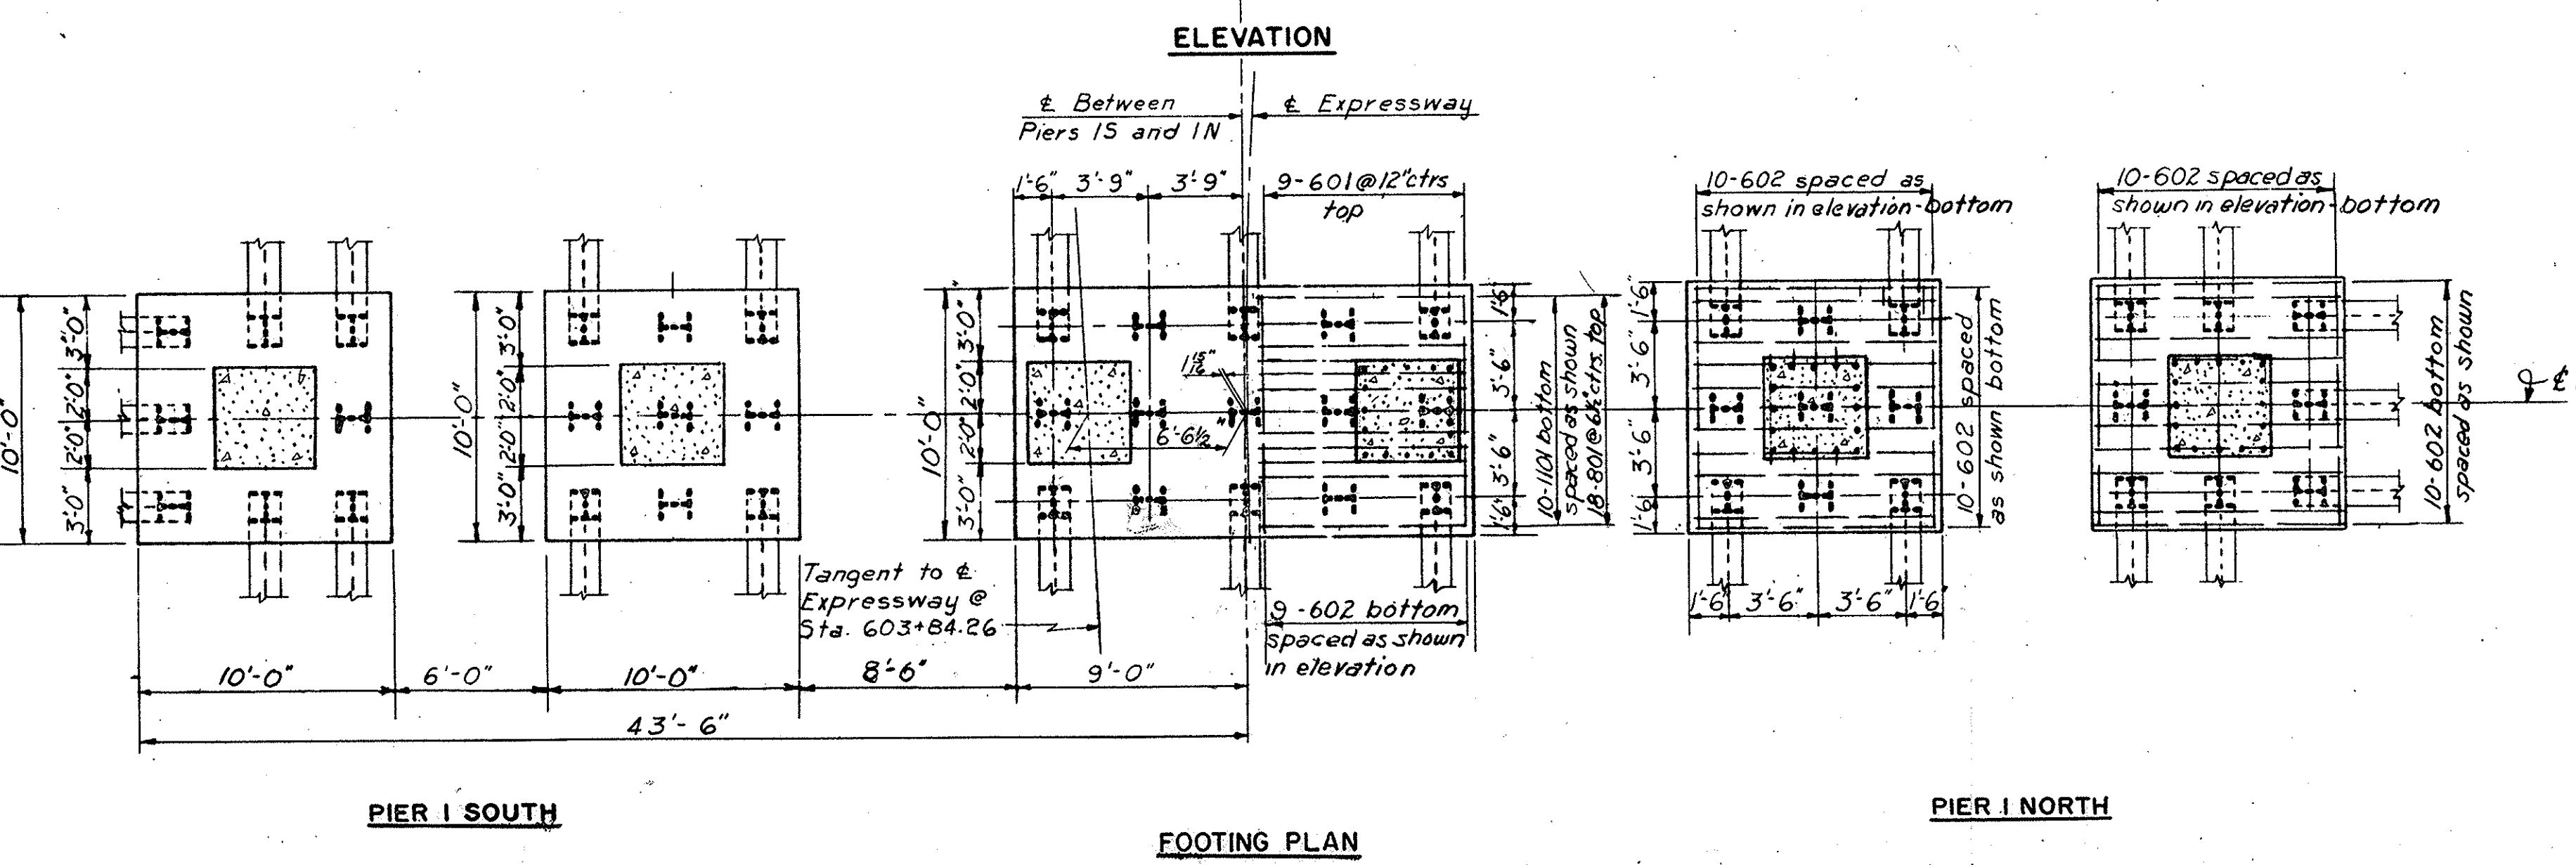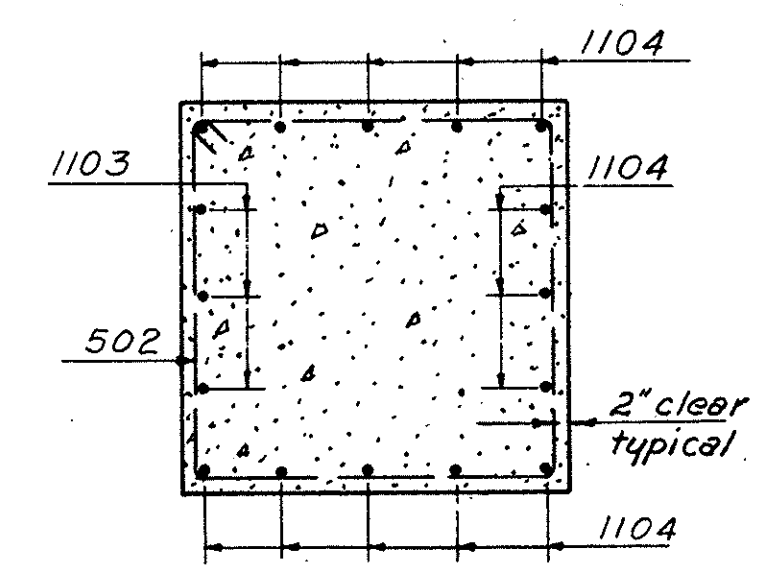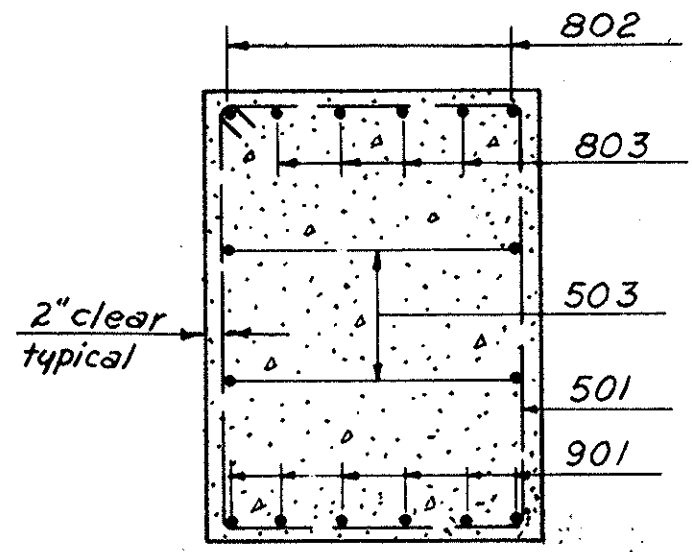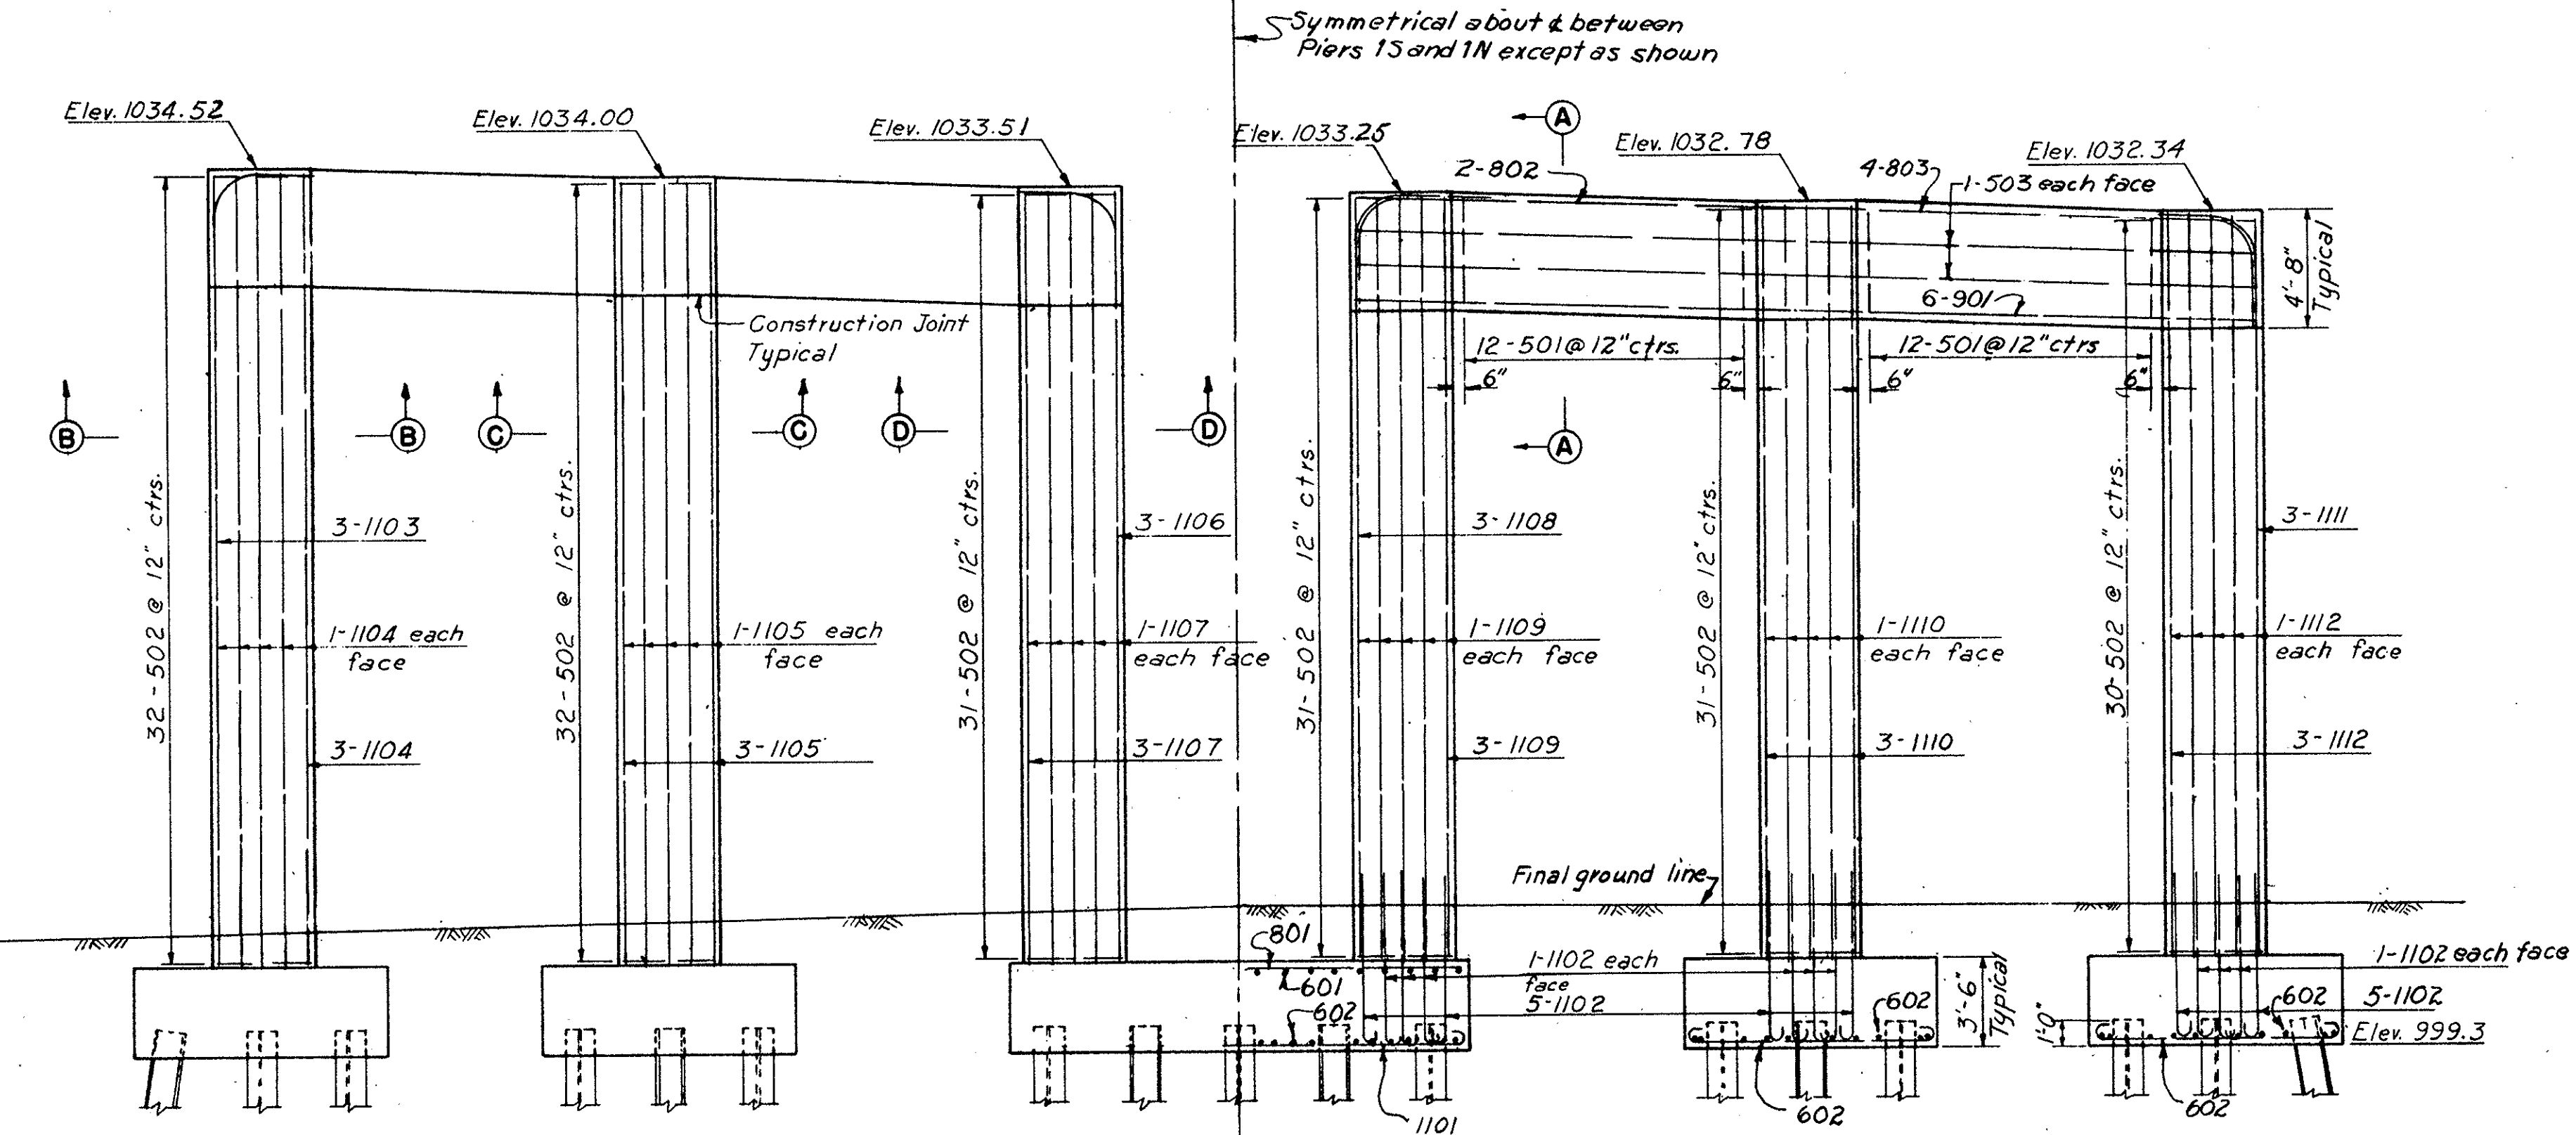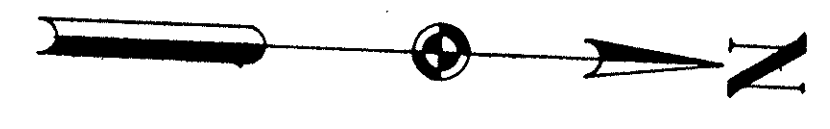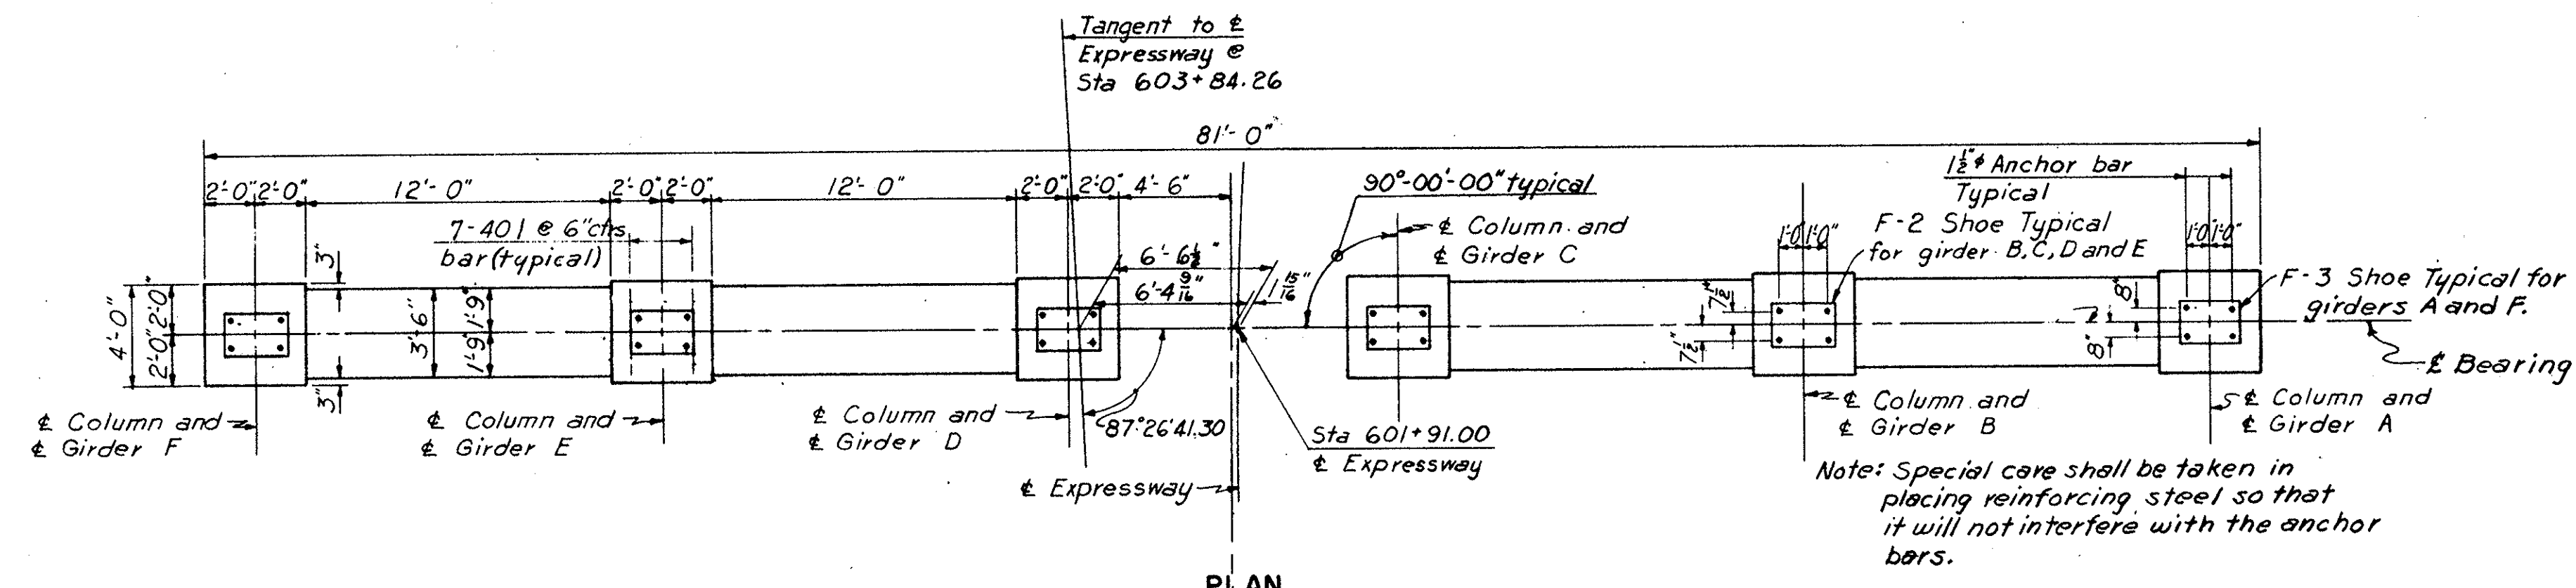

REINFORCEMENT SCHEDULE						
MARK	NUMBER	LENGTH	TYPE	DIMENSIONS		WEIGHT POUNDS
				A	B	
401	42	5'-2"	105	3'-2"	1'-0"	145
501	48	15'-6"	109	4'-4"	3'-2"	776
502	187	15'-2"	109	3'-8"	3'-8"	2958
503	8	35'-6"	Str.			296
601	18	9'-6"	Str.			257
602	100	10'-10"	100	9'-0"	0'-11"	1627
801	18	17'-6"	Str.			841
802	4	42'-2"	119	33'-2"	2'-6"	450
803	8	35'-6"	Str.			758
901	12	35'-6"	Str.			1448
1101	10	20'-4"	100	16'-6"	1'-11"	1080
1102	96	8'-2"	101	6'-3"	1'-11"	4166
1103	3	36'-1"	104	29'-10"	3'-6"	575
1104	13	31'-6"	Str.			2176
1105	16	31'-0"	Str.			2635
1106	3	35'-1"	104	28'-10"	3'-6"	559
1107	13	30'-6"	Str.			2107
1108	3	34'-9"	104	28'-6"	3'-6"	554
1109	13	30'-3"	Str.			2089
1110	16	29'-9"	Str.			2529
1111	3	33'-9"	104	27'-6"	3'-6"	539
1112	13	29'-3"	Str.			2020
<b>Total</b>						<b>50,585</b>

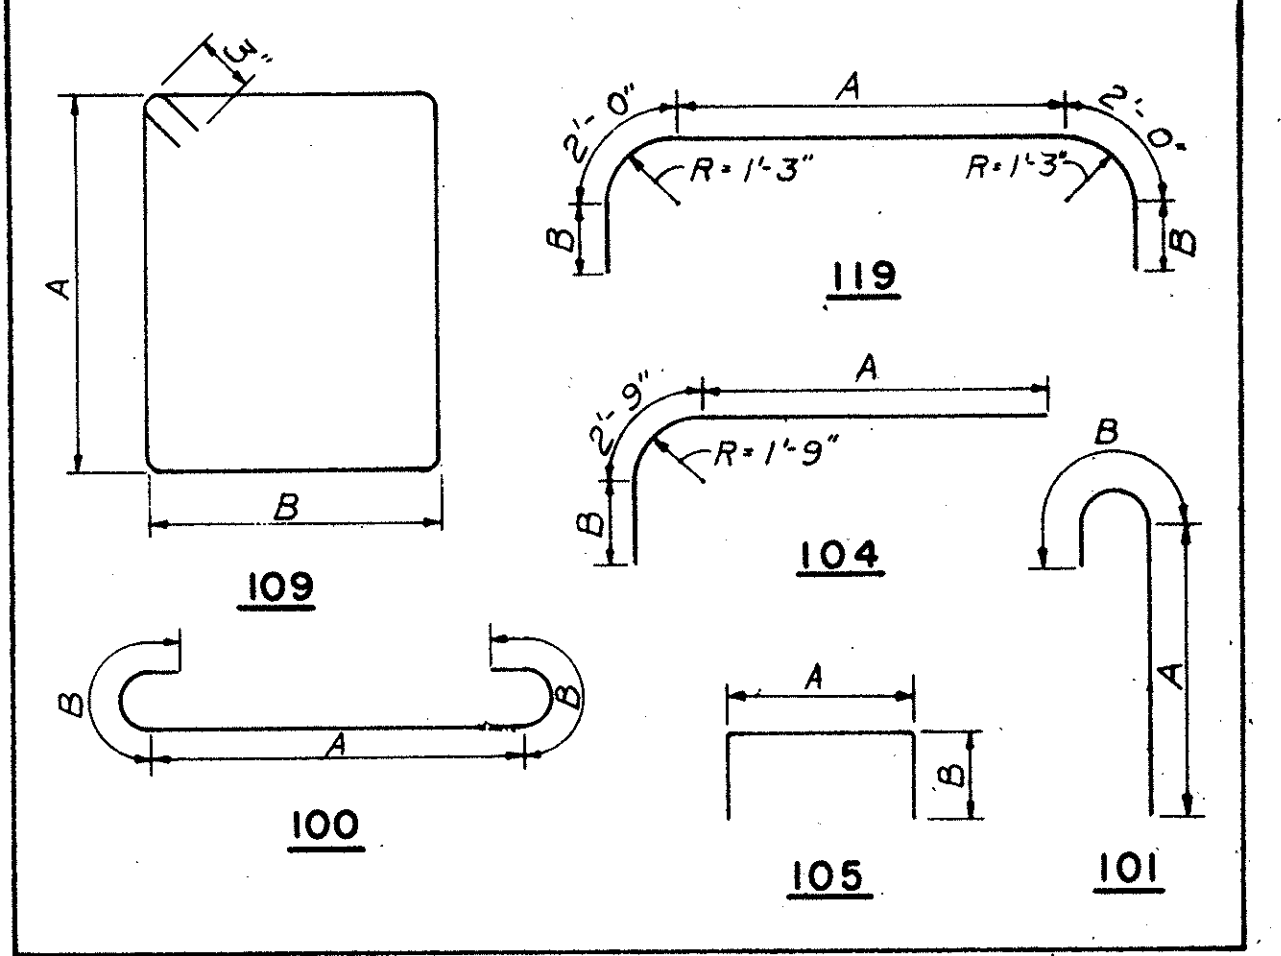

**Notes:**  
 All piles to be 14 BP 73.  
 For shoe details and details of anchor bars see sheet 79.  
 All battered piles battered 2 in 12.  
 For pile splice details see sheet 61.  
 Average vertical pile length = 35 feet

**PART 7**

**AKRON EXPRESSWAY SYSTEM**  
 WEST VIADUCT  
 BR. NO. SU-18R-135  
 PIERS 1S AND 1N



AKRON      SUMMIT COUNTY,      OHIO

SCALE 1/2" = 1'-0"  
 MADE L.W.L. DATE 7-27-55  
 TRCD. DATE \_\_\_\_\_  
 CRD. S.M.A. DATE 9-9-55



HOWARD, NEEDLES, TAMMEN & BERGENDOFF  
 CONSULTING ENGINEERS  
 KANSAS CITY      CLEVELAND      NEW YORK  
 901 SHEET 66

138

SUMMIT COUNTY  
CITY OF AKRON  
AKRON EXPRESSWAY SYSTEM

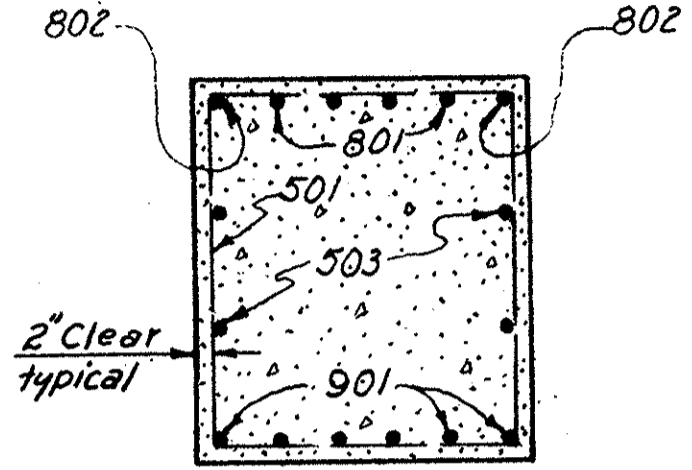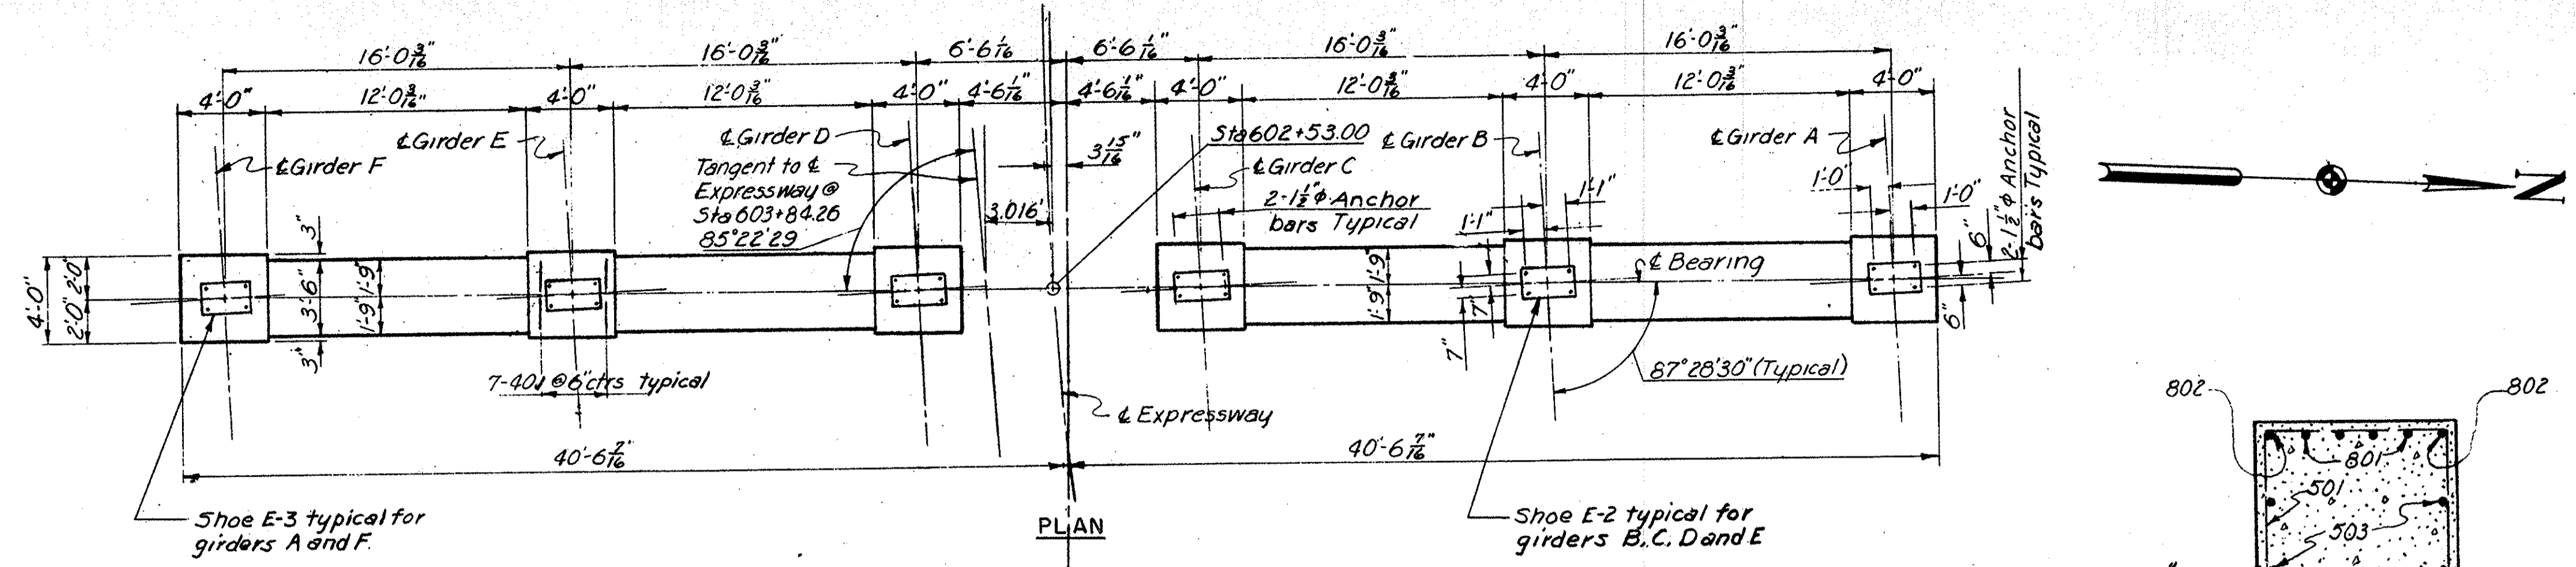


SECTION A-A  
Scale 1/2" = 1'-0"

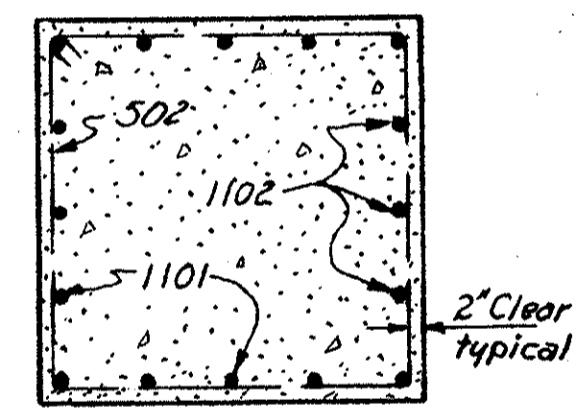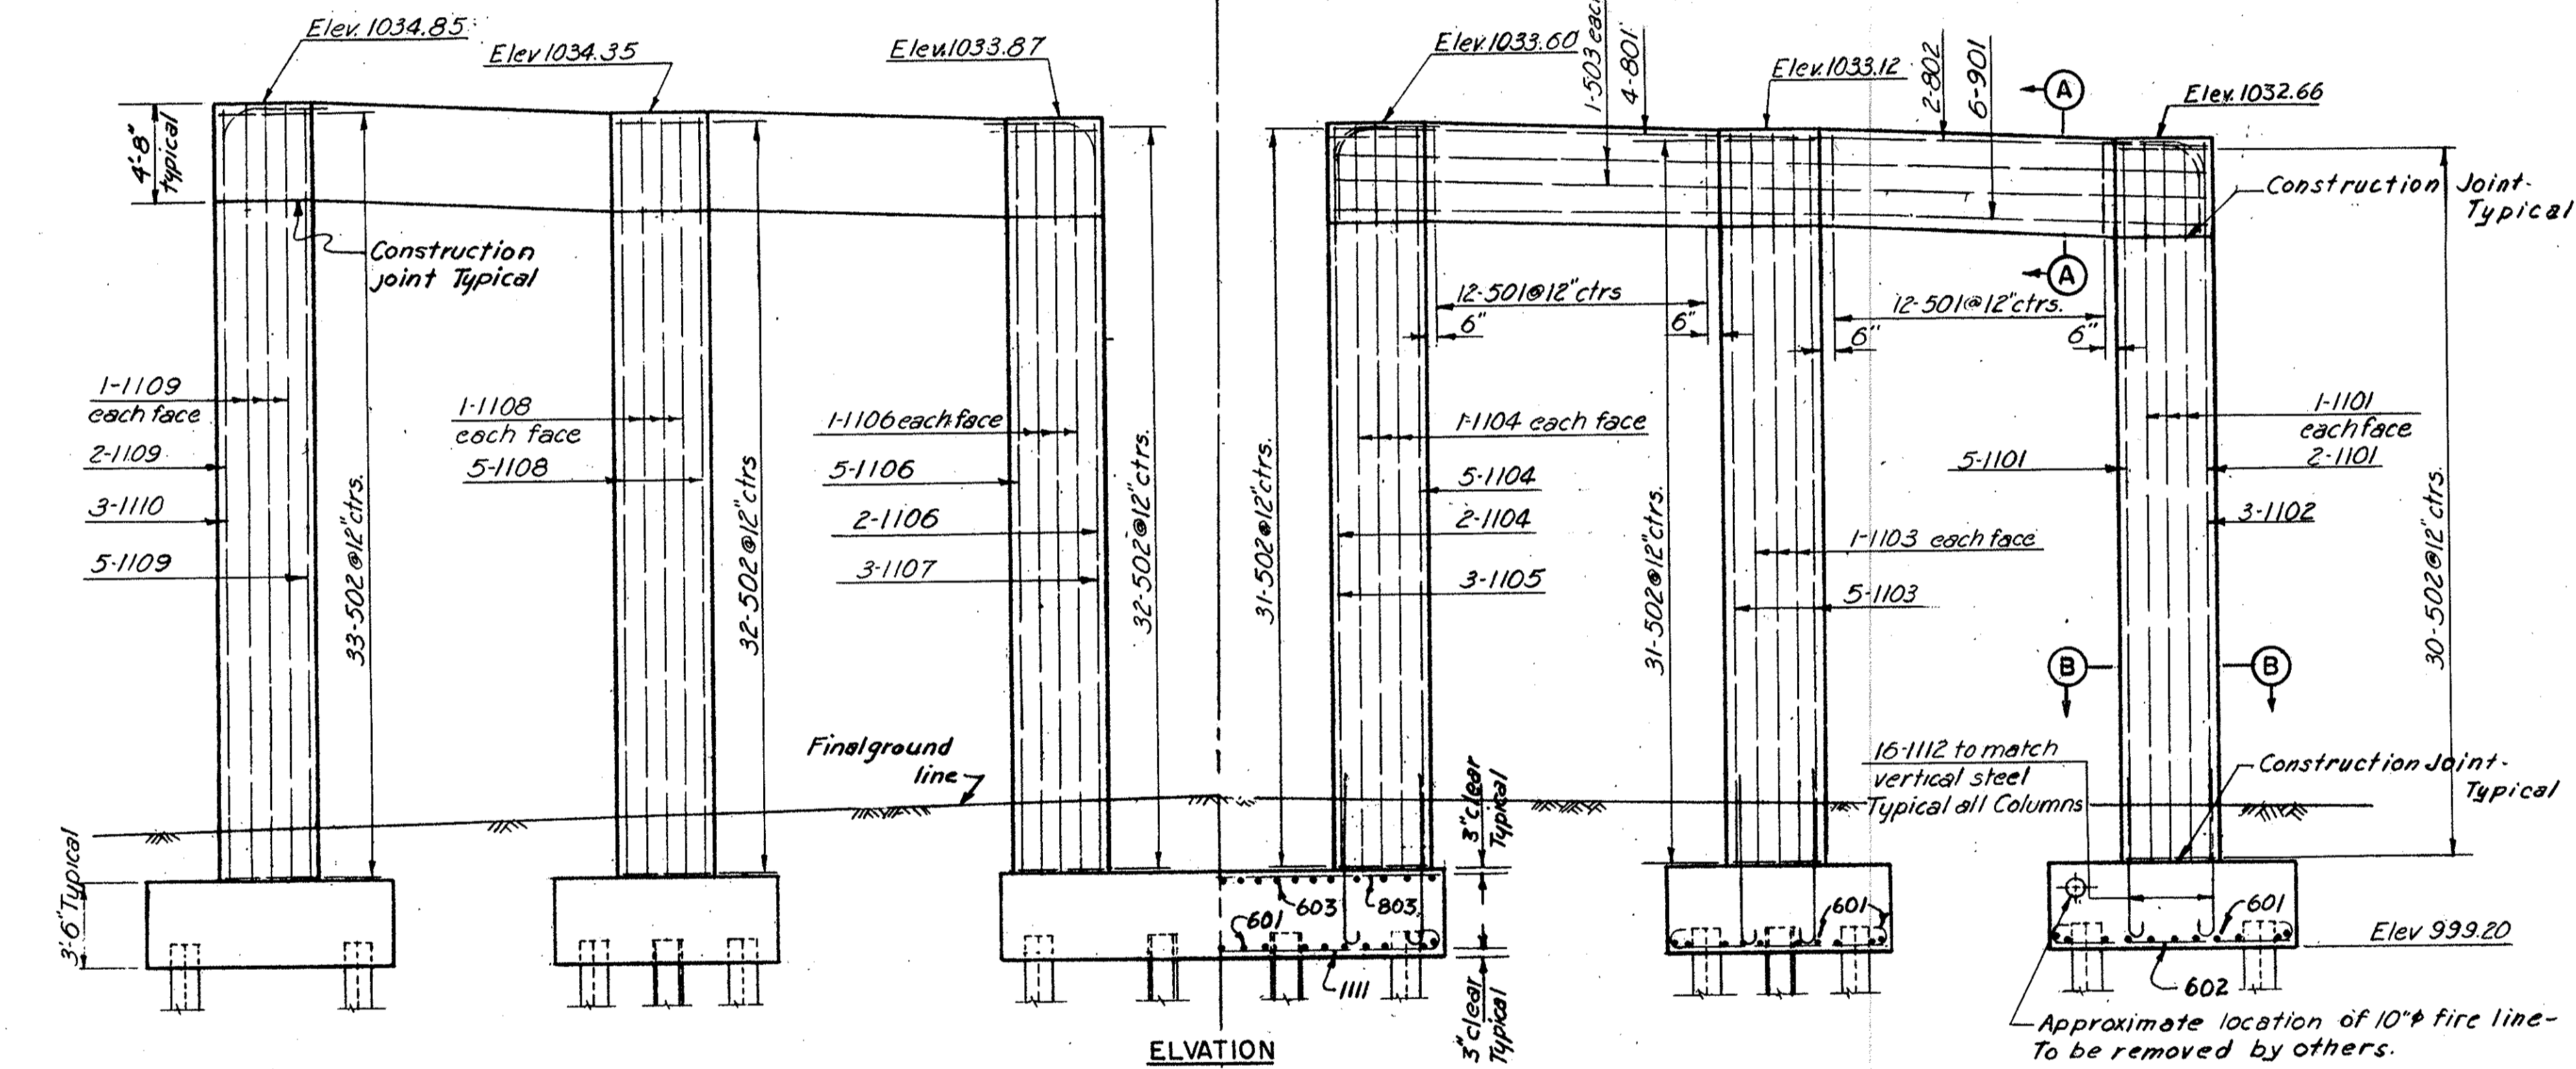


SECTION B-B  
Scale 1/2" = 1'-0"

Note: Section B-B is typical for all column except for bar marks.

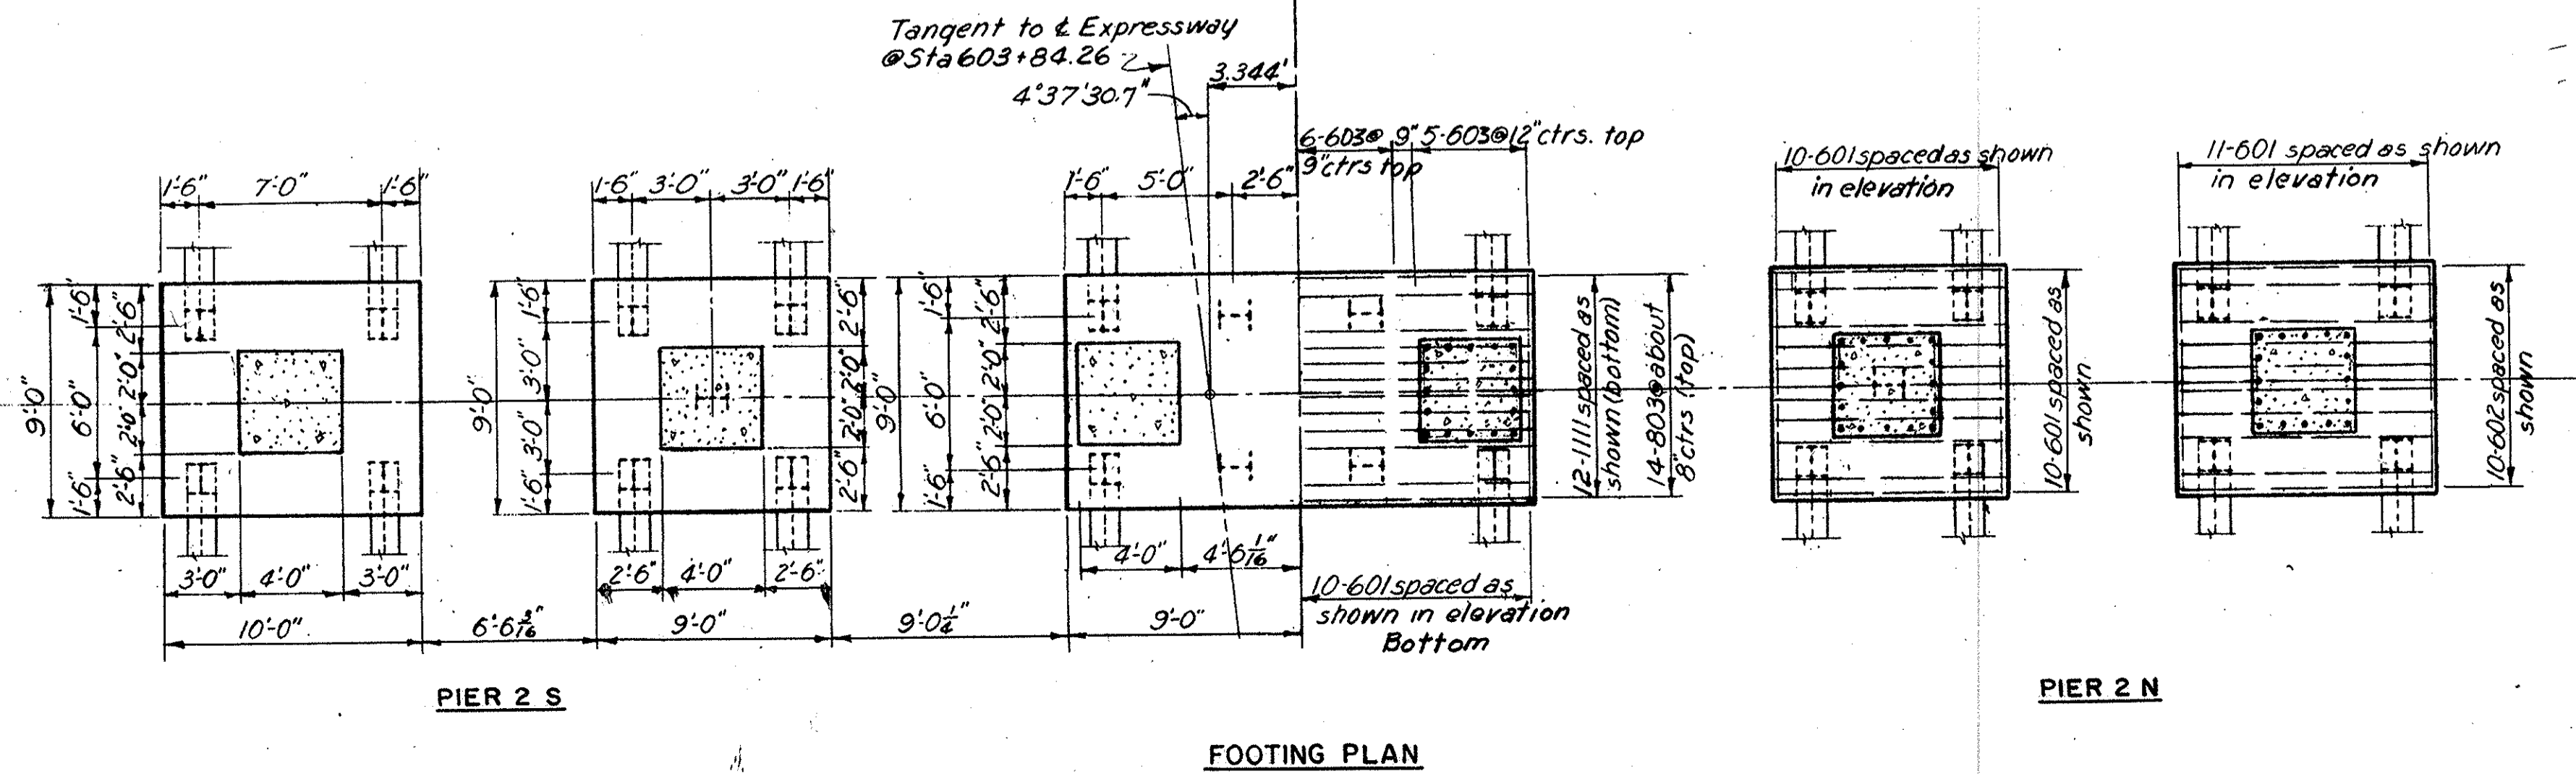

REINFORCEMENT SCHEDULE						
MARK	NUMBER	LENGTH		DIMENSIONS		WEIGHT POUNDS
				A	B	
401	42	5'-2"	105	3'-2"	1'-0"	145
501	48	14'-2"	109	3'-8"	3'-2"	709
502	189	15'-2"	109	3'-8"	3'-8"	2990
503	8	35'-6"	5tr			296
601	81	9'-10"	100	8'-0"	11"	1296
602	20	10'-10"	100	9'-0"	11"	325
603	21	8'-6"	5tr			268
801	8	35'-6"	5tr			758
802	4	4'-2"	119	33'-2"	2'-6"	450
803	14	19'-8"	100	16'-8"	1'-6"	735
901	12	35'-6"	5tr			1448
1101	13	29'-9"	5tr			2055
1102	3	34'-3"	104	28'-0"	3'-6"	546
1103	16	30'-3"	5tr			2571
1104	13	30'-9"	5tr			2124
1105	3	35'-3"	104	29'-0"	3'-6"	562
1106	13	31'-0"	5tr			2141
1107	3	35'-6"	104	29'-3"	3'-6"	566
1108	16	31'-6"	5tr			2678
1109	13	32'-0"	5tr			2210
1110	3	36'-6"	104	30'-3"	3'-6"	582
1111	12	20'-4"	100	16'-6"	1'-11"	1295
1112	96	8'-2"	101	6'-3"	1'-11"	4166
<b>Total</b>						<b>30816</b>

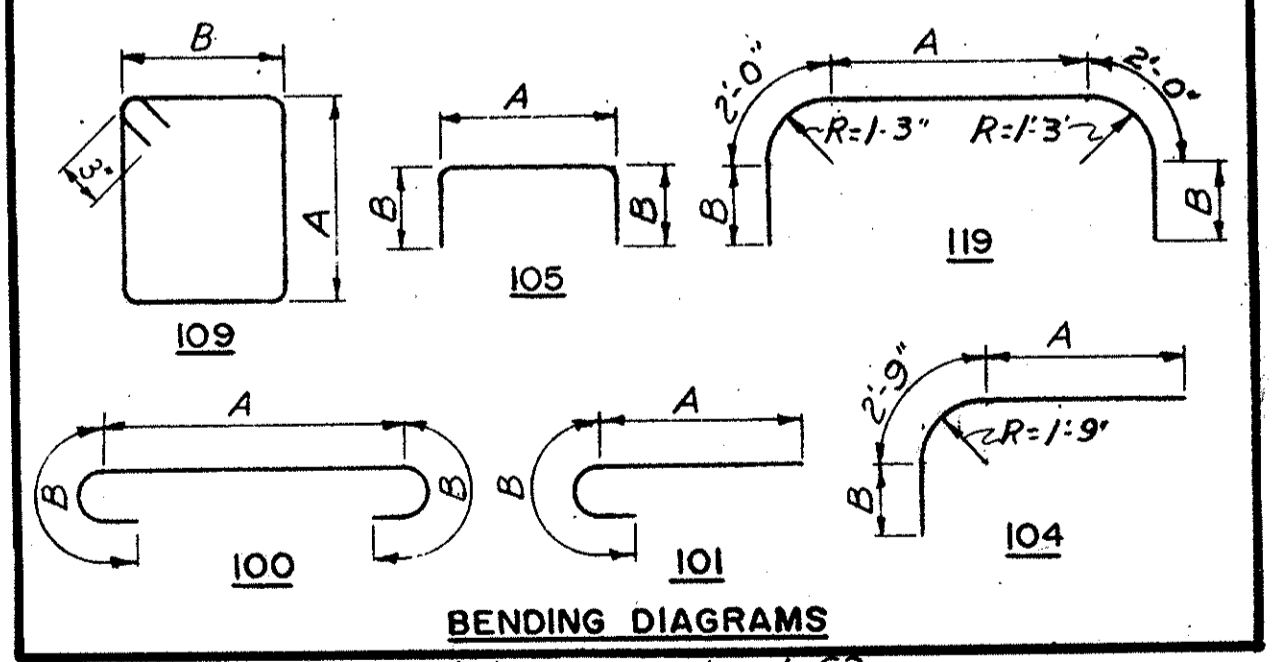

BENDING DIAGRAMS  
Note: For replacement bars see sheet 62

PART 7

**AKRON EXPRESSWAY SYSTEM**  
WEST VIADUCT  
BR. NO. SU-18R-135  
PIERS 2S AND 2N



AKRON SUMMIT COUNTY, OHIO

SCALE: 1/4" = 1'-0" unless noted.  
MADE: FEB. DATE: 7-27-55  
TRCD. DATE: \_\_\_\_\_  
CHK. S.M.A. DATE: 9-22-55


HOWARD, NEEDLES, TAMMEN & BERGENDOFF  
CONSULTING ENGINEERS  
CLEVELAND NEW YORK  
KANSAS CITY 901 SHEET 67

SUMMIT COUNTY  
CITY OF AKRON  
AKRON EXPRESSWAY SYSTEM


Note:  
Existing steam, air, and water lines -  
These lines shall not be disturbed and during  
construction every precaution shall be  
taken to insure their protection

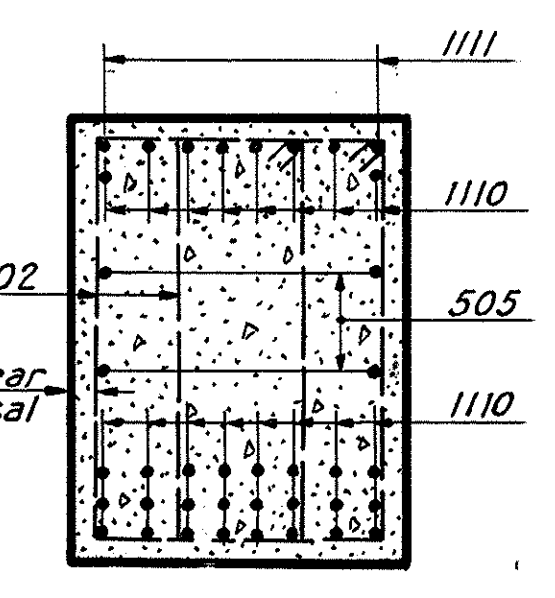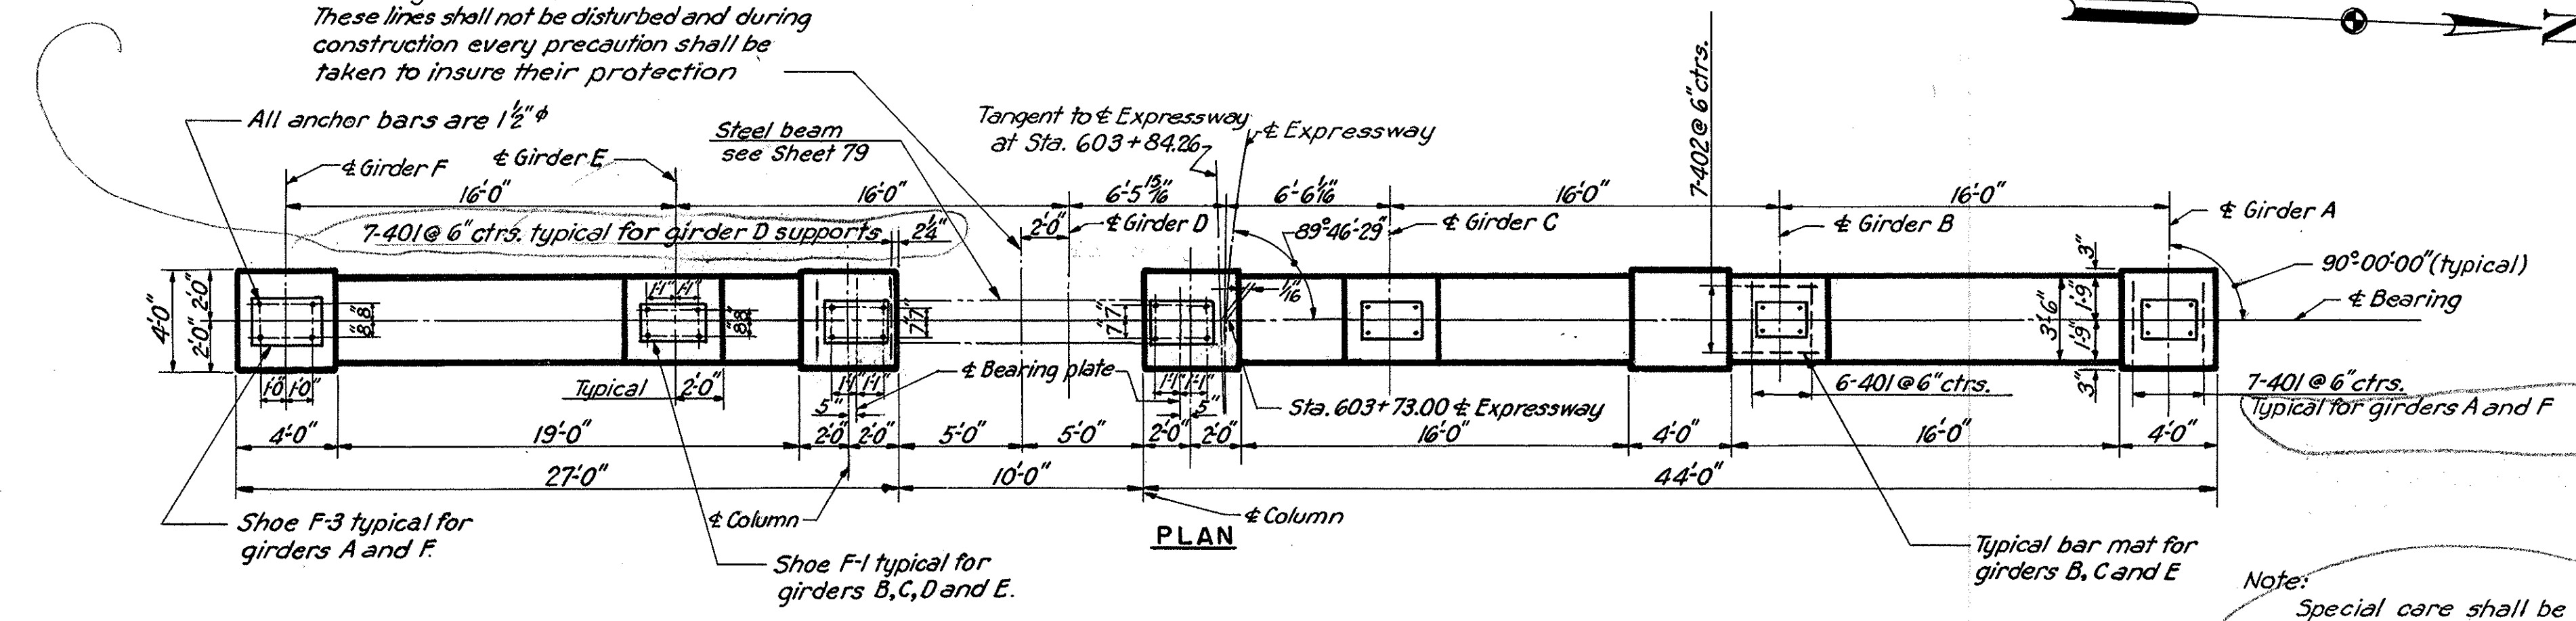


SECTION C-C  
Scale: 1/2" = 1'-0"

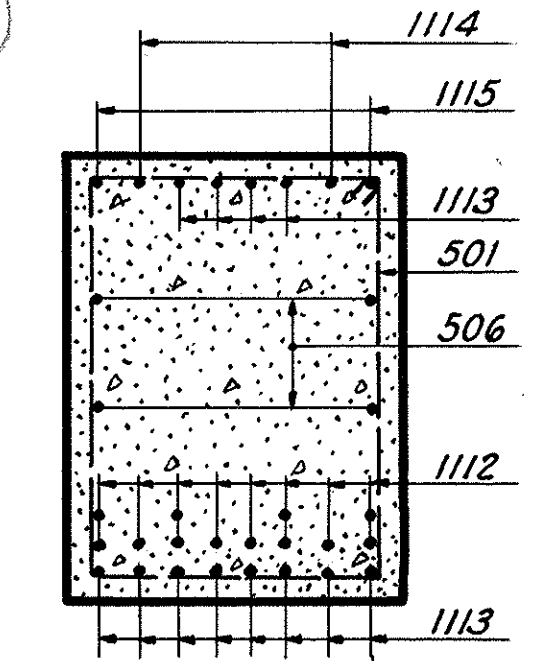

SECTION B-B  
Scale: 1/2" = 1'-0"

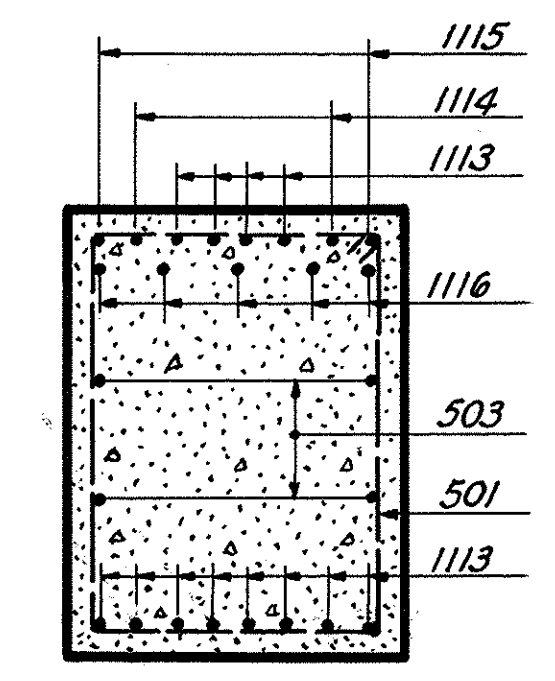


SECTION A-A  
Scale: 1/2" = 1'-0"

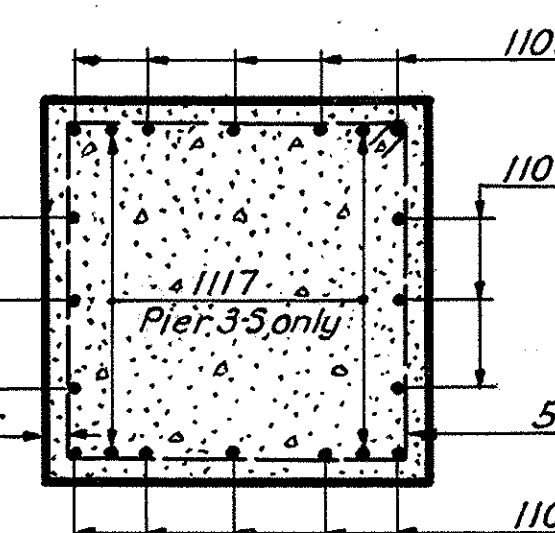


SECTION D-D  
Scale: 1/2" = 1'-0"


Note:  
Special care shall be taken  
in placing reinforcing steel so  
that it will not interfere with  
anchor bars.

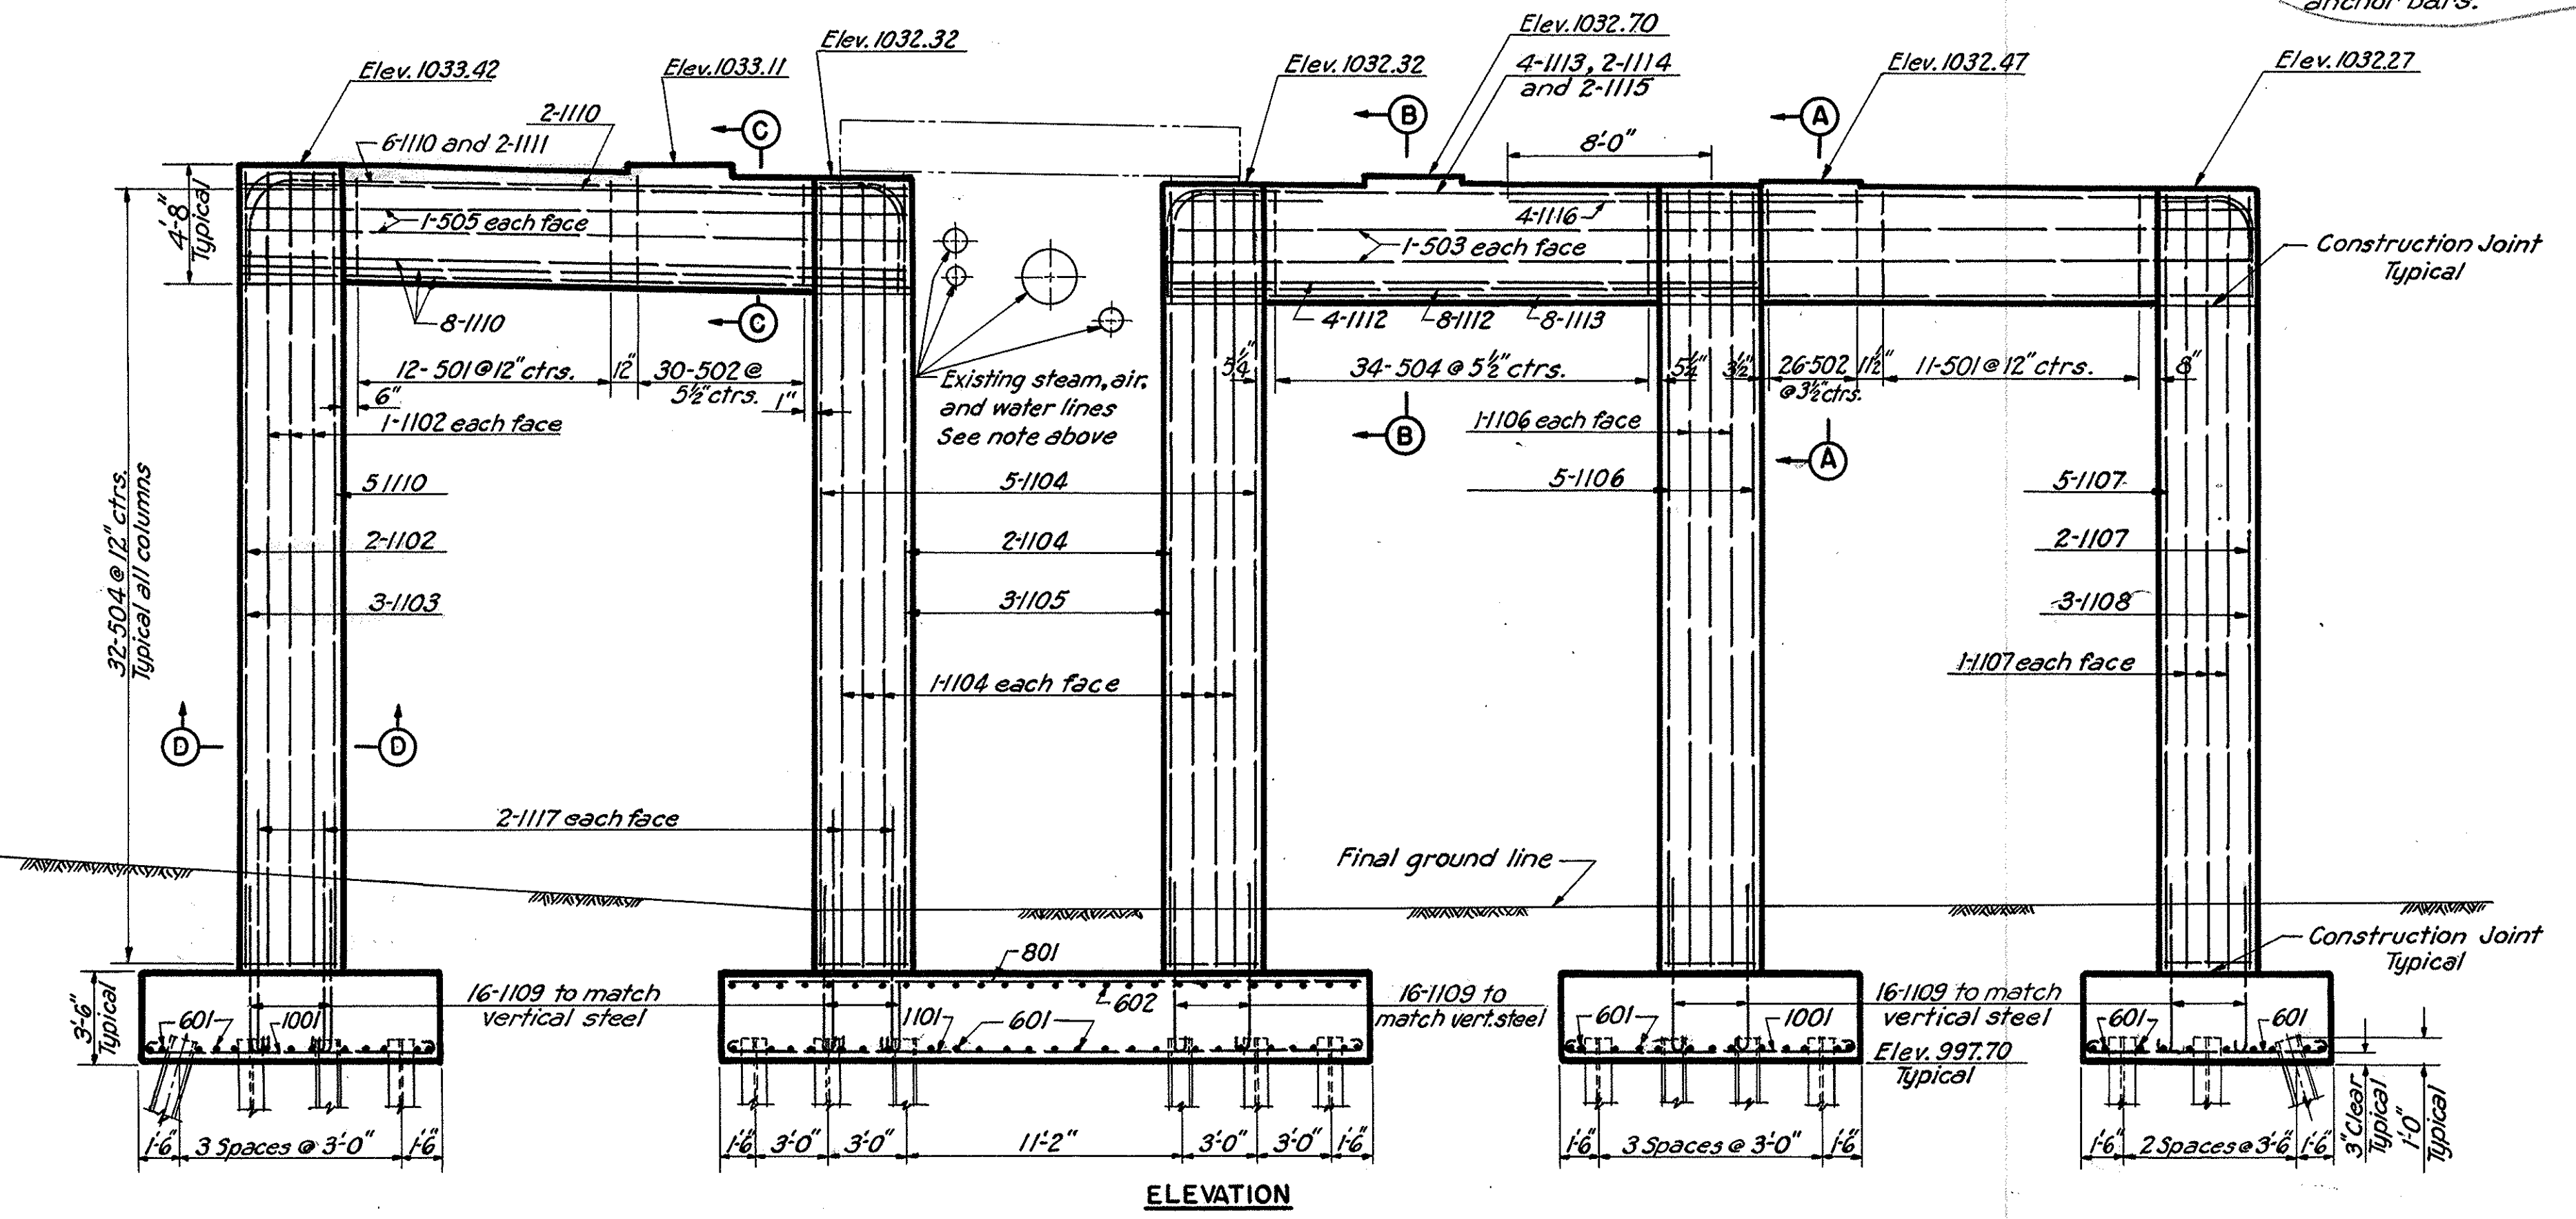

REINFORCEMENT SCHEDULE						
MARK	NUMBER	LENGTH	TYPE	DIMENSIONS		WEIGHT POUNDS
				A	B	
401	46	5'-2"	105	3'-2"	1'-0"	159
402	21	3'-6"	Sfr.			49
501	57	15'-6"	109	4'-4"	3'-2"	923
502	56	13'-6"	109	4'-4"	2'-2"	793
503	4	43'-6"	Sfr.			182
504	160	15'-2"	109	3'-8"	3'-8"	2,531
505	4	26'-6"	Sfr.			111
601	72	10'-0"	100	9'-0"	0'-11"	1172
602	22	9'-6"	Sfr.			314
801	17	25'-9"	Sfr.			1169
1001	24	14'-0"	100	10'-6"	1'-9"	1446
1101	16	28'-6"	100	24'-8"	1'-11"	2,242
1102	13	32'-0"	Sfr.			2,210
1103	3	36'-6"	104	30'-3"	3'-6"	585
1104	26	31'-0"	Sfr.			4,290
1105	6	35'-7"	104	29'-4"	3'-6"	1,135
1106	16	31'-0"	Sfr.			2,635
1107	13	30'-9"	Sfr.			2,124
1108	3	35'-3"	104	29'-0"	3'-6"	562
1109	80	8'-2"	101	6'-3"	1'-11"	3,473
1110	32	26'-6"	Sfr.			4,505
1111	2	33'-10"	119	23'-0"	2'-8"	360
1112	12	24'-0"	Sfr.			1,530
1113	12	43'-6"	Sfr.			2,774
1114	2	35'-5"	104	30'-0"	2'-8"	377
1115	2	50'-10"	119	40'-0"	2'-8"	540
1116	4	14'-0"	Sfr.			298
1117	8	11'-8"	101	9'-9"	1'-11"	497
						38,982

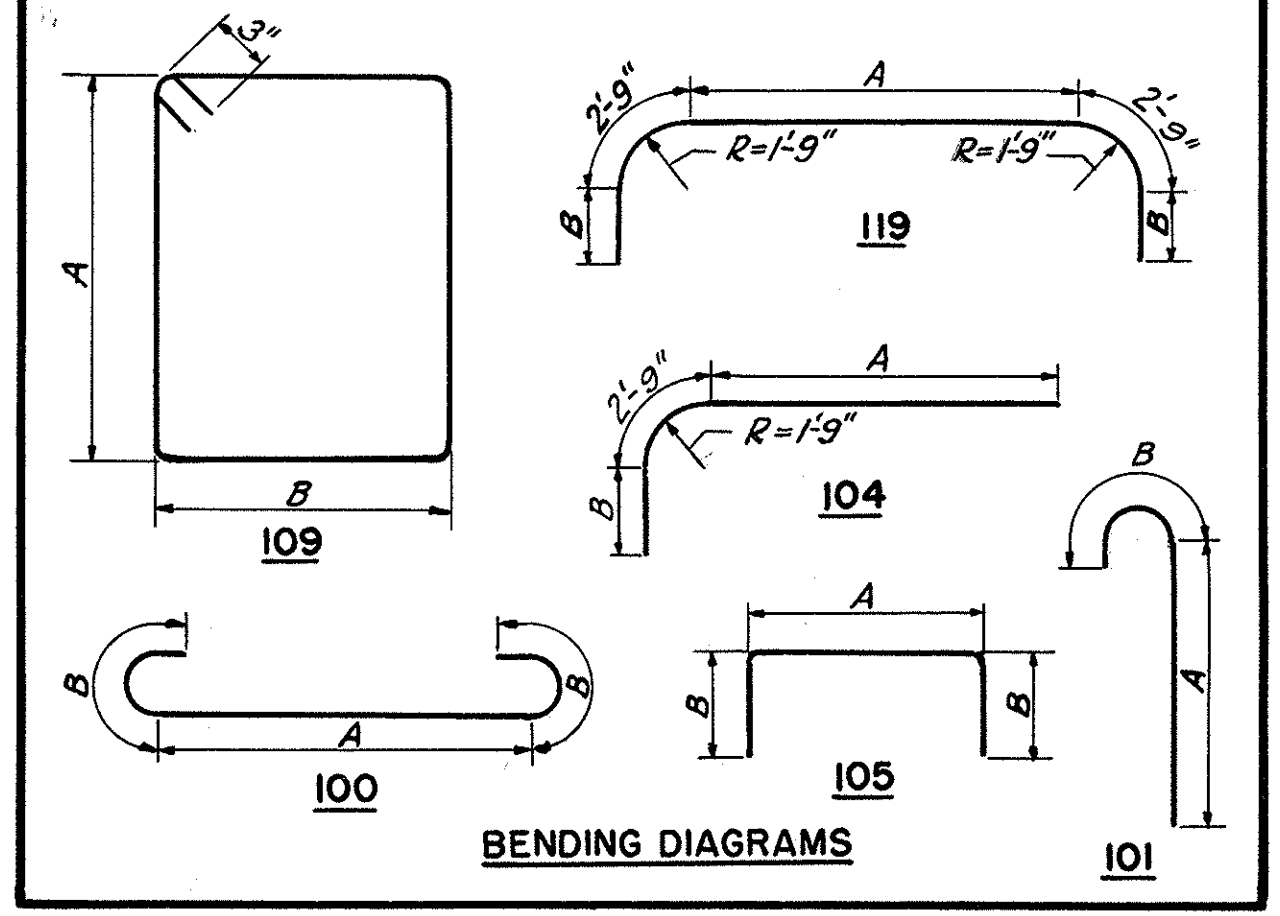

Note:  
Bar dimensions are given out to out.

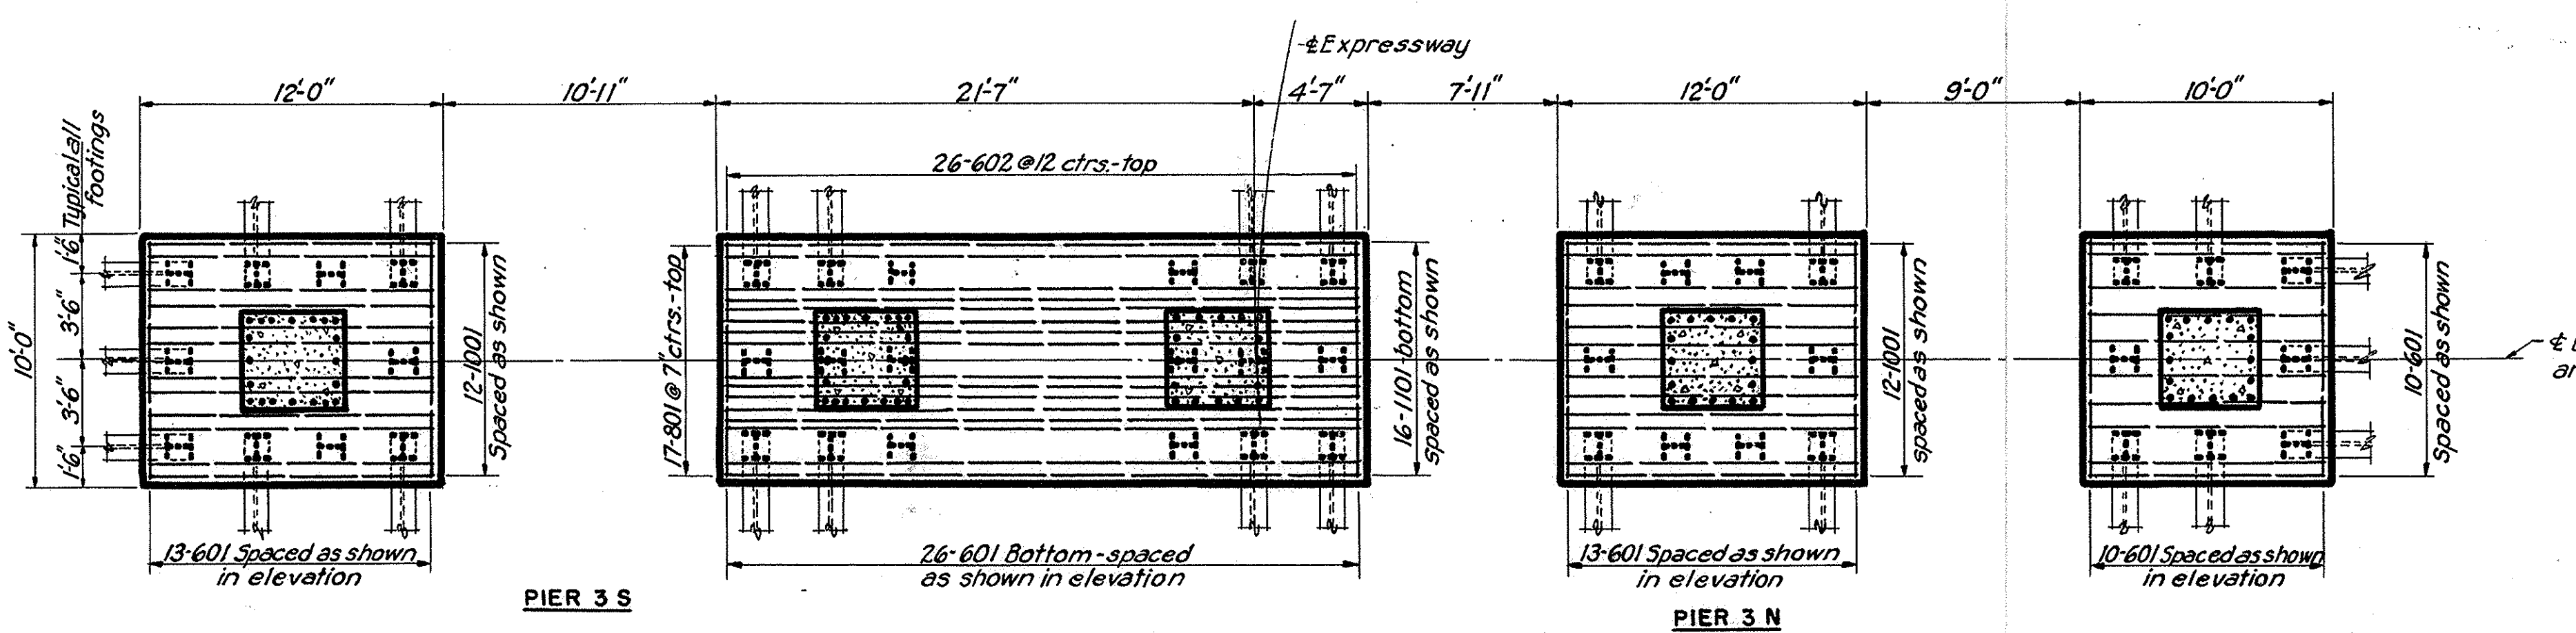

Notes:  
Average vertical pile length=48 feet.  
All piles are 14 BP 73.  
All battered piles battered 2 in 12.  
Section D-D is a typical column  
section, except for bar marks.  
All girders are parallel and normal  
to Pier.  
For anchor bars and shoes see  
Sheet 79.  
For pile details see Sheet 61.  
For replacement bars see Sheet 62.  
All pile spacings are given along  
bottom of footings.


**AKRON EXPRESSWAY SYSTEM**  
WEST VIADUCT  
BR. NO. SU-18R-135  
PIER 3 S AND 3 N

AKRON SUMMIT COUNTY, OHIO  
SCALE: 3/16" = 1'-0" Unless shown  
MADE T.O.D. DATE 7-27-55  
TRCD. C.T.H. DATE 11-9-55  
CKD. B.S.S. DATE 9-29-55

HOWARD, NEEDLES, TAMMEN & BERGENDOFF  
CONSULTING ENGINEERS  
KANSAS CITY CLEVELAND NEW YORK  
901 SHEET- 68


Revised 12-19-55

**SUMMIT COUNTY  
CITY OF AKRON  
AKRON EXPRESSWAY SYSTEM**

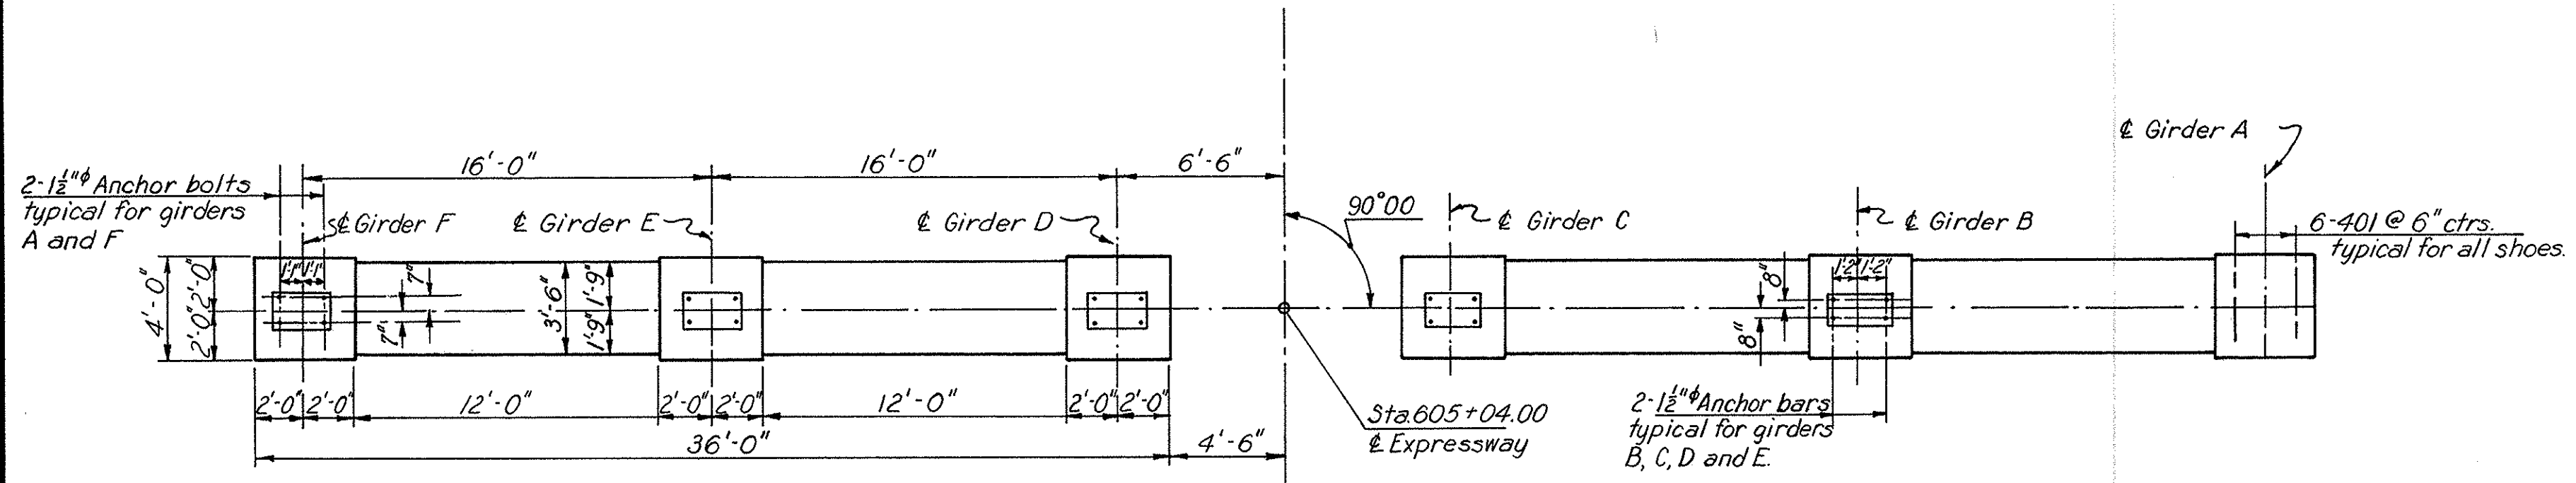


**PLAN**  
Symmetrical about  $\&$  Expressway and  $\&$  between Piers 4S and 4N except as shown.

Note: Special care shall be taken in placing reinforcing steel so that it will not interfere with the anchor bolts.

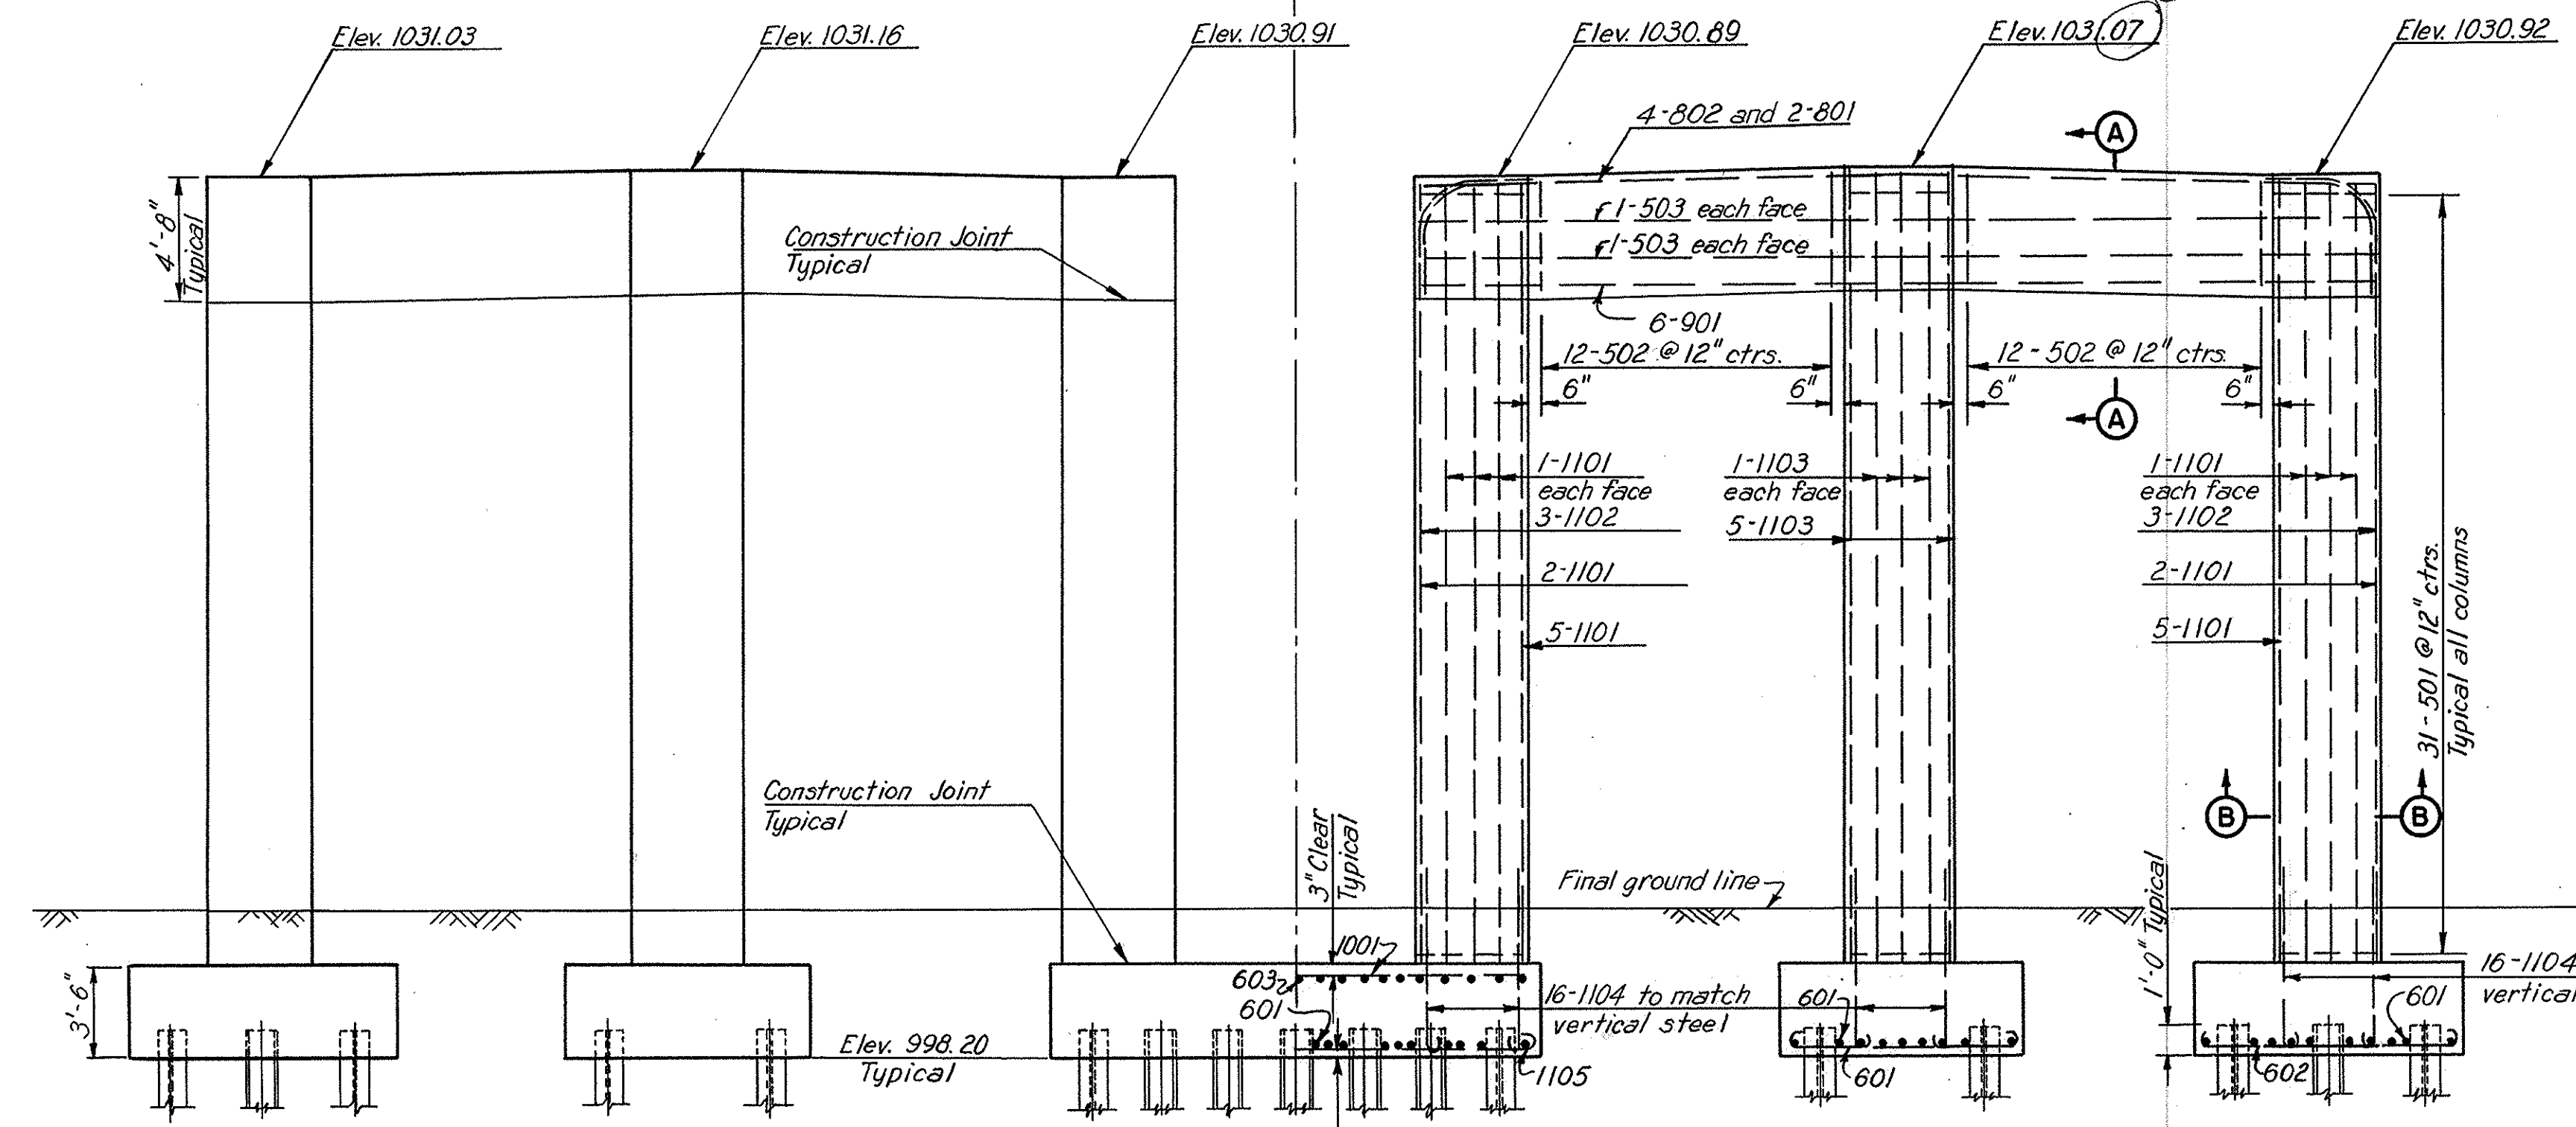



**ELEVATION**

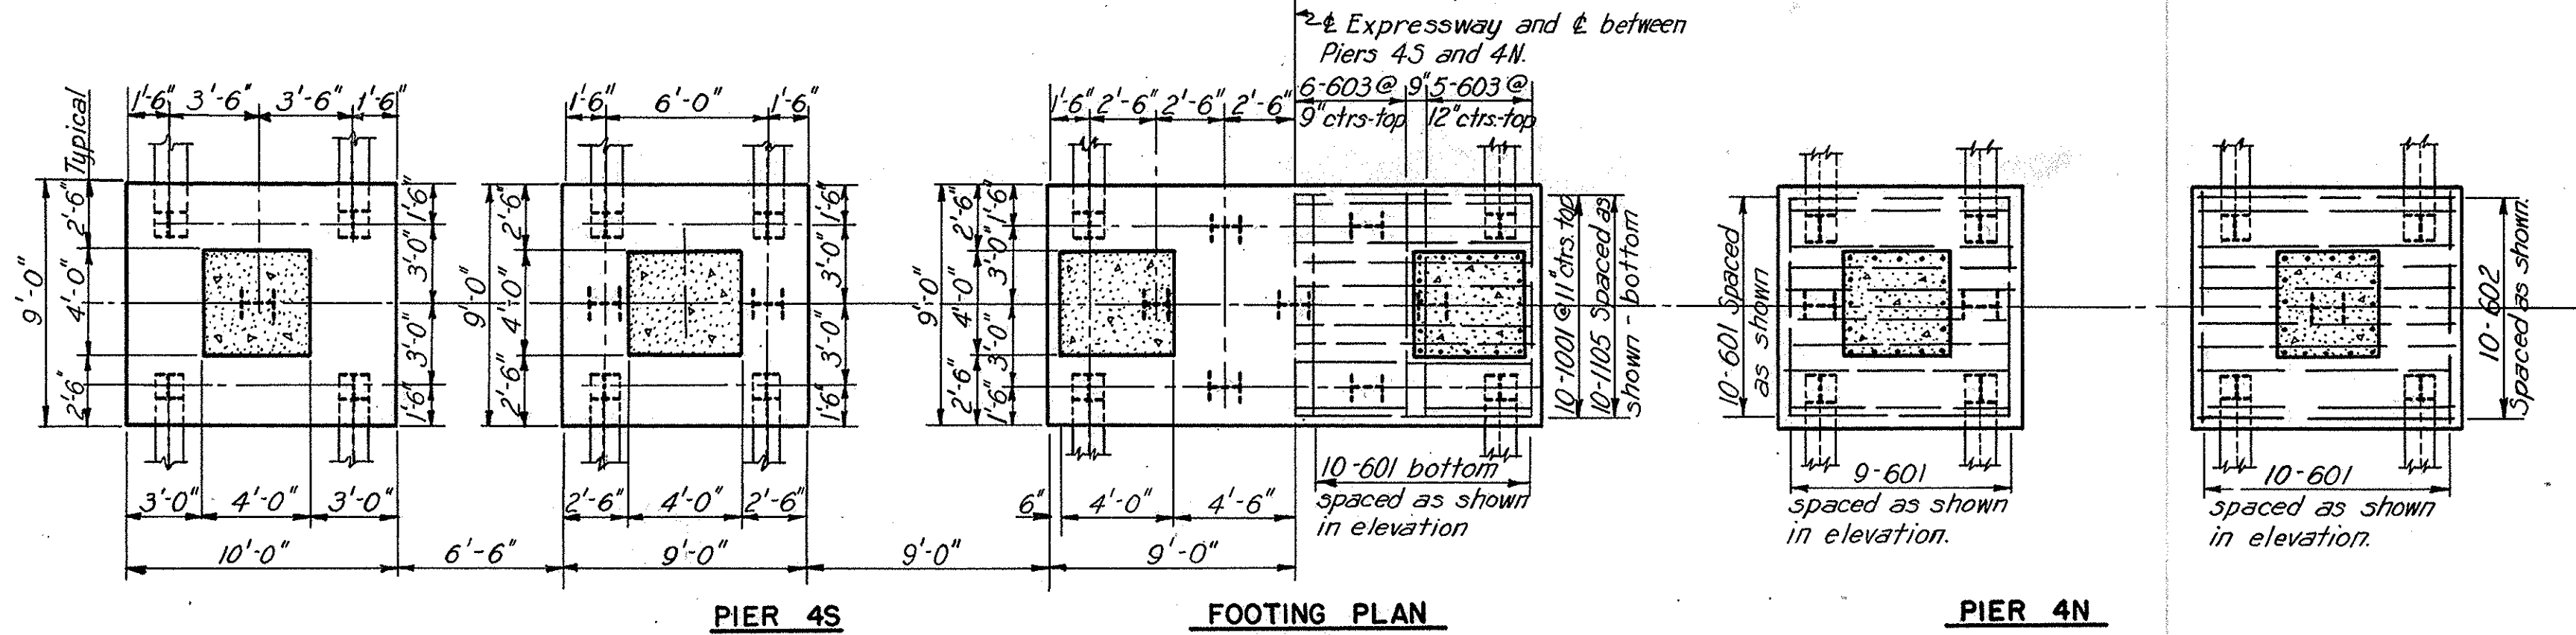


**PIER 4S**

**FOOTING PLAN**

**PIER 4N**

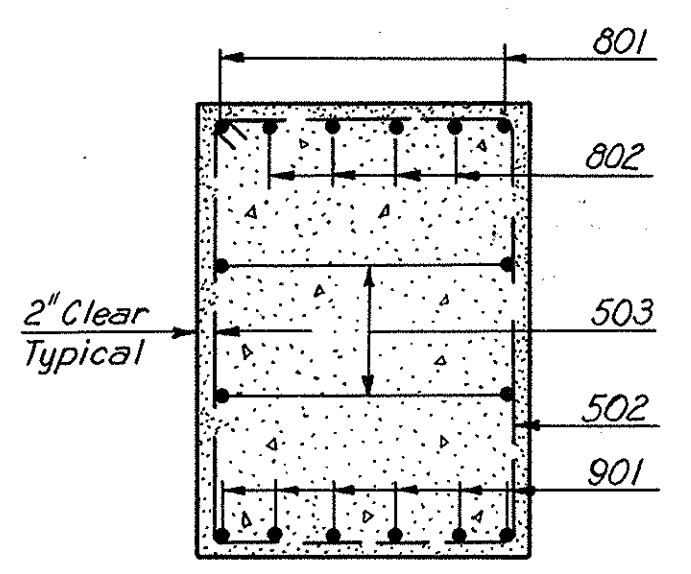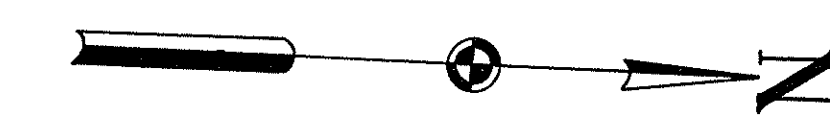


**SECTION A-A**  
Scale  $\frac{3}{8}$ " = 1'-0"

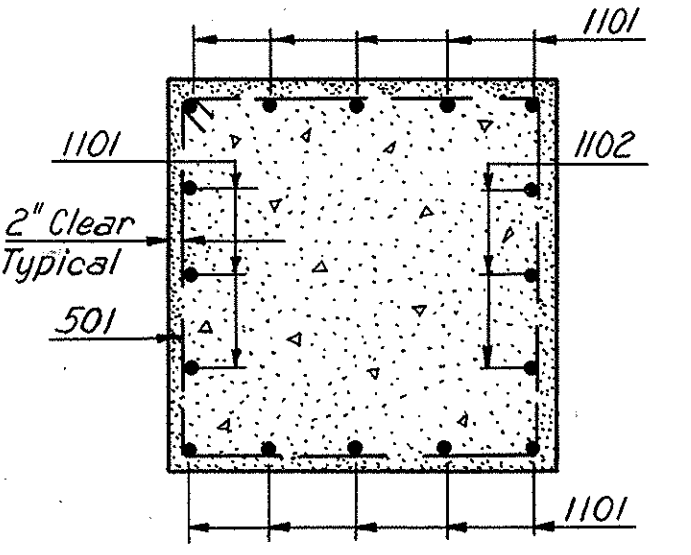

**SECTION B-B**  
Scale  $\frac{3}{8}$ " = 1'-0"

Typical for all columns except for bar marks.

REINFORCEMENT SCHEDULE						
MARK	NUMBER	LENGTH	TYPE	DIMENSIONS		WEIGHT POUNDS
				A	B	
401	36	5'-2"	105	3'-2"	1'-0"	124
501	186	14'-10"	109	3'-7"	3'-7"	2878
502	48	15'-2"	109	4'-3"	3'-1"	760
503	8	35'-6"	Str.			296
601	78	9'-10"	100	8'-0"	0'-11"	1151
602	20	10'-10"	100	9'-0"	0'-11"	325
603	21	8'-6"	Str.			268
801	4	43'-8"	119	33'-2"	2'-6"	466
802	8	35'-6"	Str.			756
901	12	35'-6"	Str.			1450
1001	10	17'-6"	Str.			753
1101	52	29'-0"	Str.			8012
1102	12	33'-6"	104	27'-3"	3'-6"	2136
1103	32	29'-0"	Str.			4930
1104	96	8'-2"	101	6'-3"	1'-11"	4165
1105	10	20'-4"	100	16'-6"	1'-11"	1080
<b>Total</b>						<b>29,550</b>

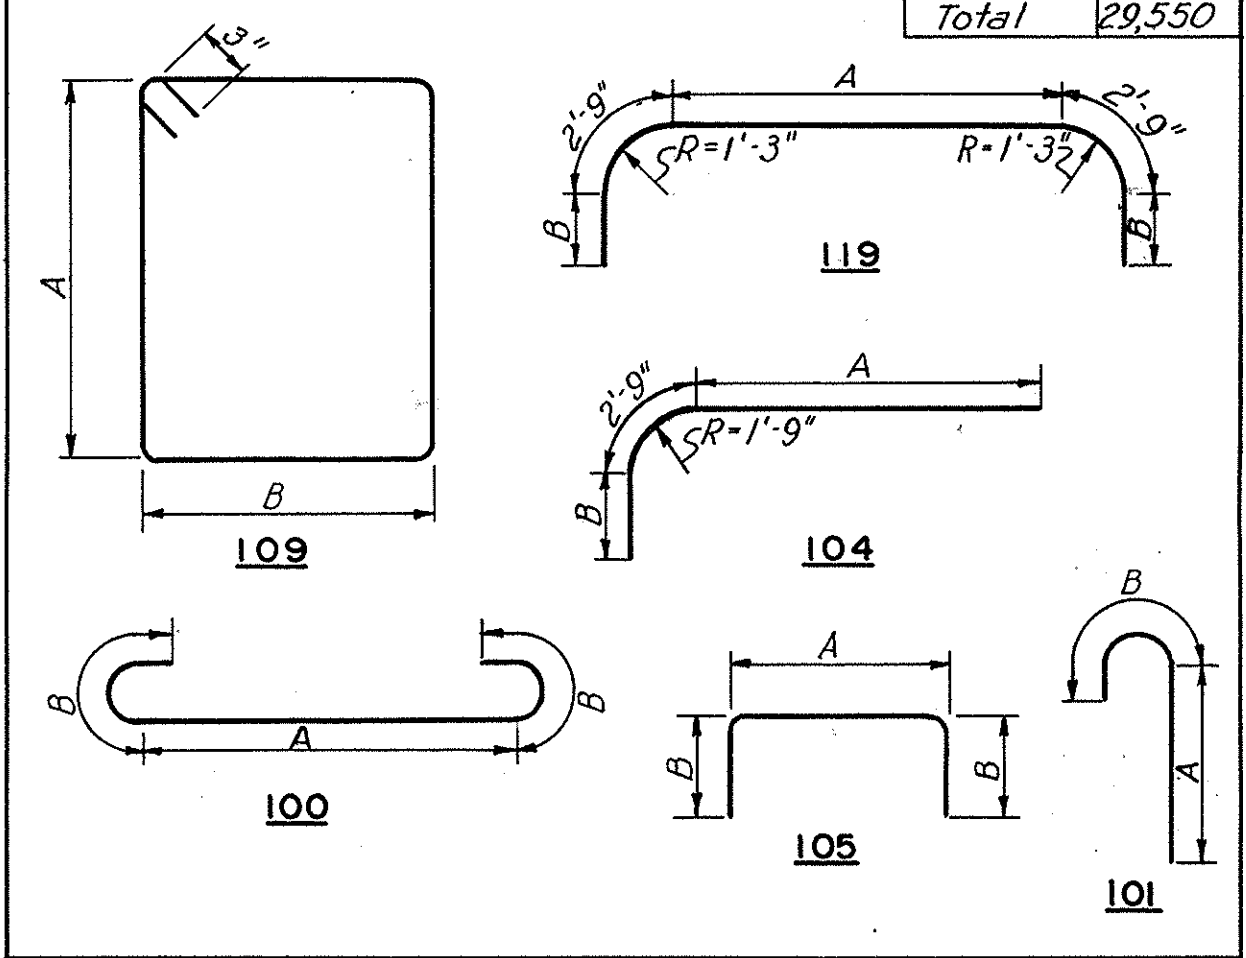

Note: For replacement bars see sheet 62. Bar dimensions are given out to out.

Notes:  
All piles are 14 BP73. All battered piles are battered 2 in 12.  
For anchor bars and shoe details see sheet 79.  
For pile splice details see sheet 61. Average vertical pile length = 70 feet.  
All pile spacings are given along bottom of footings.

**PART 7**

**AKRON EXPRESSWAY SYSTEM**

WEST VIADUCT  
BR. NO. SU-18R-135  
**PIER 4S AND PIER 4N**








AKRON SUMMIT COUNTY, OHIO

SCALE  $\frac{3}{8}$ " = 1'-0" except where shown  
MADE DD DATE 1-24-55 HOWARD, NEEDLES, TAMMEN & BERGENDOFF  
TRCD GJK DATE 10-28-55 CONSULTING ENGINEERS  
CKD JRK DATE 9-12-55 KANSAS CITY CLEVELAND NEW YORK  
901 SHEET- 69


Revised 12-19-55

SUMMIT COUNTY  
CITY OF AKRON  
AKRON EXPRESSWAY SYSTEM


Note:  
Special care shall be taken in placing reinforcing steel so that it will not interfere with the anchor bars.

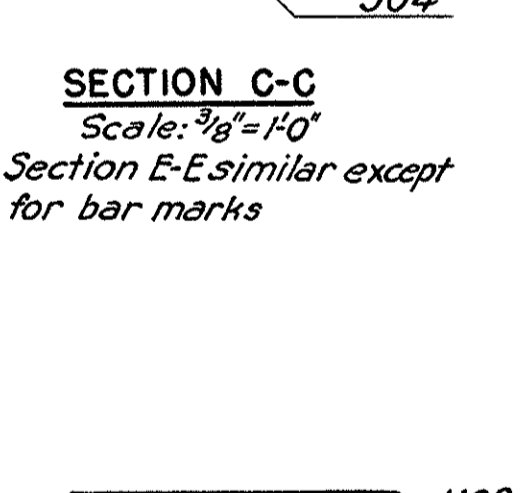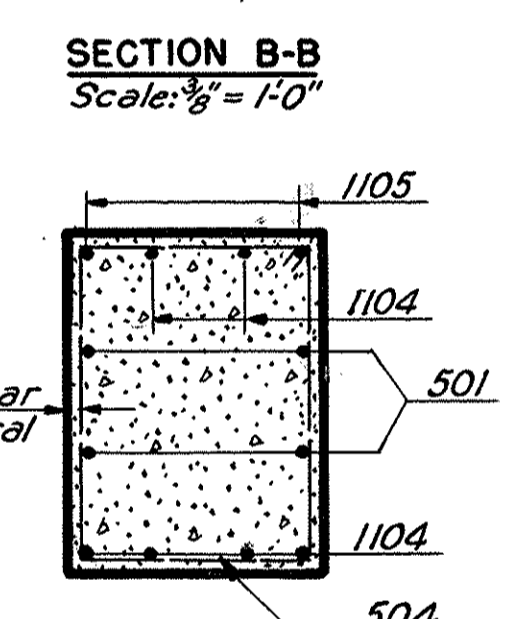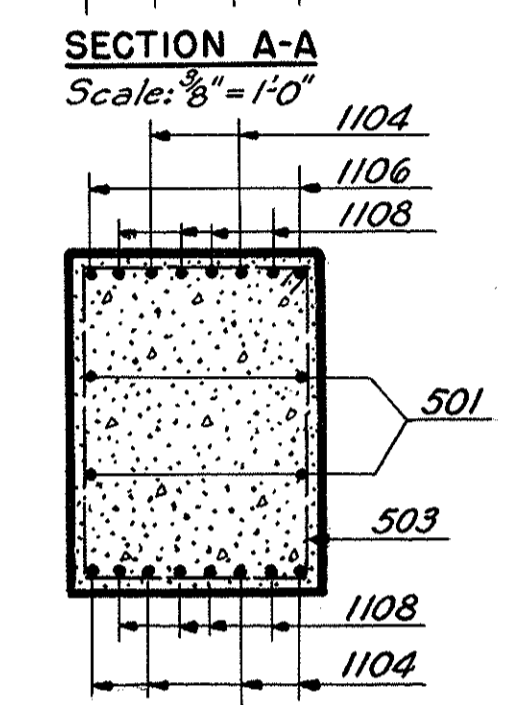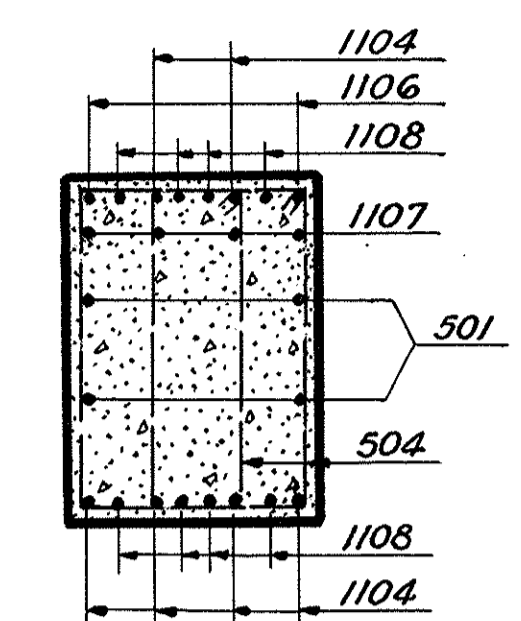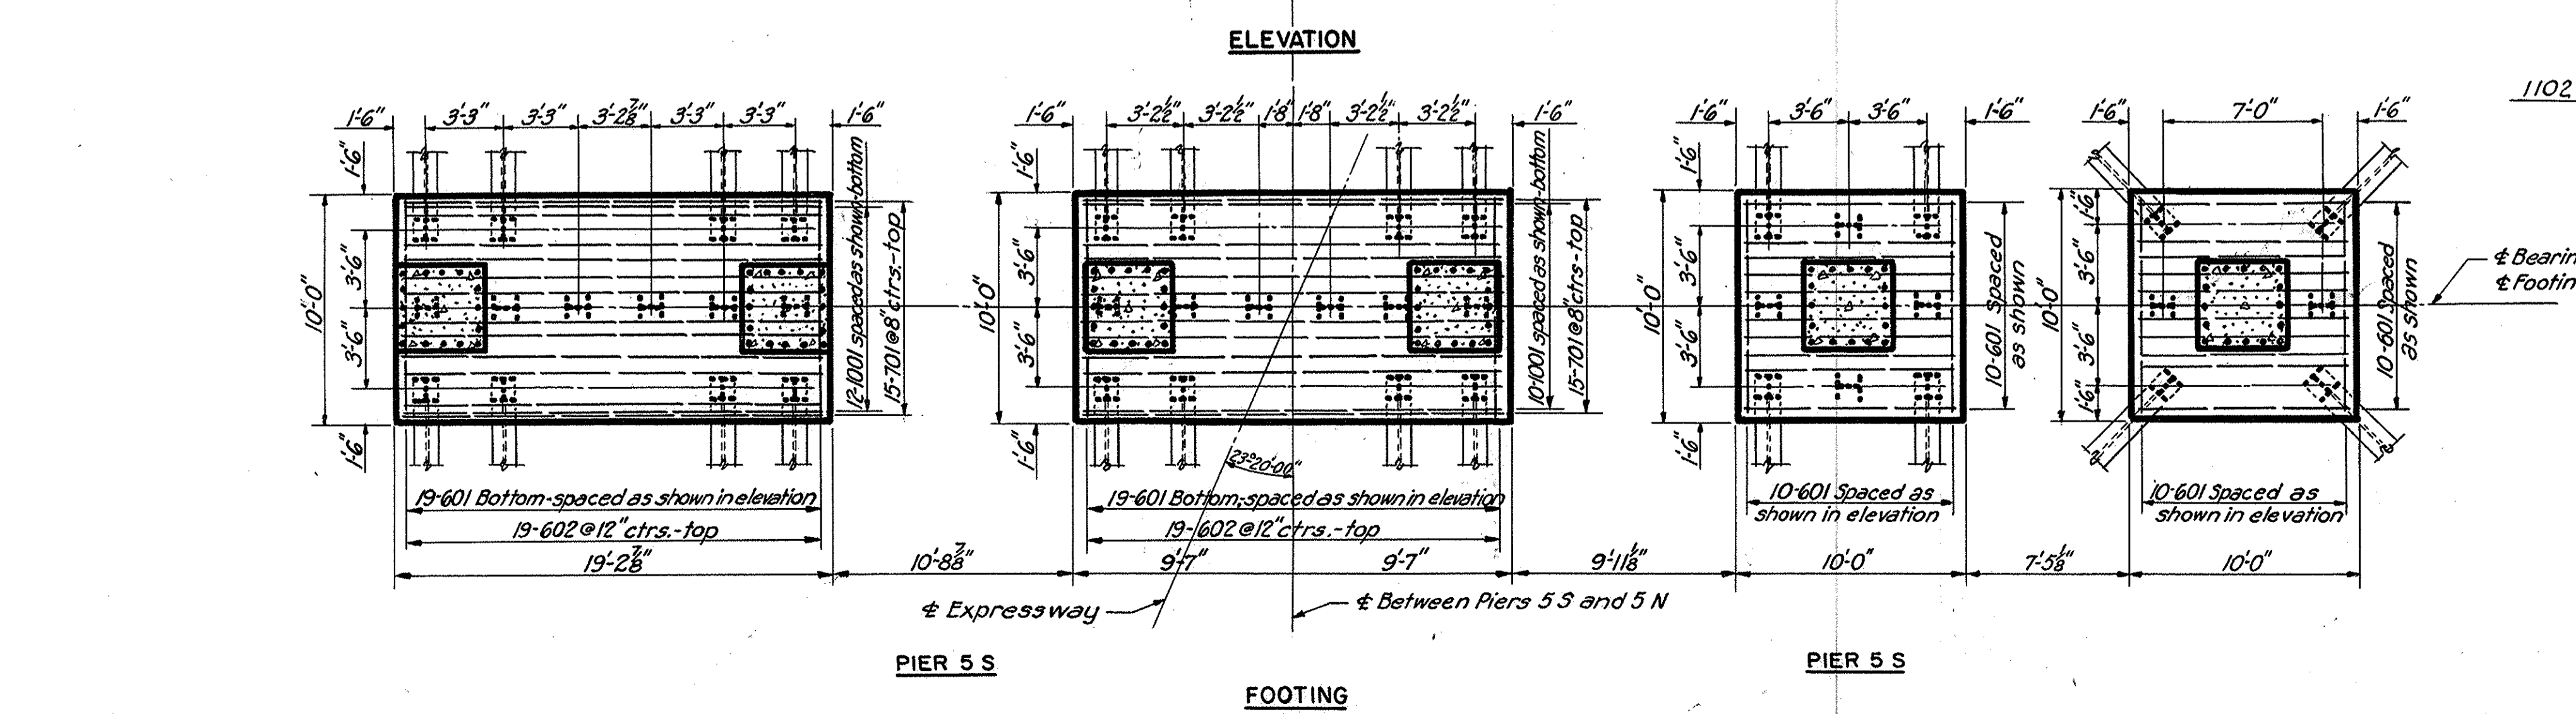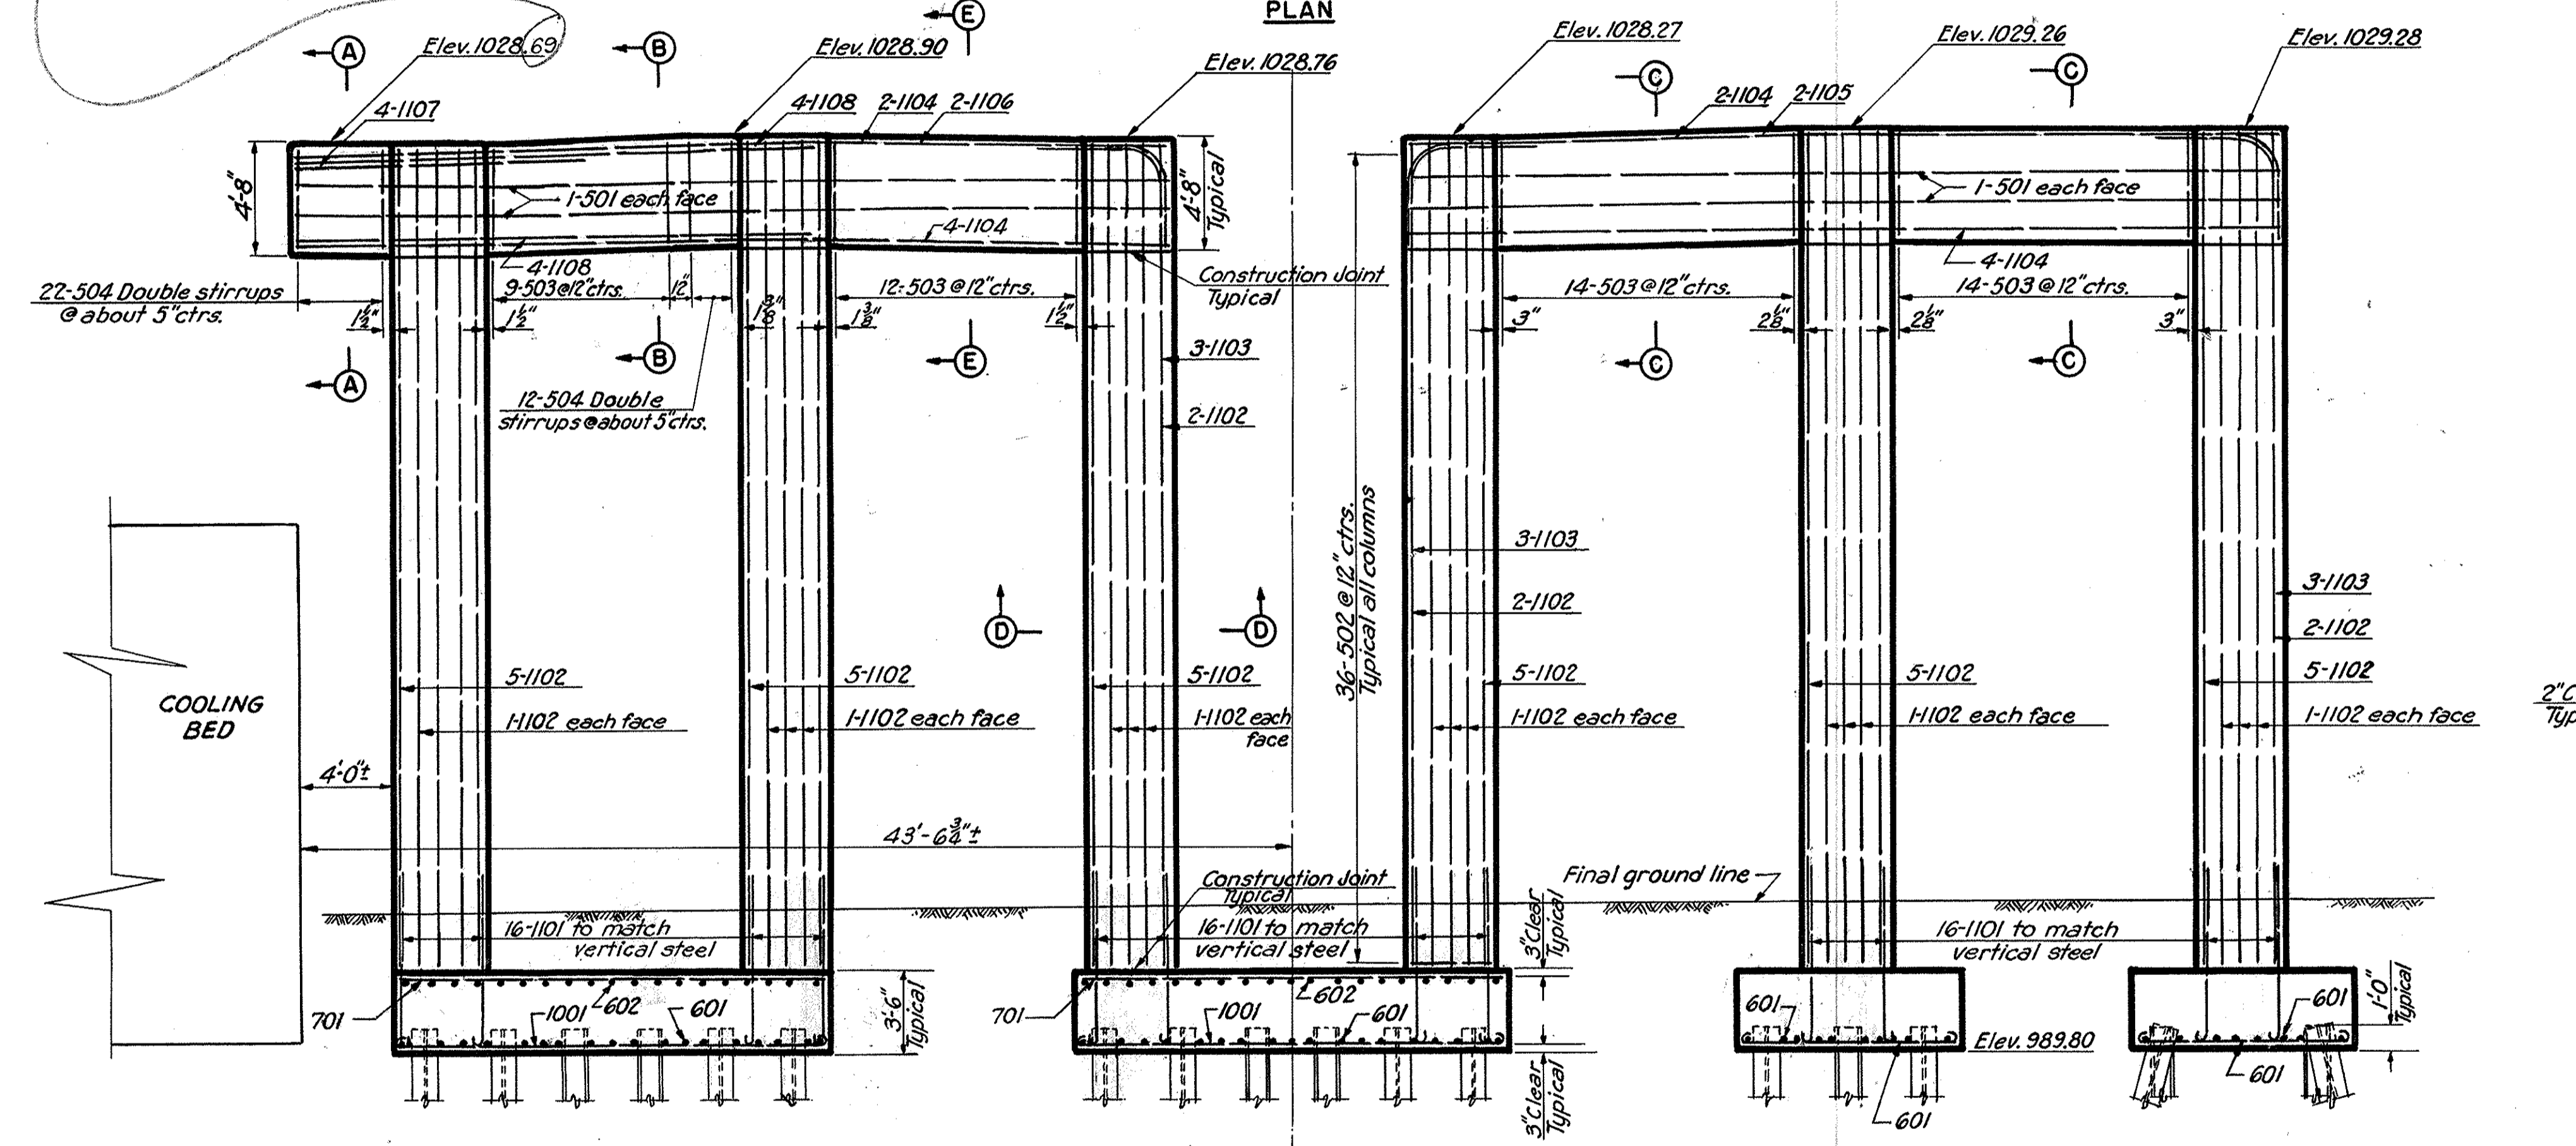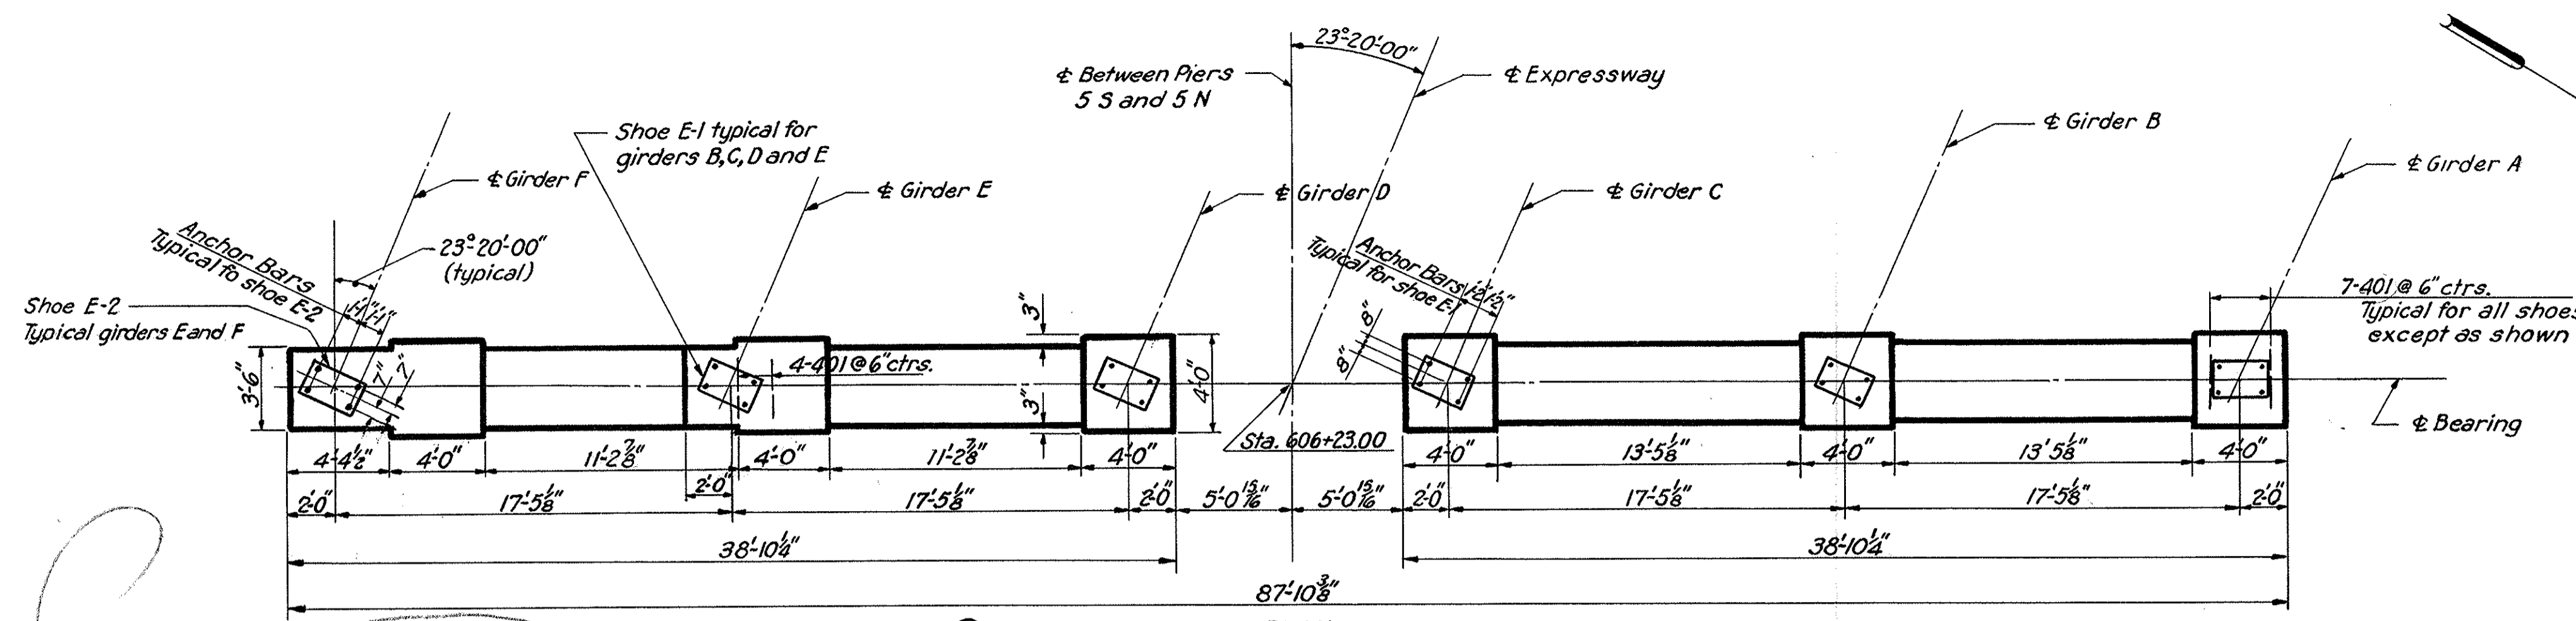

REINFORCEMENT SCHEDULE						
MARK	NUMBER	LENGTH	TYPE	DIMENSIONS		WEIGHT POUNDS
				A	B	
401	39	5'-2"	102	3'-2"	1'-0"	134
501	8	38'-6"	str.			321
502	216	15'-2"	109	3'-8"	3'-8"	3417
503	49	15'-6"	109	4'-4"	3'-2"	792
504	34	13'-2"	109	4'-4"	2'-1"	467
601	78	10'-10"	100	9'-0"	0'-11"	1269
602	38	9'-6"	str.			543
701	30	18'-9"	str.			1150
1001	22	21'-3"	100	17'-9"	1'-9"	2012
1101	96	8'-2"	101	6'-3"	1'-11"	4170
1102	87	35'-6"	str.			16,409
1103	9	40'-7"	103	34'-3"	3'-7"	1941
1104	12	38'-6"	str.			2455
1105	2	47'-4"	104	35'-0"	3'-5"	503
1106	2	43'-0"	103	36'-10"	3'-5"	456
1107	4	12'-9"	str.			271
1108	8	23'-6"	str.			999
Total =						37,309

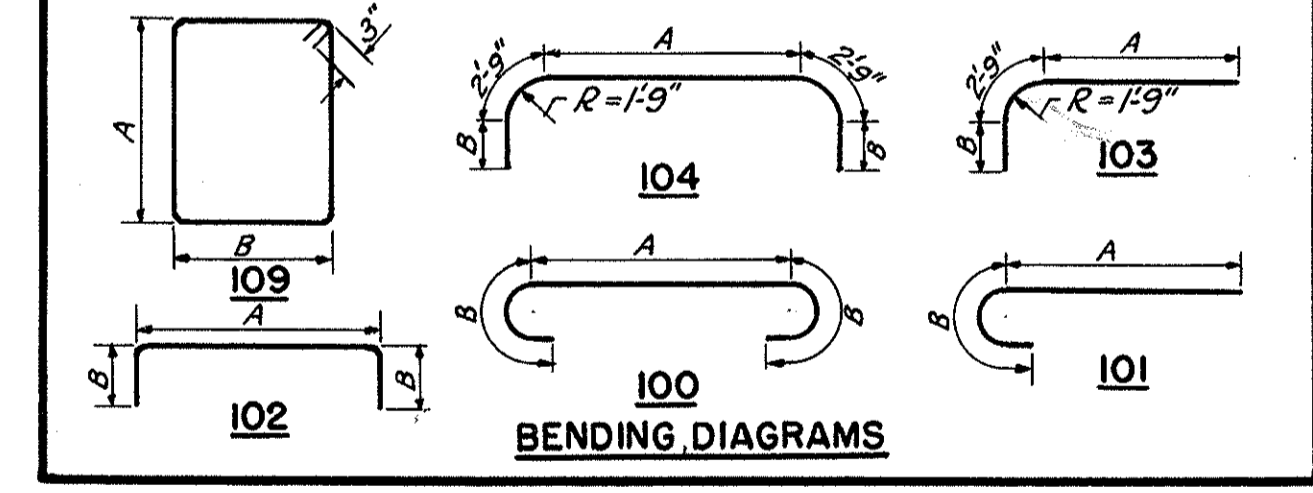

Note:  
Bar dimensions are given out to out.

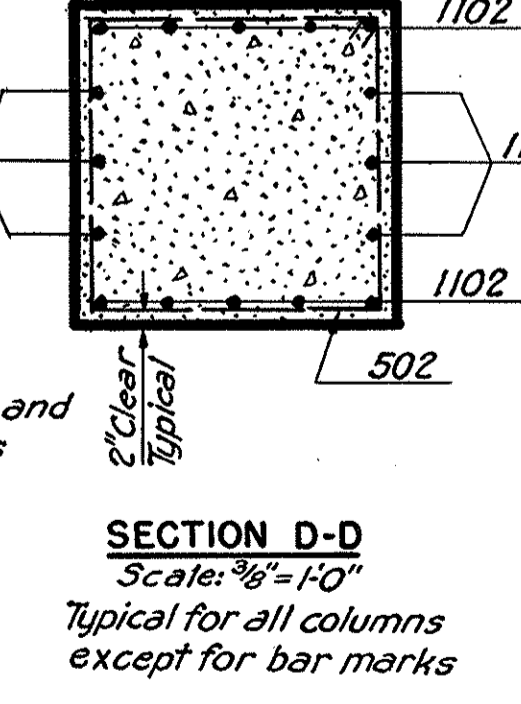

Note:  
For anchor bar and shoe details see Sheet 79.  
All piles are 14 BP 73.  
All battered piles are battered 2 in 12.  
For pile splice details see Sheet 61.  
For replacement bars see Sheet 62.  
Average vertical pile length = 25 feet.  
Pile spacings are given along bottom of footings.

Revised 12-19-55 PART 7

**AKRON EXPRESSWAY SYSTEM**  
WEST VIADUCT  
BR. NO. SU-18R-135  
PIER 5 S AND 5 N

AKRON SUMMIT COUNTY, OHIO













SCALE: 3/8" = 1'-0" Except as noted  
MADE Y.R.C. DATE 7-27-55  
TRCD. C.H.H. DATE 11-11-55  
CKD. J.R.K. DATE 7-12-55

HOWARD, NEEDLES, TAMMEN & BERGENOFF  
CONSULTING ENGINEERS  
KANSAS CITY CLEVELAND NEW YORK  
901 SHEET- 70

EXPRESSWAY PART 7 SUMMIT COUNTY  
SUM-18R-12.90  
CITY OF AKRON  
AKRON EXPRESSWAY SYSTEM

REINFORCEMENT SCHEDULE

MARK	NUMBER	LENGTH	TYPE	DIMENSIONS		WEIGHT POUNDS
				A	B	
401	49	5'-2"	105	3'-2"	1'-0"	169
501	4	43'-6"	Str.			181
502	4	38'-6"	Str.			161
503	252	14'-6"	109	3'-6"	3'-6"	3811
504	59	15'-6"	109	4'-4"	3'-2"	954
505	12	13'-10"	109	4'-4"	2'-4"	173
601	52	8'-6"	Str.			664
602	19	11'-6"	Str.			328
801	16	18'-9"	Str.			801
802	32	11'-6"	Str.			983
901	20	8'-9"	Str.			1,275
902	60	11'-6"	Str.			2,346
1101	44	11'-8"	101	9'-9"	1'-11"	2,727
1102	12	16'-8"	101	14'-9"	1'-11"	1,063
1103	24	17'-0"	Str.			2,168
1104	6	45'-3"	104	40'-0"	3'-6"	1,474
1105	42	41'-9"	Str.			9,316
1106	8	43'-6"	Str.			1,849
1107	4	24'-0"	Str.			510
1108	2	51'-6"	119	40'-0"	3'-0"	547
1109	13	42'-0"	Str.			2,901
1110	3	46'-6"	104	40'-3"	3'-6"	741
1111	12	15'-2"	101	13'-3"	1'-11"	967
1112	12	14'-0"	Str.			893
1113						
1114	3	46'-10"	104	40'-7"	3'-6"	746
1115	2	23'-0"	Str.			244
1116	4	27'-0"	Str.			574
1117	7	38'-6"	Str.			1,432
1118	2	46'-6"	119	35'-0"	3'-6"	494
1119	132	7'-11"	101	5'-10"	1'-11"	5,554
1120	29	42'-3"	Str.			6,570
						Total 52,556

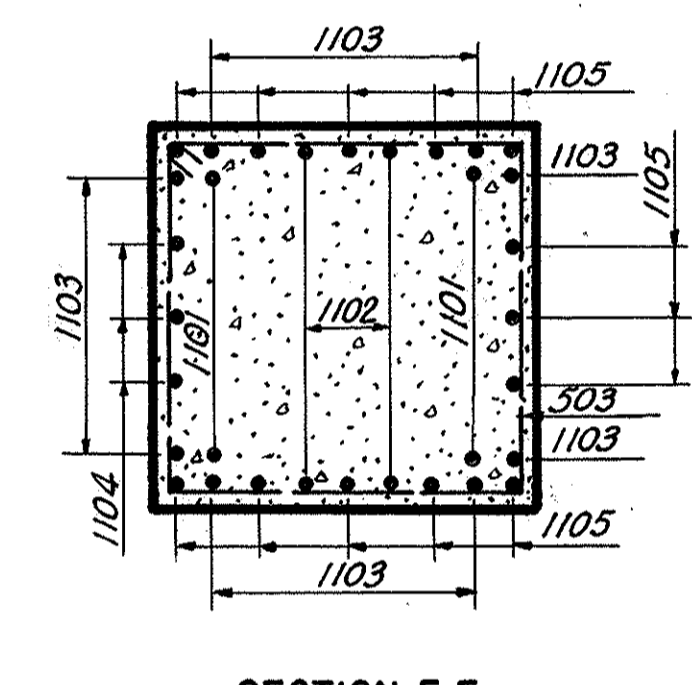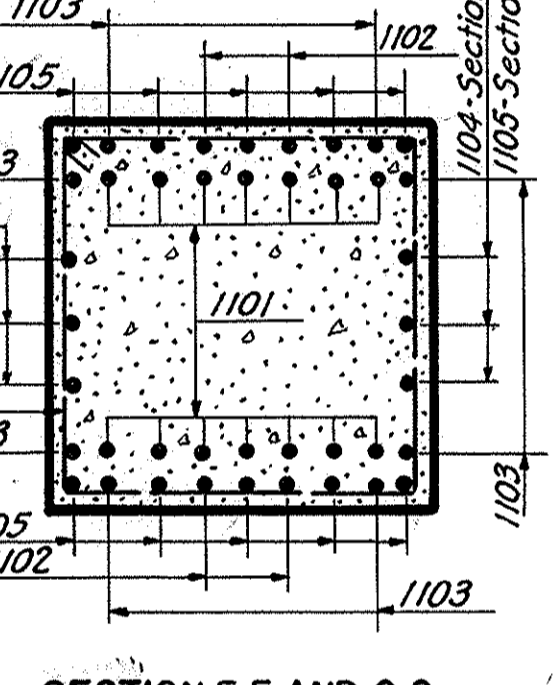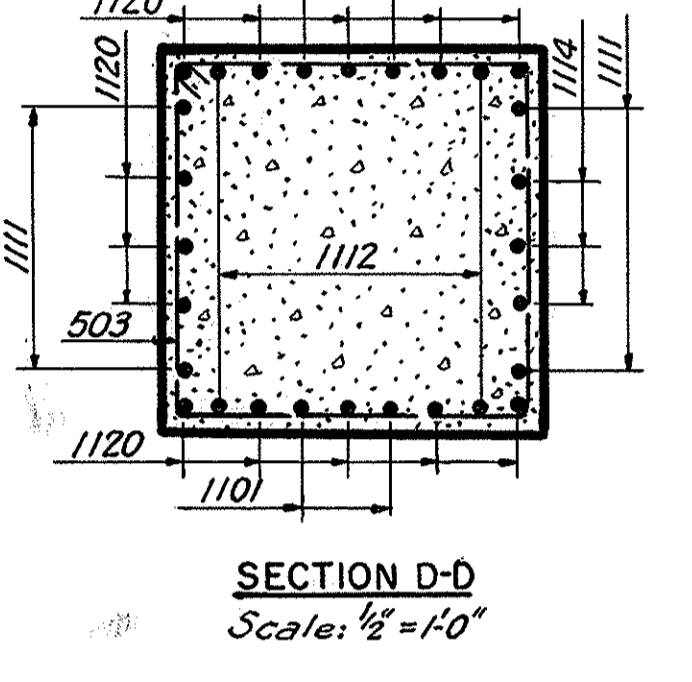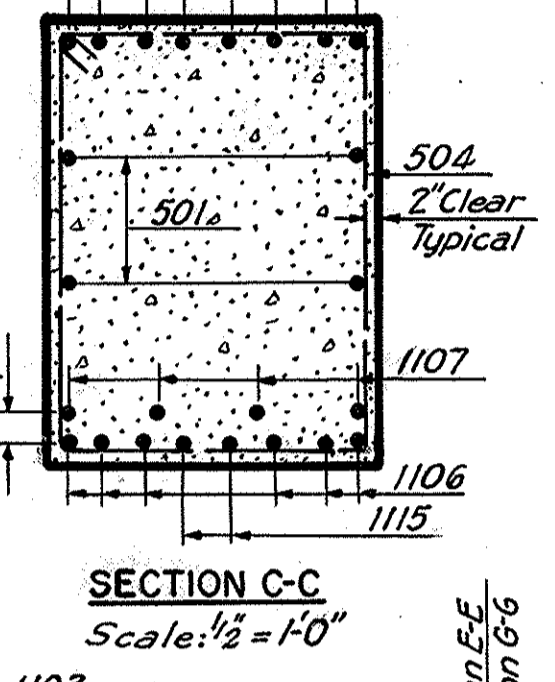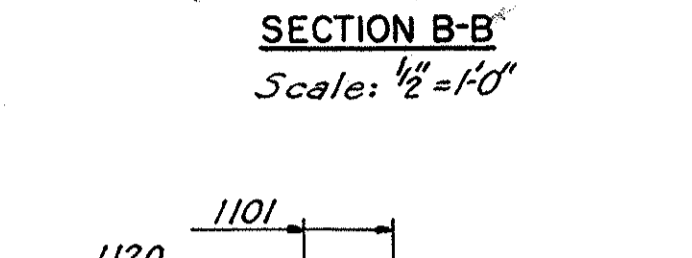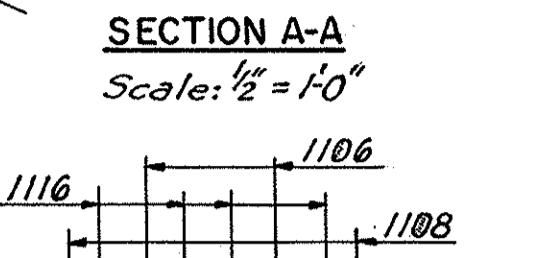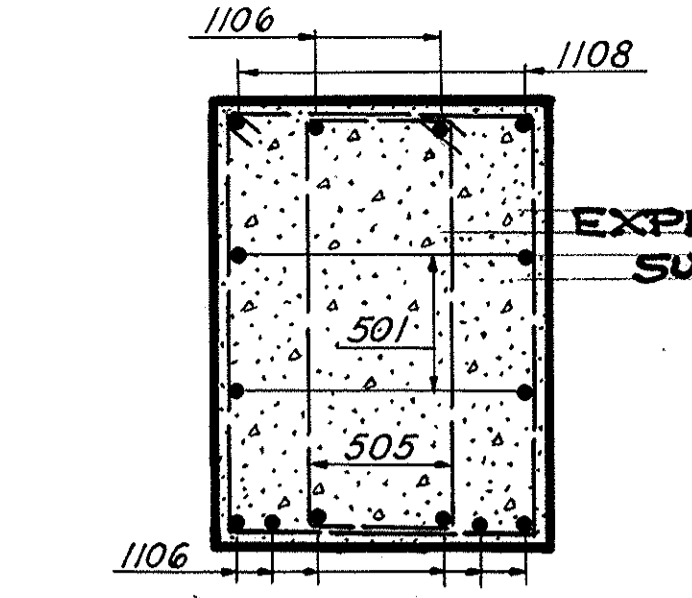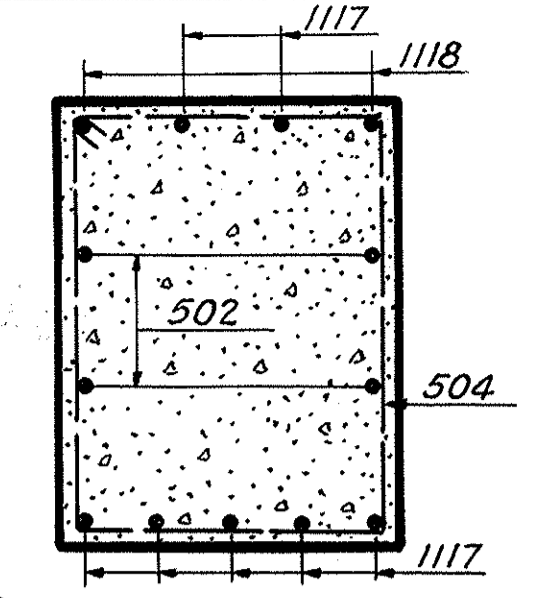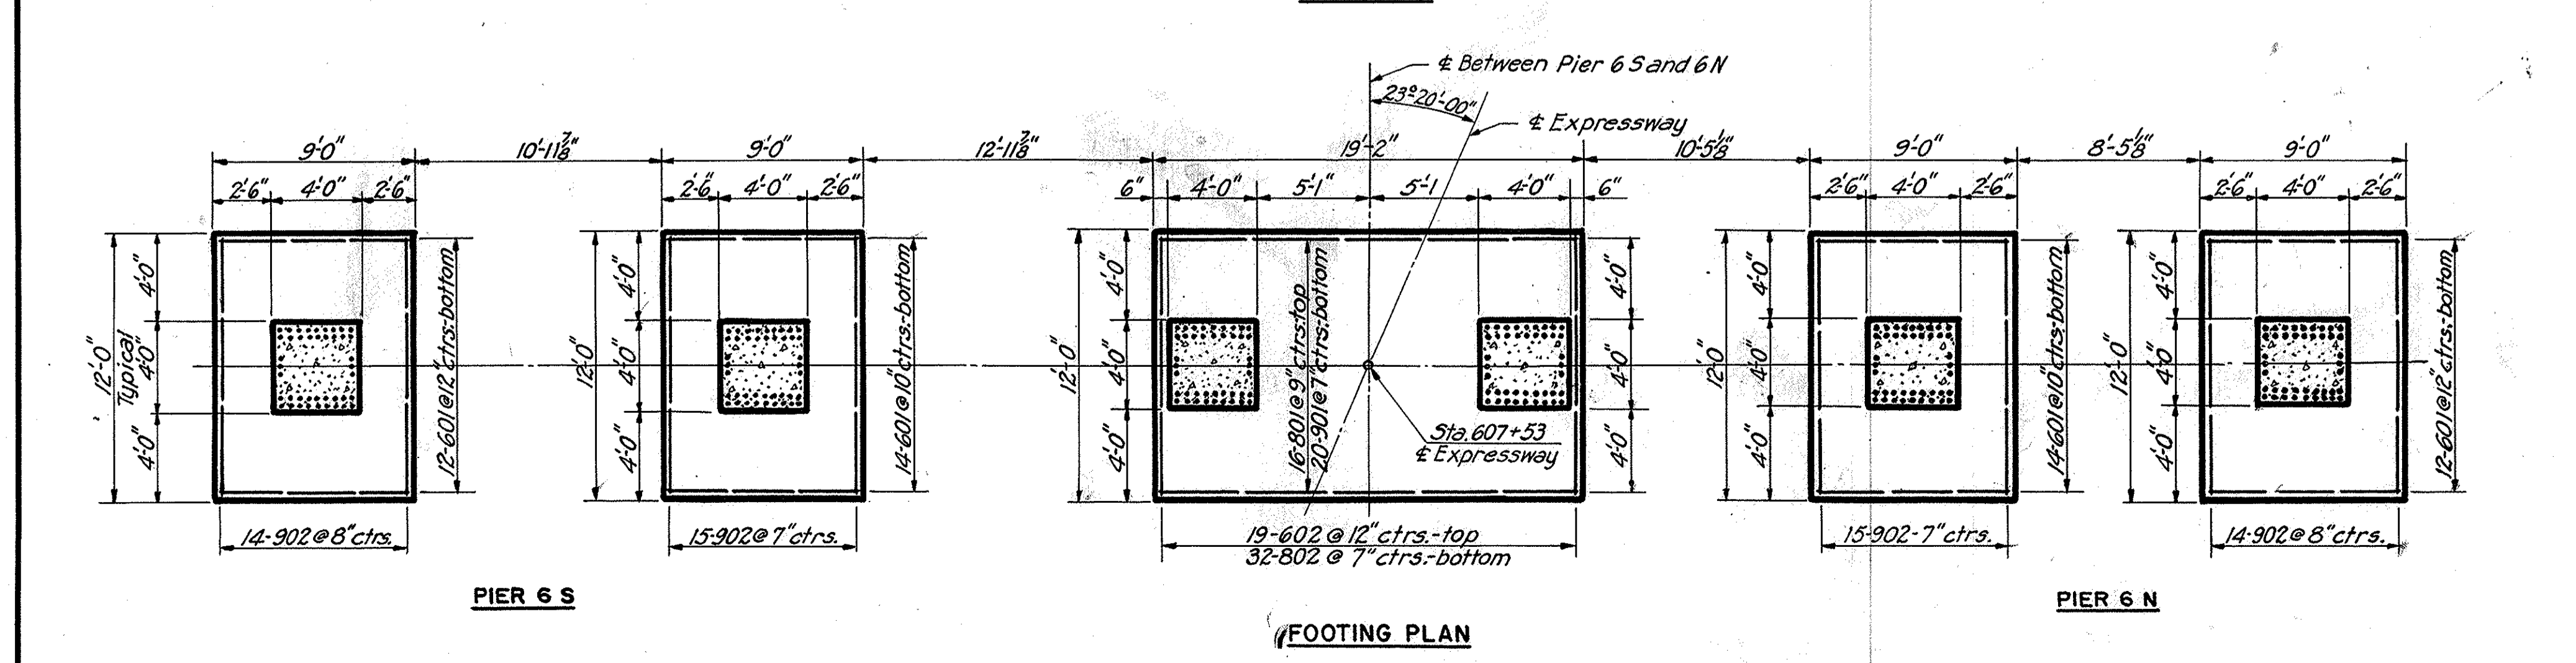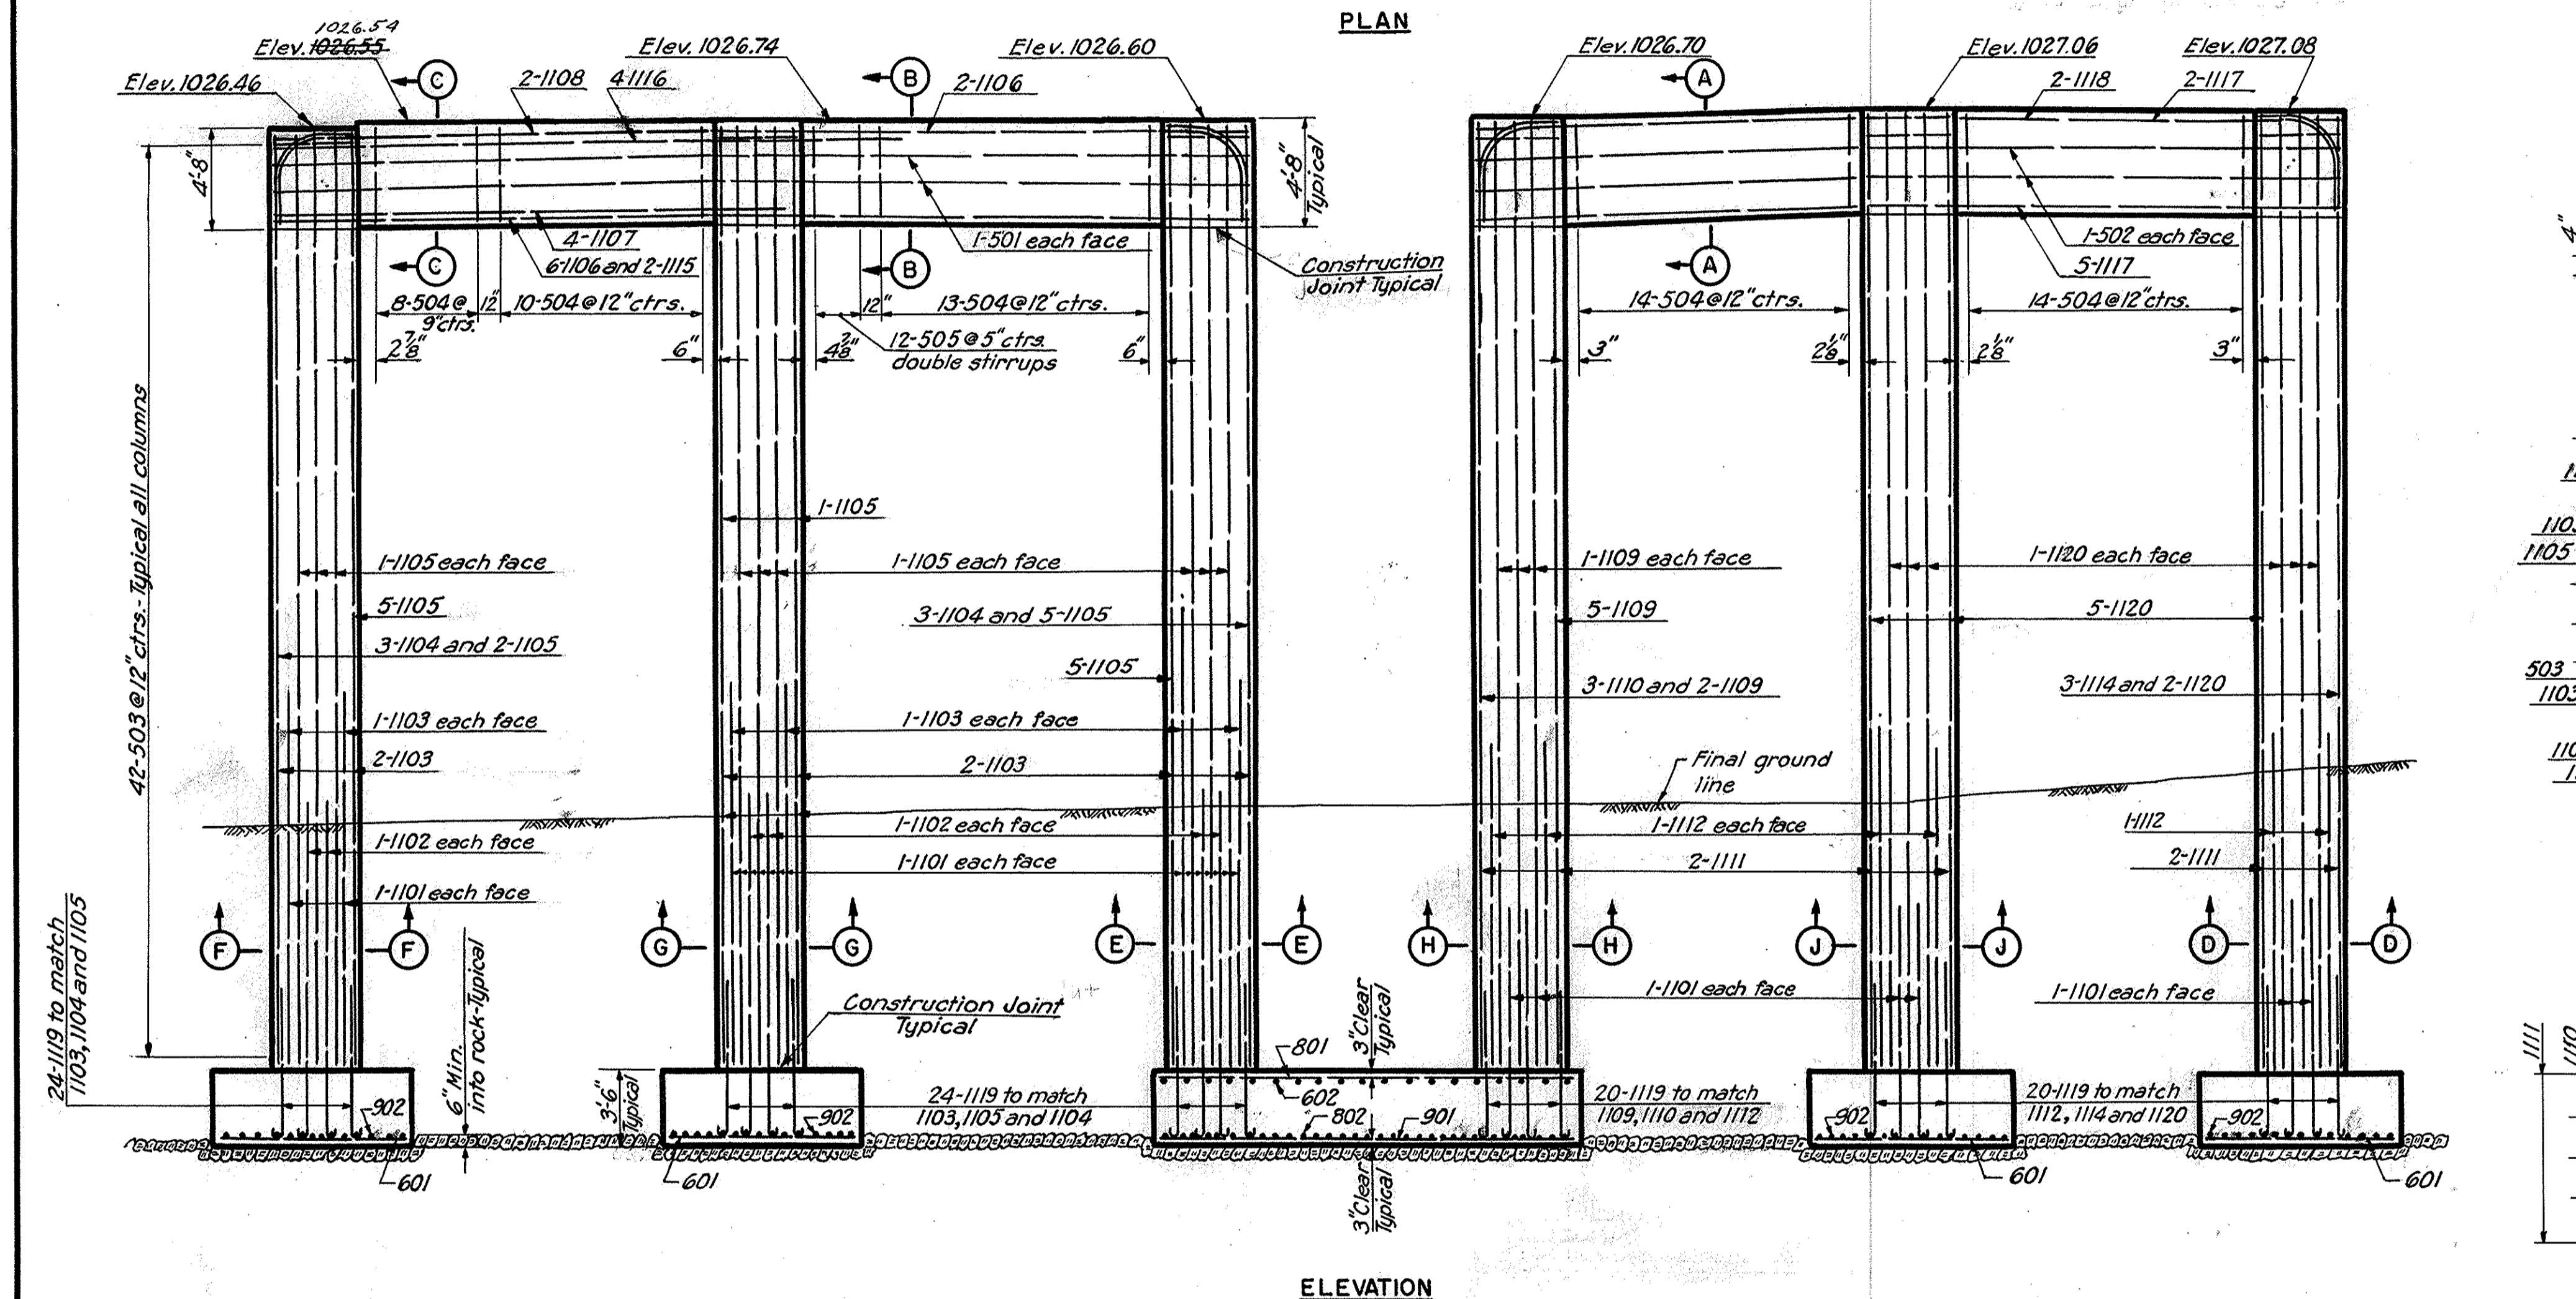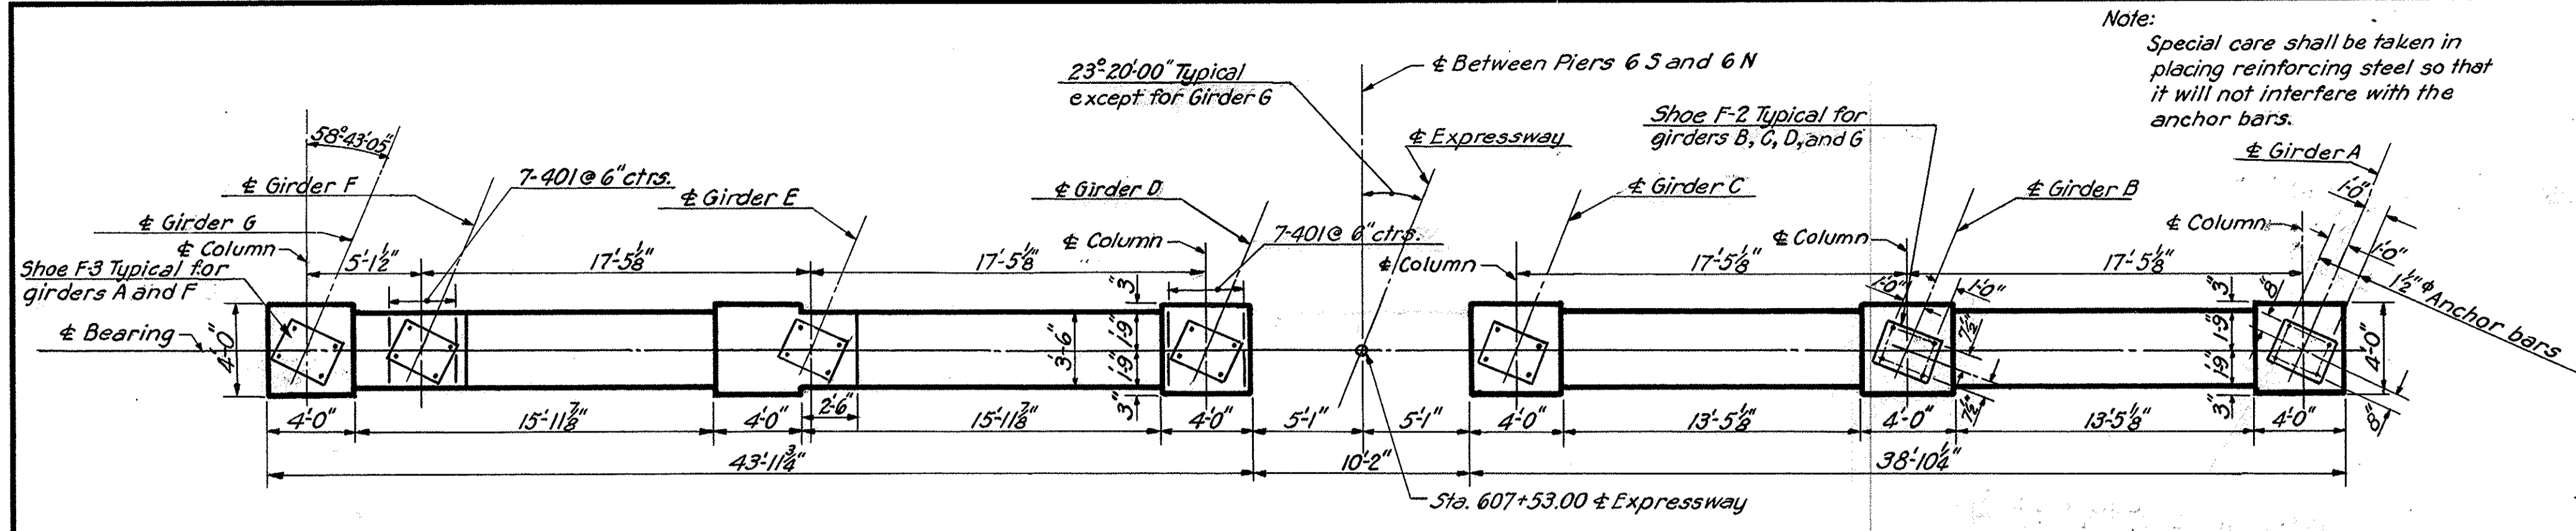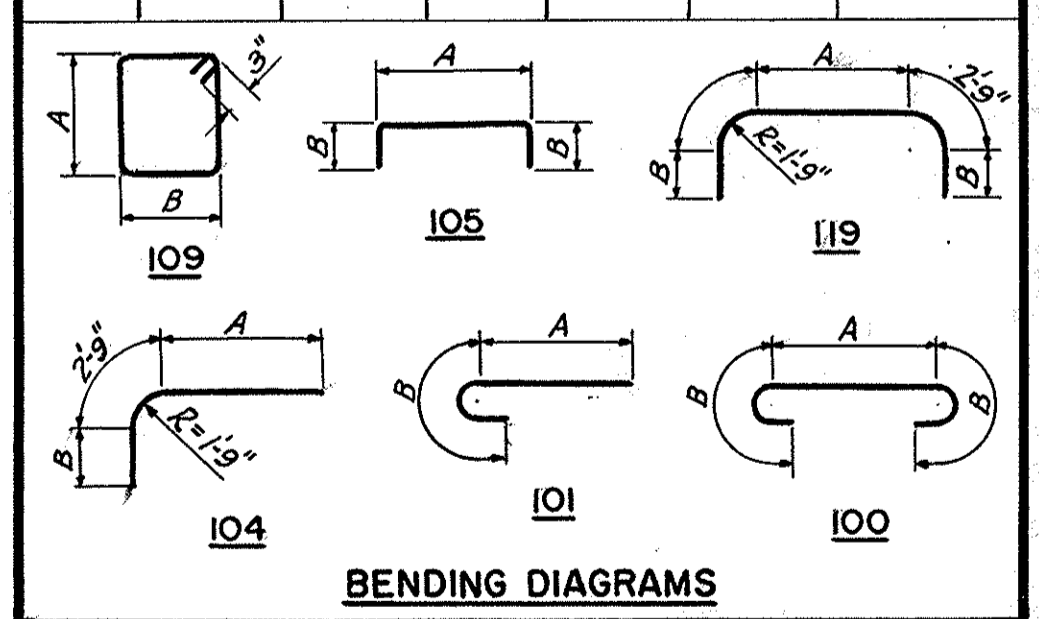

Note: Special care shall be taken in placing reinforcing steel so that it will not interfere with the anchor bars.


Notes:  
Footings shall extend a minimum of 6" into solid rock or to the elevation shown, whichever is lower. Bottom of footing elevations are subject to change when excavations are made and actual elevations of top of sound rock are determined.  
For anchor bars and shoes, see Sheet 79.  
For replacement bars, see Sheet 62.  
Bar dimensions are given out to out.  
Footing design superseded by footing details shown on sheet No. 71A.  
8-27-54

Revised 12-19-55


PART 7  
AKRON EXPRESSWAY SYSTEM  
WEST VIADUCT  
BR. NO. SU-18R-135  
PIER 6 S AND 6 N  
AKRON SUMMIT COUNTY, OHIO  
SCALE: 3/16" = 1'-0" unless otherwise shown  
MADE D.W.H. DATE 8-4-55  
TRCD C.T.H. DATE 10-13-55  
CKD U.R.K. DATE 9-13-55  
HOWARD, NEEDLES, TAMMEN & BERGENDOFF  
CONSULTING ENGINEERS  
KANSAS CITY CLEVELAND NEW YORK  
901 SHEET- 71

**SUMMIT COUNTY  
CITY OF AKRON  
AKRON EXPRESSWAY SYSTEM**

REINFORCEMENT SCHEDULE						
MARK NUMBER	LENGTH	TYPE	DIMENSIONS		WEIGHT POUNDS	
			A	B		
401	49	5'-2"	105	3'-2"	1'-0"	169
501	4	43'-6"	Str.			181
502	4	38'-6"	Str.			161
503	252	14'-6"	109	3'-6"	3'-6"	3811
504	59	15'-6"	109	4'-4"	3'-2"	954
505	12	13'-10"	109	4'-4"	2'-4"	173
601	52	8'-6"	Str.			664
602	19	11'-6"	Str.			328
*603	92	11'-6"	Str.			1589
801	16	18'-9"	Str.			801
802	32	11'-6"	Str.			983
*803	3	18'-9"	Str.			150
*804	9	11'-6"	Str.			276
901	20	8'-9"	Str.			1275
902	60	11'-6"	Str.			2346
*903	28	13'-6"	Str.	10'-0"		1285
*904	10	10'-0"	Str.		340	340
1101	44	11'-8"	101	9'-9"	1'-11"	2,727
1102	12	16'-8"	101	14'-9"	1'-11"	1,063
1103	24	17'-0"	Str.			2,168
1104	6	45'-3"	104	40'-0"	3'-6"	1,474
1105	42	41'-9"	Str.			9,316
1106	8	43'-6"	Str.			1,849
1107	4	24'-0"	Str.			510
1108	2	51'-6"	119	40'-0"	3'-0"	547
1109	13	42'-0"	Str.			2,901
1110	3	46'-6"	104	40'-3"	3'-6"	741
1111	12	15'-2"	101	13'-3"	1'-11"	967
1112	12	14'-0"	Str.			893
1114	3	46'-10"	104	40'-7"	3'-6"	746
1115	2	23'-0"	Str.			244
1116	4	27'-0"	Str.			574
1117	7	38'-6"	Str.			1,432
1118	2	46'-6"	119	35'-0"	3'-6"	494
1119	132	7'-11"	101	5'-10"	1'-11"	5,554
1120	29	42'-3"	Str.			6,510
						<b>Total 56,196</b>

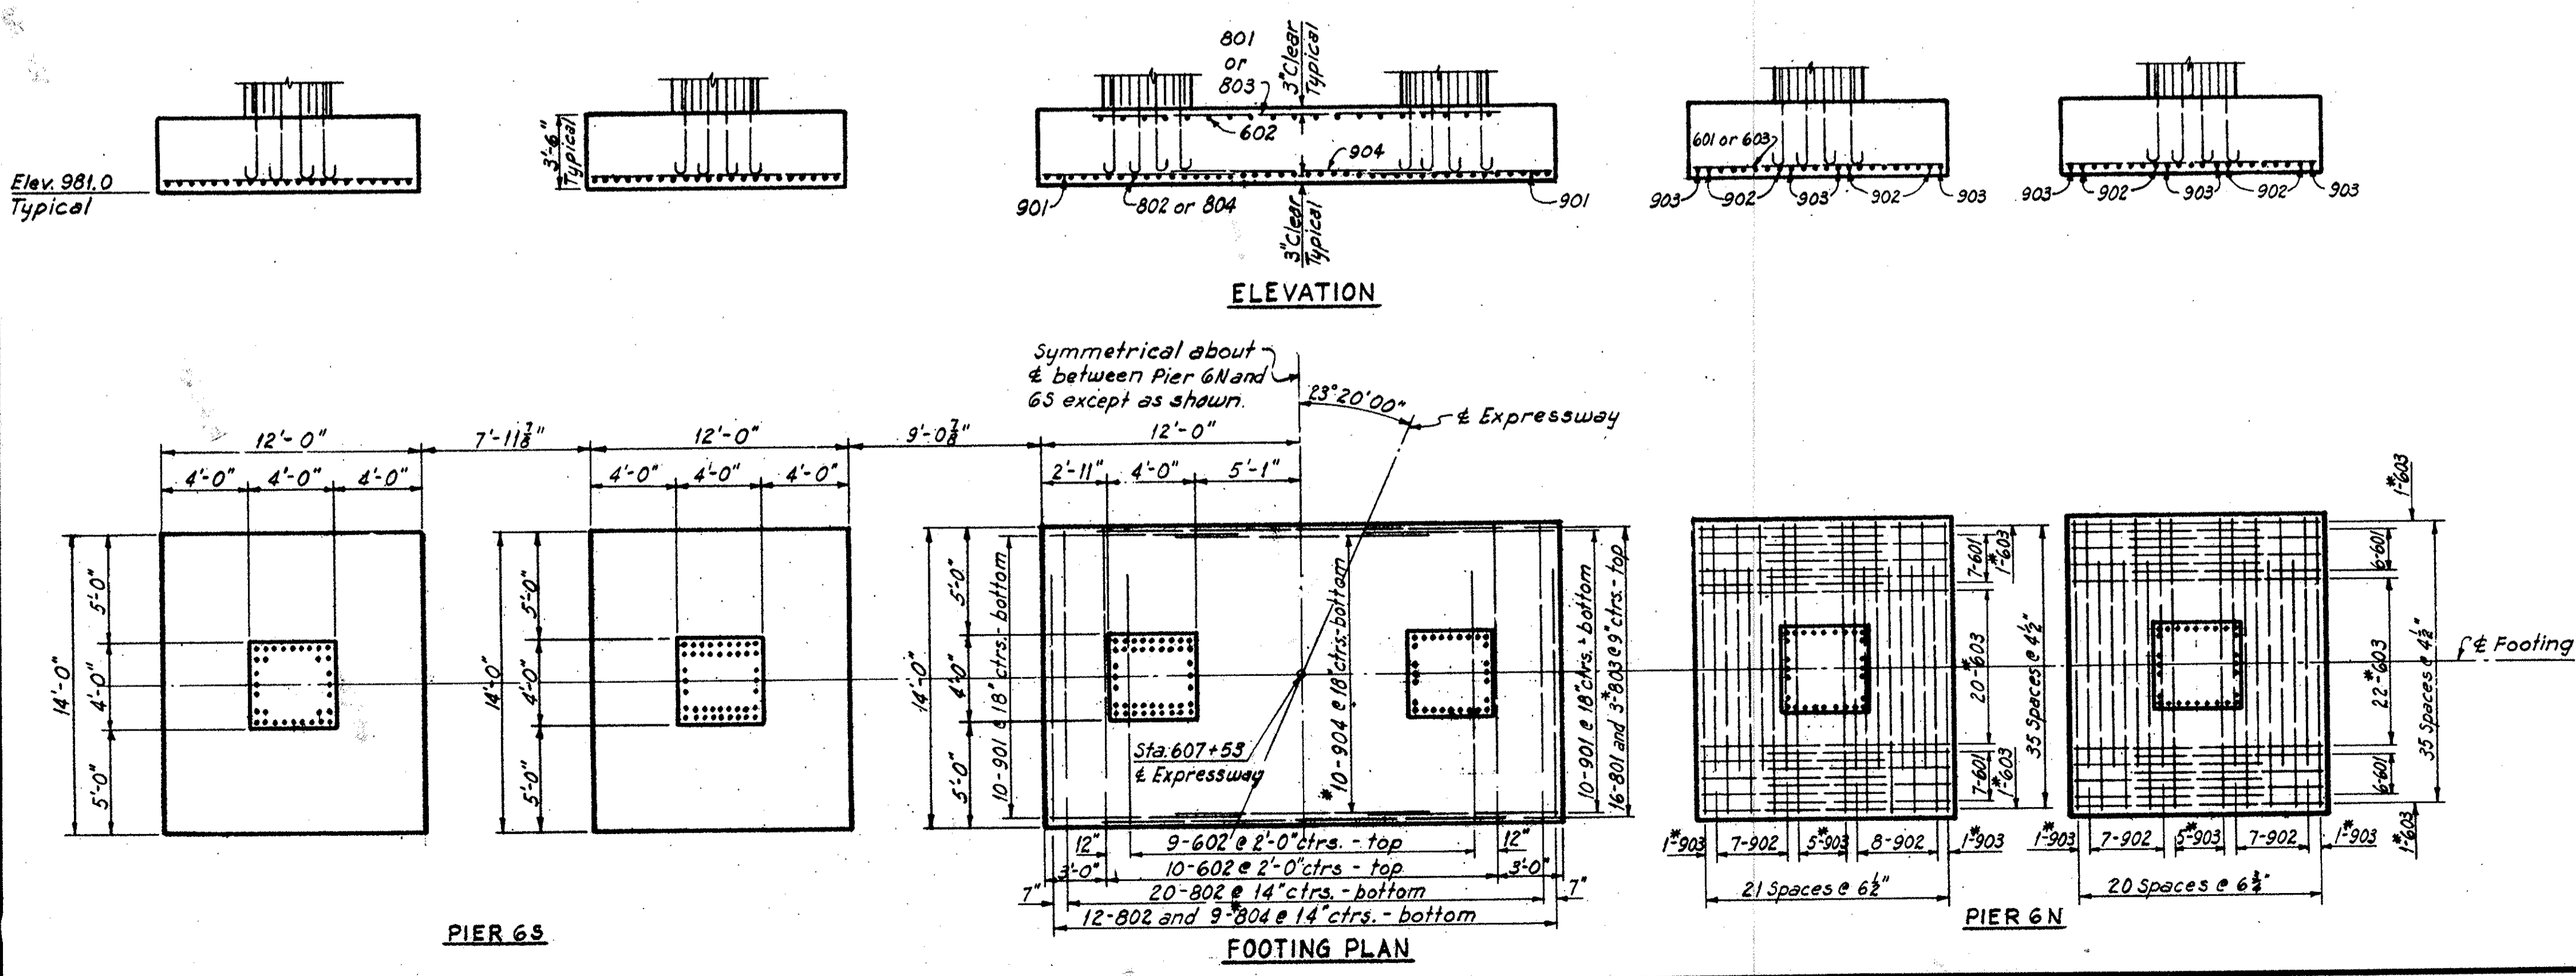

Revised As-Built  
NOTE: This sheet supplements and partly supersedes Sheet No. 71.

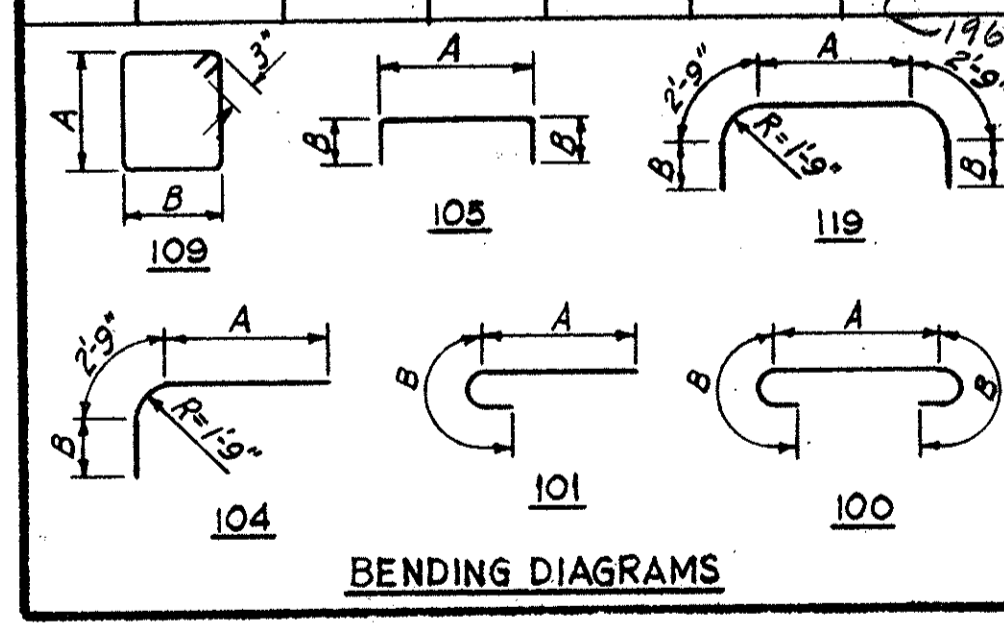

Bars shown thus \* are additional reinforcement bars resulting from revision of footings. For replacement bars see sheet 62.

Note: Footing details and reinforcement schedule supersedes footing details and reinforcement schedule on sheet 71. All other details for Piers 6N and 6S shall be as shown on sheet 71.


**AKRON EXPRESSWAY SYSTEM**  
WEST VIADUCT  
BR. NO. SU-18R-135  
REVISED FOOTING PLAN AND BAR LIST FOR PIER 6N AND 6S

AKRON SUMMIT COUNTY, OHIO  
SCALE: 3/16" = 1'-0"  
MADE G.D. DATE 8-20-56  
HOWARD, NEEDLES, TAMMEN & BERGENDOFF  
CONSULTING ENGINEERS  
KANSAS CITY CLEVELAND NEW YORK  
TRCD DATE  
CKD L.L. DATE 8-21-56  
901 SHEET-71A





SUMMIT COUNTY  
CITY OF AKRON  
AKRON EXPRESSWAY SYSTEM  
PART # 7

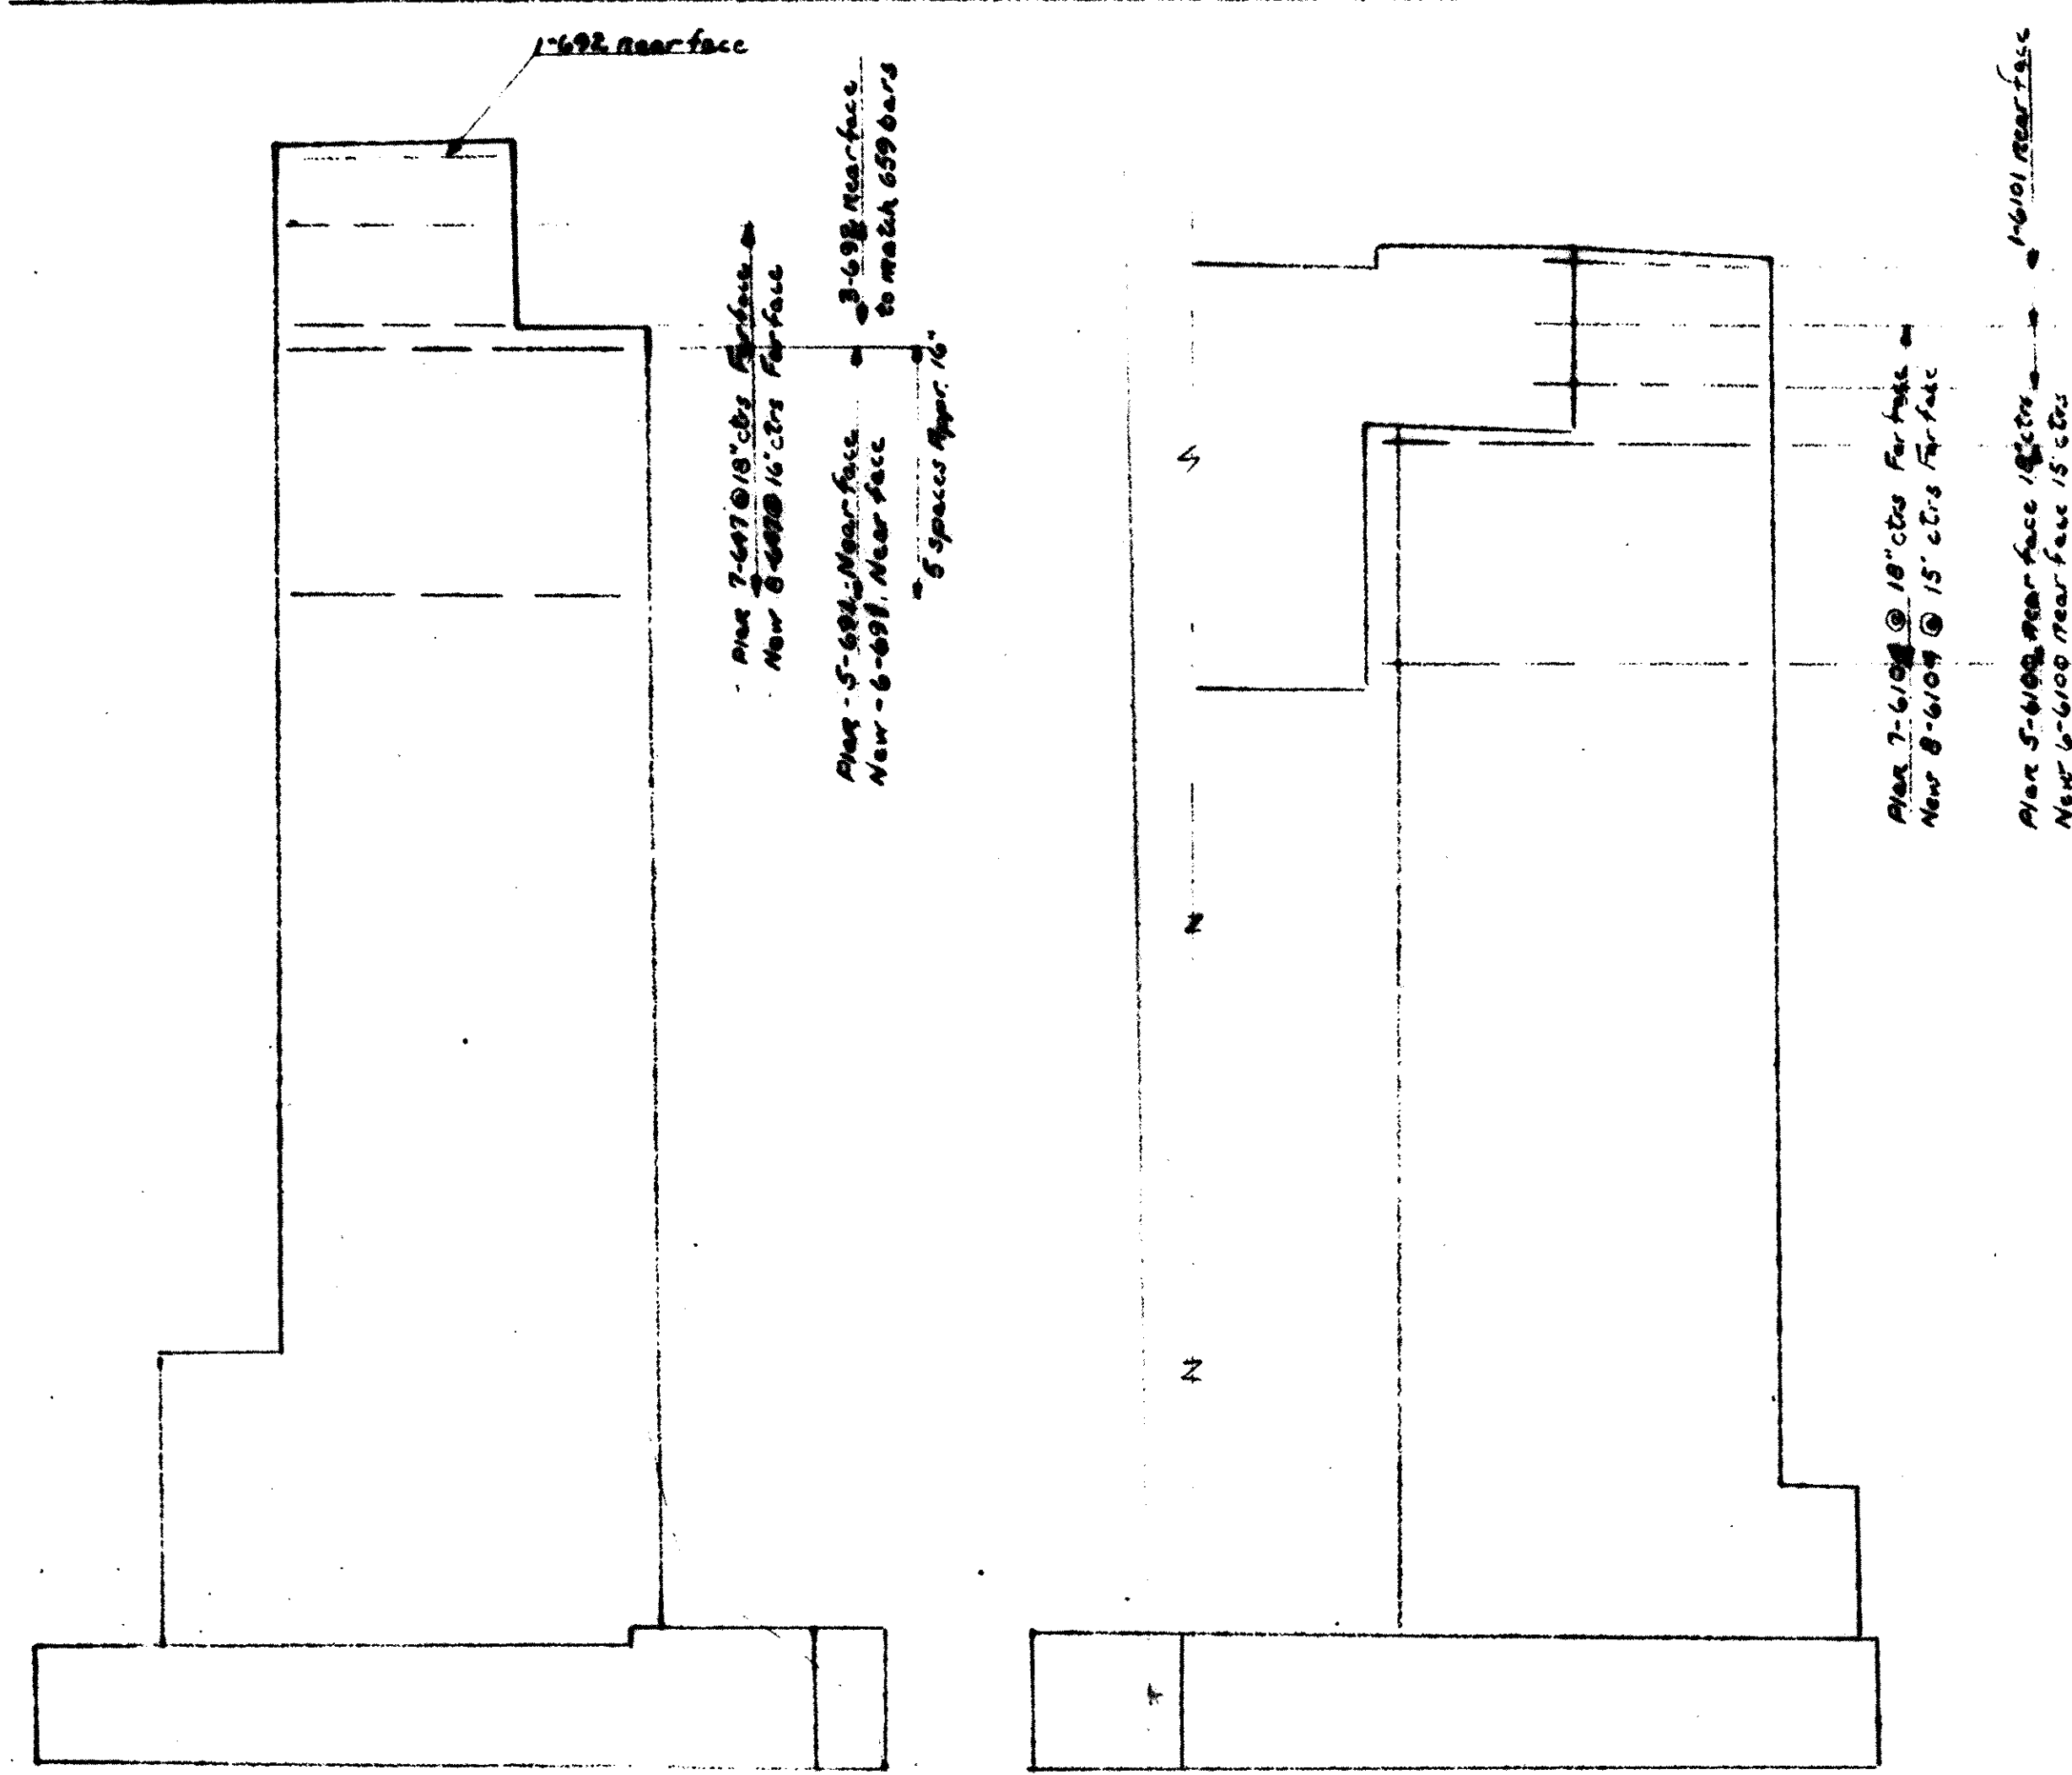

END ELEVATION NORTH BUTTRESS

END ELEVATION SOUTH BUTTRESS

BARs TO BE PLACED


Mark	Length	PLAN		NEW		Weight Change
		NO	WEIGHT	NO	WEIGHT	
647	5'-0"	7	53	8	60	7
659	4'-6"	6	419	6	419	0
661	7'-6"	2	23	2	23	0
662	4'-3"	2	124	2	124	0
663	4'-0"	10	706	12	847	141
664	4'-0"	4	264	4	264	0
665	9'-0"	2	27	2	27	0
667	3'-6"	14	788	16	901	113
668	4'-3"	10	725	12	870	145
669	6'-0"	4	36	4	36	0
682	12'-11"	82	1591	89	1727	136
684	12'-8"	2	38	2	38	0
685	4'-6"	2	14	2	14	0
686	9'-5"	123	1740	133	1881	141
688	10'-2"	1	15	1	15	0
689	11'-0"	1	17	1	17	0
691	18'-6"	5	139	6	167	28
692	13'-7"	4	81	4	81	0
6100	17'-4"	5	130	6	156	26
6101	11'-3"	3	51	3	51	0
6104	9'-0"	7	95	8	109	14
TOTALS			7,076		7,827	751

SKETCH 'A'

	PLAN	Difference	NEW	Change
#6 Bars in Place	30,443	-7.9%	28,038	-2,405
#6 Bars to be Placed	7,076		7,827	751

Note  
#6 Bars to be placed "751lb." at no cost to State.  
#6 Bars in place "2,405lb." deduct from plan wt. for 7.9% deficiency in deformations.

(1)


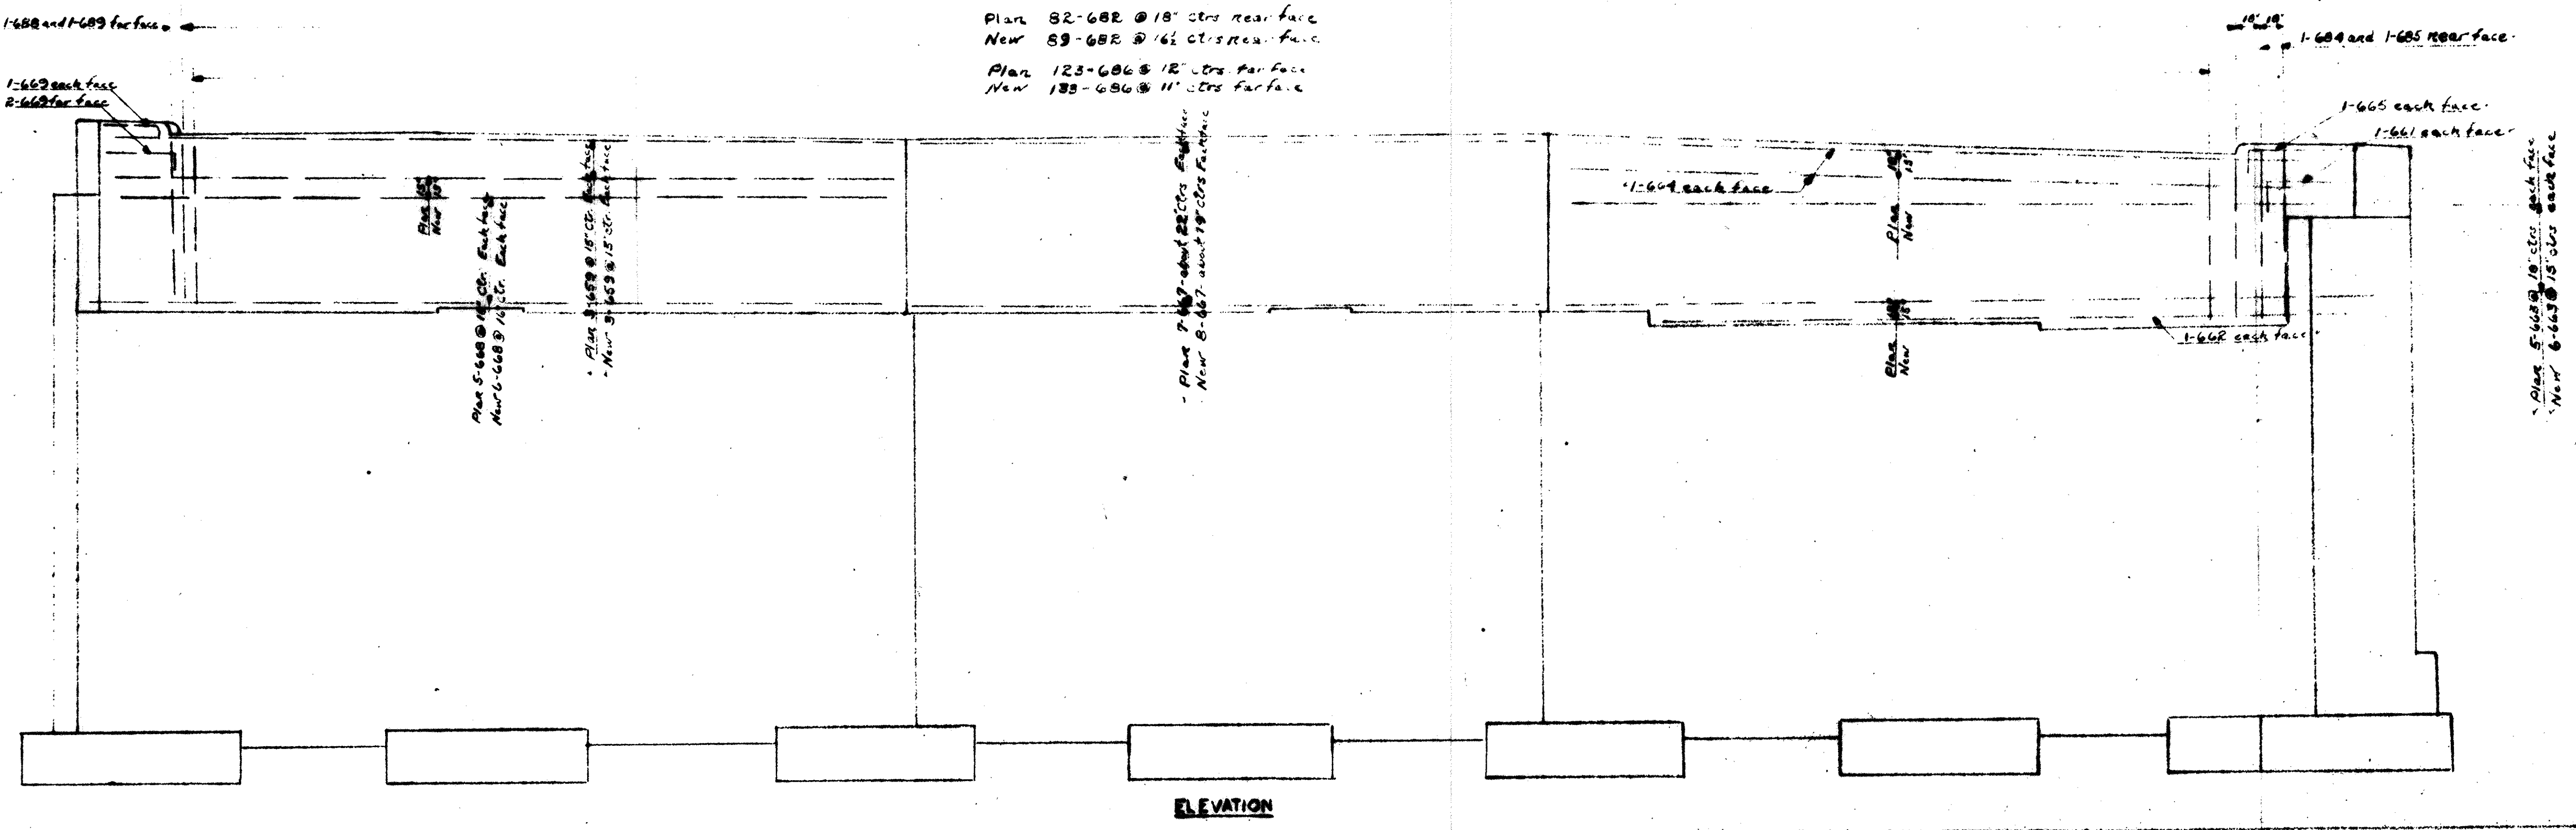


ELEVATION





CONSTRUCTION BUREAU  
JAN 2 1957

PART 7  
AKRON EXPRESSWAY SYSTEM  
WEST VIADUCT  
BR. NO. SU-18R-135  
EAST ABUTMENT  
Reinforcing Deficiency Change  
R.J.T. - P.E.

SUMMIT COUNTY  
CITY OF AKRON  
AKRON EXPRESSWAY SYSTEM

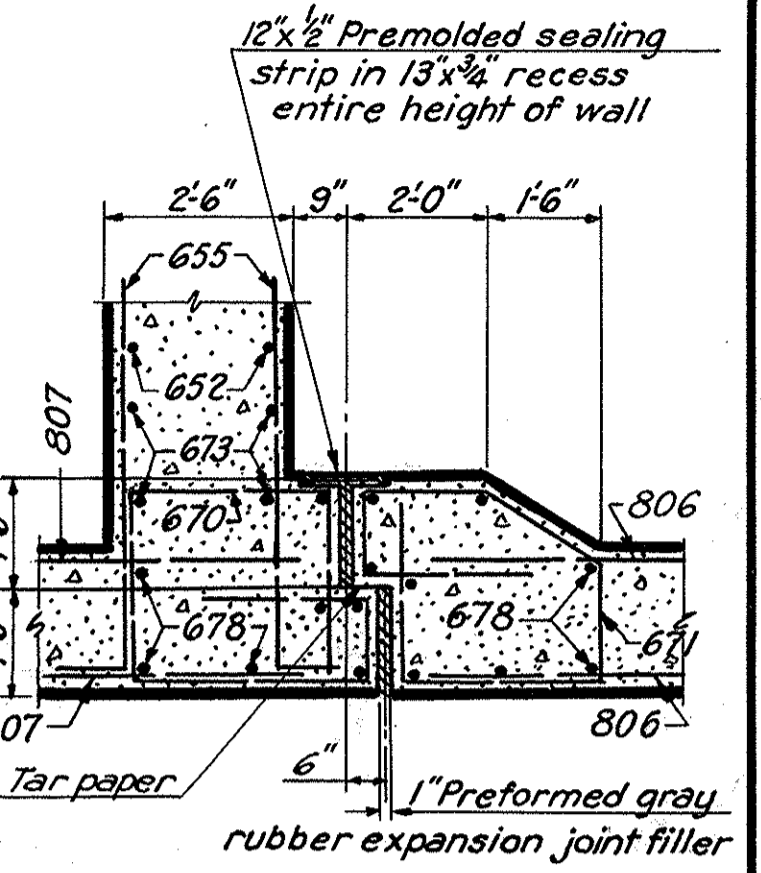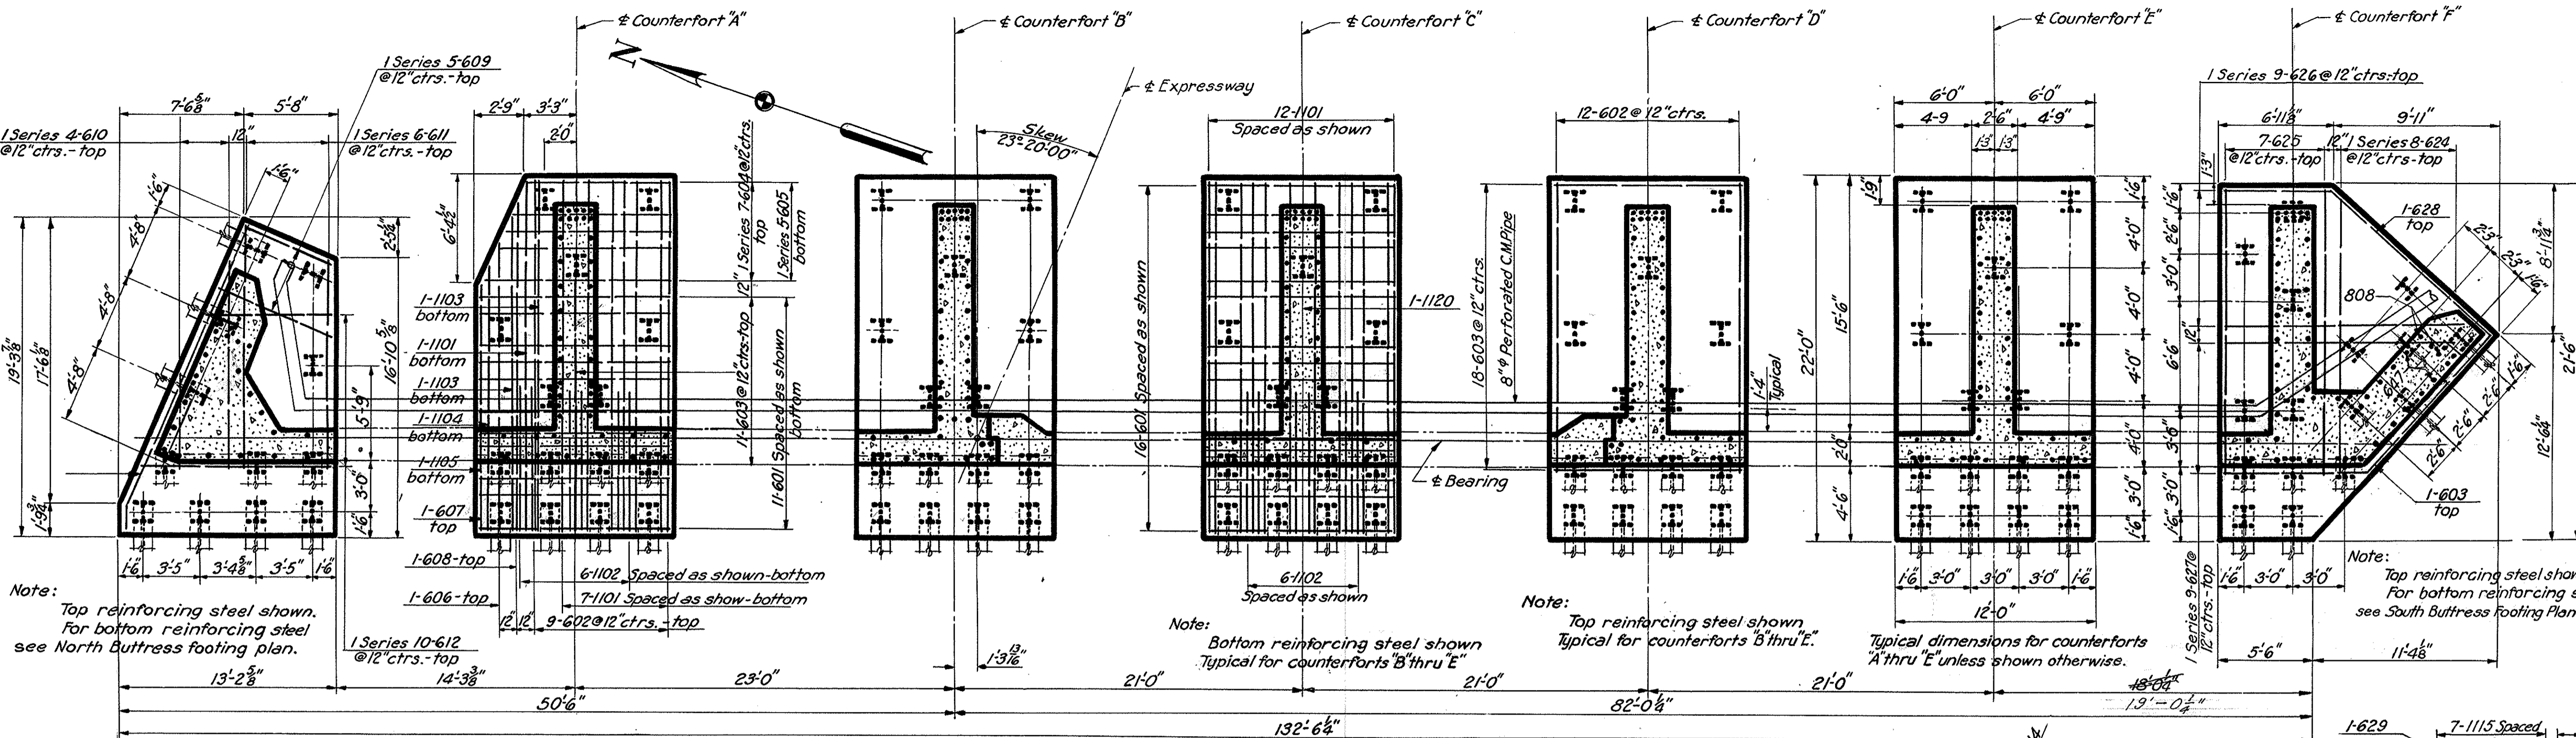

FOOTING PLAN  
Scale: 3/16" = 1'-0"

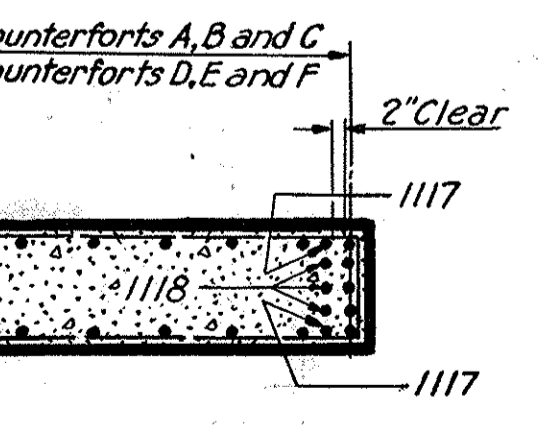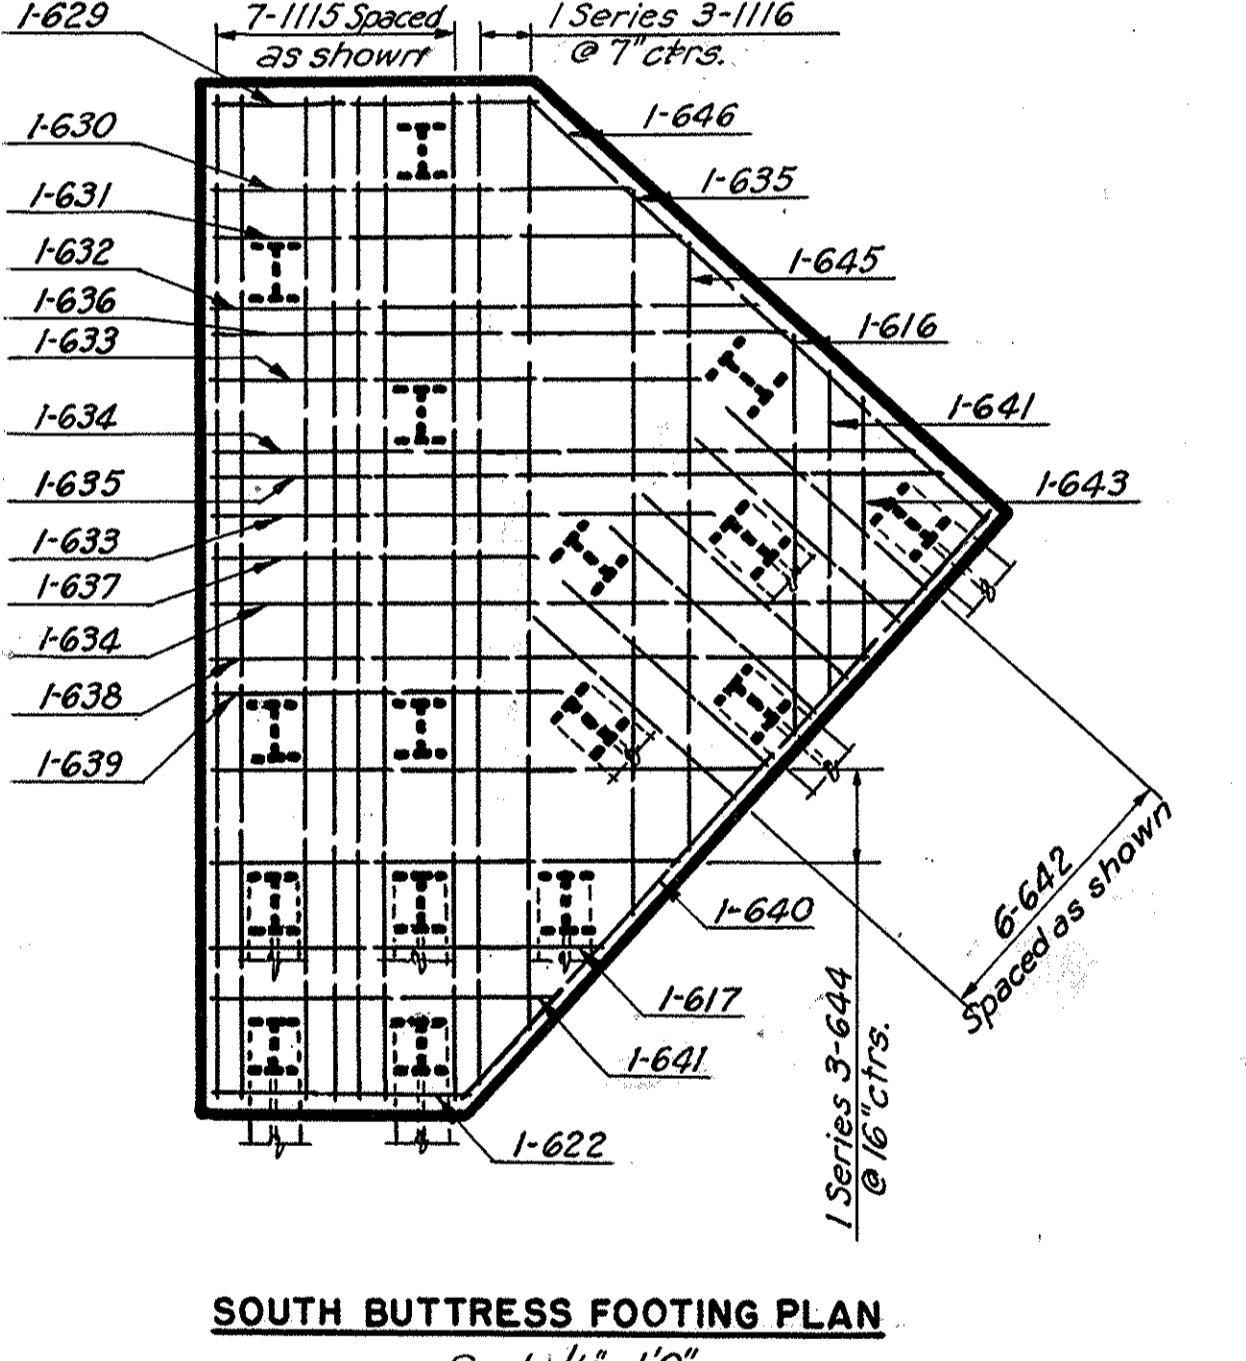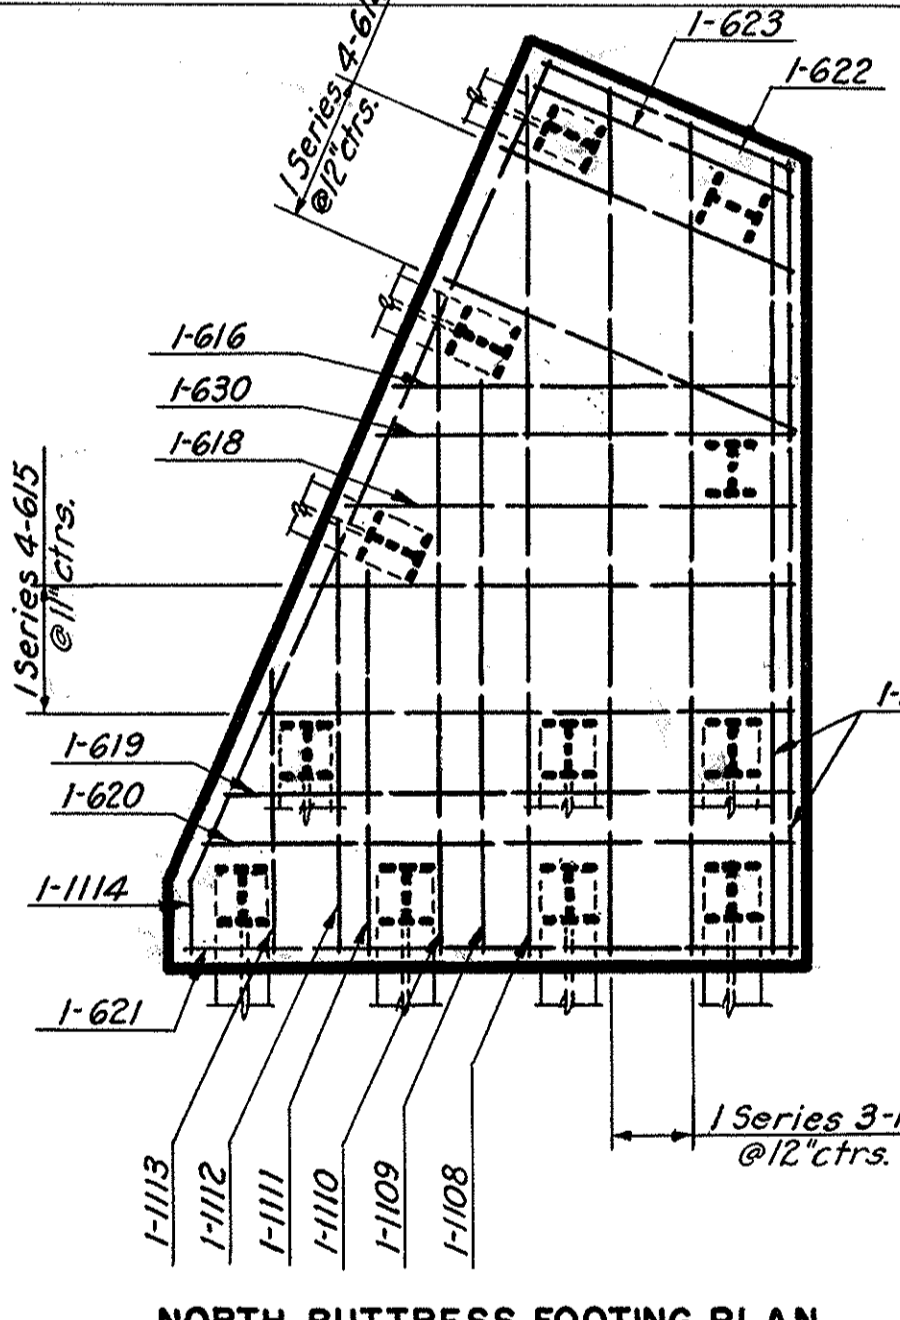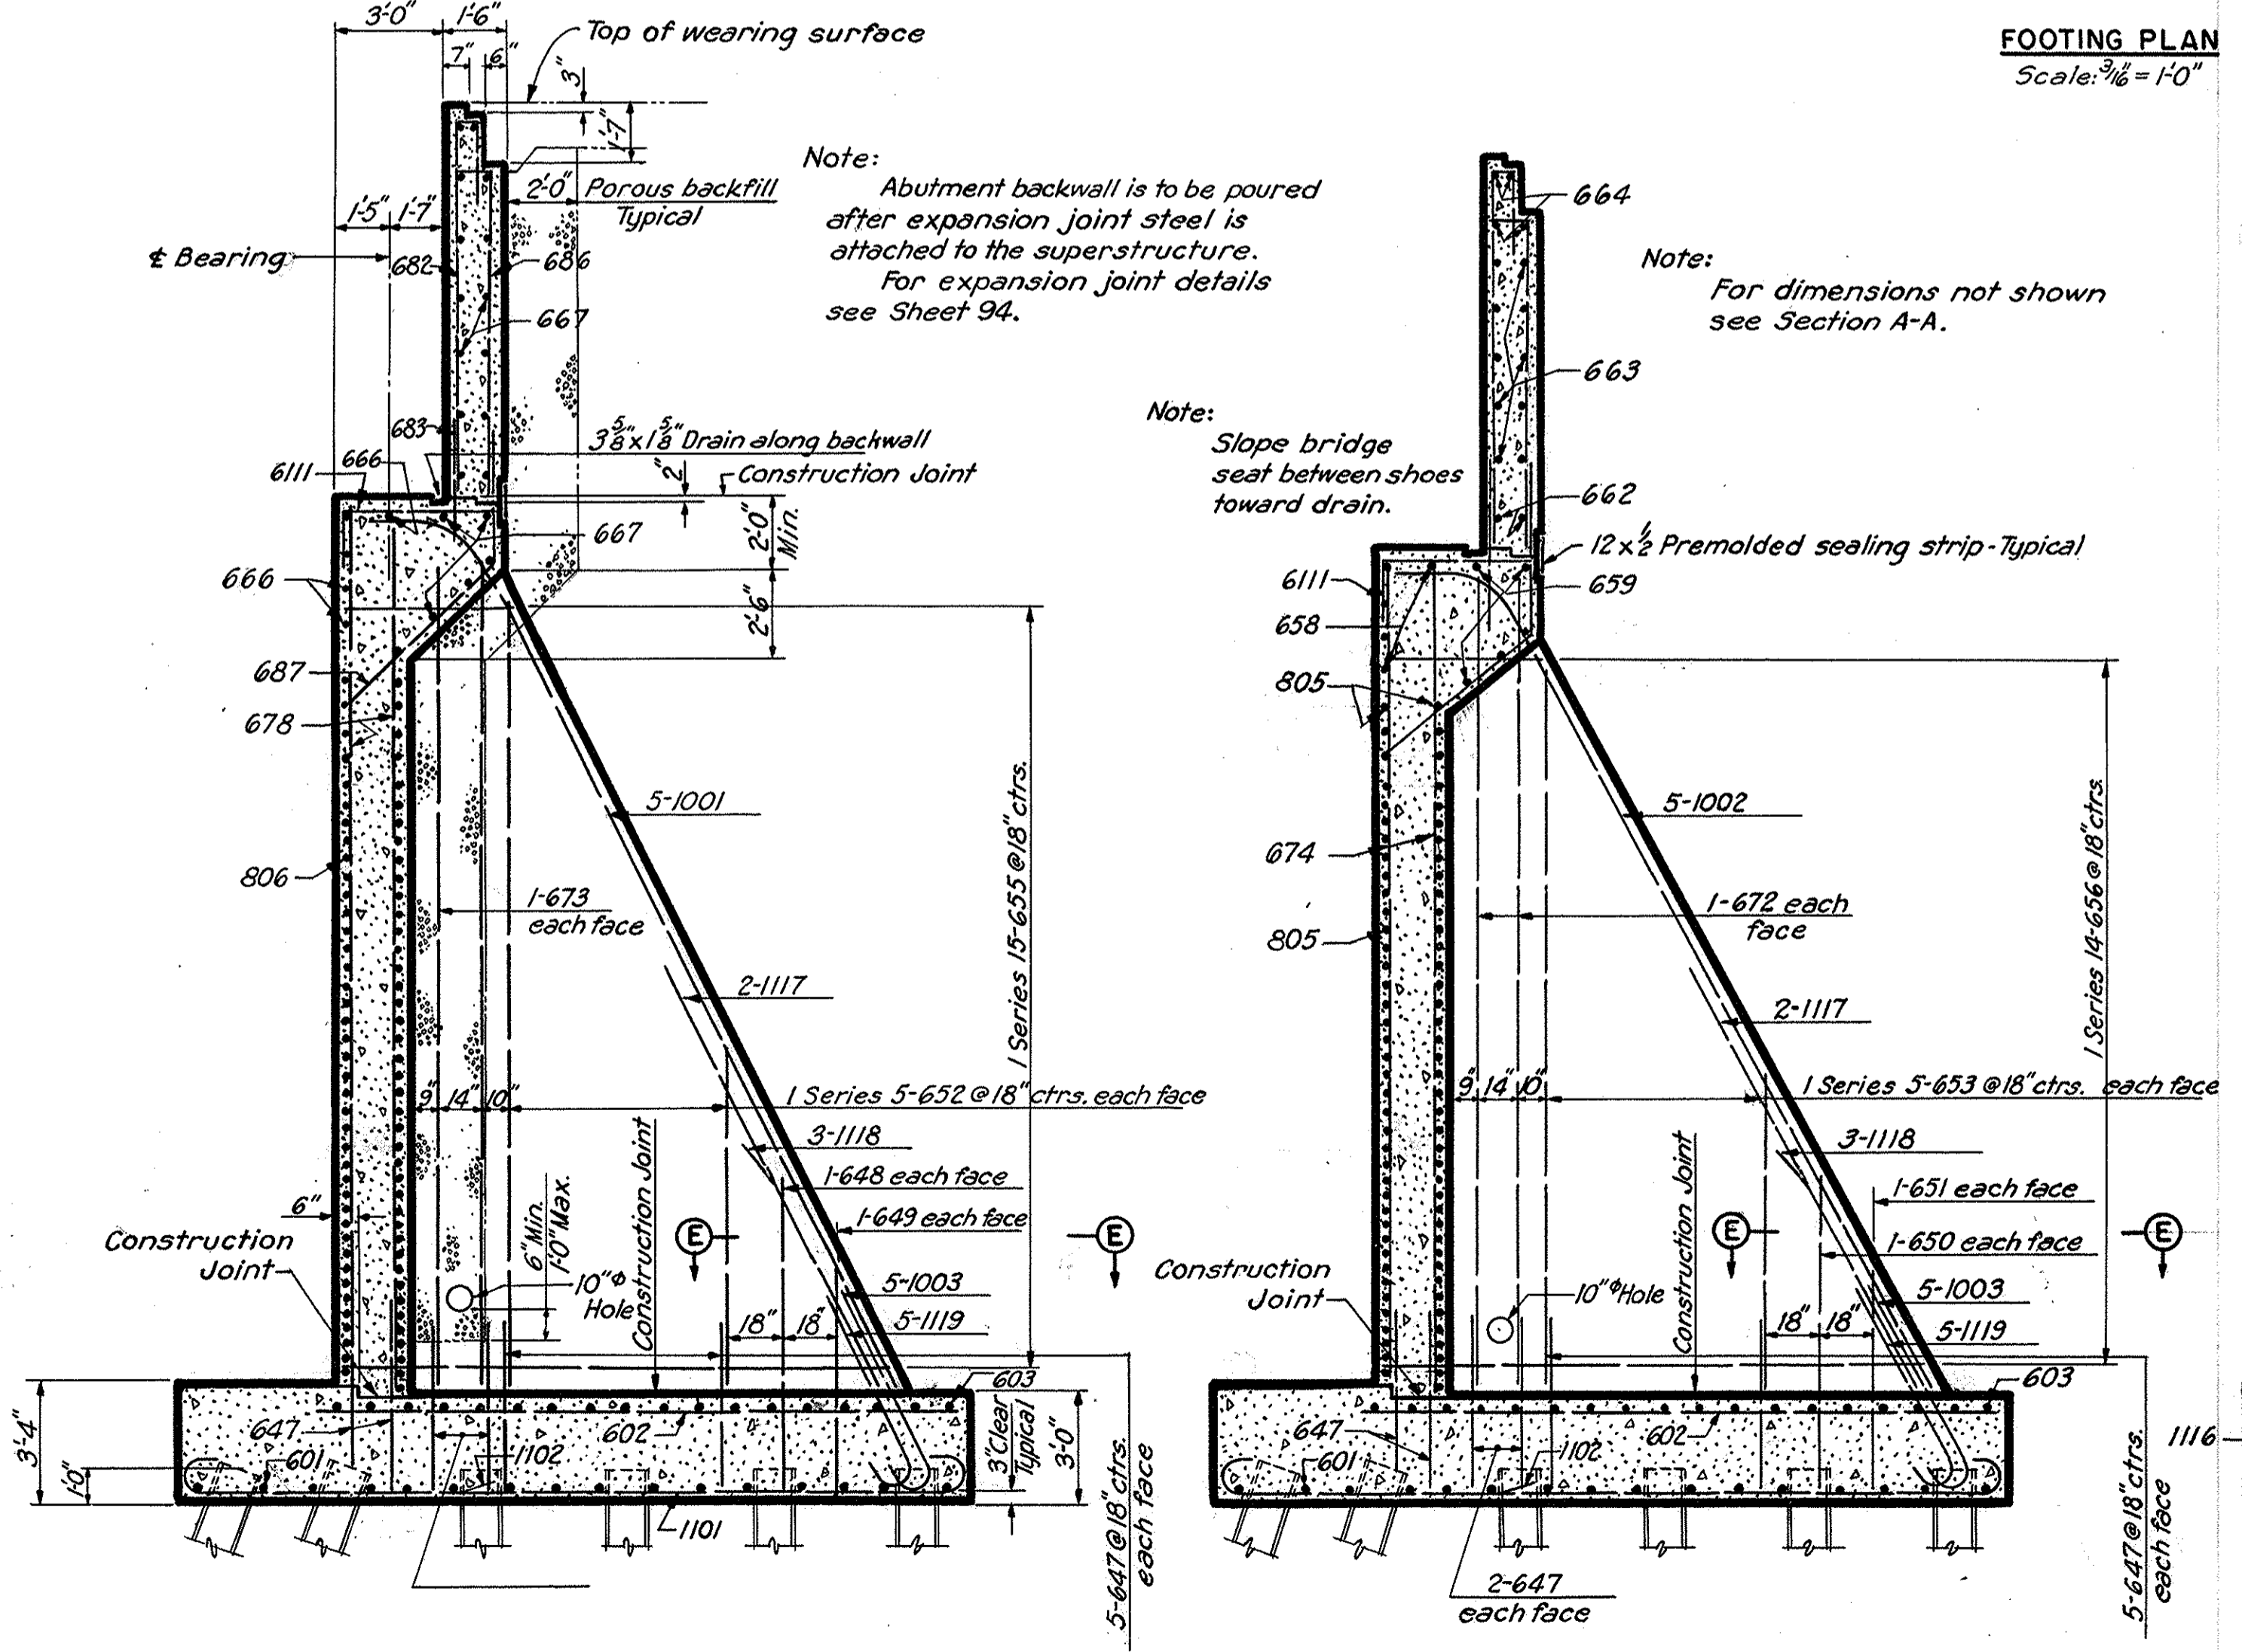

Notes:  
All piles shall be 14 BP 73.  
All battered piles shall be battered 4 in 12.  
Average vertical pile length = 34 feet.  
For location of Sections A-A, B-B, C-C and see Sheet 72.

PART 7

**AKRON EXPRESSWAY SYSTEM**  
WEST VIADUCT  
BR. NO. SU-18R-135  
EAST ABUTMENT  
FOOTING PLAN AND DETAILS

AKRON	SUMMIT COUNTY.	OHIO
-------	----------------	------


Scale: As Shown  
MADE: N.W.D. DATE 9-6-55  
TRCD. DATE 11-17-55  
CKD. DATE 9-19-55

HOWARD, NEEDLES, TAMMEN & BERGENDOFF  
CONSULTING ENGINEERS  
KANSAS CITY CLEVELAND NEW YORK  
901 SHEET 73

Revised 3-3-56  
Revised As-Built 1-17-58 JVP


FED. ROAD DIV. NO.	STATE	FED. AID PROJ. NO.	TYPE FUNDS	74 123
2	OHIO			

SUMMIT COUNTY  
CITY OF AKRON  
AKRON EXPRESSWAY SYSTEM

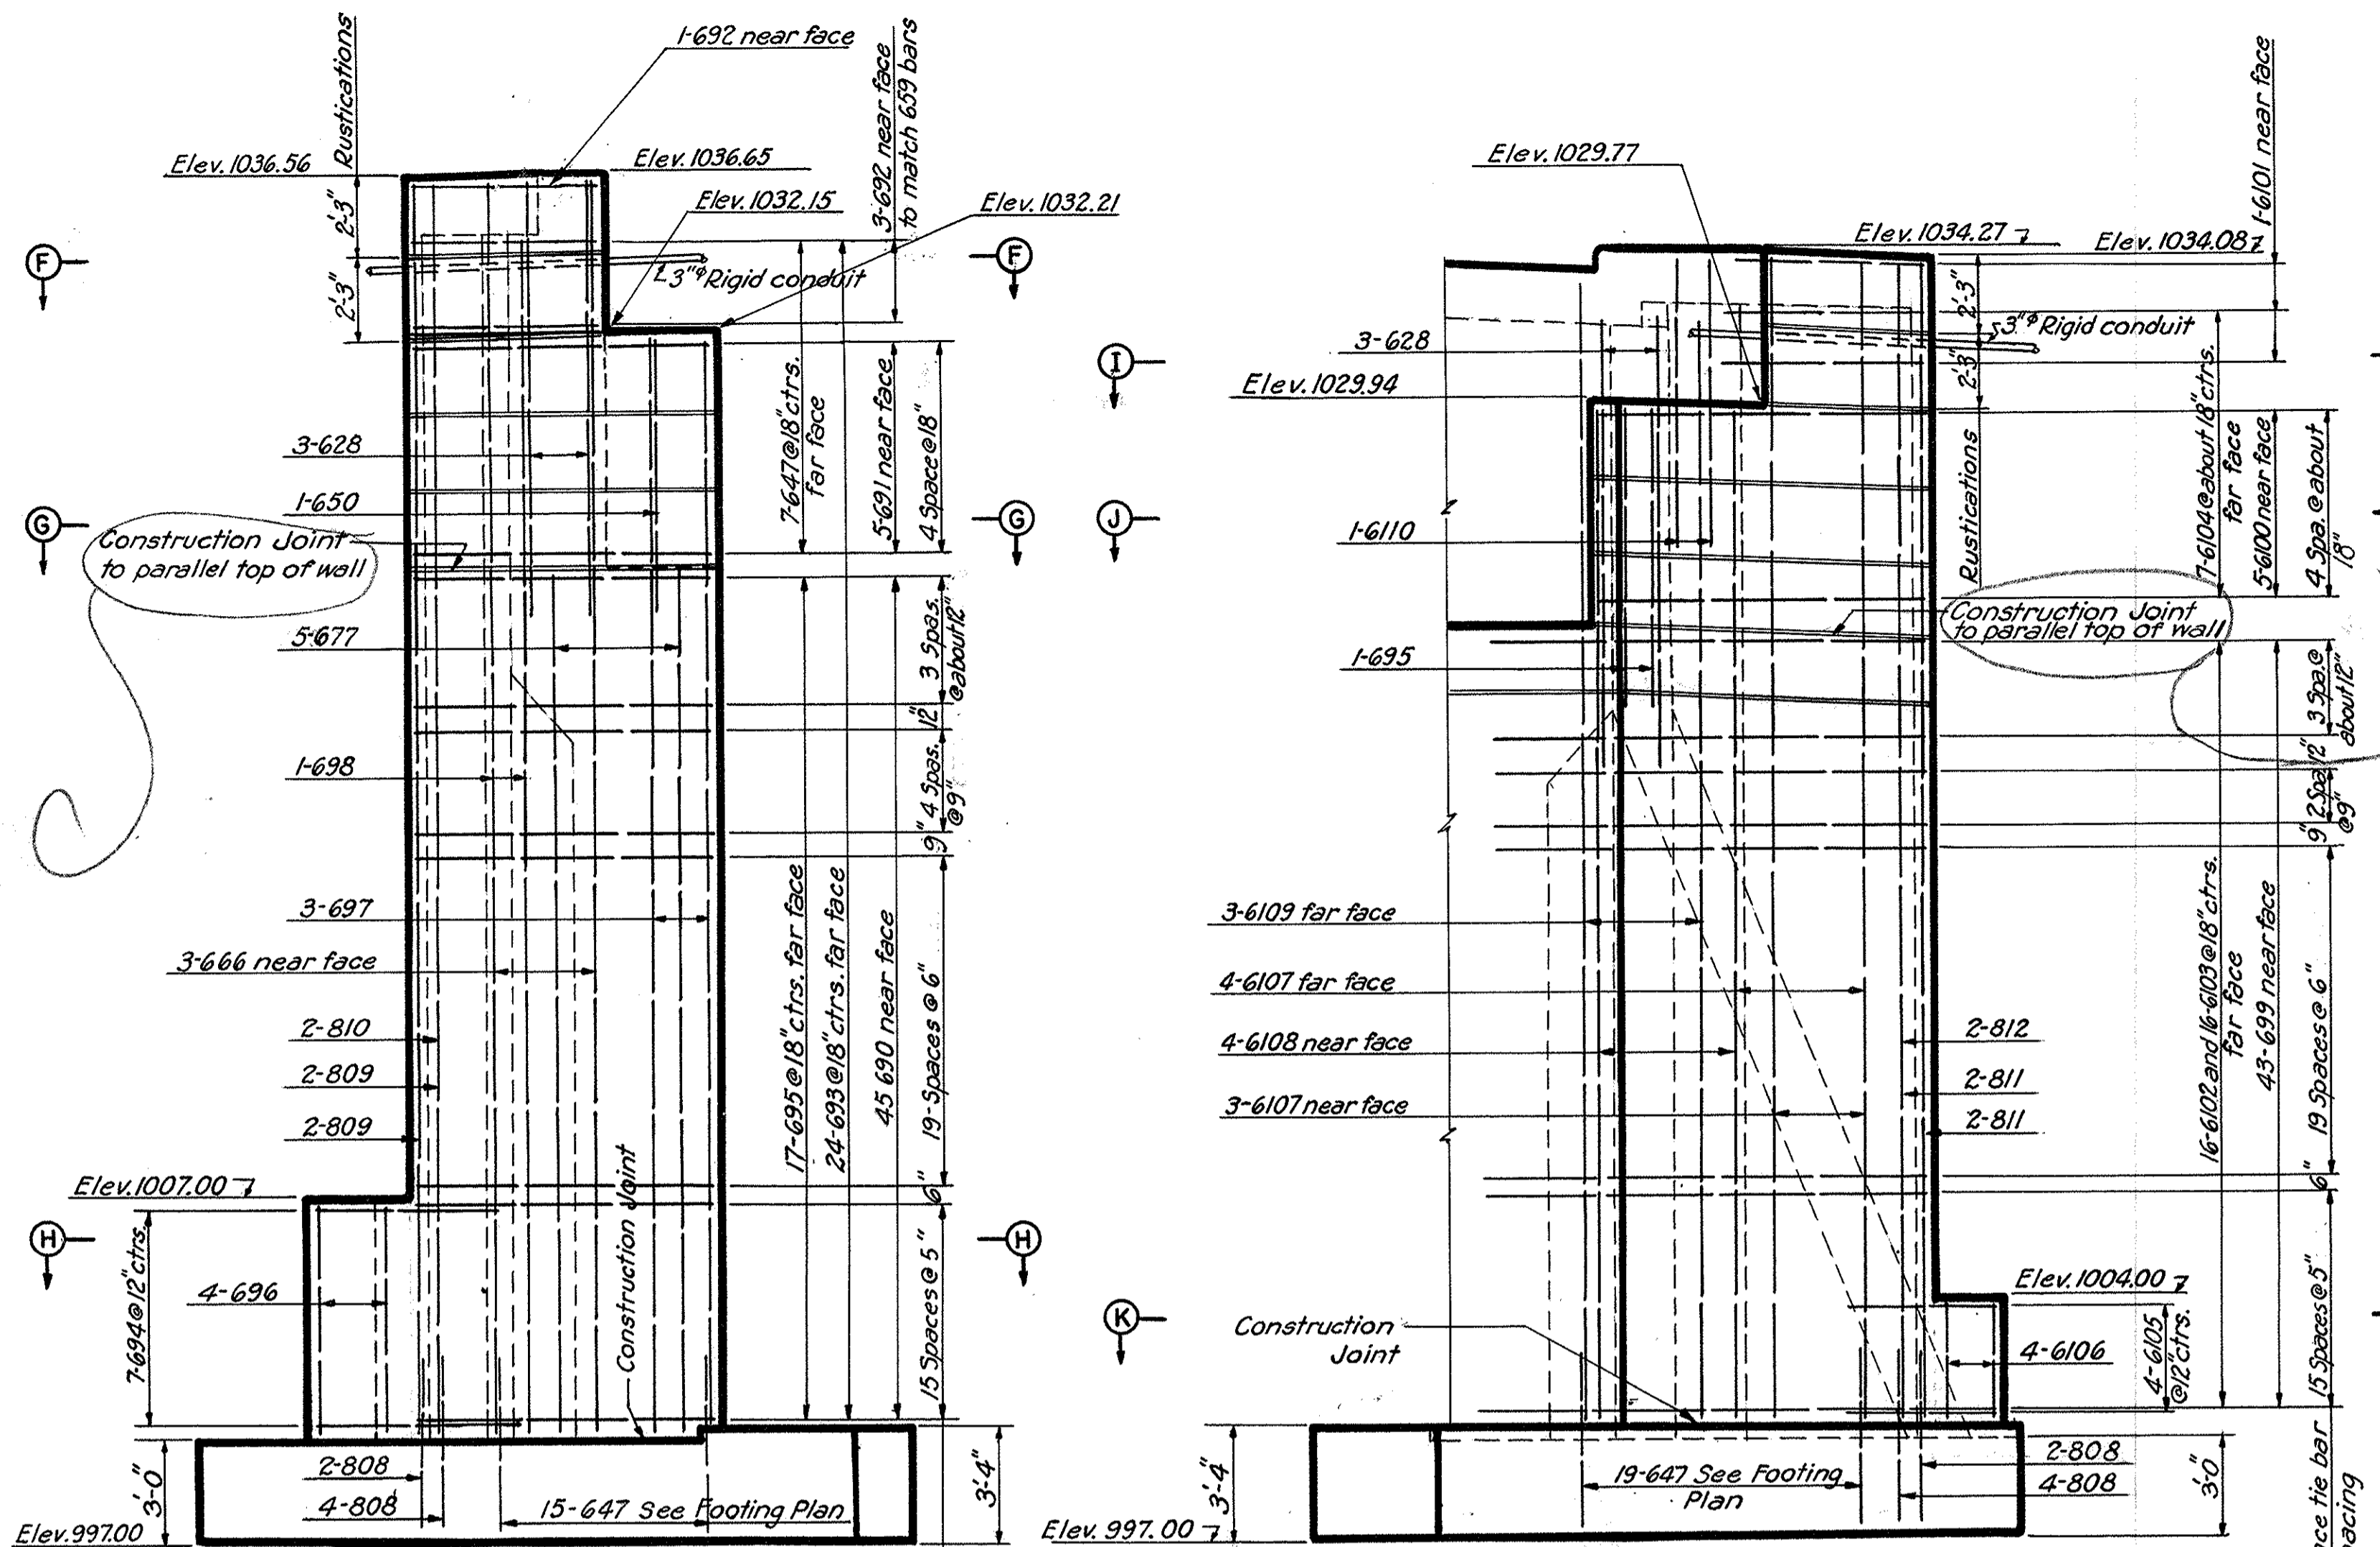


END ELEVATION NORTH BUTTRESS


END ELEVATION SOUTH BUTTRESS

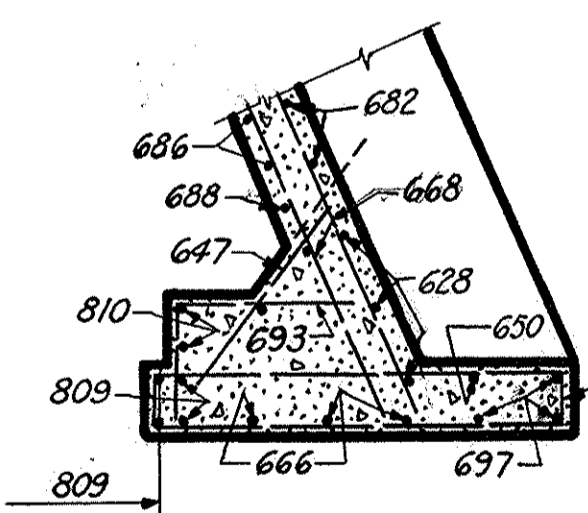


SECTION G-G

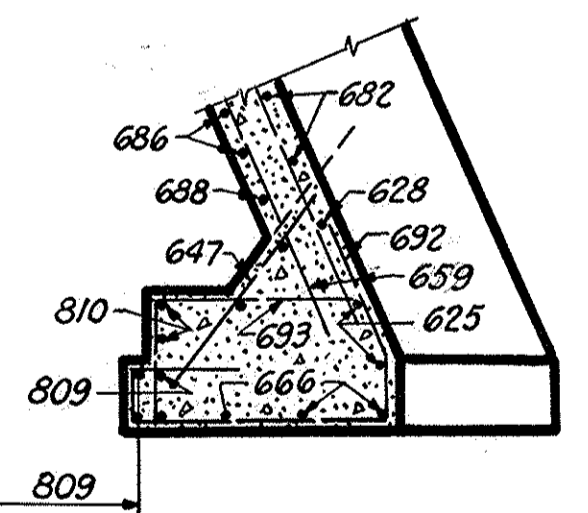


SECTION F-F

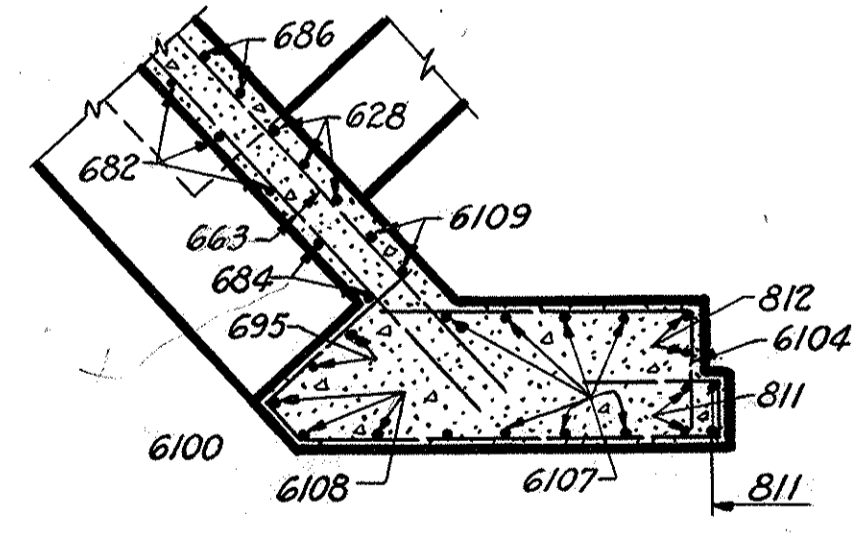


SECTION J-J

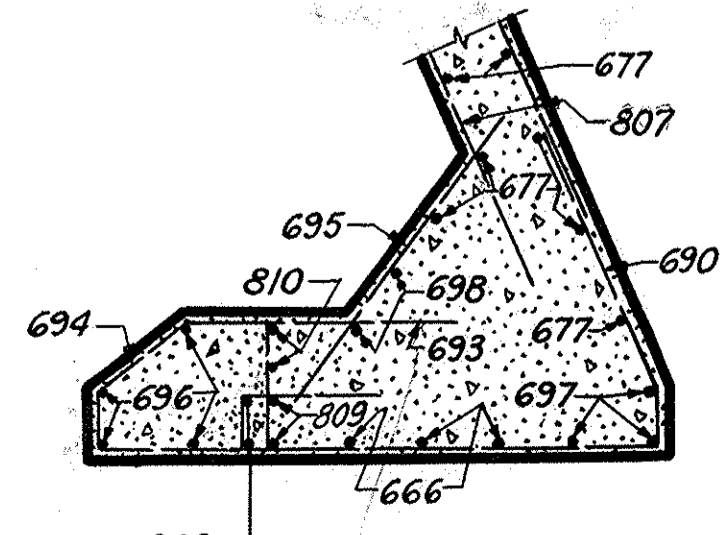

SECTION H-H

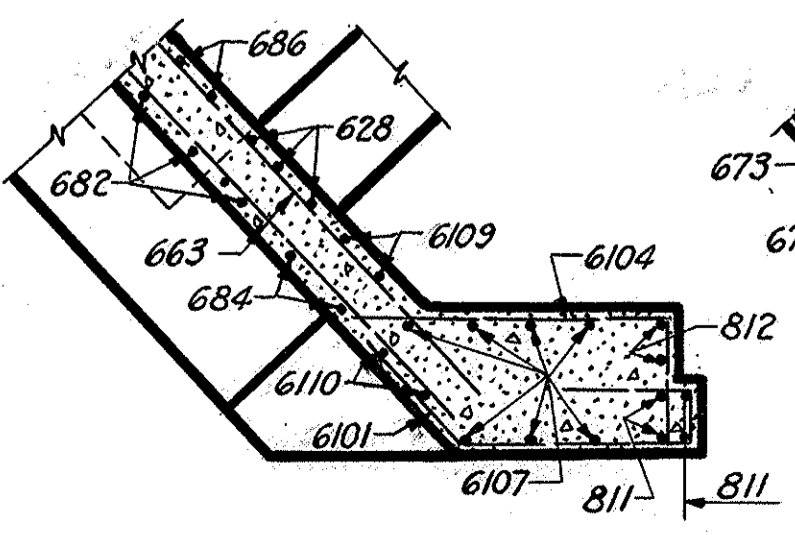

SECTION I-I

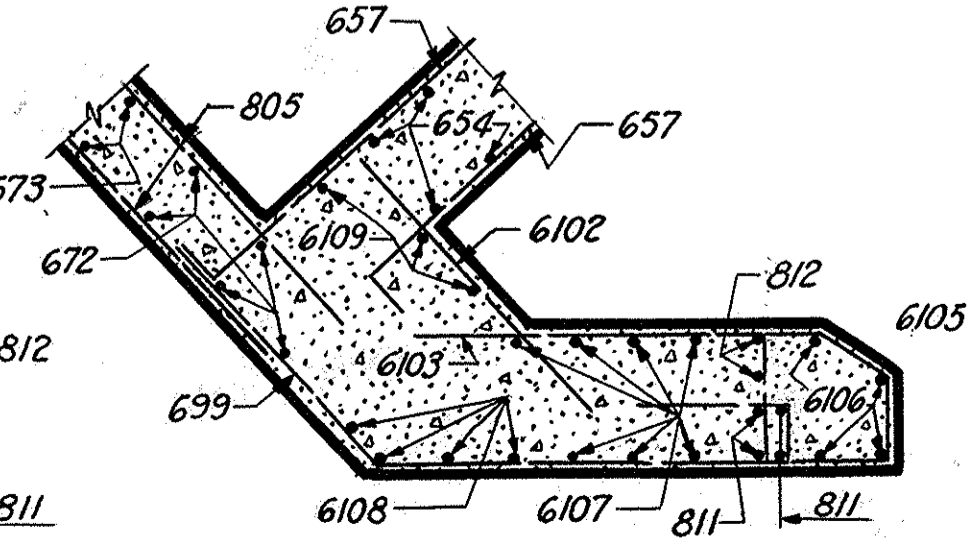

SECTION K-K

PART 7

**AKRON EXPRESSWAY SYSTEM**  
WEST VIADUCT  
BR. NO. SU-18R-135  
EAST ABUTMENT DETAILS

AKRON SUMMIT COUNTY, OHIO

SCALE: 1/4" = 1'-0"  
MADE: H.R.G. DATE 9-2-55  
TRCD: C.T.H. DATE 11-14-55  
CKD: G.D. DATE 3-20-55

HOWARD, NEEDLES, TAMMEN & BERGENDOFF  
CONSULTING ENGINEERS  
KANSAS CITY CLEVELAND NEW YORK  
901 SHEET- 74

Revised 12-19-55


145A



**SUMMIT COUNTY  
CITY OF AKRON  
AKRON EXPRESSWAY SYSTEM**

**REINFORCEMENT SCHEDULE**





MARK	NUMBER	LENGTH	TYPE	DIMENSIONS				SERIES INCREMENT	WEIGHT
				A	B	C	D		
601	10	6'-10"	100	11"	5'-0"				102
602	5	5'-6"	Str.						42
603	5	10'-10"	100	11"	9'-0"				81
604	15	6'-6"	Str.						147
605	10	14'-10"	100	11"	13'-0"				213
606	7	11'-0"	Str.						115
607	13	7'-10"	100	11"	6'-0"				153
608	15	9'-10"	100	11"	8'-0"				221
609	11	8'-6"	Str.						141
610	9	13'-0"	Str.						175
611	35	5'-0"	Str.						263
612	2	11'-3"	Str.						34
613	4	14'-0"	Str.						80
614	2	19'-9"	Str.						60
615	6	24'-3"	Str.						219
616	1 Series of 16	26'-2" to 12'-8"	122		11'-6" to 4'-9"			5 5/8"	467
617	2	9'-6"	Str.						29
618	2	12'-0"	Str.						35
619	12	16'-0"	Str.						288
620	1 Series of 11	22'-2" to 12'-8"	122		9'-6" to 4'-9"			5 5/8"	288
621	6	8'-9"	Str.						80
622	3	14'-2"	107						65
623	12	7'-3"	Str.						131
624	10	16'-6"	Str.						248
625	13	17'-9"	Str.						336
626	52	24'-6"	Str.						1915
627	10	4'-6"	Str.						68
628	2 Series of 7	12'-0" to 5'-0"	Str.					1'-2"	179
629	9	16'-3"	Str.						212
630	2 Series of 4	28'-6" to 24'-6"	Str.					1'-4"	320
631	6	8'-0"	108	3'-0"	5'-0"	10			72
632	12	10'-3"	Str.						185
633	2 Series of 4	13'-9" to 10'-9"	Str.					1'-0"	147
634	23	10'-0"	112						345
635	23	10'-6"	123						363
636	1 Series of 5	14'-2" to 12'-8"	122		5'-6" to 4'-9"			2'-4"	100
637	8	20'-6"	Str.						246
638	11	28'-9"	Str.						474
639	43	13'-2"	125						864
640	25	5'-6"	105						207
641	10	3'-0"	Str.						45
642	10	25'-9"	Str.						388
643	20	23'-3"	Str.						700
801	6	17'-8"	100	1'-6"	14'-8"				286
802	6	10'-6"	101	1'-6"	9'-0"				168
1001	3	7'-3"	101	1'-9"	5'-6"				95
1002	3	21'-6"	108	4'-9"	16'-9"	3 1/2			280
1101	3	7'-8"	101	1'-11"	5'-9"				122
1102	2	11'-5"	101	1'-11"	9'-6"				122
1103	3	29'-6"	108	4'-9"	24'-9"	3 3/8			472

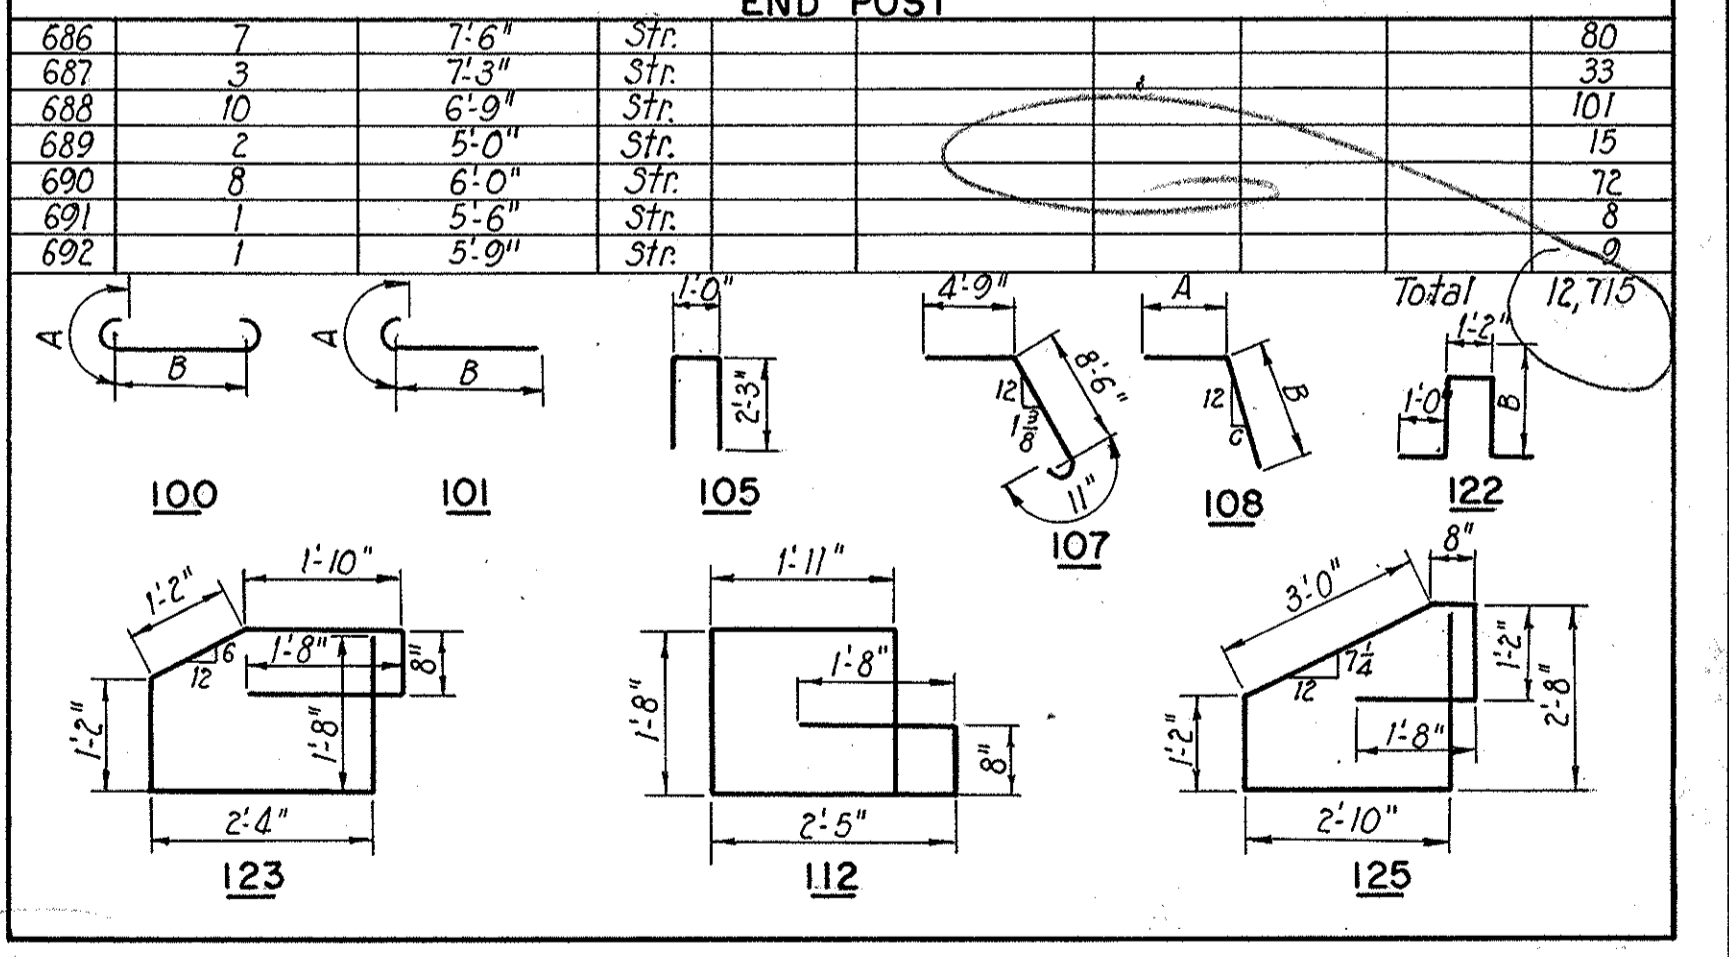

**PART 7  
AKRON EXPRESSWAY SYSTEM  
WEST VIADUCT  
BR. NO. SU-18R-135  
NORTHEAST WINGWALL**






AKRON SUMMIT COUNTY. OHIO  
SCALE: As Shown  
MADE B.S.S. DATE 7-22-55  
TRCD P.R. DATE 11-16-55  
CKD P.F.B. DATE 10-4-55  
HOWARD, NEEDLES, TAMMEN & BERGENDOFF  
CONSULTING ENGINEERS  
KANSAS CITY CLEVELAND NEW YORK  
901 SHEET- 76

Notes:  
For handrail details, see Sheet 97.  
All piles 12 B P 53. For detail, see Sheet 61.  
For replacement bars, see Sheet 62.  
Average vertical pile length - 58 feet.  
Bar dimensions are given out to out.

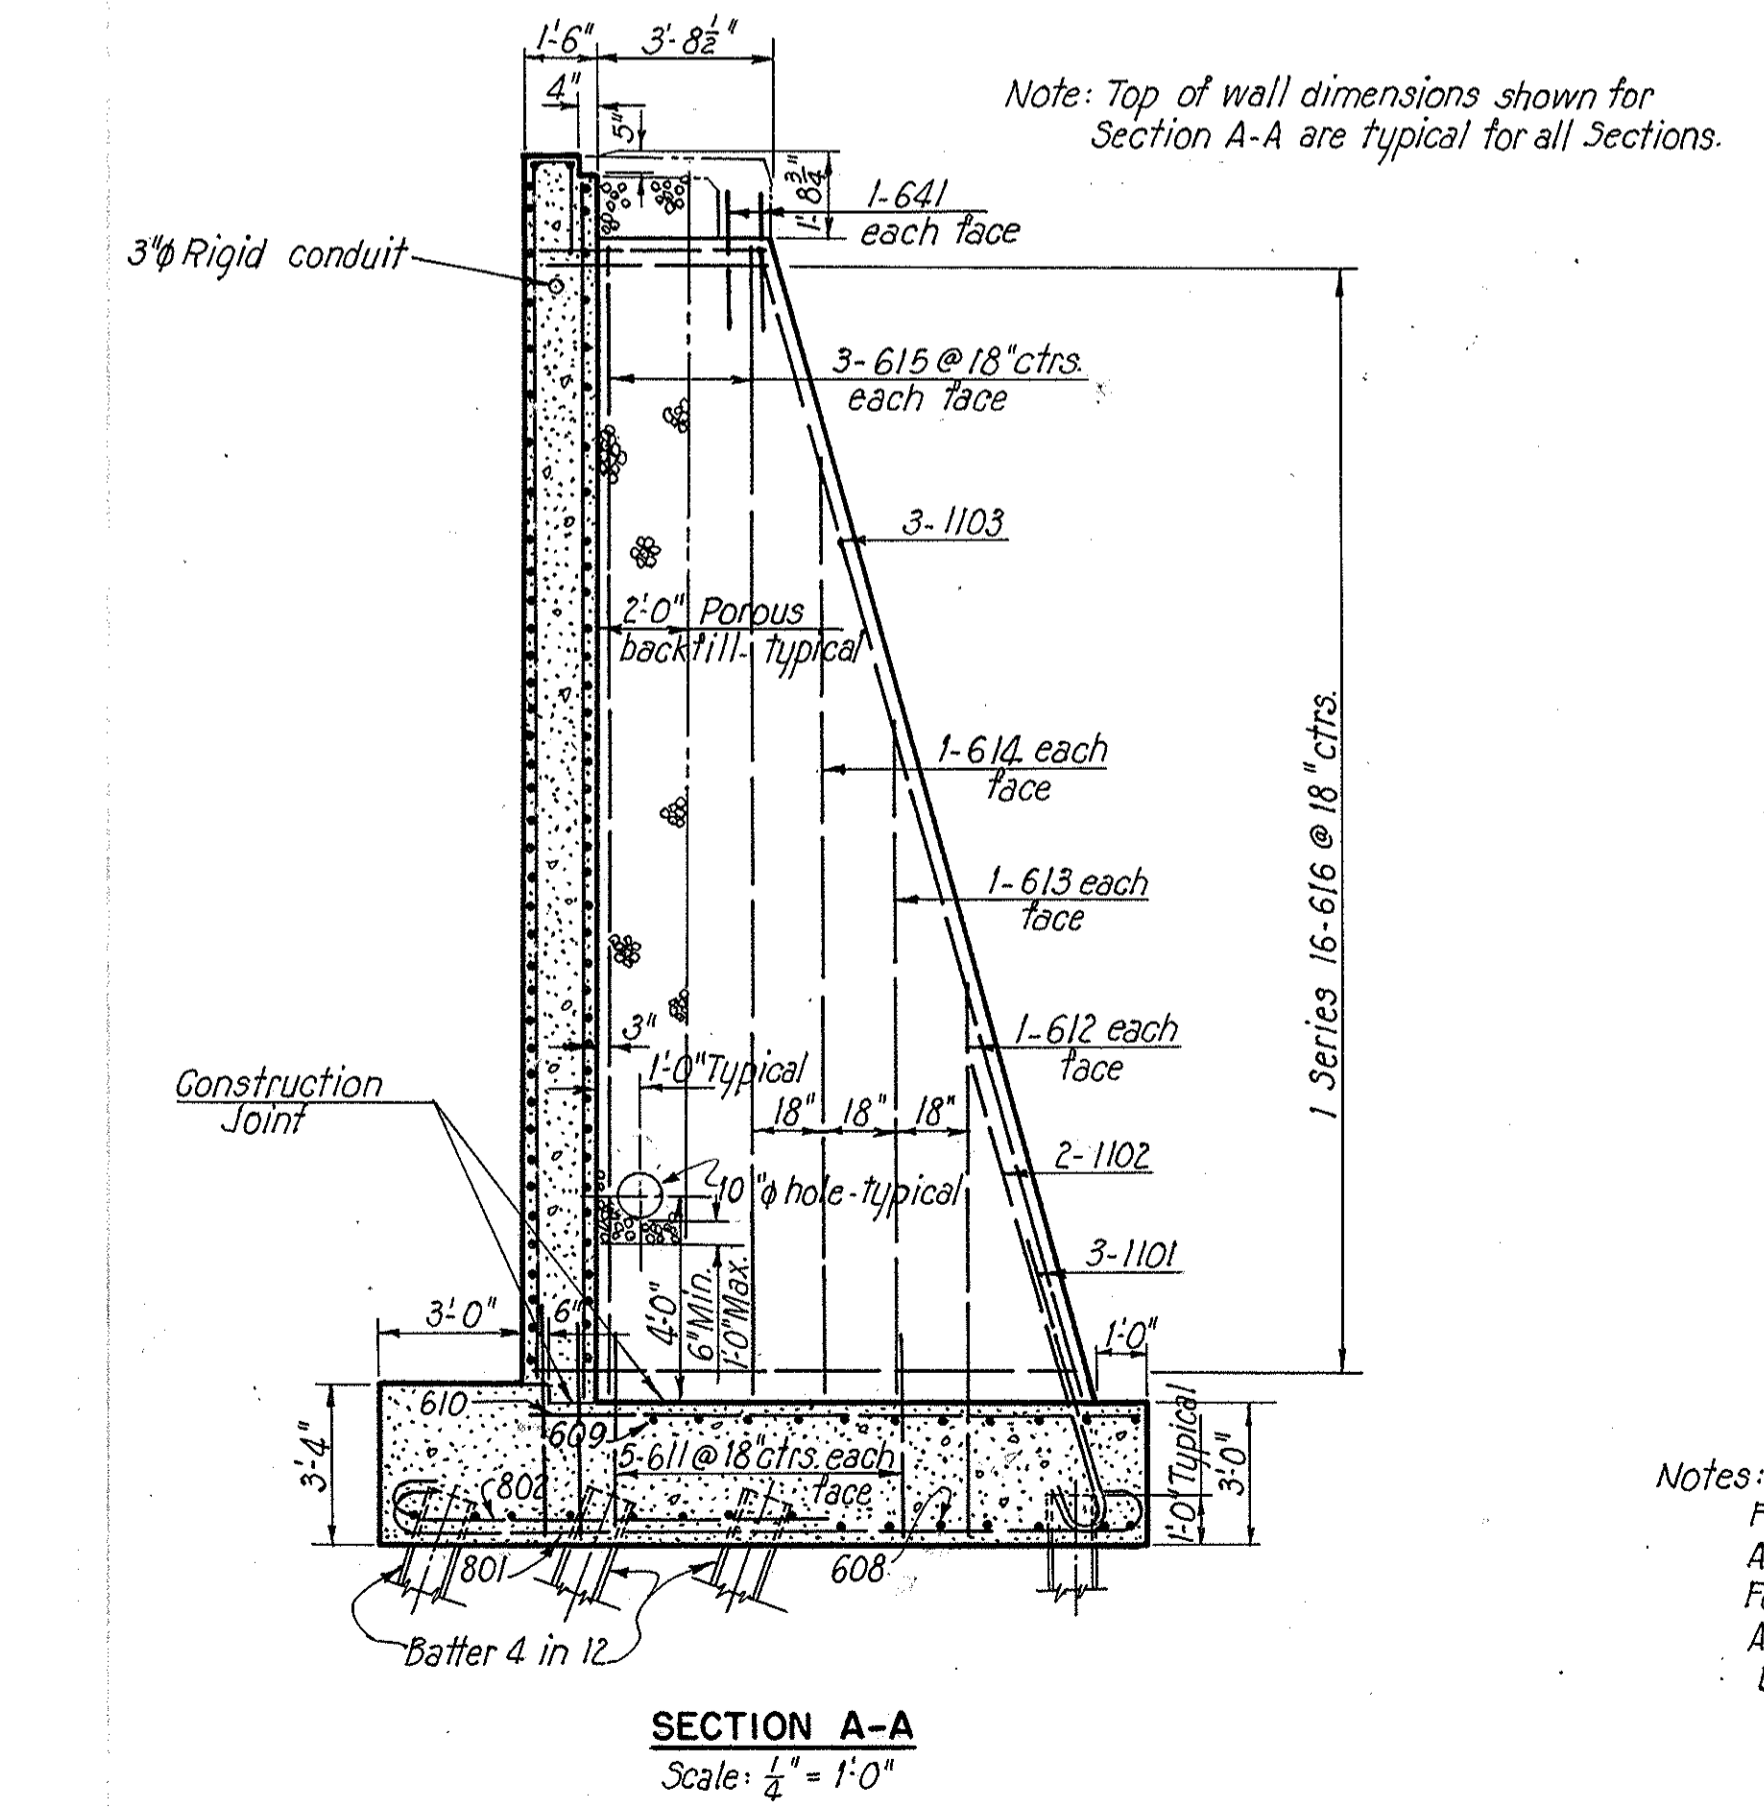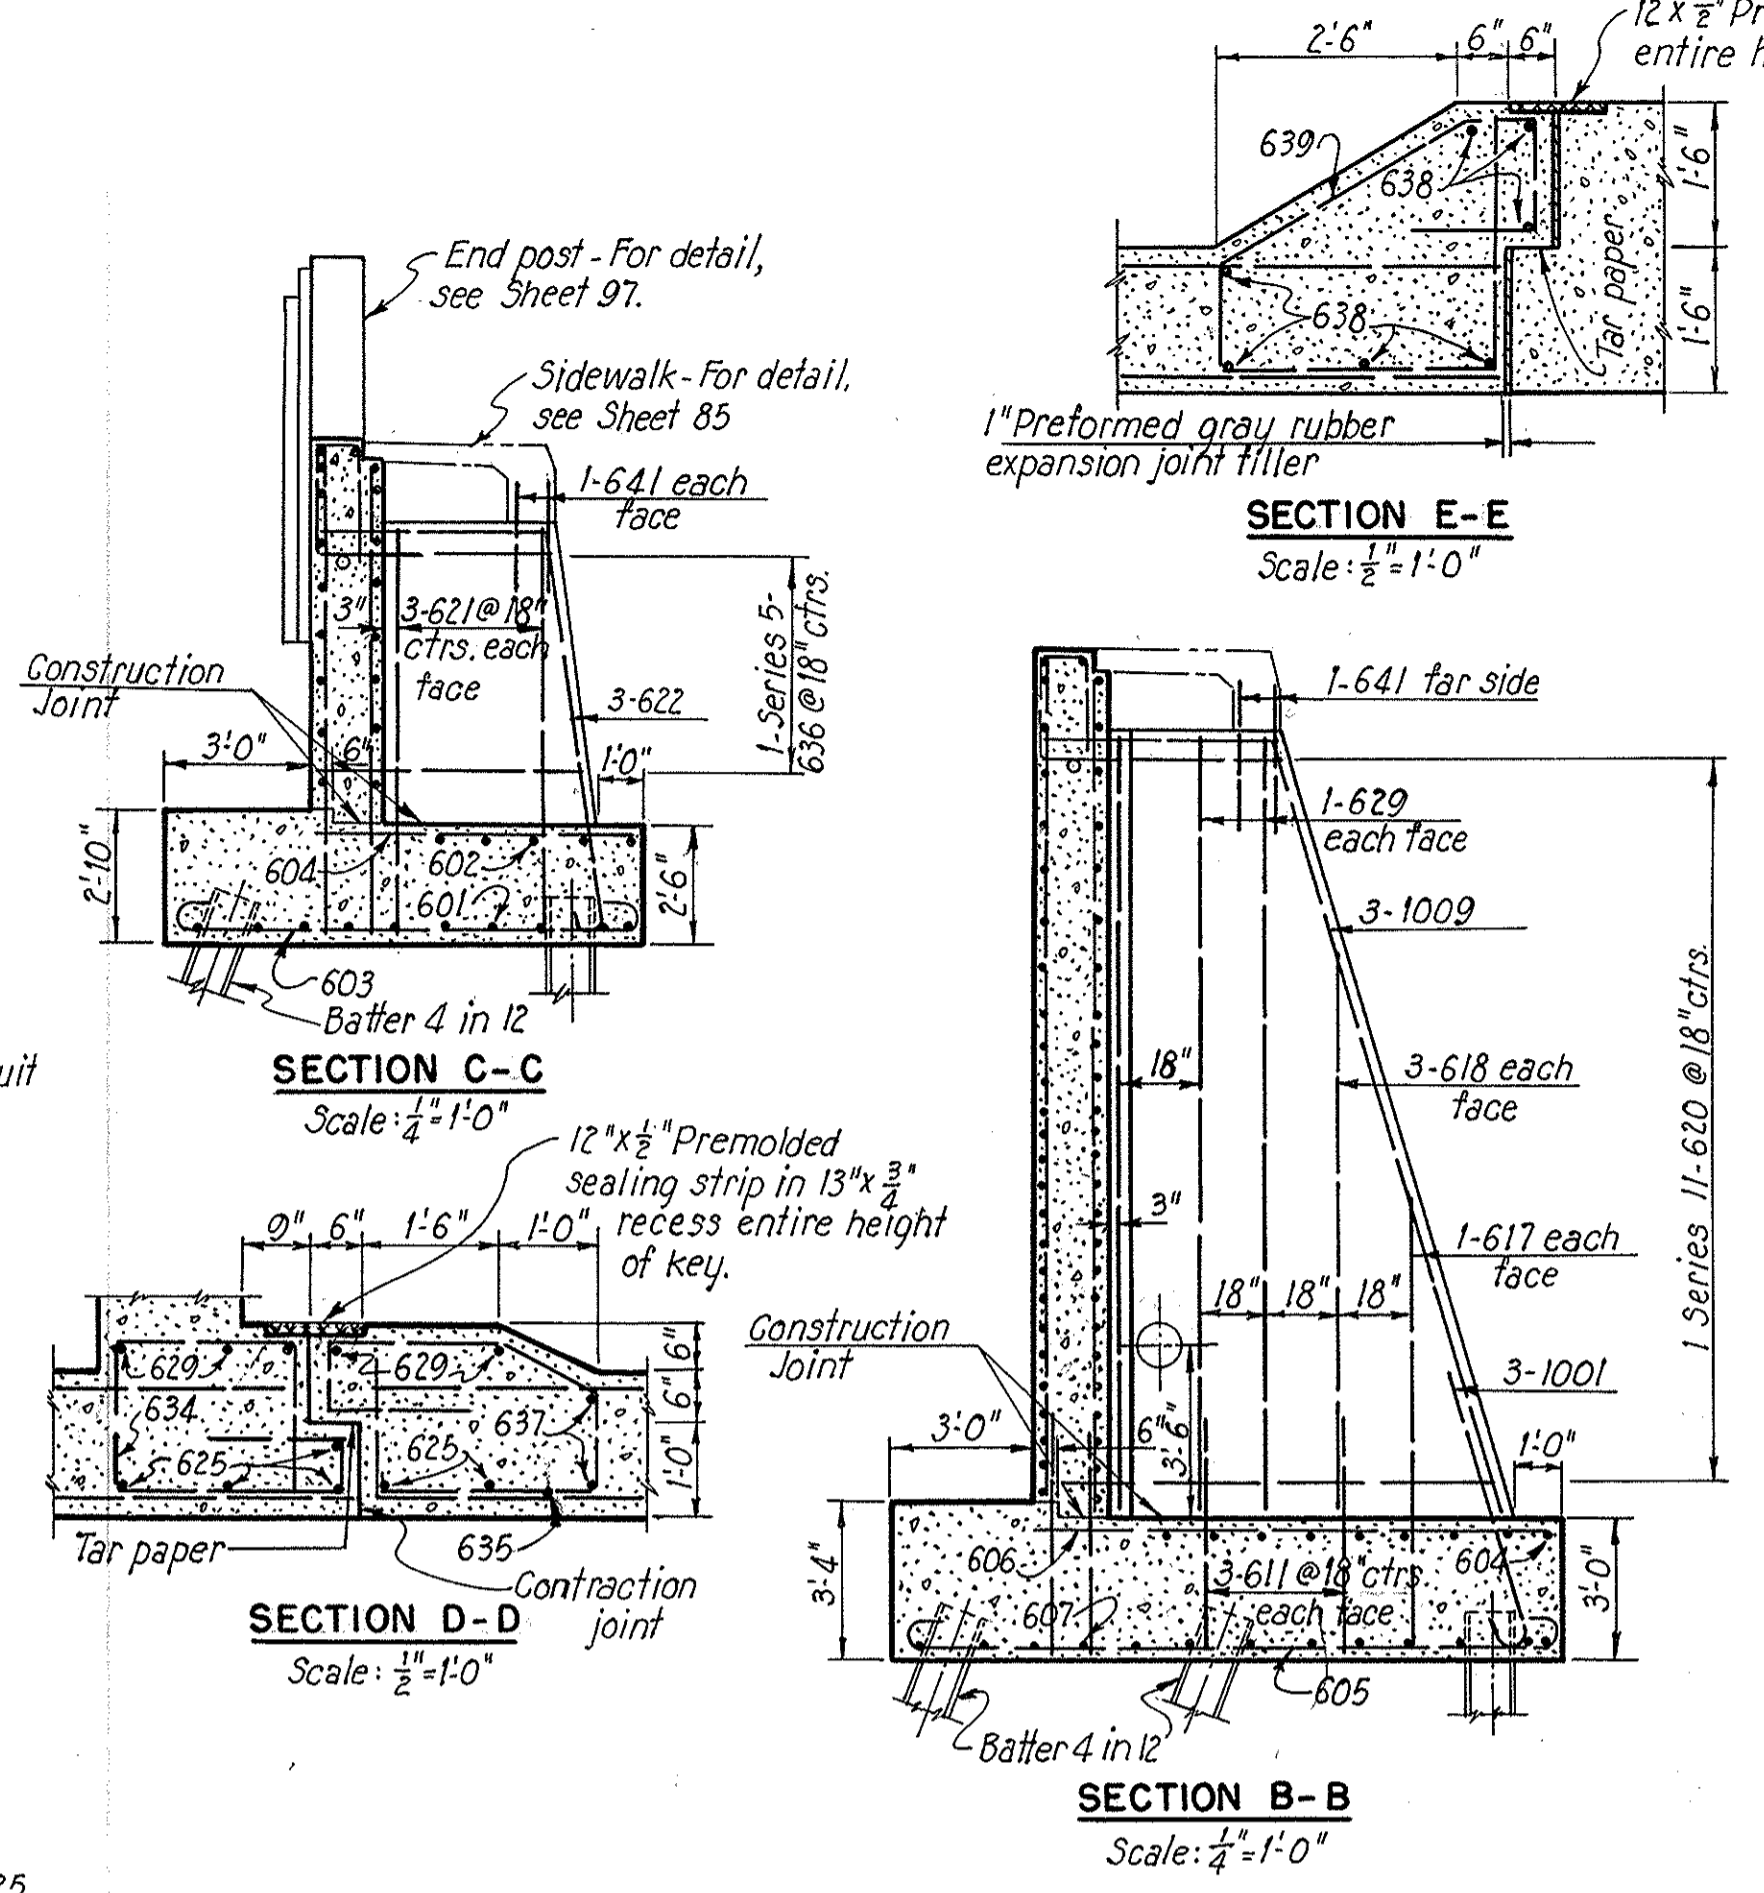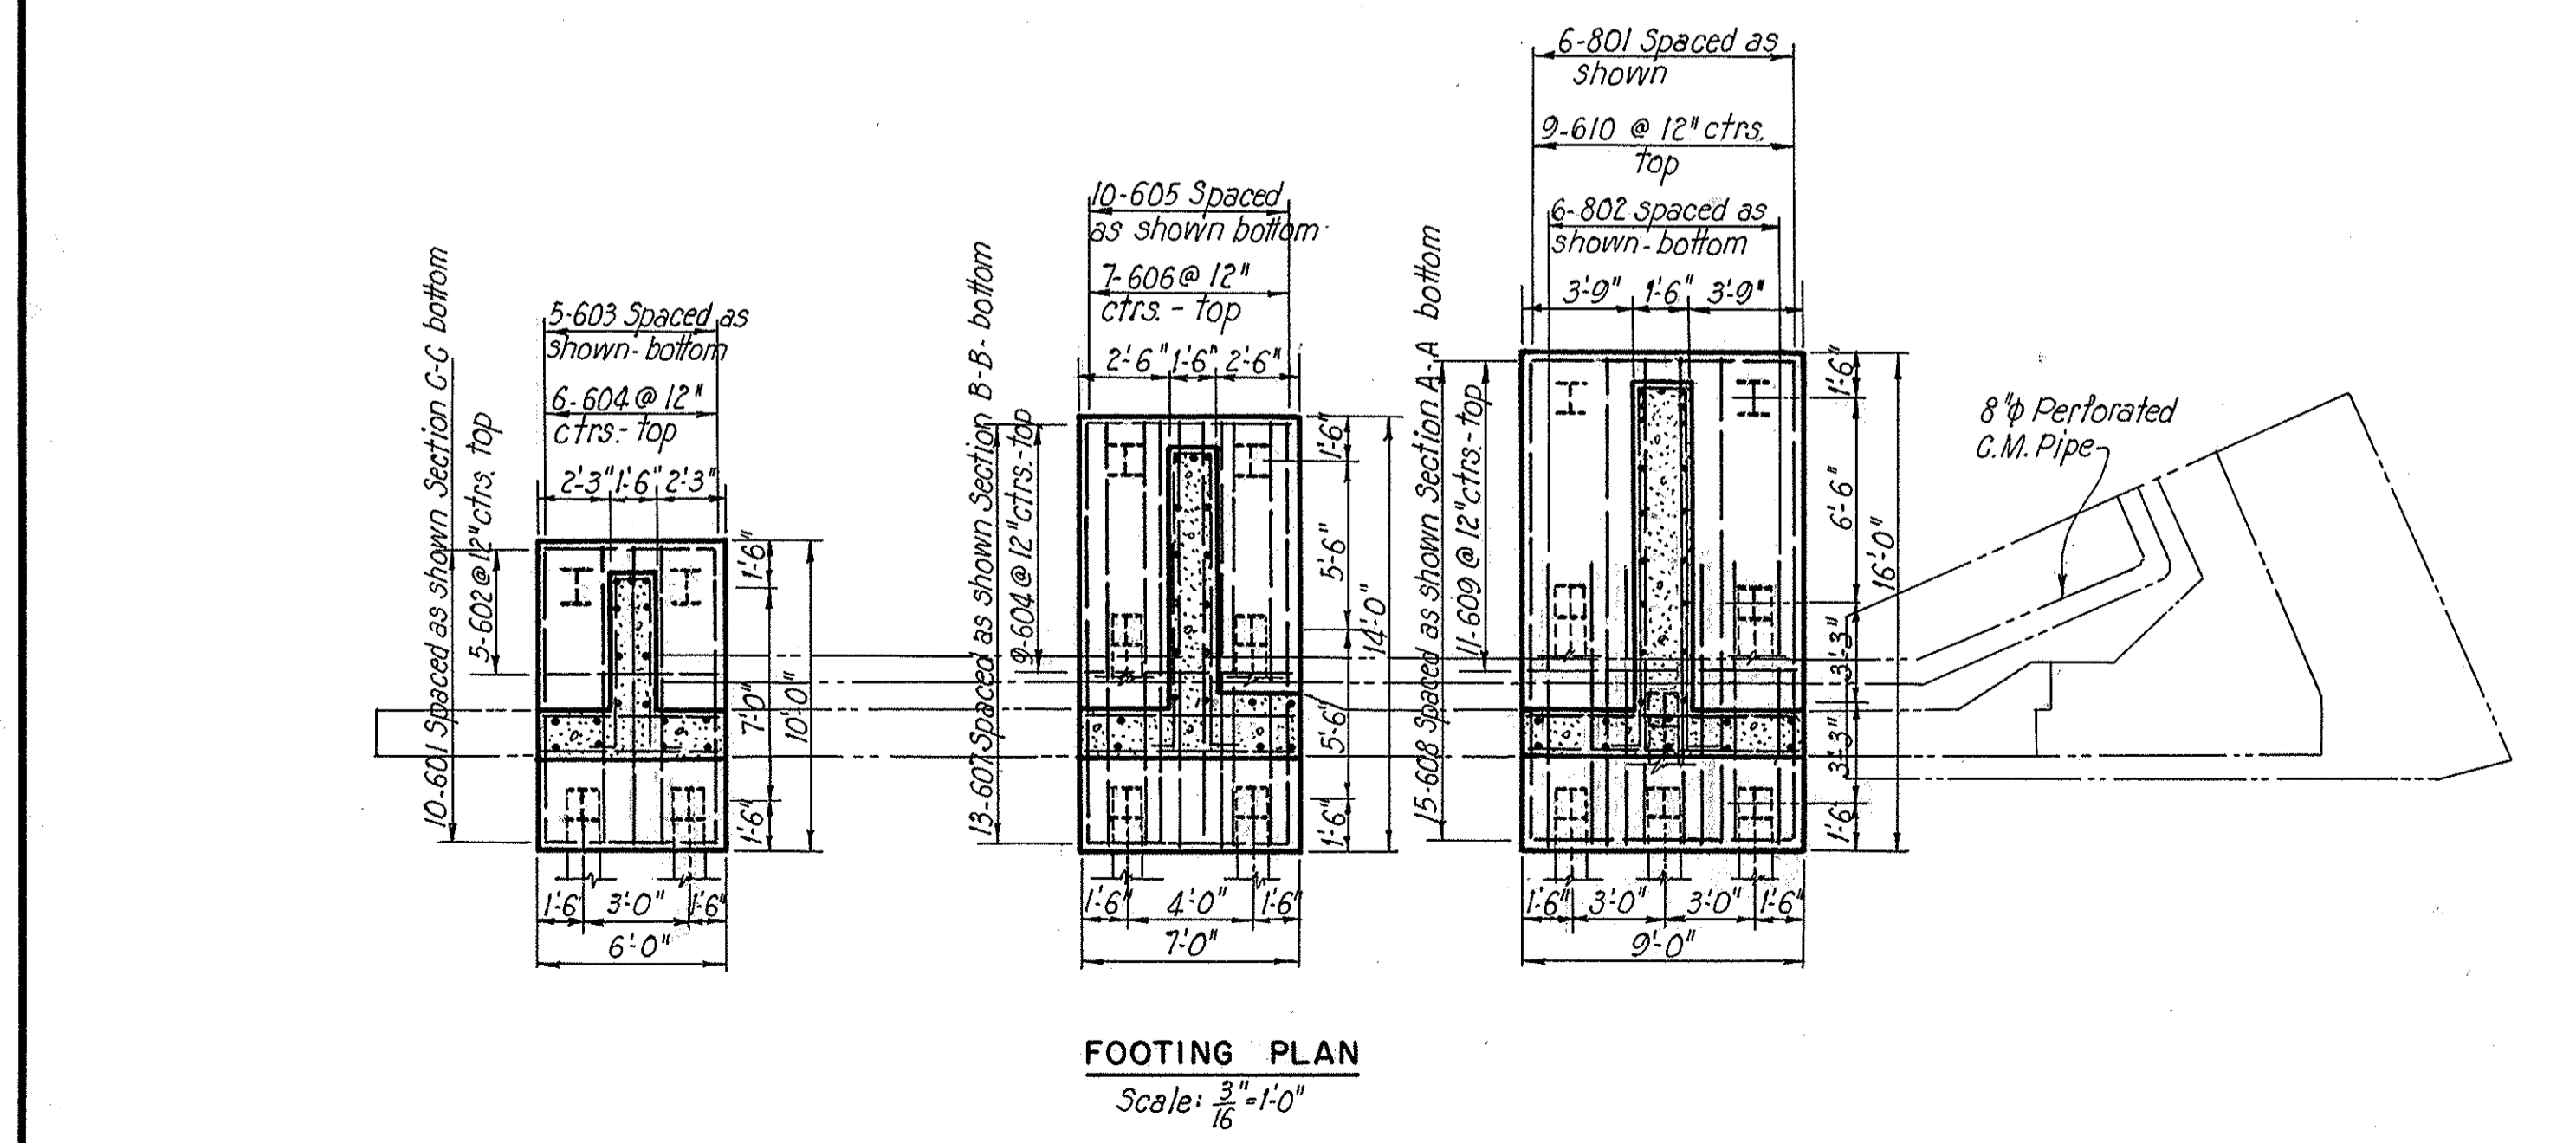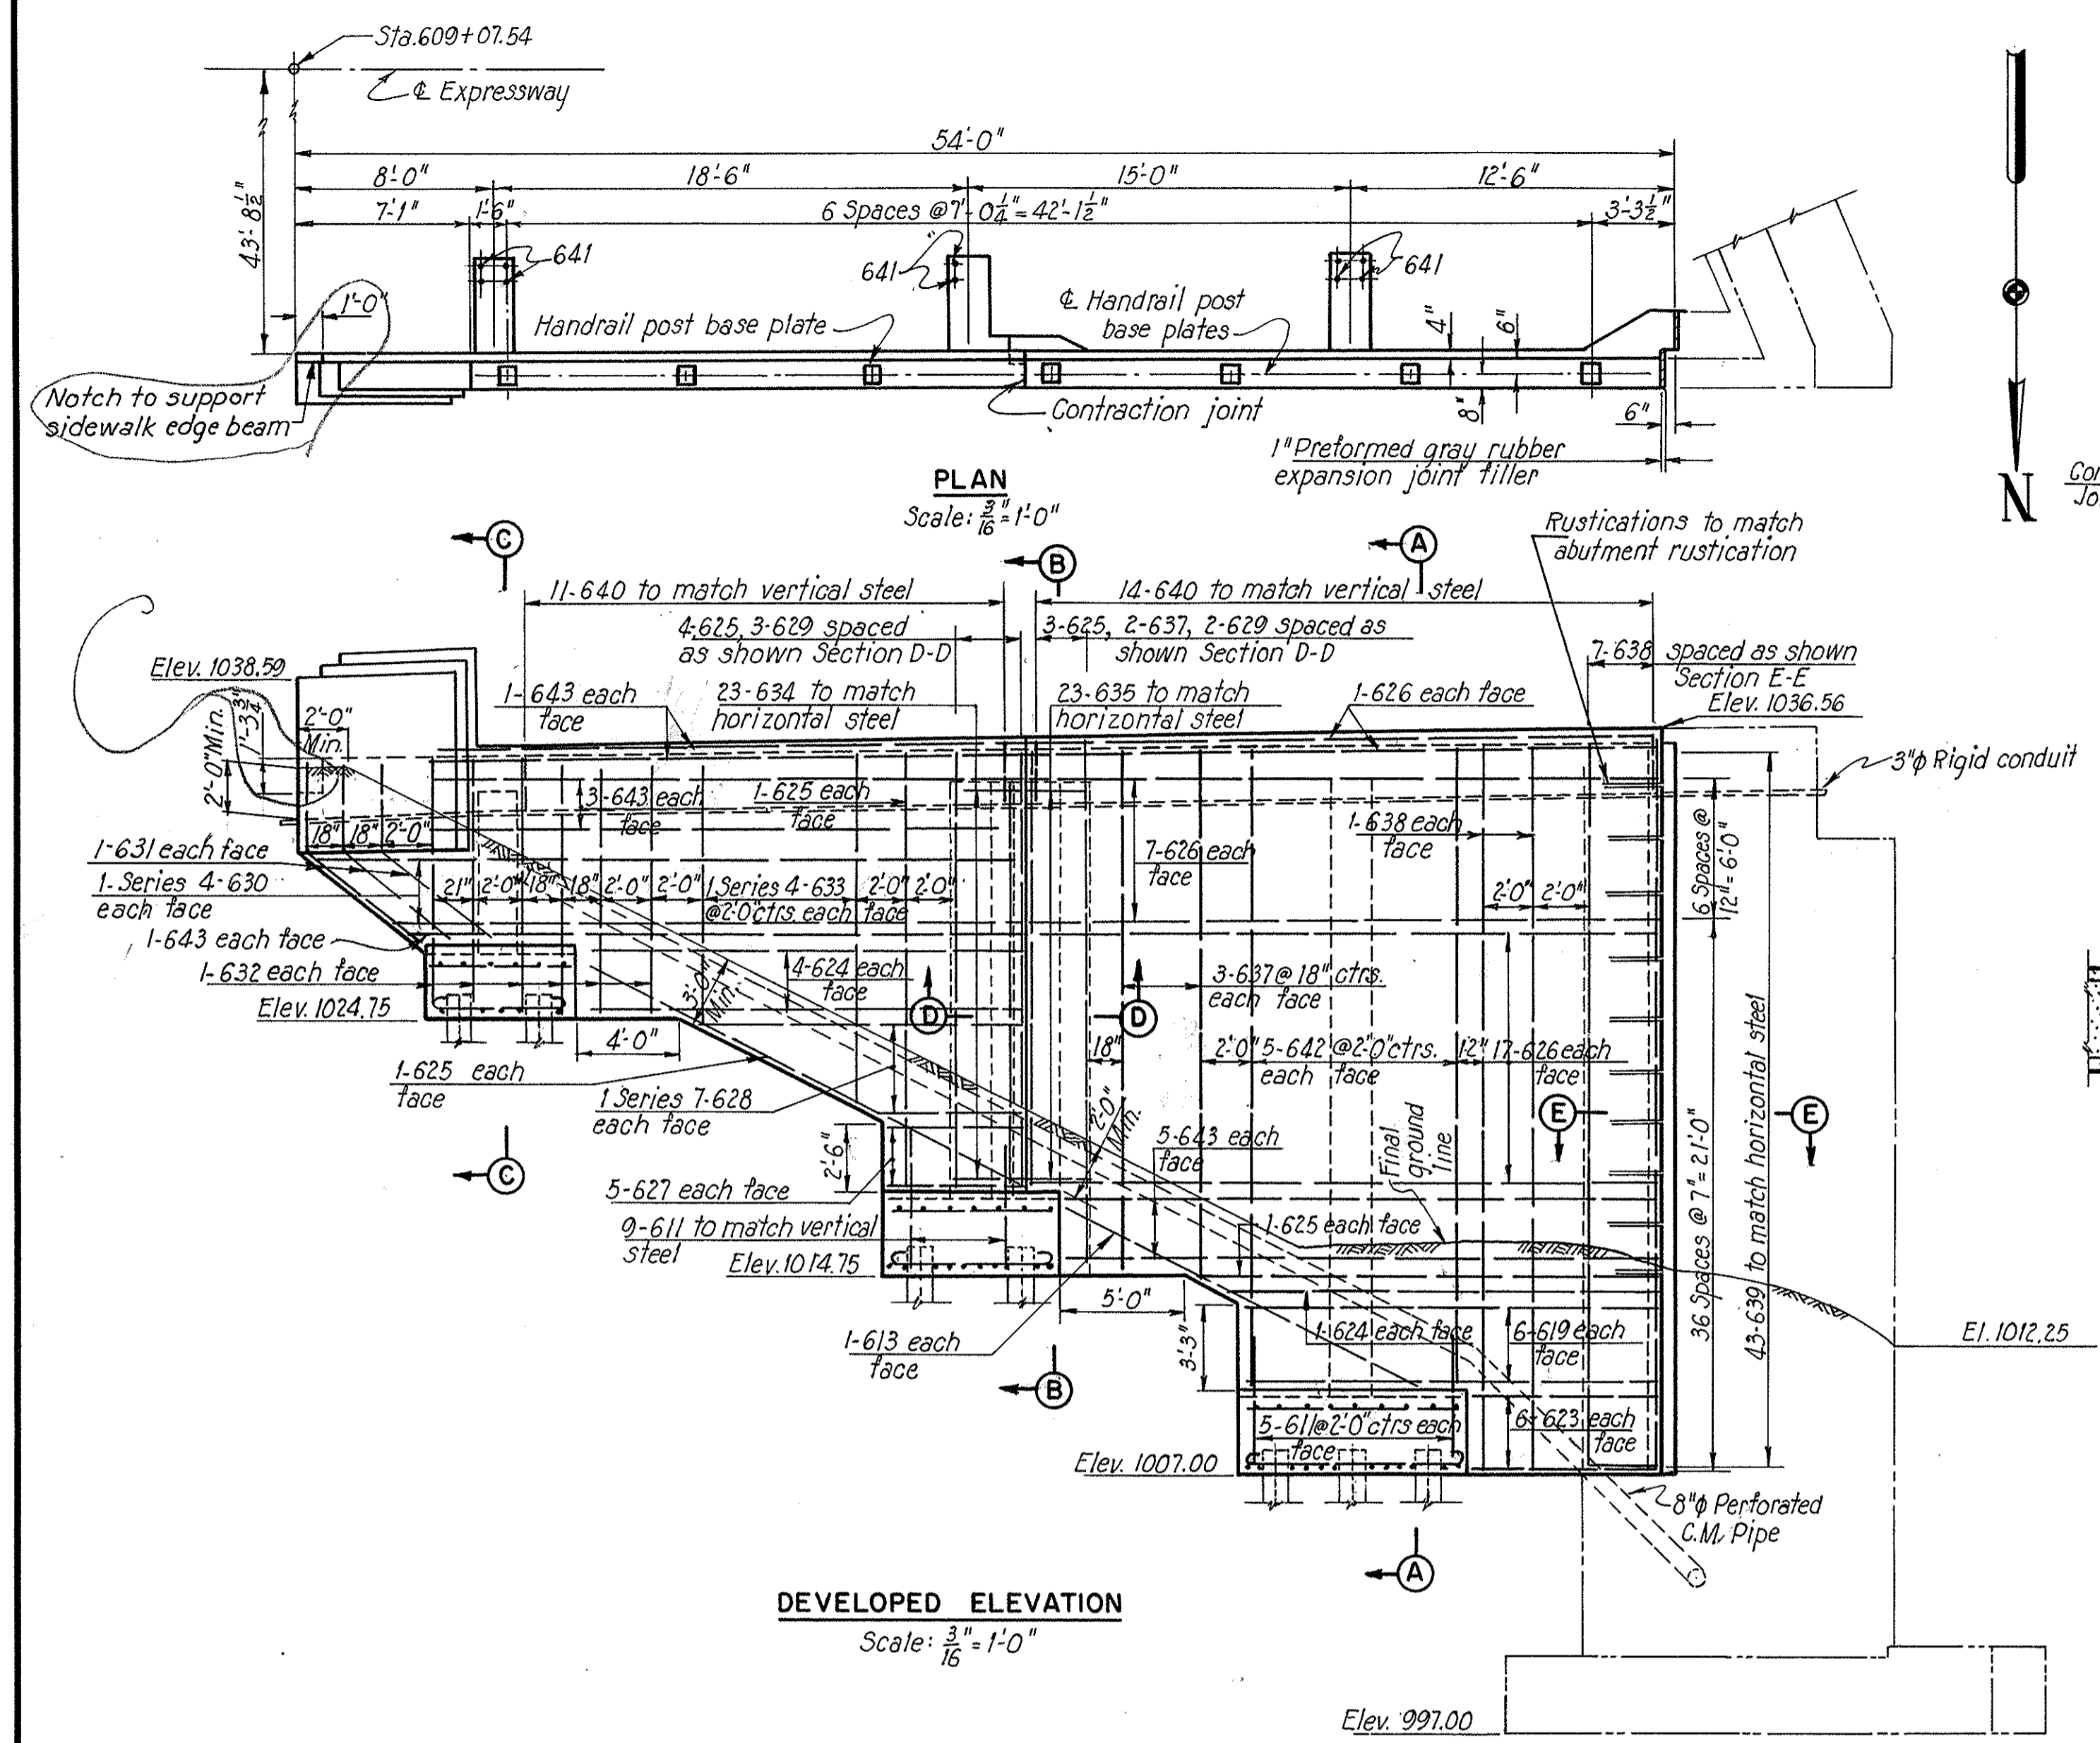

Revised 12-19-55

SUMMIT COUNTY  
CITY OF AKRON  
AKRON EXPRESSWAY SYSTEM

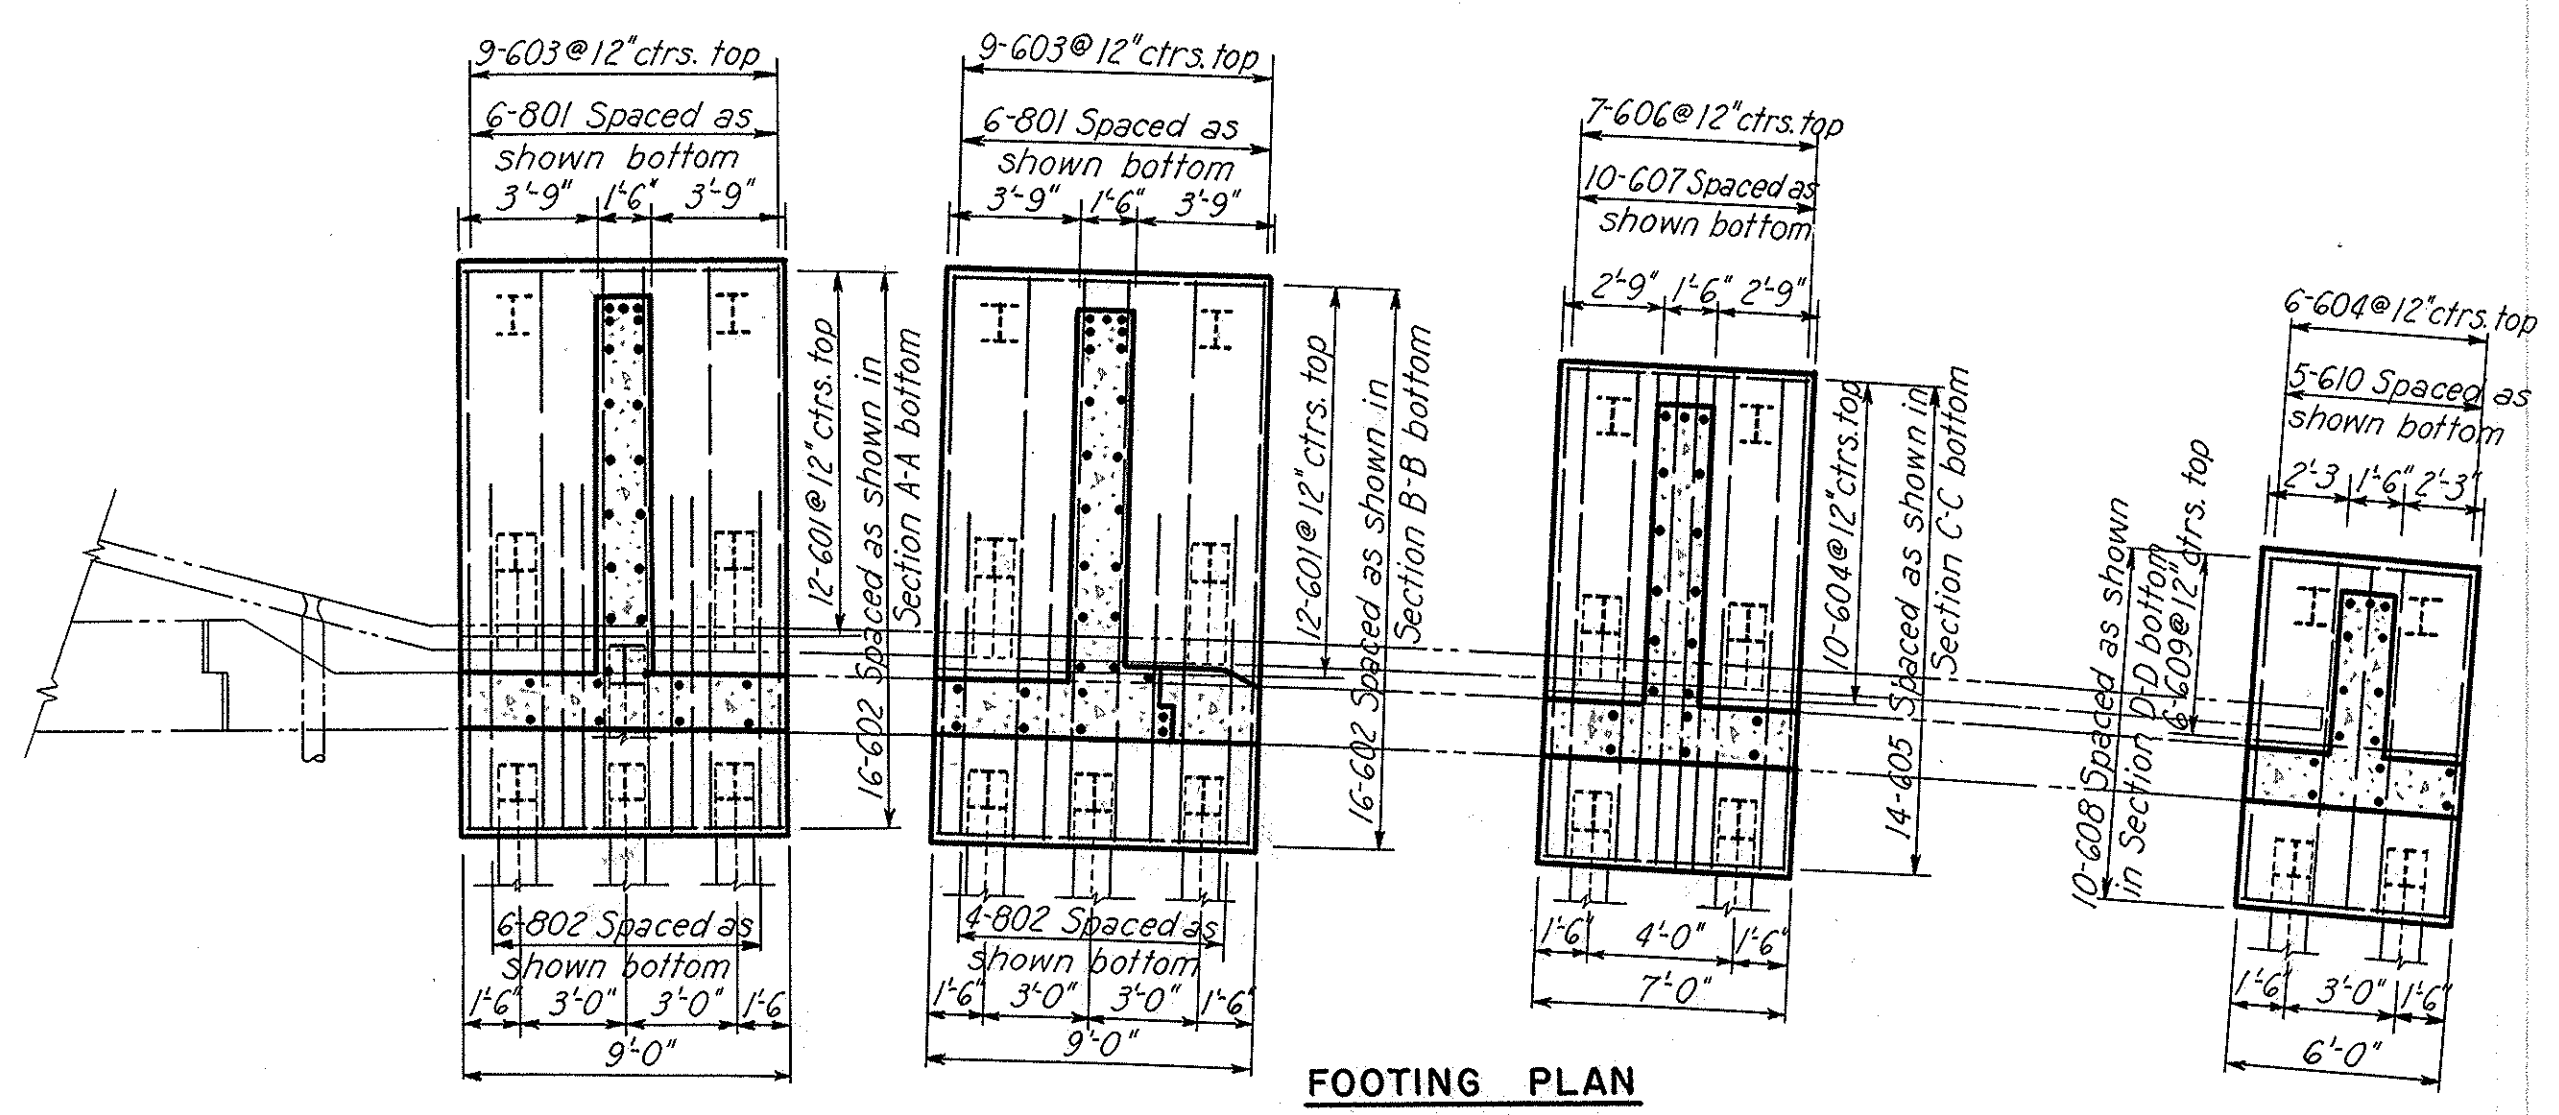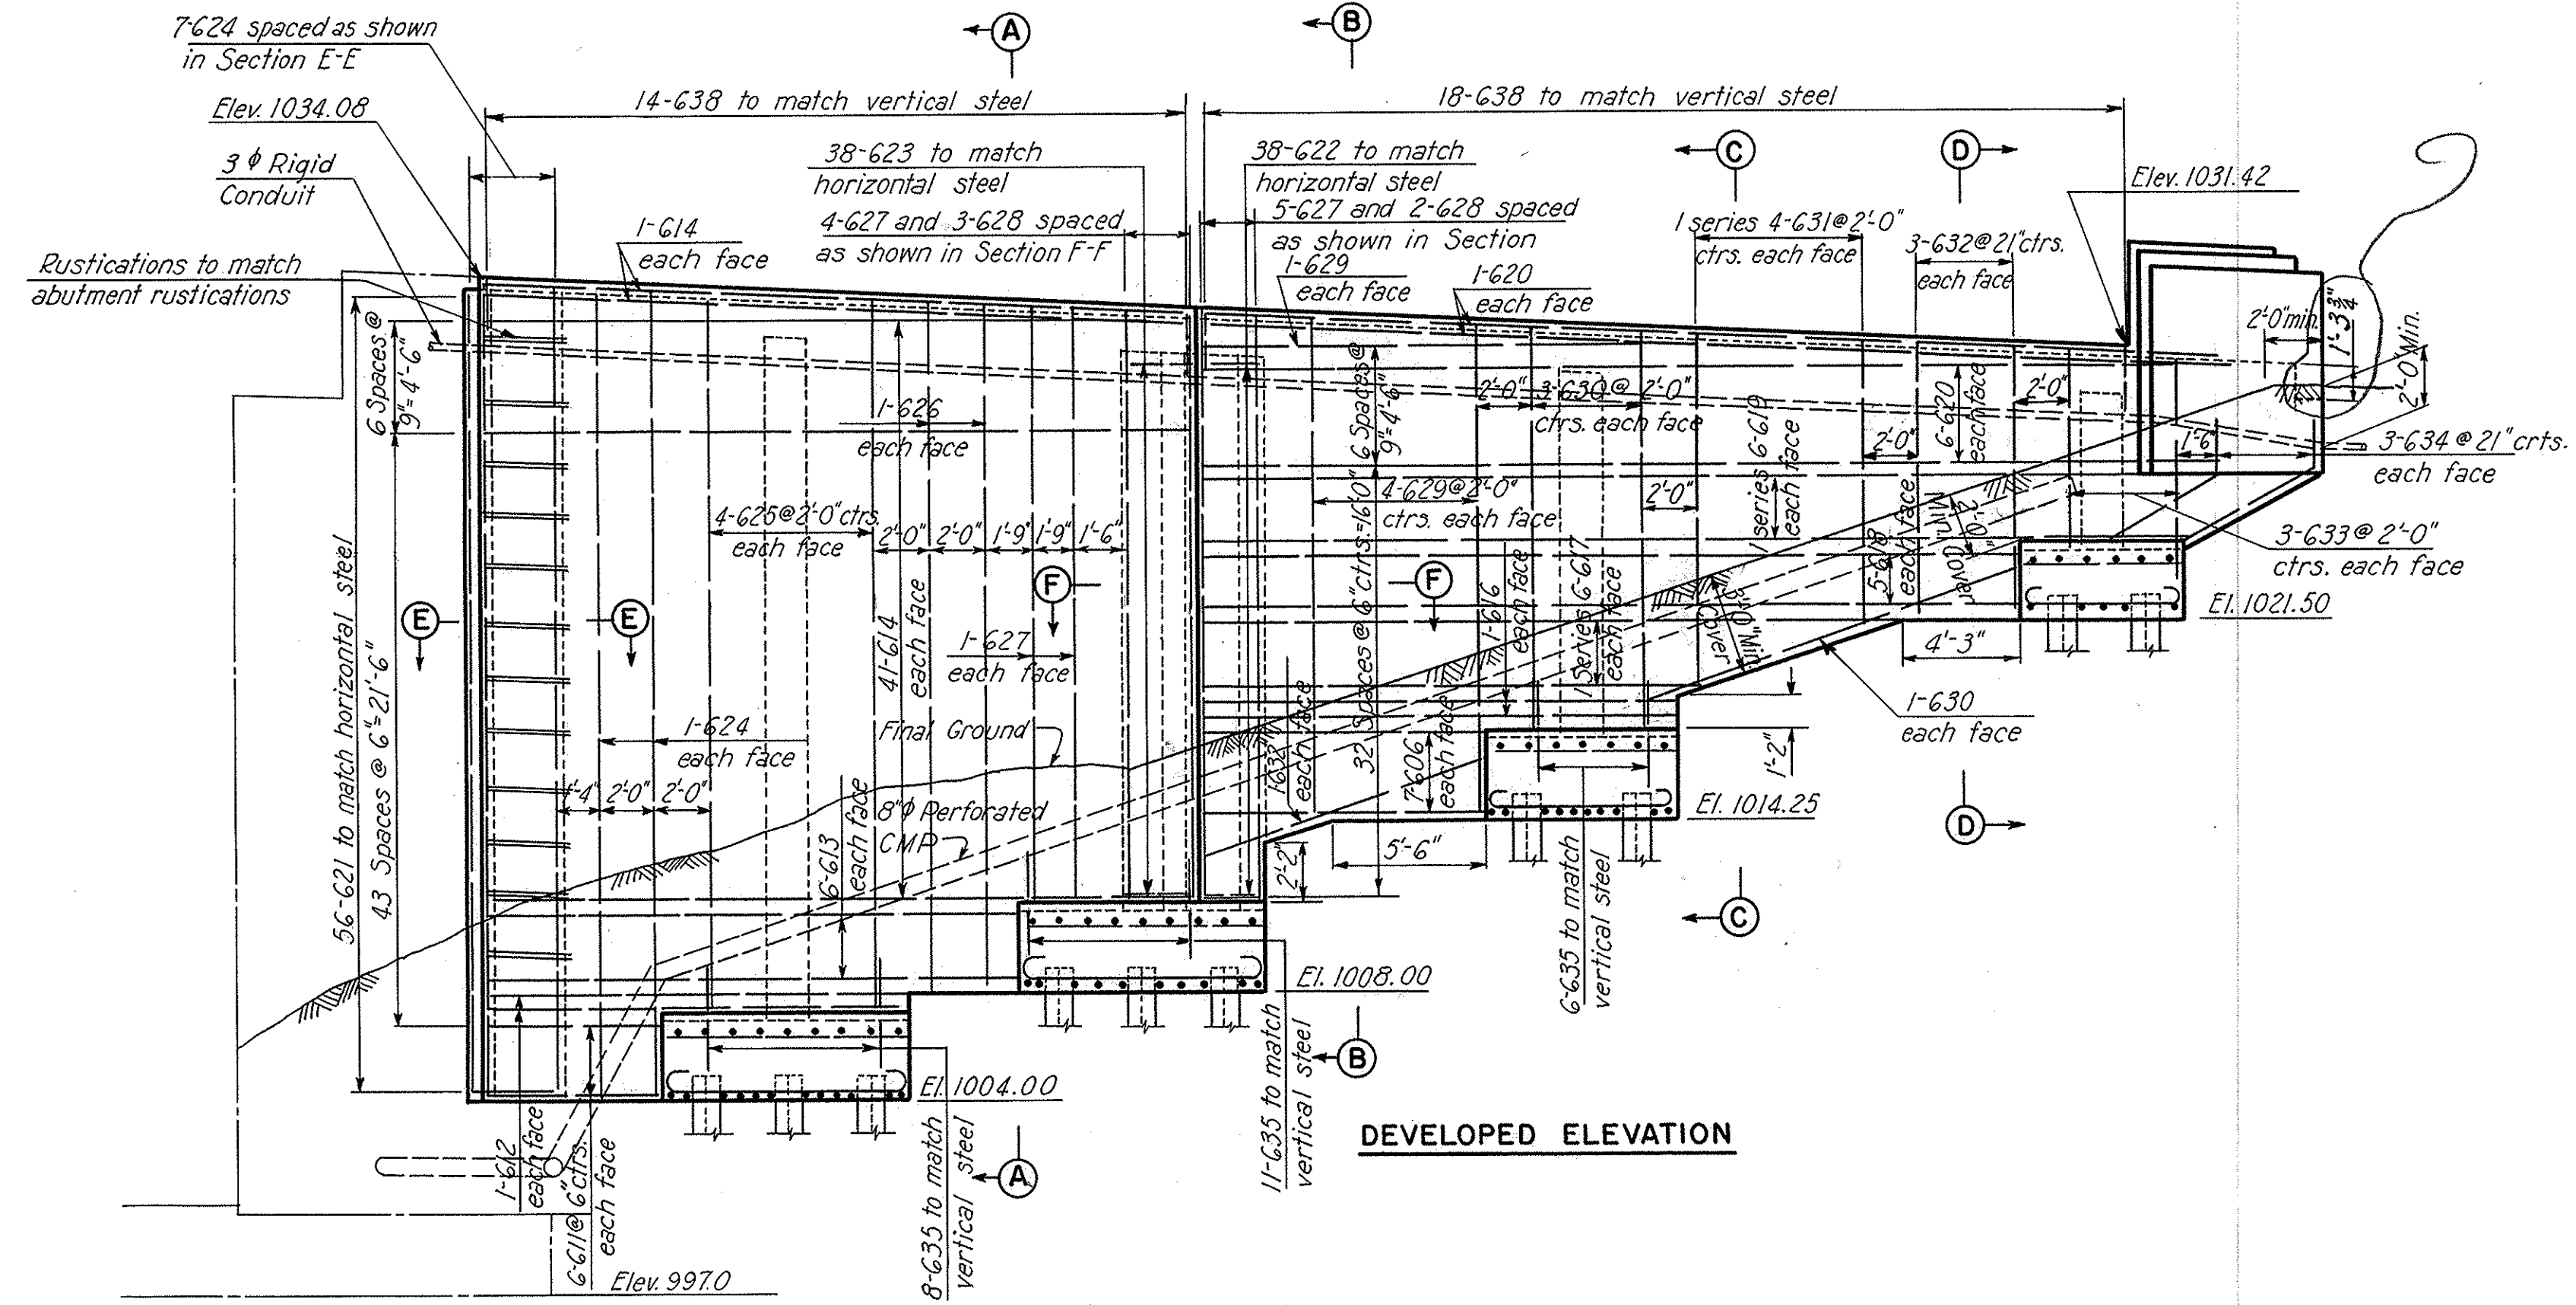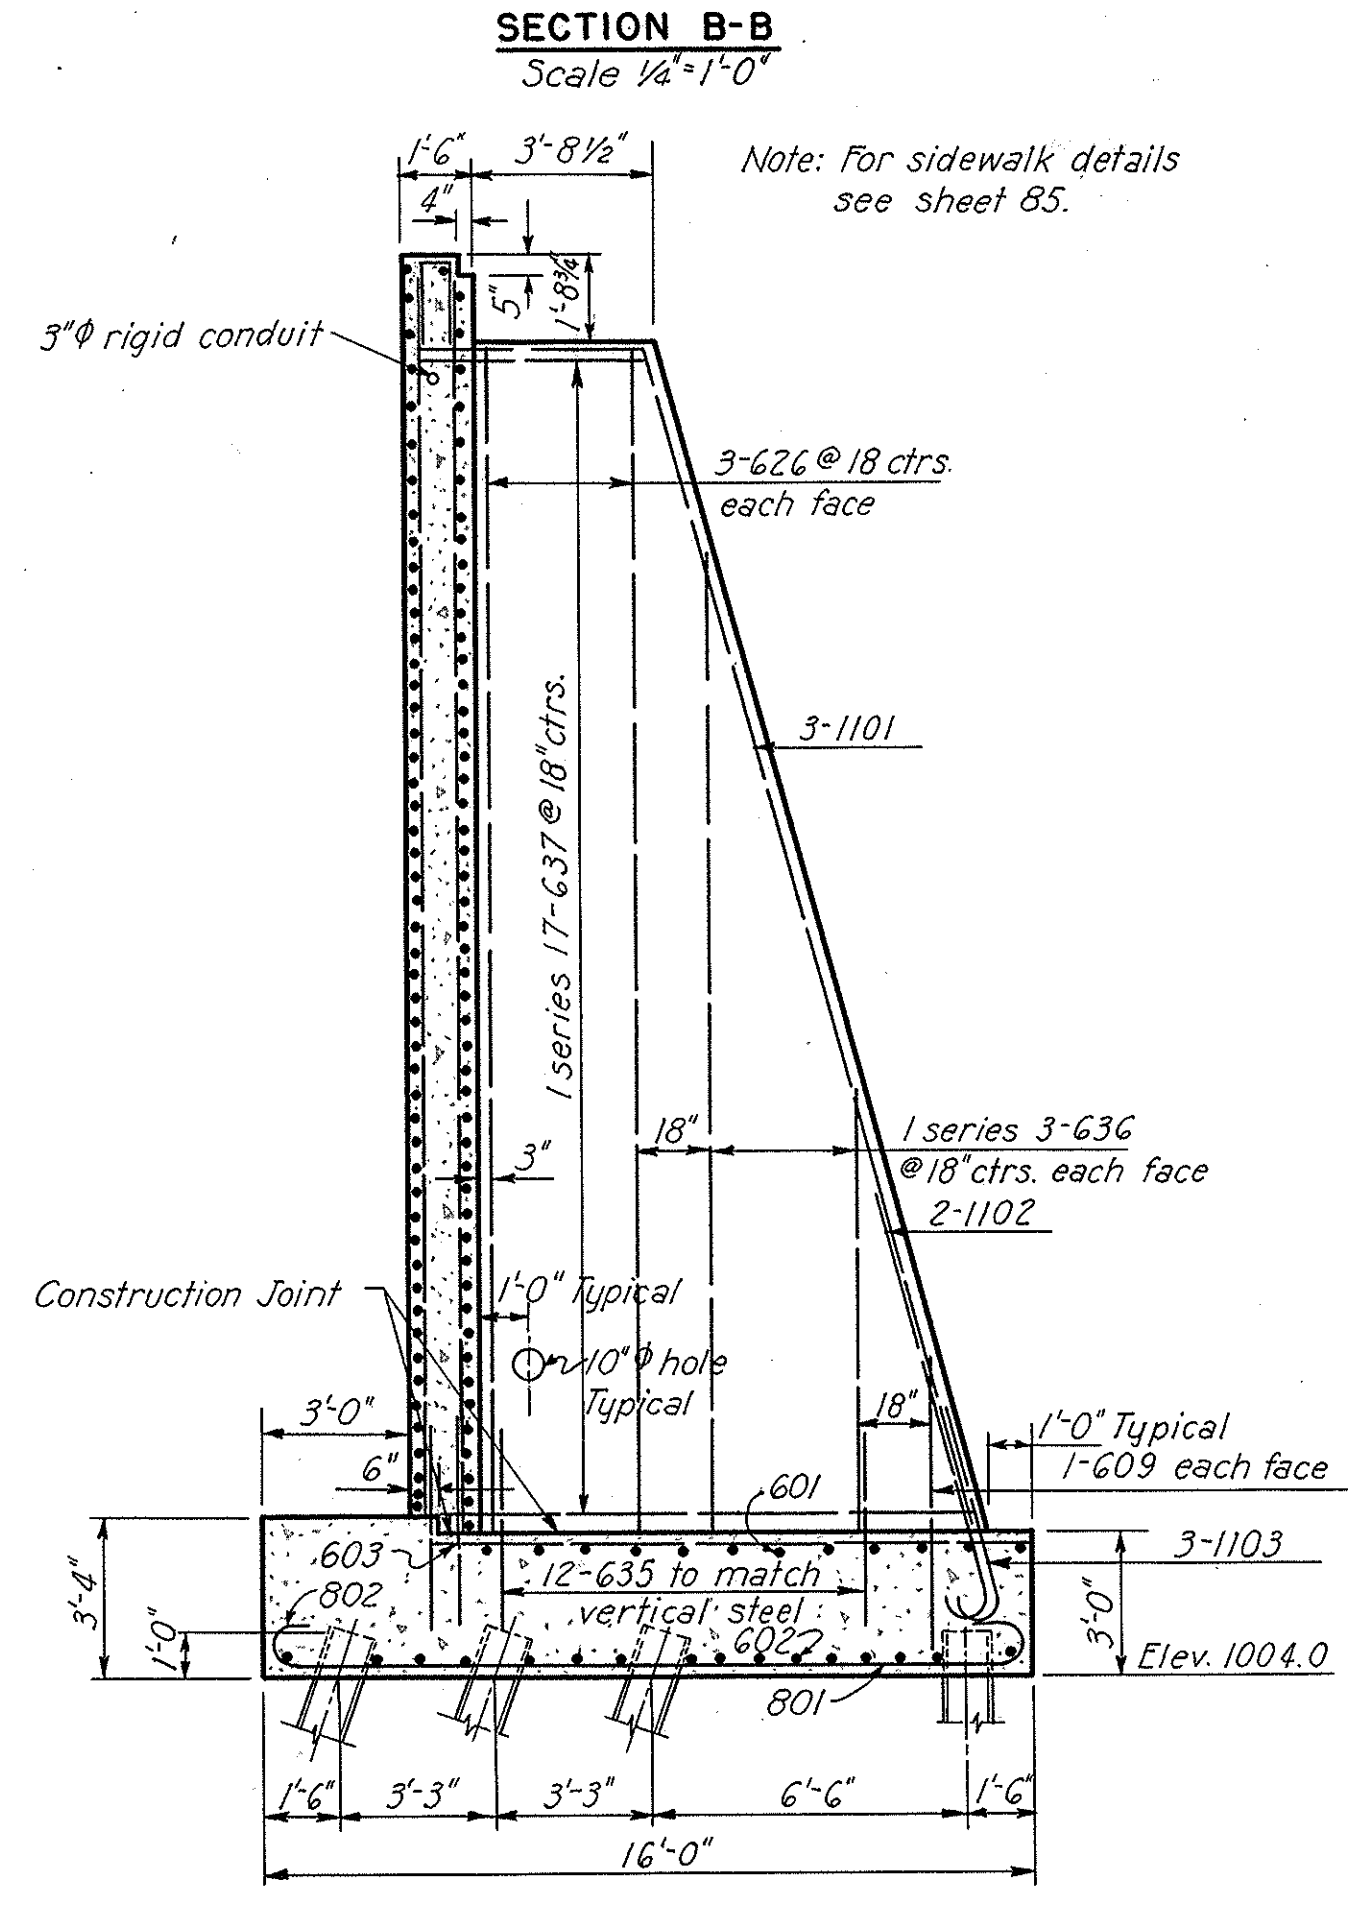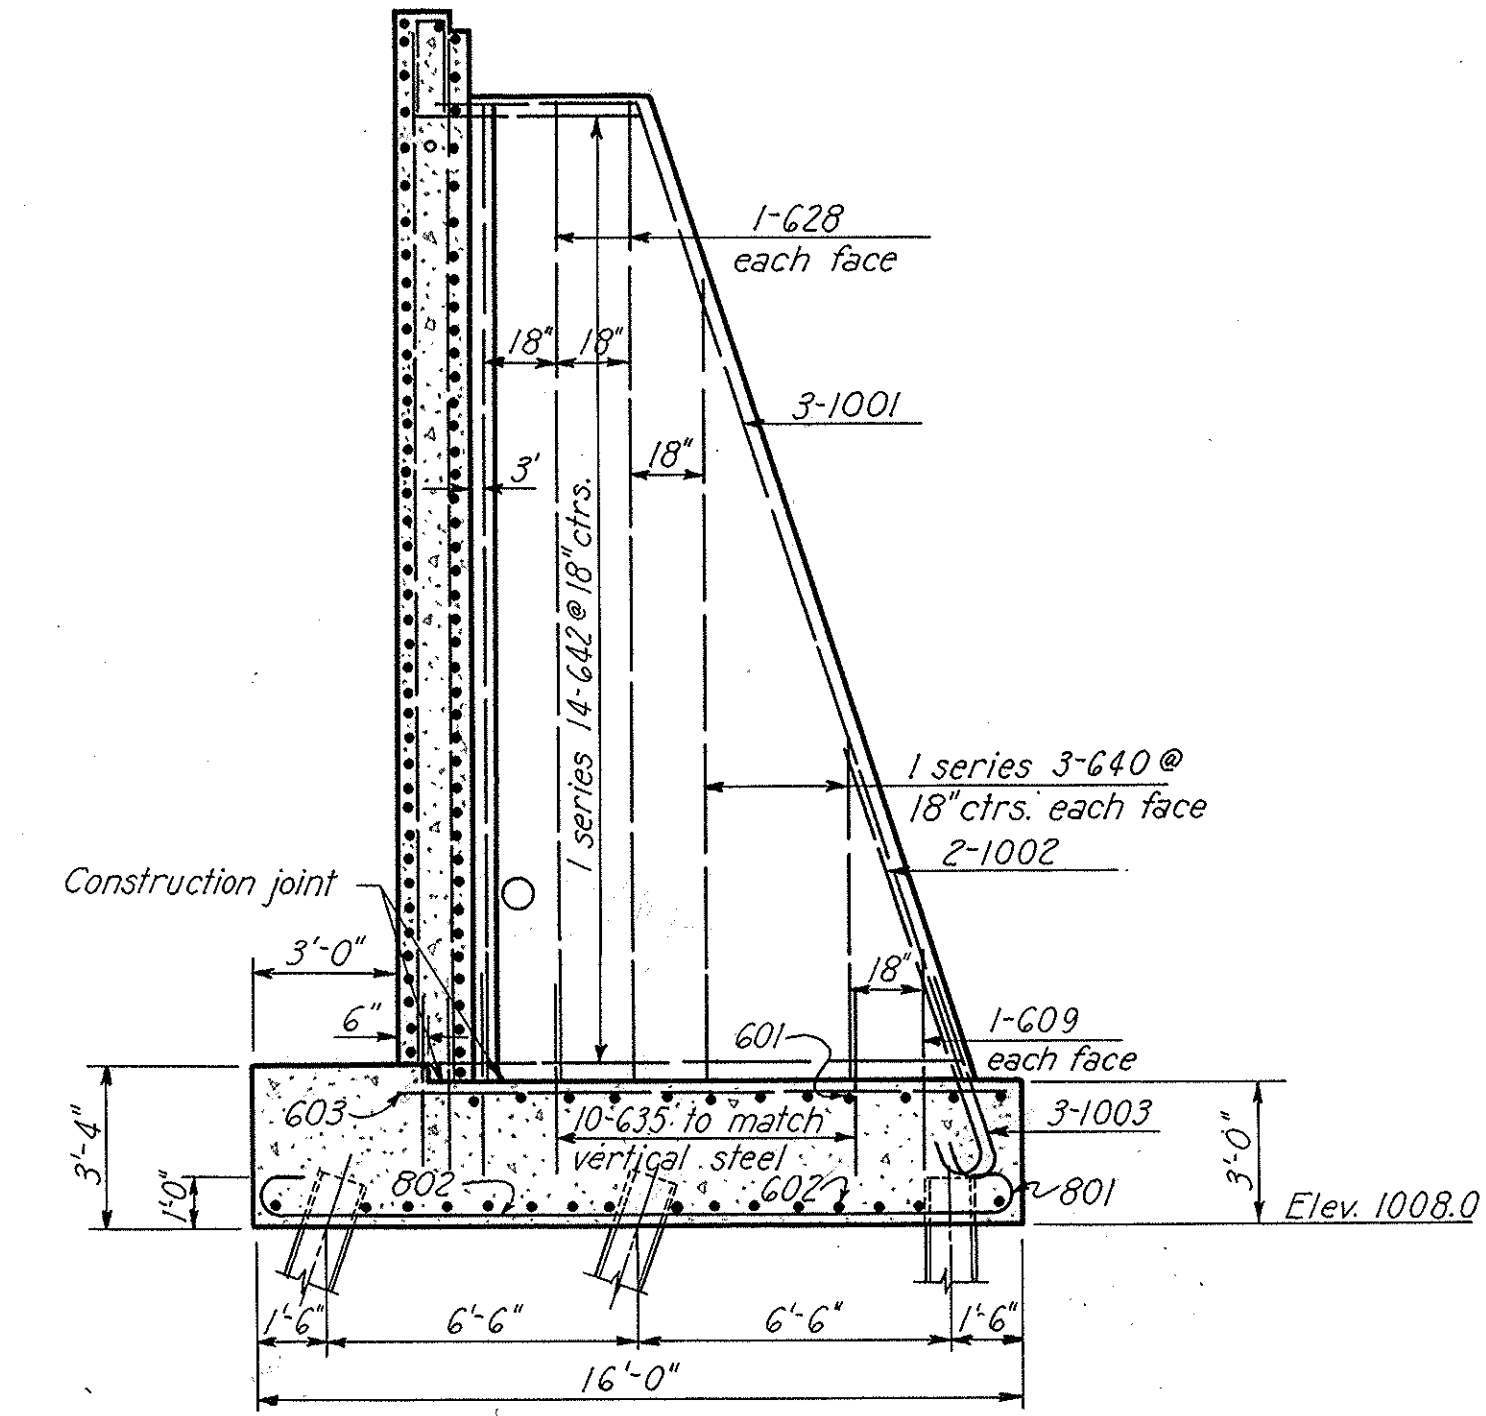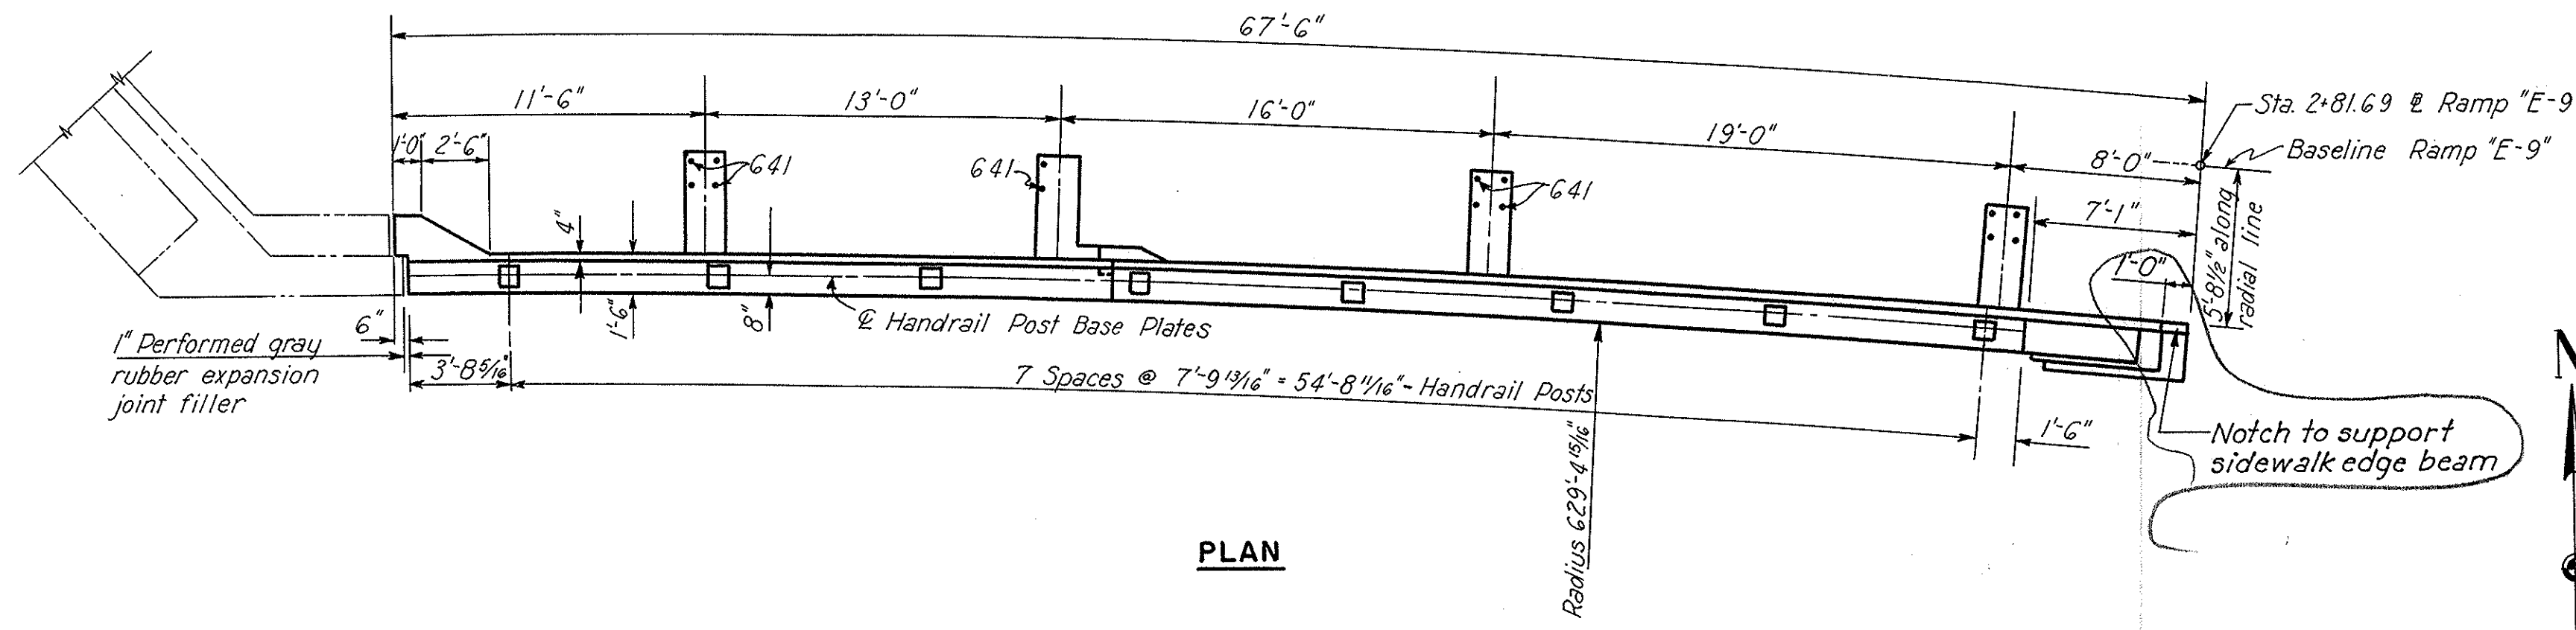

Notes: All piles shall be 12BP53.  
All battered piles are battered 4 in 12.  
For pile detail see sheet 61.  
For reinforcing schedule and Sections C-C, D-D, E-E and F-F see sheet 78.  
For handrail post details see sheet 97.  
For rustication detail see sheet 78.  
Pile spacing is measured along the bottom of footing.  
For porous backfill see sheet 78.  
Average vertical pile length 45 feet.

PART 7

**AKRON EXPRESSWAY SYSTEM**  
WEST VIADUCT  
BR. NO. SU 18R-135  
SOUTHEAST WINGWALL

AKRON SUMMIT COUNTY, OHIO

SCALE 3/16" = 1'-0" Unless Noted  
MADE O.F.B. DATE 7-23-55  
TRCD H.U.D. DATE 11-18-55  
CRD. B.S.S. DATE 2-15-55

HOWARD, NEEDLES, TAMMEN & BERGENDOFF  
CONSULTING ENGINEERS  
KANSAS CITY CLEVELAND NEW YORK  
901 SHEET - 77


Revised 12-19-55

147







SUMMIT COUNTY  
CITY OF AKRON  
AKRON EXPRESSWAY SYSTEM

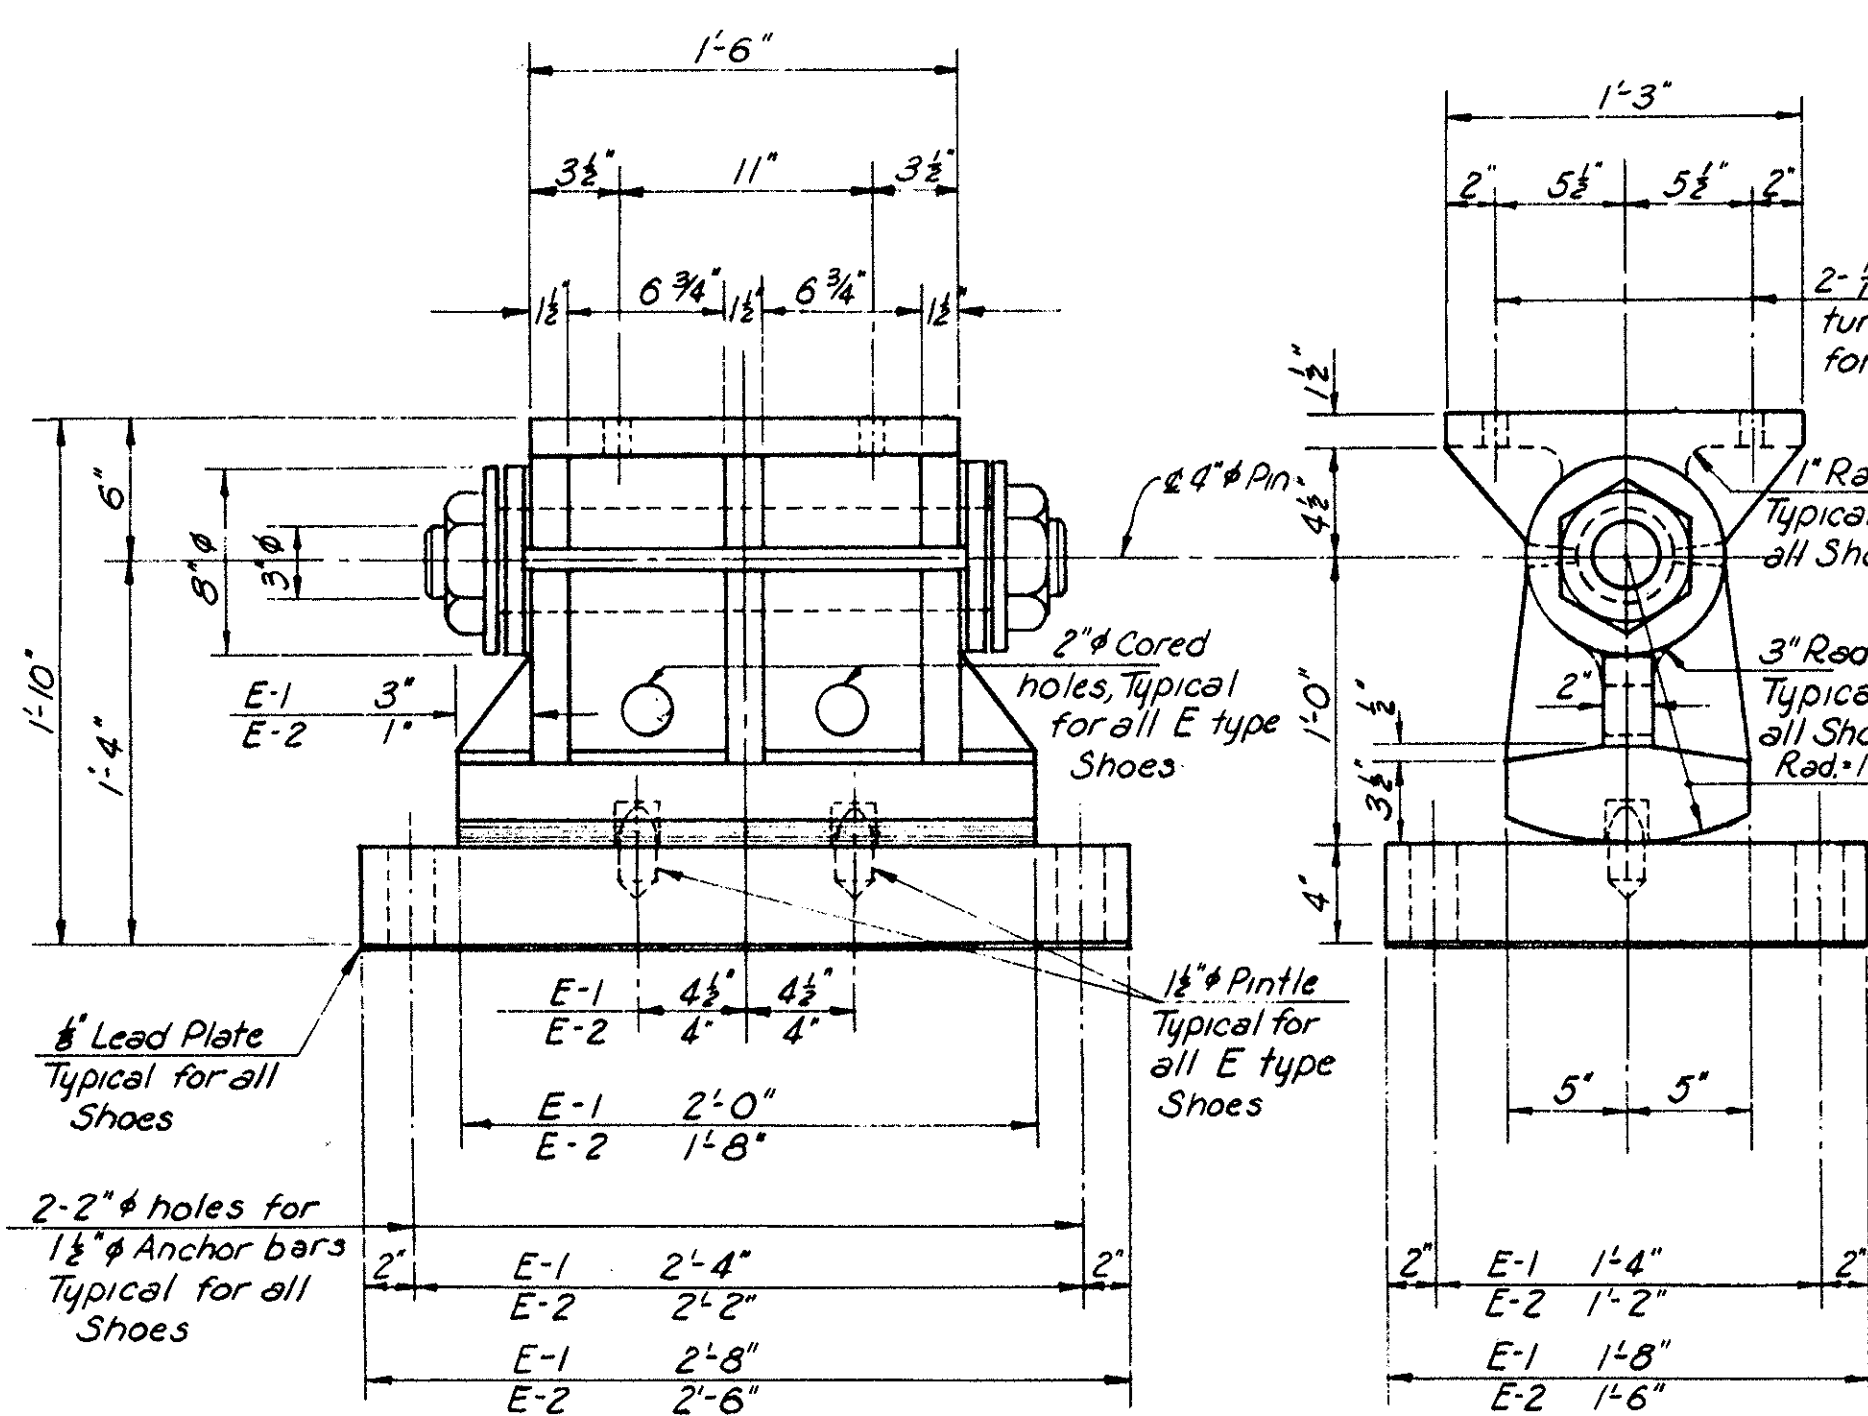

**SHOES E-1 AND E-2**  
Shoes E-1 and E-2 are similar except as shown  
Scale: 1 1/2" = 1'-0"  
8 E-1 Required  
8 E-2 Required

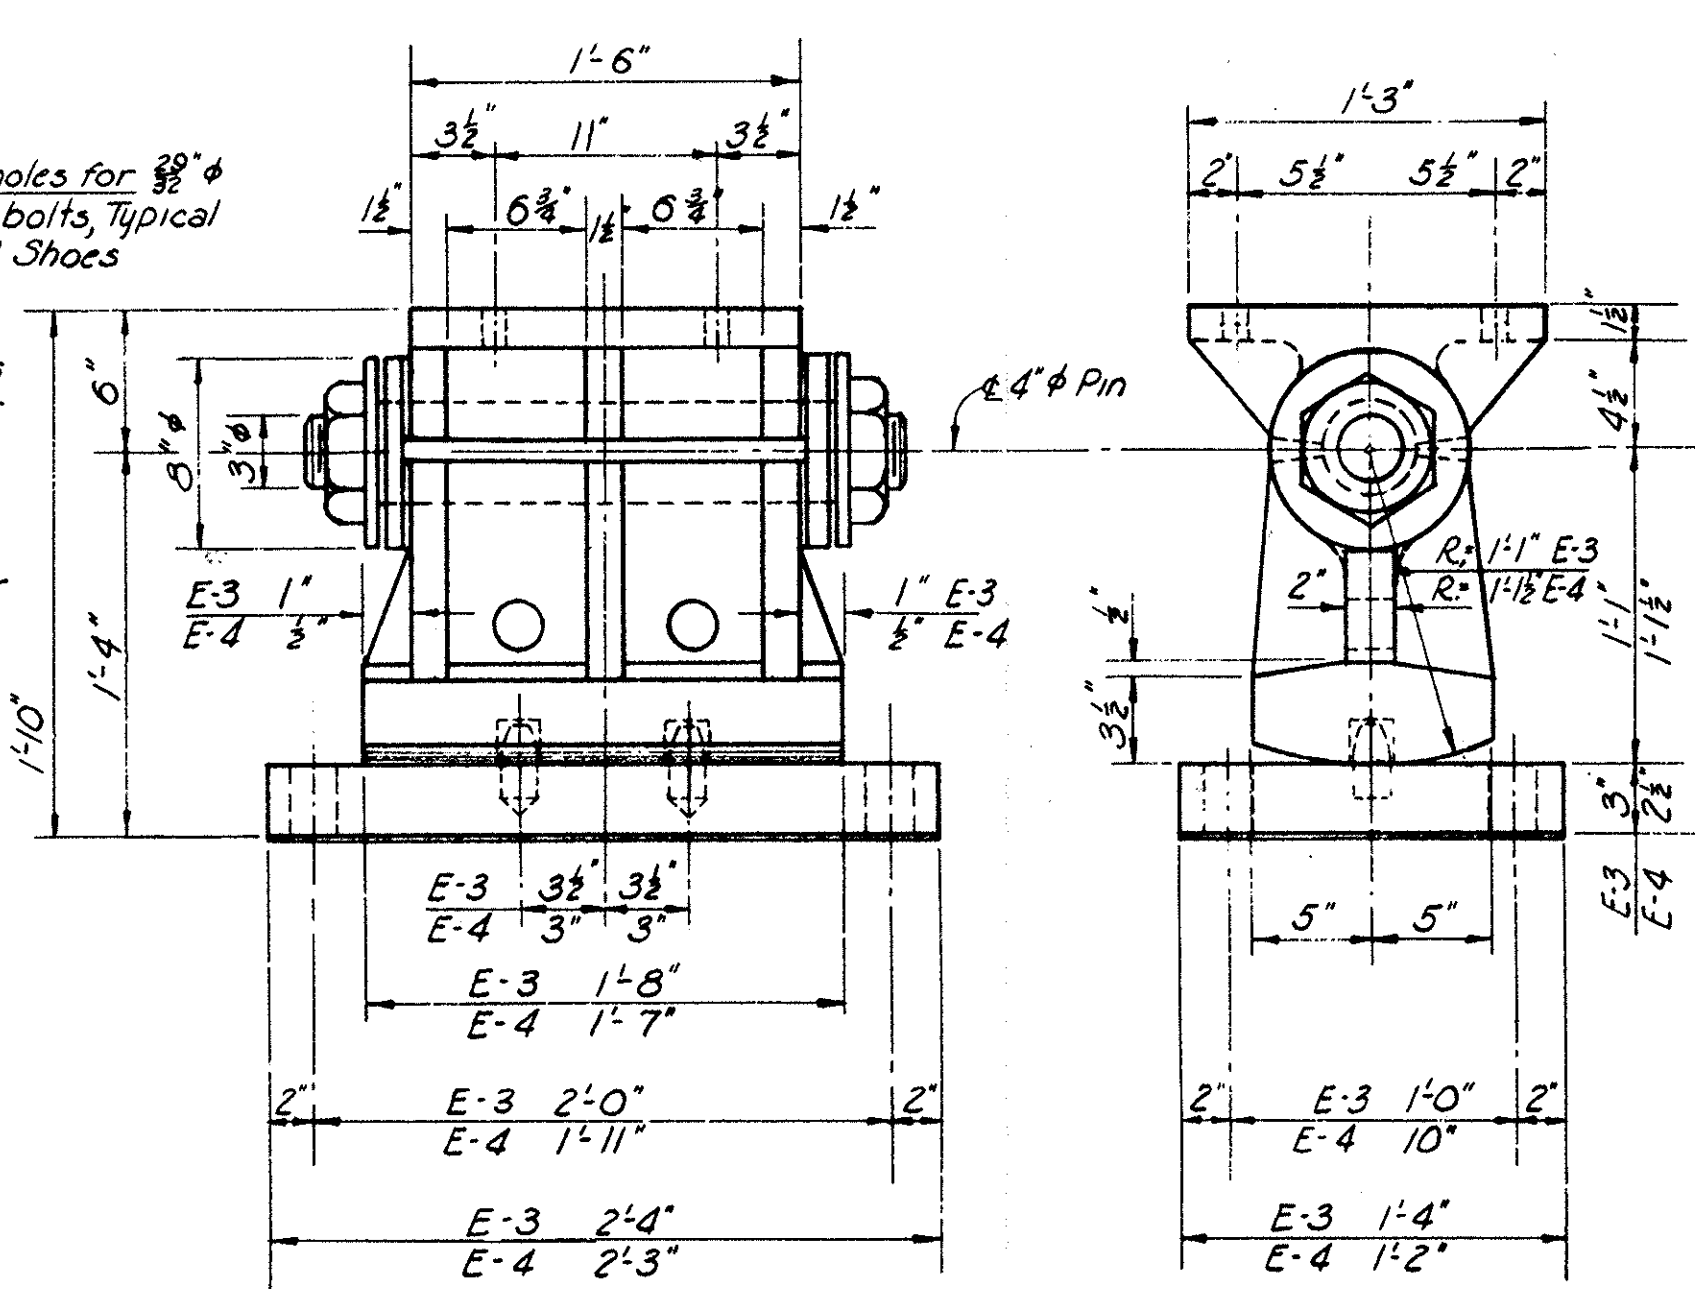


**SHOES E-3 AND E-4**  
Shoes E-3 and E-4 are similar except as shown  
Scale: 1 1/2" = 1'-0"  
10 E-3 Required  
6 E-4 Required

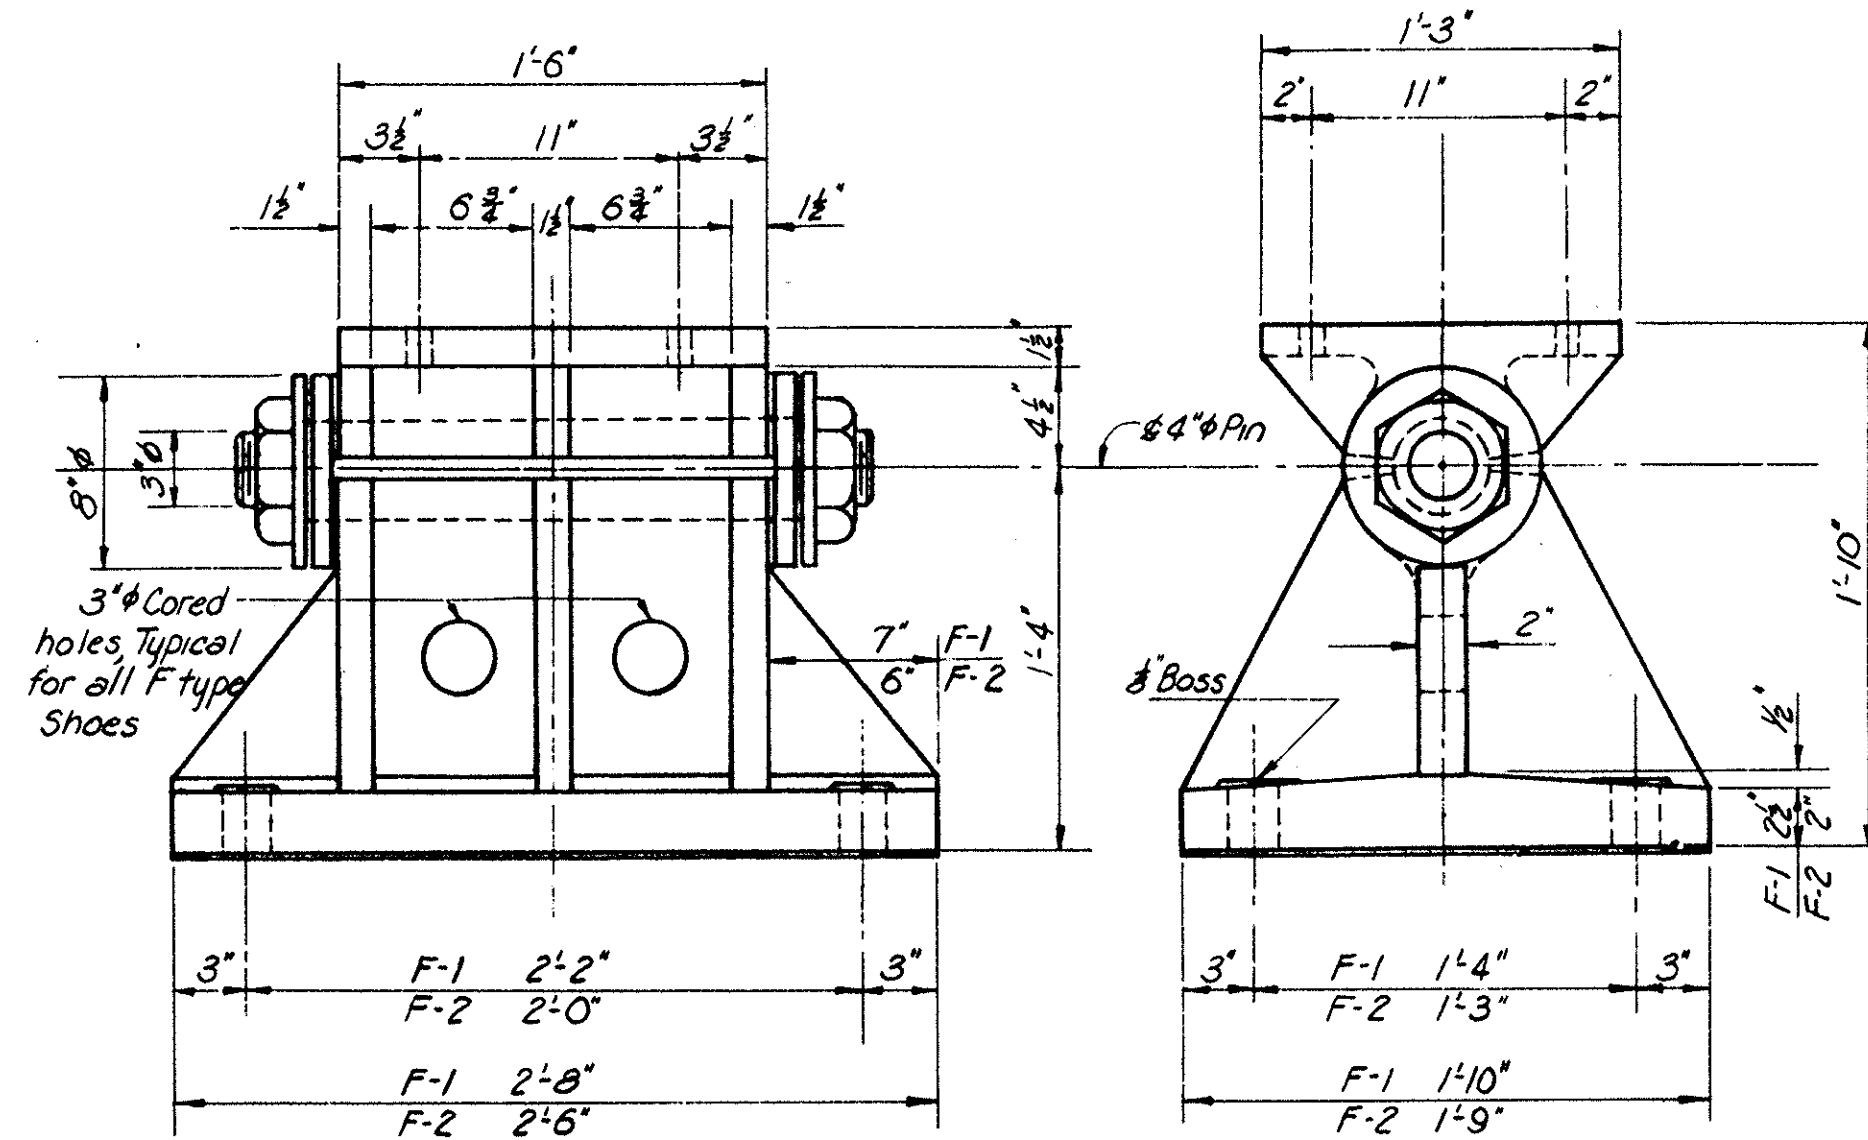


**SHOES F-1 AND F-2**  
Shoes F-1 and F-2 are similar except as shown  
Scale: 1 1/2" = 1'-0"  
F-1 Required  
F-2 Required

SCHEDULE OF SHOES	
Location	Type Shoe under Girder
	A B C D E F
West Abutment	E-4 E-3 E-3 E-3 E-3 E-4
Pier 1	F-3 F-2 F-2 F-2 F-2 F-3
Pier 2	E-3 E-2 E-2 E-2 E-2 E-3
Pier 3	F-3 F-1 F-1 F-1 F-1 F-3
Pier 4	E-2 E-1 E-1 E-1 E-1 E-2
Pier 5	E-2 E-1 E-1 E-1 E-1 E-2
Pier 6	F-3 F-2 F-2 F-2 F-2 F-3
East Abutment	E-4 E-3 E-3 E-3 E-3 E-4


\* Steel beam. See detail.

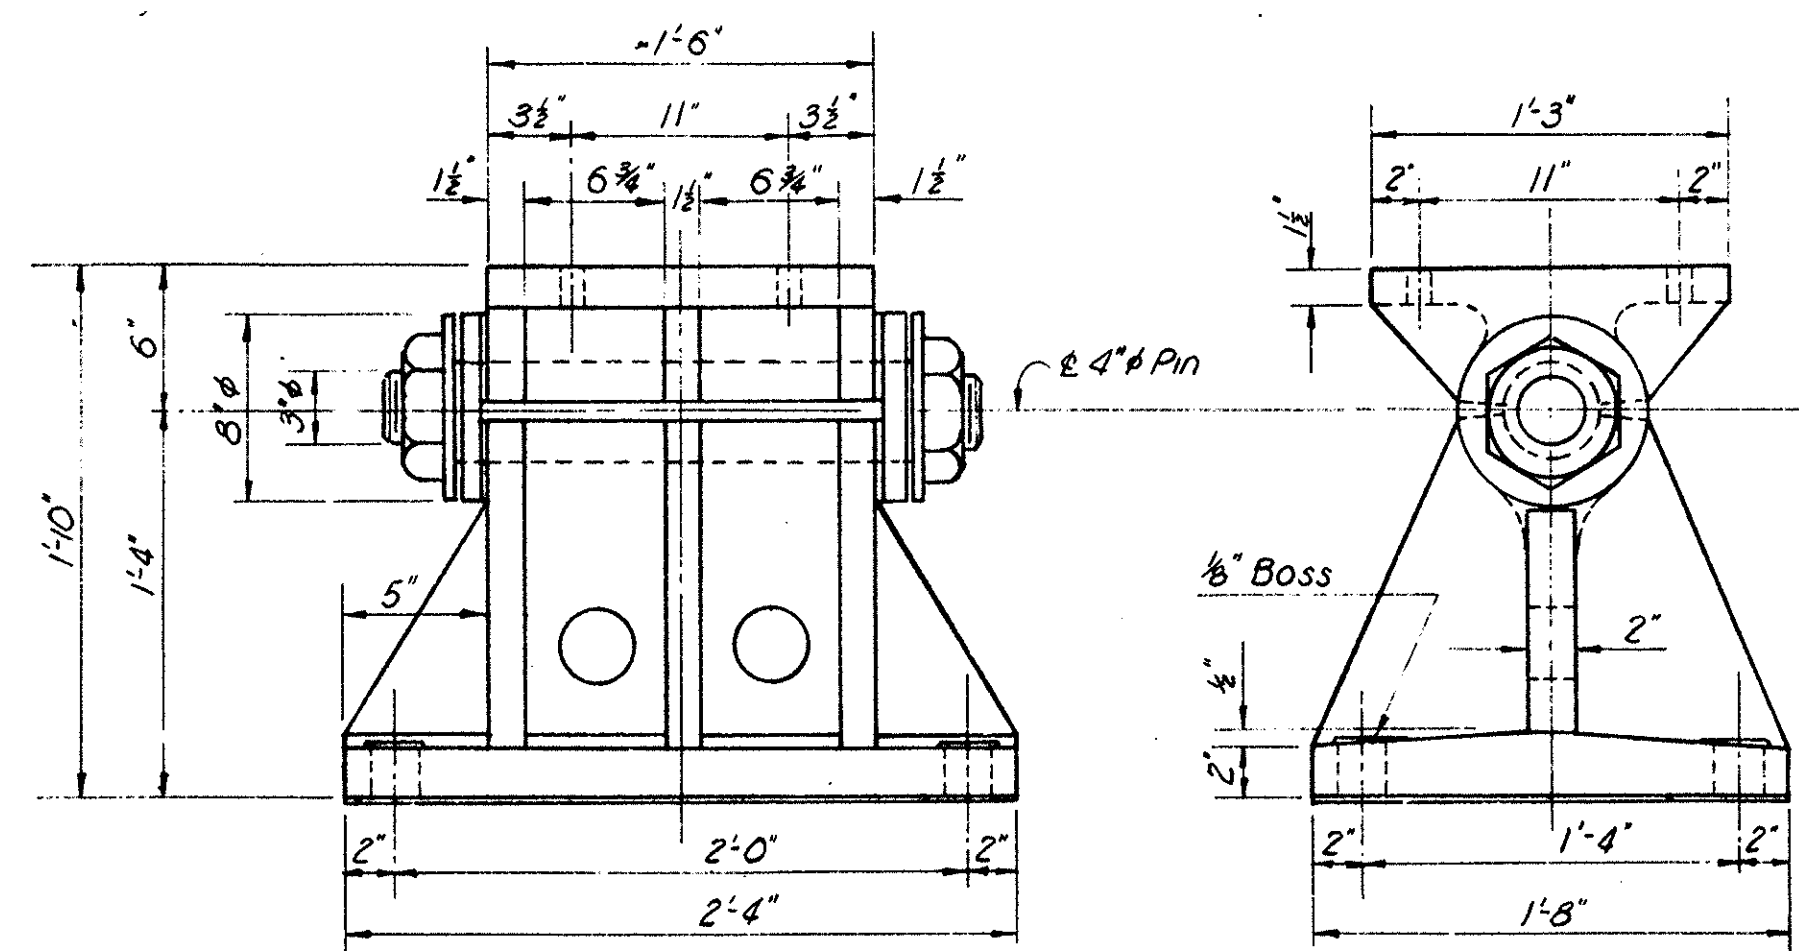

**SHOE F-3**  
Scale: 1 1/2" = 1'-0"  
7 Required

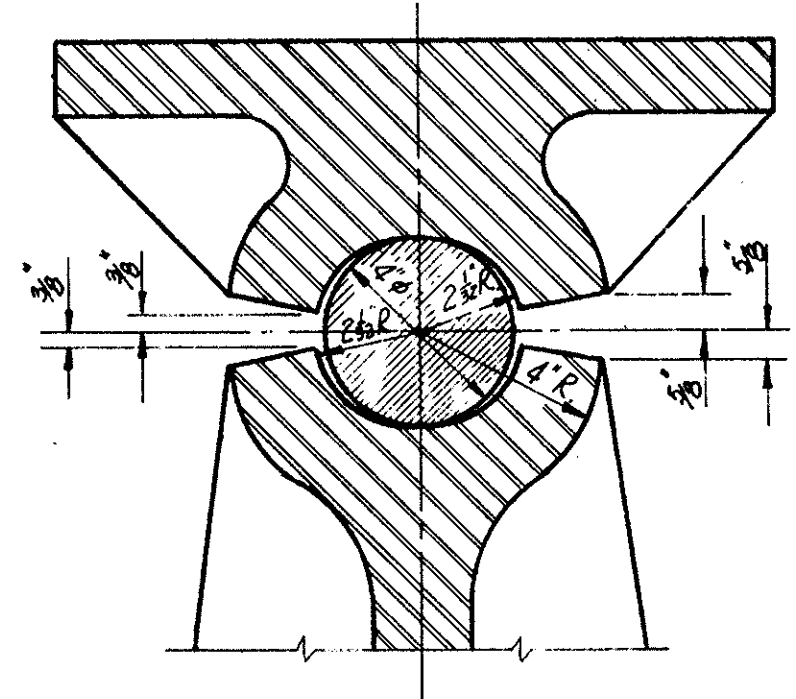


SECTION THRU PIN

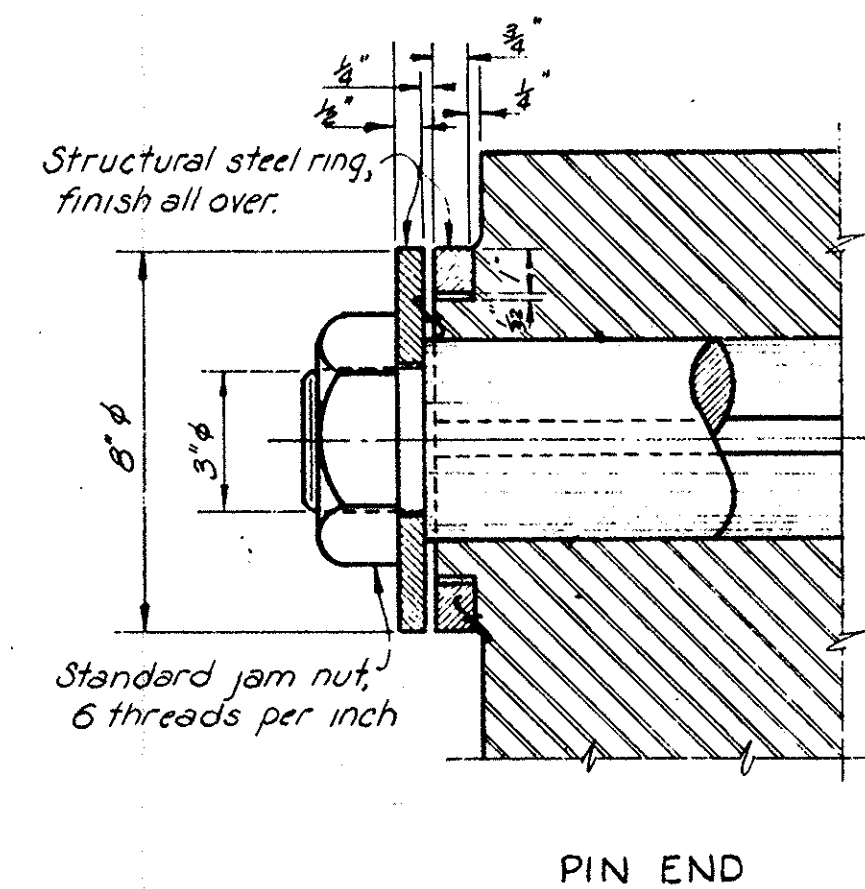


PIN END

**PIN DETAILS**  
Scale: 3" = 1'-0"

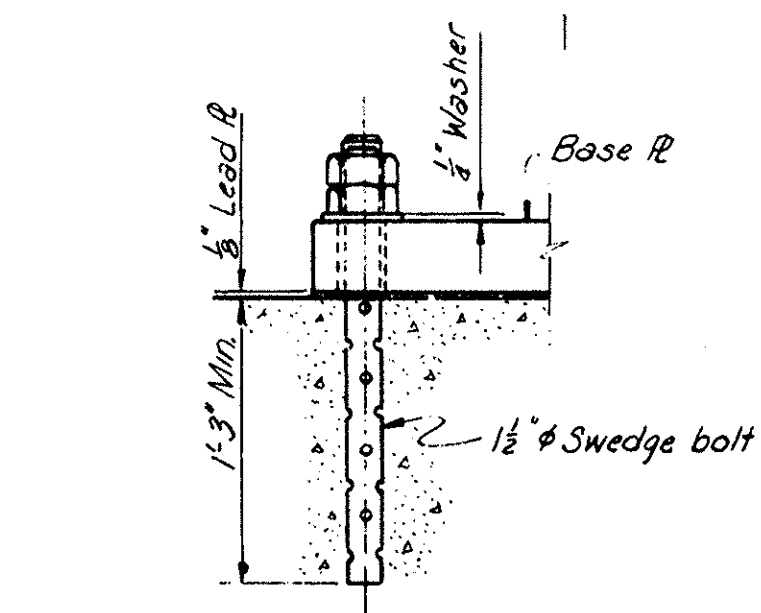


**SHOE ANCHOR BAR DETAIL**  
Scale: 1 1/2" = 1'-0"


**NOTES:**  
Shoes E-4, F-1, F-2, F-3 and also top castings of E-1, E-2, and E-3 shall be carbon steel castings A.S.T.M. A27- Grade 65-35.  
Base Plate for shoe E-4 may be carbon steel casting A.S.T.M. A27-52T Grade 65-35 or structural steel plate.  
Lower casting and base plate of shoes E-1, E-2 and E-3 shall be high strength steel castings, A.S.T.M. A148-50T Grade 90-60, or an equivalent material having a minimum yield point of 55,000 P.S.I.  
All pins, nuts, washers, and rings shall be structural carbon steel.  
Bolts to girder flanges shall have hex heads and self-locking nuts equal to "Anco" by Automatic Nut Co. of Lebanon, Pa. Provide washers under heads and nuts.  
Machined surfaces of rockers which bear on base plates and other exposed surfaces shall be painted.  
All contact surfaces between metal parts shall be finished.  
Lower castings of all shoes shall be centered in both directions under top castings for a temperature of 60°F. All base plates and shoe castings shall be scribed with center lines in both directions.  
All fillets shall be 3/4" radius unless otherwise noted.  
Spaces around anchor bolts in base plates shall be filled with an approved metallic filler before setting nuts.  
Threaded ends of the pins shall be upset, battered, or welded after assembly in field to prevent loosening of the jam nuts.

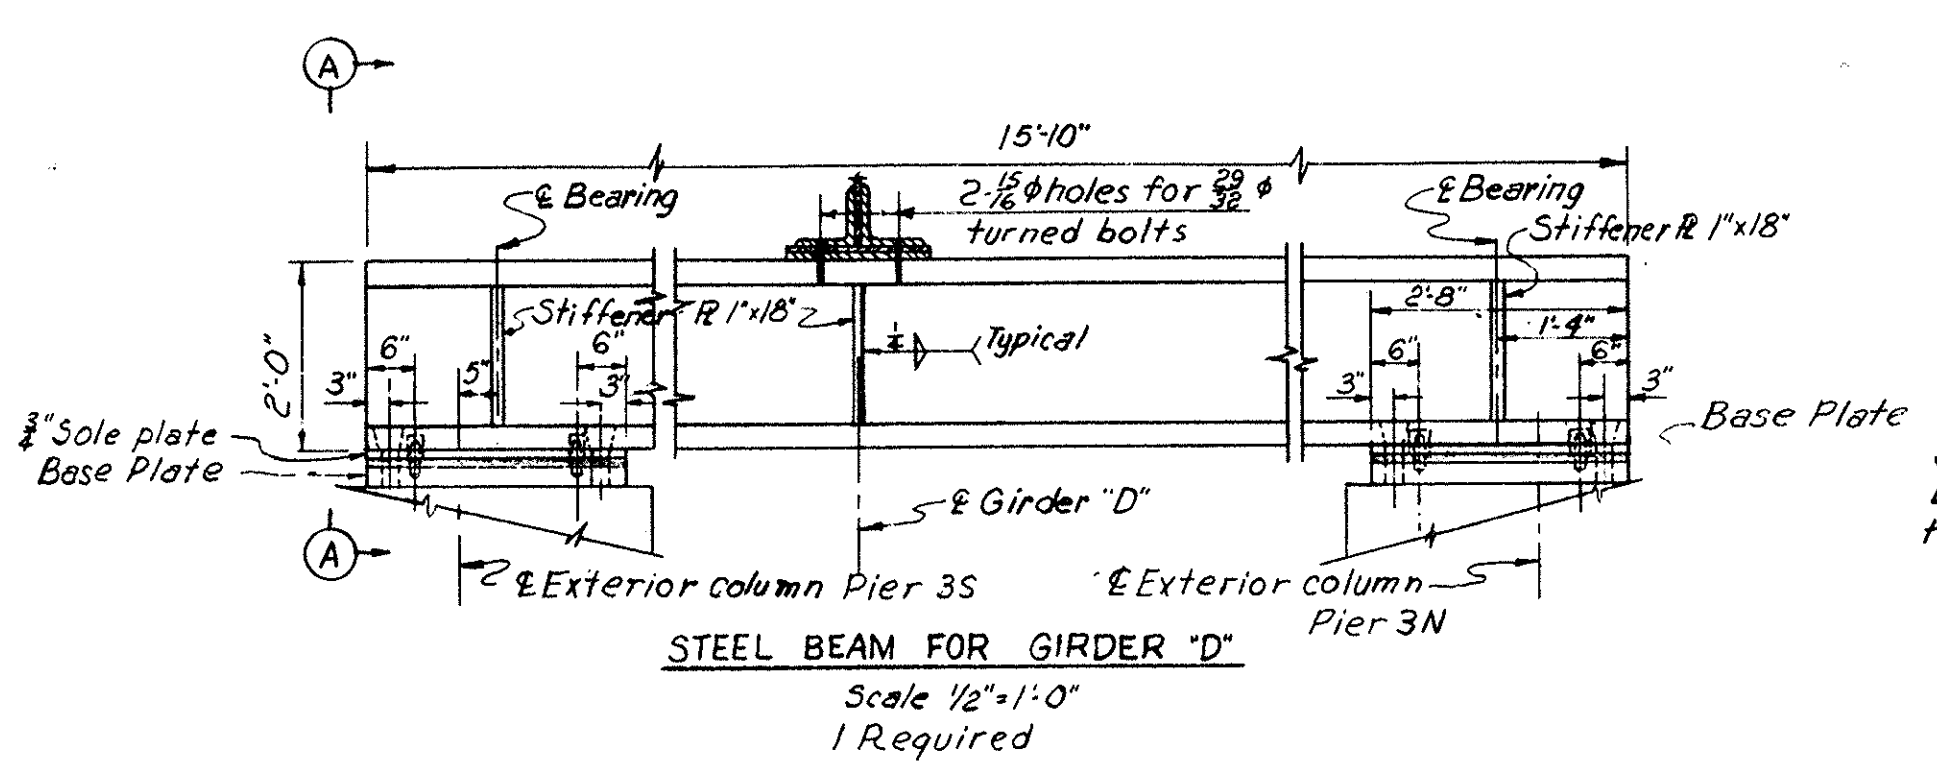


**STEEL BEAM FOR GIRDER 'D'**  
Scale 1/2" = 1'-0"  
1 Required

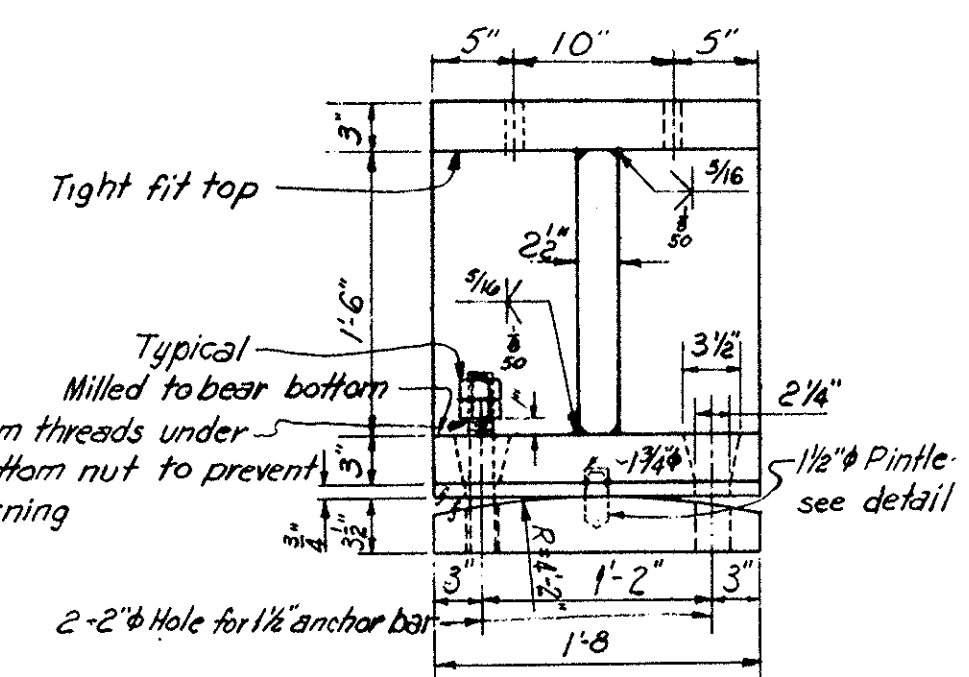

Scale 1" = 1'-0"

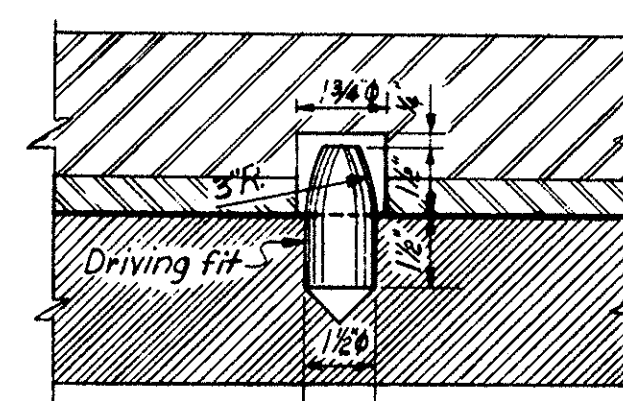

**STEEL BEAM PINTLE DETAIL**  
Scale: 3" = 1'-0"

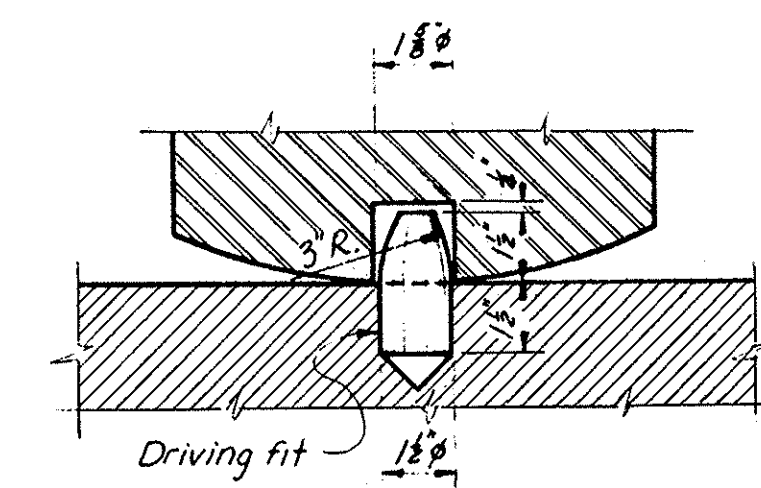

**SHOE PINTLE DETAIL**  
Scale: 3" = 1'-0"

PART 7

**AKRON EXPRESSWAY SYSTEM**  
WEST VIADUCT  
BR. NO. SU-18R-135  
**SHOES**


AKRON SUMMIT COUNTY, OHIO

SCALE As Noted  
MADE D.L.L. DATE 7-7-55  
TRCD. DATE  
KND. H.W.G. DATE 12-13-55



HOWARD, NEEDLES, TAMMEN & BERGENDOFF  
CONSULTING ENGINEERS  
CLEVELAND NEW YORK  
901 SHEET 7-9

**SUMMIT COUNTY  
CITY OF AKRON  
AKRON EXPRESSWAY SYSTEM**

Note A: Extend  $\frac{1}{2}$ " plate as required to accommodate a minimum of 10 rivets connecting bracket to tie plate.

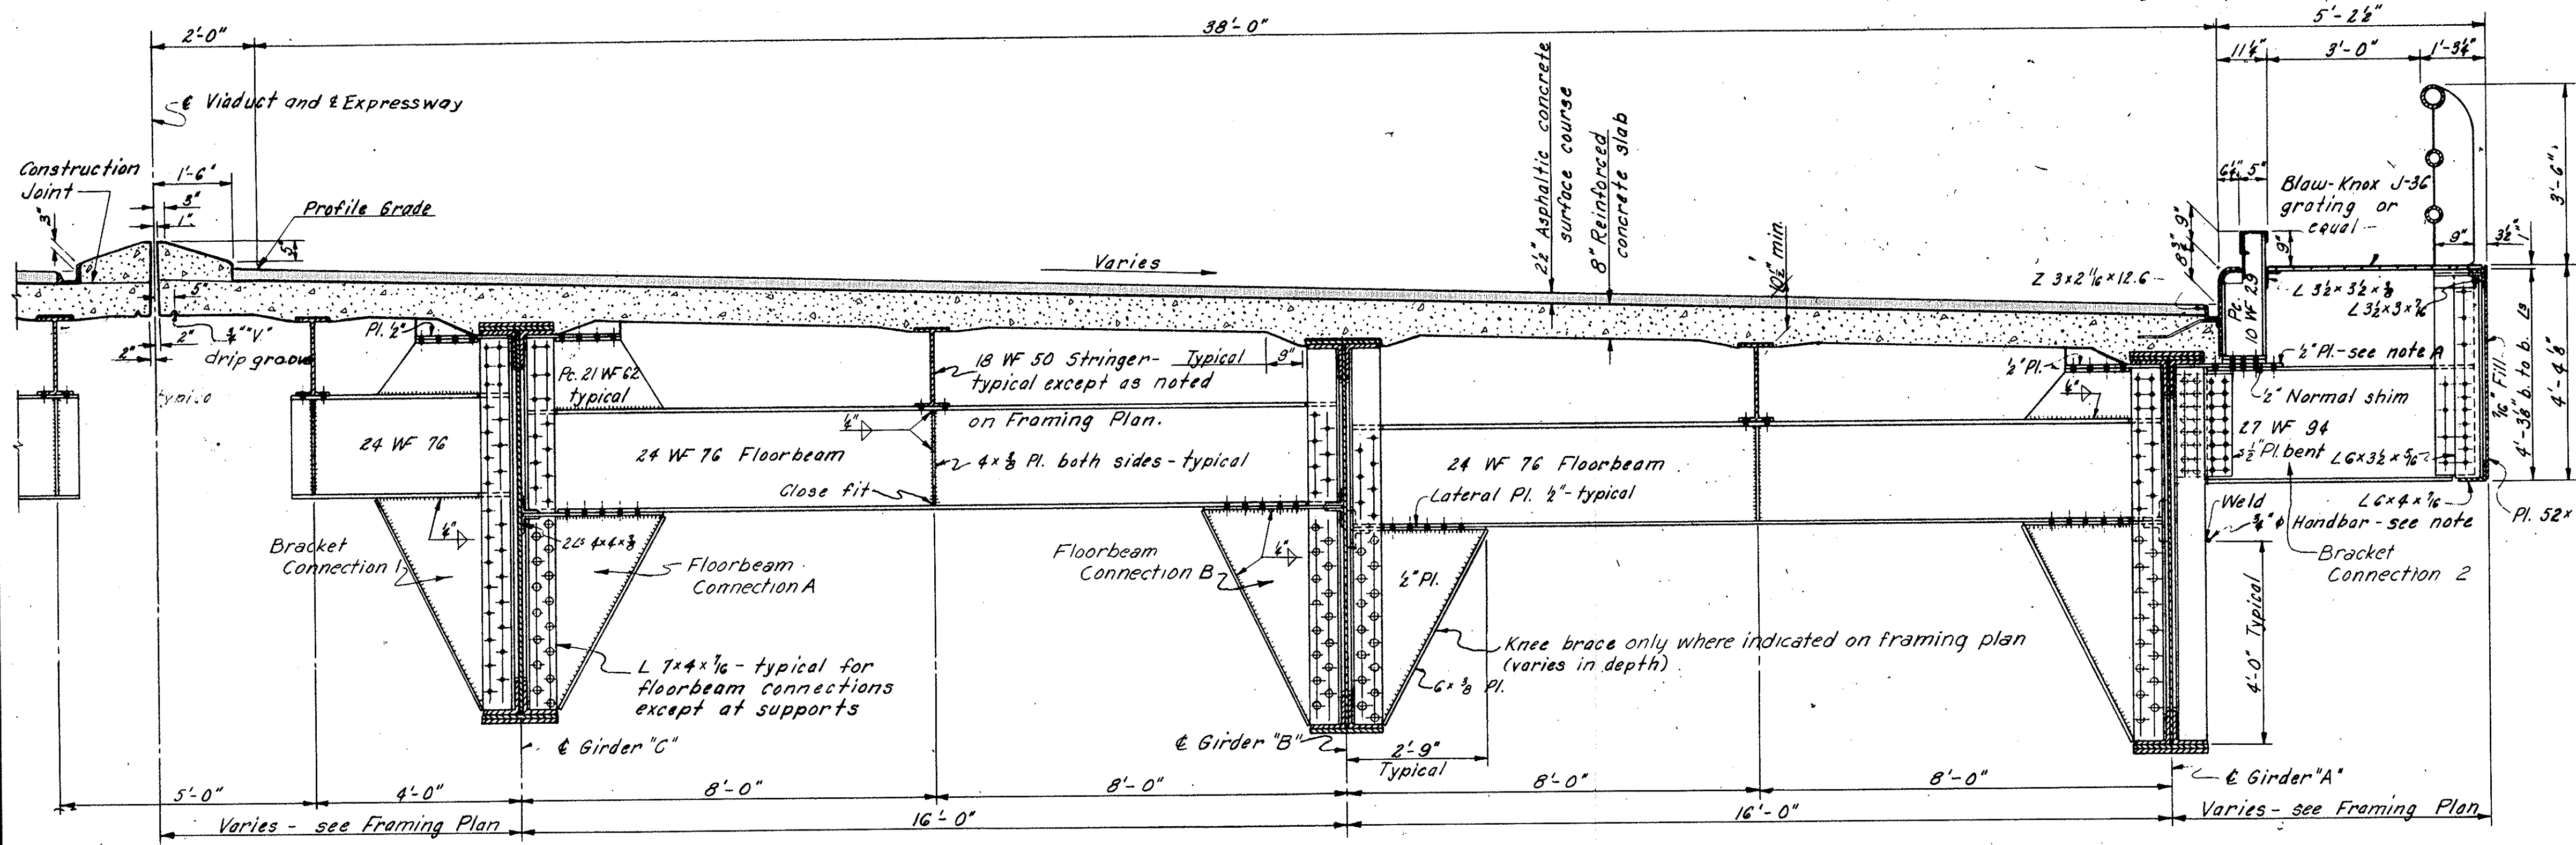

**HALF CROSS SECTION AT PANEL POINT C**

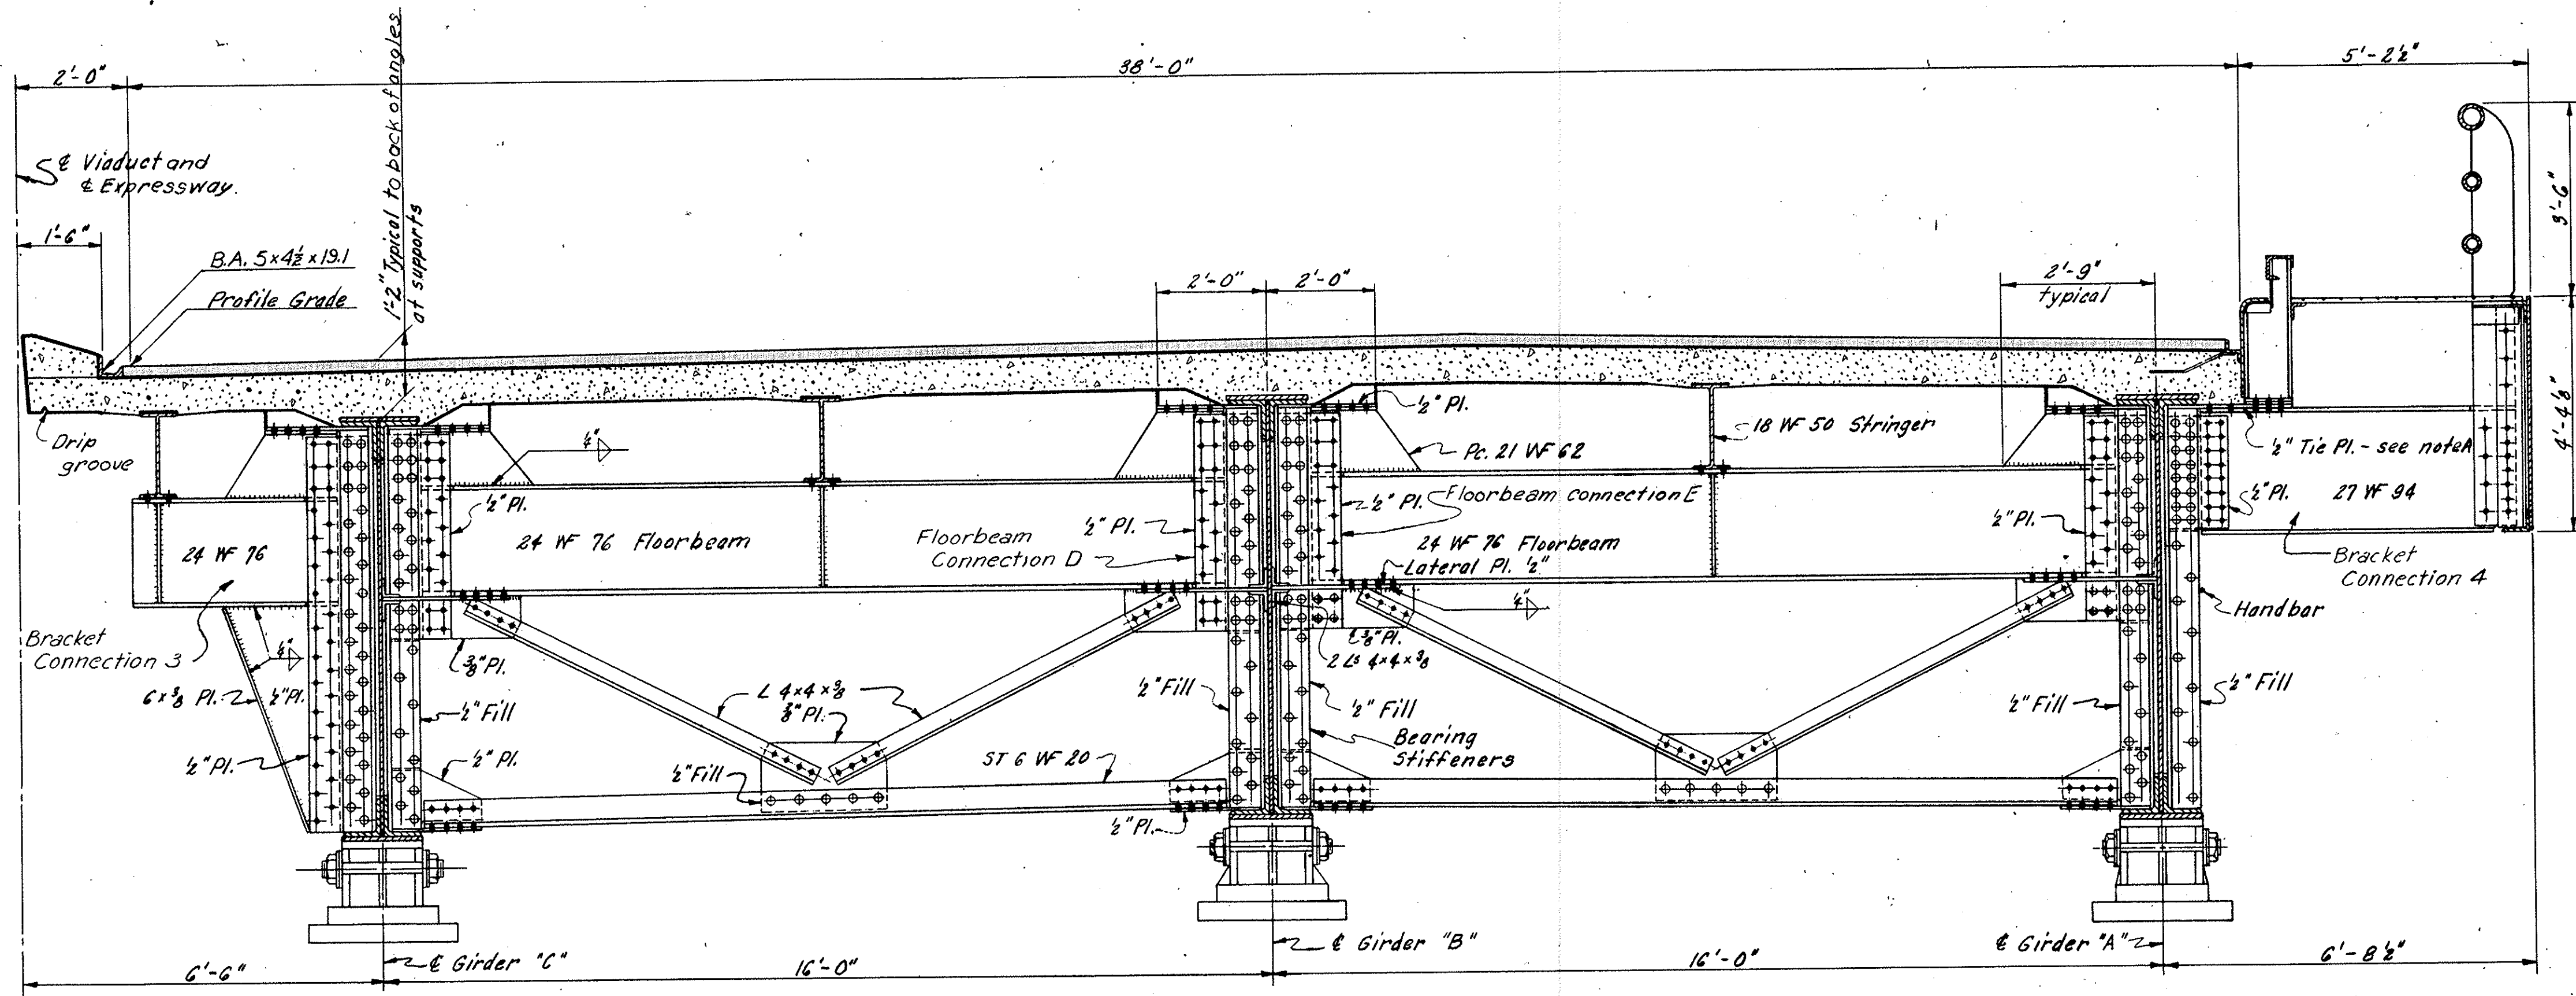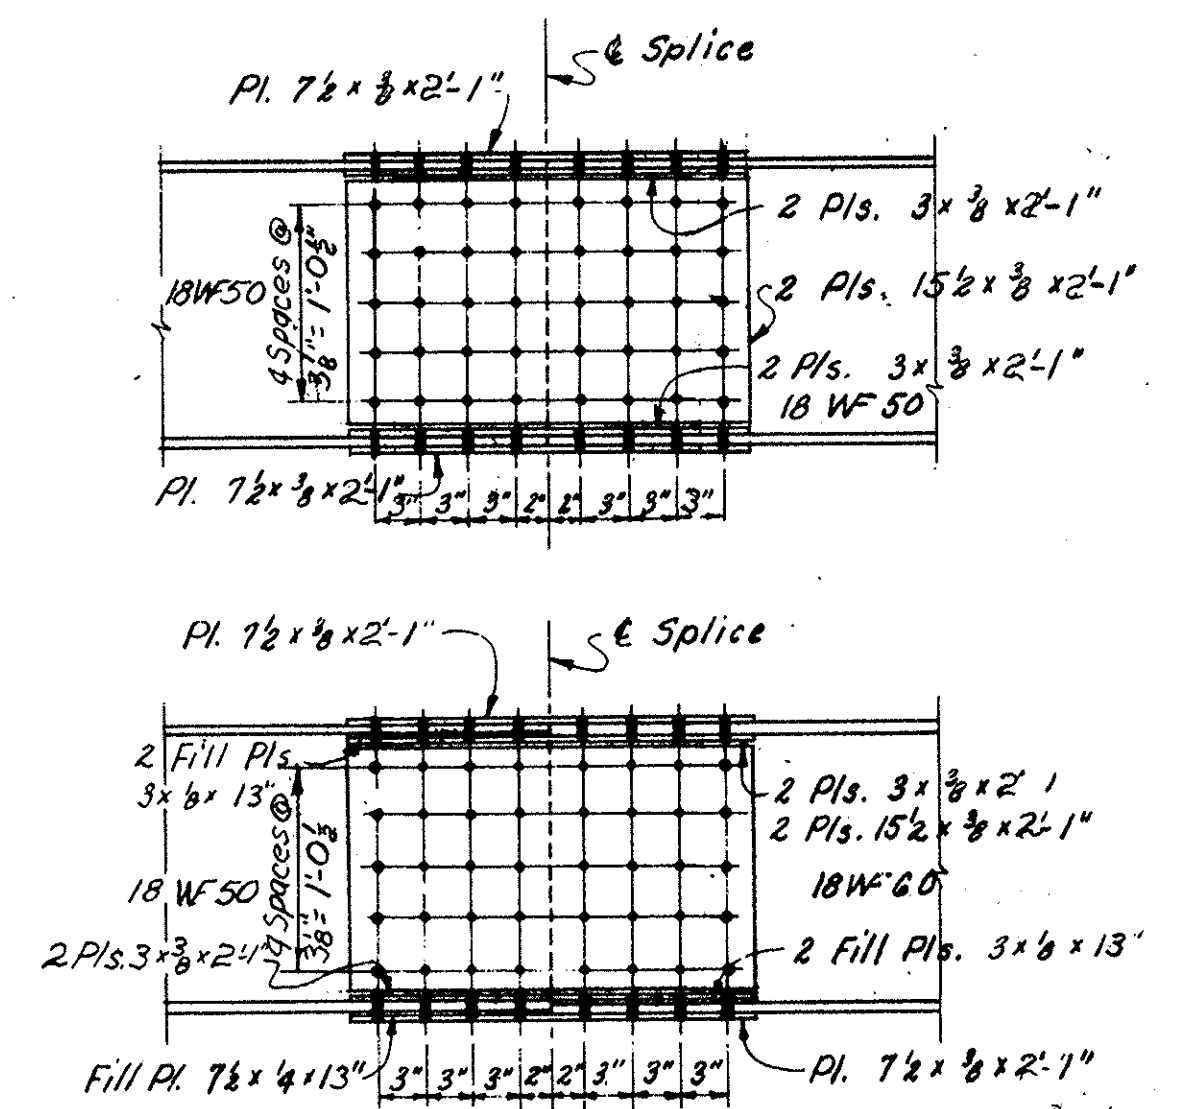

**HALF CROSS SECTION AT PIER 4**

Sections at Pier 1 and Pier 3 similar except as noted on Framing Plan. Pier 2 similar except connection plates are to be bent. West abutment similar except for connections of Girders A and F which are similar to floorbeam connection J.

- NOTES:**
- For location of knee braces see Framing Plan, Sheet B6.
  - For detail of handrail and curb see Sheet 97.
  - For Roadway Slope see Sheet B4.
  - Provide  $\frac{1}{2}$ "  $\phi$  handbars on both sides of all girders, 4'-0" above bottom flange. Shop weld bars to outstanding legs of girder stiffener angles. Provide breaks in bars when required for knee braces, floor beams, built-up diaphragms and field splices. Bend bar 90° and weld to girder web when break occurs between stiffener angles.

PART 7


**AKRON EXPRESSWAY SYSTEM**

WEST VIADUCT  
BR. NO. SU-18R-135

**ROADWAY CROSS SECTIONS**

AKRON	SUMMIT COUNTY,	OHIO
SCALE: $\frac{1}{2}$ " = 1'-0"		
MADE: FEB. DATE 7-27-55		
HOWARD, NEEDLES, TAMMEN & BERGENDOFF CONSULTING ENGINEERS		
TRCD. DATE		
KANSAS CITY CLEVELAND NEW YORK		
CKD: D.F.B. DATE 9-19-55		
901 SHEET-80		


SUMMIT COUNTY  
CITY OF AKRON  
AKRON EXPRESSWAY SYSTEM

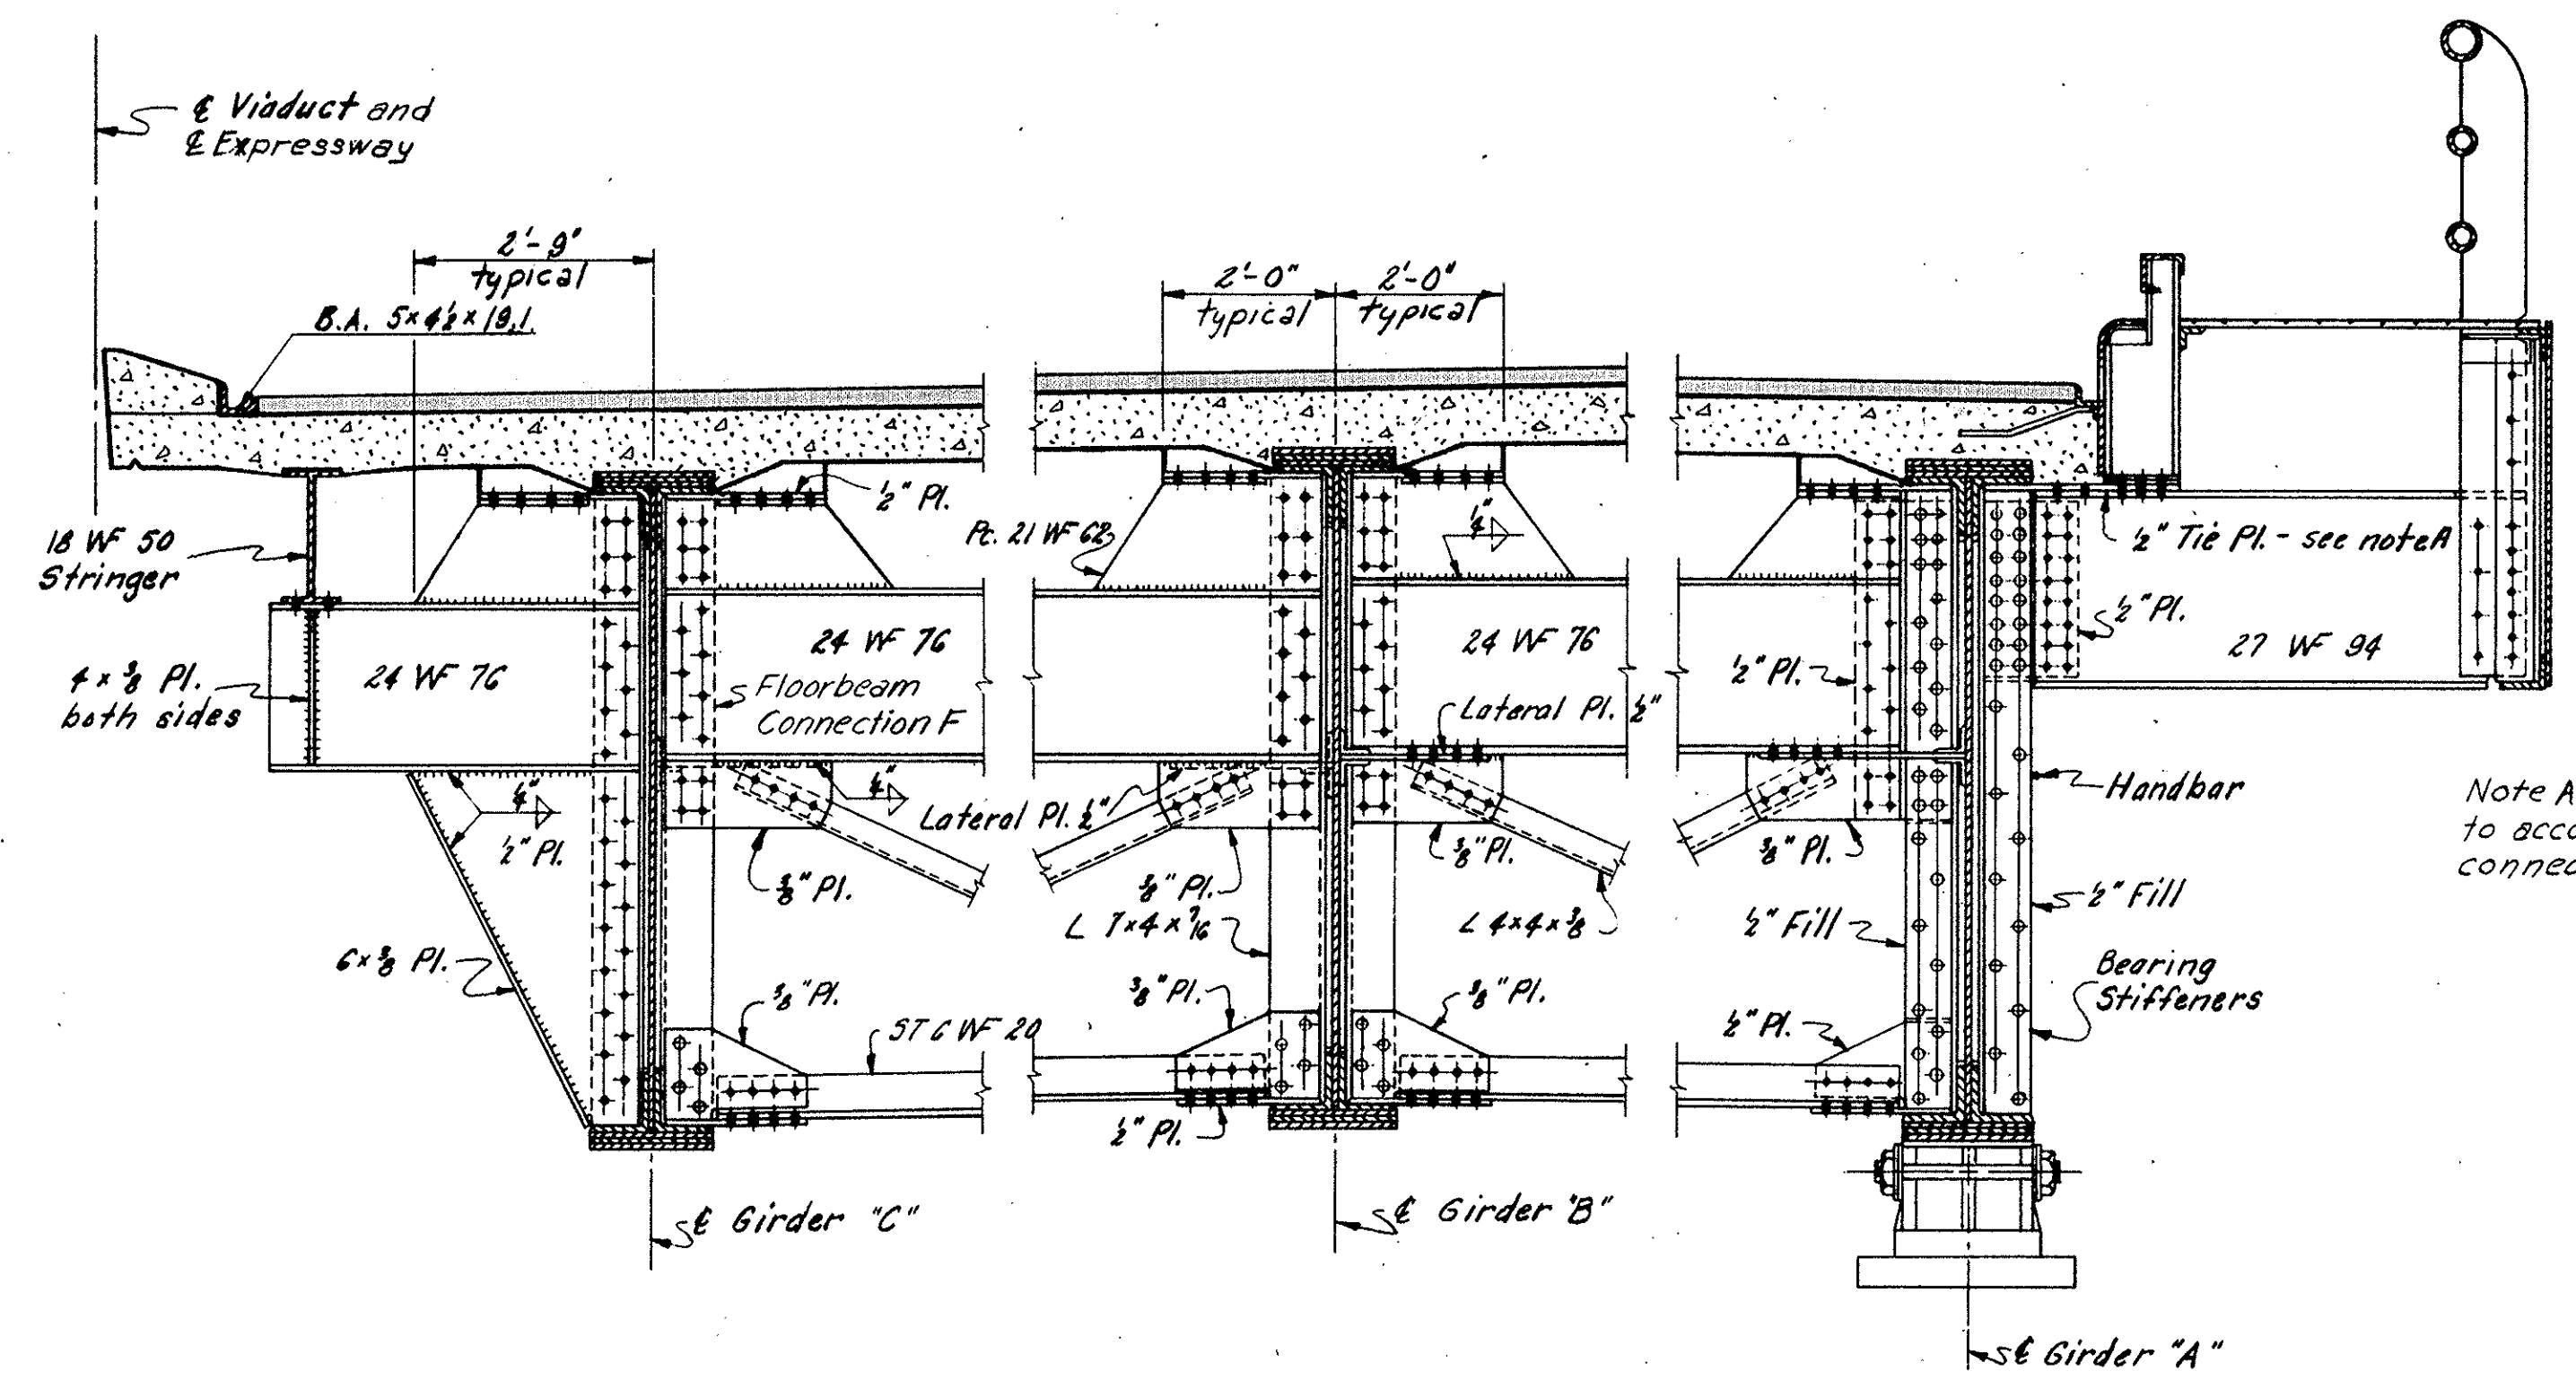

Note A: Extend 1/2" plate as required to accommodate a minimum of 10 rivets connecting bracket to tie plate.

PART CROSS SECTION AT PANEL POINT (A)

Note: Above Section shows right angle floorbeam connections to double angle bearing stiffeners and single angle stiffeners. These connections to be used for floorbeams adjacent to Piers 5 and 6. For knee brace connection to double angle bearing stiffeners at Panel Points (B) and (C) see bracket connection 3, Sheet 80.

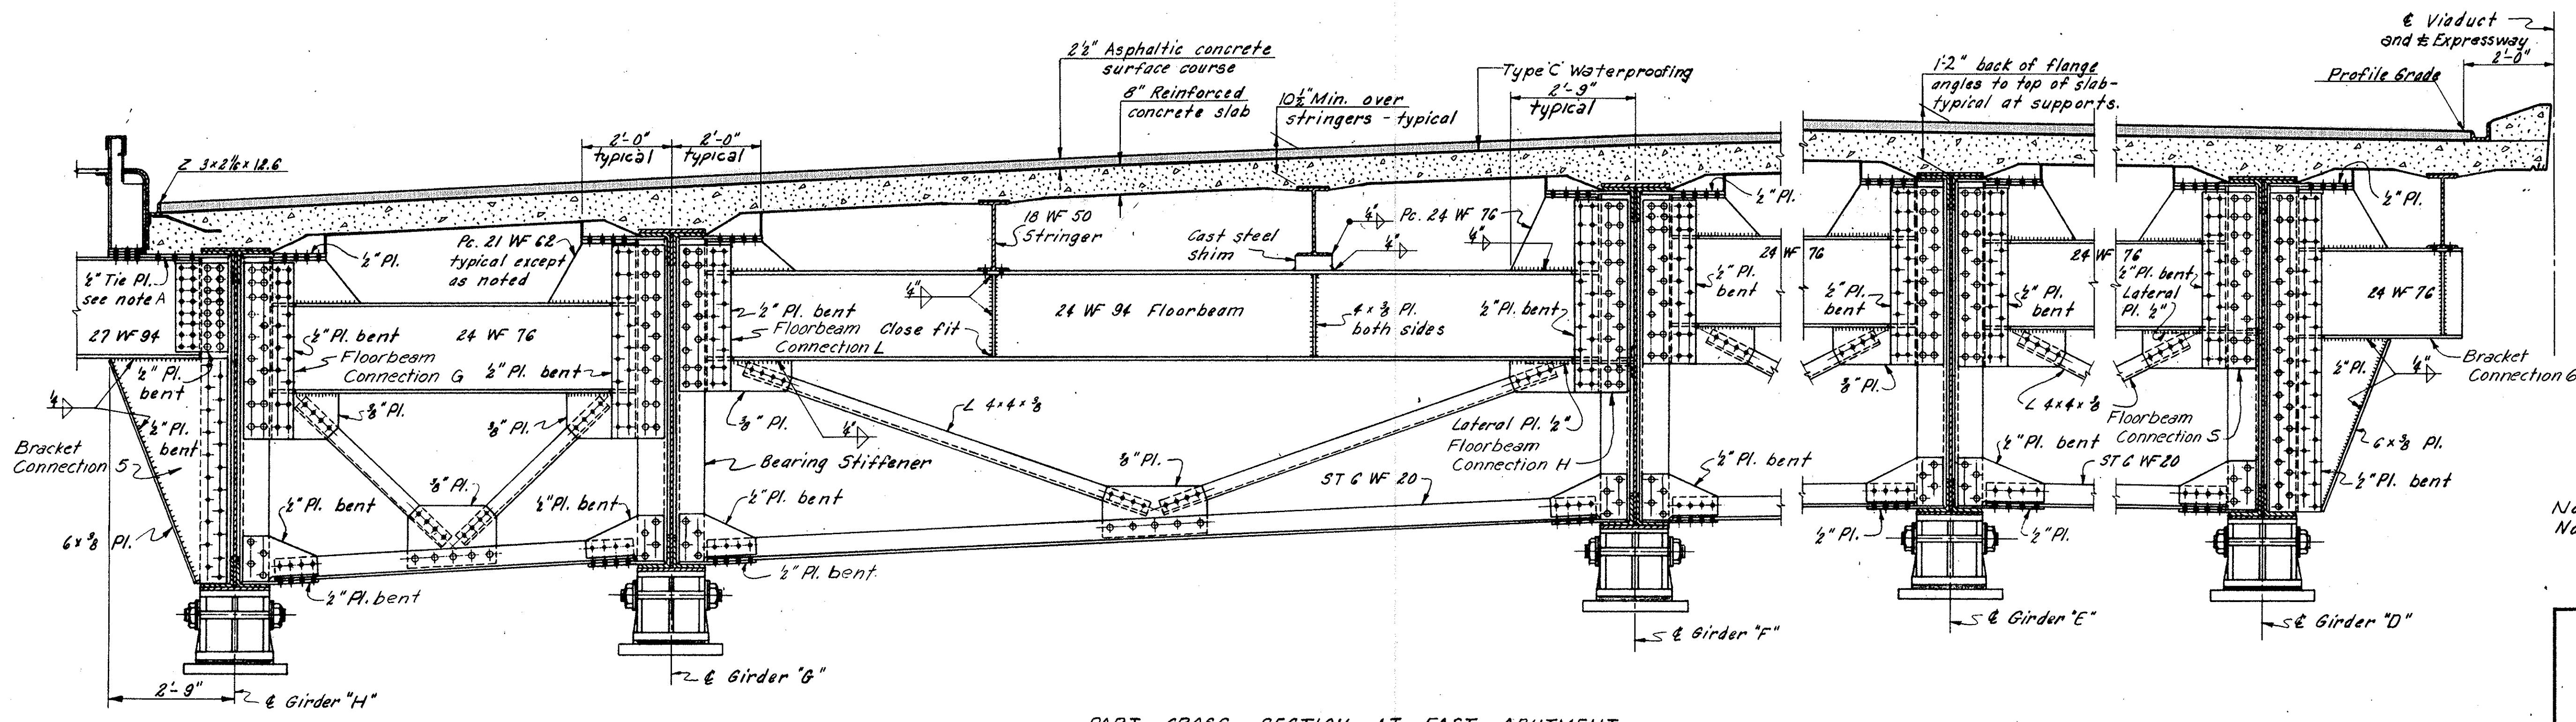

PART CROSS SECTION AT EAST ABUTMENT


Note: Connections at Girders "A", "B" and "C" similar except as noted on Framing Plan.

Note: For additional Cross Section Notes see Sheet 80.


PART 7  
AKRON EXPRESSWAY SYSTEM  
WEST VIADUCT  
BR. NO. JU-10R-135  
ROADWAY CROSS SECTIONS

SUMMIT COUNTY  
CITY OF AKRON  
AKRON EXPRESSWAY SYSTEM


Note: Extend  $\frac{1}{2}$ " plate as required to accommodate a minimum of 10 rivets connecting bracket to tie.

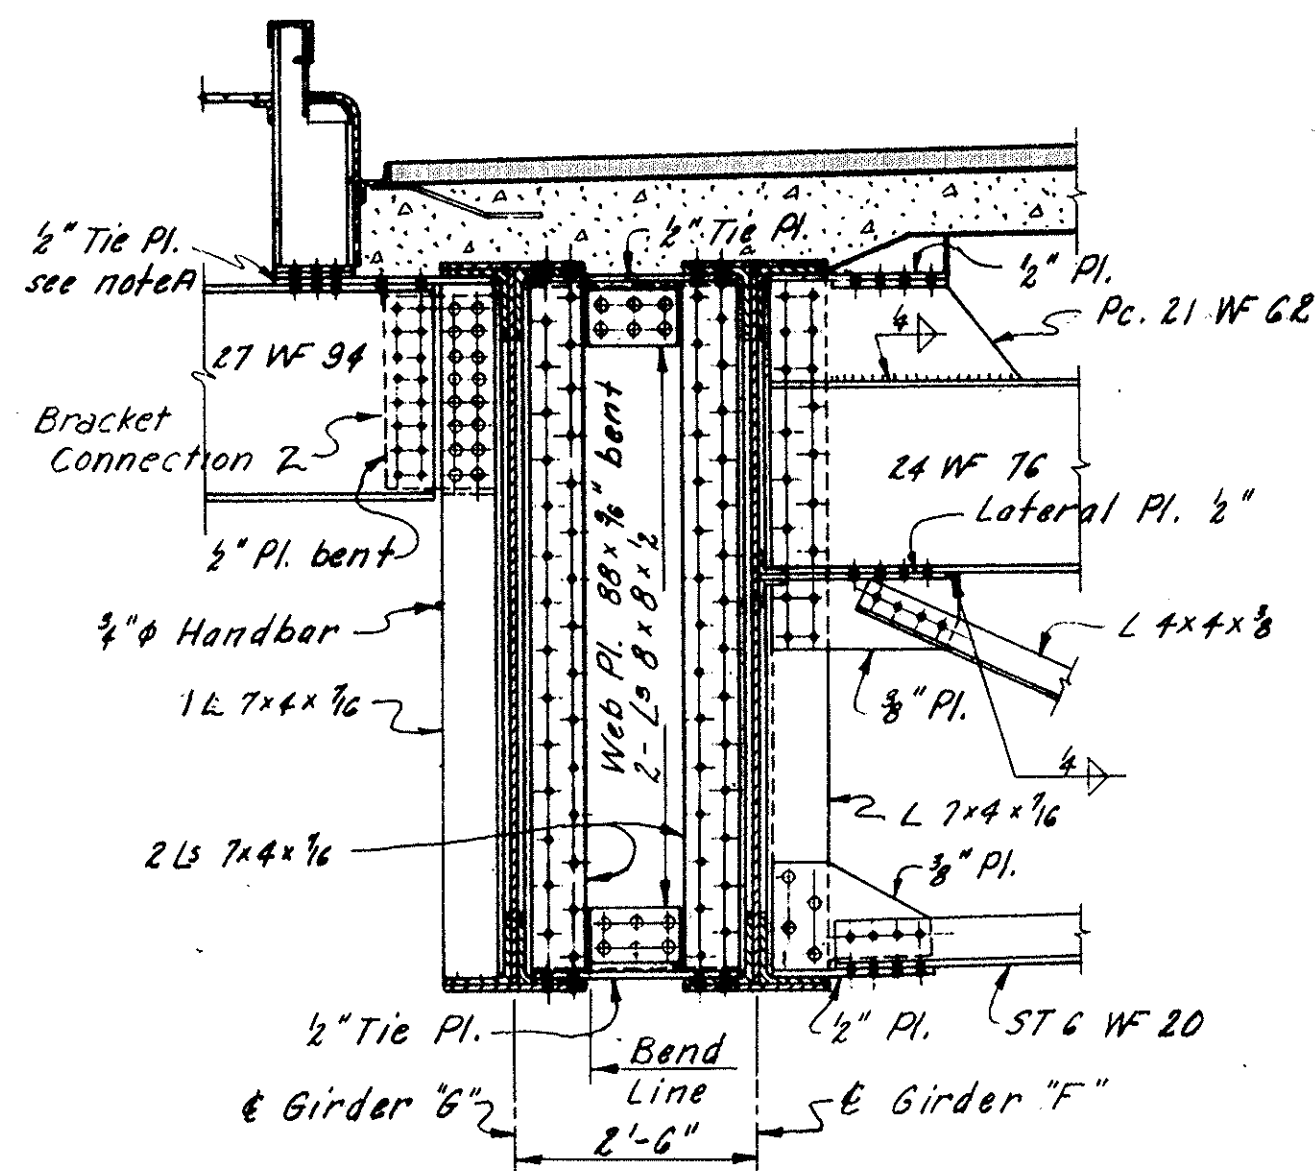


PART CROSS SECTION AT PANEL POINT 21

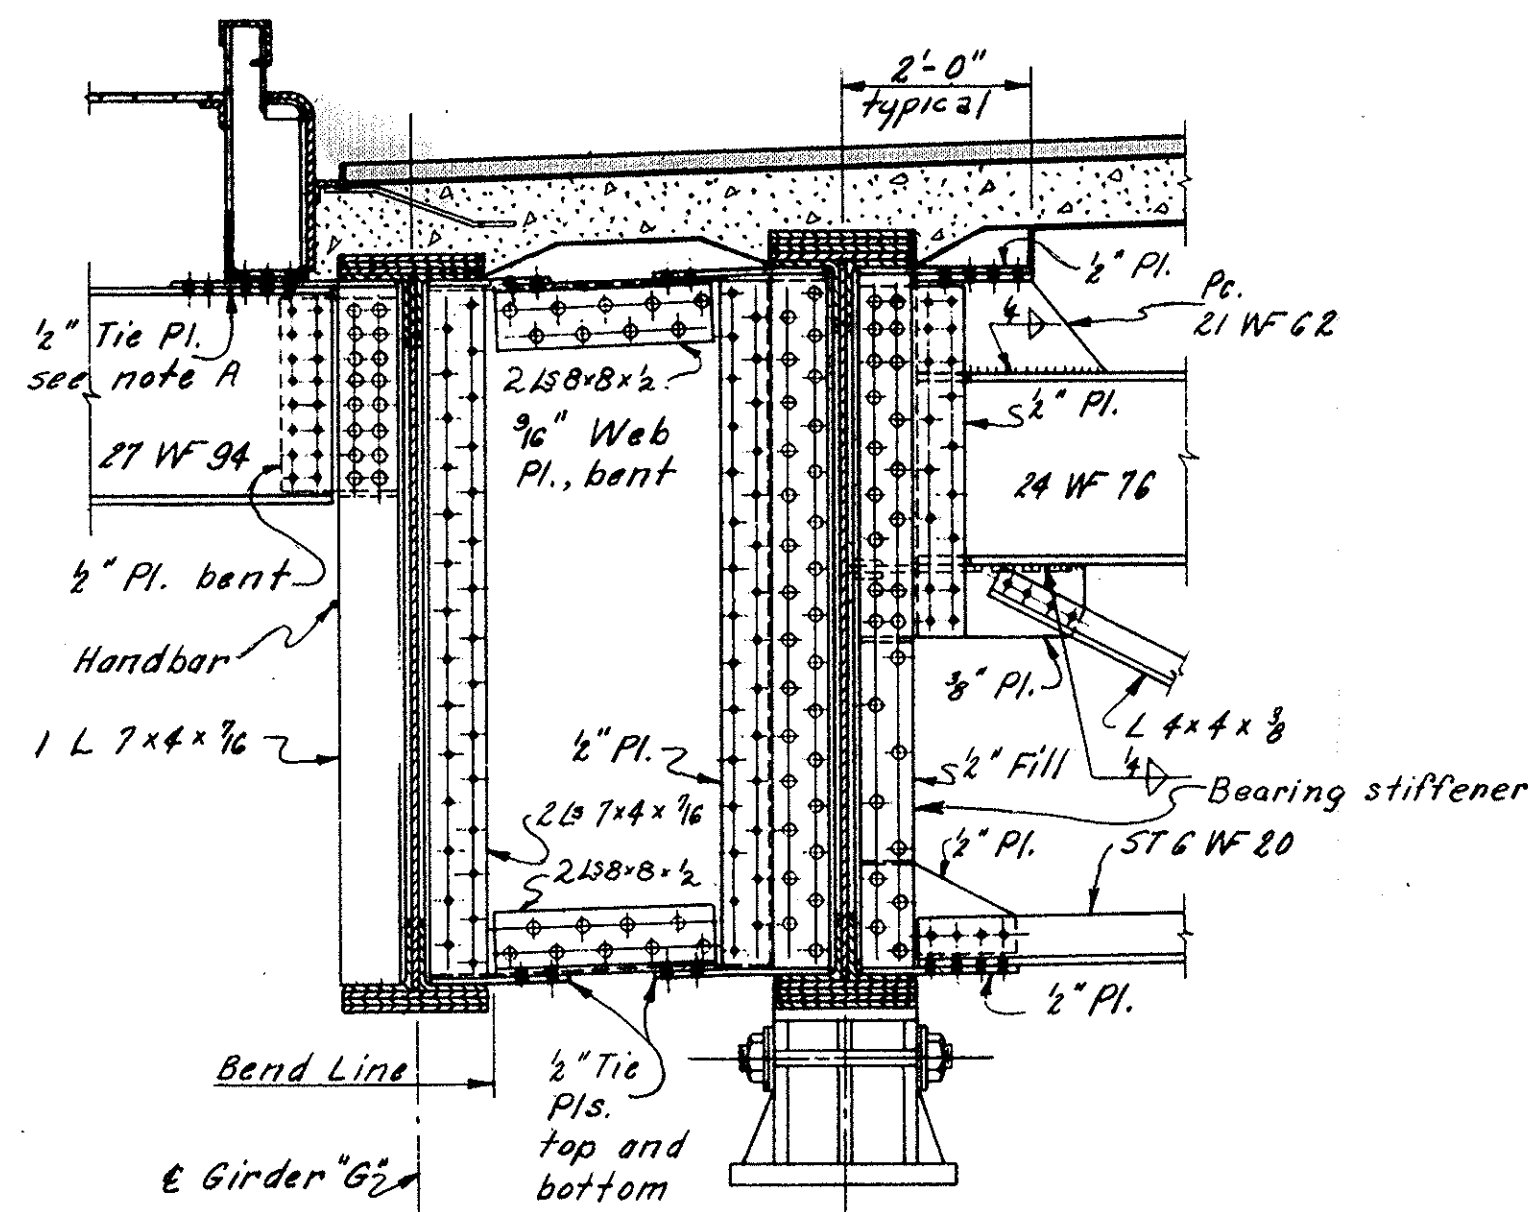


PART CROSS SECTION AT PANEL POINT 22

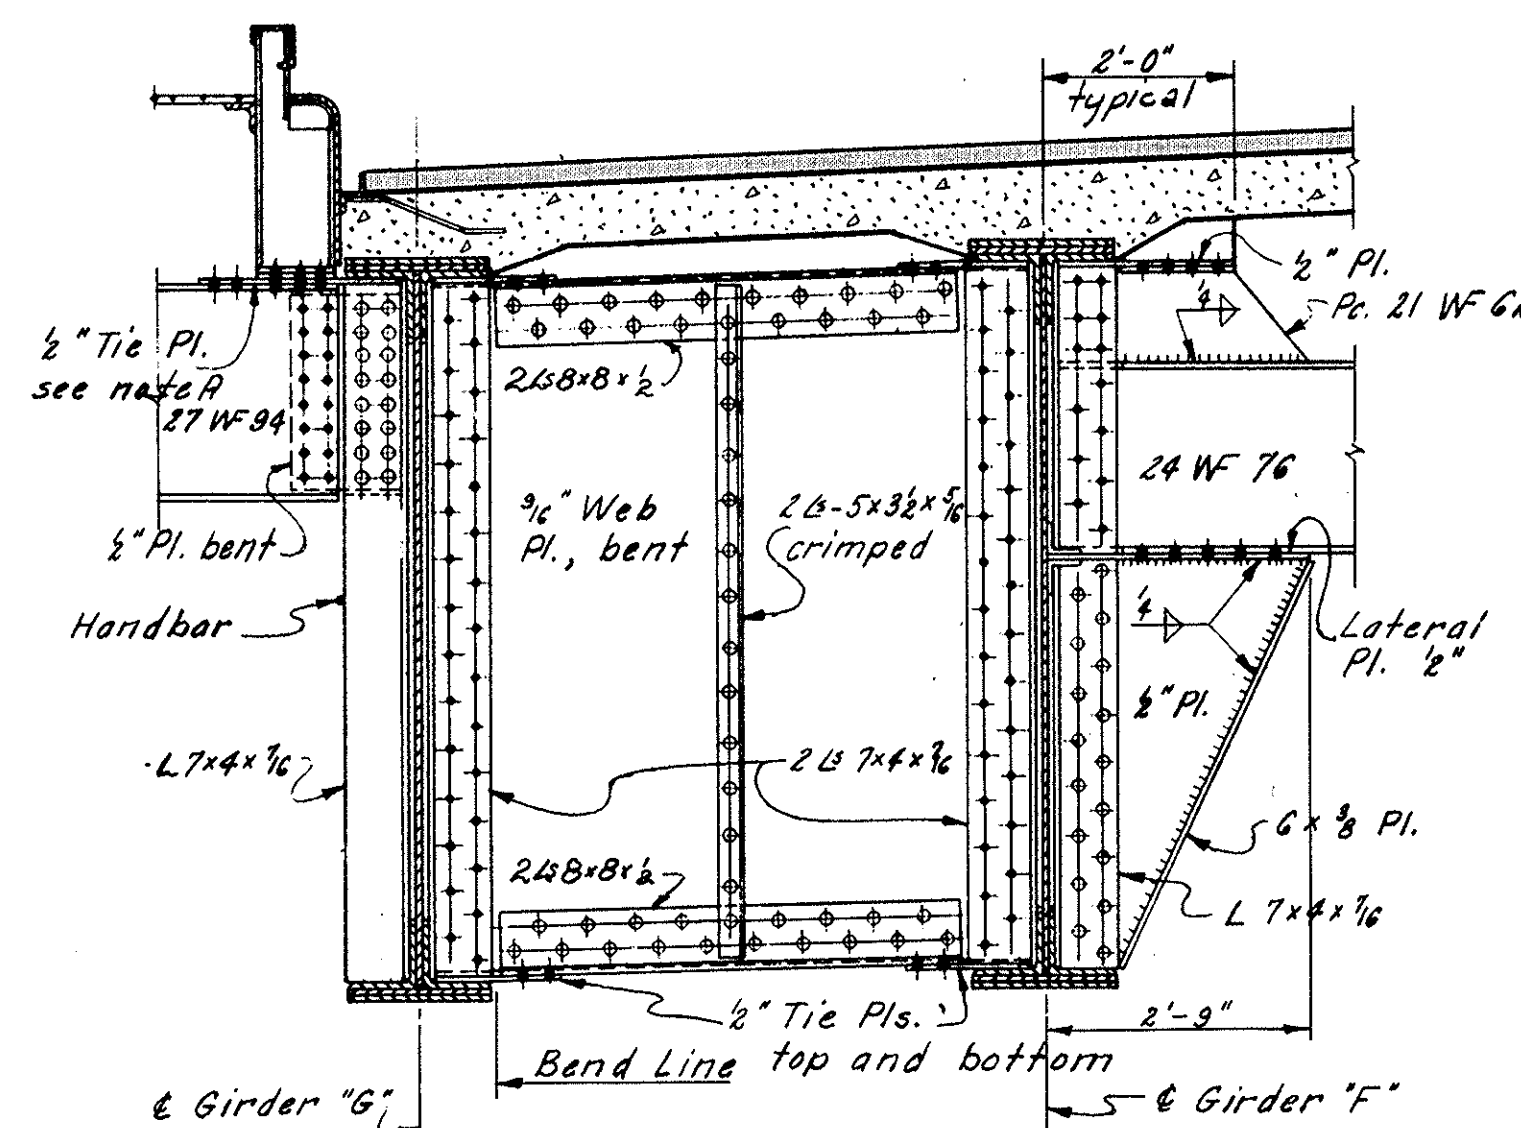


PART CROSS SECTION AT PANEL POINT 23

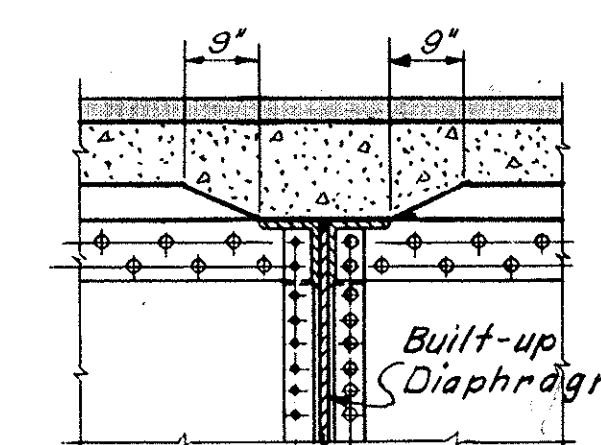


SECTION THROUGH HAUNCH OVER BUILT-UP DIAPHRAGM

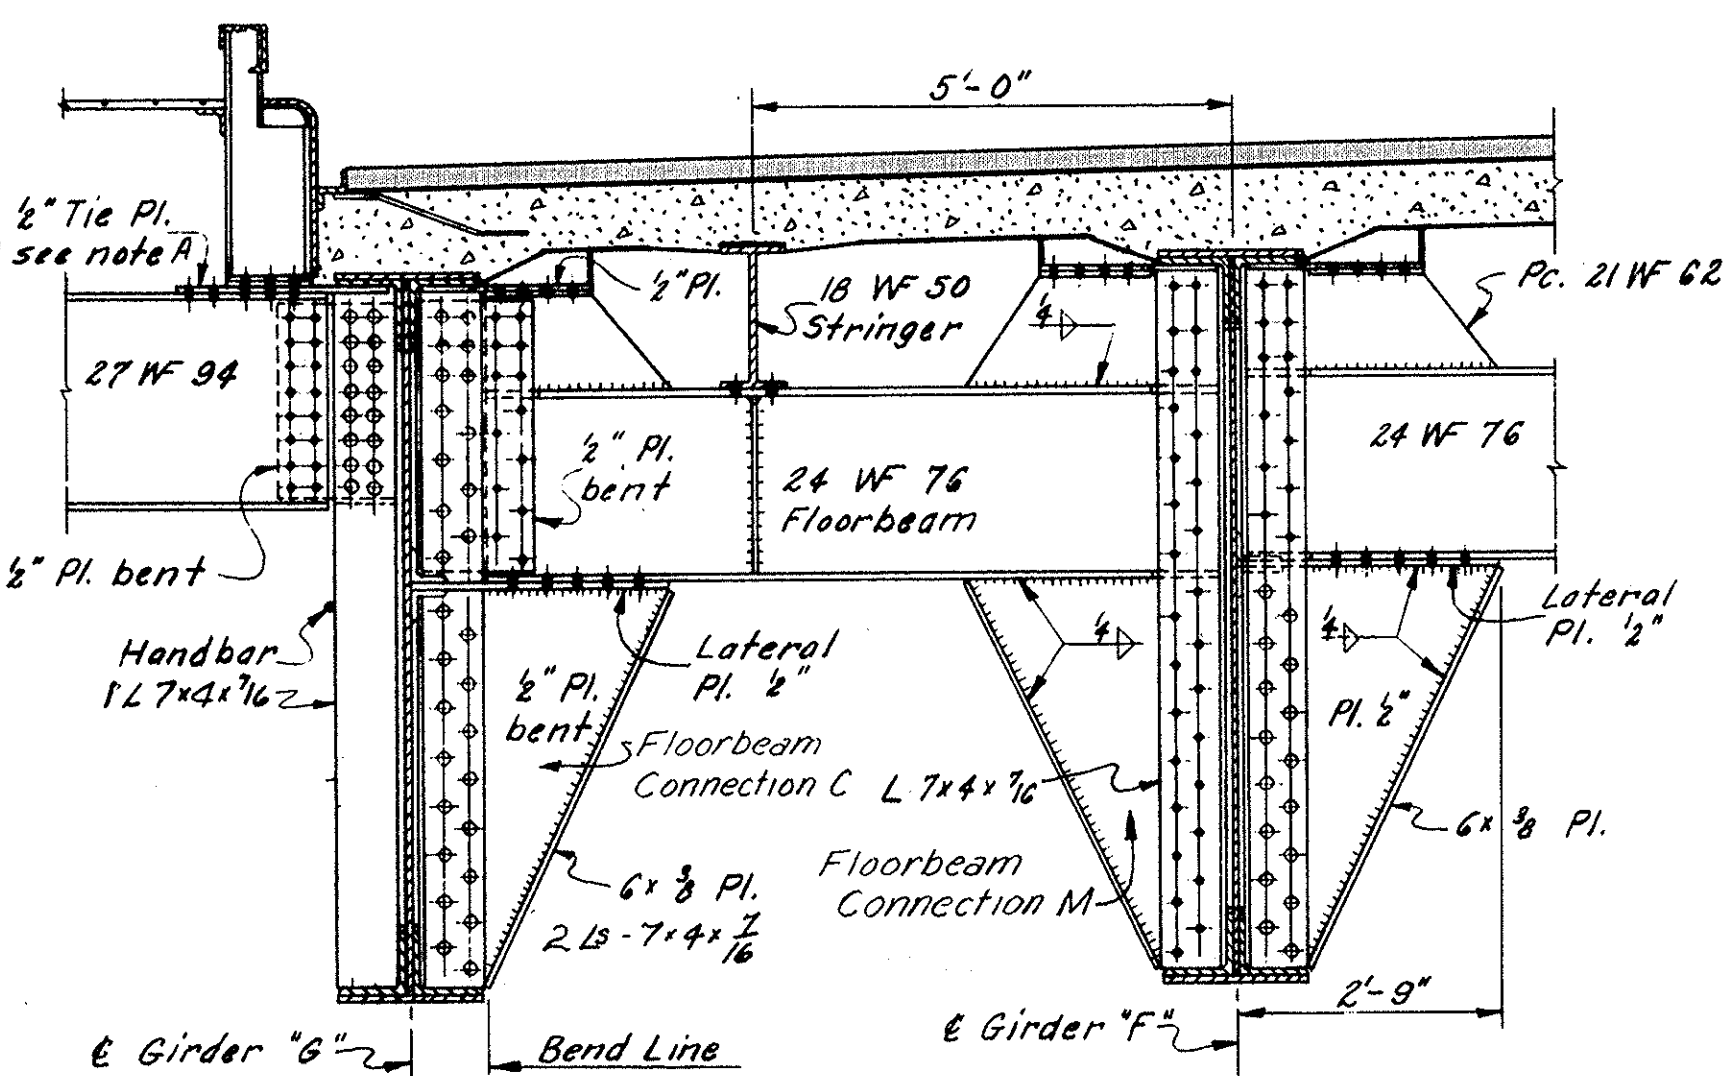


PART CROSS SECTION AT PANEL POINT 24

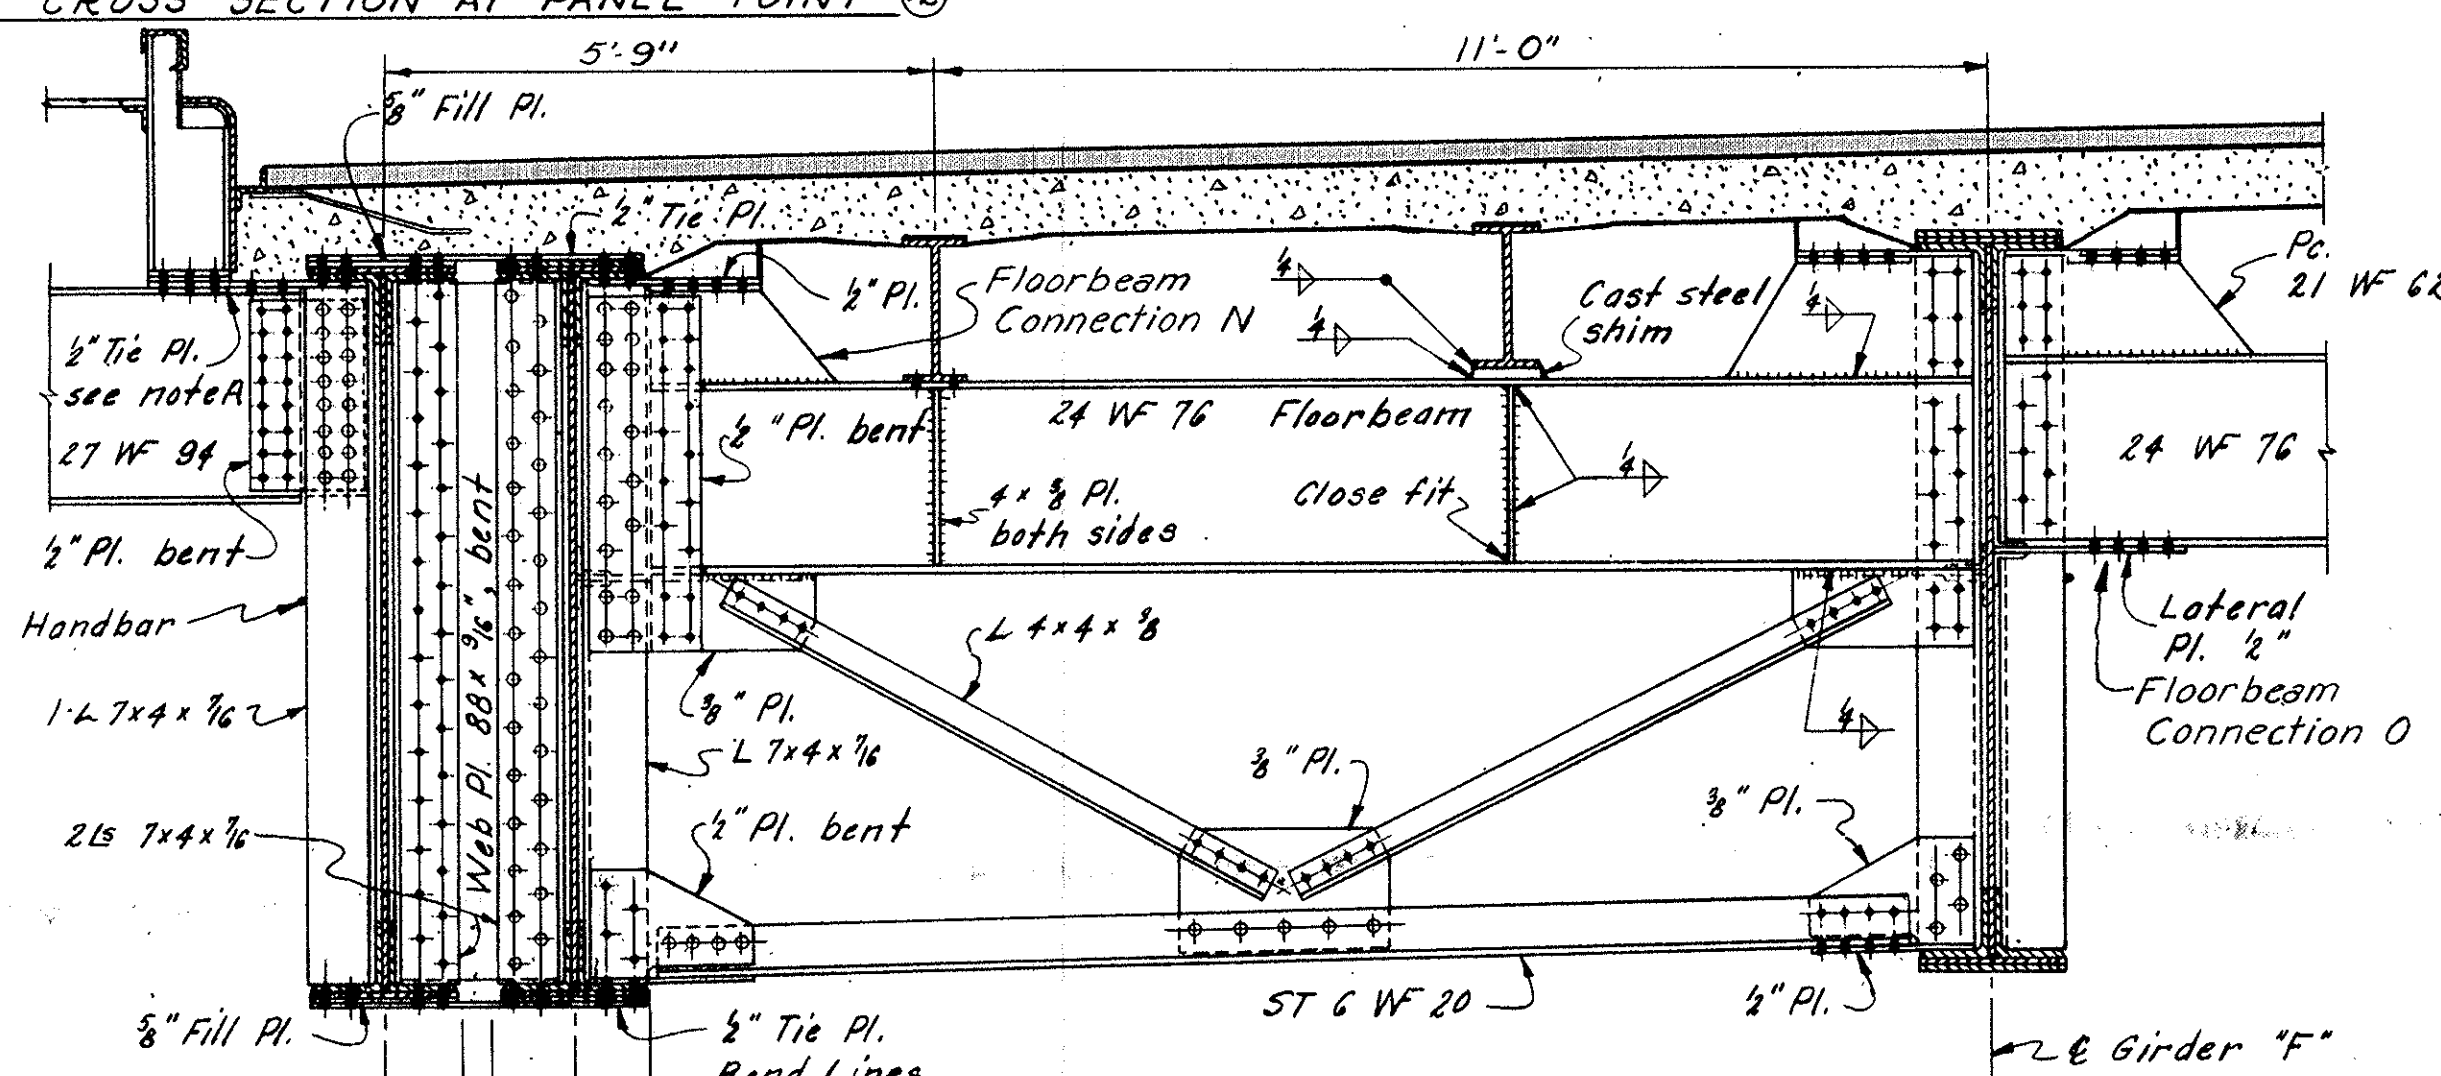


PART CROSS SECTION AT PANEL POINT 25

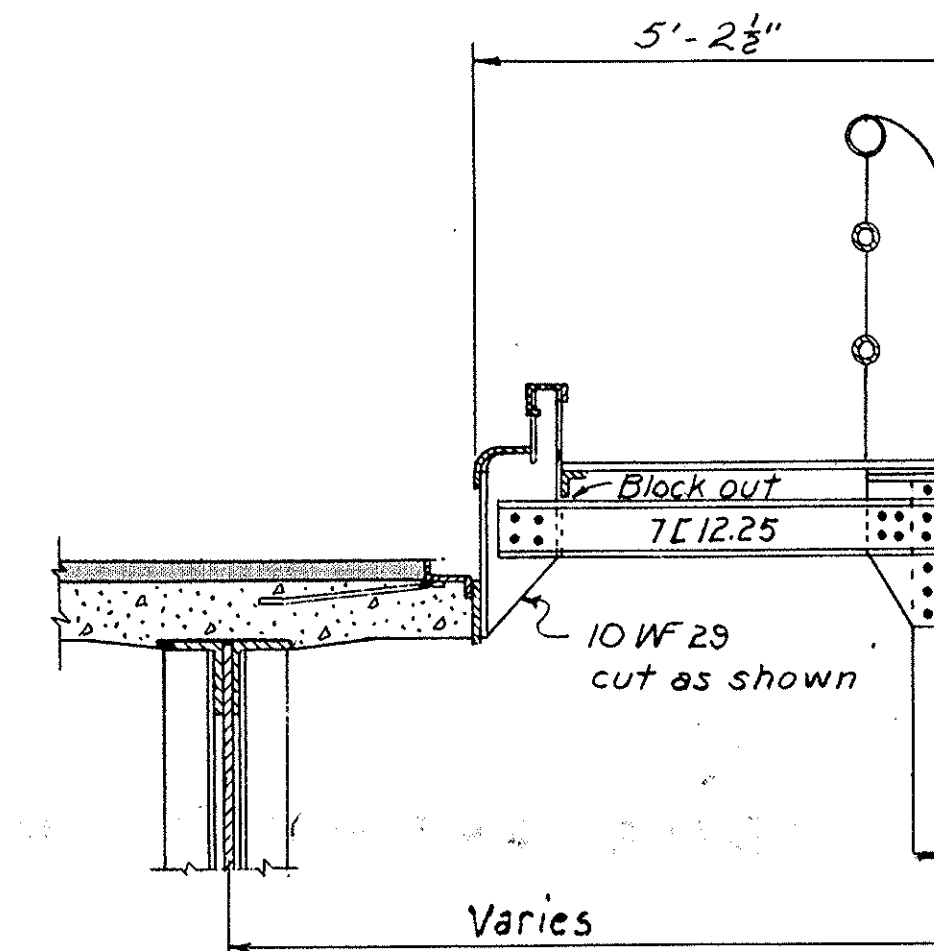

INTERMEDIATE SIDEWALK SUPPORT  
Scale  $\frac{1}{2}$ " = 1'-0"

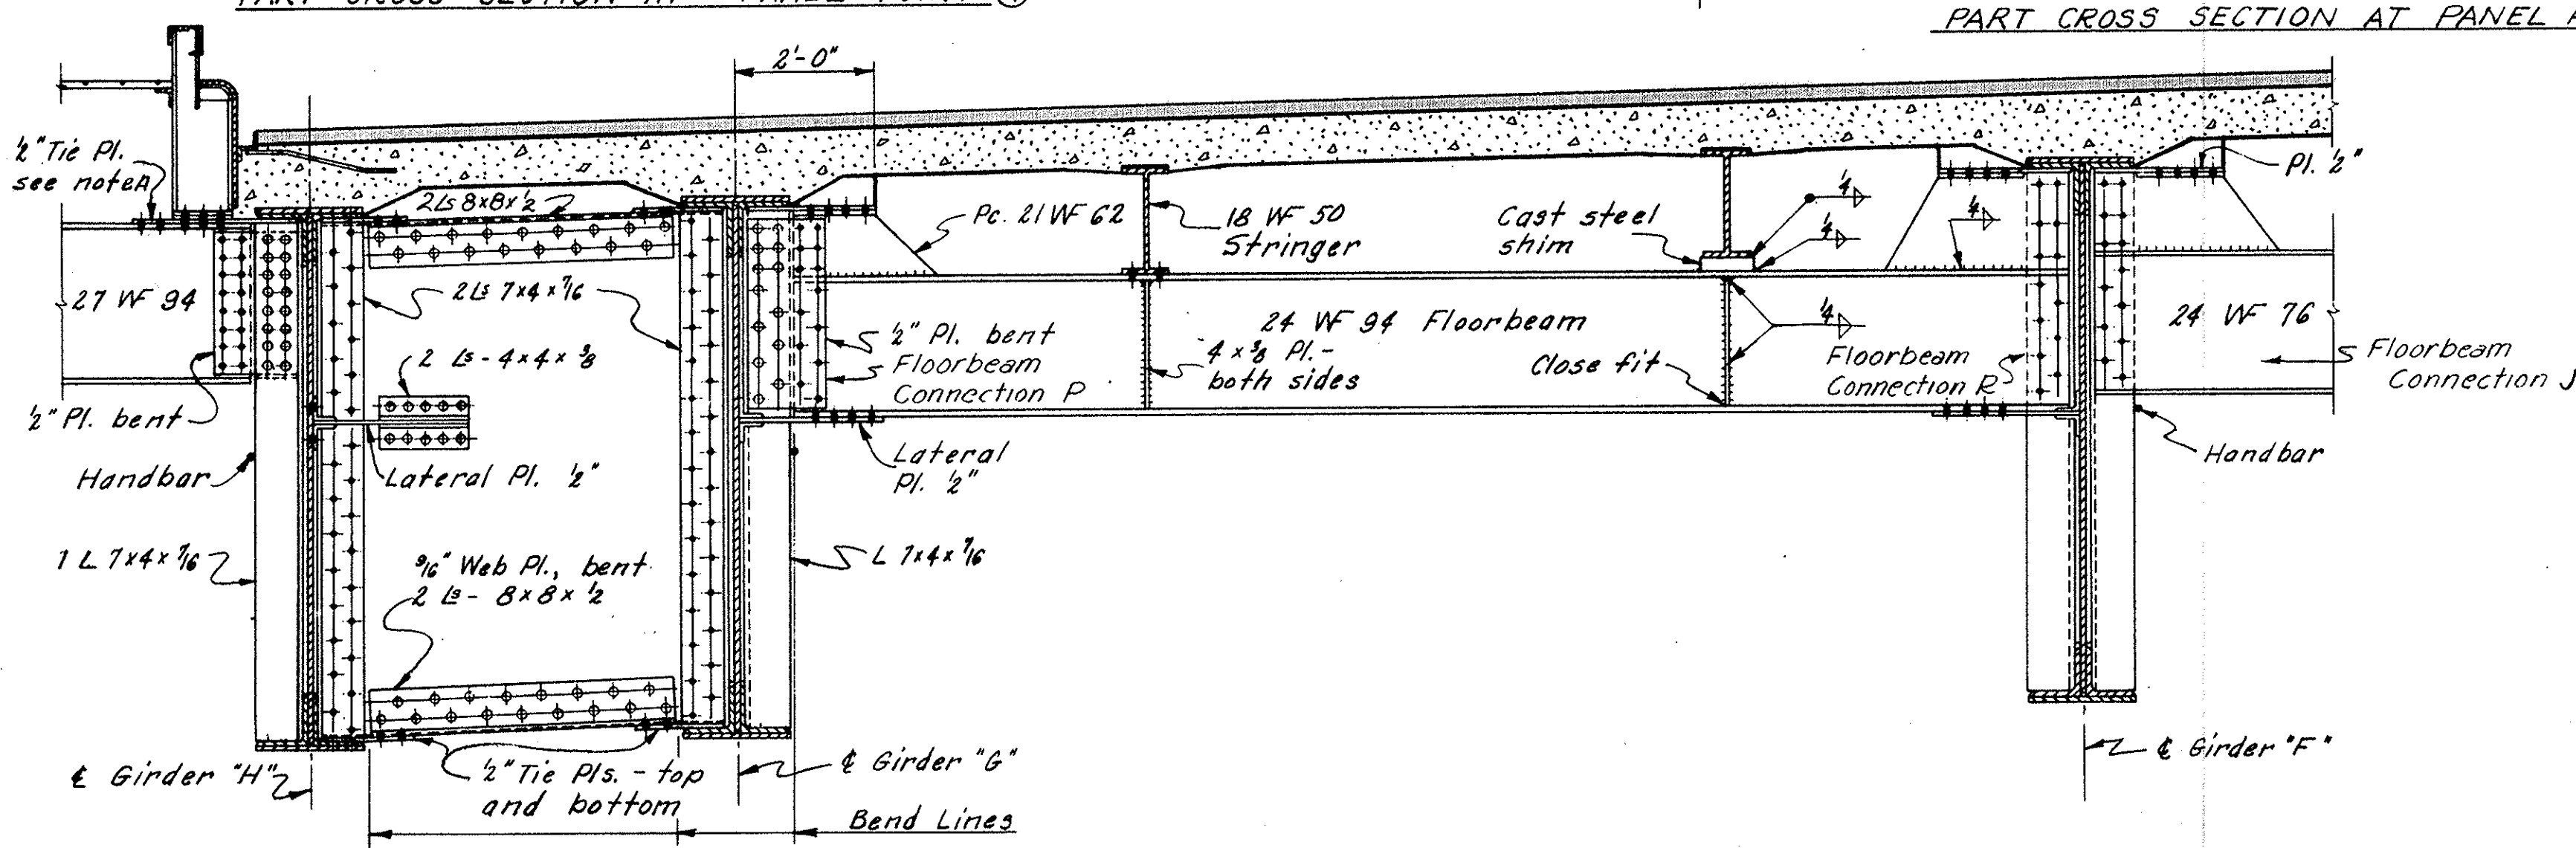

PART CROSS SECTION AT PANEL POINT 26

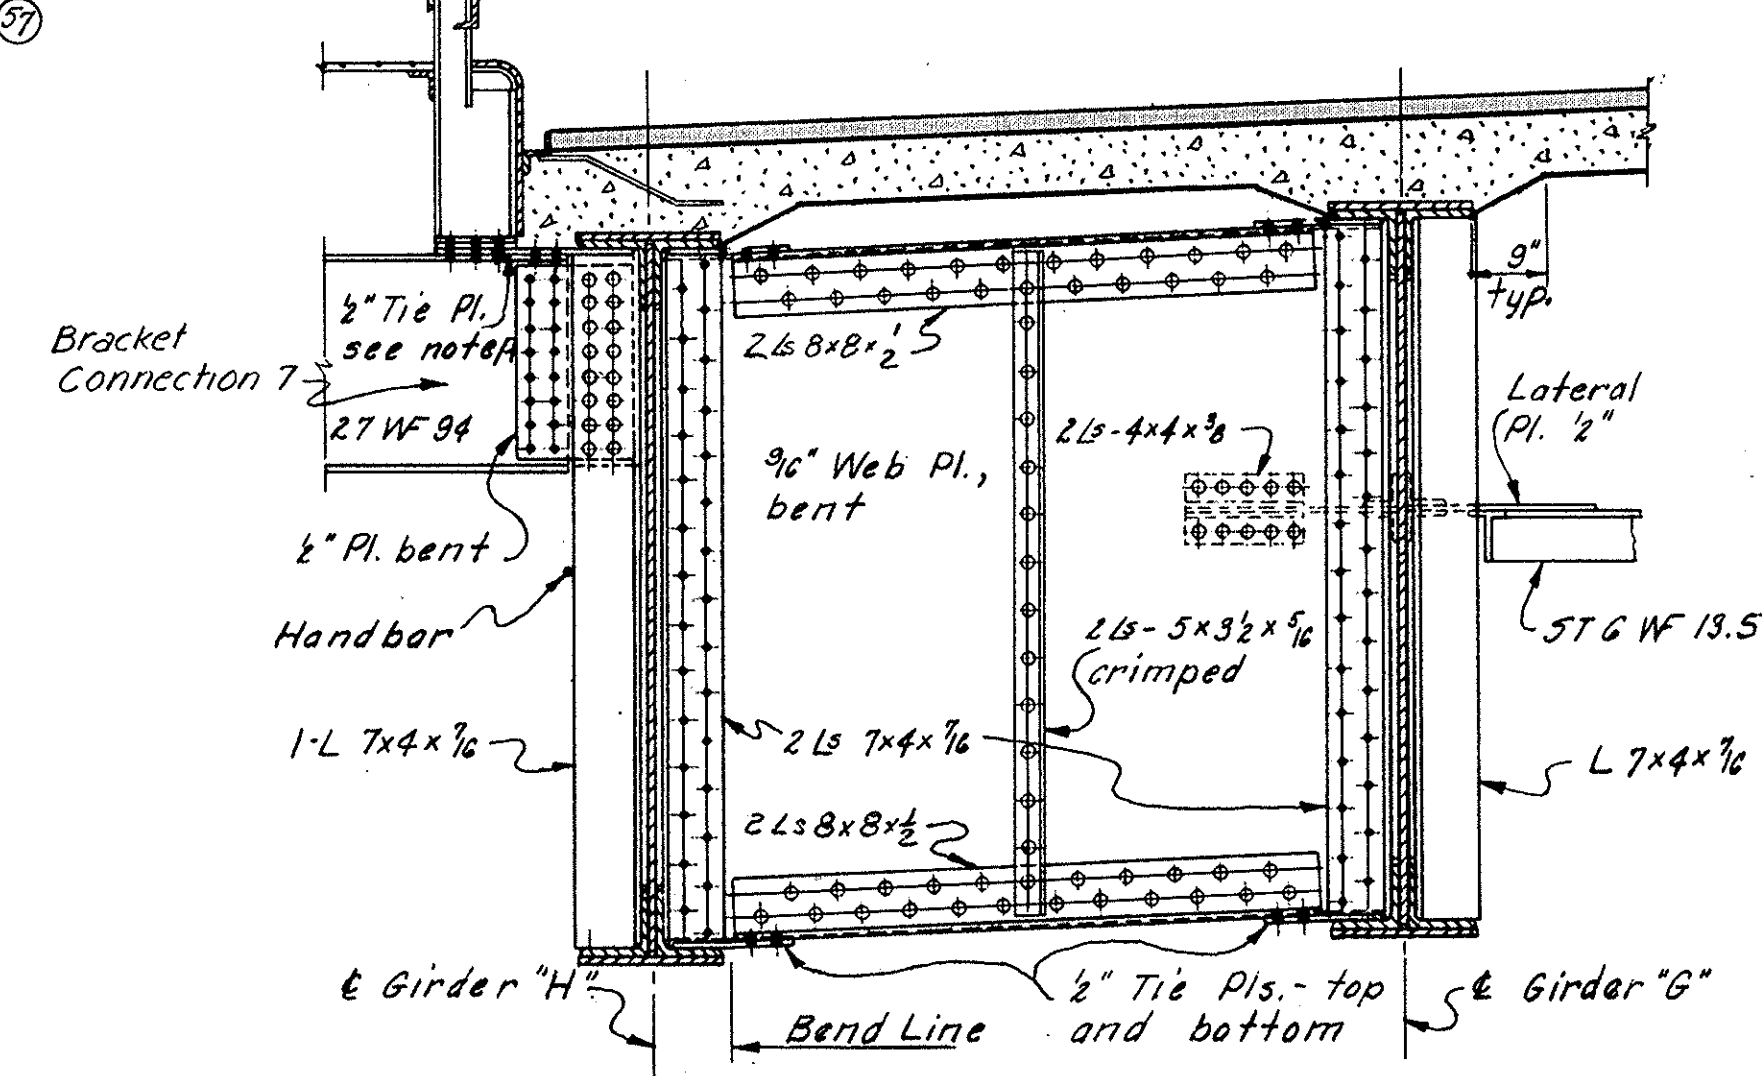

PART CROSS SECTION AT PANEL POINT 27


NOTES:  
Part Cross Sections at Panel Points 21 and 22 similar to Panel Point 23 except as shown on Framing Plan, Sheet 86.  
Part Cross Section at Panel Point 24 similar to Panel Point 23 except as shown on Framing Plan, Sheet 86.  
For additional Cross Section Notes see Sheet 80.

PART 7


**AKRON EXPRESSWAY SYSTEM**  
WEST VIADUCT  
BR. NO. SU-10R-135  
ROADWAY CROSS SECTIONS

AKRON	SUMMIT COUNTY,	OHIO
SCALE $\frac{1}{2}$ " = 1'-0"	MADE J.F.G. DATE 7-26-55	HOWARD, NEEDLES, TAMMEN & BERGENDOFF
TRCD DATE	KANSAS CITY	CLEVELAND NEW YORK
CKD. DEB. DATE 9-30-55		90 SHEET 82

SUMMIT COUNTY  
CITY OF AKRON  
AKRON EXPRESSWAY SYSTEM

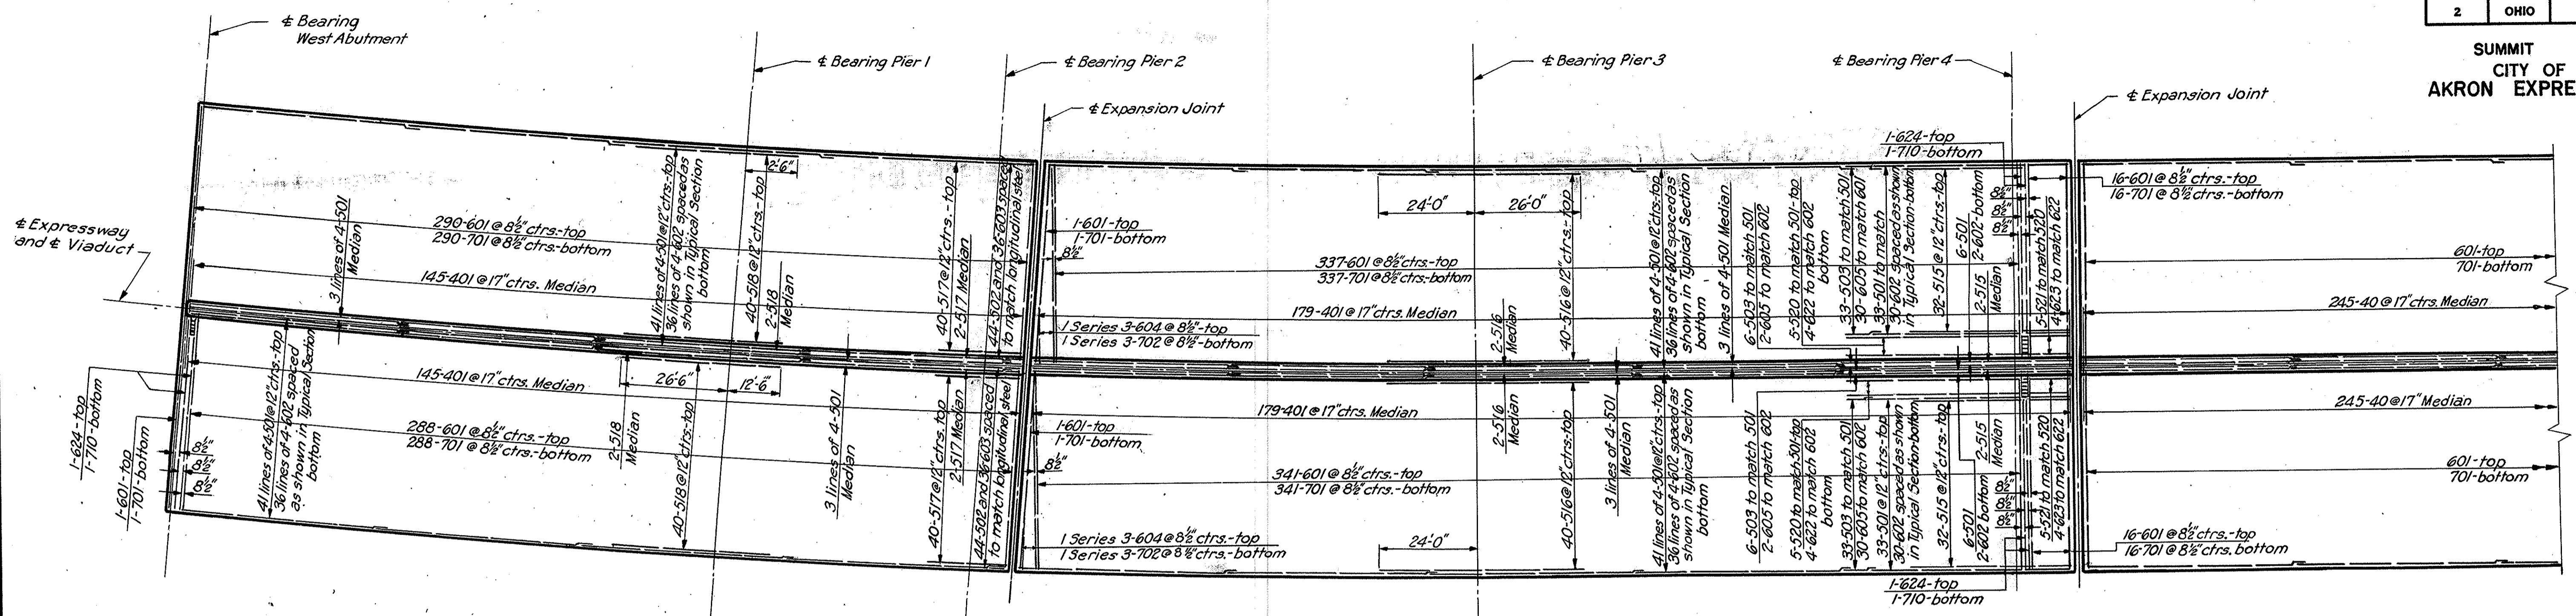


Note:  
For slab details see Sheet 84.

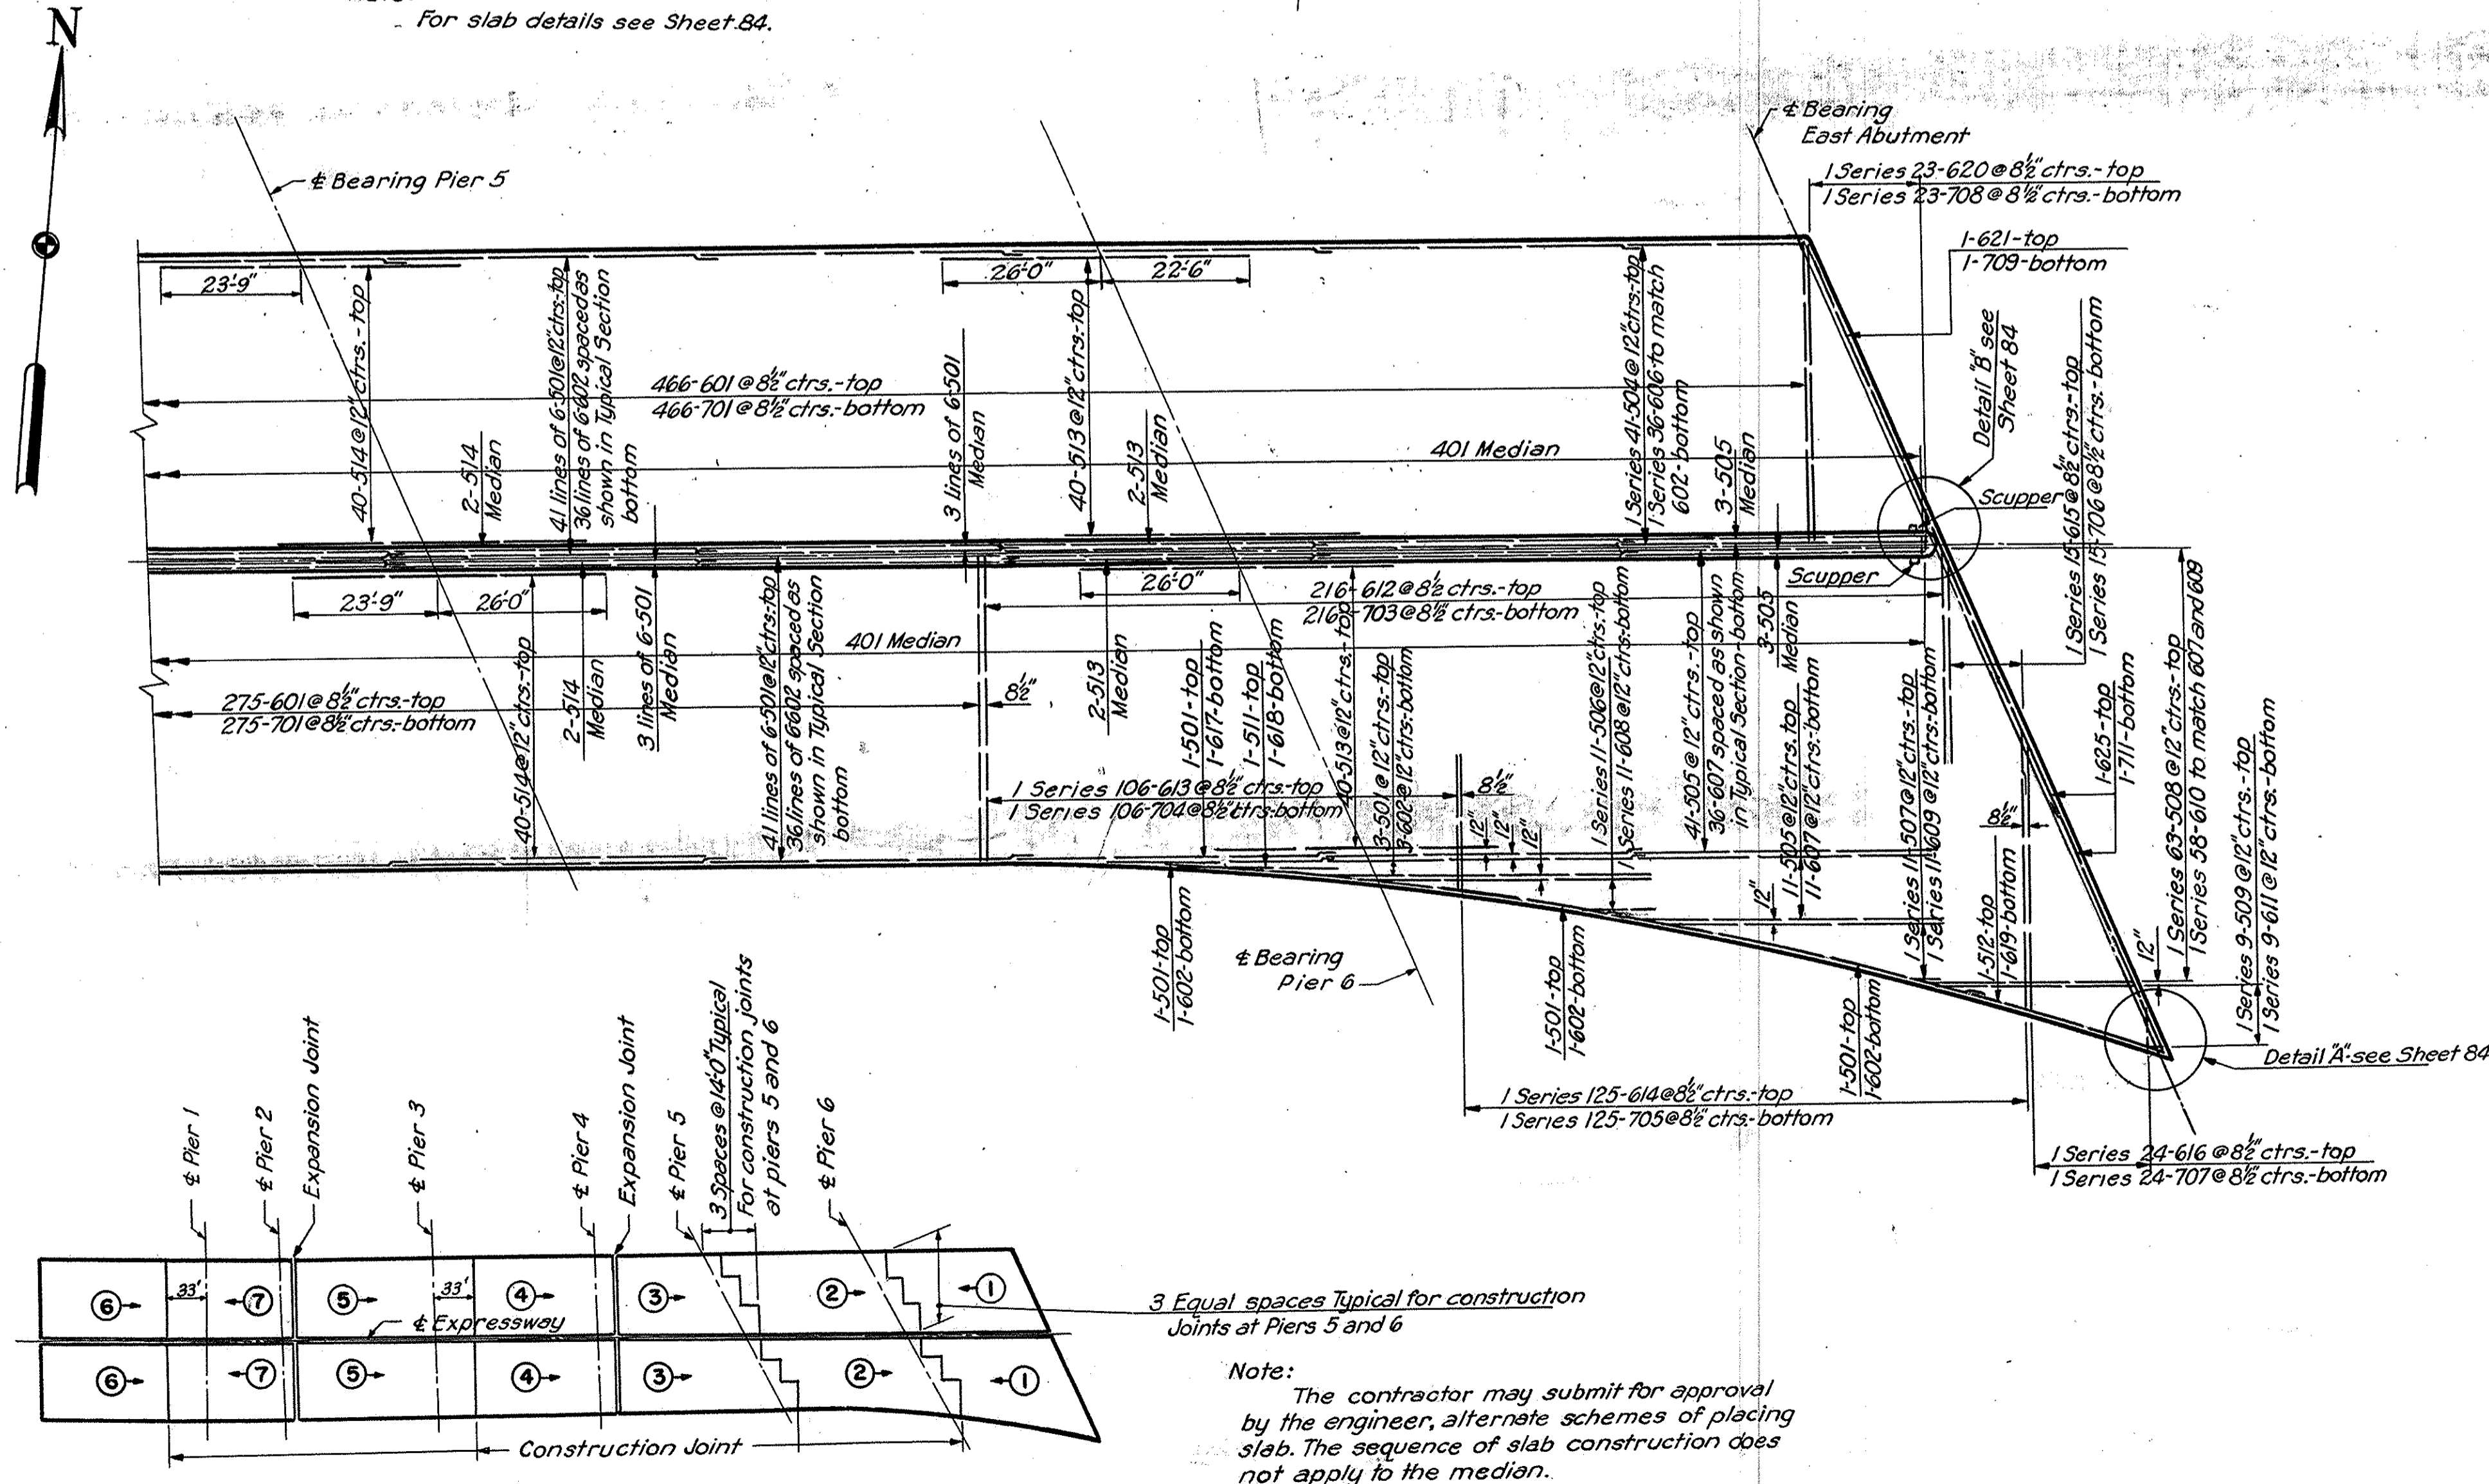

Note:  
The contractor may submit for approval by the engineer, alternate schemes of placing slab. The sequence of slab construction does not apply to the median.

REINFORCEMENT SCHEDULE														
MARK NUMBER	LENGTH	TYPE	DIMENSIONS		SERIES	WEIGHT	MARK NUMBER	LENGTH	TYPE	DIMENSIONS		SERIES	WEIGHT	
			A	B	INCREMENT	POUNDS				A	B	INCREMENT	POUNDS	
401	1150	4'-0"	120			3072	618	1	20'-0"	Str.			30	
							619	1	31'-6"	Str.			47	
501	1313	52'-0"	Str.			7122	620	1 Series 23	5'-11" to 38'-5"	101	5'-0" to 37'-6"	11"	1'-5 3/8"	766
502	88	6'-6"	Str.			587	621	1	43'-4"	100	4'-6"	11"	65	
503	78	7'-6"	Str.			610	622	8	41'-0"	Str.			492	
504	1 Series 41	23'-9" to 47'-0"	Str.			5 3/8"	1,395	623	8	10'-6"	Str.		126	
505	58	48'-0"	Str.			290	624	6	35'-4"	100	3'-6"	11"	318	
506	1 Series 8	6'-0" to 48'-0"	Str.			6'-0"	225	625	2	40'-11"	101	4'-0"	125	
507	1 Series 11	4'-0" to 48'-0"	Str.			4'-4 1/2"	298	626	7	6'-0"	101	5'-4"	63	
508	1 Series 63	4'-0" to 29'-0"	Str.			4 3/8"	1,084	701	2032	39'-3"	Str.		163,021	
509	1 Series 9	4'-0" to 28'-0"	Str.			3'-0"	1,502	702	2 Series 3	17'-6" to 37'-6"	Str.		337	
							31	703	216	30'-3"	Str.		1,355	
510	1	30'-0"	Str.				21	704	1 Ser. 106	12'-3" to 18'-9"	Str.		3,358	
511	1	20'-0"	Str.				33	705	1 Ser. 125	18'-9" to 35'-3"	Str.		6,899	
512	1	3'-6"	Str.				4,249	706	1 Series 15	9'-0" to 30'-3"	Str.		602	
513	84	48'-6"	Str.			4,359	707	1 Series 24	6'-9" to 39'-6"	Str.		1,134		
514	84	49'-9"	Str.			3,315	708	1 Series 23	5'-6" to 38'-0"	Str.		1,023		
515	68	46'-9"	101	46'-0"	9"	4,381	709	1	4'-6"	Str.		86		
516	84	50'-0"	Str.			2,026	710	6	33'-9"	Str.		414		
517	84	23'-3"	101	22'-6"	9"	3,417	711	2	40'-0"	Str.		164		
518	84	39'-0"	Str.			17	712	7	5'-6"	Str.		79		
519	4	4'-3"	119			428								
520	10	4'-0"	Str.			109								
521	10	10'-6"	Str.											
														Total = 535,330
601	2032	40'-8"	100	38'-10"	11"	124,118								
602	1078	52'-0"	Str.			84,196								
603	72	6'-6"	Str.			703								
604	2 Series 3	18'-0" to 38'-0"	101	17'-0" to 37'-6"	11"	10'-0"	252							
605	64	7'-6"	Str.			721								
606	1 Series 36	29'-9" to 47'-0"	Str.			5 3/8"	2,075							
607	47	48'-0"	Str.			3,388								
608	1 Series 8	6'-0" to 48'-0"	Str.			6'-0"	324							
609	1 Series 11	4'-0" to 48'-0"	Str.			4'-4 1/2"	429							
610	1 Series 53	4'-0" to 29'-0"	Str.			5 1/2"	1,437							
611	1 Series 9	4'-0" to 28'-0"	Str.			3'-0"	216							
612	216	26'-0"	101	25'-1"	11"	84,35								
613	1 Ser. 106	18'-0" to 24'-6"	101	17'-0" to 23'-7"	11"	3"	3,383							
614	1 Ser. 125	24'-6" to 40'-6"	101	23'-7" to 39'-7"	11"		6,102							
615	1 Ser. 15	4'-0" to 25'-0"	Str.			1'-6"	3267							
616	1 Ser. 24	7'-5" to 40'-6"	101	6'-6" to 39'-7"	11"	1'-0 1/2"	864							
617	1	30'-0"	Str.			45								

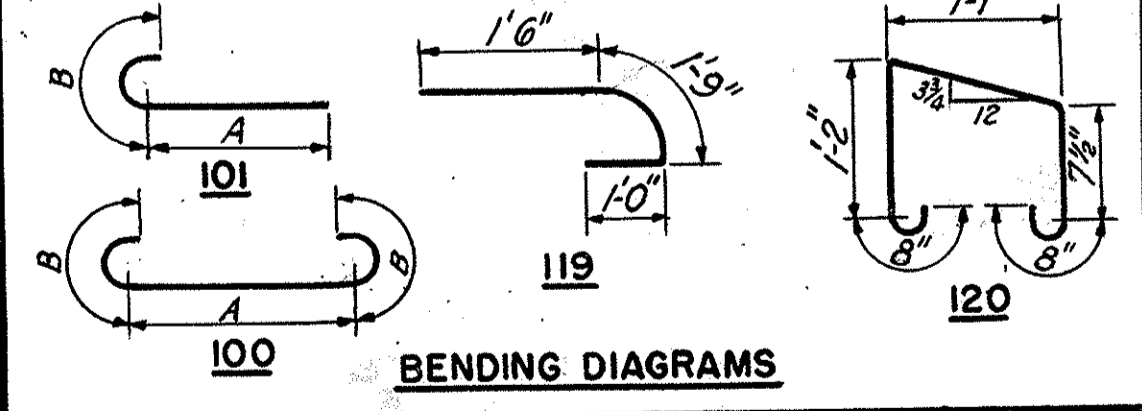

Note:  
For replacement bars see Sheet 62.  
Bar dimensions are given out to out.


**AKRON EXPRESSWAY SYSTEM**  
WEST VIADUCT  
BR. NO. SU-18R-135  
SLAB PLAN

AKRON SUMMIT COUNTY, OHIO

SCALE: No Scale  
MADE: FEB. DATE 7-2-52  
TRCD. C.I.H. DATE 12-1-55  
CRO. B.S.S. DATE 9-2-55

HOWARD, NEEDLES, TAMMEN & BERGENDOFF  
CONSULTING ENGINEERS  
KANSAS CITY CLEVELAND NEW YORK  
901 SHEET- 83

SUMMIT COUNTY  
CITY OF AKRON  
AKRON EXPRESSWAY SYSTEM

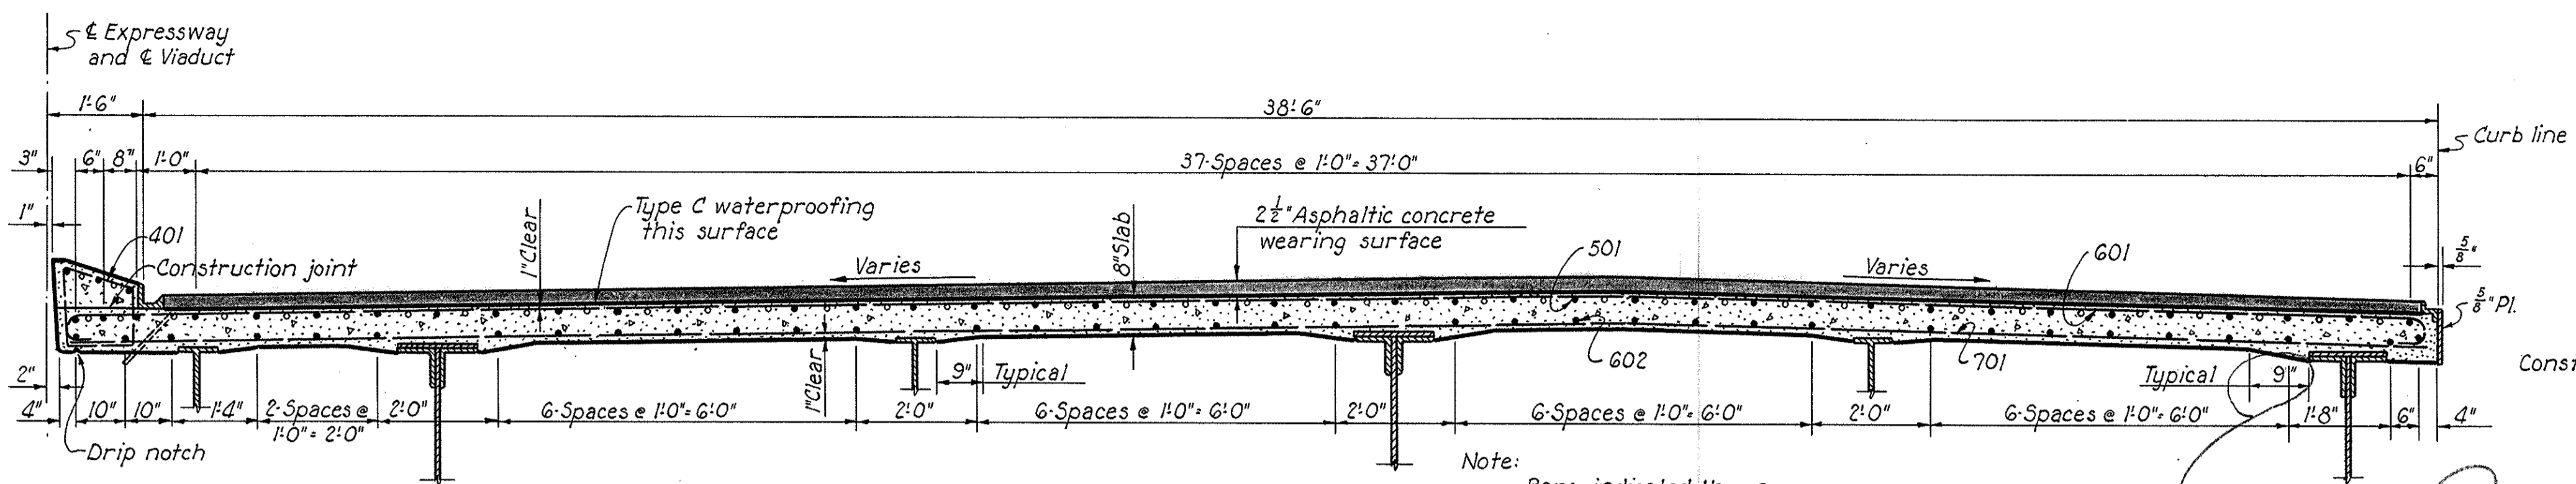


**TYPICAL SECTION THROUGH SLAB**  
Scale: 1/4" = 1'-0"  
North roadway shown. South roadway similar but opposite hand to Sta. 607+98.93.

Note: Bars indicated thus o are extra bars to be placed over piers.


Note A: 5x4 1/2 x 19.1 bulb angle gutter along median on the North roadway, shall begin at Sta. 604+50 and extend to end of superstructure at East Abutment. On South roadway, bulb angle gutter shall extend full length of superstructure.

Gutter support L 2 1/2 x 2 1/2 x 1/4 spaced at 4'-0" ctrs. maximum. Joints in bulb angle gutters preferably at intervals of not less than 25 feet are to be butt joints with milled ends. Support angles shall be placed 6" to 9" on each side of joint.

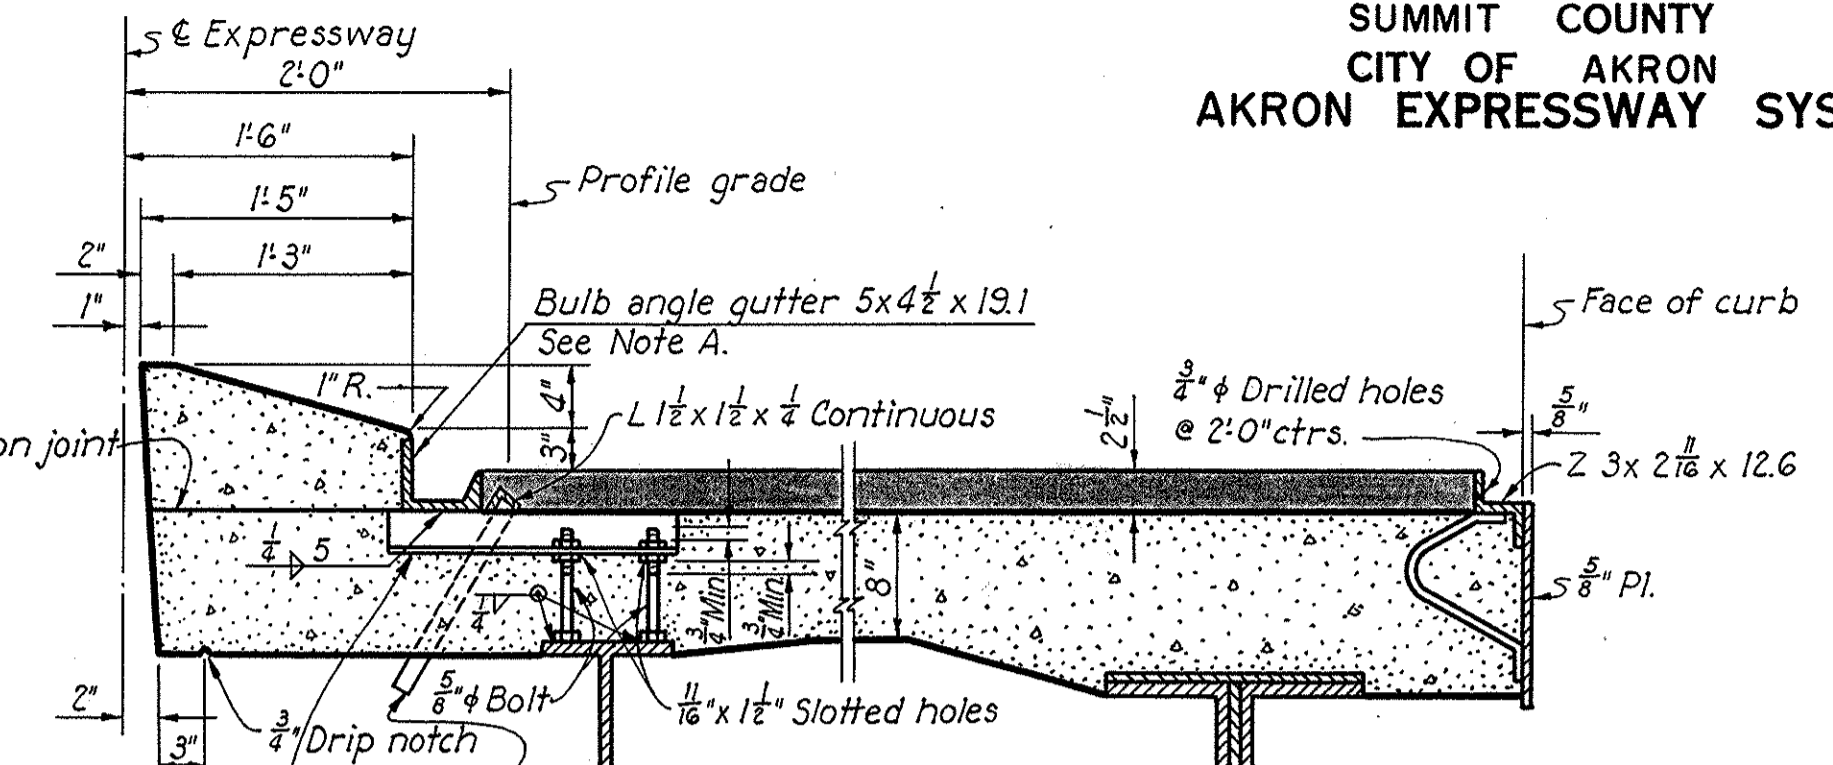

**MEDIAN STRIP AND GUTTER DETAIL**  
Scale: 1" = 1'-0"


Note: For curb detail see Sheet 85.

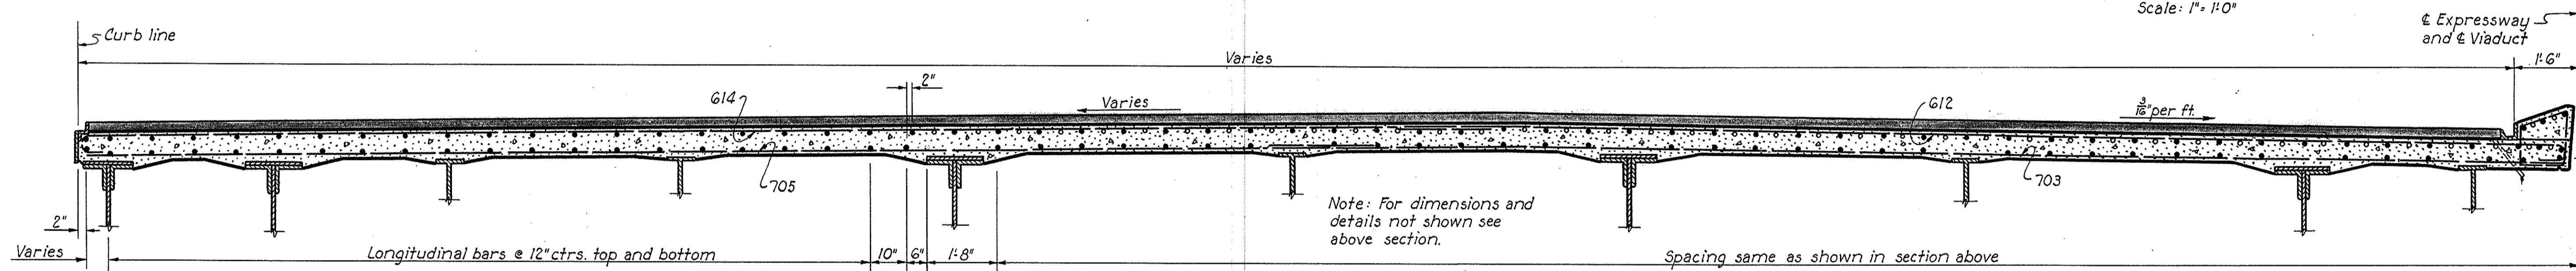


**TYPICAL SECTION THROUGH SOUTH ROADWAY FORWARD OF STA. 607+98.93**  
Scale: 1/4" = 1'-0"

Note: For dimensions and details not shown see above section.


Spacing same as shown in section above

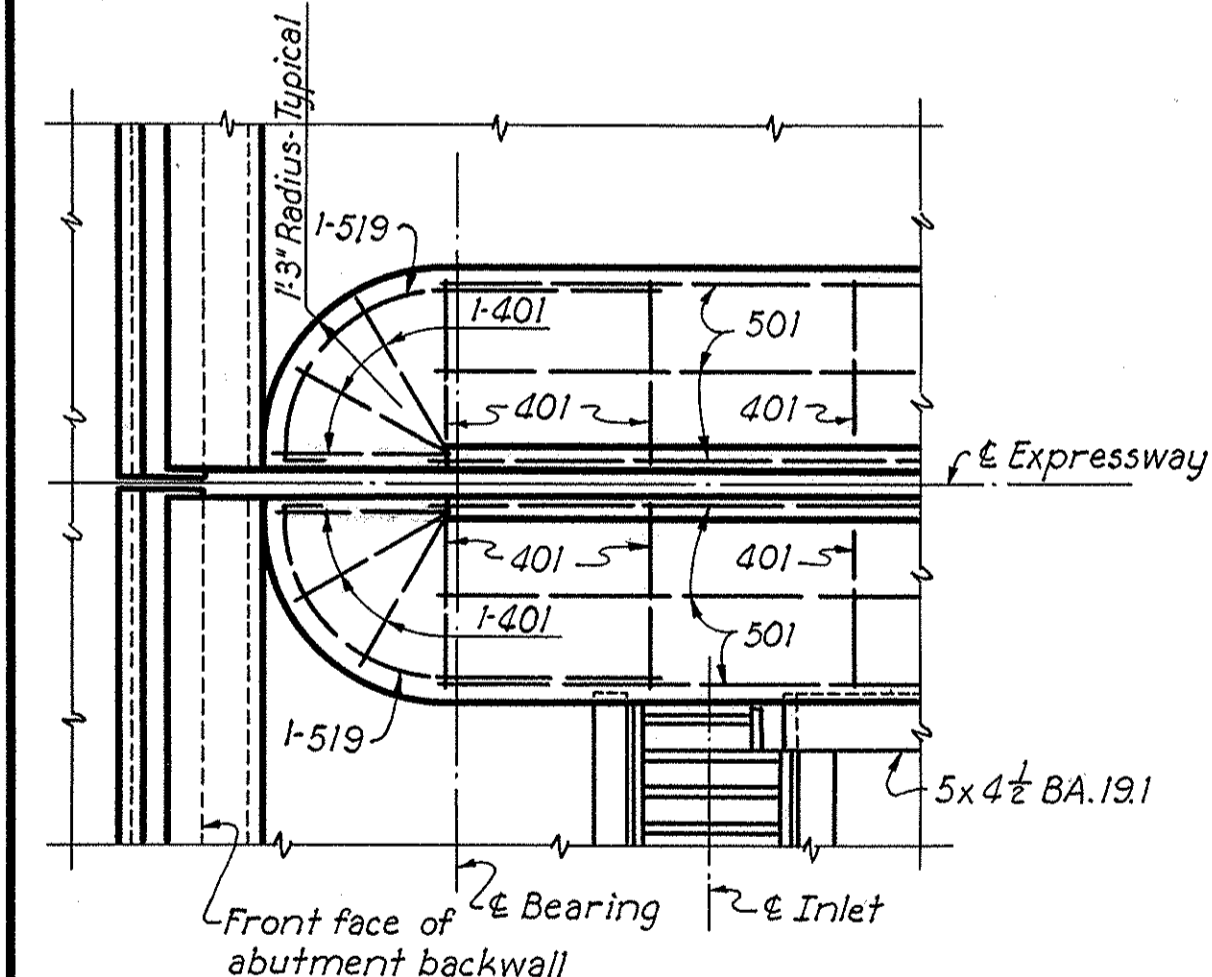


**DETAIL AT WEST END OF MEDIAN**  
Scale: 3/8" = 1'-0"

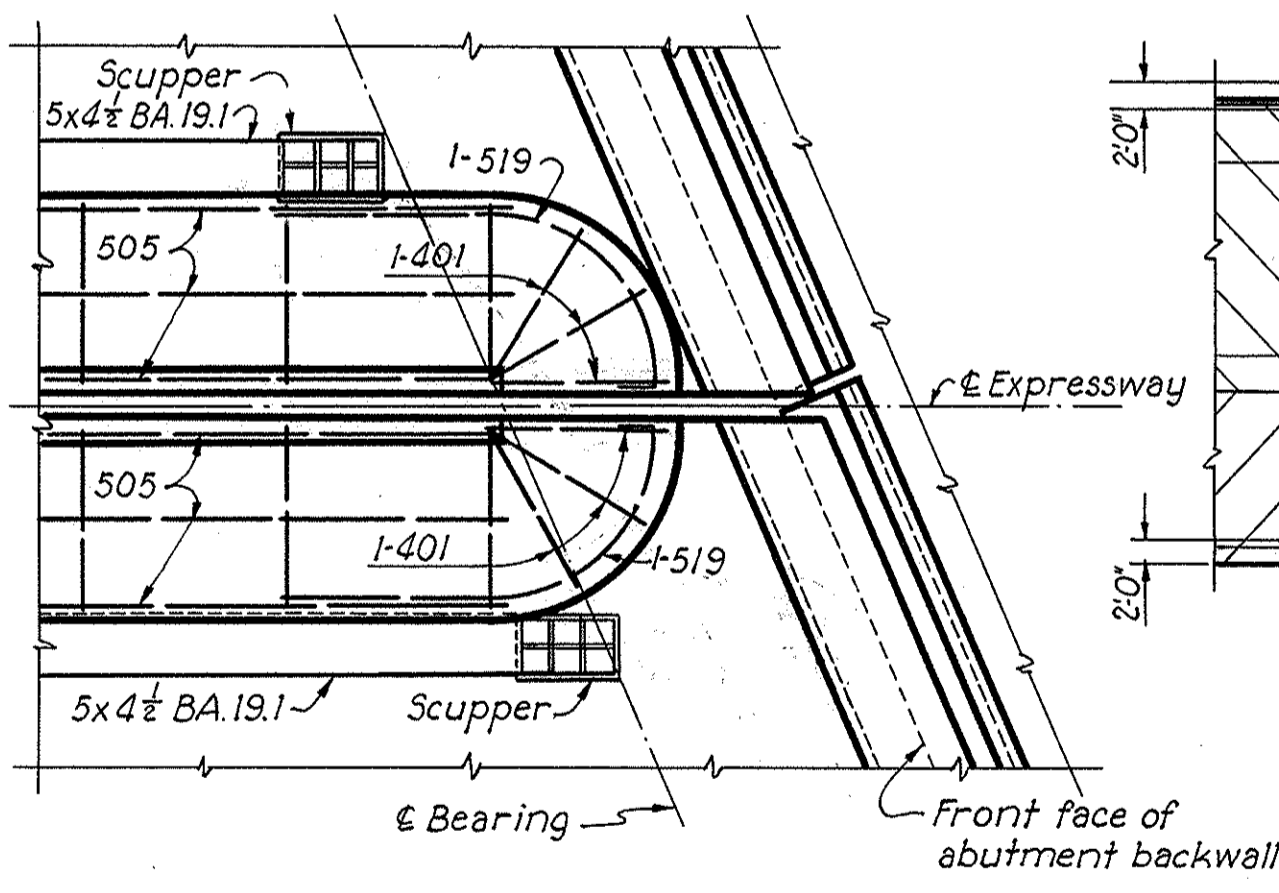

**DETAIL AT EAST END OF MEDIAN**  
Scale: 3/8" = 1'-0"

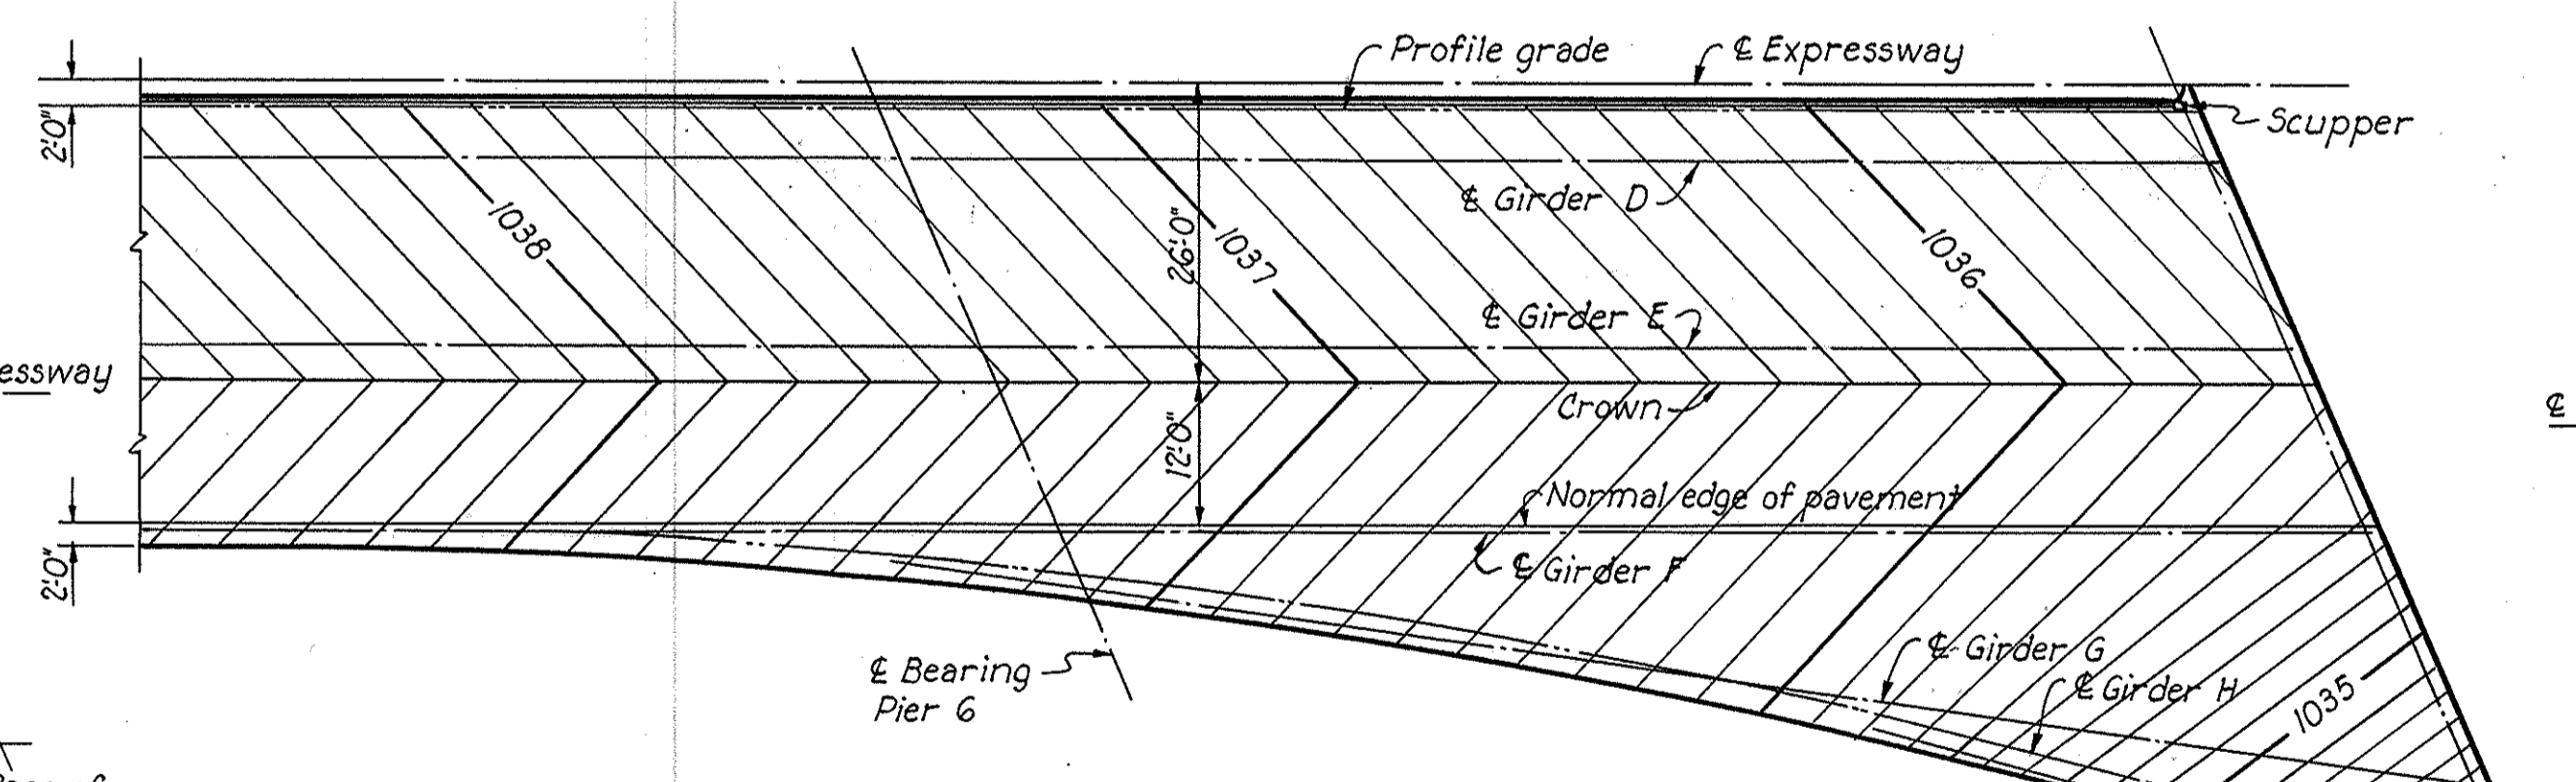


**PART CONTOUR PLAN**  
Scale: 1/8" = 1'-0"

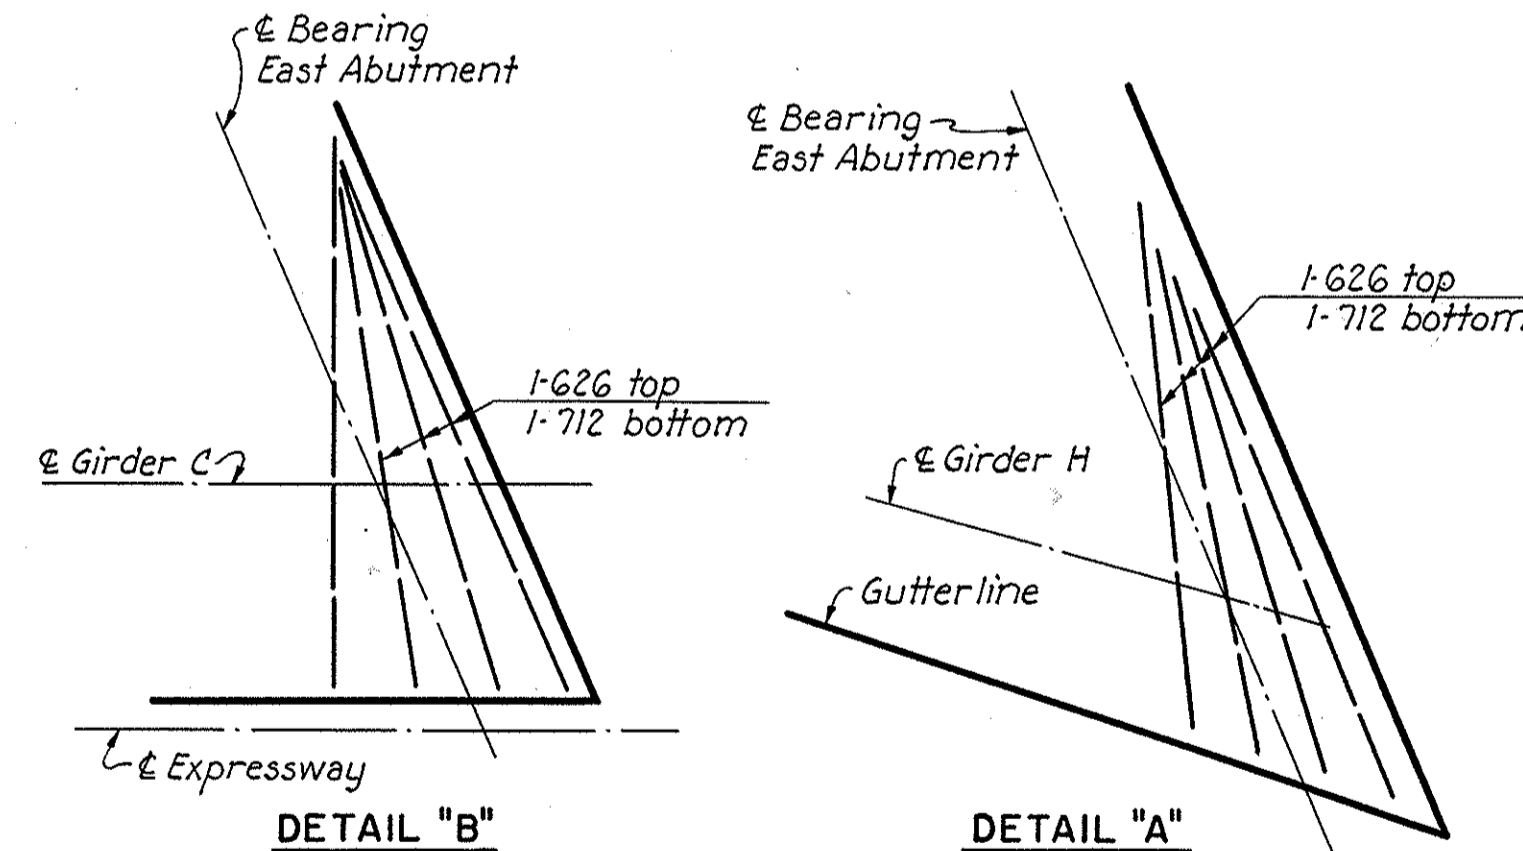


**DETAIL "B"**  
Scale: 1/2" = 1'-0"

**DETAIL "A"**  
Scale: 1/2" = 1'-0"

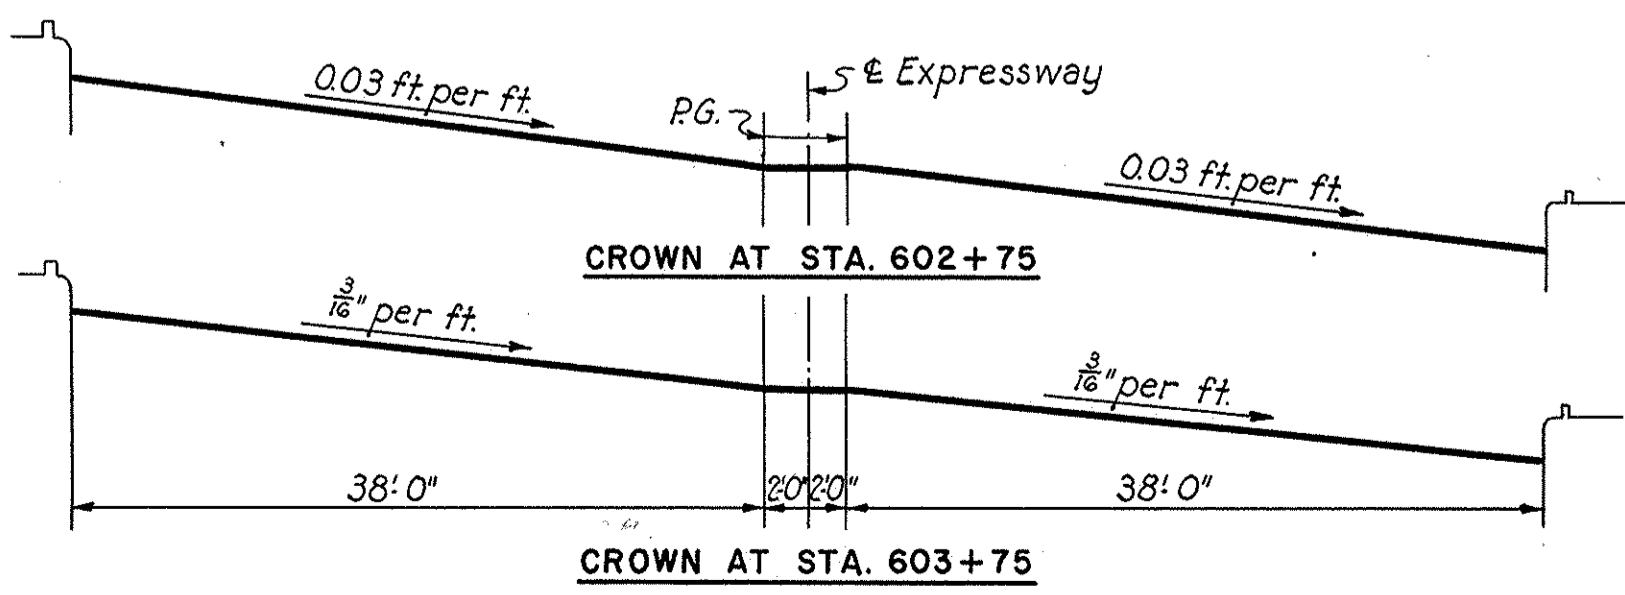

**ROADWAY CROWNS**  
Scale: None

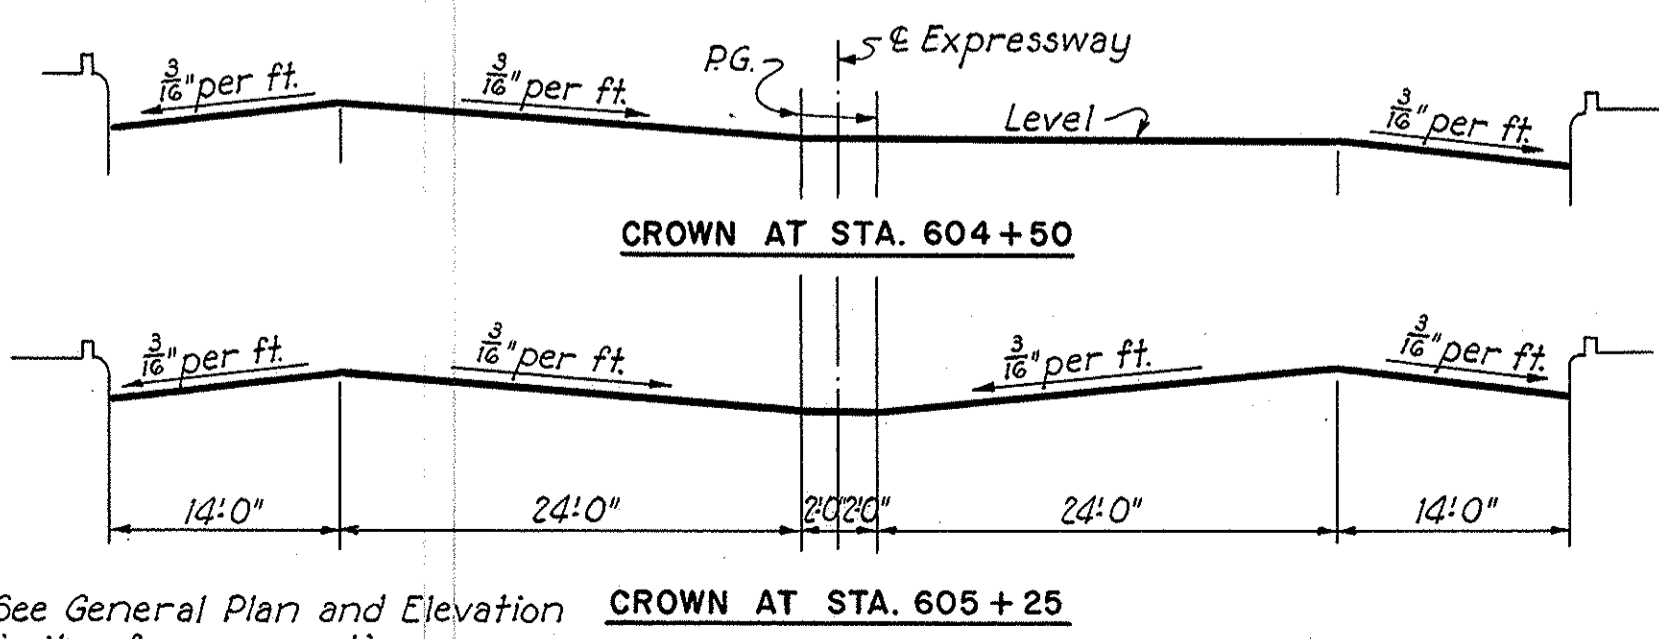

Note: See General Plan and Elevation for limits of crown sections.

**ROADWAY CROWNS**  
Scale: None

Note: For Slab Plan see Sheet 83. For drainage details see Sheet 95. For location of Detail 'A' and Detail 'B' see Sheet 83.

**AKRON EXPRESSWAY SYSTEM**  
WEST VIADUCT  
BR. NO. SU-18R-135  
SLAB DETAILS


AKRON SUMMIT COUNTY, OHIO

SCALE: As shown  
MADE D.F.B. DATE: 7-14-55  
TRCD. CAL. DATE: 12-7-55  
CRD. B.S.S. DATE: 9-8-55



HOWARD, NEEDLES, TAMMEN & BERGENDOFF  
CONSULTING ENGINEERS  
KANSAS CITY CLEVELAND NEW YORK  
901 SHEET: 84

Revised 12-19-55


SUMMIT COUNTY  
CITY OF AKRON  
AKRON EXPRESSWAY SYSTEM

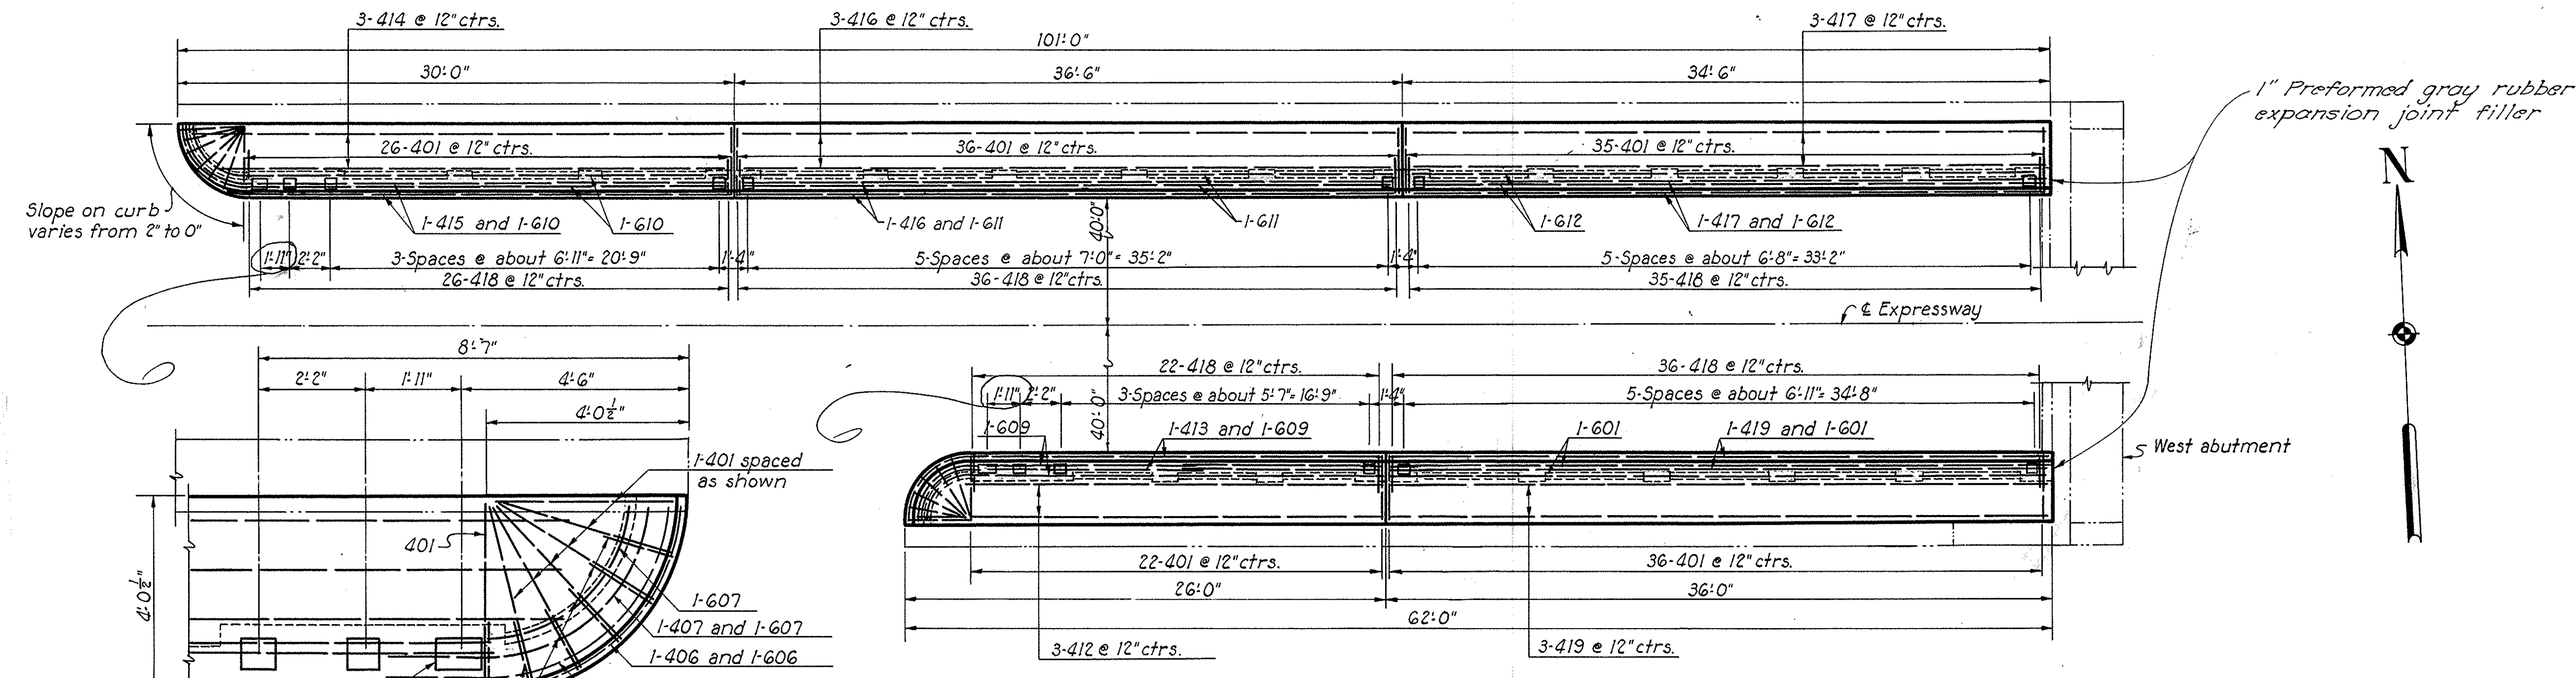

**WEST SIDEWALKS**  
Scale: 3/8" = 1'-0"

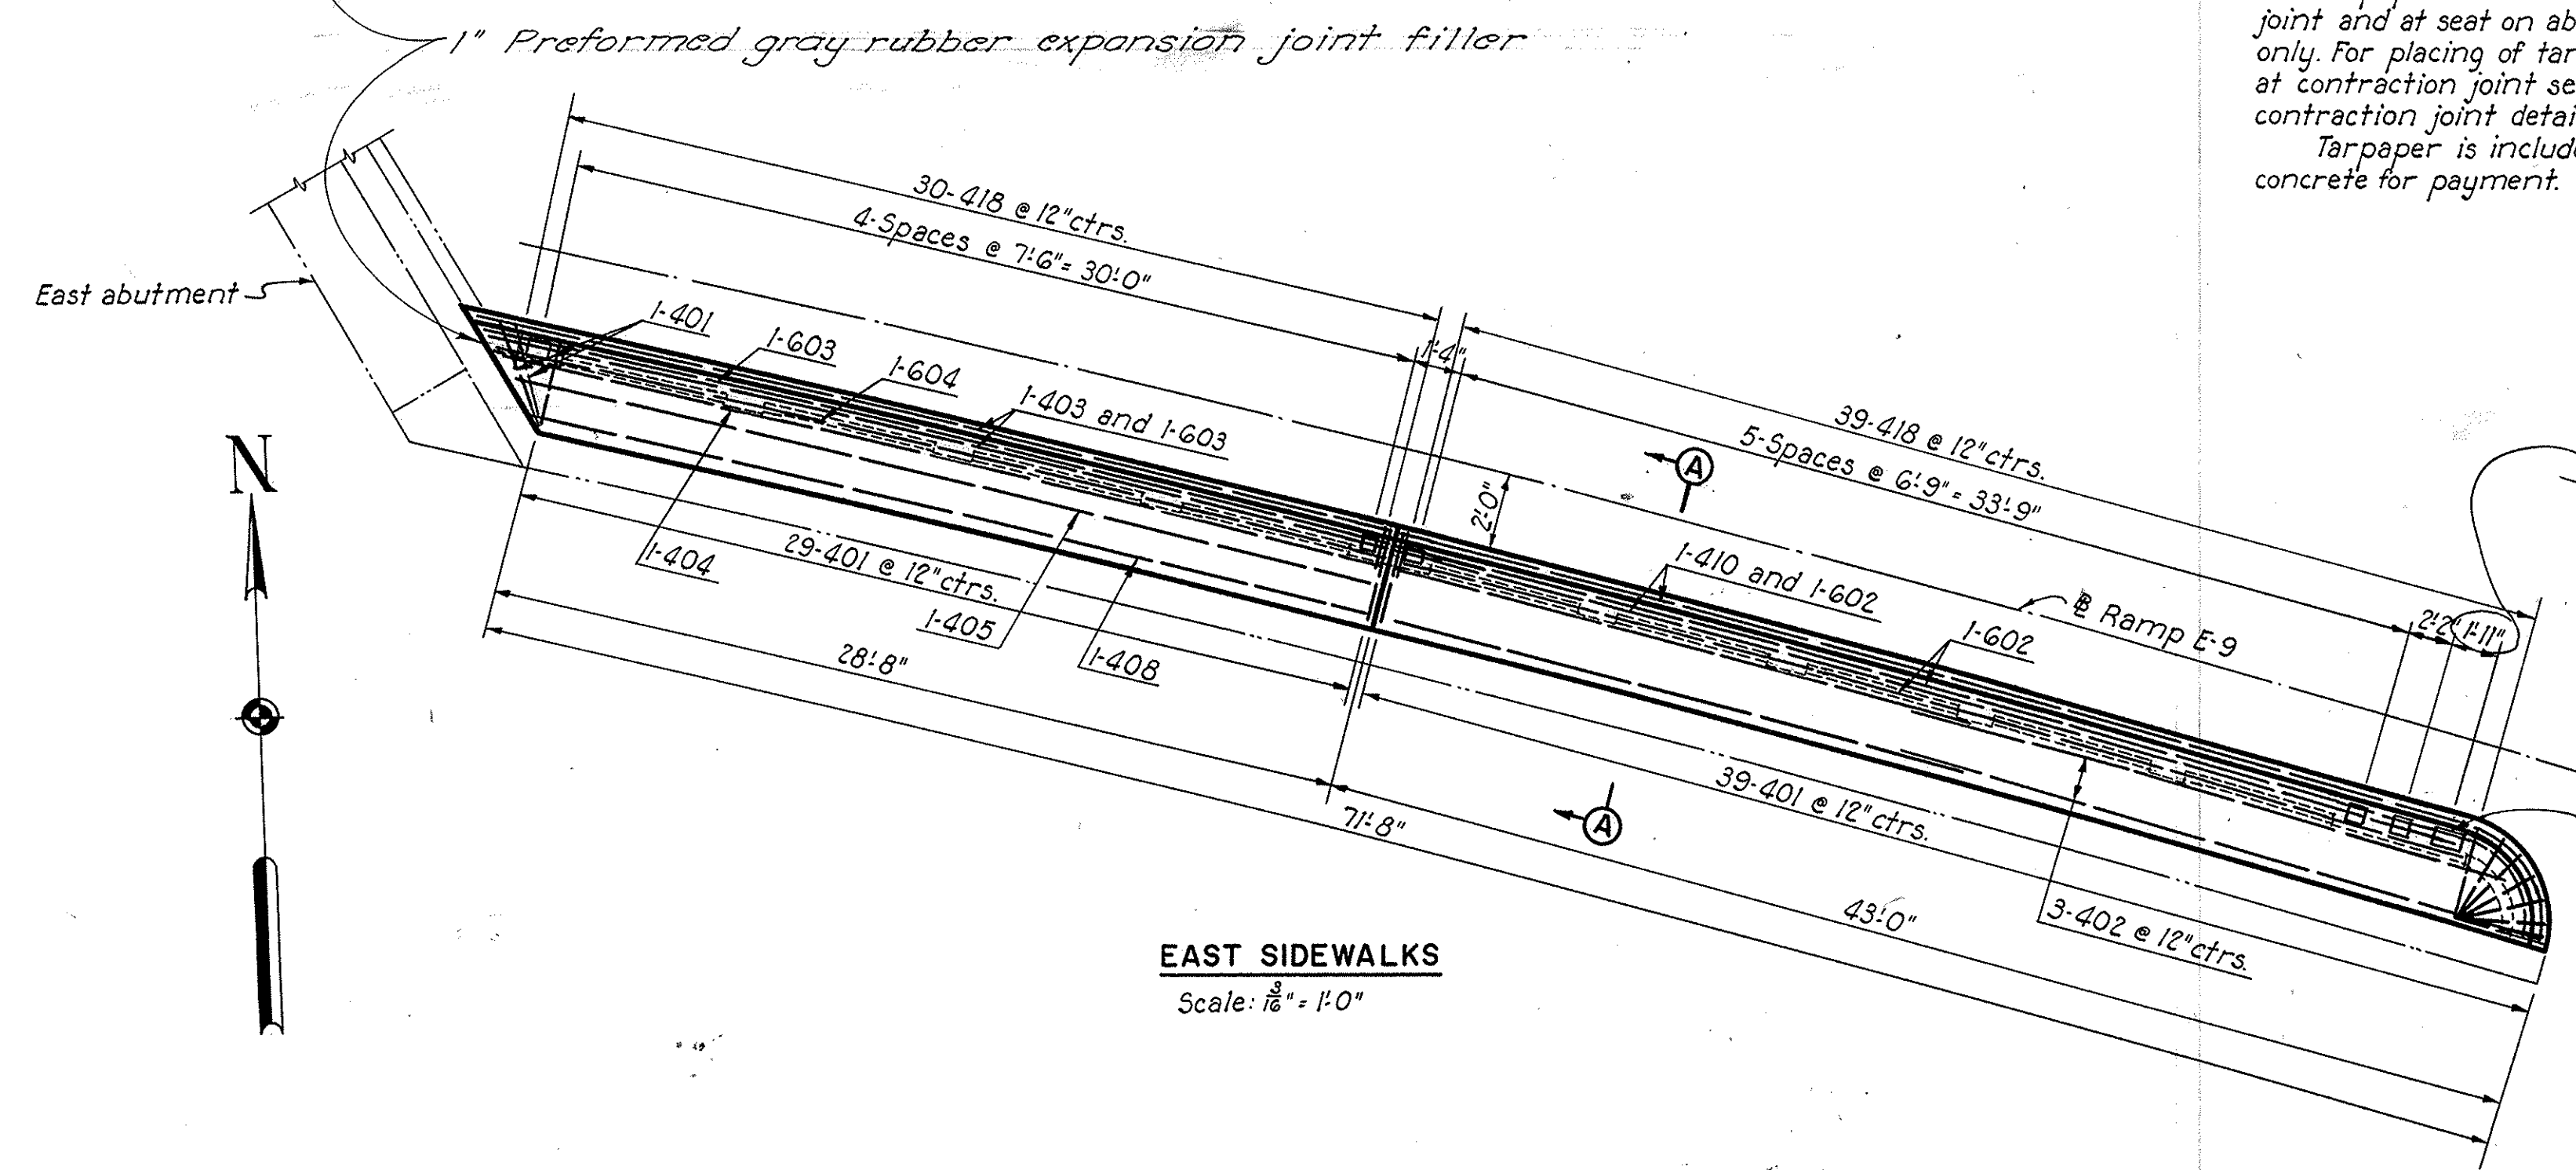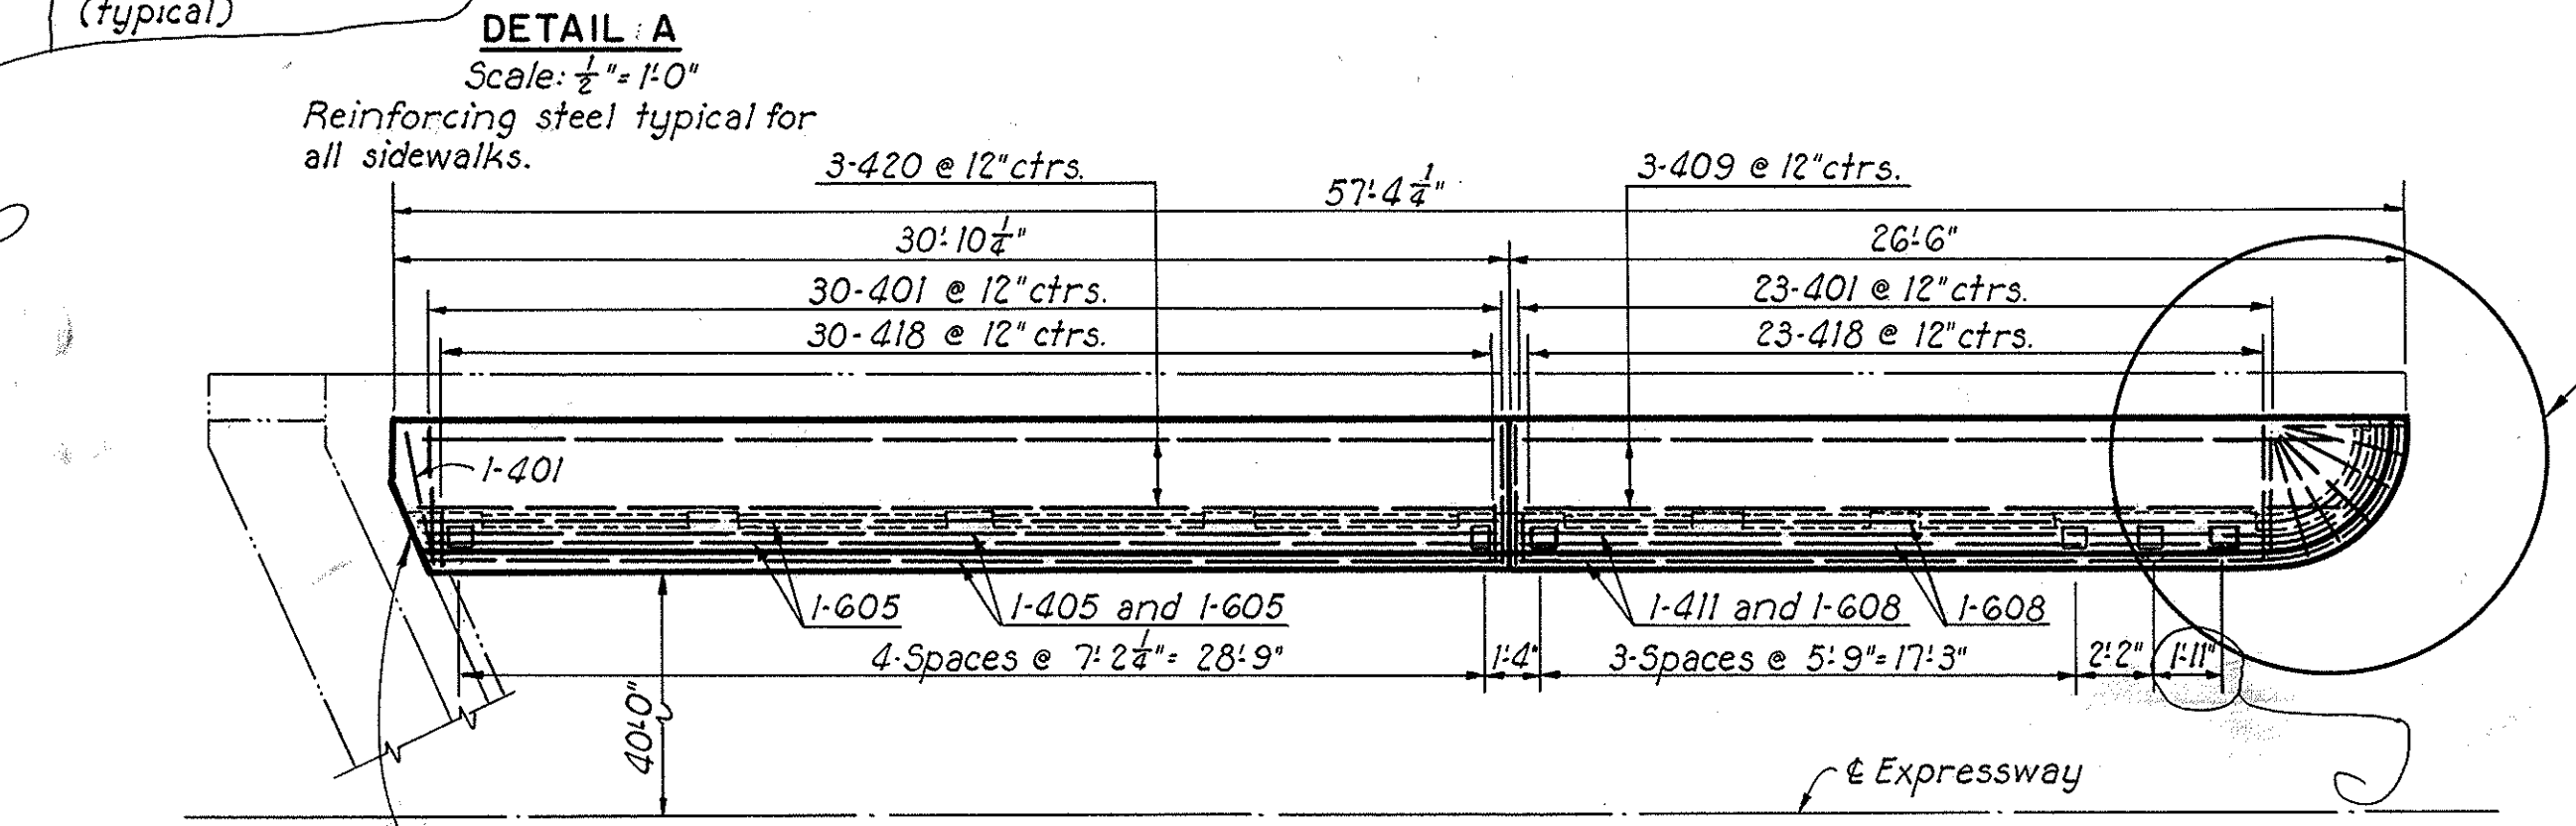


**EAST SIDEWALKS**  
Scale: 3/8" = 1'-0"

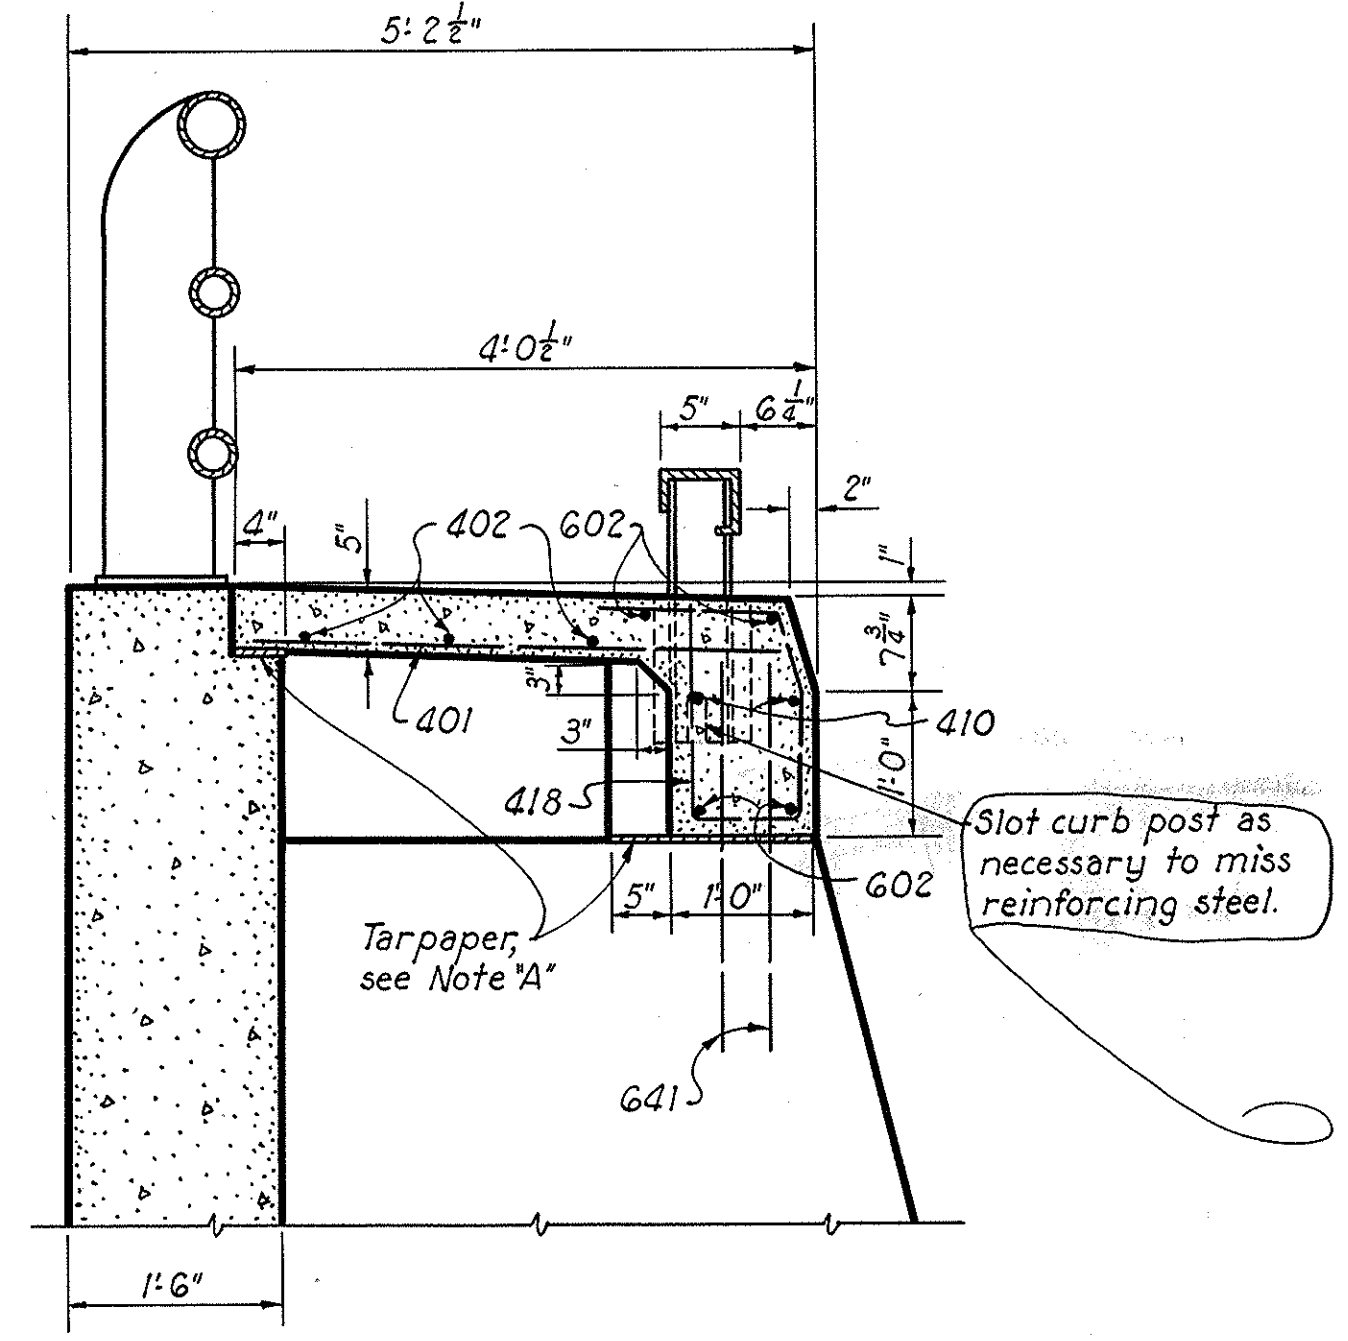


**SECTION A-A**  
Scale: 3/4" = 1'-0"  
Typical section at contraction joint except for bar marks.

REINFORCEMENT SCHEDULE						
MARK	NUMBER	LENGTH	TYPE	DIMENSIONS		WEIGHT POUNDS
				A	B	
401	303	3'-9"	Str.			751
402	3	41'-0"	Str.			82
403	2	31'-9"	Str.			42
404	1	30'-6"	Str.			21
405	3	29'-6"	Str.			59
406	4	7'-10"	101	3'-10"	5'-10"	21
407	4	6'-9"	101	3'-2"	4'-9"	18
408	1	28'-9"	Str.			19
409	3	24'-3"	Str.			49
410	2	38'-9"	Str.			52
411	2	22'-3"	Str.			30
412	3	23'-9"	Str.			48
413	2	21'-9"	Str.			29
414	3	27'-9"	Str.			56
415	2	25'-9"	Str.			34
416	5	36'-0"	Str.			120
417	5	34'-0"	Str.			114
418	297	4'-10"	102			959
419	5	35'-6"	Str.			119
420	3	30'-0"	Str.			60
601	4	35'-6"	Str.			213
602	4	38'-9"	Str.			233
603	3	31'-9"	Str.			143
604	1	30'-9"	Str.			46
605	4	29'-6"	Str.			177
606	8	7'-10"	101	3'-10"	5'-10"	94
607	8	6'-9"	101	3'-2"	4'-9"	81
608	4	22'-3"	Str.			134
609	4	21'-9"	Str.			131
610	4	25'-9"	Str.			155
611	4	36'-0"	Str.			216
612	4	34'-0"	Str.			204
Total =						4510

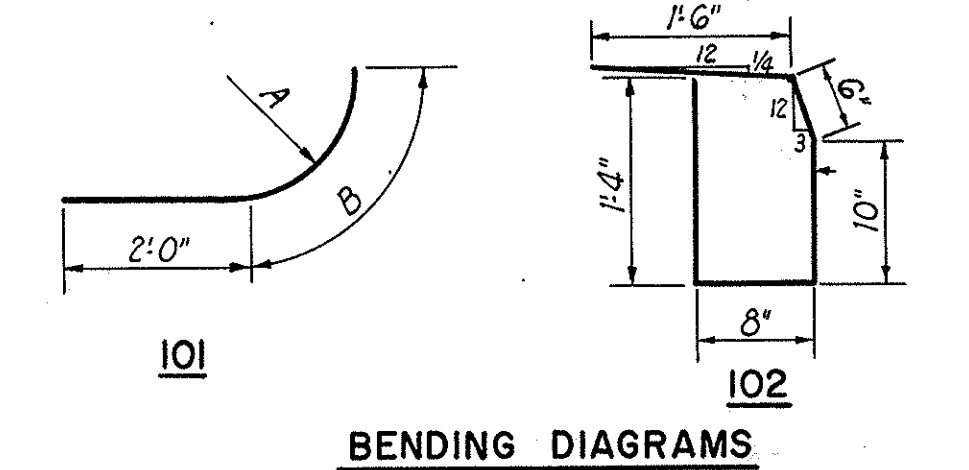

Note: Bar dimensions are given out to out.

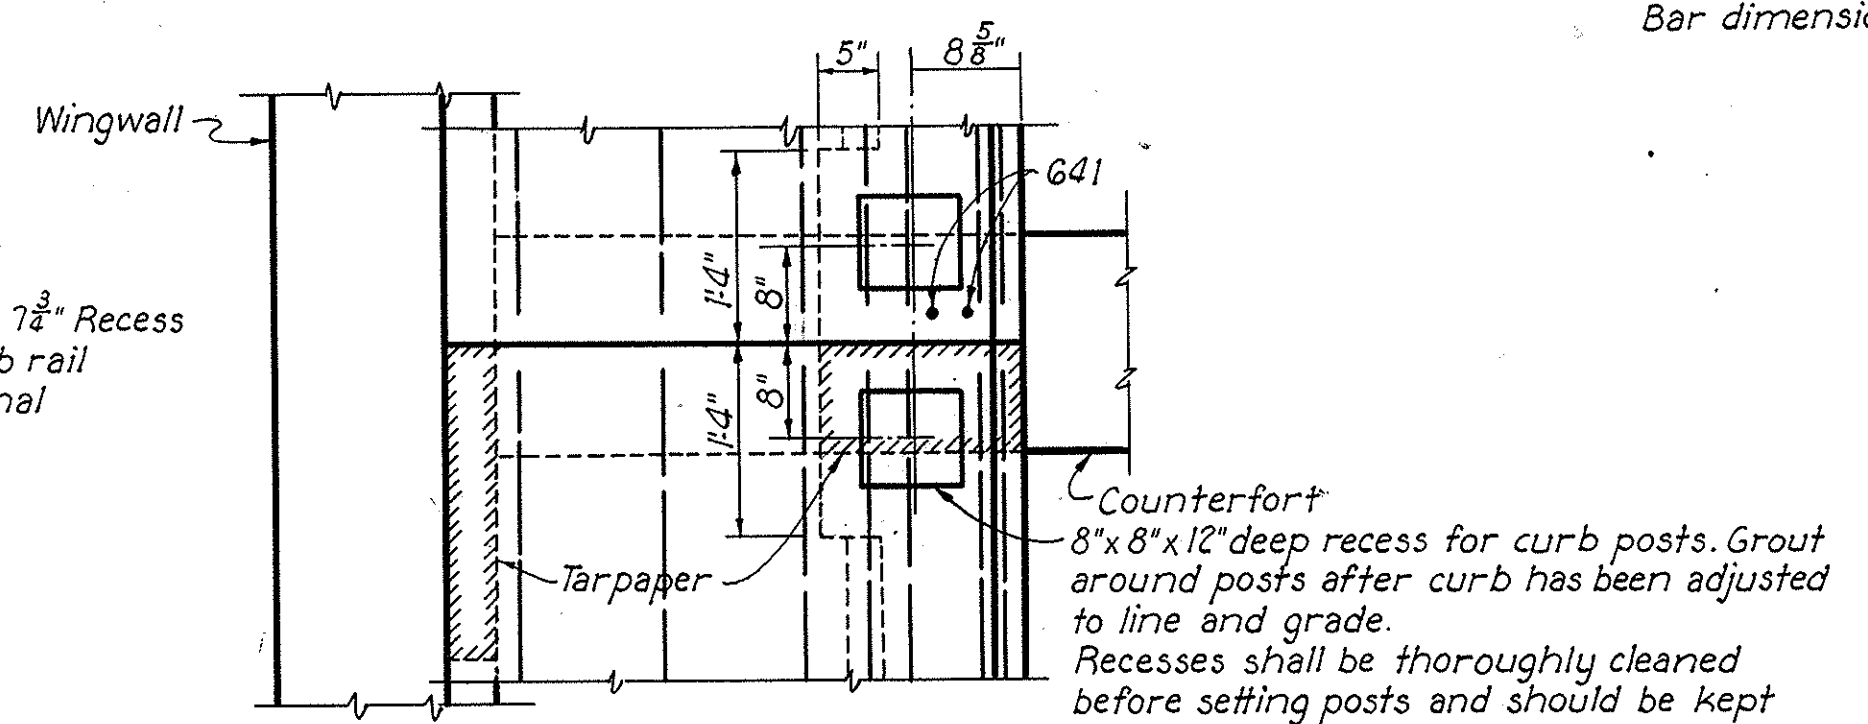

**TYPICAL CONTRACTION JOINT DETAILS**  
Scale: 3/4" = 1'-0"

Revised 3-27-56  
Revised 12-19-55

**PART 7**



**AKRON EXPRESSWAY SYSTEM**  
WEST VIADUCT  
BR. NO. SU-18R-135  
APPROACH SIDEWALKS AND CURBS

AKRON SUMMIT COUNTY. OHIO

SCALE: As shown  
MADE: DJH DATE 8-17-55  
TRCD: CAL DATE 12-3-55  
CKD: GD DATE 10-18-55

HOWARD, NEEDLES, TAMMEN & BERGENDOFF  
CONSULTING ENGINEERS  
KANSAS CITY CLEVELAND NEW YORK  
901 SHEET 85.

**SUMMIT COUNTY  
CITY OF AKRON  
AKRON EXPRESSWAY SYSTEM**

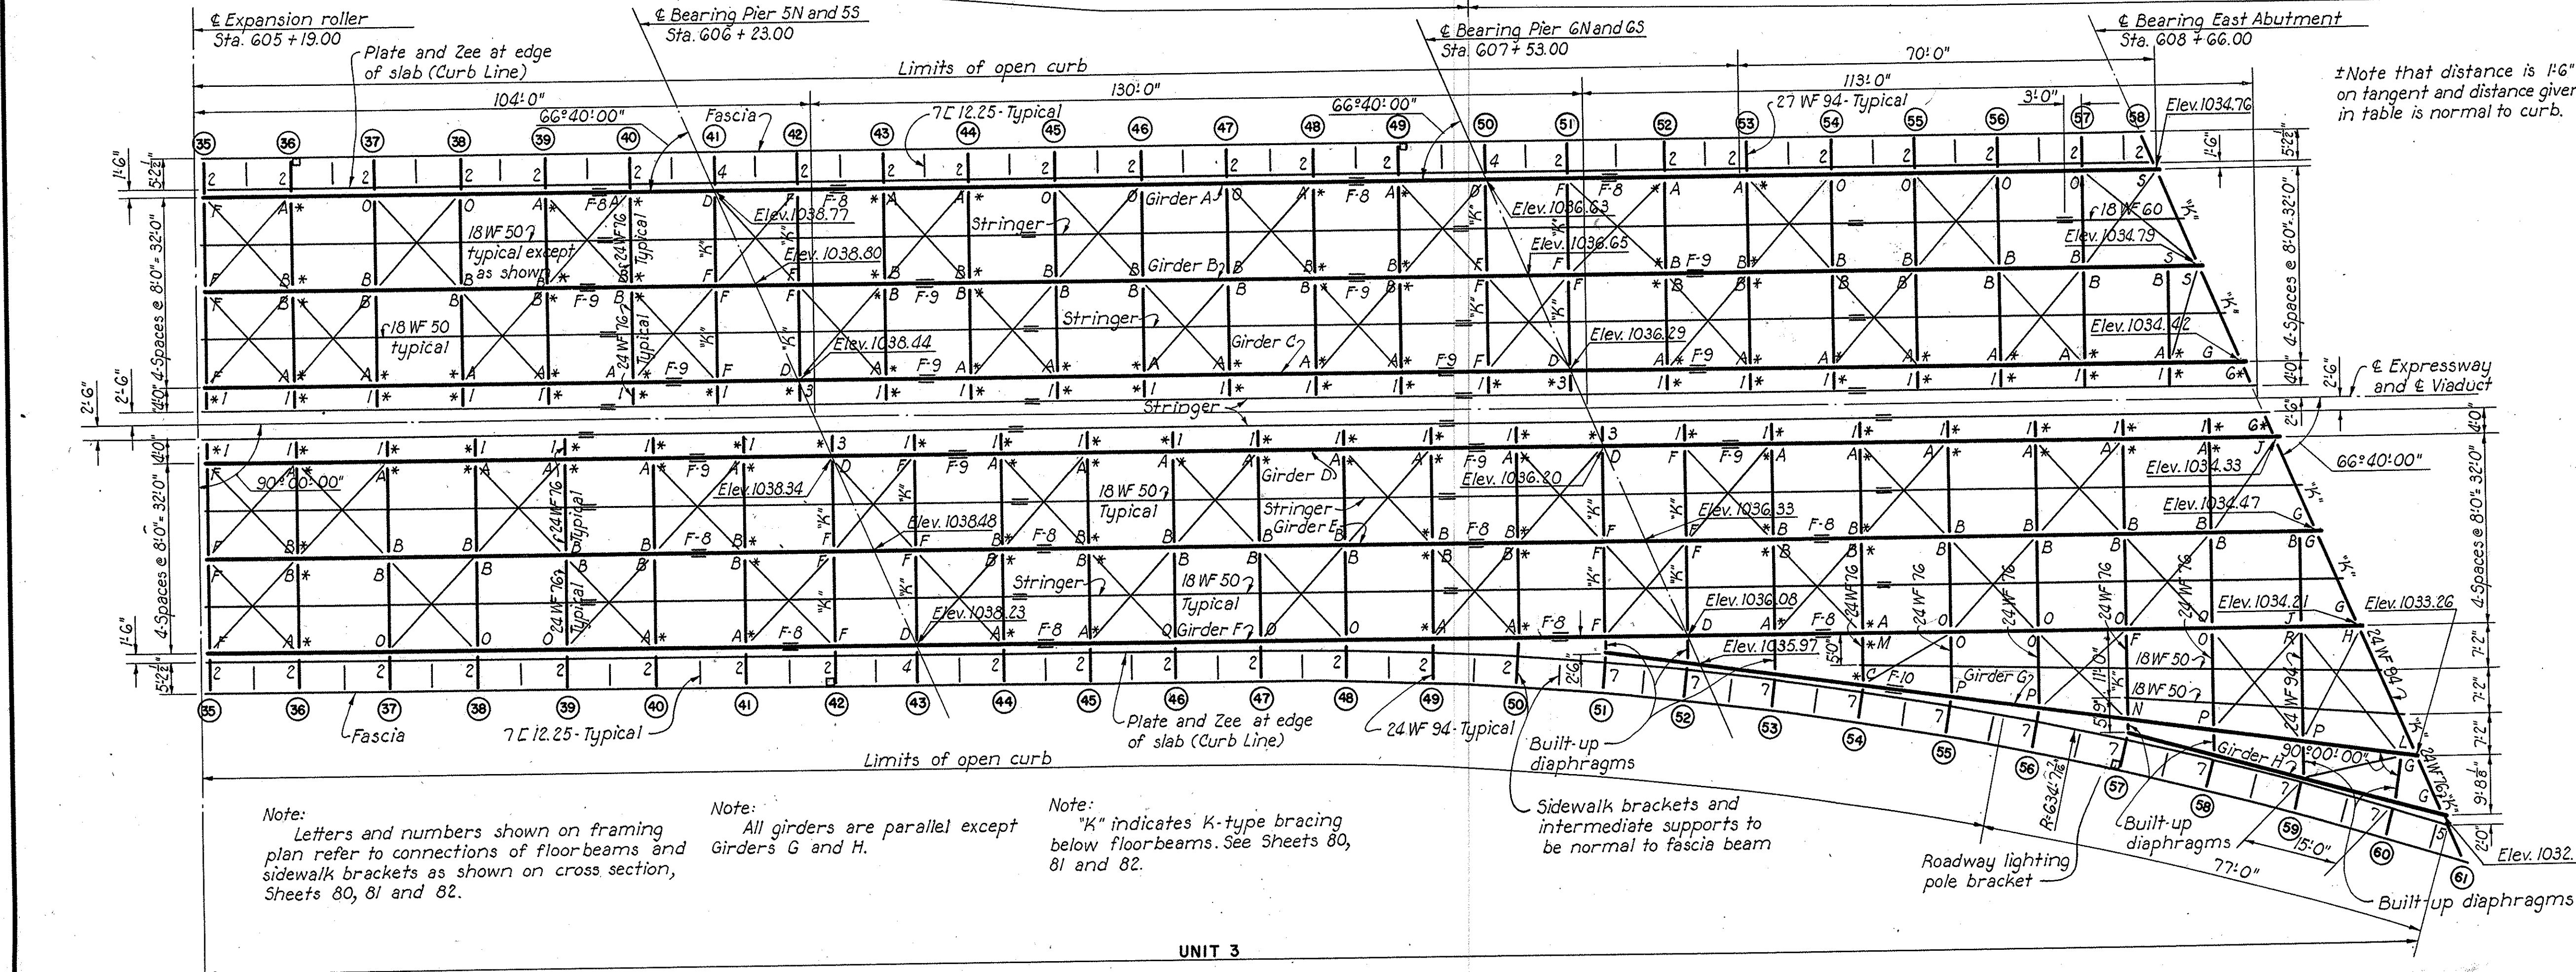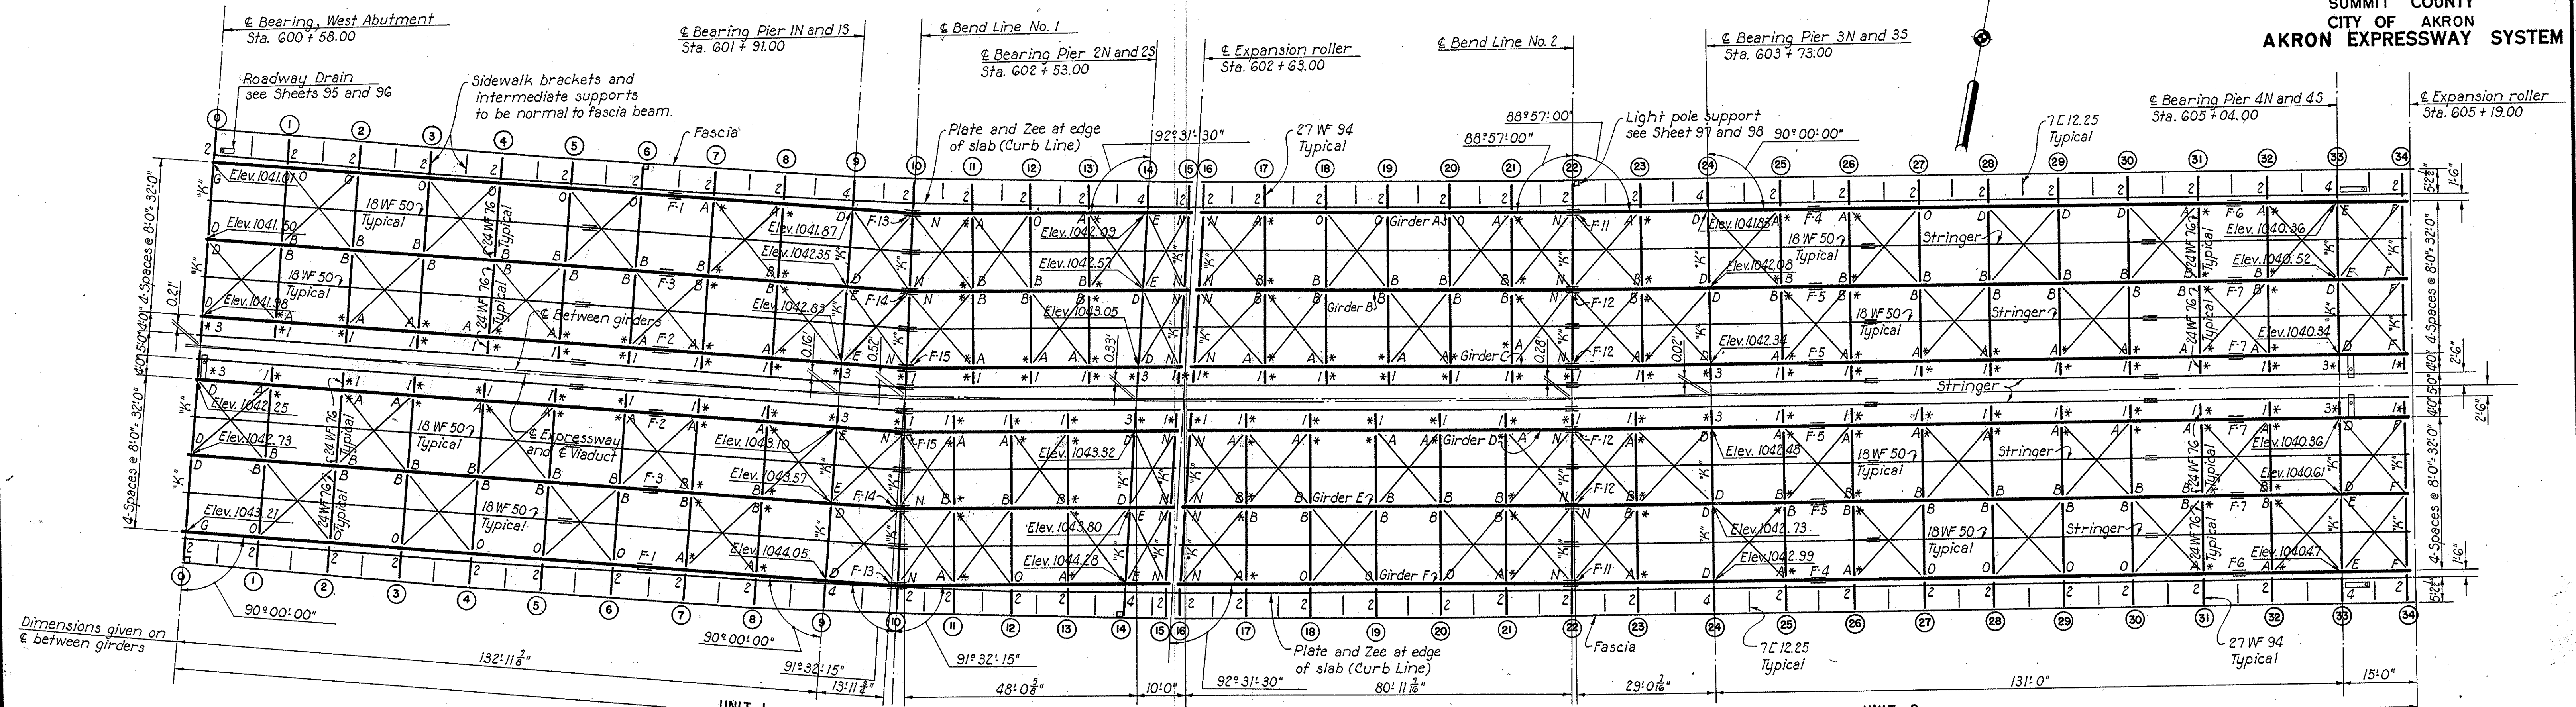

Panel Point	North Curb	South Curb	Panel Point	North Curb	South Curb
0	1.72'	1.30'	20	1.31'	1.70'
1	1.41'	1.61'	21	1.51'	1.49'
2	1.17'	1.84'	22	1.78'	1.21'
3	1.01'	1.99'	23	1.61'	1.38'
4	0.93'	2.07'	24	1.52'	1.48'
5	0.92'	2.08'	25	1.52'	1.64'
6	0.99'	2.01'	26	1.52'	2.11'
7	1.14'	1.86'	27	1.52'	2.91'
8	1.37'	1.64'	28	1.52'	1.55'
9	1.67'	1.35'	29	1.52'	1.01'
10	2.00'	0.97'	30	1.52'	0.78'
11	1.71'	1.25'	31	1.52'	0.91'
12	1.48'	1.49'	32	1.52'	1.39'
13	1.29'	1.68'	33	1.52'	2.22'
14	1.16'	1.81'	34	1.52'	1.48'
15	1.10'	1.88'	35	1.52'	1.06'
16	1.08'	1.90'	36	1.52'	1.00'
17	1.05'	1.95'	37	1.52'	1.29'
18	1.08'	1.93'			
19	1.17'	1.84'			

\*Note that distance is 1/8" on tangent and distance given in table is normal to curb.

Notes:  
 Use ST 6 WF 13.5 for laterals where cross bracing is used and ST 8 WF 29 where single bracing is used.  
 \* Indicates location of knee braces; see Sheets 80, 81 and 82.  
 Curb posts and hand-rail posts shall occur at every sidewalk bracket and intermediate sidewalk support.  
 Elevations given are to back of top flange angles over points of bearing.

Note:  
 Letters and numbers shown on framing plan refer to connections of floorbeams and sidewalk brackets as shown on cross section, Sheets 80, 81 and 82.

Note:  
 All girders are parallel except Girders G and H.

Note:  
 "K" indicates K-type bracing below floorbeams. See Sheets 80, 81 and 82.

Sidewalk brackets and intermediate supports to be normal to fascia beam

**PART 7**

**AKRON EXPRESSWAY SYSTEM  
WEST VIADUCT  
BR. NO. SU-18R-135  
STEEL FRAMING PLAN**


AKRON SUMMIT COUNTY OHIO

SCALE: 1/8" = 1'-0"  
 MADE S.M.A. DATE 7-6-55  
 TRCD. CAL. DATE 11-18-55  
 CKD. DFB. DATE 9-29-55

HOWARD, NEEDLES, TAMMEN & BERGENOFF  
 CONSULTING ENGINEERS  
 KANSAS CITY CLEVELAND NEW YORK  
 901 SHEET 86



**SUMMIT COUNTY  
CITY OF AKRON  
AKRON EXPRESSWAY SYSTEM**

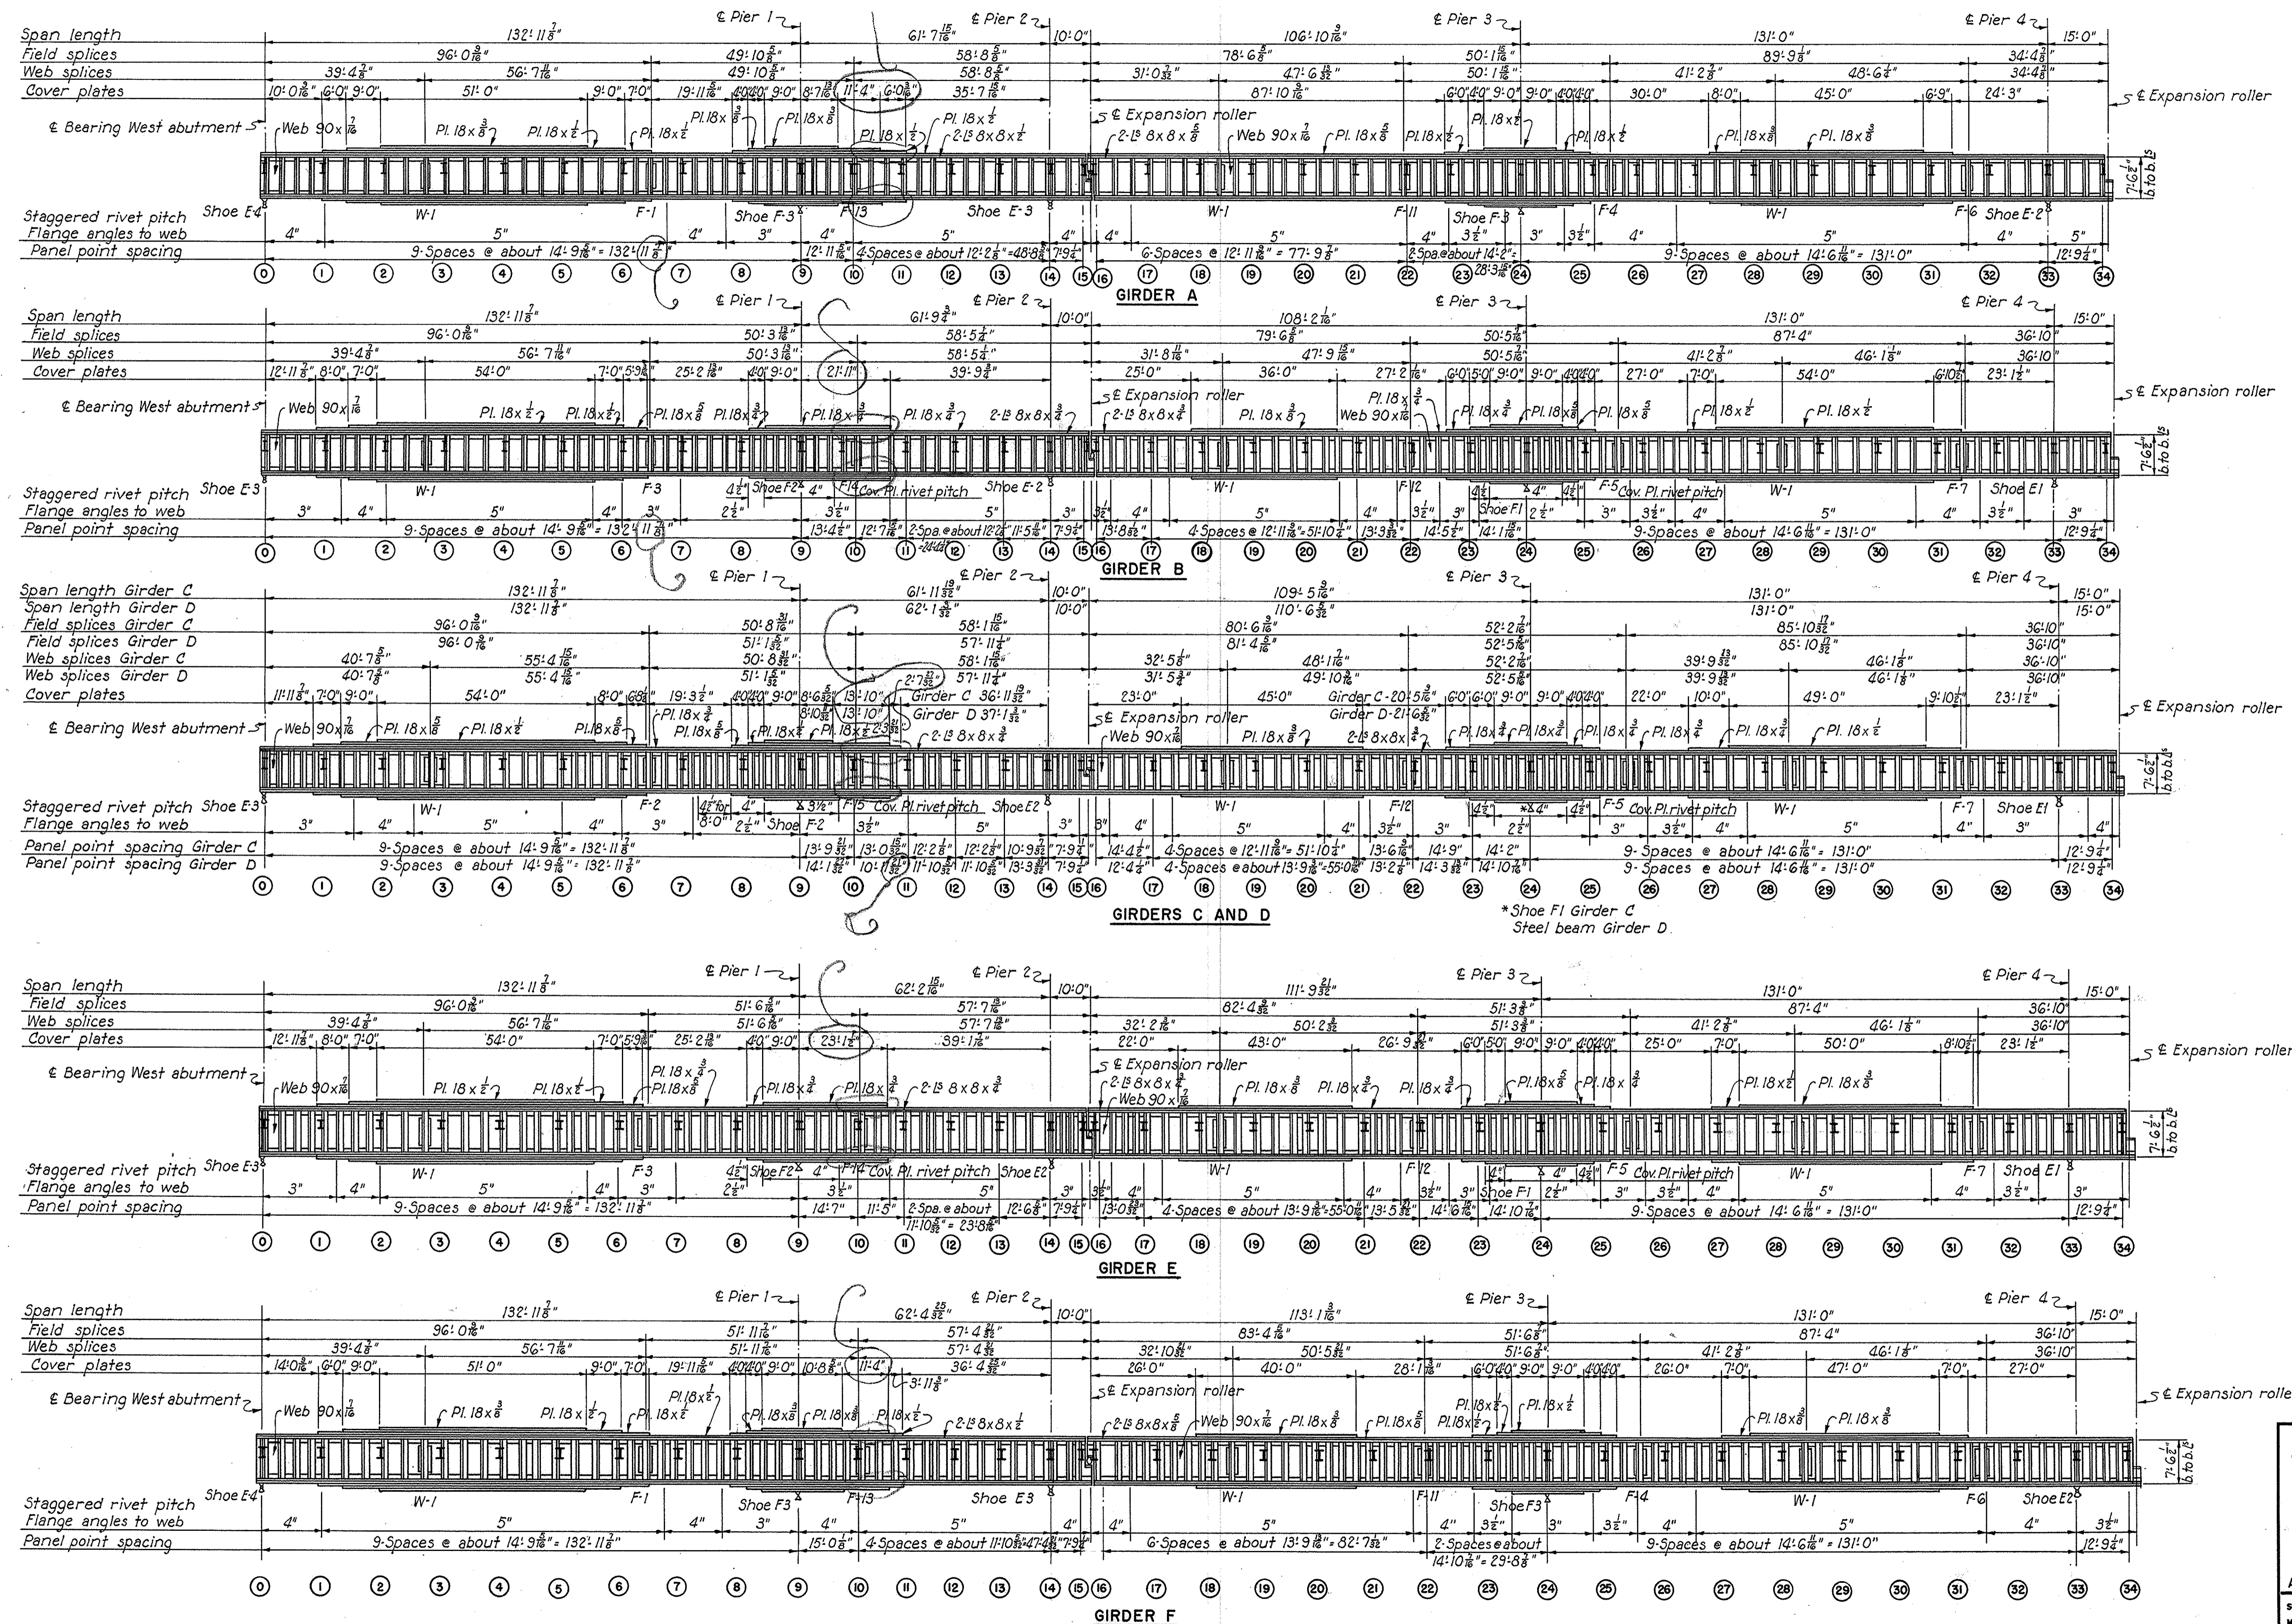

**Notes:**

- Intermediate stiffener angles are 2-1/2 x 3-3/8 x 1/8 crimped for all girders.
- For number and size of bearing stiffener angles see Sheet 91.
- Intermediate floorbeam connection angles are 2-1/2 x 7 x 4 x 1/8 on fill for all girders.
- Material, dimensions and rivet pitch shown are common to top and bottom of girder.
- Staggered rivet pitch flange angles to cover plates to be 5" except ends of cover plates or where noted on girder elevations. For developed ends of cover plates see Sheet 89.
- Numbers encircled thus  $\bigcirc$  refer to panel points as indicated on framing plan.
- Girders shall be fabricated with camber to compensate for deflections due to dead load weight of steel and slab and for vertical curvature.
- For tabulation of deflections see Sheet 99.

**PART 7**

**AKRON EXPRESSWAY SYSTEM**









**WEST VIADUCT**

**BR. NO. SU-18R-135**

**GIRDER ELEVATIONS UNITS I AND 2**

Revised 12-19-55

**SUMMIT COUNTY  
CITY OF AKRON  
AKRON EXPRESSWAY SYSTEM**

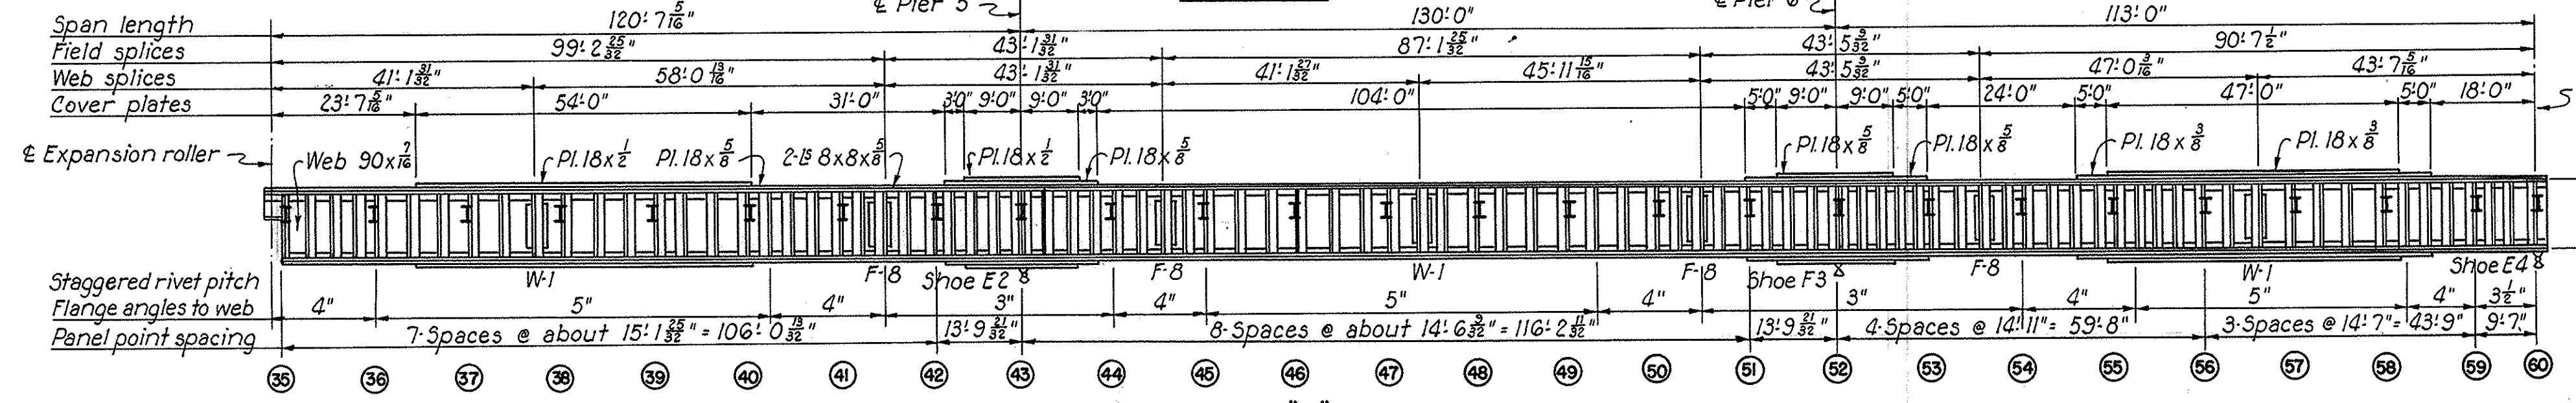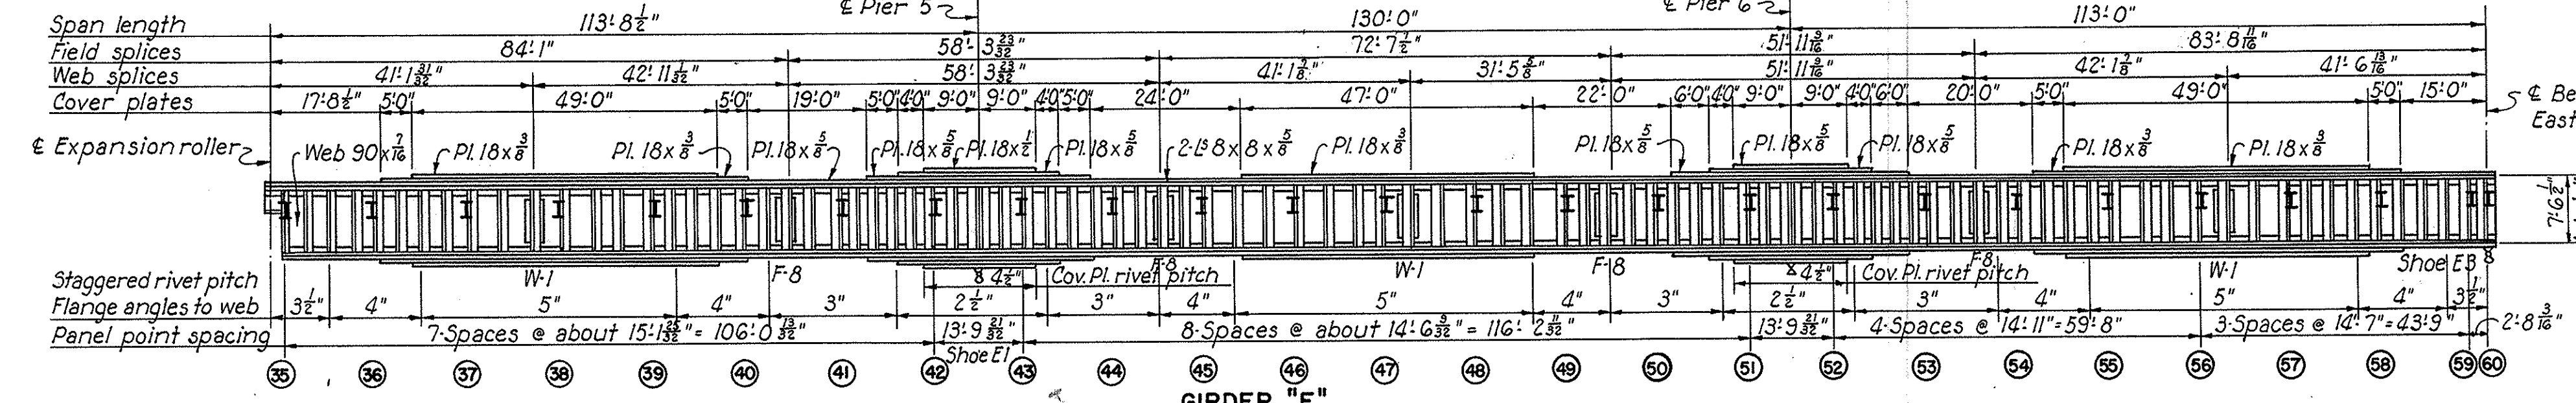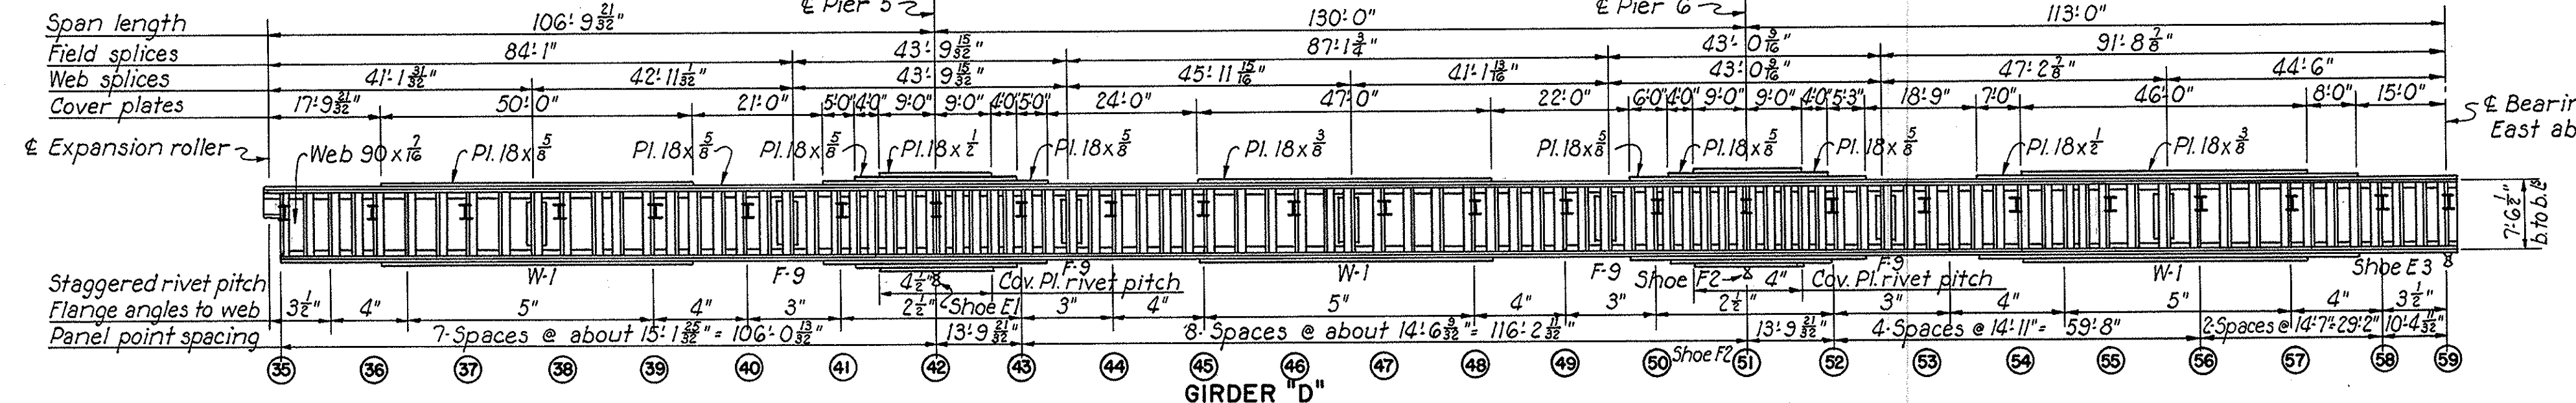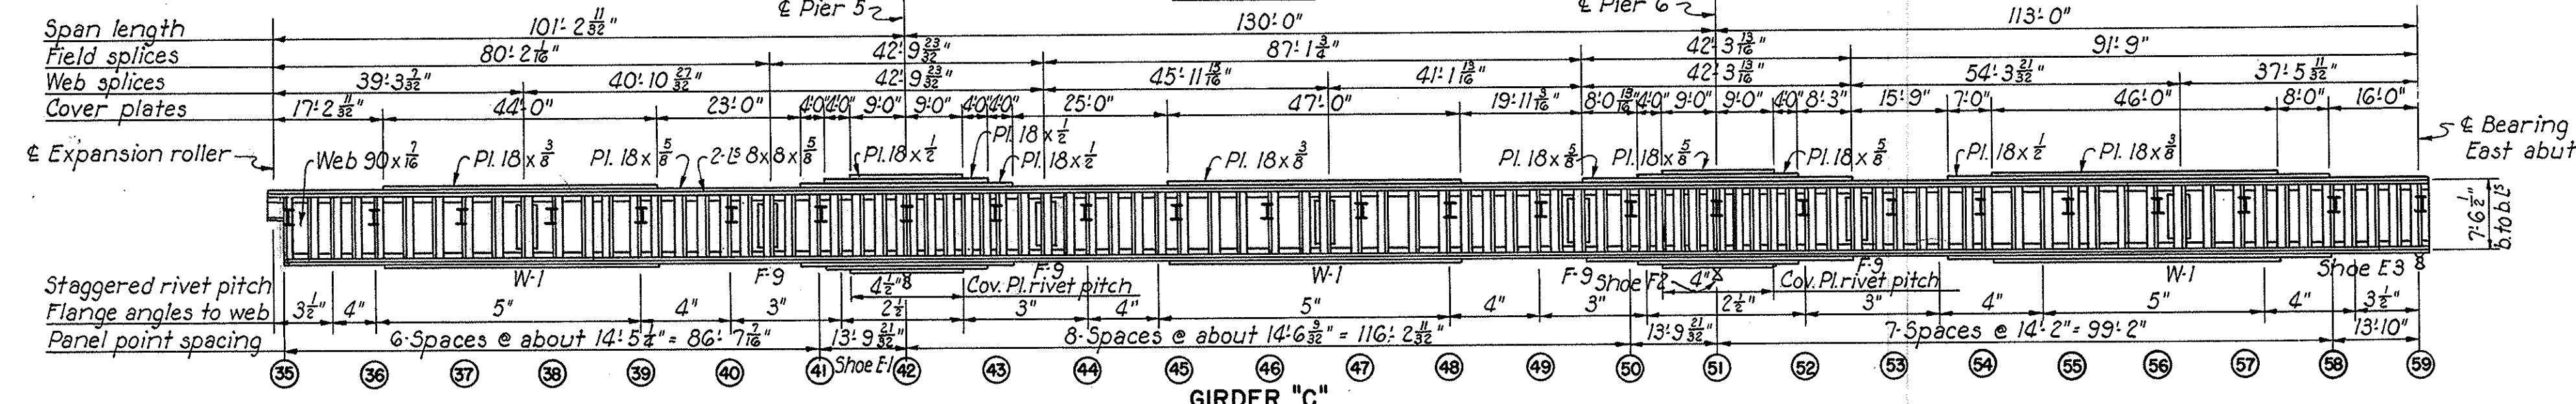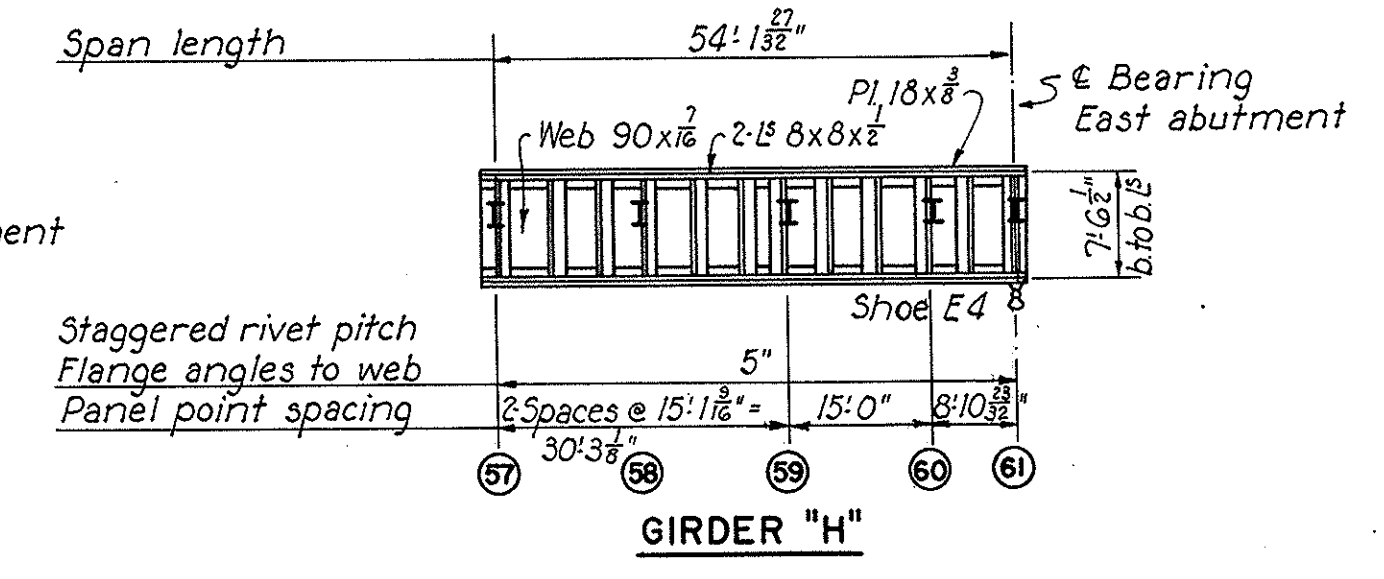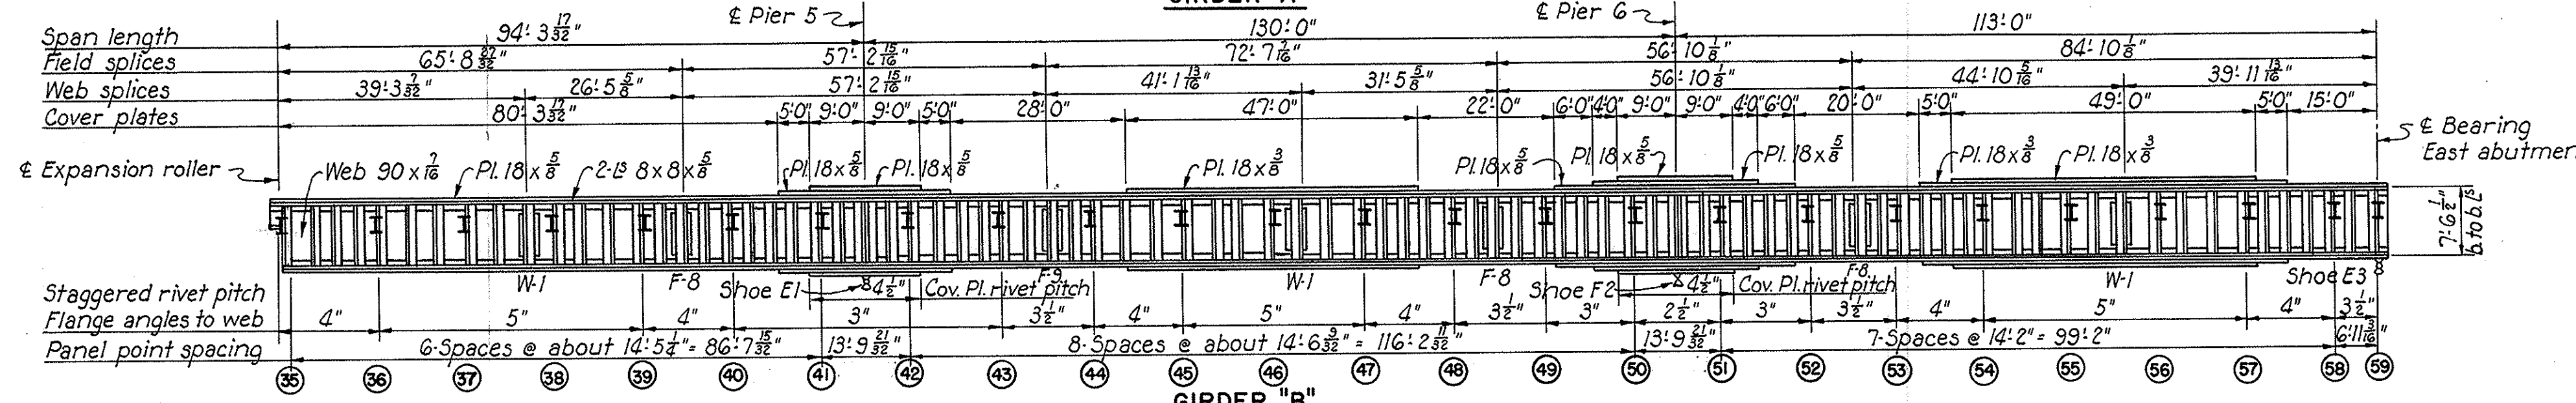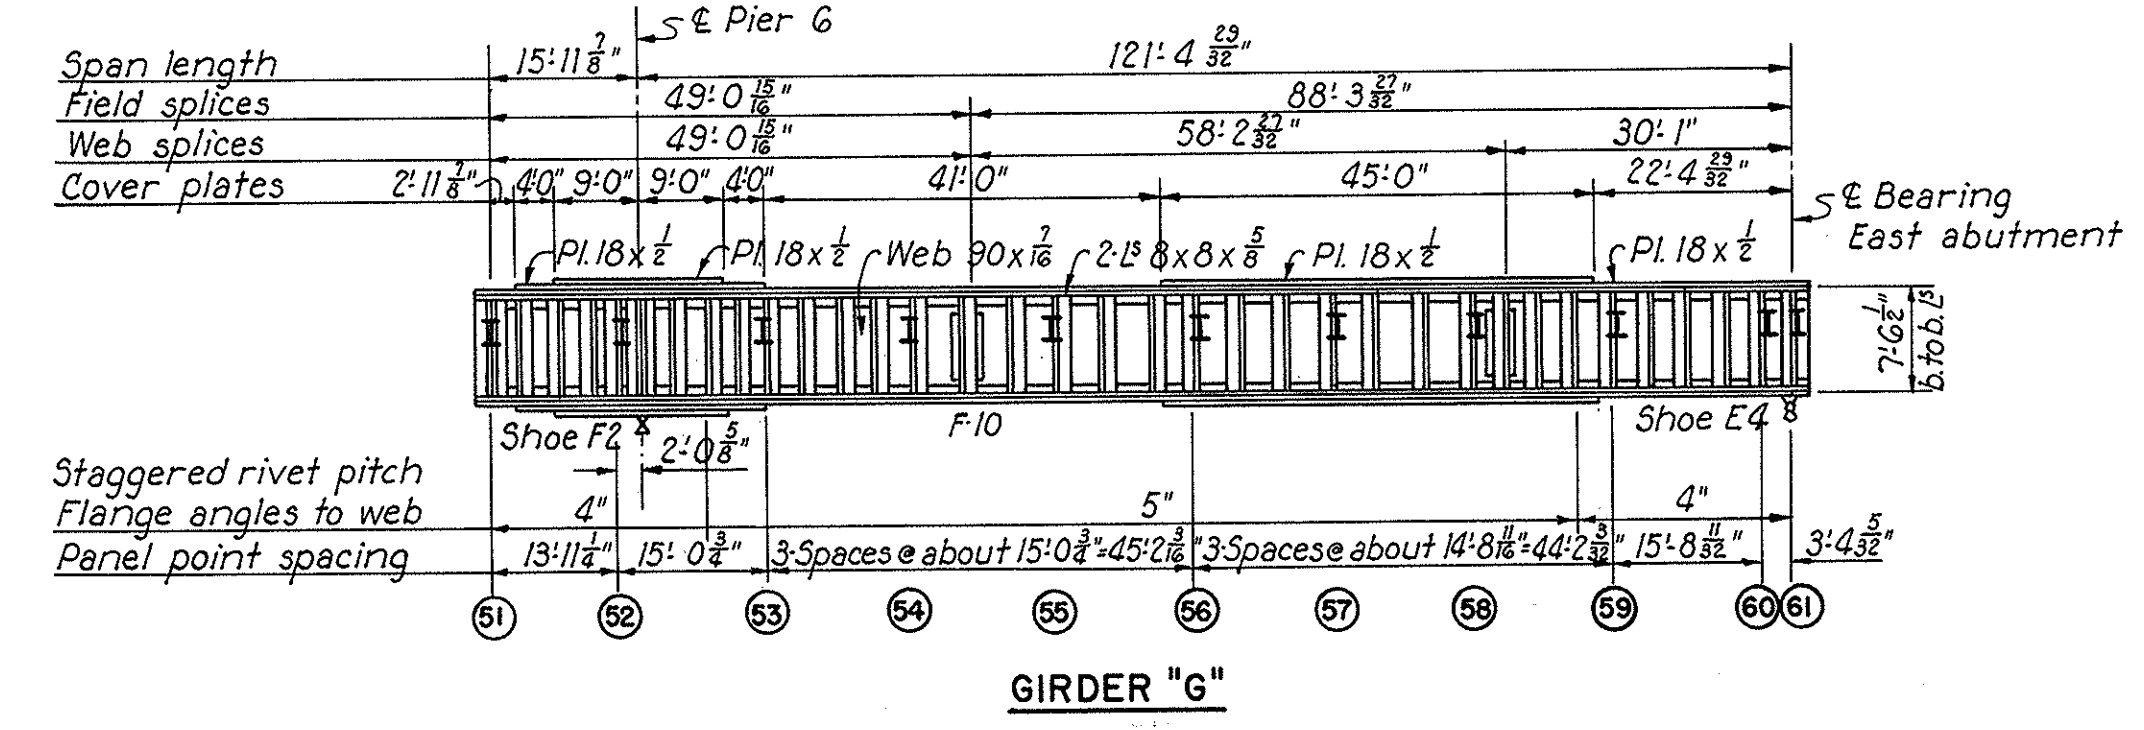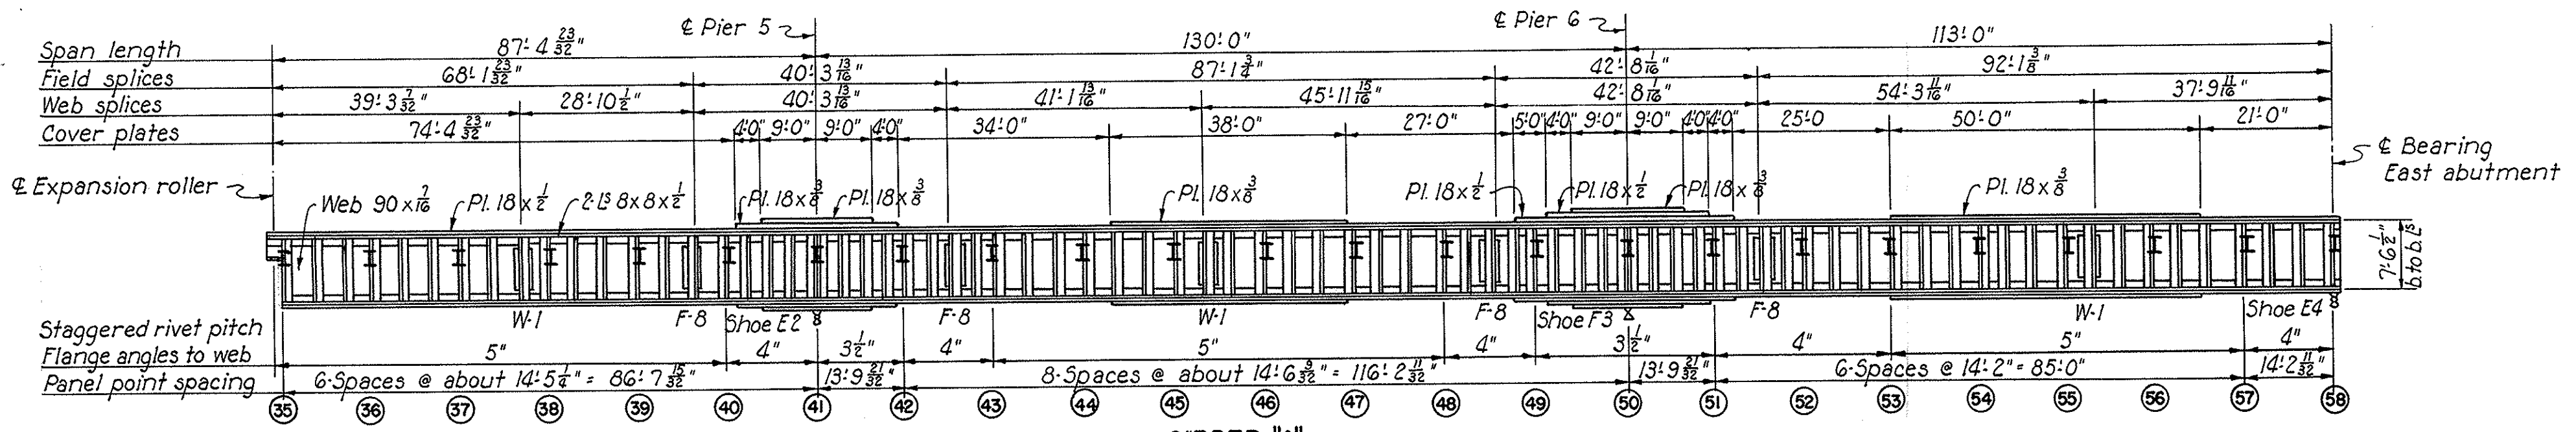

Notes:  
 Intermediate stiffener angles are 2:5 5x3 1/2 x 1/8 crimped for all girders.  
 For number and size of bearing stiffener angles see Sheet 91.  
 Intermediate floor-beam connection angles are 2:5 7x4 x 1/8 on fill for all girders.  
 Material, dimensions and rivet pitch shown are common to top and bottom of girder.  
 Staggered rivet pitch flange angles to cover plates to be 5" except ends of cover plates or where noted on girder elevations. For developed ends of Cover Pl. see Sheet 89.  
 For additional notes see Sheet 87.

PART 7


**AKRON EXPRESSWAY SYSTEM**  
 WEST VIADUCT  
 BR. NO. SU-1BR-135  
 GIRDER ELEVATIONS-UNIT 3

AKRON SUMMIT COUNTY, OHIO



SCALE 1" = 20' 0"  
 MADE J.R.K. DATE 8-29-85  
 TRCD. C.A.L. DATE 11-14-85  
 CKD. G.D. DATE 10-18-85

HOWARD, NEEDLES, TAMMEN & BERGENDOFF  
 CONSULTING ENGINEERS  
 KANSAS CITY CLEVELAND NEW YORK  
 901 SHEET. 88

SUMMIT COUNTY  
CITY OF AKRON  
AKRON EXPRESSWAY SYSTEM  
EXPRESSWAY - PART 7  
SUM-18R-12.90

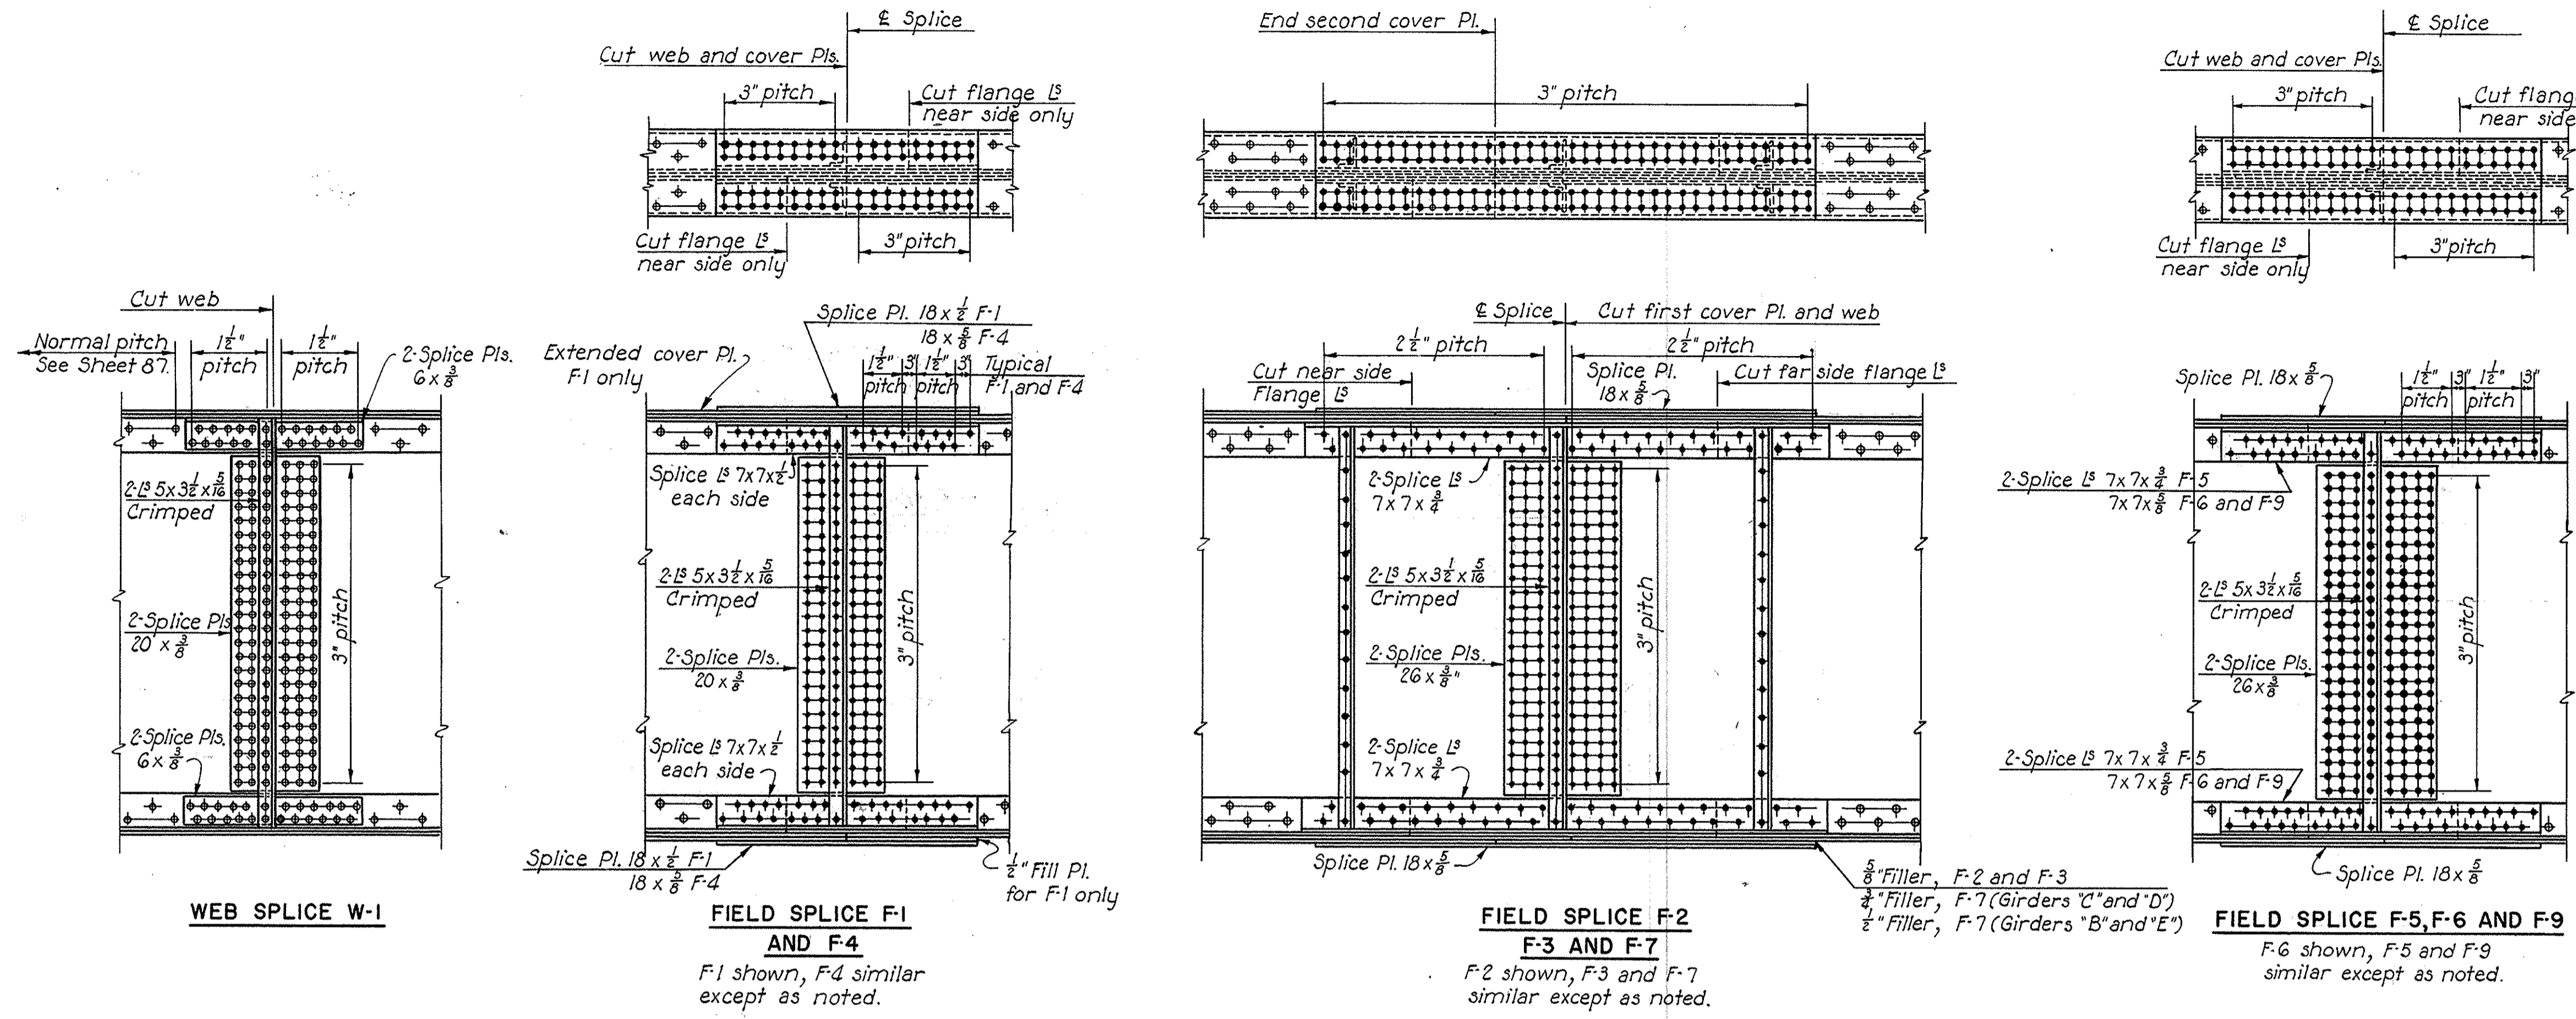

Note: In some cases for F-9 it will be necessary to provide an additional fill Pl. 5/8" under splice Pl. 18 x 5/8". Second cover Pl. will be extended to E splice.

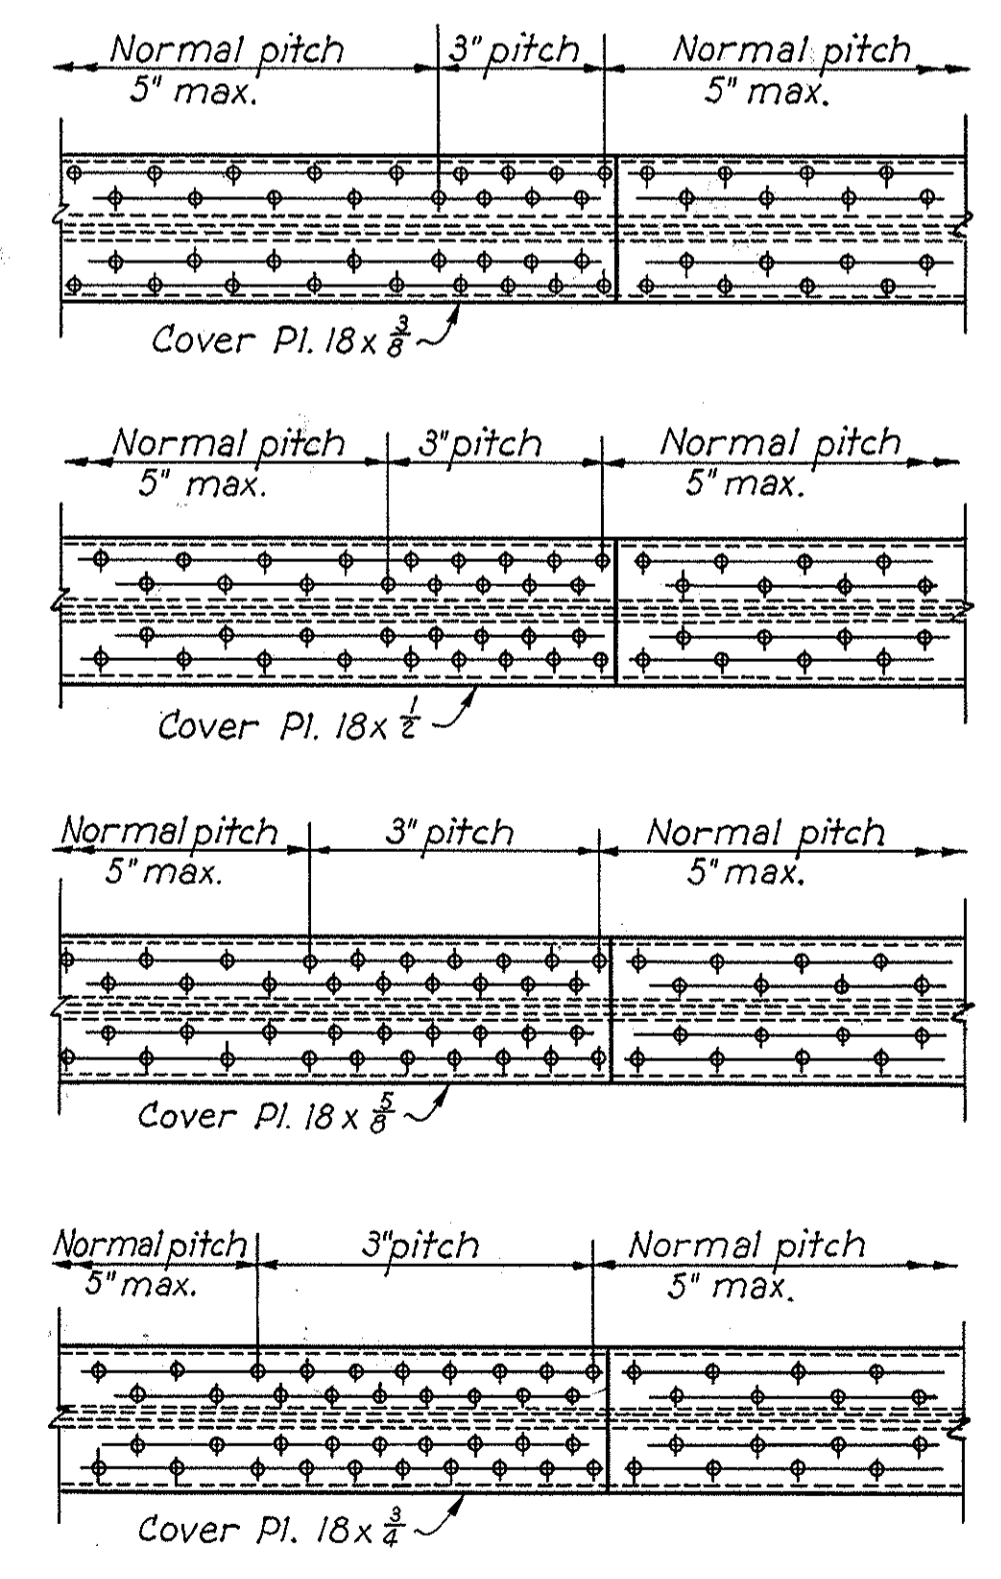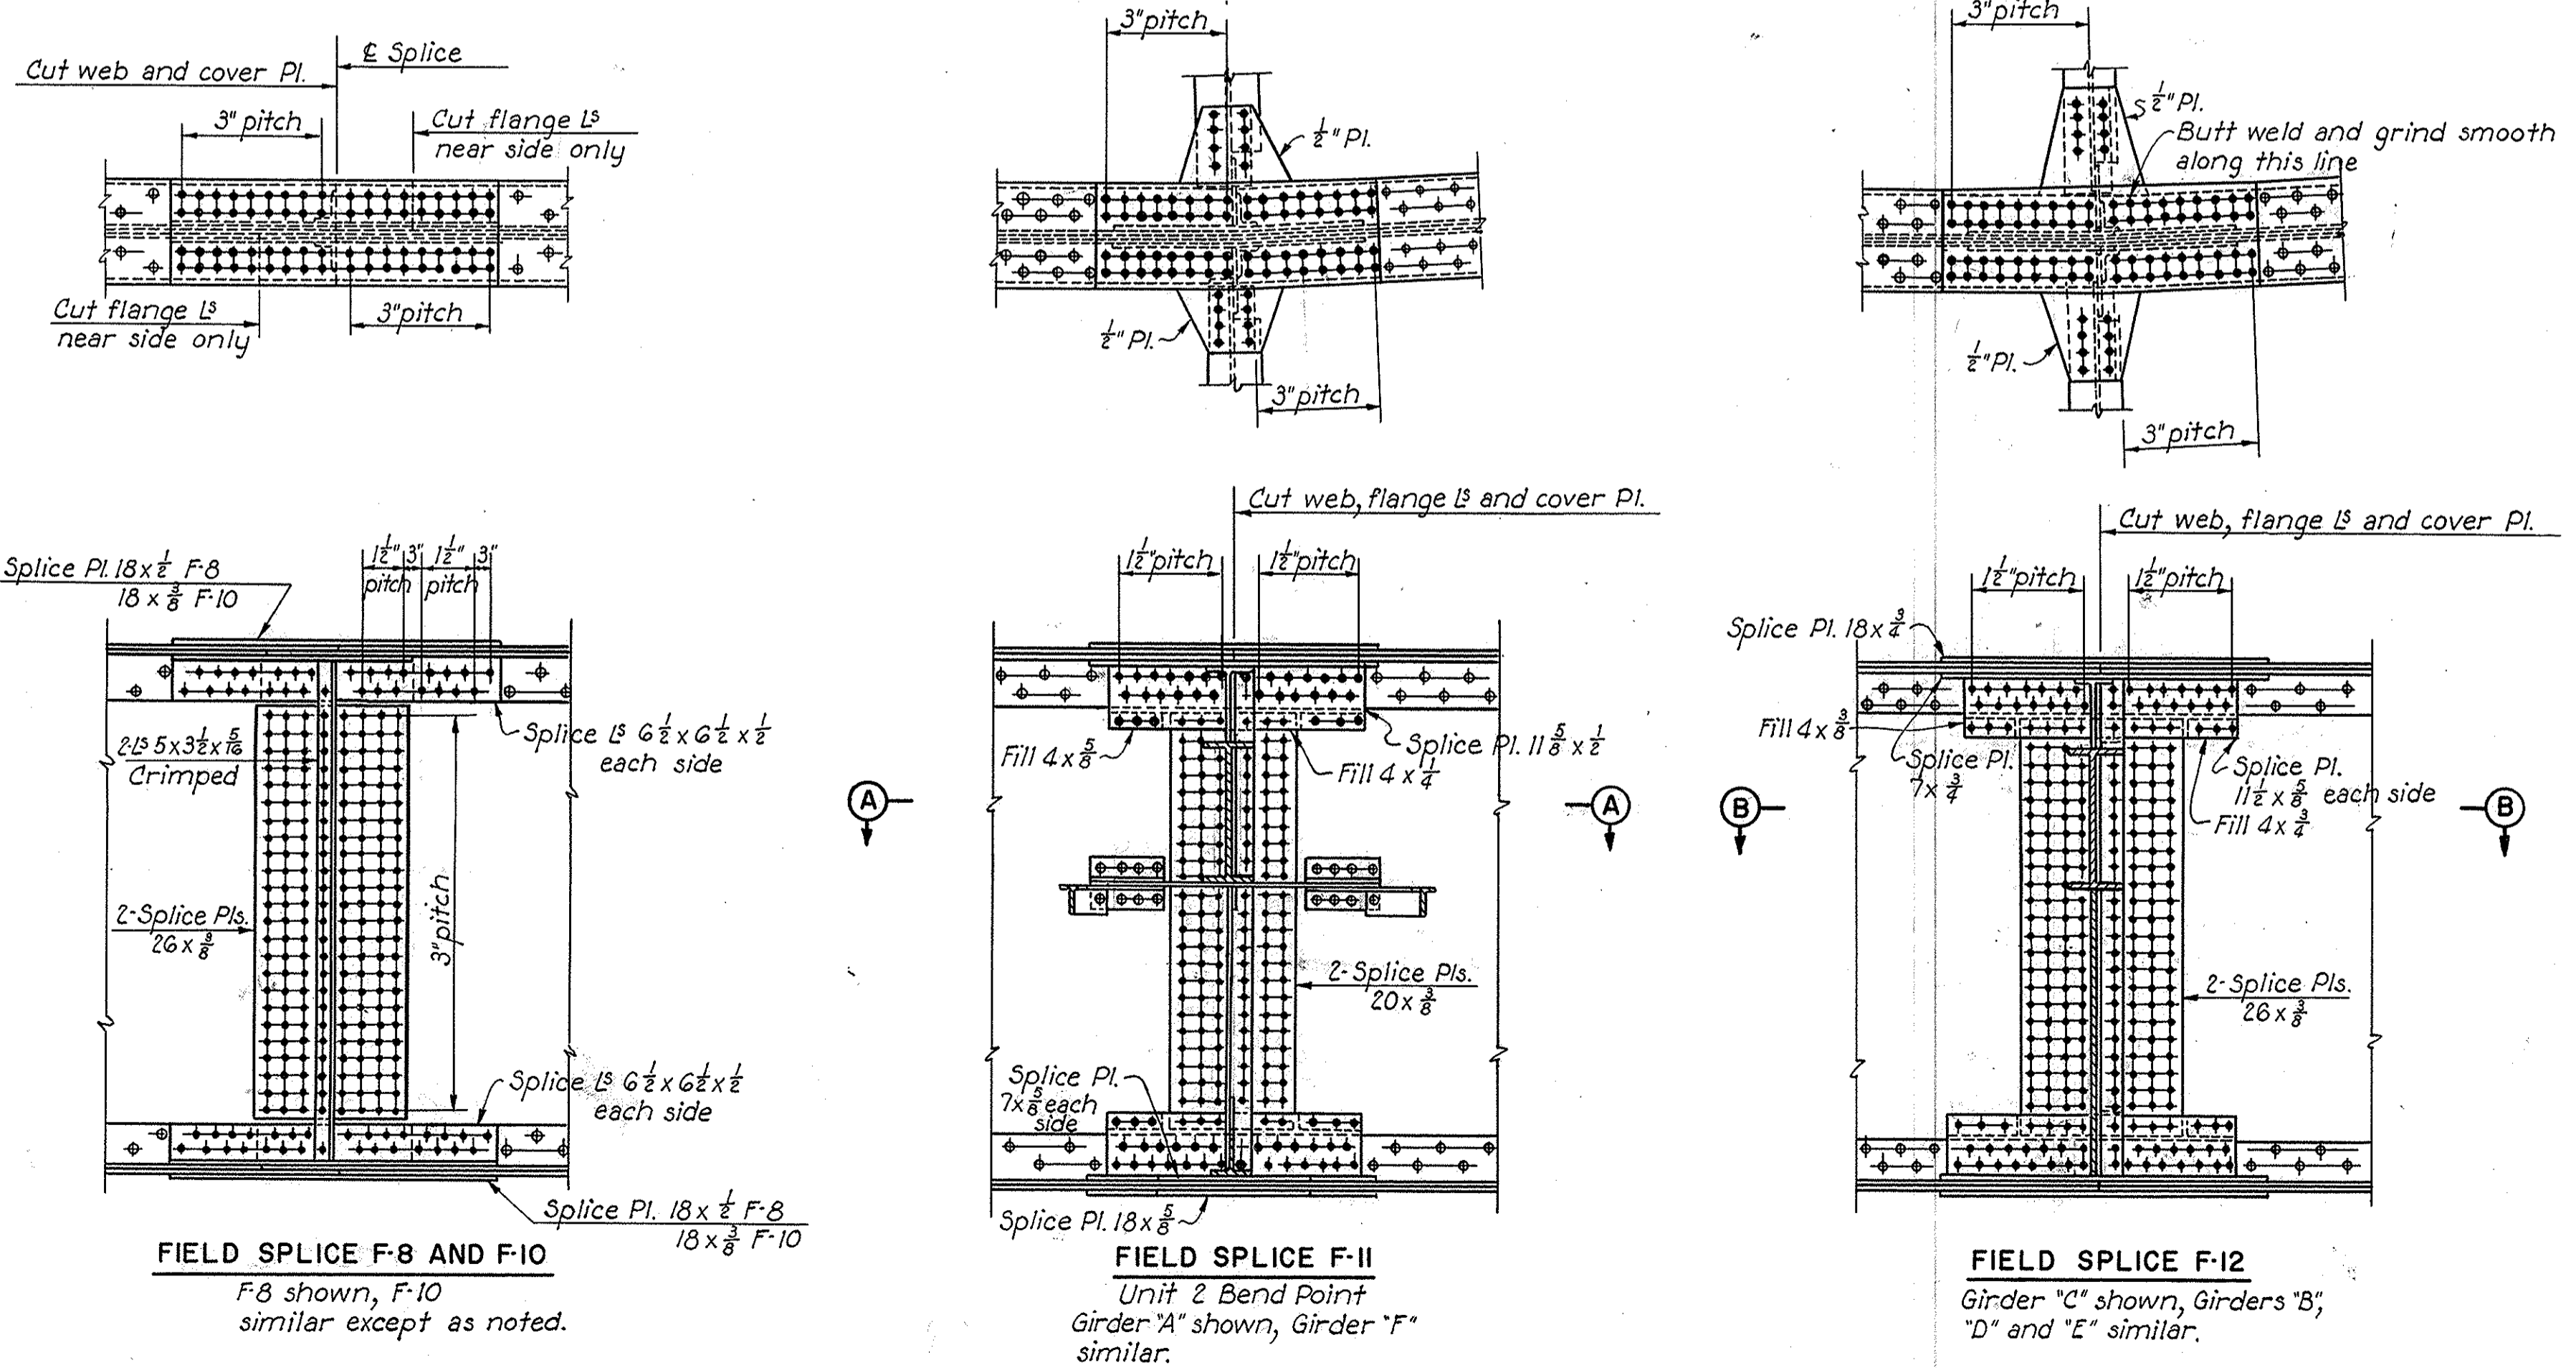





Note: For normal cover plate rivet pitch see Girder Details, Sheet 87.

Note: Section A-A similar to Section A-A on Sheet 90.  
Section B-B similar to Section E-E on Sheet 90.


PART 7  
**AKRON EXPRESSWAY SYSTEM**  
WEST VIADUCT  
BR. NO. SU-18R-135  
GIRDER DETAILS

AKRON	SUMMIT COUNTY,	OHIO
SCALE 1/2" = 1'-0"		
MADE D.L.L. DATE 8-20-55	HOWARD, NEEDLES, TAMMEN & BERGENDOFF	
TRCD. CAL. DATE 10-14-55	CONSULTING ENGINEERS	
CKD. HWG. DATE 10-7-55	KANSAS CITY	CLEVELAND NEW YORK
	901	SHEET- 89


SUMMIT COUNTY  
CITY OF AKRON  
AKRON EXPRESSWAY SYSTEM

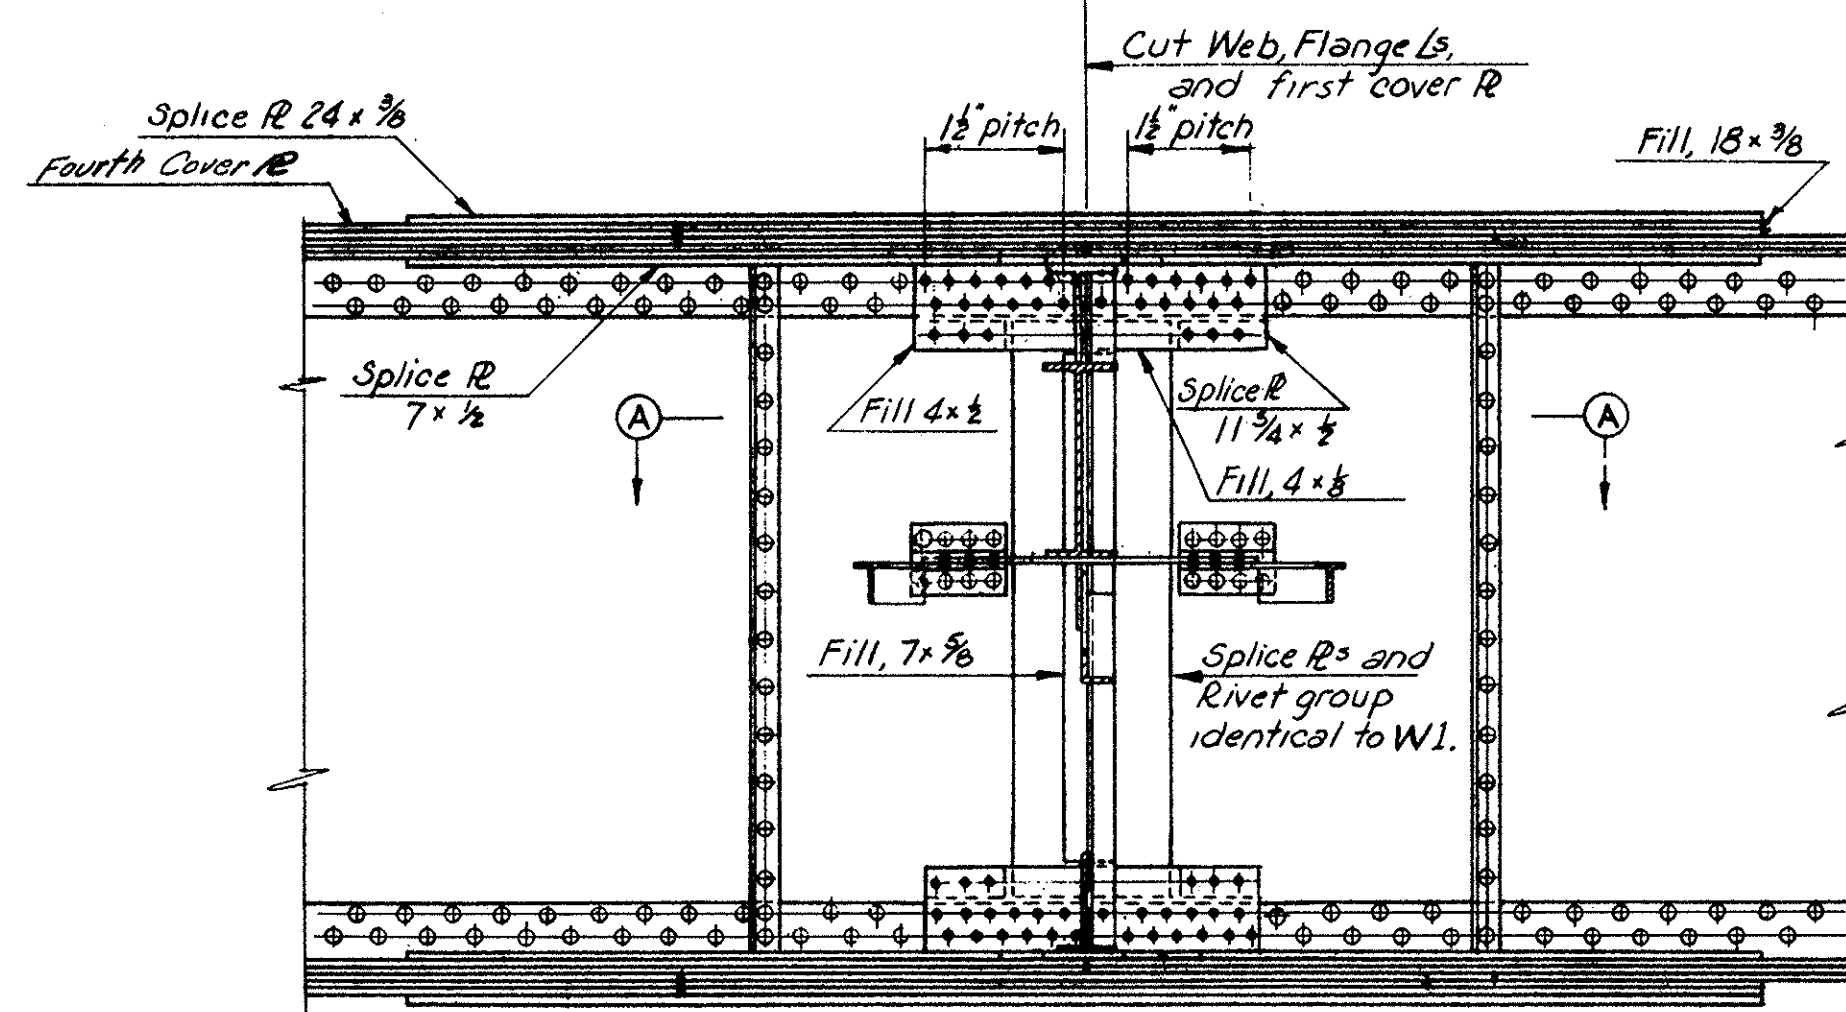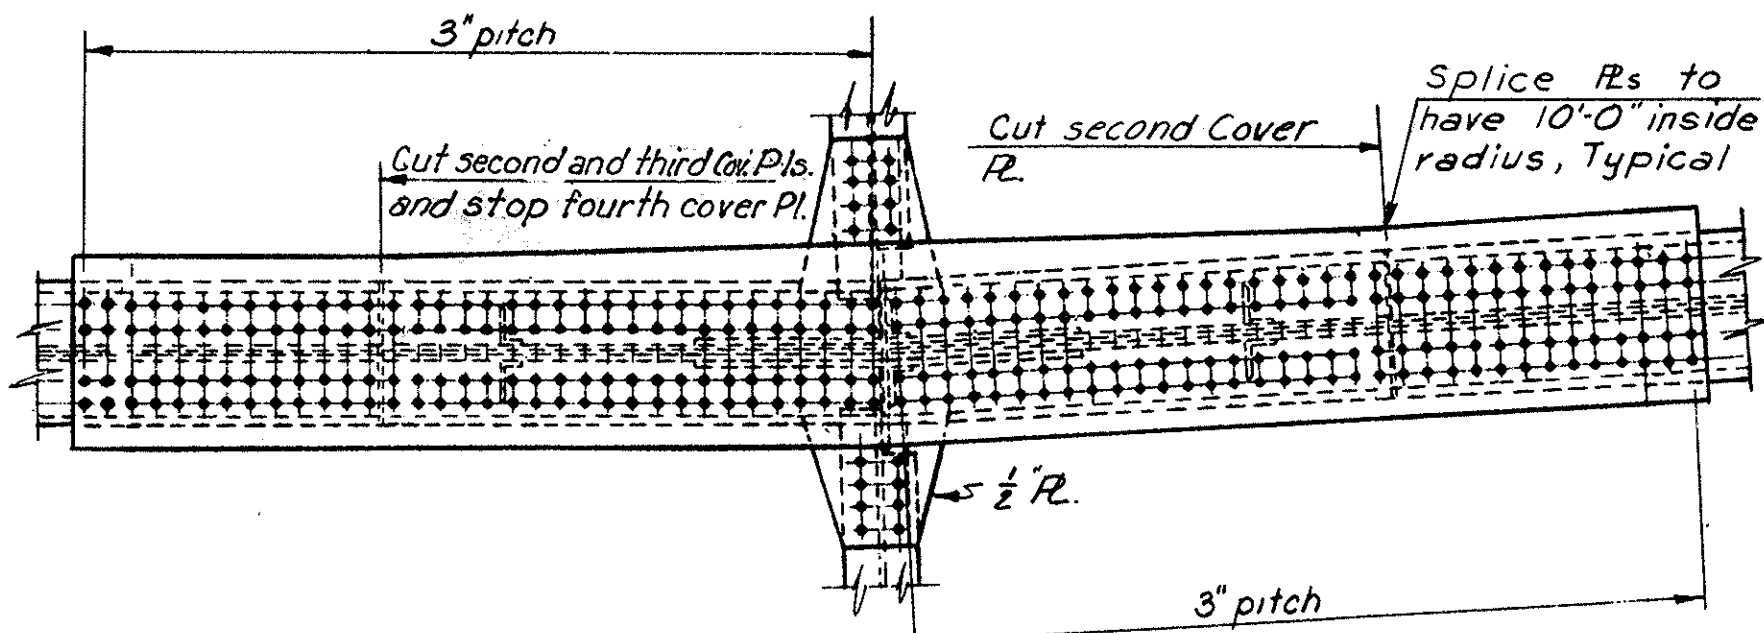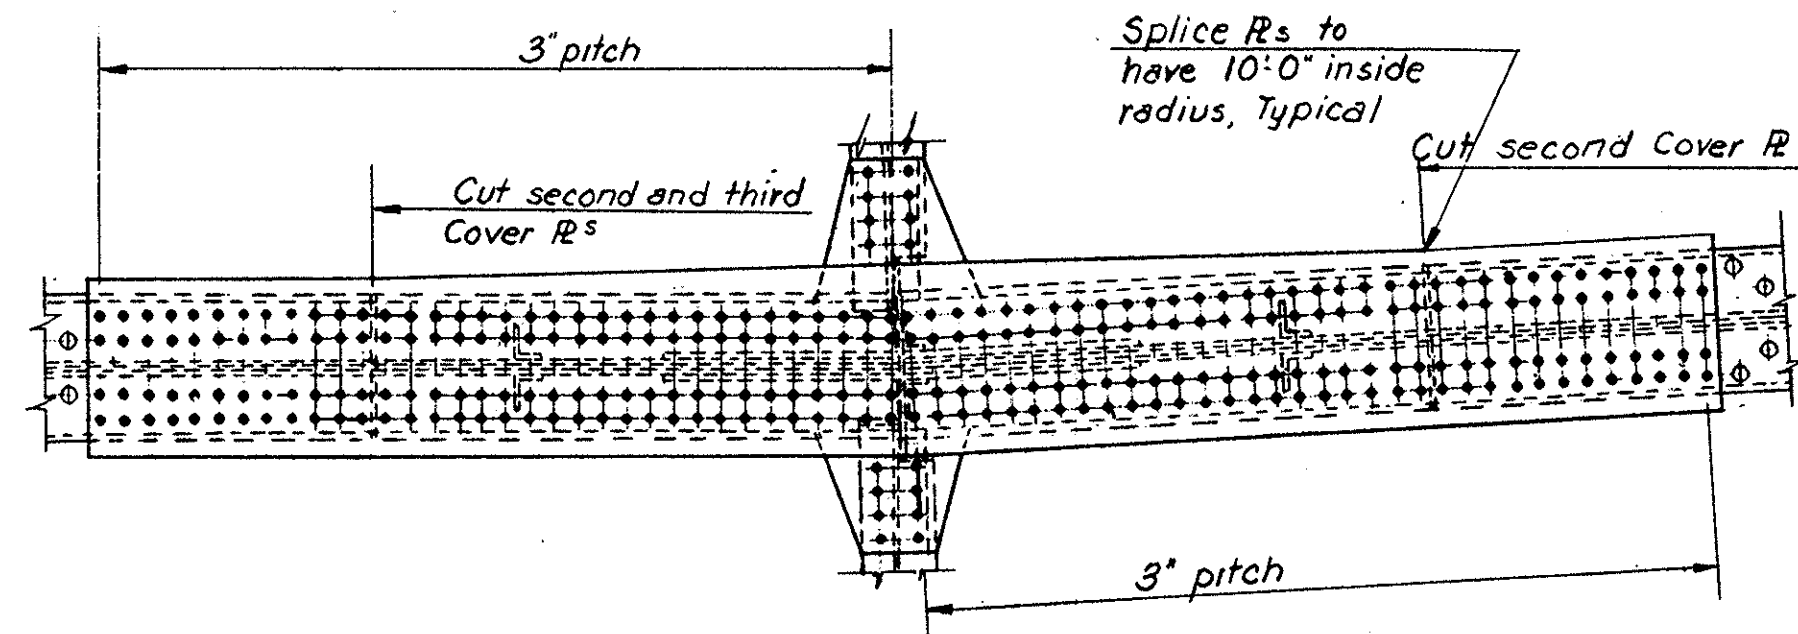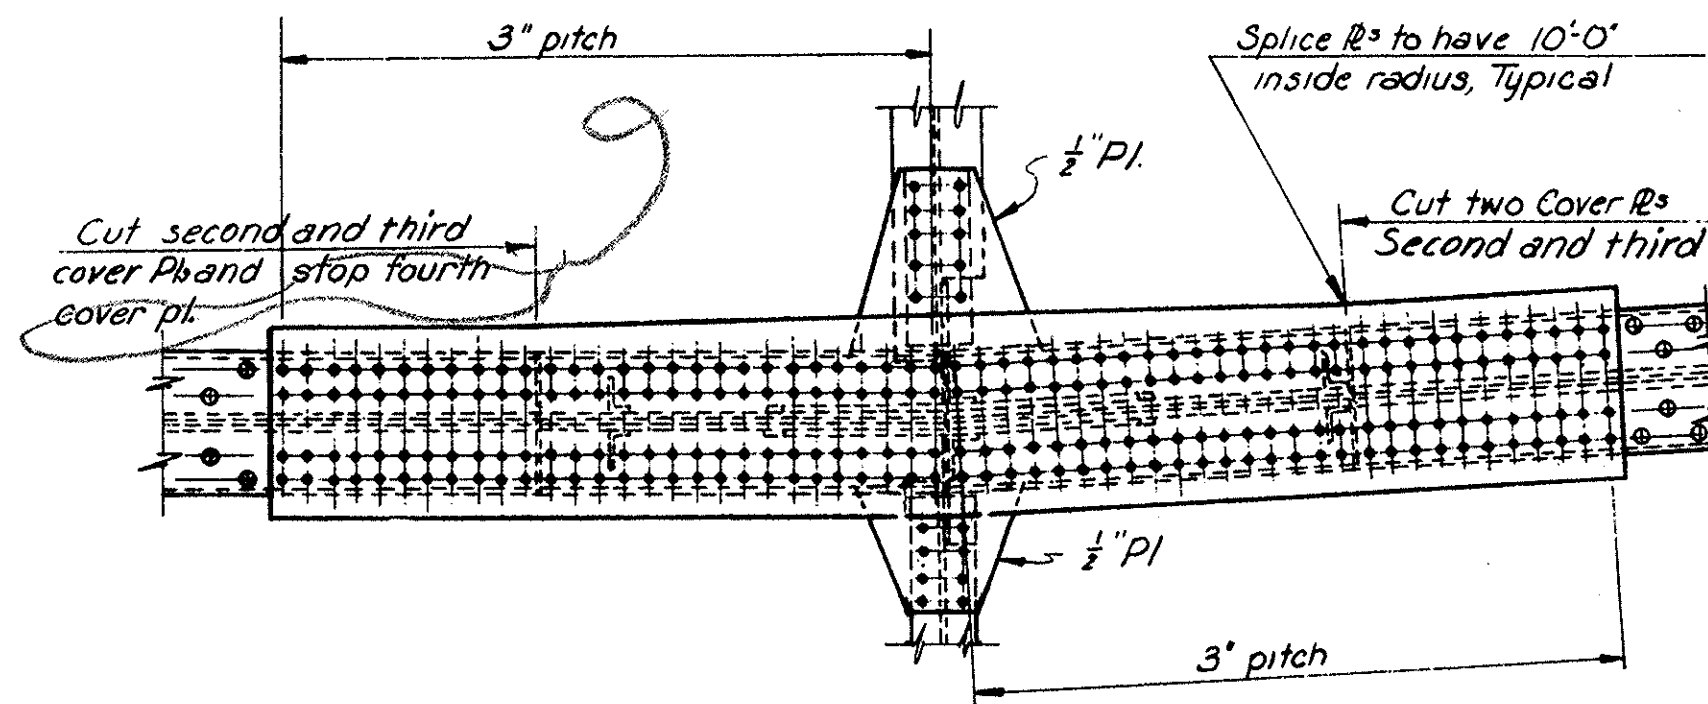


FIELD SPLICE - F13  
Unit 1 Bend Point  
Girder "A" shown, Girder "F" similar

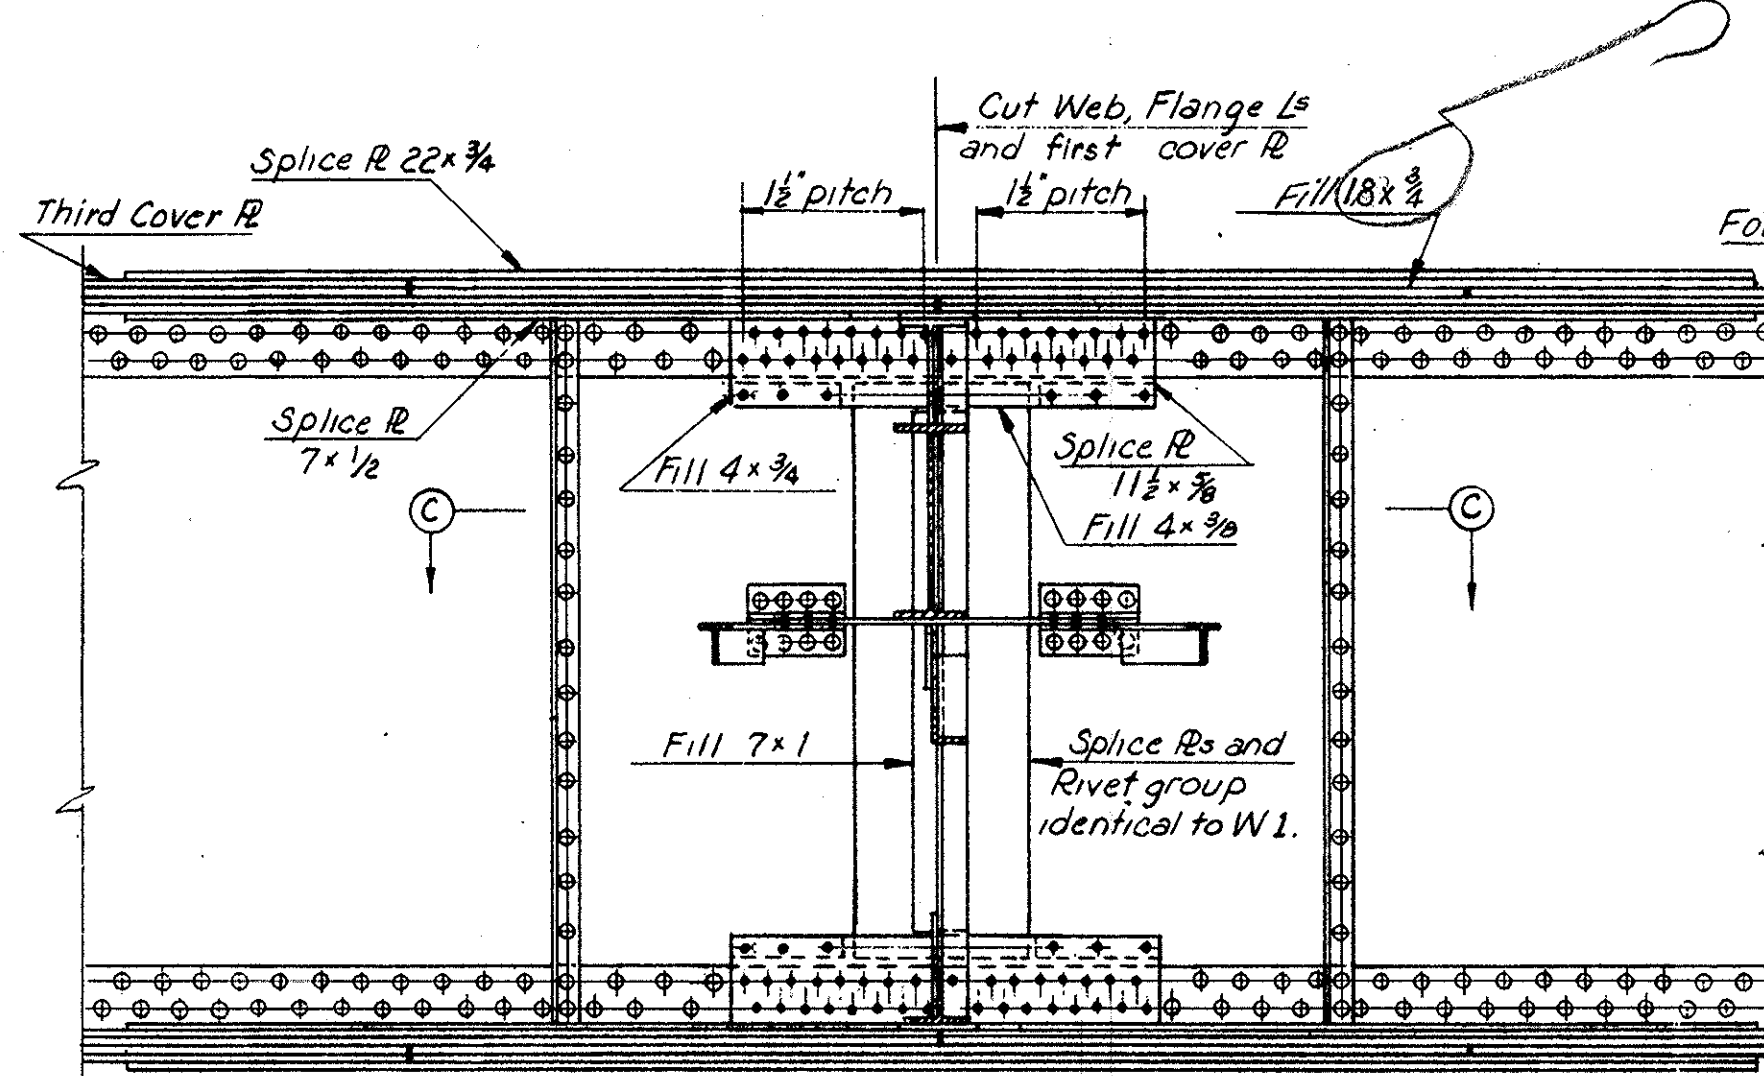


FIELD SPLICE - F14  
Unit 1 Bend Point  
Girder "B" shown, Girder "E" similar

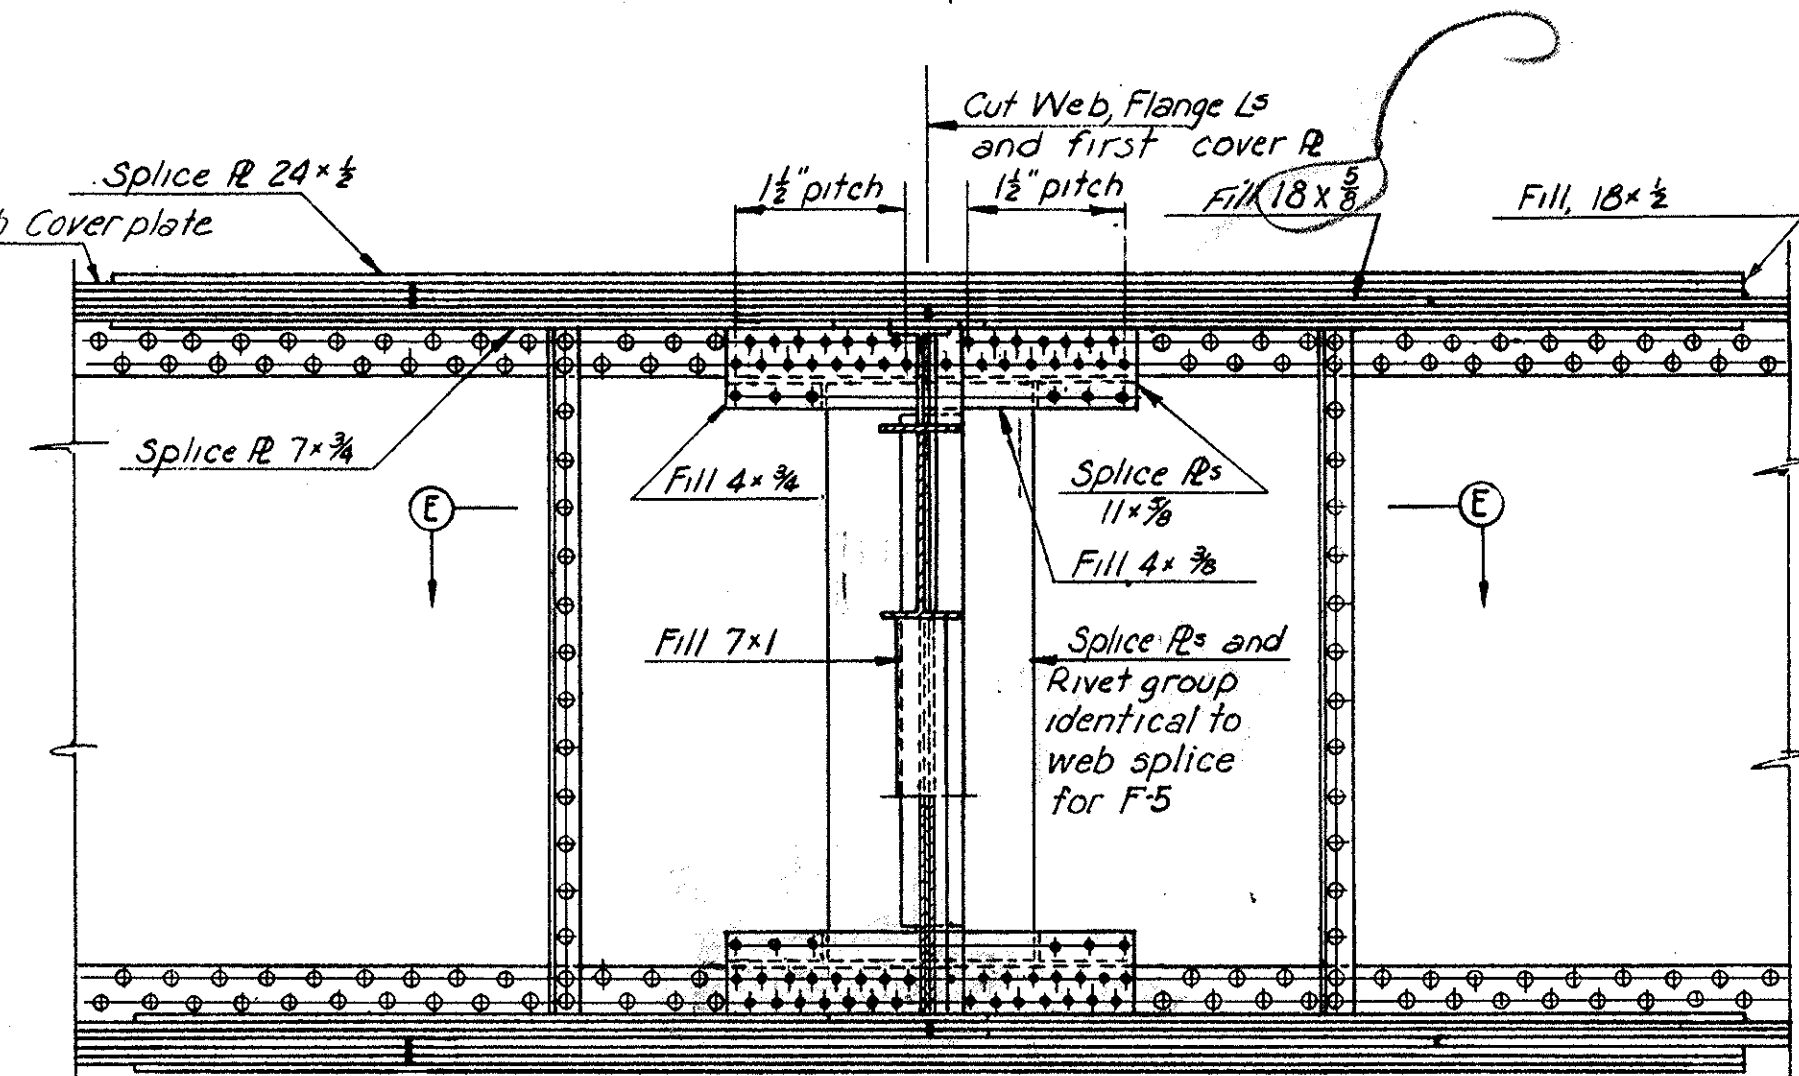


FIELD SPLICE - F15  
Unit 1 Bend Point  
Girder "C" shown, Girder "D" similar

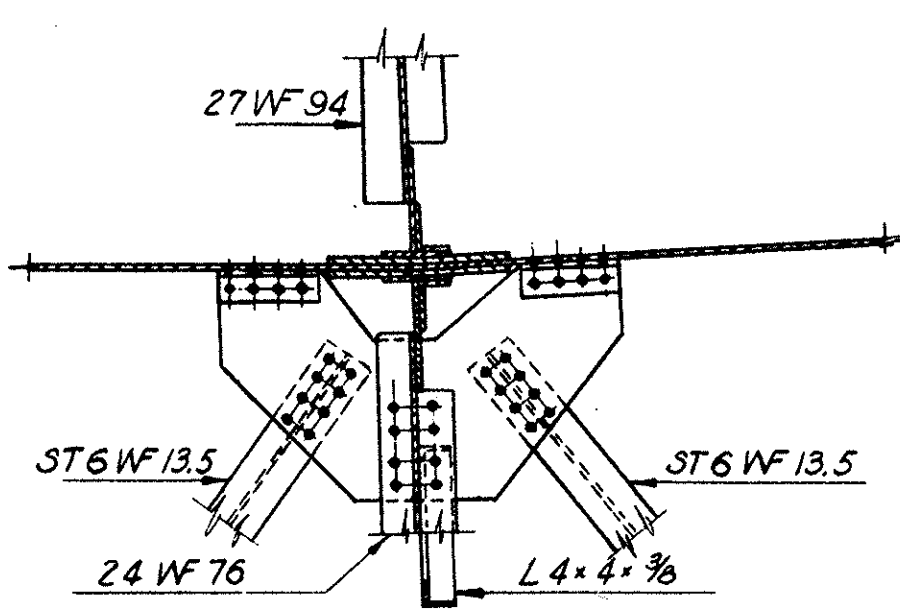




SECTION A-A

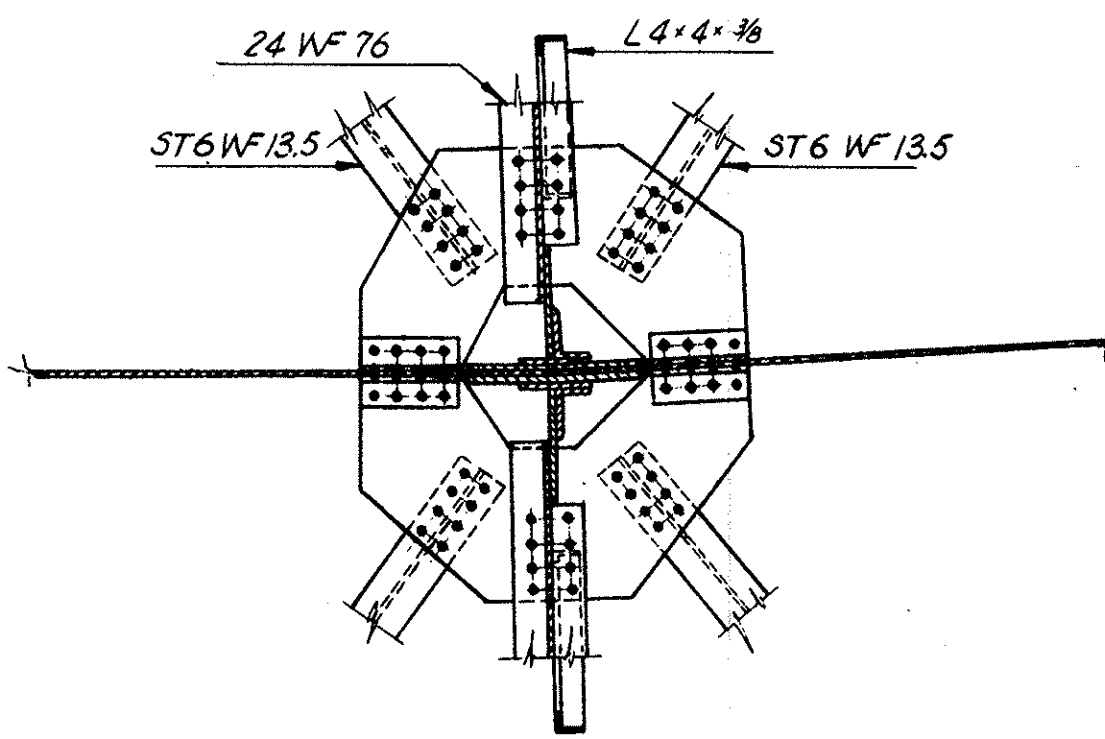

SECTION C-C

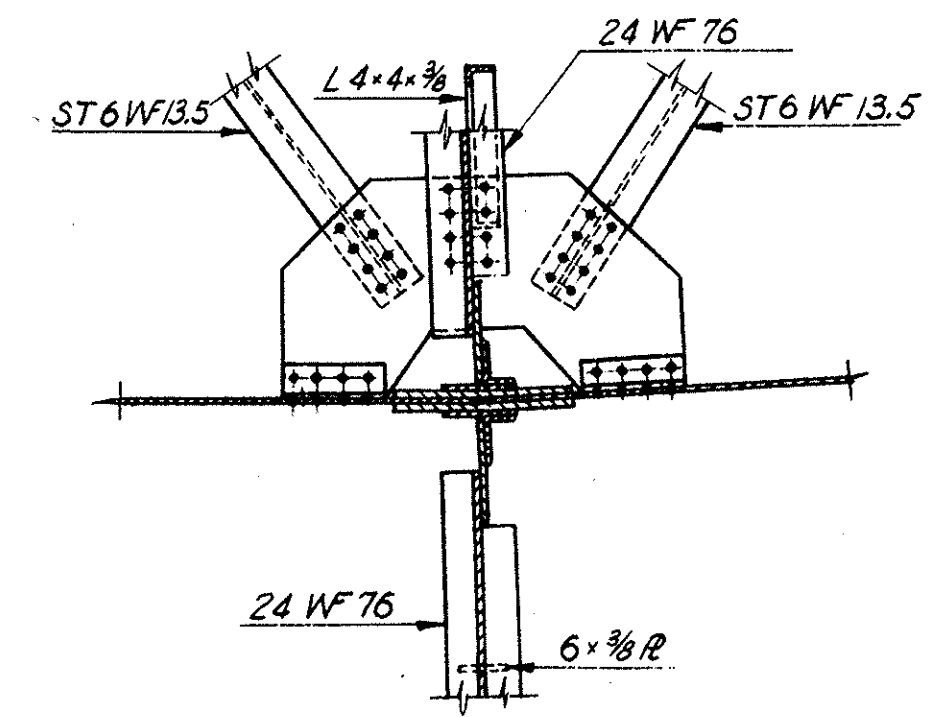

SECTION E-E

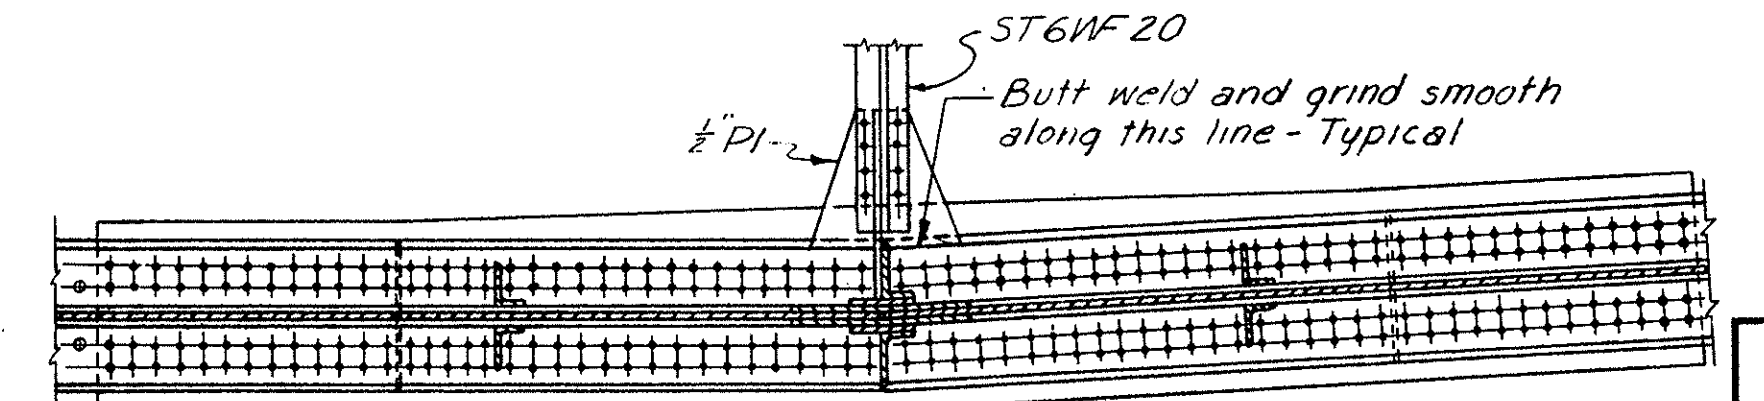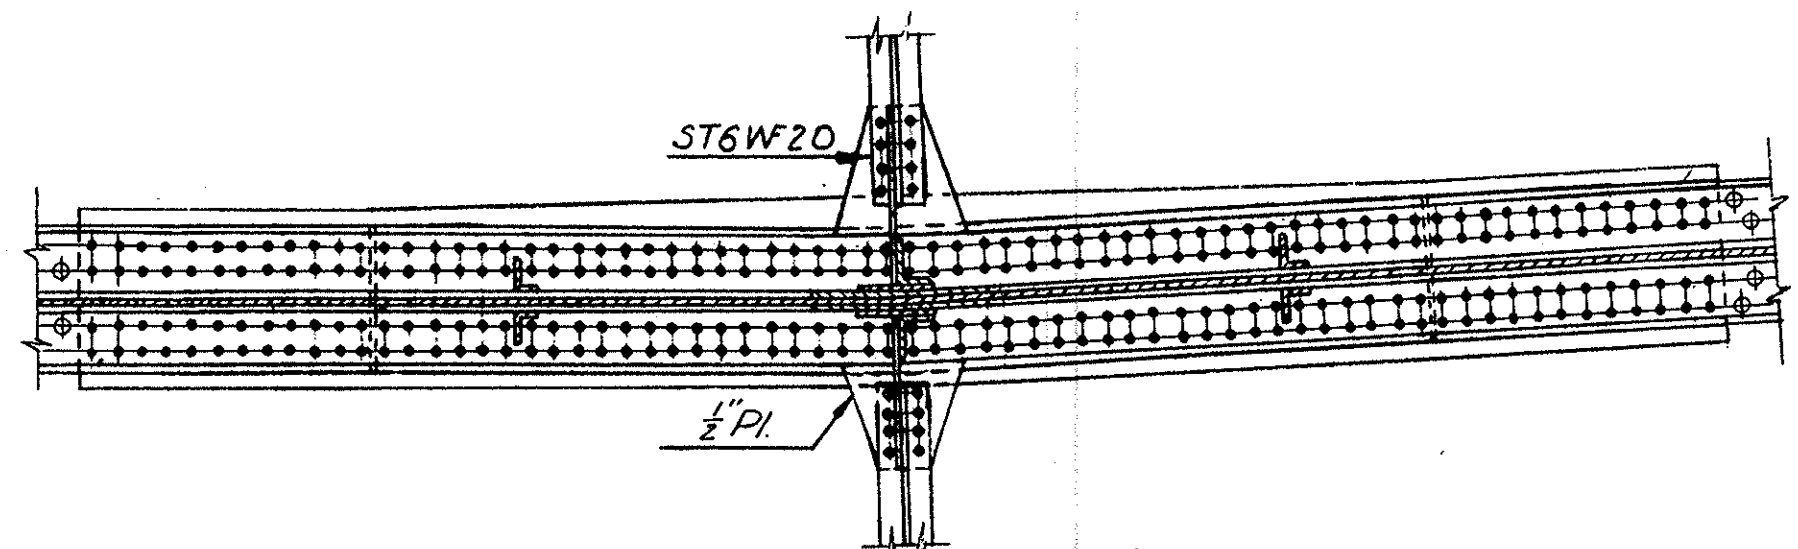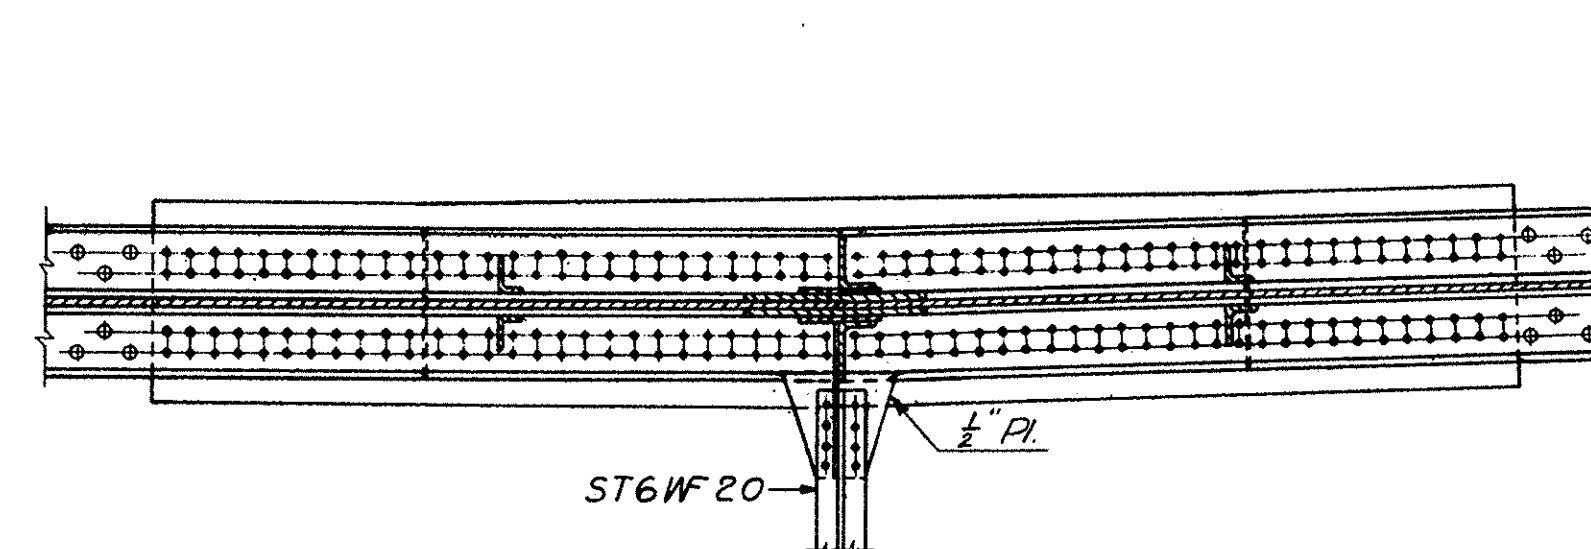

PART 7


AKRON EXPRESSWAY SYSTEM  
WEST VIADUCT  
BR. NO. SU-18R-135  
GIRDER DETAILS

AKRON SUMMIT COUNTY, OHIO  
SCALE 1/2" = 1'-0"  
MADE D.L.L. DATE 8-25-55  
TRCD DATE  
CKD HWG DATE 9-26-55  
HOWARD, NEEDLES, TAMMEN & BERGENDOFF  
CONSULTING ENGINEERS  
KANSAS CITY CLEVELAND NEW YORK  
901 SHEET 80

Revised 12-19-55



158

**SUMMIT COUNTY  
CITY OF AKRON  
AKRON EXPRESSWAY SYSTEM**

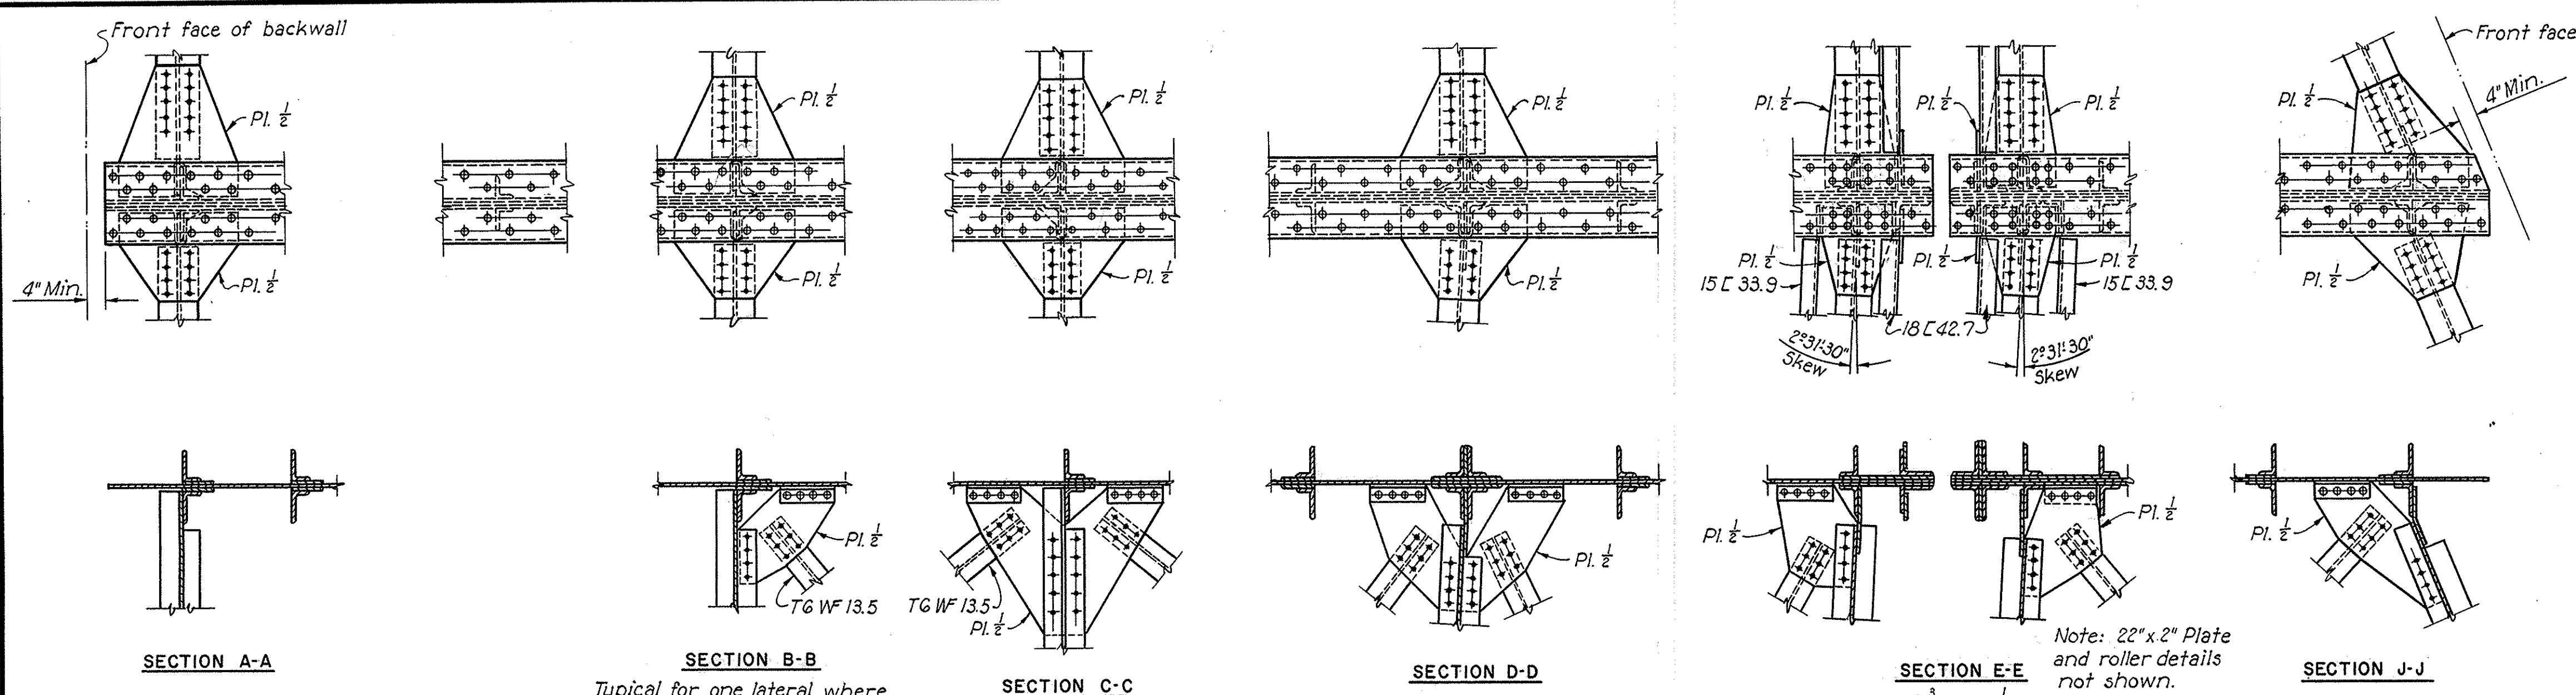



Location	Girder "A"		Girders "B", "C", "D" and "E"		Girder "F"		Girder "G"		Girder "H"	
	Brg. Stiff.	Fill Pl.	Brg. Stiff.	Fill Pl.	Brg. Stiff.	Fill Pl.	Brg. Stiff.	Fill Pl.	Brg. Stiff.	Fill Pl.
West abutment	2-B 7x4x3/8	1/2	4-B 7x4x3/8	1/2	2-B 7x4x3/8	1/2				
Pier 1	4-B 7x4x3/8	1/2	4-B 8x4x1/2	1/2	4-B 7x4x3/8	1/2				
Pier 2	4-B 7x4x3/8	1/2	4-B 7x4x3/8	1/2	4-B 7x4x3/8	1/2				
Exp. joint	Unit 1	4-B 8x6x7/8	1/2	4-B 8x6x7/8	1/2	4-B 8x6x7/8	1/2			
	Unit 2	4-B 8x6x7/8	1/2	4-B 8x6x7/8	1/2	4-B 8x6x7/8	1/2			
Pier 3	Unit 1	4-B 7x4x3/8	1/2	4-B 7x4x3/8	1/2	4-B 7x4x3/8	1/2			
	Unit 2	4-B 7x4x3/8	1/2	4-B 7x4x3/8	1/2	4-B 7x4x3/8	1/2			
Pier 4	Unit 1	4-B 7x4x3/8	1/2	4-B 7x4x3/8	1/2	4-B 7x4x3/8	1/2			
	Unit 2	4-B 8x6x7/8	1/2	4-B 8x6x7/8	1/2	4-B 8x6x7/8	1/2			
Pier 5	Unit 1	4-B 8x6x7/8	1/2	4-B 8x6x7/8	1/2	4-B 8x6x7/8	1/2			
	Unit 2	4-B 8x6x7/8	1/2	4-B 8x6x7/8	1/2	4-B 8x6x7/8	1/2			
Pier 6	Unit 1	4-B 7x4x3/8	1/2	4-B 7x4x3/8	1/2	4-B 7x4x3/8	1/2	4-B 7x4x3/8	1/2	4-B 7x4x3/8
	Unit 2	4-B 7x4x3/8	1/2	4-B 7x4x3/8	1/2	4-B 7x4x3/8	1/2	4-B 7x4x3/8	1/2	4-B 7x4x3/8
East Abutment	2-B 7x4x3/8	1/2	2-B 7x4x3/8	1/2	2-B 7x4x3/8	1/2	2-B 7x4x3/8	1/2	2-B 7x4x3/8	

Location	Girder "A"		Girders "B", "C", "D" and "E"		Girder "F"		Girder "G"		Girder "H"	
	Jacking Stiff.	Fill Pl.	Jacking Stiff.	Fill Pl.	Jacking Stiff.	Fill Pl.	Jacking Stiff.	Fill Pl.	Jacking Stiff.	Fill Pl.
West Abutment	1-Set of 2-B 7x4x3/8	1/2	1-Set of 2-B 7x4x3/8	1/2	1-Set of 2-B 7x4x3/8	1/2				
Pier 1	2-B 7x4x3/8	1/2	2-B 7x4x3/8	1/2	2-B 7x4x3/8	1/2				
Pier 2	2-B 7x4x3/8	1/2	2-B 7x4x3/8	1/2	2-B 7x4x3/8	1/2				
Pier 3	2-B 7x4x3/8	1/2	2-B 7x4x3/8	1/2	2-B 7x4x3/8	1/2				
Pier 4	2-B 7x4x3/8	1/2	2-B 7x4x3/8	1/2	2-B 7x4x3/8	1/2				
Pier 5	2-B 7x4x3/8	1/2	2-B 7x4x3/8	1/2	2-B 7x4x3/8	1/2	2-B 7x4x3/8	1/2	2-B 7x4x3/8	1/2
Pier 6	2-B 7x4x3/8	1/2	2-B 7x4x3/8	1/2	2-B 7x4x3/8	1/2	2-B 7x4x3/8	1/2	2-B 7x4x3/8	1/2
East Abutment	2-B 7x4x3/8	1/2	2-B 7x4x3/8	1/2	2-B 7x4x3/8	1/2	2-B 7x4x3/8	1/2	2-B 7x4x3/8	1/2

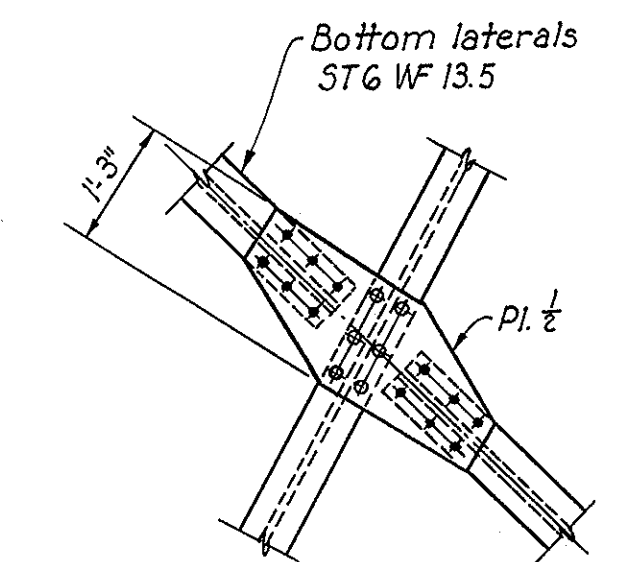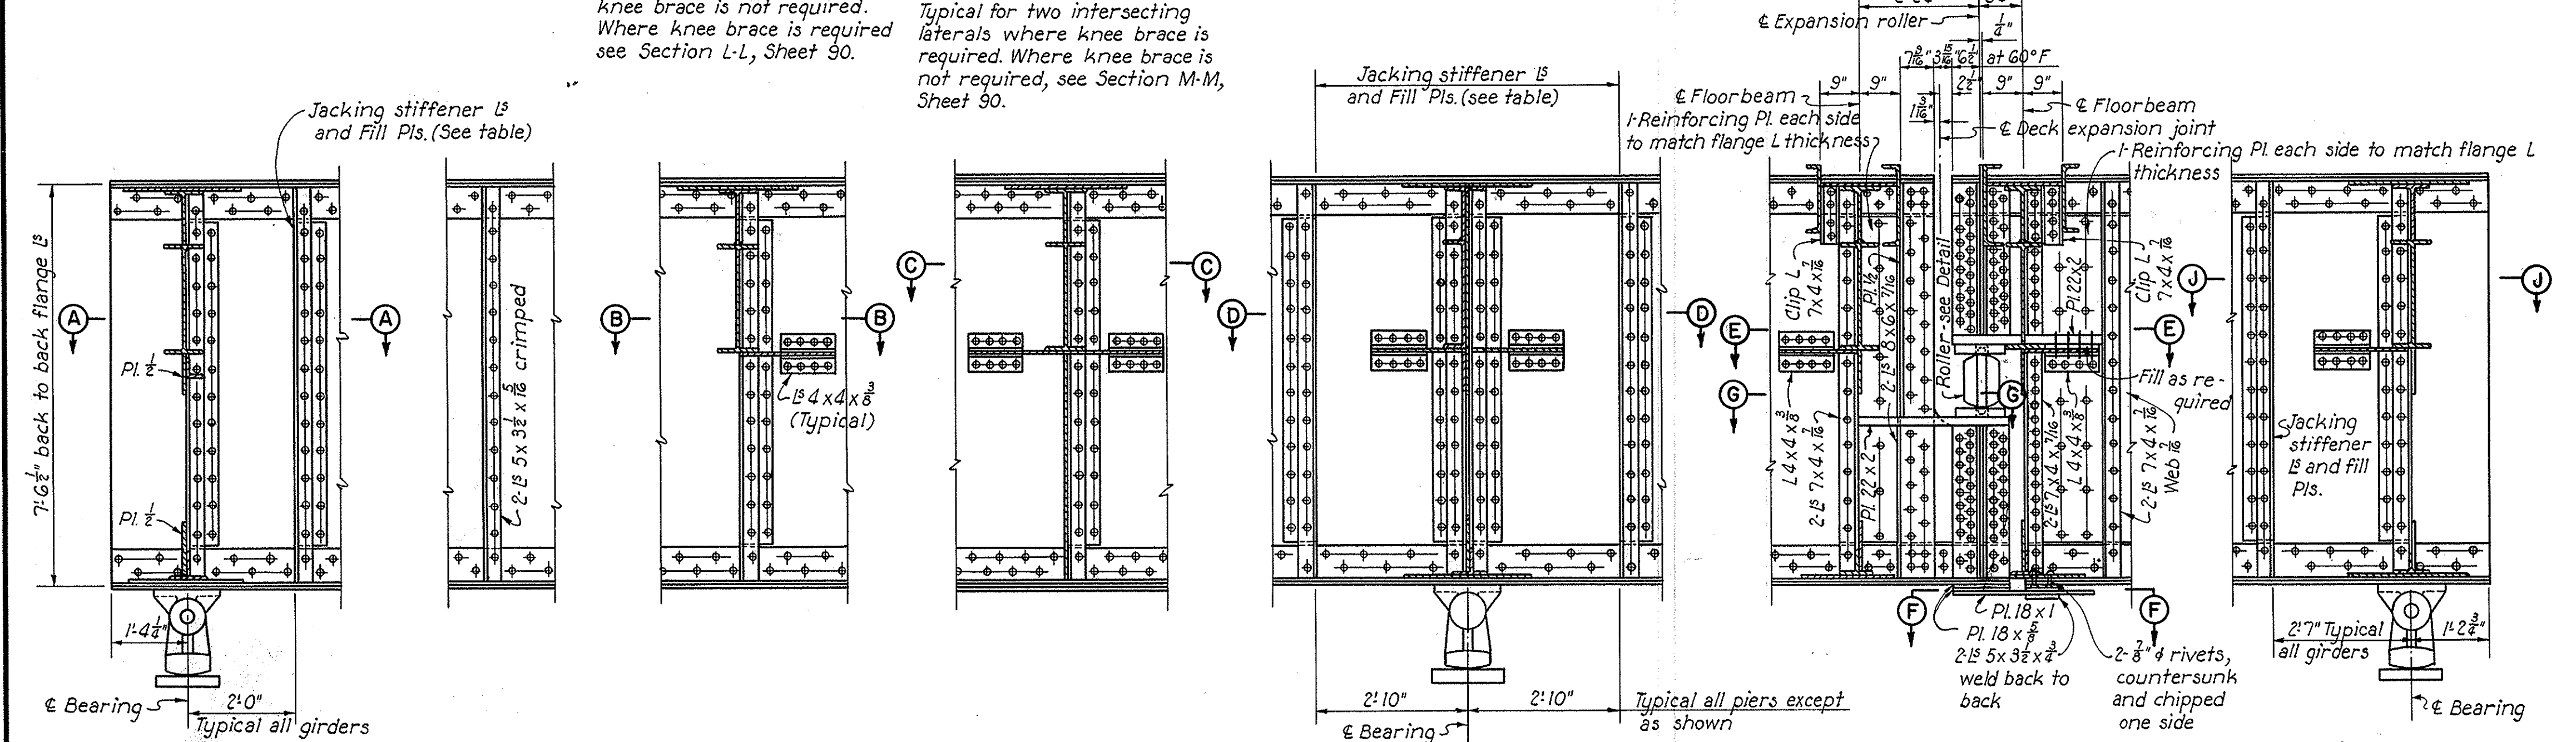

Notes:  
For furnishing and placing of high strength bolts see Supplemental Ohio Specification S-207.  
Jacking shall be done from the ground at all supports except Pier 5 where jacking shall be done from top of pier.  
Roller, bars and top and bottom plates shall be alloy steel forgings conforming to A.S.T.M. A-237-54 (Class B) or shall be an equivalent material having a minimum yield point of 55,000 lbs. per square inch.

1	0.131
2	0.274

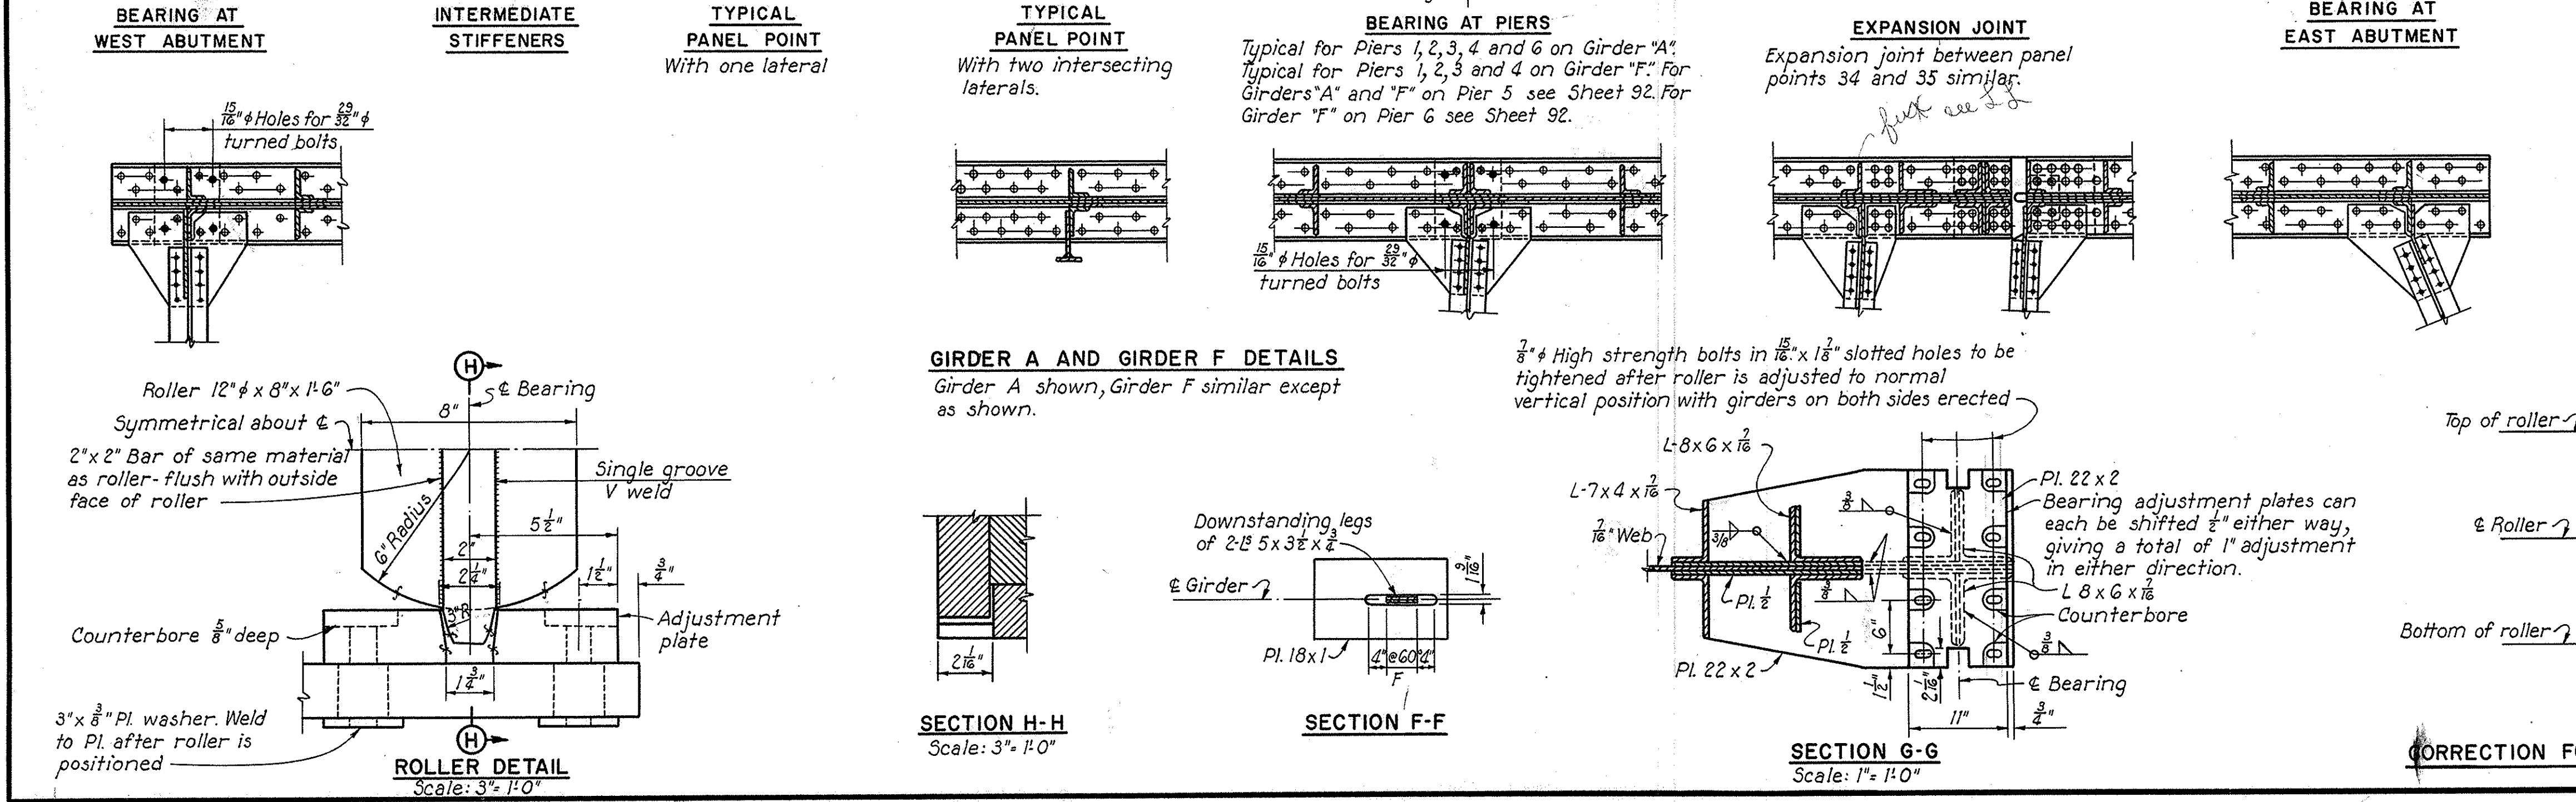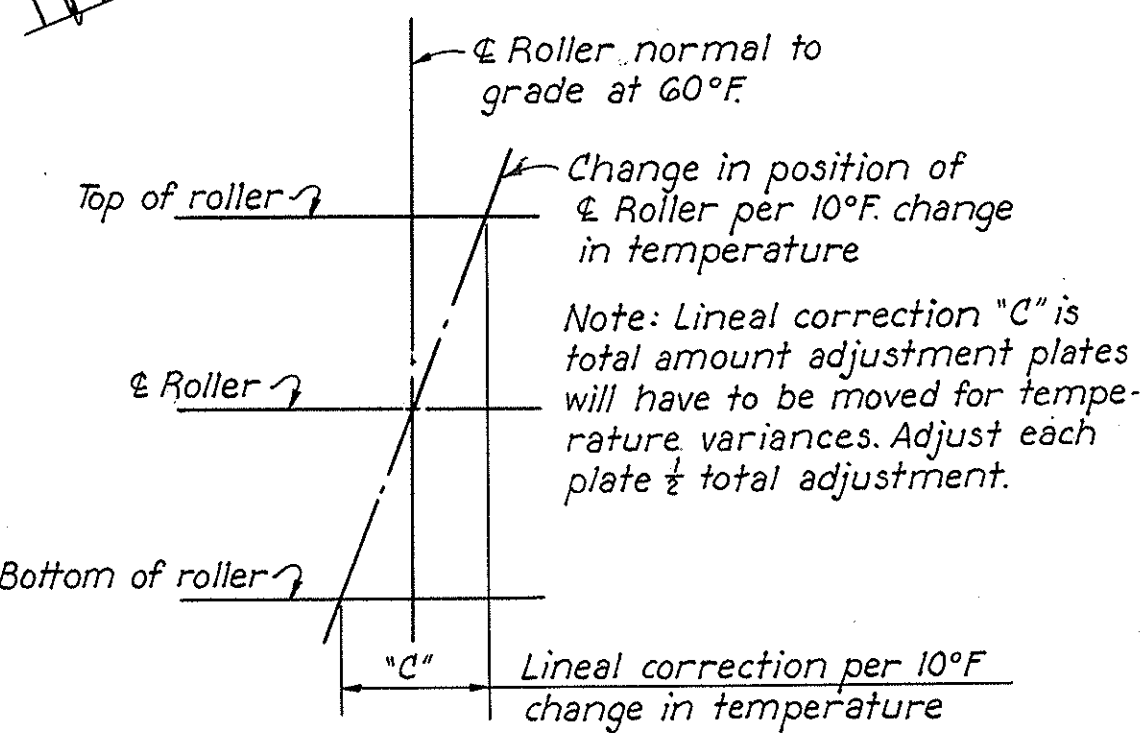


**AKRON EXPRESSWAY SYSTEM**  
WEST VIADUCT  
BR. NO. SU-18R-135  
**GIRDER DETAILS**

AKRON SUMMIT COUNTY. OHIO

SCALE: 1/4" = 1'-0"  
MADE G.D. DATE: 8-25-55  
TRCD. C.A.L. DATE: 11-9-55  
CKD. H.W.G. DATE: 9-15-55

HOWARD, NEEDLES, TAMMEN & BERGENDOFF  
CONSULTING ENGINEERS  
CLEVELAND NEW YORK  
901 SHEET 91


**SUMMIT COUNTY  
CITY OF AKRON  
AKRON EXPRESSWAY SYSTEM**

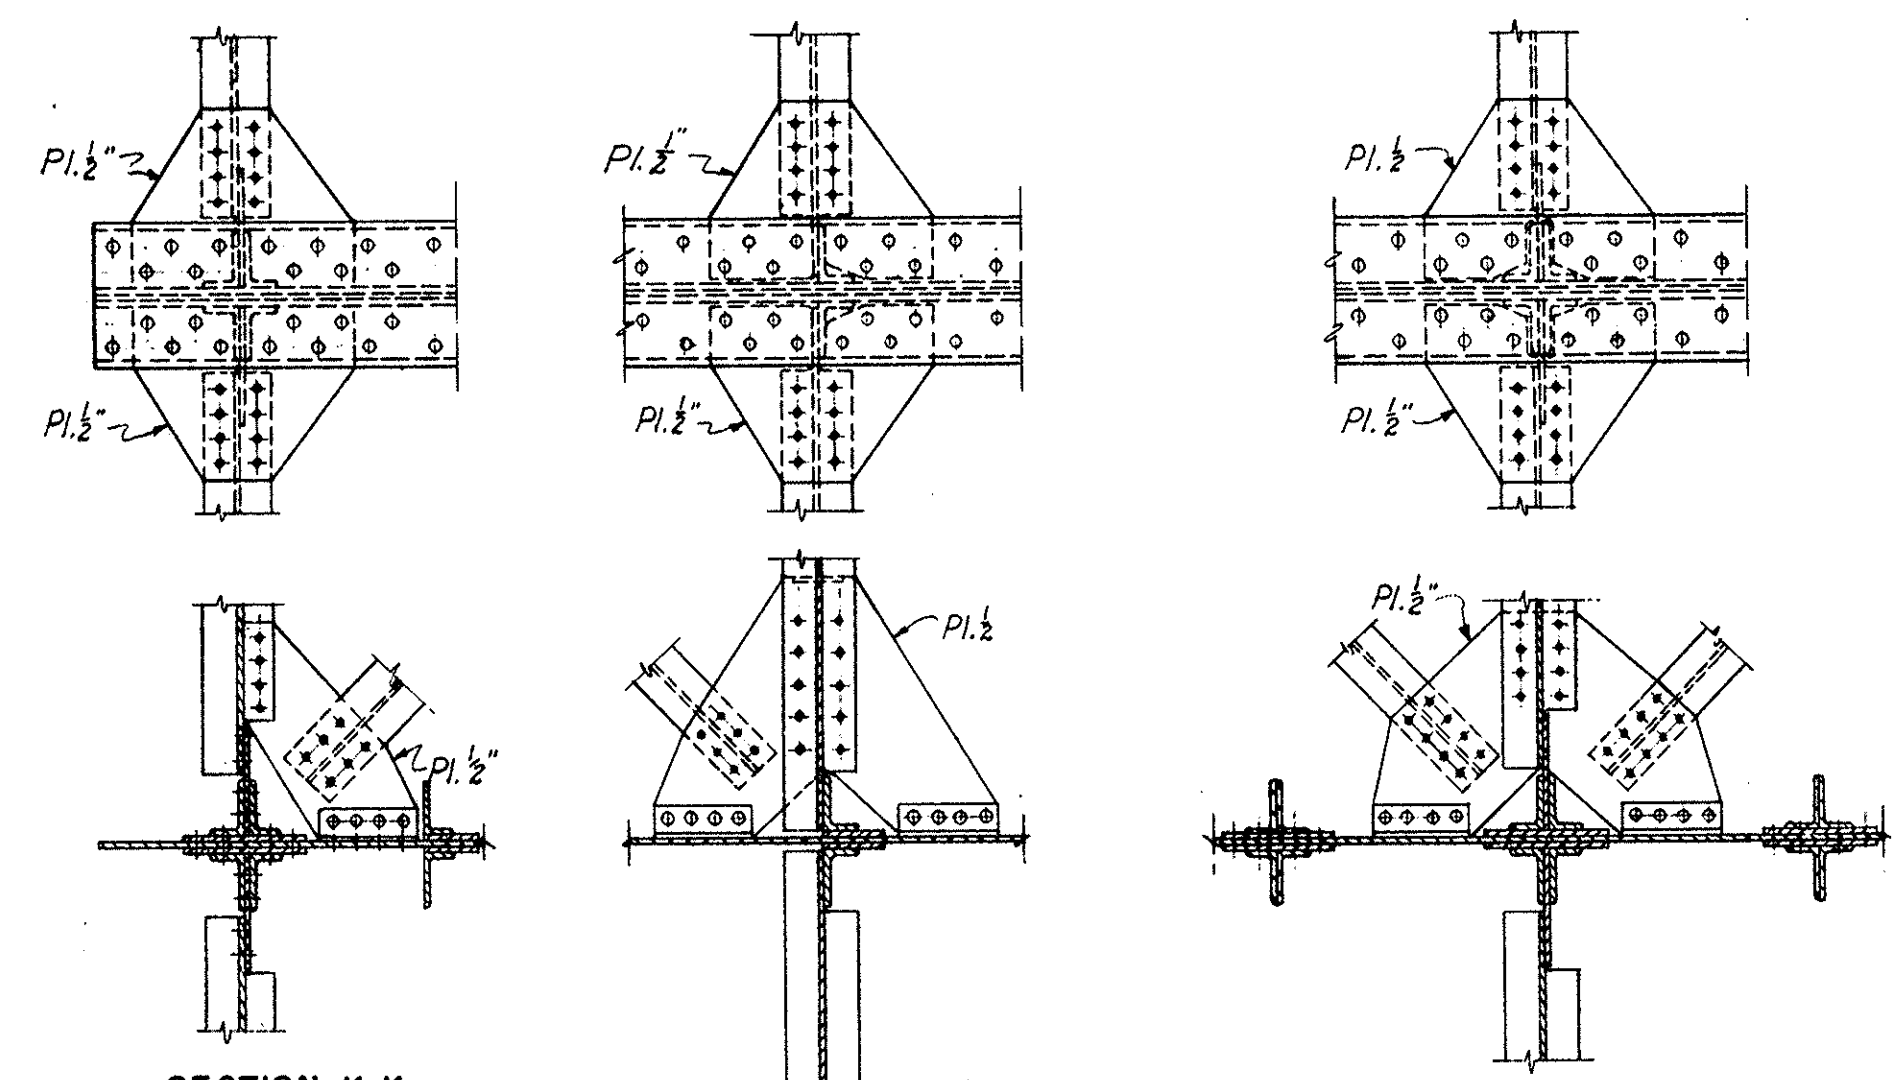

**SECTION K-K**  
Typical for one lateral where knee brace is required. Where knee brace is not required, see Section B-B Sheet 91.

**SECTION L-L**  
Typical for one lateral where knee brace is required. Where knee brace is not required see Section B-B, Sheet 91.


**SECTION M-M**  
Typical for two intersecting laterals where knee brace is not required.

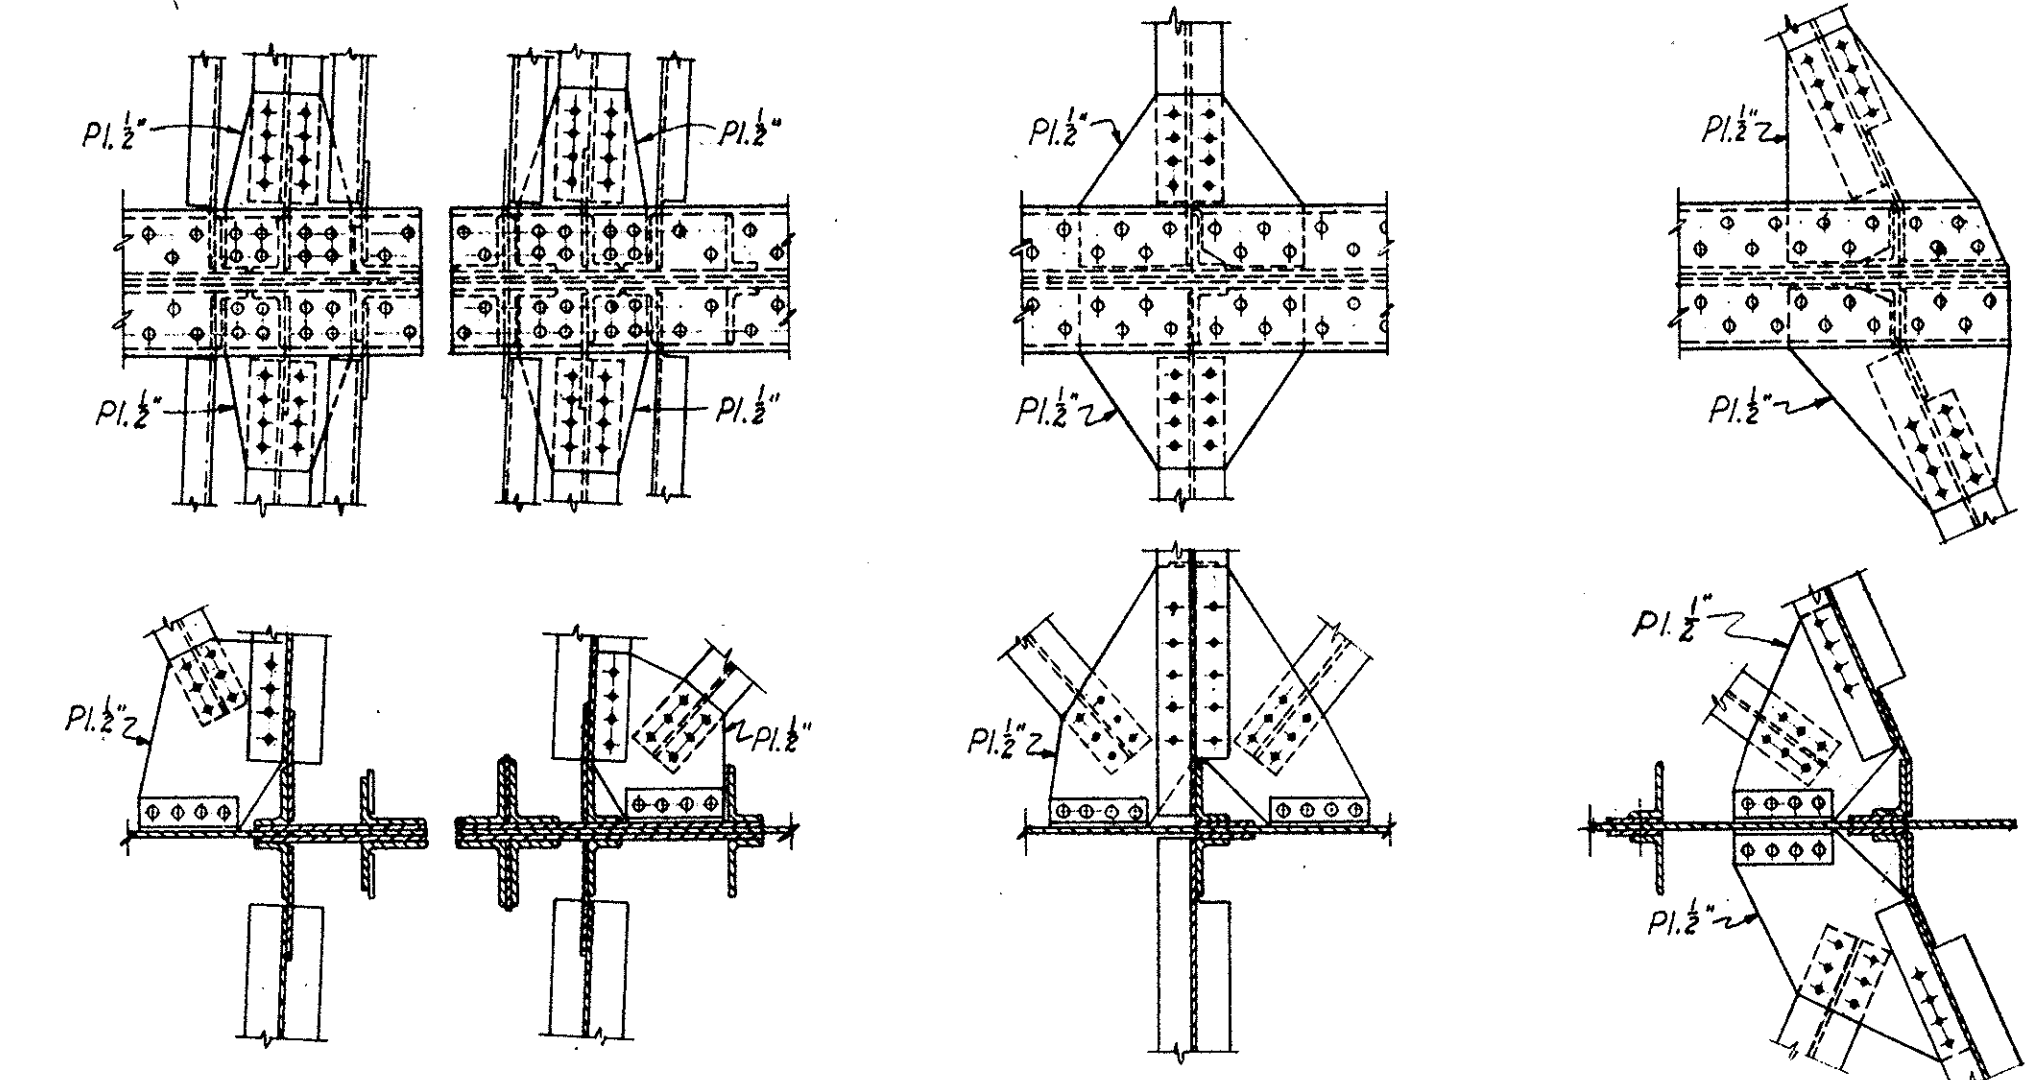


**SECTION N-N**  
Typical for two intersecting laterals where knee brace is not required.

**SECTION O-O**  
Typical for two intersecting laterals where knee brace is required.


**SECTION P-P**  
Typical for two intersecting laterals where knee brace is required.

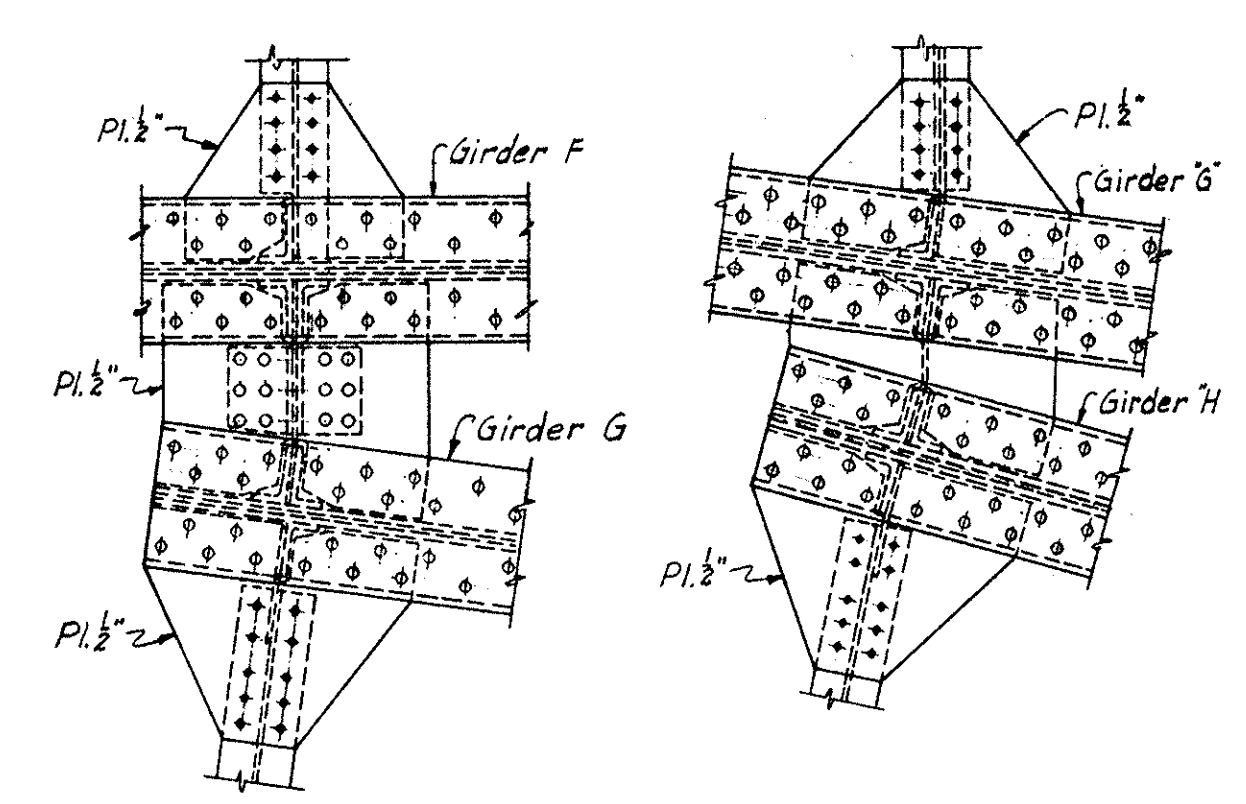

**PLAN AT PANEL POINT 51**      **PLAN AT PANEL POINT 57**

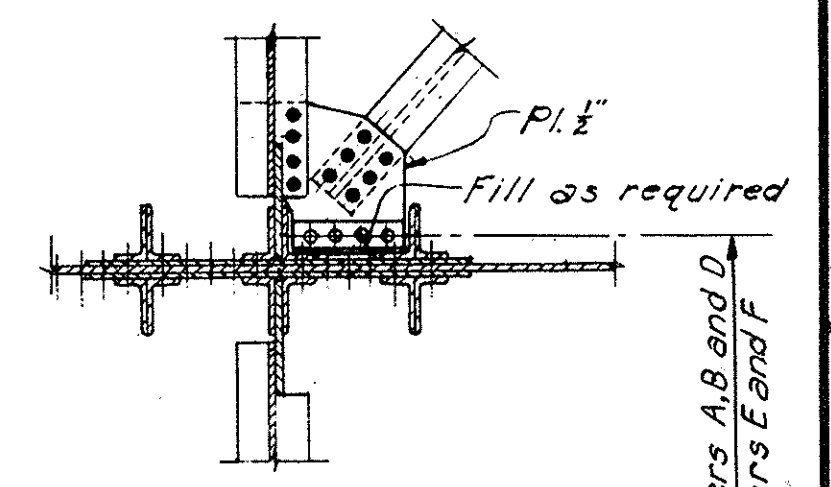


**SECTION R-R**  
Fill as required  
4 rivets, girders A, B and D  
3 rivets, girders E and F

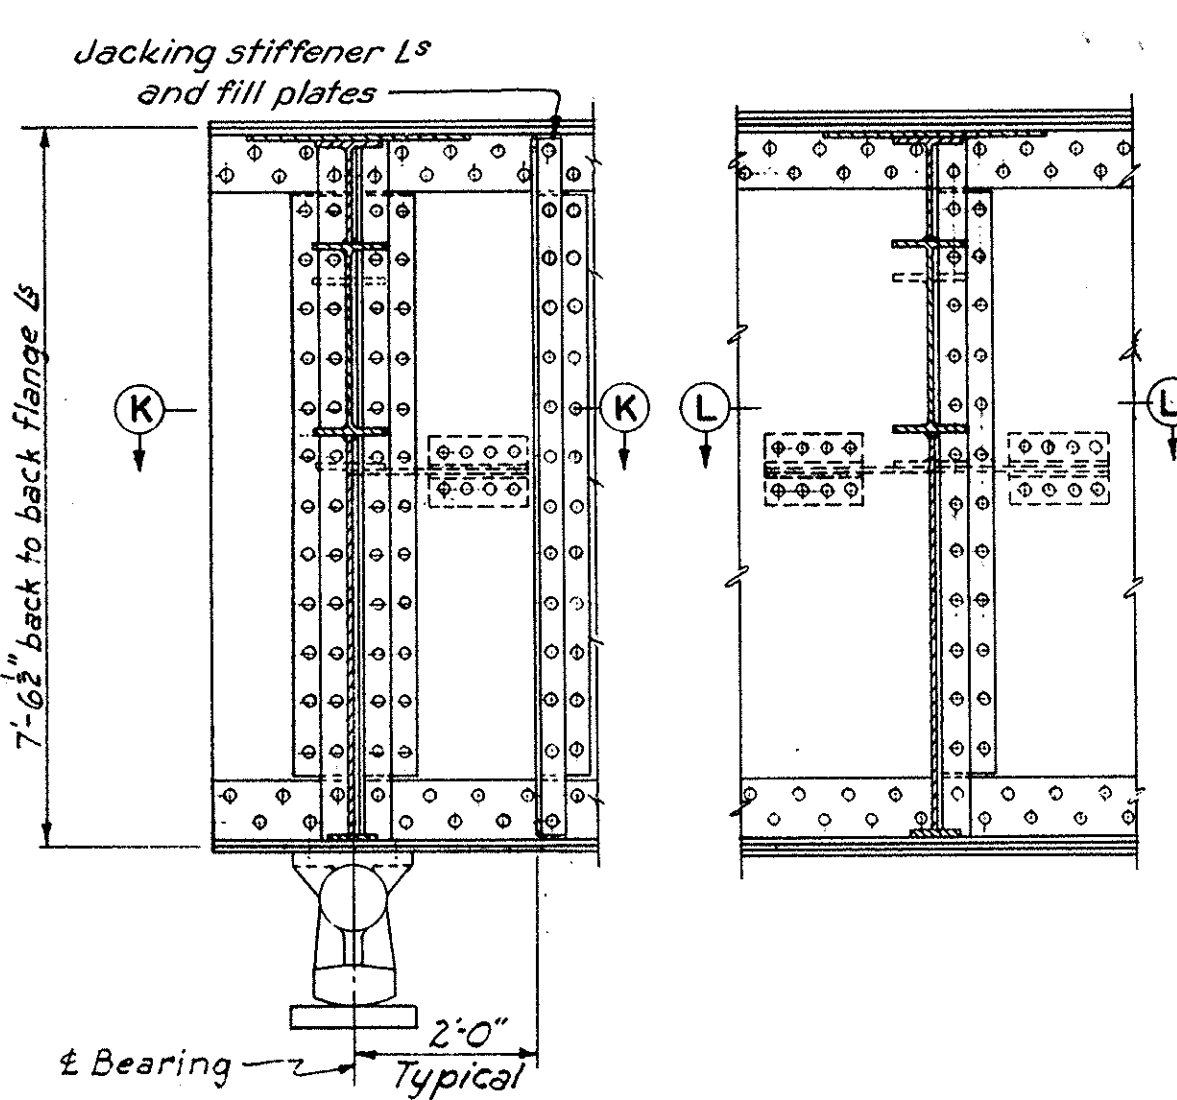


**BEARING AT WEST ABUTMENT**  
7'-6 3/4" back to back flange & jacking stiffener L's and fill plates  
2'-0" Typical  
Bearing

**TYPICAL PANEL POINT WITH ONE LATERAL**

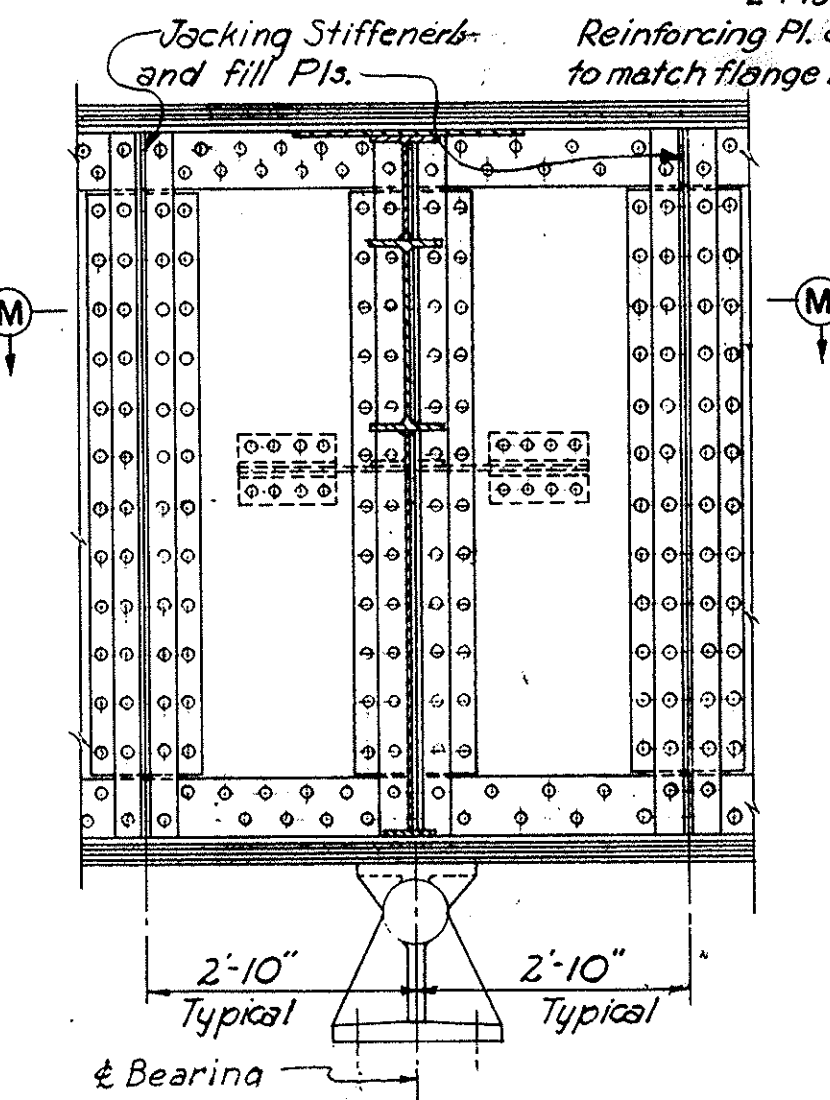


**BEARING AT PIER I**  
2'-10" Typical  
Bearing

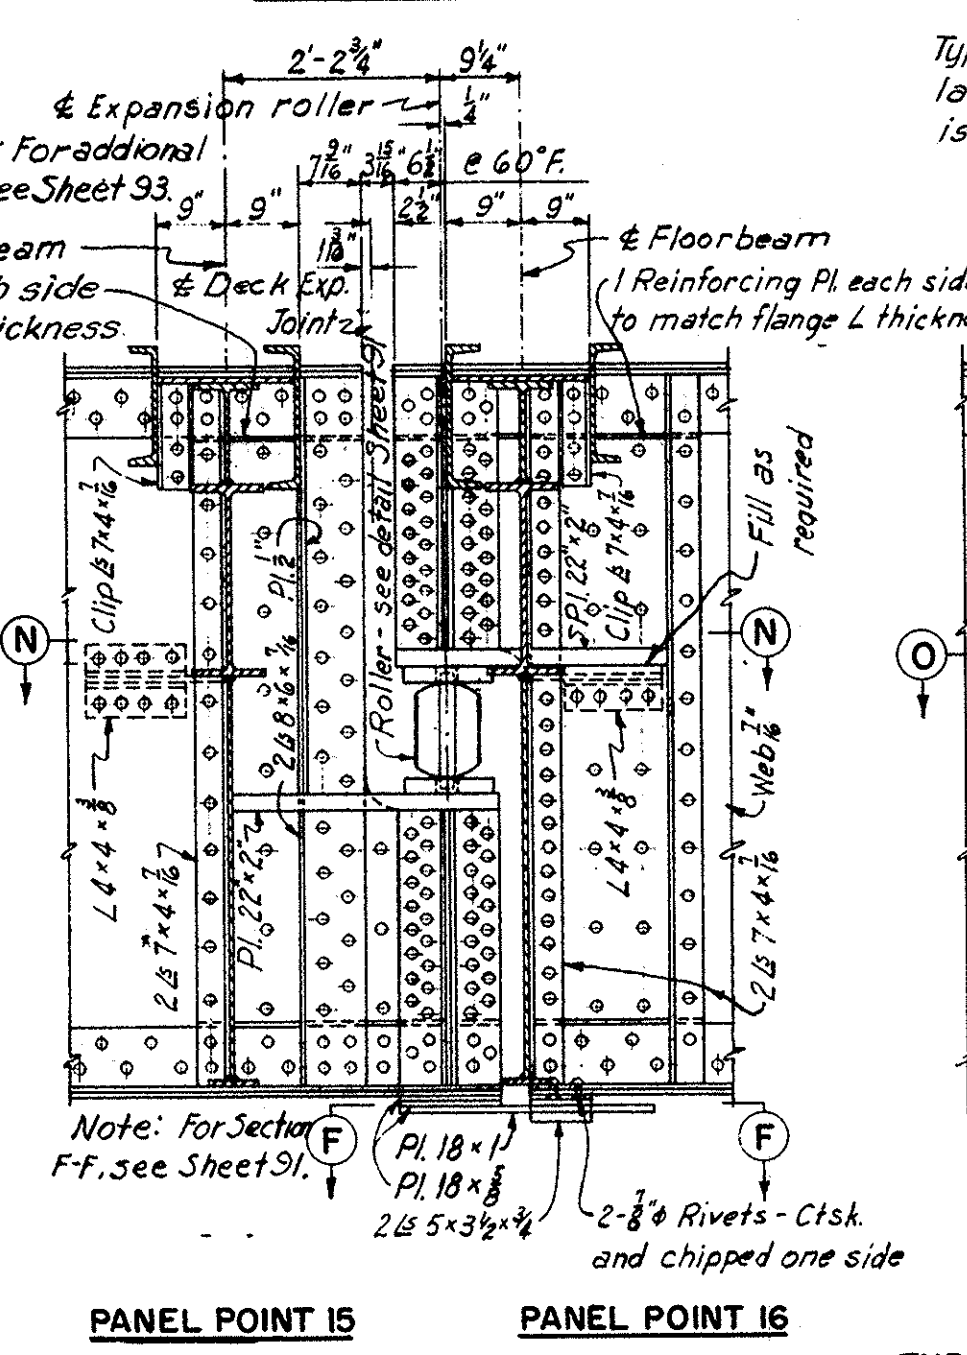


**PANEL POINT 15**      **PANEL POINT 16**  
Note: For additional details, see Sheet 93.  
Note: For Section F-F, see Sheet 91.

**EXPANSION JOINT**  
Expansion joint between panel points 34 and 35 similar

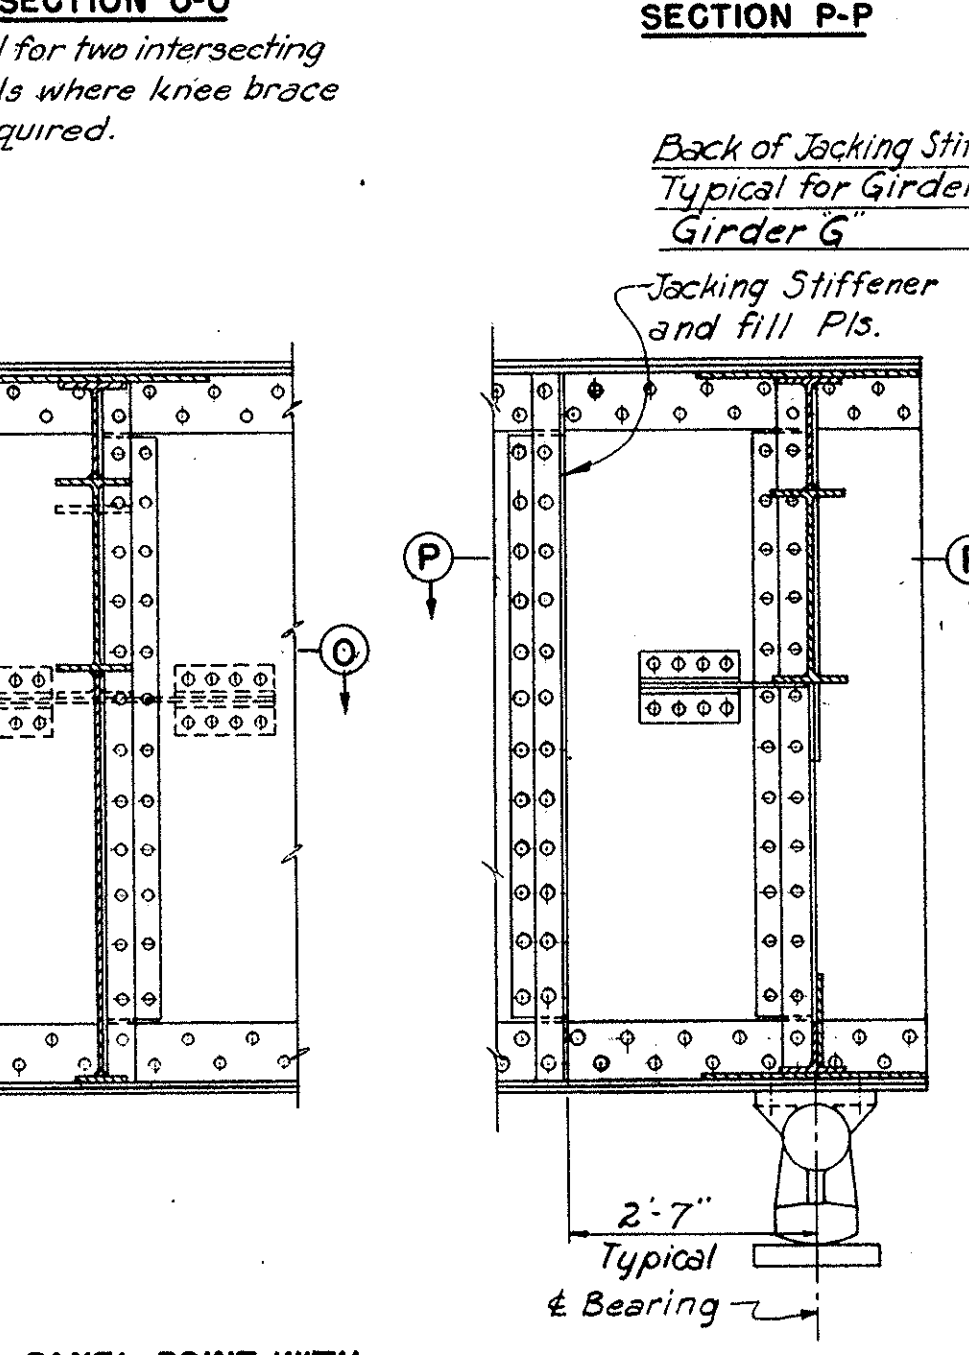


**TYPICAL PANEL POINT WITH TWO INTERSECTING LATERALS**  
Back of Jacking Stiffener & Typical for Girders A, B, C, D, E and F  
Girder G  
2'-10" 2'-10" 3'-4" 3'-4"

**BEARING AT EAST ABUTMENT**  
2'-7" Typical  
Bearing

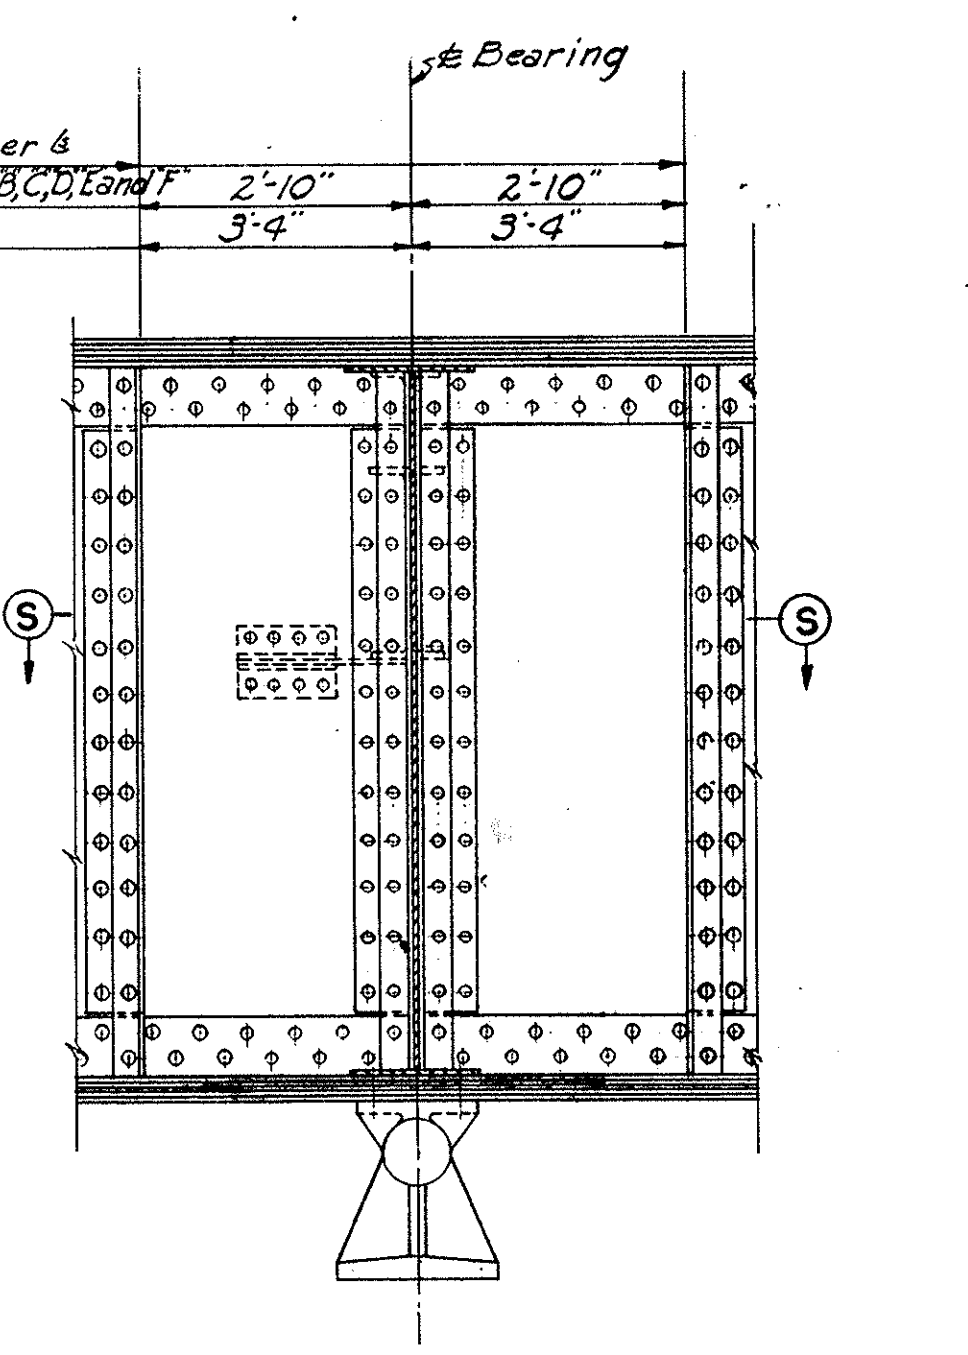


**BEARING AT PIER 6**  
Back of Jacking Stiffener & Typical for girders A, B, C and D  
Typical for girders E and F  
1'-5" 1'-5" 1'-1" 1'-1"


**BEARING AT PIER 5**

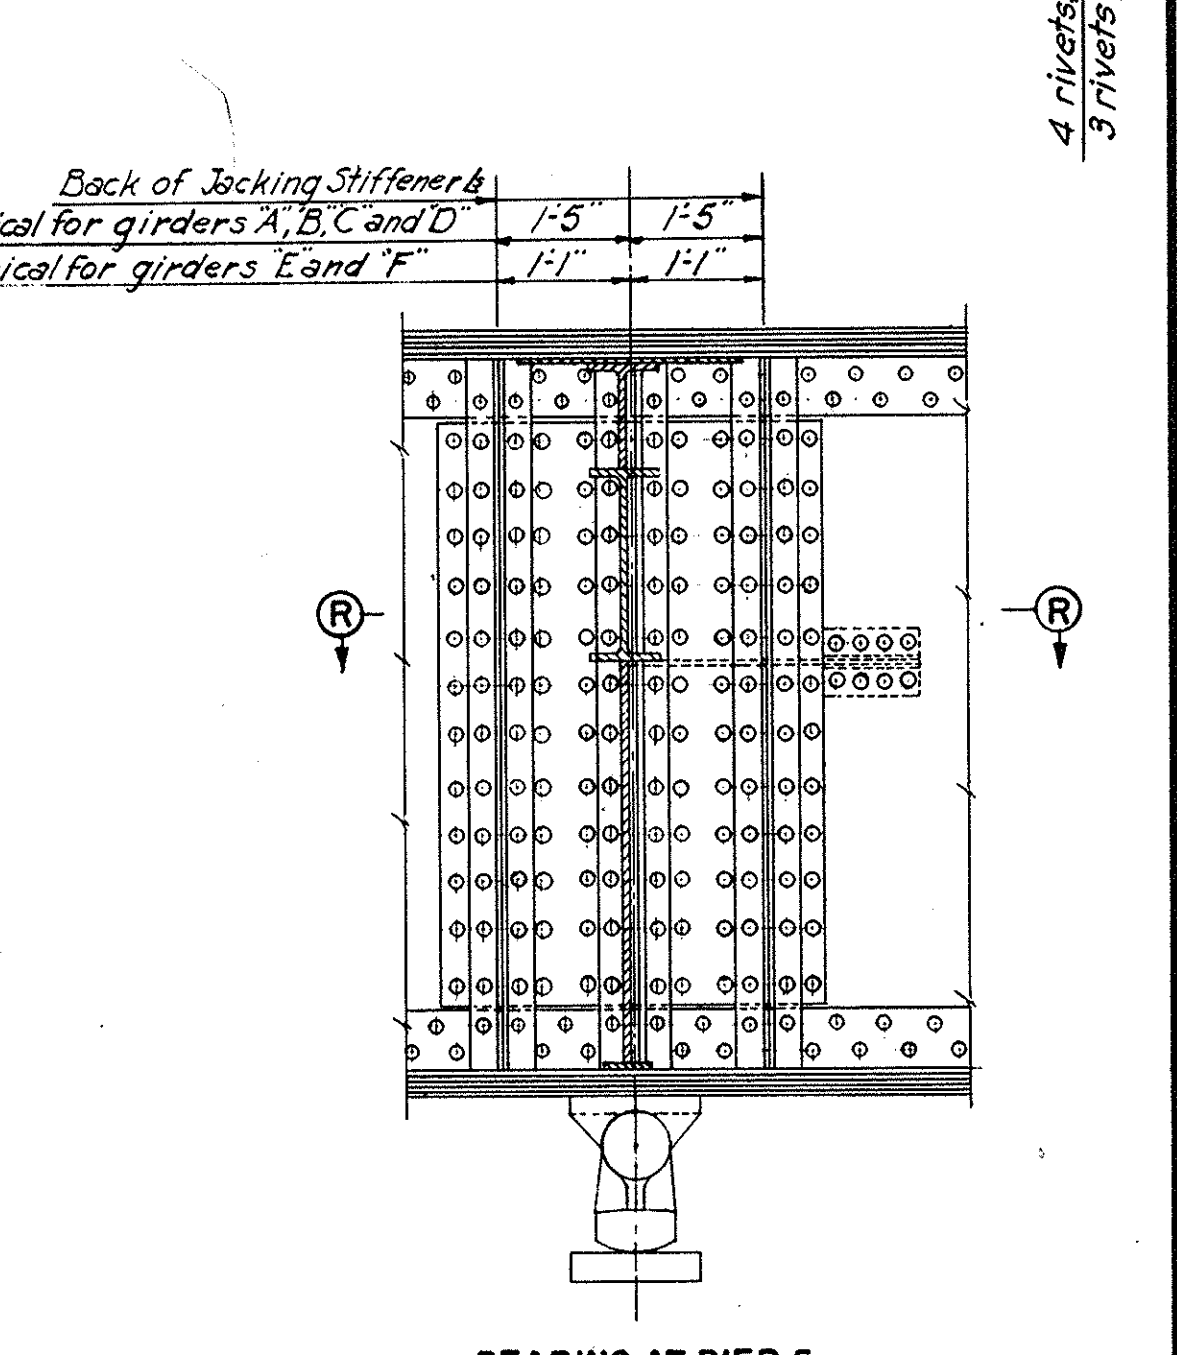


**GIRDER B, C, D, E AND F**  
Girder C shown, Girders A, B, C, D, E and F similar except as shown.

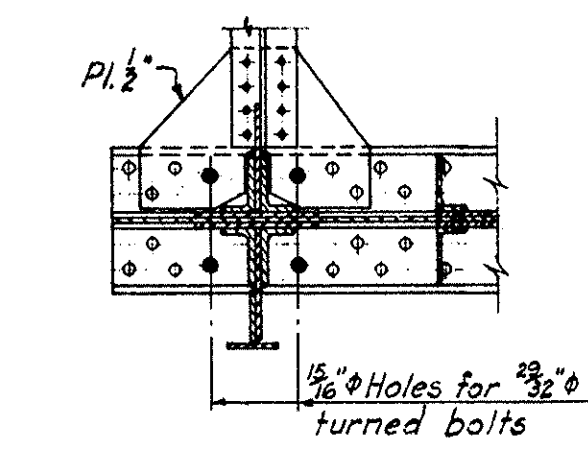


**SECTION S-S**

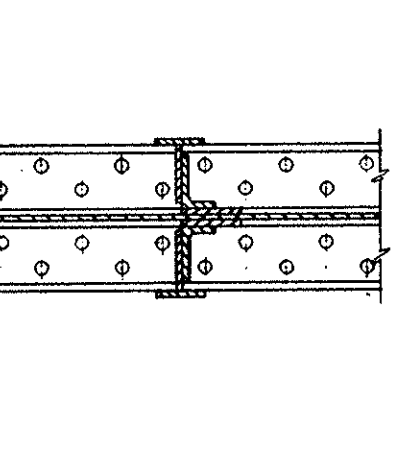


**GIRDERS B, C, D AND E**  
Girder C shown, girders B, C and E similar

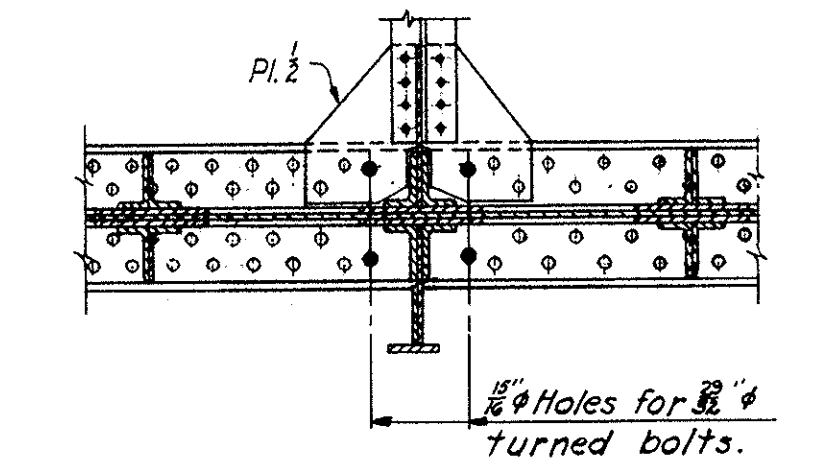


**GIRDERS B, C, D AND E**  
Girder C shown, girders B, C and E similar

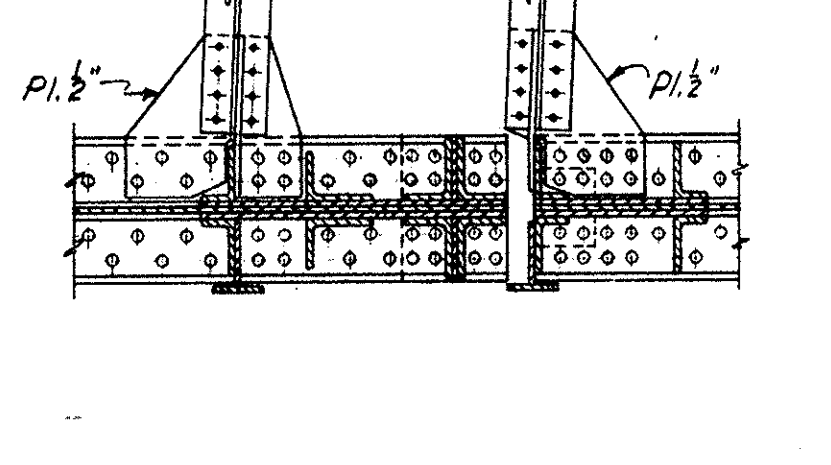

**GIRDERS B, C, D AND E**  
Girder C shown, girders B, C and E similar

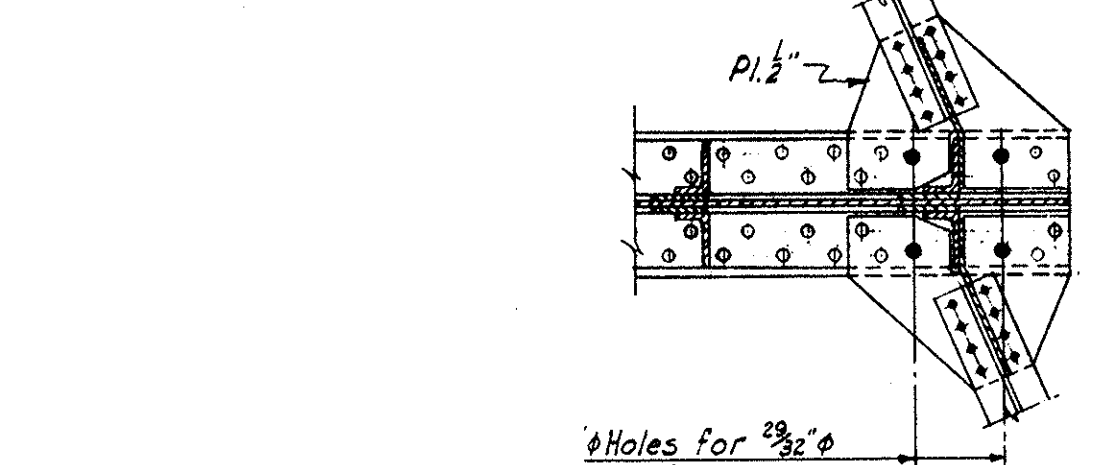

**GIRDERS B, C, D AND E**  
Girder B shown, girders C, D, E, G and H similar

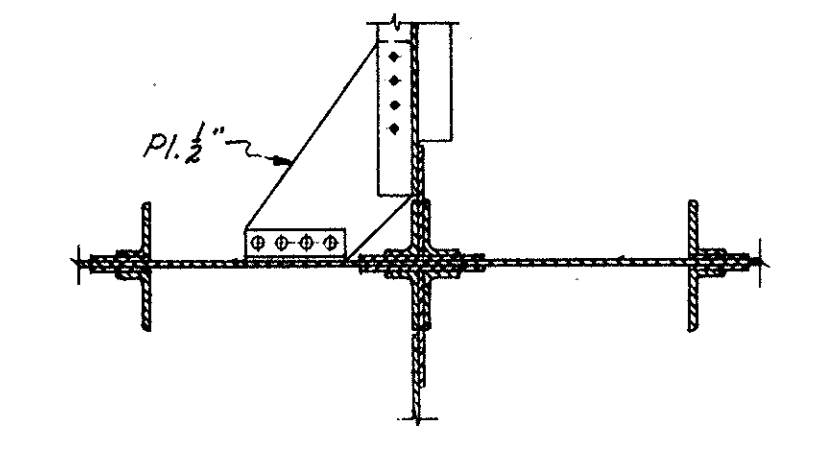

**SECTION S-S**  
**GIRDER F**

Notes: For additional details, see Sheet 91.  
For Roadway Cross Sections, see Sheets 80, 81 and 82.  
For jacking stiffeners and fill plates, see Sheet 91.  
For bearing stiffeners and fill plates see Sheet 91.  
For typical lateral intersection connection see Sheet 91.


**AKRON EXPRESSWAY SYSTEM**  
WEST VIADUCT  
BR. NO. SU-18R-135  
**GIRDER DETAILS**

AKRON      SUMMIT COUNTY,      OHIO


SCALE: 1/2" = 1'-0"  
MADE G.D. DATE 9-6-55  
TRCD. DATE  
CHK. DATE 9-20-55

HOWARD, NEEDLES, TAMMEN & BERGENDOFF  
CONSULTING ENGINEERS  
CLEVELAND      KANSAS CITY      NEW YORK  
901 SHEET 92


SUMMIT COUNTY  
CITY OF AKRON  
AKRON EXPRESSWAY SYSTEM

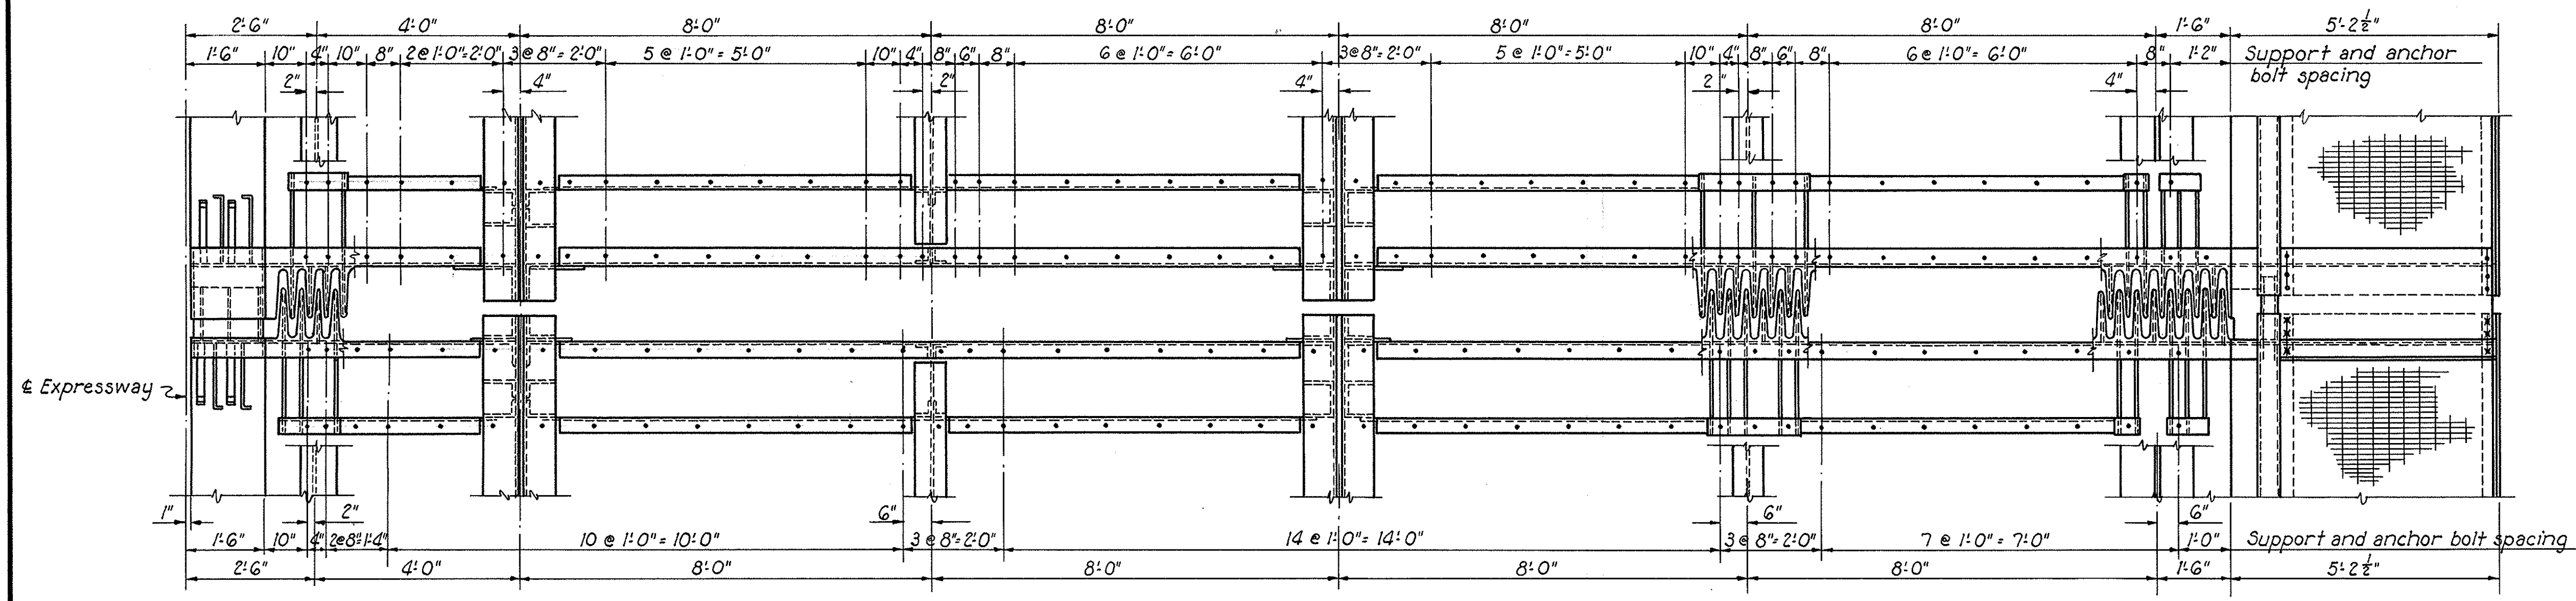


**HALF PLAN**  
Scale:  $\frac{1}{8}'' = 1'-0''$   
South expansion joint shown. North expansion joint similar but opposite hand.

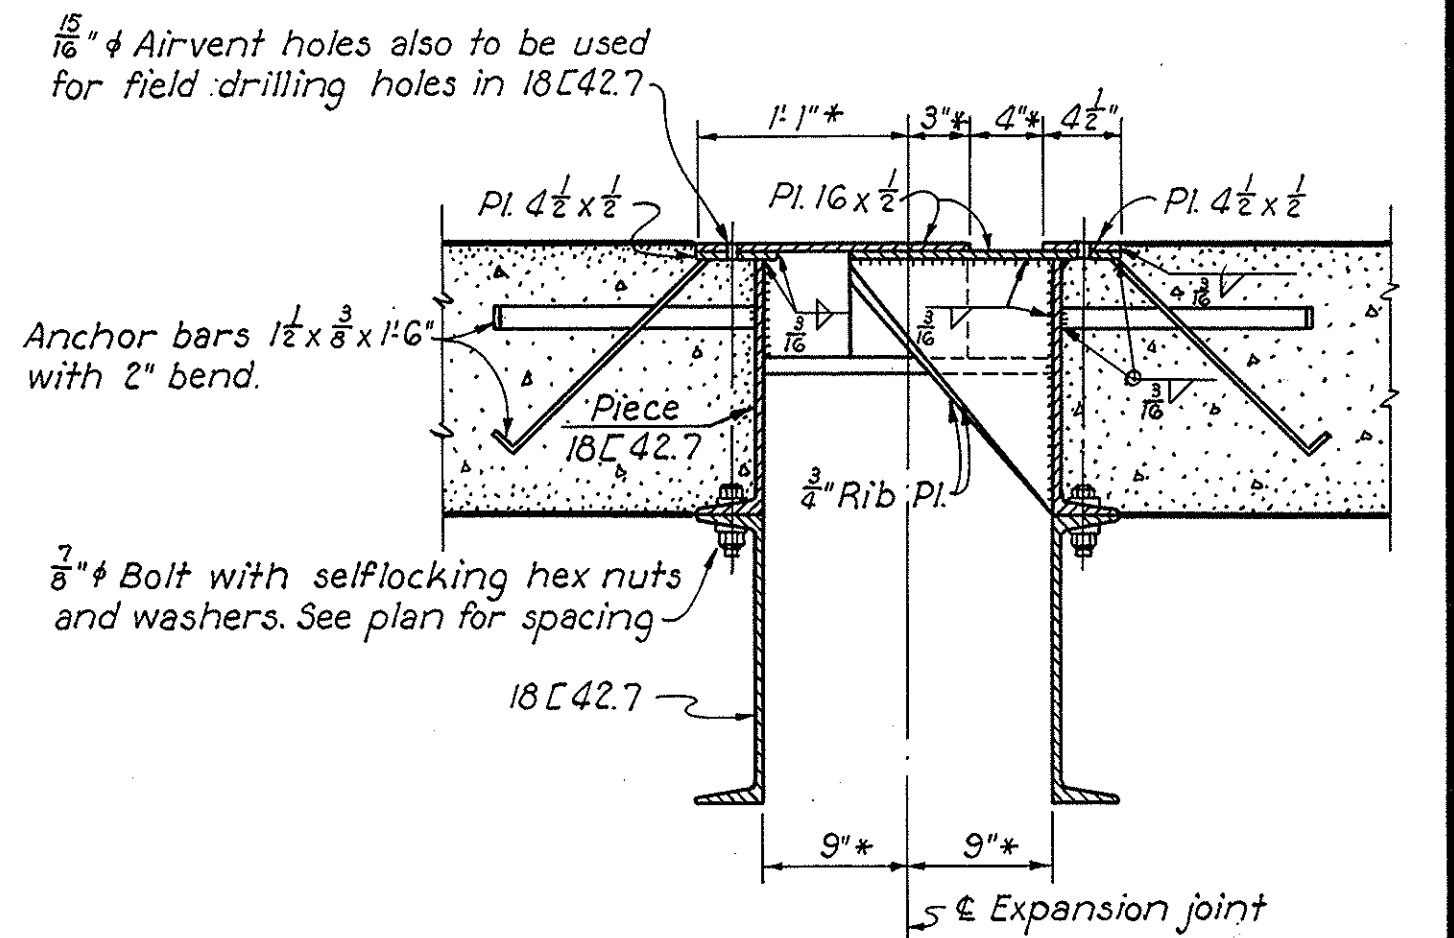


**SECTION THRU MEDIAN**

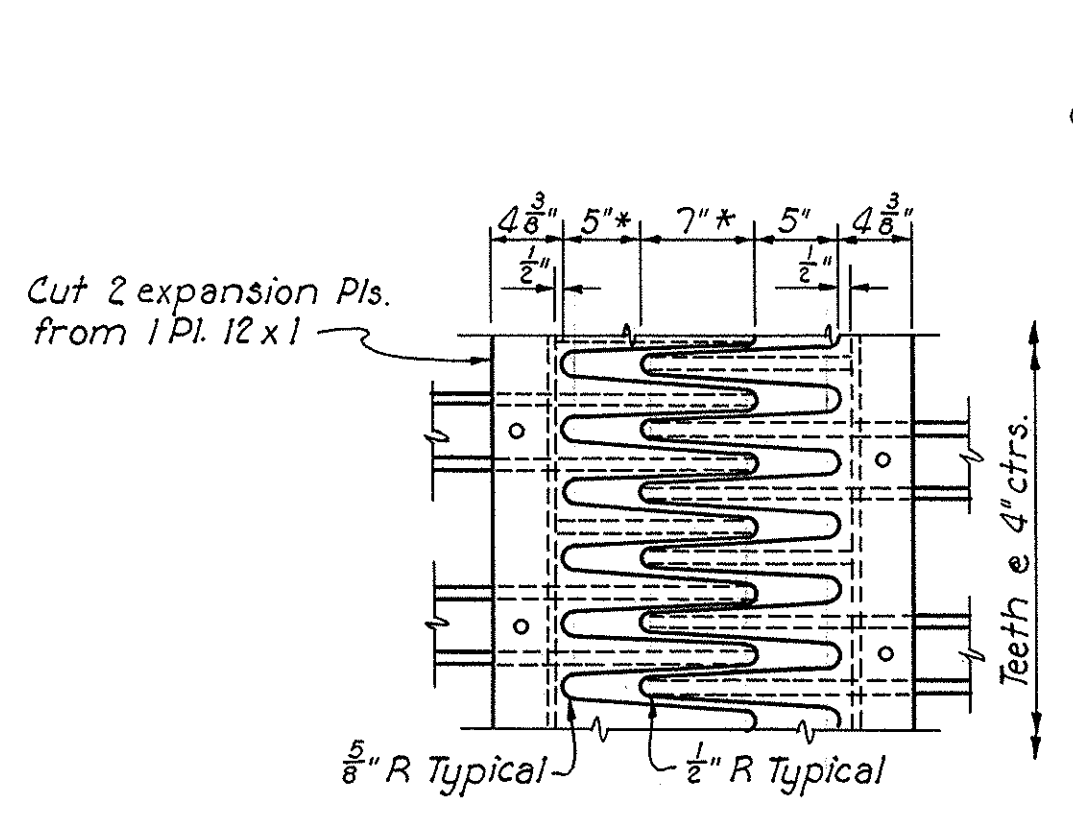


**EXPANSION PLATE DETAIL**

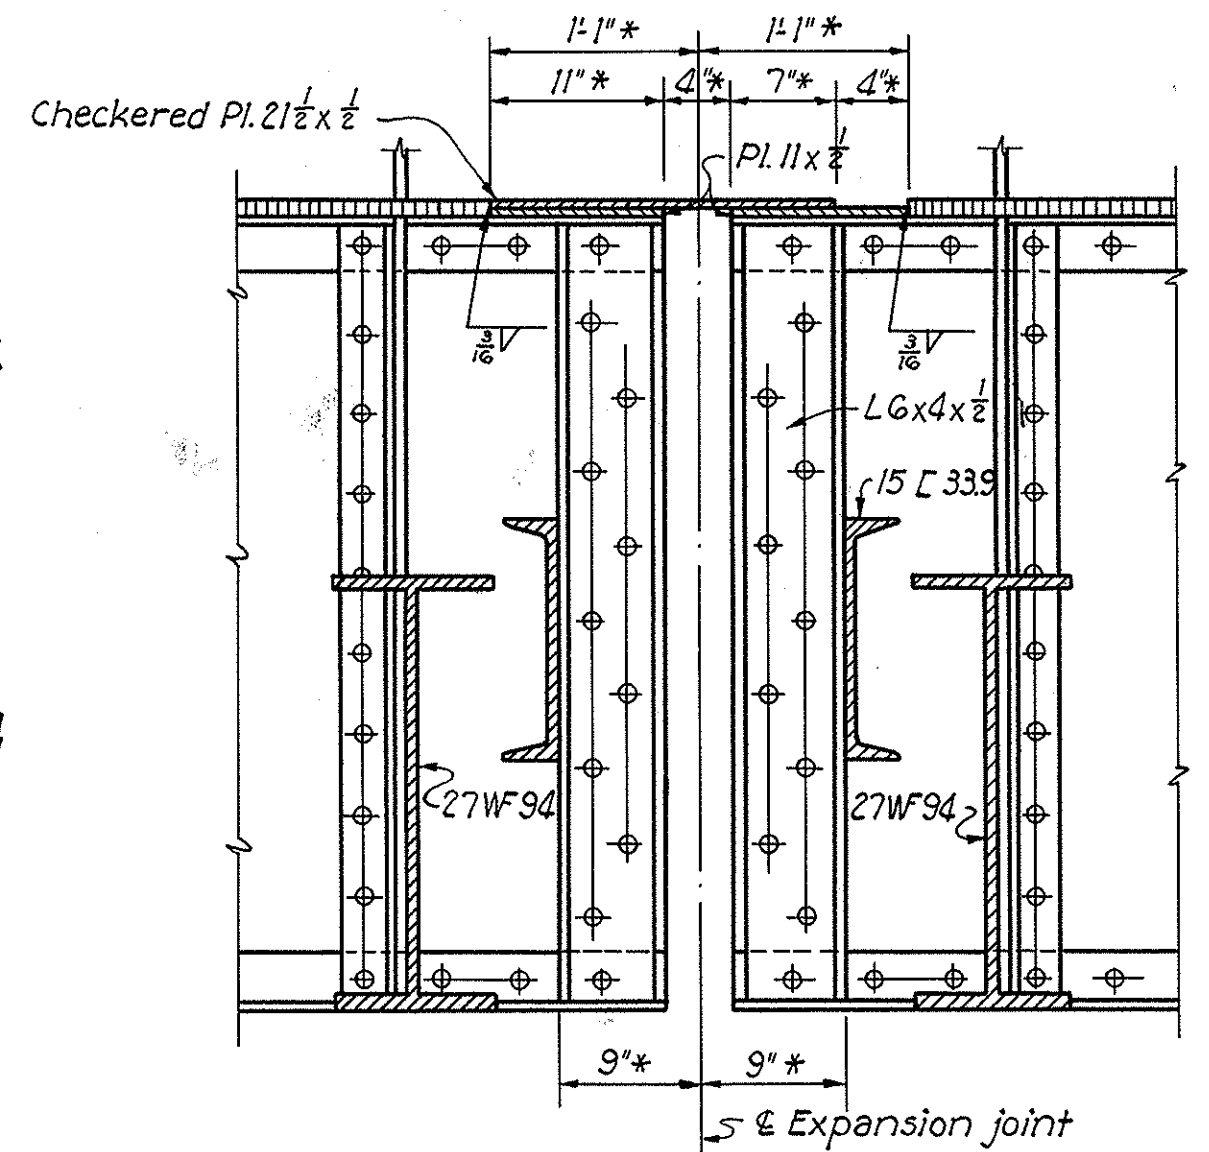




**SECTION AT FASCIA**

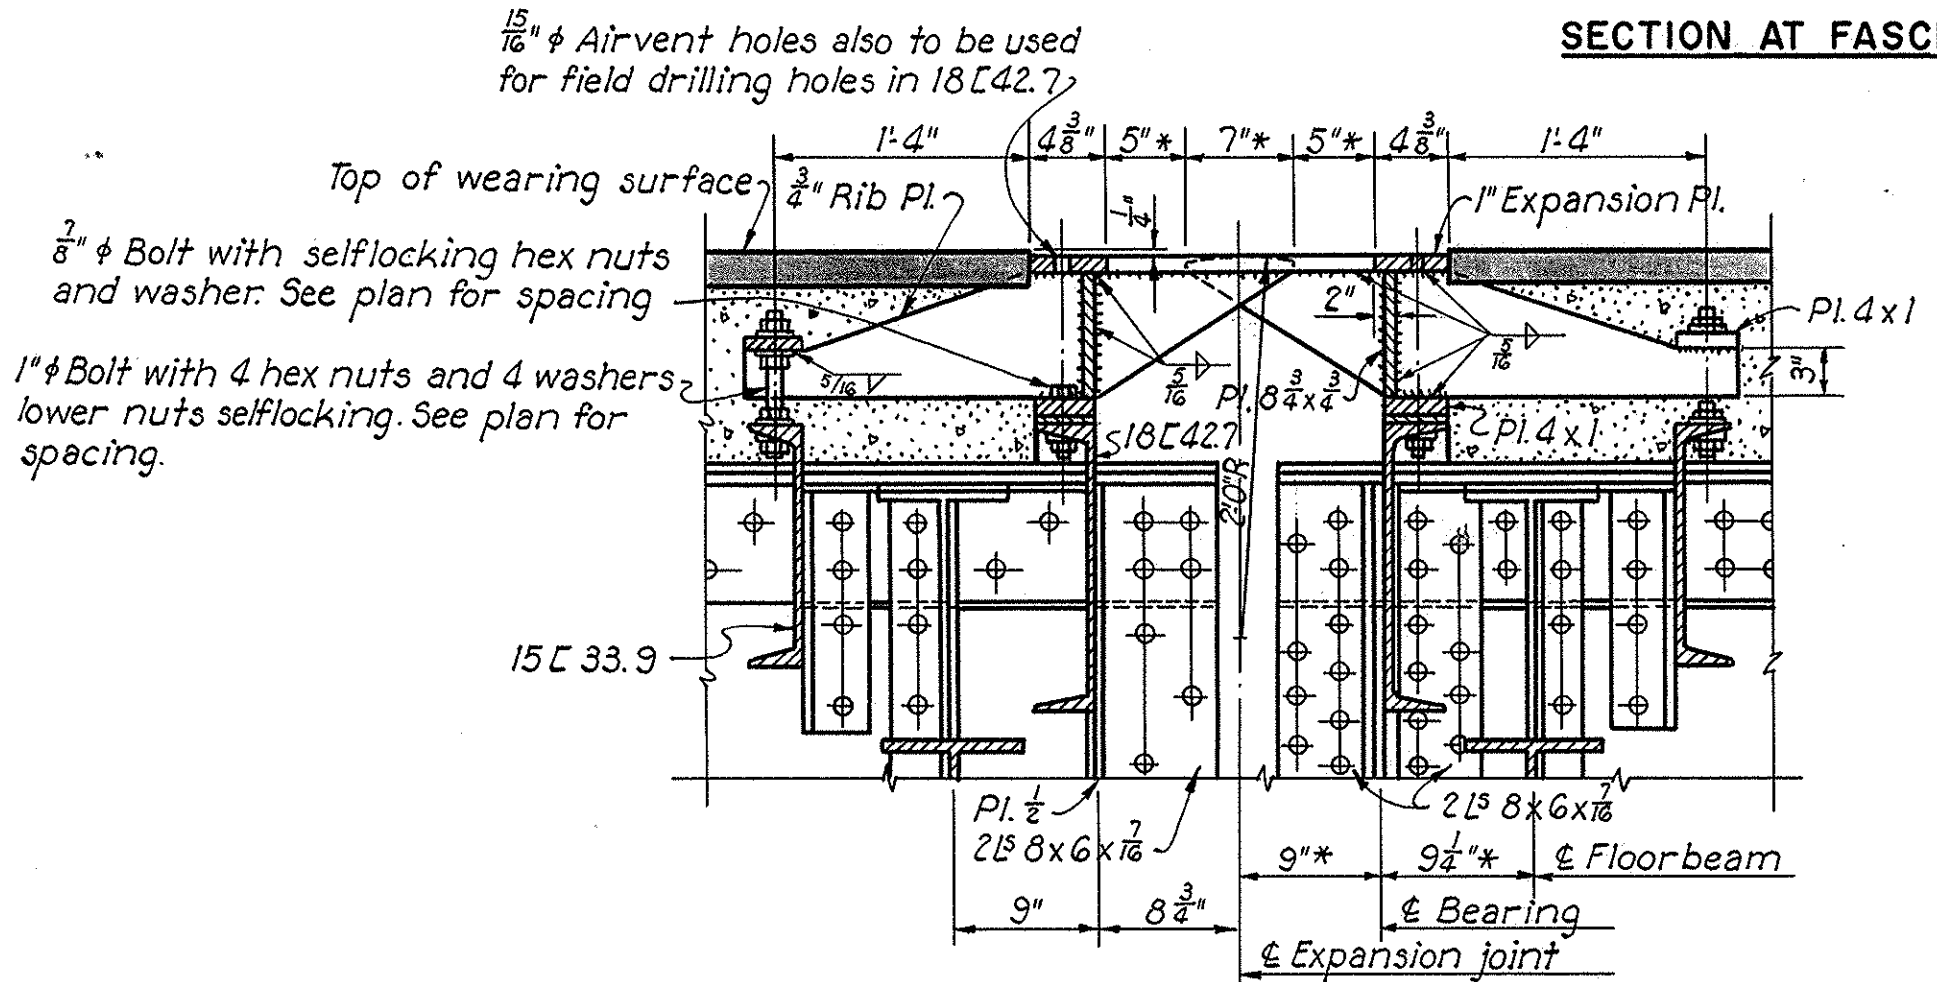


**SECTION THRU ROADWAY**  
Bend 1/2" connection Pl. for expansion joint near Pier 2.

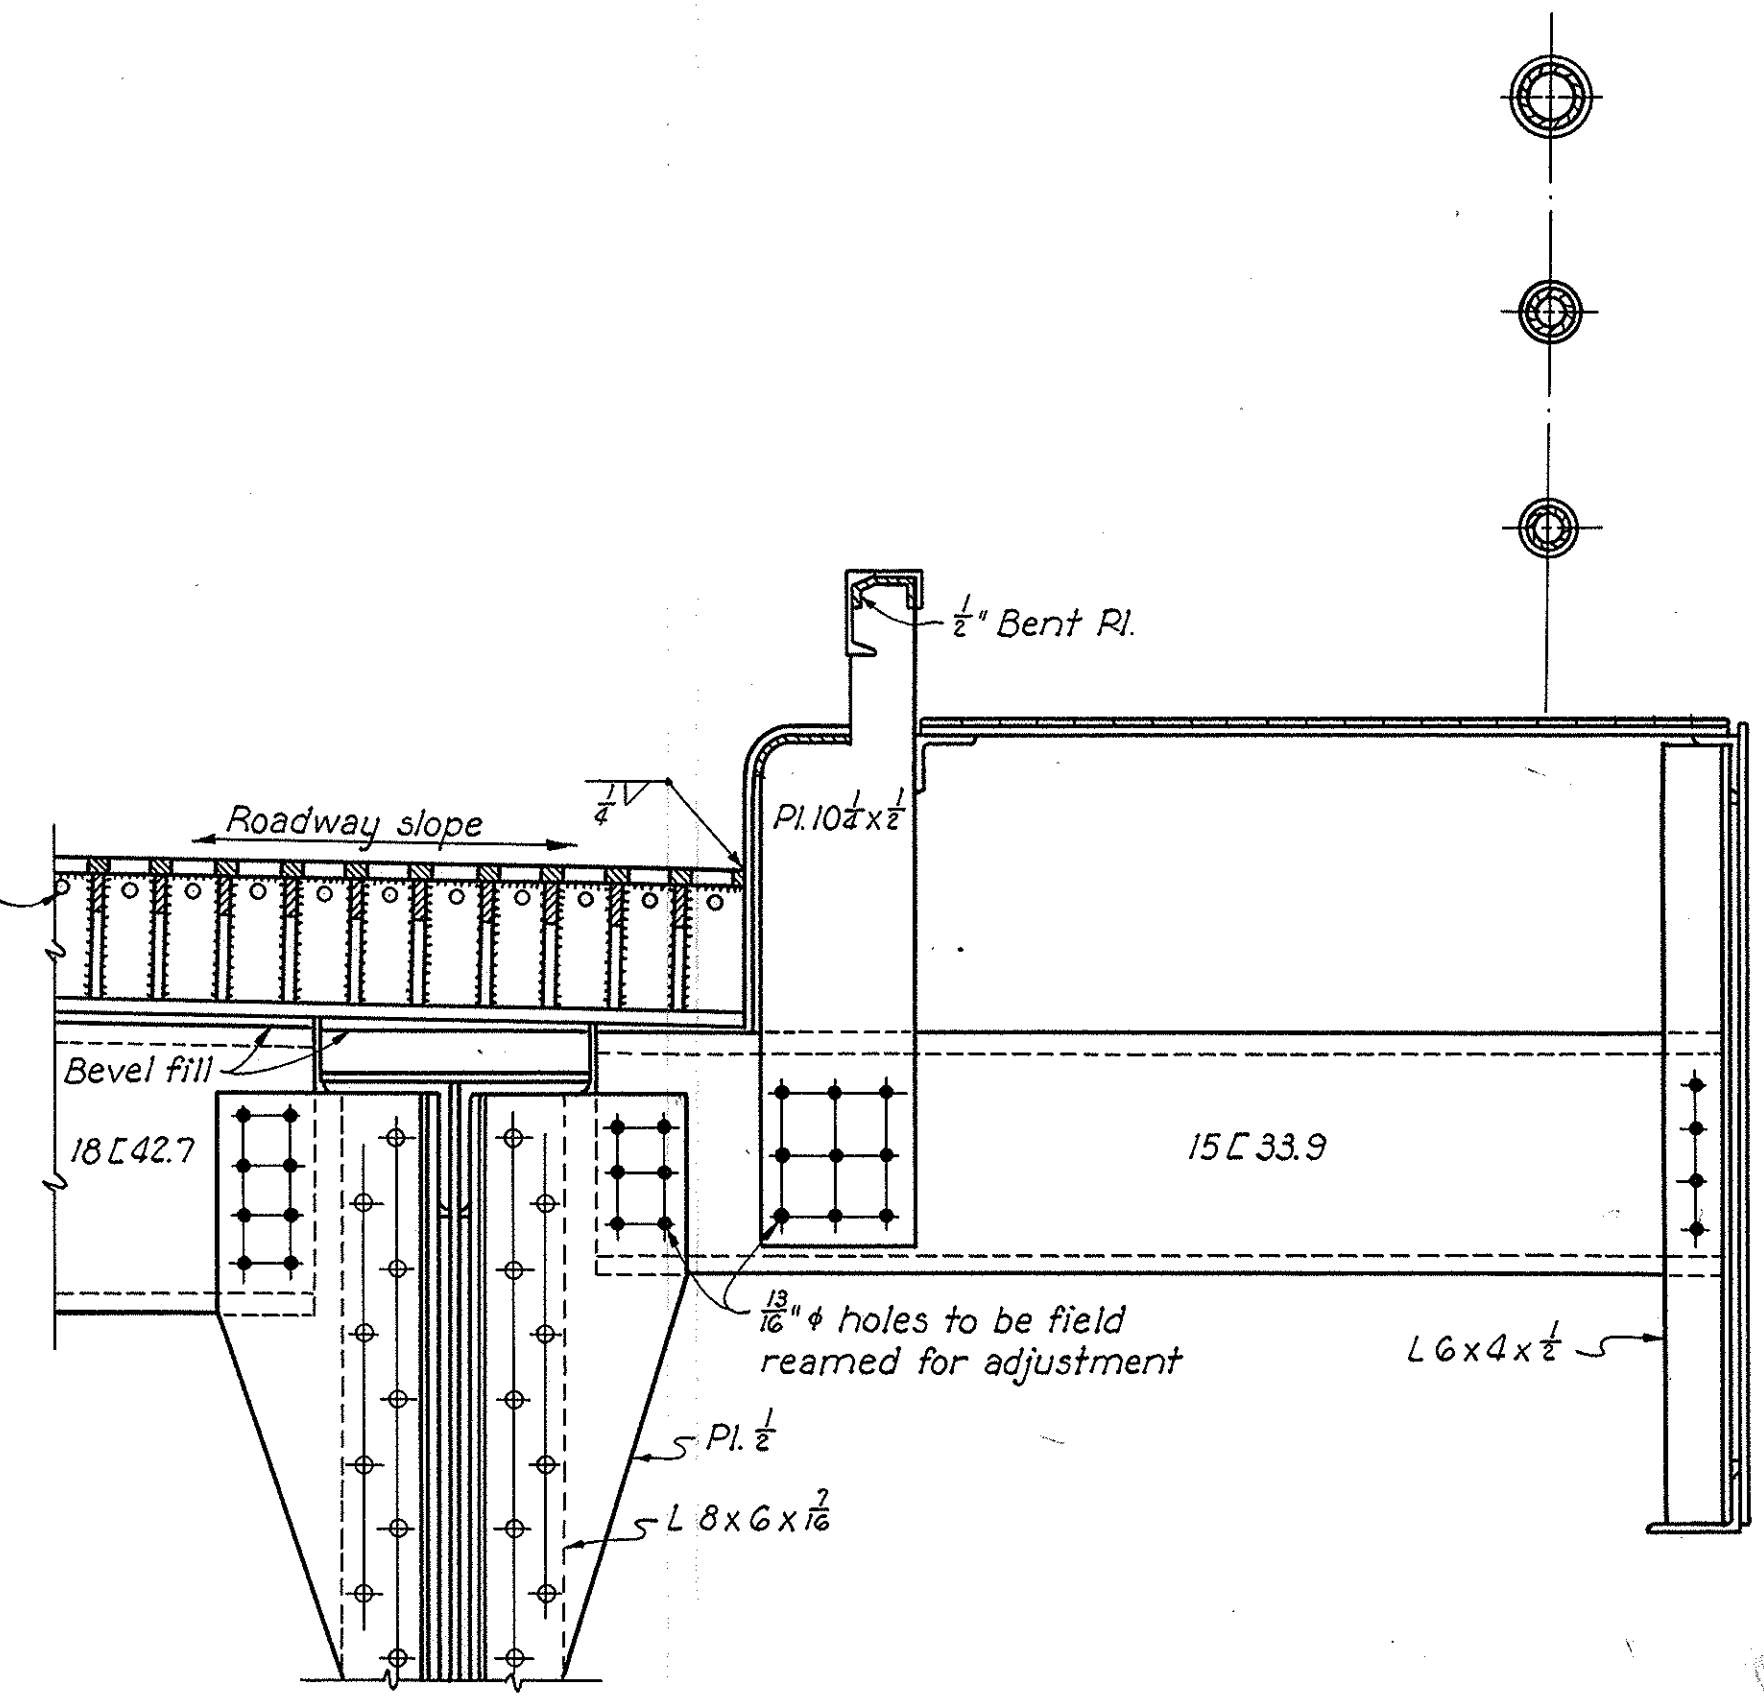

**SECTION AT EXTERIOR GIRDER**  
Bend 1/2" connection Pl. and connection L 6 x 4 x 1/2 for expansion joint near Pier 2.

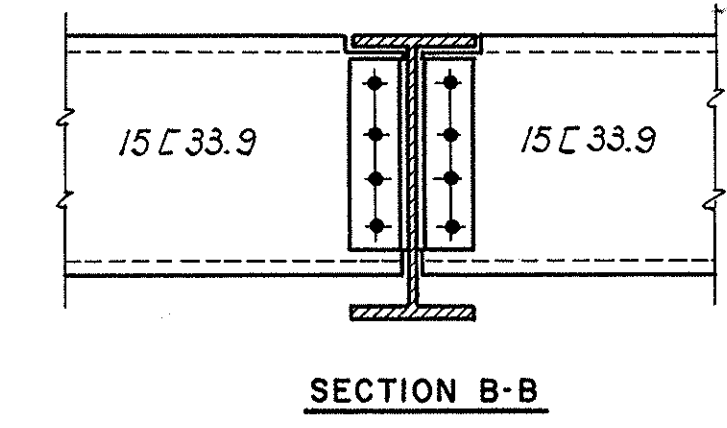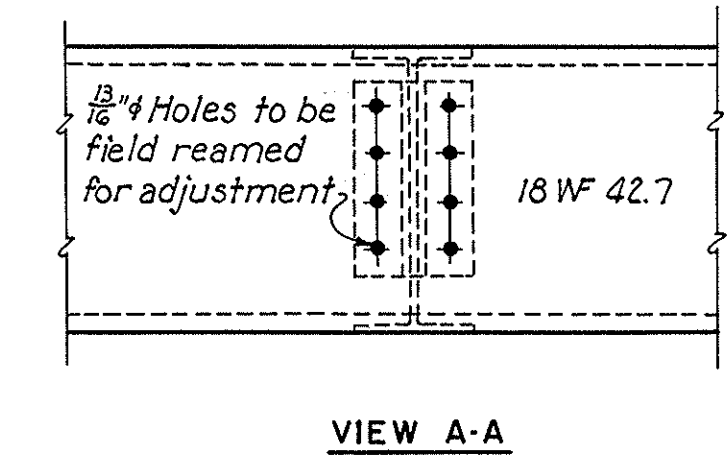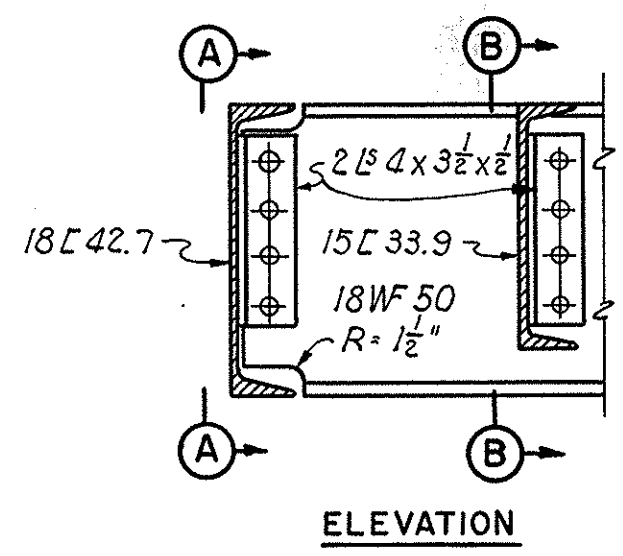

**STRINGER CONNECTION**  
Bend angles for expansion joint near Pier 2.

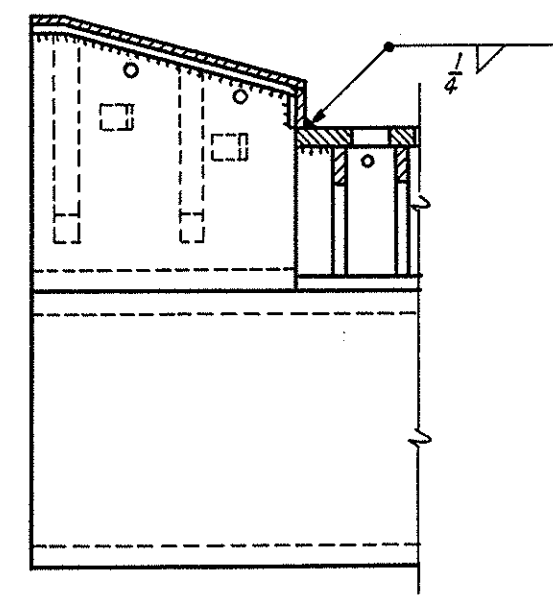


Note:  
Selflocking nuts shall be equal to Anco nuts as made by Automatic Nut Co. of Lebanon, Pa. For expansion joint in handrail and curb see Sheet 97.  
For girder details see Sheets 91 and 92. For roller details see Sheet 91.  
Sections are similar for expansion joint near Pier 2 except as noted.  
Dimensions marked thus \* are for 60°F only. For additional sections and notes see Sheet 94.

PART 7

**AKRON EXPRESSWAY SYSTEM**  
WEST VIADUCT  
BR. NO. SU-18R-135  
EXPANSION JOINT NEAR PIER 4


AKRON	SUMMIT COUNTY,	OHIO
-------	----------------	------

SCALE: 1" = 10' except as shown  
MADE BSS DATE 7-15-55 HOWARD, NEEDLES, TAMMEN & BERGENDOFF  
TRCO CAL DATE 11-23-55 CONSULTING ENGINEERS  
CKD. HVG DATE 9-7-55 KANSAS CITY CLEVELAND NEW YORK  
901 SHEET- 93

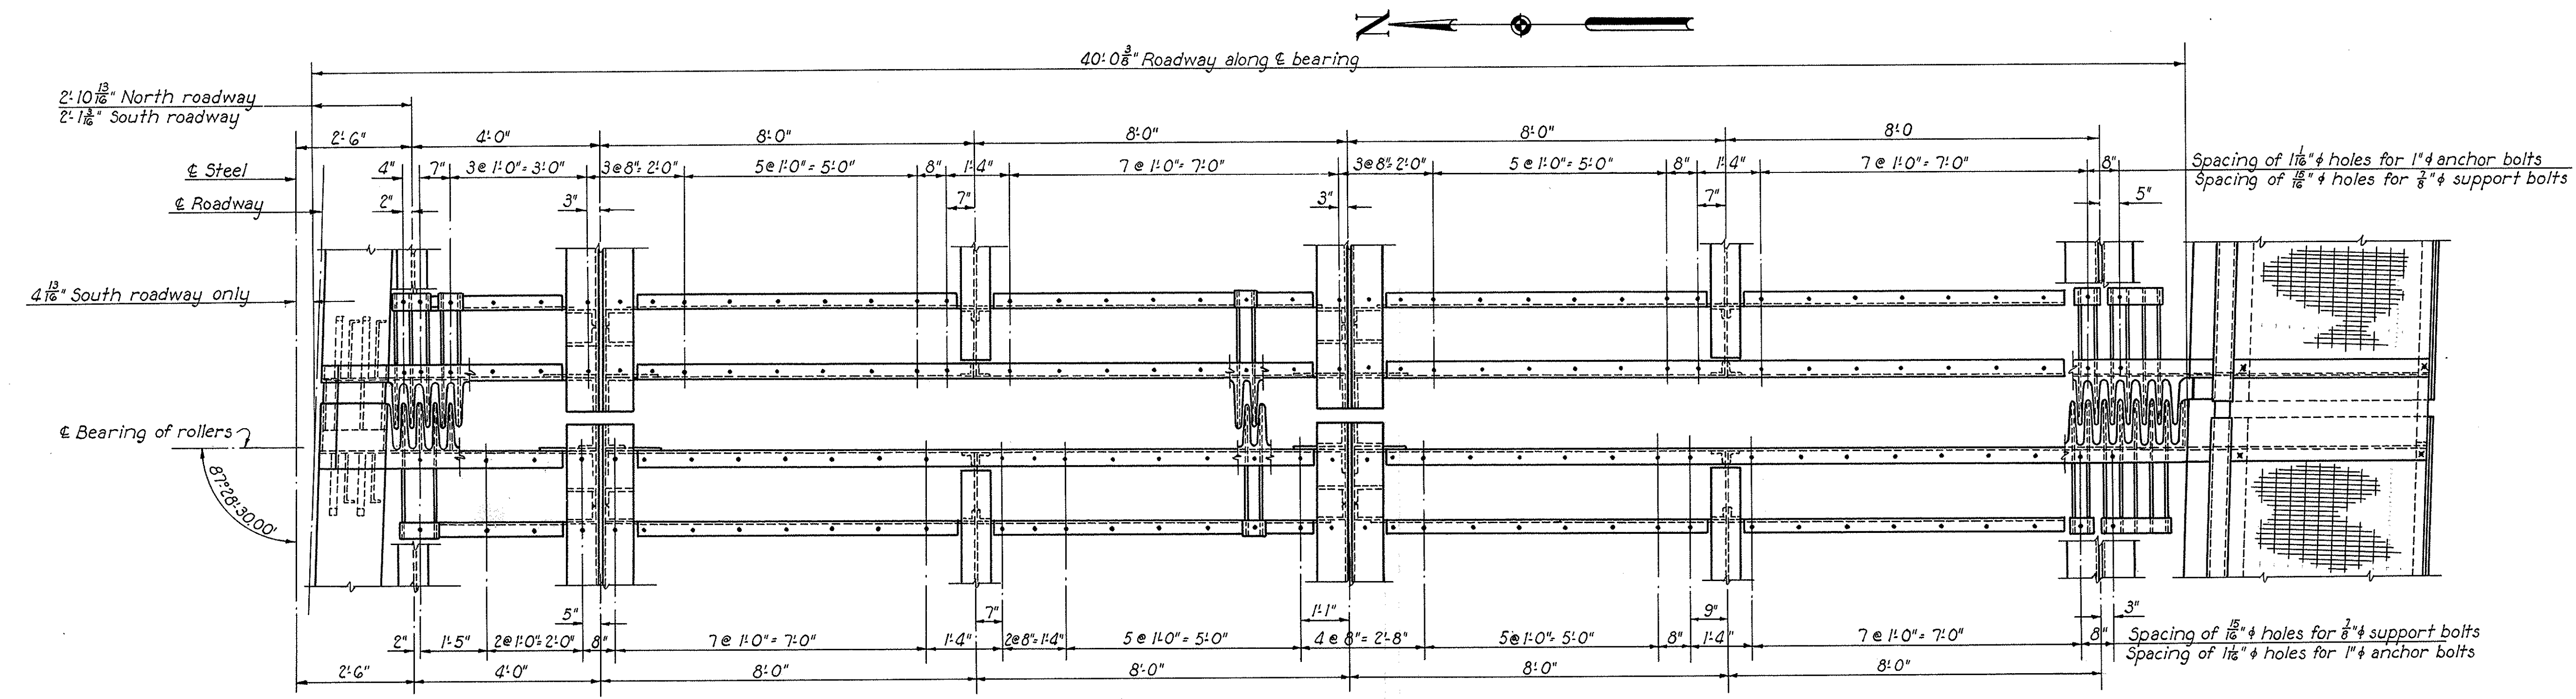


**HALF PLAN EXPANSION JOINT NEAR PIER 2**

Scale: 1/2" = 1'-0"  
South roadway shown, North roadway similar except as noted and opposite hand.

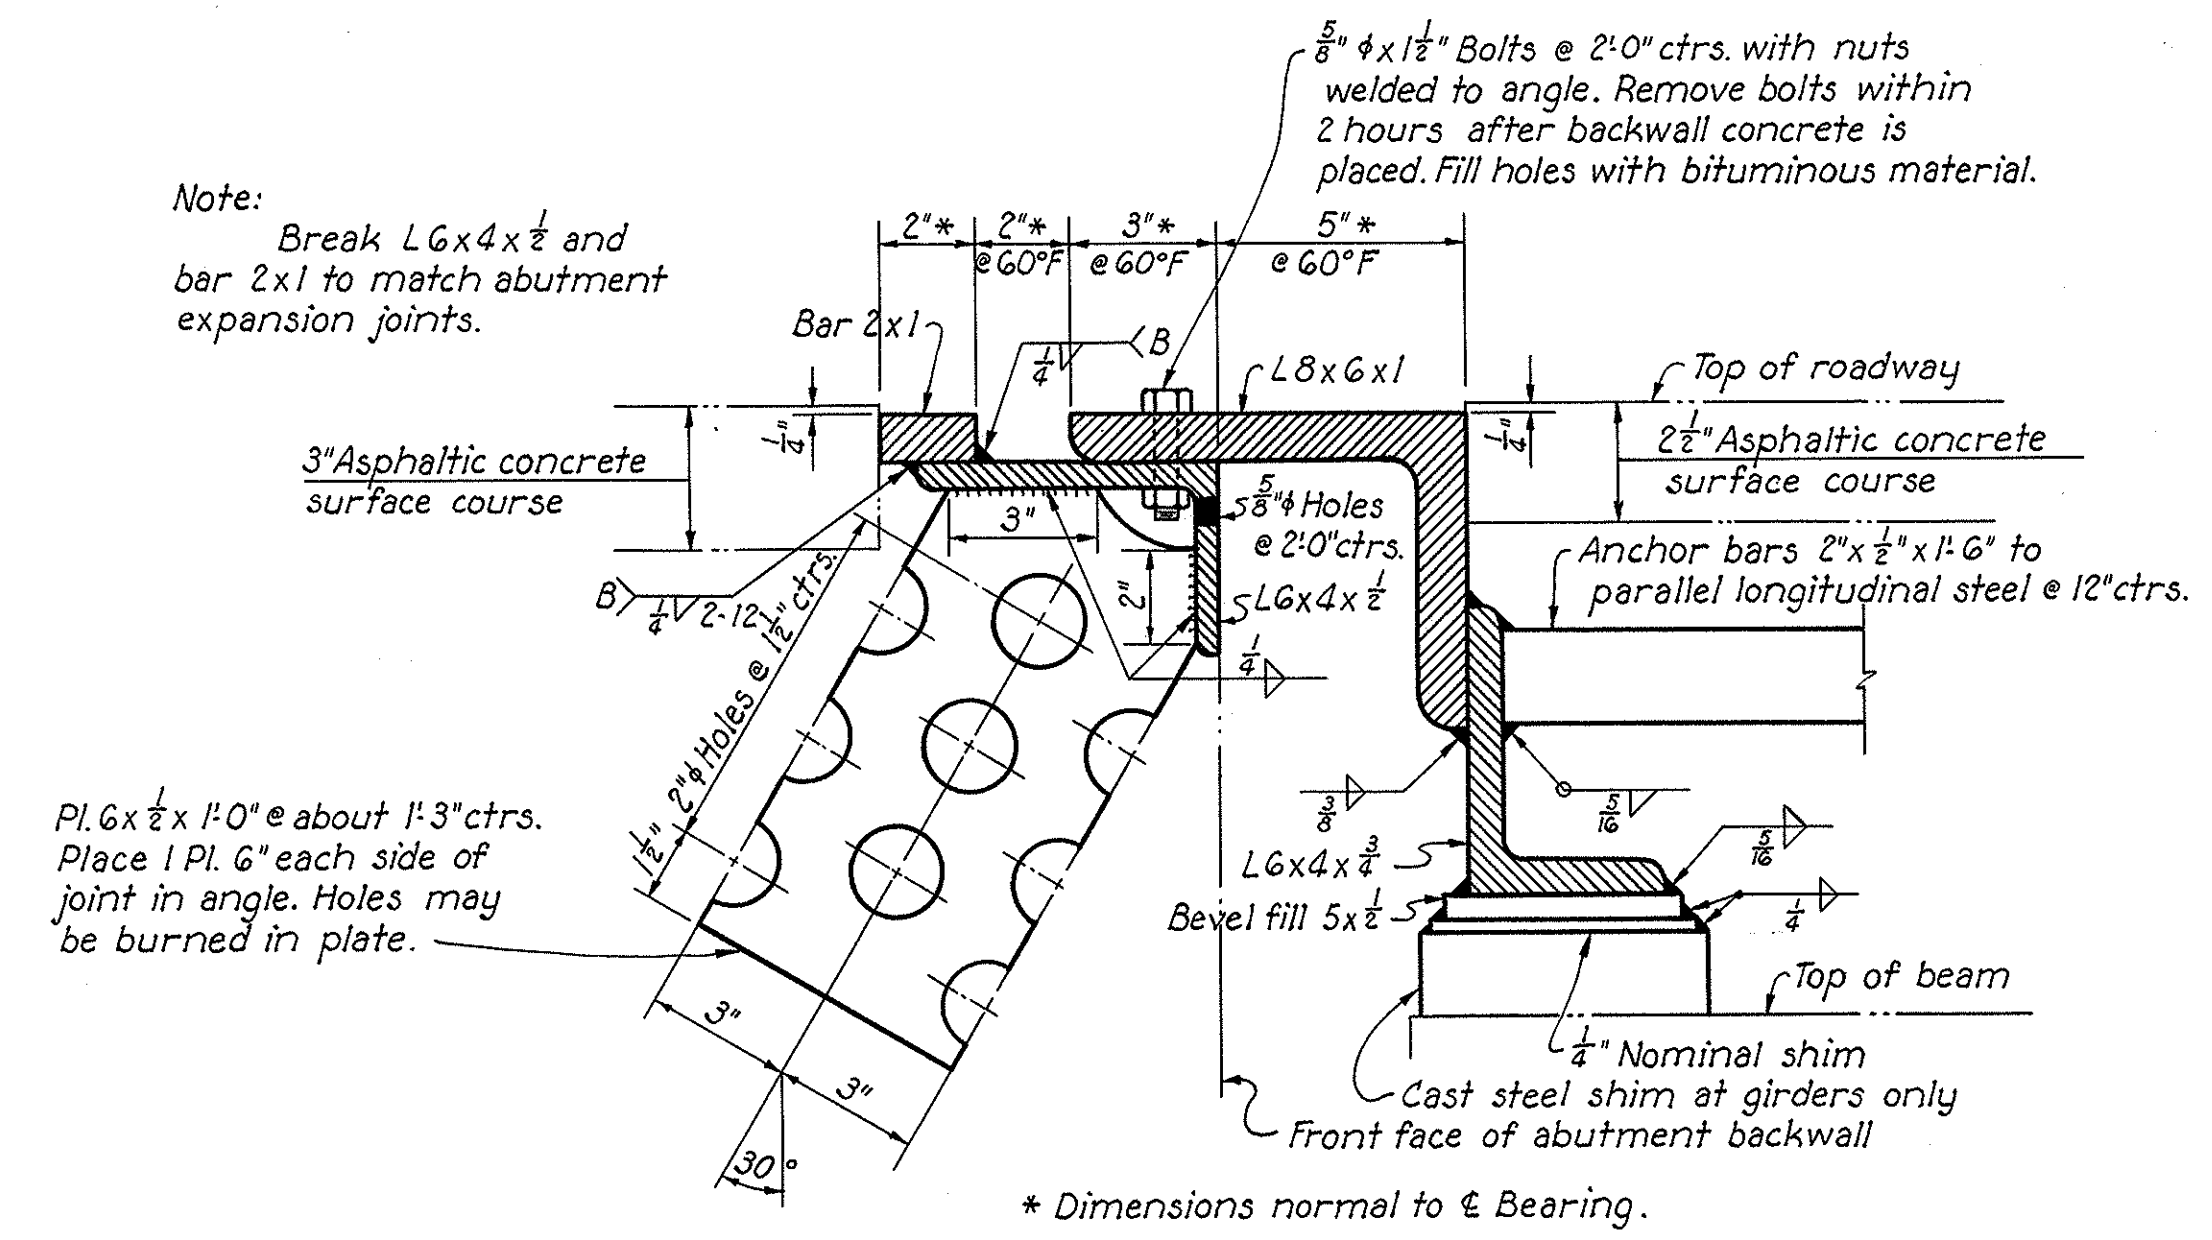


**ROADWAY EXPANSION JOINTS AT ABUTMENTS**  
Scale: 3" = 1'-0"

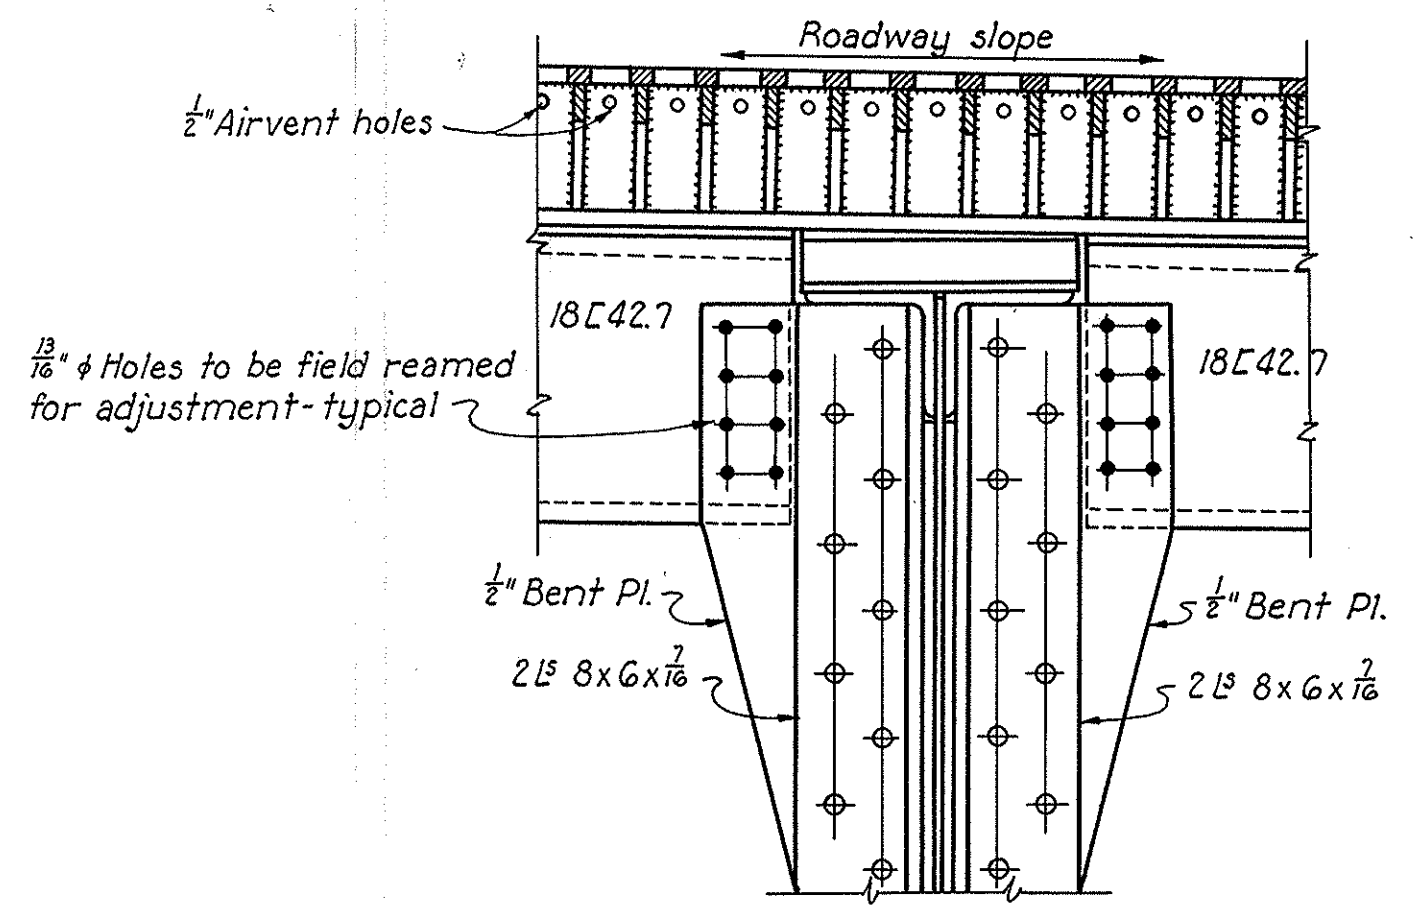


**SECTION AT INTERIOR GIRDER**

Scale: 1" = 1'-0"  
Section looking east. Expansion joint near Pier 4 similar except do not bend connection plates and angles.

**Notes:**  
Shape all roadway expansion material to the cross section of the roadway; see Sheet 84. All sections for both sides of roadway expansion joints near Pier 2 and Pier 4 shall be shop assembled allowing for normal clearance of 3/4 inch between ends and roots of mating projections. While thus assembled the joint shall be checked and corrected to provide not less than 1/8 inch clearance between sides of projections and not less than 5/16 inch clearance between ends and roots of projections. All expansion joint devices so assembled shall be matchmarked, and expansion joint devices shall be erected according to the shop matchmarking and shall be set to the longitudinal clearance required for the temperature at the time of setting, to the required grade and crown of roadway, and to provide equal side clearance between mating projections. The holes in the supporting steel shall be drilled in the field after the devices are adjusted in final position.  
Roadway abutment joint devices shall be shop assembled, corrected to provide uniform close contact between the two mating parts of each joint, matchmarked and erected to the required grade and crown. Such devices shall be set to the longitudinal clearance required for temperature at time of erection.  
Sidewalk and curb expansion joint devices shall be shop assembled, corrected to provide uniform contact between mating parts, matchmarked and erected to the required grade and lines.  
Selflocking nuts shall be equal to "Anco" nuts as made by Automatic Nut Co. of Lebanon, Pa.  
For curb and handrail details see Sheet 97.  
For girder details see Sheet 91.  
For expansion roller details see Sheet 91.  
Additional notes are on Sheet 93.

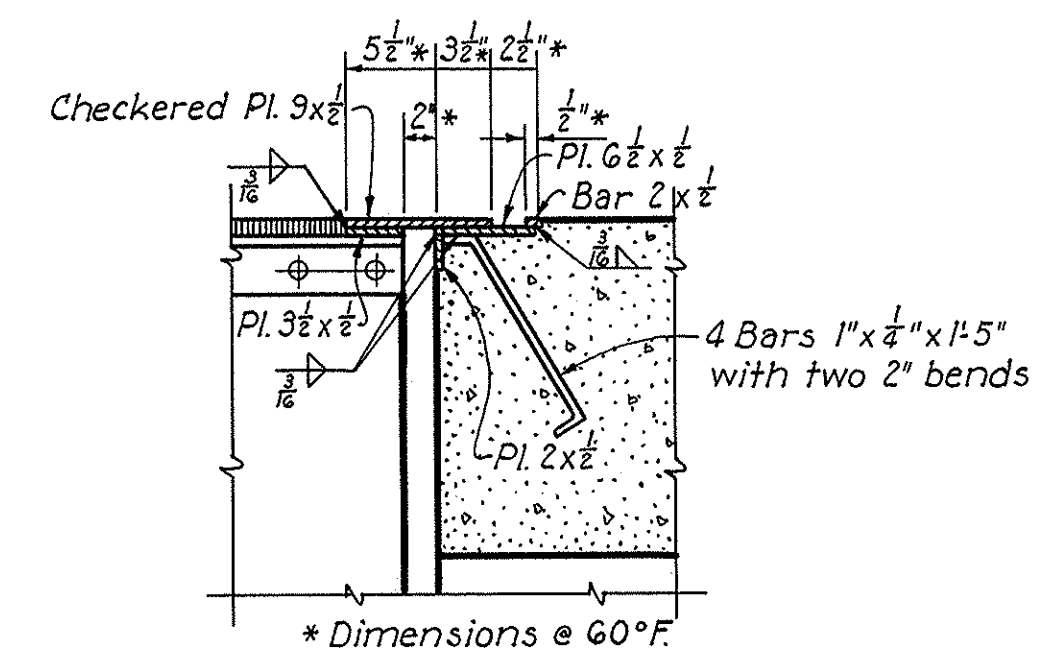

**SIDEWALK EXPANSION JOINT AT ABUTMENTS**  
Scale: 1" = 1'-0"

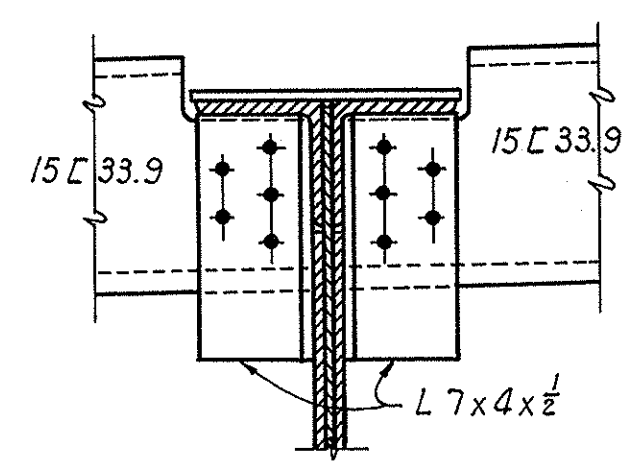


**EXPANSION JOINT SUPPORT TO GIRDER CONNECTION**  
Scale: 1" = 1'-0"






SUMMIT COUNTY  
CITY OF AKRON  
AKRON EXPRESSWAY SYSTEM  
EXPRESSWAY PART 7  
SUM-18R-12.90


Note: North curb drainage similar to South curb drainage except as shown. For details of trough see Sheet 95.

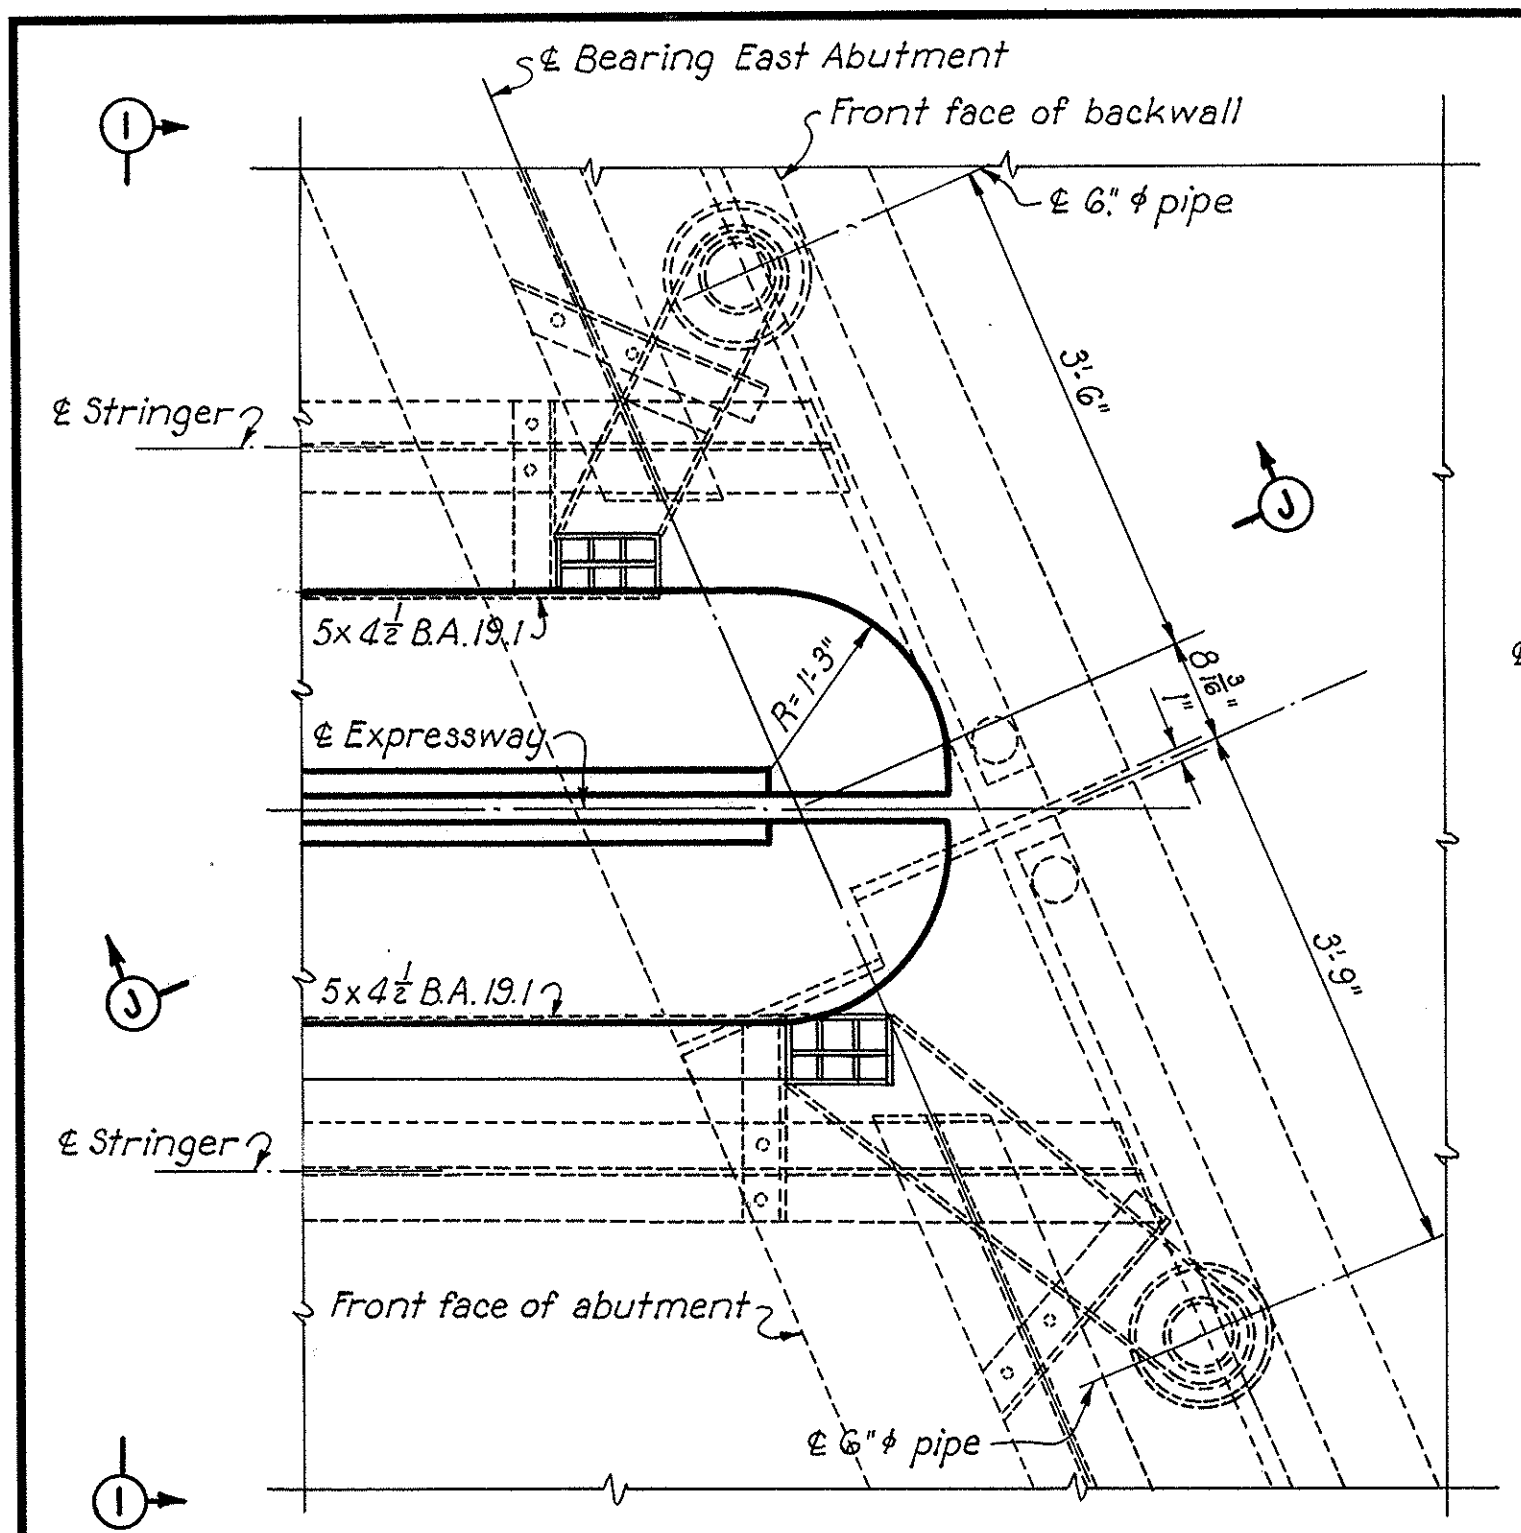


PLAN

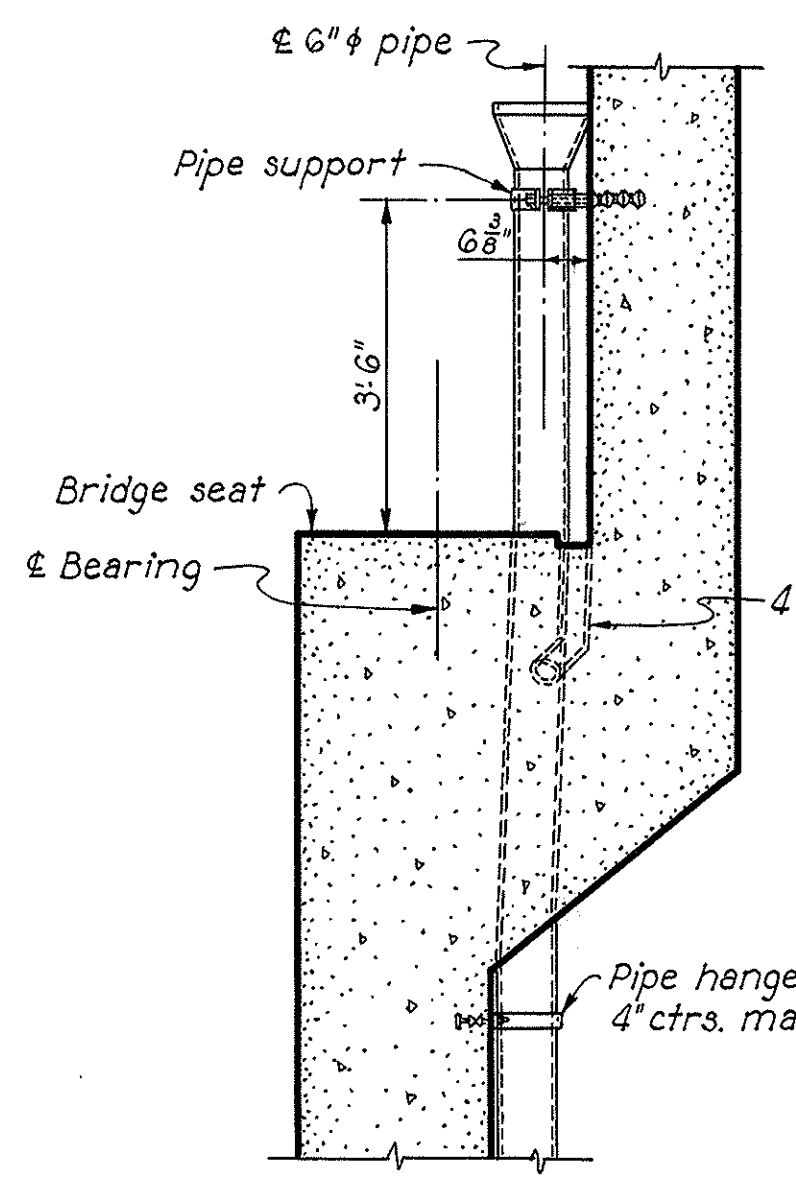

SECTION J-J

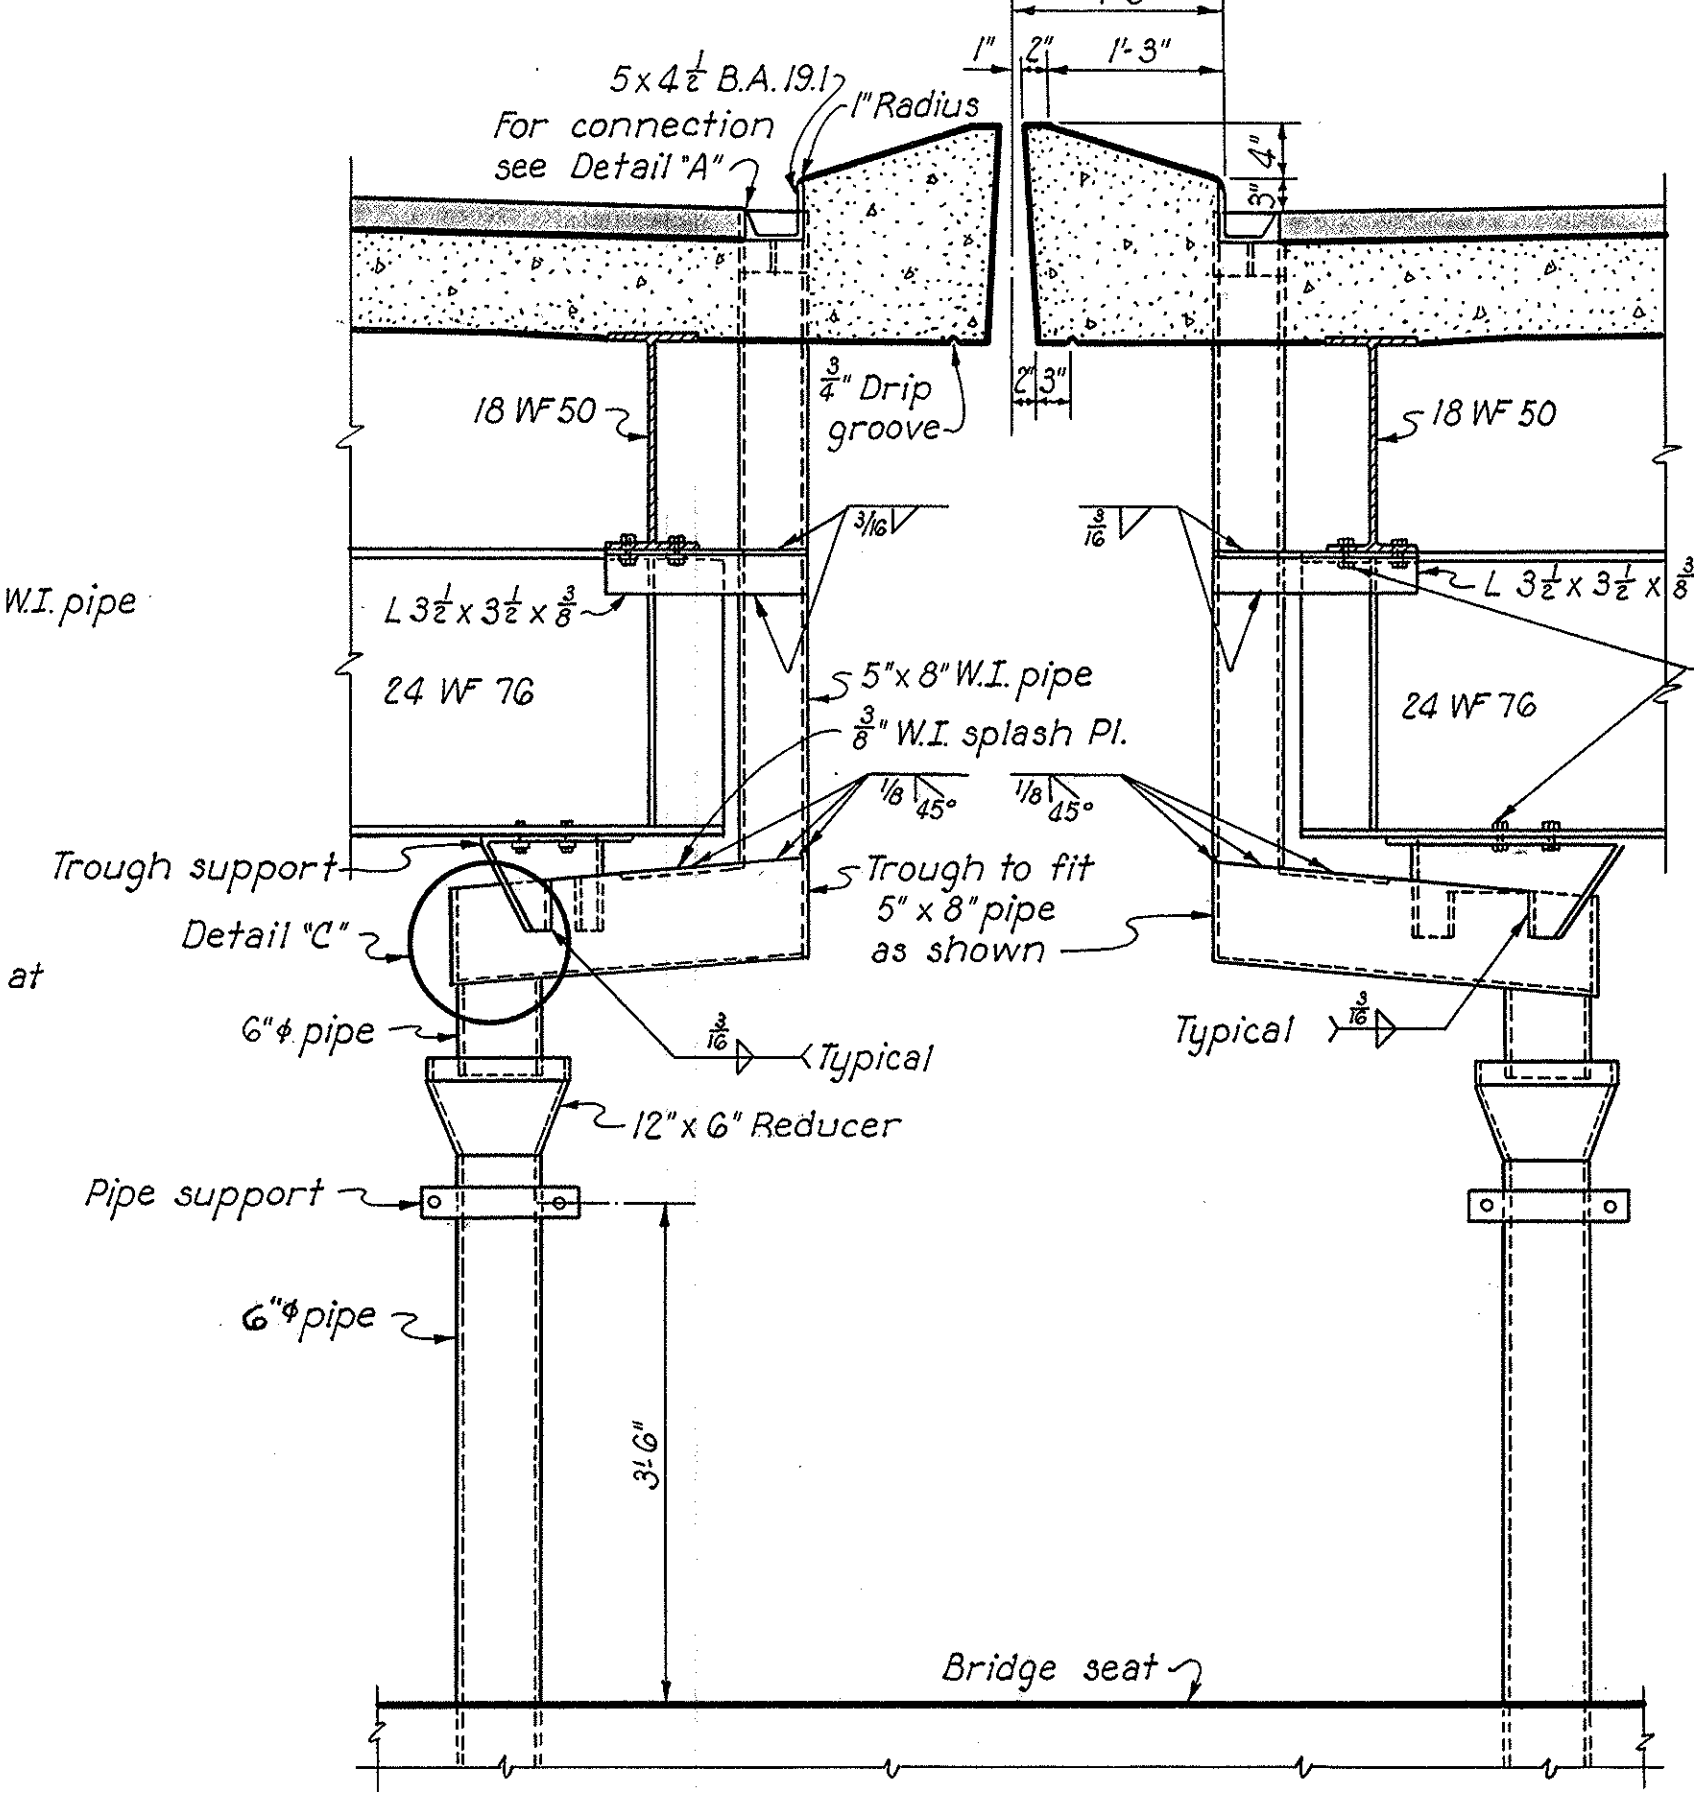


SECTION I-I

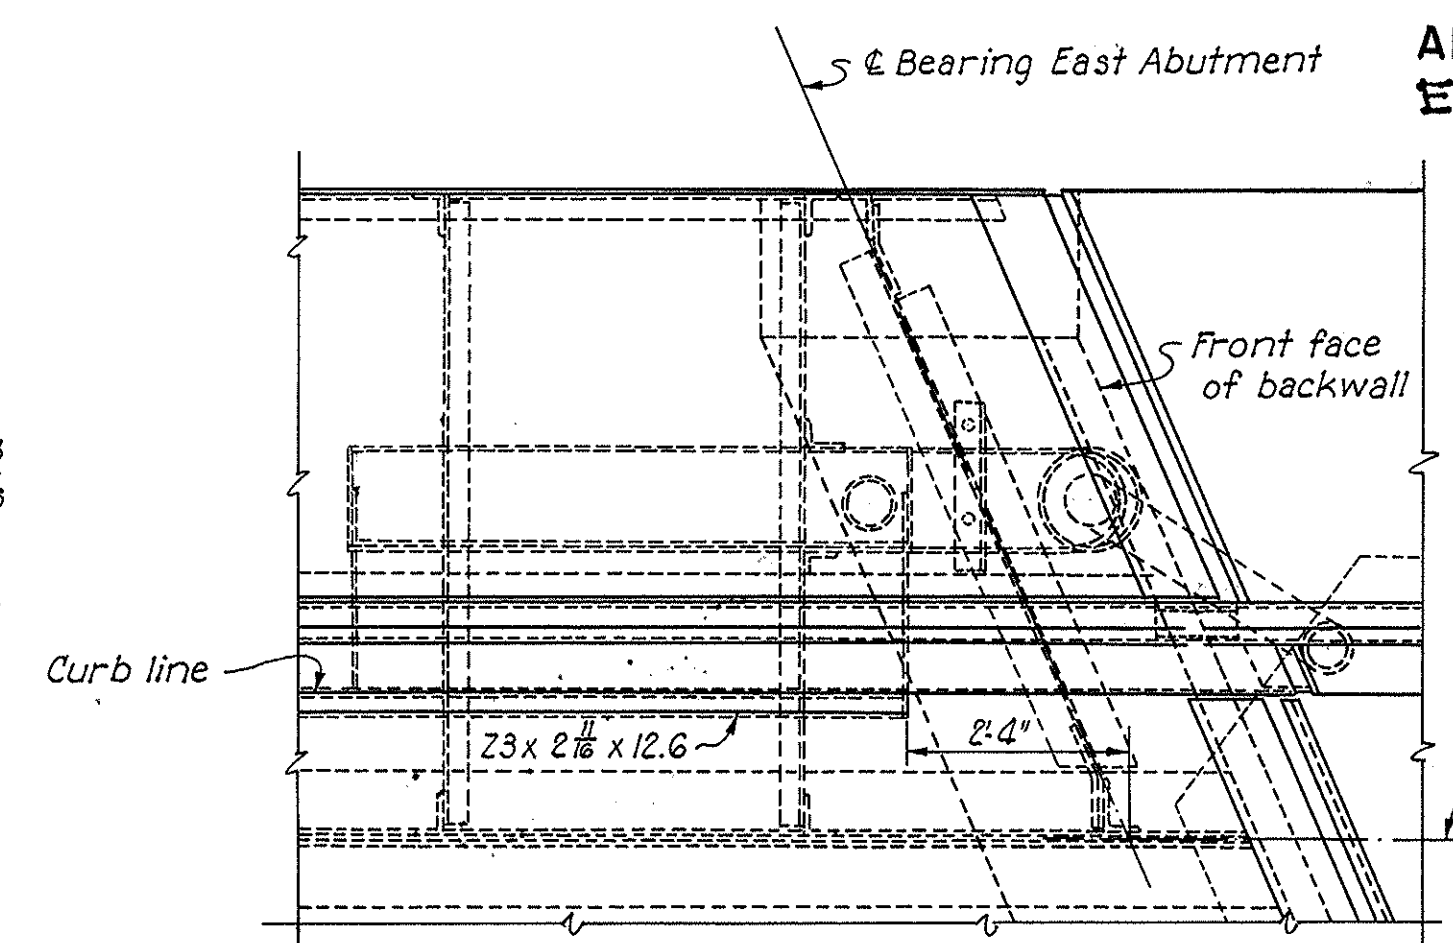

DETAILS AT NORTH CURB - EAST ABUTMENT

Scale: 1/2" = 1'-0"

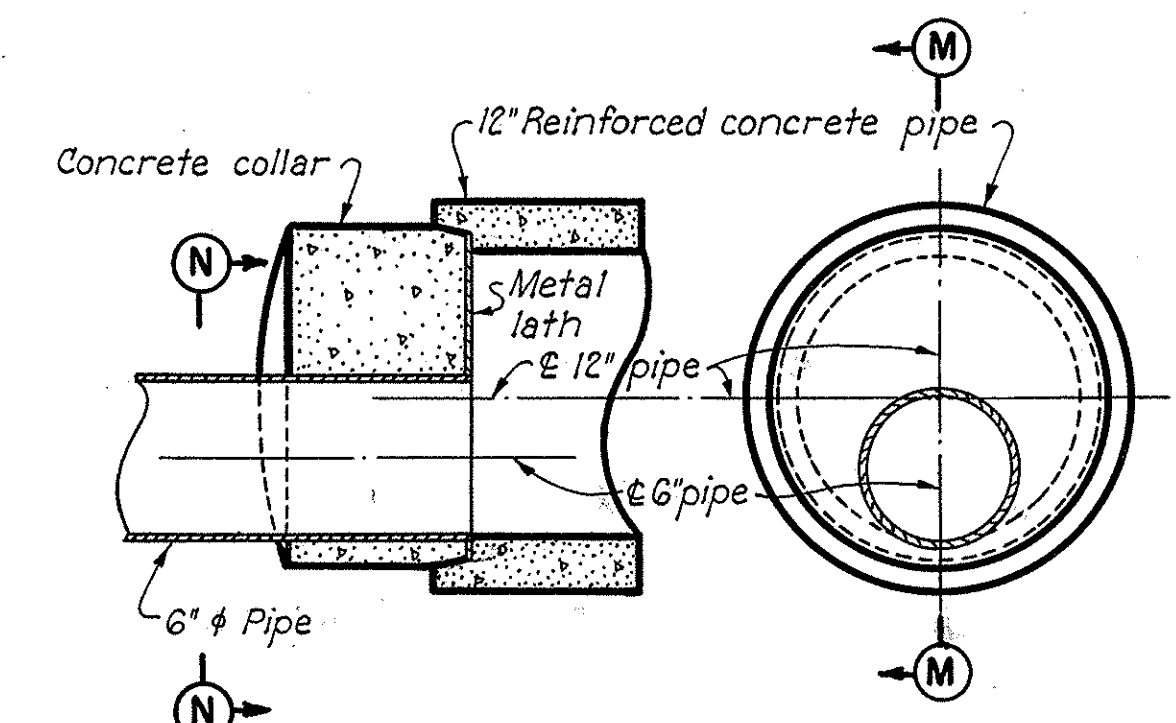


SECTION M-M

SECTION N-N

CONNECTION OF 6" W.I. PIPE TO 12" CONCRETE PIPE

Scale: 1/2" = 1'-0"

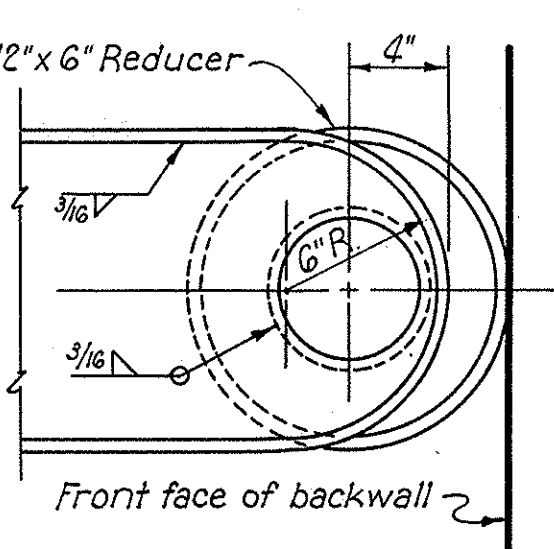


DETAIL "C"


Scale: 1/2" = 1'-0"

DRAINAGE DETAILS AT END OF MEDIAN - EAST ABUTMENT

Scale: 3/8" = 1'-0"

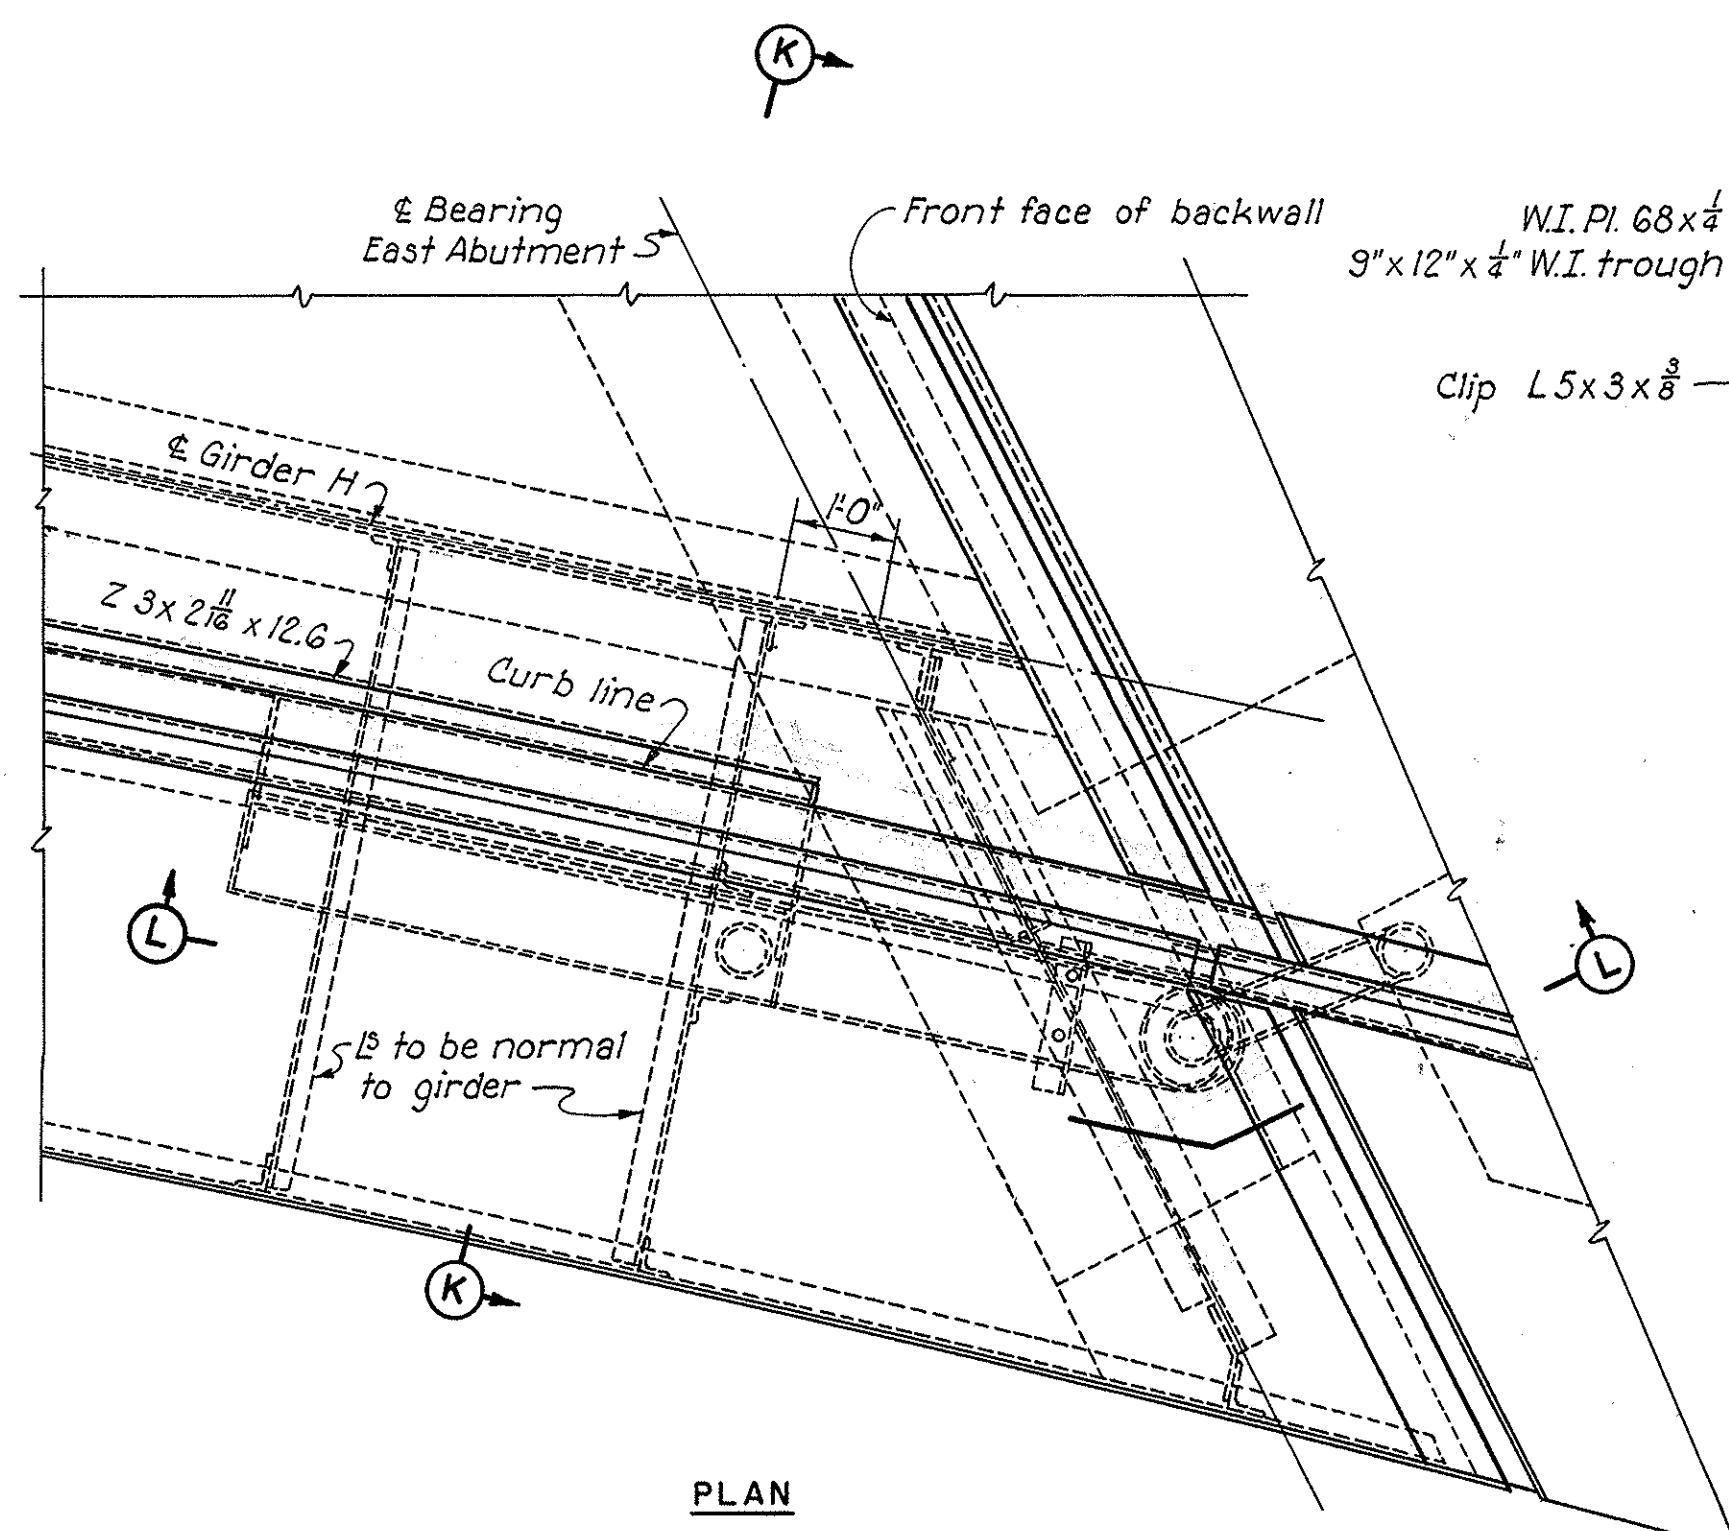


PLAN

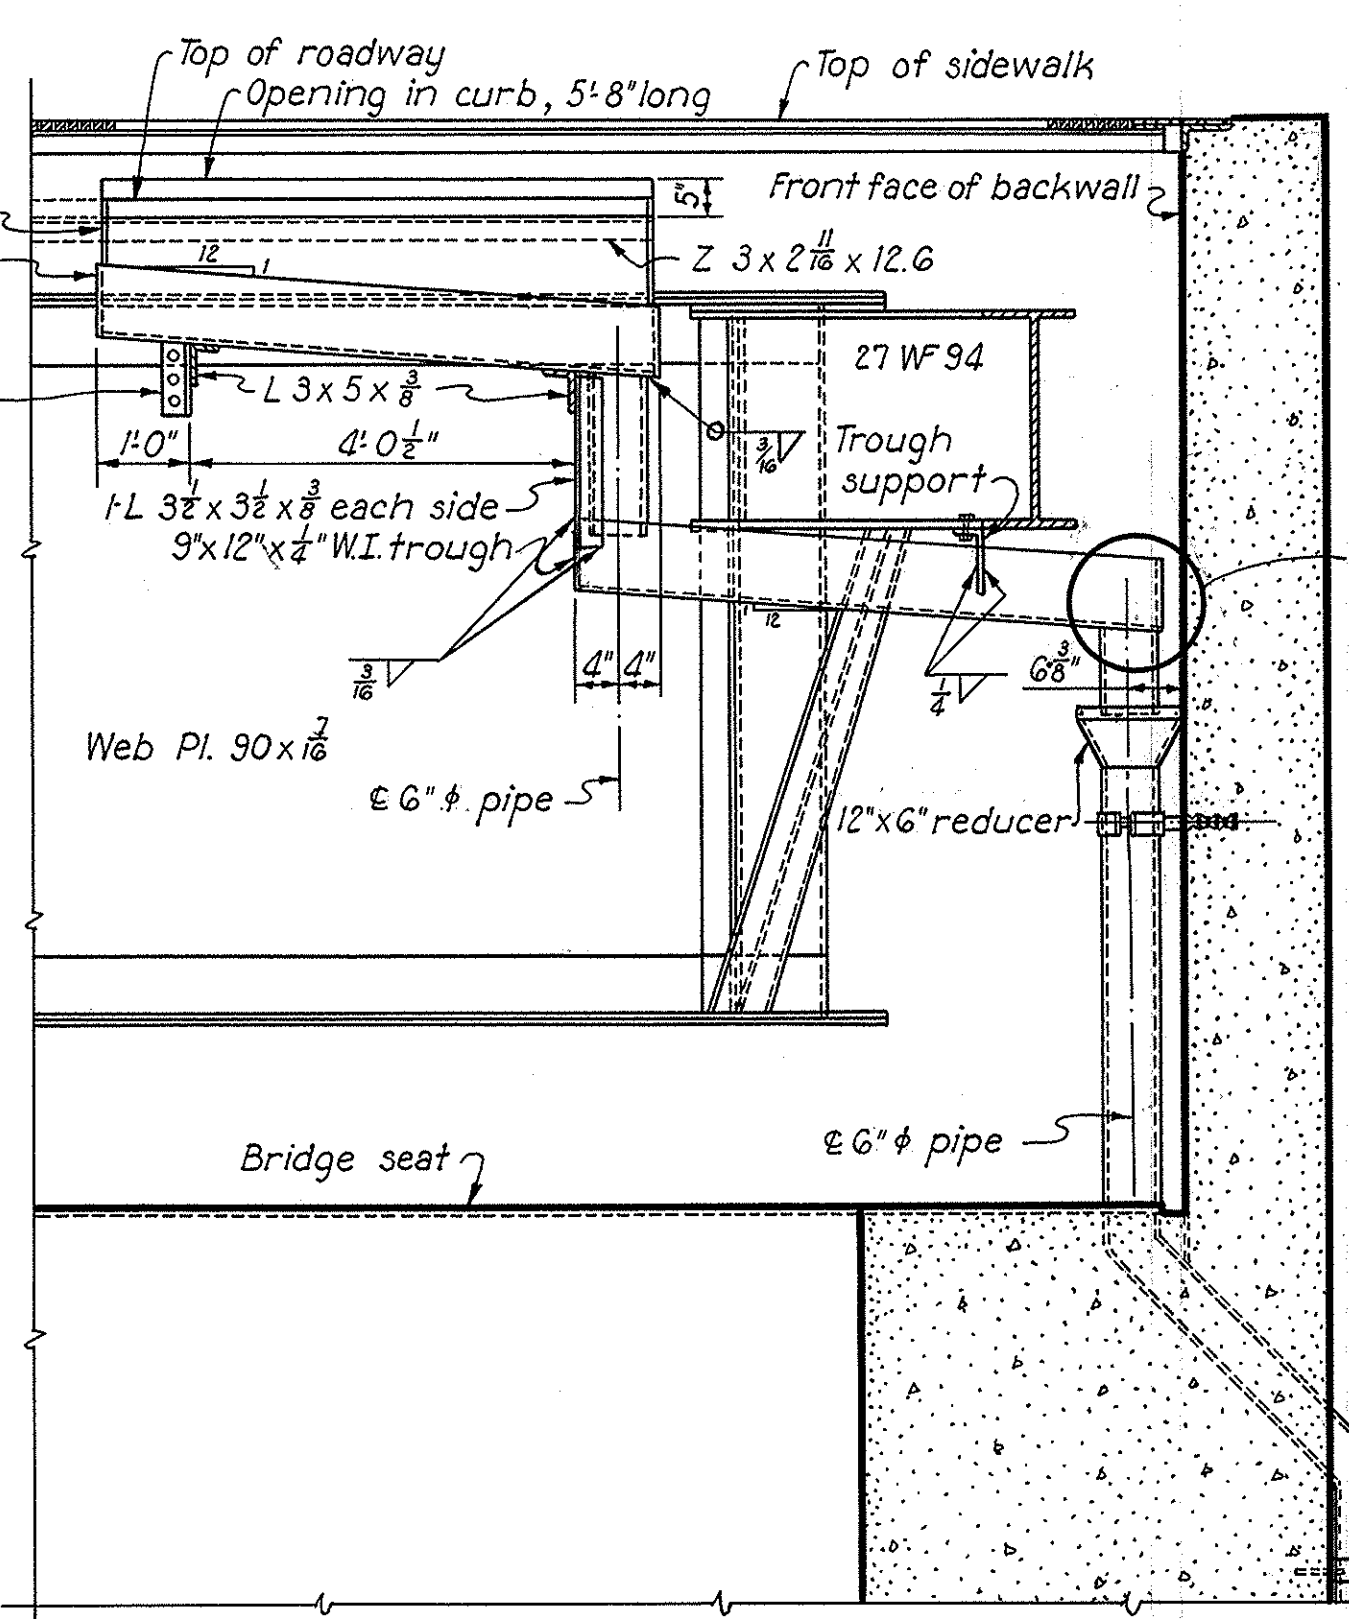


SECTION L-L

DRAINAGE DETAILS AT SOUTH CURB - EAST ABUTMENT

Scale: 1/2" = 1'-0"

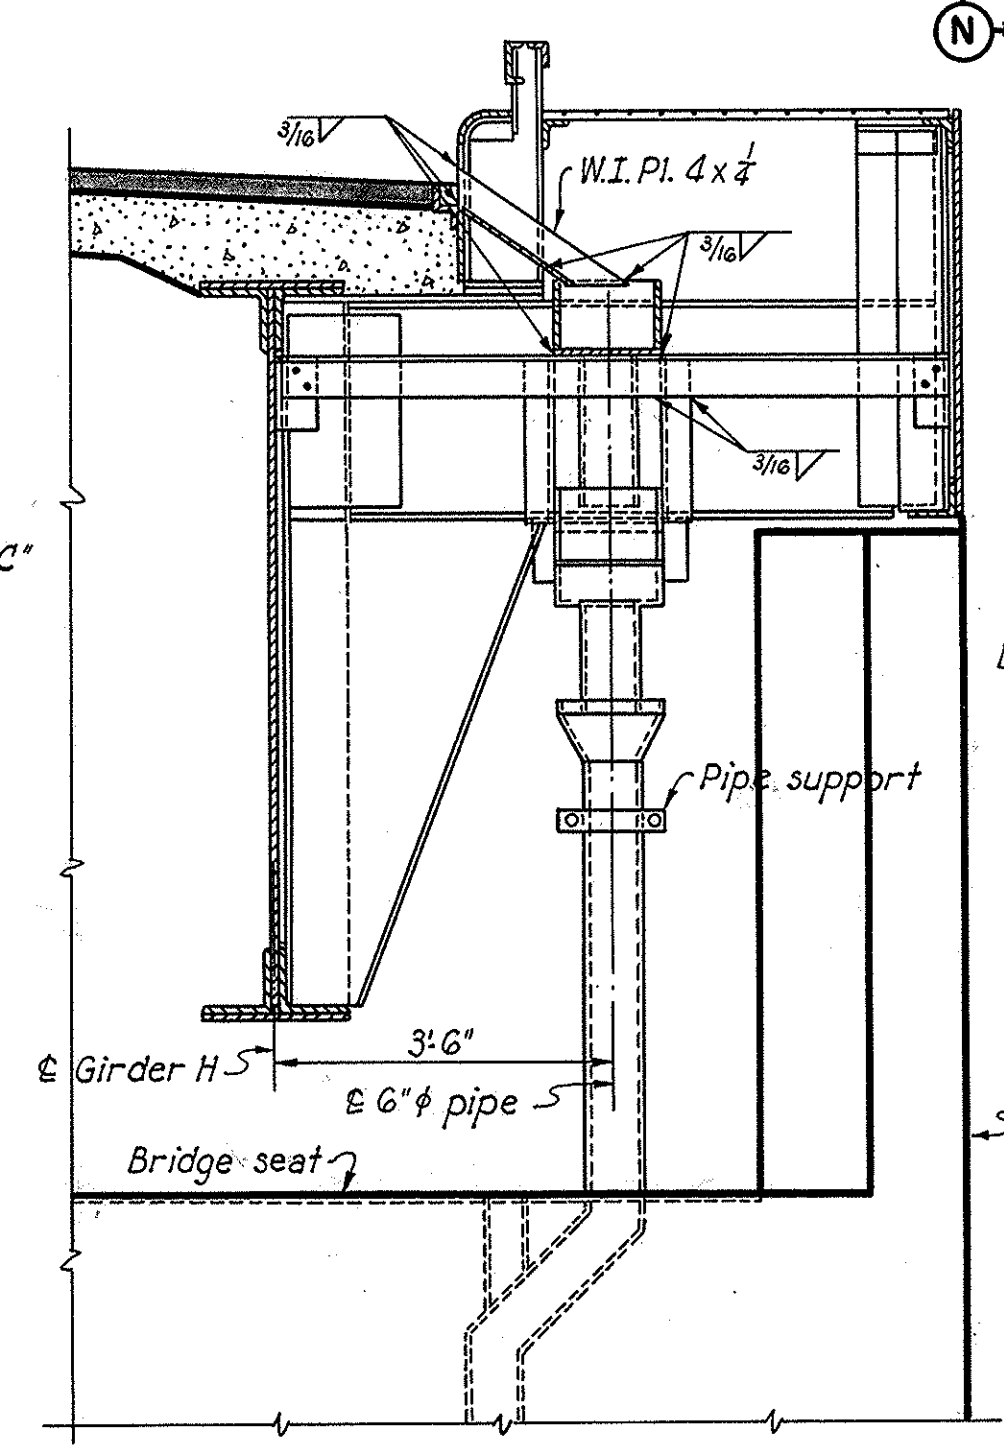


SECTION K-K

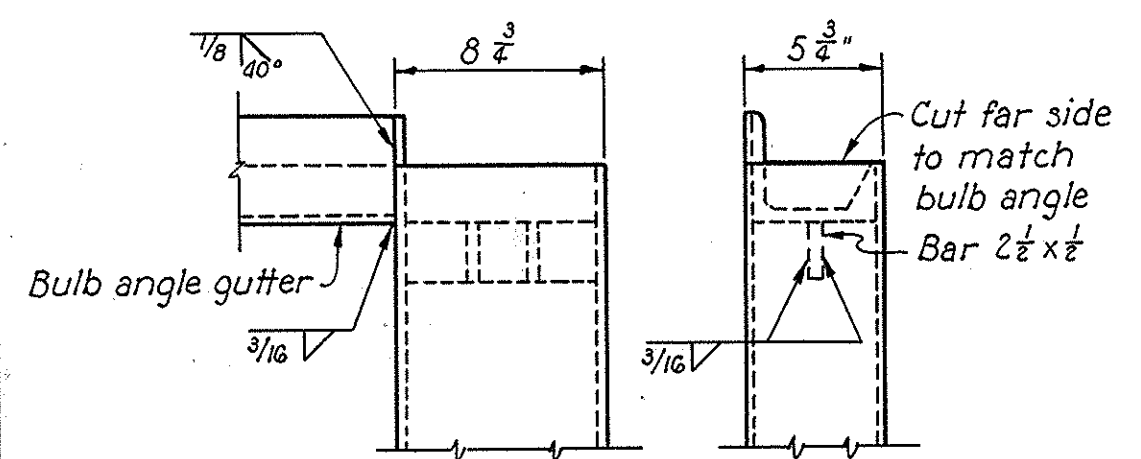

DETAIL "A"

Scale: 1/2" = 1'-0"

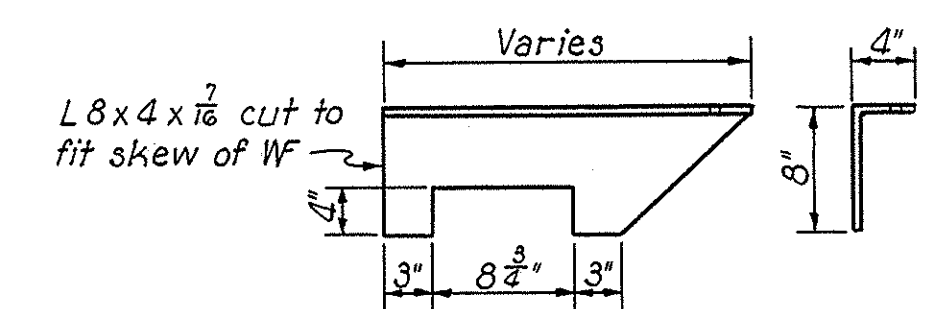

TROUGH SUPPORT

Scale: 1" = 1'-0"

Notes: For details not shown see Sheet 95. For additional notes see Sheet 95.

PART 7

AKRON EXPRESSWAY SYSTEM

WEST VIADUCT


BR. NO. SU-18R-135

DRAINAGE


AKRON SUMMIT COUNTY. OHIO

SCALE: As shown  
MADE G.D. DATE: 8-4-55  
TRCD. CAL. DATE: 10-7-55  
CRD. LWL. DATE: 9-22-55  
HOWARD, NEEDLES, TAMMEN & BERGENDOFF  
CONSULTING ENGINEERS  
KANSAS CITY CLEVELAND NEW YORK  
901 SHEET 96




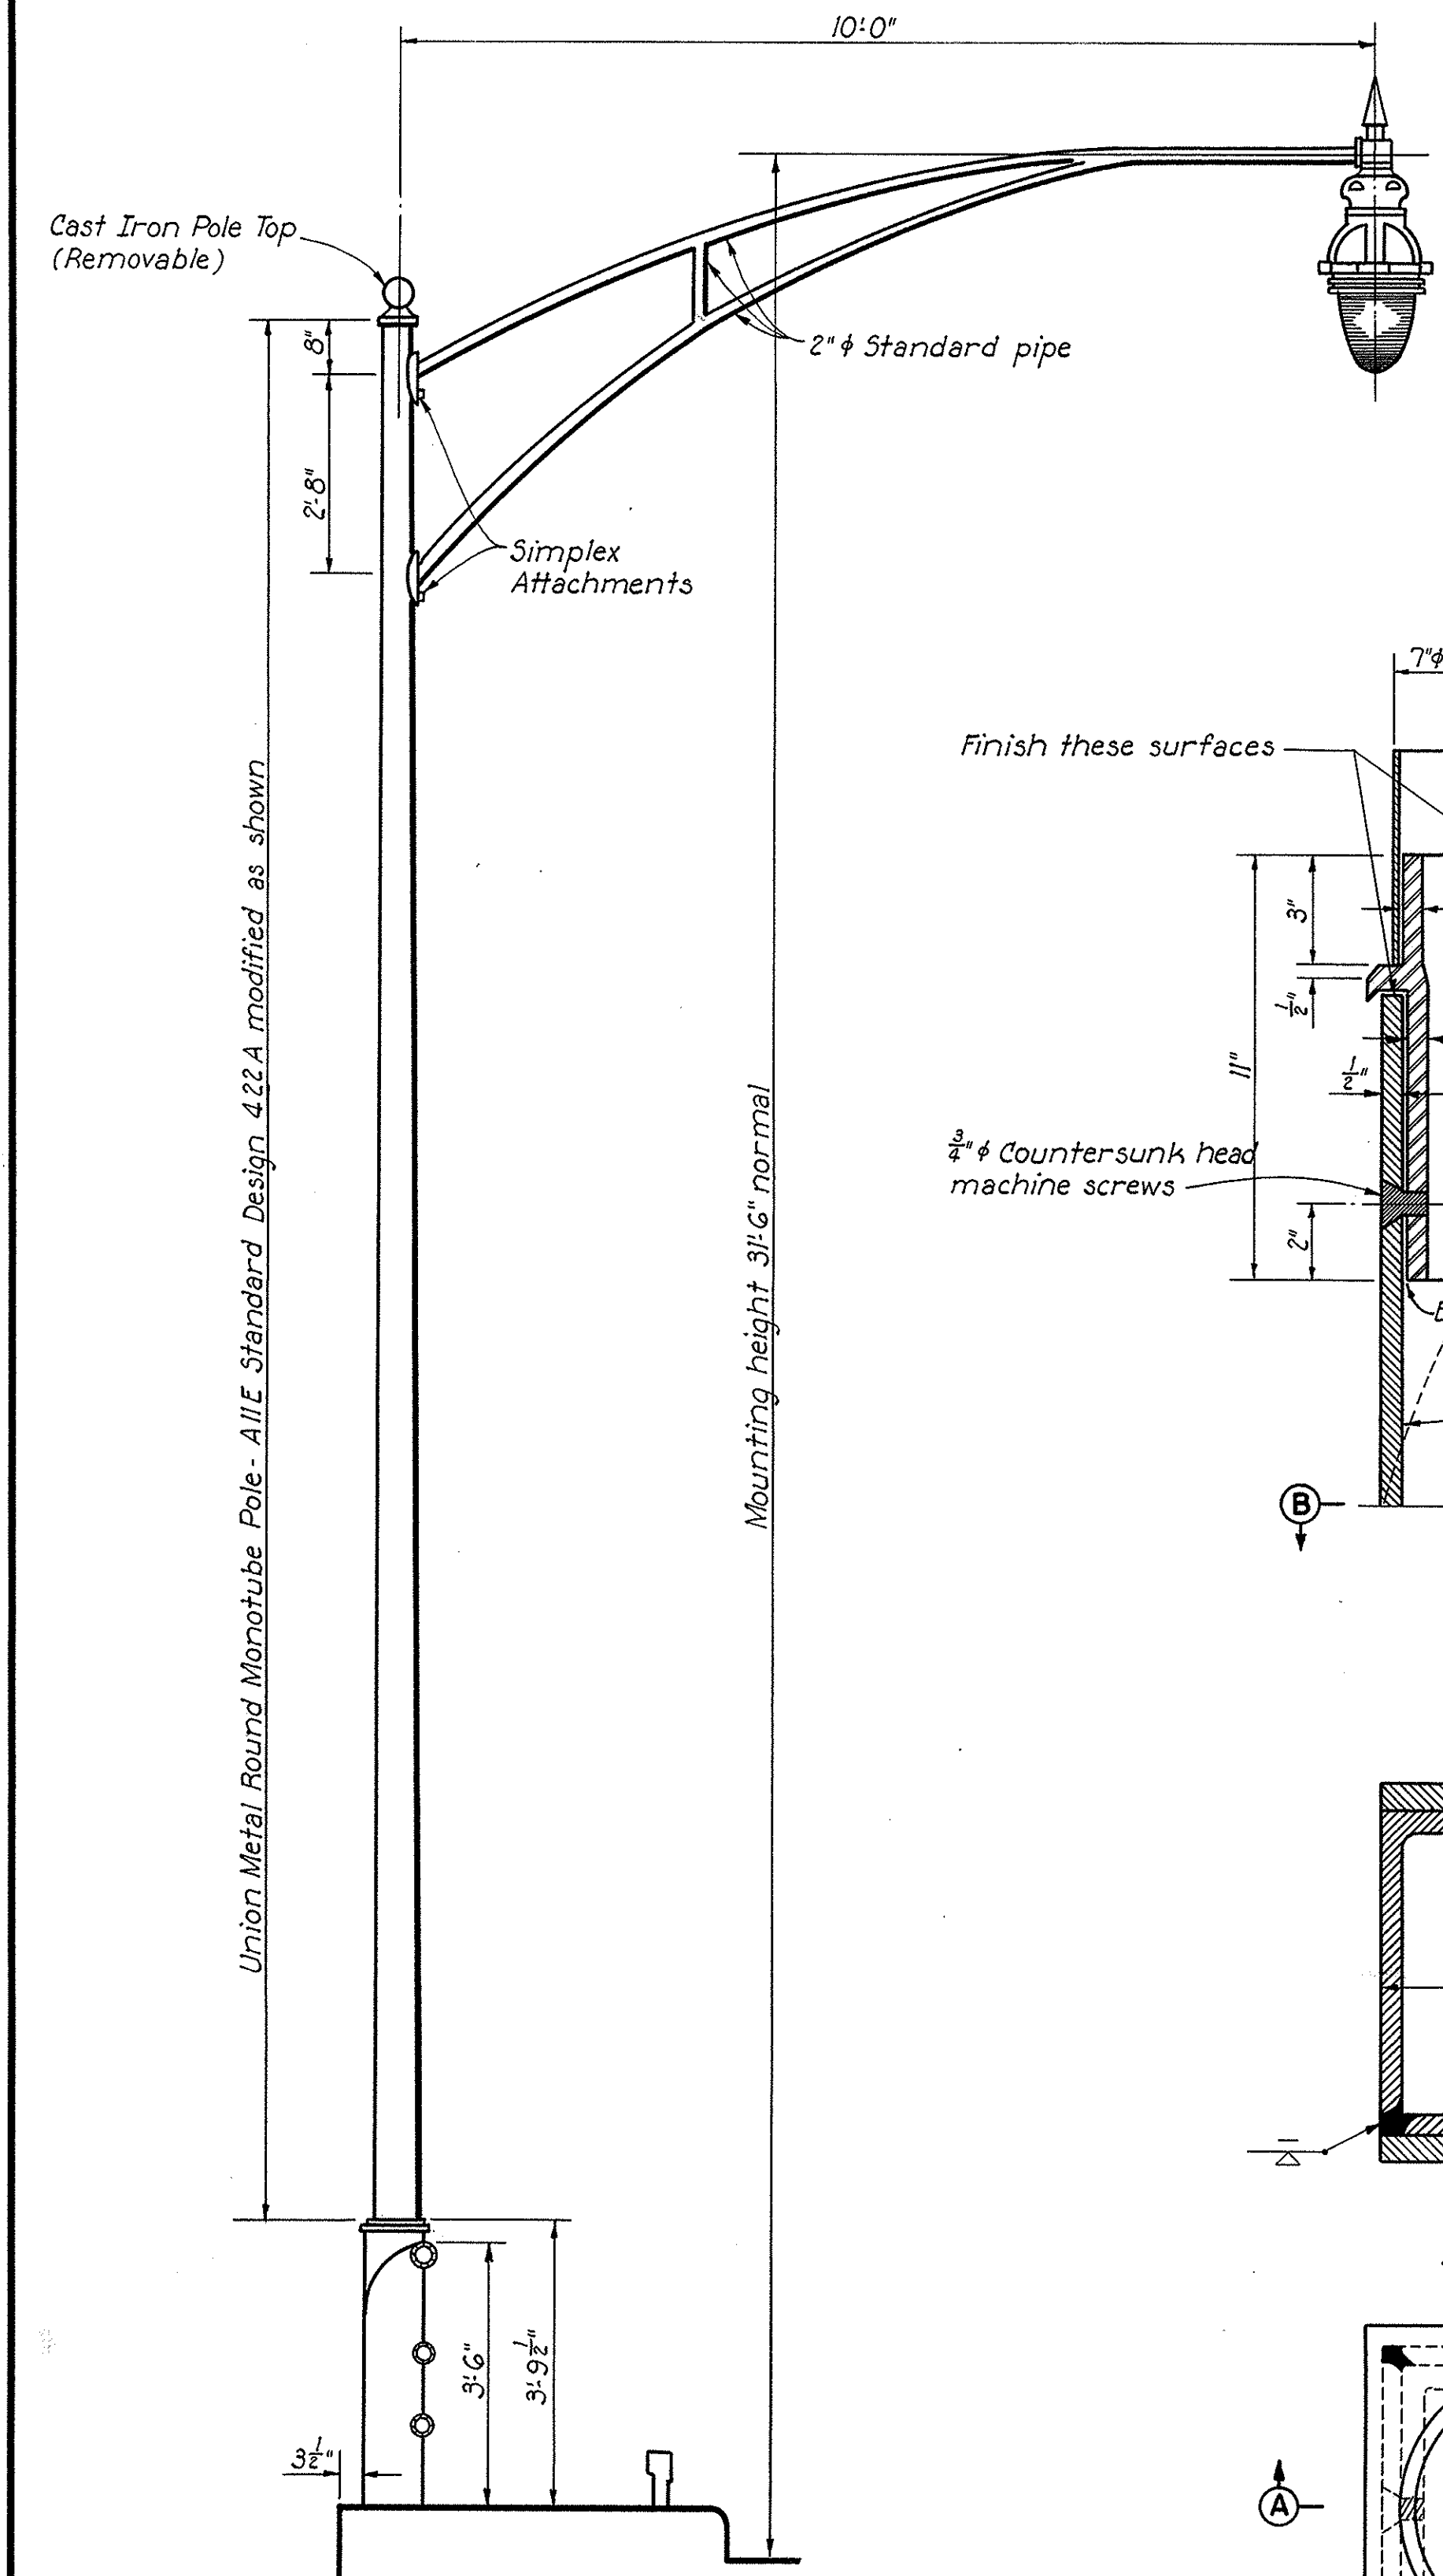


**LIGHTING STANDARD**  
Scale: 1/2" = 1'-0"  
9 Required

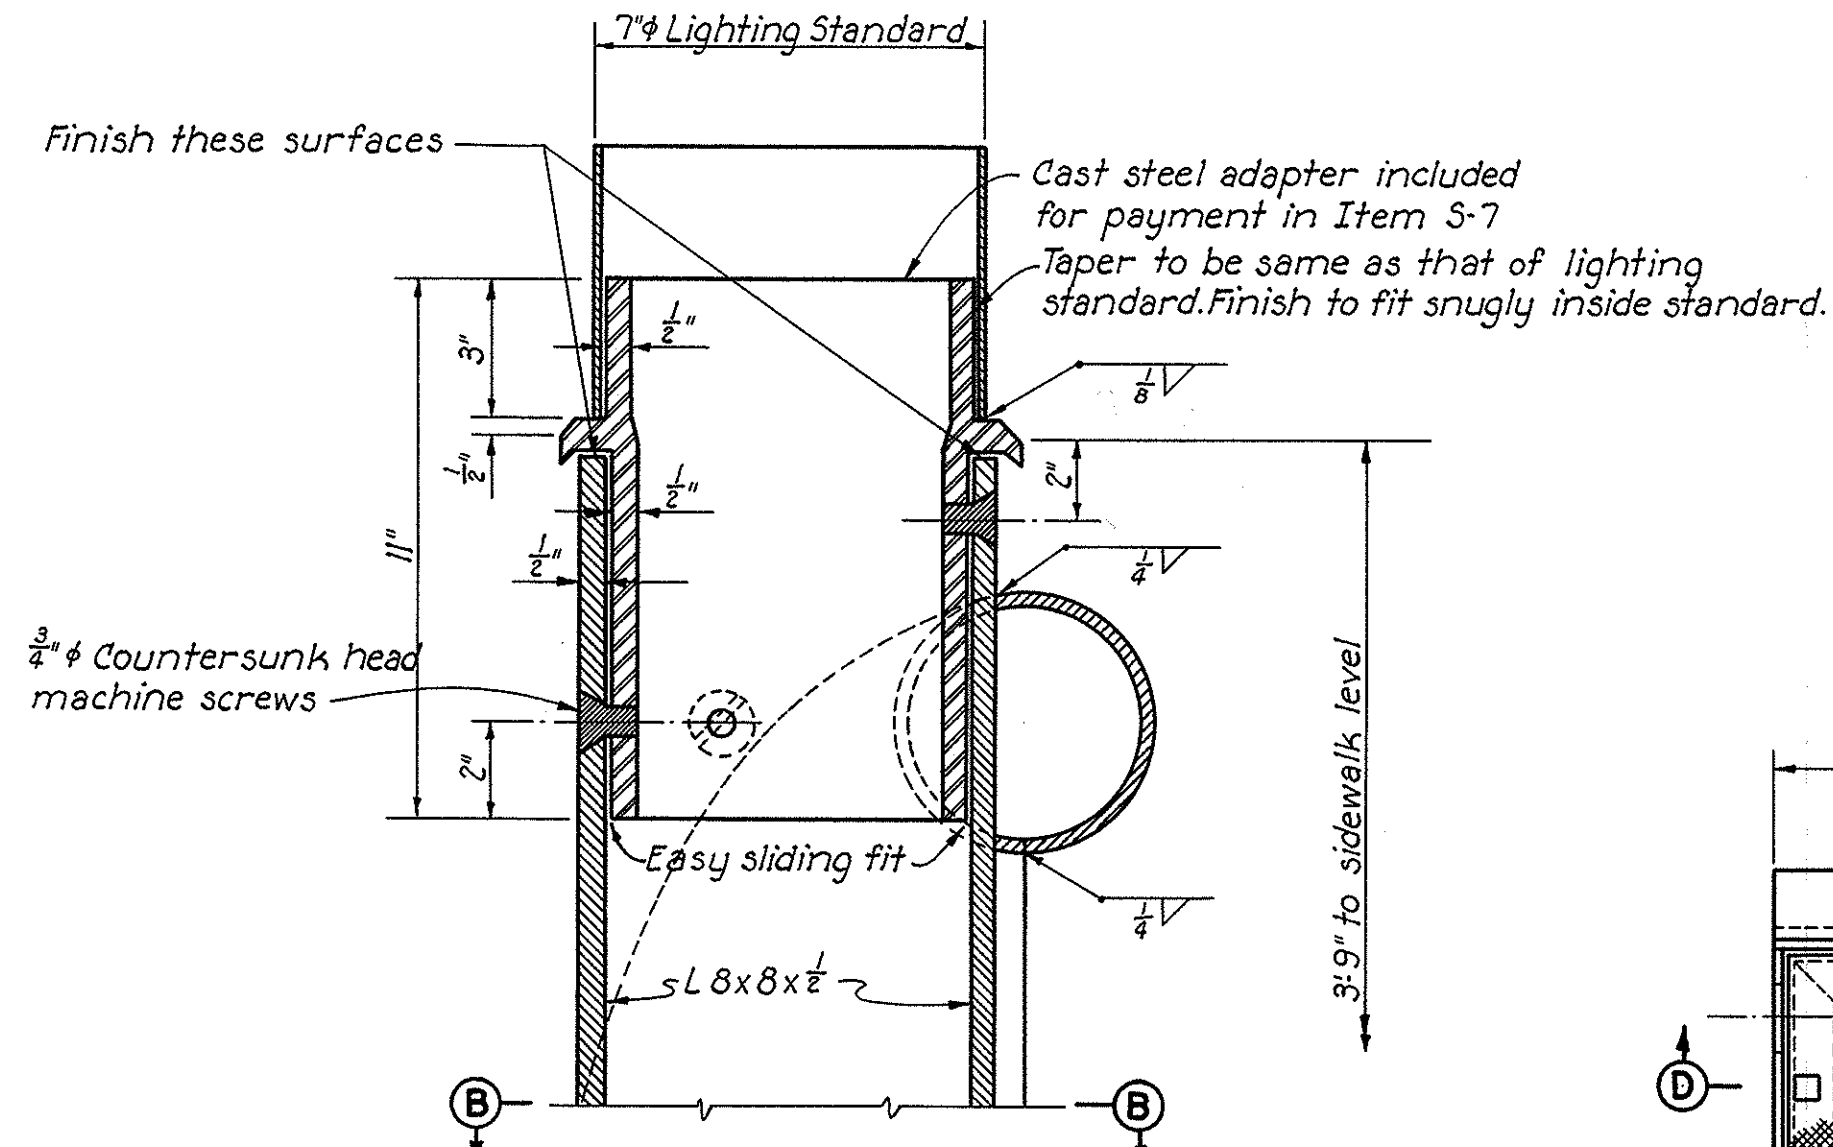

**SECTION A-A**

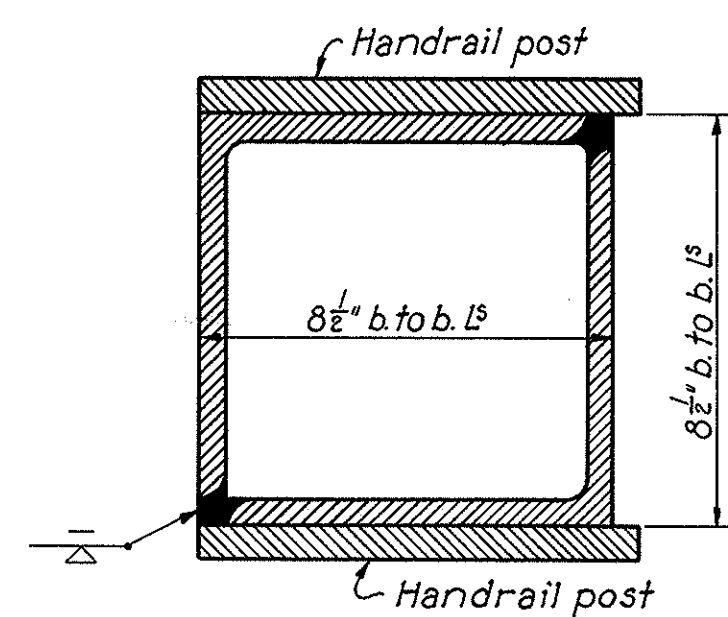


**SECTION B-B**

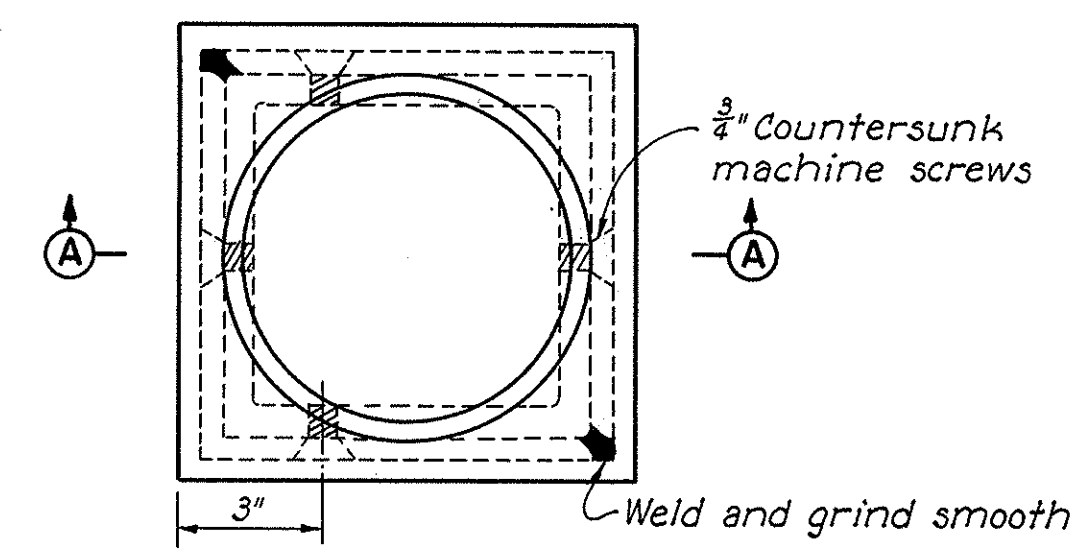


**PLAN**

**LIGHT POLE ADAPTER**  
Scale: 3/4" = 1'-0"  
9 Required


Note:  
Luminaire shall be similar to Westinghouse AK-15 or General Electric Form 101AR of Type IV distribution with 15,000 lumen 20-Amp. incandescent series street lamp.  
The cable ends of the luminaire shall be reinforced back 6 inches from the ends by wrapping glass tape and covering with clear insulating lacquer.  
The series cable shall consist of two #6 conductors equal to G.E. Coronal-Geoprene for direct burial insulated for 5Kv.

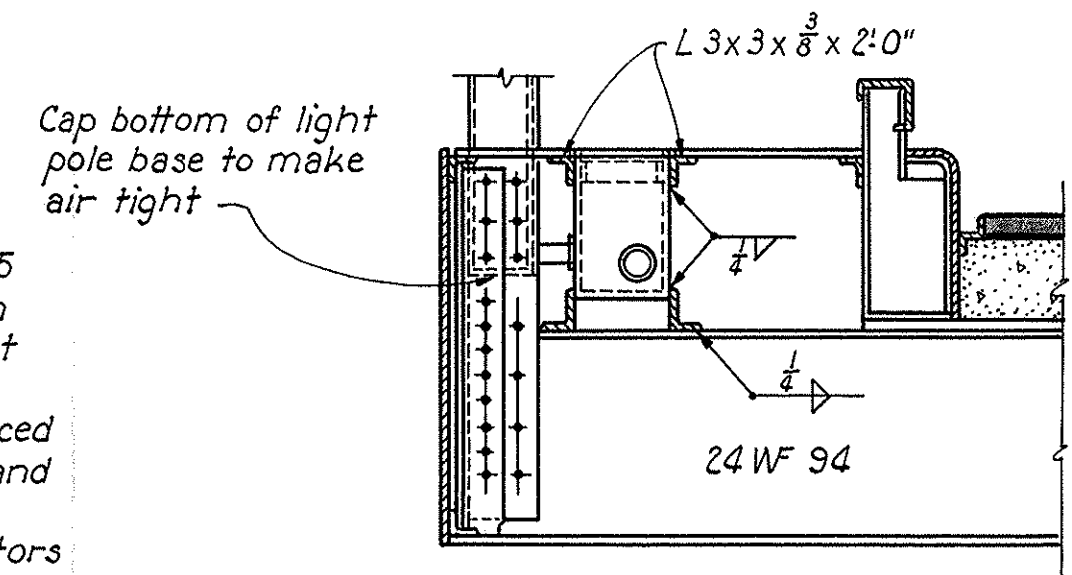


**JUNCTION BOX SUPPORTS**

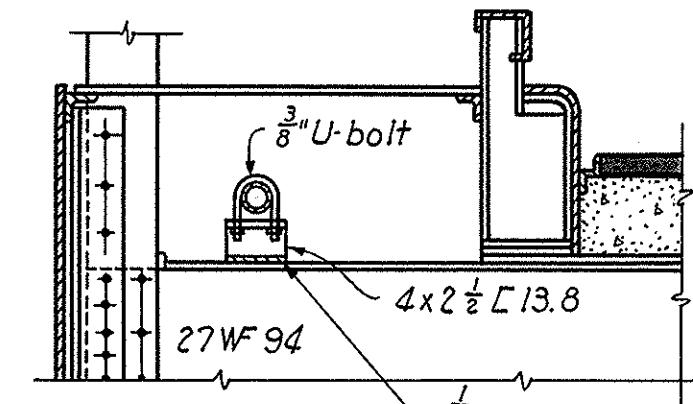


**AT FLOORBEAMS**

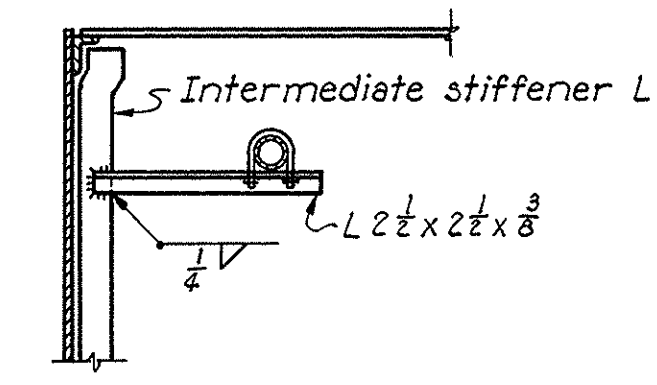


**CONDUIT SUPPORTS BETWEEN HANDRAIL POSTS**

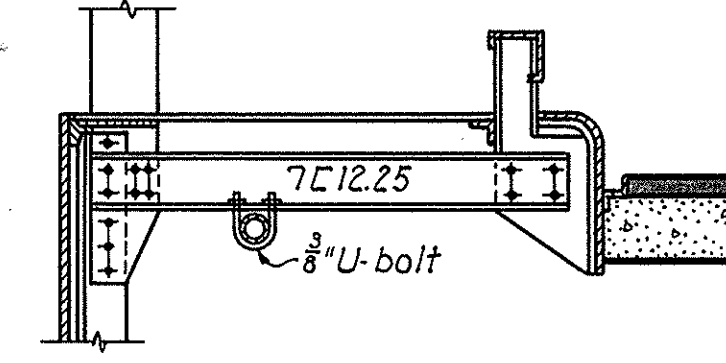

**CONDUIT SUPPORTS BETWEEN FLOORBEAMS**

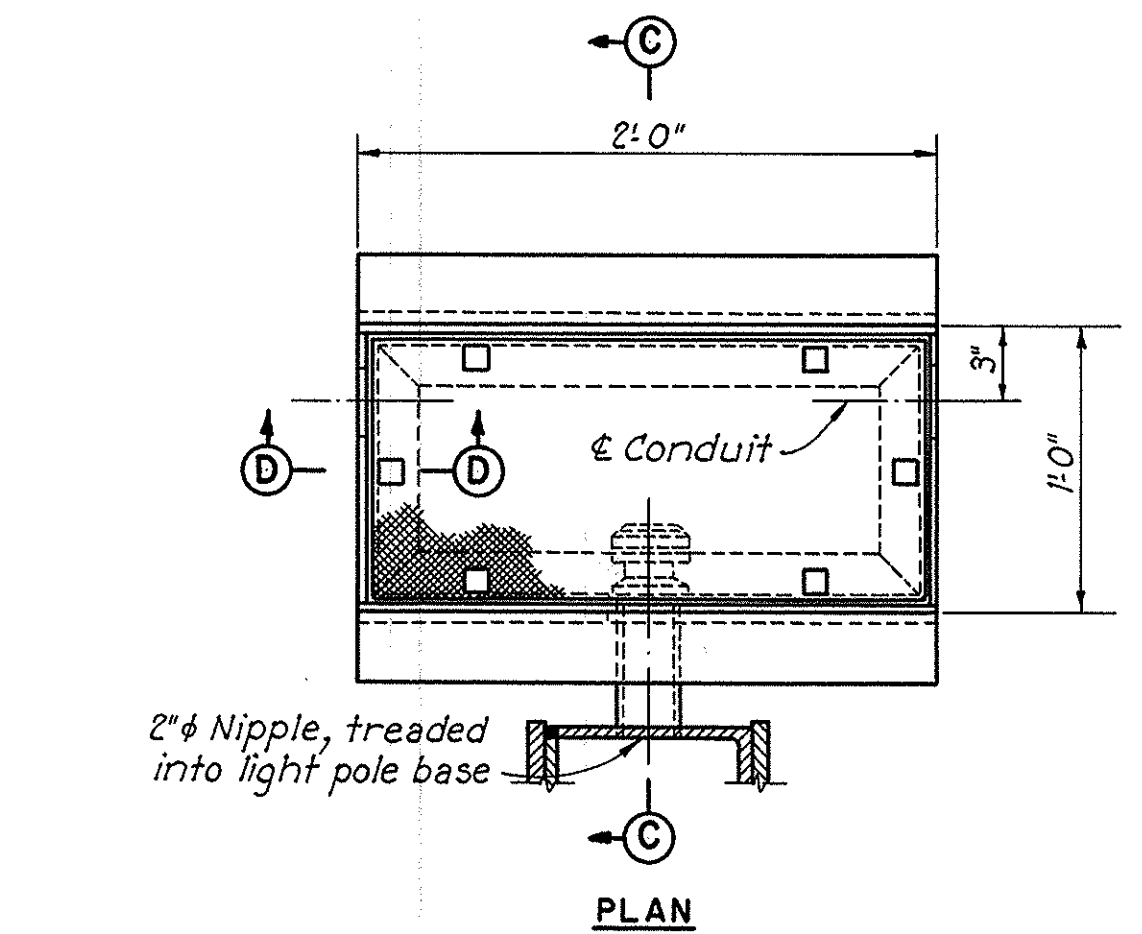


**PLAN**

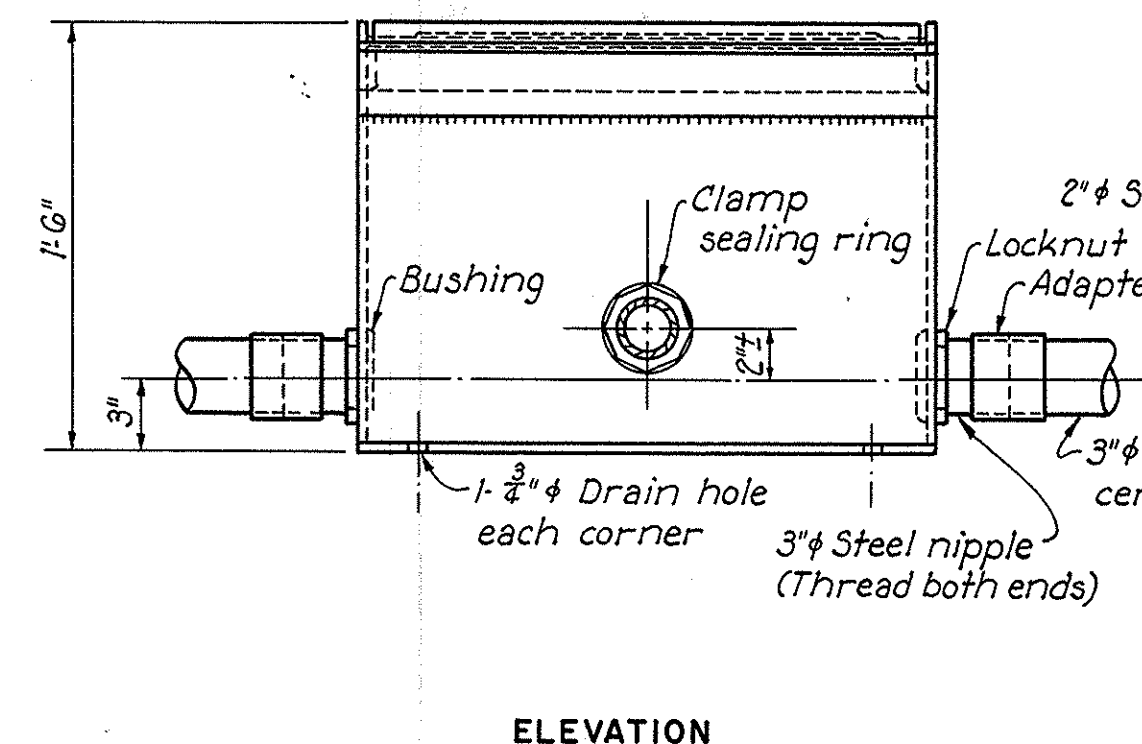


**ELEVATION**

**JUNCTION BOX DETAILS**  
Scale: 1/2" = 1'-0"  
9 Required

**CONDUIT SUPPORTS**  
Scale: 1/2" = 1'-0"

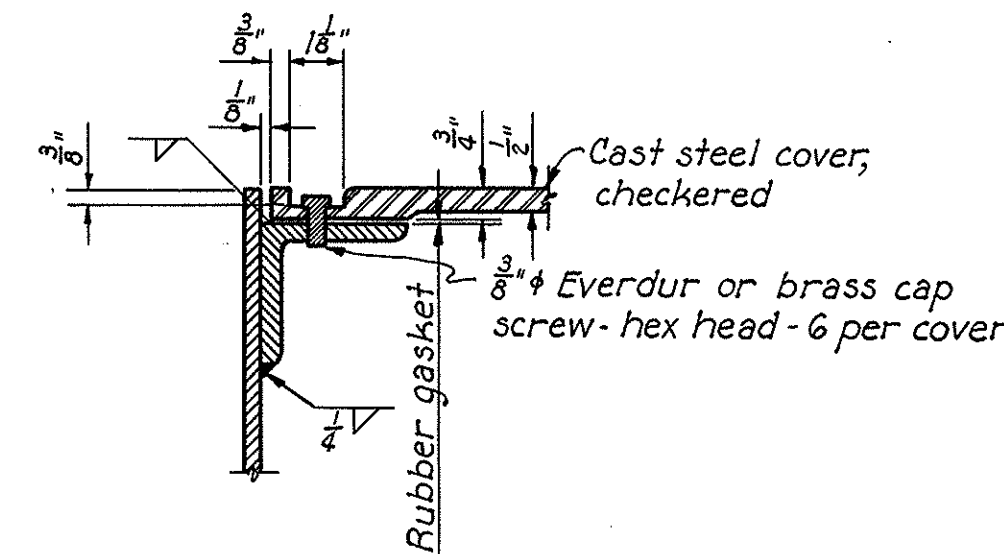

**SECTION D-D**  
Scale: 3/4" = 1'-0"

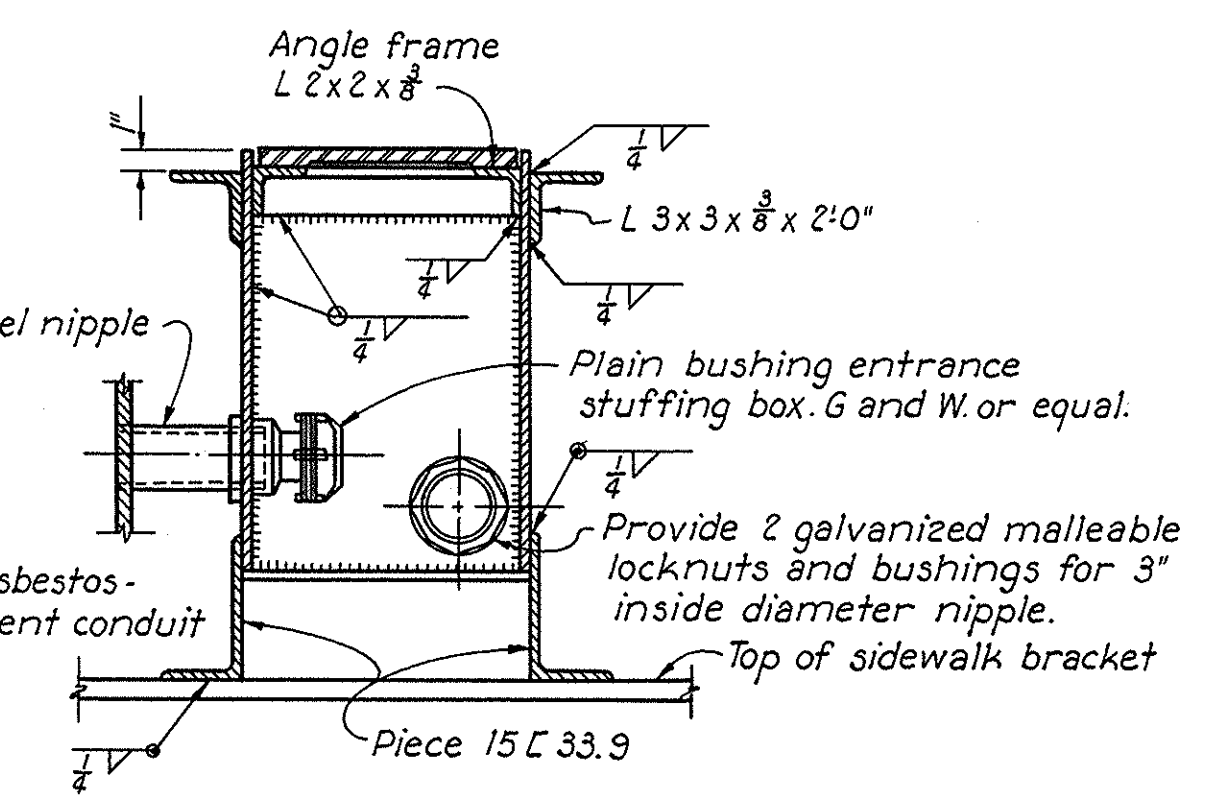

**SECTION C-C**

Notes:  
The alignment of the asbestos-cement conduit shall change gradually from the last junction boxes at each end of the superstructure to match the 3" rigid conduit on the abutments.  
Junction boxes shall be galvanized.  
One junction box shall be used for each light pole.  
For location of light poles on viaduct see framing plan, Sheet 86.  
Conduit shall be supported at each sidewalk support and midway between.  
Conduit expansion couplings shall be located not more than 40' ft apart.  
For details of light pole support see Sheet 97.  
At roadway expansion joints provide expansion couplings in conduit which will allow 5 inches of total movement.  
The lighting standards shall be made air-tight between junction box and luminaire. Finial cap, bracket attachments, base, etc., shall be provided with a gasket or otherwise sealed.  
Bridge Item 3-25, Electrical Equipment, shall include the asbestos-cement conduit on both sides of the viaduct between abutments, complete with expansion joints, supports and connections to boxes, all junction boxes and fittings, stuffing box and other items necessary to complete the system exclusive only of the poles, luminaire brackets, luminaires, lamps and wiring.

PART 7

**AKRON EXPRESSWAY SYSTEM**

WEST VIADUCT  
BR. NO. SU-18R-135

**LIGHTING DETAILS**

AKRON SUMMIT COUNTY. OHIO


SCALE as shown  
MADE D.T.H. DATE 9-10-55  
TRCD CAL DATE 11-18-55  
CKD B.S.S. DATE 9-29-55

HOWARD, NEEDLES, TAMMEN & BERGENOFF  
CONSULTING ENGINEERS  
KANSAS CITY CLEVELAND NEW YORK  
901 SHEET 98

FED. ROAD DIV. NO.	STATE	FED. AID PROJ. NO.	TYPE FUNDS
2	OHIO		

99  
123

SUMMIT COUNTY  
CITY OF AKRON  
AKRON EXPRESSWAY SYSTEM

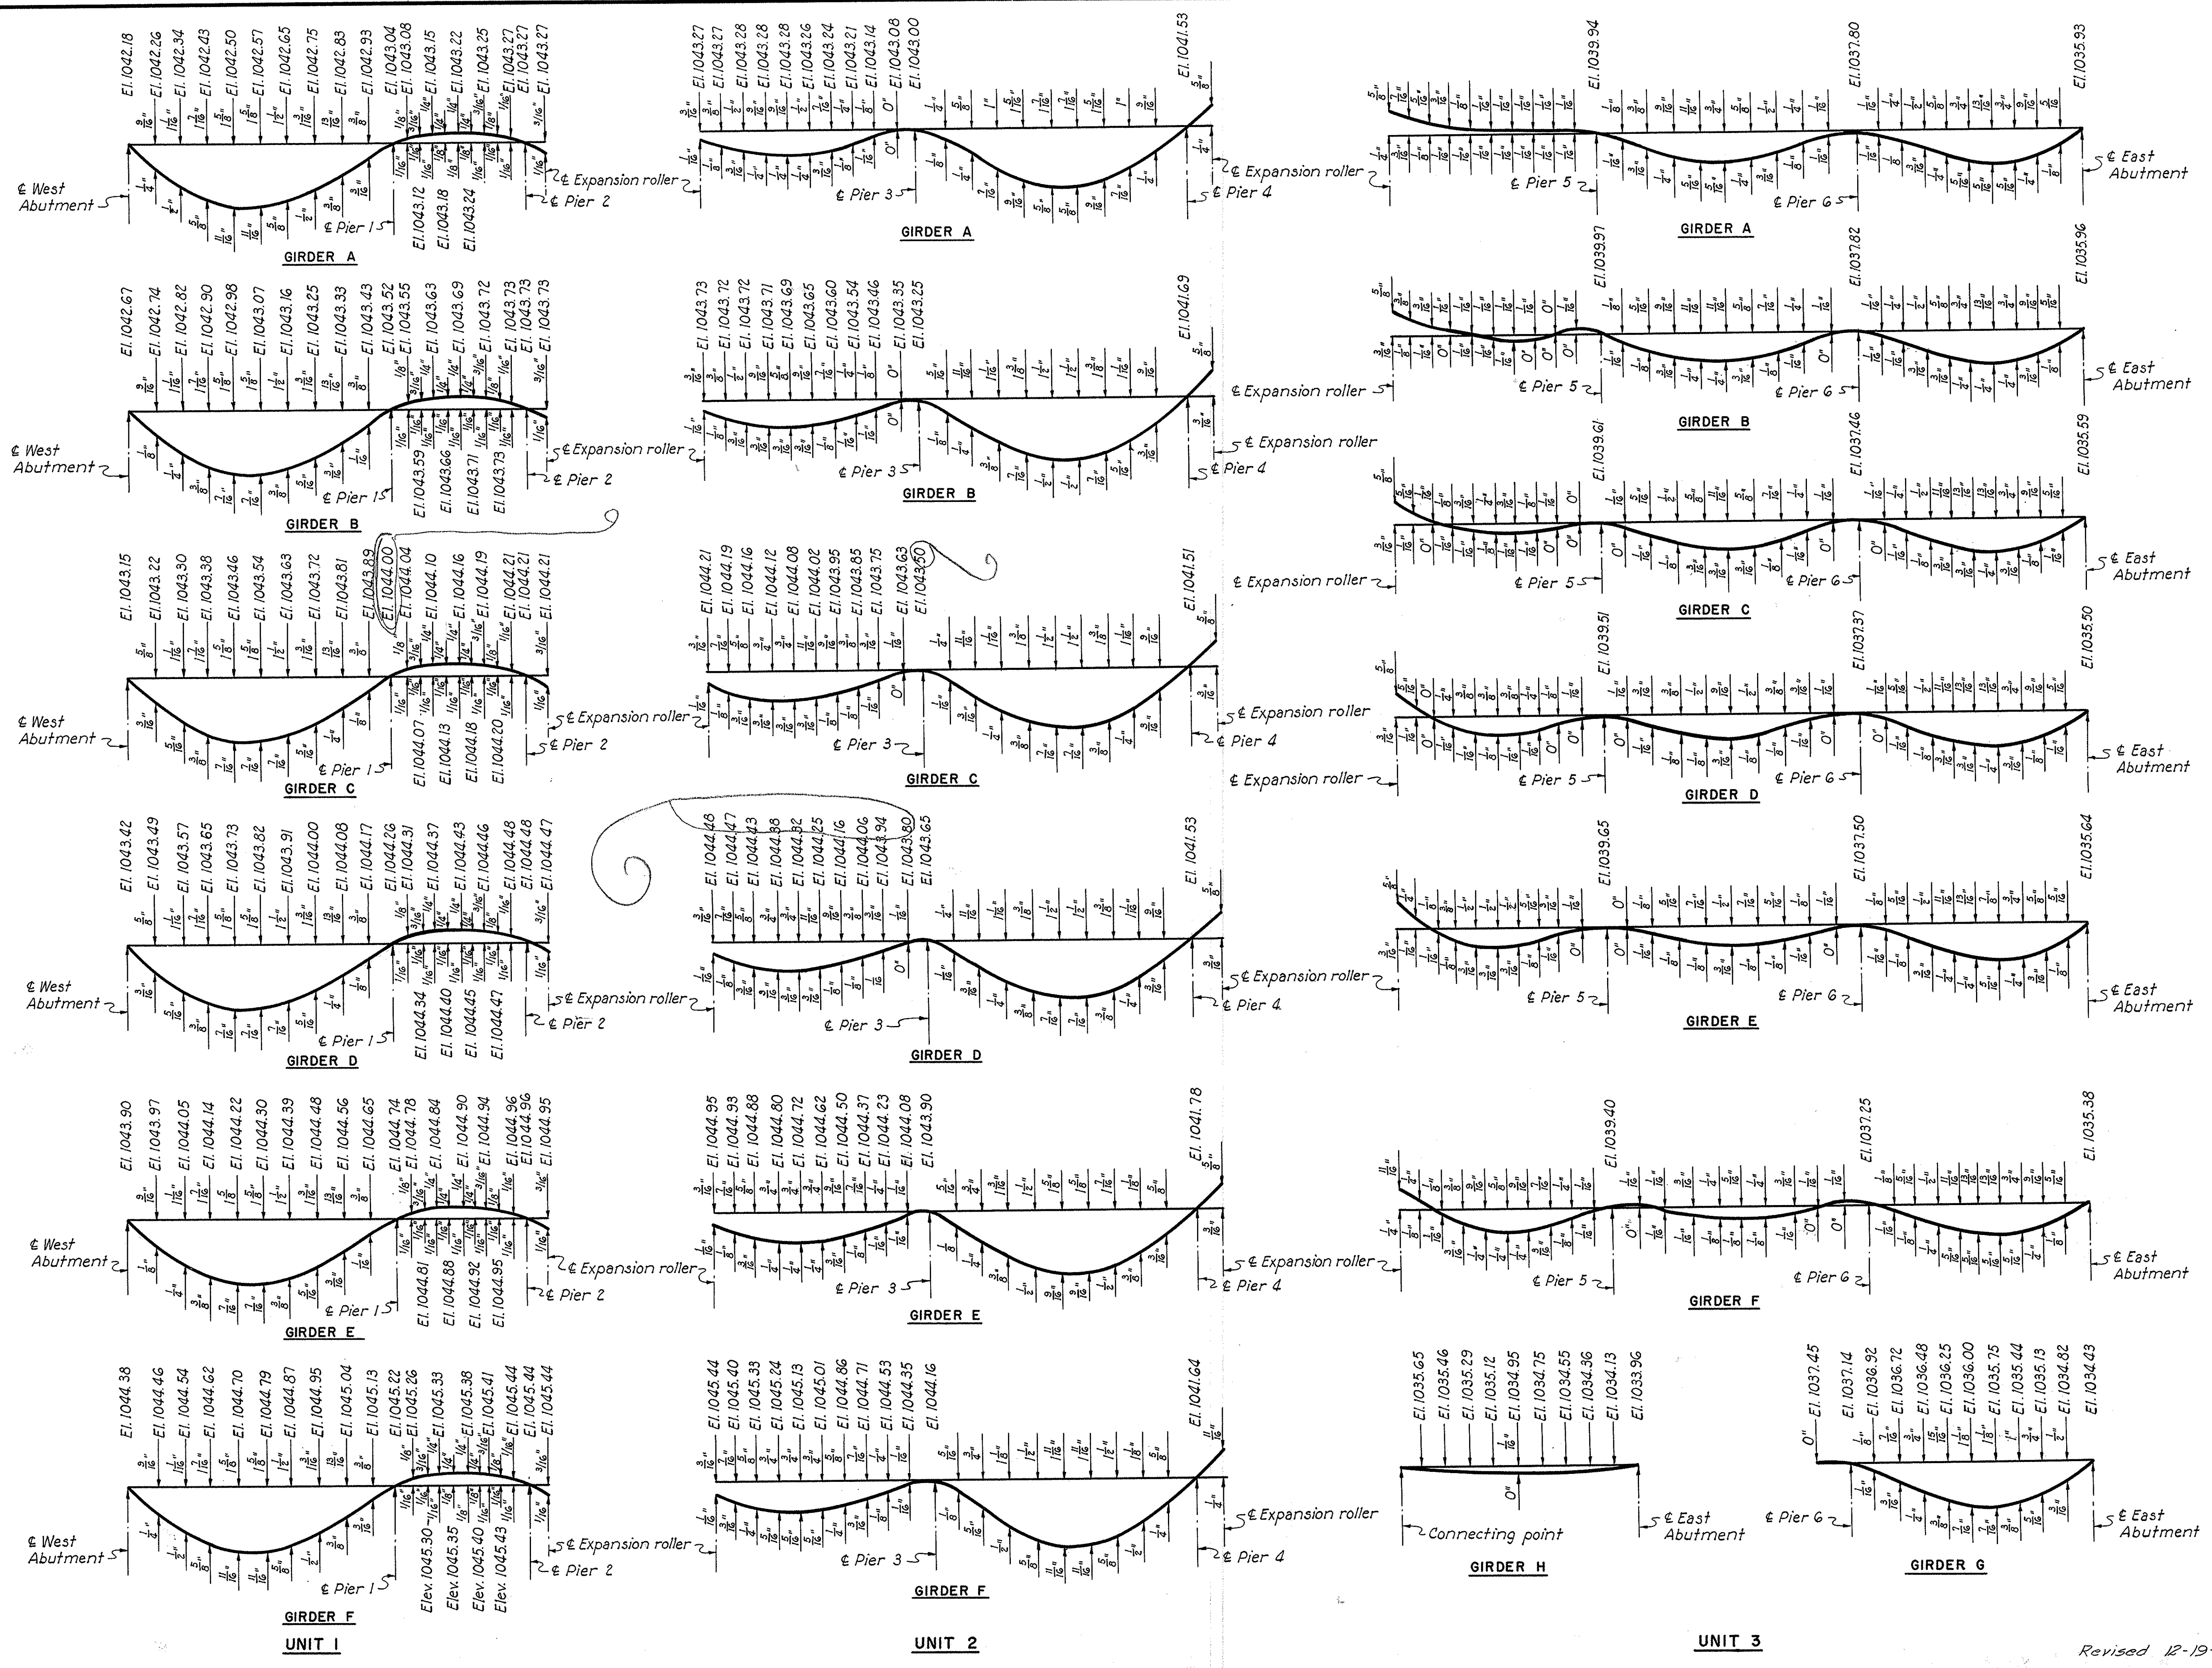

Note:  
All girders, except Girder H, shall be fully cambered to compensate for dead load deflections and vertical curvature. The elevations given in the deflection diagrams are top of finished wearing surface along girders.  
The girders under full dead load shall parallel these elevations by being fabricated to lines parallel to profiles formed by the given elevations plus additional camber equal to the amounts of anticipated dead load deflections.  
Elevations are given at one-tenth span points over girders between bearings throughout the lengths of vertical and horizontal curves.  
Deflections given above the base line are the deflections due to the dead load of the steel, concrete and wearing surface. Deflections given below the diagrams are the deflections due to the dead load of the steel.  
The allowances to be made in screed settings to compensate for the deflections due to the dead load of concrete and wearing surface are to be made above the elevation shown for finished pavement surfaces. Screeds may require further adjustments due to irregularities in the fabricated steel. At the edge of roadway slabs the steel zee section or bulb angles, where provided, will serve as screed.

PART 7  
AKRON EXPRESSWAY SYSTEM  
WEST VIADUCT  
BR. NO. SU-18R-135  
DEAD LOAD DEFLECTIONS

AKRON	SUMMIT COUNTY,	OHIO
SCALE: NONE		
MADE: DJH DATE: 8-26-55		
TRCD: CAL DATE: 12-5-55		
CKD: JRK DATE: 9-6-55		
HOWARD, NEEDLES, TAMMEN & BERGENOFF		CONSULTING ENGINEERS
KANSAS CITY		CLEVELAND NEW YORK
901		SHEET- 99

Revised 12-19-55

165

SUMMIT COUNTY  
CITY OF AKRON  
AKRON EXPRESSWAY SYSTEM

Girder and Load	UNIT 1												UNIT 2								UNIT 3												
	Reactions and Shears in Kips						Moments in Foot-Kips						Reactions and Shears in Kips				Moments in Foot-Kips				Reactions and Shears in Kips					Moments in Foot-Kips							
	W/Abut	Pier 1			Pier 2			Span 1	Pier 1	Span 2	Pier 2	Pier 3		Pier 4		Span 3	Pier 3	Span 4	Pier 4	Pier 5			Pier 6			E. Abut.	Span 5	Pier 5	Span 6	Pier 6	Span 7		
	R	Vw	Ve	R	Vw	Ve	R	+M	-M	+M	-M	Vw	Ve	R	Vw	Ve	R	+M	-M	+M	-M	Vw	Ve	R	Vw	Ve	R	R	+M	-M	+M	-M	+M
DL	130	184	116	300	31	110	140	3549	3608	-954	978	164	174	338	131	99	230	1527	4160	2340	1322	131	141	272	157	163	520	95	1014	2716	1585	3795	1990
ULL	28	39	29	68	14	28	48	771	720	195	262	30	37	72	28	31	55	540	923	784	348	24	33	62	32	69	24	366	692	577	844	591	
C.L.L.	31	36	28	36	24	33	29	547	487	244	247	33	35	31	31	31	30	421	437	554	340	30	33	30	33	33	28	30	331	363	412	410	452
Imp.	11	14	9	16	10	13	13	26	234	117	105	14	14	12	14	12	206	280	261	170	13	13	14	13	14	13	11	164	154	194	170	219	
Total Rdwy.LL+I	70	89	64	119	48	74	90	1574	1441	556	614	77	86	117	71	76	97	1167	1640	1599	858	67	79	106	78	79	110	65	861	1209	1183	1424	1262
Sdwk.LL	13	18	13	30	7	13	22	354	361	87	121	14	17	34	13	12	26	242	436	352	155	11	15	26	14	14	28	11	160	320	260	400	270
1.66 Rdwy.LL+I	117	147	106	193	79	123	158	2615	2395	922	1020	128	143	194	118	126	161	1935	2722	2654	1424	111	131	176	129	131	183	108	1430	2010	1960	2360	2090
0.8 D.L.	104	148	93	240	24	88	112	2840	2890	-763	782	131	139	270	105	79	184	1220	3330	1870	1057	105	113	218	126	130	256	76	810	2170	1270	3040	1590
Modified Total	234	313	212	463	110	224	283	5809	5646	246	1923	273	299	498	236	217	371	3397	6488	4876	2636	227	259	420	269	275	467	195	2400	4500	3490	5800	3950
DL	169	237	147	384	42	146	189	4636	4567	-1219	1315	205	216	421	164	142	306	2060	5230	2920	7090	179	184	363	200	209	409	125	1650	3780	1940	4800	2600
ULL	41	57	41	99	21	43	72	1142	1045	285	395	46	55	105	41	48	83	809	1383	1153	543	39	48	94	47	47	101	36	620	1070	840	1240	880
C.L.L.	46	52	28	52	35	48	44	807	705	358	366	49	52	45	46	44	44	621	638	818	516	46	49	43	49	49	42	44	520	550	600	600	670
Imp.	17	21	11	24	15	19	20	378	340	172	158	20	21	21	17	28	18	307	414	384	262	19	19	20	19	20	19	17	260	230	280	250	330
Total LL+I	104	130	78	170	71	110	142	2327	2090	815	919	115	127	171	105	119	145	1737	2435	2355	1321	104	116	157	115	116	162	97	1400	1850	1720	2090	1880
1.66 LL+I	173	216	130	282	117	183	235	3860	3470	1352	1522	191	211	284	174	198	241	2880	4040	3910	2190	173	193	261	191	193	269	161	2320	3070	2860	3470	3120
0.8 D.L.	135	190	117	308	34	117	151	3709	3654	-975	1052	164	172	336	131	114	244	1650	4180	2340	1430	143	147	290	160	167	327	100	1320	3020	1550	3840	2080
Modified Total	308	406	247	590	151	300	386	7569	7124	377	2574	355	383	620	305	312	485	4530	8220	6250	3620	316	340	551	351	360	596	261	3640	6090	4410	7310	5200
DL	179	253	162	415	39	154	194	4875	5013	-1363	1388	221	230	451	183	161	343	2340	5690	3090	1823	199	197	396	207	219	426	131	2100	4270	1940	4950	2770
ULL	42	58	42	102	22	8	77	1155	1080	292	393	48	56	107	42	50	87	844	1422	1178	586	43	49	98	49	48	103	37	720	1150	850	1270	900
C.L.L.	55	62	34	62	42	58	53	820	731	366	371	50	47	46	47	44	44	646	657	837	540	49	50	43	50	50	43	45	570	580	610	610	690
Imp.	19	24	12	26	17	21	22	384	351	175	158	21	20	21	17	28	18	317	425	393	278	20	19	20	19	21	20	17	290	240	290	260	330
Total LL+I	116	144	85	185	80	123	154	2359	2162	833	922	119	123	174	106	122	149	1807	2504	2408	1404	112	118	161	118	119	166	99	1580	1970	1750	2140	1920
1.66 LL+I	192	240	141	308	132	204	256	3910	3590	1380	1530	198	204	289	176	203	247	3000	4160	4000	1460	186	196	268	196	198	275	164	2620	3270	2910	3550	3190
0.8 D.L.	144	203	130	332	31	124	155	3900	4010	-1090	1110	177	184	361	146	129	275	1870	4550	2460	2330	159	158	317	166	175	341	105	1680	3420	1550	3960	2220
Modified Total	336	443	271	640	163	328	411	7810	7600	290	2640	375	388	650	320	332	522	4870	8710	6460	3790	345	354	585	362	373	616	269	4300	6690	4460	7510	5410
DL	179	253	162	415	39	154	194	4875	5013	-1363	1388	222	229	451	183	170	353	2422	5695	3010	2206	209	199	408	205	218	423	132	2440	4550	1770	4890	2790
ULL	42	58	42	102	22	8	77	1155	1080	292	393	48	56	105	42	50	89	859	1430	1178	610	45	49	101	49	48	103	37	810	1210	850	1270	900
C.L.L.	55	62	34	62	42	58	53	820	731	366	371	50	47	45	47	44	45	646	656	837	540	50	50	43	50	50	43	45	620	600	610	610	690
Imp.	19	24	12	26	17	21	22	384	351	175	158	21	20	21	17	28	18	320	425	393	284	21	19	20	19	21	20	17	310	250	290	260	340
Total LL+I	116	144	85	185	80	123	154	2359	2162	833	922	119	123	171	106	122	152	1825	2511	2408	1434	116	118	164	118	119	166	99	1740	2060	1750	2140	1930
1.66 LL+I	192	240	141	308	132	204	256	3910	3590	1380	1530	198	204	284	176	203	252	3030	4556	4000	2380	193	196	272	196	198	276	164	2890	3420	2910	3550	3200
0.8 D.L.	144	203	130	332	31	124	155	3900	4010	-1090	1110	178	183	361	146	136	282	1938	4168	2410	1770	167	159	327	164	174	338	106	1950	3640	1420	3910	2230
Modified Total	336	443	271	640	163	328	411	7810	7600	290	2640	376	387	645	322	339	534	4968	8724	6410	4150	360	355	599	360	372	614	270	4840	7060	4330	7460	5430
DL	169	237	147	384	42	146	189	4636	4567	-1219	1315	214	220	434	174	171	345	2338	5246	2720	2290	209	193	402	191	208	399	126	2710	4690	1610	4590	2700
ULL	41	57	41	99	21	43	72	1142	1045	285	395	46	55	106	41	48	89	858	1359	1163	632	47	48	101	48	47	101	36	890	1250	830	1240	880
C.L.L.	46	52	28	52	35	48	44	807	705	358	366	49	52	45	46	44	43	654	633	826	552	49	49	42	49	49	42	44	680	600	590	600	670
Imp.	17	21	11	24	15	19	20	378	340	172	158	20	21	21	17	28	18	321	408	388	293	20	19	19	19	20	19	17	330	250	280	250	320
Total LL+I	104	130	78	170	71	110	142	2327	2090	815	919	115	128	172	104	120	150	1833	2400	2377	1477	116	116	162	116	116	162	97	1900	2100	1700	2090	1870
1.66 LL+I	173	216	130	282	117	183	235	3860	3470	1352	1522	191	211	285	174	198	249	3040	3980	3940	2450	193	193	269	193	193	269	161	3150	3490	2820	3470	3100
0.8 D.L.	135	190	117	308	34	117	151	3709	3654	-975	1052	171	176	347	139	137	276	1870	4200	2180	1830	167	154	321	153	166	319	101	2170	3750	1290	3670	2160
Modified Total	308	406	247	590	151	300	386	7569	7124	377	2574	362	387	632	313	335	525	4910	8180	6120	4280	360	347	590	346	359	588	262	5320	7240	4110	7140	5160
DL	130	184	116																														