



SOURCE
 DEERFIELD TOWNSHIP, LOT 56
 PORTAGE COUNTY, OHIO
 SURVEYED BY:
 MULLERY CORPORATION
 1001 HIGH STREET, WADSWORTH, OHIO 44281
 SEPTEMBER 1995
 BASIS OF BEARING NORTH LINE OF LOTS 56
 (S 89°25'00"E AS RECORDED IN DEED
 VOLUME 988, PAGE 281 OF PORTAGE
 COUNTY RECORDS OF DEEDS.

- LEGEND**
- PROPERTY BOUNDARY
 - 1100 CONTOUR (FEET)
 - CHAIN LINK FENCE
 - CULVERT
 - POWERLINE
 - ACCESS ROAD AND GRAVEL AREA
 - RIP RAP LINED DITCH
 - POND
 - AREA OF BURIED DRUMS APPROVED IN RC WORK PLAN
 - LIMIT OF WORK AREA
 - DRAINAGE PATH/DITCH/SWALE
 - POWER POLE
 - LIGHT POLE
 - PZ-103 PIEZOMETER LOCATION
 - MW-4 (WTU) MONITORING WELL LOCATION (WTU) WATER TABLE UNIT (LIU) UPPER INTERMEDIATE UNIT (LIU) LOWER INTERMEDIATE UNIT (USU) UPPER SHARON UNIT
 - PW POTABLE WATER WELL
 - 1-1/4" HDPE POTABLE WATER LINE
 - 6" HDPE GRAVITY DRAIN
 - PIPE AND MEDIA DRAIN (PERFORATED HDPE PIPE)
 - FORCEMAIN/ELECTRICAL (POWER SUPPLY) CONDUITS/ELECTRICAL CONTROLS CONDUITS
 - MH-2 ACCESS MANHOLE
 - WET WELL
 - EW-2 ABANDONED EXTRACTION WELL
 - DEMOLITION DEBRIS FROM WATSON HOUSE
 - CONCRETE, RUBBLE AND SEDIMENT STOCKPILE



	Approved	SUMMIT NATIONAL SUPERFUND SITE DEERFIELD, OHIO	CRA CONESTOGA-ROVERS & ASSOCIATES
		SOIL REMOVAL AND TREATMENT PRE-CONSTRUCTION CONDITIONS	Drawn by: JRV Scale: 1"=40' Date: OCTOBER 1995 File No: P218 Rev. No: 0 Designed by: WVW Field book: Checked by: WVW Project No: 2372 Drawing No: E-1
0 AS RECORDED OCT 1995 WVW Revision Date Initial			OCT 11, 1995

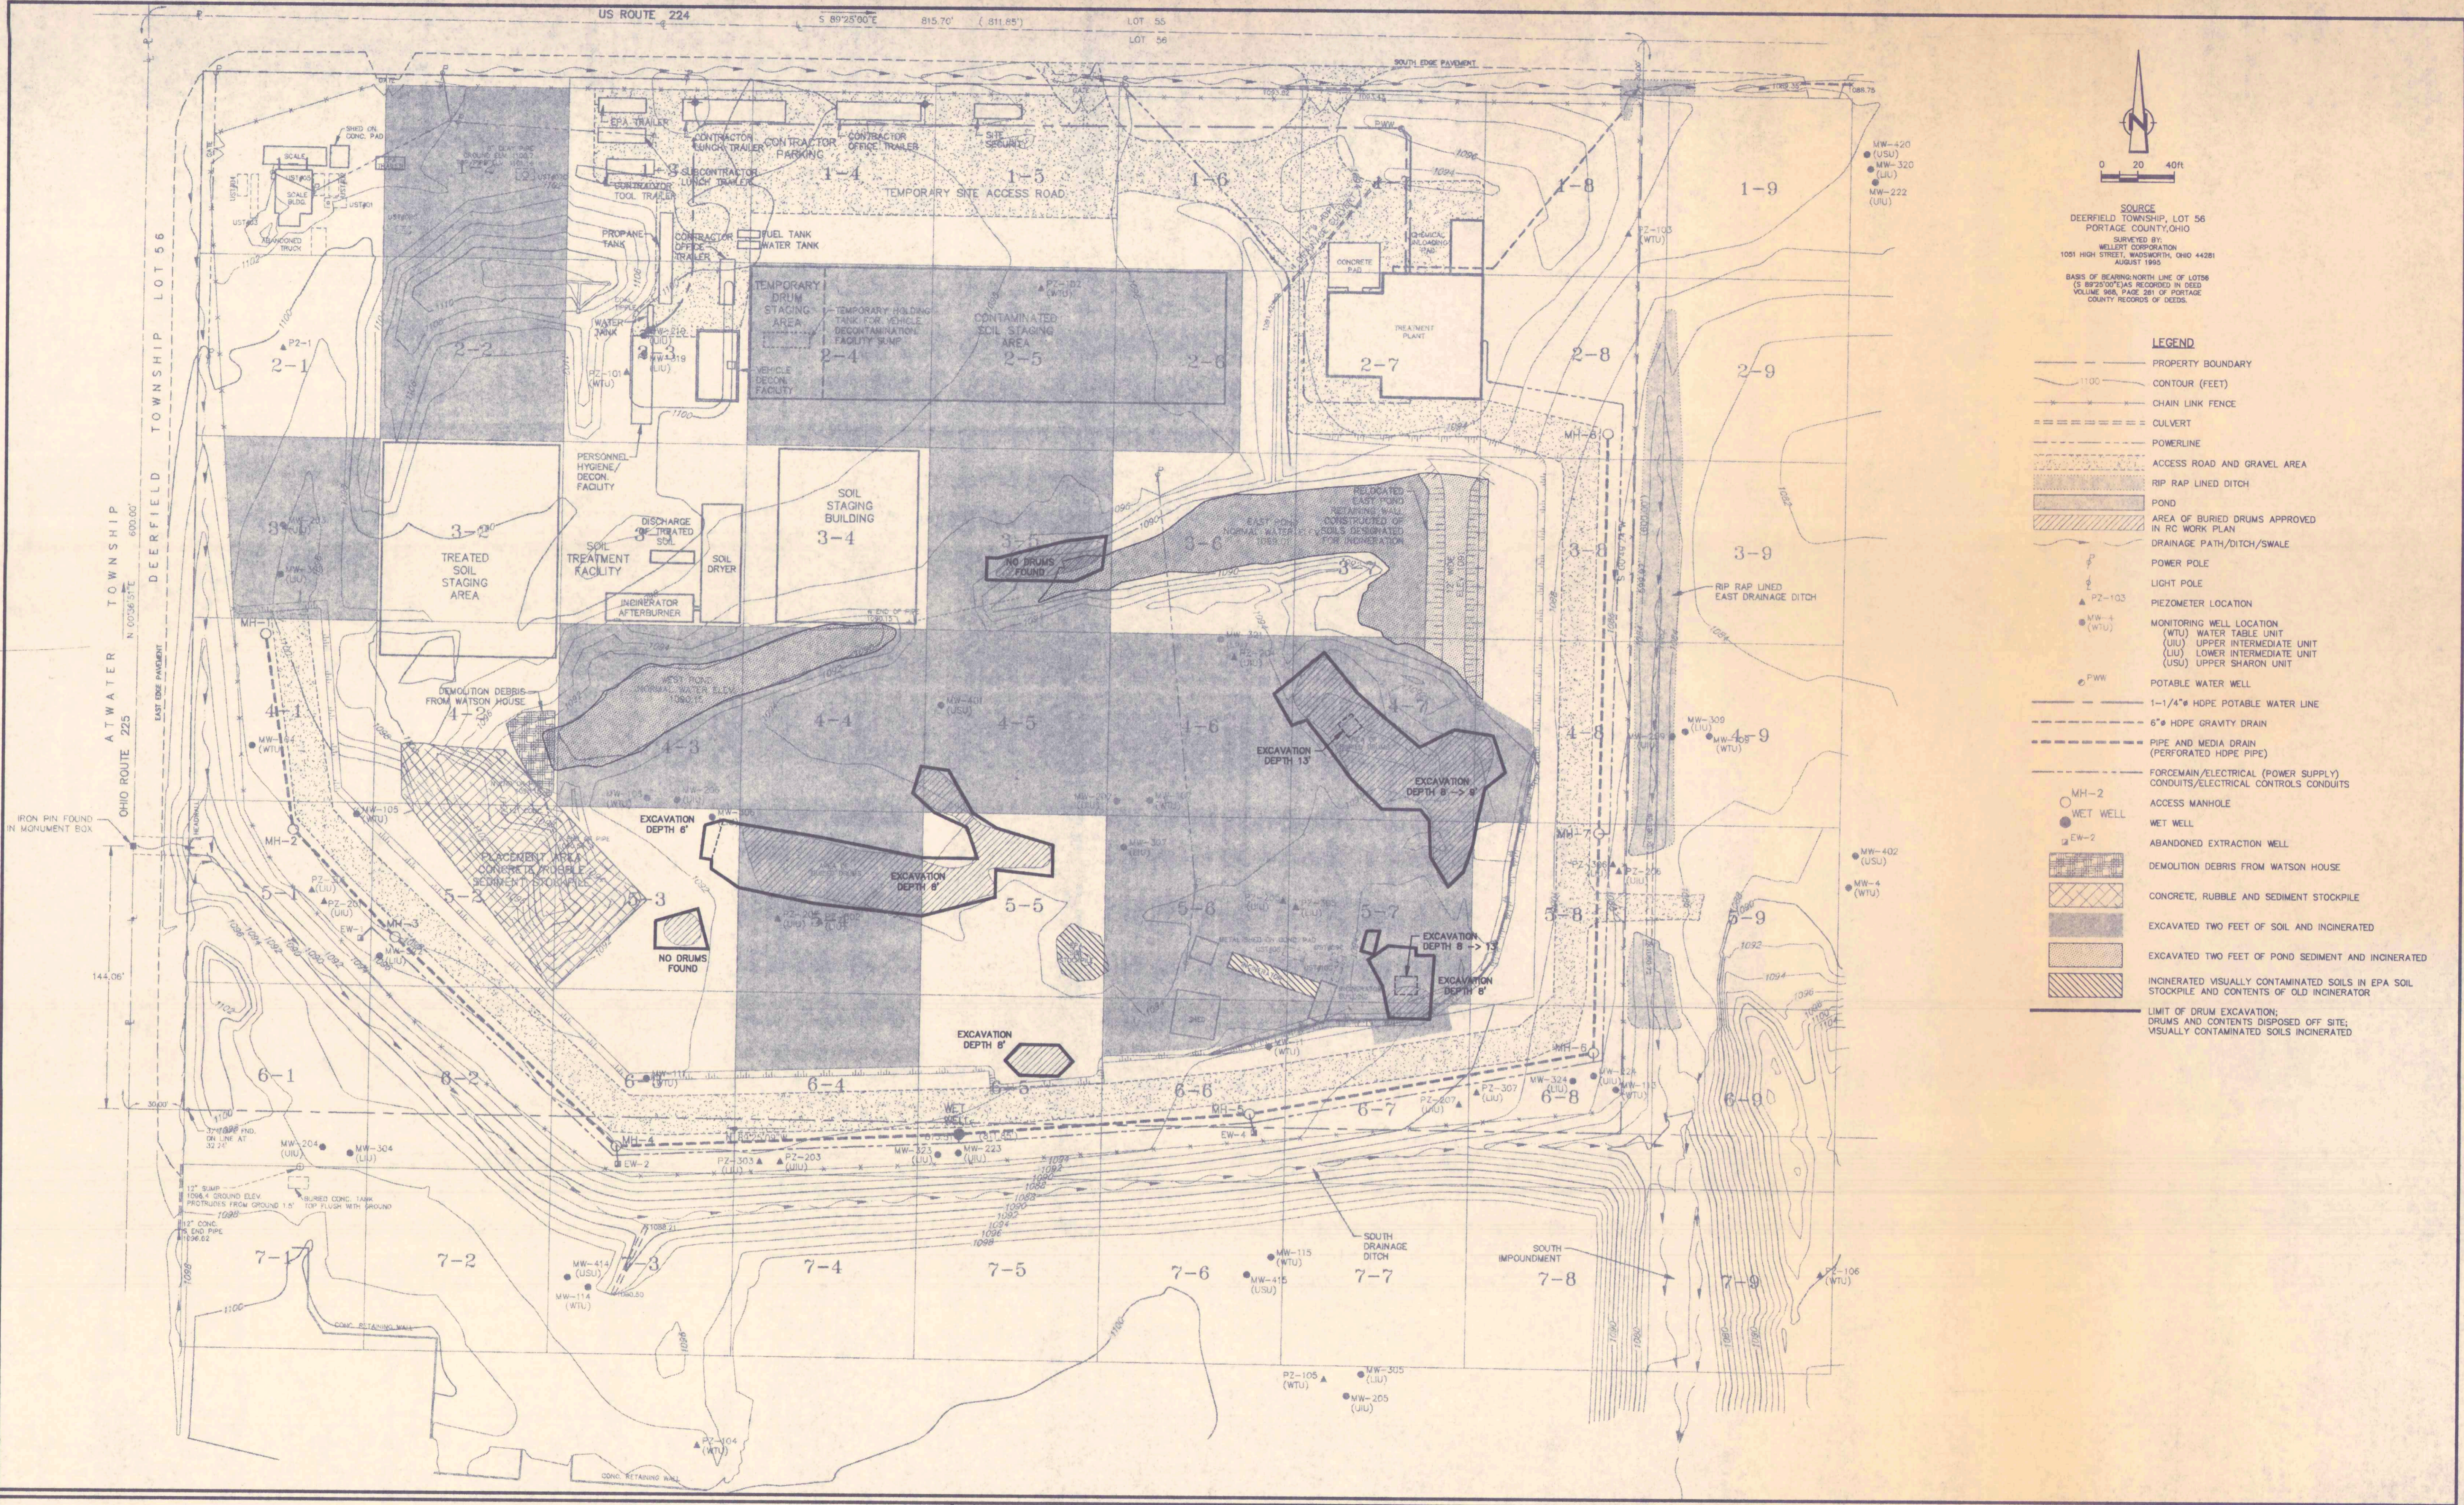


 0 20 40ft
SOURCE
 DEERFIELD TOWNSHIP, LOT 56
 PORTAGE COUNTY, OHIO
 SURVEYED BY:
 WELBERT CORPORATION
 1051 HIGH STREET, WADSWORTH, OHIO 44281
 AUGUST 1995
 BASIS OF BEARING-NORTH LINE OF LOTS 56
 (S 89°25'00"E AS RECORDED IN DEED
 VOLUME 908, PAGE 281 OF PORTAGE
 COUNTY RECORDS OF DEEDS)

- LEGEND**
- PROPERTY BOUNDARY
 - CONTOUR (FEET)
 - CHAIN LINK FENCE
 - CULVERT
 - POWERLINE
 - ACCESS ROAD AND GRAVEL AREA
 - RIP RAP LINED DITCH
 - POND
 - AREA OF BURIED DRUMS APPROVED IN RC WORK PLAN
 - DRAINAGE PATH/DITCH/SWALE
 - POWER POLE
 - LIGHT POLE
 - PZ-103
PZ-104
PZ-105
PIEZOMETER LOCATION
 - MW-4
MW-11
MW-114
MW-115
MW-204
MW-205
MW-223
MW-224
MW-304
MW-305
MW-307
MW-308
MW-309
MW-401
MW-402
MW-403
MW-450
MONITORING WELL LOCATION
 (WTU) WATER TABLE UNIT
 (LIU) LOWER INTERMEDIATE UNIT
 (USU) UPPER SHARON UNIT
 - PW-1
PW-2
PW-3
POTABLE WATER WELL
 - 1-1/4" HDPE POTABLE WATER LINE
 - 6" HDPE GRAVITY DRAIN
 - PIPE AND MEDIA DRAIN (PERFORATED HDPE PIPE)
 - FORCEMAIN/ELECTRICAL (POWER SUPPLY) CONDUITS/ELECTRICAL CONTROLS CONDUITS
 - MH-2
MH-3
MH-4
MH-5
MH-6
MH-7
MH-8
MH-9
ACCESS MANHOLE
 - WW-1
WW-2
WET WELL
 - EW-1
EW-2
ABANDONED EXTRACTION WELL
 - DEMOLITION DEBRIS FROM WATSON HOUSE
 - CONCRETE, RUBBLE AND SEDIMENT STOCKPILE
 - EXCAVATED TWO FEET OF SOIL AND INCINERATED
 - EXCAVATED TWO FEET OF POND SEDIMENT AND INCINERATED
 - INCINERATED VISUALLY CONTAMINATED SOILS IN EPA SOIL STOCKPILE AND CONTENTS OF OLD INCINERATOR
 - LIMIT OF DRUM EXCAVATION; DRUMS AND CONTENTS DISPOSED OFF SITE; VISUALLY CONTAMINATED SOILS INCINERATED

	Approved	SUMMIT NATIONAL SUPERFUND SITE DEERFIELD, OHIO	CRA CONESTOGA-ROVERS & ASSOCIATES
0 AS RECORDED	OCT 1995	WV	Drawn by: JRV Scale: 1"=40' Date: OCTOBER 1995 File No: P220 Rev. No: 0 Designed by: WV Field book: Project No: 2372 Checked by: WV Drawing No: E-3
Revision	Date	Initial	OCT 13, 1995

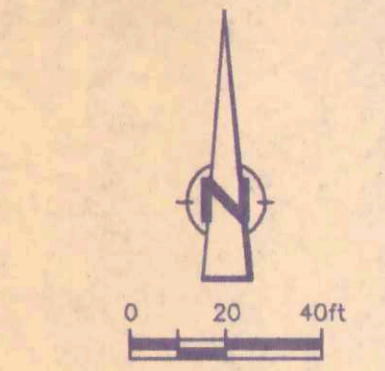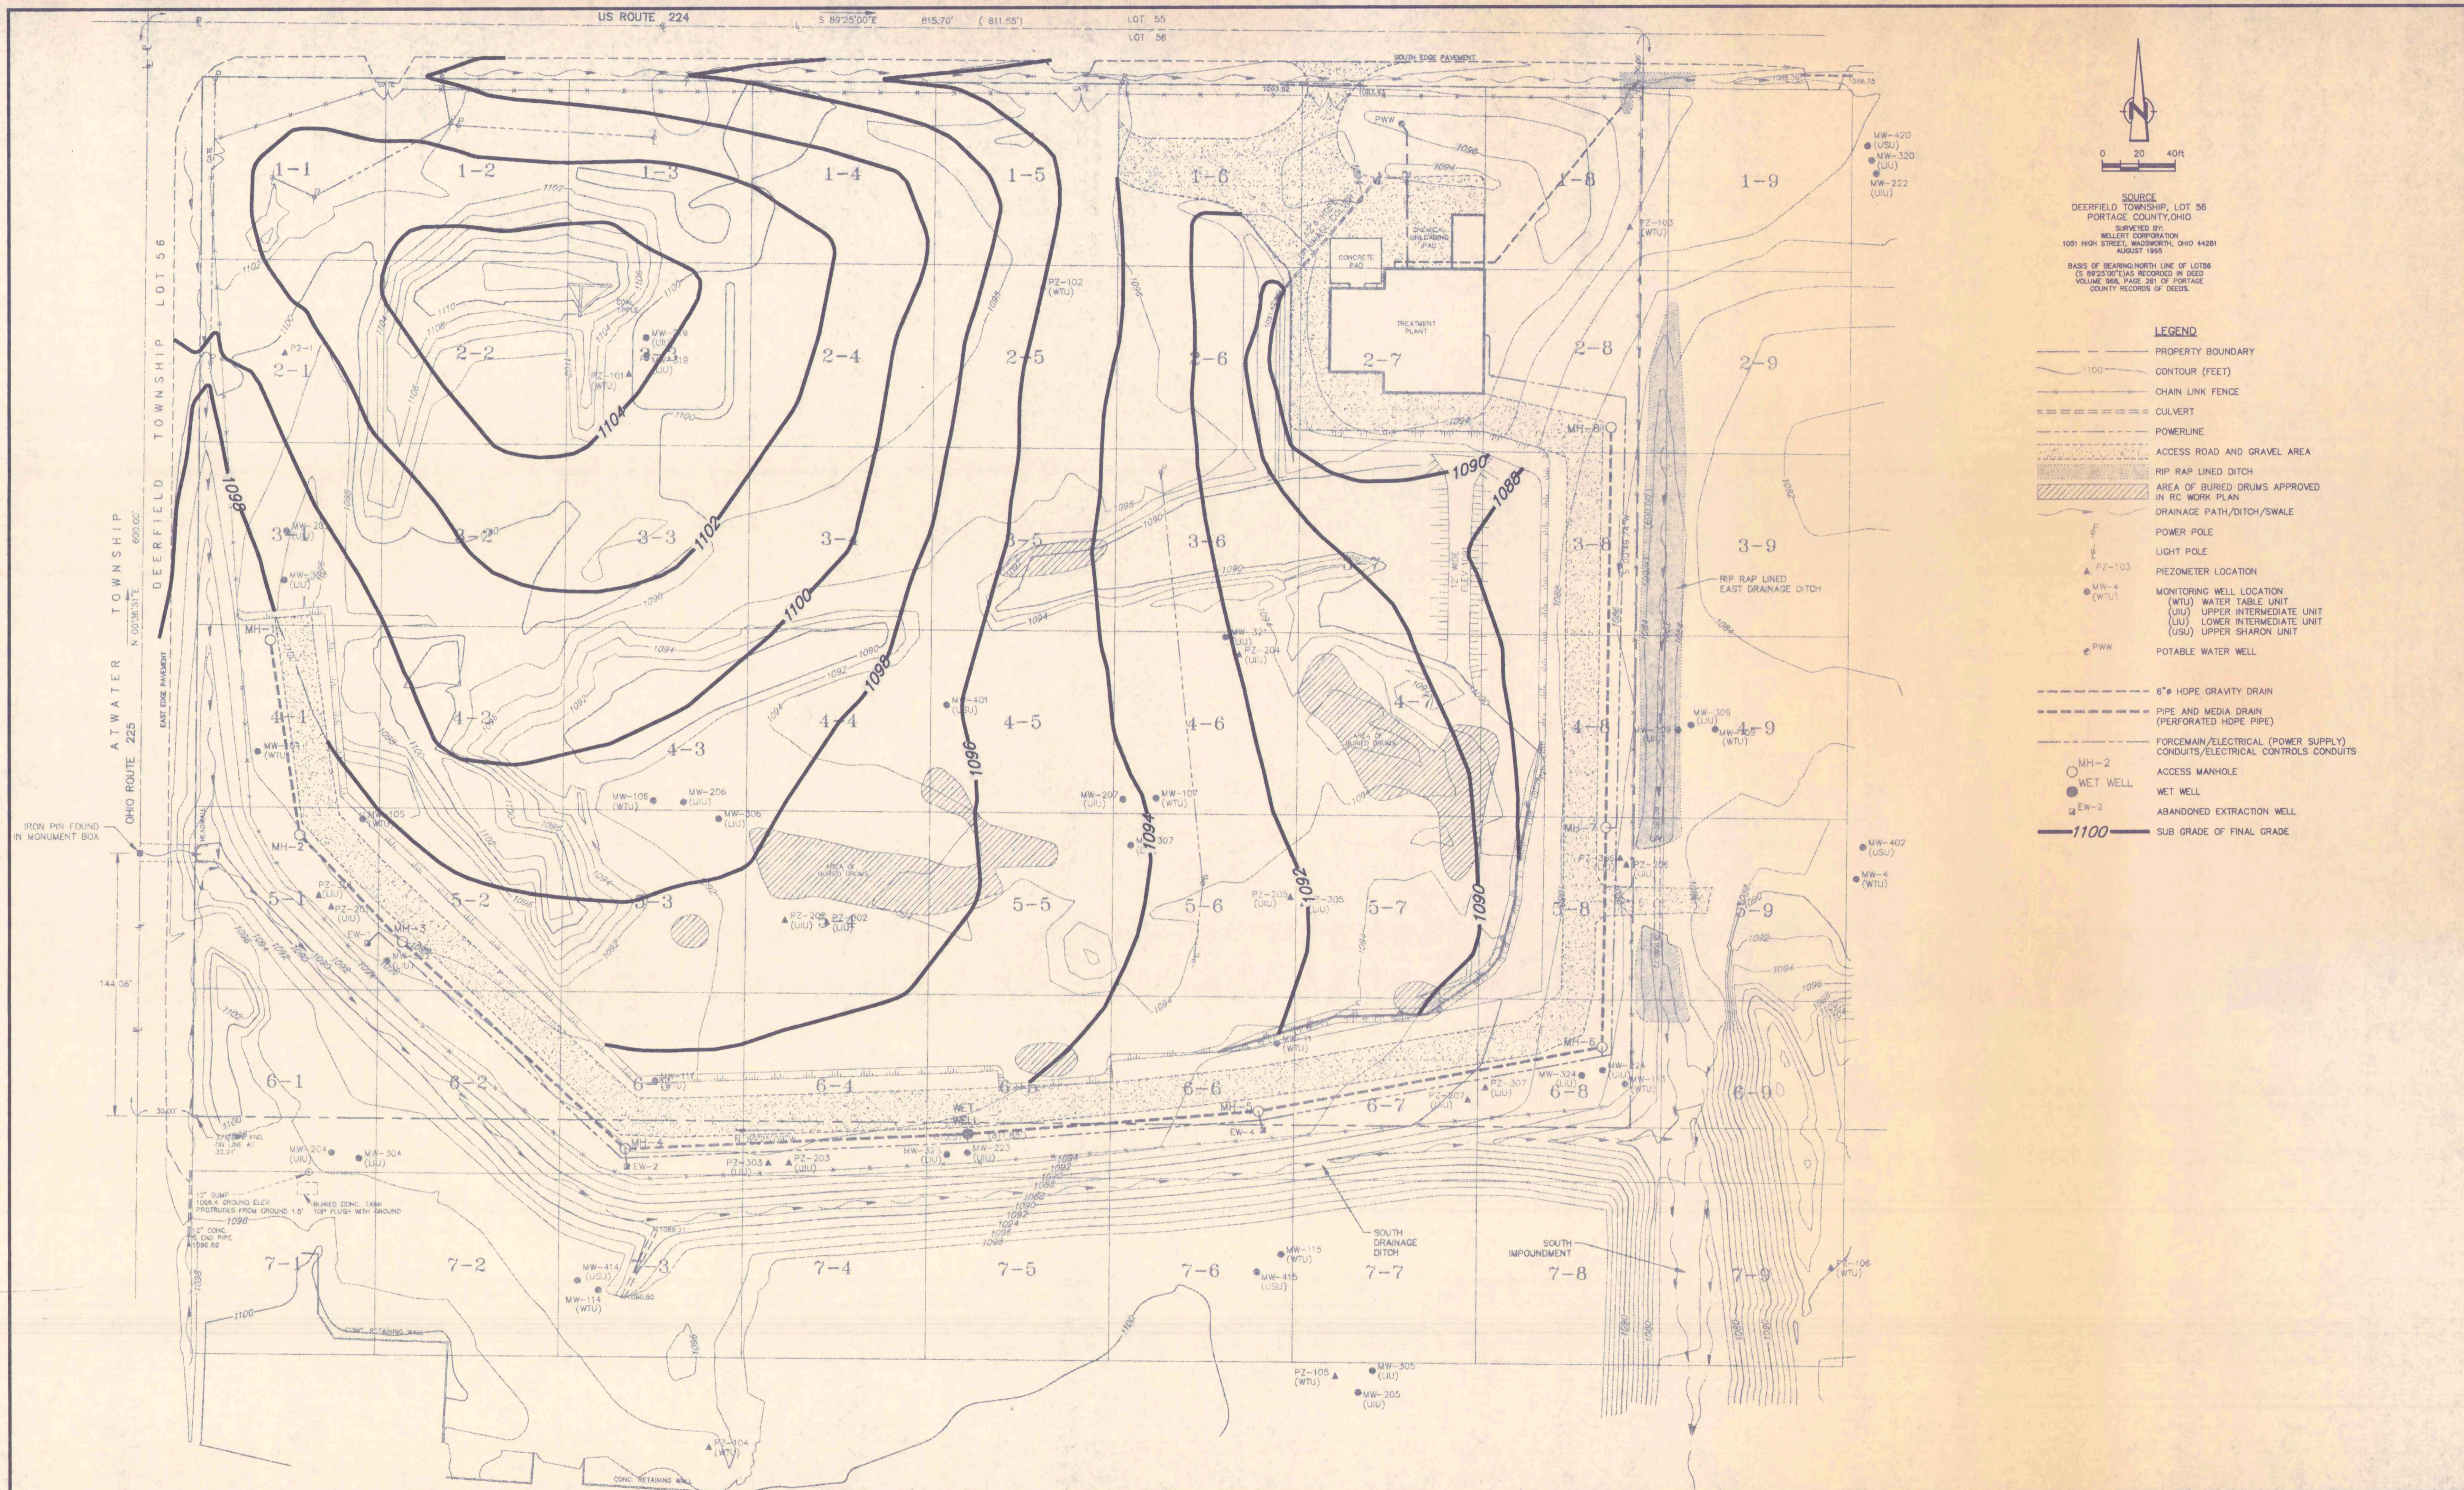

SOURCE
 DEERFIELD TOWNSHIP, LOT 56
 PORTAGE COUNTY, OHIO
 SURVEYED BY:
 WELLY CORPORATION
 1051 HIGH STREET, WADSWORTH, OHIO 44281
 AUGUST 1995
 BASIS OF BEARING NORTH LINE OF LOT 56
 (S. 89°25'00"E AS RECORDED IN DEED
 VOLUME 958, PAGE 281 OF PORTAGE
 COUNTY RECORDS OF DEEDS)

- LEGEND**
- PROPERTY BOUNDARY
 - 100' CONTOUR (FEET)
 - CHAIN LINK FENCE
 - CULVERT
 - POWERLINE
 - ACCESS ROAD AND GRAVEL AREA
 - RIP RAP LINED DITCH
 - AREA OF BURIED DRUMS APPROVED IN RC WORK PLAN
 - DRAINAGE PATH/DITCH/SWALE
 - POWER POLE
 - LIGHT POLE
 - PZ-103 (WTU) PIEZOMETER LOCATION
 - MW-4 (WTU) MONITORING WELL LOCATION (WTU) WATER TABLE UNIT (UIU) UPPER INTERMEDIATE UNIT (LIU) LOWER INTERMEDIATE UNIT (USU) UPPER SHARON UNIT
 - PWW POTABLE WATER WELL
 - 6" HDPE GRAVITY DRAIN
 - PIPE AND MEDIA DRAIN (PERFORATED HDPE PIPE)
 - FORCEMAIN/ELECTRICAL (POWER SUPPLY) CONDUITS/ELECTRICAL CONTROLS CONDUITS
 - MH-2 ACCESS MANHOLE
 - WW-2 WET WELL
 - EW-2 ABANDONED EXTRACTION WELL
 - 1100 SUB GRADE OF FINAL GRADE

	Approved	SUMMIT NATIONAL SUPERFUND SITE DEERFIELD, OHIO	CRA CONESTOGA-ROVERS & ASSOCIATES
		SOIL REMOVAL AND TREATMENT	Drawn by: JRV Scale: 1"=40' Date: OCTOBER 1995 File No: P221 Rev. No: 0
		SUB GRADE GRADING PLAN	Designed by: WVV Field book: Project No: 2372 Drawing No: E-5
			Checked by: WVV

#	Revision	Date	Initial
0	AS RECORDED	OCT 1995	WVV
1			