

Henry D. Verne B. Zimmerman  
 Cont. 0.56 Aci  
 P.R.O. 0.57 Aci  
 436/659


Robert Owen Uhrig  
 Cont. 0.26 Aci  
 P.R.O. 0.18 Aci  
 439/1

Etha Twp. T16 R 20  
 Licking Co. S.W. Qr. Sec. 9  
 U.S. Refugee Tract

John E. Edholm  
 Cont. 0.35 Aci  
 P.R.O. 0.28 Aci  
 432/357

Blanche Matharna  
 Cornolly  
 Cont. 0.20 Aci  
 P.R.O. 0.15 Aci  
 434/534

FR. 40-24-90  
 LIC. 40-(0.00)-(6.13)  
 R/W PLAT  
 LIMITED ACCE 33

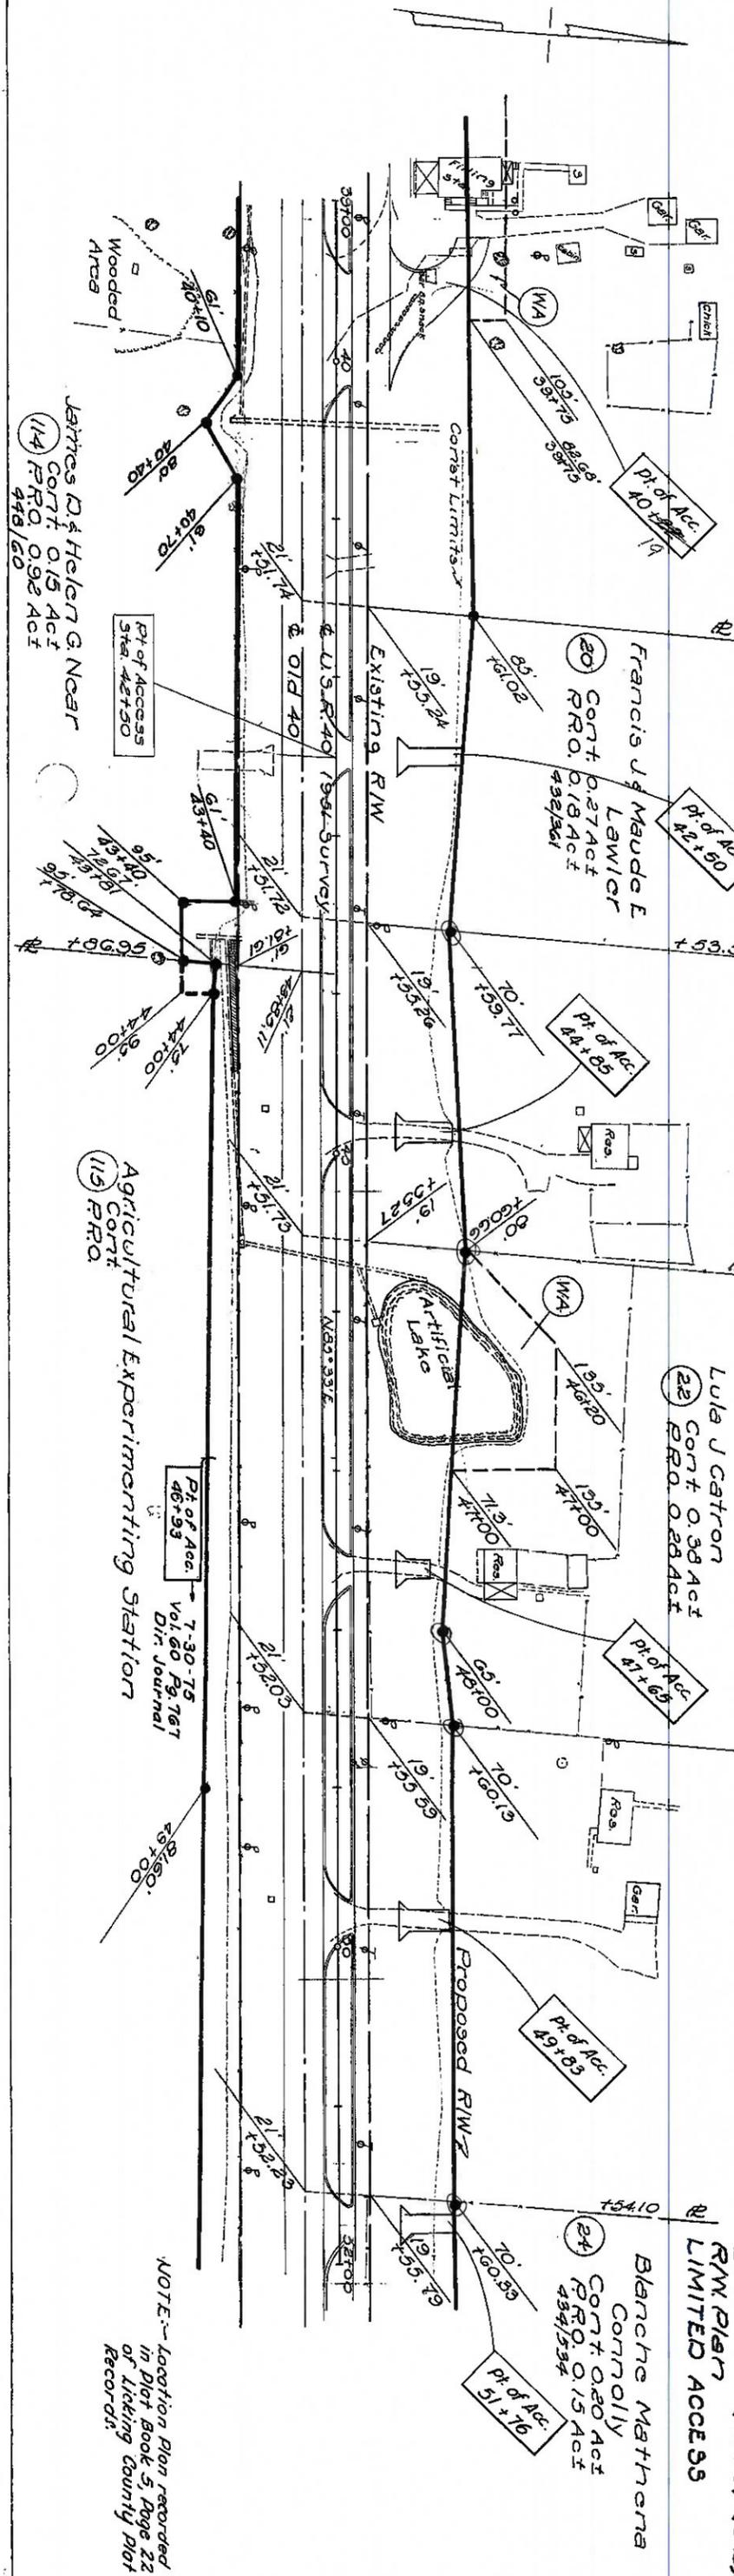

NOTE: Location Plan recorded in Plot Book 5, Page 22 of Licking County Plat Records.


Blanche Matharna Cornolly  
 Cont. 0.20 Aci  
 P.R.O. 0.15 Aci  
 434/534

Woodrow W. Coulter & Maxine Coulter  
 Cont. 0.36 Aci  
 P.R.O. 0.27 Aci  
 436/627

Etha Twp. T16 R 20  
 Licking Co. S.E. Qr. Sec. 9  
 U.S. Refugee Tract

Eva Smith Drain & Harry Howard Smith  
 Cont. 2.37 Aci  
 P.R.O. 1.55 Aci  
 432/626

NOTE: Location Plan recorded in Plot Book 5, Page 22 of Licking County Plat Records.

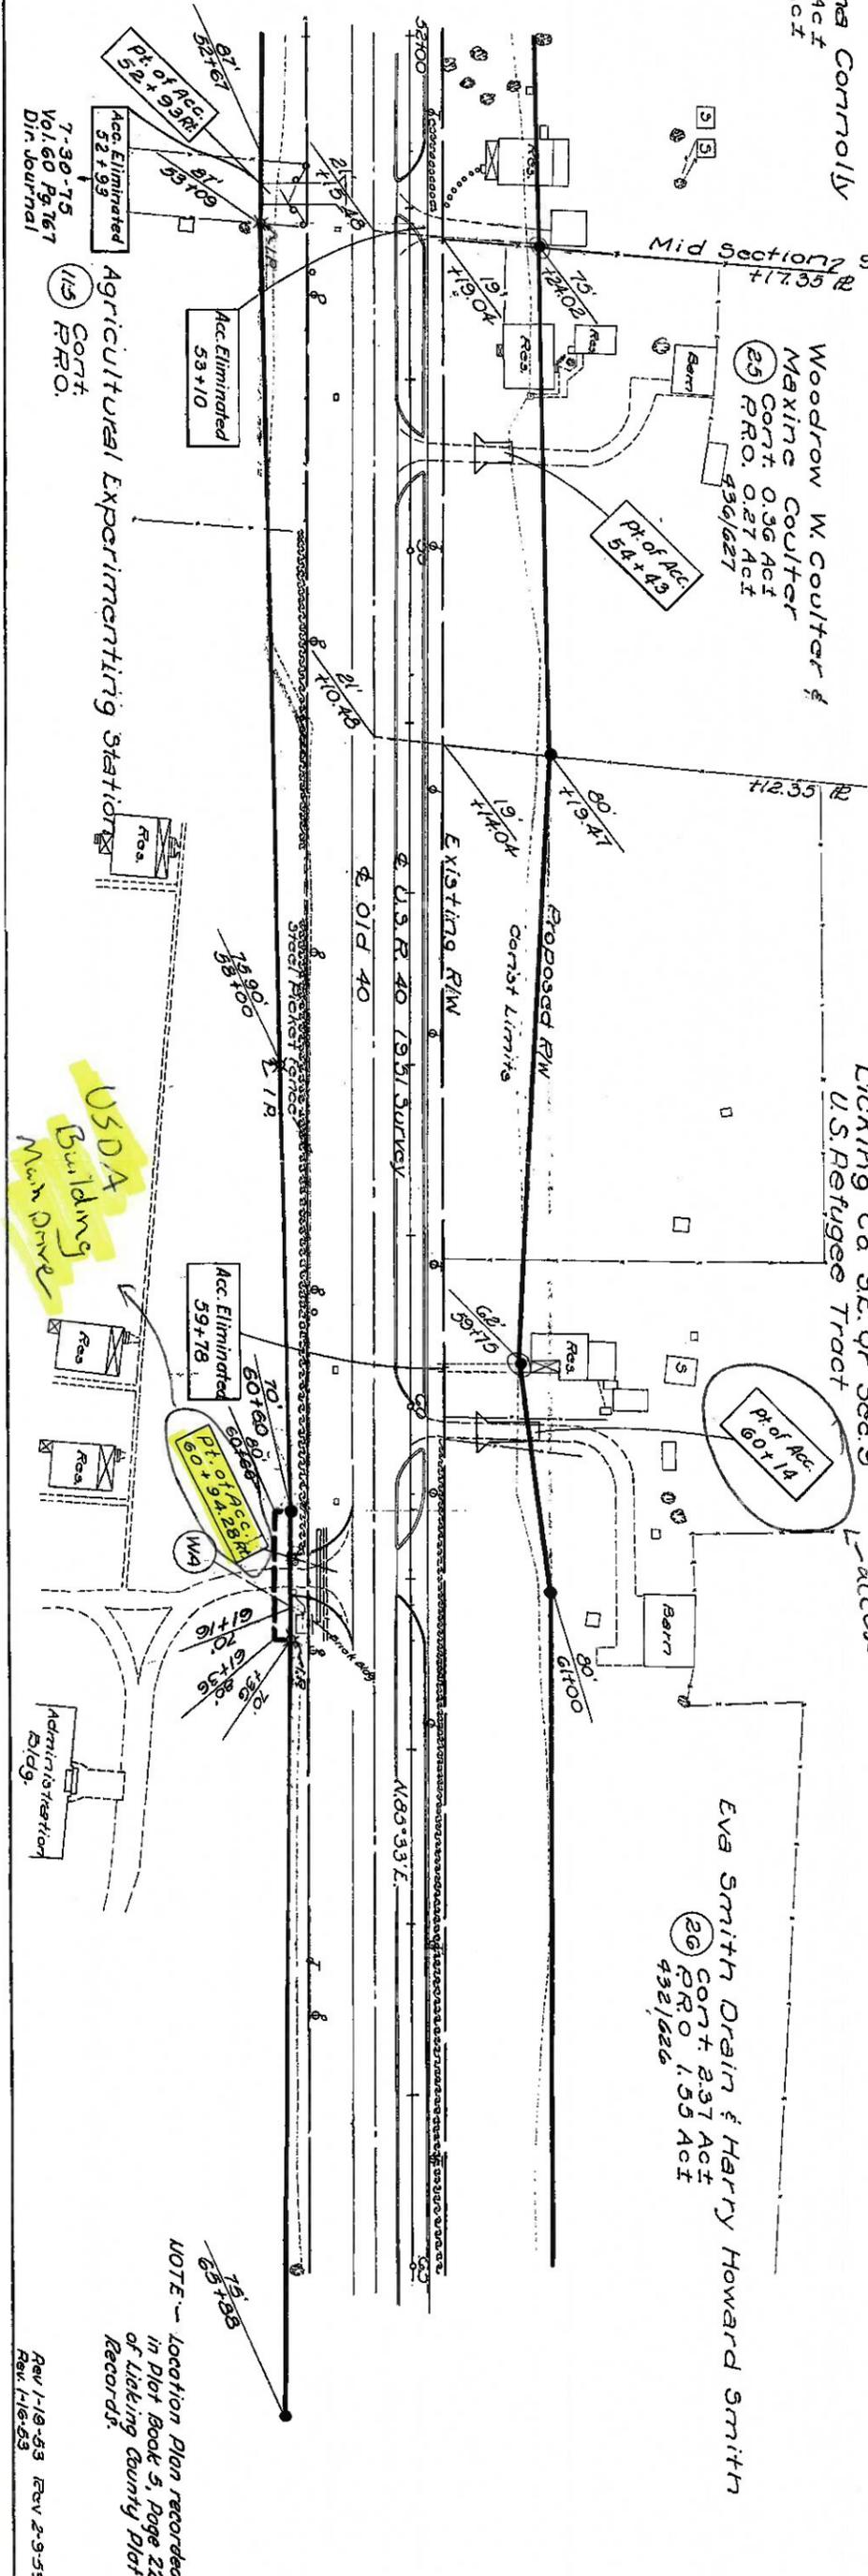

USDA Building  
 Main Drive

Rev 1-19-53 Rev 2-3-53  
 Rev 1-16-53

FILE NO.	STATE	PROJECT	THE NUMBER
2	OHIO		157

