


MUSKINGUM COUNTY
 BLUE ROCK TOWNSHIP
 SECTION 20, TOWNSHIP 12, RANGE 12
 CONGRESS LANDS EAST OF SCIOTO RIVER

RIGHT OF WAY DETAIL SHEET
 STA. 1294+75.00 TO STA. 1298+50.00

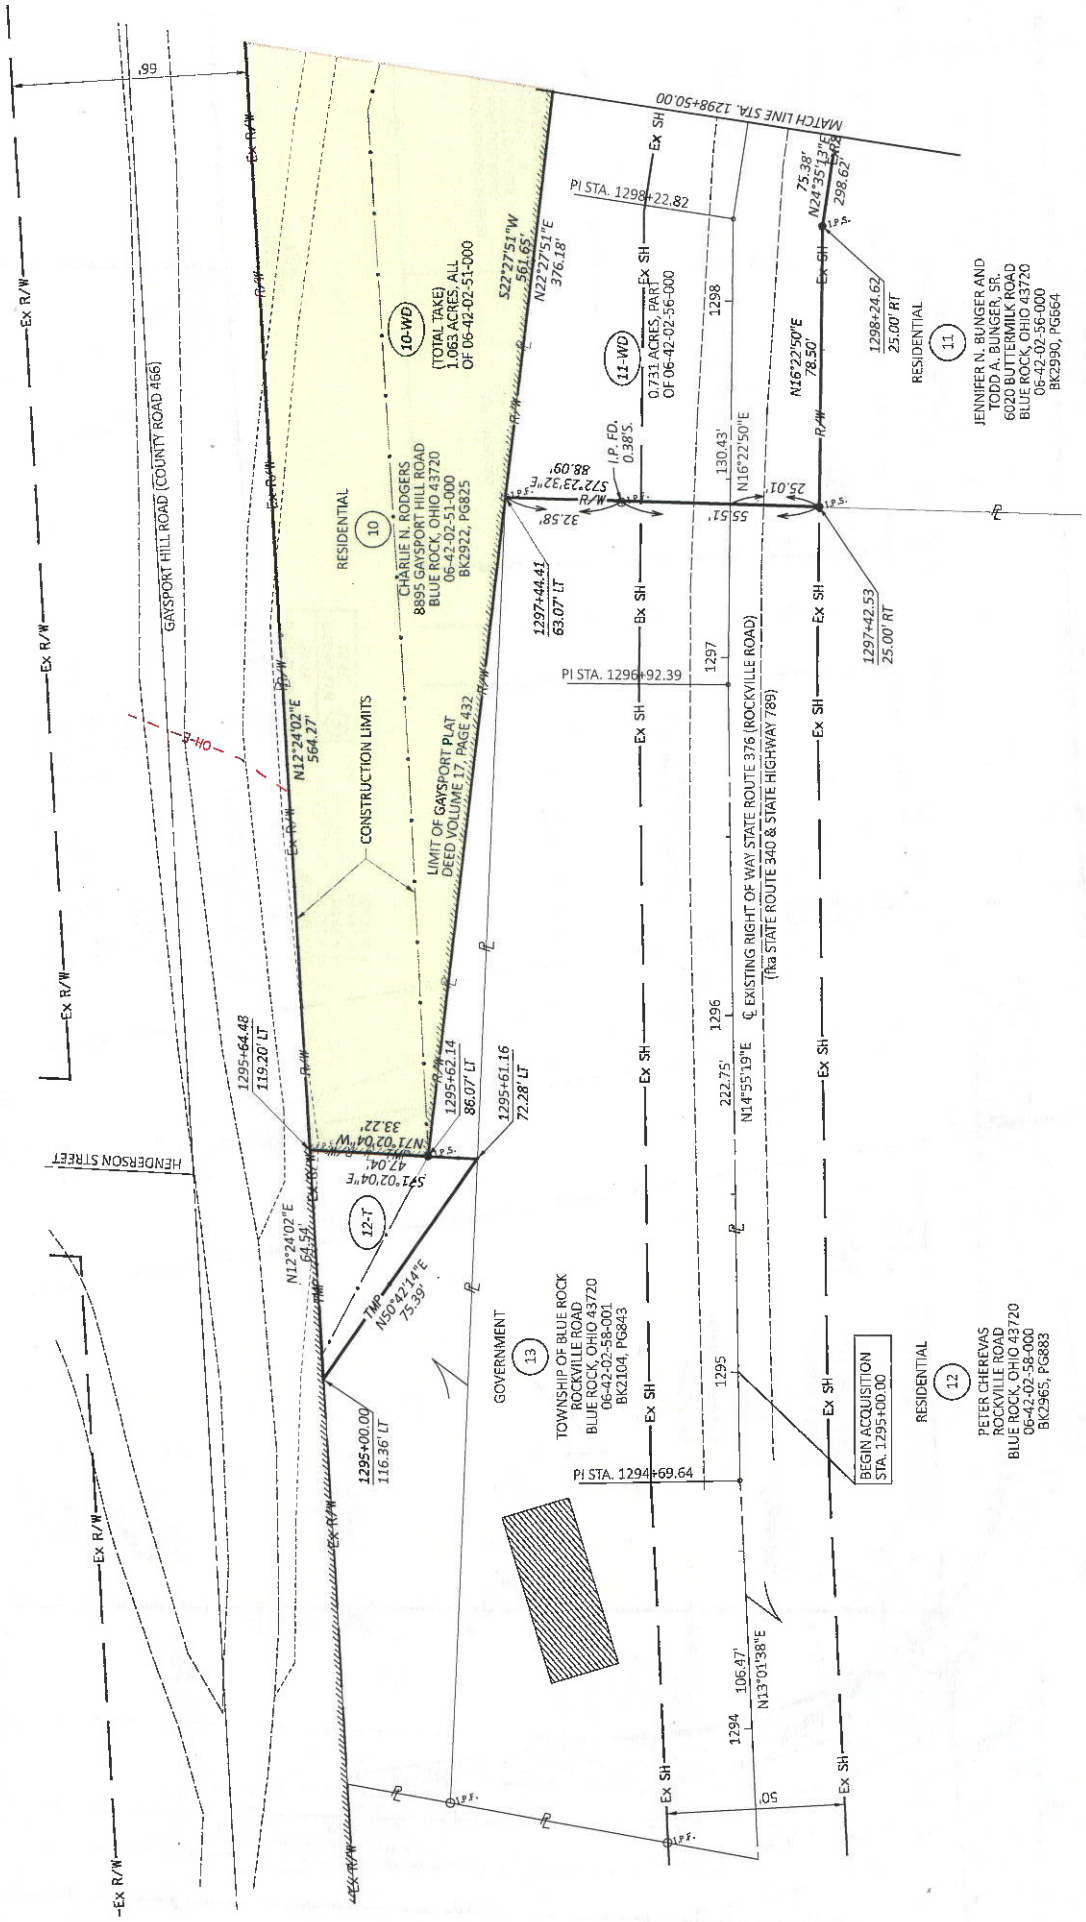


DESIGNER	JPS
REVIEWER	FDS 05/03/23
PROJECT ID	115989
SHEET TOTAL	7
R/W.6	7



DESCRIPTION
 APPROVED
 By: *[Signature]* M = 10 hours

REV. BY	DATE	DESCRIPTION

DATE COMPLETED 05/03/2023

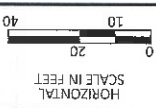


RIGHT OF WAY DETAIL SHEET
 STA. 1298+50.00 TO STA. 1304+50.00

DESIGN AGENCY	TF ASSOCIATES
DESIGNER	JPS
REVIEWER	FDS 05/03/23
PROJECT ID	115989
SHEET TOTAL	7
RAW.7	

CHARLIE N. RODGERS
 (10)

JENNIFER N. BUNGER AND
 TODD A. BUNGER, SR.
 (11)

MUSKINGUM COUNTY
 BLUE ROCK TOWNSHIP
 SECTION 20, TOWNSHIP 12, RANGE 12
 CONGRESS LANDS EAST OF SCIOTO RIVER

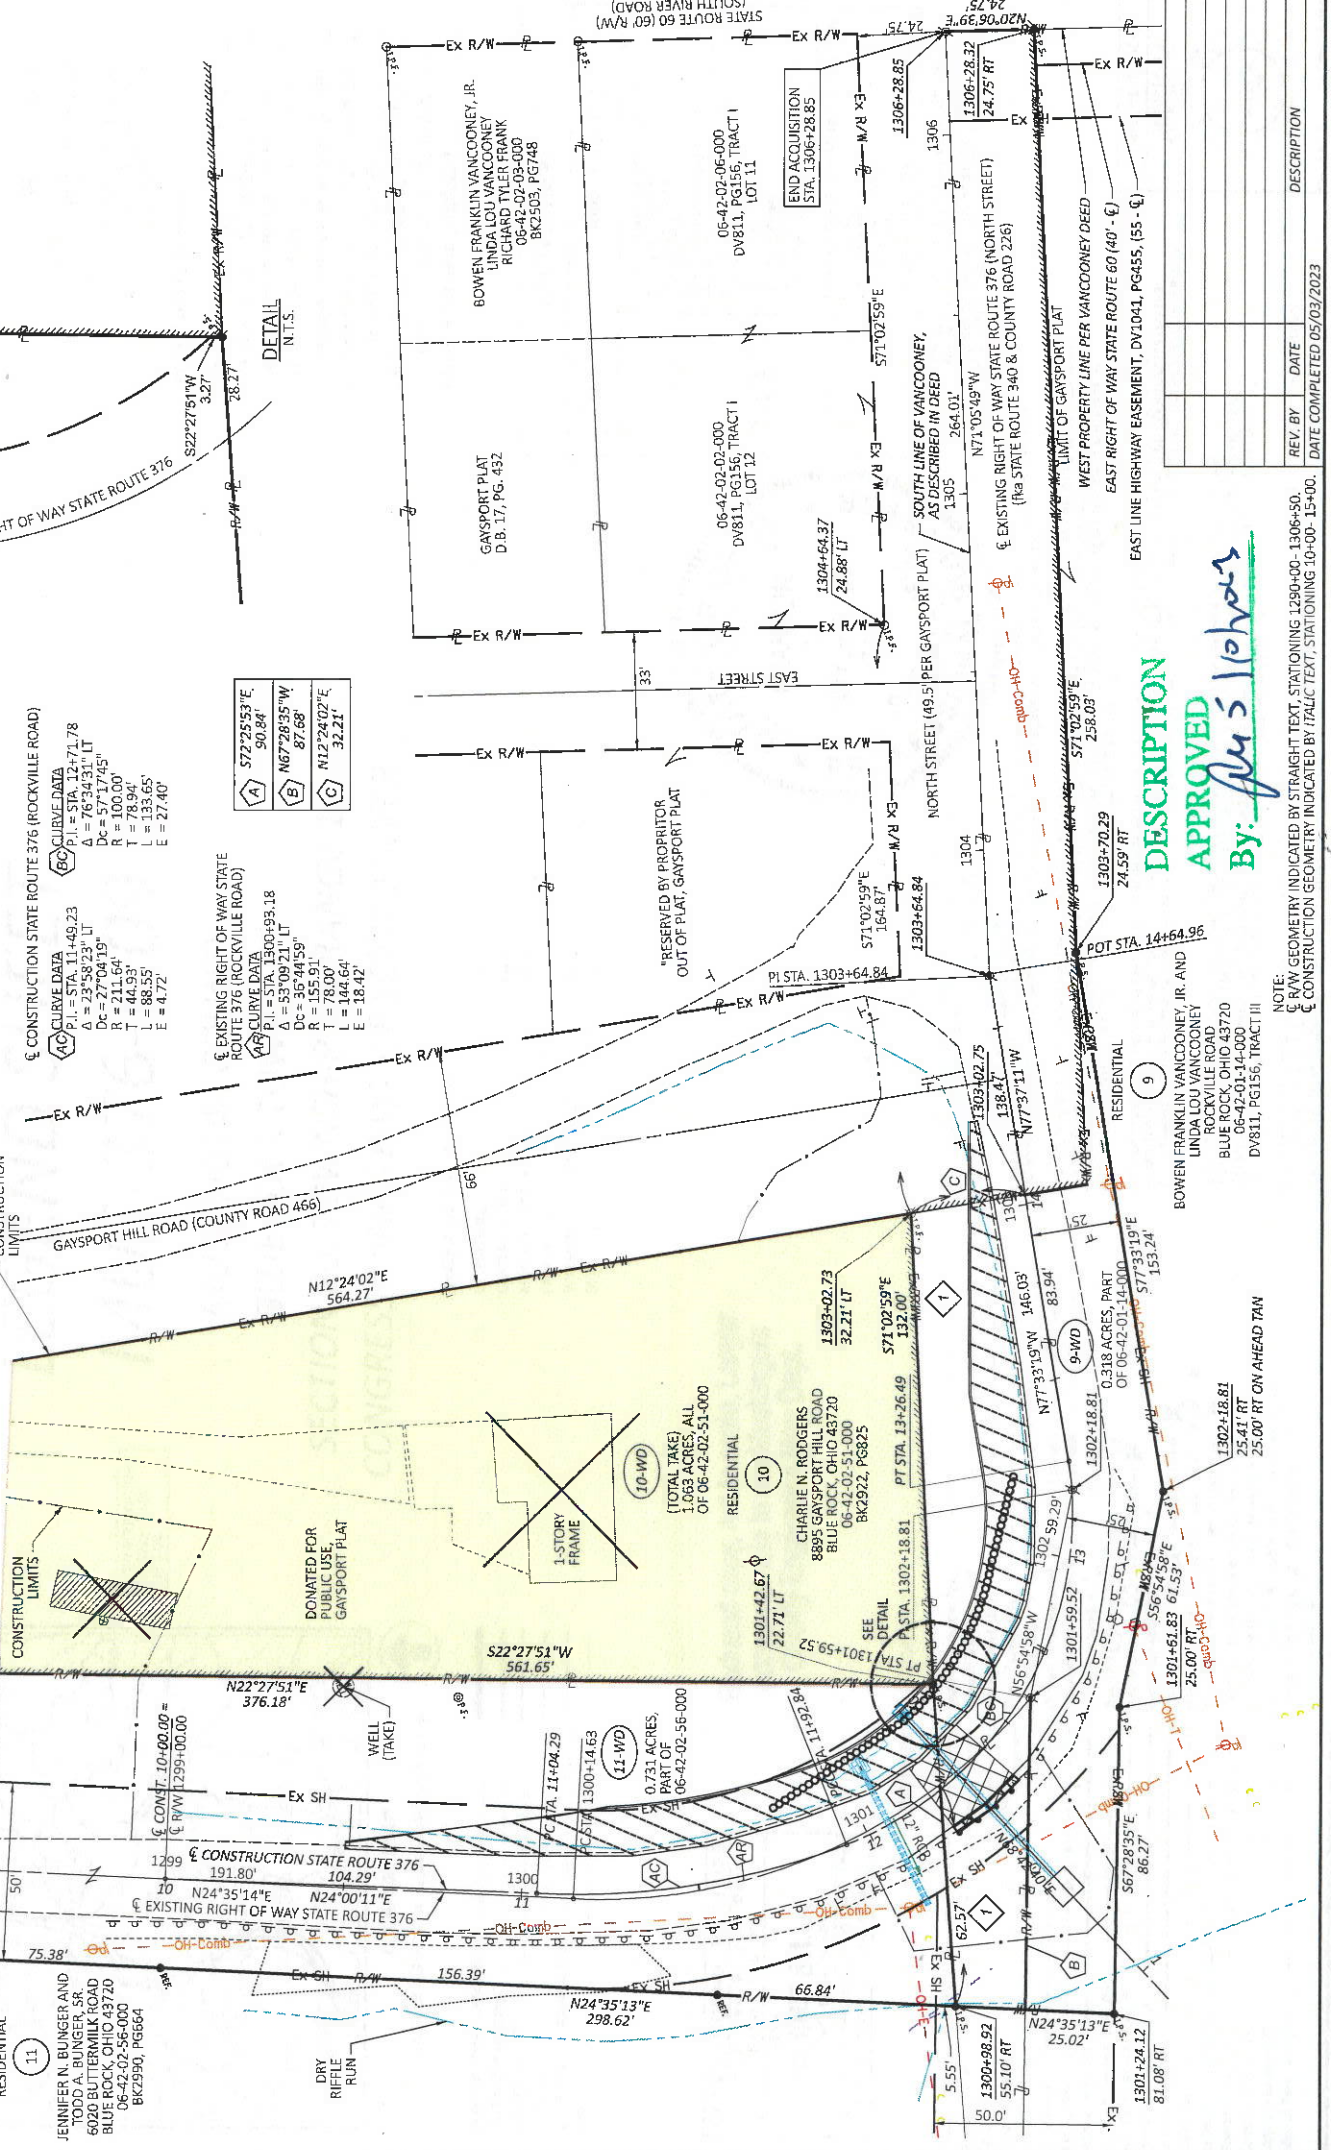

CONSTRUCTION STATE ROUTE 376 (ROCKVILLE ROAD)

CURVE DATA	
P.I. = STA. 12+71.78	
$\Delta = 76^{\circ}34'31''$ LT	
$D_c = 23^{\circ}58'23''$ LT	
$R = 100.00'$	
$T = 57^{\circ}17'45''$	
$L = 78.94'$	
$E = 133.65'$	
$E = 27.40'$	

EXISTING RIGHT OF WAY STATE ROUTE 376 (ROCKVILLE ROAD)

$S72^{\circ}25'53''E$	50.84'
$N67^{\circ}29'35''W$	87.68'
$N12^{\circ}24'02''E$	32.21'

EXISTING RIGHT OF WAY STATE ROUTE 376 (ROCKVILLE ROAD)

P.I. = STA. 10+99.18	
$\Delta = 23^{\circ}58'23''$ LT	
$D_c = 27^{\circ}04'19''$	
$R = 100.00'$	
$T = 57^{\circ}17'45''$	
$L = 78.94'$	
$E = 133.65'$	
$E = 27.40'$	

DESCRIPTION
 APPROVED
 By: *Jay's Lopez*

REV. BY	DATE	DESCRIPTION

NOTE:
 R/W GEOMETRY INDICATED BY STRAIGHT TEXT, STATIONING 1290+00 - 1306+50.
 CONSTRUCTION GEOMETRY INDICATED BY ITALIC TEXT, STATIONING 10+00 - 15+00.

THIS AREA WITHIN EXISTING RIGHTS OF WAY NOT DESCRIBED IN RECORD DEEDS.

JENNIFER N. BUNGER AND
 TODD A. BUNGER, SR.
 6010 ROCKVILLE ROAD
 BLUE ROCK, OHIO 43720
 06-42-02-SF-000
 BK2590, PG664

DONATED FOR PUBLIC USE
 GAYSPORT PLAT

RESERVED BY PROPRIETOR
 OUT OF PLAT, GAYSPORT PLAT

CHARLIE N. RODGERS
 8895 GAYSPORT HILL ROAD
 BLUE ROCK, OHIO 43720
 06-42-02-SF-000
 BK2922, PG825

BOWEN FRANKLIN VANCOONEY, JR.
 LINDA LOU VANCOONEY
 ROCKVILLE ROAD
 BLUE ROCK, OHIO 43720
 06-42-01-14-000
 DV811, PG156, TRACT III