




PLAN-CENTER SPAN

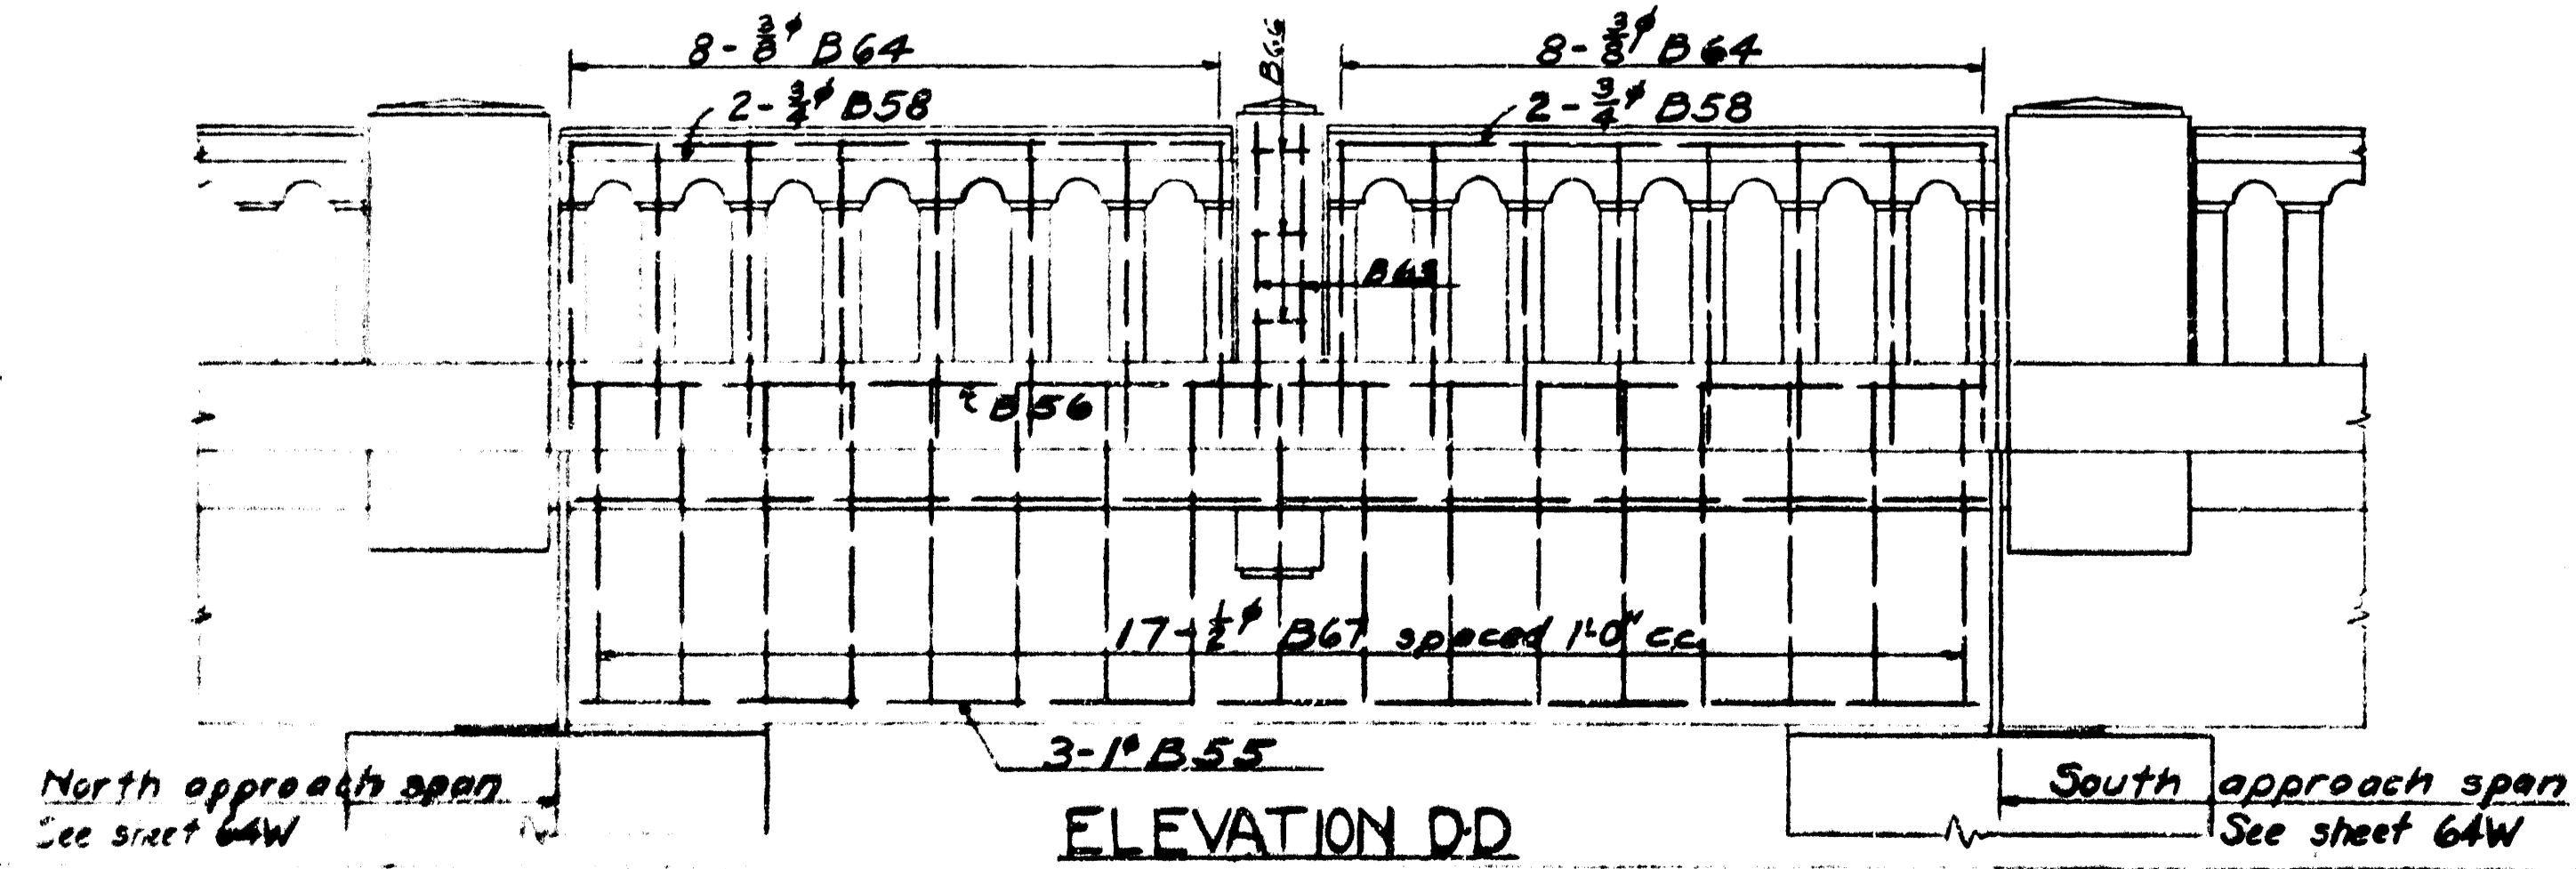


ELEVATION DD

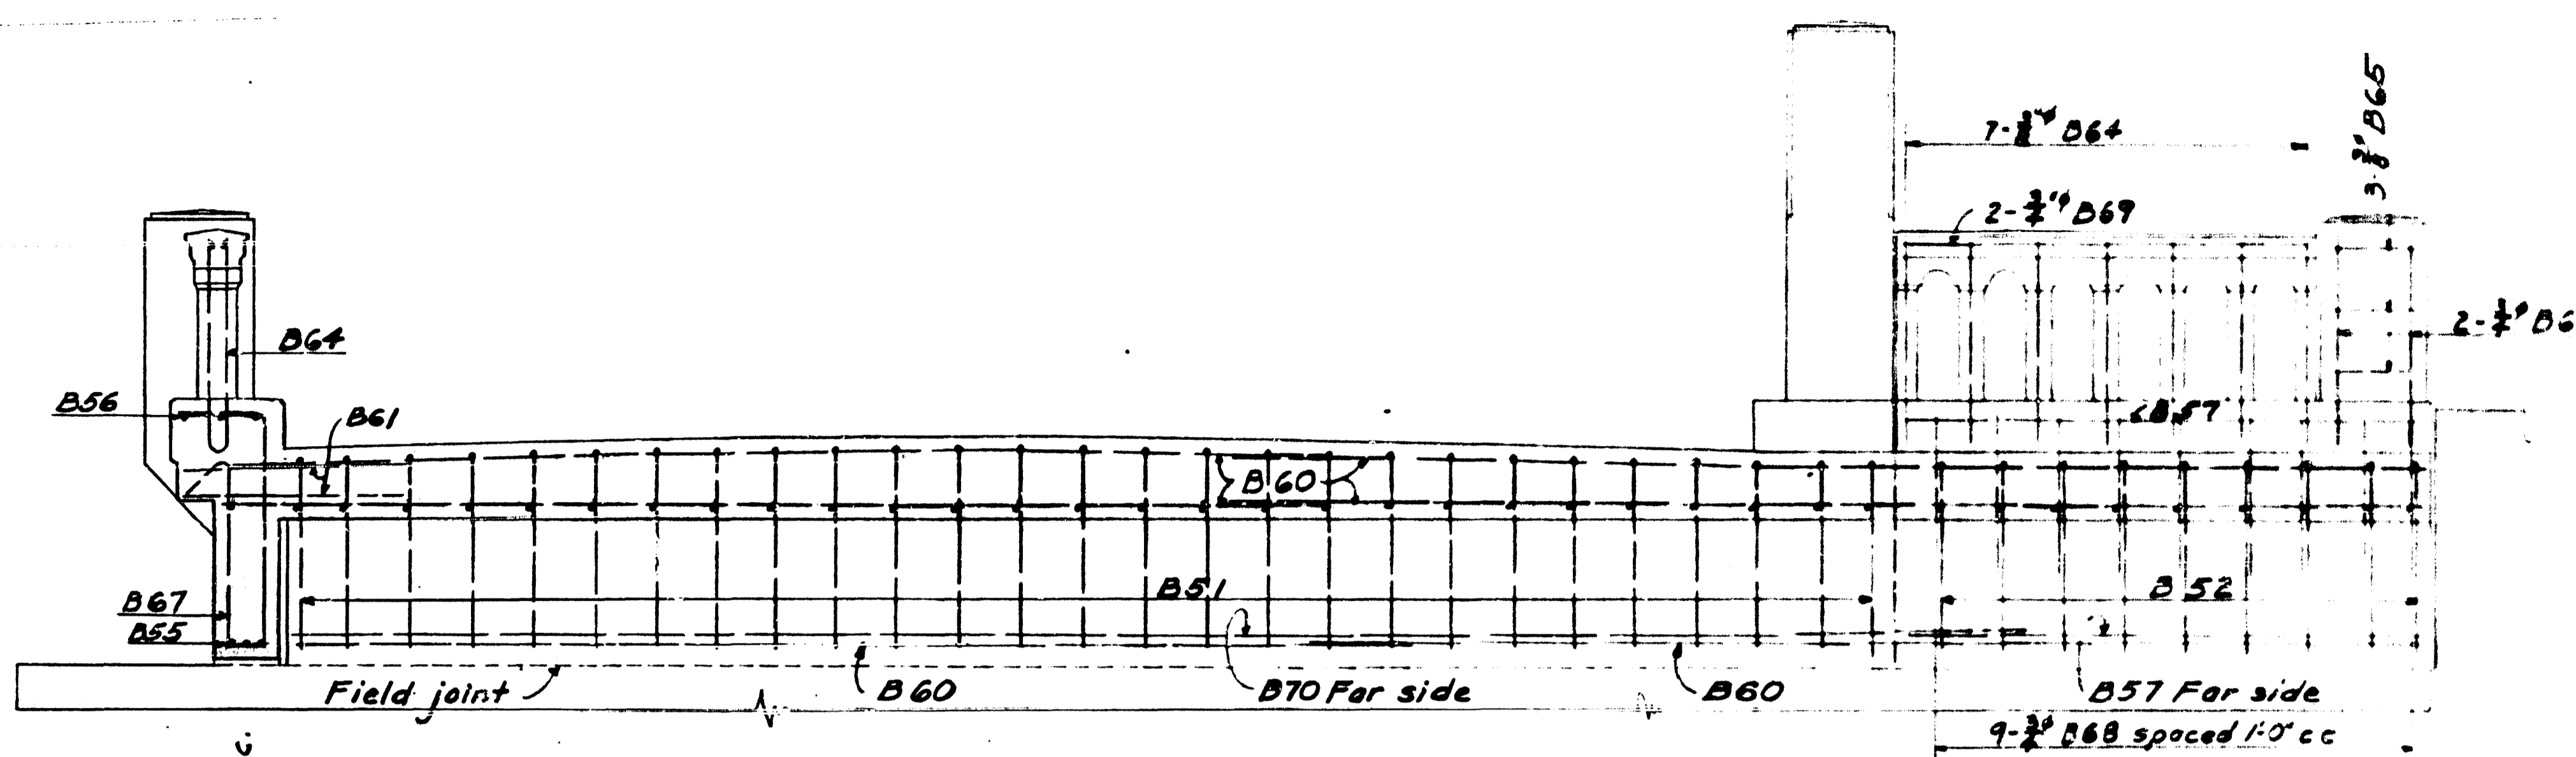


SECTION BB

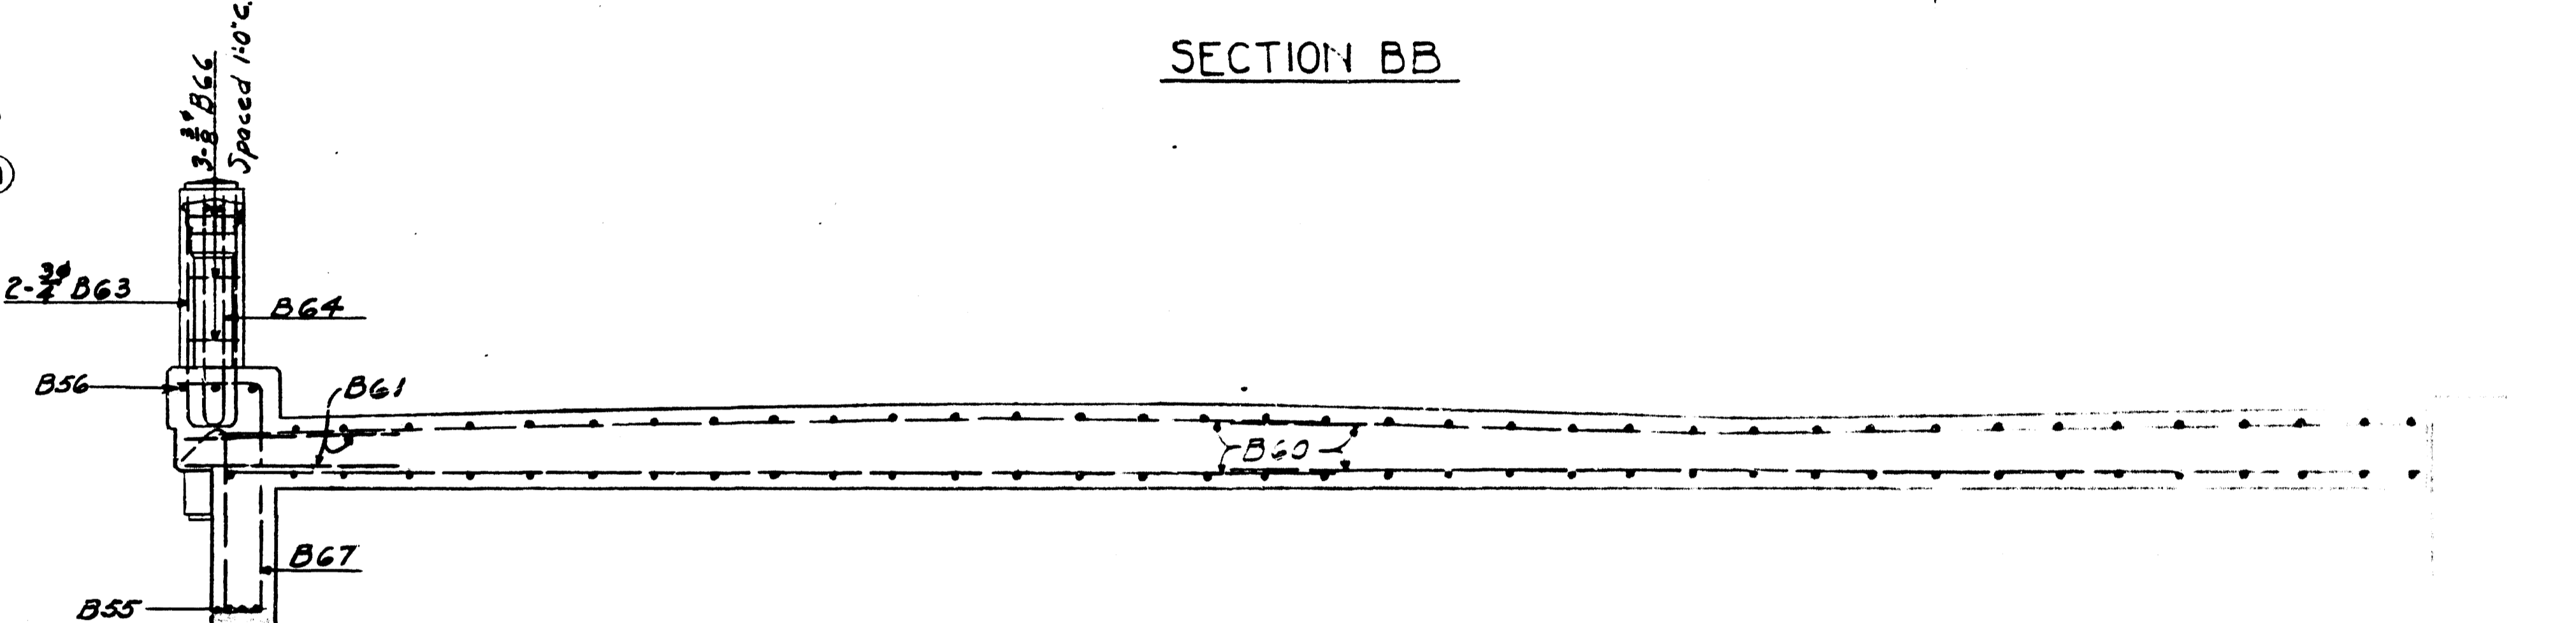

SECTION CC

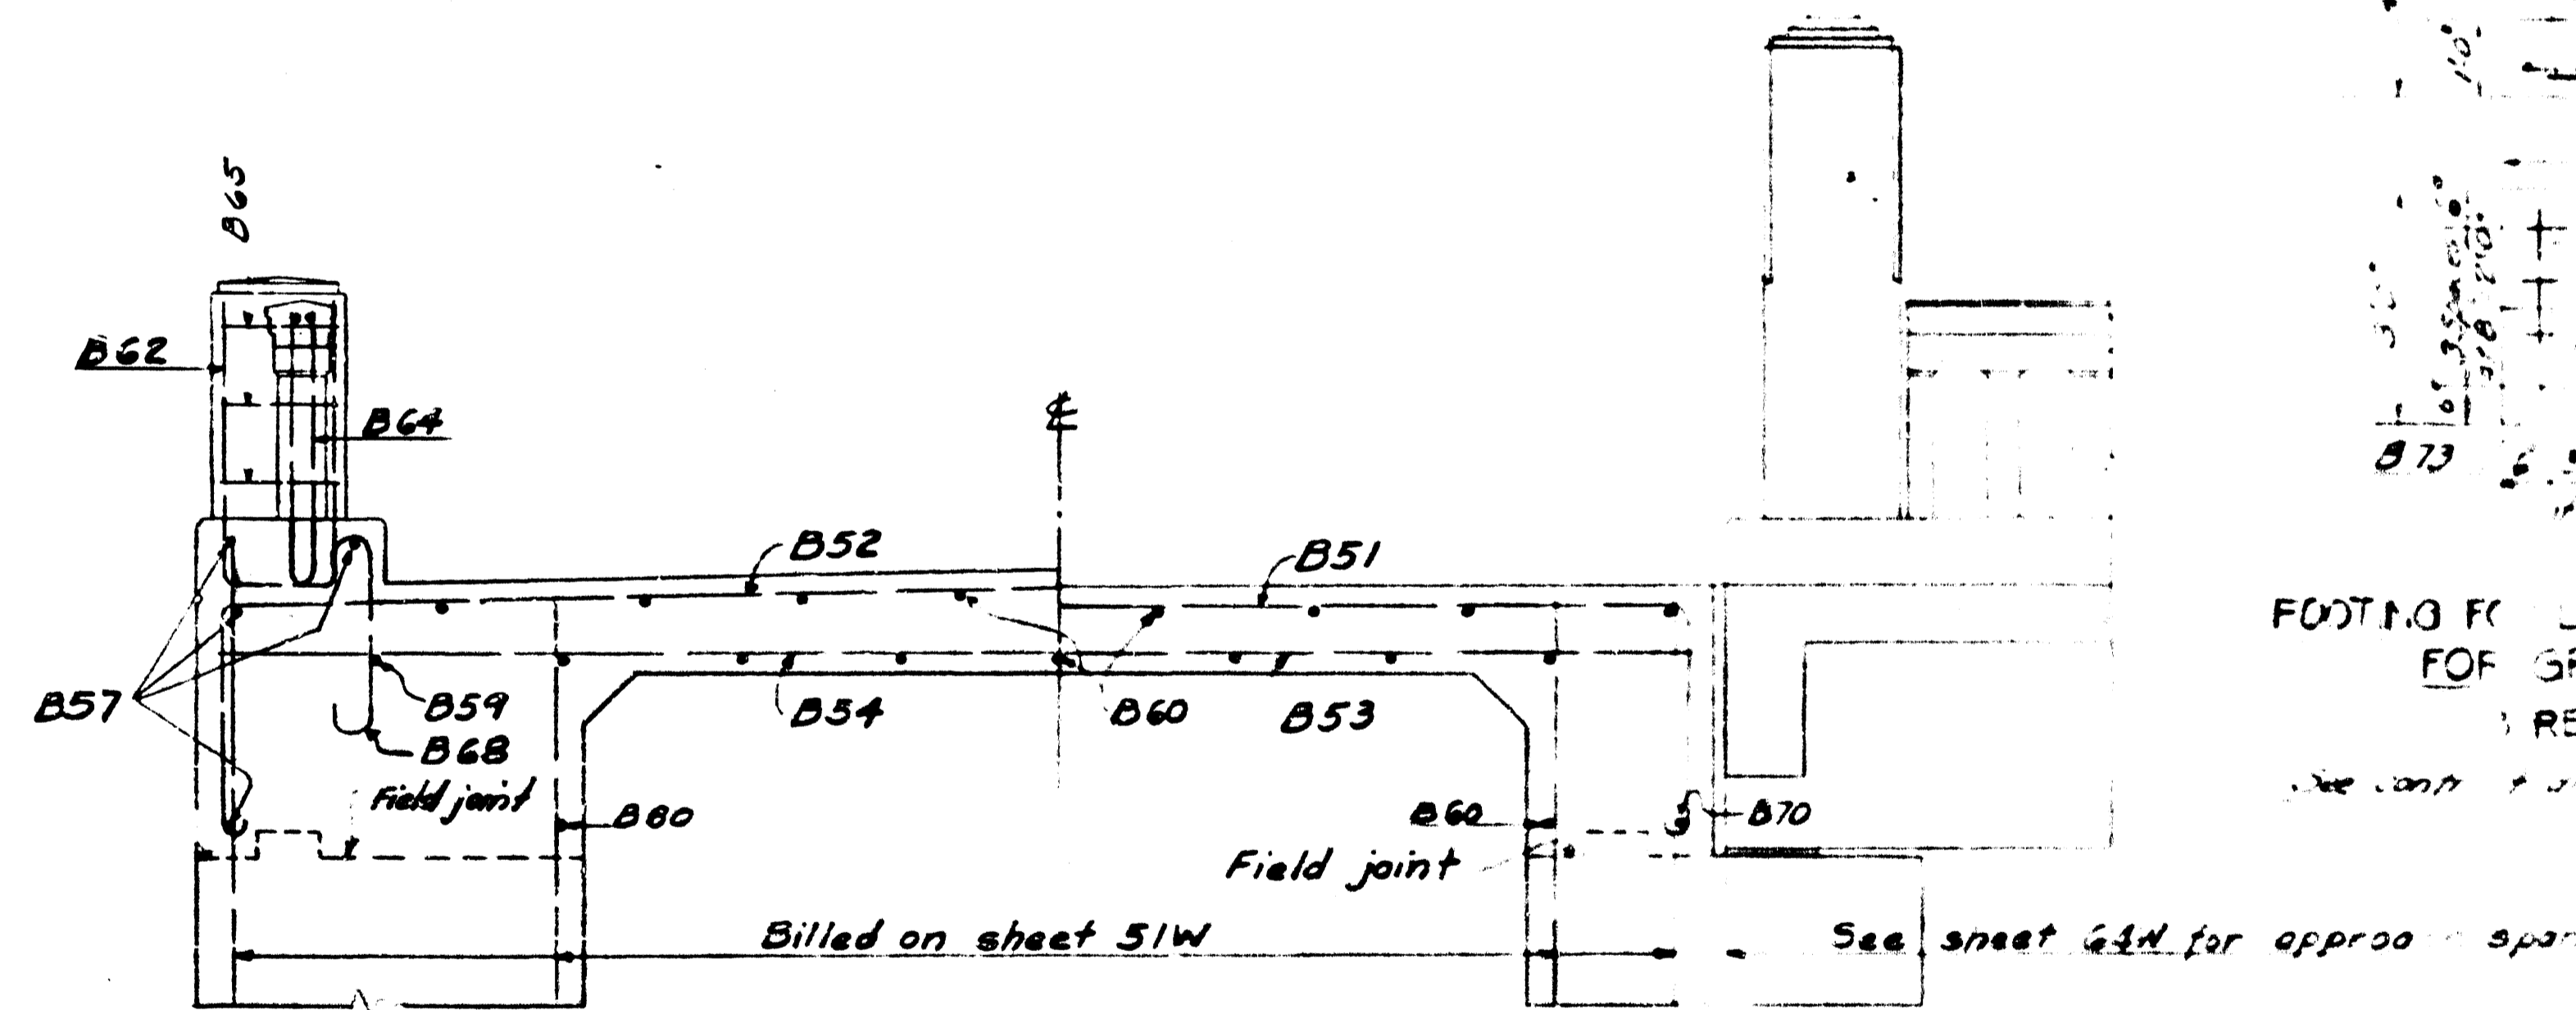

SECTION AA

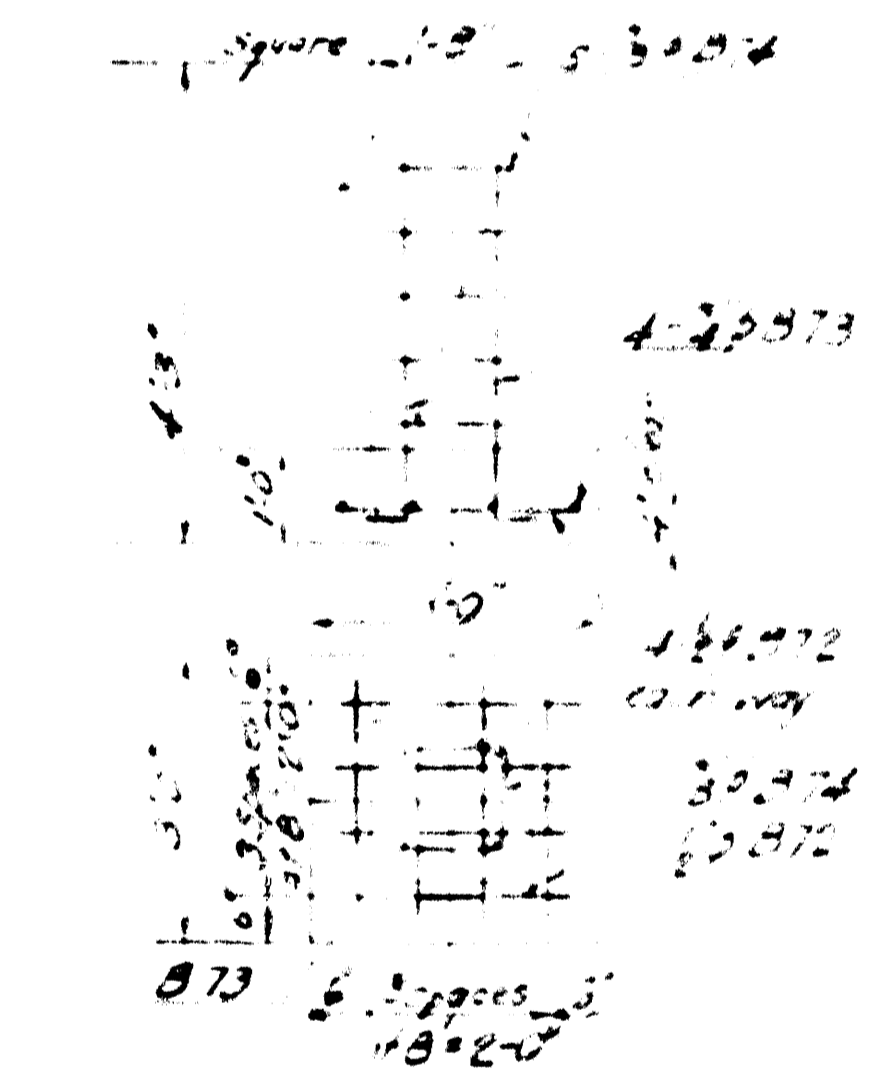

FOOTING FOR LAMP POSTS
FOR GROUNDS
REQUIRED
See sheet 63W for details of

NOTES:-
For bar schedule see sheet 68W
For reinforcement of center spans see sheet 64W
For construction details see sheets 18 & 19
Distance from face of concrete to main reinforcement is 2 inches.

WORK AS ACTUALLY CONSTRUCTED
REVISIONS
SERIAL 1541
CHECKED BY: [Signature]
SCALE: 1/4\"/>