

KNO-36-1872
BRIDGE NO

KNOX
COUNTY

36
ROUTE NO.

339
S H NO.

F
SECTION


H10 H12 H15 H20
STRENGTH

15-18 19-22 23 +
ROADWAY


12- 12-14 14 +
CLEARANCE

OPEN A B G S T
TYPE

SKETCH OF STRUCTURE SHOWING DIMENSIONS

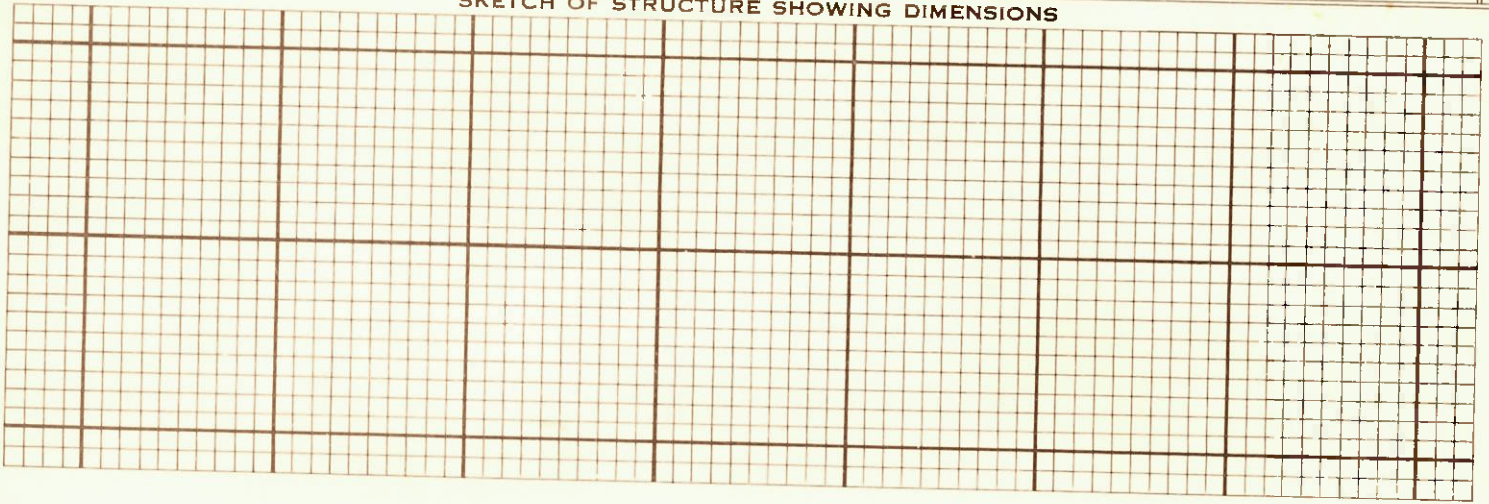

LOCATION SKETCH

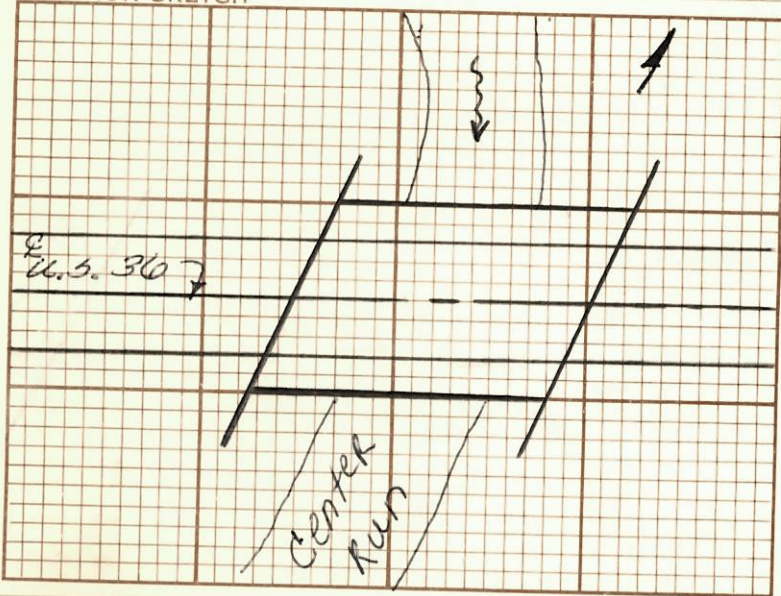

REMARKS:-

Built on project 459(90)
by: MFDANIEL'S CONST. CORP.
TOTAL PROJ COST \$ 286,855

DA, A. = 8.59 SQ. MILES