
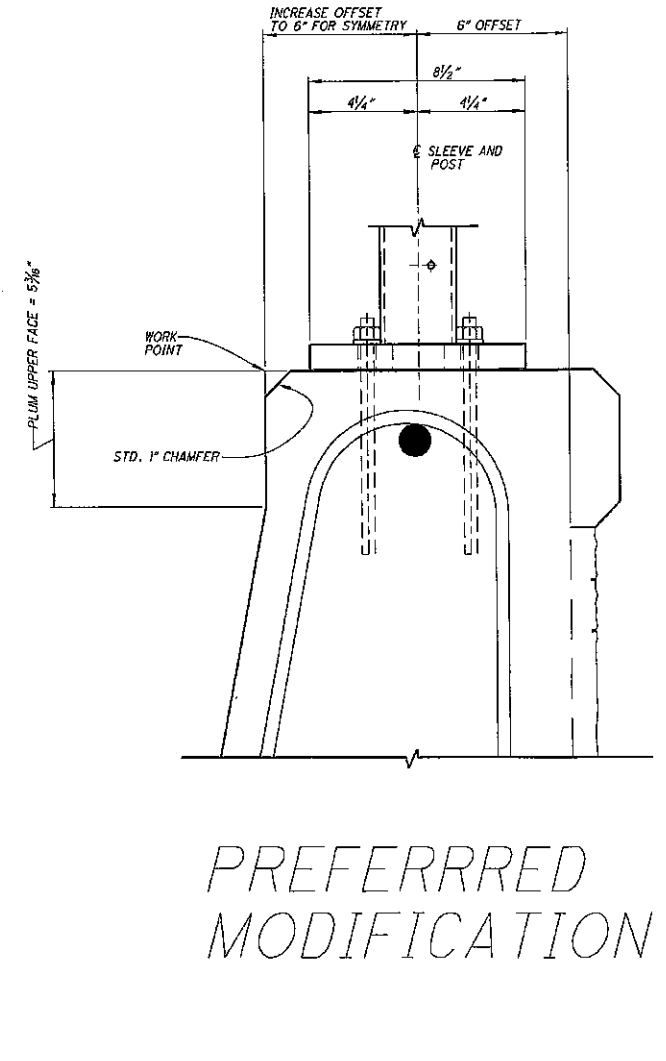
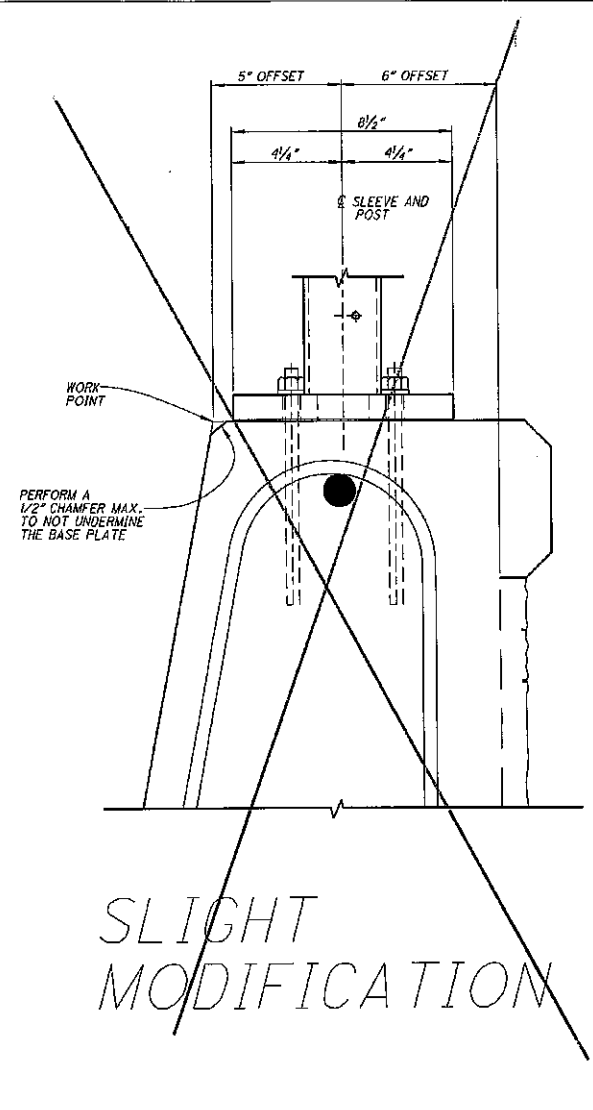


Detail With

1/27/2016 Modification

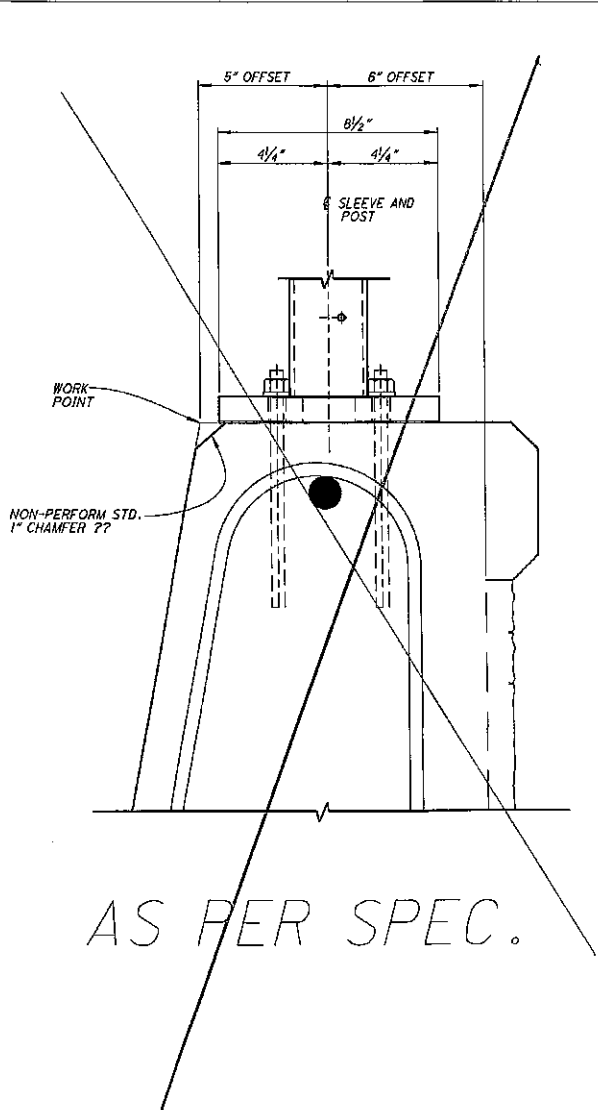

LEFT PARPET SECTION WITH FENCE ATOP