



Montoya, Katherine

From: Moran, Alan P. <APMoran@columbus.gov>
Sent: Thursday, April 18, 2024 4:16 PM
To: Law, Mark W.
Subject: RE: You're Invited to:DPS 3973E FRA--11-15.80 Noise Wall Stage 2 (2nd Review) 18 Apr 2024

Mark,

I apologize for the late response.

The proposed solution at Barrier 12 for Outlet #106400 does give me some concern that the roadway base drainage at that location would be dependent on the underdrain system for the noise wall. Instead, can the roadway underdrain outlet be extended beyond the Noise Wall 12 allowing it to outlet to the ditch?

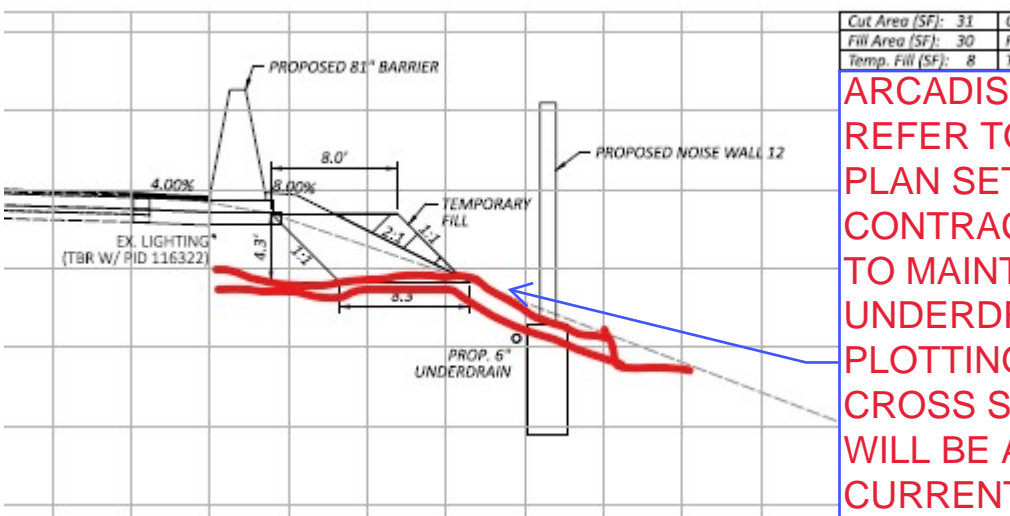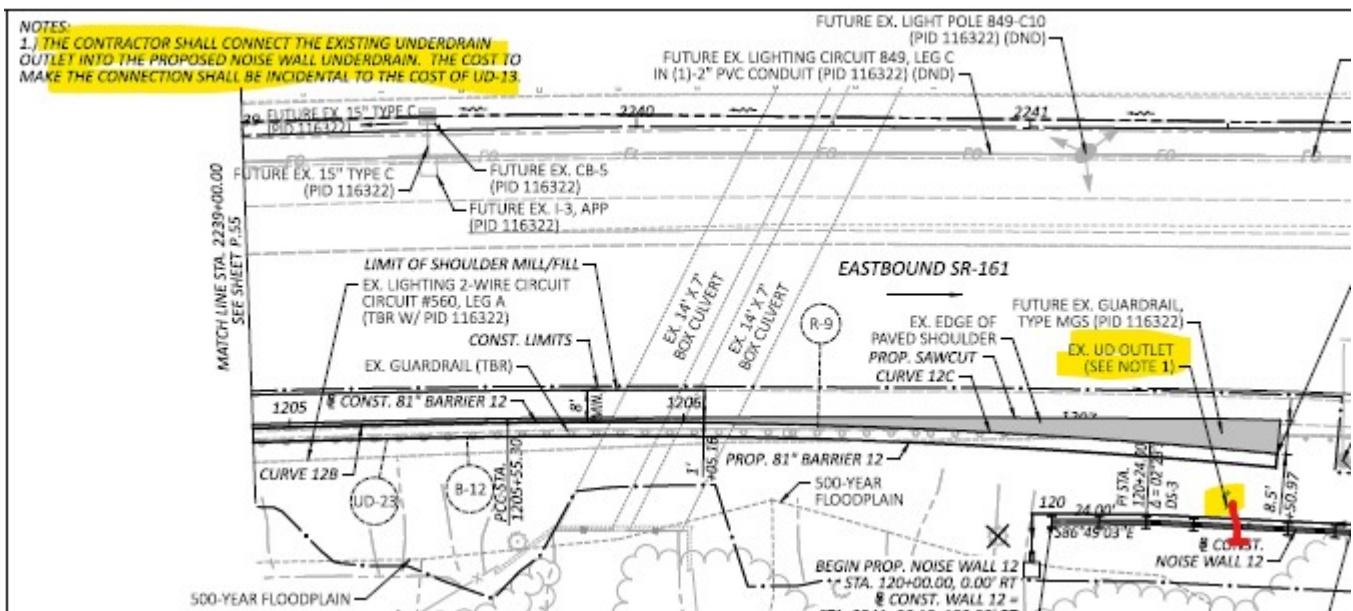

ARCADIS RESPONSE: PLEASE REFER TO PAGE 182 OF THE PLAN SET FOR NOTES AND CONTRACTOR REQUIREMENTS TO MAINTAIN POSITIVE UNDERDRAIN OUTLET. AFTER PLOTTING THE OUTLET IN THE CROSS SECTION, THE OUTLET WILL BE ABLE TO DRAIN AT IT'S CURRENT LOCATION AND WILL NOT REQUIRE TO BE EXTENDED UNDER THE NOISE WALL.

Thanks,

Alan

Alan P Moran, PE

Long Range Planning Section Manager

Direct: 614.645.7061
www.columbus.gov

From: Law, Mark W. <MWLaw@columbus.gov>
Sent: Tuesday, April 16, 2024 8:14 AM
To: Moran, Alan P. <APMoran@columbus.gov>
Subject: RE: You're Invited to:DPS 3973E FRA--11-15.80 Noise Wall Stage 2 (2nd Review) 16 Apr 2024

Alan
We included your comments on the drainage. The session for Stage 3 just closed, and I didn't see your stamp, or a note on the plans as to your status of comments addressed.

Are you satisfied they answered your concerns?

The plans are in: [O:\SDFiles\TEMP DR E UNSIGNED PLANS\E03973 \(PUB\) FRA-161-15.80 Noise Wall\2024-03-29 Stage 3 \(3rd Rev\)](O:\SDFiles\TEMP DR E UNSIGNED PLANS\E03973 (PUB) FRA-161-15.80 Noise Wall\2024-03-29 Stage 3 (3rd Rev))

They are due today, please take a look when you can, and get back to me.

Thanks

Mark Law

Plan Review Engineer

111 N. Front St., Sixth Floor
Columbus, OH 43215
Direct: 614.645.0415
Fax: 614.645.268

From: Moran, Alan P.
Sent: Tuesday, February 20, 2024 2:48 PM
To: Law, Mark W. <MWLaw@columbus.gov>; Roberts, Doug <MDRoberts@columbus.gov>
Subject: FW: You're Invited to:DPS 3973E FRA--11-15.80 Noise Wall Stage 2 (2nd Review) 20 Feb 2024

Doug/Mark,

The attached mapping and drain location information should be included with my comment on this set of plans.

Let me know if you have any questions,

Thanks,
Alan

Alan P Moran, PE

Long Range Planning Section Manager

Direct: 614.645.7061
www.columbus.gov