


Cut Area (SF):	21	Cut Vol. (CY):	37
Fill Area (SF):	1	Fill Vol. (CY):	2
Seed Width (FT):		Seed Area (SY):	

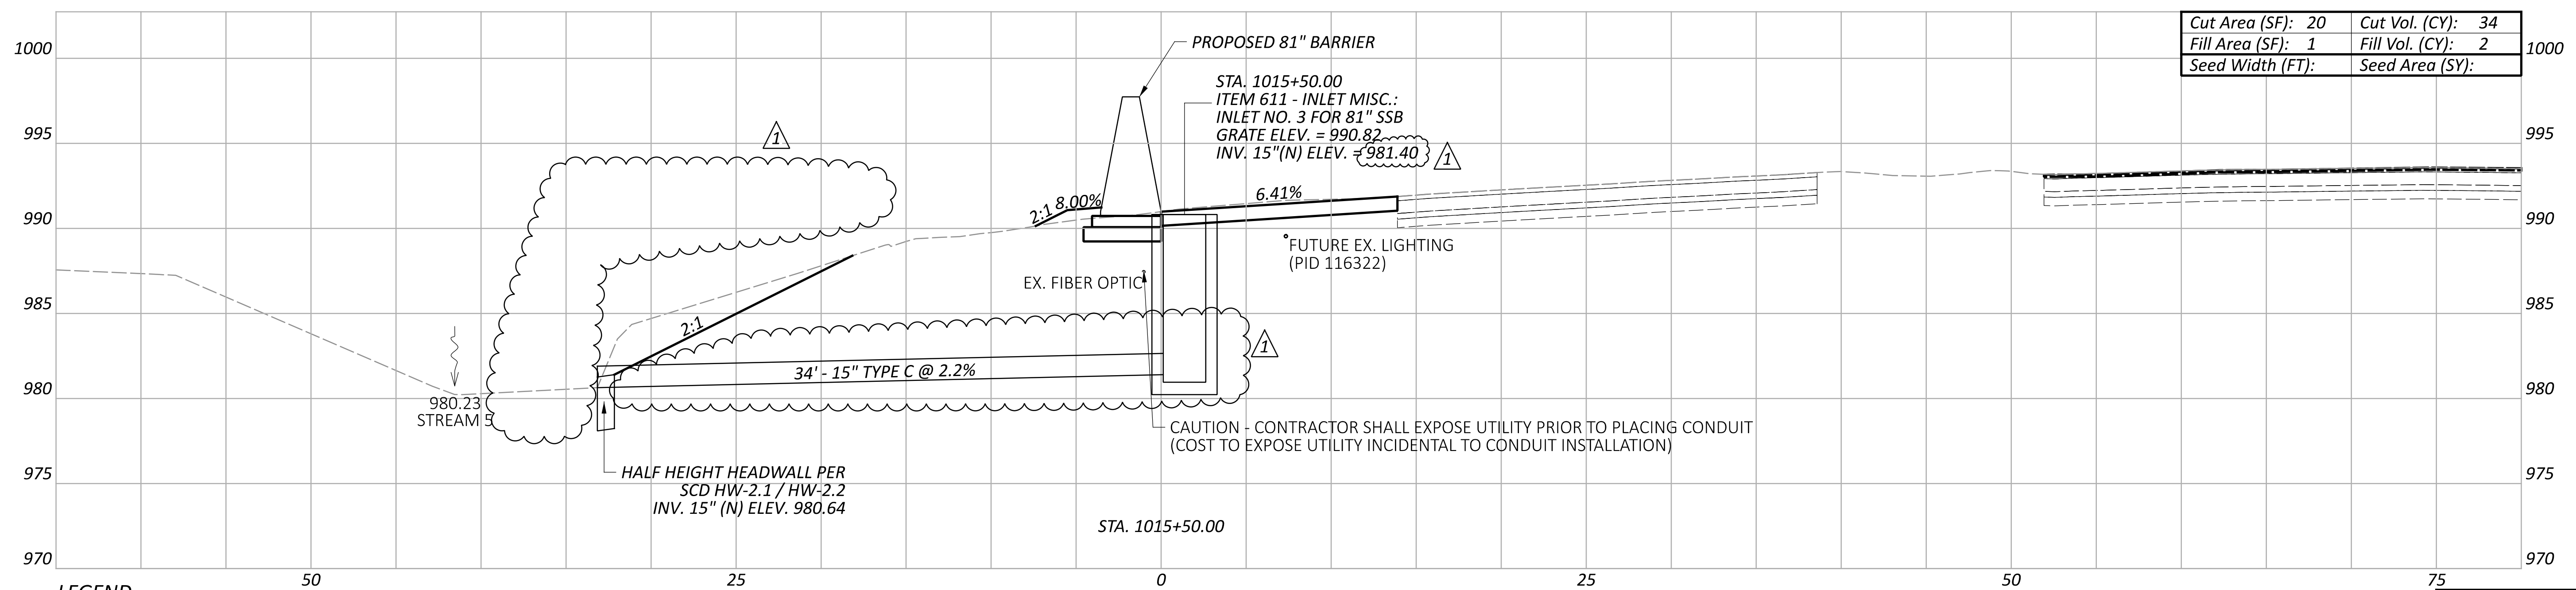

Cut Area (SF):	20	Cut Vol. (CY):	34
Fill Area (SF):	1	Fill Vol. (CY):	2
Seed Width (FT):		Seed Area (SY):	

LEGEND

- - - EXISTING SR-161 PRIOR TO PID 116322
- - - FUTURE EXISTING SR-161 AFTER CONSTRUCTION OF PID 116322

7-08-2024 - REVISED CONDUIT INVERT AND SLOPE, REMOVED RCP.

Sheet Totals			117607
Seeding	Cut	Fill	SHEET TOTAL
	71	4	P.155 P.297