


ALL SHEETS VERIFY PHASING WITH MOT NOTES

**(Ramp NW/Ramp A) Phase 1 Left-Turn from SR435 WB to SB I-71 On-Ramp**

ADD SR 435 STATIONING TO ALL SHEETS

ADD BAR SCALES AND NORTH ARROWS TO ALL SHEETS


ADD WORK ZONE HATCHING TO A LEGEND

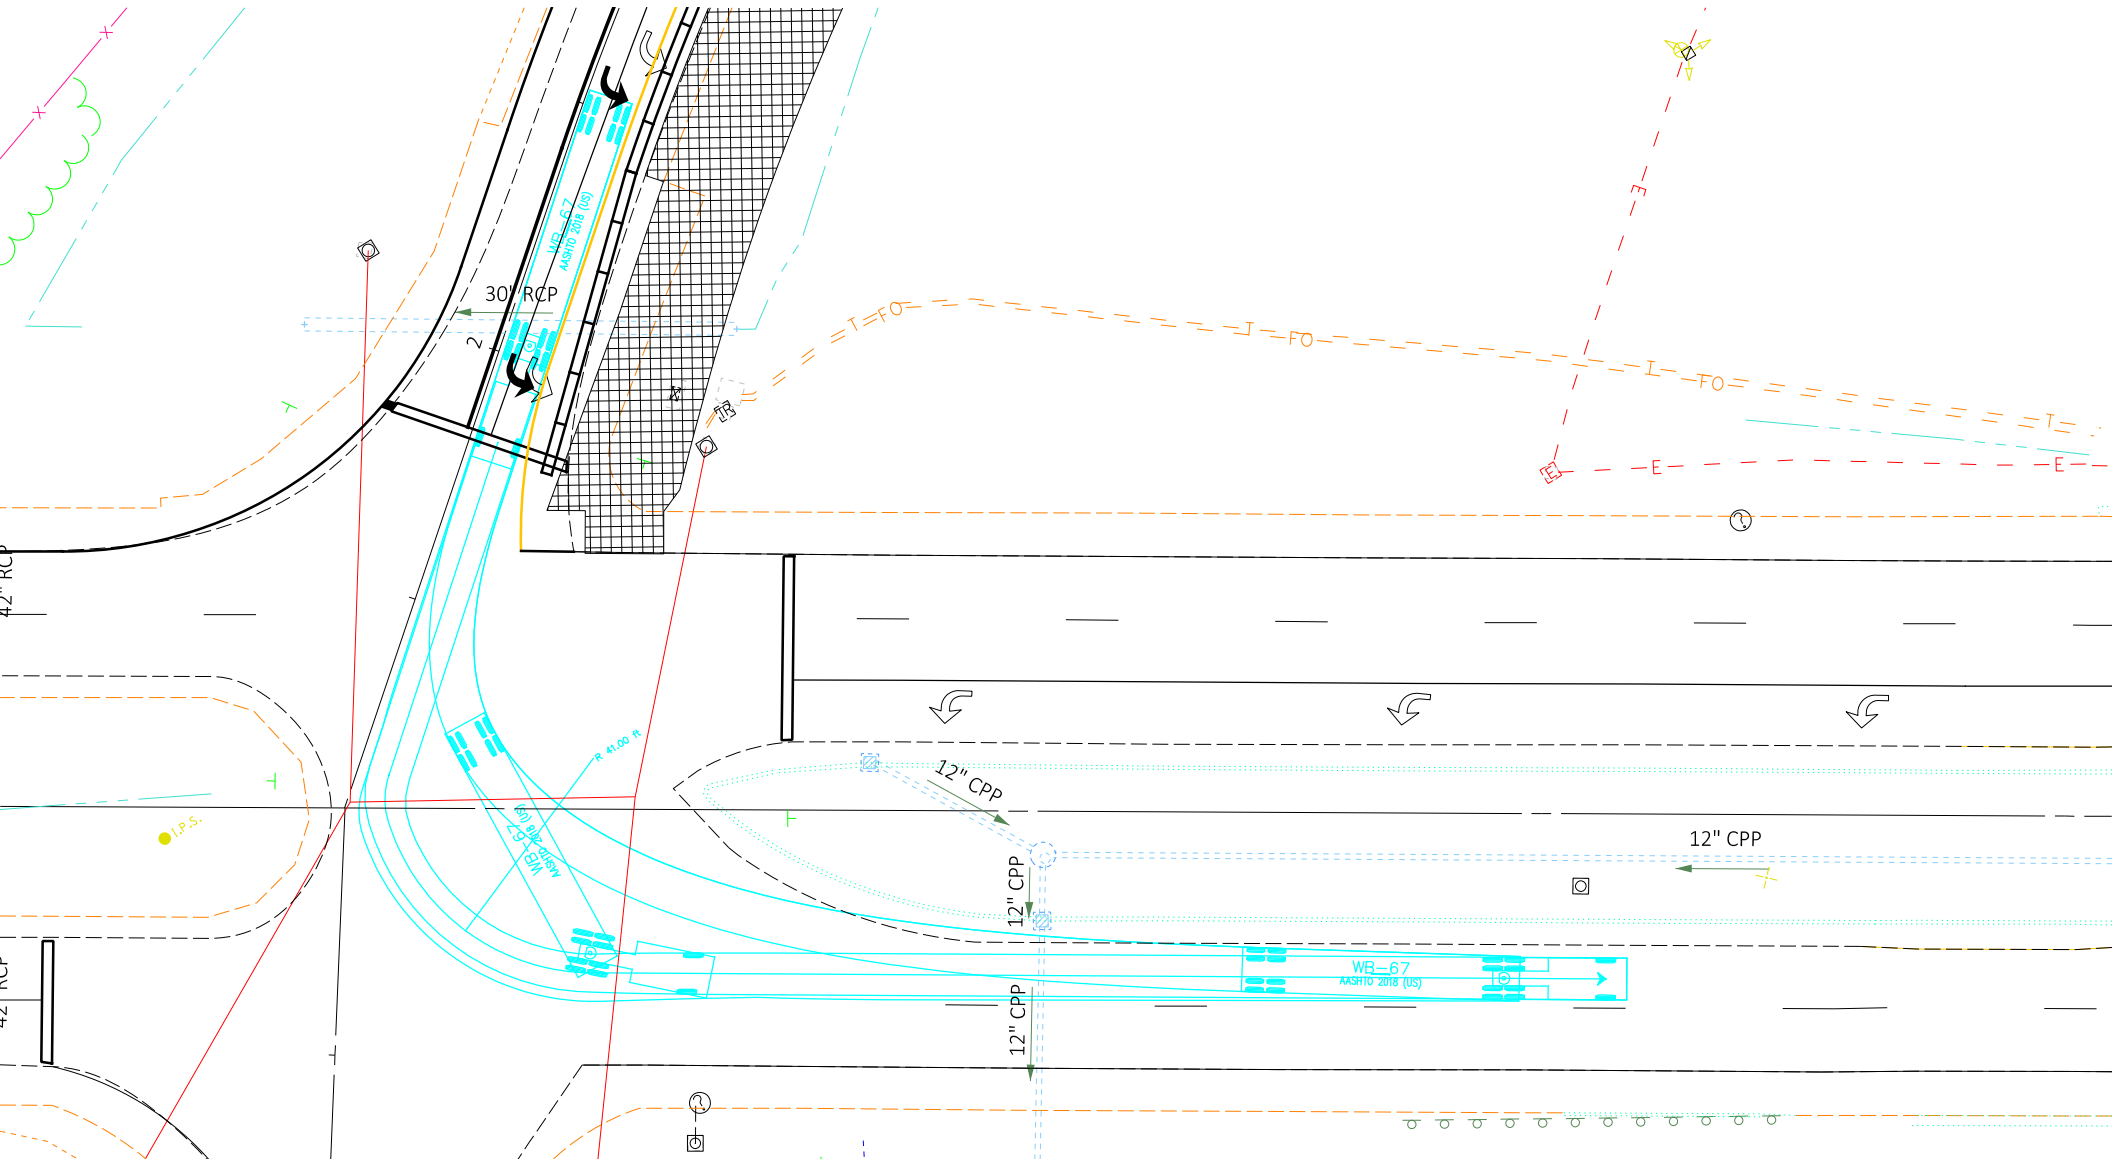

EB


Ramp EN/Ramp B Phase 2 - Left-Turn to EEB SR435




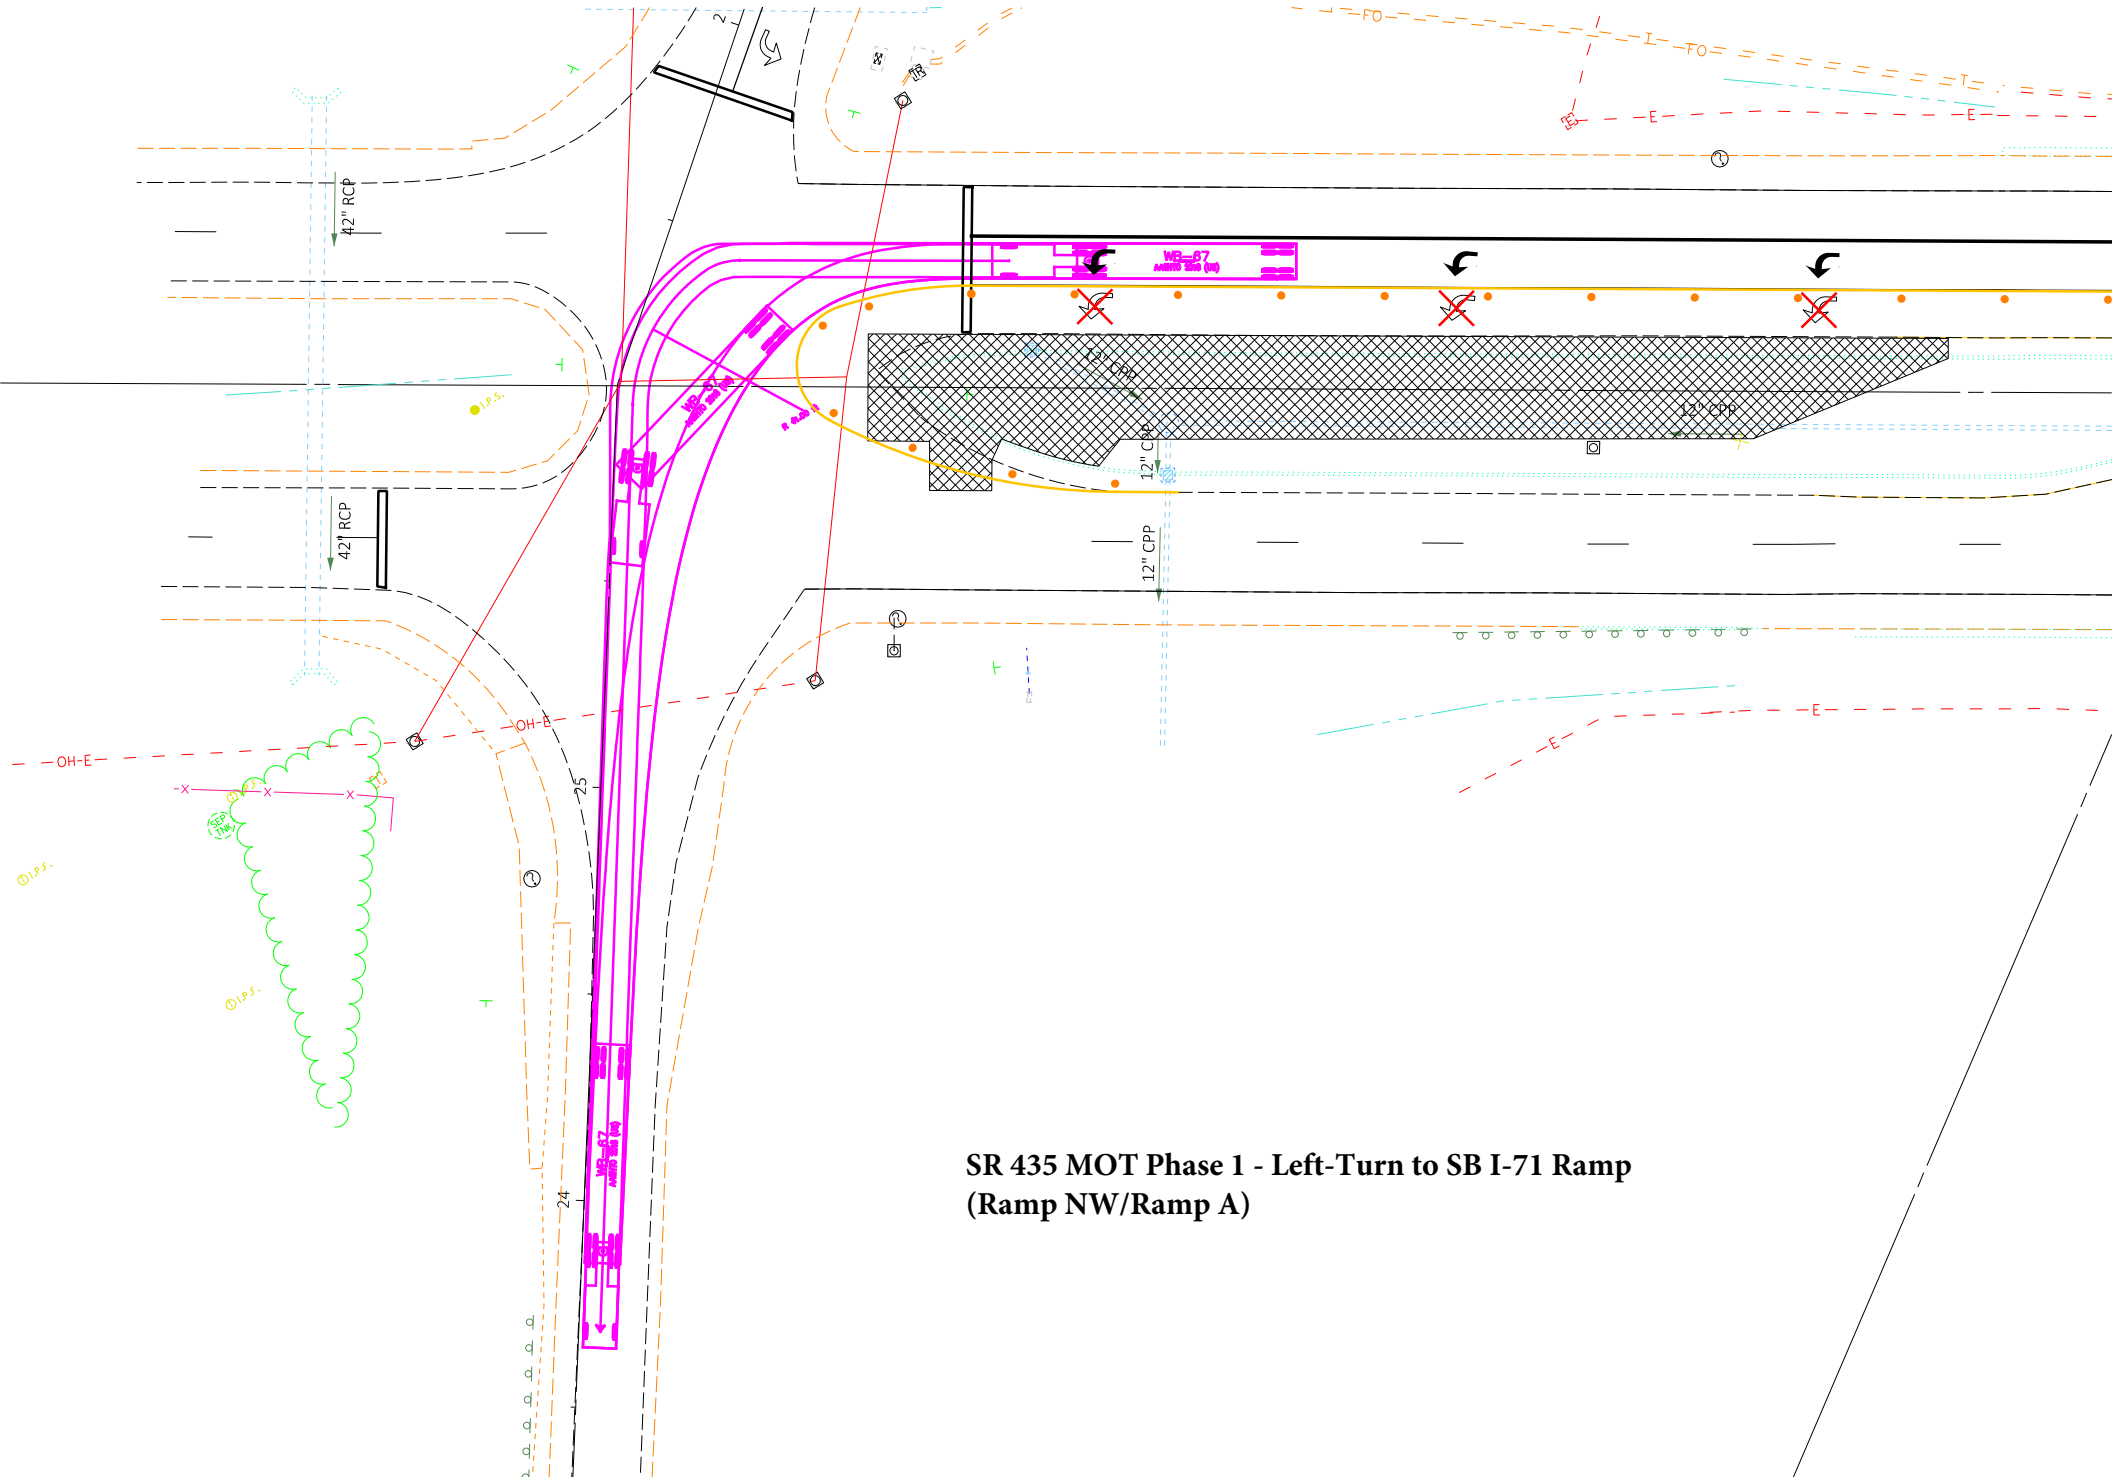


**SR 435 MOT Phase 1 - Left-Turn to SB I-71 Ramp  
(Ramp NW/Ramp A)**

**SR 435 Phase 2 - Right-Turn to I-71 NB On-Ramp  
(Ramp SE/Ramp C)**

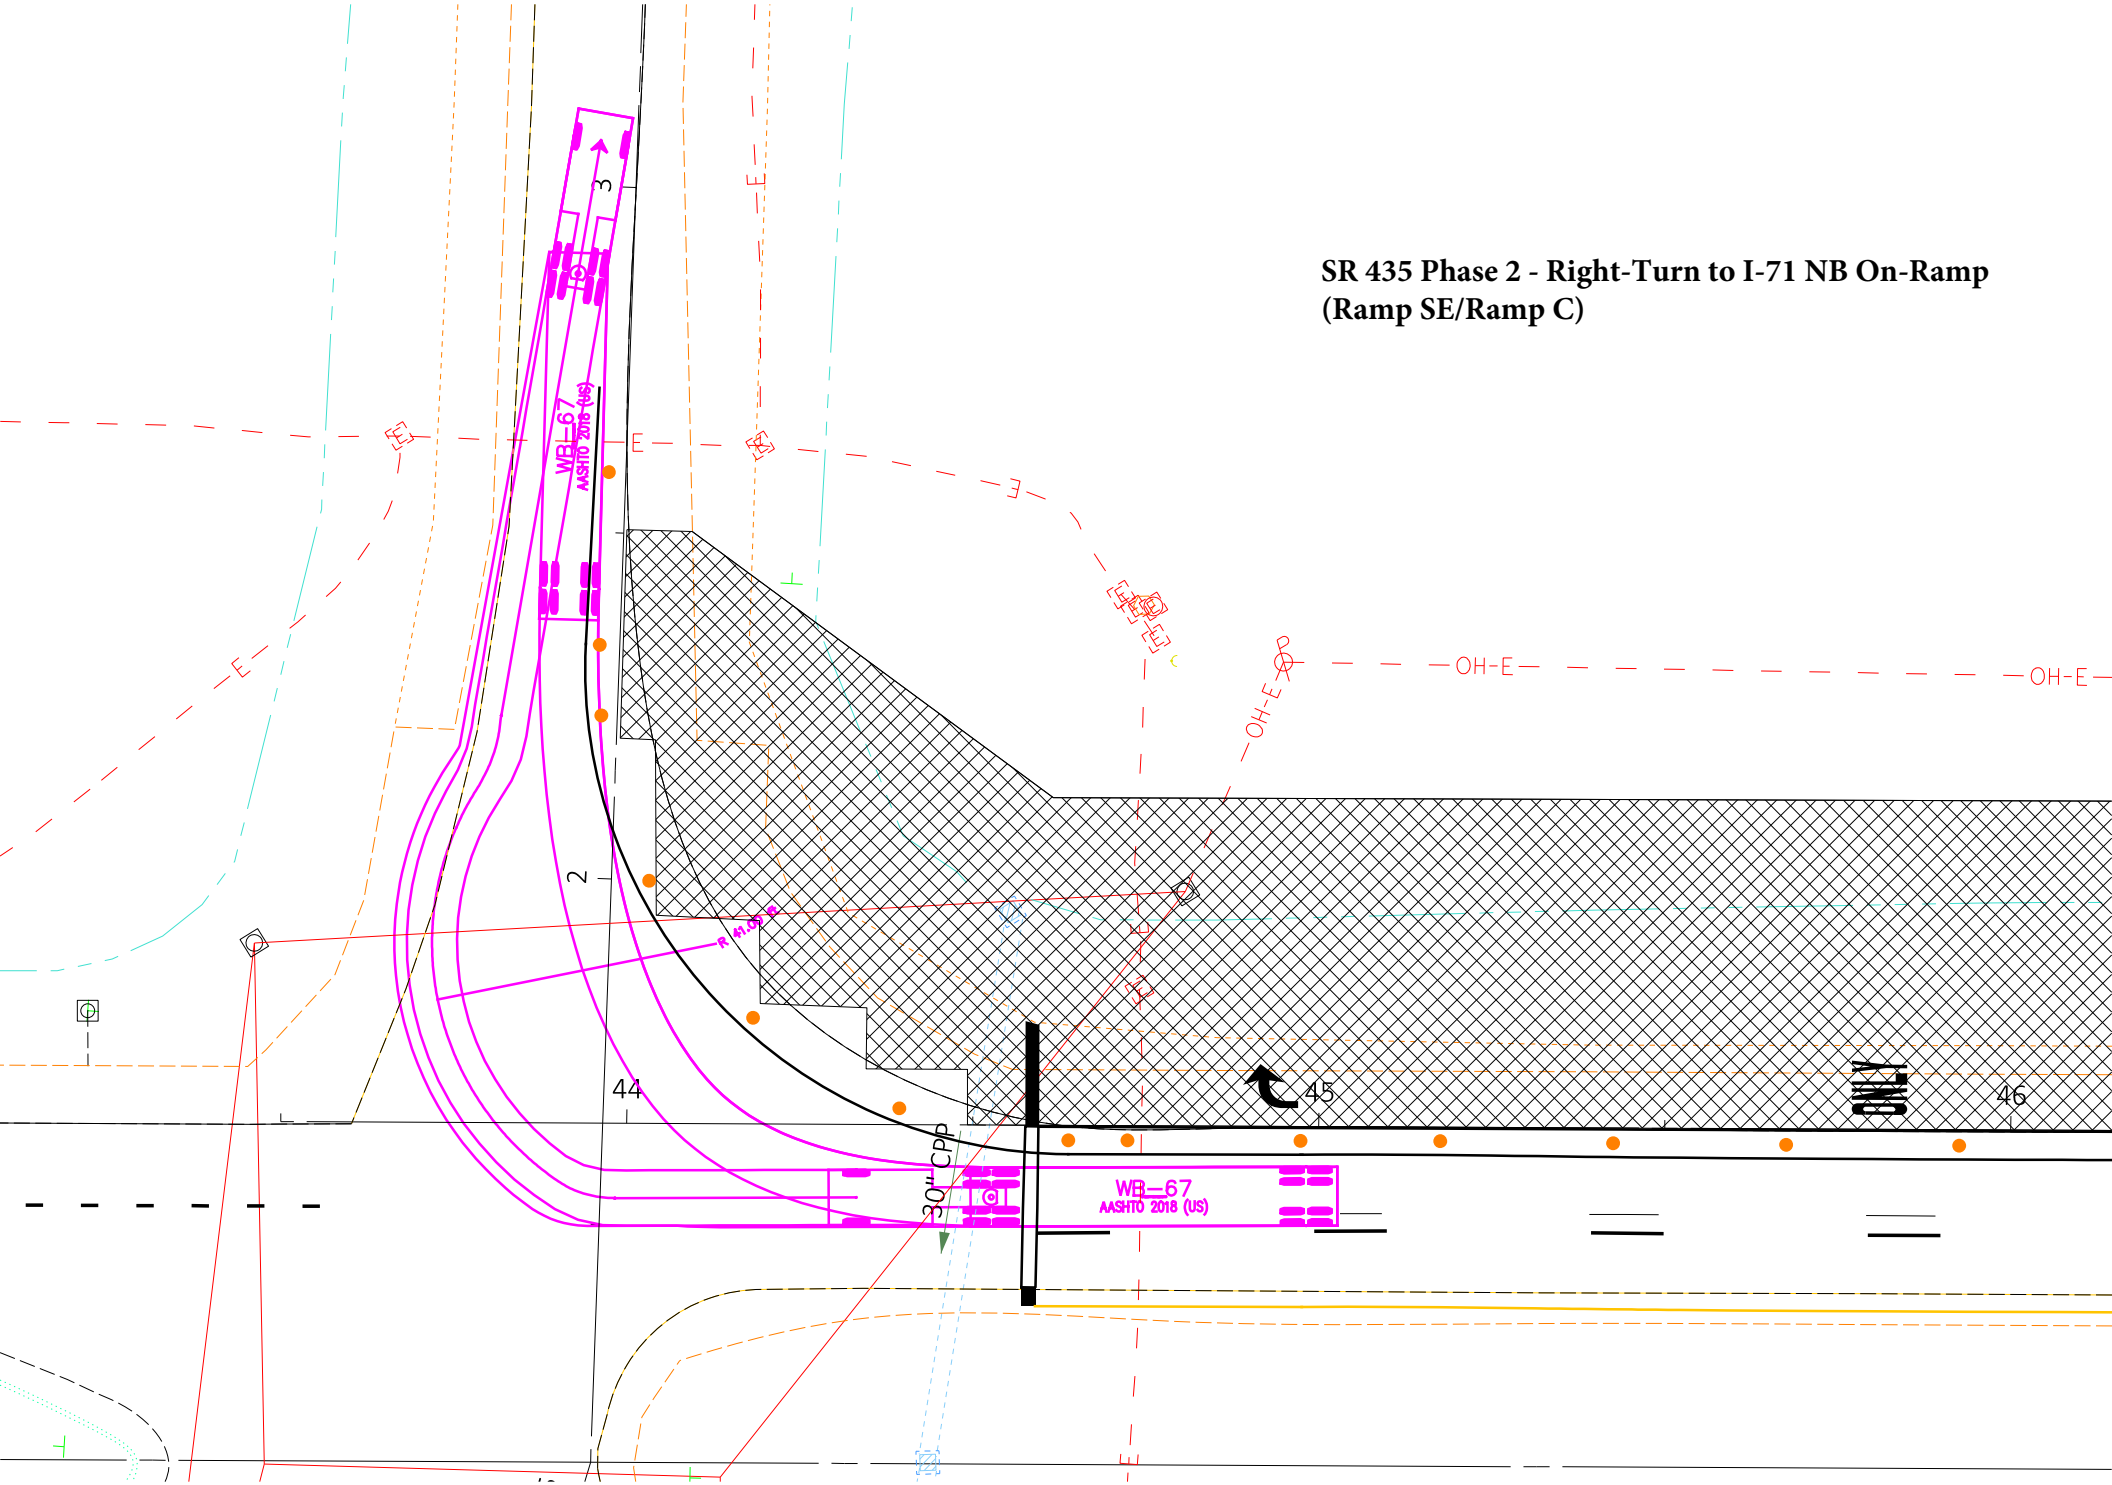


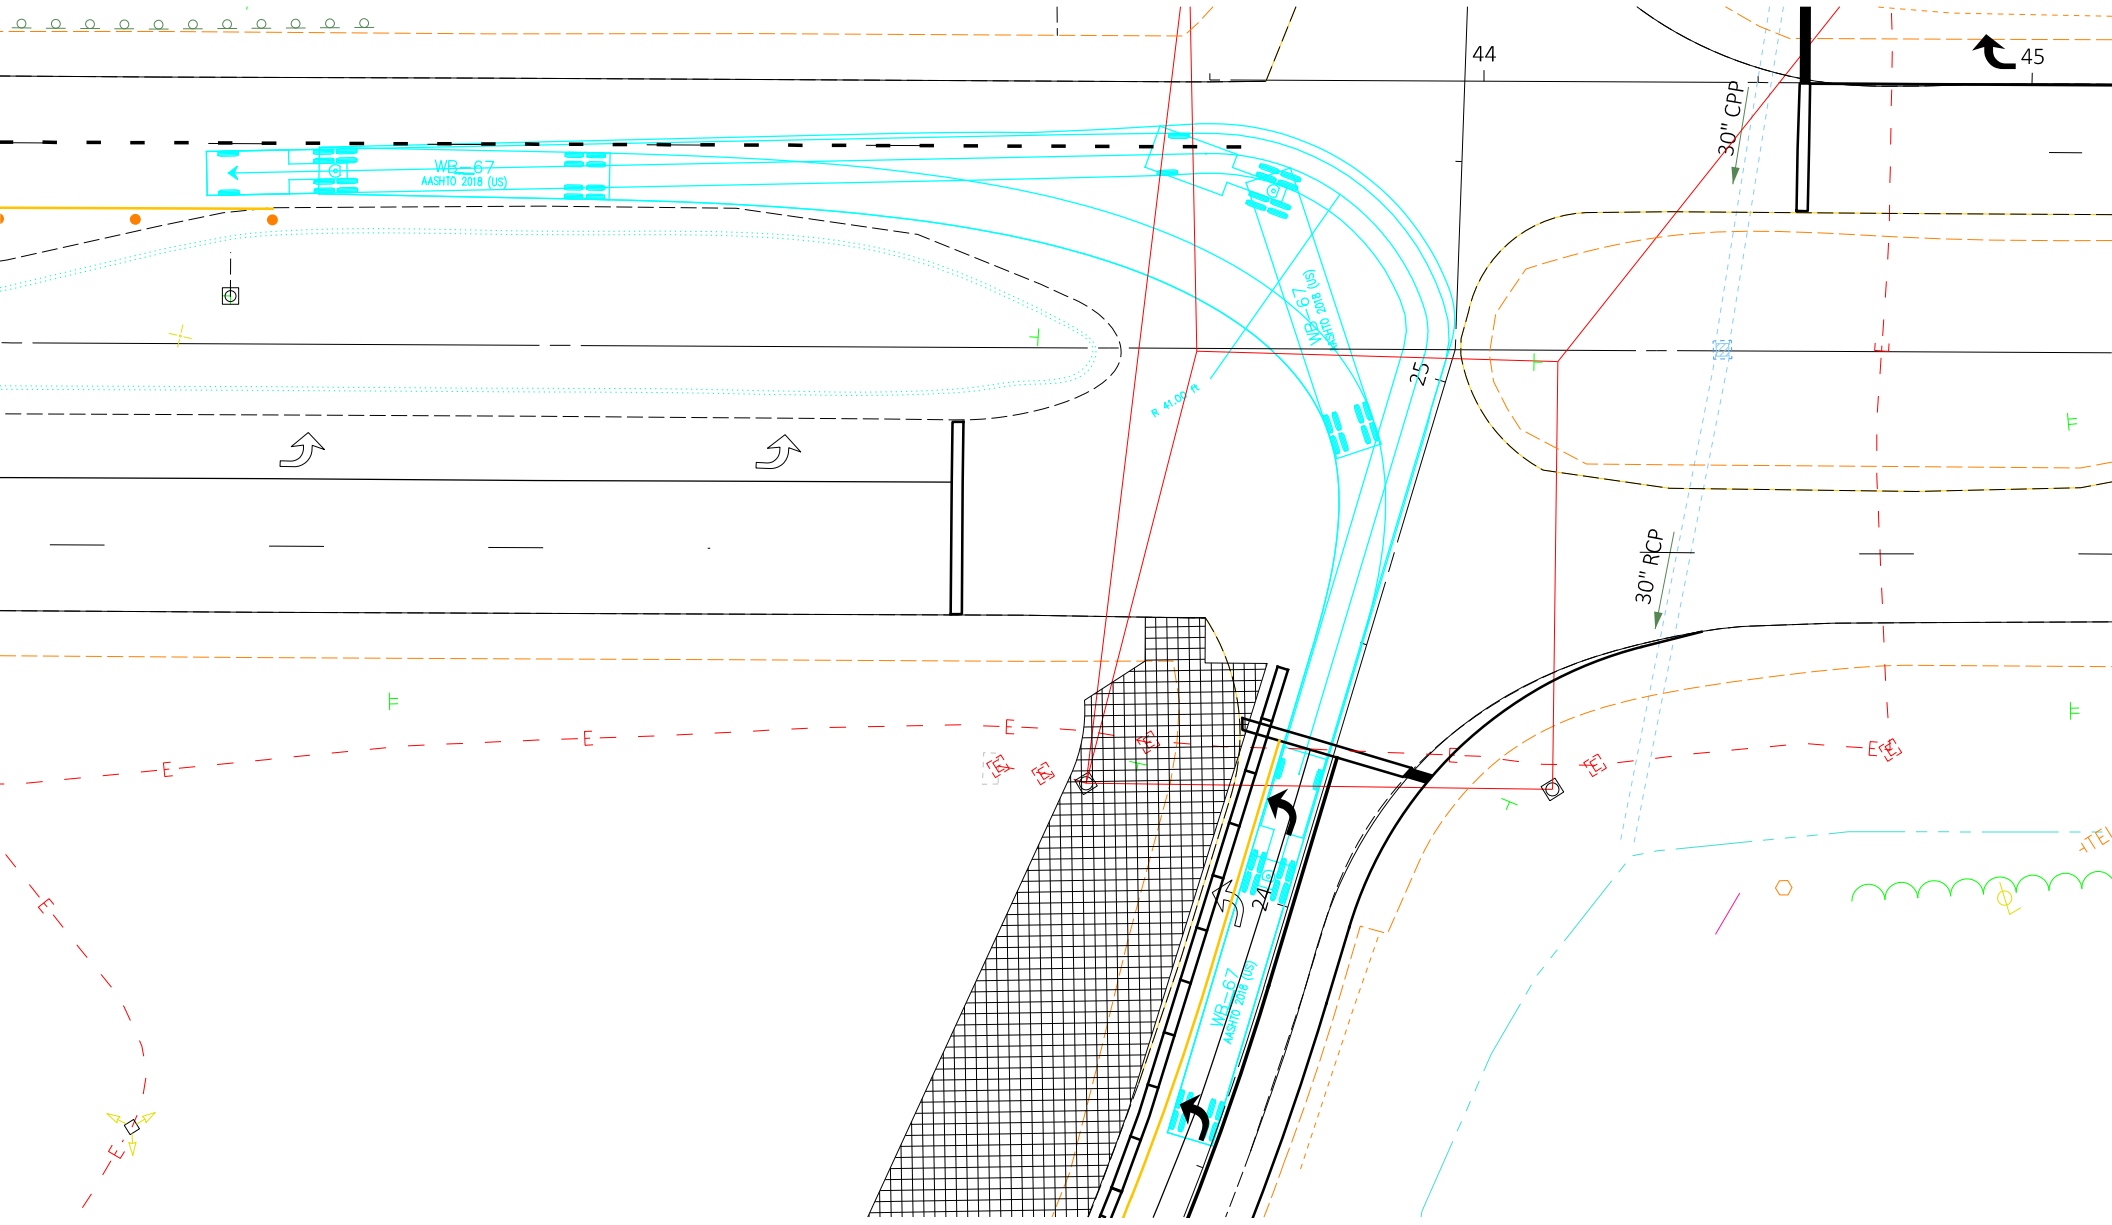

Ramp WS/Ramp D - Phase 1 Left-Turn to EB SR435

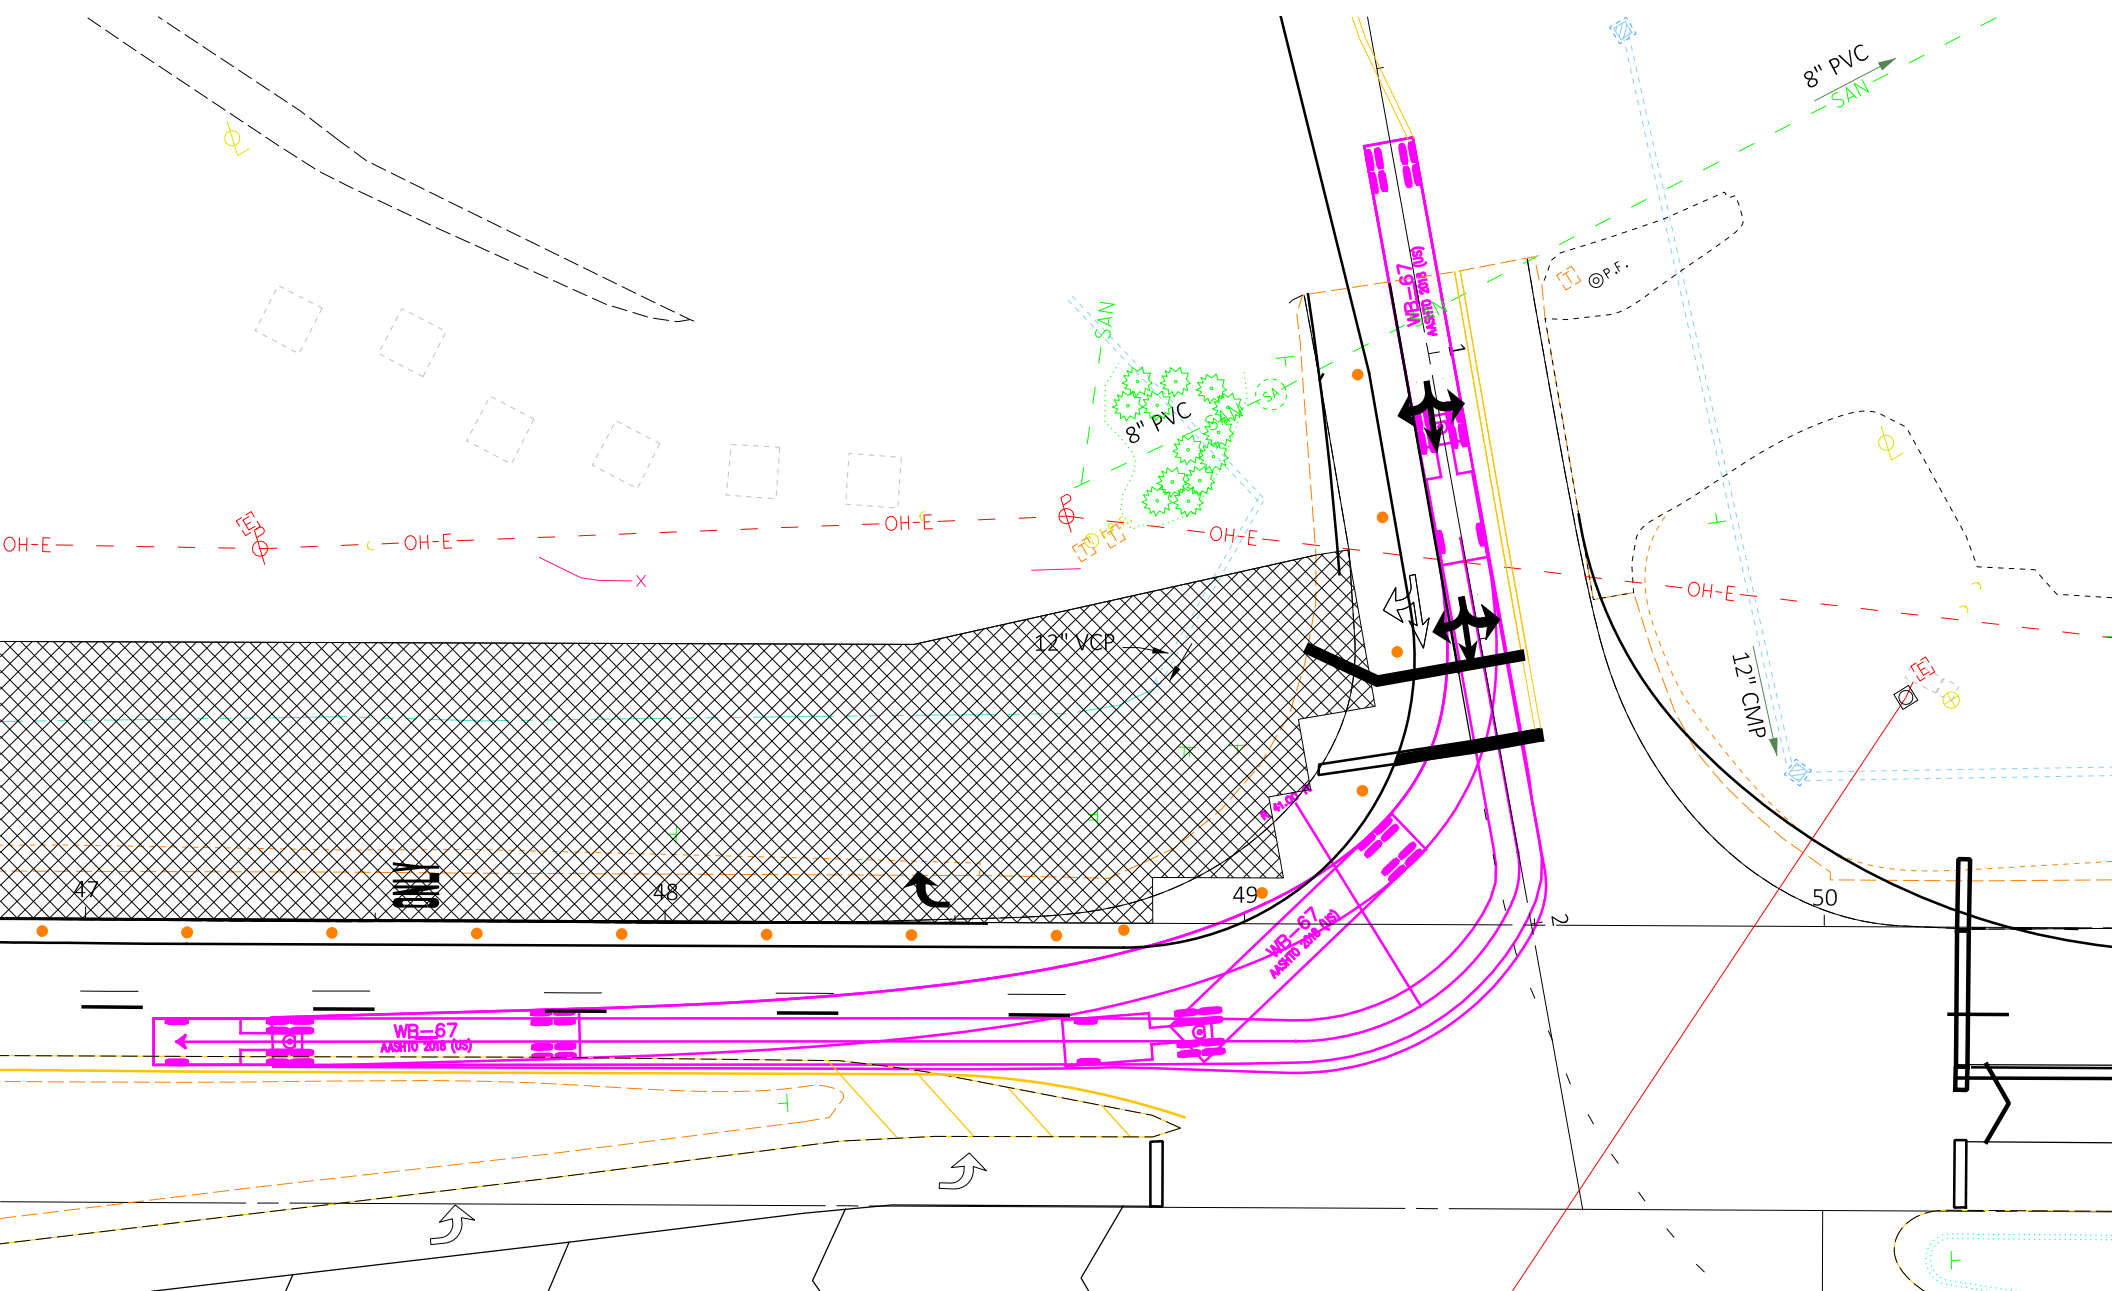


SR 435 Phase 2 - Right-Turn from Allen Rd

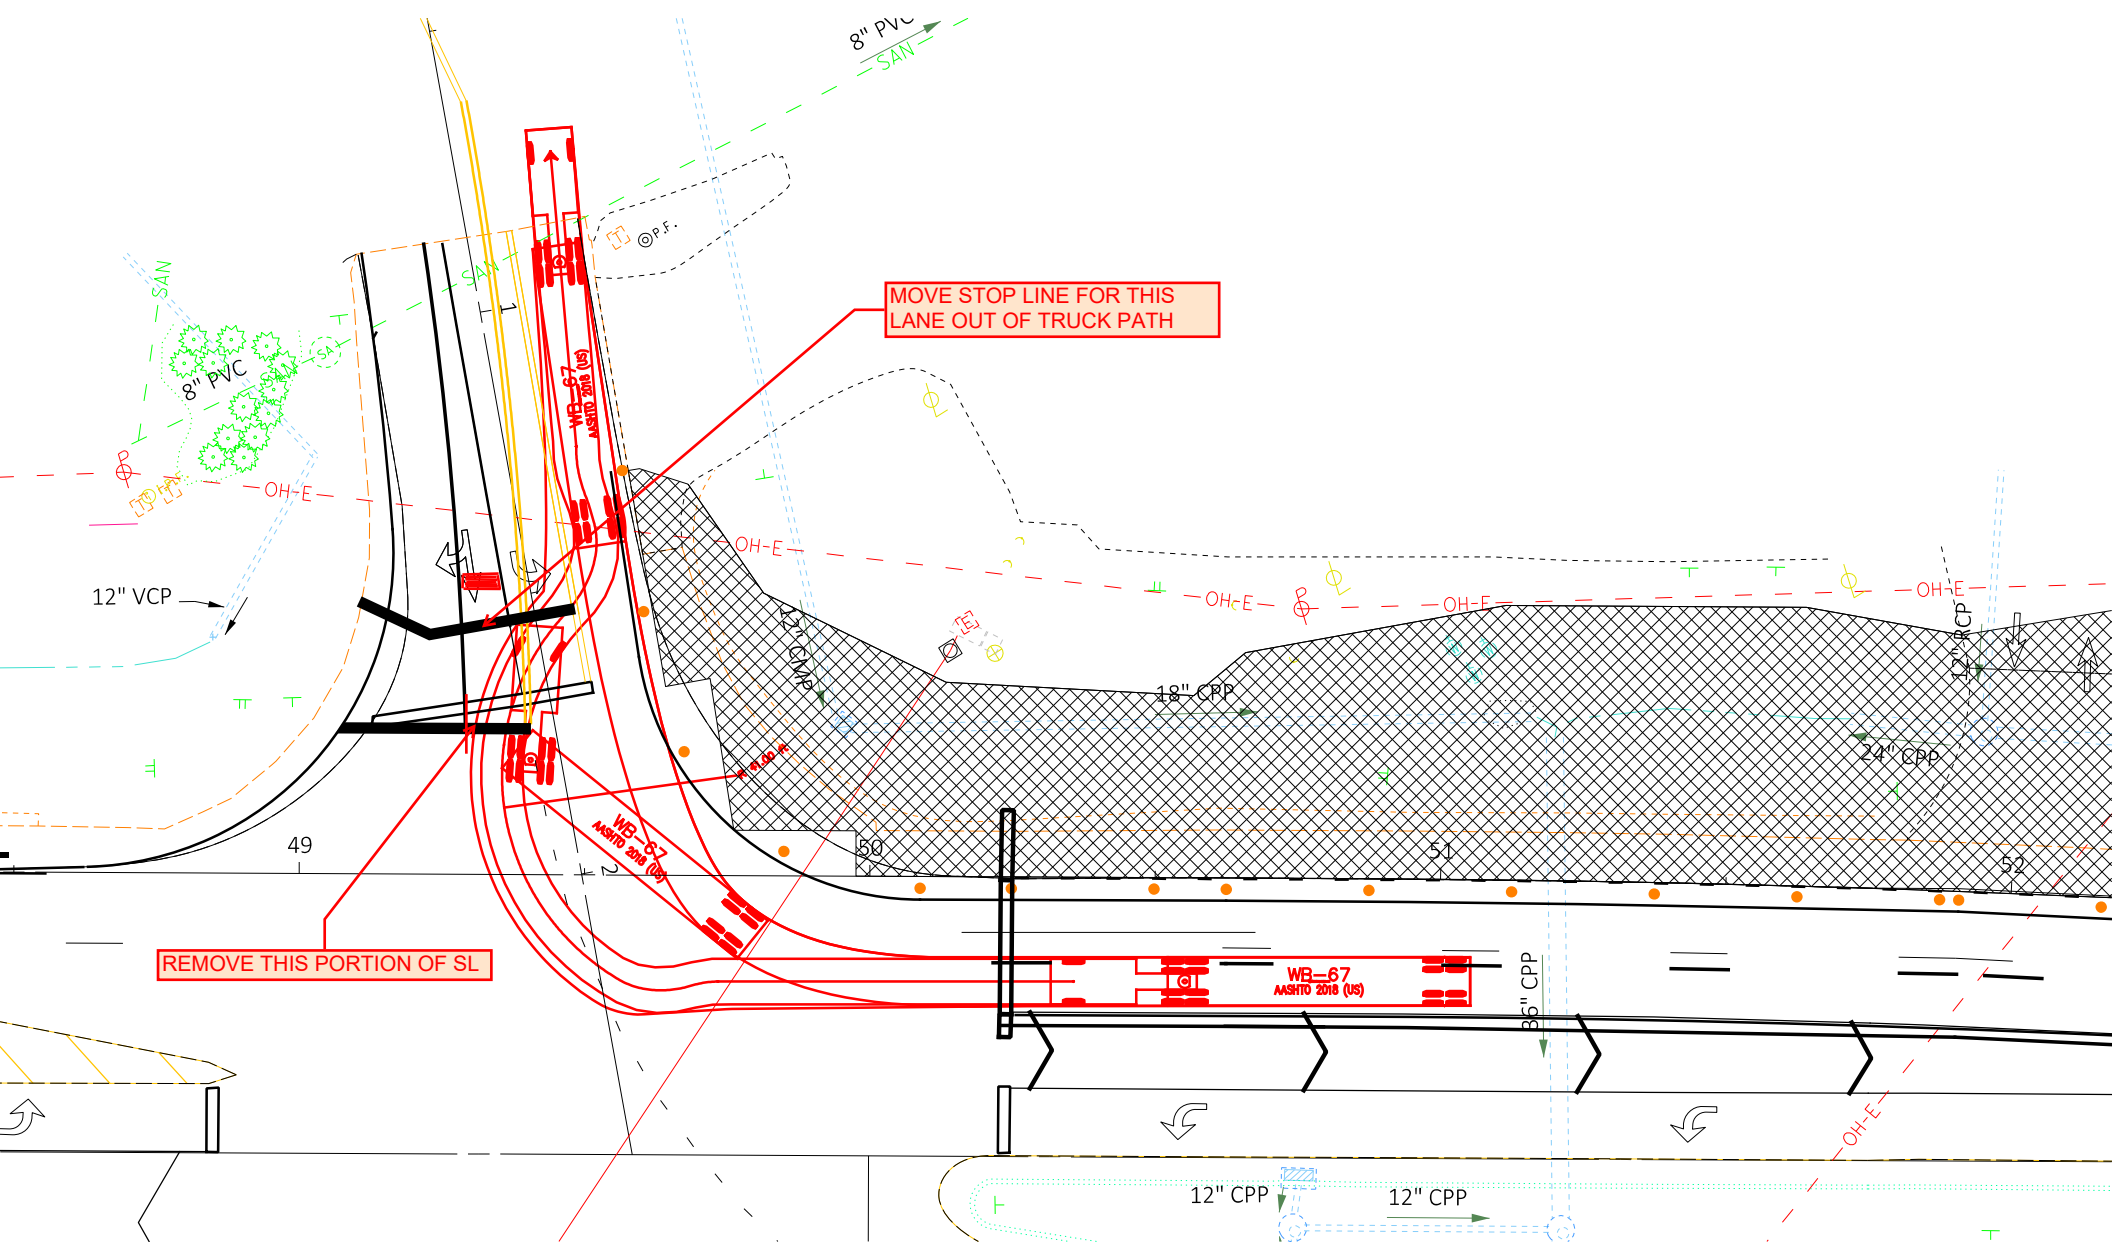

MOVE STOP LINE FOR THIS LANE OUT OF TRUCK PATH

REMOVE THIS PORTION OF SL

SR 435 Phase 1 - Right-Turn to Allen Rd

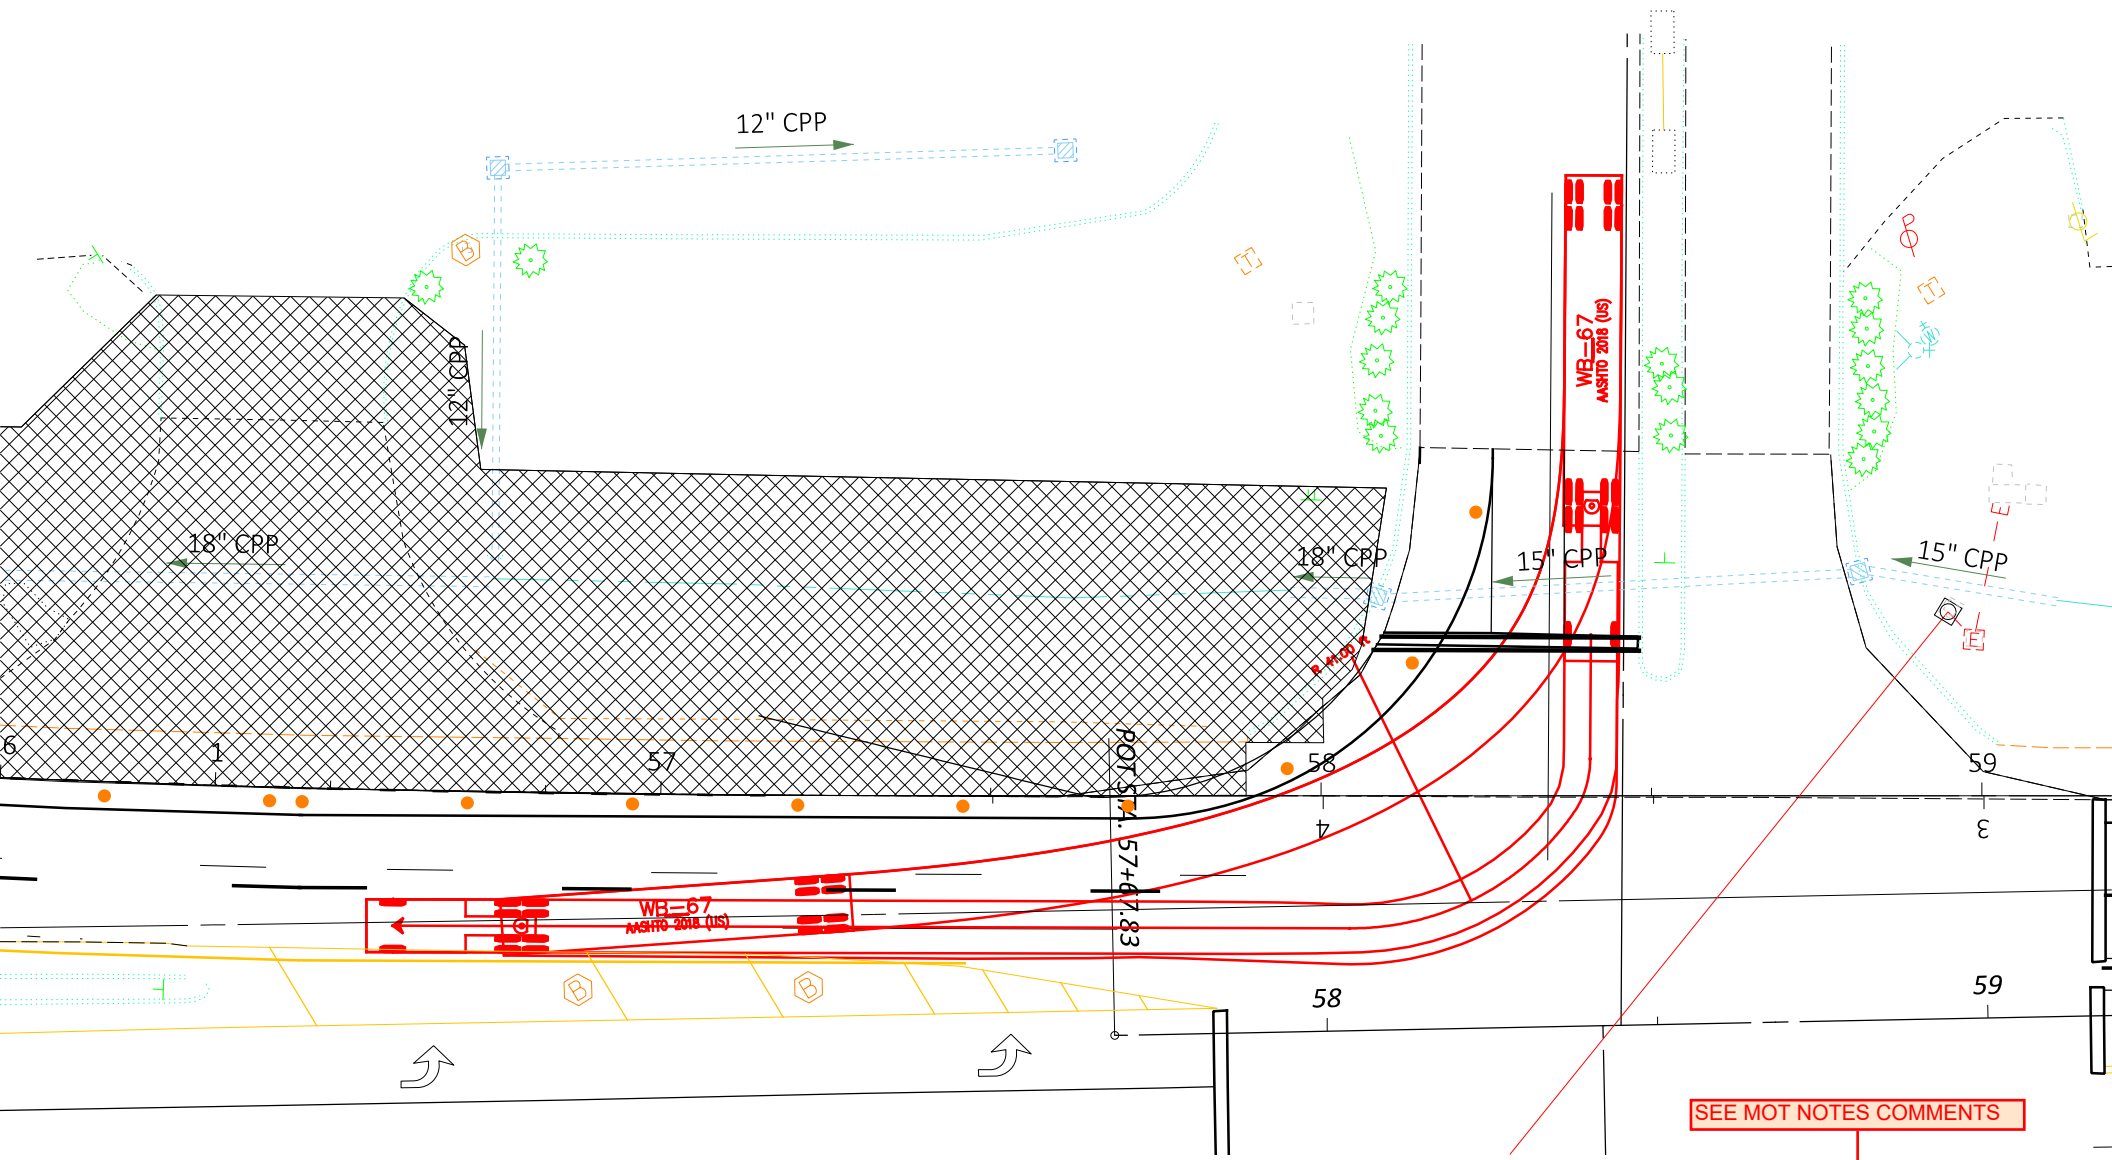

SEE MOT NOTES COMMENTS

SEE MOT NOTES COMMENTS

SR 435 Phase 1 - Right-Turn from Factory Shops Blvd.