


LEGEND

- FARM PATH - COMBINE - EASTBOUND LEFT TURNS
- FARM PATH - COMBINE - NORTHBOUND LEFT TURNS
- FARM PATH - COMBINE - RIGHT TURNS
- FARM PATH - COMBINE - WESTBOUND LEFT TURNS

ODOT Combine 9770STS

MJL - no
comments on
this sheet


Mike Lorenz - HDR - 4/5/24

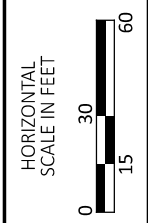

FARM PATHS
RAB - COMBINE

DESIGN AGENCY	
 8350 E. KEMPER RD. SUITE B CINCINNATI, OH 45249 513-469-1600	
DESIGNER	XXX
REVIEWER	XXX
PROJECT ID	MM-DD-YY
	117955
SHEET	TOTAL
P.0	0

comments are made based on tracking as shown - should verify what is displayed is either the body tracking or wheel tracking since there is a significant overhang with the auger portion behind the trailer wheels

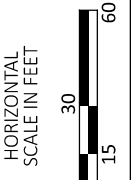

LEGEND


- FARM PATH - TRACTOR AUGER - EASTBOUND LEFT TURNS
- FARM PATH - TRACTOR AUGER - NORTHBOUND LEFT TURNS
- FARM PATH - TRACTOR AUGER - RIGHT TURNS
- FARM PATH - TRACTOR AUGER - WESTBOUND LEFT TURNS

Tractor Pulling Auger

this is tracking over the splitter island with the type 4c curb - preferable to track over the type 3 on the outside if possible

this is tracking over the splitter island with the type 4c curb - preferable to track over the type 3 on the outside if possible - highlighted in orange for other instances on the WB left movement


right turn this is tracking over the splitter island with the type 4c curb and into the other lane (cyan NB left is close as well) - revise this path to offtrack over the type 3 on the right and adjust lighting and sign locations accordingly

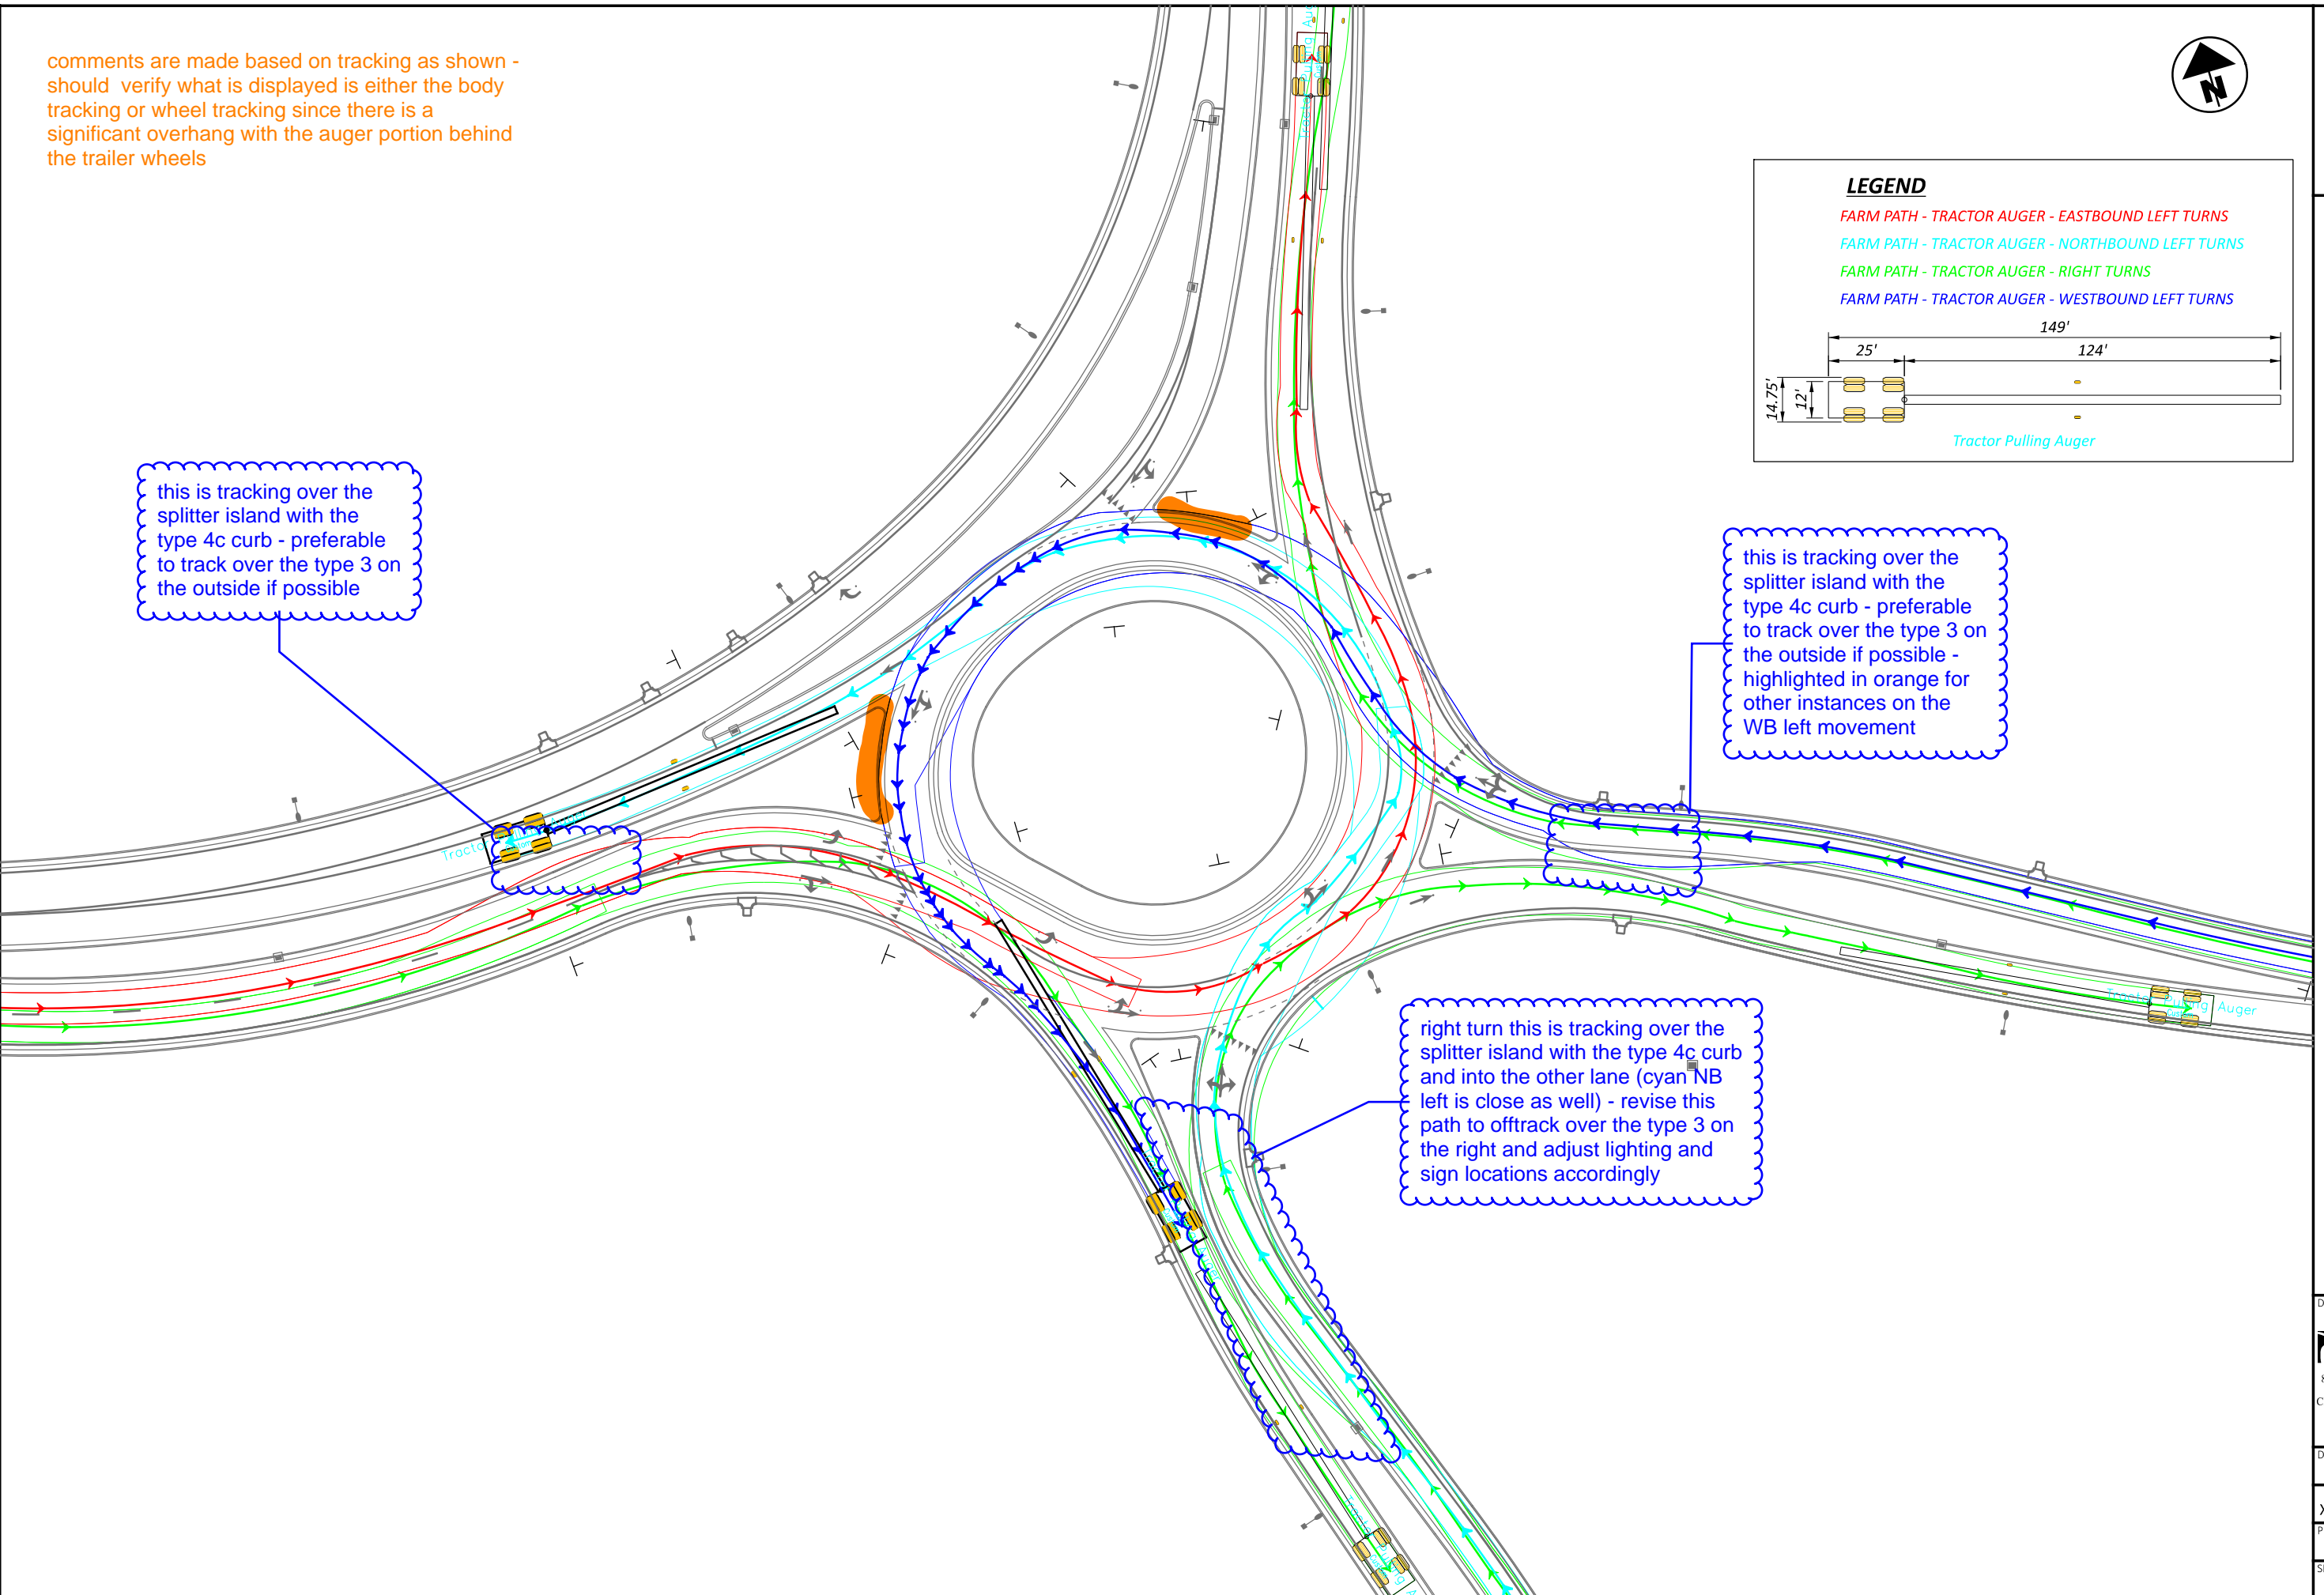

FARM PATHS
RAB - TRACTOR AUGER

DESIGN AGENCY
Palmer
ENGINEERING
8350 E. KEMPER RD.
SUITE B
CINCINNATI, OH 45249
513-469-1600

DESIGNER	XXX
REVIEWER	XXX MM-DD-YY
PROJECT ID	117955
SHEET	TOTAL
P.0	0

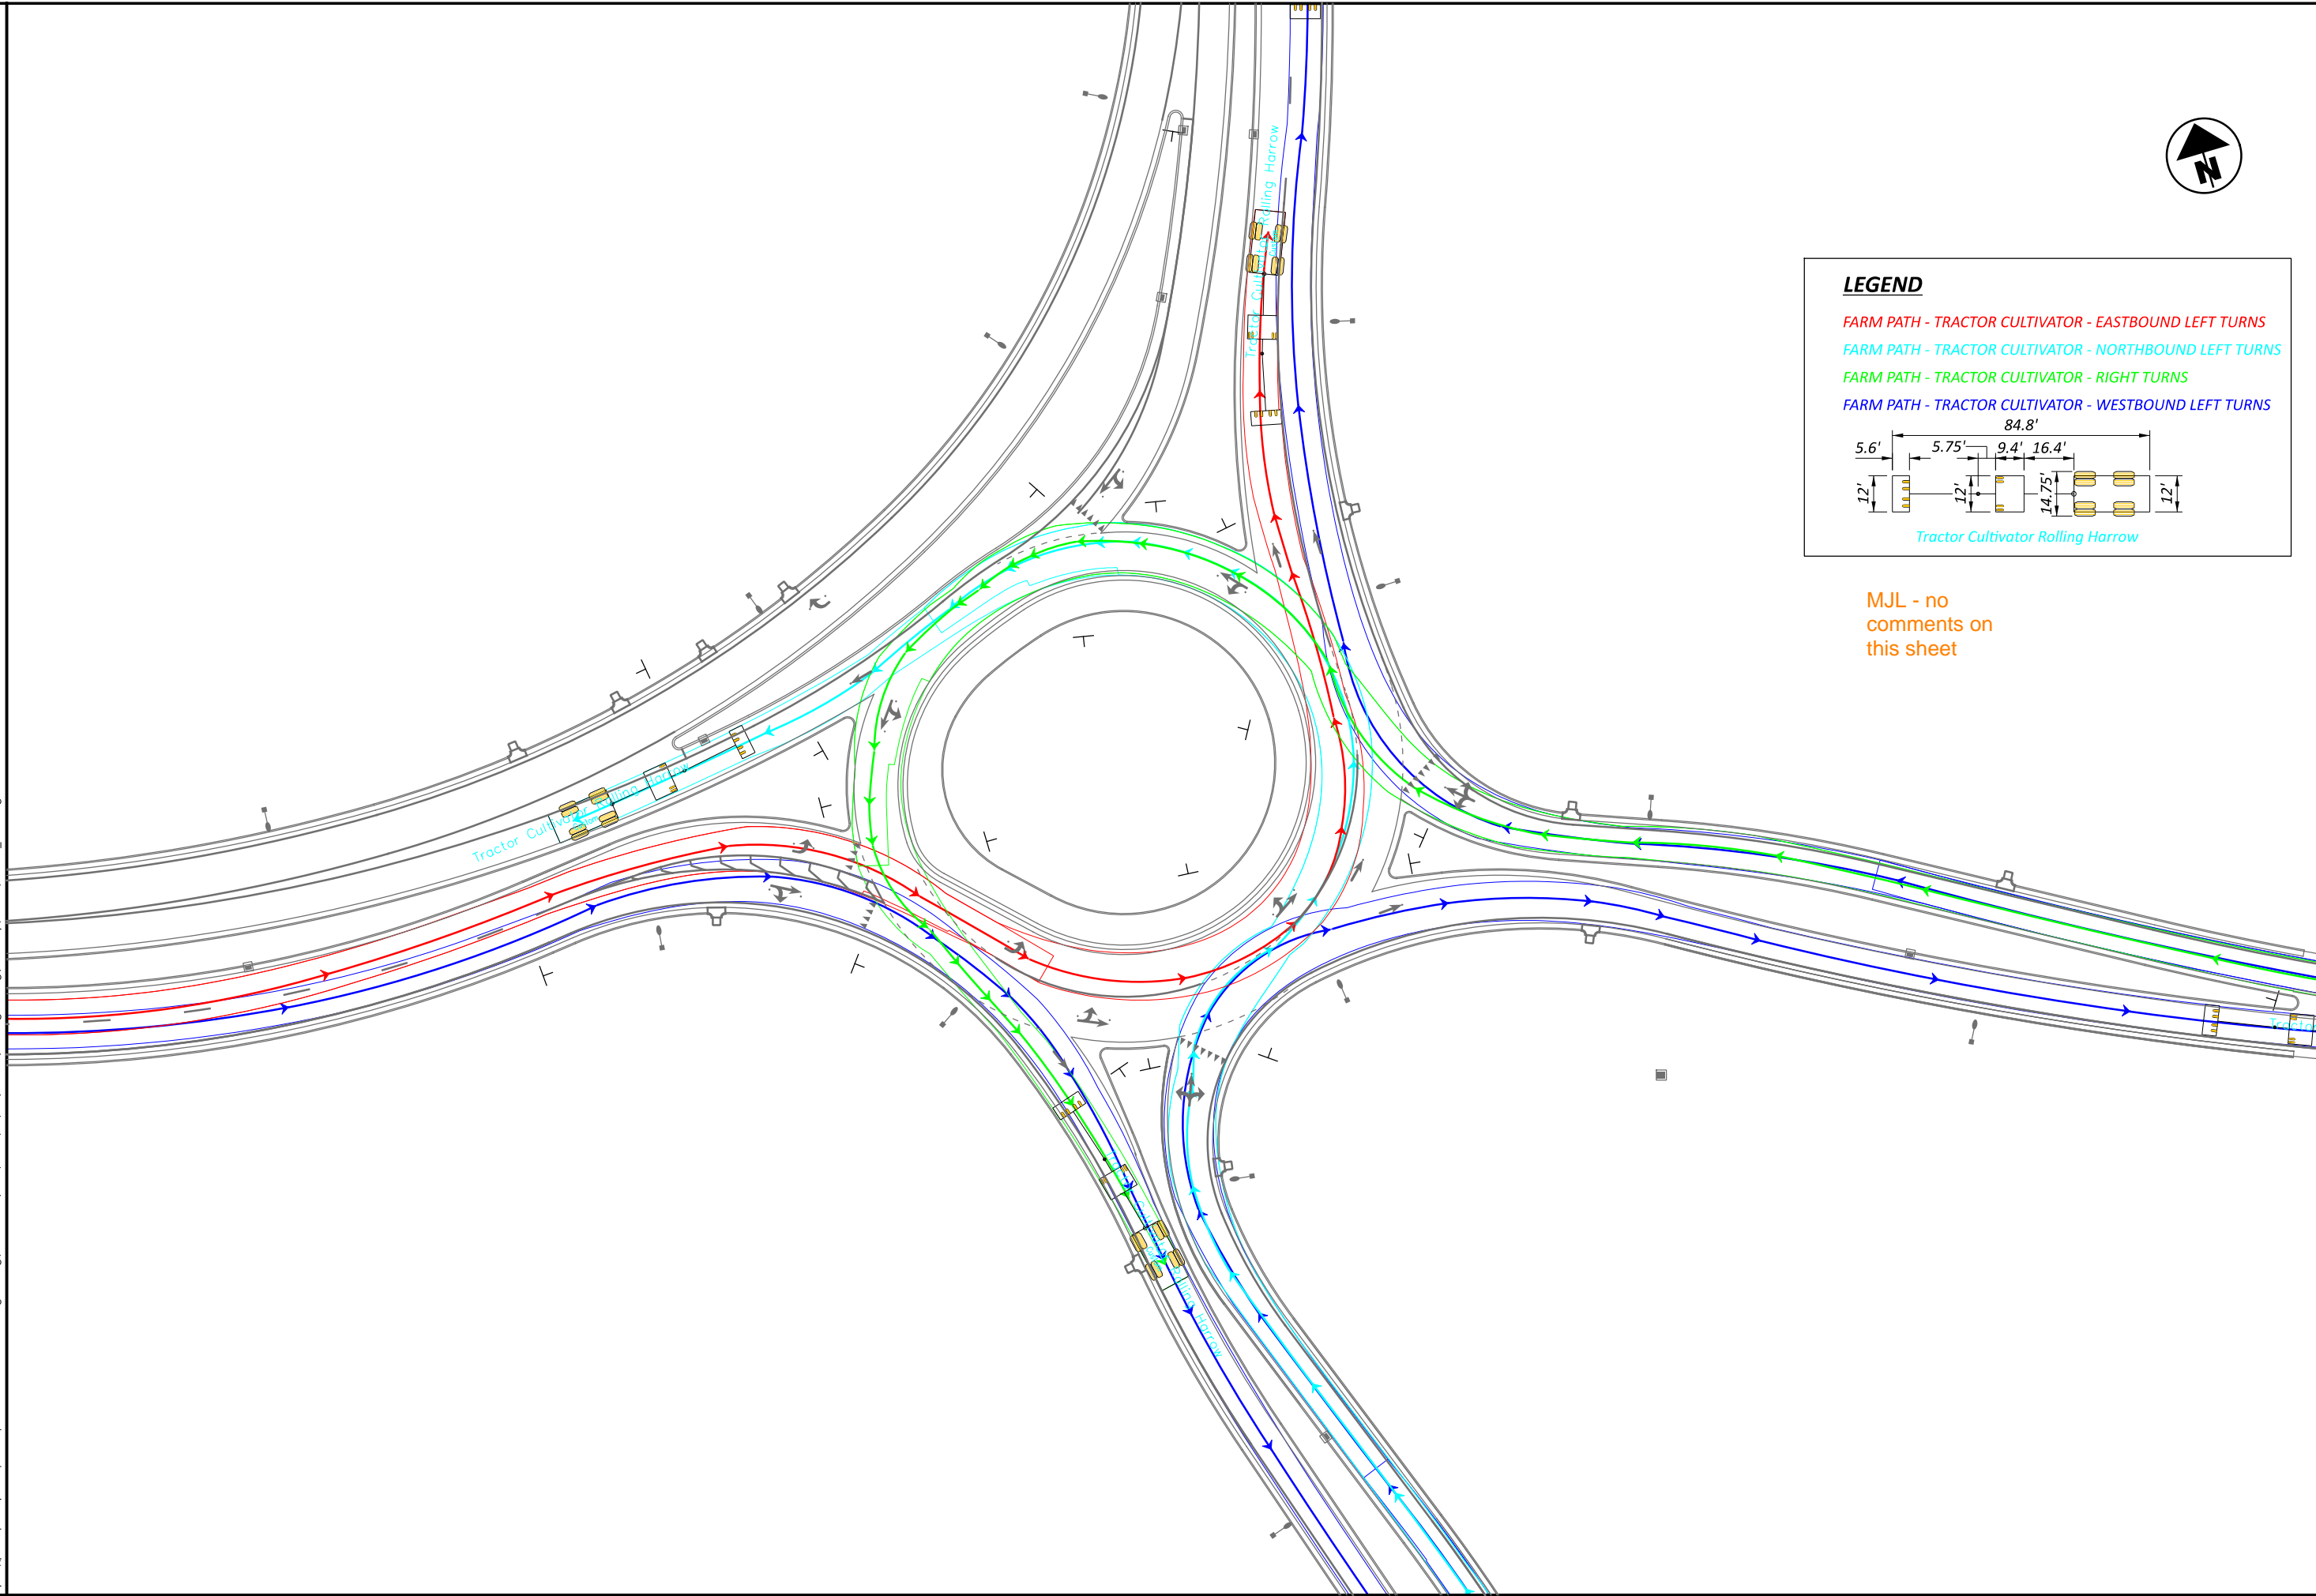

LEGEND

- FARM PATH - TRACTOR CULTIVATOR - EASTBOUND LEFT TURNS
- FARM PATH - TRACTOR CULTIVATOR - NORTHBOUND LEFT TURNS
- FARM PATH - TRACTOR CULTIVATOR - RIGHT TURNS
- FARM PATH - TRACTOR CULTIVATOR - WESTBOUND LEFT TURNS

Tractor Cultivator Rolling Harrow

MJL - no comments on this sheet



FARM PATHS
RAB - TRACTOR CULTIVATOR

DESIGN AGENCY	
 8350 E. KEMPER RD. SUITE B CINCINNATI, OH 45249 513-469-1600	
DESIGNER	XXX
REVIEWER	XXX
PROJECT ID	117955
SHEET	TOTAL
P.0	0