



DEL-61-5.44 (PID 122044)

MODEL: Part 2 Sheet PAPERSIZE: 34x22 (in.) DATE: 5/11/2026 TIME: 4:10:06 PM USER: aoldaker
pw:\structurepoint-pw.bentley.com:structurepoint-pw-01\Documents\Projects\2024\03155 - DEL 61\C. Design\122044\400-Engineering\MOT\Sheets\122044_MD001.dgn

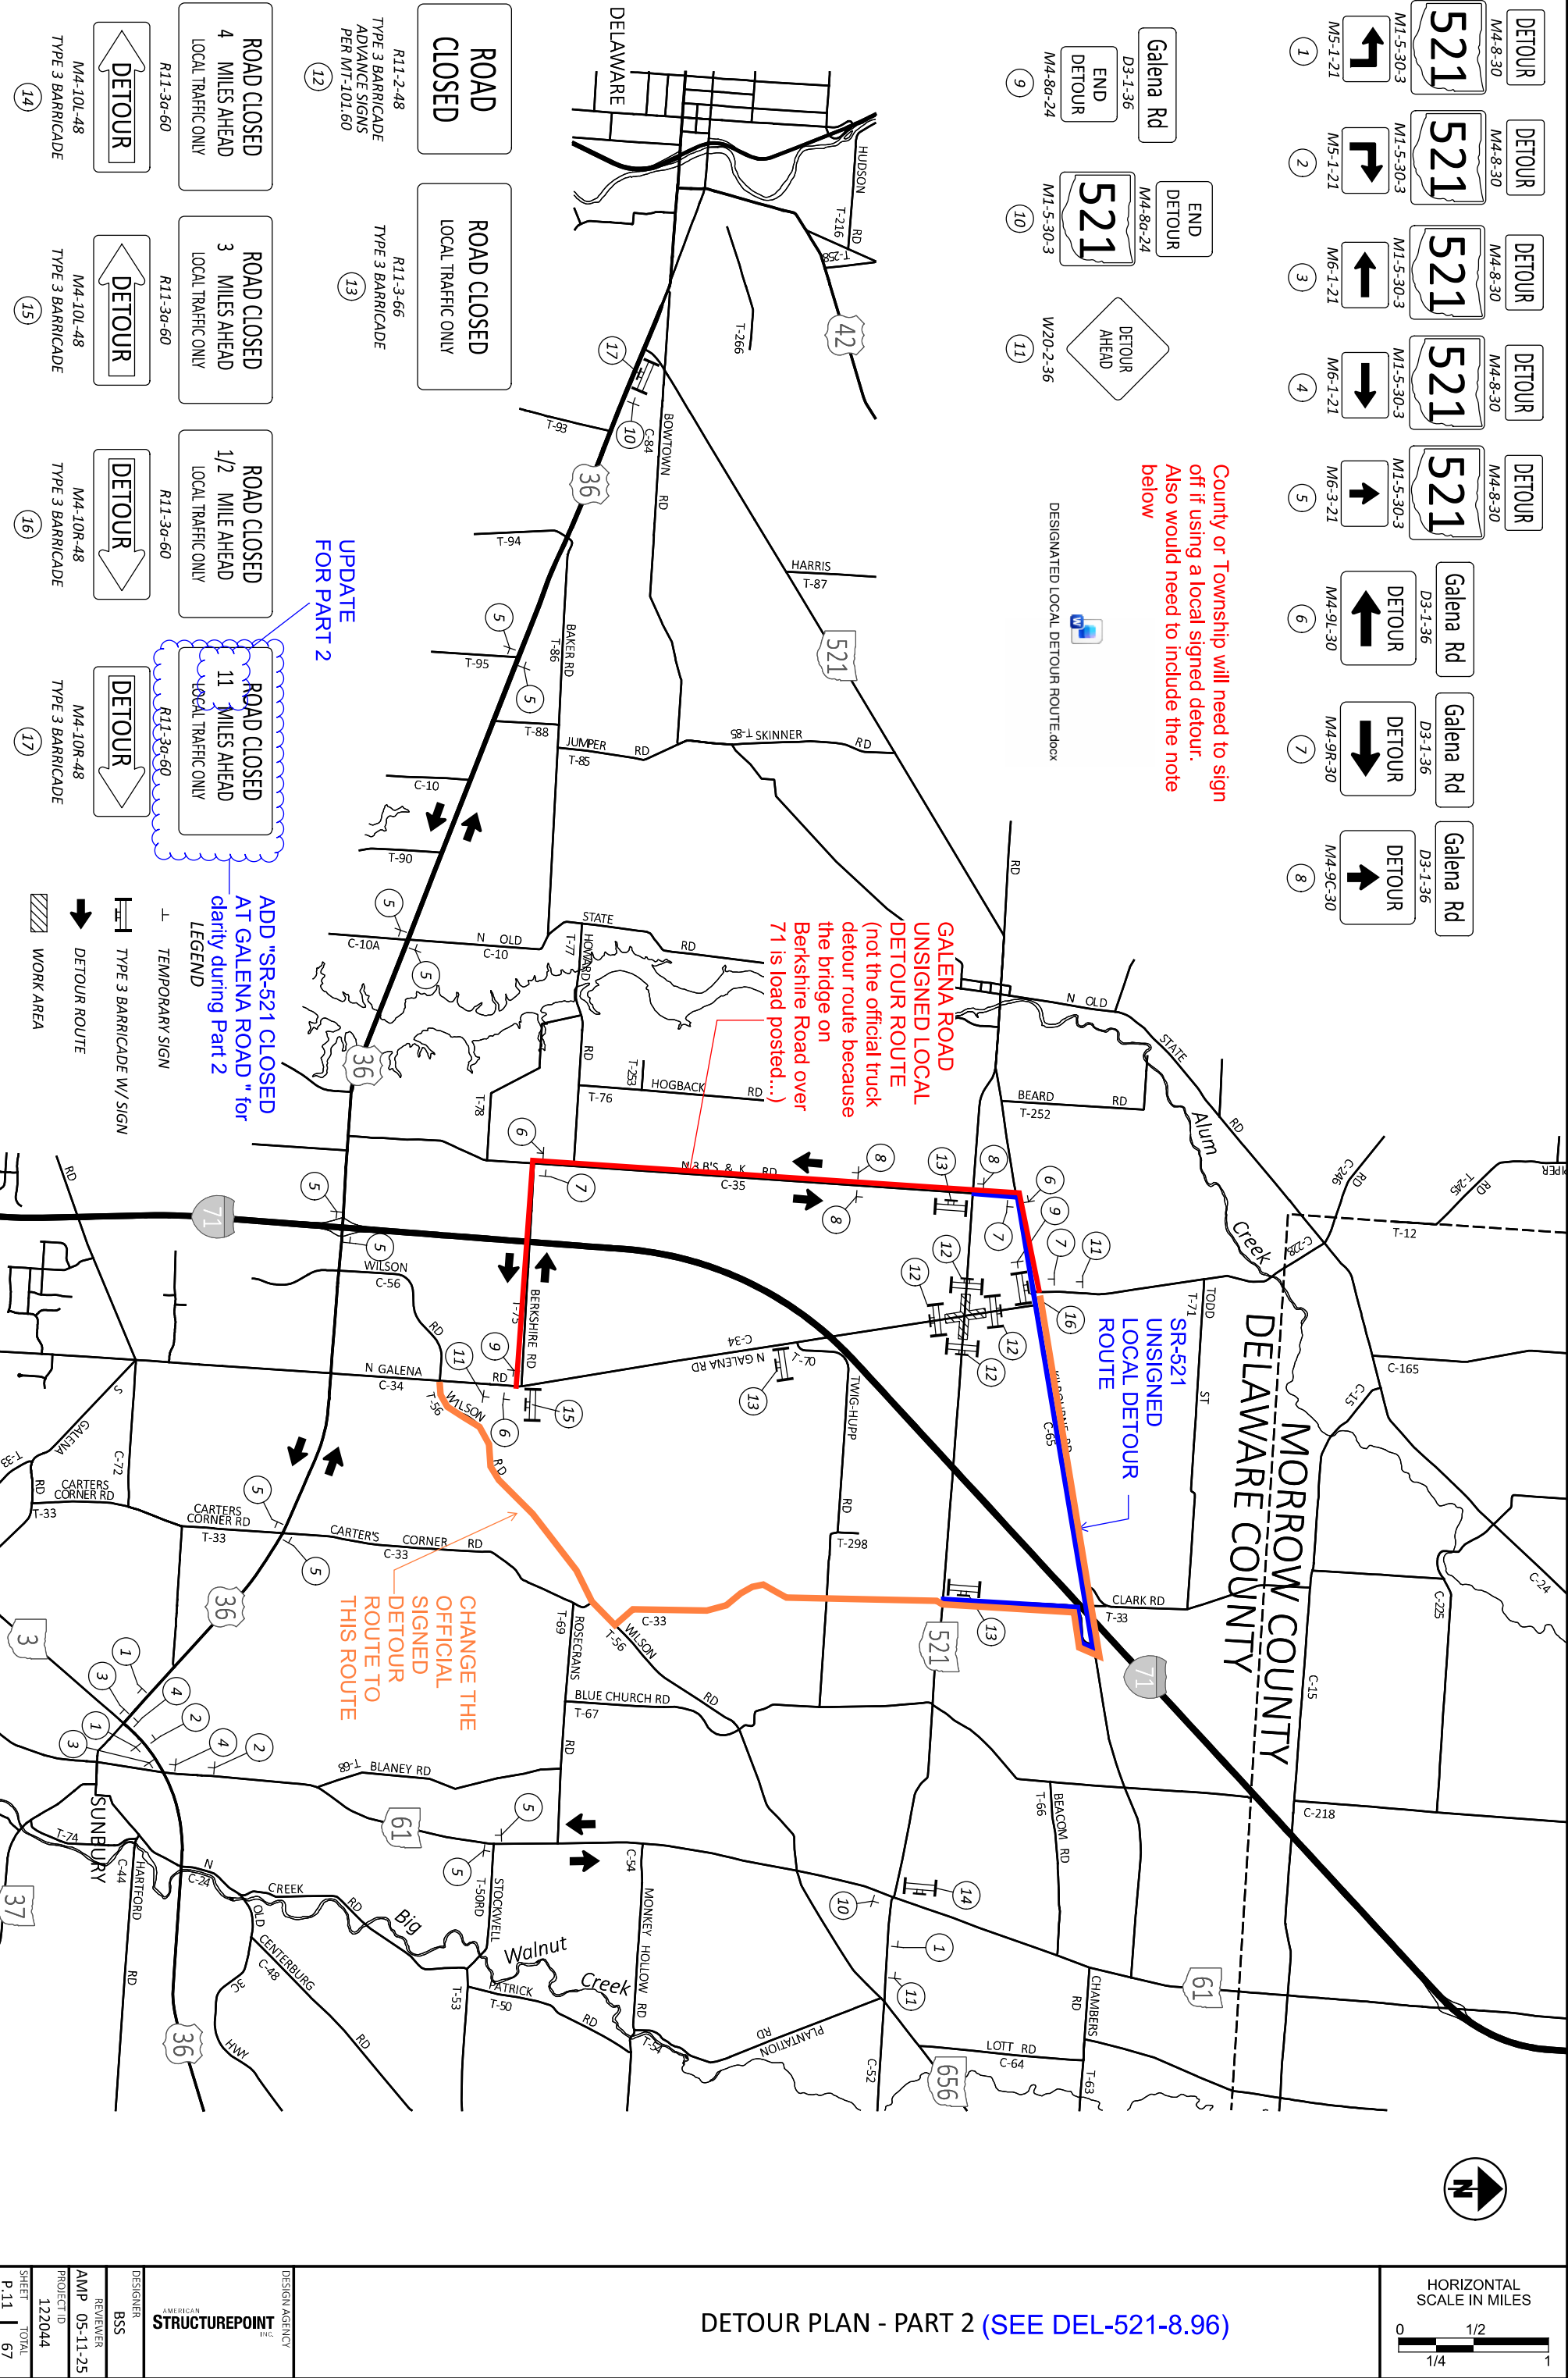

DETOUR PLAN - PART 2 (SEE DEL-521-8.96)

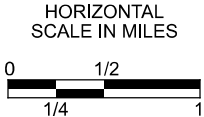

DESIGN AGENCY	AMERICAN STRUCTUREPOINT INC.
DESIGNER	BSS
REVIEWER	AMP 05-11-25
PROJECT ID	122044
SHEET TOTAL	P.11 67