

FED. RD. DIST. NO.	STATE	FED. AID PROJECT	FISCAL YEAR
10	OHIO		

1.  
6.

11-1

MADISON COUNTY  
S.H. 1. SEC. D-1.  
RIGHT OF WAY.  
LENGTH 2.46 MILES  
TITLE; 80' Mon. R.W.

State of Ohio  
Department of Highways.

---

Right of Way  
of the  
National Road.

S. D. 1. Sec. D-1.

Somerford Twp. - Madison Co.

SOMERFORD TWP.

FED. RD. DIST. NO.	STATE	FED. AID PROJECT	FISCAL YEAR
10	OHIO		

2  
6

CLARK CO.

MADISON CO.

MADISON COUNTY  
S.H. 1 SEC. D-1.  
RIGHT OF WAY.

Robert F. Morgan.

# 4200  
5336 A. (M) 1.

LINE  
COUNTY

Mary & Liddie Dunn.

# 4200  
289 A. (M) 2.

Delia Gaynard.

# 3503  
265 A. (M) 3.

Daniel Watts.

# 4200, 4424  
51.55 A. (M) 4.

George Willis.

# 4200  
121.31 A. (M) 5.


Paul S. Markley.

# 4424.  
102.39 (M) 6.

C. & L. E. RY. 51.

$\Delta = 3^{\circ} 13' R.$   
 $D = 0^{\circ} 36'.$   
 $T = 268.2$   
 $L = 536.0$   
 $E = 3.68$

87-31  
3-D  
8418

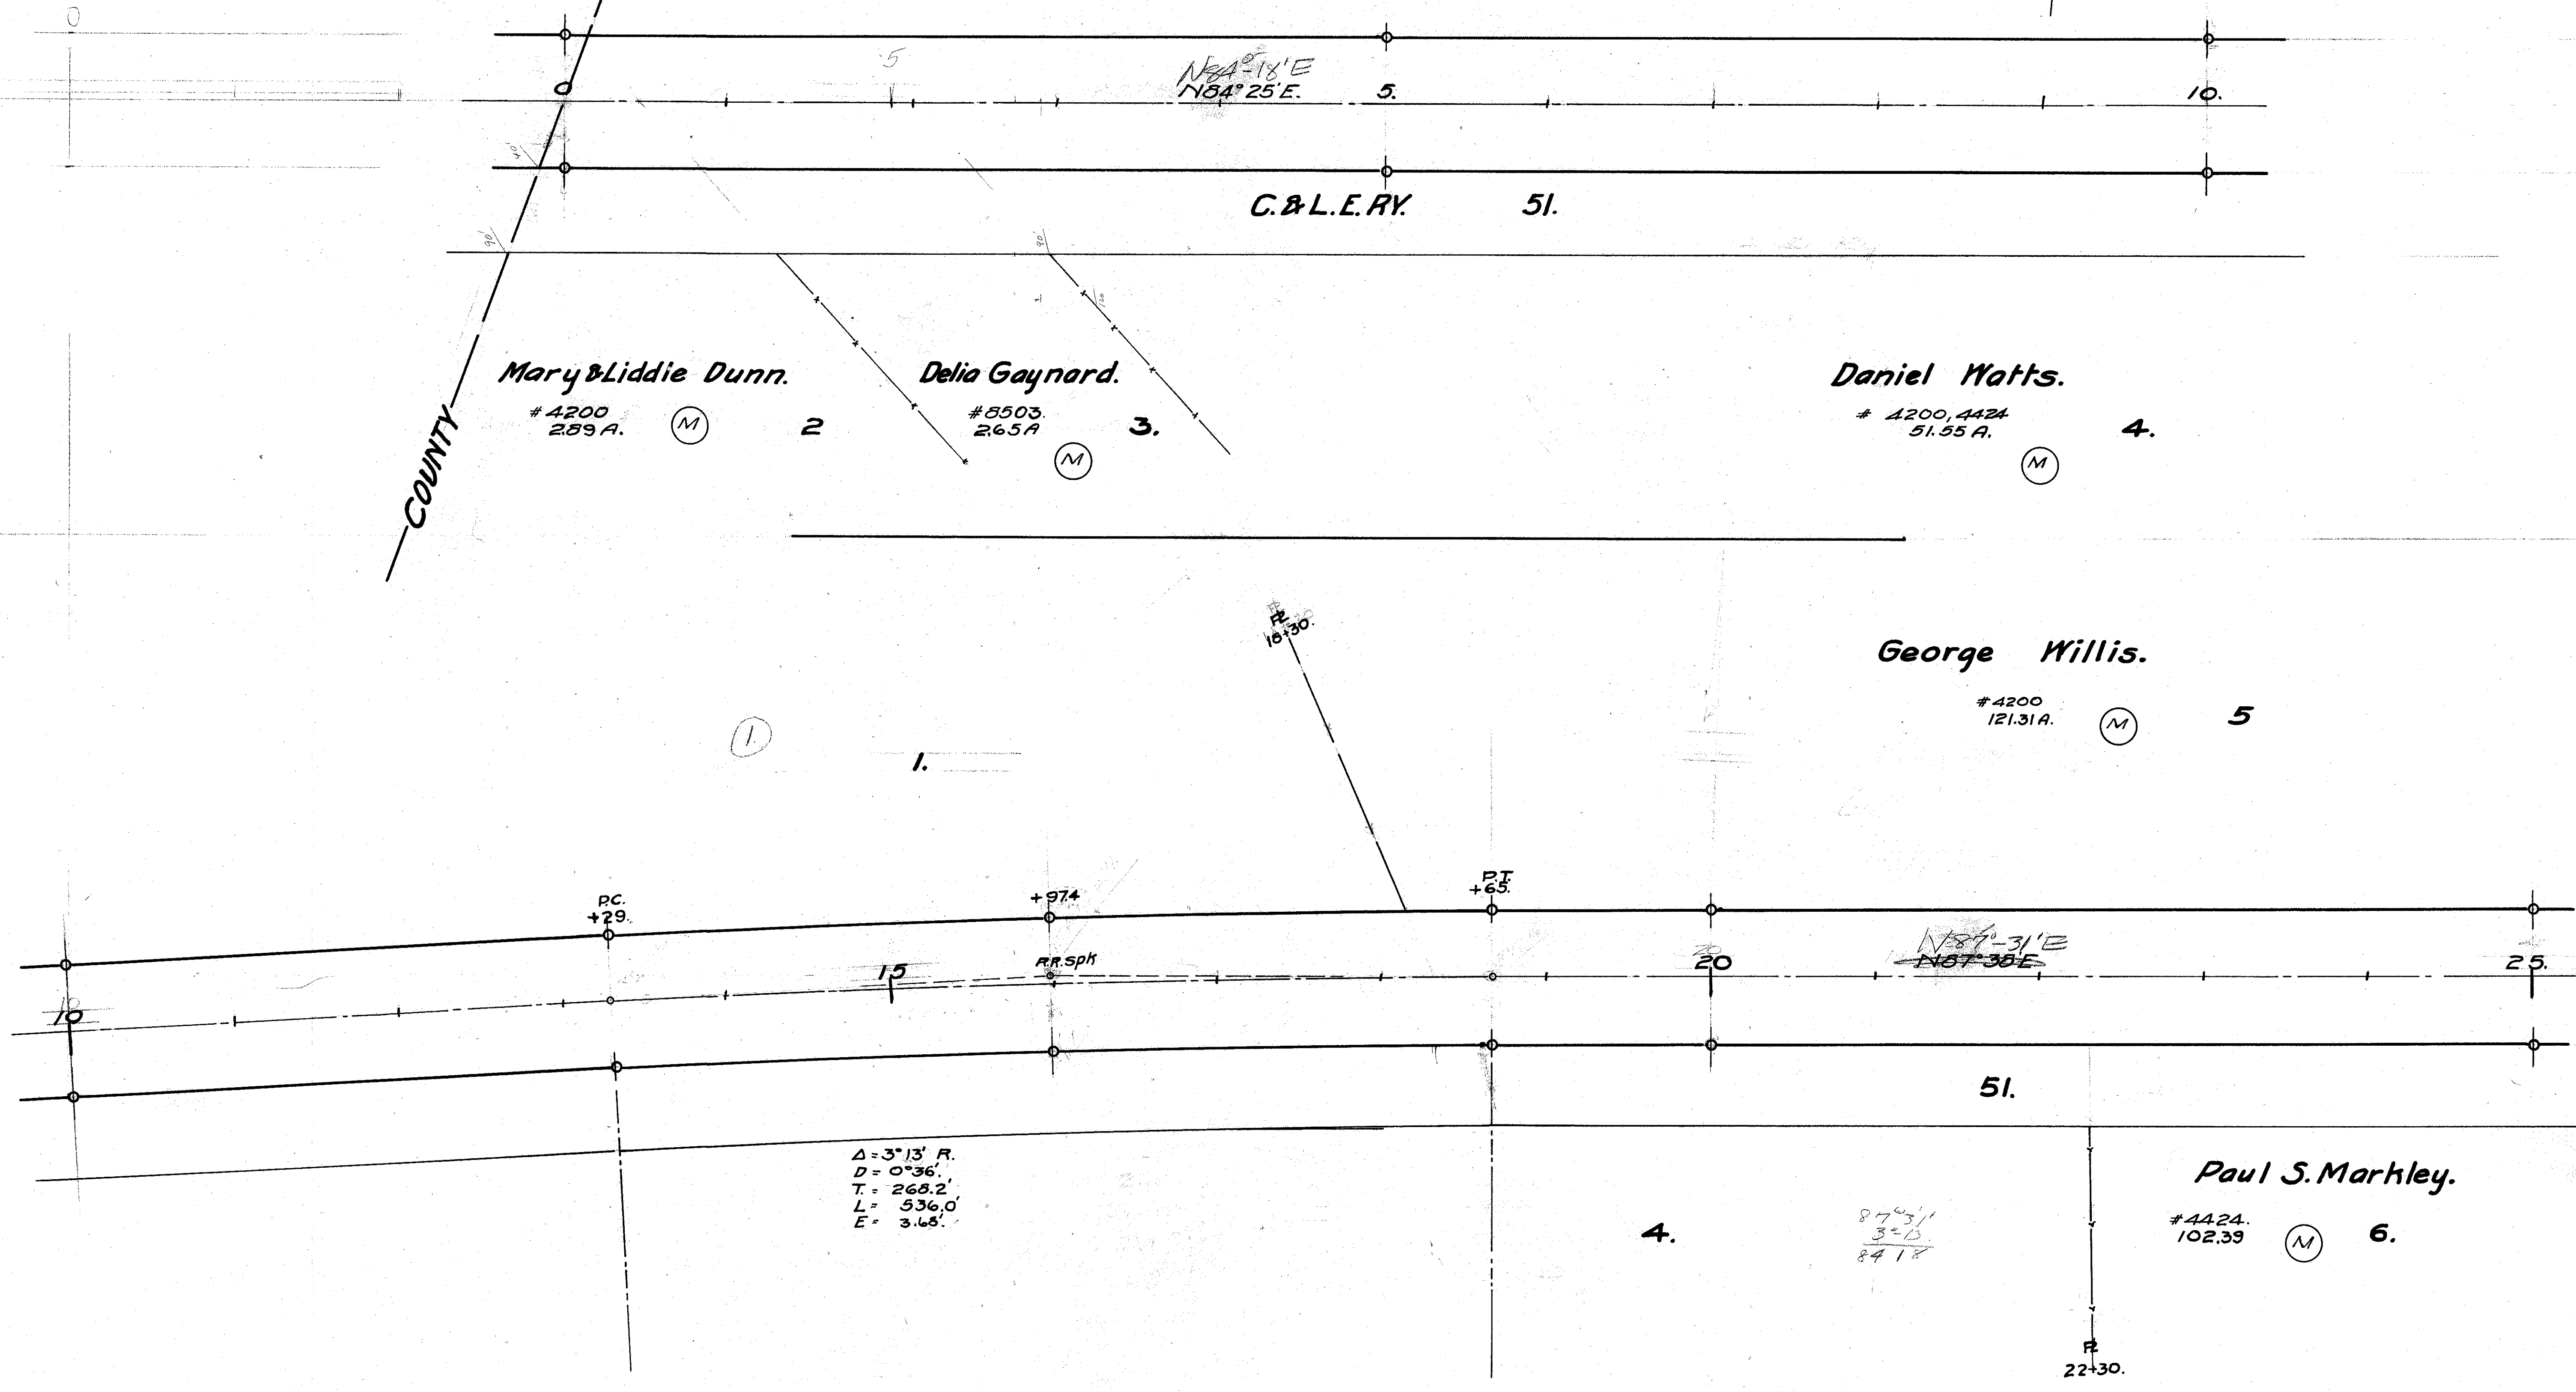

FED. RD. DIST. NO.	STATE	FED. AID PROJECT	FISCAL YEAR
10	OHIO		

3  
6

MADISON COUNTY  
S.H. 1. SEC. D-1.  
RIGHT OF WAY.


Geo. Willis

(M)

5.

N.

Geo. Willis Dike. 8.

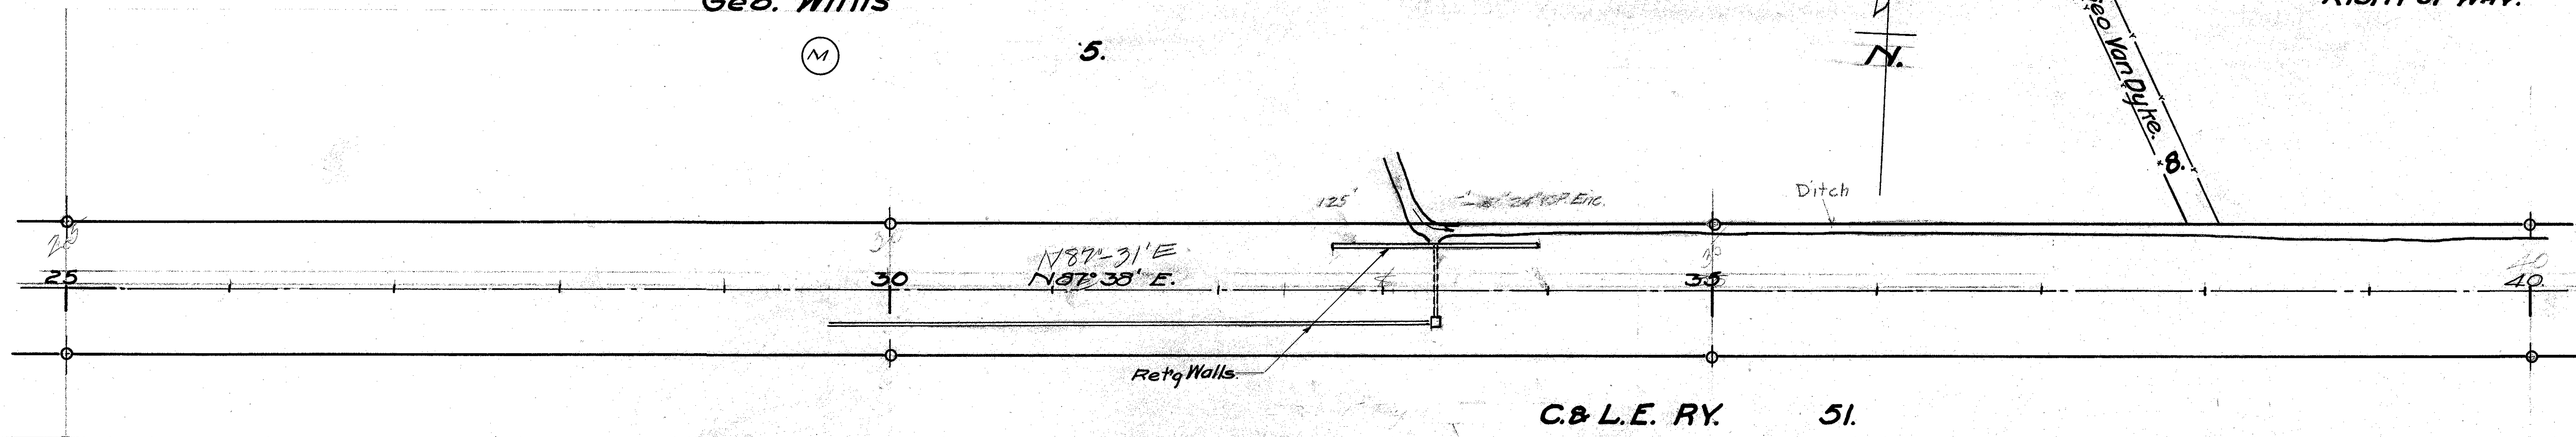

Paul S. Markley

# 4200  
102.59 A.

(M)

6.

Nancy F. Williamson. Est.

# 4200.  
61.55 A.

7.


(M)

Lamar P. Wilson.

# 4200  
70.57 A.

(M)

9.

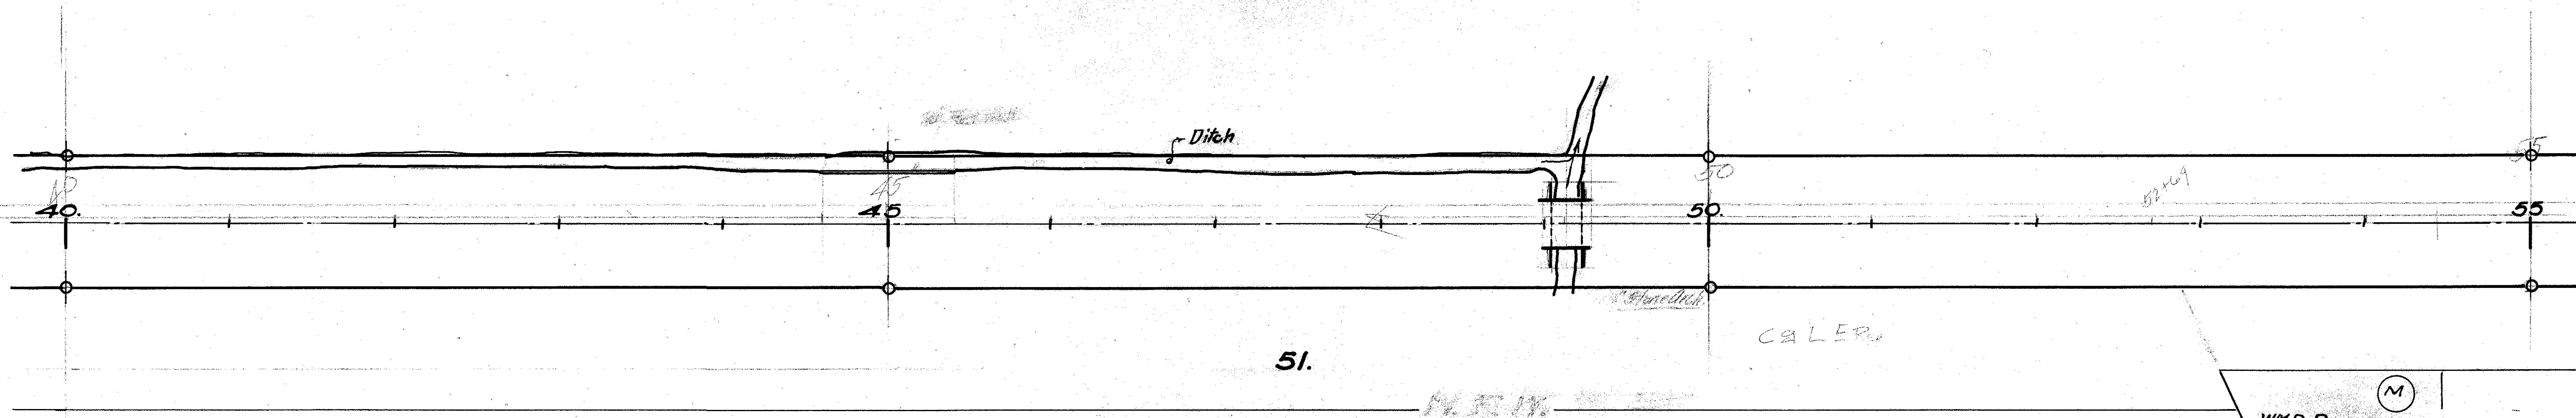

N. F. W. Est.

(M)

7.

Wm B Dormer  
9 1/2  
# 4200  
0.33 A.


(M)

8.

FED. RD. DIST. NO.	STATE	FED. AID PROJECT	FISCAL YEAR
10	OHIO		

4.  
6.

MADISON COUNTY  
S.H. 1. SEC. D-1.  
RIGHT OF WAY.

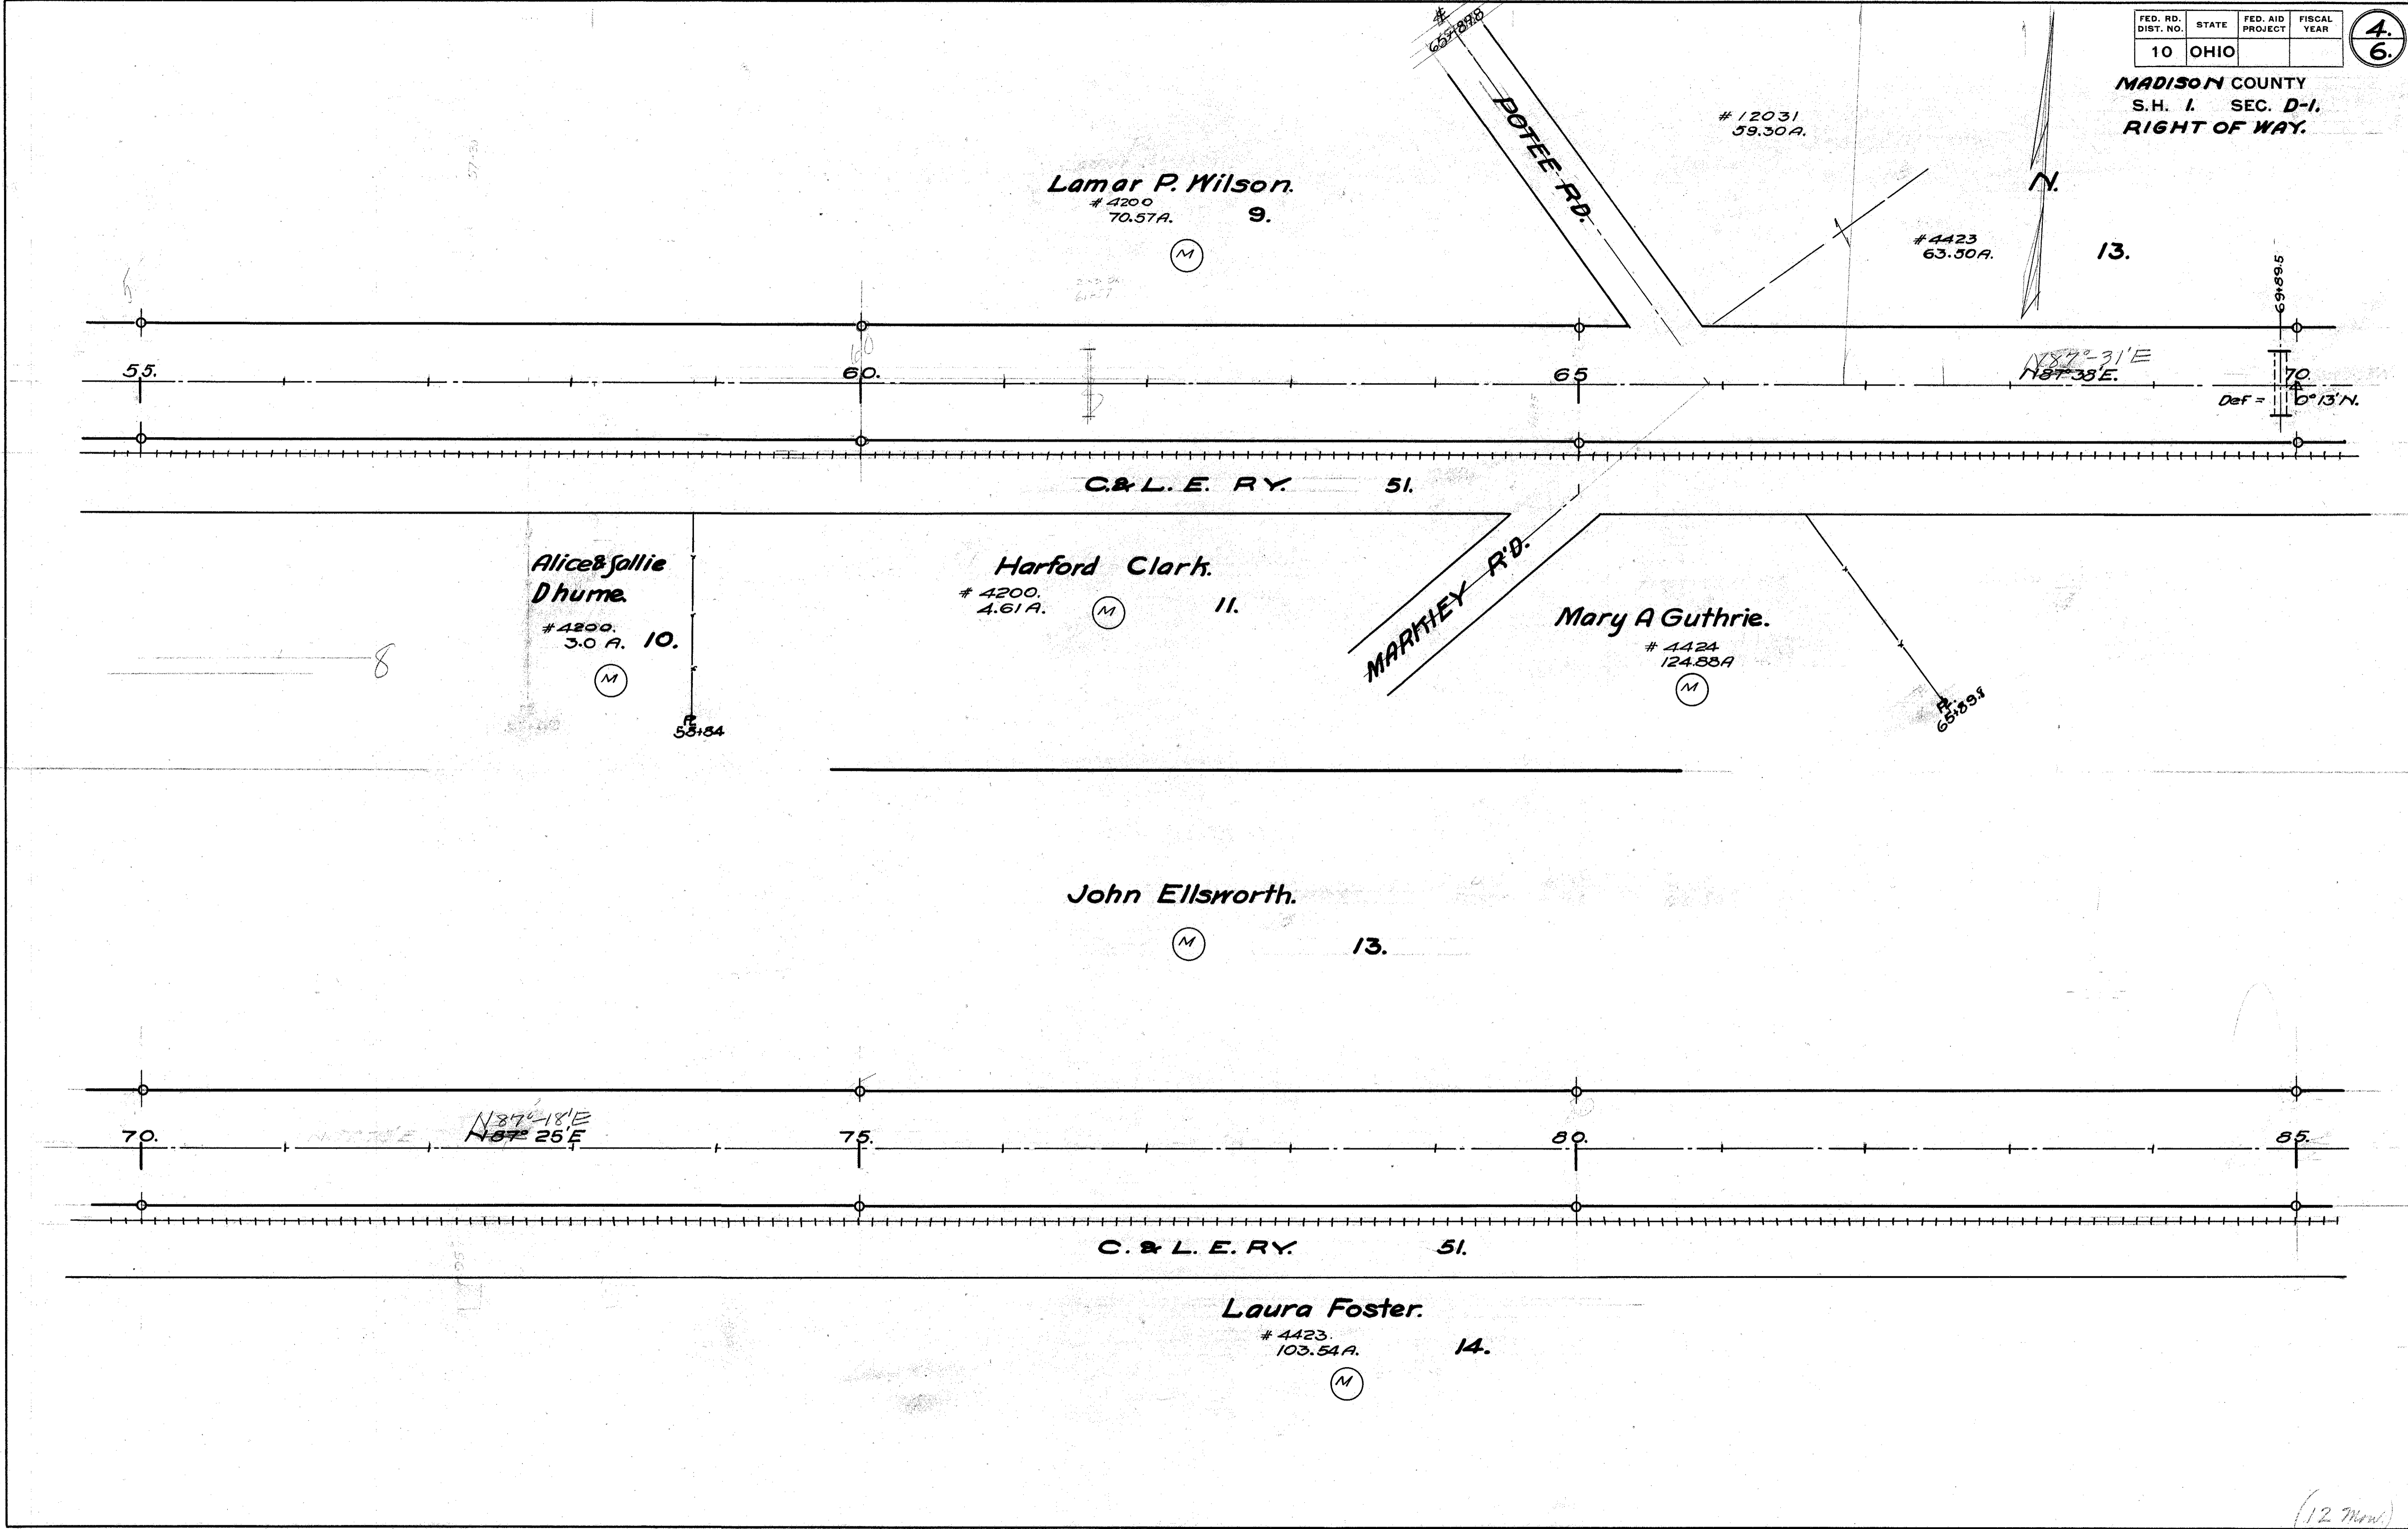

FED. RD. DIST. NO.	STATE	FED. AID PROJECT	FISCAL YEAR
10	OHIO		



5  
6

MADISON COUNTY  
S.H. 1. SEC. D-1.  
RIGHT OF WAY.

John Ellsworth

# 6288  
26.50 A. 13

(M)

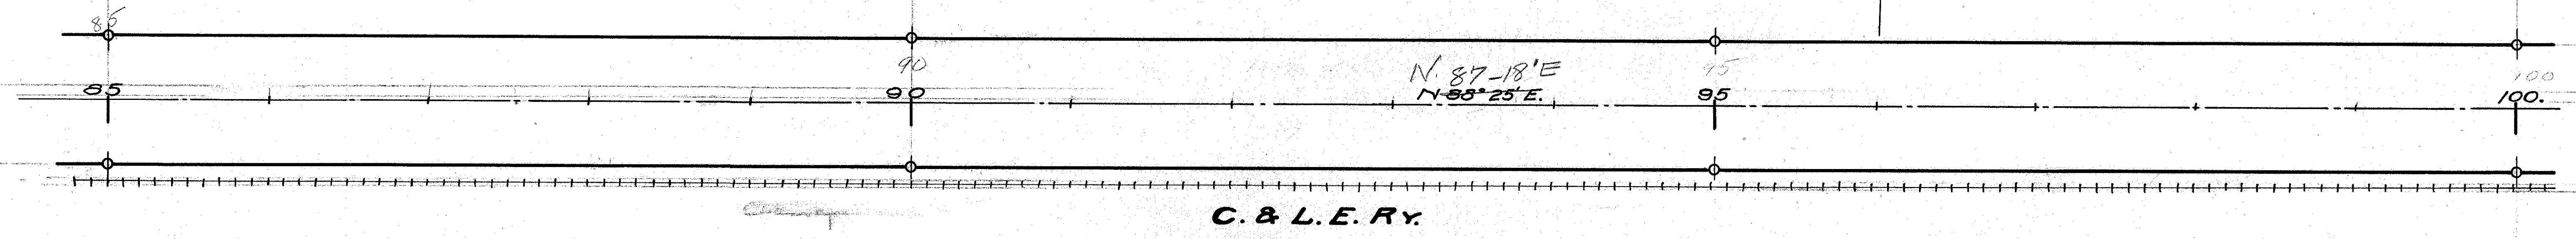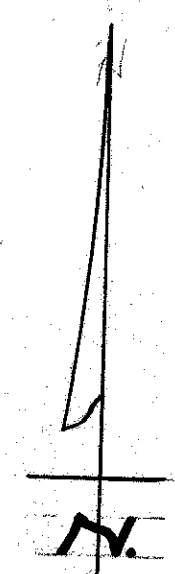

G. Prugh & Hattie Overturf.  
# 7079, # 6288  
103.89A, 9.75A 15.


(M)

WM & Anna Yardley  
# 6288  
2.00 A. 17.

(M)

Edward Heffley.  
# 6288  
69.48 18.

(M)

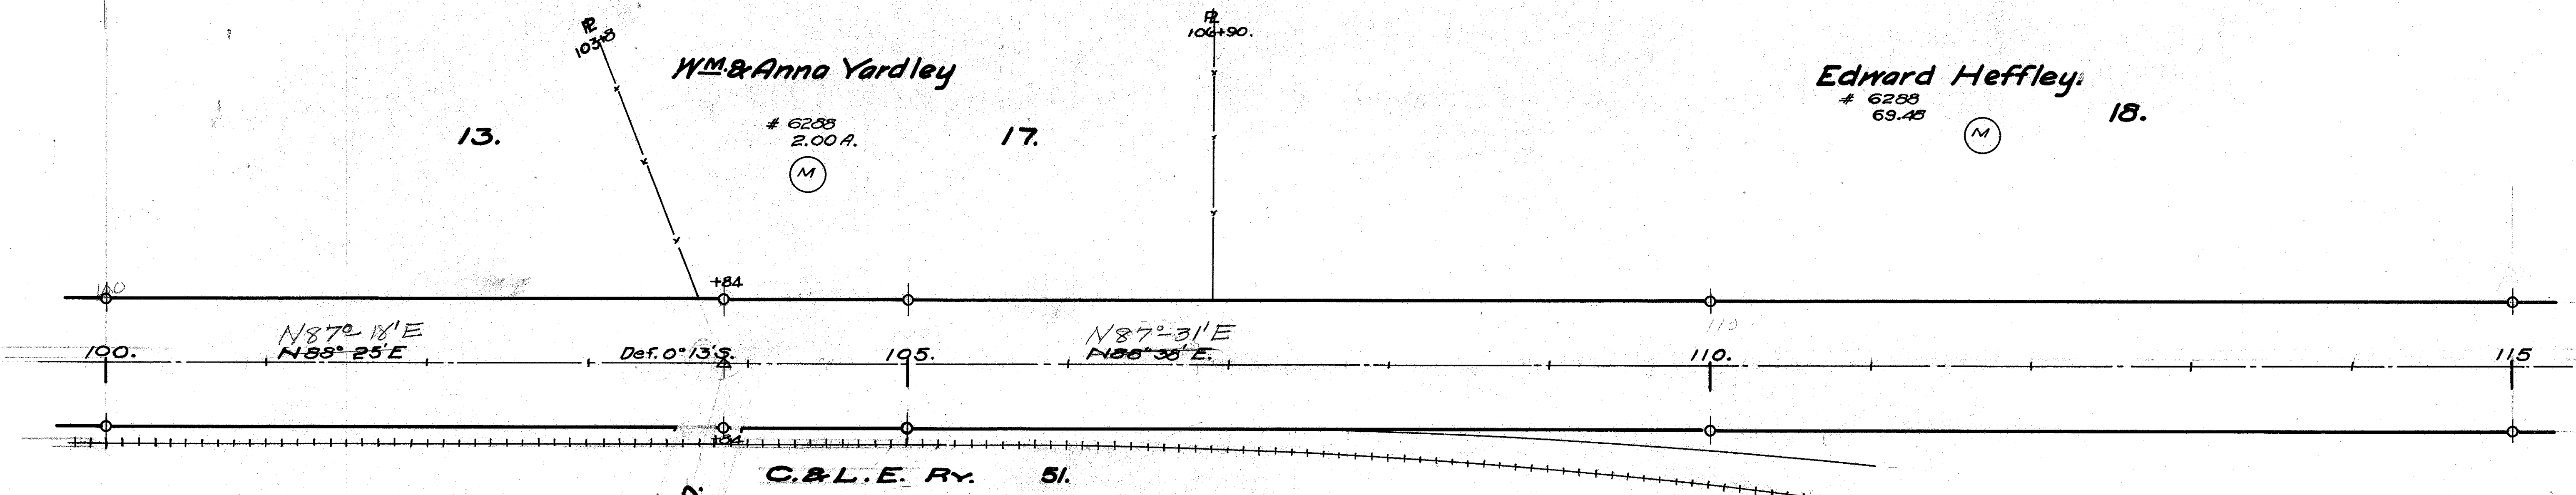

G. Prugh Overturf. et al.  
# 6288  
77.37A. 16.

(M)

15.

ROBERT'S MILL R.D.





SOMERFORD T.W.P.

FED. RD. DIST. NO.	STATE	FED. AID PROJECT	FISCAL YEAR
10	OHIO		

6  
6

MADISON COUNTY  
S.H. 1. SEC. D-1.  
RIGHT OF WAY.

VILLAGE OF SUMMERFORD.

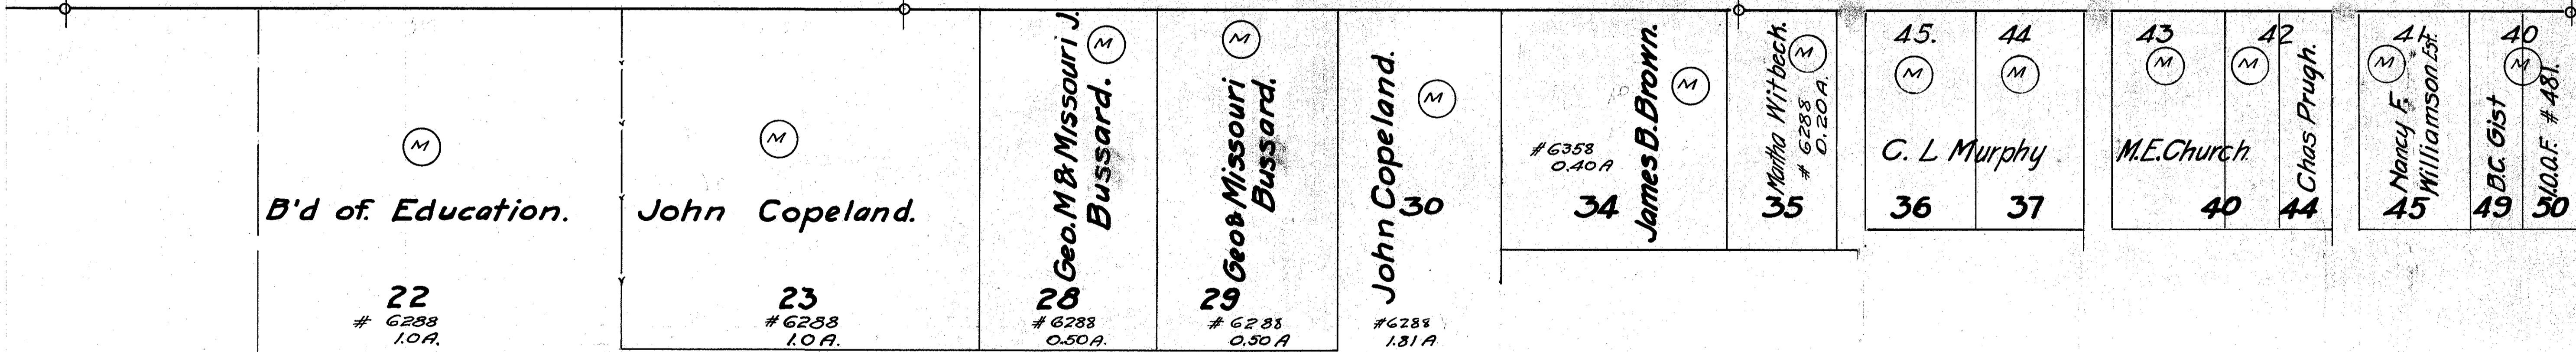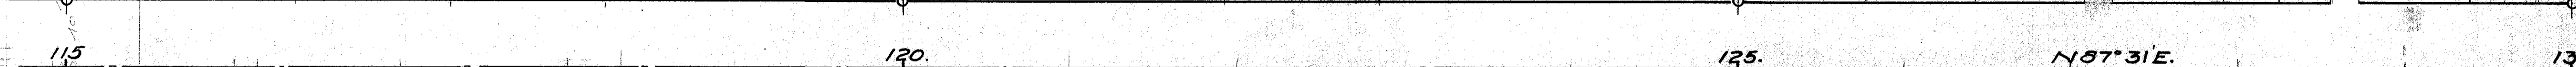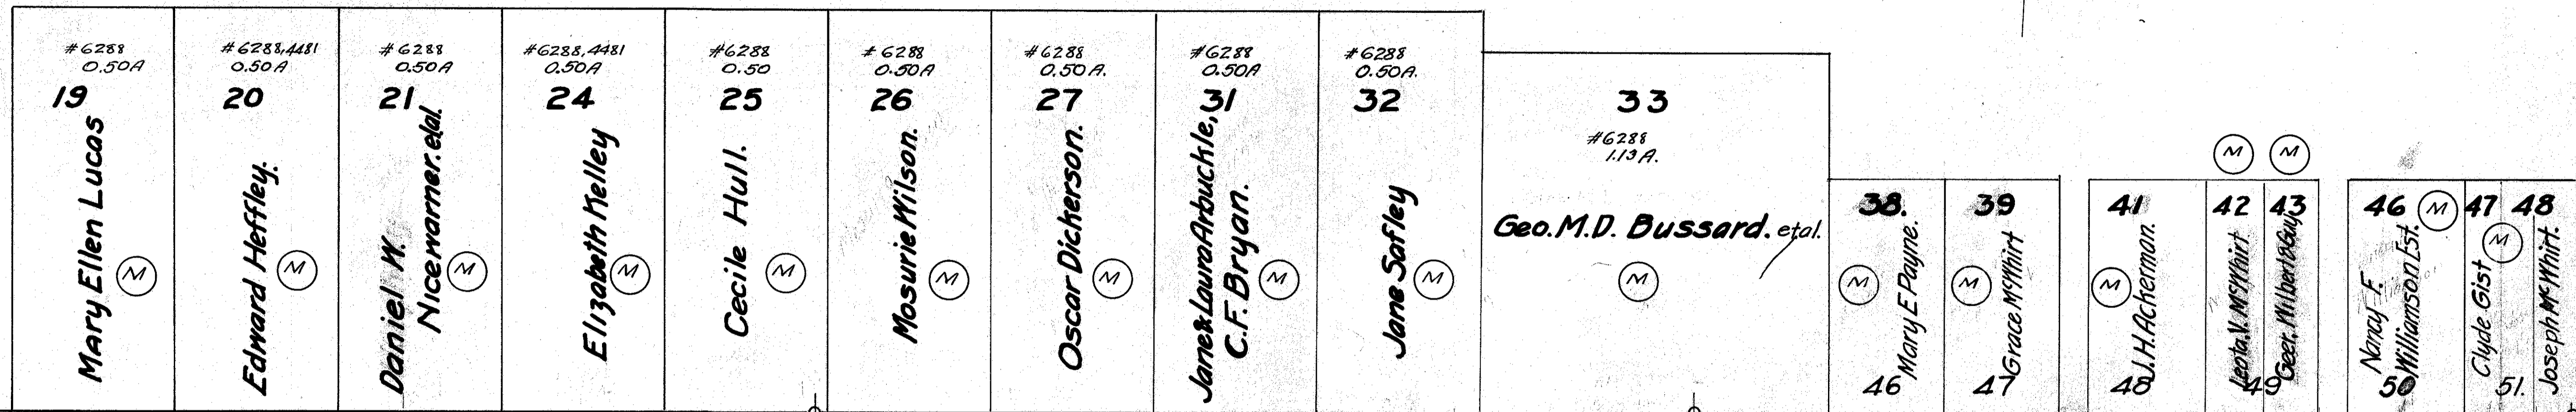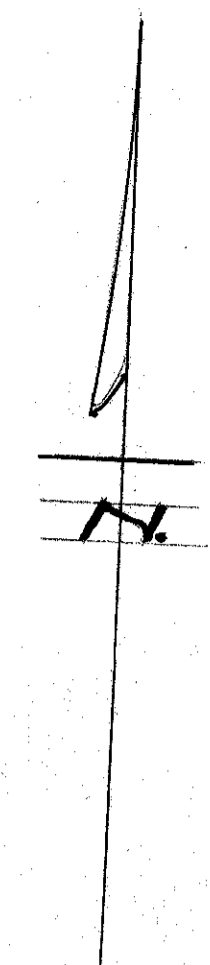

130 + 27 Eud D1

LONDON RD. Gravel

URBANA Concrete

SR50

195  
1/2  
2/10/14