

41-B  
Madison Twp.

# Myers Surveying Company, Inc.

2740 East Main Street, Columbus 43209 (Bexley), Ohio  
614-235-8677 FAX: 614-235-4559

A Boundary Survey prepared for and certified to:  
Professional Closing Title Agency

Legal Description: Situated in Ohio, County of Franklin, Township of Madison, Being 2.754 Acres, Part of the Southeast Quarter of Section 5, Township 11, Range 21, Mathews Survey of Congress Lands

Applicant: Chapon

Posted Address: 3373 Winchester Pike

F.E.M.A. Flood Zone Designation: Flood Zone "X" as per F.I.R.M. 390167 0270G

*[Signature]*



The Ohio Fuel Gas Co.

D.B. 2841, Pg. 471  
0.046 Ac.

Scale: 1" = 100 Ft.  
Date: Aug. 7, 2002

John J. & Mary A. Vatter  
no. 19970728005610  
4.1798 Ac.

George D. & Ester A. Fletcher  
O.R. 25088 G 11  
1.00 Ac.

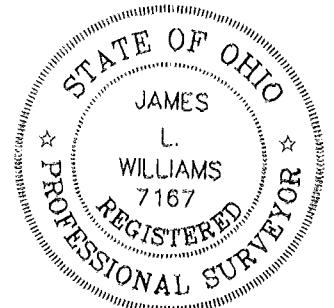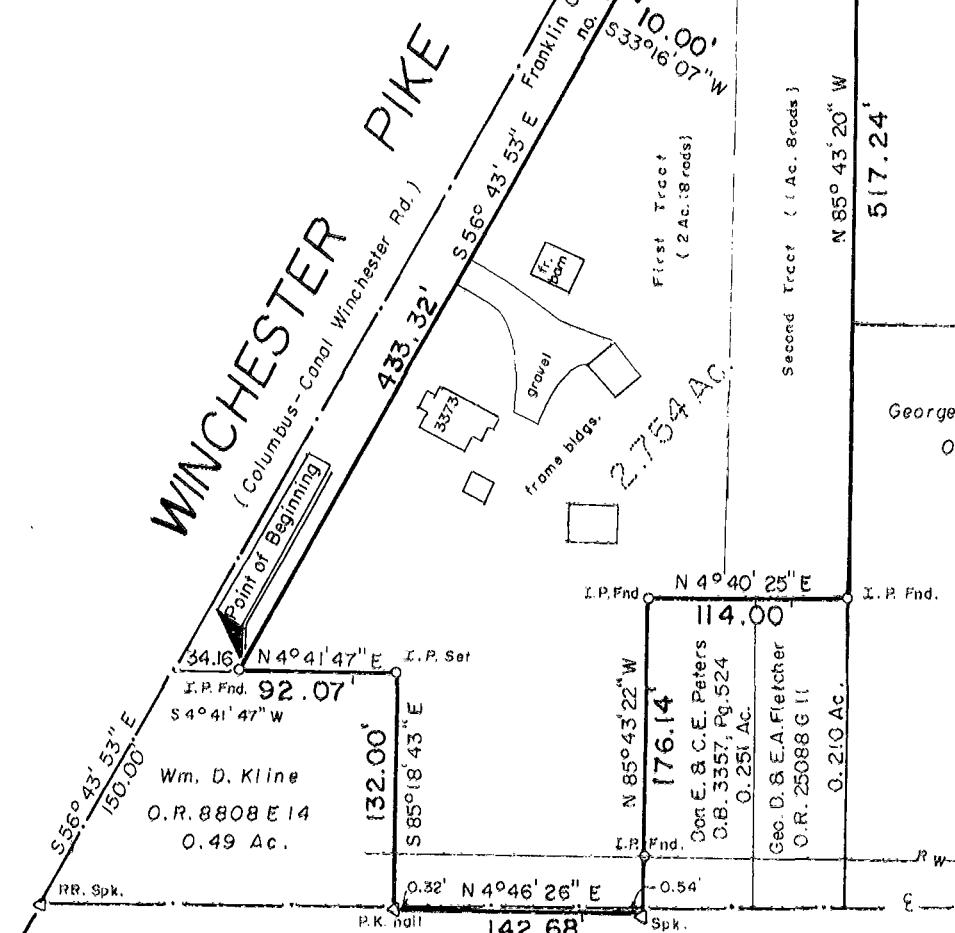

We hereby certify that the foregoing Boundary Survey was prepared from actual field measurements in accordance with Chapter 4733-37 Ohio Administrative Code. Iron pins set are 30"x1" O.D. with an orange plastic plug inscribed "P.S. 6579", unless otherwise noted. Basis of bearing is the centerline of Winchester Road held as South 56 degrees 43 minutes 53.seconds East as per Inst. 200111280275504

Myers Surveying Co., Inc.

By *[Signature]* James J. Williams  
Professional Surveyor