


STATE OF OHIO
DEPARTMENT OF TRANSPORTATION
HAM-75-3.84
HAM-74-1840/1852/1892
(BU-3)

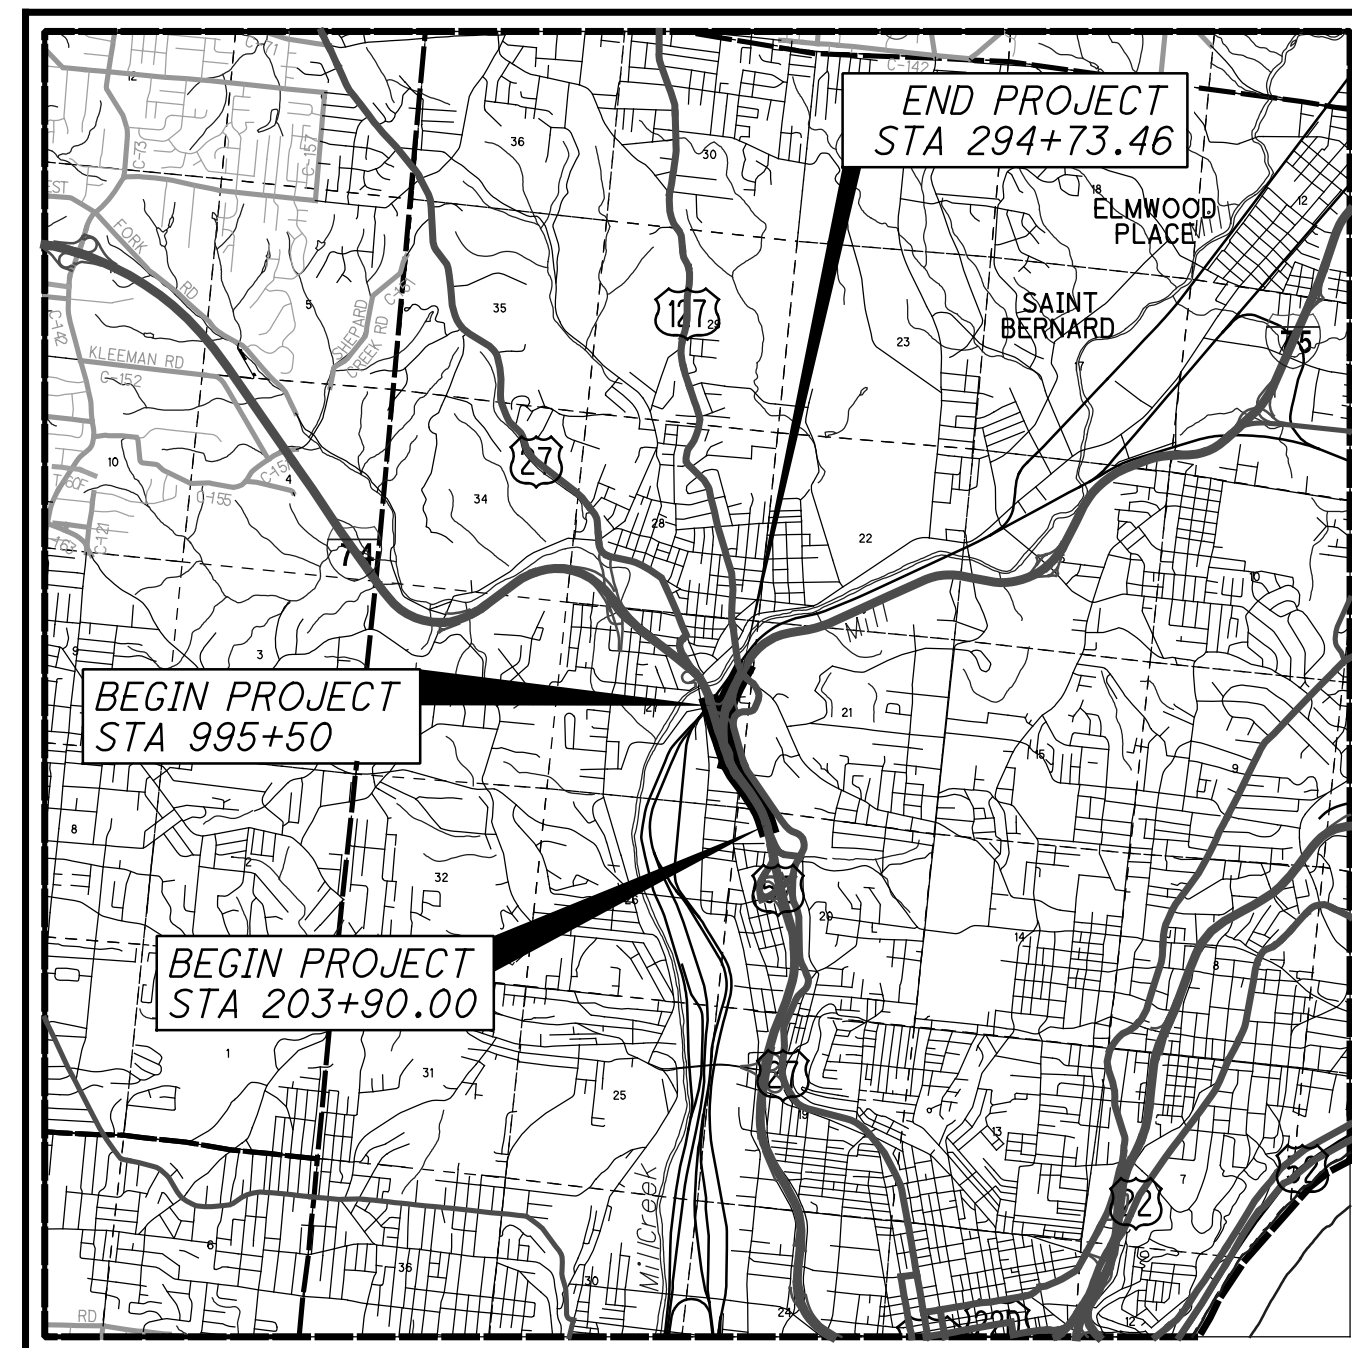

LOCATION MAP

LATITUDE: 39° 09' 03" LONGITUDE: -84° 32' 24"



PORTION TO BE IMPROVED	—————
INTERSTATE HIGHWAY	—————
FEDERAL ROUTES	—————
STATE ROUTES	—————
COUNTY & TOWNSHIP ROADS	—————
OTHER ROADS	—————

DESIGN DESIGNATION

CURRENT ADT (2010)	149,400	152,100	75,000	88,300	25,300	25,300
DESIGN YEAR ADT (2030)	174,300	179,200	89,300	102,000	29,800	29,800
DESIGN HOURLY VOLUME (2030)	14,640	15,050	8,040	9,180	4,100	4,380
DIRECTIONAL DISTRIBUTION	0.54	0.70	0.72	0.73	1.00	1.00
TRUCKS (24 HOUR B&C)	0.16	0.13	0.15	0.13	0.03	0.08
DESIGN SPEED	60 MPH	60 MPH	60 MPH	60 MPH	50 MPH	50 MPH
LEGAL SPEED	55 MPH	55 MPH	55 MPH	55 MPH	50 MPH	50 MPH
DESIGN FUNCTIONAL CLASSIFICATION:	03 URBAN INTERSTATE	03 URBAN INTERSTATE	03 URBAN INTERSTATE	03 URBAN INTERSTATE	03 URBAN INTERSTATE	03 URBAN INTERSTATE

NHS PROJECT ----- YES

DESIGN EXCEPTIONS

DESIGN FEATURE	APPROVAL DATES	SHEET NUMBERS
STOP. SIGHT DIST. - SB IR 75 (CURVE 6)	4/6/18	SEE BU-14
SHOULDER WIDTH - IR 74-1892R BRIDGE	4/10/18	
SHOULDER WIDTH - RAMP P 1908S BRIDGE	4/11/18	
CURVE RADIUS - RAMP P 1908S BRIDGE	4/11/18	
STOP. SIGHT DIST. - RAMP P 1908S BRIDGE	4/11/18	
S.E. RATE - IR 74 EB CURVE 13, 1908R BRIDGE	4/26/18	

IR 75		IR 74		DIRECTIONAL ROADWAY	
SOUTH OF MITCHELL	SOUTH OF IR 74	WEST OF BEEKMAN	EAST OF BEEKMAN	IR 75 NB TO IR 74 WB	IR 74 EB TO IR 75 SB
149,400	152,100	75,000	88,300	25,300	25,300
174,300	179,200	89,300	102,000	29,800	29,800
14,640	15,050	8,040	9,180	4,100	4,380
0.54	0.70	0.72	0.73	1.00	1.00
0.16	0.13	0.15	0.13	0.03	0.08
60 MPH	60 MPH	60 MPH	60 MPH	50 MPH	50 MPH
55 MPH	55 MPH	55 MPH	55 MPH	50 MPH	50 MPH
03 URBAN INTERSTATE	03 URBAN INTERSTATE	03 URBAN INTERSTATE	03 URBAN INTERSTATE	03 URBAN INTERSTATE	03 URBAN INTERSTATE

INDEX OF SHEETS:

TITLE SHEET	1
HAM-74-1840C	2-42
HAM-74-1852C	43-82
HAM-74-1892C	83-120
GIRDER REPAIR PLANS	121-132
Bearing Shop Drawings	133-142
SOE Shop Drawings	143-148

ENGINEERS SEAL: FOR ENTIRE PLAN EXCEPT STRUCTURES OVER 20' SIGNED: <i>Bruce Fraser</i> DATE: 1/30/19	ENGINEERS SEAL: FOR STRUCTURES OVER 20' SIGNED: <i>Christopher L. Bettinger</i> DATE: 1/30/19
---	--

STANDARD CONSTRUCTION DRAWINGS												SUPPLEMENTAL SPECIFICATIONS	
BP-1.1	7/28/00	DM-1.1	7/21/17	RM-4.5	7/21/17	HL-20.21	1/19/18	MT-98.11	1/20/17	TC-21.20	1/19/18	800-2016	1/19/18
BP-2.1	7/17/15	DM-1.2	1/18/13	RM-4.6	7/19/13	HL-20.24	1/19/18	MT-98.20	7/18/14	TC-21.50	7/15/16	804	1/15/16
BP-2.2	7/18/08	DM-1.3	7/18/14			HL-30.11	1/19/18	MT-98.21	7/18/14	TC-22.10	10/18/13	806	3/2/15
BP-2.3	7/18/14	DM-2.1	1/18/13	A-1-69	7/19/02	HL-30.21	1/17/14	MT-98.29	1/20/17	TC-22.20	1/17/14	808	10/16/15
BP-2.4	7/19/13	DM-4.1	1/15/16	AS-1-15	7/17/15	HL-30.22	1/17/14	MT-98.30	7/21/17	TC-41.30	10/18/13	809	1/19/18
BP-3.1	7/18/14	DM-4.2	7/20/12	AS-2-15	1/19/18	HL-30.31	1/17/14	MT-99.30	1/19/18	TC-42.10	10/18/13	814	7/15/16
BP-6.1	7/19/13	DM-4.3	1/15/16	EXJ-4-87	1/19/18	HL-30.32	1/17/14	MT-99.60	7/15/16	TC-42.20	10/18/13	821	4/20/12
BP-8.1	7/18/08	DM-4.4	1/15/16	GSD-1-96	7/19/02	HL-30.33	1/17/14	MT-101.70	1/17/14	TC-52.10	10/18/13	832	1/17/14
CB-1.1	1/15/16	MGS-1.1	1/19/18	PCB-91	1/18/13	HL-30.41	1/19/18	MT-101.75	7/15/16	TC-52.20	1/19/18	839	7/17/15
CB-1.2	1/15/16	MGS-2.1	1/19/18	PSID-1-13	7/15/16	HL-40.10	1/20/17	MT-101.80	1/16/18	TC-61.30	1/20/17	840	7/20/18
CB-1.3	1/15/16	MGS-3.1	1/19/18	RB-1-55	7/19/13	HL-40.20	1/20/17	MT-101.90	7/21/17	TC-65.10	1/17/14	866	4/21/17
CB-2.1	1/15/16	MGS-3.2	1/18/13	SBR-1-13	1/14/14	HL-50.11	1/16/15	MT-102.10	1/20/17	TC-65.11	7/21/17	867	4/15/16
CB-2.2	1/15/16	MGS-4.2	7/19/13	SBR-2-13	1/14/14	HL-50.21	1/19/18	MT-102.20	7/18/14	TC-71.10	1/19/18	902	12/31/12
CB-2.3	1/15/16	MGS-4.3	1/18/13	SICD-1-96	7/18/14	HL-60.12	7/15/16	MT-103.10	1/19/18	TC-72.20	7/15/16	904	7/15/16
CB-3.1	1/15/16	MGS-5.2	7/15/16	SICD-2-14	7/18/14	HL-60.21	1/16/15	MT-104.10	10/16/15	TC-73.20	7/21/17	908	10/20/17
CB-3.3	1/15/16	MGS-5.3	7/15/16	VPF-1-90	1/19/18	HL-60.31	7/21/17	MT-105.10	7/19/13	ITS-13.10	7/17/15	914	7/15/16
I-2.1	1/15/16	MGS-6.1	1/19/18	HL-10.11	1/19/18	MT-95.30	7/21/17	TC-7.65	1/15/16	ITS-14.10	7/17/15	921	4/20/12
I-2.2	1/15/16			HL-10.12	1/20/17	MT-95.31	7/21/17	TC-9.10	1/19/18	ITS-14.11	7/17/15	939	7/17/15
I-2.3	1/15/16	RM-1.1	7/18/14	HL-10.13	1/20/17	MT-95.32	7/21/17	TC-9.30	1/19/18	ITS-15.10	7/17/15		
I-2.4	1/15/16	RM-4.1	7/21/17	HL-10.15	7/17/15	MT-95.50	7/21/17	TC-12.30	1/19/18	ITS-15.11	7/17/15		
MH-1.2	1/15/16	RM-4.3	7/18/14	HL-10.31	1/19/18	MT-95.45	7/21/17	TC-15.115	10/18/13	ITS-50.10	1/19/18		
		RM-4.4	7/18/14	HL-20.11	4/21/17	MT-95.73	1/19/18	TC-16.21	1/19/18				
		RM-4.4	7/21/17	HL-20.13	1/19/18	MT-98.10	1/20/17	TC-21.10	7/21/17				

PROJECT DESCRIPTION

THIS IS PHASE 5A OF THE HAMILTON 75 CORRIDOR PROJECTS (MCE). THE PROJECT ADDS A LANE TO IR 75 SB, PROVIDES 4-LANE CONTINUITY NB, AND RECONFIGURES IR 74 EB RAMPS TO IR 75. THE PROJECT ALSO INCLUDES SURFACE COURSE AND ADDITIONAL PAVEMENT WORK TO THE SOUTH AND IMPROVEMENTS TO RAMP A AT THE HOPPLE ST INTERCHANGE.

BUILDABLE UNIT 3 DESCRIPTION

THIS BUILDABLE UNIT INCLUDES THE CONSTRUCTION OF THE HAM-74-1840/1852/1892 BRIDGE REHABILITATION WORK.

LIMITED ACCESS

THIS IMPROVEMENT IS ESPECIALLY DESIGNED FOR THROUGH TRAFFIC AND HAS BEEN DECLARED A LIMITED ACCESS HIGHWAY OR FREEWAY BY ACTION OF THE DIRECTOR IN ACCORDANCE WITH THE PROVISIONS OF SECTION 5511.02 OF THE OHIO REVISED CODE.


2016 SPECIFICATIONS

THE STANDARD SPECIFICATIONS OF THE STATE OF OHIO, DEPARTMENT OF TRANSPORTATION, INCLUDING SUPPLEMENTAL SPECIFICATIONS LISTED IN THE PLANS AND CHANGES LISTED IN THE PROPOSAL SHALL GOVERN THIS IMPROVEMENT.

I HEREBY APPROVE THESE PLANS AND DECLARE THAT THE MAKING OF THIS IMPROVEMENT WILL NOT REQUIRE THE CLOSING TO TRAFFIC OF THE HIGHWAY AND THAT PROVISIONS FOR THE MAINTENANCE AND SAFETY OF TRAFFIC WILL BE AS SET FORTH ON THE PLANS AND ESTIMATES.

APPROVED FOR CONSTRUCTION

The DBT confirms that the record drawings have been updated to incorporate all red-lined changes and have been approved by the appropriate parties. These updated drawings represent the final and accurate record of the buildable unit's design and construction.

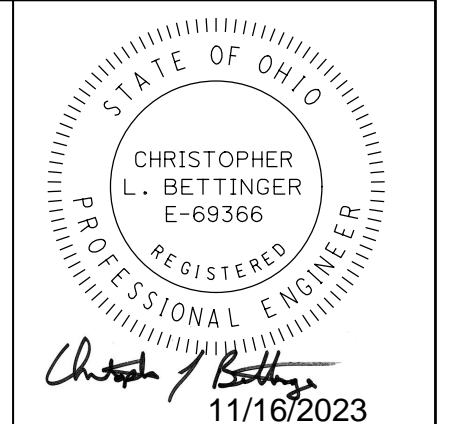

RELEASED FOR CONSTRUCTION
crowe 02/21/2019 1:53:08 PM

PLAN PREPARED BY:
AMERICAN STRUCTUREPOINT INC.
2550 CORPORATE EXCHANGE DR, STE 300
COLUMBUS, OH 43231
TEL 614.901.2235 FAX 614.901.2236
www.structurepoint.com


UNDERGROUND UTILITIES
CONTACT BOTH SERVICES TWO WORKING DAYS BEFORE YOU DIG.

Call Before You Dig
1-800-362-2764
(Non-members must be called directly)
OIL & GAS PRODUCERS UNDERGROUND PROTECTION SERVICE
1-800-925-0988

FEDERAL PROJECT NO. E170 (713)
PID NO. 104667
CONSTRUCTION PROJECT NO. 183000
RAILROAD INVOLVEMENT CSXT (CSX OP# OH1179) NORFOLK SOUTHERN
HAM-75-3.84
1/120

soltesz 1/30/2019 9:24:29 AM V:\2017\01113\C.Design\104667_HAM-75-3.84\Design\Structures\HAM0074-1840C_Sheets\74-1840GT003.dgn

SFlanagan
 11/16/2023 9:33:33 AM
 C:\2017\GIS\G.Design\104667_HAM-75-3.84.Design\Structures\HAM0074-1840C_Sheets\74-1840SP001.dgn

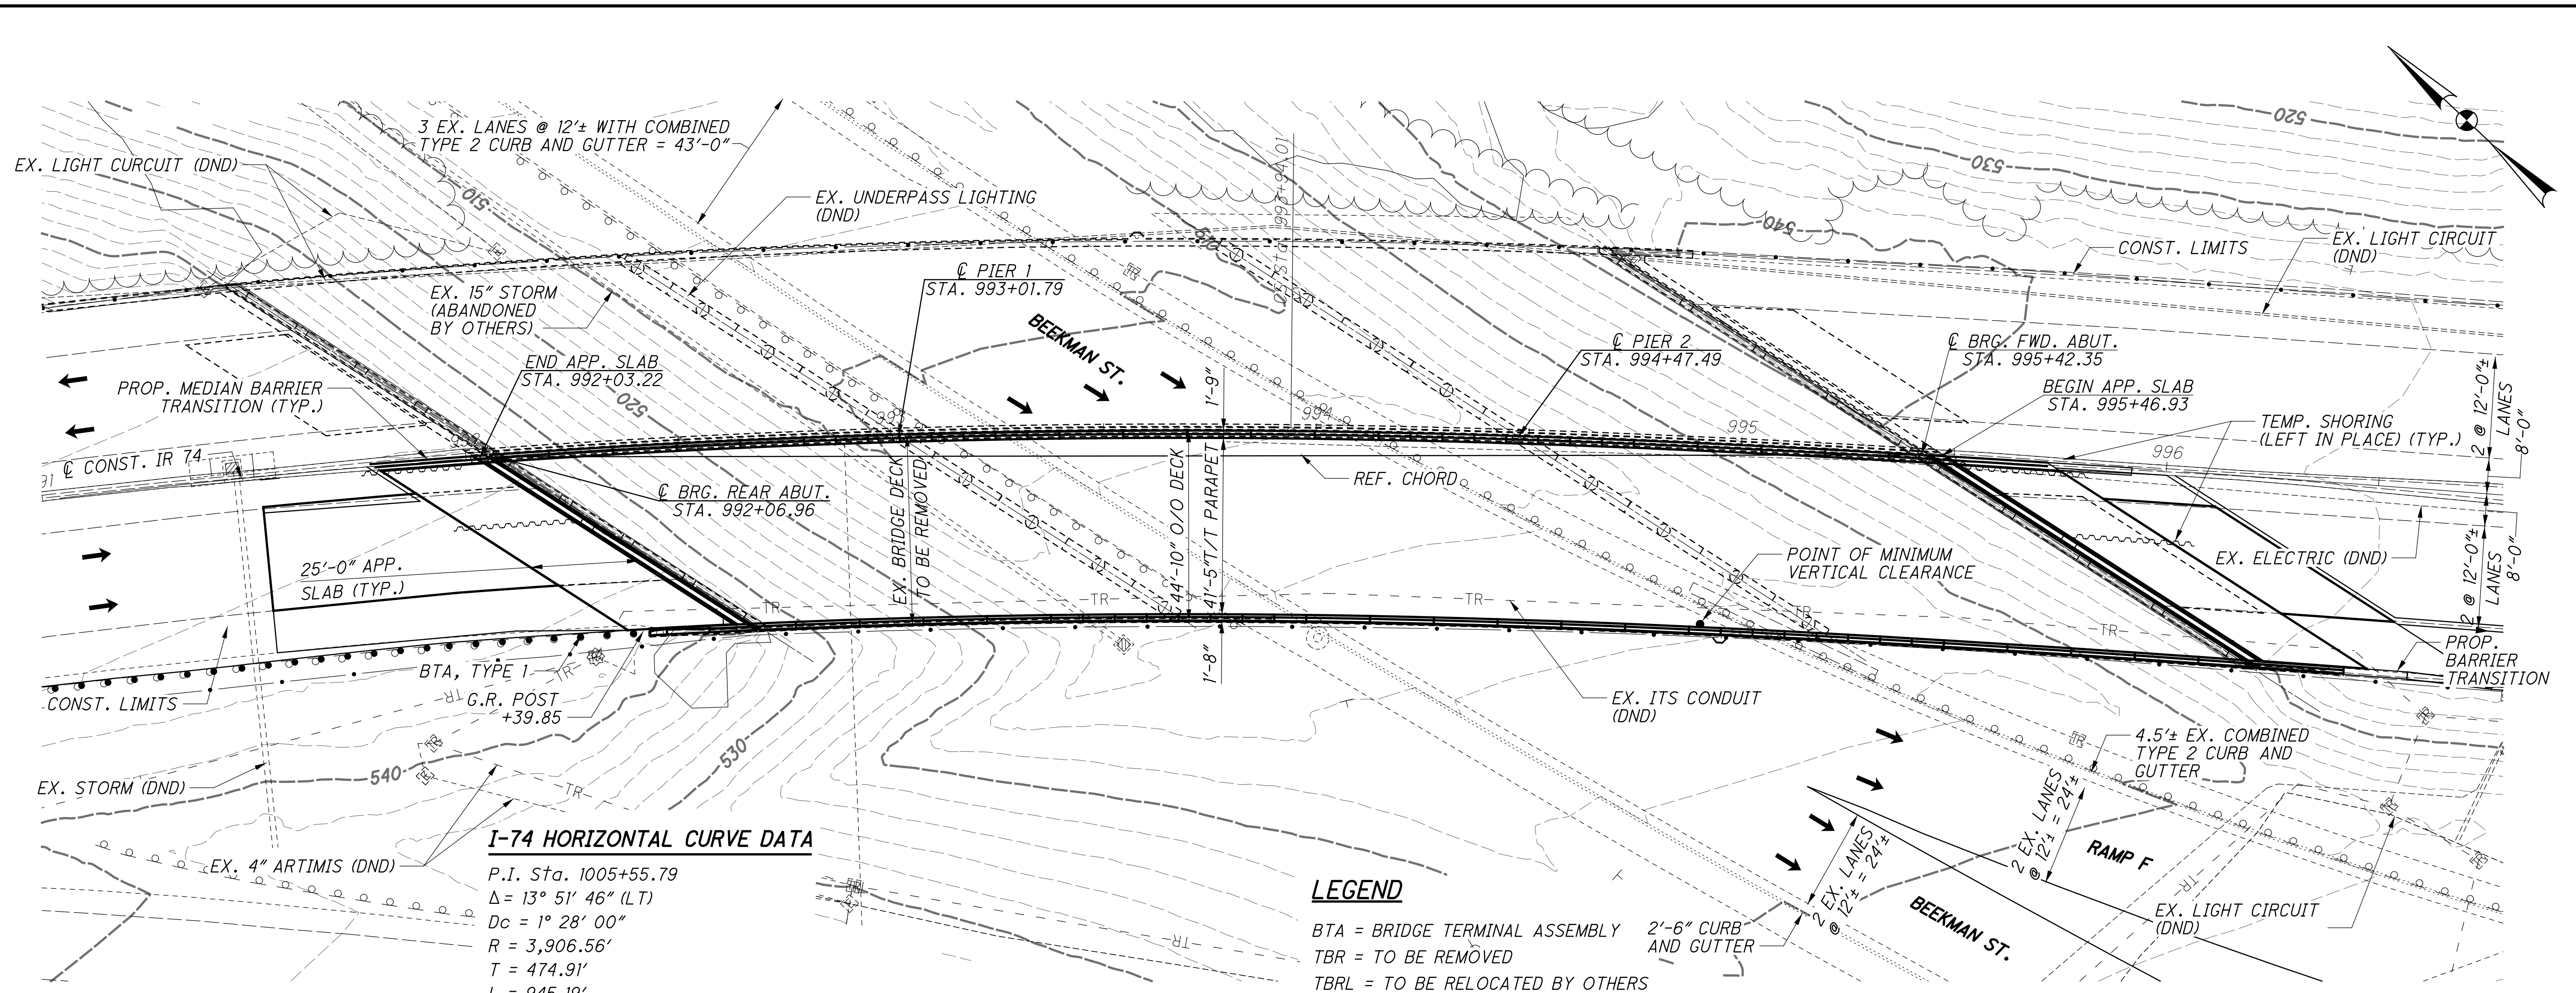


I-74 HORIZONTAL CURVE DATA

P.I. Sta. 1005+55.79
 $\Delta = 13^\circ 51' 46''$ (LT)
 $Dc = 1^\circ 28' 00''$
 $R = 3,906.56'$
 $T = 474.91'$
 $L = 945.19'$
 $E = 28.76'$
 $C = 942.89'$
 $C.B. = S 45^\circ 47' 56'' E$

LEGEND

BTA = BRIDGE TERMINAL ASSEMBLY
 TBR = TO BE REMOVED
 TBRL = TO BE RELOCATED BY OTHERS
 DND = DO NOT DISTURB
 ● 14'-6" REQUIRED MINIMUM VERTICAL CLEARANCE
 ○ 15'-3" PROVIDED MINIMUM VERTICAL CLEARANCE

PLAN

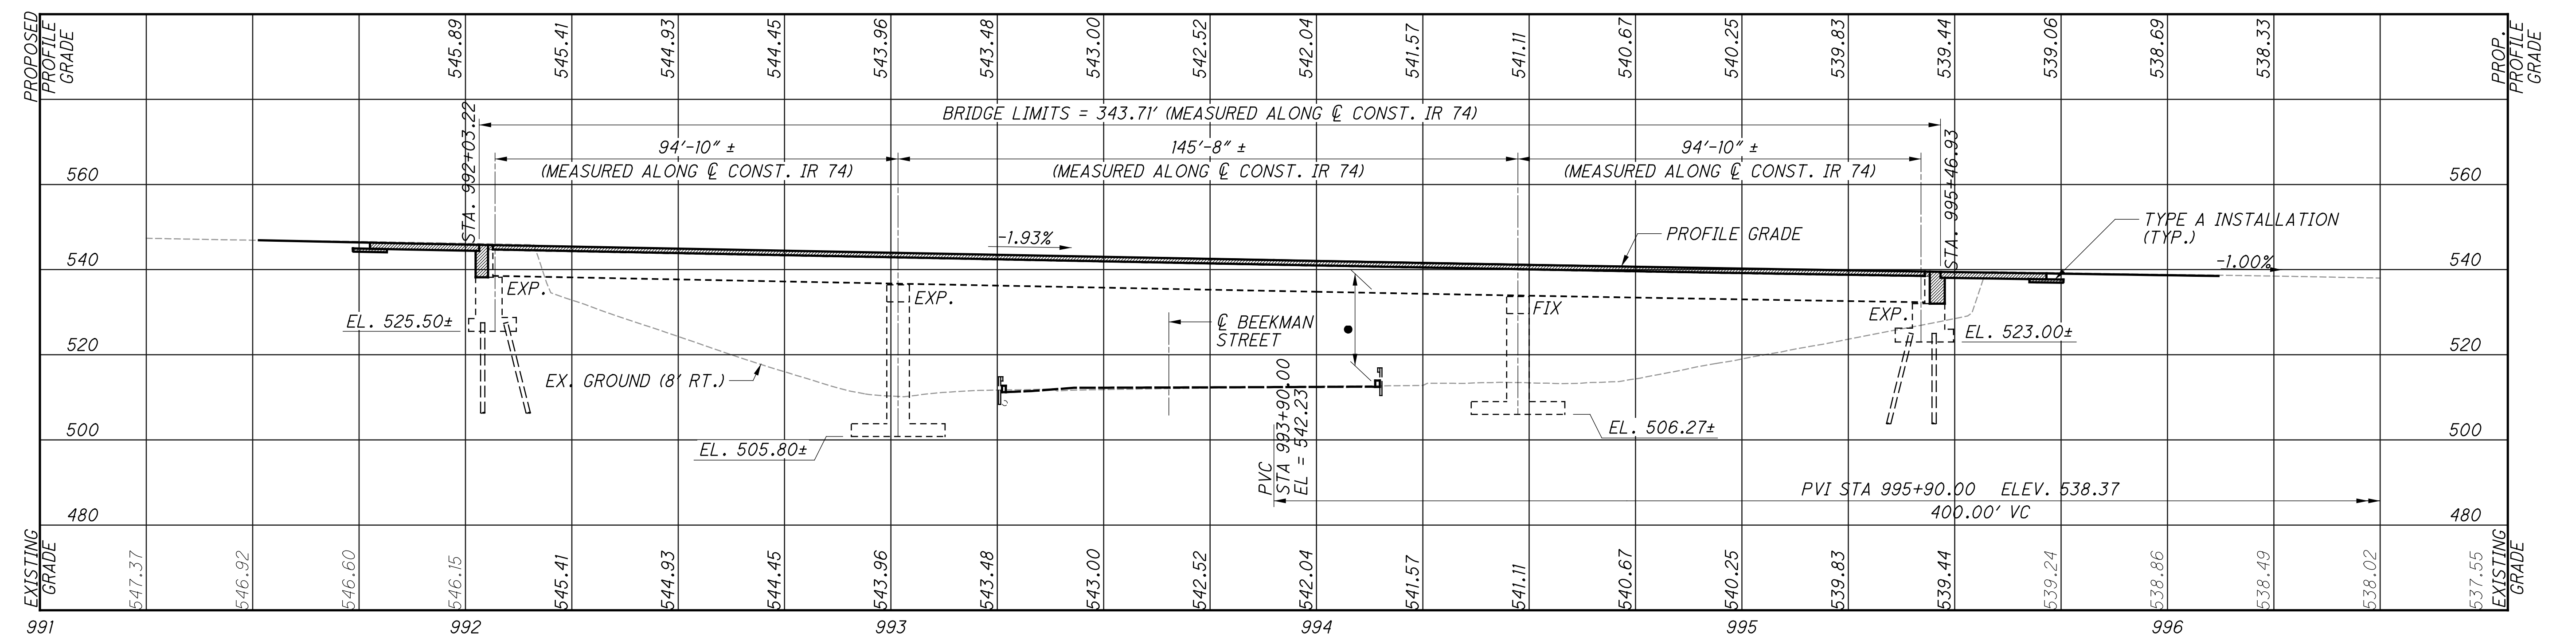


PROFILE
ELEVATION ALONG \hat{C} CONST. IR 74


NOTE:
FOR ADDITIONAL SITE PLAN INFORMATION, SEE SHEET 2/41.

	DESIGN AGENCY STRUCTUREPOINT <small>200 CORPORATE CENTER DR., SUITE 200 THE HAVEN 10000 WILSONVILLE, OR 97152 TEL: 503.261.1222 FAX: 503.261.1225 WWW.STRUCTUREPOINT.COM</small>
DATE 09/12/18	REVIEWED MDS
DRAWN DSH	CHECKED CLB
DESIGNED SUJ	STRUCTURE FILE NUMBER 3115526
HAMILTON COUNTY STA. 992+03.22 STA. 995+46.93	SITE PLAN BRIDGE NO. HAM-74-1840 L/R OVER BEEKMAN ST. (U.S.27) & RAMP F
HAM-75-3.84	PID No. 104667
1 / 41	2 / 120


S:\Flanagan\11/16/2023 9:33:34 AM\2017\01113\C.Design\104667-HAM-75-3.84\Design\Structures\HAM0074-1840C\Sheets\74-1840GP002.dgn

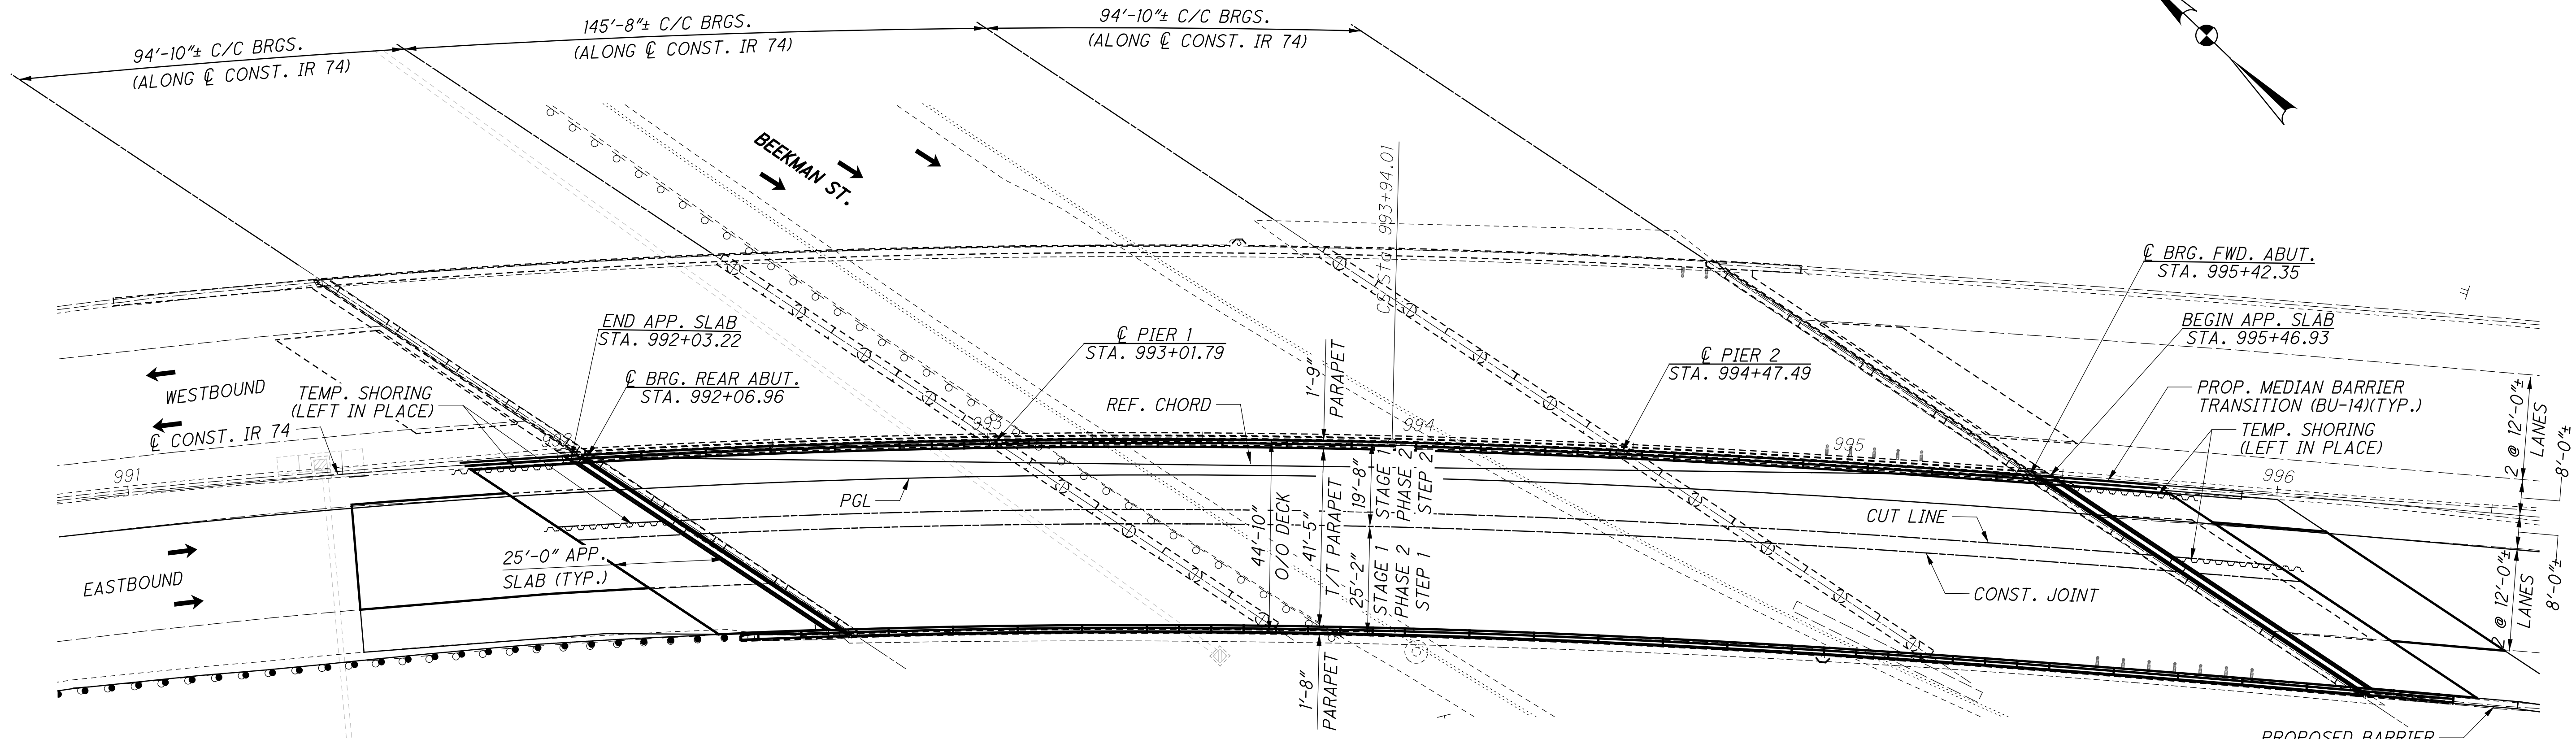


GENERAL PLAN

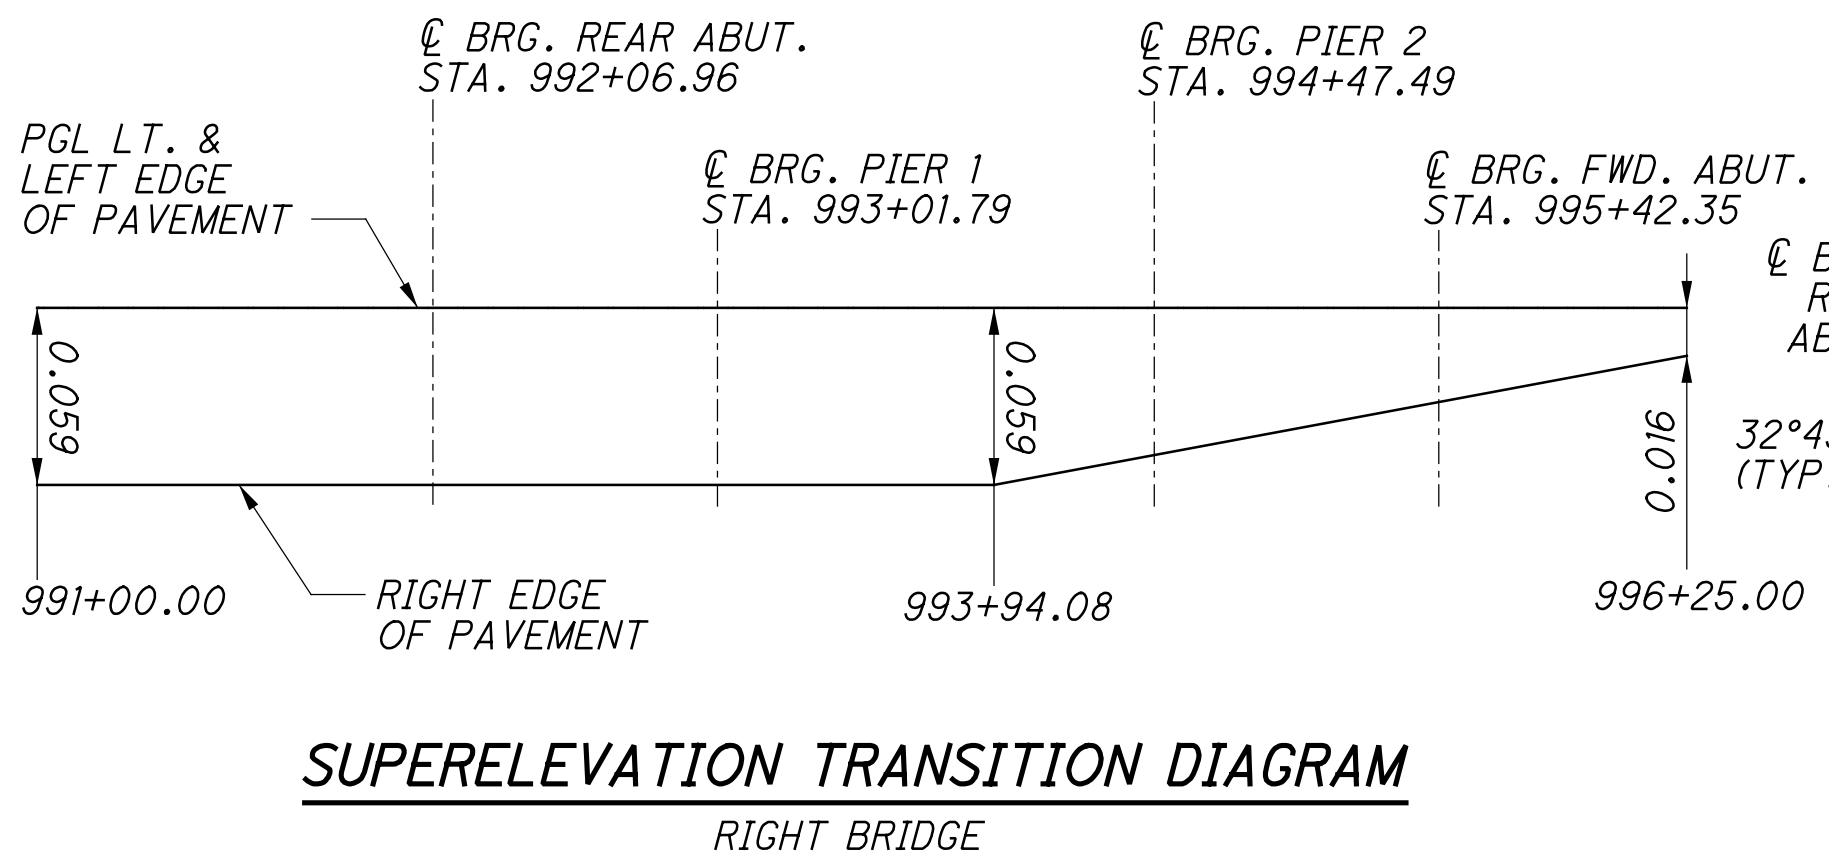

SUPERELEVATION TRANSITION DIAGRAM
RIGHT BRIDGE

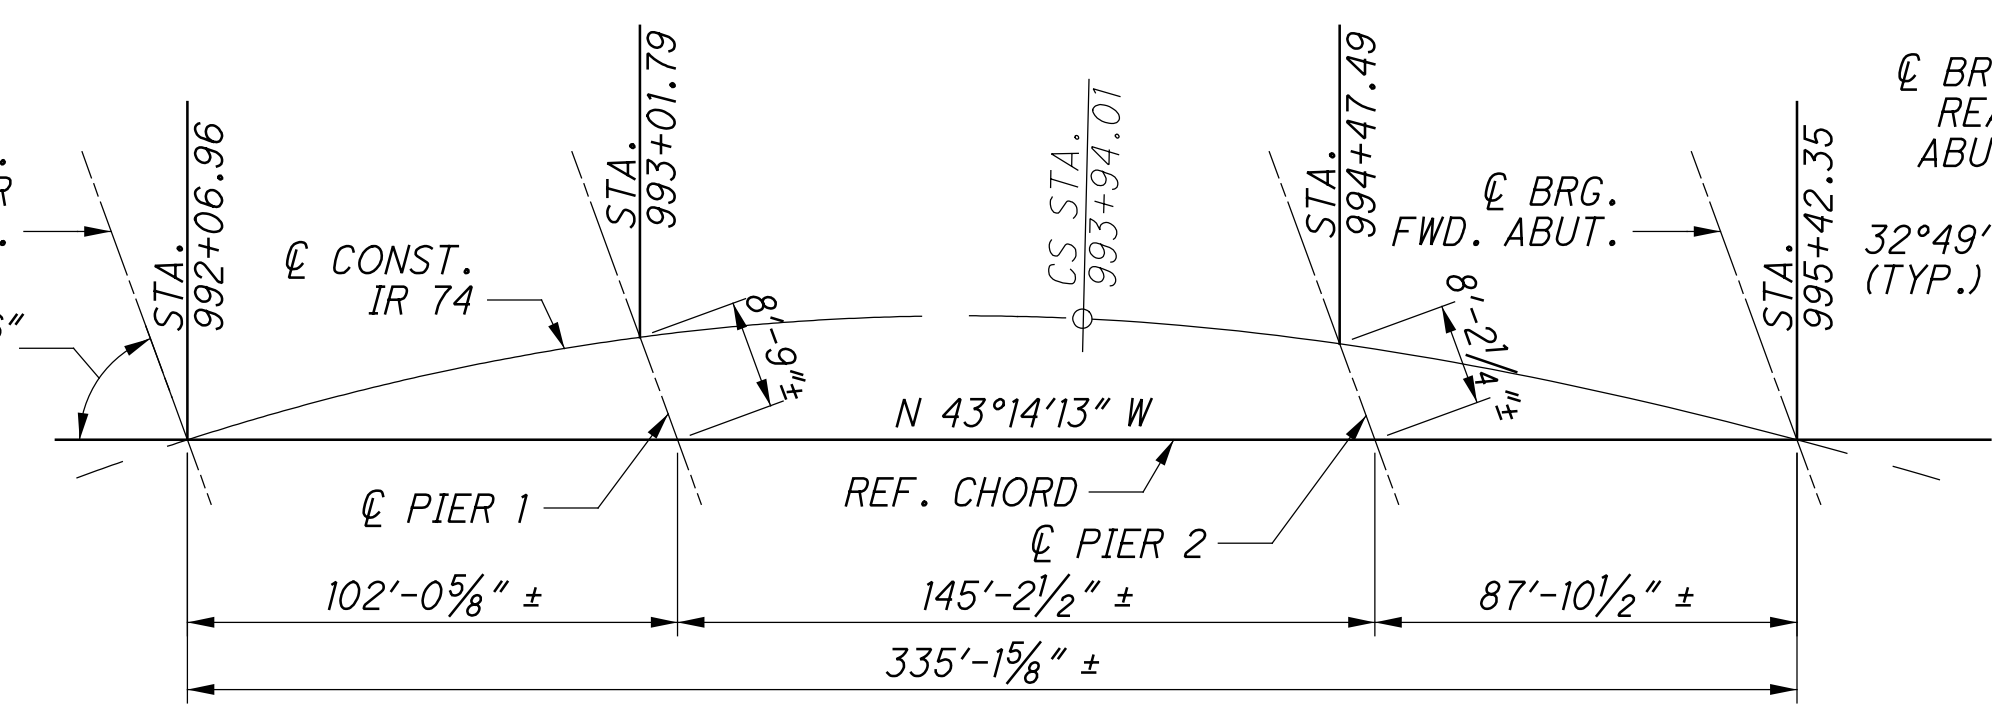

REFERENCE CHORD DIAGRAM

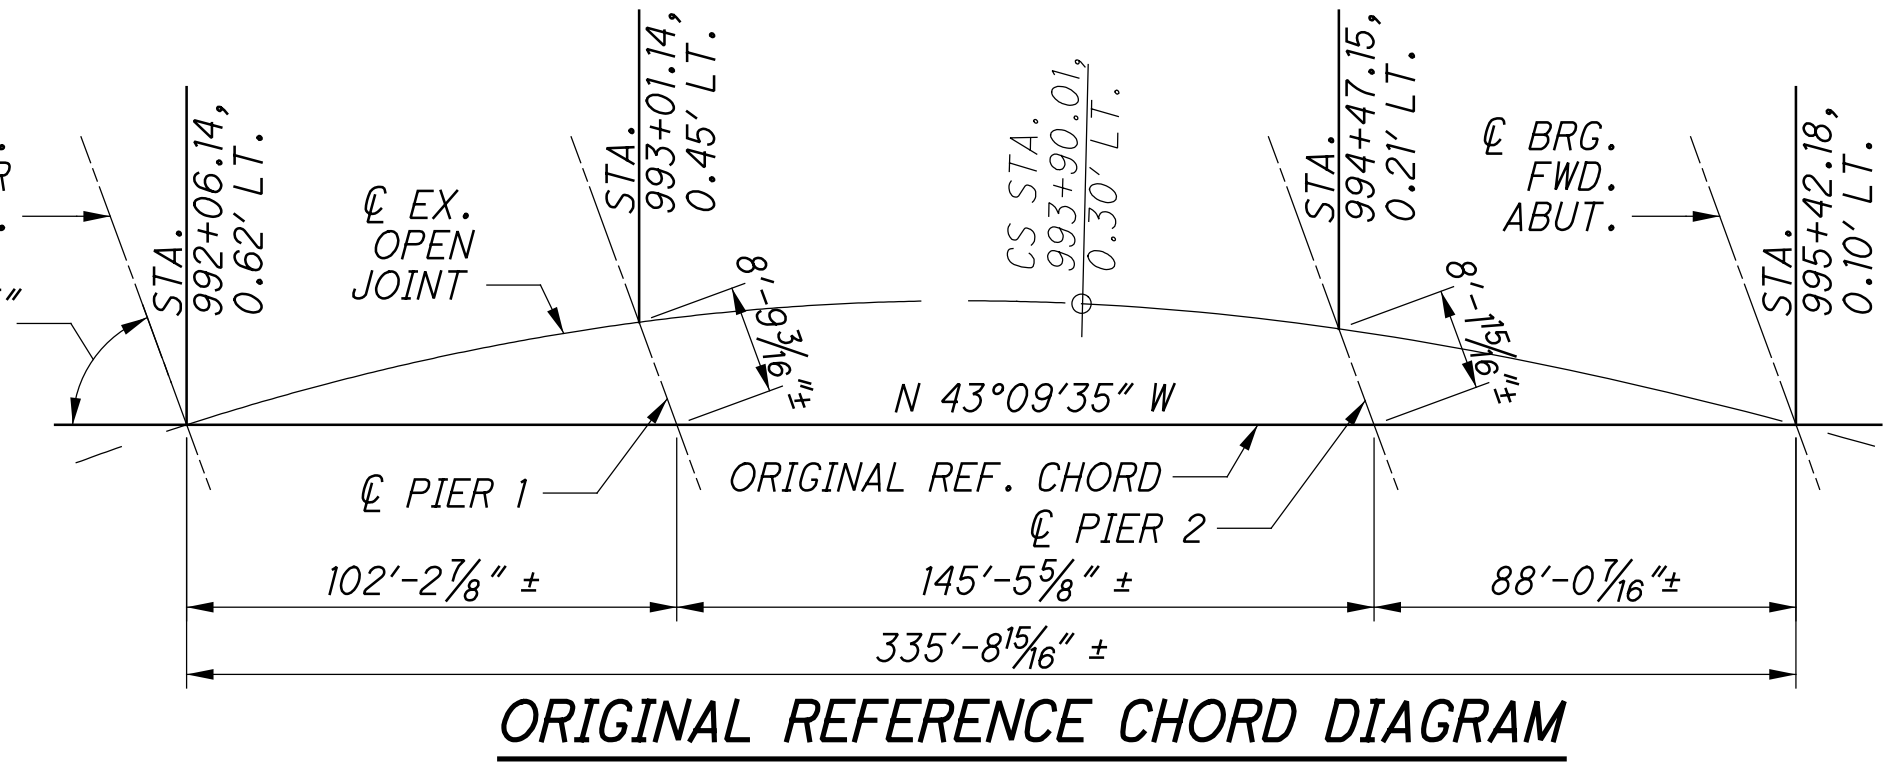

ORIGINAL REFERENCE CHORD DIAGRAM

BENCHMARK DATA	
REFER TO BU-14 FOR BENCHMARK DATA.	

NOTES
EARTHWORK LIMITS SHOWN ARE APPROXIMATE. ACTUAL SLOPES SHALL CONFORM TO PLAN CROSS SECTIONS.

DESIGN TRAFFIC:
2010 ADT = 75,000 2010 ADTT = 11,250
2030 ADT = 89,300 2030 ADTT = 13,395
DIRECTIONAL DISTRIBUTION = 0.72

EXISTING STRUCTURE
TYPE: CONTINUOUS STEEL PLATE GIRDERS WITH REINFORCED CONCRETE DECK AND SUBSTRUCTURE
SPANS: 94'-10"±, 145'-8"±, 94'-10"± C/C BRGS.
ROADWAY: 41'-5" TOE/TOE PARAPET
LOADING: HS20-44 AND THE ALTERNATE MILITARY LOADING
SKEW: 57°10'44"± RF WITH RESPECT TO REF CHORD
APPROACH SLABS: AS-1-67 (25'-0"±)
ALIGNMENT: 2°30'00"± CURVE RIGHT AND SPIRAL
CROWN: VARIES, 0.059± FT/FT MAX.
STRUCTURAL FILE NUMBER: 3115526
DATE BUILT: 1973
WEARING SURFACE: 2"± ASPHALT CONCRETE OVERLAY 1 3/4"± SDC OVERLAY
DISPOSITION: REHABILITATION

PROPOSED STRUCTURE
TYPE: RIGHT BRIDGE (EB) REPLACE DECK WITH COMPOSITE DECK, REPLACE EXPANSION JOINTS, REPLACE ABUTMENT BEARINGS WITH ELASTOMERIC BEARINGS, REMOVE AND REPLACE BACKWALL TO TOP OF BEAM SEAT, REPLACE APPROACH SLABS, PATCH EX. SUBSTRUCTURE, FIBER WRAP PIER 2 COLUMNS
LEFT BRIDGE (WB) REPLACE ABUTMENT BEARINGS WITH ELASTOMERIC BEARINGS
SPANS: 94'-10"±, 145'-8"±, 94'-10"± C/C BRGS.
ROADWAY: 41'-5" TOE/TOE PARAPET
LOADING: HS20-44 AND THE ALTERNATE MILITARY LOADING
SKEW: 57°10'44"± RF WITH RESPECT TO REF CHORD
APPROACH SLABS: 25' LONG (AS-1-15 & AS-2-15)
ALIGNMENT: 2°30'00"± CURVE RIGHT AND SPIRAL
SUPERELEVATION: VARIES, 0.059 FT/FT MAX.
WEARING SURFACE: 1" MONOLITHIC CONCRETE
COORDINATES: LATITUDE N39°09'42" LONGITUDE W84°33'06"

STANDARD DRAWINGS AND SUPPLEMENTAL SPECIFICATIONS:

REFER TO THE FOLLOWING STANDARD BRIDGE DRAWINGS:

- AS-1-15 REVISED 07-17-15
- AS-2-15 REVISED 01-19-18
- EXJ-4-87 REVISED 01-19-18
- GSD-1-96 REVISED 07-19-02
- PCB-91 REVISED 01-18-13
- SBR-1-13 REVISED 07-20-18
- SBR-2-13 REVISED 07-20-18

AND TO THE FOLLOWING PROPOSAL NOTES:

519 COMPOSITE FIBER WRAP SYSTEM REVISED 07-21-17

DESIGN SPECIFICATIONS:

THE PROPOSED WORK CONFORMS TO "STANDARD SPECIFICATIONS FOR HIGHWAY BRIDGES" ADOPTED BY THE AMERICAN ASSOCIATION OF STATE HIGHWAY AND TRANSPORTATION OFFICIALS, 17TH EDITION, AND THE 2004 ODOT BRIDGE DESIGN MANUAL.

DESIGN LOADING:

DESIGN LOADING: HS20-44, CASE I AND THE ALTERNATE MILITARY LOADING.

FUTURE WEARING SURFACE (FWS) OF 60 PSF

DESIGN DATA:

QC/QA CONCRETE, CLASS QC3 - COMPRESSIVE STRENGTH 4500 PSI (SUPERSTRUCTURE)

CONCRETE, CLASS QC3 - COMPRESSIVE STRENGTH 4000 PSI (SUBSTRUCTURE)

REINFORCING STEEL - MINIMUM YIELD STRENGTH 75,000 PSI (DECK)

REINFORCING STEEL - MINIMUM YIELD STRENGTH 60,000 PSI (SUBSTRUCTURE & PARAPETS)

STRUCTURAL STEEL - ASTM A709 GRADE 50 - YIELD STRENGTH 50 KSI (BEARINGS)

DECK PROTECTION METHOD:

EPOXY COATED REINFORCING STEEL

2 1/2" CONCRETE COVER

MONOLITHIC WEARING SURFACE:

MONOLITHIC WEARING SURFACE IS ASSUMED, FOR DESIGN PURPOSES, TO BE 1 INCH THICK.

EXISTING STRUCTURE VERIFICATION:

DETAILS AND DIMENSIONS SHOWN ON THESE PLANS PERTAINING TO THE EXISTING STRUCTURE HAVE BEEN OBTAINED FROM PLANS OF THE EXISTING STRUCTURE AND FROM FIELD OBSERVATIONS AND MEASUREMENTS. CONSEQUENTLY, THEY ARE INDICATIVE OF THE EXISTING STRUCTURE AND THE PROPOSED WORK BUT THEY SHALL BE CONSIDERED TENTATIVE AND APPROXIMATE. THE CONTRACTOR IS REFERRED TO CMS SECTIONS 102.05 AND 105.02.

BASE CONTRACT BID PRICES UPON A RECOGNITION OF THE UNCERTAINTIES DESCRIBED ABOVE AND UPON A PREBID EXAMINATION OF THE EXISTING STRUCTURE. HOWEVER, THE DEPARTMENT WILL PAY FOR ALL PROJECT WORK BASED UPON ACTUAL DETAILS AND DIMENSIONS THAT HAVE BEEN VERIFIED IN THE FIELD.

ITEM 202 - PORTIONS OF STRUCTURE REMOVED. OVER 20 FOOT SPAN. AS PER PLAN:

DESCRIPTION:

ITEMS TO BE REMOVED INCLUDE ALL EXISTING MATERIALS BEING REPLACED BY NEW CONSTRUCTION AS SHOWN IN THE PLANS AND AS PER CMS 202.

CUTLINE CONSTRUCTION JOINT PREPARATION: THOROUGHLY CLEAN THE JOINT SURFACE AND EXPOSED REINFORCEMENT OF ALL DIRT, DUST, RUST OR OTHER FOREIGN MATERIAL BY THE USE OF WATER, AIR UNDER PRESSURE, OR OTHER METHODS THAT PRODUCE SATISFACTORY RESULTS. EXISTING REINFORCING STEEL DOES NOT HAVE TO HAVE A BRIGHT STEEL FINISH, BUT REMOVE ALL PACK AND LOOSE RUST. THOROUGHLY DRENCH EXISTING CONCRETE SURFACES WITH CLEAN WATER AND ALLOW TO DRY TO A DAMP CONDITION BEFORE PLACING CONCRETE.

SUBSTRUCTURE CONCRETE REMOVAL: REMOVE CONCRETE BY MEANS OF APPROVED PNEUMATIC HAMMERS EMPLOYING POINTED AND BLUNT CHISEL TOOLS. THE WEIGHT OF THE HAMMER SHALL NOT BE MORE THAN 35 POUNDS FOR REMOVAL WITHIN 18 INCHES OF PORTIONS TO BE PRESERVED. DO NOT PLACE PNEUMATIC HAMMERS IN DIRECT CONTACT WITH REINFORCING STEEL THAT IS TO BE RETAINED IN THE REBUILT STRUCTURE.

DECK REMOVAL: PERFORM WORK CAREFULLY DURING DECK REMOVALS TO PROTECT PORTIONS OF SUCH SYSTEMS THAT ARE TO BE SALVAGED AND INCORPORATED INTO THE PROPOSED STRUCTURE. THE USE OF EXPLOSIVES OR HEADACHE BALLS IS PROHIBITED. SUBMIT CONSTRUCTION PLANS ACCORDING TO CMS 501.05.

REMOVAL METHODS: REMOVAL METHODS OVER STRUCTURAL MEMBERS SHALL ENSURE ADEQUATE DEPTH CONTROL AND PREVENT NICKING OR GOUGING THE PRIMARY STRUCTURAL MEMBERS. REPLACE OR REPAIR STRUCTURAL MEMBERS DAMAGED BY THE REMOVAL OPERATIONS AT NO COST TO THE PROJECT. AT LEAST 7 DAYS BEFORE PERFORMING REPAIR WORK, SUBMIT A PROPOSED REPAIR PLAN, DEVELOPED BY AN OHIO REGISTERED PROFESSIONAL ENGINEER TO THE DIRECTOR. OBTAIN THE DIRECTOR'S APPROVAL BEFORE PERFORMING REPAIR.

EXISTING WELDED ATTACHMENTS: REMOVE EXISTING WELDED ATTACHMENTS (E.G., FINISHING MACHINE AND FORM SUPPORTS; SUPPORTS FOR SCUPPERS AND BULB ANGLES WHICH ARE TO BE REMOVED; AND LIGHTING SUPPORTS) LOCATED IN THE DESIGNATED TENSION PORTIONS OF THE TOP FLANGES OF EXISTING STEEL MEMBERS AND GRIND THE FLANGE SURFACES SMOOTH. CAREFULLY GRIND PARALLEL TO THE FLANGES.

ITEM 510 - DOWEL HOLES WITH NONSHRINK NONMETALLIC GROUT. AS PER PLAN:

DRILL DOWEL HOLES WHERE SHOWN IN THE PLANS. INSTALL REINFORCING STEEL ACCORDING TO ITEM 510 USING EPOXY GROUT, 705.20. PRIOR TO DRILLING DOWEL HOLES, LOCATE ALL EXISTING REINFORCING STEEL BARS IN THE AREA OF THE HOLE WITH THE AID OF A REINFORCING STEEL BAR LOCATOR (PACHOMETER). IF AN EXISTING BAR IS ENCOUNTERED AT THE SAME LOCATION AS A PROPOSED DOWEL HOLE, MOVE THE DOWEL HOLE TO EITHER SIDE OF THE EXISTING BAR.

ITEM 519 - PATCHING CONCRETE STRUCTURE. AS PER PLAN:

PRIOR TO THE SURFACE CLEANING SPECIFIED IN 519.04 AND WITHIN 24 HOURS OF PLACING PATCHING MATERIAL, BLAST CLEAN ALL SURFACES TO BE PATCHED INCLUDING THE EXPOSED REINFORCING STEEL. ACCEPTABLE METHODS INCLUDE HIGH-PRESSURE WATER BLASTING WITH OR WITHOUT ABRASIVES IN THE WATER, ABRASIVE BLASTING WITH CONTAINMENT, OR VACUUM ABRASIVE BLASTING.

ITEM 519 - PATCHING OF CONCRETE STRUCTURES IS A UNIT PRICE PAY ITEM (LINE 0032).

CLASS QC3 CONCRETE WITH QC/QA. SUBSTRUCTURE. AS PER PLAN

THIS ITEM MODIFIES THE STANDARD 511 CONCRETE FOR STRUCTURES SPECIFICATION TO INCLUDE MACRO-SYNTHETIC INTO THE SUBSTRUCTURE CONCRETE. THIS ITEM SHALL CONFORM TO CMS 511 WITH THE FOLLOWING CONDITIONS AND REVISIONS:

PROVIDE MATERIALS CONFORMING TO 511.02 EXCEPT AS MODIFIED BELOW:

PORTLAND CEMENT CONCRETE - 499.03, CLASS QC 3 MEETING A DESIGN STRENGTH OF 4,000 PSI, WITH MACRO-SYNTHETIC FIBERS WITH MODIFICATION PER 511.02.

FIBERS FOR CONCRETE - ASTM C 1116, TYPE III

THE CLASS QC3 CONCRETE FOR THE SUBSTRUCTURE SHALL MEET THE FOLLOWING CRITERIA: WATER/CEMENT RATIO = 0.40 MAXIMUM; MINIMUM 4 LBS/CY MACRO-SYNTHETIC FIBERS (1.5 IN. MIN. TO 2.5 IN. MAX.) MEETING ASTM C1116 TYPE III SHALL BE ADDED TO THE MIX.

THE MACRO-SYNTHETIC FIBERS SHALL BE INCORPORATED INTO THE MIX IN SUCH A WAY THAT NO 'BALLING' OCCURS. UPON INSPECTION OF THE MIX AT THE TIME OF PLACEMENT, IF ANY 'BALLING' OCCURS, THE ENGINEER SHALL REJECT THE REMAINDER OF THE LOAD AT ANY TIME DURING THE POUR. IT IS IMPORTANT TO FOLLOW INDUSTRY STANDARDS AND ASTM SPECIFICATIONS ON THE PREMIXING OF THE CEMENT, AGGREGATE, AND MACRO-SYNTHETIC FIBERS PRIOR TO THE ADDITION OF WATER AND ADMIXTURES. PROVIDE MACRO-SYNTHETIC FIBERS THAT ARE MONOFILAMENT FIBERS MADE FROM VIRGIN POLYPROPYLENE, POLYETHYLENE, OR CO-POLYMERS THAT ARE INERT TO ALKALI ATTACK. ENSURE THE MACRO-SYNTHETIC FIBERS HAVE A MINIMUM TENSILE STRENGTH OF 70 KSI, A MINIMUM MODULUS OF ELASTICITY OF 800 KSI, A MINIMUM FILAMENT DIAMETER OF 0.012 INCHES, AND ASPECT RATIO BETWEEN 60 AND 100, AND ARE BETWEEN 1.5 AND 2.5 INCHES IN LENGTH. STORE THE MACRO-SYNTHETIC FIBERS ACCORDING TO THE MANUFACTURE'S RECOMMENDATION AND KEEP THE MATERIAL FREE FROM DUST, DIRT AND MOISTURE.

USE A MINIMUM DOSAGE RATE OF MACRO-SYNTHETIC FIBERS OF 4.0 LBS/CY OF CONCRETE. DETERMINE THE FINAL PROPOSED DOSAGE RATE THROUGH MIX TESTING. ENSURE THE FIBER REINFORCED CONCRETE MEETS OR EXCEEDS A MINIMUM EQUIVALENT FLEXURAL STRENGTH RATIO OF 25% ACCORDING TO ASTM C 1609. MACRO-SYNTHETIC FIBERS IS TO BE USED AS AN ADMIXTURE TO CONTROL CRACKING AND IS NOT TO BE USED TO SUPPLEMENT OR REPLACE REINFORCING STEEL IN THE DESIGN. ENSURE THE FINAL PROPOSED MIX IS WORKABLE AND ABLE TO BE PRODUCED SUCH THAT BALLING OR CLUMPING OF THE FIBERS IS NOT A PROBLEM AS DETERMINED BY THE ENGINEER. UTILIZE A LABORATORY REGULARLY INSPECTED BY THE CEMENT AND CONCRETE REFERENCE LABORATORY (CCRL) OF THE NATIONAL INSTITUTE OF STANDARDS AND TECHNOLOGY, OR OTHER APPROVED REFERENCE LABORATORY, TO PERFORM THE TESTING. BEFORE USE, SUBMIT DOCUMENTATION TO THE PROJECT ENGINEER CERTIFYING BOTH THE MACRO-SYNTHETIC FIBERS AND THE MIX MEET OR EXCEED THE REQUIRED PROPERTIES. SAMPLING WILL BE ALLOWED FOR TESTING PURPOSES. A DEMONSTRATION OF THE MIX PRODUCTION OR TRIAL MIX, MAY BE REQUIRED BY THE ENGINEER PRIOR TO PLACING ANY OF THE MIX ON THE PROJECT.

THE BATCH WEIGHTS SHALL BE CORRECTED TO COMPENSATE FOR THE MOISTURE CONTAINED IN THE AGGREGATE AT THE TIME OF USE. A CHEMICAL ADMIXTURE (705.12, TYPE A OR D) SHALL BE USED.

CONCRETE SUPPLIERS SHOULD RECOGNIZE THAT ADMIXTURES MAY HAVE AN EFFECT ON STRENGTH, ENTRAINED AIR CONTENT, WORKABILITY, ETC. OF THEIR CONCRETE MIXES. THE CONCRETE SUPPLIER'S CHOICE OF ADMIXTURES DOES NOT ALLEVIATE MEETING DESIGN REQUIREMENTS.

CLASS QC3 CONCRETE WITH QC/QA. SUPERSTRUCTURE. AS PER PLAN

THIS ITEM MODIFIES THE STANDARD 511 CONCRETE FOR STRUCTURES SPECIFICATION TO INCLUDE MACRO-SYNTHETIC INTO THE SUPERSTRUCTURE CONCRETE. THIS ITEM SHALL CONFORM TO CMS 511 WITH THE FOLLOWING CONDITIONS AND REVISIONS:

PROVIDE MATERIALS CONFORMING TO 511.02 EXCEPT AS MODIFIED BELOW:

PORTLAND CEMENT CONCRETE - 499.03, CLASS QC 3 MEETING A DESIGN STRENGTH OF 4,500 PSI, WITH MACRO-SYNTHETIC FIBERS WITH MODIFICATION PER 511.02.

FIBERS FOR CONCRETE - ASTM C 1116, TYPE III

THE CLASS QC3 CONCRETE FOR THE SUPERSTRUCTURE SHALL MEET THE FOLLOWING CRITERIA: WATER/CEMENT RATIO = 0.40 MAXIMUM; MINIMUM 4 LBS/CY MACRO-SYNTHETIC FIBERS (1.5 IN. MIN. TO 2.5 IN. MAX.) MEETING ASTM C1116 TYPE III SHALL BE ADDED TO THE MIX.

THE MACRO-SYNTHETIC FIBERS SHALL BE INCORPORATED INTO THE MIX IN SUCH A WAY THAT NO 'BALLING' OCCURS. UPON INSPECTION OF THE MIX AT THE TIME OF PLACEMENT, IF ANY 'BALLING' OCCURS, THE ENGINEER SHALL REJECT THE REMAINDER OF THE LOAD AT ANY TIME DURING THE POUR. IT IS IMPORTANT TO FOLLOW INDUSTRY STANDARDS AND ASTM SPECIFICATIONS ON THE PREMIXING OF THE CEMENT, AGGREGATE, AND MACRO-SYNTHETIC FIBERS PRIOR TO THE ADDITION OF WATER AND ADMIXTURES. PROVIDE MACRO-SYNTHETIC FIBERS THAT ARE MONOFILAMENT FIBERS MADE FROM VIRGIN POLYPROPYLENE, POLYETHYLENE, OR CO-POLYMERS THAT ARE INERT TO ALKALI ATTACK. ENSURE THE MACRO-SYNTHETIC FIBERS HAVE A MINIMUM TENSILE STRENGTH OF 70 KSI, A MINIMUM MODULUS OF ELASTICITY OF 800 KSI, A MINIMUM FILAMENT DIAMETER OF 0.012 INCHES, AND ASPECT RATIO BETWEEN 60 AND 100, AND ARE BETWEEN 1.5 AND 2.5 INCHES IN LENGTH. STORE THE MACRO-SYNTHETIC FIBERS ACCORDING TO THE MANUFACTURE'S RECOMMENDATION AND KEEP THE MATERIAL FREE FROM DUST, DIRT AND MOISTURE.

USE A MINIMUM DOSAGE RATE OF MACRO-SYNTHETIC FIBERS OF 4.0 LBS/CY OF CONCRETE. DETERMINE THE FINAL PROPOSED DOSAGE RATE THROUGH MIX TESTING. ENSURE THE FIBER REINFORCED CONCRETE MEETS OR EXCEEDS A MINIMUM EQUIVALENT FLEXURAL STRENGTH RATIO OF 25% ACCORDING TO ASTM C 1609. MACRO-SYNTHETIC FIBERS IS TO BE USED AS AN ADMIXTURE TO CONTROL CRACKING AND IS NOT TO BE USED TO SUPPLEMENT OR REPLACE REINFORCING STEEL IN THE DESIGN. ENSURE THE FINAL PROPOSED MIX IS WORKABLE AND ABLE TO BE PRODUCED SUCH THAT BALLING OR CLUMPING OF THE FIBERS IS NOT A PROBLEM AS DETERMINED BY THE ENGINEER. UTILIZE A LABORATORY REGULARLY INSPECTED BY THE CEMENT AND CONCRETE REFERENCE LABORATORY (CCRL) OF THE NATIONAL INSTITUTE OF STANDARDS AND TECHNOLOGY, OR OTHER APPROVED REFERENCE LABORATORY, TO PERFORM THE TESTING. BEFORE USE, SUBMIT DOCUMENTATION TO THE PROJECT ENGINEER CERTIFYING BOTH THE MACRO-SYNTHETIC FIBERS AND THE MIX MEET OR EXCEED THE REQUIRED PROPERTIES. SAMPLING WILL BE ALLOWED FOR TESTING PURPOSES. A DEMONSTRATION OF THE MIX PRODUCTION OR TRIAL MIX, MAY BE REQUIRED BY THE ENGINEER PRIOR TO PLACING ANY OF THE MIX ON THE PROJECT.

THE BATCH WEIGHTS SHALL BE CORRECTED TO COMPENSATE FOR THE MOISTURE CONTAINED IN THE AGGREGATE AT THE TIME OF USE. A CHEMICAL ADMIXTURE (705.12, TYPE A OR D) SHALL BE USED.

CONCRETE SUPPLIERS SHOULD RECOGNIZE THAT ADMIXTURES MAY HAVE AN EFFECT ON STRENGTH, ENTRAINED AIR CONTENT, WORKABILITY, ETC. OF THEIR CONCRETE MIXES. THE CONCRETE SUPPLIER'S CHOICE OF ADMIXTURES DOES NOT ALLEVIATE MEETING DESIGN REQUIREMENTS.

S:\Flanagan\11/16/2023 9:33:34 AM\0\2017\01113\C_Design\104667-HAM-75-3-84\Design\Structures\HAM0074-1840C\Sheets\74-1840GN001.dgn

DESIGN AGENCY STRUCTUREPOINT	DATE	11/16/18
	REVIEWED	MDS
DRAWN	DSH	REVISION
DESIGNED	SJF	CHECKED
FILE NUMBER	STRUCTURE FILE NUMBER	3115526
GENERAL NOTES - 1		
BRIDGE NO. HAM-74-1840 L/R		
OVER SB BEEKMAN ST. (U.S. 27) AND RAMP F		
HAM-75-3-84		
PID No. 104667		
3 / 41		
4 120		

CLASS QC3 CONCRETE WITH QC/QA, SUPERSTRUCTURE, AS PER PLAN (CONT.)

APPROACH SLABS, DIAPHRAGMS, AND BRIDGE RAILING CONCRETE ARE TO USE THE SAME MIX DESIGN AS THE BRIDGE DECK (WHEN APPLICABLE). USE SELF-COMPACTING CONCRETE ON DECORATIVE RAILING SIMILAR TO TEXAS RAILING AND MACRO-SYNTHETIC CONCRETE PER THIS SPECIFICATION ON TRADITIONAL CONCRETE RAILING WHEN APPLICABLE.

THE PLACING OF THE DECK AND THE APPROACH SLABS IN THE SAME CONCRETE POUR IS NOT PERMITTED.

DECK PLACEMENT DESIGN ASSUMPTIONS:

DECK PLACEMENT DESIGN ASSUMPTIONS: THE FOLLOWING ASSUMPTIONS OF CONSTRUCTION MEANS AND METHODS WERE MADE FOR THE ANALYSIS AND DESIGN OF THE SUPERSTRUCTURE. THE CONTRACTOR IS RESPONSIBLE FOR THE DESIGN OF THE FALSEWORK SUPPORT SYSTEM WITHIN THESE PARAMETERS AND WILL ASSUME RESPONSIBILITY FOR SUPERSTRUCTURE ANALYSIS FOR DEVIATION FROM THESE DESIGN ASSUMPTIONS.

AN EIGHT WHEEL FINISHING MACHINE WITH A MAXIMUM WHEEL LOAD OF 2.27 KIPS.

A MINIMUM OUT-TO-OUT WHEEL SPACING AT EACH END OF THE MACHINE OF 103".

A MAXIMUM SPACING OF OVERHANG FALSEWORK BRACKETS OF 48 IN.

A MAXIMUM DISTANCE FROM THE CENTERLINE OF THE FASCIA GIRDER TO THE FACE OF THE SAFETY HANDRAIL OF 65".

MECHANICAL CONNECTORS:

MECHANICAL CONNECTORS SHALL BE CAPABLE OF DEVELOPING 125 PERCENT OF THE YIELD STRENGTH OF THE CONNECTED BARS. FOR CONNECTORS WITH THREADED BAR ENDS, IN ORDER TO OFFSET THE EFFECT OF AREA REDUCTION ON THE STRENGTH OF THE BAR AND STILL MEET THE REQUIREMENTS OF ASTM A615, USE THE NEXT LARGER DIAMETER BAR OR A HIGHER GRADE OF STEEL BAR.

ITEM 514 - FIELD PAINTING. MISC.: MAIN AND SECONDARY MEMBERS:

THIS ITEM SHALL INCLUDE PAINTING AS WELL AS THE SURFACE PREPARATION OF THE MAIN AND SECONDARY MEMBERS IN THE FIELD WITH PRIME, INTERMEDIATE AND SURFACE COATS AS DIRECTED BY THE ENGINEER AT LOCATIONS WHERE THE EXISTING COATING IS DAMAGED. THE PAINT MAY BE APPLIED BY BRUSH ACCORDING TO 514.17E. SOLVENT CLEAN THE MAIN AND SECONDARY MEMBERS AS PER SSPC-SP 1 AND SSPC-SP 2, RESPECTIVELY, PRIOR TO PAINTING ACCORDING TO ITEM 514.

THE CONTRACTOR SHALL BE RESPONSIBLE FOR SELECTING THE FINISH COAT TO MATCH THE EXISTING AS CLOSE AS POSSIBLE AND SHALL RECIEVE APPROVAL FROM THE ENGINEER.

ITEM 516. JACKING AND TEMPORARY SUPPORT OF SUPERSTRUCTURE, AS PER PLAN:

THIS WORK CONSISTS OF RAISING OR REPOSITIONING EXISTING STRUCTURES TO THE DIMENSIONS AND REQUIREMENTS DEFINED IN THE PROJECT PLANS.

SUBMIT CONSTRUCTION PLANS IN ACCORDANCE WITH CMS 501.05.

IF, DURING THE JACKING OPERATIONS, DAMAGE TO THE STRUCTURE IS VISUALLY OBSERVED, IMMEDIATELY CEASE THE JACKING OPERATION AND INSTALL SUPPORTS TO THE SATISFACTION OF THE ENGINEER. ANALYZE THE DAMAGE AND SUBMIT A METHOD OF CORRECTION TO THE ENGINEER FOR APPROVAL. THE BRIDGE BEARINGS SHALL BE FULLY SEATED AT ALL CONTACT AREAS. IF FULL SEATING IS NOT ATTAINED, SUBMIT A REPAIR PLAN TO THE ENGINEER. THE DEPARTMENT WILL NOT PAY FOR THE REPAIR COSTS TO ENSURE FULL SEATING ON BEARINGS.

CONCRETE SEALER:

CHEMMASTERS SAFE CURE AND SEAL EPX (EPOXY) AND DURAGUARD 310 CRU (URETHANE) USED FOR SEALING OF CONCRETE SURFACES (EPOXY-URETHANE).

PROPOSED WORK (RIGHT BRIDGE):

- REMOVE AND REPLACE EXISTING CONCRETE DECK WITH COMPOSITE DECK
- REMOVE AND REPLACE EXISTING CONCRETE PARAPETS
- REMOVE AND REPLACE ABUTMENT BACKWALLS
- REPLACE ABUTMENT BEARINGS WITH ELASTOMERIC BEARINGS (LEFT & RIGHT BRIDGE)
- REPLACE APPROACH SLABS
- REPLACE STRIP SEAL EXPANSION JOINTS
- ADD SEISMIC PEDETALS TO REAR ABUTMENT
- FIBER WRAP PIER 2 COLUMNS
- PATCH EXISTING SUBSTRUCTURE UNITS
- SEAL CONCRETE

BUILDABLE UNIT REFERENCES:

REFERENCE THE FOLLOWING BUILDABLE UNITS FOR ADDITIONAL INFORMATION, DETAILS, AND SPECIFICATIONS:
 ROADWAY AND DRAINAGE - BU-14
 MAINTENANCE OF TRAFFIC - BU-04 AND BU-23
 LIGHTING, STRIPING, PAVEMENT MARKINGS, ITS - BU-19


UTILITY LINES

THE UTILITY(IES) SHALL BORE ALL EXPENSE INVOLVED IN RELOCATING (INSTALLING) THE AFFECTED UTILITY LINES. THE CONTRACTOR AND UTILITY(IES) ARE TO COOPERATE BY ARRANGING THEIR WORK IN SUCH A MANNER THAT INCONVENIENCE TO EITHER WILL BE HELD TO A MINIMUM.


ABBREVIATION LIST:

THE FOLLOWING STANDARD ABBREVIATIONS ARE USED THROUGHOUT THE BRIDGE PLANS.


- ABUT. = ABUTMENT
- ACT. = ACTUAL
- APP. = APPROACH
- BRG. = BEARING
- BOT. = BOTTOM
- BTW. = BETWEEN
- CB = CATCH BASIN
- C.I.P. = CAST-IN-PLACE
- C.J. = CONSTRUCTION JOINT
- CLR. = CLEARANCE
- CONST = CONSTRUCTION
- CONT. = CONTINUOUS
- DIA. = DIAMETER
- DIM. = DIMENSION
- DWG. = DRAWING
- E.S. = EACH SIDE
- EL. = ELEVATION
- EQ. = EQUAL
- EST. = ESTIMATED
- EX. = EXISTING
- EXP. = EXPANSION
- F.A. = FORWARD ABUTMENT
- F.D.S. = FINAL DECK SURFACE
- F.S. = FAR SIDE
- FTG. = FOOTING
- FWD. = FORWARD
- GR. = GUARDRAIL
- HMWM = HIGH MOLECULAR WEIGHT METHACRYLATE
- INT. = INTERIOR
- INV. = INVERT
- NPCCP = NON-PERFORATED CORRUGATED PLASTIC PIPE
- N.S. = NEAR SIDE
- O.C.J. = OPTIONAL CONSTRUCTION JOINT
- PCCP = PERFORATED CORRUGATED PLASTIC PIPE
- PEJF = PREFORMED EXPANSION JOINT FILLER
- PERP. = PERPENDICULAR
- PROP. = PROPOSED
- PT. = POINT
- R.A. = REAR ABUTMENT
- REQD. = REQUIRED
- SER. = SERIES
- SHLD. = SHOULDER
- SPA. = SPACES
- STA. = STATION
- STD. = STANDARD
- STM = STORM SEWER LINE
- T&B = TOP AND BOTTOM
- T.O.H. = TOP OF HAUNCH
- T/S = TOP OF SLOPE
- TYP. = TYPICAL
- U.N. = UNLESS NOTED

	DESIGN AGENCY STRUCTUREPOINT	DATE 11/12/18	REVIEWED MDS	FILE NUMBER 3115526
DRAWN DSH	CHECKED CLB			
GENERAL NOTES - 2 BRIDGE NO. HAM-74-1840 L/R OVER SB BEEKMAN ST. (U.S. 27) AND RAMP F				
HAM-75-3.84 PID No. 104667				
4 / 41		5 120		


SFlanagan 11/16/2023 9:33:36 AM
 0:\2017\01113.C.Design\104667.HAM-75-3.84.Design\Structures\HAM0074-1840C_Sheets\74-1840PC001.dgn

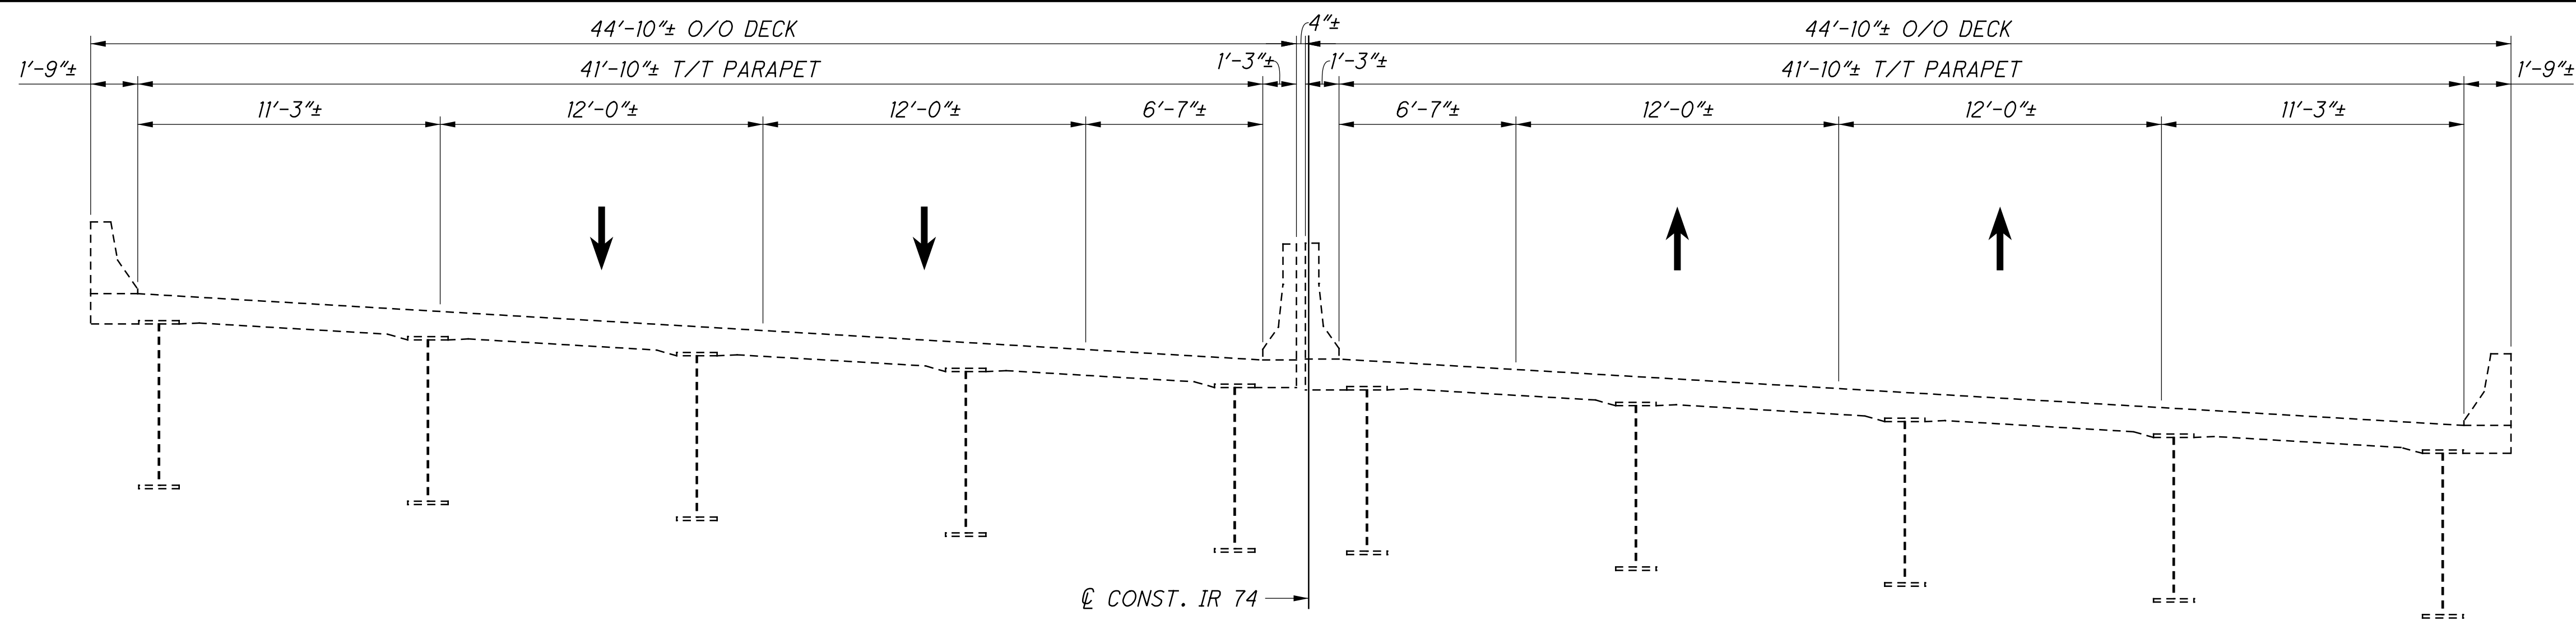

EXISTING TRANSVERSE SECTION

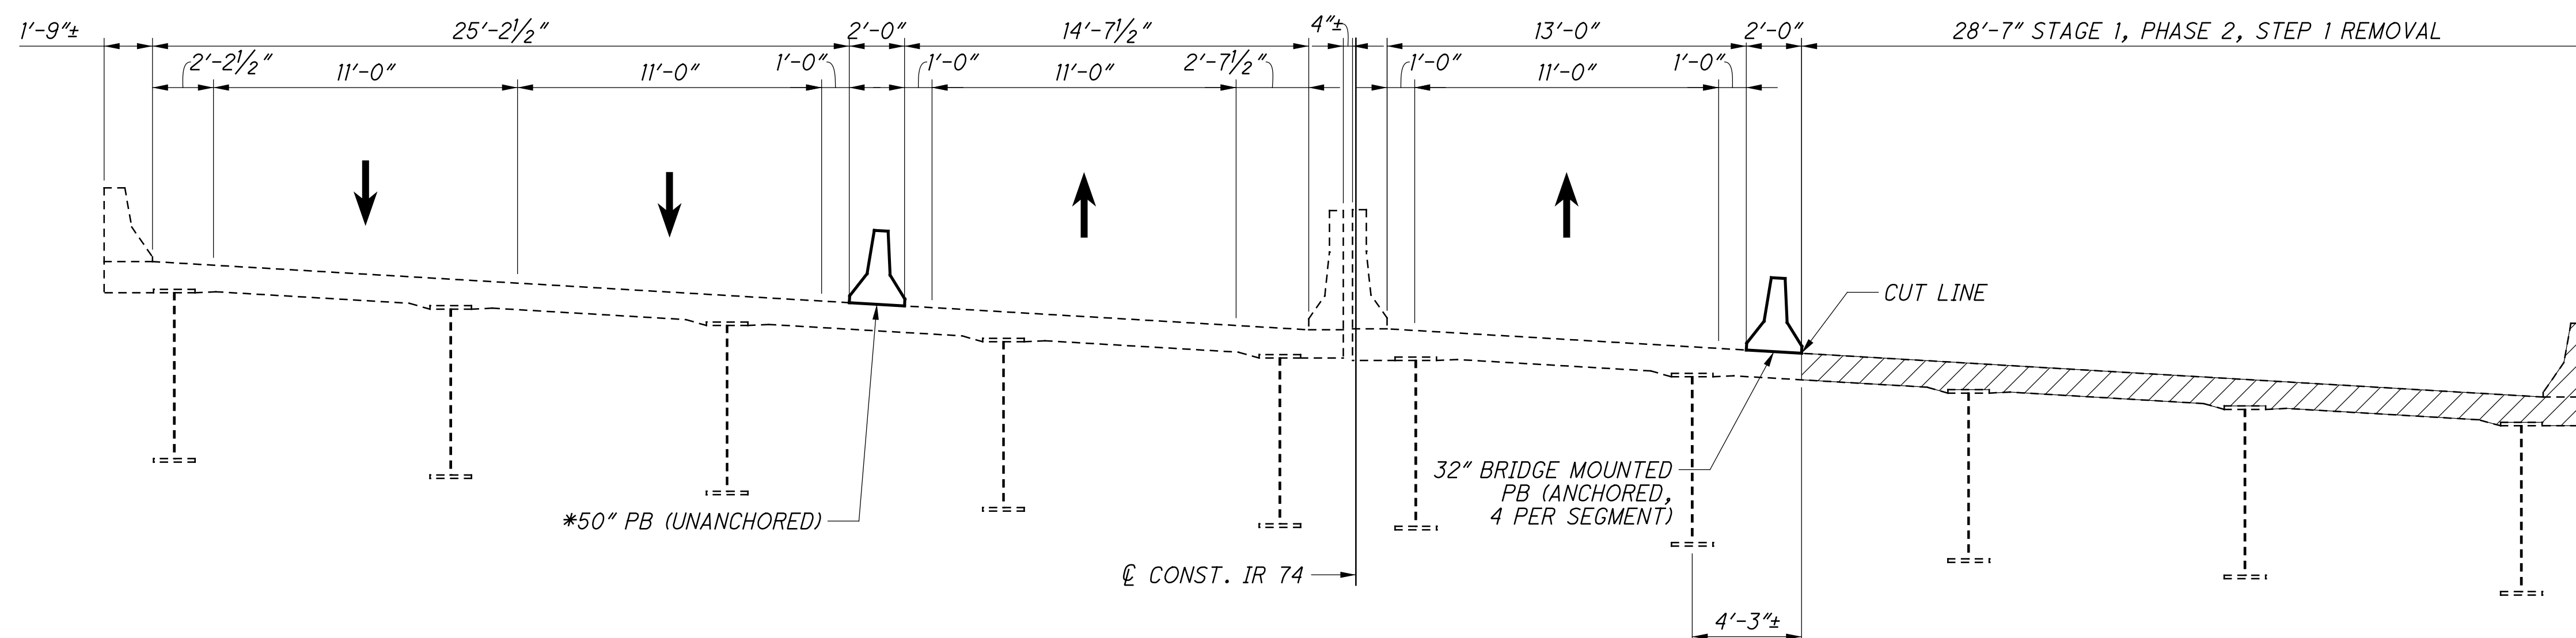

STAGE 1, PHASE 2, STEP 1 REMOVAL

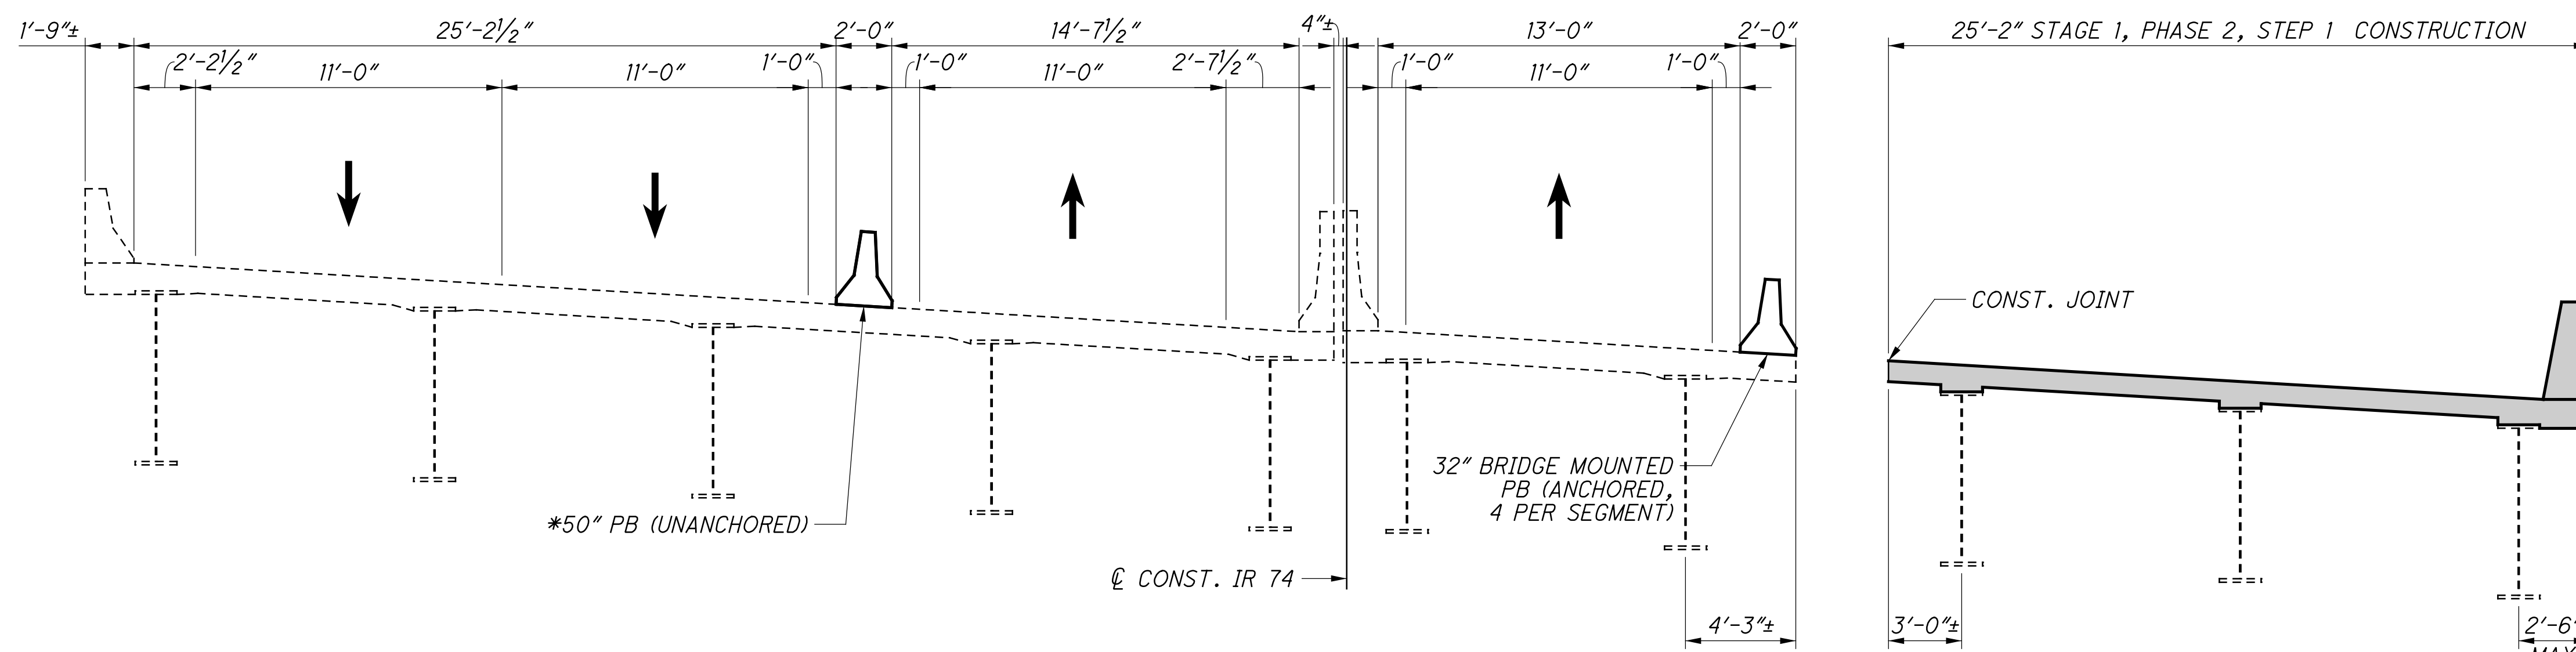

STAGE 1, PHASE 2, STEP 1 CONSTRUCTION

SEQUENCE OF CONSTRUCTION

STAGE 1/ PHASE 2/ STEP 1

1. INSTALL PB AS SHOWN IN BU-04 & BU-23 PLANS.
2. MAINTAIN TRAFFIC AS SHOWN.
3. INSTALL TEMP. SHORING.
4. REMOVE STAGE 1/ PHASE 2/ STEP 1 PORTIONS OF RIGHT BRIDGE.
5. CONSTRUCT STAGE 1/ PHASE 2/ STEP 1 PORTIONS OF RIGHT BRIDGE.


* 32" PB WITH GLARE SCREEN MAY BE USED AS AN ALTERNATE

LEGEND


LIMITS OF REMOVAL PER ITEM 202 - STRUCTURE REMOVED, OVER 20 FOOT SPAN

 STRUCTUREPOINT <small>DESIGN AGENCY</small>	DATE 9/12/18	REVIEWED MDS	STRUCTURE FILE NUMBER 3115526	DESIGNED SUJ	CHECKED CLB
PHASE CONSTRUCTION DETAILS - 1 BRIDGE NO. HAM-74-1840 L/R OVER SB BEEKMAN ST. (U.S. 27) AND RAMP F					
HAM-75-3.84 PID No. 104667					
5 / 41					
6 120					


S:\Flanagan 9:33:36 AM
 11/16/2023
 01\2017\01113.C.Design\104667_HAM-75-3.84.Design\Structures\HAM0074-1840C_Sheets\74-1840PC002.dgn

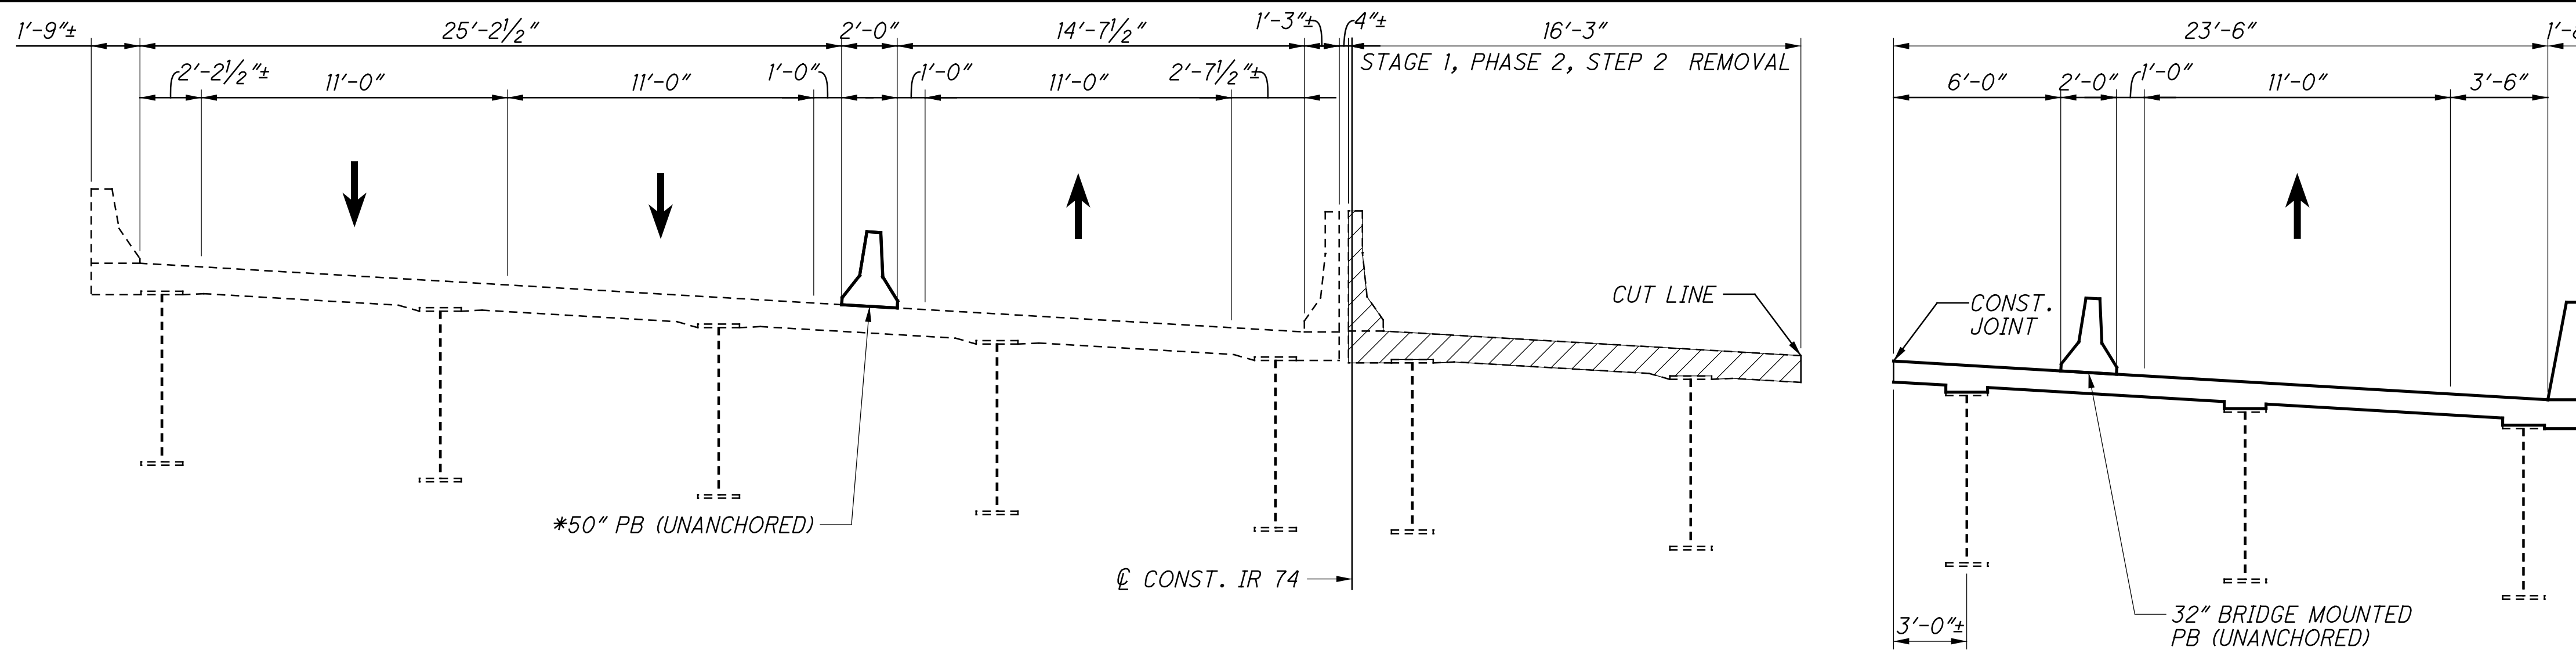

STAGE 1, PHASE 2, STEP 2 REMOVAL

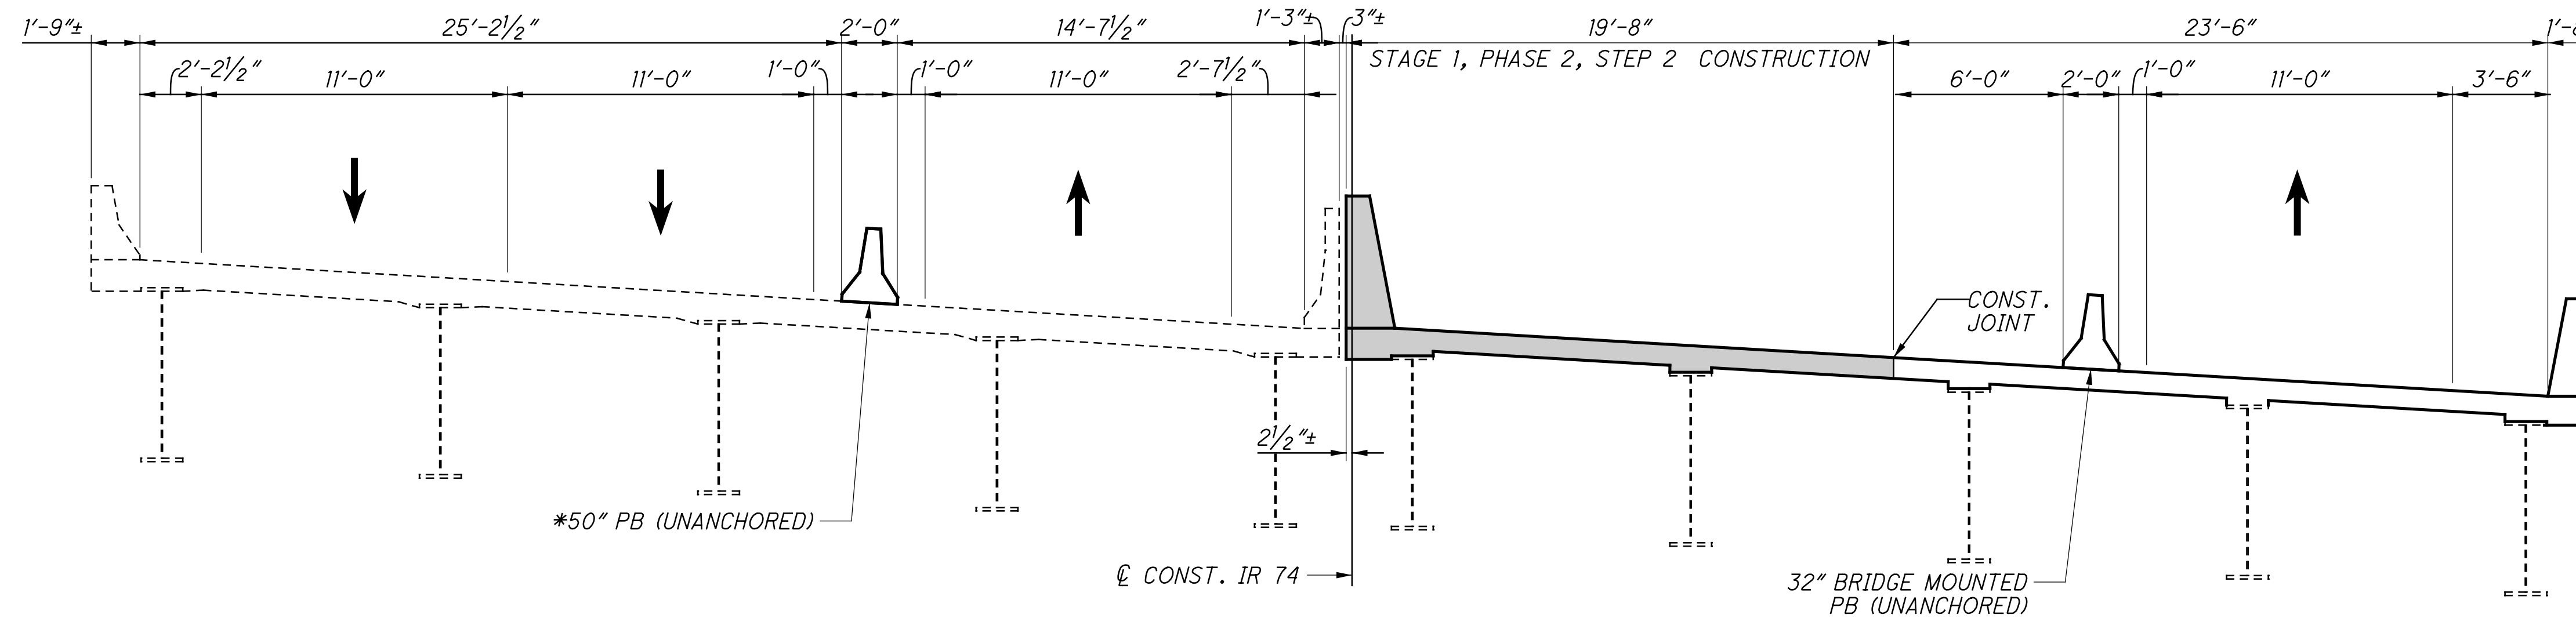

STAGE 1, PHASE 2, STEP 2 CONSTRUCTION

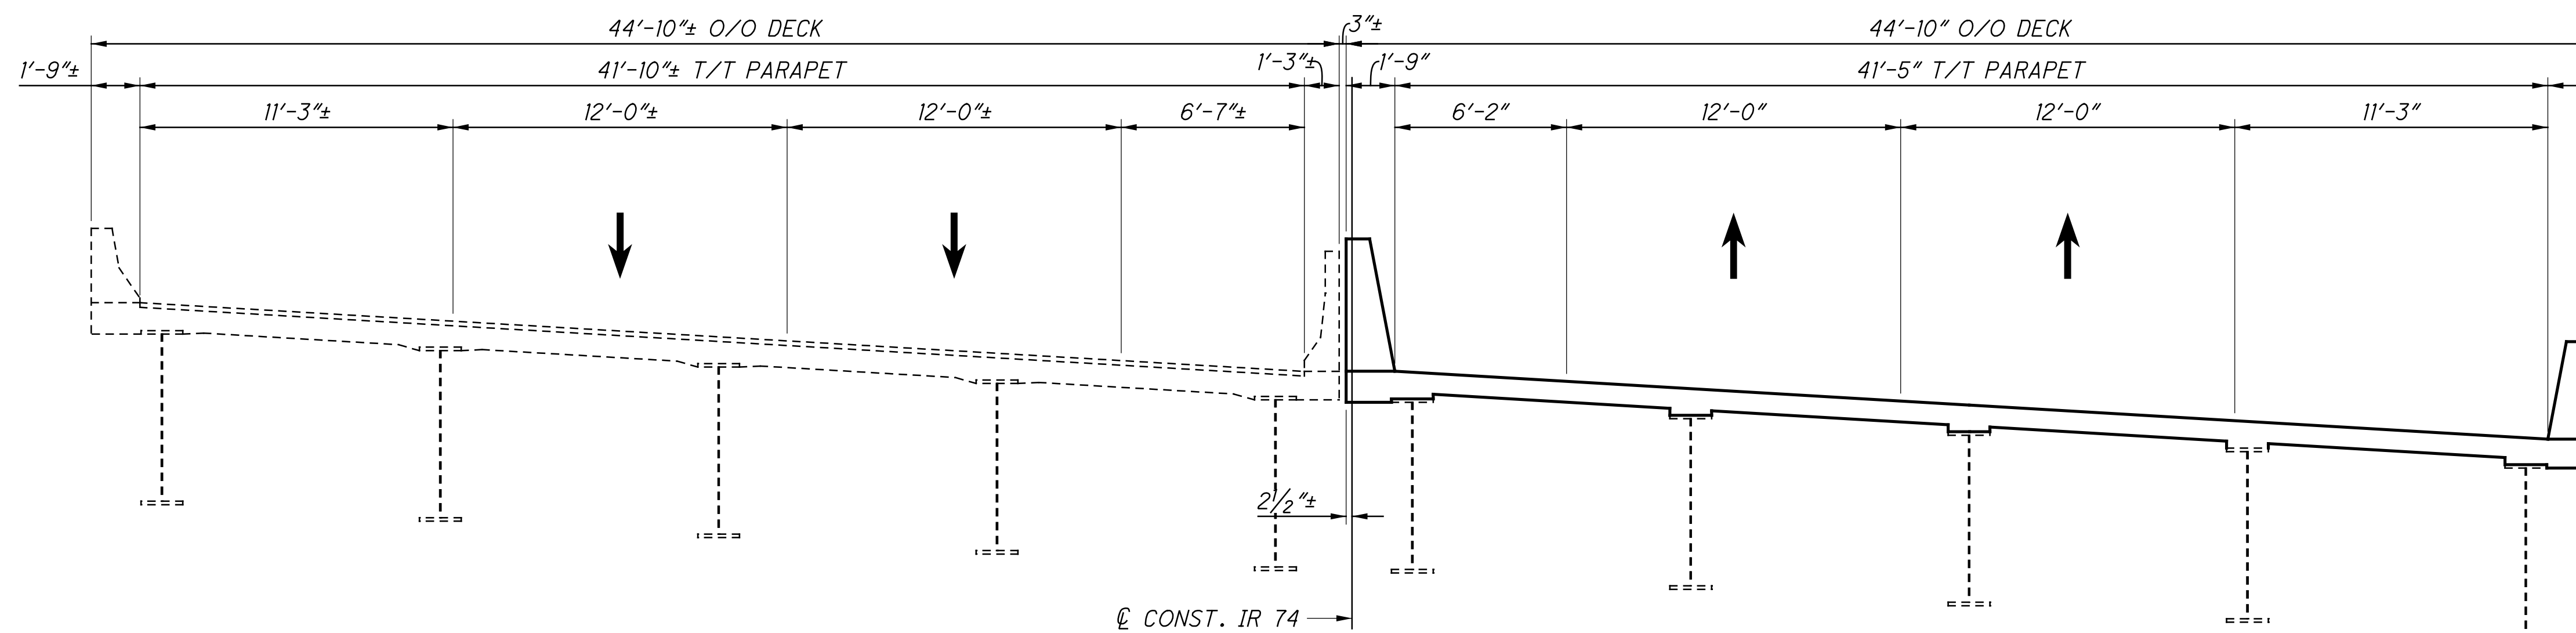

PROPOSED TRANSVERSE SECTION

SEQUENCE OF CONSTRUCTION

STAGE 1/ PHASE 2/ STEP 2

1. RELOCATE PB AS SHOWN IN BU-04 & BU-23 PLANS.
2. MAINTAIN TRAFFIC AS SHOWN.
3. INSTALL TEMP. SHORING.
4. REMOVE STAGE 1/ PHASE 2/ STEP 2 PORTIONS OF RIGHT BRIDGE.
5. CONSTRUCT STAGE 1/ PHASE 2/ STEP 2 PORTIONS OF RIGHT BRIDGE.


* 32" PB WITH GLARE SCREEN MAY BE USED AS AN ALTERNATE

LEGEND


LIMITS OF REMOVAL PER ITEM 202 - STRUCTURE REMOVED, OVER 20 FOOT SPAN

	DESIGN AGENCY STRUCTUREPOINT
DESIGNED SUJ	CHECKED CLB
DRAWN BMP	REVISED
REVIEWED MDS	STRUCTURE FILE NUMBER 3115526
DATE 9/12/18	FILE NUMBER 3115526
PHASE CONSTRUCTION DETAILS - 2 BRIDGE NO. HAM-74-1840 L/R OVER SB BEEKMAN ST. (U.S. 27) AND RAMP F	
HAM-75-3.84 PID No. 104667	
6 / 41	7 120

SFlanagan 11/16/2023 9:33:37 AM
 \\0\2017\01113\C.Design\104667-HAM-75-3.84\Design\Structures\HAM0074_1840C_Sheets\74_1840RE001.dgn

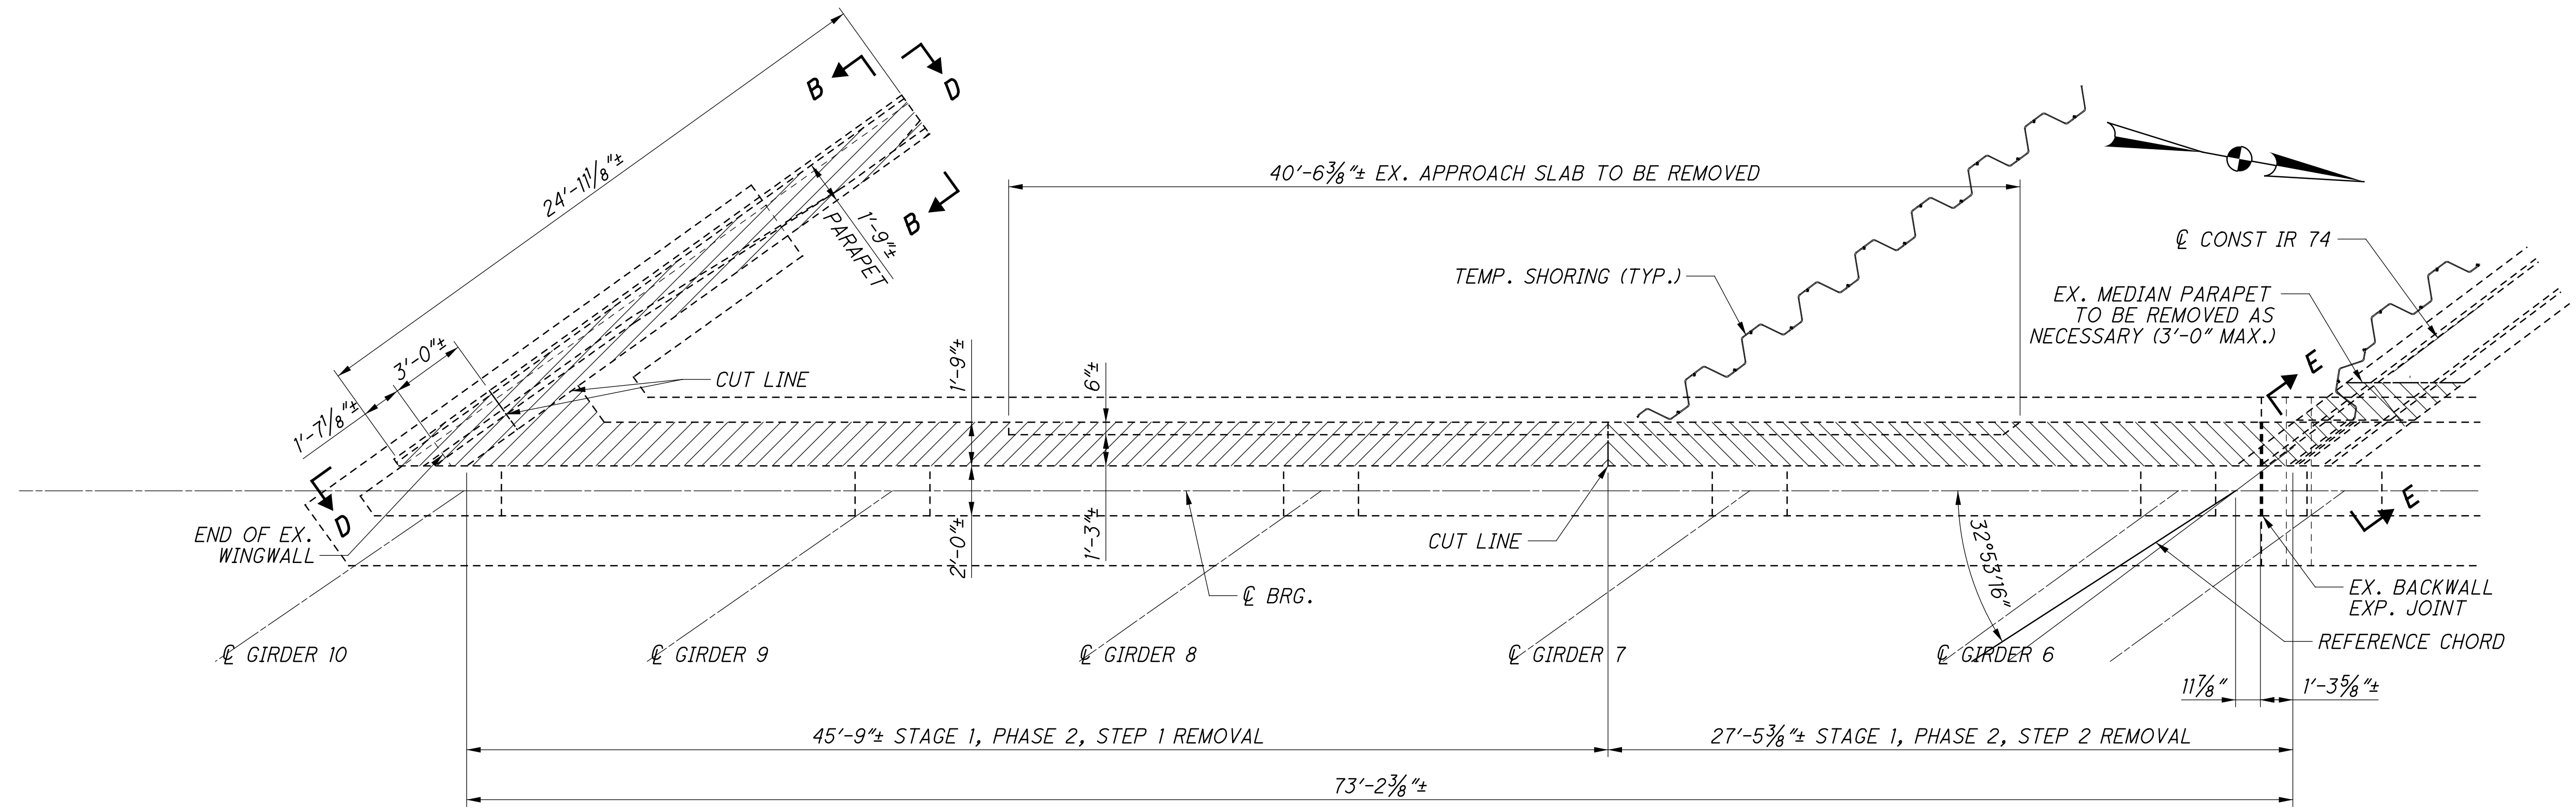

PLAN - REAR ABUTMENT

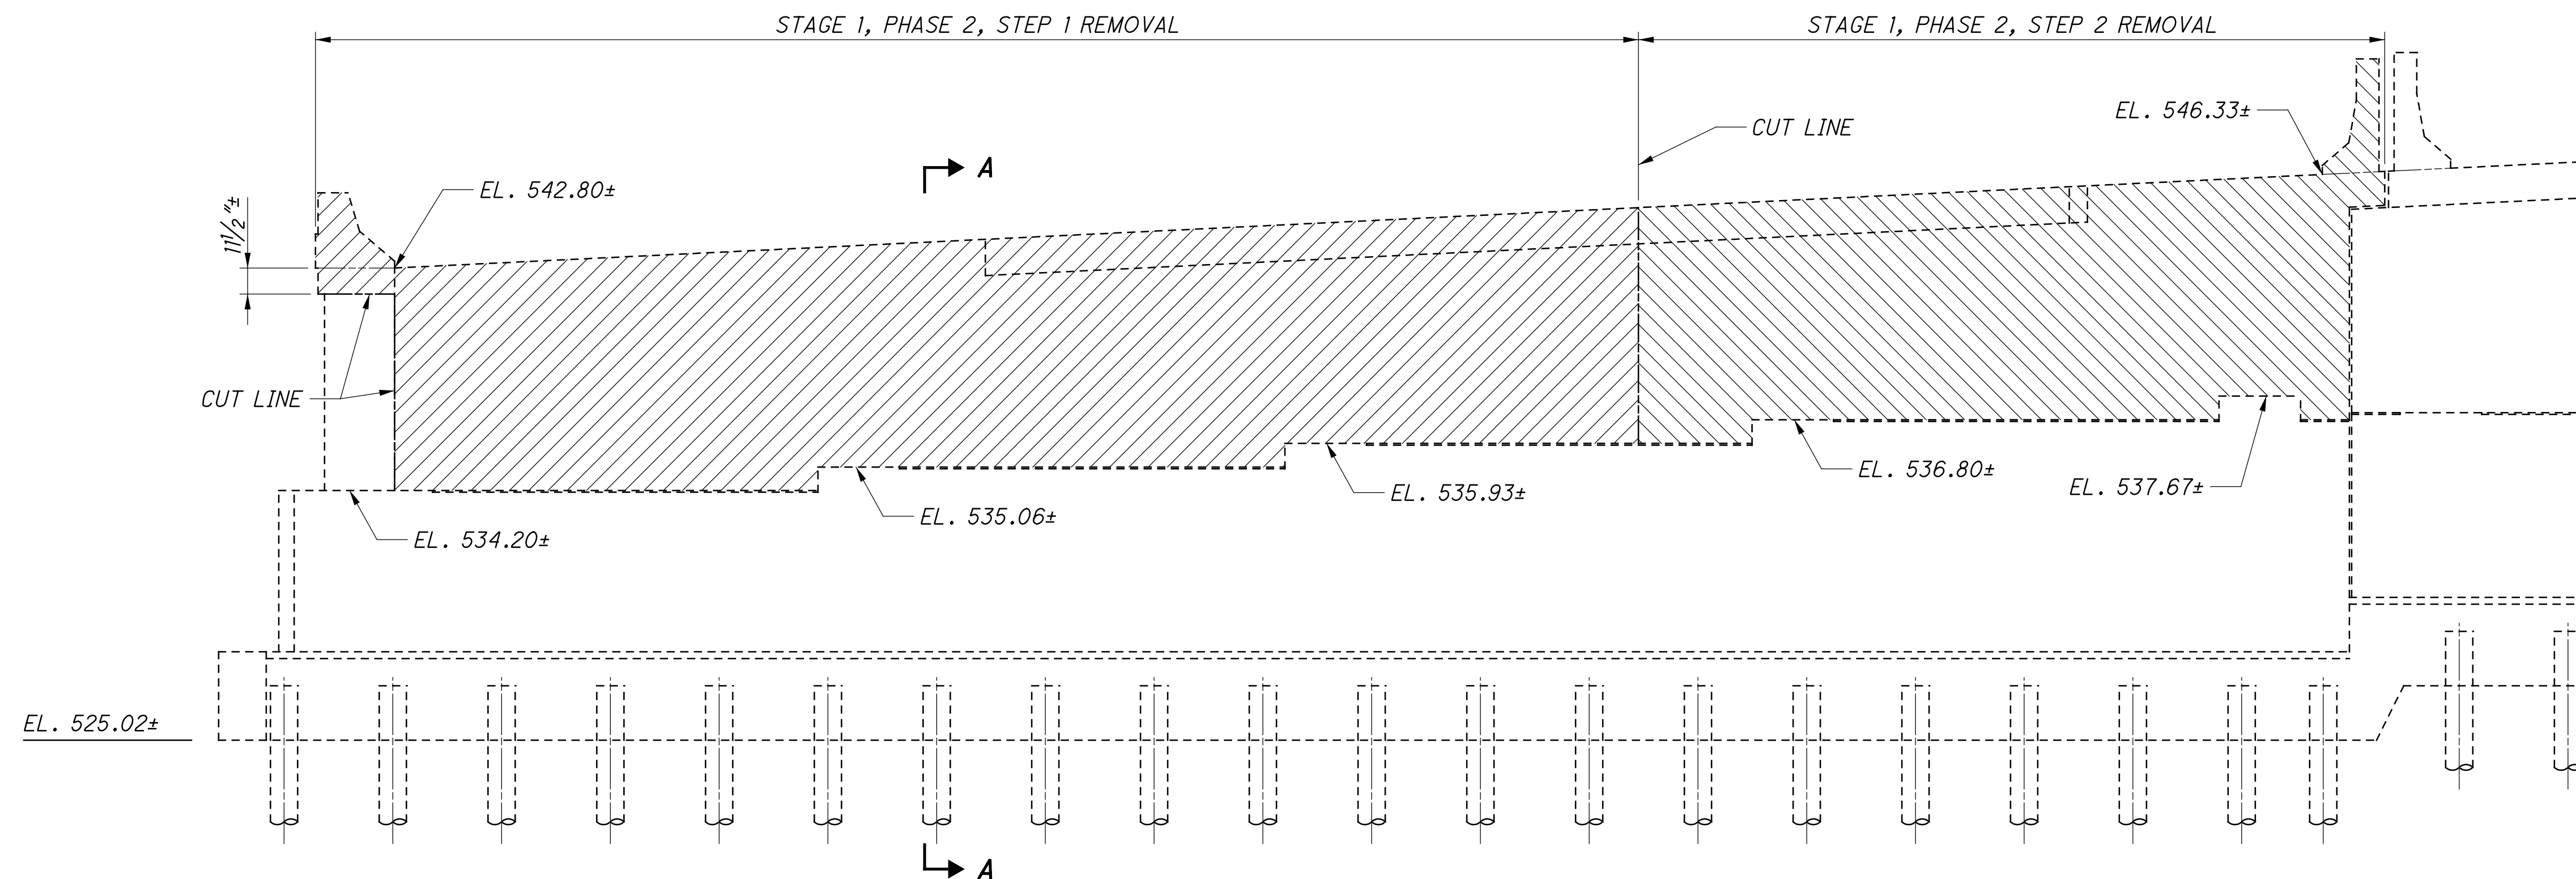

ELEVATION - REAR ABUTMENT

LEGEND



LIMITS OF REMOVAL PER ITEM 202

NOTES:

FOR SECTIONS A-A, B-B AND E-E, AND VIEW D-D, SEE SHEET 9/41.

DESIGNED SUF	CHECKED CLB	DRAWN DSH	REVIEWED MDS	DATE 11/12/18	DESIGN AGENCY STRUCTUREPOINT
BRIDGE NO. HAM-74-1840 L/R	OVER SB BEEKMAN ST. (U.S. 27) AND RAMP F	STRUCTURE FILE NUMBER 3115526			
HAM-75-3.84		PID No. 104667		7/41	
				8	120

S:\Flanagan\11/16/2023 9:33:37 AM
0\2017\01113\C.Design\104667-HAM-75-3.84\Design\Structures\HAM0074_1840C\Sheets\74_1840RE002.dgn

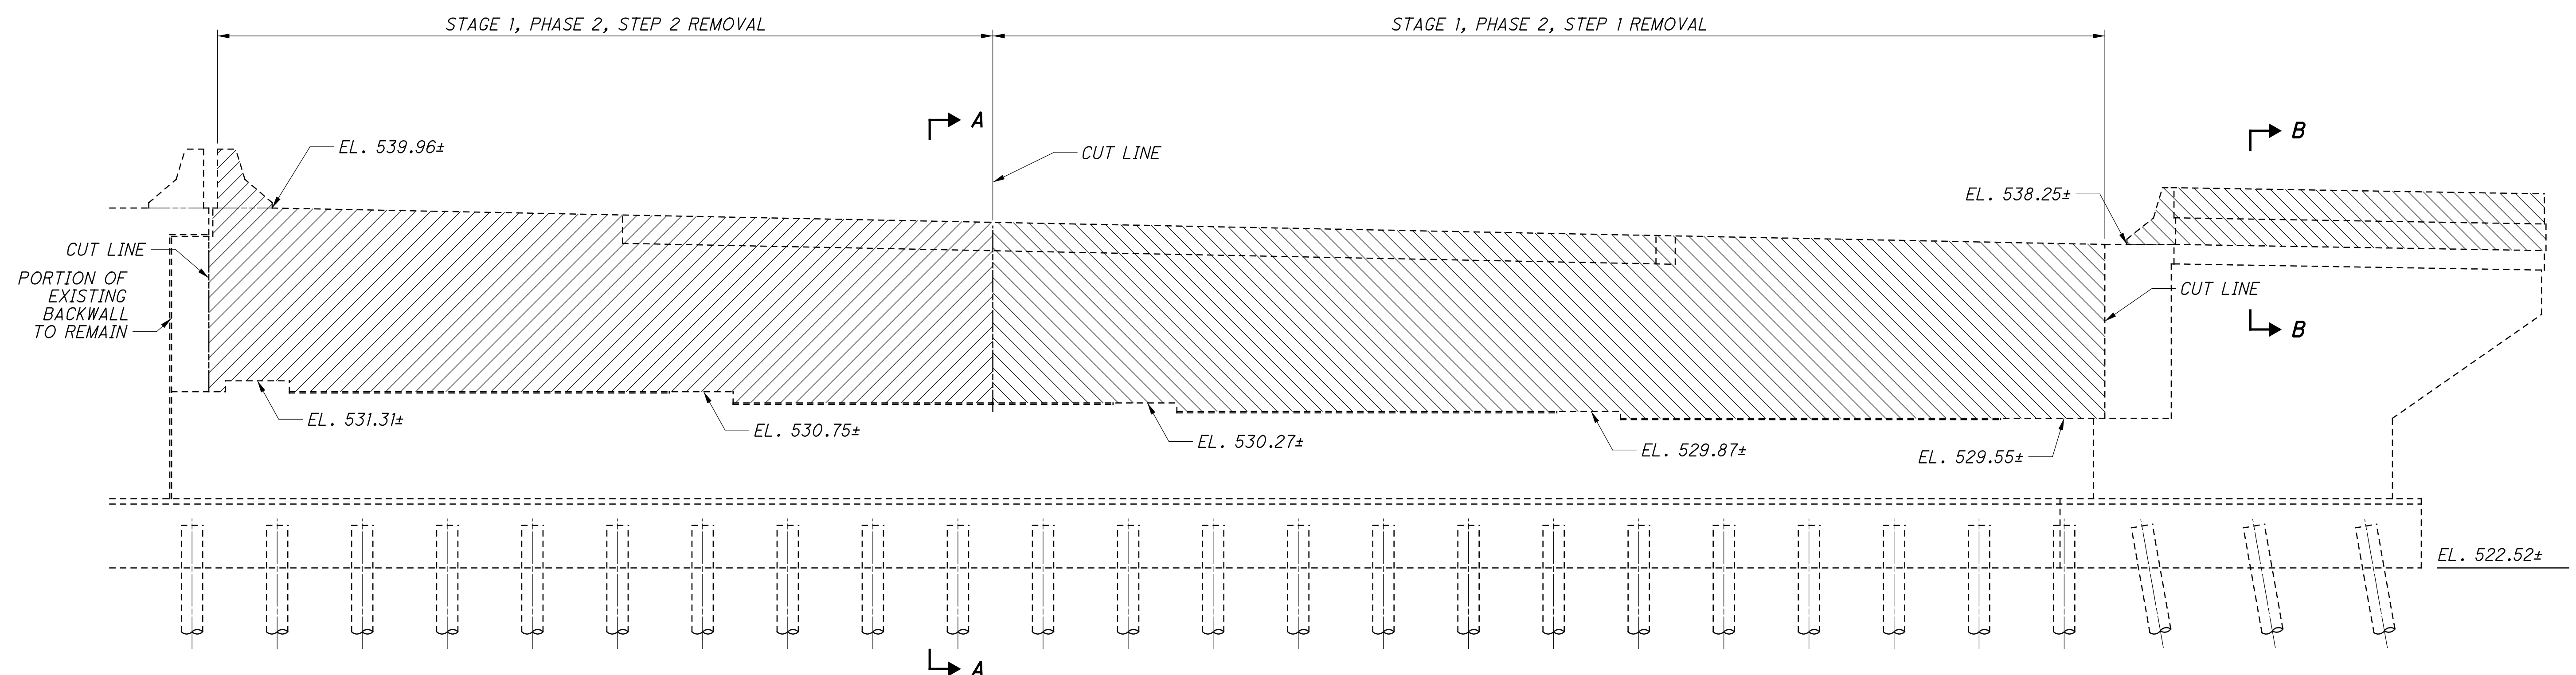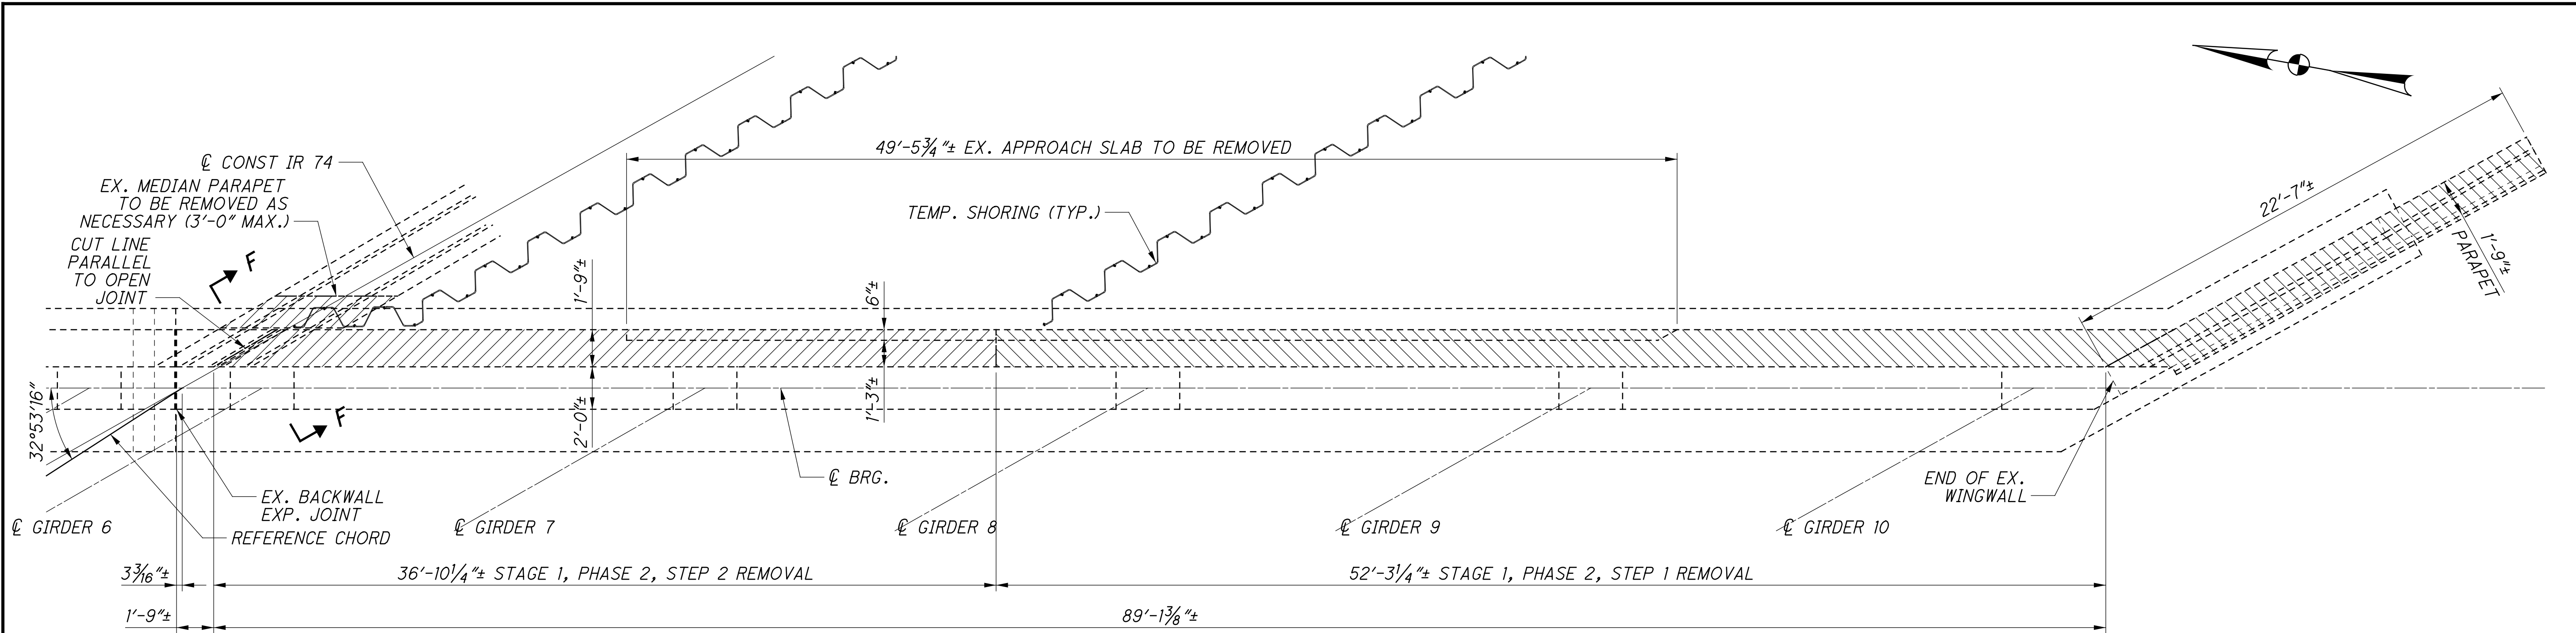

LEGEND
LIMITS OF REMOVAL PER ITEM 202


NOTES:
FOR SECTIONS A-A, B-B AND F-F, SEE SHEET 9/41.

DESIGNED	SJF	CHECKED	CLB
DRAWN	DSH	REVISED	
REVIEWED	MDS	STRUCTURE FILE NUMBER	3115526
DATE	11/12/18	DESIGN AGENCY	STRUCTUREPOINT


ABUTMENT REMOVAL DETAILS (RIGHT BRIDGE)
BRIDGE NO. HAM-74-1840 L/R
OVER SB BEEKMAN ST. (U.S. 27) AND RAMP F

HAM-75-3.84
PID No. 104667


8 / 41
9
120

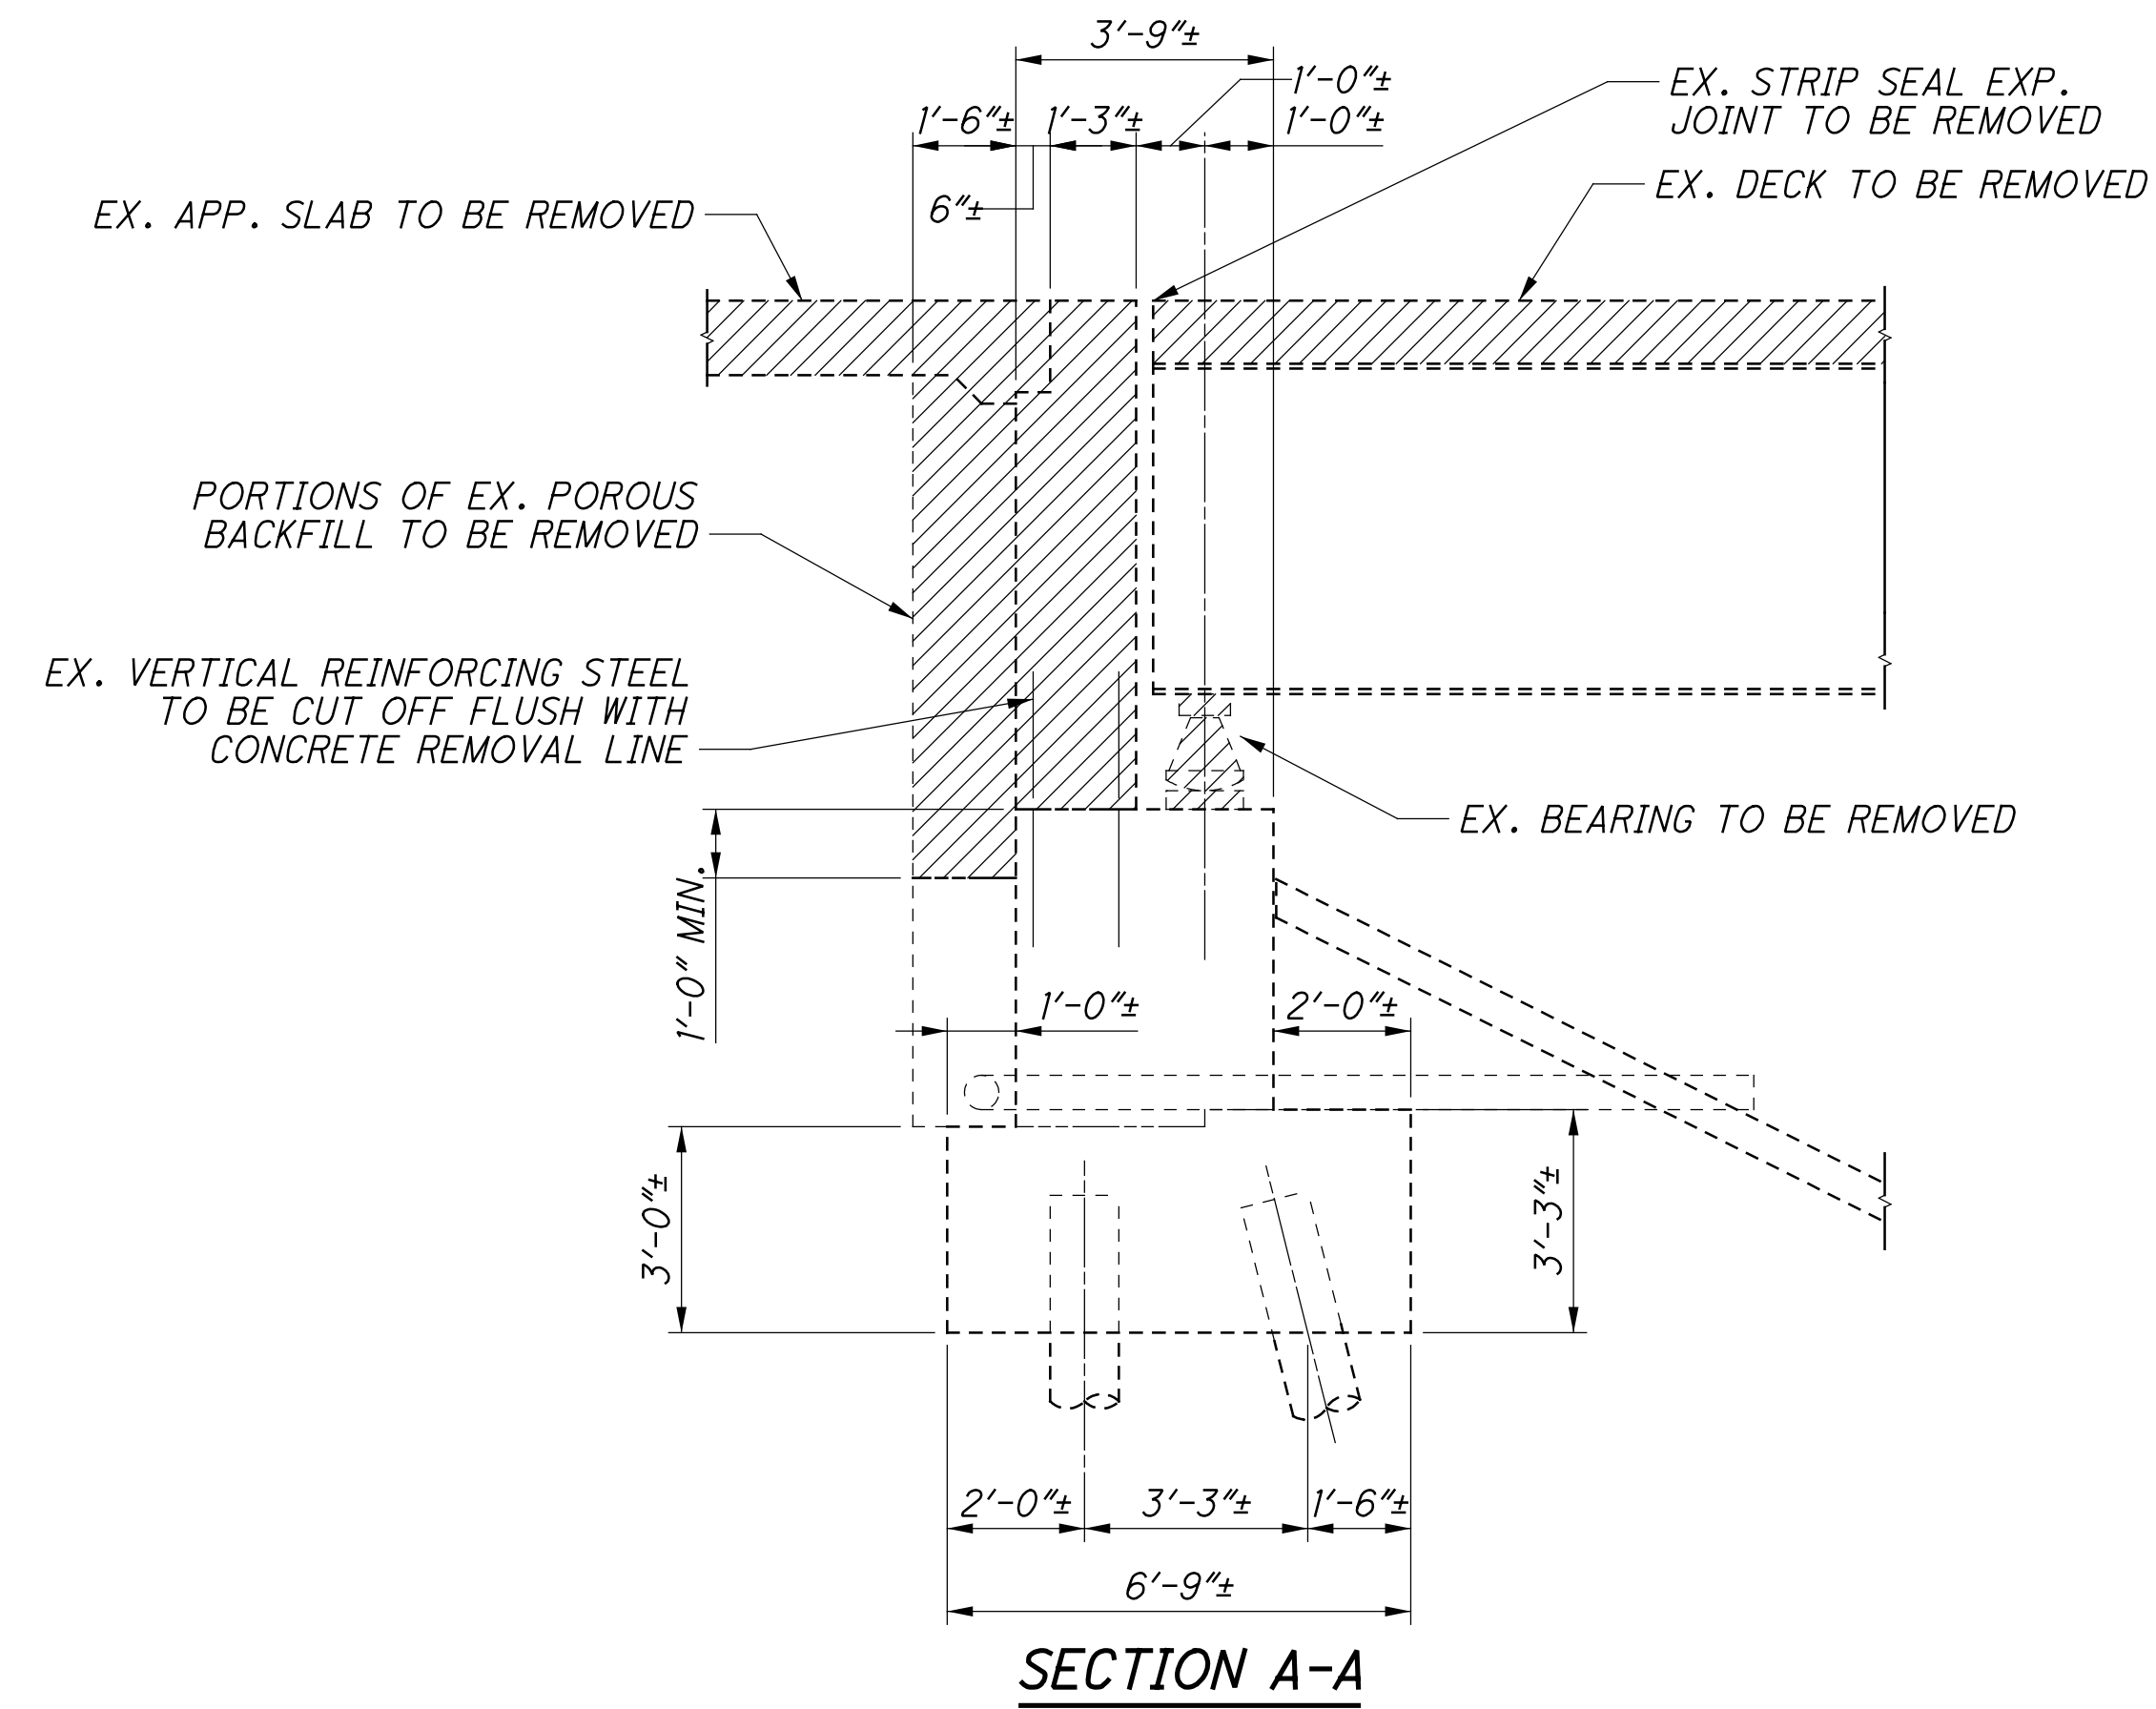


SECTION A-A

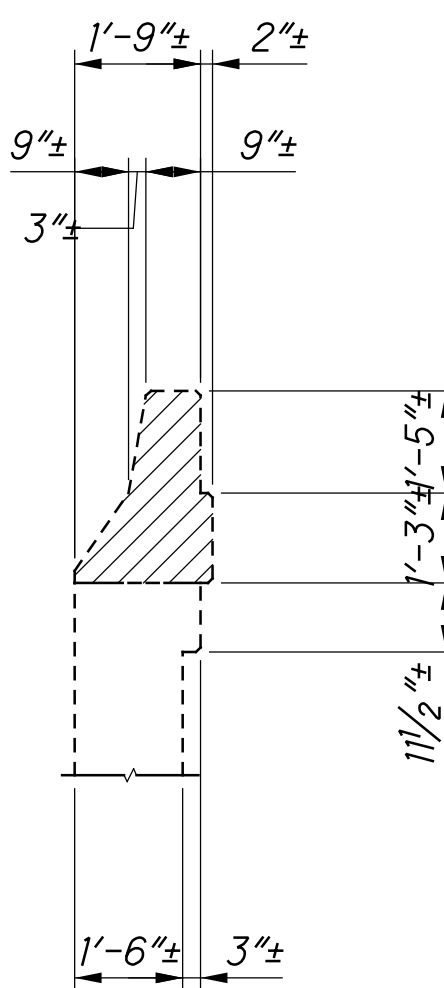


SECTION B-B

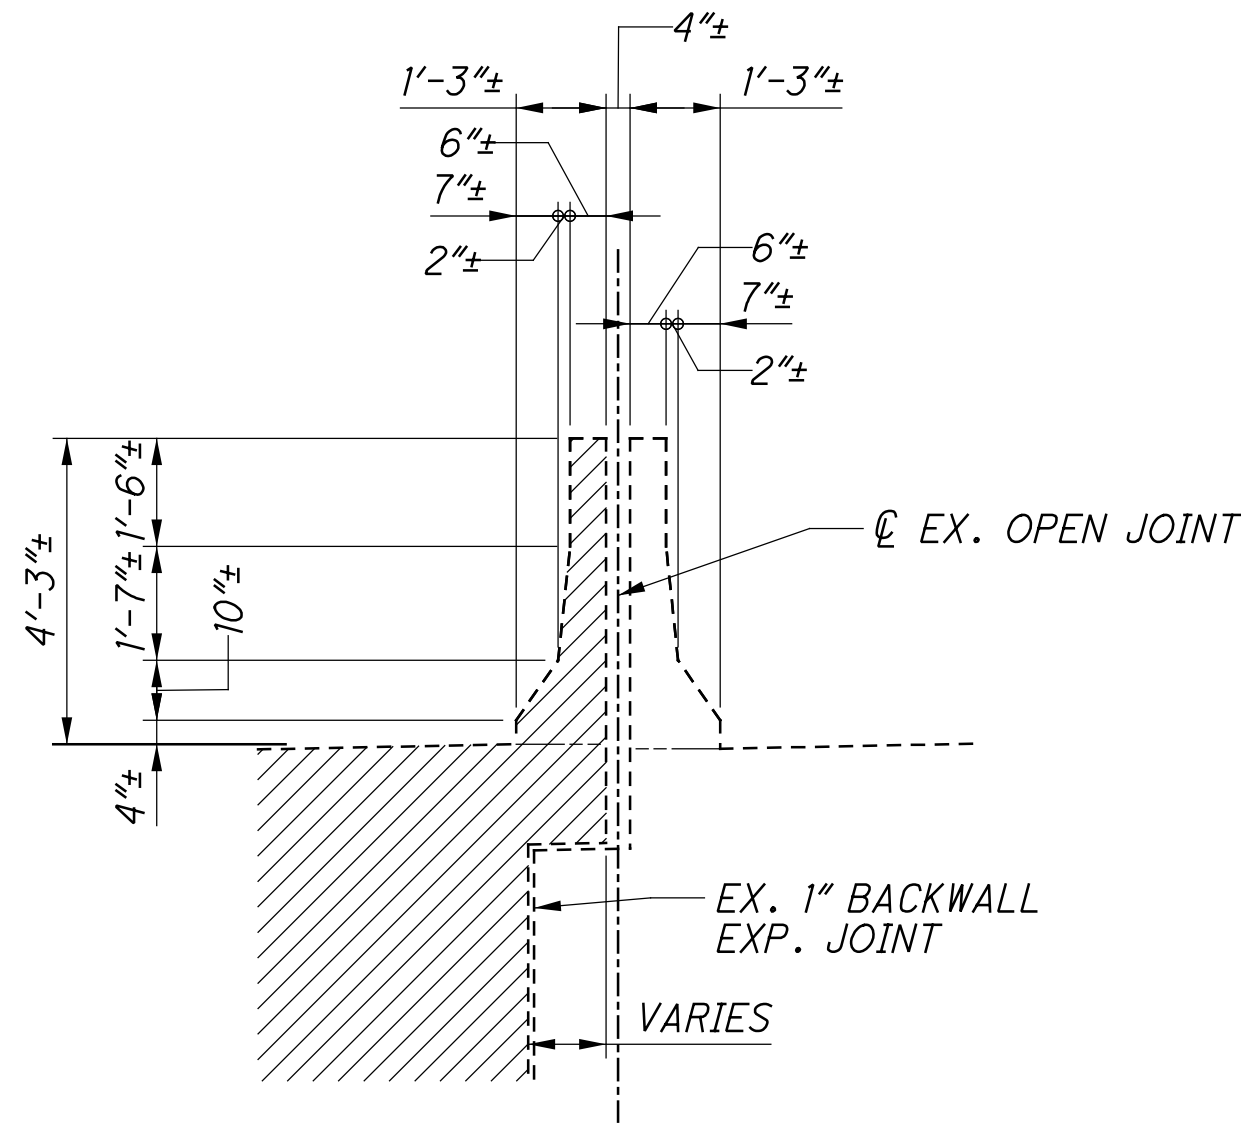

SECTION E-E

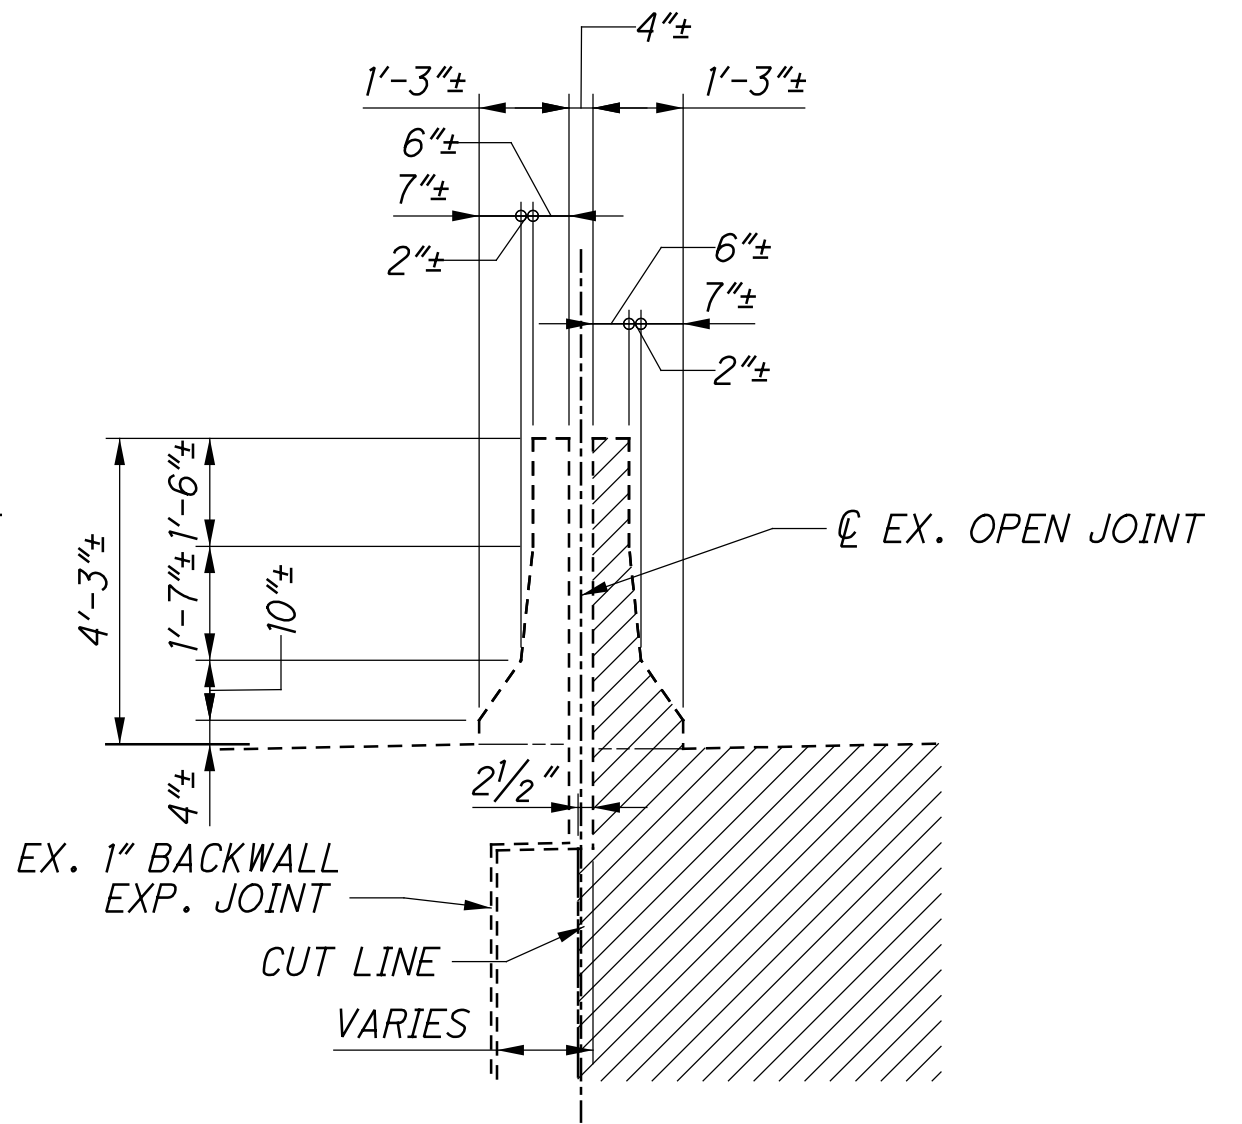


SECTION F-F

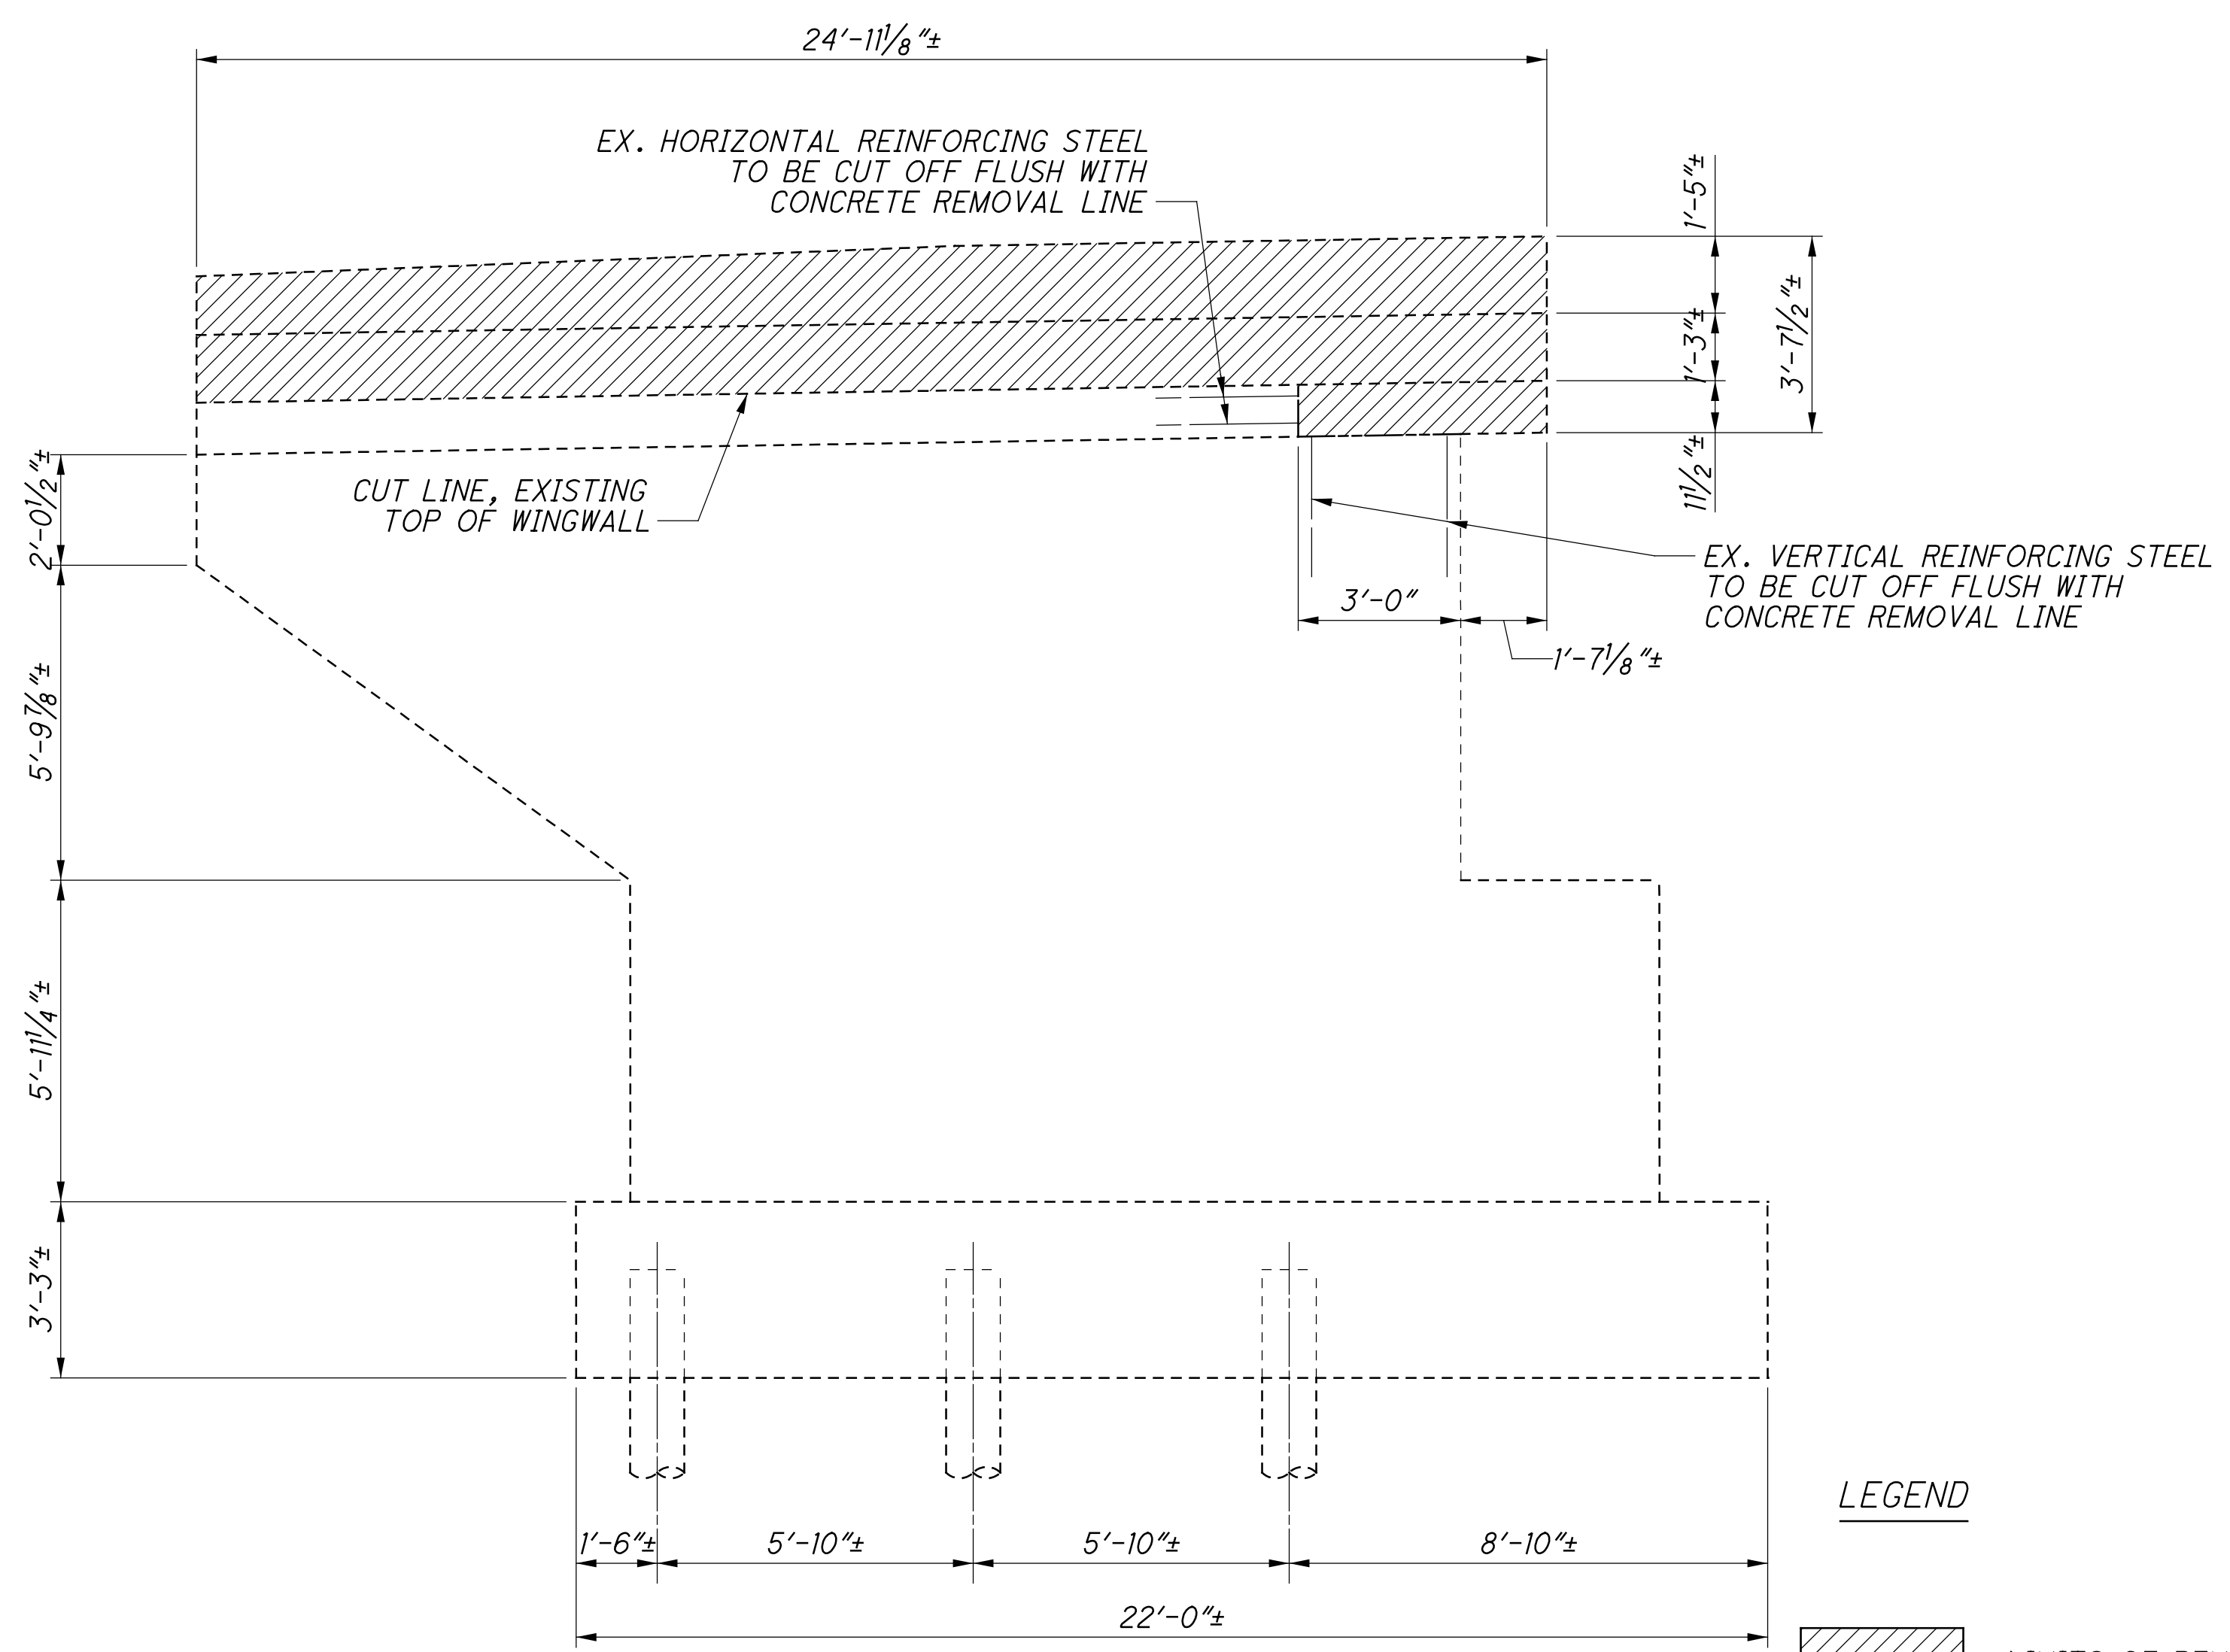

VIEW D-D


LEGEND

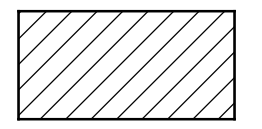

LIMITS OF REMOVAL PER ITEM 202

DESIGN AGENCY STRUCTUREPOINT		DATE 11/12/18	DESIGN AGENCY 200 CORPORATE PARKWAY DR. STE. 200 ANN ARBOR, MI 48106 TEL: 734.769.3333 FAX: 734.769.3335
DESIGNED SUF	CHECKED CLB	REVIEWED MDS	STRUCTURE FILE NUMBER 3115526
HAM-75-3.84 ABUTMENT REMOVAL DETAILS (RIGHT BRIDGE) BRIDGE NO. HAM-74-1840 L/R OVER SB BEEKMAN ST. (U.S. 27) AND RAMP F			
DRAWN DSH		REVISED	
9 / 41 10 120			


S:\Plans\23
 11/16/2023 9:33:38 AM
 \O:\2017\01113\C.Design\104667_HAM-75-3.84\Design\Structures\HAM0074_1840C_Sheets\7.4_1840RE005.dgn

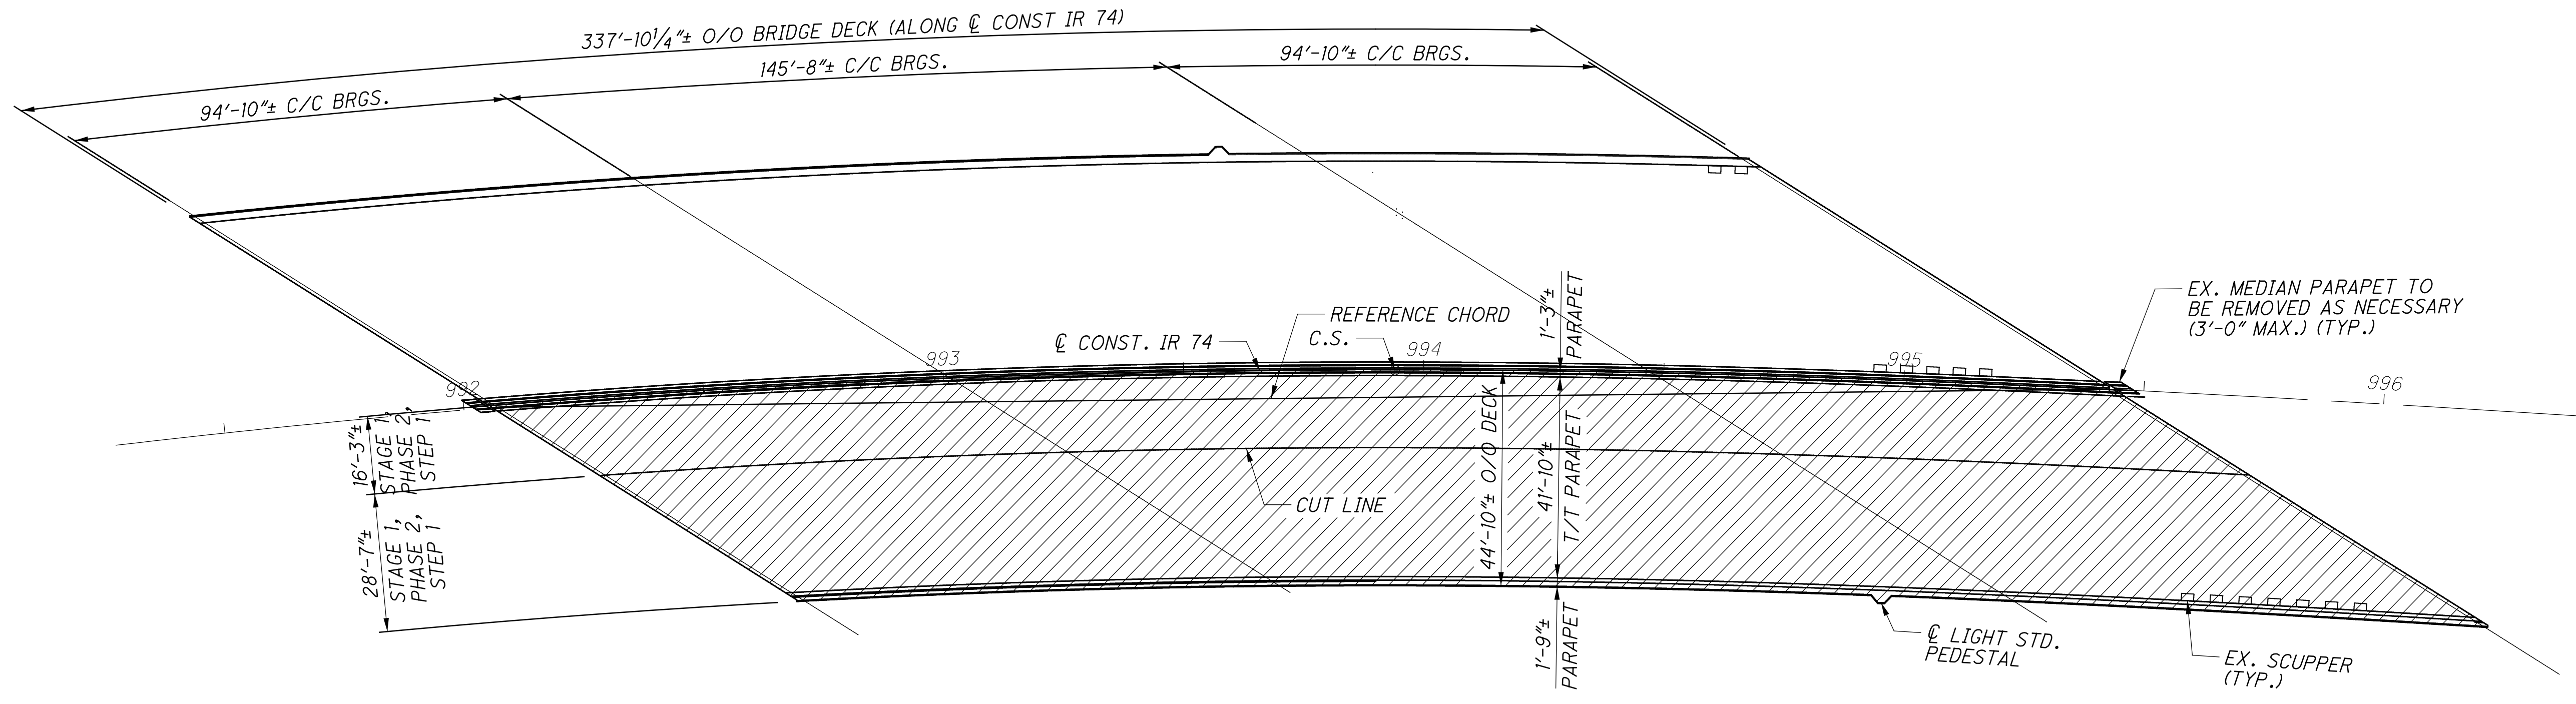


PLAN


LEGEND

LIMITS OF REMOVAL PER ITEM 202

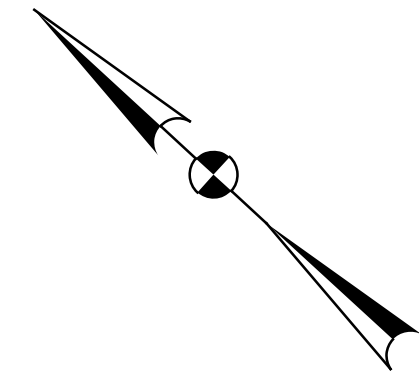


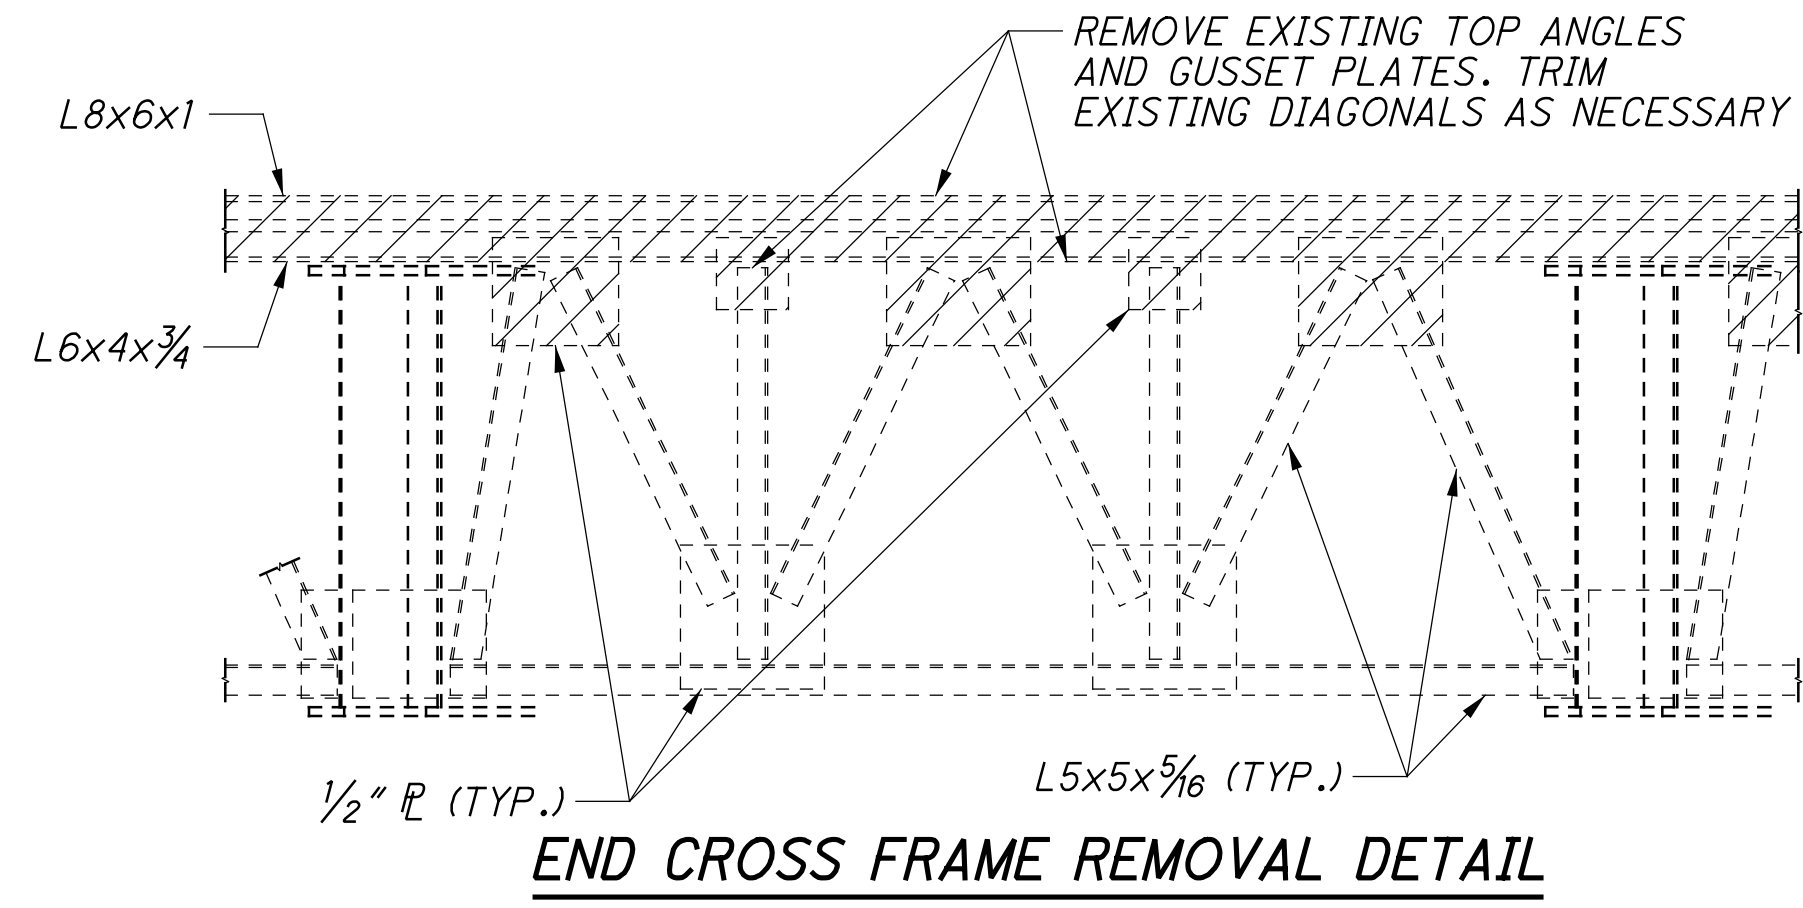


SFlanagan 11/16/2023 9:33:40 AM
 \\01\2017\01113\C.Design\104667-HAM-75-3.84\Design\Structures\HAM0074_1840C\Sheets\74_1840A\001.dgn

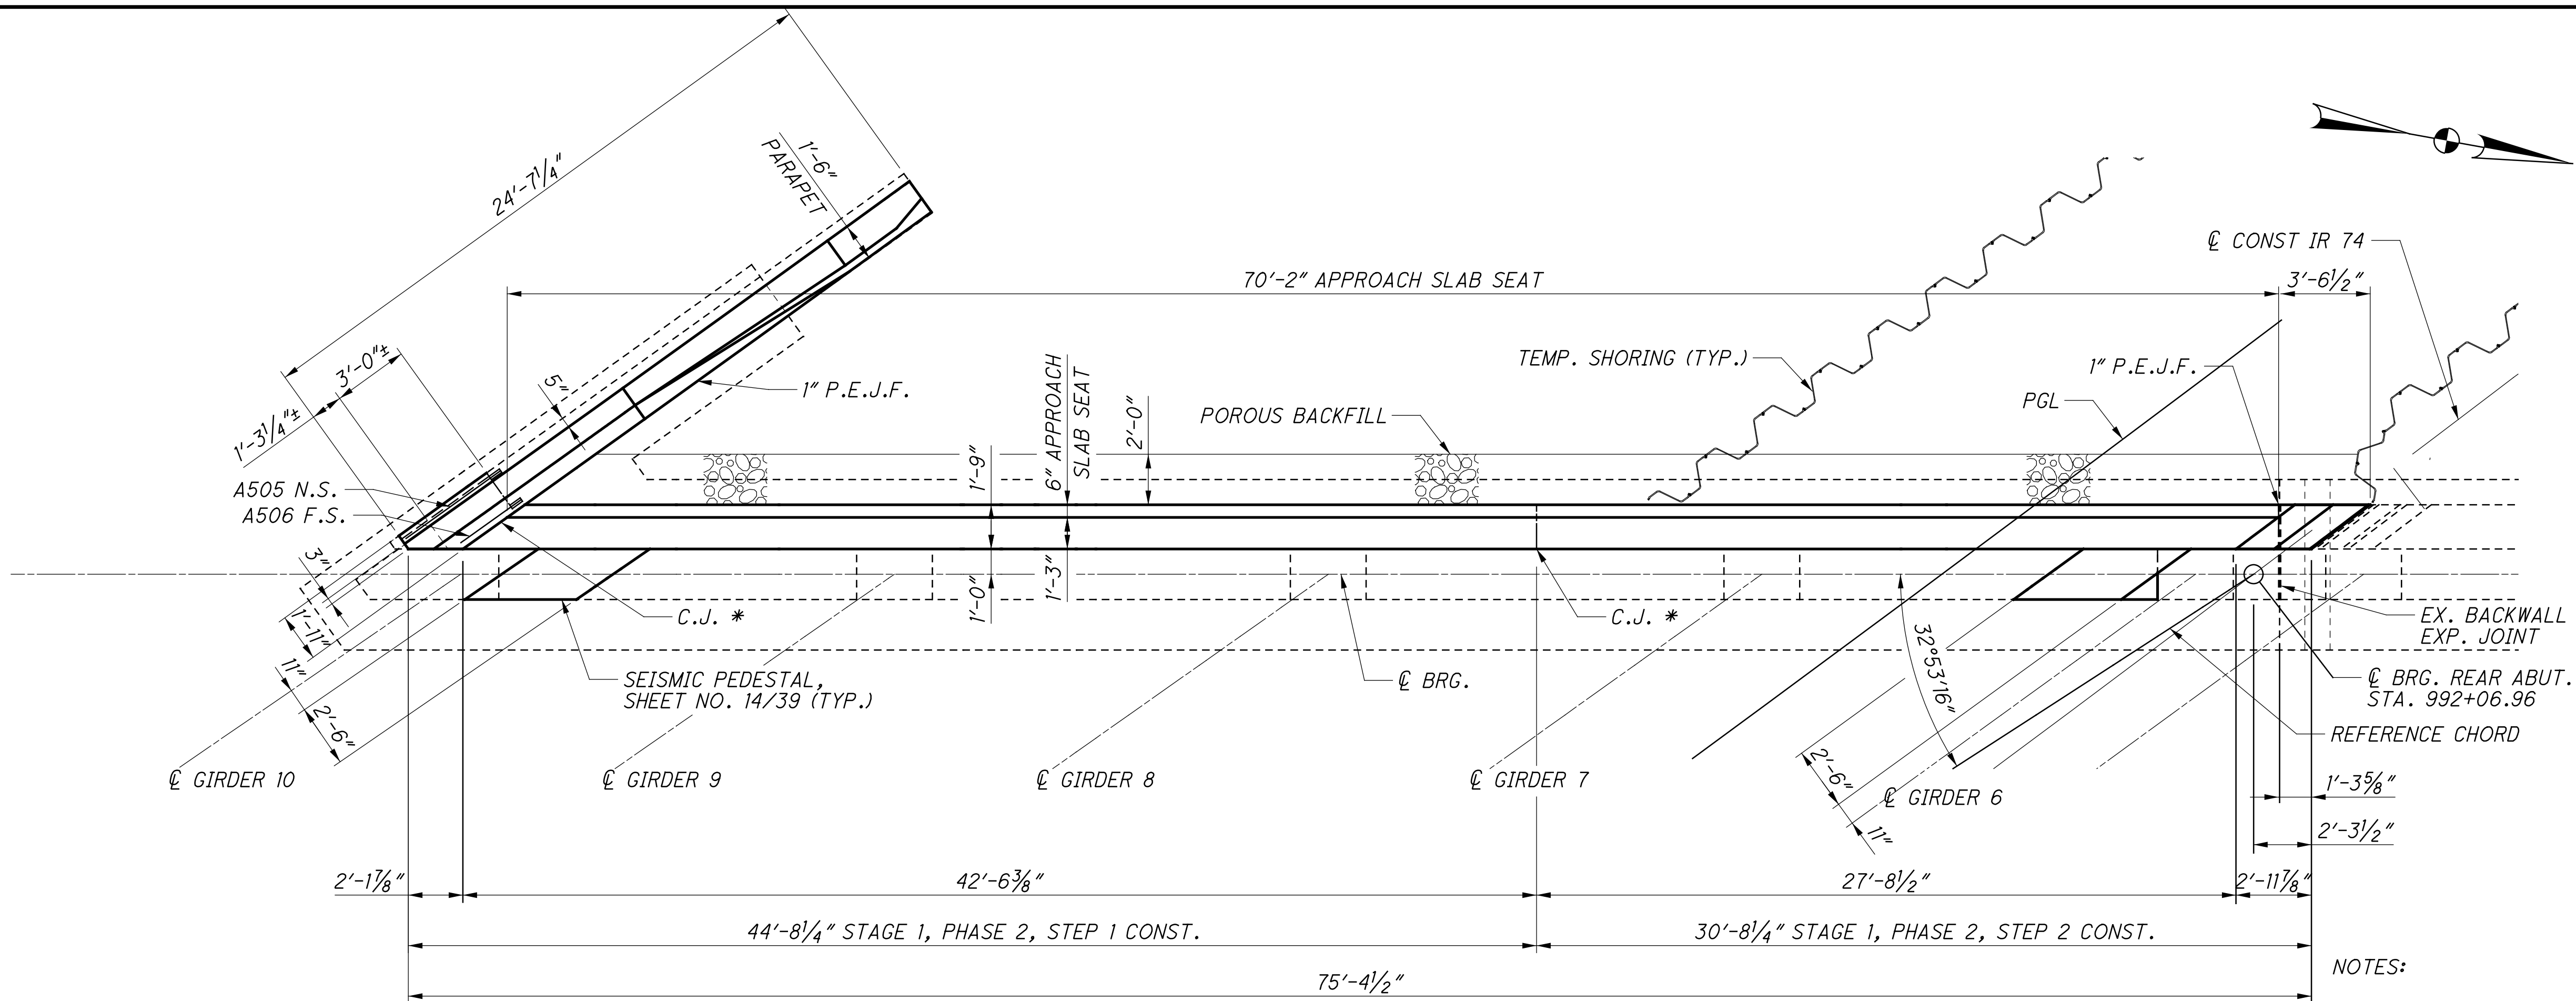


- NOTES:
- * 3'-0" WIDE TYPE 2 WATERPROOFING ON BACK FACE CENTERED ON JOINT FROM TOP OF SEAT TO BOTTOM OF APPROACH SLAB.
 - FOR PARAPET DETAILS, SEE SHEET 31/41.
 - FOR SECTION A-A, SEE SHEET 13/41.

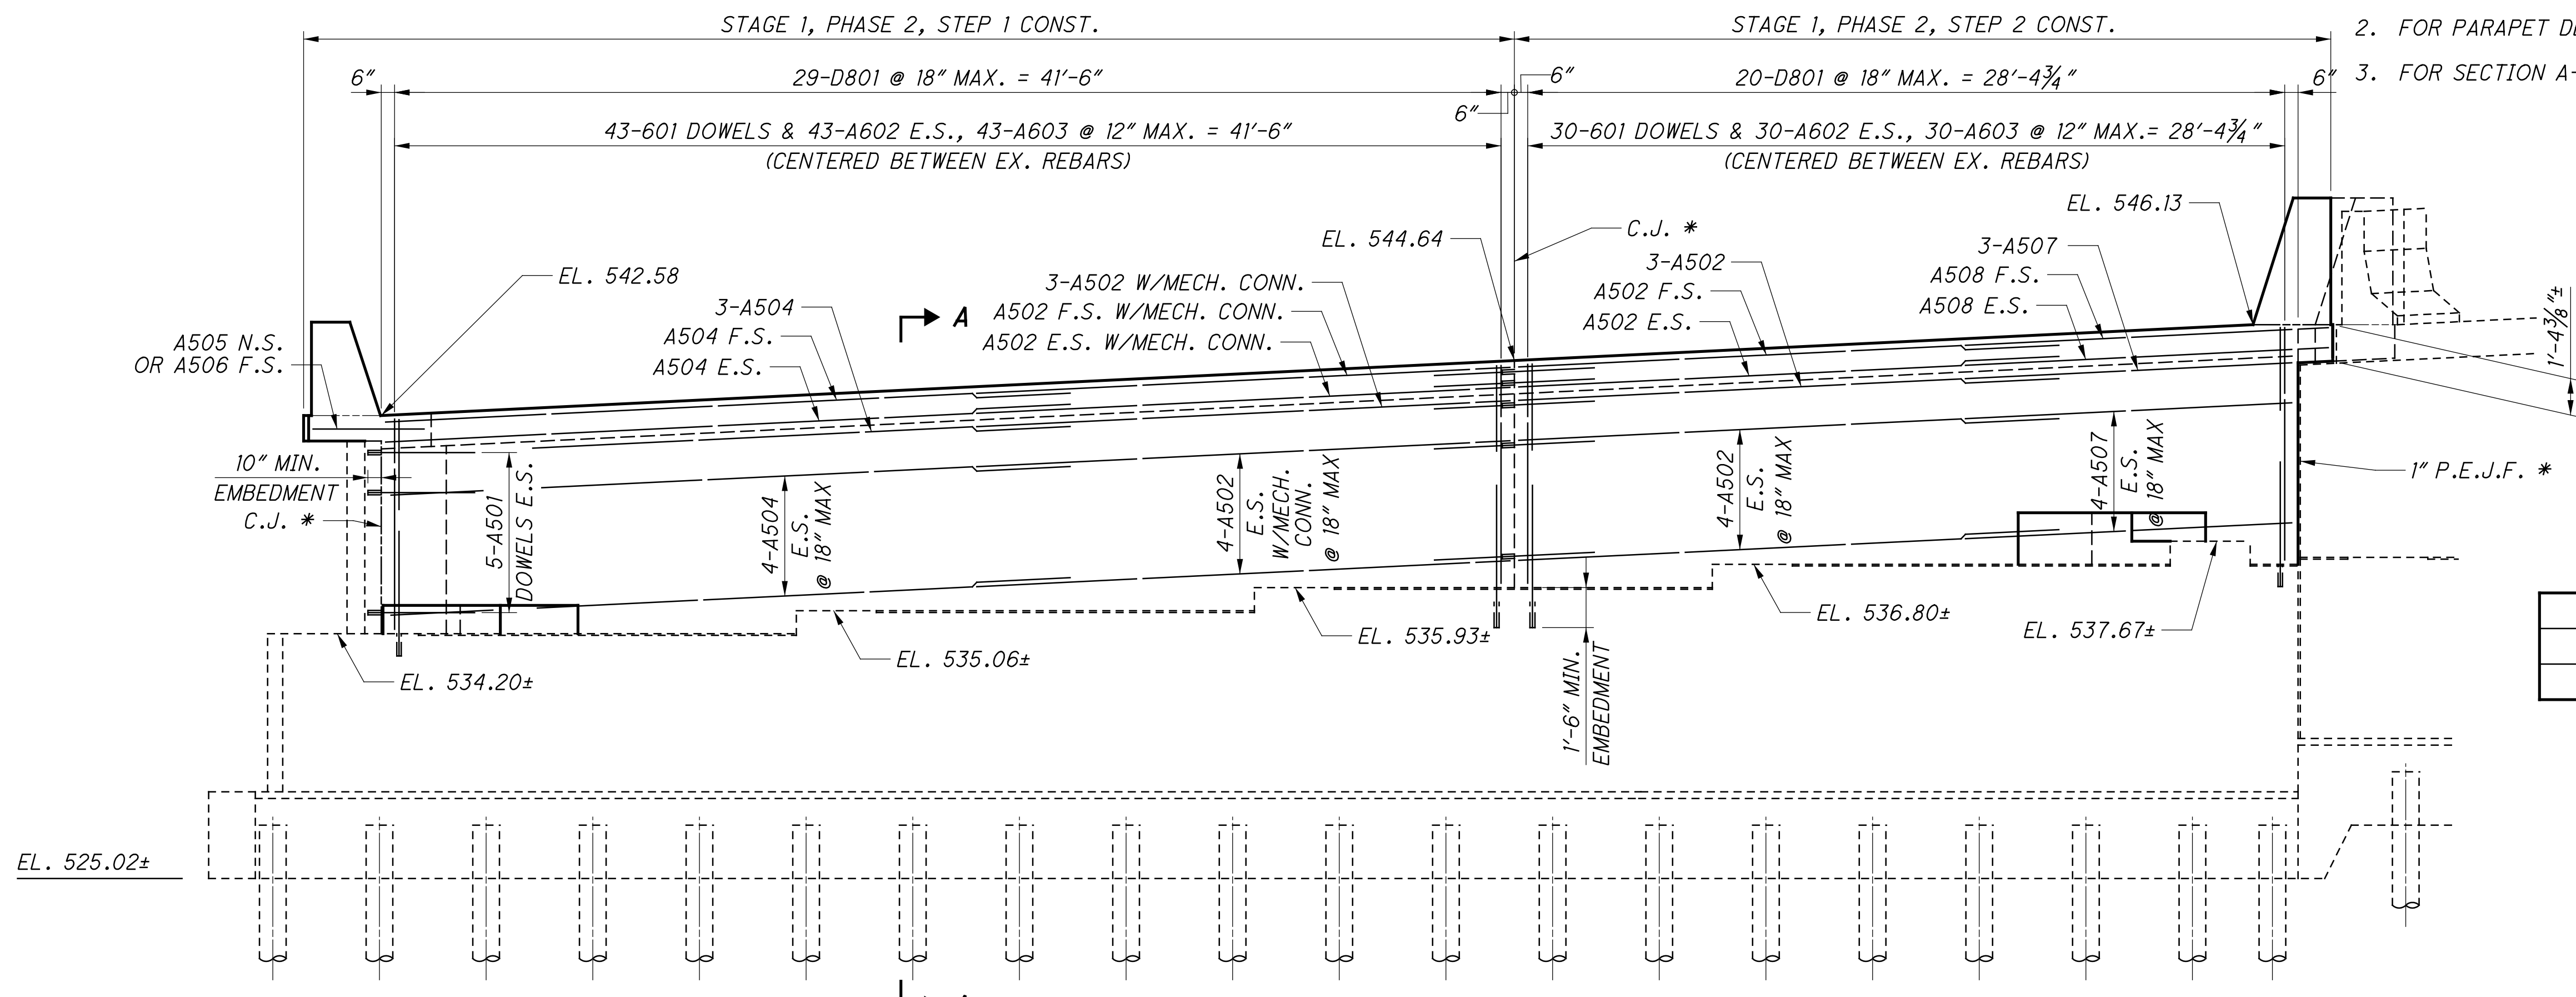


MINIMUM BAR LAP	
#5	3'-6"
#6	3'-10"

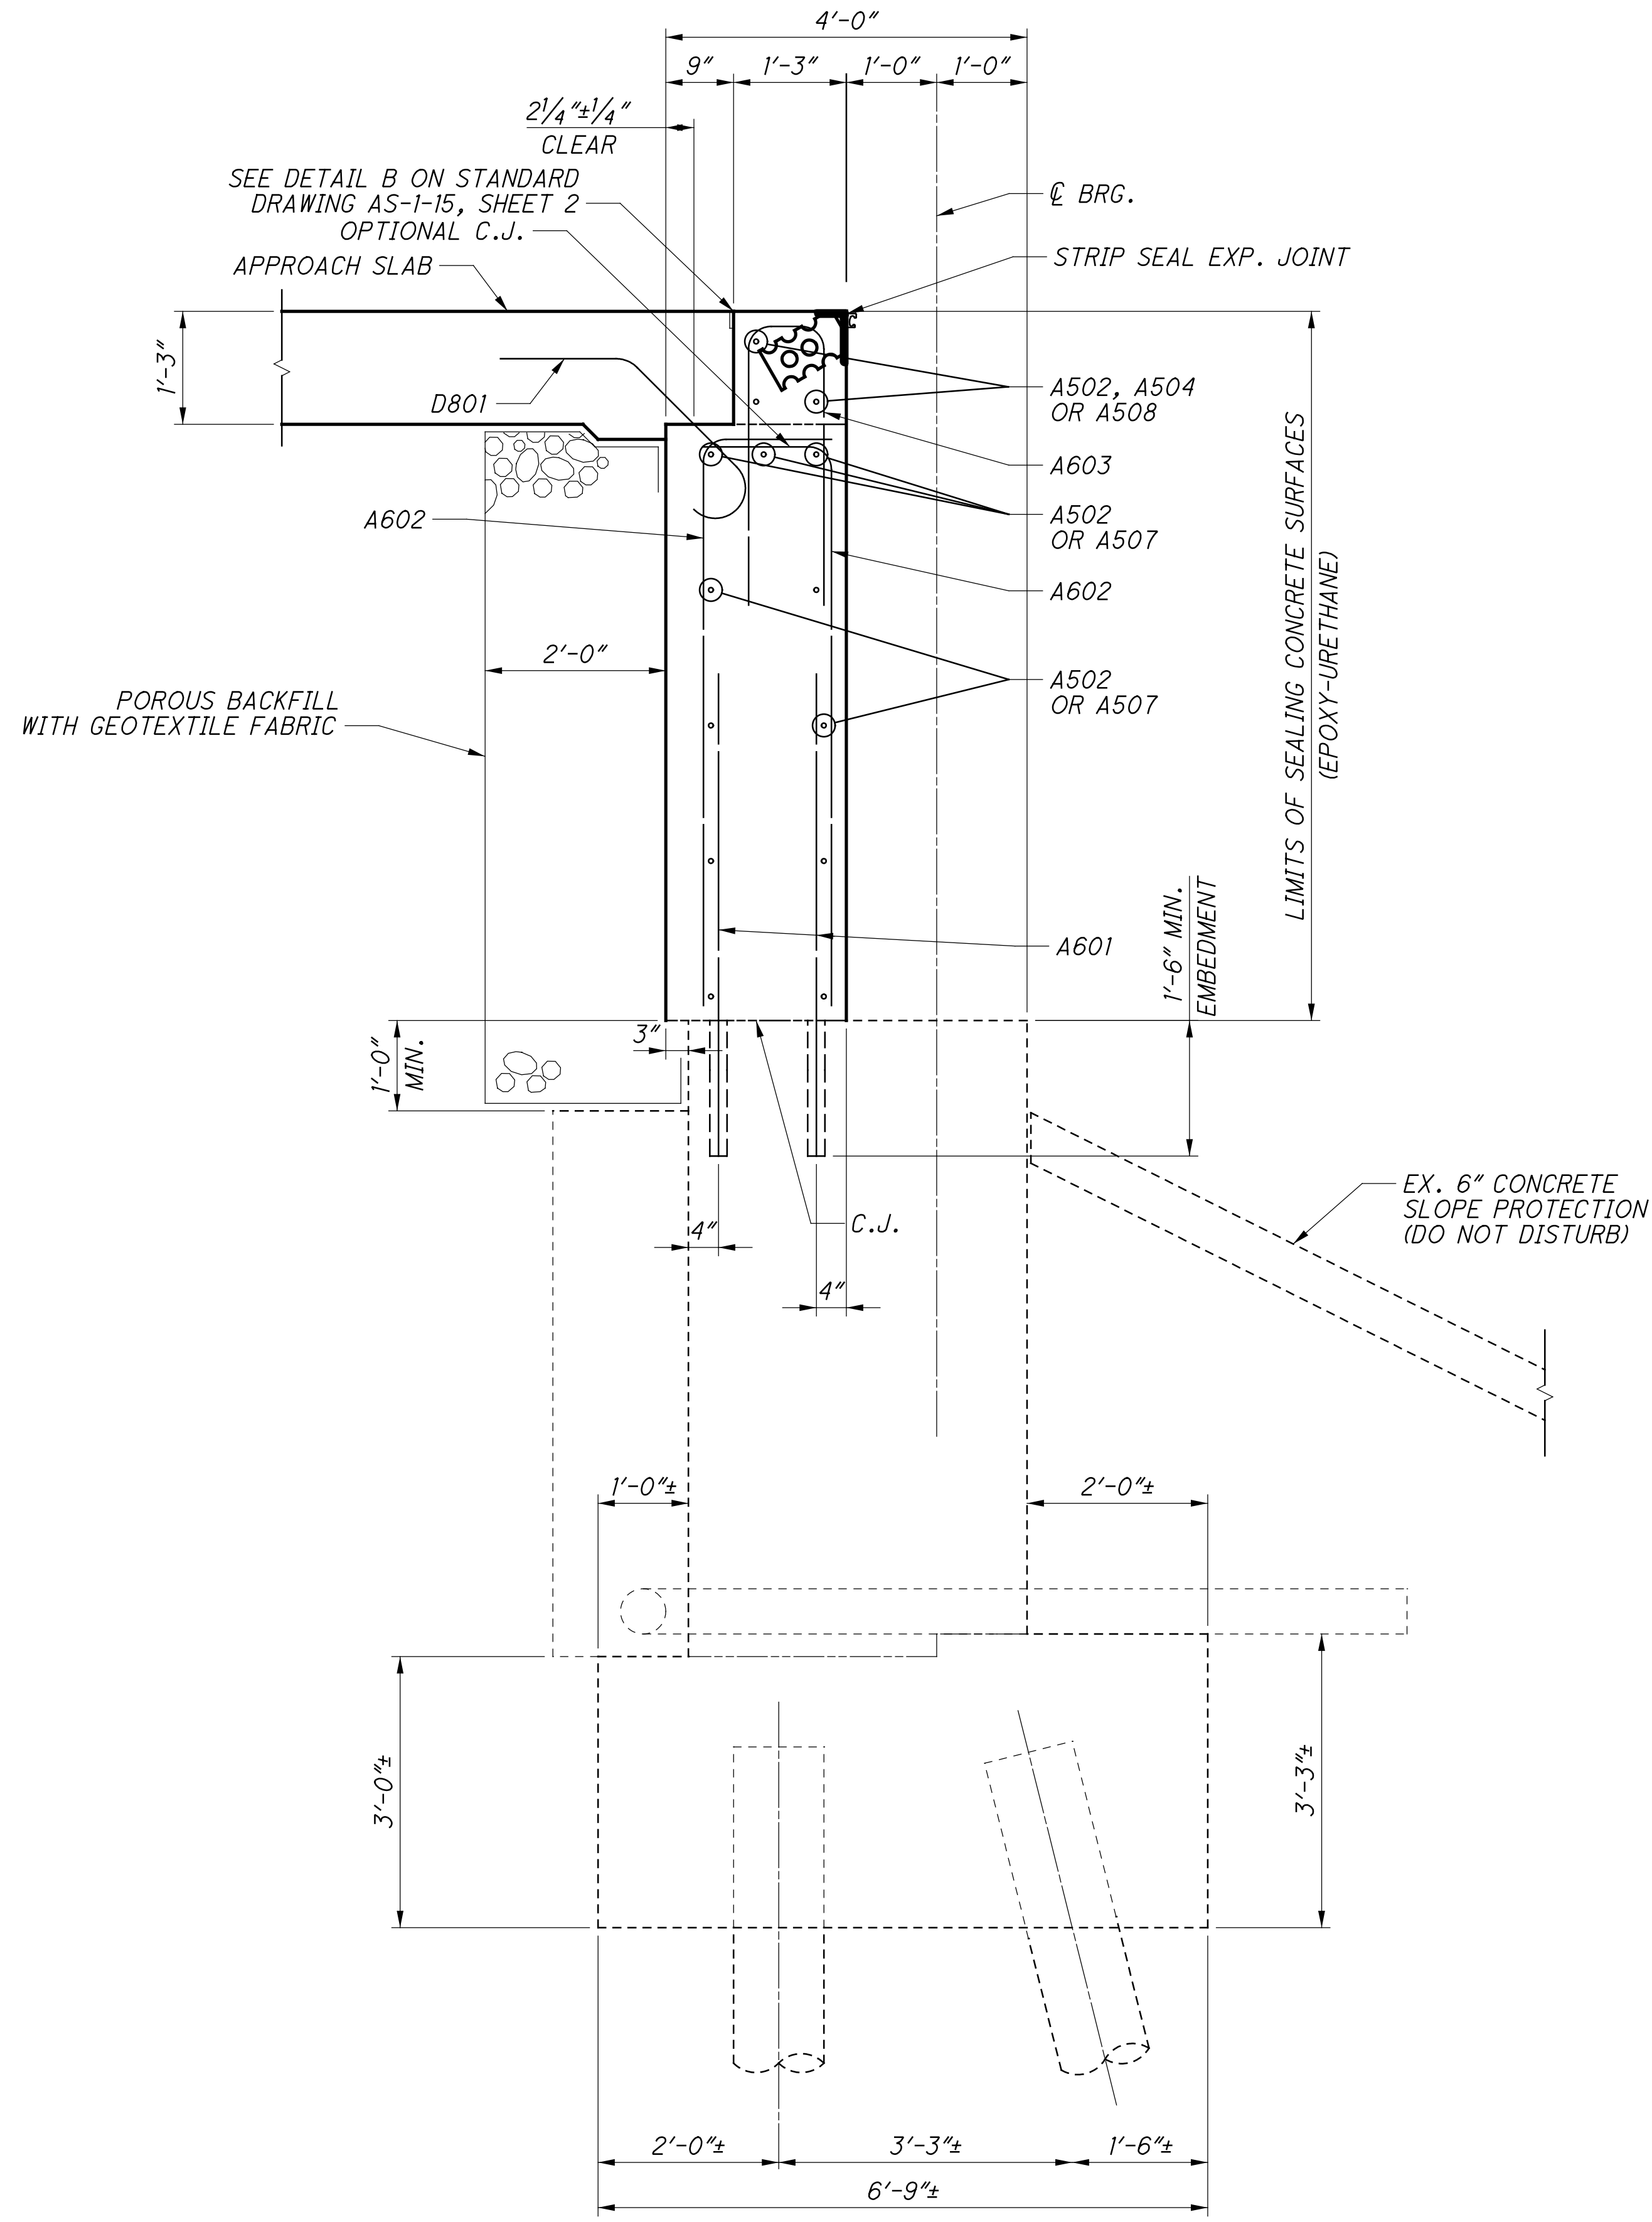


SECTION A-A

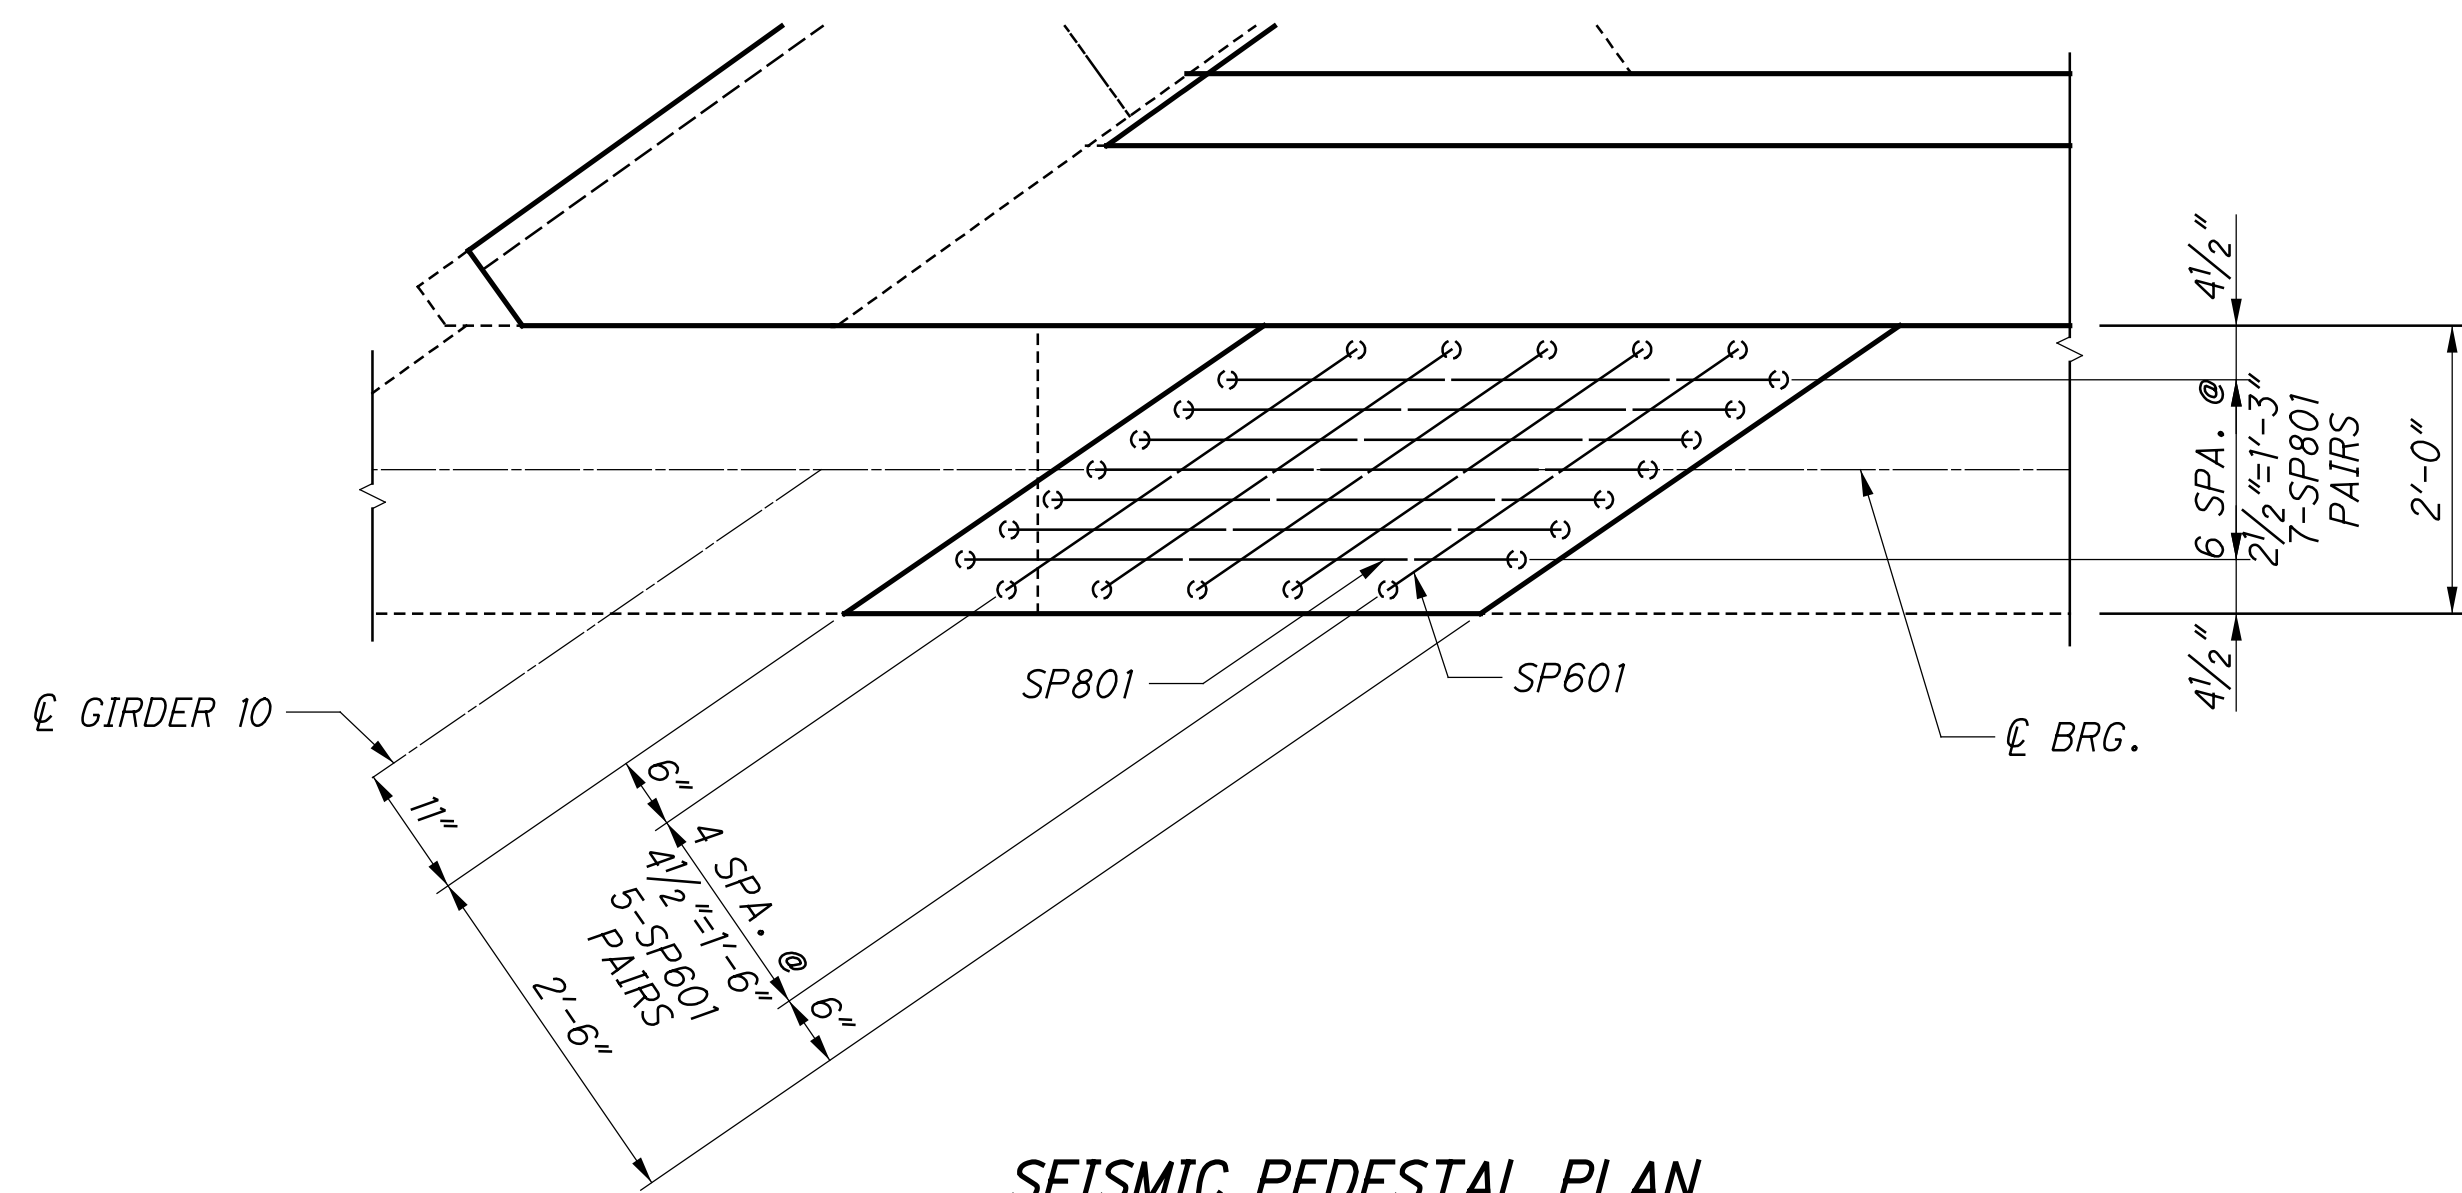


**SEISMIC PEDESTAL PLAN
 AT GIRDER 10**

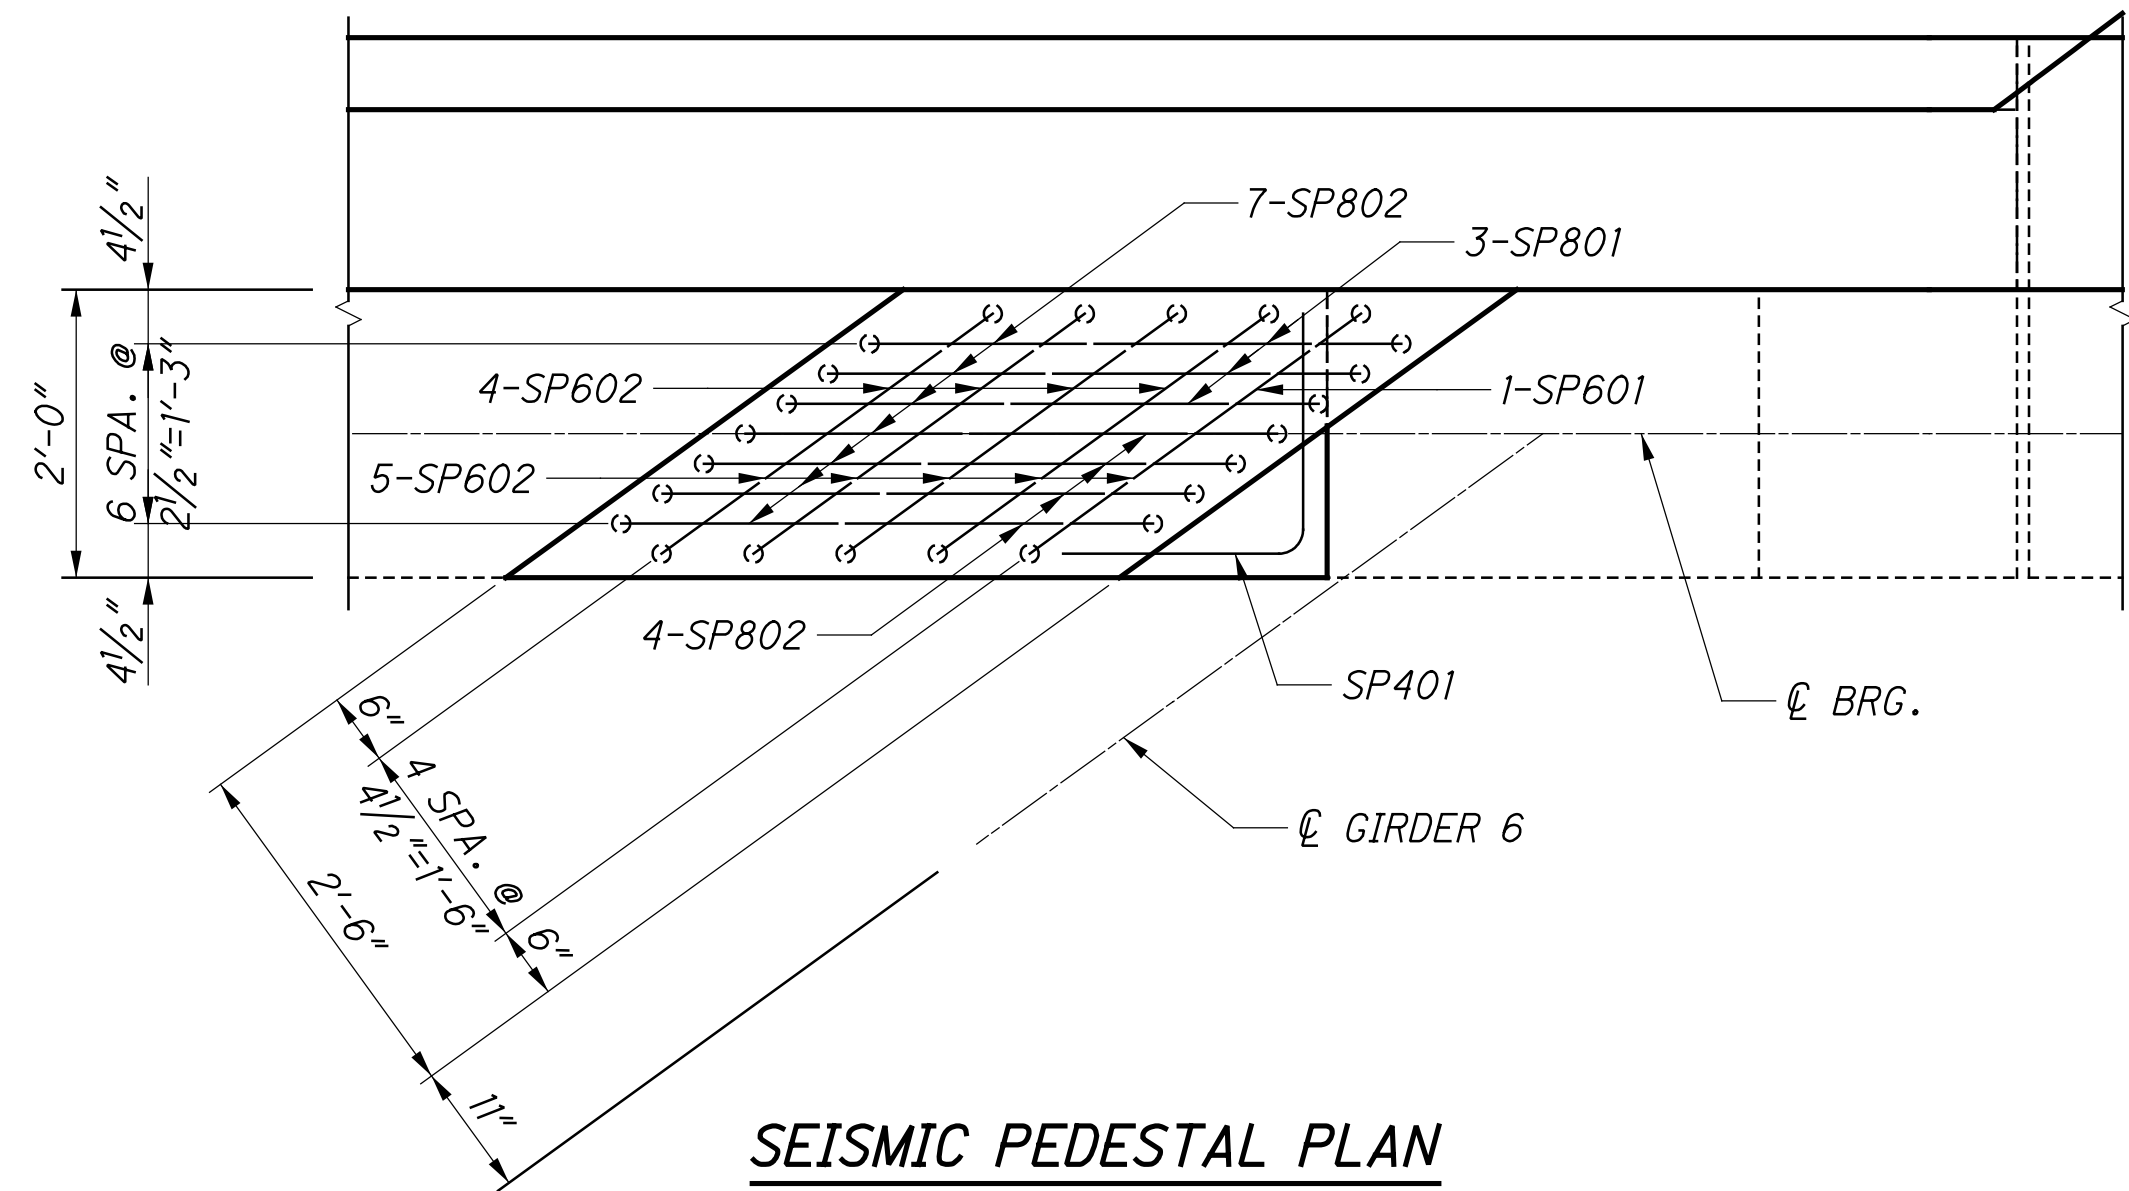

**SEISMIC PEDESTAL PLAN
 AT GIRDER 6**

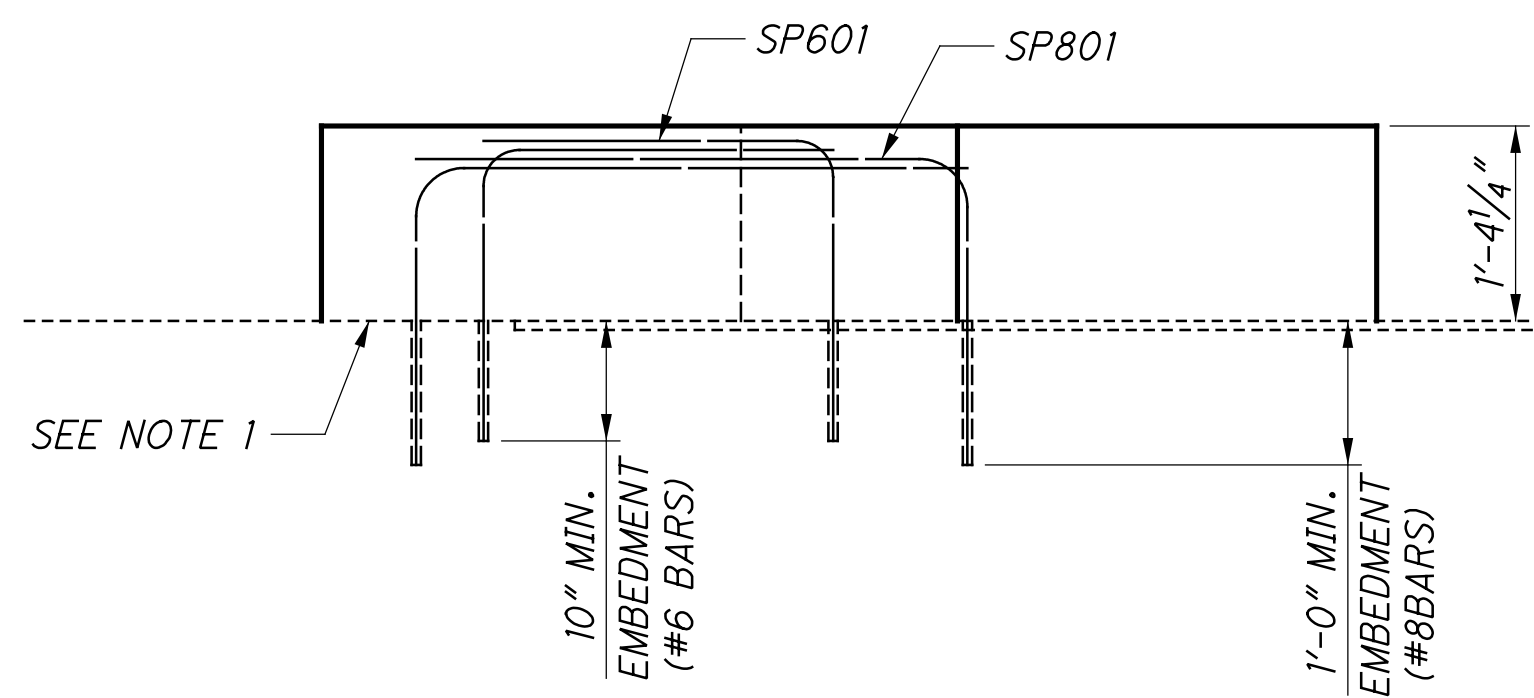

**SEISMIC PEDESTAL ELEVATION
 AT GIRDER 10**

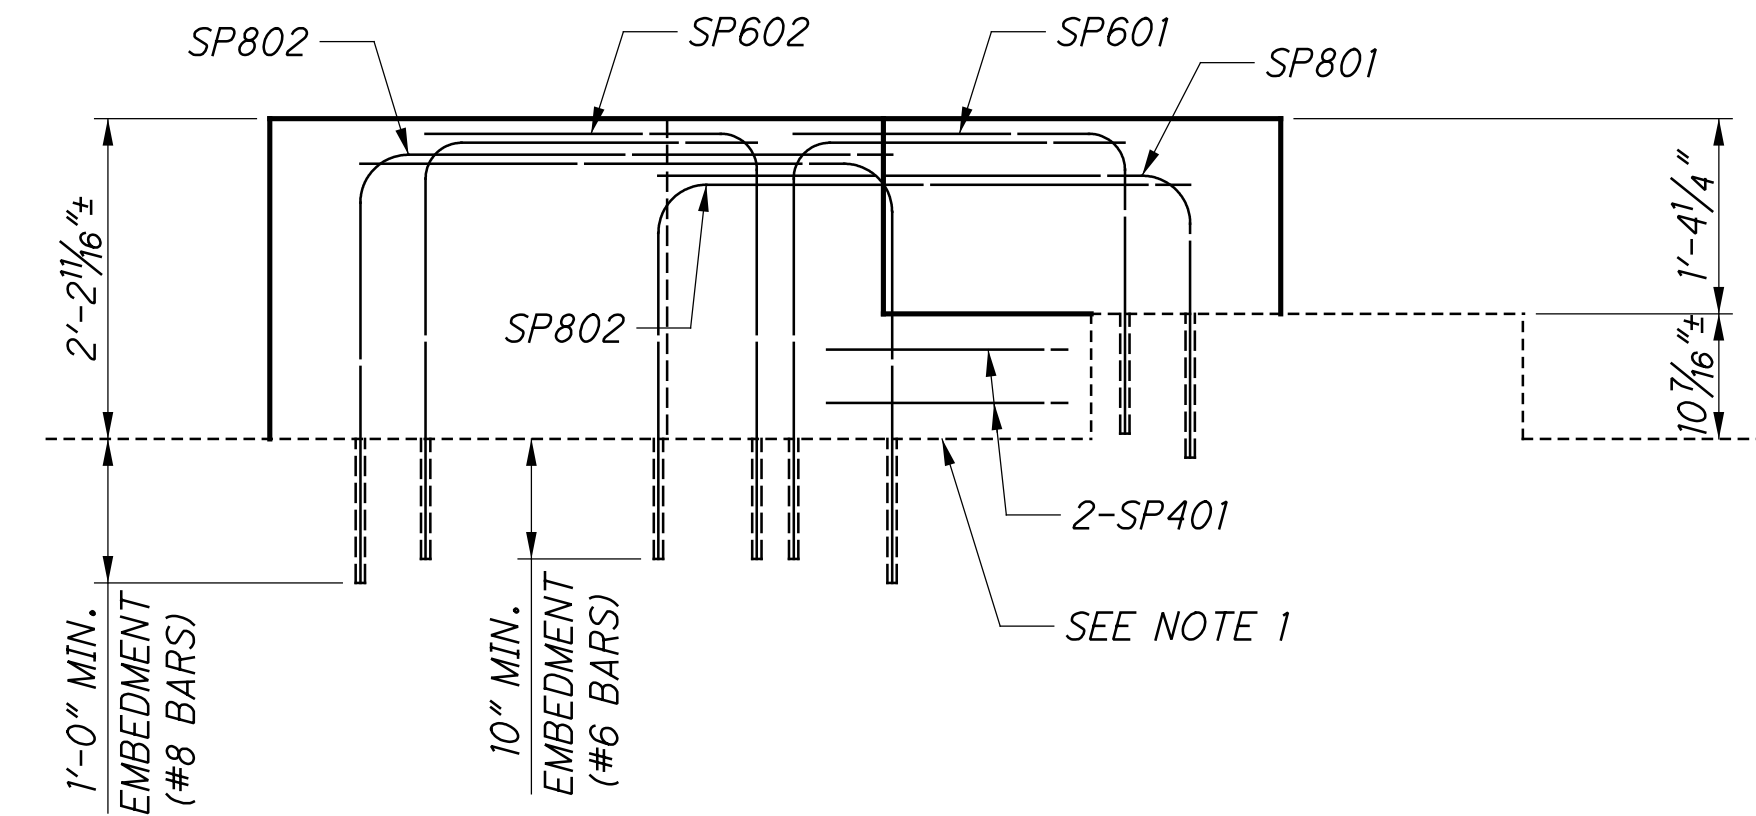


**SEISMIC PEDESTAL ELEVATION
 AT GIRDER 6**

NOTES:

1. INTENTIONALLY ROUGHEN PORTIONS OF EXISTING BEAM SEAT BENEATH SEISMIC PEDESTAL TO A FULL AMPLITUDE OF APPROXIMATELY 1/4 INCH

HAM-75-3.84 PID No. 104667	REAR ABUTMENT DETAILS (RIGHT BRIDGE) BRIDGE NO. HAM-74-1840 L/R OVER SB BEEKMAN ST. (U.S. 27) AND RAMP F	DESIGNED	CHECKED	DRAWN	REVIEWED	DATE	DESIGN AGENCY
		SUF	CLB	DSH	MDS	11/12/18	STRUCTUREPOINT
		STRUCTURE FILE NUMBER		3115526			
		15		14 / 41			

SFlanagan
 11/16/2023 9:33:41 AM
 \\0\2017\01113\C.Design\104667-HAM-75-3.84\Design\Structures\HAM0074_1840C\Sheets\74_1840A R004.dgn

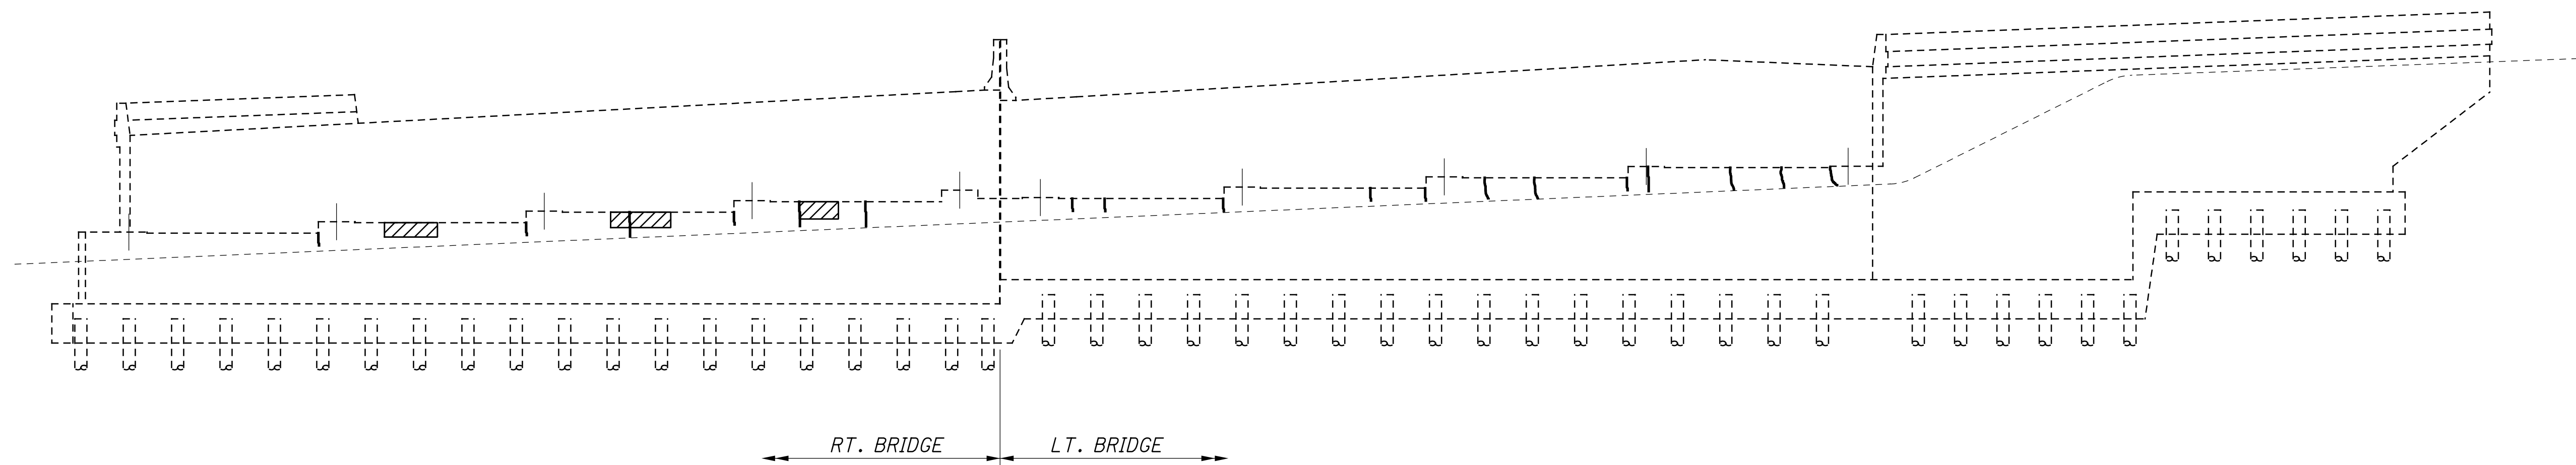

REAR ABUTMENT - RIGHT BRIDGE


REAR ABUTMENT - LEFT BRIDGE

<u>SUMMARY OF ABUT. REPAIR QUANTITIES</u>		
	<u>PATCH</u>	<u>EPOXY INJECTION</u>
	<u>(SQ FT)</u>	<u>(FT)</u>
<u>REAR ABUTMENT</u>	* 1.75	* 51.08

* FIELD MEASURED TOTAL FOR LEFT AND RIGHT BRIDGES

REAR ABUTMENT ELEVATION
 (LOOKING WEST)

LEGEND

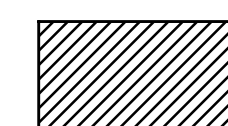

AREA TO BE PATCHED PER ITEM 519 -
 PATCHING CONCRETE STRUCTURE, AS
 PER PLAN.

NOTES:

- ITEM 519 - PATCHING CONCRETE STRUCTURES, AS PER PLAN AND ITEM 512 - CONCRETE REPAIR BY EPOXY INJECTION ARE UNIT PRICE PAY ITEMS (31 AND 32).

HAM-75-3.84
 PID No. 104667

15 / 41


16
 120

PATCHING DETAILS - REAR ABUTMENT
 BRIDGE NO. HAM-74-1840 L/R
 OVER SB BEEKMAN ST. (U.S. 27) AND RAMP F

DESIGNED: SUJ
 CHECKED: CLB
 DRAWN: DSH
 REVISED:
 REVIEWED: MDS
 DATE: 11/12/18
 STRUCTURE FILE NUMBER: 3115526


DESIGN AGENCY
STRUCTUREPOINT
 2000 CORPORATE CENTER DR., STE. 200
 WASHINGTON, DC 20004
 TEL: (301) 251-1300 FAX: (301) 251-1306
 WWW.STRUCTUREPOINT.COM

S:\Flanagan\11/16/2023 9:33:42 AM\0\2017\01113\C.Design\104667 -HAM-75-3.84\Design\Structures\HAM0074_1840C_Sheets\74_1840A\F001.dgn

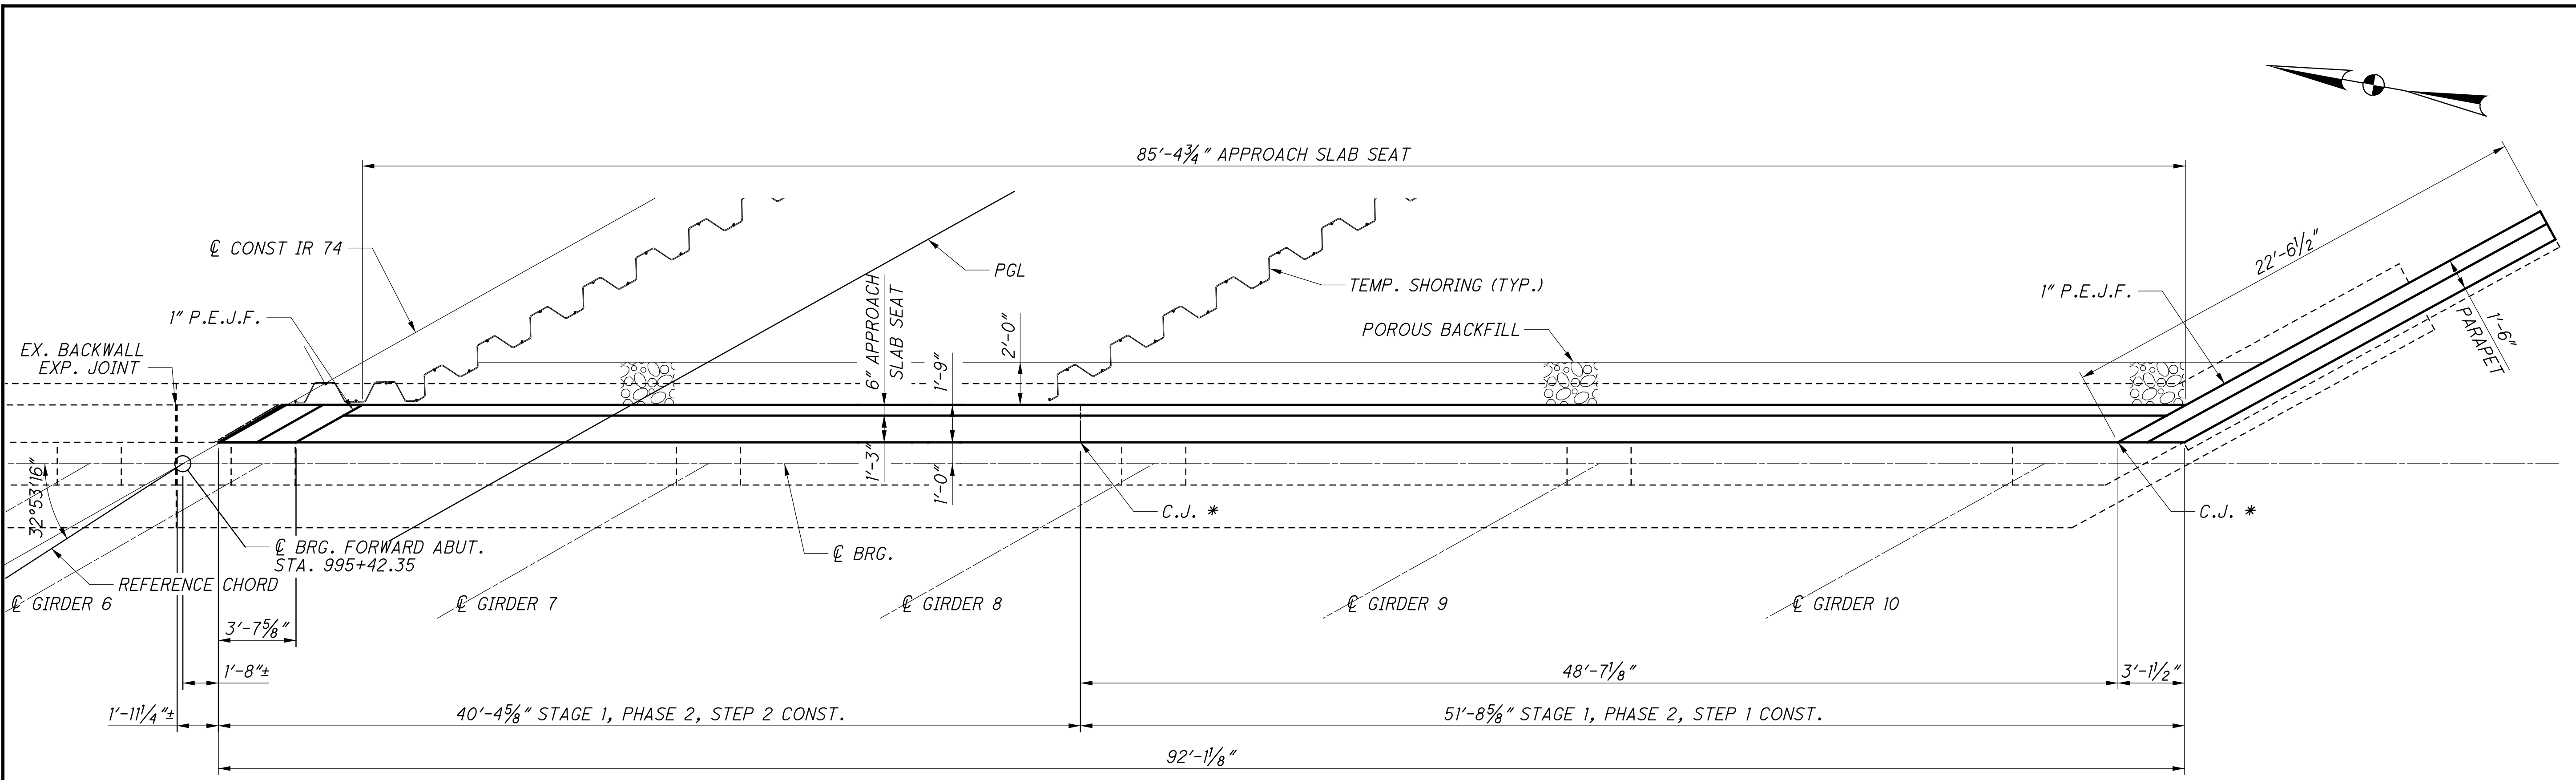

PLAN - FORWARD ABUTMENT

MINIMUM BAR LAP	
#5	3'-6"
#6	3'-10"

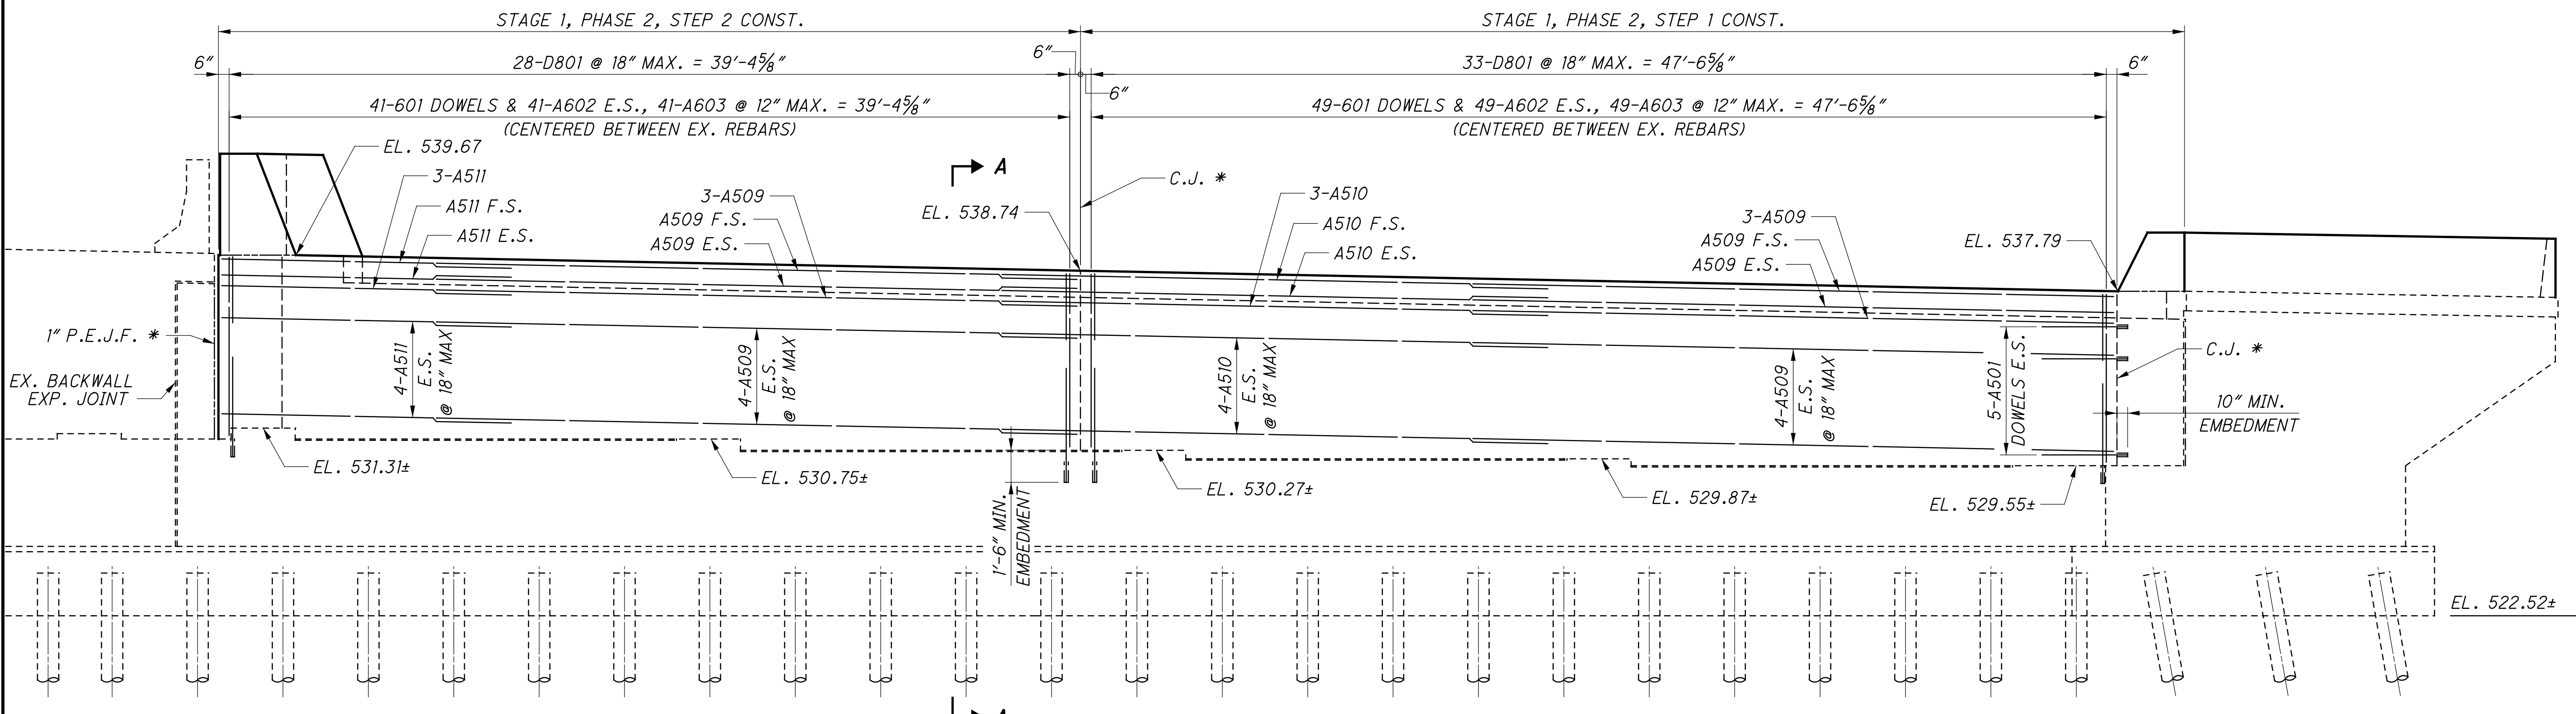

ELEVATION - FORWARD ABUTMENT

- NOTES:
- * 3'-0" WIDE TYPE 2 WATERPROOFING ON BACK FACE CENTERED ON JOINT FROM TOP OF SEAT TO BOTTOM OF APPROACH SLAB.
 - FOR PARAPET DETAILS, SEE SHEETS 32/41.
 - FOR SECTION A-A, SEE SHEET 17/41.

DESIGN AGENCY
STRUCTUREPOINT


DATE 11/12/18
REVIEWED MDS
DRAWN DSH
DESIGNED SUJ
CHECKED CLB

STRUCTURE FILE NUMBER 3115526

FORWARD ABUTMENT DETAILS (RIGHT BRIDGE)
BRIDGE NO. HAM-74-1840 L/R
OVER SB BEEKMAN ST. (U.S. 27) AND RAMP F


HAM-75-3.84
PID No. 104667

16 / 41
17
120

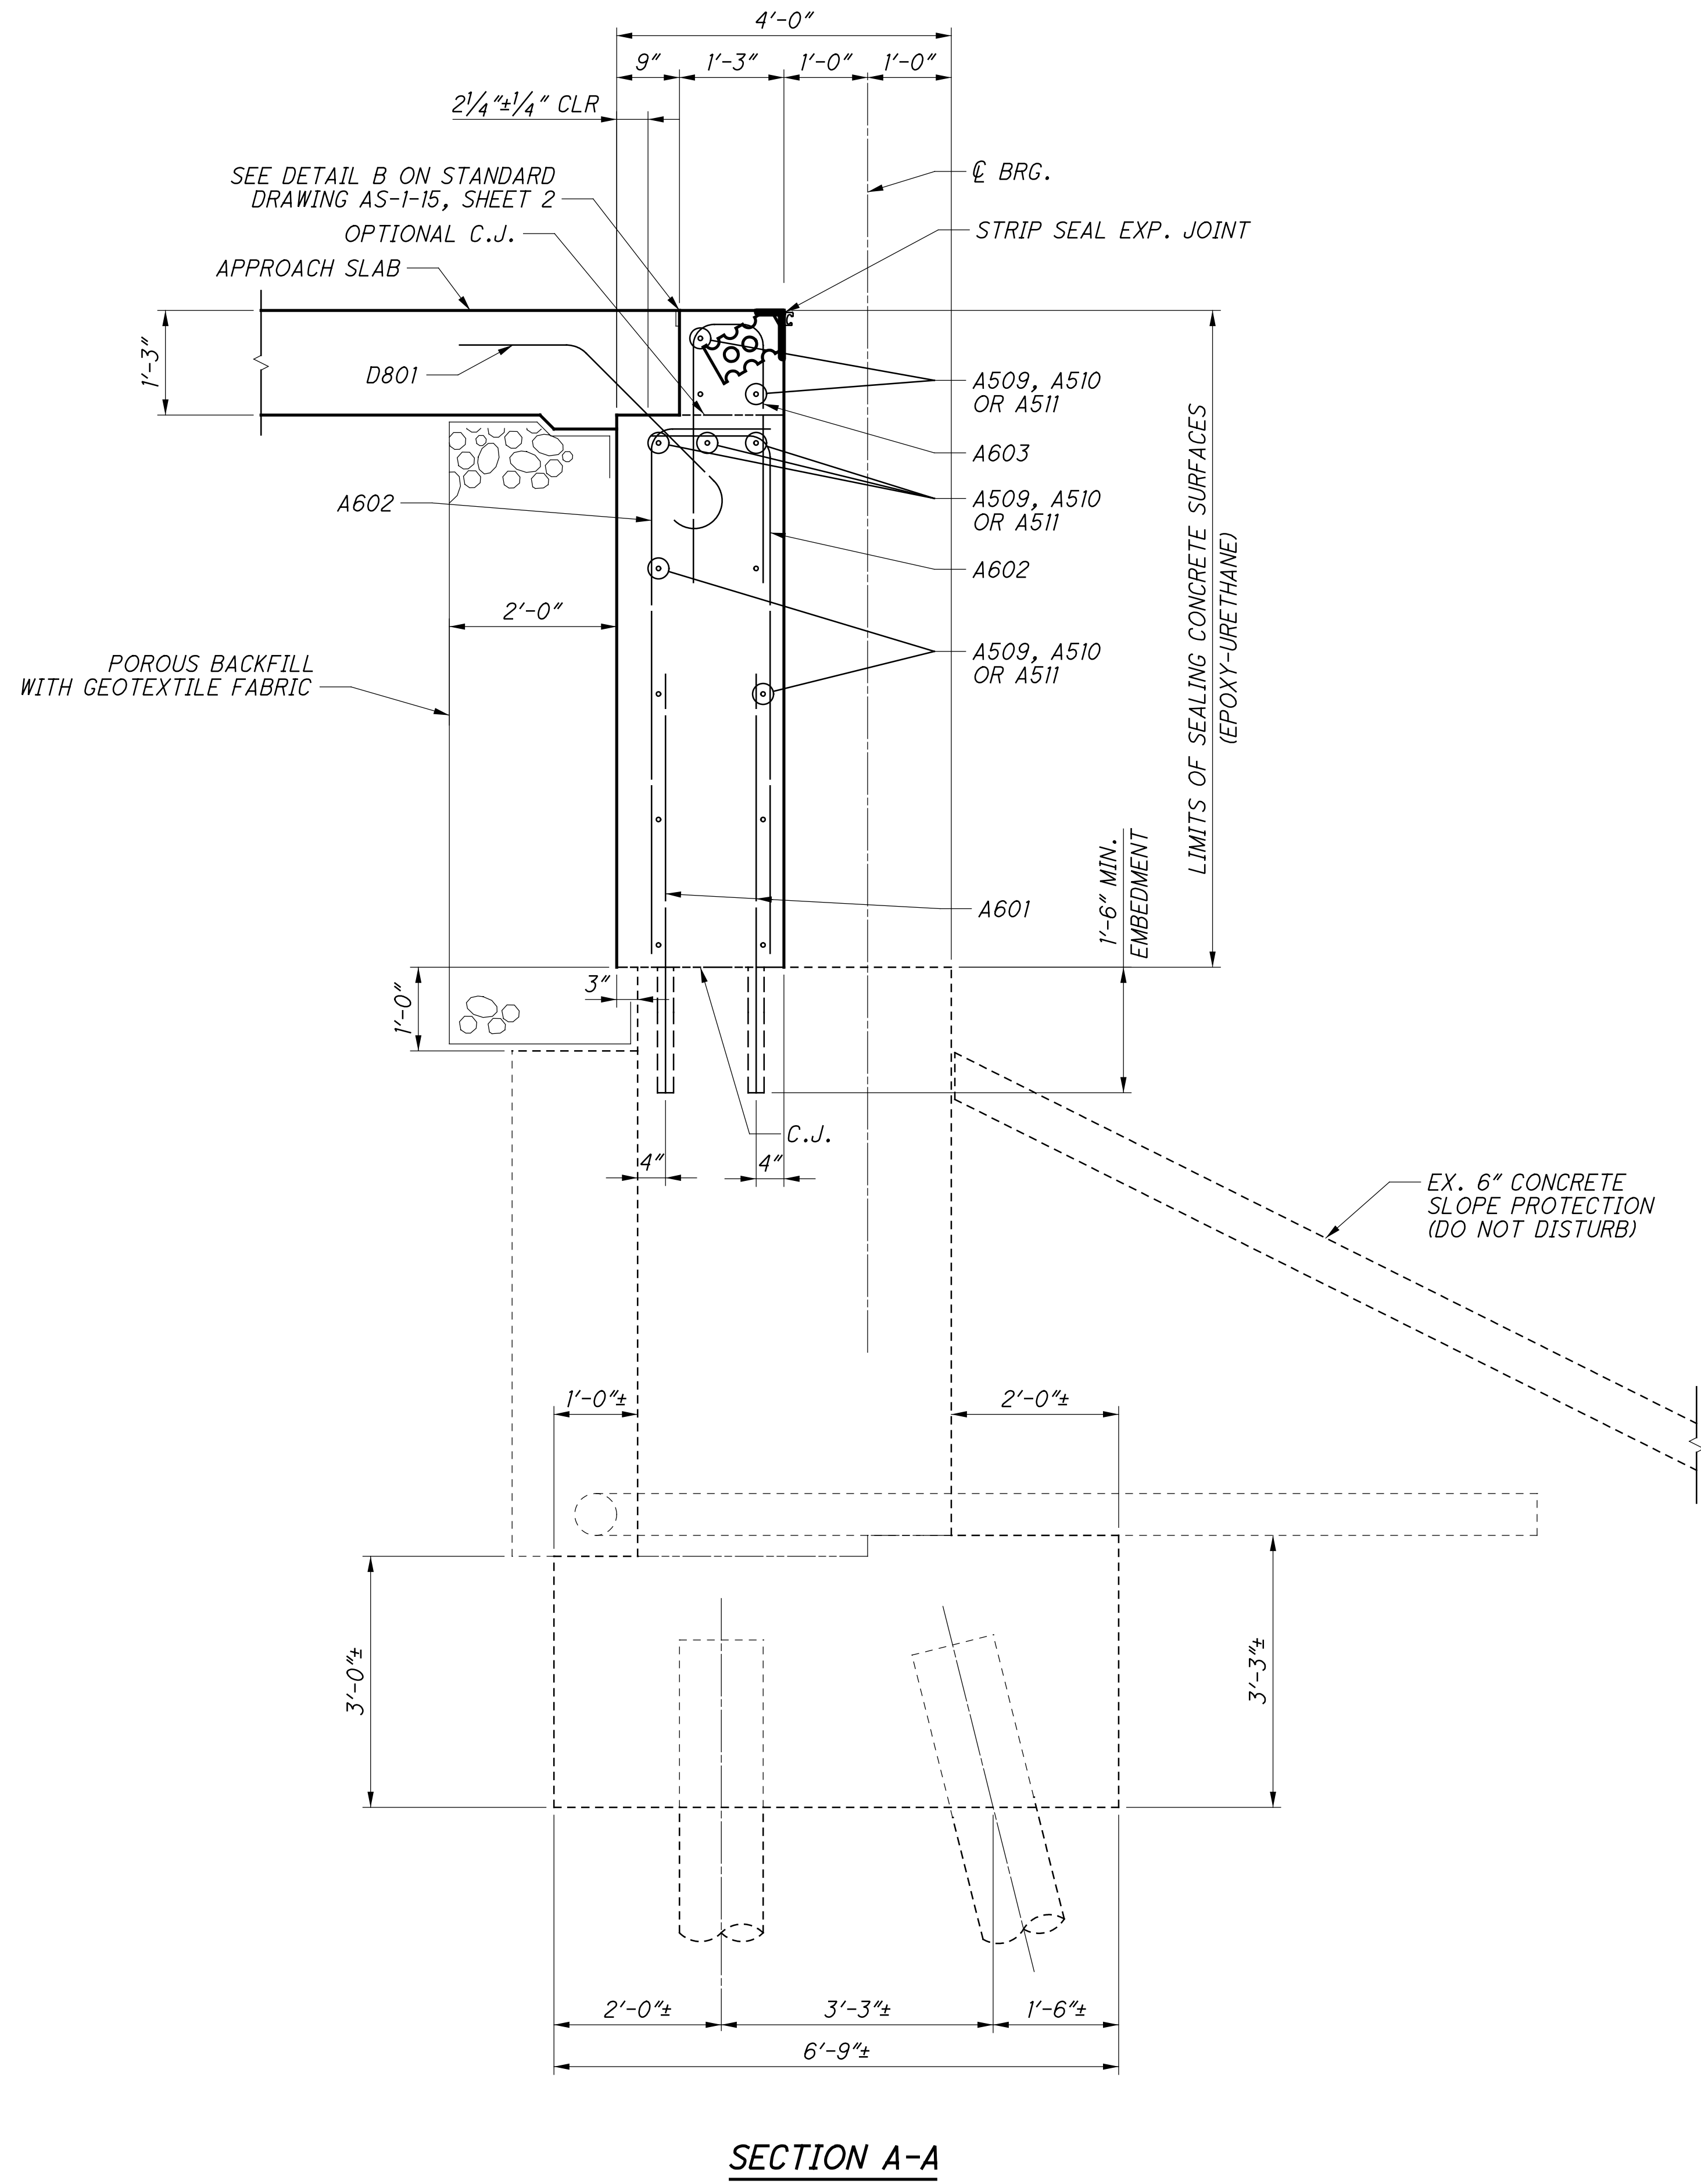

SECTION A-A

DESIGN AGENCY STRUCTUREPOINT <small>INCORPORATED</small> 2000 CORPORATE CENTER DR., STE. 200 FARMINGTON, CT 06030 TEL: 860.633.8000 FAX: 860.633.8001 WWW.STRUCTUREPOINT.COM	
DESIGNED SUJ	CHECKED CLB
DRAWN DSH	REVISED
REVIEWED MDS	DATE 11/12/18
STRUCTURE FILE NUMBER 3115526	
FORWARD ABUTMENT DETAILS (RIGHT BRIDGE) BRIDGE NO. HAM-74-1840 L/R OVER SB BEEKMAN ST. (U.S. 27) AND RAMP F	
HAM-75-3.84 PID No. 104667	
17 / 41	
18 120	

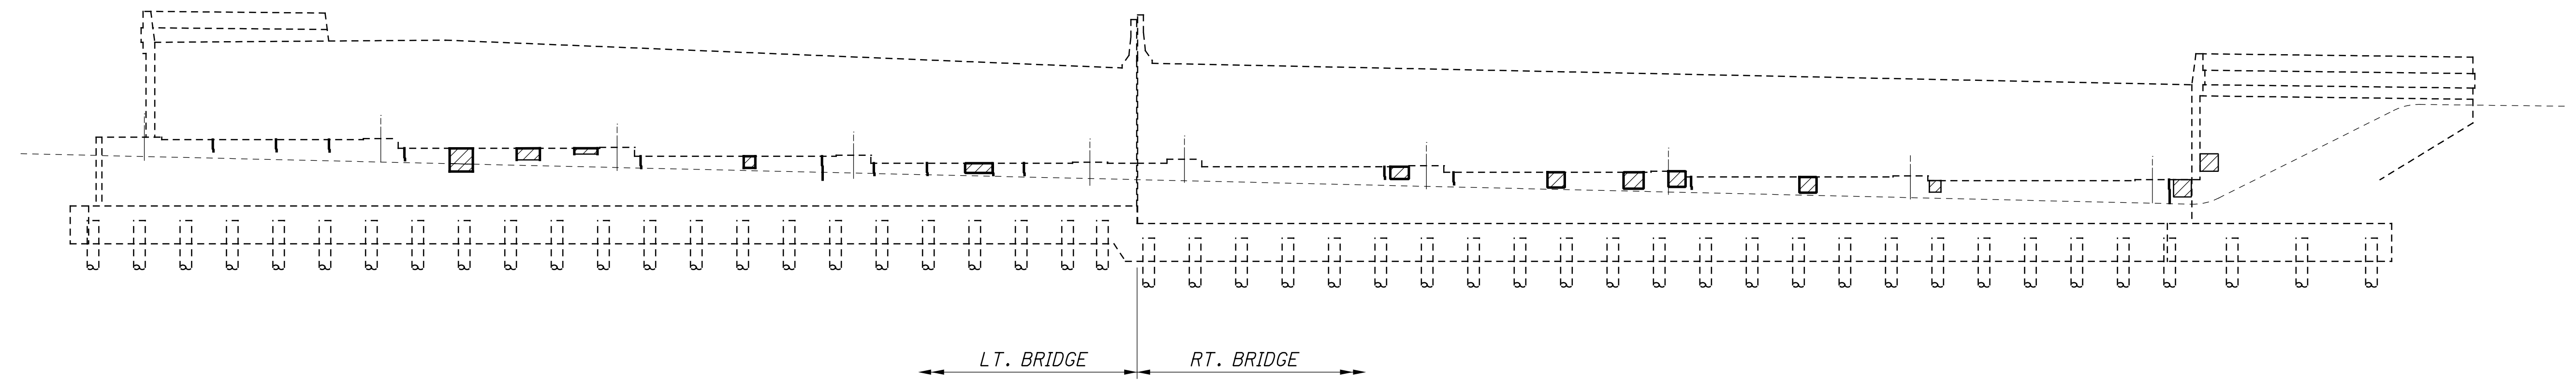

FORWARD ABUTMENT - LEFT BRIDGE


FORWARD ABUTMENT - RIGHT BRIDGE

SUMMARY OF ABUT. REPAIR QUANTITIES		
	PATCH (SQ FT)	EPOXY INJECTION (FT)
FORWARD ABUTMENT	* 17.41	* 59.33

* FIELD MEASURED TOTAL FOR LEFT AND RIGHT BRIDGES

**FORWARD ABUTMENT
 (LOOKING EAST)**

LEGEND


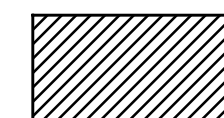


AREA TO BE PATCHED PER ITEM 519 -
 PATCHING CONCRETE STRUCTURE, AS
 PER PLAN.

NOTES:

- ITEM 519 - PATCHING CONCRETE STRUCTURES, AS PER PLAN AND ITEM 512 - CONCRETE REPAIR BY EPOXY INJECTION ARE UNIT PRICE PAY ITEMS (31 AND 32).


SFlanagan 11/16/2023 9:33:44 AM
 \0\2017\01113\C.Design\104667-HAM-75-3.84.Design\Structures\HAM0074_1840C\Sheets\74_1840P1001.dgn

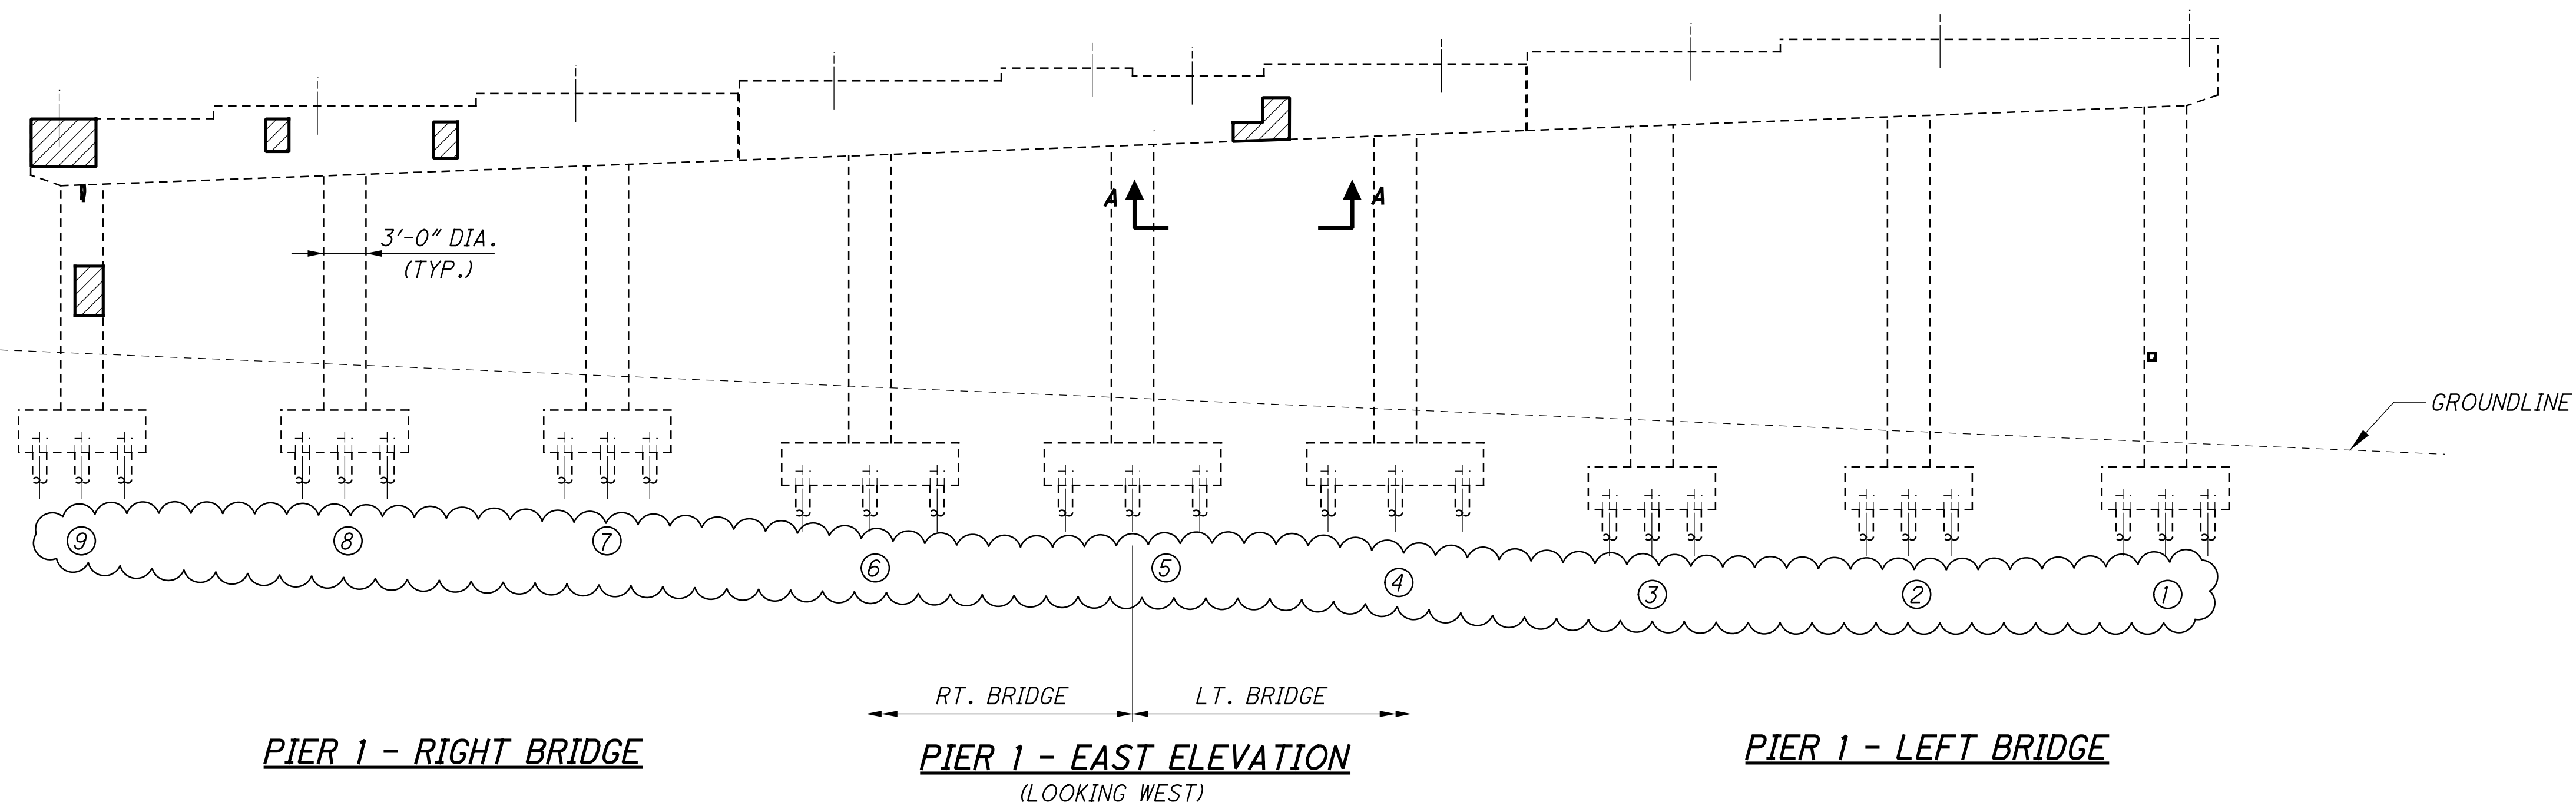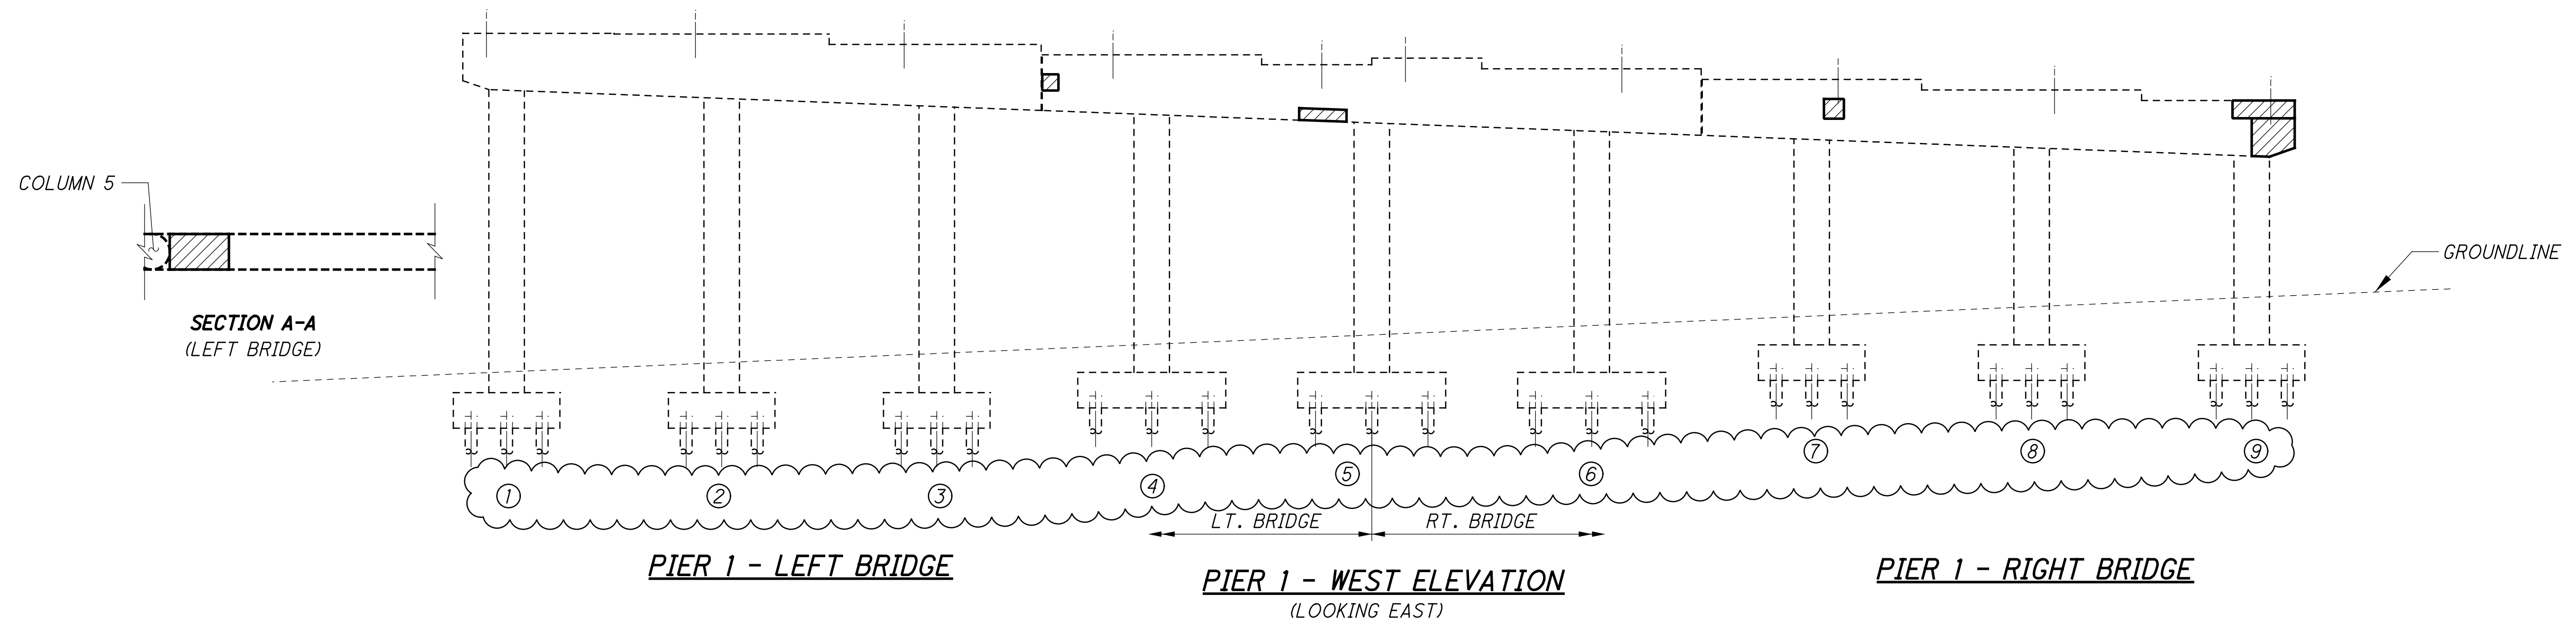

SUMMARY OF PIER 1 REPAIR QUANTITIES		
	PATCH (SQ FT)	EPOXY INJECTION (FT)
PIER 1	* 89.64	* 0

* FIELD MEASURED TOTAL FOR LEFT AND RIGHT BRIDGES


LEGEND

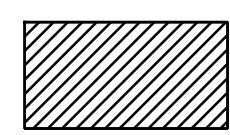 AREA TO BE PATCHED PER ITEM 519 - PATCHING CONCRETE STRUCTURE, AS PER PLAN.


NOTES:

- ITEM 519 - PATCHING CONCRETE STRUCTURES, AS PER PLAN AND ITEM 512 - CONCRETE REPAIR BY EPOXY INJECTION ARE UNIT PRICE PAY ITEMS (31 AND 32).

DESIGN AGENCY: STRUCTUREPOINT
 DATE: 11/12/18
 REVIEWED: MDS
 DRAWN: DSH
 DESIGNED: SUJ
 CHECKED: CLB
 STRUCTURE FILE NUMBER: 3115526
 PIER 1 DETAILS
 BRIDGE NO. HAM-74-1840 L/R
 OVER SB BEEKMAN ST. (U.S. 27) AND RAMP F
 HAM-75-3.84
 PID No. 104667
 19 / 41
 20
 120

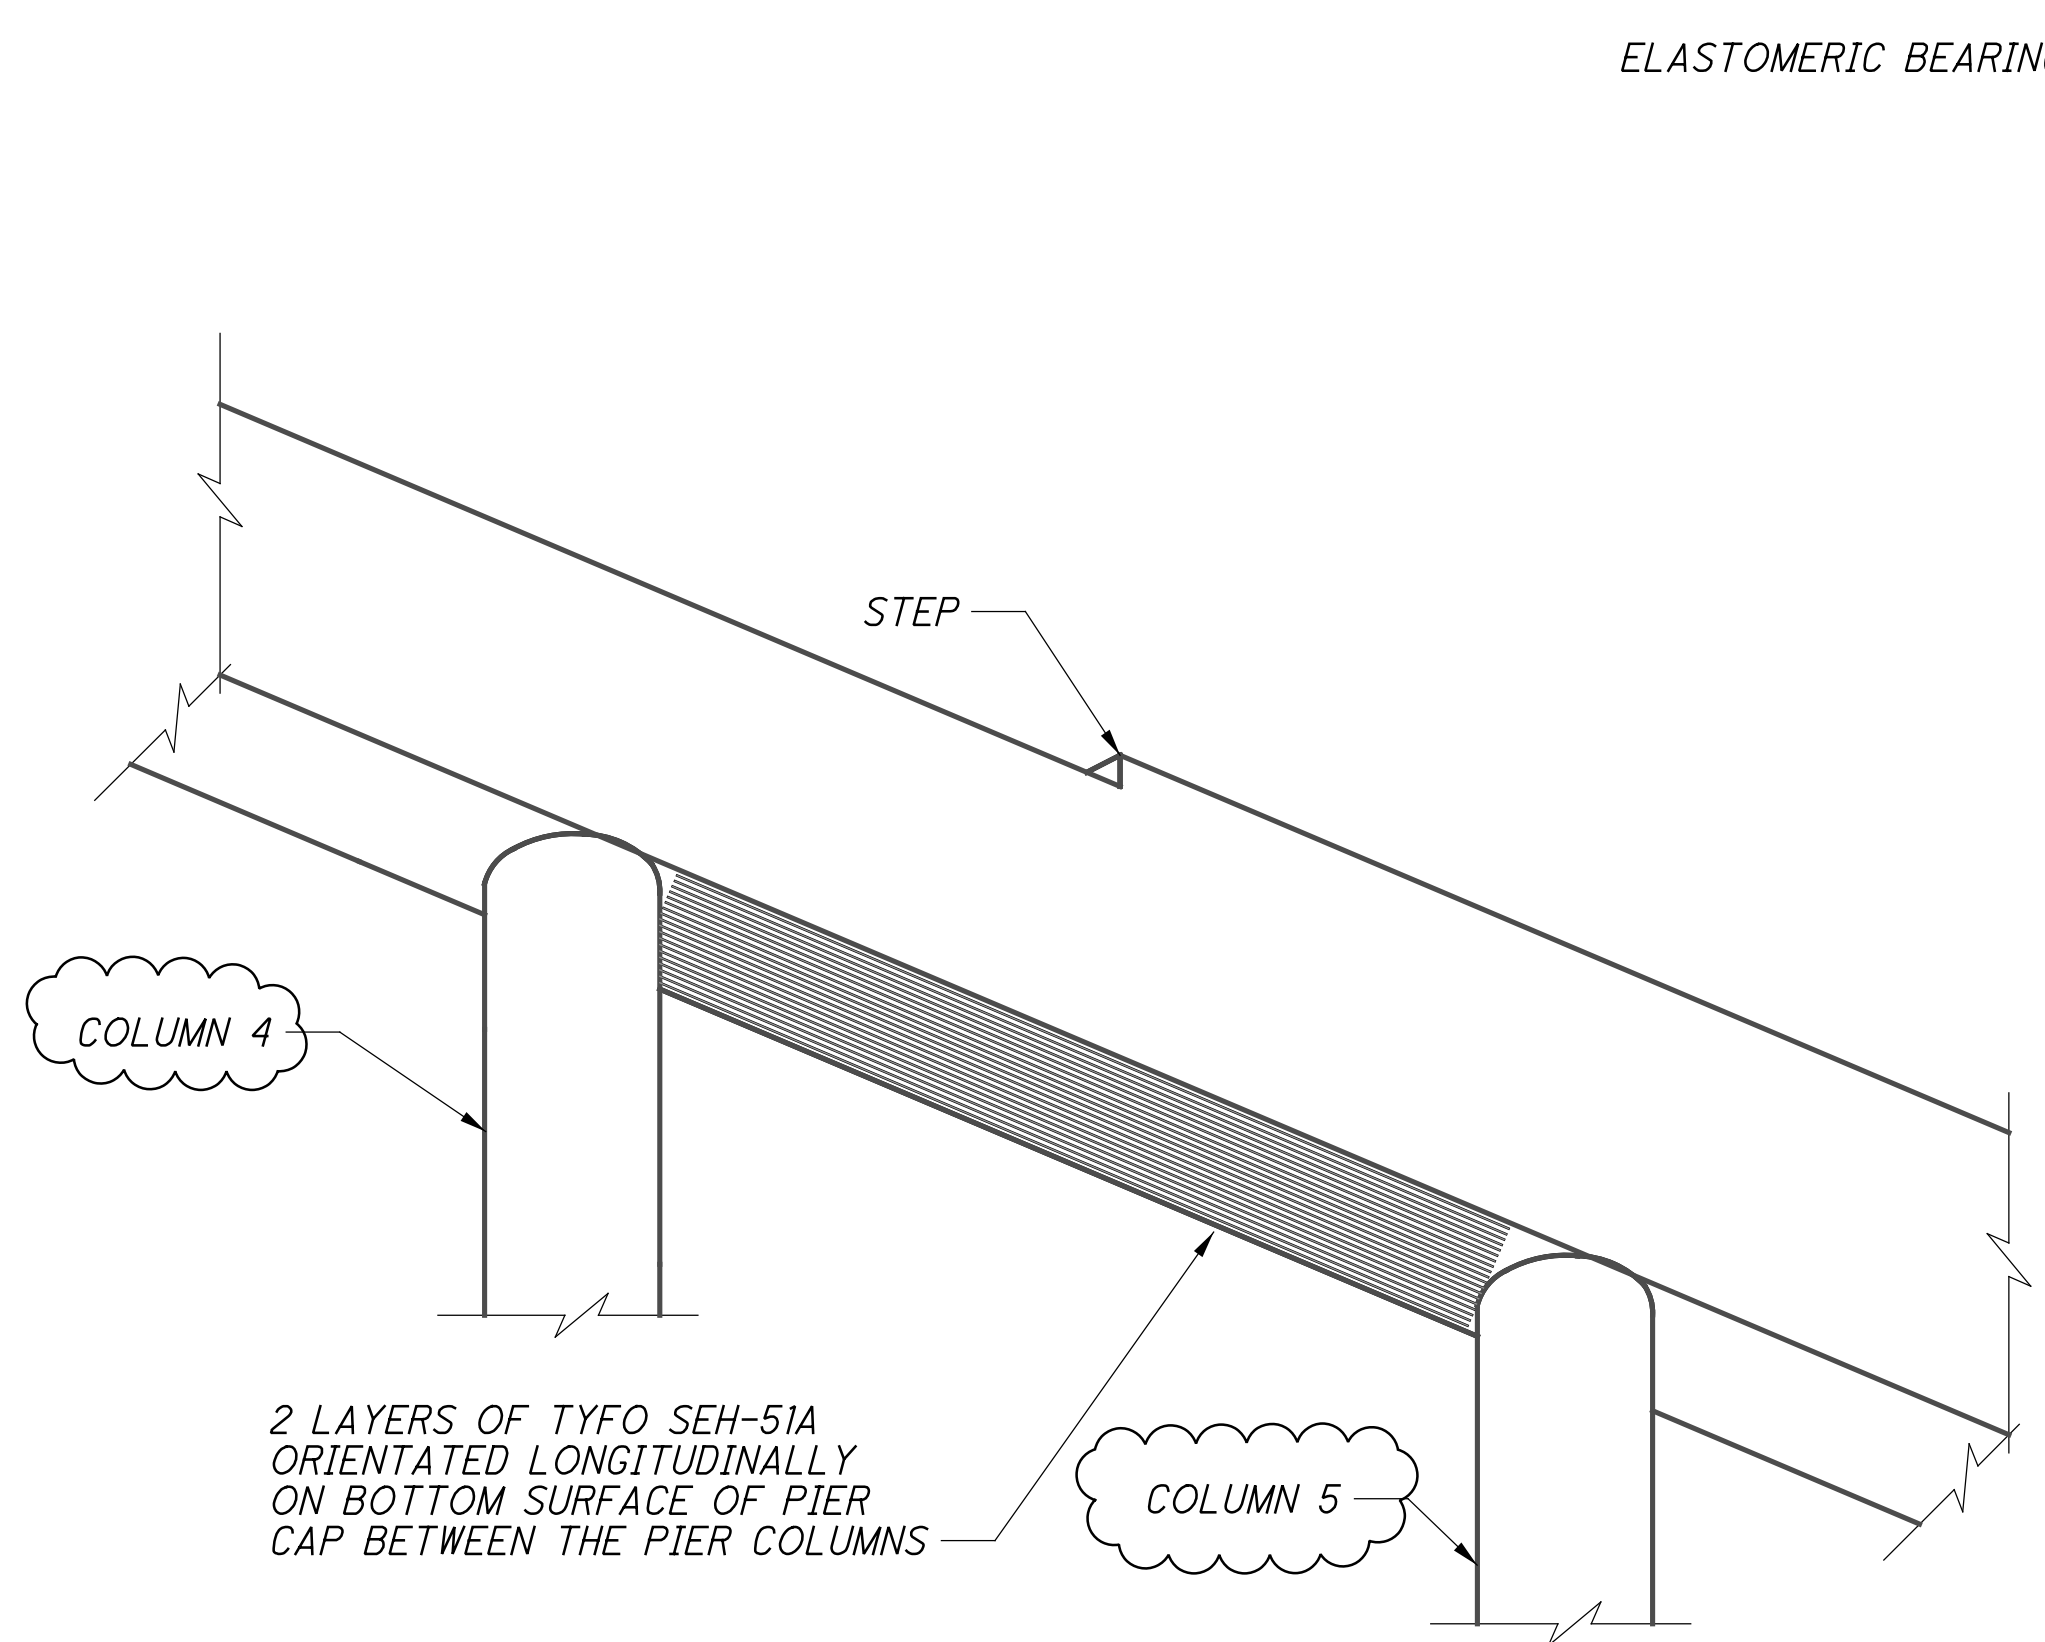


STEP 1

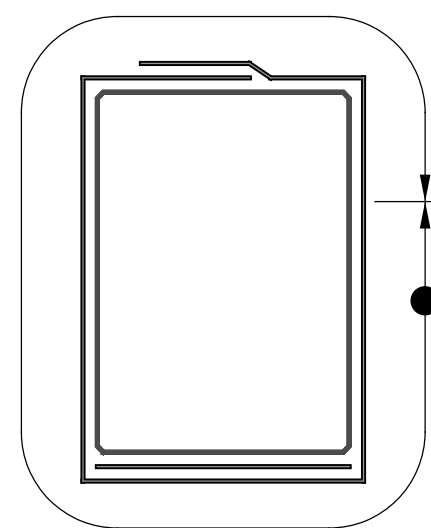


IN THE LOCATION OF THE FIBER WRAP, SEAL THE ENTIRE SURFACE PERIMETER WITH EPOXY-URETHANE SEALER AFTER THE WRAP IS COMPLETED.


SEALING DETAIL

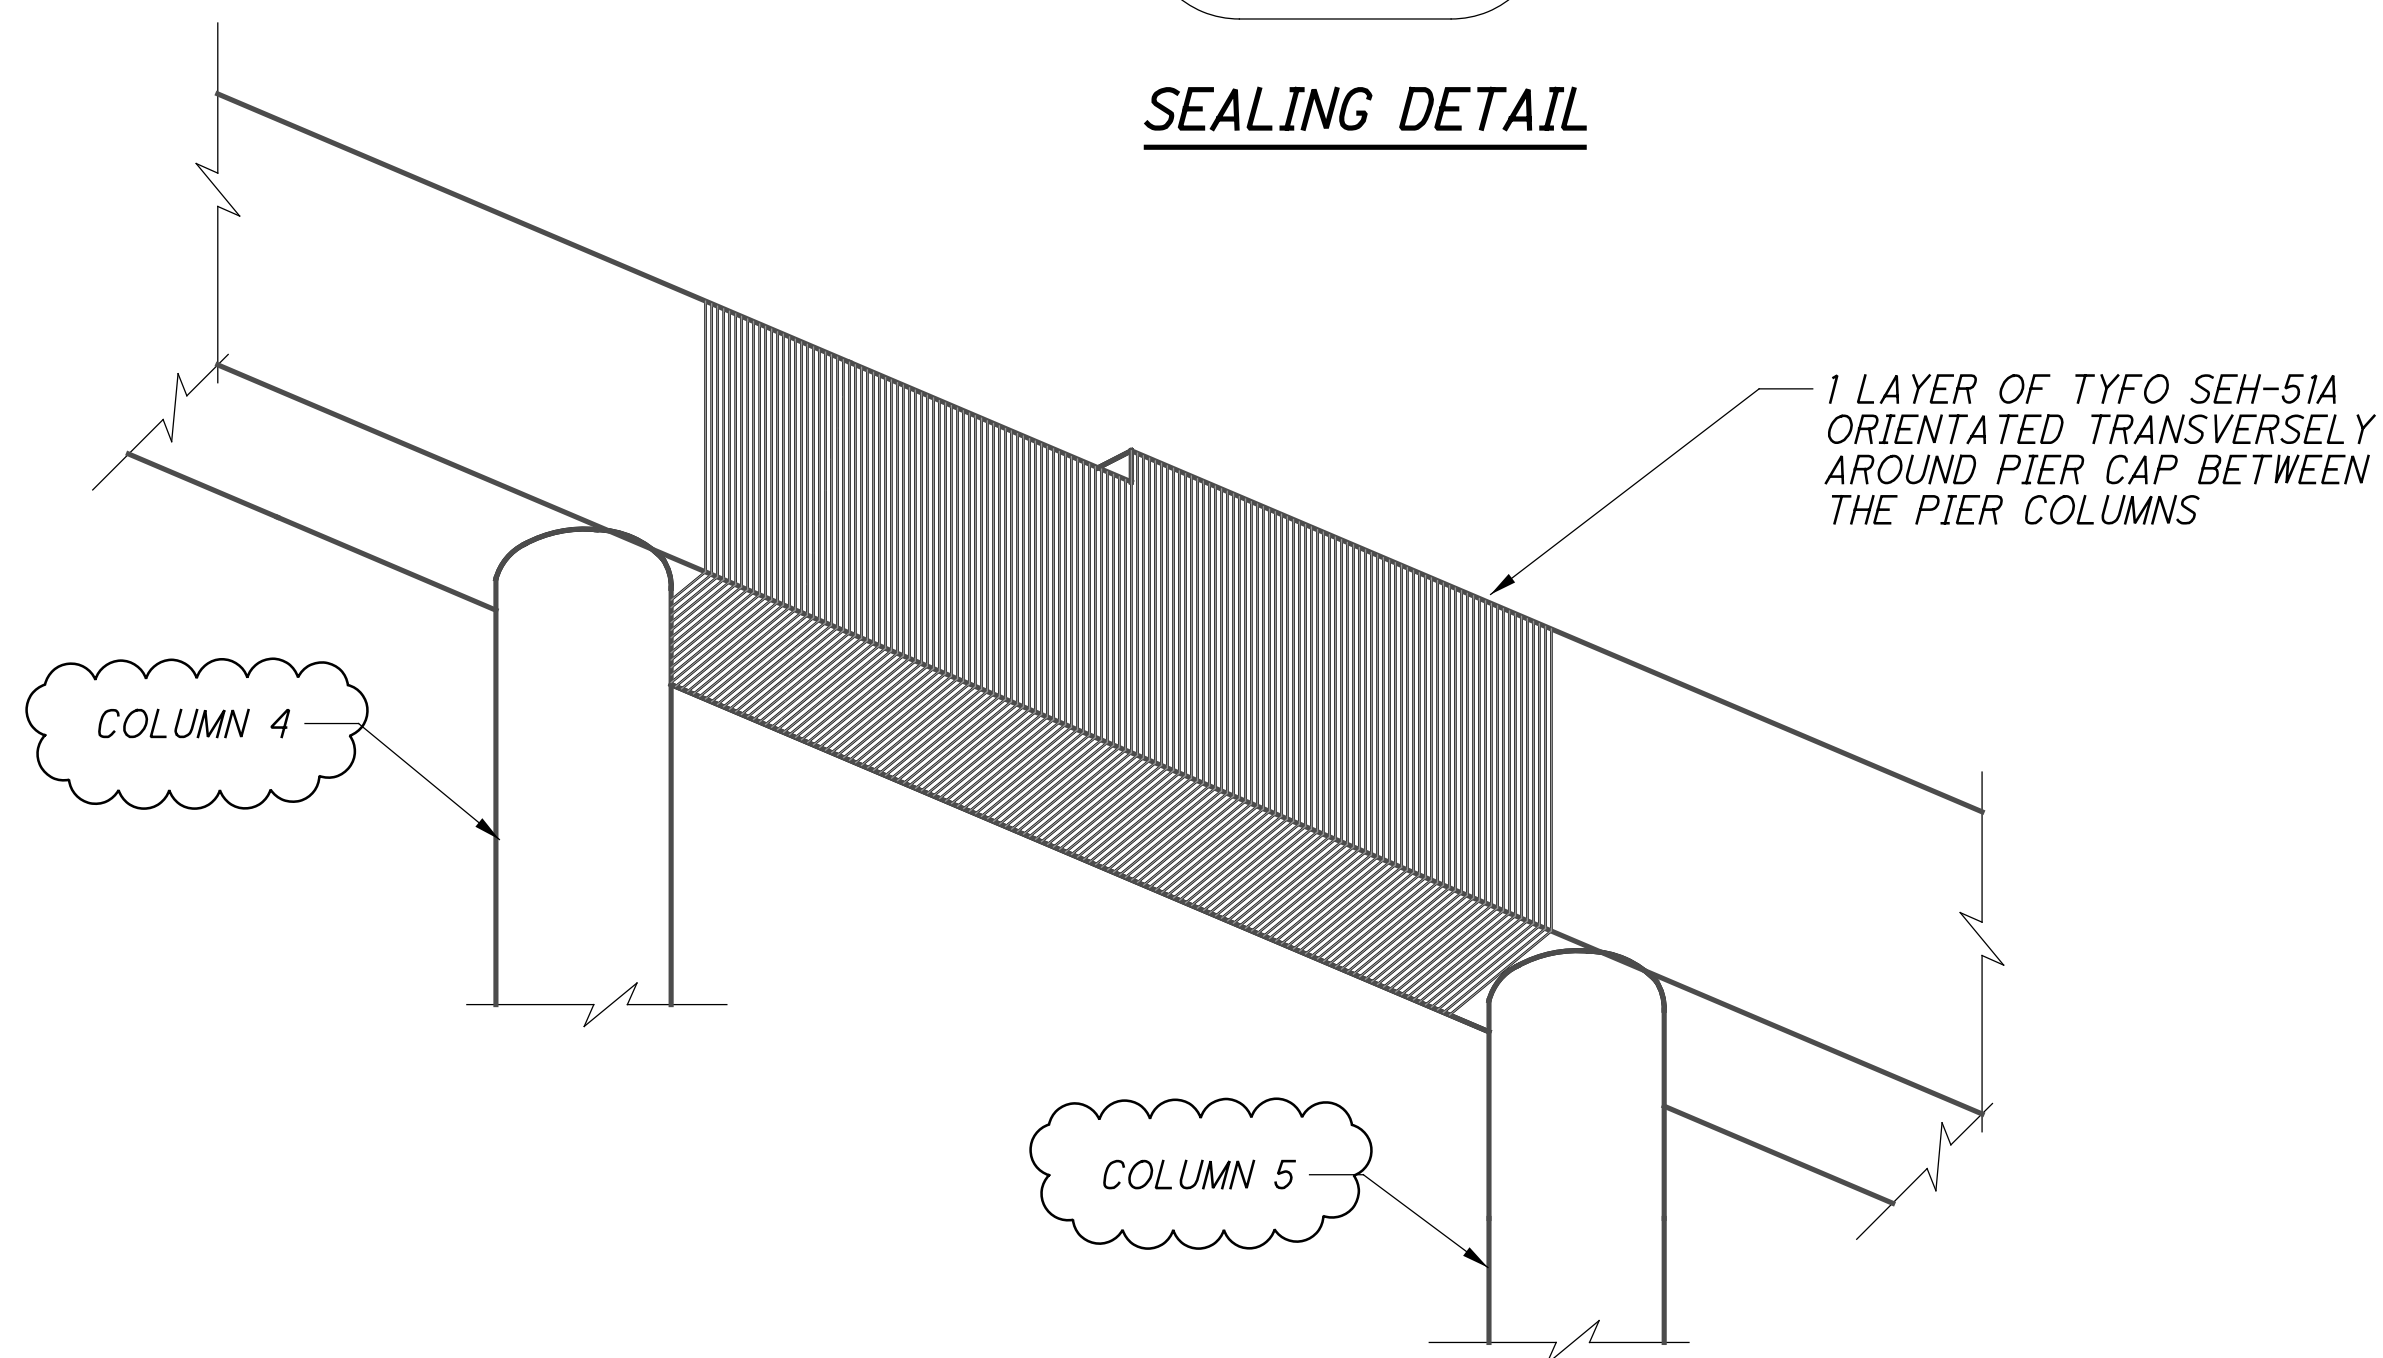

STEP 2

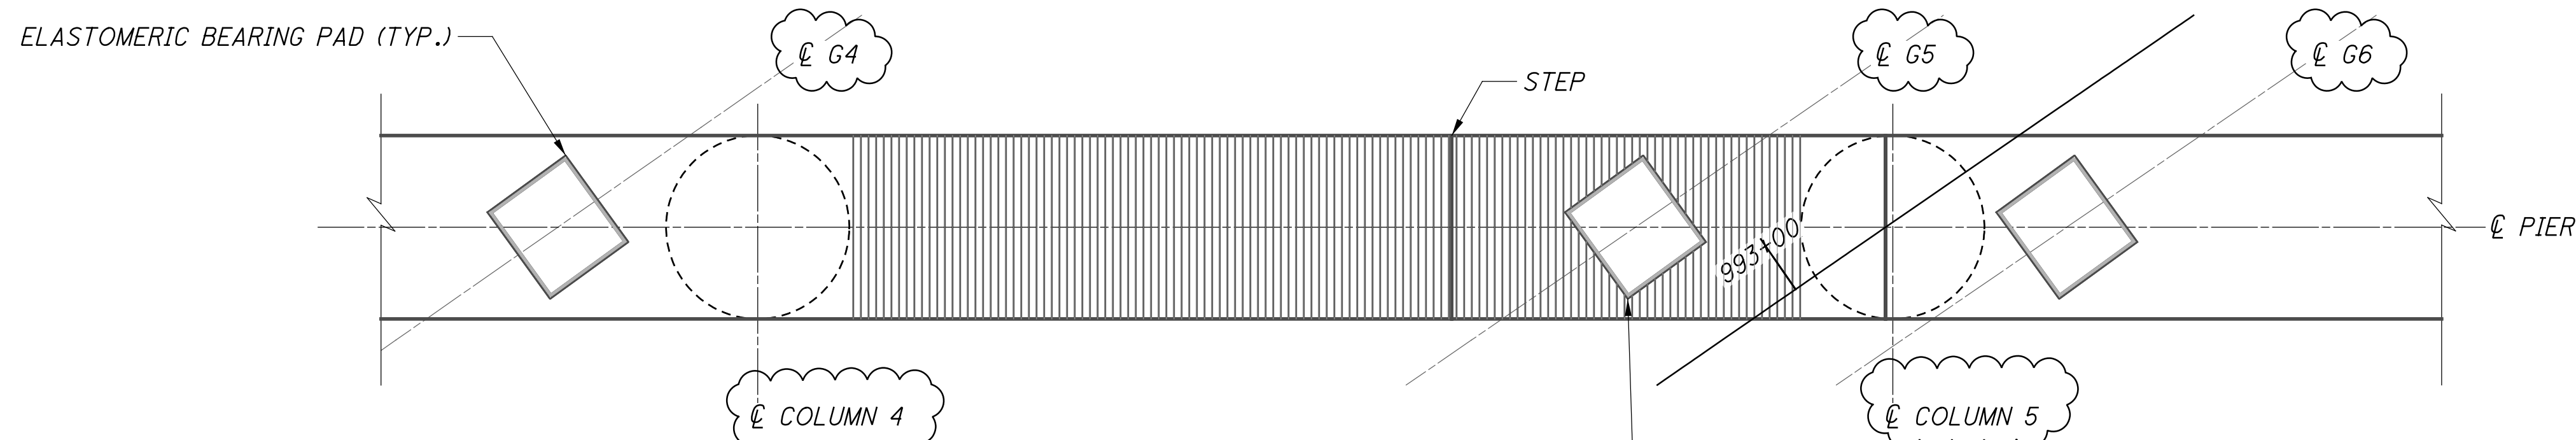


PIER 1 PLAN
(PIER 2 SIMILAR)

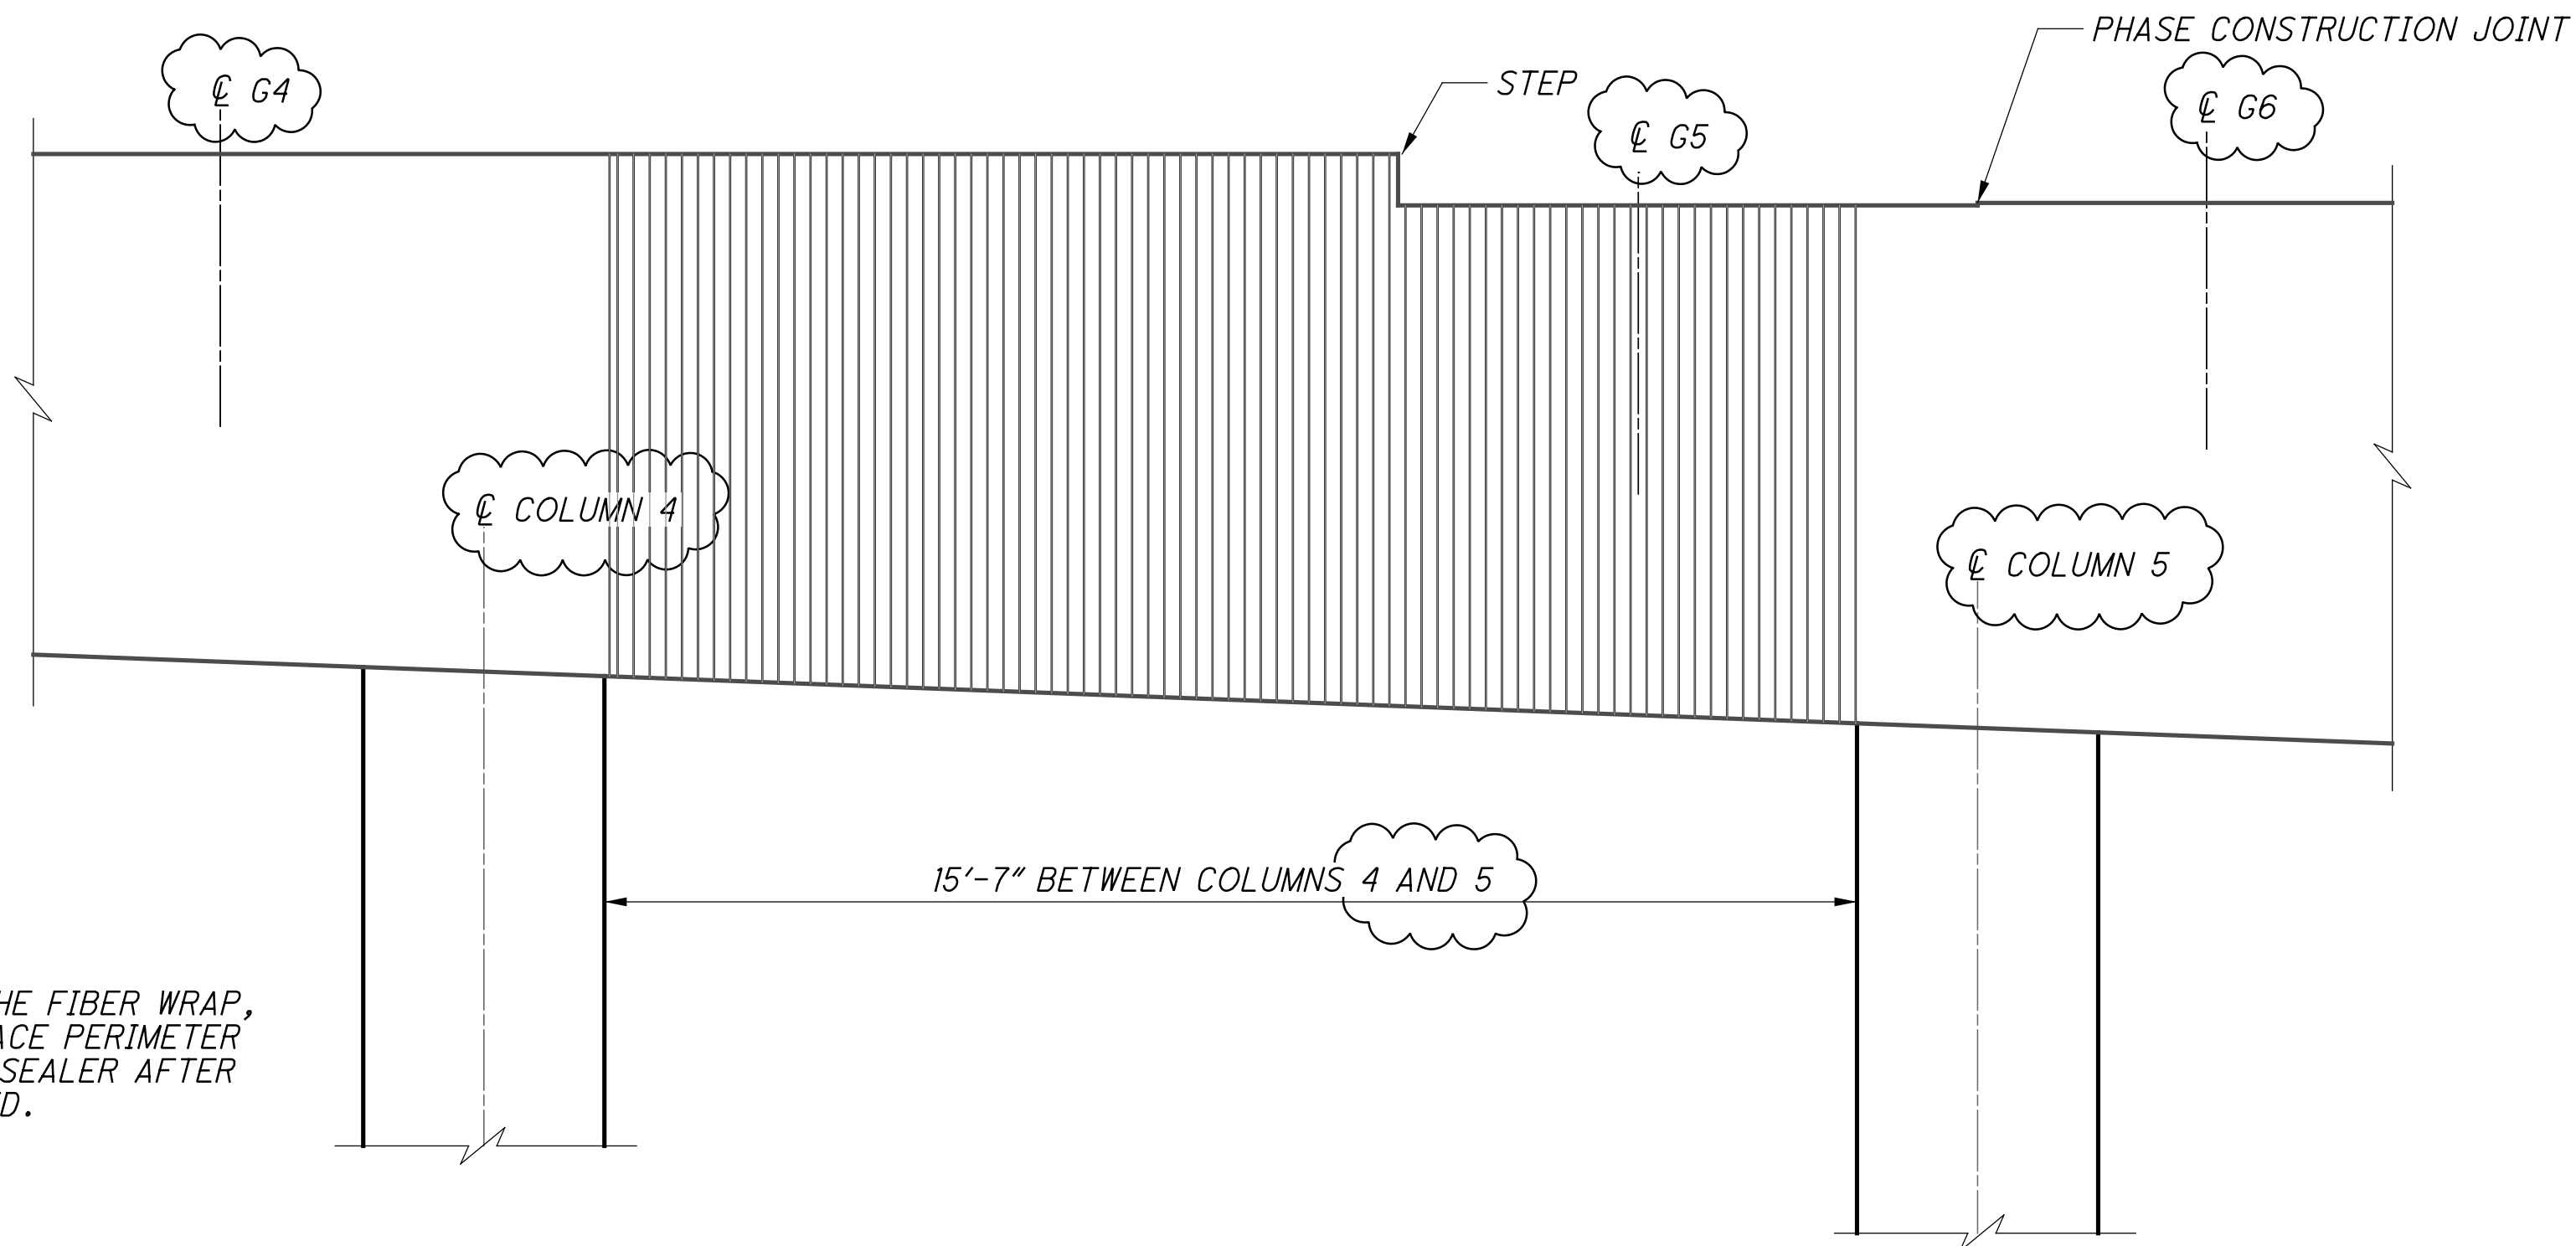

PIER 1 ELEVATION
(PIER 2 SIMILAR)


NOTES:

1. 24 TO 72 HOURS AFTER THE FIBER WRAP HAS BEEN PLACED, SEAL THE PIER CAP A MINIMUM OF 1'-0" PAST THE LIMITS OF THE FIBER WRAP WITH AN EPOXY-URETHANE SEALER.

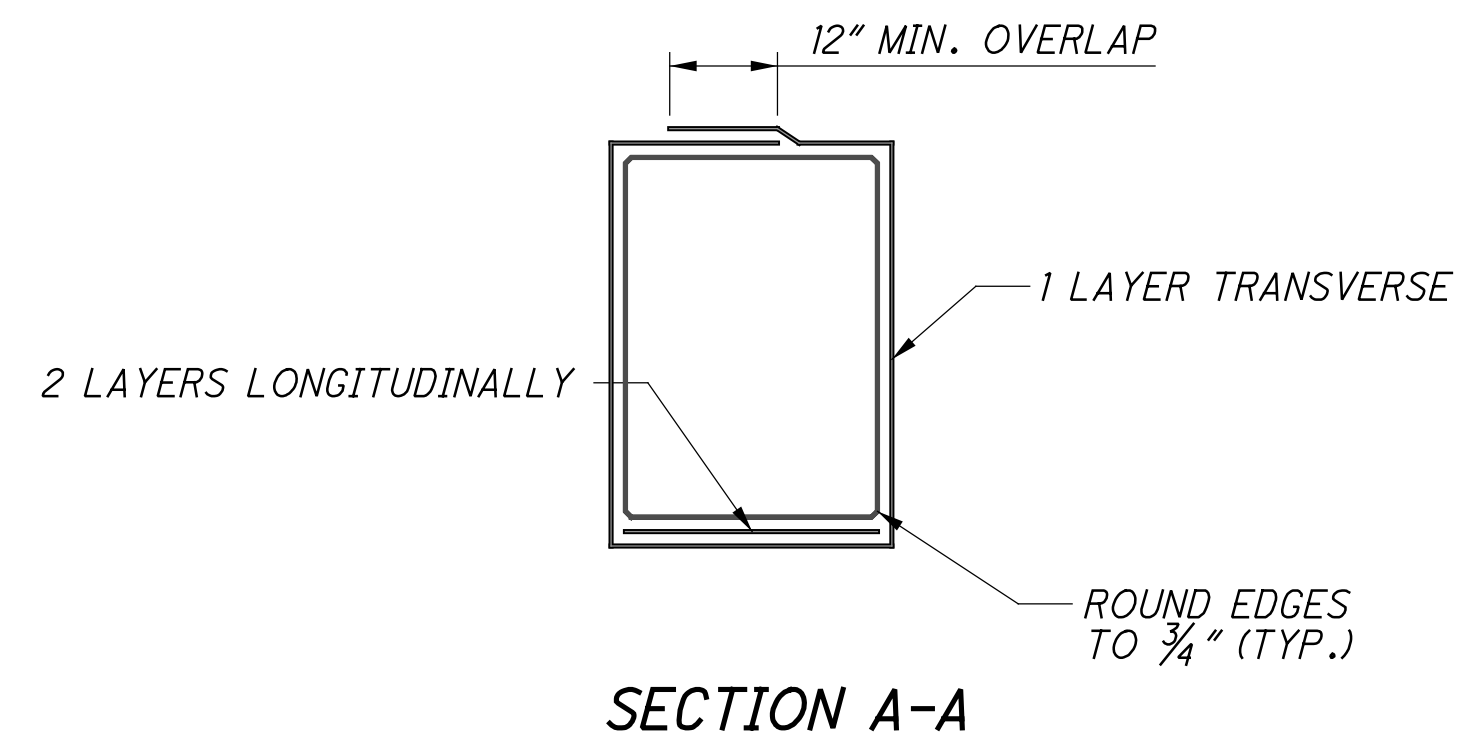

DESIGNED SUF	DRAWN DSH	REVIEWED MDS	DATE 11/12/18	DESIGN AGENCY STRUCTUREPOINT
CHECKED CLB	REVISED	STRUCTURE FILE NUMBER 3115526		
PIER 1 DETAILS BRIDGE NO. HAM-74-1840 L/R OVER SB BEEKMAN ST. (U.S. 27) AND RAMP F				
HAM-75-3.84 PID No. 104667				
20/41 21 120				


SFlanagan 11/16/2023 9:33:46 AM
 \\0\2017\01113\C.Design\104667-HAM-75-3.84\Design\Structures\HAM0074_1840C\Sheets\74_1840P1002.dgn

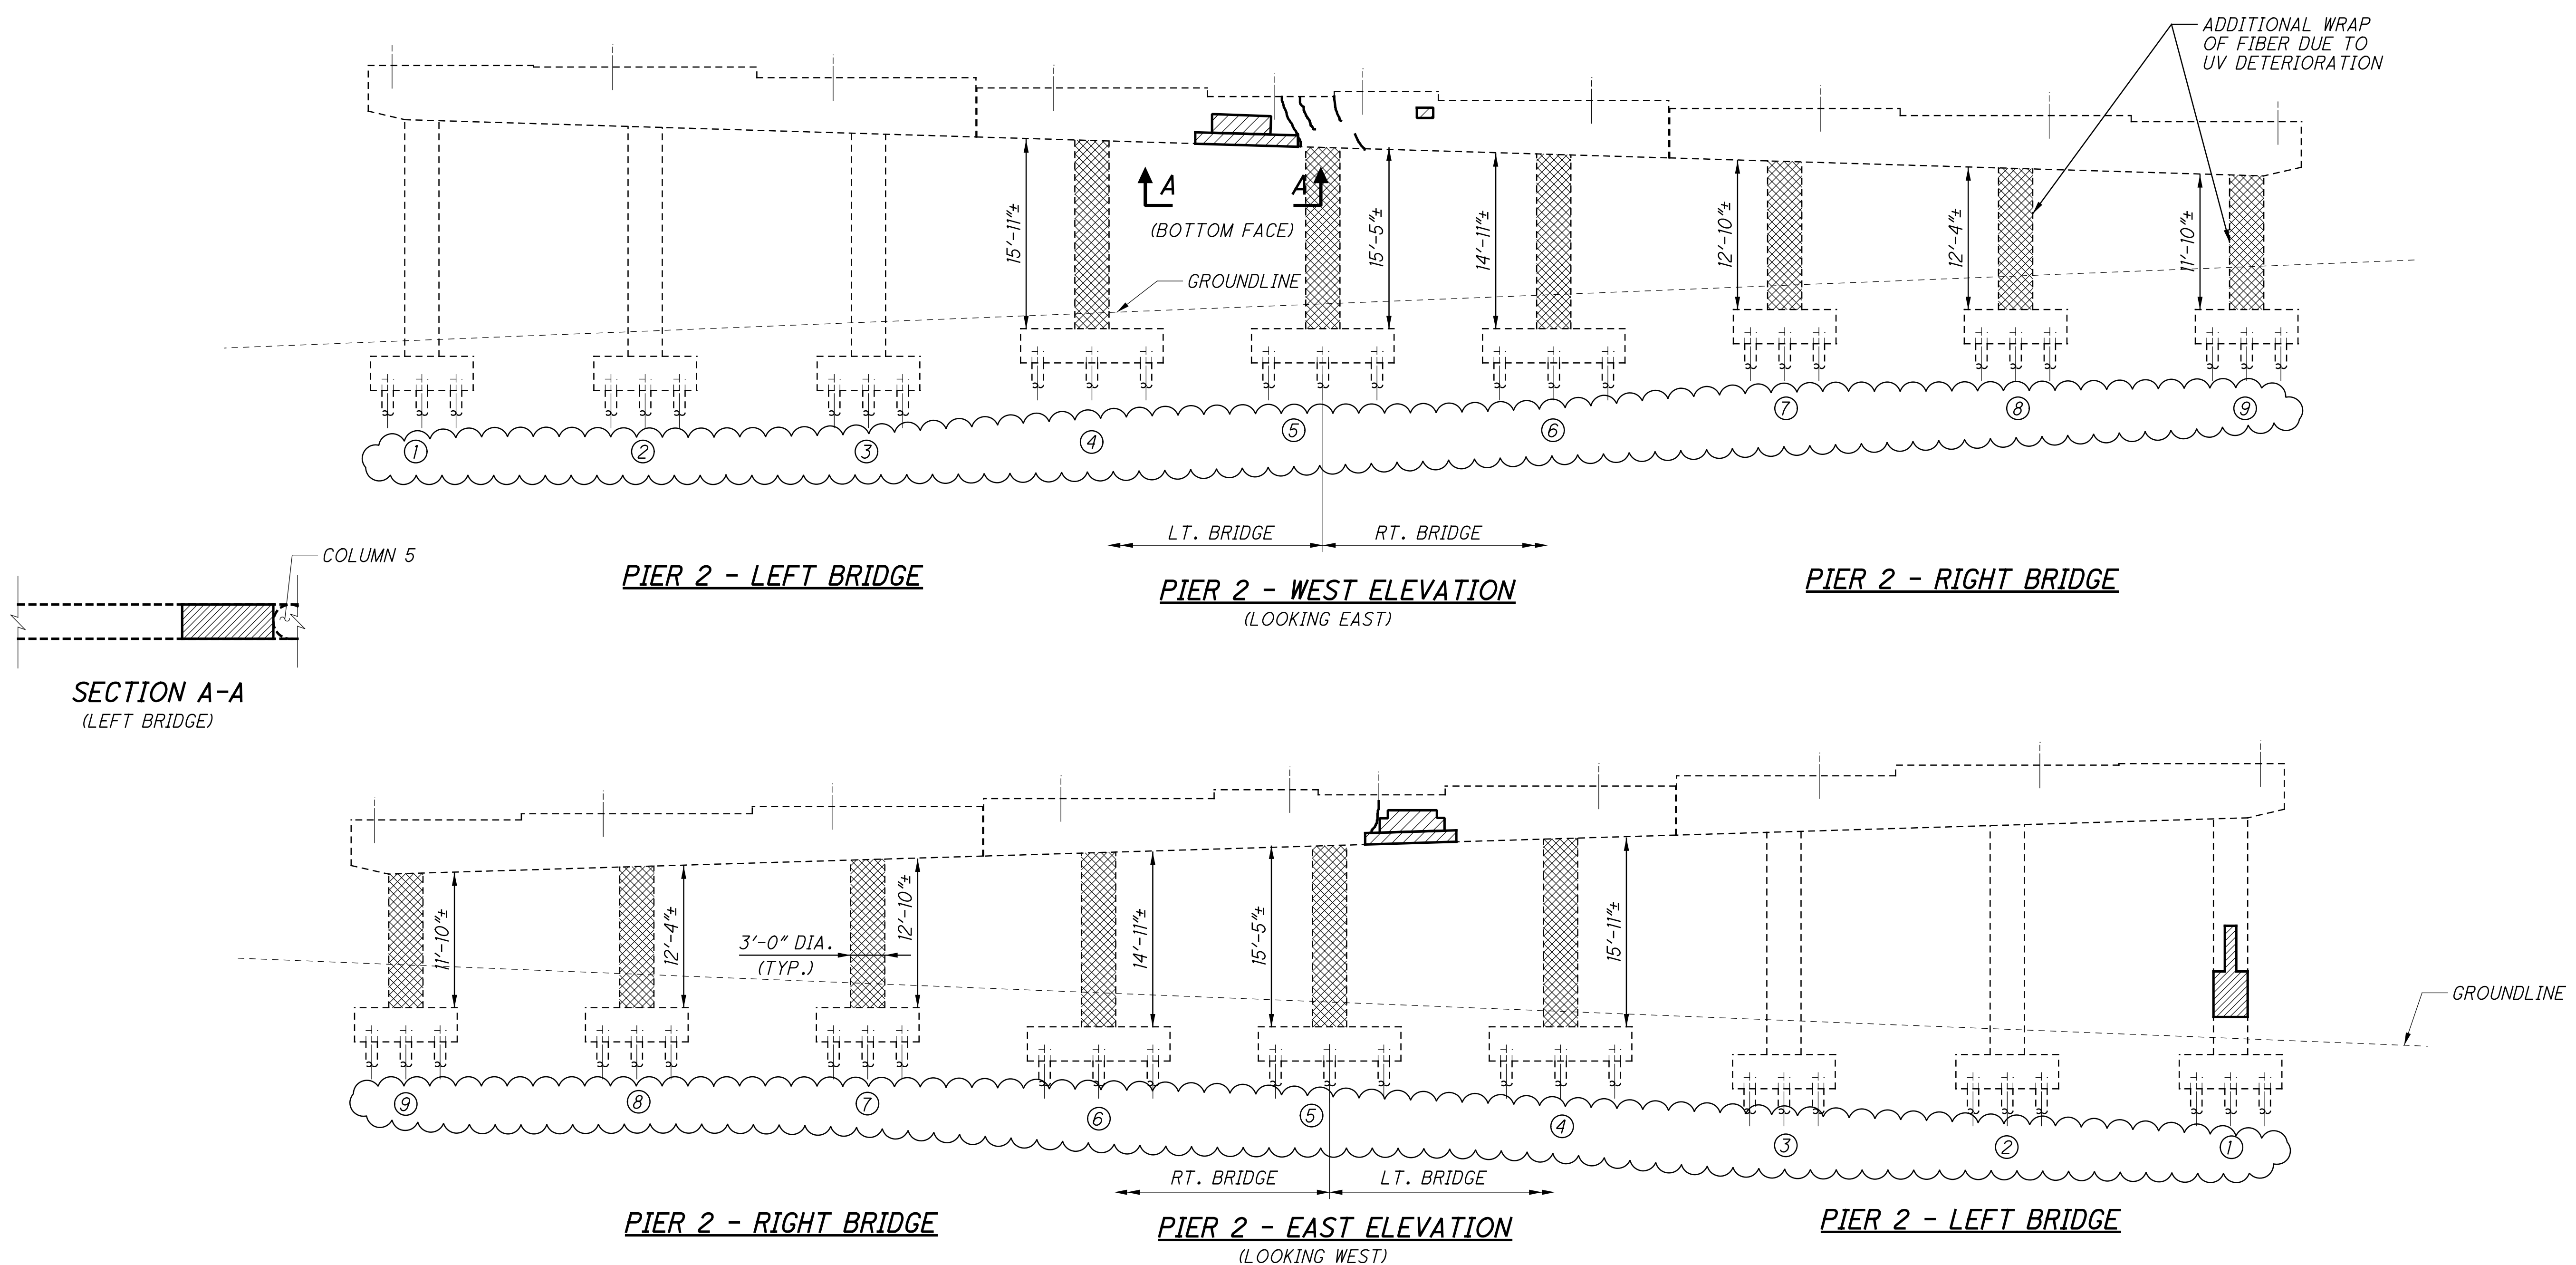


SUMMARY OF PIER 2 REPAIR QUANTITIES		
	PATCH (SQ FT)	EPOXY INJECTION (FT)
PIER 2	* 84.16	* 0

* FIELD MEASURED TOTAL FOR LEFT AND RIGHT BRIDGES

LEGEND

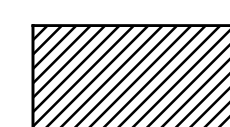

 AREA TO BE PATCHED PER ITEM 519 - PATCHING CONCRETE STRUCTURE, AS PER PLAN.




FIBER WRAP COLUMN FROM TOP OF FOOTING TO BOTTOM OF CAP. TOP AND BOTTOM 3'-0" REQUIRE FRP JACKET (F') OF 0.3 KSI, REMAINING LENGTH (F') OF 0.15 KSI


NOTES:

- ITEM 519 - PATCHING CONCRETE STRUCTURES, AS PER PLAN AND ITEM 512 - CONCRETE REPAIR BY EPOXY INJECTION ARE UNIT PRICE PAY ITEMS (31 AND 32).


DESIGN AGENCY: STRUCTUREPOINT
 DATE: 11/12/18
 REVIEWED: MDS
 DRAWN: DSH
 DESIGNED: SUJ
 CHECKED: CLB
 STRUCTURE FILE NUMBER: 3115526
 PIER 2 DETAILS
 BRIDGE NO. HAM-74-1840 L/R
 OVER SB BEEKMAN ST. (U.S. 27) AND RAMP F
 HAM-75-3.84
 PID No. 104667
 21/41
 22/120

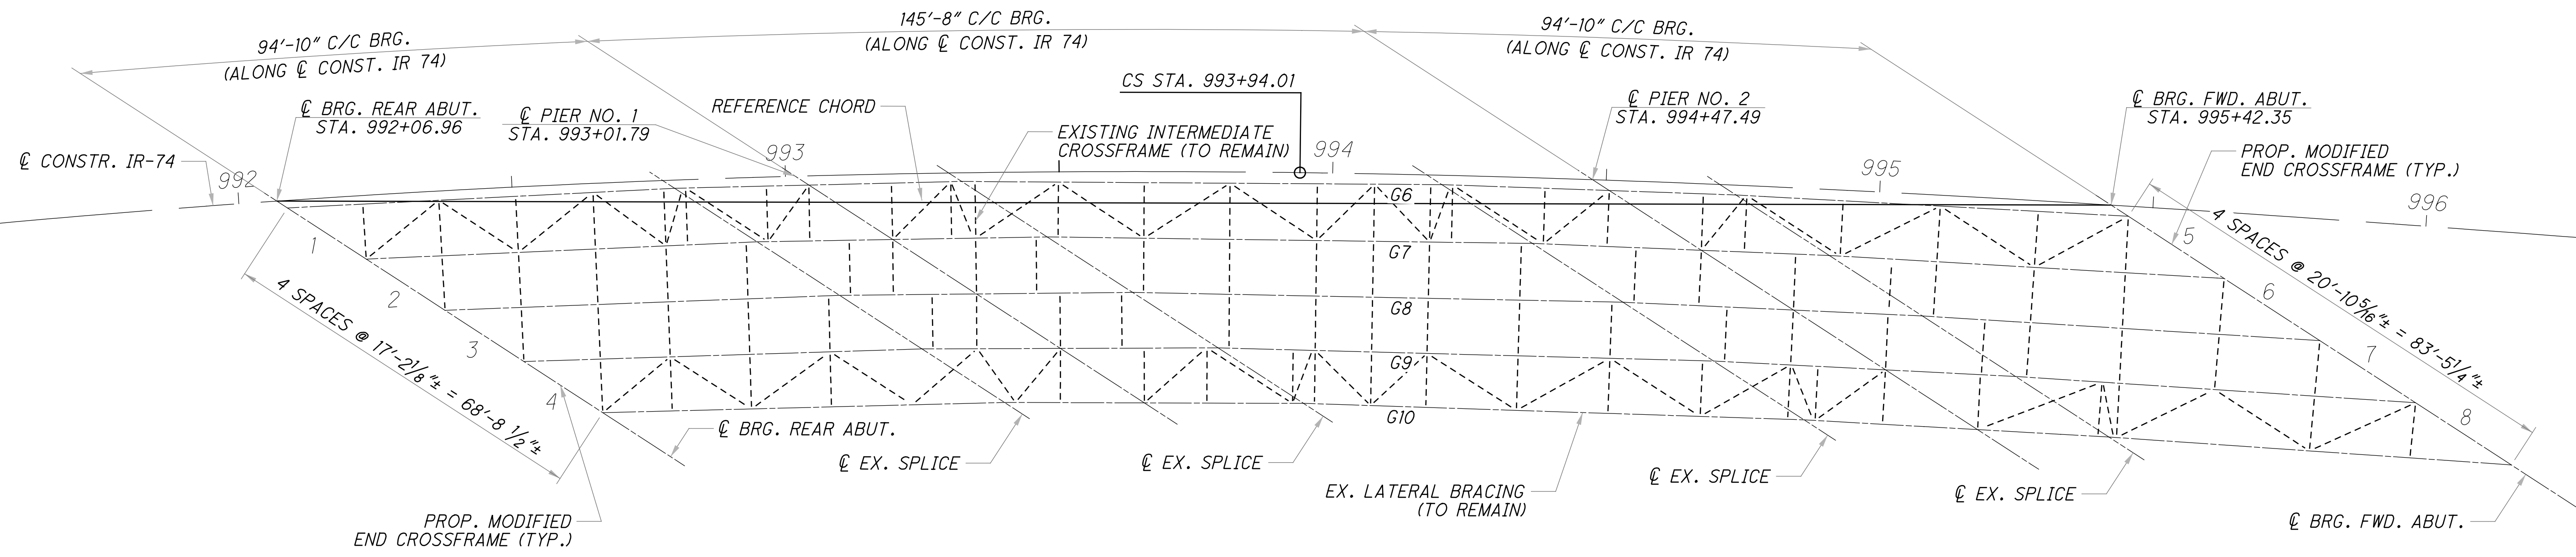

FRAMING PLAN

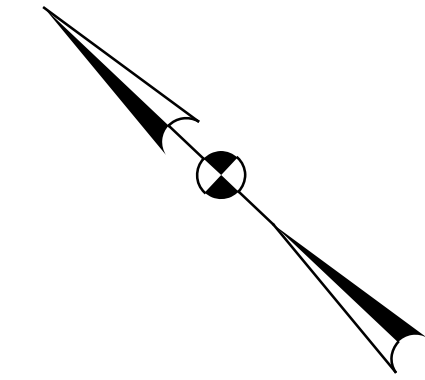


HAM-75-3.84 PID No. 104667	22 / 41 23 120	FRAMING PLAN (RIGHT BRIDGE) BRIDGE NO. HAM-74-1840 L/R OVER SB BEEKMAN ST., (U.S. 27) AND RAMP F		DESIGNED SUJ CHECKED CLB	DRAWN DSH REVISED	REVIEWED MDS STRUCTURE FILE NUMBER 3115526	DATE 11/12/18	DESIGN AGENCY STRUCTUREPOINT 2000 CORPORATE CENTER DR., 17TH FLOOR TEL: 610.426.7000 FAX: 610.426.7001 WWW.STRUCTUREPOINT.COM
		DESIGN AGENCY STRUCTUREPOINT						

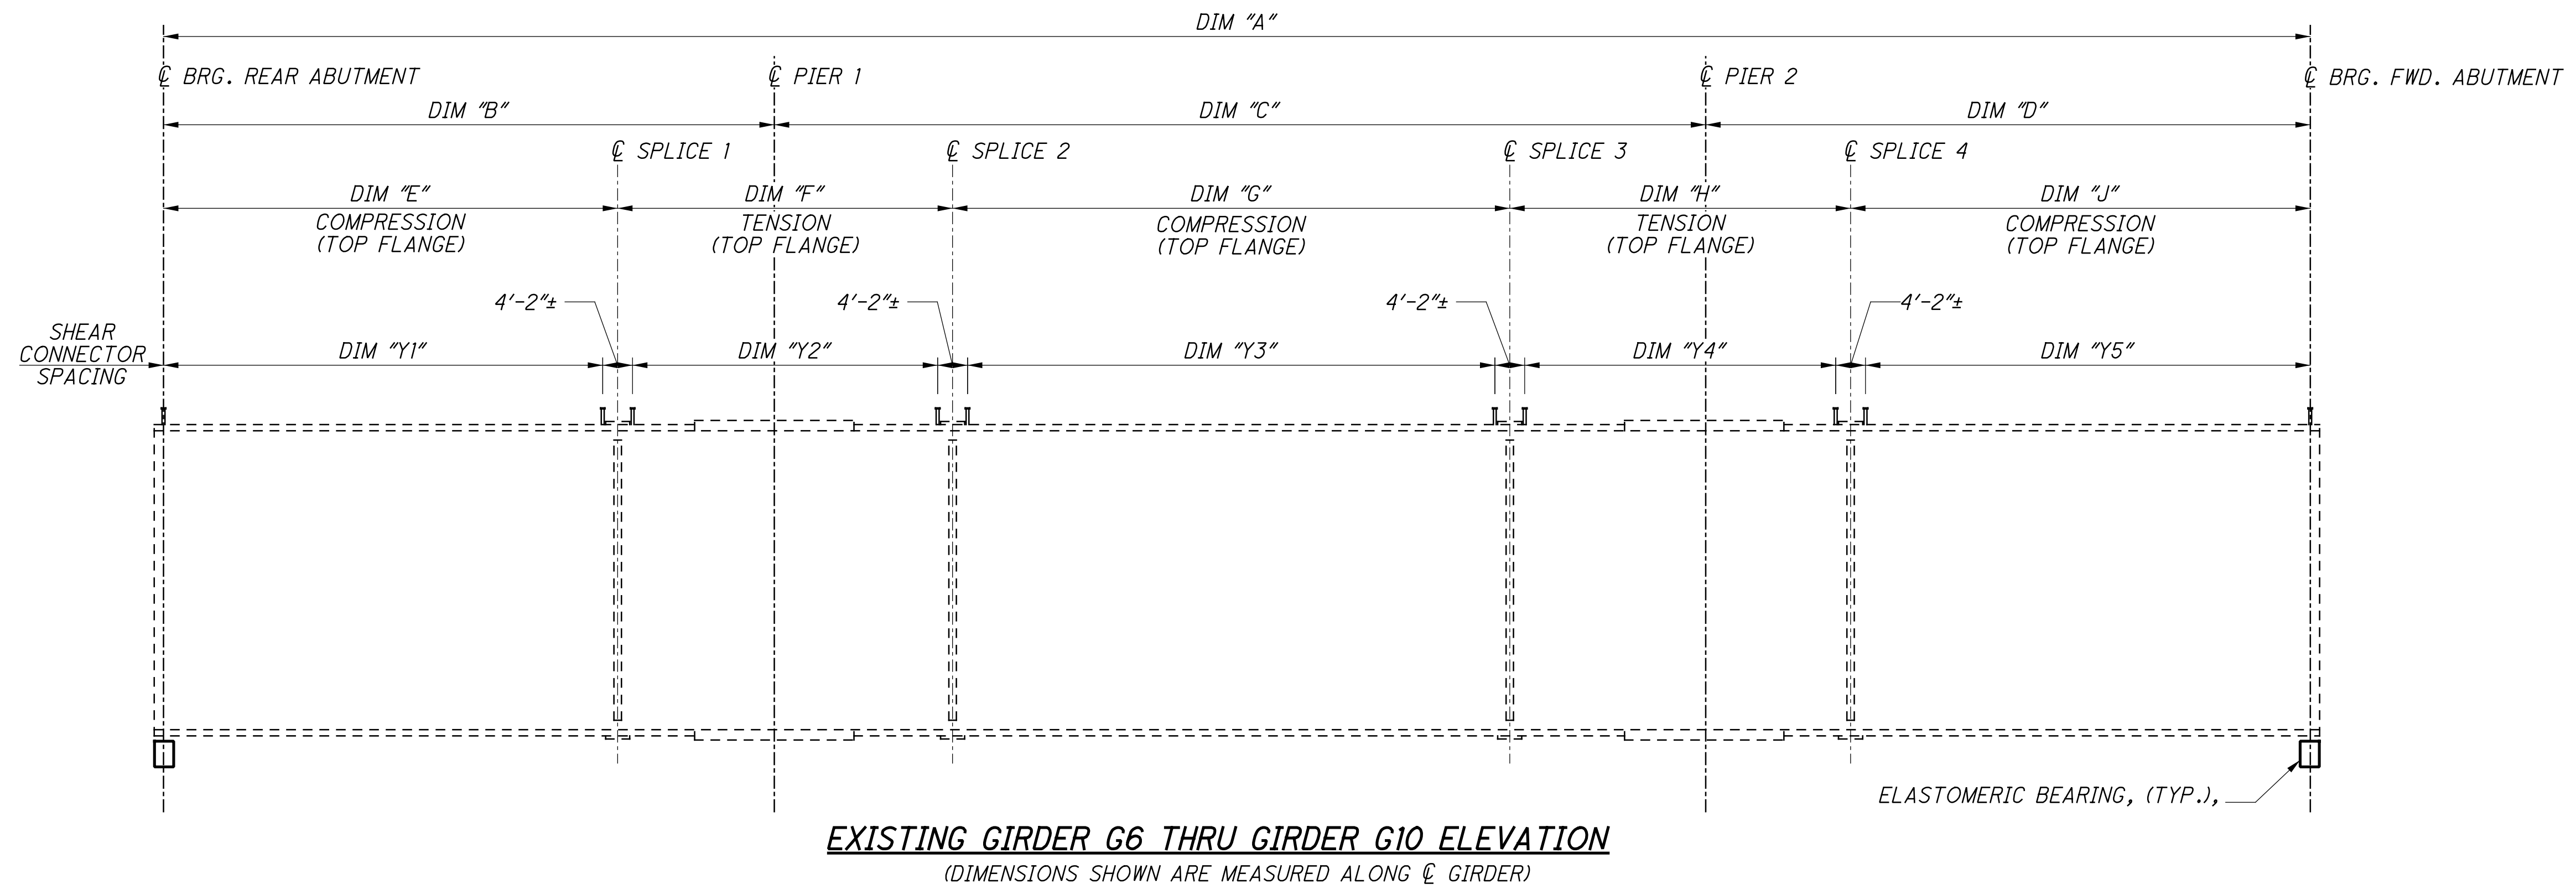

EXISTING GIRDER G6 THRU GIRDER G10 ELEVATION
(DIMENSIONS SHOWN ARE MEASURED ALONG \bar{C} GIRDER)

ELASTOMERIC BEARING, (TYP.),

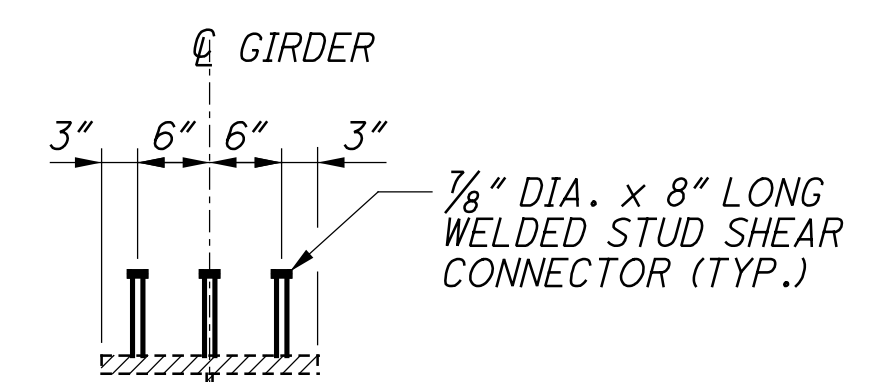

SHEAR CONNECTOR SECTION

(STUD PLACEMENT ON FLANGE SPLICE PLATES IS NOT PERMITTED.)

NOTES:

- ALL PROPOSED STRUCTURAL STEEL SHALL BE A709 GRADE 50.
- HIGH STRENGTH BOLTS SHALL BE 7/8" DIAMETER A325 UNLESS OTHERWISE NOTED.
- WELD ATTACHMENT OF SUPPORTS FOR CONCRETE DECK FINISHING MACHINE TO AREAS OF THE FASCIA STRINGER FLANGES DESIGNATED "COMPRESSION". DO NOT WELD ATTACHMENTS TO AREAS DESIGNATED "TENSION". FILLET WELDS TO COMPRESSION FLANGES SHALL BE AT LEAST 1" FROM EDGE OF FLANGE, BE NO MORE THAN 2" LONG, AND BE AT LEAST 1/4" FOR THICKNESSES UP TO 3/4" OR 5/16" FOR GREATER THAN 3/4" THICK.

SPAN LENGTHS				
	DIM "A"	DIM "B"	DIM "C"	DIM "D"
G6	336'-7 ³ / ₈ "±	95'-4 ¹ / ₂ "±	146'-3 ³ / ₈ "±	94'-11 ¹ / ₂ "±
G7	339'-8 ³ / ₈ "±	96'-3 ¹ / ₄ "±	147'-9 ³ / ₈ "±	95'-7 ³ / ₄ "±
G8	342'-9 ³ / ₄ "±	97'-2"±	149'-3 ⁵ / ₈ "±	96'-4 ¹ / ₈ "±
G9	345'-11"±	98'-0 ¹³ / ₁₆ "±	150'-9 ³ / ₄ "±	97'-0 ¹ / ₁₆ "±
G10	349'-0 ⁹ / ₁₆ "±	98'-11 ¹ / ₁₆ "±	152'-4 ¹ / ₄ "±	97'-8 ⁵ / ₈ "±

TENSION AND COMPRESSION AREAS					
	DIM "E"	DIM "F"	DIM "G"	DIM "H"	DIM "J"
G6	70'-10 ¹ / ₈ "±	52'-5 ⁹ / ₁₆ "±	87'-8 ¹ / ₁₆ "±	53'-9 ¹ / ₂ "±	71'-9 ¹ / ₂ "±
G7	71'-5 ¹³ / ₁₆ "±	53'-0"±	88'-8"±	54'-3 ⁵ / ₁₆ "±	72'-3 ¹ / ₄ "±
G8	72'-1 ⁹ / ₁₆ "±	53'-6 ¹ / ₂ "±	89'-7 ¹ / ₁₆ "±	54'-9 ³ / ₁₆ "±	72'-9 ¹ / ₁₆ "±
G9	72'-9 ⁵ / ₁₆ "±	54'-0 ¹⁵ / ₁₆ "±	90'-6 ¹³ / ₁₆ "±	55'-3 ¹ / ₁₆ "±	73'-2 ⁷ / ₈ "±
G10	73'-5 ¹ / ₈ "±	54'-7 ¹ / ₂ "±	91'-6 ¹ / ₄ "±	55'-9"±	73'-8 ¹ / ₁₆ "±

SHEAR CONNECTOR SPACING						
	DIM "Y1"	DIM "Y2"	DIM "Y3"	DIM "Y4"	DIM "Y5"	QUANTITY
G6	63 SPA. @ 13" MAX. = 68'-3"±	44 SPA. @ 13" MAX. = 47'-8"±	77 SPA. @ 13" MAX. = 83'-5"±	45 SPA. @ 13" MAX. = 48'-9"±	64 SPA. @ 13" MAX. = 69'-4"±	894
G7	64 SPA. @ 13" MAX. = 69'-4"±	45 SPA. @ 13" MAX. = 48'-9"±	78 SPA. @ 13" MAX. = 84'-6"±	46 SPA. @ 13" MAX. = 49'-10"±	64 SPA. @ 13" MAX. = 69'-4"±	906
G8	64 SPA. @ 13" MAX. = 69'-4"±	45 SPA. @ 13" MAX. = 48'-9"±	79 SPA. @ 13" MAX. = 85'-7"±	46 SPA. @ 13" MAX. = 49'-10"±	65 SPA. @ 13" MAX. = 70'-5"±	912
G9	65 SPA. @ 13" MAX. = 70'-5"±	46 SPA. @ 13" MAX. = 49'-10"±	79 SPA. @ 13" MAX. = 85'-7"±	47 SPA. @ 13" MAX. = 50'-11"±	65 SPA. @ 13" MAX. = 70'-5"±	921
G10	66 SPA. @ 13" MAX. = 71'-6"±	46 SPA. @ 13" MAX. = 49'-10"±	80 SPA. @ 13" MAX. = 86'-8"±	47 SPA. @ 13" MAX. = 50'-11"±	66 SPA. @ 13" MAX. = 71'-6"±	930

S:\Flanagan\11/16/2023 9:33:47 AM\0\2017\01113\C.Design\104667-HAM-75-3.84.Design\Structures\HAM0074_1840C\Sheets\74_1840SD002.dgn

Name	No. of Plates	Plate 1	Plate 2
1-A	1	6"x6"x1"	N/A
1-B	2	7"x7"x1"	6"x6"x1"
1-C	2	7"x7"x1"	6"x6"x1"
1-D	2	7"x7"x1"	6"x6"x1"
1-E	2	7"x7"x1"	6"x6"x1"
1-F	1	6"x6"x1"	6"x6"x1"
1-G	0	N/A	N/A
1-H	2	7"x7"x1"	6"x6"x1"

Name	No. of Plates	Plate 1
2-A	1	6"x6"x $\frac{3}{8}$ "
2-B	1	6"x6"x $\frac{3}{8}$ "
2-C	1	6"x6"x $\frac{3}{8}$ "
2-D	0	N/A
2-E	1	6"x6"x1"
2-F	1	6"x6"x1"
2-G	1	6"x6"x1"
2-H	0	N/A

Name	No. of Plates	Plate 1
3-A	0	N/A
3-B	1	5"x5"x $\frac{3}{8}$ "
3-C	0	N/A
3-D	0	N/A
3-E	0	N/A
3-F	0	N/A
3-G	0	N/A
3-H	0	N/A

Name	No. of Plates	Plate 1
4-A	1	5"x5"x $\frac{1}{4}$ "
4-B	1	5"x5"x1"
4-C	1	5"x5"x1"
4-D	1	5"x5"x1"
4-E	1	5"x5"x $\frac{1}{4}$ "
4-F	1	5"x5"x $\frac{1}{8}$ "
4-G	0	N/A
4-H	0	N/A


Name	No. of Plates	Plate 1	Plate 2	Notes
5-A	2	7"x7x1"	6"x6x1"	
5-B	2	7"x7x1"	6"x6x1"	
5-C	2	7"x7x1"	6"x6x1"	
5-D	2	7"x7x1"	6"x6x1"	
5-E	2	7"x7x1"	6"x6x1"	
5-F	1	6"x6x1"	N/A	TOP OF FLANGE CUT OFF
5-G	1	6"x6x1"	N/A	
5-H	1	6"x6x1"	N/A	

Name	No. of Plates	Plate 1	Notes
6-A	1	6"x6"x1"	1"x1" CLIP
6-B	1	6"x6"x1"	4"x4" CLIP
6-C	1	6"x6"x1"	2 $\frac{1}{2}$ "x 2 $\frac{1}{2}$ " CLIP
6-D	1	6"x6"x1"	
6-E	1	6"x6"x1"	4"x4" CLIP
6-F	1	6"x6"x1"	3"x3" CLIP
6-G	0	N/A	
6-H	0	N/A	


Name	No. of Plates	Plate 1	Plate 2	Notes
7-A	1	6"x6"x $\frac{1}{2}$ "	N/A	12" OF WELD
7-B	1	5"x5"x $\frac{1}{4}$ "	N/A	13" OF WELD
7-C	1	6"x6"x $\frac{3}{4}$ "	N/A	
7-D	1	5"x5"x1"	N/A	15" OF WELD
7-E	2	5"x5"x $\frac{1}{4}$ "	4 $\frac{1}{2}$ "x4 $\frac{1}{2}$ "x $\frac{1}{2}$ "	12.5" OF WELD
7-F	1	6"x6"x $\frac{1}{2}$ "	N/A	
7-G	1	6"x6"x $\frac{1}{2}$ "	N/A	
7-H	0	N/A	N/A	

Name	No. of Plates	Plate 1
8-A	1	6"x6"x $\frac{1}{2}$ "
8-B	1	6"x6"x $\frac{1}{2}$ "
8-C	1	6"x6"x $\frac{1}{2}$ "
8-D	1	6"x6"x $\frac{1}{2}$ "
8-E	1	6"x6"x $\frac{1}{2}$ "
8-F	1	6"x6"x $\frac{1}{2}$ "
8-G	1	6"x6"x $\frac{1}{2}$ "
8-H	1	6"x6"x $\frac{1}{2}$ "

TABLE LEGEND
 NAME - 1-A
 BAY LOCATION (SEE SHEET 22/41) — END CROSS FRAME GUSSET PLATE LOCATION (SEE DETAIL ABOVE)

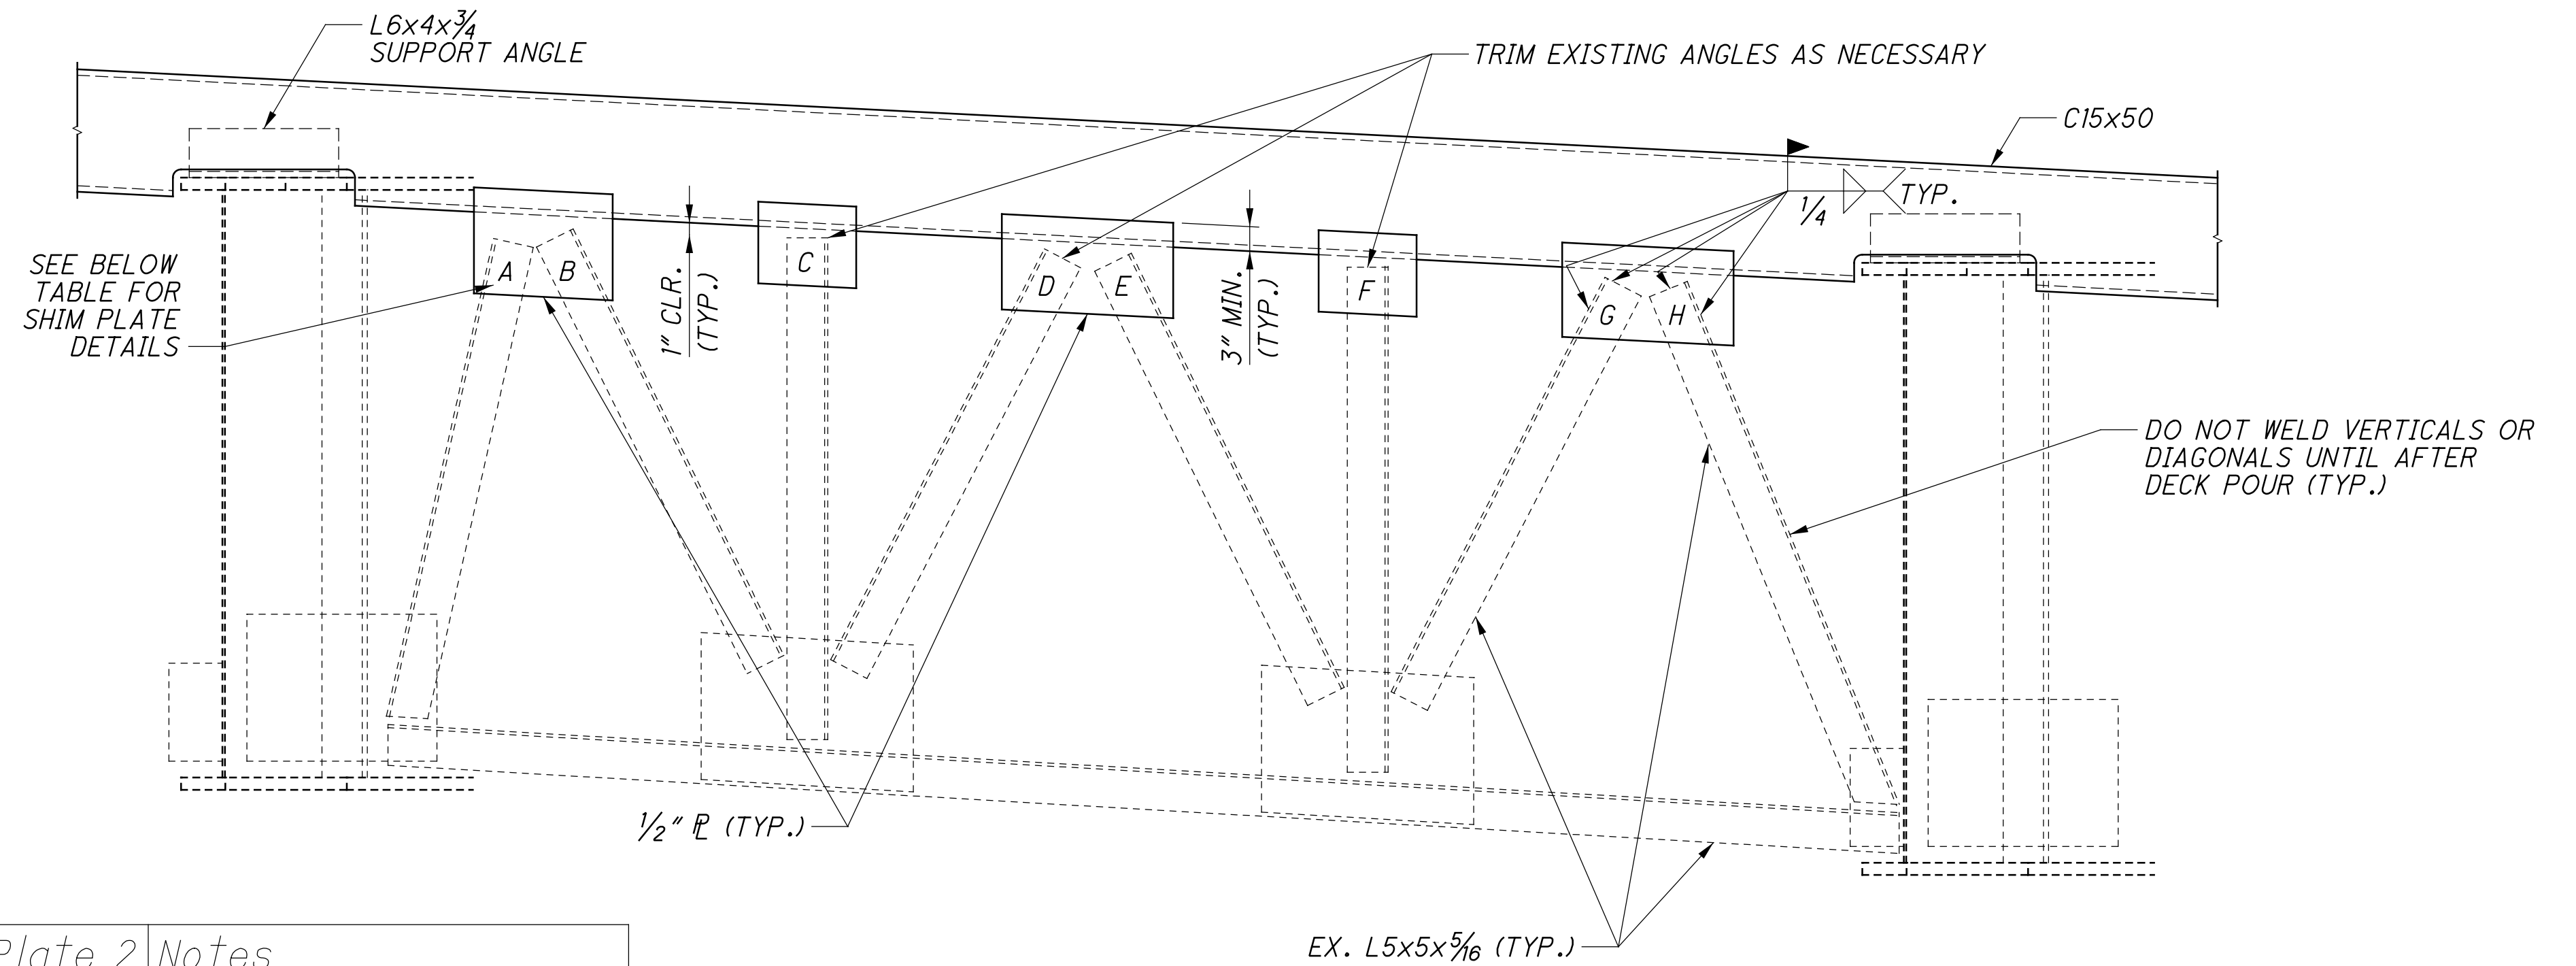


END CROSS FRAME REHABILITATION DETAIL

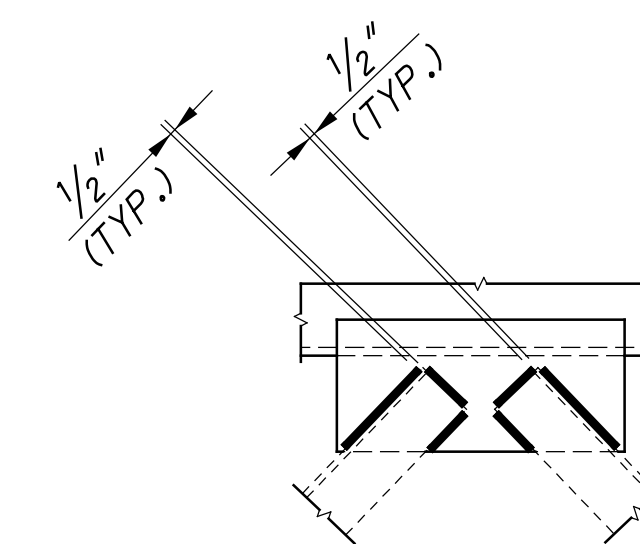


WELD TERMINATION DETAIL

- NOTES:
- ALL PROPOSED STRUCTURAL STEEL SHALL BE A709 GRADE 50.
 - FOR ADDITIONAL NOTES AND DETAILS, SEE STD. DWG. GSD-1-96.

SFlanagan 11/16/2023 9:33:49 AM 0:\2017\01113.C.Design\104667_HAM-75-3.84.Design\Structures\HAM0074-1840C_Sheets\74-1840TS001.dgn

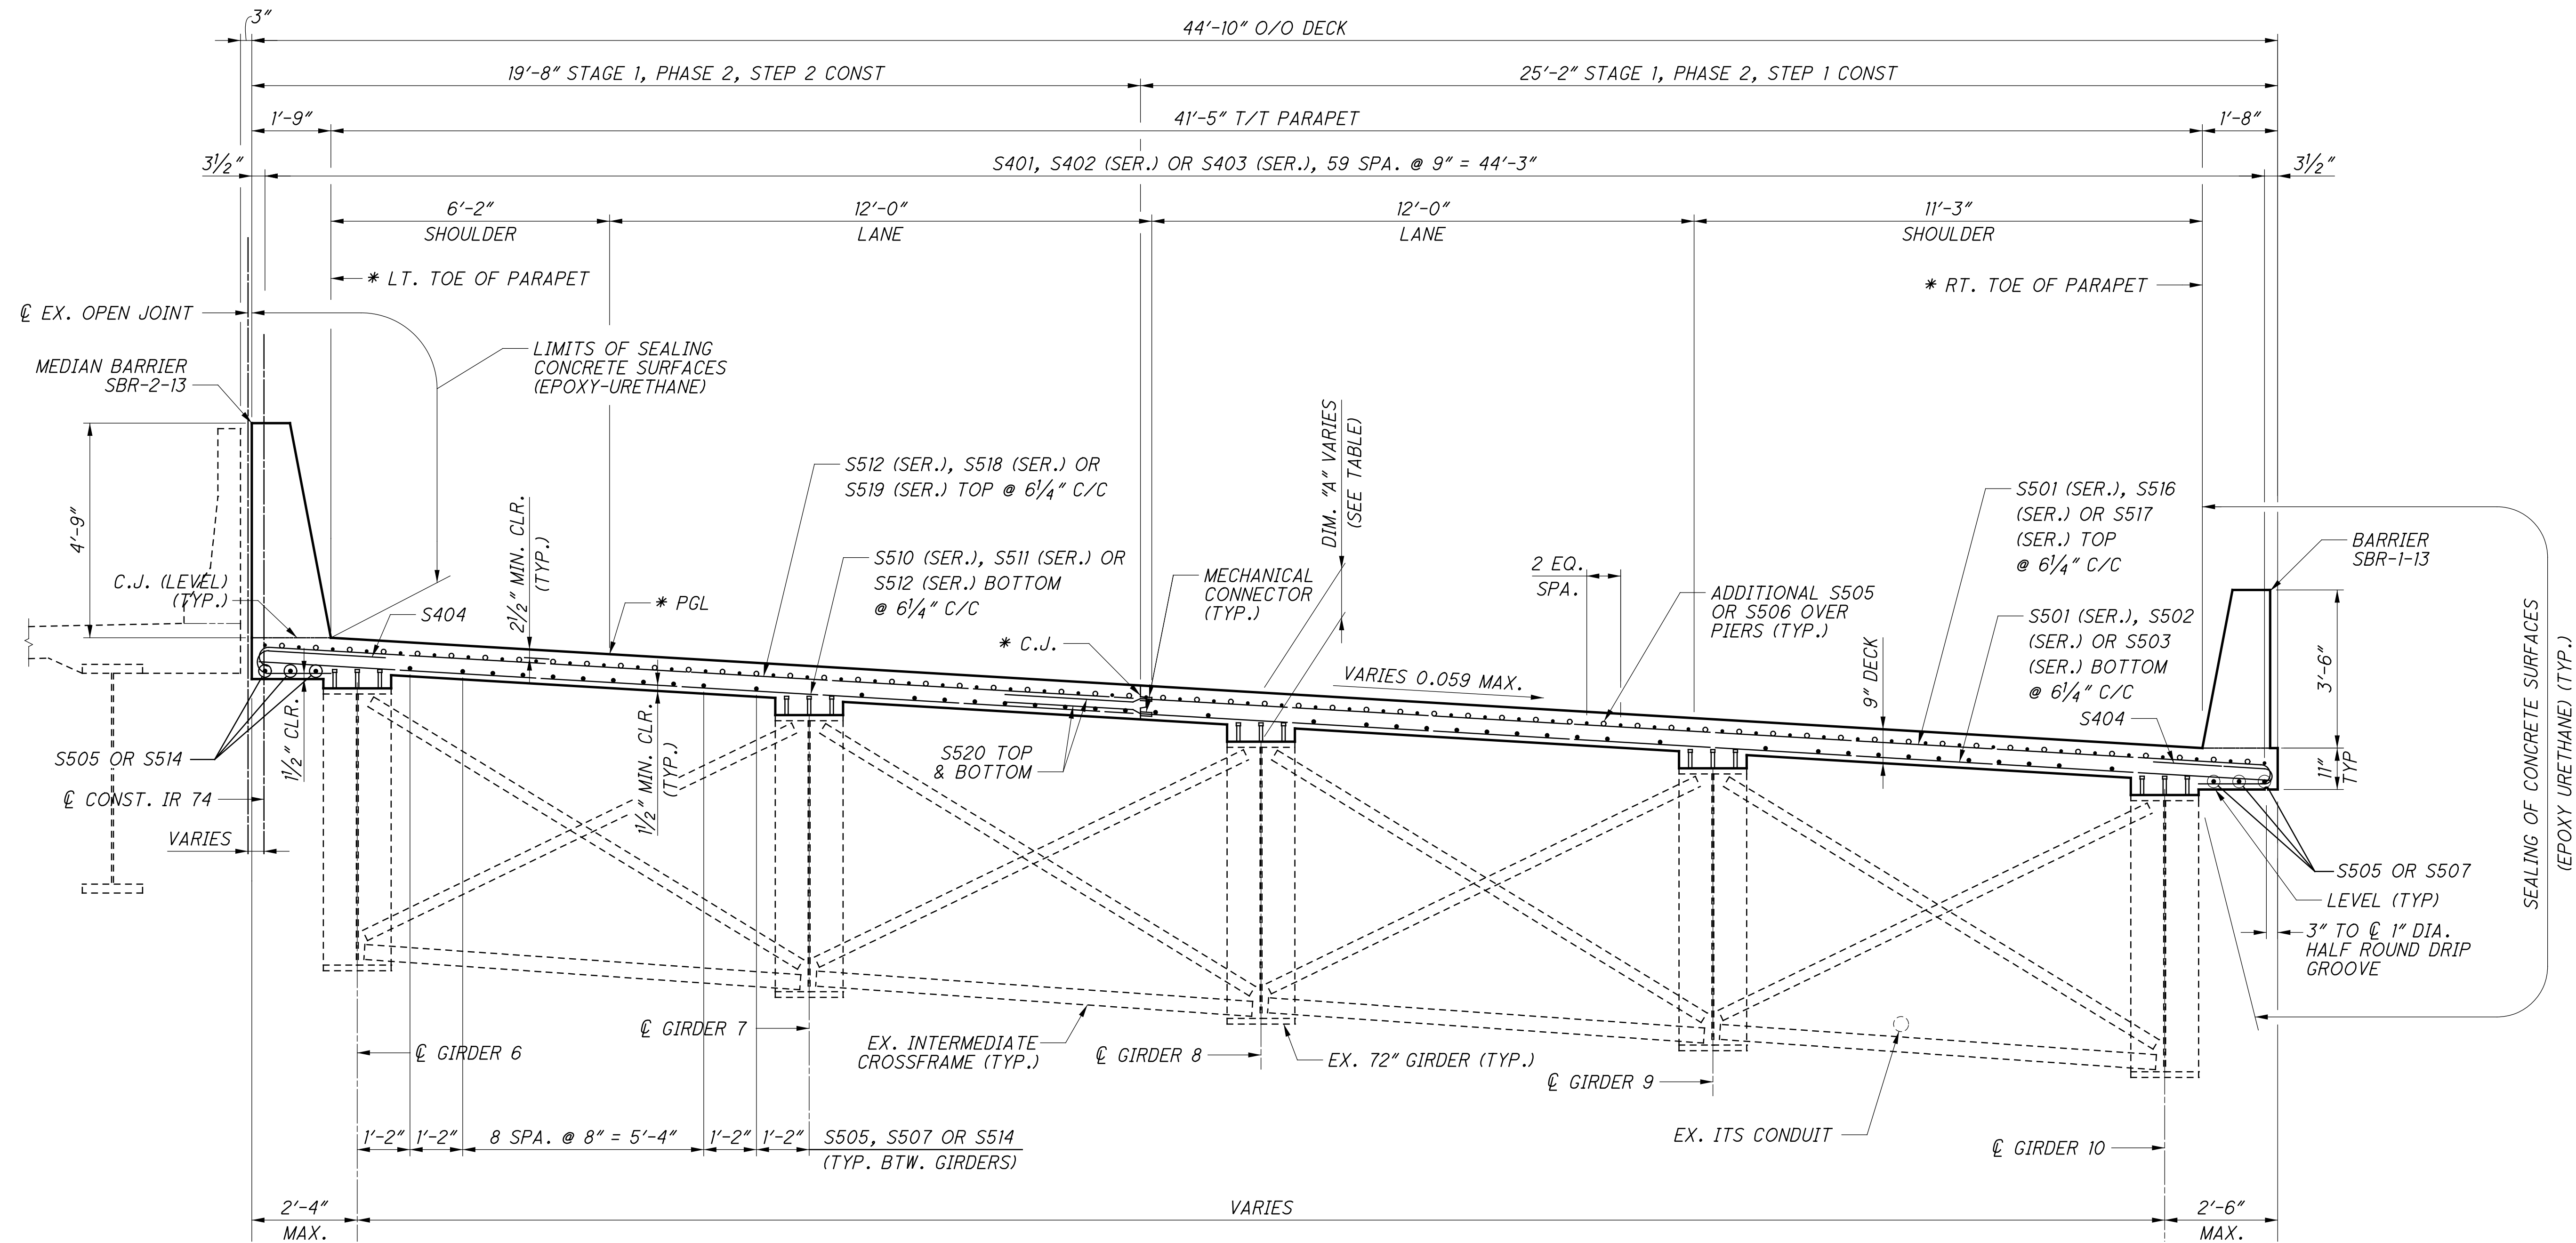

TRANSVERSE SECTION

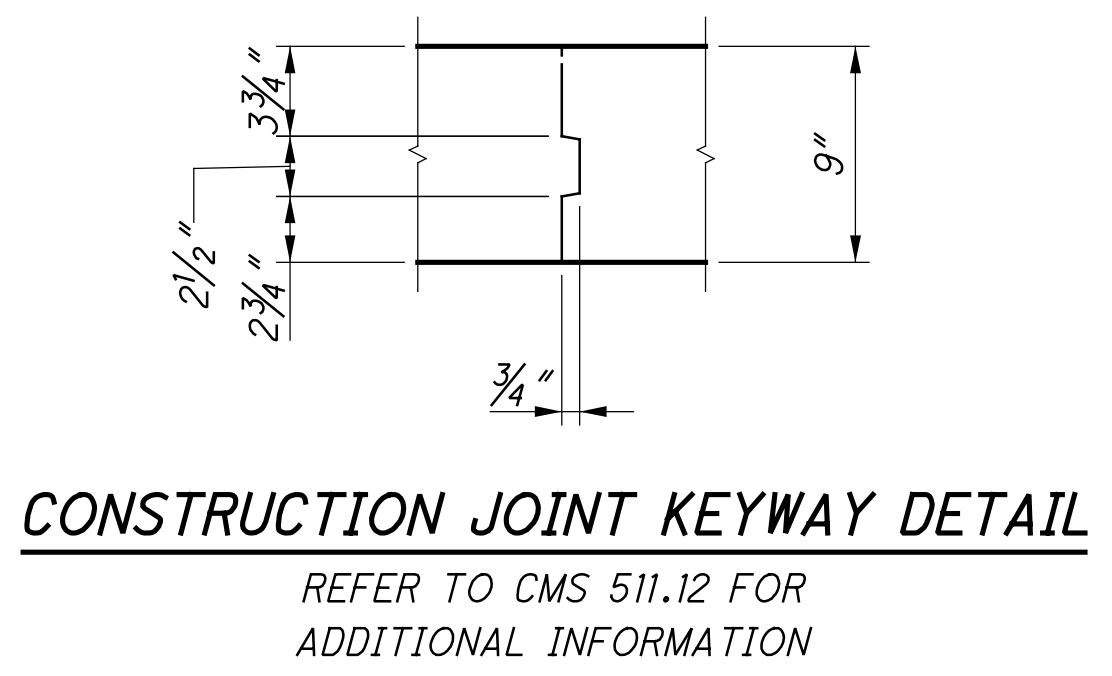


DIMENSION "A" (TOP OF SLAB TO TOP OF FLANGE)				
LOCATION	¢ BRG. R.A.	¢ BRG. PIER 1	¢ BRG. PIER 2	¢ BRG. F.A.
GIRDER 6	1'-0 ⁵ / ₁₆ "	11 ¹ / ₄ "	11 ⁹ / ₁₆ "	1'-0 ³ / ₁₆ "
GIRDER 7	1'-0 ¹ / ₈ "	11 ⁹ / ₁₆ "	11 ⁹ / ₁₆ "	1'-0"
GIRDER 8	1'-0"	11 ⁹ / ₁₆ "	11 ⁵ / ₁₆ "	11 ¹ / ₁₆ "
GIRDER 9	1'-0 ¹ / ₄ "	11 ⁷ / ₁₆ "	10 ¹⁵ / ₁₆ "	11 ⁹ / ₁₆ "
GIRDER 10	1'-0 ¹ / ₁₆ "	11 ¹ / ₈ "	10 ¹ / ₁₆ "	11 ⁵ / ₈ "

- NOTES:
- FOR PARAPET DETAILS SEE SHEETS 29/41 AND 30/41.
 - FOR SLAB REINFORCING PLAN SEE SHEET 26/41.
 - * SCREED ELEVATION LOCATIONS.

DESIGN AGENCY: STRUCTUREPOINT
 DATE: 09/12/18
 REVIEWED: MDS
 DRAWN: BMP
 DESIGNED: SUJ
 CHECKED: CLB
 STRUCTURE FILE NUMBER: 3115526
 TRANSVERSE SECTION (RIGHT BRIDGE)
 BRIDGE NO. HAM-74-1840 L/R
 OVER SB BECKMAN ST. (US-27) AND RAMP F
 HAM-75-3.84
 PID No. 104667
 25 / 41
 26
 120

SFlanagan
11/16/2023 9:33:49 AM
\\01\2017\01113\C.Design\104667-HAM-75-3.84.Design\Structures\HAM0074-1840C\Sheets\74-1840DP001.dgn

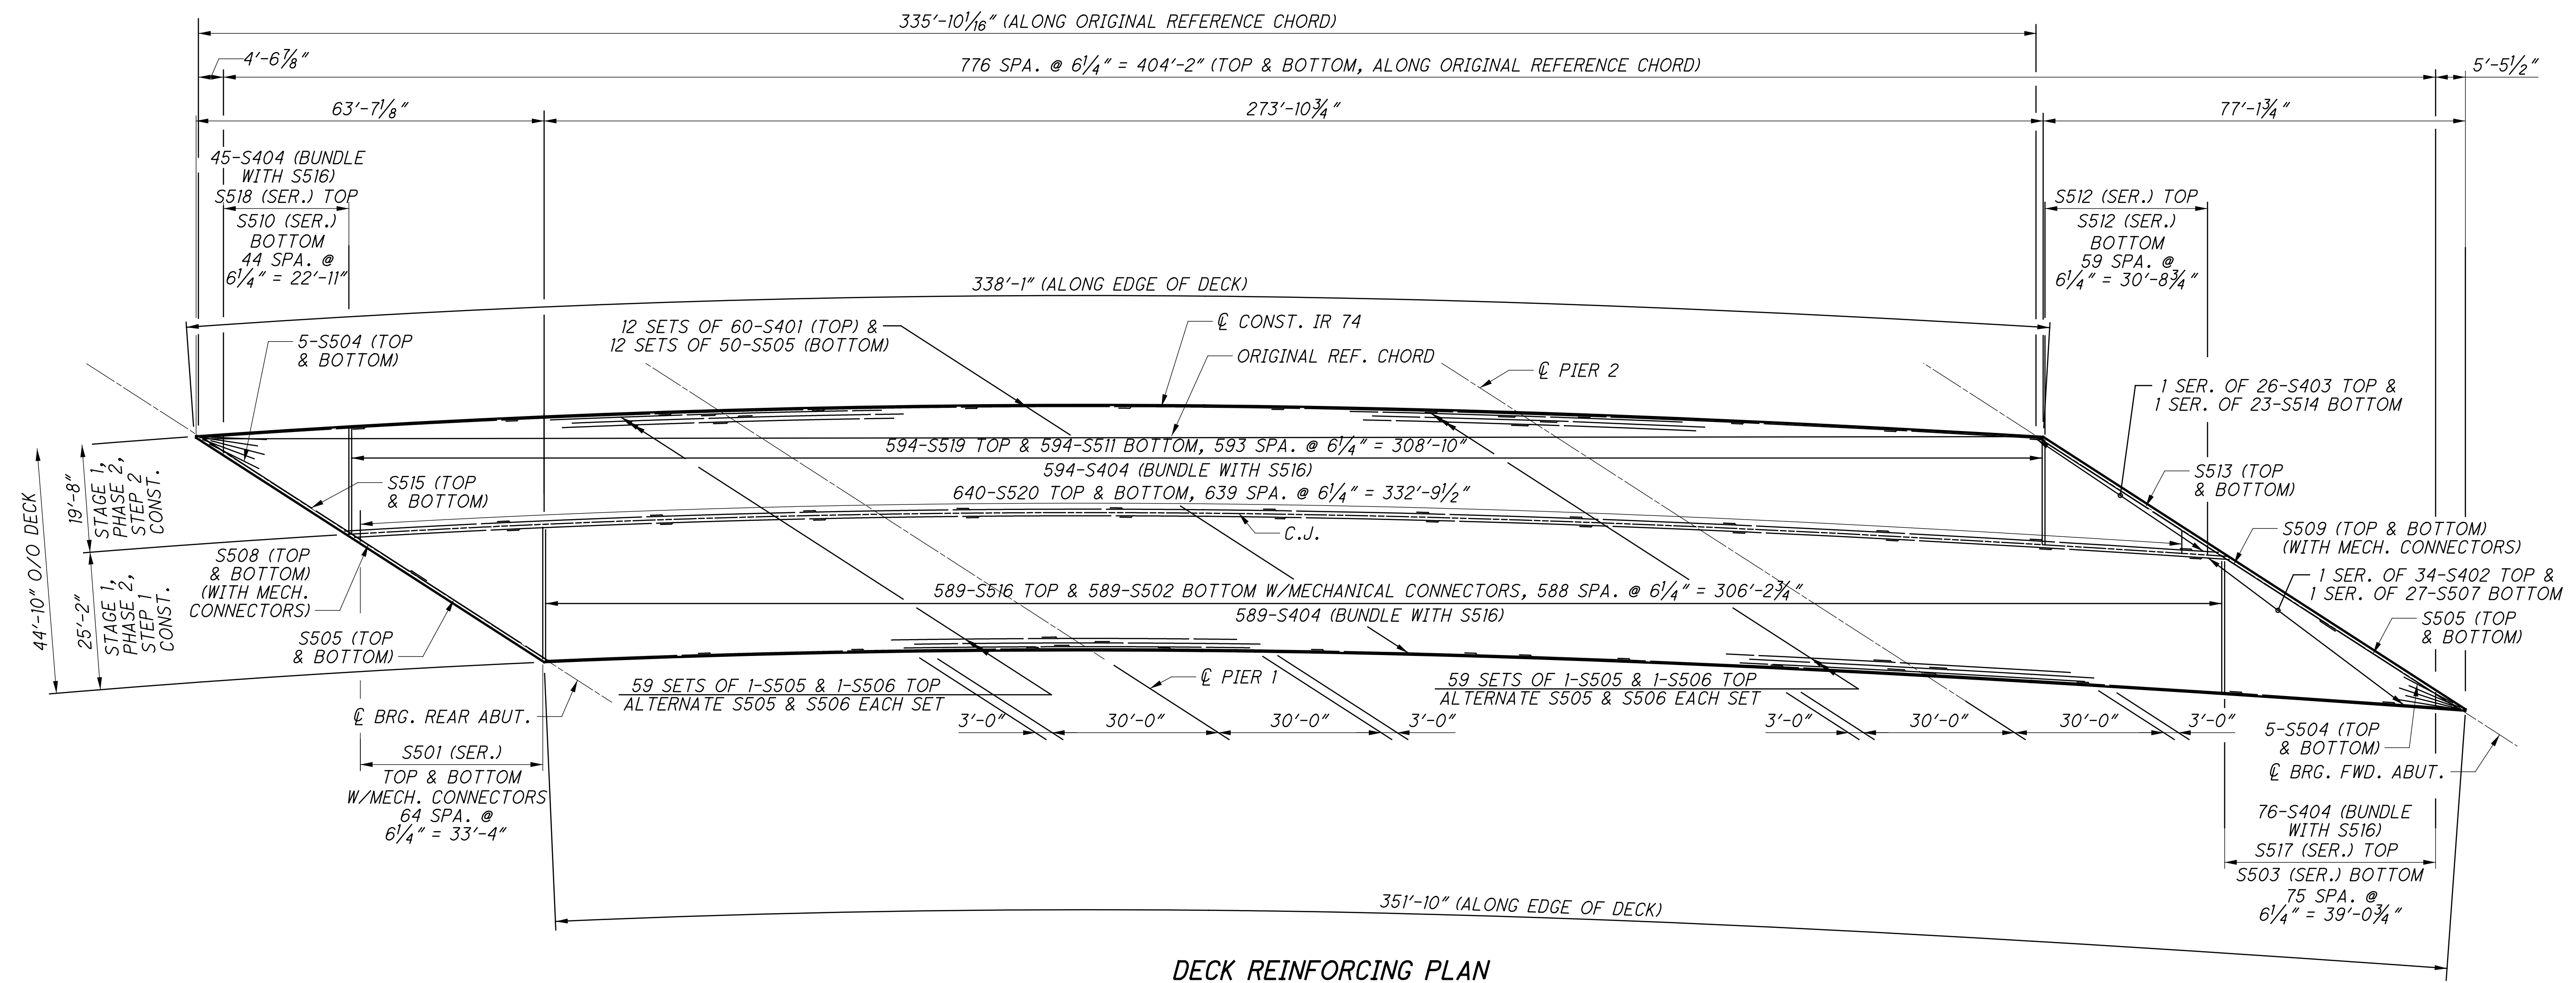

DECK REINFORCING PLAN

MINIMUM BAR LAP	
#4	2'-6"
#5 (LONGITUDINAL)	3'-1"
#5 (TRANSVERSE)	4'-0"

NOTES:

1. FOR TRANSVERSE SECTION, SEE SHEET 25/41.
2. DECK POUR SEQUENCE: CONTINUOUSLY POUR FROM ONE END TO OTHER IN EACH STEP OF CONSTRUCTION. TO AVOID UPLIFT AT THE ABUTMENT, HOLD DOWN OR COUNTER WEIGHT CAPABLE OF RESISTING 4.5K PER GIRDER SHALL BE UTILIZED.

HAM-75-3.84
PID No. 104667

26/41

27
120

DECK PLAN (RIGHT BRIDGE)

BRIDGE NO. HAM-74-1840 L/R

OVER SB BEEKMAN ST. (U.S. 27) AND RAMP F


DESIGNED
SUF
CHECKED
CLB

DRAWN
DSH
REVISED

REVIEWED
MDS
DATE
11/14/18
STRUCTURE FILE NUMBER
3115526

DESIGN AGENCY
STRUCTUREPOINT
INC.

2020 CORPORATE REGISTRATION NO. 0178 000
TEL: 610.426.8000 FAX: 610.426.8001
WWW.STRUCTUREPOINT.COM

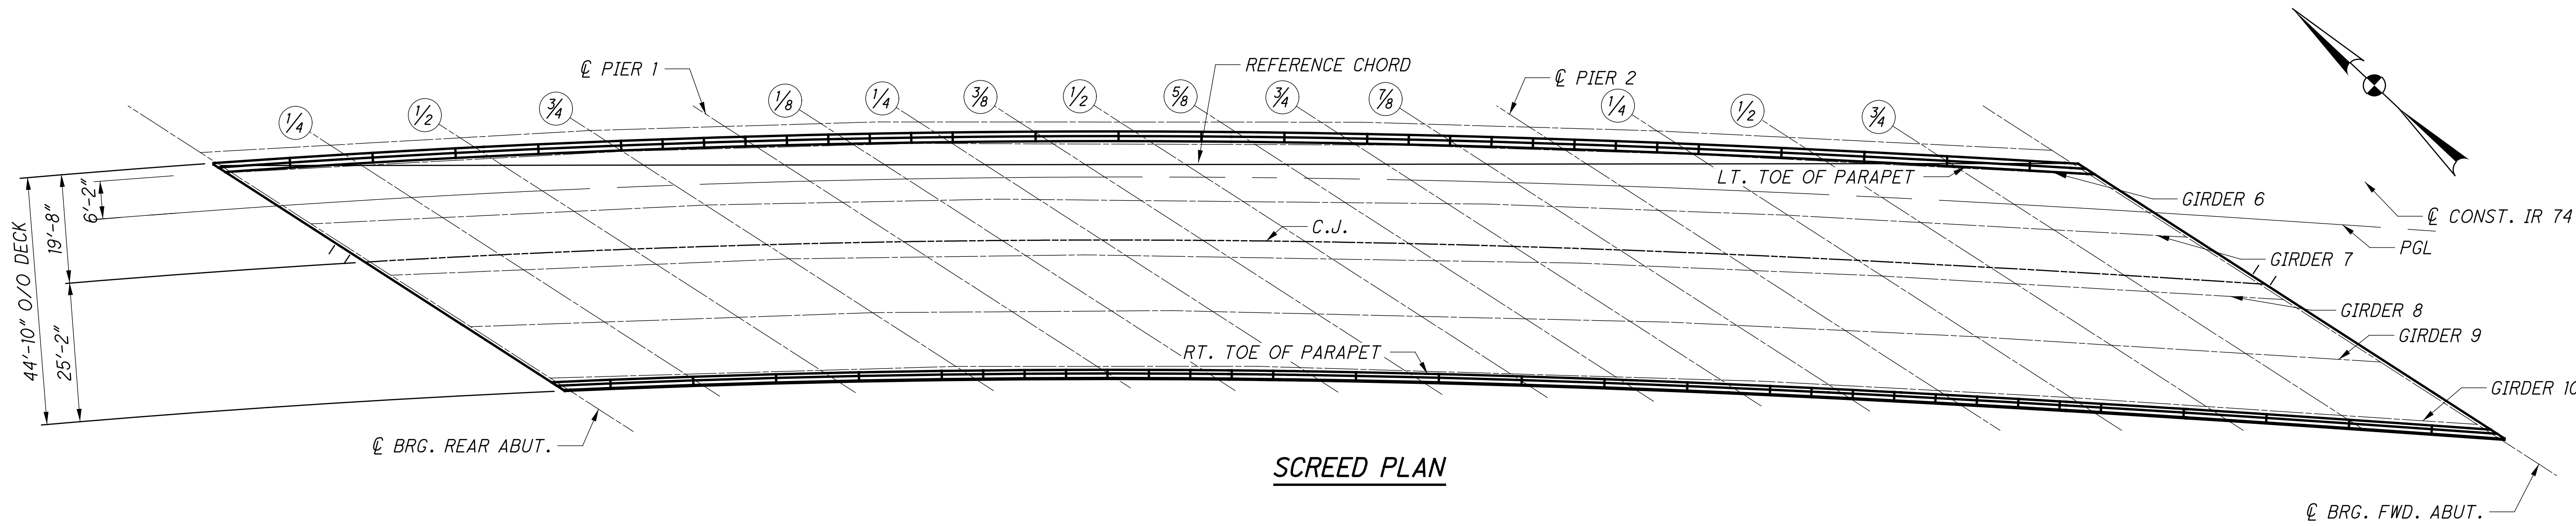

SCREED PLAN

- NOTES:**
1. SCREED ELEVATIONS SHOWN REPRESENT THE THEORETICAL DECK SURFACE LOCATION PRIOR TO DEFLECTIONS CAUSED BY DECK PLACEMENT AND OTHER ANTICIPATED DEAD LOADS.
 2. FOR TOP OF HAUNCH (T.O.H.) ELEVATIONS TABLE, SEE SHEET 28/41.
 3. FINAL DECK SURFACE (F.D.S.) ELEVATIONS SHOWN REPRESENT THE DECK SURFACE LOCATION AFTER ALL ANTICIPATED DEAD LOAD DEFLECTIONS HAVE OCCURRED.

SCREED ELEVATIONS TABLE

DESCRIPTION	☉ BRG. REAR ABUT.	1/4 POINT	1/2 POINT	3/4 POINT	☉ PIER NO. 1	1/8 POINT	1/4 POINT	3/8 POINT	1/2 POINT	5/8 POINT	3/4 POINT	7/8 POINT	☉ PIER NO. 2	1/4 POINT	1/2 POINT	3/4 POINT	☉ BRG. FWD. ABUT.	
HAM-74-1840 SCREED ELEVATIONS																		
LT. TOE OF PARAPET	STATION	992+08.58	992+32.38	992+56.19	992+79.99	993+03.81	993+22.10	993+40.40	993+58.70	993+77.00	993+95.30	994+13.61	994+31.91	994+50.21	994+74.03	994+97.84	995+21.64	995+45.43
	OFFSET	1.22	1.26	1.30	1.34	1.39	1.42	1.45	1.46	1.51	1.54	1.58	1.60	1.63	1.66	1.69	1.72	1.74
	F.D.S. ELEV.	546.07	545.60	545.14	544.69	544.23	543.89	543.52	543.15	542.79	542.45	542.11	541.74	541.39	540.94	540.50	540.09	539.70
	SCREED ELEV.	546.07	545.61	545.15	544.69	544.23	543.91	543.58	543.25	542.91	542.56	542.18	541.77	541.39	540.94	540.51	540.10	539.70
PGL	STATION	992+16.86	992+40.84	992+64.84	992+88.84	993+12.85	993+31.30	993+49.76	993+68.23	993+86.70	994+05.17	994+23.65	994+42.11	994+60.55	994+84.56	995+08.54	995+32.49	995+56.40
	OFFSET	7.40	7.44	7.48	7.53	7.57	7.60	7.63	7.66	7.70	7.73	7.76	7.79	7.81	7.84	7.87	7.89	7.90
	F.D.S. ELEV.	545.57	545.11	544.68	544.18	543.74	543.38	543.01	542.67	542.29	541.92	541.58	541.26	540.92	540.54	540.09	539.67	539.29
	SCREED ELEV.	545.57	545.12	544.69	544.17	543.74	543.41	543.08	542.77	542.41	542.02	541.66	541.30	540.92	540.54	540.10	539.69	539.29
C.J.	STATION	992+33.87	992+57.21	992+81.78	993+05.96	993+30.37	993+49.13	993+67.91	993+86.70	994+05.50	994+24.30	994+43.08	994+61.83	994+80.55	995+04.89	995+29.16	995+53.38	995+77.53
	OFFSET	19.18	19.22	19.26	19.31	19.35	19.38	19.41	19.45	19.48	19.51	19.54	19.56	19.59	19.62	19.64	19.66	19.68
	F.D.S. ELEV.	545.17	544.34	543.61	543.29	542.69	542.29	541.89	541.74	541.26	540.84	540.82	540.45	540.82	539.96	539.48	539.02	538.73
	SCREED ELEV.	545.17	544.35	543.62	543.28	542.69	542.32	541.96	541.85	541.39	540.95	540.90	540.48	540.82	539.96	539.49	539.04	538.73
RT. TOE OF PARAPET	STATION	992+65.88	992+90.99	993+16.14	993+41.33	993+66.58	993+86.01	994+05.47	994+24.93	994+44.36	994+63.75	994+83.09	995+02.36	995+21.57	995+46.46	995+71.19	995+95.78	996+20.23
	OFFSET	42.74	42.78	42.82	42.87	42.91	42.95	42.98	43.01	43.04	43.07	43.09	43.11	43.13	43.15	43.15	43.15	
	F.D.S. ELEV.	542.60	542.15	541.69	541.16	540.67	540.31	539.98	539.72	539.45	539.25	539.05	538.85	538.67	538.43	538.18	537.96	537.78
	SCREED ELEV.	542.60	542.16	541.68	541.14	540.67	540.35	540.07	539.85	539.59	539.37	539.13	538.88	538.67	538.43	538.20	537.98	537.78

S:\Flansburg\11-16-2023\01113 C. Design\104667-HAM-75-3.84\Design\Structures\HAM0074-1840C_Sheets\74-1840SD004.dgn

DESIGN AGENCY: STRUCTUREPOINT
 DATE: 11/14/18
 REVIEWED: MDS
 DRAWN: BNM
 DESIGNED: SUJ
 CHECKED: CLB
 STRUCTURE FILE NUMBER: 3115526
 SCREED PLAN (RIGHT BRIDGE)
 BRIDGE NO. HAM-74-1840 L/R
 OVER SB BEEKMAN ST. (U.S. 27) AND RAMP F
 HAM-75-3.84
 PID No. 104667
 28 / 41
 28 / 120

HAUNCH ELEVATIONS TABLE

SCREED LINE	DESCRIPTION	℄ BRG. REAR ABUT.	¼ POINT	½ POINT	¾ POINT	℄ PIER NO. 1	⅙ POINT	¼ POINT	⅓ POINT	½ POINT	⅔ POINT	¾ POINT	⅞ POINT	℄ PIER NO. 2	¼ POINT	½ POINT	¾ POINT	℄ BRG. FWD. ABUT.
HAM-74-1840 TOP OF HAUNCH ELEVATIONS																		
GIRDER 6	STATION	992+08.80	992+32.94	992+56.74	992+80.22	993+04.24	993+22.45	993+40.83	993+59.46	993+77.86	993+96.03	994+13.98	994+32.26	994+50.62	994+74.24	994+98.31	995+22.10	995+45.63
	OFFSET	1.38	1.67	1.70	1.50	1.68	1.65	1.74	1.98	2.06	2.00	1.81	1.82	1.88	1.79	1.97	1.98	1.85
	F.D.S. ELEV.	546.07	545.60	545.14	544.69	544.23	543.89	543.52	543.15	542.79	542.45	542.11	541.74	541.39	540.94	540.50	540.09	539.70
	DEFLECTION	0.00	0.01	0.01	0.00	0.00	0.03	0.07	0.10	0.12	0.11	0.08	0.03	0.00	-0.01	0.00	0.01	0.00
GIRDER 7	STATION	992+22.61	992+47.07	992+71.20	992+95.00	993+19.37	993+37.85	993+56.52	993+75.42	993+94.11	994+12.56	994+30.77	994+49.30	994+67.89	994+91.78	995+16.10	995+40.10	995+63.84
	OFFSET	11.65	11.95	11.99	11.79	11.99	11.96	12.05	12.29	12.37	12.31	12.11	12.11	12.16	12.05	12.20	12.20	12.07
	F.D.S. ELEV.	545.24	544.71	544.23	543.79	543.33	542.98	542.61	542.23	541.86	541.51	541.20	540.90	540.61	540.24	539.82	539.44	539.10
	DEFLECTION	0.00	0.01	0.01	0.00	0.00	0.03	0.07	0.10	0.12	0.11	0.07	0.03	0.00	0.00	0.01	0.02	0.00
GIRDER 8	STATION	992+36.53	992+61.33	992+85.78	993+09.91	993+34.64	993+53.40	993+72.34	993+91.53	994+10.50	994+29.22	994+47.69	994+66.46	994+85.27	995+09.46	995+33.97	995+58.18	995+82.12
	OFFSET	21.84	22.14	22.19	21.99	22.19	22.16	22.25	22.49	22.56	22.49	22.30	22.29	22.33	22.24	22.36	22.35	22.22
	F.D.S. ELEV.	544.29	543.84	543.33	542.94	542.44	542.00	541.66	541.28	540.95	540.67	540.37	540.04	539.88	539.53	539.20	538.87	538.58
	DEFLECTION	0.00	0.01	0.01	-0.01	0.00	0.03	0.08	0.11	0.12	0.11	0.08	0.03	0.00	0.00	0.02	0.02	0.00
GIRDER 9	STATION	992+50.60	992+75.73	993+00.51	993+24.97	993+50.06	993+69.09	993+88.31	994+07.79	994+27.03	994+46.00	994+64.73	994+83.73	995+02.75	995+27.20	995+51.92	995+76.33	996+00.44
	OFFSET	31.95	32.26	32.30	32.09	32.29	32.27	32.35	32.58	32.65	32.58	32.39	32.38	32.42	32.33	32.44	32.43	32.32
	F.D.S. ELEV.	543.47	542.99	542.51	542.04	541.56	541.16	540.81	540.41	540.15	539.94	539.63	539.41	539.29	538.99	538.69	538.32	538.10
	DEFLECTION	0.00	0.01	0.00	-0.01	0.00	0.03	0.08	0.12	0.13	0.11	0.08	0.03	0.00	0.00	0.02	0.02	0.00
GIRDER 10	STATION	992+64.78	992+90.25	993+15.37	993+40.15	993+65.61	993+84.91	994+04.42	994+24.17	994+43.67	994+62.90	994+81.87	995+01.08	995+20.31	995+45.02	995+69.93	995+94.52	996+18.80
	OFFSET	41.97	42.28	42.31	42.09	42.29	42.26	42.33	42.55	42.63	42.56	42.38	42.38	42.42	42.35	42.46	42.46	42.38
	F.D.S. ELEV.	542.60	542.15	541.69	541.16	540.67	540.31	539.98	539.72	539.45	539.25	539.05	538.85	538.67	538.43	538.18	537.96	537.78
	DEFLECTION	0.00	0.00	0.00	-0.02	0.00	0.04	0.09	0.13	0.14	0.12	0.08	0.03	0.00	0.00	0.02	0.02	0.00
	T.O.H. ELEV.	541.68	541.24	540.77	540.23	539.76	539.43	539.15	538.93	538.67	538.45	538.21	537.96	537.75	537.51	537.28	537.06	536.86

SCREED PLAN (RIGHT BRIDGE)
 BRIDGE NO. HAM-74-1840 L/R
 OVER SB BEEKMAN ST. (U.S. 27) AND RAMP F

DESIGN AGENCY: **STRUCTUREPOINT**
 DATE: 11/14/18
 REVIEWED: MDS
 DRAWN: BNM
 DESIGNED: SJF
 CHECKED: CLB


HAM-75-3.84
 PID No. 104667

28 / 41
 29
 120

- NOTES:
- FOR SCREED LINE LOCATIONS AND ELEVATIONS TABLE, SEE SHEET 27/41.
 - TOP OF HAUNCH (T.O.H.) ELEVATIONS SHOWN REPRESENT THE THEORETICAL LOCATION OF THE BOTTOM OF THE DECK ABOVE THE BEAM HAUNCH PRIOR TO DEFLECTIONS CAUSED BY DECK PLACEMENT AND OTHER ANTICIPATED DEAD LOADS.
 - FINAL DECK SURFACE (F.D.S.) ELEVATIONS SHOWN REPRESENT THE DECK SURFACE LOCATION AFTER ALL ANTICIPATED DEAD LOAD DEFLECTIONS HAVE OCCURRED.


S:\Flansburg\11-16-2023\01-2017\01113 C. Design\104667_HAM-75-3.84_Design\Structures\HAM0074_1840C_Sheets\74_1840SD005.dgn

SFlanagan 11/16/2023 9:34:01 AM
 \0\2017\01113\C.Design\104667-HAM-75-3.84\Design\Structures\HAM0074_1840C\Sheets\74_1840RA001.dgn

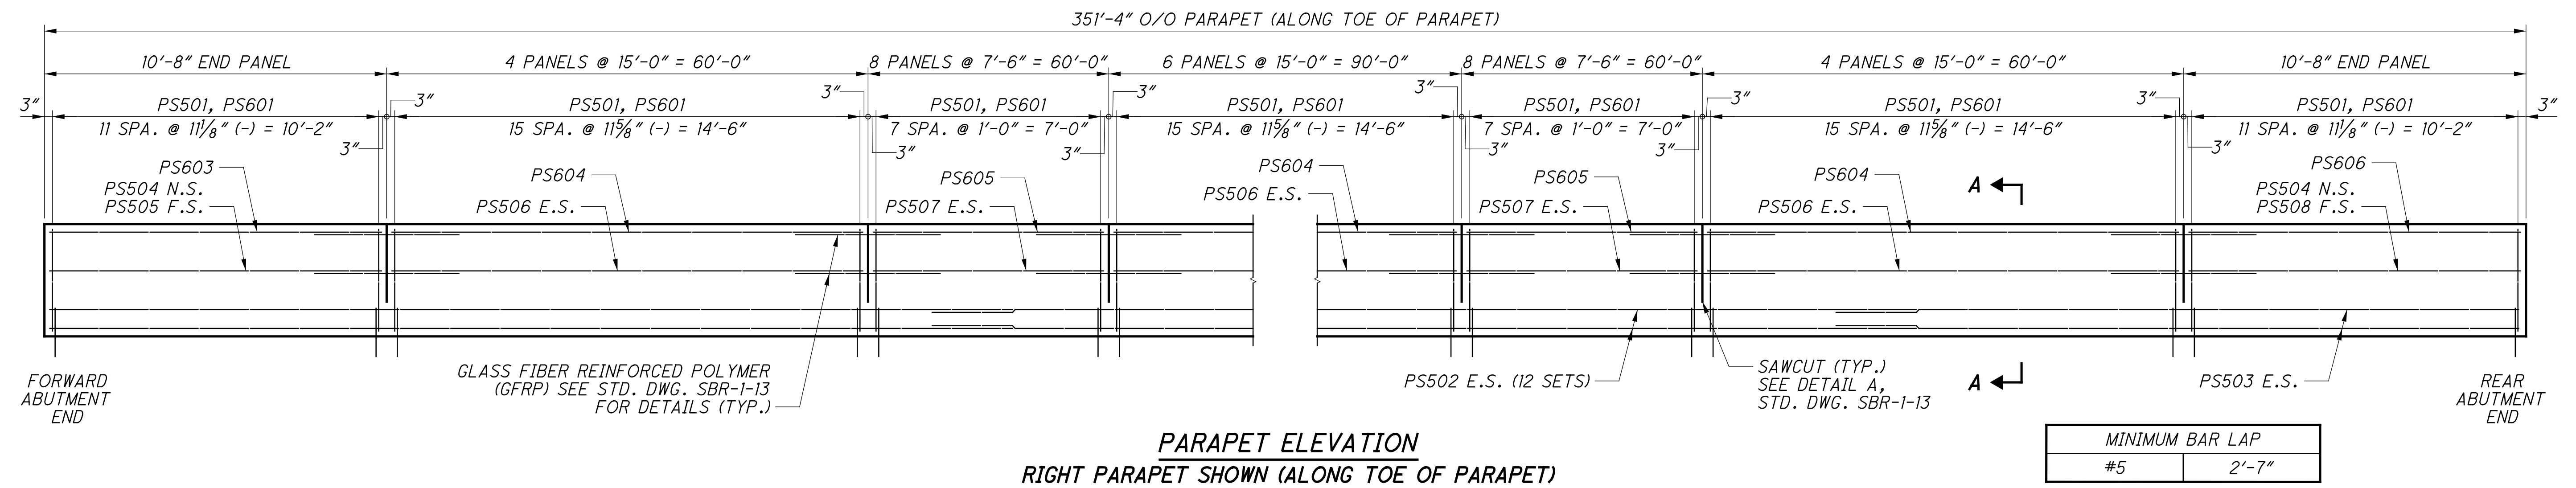

PARAPET ELEVATION
 RIGHT PARAPET SHOWN (ALONG TOE OF PARAPET)

MINIMUM BAR LAP	
#5	2'-7"

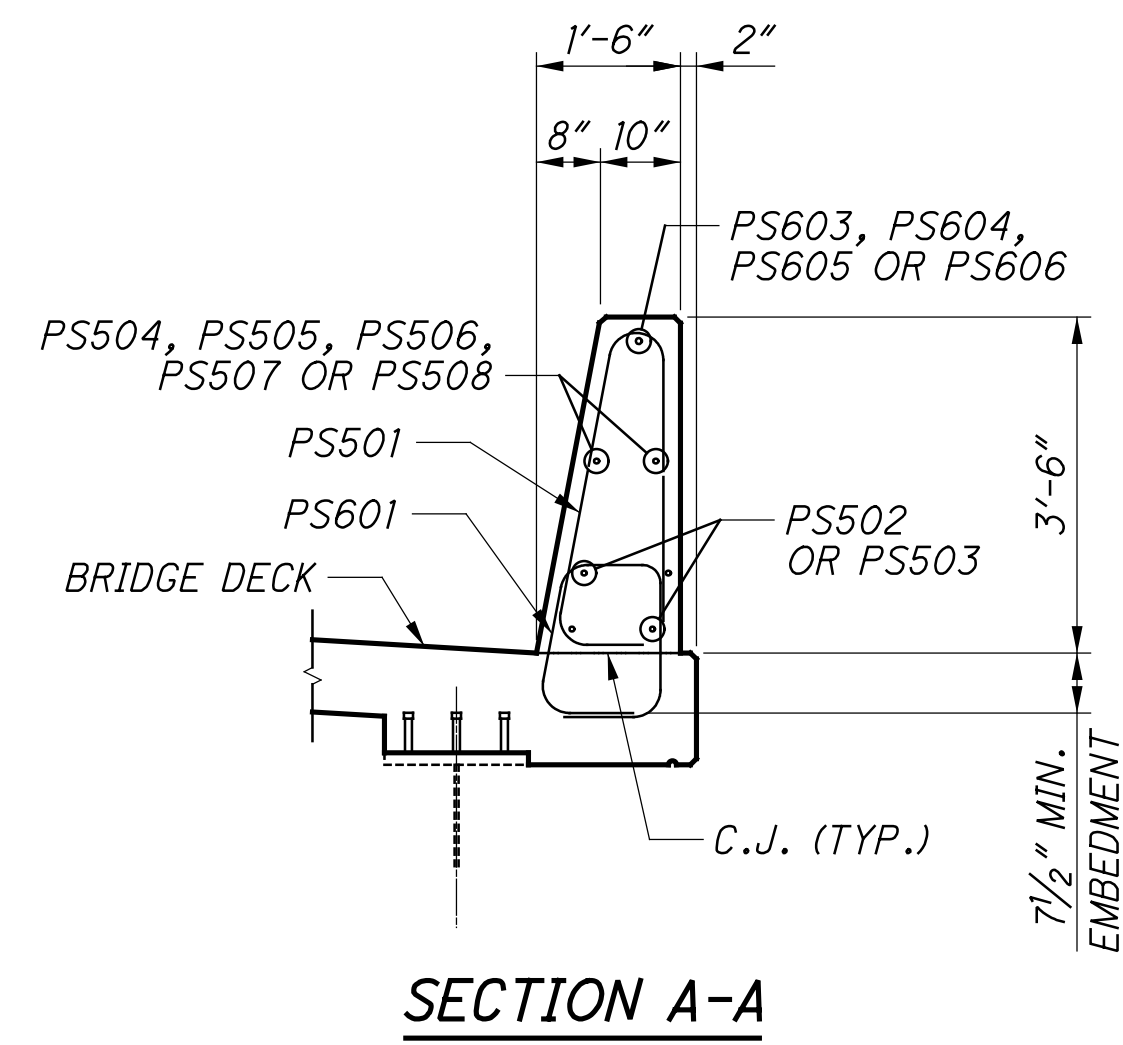


SECTION A-A

NOTES:
 1. SEE STANDARD BRIDGE DRAWING SBR-1-13 FOR ADDITIONAL DETAILS.


DESIGN AGENCY: STRUCTUREPOINT
 DATE: 11/12/18
 REVIEWED: MDS
 DRAWN: DSH
 DESIGNED: SUJ
 CHECKED: CLB
 STRUCTURE FILE NUMBER: 3115526
PARAPET DETAILS (RIGHT BRIDGE)
 BRIDGE NO. HAM-74-1840 L/R
 OVER SB BEEKMAN ST. (U.S. 27) AND RAMP F
HAM-75-3.84
PID No. 104667
 29 / 41
 30
 120

SFlanagan
 11/16/2023 9:34:02 AM
 \\0\2017\01113\C.Design\104667-HAM-75-3.84\Design\Structures\HAM0074_1840C\Sheets\74_1840RA002.dgn

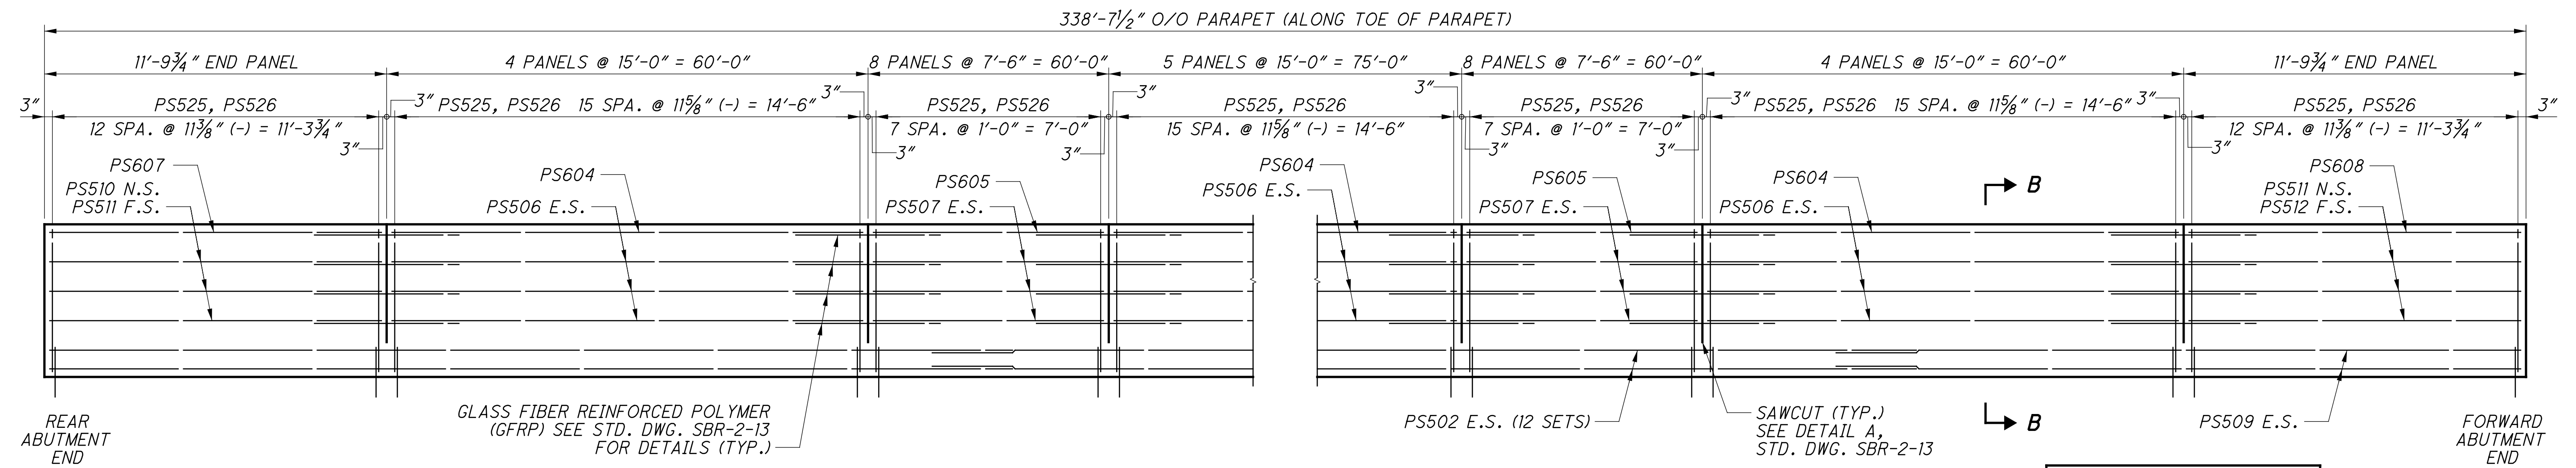

PARAPET ELEVATION
 LEFT PARAPET SHOWN (ALONG F.F. PARAPET)

MINIMUM BAR LAP	
#5	2'-7"

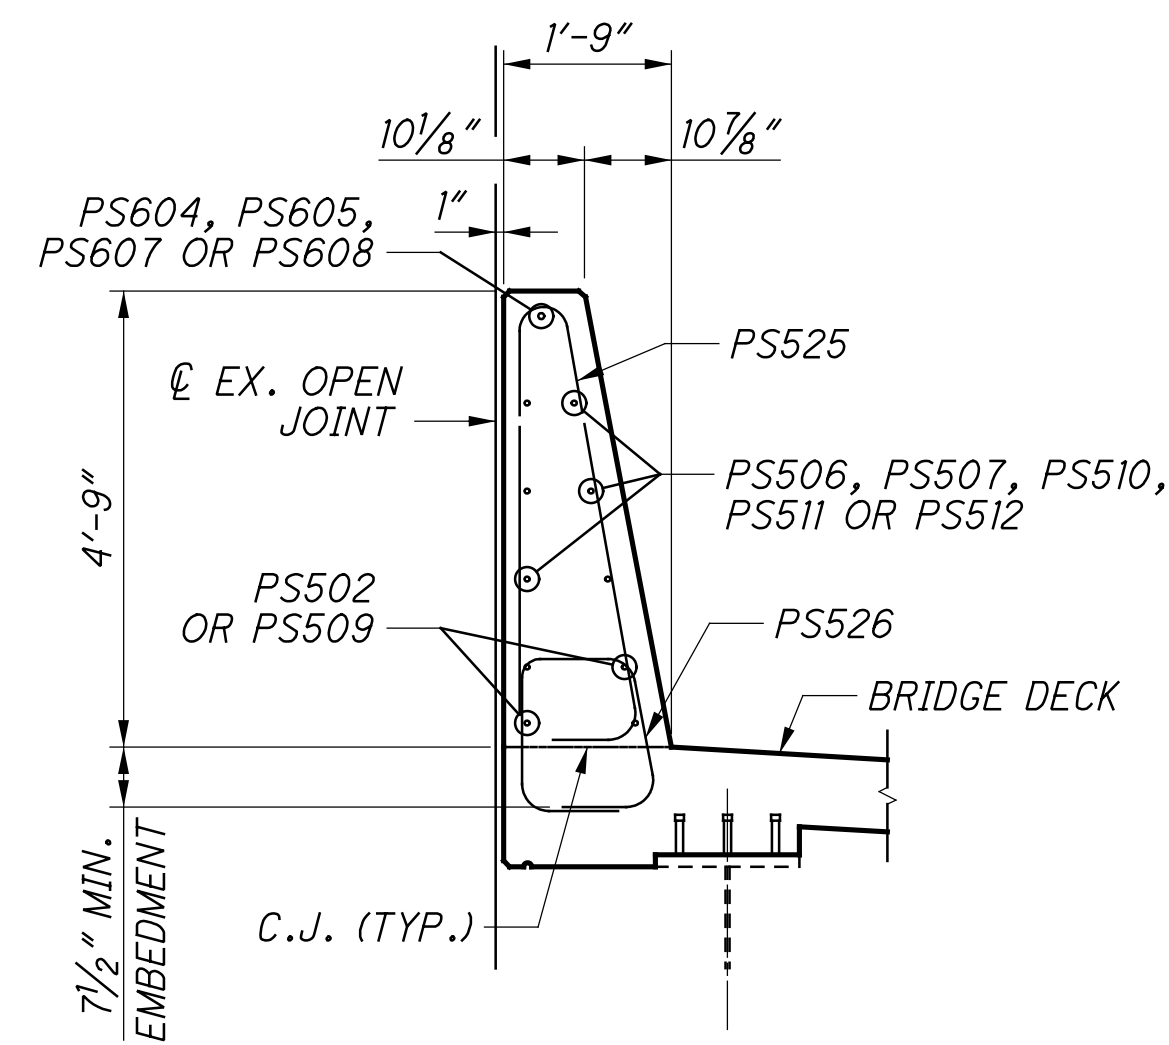

SECTION B-B

NOTES:

- SEE STANDARD BRIDGE DRAWING SBR-2-13 FOR ADDITIONAL DETAILS.

DESIGN AGENCY: STRUCTUREPOINT

DATE: 11/12/18

REVIEWED: MDS

STRUCTURE FILE NUMBER: 3115526

DESIGNED: SUJ

CHECKED: CLB

DRAWN: DSH

REVISED:

PARAPET DETAILS (RIGHT BRIDGE)

BRIDGE NO. HAM-74-1840 L/R

OVER SB BEEKMAN ST. (U.S. 27) AND RAMP F

HAM-75-3.84


PID No. 104667

30/39


31

114


SFlanagan
 11/16/2023 9:34:02 AM
 \\01\2017\01113\C.Design\104667-HAM-75-3.84\Design\Structures\HAM0074_1840C\Sheets\74_1840RA003.dgn

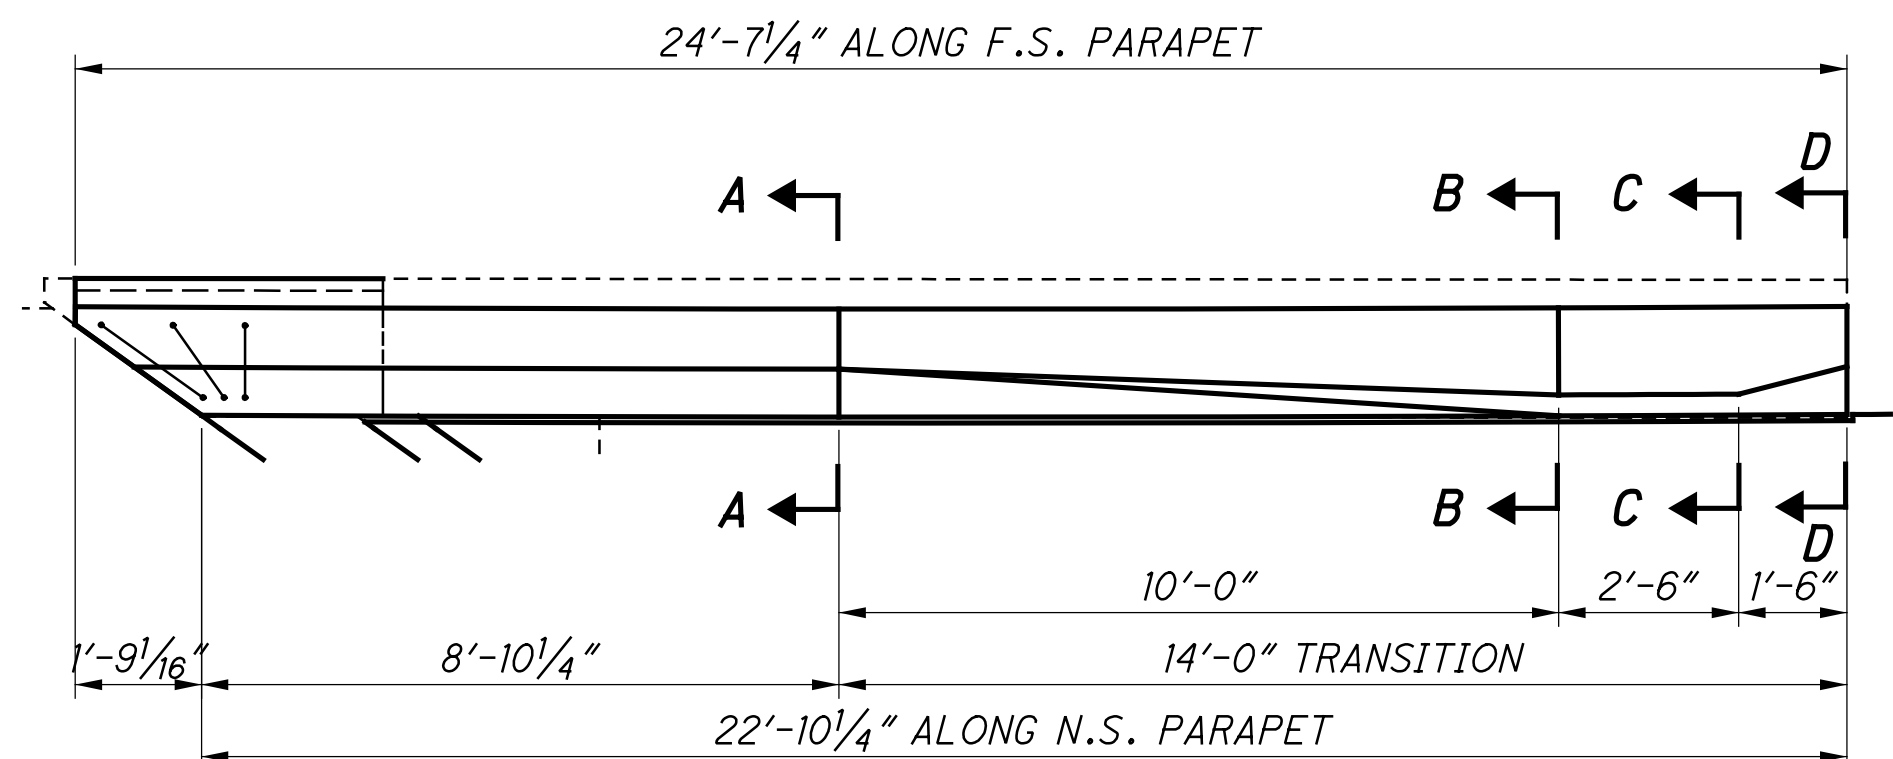


PARAPET PLAN
 AT SOUTH WINGWALL REAR ABUTMENT

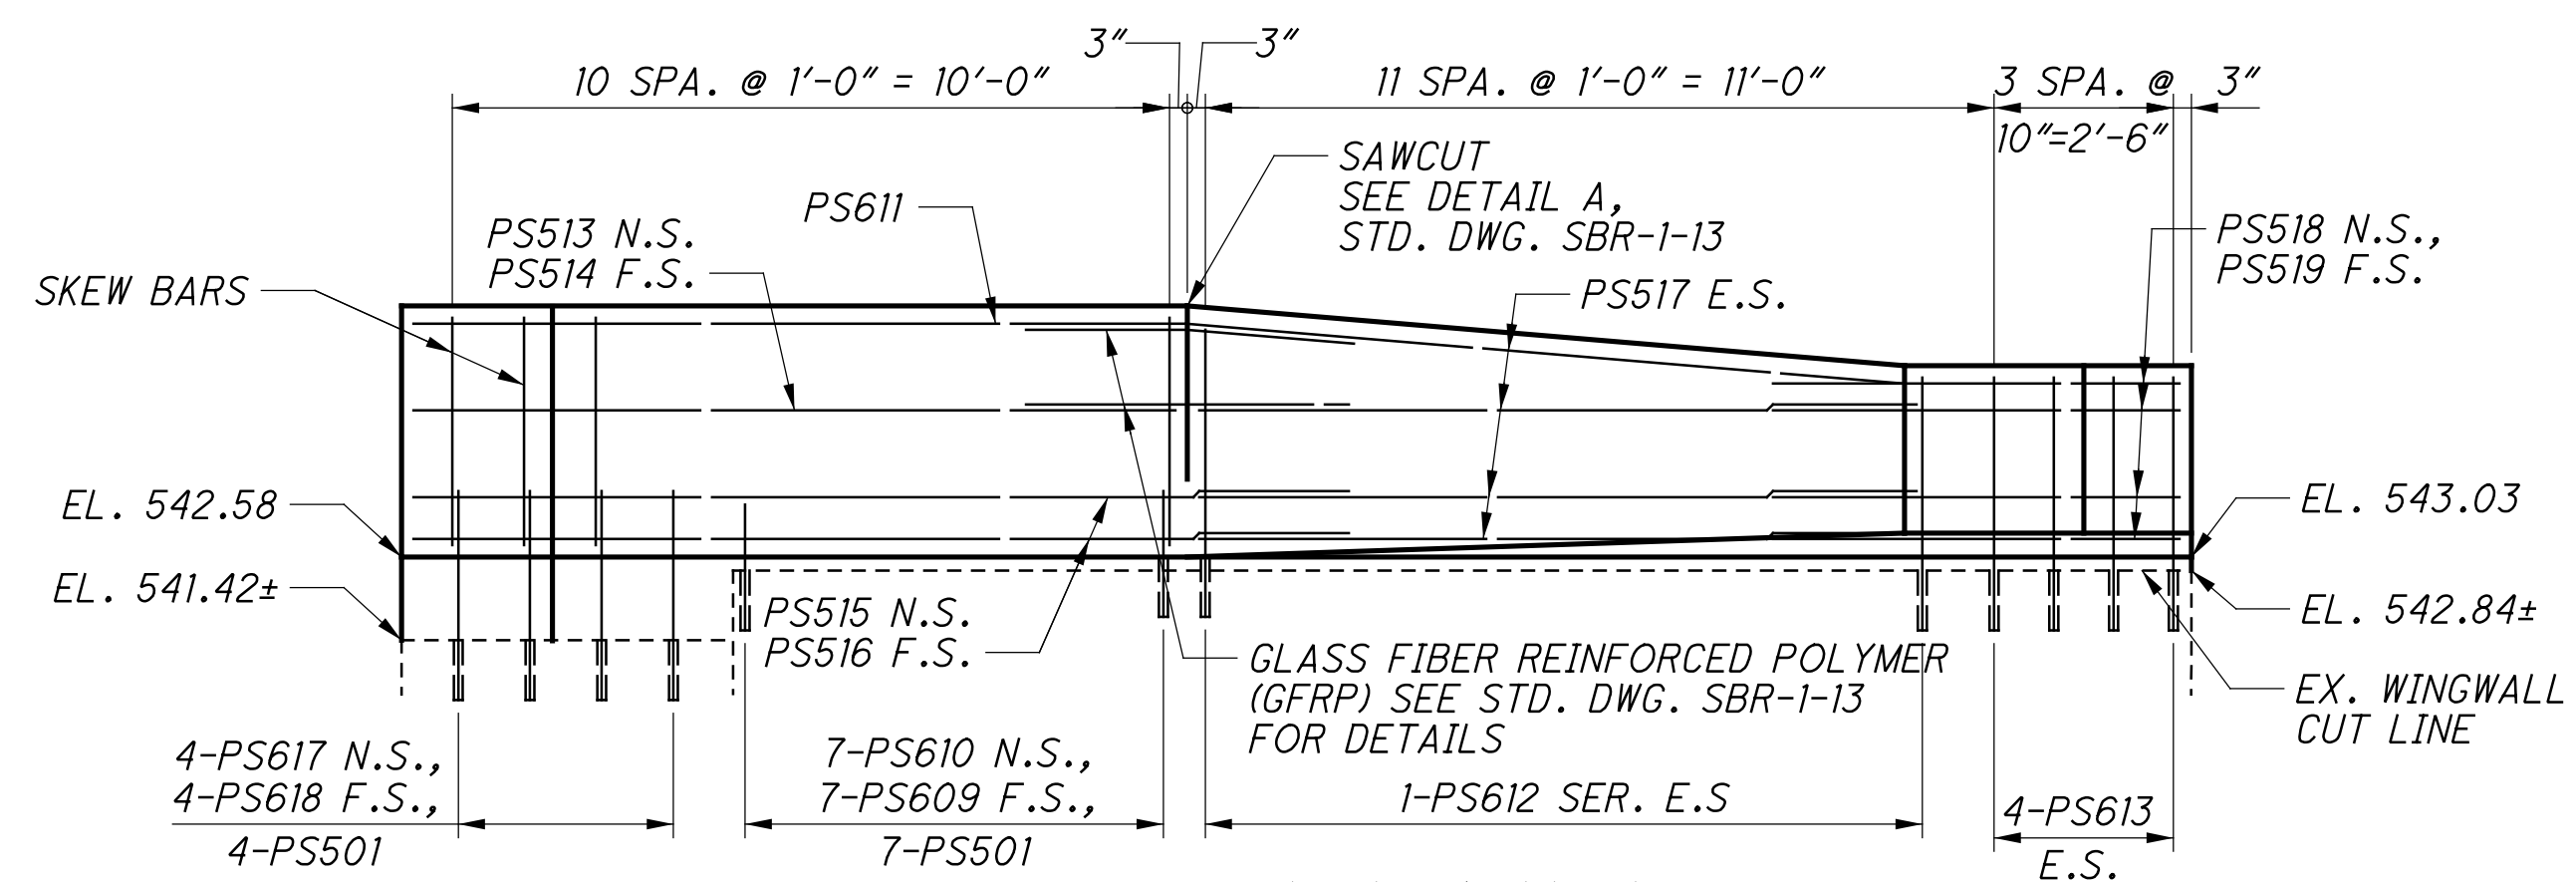


PARAPET ELEVATION
 AT SOUTH WINGWALL REAR ABUTMENT

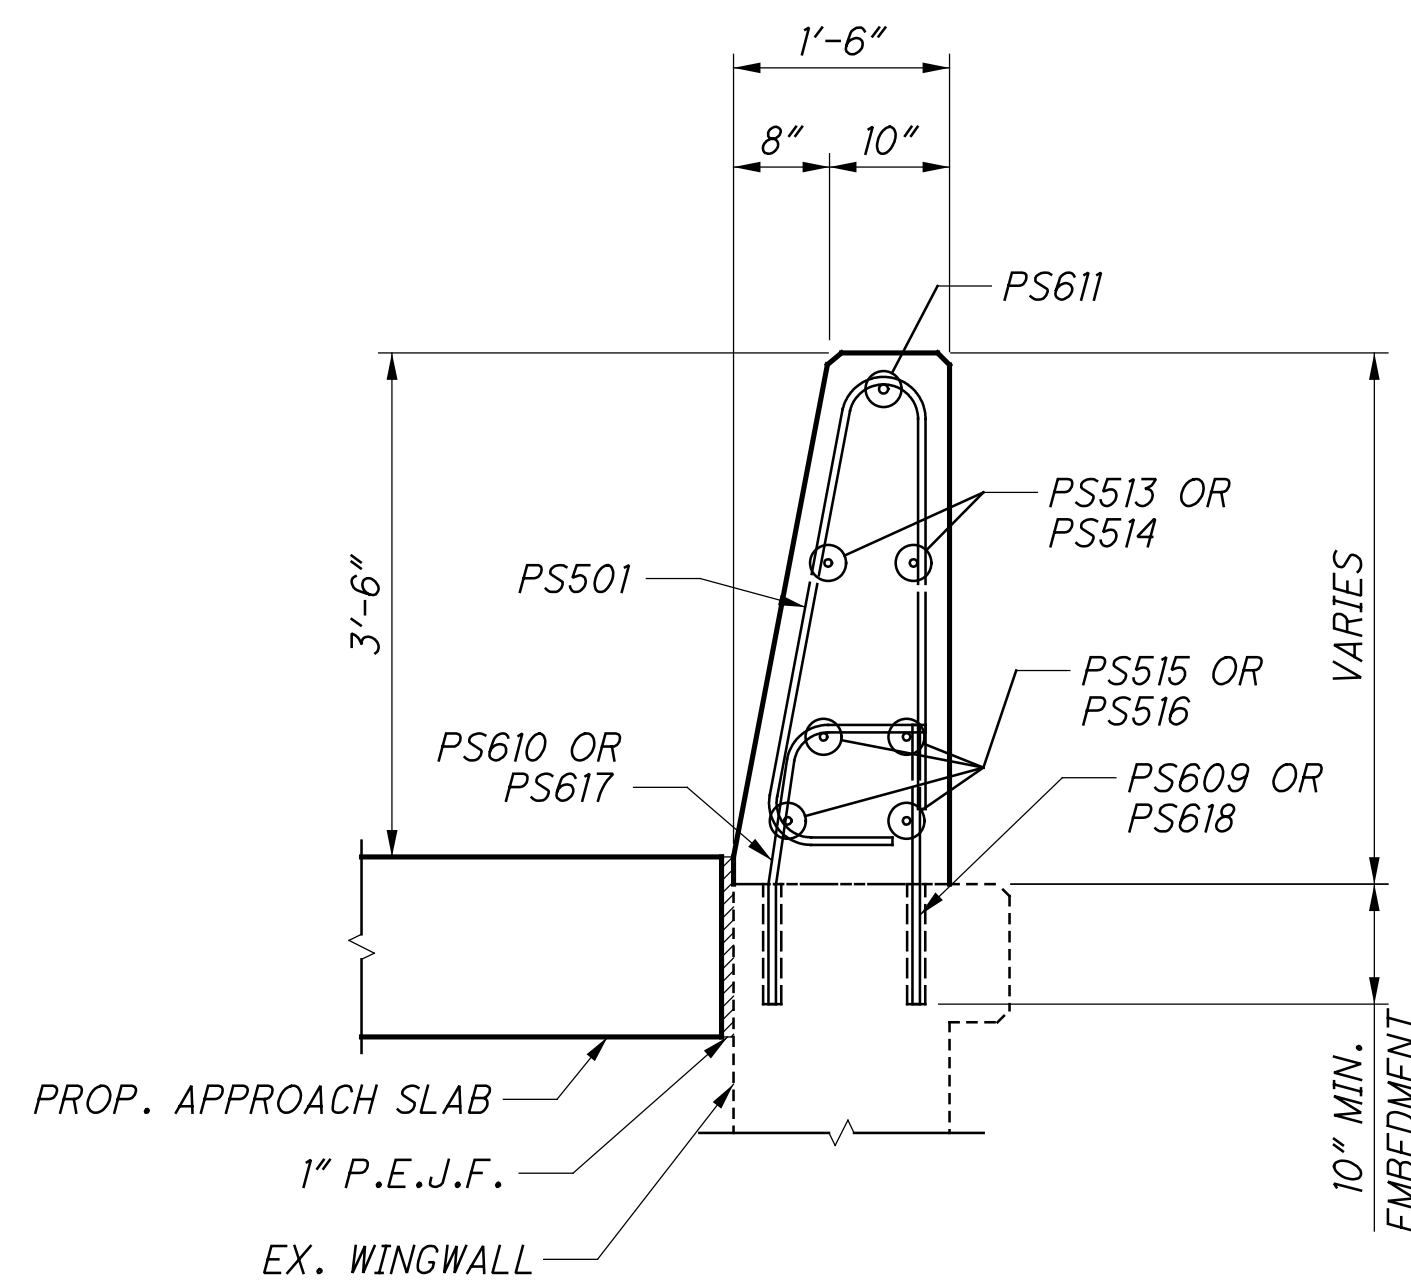


SECTION A-A

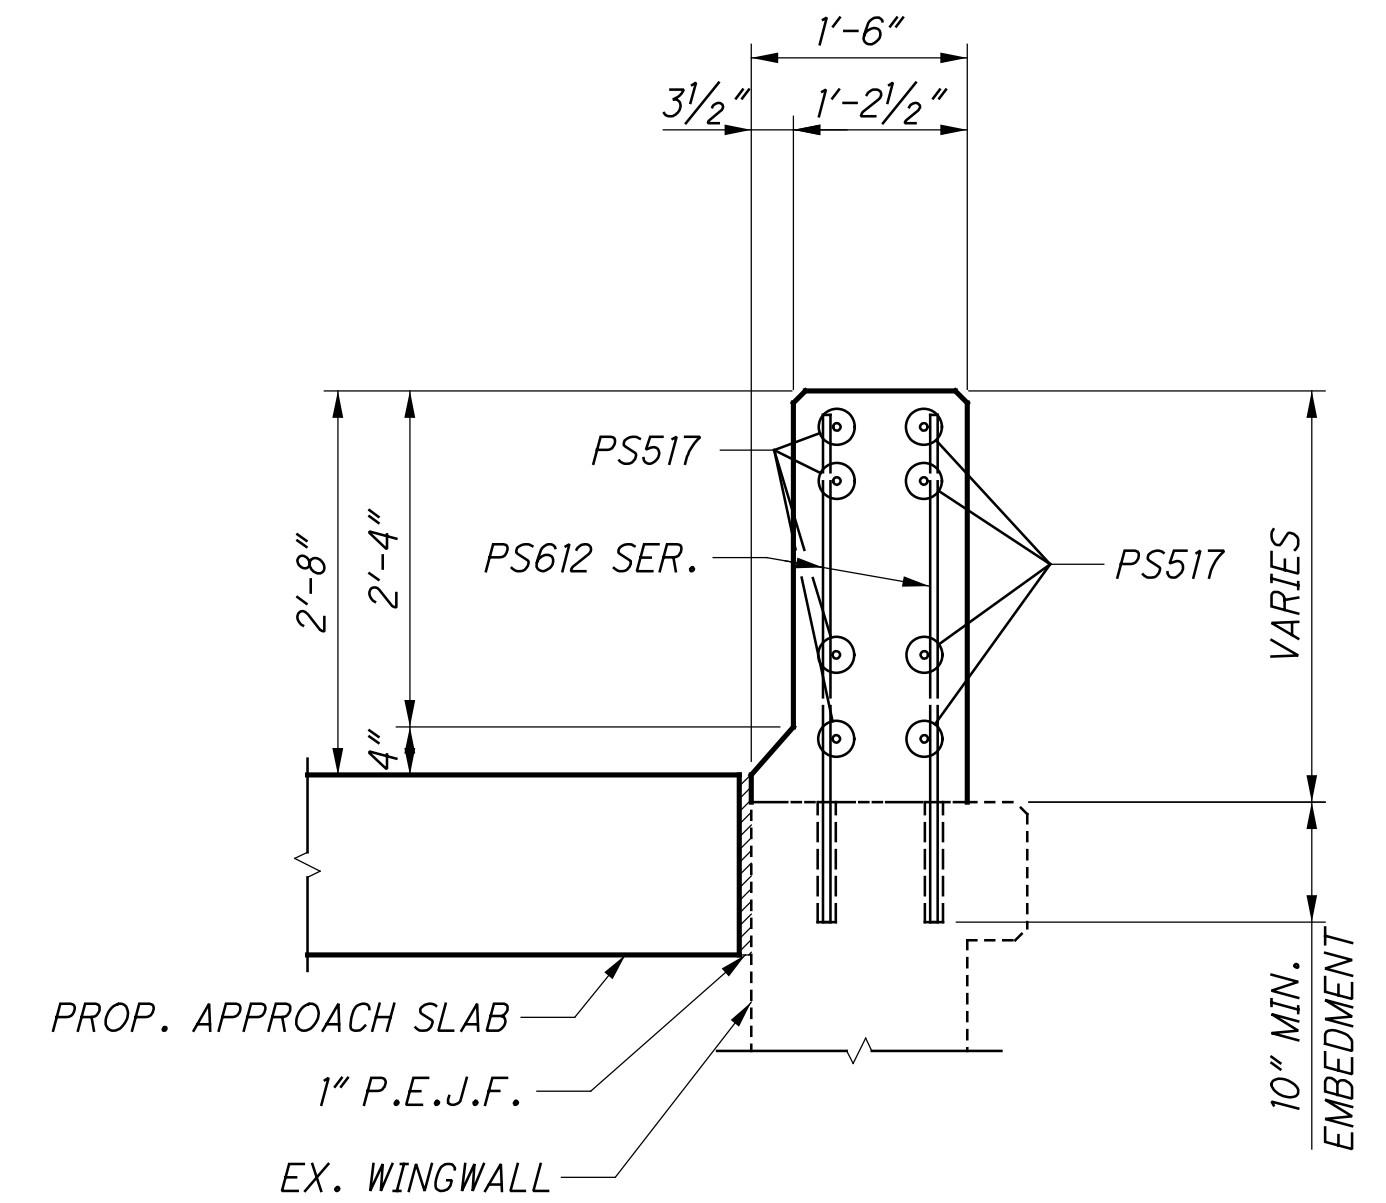

SECTION B-B

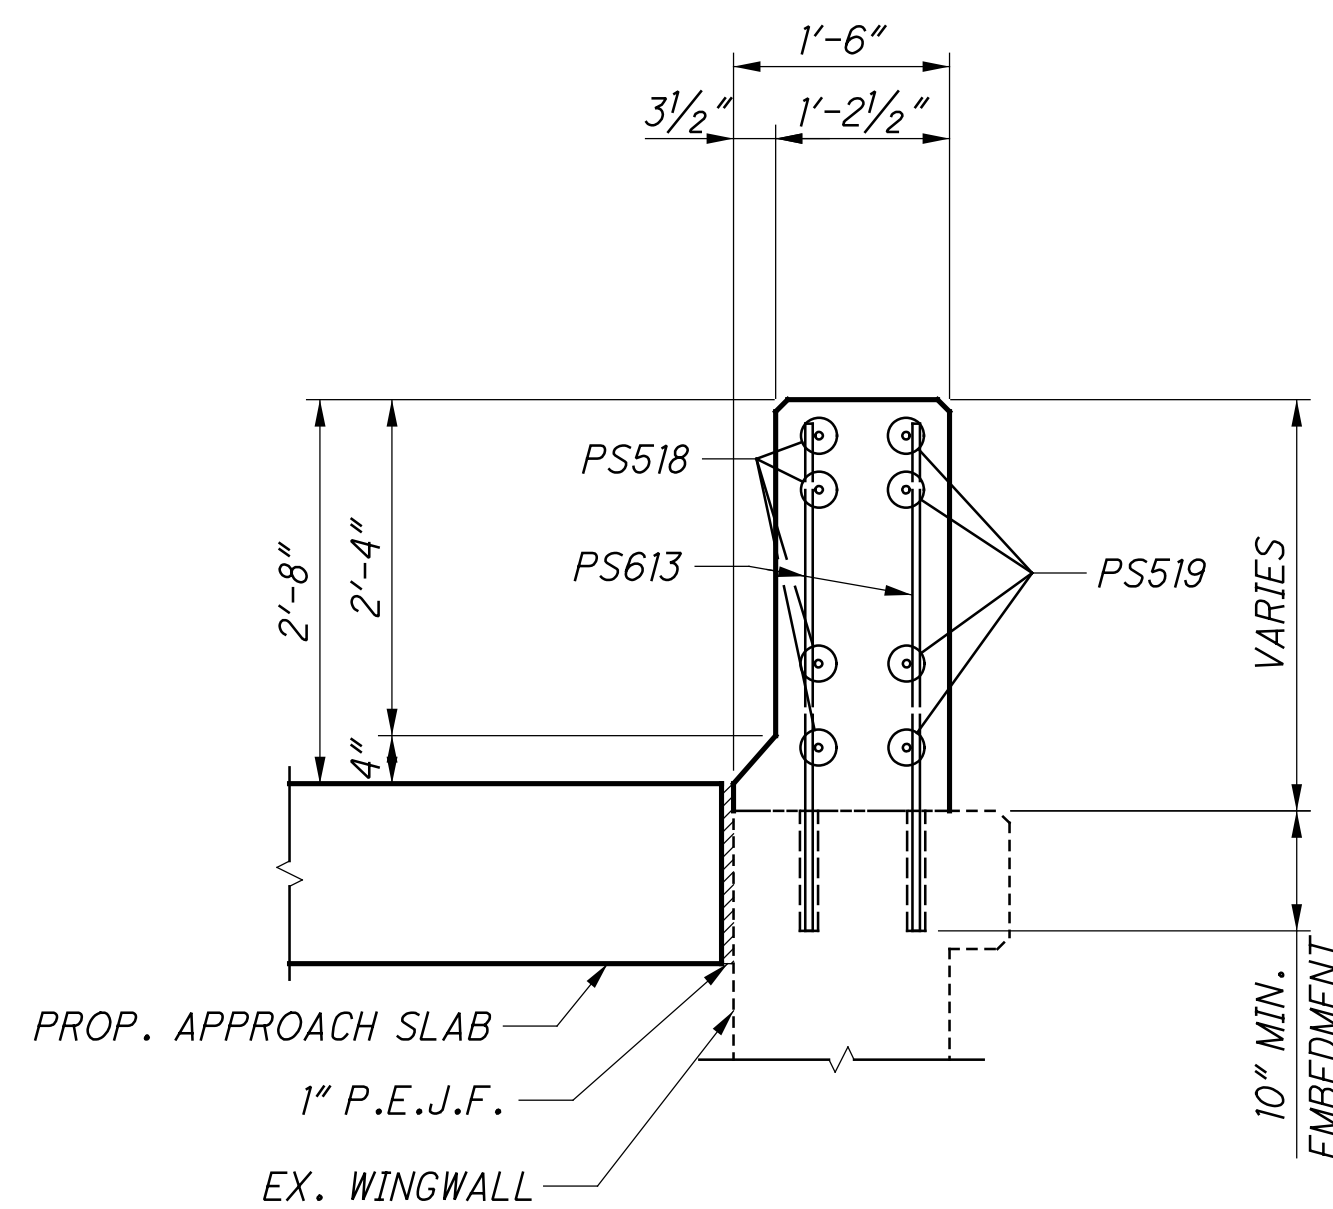

SECTION C-C

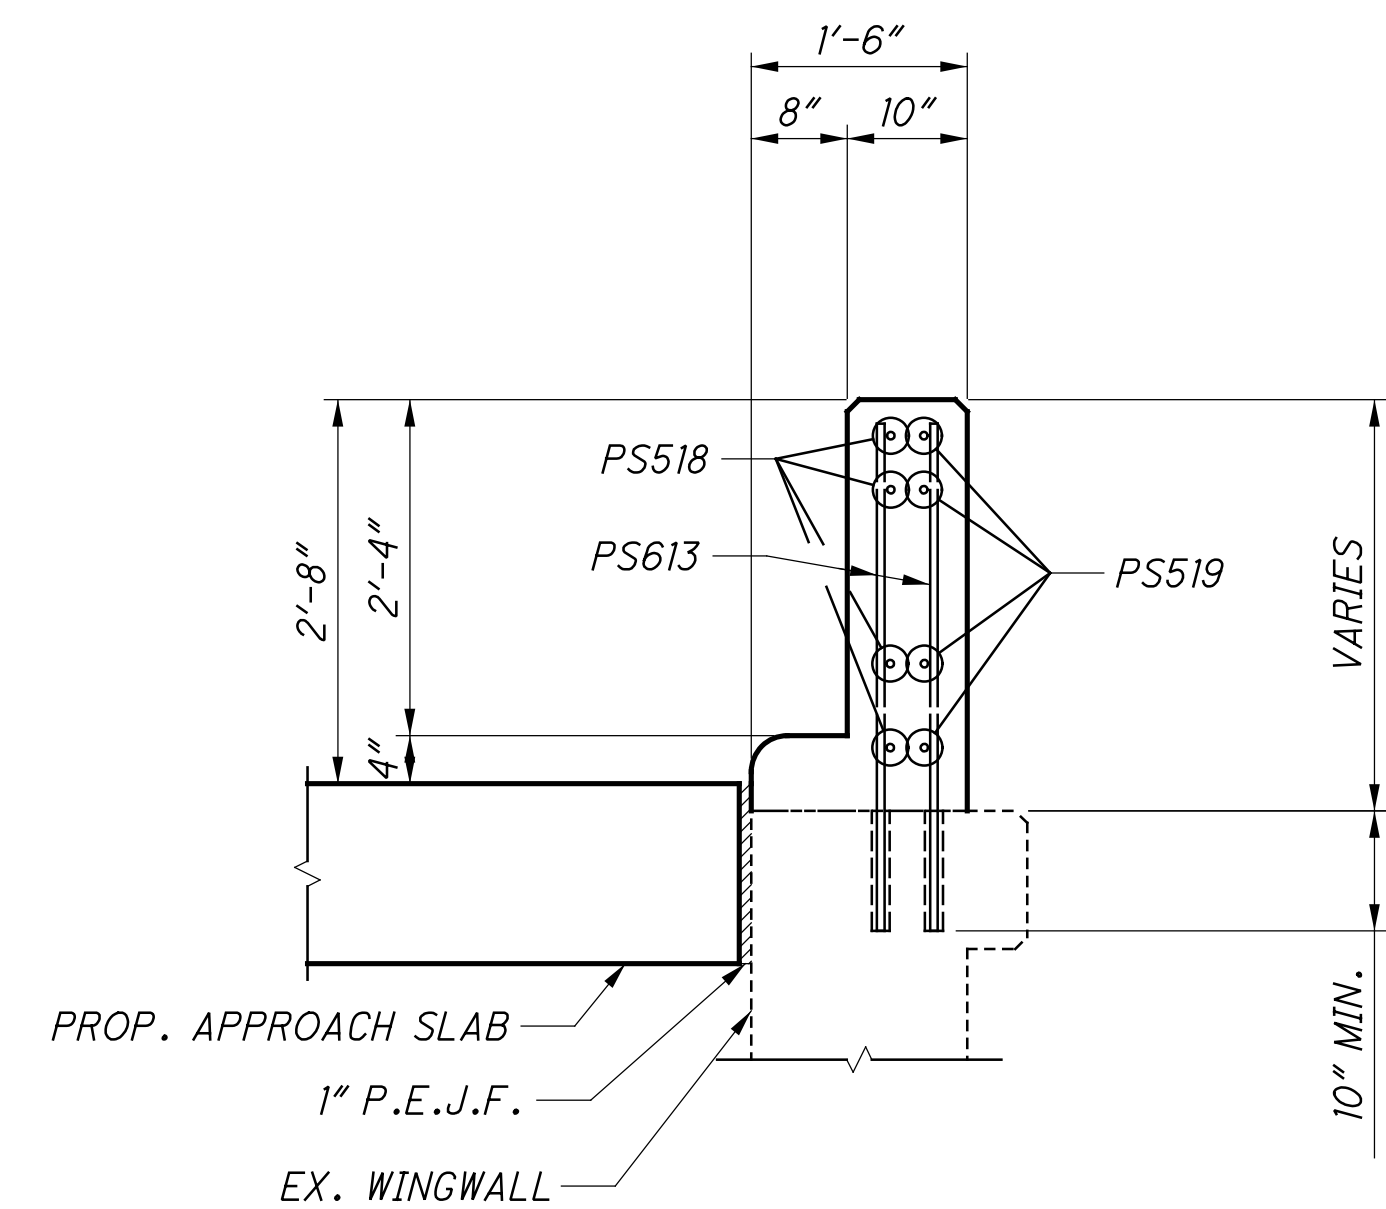

SECTION D-D

MINIMUM BAR LAP	
#5	2'-7"

NOTES:

- SEE STANDARD BRIDGE DRAWING SBR-1-13 FOR ADDITIONAL DETAILS.


DESIGN AGENCY: **STRUCTUREPOINT**
 DATE: 11/12/18
 REVIEWED: MDS
 DRAWN: DSH
 CHECKED: SUJ
 DESIGNED: SUJ
 FILE NUMBER: 3115526
 STRUCTURE FILE NUMBER: 3115526
 CLB
 CLB

PARAPET DETAILS (RIGHT BRIDGE)
 BRIDGE NO. HAM-74-1840 L/R
 OVER SB BEEKMAN ST. (U.S. 27) AND RAMP F


HAM-75-3.84
 PID No. 104667

31 / 41
 32
 120


SFlanagan 11/16/2023 9:34:03 AM
 \\0\2017\01113\C.Design\104667-HAM-75-3.84\Design\Structures\HAM0074_1840C\Sheets\74_1840RA004.dgn

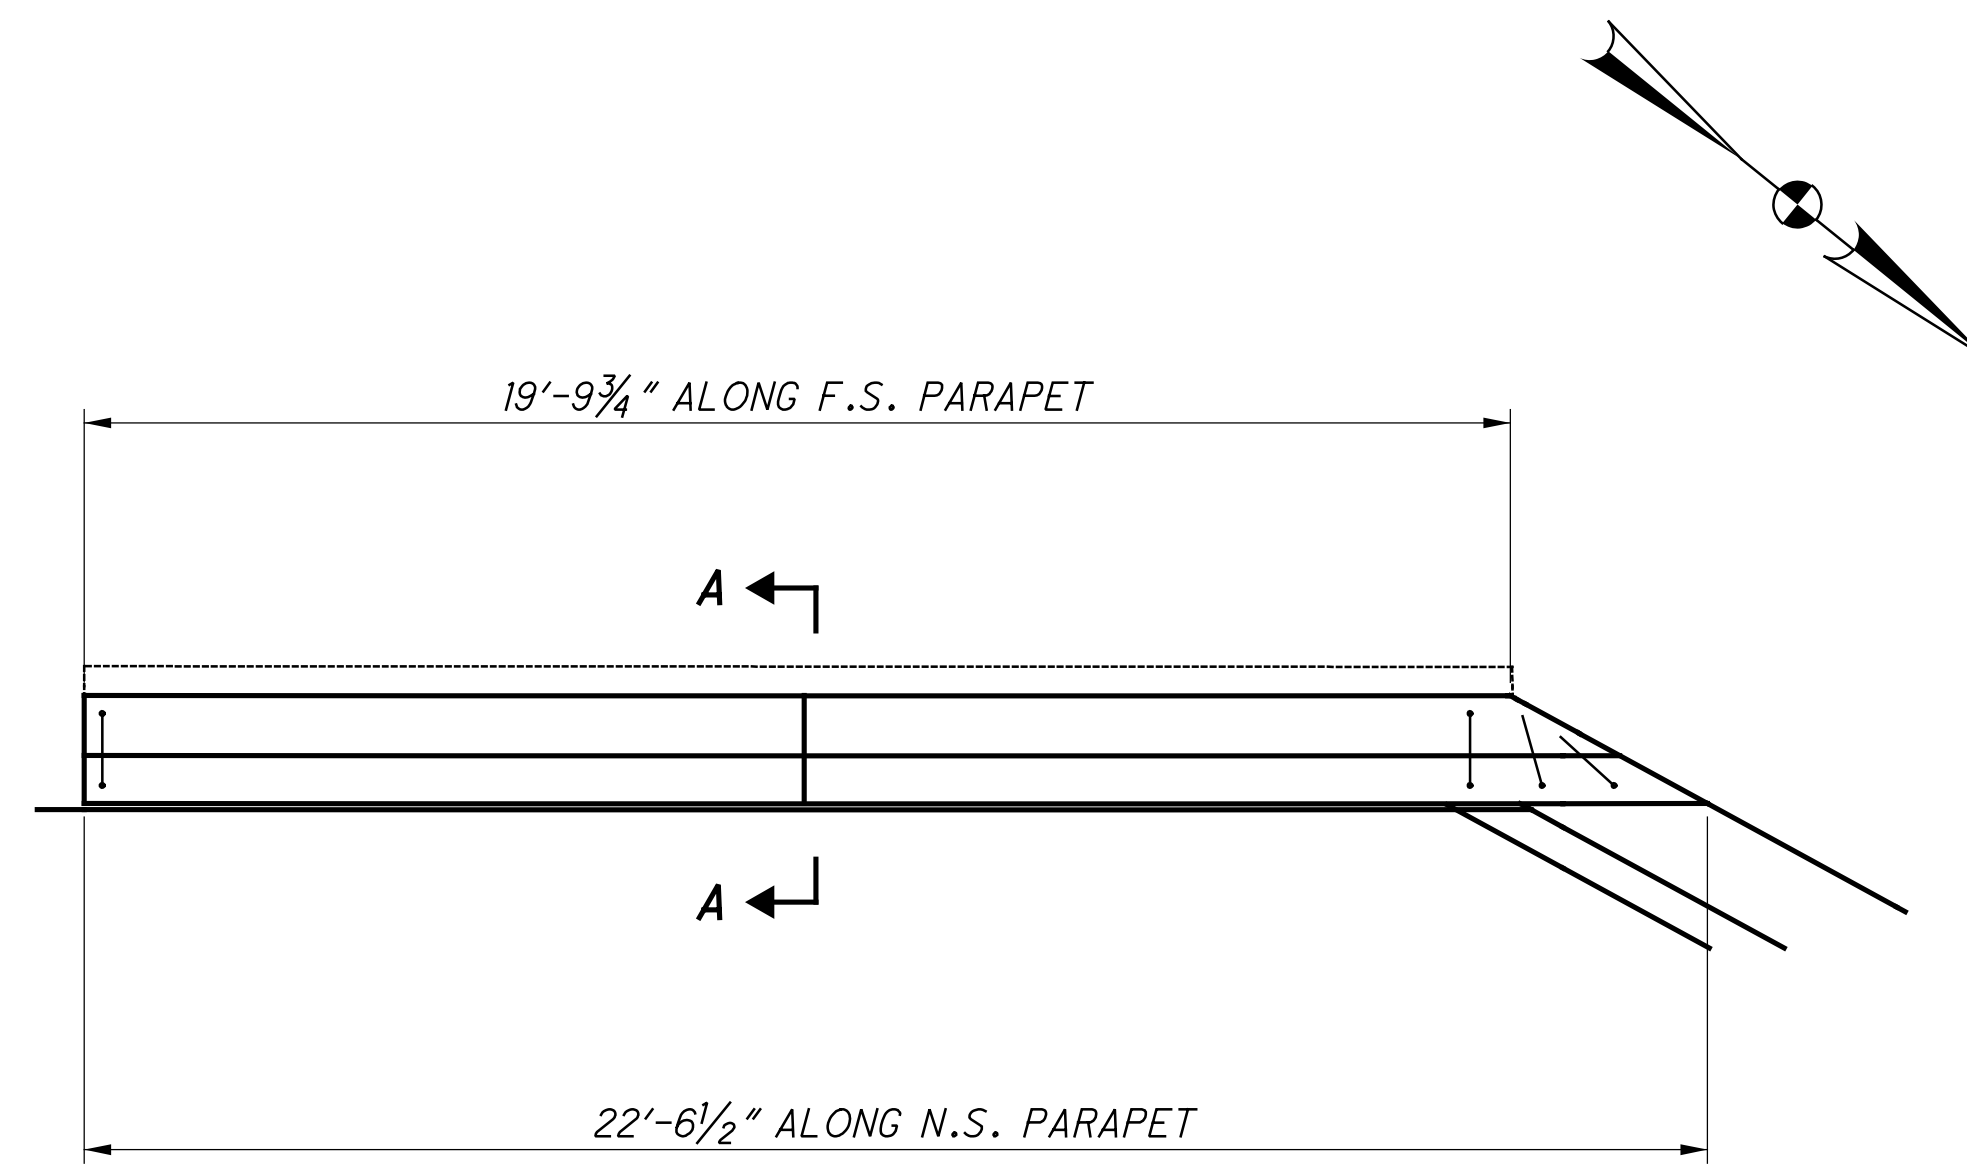

PARAPET PLAN
 AT SOUTH WINGWALL FORWARD ABUTMENT

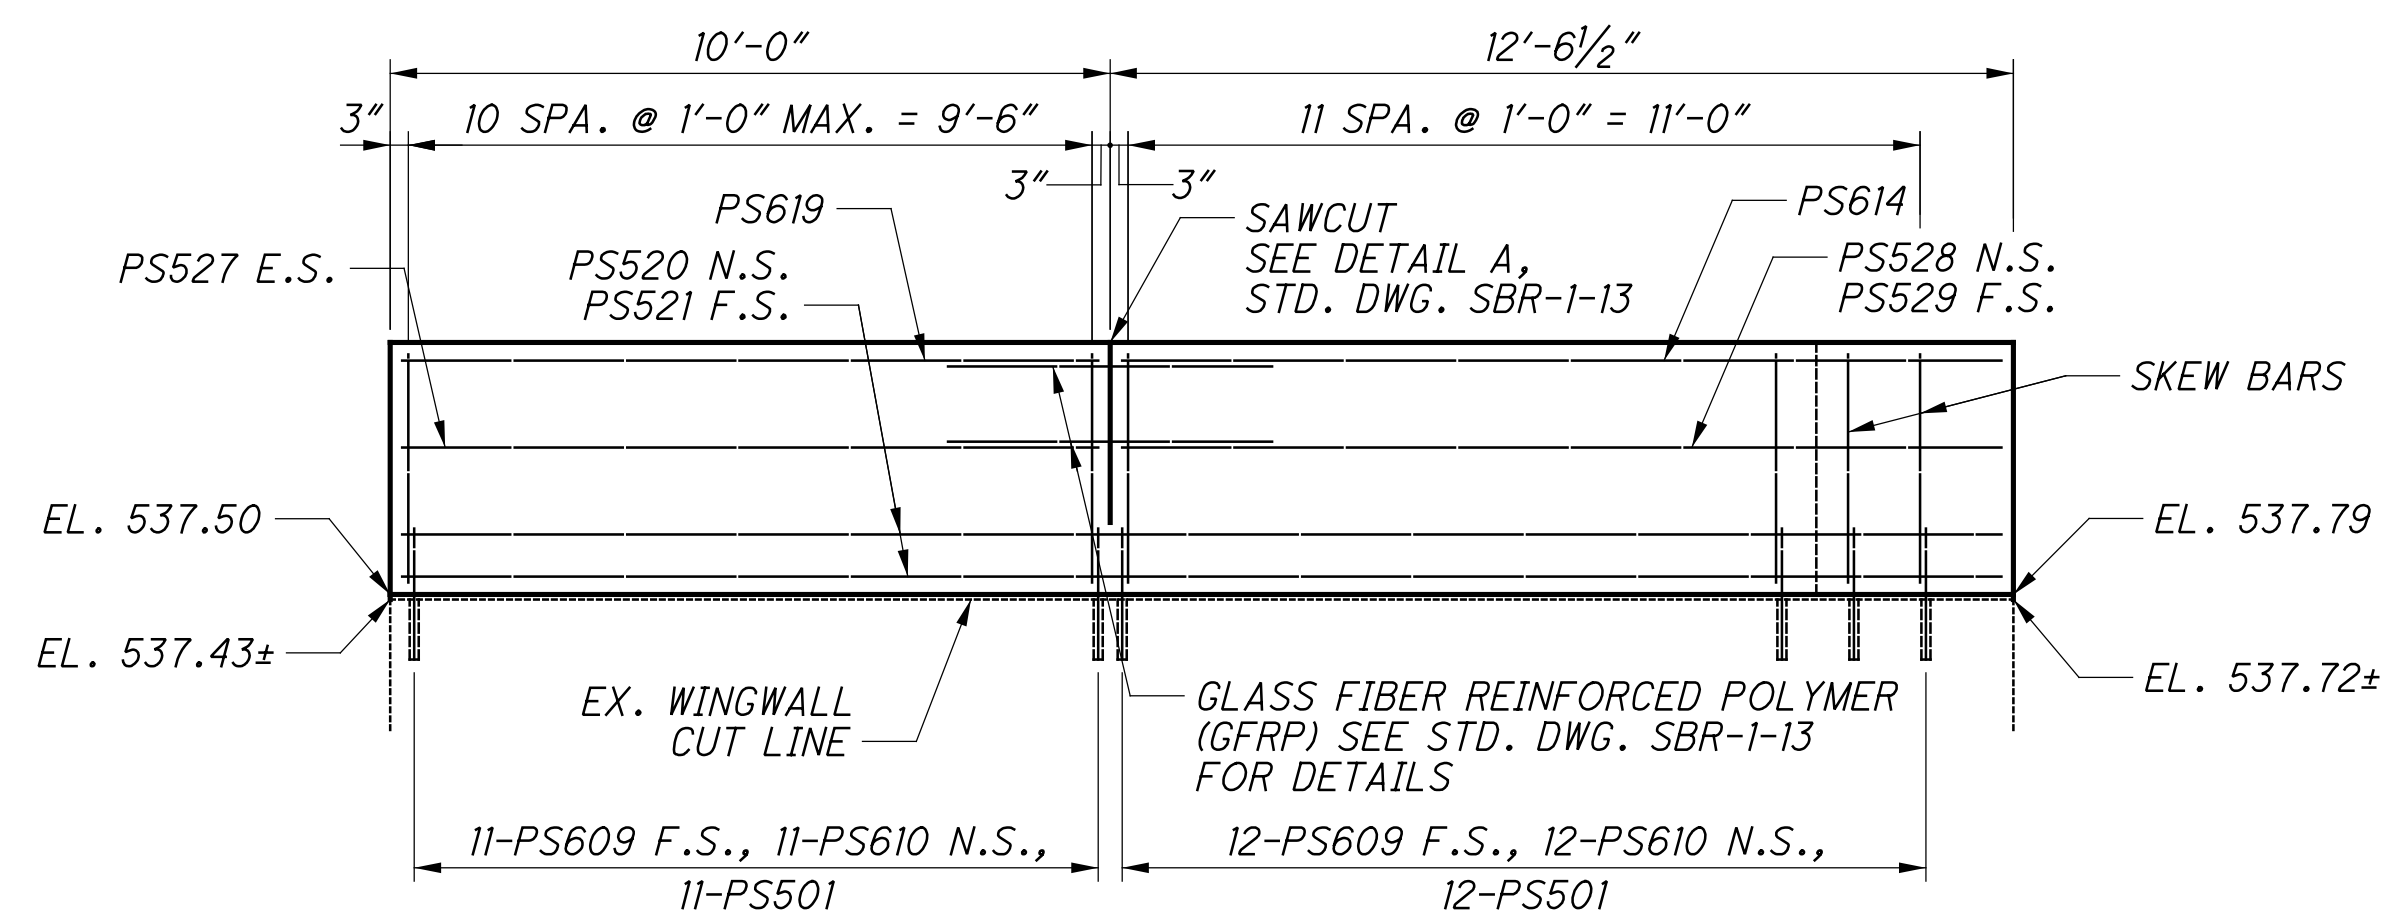

PARAPET ELEVATION
 AT SOUTH WINGWALL FORWARD ABUTMENT

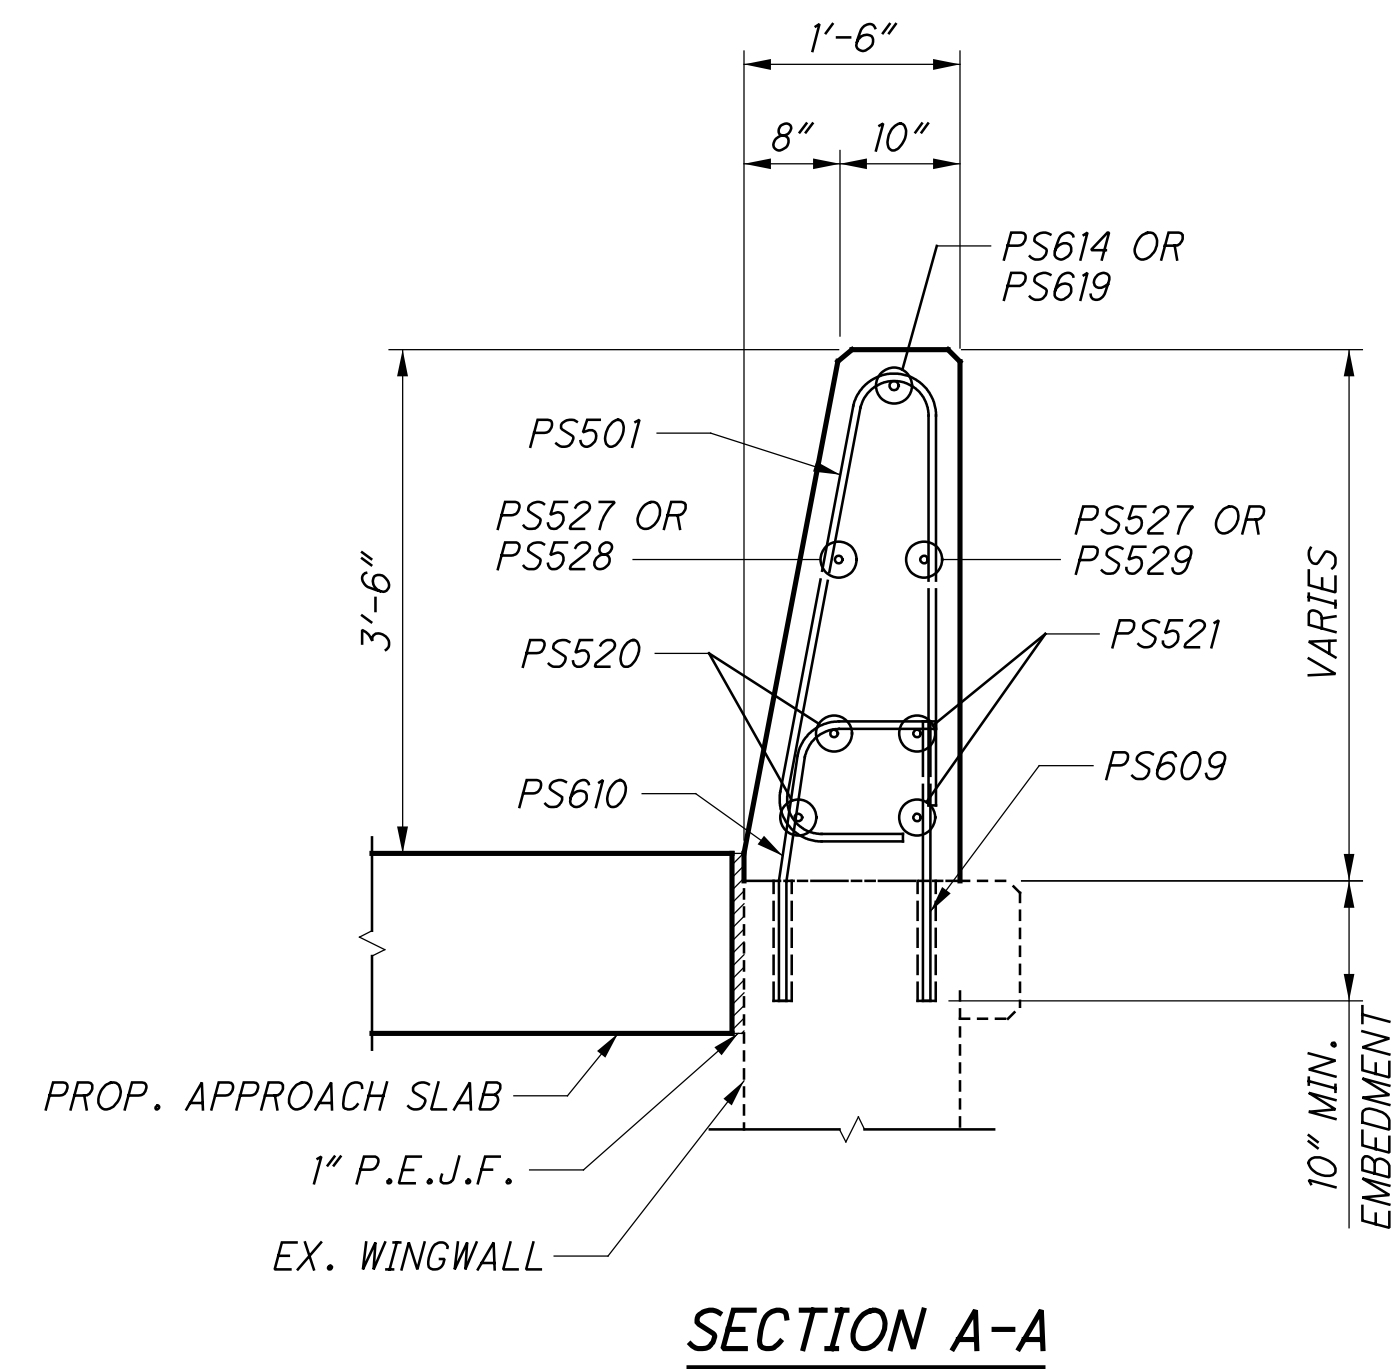

SECTION A-A


NOTES:

1. SEE STANDARD BRIDGE DRAWING SBR-1-13 FOR ADDITIONAL DETAILS.


DESIGNED	DATE	REVIEWED	DATE
SUF	11/12/18	MDS	11/12/18
CHECKED	FILE NUMBER	STRUCTURE	FILE NUMBER
CLB		3115526	

PARAPET DETAILS (RIGHT BRIDGE)
 BRIDGE NO. HAM-74-1840 L/R
 OVER SB BEEKMAN ST., (U.S. 27) AND RAMP F


HAM-75-3.84
 PID No. 104667

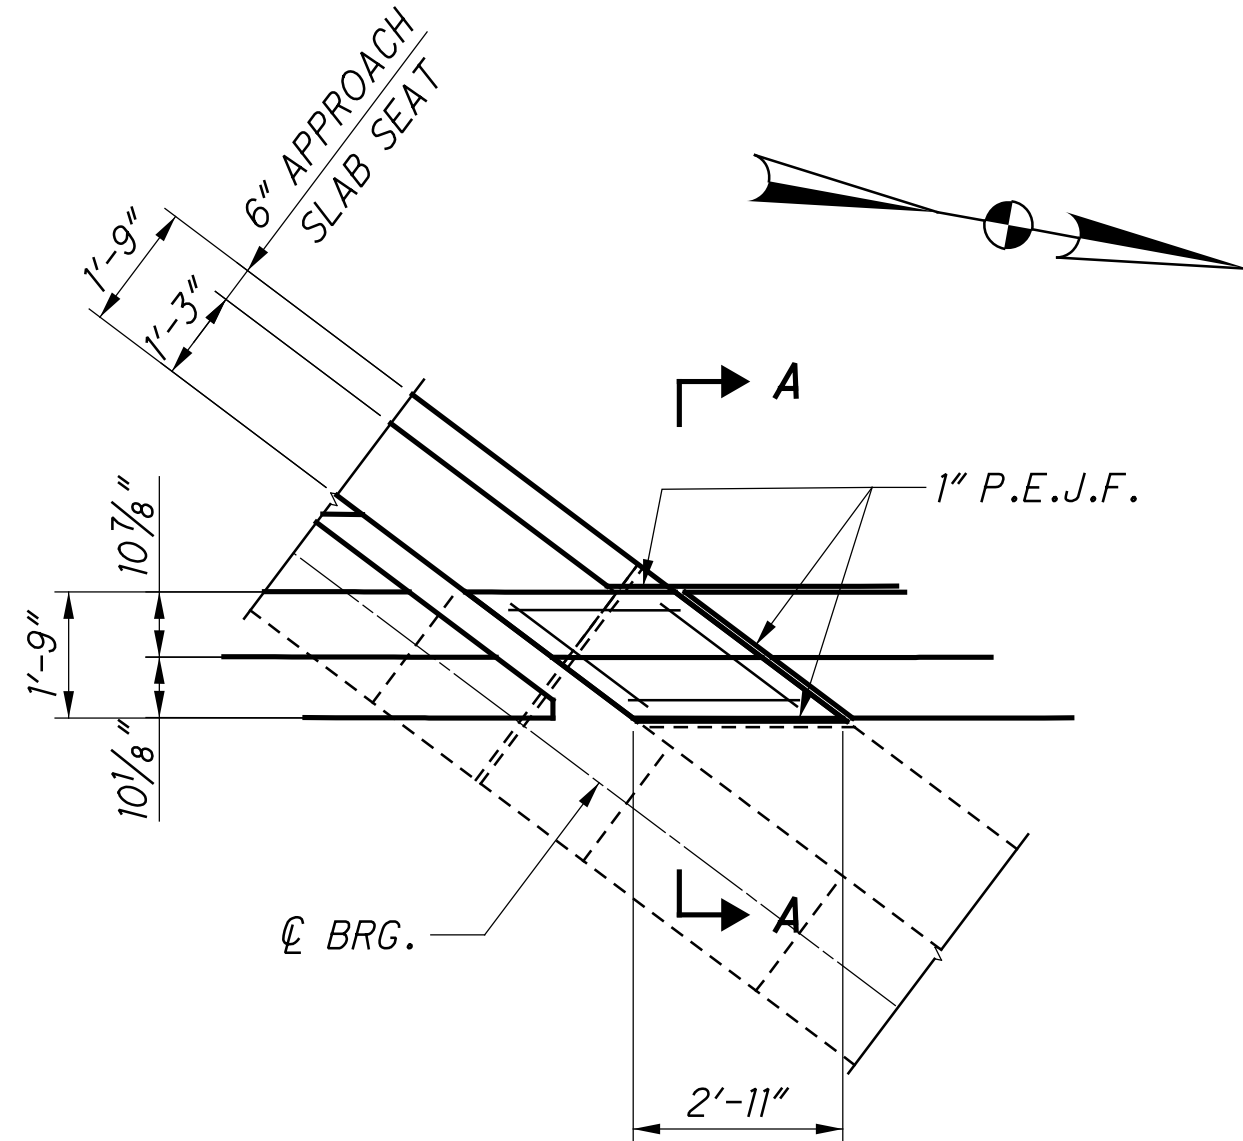


PLAN AT MEDIAN - REAR ABUTMENT

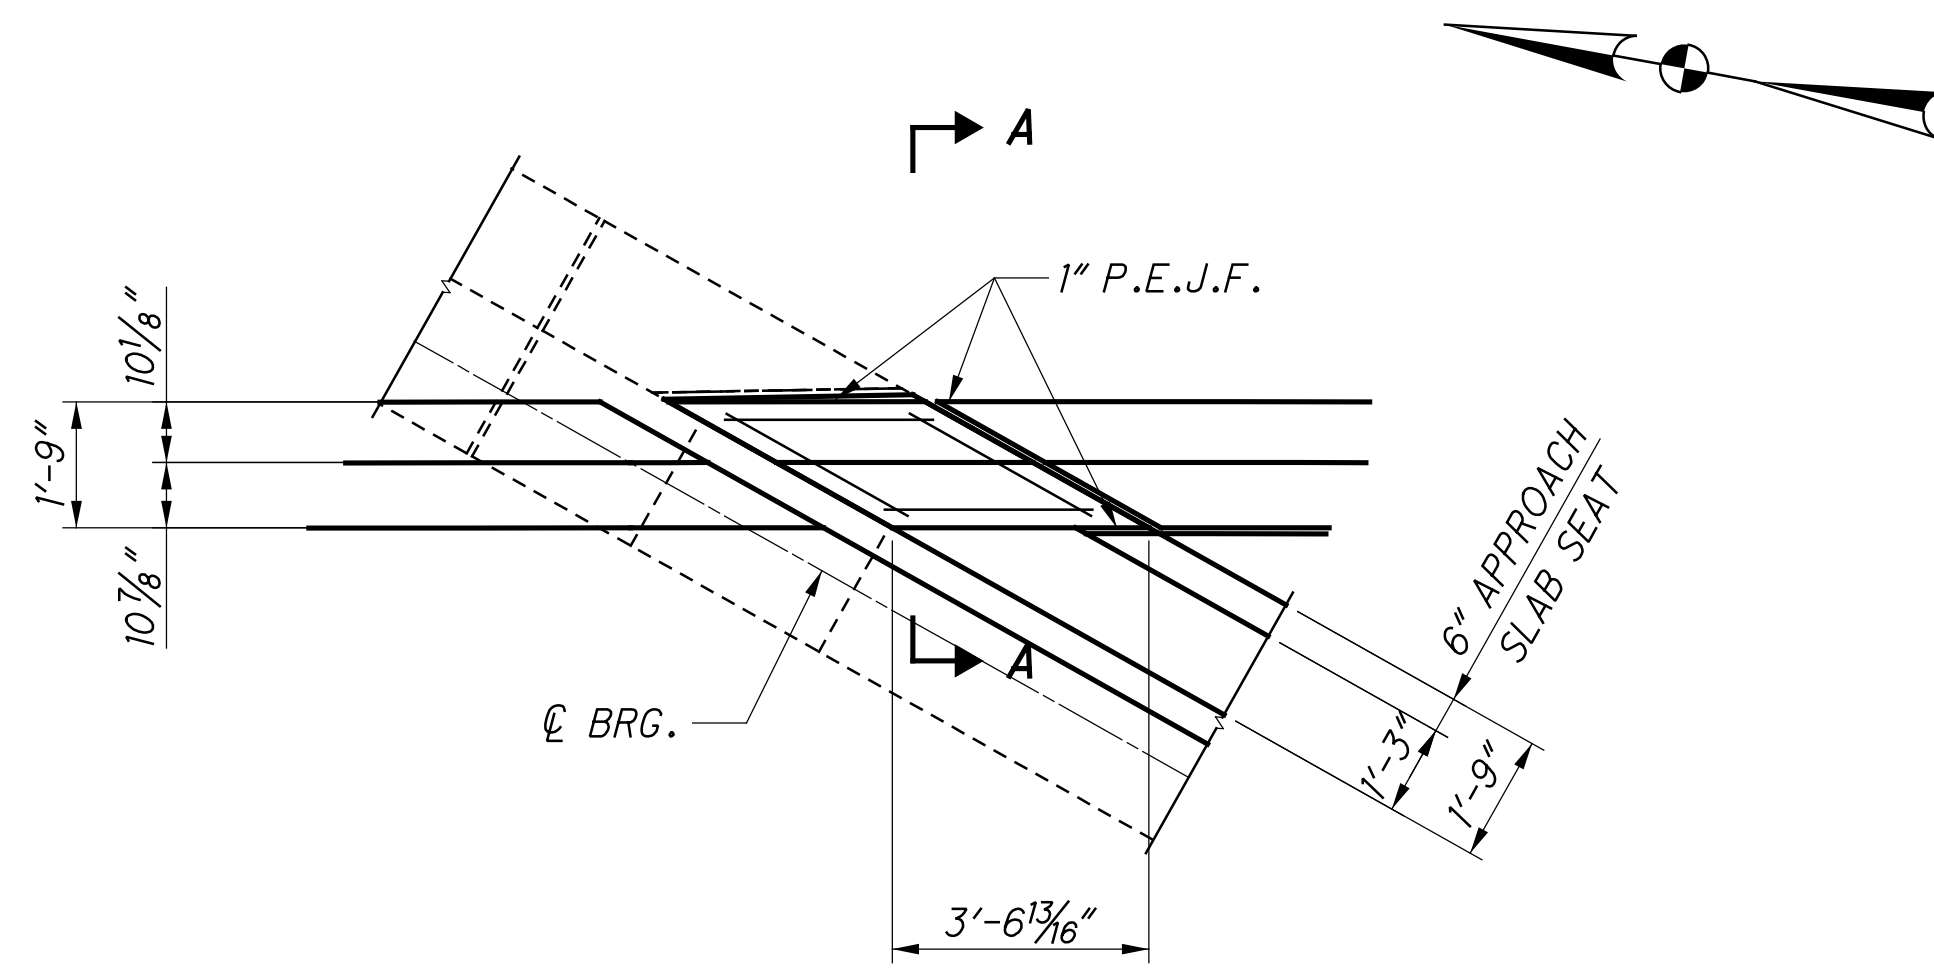


PLAN AT MEDIAN - FORWARD ABUTMENT

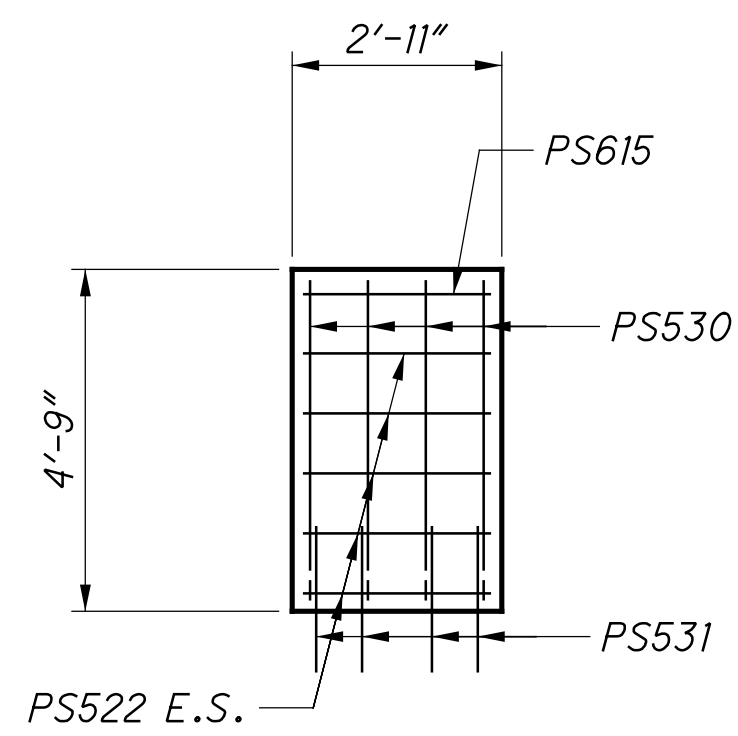

ELEVATION AT MEDIAN - REAR ABUTMENT

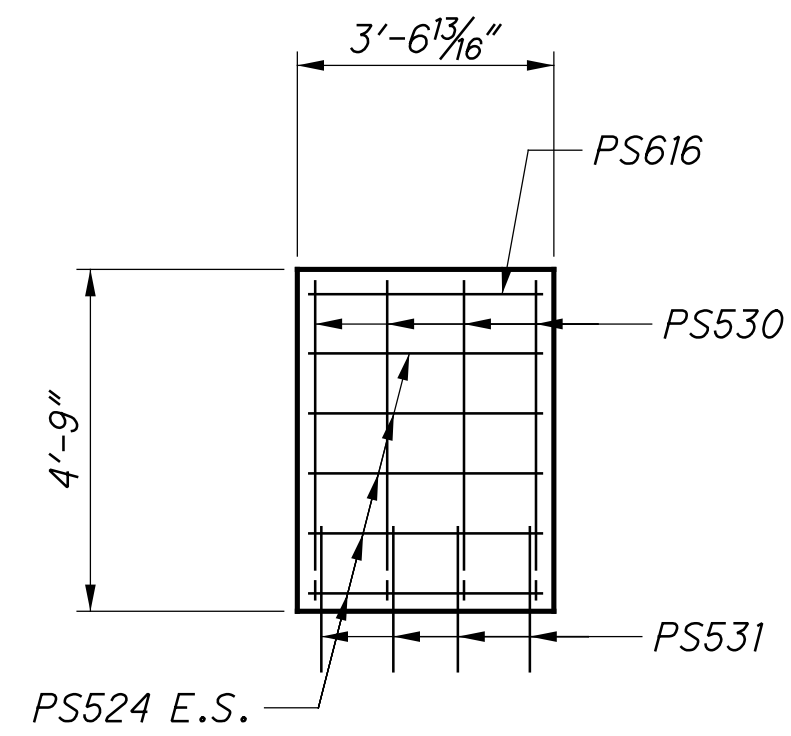

ELEVATION AT MEDIAN - FORWARD ABUTMENT

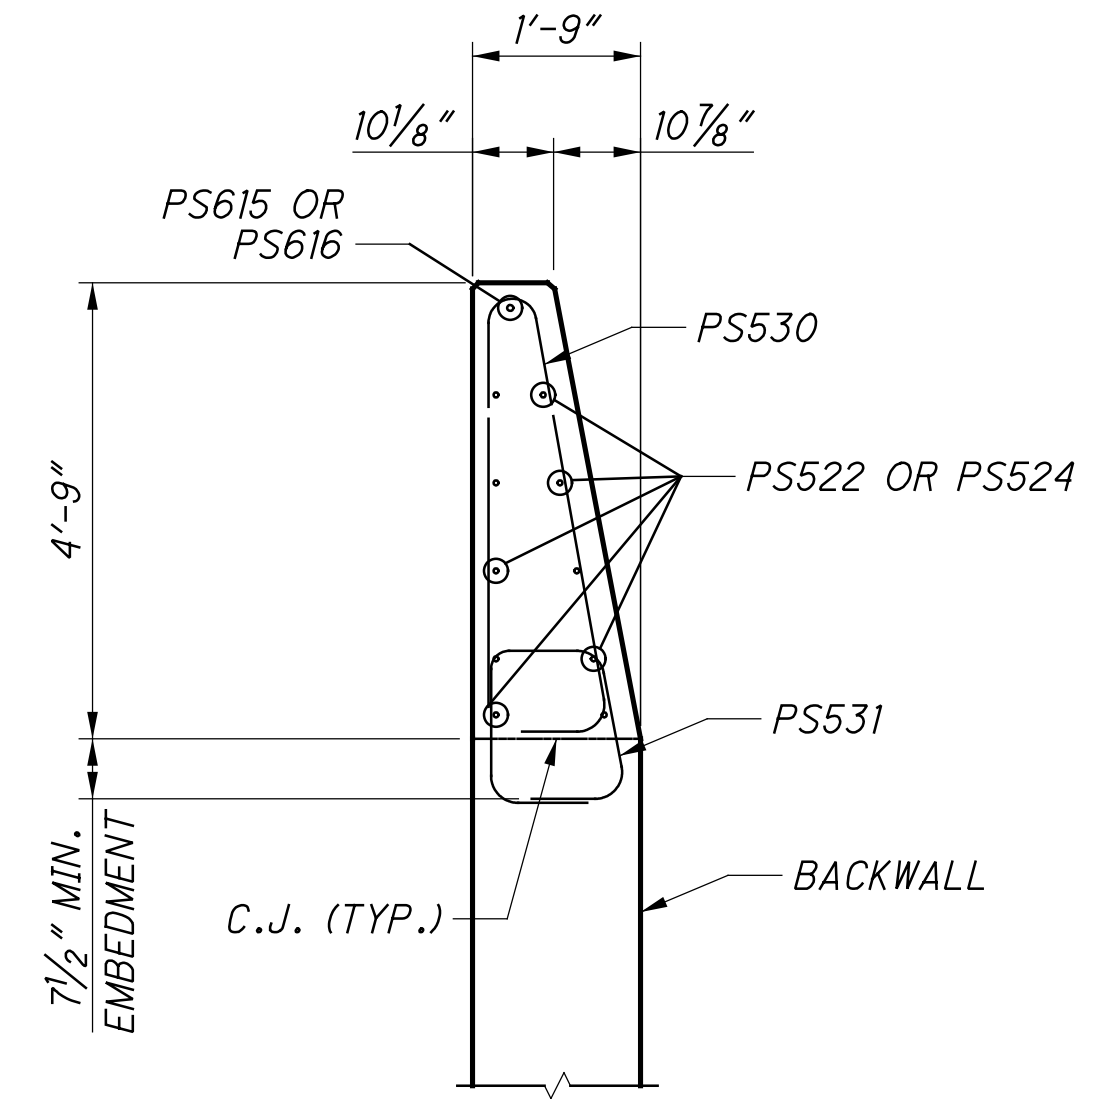


SECTION A-A

PARAPET DETAILS (RIGHT BRIDGE)
 BRIDGE NO. HAM-74-1840 L/R
 OVER SB BEEKMAN ST. (U.S. 27) AND RAMP F

HAM-75-3.84
PID No. 104667

DESIGNED	REVIEWED	DATE
SUF	MDS	11/12/18
CHECKED	STRUCTURE FILE NUMBER	
CLB	REVISED	3115526


BRIDGE	BEARING SCHEDULE									BEVELED STEEL SOLE PLATE L x W	1/2" STEEL LOAD PLATE L x W
	LOCATION	ASSEMBLY TYPE	NO. OF BEARINGS	SIZE D x T	NO. OF STEEL LAMINATES	t_i	NO. OF t_i LAYERS	t_e	NO. OF t_e LAYERS		
LEFT	REAR ABUT.	EXPANSION	5	16 1/2" x 4 1/8"	8	0.406"	8	0.25"	1	1'-5 1/2" x 1-8"	1'-5 1/2" x 1-5 1/2"
LEFT	FWD. ABUT.	EXPANSION	5	16 1/2" x 3 1/8"	6	0.406"	6	0.25"	1	1'-5 1/2" x 1-8"	1'-5 1/2" x 1-5 1/2"
RIGHT	REAR ABUT.	EXPANSION	5	16 1/2" x 4 1/8"	8	0.406"	8	0.25"	1	1'-5 1/2" x 1-8"	1'-5 1/2" x 1-5 1/2"
RIGHT	FWD. ABUT.	EXPANSION	5	16 1/2" x 3 1/8"	6	0.406"	6	0.25"	1	1'-5 1/2" x 1-8"	1'-5 1/2" x 1-5 1/2"

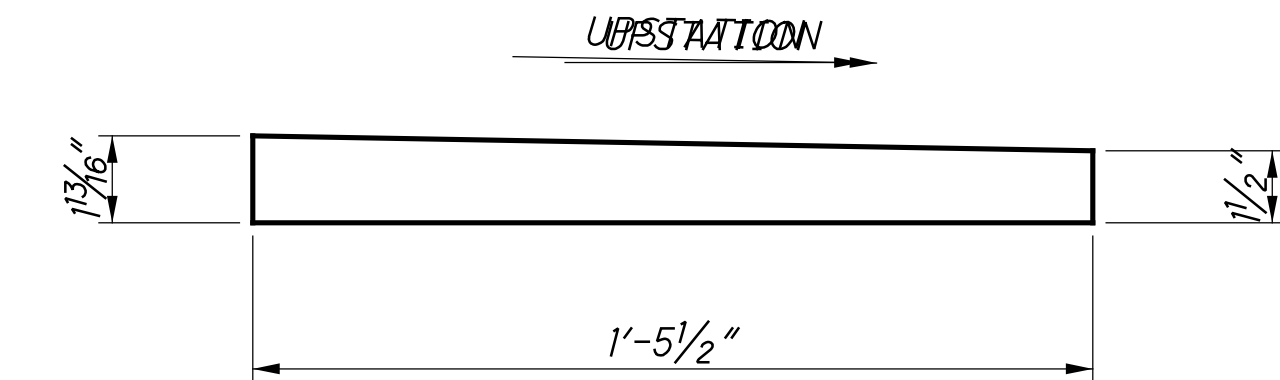


BEVELED SOLE PLATE

UNFACTORED ELASTOMERIC BEARING LOADS:


	R.A.	F.A.
DEAD LOAD	= 69 K	85 K
LIVE LOAD	= 60 K	85 K
TOTAL LOAD	= 129 K	170 K

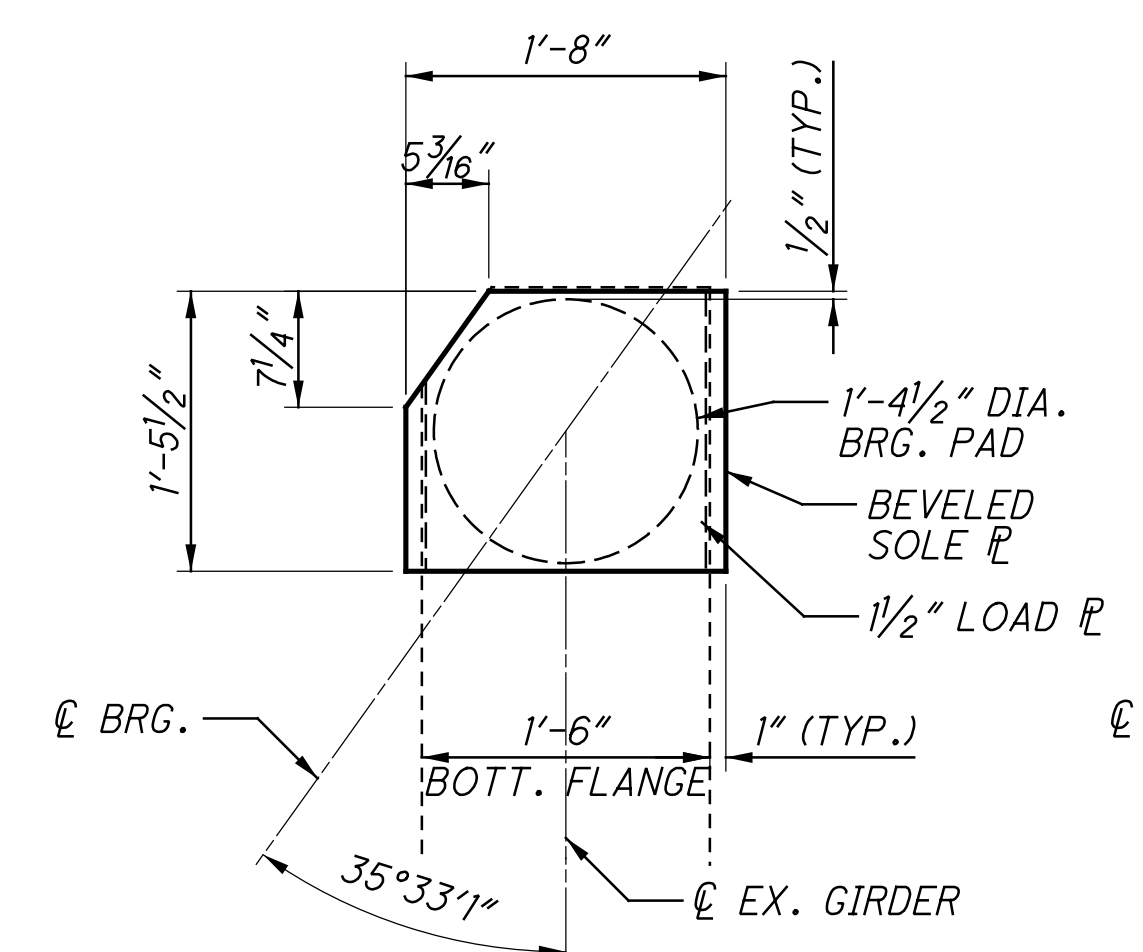


PLAN @ R.A.

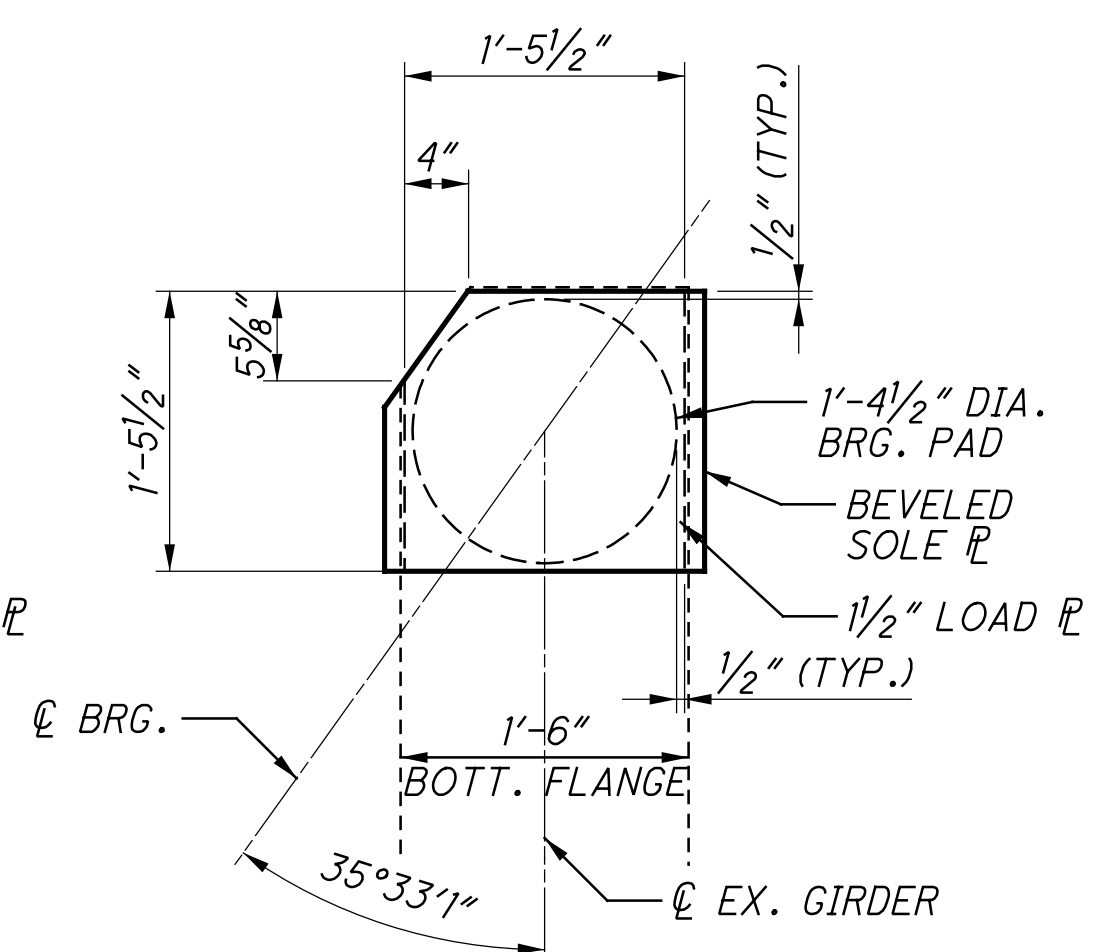

**R.A. LOAD PLATE
DETAIL**


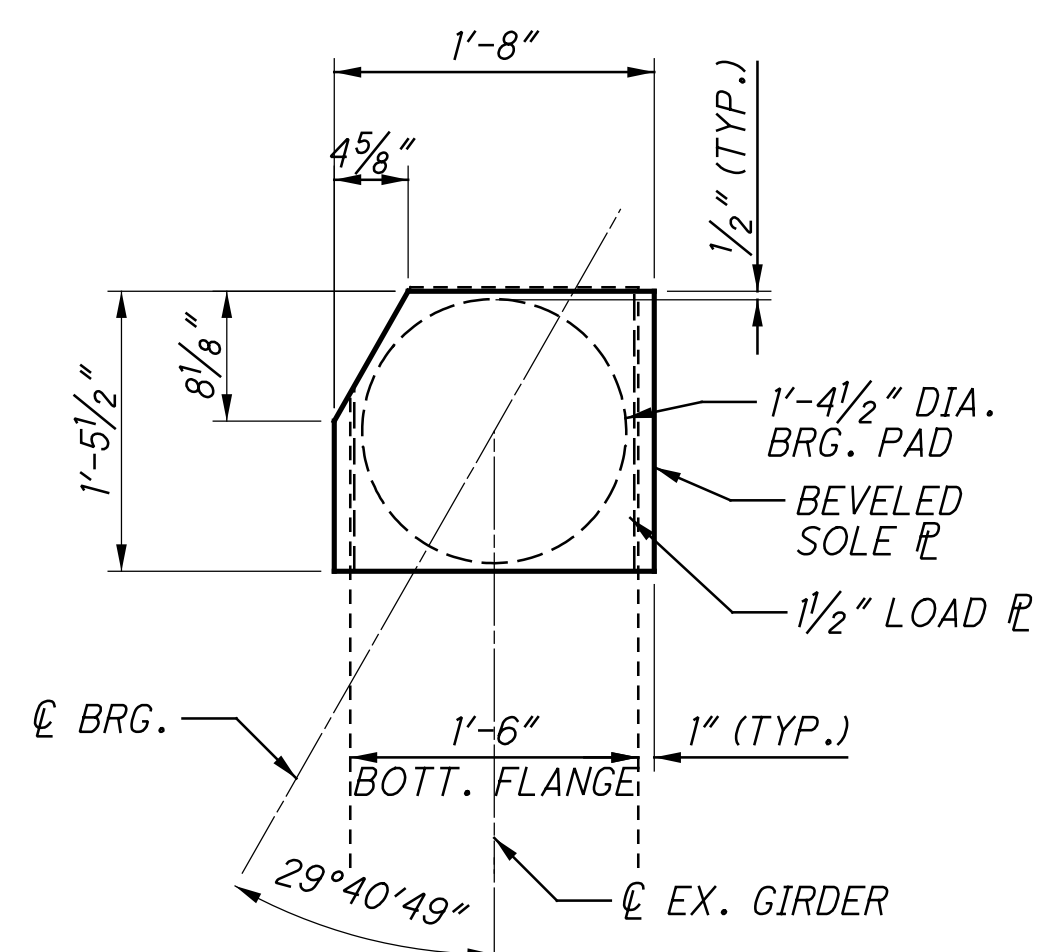


PLAN @ F.A.

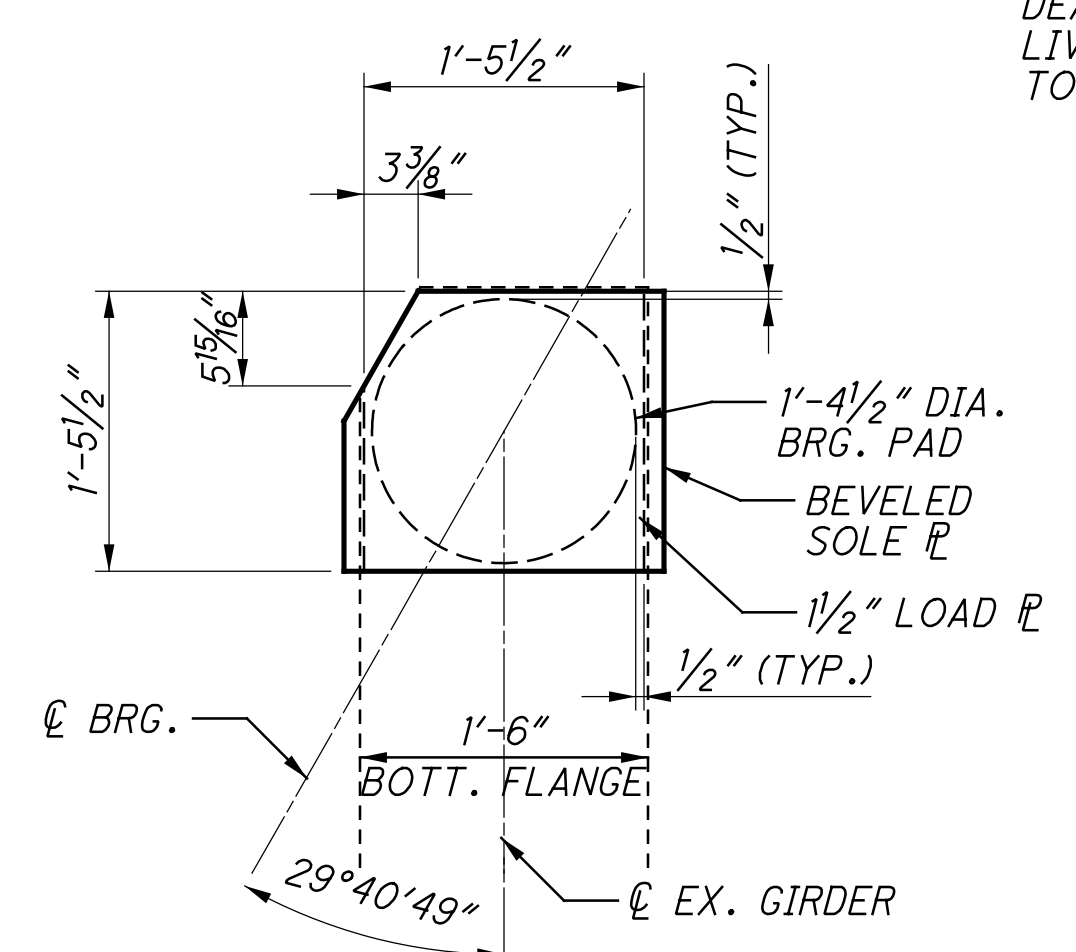

**F.A. LOAD PLATE
DETAIL**

LOCATION	REAR ABUTMENT		FWD. ABUTMENT	
	A	B	A	B
G1	1'-1 9/16"	6 7/32"	1'-1 7/16"	7 5/32"
G2	1'-1 1/16"	6 13/32"	1'-2 1/8"	7 7/32"
G3	1'-1 7/8"	6 19/32"	1'-2"	7 23/32"
G4	1'-1 7/8"	6 19/32"	1'-2 3/16"	7 29/32"
G5	1'-1 5/16"	6 27/32"	1'-1 7/8"	7 19/32"
G6	1'-1 5/16"	6 5/8"	1'-1 3/16"	7 1/2"
G7	1'-1 5/16"	6 5/8"	1'-1 5/16"	7 5/8"
G8	1'-1 5/16"	6 1/2"	1'-1 3/16"	7 1/2"
G9	1'-1 5/16"	6 5/8"	1'-1 5/16"	7 5/8"
G10	1'-1 5/16"	6 5/8"	1'-1 5/16"	7 5/8"

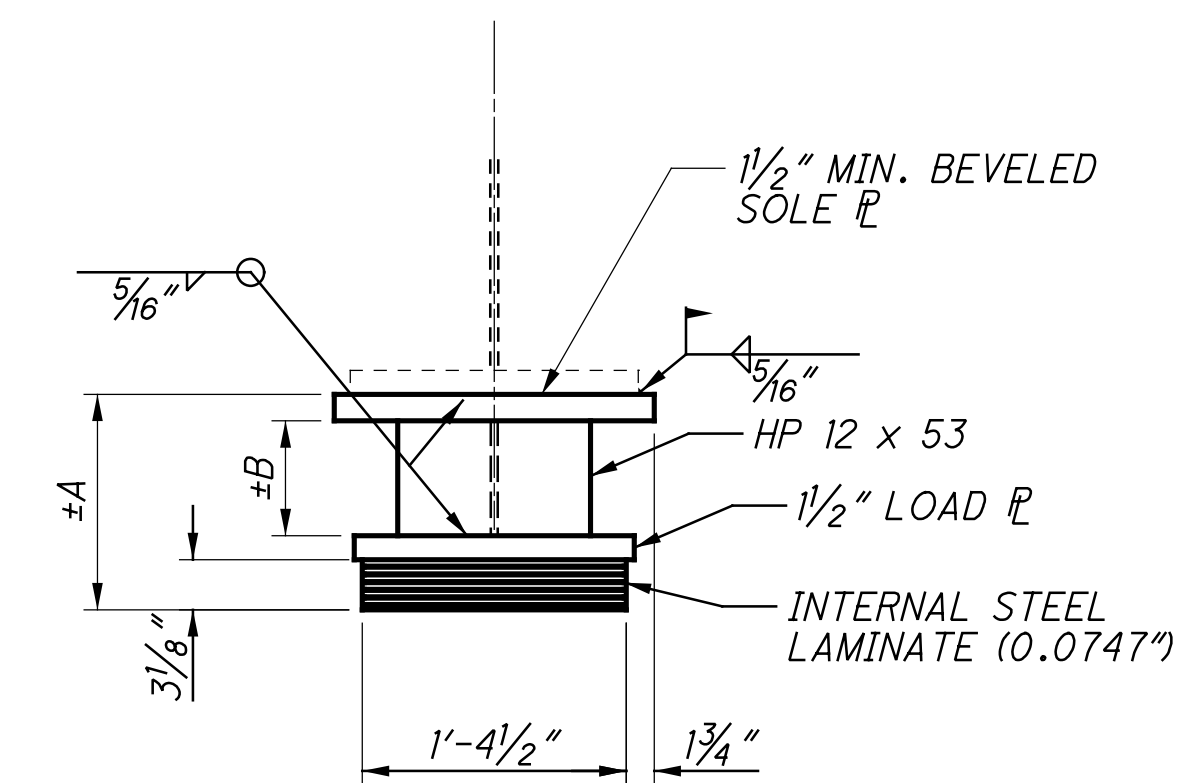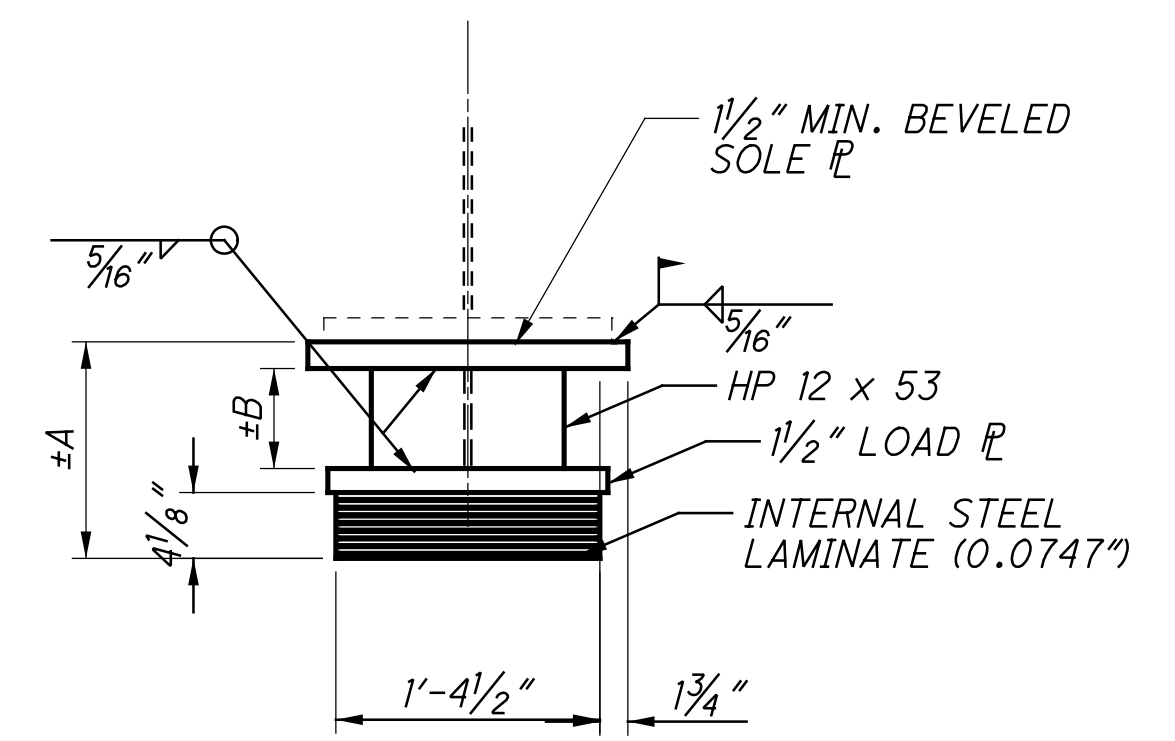

EXPANSION BEARINGS AT ABUTMENTS


NOTES:

- THE ELASTOMER SHALL HAVE A HARDNESS OF 50 DUROMETER. THE BEARINGS WERE DESIGNED UNDER DIVISION 1, SECTION 14.6.6 (METHOD A) OF THE AASHTO STANDARD SPECIFICATION FOR HIGHWAY BRIDGES.
- THE STEEL LOAD PLATES FOR ELASTOMERIC BEARINGS SHALL CONFORM TO THE REQUIREMENTS OF ASTM A709, GRADE 50. THE LOAD PLATE SHALL BE BONDED BY VULCANIZATION TO THE ELASTOMER DURING THE MOLDING PROCESS. STRUCTURAL STEEL LOAD PLATES SHALL BE PAINTED PER CMS 513 AND 514.
- ALL BEARINGS SHALL BE MARKED PRIOR TO SHIPPING. THE MARKS SHALL INCLUDE THE BEARING LOCATION ON THE BRIDGE, AND A DIRECTION ARROW THAT POINTS UP-STATION. ALL MARKS SHALL BE PERMANENT AND BE VISIBLE AFTER THE BEARING IS INSTALLED.
- CONTRACTOR SHALL VERIFY EXISTING BEARING HEIGHT PRIOR TO FABRICATION OF PROPOSED BEARING.

S:\Plans\gen 9-34-04 AM 11/16/2023 0:\2017\01113\C_Design\104667_HAM-75-3.84_Design\Structures\HAM0074_1840C_Sheets\7.4-1840BR001.dgn

DESIGN AGENCY: STRUCTUREPOINT
 DATE: 11/12/18
 REVIEWED: MDS
 DRAWN: SUJ
 DESIGNED: SUJ
 CHECKED: CLB
 STRUCTURE FILE NUMBER: 3115526
 BEARING DETAILS
 BRIDGE NO. HAM-74-1840 L/R
 OVER SB BECKMAN ST. (US 27) AND RAMP F
 HAM-75-3.84
 PID No. 104667
 34 / 41
 35
 120

SFlanagan 11/16/2023 9:34:05 AM
 O:\2017\01113\C.Design\104667-HAM-75-3.84\Design\Structures\HAM0074_1840C\Sheets\74_1840EX001.dgn

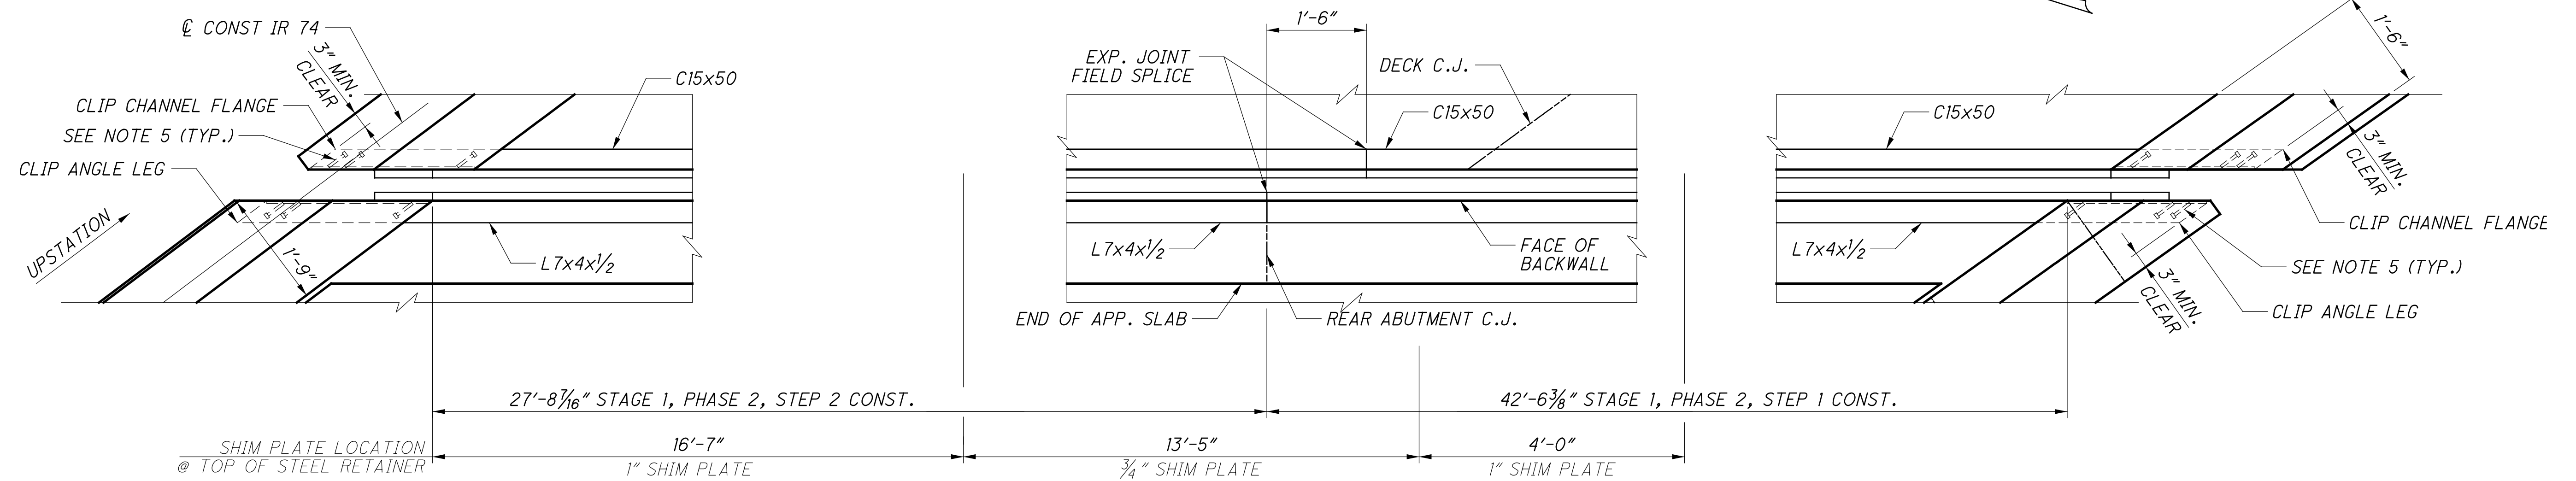


**PARTIAL PLAN - REAR ABUTMENT
 EXPANSION JOINT DETAILS**

NOTES:


1. SEE STD. DWG. EXJ-4-87 FOR ADDITIONAL DETAILS.
2. ALL CHANNELS, ANGLES AND PLATES SHALL BE ASTM A709 GRADE 50.
3. COAT ALL STEEL PARTS OF THE JOINT ASSEMBLY ACCORDING TO 516.
4. FOR ADDITIONAL STRIP SEAL DETAILS, SEE SHEET 37/41.
5. SHEAR STUDS SHALL BE WELDED AT AN ANGLE TO MAINTAIN CLEARANCE IN PARAPET.

 STRUCTUREPOINT <small>AN IRVING-CLOUD COMPANY</small>	DESIGN AGENCY	DATE 11/12/18	REVIEWED MDS	STRUCTURE FILE NUMBER 3115526
DESIGNED SUJ	DRAWN BMP	CHECKED CLB	REVISED XXX	FILE NUMBER 3115526
EXPANSION JOINT DETAILS (RIGHT BRIDGE) BRIDGE NO. HAM-74-1840 L/R OVER SB BEEKMAN ST. (U.S. 27) AND RAMP F				
HAM-75-3.84 PID No. 104667				
35 / 41				
36 120				

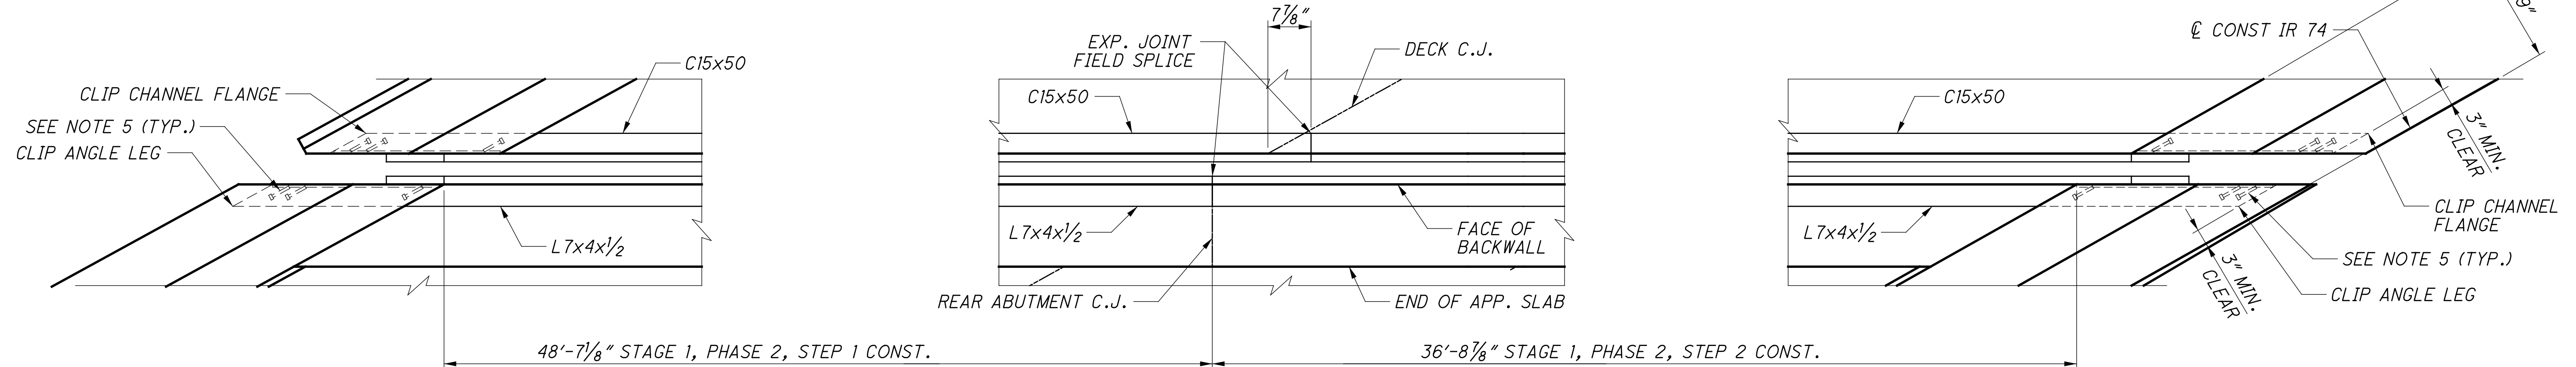


PARTIAL PLAN - FORWARD ABUTMENT
EXPANSION JOINT DETAILS

- NOTES:
1. SEE STD. DWG. EXJ-4-87 FOR ADDITIONAL DETAILS.
 2. ALL CHANNELS, ANGLES AND PLATES SHALL BE ASTM A709 GRADE 50.
 3. COAT ALL STEEL PARTS OF THE JOINT ASSEMBLY ACCORDING TO 516.
 4. FOR ADDITIONAL STRIP SEAL DETAILS, SEE SHEET 37/41.
 5. SHEAR STUDS SHALL BE WELDED AT AN ANGLE TO MAINTAIN CLEARANCE IN PARAPET.

 DESIGN AGENCY STRUCTUREPOINT <small>INCORPORATED</small>	REVIEWED MDS	DATE 11/12/18	STRUCTURE FILE NUMBER 3115526	DRAWN BMP	REVISIONS XXX
DESIGNED SUJ	CHECKED CLB	EXPANSION JOINT DETAILS (RIGHT BRIDGE) BRIDGE NO. HAM-74-1840 L/R OVER SB BEEKMAN ST. (U.S. 27) AND RAMP F			
HAM-75-3.84 PID No. 104667					
36 / 41					
37 120					

SFlanagan 11/16/2023 9:34:06 AM
 \0\2017\01113\C.Design\104667-HAM-75-3.84.Design\Structures\HAM0074-1840C\Sheets\74-1840EX003.dgn

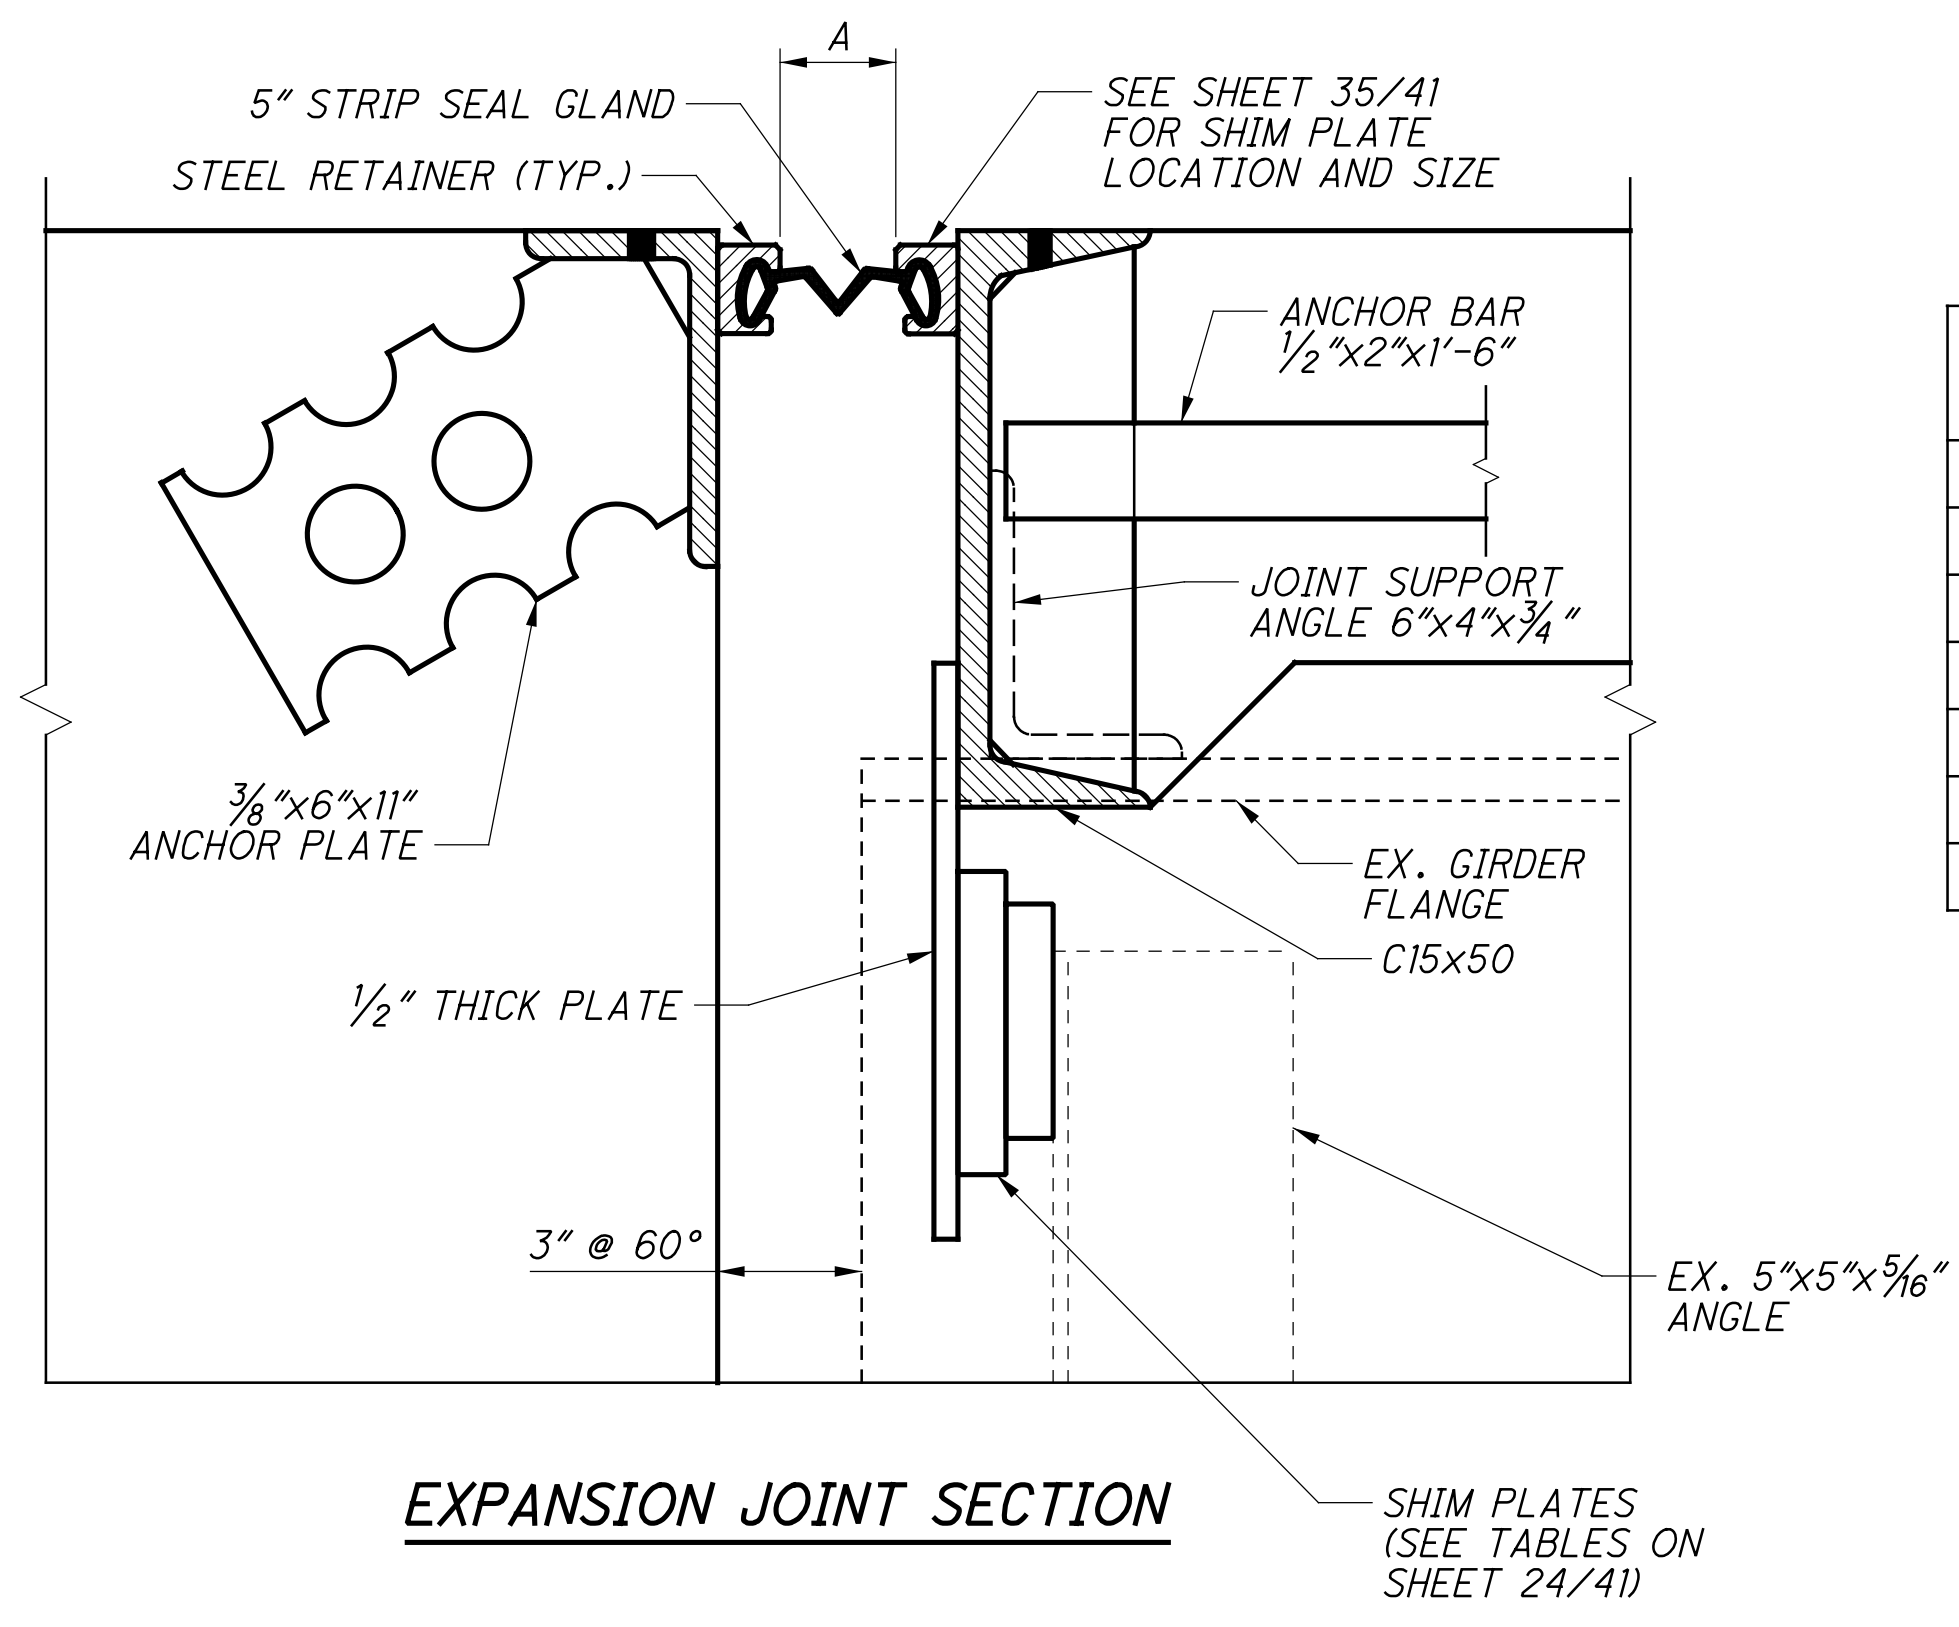


REAR 5" STRIP SEAL DETAIL

AMBIENT TEMP.	DIMENSION "A" (IN.)
30°	2 7/8"
40°	2 3/4"
50°	2 11/16"
60°	2 5/8"
70°	2 1/2"
80°	2 7/16"
90°	2 5/16"

FWD 5" STRIP SEAL DETAIL

AMBIENT TEMP.	DIMENSION "A" (IN.)
30°	2 11/16"
40°	2 11/16"
50°	2 5/8"
60°	2 5/8"
70°	2 9/16"
80°	2 9/16"
90°	2 1/2"

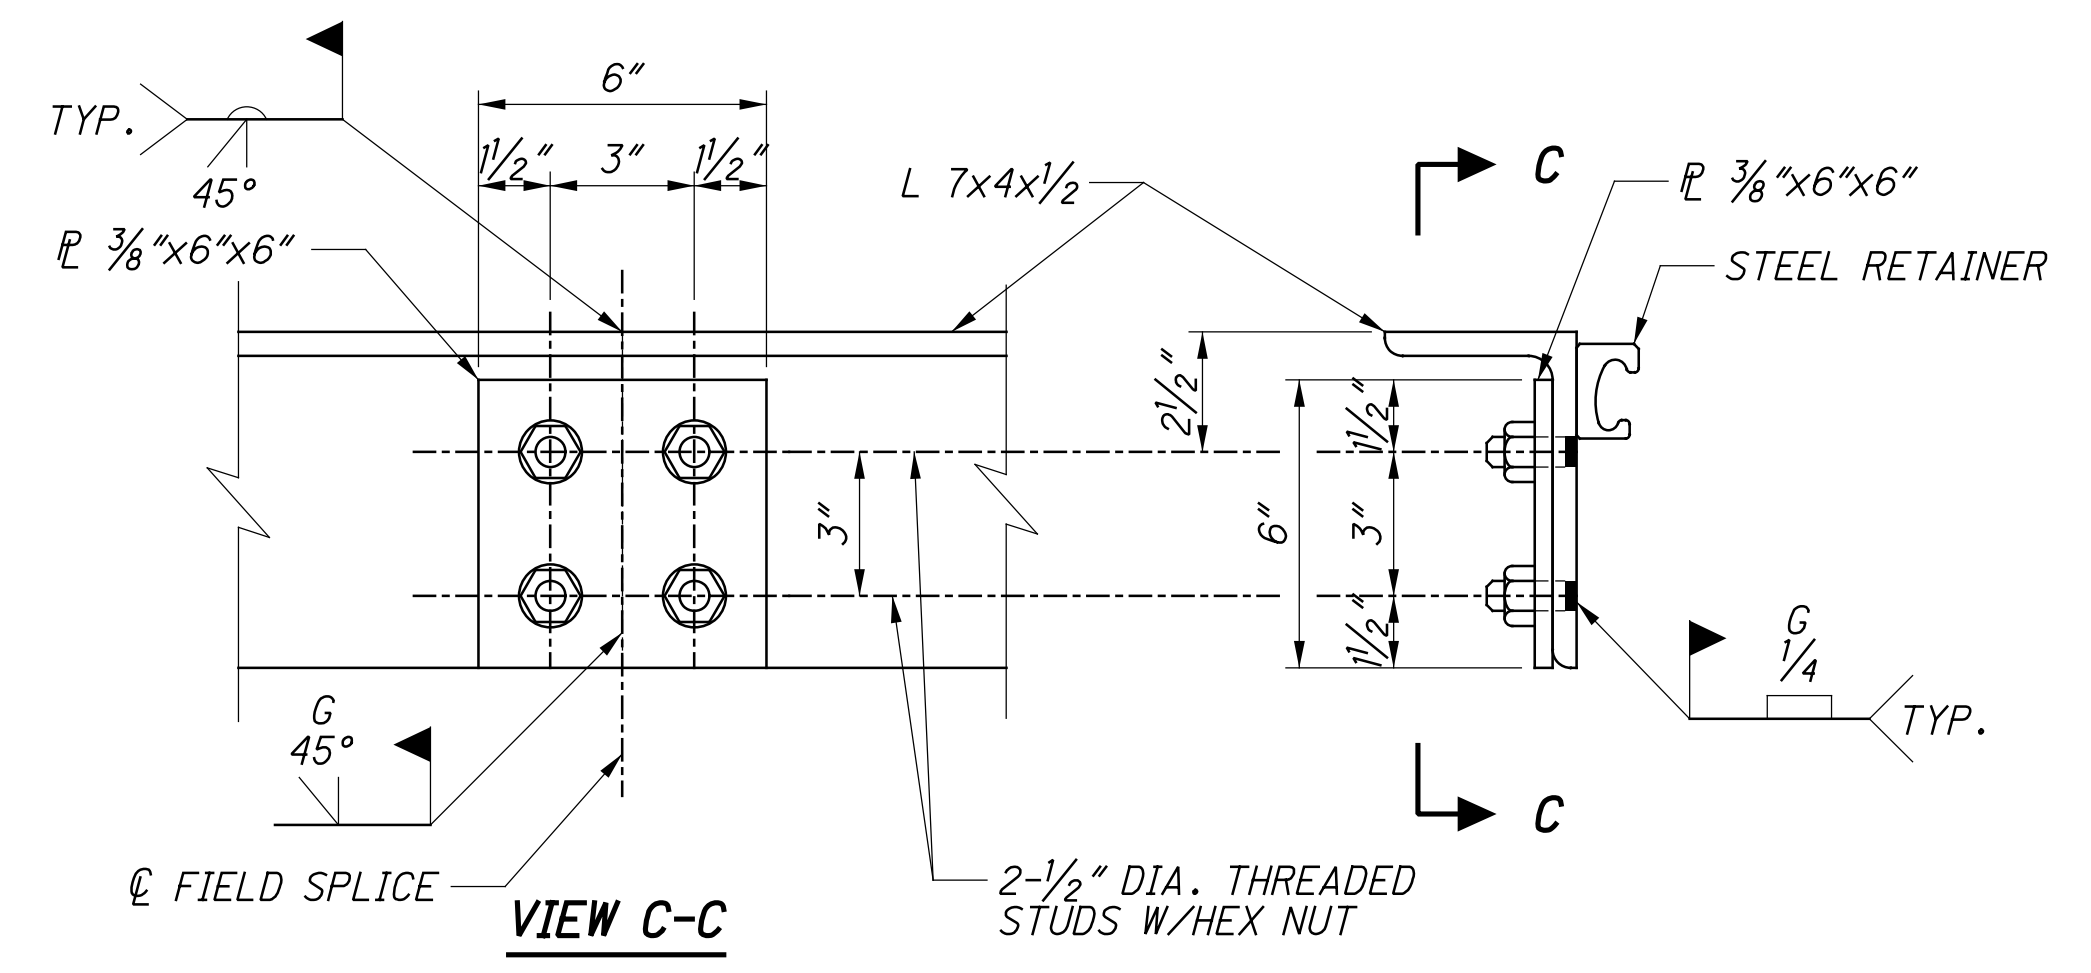

END OF BACKWALL ANGLE FIELD SPLICE DETAILS
 (FOR ADDITIONAL DETAILS, SEE STD. DWG. EXJ-4-87)

NOTES:
 1. FOR ADDITIONAL STRIP SEAL JOINT DETAILS AND NOTES, SEE STANDARD DWG. EXJ-4-87.

DESIGN AGENCY: **STRUCTUREPOINT**
 2000 CORPORATE CENTER DR., STE. 200
 WASHINGTON, DC 20004
 TEL: (800) 333-3333 FAX: (202) 462-1000
 WWW.STRUCTUREPOINT.COM

DATE: 11/12/18
 REVIEWED: MDS
 STRUCTURE FILE NUMBER: 3115577

DRAWN: BMP
 REVISED:


DESIGNED: SJF
 CHECKED: CLB

EXPANSION JOINT DETAILS (RIGHT BRIDGE)
 BRIDGE NO. HAM-74-1840 L/R
 OVER SB BEEKMAN ST. (U.S. 27)

HAM-75-3.84
 PID No. 104667

37 / 41
 38
 120

SFlanagan 11/16/2023 9:34:07 AM
 \\01\2017\01113\C.Design\104667-HAM-75-3.84.Design\Structures\HAM0074_1840C_Sheets\74_1840M001.dgn

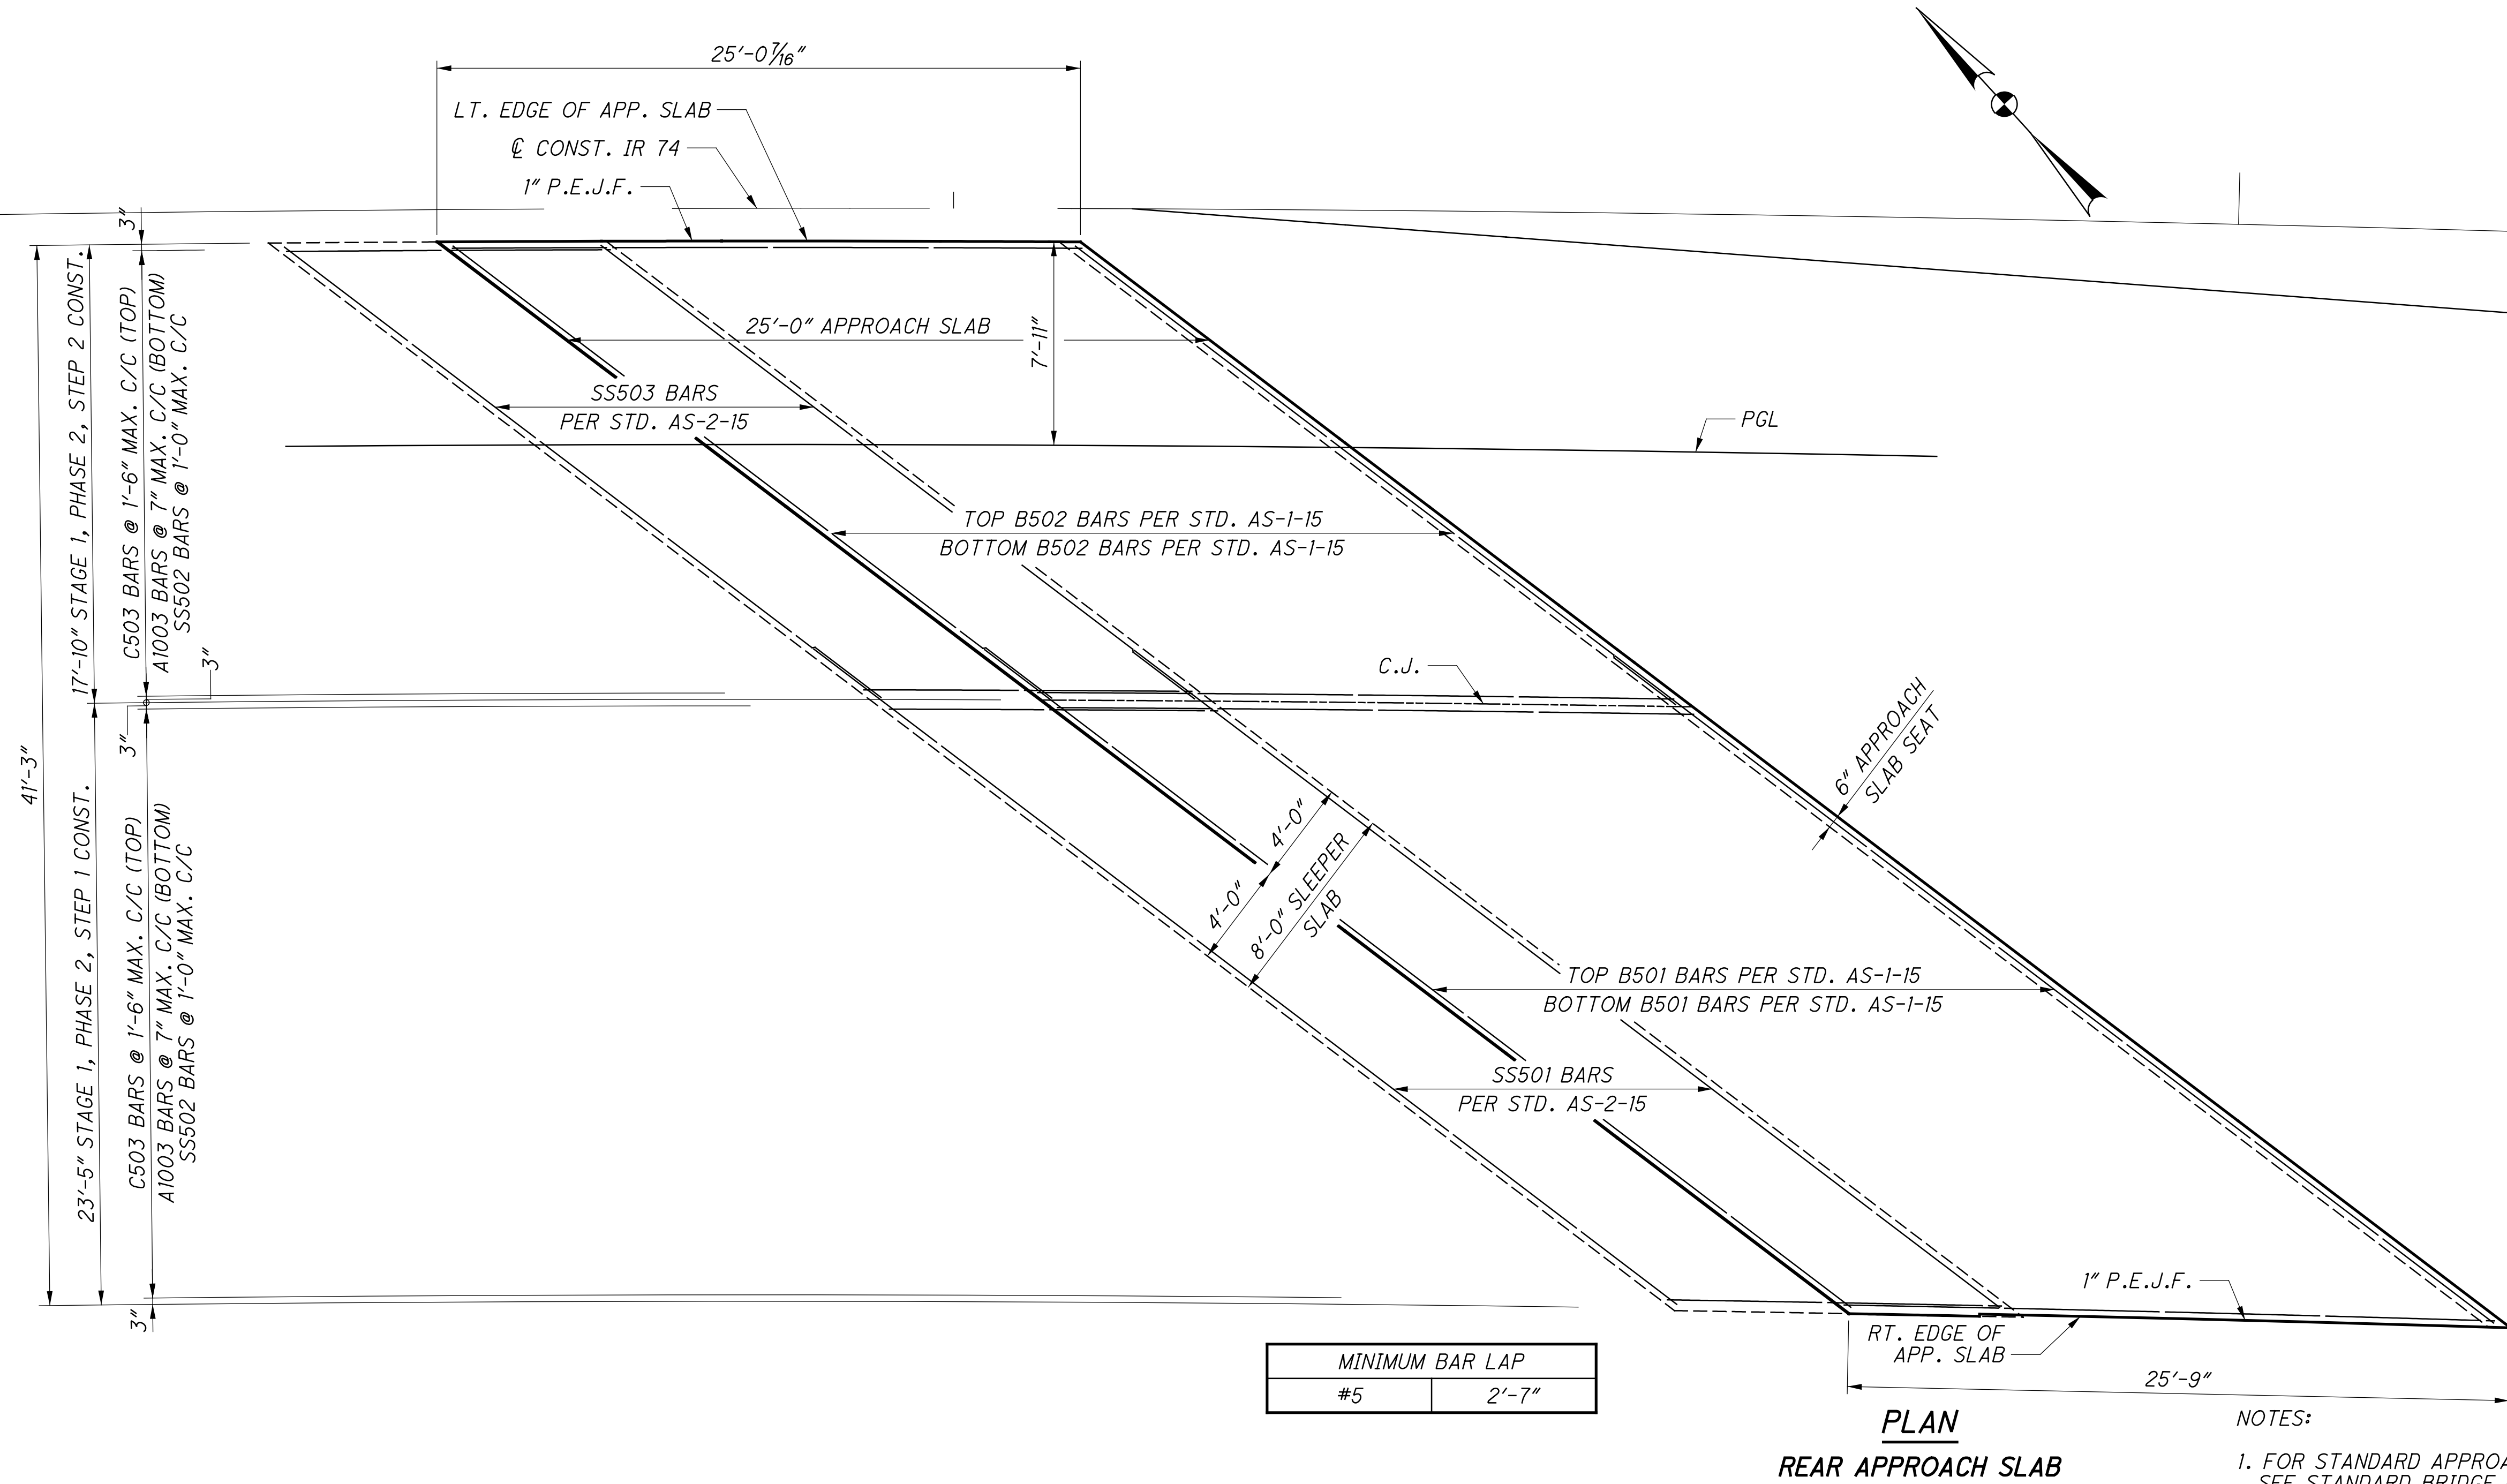


NOTES:
 1. FOR STANDARD APPROACH SLAB DETAILS, SEE STANDARD BRIDGE DWG. AS-1-15 AND STANDARD BRIDGE DWG. AS-2-15.

APPROACH SLAB ELEVATIONS											
APPROACH LINE		DESCRIPTION	BEGIN REAR SLEEPER SLAB	BEGIN REAR APPROACH SLAB	END REAR SLEEPER SLAB	END REAR APPROACH SLAB	STRUCTURE LIMITS	BEGIN FWD. APPROACH SLAB	BEGIN FWD. SLEEPER SLAB	END FWD. APPROACH SLAB	END FWD. SLEEPER SLAB
LT. EDGE APP. SLAB	STATION		991+73.34	991+79.89	991+86.48	992+04.94		995+50.01	995+66.81	995+75.02	995+83.24
	OFFSET		1.24	1.25	1.27	1.30		1.74	1.74	1.74	1.73
	ELEVATION		545.52	546.64	545.26	546.16		539.62	538.09	539.21	537.83
PGL	STATION		991+81.24	991+87.85	991+94.48	992+13.08		995+61.00	995+77.86	995+86.04	995+94.25
	OFFSET		7.34	7.42	7.43	7.39		7.90	7.90	7.90	7.89
	ELEVATION		545.01	546.13	544.75	545.64		539.27	537.76	538.89	537.52
C.J.	STATION		991+97.74	992+03.77	992+10.16	992+29.03		995+82.52	995+99.40	996+07.59	996+15.80
	OFFSET		19.12	19.42	19.43	19.17		19.90	19.90	19.90	19.89
	ELEVATION		543.99	545.11	543.74	544.64		538.66	537.20	538.35	537.00
RT. EDGE APP. SLAB	STATION		992+28.65	992+35.55	992+42.48	992+61.80		996+24.93	996+42.11	996+50.34	996+58.71
	OFFSET		42.67	42.67	42.68	42.64		40.15	40.15	40.15	40.14
	ELEVATION		542.01	543.13	541.75	542.63		537.82	536.34	537.48	536.12

DESIGN AGENCY: STRUCTUREPOINT
 DATE: 11/12/18
 REVIEWED: MDS
 DRAWN: DSH
 DESIGNED: SUJ
 CHECKED: CLB
 STRUCTURE FILE NUMBER: 3115526
 APPROACH SLAB DETAILS (RIGHT BRIDGE)
 BRIDGE NO. HAM-74-1840 L/R
 OVER SB BEEKMAN ST. (U.S. 27) AND RAMP F
 HAM-75-3.84
 PID No. 104667
 38/41
 39
 120

SFlanagan 11/16/2023 9:34:07 AM
 \O\2017\01113\C.Design\104667-HAM-75-3.84\Design\Structures\HAM0074_1840C\Sheets\74_1840MD002.dgn

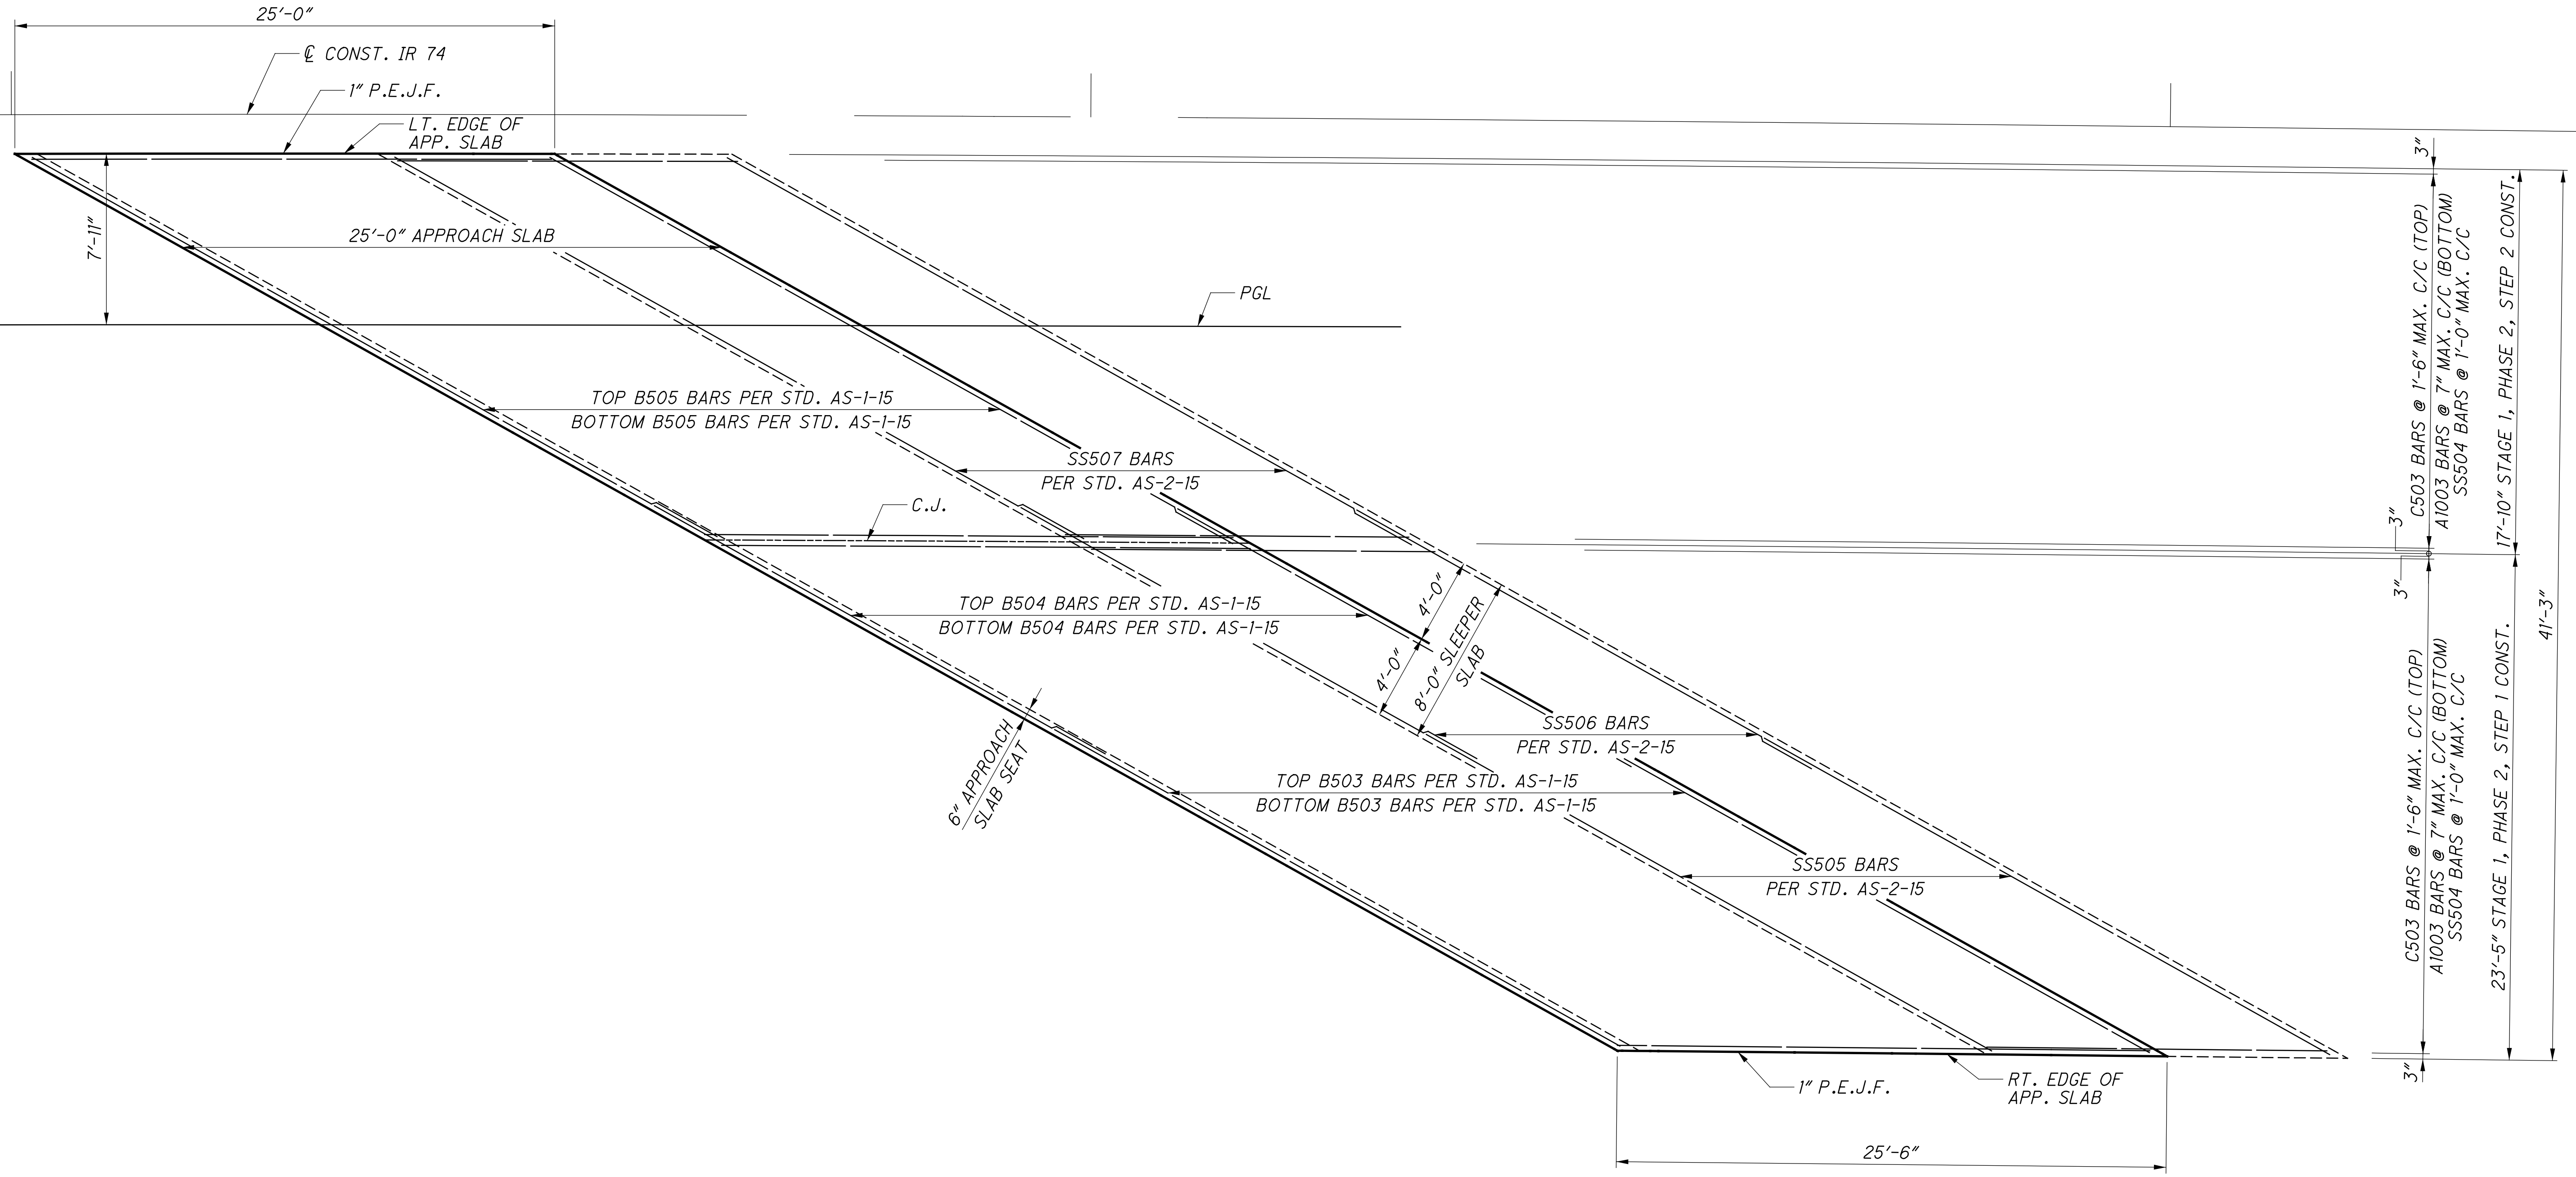


PLAN
FORWARD APPROACH SLAB

MINIMUM BAR LAP	
#5	2'-7"

NOTES:

- FOR STANDARD APPROACH SLAB DETAILS, SEE STANDARD BRIDGE DWG. AS-1-15 AND STANDARD BRIDGE DWG. AS-2-15.
- FOR APPROACH SLAB ELEVATIONS, SEE SHEET 38/41.

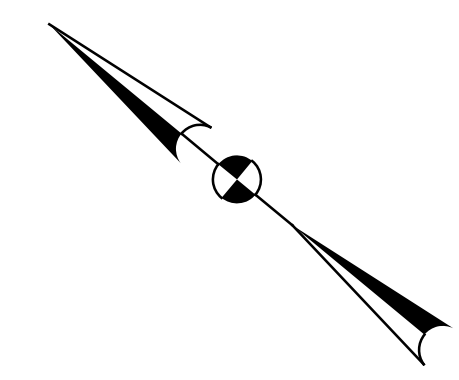





 DESIGN AGENCY STRUCTUREPOINT <small>INCORPORATED</small>	DATE 11/12/18
	STRUCTURE FILE NUMBER 3115526
DRAWN DSH	REVISIONS XXX
DESIGNED SUJ	CHECKED CLB
APPROACH SLAB DETAILS (RIGHT BRIDGE) BRIDGE NO. HAM-74-1840 L/R OVER SB BEEKMAN ST. (U.S. 27) AND RAMP F	
HAM-75-3.84	PID No. 104667
39 / 41	<div style="border: 1px solid black; border-radius: 50%; width: 30px; height: 30px; display: flex; align-items: center; justify-content: center;"> <div style="border: 1px solid black; border-radius: 50%; width: 15px; height: 15px; display: flex; align-items: center; justify-content: center;">40</div> <div style="margin-left: 5px;">120</div> </div>

SFlanagan
11/16/2023 9:34:08 AM
\\0\2017\01113\C_Design\104667-HAM-75-3.84\Design\Structures\HAM0074_1840C\Sheets\74_1840RL001.dgn

REINFORCING STEEL LIST												
MARK	NUMBER			LENGTH	WEIGHT	TYPE	DIMENSIONS					
	REAR ABUT.	FORWARD ABUT.	TOTAL				A	B	C	D	E	R
ABUTMENTS												
A501	10	10	20	4'-4"	91	STR						
① A502	28		28	20'-0"	584	STR						
A503	NOT USED											
A504	14		14	25'-8"	375	STR						
A505	1		1	4'-10"	5	STR						
A506	1		1	3'-3"	3	STR						
A507	11		11	12'-10"	147	STR						
A508	3		3	16'-6"	52	STR						
A509		28	28	30'-0"	876	STR						
A510		14	14	28'-9"	420	STR						
A511		14	14	13'-7"	198	STR						
ABUTMENTS												
A601	146	180	326	5'-8"	2775	STR						
A602	146	180	326	7'-11"	3876	1	1'-4"	6'-9"				
A603	73	90	163	10'-1"	2469	2	4'-9"	0'-11"	4'-9"			
ABUTMENTS												
D801	49	61	110	5'-10"	1711	18	3'-8"	1'-0"	1'-0"			
ABUTMENTS												
SP401	2		2	3'-3"	4	1	1'-8"	1'-8"				
ABUTMENTS												
SP601	11		11	4'-8"	77	1	2'-0"	2'-10"				
SP602	9		9	5'-6"	74	1	2'-10"	2'-10"				
ABUTMENTS												
SP801	17		17	5'-7"	253	1	2'-2"	3'-8"				
SP802	11		11	6'-5"	188	1	3'-0"	3'-8"				
SUB-TOTAL					14,178							

① REQUIRES MECHANICAL CONNECTORS. (14 REQUIRED)

REINFORCING STEEL LIST												
MARK	NUMBER			LENGTH	WEIGHT	TYPE	DIMENSIONS					
	REAR ABUT.	FORWARD ABUT.	TOTAL				A	B	C	D	E	R
APPROACH SLABS												
B501	57		57	43'-0"	2556	STR						
B502	57		57	29'-0"	1724	STR						
B503		57	57	30'-0"	1784	STR						
B504		57	57	24'-0"	1427	STR						
B505		57	57	36'-3"	2155	STR						
APPROACH SLABS												
C503	30	30	60	24'-6"	1533	STR						
APPROACH SLABS												
SS501	8		8	42'-6"	355	STR						
SS502	43		43	12'-6"	561	STR						
SS503	8		8	29'-0"	242	STR						
SS504		43	43	15'-9"	706	STR						
SS505		8	8	30'-0"	250	STR						
SS506		8	8	24'-6"	204	STR						
SS507		8	8	36'-3"	302	STR						
APPROACH SLABS												
A1003	72	72	144	25'-11"	16059	16	24'-6"					
SUB-TOTAL					29,858							

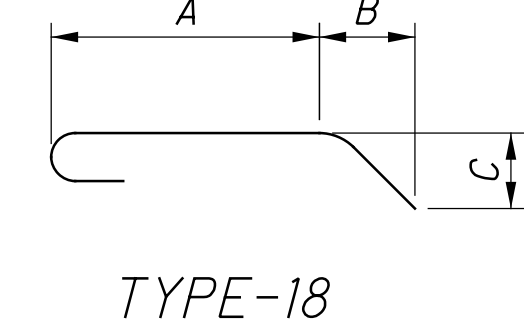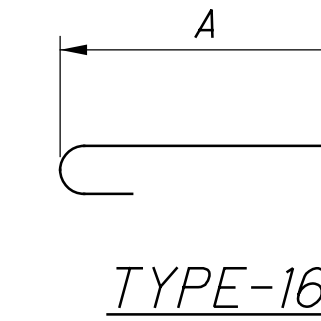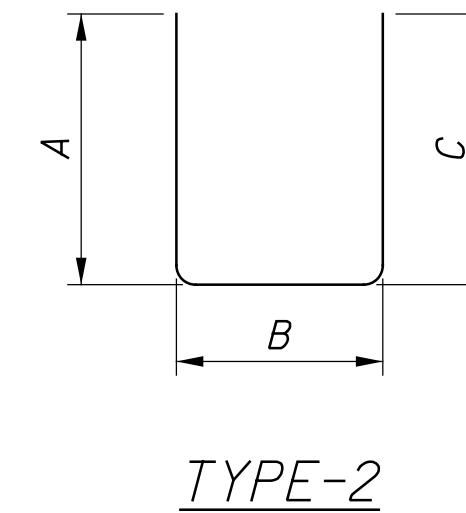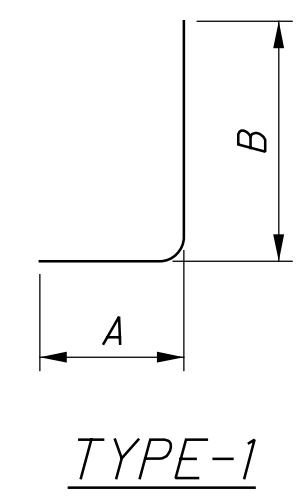

NOTES:

① REQUIRES MECHANICAL CONNECTORS (NON-PROTRUDING TYPE)

AN APPROVED TYPE OF MECHANICAL CONNECTOR FOR REINFORCING SHALL BE PROVIDED. INSTALLATION OF THE CONNECTORS SHALL CONFORM WITH RECOMMENDED MANUFACTURER'S PROCEDURES. IF A DOWEL BAR SPLICE IS FURNISHED, THE MINIMUM DOWEL BAR LENGTH TO BE INCLUDED WITH THE CONNECTOR SHALL BE GIVEN BY THE DIMENSION "L" SHOWN BELOW :
#5 REINFORCING BAR, L = 3'-6"

WHERE MECHANICAL CONNECTORS ARE REQUIRED THE REINFORCING BAR LENGTH IS MEASURED TO THE CONSTRUCTION JOINT. EXTRA BAR LENGTH AND/OR BAR PREPARATION MAY BE NECESSARY DEPENDING ON THE TYPE OF MECHANICAL CONNECTOR FURNISHED.

DESIGN AGENCY
STRUCTUREPOINT
200 CORPORATE CENTER DR., 10TH FLOOR
ANN ARBOR, MI 48106
TEL: 734.993.3300 FAX: 734.993.3302

DESIGNED BY: SUJ
CHECKED BY: CLB

DRAWN BY: DSH
REVISED BY:

REVIEWED BY: MDS
STRUCTURE FILE NUMBER: 3115526

DATE: 11/12/18

REINFORCING STEEL LIST (RIGHT BRIDGE)
BRIDGE NO. HAM-74-1840 L/R
OVER SB BEEKMAN ST. (U.S. 27) AND RAMP F

HAM-75-3.84
PID No. 104667


40 / 41

41
120


S:\Flanagan\11/16/2023 9:34:08 AM
 11/16/2023 9:34:08 AM
 01\2017\01113\C.Design\104667 - HAM-75-3.84 - Design\Structures\HAM0074_1840C\Sheets\74_1840RL002.dgn

MARK	NUMBER TOTAL	LENGTH	WEIGHT	TYPE	DIMENSIONS						
					A	B	C	D	E	R	INC
SUPERSTRUCTURE											
S401	720	30'-0"	14429	STR							
	1 SR	12'-7"									
S402	OF	TO	370	STR							0'-2 3/4"
	34	20'-0"									
	1 SR	6'-9"									
S403	OF	TO	166	STR							0'-2 3/4"
	26	12'-4"									
S404	1304	4'-6"	3920	2	2'-7"	0'-6 1/4"	1'-7"				
	2 SR	1'-4"									
① S501	OF	TO	1751	STR							0'-4 1/4"
	65	24'-6"									
① S502	589	25'-0"	15358	STR							
	1 SR	2'-9"									
S503	OF	TO	1097	STR							0'-3 1/2"
	76	24'-11"									
S504	20	10'-0"	209	STR							
S505	722	30'-0"	22591	STR							
S506	118	36'-1"	4441	STR							
	1 SR	19'-7"									
S507	OF	TO	656	STR							0'-3 1/2"
	27	27'-0"									
① S508	2	16'-10"	35	STR							
① S509	2	25'-8"	54	STR							
	1 SR	3'-2"									
S510	OF	TO	530	STR							0'-4 1/2"
	45	19'-5"									
S511	594	19'-5"	12029	STR							
	2 SR	1'-8"									
S512	OF	TO	1288	STR							0'-3 1/2"
	60	18'-11"									
S513	2	36'-4"	76	STR							
	1 SR	13'-9"									
S514	OF	TO	397	STR							0'-3"
	23	19'-4"									
S515	2	32'-7"	68	STR							
① S516	589	25'-7"	15717	16	25'-0"						
	1 SR	3'-4"			2'-9"						
S517	OF	TO	1143	16	TO						0'-3 1/2"
	76	25'-6"			24'-11"						
	1 SR	3'-9"			3'-2"						
S518	OF	TO	559	16	TO						0'-4 1/2"
	45	20'-0"			19'-5"						
S519	594	20'-0"	12391	16	19'-5"						
S520	1280	4'-2"	5563	STR							
		SUB-TOTAL	114,838								


① REQUIRES MECHANICAL CONNECTORS. (1312 REQUIRED)

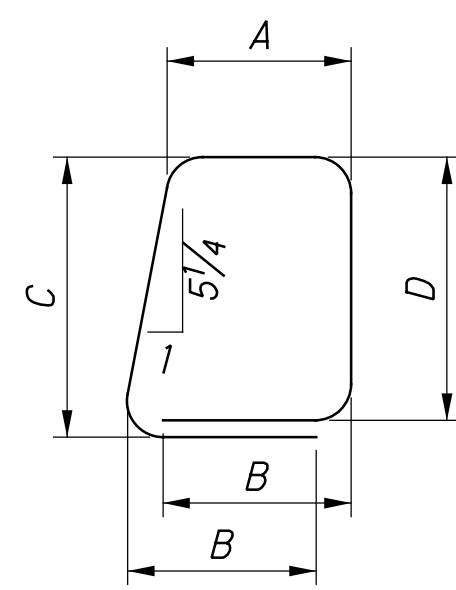


TYPE-40

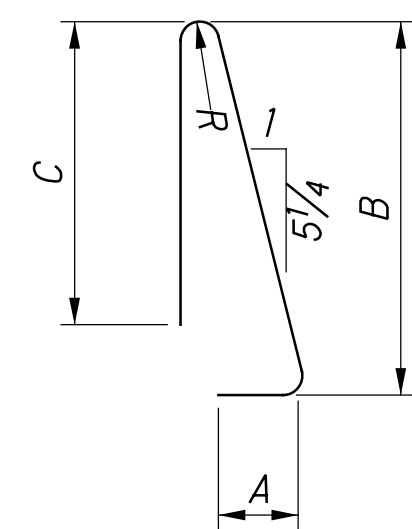


TYPE-41

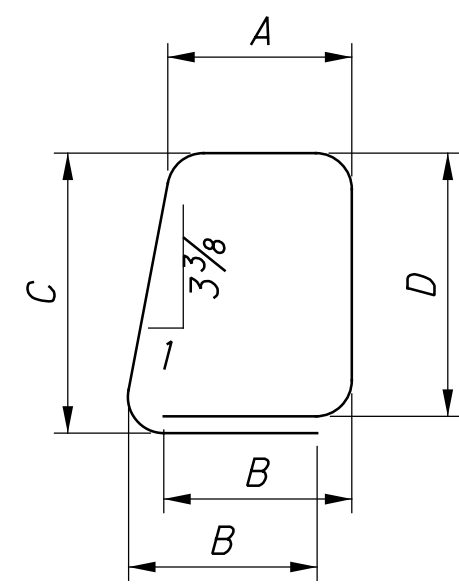

TYPE-43

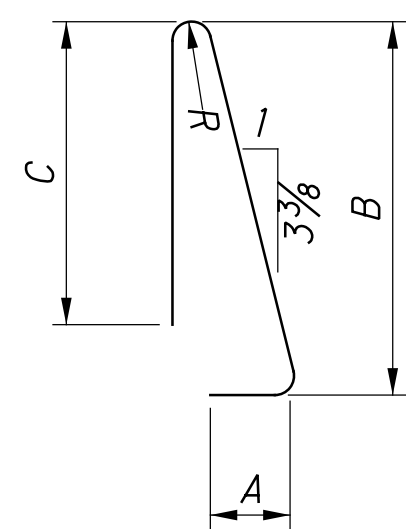

TYPE-44

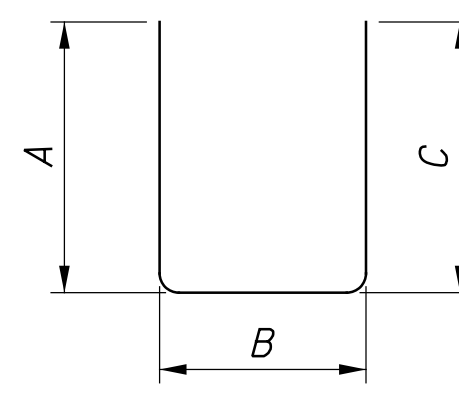

TYPE-2

MARK	NUMBER TOTAL	LENGTH	WEIGHT	TYPE	DIMENSIONS						
					A	B	C	D	E	R	INC
PARAPETS											
PS501	410	7'-4"	3136	23	0'-11"	3'-3"	3'-0"				0'-3"
PS502	96	30'-0"	3004	STR							
PS503	4	22'-0"	92	STR							
PS504	2	10'-4"	22	STR							
PS505	1	12'-10"	13	STR							
PS506	106	14'-8"	1622	STR							
PS507	128	7'-2"	957	STR							
PS508	1	8'-2"	9	STR							
PS509	4	9'-4"	39	STR							
PS510	3	11'-5"	36	STR							
PS511	6	13'-5"	84	STR							
PS512	3	8'-4"	26	STR							
PS513	1	8'-6"	9	STR							
PS514	1	10'-7"	11	STR							
PS515	2	11'-4"	24	STR							
PS516	2	13'-5"	28	STR							
PS517	8	9'-7"	80	STR							
PS518	4	5'-9"	24	25	1'-10"	2'-5"	1'-5"	0'-1 1/2"	0'-5"		
PS519	4	6'-3"	26	STR							
PS520	2	22'-2"	46	STR							
PS521	2	19'-5"	41	STR							
PS522	10	2'-7"	27	STR							
PS524	10	3'-2"	33	STR							
PS525	362	10'-0"	3776	41	0'-11"	4'-6"	4'-3"				0'-3"
PS526	362	6'-2"	2328	40	1'-4"	1'-2"	1'-7"	1'-7"			
PS527	2	9'-8"	20	STR							
PS528	1	12'-2"	13	STR							
PS529	1	9'-5"	10	STR							
PS530	8	10'-5"	87	44	1'-0"	4'-6"	4'-3"				0'-6 1/4"
PS531	8	9'-6"	79	43	2'-0"	2'-3"	1'-7"	1'-7"			
PS601	376	5'-7"	3153	40	1'-1"	1'-0"	1'-7"	1'-7"			
PS603	1	11'-7"	17	STR							
PS604	27	14'-8"	595	STR							
PS605	32	7'-2"	344	STR							
PS606	1	9'-3"	14	STR							
PS607	1	12'-5"	19	STR							
PS608	1	9'-11"	15	STR							
PS609	30	2'-0"	90	STR							
PS610	30	2'-9"	124	13	1'-0"	0'-11"	0'-2 1/4"	0'-11"			
PS611	1	9'-6"	14	STR							
	2 SR	3'-6"									
PS612	OF	TO	129	STR							0'-1"
	11	4'-4"									
PS613	8	3'-5"	41	STR							
PS614	1	20'-10"	31	STR							
PS615	1	2'-7"	4	STR							
PS616	1	3'-2"	5	STR							
PS617	4	3'-9"	23	13	2'-0"	0'-11"	0'-2"	0'-11"			
PS618	4	2'-11"	18	STR							
PS619	1	9'-8"	15	STR							
		SUB-TOTAL	20,353								


PS523 AND PS602 NOT USED.

NOTES:


① REQUIRES MECHANICAL CONNECTORS (NON-PROTRUDING TYPE)

AN APPROVED TYPE OF MECHANICAL CONNECTOR FOR REINFORCING SHALL BE PROVIDED. INSTALLATION OF THE CONNECTORS SHALL CONFORM WITH RECOMMENDED MANUFACTURER'S PROCEDURES. IF A DOWEL BAR SPLICE IS FURNISHED, THE MINIMUM DOWEL BAR LENGTH TO BE INCLUDED WITH THE CONNECTOR SHALL BE GIVEN BY THE DIMENSION "L" SHOWN BELOW :
 #5 REINFORCING BAR, L = 3'-6"


WHERE MECHANICAL CONNECTORS ARE REQUIRED THE REINFORCING BAR LENGTH IS MEASURED TO THE CONSTRUCTION JOINT. EXTRA BAR LENGTH AND/OR BAR PREPARATION MAY BE NECESSARY DEPENDING ON THE TYPE OF MECHANICAL CONNECTOR FURNISHED.

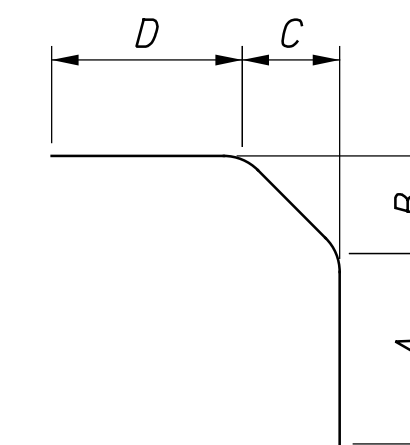


TYPE-13

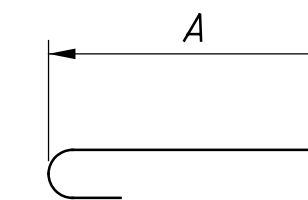


TYPE-16

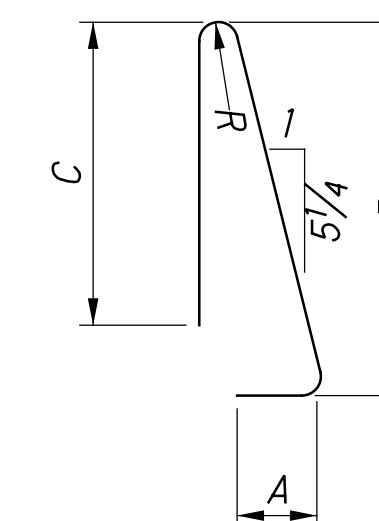


TYPE-23

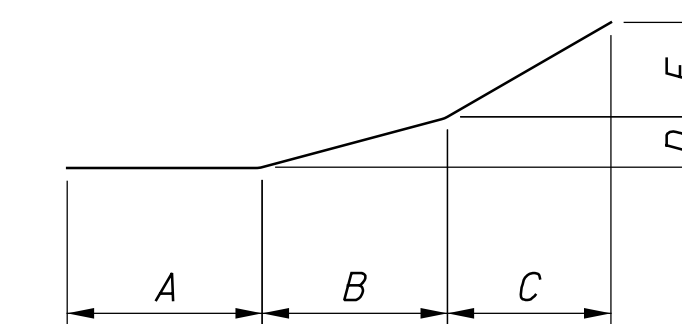

TYPE-25

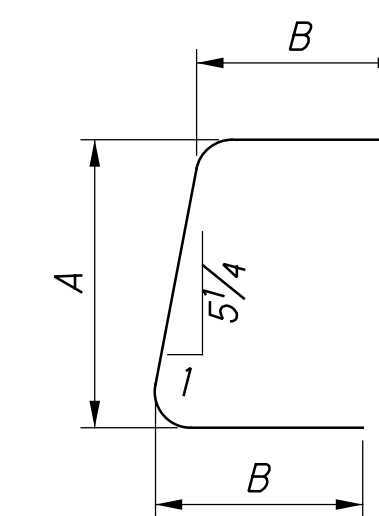

TYPE-28

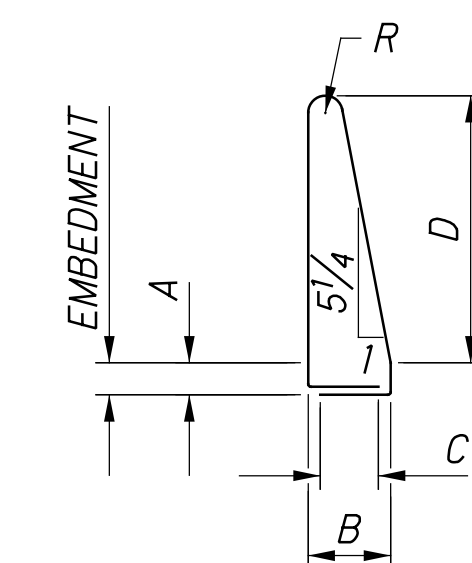

TYPE-35

DESIGN AGENCY
STRUCTUREPOINT
 2000 CORPORATE CENTER DRIVE, SUITE 200
 FARMINGTON, CT 06030
 TEL: (860) 326-8000 FAX: (860) 326-8001
 WWW.STRUCTUREPOINT.COM

REVIEWED DATE 11/15/18
 MDS
 STRUCTURE FILE NUMBER 3115526

DRAWN TLH
 REVISED

DESIGNED SUJ
 CHECKED CLB

REINFORCING STEEL LIST (RIGHT BRIDGE)


BRIDGE NO. HAM-74-1840 L/R
 OVER SB BEEKMAN ST. (U.S. 27) AND RAMP F

HAM-75-3.84
 PID No. 104667

41 / 41

42
 120


S:\Plans\2017\01113\C.Design\104667_HAM-75-3.84\Design\Structures\HAM0074-1852C_Sheets\74-1852SP001.dgn
 11/16/2017 9:34:12 AM
 2017\01113\C.Design\104667_HAM-75-3.84\Design\Structures\HAM0074-1852C_Sheets\74-1852SP001.dgn

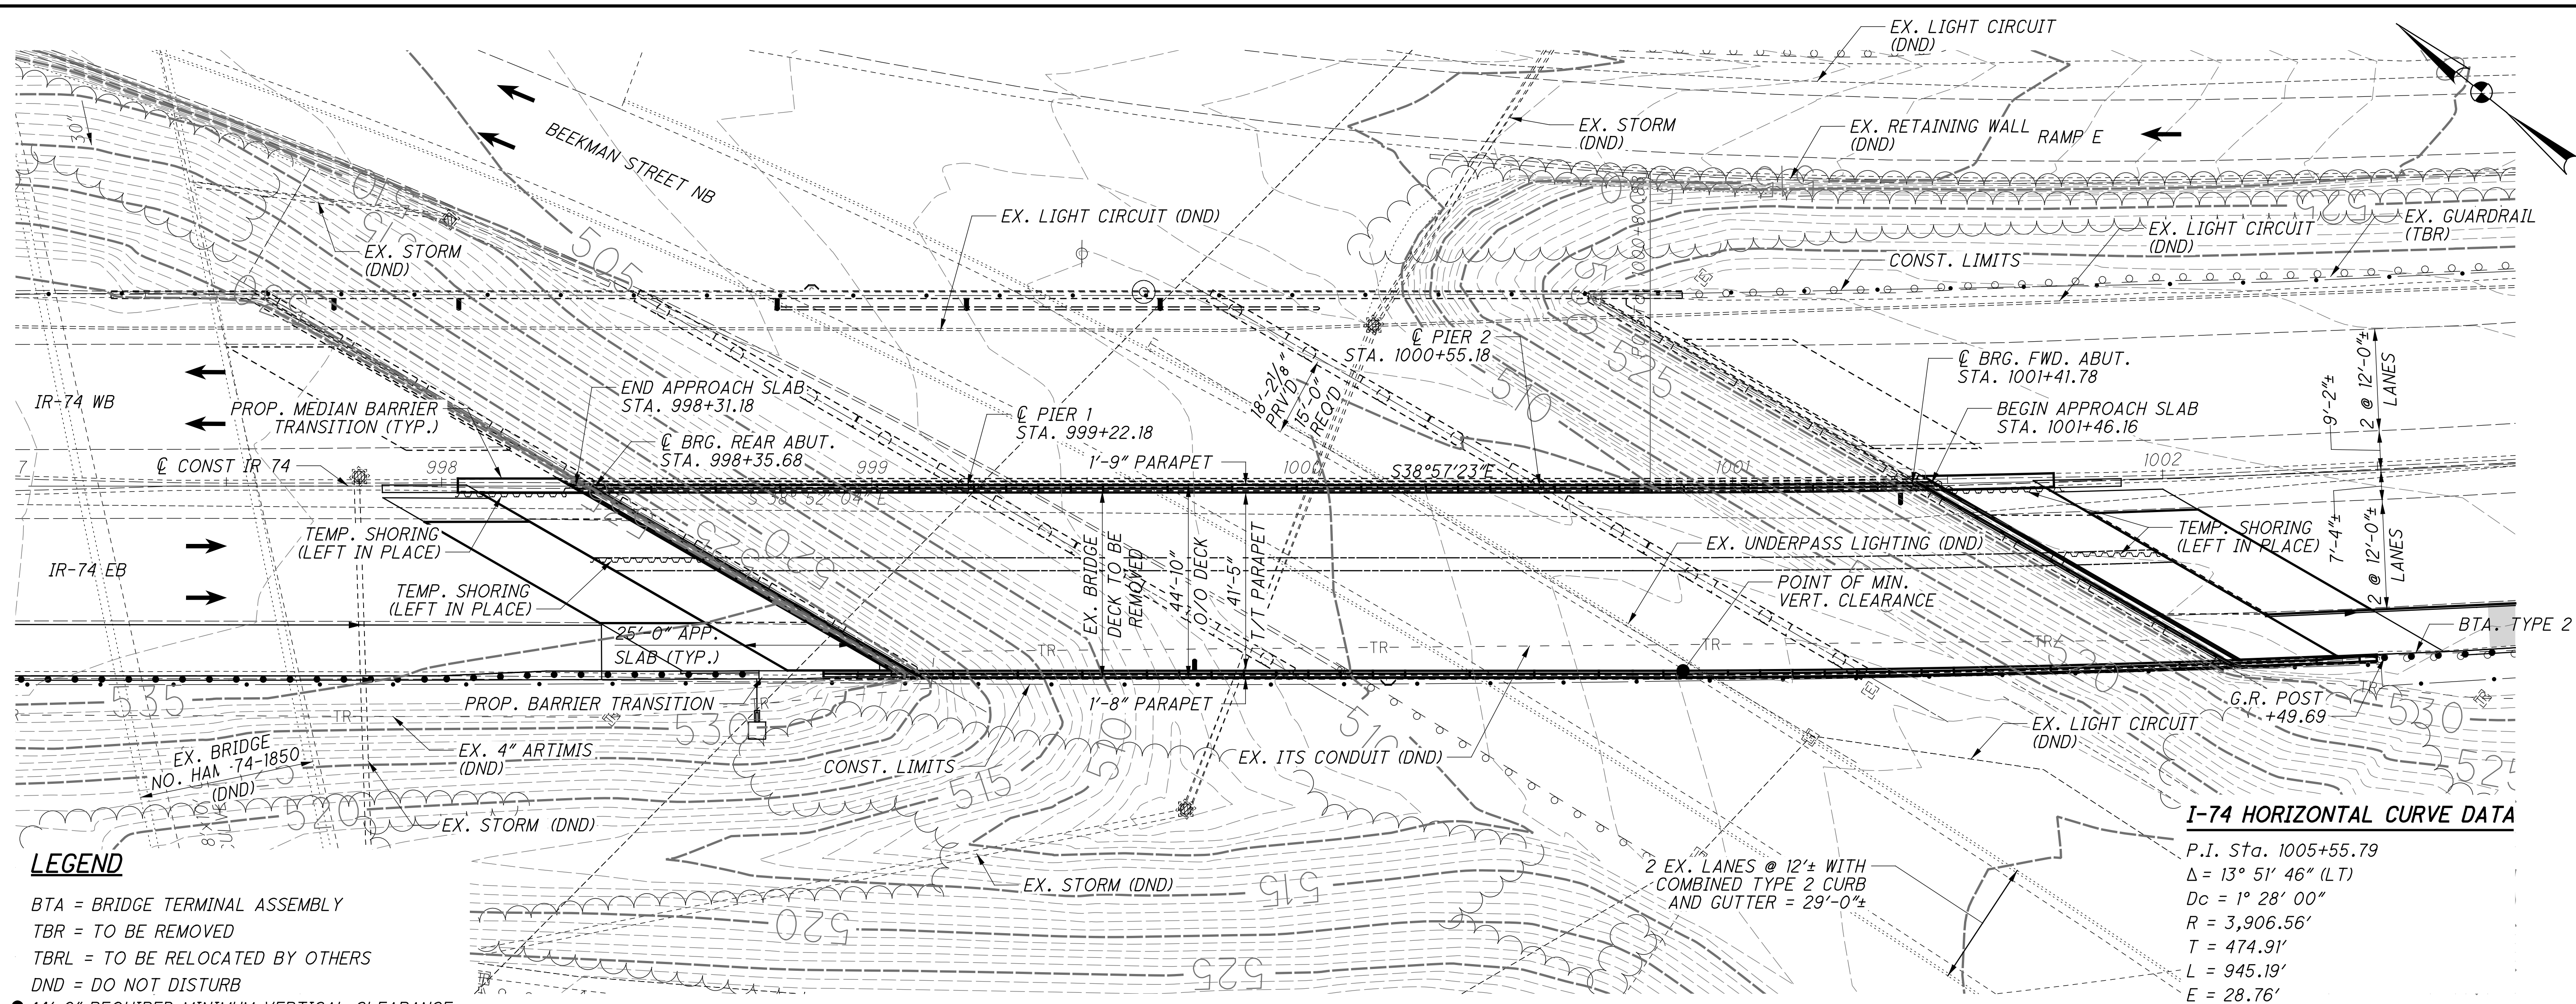

I-74 HORIZONTAL CURVE DATA

P.I. Sta.	1005+55.79
Δ	$13^\circ 51' 46''$ (LT)
D_c	$1^\circ 28' 00''$
R	3,906.56'
T	474.91'
L	945.19'
E	28.76'
C	942.89'
$C.B.$	$S 45^\circ 47' 56'' E$




- LEGEND**
- BTA = BRIDGE TERMINAL ASSEMBLY
 - TBR = TO BE REMOVED
 - TBR/L = TO BE RELOCATED BY OTHERS
 - DND = DO NOT DISTURB
 - 14'-6" REQUIRED MINIMUM VERTICAL CLEARANCE
 - 15'-5" PROVIDED MINIMUM VERTICAL CLEARANCE

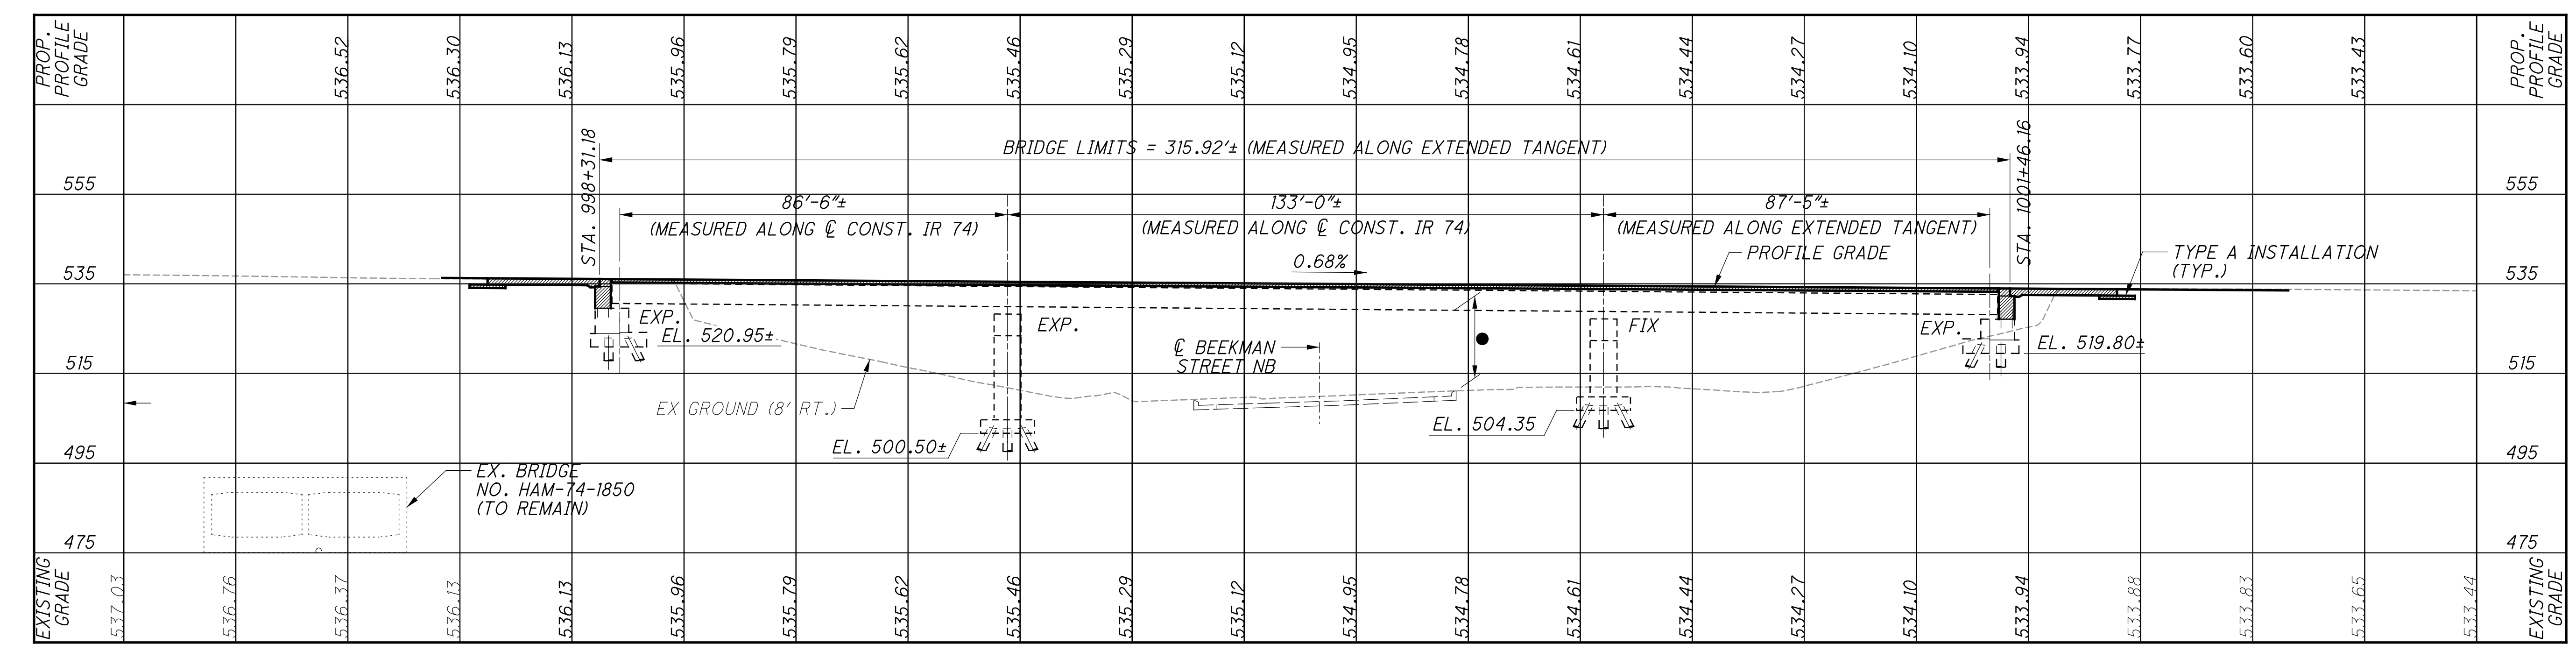

PROFILE
 ELEVATION ALONG CL CONST. IR 74

NOTE:
 FOR ADDITIONAL SITE PLAN INFORMATION, SEE SHEET 2/40.

	DESIGN AGENCY	DATE	09/12/18
	STRUCTUREPOINT	REVIEWED	MDS
	HAMILTON COUNTY	DRAWN	DSH
	STA. 998+31.18	CHECKED	SJF
	STA. 1001+46.16	DESIGNED	SUF
	BRIDGE NO. HAM-74-1852 L/R	REVISION	DND
	OVER NB BEEKMAN ST. (U.S. 27)	FILE NUMBER	3115577
HAM-75-3.84 PID No. 104667		1/40	
43 120			

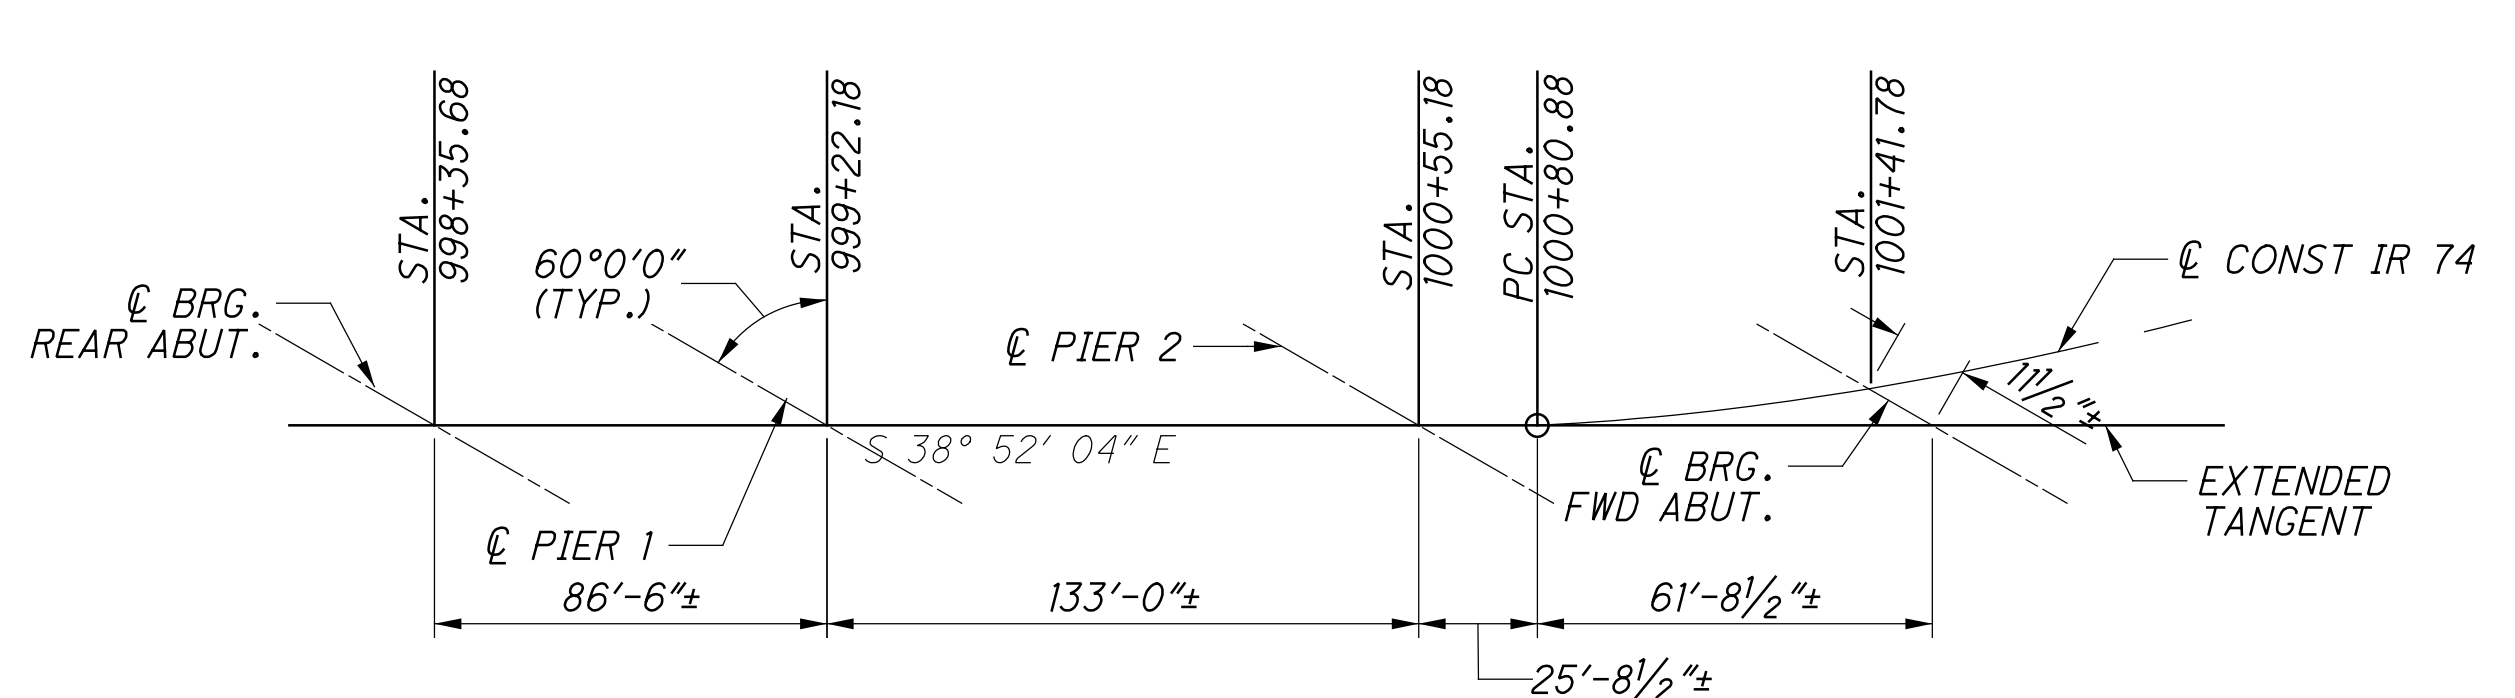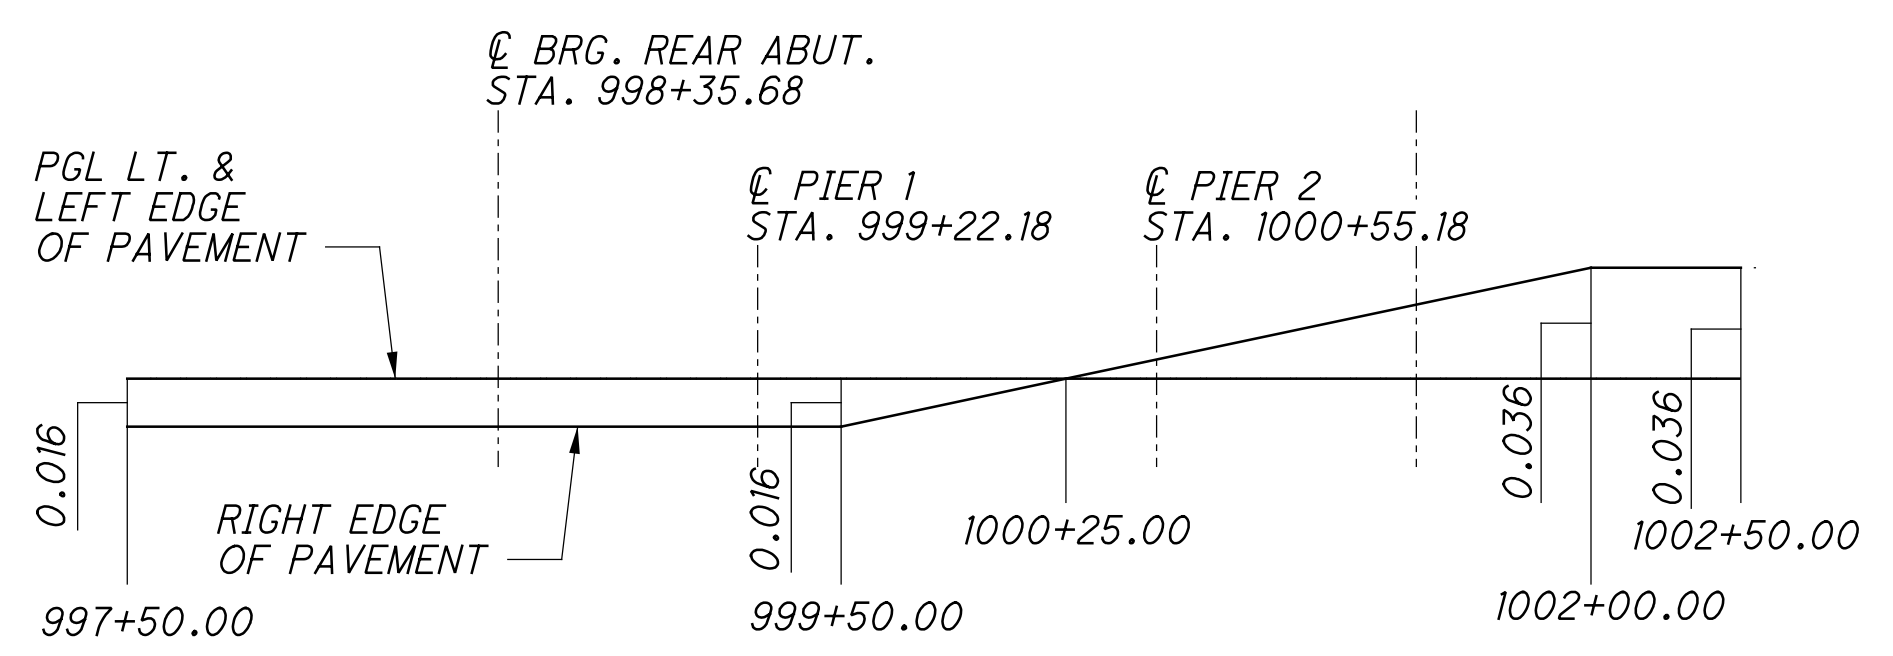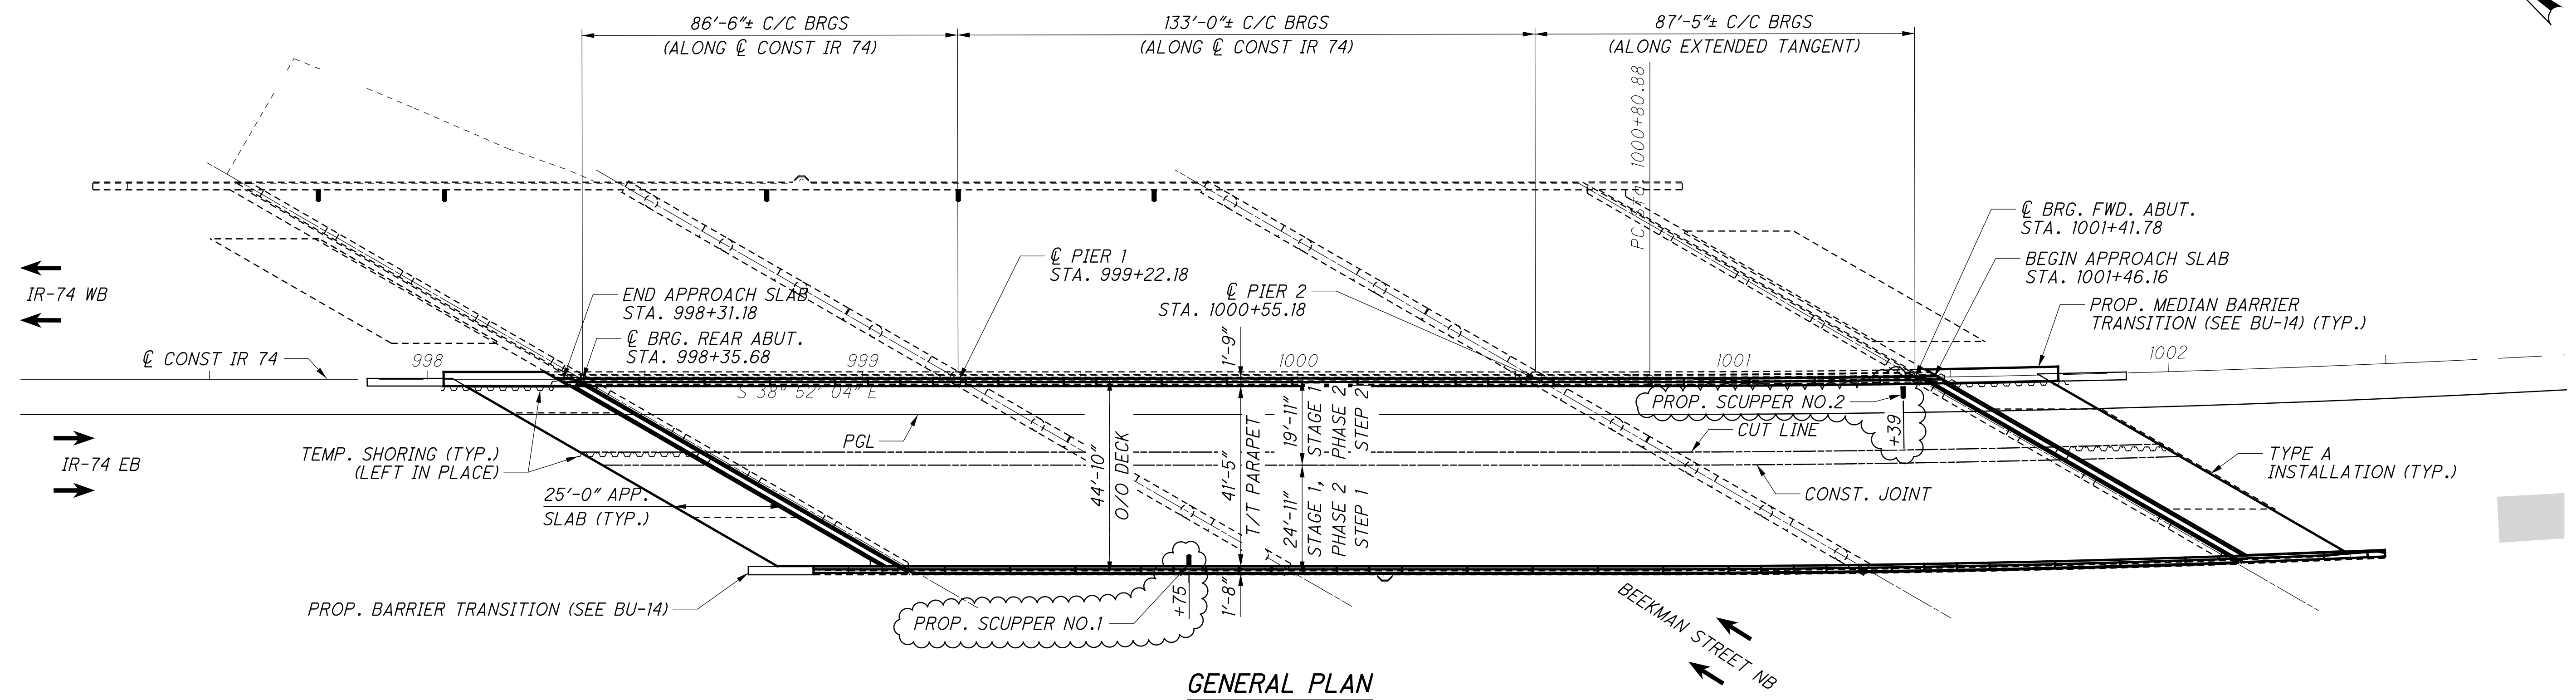

BENCHMARK DATA
REFER TO BU-14 FOR BENCHMARK DATA.

NOTES
 EARTHWORK LIMITS SHOWN ARE APPROXIMATE. ACTUAL SLOPES SHALL CONFORM TO PLAN CROSS SECTIONS.

DESIGN TRAFFIC:
 2010 ADT = 75,000 2010 ADTT = 11,250
 2030 ADT = 89,300 2030 ADTT = 13,395
 DIRECTIONAL DISTRIBUTION = 0.72

EXISTING STRUCTURE

TYPE: CONTINUOUS STEEL PLATE GIRDERS WITH REINFORCED CONCRETE DECK AND SUBSTRUCTURE

SPANS: 86'-6"±, 133'-0"±, 87'-5"± C/C BRGS. (ALONG EXTENDED TANGENT)
 ROADWAY: 41'-10"± TOE/TOE PARAPET
 LOADING: HS20-44 AND THE ALTERNATE MILITARY LOADING
 SKEW: 60°00'± RF
 APPROACH SLABS: AS-1-67 (25'-0"±)
 ALIGNMENT: TANGENT AND 1°28'00"± CURVE LEFT
 CROWN: VARIES, 0.036± FT/FT MAX.
 STRUCTURAL FILE NUMBER: 3115577
 DATE BUILT: 1973
 WEARING SURFACE: 2"± ASPHALT CONCRETE OVERLAY
 1 1/4"± SDC OVERLAY

DISPOSITION: REHABILITATION

PROPOSED STRUCTURE

TYPE: RIGHT BRIDGE (EB)
 REPLACE DECK WITH COMPOSITE DECK, REPLACE EXPANSION JOINTS, REPLACE ABUTMENT BEARINGS WITH ELASTOMERIC BEARINGS, REMOVE AND REPLACE BACKWALL TO TOP OF BEAM SEAT, REPLACE APPROACH SLABS, PATCH EX. SUBSTRUCTURE, FIBER WRAP PIER 2 COLUMNS

LEFT BRIDGE (WB)
 REPLACE ABUTMENT BEARINGS WITH ELASTOMERIC BEARINGS

SPANS: 86'-6"±, 133'-0"±, 87'-5"± C/C BRGS. (ALONG EXTENDED TANGENT)
 ROADWAY: 41'-5" TOE/TOE PARAPET
 LOADING: HS20-44 AND THE ALTERNATE MILITARY LOADING
 SKEW: 60°00'± RF
 APPROACH SLABS: 25' LONG (AS-1-15 & AS-2-15)
 ALIGNMENT: TANGENT AND 1°28'00" CURVE LEFT
 SUPERELEVATION: VARIES, 0.036 FT/FT MAX.
 WEARING SURFACE: 1" MONOLITHIC CONCRETE
 COORDINATES: LATITUDE N39°09'33.80"
 LONGITUDE W84°33'02.07"

S:\Flanagan\11/16/2023 9:34:13 AM\01\2017\01113\C.Design\104667-HAM-75-3.84\Design\Structures\HAM0074_1852C\Sheets\74_1852GP002.dgn

STANDARD DRAWINGS AND SUPPLEMENTAL SPECIFICATIONS:

REFER TO THE FOLLOWING STANDARD BRIDGE DRAWINGS:

- AS-1-15 REVISED 07-17-15
- AS-2-15 REVISED 01-19-18
- EXJ-4-87 REVISED 01-19-18
- GSD-1-96 REVISED 07-19-02
- PCB-91 REVISED 01-18-13
- SBR-1-13 REVISED 07-20-18
- SBR-2-13 REVISED 07-20-18

AND TO THE FOLLOWING PROPOSAL NOTES:

519 COMPOSITE FIBER WRAP SYSTEM REVISED 07-21-17

DESIGN SPECIFICATIONS:

THE PROPOSED WORK CONFORMS TO "STANDARD SPECIFICATIONS FOR HIGHWAY BRIDGES" ADOPTED BY THE AMERICAN ASSOCIATION OF STATE HIGHWAY AND TRANSPORTATION OFFICIALS, 17TH EDITION, AND THE 2004 ODOT BRIDGE DESIGN MANUAL.

DESIGN LOADING:

DESIGN LOADING: HS20-44, CASE I AND THE ALTERNATE MILITARY LOADING.

FUTURE WEARING SURFACE (FWS) OF 60 PSF

DESIGN DATA:

QC/QA CONCRETE, CLASS QC3 - COMPRESSIVE STRENGTH 4500 PSI (SUPERSTRUCTURE)

CONCRETE, CLASS QC3 - COMPRESSIVE STRENGTH 4000 PSI (SUBSTRUCTURE)

REINFORCING STEEL - MINIMUM YIELD STRENGTH 75,000 PSI (DECK)

REINFORCING STEEL - MINIMUM YIELD STRENGTH 60,000 PSI (SUBSTRUCTURE & PARAPETS)

STRUCTURAL STEEL - ASTM A709 GRADE 50 - YIELD STRENGTH 50 KSI (BEARINGS)

DECK PROTECTION METHOD:

EPOXY COATED REINFORCING STEEL

2 1/2" CONCRETE COVER

MONOLITHIC WEARING SURFACE:

MONOLITHIC WEARING SURFACE IS ASSUMED, FOR DESIGN PURPOSES, TO BE 1 INCH THICK.

EXISTING STRUCTURE VERIFICATION:

DETAILS AND DIMENSIONS SHOWN ON THESE PLANS PERTAINING TO THE EXISTING STRUCTURE HAVE BEEN OBTAINED FROM PLANS OF THE EXISTING STRUCTURE AND FROM FIELD OBSERVATIONS AND MEASUREMENTS. CONSEQUENTLY, THEY ARE INDICATIVE OF THE EXISTING STRUCTURE AND THE PROPOSED WORK BUT THEY SHALL BE CONSIDERED TENTATIVE AND APPROXIMATE. THE CONTRACTOR IS REFERRED TO CMS SECTIONS 102.05 AND 105.02.

BASE CONTRACT BID PRICES UPON A RECOGNITION OF THE UNCERTAINTIES DESCRIBED ABOVE AND UPON A PREBID EXAMINATION OF THE EXISTING STRUCTURE. HOWEVER, THE DEPARTMENT WILL PAY FOR ALL PROJECT WORK BASED UPON ACTUAL DETAILS AND DIMENSIONS THAT HAVE BEEN VERIFIED IN THE FIELD.

ITEM 202 - PORTIONS OF STRUCTURE REMOVED. OVER 20 FOOT SPAN. AS PER PLAN:

DESCRIPTION:

ITEMS TO BE REMOVED INCLUDE ALL EXISTING MATERIALS BEING REPLACED BY NEW CONSTRUCTION AS SHOWN IN THE PLANS AND AS PER CMS 202.

CUTLINE CONSTRUCTION JOINT PREPARATION: THOROUGHLY CLEAN THE JOINT SURFACE AND EXPOSED REINFORCEMENT OF ALL DIRT, DUST, RUST OR OTHER FOREIGN MATERIAL BY THE USE OF WATER, AIR UNDER PRESSURE, OR OTHER METHODS THAT PRODUCE SATISFACTORY RESULTS. EXISTING REINFORCING STEEL DOES NOT HAVE TO HAVE A BRIGHT STEEL FINISH, BUT REMOVE ALL PACK AND LOOSE RUST. THOROUGHLY DRENCH EXISTING CONCRETE SURFACES WITH CLEAN WATER AND ALLOW TO DRY TO A DAMP CONDITION BEFORE PLACING CONCRETE.

SUBSTRUCTURE CONCRETE REMOVAL: REMOVE CONCRETE BY MEANS OF APPROVED PNEUMATIC HAMMERS EMPLOYING POINTED AND BLUNT CHISEL TOOLS. THE WEIGHT OF THE HAMMER SHALL NOT BE MORE THAN 35 POUNDS FOR REMOVAL WITHIN 18 INCHES OF PORTIONS TO BE PRESERVED. DO NOT PLACE PNEUMATIC HAMMERS IN DIRECT CONTACT WITH REINFORCING STEEL THAT IS TO BE RETAINED IN THE REBUILT STRUCTURE.

DECK REMOVAL: PERFORM WORK CAREFULLY DURING DECK REMOVALS TO PROTECT PORTIONS OF SUCH SYSTEMS THAT ARE TO BE SALVAGED AND INCORPORATED INTO THE PROPOSED STRUCTURE. THE USE OF EXPLOSIVES OR HEADACHE BALLS IS PROHIBITED. SUBMIT CONSTRUCTION PLANS ACCORDING TO CMS 501.05.

REMOVAL METHODS: REMOVAL METHODS OVER STRUCTURAL MEMBERS SHALL ENSURE ADEQUATE DEPTH CONTROL AND PREVENT NICKING OR GOUGING THE PRIMARY STRUCTURAL MEMBERS. REPLACE OR REPAIR STRUCTURAL MEMBERS DAMAGED BY THE REMOVAL OPERATIONS AT NO COST TO THE PROJECT. AT LEAST 7 DAYS BEFORE PERFORMING REPAIR WORK, SUBMIT A PROPOSED REPAIR PLAN, DEVELOPED BY AN OHIO REGISTERED PROFESSIONAL ENGINEER TO THE DIRECTOR. OBTAIN THE DIRECTOR'S APPROVAL BEFORE PERFORMING REPAIR.

EXISTING WELDED ATTACHMENTS: REMOVE EXISTING WELDED ATTACHMENTS (E.G., FINISHING MACHINE AND FORM SUPPORTS; SUPPORTS FOR SCUPPERS AND BULB ANGLES WHICH ARE TO BE REMOVED; AND LIGHTING SUPPORTS) LOCATED IN THE DESIGNATED TENSION PORTIONS OF THE TOP FLANGES OF EXISTING STEEL MEMBERS AND GRIND THE FLANGE SURFACES SMOOTH. CAREFULLY GRIND PARALLEL TO THE FLANGES.

ITEM 510 - DOWEL HOLES WITH NONSHRINK NONMETALLIC GROUT. AS PER PLAN:

DRILL DOWEL HOLES WHERE SHOWN IN THE PLANS. INSTALL REINFORCING STEEL ACCORDING TO ITEM 510 USING EPOXY GROUT, 705.20. PRIOR TO DRILLING DOWEL HOLES, LOCATE ALL EXISTING REINFORCING STEEL BARS IN THE AREA OF THE HOLE WITH THE AID OF A REINFORCING STEEL BAR LOCATOR (PACHOMETER). IF AN EXISTING BAR IS ENCOUNTERED AT THE SAME LOCATION AS A PROPOSED DOWEL HOLE, MOVE THE DOWEL HOLE TO EITHER SIDE OF THE EXISTING BAR.

ITEM 519 - PATCHING CONCRETE STRUCTURE. AS PER PLAN:

PRIOR TO THE SURFACE CLEANING SPECIFIED IN 519.04 AND WITHIN 24 HOURS OF PLACING PATCHING MATERIAL, BLAST CLEAN ALL SURFACES TO BE PATCHED INCLUDING THE EXPOSED REINFORCING STEEL. ACCEPTABLE METHODS INCLUDE HIGH-PRESSURE WATER BLASTING WITH OR WITHOUT ABRASIVES IN THE WATER, ABRASIVE BLASTING WITH CONTAINMENT, OR VACUUM ABRASIVE BLASTING.

ITEM 519 - PATCHING OF CONCRETE STRUCTURES IS A UNIT PRICE PAY ITEM (LINE 0032).

CLASS QC3 CONCRETE WITH QC/QA. SUBSTRUCTURE. AS PER PLAN

THIS ITEM MODIFIES THE STANDARD 511 CONCRETE FOR STRUCTURES SPECIFICATION TO INCLUDE MACRO-SYNTHETIC INTO THE SUBSTRUCTURE CONCRETE. THIS ITEM SHALL CONFORM TO CMS 511 WITH THE FOLLOWING CONDITIONS AND REVISIONS:

PROVIDE MATERIALS CONFORMING TO 511.02 EXCEPT AS MODIFIED BELOW:

PORTLAND CEMENT CONCRETE - 499.03, CLASS QC 3 MEETING A DESIGN STRENGTH OF 4,000 PSI, WITH MACRO-SYNTHETIC FIBERS WITH MODIFICATION PER 511.02.

FIBERS FOR CONCRETE - ASTM C 1116, TYPE III

THE CLASS QC3 CONCRETE FOR THE SUBSTRUCTURE SHALL MEET THE FOLLOWING CRITERIA: WATER/CEMENT RATIO = 0.40 MAXIMUM; MINIMUM 4 LBS/CY MACRO-SYNTHETIC FIBERS (1.5 IN. MIN. TO 2.5 IN. MAX.) MEETING ASTM C1116 TYPE III SHALL BE ADDED TO THE MIX.

THE MACRO-SYNTHETIC FIBERS SHALL BE INCORPORATED INTO THE MIX IN SUCH A WAY THAT NO 'BALLING' OCCURS. UPON INSPECTION OF THE MIX AT THE TIME OF PLACEMENT, IF ANY 'BALLING' OCCURS, THE ENGINEER SHALL REJECT THE REMAINDER OF THE LOAD AT ANY TIME DURING THE POUR. IT IS IMPORTANT TO FOLLOW INDUSTRY STANDARDS AND ASTM SPECIFICATIONS ON THE PREMIXING OF THE CEMENT, AGGREGATE, AND MACRO-SYNTHETIC FIBERS PRIOR TO THE ADDITION OF WATER AND ADMIXTURES. PROVIDE MACRO-SYNTHETIC FIBERS THAT ARE MONOFILAMENT FIBERS MADE FROM VIRGIN POLYPROPYLENE, POLYETHYLENE, OR CO-POLYMERS THAT ARE INERT TO ALKALI ATTACK. ENSURE THE MACRO-SYNTHETIC FIBERS HAVE A MINIMUM TENSILE STRENGTH OF 70 KSI, A MINIMUM MODULUS OF ELASTICITY OF 800 KSI, A MINIMUM FILAMENT DIAMETER OF 0.012 INCHES, AND ASPECT RATIO BETWEEN 60 AND 100, AND ARE BETWEEN 1.5 AND 2.5 INCHES IN LENGTH. STORE THE MACRO-SYNTHETIC FIBERS ACCORDING TO THE MANUFACTURE'S RECOMMENDATION AND KEEP THE MATERIAL FREE FROM DUST, DIRT AND MOISTURE.

USE A MINIMUM DOSAGE RATE OF MACRO-SYNTHETIC FIBERS OF 4.0 LBS/CY OF CONCRETE. DETERMINE THE FINAL PROPOSED DOSAGE RATE THROUGH MIX TESTING. ENSURE THE FIBER REINFORCED CONCRETE MEETS OR EXCEEDS A MINIMUM EQUIVALENT FLEXURAL STRENGTH RATIO OF 25% ACCORDING TO ASTM C 1609. MACRO-SYNTHETIC FIBERS IS TO BE USED AS AN ADMIXTURE TO CONTROL CRACKING AND IS NOT TO BE USED TO SUPPLEMENT OR REPLACE REINFORCING STEEL IN THE DESIGN. ENSURE THE FINAL PROPOSED MIX IS WORKABLE AND ABLE TO BE PRODUCED SUCH THAT BALLING OR CLUMPING OF THE FIBERS IS NOT A PROBLEM AS DETERMINED BY THE ENGINEER. UTILIZE A LABORATORY REGULARLY INSPECTED BY THE CEMENT AND CONCRETE REFERENCE LABORATORY (CCRL) OF THE NATIONAL INSTITUTE OF STANDARDS AND TECHNOLOGY, OR OTHER APPROVED REFERENCE LABORATORY, TO PERFORM THE TESTING. BEFORE USE, SUBMIT DOCUMENTATION TO THE PROJECT ENGINEER CERTIFYING BOTH THE MACRO-SYNTHETIC FIBERS AND THE MIX MEET OR EXCEED THE REQUIRED PROPERTIES. SAMPLING WILL BE ALLOWED FOR TESTING PURPOSES. A DEMONSTRATION OF THE MIX PRODUCTION OR TRIAL MIX, MAY BE REQUIRED BY THE ENGINEER PRIOR TO PLACING ANY OF THE MIX ON THE PROJECT.

THE BATCH WEIGHTS SHALL BE CORRECTED TO COMPENSATE FOR THE MOISTURE CONTAINED IN THE AGGREGATE AT THE TIME OF USE. A CHEMICAL ADMIXTURE (705.12, TYPE A OR D) SHALL BE USED.

CONCRETE SUPPLIERS SHOULD RECOGNIZE THAT ADMIXTURES MAY HAVE AN EFFECT ON STRENGTH, ENTRAINED AIR CONTENT, WORKABILITY, ETC. OF THEIR CONCRETE MIXES. THE CONCRETE SUPPLIER'S CHOICE OF ADMIXTURES DOES NOT ALLEVIATE MEETING DESIGN REQUIREMENTS.

CLASS QC3 CONCRETE WITH QC/QA. SUPERSTRUCTURE. AS PER PLAN

THIS ITEM MODIFIES THE STANDARD 511 CONCRETE FOR STRUCTURES SPECIFICATION TO INCLUDE MACRO-SYNTHETIC INTO THE SUPERSTRUCTURE CONCRETE. THIS ITEM SHALL CONFORM TO CMS 511 WITH THE FOLLOWING CONDITIONS AND REVISIONS:

PROVIDE MATERIALS CONFORMING TO 511.02 EXCEPT AS MODIFIED BELOW:

PORTLAND CEMENT CONCRETE - 499.03, CLASS QC 3 MEETING A DESIGN STRENGTH OF 4,500 PSI, WITH MACRO-SYNTHETIC FIBERS WITH MODIFICATION PER 511.02.

FIBERS FOR CONCRETE - ASTM C 1116, TYPE III

THE CLASS QC3 CONCRETE FOR THE SUPERSTRUCTURE SHALL MEET THE FOLLOWING CRITERIA: WATER/CEMENT RATIO = 0.40 MAXIMUM; MINIMUM 4 LBS/CY MACRO-SYNTHETIC FIBERS (1.5 IN. MIN. TO 2.5 IN. MAX.) MEETING ASTM C1116 TYPE III SHALL BE ADDED TO THE MIX.

THE MACRO-SYNTHETIC FIBERS SHALL BE INCORPORATED INTO THE MIX IN SUCH A WAY THAT NO 'BALLING' OCCURS. UPON INSPECTION OF THE MIX AT THE TIME OF PLACEMENT, IF ANY 'BALLING' OCCURS, THE ENGINEER SHALL REJECT THE REMAINDER OF THE LOAD AT ANY TIME DURING THE POUR. IT IS IMPORTANT TO FOLLOW INDUSTRY STANDARDS AND ASTM SPECIFICATIONS ON THE PREMIXING OF THE CEMENT, AGGREGATE, AND MACRO-SYNTHETIC FIBERS PRIOR TO THE ADDITION OF WATER AND ADMIXTURES. PROVIDE MACRO-SYNTHETIC FIBERS THAT ARE MONOFILAMENT FIBERS MADE FROM VIRGIN POLYPROPYLENE, POLYETHYLENE, OR CO-POLYMERS THAT ARE INERT TO ALKALI ATTACK. ENSURE THE MACRO-SYNTHETIC FIBERS HAVE A MINIMUM TENSILE STRENGTH OF 70 KSI, A MINIMUM MODULUS OF ELASTICITY OF 800 KSI, A MINIMUM FILAMENT DIAMETER OF 0.012 INCHES, AND ASPECT RATIO BETWEEN 60 AND 100, AND ARE BETWEEN 1.5 AND 2.5 INCHES IN LENGTH. STORE THE MACRO-SYNTHETIC FIBERS ACCORDING TO THE MANUFACTURE'S RECOMMENDATION AND KEEP THE MATERIAL FREE FROM DUST, DIRT AND MOISTURE.

USE A MINIMUM DOSAGE RATE OF MACRO-SYNTHETIC FIBERS OF 4.0 LBS/CY OF CONCRETE. DETERMINE THE FINAL PROPOSED DOSAGE RATE THROUGH MIX TESTING. ENSURE THE FIBER REINFORCED CONCRETE MEETS OR EXCEEDS A MINIMUM EQUIVALENT FLEXURAL STRENGTH RATIO OF 25% ACCORDING TO ASTM C 1609. MACRO-SYNTHETIC FIBERS IS TO BE USED AS AN ADMIXTURE TO CONTROL CRACKING AND IS NOT TO BE USED TO SUPPLEMENT OR REPLACE REINFORCING STEEL IN THE DESIGN. ENSURE THE FINAL PROPOSED MIX IS WORKABLE AND ABLE TO BE PRODUCED SUCH THAT BALLING OR CLUMPING OF THE FIBERS IS NOT A PROBLEM AS DETERMINED BY THE ENGINEER. UTILIZE A LABORATORY REGULARLY INSPECTED BY THE CEMENT AND CONCRETE REFERENCE LABORATORY (CCRL) OF THE NATIONAL INSTITUTE OF STANDARDS AND TECHNOLOGY, OR OTHER APPROVED REFERENCE LABORATORY, TO PERFORM THE TESTING. BEFORE USE, SUBMIT DOCUMENTATION TO THE PROJECT ENGINEER CERTIFYING BOTH THE MACRO-SYNTHETIC FIBERS AND THE MIX MEET OR EXCEED THE REQUIRED PROPERTIES. SAMPLING WILL BE ALLOWED FOR TESTING PURPOSES. A DEMONSTRATION OF THE MIX PRODUCTION OR TRIAL MIX, MAY BE REQUIRED BY THE ENGINEER PRIOR TO PLACING ANY OF THE MIX ON THE PROJECT.

THE BATCH WEIGHTS SHALL BE CORRECTED TO COMPENSATE FOR THE MOISTURE CONTAINED IN THE AGGREGATE AT THE TIME OF USE. A CHEMICAL ADMIXTURE (705.12, TYPE A OR D) SHALL BE USED.

CONCRETE SUPPLIERS SHOULD RECOGNIZE THAT ADMIXTURES MAY HAVE AN EFFECT ON STRENGTH, ENTRAINED AIR CONTENT, WORKABILITY, ETC. OF THEIR CONCRETE MIXES. THE CONCRETE SUPPLIER'S CHOICE OF ADMIXTURES DOES NOT ALLEVIATE MEETING DESIGN REQUIREMENTS.

S:\Flanagan\11/16/2023 9:34:14 AM\0\2017\01113\C.Design\104667-HAM-75-3-84.Design\Structures\HAM0074-1852C\Sheets\74-1852GN001.dgn

DESIGN AGENCY STRUCTUREPOINT	DATE	11/16/18
	REVIEWED	MDS
DRAWN	DSH	REVISED
DESIGNED	SJF	CHECKED
GENERAL NOTES	CLB	
BRIDGE NO. HAM-74-1852 L/R OVER NB BEEKMAN ST. (U.S. 27)		
HAM-75-3-84	PID No. 104667	
3	40	
45	120	

CLASS QC3 CONCRETE WITH QC/QA, SUPERSTRUCTURE, AS PER PLAN (CONT.)

APPROACH SLABS, DIAPHRAGMS, AND BRIDGE RAILING CONCRETE ARE TO USE THE SAME MIX DESIGN AS THE BRIDGE DECK (WHEN APPLICABLE). USE SELF-COMPACTING CONCRETE ON DECORATIVE RAILING SIMILAR TO TEXAS RAILING AND MACRO-SYNTHETIC CONCRETE PER THIS SPECIFICATION ON TRADITIONAL CONCRETE RAILING WHEN APPLICABLE.

THE PLACING OF THE DECK AND THE APPROACH SLABS IN THE SAME CONCRETE POUR IS NOT PERMITTED.

DECK PLACEMENT DESIGN ASSUMPTIONS:

DECK PLACEMENT DESIGN ASSUMPTIONS: THE FOLLOWING ASSUMPTIONS OF CONSTRUCTION MEANS AND METHODS WERE MADE FOR THE ANALYSIS AND DESIGN OF THE SUPERSTRUCTURE. THE CONTRACTOR IS RESPONSIBLE FOR THE DESIGN OF THE FALSEWORK SUPPORT SYSTEM WITHIN THESE PARAMETERS AND WILL ASSUME RESPONSIBILITY FOR SUPERSTRUCTURE ANALYSIS FOR DEVIATION FROM THESE DESIGN ASSUMPTIONS.

AN EIGHT WHEEL FINISHING MACHINE WITH A MAXIMUM WHEEL LOAD OF 2.27 KIPS.

A MINIMUM OUT-TO-OUT WHEEL SPACING AT EACH END OF THE MACHINE OF 103".

A MAXIMUM SPACING OF OVERHANG FALSEWORK BRACKETS OF 48 IN.

A MAXIMUM DISTANCE FROM THE CENTERLINE OF THE FASCIA GIRDER TO THE FACE OF THE SAFETY HANDRAIL OF 65".

MECHANICAL CONNECTORS:

MECHANICAL CONNECTORS SHALL BE CAPABLE OF DEVELOPING 125 PERCENT OF THE YIELD STRENGTH OF THE CONNECTED BARS. FOR CONNECTORS WITH THREADED BAR ENDS, IN ORDER TO OFFSET THE EFFECT OF AREA REDUCTION ON THE STRENGTH OF THE BAR AND STILL MEET THE REQUIREMENTS OF ASTM A615, USE THE NEXT LARGER DIAMETER BAR OR A HIGHER GRADE OF STEEL BAR.

ITEM 514 - FIELD PAINTING. MISC.: MAIN AND SECONDARY MEMBERS:

THIS ITEM SHALL INCLUDE PAINTING AS WELL AS THE SURFACE PREPARATION OF THE MAIN AND SECONDARY MEMBERS IN THE FIELD WITH PRIME, INTERMEDIATE AND SURFACE COATS AS DIRECTED BY THE ENGINEER AT LOCATIONS WHERE THE EXISTING COATING IS DAMAGED. THE PAINT MAY BE APPLIED BY BRUSH ACCORDING TO 514.17E. SOLVENT CLEAN THE MAIN AND SECONDARY MEMBERS AS PER SSPC-SP 1 AND SSPC-SP 2, RESPECTIVELY, PRIOR TO PAINTING ACCORDING TO ITEM 514.

THE CONTRACTOR SHALL BE RESPONSIBLE FOR SELECTING THE FINISH COAT TO MATCH THE EXISTING AS CLOSE AS POSSIBLE AND SHALL RECIEVE APPROVAL FROM THE ENGINEER.

ITEM 516. JACKING AND TEMPORARY SUPPORT OF SUPERSTRUCTURE. AS PER PLAN:

THIS WORK CONSISTS OF RAISING OR REPOSITIONING EXISTING STRUCTURES TO THE DIMENSIONS AND REQUIREMENTS DEFINED IN THE PROJECT PLANS.

SUBMIT CONSTRUCTION PLANS IN ACCORDANCE WITH CMS 501.05.

IF, DURING THE JACKING OPERATIONS, DAMAGE TO THE STRUCTURE IS VISUALLY OBSERVED, IMMEDIATELY CEASE THE JACKING OPERATION AND INSTALL SUPPORTS TO THE SATISFACTION OF THE ENGINEER. ANALYZE THE DAMAGE AND SUBMIT A METHOD OF CORRECTION TO THE ENGINEER FOR APPROVAL. THE BRIDGE BEARINGS SHALL BE FULLY SEATED AT ALL CONTACT AREAS. IF FULL SEATING IS NOT ATTAINED, SUBMIT A REPAIR PLAN TO THE ENGINEER. THE DEPARTMENT WILL NOT PAY FOR THE REPAIR COSTS TO ENSURE FULL SEATING ON BEARINGS.

CONCRETE SEALER:

CHEMMASTERS SAFE CURE AND SEAL EPX (EPOXY) AND DURAGUARD 310 CRU (URETHANE) USED FOR SEALING OF CONCRETE SURFACES (EPOXY-URETHANE).

PROPOSED WORK (RIGHT BRIDGE):

- REMOVE AND REPLACE EXISTING CONCRETE DECK WITH COMPOSITE DECK
- REMOVE AND REPLACE EXISTING CONCRETE PARAPETS
- REMOVE AND REPLACE ABUTMENT BACKWALLS
- REPLACE ABUTMENT BEARINGS WITH ELASTOMERIC BEARINGS (LEFT & RIGHT BRIDGE)
- REPLACE APPROACH SLABS
- REPLACE STRIP SEAL EXPANSION JOINTS
- ADD SEISMIC PEDETALS TO REAR ABUTMENT
- ADD CROSS FRAMES AT FIXED PIER
- FIBER WRAP PIER 2 COLUMNS
- PATCH EXISTING SUBSTRUCTURE UNITS
- SEAL CONCRETE

BUILDABLE UNIT REFERENCES:

REFERENCE THE FOLLOWING BUILDABLE UNITS FOR ADDITIONAL INFORMATION, DETAILS, AND SPECIFICATIONS:
 ROADWAY AND DRAINAGE - BU-14
 MAINTENANCE OF TRAFFIC - BU-04 AND BU-23
 LIGHTING, STRIPING, PAVEMENT MARKINGS, ITS - BU-19


UTILITY LINES

THE UTILITY(IES) SHALL BORE ALL EXPENSE INVOLVED IN RELOCATING (INSTALLING) THE AFFECTED UTILITY LINES. THE CONTRACTOR AND UTILITY(IES) ARE TO COOPERATE BY ARRANGING THEIR WORK IN SUCH A MANNER THAT INCONVENIENCE TO EITHER WILL BE HELD TO A MINIMUM.


ABBREVIATION LIST:

THE FOLLOWING STANDARD ABBREVIATIONS ARE USED THROUGHOUT THE BRIDGE PLANS.


- ABUT. = ABUTMENT
- ACT. = ACTUAL
- APP. = APPROACH
- BRG. = BEARING
- BOT. = BOTTOM
- BTW. = BETWEEN
- CB = CATCH BASIN
- C.I.P. = CAST-IN-PLACE
- C.J. = CONSTRUCTION JOINT
- CLR. = CLEARANCE
- CONST = CONSTRUCTION
- CONT. = CONTINUOUS
- DIA. = DIAMETER
- DIM. = DIMENSION
- DWG. = DRAWING
- E.S. = EACH SIDE
- EL. = ELEVATION
- EQ. = EQUAL
- EST. = ESTIMATED
- EX. = EXISTING
- EXP. = EXPANSION
- F.A. = FORWARD ABUTMENT
- F.D.S. = FINAL DECK SURFACE
- F.S. = FAR SIDE
- FTG. = FOOTING
- FWD. = FORWARD
- GR. = GUARDRAIL
- HMWM = HIGH MOLECULAR WEIGHT METHACRYLATE
- INT. = INTERIOR
- INV. = INVERT
- NPCCP = NON-PERFORATED CORRUGATED PLASTIC PIPE
- N.S. = NEAR SIDE
- O.C.J. = OPTIONAL CONSTRUCTION JOINT
- PCCP = PERFORATED CORRUGATED PLASTIC PIPE
- PEJF = PREFORMED EXPANSION JOINT FILLER
- PERP. = PERPENDICULAR
- PROP. = PROPOSED
- PT. = POINT
- R.A. = REAR ABUTMENT
- REQD. = REQUIRED
- SER. = SERIES
- SHLD. = SHOULDER
- SPA. = SPACES
- STA. = STATION
- STD. = STANDARD
- STM = STORM SEWER LINE
- T&B = TOP AND BOTTOM
- T.O.H. = TOP OF HAUNCH
- T/S = TOP OF SLOPE
- TYP. = TYPICAL
- U.N. = UNLESS NOTED

	DESIGN AGENCY STRUCTUREPOINT	DATE 11/16/18	REVIEWED MDS	FILE NUMBER 3115577
DRAWN DSH	CHECKED CLB	GENERAL NOTES - 2 BRIDGE NO. HAM-74-1852 L/R OVER NB BEEKMAN ST. (U.S. 27)		
HAM-75-3.84 PID No. 104667		4 / 40		
46 120				


SFlanagan
 11/16/2023 9:34:15 AM
 O:\2017\01113\C.Design\104667_HAM-75-3.84\Design\Structures\HAM0074_1852C_Sheets\74-1852PC001.dgn

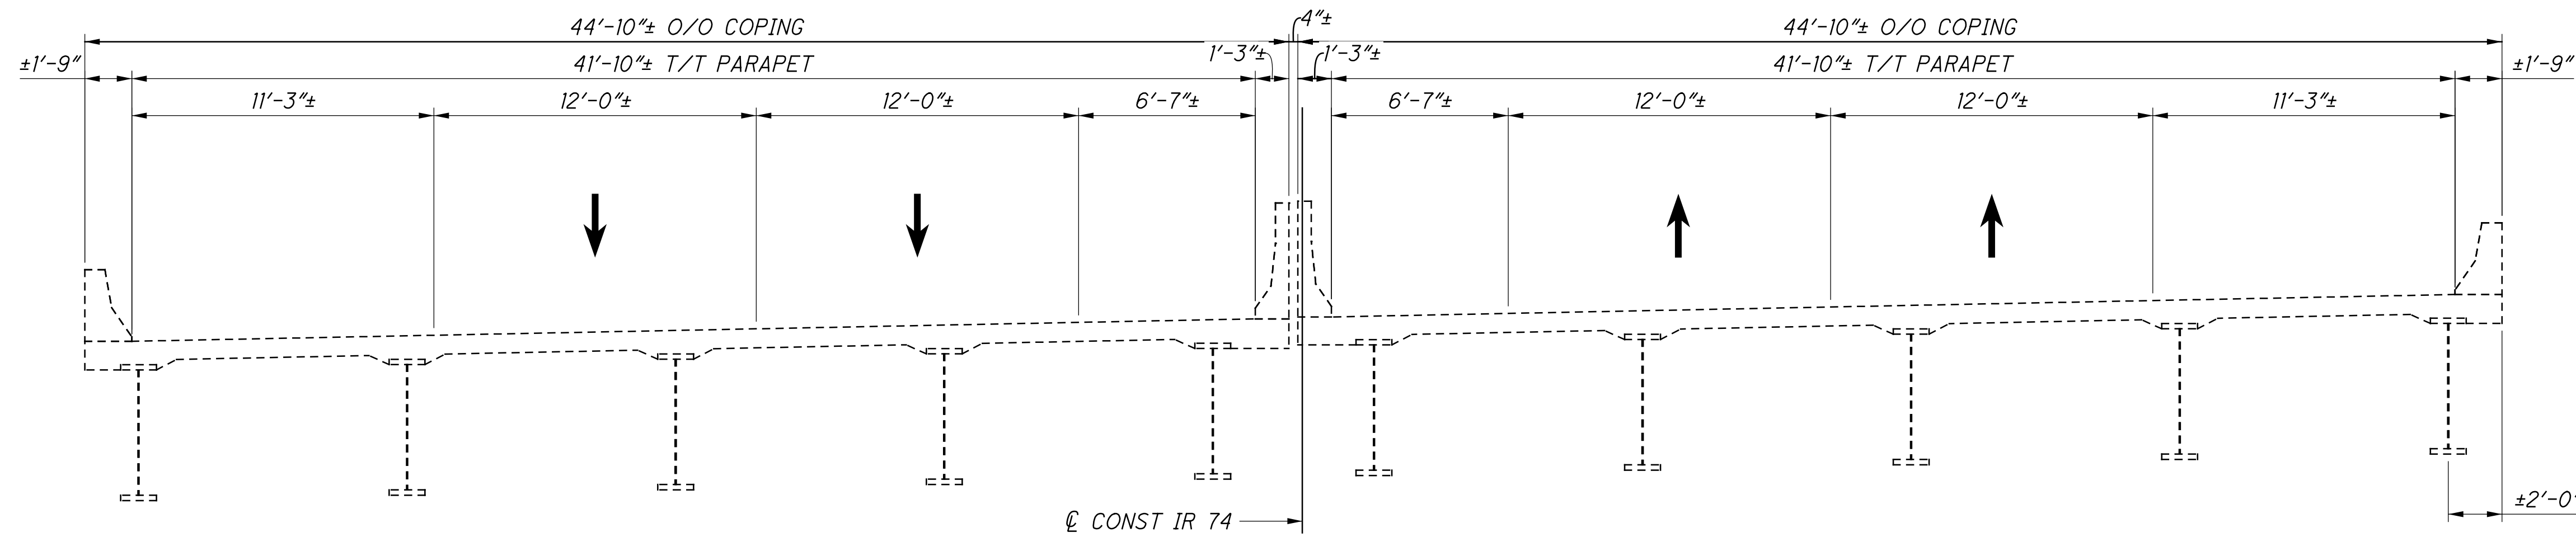

EXISTING TRANSVERSE SECTION

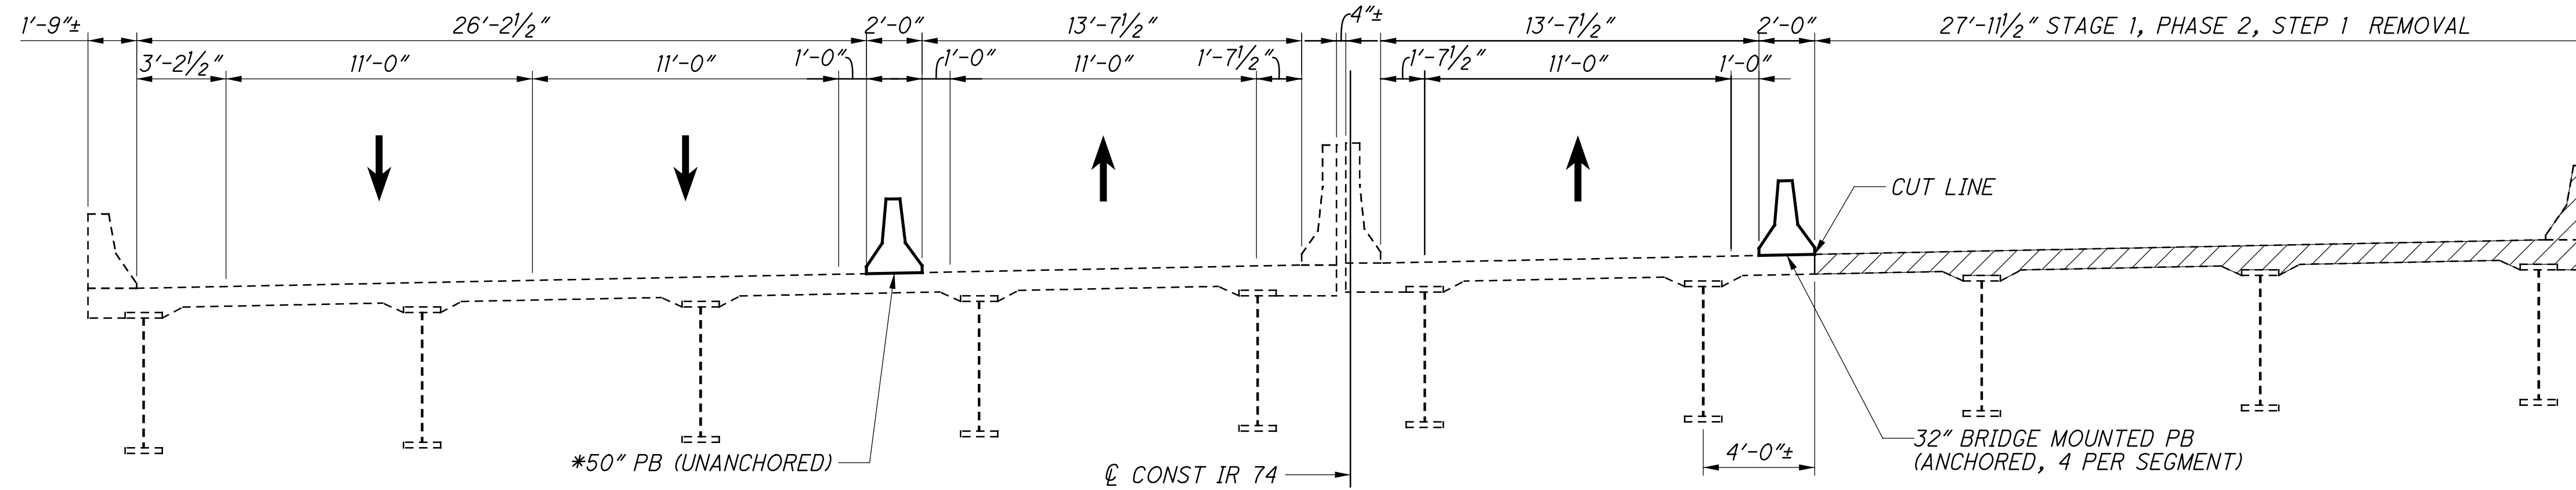

STAGE 1, PHASE 2, STEP 1 REMOVAL

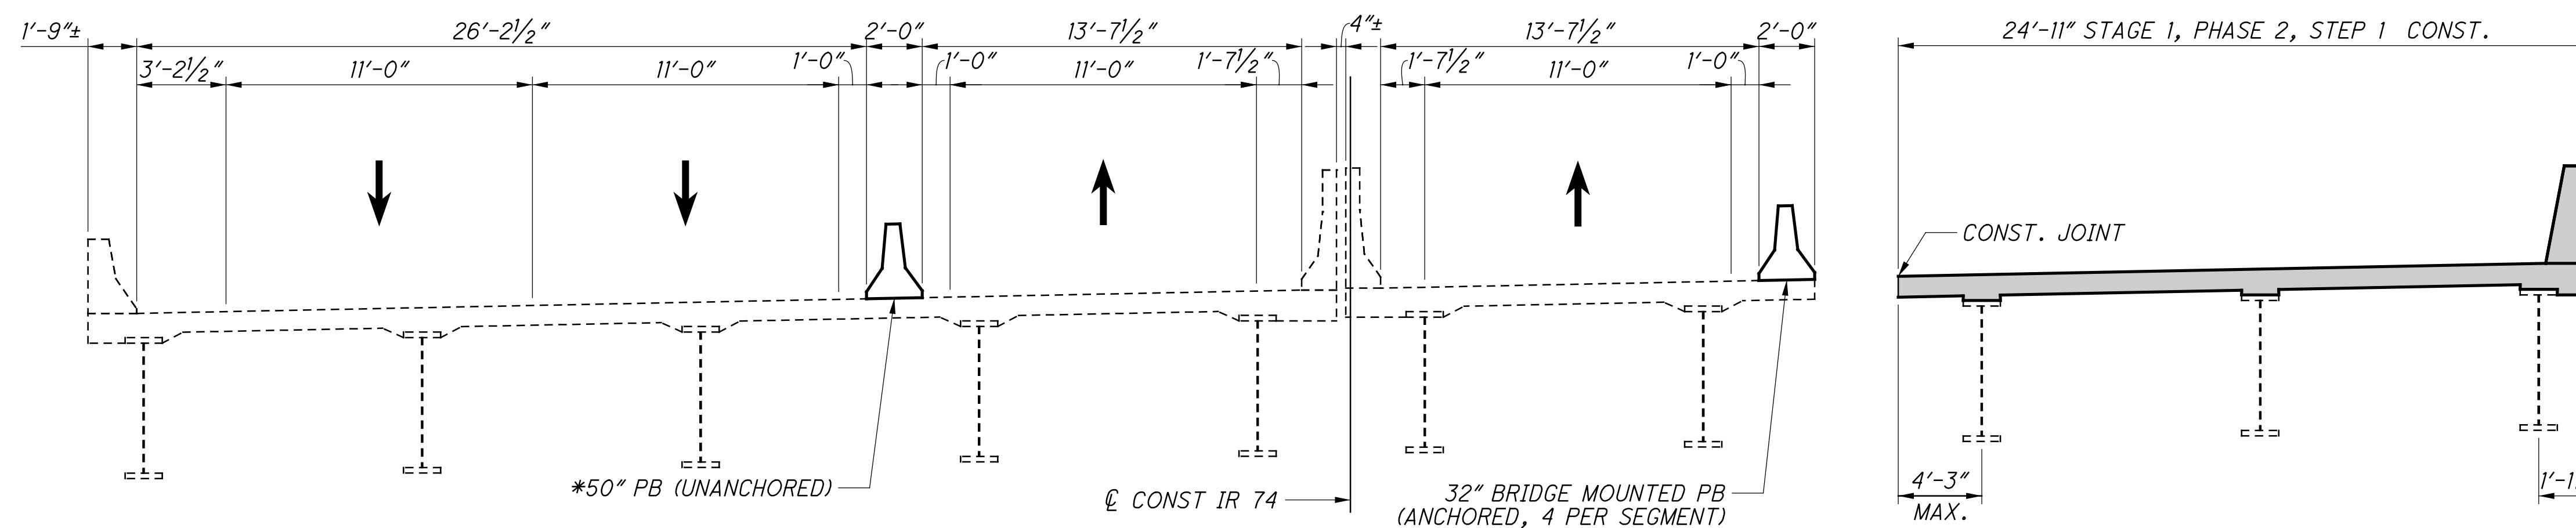

STAGE 1, PHASE 2, STEP 1 CONSTRUCTION

SEQUENCE OF CONSTRUCTION

STAGE 1/ PHASE 2/ STEP 1


1. INSTALL PB AS SHOWN IN BU-04 & BU-23 PLANS.
2. MAINTAIN TRAFFIC AS SHOWN.
3. INSTALL TEMP. SHORING.
4. REMOVE STAGE 1/ PHASE 2/ STEP 1 PORTIONS OF RIGHT BRIDGE.
5. CONSTRUCT STAGE 1/ PHASE 2/ STEP 1 PORTIONS OF RIGHT BRIDGE.

* 32" PB WITH GLARE SCREEN MAY BE USED AS AN ALTERNATE


LEGEND

LIMITS OF REMOVAL PER ITEM 202 - STRUCTURE REMOVED, OVER 20 FOOT SPAN

S:\Flanagan\11/16/2023\9:34:15 AM\01/2017/01113.C.Design\104667.HAM-75-3.84.Design.Structures.HAM0074.1852C.Sheets\74-1852PC002.dgn

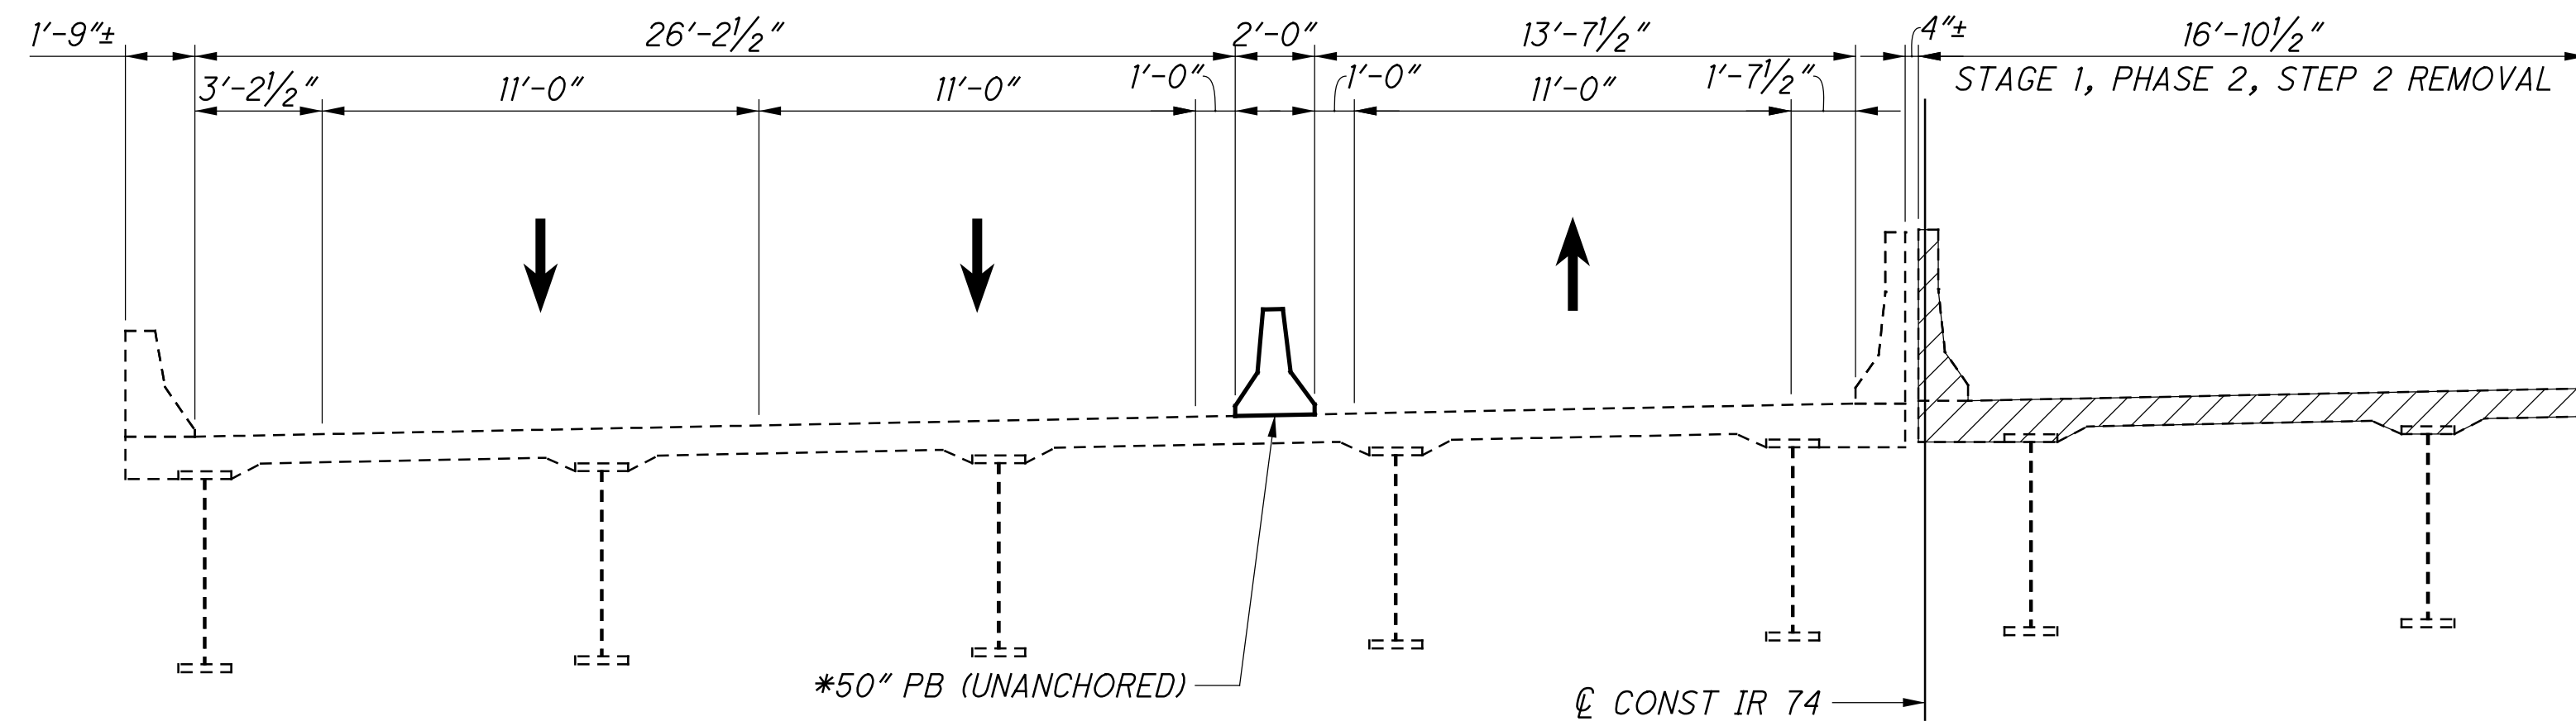


STAGE 1, PHASE 2, STEP 2 REMOVAL

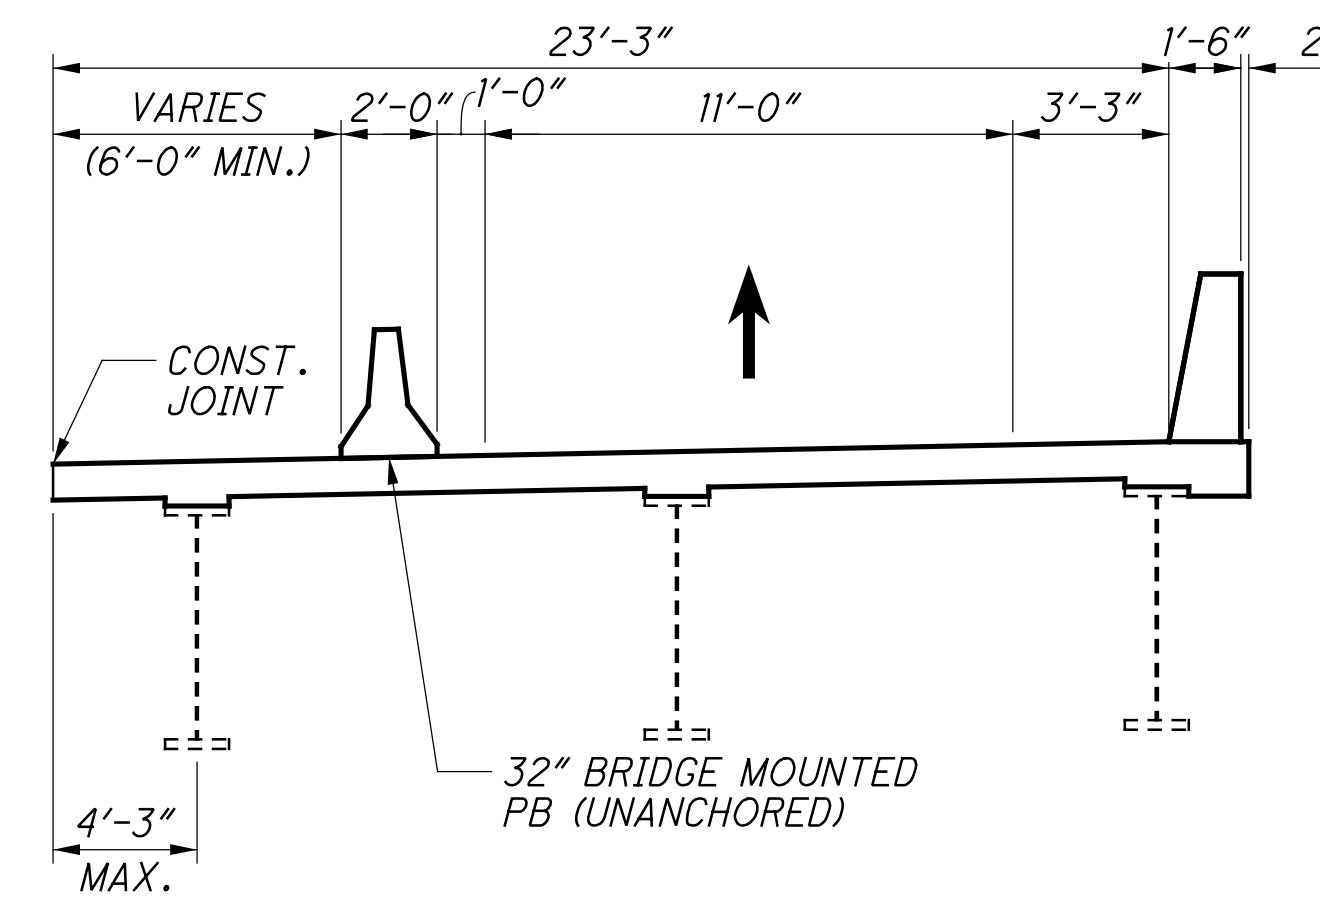


SEQUENCE OF CONSTRUCTION

STAGE 1/ PHASE 2/ STEP 2

1. RELOCATE PB AS SHOWN IN BU-04 & BU-23 PLANS.
2. MAINTAIN TRAFFIC AS SHOWN.
3. INSTALL TEMP. SHORING.
4. REMOVE STAGE 1/ PHASE 2/ STEP 2 PORTIONS OF RIGHT BRIDGE.
5. CONSTRUCT STAGE 1/ PHASE 2/ STEP 2 PORTIONS OF RIGHT BRIDGE.

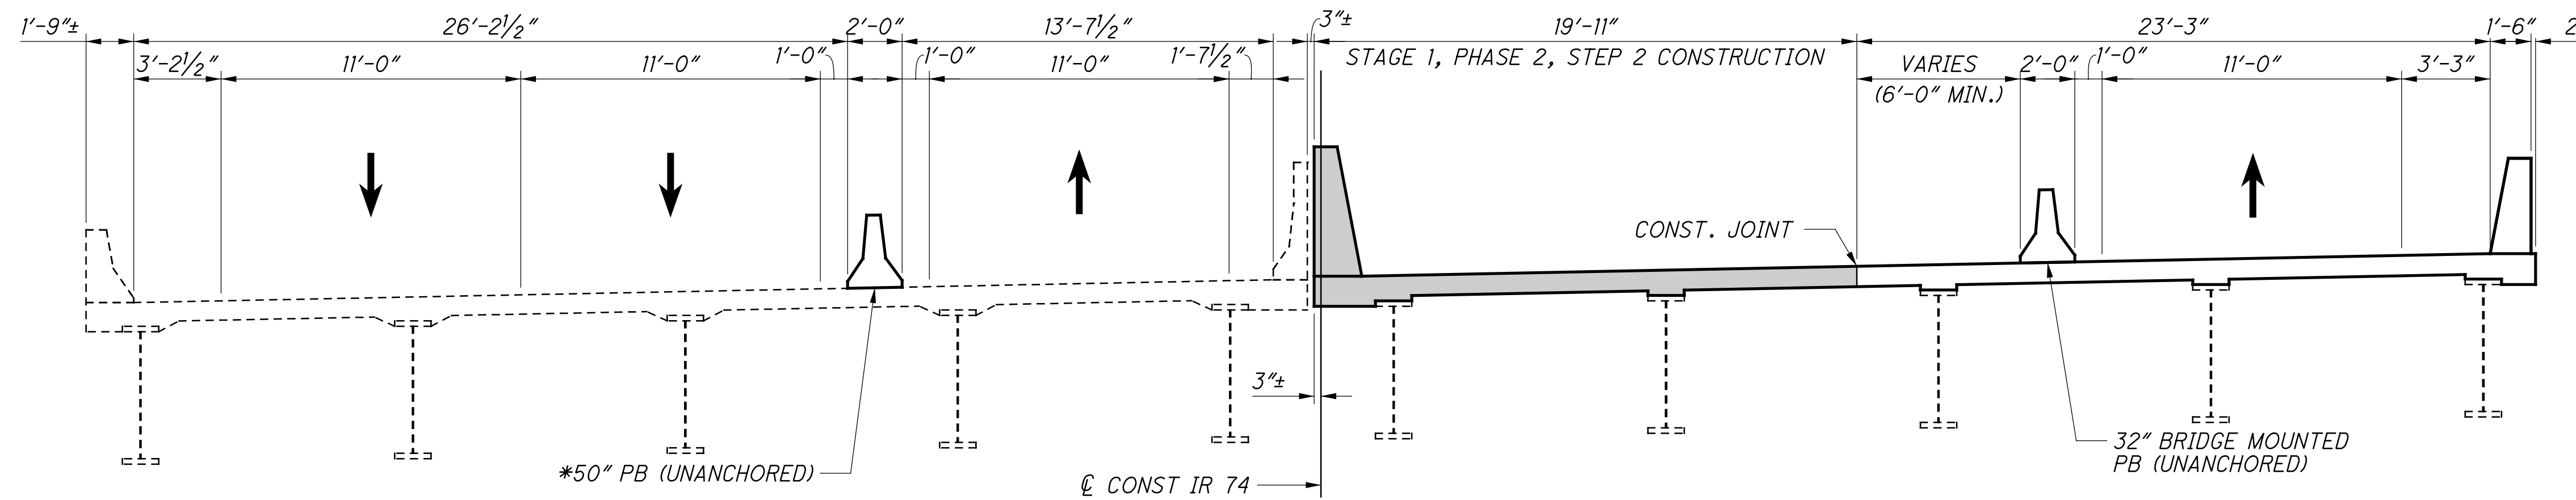

STAGE 1, PHASE 2, STEP 2 CONSTRUCTION

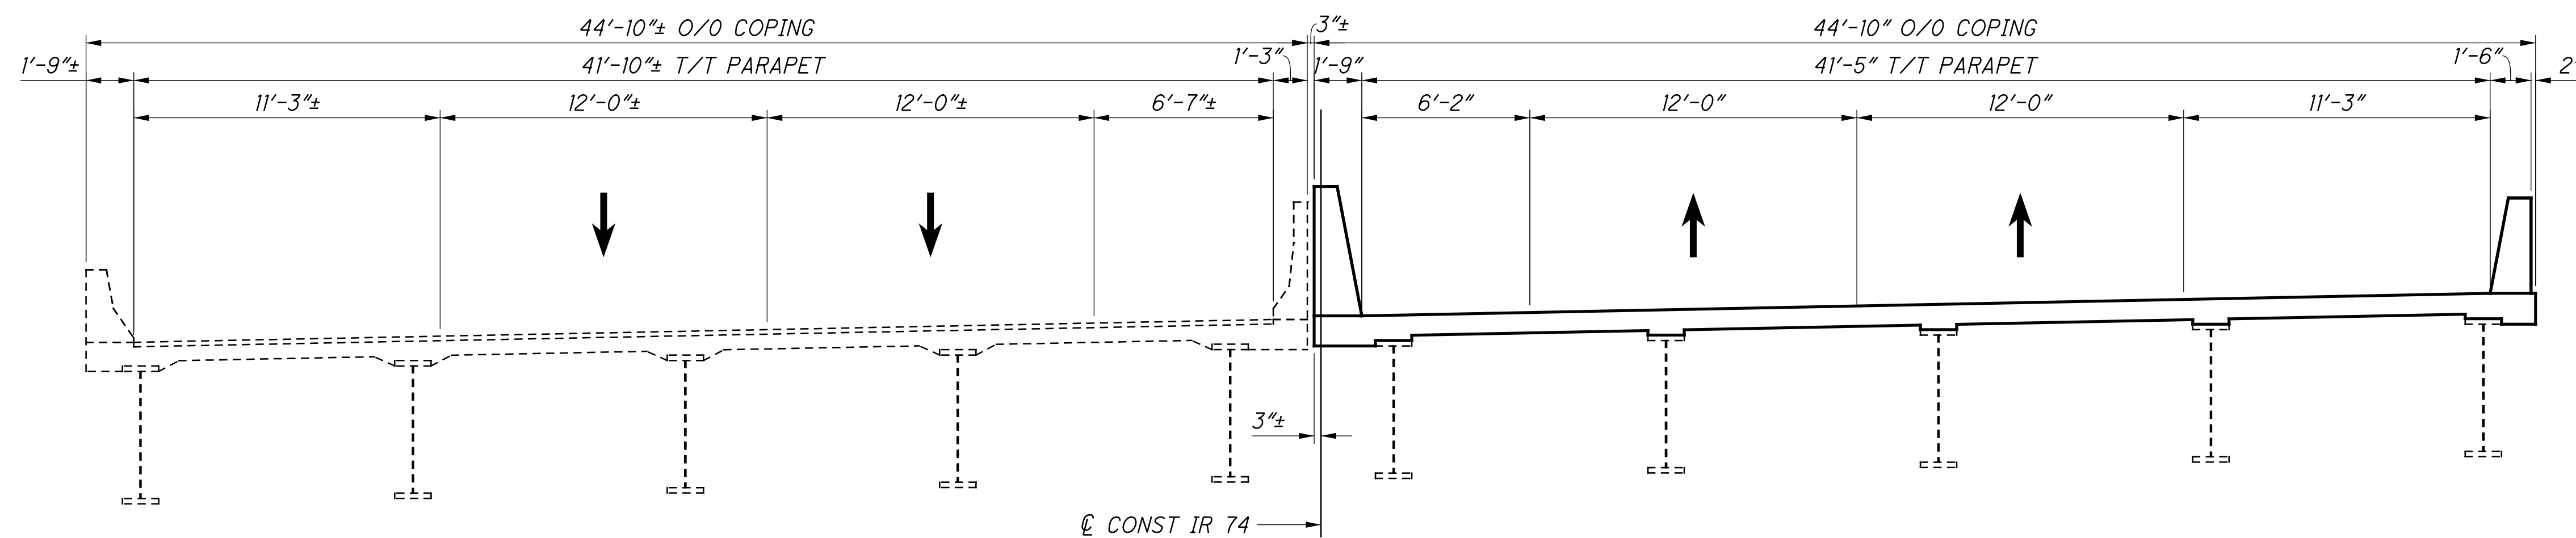

PROPOSED TRANSVERSE SECTION


* 32" PB WITH GLARE SCREEN MAY BE USED AS AN ALTERNATE

LEGEND


LIMITS OF REMOVAL PER ITEM 202 - STRUCTURE REMOVED, OVER 20 FOOT SPAN

	DESIGN AGENCY STRUCTUREPOINT <small>2020 CORPORATION LICENSED BY THE SD PROFESSIONAL ENGINEER REG. NO. 10000 TEL: 616.433.8000 FAX: 616.433.8001 WWW.STRUCTUREPOINT.COM</small>
DESIGNED SUJ	CHECKED CLB
DRAWN BMP	REVISED
REVIEWED MDS	STRUCTURE FILE NUMBER 3115577
DATE 9/12/18	3115577
PHASE CONSTRUCTION DETAILS - 2 BRIDGE NO. HAM-74-1852 L/R OVER NB BEEKMAN ST. (U.S. 27)	
HAM-75-3.84 PID No. 104667	
6 / 40	
48 120	

SFlanagan
 11/16/2023 9:34:16 AM
 \\0\2017\01113\C.Design\104667-HAM-75-3.84\Design\Structures\HAM0074_1852C\Sheets\74_1852RE001.dgn

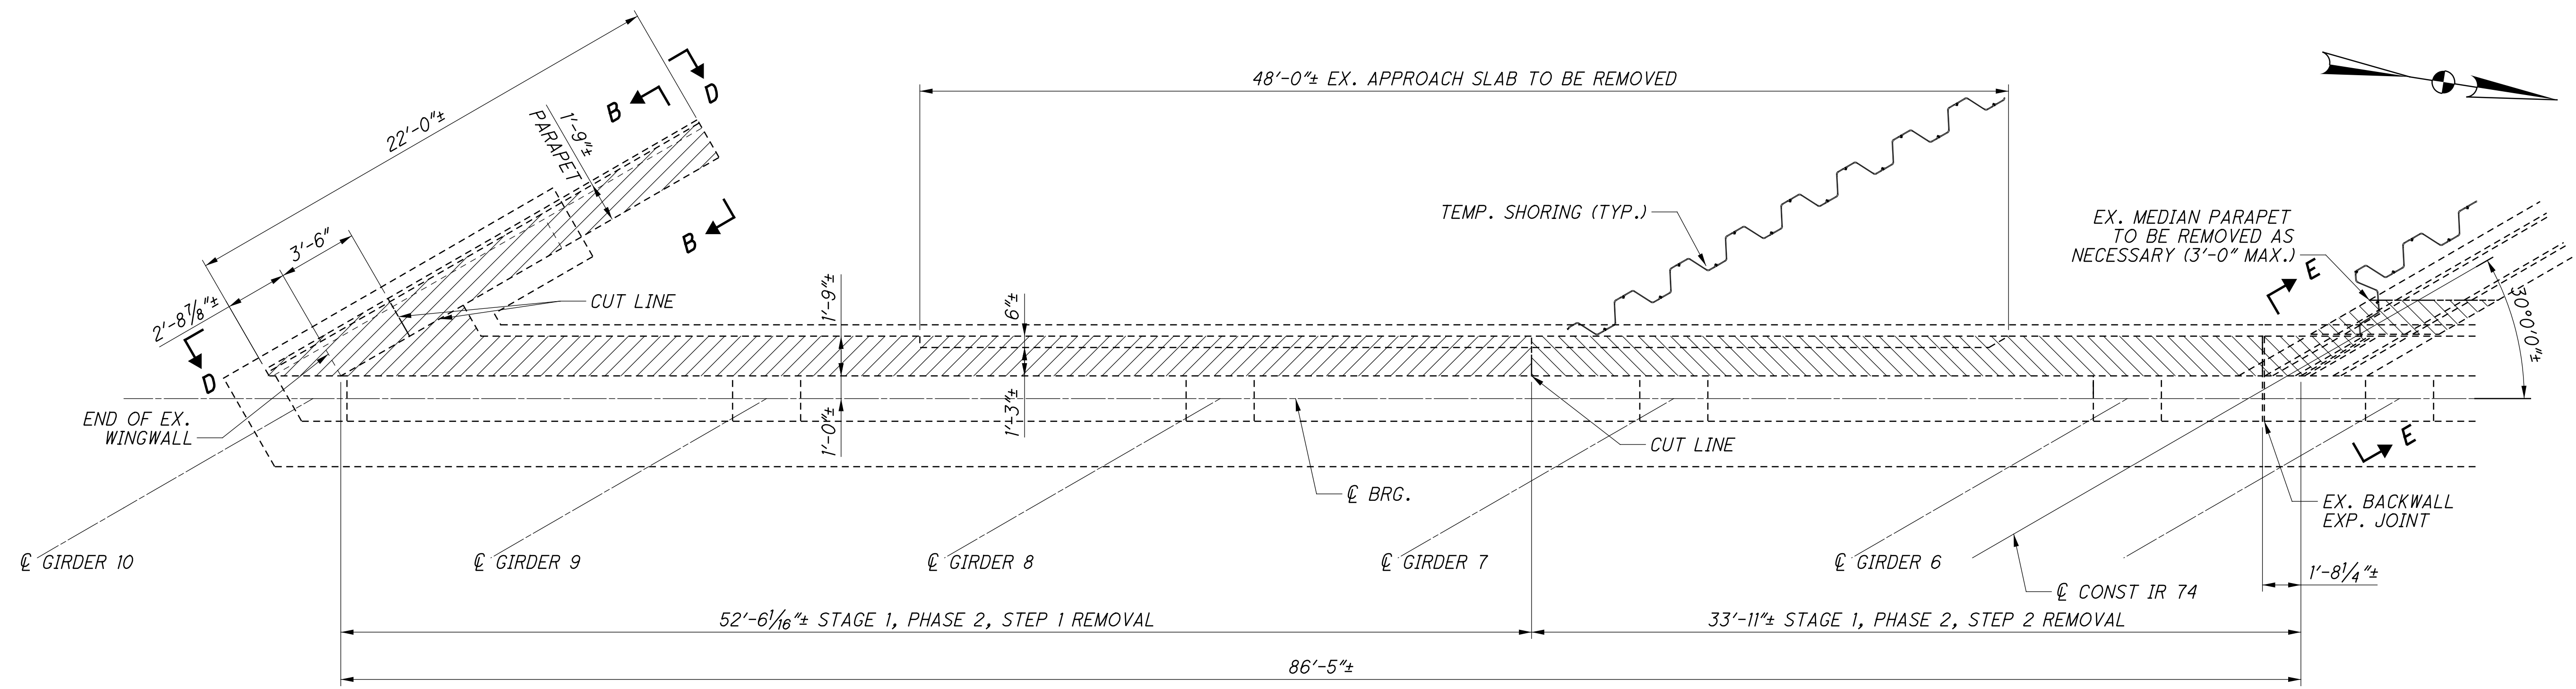

PLAN - REAR ABUTMENT

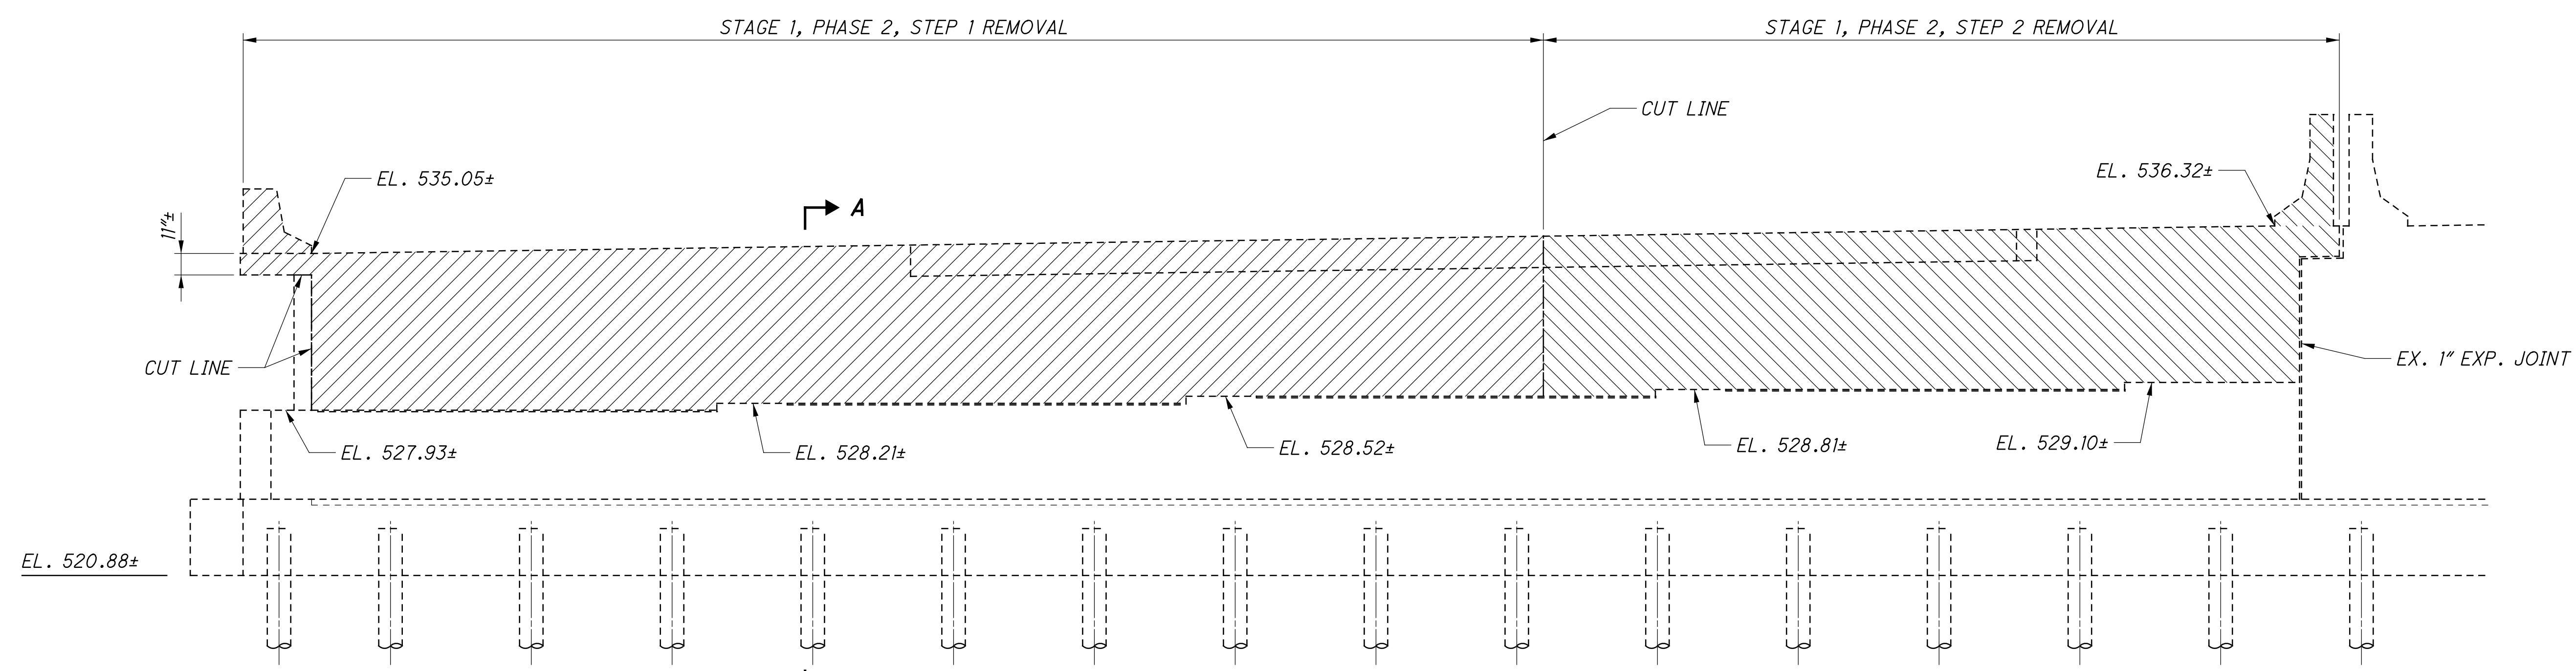

ELEVATION - REAR ABUTMENT

LEGEND


LIMITS OF REMOVAL PER ITEM 202

NOTES:


FOR SECTIONS A-A, B-B AND E-E,
 AND VIEW D-D, SEE SHEET 9/40.

 <small>DESIGN AGENCY</small> <small>2000 CORPORATE PARKWAY SUITE 100 WESTMINSTER, CO 80057 TEL: 303.440.1333 FAX: 303.440.1334 WWW.STRUCTUREPOINT.COM</small>
<small>DESIGNED</small> SUJ <small>CHECKED</small> CLB <small>DRAWN</small> DSH <small>REVISED</small> <small>REVIEWED</small> MDS <small>DATE</small> 11/12/18 <small>STRUCTURE POINT FILE NUMBER</small> 3115577
ABUTMENT REMOVAL DETAILS (RIGHT BRIDGE) <small>BRIDGE NO. HAM-74-1852 L/R OVER NB BEEKMAN ST., (U.S. 27)</small>
HAM-75-3.84 PID No. 104667
7 / 40 49 120

S:\Flanagan
 11/16/2023 9:34:16 AM
 \0\2017\01113\C.Design\104667-HAM-75-3.84\Design\Structures\HAM0074_1852C\Sheets\74_1852RE002.dgn

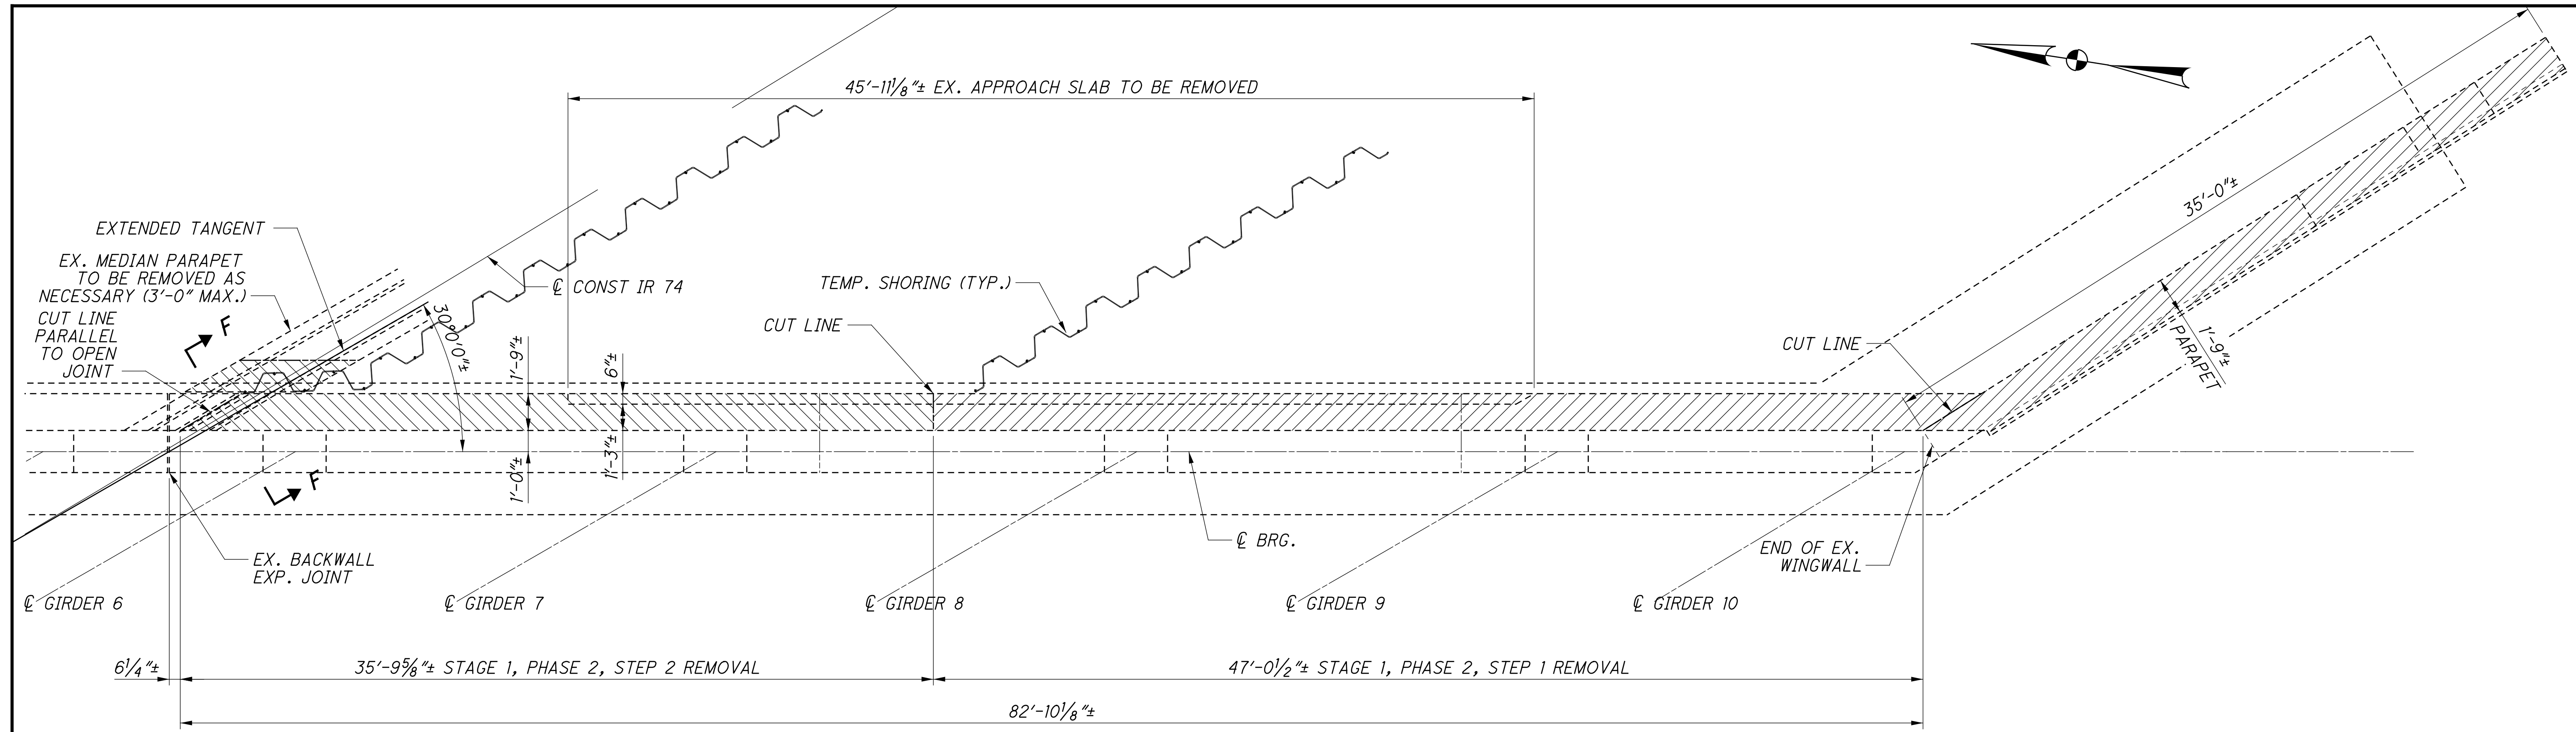

PLAN - FORWARD ABUTMENT

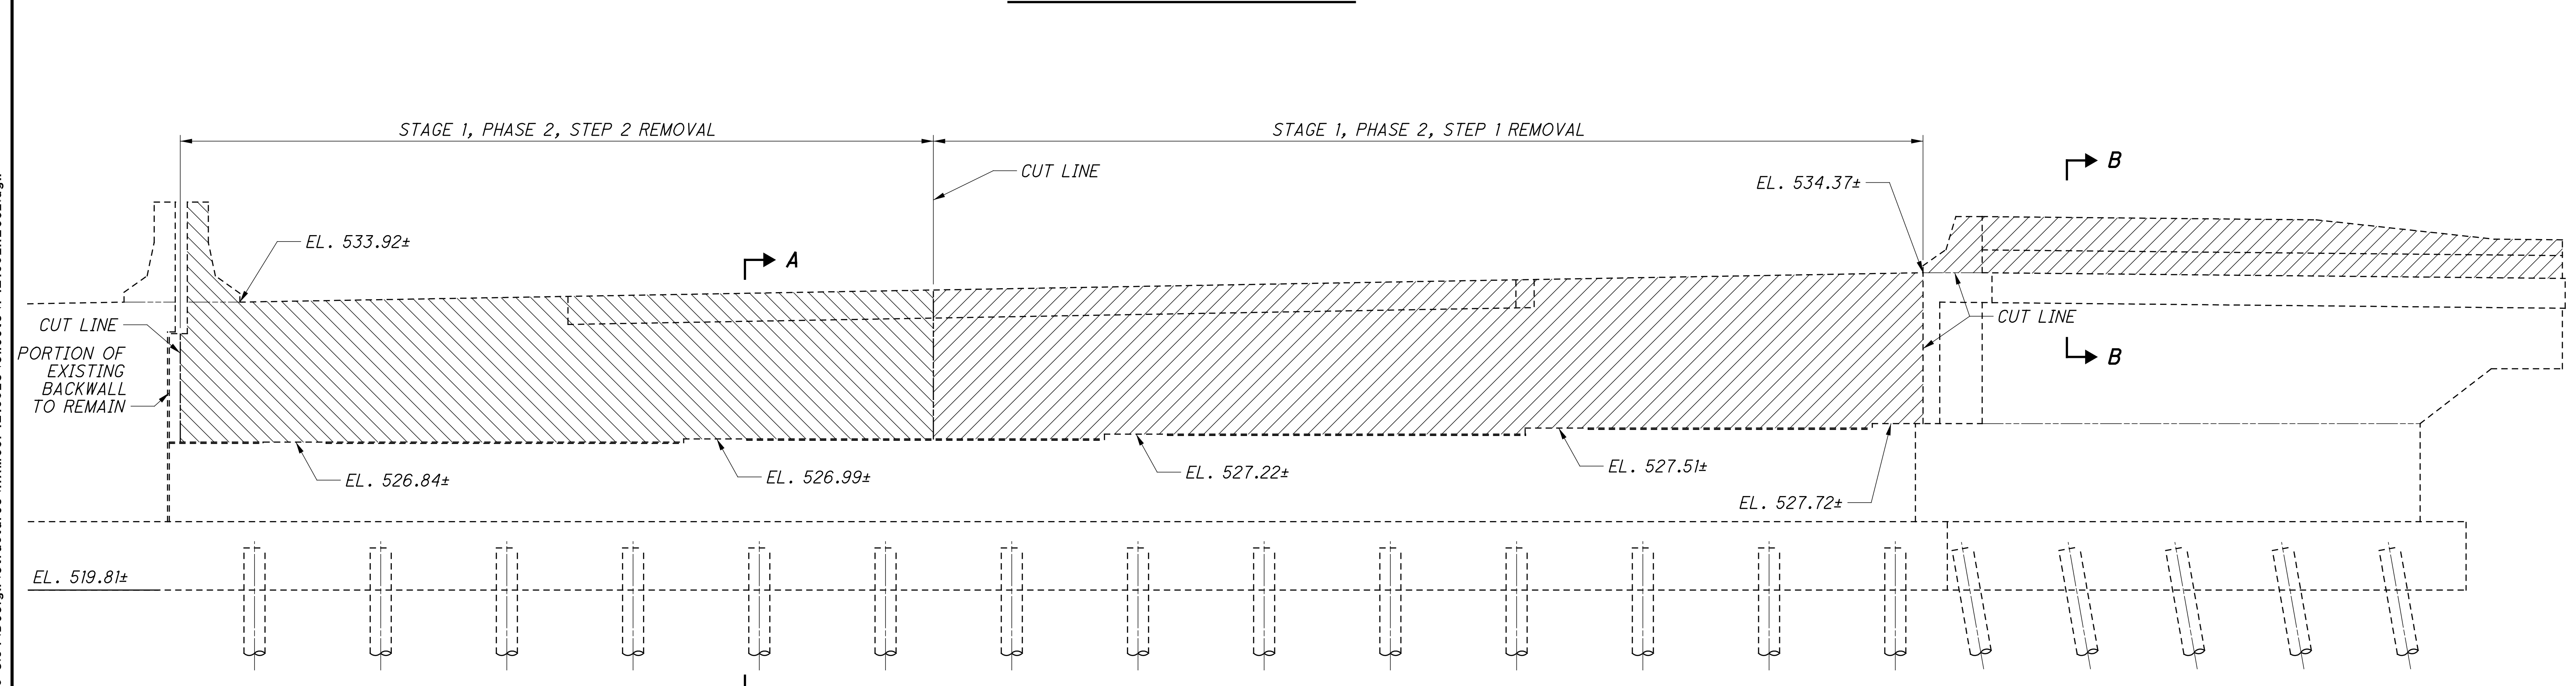

ELEVATION - FORWARD ABUTMENT


LEGEND

LIMITS OF REMOVAL PER ITEM 202


NOTES:
 FOR SECTIONS A-A, B-B AND F-F, SEE SHEET 9/40.

 DESIGN AGENCY STRUCTUREPOINT 2000 CORPORATE CENTER DR., STE. 200 FARMINGTON, CT 06030 TEL: 860.633.7000 FAX: 860.633.7001 WWW.STRUCTUREPOINT.COM	DATE: 11/12/18 REVIEWED: MDS DRAWN: DSH DESIGNED: SUJ CHECKED: CLB	FILE NUMBER: 3115577 STRUCTURE FILE NUMBER: 3115577
	ABUTMENT REMOVAL DETAILS (RIGHT BRIDGE) BRIDGE NO. HAM-74-1852 L/R OVER BEEKMAN ST. (U.S. 27)	
	HAM-75-3.84 PID No. 104667	
	8 / 40 	


SFlanagan
 11/16/2023 9:34:17 AM
 \\0\2017\01113\C.Design\104667-HAM-75-3.84\Design\Structures\HAM0074_1852C_Sheets\74_1852RE003.dgn

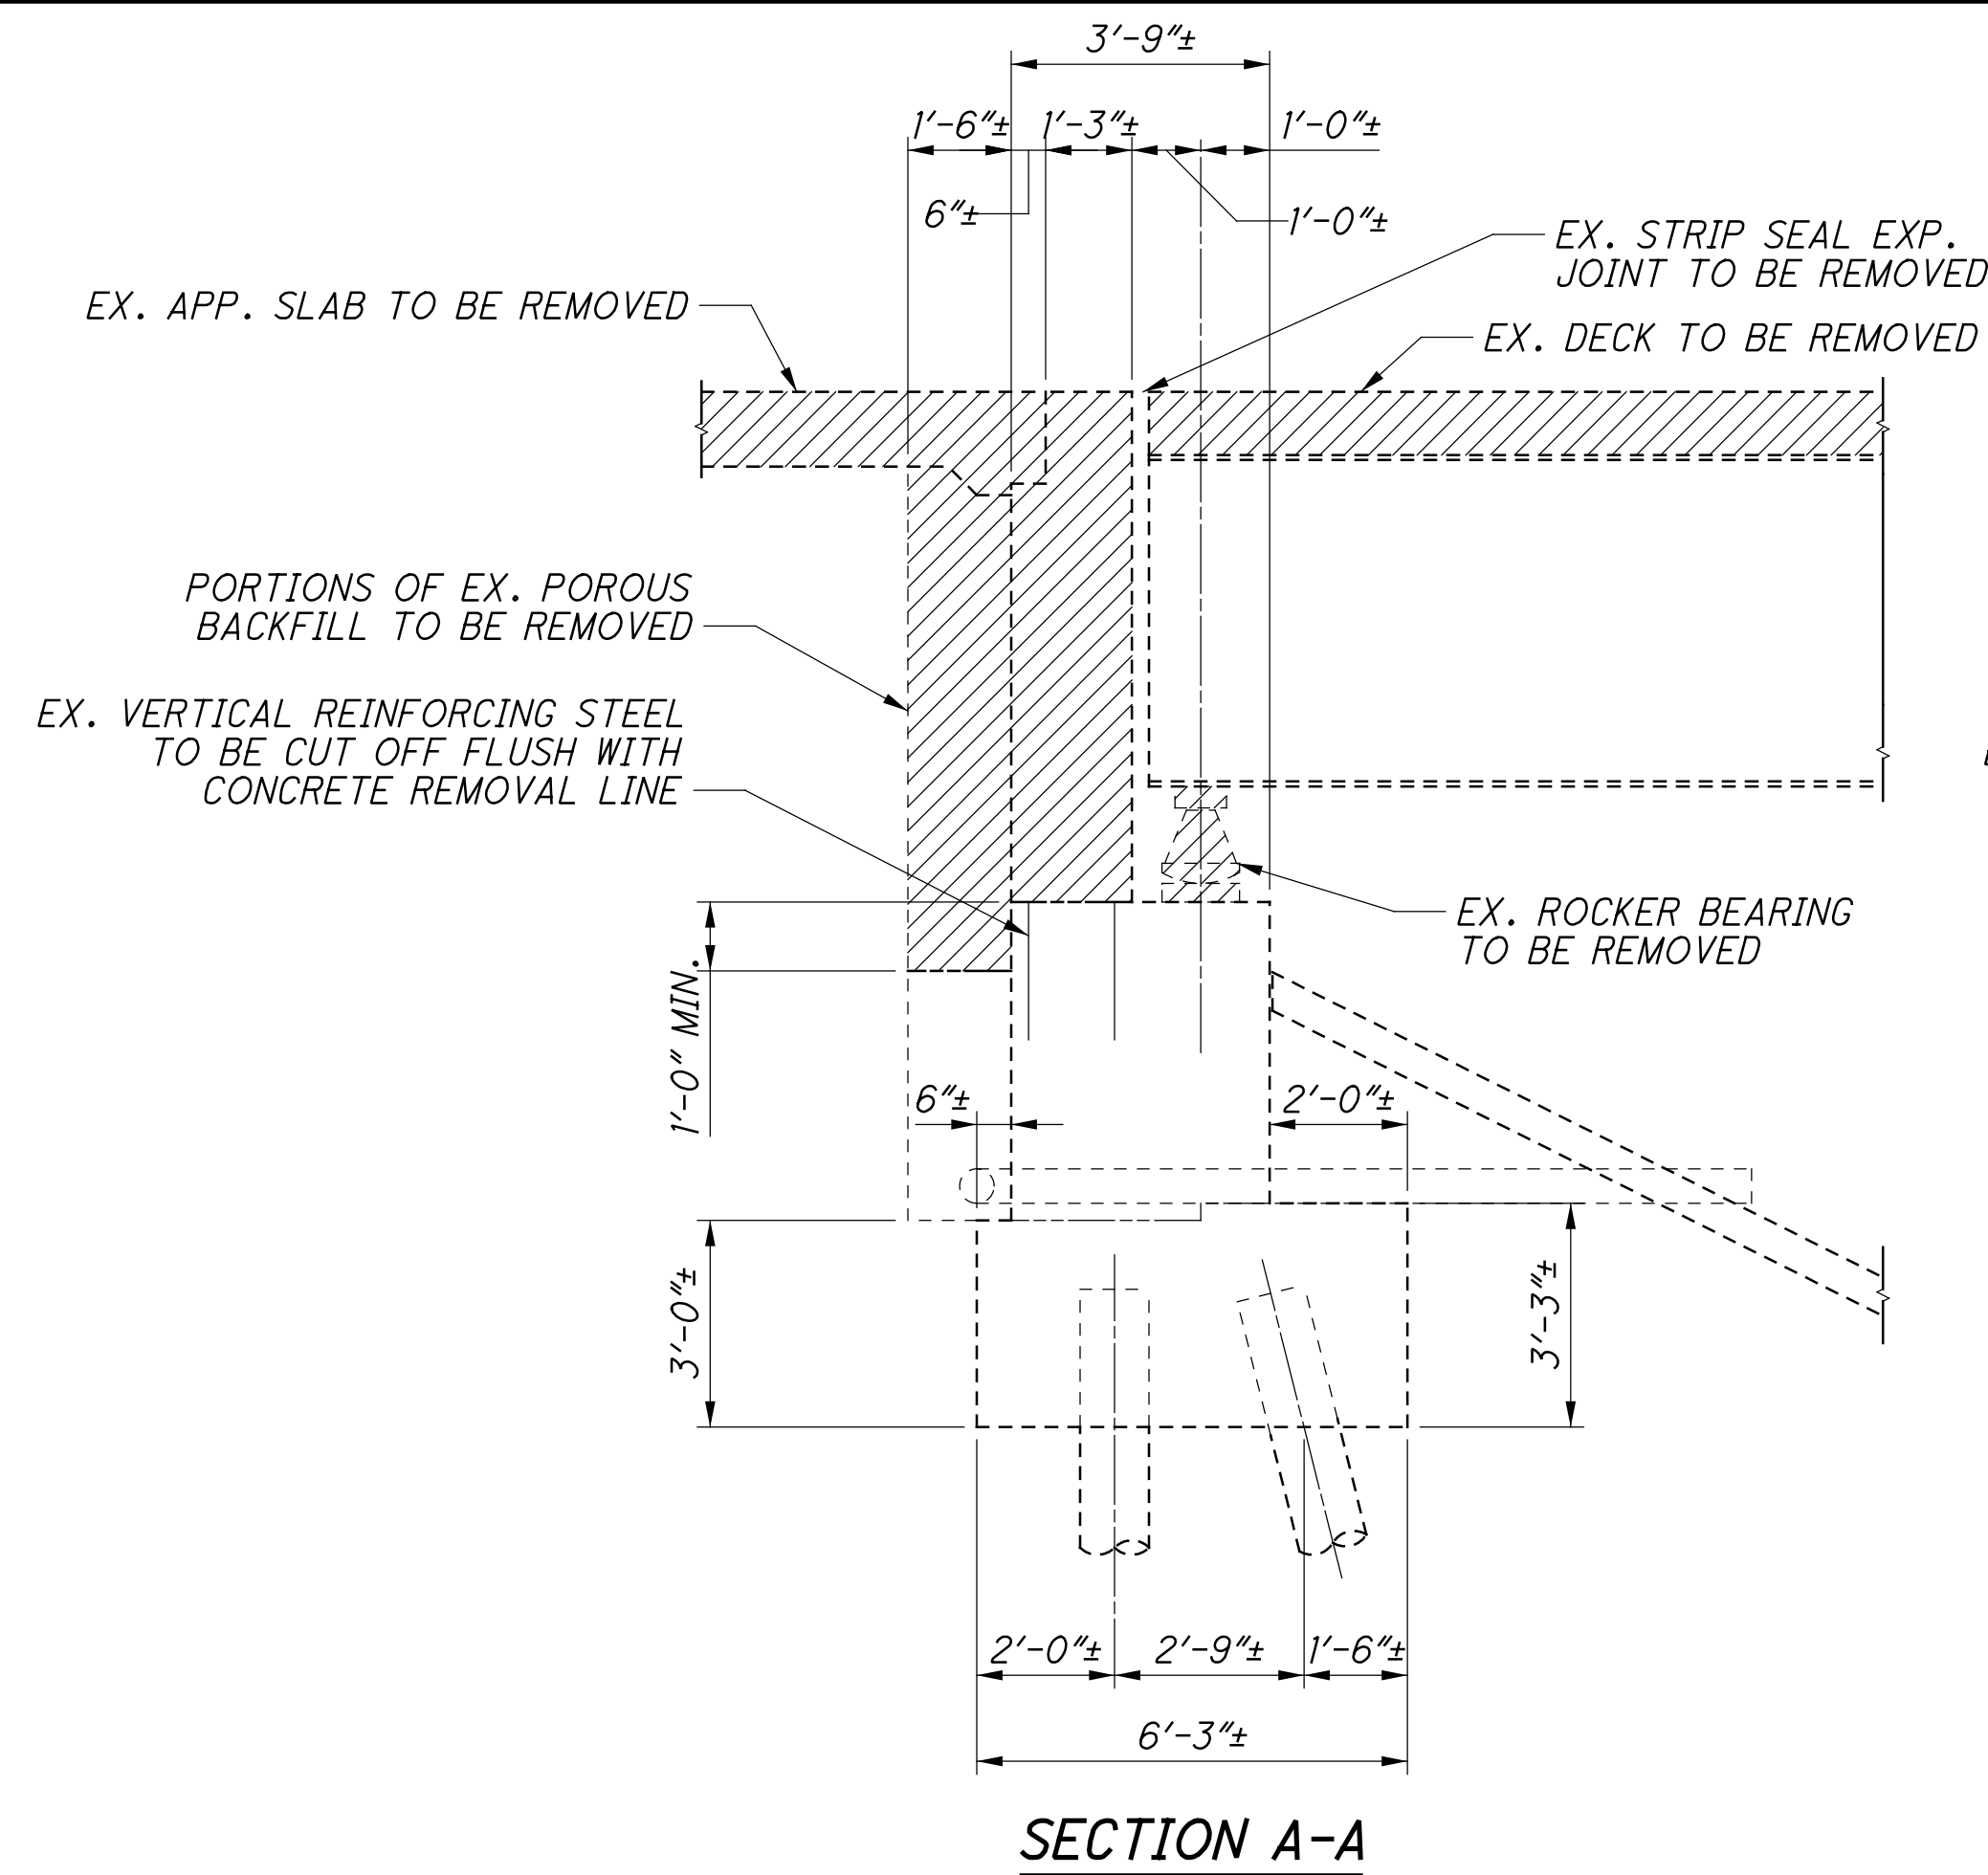


SECTION A-A

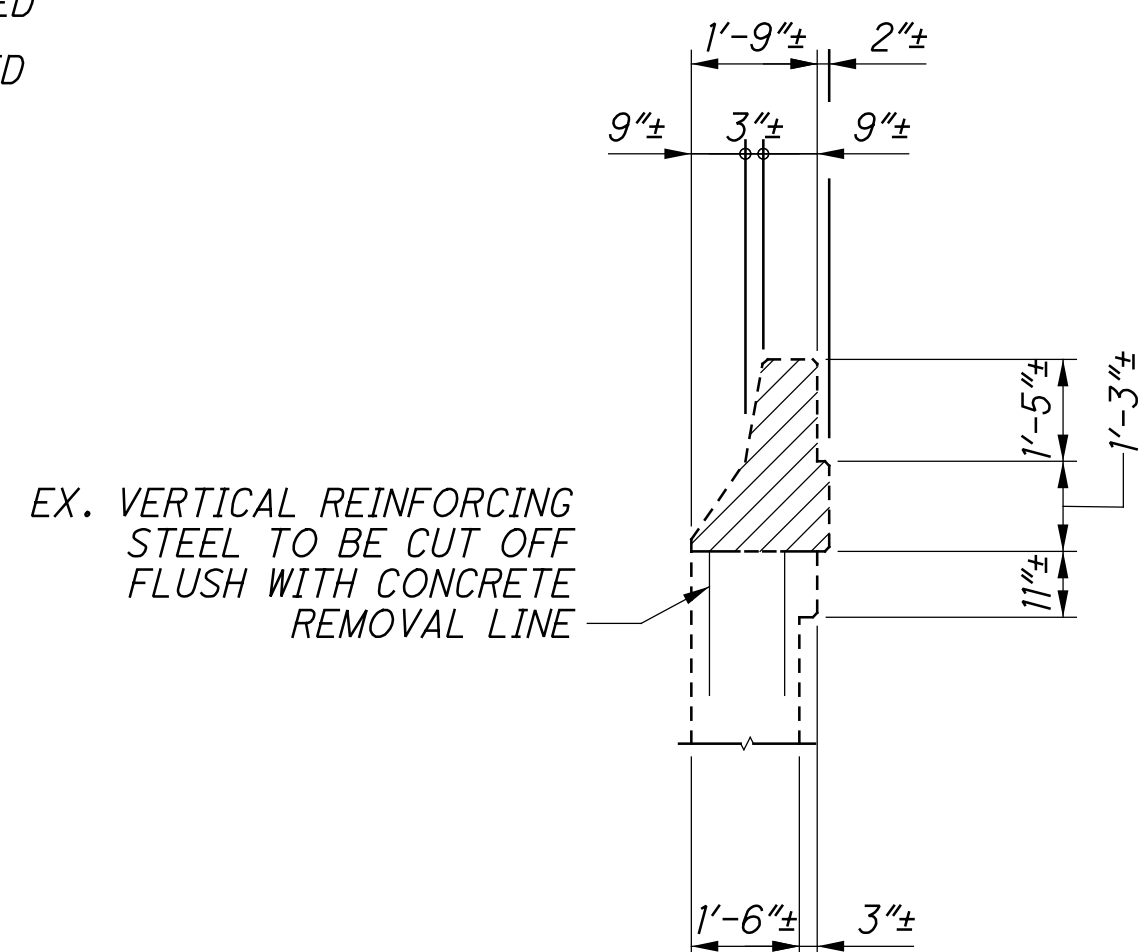


SECTION B-B

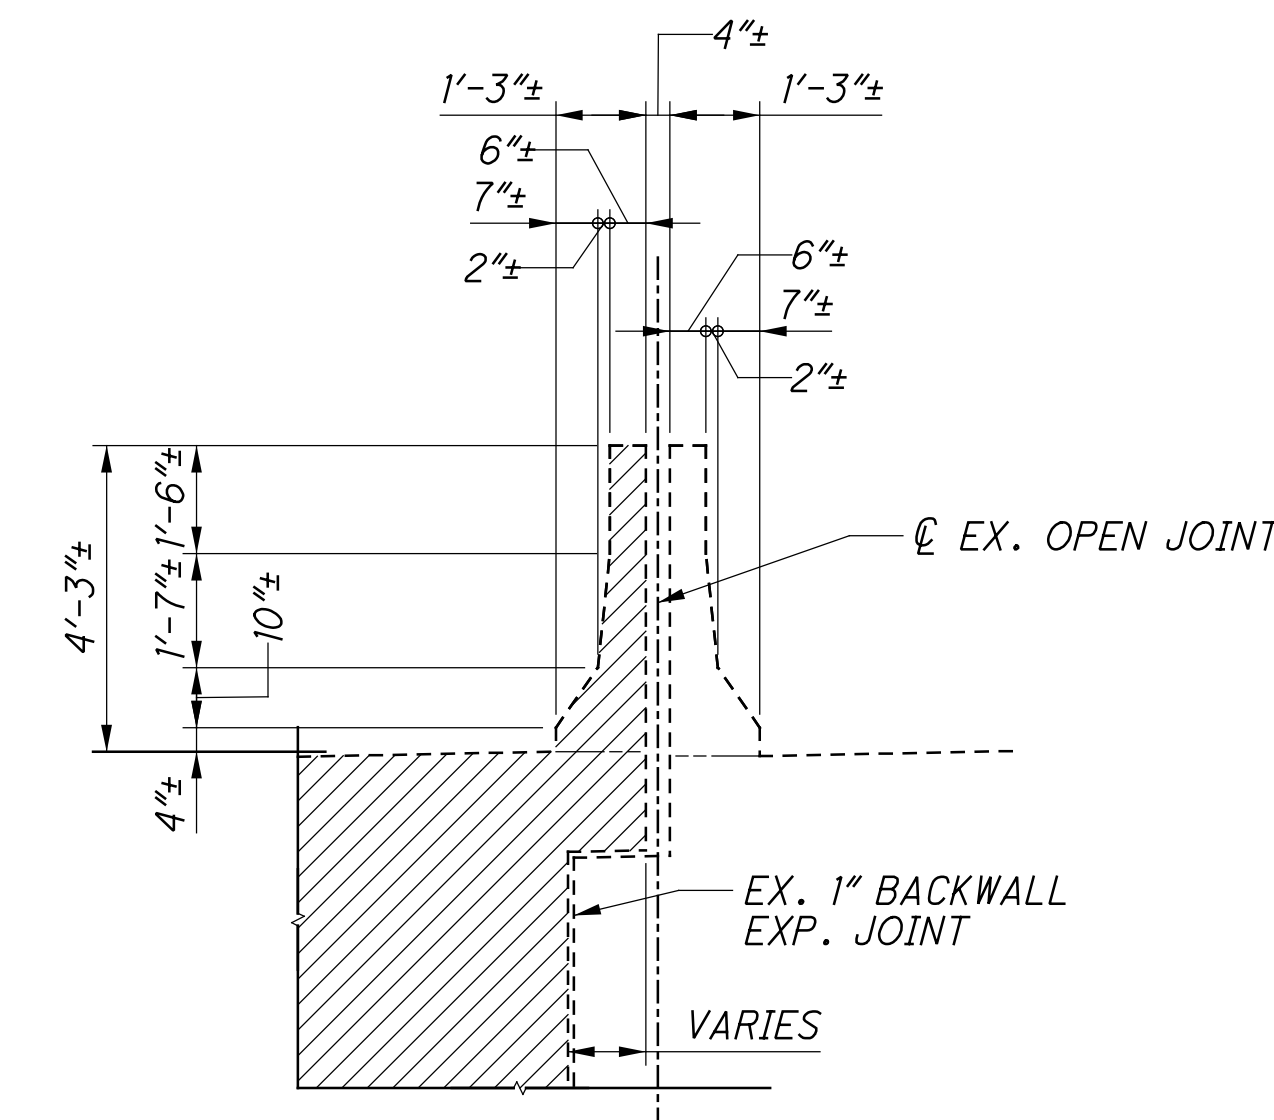

SECTION E-E

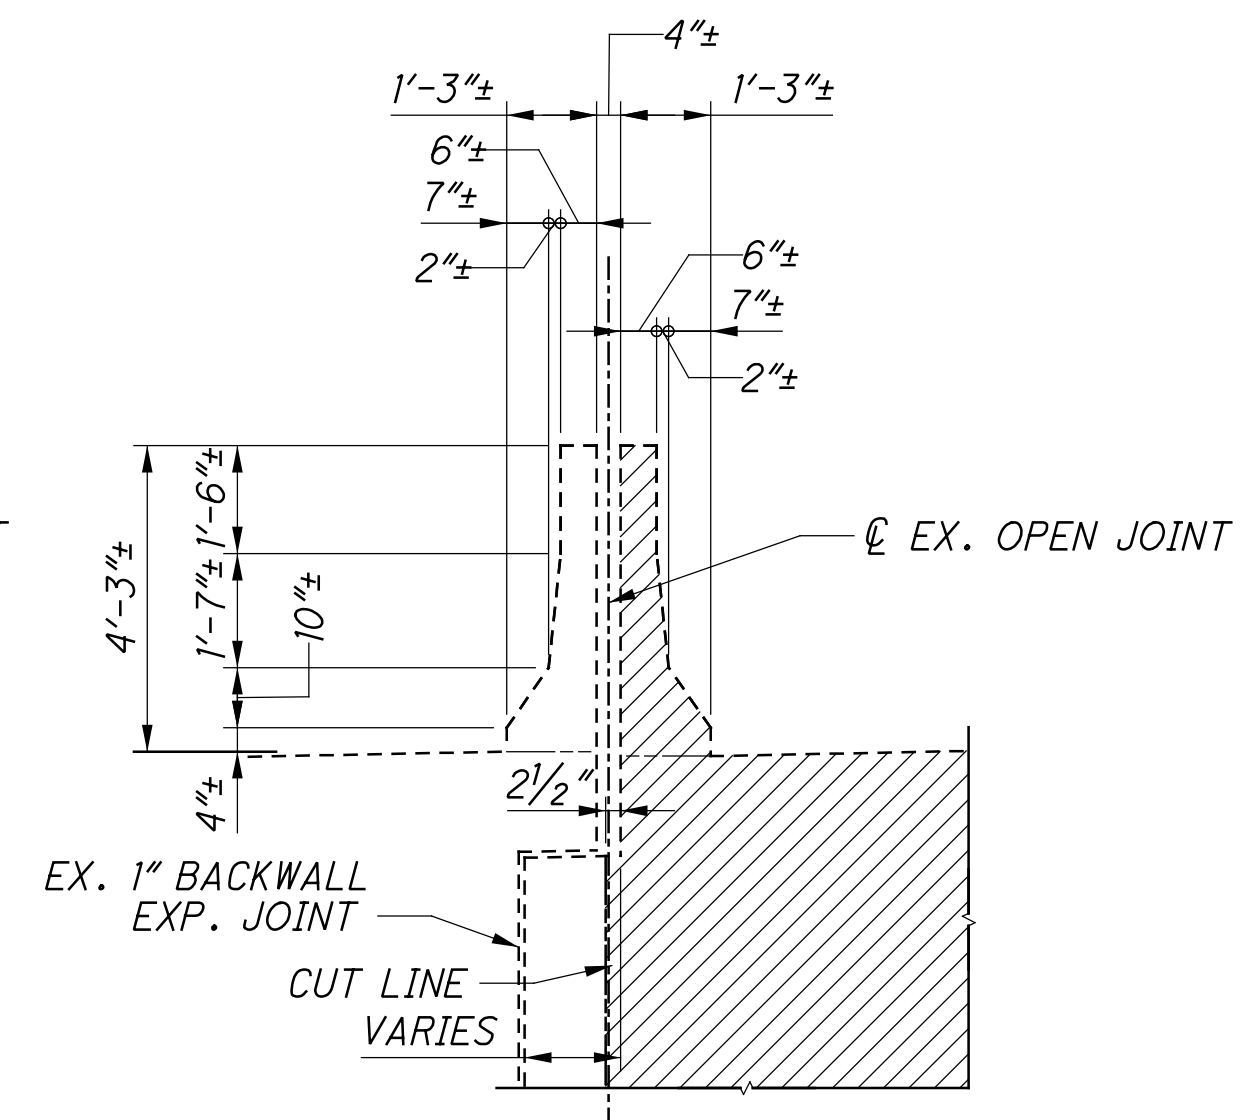


SECTION F-F

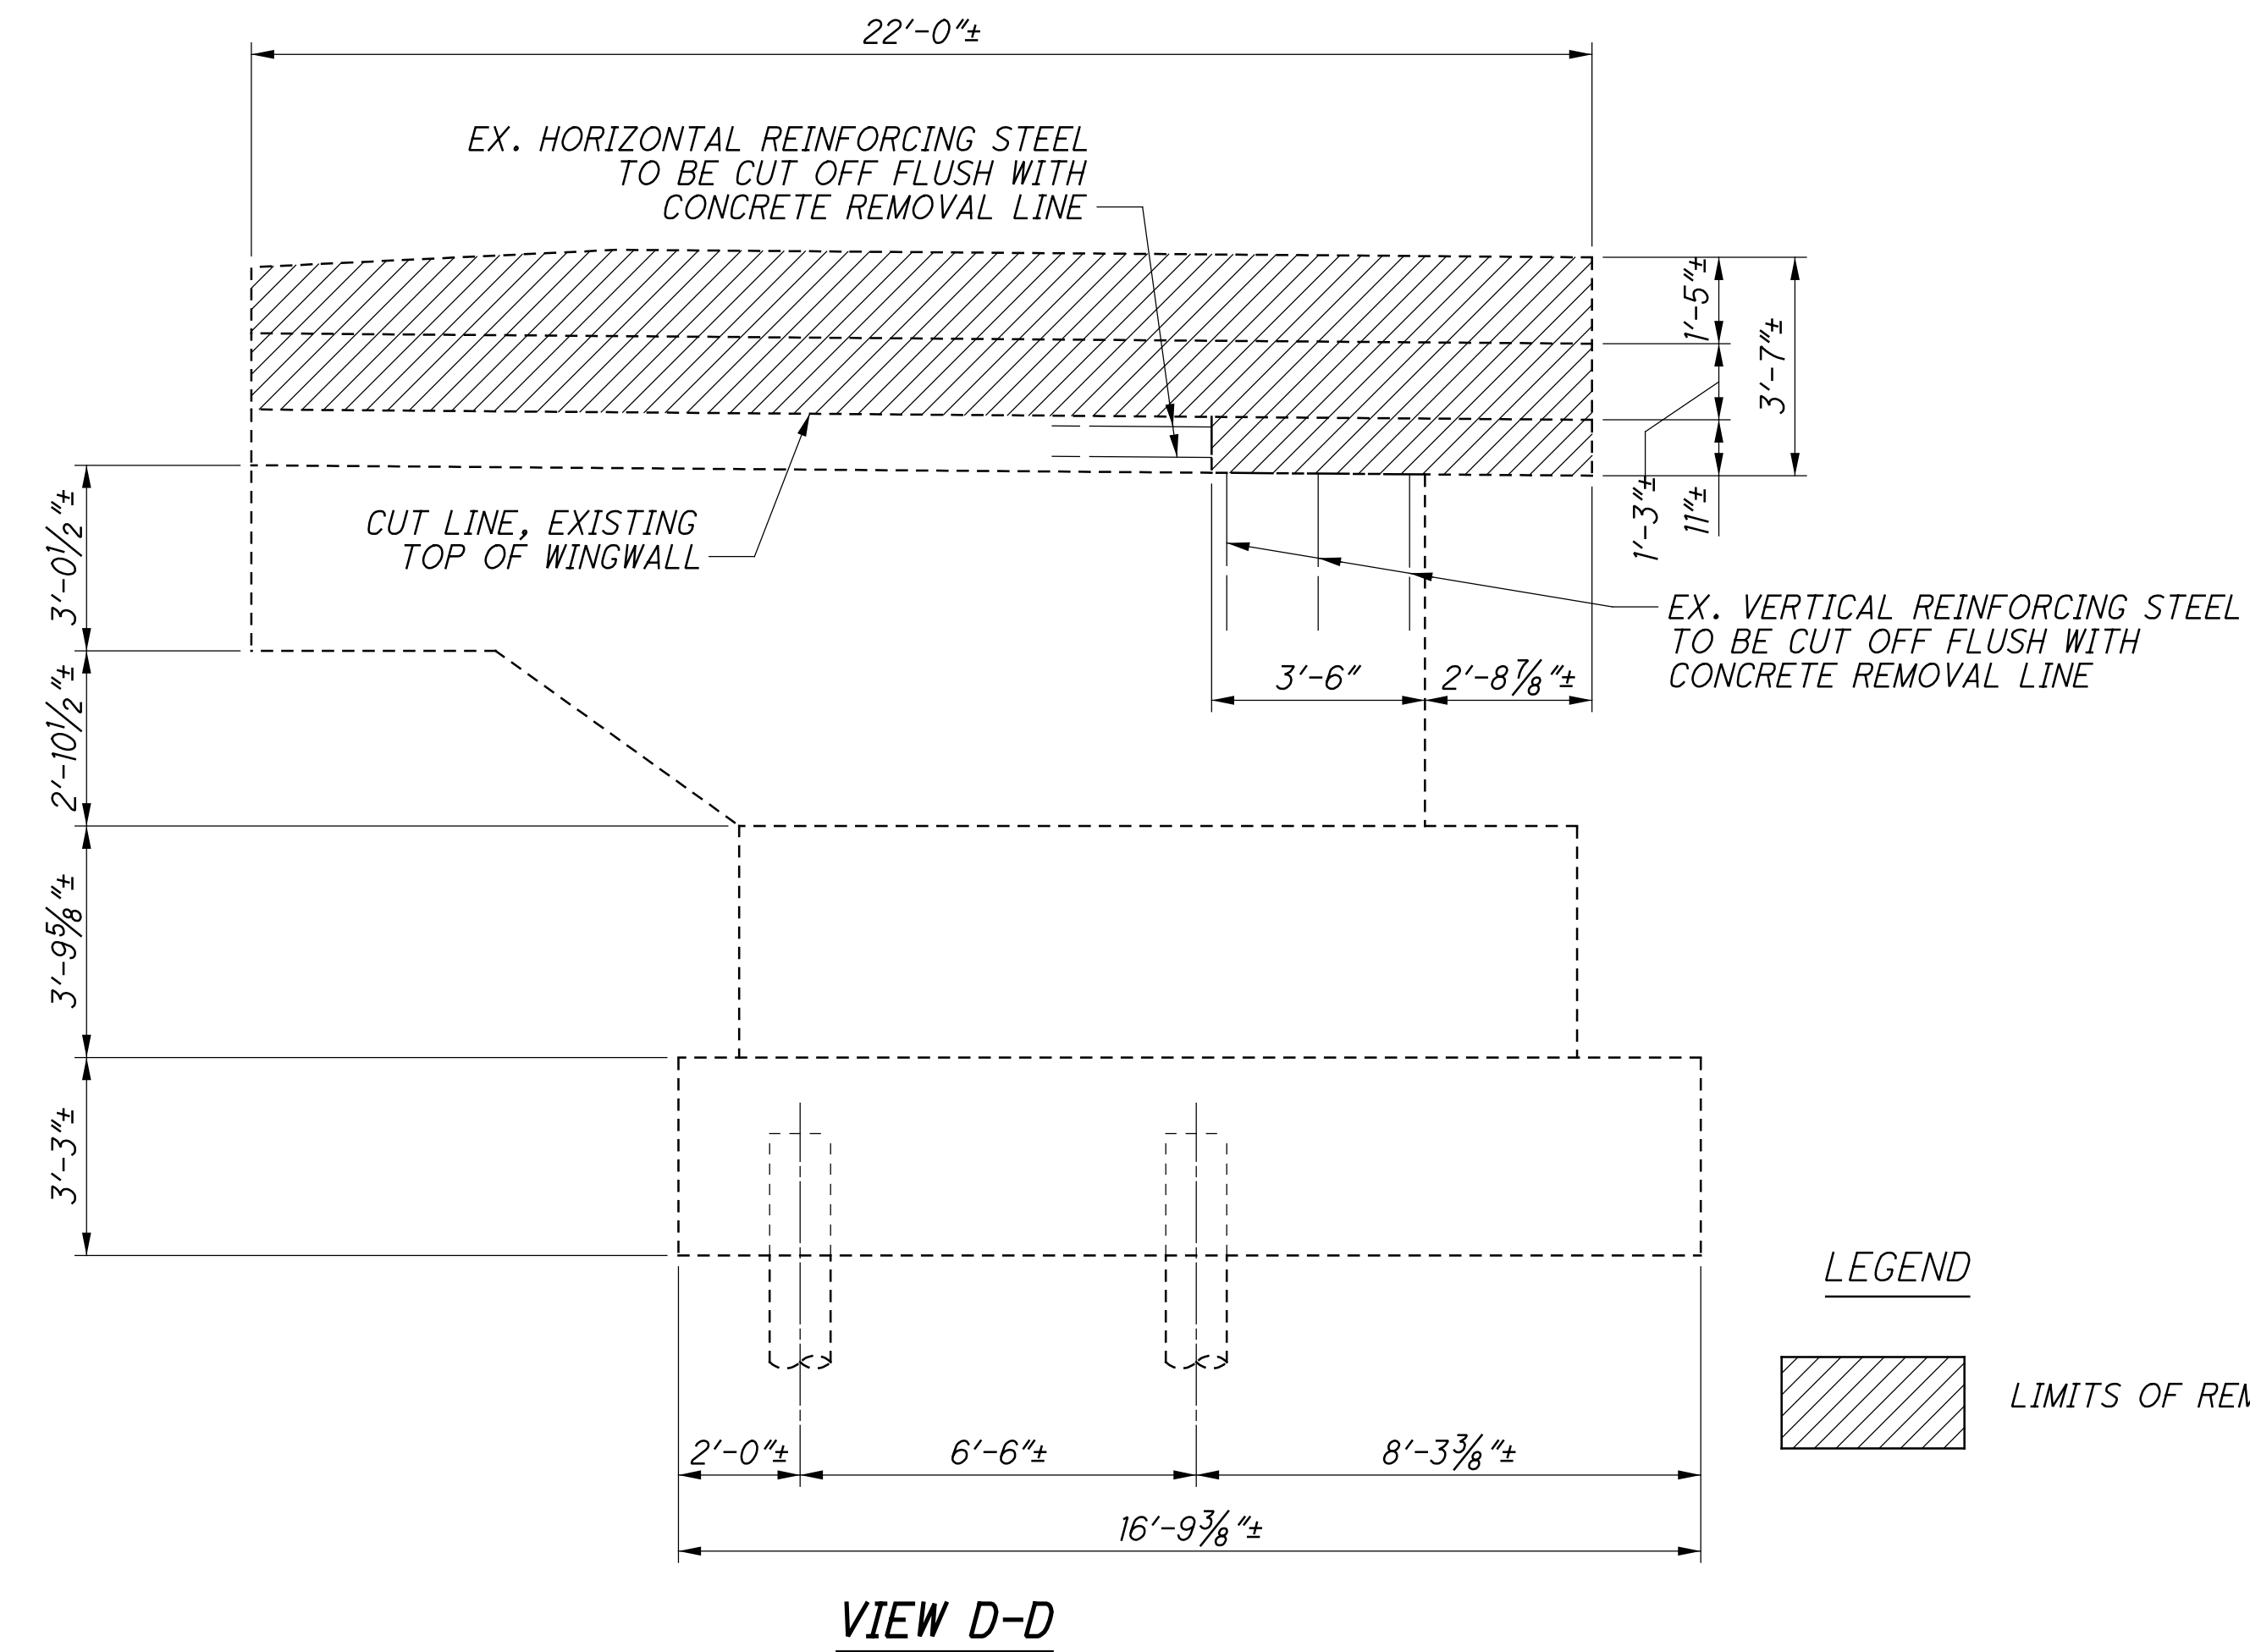


VIEW D-D

LEGEND

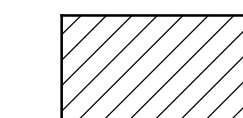

LIMITS OF REMOVAL PER ITEM 202


DESIGN AGENCY STRUCTUREPOINT		DATE 11/12/18	DESIGNED SUF	DRAWN DSH	REVIEWED MDS	DATE 11/12/18	DESIGN AGENCY STRUCTUREPOINT
BRIDGE NO. HAM-74-1852 L/R OVER BEKMAN ST. (U.S. 27)		STRUCTURE FILE NUMBER 3115577	CHECKED CLB	REVISED	FILE NUMBER	3115577	DESIGN AGENCY STRUCTUREPOINT
HAM-75-3.84		PID No. 104667		9 / 40		51	
						120	

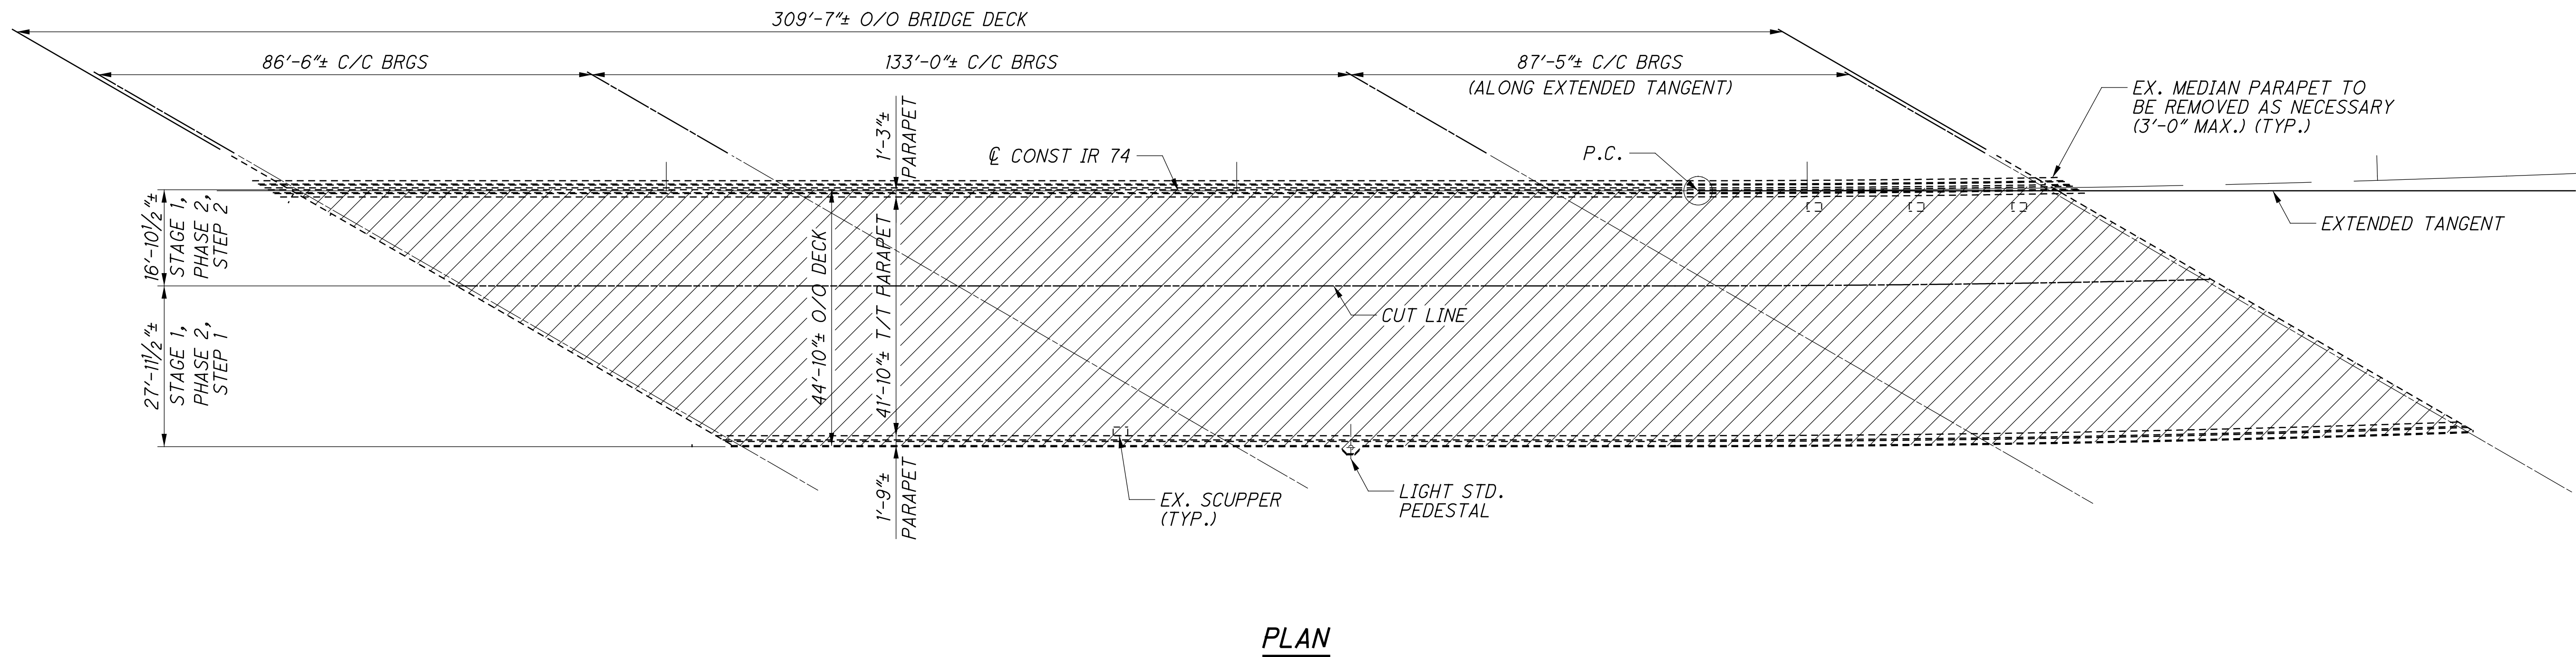

PLAN

LEGEND

 LIMITS OF REMOVAL PER ITEM 202

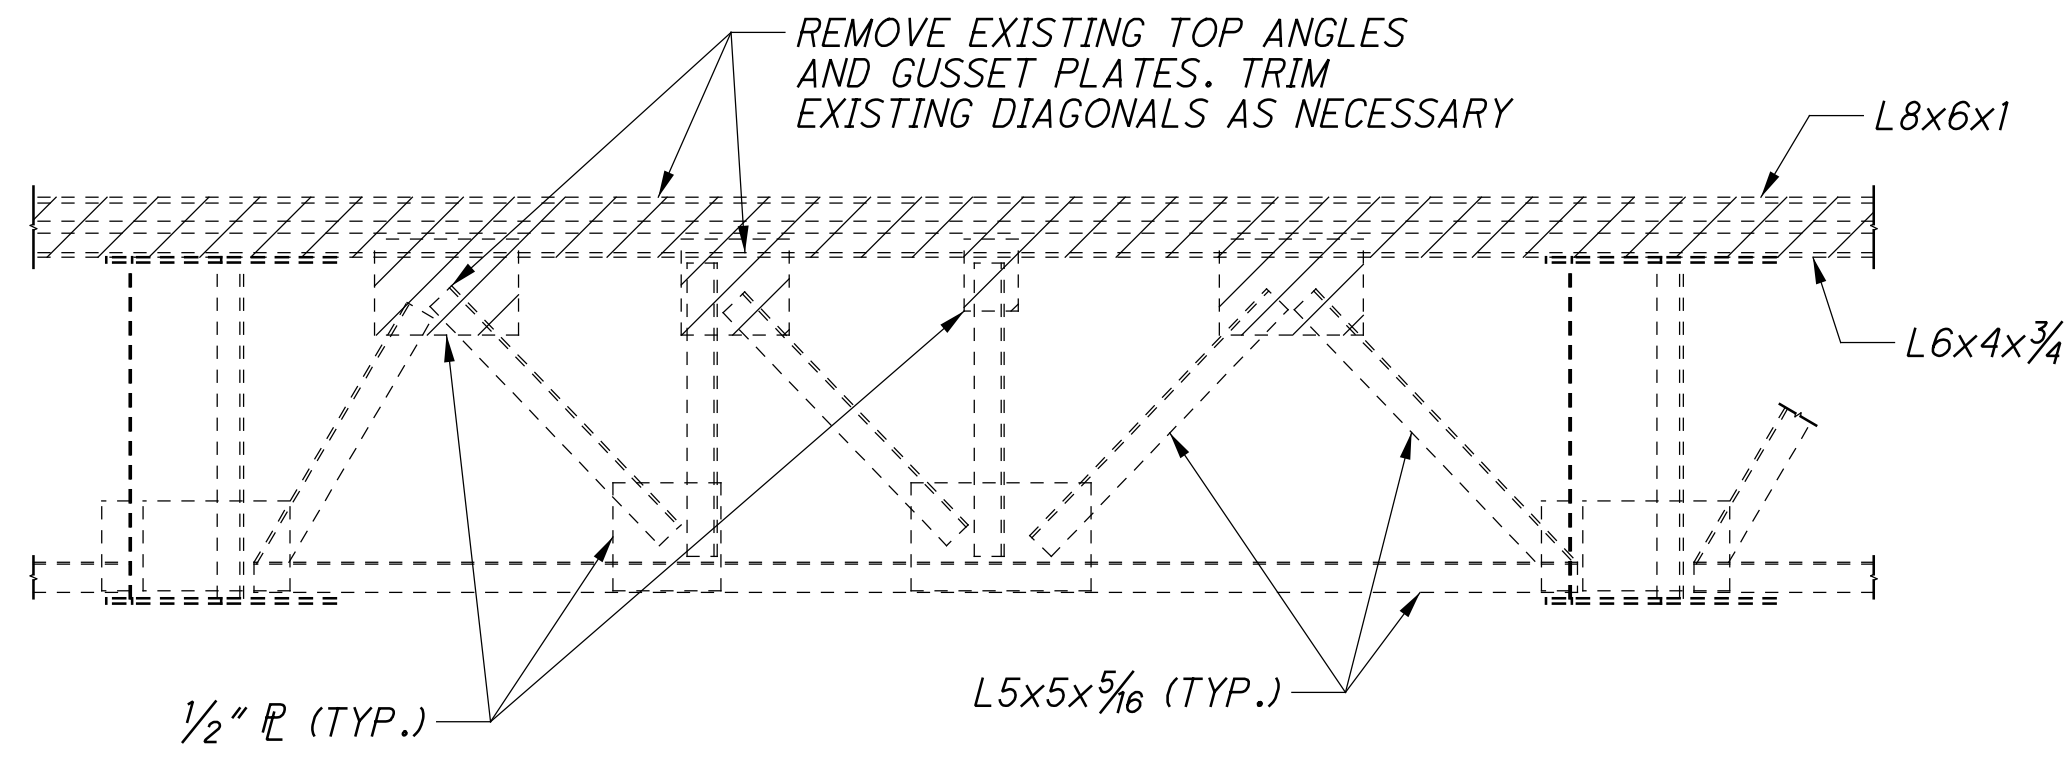


END CROSS FRAME REMOVAL DETAIL

DESIGNED	SJF	CHECKED	CLB
DRAWN	DSH	REVISED	
REVIEWED	MDS	STRUCTURE FILE NUMBER	3115577


DATE	11/12/18
STRUCTURE FILE NUMBER	3115577

S:\Flanagan\11/16/2023 9:34:18 AM\0\2017\01113\C.Design\104667-HAM-75-3.84\Design\Structures\HAM0074_1852C\Sheets\74_1852AR001.dgn

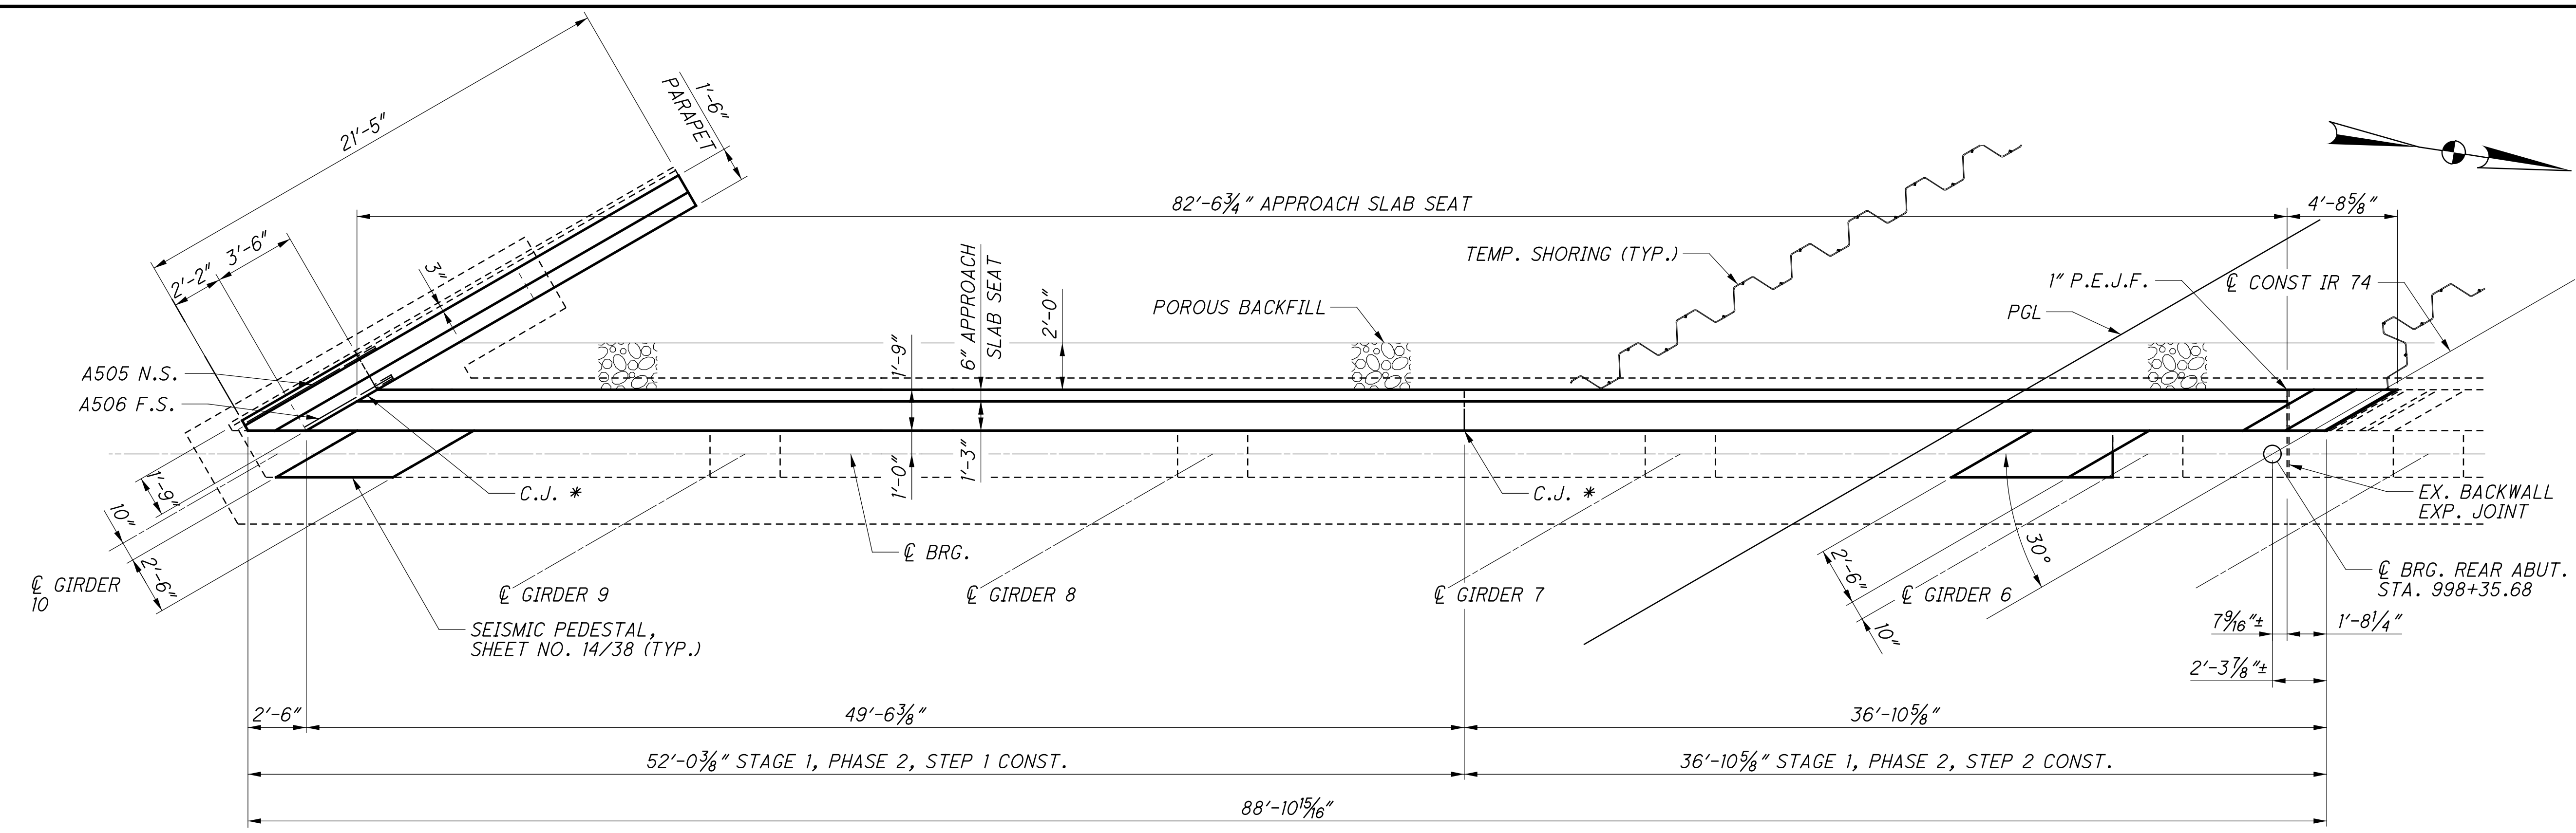

PLAN - REAR ABUTMENT

MINIMUM BAR LAP	
#5	3'-6"
#6	3'-10"

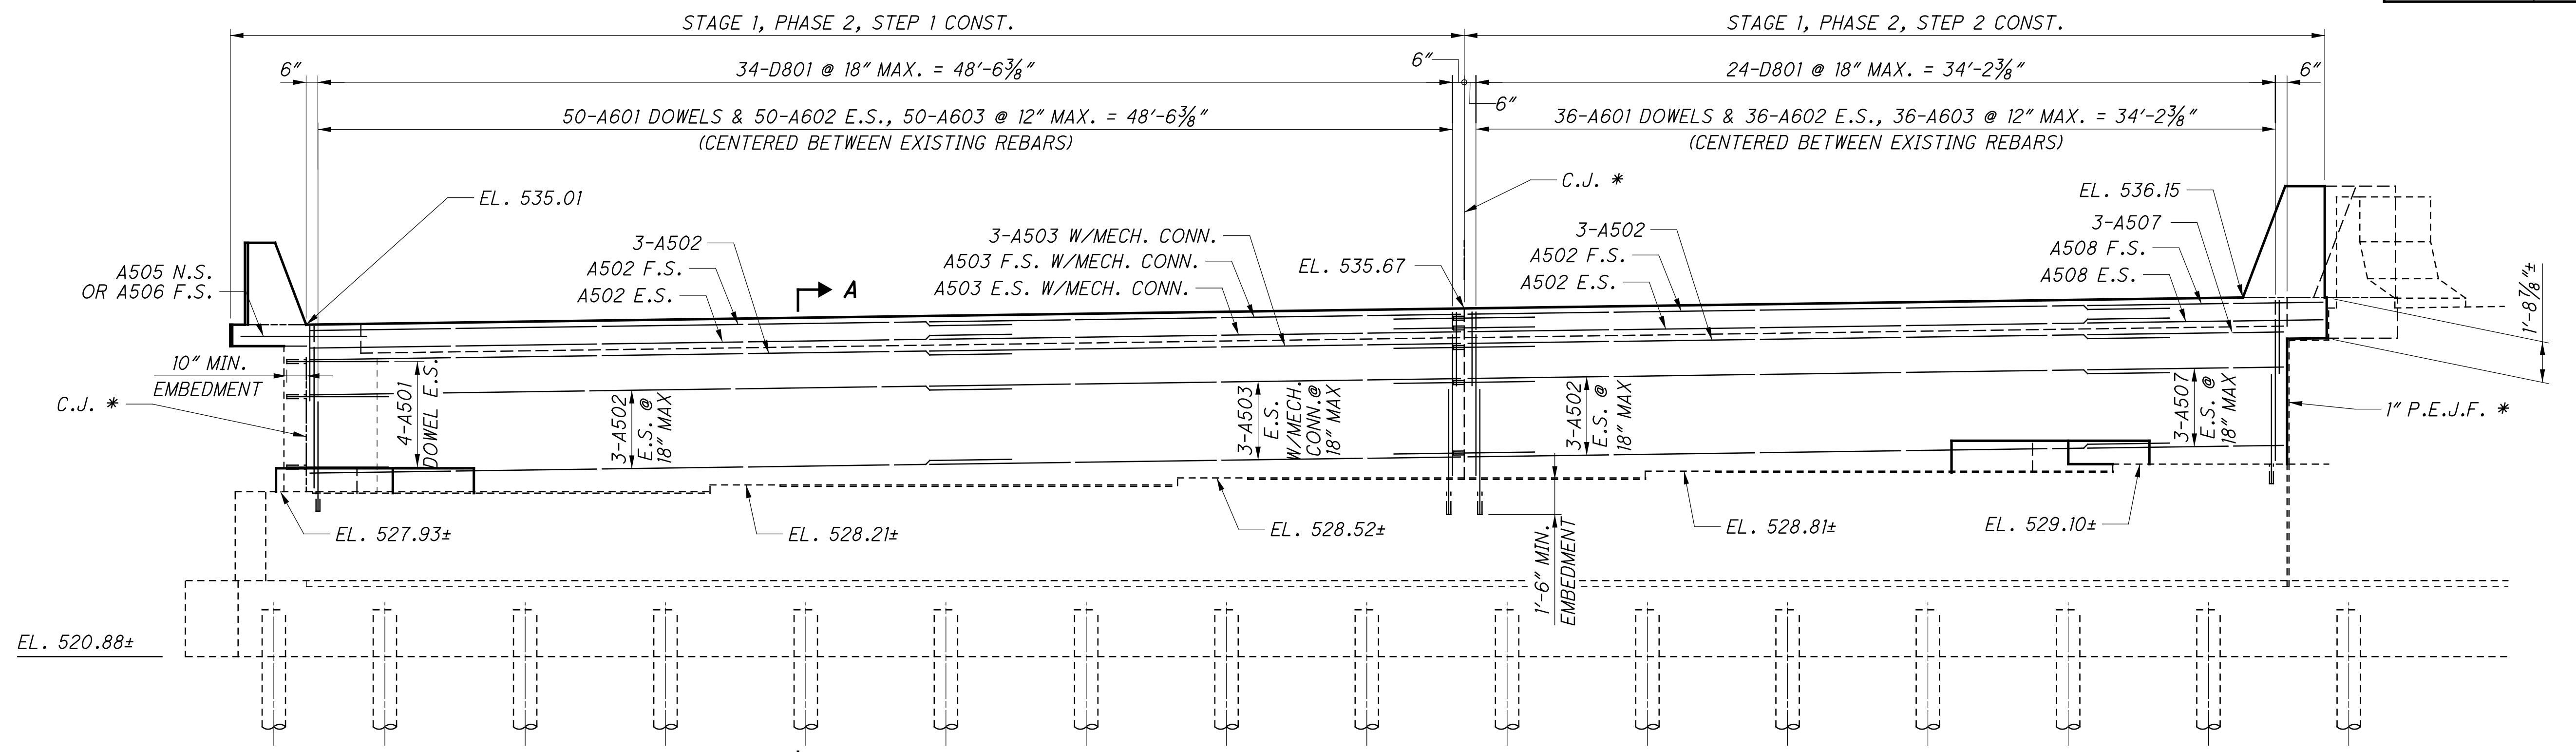

ELEVATION - REAR ABUTMENT

- NOTES:
- * 3'-0" WIDE TYPE 2 WATERPROOFING ON BACK FACE CENTERED ON JOINT FROM TOP OF SEAT TO BOTTOM OF APPROACH SLAB.
 - FOR PARAPET DETAILS, SEE SHEET 30/40 & 32/40.
 - FOR SECTION A-A, SEE SHEET 13/40.

DESIGN AGENCY: STRUCTUREPOINT

DATE: 11/12/18

REVIEWED: MDS

DRAWN: DSH

DESIGNED: SUJ

CHECKED: CLB

BRIDGE NO. HAM-74-1852 L/R

OVER NB BEEKMAN ST. (U.S. 27)


HAM-75-3.84

PID No. 104667

12/40


54

120

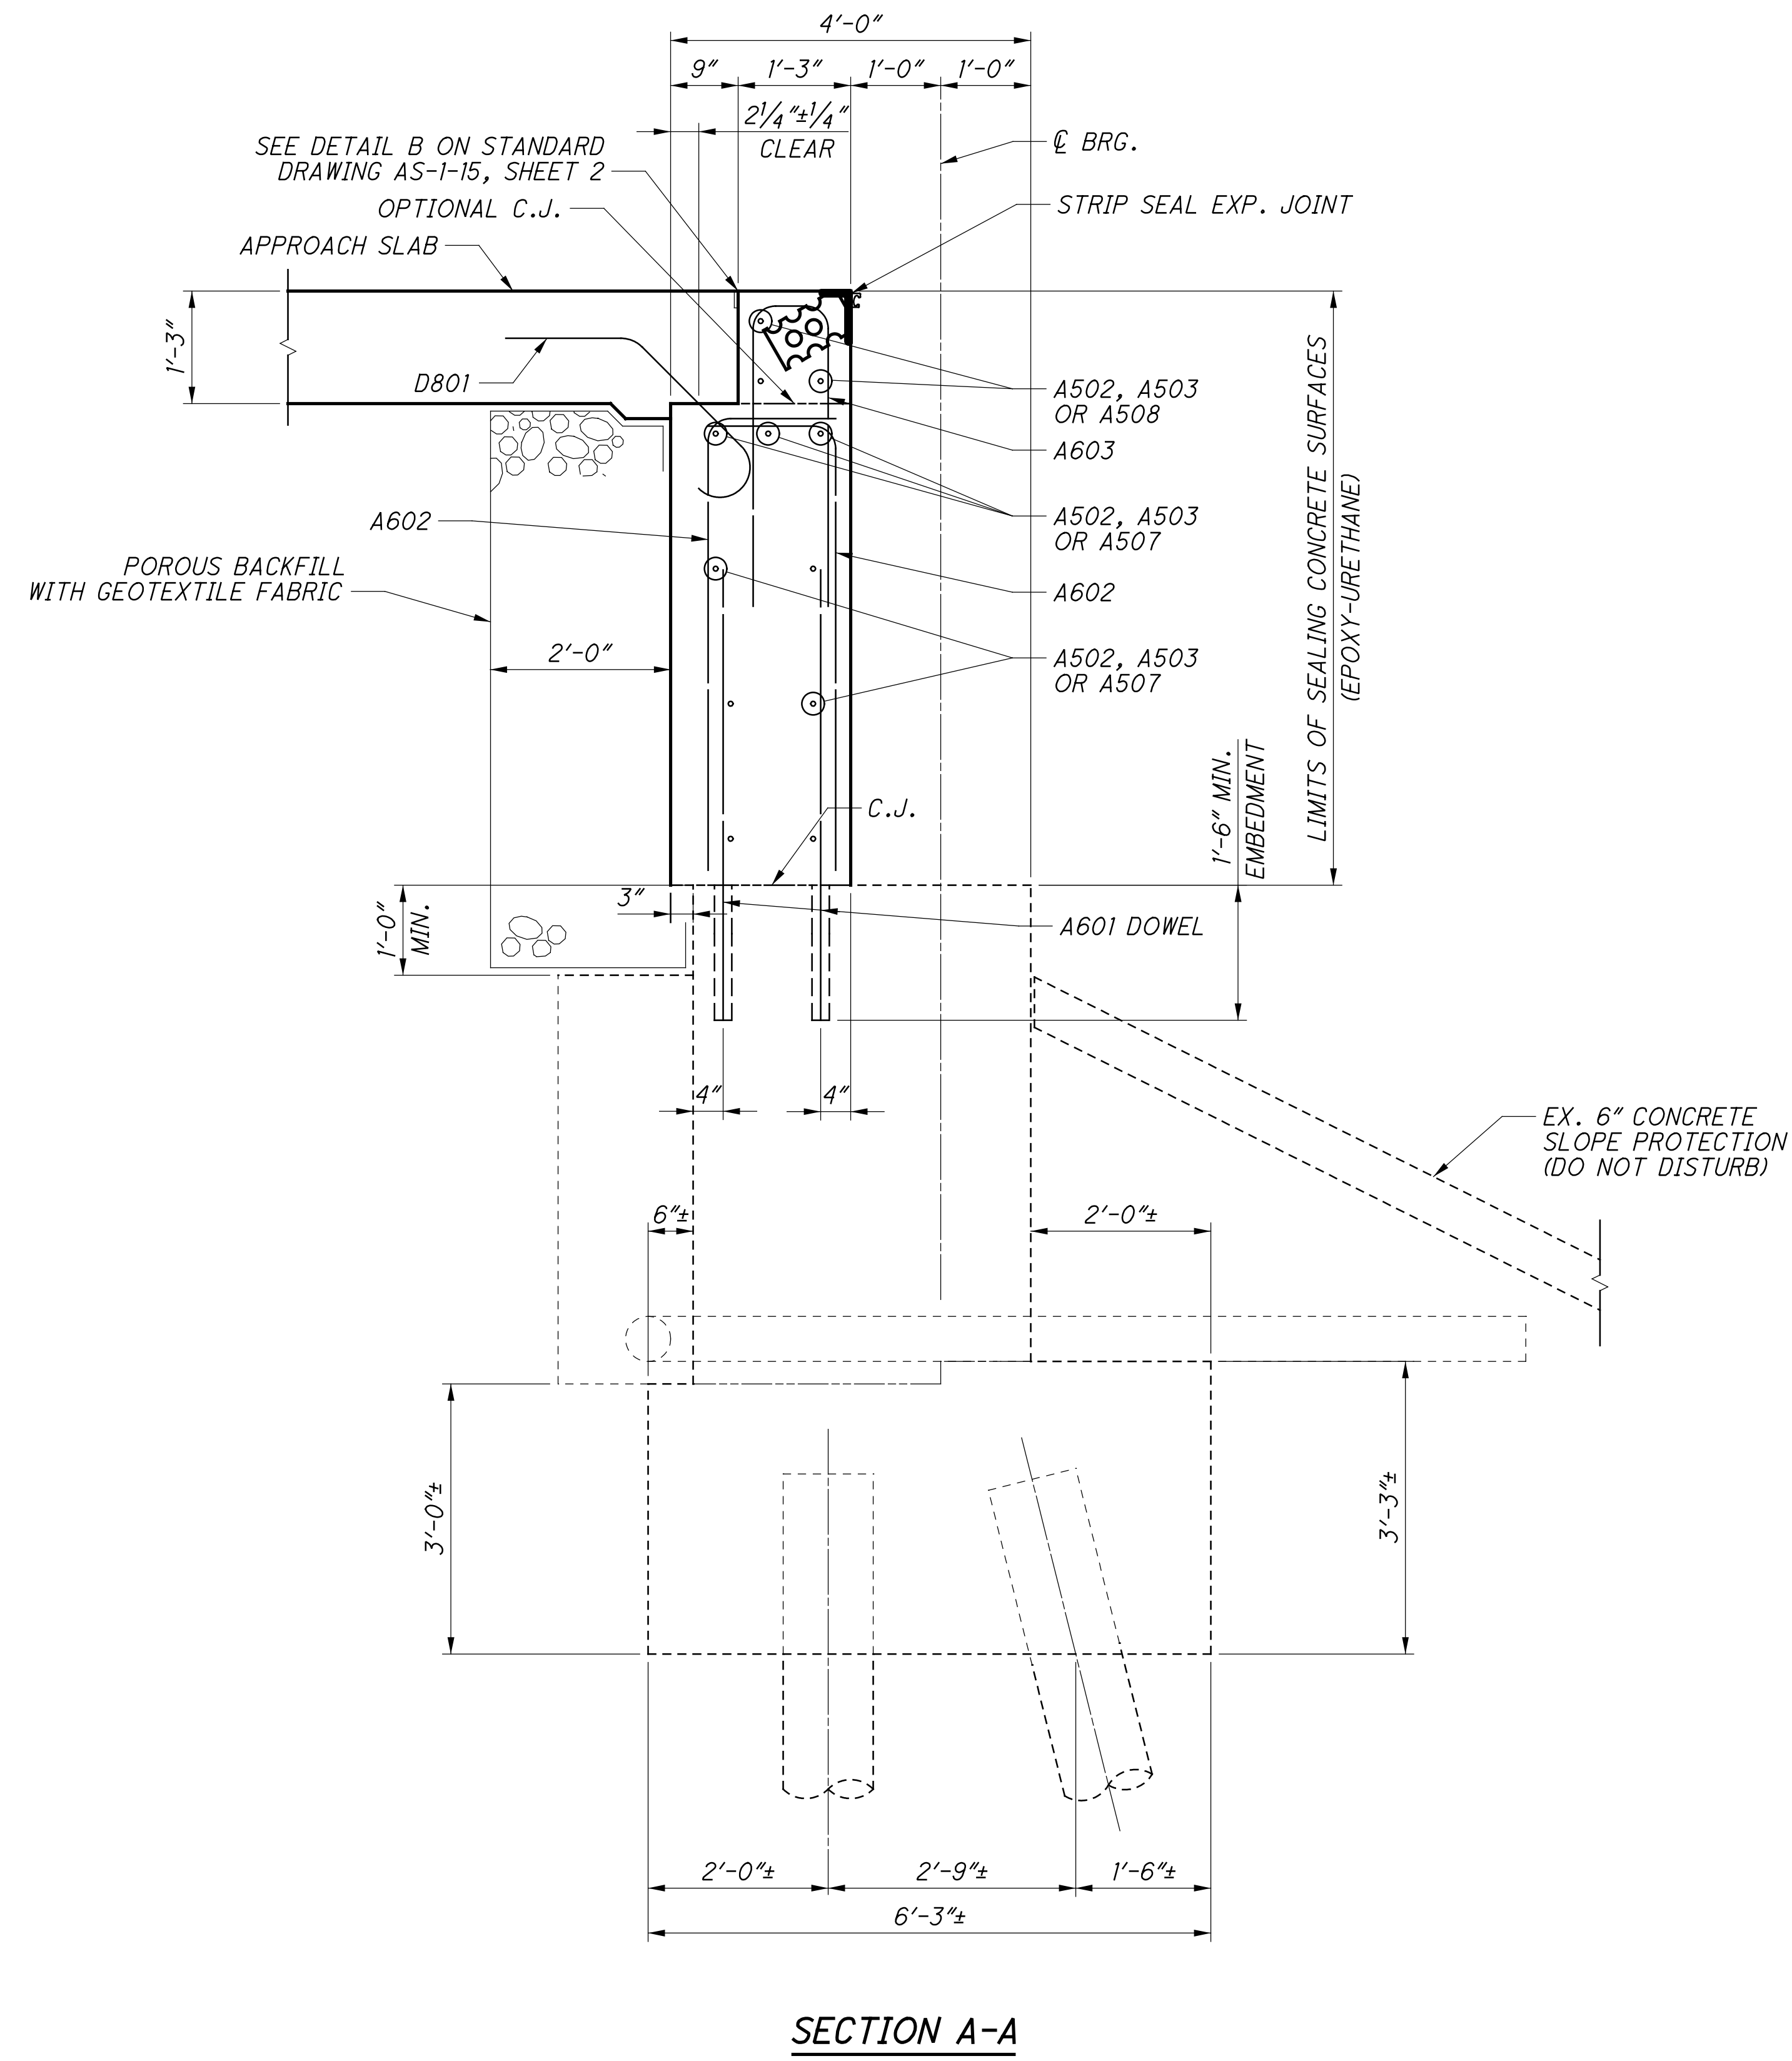

SECTION A-A


HAM-75-3.84 PID No. 104667	REAR ABUTMENT DETAILS (RIGHT BRIDGE) BRIDGE NO. HAM-74-1852 L/R OVER NB BEEKMAN ST. (U.S. 27)		DESIGNED SUJ CHECKED CLB	DRAWN DSH REVISED	REVIEWED MDS STRUCTURE FILE NUMBER 3115577	DATE 11/12/18	DESIGN AGENCY STRUCTUREPOINT <small>INCORPORATED</small> <small>2000 CORPORATE PARKWAY SUITE 200</small> <small>WILMINGTON, DE 19810</small> <small>TEL: 302.485.2000 FAX: 302.485.2001</small>
	13/40	55 120					

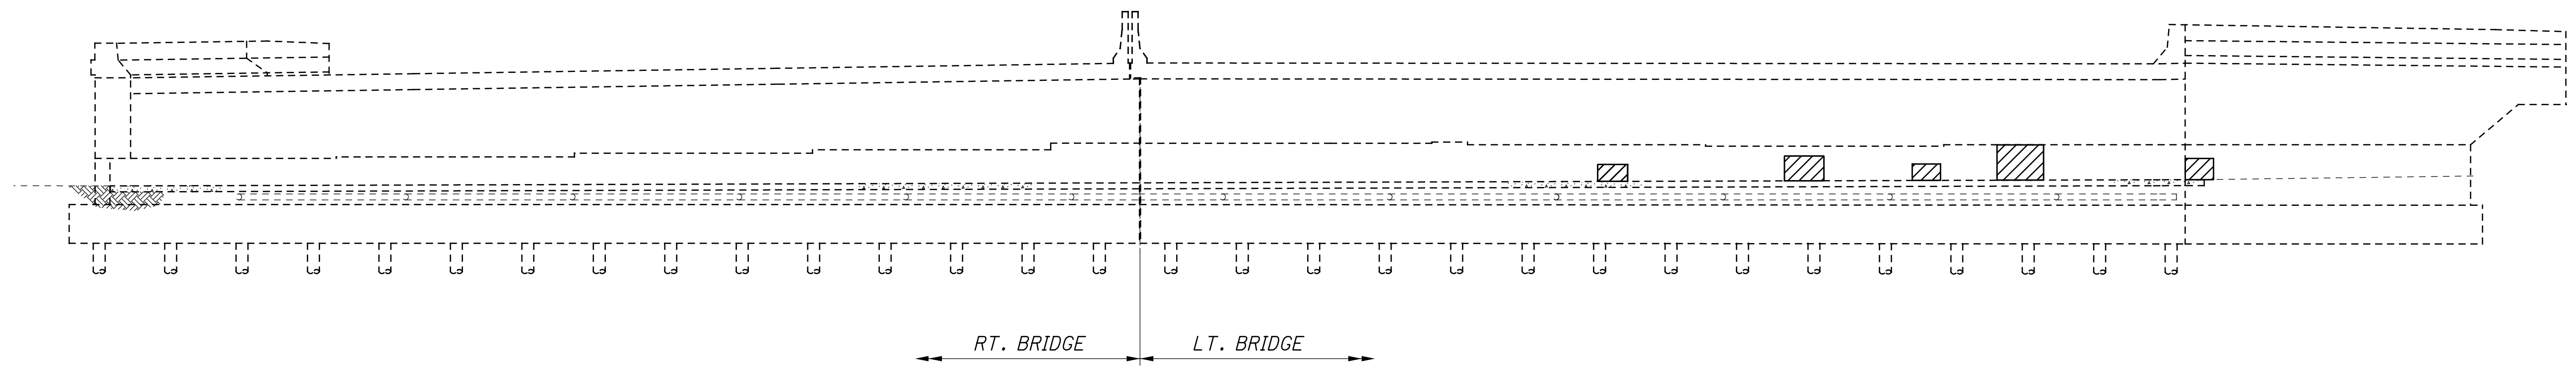

SUMMARY OF ABUT. REPAIR QUANTITIES		
	PATCH (SQ FT)	EPOXY INJECTION (FT)
REAR ABUTMENT	* 25.91	* 83.92

* FIELD MEASURED TOTAL FOR LEFT AND RIGHT BRIDGES

LEGEND

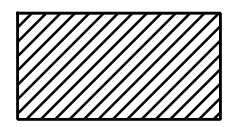
 AREA TO BE PATCHED PER ITEM 519 - PATCHING CONCRETE STRUCTURE, AS PER PLAN.

NOTES:

1. ITEM 519 - PATCHING CONCRETE STRUCTURES, AS PER PLAN AND ITEM 512 - CONCRETE REPAIR BY EPOXY INJECTION ARE UNIT PRICE PAY ITEMS (31 AND 32).


		DESIGN AGENCY STRUCTUREPOINT <small>2000 CORPORATE PARKWAY SUITE 200 TEL: 610.426.8000 FAX: 610.426.8001 WWW.STRUCTUREPOINT.COM</small>
DESIGNED SUJ CHECKED CLB	DRAWN DSH REVISED	REVIEWED MDS STRUCTURE FILE NUMBER 3115577
DATE 11/12/18		
PATCHING DETAILS - REAR ABUTMENT BRIDGE NO. HAM-74-1852 L/R OVER NB BEEKMAN ST. (U.S. 27)		
HAM-75-3.84 PID No. 104667		
15 / 40		57 120

S:\Flanagan\11/16/2023 9:34:21 AM\01\2017\01113\C.Design\104667-HAM-75-3.84\Design\Structures\HAM0074_1852C_Sheets\74_1852A\F001.dgn

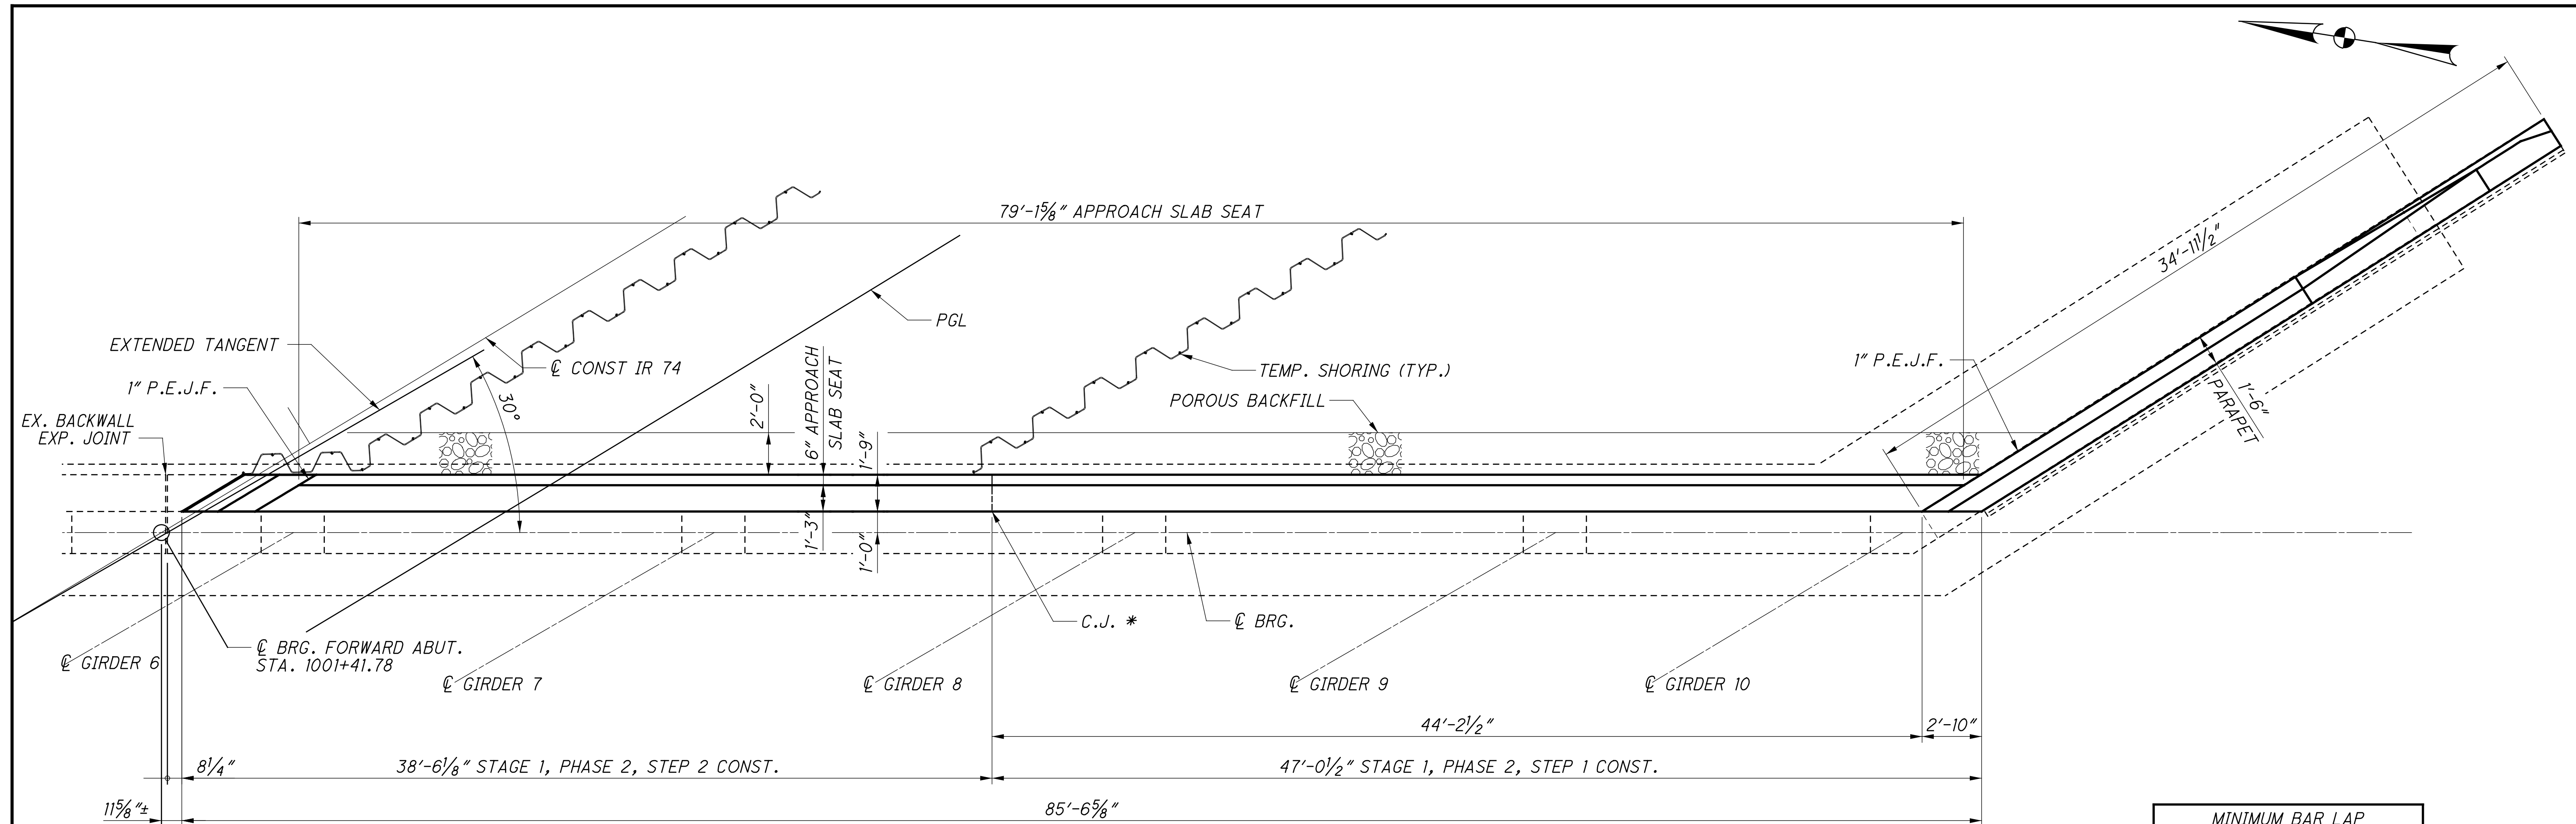

PLAN - FORWARD ABUTMENT

MINIMUM BAR LAP	
#5	3'-6"
#6	3'-10"

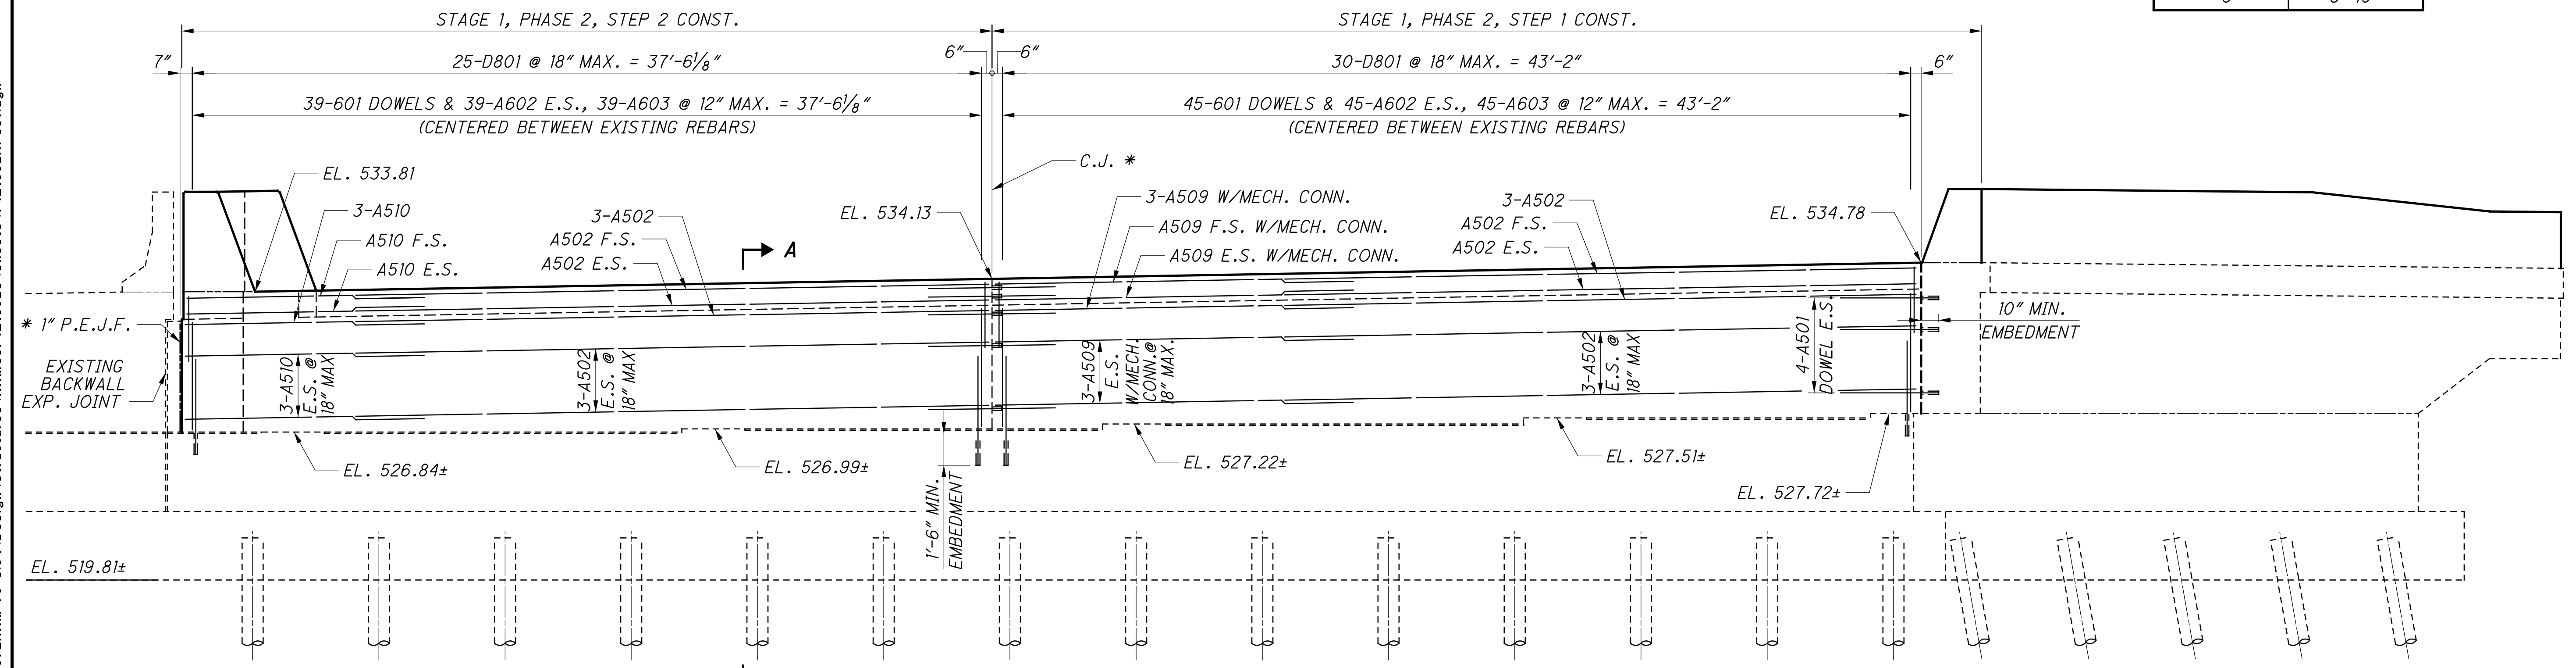

ELEVATION - FORWARD ABUTMENT

- NOTES:
- * 3'-0" WIDE TYPE 2 WATERPROOFING ON BACK FACE CENTERED ON JOINT FROM TOP OF SEAT TO BOTTOM OF APPROACH SLAB.
 - FOR PARAPET DETAILS, SEE SHEETS 31/40 AND 32/40.
 - FOR SECTION A-A, SEE SHEET 17/40.

DESIGN AGENCY: STRUCTUREPOINT

DATE: 11/12/18

REVIEWED: MDS

DRAWN: DSH

DESIGNED: SUJ

CHECKED: CLB

BRIDGE NO. HAM-74-1852 L/R

OVER NB BEEKMAN ST. (U.S. 27)


HAM-75-3.84

PID No. 104667


16/40

58

120

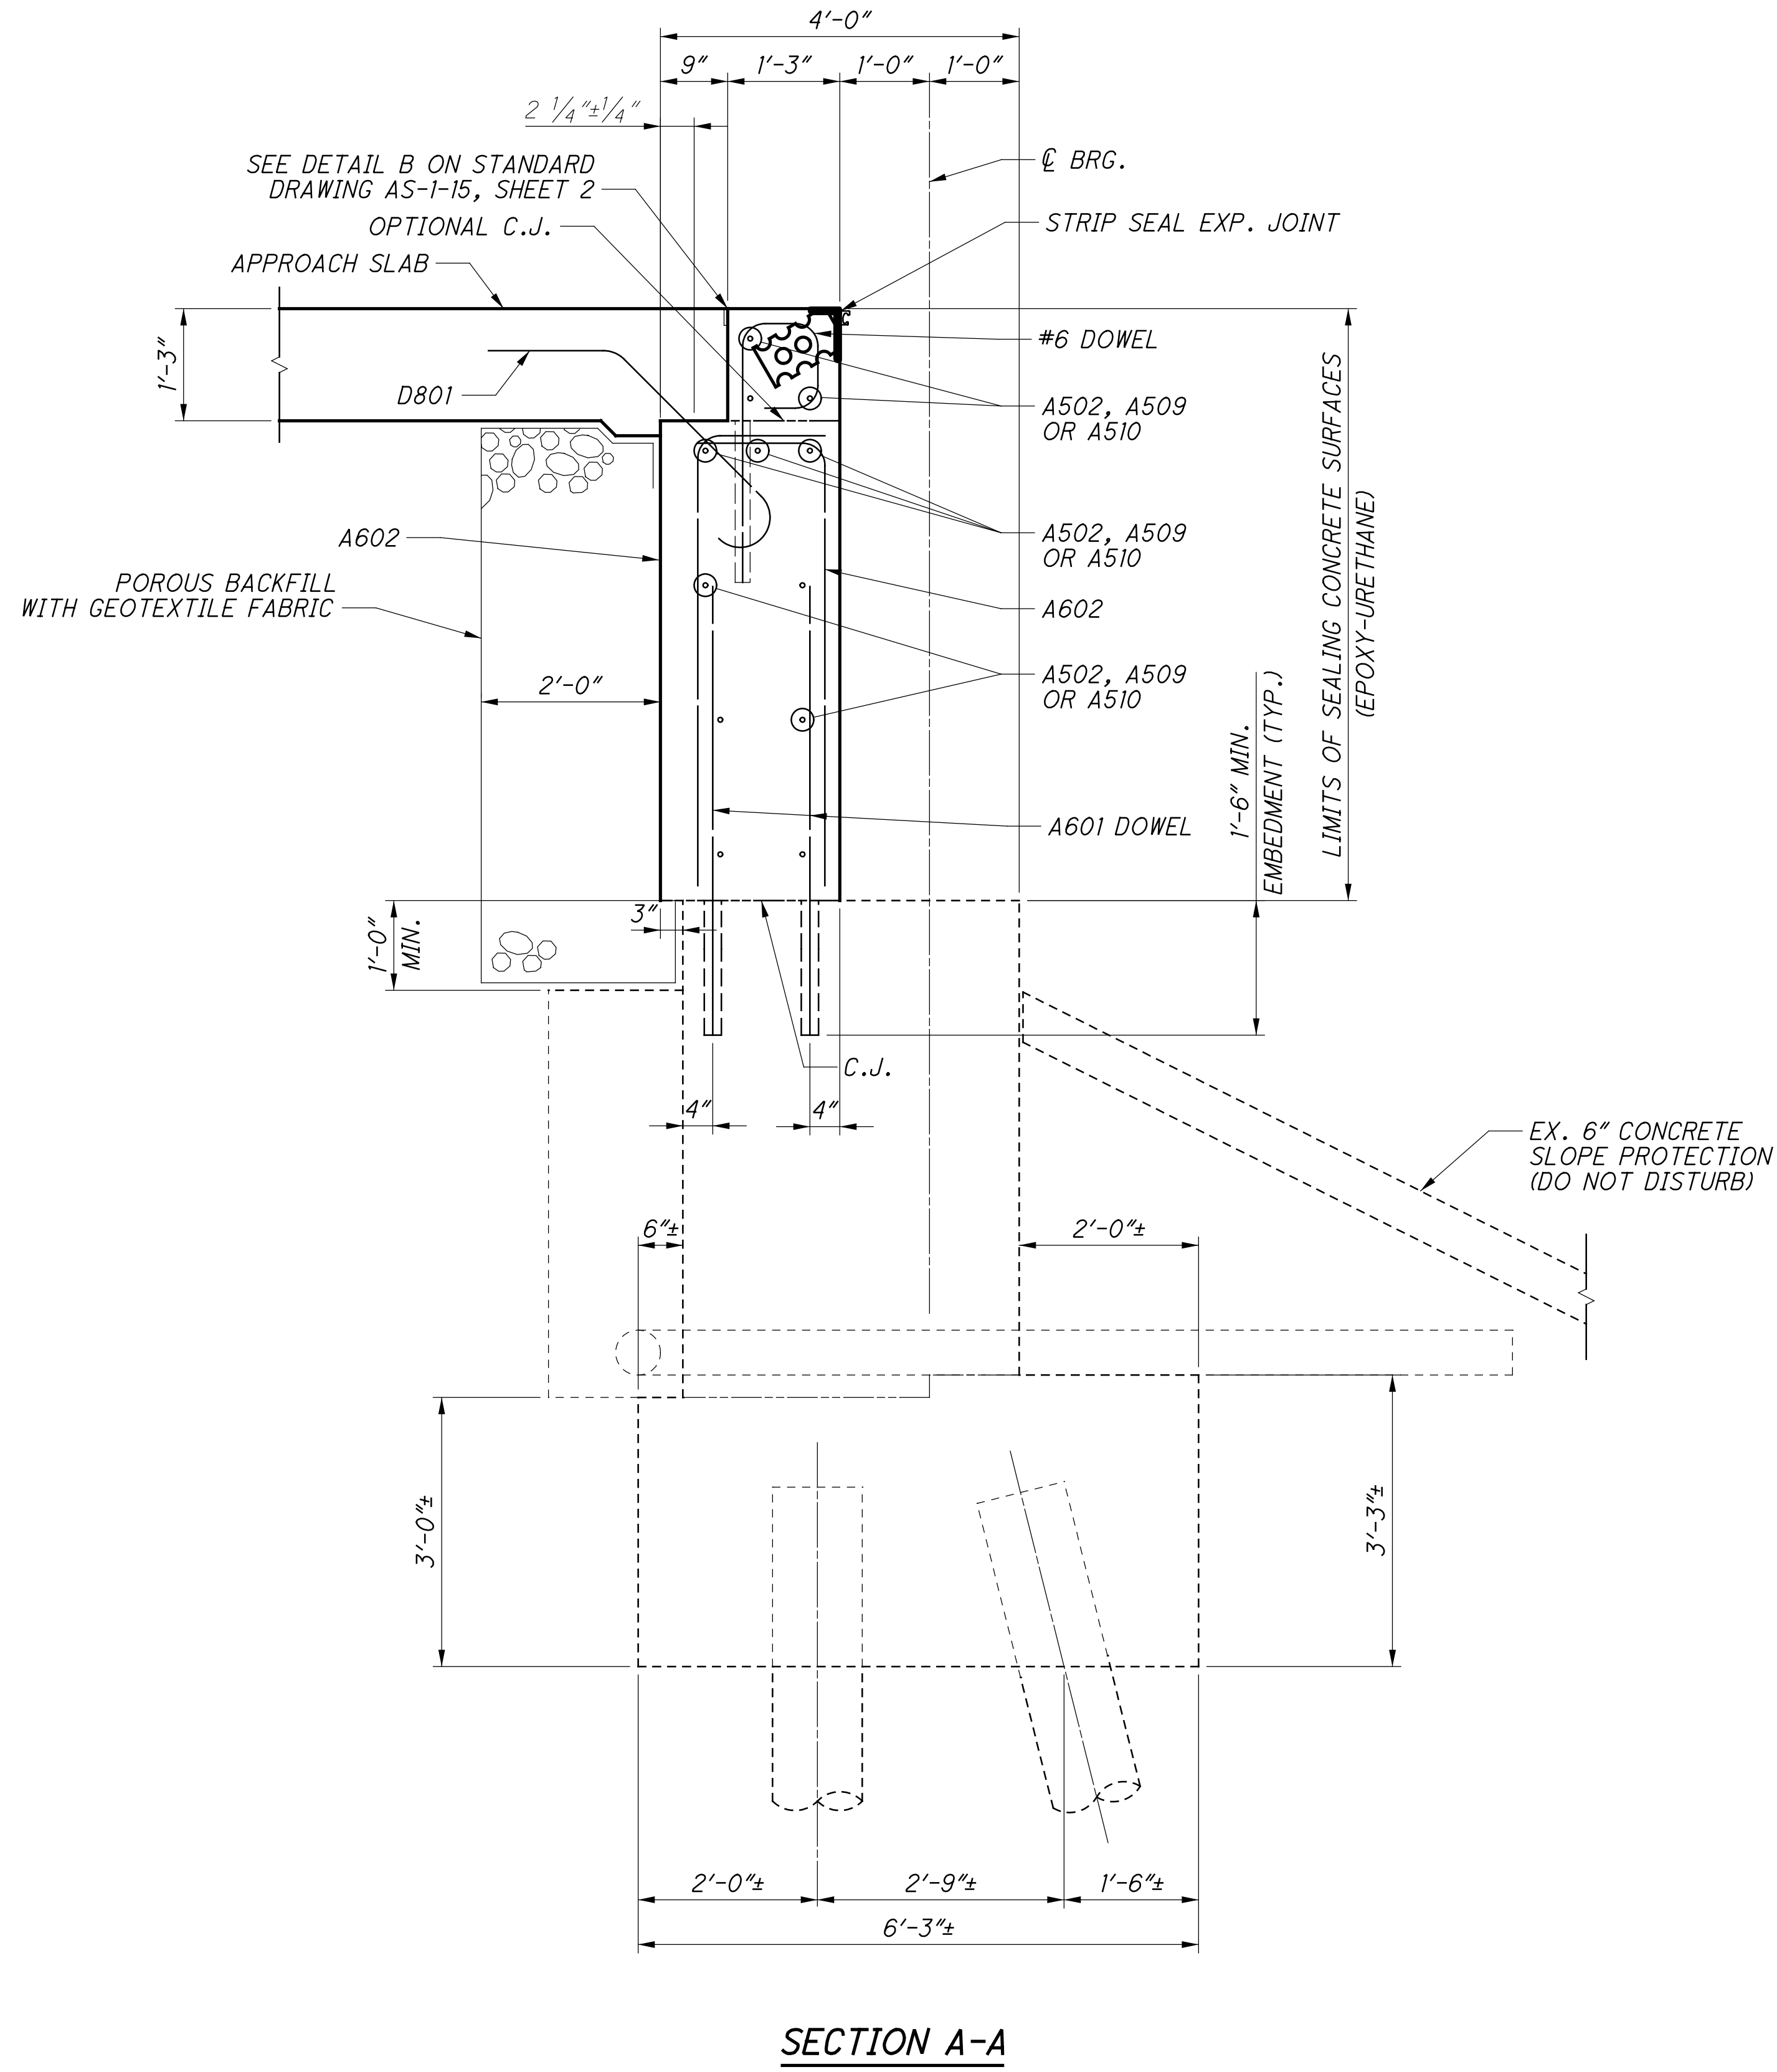


DESIGN AGENCY STRUCTUREPOINT <small>INCORPORATED</small>	DATE 11/12/18
	STRUCTURE FILE NUMBER 3115577
REVIEWED MDS	DATE 11/12/18
DRAWN DSH	STRUCTURE FILE NUMBER 3115577
DESIGNED SJF	CHECKED CLB
FORWARD ABUTMENT DETAILS (RIGHT BRIDGE) BRIDGE NO. HAM-74-1852 L/R OVER NB BEEKMAN ST. (U.S. 27)	
HAM-75-3.84 PID No. 104667	
17 / 40	
59 120	

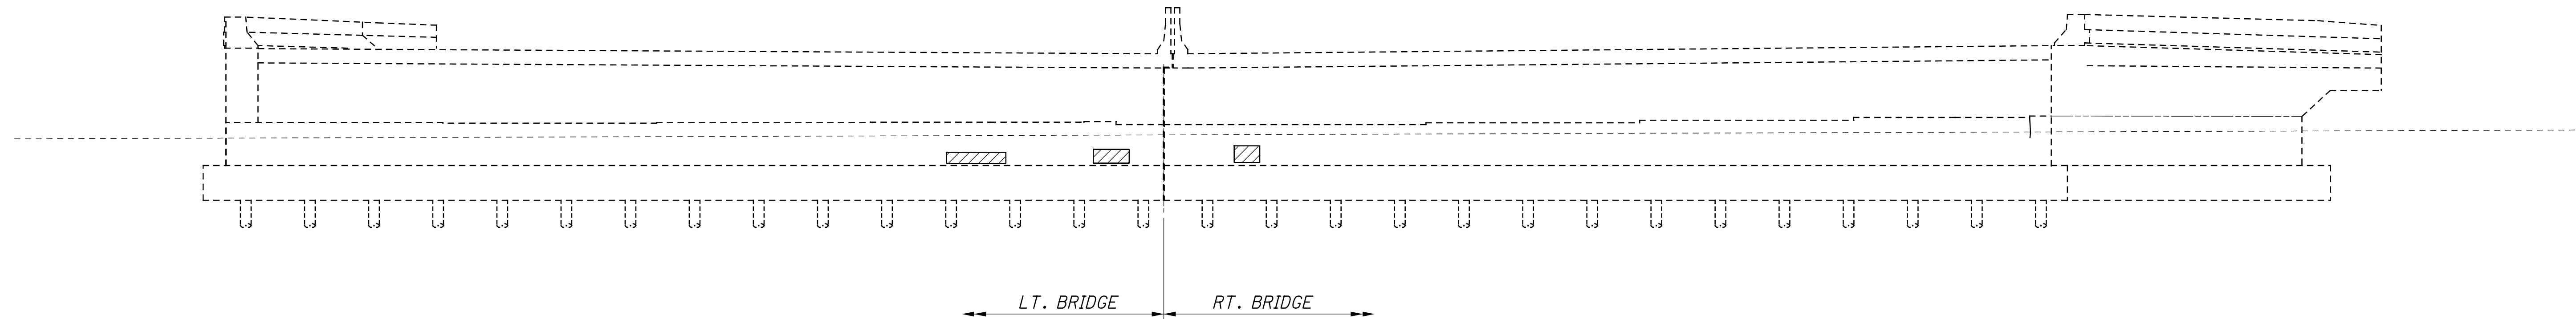

SUMMARY OF ABUT. REPAIR QUANTITIES		
	<i>PATCH (SQ FT)</i>	<i>EPOXY INJECTION (FT)</i>
FORWARD ABUTMENT	* 6.36	* 21.08

* FIELD MEASURED TOTAL FOR LEFT AND RIGHT BRIDGE





LEGEND

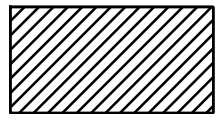 AREA TO BE PATCHED PER ITEM 519 -
 PATCHING CONCRETE STRUCTURE, AS
 PER PLAN.

NOTES:

- ITEM 519 - PATCHING CONCRETE STRUCTURES, AS PER PLAN AND ITEM 512 - CONCRETE REPAIR BY EPOXY INJECTION ARE UNIT PRICE PAY ITEMS (31 AND 32).


SFlanagan
 11/16/2023 9:34:22 AM
 \\0\2017\01113\C.Design\104667-HAM-75-3.84.Design\Structures\HAM0074_1852C\Sheets\74_1852PI001.dgn

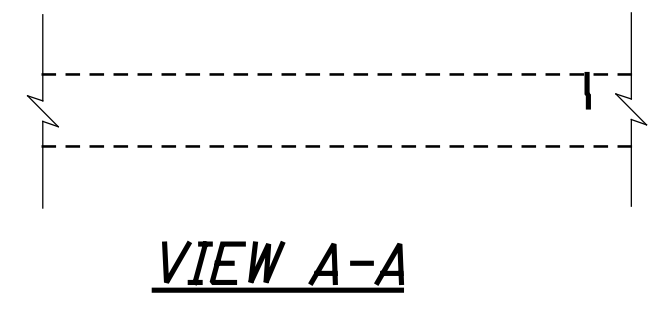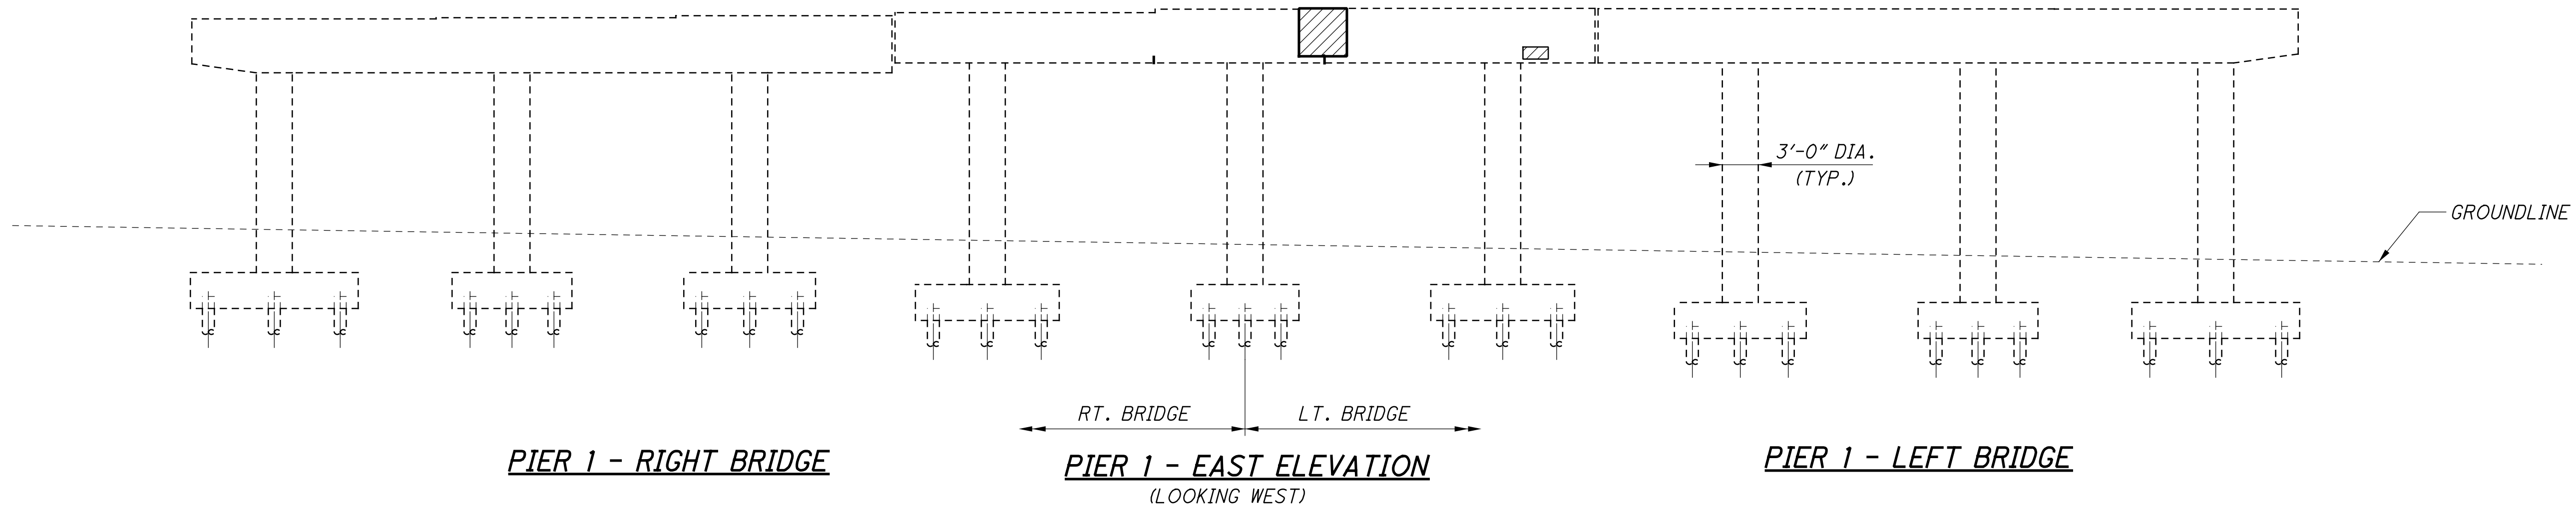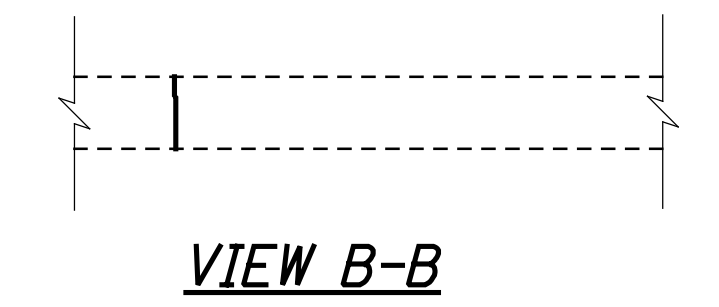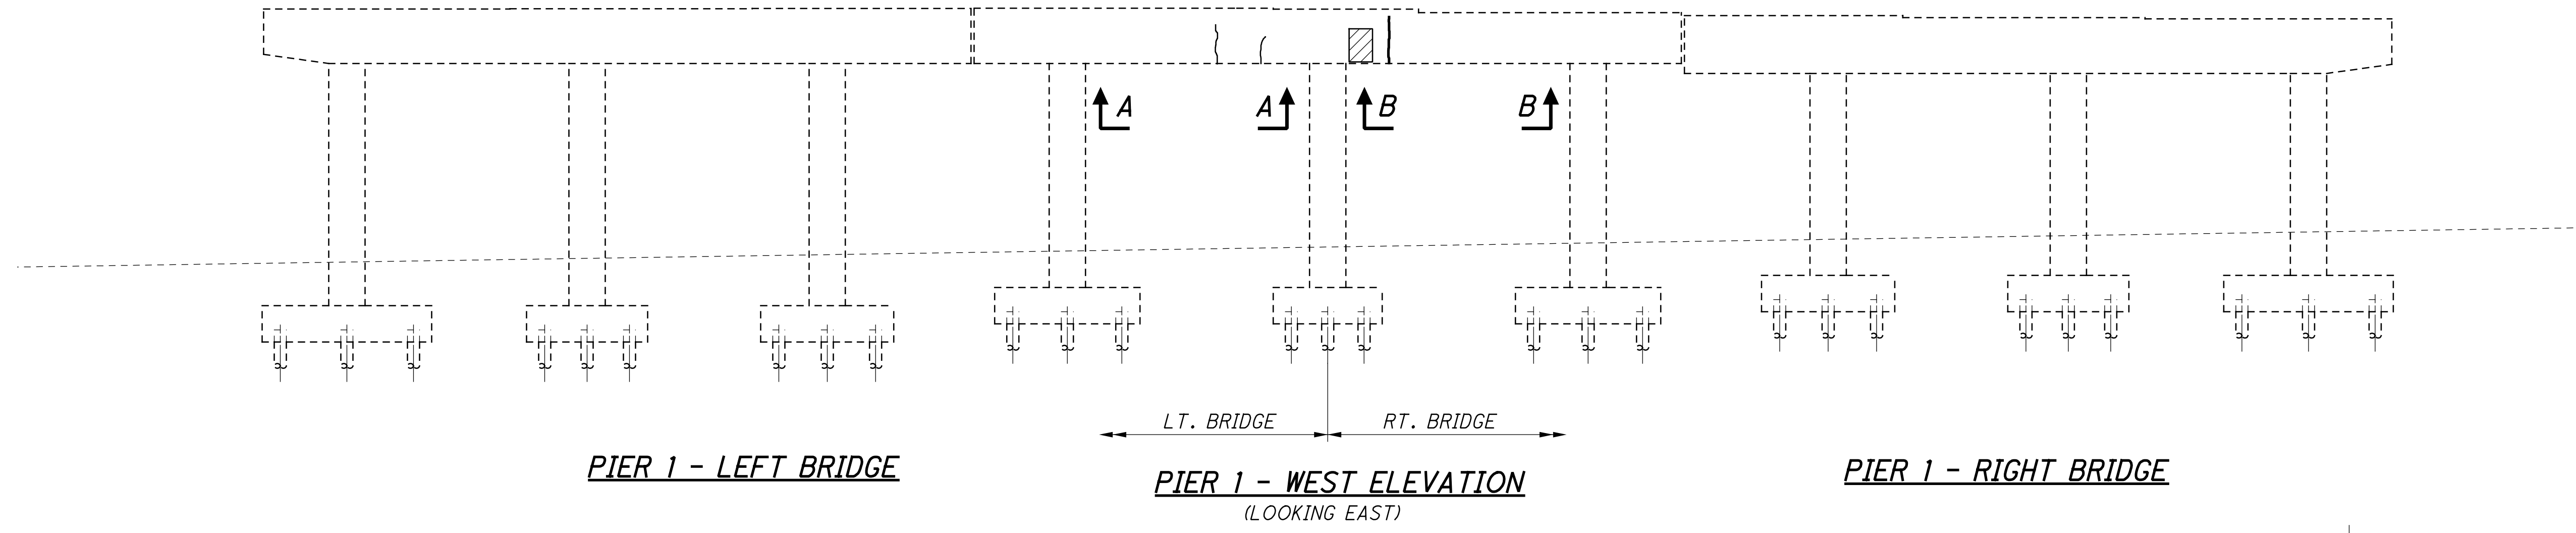

SUMMARY OF PIER 1 REPAIR QUANTITIES		
	PATCH (SQ FT)	EPOXY INJECTION (FT)
PIER 1	* 37.68	* 24

* FIELD MEASURED TOTAL FOR LEFT AND RIGHT BRIDGES


LEGEND

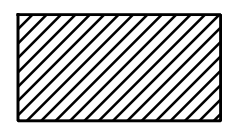 AREA TO BE PATCHED PER ITEM 519 - PATCHING CONCRETE STRUCTURE, AS PER PLAN.

NOTES:

- ITEM 519 - PATCHING CONCRETE STRUCTURES, AS PER PLAN AND ITEM 512 - CONCRETE REPAIR BY EPOXY INJECTION ARE UNIT PRICE PAY ITEMS (31 AND 32).


SFlanagan
 11/16/2023 9:34:23 AM
 \\0\2017\01113\C.Design\104667-HAM-75-3.84\Design\Structures\HAM0074_1852C\Sheets\74_1852PI002.dgn

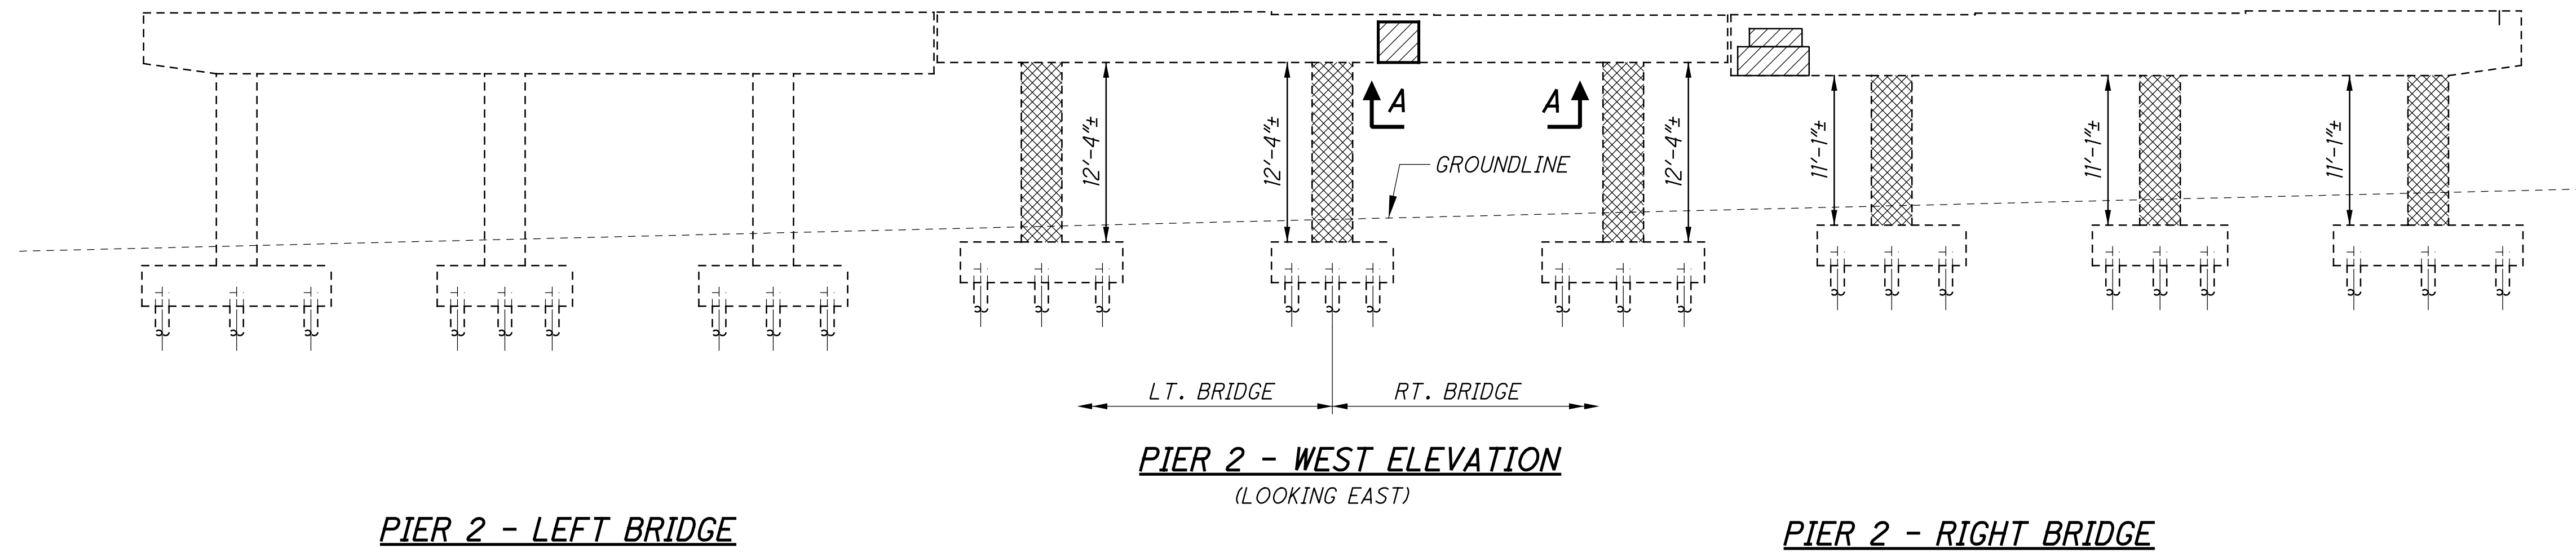

PIER 2 - LEFT BRIDGE

PIER 2 - WEST ELEVATION
(LOOKING EAST)

PIER 2 - RIGHT BRIDGE

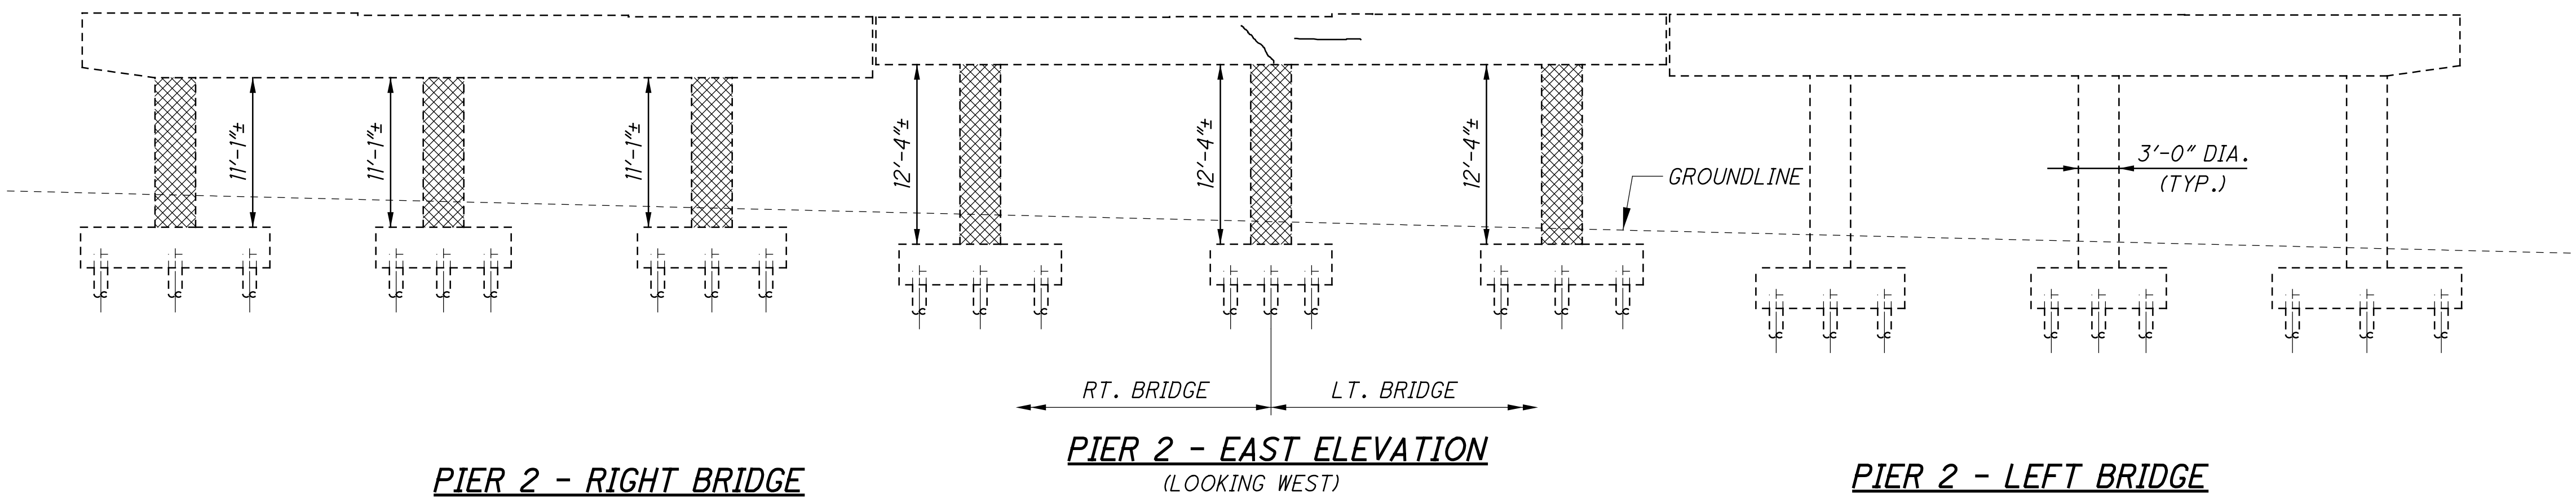


PIER 2 - RIGHT BRIDGE

PIER 2 - EAST ELEVATION
(LOOKING WEST)

PIER 2 - LEFT BRIDGE

SUMMARY OF PIER 2 REPAIR QUANTITIES		
	PATCH (SQ FT)	EPOXY INJECTION (FT)
PIER 2	* 28.25	* 14.41

* FIELD MEASURED TOTAL FOR LEFT AND RIGHT BRIDGES

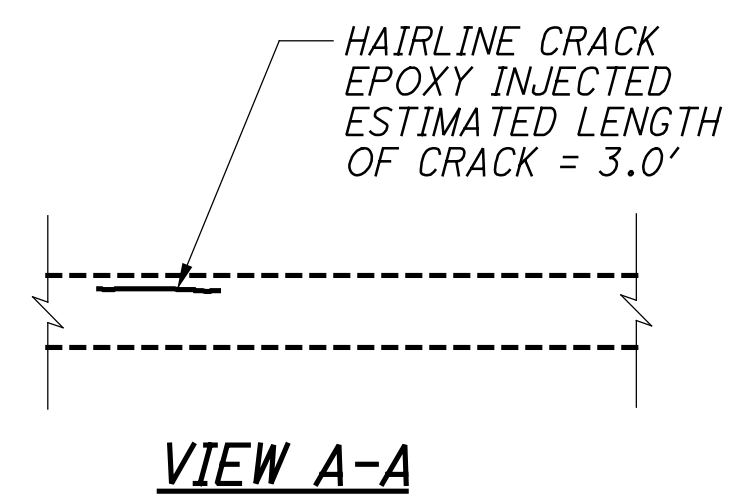



LEGEND

- AREA TO BE PATCHED PER ITEM 519 - PATCHING CONCRETE STRUCTURE, AS PER PLAN.
- FIBER WRAP COLUMN FROM TOP OF FOOTING TO BOTTOM OF CAP. TOP AND BOTTOM 3'-0" REQUIRE FRP JACKET (f') OF 0.3 KSI, REMAINING LENGTH (f') OF 0.15 KSI

NOTES:

1. ITEM 519 - PATCHING CONCRETE STRUCTURES, AS PER PLAN AND ITEM 512 - CONCRETE REPAIR BY EPOXY INJECTION ARE UNIT PRICE PAY ITEMS (31 AND 32).

	DESIGN AGENCY STRUCTUREPOINT <small>INCORPORATED</small>	DATE 11/12/18	REVIEWED MDS	FILE NUMBER 3115577
DRAWN DSH	CHECKED CLB	DESIGNED SUJ	REVISER REVISED	
PIER 2 DETAILS BRIDGE NO. HAM-74-1852 L/R OVER NB BEEKMAN ST. (U.S. 27)				
HAM-75-3.84 PID No. 104667				
20/40 62 120				

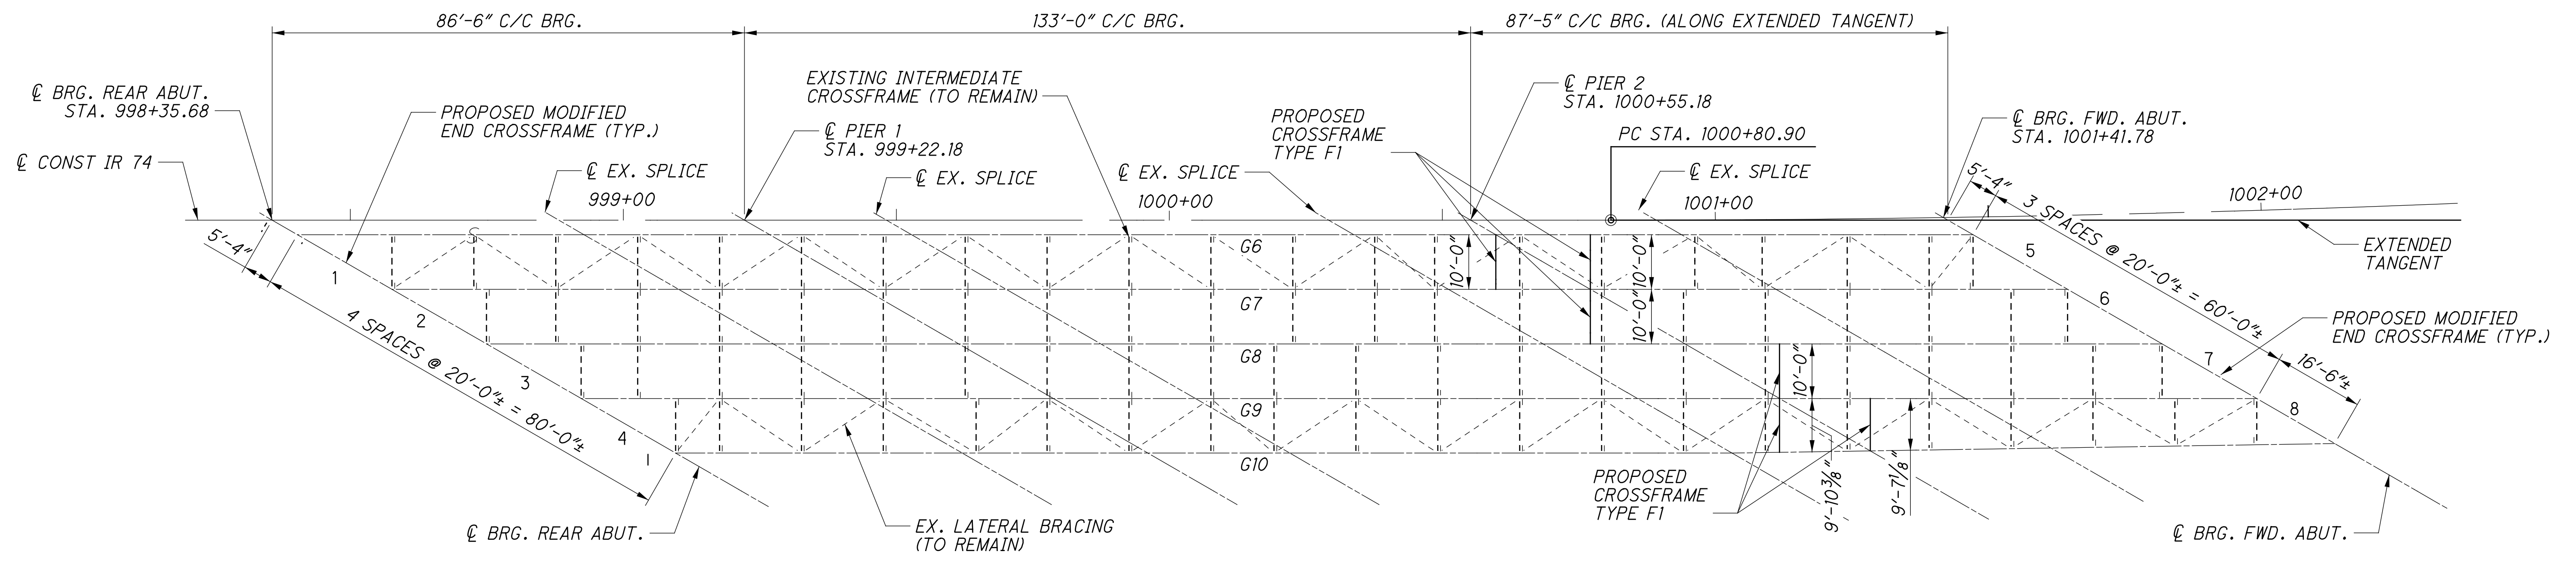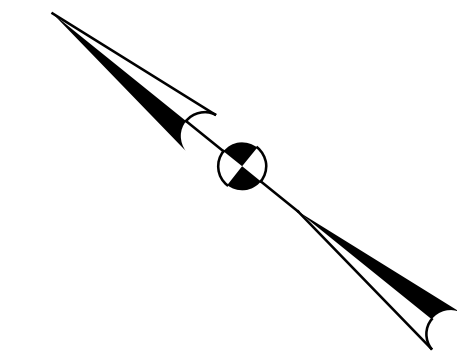


FRAMING PLAN

SFlanagan 11/16/2023 9:34:23 AM
 \\0\2017\01113\C.Design\104667-HAM-75-3.84\Design\Structures\HAM0074_1852C_Sheets\74_1852SD001.dgn



DESIGNED	DATE	REVIEWED	DATE
SJF	11/12/18	MDS	11/12/18
CHECKED	FILE NUMBER	STRUCTURE FILE NUMBER	
CLB		3115577	

FRAMING PLAN (RIGHT BRIDGE)
 BRIDGE NO. HAM-74-1852 L/R
 OVER NB BEEKMAN ST. (U.S. 27)

SFlanagan
11/16/2023 9:34:24 AM
0\2017\01113\C.Design\104667-HAM-75-3.84\Design\Structures\HAM0074_1852C_Sheets\74_1852SD002.dgn

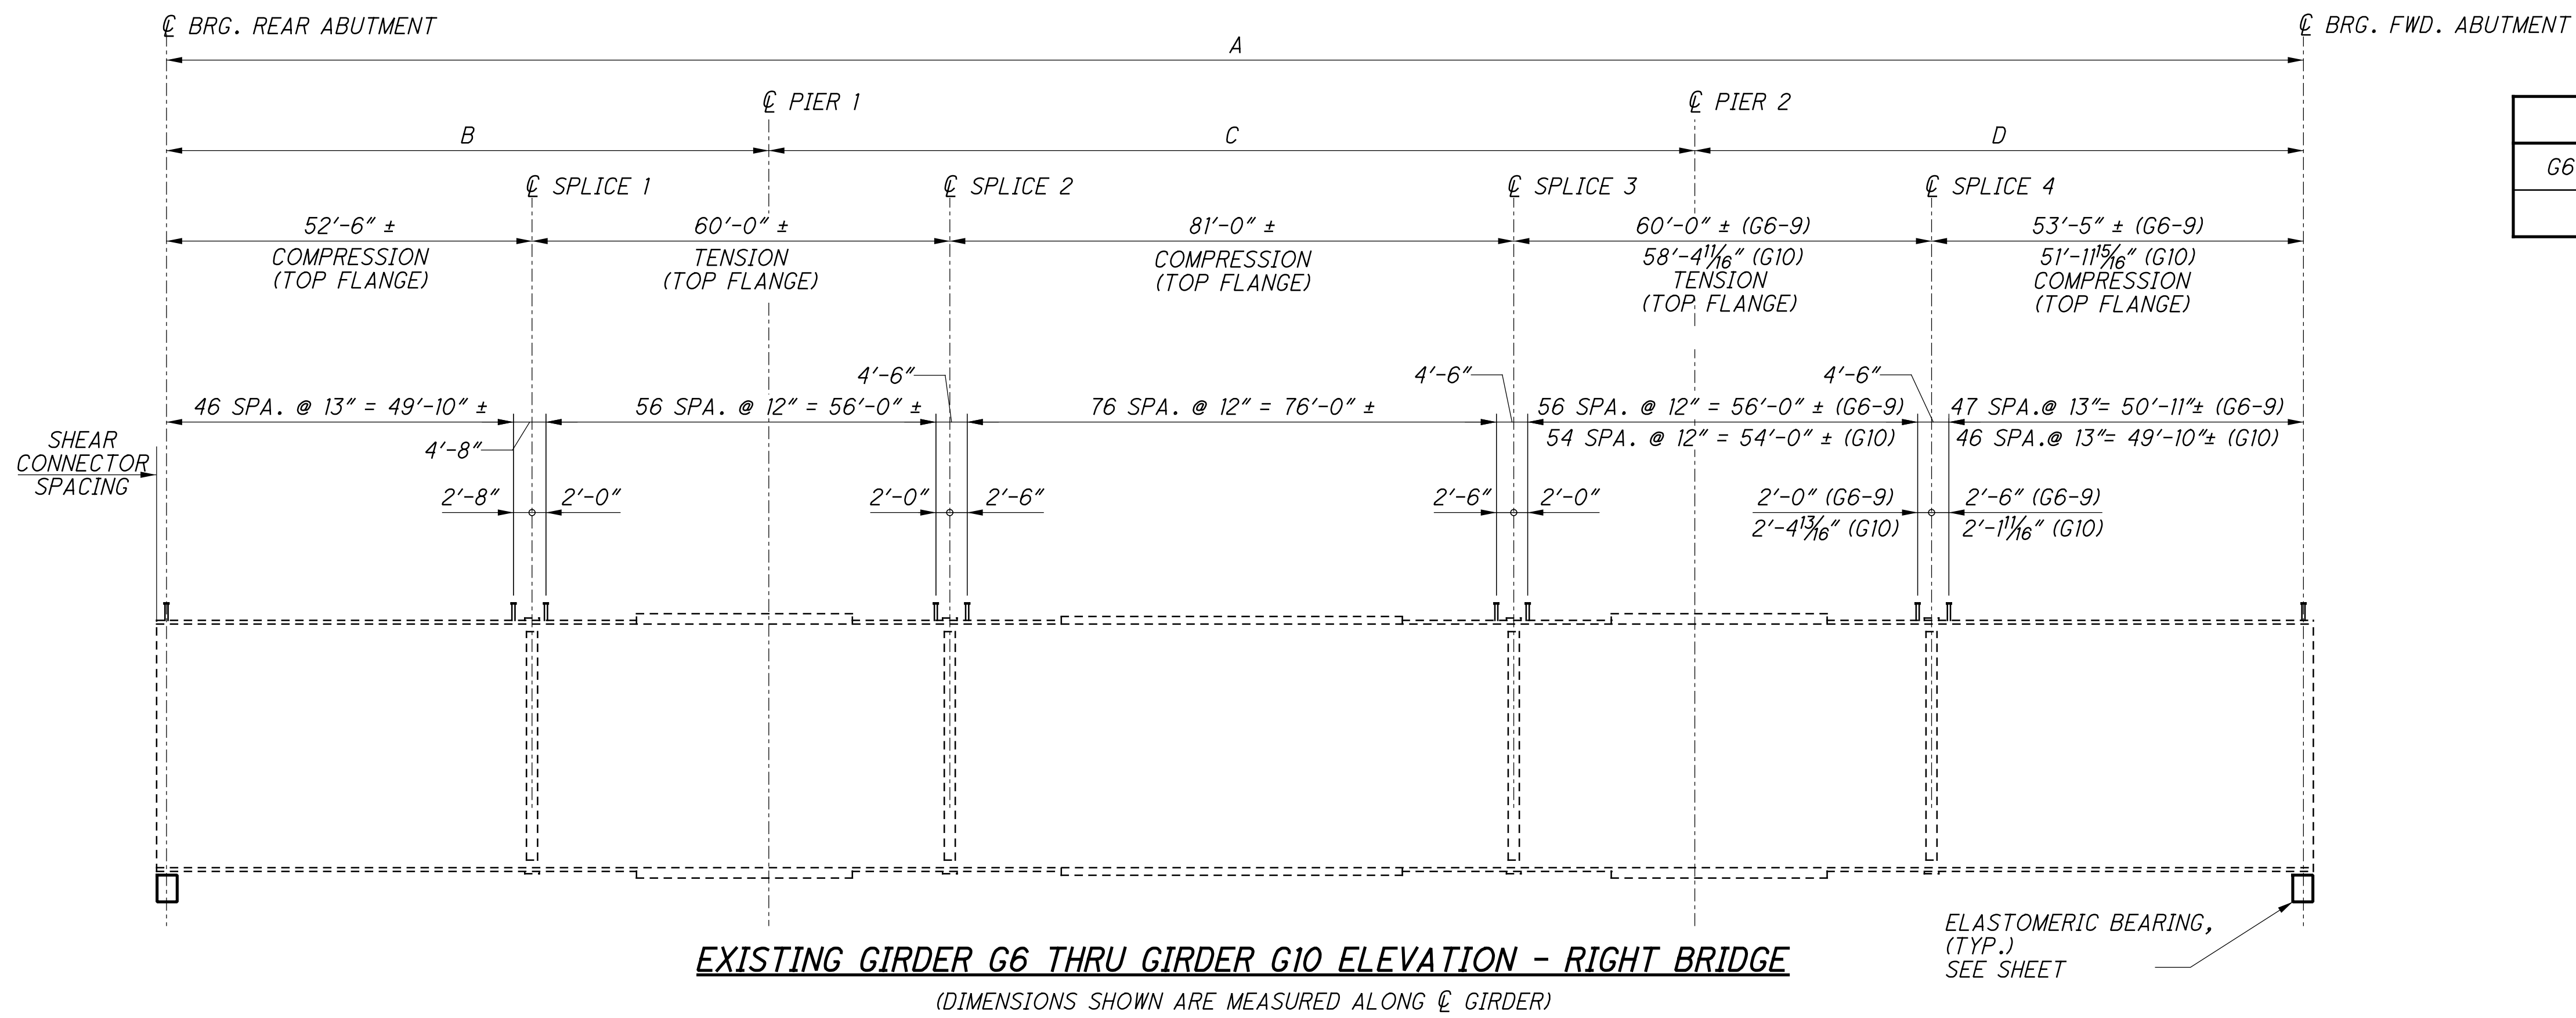


	A	B	C	D
G6 THRU G9	306'-11"±	86'-6"±	133'-0"±	87'-5"±
G10	304'-7 ¹ / ₁₆ "±	86'-6"±	133'-0"±	85'-1 ¹ / ₁₆ "±

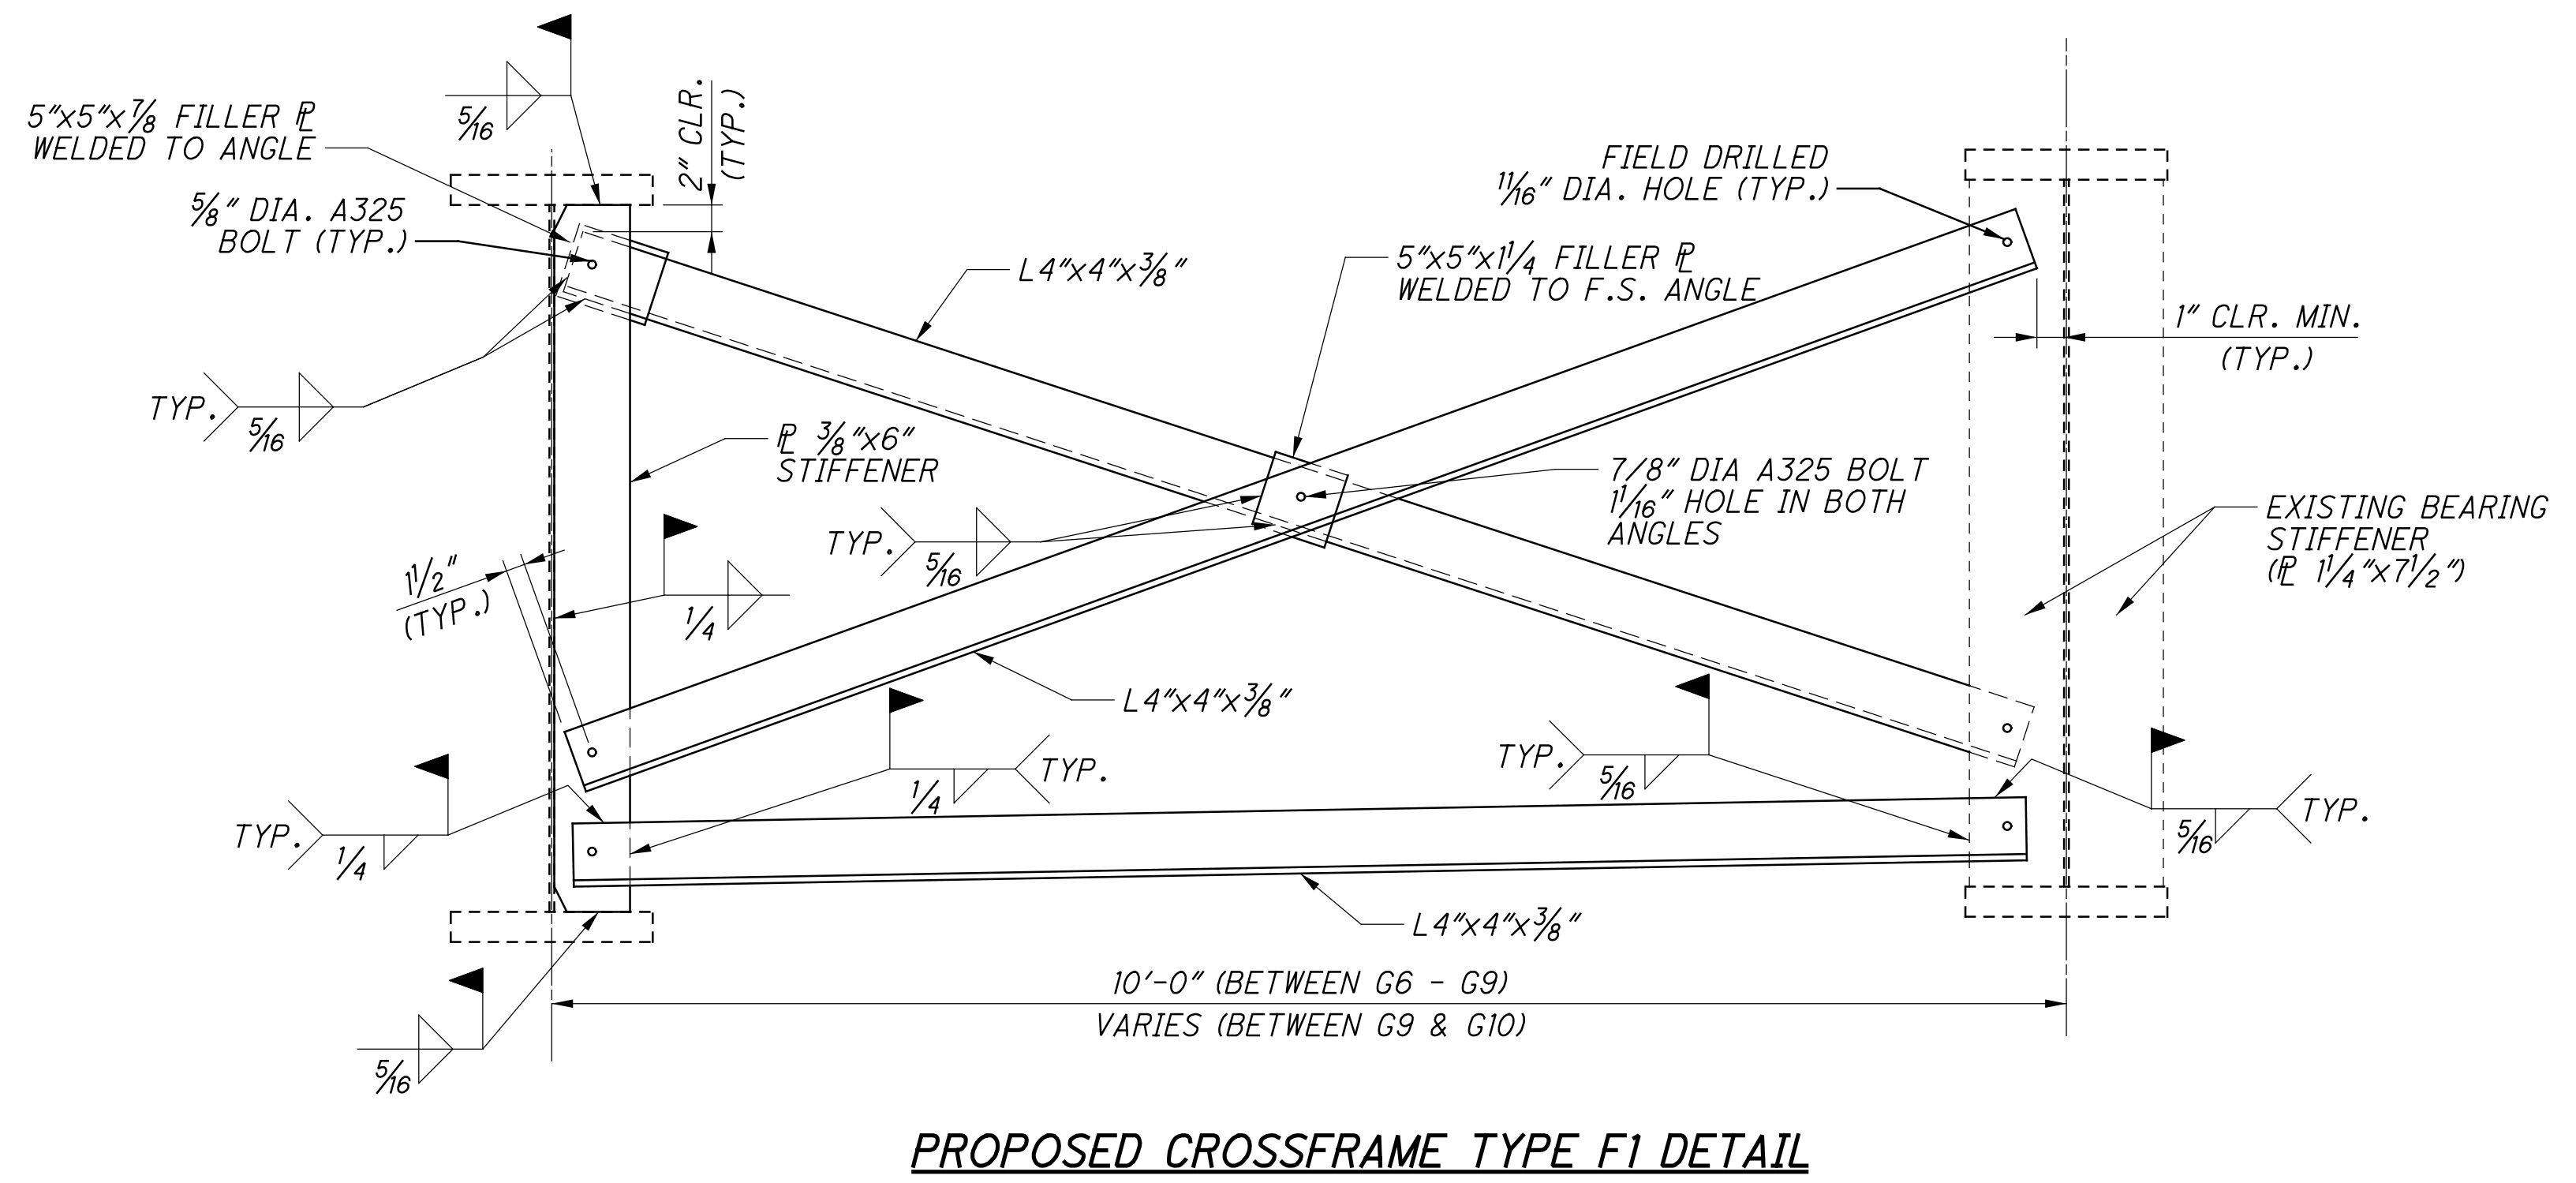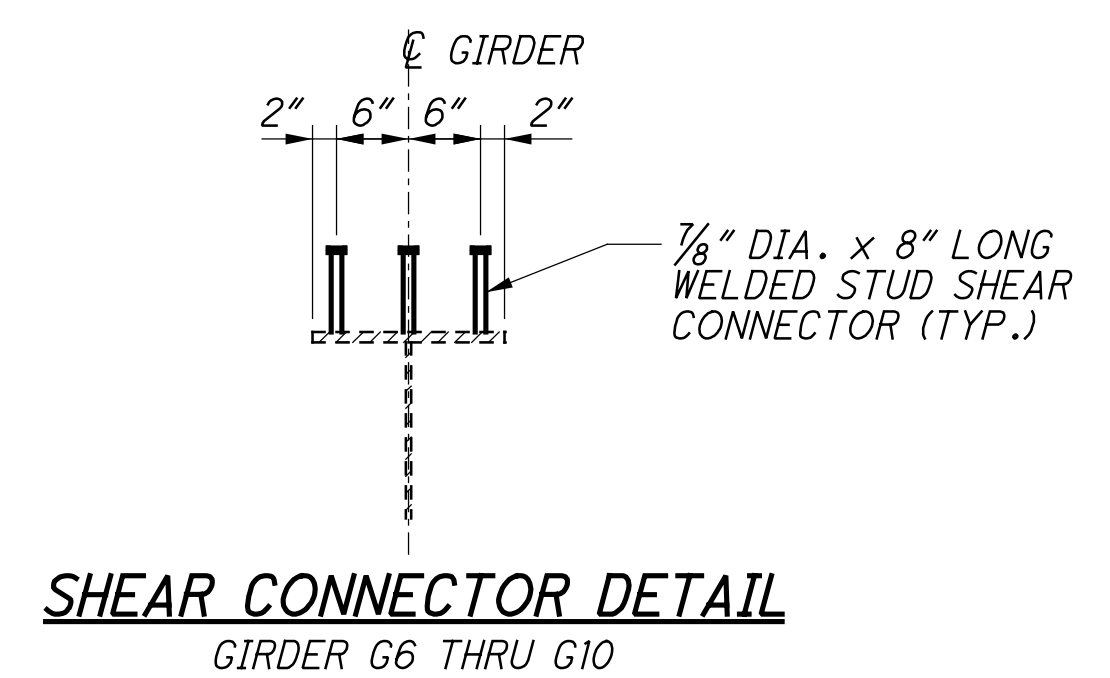


- NOTES:
1. ALL PROPOSED STRUCTURAL STEEL SHALL BE A709 GRADE 50.
 2. HIGH STRENGTH BOLTS SHALL BE 7/8" DIAMETER A325 UNLESS OTHERWISE NOTED.
 3. WELD ATTACHMENT OF SUPPORTS FOR CONCRETE DECK FINISHING MACHINE TO AREAS OF THE FASCIA STRINGER FLANGES DESIGNATED "COMPRESSION". DO NOT WELD ATTACHMENTS TO AREAS DESIGNATED "TENSION". FILLET WELDS TO COMPRESSION FLANGES SHALL BE AT LEAST 1" FROM EDGE OF FLANGE, BE NO MORE THAN 2" LONG, AND BE AT LEAST 1/4" FOR THICKNESSES UP TO 3/4" OR 5/16" FOR GREATER THAN 3/4" THICK.

DESIGN AGENCY: STRUCTUREPOINT
DATE: 11/12/18
REVIEWED: MDS
DRAWN: DSH
DESIGNED: SUJ
CHECKED: CLB
STRUCTURE FILE NUMBER: 3115577
GIRDER ELEVATION (RIGHT BRIDGE)
BRIDGE NO. HAM-74-1852 L/R
OVER NB BEEKMAN ST. (U.S. 27)
HAM-75-3.84
PID No. 104667
22/40
64
120

SFlanagan 11/16/2023 9:34:24 AM
 \O\2017\01113\C.Design\104667-HAM-75-3.84.Design\Structures\HAM0074_1852C_Sheets\74_1852SD003.dgn

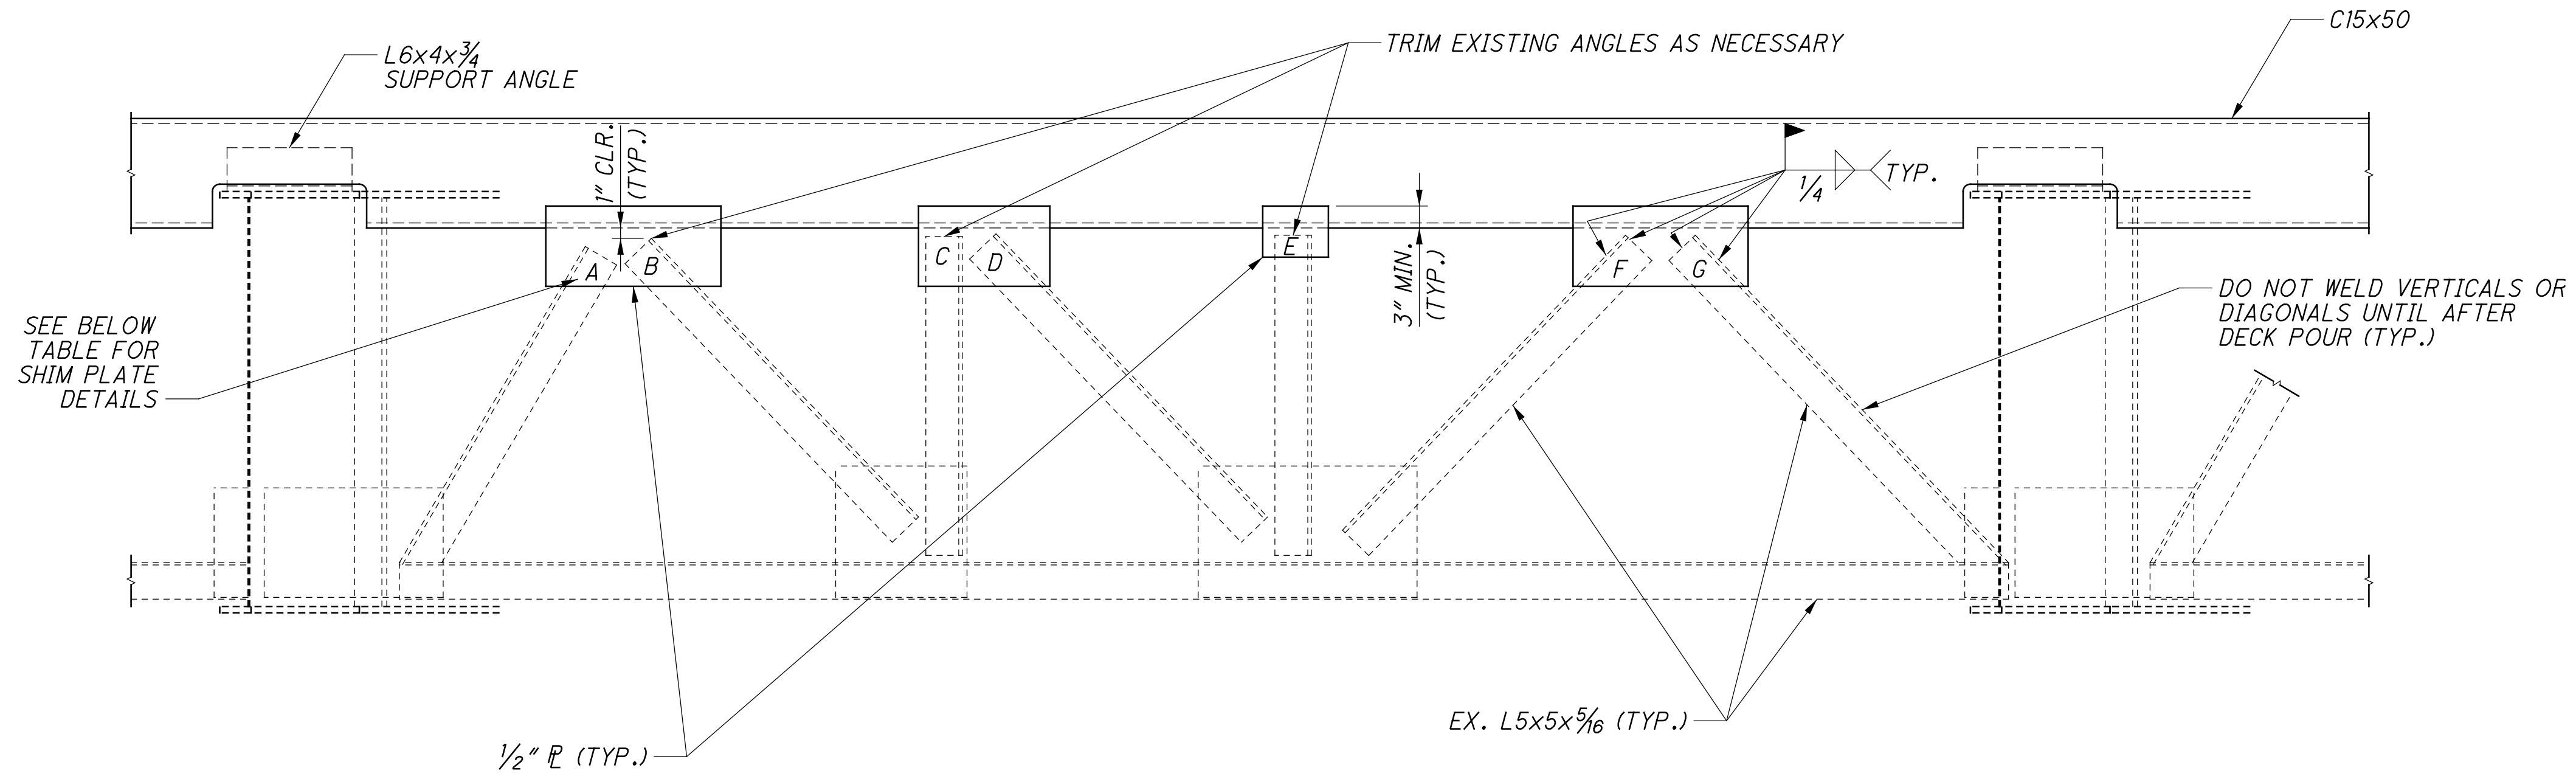

END CROSS FRAME DETAIL

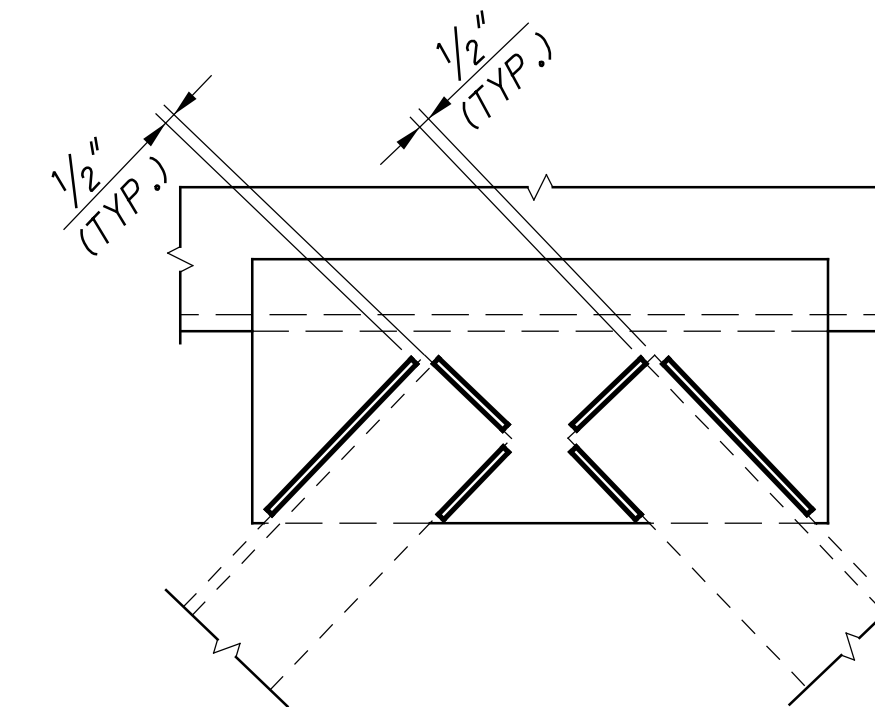

WELD TERMINATION DETAIL


Name	# of Plates	Plate 1	Notes	Name	# of Plates	Plate 1	Name	# of Plates	Plate 1	Name	# of Plates	Plate 1
1-A	0	N/A	N/A	2-A	0	N/A	3-A	0	N/A	4-A	0	N/A
1-B	1	6x6x1	N/A	2-B	0	N/A	3-B	1	6"x6"x1"	4-B	0	N/A
1-C	1	6x6x1	3x3 CLIP	2-C	1	6x6x1	3-C	0	N/A	4-C	0	N/A
1-D	1	6x6x1	4x5 CLIP	2-D	1	6x6x1	3-D	0	N/A	4-D	0	N/A
1-E	1	6x6x1	3x3 CLIP	2-E	1	6x6x1	3-E	0	N/A	4-E	1	8"x6"x1 1/4"
1-F	1	6x6x1	2x2 CLIP	2-F	1	6x6x1	3-F	0	N/A	4-F	1	N/A
1-G	0	N/A	N/A	2-G	0	N/A	3-G	0	N/A	4-G	0	N/A

Name	# of Plates	Plate 1	Plate 2	Notes	Name	# of Plates	Plate 1	Notes	Name	# of Plates	Plate 1
6-A	0	N/A	N/A	4x4 CLIP	7-A	1	6"x6"x1"	N/A	8-A	0	N/A
6-B	0	N/A	N/A	3x4 CLIP	7-B	1	8"x6"x1 1/4"	N/A	8-B	1	8"x6"x1 1/4"
6-C	1	6"x6"x1"	N/A	1x1 CLIP	7-C	1	8"x6"x1 1/4"	N/A	8-C	1	8"x6"x1 1/4"
6-D	1	8"x6"x1 1/2"	N/A	4x4 CLIP	7-D	1	8"x6"x1 1/4"	4x4 CLIP	8-D	1	8"x6"x1 1/4"
6-E	2	7"x7"x1"	6"x6"x1"	N/A	7-E	1	8"x6"x1 1/4"	4x4 CLIP	8-E	1	8"x6"x1 1/4"
6-F	2	7"x7"x1"	6"x6"x1 1/4"	N/A	7-F	1	8"x6"x1 1/4"	2x2 CLIP	8-F	1	8"x6"x1 1/4"
6-G	1	8"x6"x1 1/2"	N/A	4x4 CLIP	7-G	0	N/A	N/A	8-G	0	N/A

TABLE LEGEND
 NAME - 1-A
 BAY LOCATION (SEE SHEET 21/40)
 END CROSS FRAME GUSSET PLATE LOCATION (SEE DETAIL ABOVE)

- NOTES:**
- ALL PROPOSED STRUCTURAL STEEL SHALL BE A709 GRADE 50.
 - FOR ADDITIONAL NOTES AND DETAILS, SEE STD. DWG. GSD-1-96.


S:\Plans\23 11/16/2023 9:34:25 AM
 2017\01113\C.Design\104667.HAM-75-3.84.Design\Structures\HAM0074_1852C_Sheets\7.4_1852TS001.dgn

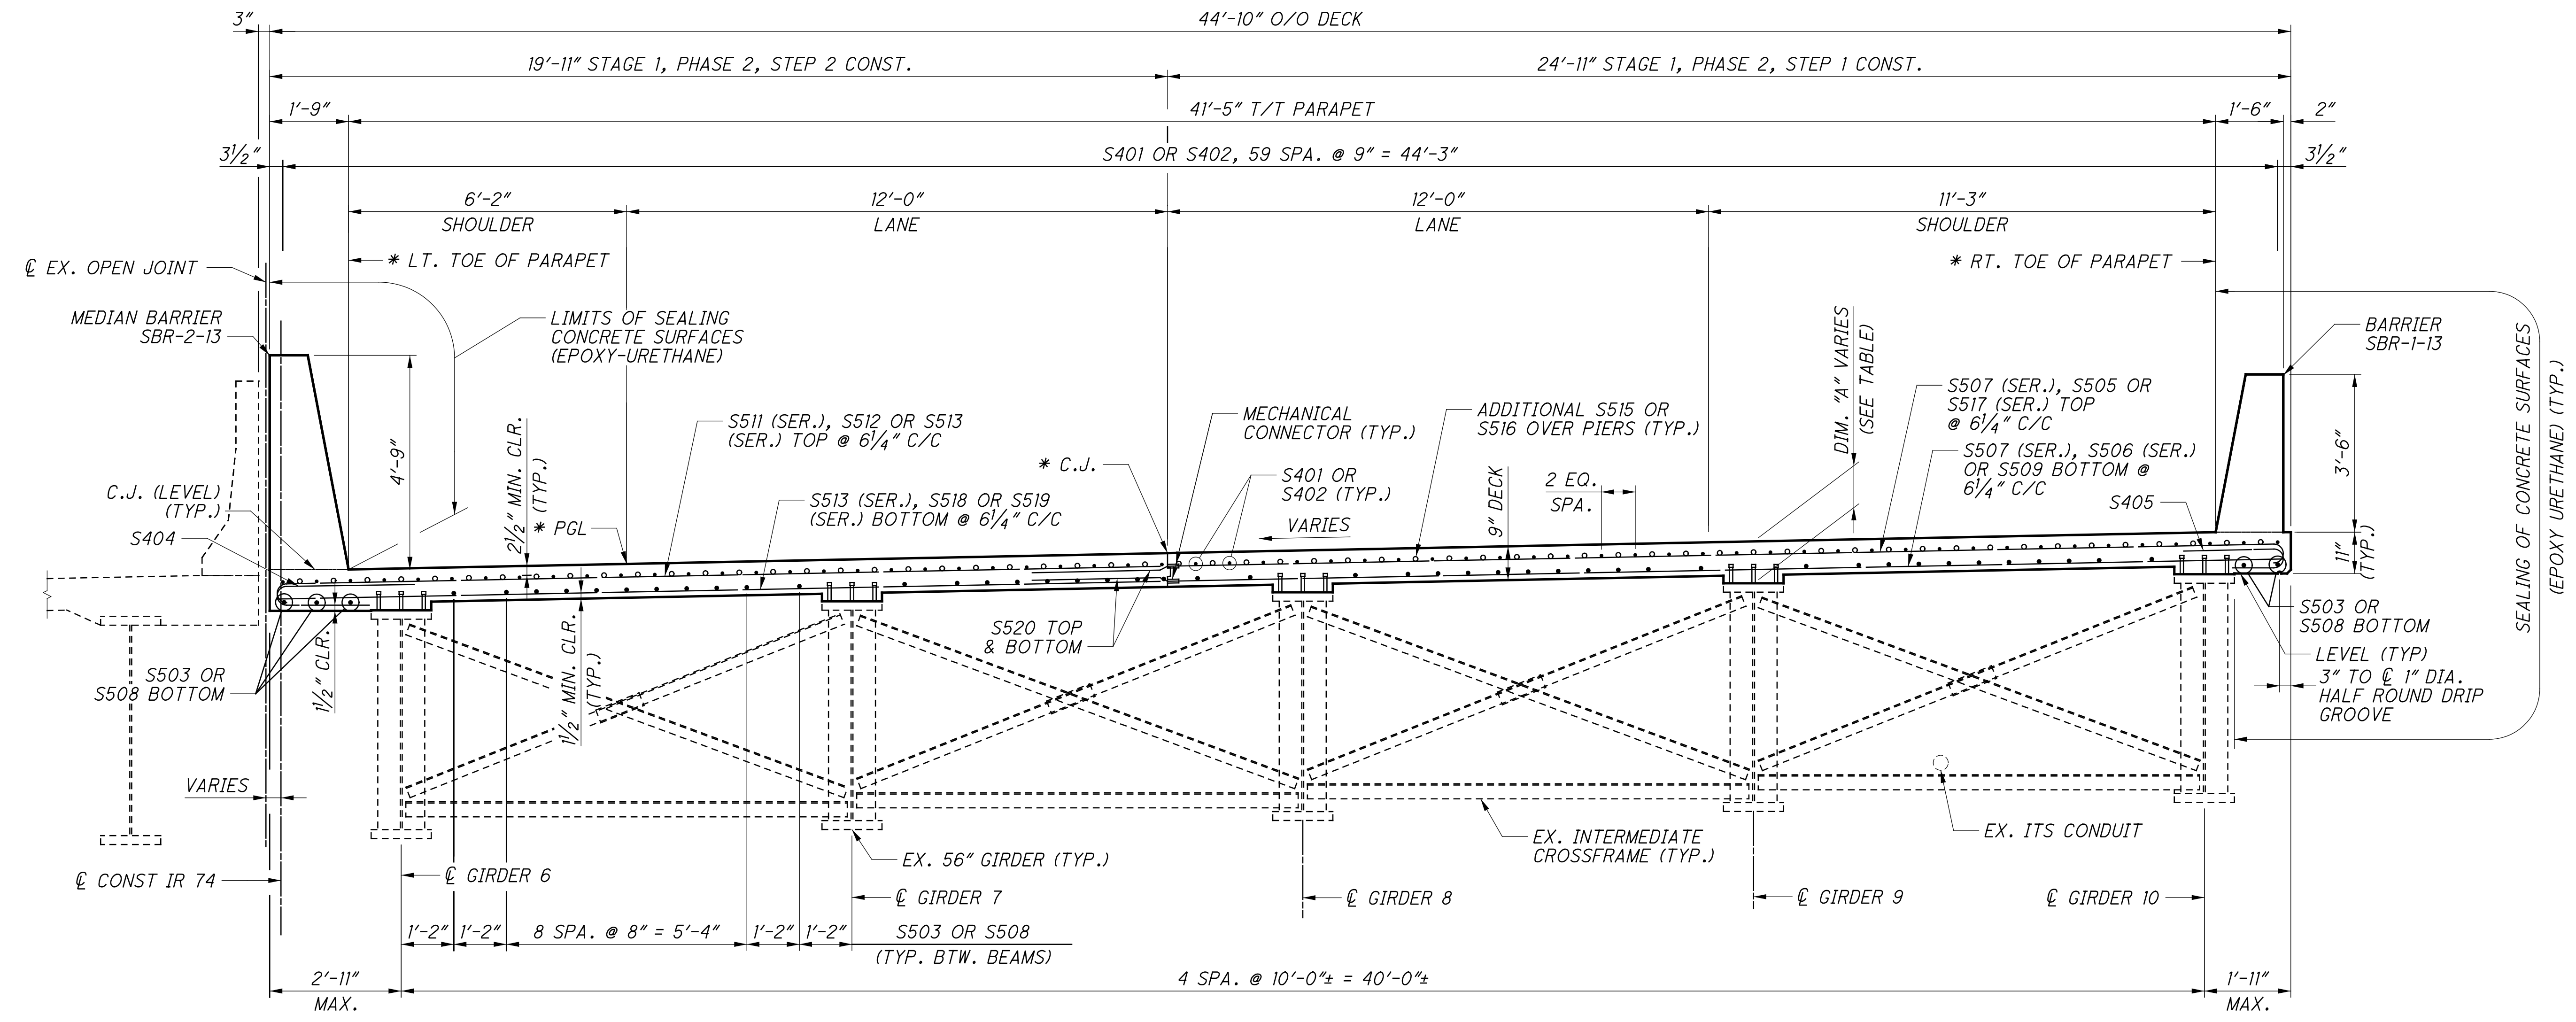


TRANSVERSE SECTION

CONSTRUCTION JOINT KEYWAY DETAIL

REFER TO CMS 511.12 FOR ADDITIONAL INFORMATION

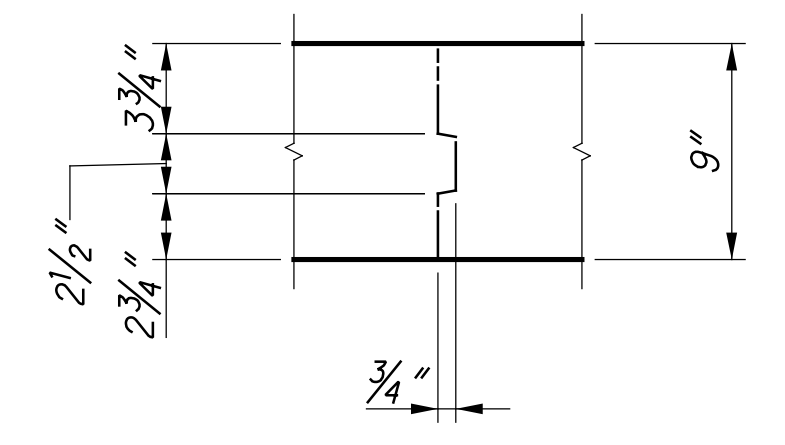

HAUNCH REINFORCING DETAIL

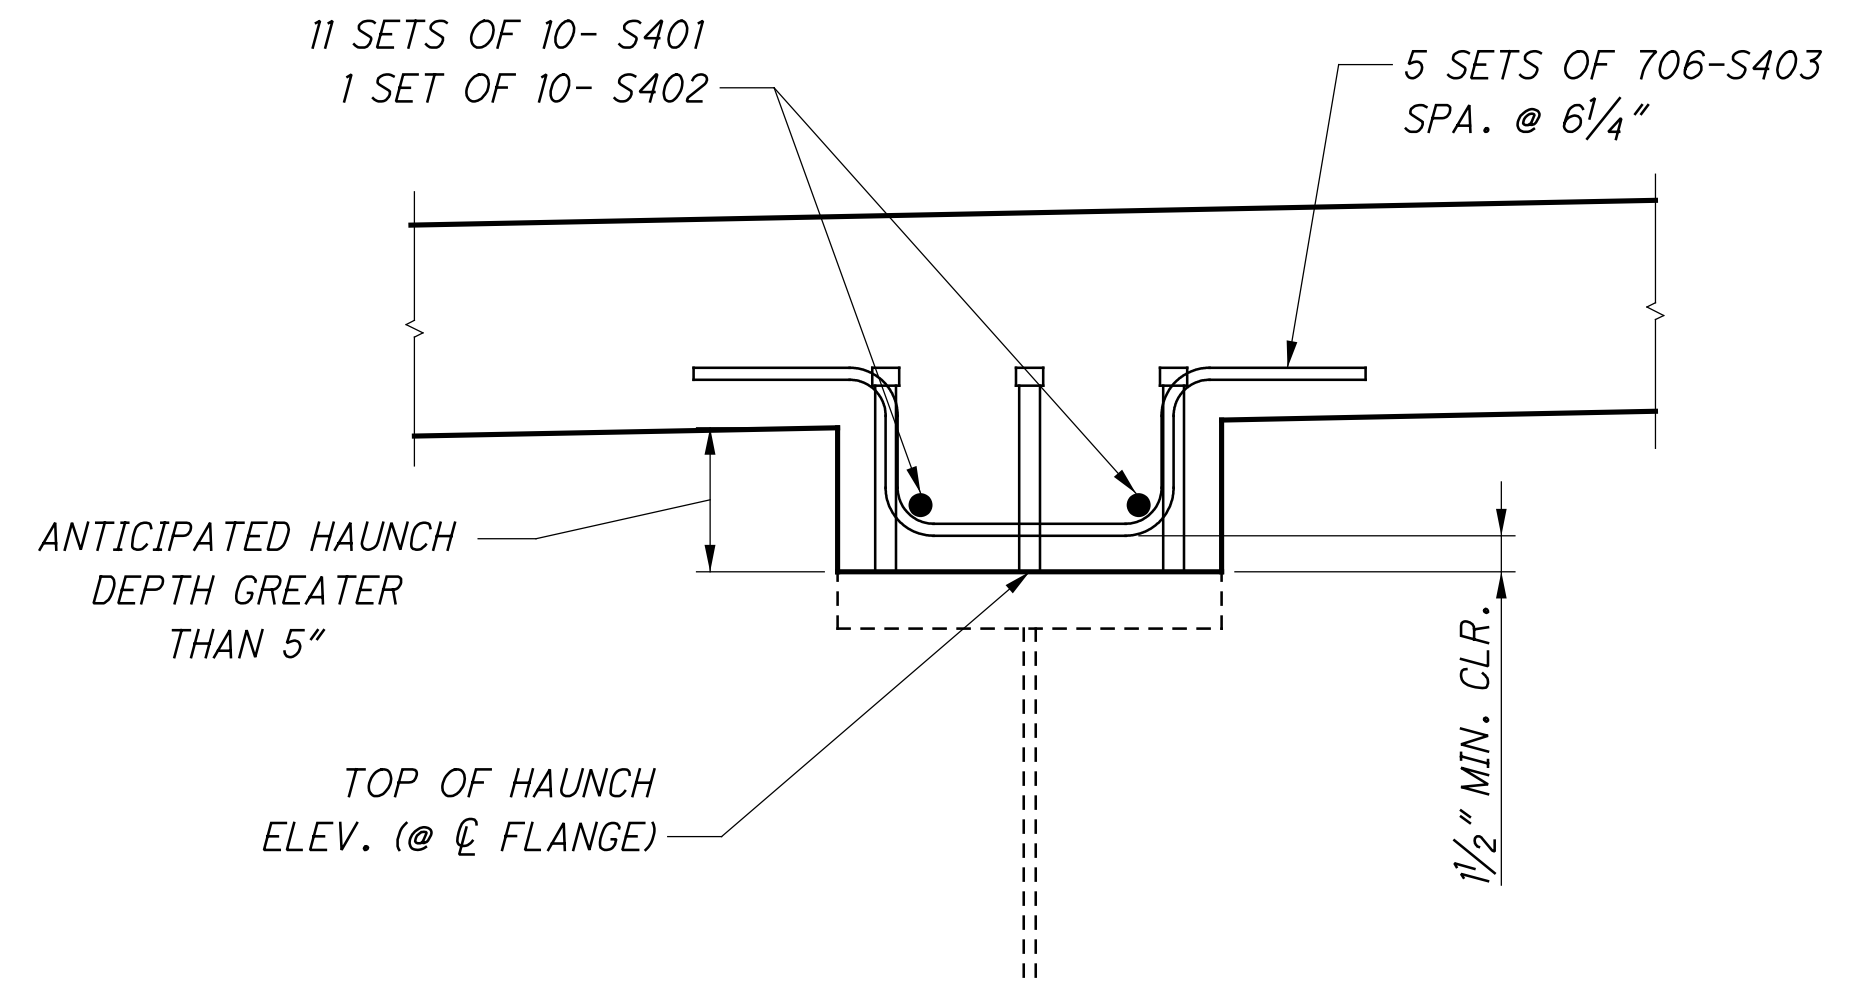


DIMENSION "A"				
(TOP OF SLAB TO TOP OF FLANGE)				
LOCATION	CL BRG. R.A.	CL BRG. PIER 1	CL BRG. PIER 2	CL BRG. F.A.
GIRDER 6	1'-2 1/8"	1'-0 7/16"	11 3/16"	1'-2 1/4"
GIRDER 7	1'-1 1/8"	1'-0 3/16"	11 3/4"	1'-2"
GIRDER 8	1'-2 3/16"	11 5/16"	11 3/16"	1'-2 5/16"
GIRDER 9	1'-2 7/8"	11 3/16"	11 3/16"	1'-2 9/16"
GIRDER 10	1'-3 3/16"	11 1/16"	11 3/16"	1'-3 1/16"

NOTES:


- FOR PARAPET DETAILS SEE SHEETS 28/40 AND 29/40.
- FOR SLAB REINFORCING PLAN SEE SHEET 25/40.
- HAUNCHES OVER 5 INCHES SHALL BE REINFORCED AS SHOWN ON THIS SHEET. HAUNCH STIRRUPS SHALL BE AT THE SAME SPACING AS THE TRANSVERSE DECK REINFORCING.
- * SCREED ELEVATION LOCATIONS.

DESIGN AGENCY: STRUCTUREPOINT
 DATE: 09/12/18
 REVIEWED: MDS
 DRAWN: TMT
 CHECKED: CLB
 DESIGNED: SUJ
 STRUCTURE FILE NUMBER: 3115577
 TRANSVERSE SECTION (RIGHT BRIDGE)
 BRIDGE NO. HAM-74-1852 L/R
 OVER NB BEEKMAN ST., (U.S. 27)
 HAM-75-3.84
 PID No. 104667
 24/40
 66
 120

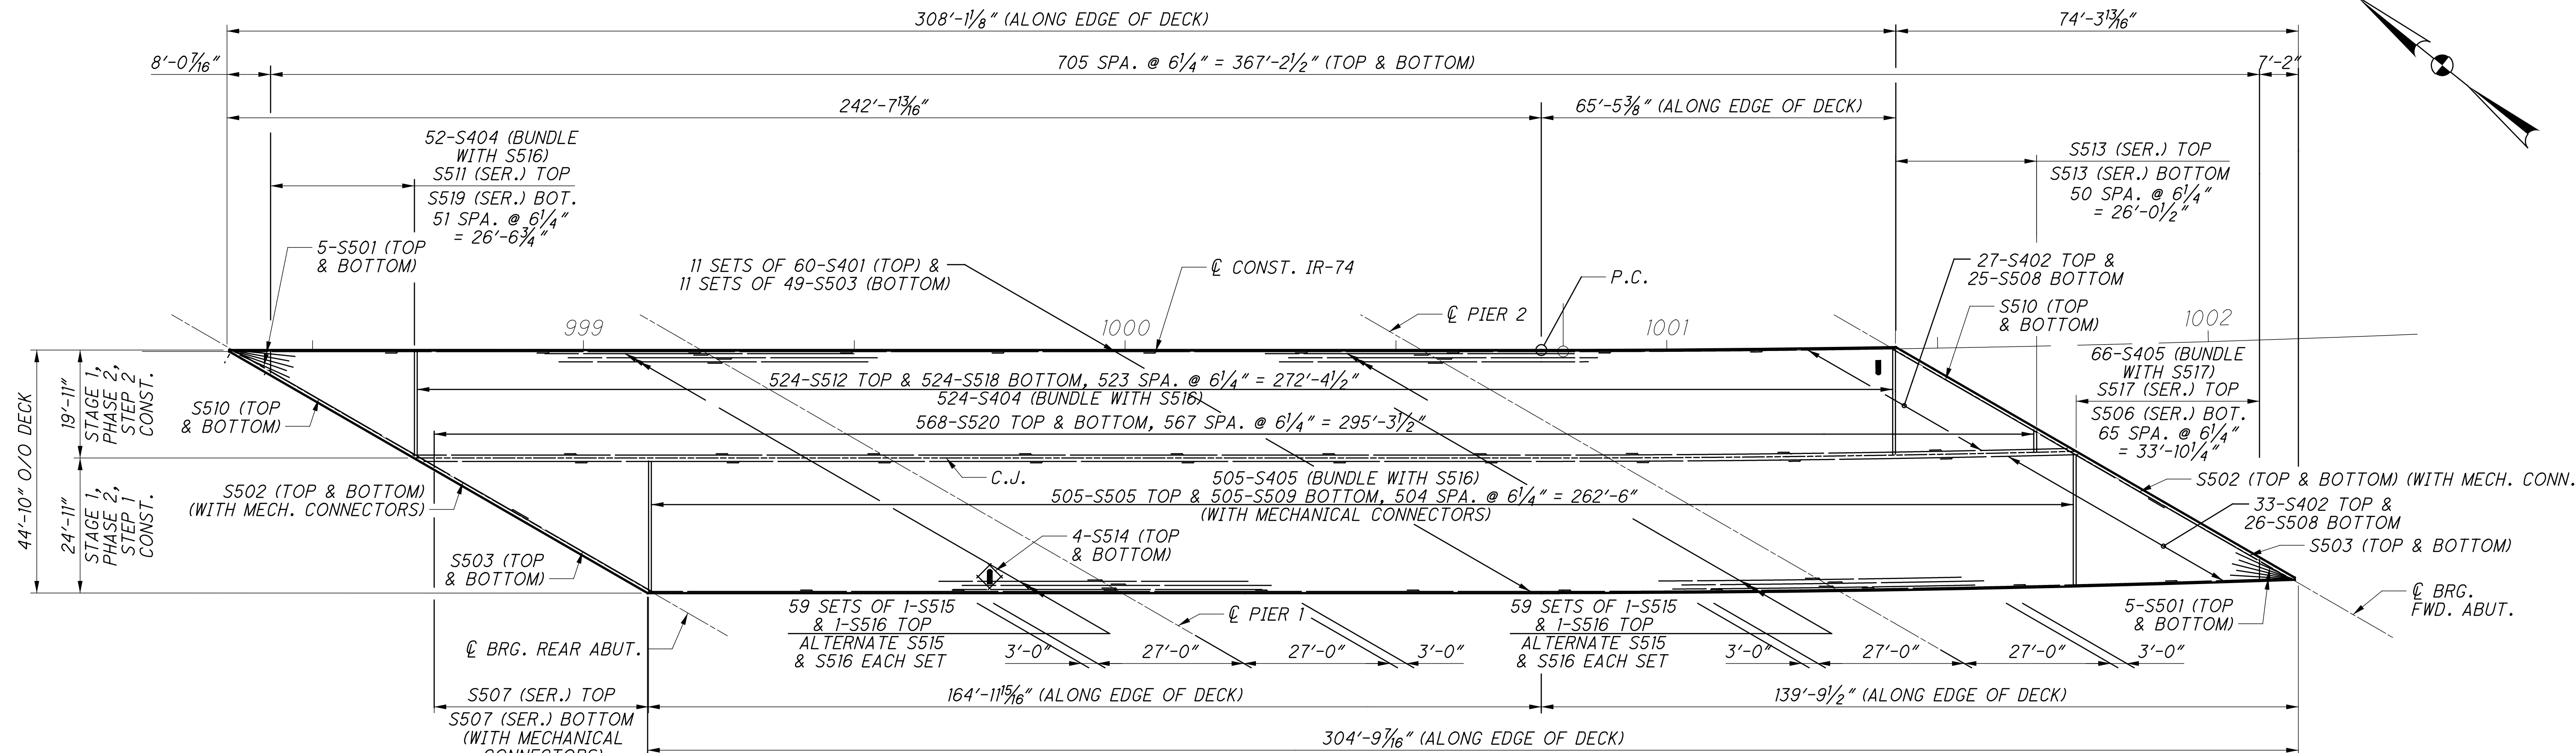


DECK REINFORCING PLAN


MINIMUM BAR LAP	
#4	2'-6"
#5 (LONGITUDINAL)	3'-1"
#5 (TRANSVERSE)	4'-0"

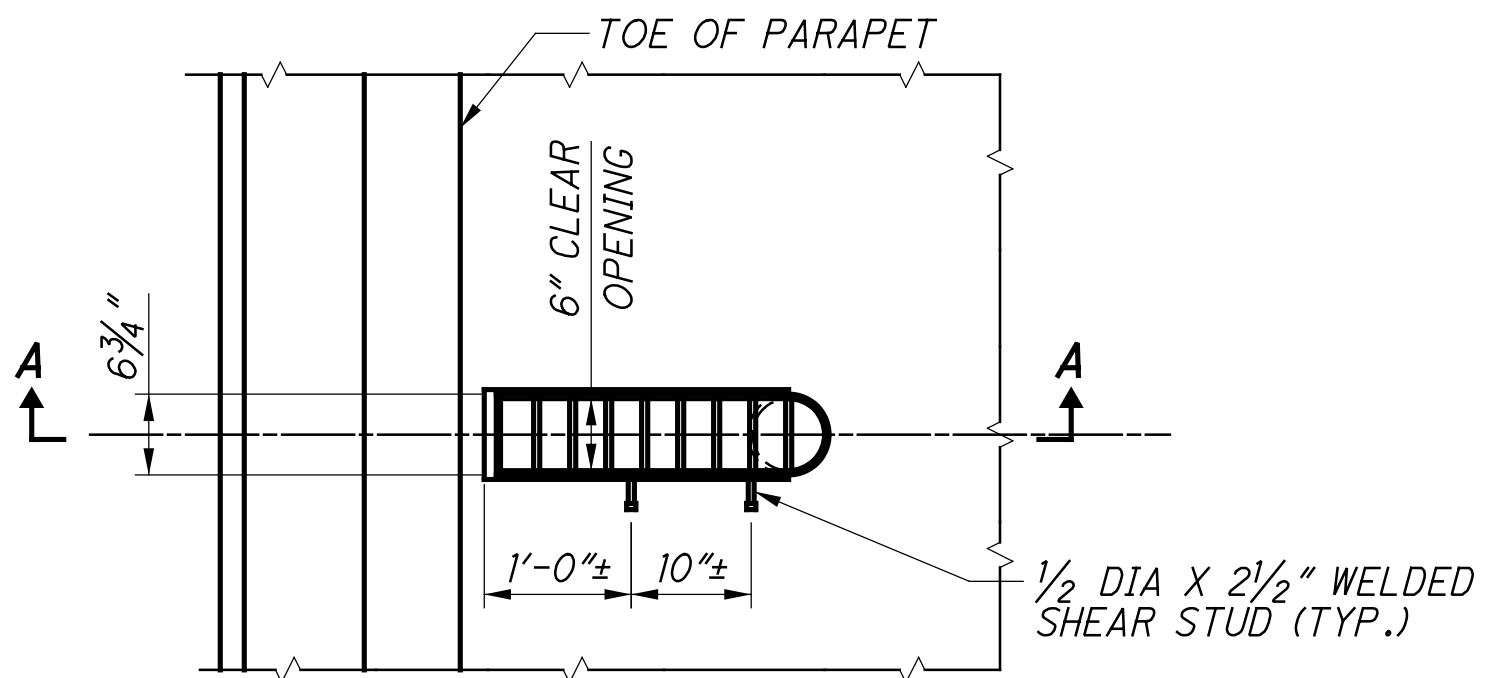


PLAN
SCUPPER NO. 1

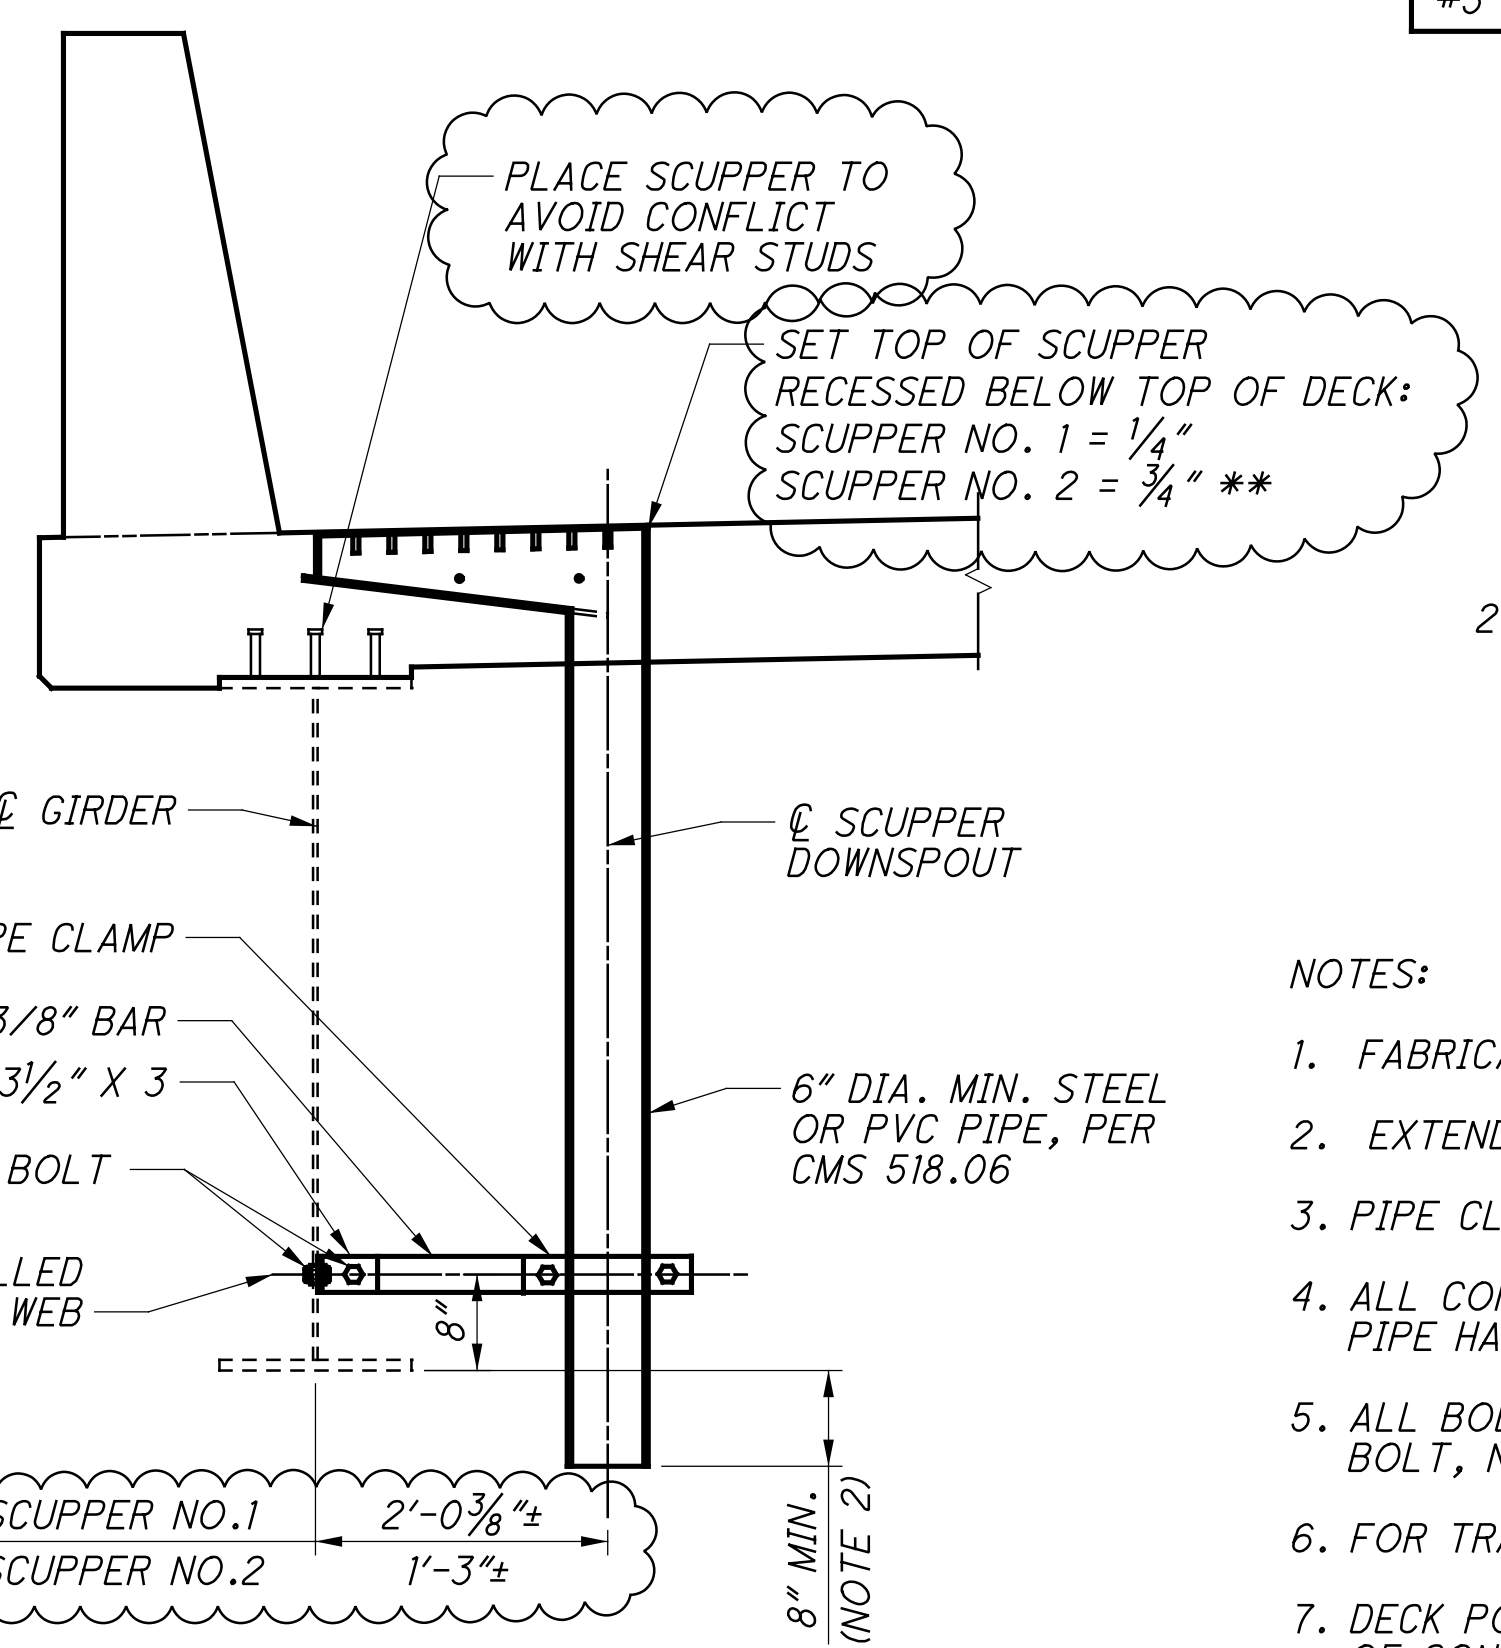

TYPICAL SECTION

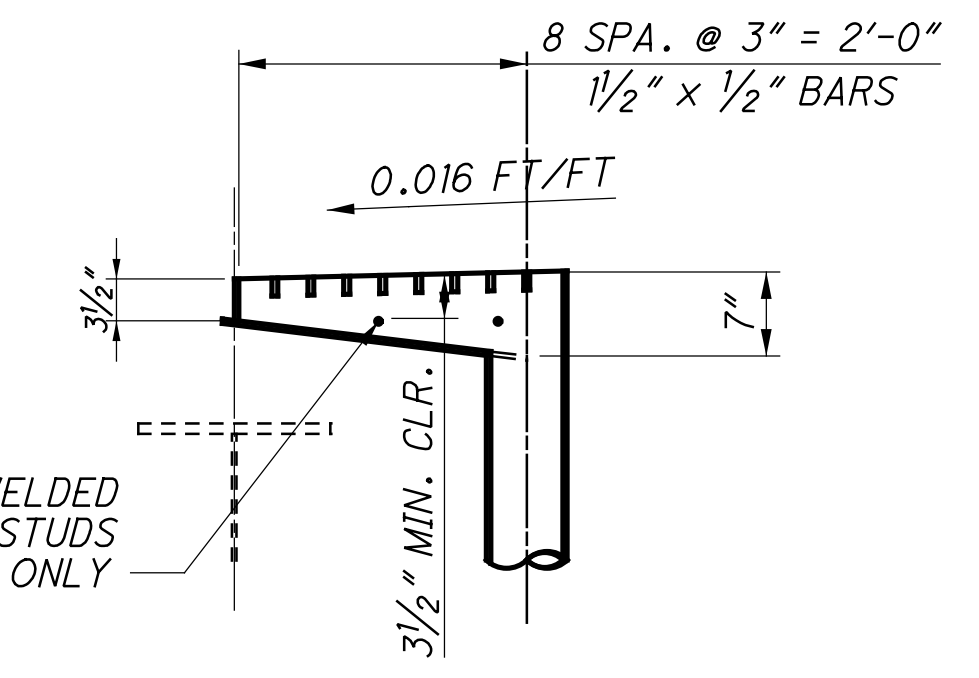

SECTION A-A

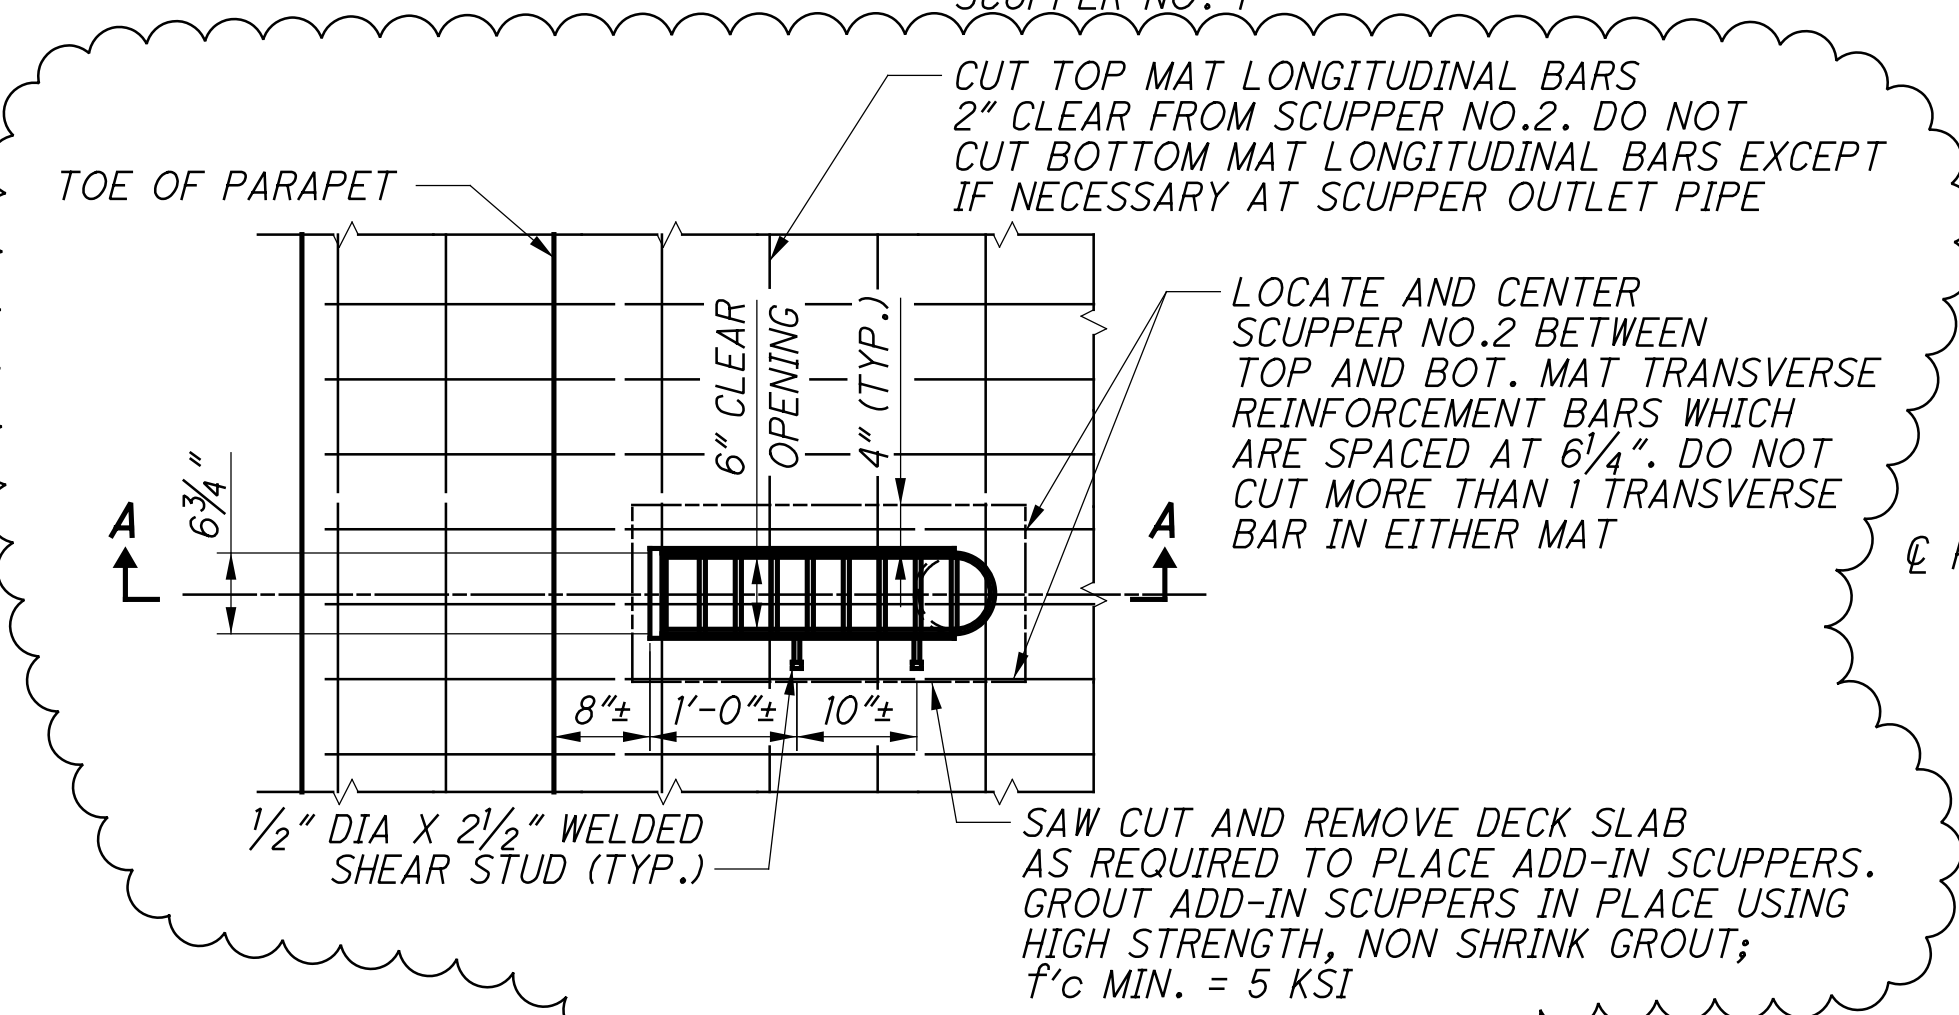

PLAN
SCUPPER NO. 2

SCUPPER DETAILS


(2) REQUIRED
** GRIND AS NEEDED TO DRAIN AND PROVIDE A MAXIMUM 6:1 SLOPE TO SCUPPER

NOTES:

- FABRICATE SCUPPERS FROM MIN. 3/8" THICK STEEL PLATE; ASTM A36 OR EQUAL.
- EXTEND DOWNDRAIN 8" MIN. BEYOND BOTTOM OF EXISTING GIRDER.
- PIPE CLAMPS SHALL BE EATON B-LINE SERIES B3140-8 OR APPROVED EQUAL.
- ALL COMPONENTS (ANGLES, BARS, CLAMPS, ANCHORS, BOLT COUPLERS, PIPE HANGERS, ETC.) SHALL BE GALVANIZED.
- ALL BOLTS SHALL BE A325, TYPE 1 GALVANIZED. EACH ASSEMBLY SHALL INCLUDE BOLT, NUT, AND TWO WASHERS. TIGHTEN ACCORDING TO CMS 513.
- FOR TRANSVERSE SECTION, SEE SHEET 24/40.
- DECK POUR SEQUENCE: CONTINUOUSLY POUR FROM ONE END TO OTHER IN EACH STEP OF CONSTRUCTION. TO AVOID UPLIFT AT THE ABUTMENT, HOLD DOWN OR COUNTER WEIGHT CAPABLE OF RESISTING 7K PER GIRDER SHALL BE UTILIZED.
- PRIOR TO REMOVING PORTIONS OF DECK TO INSTALL SCUPPER NO.2, VERIFY SCUPPER WILL NOT CONFLICT WITH EXISTING CROSSFRAMES.

SFlanagan 11/16/2023 9:34:26 AM 0:\2017\01113\C.Design\104667-HAM-75-3.84.Design\Structures\HAM0074-1852C\Sheets\74-1852DP001.dgn

DESIGN AGENCY: STRUCTUREPOINT
 DATE: 11/12/18
 REVIEWED: MDS
 DRAWN: DSH
 DESIGNED: SJF
 CHECKED: CLB
 STRUCTURE FILE NUMBER: 3115577
DECK PLAN (RIGHT BRIDGE)
 BRIDGE NO. HAM-74-1852 L/R
 OVER NB BEEKMAN ST. (U.S. 27)
HAM-75-3.84
 PID No. 104667
 25/40
 67
 120

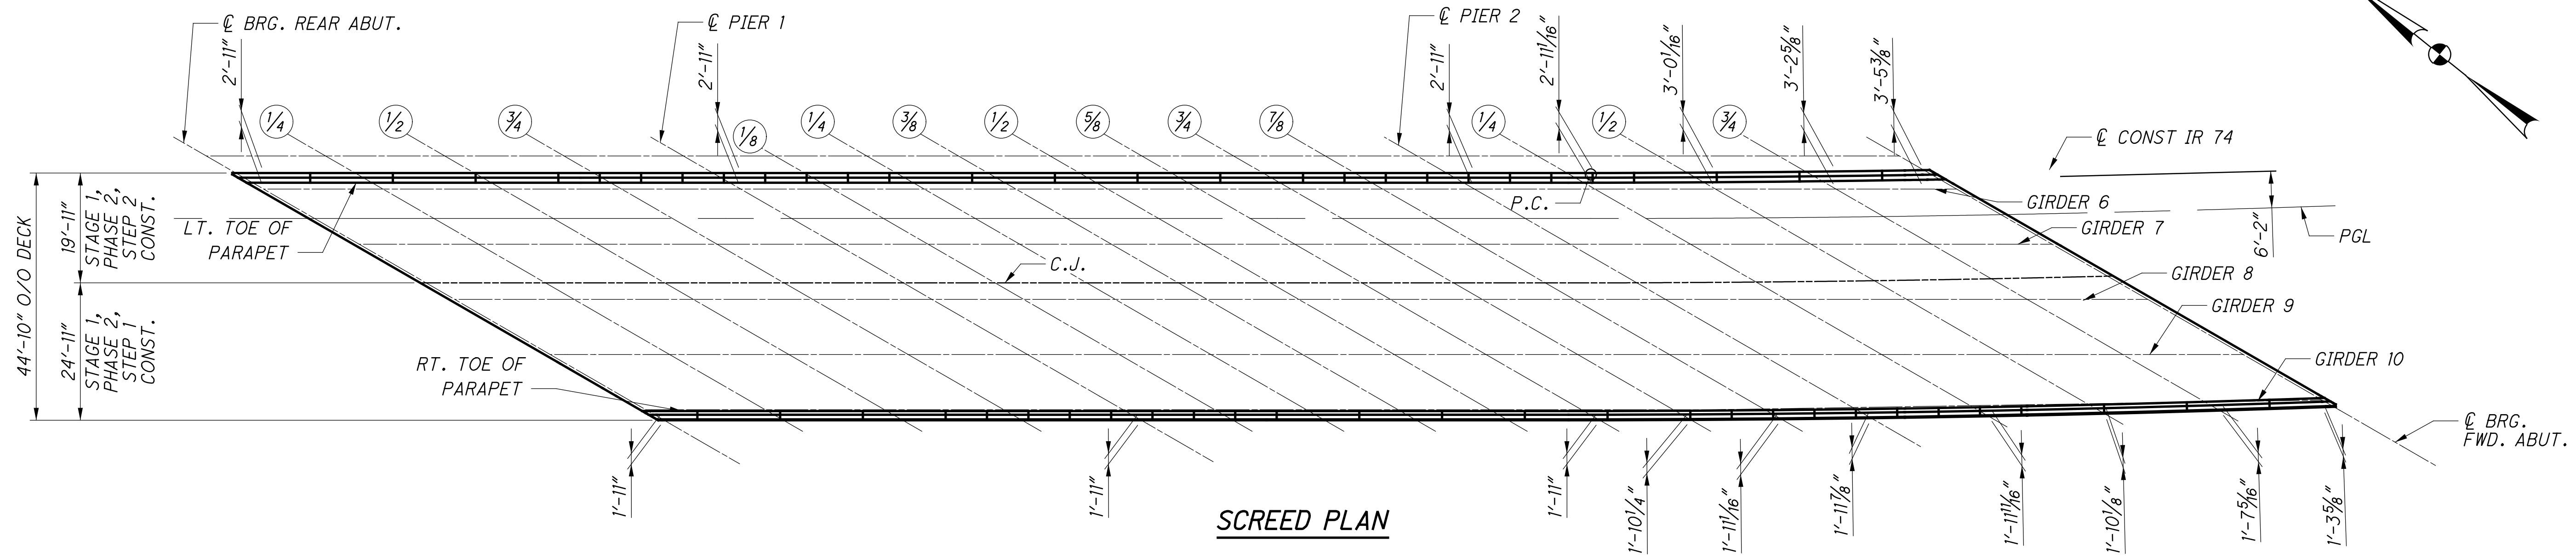

SCREED PLAN

- NOTES:
1. SCREED ELEVATIONS SHOWN REPRESENT THE THEORETICAL DECK SURFACE LOCATION PRIOR TO DEFLECTIONS CAUSED BY DECK PLACEMENT AND OTHER ANTICIPATED DEAD LOADS.
 2. FOR TOP OF HAUNCH (T.O.H.) ELEVATIONS TABLE, SEE SHEET 27/40.
 3. FINAL DECK SURFACE (F.D.S.) ELEVATIONS SHOWN REPRESENT THE DECK SURFACE LOCATION AFTER ALL ANTICIPATED DEAD LOAD DEFLECTIONS HAVE OCCURRED.

SCREED ELEVATIONS TABLE

DESCRIPTION	Ø BRG. REAR ABUT.	¼ POINT	½ POINT	¾ POINT	Ø PIER NO. 1	⅛ POINT	¼ POINT	⅜ POINT	½ POINT	⅝ POINT	¾ POINT	⅞ POINT	Ø PIER NO. 2	¼ POINT	½ POINT	¾ POINT	Ø BRG. FWD. ABUT.	
HAM-74-1852 SCREED ELEVATIONS																		
LT. TOE OF PARAPET	STATION	1.50	1.50	1.50	1.50	1.50	1.50	1.50	1.50	1.50	1.50	1.50	1.50	1.50	1.47	1.45	1.43	
	OFFSET	536.12	535.97	535.84	535.70	535.56	535.45	535.30	535.17	535.08	534.92	534.80	534.68	534.56	534.38	534.17	534.05	533.90
	F.D.S. ELEV.	0.00	0.03	0.04	0.01	0.00	0.02	0.06	0.10	0.12	0.11	0.08	0.04	0.00	-0.01	0.01	0.02	0.00
	DEFLECTION	536.12	536.01	535.87	535.71	535.56	535.47	535.36	535.27	535.20	535.03	534.88	534.72	534.56	534.37	534.18	534.07	533.90
	SCREED ELEV.	998+48.95	998+70.58	998+92.20	999+13.83	999+35.45	999+52.08	999+68.70	999+85.33	1000+01.95	1000+18.58	1000+35.20	1000+51.83	1000+68.45	1000+90.25	1001+11.83	1001+33.21	1001+54.40
PGL	STATION	7.66	7.66	7.66	7.66	7.66	7.66	7.66	7.66	7.66	7.66	7.66	7.66	7.66	7.65	7.63	7.59	
	OFFSET	536.00	535.82	535.66	535.54	535.38	535.27	535.15	535.05	534.92	534.82	534.70	534.60	534.48	534.32	534.14	534.04	533.92
	F.D.S. ELEV.	0.00	0.03	0.03	0.01	0.00	0.02	0.06	0.10	0.11	0.10	0.07	0.03	0.00	0.00	0.02	0.02	0.00
	DEFLECTION	536.00	535.85	535.69	535.54	535.38	535.29	535.21	535.15	535.03	534.93	534.78	534.63	534.48	534.32	534.16	534.06	533.92
	SCREED ELEV.	998+69.74	998+91.36	999+12.99	999+34.61	999+56.24	999+72.86	999+89.49	1000+06.11	1000+22.74	1000+39.36	1000+55.99	1000+72.61	1000+89.17	1001+10.69	1001+32.02	1001+53.15	1001+74.09
C.J.	STATION	19.66	19.66	19.66	19.66	19.66	19.66	19.66	19.66	19.66	19.66	19.66	19.66	19.65	19.63	19.61	19.57	
	OFFSET	536.14	535.74	535.34	535.70	535.32	535.00	535.43	534.98	535.04	534.72	534.77	534.58	535.00	534.54	534.45	534.36	534.14
	F.D.S. ELEV.	0.00	0.03	0.02	0.00	0.00	0.03	0.07	0.10	0.11	0.10	0.07	0.03	0.00	0.00	0.02	0.03	0.00
	DEFLECTION	536.14	535.77	535.37	535.70	535.32	535.03	535.50	535.08	535.15	534.82	534.84	534.60	535.00	534.53	534.47	534.38	534.14
	SCREED ELEV.	999+10.01	999+31.63	999+53.26	999+74.88	999+96.51	1000+13.13	1000+29.76	1000+46.38	1000+63.01	1000+79.64	1000+96.02	1001+12.26	1001+28.40	1001+49.44	1001+70.29	1001+90.96	1002+11.46
RT. TOE OF PARAPET	STATION	42.91	42.91	42.91	42.91	42.91	42.91	42.91	42.91	42.91	42.91	42.90	42.88	42.86	42.84	42.82	42.80	
	OFFSET	534.96	534.86	534.82	534.81	534.83	534.80	534.80	534.79	534.82	534.81	534.79	534.79	534.80	534.80	534.82	534.77	534.77
	F.D.S. ELEV.	0.00	0.02	0.01	-0.01	0.00	0.03	0.08	0.11	0.11	0.11	0.09	0.06	0.02	0.00	0.01	0.03	0.03
	DEFLECTION	534.96	534.88	534.83	534.80	534.83	534.83	534.87	534.90	534.93	534.90	534.85	534.81	534.80	534.80	534.85	534.80	534.77
	SCREED ELEV.	534.99	534.86	534.73	534.73	534.76	534.81	534.86	534.90	534.91	534.90	534.87	534.84	534.83	534.85	534.88	534.89	534.79

SFlanagan 11/16/2023 9:34:31 AM C:\2017\01113\C.Design\104667-HAM-75-3.84.Design\Structures\HAM0074-1852C\Sheets\74-1852SD004.dgn

DESIGN AGENCY: STRUCTUREPOINT
 DATE: 11/12/18
 REVIEWED: MDS
 DRAWN: BNM
 DESIGNED: SUJ
 CHECKED: CLB
 STRUCTURE FILE NUMBER: 3115577
 SCREED PLAN (RIGHT BRIDGE)
 BRIDGE NO. HAM-74-1852 L/R
 OVER NB BEEKMAN ST. (U.S. 27)
 HAM-75-3.84
 PID No. 104667
 26/40
 68
 120

HAUNCH ELEVATIONS TABLE

SCREED LINE	DESCRIPTION	℄ BRG. REAR ABUT.	¼ POINT	½ POINT	¾ POINT	℄ PIER NO. 1	⅙ POINT	¼ POINT	⅓ POINT	½ POINT	⅔ POINT	¾ POINT	⅞ POINT	℄ PIER NO. 2	¼ POINT	½ POINT	¾ POINT	℄ BRG. FWD. ABUT.
		HAM-74-1852 TOP OF HAUNCH ELEVATIONS																
GIRDER 6	STATION	998+40.29	998+61.92	998+83.54	999+05.17	999+26.79	999+43.42	999+60.04	999+76.67	999+93.29	1000+09.92	1000+26.54	1000+43.17	1000+59.79	1000+81.65	1001+03.49	1001+25.33	1001+47.16
	OFFSET	2.66	2.66	2.66	2.66	2.66	2.66	2.66	2.66	2.66	2.66	2.66	2.66	2.66	2.66	2.73	2.92	3.23
	F.D.S. ELEV.	536.10	535.97	535.84	535.70	535.56	535.45	535.30	535.17	535.08	534.92	534.80	534.68	534.56	534.38	534.17	534.05	533.89
	DEFLECTION	0.00	0.03	0.04	0.01	0.00	0.02	0.06	0.10	0.12	0.11	0.08	0.04	0.00	-0.01	0.01	0.02	0.00
GIRDER 7	STATION	998+57.61	998+79.24	999+00.86	999+22.49	999+44.11	999+60.74	999+77.36	999+93.99	1000+10.61	1000+27.24	1000+43.86	1000+60.49	1000+77.11	1000+98.91	1001+20.70	1001+42.47	1001+64.25
	OFFSET	12.66	12.66	12.66	12.66	12.66	12.66	12.66	12.66	12.66	12.66	12.66	12.66	12.66	12.71	12.87	13.15	13.56
	F.D.S. ELEV.	535.82	535.69	535.54	535.38	535.26	535.14	535.05	534.95	534.87	534.76	534.66	534.57	534.49	534.36	534.21	534.10	533.98
	DEFLECTION	0.00	0.03	0.03	0.01	0.00	0.02	0.06	0.10	0.11	0.10	0.07	0.03	0.00	0.00	0.02	0.02	0.00
GIRDER 8	STATION	998+74.94	998+96.56	999+18.19	999+39.81	999+61.44	999+78.06	999+94.69	1000+11.31	1000+27.94	1000+44.56	1000+61.19	1000+77.81	1000+94.10	1001+16.09	1001+37.81	1001+59.53	1001+81.25
	OFFSET	22.66	22.66	22.66	22.66	22.66	22.66	22.66	22.66	22.66	22.66	22.66	22.66	22.69	22.82	23.08	23.46	23.96
	F.D.S. ELEV.	535.52	535.38	535.24	535.12	535.02	534.94	534.87	534.84	534.79	534.71	534.65	534.59	534.53	534.47	534.36	534.29	534.23
	DEFLECTION	0.00	0.03	0.02	0.00	0.00	0.03	0.07	0.10	0.11	0.10	0.07	0.03	0.00	0.00	0.02	0.03	0.00
GIRDER 9	STATION	998+92.26	999+13.88	999+35.51	999+57.13	999+78.76	999+95.38	1000+12.01	1000+28.63	1000+45.26	1000+61.88	1000+78.51	1000+95.02	1001+11.50	1001+33.17	1001+54.84	1001+76.50	1001+98.16
	OFFSET	32.66	32.66	32.66	32.66	32.66	32.66	32.66	32.66	32.66	32.66	32.66	32.69	32.79	33.02	33.37	33.84	34.44
	F.D.S. ELEV.	535.28	535.14	535.03	534.96	534.92	534.84	534.84	534.83	534.81	534.75	534.74	534.72	534.77	534.66	534.61	534.57	534.57
	DEFLECTION	0.00	0.02	0.01	0.00	0.00	0.03	0.07	0.10	0.11	0.09	0.06	0.02	0.00	0.01	0.03	0.03	0.00
GIRDER 10	STATION	999+09.58	999+31.20	999+52.83	999+74.45	999+96.08	1000+12.70	1000+29.33	1000+45.95	1000+62.58	1000+79.21	1000+95.67	1001+11.87	1001+27.88	1001+48.92	1001+69.96	1001+91.00	1002+12.04
	OFFSET	42.66	42.66	42.66	42.66	42.66	42.66	42.66	42.66	42.66	42.66	42.69	42.64	42.55	42.53	42.62	42.82	43.14
	F.D.S. ELEV.	534.01	534.86	534.82	534.81	534.83	534.80	534.80	534.79	534.82	534.81	534.79	534.79	534.79	534.80	534.82	534.77	534.71
	DEFLECTION	0.00	0.02	0.01	-0.01	0.00	0.03	0.08	0.11	0.11	0.09	0.06	0.02	0.00	0.01	0.03	0.03	0.00
GIRDER 10	STATION	999+09.58	999+31.20	999+52.83	999+74.45	999+96.08	1000+12.70	1000+29.33	1000+45.95	1000+62.58	1000+79.21	1000+95.67	1001+11.87	1001+27.88	1001+48.92	1001+69.96	1001+91.00	1002+12.04
	OFFSET	42.66	42.66	42.66	42.66	42.66	42.66	42.66	42.66	42.66	42.66	42.69	42.64	42.55	42.53	42.62	42.82	43.14
	F.D.S. ELEV.	534.01	534.86	534.82	534.81	534.83	534.80	534.80	534.79	534.82	534.81	534.79	534.79	534.79	534.80	534.82	534.77	534.71
	DEFLECTION	0.00	0.02	0.01	-0.01	0.00	0.03	0.08	0.11	0.11	0.09	0.06	0.02	0.00	0.01	0.03	0.03	0.00
SCREED PLAN (RIGHT BRIDGE)
 BRIDGE NO. HAM-74-1852 L/R
 OVER NB BEEKMAN ST. (U.S. 27)

HAM-75-3.84
 PID No. 104667

27/40


69
120

DESIGN AGENCY: STRUCTUREPOINT
 DATE: 11/12/18
 REVIEWED: MDS
 DRAWN: BNM
 DESIGNED: SJF
 CHECKED: CLB
 STRUCTURE FILE NUMBER: 3115577


- NOTES:
- FOR SCREED LINE LOCATIONS AND ELEVATIONS TABLE, SEE SHEET 26/40.
 - TOP OF HAUNCH (T.O.H.) ELEVATIONS SHOWN REPRESENT THE THEORETICAL LOCATION OF THE BOTTOM OF THE DECK ABOVE THE GIRDER HAUNCH PRIOR TO DEFLECTIONS CAUSED BY DECK PLACEMENT AND OTHER ANTICIPATED DEAD LOADS.
 - FINAL DECK SURFACE (F.D.S.) ELEVATIONS SHOWN REPRESENT THE DECK SURFACE LOCATION AFTER ALL ANTICIPATED DEAD LOAD DEFLECTIONS HAVE OCCURRED.

S:\pians\11/16/2023 9:34:37 AM
 O:\2017\01113 C. Design\104667_HAM-75-3.84\Design\Structures_HAM0074_1852C_Sheets\74_1852SD005.dgn

SFlanagan
11/16/2023 9:34:37 AM
\\0\2017\01113\C.Design\104667-HAM-75-3.84\Design\Structures\HAM0074_1852C\Sheets\74_1852RA001.dgn

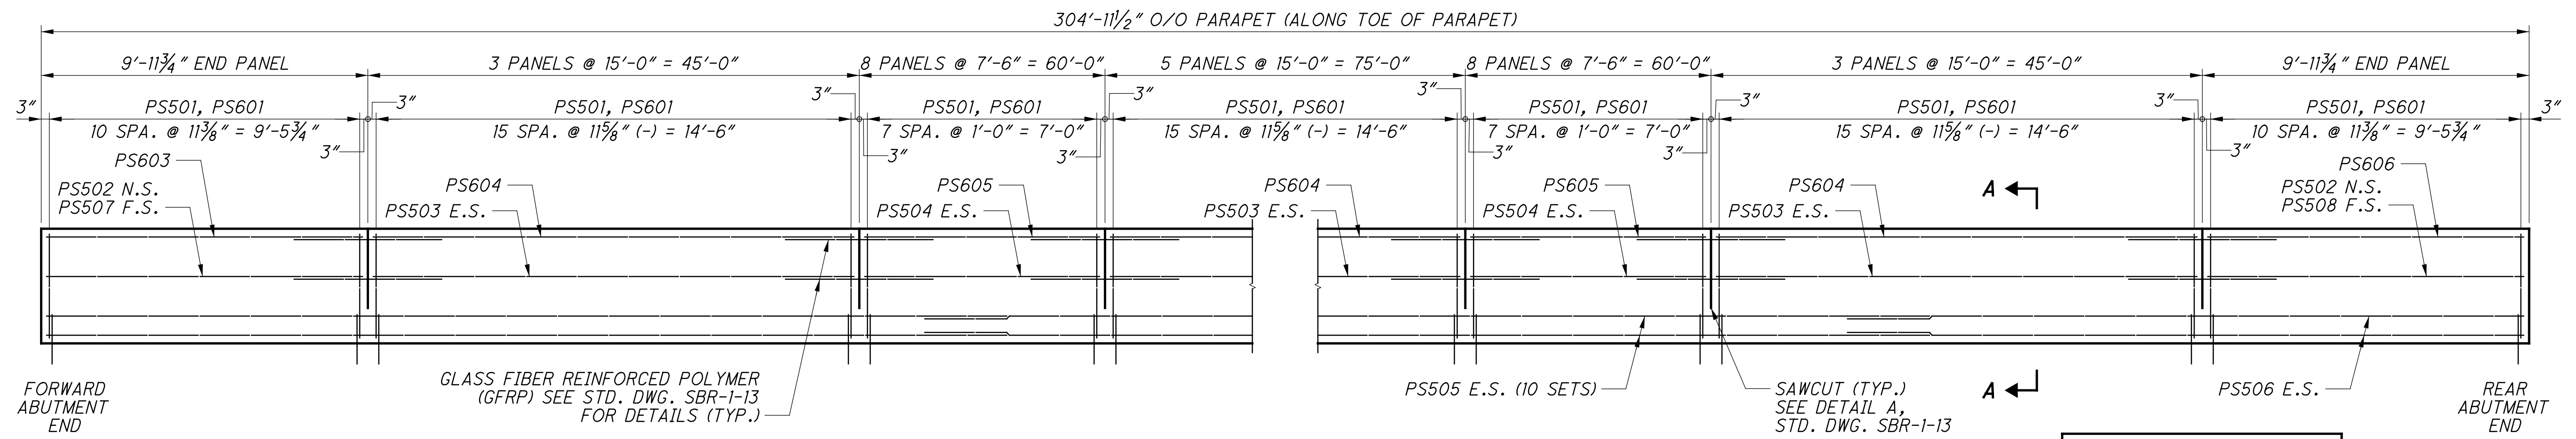


PARAPET ELEVATION
RIGHT PARAPET SHOWN (ALONG TOE OF PARAPET)

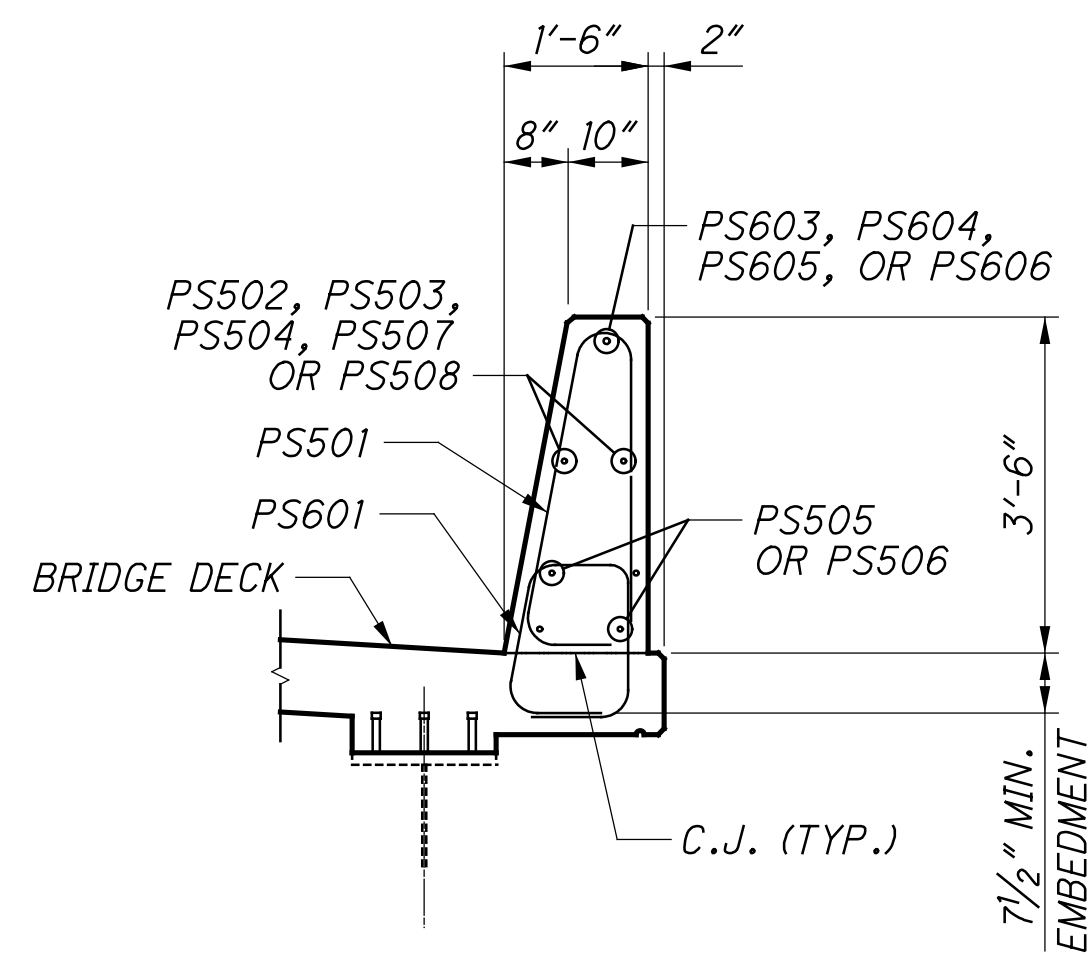

NOTES:
1. SEE STANDARD BRIDGE DRAWING SBR-1-13 FOR ADDITIONAL DETAILS.


	DESIGN AGENCY STRUCTUREPOINT 2000 CORPORATE CENTER DR., 4TH FL. ANN ARBOR, MI 48106 TEL: 734.939.3300 FAX: 734.939.3300 WWW.STRUCTUREPOINT.COM
DATE 11/12/18	STRUCTURE FILE NUMBER 3115577
REVIEWED MDS	DRAWN DSH
DESIGNED SUF	CHECKED CLB
PARAPET DETAILS (RIGHT BRIDGE) BRIDGE NO. HAM-74-1852 L/R OVER NB BEEKMAN ST. (U.S. 27)	
HAM-75-3.84 PID No. 104667	
28 / 40	
<div style="border: 1px solid black; border-radius: 50%; width: 30px; height: 30px; display: flex; align-items: center; justify-content: center; margin: 0 auto;"> 70 120 </div>	

SFlanagan
 11/16/2023 9:34:38 AM
 \\0\2017\01113\C.Design\104667-HAM-75-3.84\Design\Structures\HAM0074_1852C\Sheets\74_1852RA002.dgn

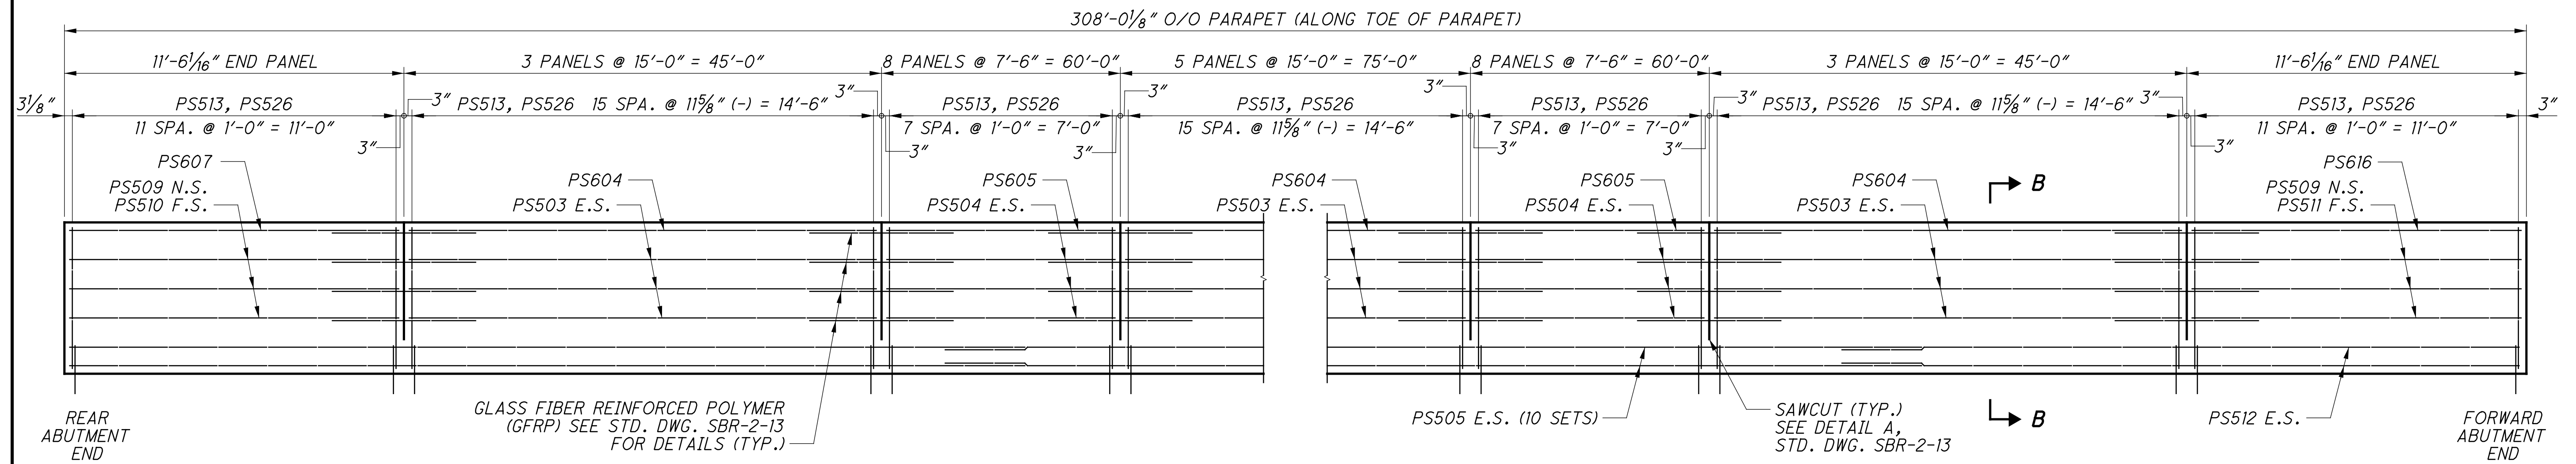

PARAPET ELEVATION
 LEFT PARAPET SHOWN (ALONG TOE OF PARAPET)

MINIMUM BAR LAP	
#5	2'-7"

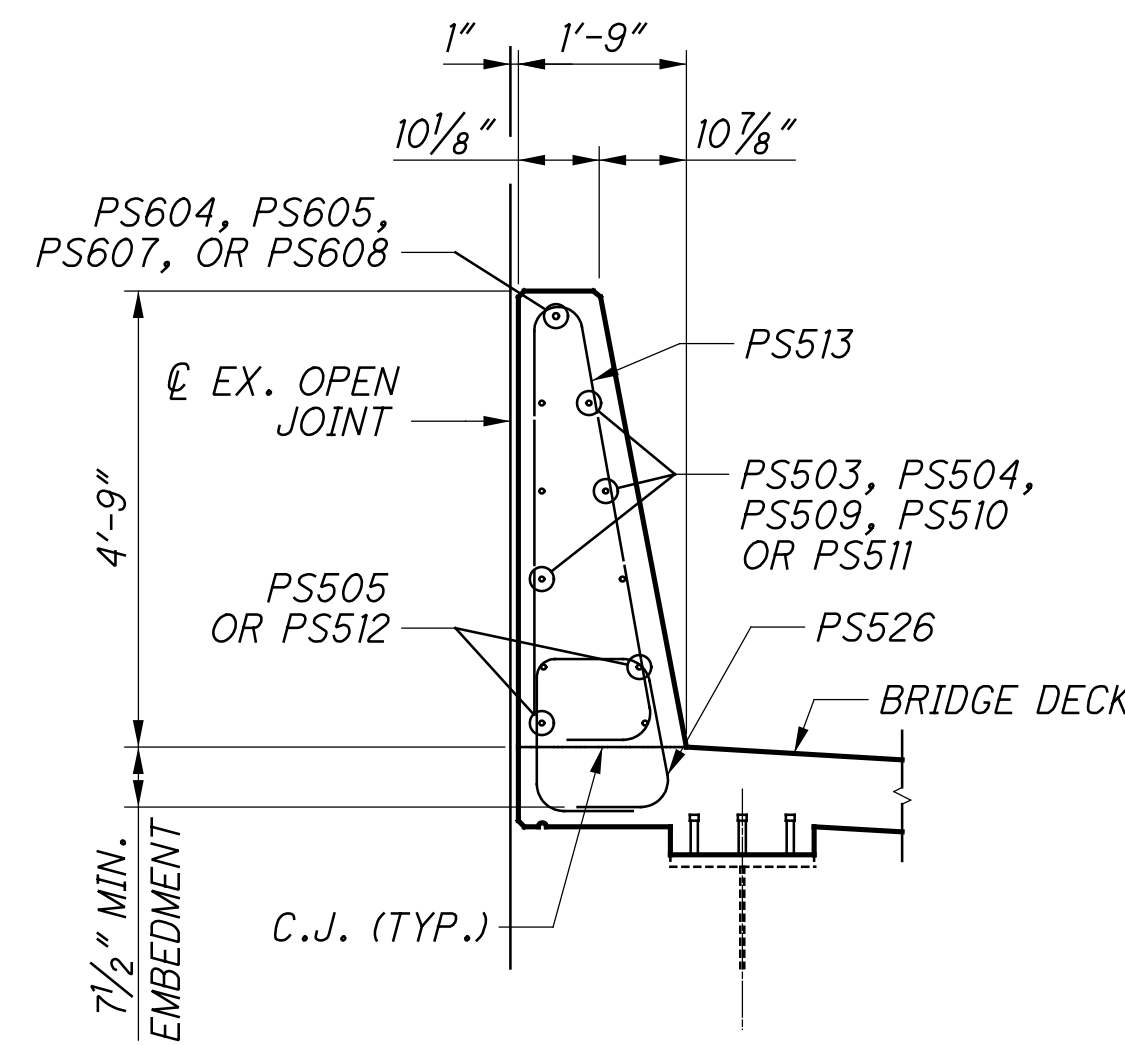


SECTION B-B


NOTES:

- SEE STANDARD BRIDGE DRAWING SBR-2-13 FOR ADDITIONAL DETAILS.


SFlanagan
 11/16/2023 9:34:38 AM
 \\0\2017\01113\C.Design\104667-HAM-75-3.84\Design\Structures\HAM0074_1852C\Sheets\74_1852RA003.dgn

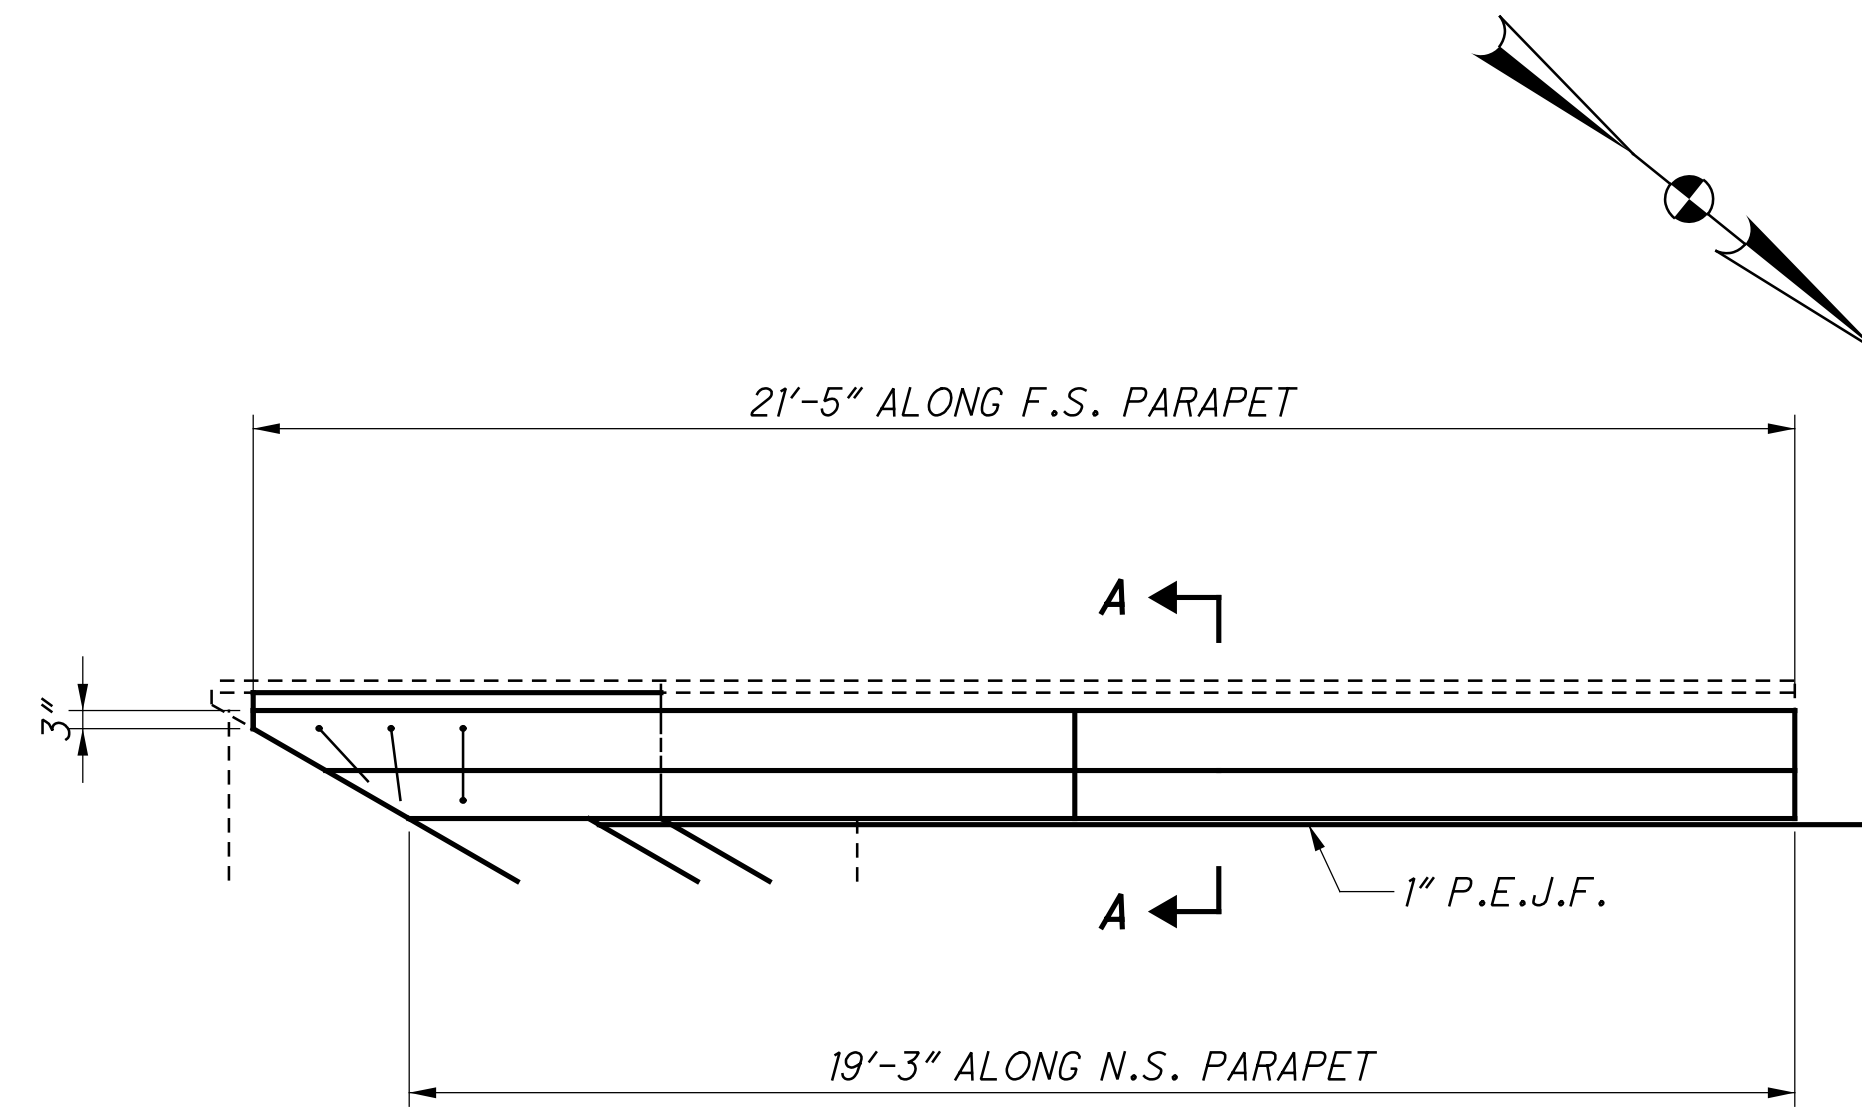


PARAPET PLAN
 AT SOUTH WINGWALL REAR ABUTMENT

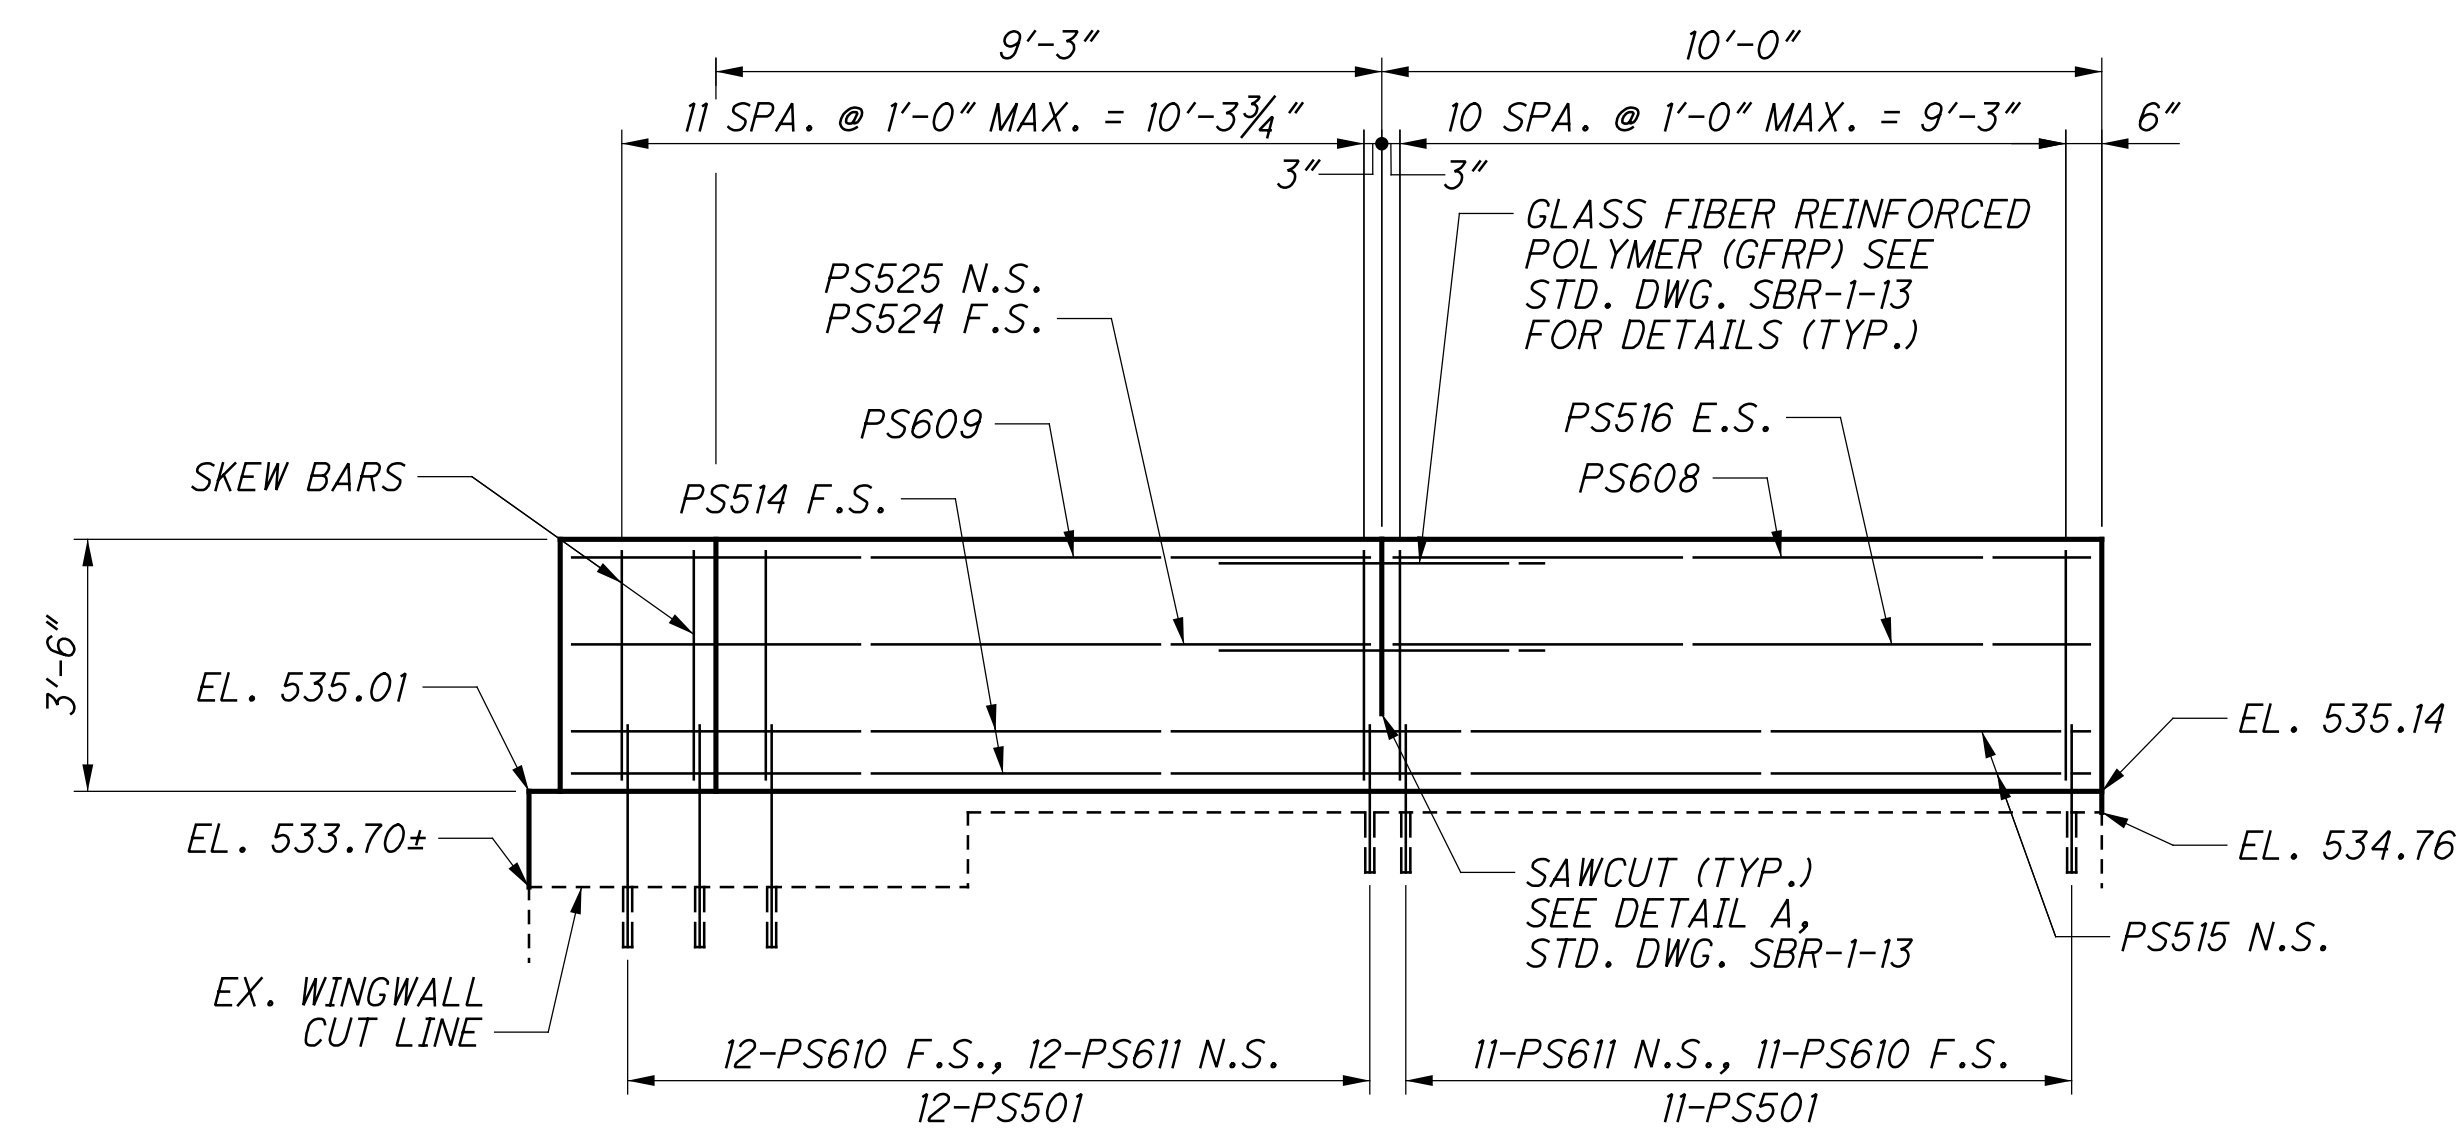

PARAPET ELEVATION
 AT SOUTH WINGWALL REAR ABUTMENT

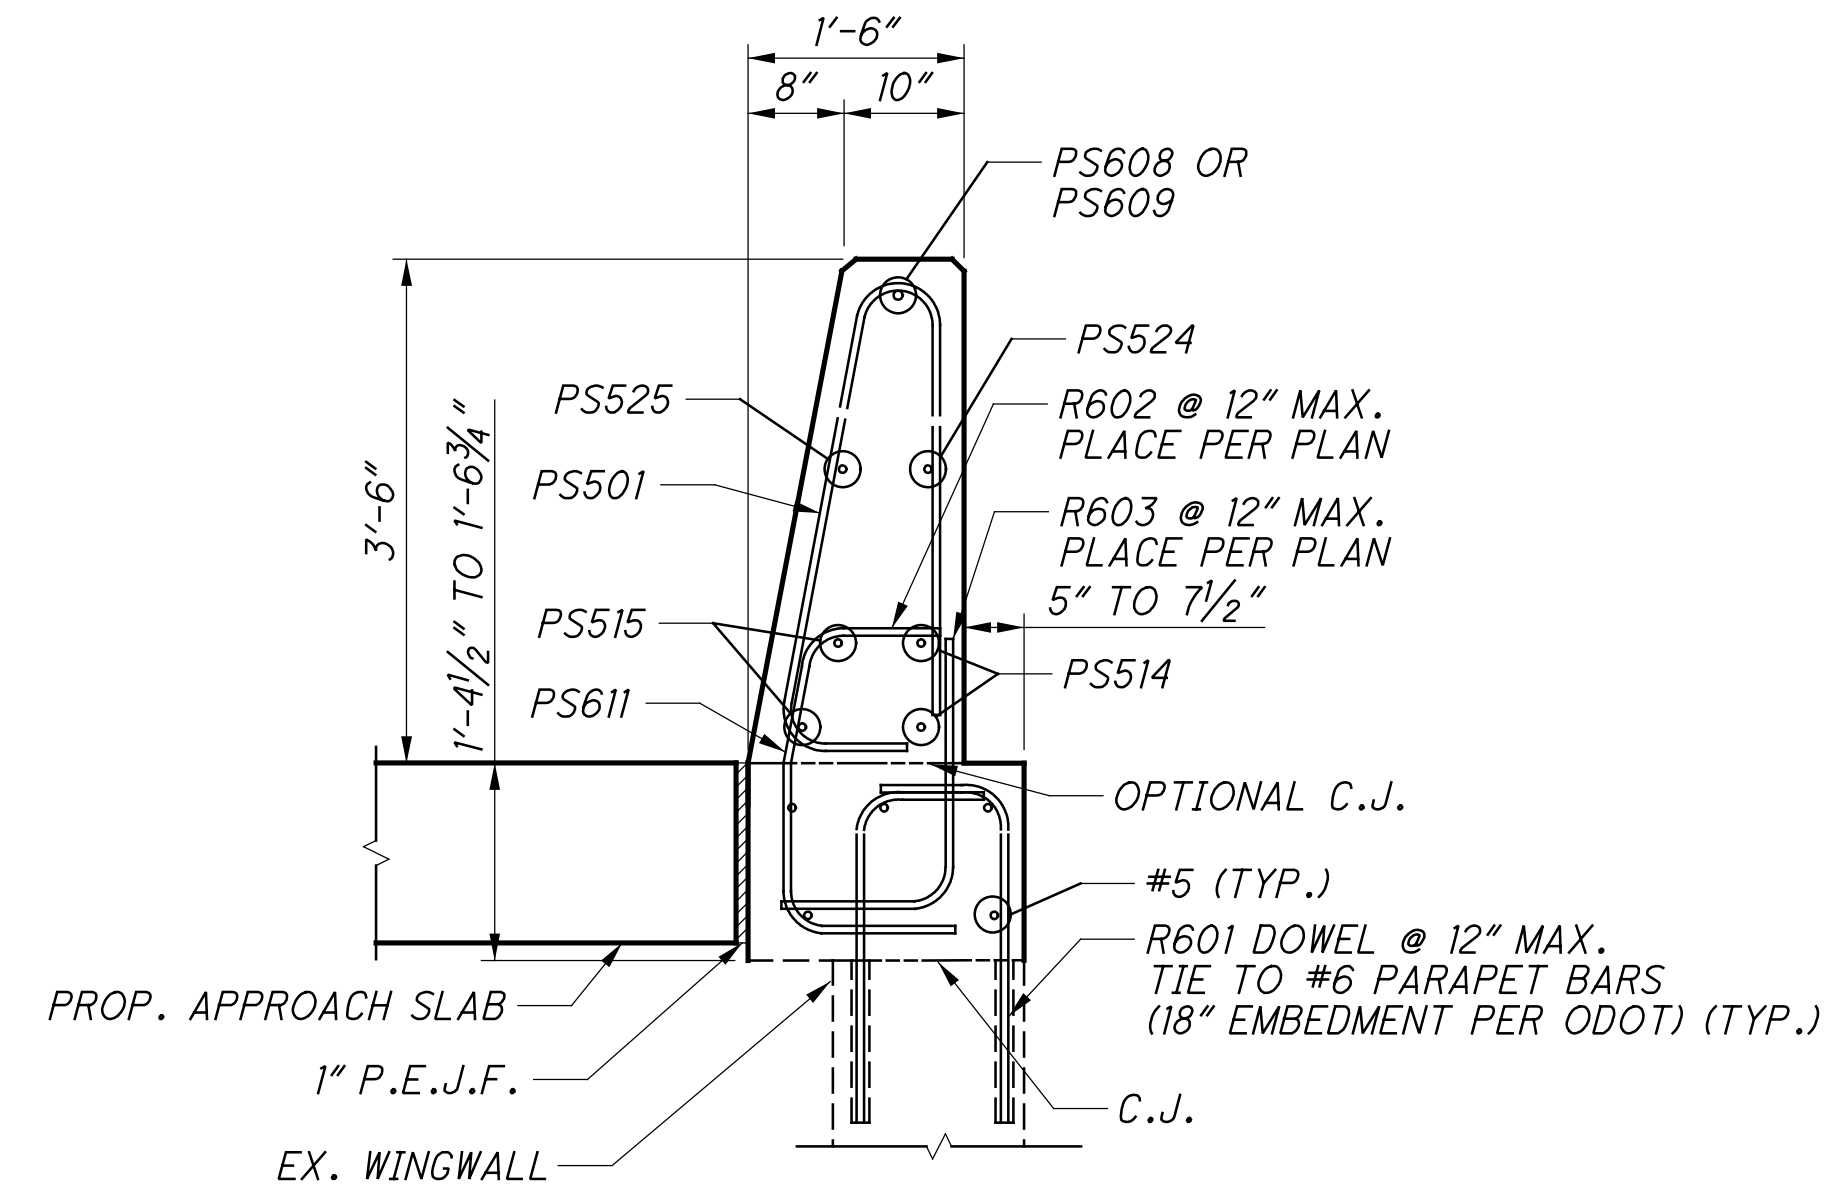

SECTION A-A

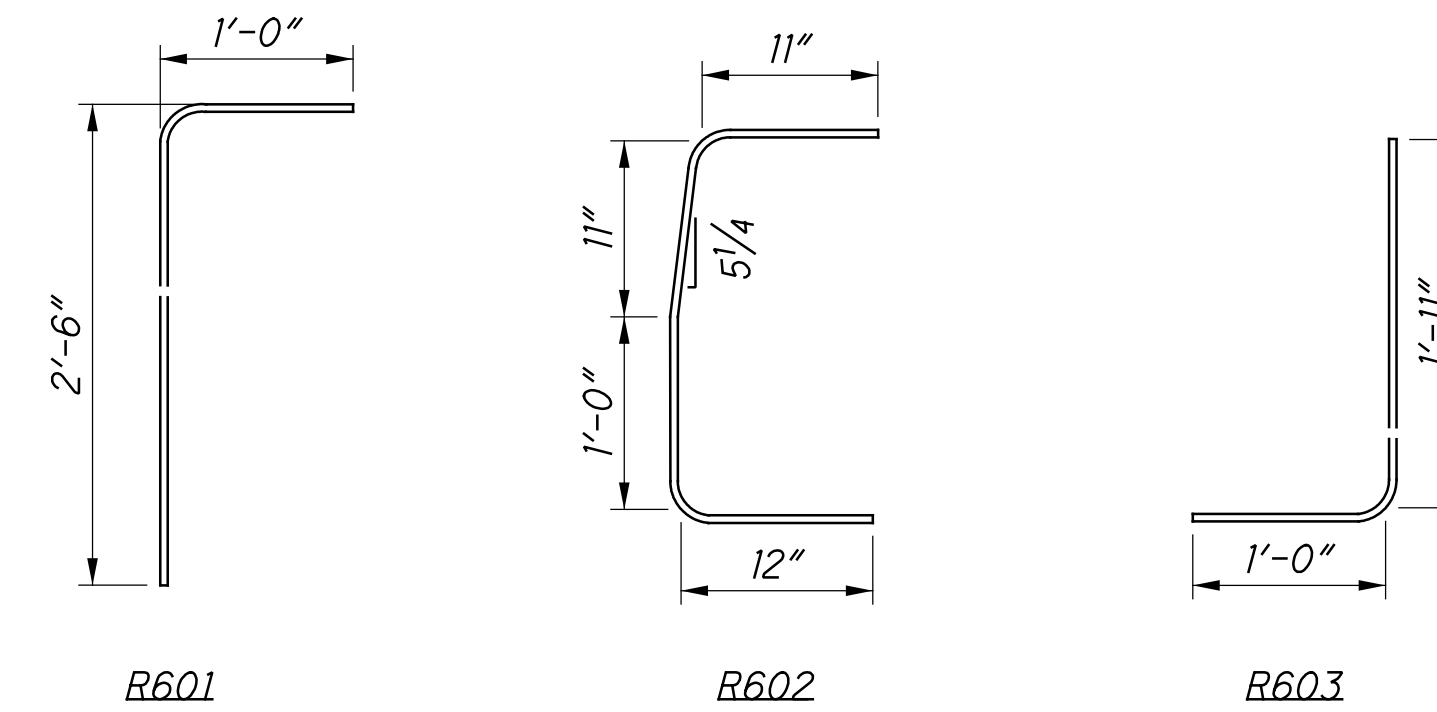

MINIMUM BAR LAP	
#5	2'-7"

NOTES:


- SEE STANDARD BRIDGE DRAWING SBR-1-13 FOR ADDITIONAL DETAILS.

DESIGNED	DRAWN	REVIEWED	DATE
SJF	DSH	MDS	11/12/18
CHECKED	REVISED	STRUCTURE FILE NUMBER	
CLB		3115577	


PARAPET DETAILS (RIGHT BRIDGE)
 BRIDGE NO. HAM-74-1852 L/R
 OVER NB BEEKMAN ST. (U.S. 27)

HAM-75-3.84
 PID No. 104667



SFlanagan
 11/16/2023 9:34:39 AM
 \\0\2017\01113\C.Design\104667-HAM-75-3.84\Design\Structures\HAM0074_1852C\Sheets\74_1852RA004.dgn

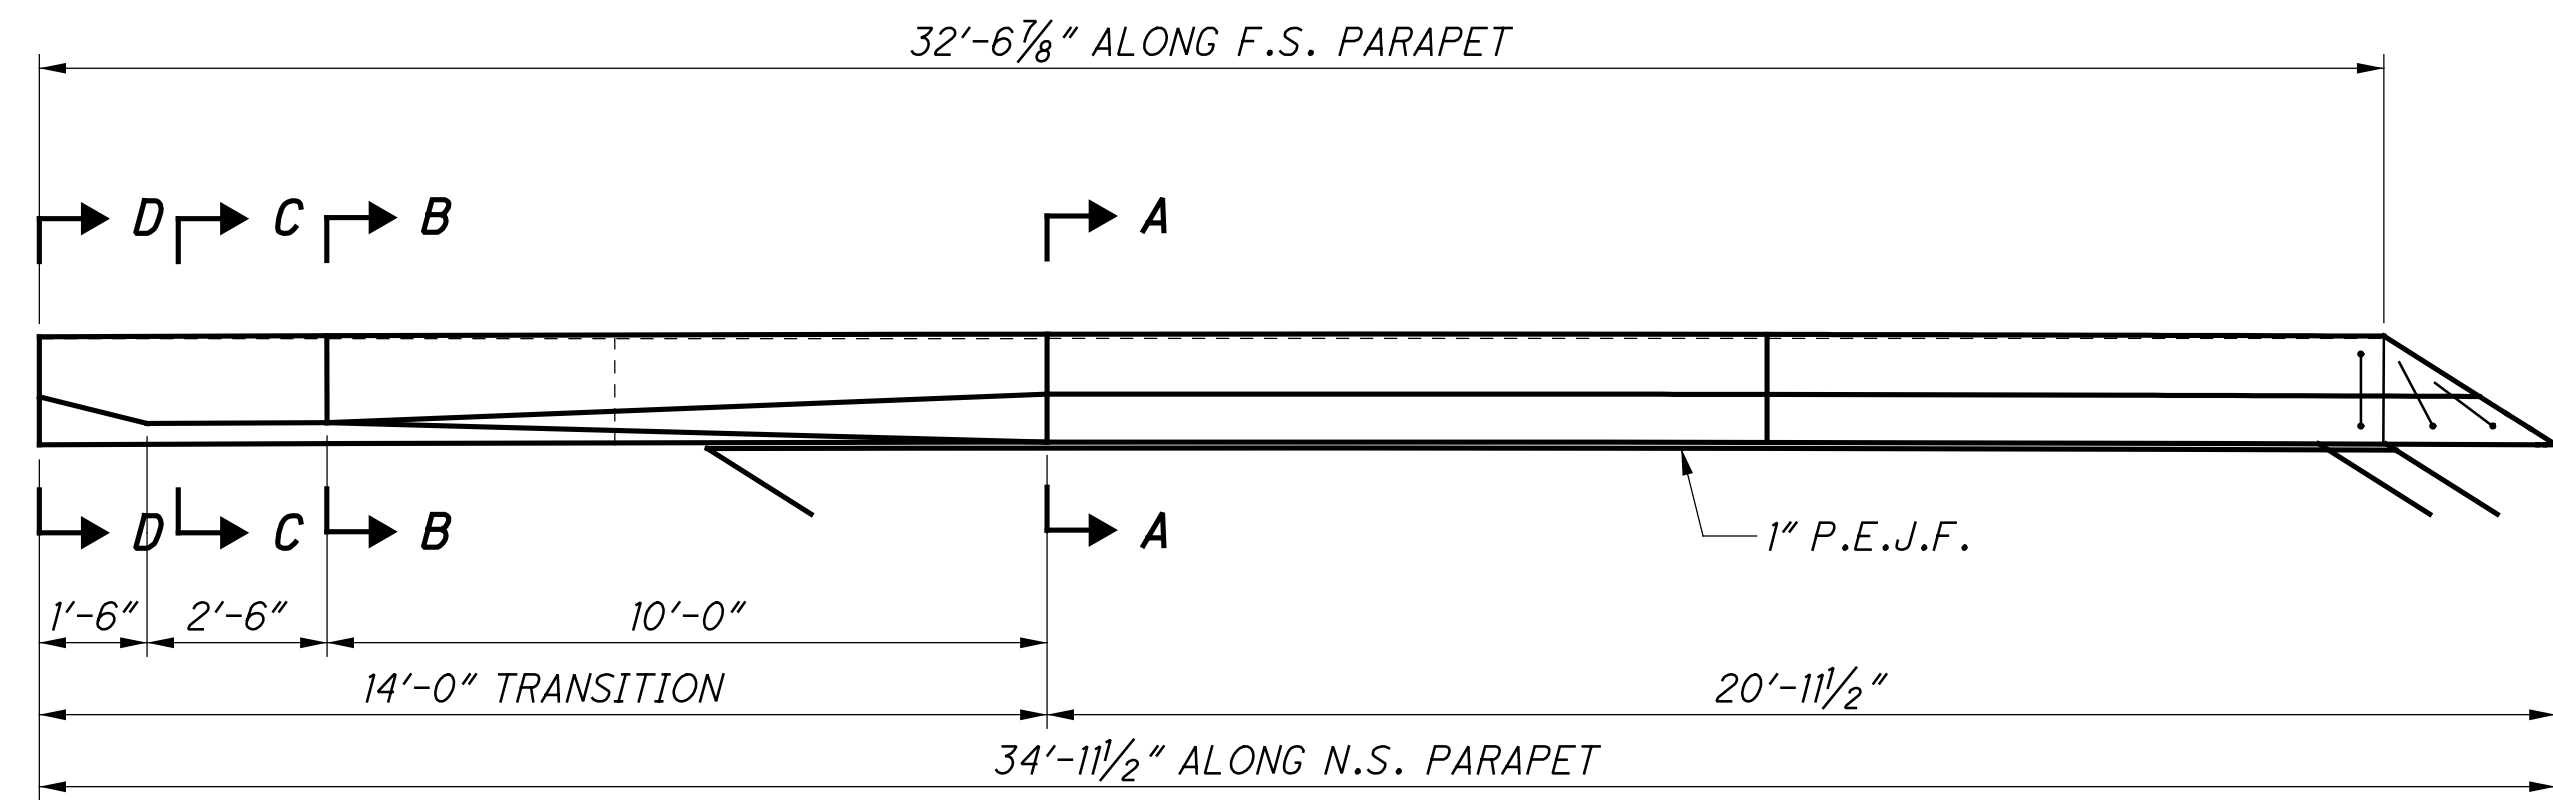


PARAPET PLAN
 AT SOUTH WINGWALL FORWARD ABUTMENT

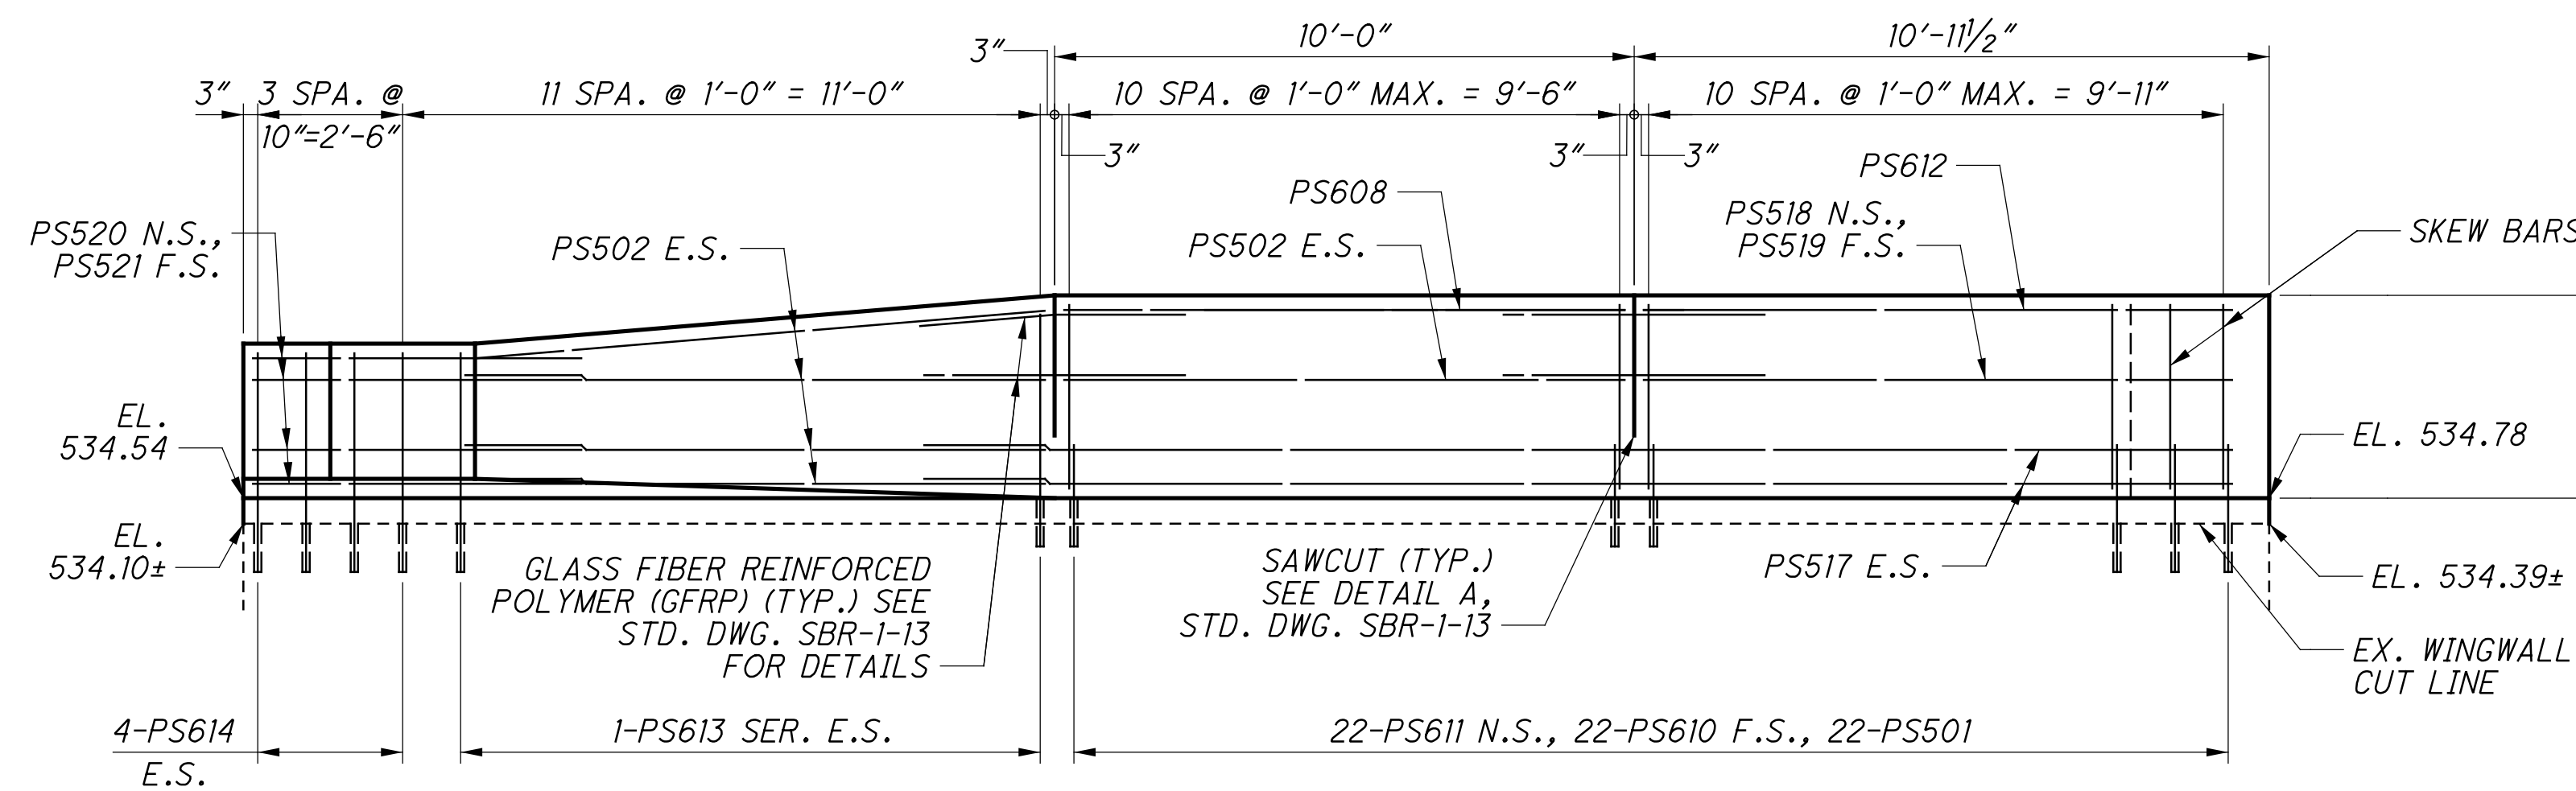


PARAPET ELEVATION
 AT SOUTH WINGWALL FORWARD ABUTMENT

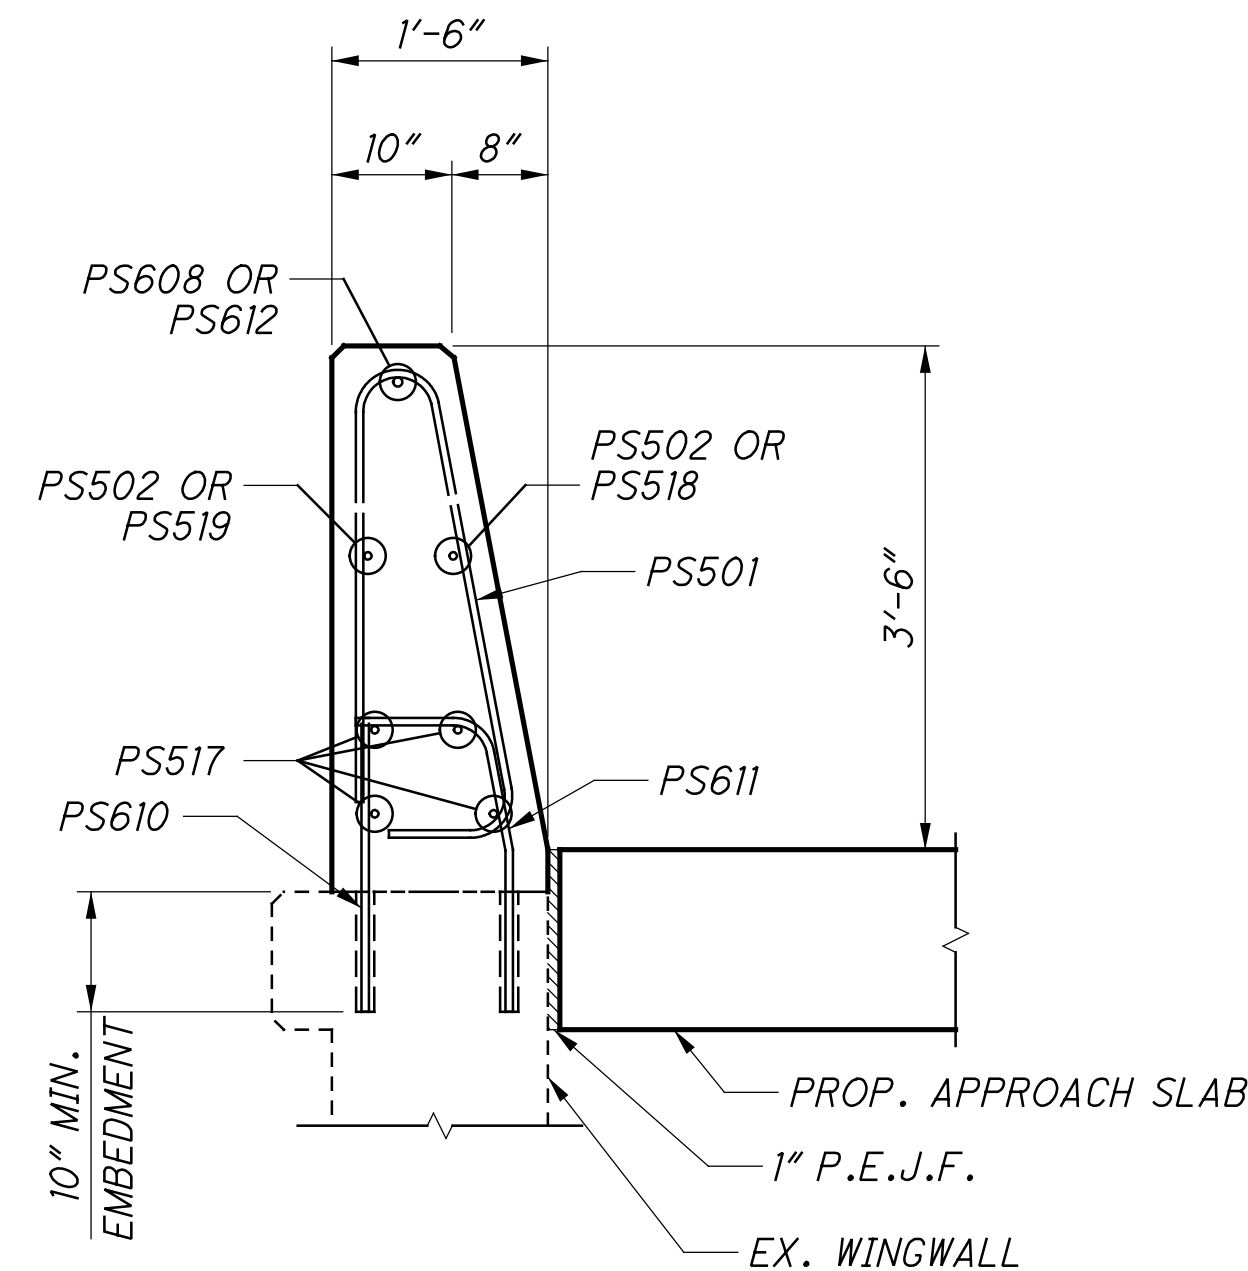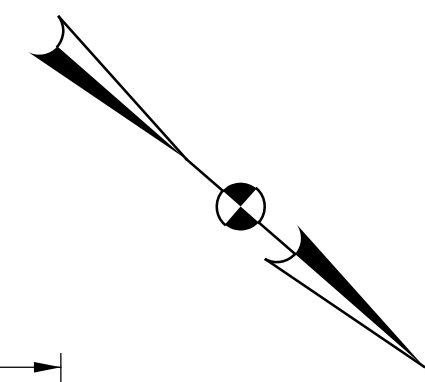


SECTION A-A

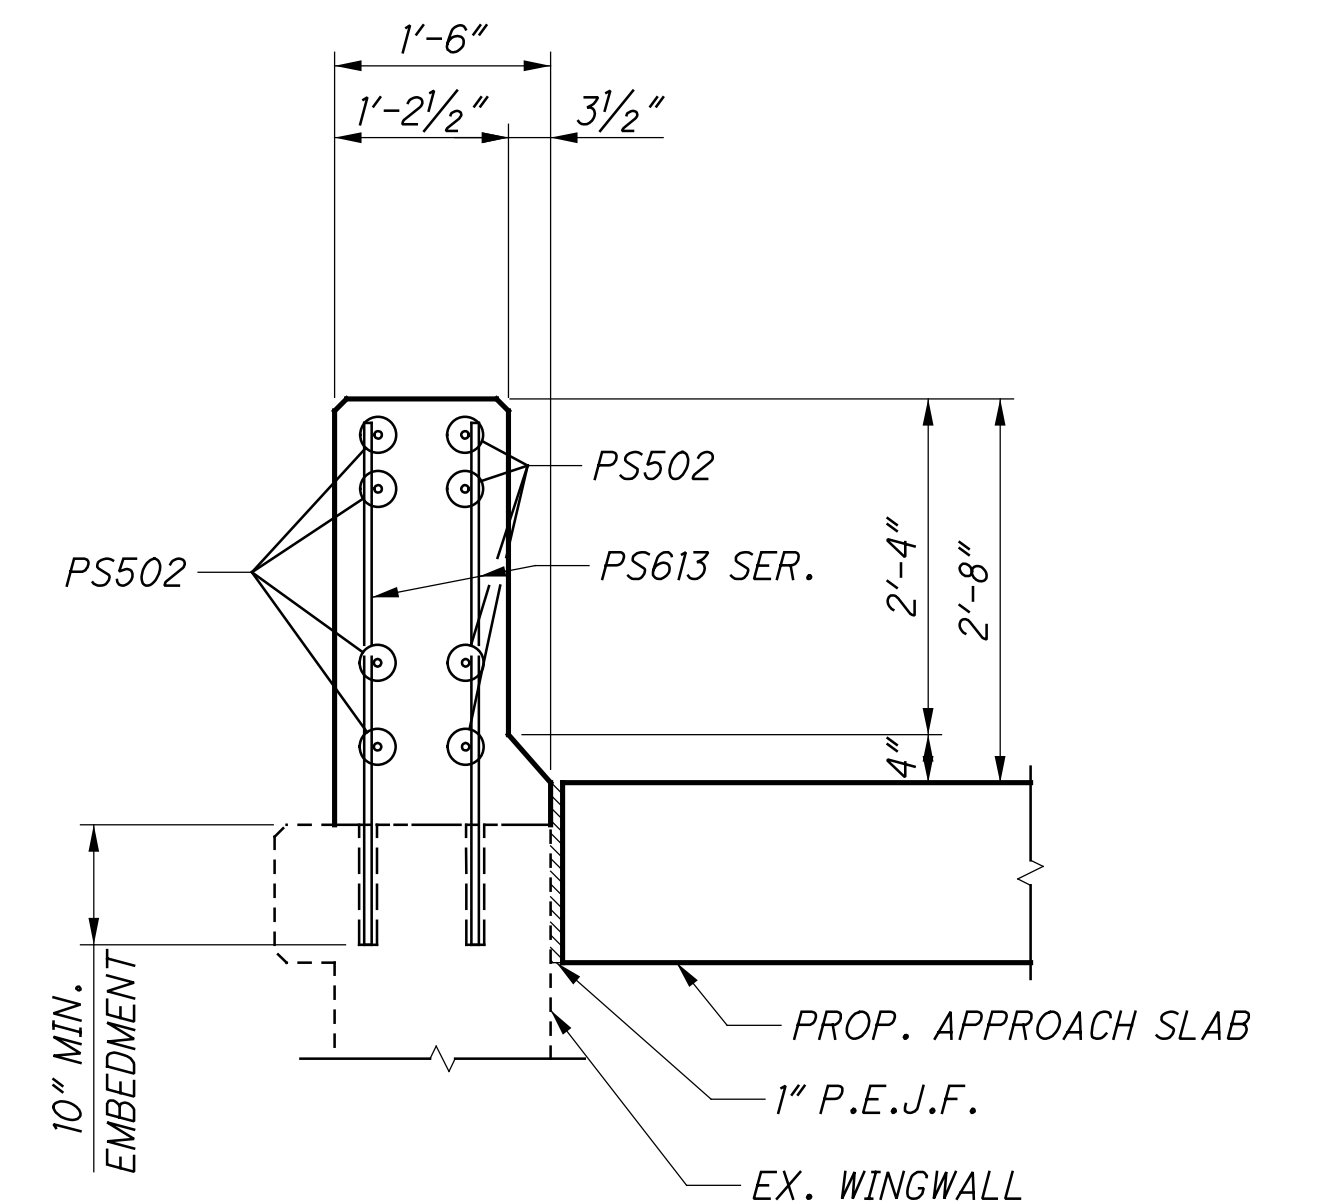

SECTION B-B

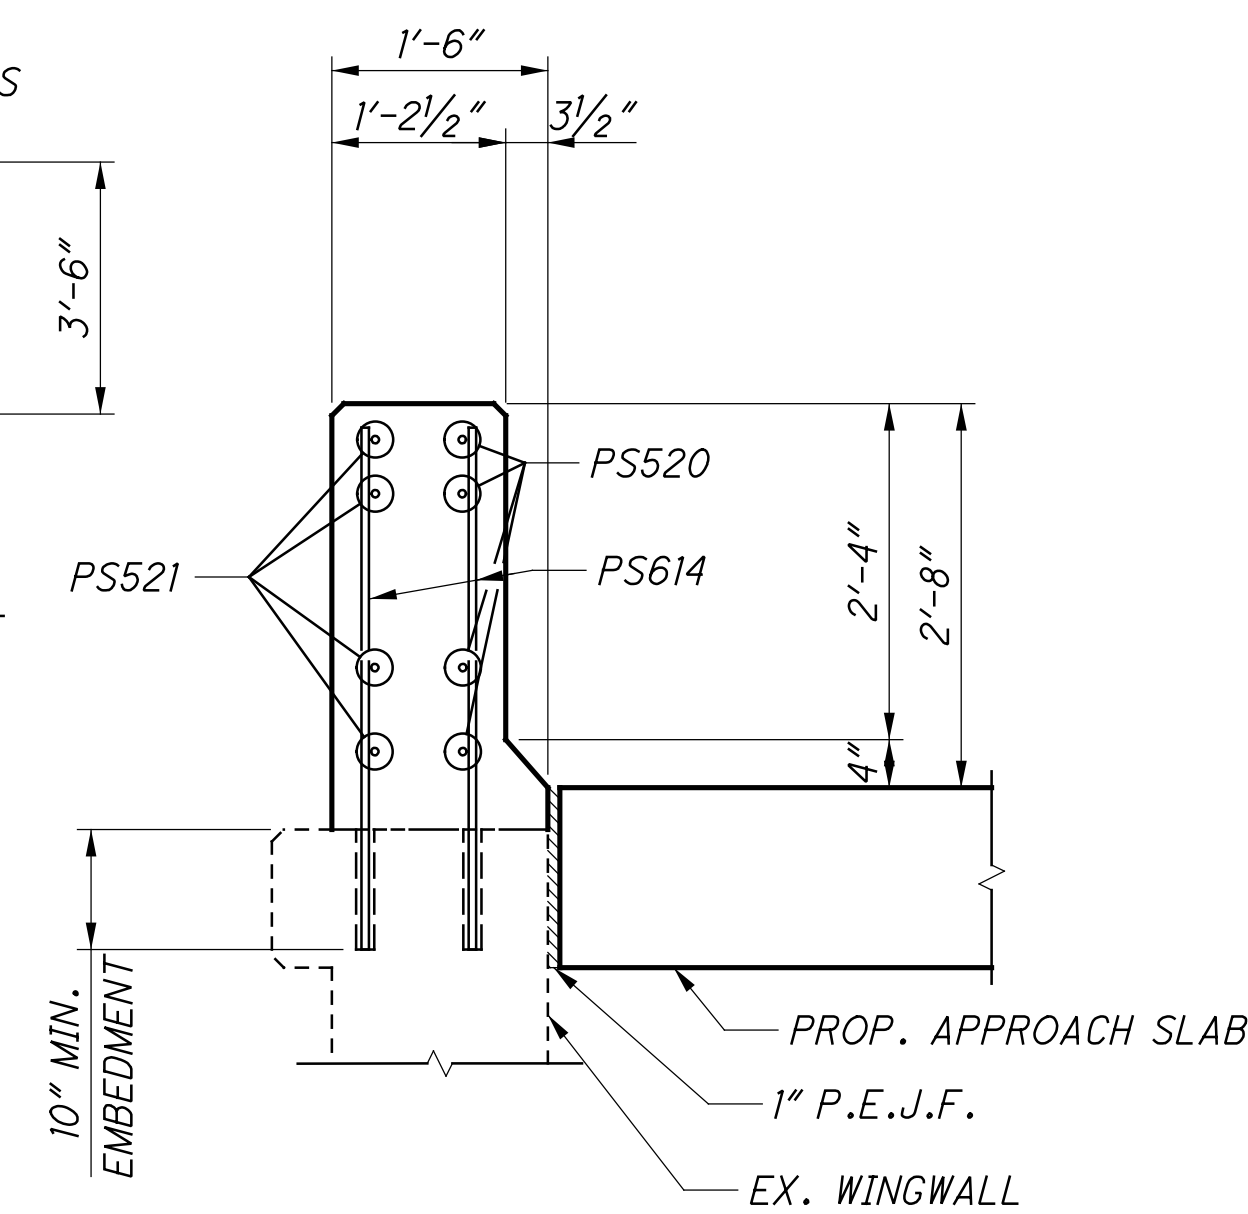

SECTION C-C

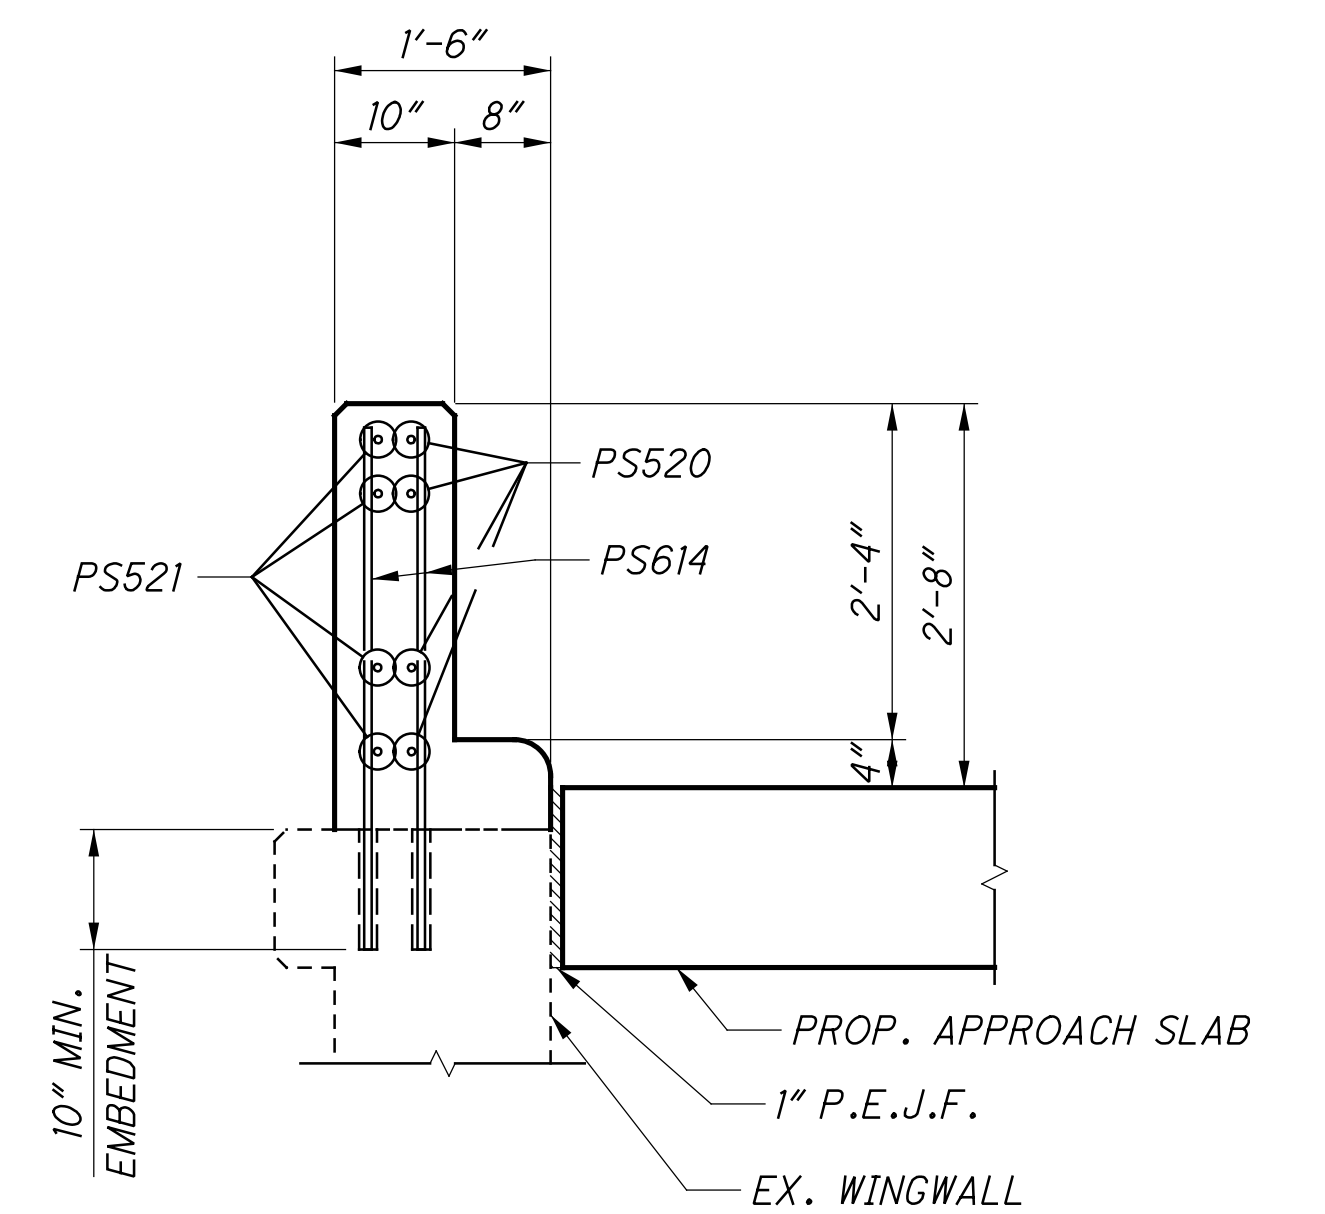


SECTION D-D

MINIMUM BAR LAP	
#5	2'-7"


- NOTES:
- SEE STANDARD BRIDGE DRAWING SBR-1-13 FOR ADDITIONAL DETAILS.
 - FOR BRIDGE TERMINAL ASSEMBLY, SEE STANDARD CONSTRUCTION DRAWING MGS 3.1.

DESIGN AGENCY: **STRUCTUREPOINT**
 DATE: 11/15/18
 REVIEWED: MDS
 DRAWN: DSH
 CHECKED: SUJ
 DESIGNED: CLB
 STRUCTURE FILE NUMBER: 3115577
PARAPET DETAILS (RIGHT BRIDGE)
 BRIDGE NO. HAM-74-1852 L/R
 NB BEEKMAN ST. (U.S. 27)
HAM-75-3.84
 PID No. 104667
 31/40
 73
 120


S:\Flanagan\11/16/2023 9:34:40 AM\0\2017\01113\C.Design\104667-HAM-75-3.84\Design\Structures\HAM0074_1852C_Sheets\74_1852RA005.dgn

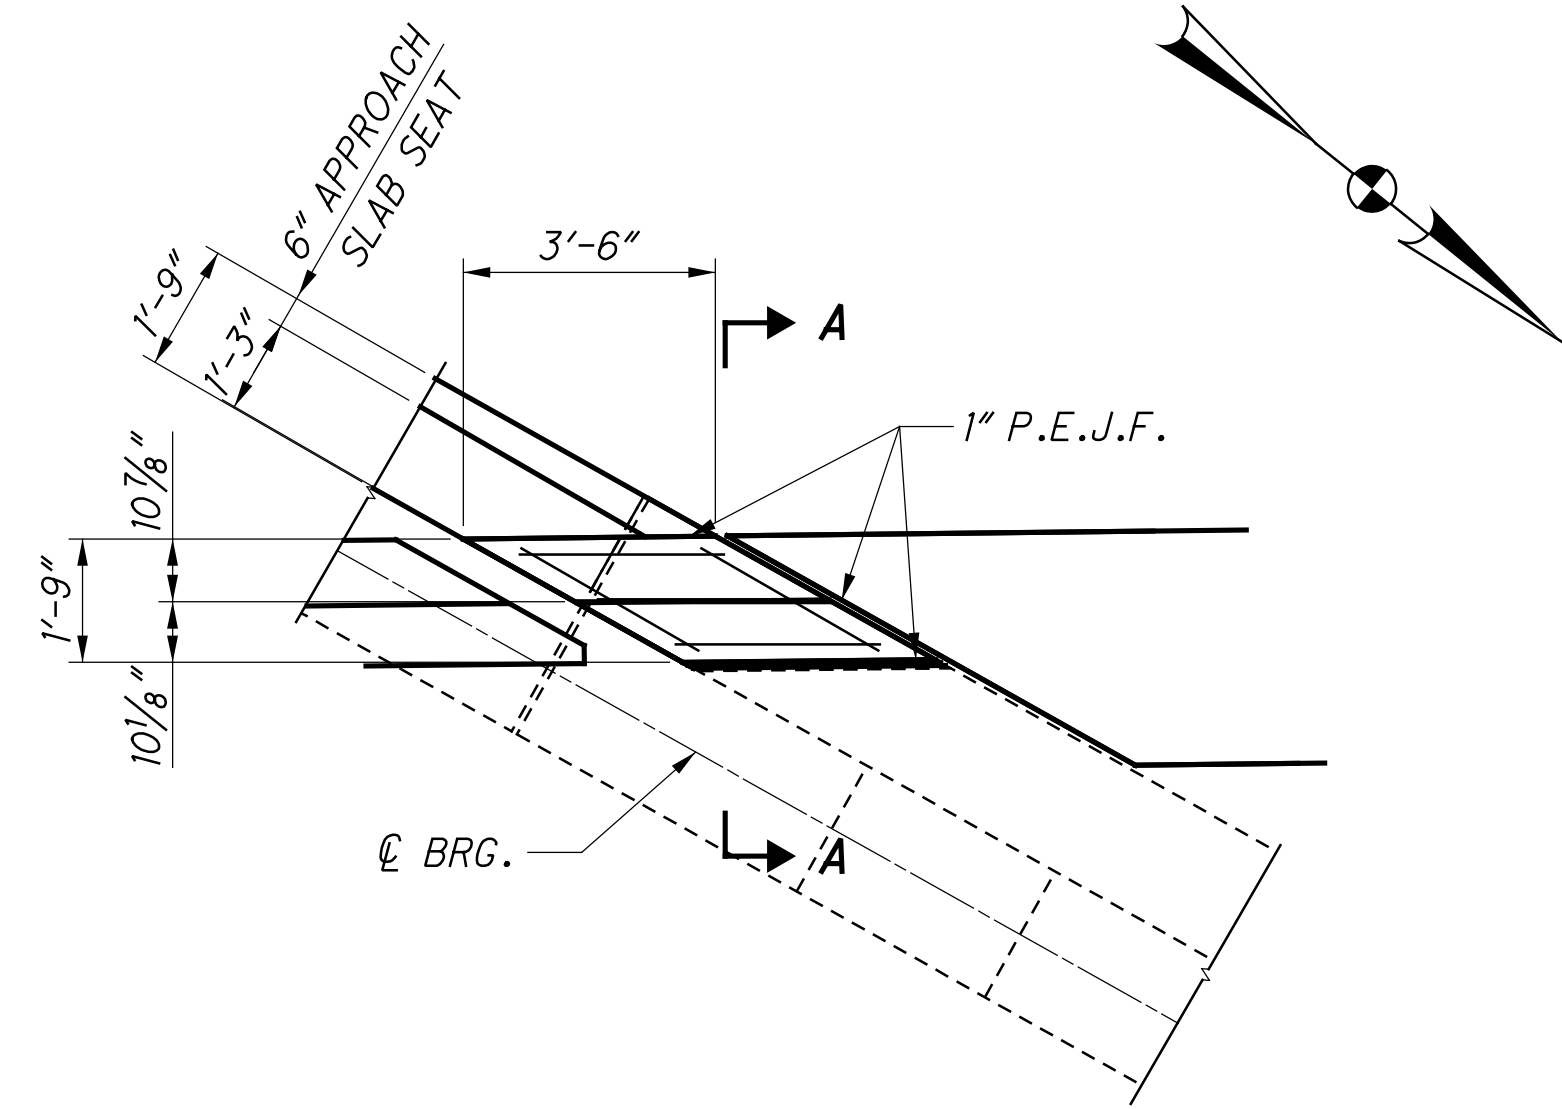


PLAN AT MEDIAN - REAR ABUTMENT

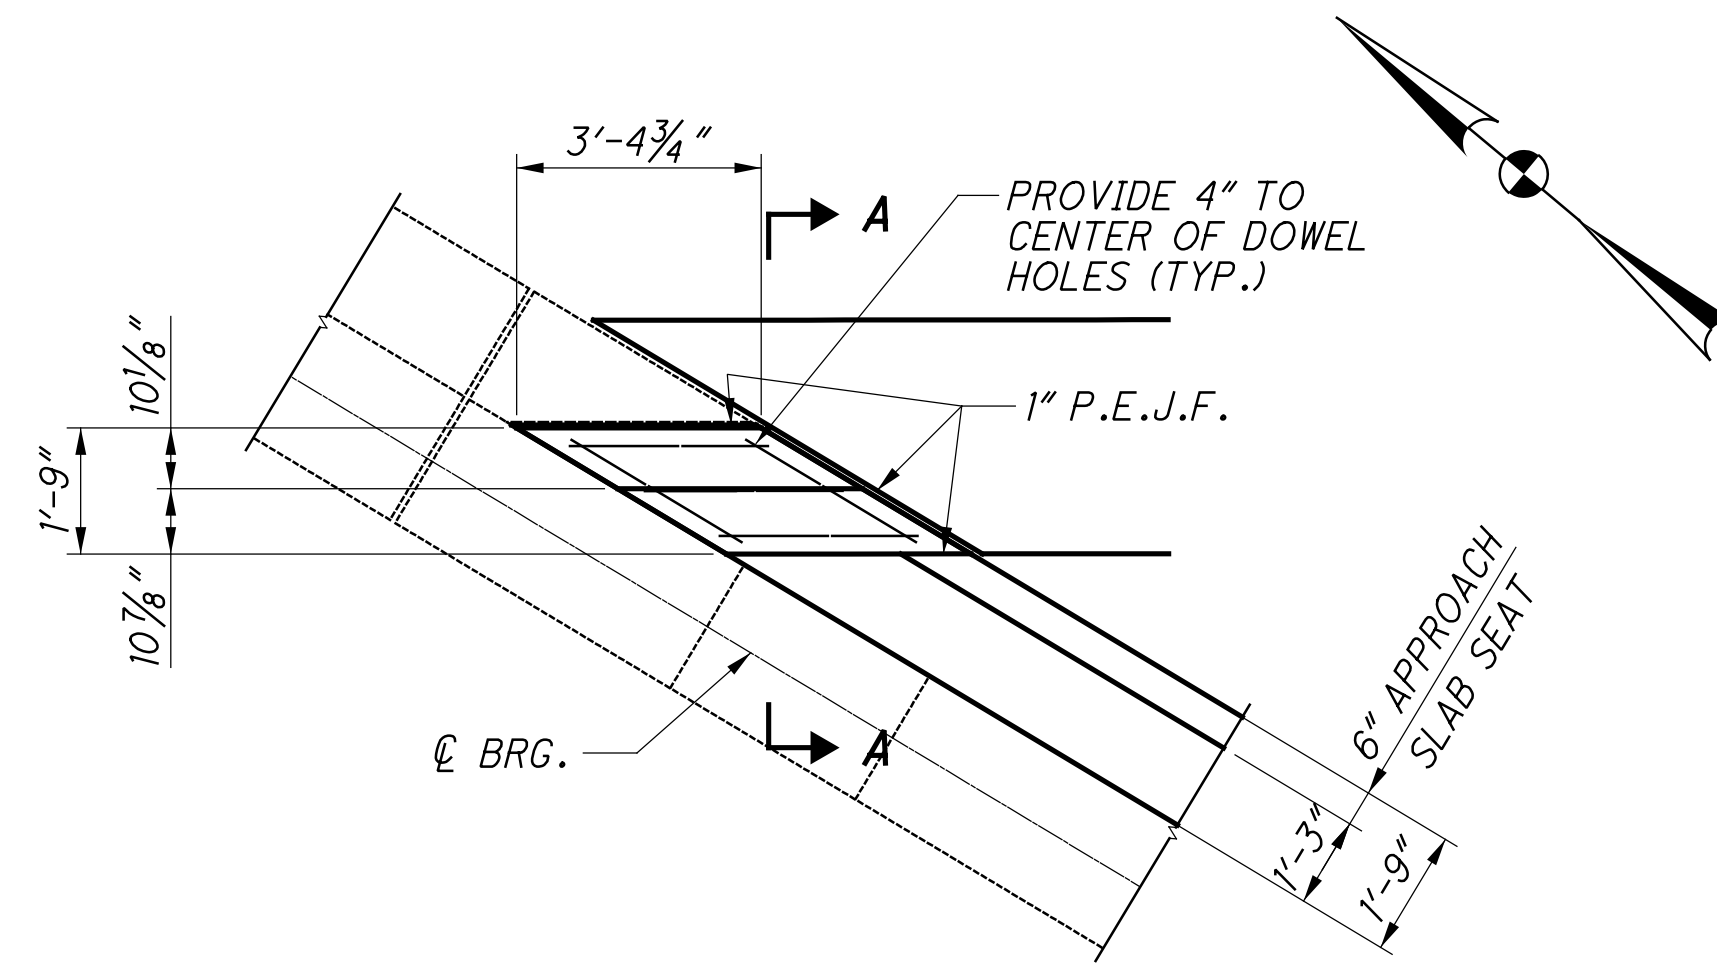


PLAN AT MEDIAN - FORWARD ABUTMENT

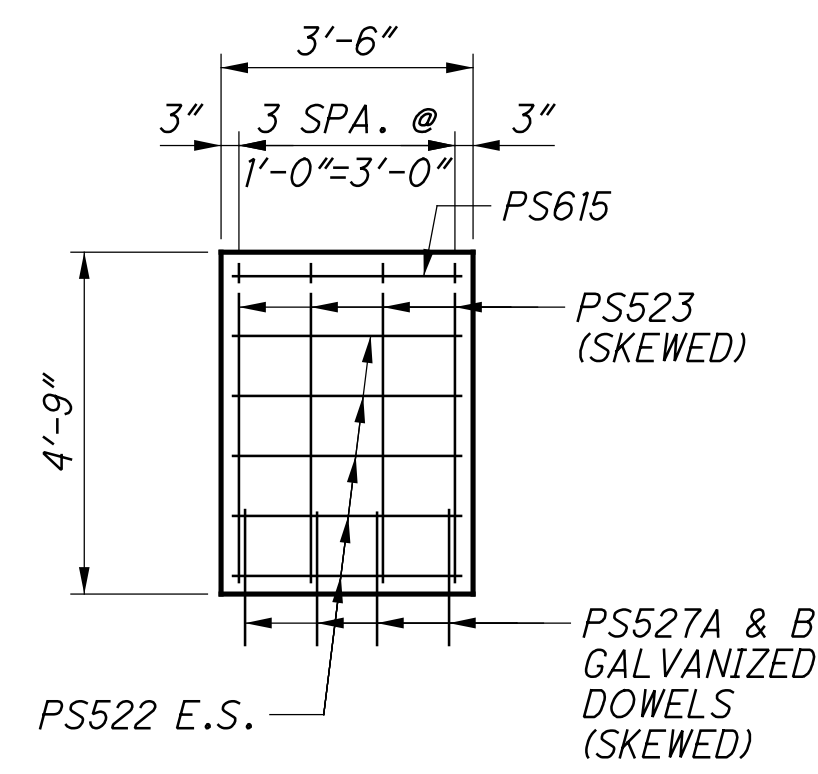


ELEVATION AT MEDIAN - REAR ABUTMENT

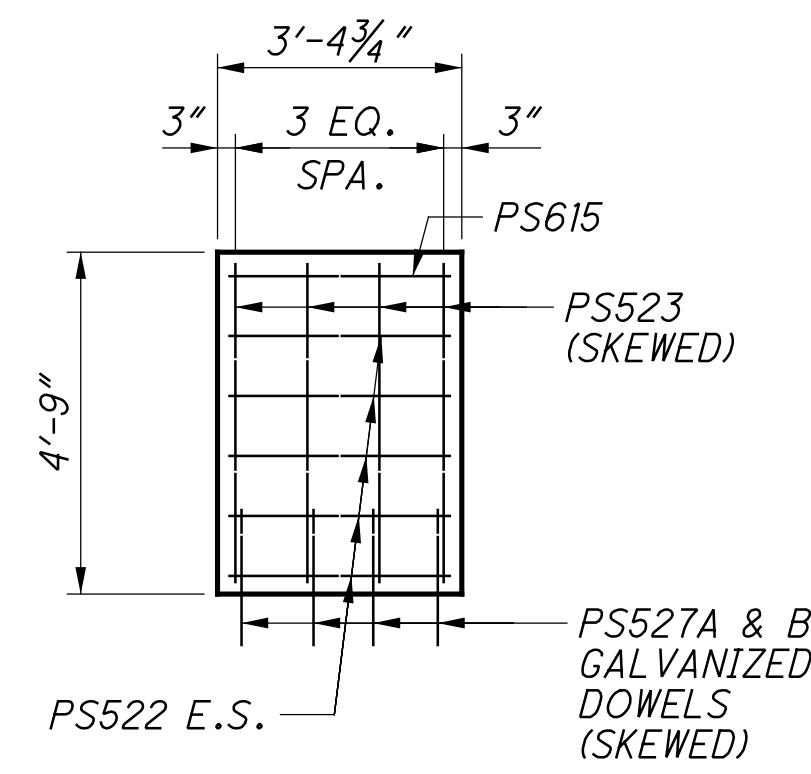

ELEVATION AT MEDIAN - FORWARD ABUTMENT

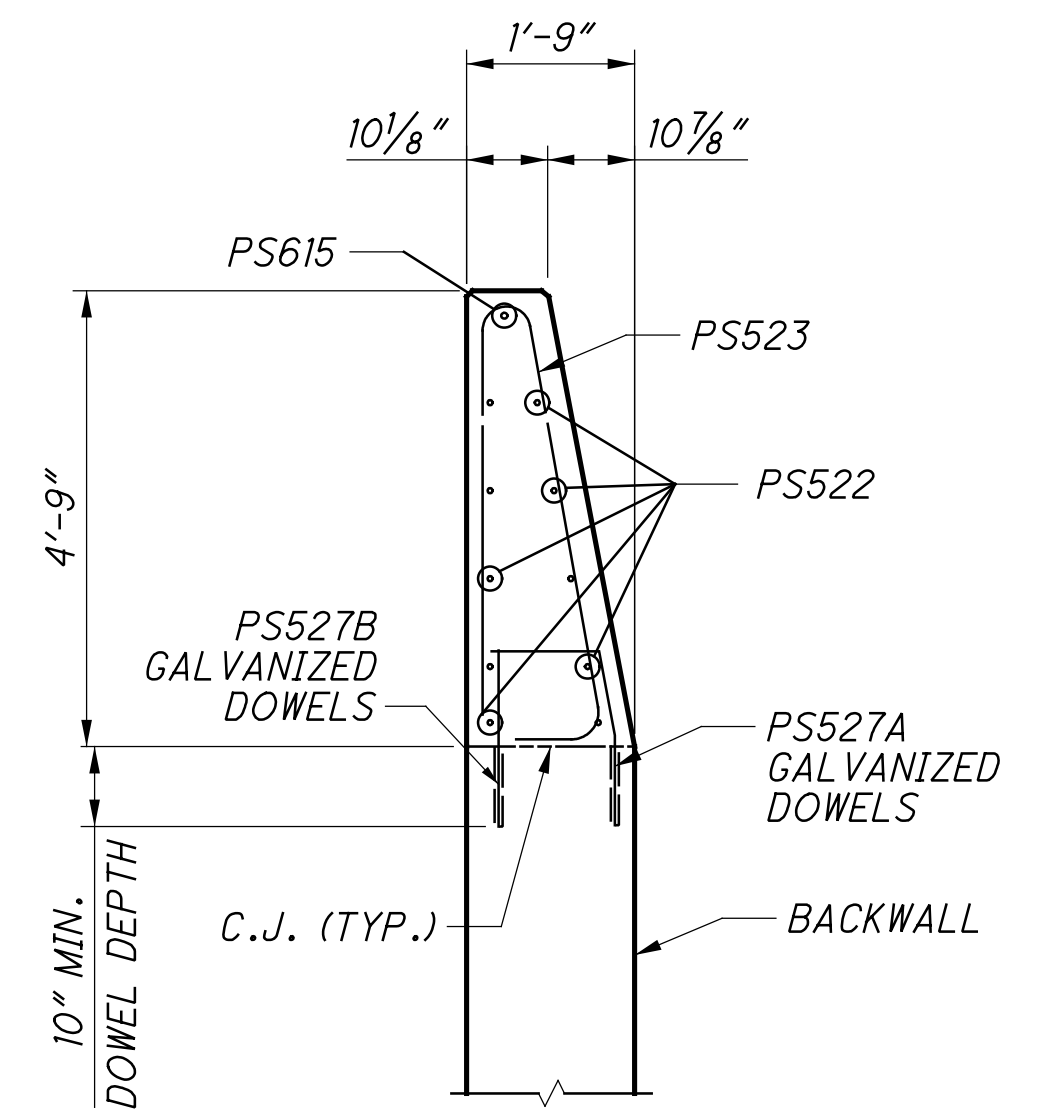


SECTION A-A

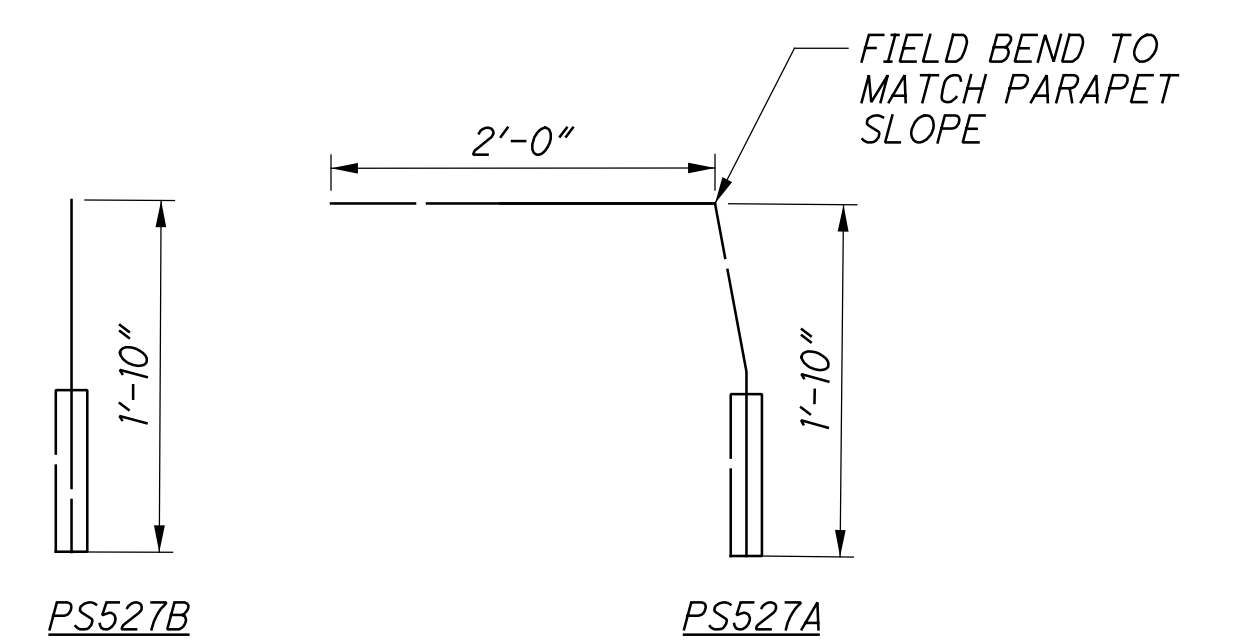


DESIGN AGENCY 	DATE 11/15/18 REVIEWED MDS STRUCTURE FILE NUMBER 3115577
	DESIGNED SUJ CHECKED CLB DRAWN DSH REVISED
PARAPET DETAILS (RIGHT BRIDGE) BRIDGE NO. HAM-74-1852 L/R OVER NB BEEKMAN ST. (U.S. 27)	
HAM-75-3.84 PID No. 104667	
32 / 40 74 120	

BRIDGE	BEARING SCHEDULE									BEVELED STEEL SOLE PLATE L x W	1/2" STEEL LOAD PLATE L x W
	LOCATION	ASSEMBLY TYPE	NO. OF BEARINGS	SIZE D x T	NO. OF STEEL LAMINATES	t _i	NO. OF t _i LAYERS	t _e	NO. OF t _e LAYERS		
LEFT	REAR ABUT.	EXPANSION	5	14 1/2" x 3 5/8"	7	0.406"	7	0.25"	1	1'-3 1/2" x 1-6"	1'-3 1/2" x 1-3 1/2"
LEFT	FWD. ABUT.	EXPANSION	5	13 1/2" x 2 1/2"	5	0.375"	5	0.25"	1	1'-2 1/2" x 1-6"	1'-2 1/2" x 1-2 1/2"
RIGHT	REAR ABUT.	EXPANSION	5	14 1/2" x 3 5/8"	7	0.406"	7	0.25"	1	1'-3 1/2" x 1-6"	1'-3 1/2" x 1-3 1/2"
RIGHT	FWD. ABUT.	EXPANSION	5	13 1/2" x 2 1/2"	5	0.375"	5	0.25"	1	1'-2 1/2" x 1-6"	1'-2 1/2" x 1-2 1/2"

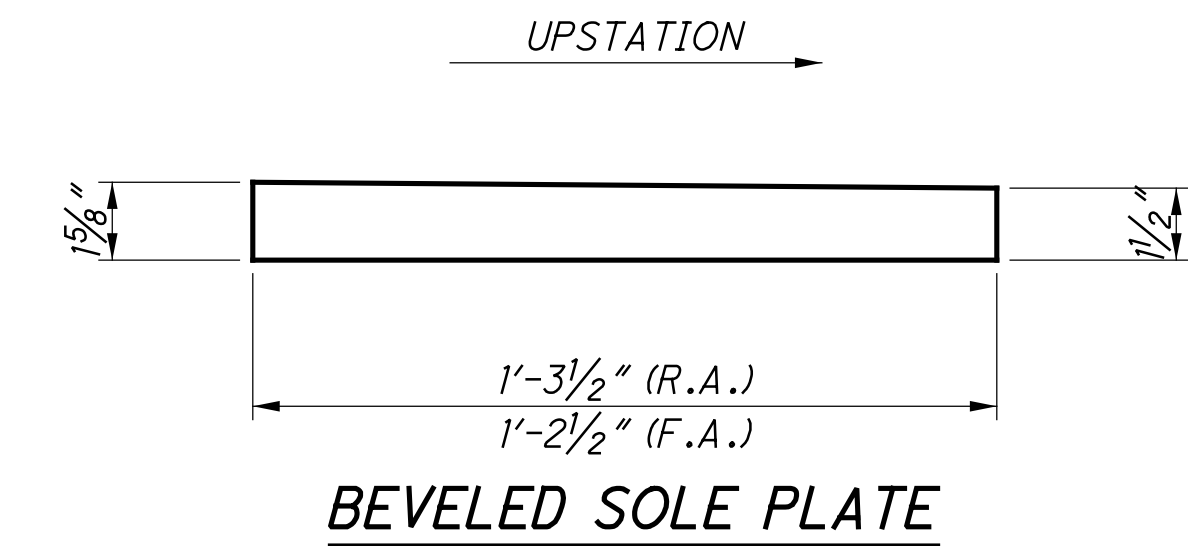


UNFACTORED ELASTOMERIC BEARING LOADS:


	R.A.	F.A.
DEAD LOAD	= 56 K	62 K
LIVE LOAD	= 56 K	54 K
TOTAL LOAD	= 112 K	116 K

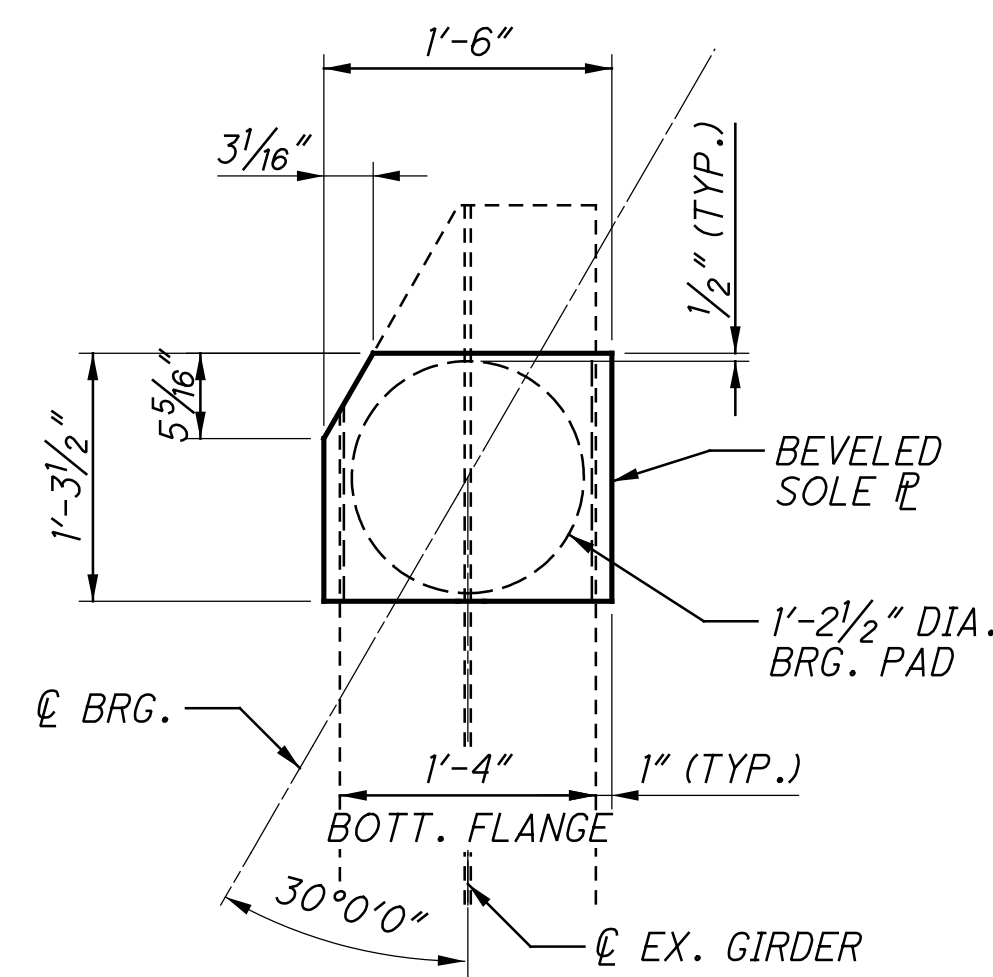


PLAN @ R.A.

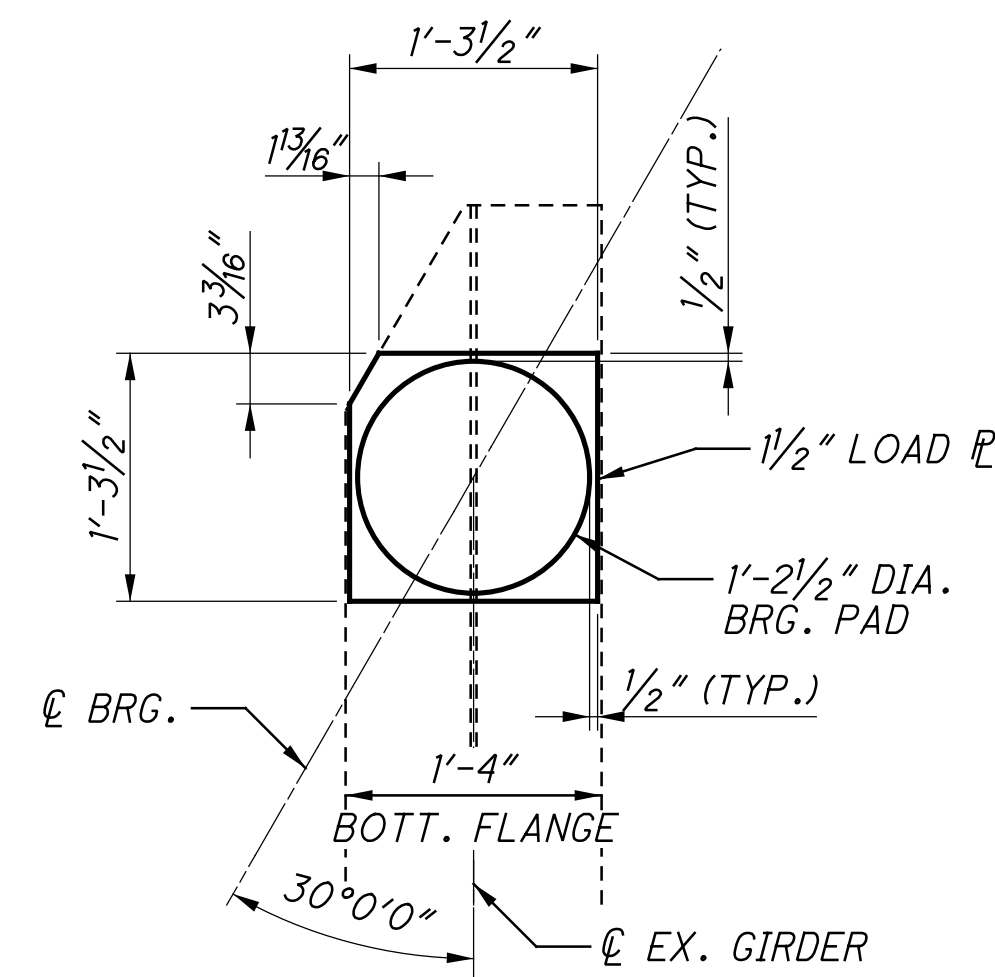



**R.A. LOAD PLATE
DETAIL**

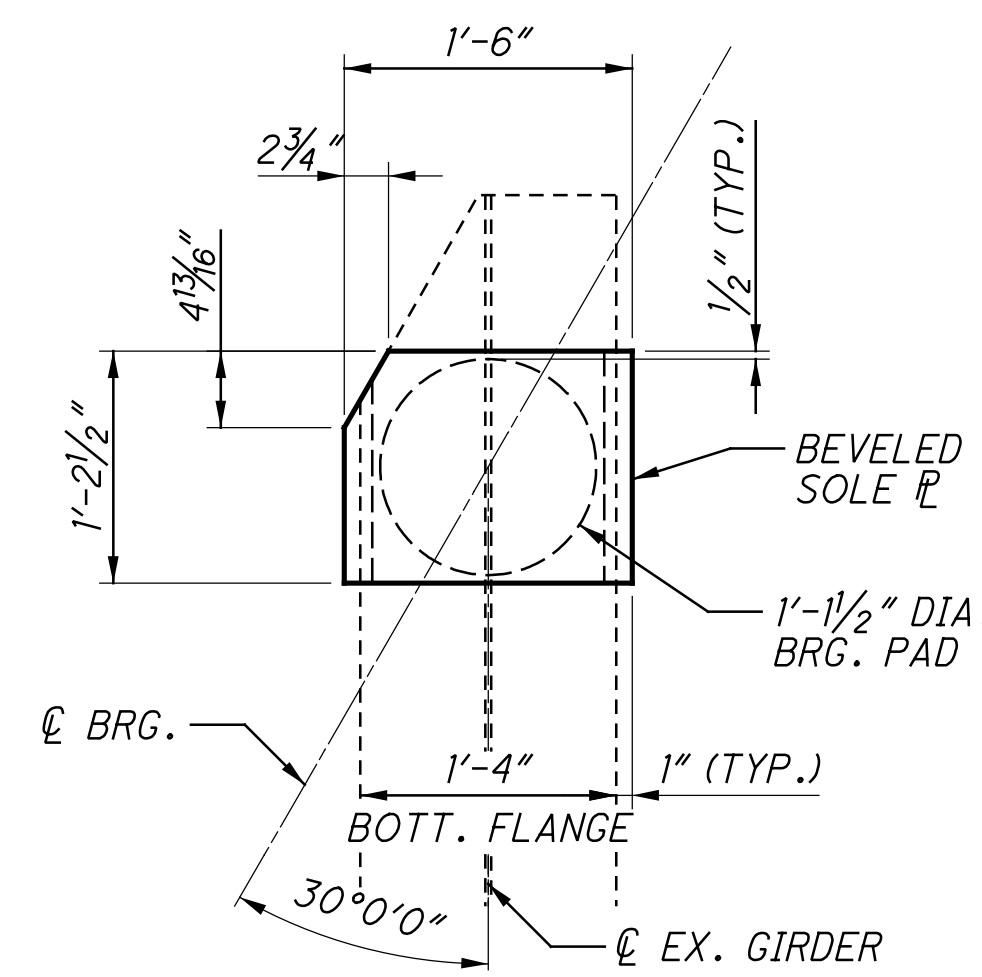

PLAN @ F.A.

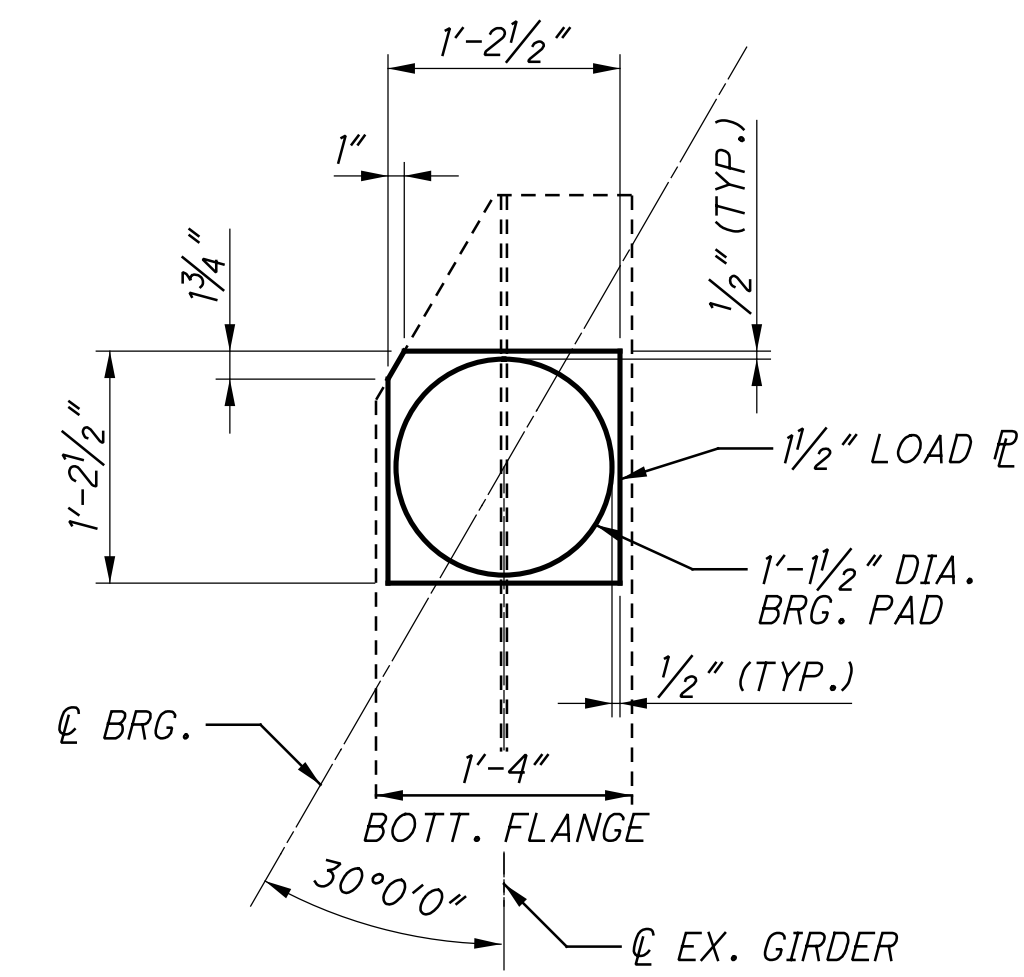

**F.A. LOAD PLATE
DETAIL**

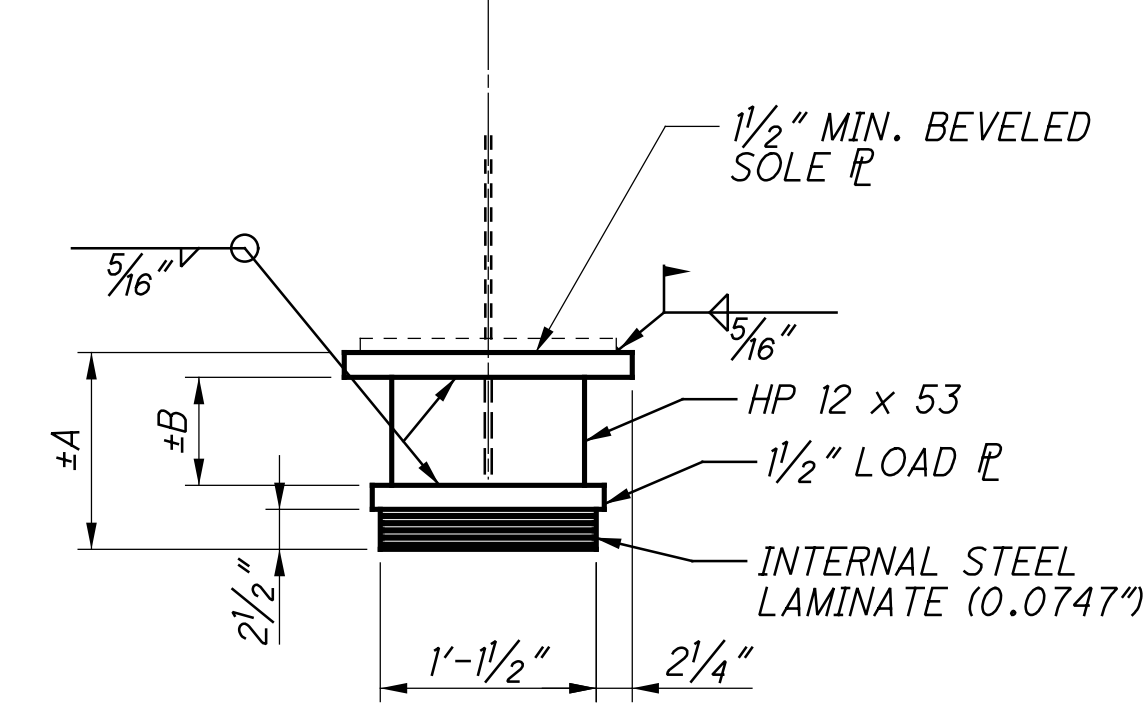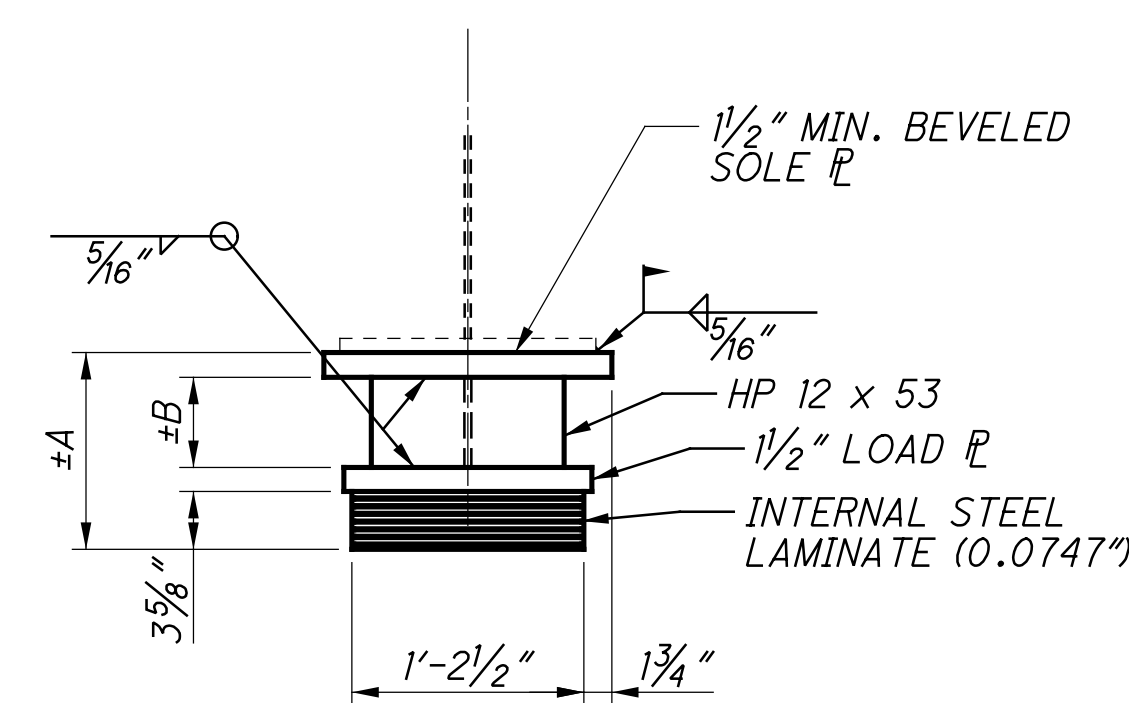

EXPANSION BEARINGS AT ABUTMENTS

LOCATION	BEARING HEIGHT TABLE			
	REAR ABUTMENT		FWD. ABUTMENT	
	A	B	A	B
G1	1'-2 1/2"	7 13/16"	1'-0 5/16"	7 3/8"
G2	1'-2 1/16"	8"	1'-0 9/16"	7"
G3	1'-2 1/16"	8"	1'-0 3/4"	7 3/16"
G4	1'-2 1/2"	7 13/16"	1'-0 3/4"	7 3/16"
G5	1'-2 3/8"	7 11/16"	1'-0 5/16"	6 3/4"
G6	1'-3"	8 5/16"	1'-0 3/8"	6 3/16"
G7	1'-2 7/8"	8 3/16"	1'-0 5/8"	7"
G8	1'-2 5/8"	8"	1'-0 3/8"	6 13/16"
G9	1'-2 1/8"	8 7/16"	1'-0 1/2"	6 5/16"
G10	1'-2 3/4"	8 1/16"	1'-0 3/8"	6 13/16"


NOTES:

- THE ELASTOMER SHALL HAVE A HARDNESS OF 50 DUROMETER. THE BEARINGS WERE DESIGNED UNDER DIVISION I, SECTION 14.6.6 (METHOD A) OF THE AASHTO STANDARD SPECIFICATION FOR HIGHWAY BRIDGES.
- THE STEEL LOAD PLATES FOR ELASTOMERIC BEARINGS SHALL CONFORM TO THE REQUIREMENTS OF ASTM A709, GRADE 50. THE LOAD PLATE SHALL BE BONDED BY VULCANIZATION TO THE ELASTOMER DURING THE MOLDING PROCESS. STRUCTURAL STEEL LOAD PLATES SHALL BE PAINTED PER CMS 513 AND 514.
- ALL BEARINGS SHALL BE MARKED PRIOR TO SHIPPING. THE MARKS SHALL INCLUDE THE BEARING LOCATION ON THE BRIDGE, AND A DIRECTION ARROW THAT POINTS UP-STATION. ALL MARKS SHALL BE PERMANENT AND BE VISIBLE AFTER THE BEARING IS INSTALLED.
- CONTRACTOR SHALL VERIFY EXISTING BEARING HEIGHT PRIOR TO FABRICATION OF PROPOSED BEARING.

S:\Plans\2017\01113\C.Design\104667.HAM-75-3.84.Design\Structures\HAM0074-1852C.Sheets\7.4-1852BR001.dgn 11/16/2017 9:34:40 AM

DESIGN AGENCY: STRUCTUREPOINT
 DATE: 11/12/18
 REVIEWED: MDS
 DRAWN: SUJ
 DESIGNED: SUJ
 CHECKED: CLB
 STRUCTURE FILE NUMBER: 3115577
BEARING DETAILS
 BRIDGE NO. HAM-74-1852 L/R
 OVER NB BEEKMAN ST. (U.S. 27)
HAM-75-3.84
 PID No. 104667
 33/40
 75
 120

SFlanagan
 11/16/2023 9:34:41 AM
 \\0\2017\01113\C_Design\104667-HAM-75-3.84\Design\Structures\HAM0074_1852C\Sheets\74_1852EX010.dgn

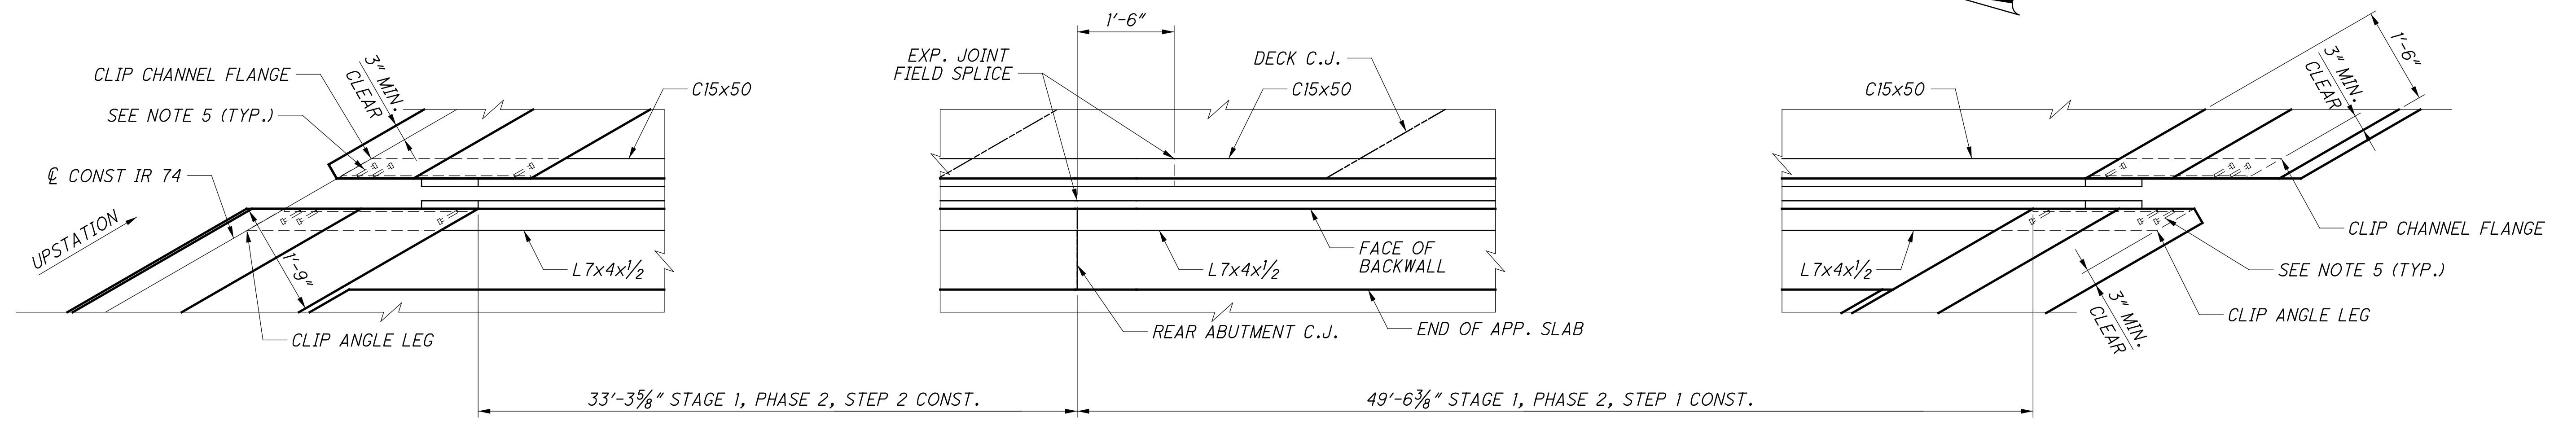


**PARTIAL PLAN - REAR ABUTMENT
 EXPANSION JOINT DETAILS**

NOTES:

1. SEE STD. DWG. EXJ-4-87 FOR ADDITIONAL DETAILS.
2. ALL CHANNELS, ANGLES AND PLATES SHALL BE ASTM A709 GRADE 50.
3. COAT ALL STEEL PARTS OF THE JOINT ASSEMBLY ACCORDING TO 516.
4. FOR ADDITIONAL STRIP SEAL DETAILS, SEE SHEET 36/40.
5. SHEAR STUDS SHALL BE WELDED AT AN ANGLE TO MAINTAIN CLEARANCE IN PARAPET.

HAM-75-3.84	PID No. 104667	34/40	<div style="border: 1px solid black; border-radius: 50%; width: 30px; height: 30px; margin: 0 auto; display: flex; align-items: center; justify-content: center;"> 76 120 </div>	EXPANSION JOINT DETAILS (RIGHT BRIDGE) BRIDGE NO. HAM-74-1852 L/R OVER NB BEELMAN ST. (U.S. 27)	DESIGNED: SUJ CHECKED: CLB DRAWN: DSH REVISED:	REVIEWED: MDS DATE: 11/12/18 STRUCTURE FILE NUMBER: 3115577	DESIGN AGENCY: STRUCTUREPOINT <small>INCORPORATED</small> <small>2000 CORPORATE PARKWAY SUITE 100</small> <small>TEL: 610.326.8000 FAX: 610.326.8001</small>
--------------------	-----------------------	-------	---	--	---	---	---

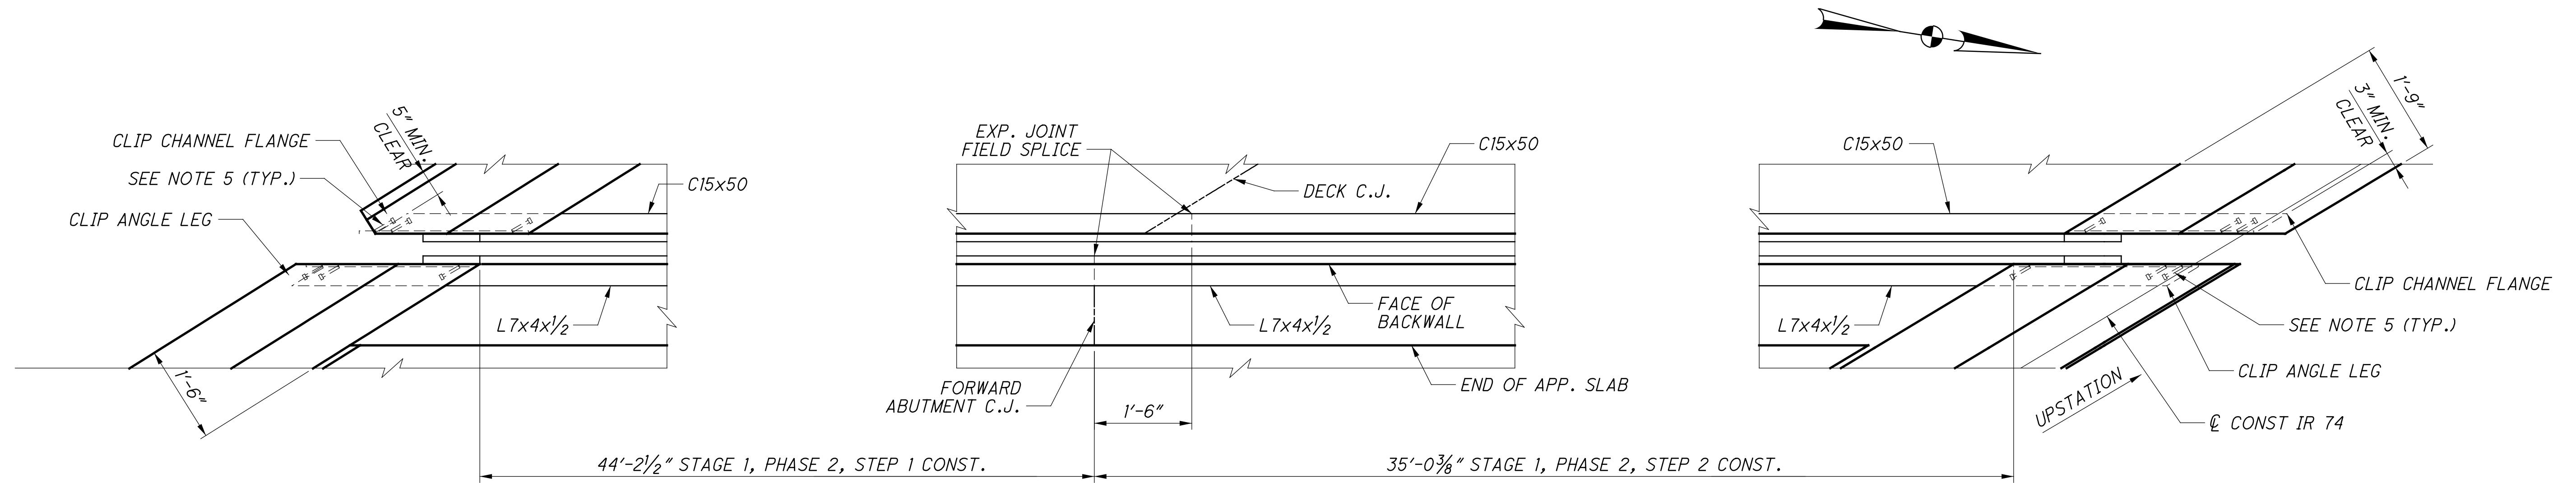


PARTIAL PLAN - FORWARD ABUTMENT
EXPANSION JOINT DETAILS

NOTES:

1. SEE STD. DWG. EXJ-4-87 FOR ADDITIONAL DETAILS.
2. ALL CHANNELS, ANGLES AND PLATES SHALL BE ASTM A709 GRADE 50.
3. COAT ALL STEEL PARTS OF THE JOINT ASSEMBLY ACCORDING TO 516.
4. FOR ADDITIONAL STRIP SEAL DETAILS, SEE SHEET 36/40.
5. SHEAR STUDS SHALL BE WELDED AT AN ANGLE TO MAINTAIN CLEARANCE IN PARAPET.

DESIGNED		CHECKED		DESIGN AGENCY	
SUJ		CLB		STRUCTUREPOINT	
DRAWN		REVISED		DATE	
DSH				11/12/18	
REVISED				STRUCTURE FILE NUMBER	
				3115577	
EXPANSION JOINT DETAILS (RIGHT BRIDGE)					
BRIDGE NO. HAM-74-1852 L/R					
OVER NB BEEKMAN ST. (U.S. 27)					
HAM-75-3.84					
PID No. 104667					
35/40					
77					
120					

SFlanagan 11/16/2023 9:34:42 AM
 \0\2017\01113\C.Design\104667-HAM-75-3.84\Design\Structures\HAM0074-1852C\Sheets\74-1852EX012.dgn

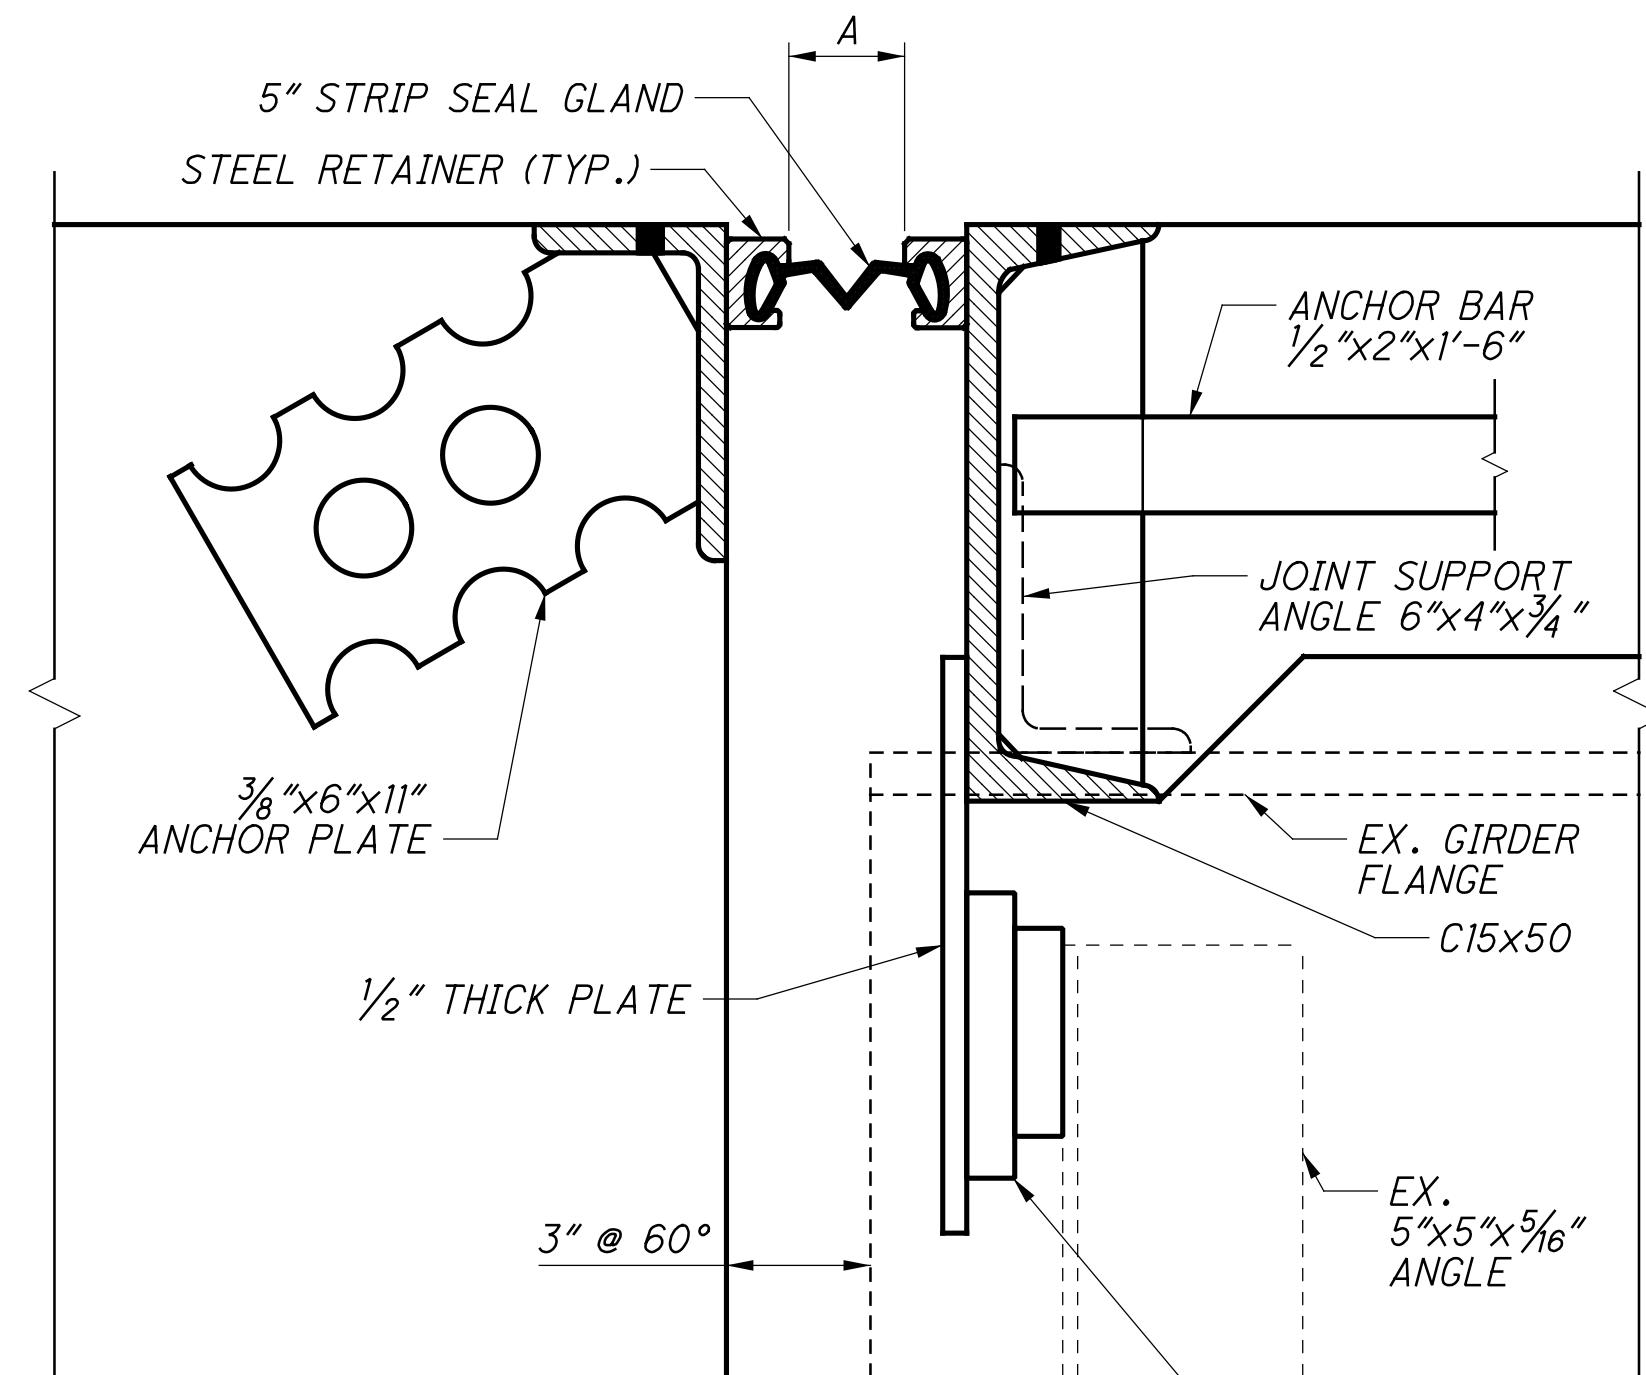

EXPANSION JOINT SECTION


SHIM PLATES
 (SEE TABLES ON
 SHEET 23/40).

REAR 5" STRIP SEAL DETAIL

AMBIENT TEMP.	DIMENSION "A" (IN.)
30°	2 7/8"
40°	2 3/4"
50°	2 1/6"
60°	2 5/8"
70°	2 1/2"
80°	2 1/6"
90°	2 5/8"

FWD 5" STRIP SEAL DETAIL

AMBIENT TEMP.	DIMENSION "A" (IN.)
30°	2 1/6"
40°	2 1/6"
50°	2 5/8"
60°	2 5/8"
70°	2 9/16"
80°	2 9/16"
90°	2 1/2"

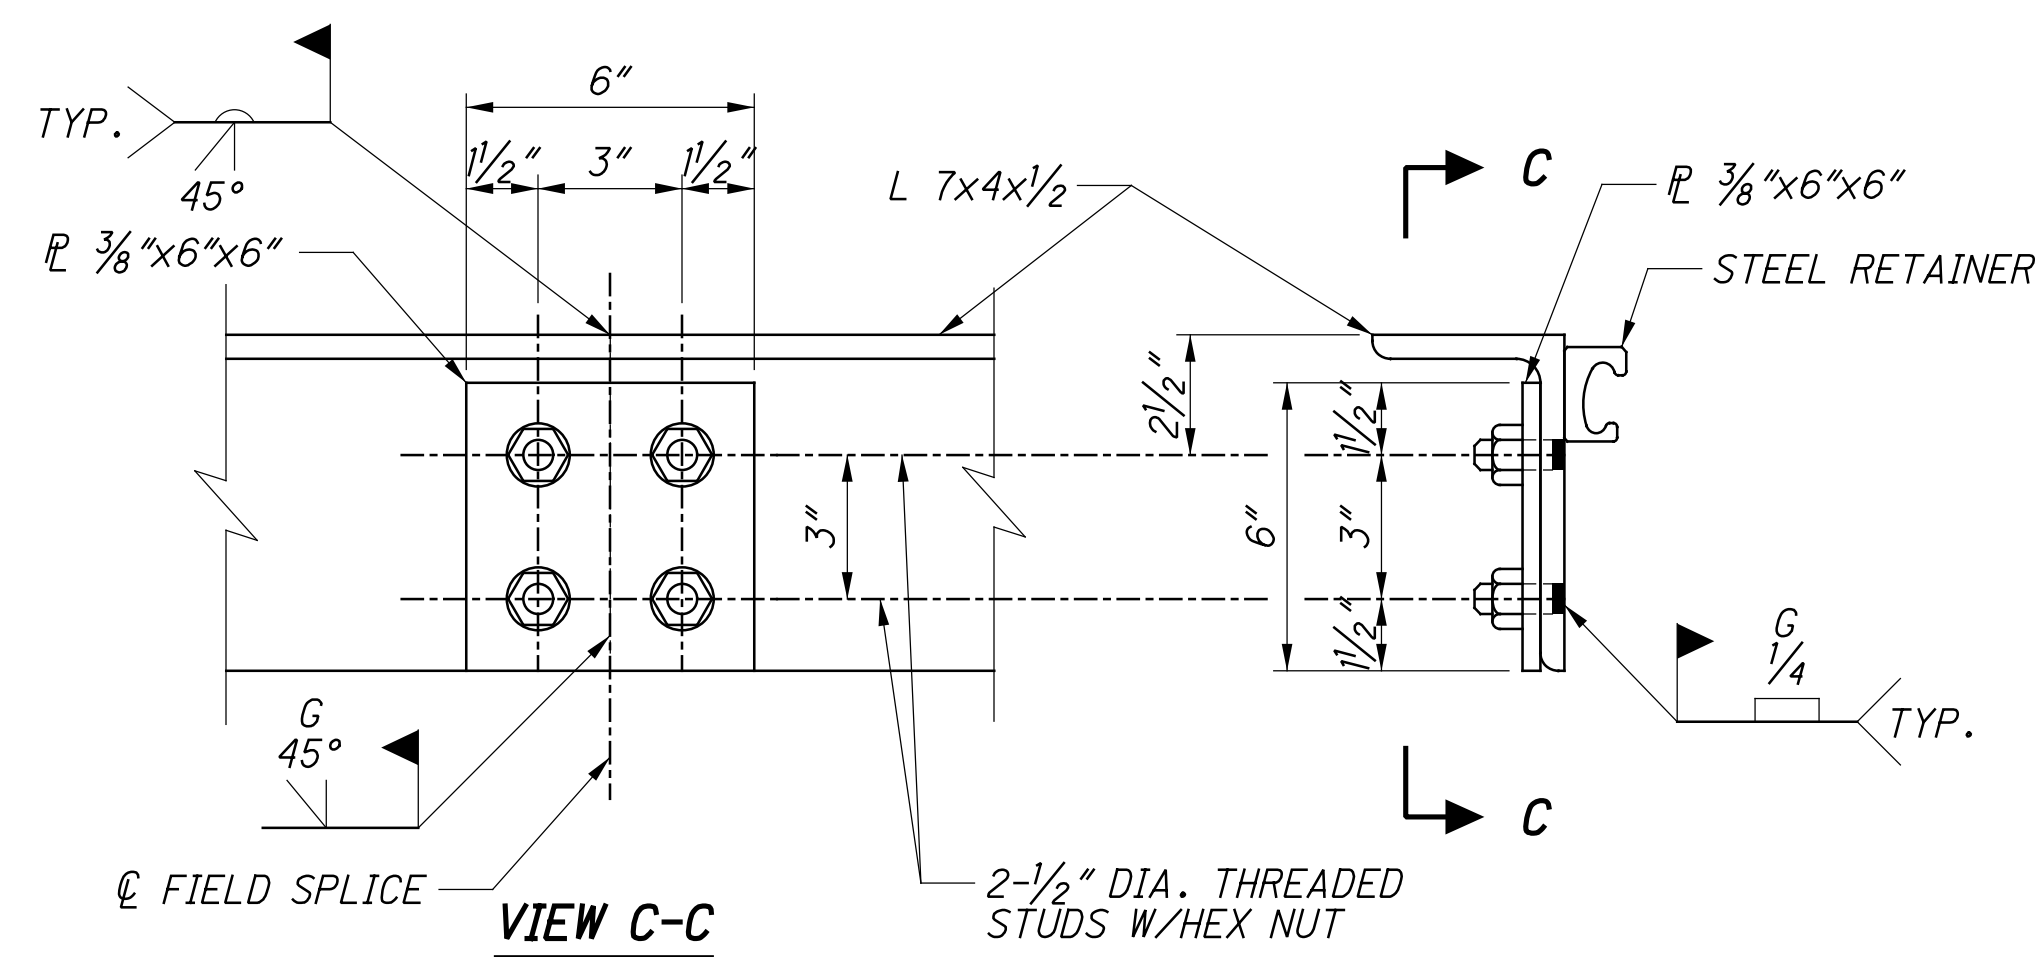



**END OF BACKWALL ANGLE
 FIELD SPLICE DETAILS**

(FOR ADDITIONAL DETAILS, SEE STD. DWG. EXJ-4-87)

NOTES:

1. FOR ADDITIONAL STRIP SEAL JOINT DETAILS AND NOTES, SEE STANDARD DWG. EXJ-4-87.

S:\Flanagan 11/16/2023 9:34:42 AM 11/16/2023 9:34:42 AM
 \01\2017\01113\C.Design\104667-HAM-75-3.84\Design\Structures\HAM0074_1852C_Sheets\74_1852MD001.dgn

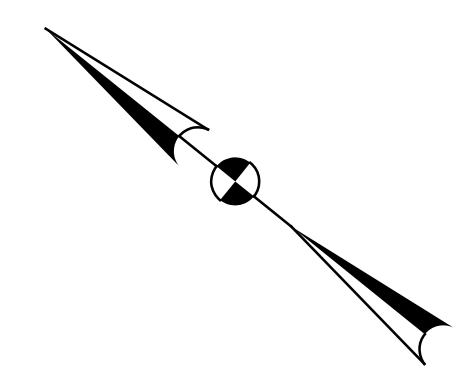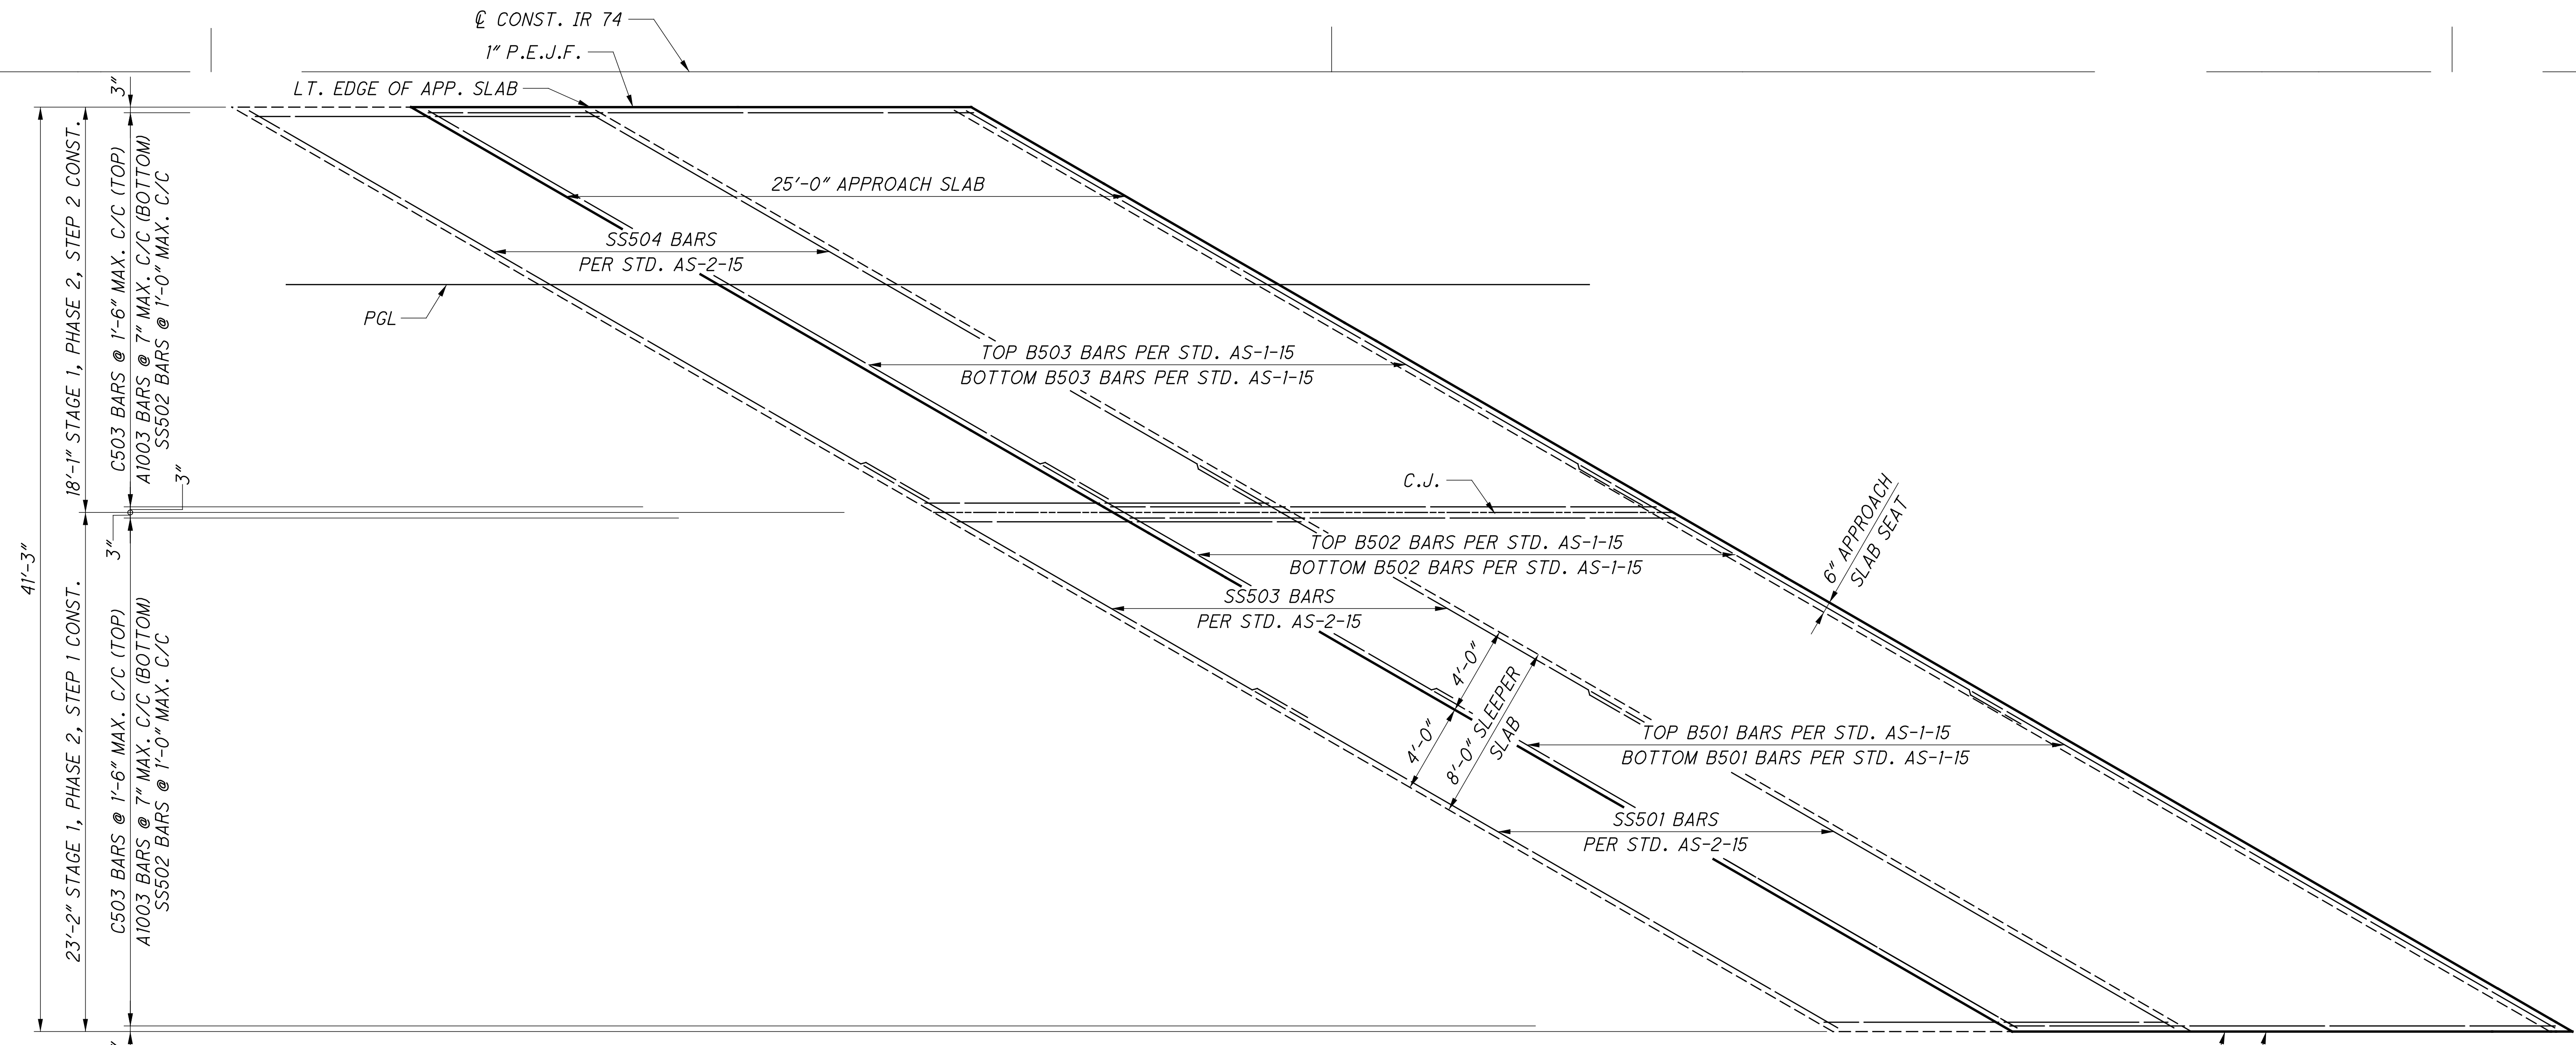

APPROACH SLAB ELEVATIONS										
APPROACH LINE	DESCRIPTION	BEGIN REAR SLEEPER SLAB	BEGIN REAR APPROACH SLAB	END REAR SLEEPER SLAB	END REAR APPROACH SLAB	STRUCTURE LIMITS	BEGIN FWD. APPROACH SLAB	BEGIN FWD. SLEEPER SLAB	END FWD. APPROACH SLAB	END FWD. SLEEPER SLAB
LT. EDGE APP. SLAB	STATION	998+00.77	998+08.77	998+08.77	998+33.77		1001+48.53	1001+64.95	1001+72.64	1001+80.30
	OFFSET	1.50	1.50	1.50	1.50		1.43	1.41	1.40	1.39
	ELEVATION	535.14	536.34	535.09	536.17		533.79	532.91	533.59	532.78
PGL	STATION	998+11.45	998+19.45	998+19.45	998+44.45		1001+58.74	1001+75.06	1001+82.70	1001+90.32
	OFFSET	7.66	7.66	7.66	7.66		7.58	7.56	7.56	7.55
	ELEVATION	534.97	536.17	534.92	536.00		533.88	533.02	533.71	532.91
C.J.	STATION	998+32.24	998+40.24	998+40.24	998+65.24		1001+78.39	1001+94.52	1002+02.08	1002+09.61
	OFFSET	19.66	19.66	19.66	19.66		19.56	19.54	19.54	19.53
	ELEVATION	534.64	535.84	534.59	535.67		534.12	533.30	534.02	533.21
RT. EDGE APP. SLAB	STATION	998+72.51	998+80.51	998+80.51	999+05.51		1002+15.67	1002+31.47	1002+38.87	1002+46.24
	OFFSET	42.91	42.91	42.91	42.91		42.77	42.76	42.75	42.74
	ELEVATION	534.00	535.19	533.94	535.02		534.76	533.90	534.60	533.80

MINIMUM BAR LAP	
#5	2'-7"

NOTES:
 1. FOR STANDARD APPROACH SLAB DETAILS, SEE STANDARD BRIDGE DWG. AS-1-15 AND STANDARD BRIDGE DWG. AS-2-15.

APPROACH SLAB DETAILS (RIGHT BRIDGE)
 BRIDGE NO. HAM-74-1852 L/R
 OVER NB BEEKMAN ST. (U.S. 27)


DESIGNED	REVIEWED	DATE	DESIGN AGENCY
SUF	MDS	11/12/18	STRUCTUREPOINT
CHECKED	STRUCTURE FILE NUMBER	3115577	
CLB	REVISED		

HAM-75-3.84
PID No. 104667

37/40

79
120

SFlanagan 11/16/2023 9:34:43 AM
 \\0\2017\01113\C.Design\104667-HAM-75-3.84\Design\Structures\HAM0074_1852C\Sheets\74_1852MD002.dgn

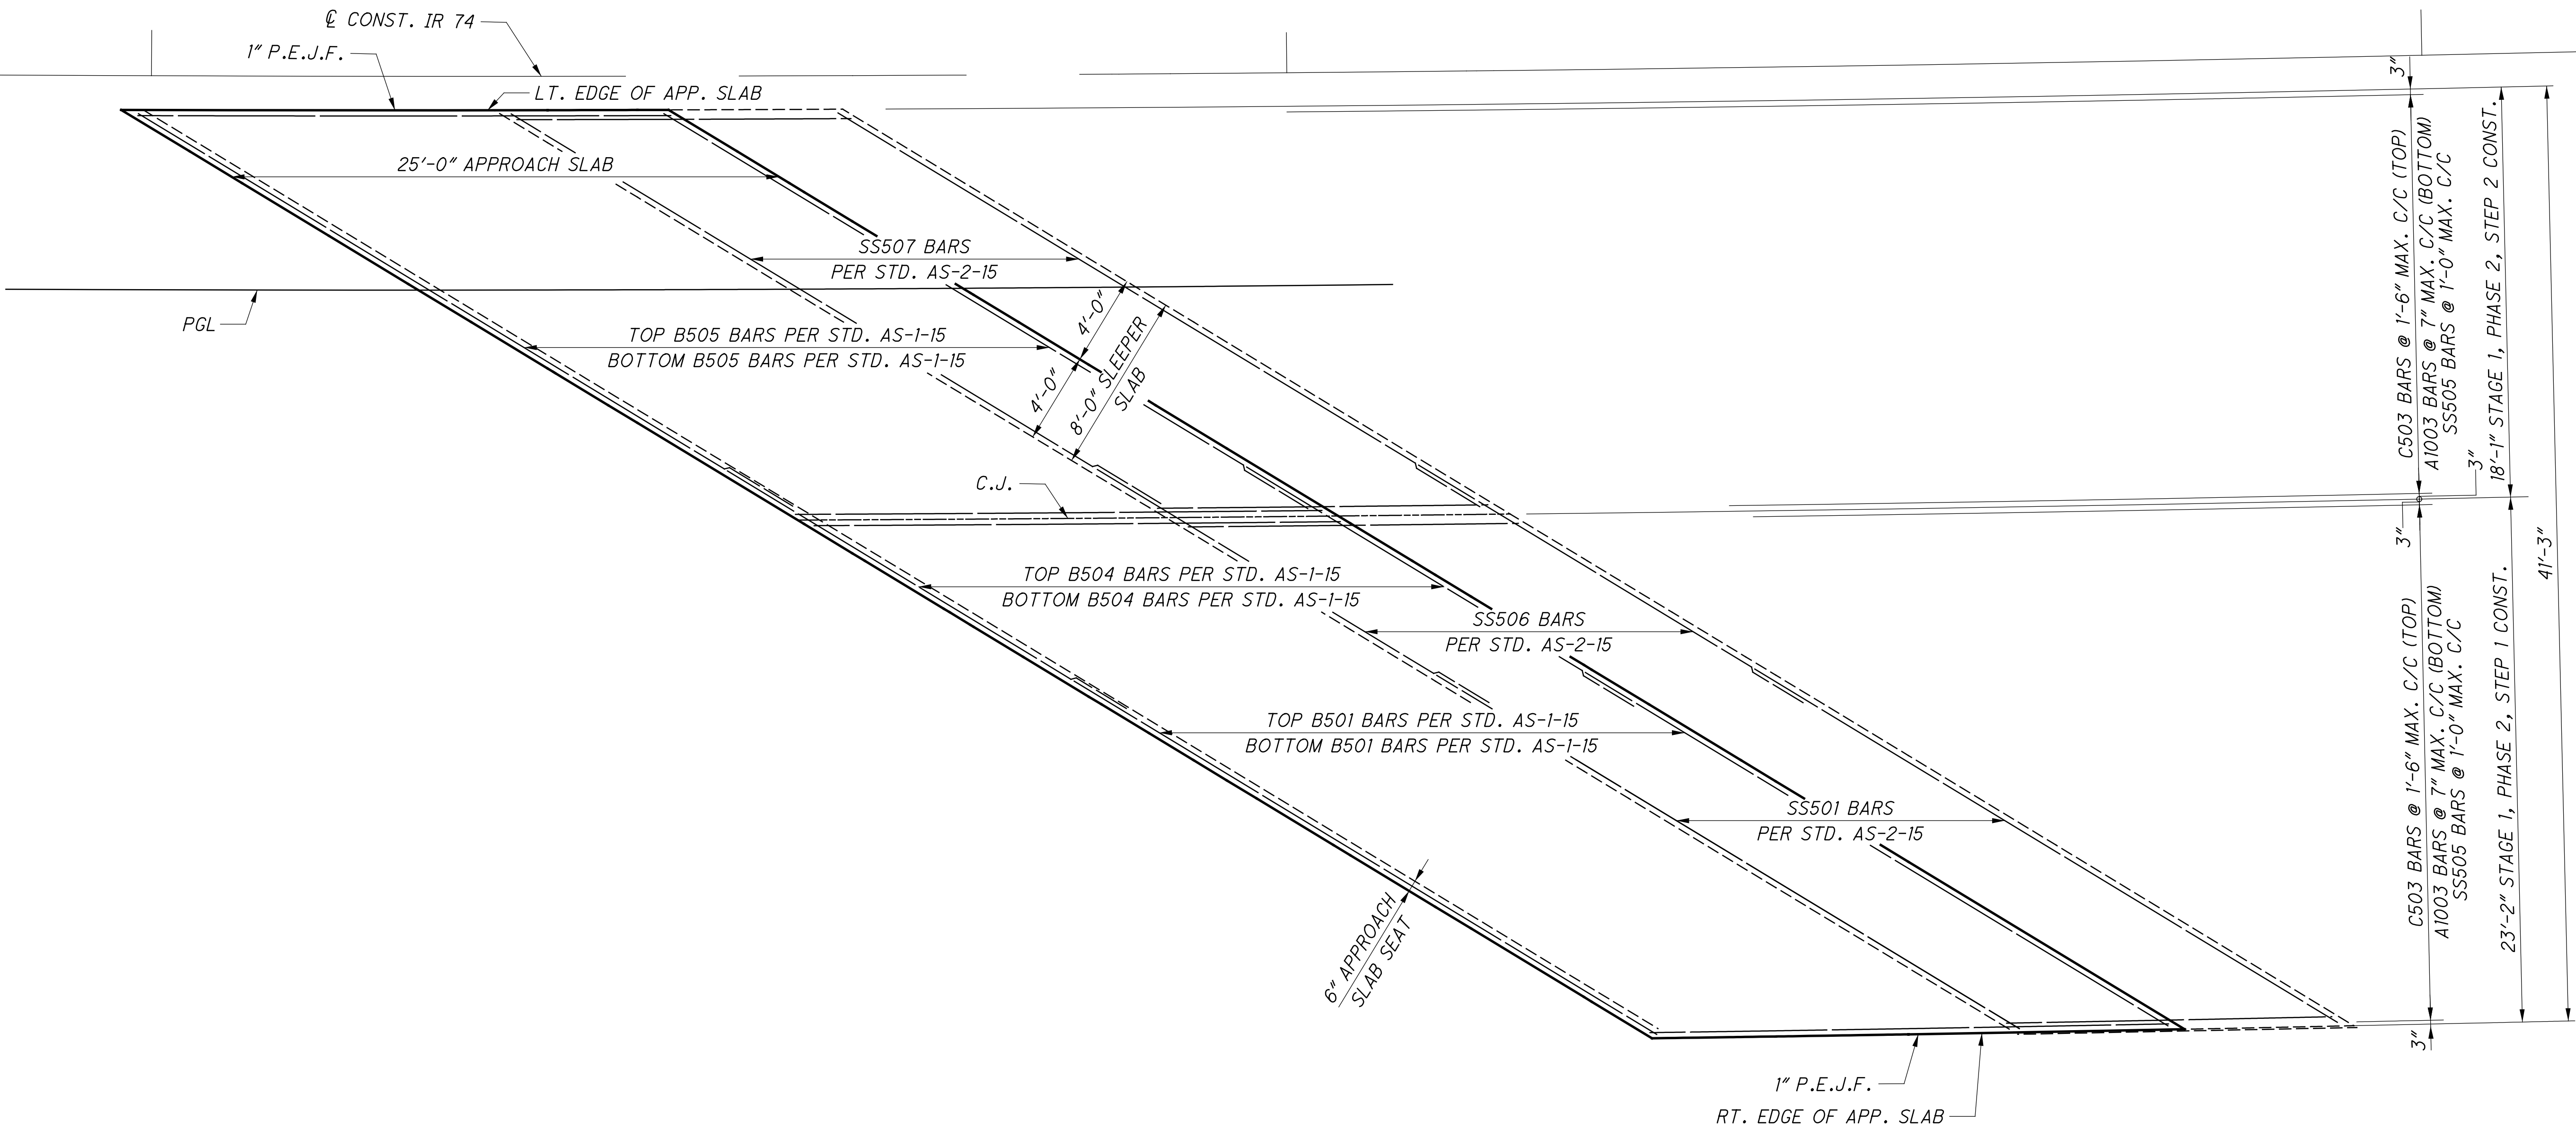

PLAN
FORWARD APPROACH SLAB

MINIMUM BAR LAP	
#5	2'-7"

- NOTES:
- FOR STANDARD APPROACH SLAB DETAILS, SEE STANDARD BRIDGE DWG. AS-1-15 AND STANDARD BRIDGE DWG. AS-2-15.
 - FOR APPROACH SLAB ELEVATIONS, SEE SHEET 37/40.





S:\Flanagan\11/16/2023 9:34:43 AM\0\2017\01113\C.Design\104667-HAM-75-3.84.Design\Structures\HAM0074_1852C\Sheets\74_1852RL001.dgn

REINFORCING STEEL LIST

MARK	NUMBER			LENGTH	WEIGHT	TYPE	DIMENSIONS						
	REAR ABUT.	FORWARD ABUT.	TOTAL				A	B	C	D	E	R	INC
ABUTMENTS													
A501	8	8	16	4'-4"	72	STR							
① A502	24	24	48	30'-0"	1502	STR							
① A503	12		12	23'-0"	288	STR							
A504	NOT USED												
A505	1		1	6'-3"	7	STR							
A506	1		1	4'-3"	4	STR							
A507	9		9	8'-9"	82	STR							
A508	3		3	13'-6"	42	STR							
A509		12	12	20'-6"	257	STR							
A510		12	12	12'-0"	150	STR							
A601	172	168	340	5'-3"	2681	STR							
A602	172	168	340	6'-6"	3320	1	1'-4"	5'-4"					
A603	86	84	170	10'-1"	2575	2	4'-9"	0'-11"	4'-9"				
D801	58	55	113	5'-10"	1760	18	3'-8"	1'-0"	1'-0"				
SP601	11		11	4'-9"	78	1	1'-11"	3'-0"					
SP602	9		9	5'-0"	68	1	2'-2"	3'-0"					
SP801	16		16	5'-10"	249	1	2'-1"	4'-0"					
SP802	12		12	6'-1"	195	1	2'-4"	4'-0"					
SUB-TOTAL					13,330								

① REQUIRES MECHANICAL CONNECTORS. (12 REQUIRED)

MARK	NUMBER			LENGTH	WEIGHT	TYPE	DIMENSIONS						
	REAR ABUT.	FORWARD ABUT.	TOTAL				A	B	C	D	E	R	INC
APPROACH SLABS													
B501	57	57	114	30'-0"	3567	STR							
B502	57		57	23'-0"	1367	STR							
B503	57		57	34'-9"	2066	STR							
B504		57	57	20'-6"	1219	STR							
B505		57	57	33'-3"	1977	STR							
C503	30	30	60	24'-6"	1533	STR							
SS501	8	8	16	30'-0"	501	STR							
SS502	43		43	15'-4"	688	STR							
SS503	8		8	23'-0"	192	STR							
SS504	8		8	34'-9"	290	STR							
SS505		43	43	14'-6"	650	STR							
SS506		8	8	20'-6"	171	STR							
SS507		8	8	33'-3"	277	STR							
A1003	72	72	144	25'-11"	16059	16	24'-6"						
SUB-TOTAL					30,557								

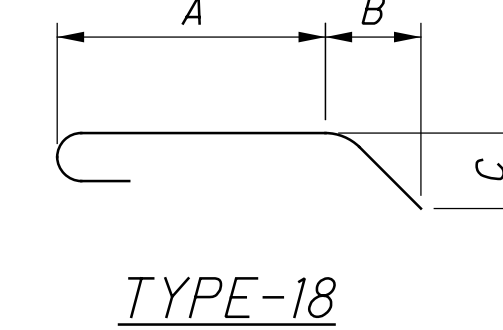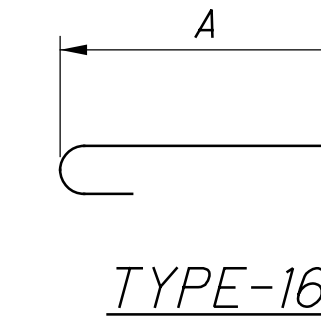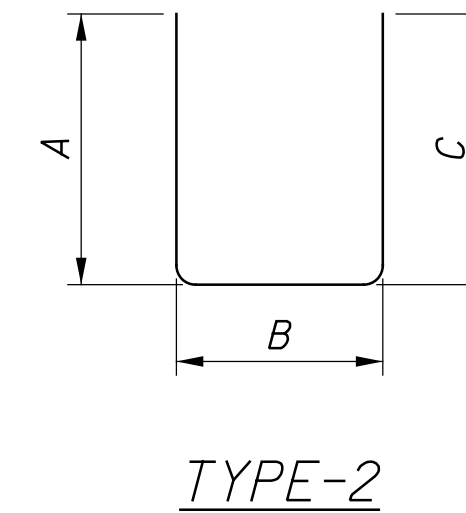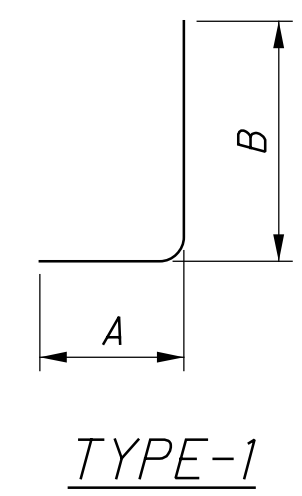

NOTES:

① REQUIRES MECHANICAL CONNECTORS (NON-PROTRUDING TYPE)

AN APPROVED TYPE OF MECHANICAL CONNECTOR FOR REINFORCING SHALL BE PROVIDED. INSTALLATION OF THE CONNECTORS SHALL CONFORM WITH RECOMMENDED MANUFACTURER'S PROCEDURES. IF A DOWEL BAR SPLICE IS FURNISHED, THE MINIMUM DOWEL BAR LENGTH TO BE INCLUDED WITH THE CONNECTOR SHALL BE GIVEN BY THE DIMENSION "L" SHOWN BELOW :
#5 REINFORCING BAR, L = 3'-6"

WHERE MECHANICAL CONNECTORS ARE REQUIRED THE REINFORCING BAR LENGTH IS MEASURED TO THE CONSTRUCTION JOINT. EXTRA BAR LENGTH AND/OR BAR PREPARATION MAY BE NECESSARY DEPENDING ON THE TYPE OF MECHANICAL CONNECTOR FURNISHED.

REINFORCING STEEL LIST (RIGHT BRIDGE)

BRIDGE NO. HAM-74-1852 L/R
OVER NB BEEKMAN ST. (U.S. 27)

HAM-75-3.84
PID No. 104667

39/40

81
120

DESIGN AGENCY
STRUCTUREPOINT
200 CORPORATE CENTER DR., 17TH FL.
ANN ARBOR, MI 48106
TEL: 734.964.3333 FAX: 734.964.3336
WWW.STRUCTUREPOINT.COM

DESIGNED BY
SUF
CHECKED BY
CLB

DRAWN BY
DSH
REVISED


REVIEWED BY
MDS
STRUCTURE FILE NUMBER
3115577

DATE
11/12/18

S:\Flanagan\11/16/2023\01\2017\01113\C.Design\104667-HAM-75-3.84\Design\Structures\HAM0074_1852C\Sheets\74_1852RL002.dgn

MARK	NUMBER TOTAL	LENGTH	WEIGHT	TYPE	DIMENSIONS						
					A	B	C	D	E	R	INC
SUPERSTRUCTURE											
S401	770	30'-0"	15431	STR							
S402	70	4'-1"	191	STR							
S403	3530	3'-1"	7271	6	1'-0"	0'-7"	0'-8"				
S404	576	5'-4"	2052	2	3'-0"	0'-6 1/4"	2'-0"				
S405	571	3'-6"	1335	2	2'-1"	0'-6 1/4"	1'-1"				
S501	20	10'-0"	209	STR							
① S502	4	23'-6"	98	STR							
S503	543	30'-0"	16990	STR							
S504	NOT USED										
① S505	505	25'-2"	13256	16	24'-7"						
	1 SR	3'-9"									
S506	OF	TO	964	STR						0'-3 3/4"	
	66	24'-3"									
	2 SR	1'-6"									
① S507	OF	TO	2075	STR						0'-3 1/2"	
	77	24'-4"									
S508	51	10'-6"	559	STR							
① S509	505	24'-7"	12948	STR							
S510	4	39'-2"	163	STR							
	1 SR	4'-7"			4'-0"						
S511	OF	TO	664	16	TO					0'-3 1/2"	
	52	19'-11"			19'-4"						
S512	524	20'-2"	11022	16	19'-7"						
	2 SR	3'-9"									
S513	OF	TO	1228	STR						0'-3 3/4"	
	51	19'-4"									
S514	8	3'-6"	29	STR							
S515	118	40'-0"	4923	STR							
S516	118	20'-1"	2472	STR							
	1 SR	4'-4"			3'-9"						
S517	OF	TO	1004	16	TO					0'-3 3/4"	
	66	24'-10"			24'-3"						
S518	524	19'-7"	10703	STR							
	1 SR	4'-0"									
S519	OF	TO	633	STR						0'-3 1/2"	
	52	19'-4"									
S520	1136	4'-2"	4937	STR							
SUB-TOTAL			111,157								

① REQUIRES MECHANICAL CONNECTORS. (1168 REQUIRED)

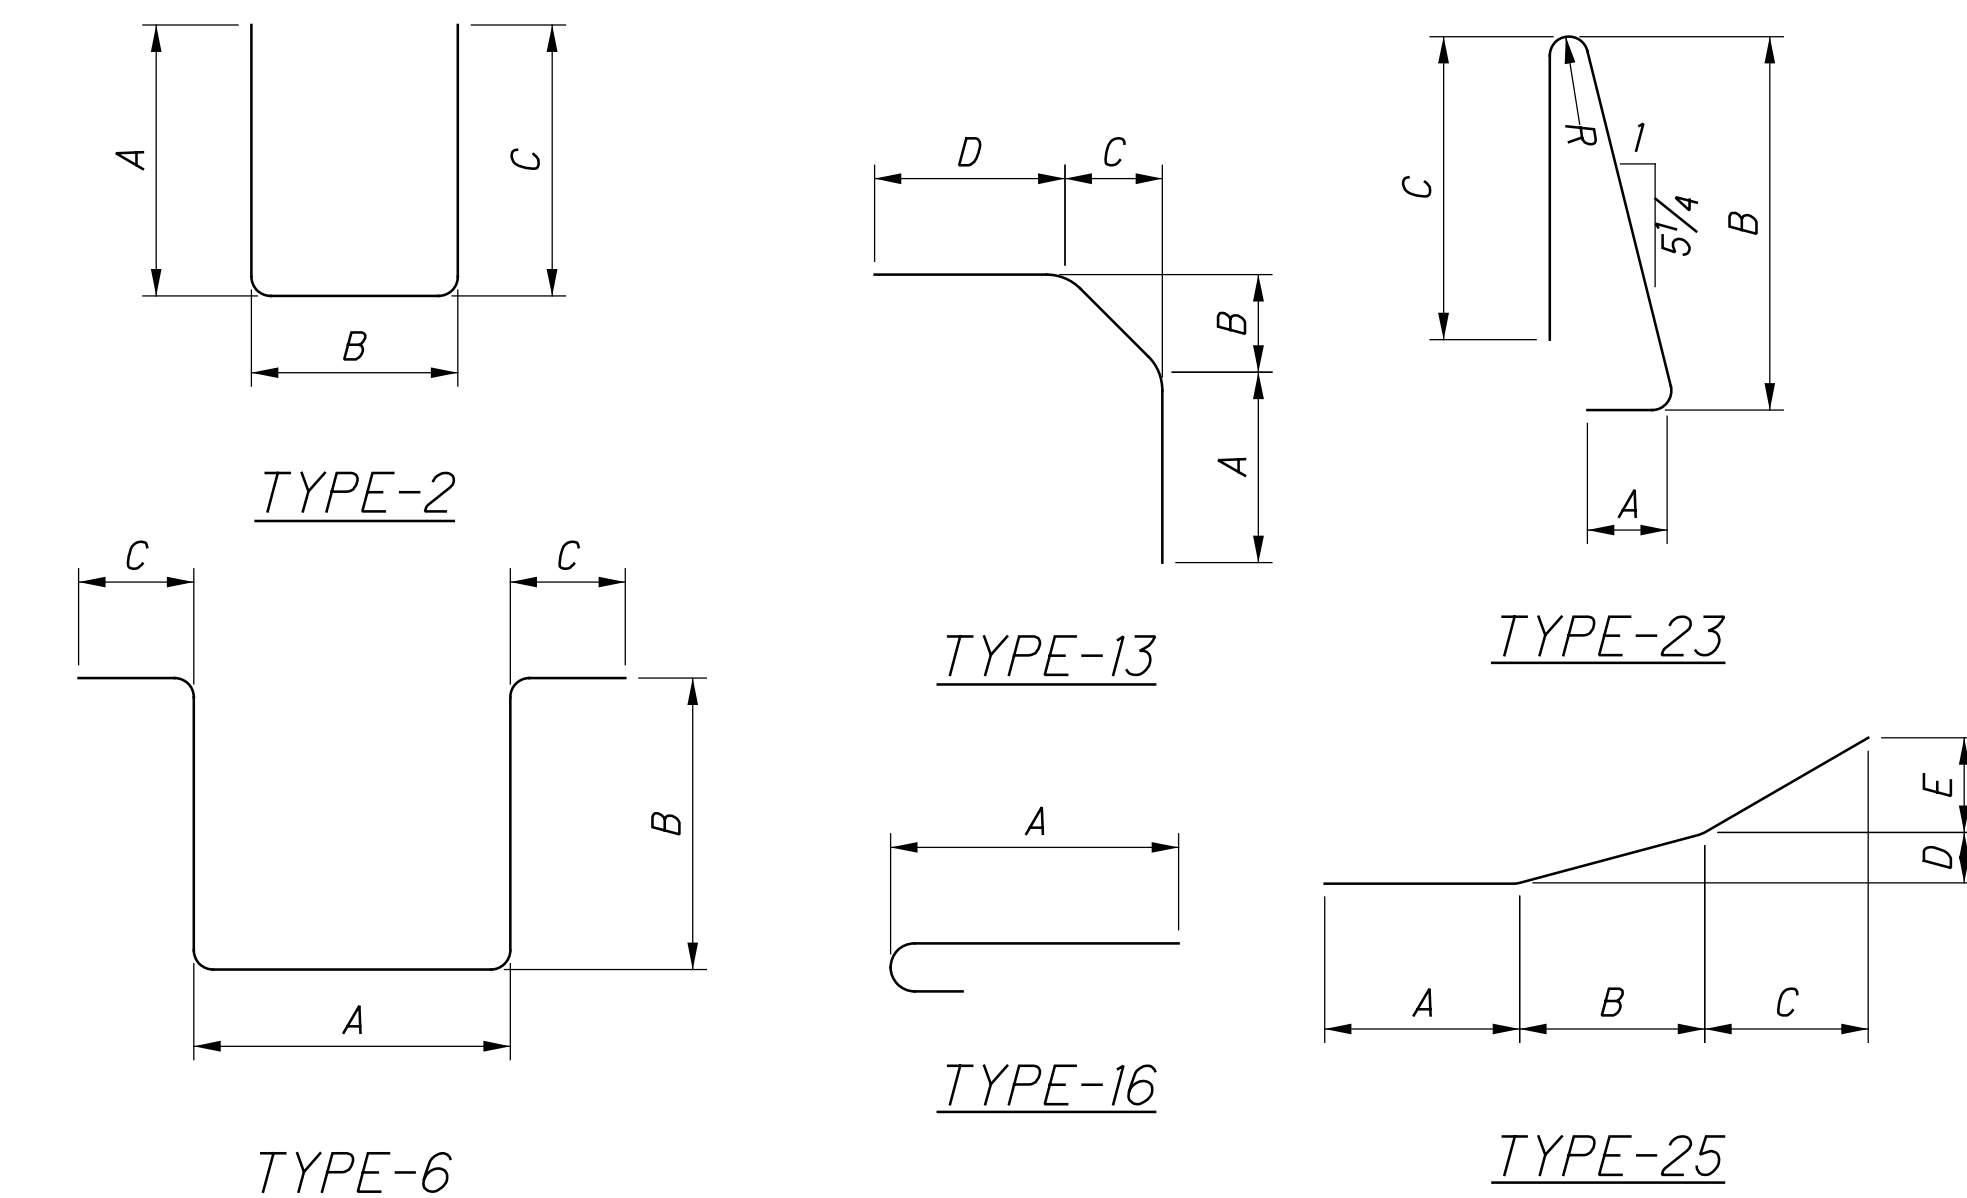

MARK	NUMBER TOTAL	LENGTH	WEIGHT	TYPE	DIMENSIONS						
					A	B	C	D	E	R	INC
PARAPETS											
PS501	371	7'-4"	2838	23	0'-11"	3'-3"	3'-0"			0'-3"	
PS502	12	9'-7"	120	STR							
PS503	88	14'-8"	1346	STR							
PS504	128	7'-2"	957	STR							
PS505	80	30'-0"	2503	STR							
PS506	4	30'-6"	127	STR							
PS507	1	11'-10"	12	STR							
PS508	1	7'-0"	7	STR							
PS509	6	11'-2"	70	STR							
PS510	3	13'-9"	43	STR							
PS511	3	8'-3"	26	STR							
PS512	4	33'-7"	140	STR							
PS513	328	9'-10"	3364	41	0'-11"	4'-3"	4'-0"			0'-3"	
PS514	2	21'-0"	44	STR							
PS515	2	18'-11"	39	STR							
PS516	2	9'-8"	20	STR							
PS517	4	23'-5"	98	STR							
PS518	1	9'-6"	10	STR							
PS519	1	8'-2"	9	STR							
PS520	4	5'-9"	24	25	1'-10"	2'-5"	1'-5"	0'-1 1/2"	0'-5"		
PS521	4	6'-3"	26	STR							
PS522	20	3'-0"	63	STR							
PS523	8	10'-5"	87	44	1'-0"	4'-6"	4'-3"			0'-6 1/4"	
PS524	1	11'-1"	12	STR							
PS525	1	8'-11"	9	STR							
PS526	328	5'-7"	1910	43	1'-1"	1'-0"	1'-7"	1'-7"			
PS527	8	9'-6"	79	43	2'-0"	2'-3"	1'-7"	1'-7"			
PS601	326	5'-7"	2734	40	1'-1"	1'-0"	1'-7"	1'-7"			
PS603	1	10'-9"	16	STR							
PS604	22	14'-8"	485	STR							
PS605	32	7'-2"	344	STR							
PS606	1	8'-4"	13	STR							
PS607	1	12'-5"	19	STR							
PS608	2	9'-8"	29	STR							
PS609	1	10'-2"	15	STR							
PS610	45	3'-1"	208	STR							
PS611	45	3'-11"	265	13	2'-2"	0'-11"	0'-2 1/4"	0'-11"			
PS612	1	8'-10"	13	STR							
	2 SR	3'-5"									
PS613	OF	TO	127	STR						0'-1"	
	11	4'-3"									
PS614	8	3'-5"	41	STR							
PS615	2	3'-0"	9	STR							
PS616	1	10'-0"	15	STR							
SUB-TOTAL			18,316								
*PS527A	8	-	-	-							
*PS527B	8	-	-	-							

PS602 NOT USED.
* GALVANIZED BAR, SEE SHEET 32/40 FOR DETAILS.

NOTES:

① REQUIRES MECHANICAL CONNECTORS (NON-PROTRUDING TYPE)

AN APPROVED TYPE OF MECHANICAL CONNECTOR FOR REINFORCING SHALL BE PROVIDED. INSTALLATION OF THE CONNECTORS SHALL CONFORM WITH RECOMMENDED MANUFACTURER'S PROCEDURES. IF A DOWEL BAR SPLICE IS FURNISHED, THE MINIMUM DOWEL BAR LENGTH TO BE INCLUDED WITH THE CONNECTOR SHALL BE GIVEN BY THE DIMENSION "L" SHOWN BELOW :
#5 REINFORCING BAR, L = 3'-6"

WHERE MECHANICAL CONNECTORS ARE REQUIRED THE REINFORCING BAR LENGTH IS MEASURED TO THE CONSTRUCTION JOINT. EXTRA BAR LENGTH AND/OR BAR PREPARATION MAY BE NECESSARY DEPENDING ON THE TYPE OF MECHANICAL CONNECTOR FURNISHED.

REINFORCING STEEL LIST (RIGHT BRIDGE)

BRIDGE NO. HAM-74-1852 L/R
OVER NB BEEKMAN ST. (U.S. 27)

DESIGN AGENCY: **STRUCTUREPOINT**

REVIEWED: MDS 11/15/18
DATE: 11/15/18
FILE NUMBER: 3115577

DRAWN: TLH
CHECKED: CLB


DESIGNED: SUJ
CHECKED: CLB

HAM-75-3.84
PID No. 104667

40/40


82
120

SFlannagan
 11/16/2023 9:34:46 AM
 C:\2017\GIS\Gis\Design\104667_HAM-75-3.84\Design\Structures\HAM0074-18926_Sheets\74-18926P001.dgn

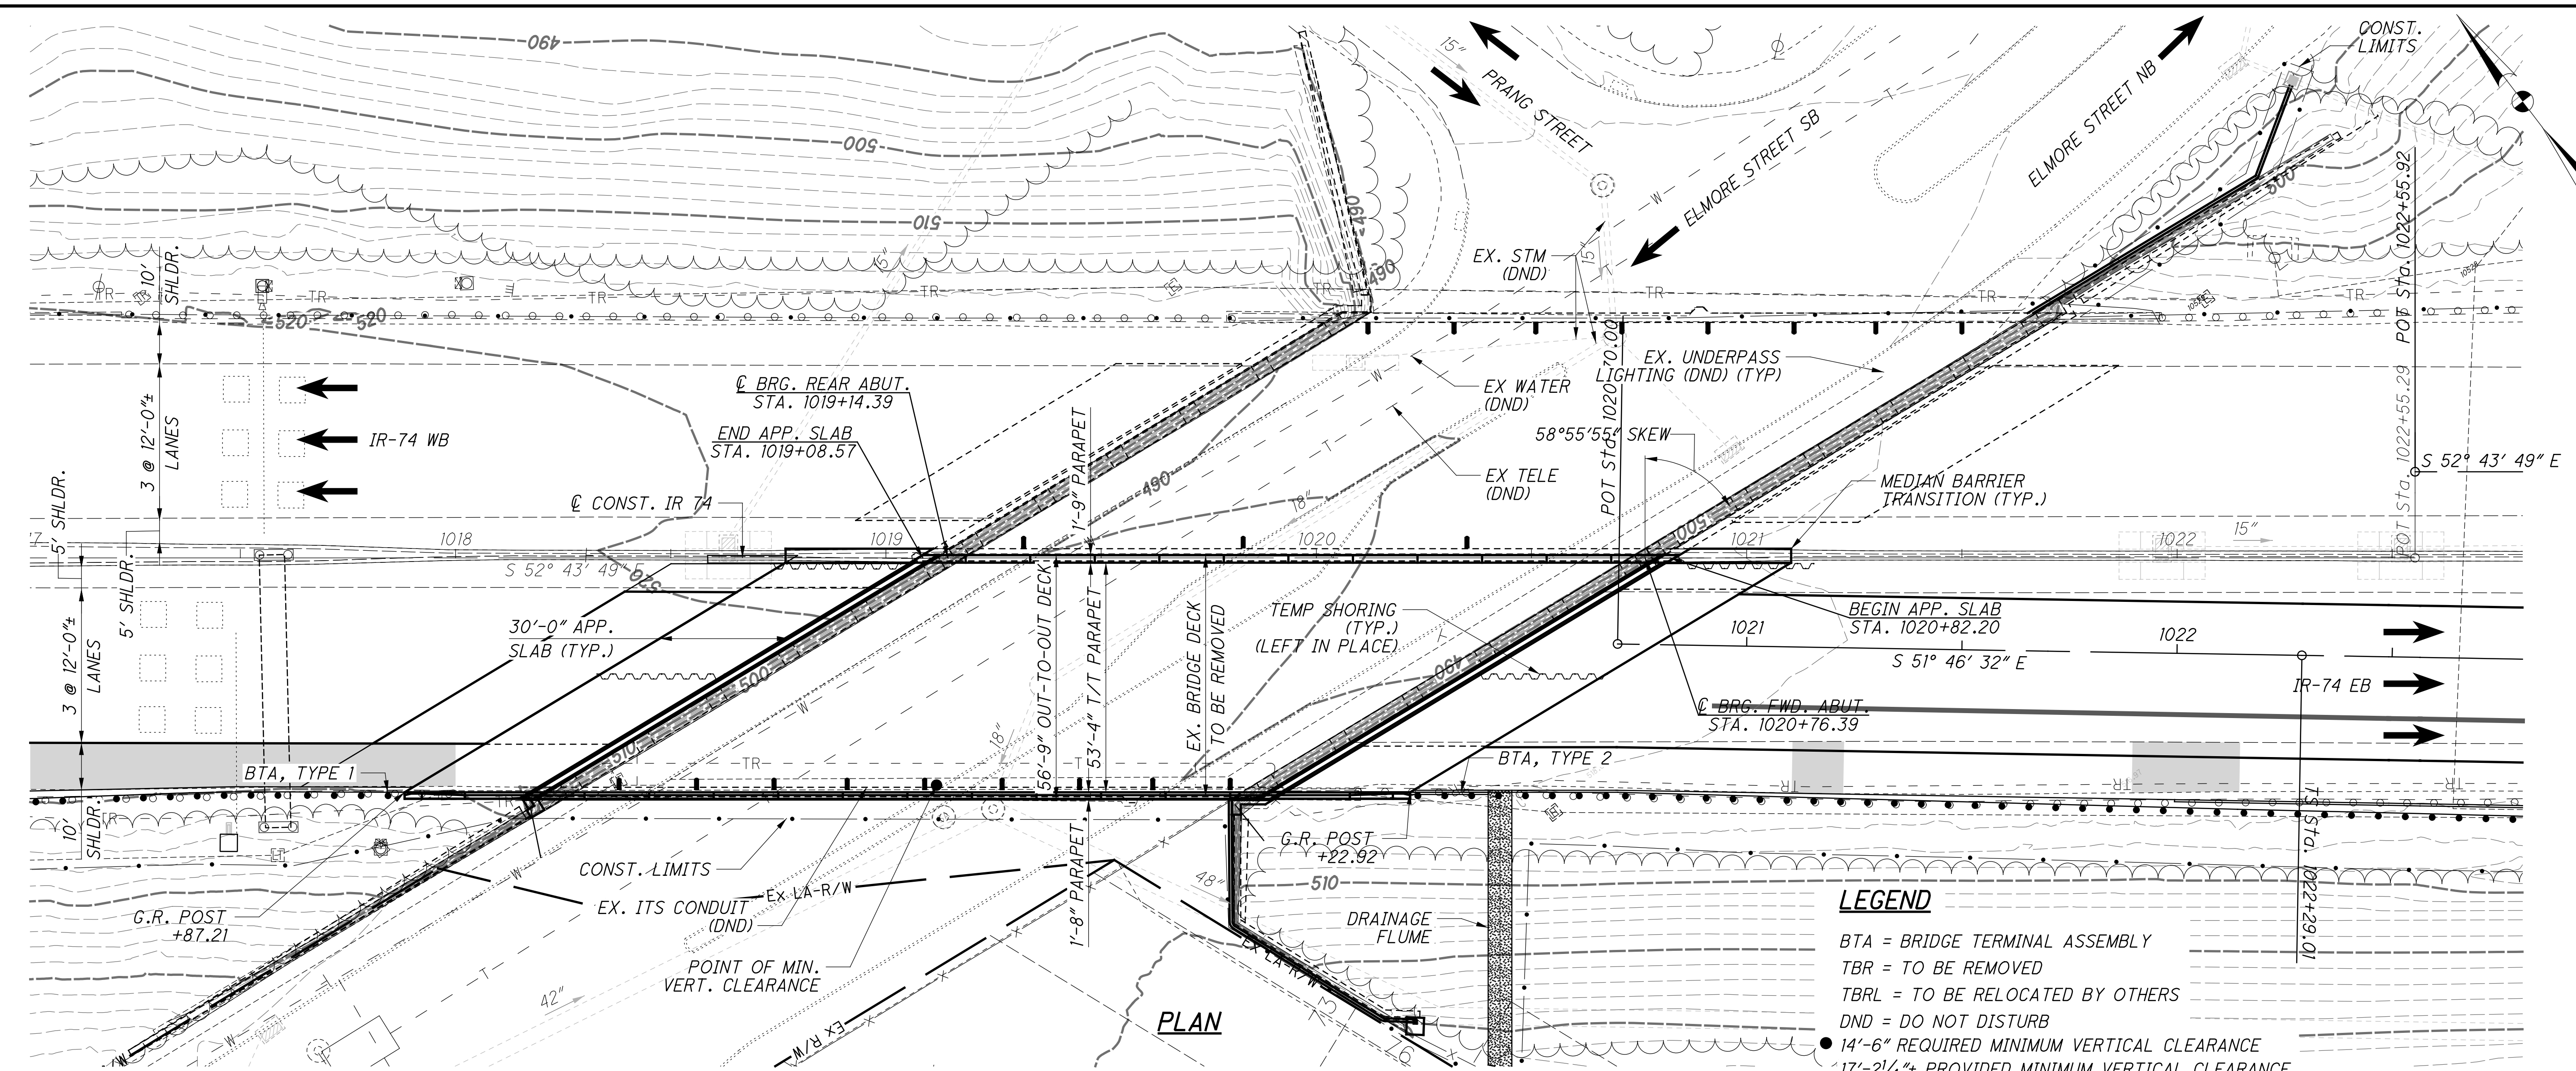

LEGEND

BTA = BRIDGE TERMINAL ASSEMBLY
 TBR = TO BE REMOVED
 TBRL = TO BE RELOCATED BY OTHERS
 DND = DO NOT DISTURB
 14'-6" REQUIRED MINIMUM VERTICAL CLEARANCE
 17'-2 1/4" PROVIDED MINIMUM VERTICAL CLEARANCE

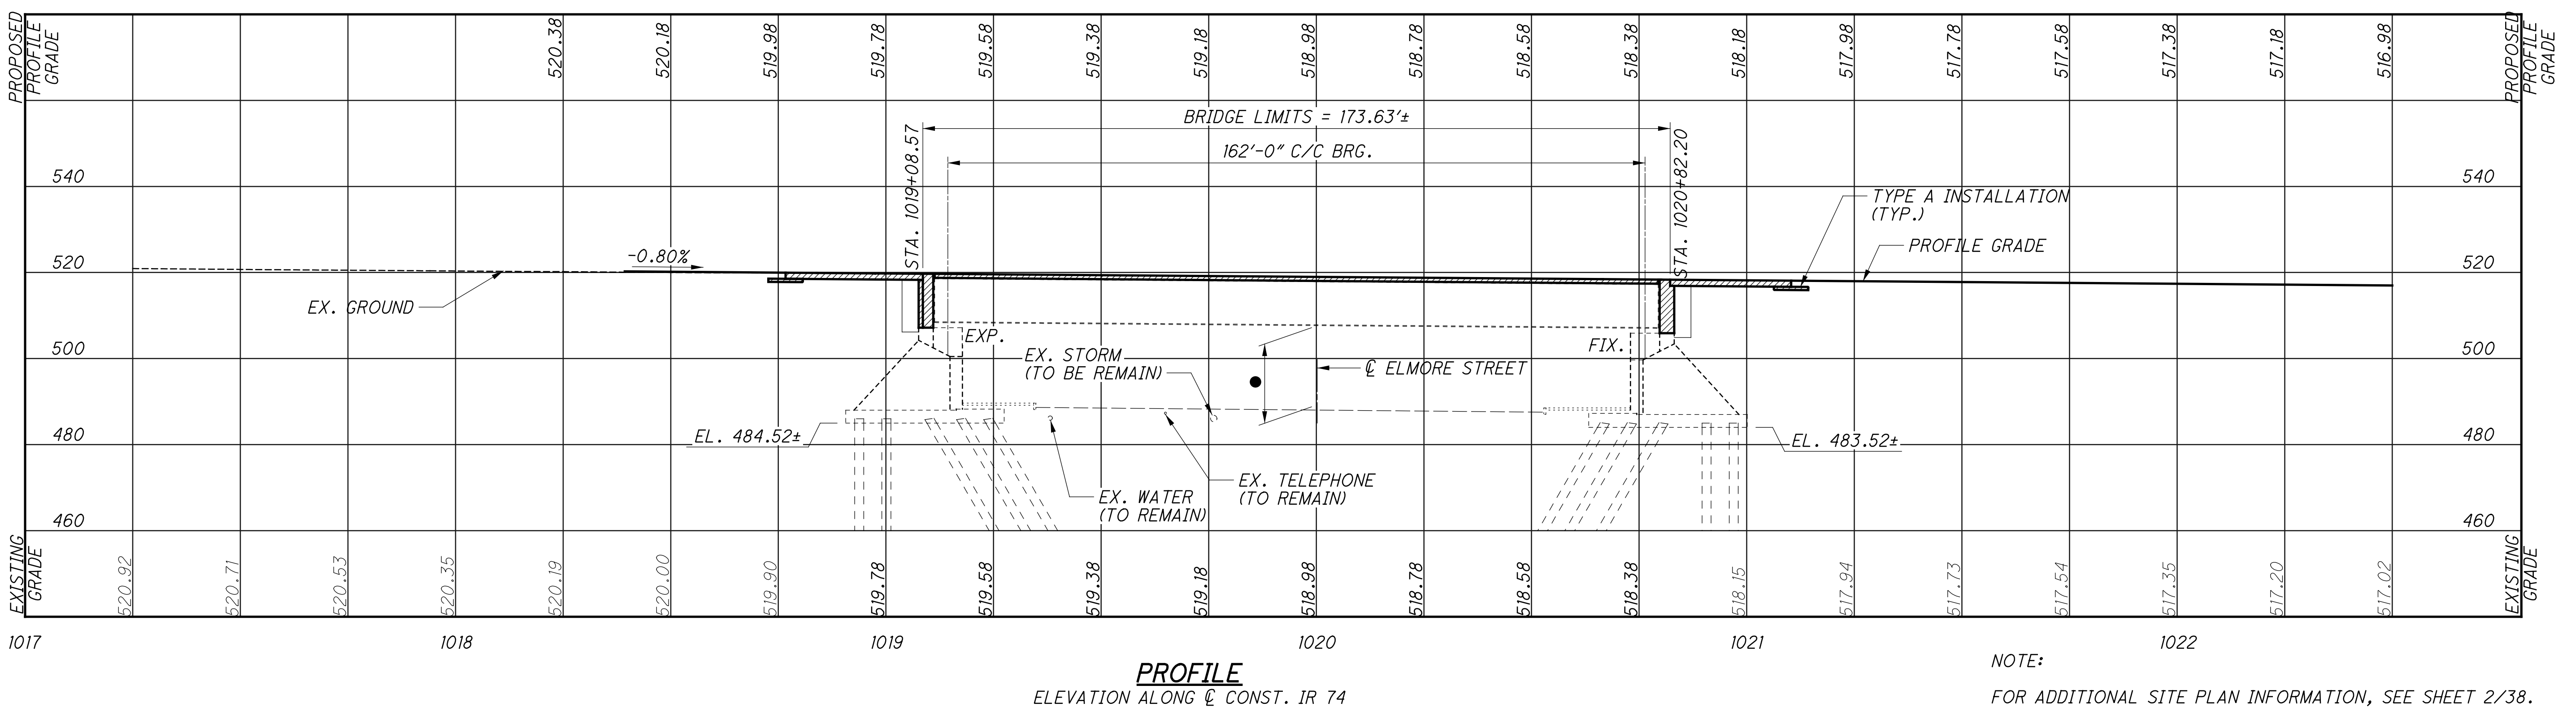

NOTE:
 FOR ADDITIONAL SITE PLAN INFORMATION, SEE SHEET 2/38.

DESIGN AGENCY
STRUCTUREPOINT
 2000 CORPORATE CENTER DR., 10TH FLOOR
 WASHINGTON, DC 20004
 TEL: (800) 422-2222 FAX: (202) 462-6000

DATE: 9/12/18
 REVIEWED: MDS
 DRAWN: BMP
 DESIGNED: SJF
 CHECKED: CLB


HAMILTON COUNTY
 STA. 1019+08.57
 STA. 1020+82.20

SITE PLAN
 BRIDGE NO. HAM-74-1892 L/R
 OVER ELMORE STREET

HAM-75-3.84
 PID No. 104667

1/38
 83
 120

S:\Flanagan\11/16/2023 9:34:47 AM\0\2017\01113\C.Design\104667-HAM-75-3.84\Design\Structures\HAM0074_1892C\Sheets\74_1892GP002.dgn

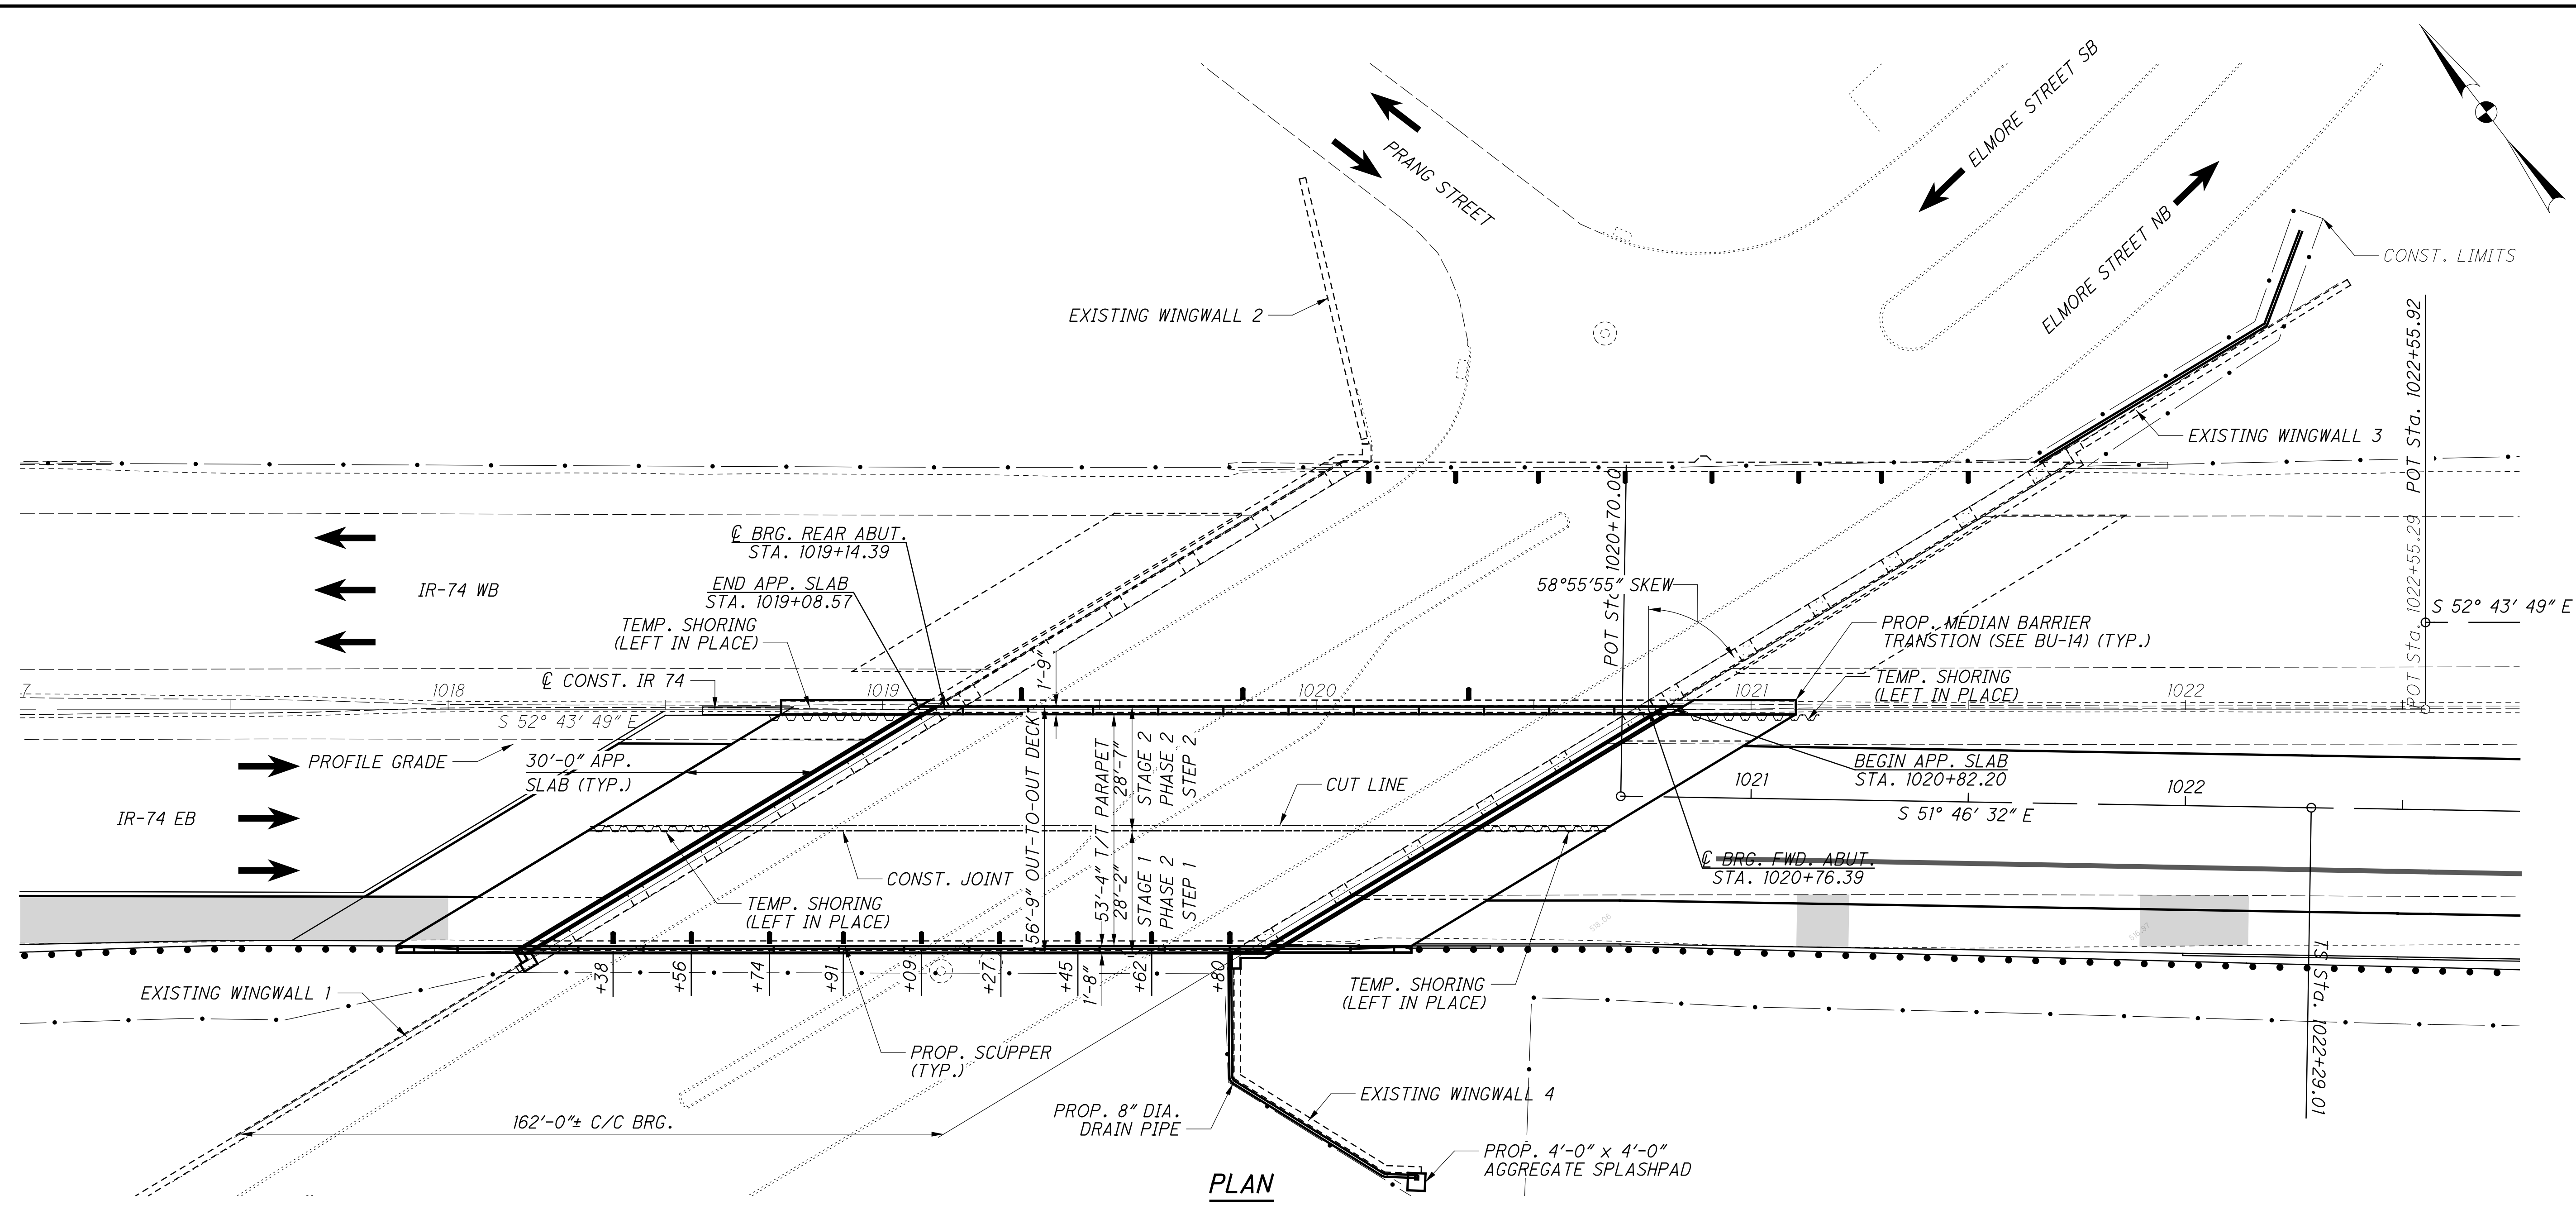

BENCHMARK DATA
REFER TO BU-14 FOR BENCHMARK DATA.

NOTES
 EARTHWORK LIMITS SHOWN ARE APPROXIMATE. ACTUAL SLOPES SHALL CONFORM TO PLAN CROSS SECTIONS.

DESIGN TRAFFIC:
 2010 ADT = 88,300 2010 ADTT = 11,479
 2030 ADT = 102,000 2030 ADTT = 13,260
 DIRECTIONAL DISTRIBUTION = 0.73

EXISTING STRUCTURE
TYPE: STEEL PLATE GIRDERS WITH REINFORCED CONCRETE DECK AND SUBSTRUCTURE
SPAN: 162'-0"± C/C BRG.
ROADWAY: 52'-7"± TOE/TOE PARAPET
LOADING: C.F.= 2000(57), ADEQUATE FOR AASHTO ALTERNATE LOADING
SKEW: 58°55'55"± LF
APPROACH SLABS: AS-1-67 (30'-0"±)
ALIGNMENT: TANGENT
CROWN: 0.016± FT/FT
STRUCTURAL FILE NUMBER: 3115690
DATE BUILT: 1973
WEARING SURFACE: 1¾"± SDC OVERLAY
DISPOSITION: REHABILITATION

PROPOSED STRUCTURE
PROPOSED WORK: REPLACE DECK WITH COMPOSITE DECK, REPLACE APPROACH SLABS, REMOVE AND REPLACE BACKWALL TO TOP OF BEAM SEAT, REPLACE EXPANSION JOINTS, PATCH EX. SUBSTRUCTURE
SPANS: 162'-0"± C/C BRG.
ROADWAY: 53'-4" TOE/TOE PARAPET
LOADING: HS20-44 AND THE ALTERNATE MILITARY LOADING
SKEW: 58°55'55"± LF
APPROACH SLABS: 30' LONG (AS-1-15 & AS-2-15)
ALIGNMENT: TANGENT
CROWN: 0.016 FT/FT
WEARING SURFACE: 1" MONOLITHIC CONCRETE
COORDINATES: LATITUDE N39°09'20" LONGITUDE W84°32'41"

DESIGN AGENCY: **STRUCTUREPOINT**

DATE: 9/12/18

REVIEWED: MDS

DRAWN: BMP

DESIGNED: SUJ

STRUCTURE FILE NUMBER: 3115690

GENERAL PLAN

BRIDGE NO. HAM-74-1892 L/R

OVER ELMORE STREET

HAM-75-3.84

PID No. 104667

2 / 38

84

120

STANDARD DRAWINGS AND SUPPLEMENTAL SPECIFICATIONS:

REFER TO THE FOLLOWING STANDARD BRIDGE DRAWINGS:

- AS-1-15 REVISED 07-17-15
- AS-2-15 REVISED 01-19-18
- EXJ-4-87 REVISED 01-19-18
- GSD-1-96 REVISED 07-19-02
- PCB-91 REVISED 01-18-13
- SBR-1-13 REVISED 07-20-18
- SBR-2-13 REVISED 07-20-18

DESIGN SPECIFICATIONS:

THE PROPOSED WORK CONFORMS TO "STANDARD SPECIFICATIONS FOR HIGHWAY BRIDGES" ADOPTED BY THE AMERICAN ASSOCIATION OF STATE HIGHWAY AND TRANSPORTATION OFFICIALS, 17TH EDITION, AND THE 2004 ODOT BRIDGE DESIGN MANUAL.

DESIGN LOADING:

DESIGN LOADING: HS20-44, CASE I AND THE ALTERNATE MILITARY LOADING.

FUTURE WEARING SURFACE (FWS) OF 60 PSF

DESIGN DATA:

QC/QA CONCRETE, CLASS QC3 - COMPRESSIVE STRENGTH 4500 PSI (SUPERSTRUCTURE)

CONCRETE, CLASS QC3 - COMPRESSIVE STRENGTH 4000 PSI (SUBSTRUCTURE)

REINFORCING STEEL - MINIMUM YIELD STRENGTH 75,000 PSI (DECK)

REINFORCING STEEL - MINIMUM YIELD STRENGTH 60,000 PSI (SUBSTRUCTURE & PARAPETS)

STRUCTURAL STEEL - ASTM A709 GRADE 50 - YIELD STRENGTH 50 KSI (BEARINGS)

DECK PROTECTION METHOD:

EPOXY COATED REINFORCING STEEL

2 1/2" CONCRETE COVER

MONOLITHIC WEARING SURFACE:

MONOLITHIC WEARING SURFACE IS ASSUMED, FOR DESIGN PURPOSES, TO BE 1 INCH THICK.

EXISTING STRUCTURE VERIFICATION:

DETAILS AND DIMENSIONS SHOWN ON THESE PLANS PERTAINING TO THE EXISTING STRUCTURE HAVE BEEN OBTAINED FROM PLANS OF THE EXISTING STRUCTURE AND FROM FIELD OBSERVATIONS AND MEASUREMENTS. CONSEQUENTLY, THEY ARE INDICATIVE OF THE EXISTING STRUCTURE AND THE PROPOSED WORK BUT THEY SHALL BE CONSIDERED TENTATIVE AND APPROXIMATE. THE CONTRACTOR IS REFERRED TO CMS SECTIONS 102.05 AND 105.02.

BASE CONTRACT BID PRICES UPON A RECOGNITION OF THE UNCERTAINTIES DESCRIBED ABOVE AND UPON A PREBID EXAMINATION OF THE EXISTING STRUCTURE. HOWEVER, THE DEPARTMENT WILL PAY FOR ALL PROJECT WORK BASED UPON ACTUAL DETAILS AND DIMENSIONS THAT HAVE BEEN VERIFIED IN THE FIELD.

ITEM 202 - PORTIONS OF STRUCTURE REMOVED. OVER 20 FOOT SPAN. AS PER PLAN:

DESCRIPTION:

ITEMS TO BE REMOVED INCLUDE ALL EXISTING MATERIALS BEING REPLACED BY NEW CONSTRUCTION AS SHOWN IN THE PLANS AND AS PER CMS 202.

CUTLINE CONSTRUCTION JOINT PREPARATION: THOROUGHLY CLEAN THE JOINT SURFACE AND EXPOSED REINFORCEMENT OF ALL DIRT, DUST, RUST OR OTHER FOREIGN MATERIAL BY THE USE OF WATER, AIR UNDER PRESSURE, OR OTHER METHODS THAT PRODUCE SATISFACTORY RESULTS. EXISTING REINFORCING STEEL DOES NOT HAVE TO HAVE A BRIGHT STEEL FINISH, BUT REMOVE ALL PACK AND LOOSE RUST. THOROUGHLY DRENCH EXISTING CONCRETE SURFACES WITH CLEAN WATER AND ALLOW TO DRY TO A DAMP CONDITION BEFORE PLACING CONCRETE.

SUBSTRUCTURE CONCRETE REMOVAL: REMOVE CONCRETE BY MEANS OF APPROVED PNEUMATIC HAMMERS EMPLOYING POINTED AND BLUNT CHISEL TOOLS. THE WEIGHT OF THE HAMMER SHALL NOT BE MORE THAN 35 POUNDS FOR REMOVAL WITHIN 18 INCHES OF PORTIONS TO BE PRESERVED. DO NOT PLACE PNEUMATIC HAMMERS IN DIRECT CONTACT WITH REINFORCING STEEL THAT IS TO BE RETAINED IN THE REBUILT STRUCTURE.

DECK REMOVAL: PERFORM WORK CAREFULLY DURING DECK REMOVALS TO PROTECT PORTIONS OF SUCH SYSTEMS THAT ARE TO BE SALVAGED AND INCORPORATED INTO THE PROPOSED STRUCTURE. THE USE OF EXPLOSIVES OR HEADACHE BALLS IS PROHIBITED. SUBMIT CONSTRUCTION PLANS ACCORDING TO CMS 501.05.

REMOVAL METHODS: REMOVAL METHODS OVER STRUCTURAL MEMBERS SHALL ENSURE ADEQUATE DEPTH CONTROL AND PREVENT NICKING OR GOUGING THE PRIMARY STRUCTURAL MEMBERS. REPLACE OR REPAIR STRUCTURAL MEMBERS DAMAGED BY THE REMOVAL OPERATIONS AT NO COST TO THE PROJECT. AT LEAST 7 DAYS BEFORE PERFORMING REPAIR WORK, SUBMIT A PROPOSED REPAIR PLAN, DEVELOPED BY AN OHIO REGISTERED PROFESSIONAL ENGINEER TO THE DIRECTOR. OBTAIN THE DIRECTOR'S APPROVAL BEFORE PERFORMING REPAIR.

EXISTING WELDED ATTACHMENTS: REMOVE EXISTING WELDED ATTACHMENTS (E.G., FINISHING MACHINE AND FORM SUPPORTS; SUPPORTS FOR SCUPPERS AND BULB ANGLES WHICH ARE TO BE REMOVED; AND LIGHTING SUPPORTS) LOCATED IN THE DESIGNATED TENSION PORTIONS OF THE TOP FLANGES OF EXISTING STEEL MEMBERS AND GRIND THE FLANGE SURFACES SMOOTH. CAREFULLY GRIND PARALLEL TO THE FLANGES.

ITEM 510 - DOWEL HOLES WITH NONSHRINK NONMETALLIC GROUT. AS PER PLAN:

DRILL DOWEL HOLES WHERE SHOWN IN THE PLANS. INSTALL REINFORCING STEEL ACCORDING TO ITEM 510 USING EPOXY GROUT, 705.20. PRIOR TO DRILLING DOWEL HOLES, LOCATE ALL EXISTING REINFORCING STEEL BARS IN THE AREA OF THE HOLE WITH THE AID OF A REINFORCING STEEL BAR LOCATOR (PACHOMETER). IF AN EXISTING BAR IS ENCOUNTERED AT THE SAME LOCATION AS A PROPOSED DOWEL HOLE, MOVE THE DOWEL HOLE TO EITHER SIDE OF THE EXISTING BAR.

ITEM 519 - PATCHING CONCRETE STRUCTURE. AS PER PLAN:

PRIOR TO THE SURFACE CLEANING SPECIFIED IN 519.04 AND WITHIN 24 HOURS OF PLACING PATCHING MATERIAL, BLAST CLEAN ALL SURFACES TO BE PATCHED INCLUDING THE EXPOSED REINFORCING STEEL. ACCEPTABLE METHODS INCLUDE HIGH-PRESSURE WATER BLASTING WITH OR WITHOUT ABRASIVES IN THE WATER, ABRASIVE BLASTING WITH CONTAINMENT, OR VACUUM ABRASIVE BLASTING.

ITEM 519 - PATCHING OF CONCRETE STRUCTURES IS A UNIT PRICE PAY ITEM (LINE 0032).

CLASS QC3 CONCRETE WITH QC/QA. SUBSTRUCTURE. AS PER PLAN

THIS ITEM MODIFIES THE STANDARD 511 CONCRETE FOR STRUCTURES SPECIFICATION TO INCLUDE MACRO-SYNTHETIC INTO THE SUBSTRUCTURE CONCRETE. THIS ITEM SHALL CONFORM TO CMS 511 WITH THE FOLLOWING CONDITIONS AND REVISIONS:

PROVIDE MATERIALS CONFORMING TO 511.02 EXCEPT AS MODIFIED BELOW:

PORTLAND CEMENT CONCRETE - 499.03, CLASS QC 3 MEETING A DESIGN STRENGTH OF 4,000 PSI, WITH MACRO-SYNTHETIC FIBERS WITH MODIFICATION PER 511.02.

FIBERS FOR CONCRETE - ASTM C 1116, TYPE III

THE CLASS QC3 CONCRETE FOR THE SUBSTRUCTURE SHALL MEET THE FOLLOWING CRITERIA: WATER/CEMENT RATIO = 0.40 MAXIMUM; MINIMUM 4 LBS/CY MACRO-SYNTHETIC FIBERS (1.5 IN. MIN. TO 2.5 IN. MAX.) MEETING ASTM C1116 TYPE III SHALL BE ADDED TO THE MIX.

THE MACRO-SYNTHETIC FIBERS SHALL BE INCORPORATED INTO THE MIX IN SUCH A WAY THAT NO 'BALLING' OCCURS. UPON INSPECTION OF THE MIX AT THE TIME OF PLACEMENT, IF ANY 'BALLING' OCCURS, THE ENGINEER SHALL REJECT THE REMAINDER OF THE LOAD AT ANY TIME DURING THE POUR. IT IS IMPORTANT TO FOLLOW INDUSTRY STANDARDS AND ASTM SPECIFICATIONS ON THE PREMIXING OF THE CEMENT, AGGREGATE, AND MACRO-SYNTHETIC FIBERS PRIOR TO THE ADDITION OF WATER AND ADMIXTURES. PROVIDE MACRO-SYNTHETIC FIBERS THAT ARE MONOFILAMENT FIBERS MADE FROM VIRGIN POLYPROPYLENE, POLYETHYLENE, OR CO-POLYMERS THAT ARE INERT TO ALKALI ATTACK. ENSURE THE MACRO-SYNTHETIC FIBERS HAVE A MINIMUM TENSILE STRENGTH OF 70 KSI, A MINIMUM MODULUS OF ELASTICITY OF 800 KSI, A MINIMUM FILAMENT DIAMETER OF 0.012 INCHES, AND ASPECT RATIO BETWEEN 60 AND 100, AND ARE BETWEEN 1.5 AND 2.5 INCHES IN LENGTH. STORE THE MACRO-SYNTHETIC FIBERS ACCORDING TO THE MANUFACTURE'S RECOMMENDATION AND KEEP THE MATERIAL FREE FROM DUST, DIRT AND MOISTURE.

USE A MINIMUM DOSAGE RATE OF MACRO-SYNTHETIC FIBERS OF 4.0 LBS/CY OF CONCRETE. DETERMINE THE FINAL PROPOSED DOSAGE RATE THROUGH MIX TESTING. ENSURE THE FIBER REINFORCED CONCRETE MEETS OR EXCEEDS A MINIMUM EQUIVALENT FLEXURAL STRENGTH RATIO OF 25% ACCORDING TO ASTM C 1609. MACRO-SYNTHETIC FIBERS IS TO BE USED AS AN ADMIXTURE TO CONTROL CRACKING AND IS NOT TO BE USED TO SUPPLEMENT OR REPLACE REINFORCING STEEL IN THE DESIGN. ENSURE THE FINAL PROPOSED MIX IS WORKABLE AND ABLE TO BE PRODUCED SUCH THAT BALLING OR CLUMPING OF THE FIBERS IS NOT A PROBLEM AS DETERMINED BY THE ENGINEER. UTILIZE A LABORATORY REGULARLY INSPECTED BY THE CEMENT AND CONCRETE REFERENCE LABORATORY (CCRL) OF THE NATIONAL INSTITUTE OF STANDARDS AND TECHNOLOGY, OR OTHER APPROVED REFERENCE LABORATORY, TO PERFORM THE TESTING. BEFORE USE, SUBMIT DOCUMENTATION TO THE PROJECT ENGINEER CERTIFYING BOTH THE MACRO-SYNTHETIC FIBERS AND THE MIX MEET OR EXCEED THE REQUIRED PROPERTIES. SAMPLING WILL BE ALLOWED FOR TESTING PURPOSES. A DEMONSTRATION OF THE MIX PRODUCTION OR TRIAL MIX, MAY BE REQUIRED BY THE ENGINEER PRIOR TO PLACING ANY OF THE MIX ON THE PROJECT.

THE BATCH WEIGHTS SHALL BE CORRECTED TO COMPENSATE FOR THE MOISTURE CONTAINED IN THE AGGREGATE AT THE TIME OF USE. A CHEMICAL ADMIXTURE (705.12, TYPE A OR D) SHALL BE USED.

CONCRETE SUPPLIERS SHOULD RECOGNIZE THAT ADMIXTURES MAY HAVE AN EFFECT ON STRENGTH, ENTRAINED AIR CONTENT, WORKABILITY, ETC. OF THEIR CONCRETE MIXES. THE CONCRETE SUPPLIER'S CHOICE OF ADMIXTURES DOES NOT ALLEVIATE MEETING DESIGN REQUIREMENTS.

CLASS QC3 CONCRETE WITH QC/QA. SUPERSTRUCTURE. AS PER PLAN

THIS ITEM MODIFIES THE STANDARD 511 CONCRETE FOR STRUCTURES SPECIFICATION TO INCLUDE MACRO-SYNTHETIC INTO THE SUPERSTRUCTURE CONCRETE. THIS ITEM SHALL CONFORM TO CMS 511 WITH THE FOLLOWING CONDITIONS AND REVISIONS:

PROVIDE MATERIALS CONFORMING TO 511.02 EXCEPT AS MODIFIED BELOW:

PORTLAND CEMENT CONCRETE - 499.03, CLASS QC 3 MEETING A DESIGN STRENGTH OF 4,500 PSI, WITH MACRO-SYNTHETIC FIBERS WITH MODIFICATION PER 511.02

FIBERS FOR CONCRETE - ASTM C 1116, TYPE III

THE CLASS QC3 CONCRETE FOR THE SUPERSTRUCTURE SHALL MEET THE FOLLOWING CRITERIA: WATER/CEMENT RATIO = 0.40 MAXIMUM; MINIMUM 4 LBS/CY MACRO-SYNTHETIC FIBERS (1.5 IN. MIN. TO 2.5 IN. MAX.) MEETING ASTM C1116 TYPE III SHALL BE ADDED TO THE MIX.

THE MACRO-SYNTHETIC FIBERS SHALL BE INCORPORATED INTO THE MIX IN SUCH A WAY THAT NO 'BALLING' OCCURS. UPON INSPECTION OF THE MIX AT THE TIME OF PLACEMENT, IF ANY 'BALLING' OCCURS, THE ENGINEER SHALL REJECT THE REMAINDER OF THE LOAD AT ANY TIME DURING THE POUR. IT IS IMPORTANT TO FOLLOW INDUSTRY STANDARDS AND ASTM SPECIFICATIONS ON THE PREMIXING OF THE CEMENT, AGGREGATE, AND MACRO-SYNTHETIC FIBERS PRIOR TO THE ADDITION OF WATER AND ADMIXTURES. PROVIDE MACRO-SYNTHETIC FIBERS THAT ARE MONOFILAMENT FIBERS MADE FROM VIRGIN POLYPROPYLENE, POLYETHYLENE, OR CO-POLYMERS THAT ARE INERT TO ALKALI ATTACK. ENSURE THE MACRO-SYNTHETIC FIBERS HAVE A MINIMUM TENSILE STRENGTH OF 70 KSI, A MINIMUM MODULUS OF ELASTICITY OF 800 KSI, A MINIMUM FILAMENT DIAMETER OF 0.012 INCHES, AND ASPECT RATIO BETWEEN 60 AND 100, AND ARE BETWEEN 1.5 AND 2.5 INCHES IN LENGTH. STORE THE MACRO-SYNTHETIC FIBERS ACCORDING TO THE MANUFACTURE'S RECOMMENDATION AND KEEP THE MATERIAL FREE FROM DUST, DIRT AND MOISTURE.

USE A MINIMUM DOSAGE RATE OF MACRO-SYNTHETIC FIBERS OF 4.0 LBS/CY OF CONCRETE. DETERMINE THE FINAL PROPOSED DOSAGE RATE THROUGH MIX TESTING. ENSURE THE FIBER REINFORCED CONCRETE MEETS OR EXCEEDS A MINIMUM EQUIVALENT FLEXURAL STRENGTH RATIO OF 25% ACCORDING TO ASTM C 1609. MACRO-SYNTHETIC FIBERS IS TO BE USED AS AN ADMIXTURE TO CONTROL CRACKING AND IS NOT TO BE USED TO SUPPLEMENT OR REPLACE REINFORCING STEEL IN THE DESIGN. ENSURE THE FINAL PROPOSED MIX IS WORKABLE AND ABLE TO BE PRODUCED SUCH THAT BALLING OR CLUMPING OF THE FIBERS IS NOT A PROBLEM AS DETERMINED BY THE ENGINEER. UTILIZE A LABORATORY REGULARLY INSPECTED BY THE CEMENT AND CONCRETE REFERENCE LABORATORY (CCRL) OF THE NATIONAL INSTITUTE OF STANDARDS AND TECHNOLOGY, OR OTHER APPROVED REFERENCE LABORATORY, TO PERFORM THE TESTING. BEFORE USE, SUBMIT DOCUMENTATION TO THE PROJECT ENGINEER CERTIFYING BOTH THE MACRO-SYNTHETIC FIBERS AND THE MIX MEET OR EXCEED THE REQUIRED PROPERTIES. SAMPLING WILL BE ALLOWED FOR TESTING PURPOSES. A DEMONSTRATION OF THE MIX PRODUCTION OR TRIAL MIX, MAY BE REQUIRED BY THE ENGINEER PRIOR TO PLACING ANY OF THE MIX ON THE PROJECT.

THE BATCH WEIGHTS SHALL BE CORRECTED TO COMPENSATE FOR THE MOISTURE CONTAINED IN THE AGGREGATE AT THE TIME OF USE. A CHEMICAL ADMIXTURE (705.12, TYPE A OR D) SHALL BE USED.

CONCRETE SUPPLIERS SHOULD RECOGNIZE THAT ADMIXTURES MAY HAVE AN EFFECT ON STRENGTH, ENTRAINED AIR CONTENT, WORKABILITY, ETC. OF THEIR CONCRETE MIXES. THE CONCRETE SUPPLIER'S CHOICE OF ADMIXTURES DOES NOT ALLEVIATE MEETING DESIGN REQUIREMENTS.

S:\Flanagan\11\16\2023\0\2017\01113\C.Design\104667-HAM-75-3.84.Design\Structures\HAM0074_1892C\Sheets\74_1892GN001.dgn

DESIGN AGENCY: STRUCTUREPOINT

DATE: 11/12/18

REVIEWED: MDS

DRAWN: DSH

DESIGNED: SUJ

CHECKED: CLB

STRUCTURE FILE NUMBER: 3115690

GENERAL NOTES - 1

BRIDGE NO. HAM-74-1892 L/R

OVER ELMORE STREET

HAM-75-3.84

PID No. 104667

3 / 38

85

120

CLASS QC3 CONCRETE WITH QC/QA, SUPERSTRUCTURE, AS PER PLAN (CONT.)

APPROACH SLABS, DIAPHRAGMS, AND BRIDGE RAILING CONCRETE ARE TO USE THE SAME MIX DESIGN AS THE BRIDGE DECK (WHEN APPLICABLE). USE SELF-COMPACTING CONCRETE ON DECORATIVE RAILING SIMILAR TO TEXAS RAILING AND MACRO-SYNTHETIC CONCRETE PER THIS SPECIFICATION ON TRADITIONAL CONCRETE RAILING WHEN APPLICABLE.

THE PLACING OF THE DECK AND THE APPROACH SLABS IN THE SAME CONCRETE POUR IS NOT PERMITTED.

ITEM 511 - CLASS QC3 CONCRETE SUPERSTRUCTURE, AS PER PLAN:

LOCATE THE LOWER CONTACT POINT OF THE OVERHANG FALSEWORK AT 42 INCHES ± 2 IN. ABOVE THE TOP OF THE GIRDER'S BOTTOM FLANGE. DECK OVERHANG FALSEWORK BRACKETS SHALL BE PLACED AT LOCATIONS DIRECTLY ADJACENT TO EXISTING INTERMEDIATE STIFFENERS. THE BRACKET CONTACT POINT LOCATION REQUIREMENTS OF C&MS 508 DO NOT APPLY.

DECK PLACEMENT DESIGN ASSUMPTIONS:

DECK PLACEMENT DESIGN ASSUMPTIONS:
THE FOLLOWING ASSUMPTIONS OF CONSTRUCTION MEANS AND METHODS WERE MADE FOR THE ANALYSIS AND DESIGN OF THE SUPERSTRUCTURE. THE CONTRACTOR IS RESPONSIBLE FOR THE DESIGN OF THE FALSEWORK SUPPORT SYSTEM WITHIN THESE PARAMETERS AND WILL ASSUME RESPONSIBILITY FOR SUPERSTRUCTURE ANALYSIS FOR DEVIATION FROM THESE DESIGN ASSUMPTIONS.

AN EIGHT WHEEL FINISHING MACHINE WITH A MAXIMUM WHEEL LOAD OF 2.44 KIPS.

A MINIMUM OUT-TO-OUT WHEEL SPACING AT EACH END OF THE MACHINE OF 103".

A MAXIMUM SPACING OF OVERHANG FALSEWORK BRACKETS OF 48 IN.

A MAXIMUM DISTANCE FROM THE CENTERLINE OF THE FASCIA GIRDER TO THE FACE OF THE SAFETY HANDRAIL OF 65".

MECHANICAL CONNECTORS:

MECHANICAL CONNECTORS SHALL BE CAPABLE OF DEVELOPING 125 PERCENT OF THE YIELD STRENGTH OF THE CONNECTED BARS. FOR CONNECTORS WITH THREADED BAR ENDS, IN ORDER TO OFFSET THE EFFECT OF AREA REDUCTION ON THE STRENGTH OF THE BAR AND STILL MEET THE REQUIREMENTS OF ASTM A615, USE THE NEXT LARGER DIAMETER BAR OR A HIGHER GRADE OF STEEL BAR.

ITEM 514 - FIELD PAINTING, MISC.: MAIN AND SECONDARY MEMBERS:

THIS ITEM SHALL INCLUDE PAINTING AS WELL AS THE SURFACE PREPARATION OF THE MAIN AND SECONDARY MEMBERS IN THE FIELD WITH PRIME, INTERMEDIATE AND SURFACE COATS AS DIRECTED BY THE ENGINEER AT LOCATIONS WHERE THE EXISTING COATING IS DAMAGED. THE PAINT MAY BE APPLIED BY BRUSH ACCORDING TO 514.17E. SOLVENT CLEAN THE MAIN AND SECONDARY MEMBERS AS PER SSPC-SP 1 AND SSPC-SP 2, RESPECTIVELY, PRIOR TO PAINTING ACCORDING TO ITEM 514.

THE CONTRACTOR SHALL BE RESPONSIBLE FOR SELECTING THE FINISH COAT TO MATCH THE EXISTING AS CLOSE AS POSSIBLE AND SHALL RECEIVE APPROVAL FROM THE ENGINEER.

CONCRETE SEALER:

CHEMMASTERS TEXTURE DOT SMOOTH (1 COAT ACRYLIC) USED FOR SEALING OF CONCRETE SURFACES (EPOXY-URETHANE).

PROPOSED WORK (LEFT BRIDGE):

- REMOVE AND REPLACE EXISTING CONCRETE DECK WITH COMPOSITE DECK
- REMOVE AND REPLACE EXISTING CONCRETE PARAPETS
- REMOVE AND REPLACE ABUTMENT BACKWALLS
- REPLACE APPROACH SLABS
- REPLACE STRIP SEAL EXPANSION JOINTS
- PATCH EXISTING SUBSTRUCTURE UNITS
- SEAL CONCRETE

BUILDABLE UNIT REFERENCES:

REFERENCE THE FOLLOWING BUILDABLE UNITS FOR ADDITIONAL INFORMATION, DETAILS, AND SPECIFICATIONS:
ROADWAY AND DRAINAGE - BU-14
MAINTENANCE OF TRAFFIC - BU-04 AND BU-23
LIGHTING, STRIPING, PAVEMENT MARKINGS, ITS - BU-19

UTILITY LINES

THE UTILITY(IES) SHALL BORE ALL EXPENSE INVOLVED IN RELOCATING (INSTALLING) THE AFFECTED UTILITY LINES. THE CONTRACTOR AND UTILITY(IES) ARE TO COOPERATE BY ARRANGING THEIR WORK IN SUCH A MANNER THAT INCONVENIENCE TO EITHER WILL BE HELD TO A MINIMUM.

ABBREVIATION LIST:

THE FOLLOWING STANDARD ABBREVIATIONS ARE USED THROUGHOUT THE BRIDGE PLANS.

- ABUT. = ABUTMENT
- ACT. = ACTUAL
- APP. = APPROACH
- BRG. = BEARING
- BOT. = BOTTOM
- BTW. = BETWEEN
- CB = CATCH BASIN
- C.I.P. = CAST-IN-PLACE
- C.J. = CONSTRUCTION JOINT
- CLR. = CLEARANCE
- CONST = CONSTRUCTION
- CONT. = CONTINUOUS
- DIA. = DIAMETER
- DIM. = DIMENSION
- DWG. = DRAWING
- E.S. = EACH SIDE
- EL. = ELEVATION
- EQ. = EQUAL
- EST. = ESTIMATED
- EX. = EXISTING
- EXP. = EXPANSION
- F.A. = FORWARD ABUTMENT
- F.D.S. = FINAL DECK SURFACE
- F.S. = FAR SIDE
- FTG. = FOOTING
- FWD. = FORWARD
- GR. = GUARDRAIL
- HMWM = HIGH MOLECULAR WEIGHT METHACRYLATE
- INT. = INTERIOR
- INV. = INVERT
- NPCCP = NON-PERFORATED CORRUGATED PLASTIC PIPE
- N.S. = NEAR SIDE
- O.C.J. = OPTIONAL CONSTRUCTION JOINT
- PCCP = PERFORATED CORRUGATED PLASTIC PIPE
- PEJF = PREFORMED EXPANSION JOINT FILLER
- PERP. = PERPENDICULAR
- PROP. = PROPOSED
- PT. = POINT
- R.A. = REAR ABUTMENT
- REQD. = REQUIRED
- SER. = SERIES
- SHLD. = SHOULDER
- SPA. = SPACES
- STA. = STATION
- STD. = STANDARD
- STM = STORM SEWER LINE
- T&B = TOP AND BOTTOM
- T.O.H. = TOP OF HAUNCH
- T/S = TOP OF SLOPE
- TYP. = TYPICAL
- U.N. = UNLESS NOTED

DESIGN AGENCY
STRUCTUREPOINT

DESIGNED	DRAWN	REVIEWED	DATE
SUF	DSH	MDS	11/12/18
CHECKED	REVISED	STRUCTURE FILE NUMBER	
CLB		3115690	


GENERAL NOTES - 2
BRIDGE NO. HAM-74-1892 L/R
OVER ELMORE STREET

HAM-75-3.84
PID No. 104667


4 / 38

86
120


SFlanagan 9:34:49 AM
 11/16/2023
 0:\2017\01113.C.Design\104667_HAM-75-3.84.Design\Structures\HAM0074-1892C_Sheets\74-1892PC001.dgn

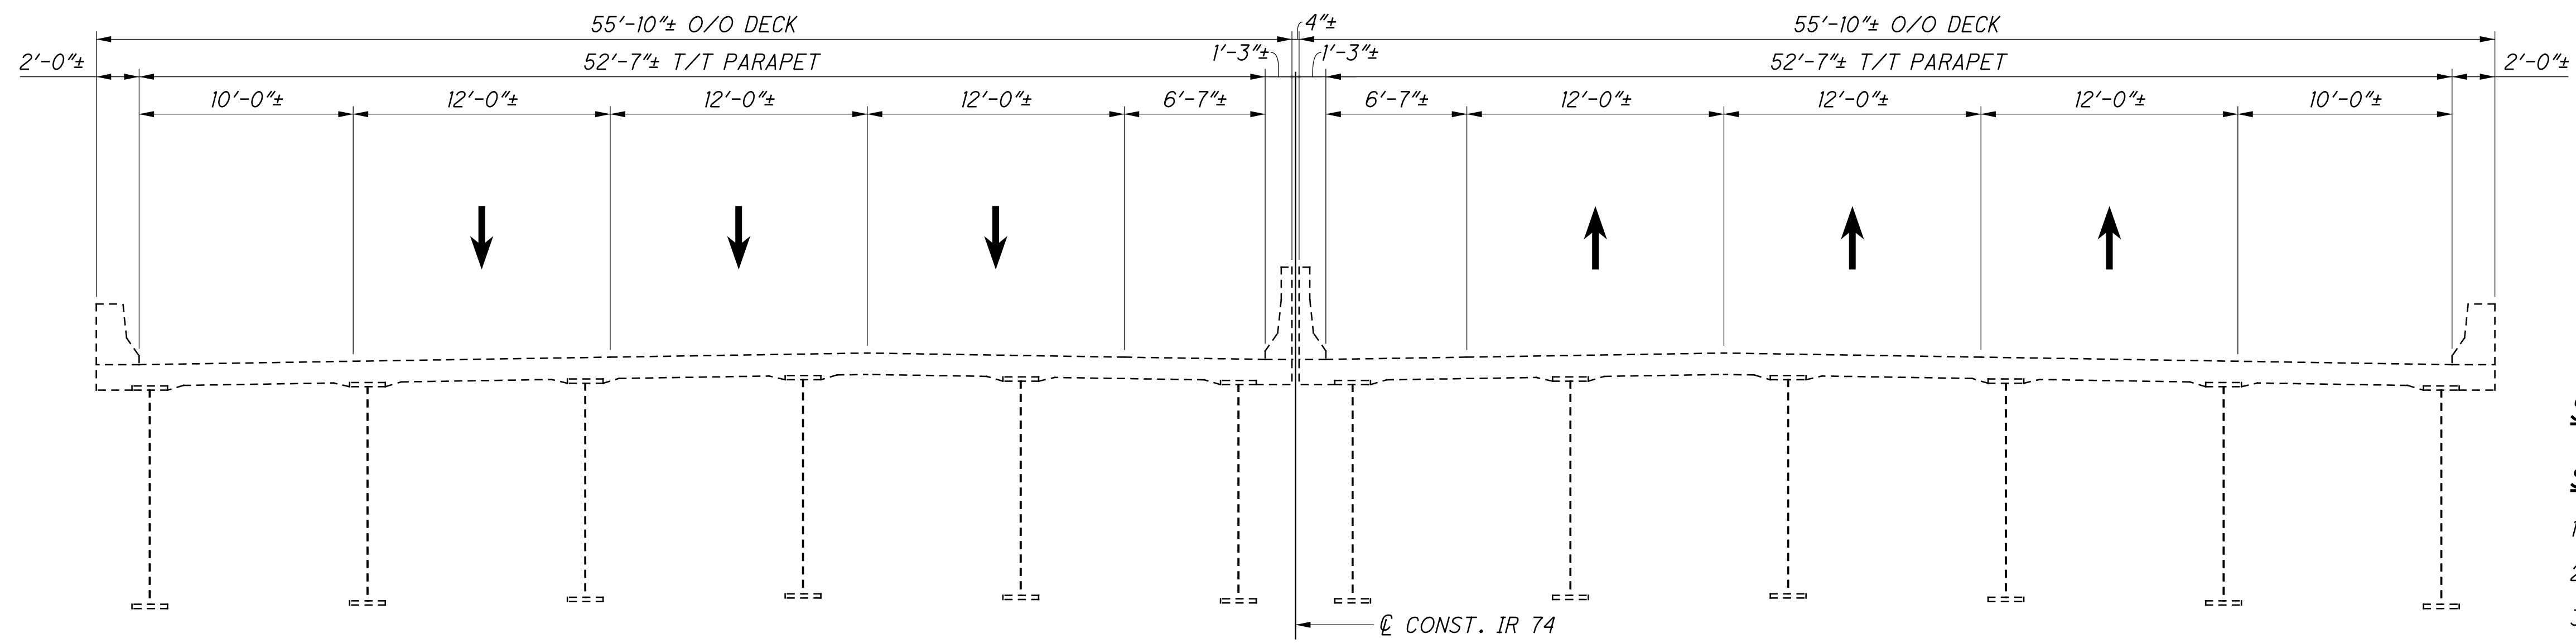

EXISTING TRANSVERSE SECTION

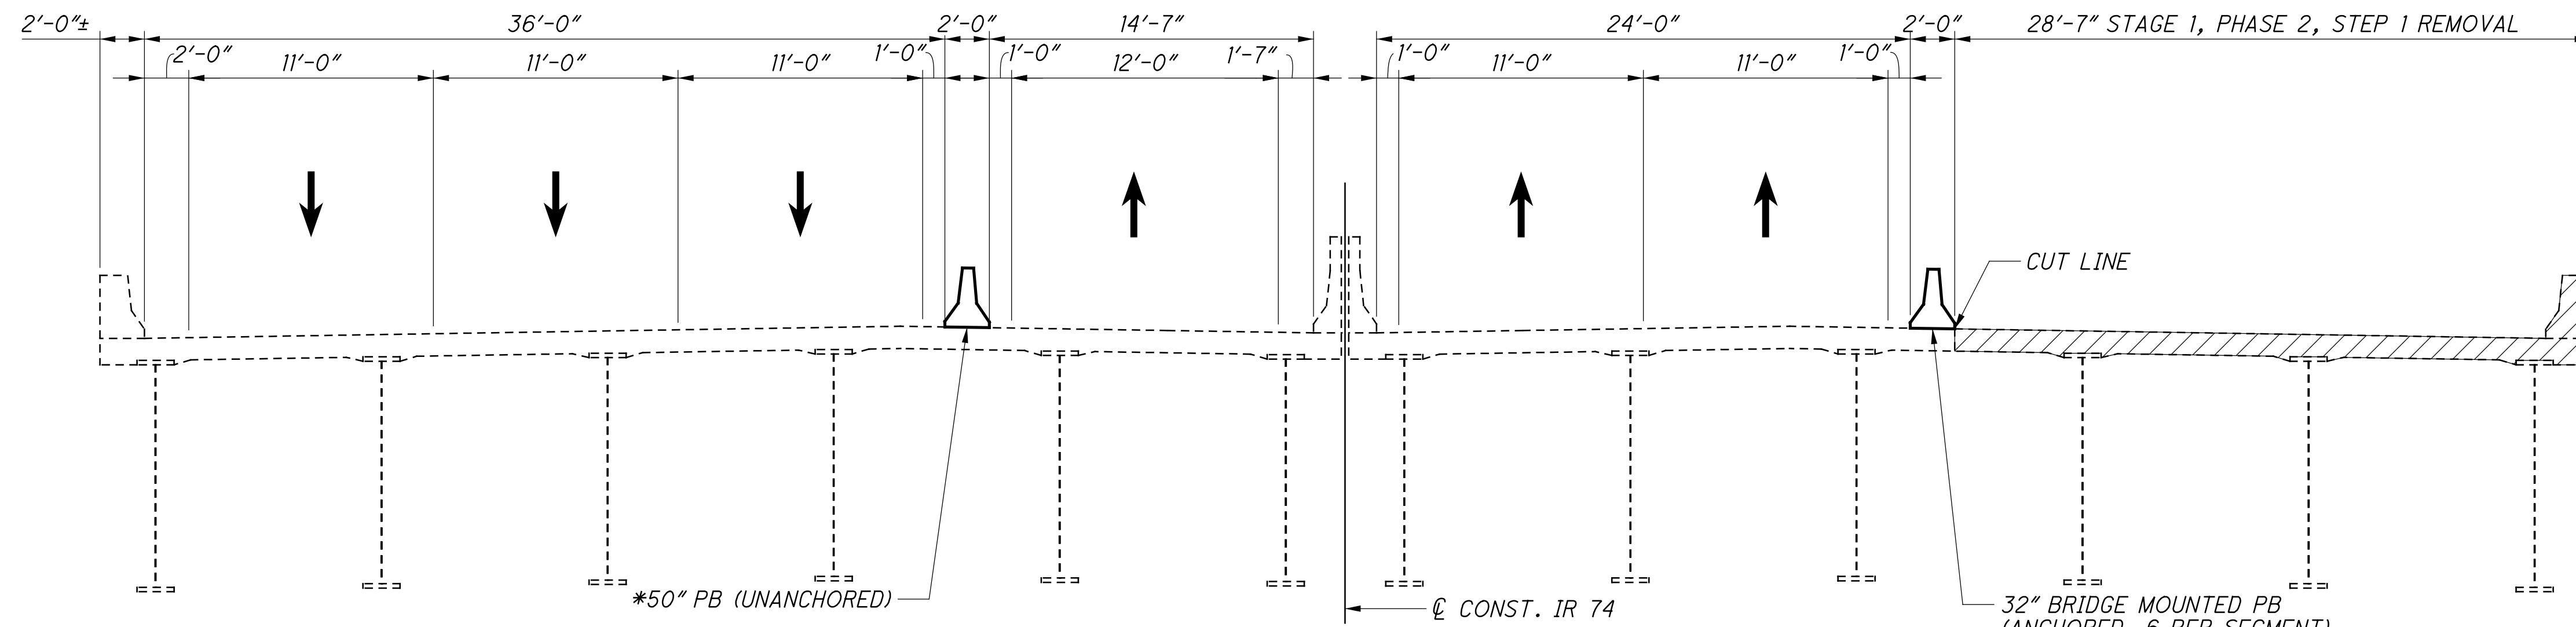

STAGE 1, PHASE 2, STEP 1 REMOVAL

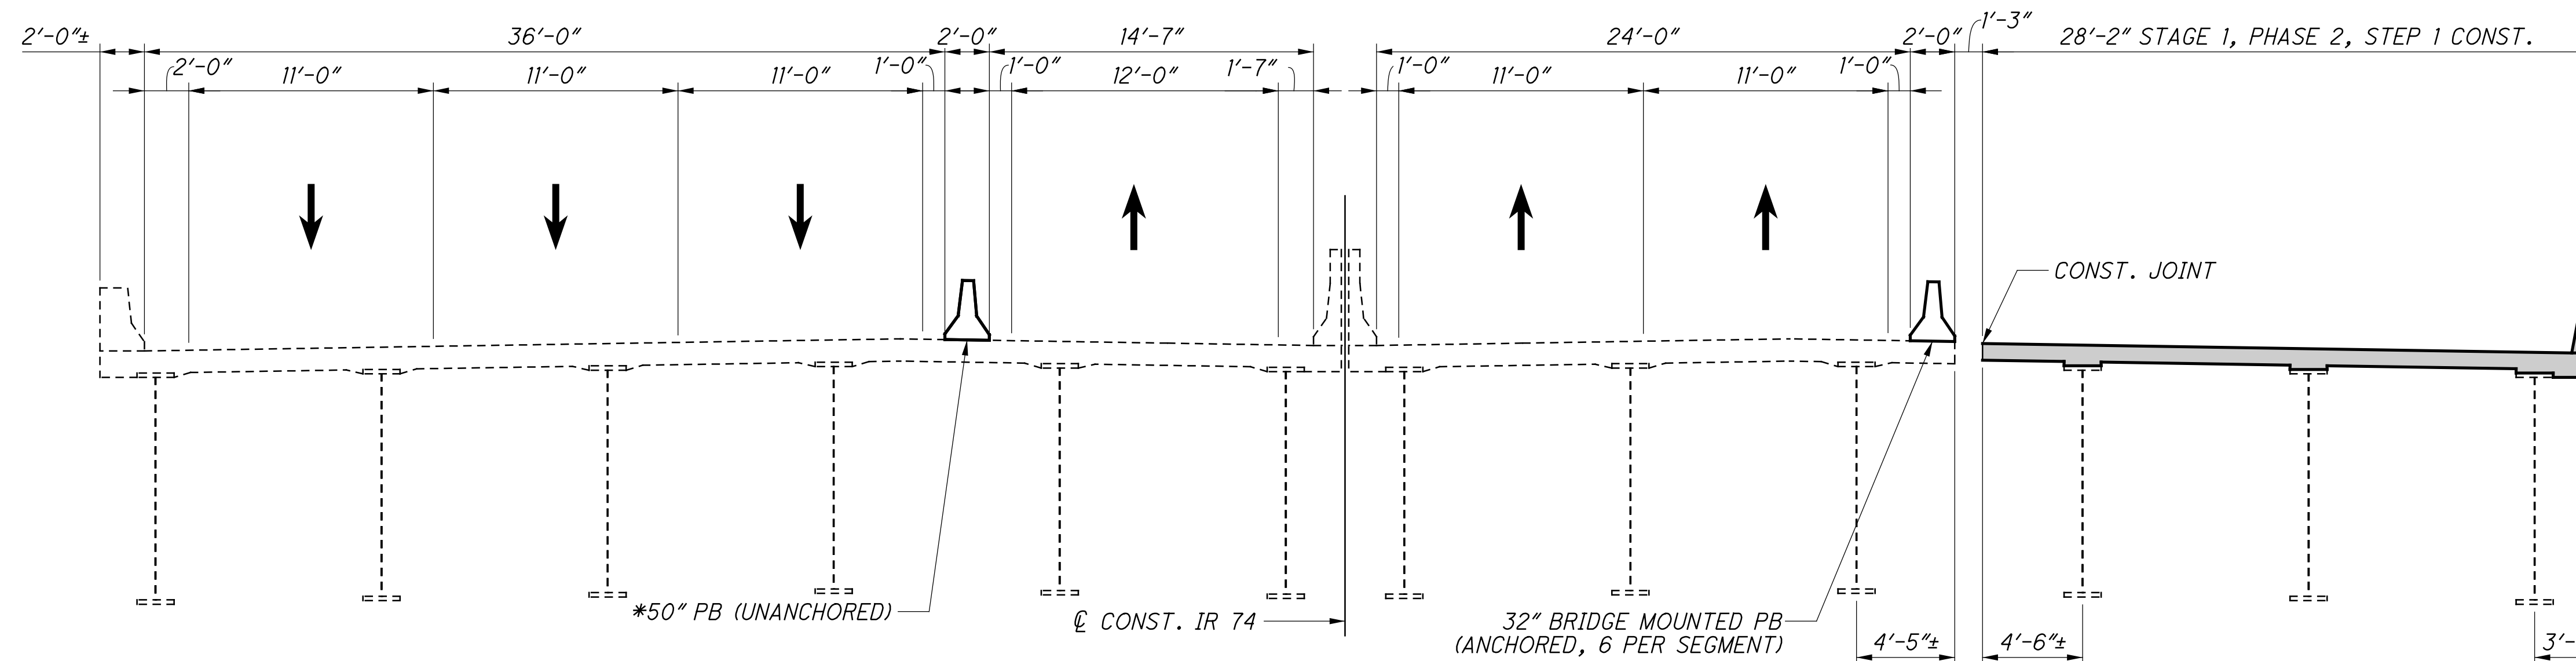

STAGE 1, PHASE 2, STEP 1 CONSTRUCTION

SEQUENCE OF CONSTRUCTION

STAGE 1/ PHASE 2/ STEP 1


1. INSTALL PB AS SHOWN IN BU-04 & BU-23 PLANS.
2. MAINTAIN TRAFFIC AS SHOWN.
3. INSTALL TEMP. SHORING.
4. REMOVE STAGE 1/ PHASE 2/ STEP 1 PORTIONS OF RIGHT BRIDGE.
5. CONSTRUCT STAGE 1/ PHASE 2/ STEP 1 PORTIONS OF RIGHT BRIDGE.

* 32" PB WITH GLARE SCREEN MAY BE USED AS AN ALTERNATE


LEGEND

LIMITS OF REMOVAL PER ITEM 202 - STRUCTURE REMOVED, OVER 20 FOOT SPAN


SFlanagan 9:34:50 AM
 11/16/2023
 0:\2017\01113.C.Design\104667_HAM-75-3.84.Design\Structures\HAM0074-1892C_Sheets\74-1892PC002.dgn

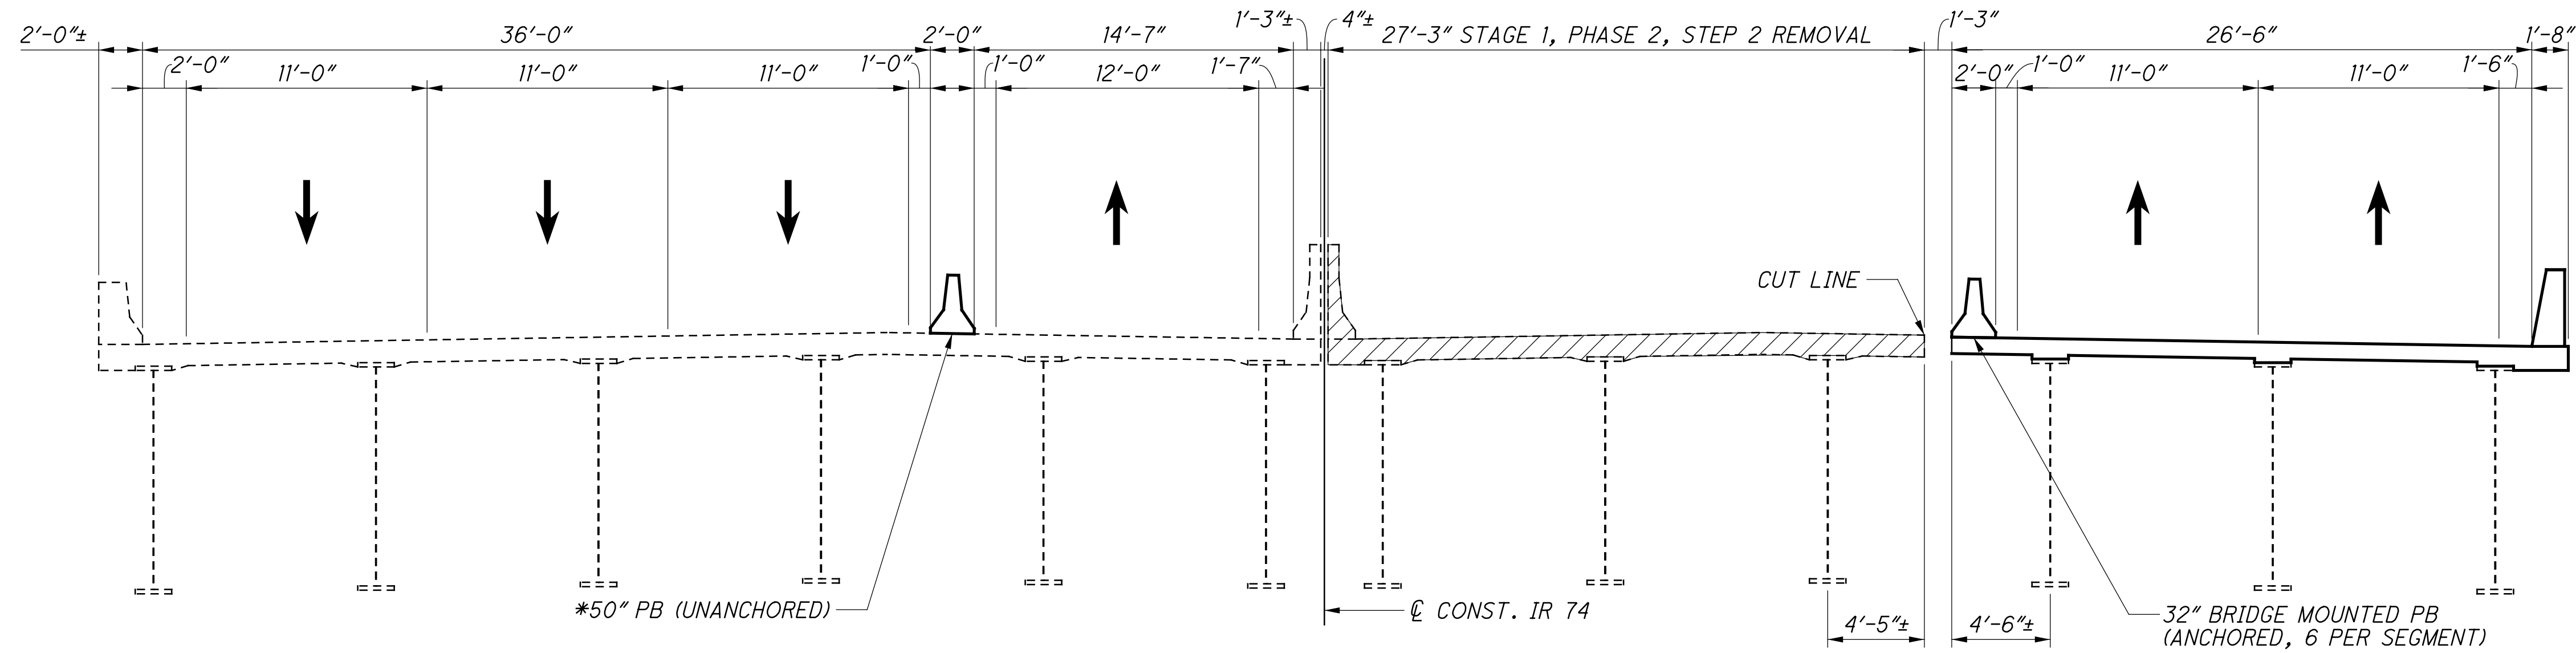

STAGE 1, PHASE 2, STEP 2 REMOVAL

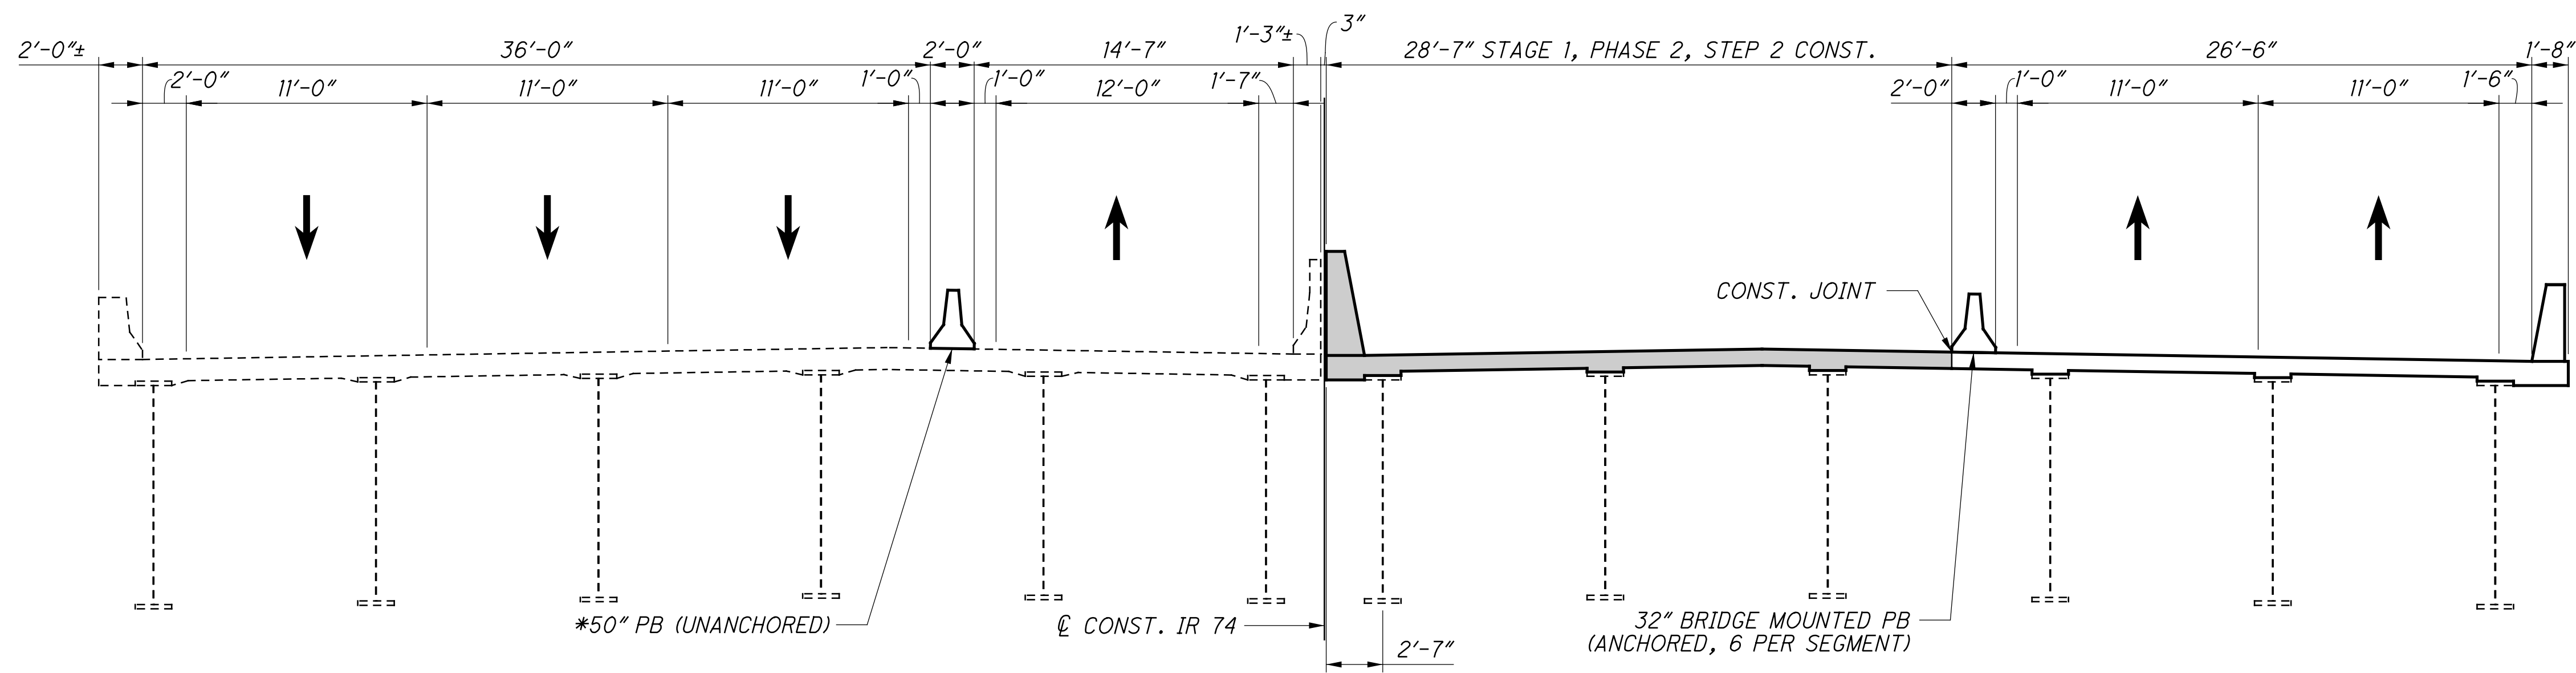

STAGE 1, PHASE 2, STEP 2 CONSTRUCTION

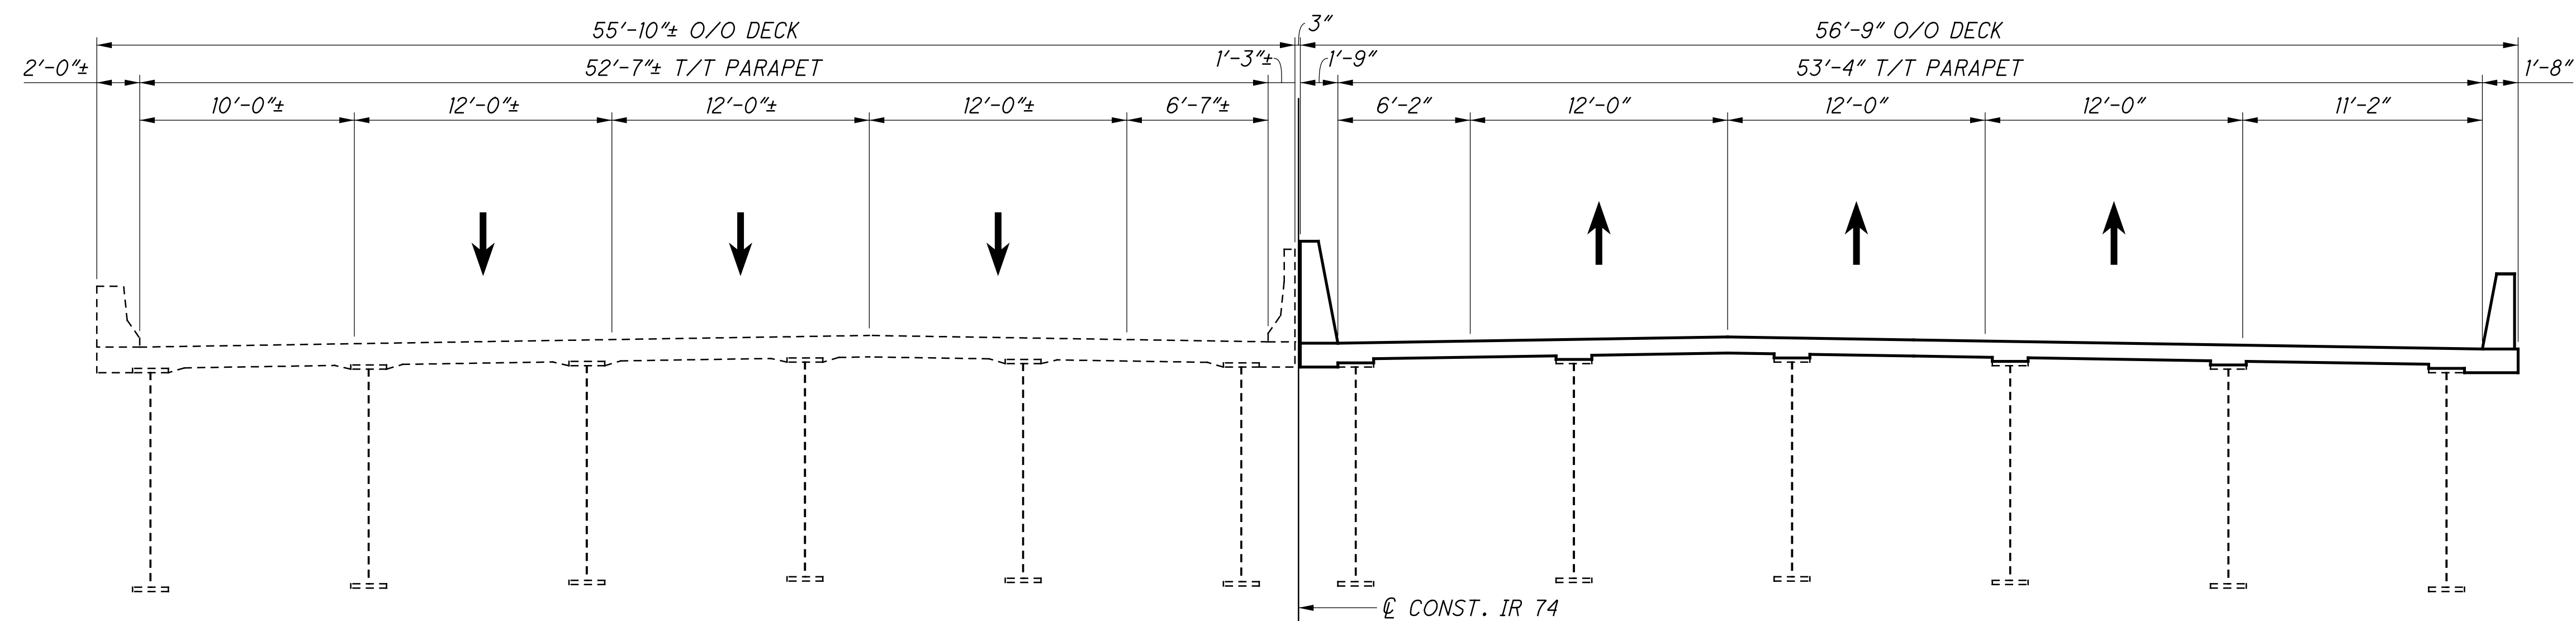

PROPOSED TRANSVERSE SECTION

SEQUENCE OF CONSTRUCTION

STAGE 1/ PHASE 2/ STEP 2


1. RELOCATE PB AS SHOWN IN BU-04 & BU-23 PLANS.
2. MAINTAIN TRAFFIC AS SHOWN.
3. INSTALL TEMP. SHORING.
4. REMOVE STAGE 1/ PHASE 2/ STEP 2 PORTIONS OF RIGHT BRIDGE.
5. CONSTRUCT STAGE 1/ PHASE 2/ STEP 2 PORTIONS OF RIGHT BRIDGE.

* 32" PB WITH GLARE SCREEN MAY BE USED AS AN ALTERNATE


LEGEND

 LIMITS OF REMOVAL PER ITEM 202 - STRUCTURE REMOVED, OVER 20 FOOT SPAN

DESIGNED	DESIGNED BY	DATE	DESIGN AGENCY
CHECKED	SJF	9/12/18	STRUCTUREPOINT
DRAWN	BMP	REVIEWED	STRUCTUREPOINT
REVISIONS	FILE NUMBER	3115690	
PHASE CONSTRUCTION DETAILS - 2			
BRIDGE NO. HAM-74-1892 L/R			
IR-74 OVER ELMORE STREET			
HAM-75-3.84			
PID No. 104667			
6 / 38			
88			
120			

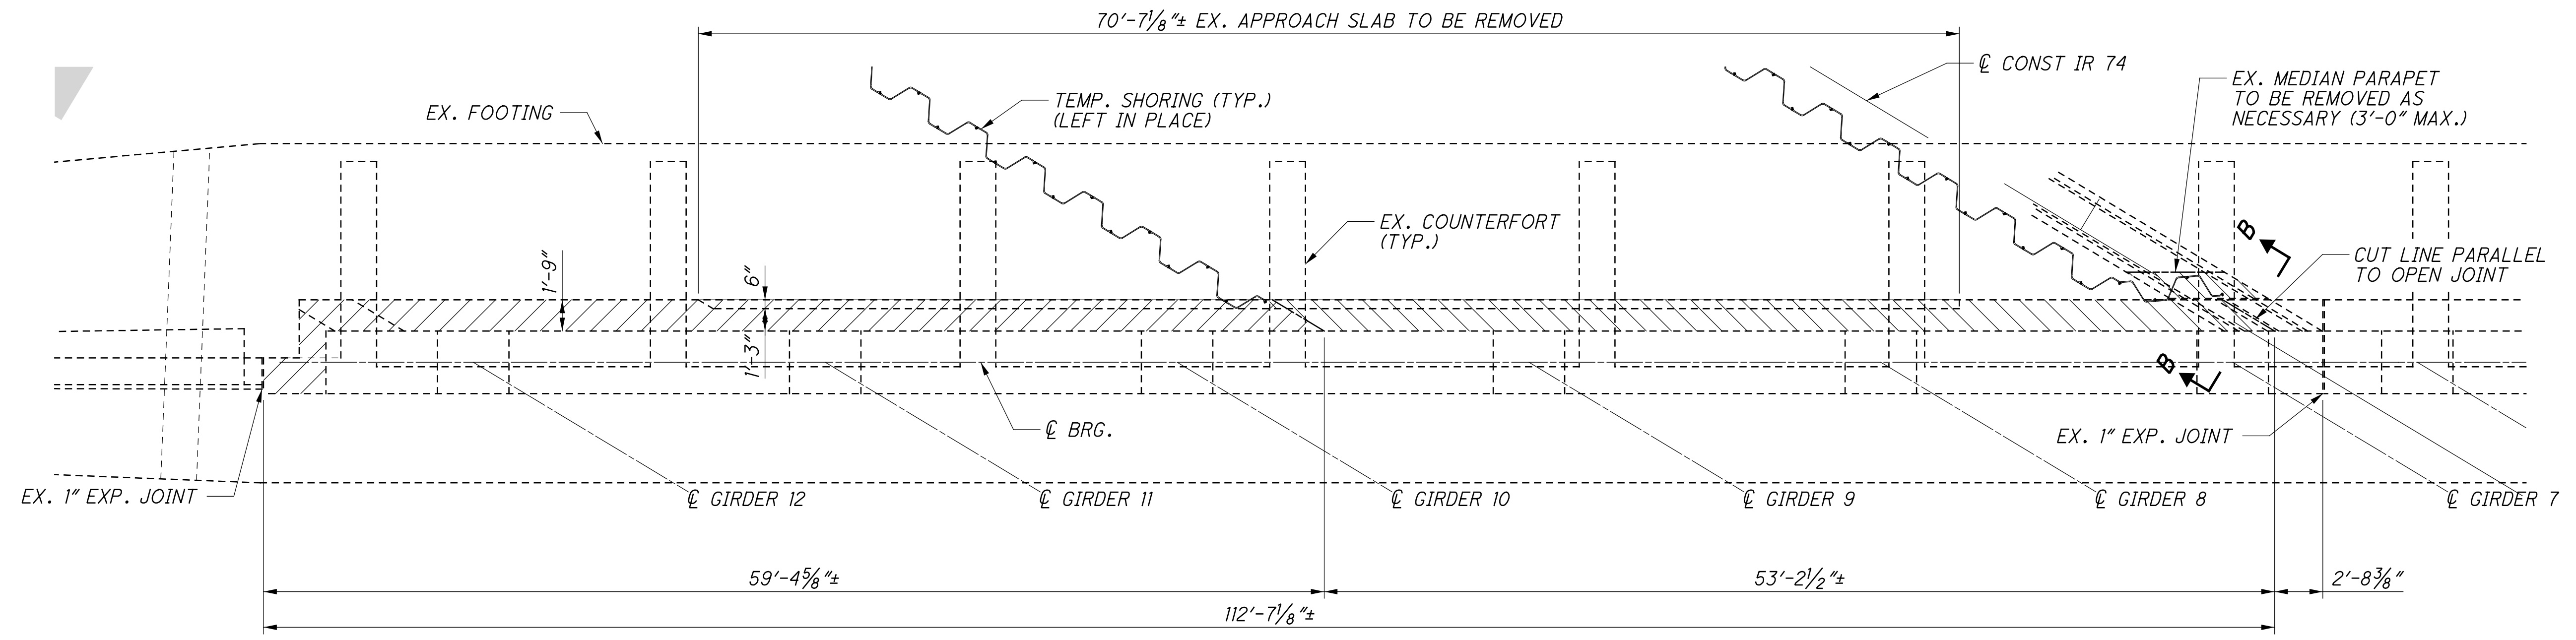

PLAN - REAR ABUTMENT

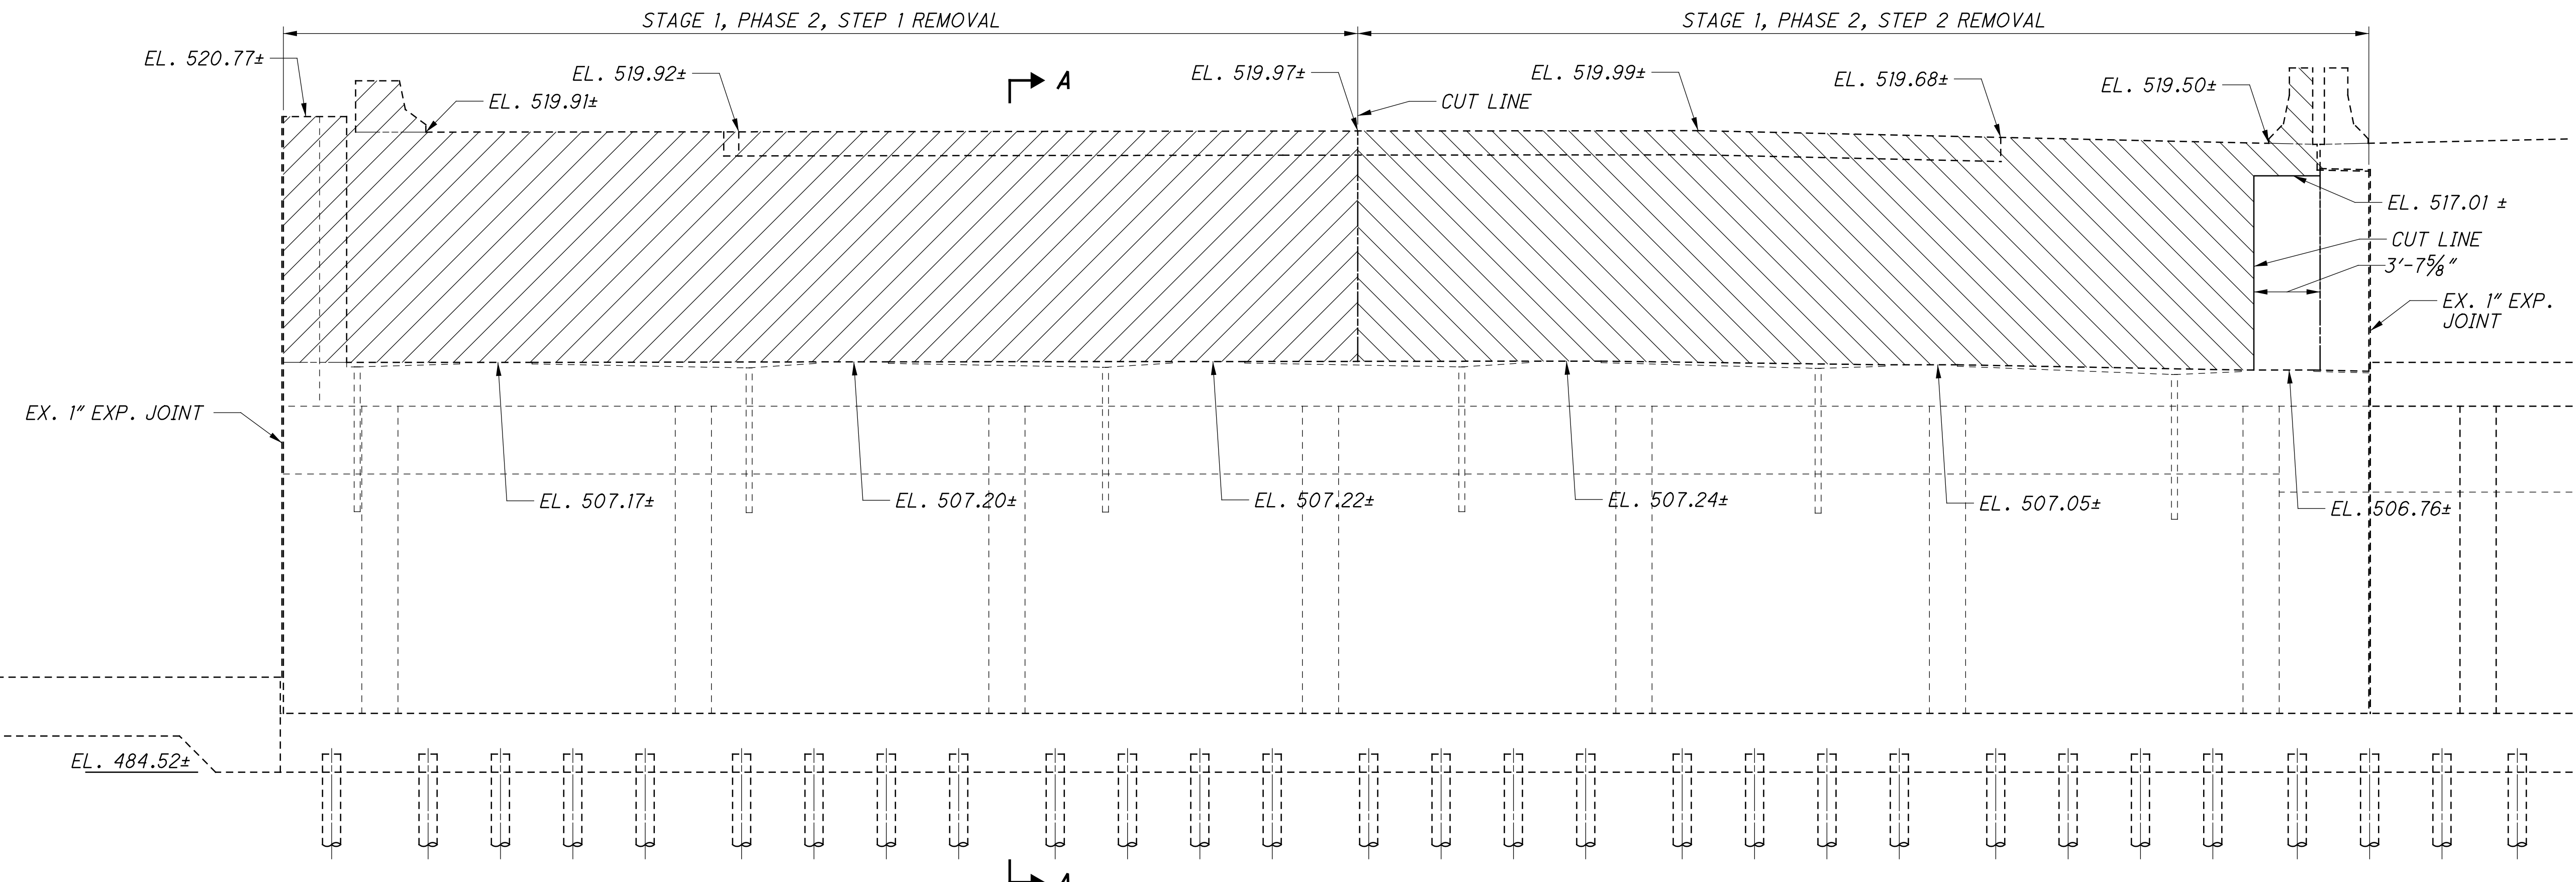


ELEVATION - REAR ABUTMENT

LEGEND
 [Hatched Box] LIMITS OF REMOVAL PER ITEM 202
NOTES:
 FOR SECTIONS A-A AND B-B, SEE SHEET 9/38.


S:\Plans\2017\01113\C.Design\104667_HAM-75-3.84\Design\Structures\HAM0074_1892C_Sheets\74_1892RE001.dgn
 11/16/2023 9:34:50 AM
 S:\Plans\2017\01113\C.Design\104667_HAM-75-3.84\Design\Structures\HAM0074_1892C_Sheets\74_1892RE001.dgn

 DESIGN AGENCY 2000 CORPORATE CENTER DR., STE. 200 FARMINGTON, CT 06030 TEL: 860.633.9000 FAX: 860.633.9001 WWW.STRUCTUREPOINT.COM	
DATE: 11/12/18 REVIEWED: MDS DRAWN: BMP DESIGNED: SJF CHECKED: CLB	STRUCTURE FILE NUMBER: 3115690 REVISED:
ABUTMENT REMOVAL DETAILS (RIGHT BRIDGE) BRIDGE NO. HAM-74-1892 L/R OVER ELMORE STREET	
HAM-75-3.84 PID No. 104667	
7 / 38 89 120	

S:\Plans\23 11/16/2023 9:34:51 AM
 2017\01113\C.Design\104667.HAM-75-3.84\Design\Structures\HAM0074_1892C_Sheets\7.4_1892RE002.dgn

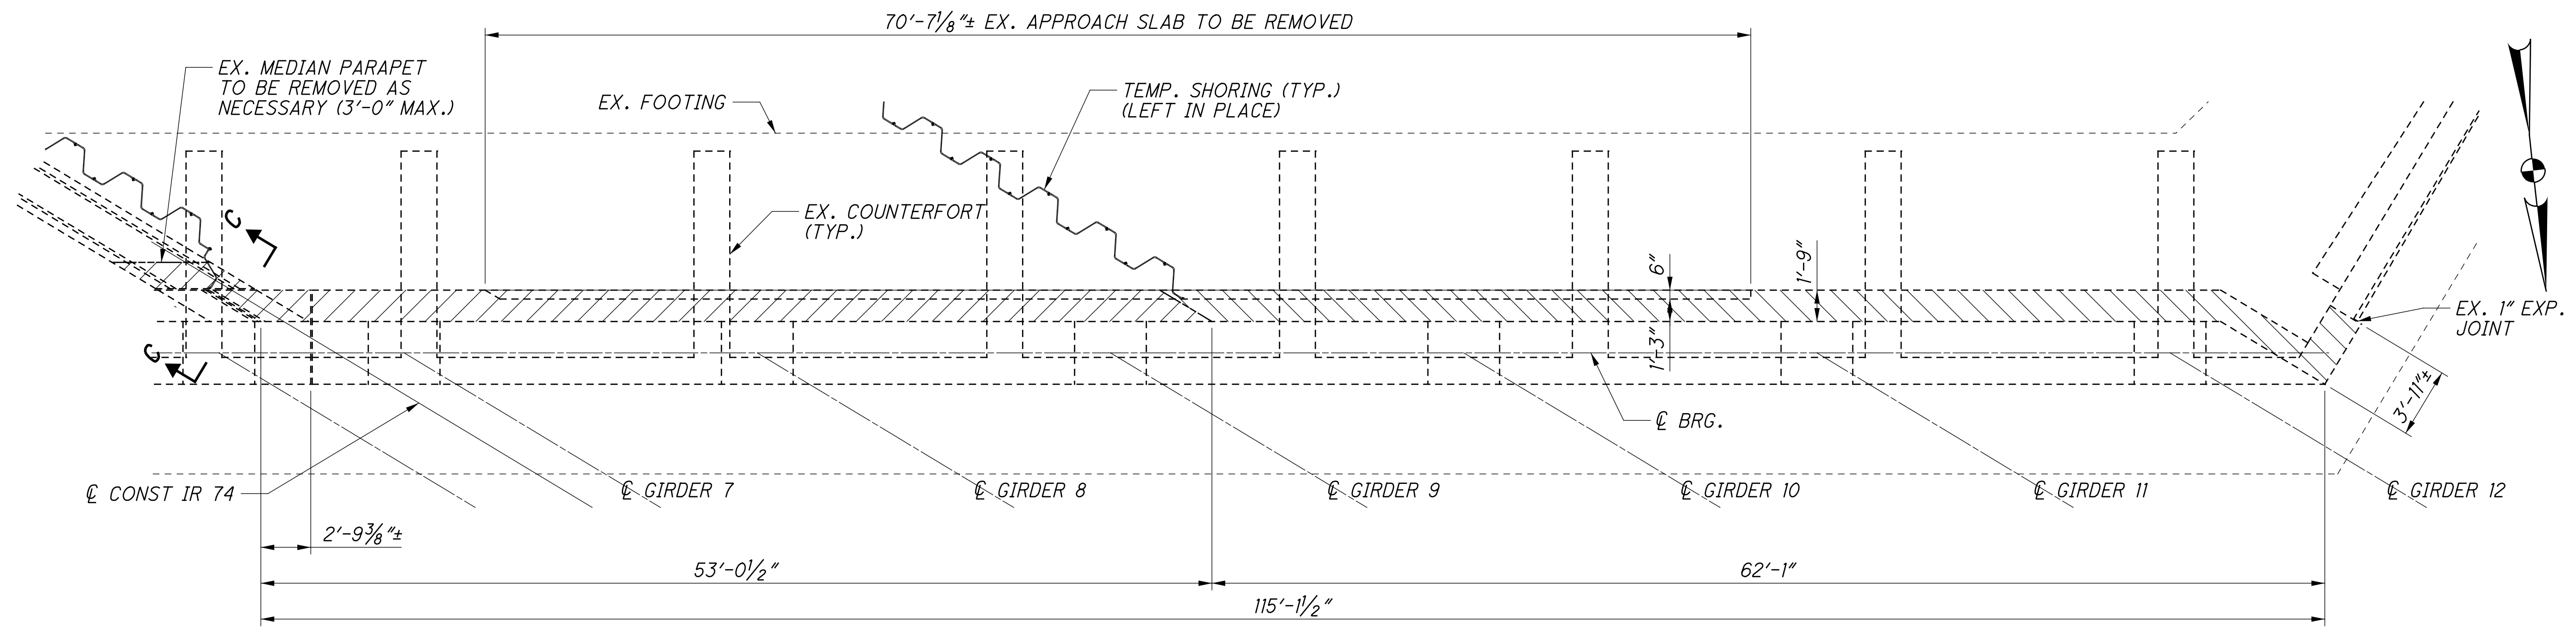

PLAN - FORWARD ABUTMENT

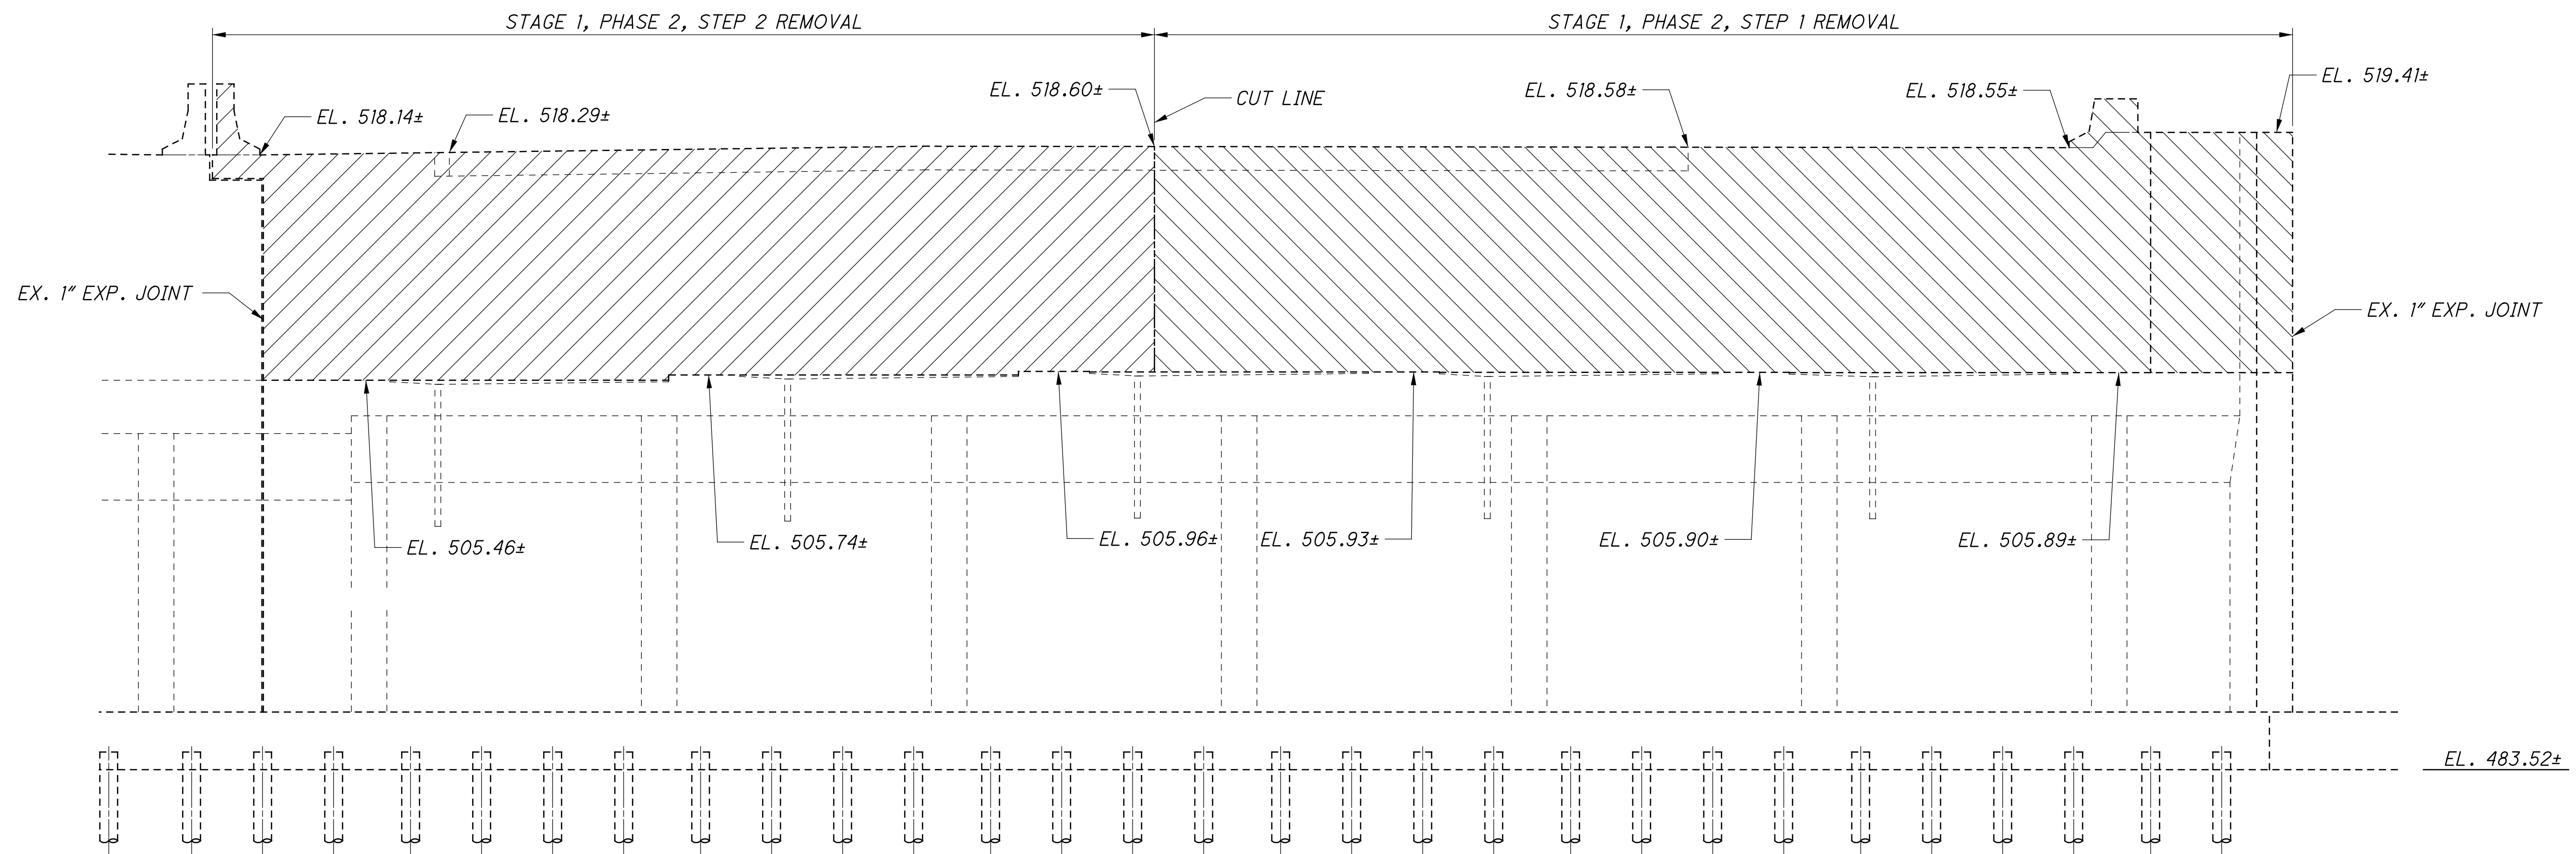

ELEVATION - FORWARD ABUTMENT

LEGEND



LIMITS OF REMOVAL PER ITEM 202

NOTES:


FOR SECTIONS A-A AND C-C, SEE SHEET 9/38.

DESIGN AGENCY STRUCTUREPOINT <small>INCORPORATED</small>	DATE 11/12/18
	REVIEWED MDS
	DRAWN DSH
	DESIGNED SUJ
STRUCTURE FILE NUMBER 3115690	CHECKED CLB
ABUTMENT REMOVAL DETAILS (RIGHT BRIDGE) BRIDGE NO. HAM-74-1892 L/R OVER ELMORE STREET	
HAM-75-3.84 PID No. 104667	
8 / 38	
90 120	


S:\Plans\gcn 9-34-51 AM 11/16/2023 10:2017\01113\C.Design\104667_HAM-75-3.84\Design\Structures\HAM0074_1892C_Sheets\7.4_1892RE003.dgn

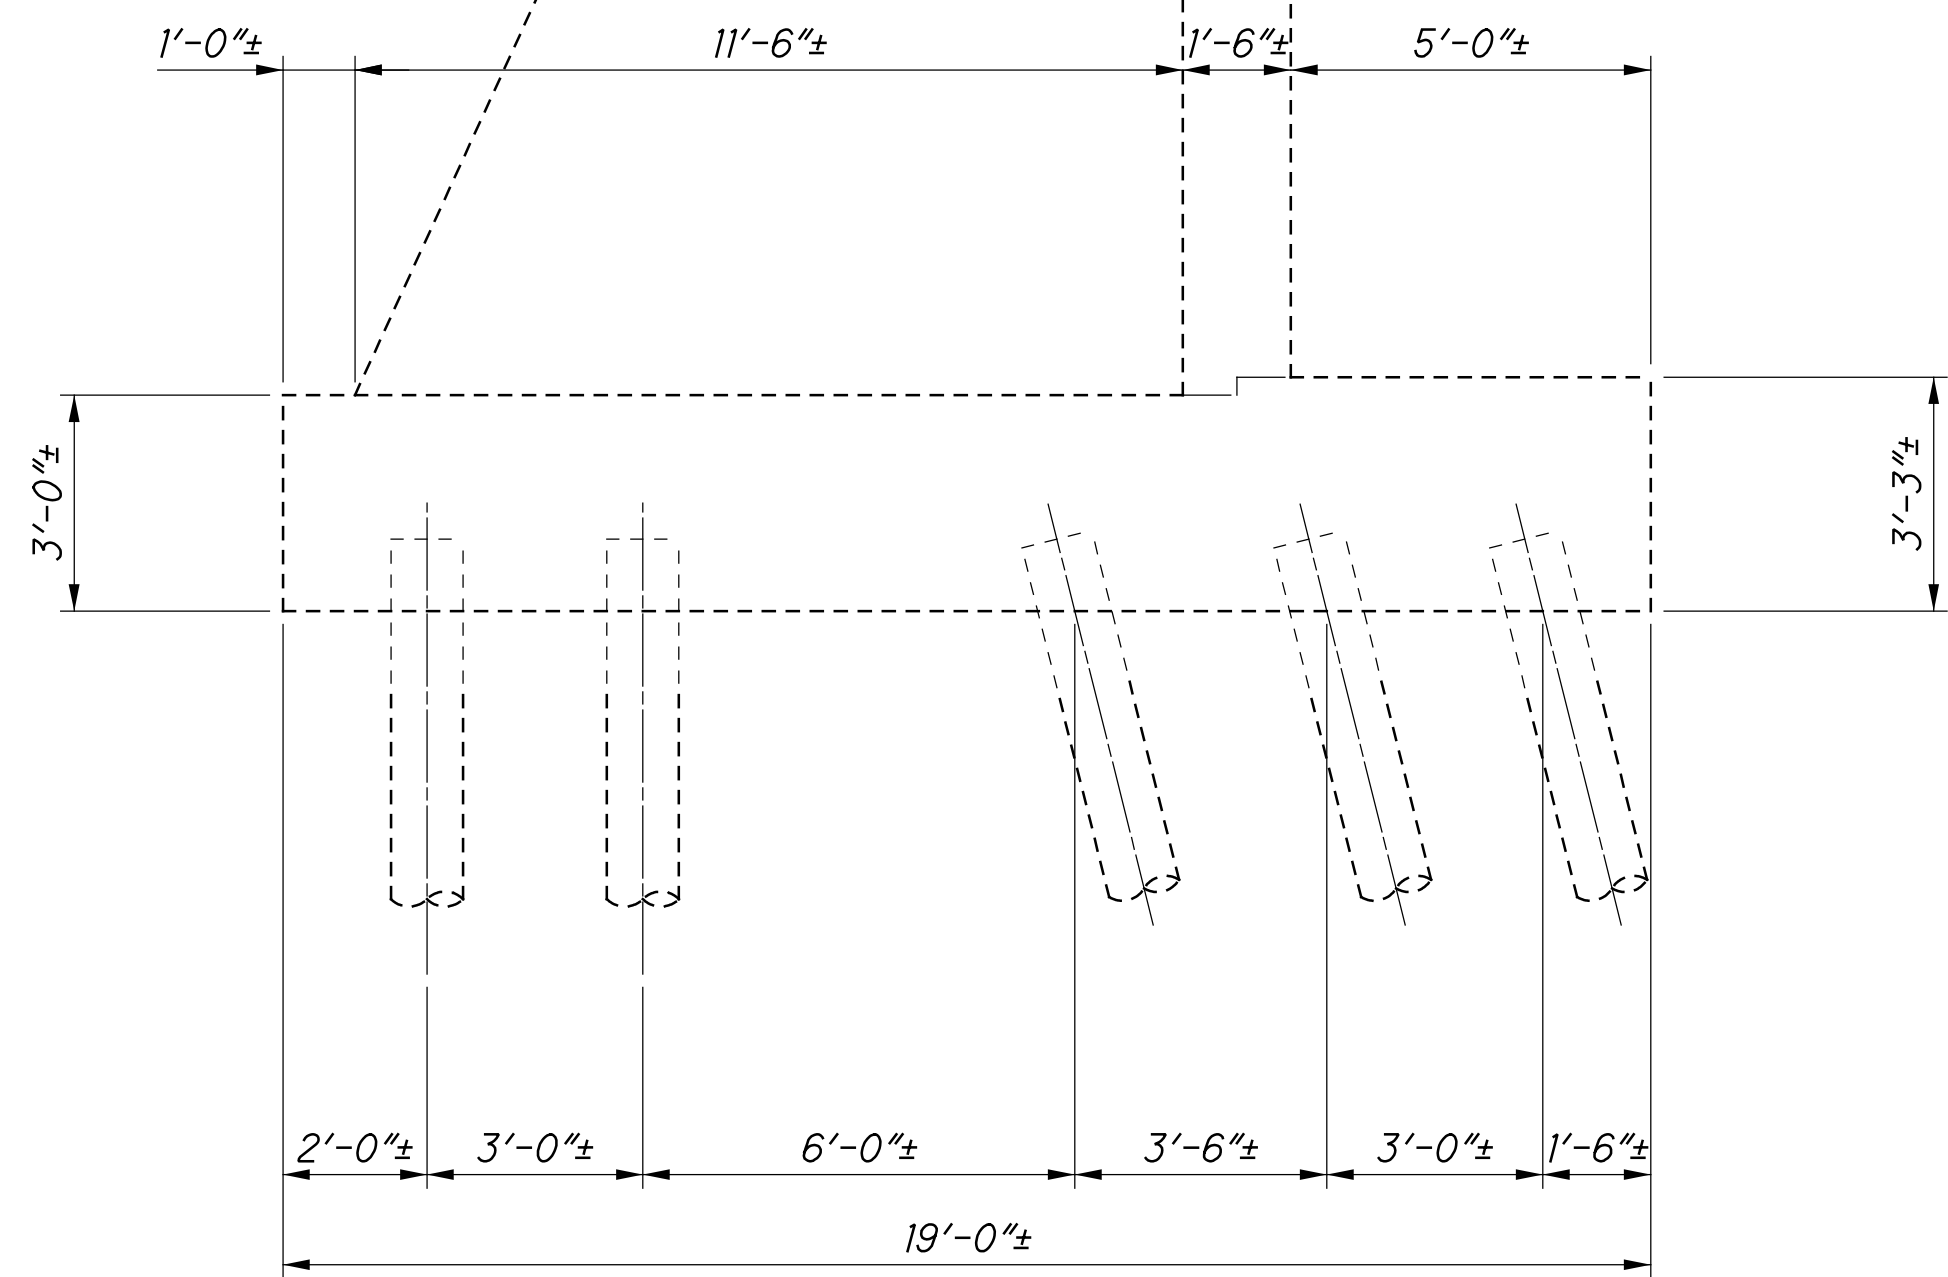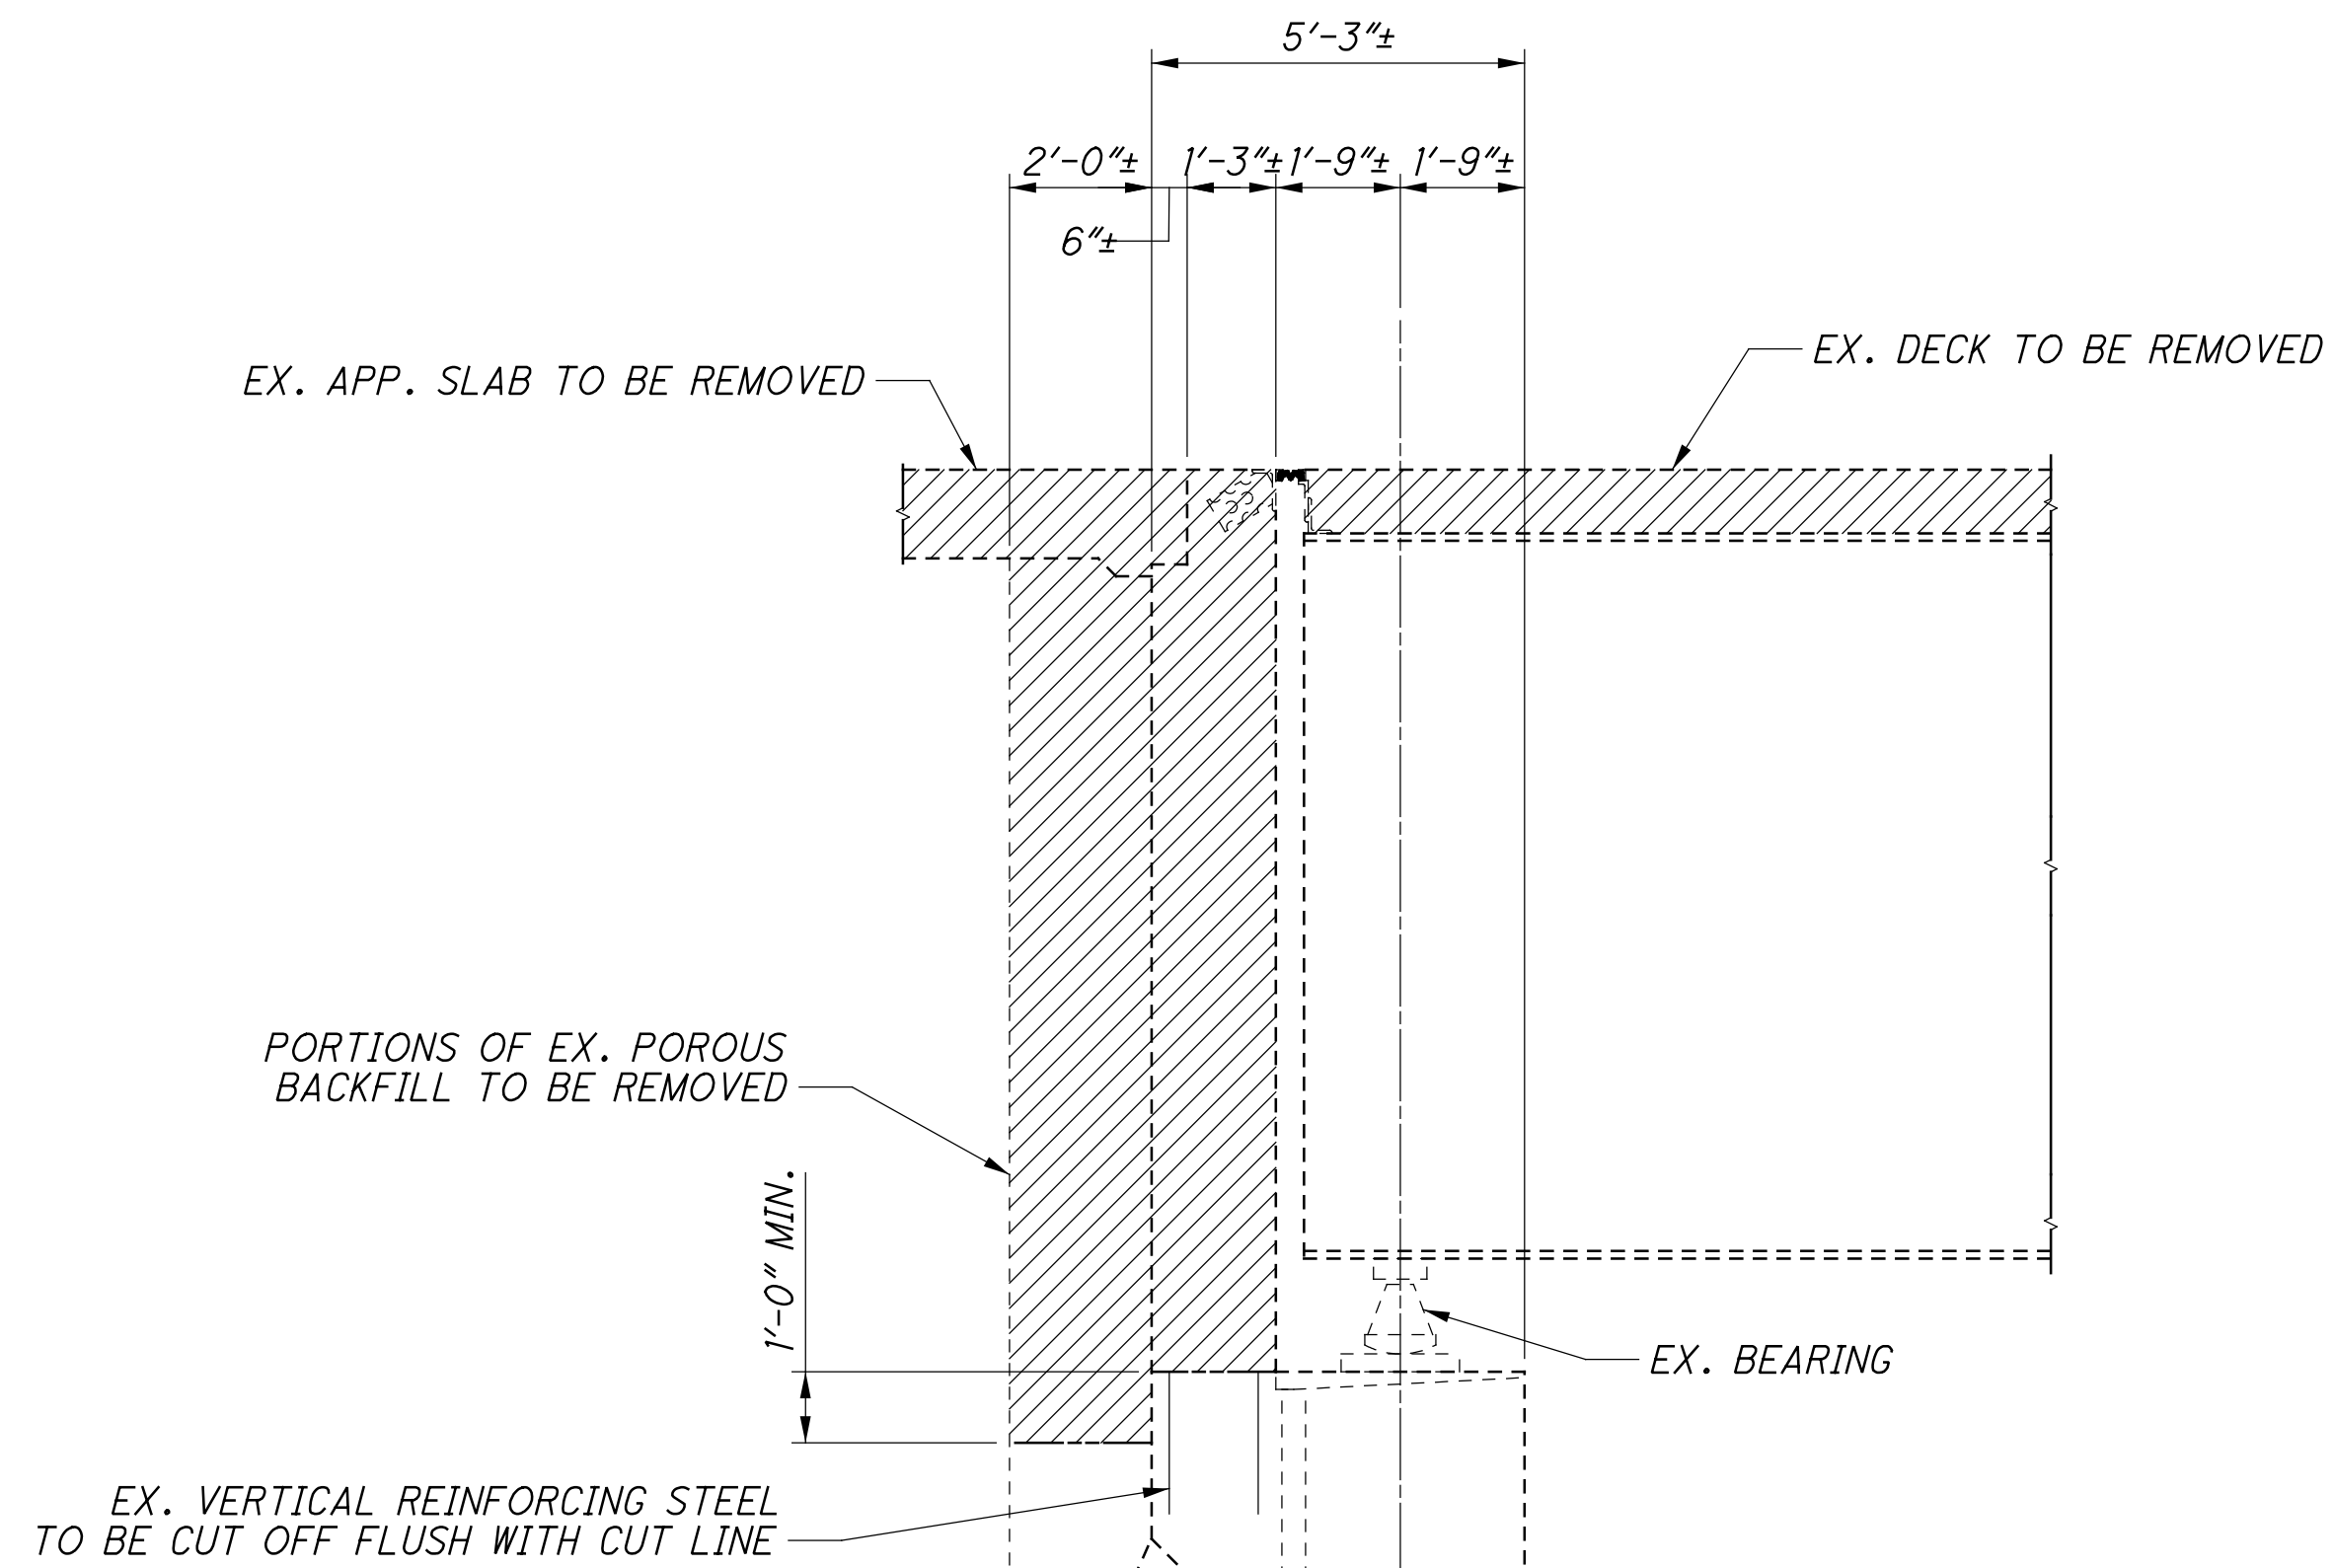

SECTION A-A

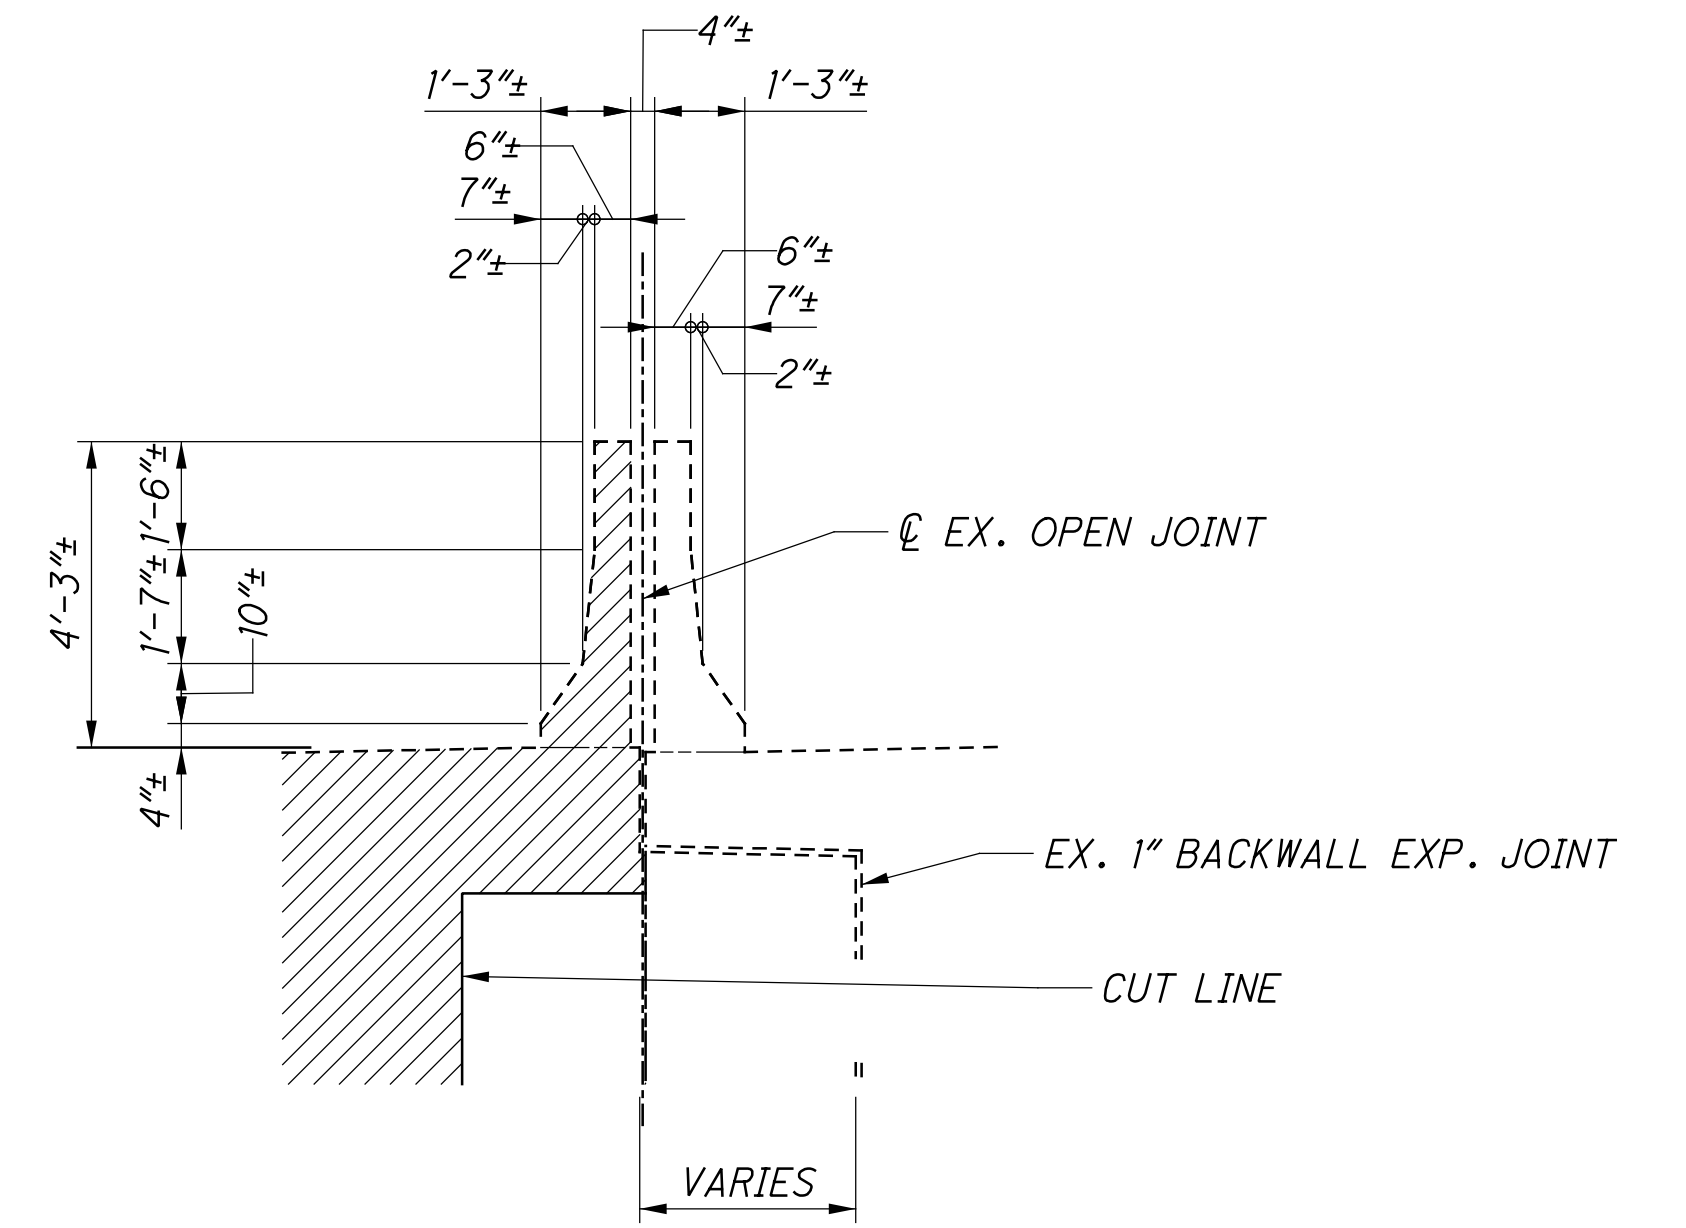

SECTION B-B

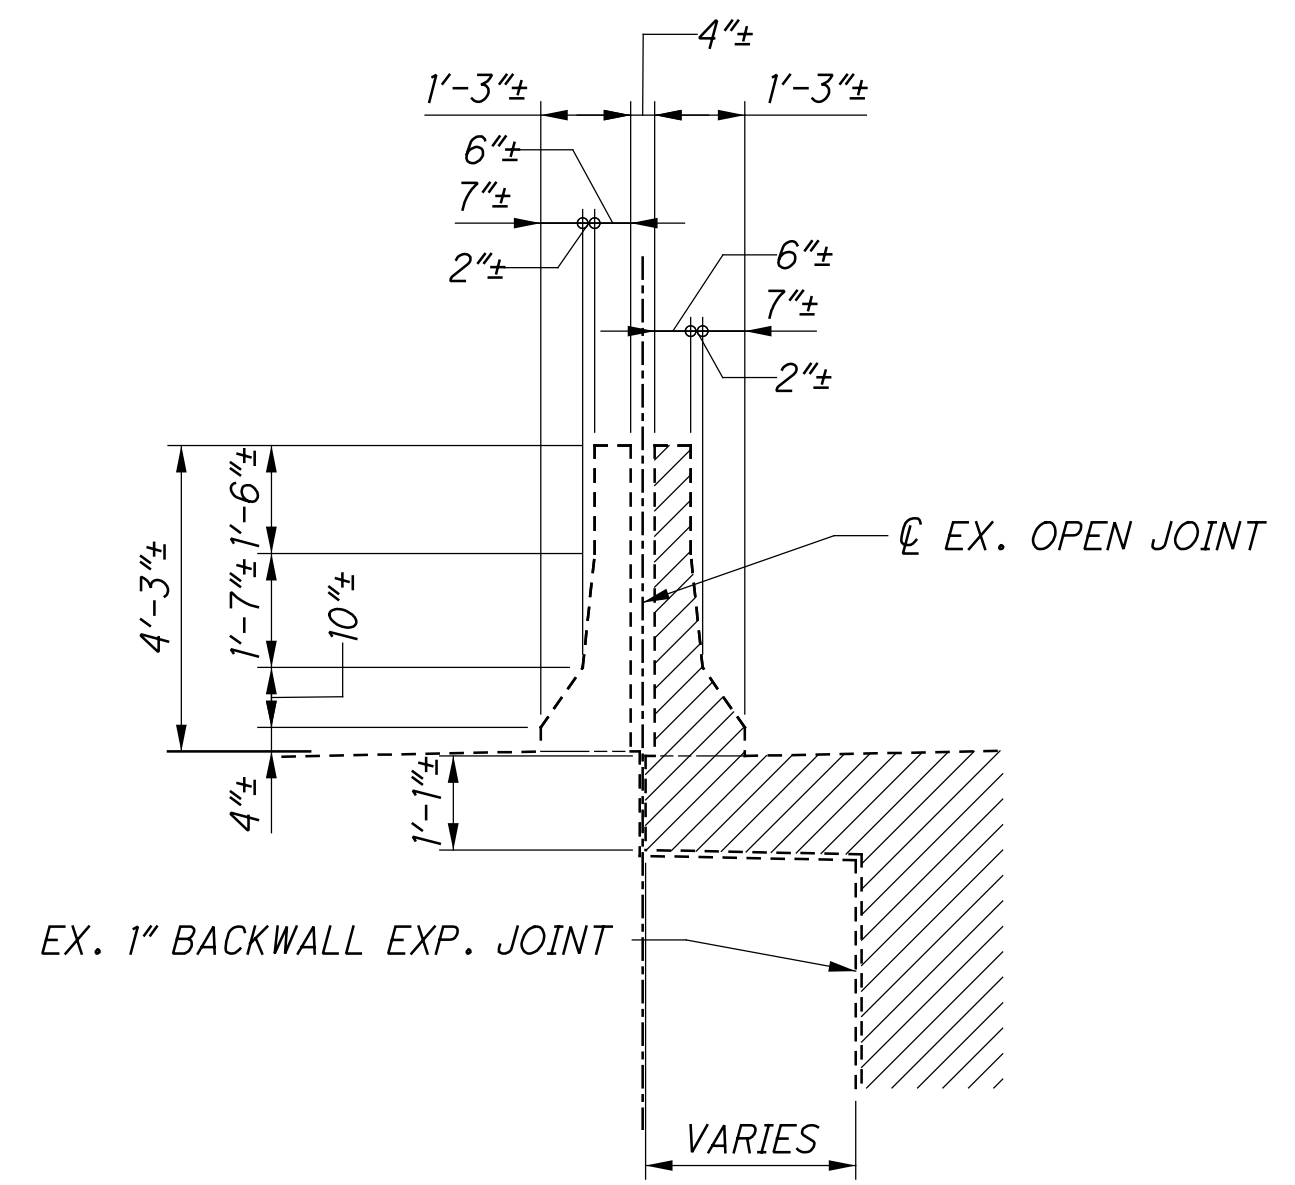


SECTION C-C

LEGEND



LIMITS OF REMOVAL PER ITEM 202


S:\Plans\2017\01113\C.Design\104667_HAM-75-3.84\Design\Structures\HAM0074_1892C_Sheets\7.4_1892RE004.dgn
 11/16/2023 9:34:52 AM

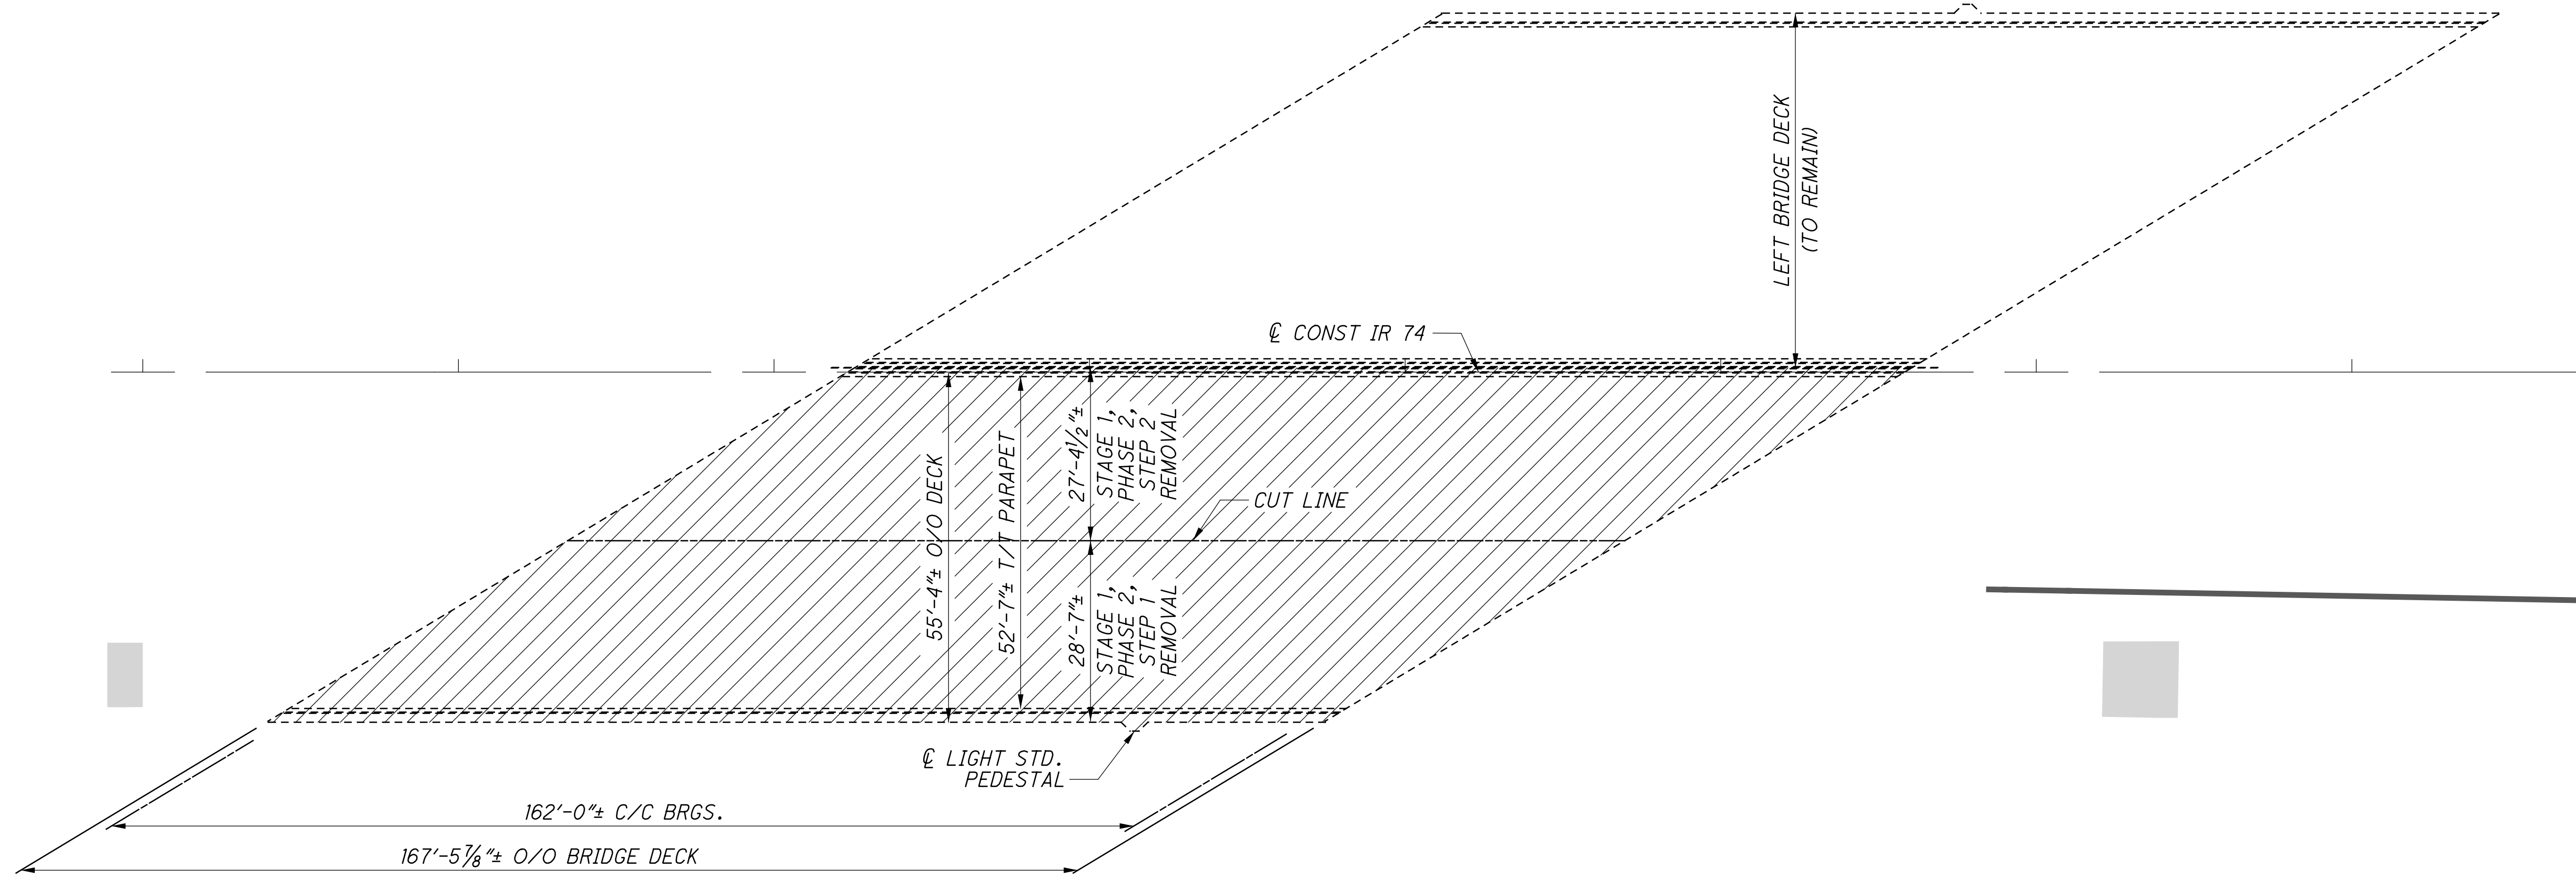


PLAN

LEGEND


 LIMITS OF REMOVAL PER ITEM 202

HAM - 75 - 3.84 PID No. 104667		DESIGN AGENCY 	
BRIDGE NO. HAM-74-1892 L/R OVER ELMORE STREET		DATE 11/12/18 REVIEWED MDS STRUCTURE FILE NUMBER 3115690	
SUPERSTRUCTURE REMOVAL DETAILS (RIGHT BRIDGE)		DESIGNED SUJ CHECKED CLB	
DRAWN DSH REVISED		REVIEWED MDS STRUCTURE FILE NUMBER 3115690	
10 / 38		92 / 120	

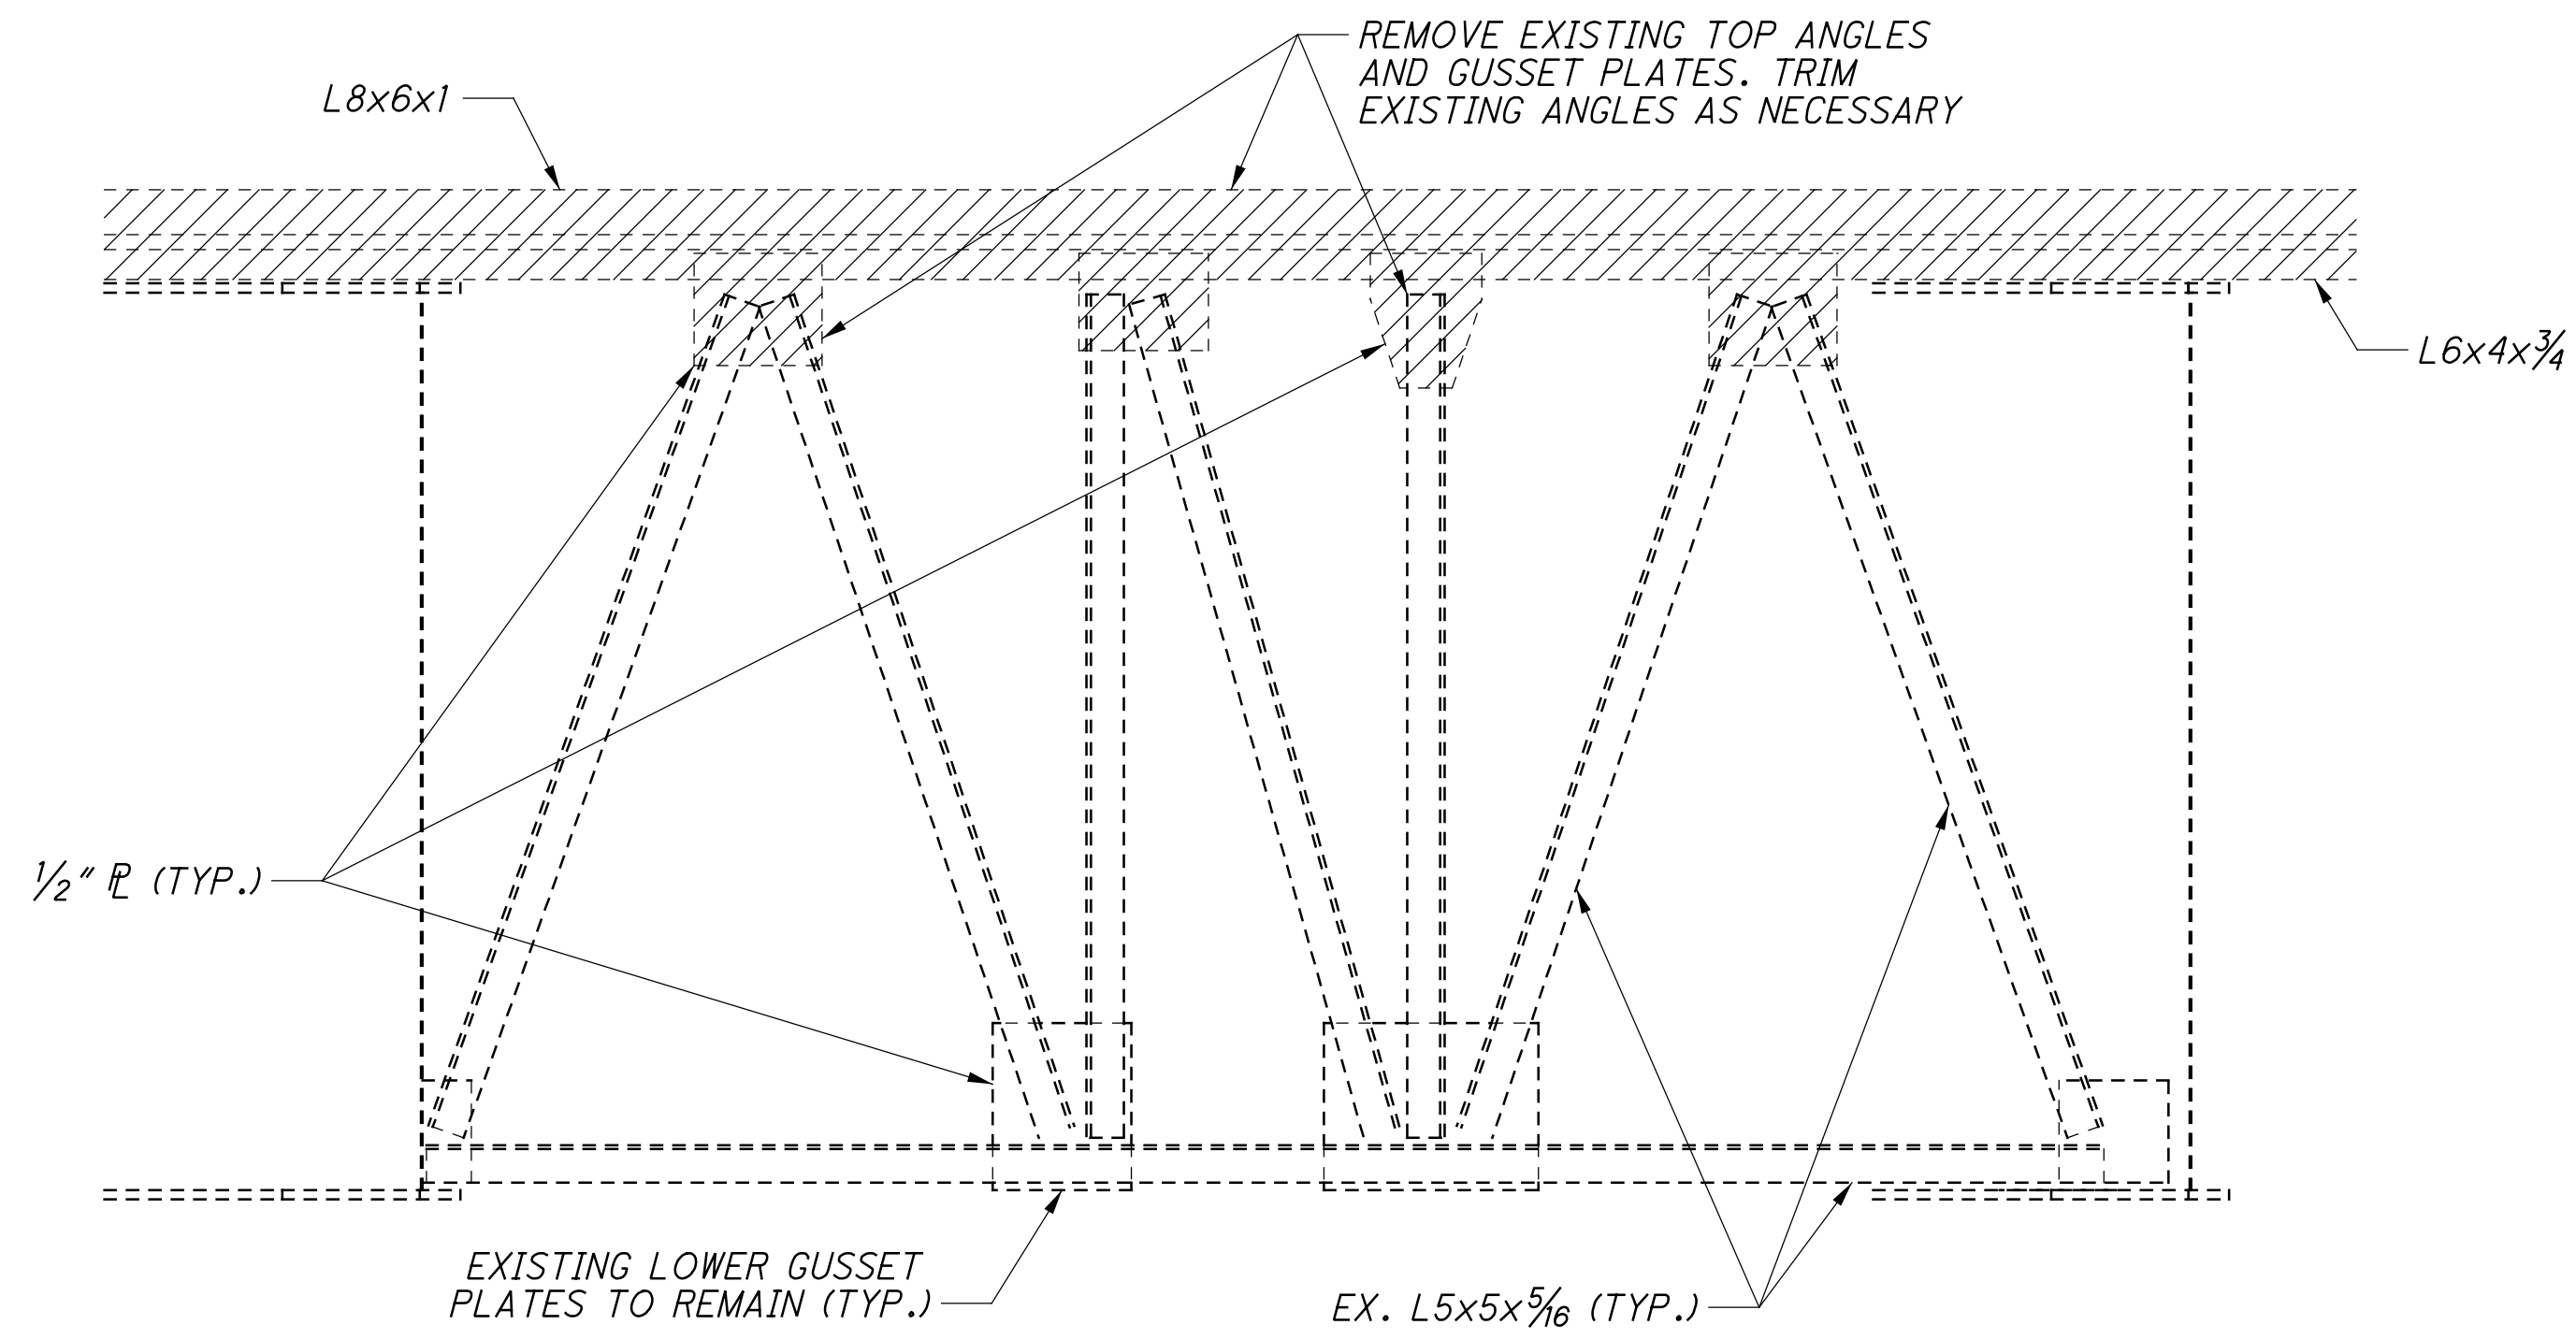


END CROSS FRAME REMOVAL DETAIL

S:\Plans\9-34-53 AM 11/16/2023 11:16:20 AM 2017\01113 C. Design\104667 HAM-75-3.84 Design\Structures\HAM0074-1892C_Sheets\7.4-1892AR001.dgn

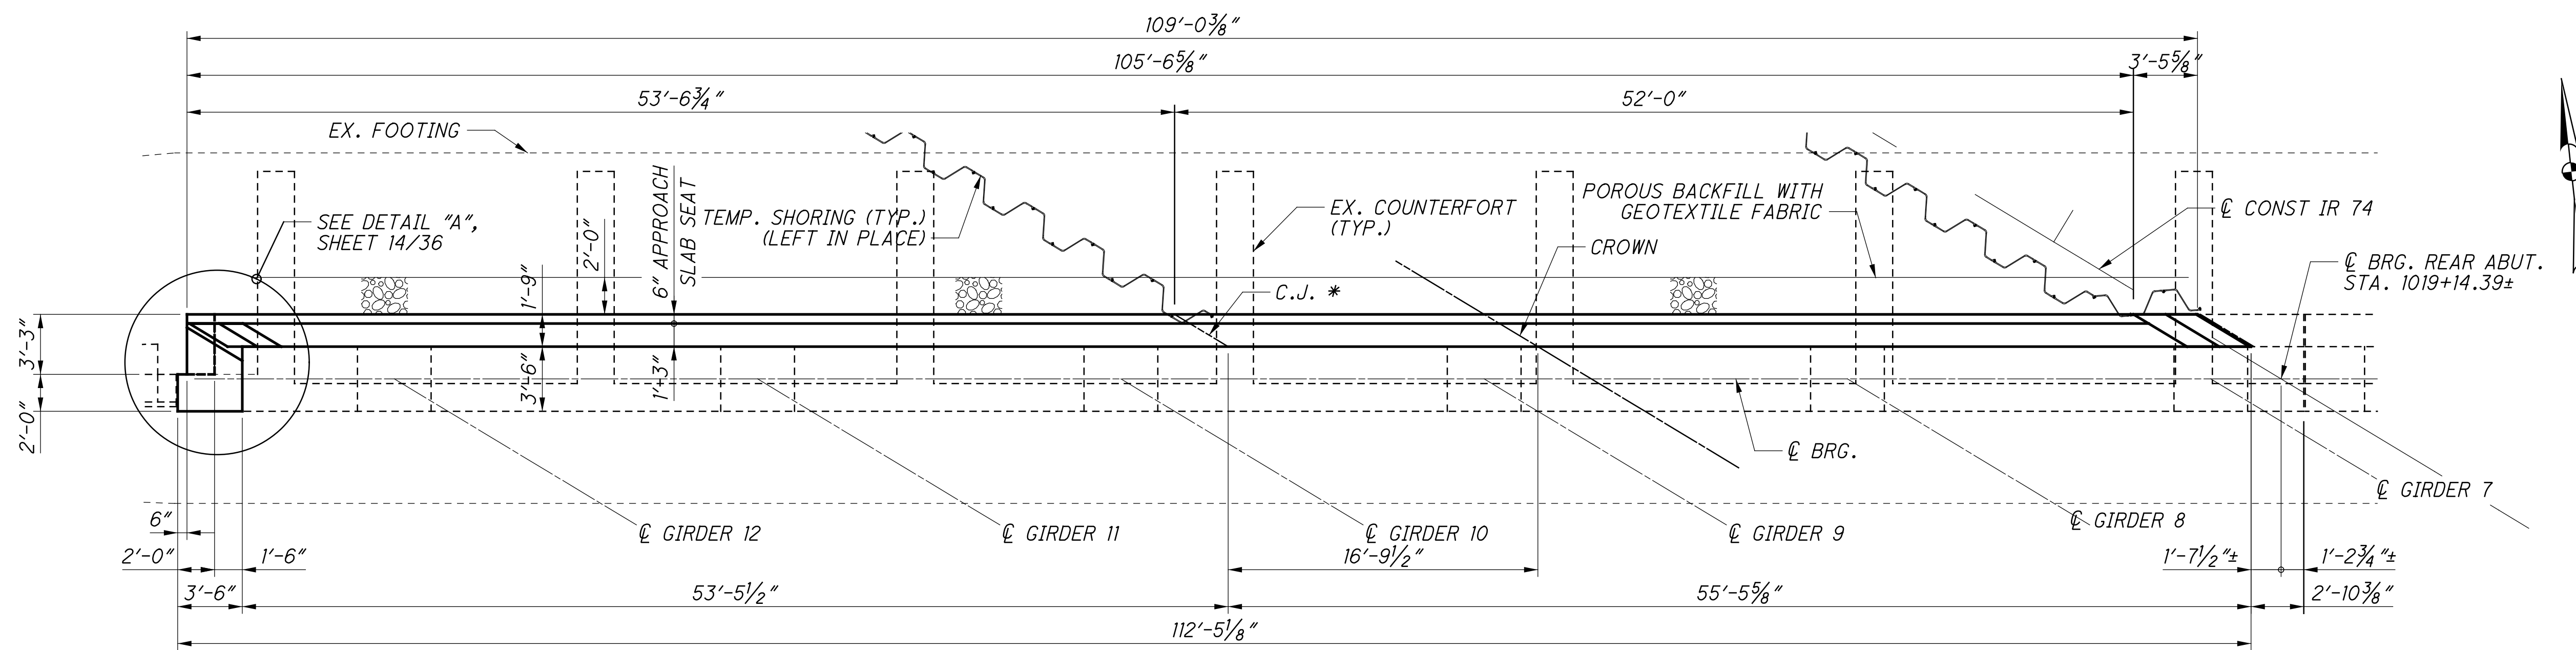

PLAN - REAR ABUTMENT

MINIMUM BAR LAP	
#5	3'-6"
#6	3'-10"

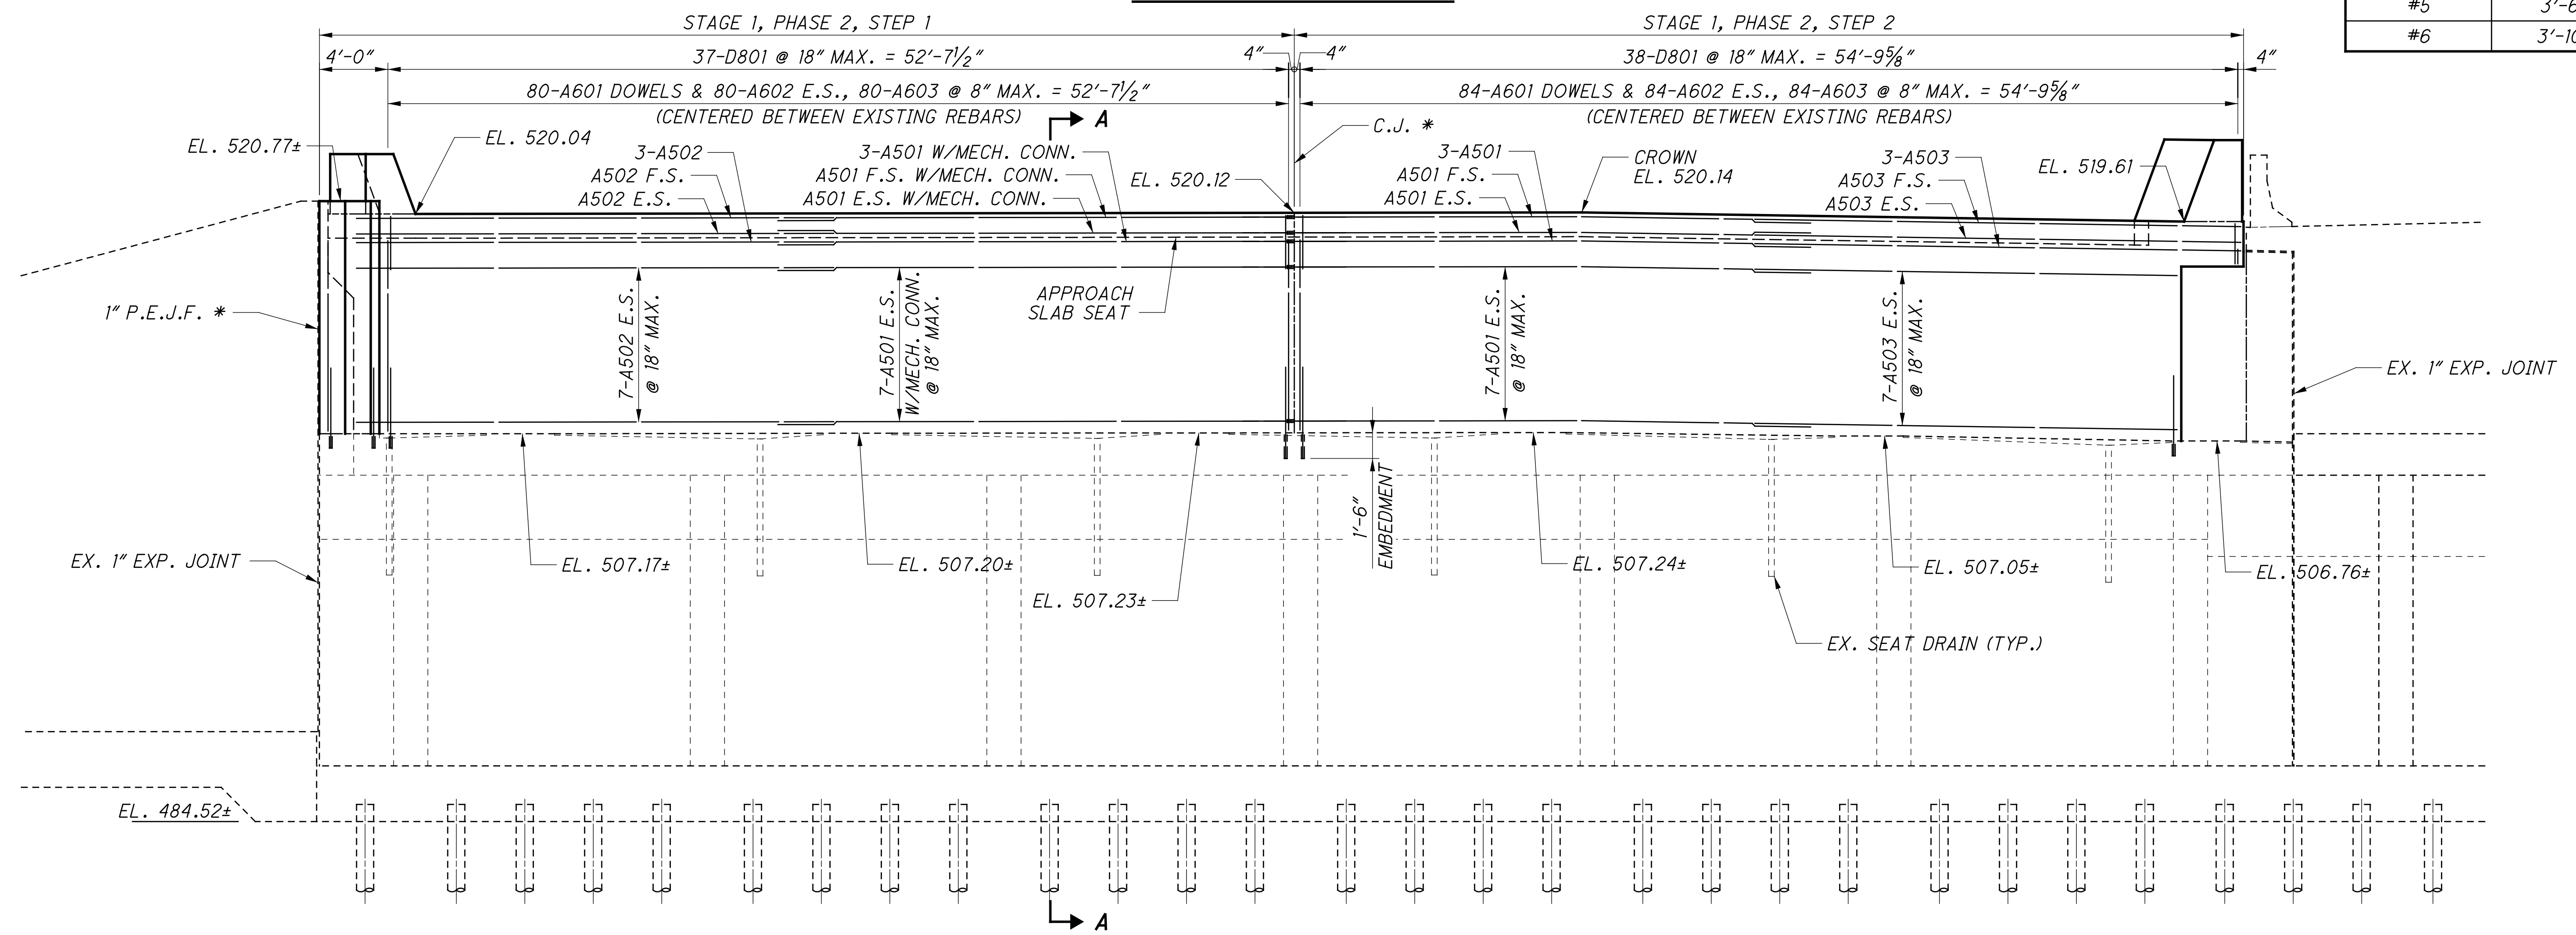

ELEVATION - REAR ABUTMENT

- NOTES:
- * 3'-0" WIDE TYPE 2 WATERPROOFING ON BACK FACE CENTERED ON JOINT FROM TOP OF SEAT TO BOTTOM OF APPROACH SLAB.
 - FOR PARAPET DETAILS, SEE SHEETS 26/38 AND 28/38.
 - FOR SECTION A-A, SEE SHEET 13/38.
 - ELEVATIONS PROVIDED AT FRONT FACE OF BACKWALL.

DESIGN AGENCY
STRUCTUREPOINT

DESIGNED
SUF
CHECKED
CLB

DRAWN
DSH
REVISED

REVIEWED
MDS
DATE
11/12/18
STRUCTURE FILE NUMBER
3115690

BRIDGE NO. HAM-74-1892 L/R
OVER ELMORE STREET


REAR ABUTMENT DETAILS (RIGHT BRIDGE)

HAM-75-3.84
PID No. 104667

12/38

94
120






S:\Plans\gpn 9-34-54 AM
 11/16/2023
 \O:\2017\01113\C.Design\104667_HAM-75-3.84\Design\Structures\HAM0074_1892C_Sheets\7.4_1892AR002.dgn

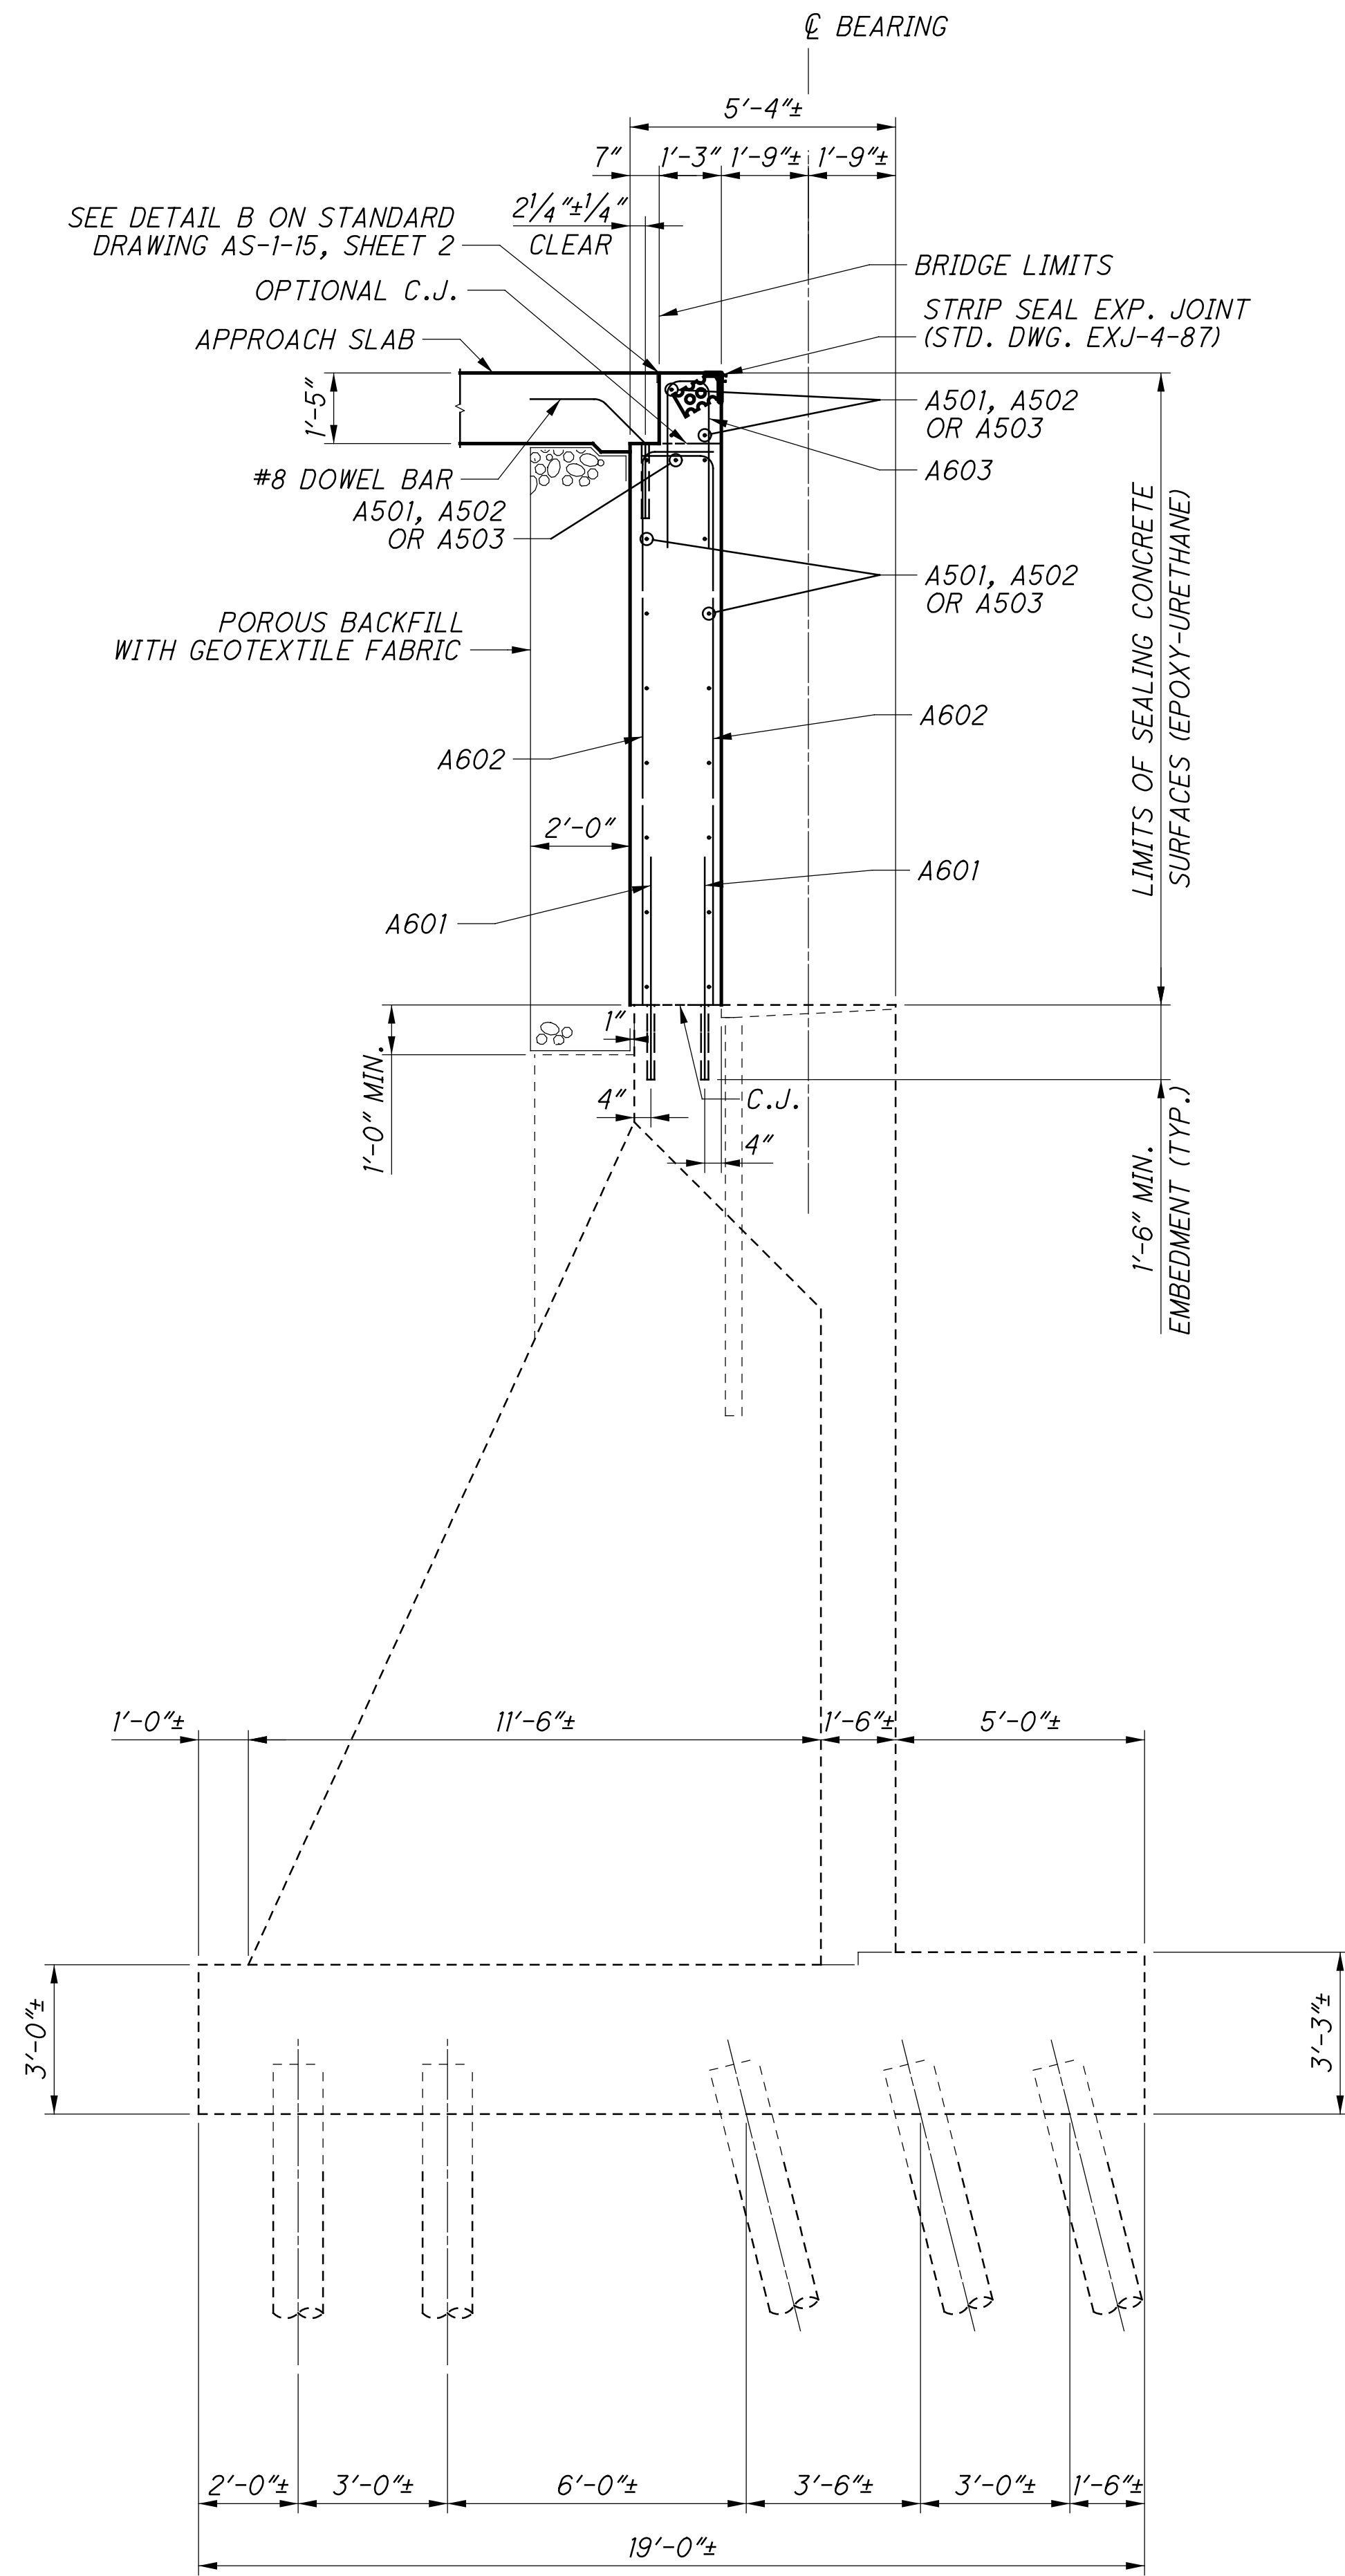

SECTION A-A


DESIGNED		DRAWN		REVIEWED		DATE		DESIGN AGENCY	
SUF		DSH		MDS		11/12/18		STRUCTUREPOINT	
CHECKED		REVISED		STRUCTURE FILE NUMBER		3115690		2020 CORPORATE OFFICE: 2415 10TH AVE. SUITE 200 TEL: 610.326.1000 FAX: 610.326.1001 WWW.STRUCTUREPOINT.COM	
CLB								REAR ABUTMENT DETAILS (RIGHT BRIDGE)	
								BRIDGE NO. HAM-74-1892 L/R OVER ELMORE STREET	
								HAM-75-3.84	
								PID No. 104667	
								13 / 38	
								95 120	

S:\Plans\23
 11/16/2023 9:34:54 AM
 2017\01113\C.Design\104667_HAM-75-3.84\Design\Structures\HAM0074_1892C_Sheets\74_1892AR003.dgn

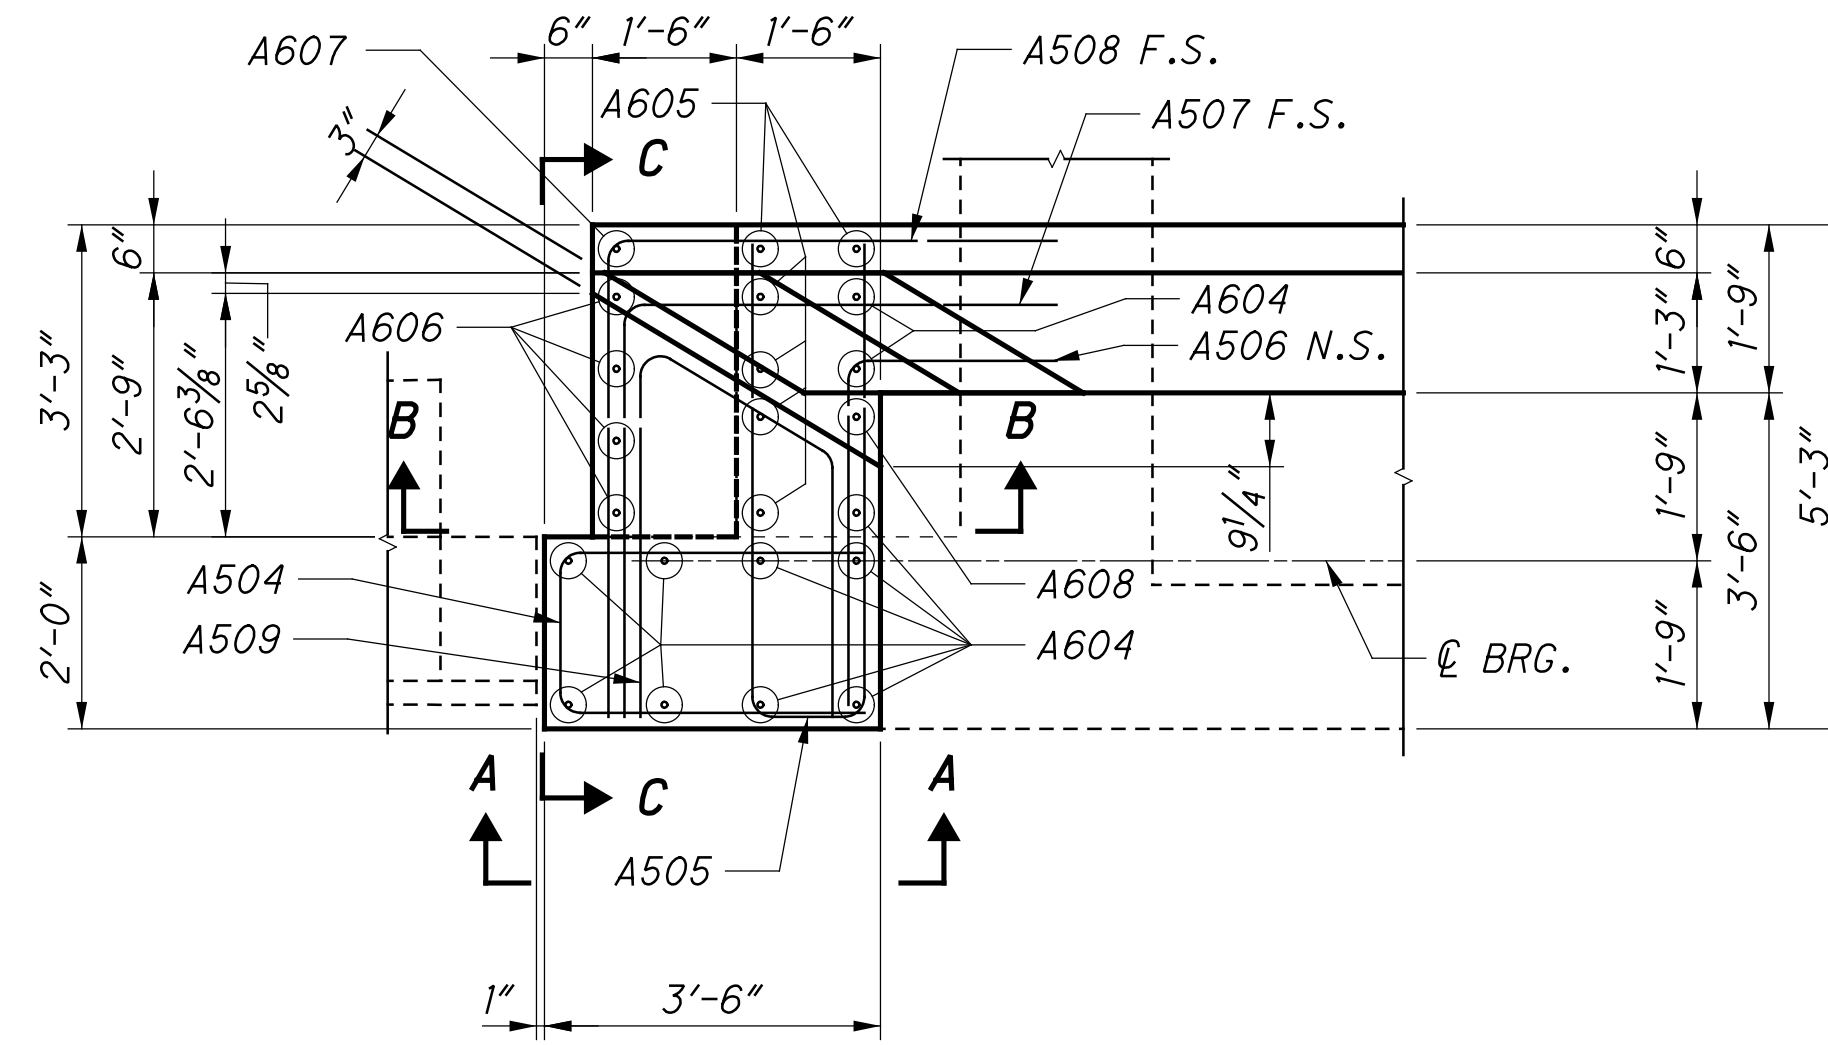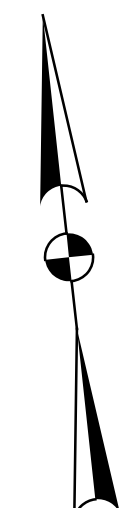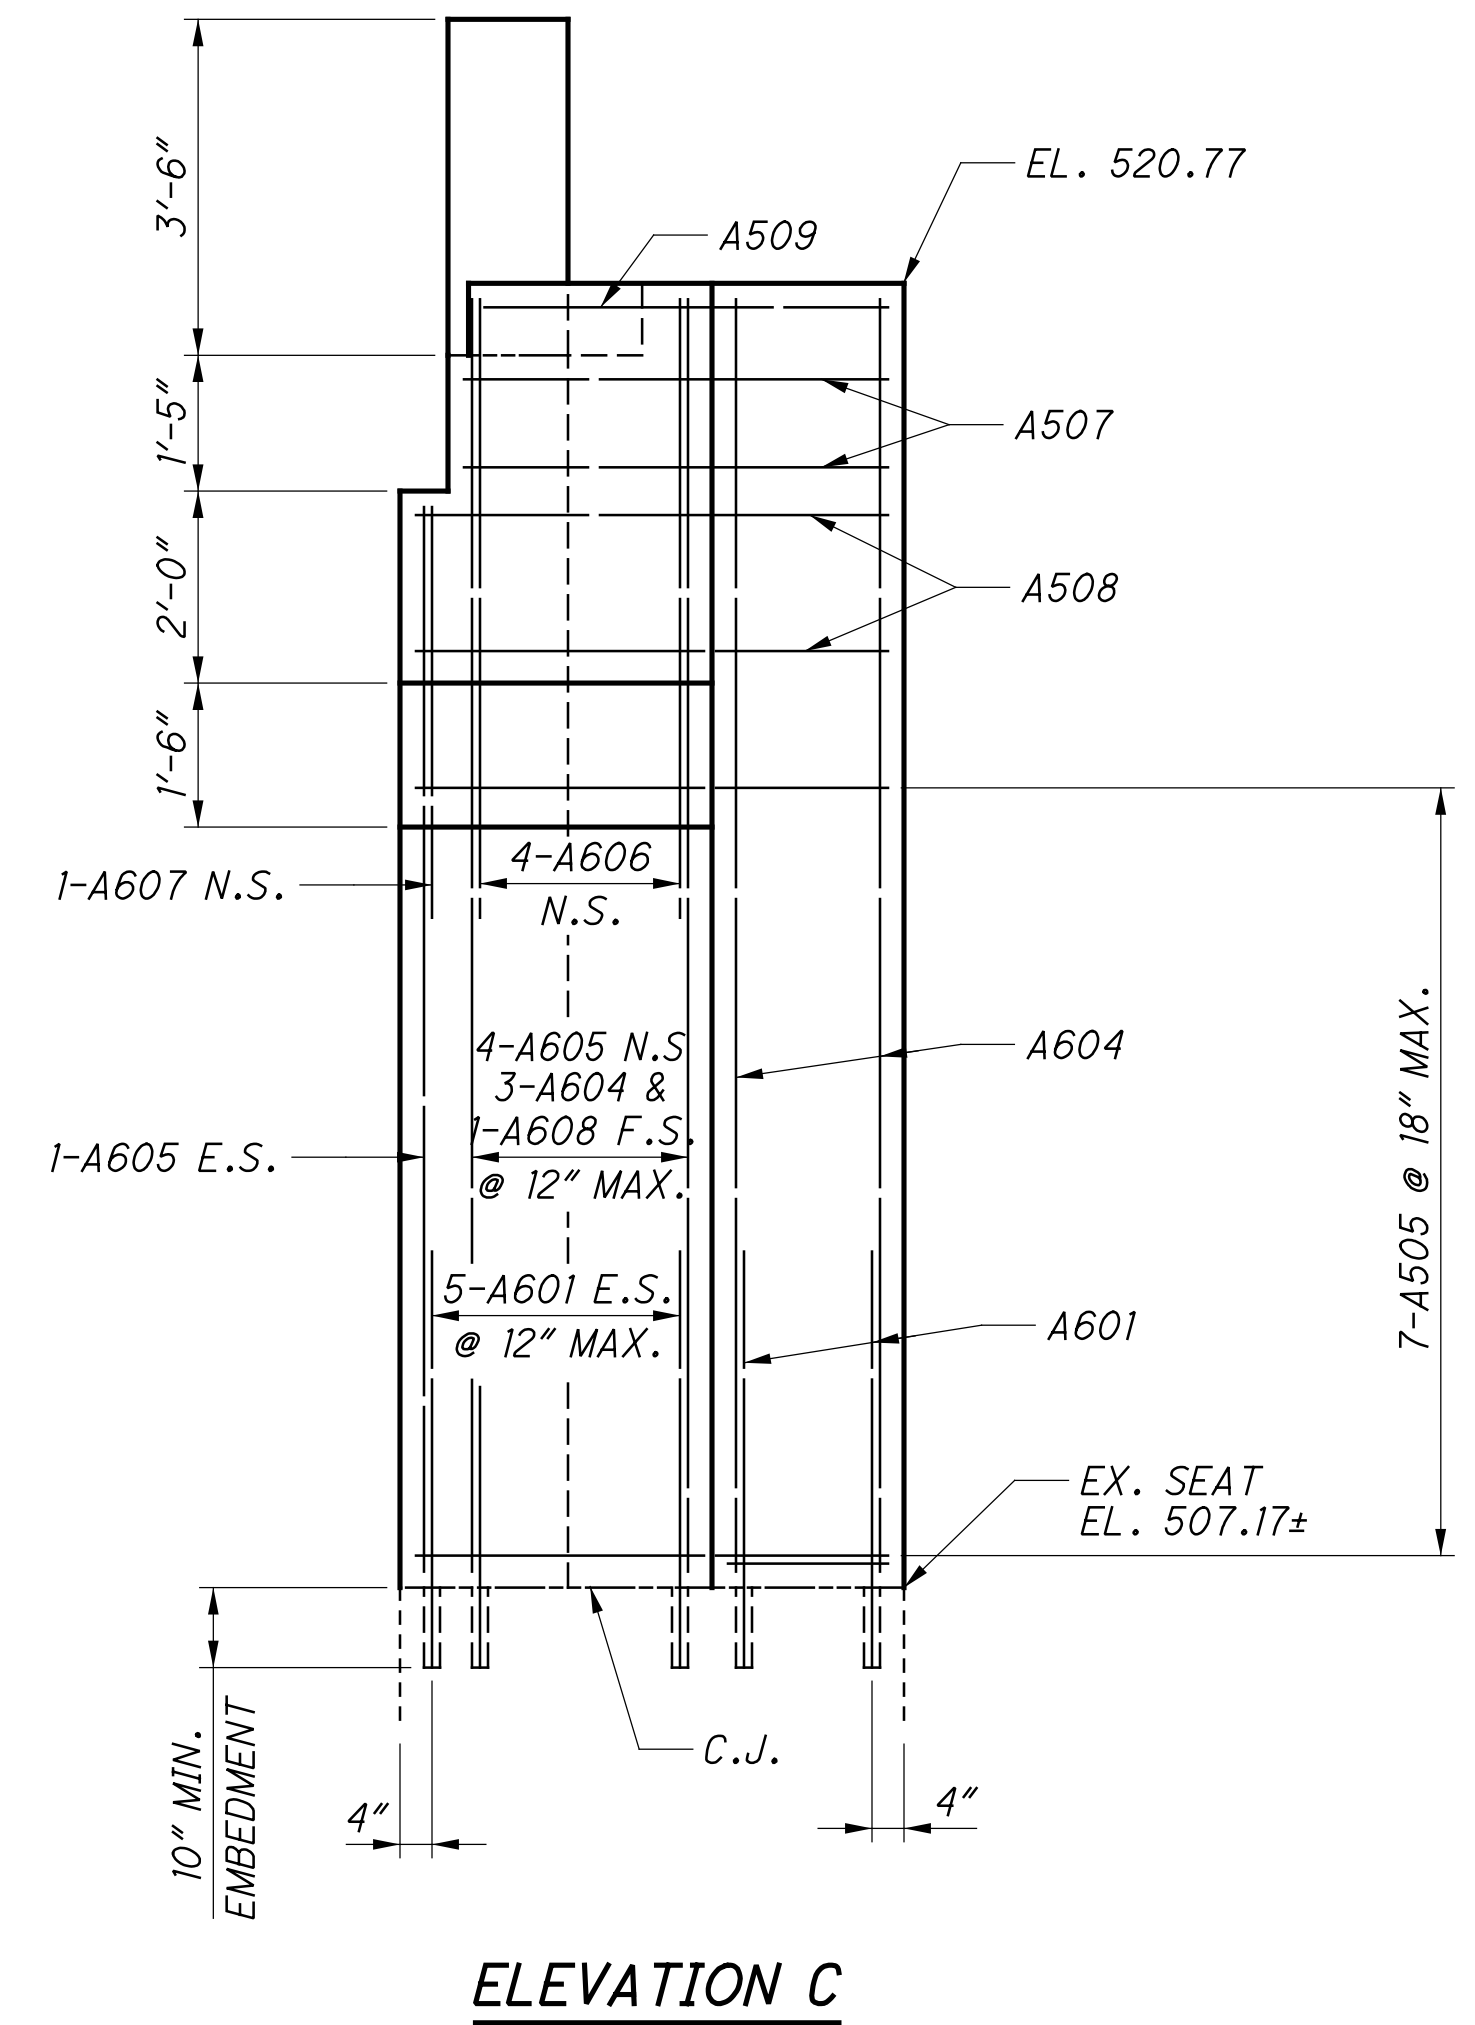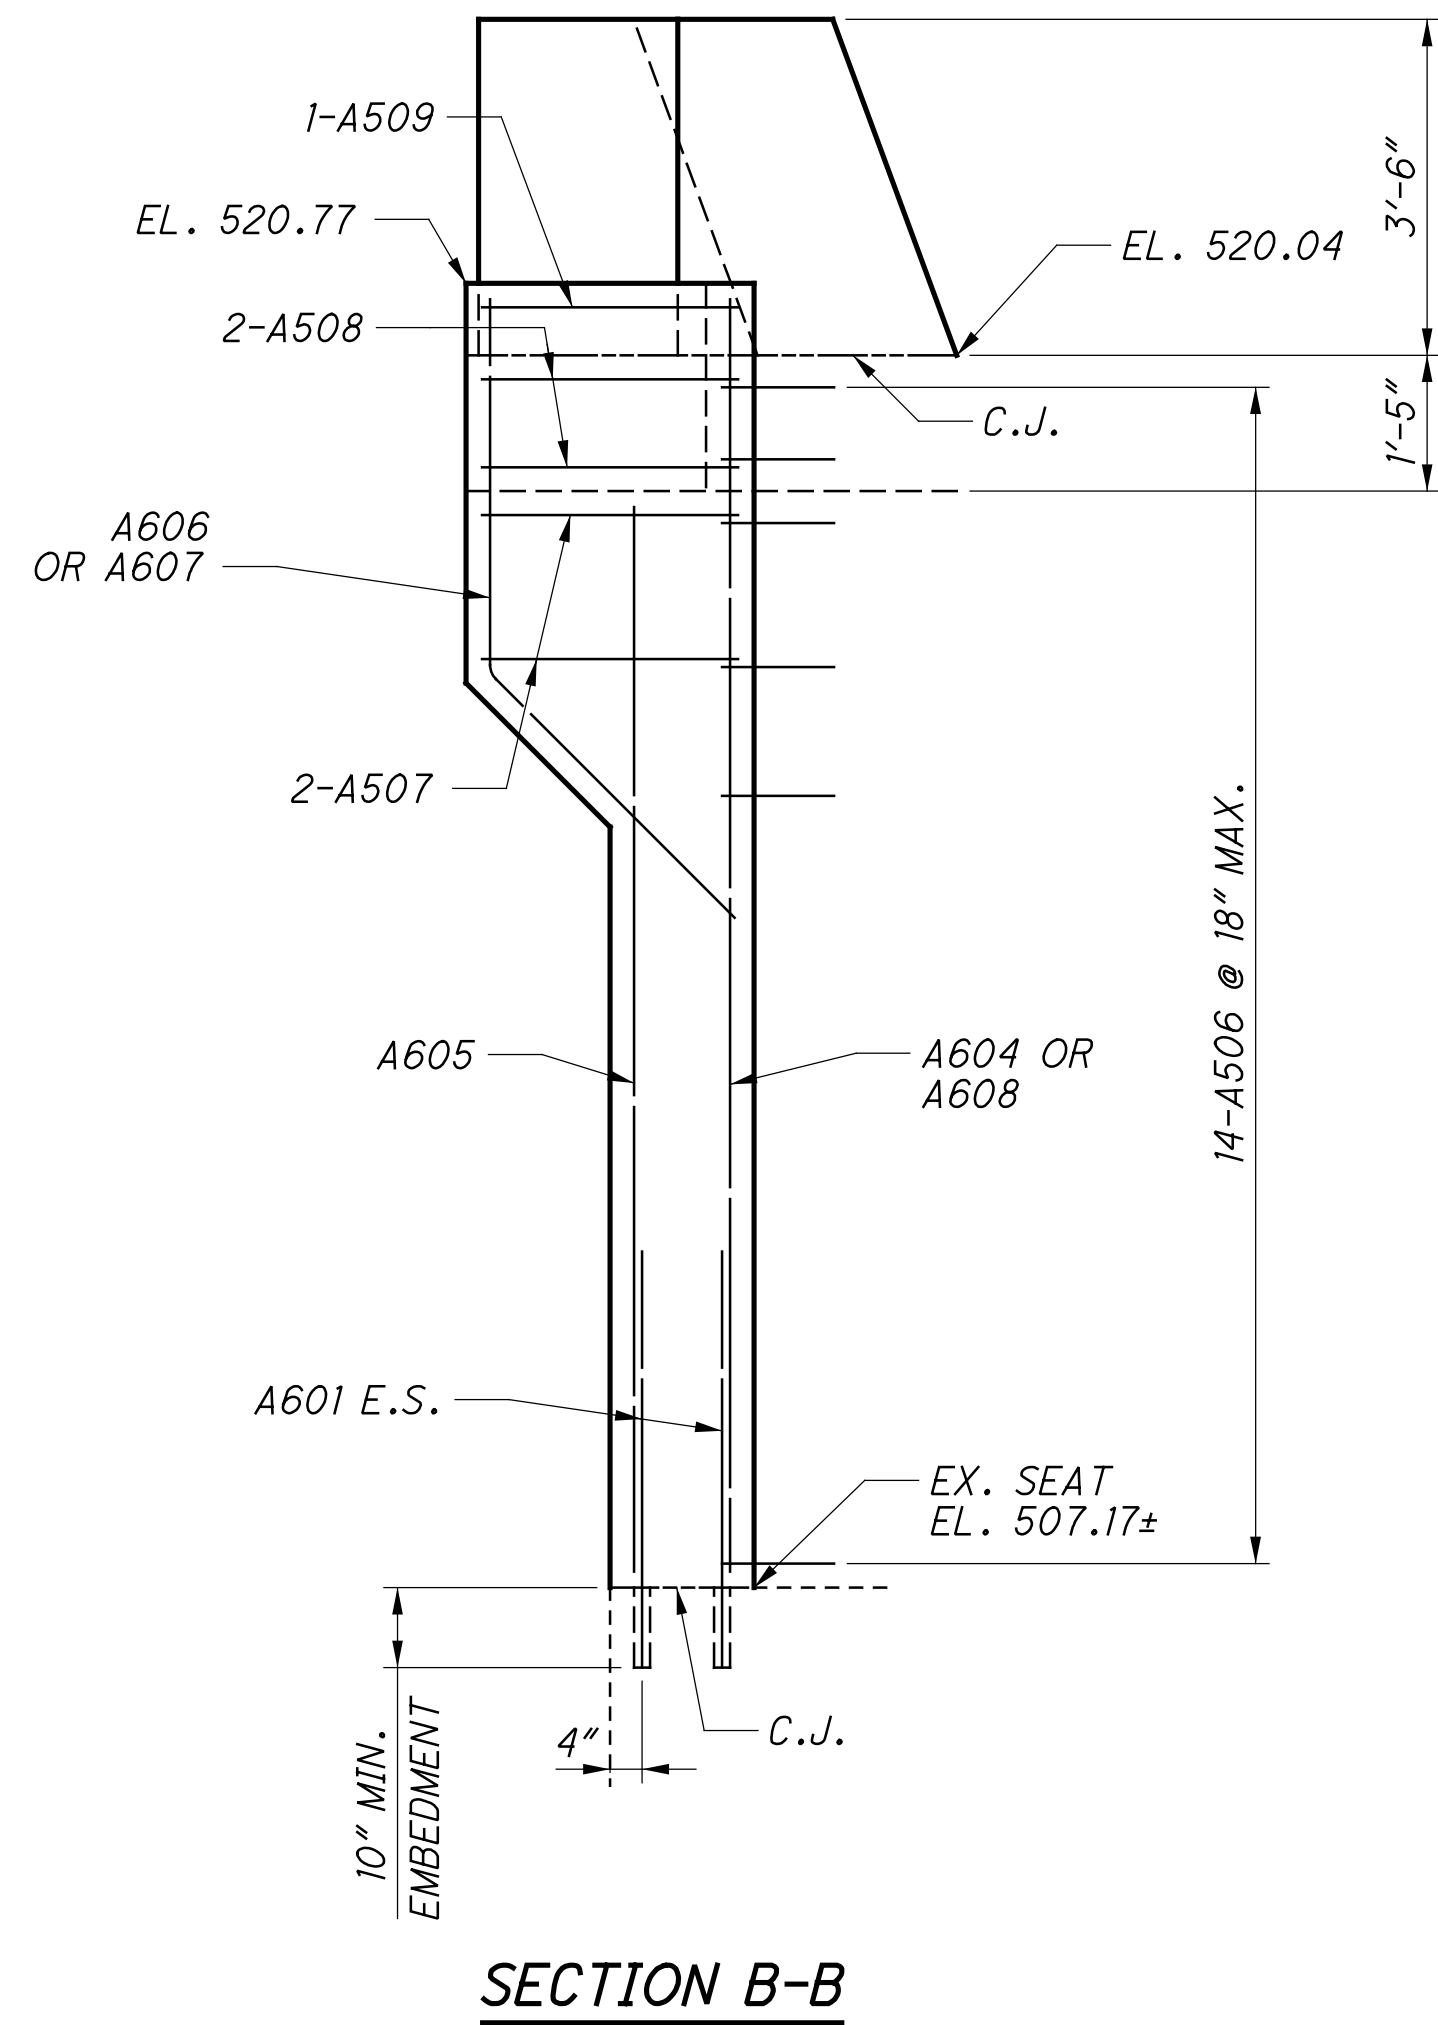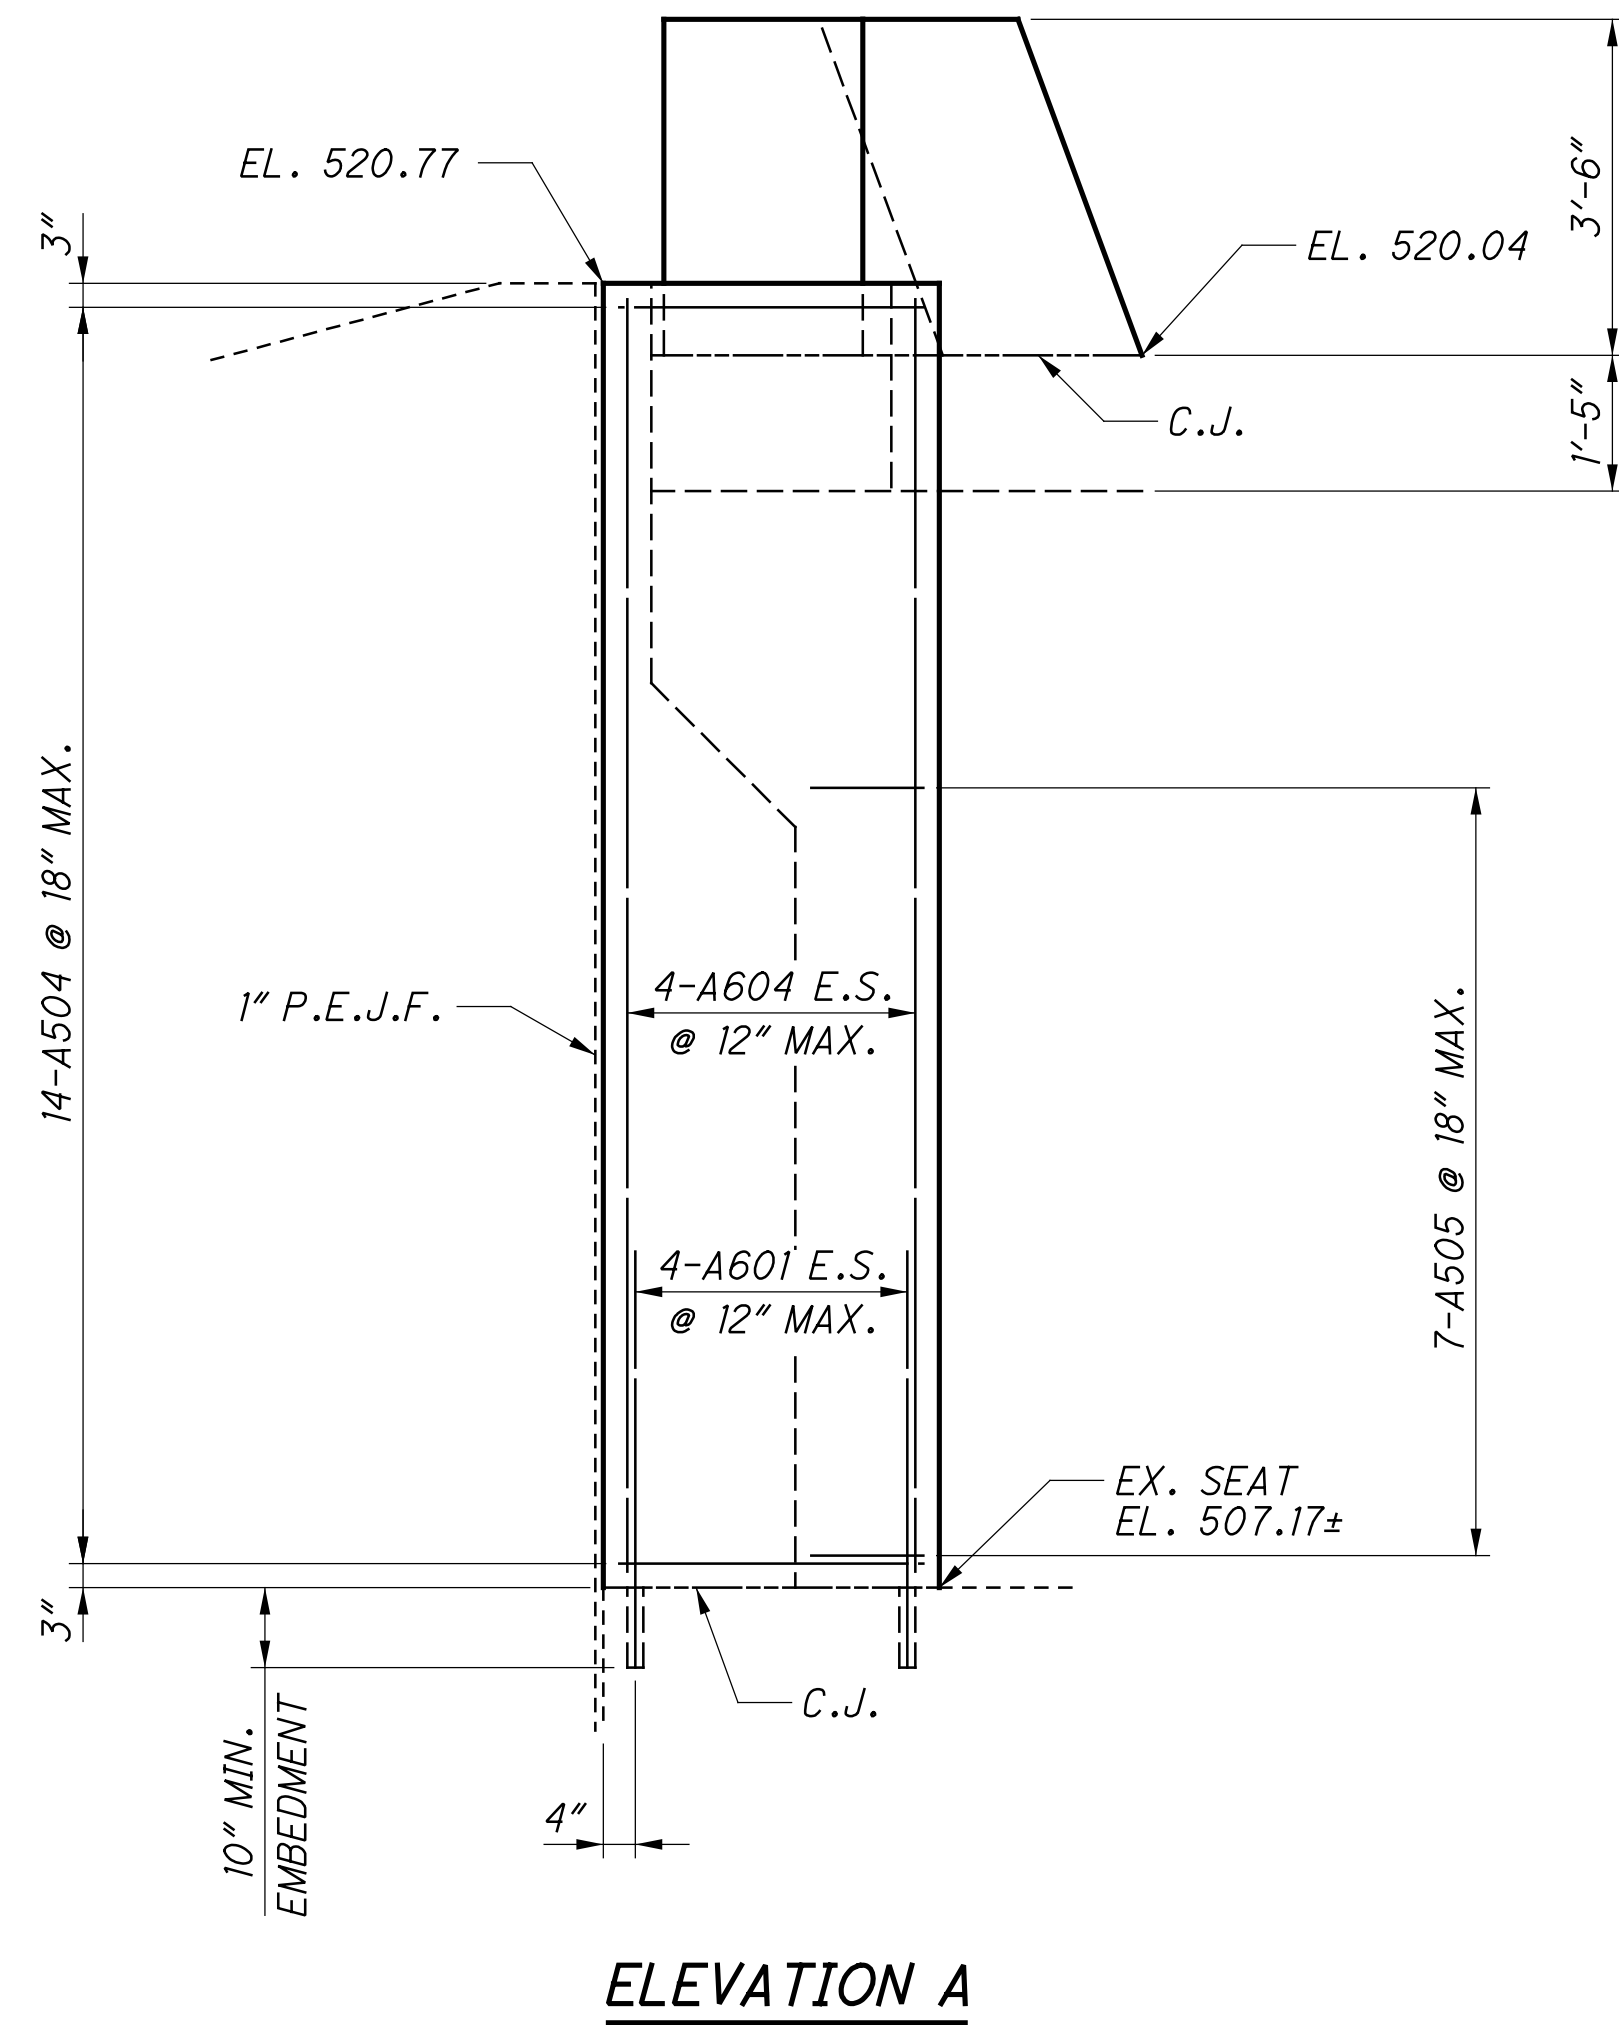


 DESIGN AGENCY 2000 CORPORATE CENTER DR., STE. 200 FARMINGTON, CT 06030 TEL: 860.633.7000 FAX: 860.633.7001 WWW.STRUCTUREPOINT.COM	DATE 11/12/18
	REVIEWED MDS
DRAWN DSH	STRUCTURE POINT FILE NUMBER 3115690
DESIGNED SUJ	CHECKED CLB
REAR ABUTMENT DETAILS (RIGHT BRIDGE) BRIDGE NO. HAM-74-1892 L/R OVER ELMORE STREET	
HAM-75-3.84 PID No. 104667	
14 / 38	
96 120	

S:\Plans\23 11/16/2023 9:34:55 AM
 \0\2017\01113\C.Design\104667_HAM-75-3.84.Design\104667_HAM-75-3.84.Design\Structures\HAM0074_1892C_Sheets\74_1892AR004.dgn

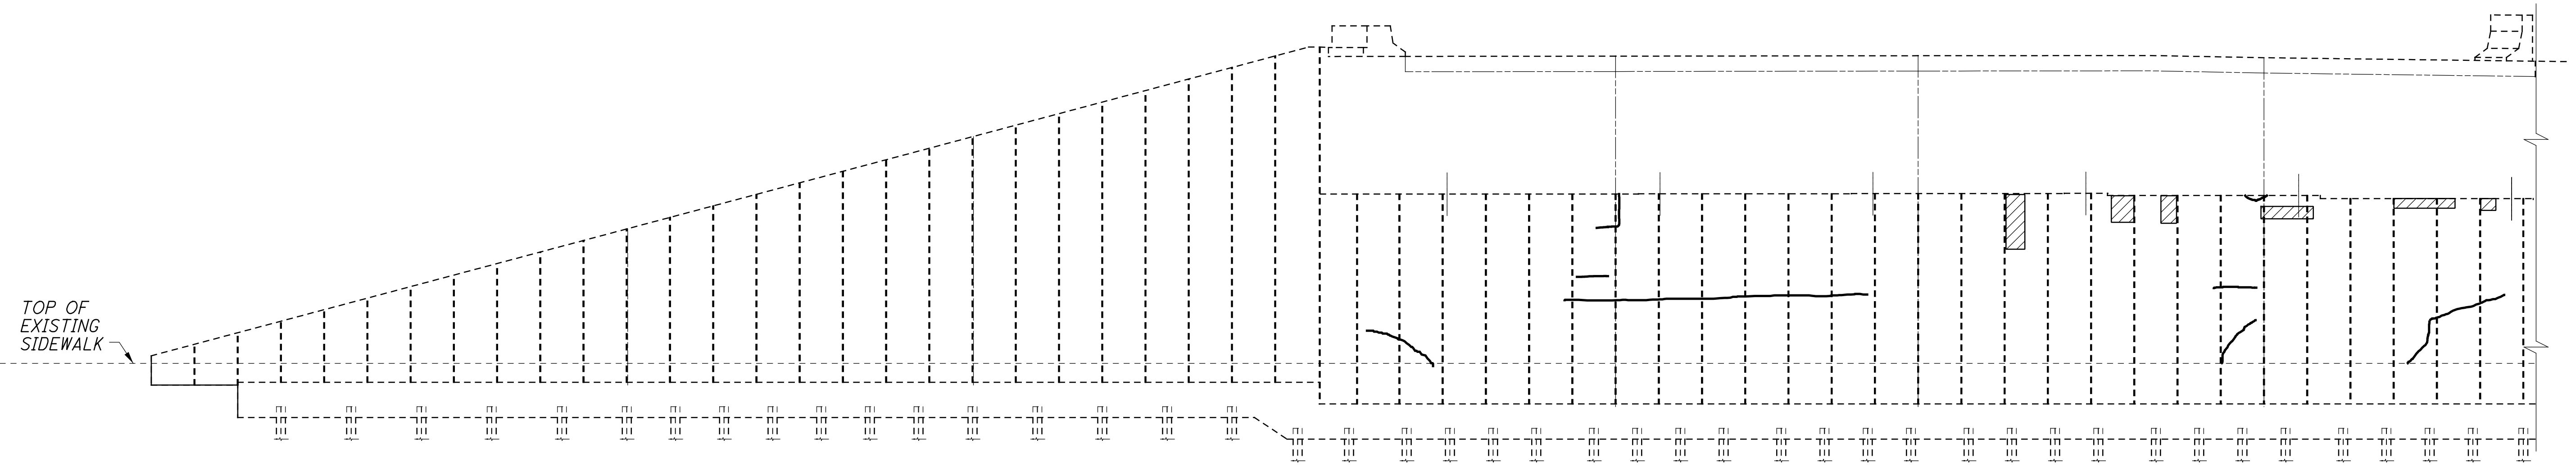


PART ELEVATION - REAR ABUTMENT

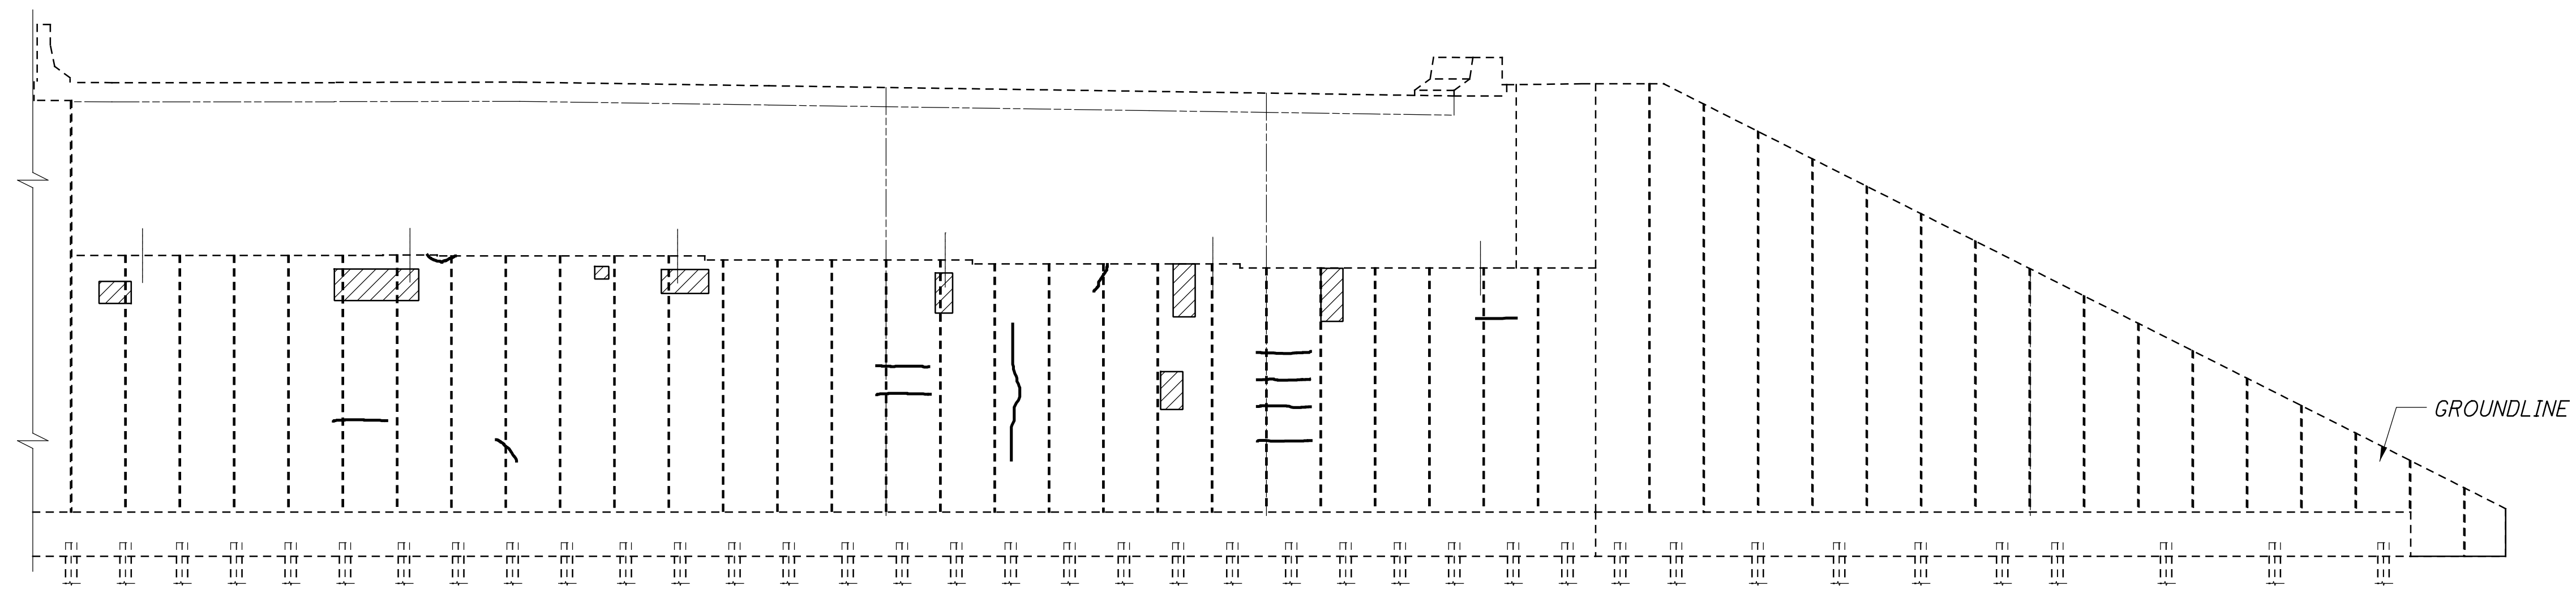

PART ELEVATION - REAR ABUTMENT

LEGEND

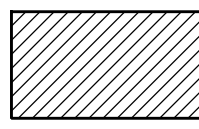 AREA TO BE PATCHED PER ITEM 519 - PATCHING CONCRETE STRUCTURE, AS PER PLAN.

SUMMARY OF REPAIR QUANTITIES		
ELEVATION	PATCH (SQ FT)	EPOXY INJECTION (FT)
REAR ABUTMENT	* 92.91	* 108.91

* FIELD MEASURED TOTAL FOR LEFT AND RIGHT BRIDGES

NOTES:


- ITEM 519 - PATCHING CONCRETE STRUCTURES, AS PER PLAN AND ITEM 512 - CONCRETE REPAIR BY EPOXY INJECTION ARE UNIT PRICE PAY ITEMS (31 AND 32).

DESIGN AGENCY: **STRUCTUREPOINT**
 DATE: 11/12/18
 REVIEWED: MDS
 DRAWN: DSH
 DESIGNED: SUJ
 CHECKED: CLB
 STRUCTURE FILE NUMBER: 3115690

PATCHING DETAILS - REAR ABUTMENT
 BRIDGE NO. HAM-74-1892 L/R
 OVER ELMORE STREET


HAM-75-3.84
PID No. 104667

15 / 38
 97
 120

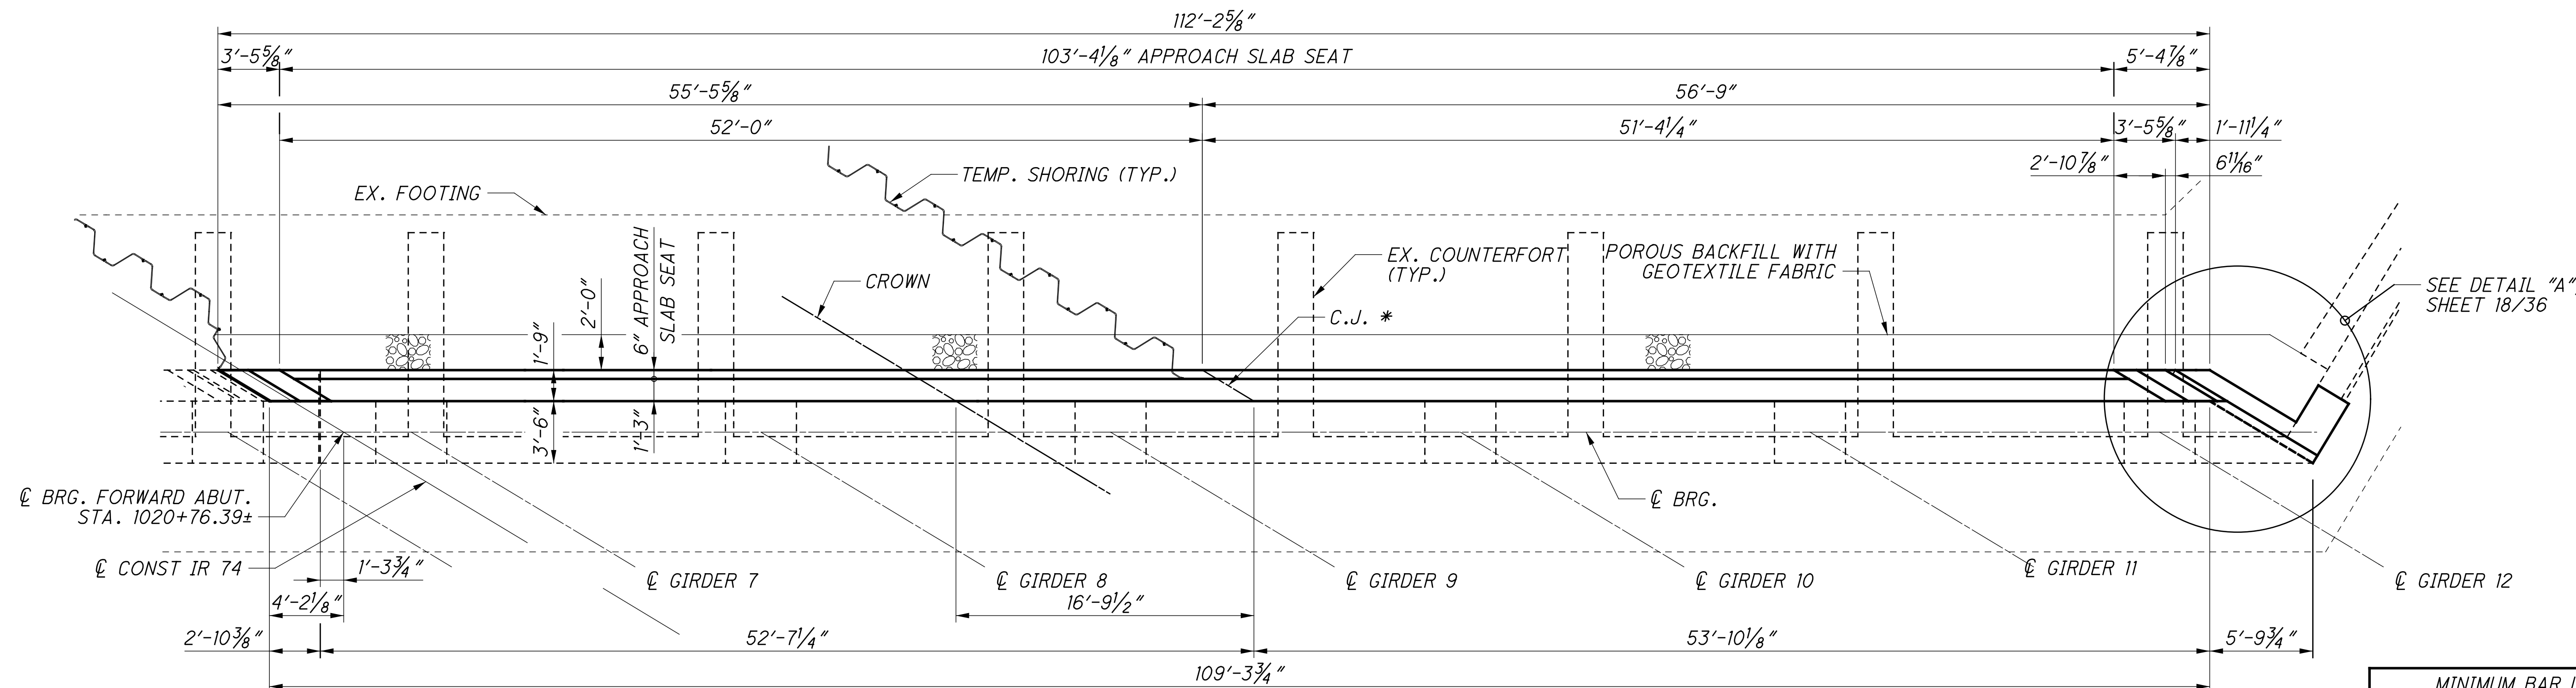

PLAN - FORWARD ABUTMENT

MINIMUM BAR LAP	
#5	3'-6"
#6	3'-10"

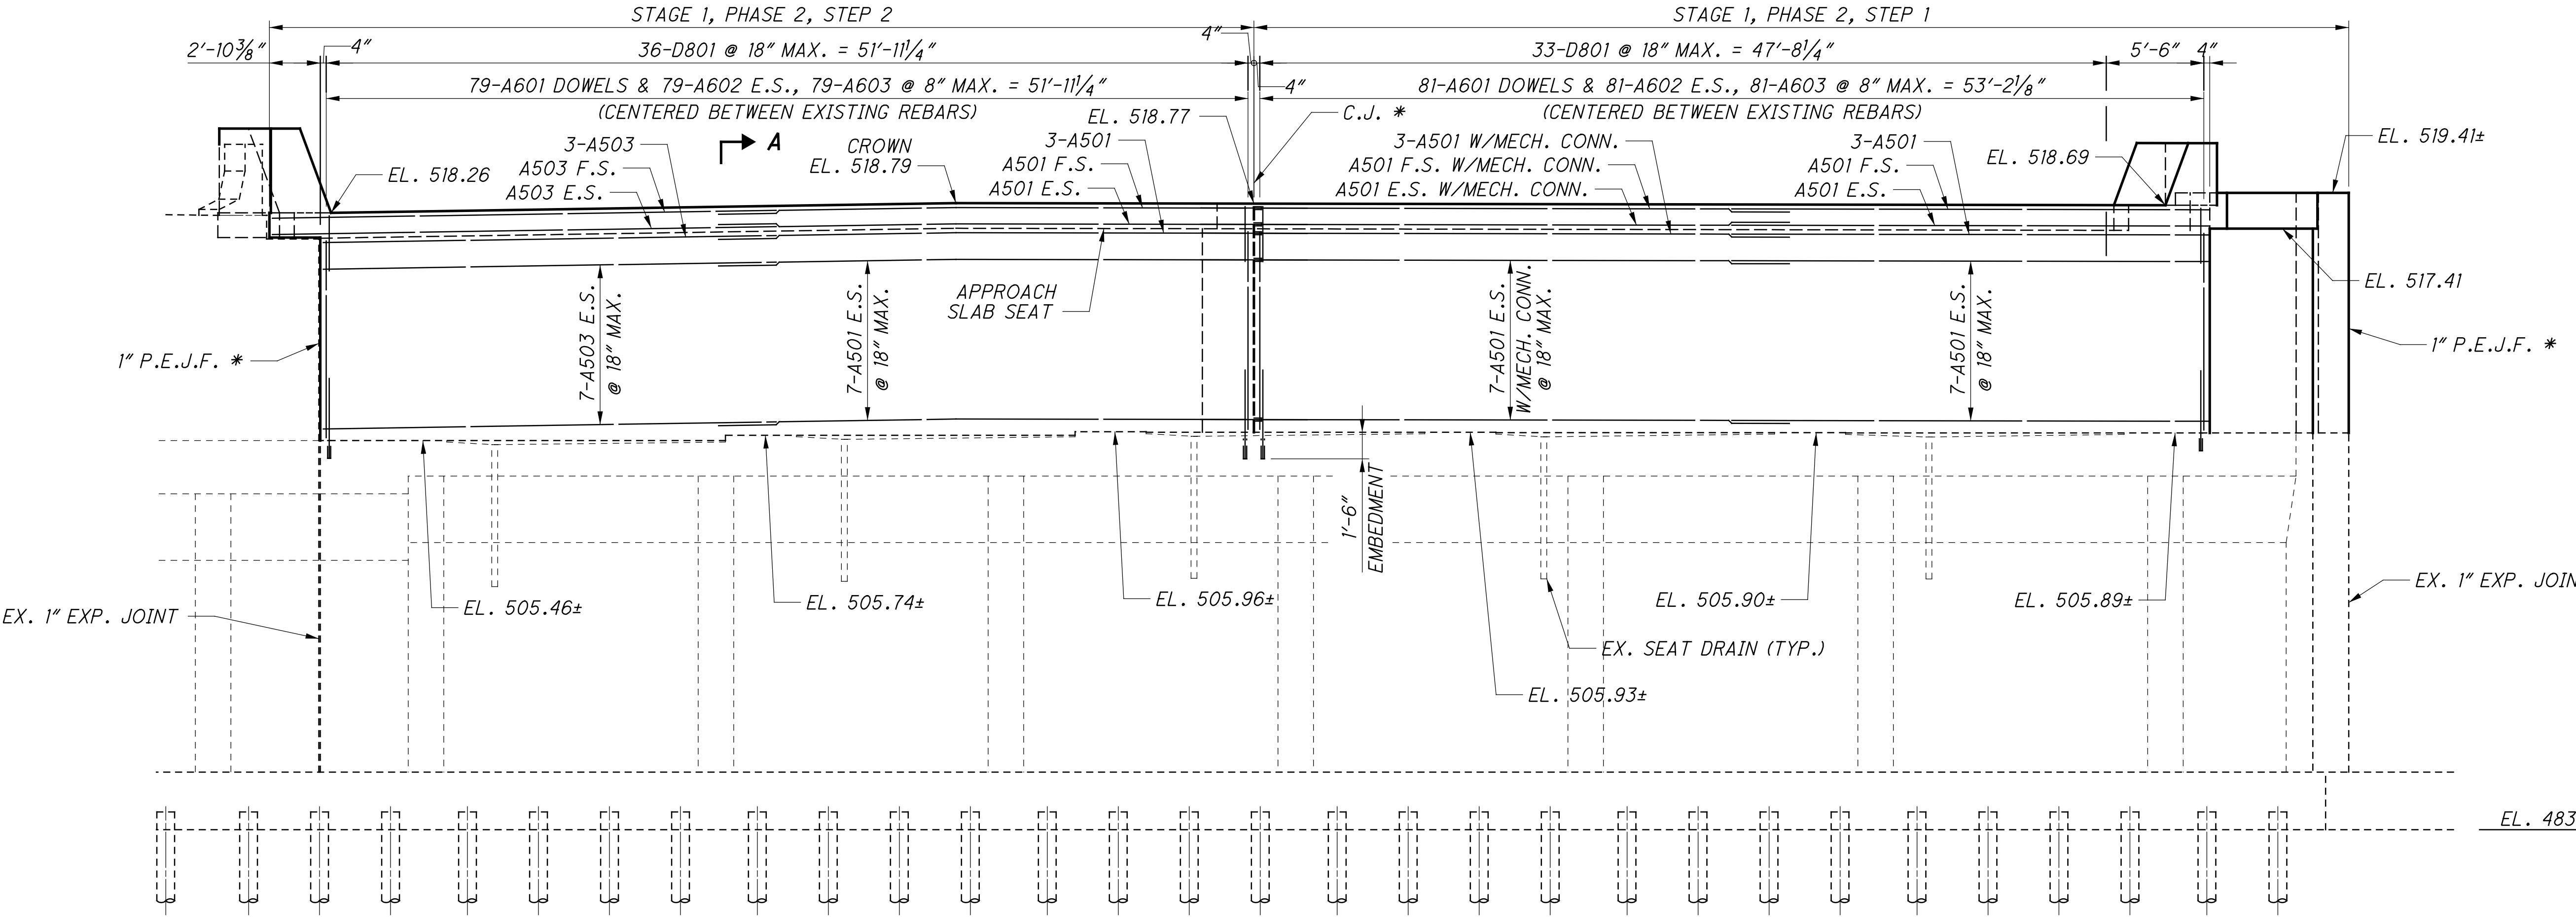

ELEVATION - FORWARD ABUTMENT

- NOTES:
- * 3'-0" WIDE TYPE 2 WATERPROOFING ON BACK FACE CENTERED ON JOINT FROM TOP OF SEAT TO BOTTOM OF APPROACH SLAB.
 - FOR PARAPET DETAILS, SEE SHEETS 26/38 AND 28/38.
 - FOR SECTION A-A, SEE SHEET 17/38.
 - ELEVATIONS PROVIDED AT FRONT FACE OF BACKWALL.

S:\Plans\23 11/16/2023 9:34:55 AM
 2017\01113\C.Design\104667_HAM-75-3.84.Design\Structures\HAM0074_1892C.Sheets\74_1892AF001.dgn

DESIGN AGENCY: STRUCTUREPOINT

DATE: 11/12/18

REVIEWED: MDS

STRUCTURE FILE NUMBER: 3115690

DESIGNED: SUJ

CHECKED: CLB

FORWARD ABUTMENT DETAILS (RIGHT BRIDGE)

BRIDGE NO. HAM-74-1892 L/R

OVER ELMORE STREET

HAM-75-3.84


PID No. 104667

16/38

98

120






S:\Plans\gdn 11/16/2023 9:34:56 AM
 \O:\2017\01113\C.Design\104667_HAM-75-3.84\Design\Structures\HAM0074_1892C_Sheets\74_1892AF002.dgn

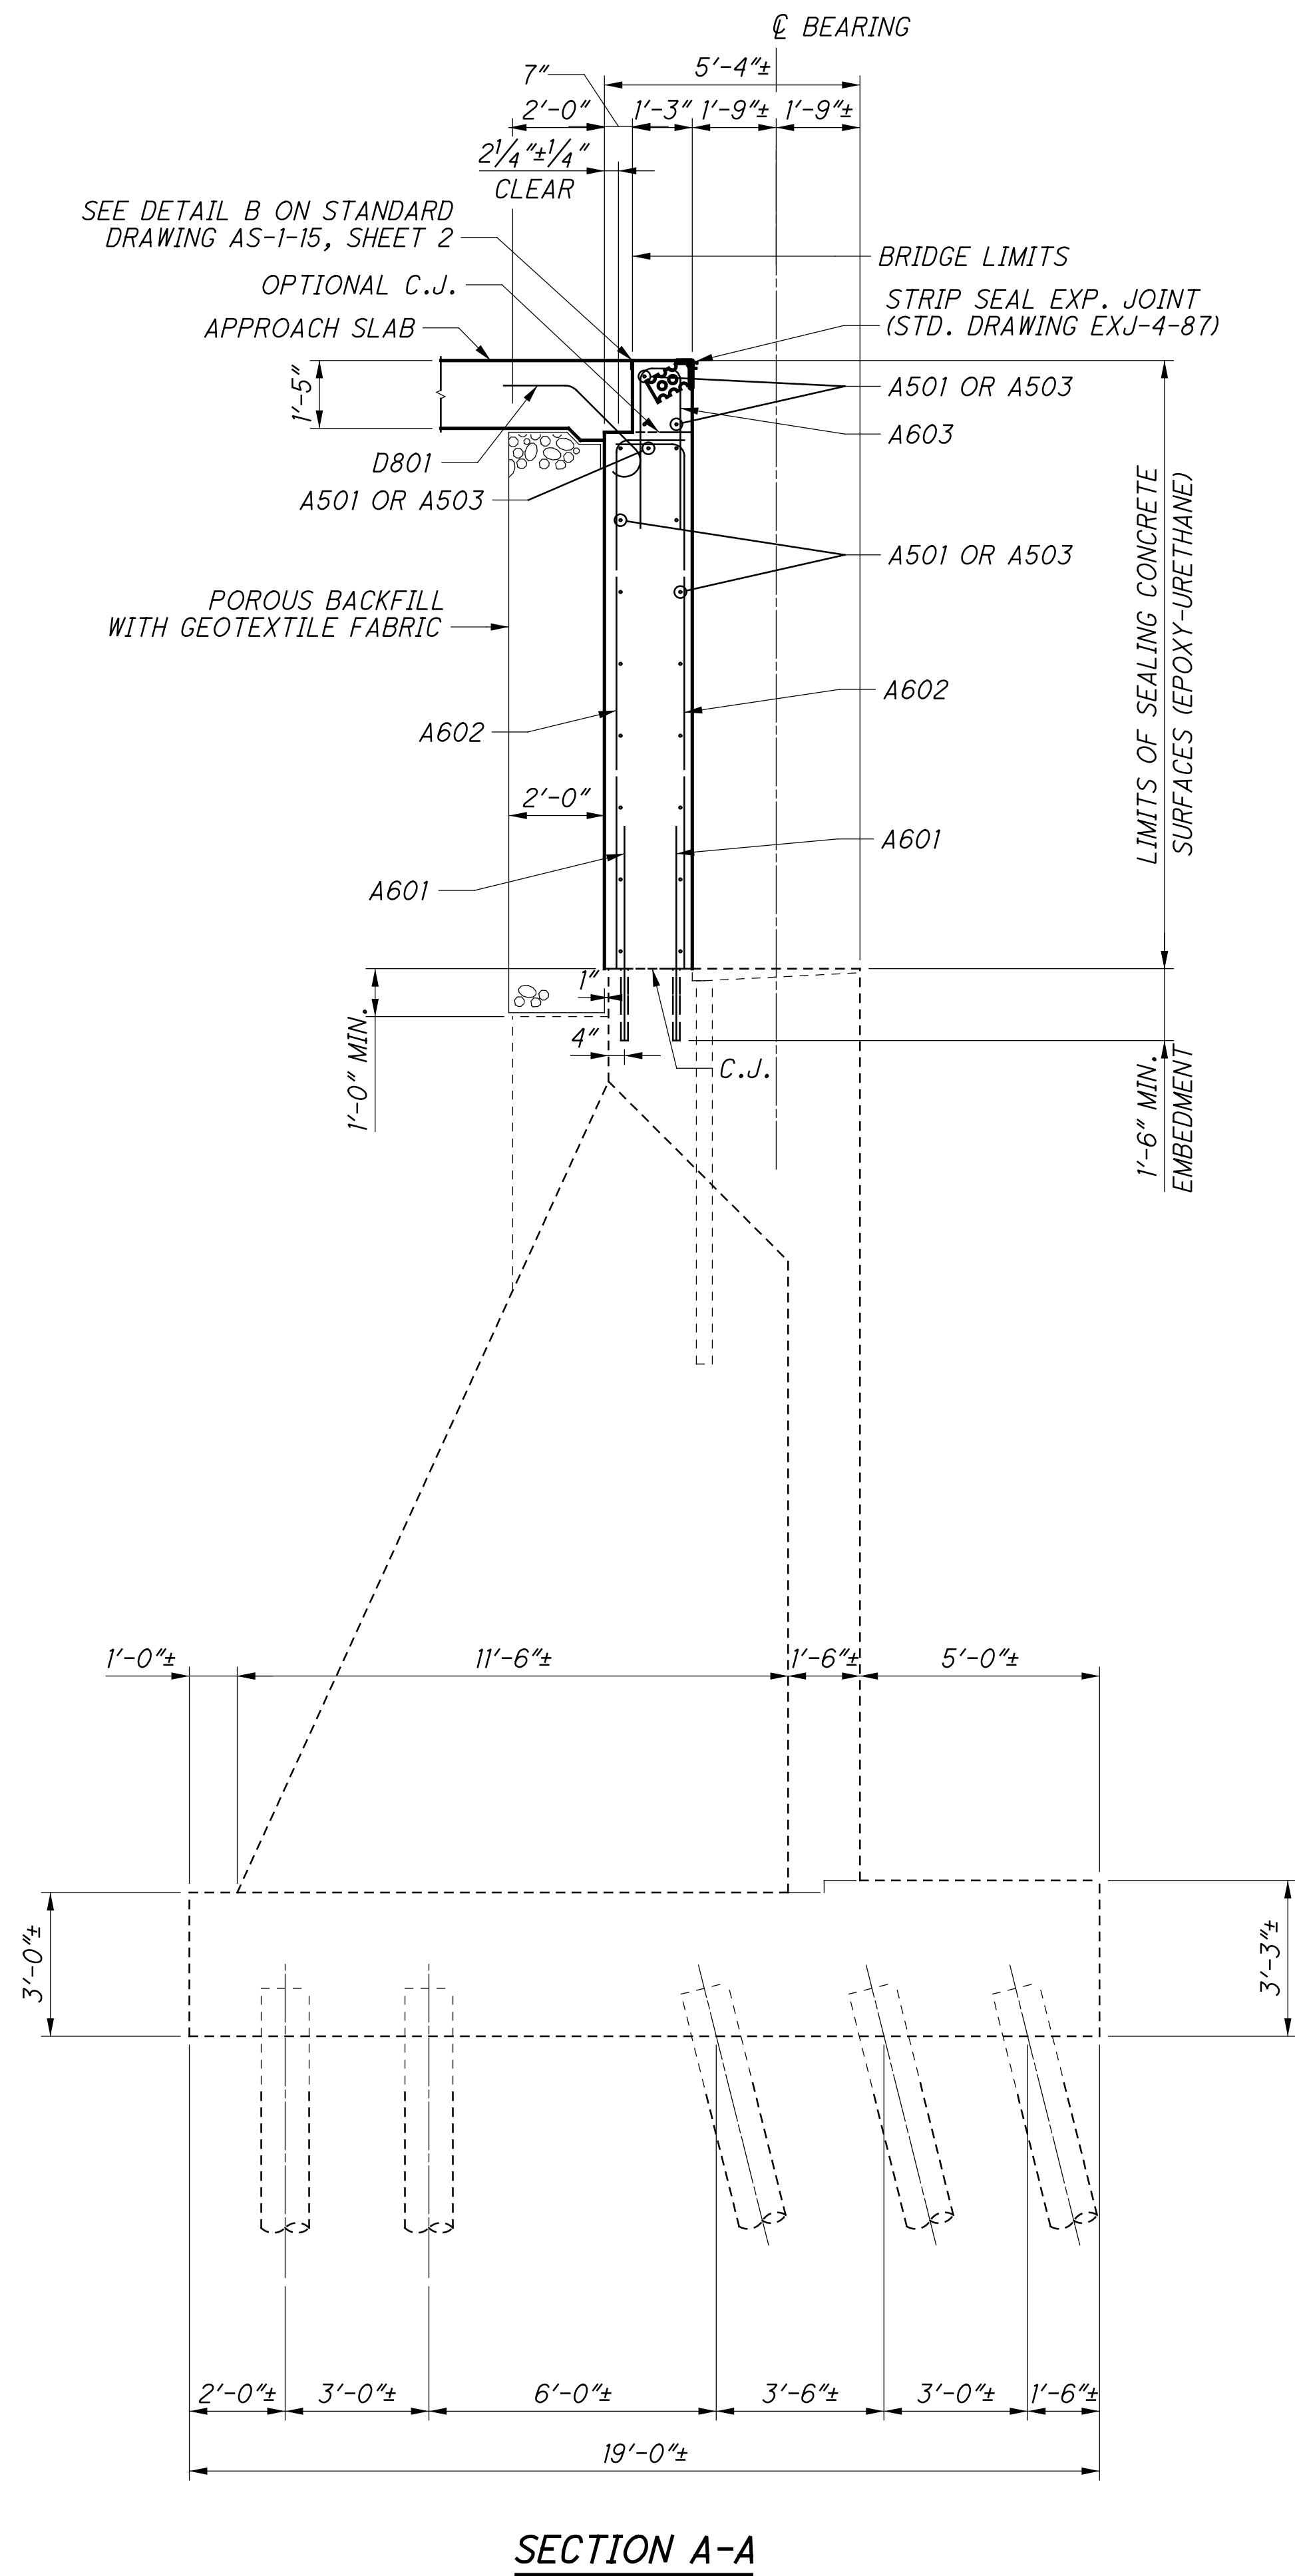


SECTION A-A

DESIGN AGENCY STRUCTUREPOINT <small>INCORPORATED</small> <small>2000 CORPORATE PARKWAY SUITE 400 TEL: 610.328.8000 FAX: 610.328.8001 WWW.STRUCTUREPOINT.COM</small>	
DESIGNED SUJ CHECKED CLB	DRAWN DSH REVISED
REVIEWED MDS	DATE 11/12/18
STRUCTURE FILE NUMBER 3115690	
FORWARD ABUTMENT DETAILS (RIGHT BRIDGE) BRIDGE NO. HAM-74-1892 L/R OVER ELMORE STREET	
HAM-75-3.84 PID No. 104667	
17 / 38	
99 120	


S:\Plans\23 11/16/2023 9:34:56 AM
 2017\01113\C.Design\104667_HAM-75-3.84\Design\Structures\HAM0074_1892C_Sheets\7.4_1892AF003.dgn

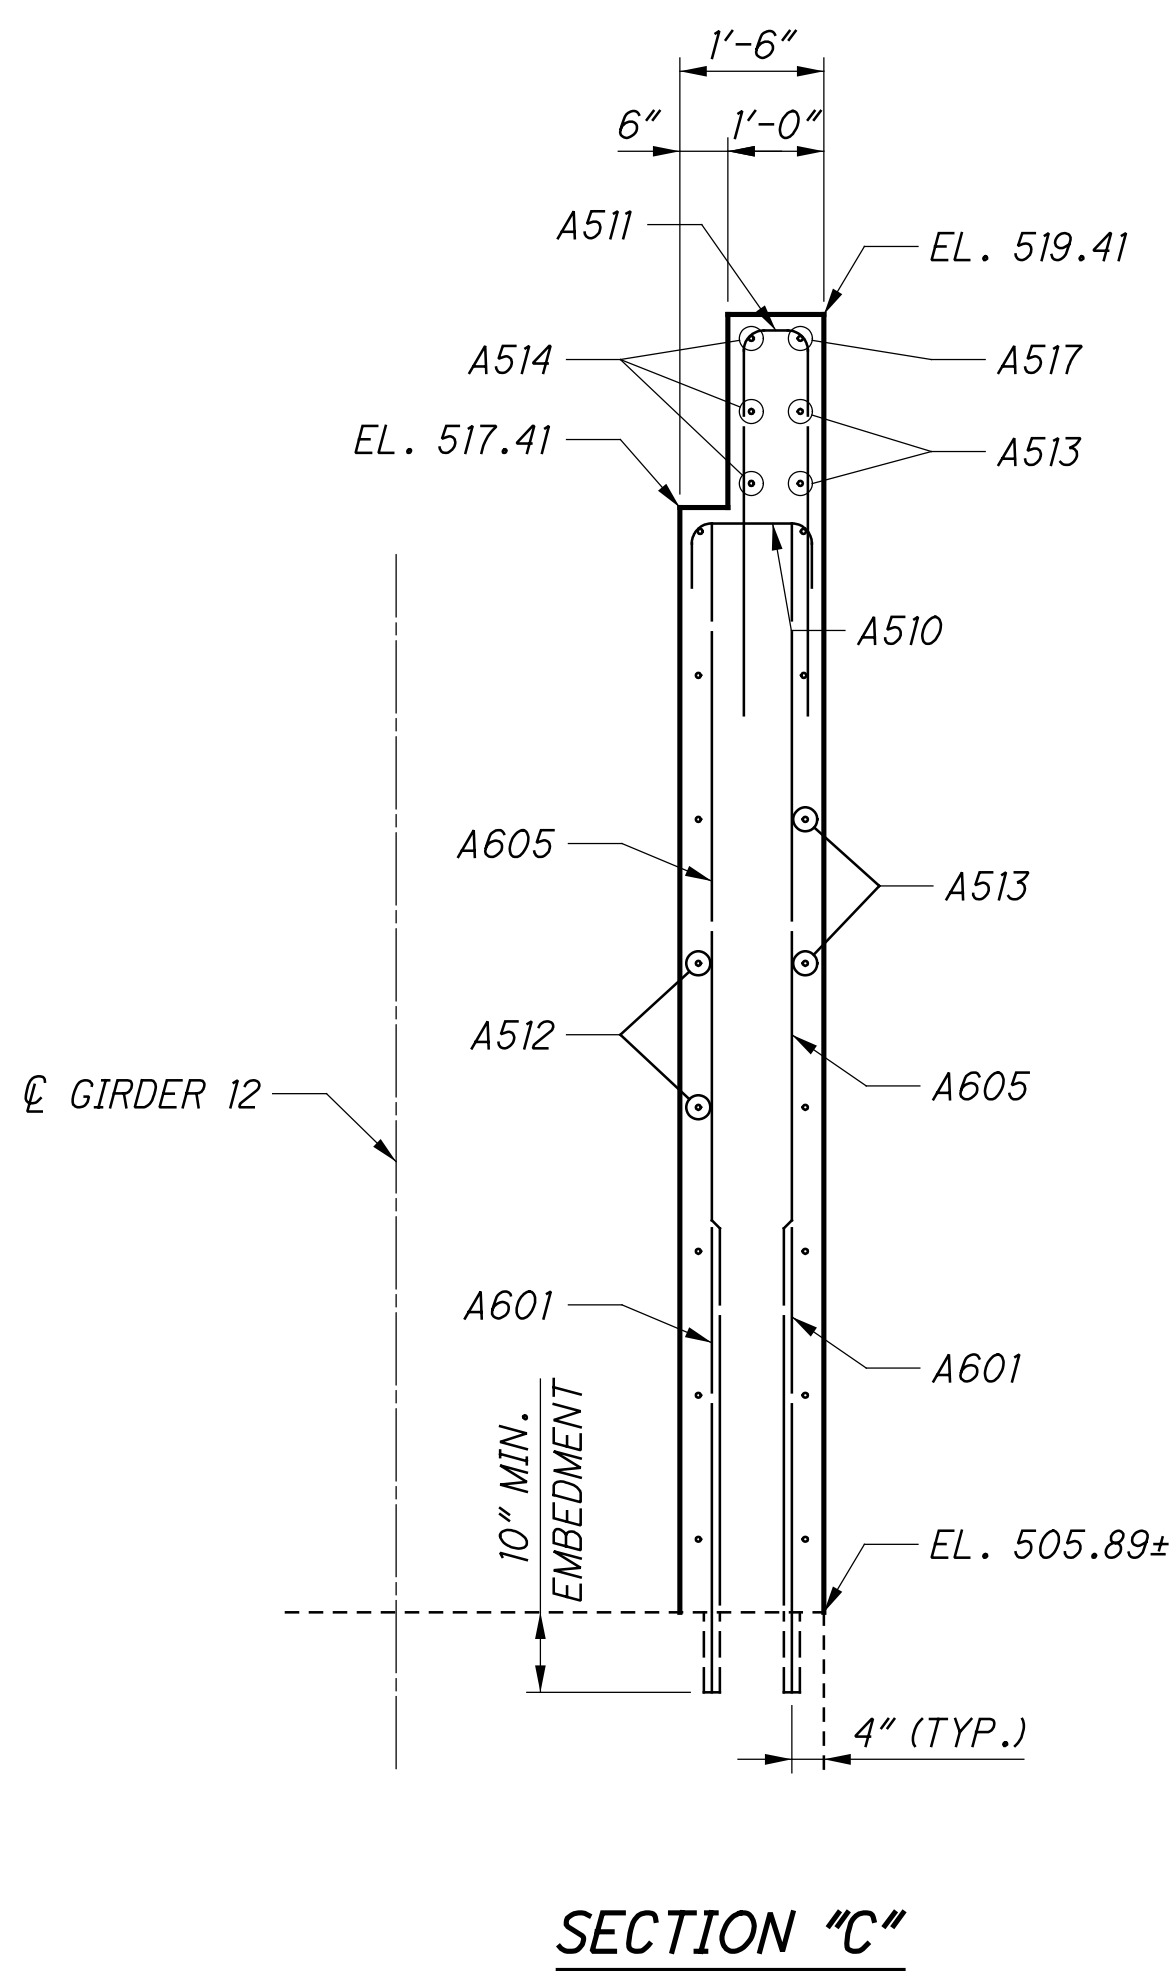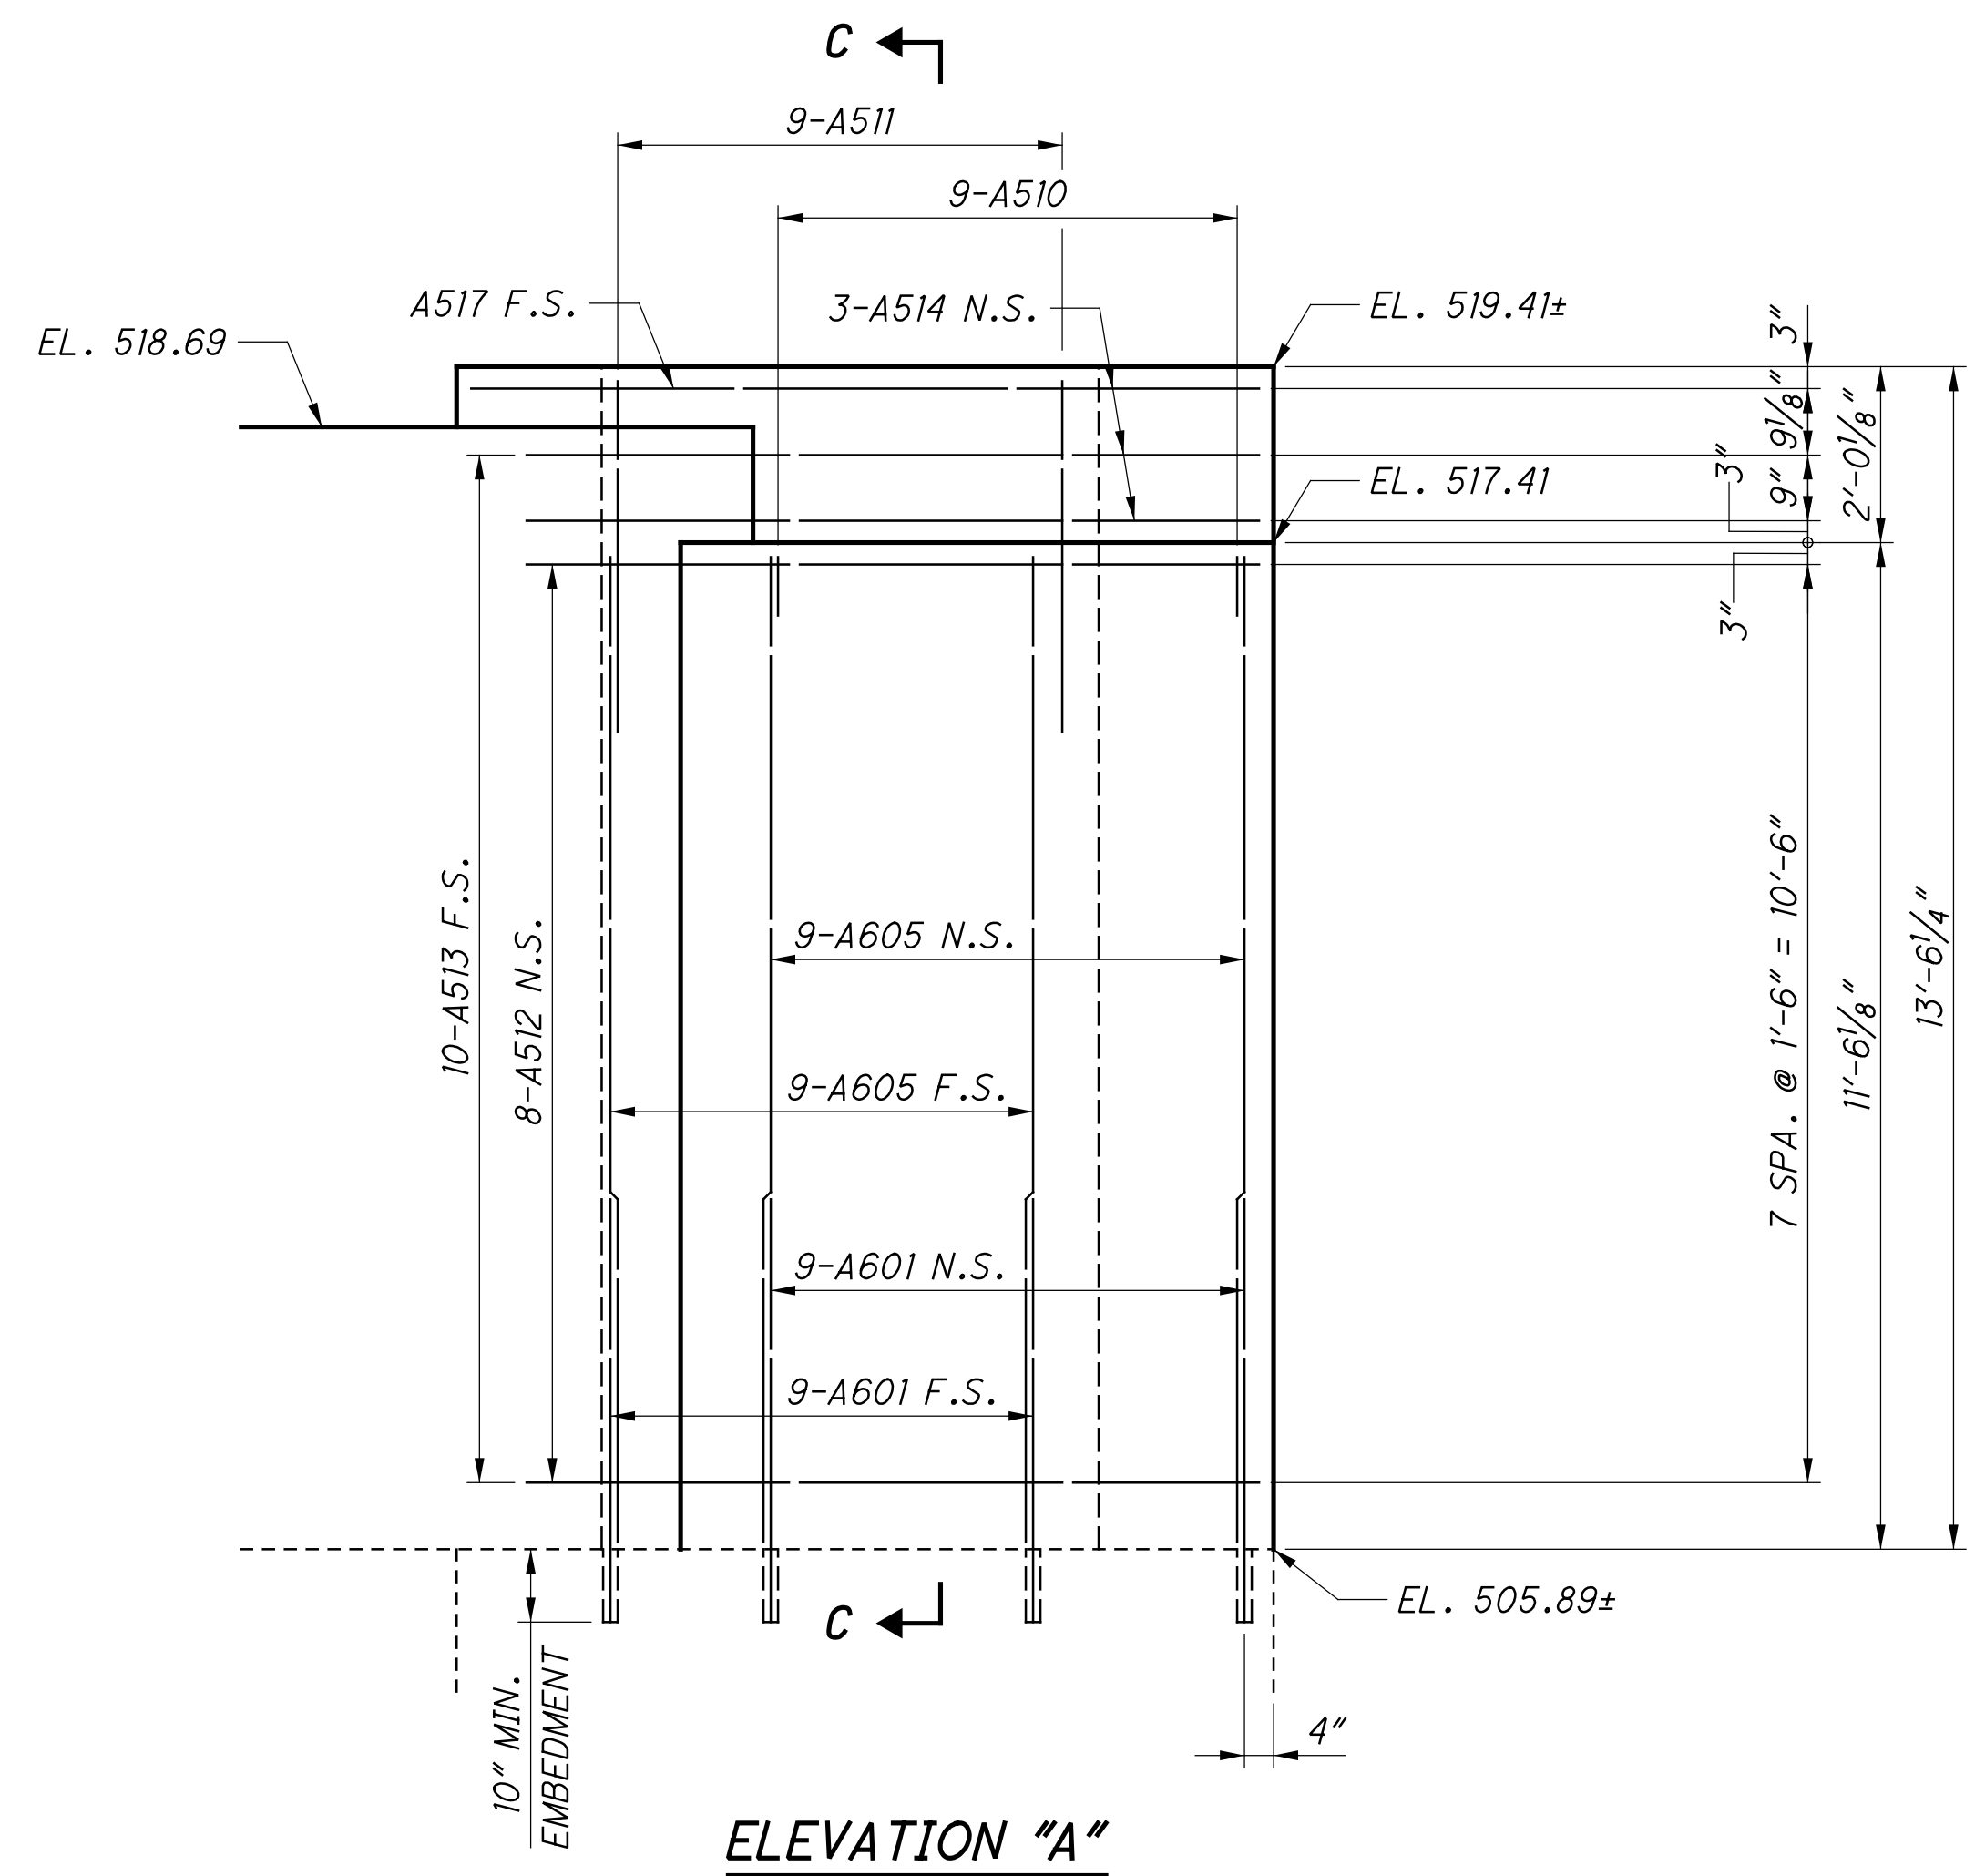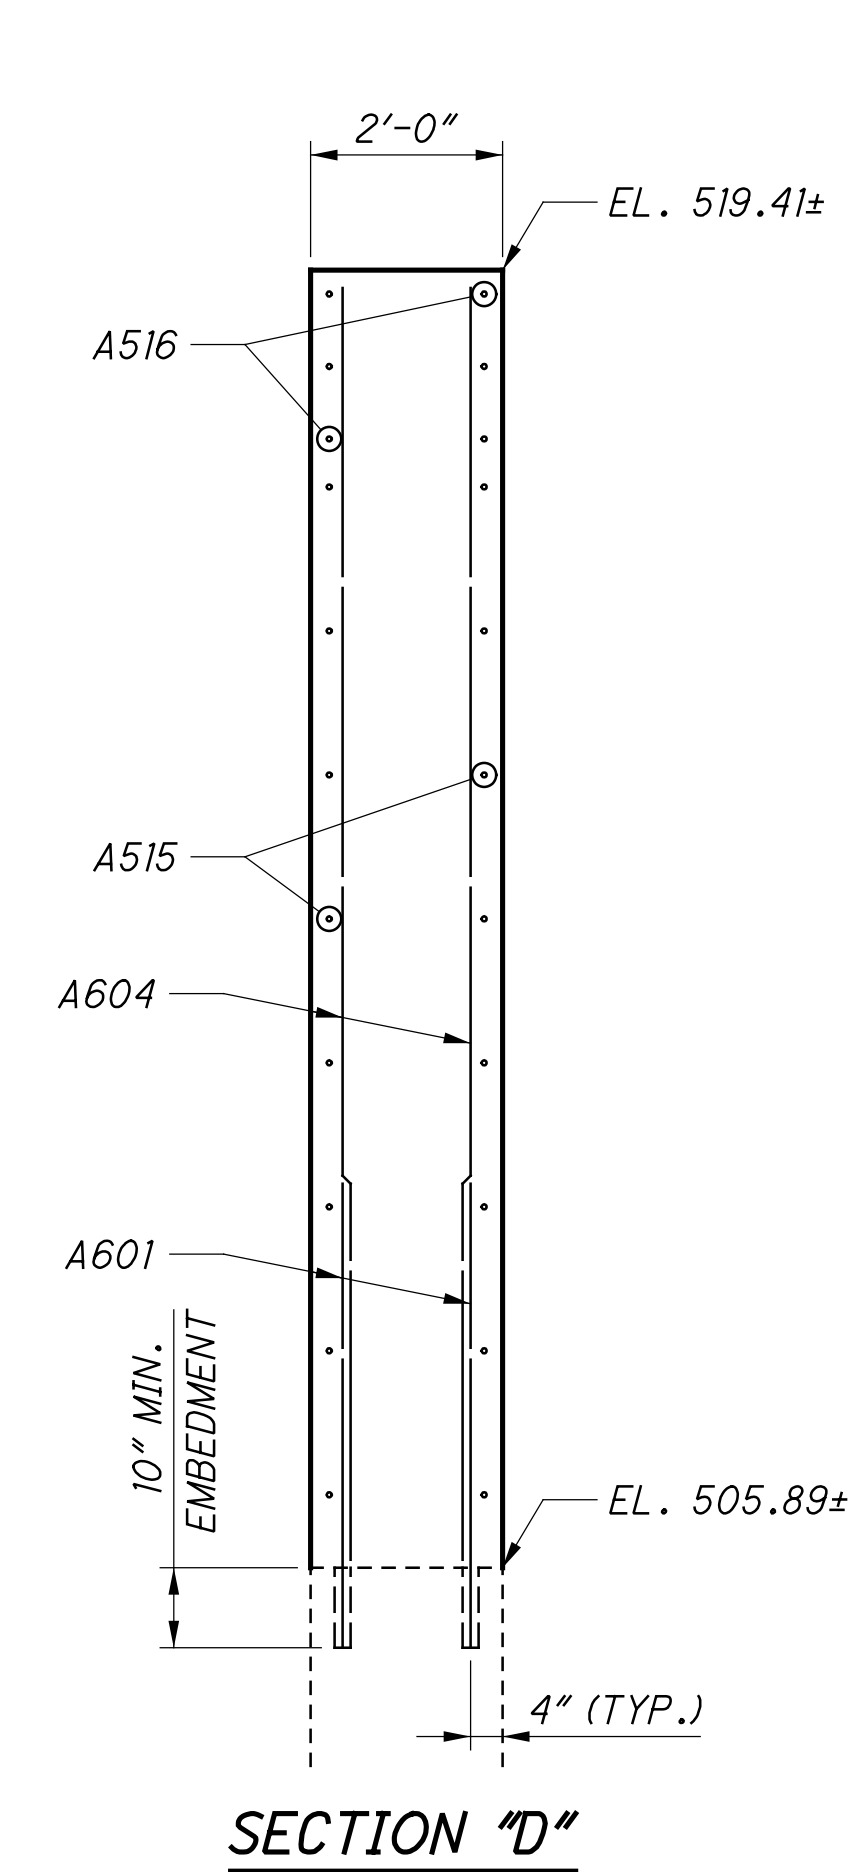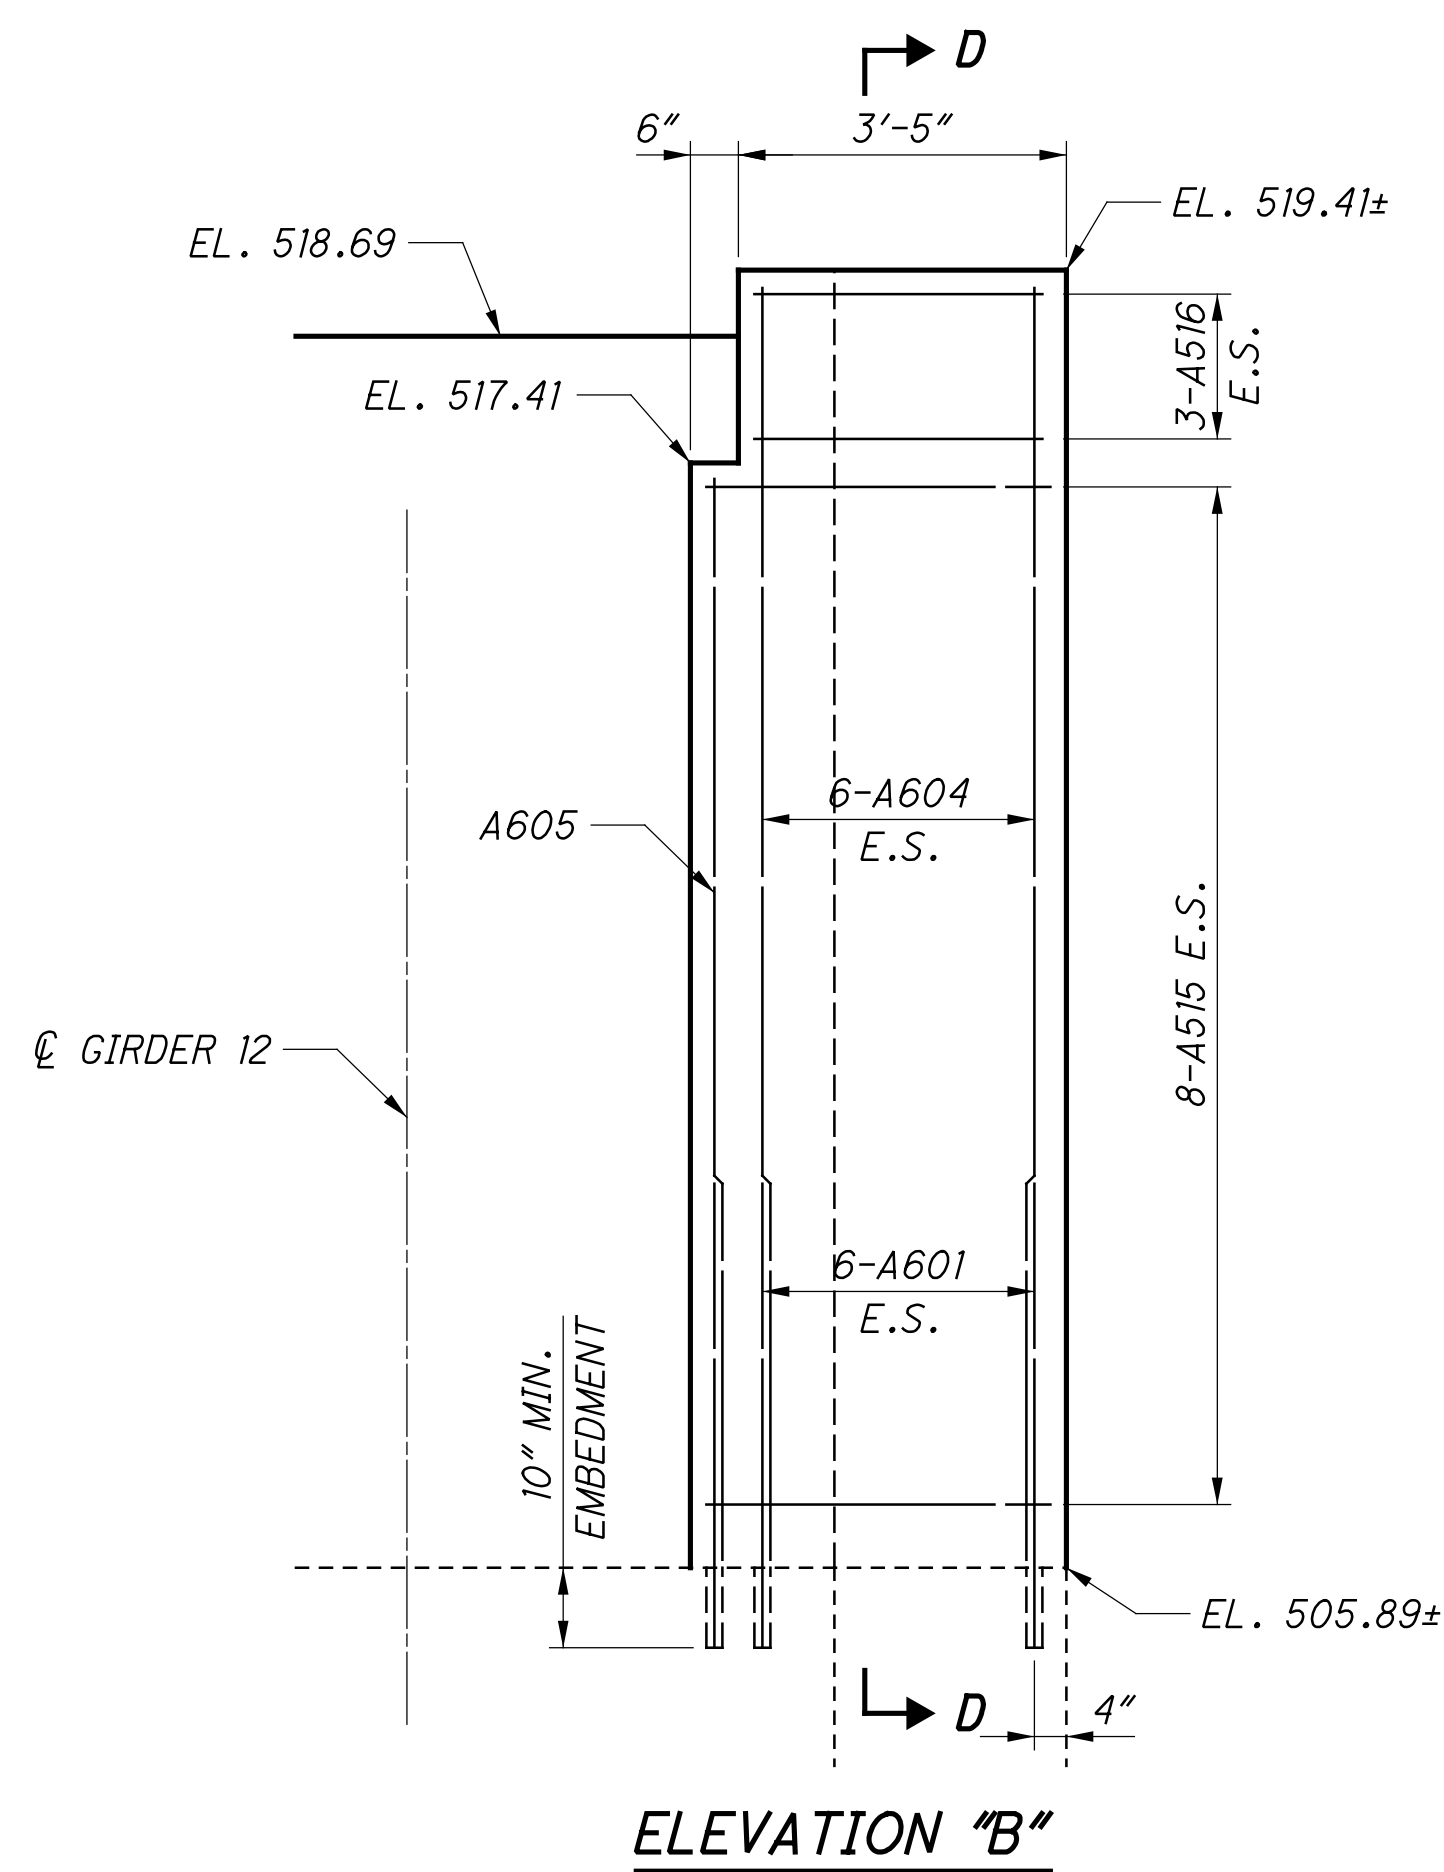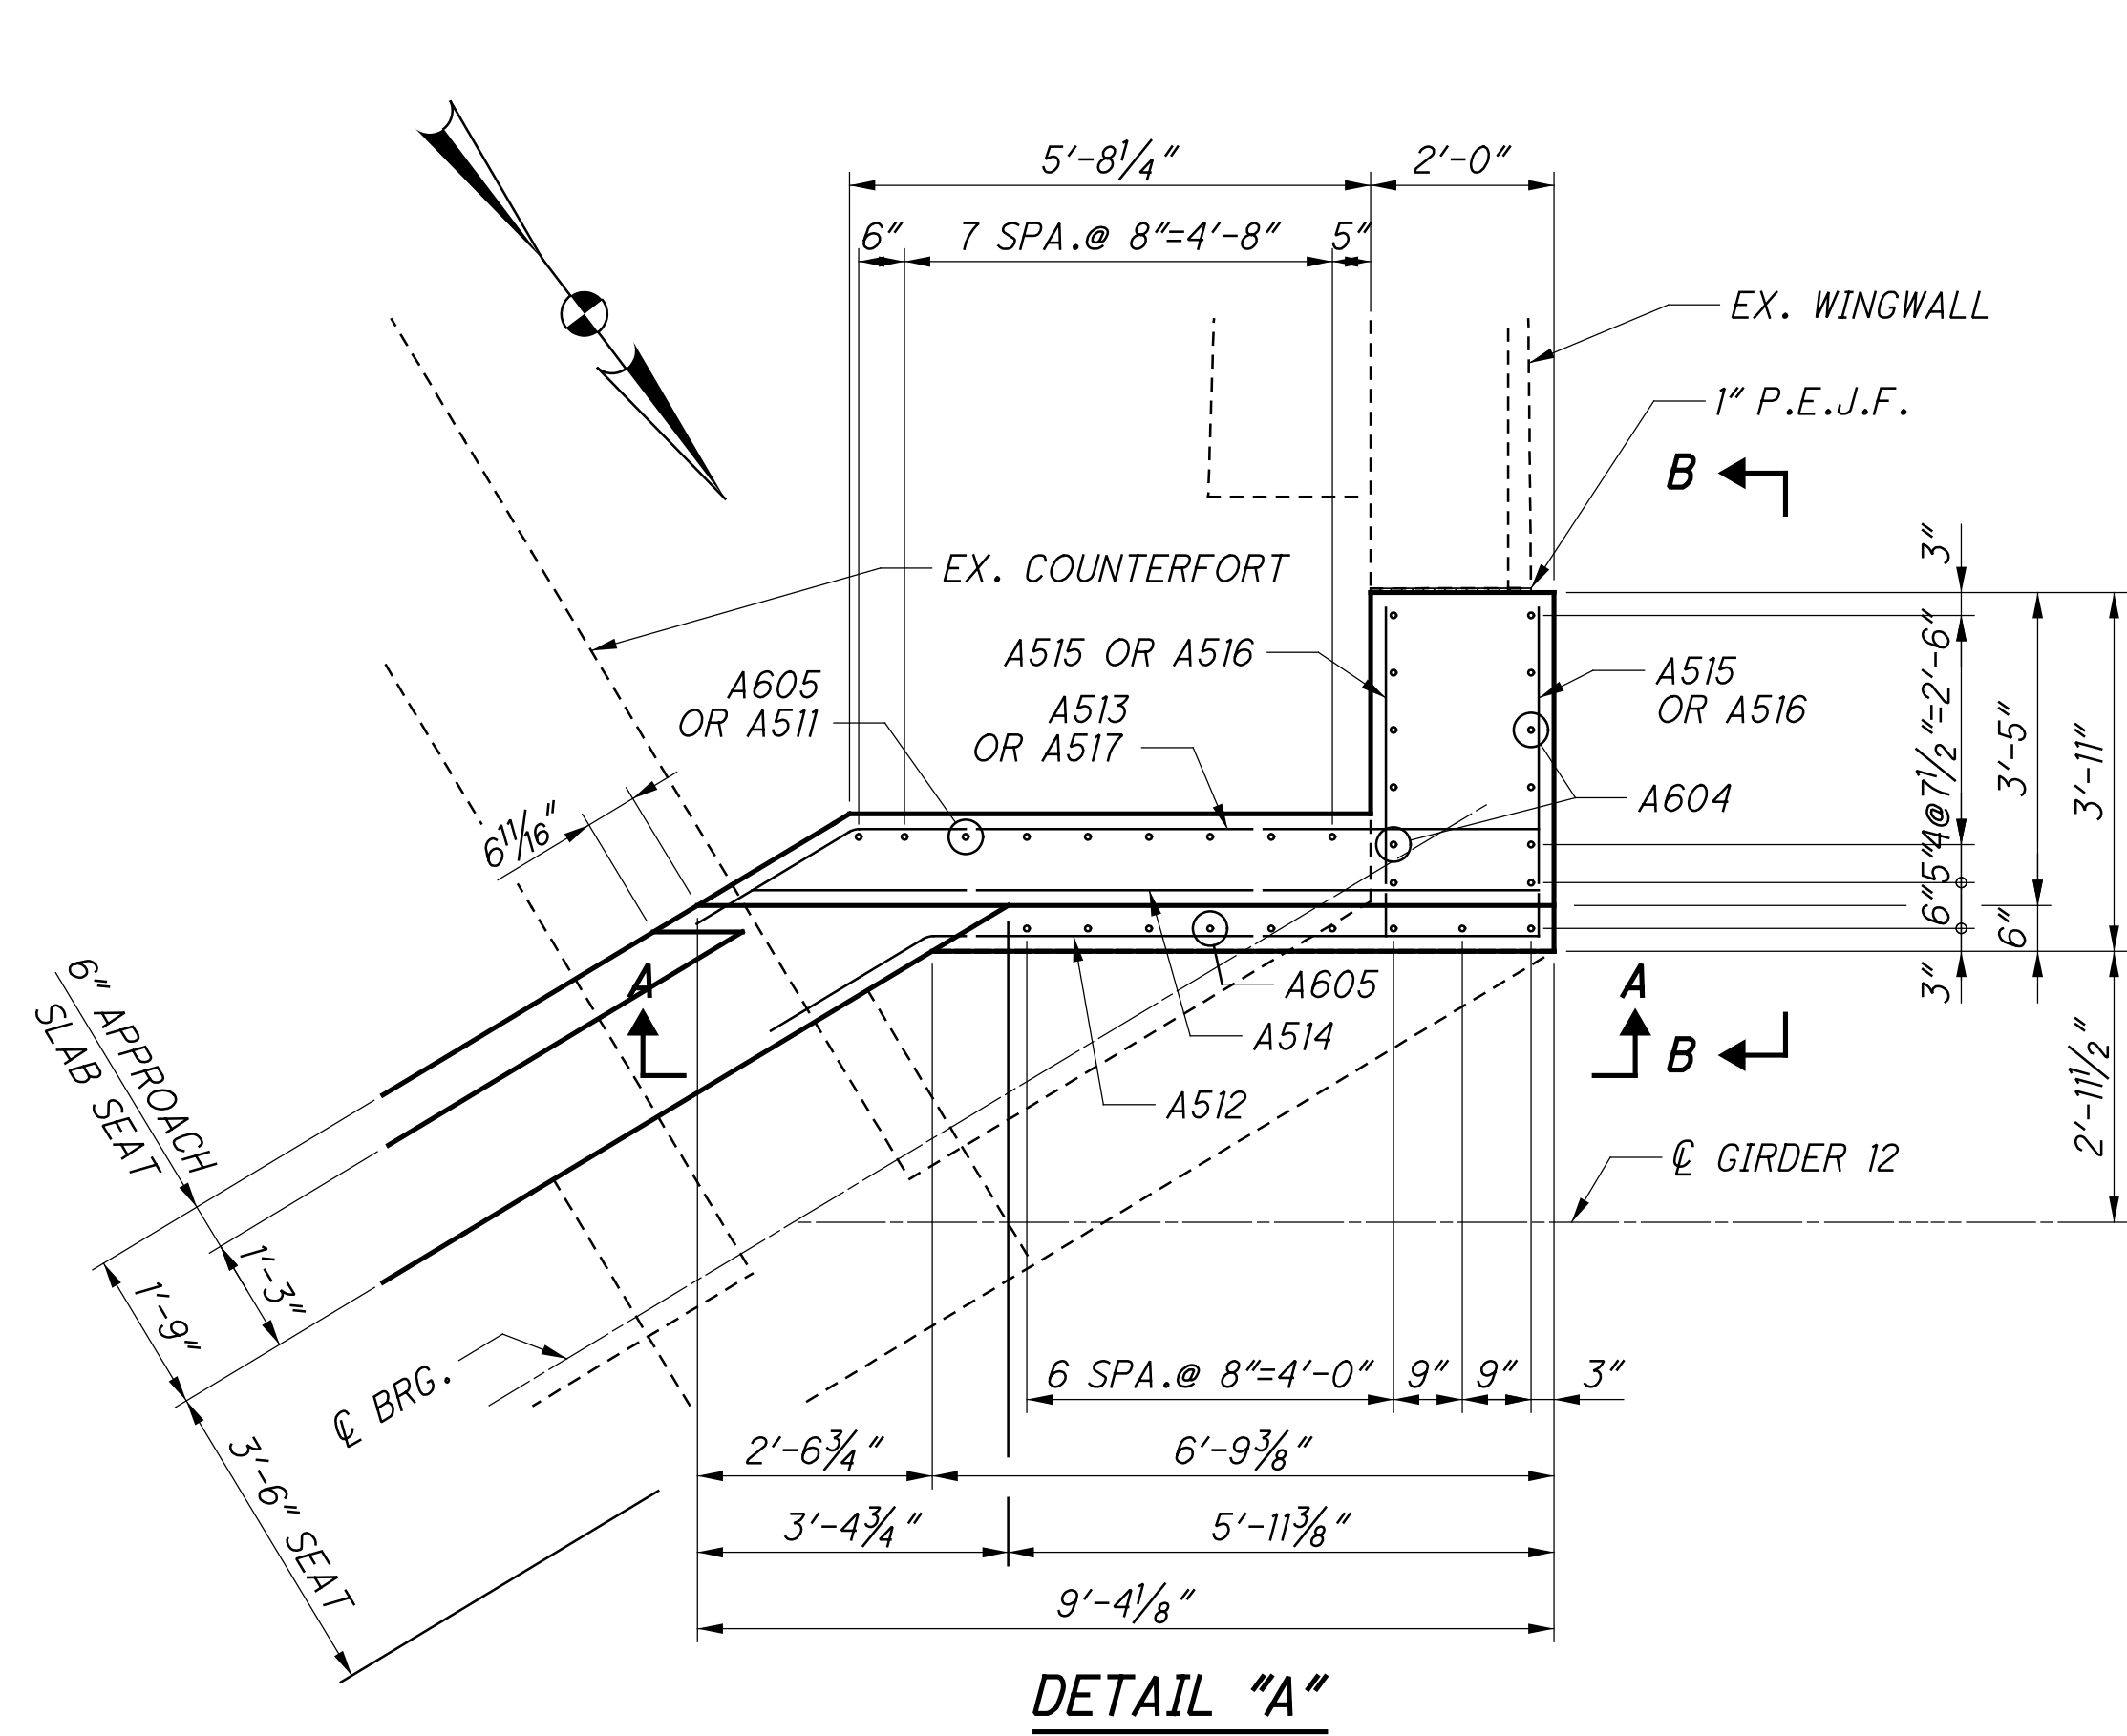

S:\Plans\23 11/16/2023 9:35:07 AM
 2017\01113\C.Design\104667_HAM-75-3.84\Design\Structures_HAM0074_1892C_Sheets\74_1892AF004.dgn

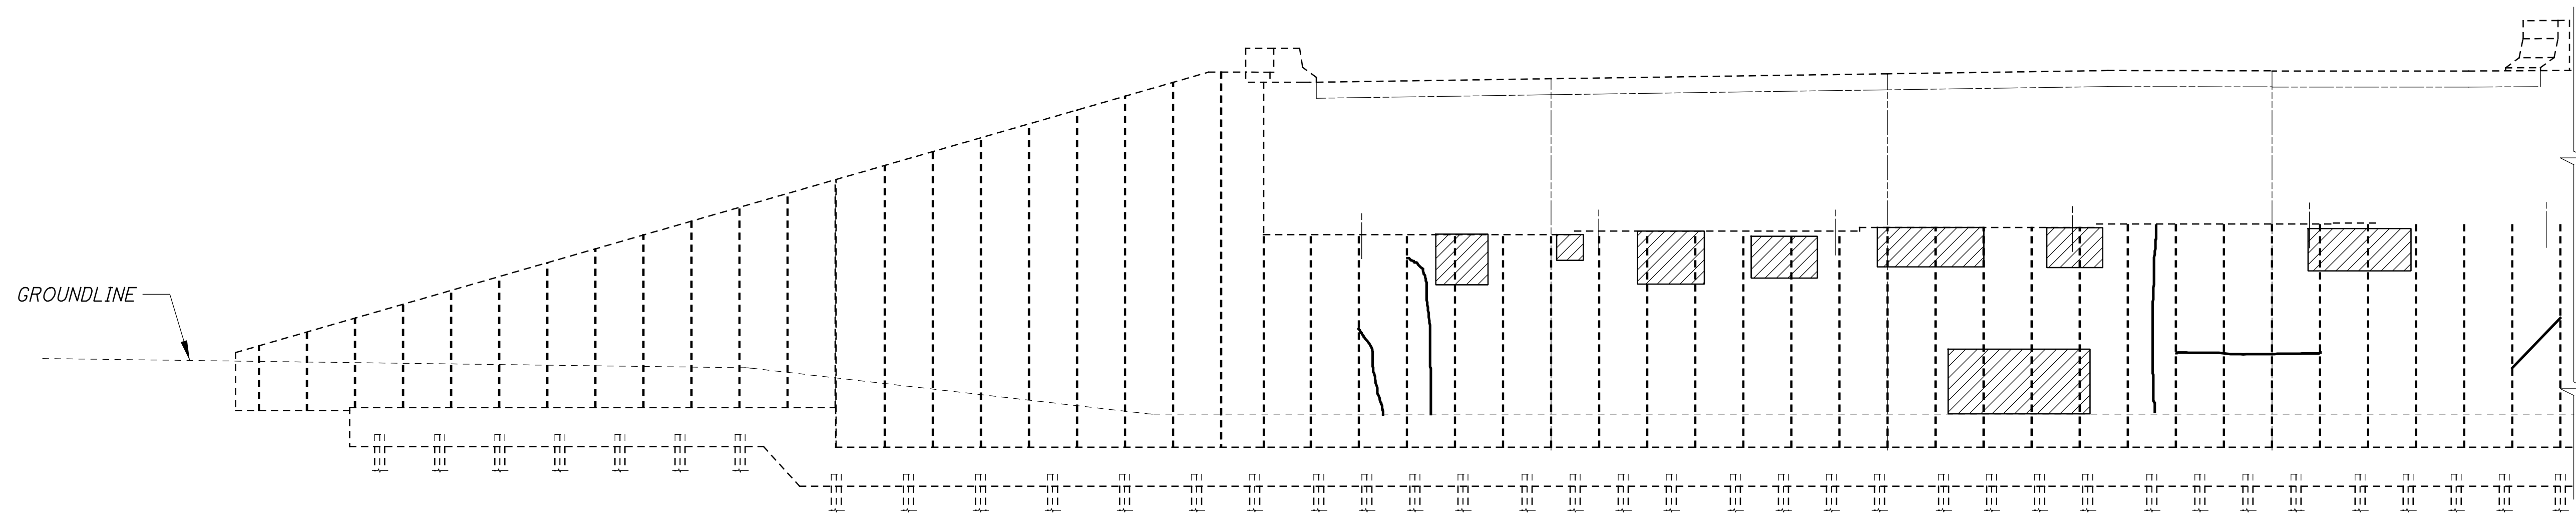


PART ELEVATION - FORWARD ABUTMENT

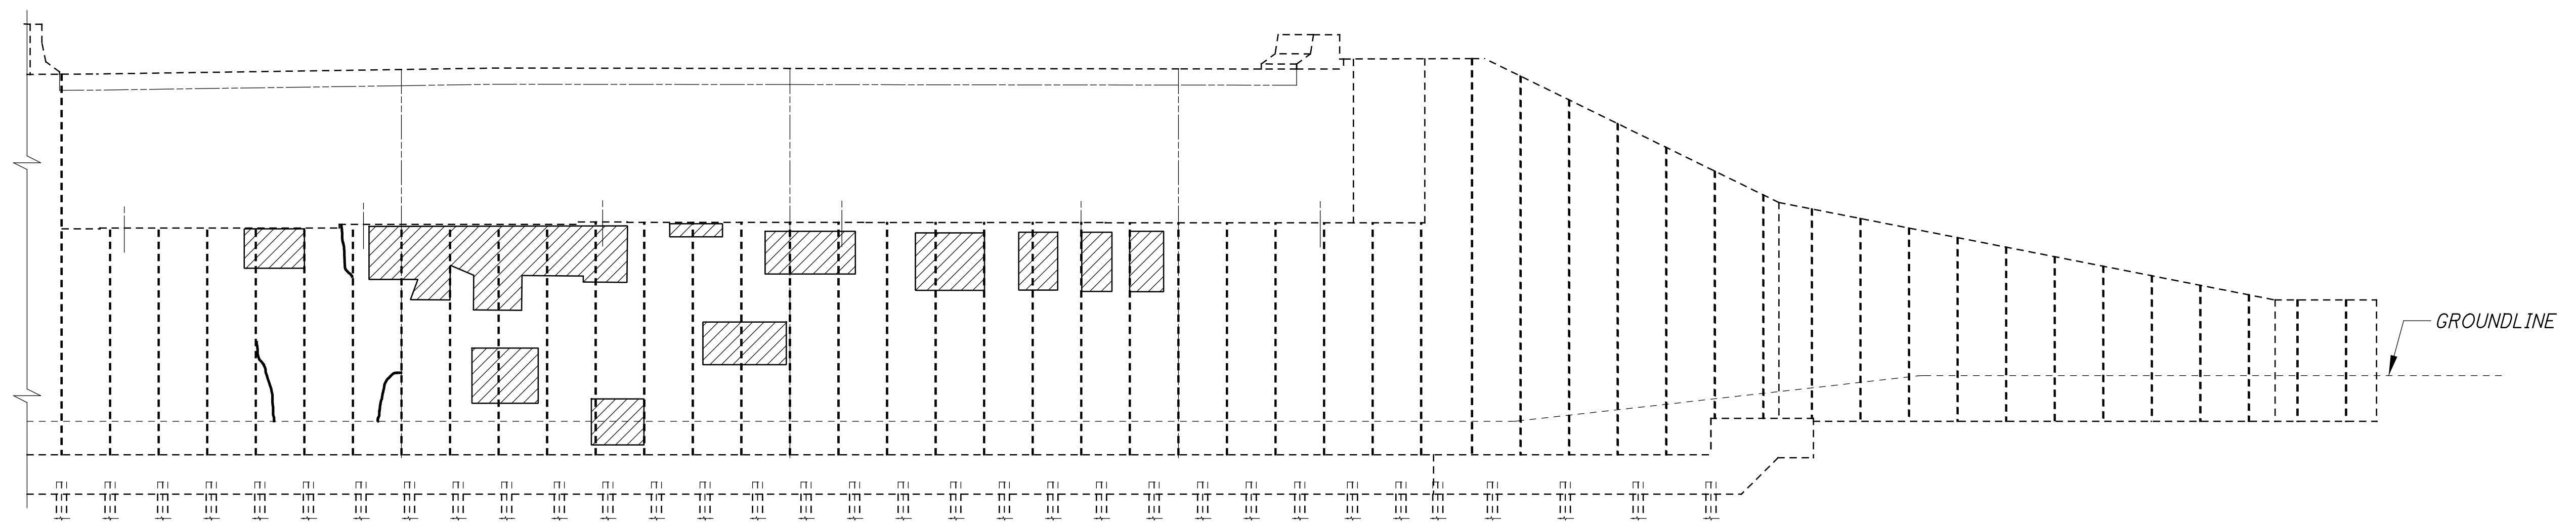

PART ELEVATION - FORWARD ABUTMENT

LEGEND

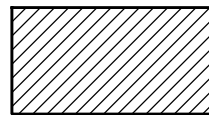
 AREA TO BE PATCHED PER ITEM 519 - PATCHING CONCRETE STRUCTURE, AS PER PLAN.

SUMMARY OF REPAIR QUANTITIES		
ELEVATION	PATCH (SQ FT)	EPOXY INJECTION (FT)
FORWARD ABUTMENT	*193.46	* 58.58


*FIELD MEASURED TOTAL FOR LEFT AND RIGHT BRIDGES

NOTES:

- ITEM 519 - PATCHING CONCRETE STRUCTURES, AS PER PLAN AND ITEM 512 - CONCRETE REPAIR BY EPOXY INJECTION ARE UNIT PRICE PAY ITEMS (31 AND 32).

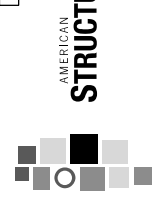 DESIGN AGENCY STRUCTUREPOINT	DATE 11/12/18
	REVIEWED MDS
DRAWN DSH	STRUCTURE FILE NUMBER 3115690
DESIGNED SJF	CHECKED CLB
PATCHING DETAILS - FORWARD ABUTMENT BRIDGE NO. HAM-74-1892 L/R OVER ELMORE STREET	
HAM-75-3.84 PID No. 104667	
19 / 38	
101 120	


SFlanagan 11/16/2023 9:35:08 AM
 0:\2017\01113.C. Design\104667 -HAM-75-3.84\Design\Structures\HAM0074-1892C\Sheets\74-1892SD001.dgn

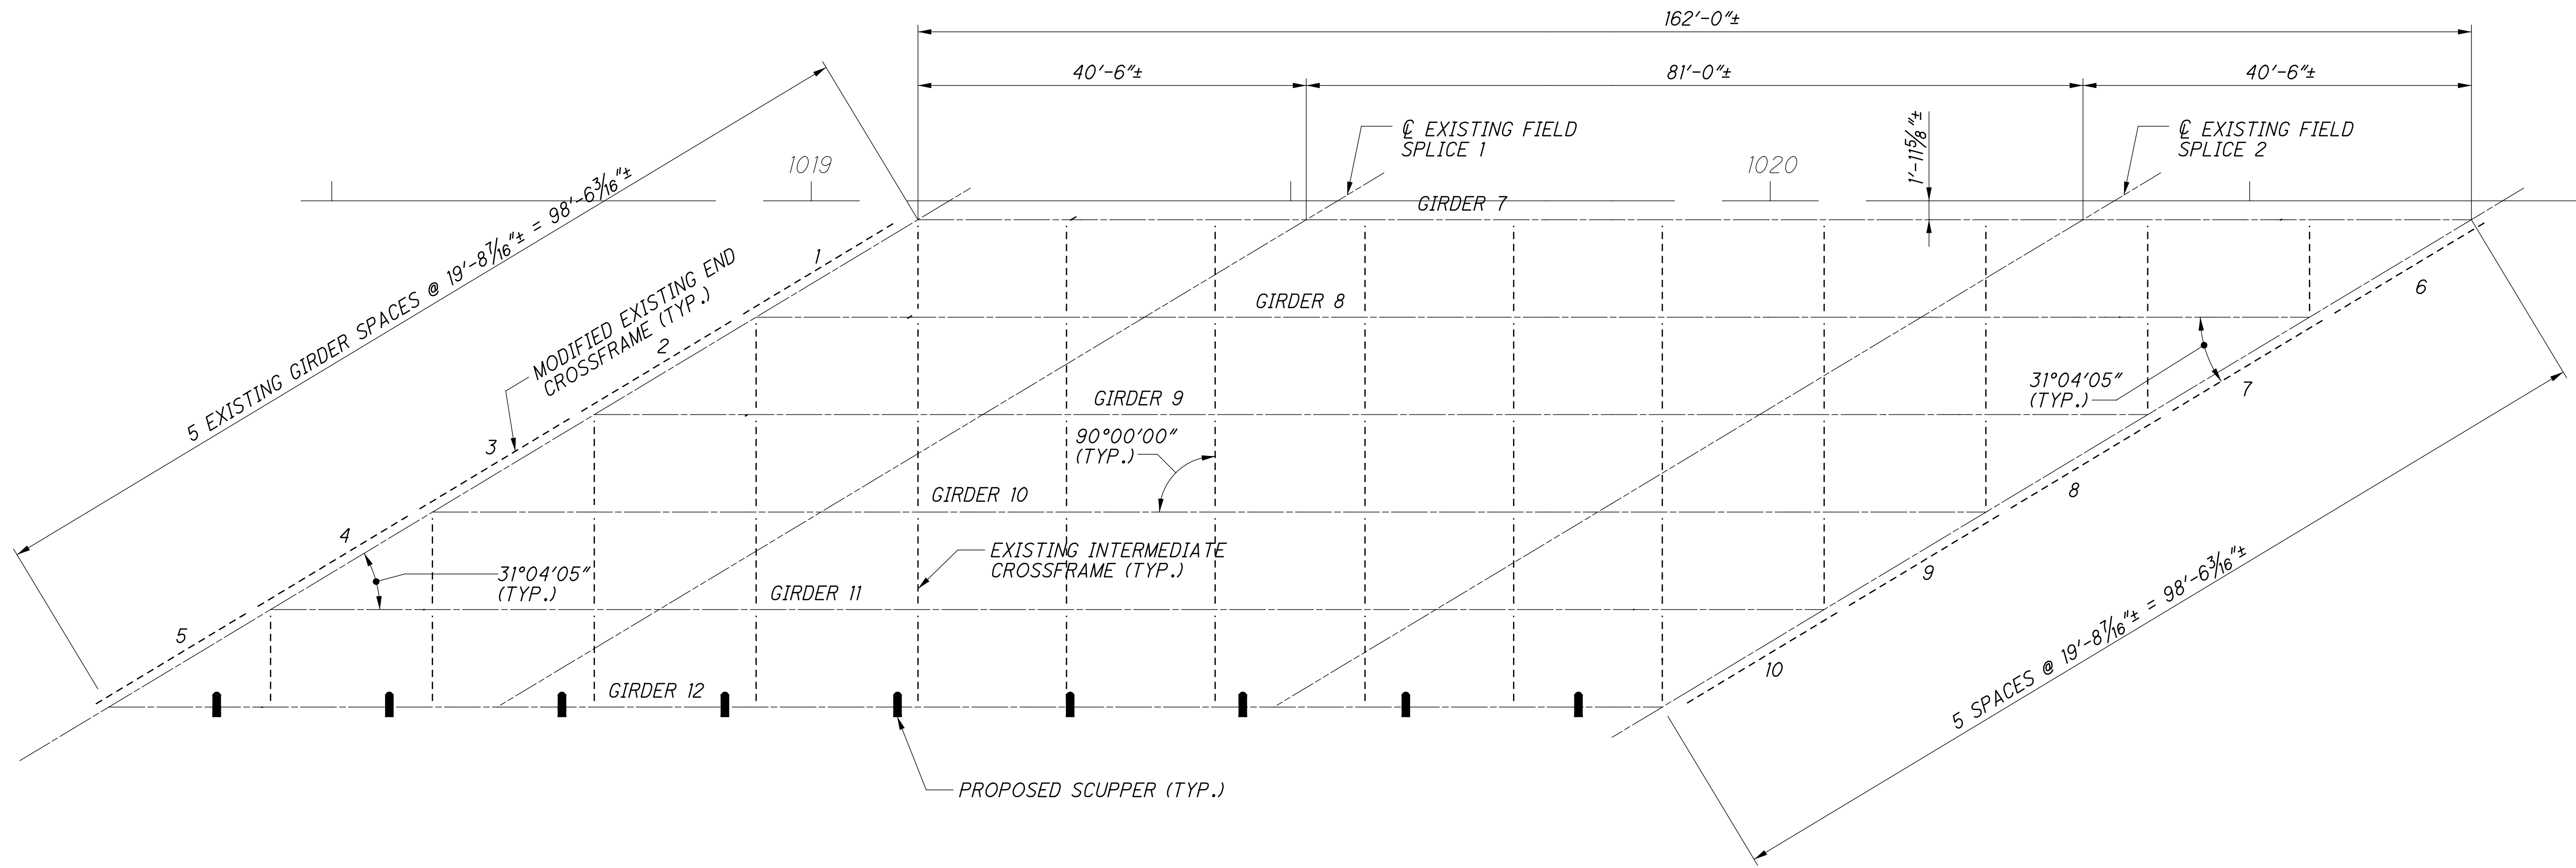


FRAMING PLAN

DESIGN AGENCY STRUCTUREPOINT <small>INCORPORATED</small>	
DATE 11/13/18	STRUCTURE FILE NUMBER 3115690
REVIEWED MDS	DRAWN DSH
DESIGNED SUJ	CHECKED CLB
FRAMING PLAN (RIGHT BRIDGE) BRIDGE NO. HAM-74-1892 L/R OVER ELMORE STREET	
HAM-75-3.84 PID No. 104667	
20 / 38	
102 120	

SFlanagan
 11/16/2023 9:35:09 AM
 O:\2017\01113.C. Design\104667_HAM-75-3.84\Design\Structures\HAM0074-1892C\Sheets\74-1892SD002.dgn

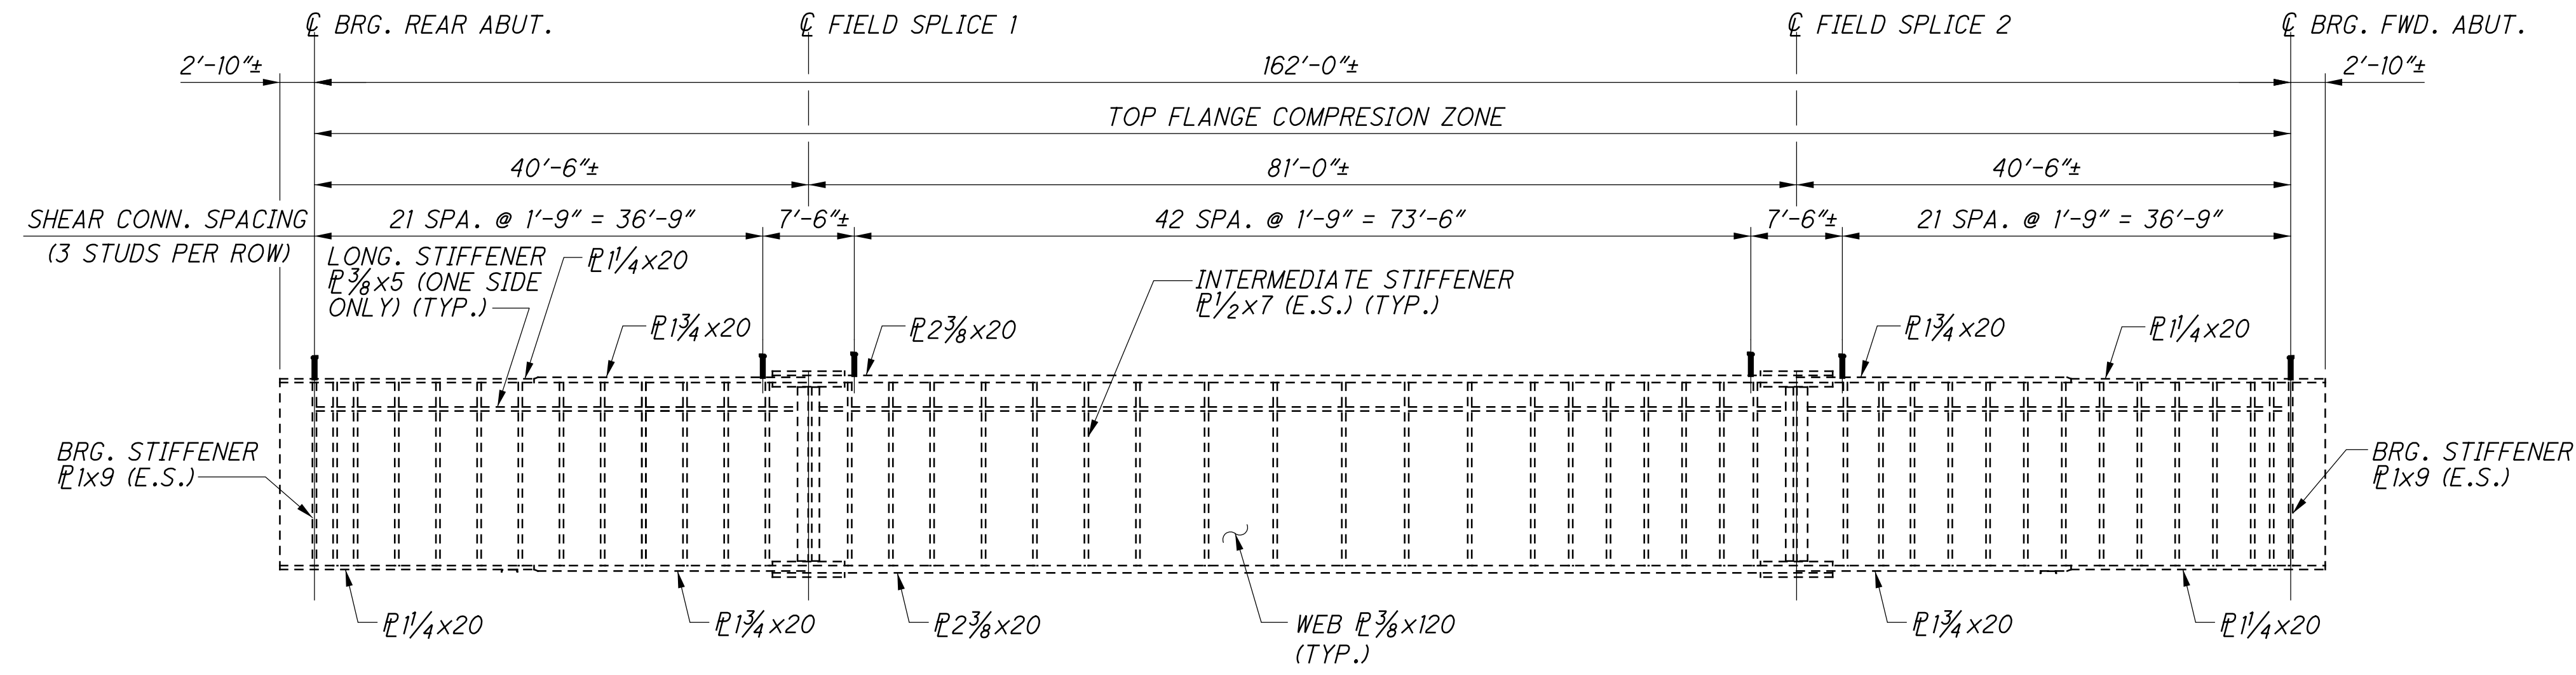


EXISTING GIRDER ELEVATION

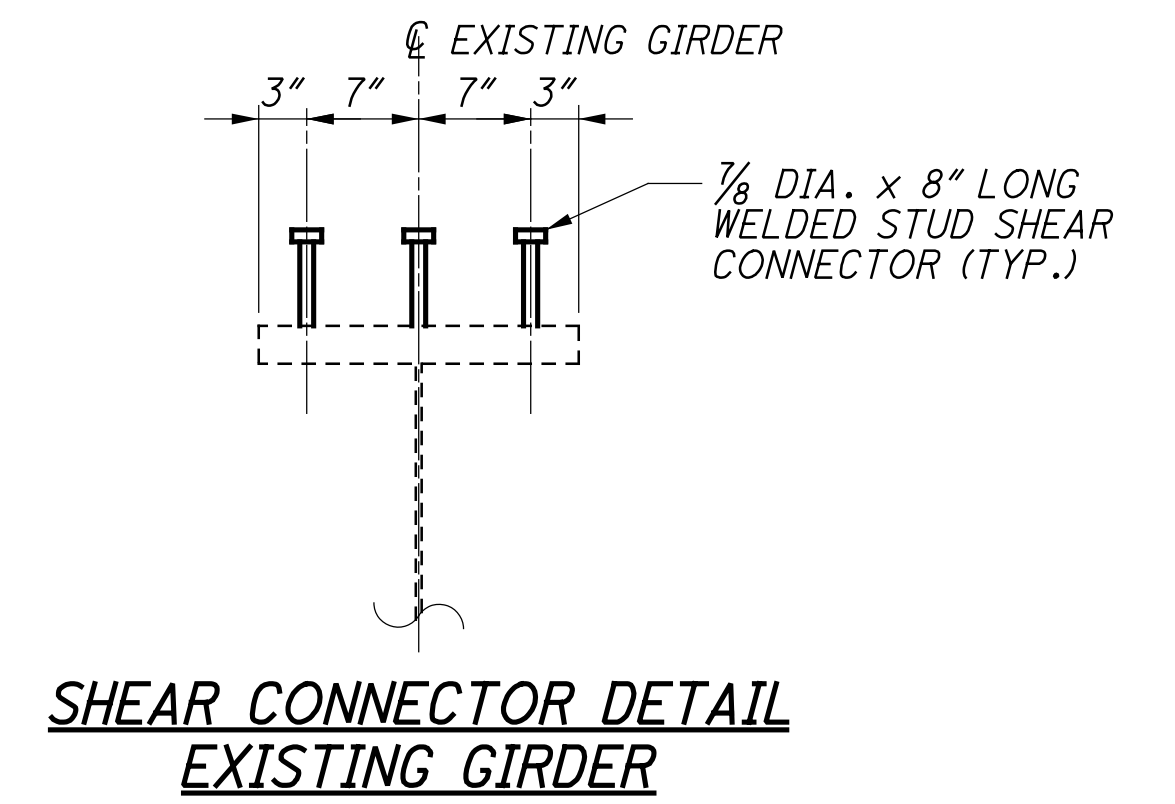

**SHEAR CONNECTOR DETAIL
 EXISTING GIRDER**

		DESIGN AGENCY STRUCTUREPOINT
DESIGNED SUJ	DRAWN DSH	REVIEWED MDS
CHECKED CLB	REVISED	DATE 11/13/18
BRIDGE NO. HAM-74-1892 L/R OVER ELMORE STREET		STRUCTURE FILE NUMBER 3115690
HAM-75-3.84 PID No. 104667		21 / 38
103 120		

SFlanagan 9:35:09 AM
 11/16/2023
 O:\2017\01113.C.Design\104667_HAM-75-3.84.Design\Structures\HAM0074-1892C\Sheets\74-1892SD003.dgn


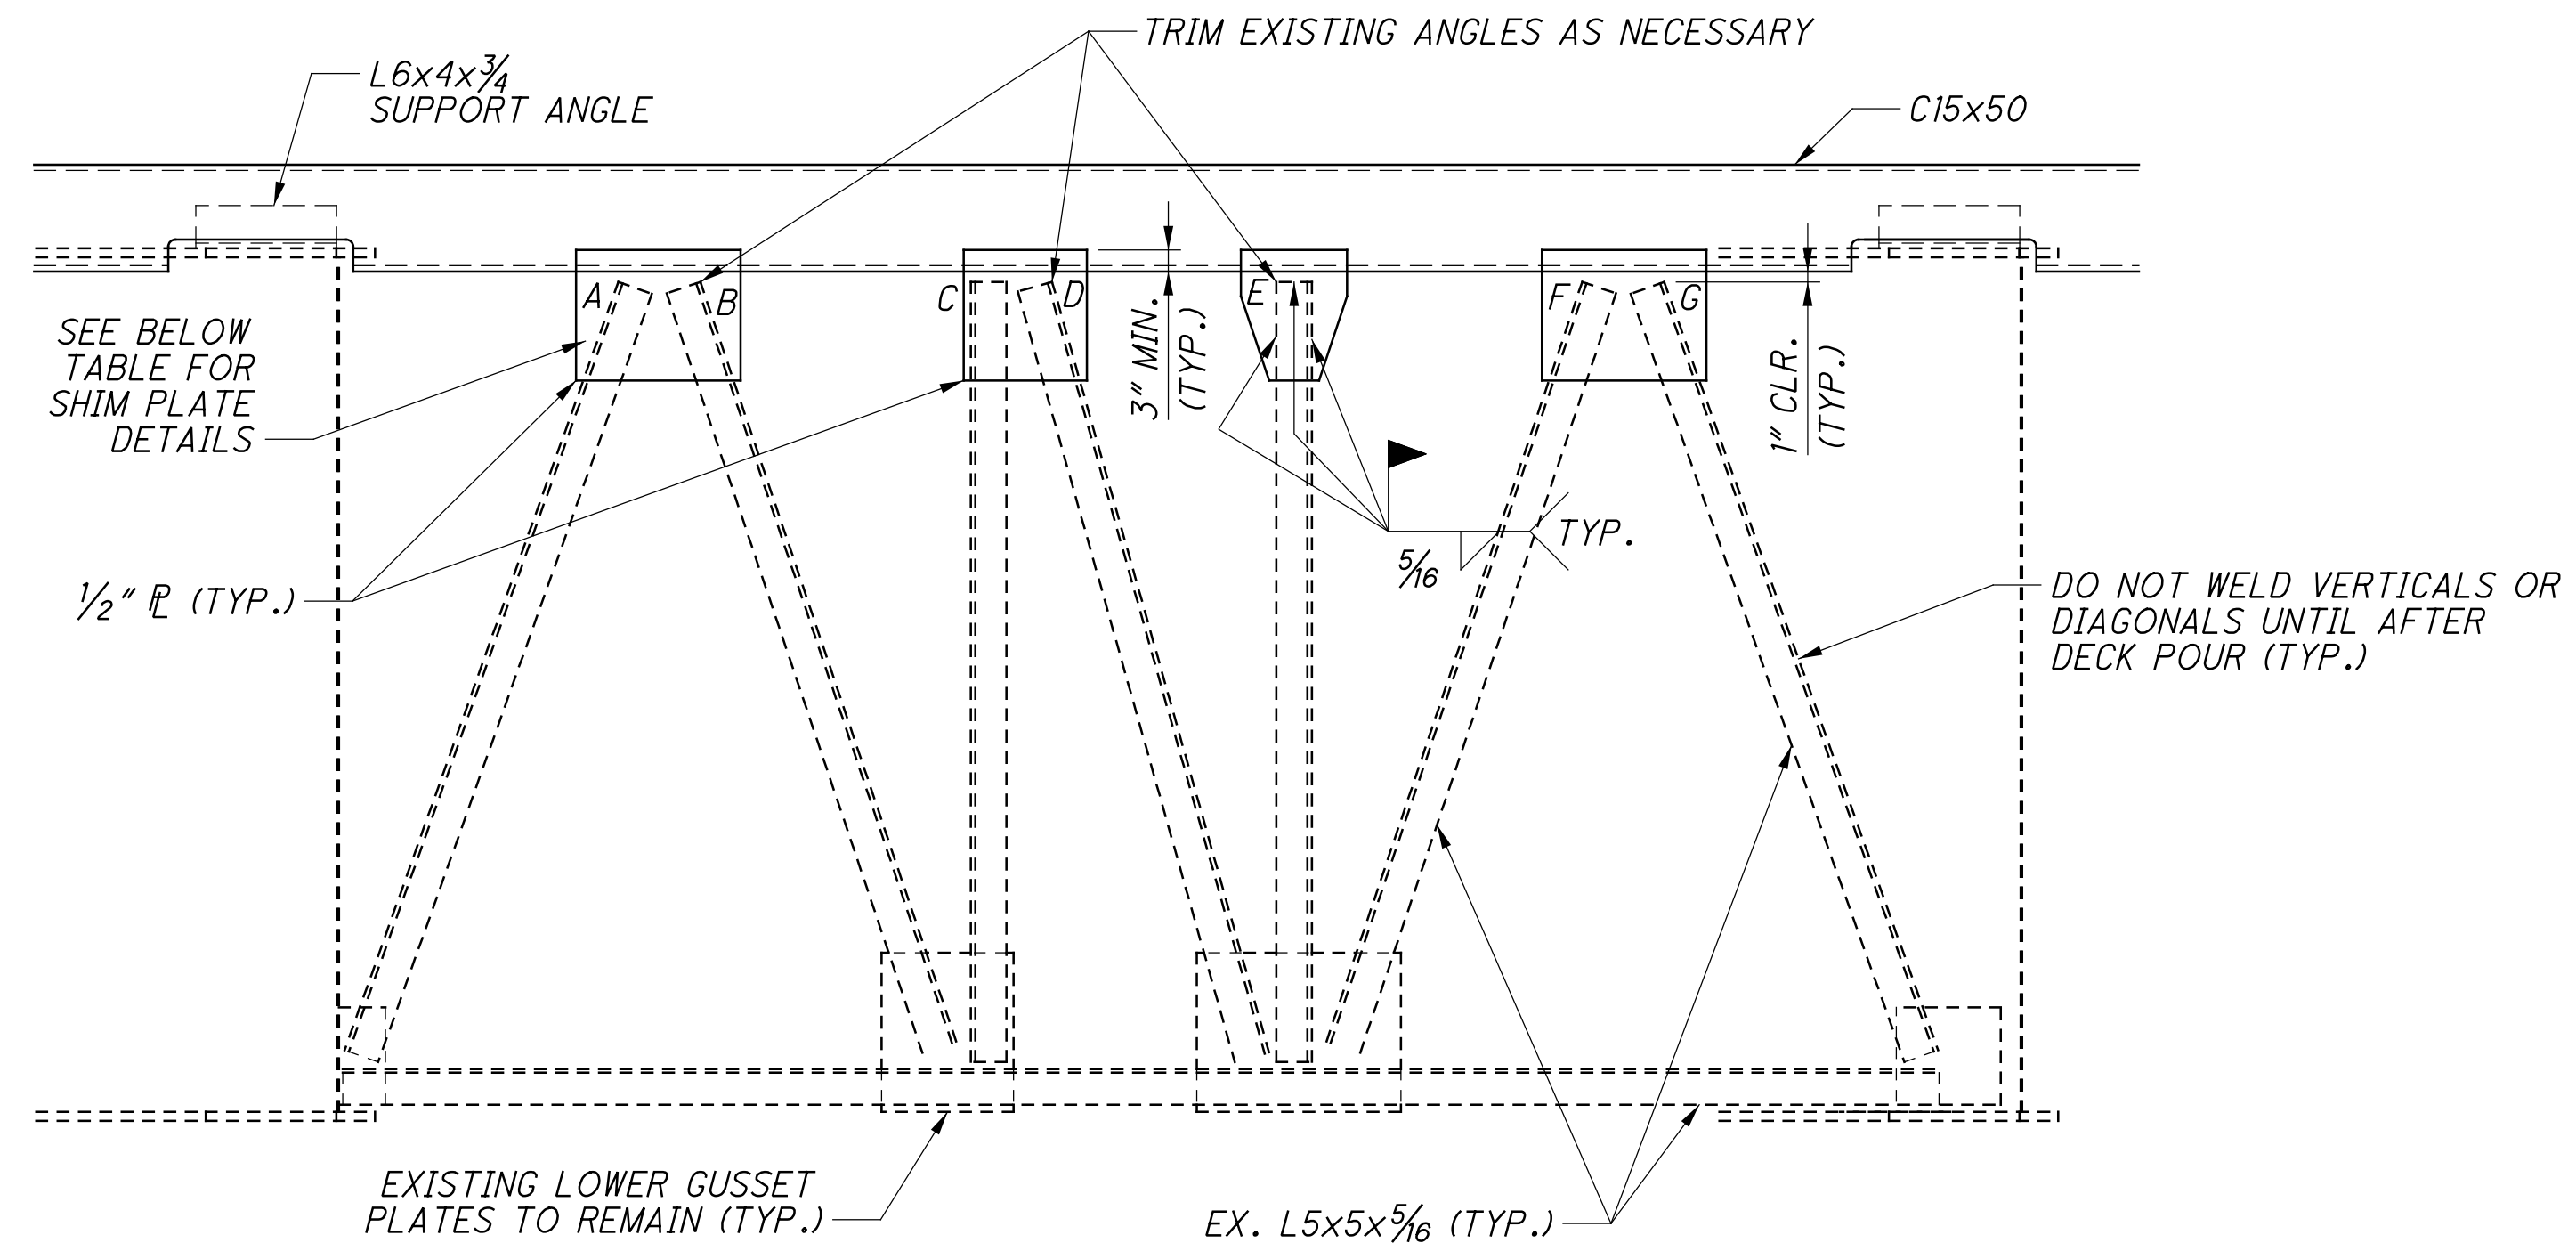


END CROSS FRAME DETAIL

Name	# of Plates	Plate 1	Plate 2
8-A	0	N/A	N/A
8-B	0	N/A	N/A
8-C	0	N/A	N/A
8-D	0	N/A	N/A
8-E	2	6"x6"x1 1/4"	6"x6"x1 1/4"
8-F	0	N/A	N/A
8-G	0	N/A	N/A

Name	# of Plates	Plate 1	Plate 2
9-A	0	N/A	N/A
9-B	0	N/A	N/A
9-C	0	N/A	N/A
9-D	0	N/A	N/A
9-E	0	N/A	N/A
9-F	0	N/A	N/A
9-G	2	8"x8"x1 1/4"	8"x8"x1"

Name	# of Plates	Plate 1	Plate 2
10-A	1	8"x8"x1 1/4"	N/A
10-B	2	8"x8"x1 1/4"	8"x8"x1 1/4"
10-C	2	8"x8"x1 1/4"	8"x8"x1 1/4"
10-D	2	8"x8"x1 1/4"	8"x8"x1 1/4"
10-E	2	8"x8"x1 1/4"	8"x8"x1 1/4"
10-F	2	8"x8"x1 1/4"	8"x8"x1 1/4"
10-G	1	8"x8"x1 1/4"	N/A

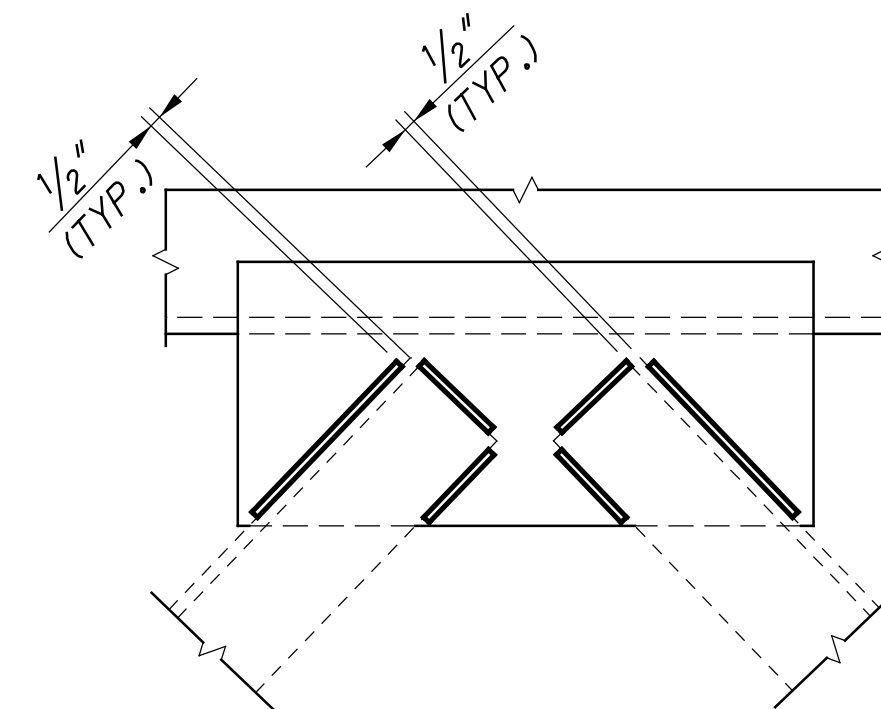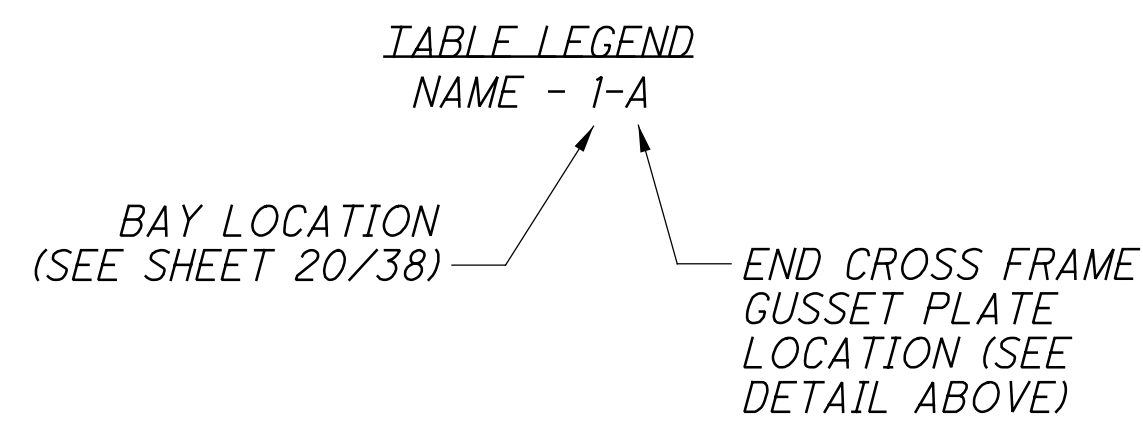

WELD TERMINATION DETAIL

NOTES:

1. ALL STRUCTURAL STEEL SHALL BE ASTM A709 GRADE 50.
2. FOR ADDITIONAL NOTES AND DETAILS, SEE STD. DWG. GSD-1-96.

DESIGN AGENCY
STRUCTUREPOINT
INCORPORATED

DESIGNED SUJ **CHECKED** CLB
DRAWN DSH **REVISED**
REVIEWED MDS **DATE** 11/13/18
STRUCTURE FILE NUMBER 3115690


SUPERSTRUCTURE DETAILS (RIGHT BRIDGE)
 BRIDGE NO. HAM-74-1892 L/R
 OVER ELMORE STREET

HAM-75-3.84
PID No. 104667

22 / 38

104
120

SFlanagan
11/16/2023 9:35:10 AM
O:\2017\01113.C. Design\104667_HAM-75-3.84.Design\Structures\HAM0074-1892C_Sheets\74-1892TS001.dgn

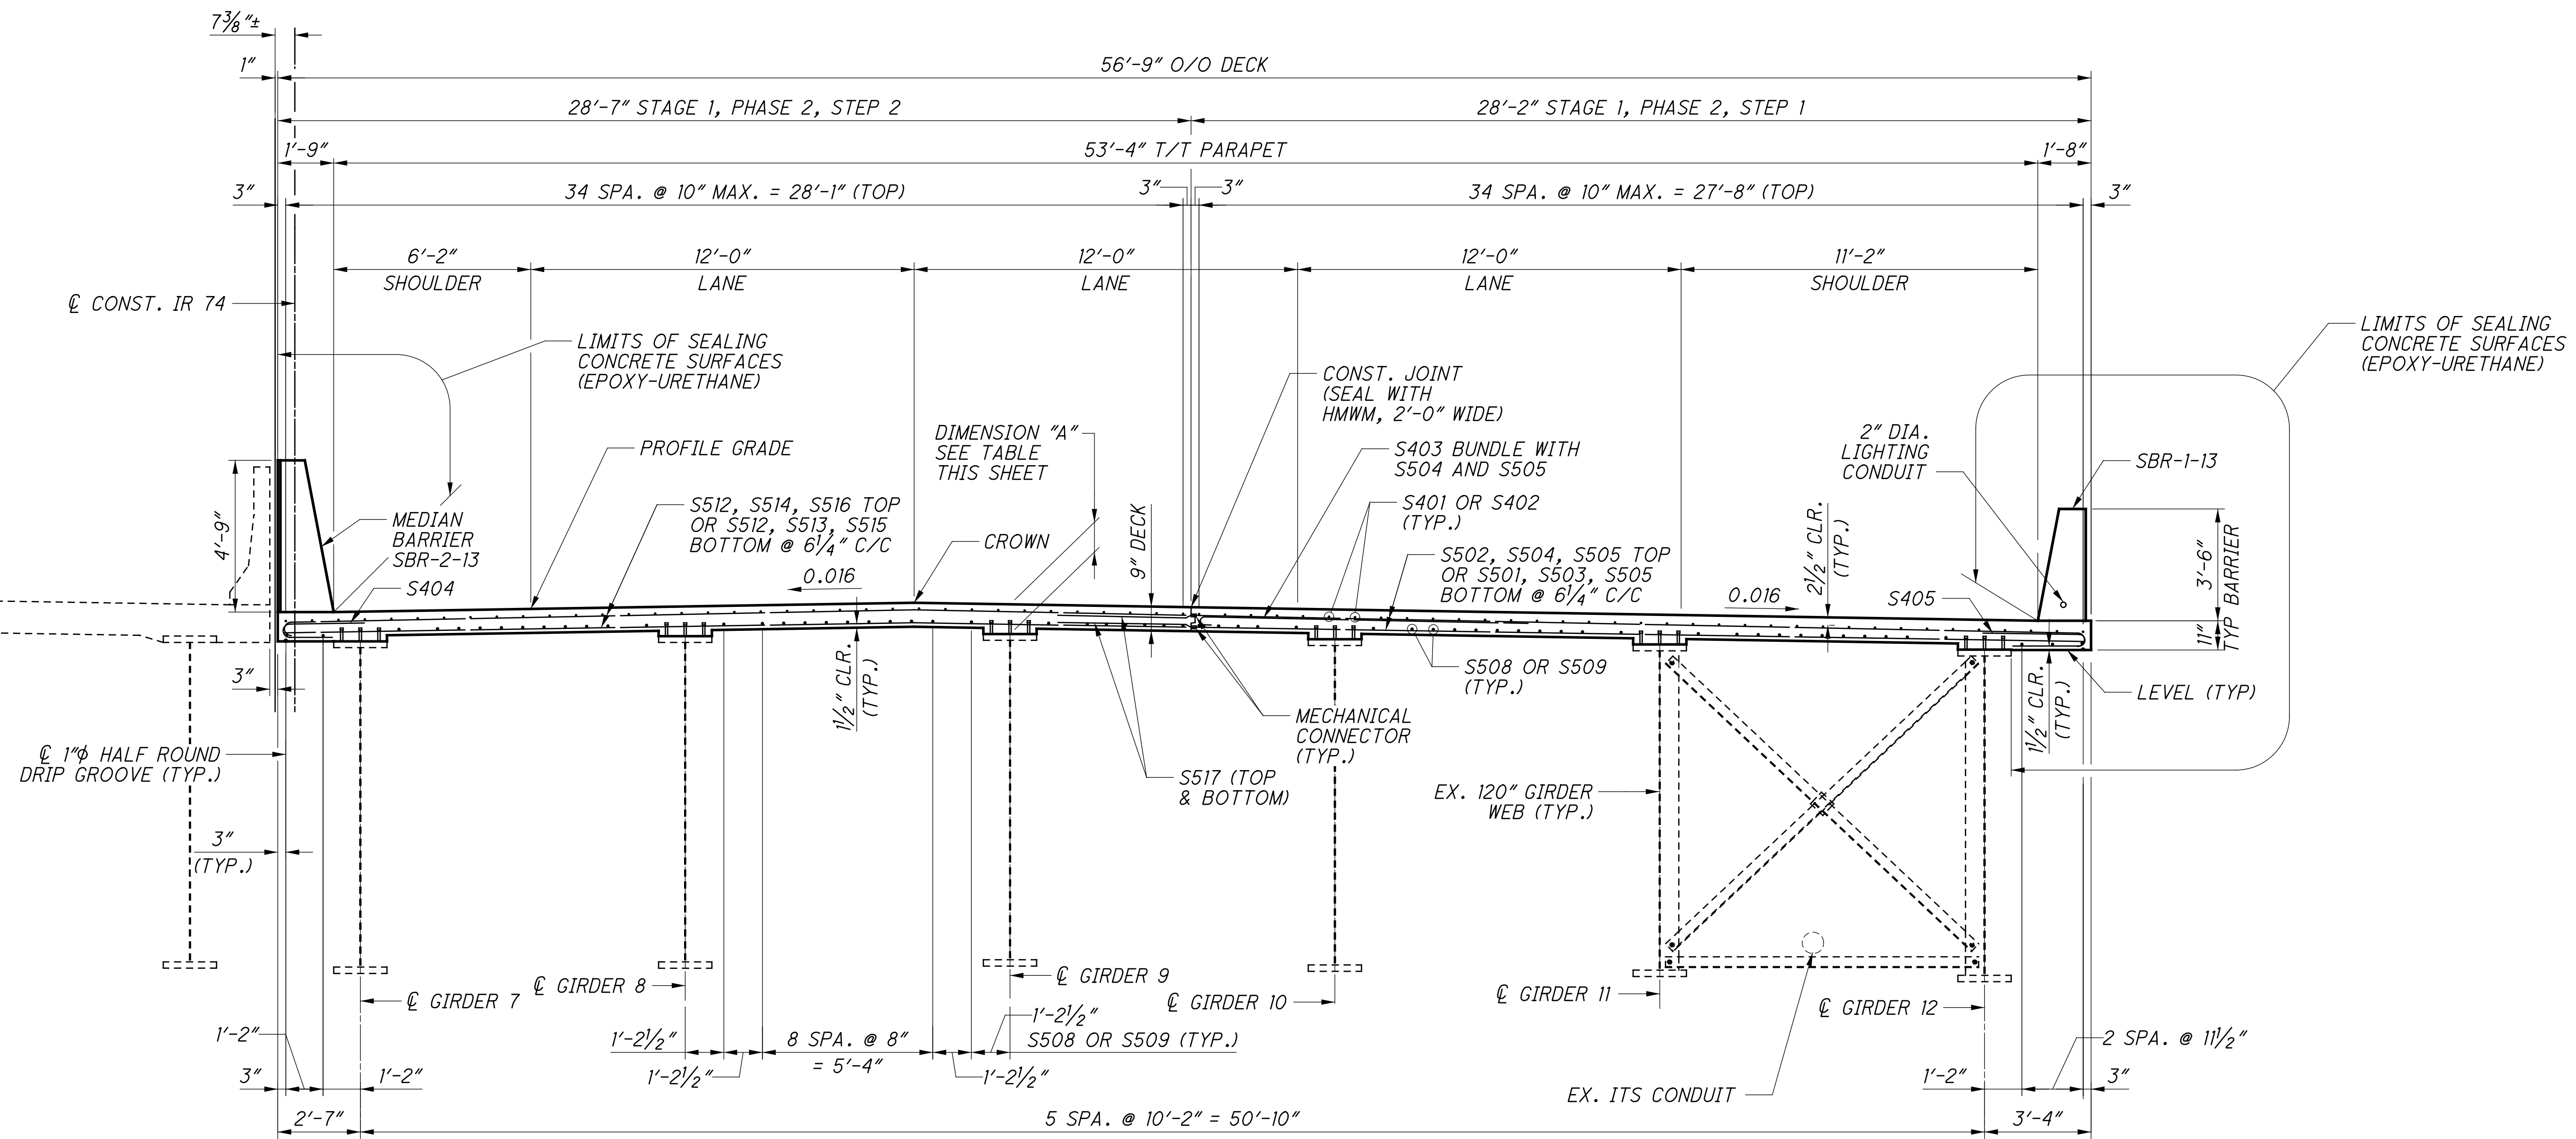

TRANSVERSE SECTION

DIMENSION "A" (TOP OF SLAB TO TOP OF FLANGE)		
LOCATION	CL BRG. R.A.	CL BRG. F.A.
GIRDER 7	1'-0 1/2"	1'-0 1/2"
GIRDER 8	1'-0 1/2"	1'-0 5/8"
GIRDER 9	1'-0 1/2"	1'-0 1/2"
GIRDER 10	1'-0 1/2"	1'-0 3/4"
GIRDER 11	1'-0 3/8"	1'-0 1/2"
GIRDER 12	1'-0 1/2"	1'-0 3/8"

- NOTES:
- FOR PARAPET DETAILS SEE SHEETS 26/38 TO 28/38.
 - FOR SLAB REINFORCING PLAN SEE SHEET 24/38.
 - SEE HL-30.31 FOR ADDITIONAL LIGHTING CONDUIT DETAILS.

DESIGN AGENCY: **STRUCTUREPOINT**

DATE: 9/12/18

REVIEWED: MDS

DRAWN: BMP

DESIGNED: SJF

CHECKED: CLB

STRUCTURE FILE NUMBER: 3115690

TRANSVERSE SECTION (RIGHT BRIDGE)

BRIDGE NO. HAM-74-1892 L/R

IR-74 OVER ELMORE STREET


HAM-75-3.84

PID No. 104667

23/38


105
120

S:\Plans\2017\01113\C.Design\104667_HAM-75-3.84\Design\Structures\HAM0074_1892C_Sheets\74_1892DP001.dgn
 11/16/2023 9:35:11 AM
 O:\2017\01113\C.Design\104667_HAM-75-3.84\Design\Structures\HAM0074_1892C_Sheets\74_1892DP001.dgn

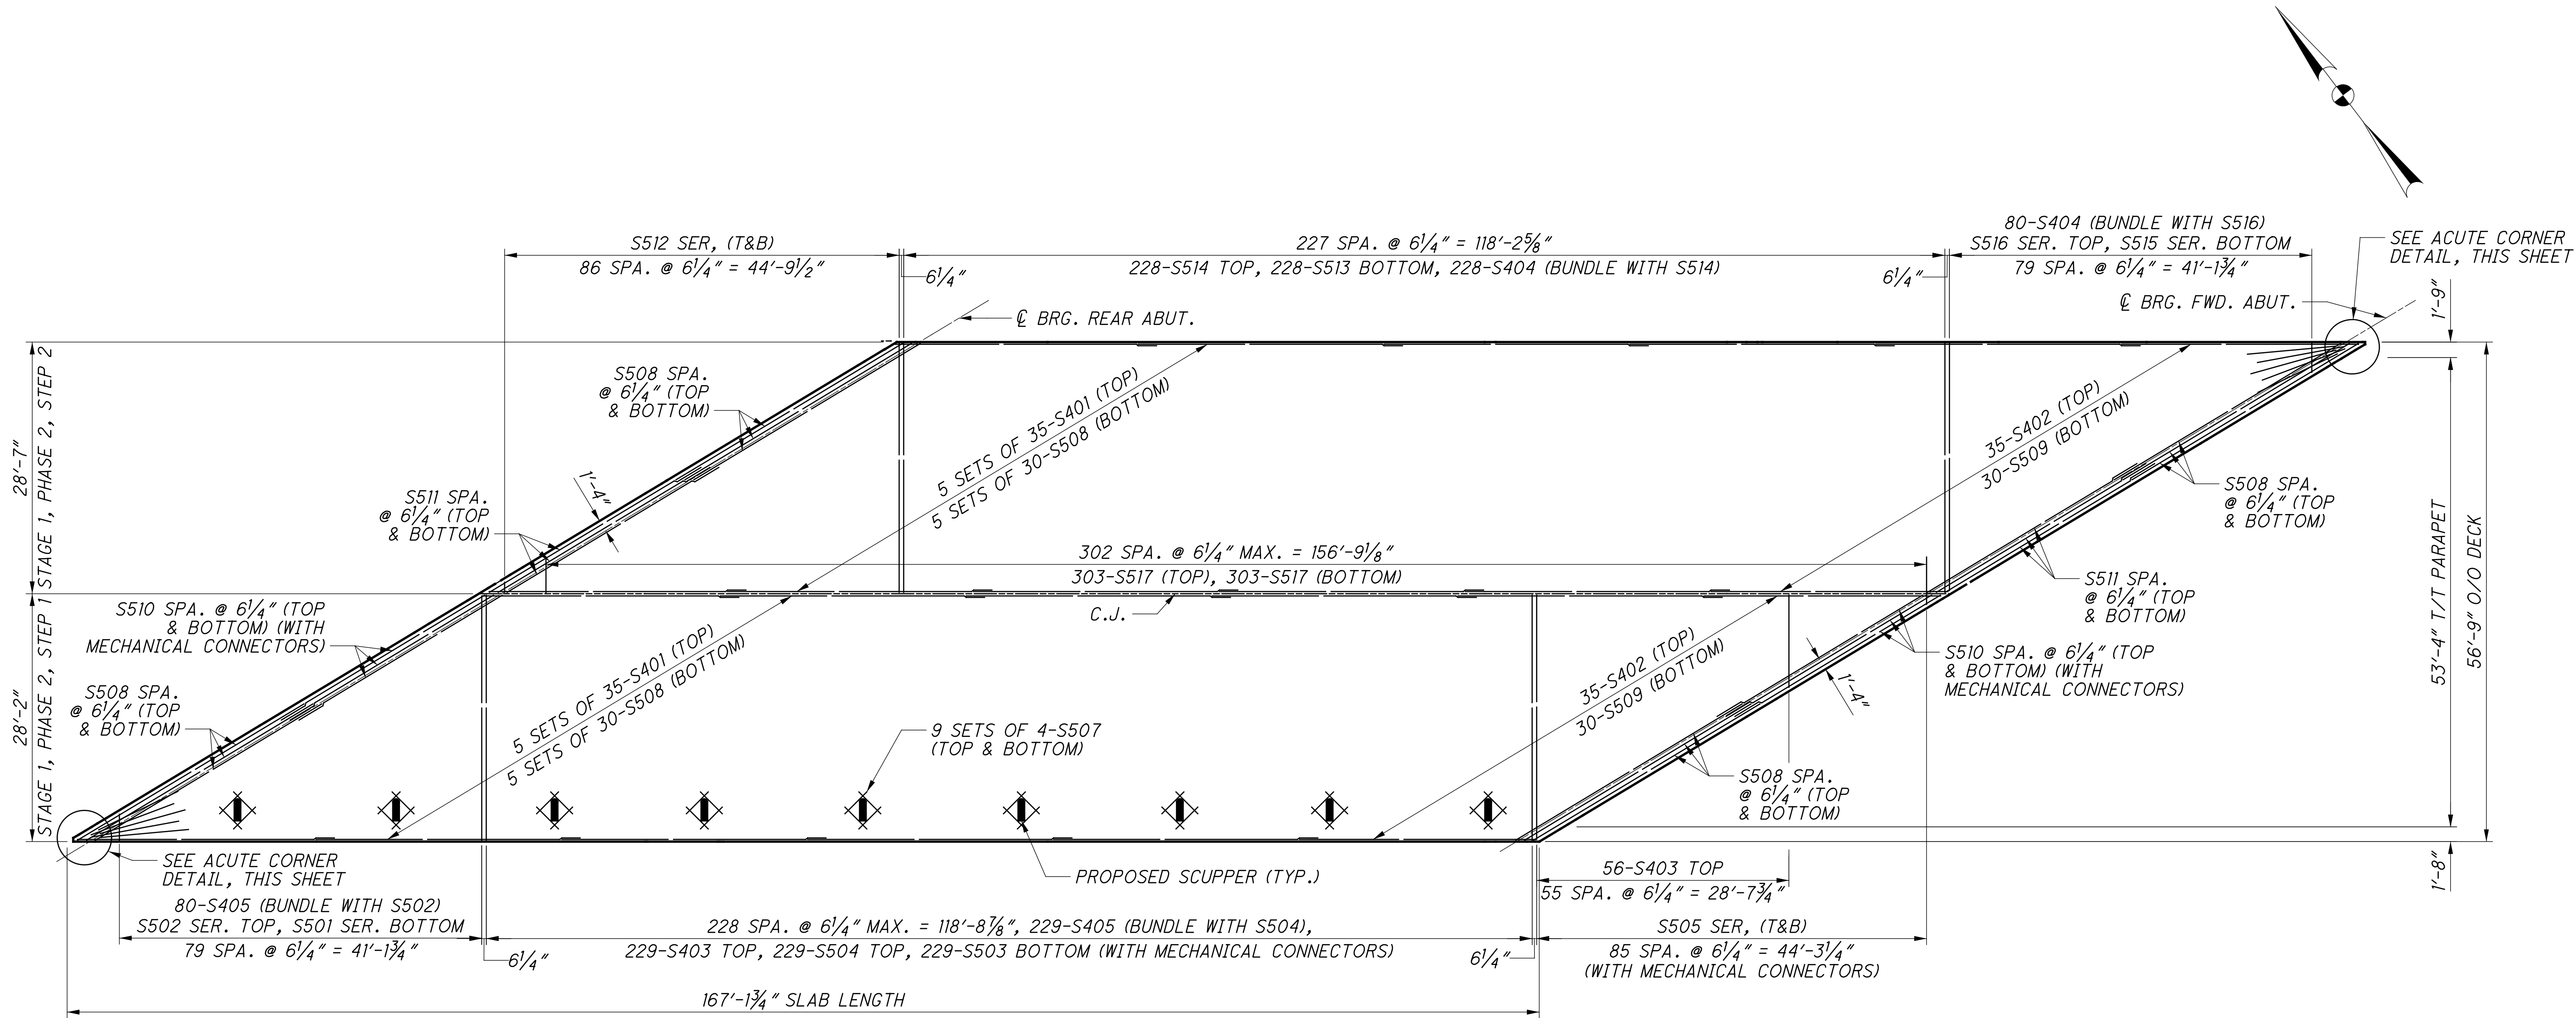

SLAB REINFORCING PLAN

MINIMUM BAR LAP	
#4	2'-6"
#5 (LONGITUDINAL)	3'-1"
#5 (TRANSVERSE)	4'-0"

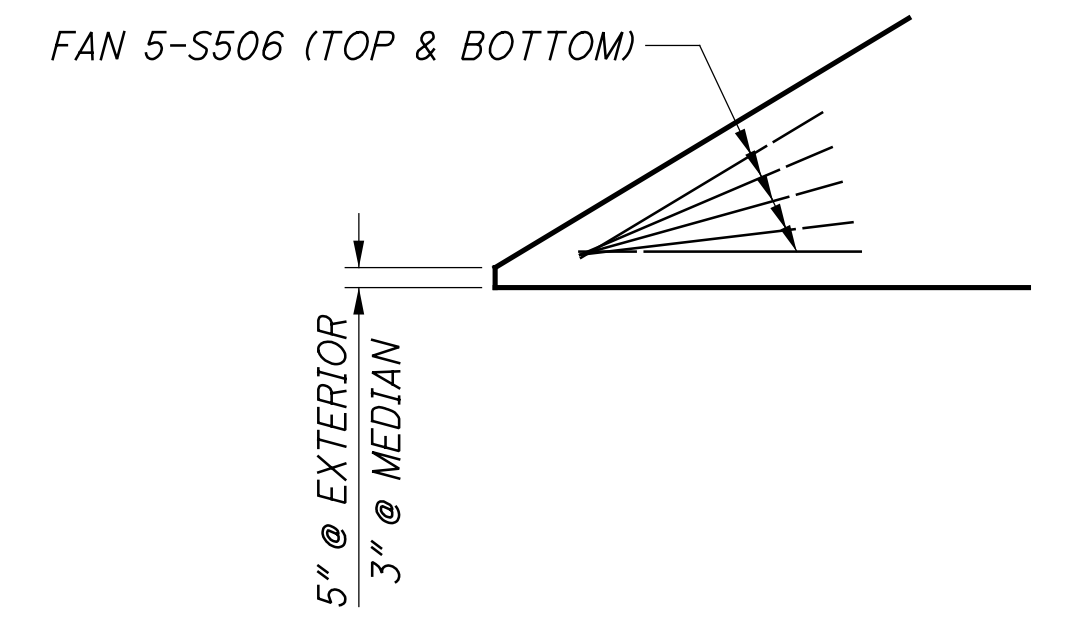

ACUTE CORNER DETAIL

NOTES:
 MECHANICAL CONNECTORS FOR REINFORCING BARS SHALL BE USED AT LONGITUDINAL CONSTRUCTION JOINT.
 FOR PARAPET DETAILS, SEE SHEETS 26/38 THRU 28/38.



DESIGN AGENCY: **STRUCTUREPOINT**
 DATE: 11/12/18
 REVIEWED: MDS
 DRAWN: TMT
 DESIGNED: SUJ
 CHECKED: CLB
 STRUCTURE FILE NUMBER: 3115690
 REVISIONS: 0
 FILE NUMBER: 3115690

SLAB REINFORCING PLAN (RIGHT BRIDGE)
 BRIDGE NO. HAM-74-1892 L/R
 OVER ELMORE STREET

HAM-75-3.84
 PID No. 104667

24 / 38
 106
 120

S:\Plans\11/16/2023 9:35:16 AM
 O:\2017\01113\C.Design\104667_HAM-75-3.84.Design\Structures\HAM0074-1892C_Sheets\74-1892SD004.dgn

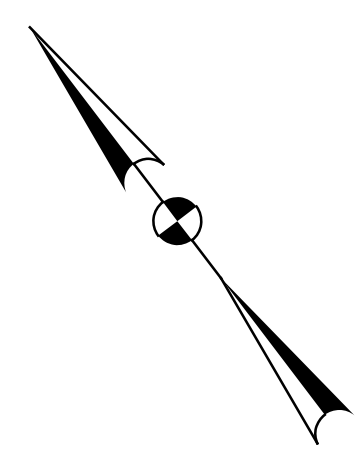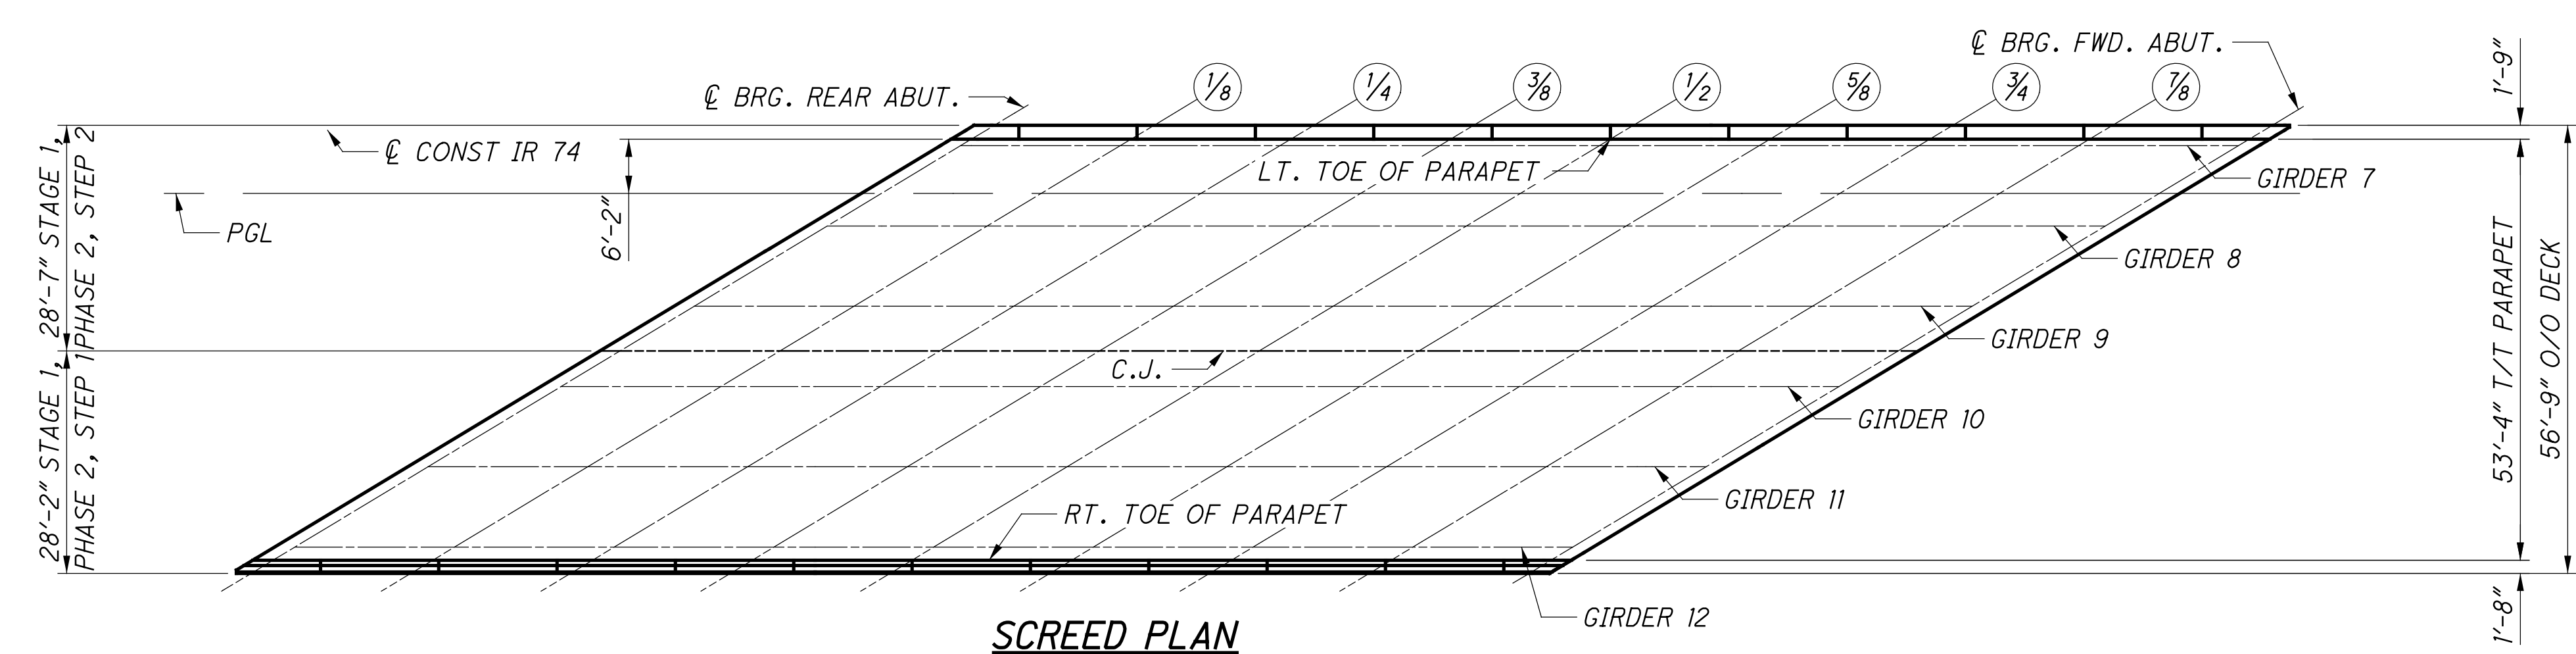

HAUNCH AND SCREED ELEVATIONS TABLE


SCREED LINE	DESCRIPTION	¢ BRG. R. A.	1/8 POINT	1/4 POINT	3/8 POINT	1/2 POINT	5/8 POINT	3/4 POINT	7/8 POINT	¢ BRG. F. A.
HAM-74-1892 SCREED ELEVATIONS										
LT. TOE OF PARAPET	STATION	1019+12.51	1019+32.76	1019+53.01	1019+73.26	1019+93.51	1020+13.76	1020+34.01	1020+54.26	1020+74.51
	F.D.S. ELEV.	519.76	519.59	519.40	519.25	519.10	518.92	518.78	518.60	518.53
	DEFLECTION	0.00	0.06	0.11	0.14	0.15	0.14	0.11	0.06	0.00
PGL	STATION	1019+02.27	1019+22.52	1019+42.77	1019+63.02	1019+83.27	1020+03.52	1020+23.77	1020+44.02	1020+64.27
	F.D.S. ELEV.	519.76	519.59	519.41	519.26	519.11	518.93	518.79	518.60	518.53
	DEFLECTION	0.00	0.06	0.10	0.13	0.14	0.13	0.10	0.06	0.00
CROWN	STATION	1018+82.36	1019+02.61	1019+22.86	1019+43.11	1019+63.36	1019+83.61	1020+03.86	1020+24.11	1020+44.36
	F.D.S. ELEV.	520.13	520.01	519.80	519.62	519.47	518.58	519.15	518.96	518.85
	DEFLECTION	0.00	0.05	0.10	0.12	0.13	0.12	0.10	0.05	0.00
C.J.	STATION	1018+67.98	1018+88.23	1019+08.48	1019+28.73	1019+48.98	1019+69.23	1019+89.48	1020+09.73	1020+29.98
	F.D.S. ELEV.	520.11	519.93	519.76	519.60	519.44	519.29	519.14	518.98	518.85
	DEFLECTION	0.00	0.05	0.10	0.12	0.13	0.12	0.10	0.05	0.00
RT. TOE OF PARAPET	STATION	1018+23.99	1018+44.24	1018+64.49	1018+84.74	1019+04.99	1019+25.24	1019+45.49	1019+65.74	1019+85.99
	F.D.S. ELEV.	520.08	519.85	519.71	519.53	519.36	519.22	519.08	518.89	518.72
	DEFLECTION	0.00	0.06	0.11	0.15	0.16	0.15	0.12	0.07	0.00
HAM-74-1892 TOP OF HAUNCH ELEVATIONS										
GIRDER 7	STATION	1019+11.13	1019+31.38	1019+51.63	1019+71.88	1019+92.13	1020+12.38	1020+32.63	1020+52.88	1020+73.13
	F.D.S. ELEV.	519.76	519.59	519.40	519.25	519.10	518.92	518.78	518.60	518.53
	DEFLECTION	0.00	0.06	0.11	0.14	0.15	0.14	0.11	0.06	0.00
GIRDER 8	STATION	1018+94.25	1019+14.50	1019+34.75	1019+55.00	1019+75.25	1019+95.50	1020+15.75	1020+36.00	1020+56.25
	F.D.S. ELEV.	519.92	519.77	519.55	519.40	519.29	519.10	518.91	518.79	518.61
	DEFLECTION	0.00	0.06	0.10	0.13	0.14	0.13	0.10	0.06	0.00
GIRDER 9	STATION	1018+77.38	1018+97.63	1019+17.88	1019+38.13	1019+58.38	1019+78.63	1019+98.88	1020+19.13	1020+39.38
	F.D.S. ELEV.	520.11	519.95	519.79	519.61	519.44	519.29	519.13	518.95	518.89
	DEFLECTION	0.00	0.05	0.10	0.12	0.13	0.12	0.10	0.05	0.00
GIRDER 10	STATION	1018+60.51	1018+80.76	1019+01.01	1019+21.26	1019+41.51	1019+61.76	1019+82.01	1020+02.26	1020+22.51
	F.D.S. ELEV.	520.10	519.92	519.73	519.60	519.44	519.29	519.15	519.01	518.81
	DEFLECTION	0.00	0.05	0.10	0.12	0.13	0.12	0.10	0.05	0.00
GIRDER 11	STATION	1018+43.63	1018+63.88	1018+84.13	1019+04.38	1019+24.63	1019+44.88	1019+65.13	1019+85.38	1020+05.63
	F.D.S. ELEV.	520.08	519.88	519.72	519.57	519.41	519.26	519.12	518.95	518.77
	DEFLECTION	0.00	0.06	0.10	0.13	0.14	0.13	0.10	0.06	0.00
GIRDER 12	STATION	1018+26.76	1018+47.01	1018+67.26	1018+87.51	1019+07.76	1019+28.01	1019+48.26	1019+68.51	1019+88.76
	F.D.S. ELEV.	520.06	519.83	519.72	519.54	519.38	519.22	519.10	518.90	518.73
	DEFLECTION	0.00	0.06	0.11	0.15	0.16	0.15	0.12	0.07	0.00
GIRDER 12	STATION	1018+26.76	1018+47.01	1018+67.26	1018+87.51	1019+07.76	1019+28.01	1019+48.26	1019+68.51	1019+88.76
	F.D.S. ELEV.	520.06	519.83	519.72	519.54	519.38	519.22	519.10	518.90	518.73
	DEFLECTION	0.00	0.06	0.11	0.15	0.16	0.15	0.12	0.07	0.00
NOTES:


1. SCREED ELEVATIONS SHOWN REPRESENT THE THEORETICAL DECK SURFACE LOCATION PRIOR TO DEFLECTIONS CAUSED BY DECK PLACEMENT AND OTHER ANTICIPATED DEAD LOADS.
2. TOP OF HAUNCH (T.O.H.) ELEVATIONS SHOWN REPRESENT THE THEORETICAL LOCATION OF THE BOTTOM OF THE DECK ABOVE THE GIRDER HAUNCH PRIOR TO DEFLECTIONS CAUSED BY DECK PLACEMENT AND OTHER ANTICIPATED DEAD LOADS.
3. FINAL DECK SURFACE (F.D.S.) ELEVATIONS SHOWN REPRESENT THE DECK SURFACE LOCATION AFTER ALL ANTICIPATED DEAD LOAD DEFLECTIONS HAVE OCCURRED.

 DESIGN AGENCY STRUCTUREPOINT	DATE 11/12/18	REVIEWED MDS	STRUCTURE FILE NUMBER 3115690	DRAWN BNM	REVISIONS REVISED
DESIGNED SUJ	CHECKED CLB	SCREED PLAN (RIGHT BRIDGE) BRIDGE NO. HAM-74-1892 L/R OVER ELMORE STREET			
HAM-75-3.84		PID No. 104667		25 / 38	
107		120			

S:\Plans\23 11/16/2023 9:35:17 AM
 2017\01113\C.Design\104667_HAM-75-3.84\Design\Structures\HAM0074_1892C_Sheets\7.4_1892RA001.dgn

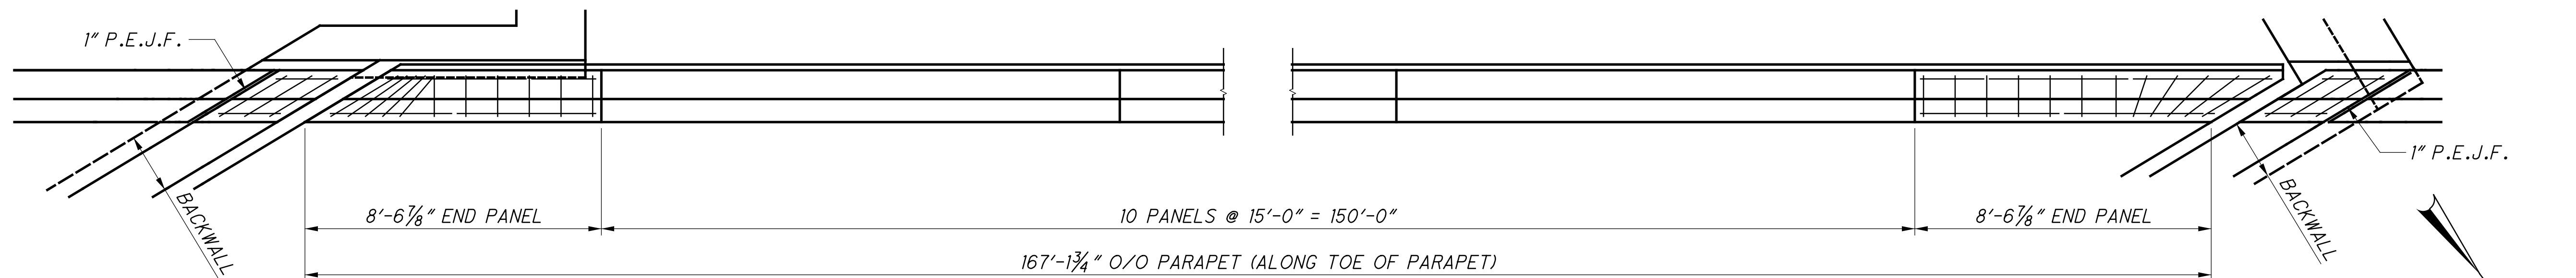

PARAPET PLAN

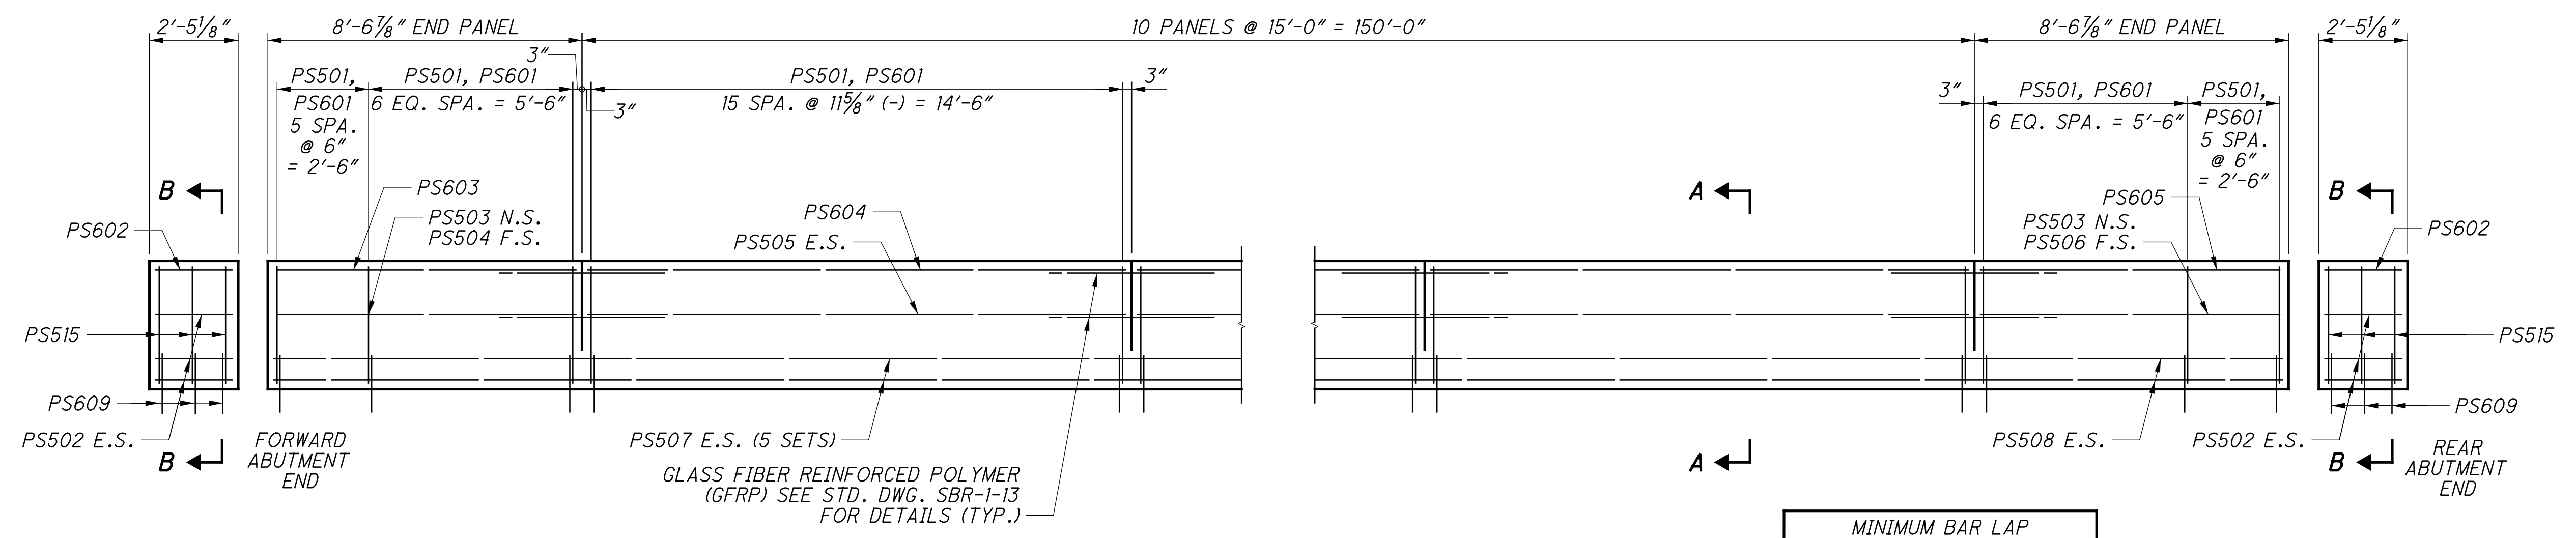


PARAPET ELEVATION


RIGHT PARAPET SHOWN (ALONG TOE OF PARAPET)

MINIMUM BAR LAP	
#5	2'-7"

NOTES:
 1. SEE STANDARD BRIDGE DRAWING SBR-1-13 FOR ADDITIONAL DETAILS.

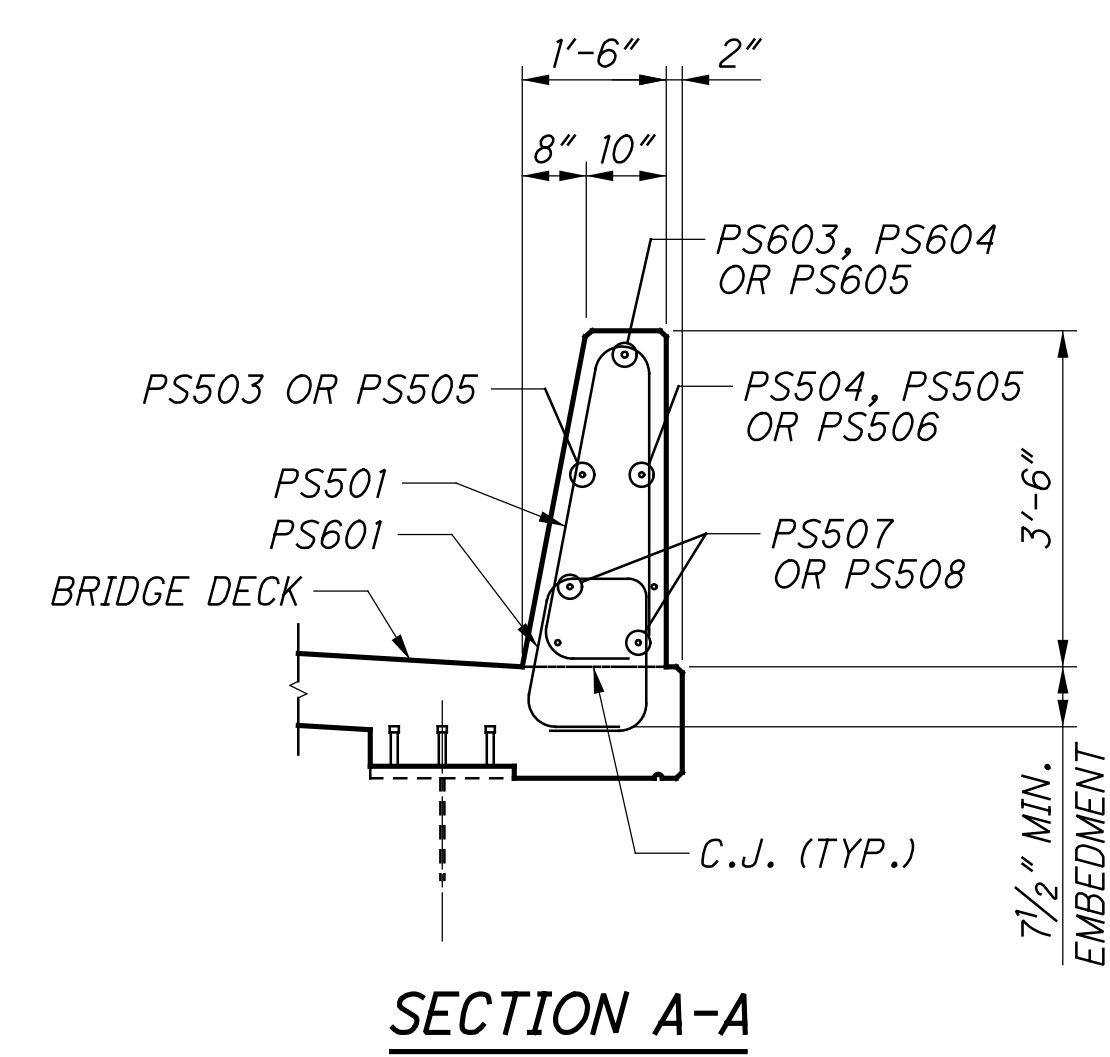


SECTION A-A

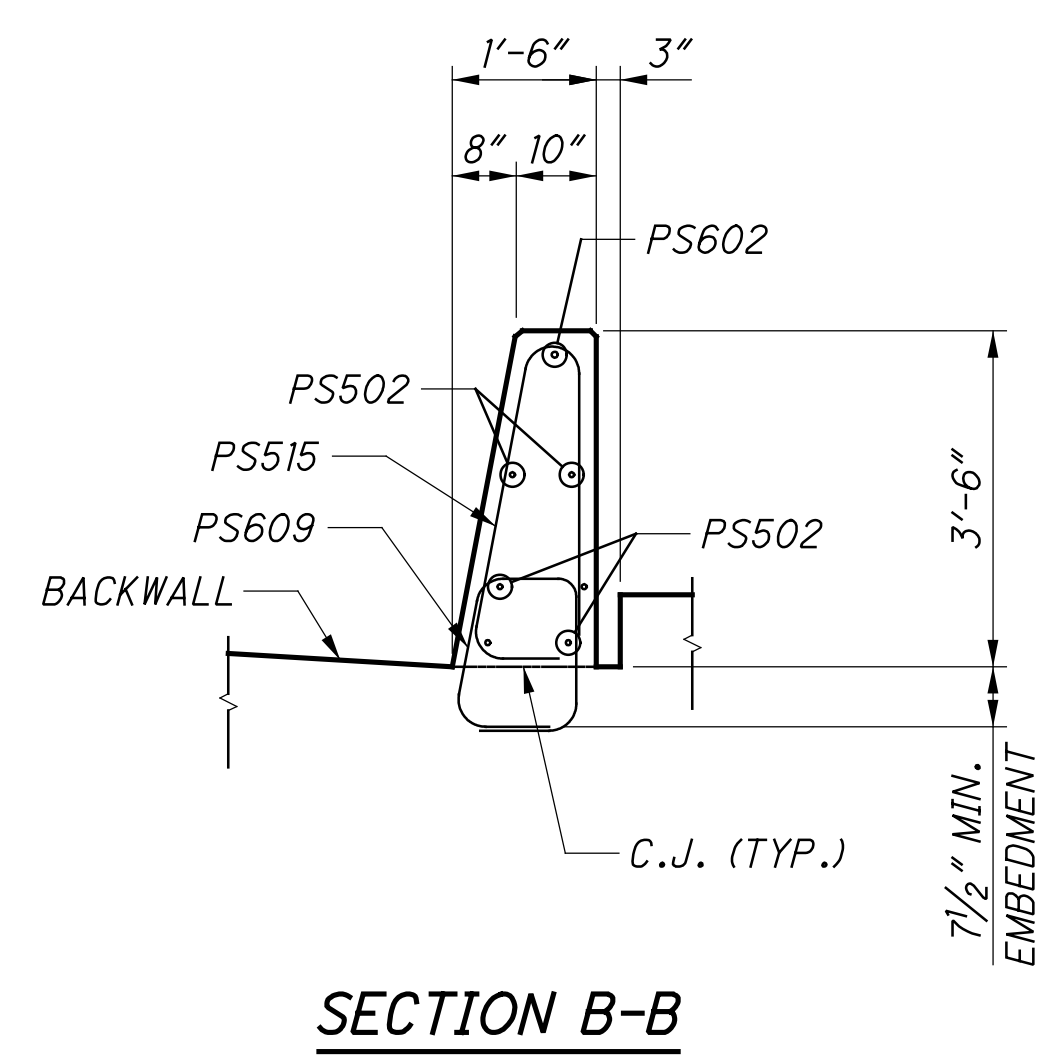


SECTION B-B

DESIGN AGENCY: **STRUCTUREPOINT**
 DATE: 11/13/18
 REVIEWED: MDS
 DRAWN: DSH
 DESIGNED: SUJ
 CHECKED: CLB
 STRUCTURE FILE NUMBER: 3115690
PARAPET DETAILS (RIGHT BRIDGE)
 BRIDGE NO. HAM-74-1892 L/R
 OVER ELMORE STREET
HAM-75-3.84
 PID No. 104667
 26/38
 108
 120


S:\Plans\23 11/16/2013 9:35:17 AM
 2017\01113\C.Design\104667.HAM-75-3.84\Design\Structures\HAM0074_1892C_Sheets\7.4_1892RA002.dgn

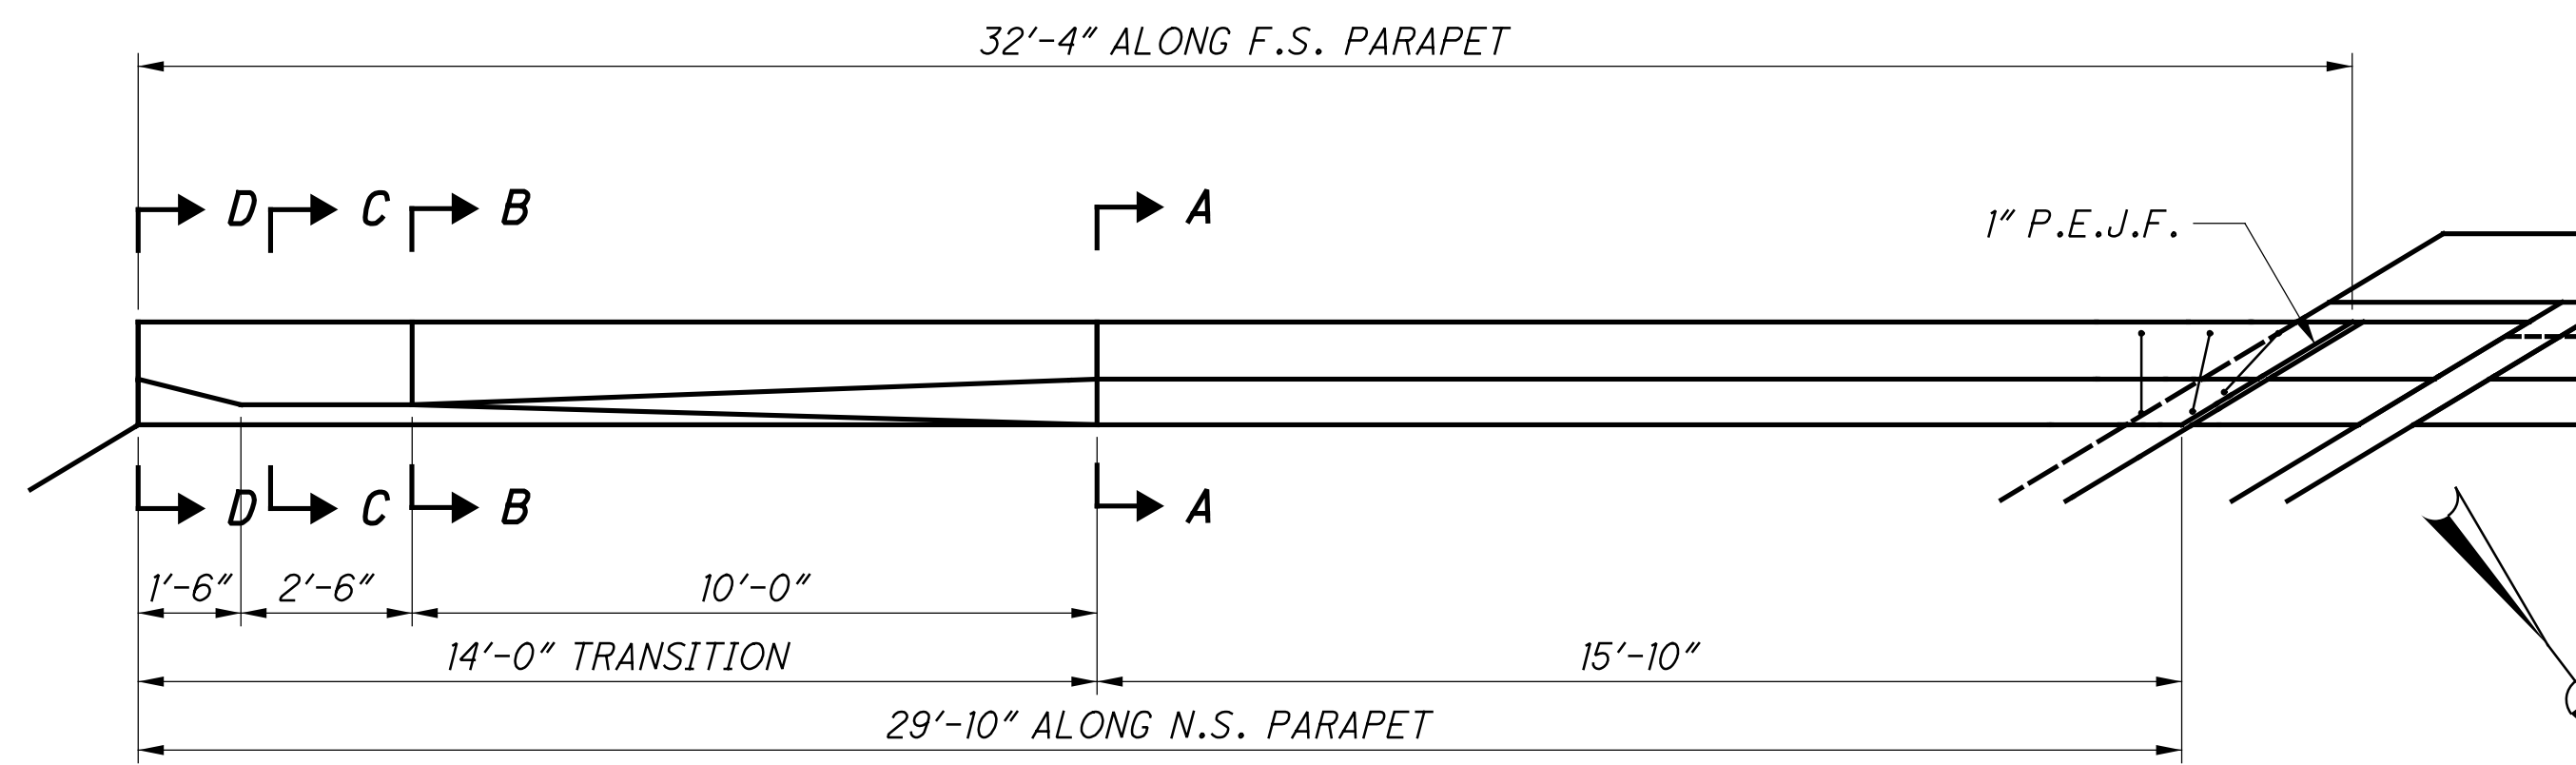


PARAPET PLAN
AT WEST WINGWALL FORWARD ABUTMENT

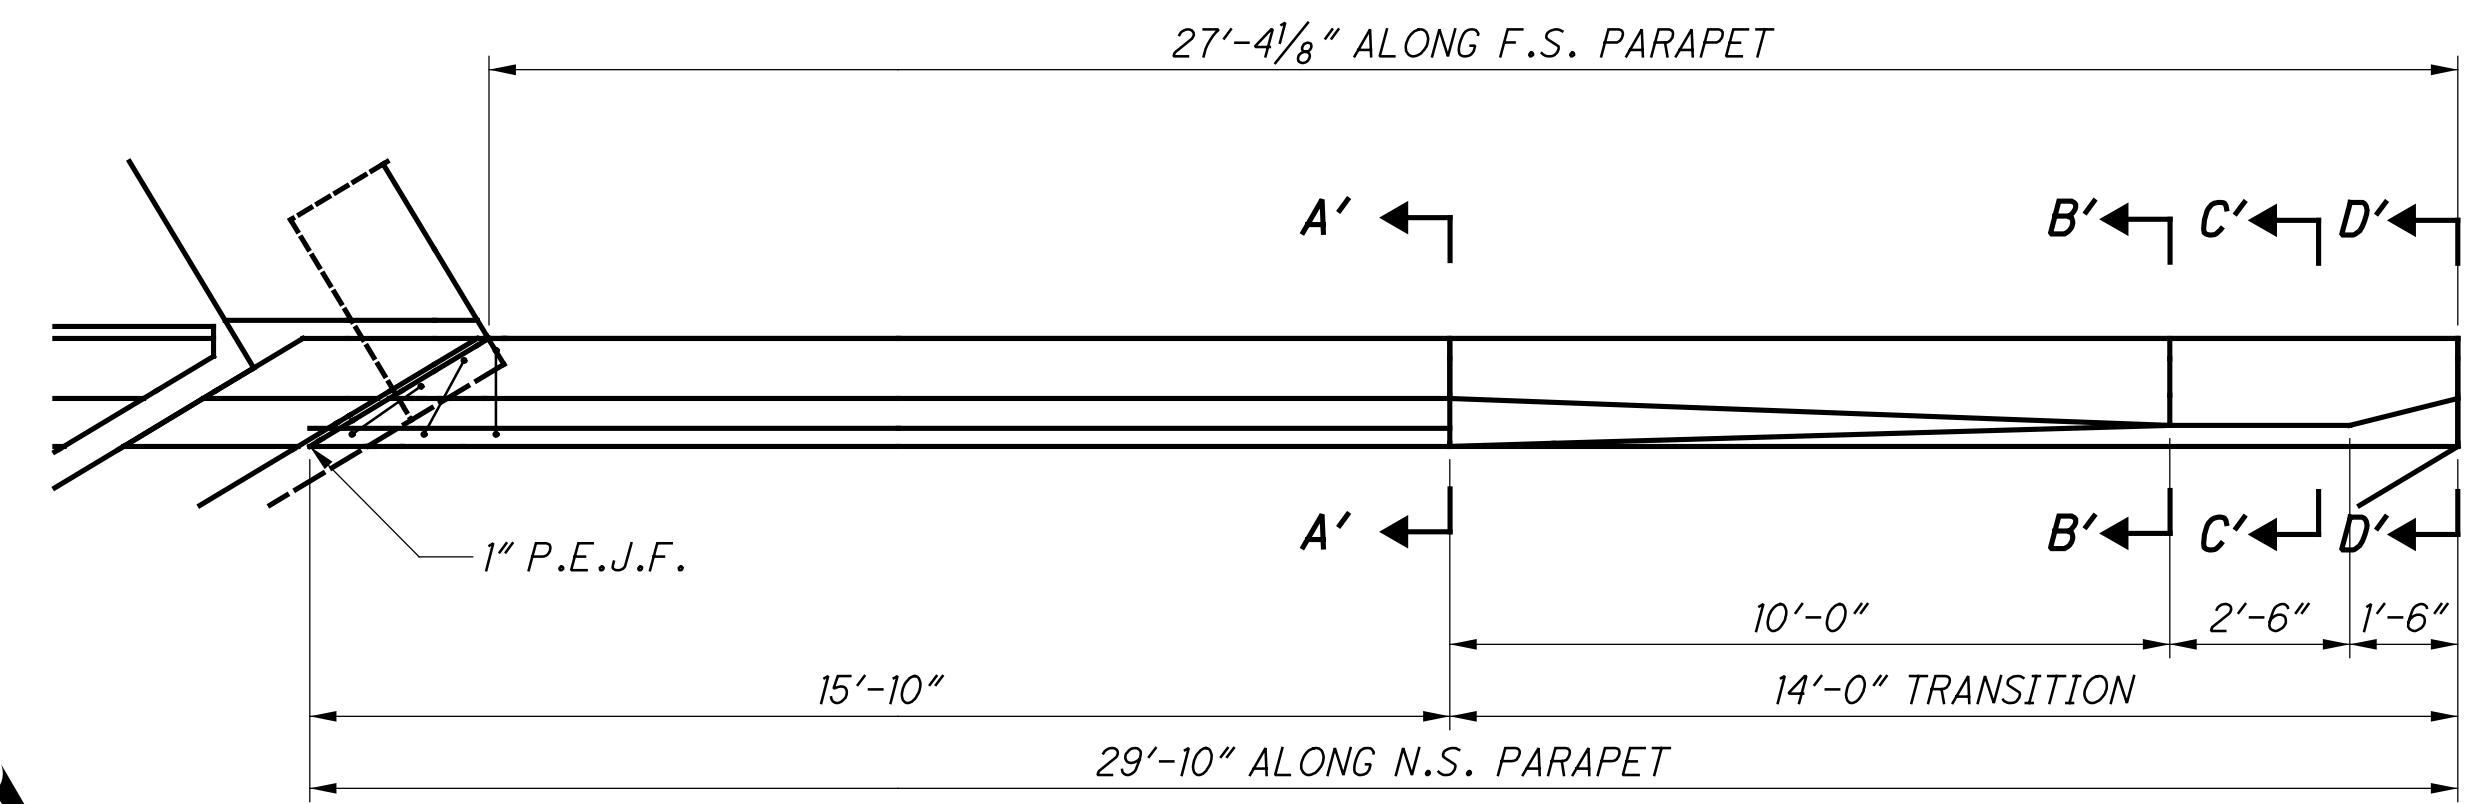

PARAPET PLAN
AT WEST WINGWALL REAR ABUTMENT

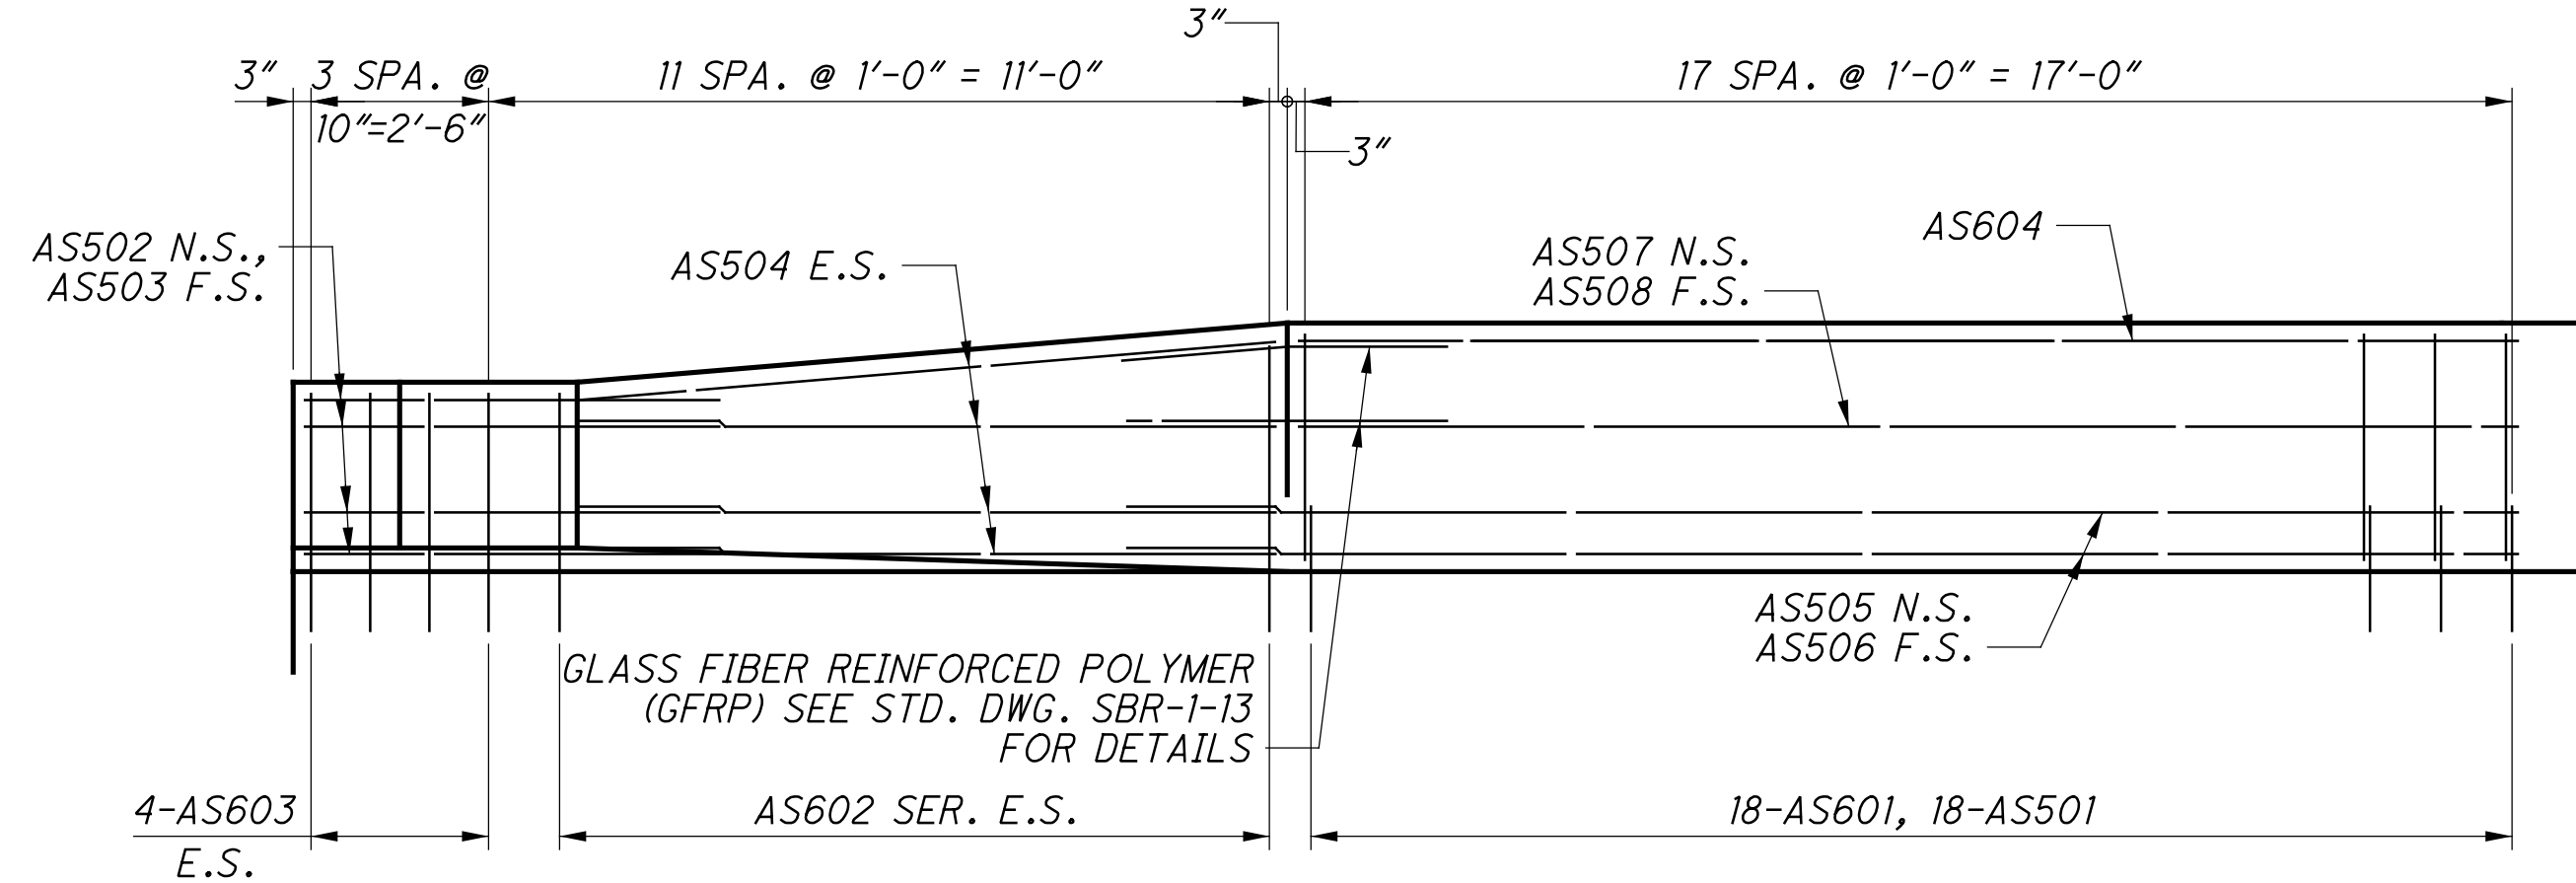

PARAPET ELEVATION
AT WEST WINGWALL FORWARD ABUTMENT

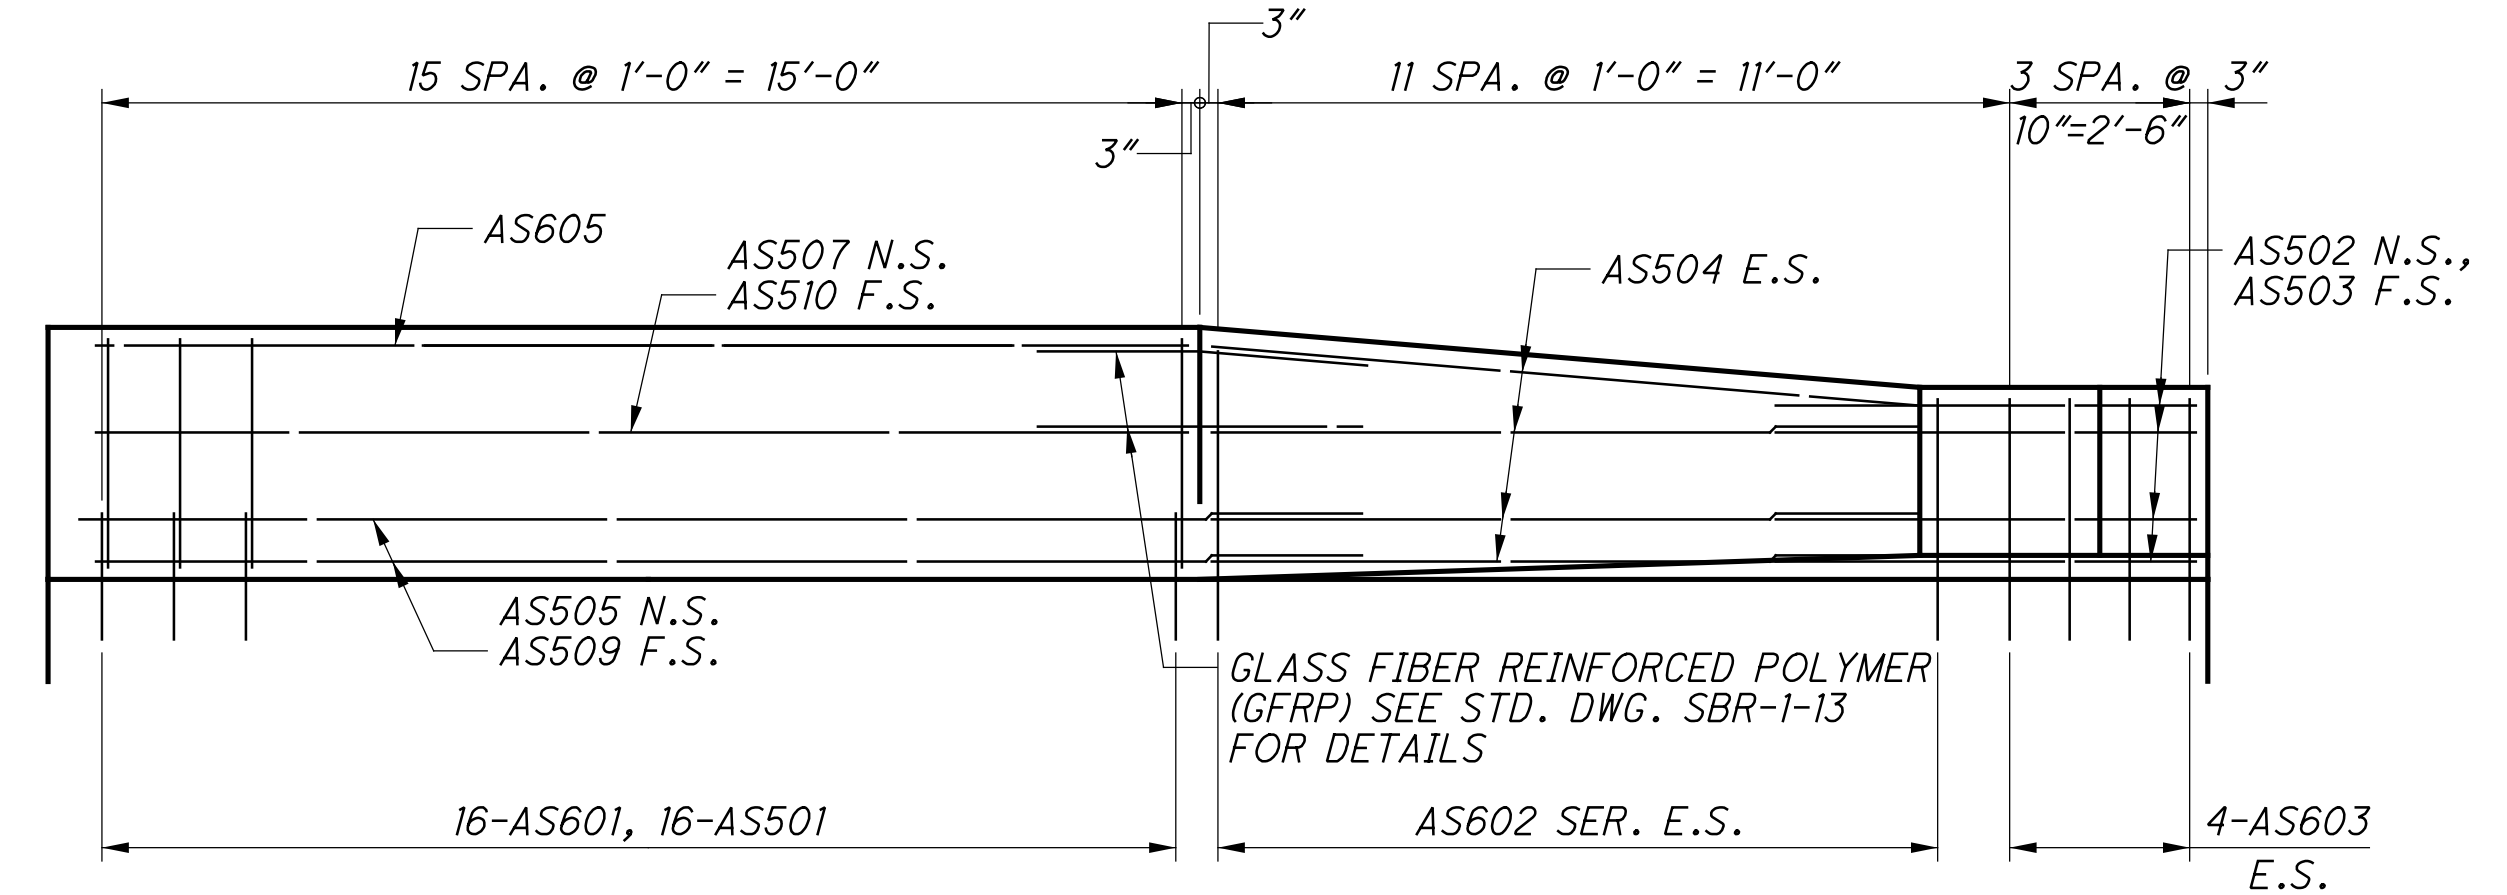


PARAPET ELEVATION
AT WEST WINGWALL REAR ABUTMENT


MINIMUM BAR LAP	
#5	2'-7"

NOTES:


- SEE STANDARD BRIDGE DRAWING SBR-1-13 FOR ADDITIONAL DETAILS.

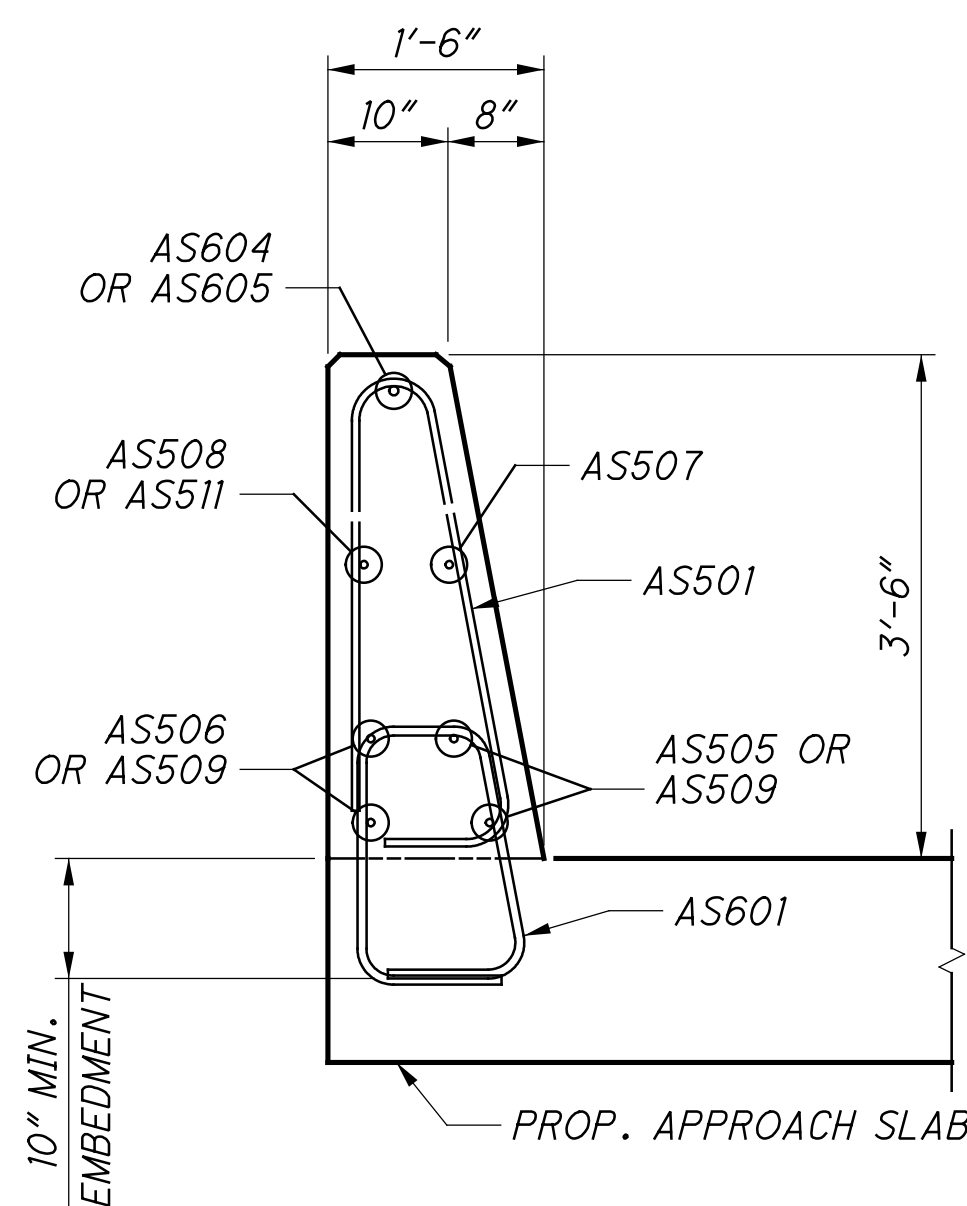


SECTION A-A
SECTION A'-A' SIMILAR

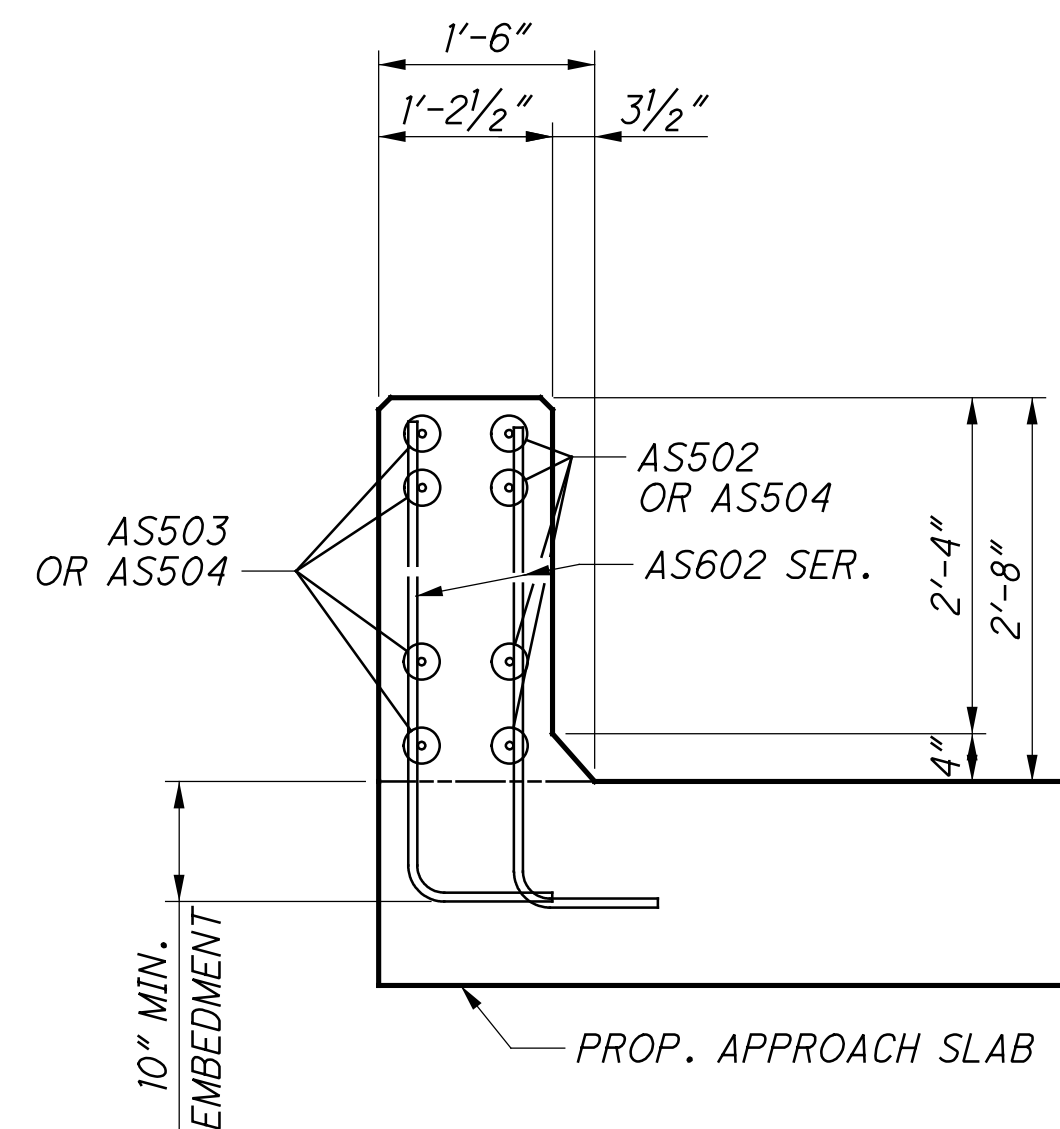

SECTION B-B
SECTION B'-B' SIMILAR

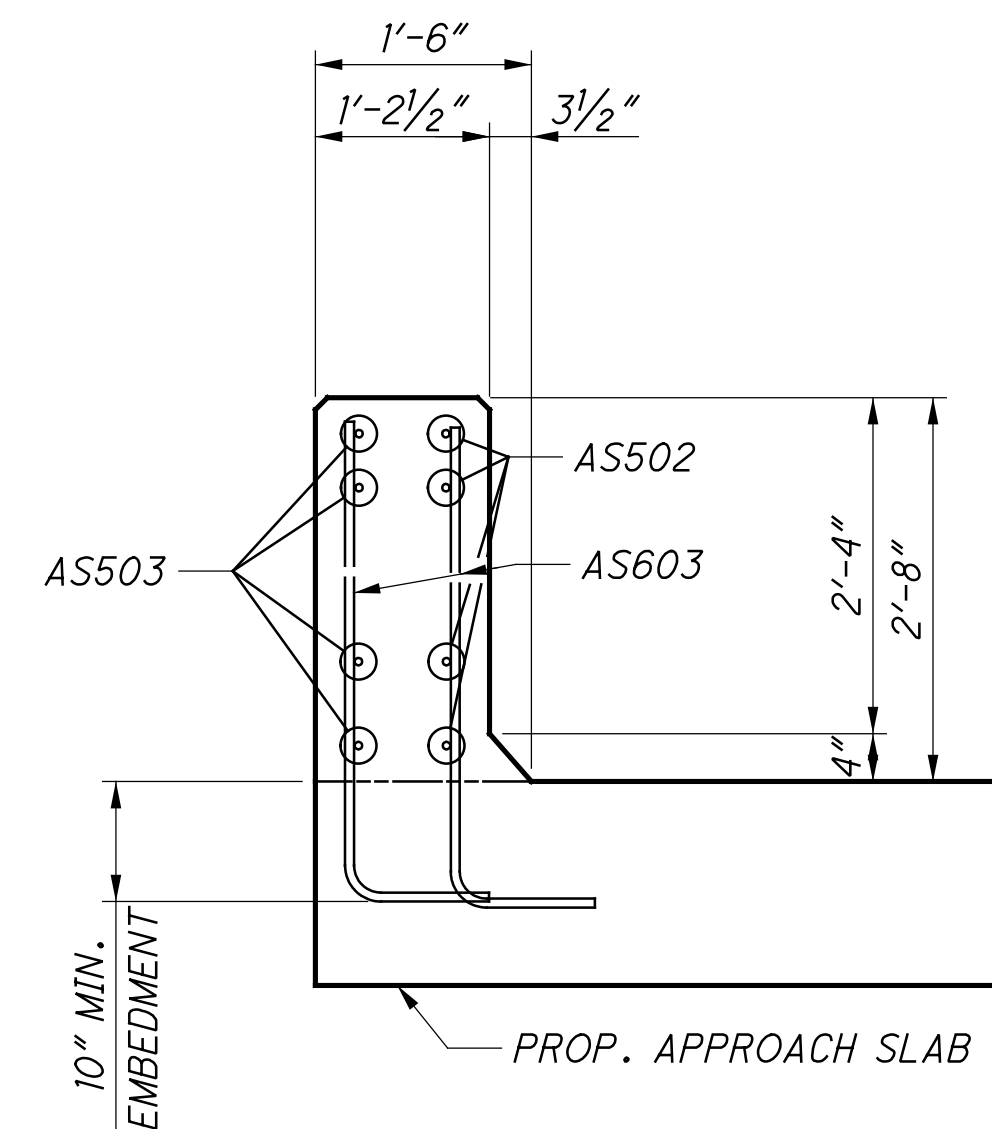


SECTION C-C
SECTION C'-C' SIMILAR

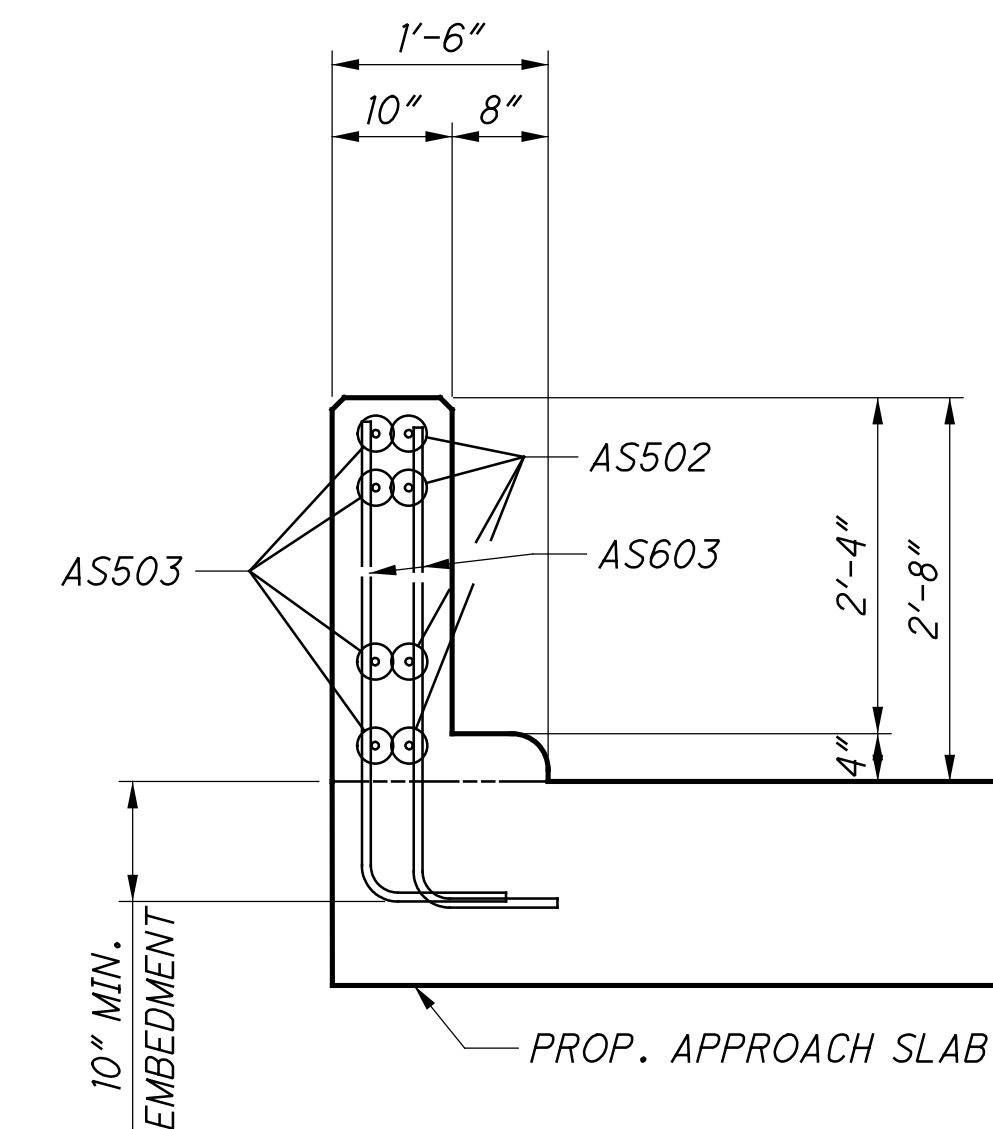


SECTION D-D
SECTION D'-D' SIMILAR

DESIGN AGENCY: STRUCTUREPOINT
 DATE: 11/13/18
 REVIEWED: MDS
 DRAWN: DSH
 DESIGNED: SUJ
 CHECKED: CLB
 STRUCTURE FILE NUMBER: 3115690
PARAPET DETAILS (RIGHT BRIDGE)
 BRIDGE NO. HAM-74-1892 L/R
 OVER ELMORE STREET
HAM-75-3.84
 PID No. 104667
 27/38
 109
 120


S:\Plans\23
11/16/2023
9:35:18 AM
C:\Users\104667\OneDrive\Documents\104667\HAM-75-3.84\Design\Structures\HAM0074_1892C_Sheets\7.4_1892RA003.dgn

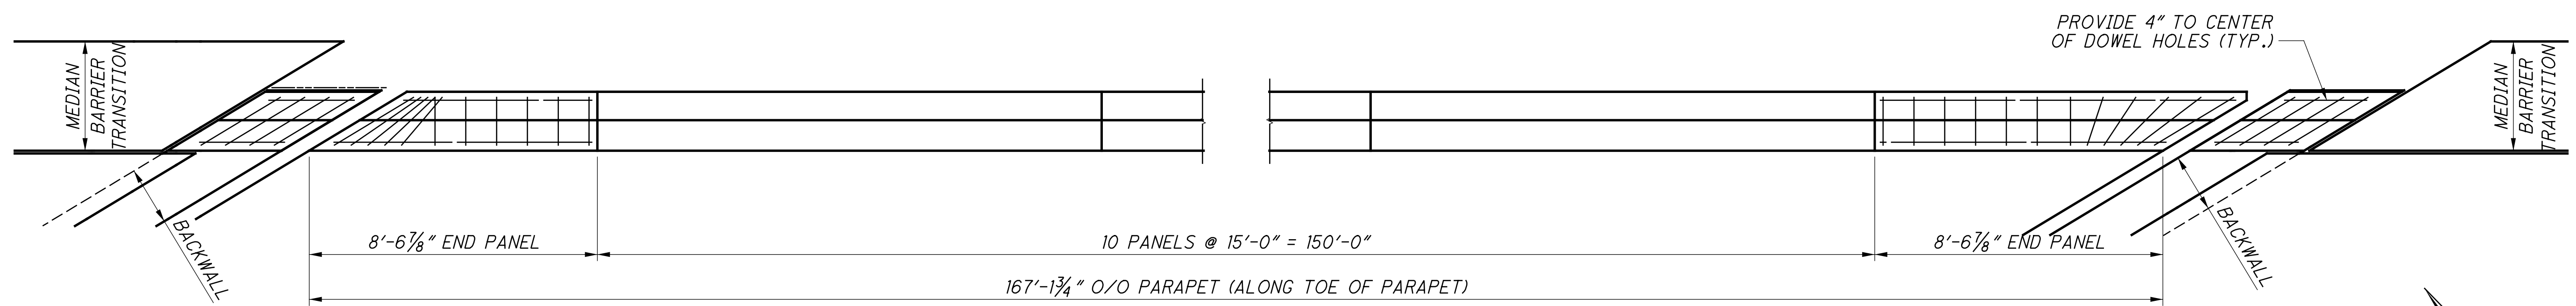


PARAPET PLAN

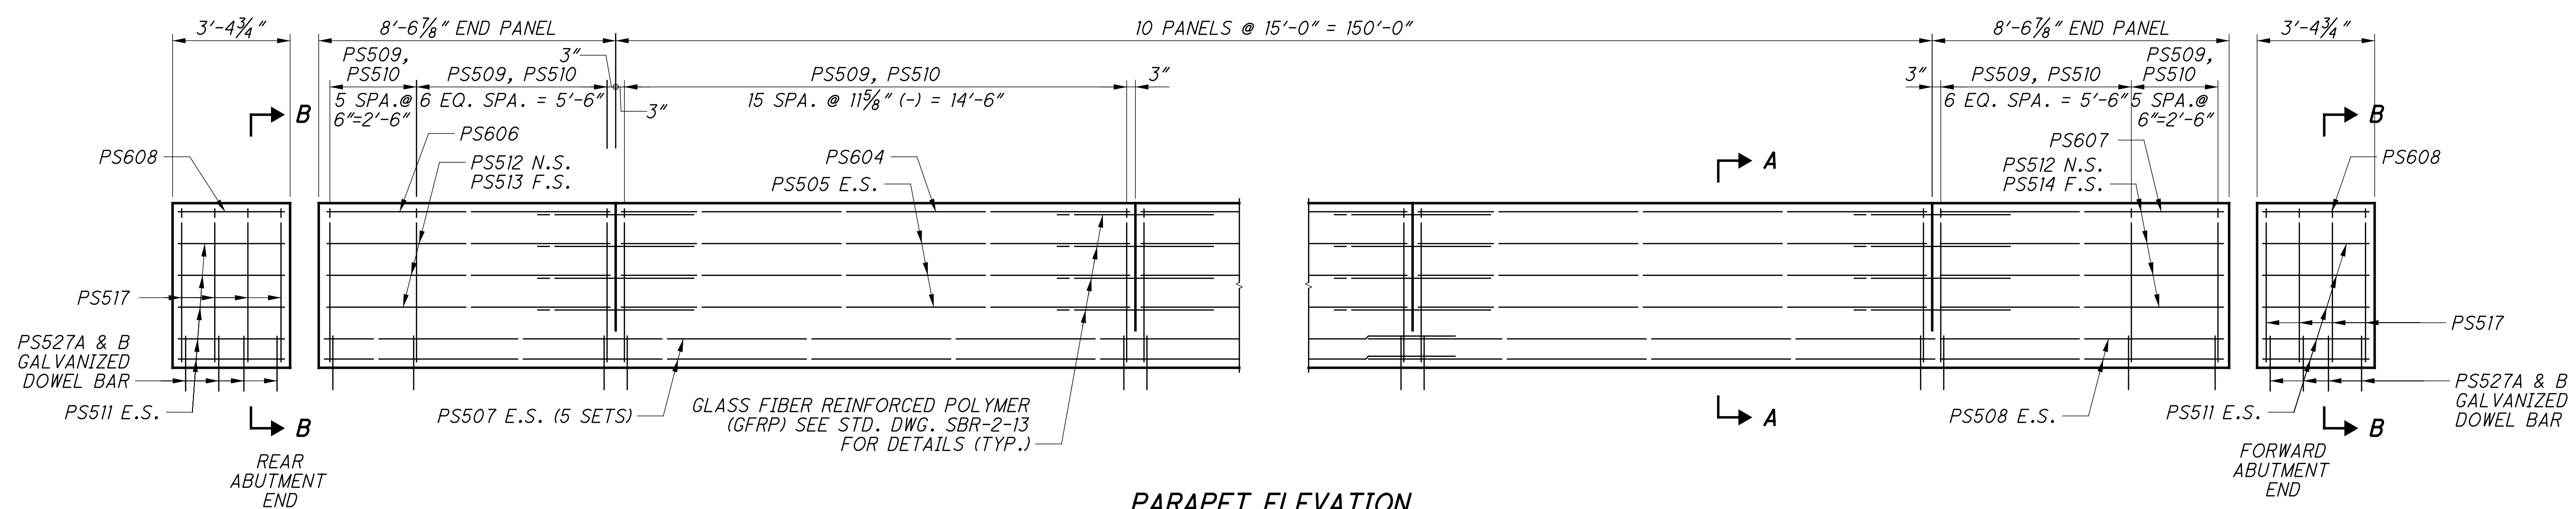


PARAPET ELEVATION
LEFT PARAPET SHOWN (ALONG TOE OF PARAPET)

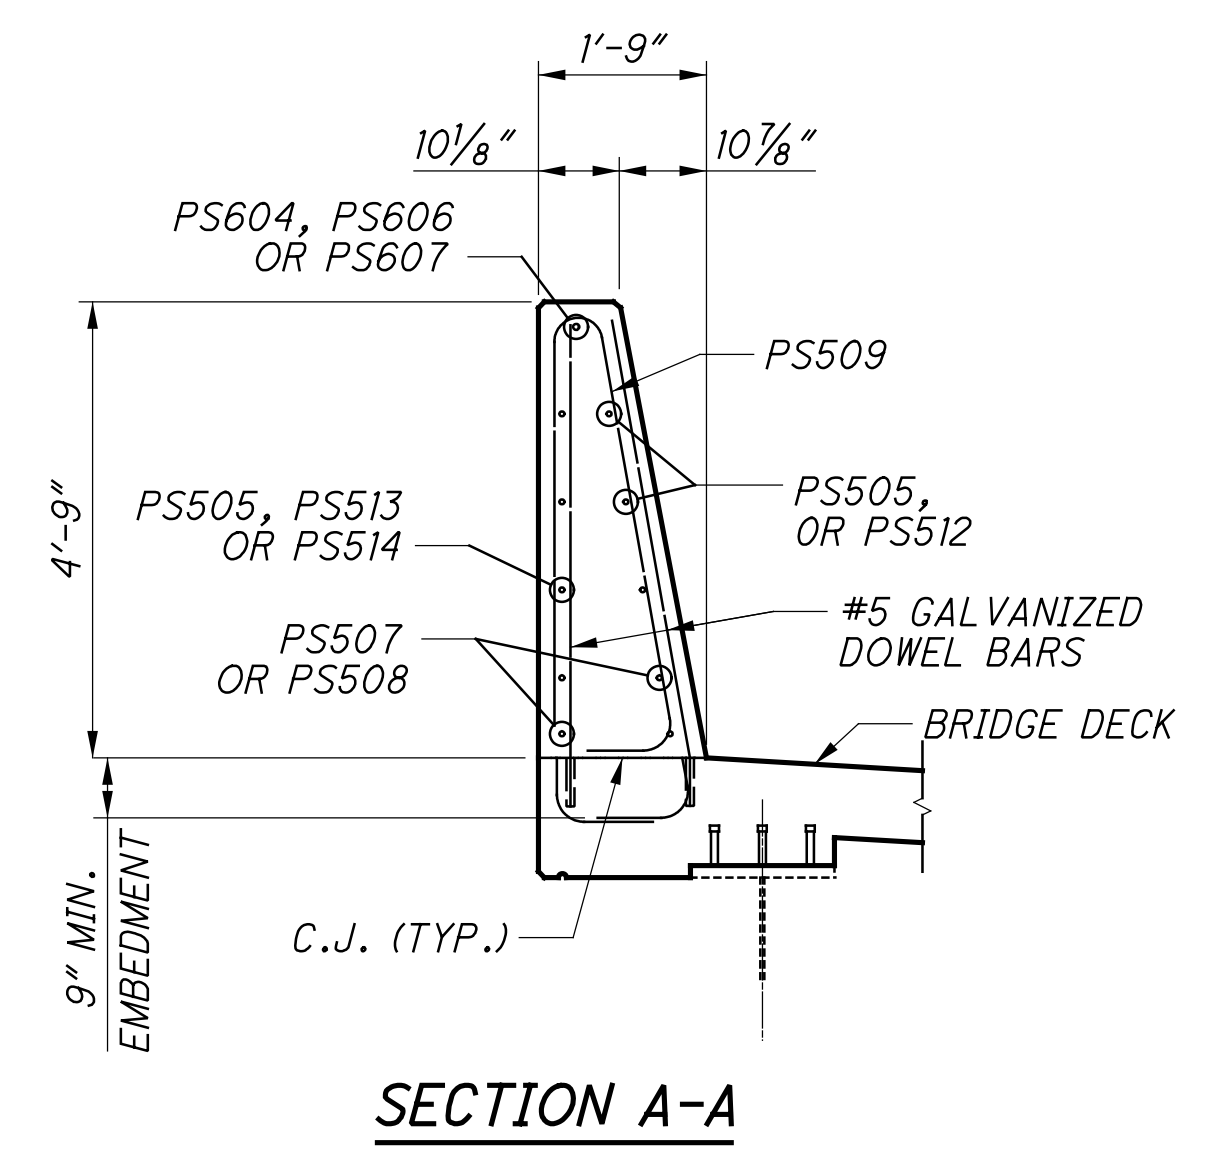

SECTION A-A

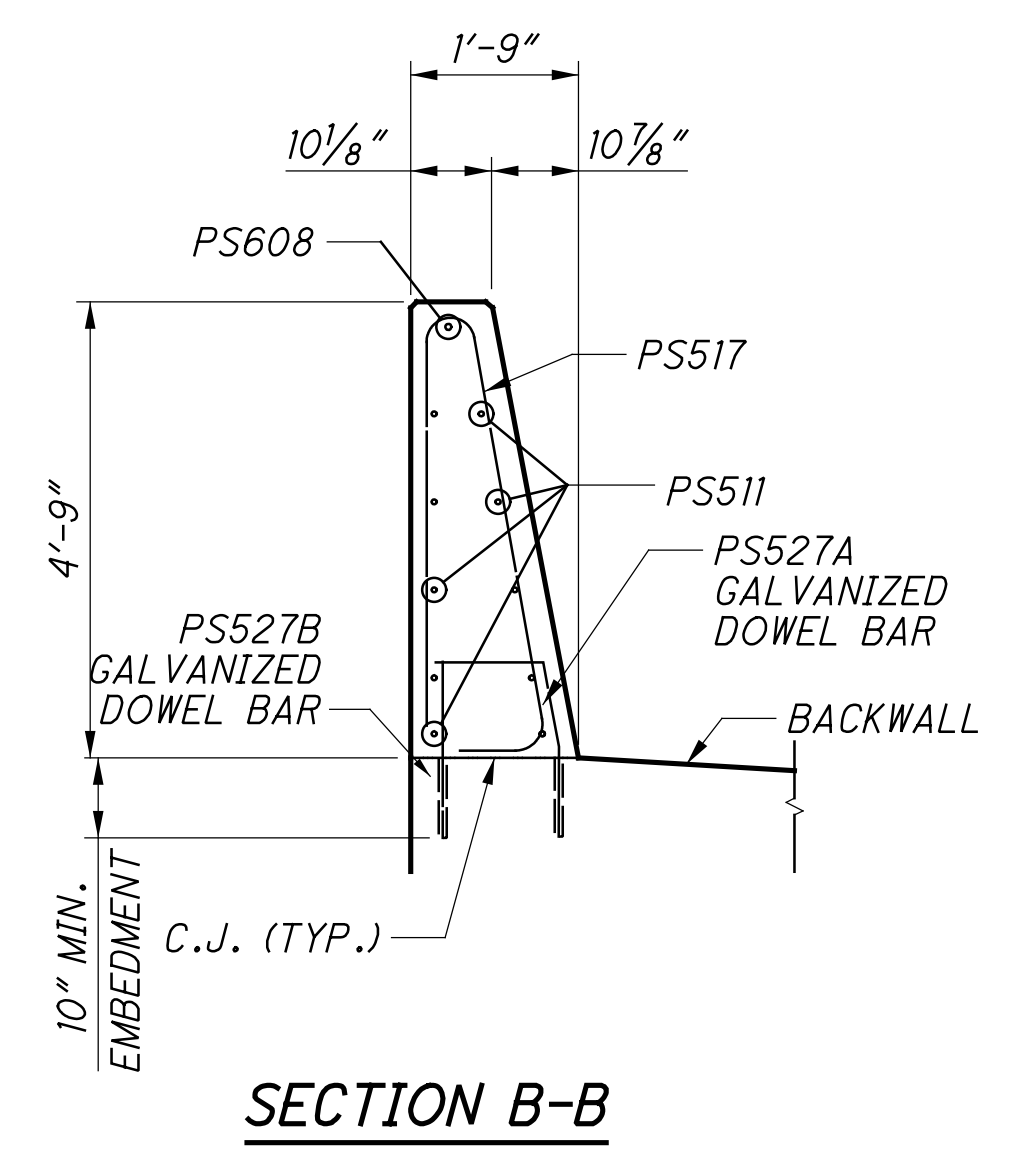

SECTION B-B

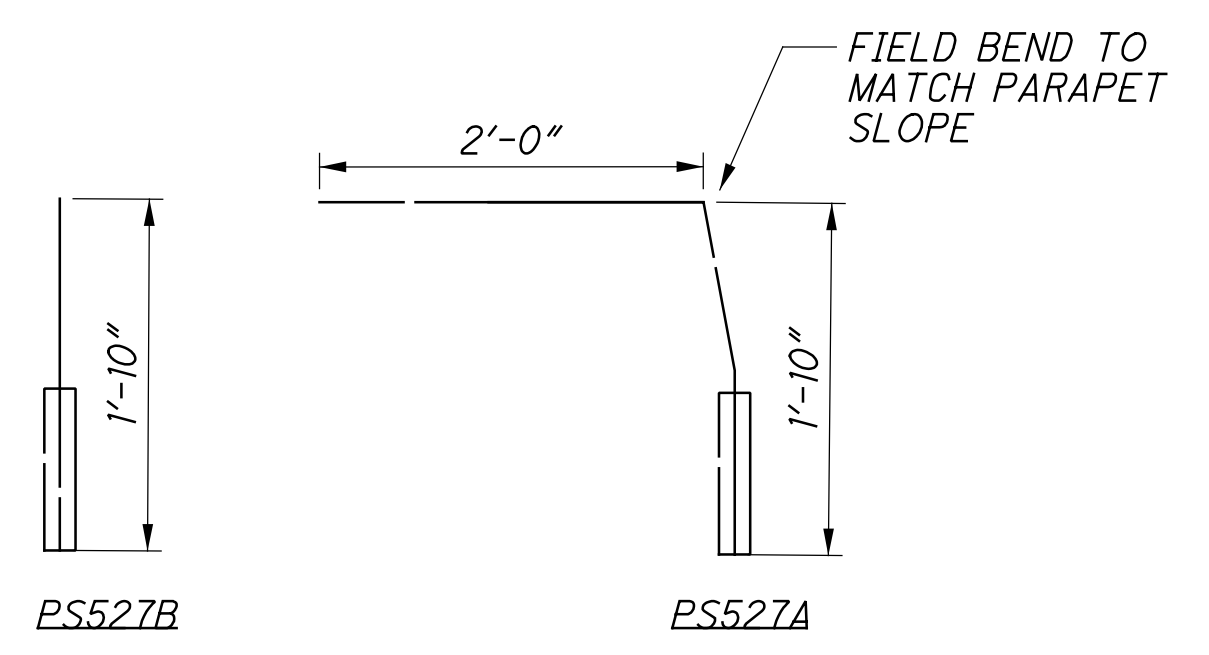

MINIMUM BAR LAP	
#5	2'-7"

NOTES:
1. SEE STANDARD BRIDGE DRAWING SBR-2-13 FOR ADDITIONAL DETAILS.

DESIGN AGENCY: **STRUCTUREPOINT**

DATE: 11/13/18
REVIEWED: MDS
DRAWN: DSH
DESIGNED: SUJ
CHECKED: CLB

STRUCTURE FILE NUMBER: 3115690


PARAPET DETAILS (RIGHT BRIDGE)
BRIDGE NO. HAM-74-1892 L/R
OVER ELMORE STREET

HAM-75-3.84
PID No. 104667

28/38

110
120


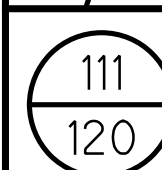
S:\Plans.dgn 9:35:19 AM
 11/16/2023
 C:\2017\01113\C.Design\104667_HAM-75-3.84.Design\Structures\HAM0074_1892C_Sheets\74_1892EX010.dgn

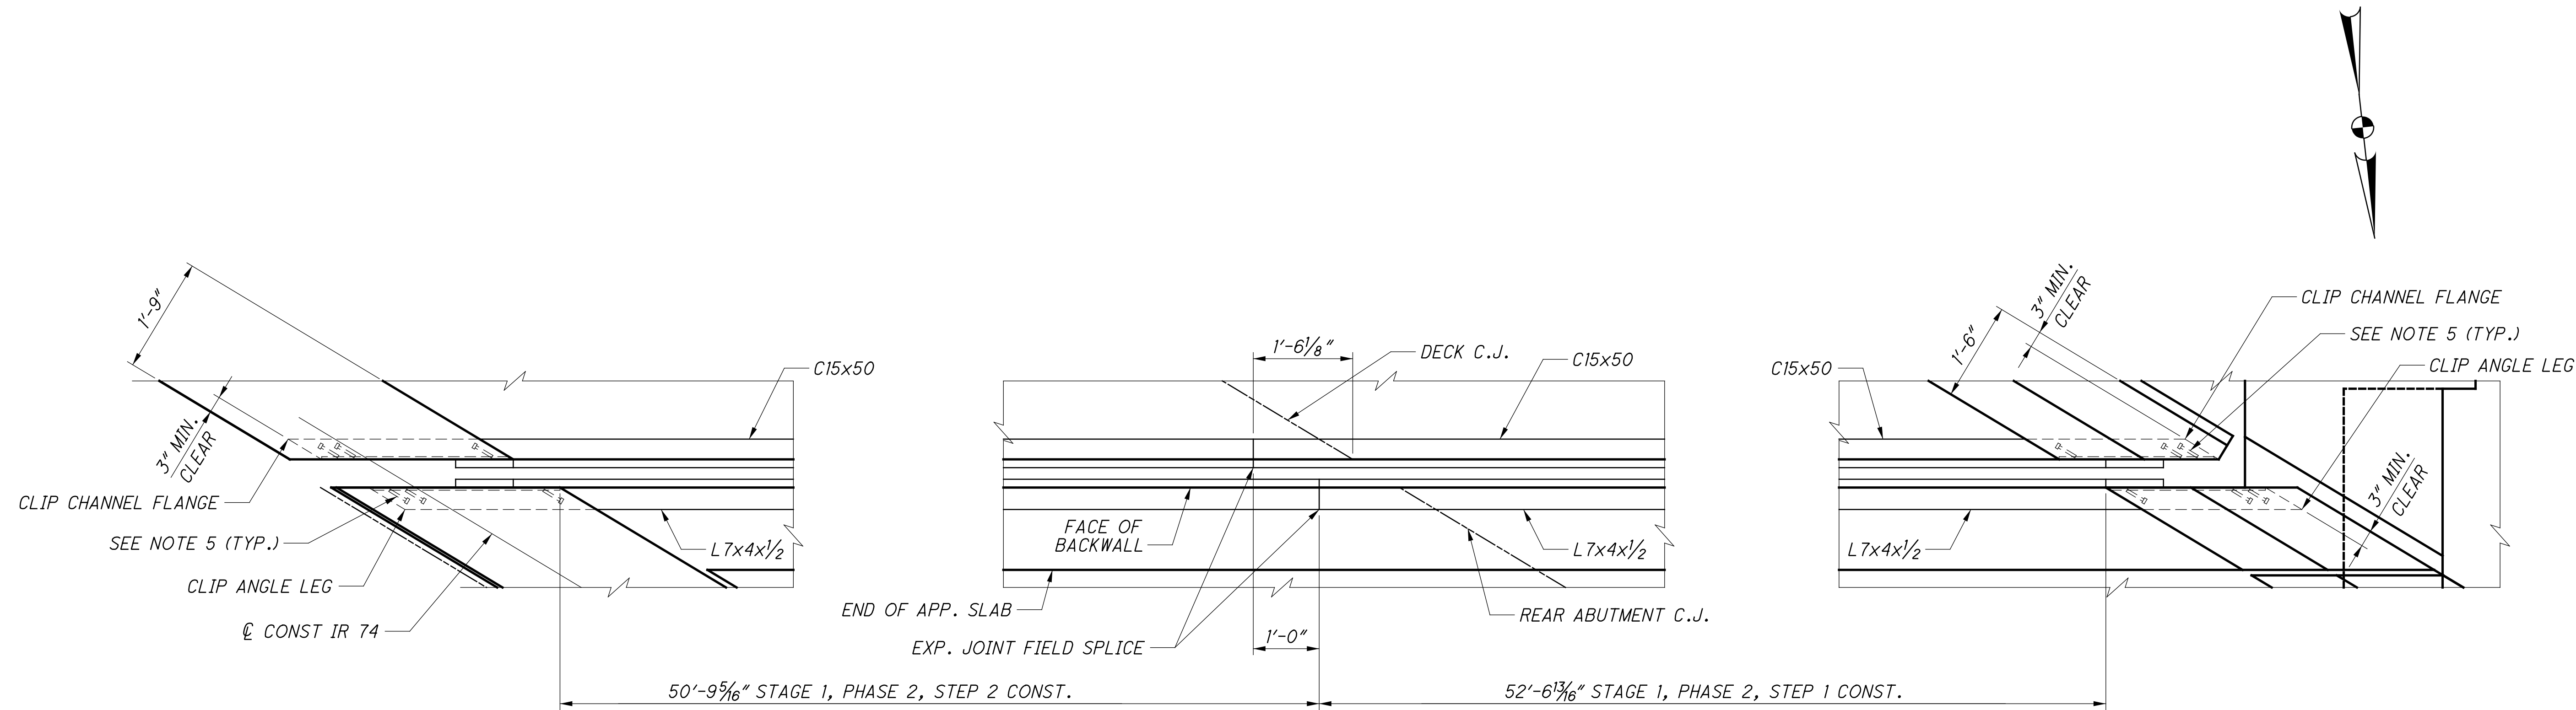


**PARTIAL PLAN - REAR ABUTMENT
 PARAPET JOINT DETAILS**

NOTES:

1. SEE STD. DWG. EXJ-4-87 FOR ADDITIONAL DETAILS.
2. ALL CHANNELS, ANGLES AND PLATES SHALL BE ASTM A709 GRADE 50.
3. COAT ALL STEEL PARTS OF THE JOINT ASSEMBLY ACCORDING TO 516.
4. FOR ADDITIONAL STRIP SEAL DETAILS, SEE SHEET 31/38.
5. SHEAR STUDS SHALL BE WELDED AT AN ANGLE TO MAINTAIN CLEARANCE IN PARAPET.

	DESIGN AGENCY <small>2000 CORPORATE PARKWAY SUITE 100 WESTMINSTER, CO 80057 TEL: 303.440.3333 FAX: 303.440.3335 WWW.STRUCTUREPOINT.COM</small>	DATE 11/13/18	REVIEWED MDS	STRUCTURE FILE NUMBER 3115690
DESIGNED SUJ	DRAWN DSH	CHECKED CLB	REVISED	FILE NUMBER 3115690
EXPANSION JOINT DETAILS (RIGHT BRIDGE) BRIDGE NO. HAM-74-1892 L/R OVER ELMORE STREET				
HAM-75-3.84 PID No. 104667		29 / 38		
				

S:\Plans\gen 11/16/2023 9:35:20 AM
 \0\2017\01113\C.Design\104667_HAM-75-3.84.Design\Structures\HAM0074_1892C_Sheets\7.4_1892EX011.dgn

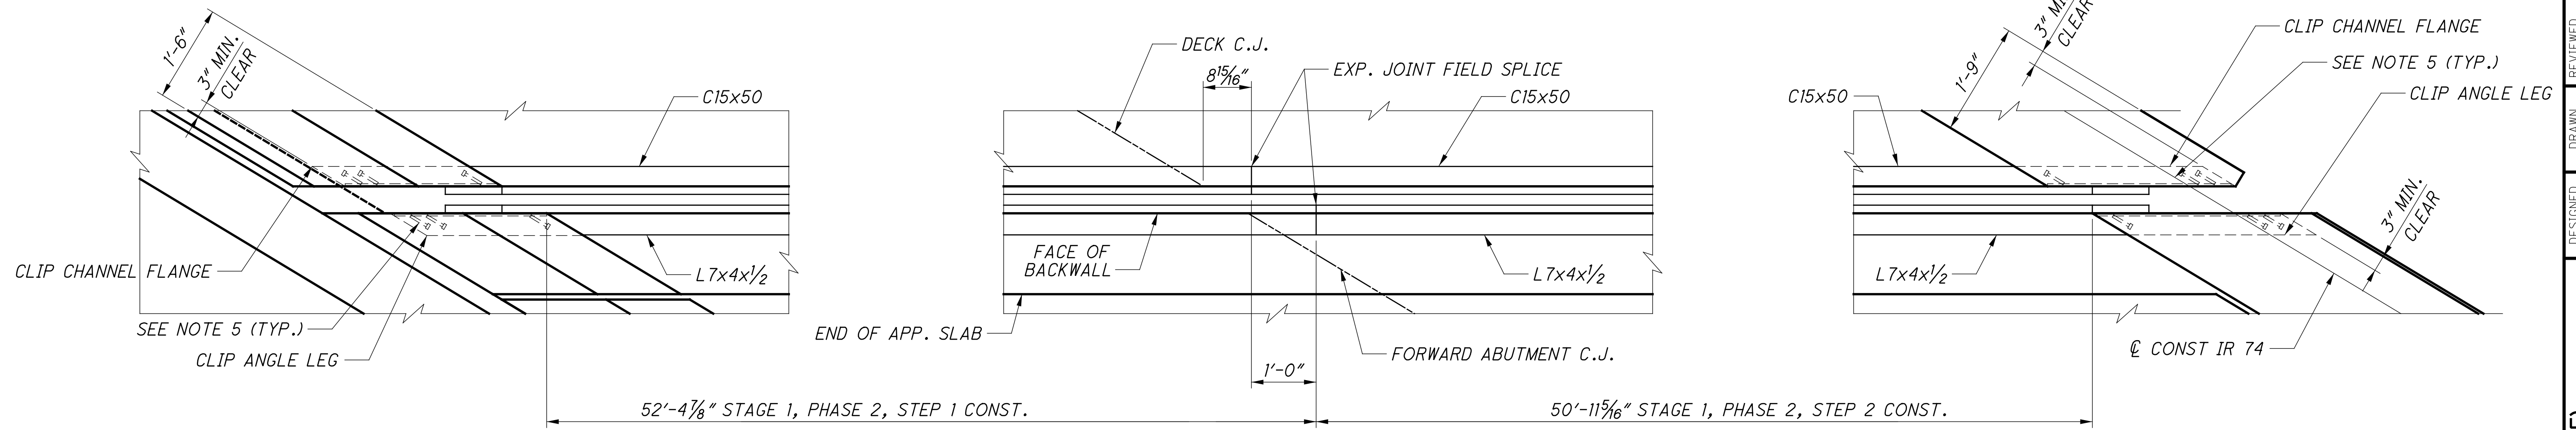


**PARTIAL PLAN - FORWARD ABUTMENT
 PARAPET JOINT DETAILS**

NOTES:

1. SEE STD. DWG. EXJ-4-87 FOR ADDITIONAL DETAILS.
2. ALL CHANNELS, ANGLES AND PLATES SHALL BE ASTM A709 GRADE 50.
3. COAT ALL STEEL PARTS OF THE JOINT ASSEMBLY ACCORDING TO 516.
4. FOR ADDITIONAL STRIP SEAL DETAILS, SEE SHEET 31/38.
5. SHEAR STUDS SHALL BE WELDED AT AN ANGLE TO MAINTAIN CLEARANCE IN PARAPET.

 DESIGN AGENCY <small>2020 CORPORATION LICENSED BY THE STATE OF CALIFORNIA</small>	DATE 11/13/18	REVIEWED MDS	STRUCTURE FILE NUMBER 3115690	
DRAWN DSH	CHECKED CLB	REVISED	FILE NUMBER 3115690	PROJECT BRIDGE NO. HAM-74-1892 L/R OVER ELMORE STREET
HAM - 75 - 3.84 PID No. 104667				30 / 38 <div style="border: 1px solid black; border-radius: 50%; width: 30px; height: 30px; display: flex; align-items: center; justify-content: center; margin: 0 auto;"> 112 120 </div>

SFlanagan
 11/16/2023 9:35:20 AM
 \\01\2017\01113\C.Design\104667-HAM-75-3.84\Design\Structures\HAM0074_1892C\Sheets\74_1892EX012.dgn

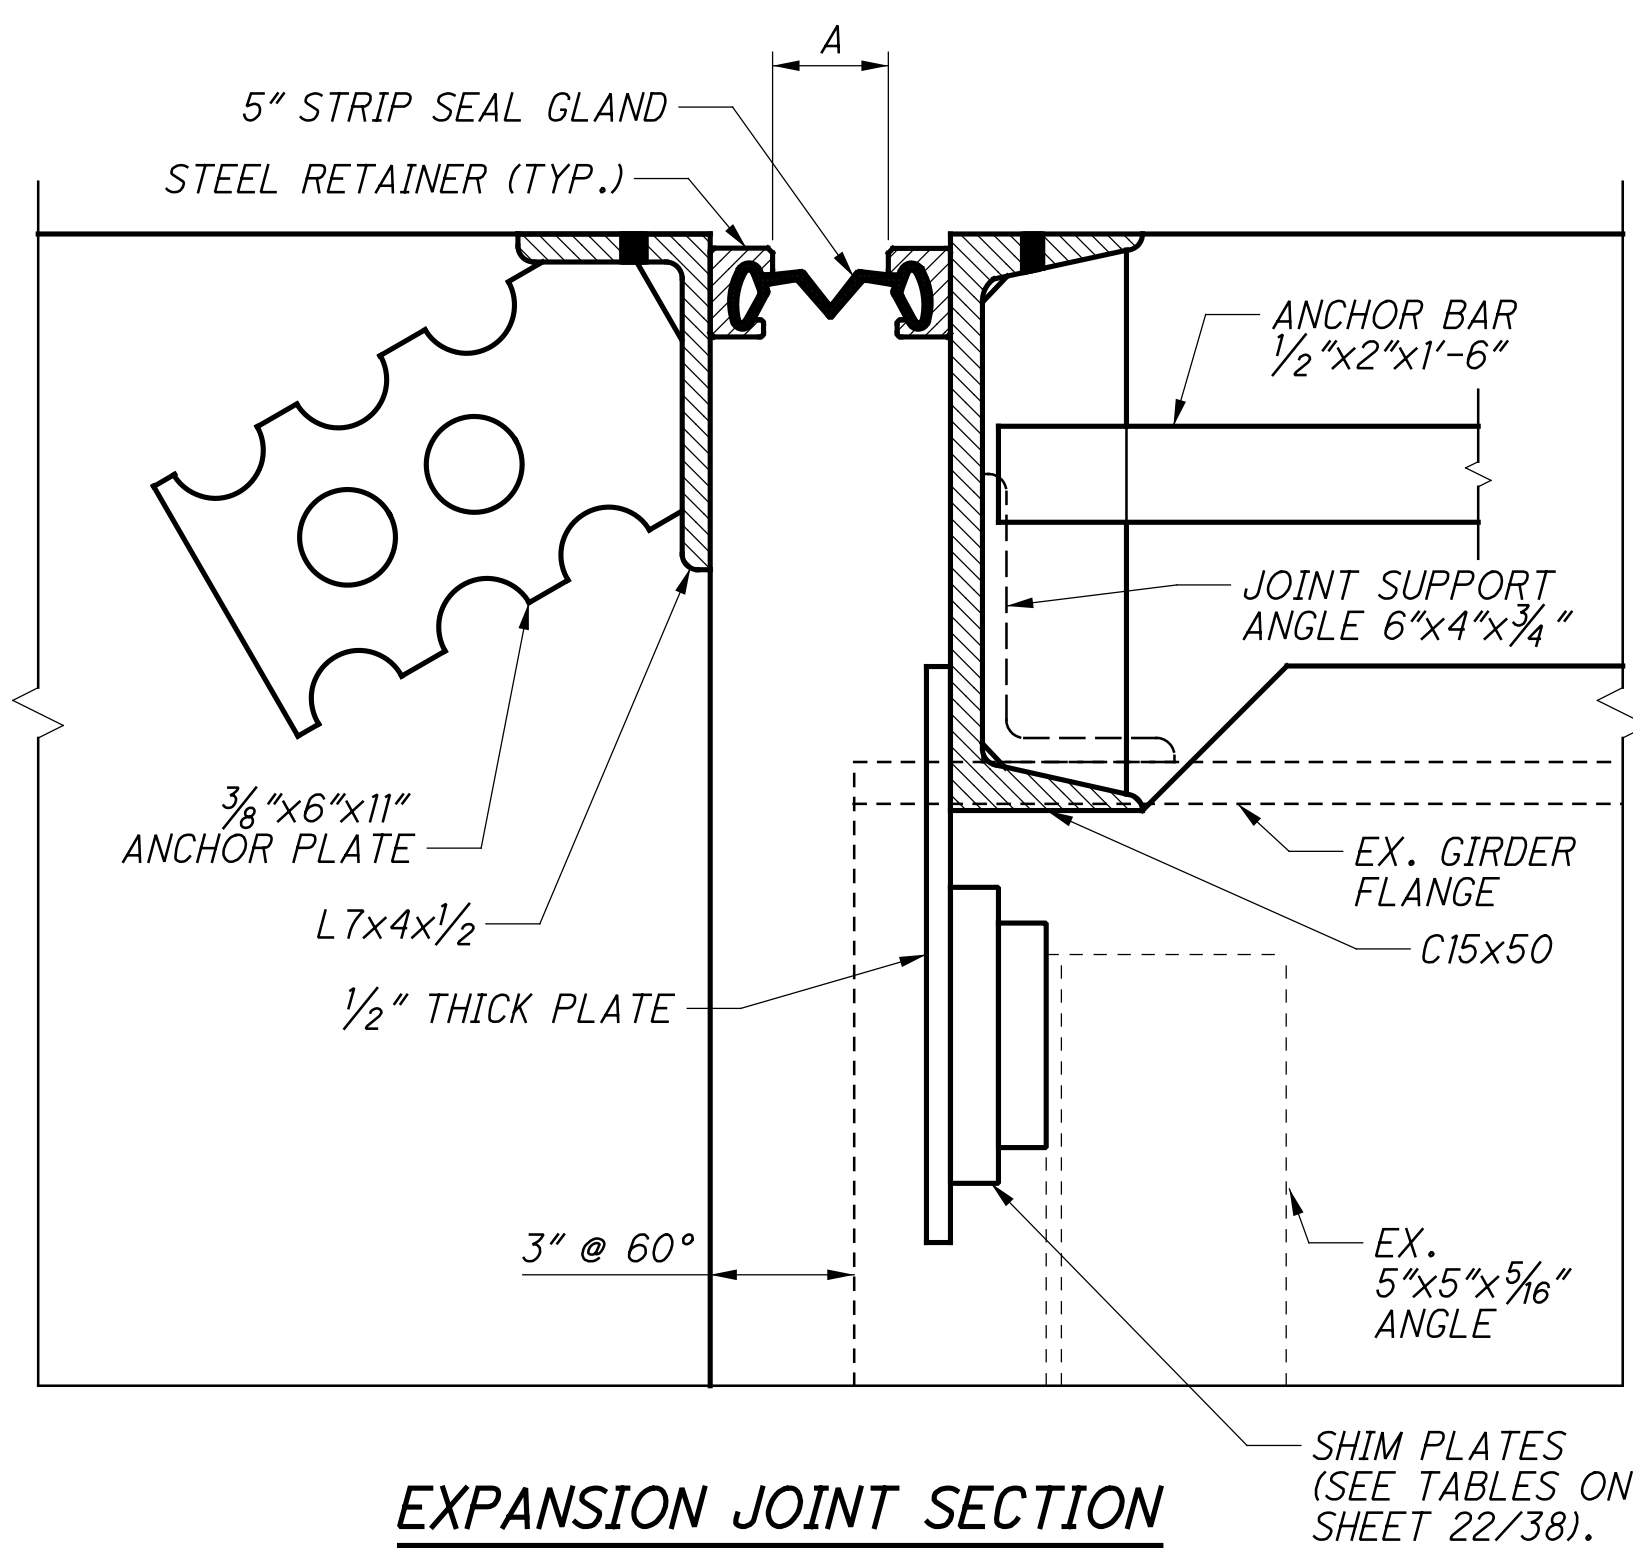


EXPANSION JOINT SECTION

REAR 4\"/>

AMBIENT TEMP.	DIMENSION "A" (IN.)
30°	2 ⁷ / ₈ "
40°	2 ³ / ₄ "
50°	2 ¹ / ₆ "
60°	2 ⁵ / ₈ "
70°	2 ¹ / ₂ "
80°	2 ¹ / ₆ "
90°	2 ⁵ / ₁₆ "

FWD 4\"/>

AMBIENT TEMP.	DIMENSION "A" (IN.)
30°	2 ¹ / ₆ "
40°	2 ¹ / ₆ "
50°	2 ⁵ / ₈ "
60°	2 ⁵ / ₈ "
70°	2 ⁹ / ₁₆ "
80°	2 ⁹ / ₁₆ "
90°	2 ¹ / ₂ "

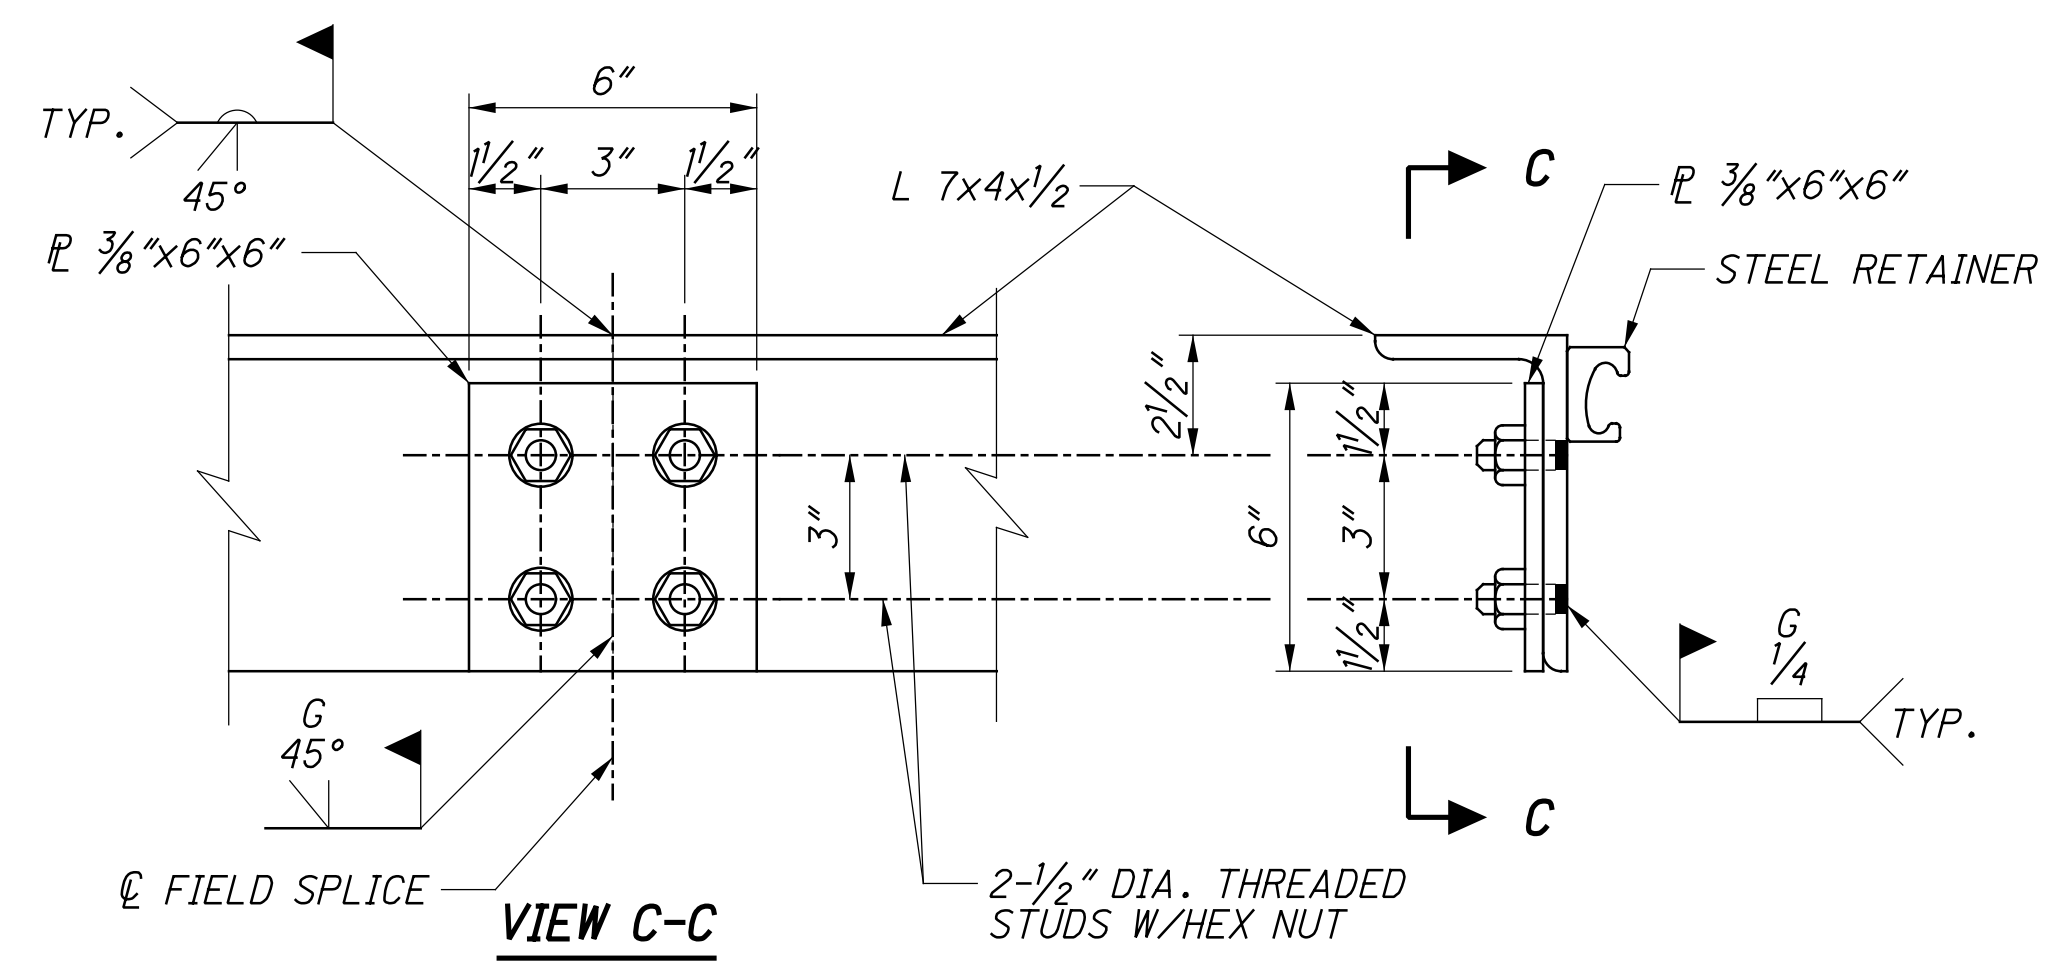

**END OF BACKWALL ANGLE
 FIELD SPLICE DETAILS**

(FOR ADDITIONAL DETAILS, SEE STD. DWG. EXJ-4-87)

NOTES:

1. FOR ADDITIONAL STRIP SEAL JOINT DETAILS AND NOTES, SEE STANDARD DWG. EXJ-4-87.


EXPANSION JOINT DETAILS (RIGHT BRIDGE)
 BRIDGE NO. HAM-74-1982 L/R
 OVER ELMORE STREET

DESIGNED SUF	DRAWN DSH	REVIEWED MDS	DATE 11/12/18
CHECKED CLB	REVISED	STRUCTURE FILE NUMBER 3115690	DESIGN AGENCY STRUCTUREPOINT

HAM-75-3.84
 PID No. 104667

31 / 38


113
120

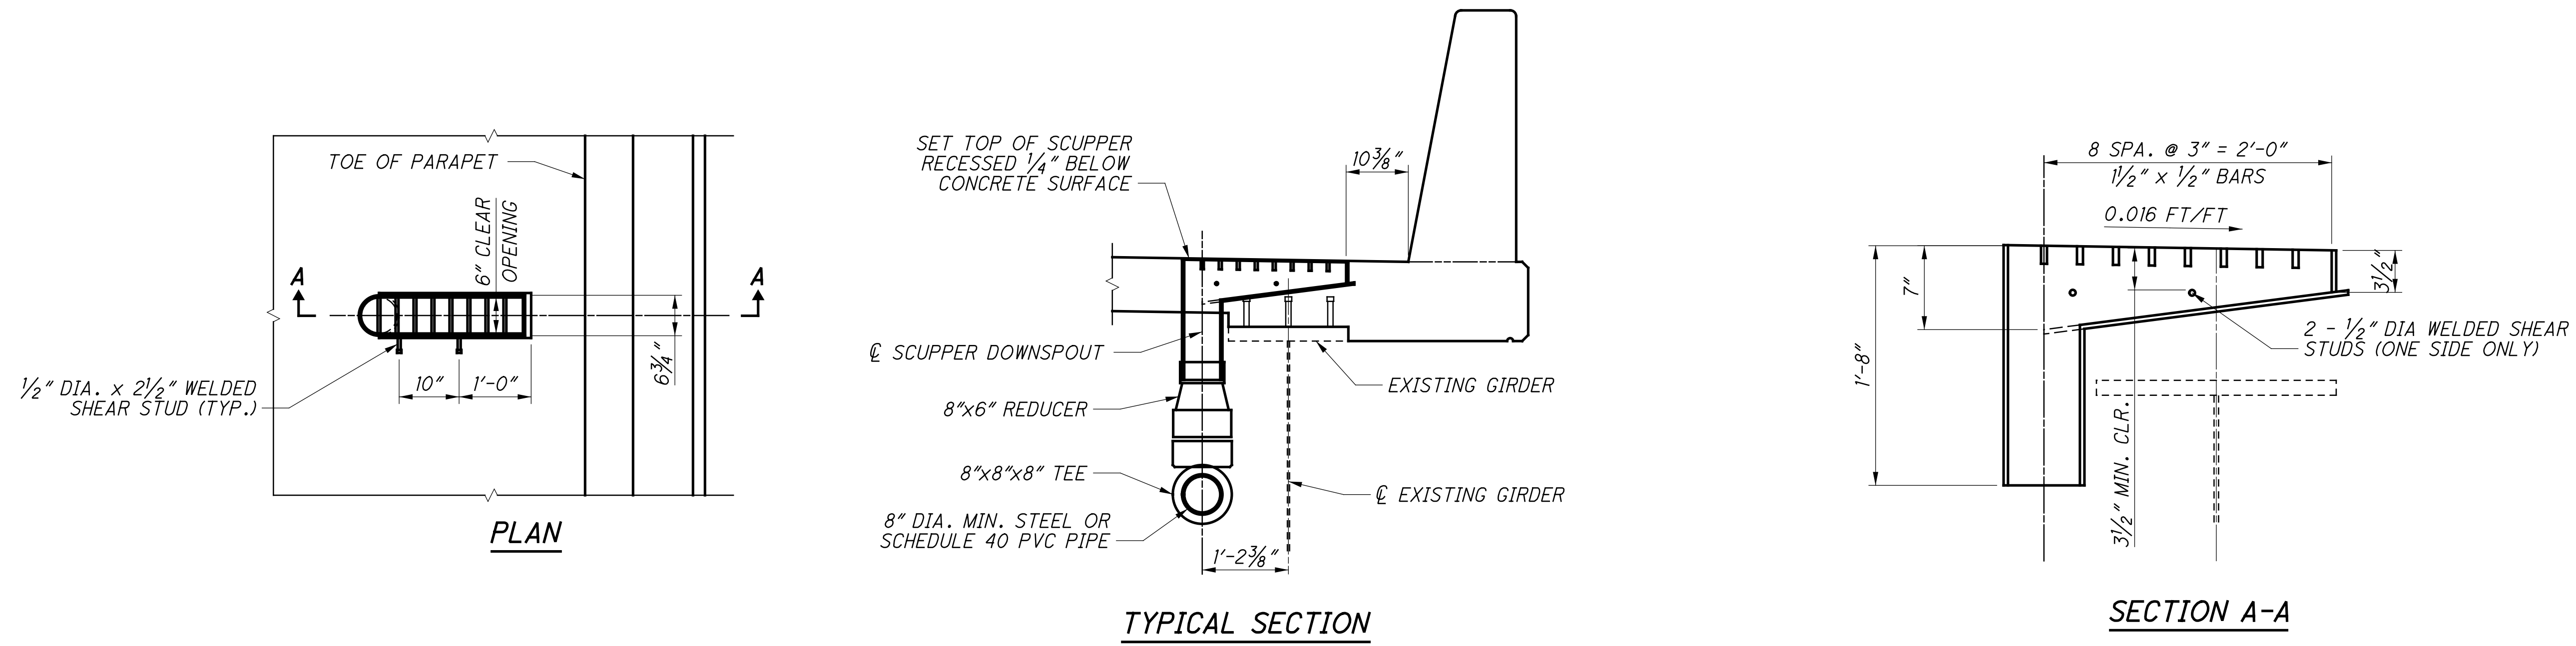

SCUPPER DETAILS

NOTES:

1. FABRICATE SCUPPERS FROM MIN. 3/8" THICK STEEL PLATE; ASTM A36 OR EQUAL.
2. ALL COMPONENTS (ANCHORS, PIPE HANGERS, PIPE SUPPORT STRAPS, COUPLERS, ETC.) SHALL BE GALVANIZED.
3. ALL BOLTS SHALL BE A325, TYPE 1 GALVANIZED. EACH ASSEMBLY SHALL INCLUDE BOLT, NUT, AND TWO WASHERS. TIGHTEN ACCORDING TO CMS 513.

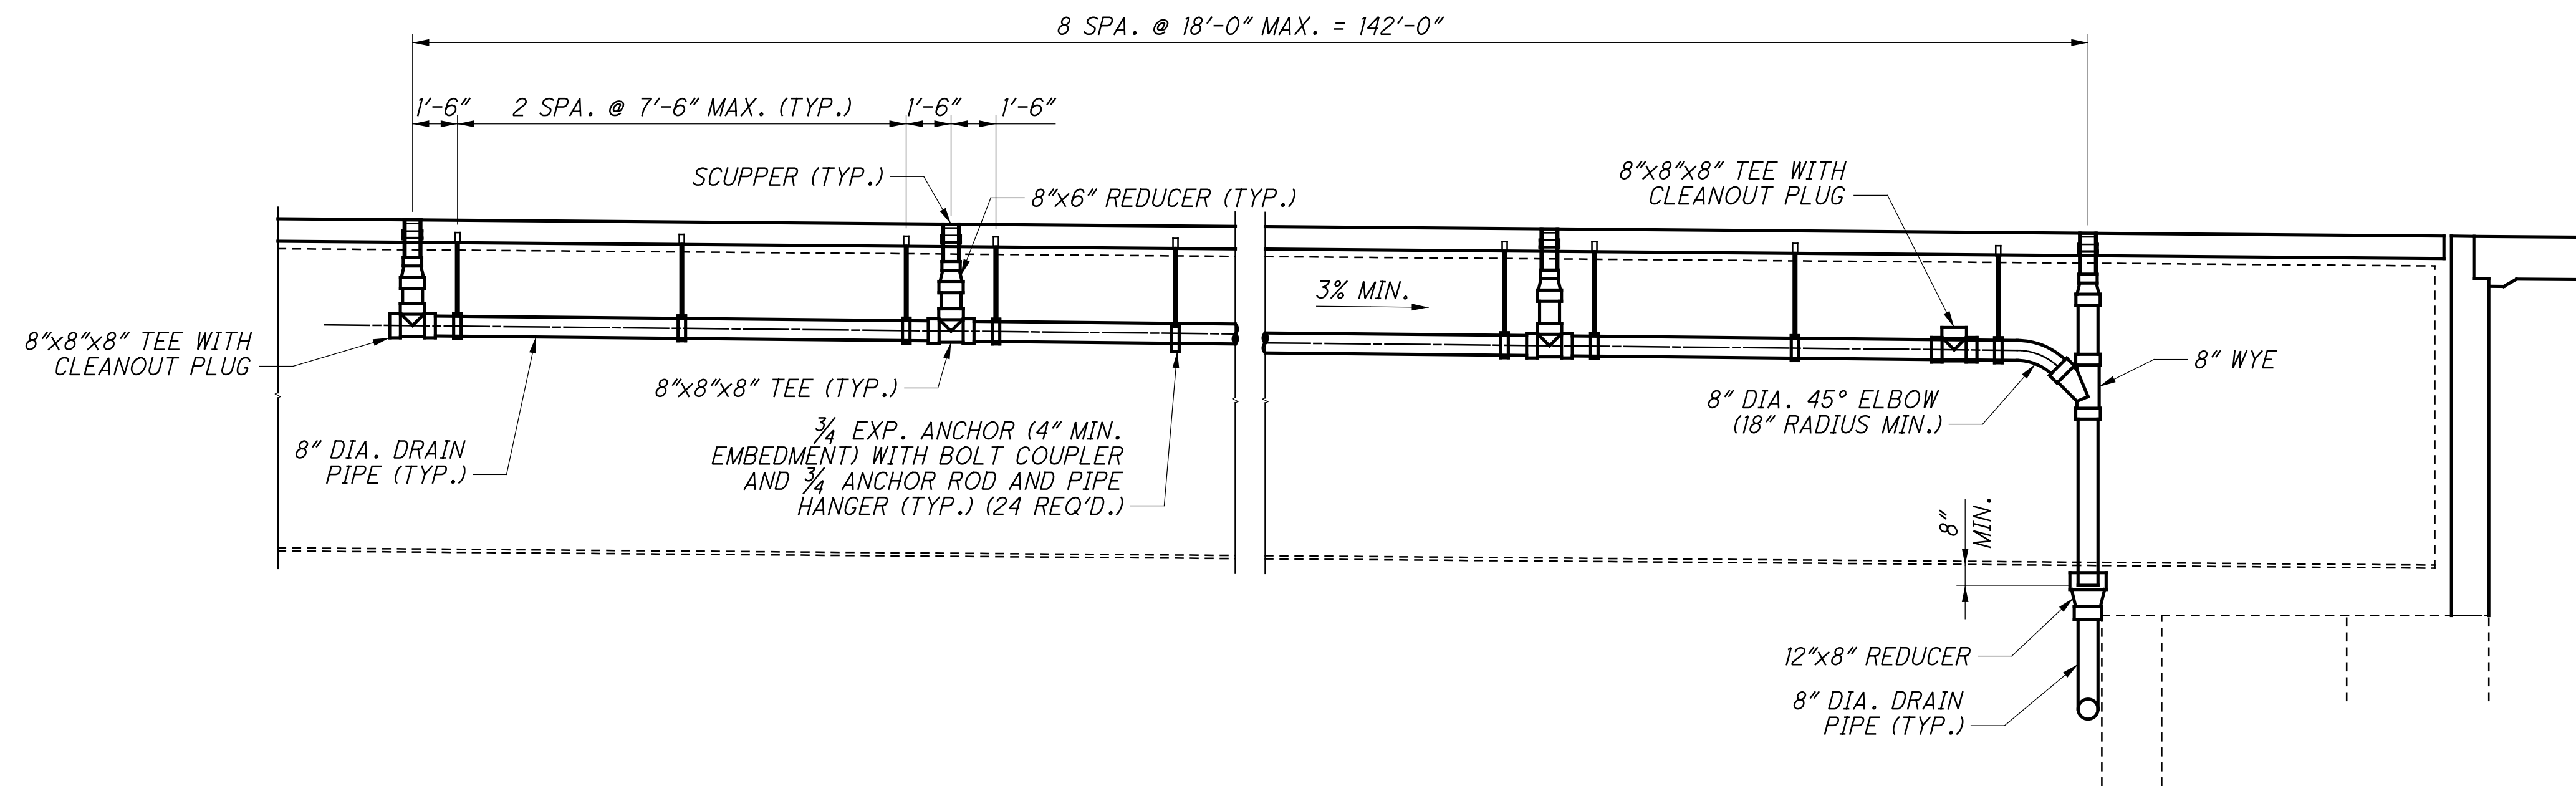

ELEVATION - CLOSED DRAINAGE SYSTEM - OUTSIDE SHOULDER


NOTES:

1. SEE SHEET 32/38 FOR NOTES.
2. PIPE HANGERS SHALL BE EATON B-LINE SERIES B3110-B OR APPROVED EQUAL AND SHALL BE GALVANIZED.


DESIGNED	DATE	REVIEWED	DATE
SUF	11/12/18	MDS	11/12/18
CHECKED	FILE NUMBER	STRUCTURE	FILE NUMBER
CLB		3115690	

DRAINAGE DETAILS (RIGHT BRIDGE)
 BRIDGE NO. HAM-74-1892 L/R
 OVER ELMORE STREET

S:\Flanagan\11/16/2023 9:35:22 AM\0\2017\01113\C.Design\104667-HAM-75-3.84\Design\Structures\HAM0074-1892C\Sheets\74-1892DR006.dgn

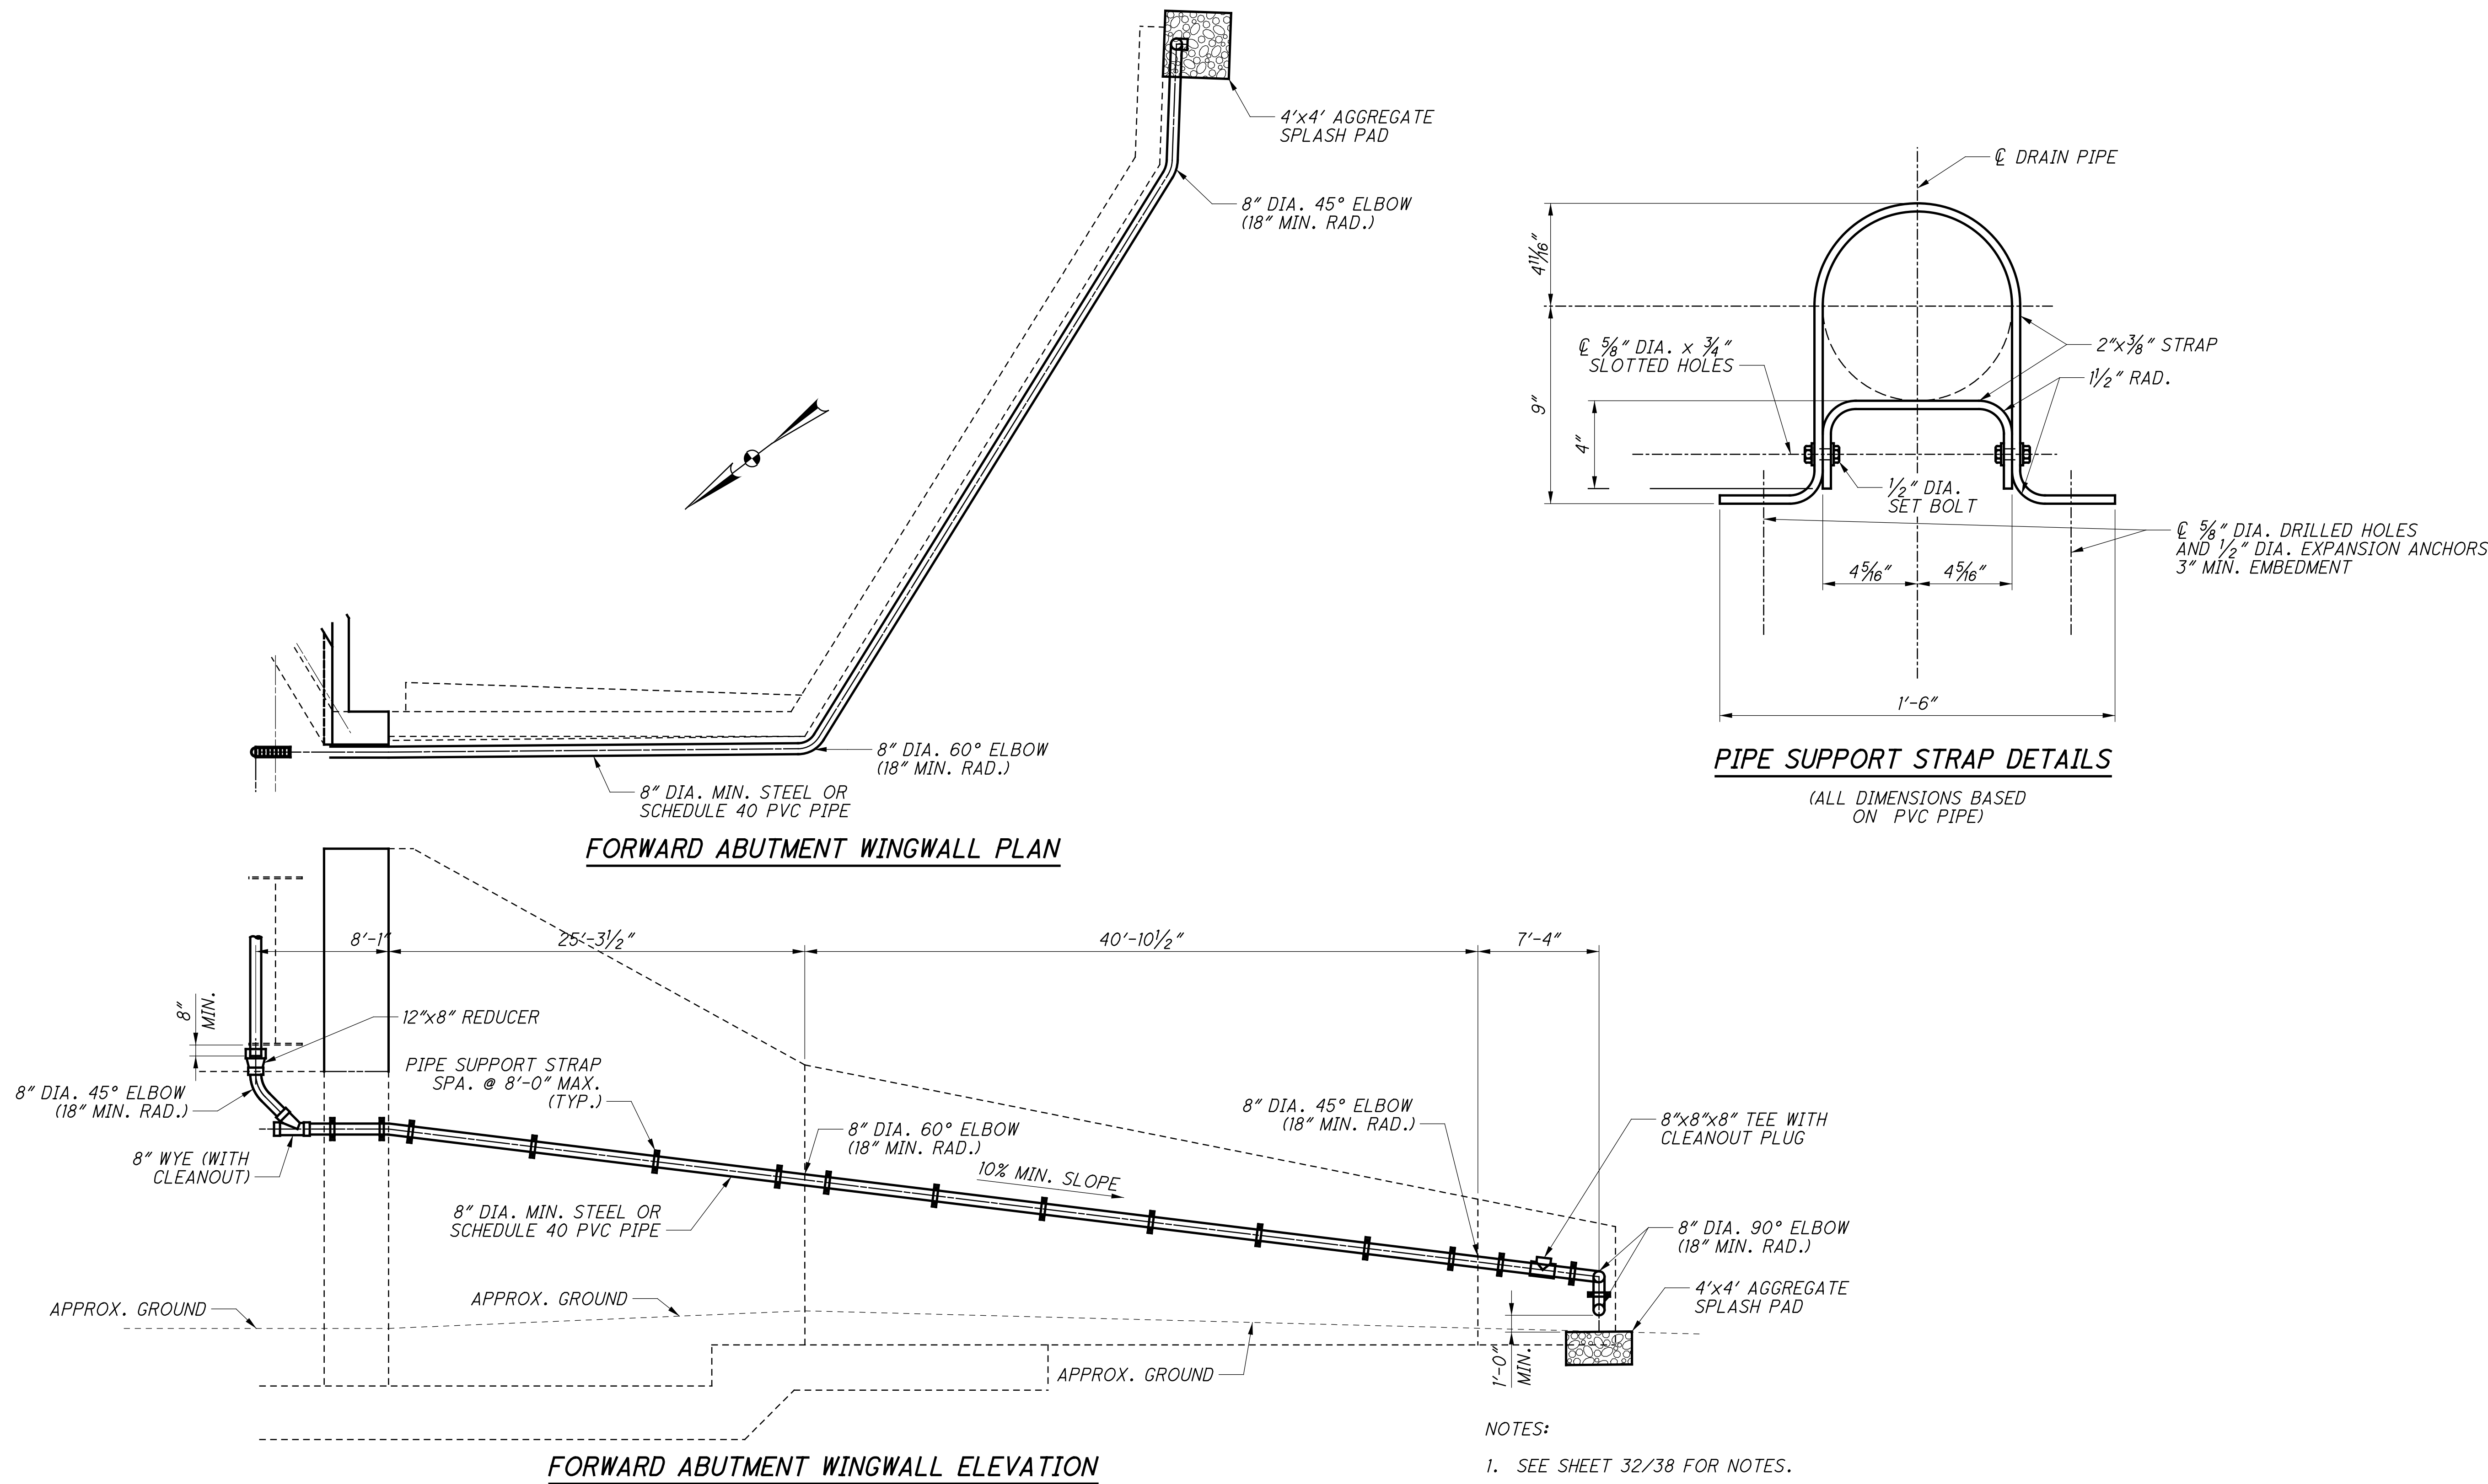

DESIGNED	CLB
CHECKED	SUF
DRAWN	DSH
REVIEWED	MDS
DATE	11/12/18
STRUCTURE POINT FILE NUMBER	3115690
DRAINAGE DETAILS (RIGHT BRIDGE) BRIDGE NO. HAM-74-1892 L/R OVER ELMORE STREET	
HAM-75-3.84 PID No. 104667	
34 / 38	
116 120	

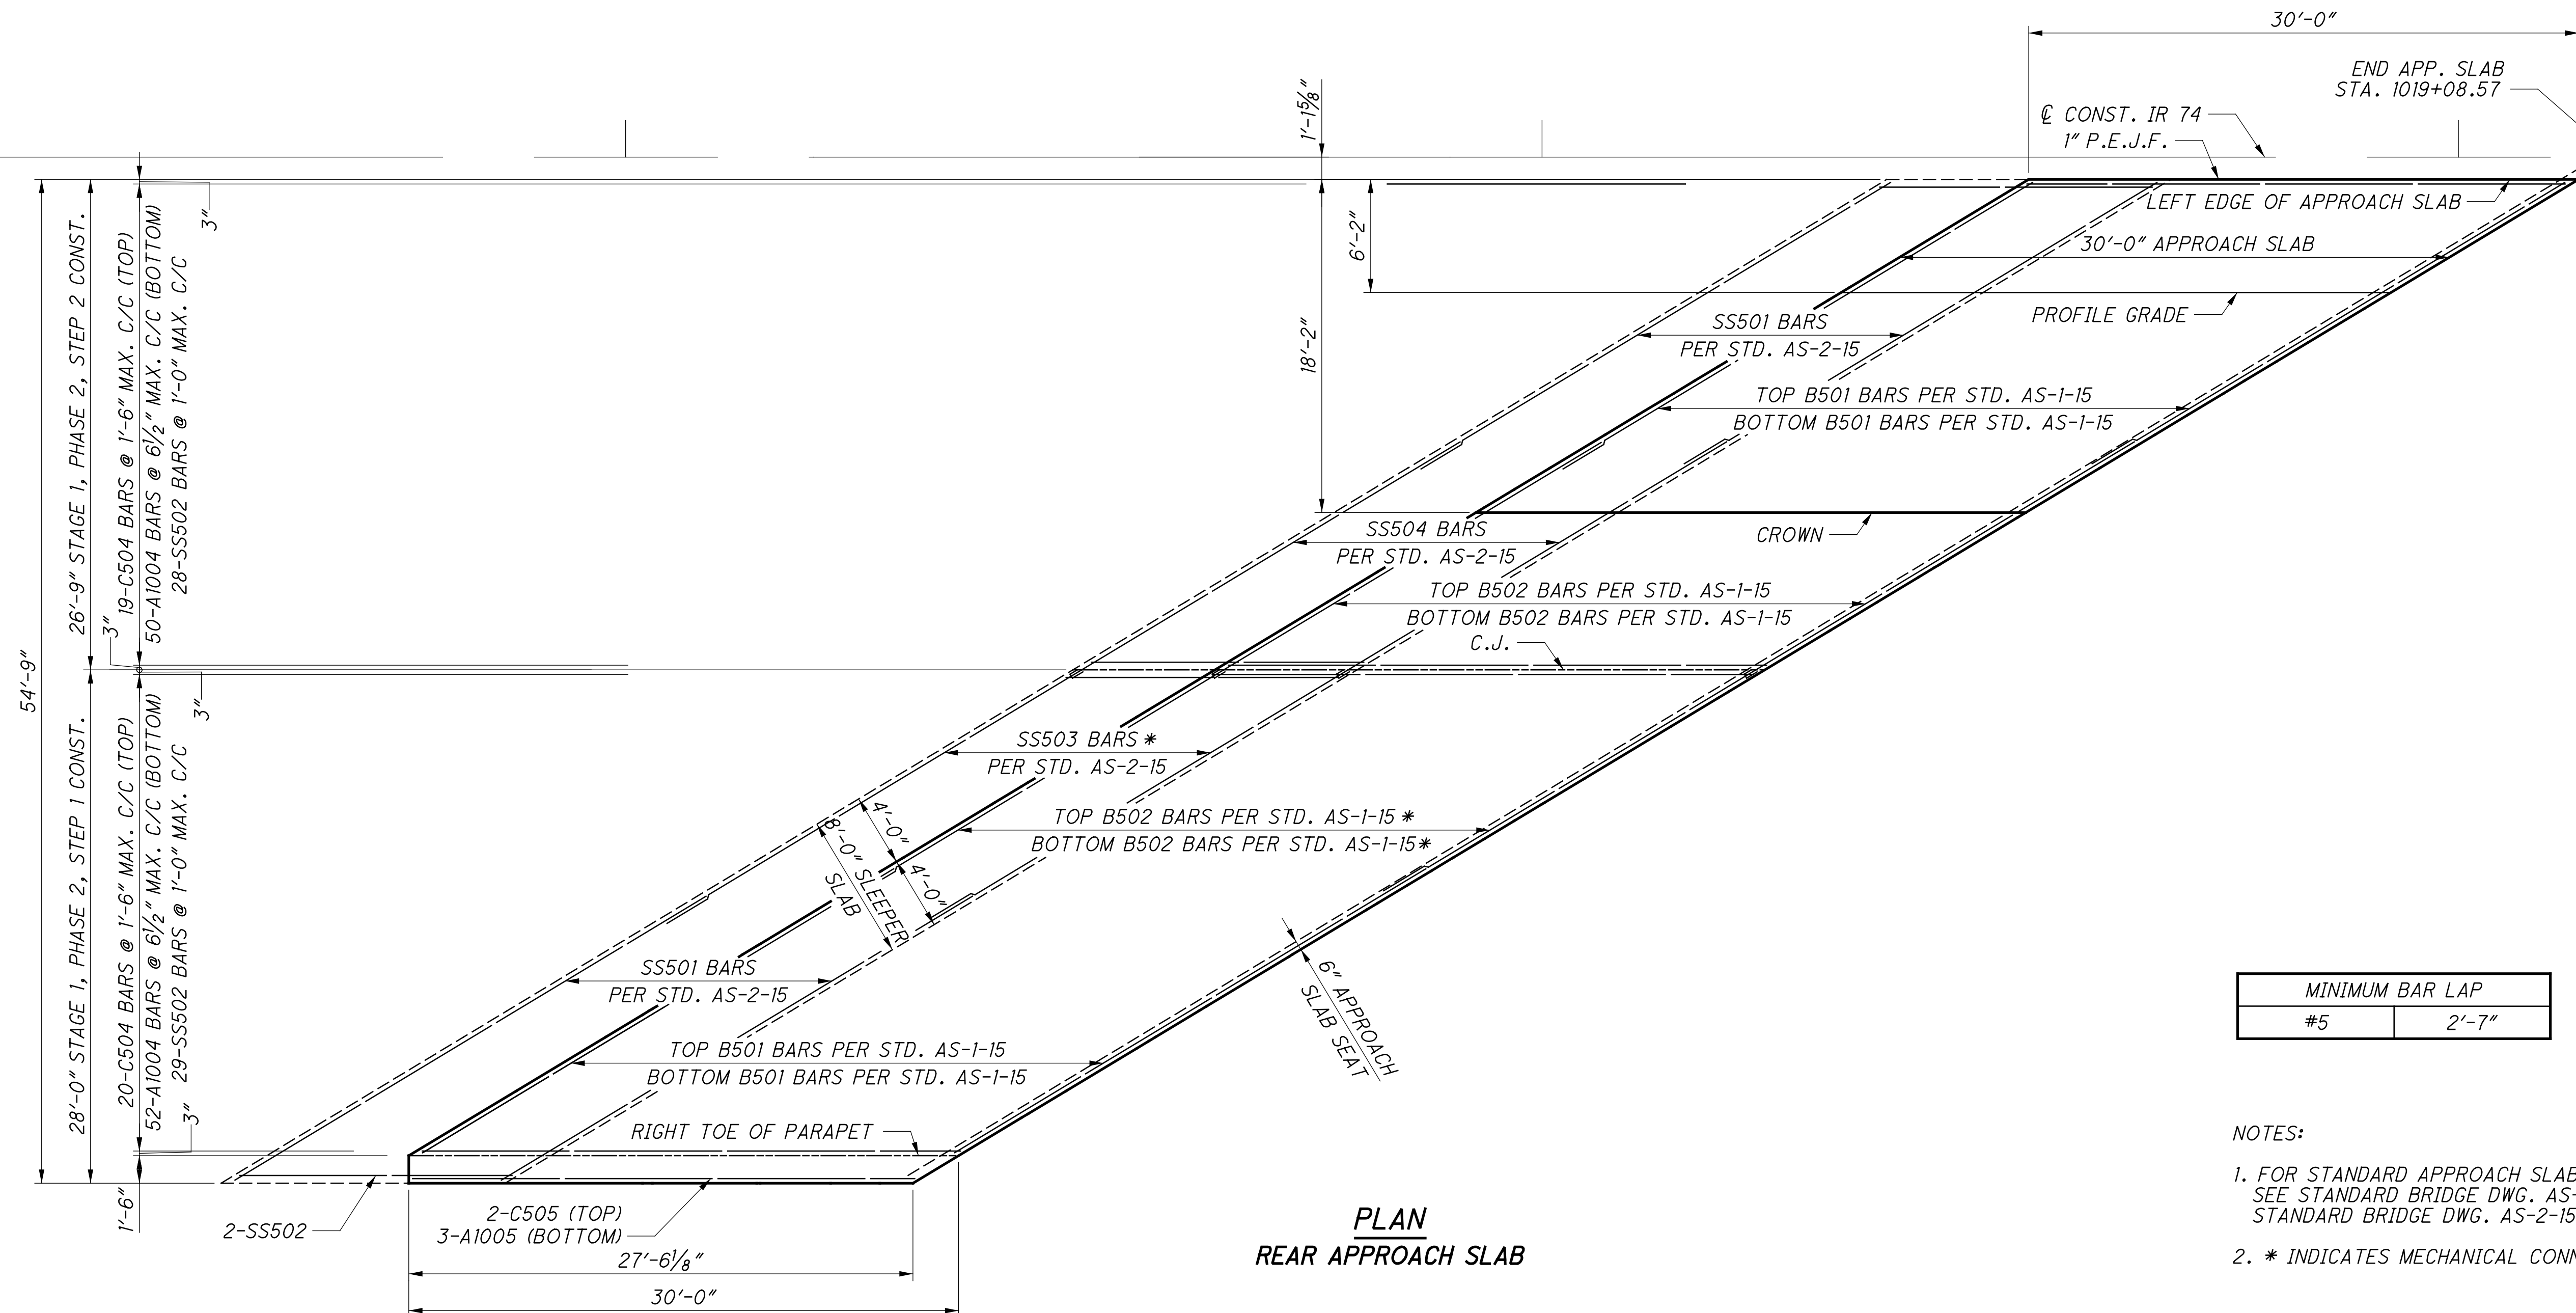


PLAN
REAR APPROACH SLAB

MINIMUM BAR LAP	
#5	2'-7"

- NOTES:
- FOR STANDARD APPROACH SLAB DETAILS, SEE STANDARD BRIDGE DWG. AS-1-15 AND STANDARD BRIDGE DWG. AS-2-15.
 - * INDICATES MECHANICAL CONNECTOR REQUIRED.

APPROACH SLAB ELEVATIONS										
APPROACH LINE	DESCRIPTION	BEGIN REAR SLEEPER SLAB	BEGIN REAR APPROACH SLAB	END REAR SLEEPER SLAB	END REAR APPROACH SLAB	STRUCTURE LIMITS	BEGIN FWD. APPROACH SLAB	BEGIN FWD. SLEEPER SLAB	END FWD. APPROACH SLAB	END FWD. SLEEPER SLAB
	LT. EDGE APP. SLAB	STATION	1018+68.94	1018+76.69	1018+84.44	1019+06.69		1020+80.32	1021+02.57	1021+10.32
OFFSET		1.13	1.13	1.13	1.13		1.13	1.13	1.13	1.13
ELEVATION		518.51	519.87	518.39	519.63		518.24	516.64	518.00	516.52
PGL	STATION	1018+58.70	1018+66.45	1018+74.20	1018+96.45		1020+70.08	1020+92.33	1021+00.08	1021+07.83
	OFFSET	7.30	7.30	7.30	7.30		7.30	7.30	7.30	7.30
	ELEVATION	518.69	520.05	518.57	519.81		518.42	516.82	518.18	516.70
CROWN	STATION	1018+38.79	1018+46.54	1018+54.29	1018+76.54		1020+50.17	1020+72.42	1020+80.17	1020+87.92
	OFFSET	19.30	19.30	19.30	19.30		19.30	19.30	19.30	19.30
	ELEVATION	519.05	520.40	518.92	520.16		518.77	517.18	518.53	517.05
C.J.	STATION	1018+24.41	1018+32.16	1018+39.91	1018+62.16		1020+35.79	1020+58.04	1020+65.79	1020+73.54
	OFFSET	27.97	27.97	27.97	27.97		27.97	27.97	27.97	27.97
	ELEVATION	519.02	520.38	518.90	520.14		518.75	517.15	518.51	517.03
RT. TOE OF PARAPET	STATION	1017+80.42	1017+88.17	1017+95.92	1018+18.17		1019+91.80	1020+14.05	1020+21.80	1020+29.55
	OFFSET	54.47	54.47	54.47	54.47		54.47	54.47	54.47	54.47
	ELEVATION	518.95	520.30	518.83	520.06		518.67	517.08	518.43	516.96

SFlanagan
 11/16/2023 9:35:23 AM
 \\0\2017\01113\C.Design\104667-HAM-75-3.84.Design\Structures\HAM0074_1892C\Sheets\74_1892MD002.dgn

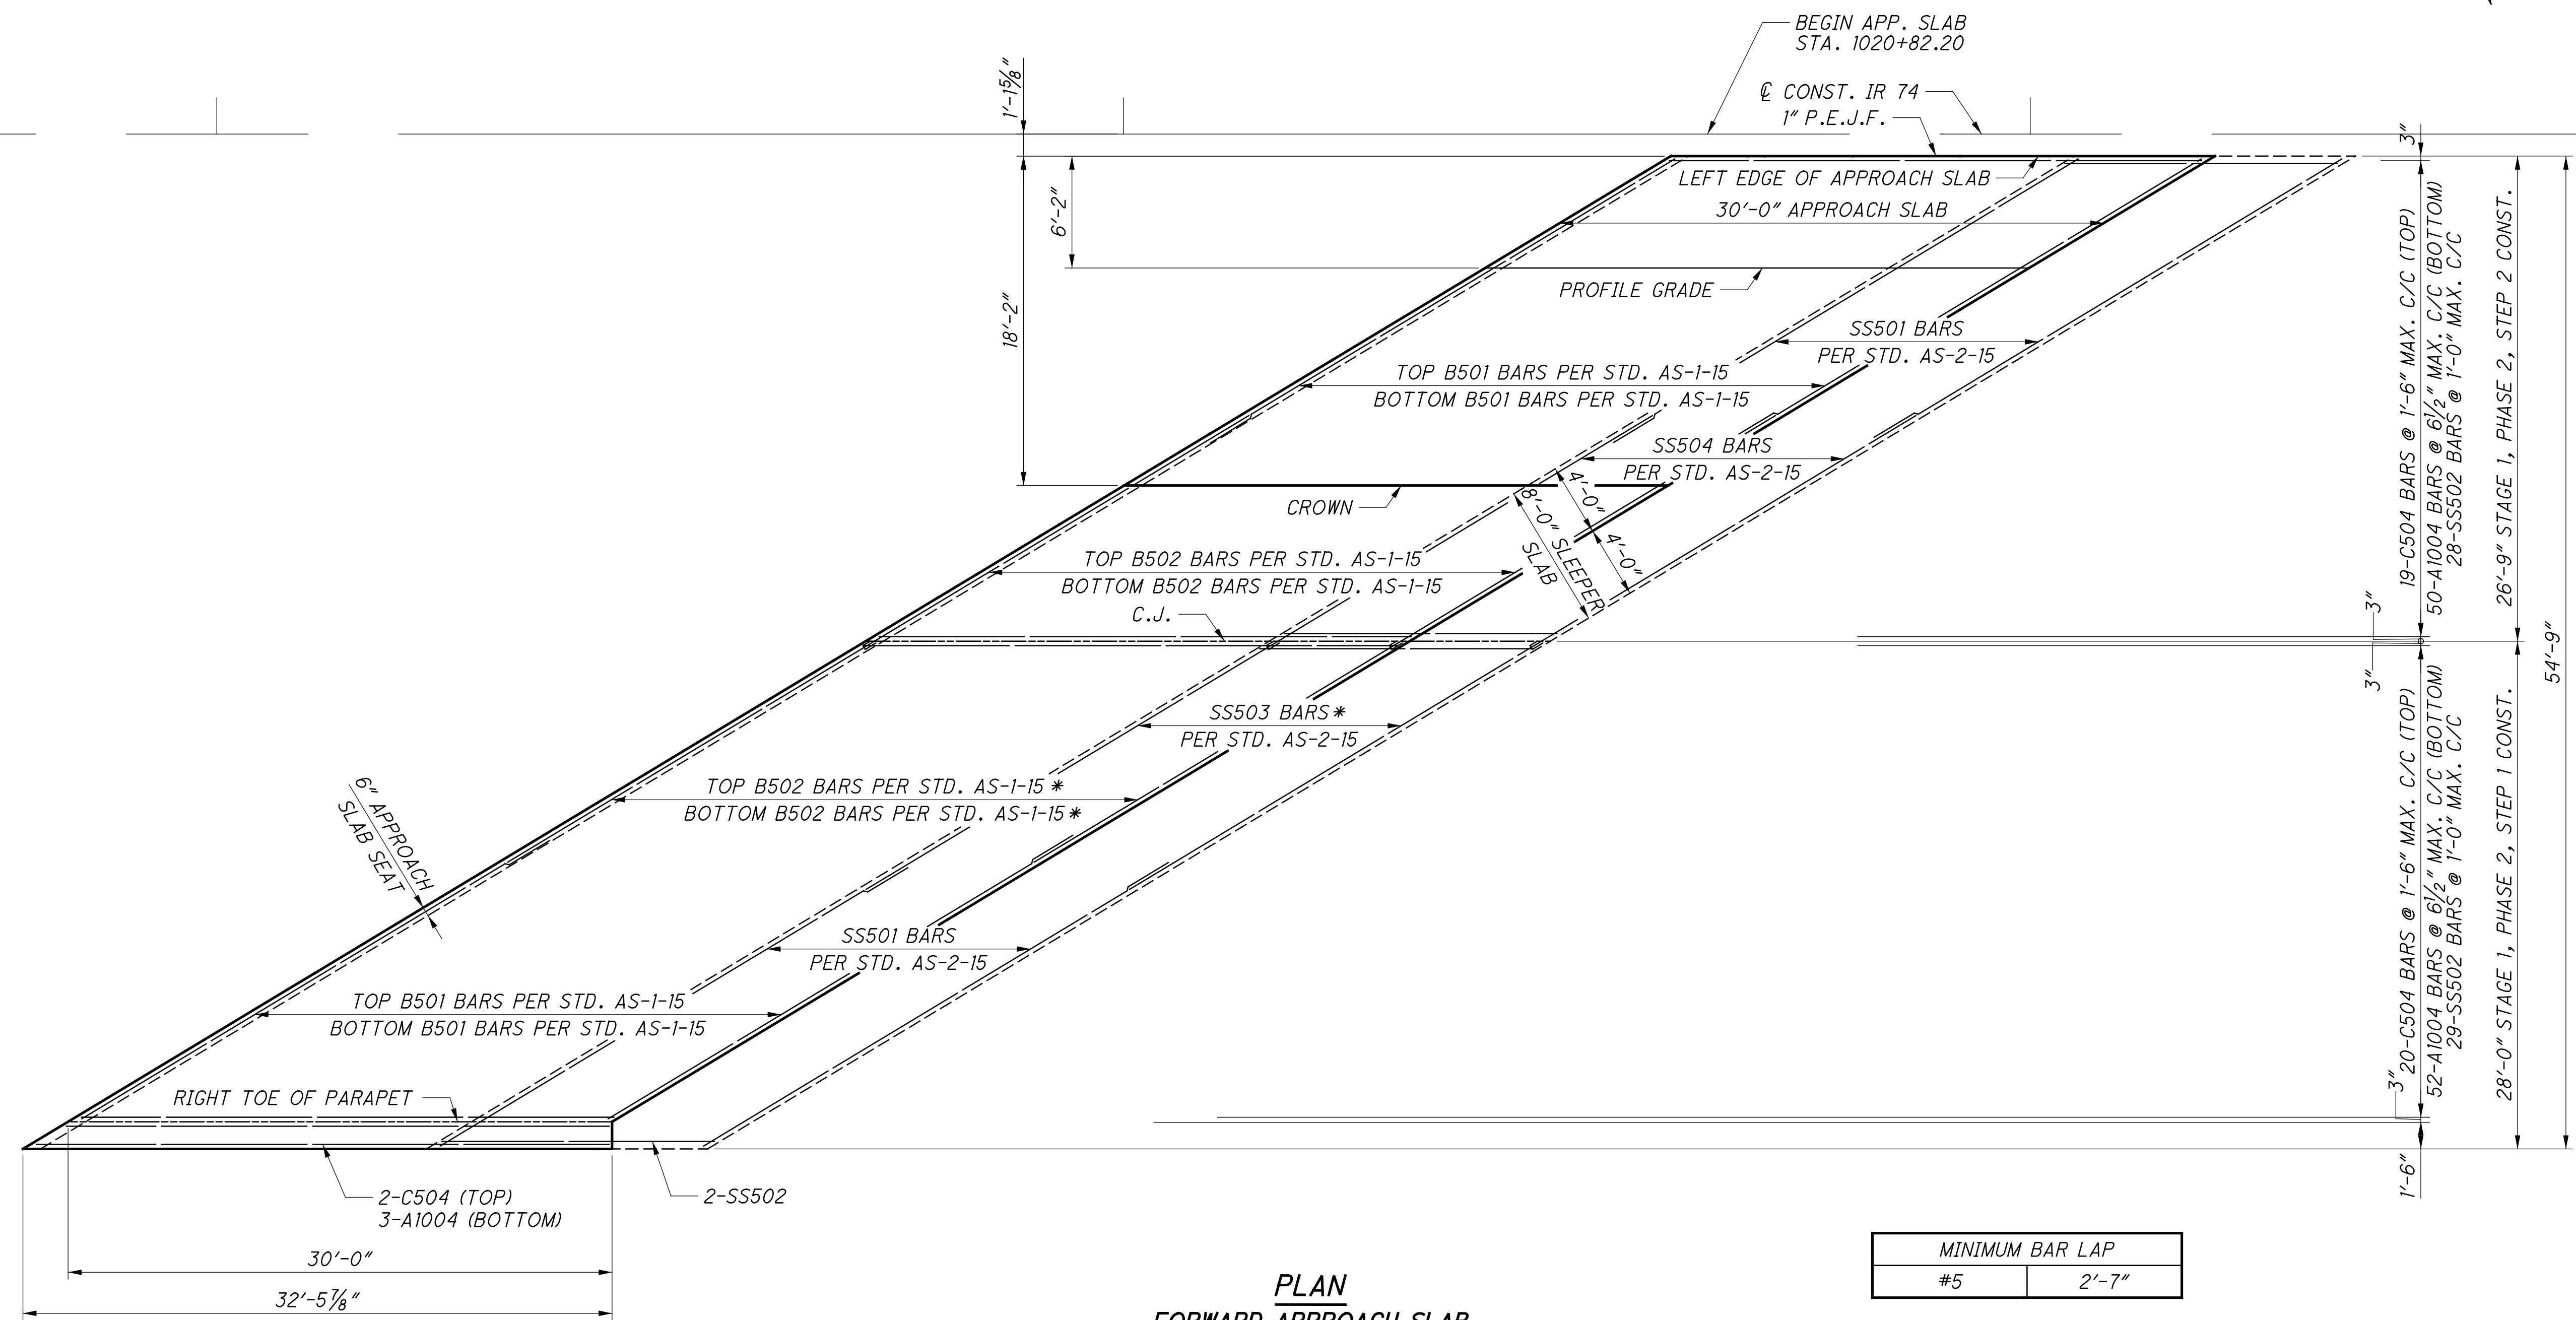

PLAN
 FORWARD APPROACH SLAB

MINIMUM BAR LAP	
#5	2'-7"

NOTES:

1. FOR STANDARD APPROACH SLAB DETAILS, SEE STANDARD BRIDGE DWG. AS-1-15 AND STANDARD BRIDGE DWG. AS-2-15.
2. * INDICATES MECHANICAL CONNECTOR REQUIRED.
3. FOR APPROACH SLAB ELEVATIONS, SEE SHEET 35/38.

DESIGN AGENCY STRUCTUREPOINT <small>INCORPORATED</small>	DATE 11/13/18
	STRUCTURE FILE NUMBER 3115690
REVIEWED MDS	DRAWN DSH
DESIGNED SUJ	CHECKED CLB
FORWARD APPROACH SLAB DETAILS (RIGHT BRIDGE) BRIDGE NO. HAM-74-1892 L/R OVER ELMORE STREET	
HAM-75-3.84 PID No. 104667	36 / 38 118 120

S:\Flanagan\11/16/2023 9:35:23 AM\0\2017\01113\C.Design\104667-HAM-75-3.84.Design\Structures\HAM0074_1892C\Sheets\74_1892RLO01.dgn


REINFORCING STEEL LIST

MARK	NUMBER			LENGTH	WEIGHT	TYPE	DIMENSIONS						
	REAR ABUT.	FORWARD ABUT.	TOTAL				A	B	C	D	E	R	INC
ABUTMENTS													
① A501	40	60	100	30'-0"	3129	STR							
A502	20		20	28'-6"	595	STR							
A503	20	20	40	29'-0"	1210	STR							
A504	14		14	7'-9"	113	2	3'-2"	1'-8"	3'-2"				
A505	7		7	10'-9"	78	2	4'-11"	1'-2"	4'-11"				
A506	14		14	5'-10"	85	1	3'-6"	2'-6"					
A507	2		2	9'-8"	20	1	4'-4"	5'-6"					
A508	2		2	10'-2"	21	1	4'-10"	5'-6"					
A509	1		1	9'-3"	10	37	4'-0"	2'-8"	1'-8"	2'-5"			
A510		9	9	2'-11"	27	2	1'-0"	1'-2"	1'-0"				
A511		9	9	8'-5"	79	2	4'-0"	0'-8"	4'-0"				
A512		8	8	8'-8"	72	19	6'-8"	1'-8 1/2"	1'-0"				
A513		10	10	9'-5"	98	19	7'-5"	1'-8 1/2"	1'-0"				
A514		3	3	8'-6"	27	STR							
A515		16	16	3'-7"	60	STR							
A516		6	6	3'-1"	19	STR							
A517		1	1	8'-8"	9	19	7'-5"	1'-1"	0'-8"				
A601	346	350	696	5'-0"	5227	STR							
A602	328	320	648	12'-5"	12085	1	1'-4"	11'-3"					
A603	164	160	324	6'-7"	3204	2	3'-0"	0'-11"	3'-0"				
A604	11	12	23	13'-3"	458	STR							
A605	6	18	24	11'-3"	406	STR							
A606	4		4	7'-4"	44	19	3'-10"	2'-6"	2'-6"				
A607	1		1	5'-2"	8	19	1'-8"	2'-6"	2'-6"				
A608	1		1	12'-8"	19	STR							
D801	75	69	144	5'-10"	2243	18	3'-8"	1'-0"	1'-0"				
			SUB-TOTAL		29,346								

① REQUIRES MECHANICAL CONNECTORS. (40 REQUIRED)

MARK	NUMBER			LENGTH	WEIGHT	TYPE	DIMENSIONS						
	REAR ABUT.	FORWARD ABUT.	TOTAL				A	B	C	D	E	R	INC
APPROACH SLABS													
B501	130	130	260	30'-0"	8135	STR							
① B502	130	130	260	24'-0"	6508	STR							
C504	39	41	80	29'-6"	2461	STR							
C505	2		2	27'-4"	57	STR							
SS501	16	16	32	30'-0"	1001	STR							
SS502	59	59	118	14'-9"	1815	STR							
① SS503	8	8	16	26'-9"	446	STR							
SS504	8	8	16	24'-0"	401	STR							
A1004	102	105	207	30'-11"	27538	16	29'-6"						
A1005	3		3	28'-9"	371	16	27'-4"						
			SUB-TOTAL		48,733								

① REQUIRES MECHANICAL CONNECTORS. (276 REQUIRED)

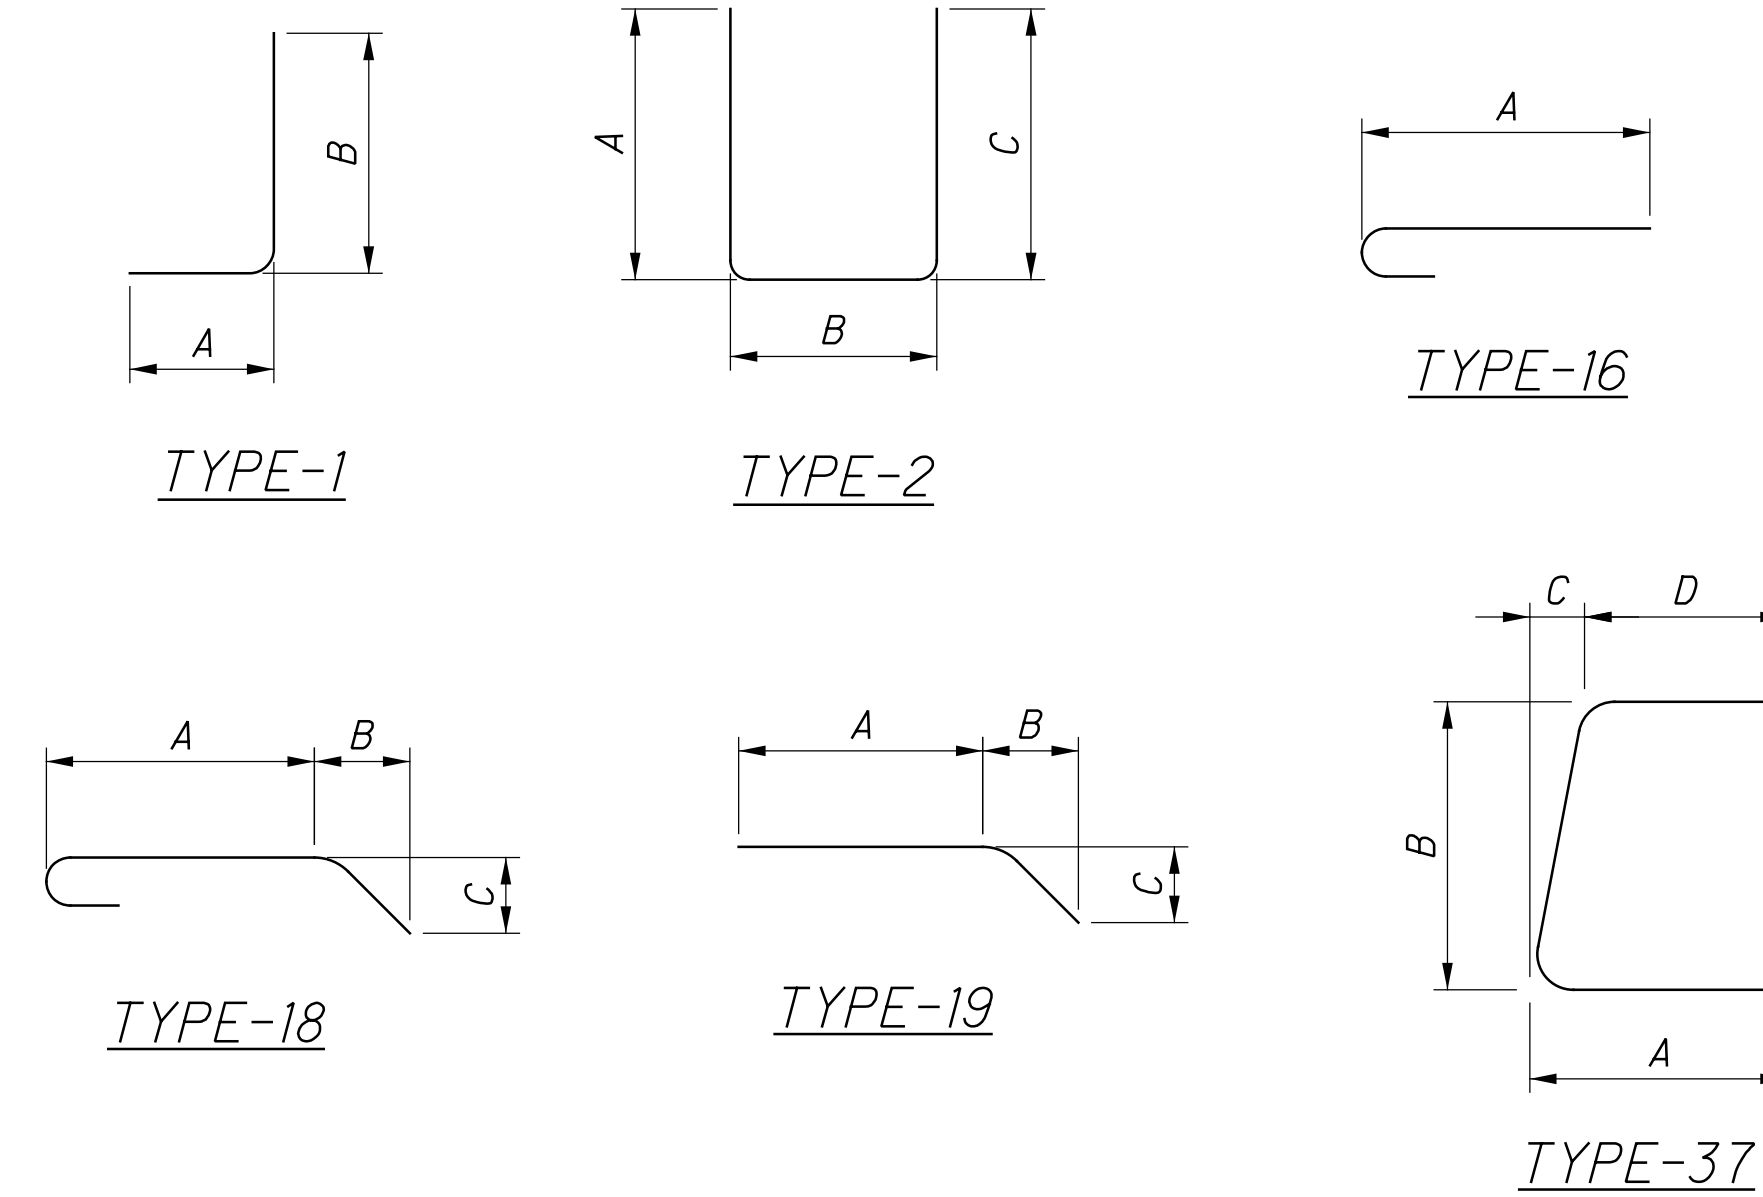

NOTES:

① REQUIRES MECHANICAL CONNECTORS (NON-PROTRUDING TYPE)

AN APPROVED TYPE OF MECHANICAL CONNECTOR FOR REINFORCING SHALL BE PROVIDED. INSTALLATION OF THE CONNECTORS SHALL CONFORM WITH RECOMMENDED MANUFACTURER'S PROCEDURES. IF A DOWEL BAR SPLICE IS FURNISHED, THE MINIMUM DOWEL BAR LENGTH TO BE INCLUDED WITH THE CONNECTOR SHALL BE GIVEN BY THE DIMENSION "L" SHOWN BELOW :
#5 REINFORCING BAR, L = 3'-6"

WHERE MECHANICAL CONNECTORS ARE REQUIRED THE REINFORCING BAR LENGTH IS MEASURED TO THE CONSTRUCTION JOINT. EXTRA BAR LENGTH AND/OR BAR PREPARATION MAY BE NECESSARY DEPENDING ON THE TYPE OF MECHANICAL CONNECTOR FURNISHED.

DESIGN AGENCY: STRUCTUREPOINT
 DATE: 11/12/18
 REVIEWED: MDS
 DRAWN: DSH
 DESIGNED: SJF
 CHECKED: CLB
 STRUCTURE FILE NUMBER: 3115690
REINFORCING STEEL LIST (RIGHT BRIDGE)
 BRIDGE NO. HAM-74-1892 L/R
 OVER ELMORE STREET
HAM-75-3.84
PID No. 104667
 37 / 38
 119
 120


S:\Projects\11113.C.Design\104667.HAM-75-3.84.Design\Structures\HAM0074-1892C.Sheets\7.4-1892RL002.dgn 9:35:24 AM 11/16/2023

MARK	NUMBER TOTAL	LENGTH	WEIGHT	TYPE	DIMENSIONS						
					A	B	C	D	E	R	INC
PARAPETS											
PS501	190	7'-4"	1453	23	0'-11"	3'-3"	3'-0"				0'-3"
PS502	12	2'-1"	26	STR							
PS503	2	7'-7"	16	STR							
PS504	1	5'-9"	6	STR							
PS505	80	14'-8"	1224	STR							
PS506	1	10'-1"	11	STR							
PS507	40	30'-0"	1252	STR							
PS508	8	29'-9"	248	STR							
PS509	192	9'-10"	1969	41	0'-11"	4'-3"	4'-0"				0'-3"
PS510	192	5'-9"	1152	40	1'-1"	1'-0"	1'-7"	1'-7"			
PS511	20	3'-0"	63	STR							
PS512	6	7'-7"	47	STR							
PS513	3	5'-4"	17	STR							
PS514	3	10'-6"	33	STR							
PS515	6	7'-10"	49	44	1'-0"	3'-3"	3'-0"				0'-6 3/4"
PS516	8	9'-6"	79	43	2'-0"	2'-3"	1'-7"	1'-7"			
PS517	8	10'-5"	87	44	1'-0"	4'-6"	4'-3"				0'-6 1/4"
SUB-TOTAL			9,944								
**PS527A	8	-	-	-							
**PS527B	8	-	-	-							
PARAPETS (ON APPROACH SLAB)											
AS501	34	7'-4"	260	23	0'-11"	3'-3"	3'-0"				0'-3"
AS502	8	5'-9"	48	25	1'-10"	2'-5"	1'-5"	0'-1 1/2"	0'-5"		0'-2 3/4"
AS503	8	5'-8"	47	STR							
AS504	16	10'-0"	167	STR							
AS505	4	18'-5"	77	STR							
AS506	2	20'-10"	43	STR							
AS507	2	15'-0"	31	STR							
AS508	1	17'-5"	18	STR							
AS509	1	16'-0"	17	STR							
AS510	1	13'-0"	14	STR							
PS601	34	5'-7"	285	40	1'-1"	1'-0"	1'-7"	1'-7"			
	4 SR	4'-1"				3'-3"					
PS602	OF	TO	303	1	1'-0"	TO					0'-1"
	11	5'-0"				4'-2"					
PS603	16	4'-1"	98	1	1'-0"	3'-3"					
AS604	1	16'-11"	25	STR							
AS605	1	14'-5"	22	STR							
SUB-TOTAL			1,455								


** GALVANIZED BAR, SEE SHEET 28/38 FOR DETAILS.

MARK	NUMBER TOTAL	LENGTH	WEIGHT	TYPE	DIMENSIONS						
					A	B	C	D	E	R	INC
SUPERSTRUCTURE											
S401	350	30'-0"	7014	STR							
S402	70	29'-5"	1376	STR							
S403	285	10'-9"	2047	16	10'-2 3/4"						
S404	308	4'-4"	892	2	2'-6"	0'-6 1/4"	1'-6"				
S405	309	5'-10"	1204	2	3'-3"	0'-6 1/4"	2'-3"				
	1 SR	2'-11"									
S501	OF	TO	1276	STR							0'-3 3/4"
	80	27'-8"									
	1 SR	3'-6"			2'-11"						
S502	OF	TO	1328	16	TO						0'-3 3/4"
	80	28'-3"			27'-8"						
① S503	229	27'-10"	6648	STR							
① S504	229	28'-5"	6787	16	27'-10"						
	2 SR	1'-0"									
① S505	OF	TO	2586	STR							0'-3 3/4"
	86	27'-10"									
S506	20	10'-0"	209	STR							
S507	72	3'-6"	263	STR							
S508	324	30'-0"	10138	STR							
S509	60	32'-3"	2018	STR							
① S510	12	28'-3"	354	STR							
S511	12	29'-1"	364	STR							
	2 SR	1'-1"									
S512	OF	TO	2662	STR							0'-3 3/4"
	87	28'-3"									
S513	228	28'-3"	6718	STR							
S514	228	28'-10"	6857	16	28'-3"						
	1 SR	3'-3"									
S515	OF	TO	1304	STR							0'-3 3/4"
	80	28'-0"									
	1 SR	3'-10"			3'-3"						
S516	OF	TO	1349	16	TO						0'-3 3/4"
	80	28'-7"			28'-0"						
S517	606	4'-2"	2634	STR							
SUB-TOTAL			66,028								


① REQUIRES MECHANICAL CONNECTORS. (642 REQUIRED)

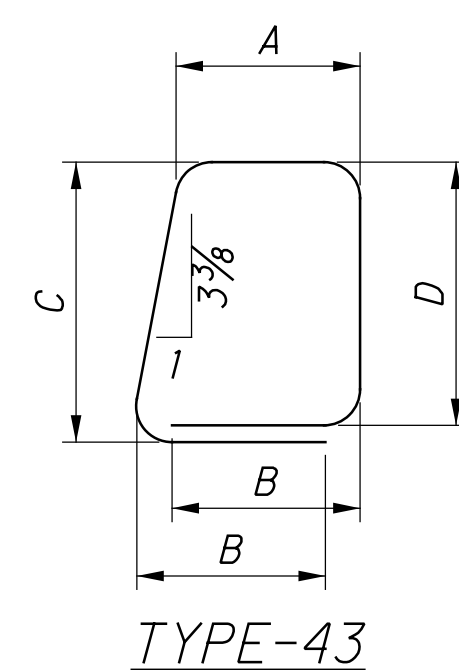


TYPE-43

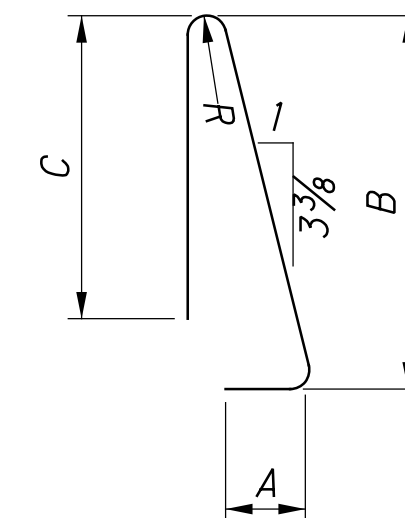


TYPE-44

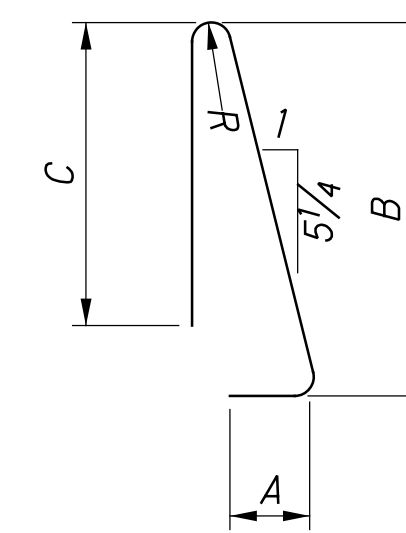


TYPE-41

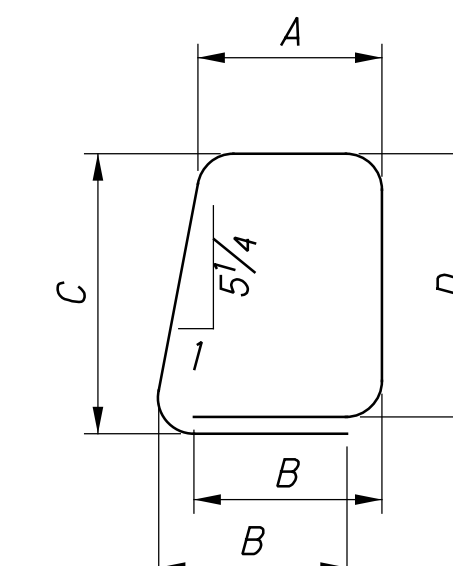


TYPE-40

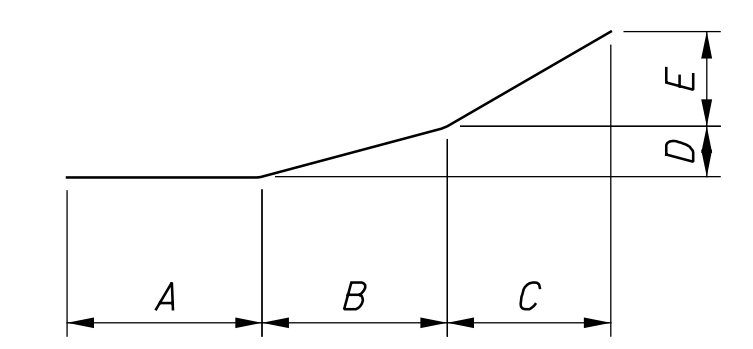


TYPE-25

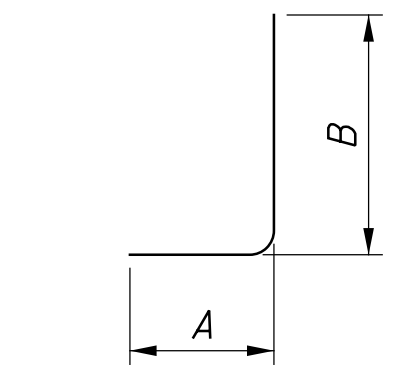


TYPE-1

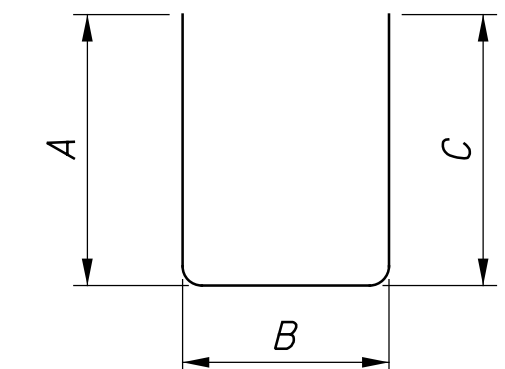

TYPE-2

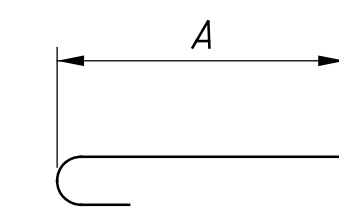

TYPE-16

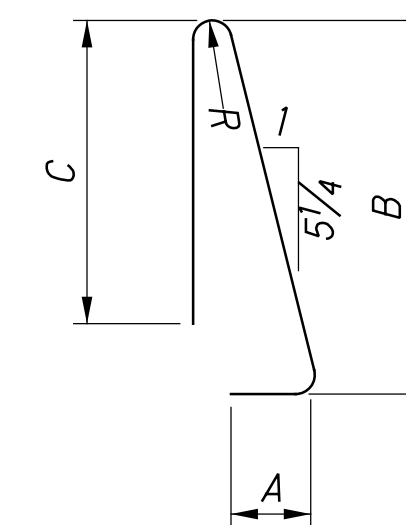

TYPE-23

NOTES:

① REQUIRES MECHANICAL CONNECTORS (NON-PROTRUDING TYPE)

AN APPROVED TYPE OF MECHANICAL CONNECTOR FOR REINFORCING SHALL BE PROVIDED. INSTALLATION OF THE CONNECTORS SHALL CONFORM WITH RECOMMENDED MANUFACTURER'S PROCEDURES. IF A DOWEL BAR SPLICE IS FURNISHED, THE MINIMUM DOWEL BAR LENGTH TO BE INCLUDED WITH THE CONNECTOR SHALL BE GIVEN BY THE DIMENSION "L" SHOWN BELOW :
#5 REINFORCING BAR, L = 3'-6"

WHERE MECHANICAL CONNECTORS ARE REQUIRED THE REINFORCING BAR LENGTH IS MEASURED TO THE CONSTRUCTION JOINT. EXTRA BAR LENGTH AND/OR BAR PREPARATION MAY BE NECESSARY DEPENDING ON THE TYPE OF MECHANICAL CONNECTOR FURNISHED.

DESIGN AGENCY: STRUCTUREPOINT
 DATE: 11/19/18
 REVIEWED: MDS
 DRAWN: TLH
 DESIGNED: SUJ
 CHECKED: CLB
 STRUCTURE FILE NUMBER: 3115690
REINFORCING STEEL LIST (RIGHT BRIDGE)
 BRIDGE NO. HAM-74-1892 L/R
 OVER ELMORE STREET
HAM-75-3.84
 PID No. 104667
 38 / 38
 120 / 120

cbettinger 6/3/2019 2:12:25 PM \\0\2017\01113\C_Design\104667 -HAM-75-3.84\Design\Structures\HAM0074_1840C\Sheets\74_1840GN003.dgn

CORRECTIVE WORK PLAN:

PER C&MS 501.05.D.

SUPPLEMENTAL SPECIFICATIONS:

REFER TO SS 849 AS NOTED IN THE PLANS.

SEQUENCE OF WORK:

REPAIR CUT LOCATIONS WITH FULL PENETRATION WELDS AND GRINDING PER PLANS AND SS 849.14. REPLACE CROSSFRAME MEMBERS.

REPLACE TOP SPLICE PLATE ON GIRDER 10.

REPAIR STRUCTURAL STEEL COATING SYSTEM AT ALL LOCATIONS DAMAGED DURING DEMOLITION AND DURING THE REPAIR PROCEDURES PER ITEM 514 - FIELD PAINTING OF DAMAGED STRUCTURAL STEEL, AS PER PLAN (ONE COAT)

ITEM 513 - STRUCTURAL STEEL MEMBERS, LEVEL UF, AS PER PLAN:

ALL REQUIREMENTS OF 513 APPLY TO SHOP FABRICATED MEMBERS. PERFORM WORK FOR FIELD FABRICATED MEMBERS ACCORDING TO ITEM 513, EXCEPT AS MODIFIED HEREIN. THE DEPARTMENT WILL NOT REQUIRE THE CONTRACTOR PERFORMING FIELD FABRICATION TO BE PRE-QUALIFIED AS SPECIFIED IN SUPPLEMENT 1078. SUBMIT A WRITTEN LETTER OF MATERIAL ACCEPTANCE, 501.06, TO THE ENGINEER. PROVIDE SHOP DRAWINGS ACCORDING TO 513.06 OR SUPPLY THE ENGINEER WITH "AS BUILT" DRAWINGS MEETING 513.06 AFTER COMPLETION OF FIELD FABRICATION. THE ENGINEER WILL REVIEW THE SUBMITTED DRAWINGS FOR CONCURRENCE WITH THE FINAL AS-BUILT CONDITION. THE ENGINEER MAY CONTACT THE OFFICE OF STRUCTURAL ENGINEERING FOR TECHNICAL ASSISTANCE. IF THE ENGINEER IS SATISFIED WITH THE "AS-BUILT" DRAWINGS AND THE DELIVERED MATERIALS. SUPPLY A COPY OF THE DRAWINGS, STAMPED, SEALED AND DATED, ACCORDING S1002, TO THE STRUCTURAL, WELDING AND METALS SECTION OF THE OFFICE OF MATERIAL MANAGEMENT FOR RECORD PURPOSES. SPLICE PLATE REPLACEMENT FOR THE REPAIR OF THE GIRDER 10 TOP FLANGE AND CROSS FRAME ANGLE REPLACEMENT ARE INCLUDED IN THIS ITEM.

ITEM 513 - STRUCTURAL STEEL MISC., REPAIR OF DAMAGED MAIN MEMBER, COMPLETE PENETRATION WELDING:

AFTER DAMAGED AREAS HAVE BEEN INSPECTED ACCORDING TO ITEM 849 DAMAGE ASSESSMENT. PREPARE THE DAMAGED MATERIAL FOR WELDING, PROVIDE RUNOFF TABS FOR ALL COMPLETE PENETRATION WELDS. PERFORMING COMPLETE PENETRATION WELDS ACCORDING TO C&MS 513 USING APPROVED ELECTRODES, PROCEDURES AND WELDERS. REMOVE RUNOFF TABS AND GRIND THE COMPLETED EDGES SMOOTH. GRIND THE COMPLETED WELDS SMOOTH AND FLUSH WITH THE ADJACENT SURFACES TO PROVIDE A SURFACE FINISH ACCORDING TO ANSI B46.1 OF 250 MIL. DO NOT OVER GRIND AS TO REDUCE THE MATERIAL THICKNESS OR WIDTH OF THE NEW OR EXISTING MATERIALS. PREPARE ALL REENTRANT CORNERS WITH A ONE INCH RADIUS. REMOVE WELDING, START AND STOP DISCONTINUITIES. RADIOGRAPHIC TEST THE FINISHED WELDS ACCORDING TO C&MS 513.25A AND SUBMIT COPIES OF THE REPORTS TO THE ENGINEER. THE ENGINEER MAY OBTAIN TECHNICAL ASSISTANCE FROM THE OFFICE OF MATERIALS MANAGEMENT.

ITEM 514 - FIELD PAINTING OF DAMAGED STRUCTURAL STEEL, AS PER PLAN (ONE COAT):

1.0 DESCRIPTION: THIS ITEM CONSISTS OF FIELD PAINTING STRUCTURAL STEEL PREVIOUSLY COATED WITH AN UNKNOWN EXISTING PAINT TO CORRECT DAMAGE FROM DEMOLITION AND REPAIR PROCEDURES. THIS WORK CONSISTS OF PERFORMING SURFACE PREPARATION AND APPLYING A PRIMER TO THE PREPARED STEEL AND FEATHERED REMOVAL AREAS OF UNKNOWN EXISTING PAINT SYSTEMS. ALL STRUCTURAL STEEL SURFACE AREAS DAMAGED BY DEMOLITION OR REPAIR PROCEDURES, THAT WILL BE EXPOSED AFTER FINAL CONSTRUCTION COMPLETE, SHALL BE PAINTED.

2.0 GENERAL: C&MS 514.05 THROUGH 514.10 AND 514.13.D APPLY UNLESS MODIFIED BY THESE NOTES.

3.0 WASHING EXISTING PAINTED SURFACES: CLEAN SURFACES TO BE COATED WITH LOW PRESSURE WATER CLEANING TO REMOVE ALL DIRT, DEBRIS, ANIMAL EXCREMENT, SALT CONTAMINANTS AND OTHER ACCUMULATED FOREIGN MATERIAL IN ACCORDANCE WITH SSPC-SPI2 (LP WC), LOW PRESSURE WATER CLEANING. THE PRESSURE WASHER SHALL BE CAPABLE OF ACHIEVING AT LEAST 2000 POUNDS PER SQUARE INCH AT THE NOZZLE. WHEN USING THE POWER WASHING EQUIPMENT, THE NOZZLE SHALL BE MAINTAINED NO MORE THAN 10 INCHES FROM THE SURFACE. SUPPLY AND USE POTABLE WATER. PROVIDE TO THE ENGINEER A LETTER OF WRITTEN ACCEPTANCE FOR ANY BIODEGRADABLE DETERGENTS OR CLEANERS USED IN CONJUNCTION WITH THIS METHOD.

COLLECT AND CONTAIN WATER AND DEBRIS REMOVED DURING WASHING OPERATIONS ABOVE WATER FEATURES IN CONFORMANCE WITH C&MS 514.08 AND C&MS 514.13.D FOR ANY DEBRIS. CREATE SETTLEMENT COLLECTION BASINS AND STRAIN ALL WASH WATER ABOVE LAND FEATURES AS NECESSARY TO PRODUCE VISIBLY CLEAR WATER AND COMPLY WITH CMS 514.08 AND C&MS 514.13.D FOR ANY DEBRIS.

4.0 SURFACE PREPARATION: AFTER THE PRESSURE WASHED SURFACE HAS DRIED, REMOVE EXISTING PAINT COATING TO CONTRACT LIMITS OR AS DIRECTED BY THE ENGINEER ACCORDING TO: SSPC-SP 11, POWER TOOL CLEANING TO BARE METAL, AS SHOWN ON THE PICTORIAL SURFACE PREPARATION STANDARDS FOR PAINTING STEEL SURFACES SHOWN IN SSPC-VIS 3; SSPC SP6, COMMERCIAL BLAST CLEANING, AS SHOWN ON THE PICTORIAL SURFACE PREPARATION STANDARDS FOR PAINTING STEEL SURFACES SHOWN IN SSPC-VIS 1; OR SSPC SPI2 UHP WJ-4, ULTRAHIGH-PRESSURE WATER JETTING, AS SHOWN ON THE PICTORIAL SURFACE PREPARATION STANDARDS FOR PAINTING STEEL SURFACES SHOWN IN SSPC-VIS 4. SUPPLY BLAST WATER CONTAINING A COMMERCIALY AVAILABLE RUST INHIBITOR AT A DOSAGE THAT PREVENTS FLASH RUSTING FOR 12 HOURS AND DOCUMENTED AS ACCEPTABLE TO THE COATING'S MANUFACTURER. THE ENGINEER WILL USE THE SSPC-VIS 1, SSPC-VIS 3 OR SSPC-VIS 4 TO DETERMINE THE ACCEPTANCE OF THE SURFACE PREPARATION. FEATHER THE EXISTING PAINT TO ROUGHEN A MINIMUM OF 1/2 INCH OF THE EXISTING PAINT. CONTAIN AND DISPOSE OF WASTE GENERATED BY THE CLEANING ACCORDING TO C&MS 514.13.D.

ROUND ALL EXPOSED CORNERS OF MAIN MATERIAL TO BE PAINTED AS NECESSARY TO ACHIEVE A 1/16 INCH RADIUS OR EQUIVALENT FLAT SURFACE AT A 45 DEGREE ANGLE.

5.0 FIELD PAINTING: APPLY THE PRIME COAT OF THE THREE-COAT PAINT SYSTEM SPECIFIED IN C&MS 708.02, ACCORDING TO C&MS 514.15, 514.16, 514.17, 514.19 AND 514.20 TO THE CONTRACT LIMITS OR AS DIRECTED BY THE ENGINEER. THE ENGINEER WILL DETERMINE THE PRIME COAT THICKNESS USING A TYPE 2 MAGNETIC GAGE AT SPOT LOCATIONS. DO NOT APPLY THE INTERMEDIATE OR FINISH COAT. THE PRIME COAT OF PAINT SHALL MEET THE MINIMUM DRY FILM THICKNESS REQUIREMENTS OF C&MS 514.20. APPLY PAINT AS FOLLOWS:



APPLY THE PRIME COAT ONLY TO THE PREPARED SURFACE OF THE BARE STEEL AND THE EXISTING UNKNOWN PAINT SYSTEM ROUGHENED BY FEATHERING. AT THE PERIMETER OF THE REPAIR AREA, APPLY THE PRIME COAT USING A BRUSH. IN LIEU OF BRUSHING THE CONTRACTOR MAY DOUBLE MASK THE AREAS NOT TO BE COATED AND SPRAY TO FEATHERED REMOVAL LINES.



Christopher L. Bettinger

6/3/2019

 DESIGN AGENCY 2000 CORPORATE PARKWAY DR. STE. 200 WILSON, OHIO 45394 TEL: 614.941.3333 FAX: 614.941.3336 www.structurepoint.com	DATE 5/16/19	REVIEWED SUJ	STRUCTURE FILE NUMBER 3115526	DRAWN DSH	REVISED	DESIGNED AMI	CHECKED CLB
CORRECTIVE WORK PLAN - GIRDER REPAIR NOTES BRIDGE NO. HAM-74-1840 L/R OVER SB BEEKMAN ST. (U.S. 27) AND RAMP F							
HAM-75-3.84 PID No. 104667							
1 / 4 							

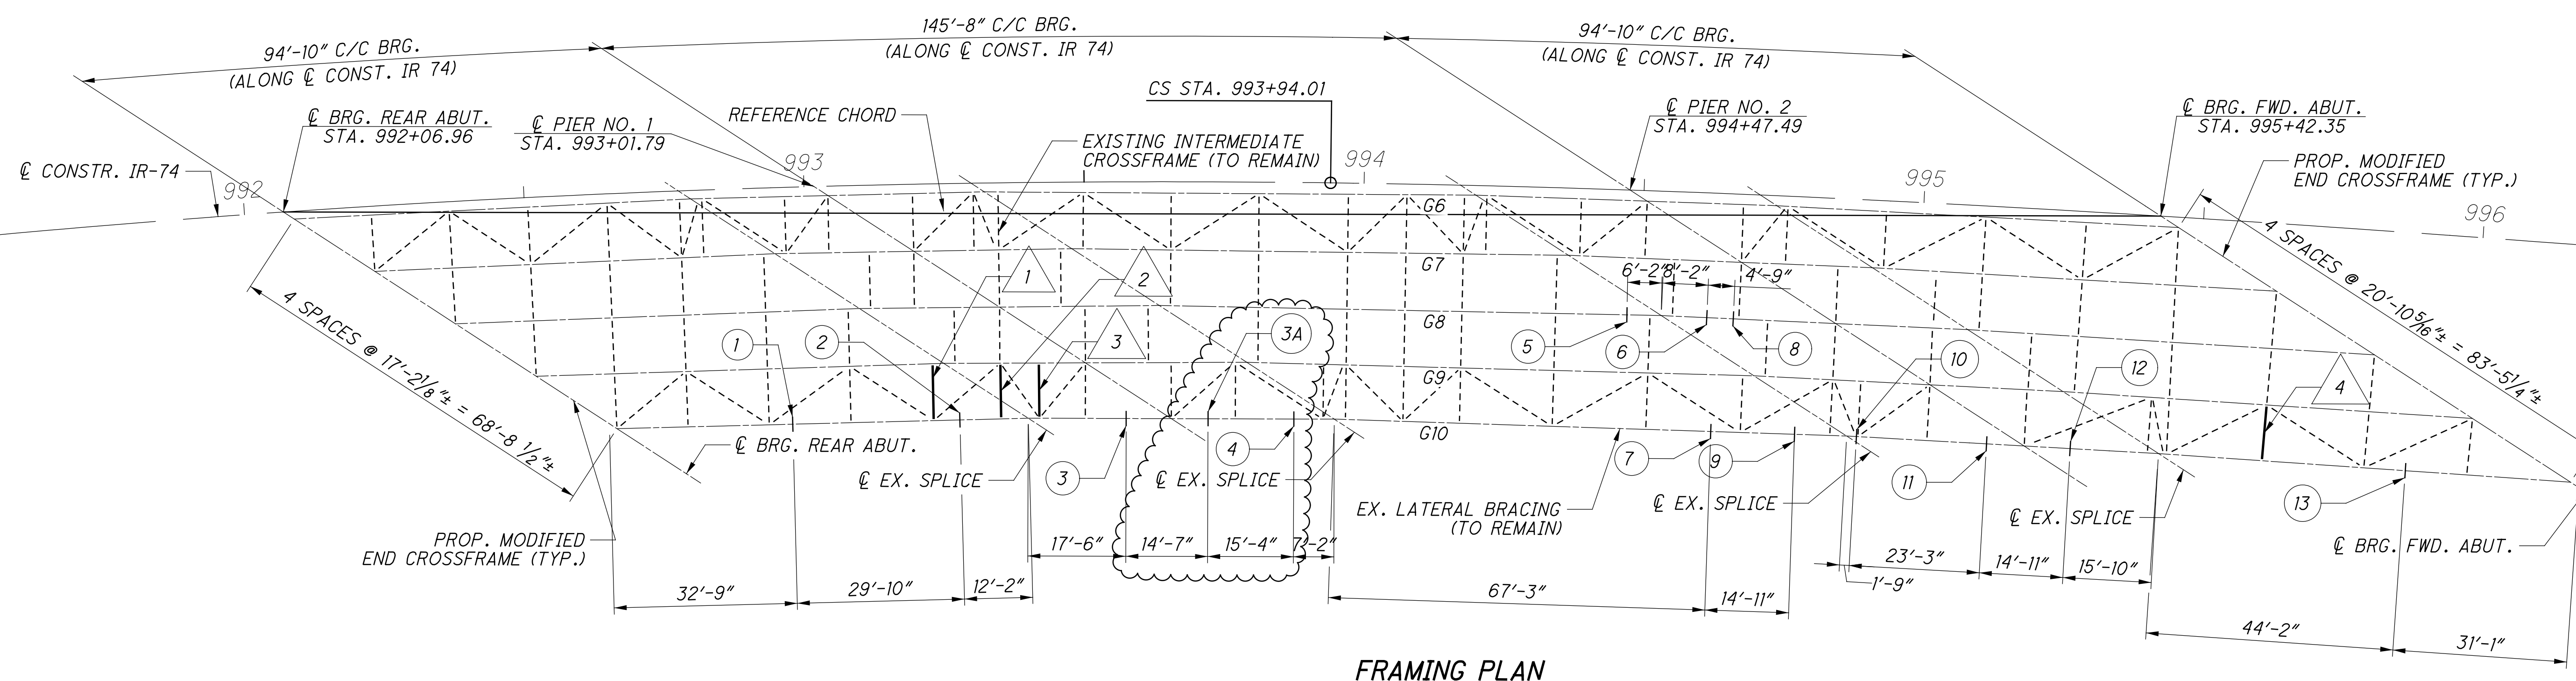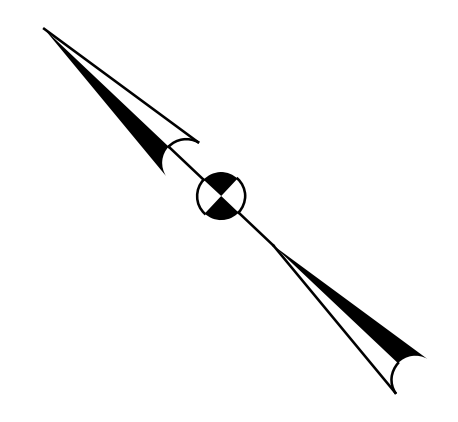


FRAMING PLAN

- ⊙ "X" INDICATES CUT LOCATION NUMBER
- △ "X" INDICATES CROSS-FRAME DAMAGE LOCATION NUMBER


- NOTES:
1. CROSS-FRAME DAMAGE LOCATIONS 1-3
REPLACE DAMAGED TOP MEMBER (L4x4x5/16)
 2. CROSS-FRAME DAMAGE LOCATION 4
REPLACE DAMAGED DIAGONAL (L3x3x5/16)
 3. SEE SHEET 4/4 FOR CROSS FRAME REPAIR DETAILS.
 4. SEE SHEET 3/4 FOR CUT LOCATION 10 SPLICE
PLATE REPLACEMENT DETAILS.

CUT LOCATION	L	D	T	REPAIR TYPE
1	4 1/4"	7/16"	1 1/2"	WELD
2	3 7/16"	5/16"	1 1/2"	WELD
3	8"	1 1/8"	2 1/2"	WELD
3A	4 3/4"	5/8"	2 1/2"	WELD
4	1 1/2"	3/16"	1 1/2"	GRIND
5	1 1/16"	9/16"	1 1/2"	GRIND
6	1 5/8"	5/8"	1 1/2"	WELD
7	5 1/4"	3/16"	1 1/2"	WELD
8	1 3/8"	1/2"	1 1/2"	GRIND
9	6 3/16"	5/8"	1 1/2"	WELD
10	8 1/8"	* 7/8"	** 1 1/2"	WELD
11	6 9/16"	1 3/16"	2 1/2"	WELD
12	7 1/8"	9/16"	2 1/2"	WELD
13	8 3/4"	1 1/16"	1 1/2"	WELD

* INCLUDES 3/4" TOP SPLICE PLATE
CUT COMPLETELY THROUGH
 ** FLANGE THICKNESS ONLY.

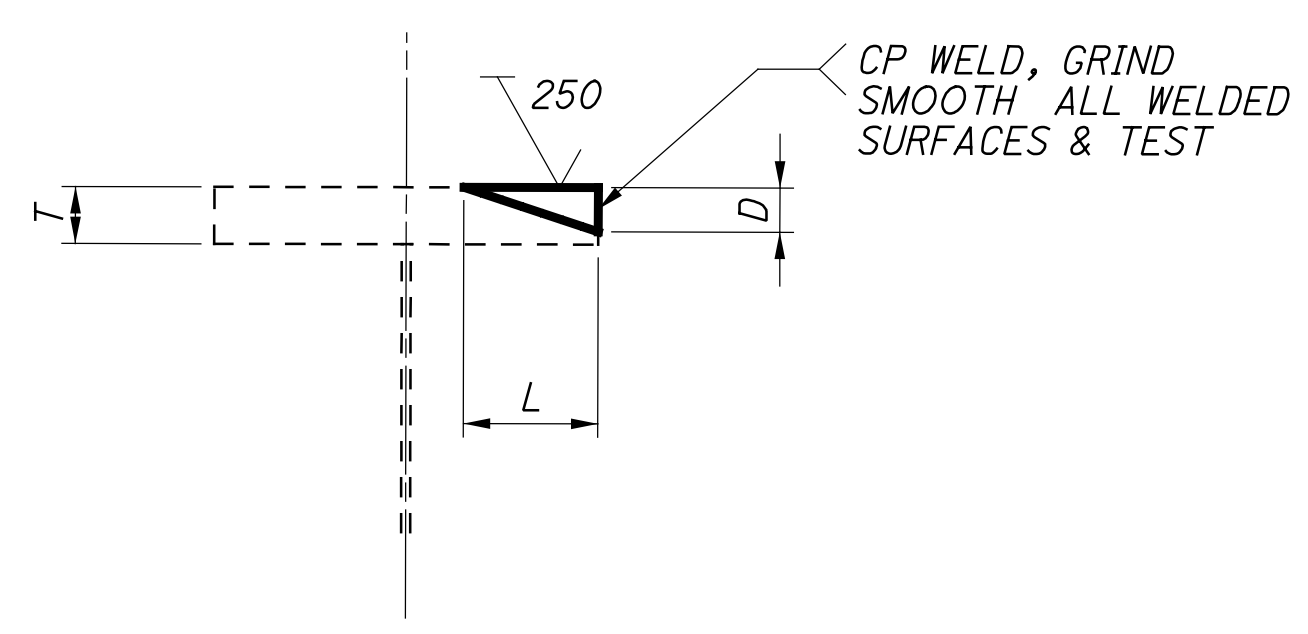


TYPICAL WELD REPAIR

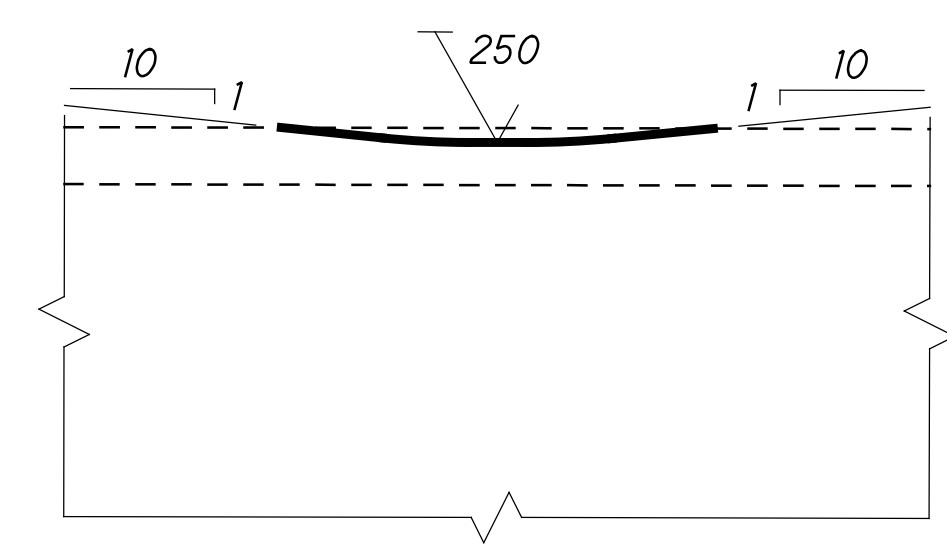


TYPICAL GRINDING REPAIR

dhutchinson 7:53:44 AM 9/8/2019 C:\2017\01113\C.Design\104667-HAM-75-3.84\Design\Structures\HAM0074_1840C\Sheets\74_1840SD006.dgn

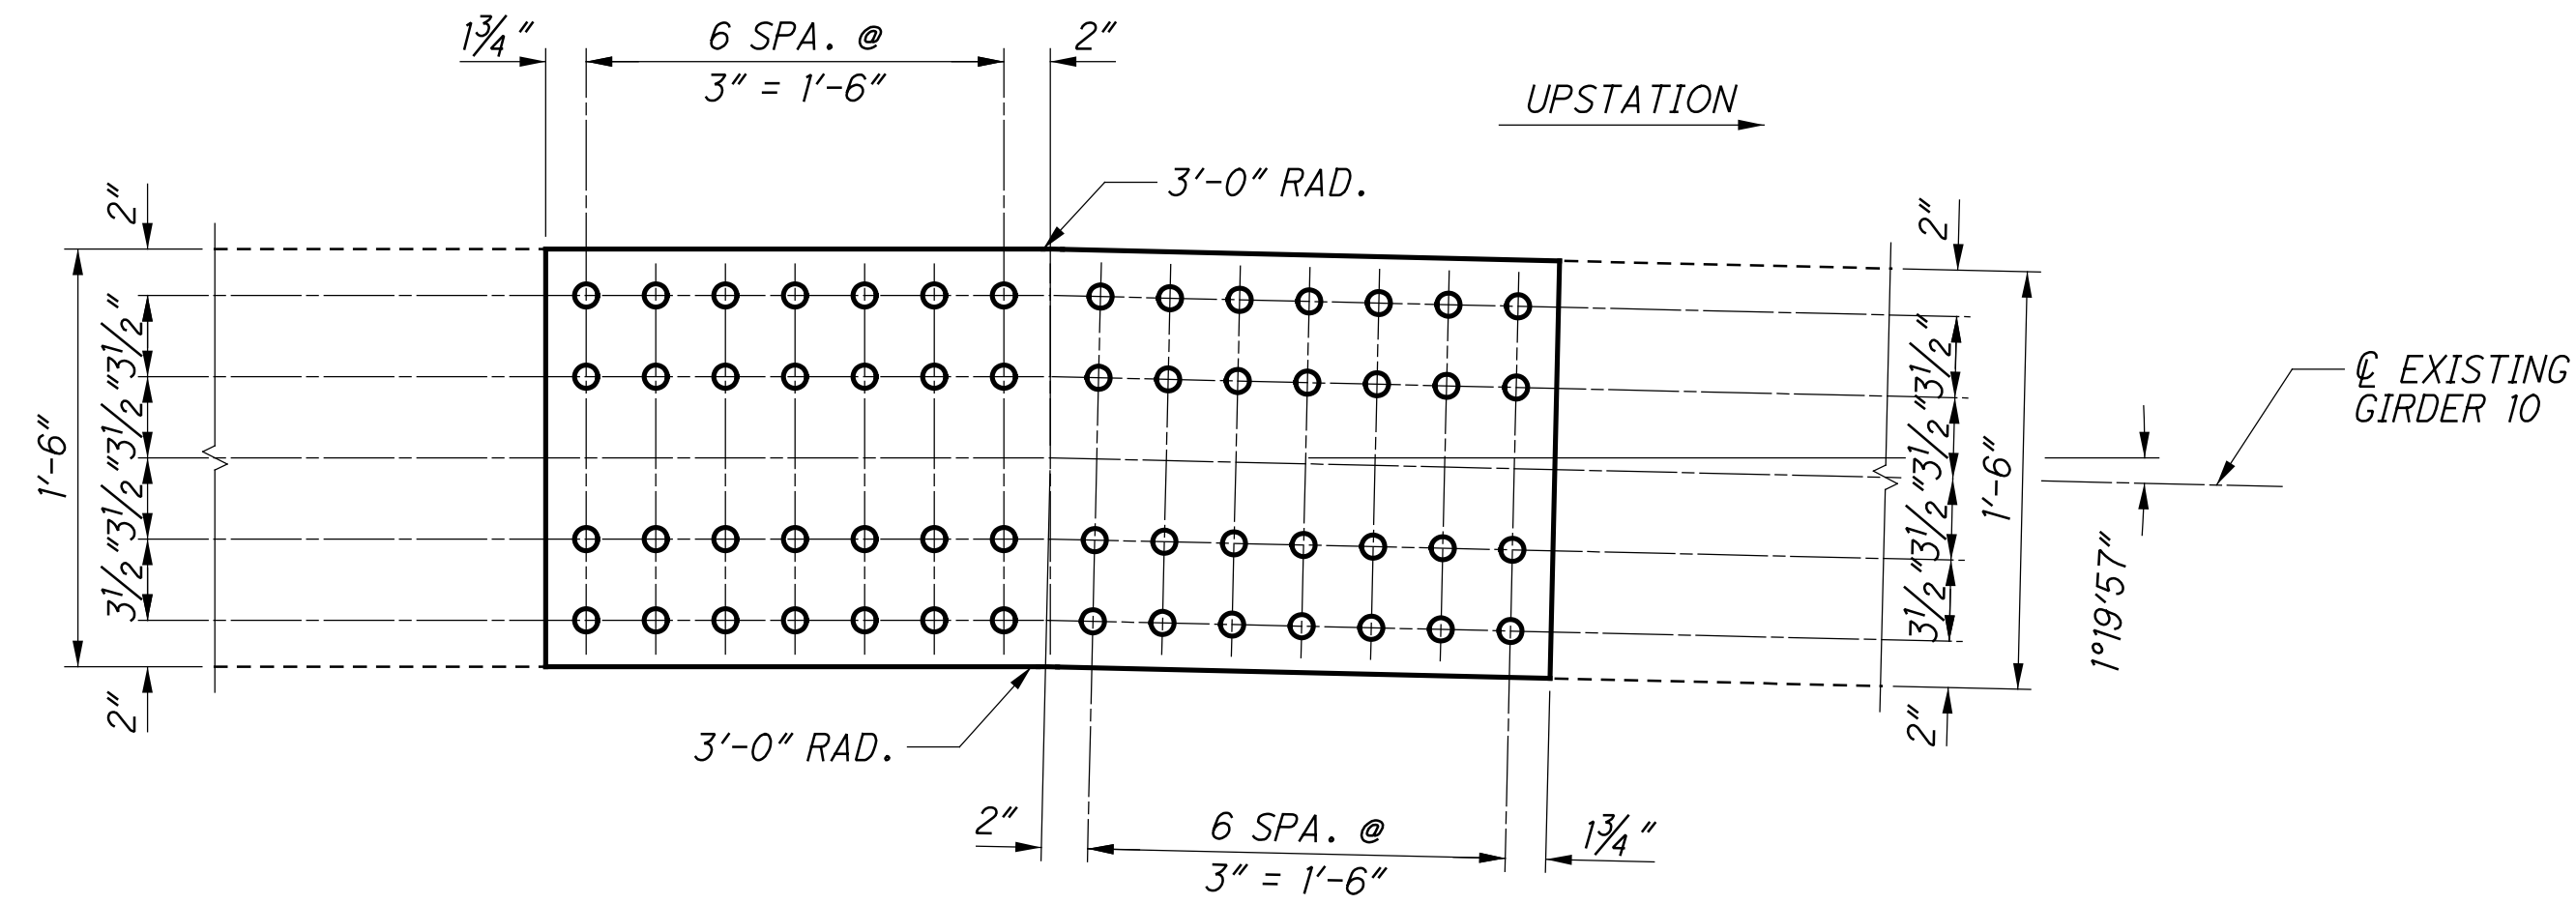

TOP SPLICE PLATE PLAN


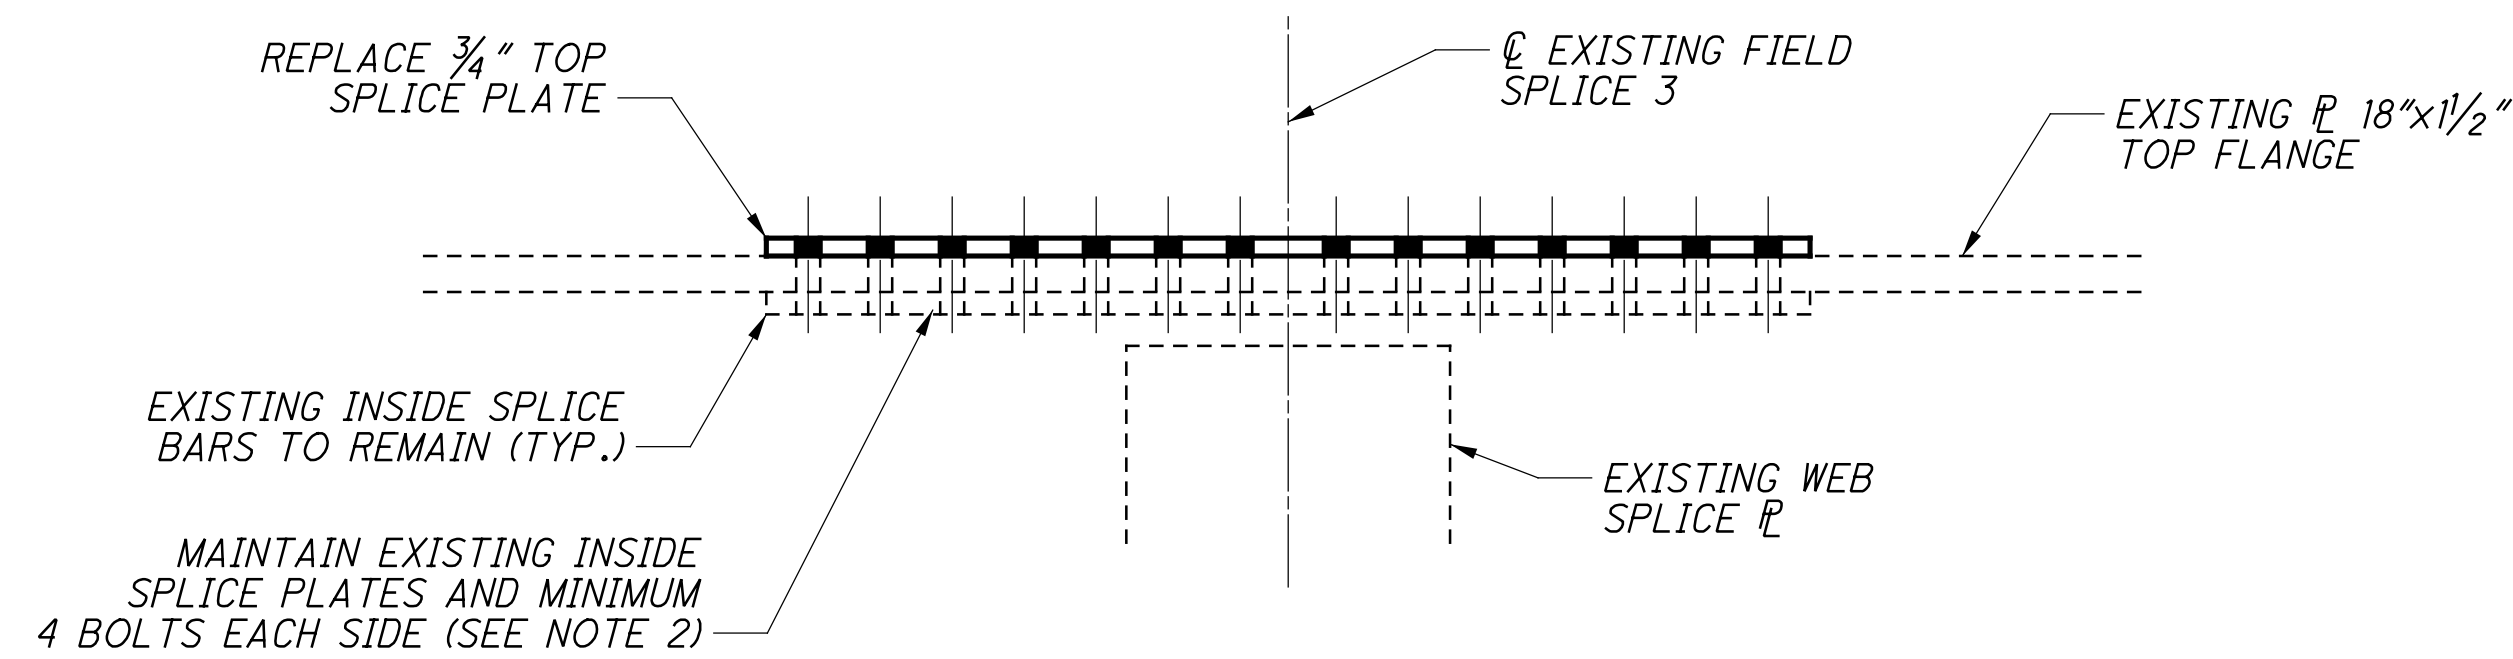


TOP SPLICE PLATE ELEVATION

**GIRDER 10 CUT LOCATION 10
SPLICE PLATE REPLACEMENT DETAILS**

NOTES:

1. WELD REPAIRS PER SHEET 2/ 4 AND SS 849.14 SHALL BE COMPLETED AT CUT LOCATION 10 PRIOR TO INSTALLATION NEW TOP SPLICE PLATE.
2. MAINTAIN MINIMUM OF 4 BOLTS EACH SIDE OF EXISTING SPLICE INCLUDING INSIDE SPLICE PLATES AT ALL TIMES FOR SHEAR AND HOLE ALIGNMENT. BOLTS DO NOT REQUIRE PRETENSIONING FOR TEMPORARY CONDITION. DRIFT/BULL PINS MAY BE USED TEMPORARILY TO REMOVE EXISTING TOP SPLICE PLATE AND PLACE NEW PLATE.
3. REPLACE ALL BOLTS IN THE TOP SPLICE PLATE. BOLTS ARE ASTM F3125 GRADE A325 7/8" DIA. HIGH STRENGTH BOLTS.
4. SPLICE PLATE SHALL BE ASTM A709 GRADE 50.
5. SPLICE PLATE MATERIAL SHALL MEET THE MINIMUM NOTCH TOUGHNESS REQUIREMENTS AS SPECIFIED IN 711.01.
6. ALL DIMENSIONS PROVIDED ARE BASED ON EXISTING PLANS. CONTRACTOR SHALL VERIFY ALL DIMENSIONS PRIOR TO FABRICATION.

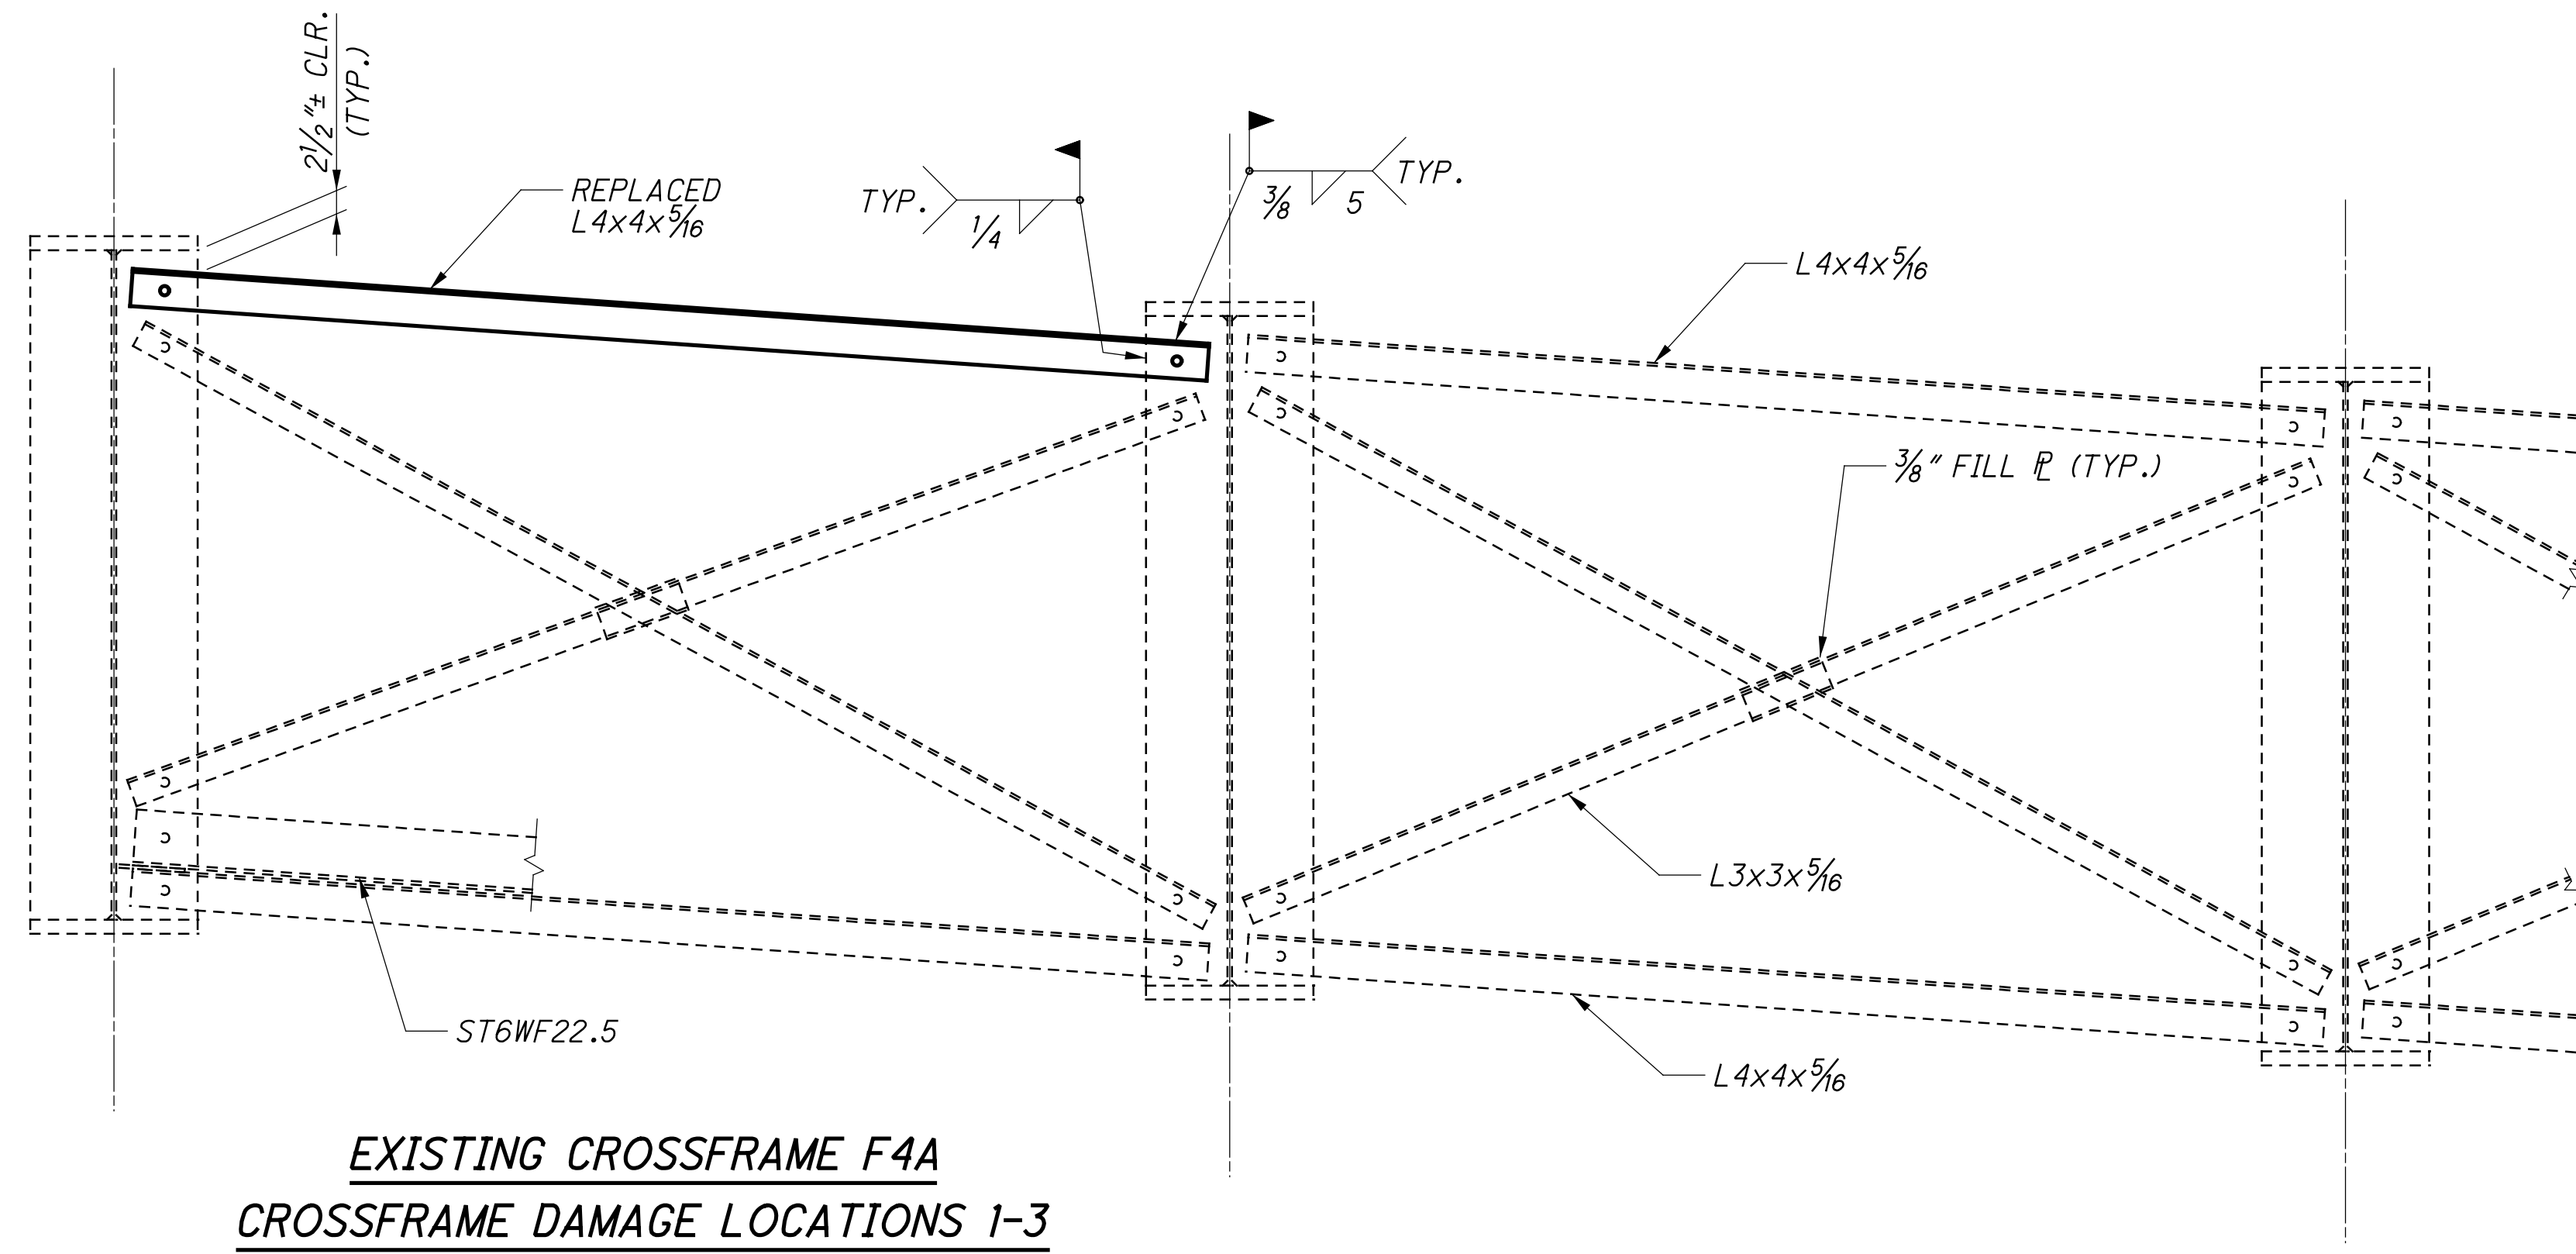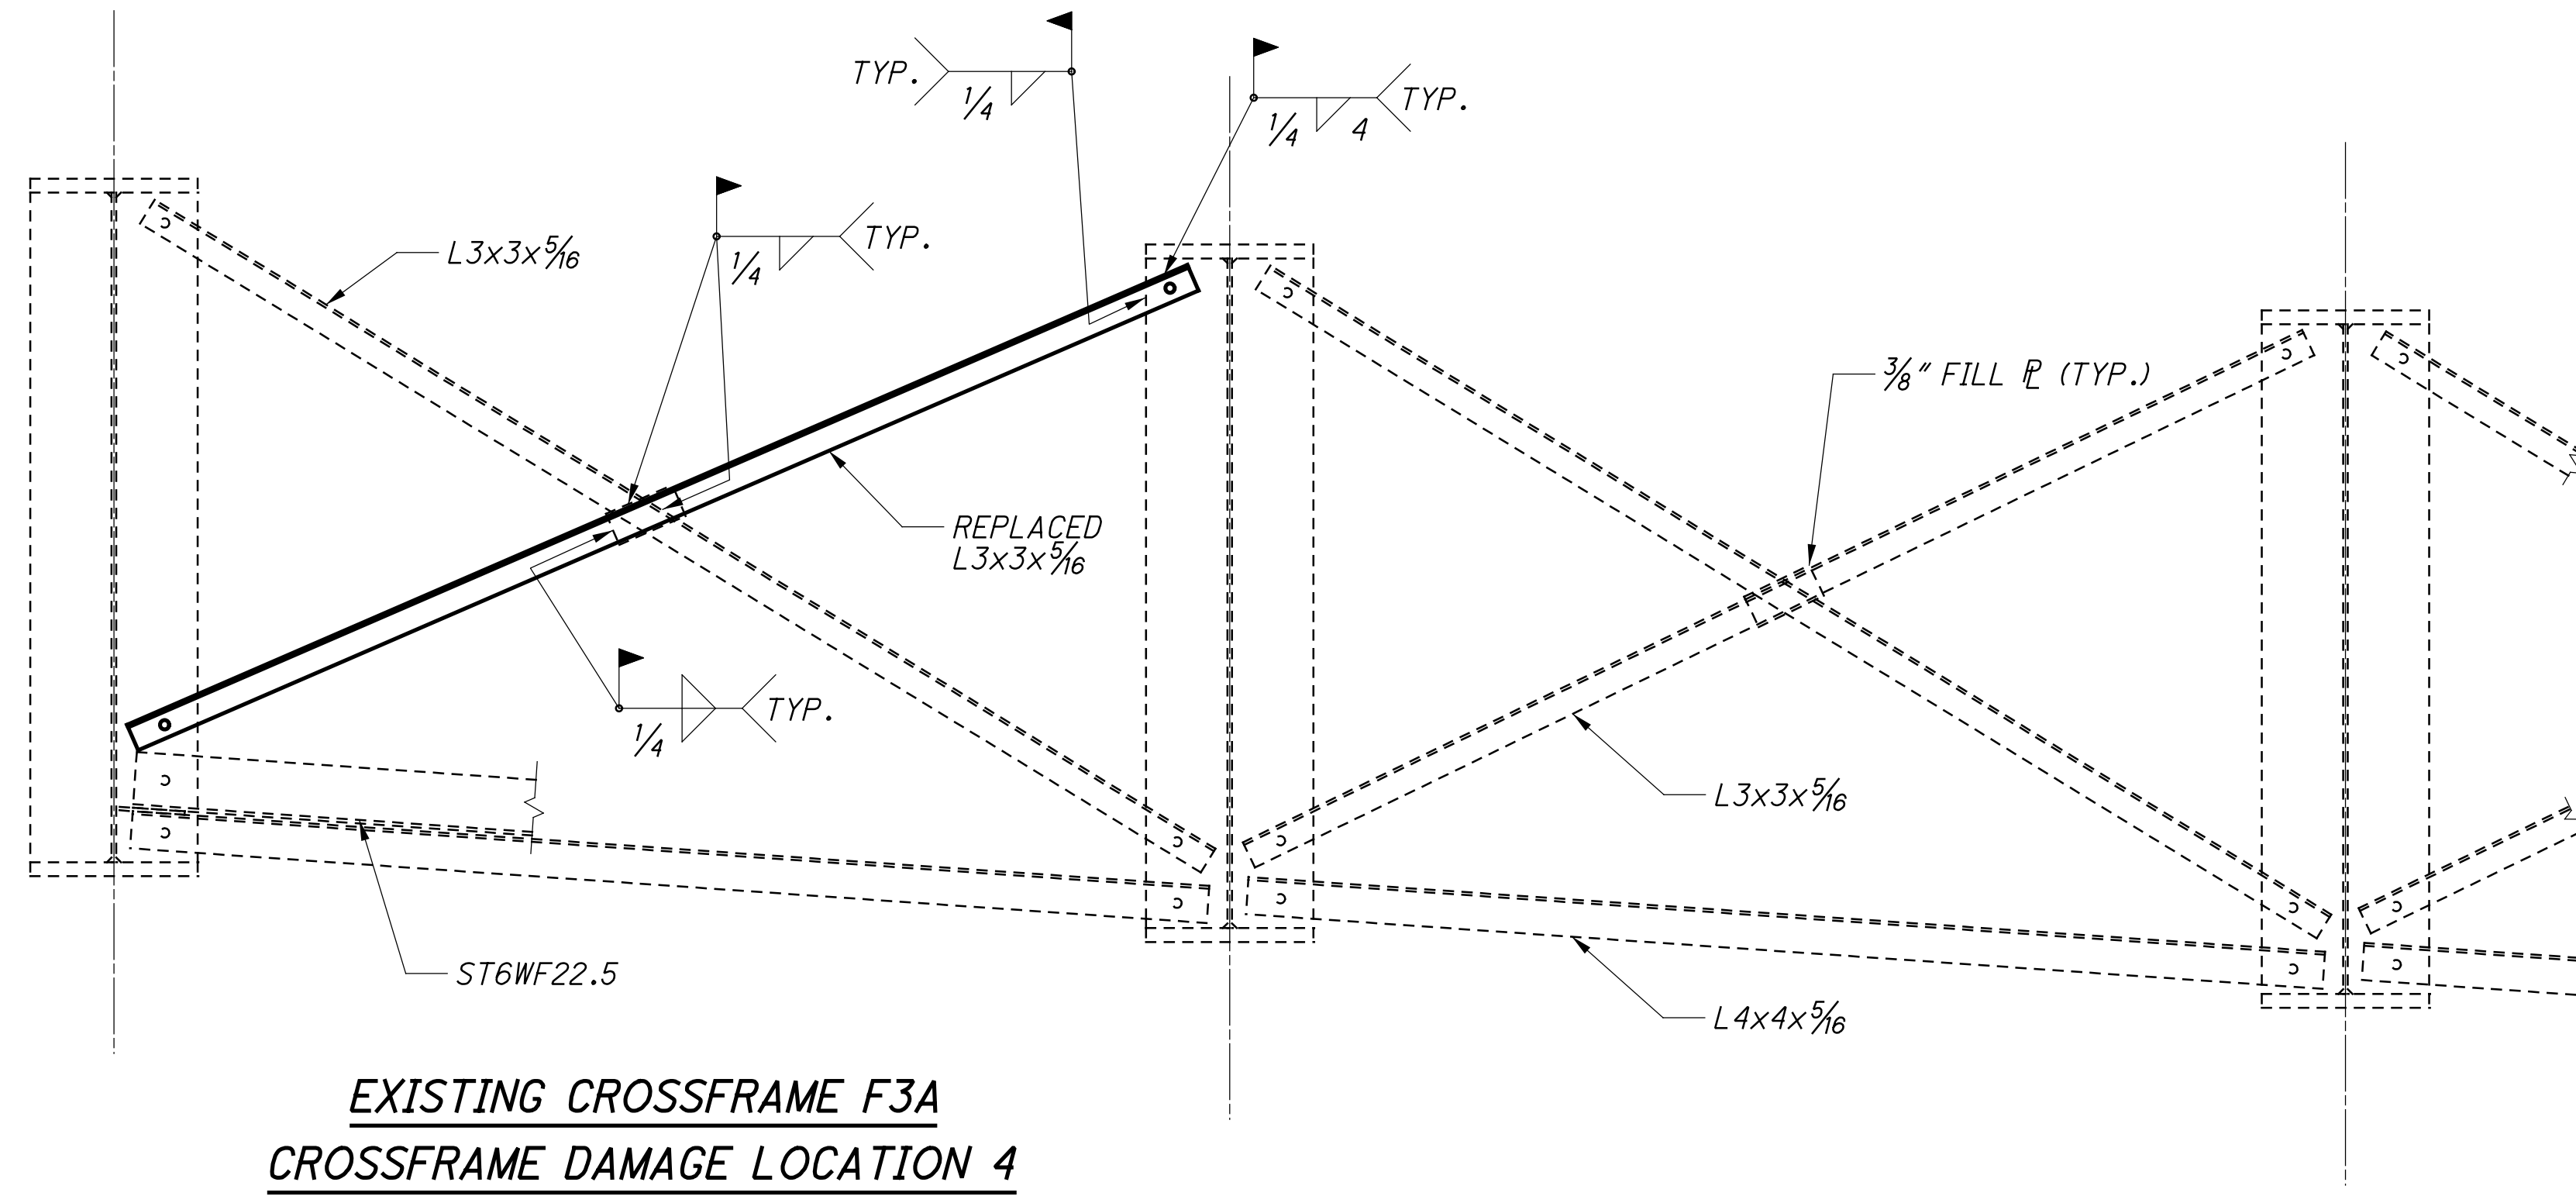

NOTES:

1. STRUCTURAL STEEL SHALL BE ASTM A709 GRADE 50.
2. CROSSFRAMES TO BE REPLACED PRIOR TO DECK POUR.
3. ALL FOUR CROSSFRAME REPLACEMENT LOCATIONS SHOWN ON SHEET 2/4 MAY BE REPLACED CONCURRENTLY.

	DESIGN AGENCY STRUCTUREPOINT	DATE 5/16/19	REVIEWED SUJ	STRUCTURE FILE NUMBER 3115526
DRAWN DSH	DESIGNED AMI			
CHECKED CLB	REVISED			
CORRECTIVE WORK PLAN - CROSSFRAME REPAIR DETAILS BRIDGE NO. HAM-74-1840 L/R OVER SB BEEKMAN ST. (U.S. 27) AND RAMP F				
HAM-75-3.84 PID No. 104667				
4 / 4				

cbettinger 12/19/2019 12:58:12 PM \\0\2017\01113\C_Design\104667-HAM-75-3.84_Design\Structures\HAM0074_1852C_Sheets\74_1852GN003.dgn

CORRECTIVE WORK PLAN:

PER CMS 505.05.D

SUPPLEMENTAL SPECIFICATIONS:

REFER TO SS 849 AS NOTED IN THE PLANS.

SEQUENCE OF WORK:

REPAIR CUT LOCATIONS WITH SPLICE PLATES PER PLANS

REPAIR CUT LOCATIONS WITH FULL PENETRATION WELDS AND GRINDING PER PLANS AND SS 849.14

REPAIR STRUCTURAL STEEL COATING SYSTEM AT ALL LOCATIONS DAMAGED DURING DEMOLITION AND DURING THE REPAIR PROCEDURES PER ITEM 514 - FIELD PAINTING OF DAMAGED STRUCTURAL STEEL, AS PER PLAN (ONE COAT)

ITEM 513 - STRUCTURAL STEEL MEMBERS, LEVEL UF, AS PER PLAN:

ALL REQUIREMENTS OF 513 APPLY TO SHOP FABRICATED MEMBERS. PERFORM WORK FOR FIELD FABRICATED MEMBERS ACCORDING TO ITEM 513, EXCEPT AS MODIFIED HEREIN. THE DEPARTMENT WILL NOT REQUIRE THE CONTRACTOR PERFORMING FIELD FABRICATION TO BE PRE-QUALIFIED AS SPECIFIED IN SUPPLEMENT 1078. SUBMIT A WRITTEN LETTER OF MATERIAL ACCEPTANCE, 501.06, TO THE ENGINEER. PROVIDE SHOP DRAWINGS ACCORDING TO 513.06 OR SUPPLY THE ENGINEER WITH "AS BUILT" DRAWINGS MEETING 513.06 AFTER COMPLETION OF FIELD FABRICATION. THE ENGINEER WILL REVIEW THE SUBMITTED DRAWINGS FOR CONCURRENCE WITH THE FINAL AS-BUILT CONDITION. THE ENGINEER MAY CONTACT THE OFFICE OF STRUCTURAL ENGINEERING FOR TECHNICAL ASSISTANCE. IF THE ENGINEER IS SATISFIED WITH THE "AS-BUILT" DRAWINGS AND THE DELIVERED MATERIALS. SUPPLY A COPY OF THE DRAWINGS, STAMPED, SEALED AND DATED, ACCORDING S1002, TO THE STRUCTURAL, WELDING AND METALS SECTION OF THE OFFICE OF MATERIAL MANAGEMENT FOR RECORD PURPOSES. SPLICE PLATES FOR THE REPAIR OF THE GIRDER 10 TOP FLANGE ARE INCLUDED IN THIS ITEM.

ITEM 513 - STRUCTURAL STEEL MISC., REPAIR OF DAMAGED MEMBERS, COPE HOLES:

COPE HOLE IS REQUIRED AT EACH LOCATION WHERE THE GIRDER WEB WAS CUT (FOUR LOCATIONS). PROVIDE A 2" DIAMETER HOLE ACCORDING TO PLAN DETAILS OR AS DIRECTED BY THE ENGINEER. GRIND THE HOLES SMOOTH ACCORDING TO C&MS 513.19.

ITEM 513 - STRUCTURAL STEEL MISC., REPAIR OF DAMAGED MAIN MEMBER, COMPLETE PENETRATION WELDING:

AFTER DAMAGED AREAS HAVE BEEN INSPECTED ACCORDING TO ITEM 849 DAMAGE ASSESSMENT. PREPARE THE DAMAGED MATERIAL FOR WELDING, PROVIDE RUNOFF TABS FOR ALL COMPLETE PENETRATION WELDS. PERFORMING COMPLETE PENETRATION WELDS ACCORDING TO C&MS 513 USING APPROVED ELECTRODES, PROCEDURES AND WELDERS. REMOVE RUNOFF TABS AND GRIND THE COMPLETED EDGES SMOOTH. GRIND THE COMPLETED WELDS SMOOTH AND FLUSH WITH THE ADJACENT SURFACES TO PROVIDE A SURFACE FINISH ACCORDING TO ANSI B46.1 OF 250 MIL. DO NOT OVER GRIND AS TO REDUCE THE MATERIAL THICKNESS OR WIDTH OF THE NEW OR EXISTING MATERIALS. PREPARE ALL REENRANT CORNERS WITH A ONE INCH RADIUS. REMOVE WELDING, START AND STOP DISCONTINUITIES. RADIOGRAPHIC TEST THE FINISHED WELDS ACCORDING TO C&MS 513.25A AND SUBMIT COPIES OF THE REPORTS TO THE ENGINEER. THE ENGINEER MAY OBTAIN TECHNICAL ASSISTANCE FROM THE OFFICE OF MATERIALS MANAGEMENT.

ITEM 514 - FIELD PAINTING OF DAMAGED STRUCTURAL STEEL, AS PER PLAN (ONE COAT):

1.0 DESCRIPTION: THIS ITEM CONSISTS OF FIELD PAINTING STRUCTURAL STEEL PREVIOUSLY COATED WITH AN UNKNOWN EXISTING PAINT TO CORRECT DAMAGE FROM DEMOLITION AND REPAIR PROCEDURES. THIS WORK CONSISTS OF PERFORMING SURFACE PREPARATION AND APPLYING A PRIMER TO THE PREPARED STEEL AND FEATHERED REMOVAL AREAS OF UNKNOWN EXISTING PAINT SYSTEMS. ALL STRUCTURAL STEEL SURFACE AREAS, THAT WILL BE EXPOSED AFTER CONSTRUCTION COMPLETE, DAMAGED BY DEMOLITION OR REPAIR PROCEDURES SHALL BE PAINTED.

2.0 GENERAL: C&MS 514.05 THROUGH 514.10 AND 514.13.D APPLY UNLESS MODIFIED BY THESE NOTES.

3.0 WASHING EXISTING PAINTED SURFACES: CLEAN SURFACES TO BE COATED WITH LOW PRESSURE WATER CLEANING TO REMOVE ALL DIRT, DEBRIS, ANIMAL EXCREMENT, SALT CONTAMINANTS AND OTHER ACCUMULATED FOREIGN MATERIAL IN ACCORDANCE WITH SSPC-SPI2 (LP WC), LOW PRESSURE WATER CLEANING. THE PRESSURE WASHER SHALL BE CAPABLE OF ACHIEVING AT LEAST 2000 POUNDS PER SQUARE INCH AT THE NOZZLE. WHEN USING THE POWER WASHING EQUIPMENT, THE NOZZLE SHALL BE MAINTAINED NO MORE THAN 10 INCHES FROM THE SURFACE. SUPPLY AND USE POTABLE WATER. PROVIDE TO THE ENGINEER A LETTER OF WRITTEN ACCEPTANCE FOR ANY BIODEGRADABLE DETERGENTS OR CLEANERS USED IN CONJUNCTION WITH THIS METHOD.

COLLECT AND CONTAIN WATER AND DEBRIS REMOVED DURING WASHING OPERATIONS ABOVE WATER FEATURES IN CONFORMANCE WITH C&MS 514.08 AND C&MS 514.13.D FOR ANY DEBRIS. CREATE SETTLEMENT COLLECTION BASINS AND STRAIN ALL WASH WATER ABOVE LAND FEATURES AS NECESSARY TO PRODUCE VISIBLY CLEAR WATER AND COMPLY WITH CMS 514.08 AND C&MS 514.13.D FOR ANY DEBRIS.

4.0 SURFACE PREPARATION: AFTER THE PRESSURE WASHED SURFACE HAS DRIED, REMOVE EXISTING PAINT COATING TO CONTRACT LIMITS OR AS DIRECTED BY THE ENGINEER ACCORDING TO: SSPC-SP 11, POWER TOOL CLEANING TO BARE METAL, AS SHOWN ON THE PICTORIAL SURFACE PREPARATION STANDARDS FOR PAINTING STEEL SURFACES SHOWN IN SSPC-VIS 3; SSPC SP6, COMMERCIAL BLAST CLEANING, AS SHOWN ON THE PICTORIAL SURFACE PREPARATION STANDARDS FOR PAINTING STEEL SURFACES SHOWN IN SSPC-VIS 1; OR SSPC SPI2 UHP WJ-4, ULTRAHIGH-PRESSURE WATER JETTING, AS SHOWN ON THE PICTORIAL SURFACE PREPARATION STANDARDS FOR PAINTING STEEL SURFACES SHOWN IN SSPC-VIS 4. SUPPLY BLAST WATER CONTAINING A COMMERCIALY AVAILABLE RUST INHIBITOR AT A DOSAGE THAT PREVENTS FLASH RUSTING FOR 12 HOURS AND DOCUMENTED AS ACCEPTABLE TO THE COATING'S MANUFACTURER. THE ENGINEER WILL USE THE SSPC-VIS 1, SSPC-VIS 3 OR SSPC-VIS 4 TO DETERMINE THE ACCEPTANCE OF THE SURFACE PREPARATION. FEATHER THE EXISTING PAINT TO ROUGHEN A MINIMUM OF 1/2 INCH OF THE EXISTING PAINT. CONTAIN AND DISPOSE OF WASTE GENERATED BY THE CLEANING ACCORDING TO C&MS 514.13.D.

ROUND ALL EXPOSED CORNERS OF MAIN MATERIAL TO BE PAINTED AS NECESSARY TO ACHIEVE A 1/8 INCH RADIUS OR EQUIVALENT FLAT SURFACE AT A 45 DEGREE ANGLE.


5.0 FIELD PAINTING: APPLY THE PRIME COAT OF THE THREE-COAT PAINT SYSTEM SPECIFIED IN C&MS 708.02, ACCORDING TO C&MS 514.15, 514.16, 514.17, 514.19 AND 514.20 TO THE CONTRACT LIMITS OR AS DIRECTED BY THE ENGINEER. THE ENGINEER WILL DETERMINE THE PRIME COAT THICKNESS USING A TYPE 2 MAGNETIC GAGE AT SPOT LOCATIONS. DO NOT APPLY THE INTERMEDIATE OR FINISH COAT. THE PRIME COAT OF PAINT SHALL MEET THE MINIMUM DRY FILM THICKNESS REQUIREMENTS OF C&MS 514.20. APPLY PAINT AS FOLLOWS:

APPLY THE PRIME COAT ONLY TO THE PREPARED SURFACE OF THE BARE STEEL AND THE EXISTING UNKNOWN PAINT SYSTEM ROUGHENED BY FEATHERING. AT THE PERIMETER OF THE REPAIR AREA, APPLY THE PRIME COAT USING A BRUSH. IN LIEU OF BRUSHING THE CONTRACTOR MAY DOUBLE MASK THE AREAS NOT TO BE COATED AND SPRAY TO FEATHERED REMOVAL LINES.



DESIGN AGENCY		DATE	4/17/19
STRUCTUREPOINT		REVIEWED	SJF
STRUCTUREPOINT		DRAWN	DSH
STRUCTUREPOINT		DESIGNED	AMI
STRUCTUREPOINT		CHECKED	CLB
STRUCTUREPOINT		REVISSED	
STRUCTUREPOINT		STRUCTURE FILE NUMBER	3115577
CORRECTIVE WORK PLAN - GIRDER REPAIR NOTES			
BRIDGE NO. HAM-74-1852 L/R OVER NB BEEKMAN ST. (U.S. 27)			
HAM-75-3.84			
PID No. 104667			
1/4			
1/4			


cbettinger 12/19/2019 12:58:13 PM
 \\0\2017\01113\C.Design\104667 -HAM-75-3.84\Structures\HAM0074_1852C_Sheets\74_1852SD008.dgn

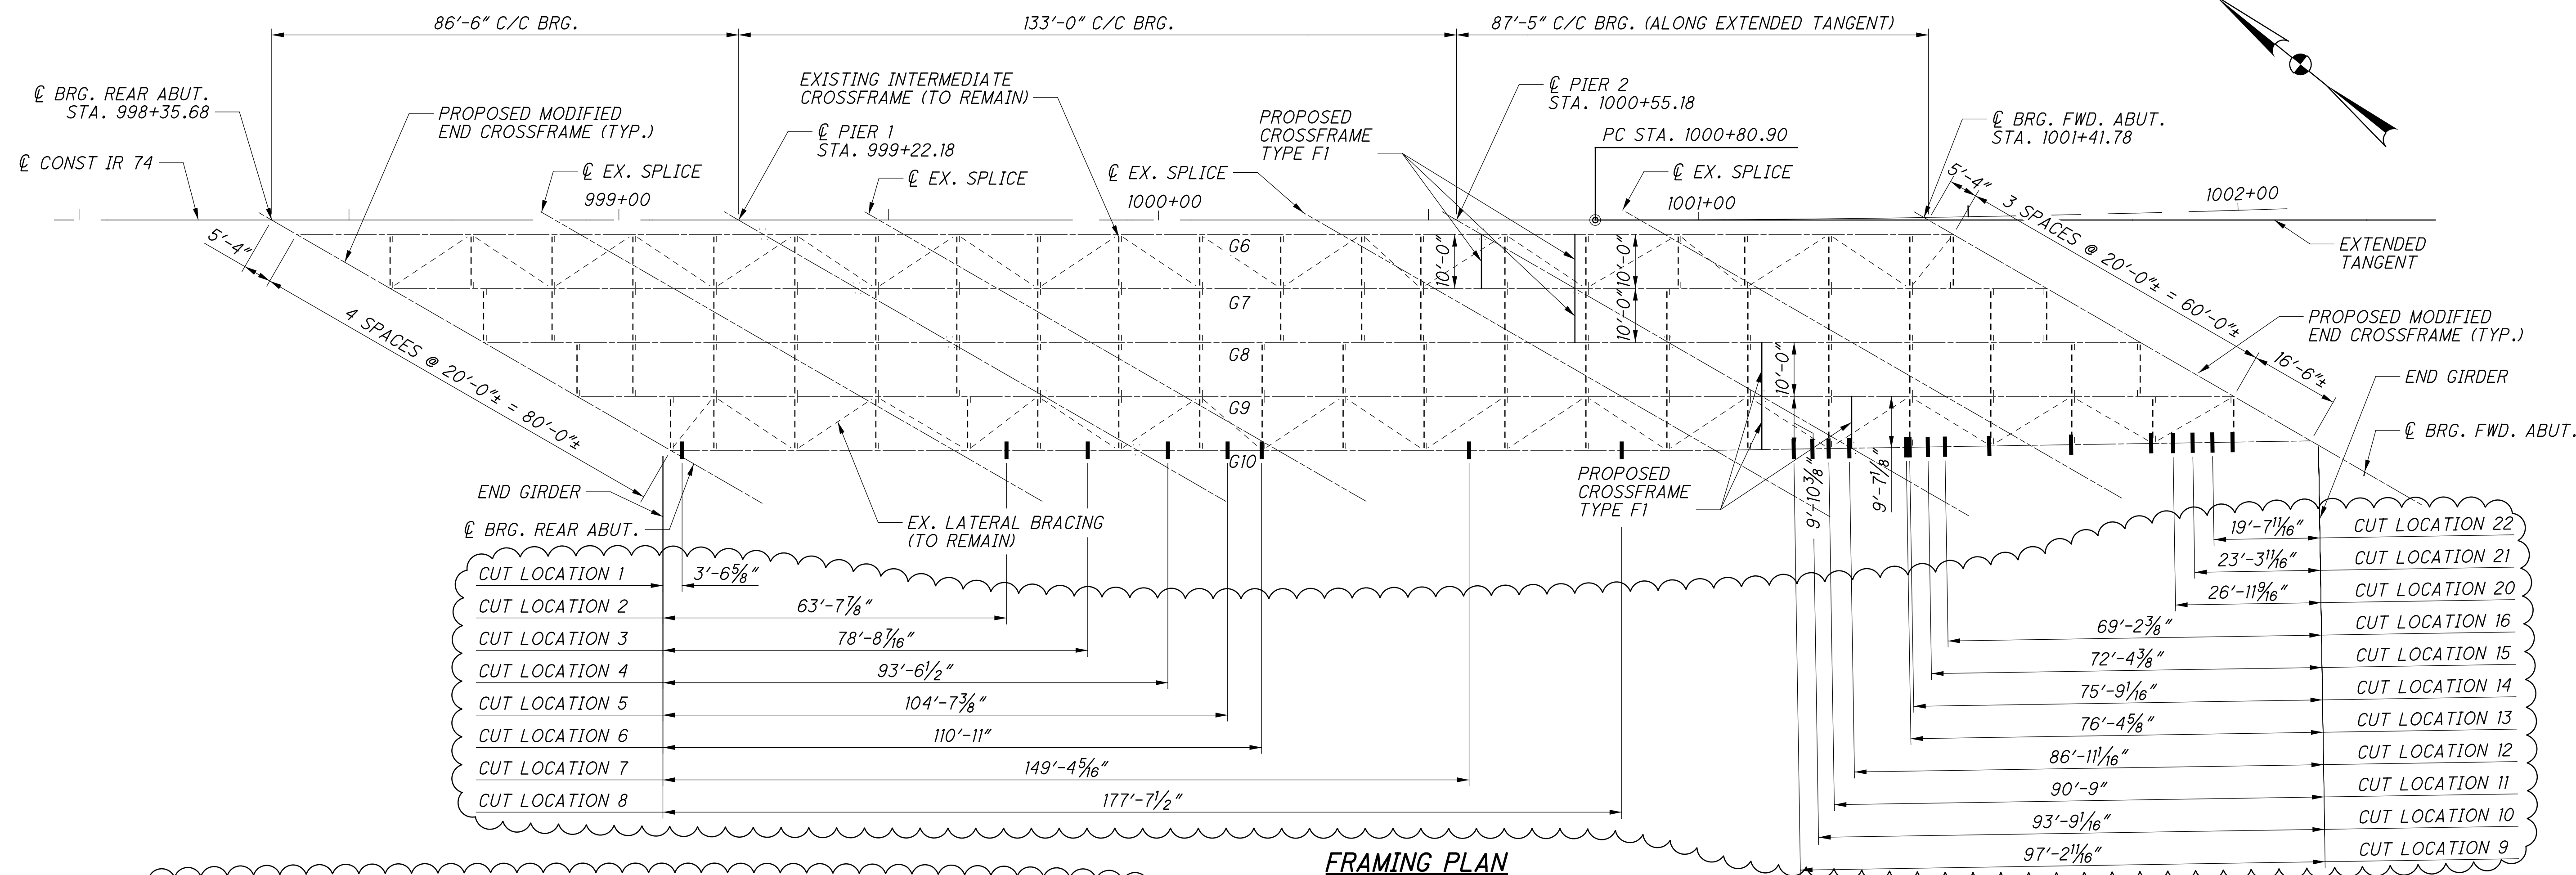


FRAMING PLAN

DAMAGE DESCRIPTIONS (LOCATIONS 1-14, GIRDER 10)				
CUT LOCATION	L	D	T	REPAIR TYPE
1	6"	7/16"	7/8"	WELD
2	4"	1/16"	7/8"	GRIND
3	12"	1 1/2"	2 3/8"	WELD
4	12 1/2"	1 3/8"	2 3/8"	WELD
5	10 3/8"	5/8"	1 1/4"	WELD
6	12 1/16"	1 1/16"	1 1/4"	WELD
7	4 5/8"	5/16"	1 3/4"	WELD
8A	1 1/2"	3/16"	1 3/4"	WELD
8B	3 1/8"	3/16"	1 3/4"	WELD
9A	4 1/2"	9/16"	2 3/8"	WELD
9B	4 1/8"	1/8"	2 3/8"	WELD
9C	2 5/8"	5/16"	2 3/8"	WELD
10	8 1/8"	1/8"	2 3/8"	GRIND
11	14 1/4"	2 1/16"	2 3/8"	WELD
12A	9 13/16"	1/4"	2 3/8"	WELD
12B	9 13/16"	1/4"	2 3/8"	WELD
13A	4"	1/4"	2 3/8"	WELD
13B	2 5/16"	1/16"	2 3/8"	WELD
14	13 1/2"	1 5/8"	2 3/8"	WELD


DAMAGE DESCRIPTIONS (LOCATIONS 15, 16, 20-22 GIRDER 10)				
CUT LOCATION	L	D	T	REPAIR TYPE
15	5 3/4"	1/16"	2 3/8"	GRIND
16A	1 5/8"	3/16"	2 3/8"	GRIND
16B	2 3/16"	1/16"	2 3/8"	GRIND
20	4 1/2"	1/8"	7/8"	WELD
21	1 3/4"	1/16"	7/8"	GRIND
22	1 9/16"	1/8"	7/8"	GRIND

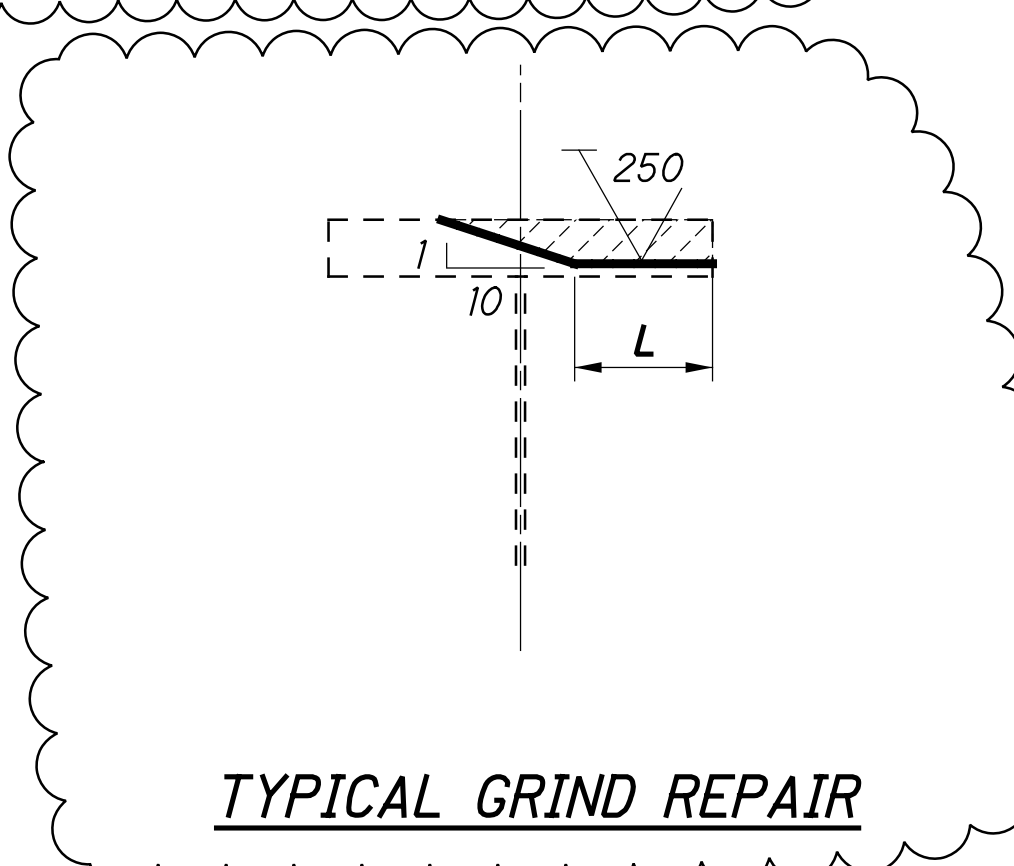

TYPICAL GRIND REPAIR

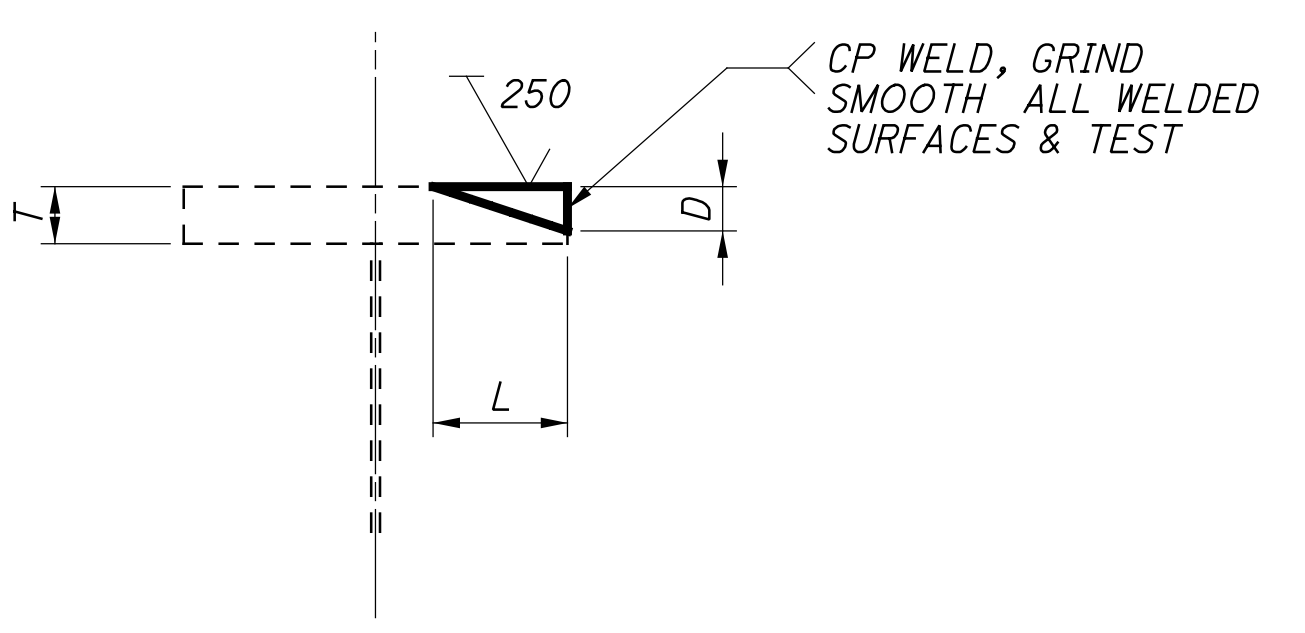


TYPICAL WELD REPAIR

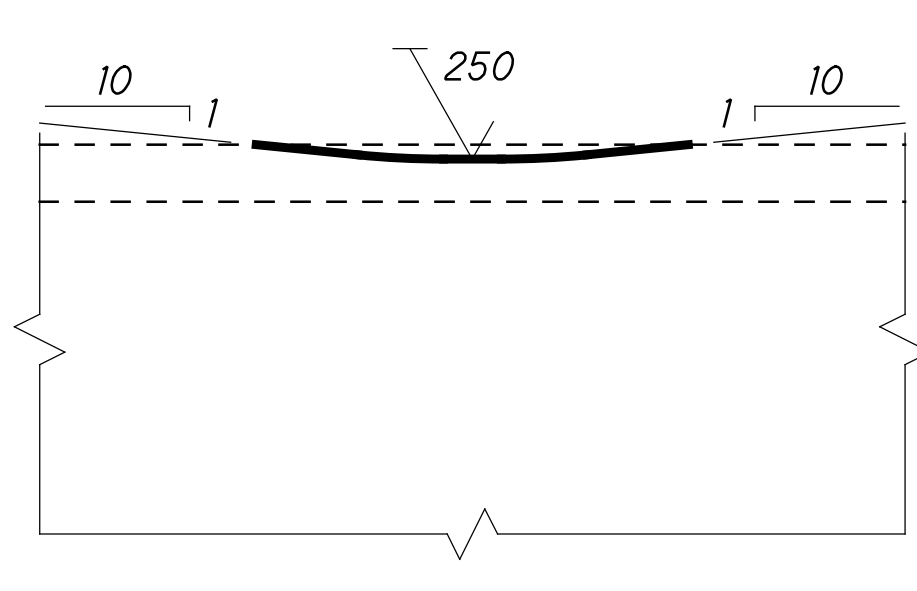

TYPICAL GRINDING REPAIR

- REPAIR CUT BY GRINDING ACCORDING TO SUPPLEMENTAL SPECIFICATION 849, REPAIR DAMAGED MEMBERS. PERFORM GRINDING ACCORDING TO SUPPLEMENTAL SPECIFICATION 849 AND AS ILLUSTRATED IN DETAIL
- REPAIR CUT BY WELDING ACCORDING TO SUPPLEMENTAL SPECIFICATION 849 REPAIRING DAMAGED MEMBERS, AS ILLUSTRATED IN DETAIL FC2-3. PERFORM COMPLETE PENETRATION WELDING ACCORDING TO C&MS 513.21 BY ATTACHING RUN OFF TABS AND GRIND ALL WELDED SURFACES SMOOTH ACCORDING TO ANSI B46.1 OF 250 mil
- PERFORM NDT TESTING ACCORDING TO C&MS 513.25A

 DESIGN AGENCY STRUCTUREPOINT	DATE: 4/17/19 REVIEWED: SUJ DRAWN: DSH DESIGNED: AMI CHECKED: CLB	BRIDGE NO. HAM-74-1852 L/R OVER NB BEEKMAN ST. (U.S. 27)	CORRECTIVE WORK PLAN - GIRDER REPAIR WELD/GRINDING DETAILS	PID No. 104667
FILE NUMBER: 3115577				
2 / 4		2 / 4		



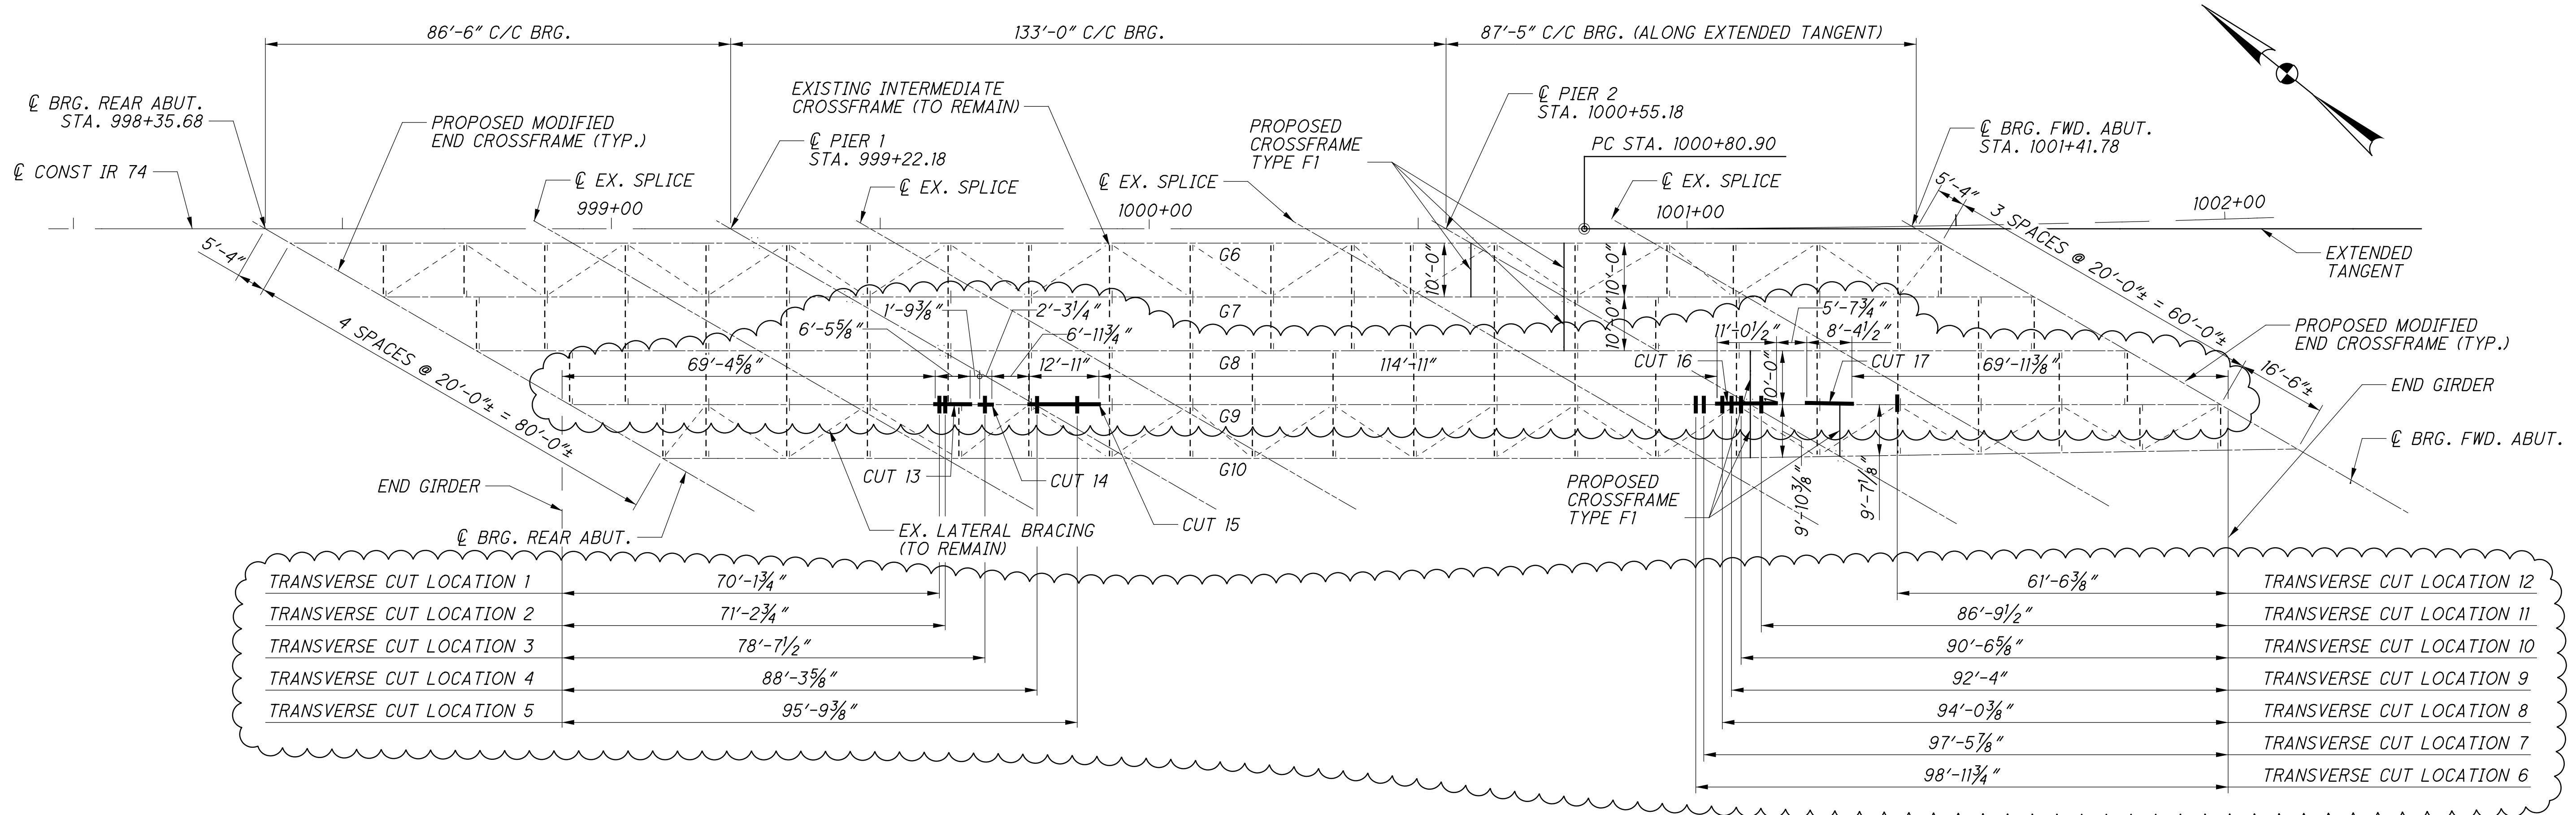


TRANSVERSE CUT LOCATION 1	70'-1 3/4"	TRANSVERSE CUT LOCATION 12	61'-6 3/8"
TRANSVERSE CUT LOCATION 2	71'-2 3/4"	TRANSVERSE CUT LOCATION 11	86'-9 1/2"
TRANSVERSE CUT LOCATION 3	78'-7 1/2"	TRANSVERSE CUT LOCATION 10	90'-6 5/8"
TRANSVERSE CUT LOCATION 4	88'-3 5/8"	TRANSVERSE CUT LOCATION 9	92'-4"
TRANSVERSE CUT LOCATION 5	95'-9 3/8"	TRANSVERSE CUT LOCATION 8	94'-0 3/8"
		TRANSVERSE CUT LOCATION 7	97'-5 7/8"
		TRANSVERSE CUT LOCATION 6	98'-11 3/4"

CUT LOCATION	L	D	WIDTH	T	REPAIR TYPE
1	2"	1/2"	3/8"	2 3/8"	WELD
2	1/2"	3/8"	3/8"	2 3/8"	WELD
3	1"	3/4"	3/8"	2 3/8"	WELD
4	1 1/4"	1/2"	3/8"	2 3/8"	WELD
5	1 1/4"	3/8"	3/8"	2 3/8"	WELD
6	1"	5/16"	3/8"	2 3/8"	WELD
7	1 1/2"	1/2"	3/8"	2 3/8"	WELD
8	1 1/4"	1/4"	3/8"	2 3/8"	WELD
9	7/8"	1/8"	3/8"	2 3/8"	GRIND
10	1 1/4"	1/8"	3/8"	2 3/8"	WELD
11	1"	1/8"	3/8"	2 3/8"	GRIND
12	2 1/4"	3/8"	3/8"	7/8"	WELD


CUT LOCATION	L	D	WIDTH	T	REPAIR TYPE
13	6'-5 5/8"	1/4"	3/8"	2 3/8"	GRIND
14	2'-3 1/4"	1/4"	3/8"	2 3/8"	GRIND
15	12'-11"	1/4"	3/8"	2 3/8"	GRIND
16	11'-0 1/2"	1/4"	3/8"	2 3/8"	GRIND
17	8'-4 1/2"	1/4"	3/8"	2 3/8"	GRIND

FRAMING PLAN

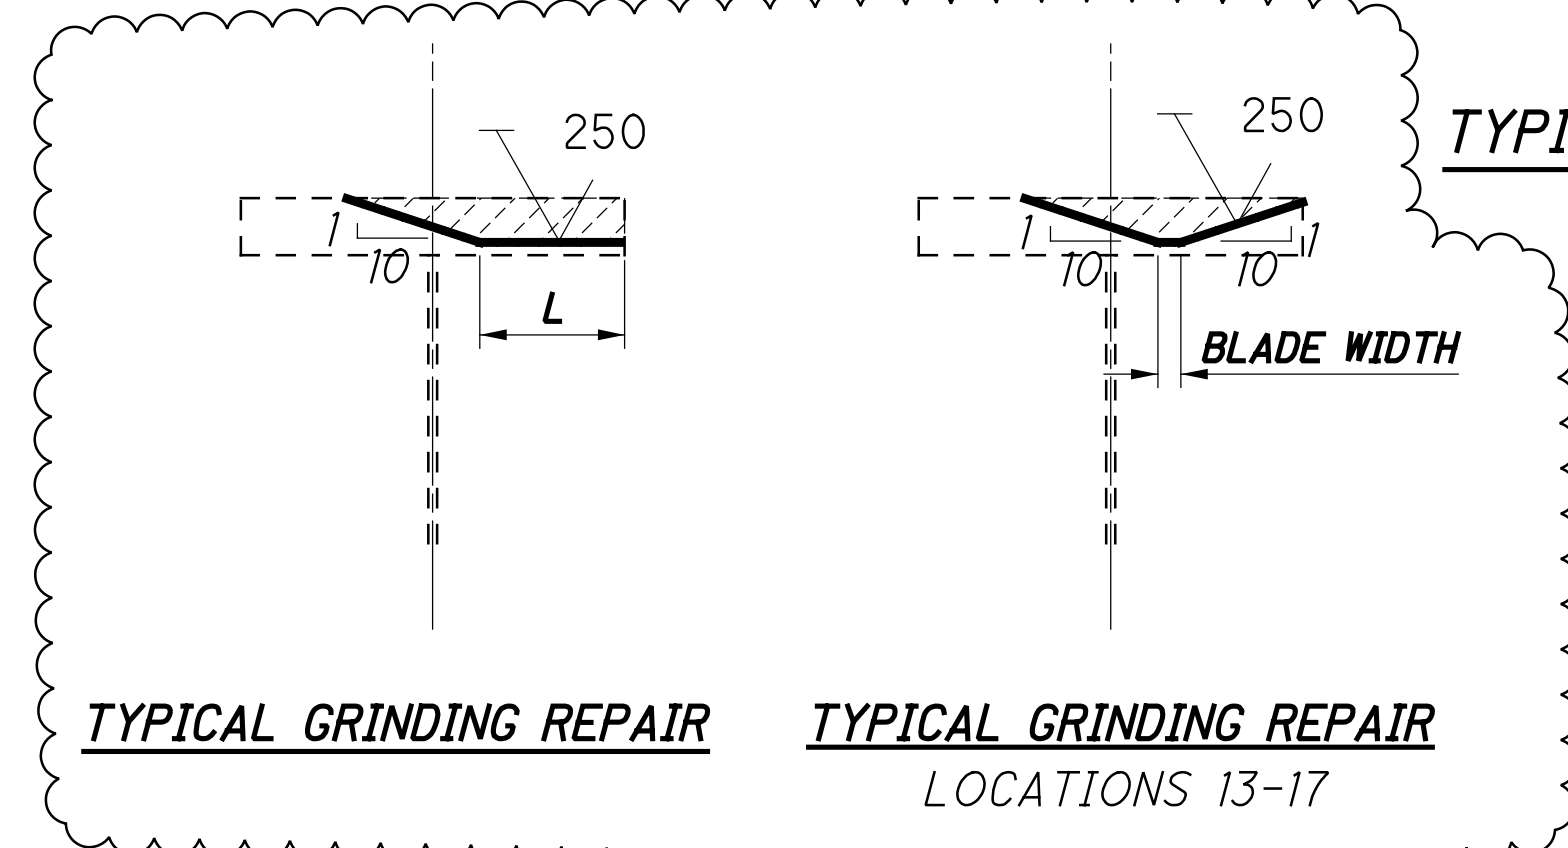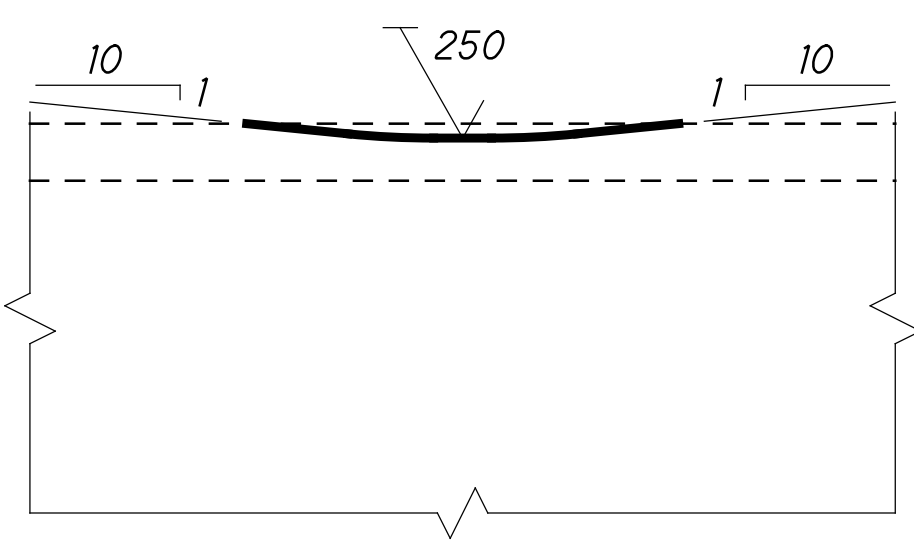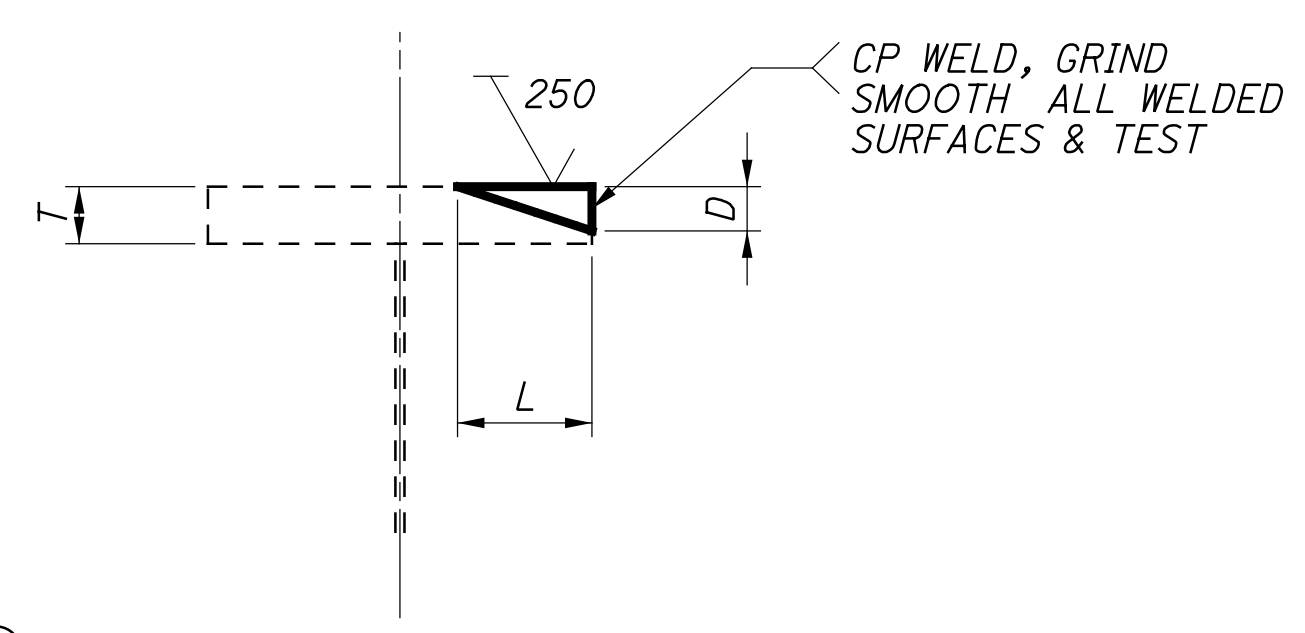




- REPAIR CUT BY GRINDING ACCORDING TO SUPPLEMENTAL SPECIFICATION 849, REPAIR DAMAGED MEMBERS. PERFORM GRINDING ACCORDING TO SUPPLEMENTAL SPECIFICATION 849 AND AS ILLUSTRATED IN DETAIL
- REPAIR CUT BY WELDING ACCORDING TO SUPPLEMENTAL SPECIFICATION 849 REPAIRING DAMAGED MEMBERS, AS ILLUSTRATED IN DETAIL FC2-3. PERFORM COMPLETE PENETRATION WELDING ACCORDING TO C&MS 513.21 BY ATTACHING RUN OFF TABS AND GRIND ALL WELDED SURFACES SMOOTH ACCORDING TO ANSI B46.1 OF 250 mil
- PERFORM NDT TESTING ACCORDING TO C&MS 513.25A

cbettinger 12/19/2019 12:58:16 PM
 \O\2017\01113\C.Design\104667 -HAM-75-3.84\Structures\HAM0074_1852C_Sheets\74_1852SD010.dgn

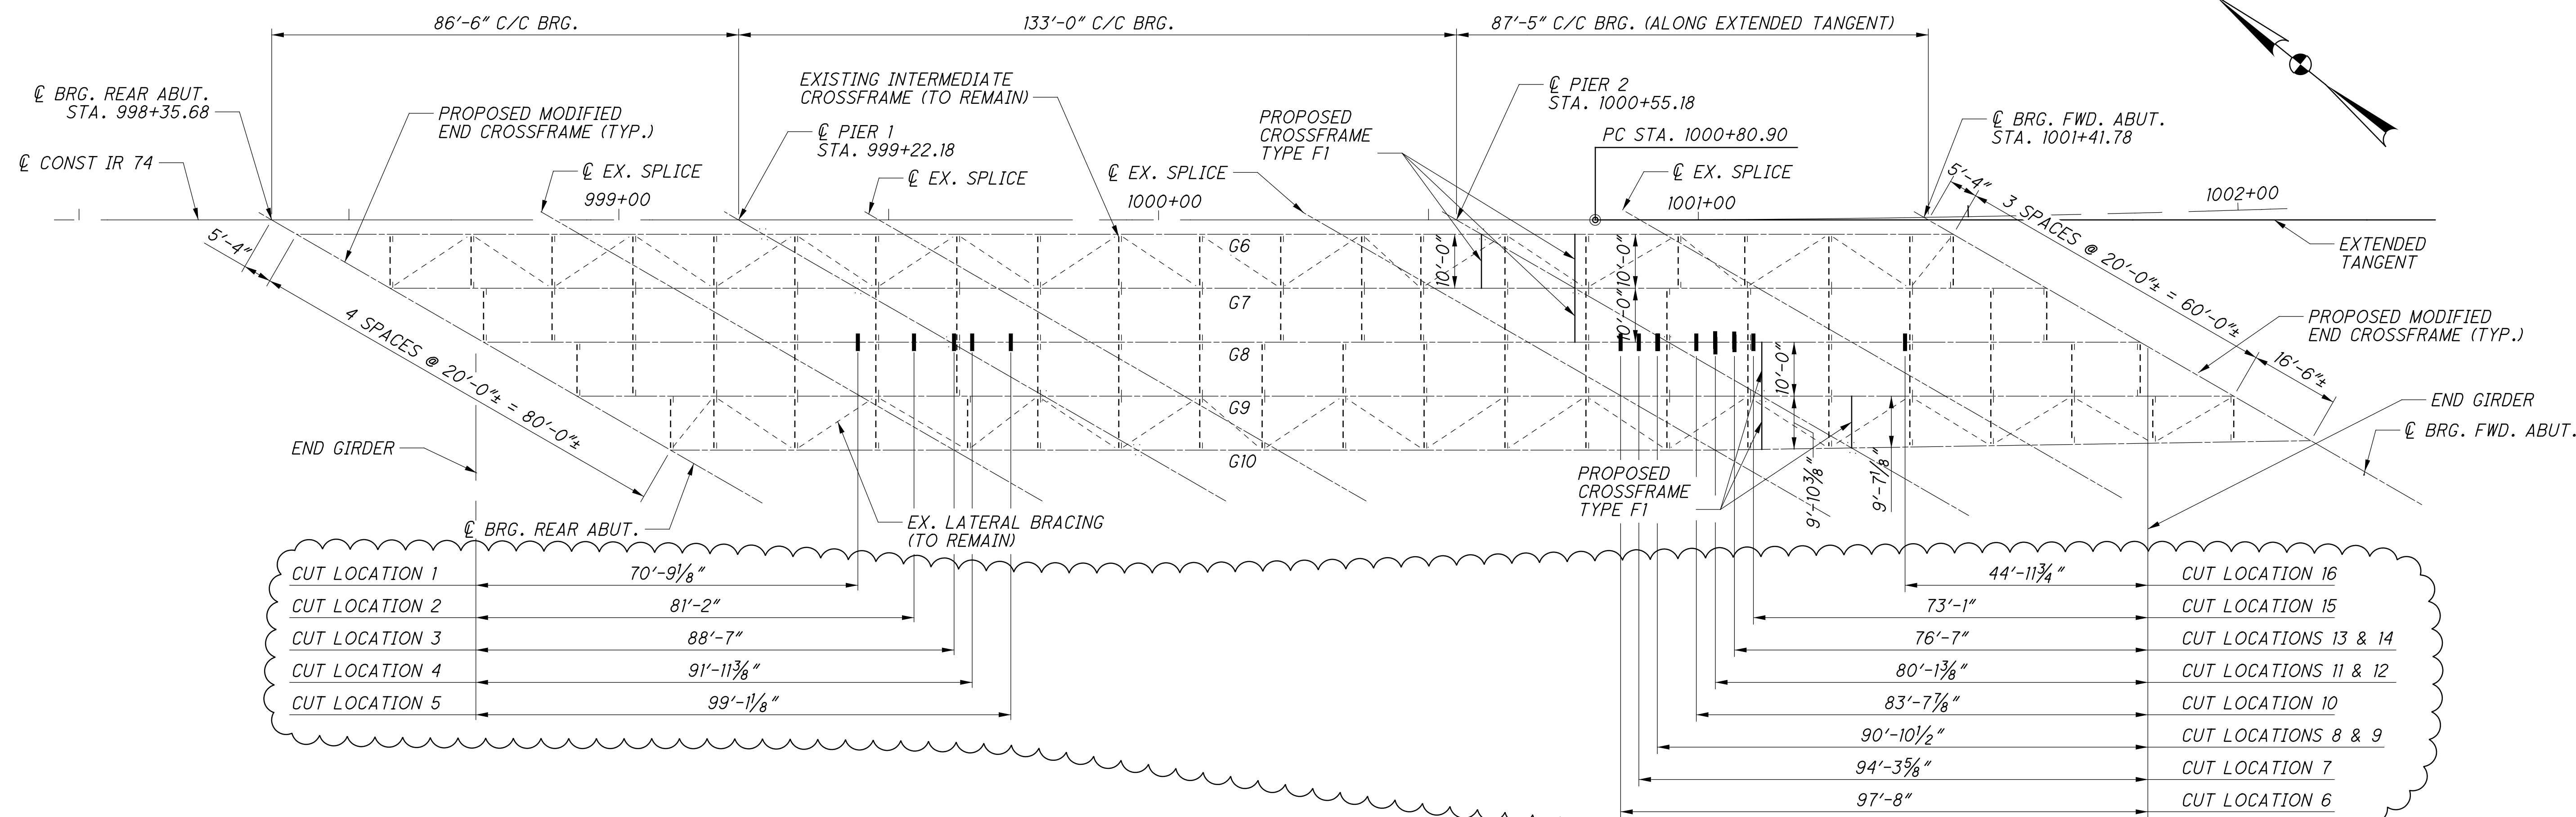

FRAMING PLAN


DAMAGE DESCRIPTIONS (LOCATIONS 1-16, GIRDER G8)					
CUT LOCATION	L	D	WIDTH	T	REPAIR TYPE
1	2 1/4"	1/2"	3/8"	2 3/8"	WELD
2	2"	1/8"	3/8"	2 3/8"	GRIND
3	2 1/2"	3/4"	3/8"	2 3/8"	WELD
4	1"	5/16"	3/8"	2 3/8"	WELD
5	3 1/4"	5/16"	3/8"	2 3/8"	WELD
6	2"	1/2"	3/8"	2 3/8"	WELD
7	1"	1/4"	3/8"	2 3/8"	WELD
8	2"	3/4"	3/8"	2 3/8"	WELD
9	1"	1/8"	3/8"	2 3/8"	GRIND
10	1"	1/4"	3/8"	2 3/8"	WELD
11	1 1/2"	3/4"	3/8"	2 3/8"	WELD
12	10"	1/8"	3/8"	2 3/8"	WELD
13	3 1/2"	1/4"	3/8"	2 3/8"	WELD
14	9"	1/4"	3/8"	2 3/8"	WELD
15	16"	1/8" - 3/4"	3/8"	2 3/8"	WELD
16	1/4"	1/4"	3/8"	7/8"	WELD

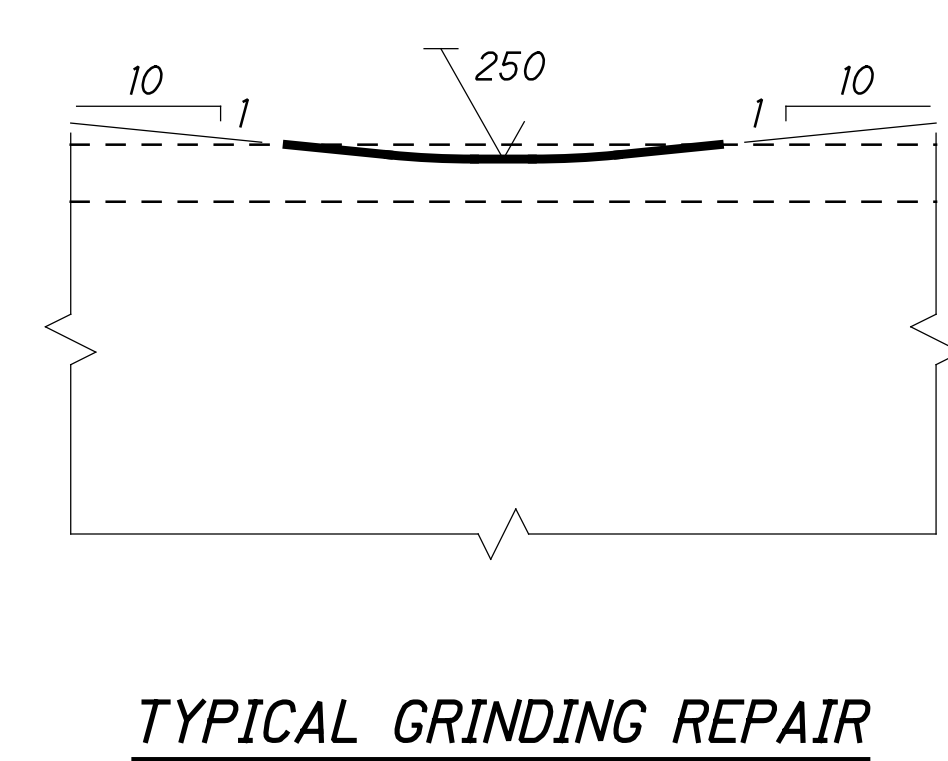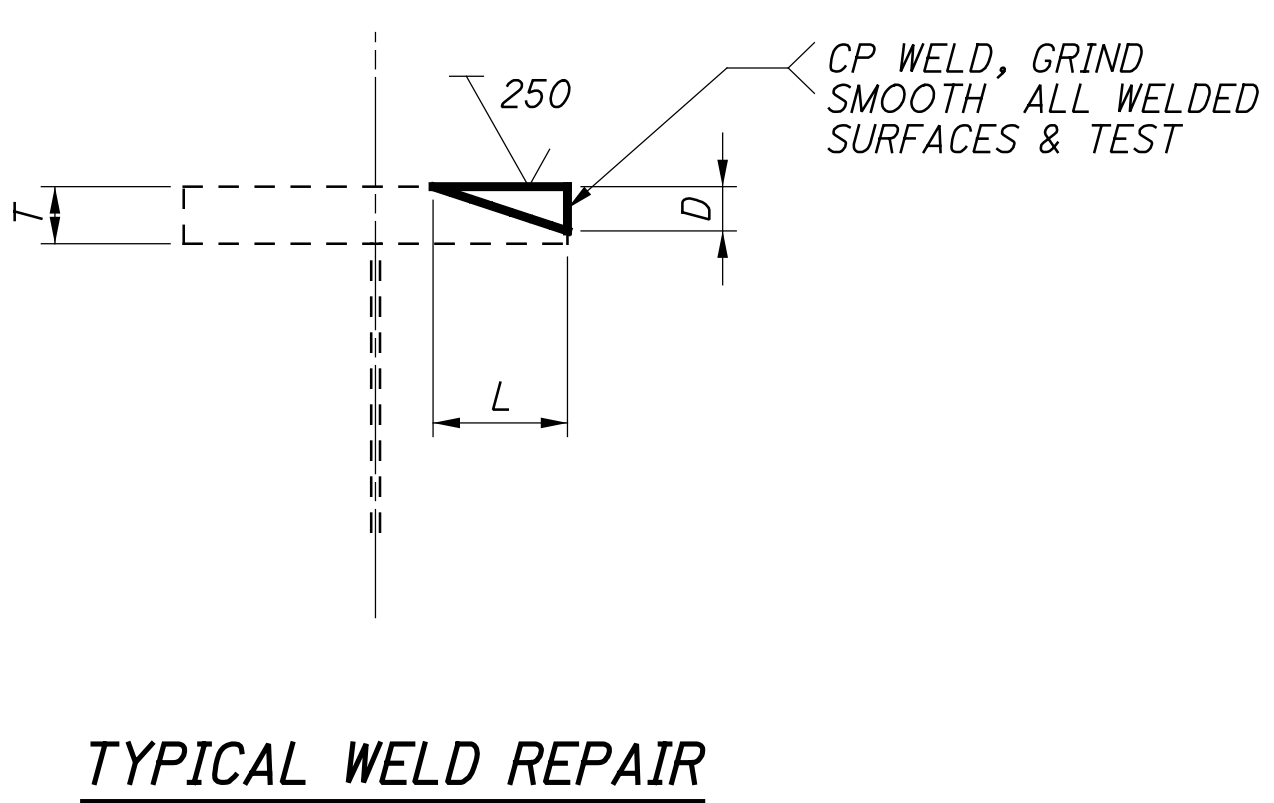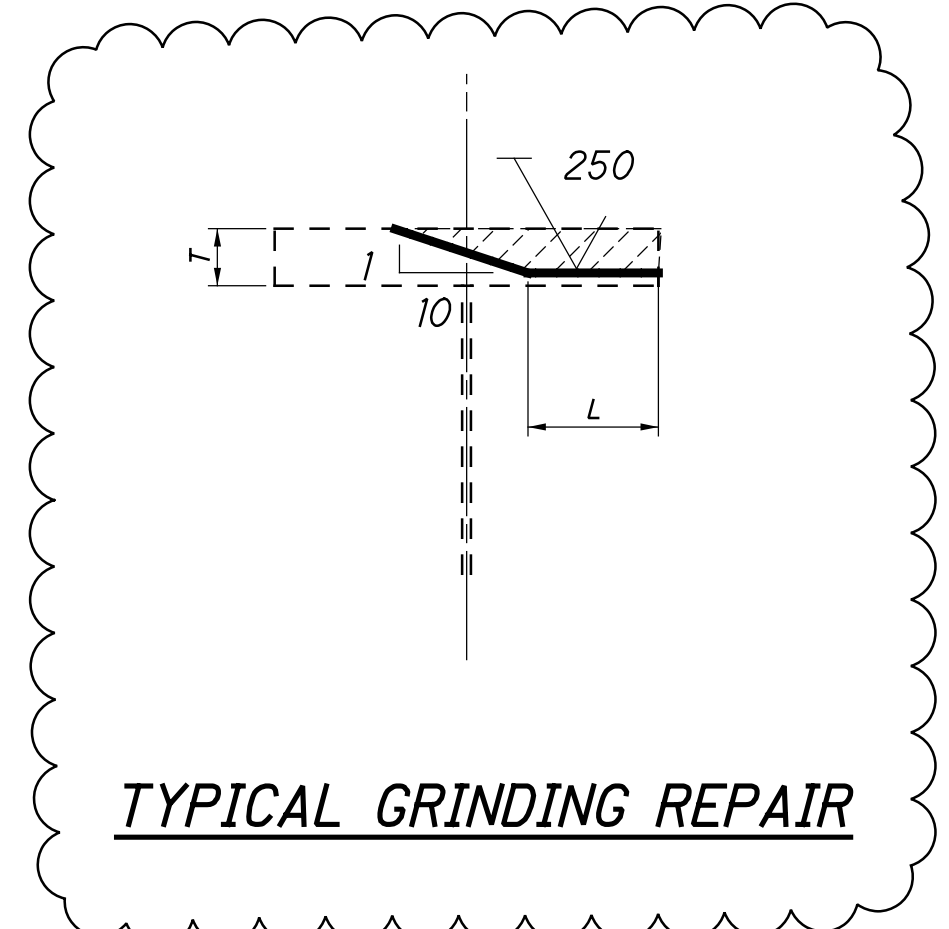

- REPAIR CUT BY GRINDING ACCORDING TO SUPPLEMENTAL SPECIFICATION 849, REPAIR DAMAGED MEMBERS. PERFORM GRINDING ACCORDING TO SUPPLEMENTAL SPECIFICATION 849 AND AS ILLUSTRATED IN DETAIL
- REPAIR CUT BY WELDING ACCORDING TO SUPPLEMENTAL SPECIFICATION 849 REPAIRING DAMAGED MEMBERS, AS ILLUSTRATED IN DETAIL FC2-3. PERFORM COMPLETE PENETRATION WELDING ACCORDING TO C&MS 513.21 BY ATTACHING RUN OFF TABS AND GRIND ALL WELDED SURFACES SMOOTH ACCORDING TO ANSI B46.1 OF 250 mil
- PERFORM NDT TESTING ACCORDING TO C&MS 513.25A

DESIGN AGENCY: STRUCTUREPOINT
 DATE: 4/17/19
 REVIEWED: SUJ
 DRAWN: DSH
 DESIGNED: AMI
 CHECKED: CLB
 BRIDGE NO. HAM-74-1852 L/R
 OVER NB BEEKMAN ST. (U.S. 27)
 HAM-75-3.84
 PID No. 104667
 2B/4
 2B/4

cbettinger 12/19/2019 12:58:14 PM
 \\0\2017\01113\C.Design\104667-HAM-75-3.84\Design\Structures\HAM0074_1852C_Sheets\74_1852SD006.dgn

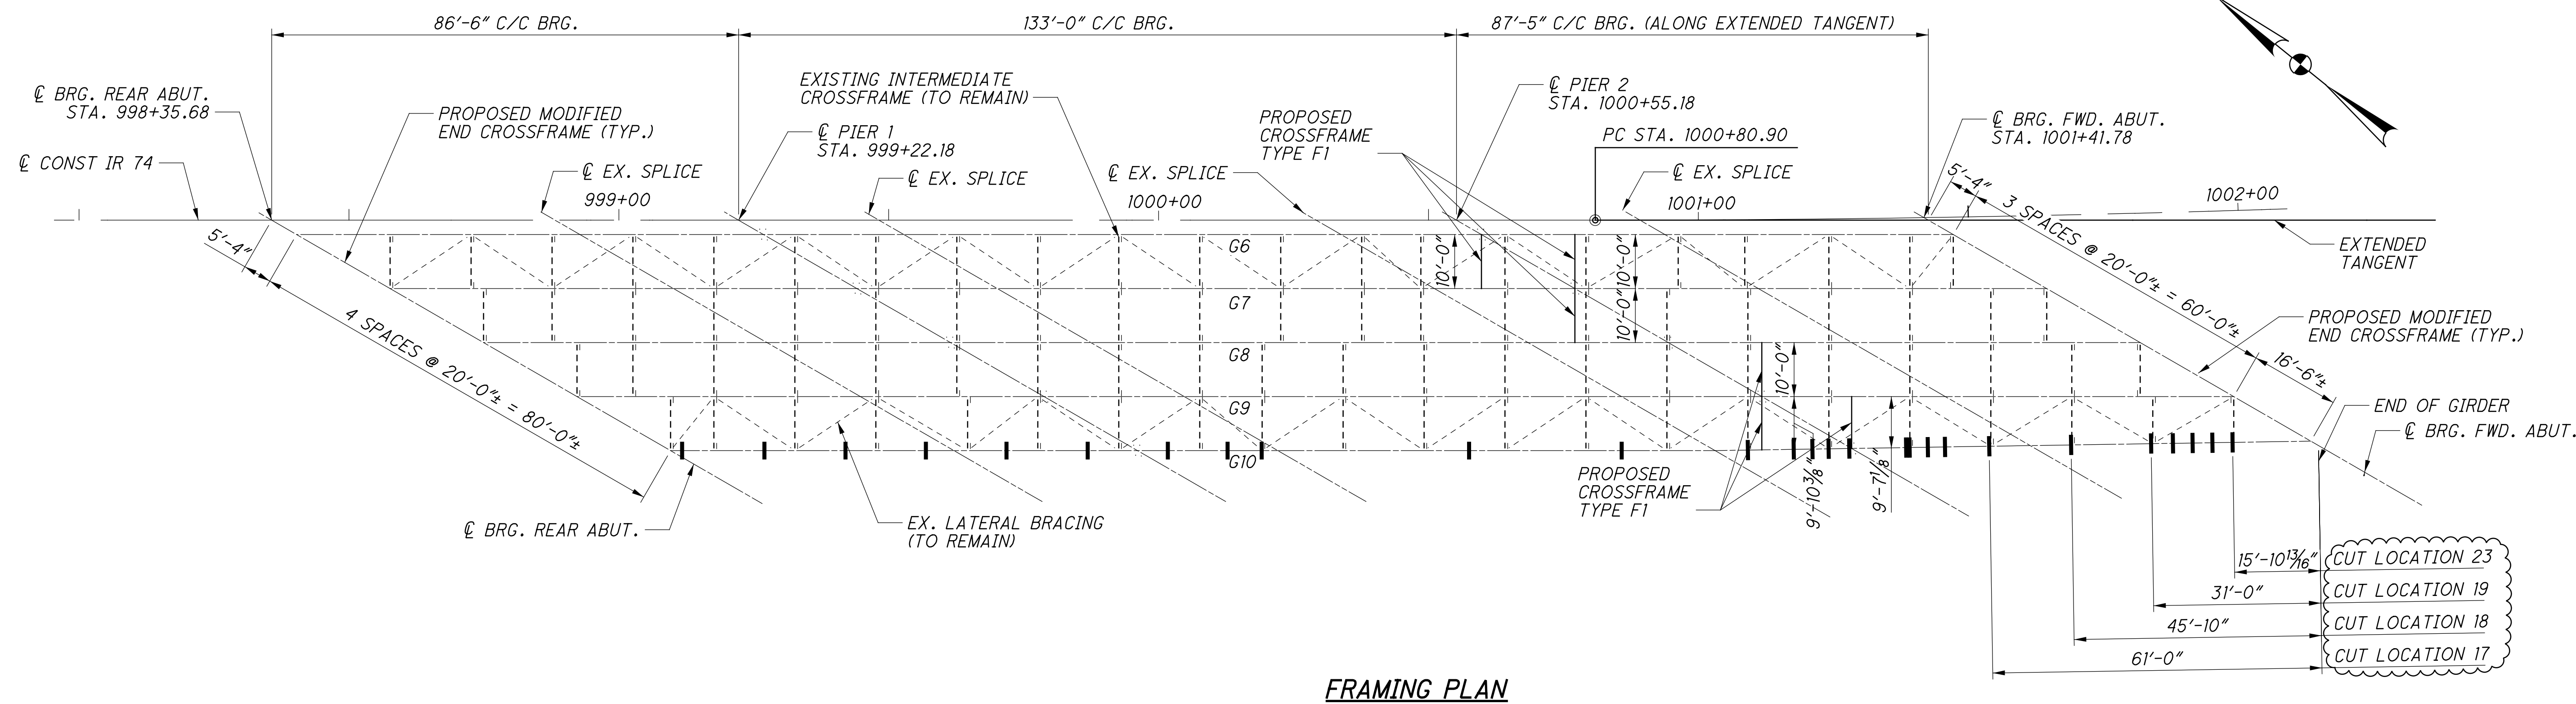


DAMAGE DESCRIPTIONS
 (LOCATIONS 17, 18, 19 & 23 GIRDER 10)

CUT LOCATION 17 :
 11" WIDTH OF FLANGE FULL DEPTH;
 1/4" INTO WEB.



CUT LOCATION 18 :
 11" WIDTH OF FLANGE FULL DEPTH;
 1" INTO WEB.

CUT LOCATION 19 :
 5" WIDTH OF FLANGE FULL DEPTH;
 1/8" INTO WEB.

CUT LOCATION 23 :
 7" WIDTH OF FLANGE FULL DEPTH;
 1/4" INTO WEB.

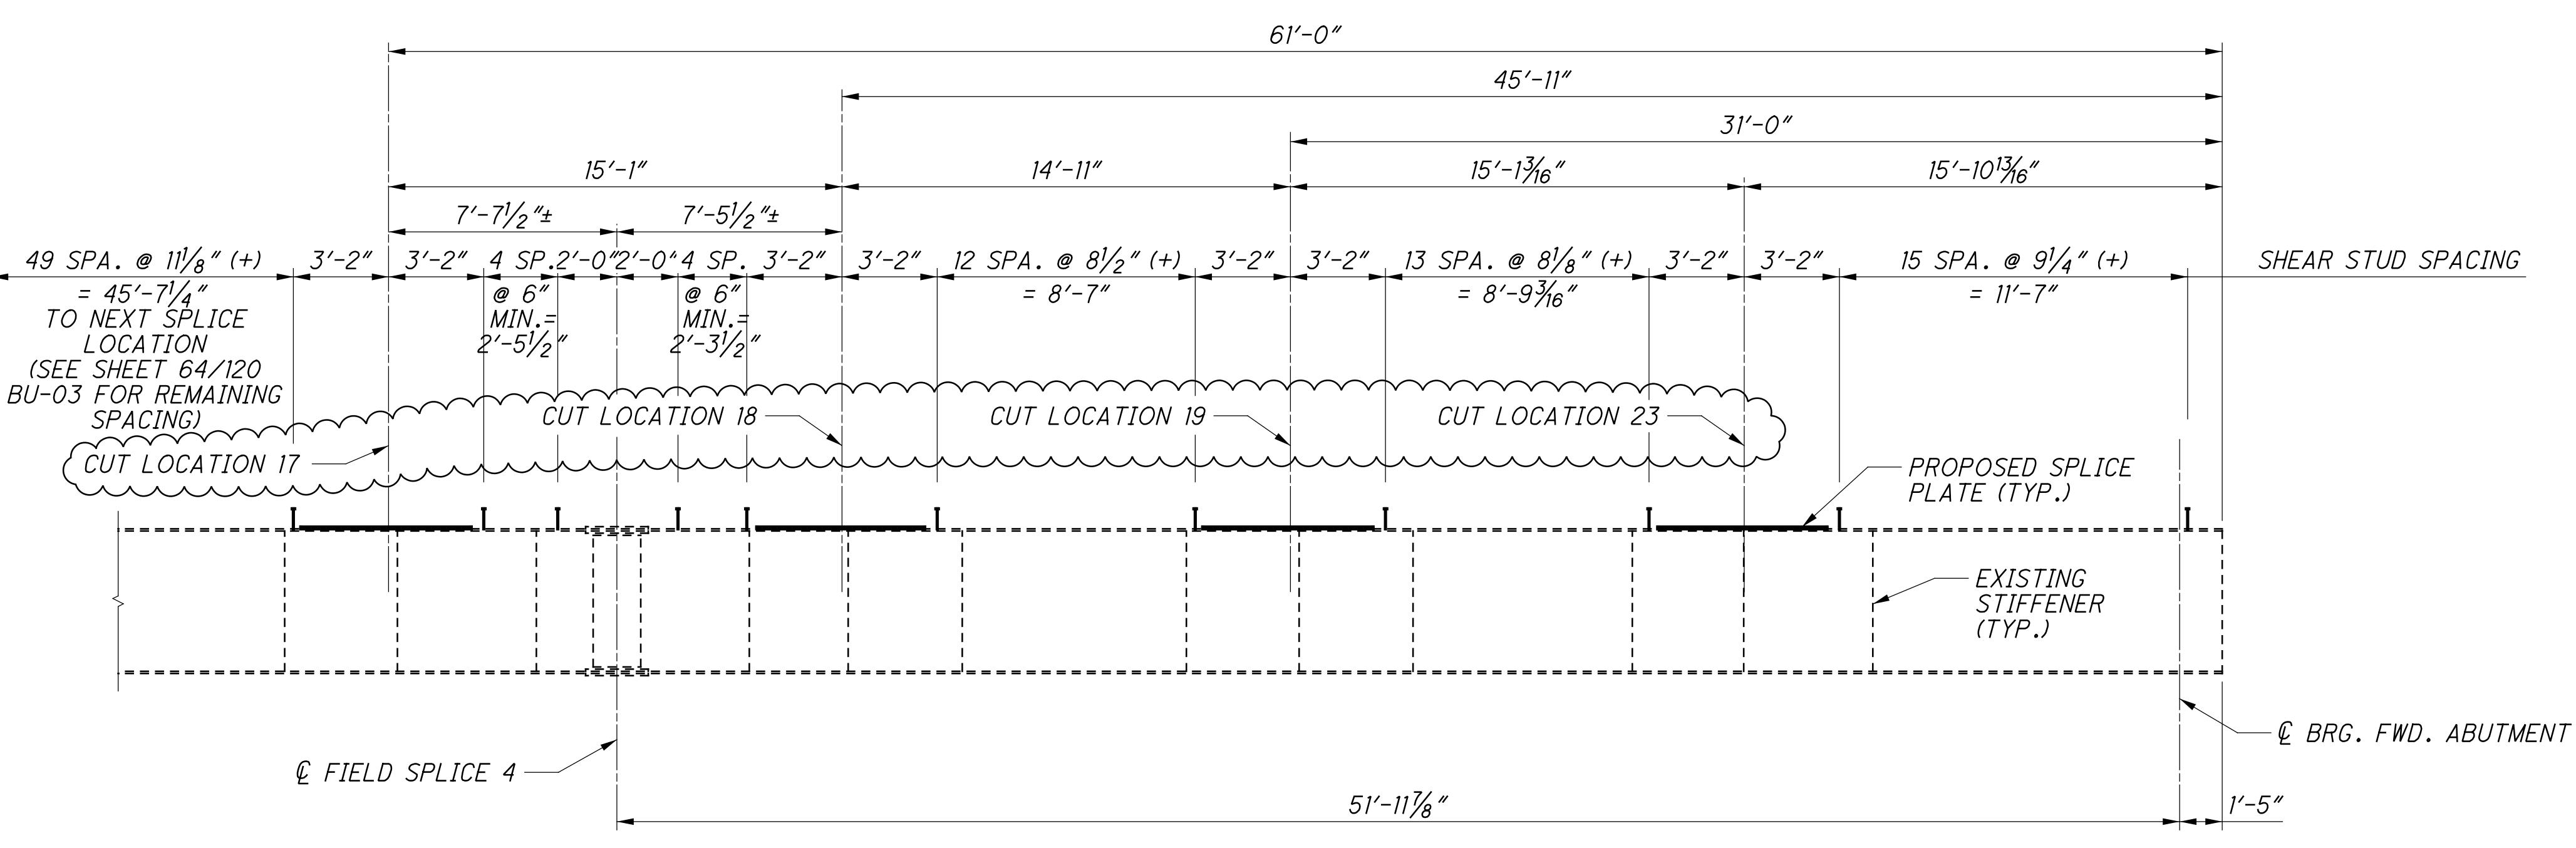

	DESIGN AGENCY STRUCTUREPOINT
DATE 4/17/19	REVIEWED SUJ
DRAWN DSH	REVISIONS REVISED
DESIGNED AMI	CHECKED CLB
CORRECTIVE WORK PLAN - GIRDER REPAIR SPLICE DETAILS BRIDGE NO. HAM-74-1852 L/R OVER NB BEEKMAN ST. (U.S. 27)	
HAM-75-3.84 PID No. 104667	STRUCTURE FILE NUMBER 3115577
3 / 4	

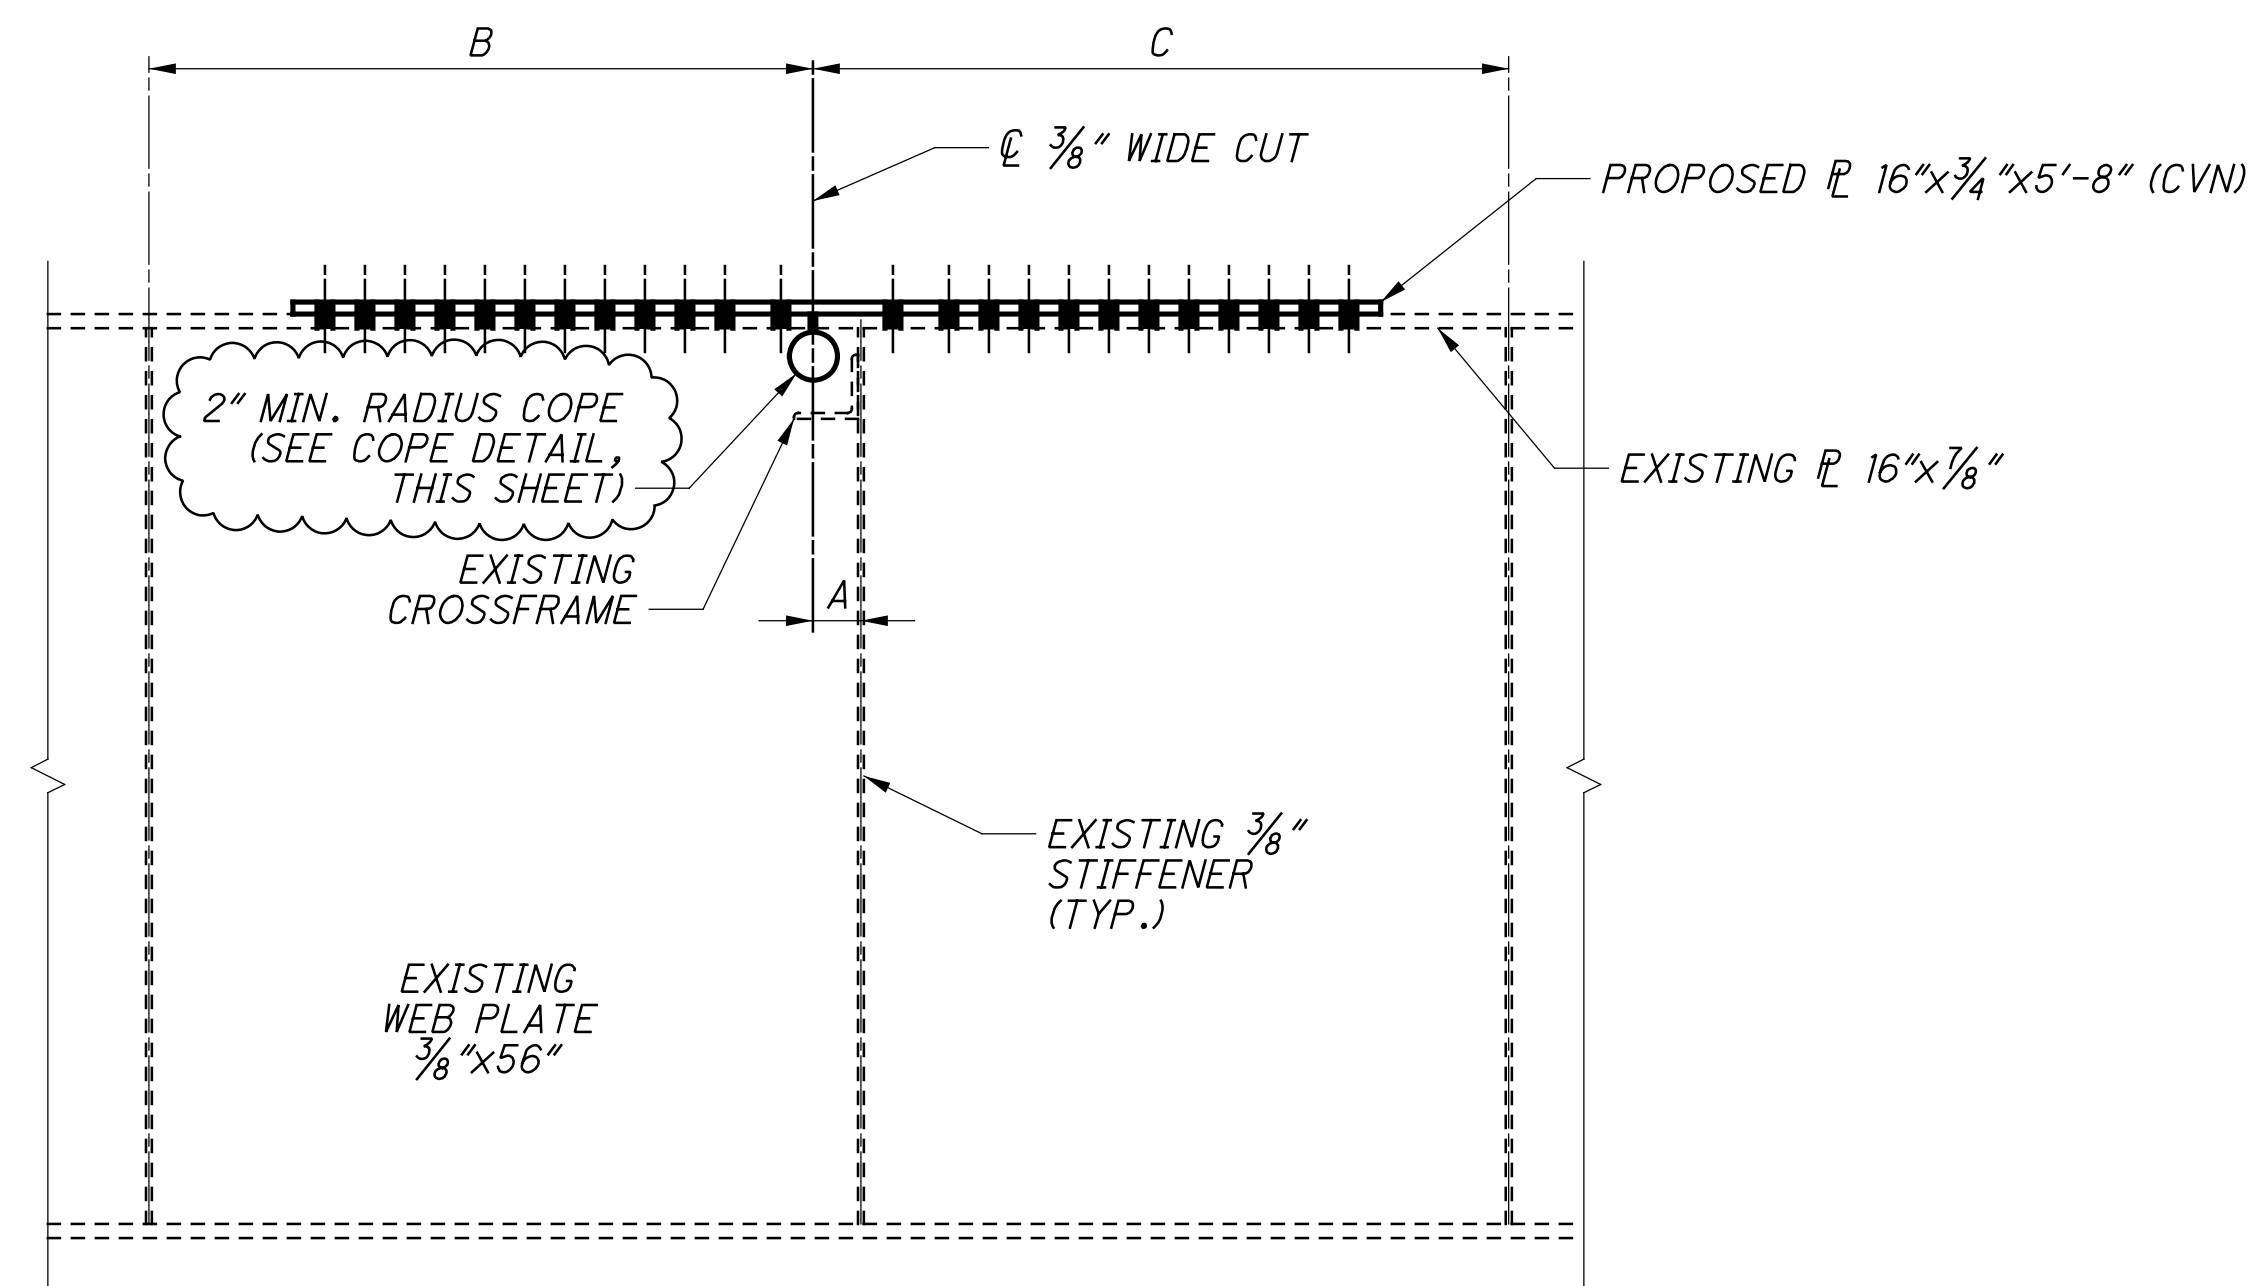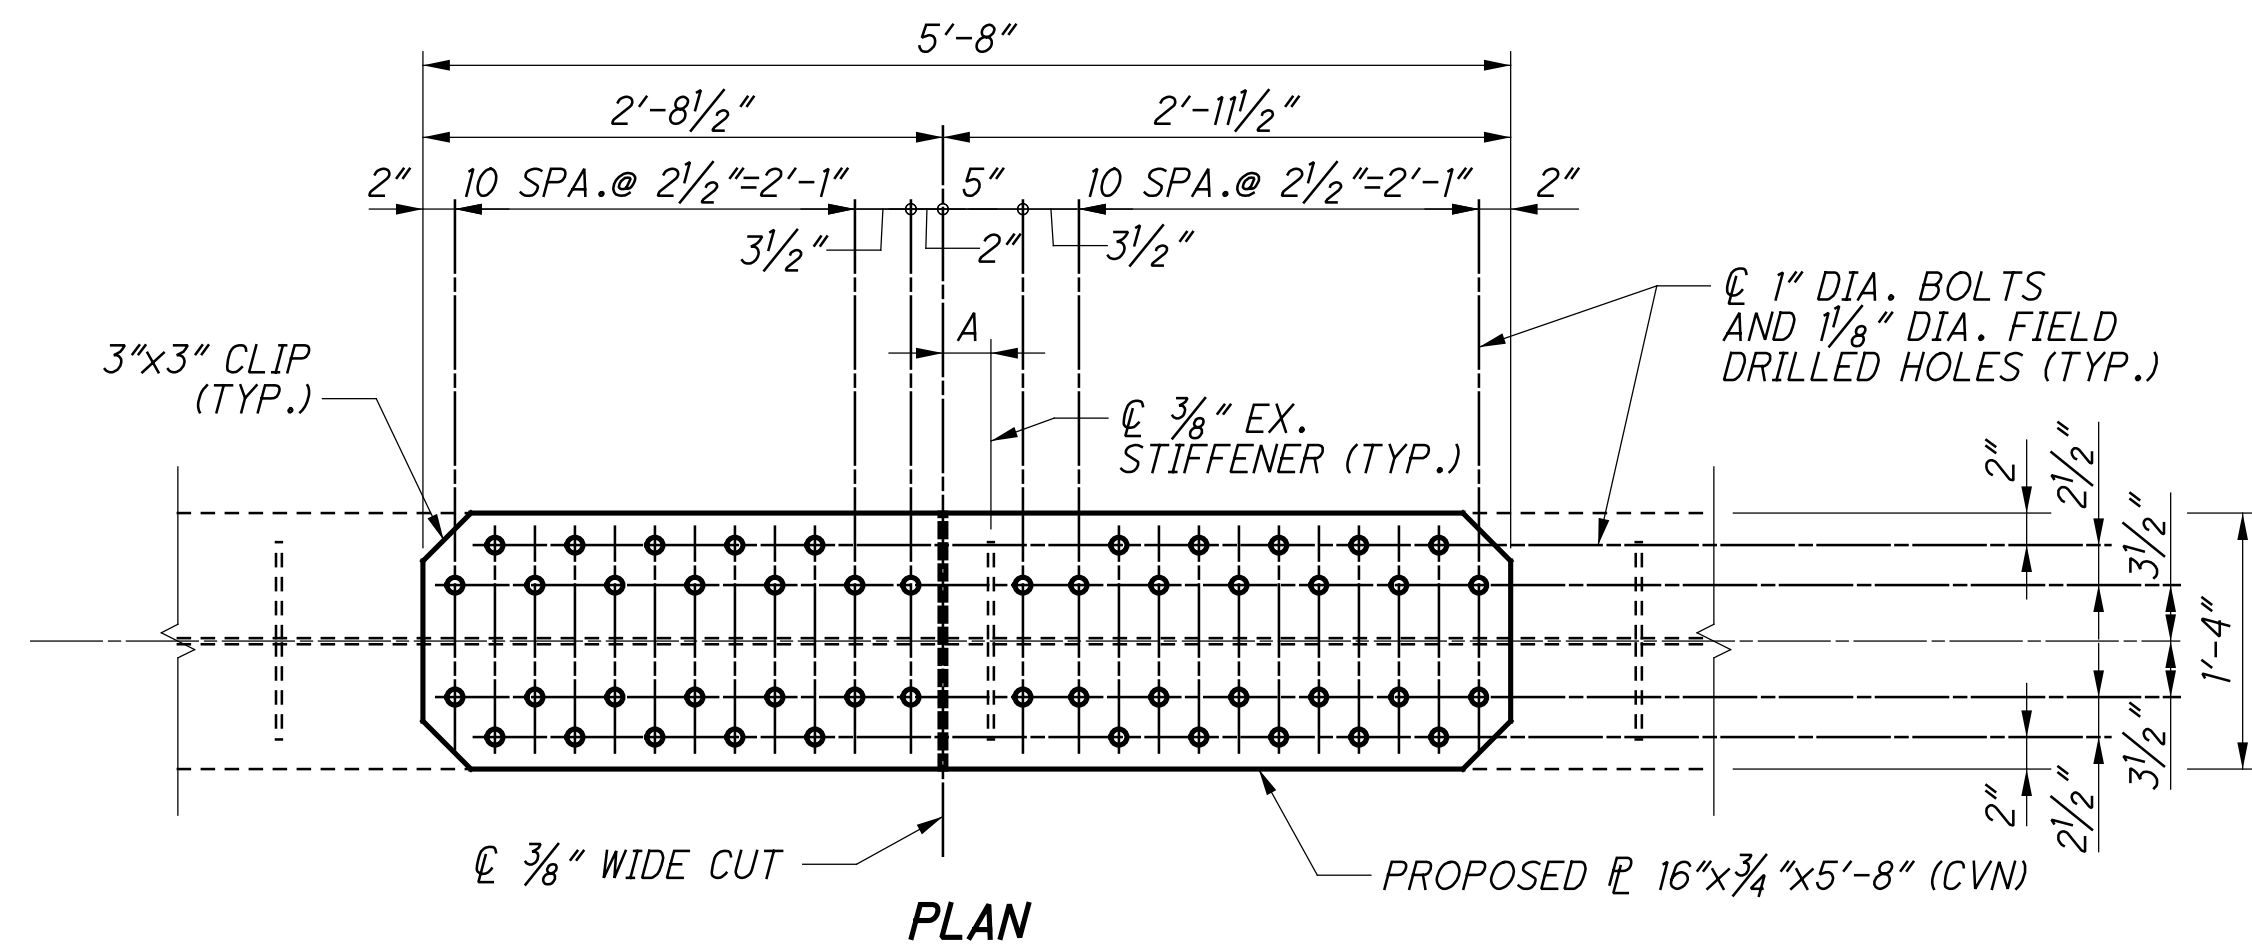

ELEVATION
SPLICE DETAILS
CUT LOCATIONS 17, 18, 19 & 23

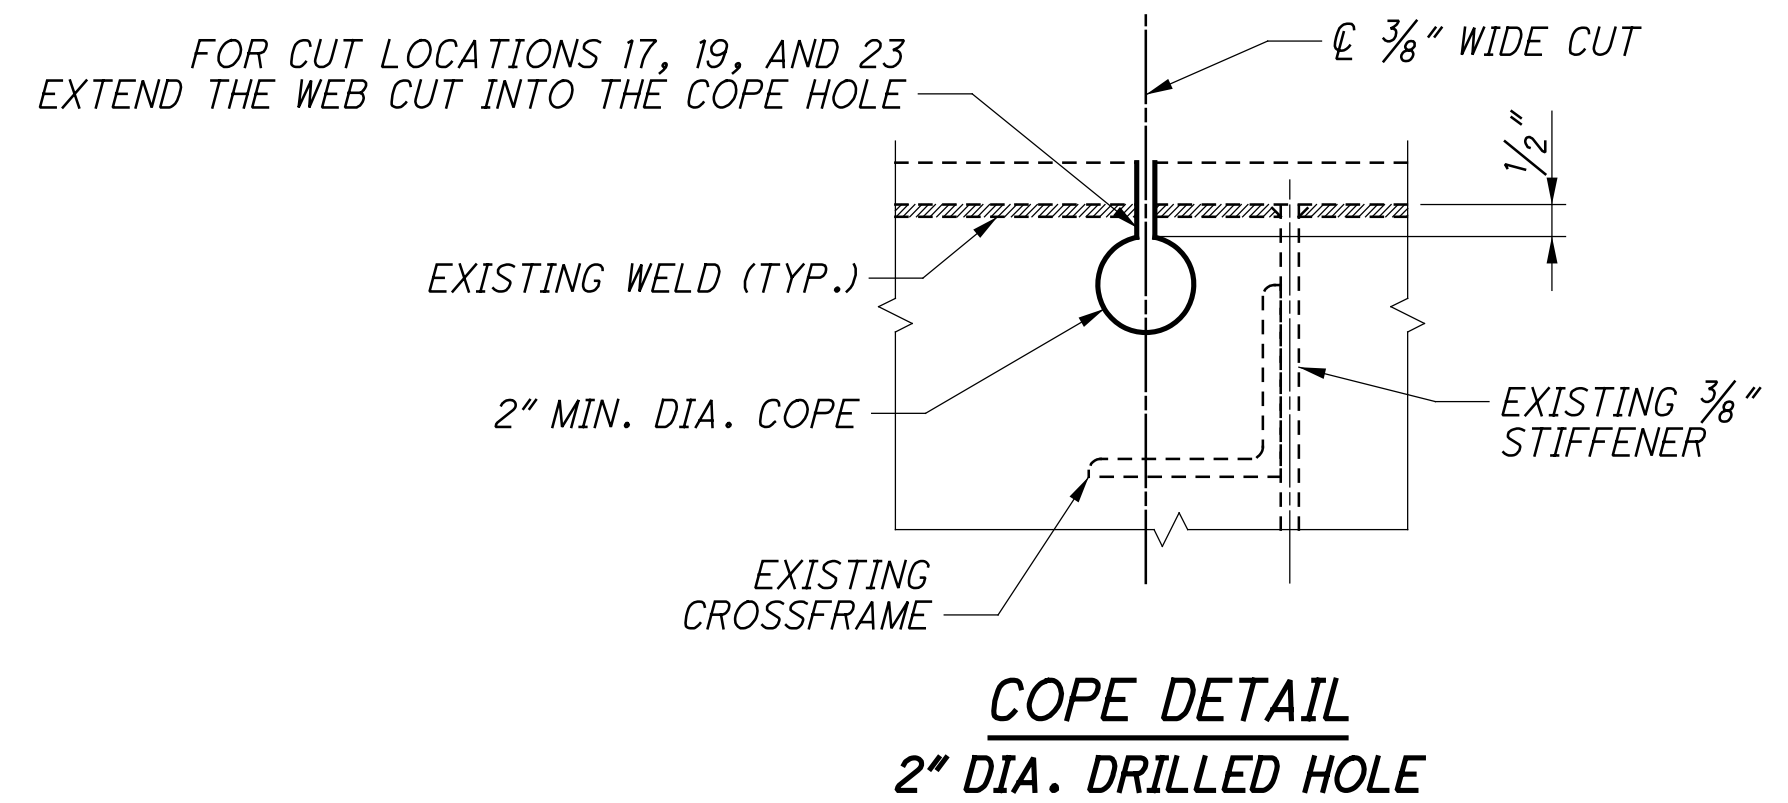


TABLE OF DIMENSIONS			
CUT LOCATION	A	B	C
17	3 1/2"	3'-5 1/2"	4'-11"
18	2 1/2"	3'-1"	4'-0"
19	3 1/2"	3'-5 1/2"	4'-1"
23	3"	3'-5 1/2"	4'-6 1/2"

NOTES :

- STEEL SPLICE PLATES SHALL BE ASTM A709 GRADE 50.
- WHERE A PLATE IS DESIGNATED (CVN), FURNISH MATERIAL THAT MEETS THE MINIMUM NOTCH TOUGHNESS REQUIREMENTS AS SPECIFIED IN 711.01.
- HIGH STRENGTH BOLTS SHALL BE 1" DIAMETER ASTM F3125 GRADE A325, UNLESS OTHERWISE NOTED.

chettinger 8:39:57 PM
6/17/2019
\\01\2017\C.Design\104667-HAM-75-3.84.Design\Structures\HAM0074-1892C_Sheets\7.4-1892GN003.dgn

SUPPLEMENTAL SPECIFICATIONS:

REFER TO SS 849 AS NOTED IN THE PLANS.

SEQUENCE OF WORK:

REPAIR CUT LOCATIONS BY GRINDING PER PLANS AND SS 849.14 AND REPLACE DAMAGED BOLTS.

REPAIR STRUCTURAL STEEL COATING SYSTEM AT ALL LOCATIONS DAMAGED DURING DEMOLITION AND DURING THE REPAIR PROCEDURES PER ITEM 514 - FIELD PAINTING OF DAMAGED STRUCTURAL STEEL, AS PER PLAN (ONE COAT)

ITEM 514 - FIELD PAINTING OF DAMAGED STRUCTURAL STEEL, AS PER PLAN (ONE COAT):

1.0 DESCRIPTION: THIS ITEM CONSISTS OF FIELD PAINTING STRUCTURAL STEEL PREVIOUSLY COATED WITH AN UNKNOWN EXISTING PAINT TO CORRECT DAMAGE FROM DEMOLITION AND REPAIR PROCEDURES. THIS WORK CONSISTS OF PERFORMING SURFACE PREPARATION AND APPLYING A PRIMER TO THE PREPARED STEEL AND FEATHERED REMOVAL AREAS OF UNKNOWN EXISTING PAINT SYSTEMS. ALL STRUCTURAL STEEL SURFACE AREAS, THAT WILL BE EXPOSED AFTER CONSTRUCTION COMPLETE, DAMAGED BY DEMOLITION OR REPAIR PROCEDURES SHALL BE PAINTED.

2.0 GENERAL: C&MS 514.05 THROUGH 514.10 AND 514.13.D APPLY UNLESS MODIFIED BY THESE NOTES.

3.0 WASHING EXISTING PAINTED SURFACES:
CLEAN SURFACES TO BE COATED WITH LOW PRESSURE WATER CLEANING TO REMOVE ALL DIRT, DEBRIS, ANIMAL EXCREMENT, SALT CONTAMINANTS AND OTHER ACCUMULATED FOREIGN MATERIAL IN ACCORDANCE WITH SSPC-SPI2 (LP WC), LOW PRESSURE WATER CLEANING. THE PRESSURE WASHER SHALL BE CAPABLE OF ACHIEVING AT LEAST 2000 POUNDS PER SQUARE INCH AT THE NOZZLE. WHEN USING THE POWER WASHING EQUIPMENT, THE NOZZLE SHALL BE MAINTAINED NO MORE THAN 10 INCHES FROM THE SURFACE. SUPPLY AND USE POTABLE WATER. PROVIDE TO THE ENGINEER A LETTER OF WRITTEN ACCEPTANCE FOR ANY BIODEGRADABLE DETERGENTS OR CLEANERS USED IN CONJUNCTION WITH THIS METHOD.

COLLECT AND CONTAIN WATER AND DEBRIS REMOVED DURING WASHING OPERATIONS ABOVE WATER FEATURES IN CONFORMANCE WITH C&MS 514.08 AND C&MS 514.13.D FOR ANY DEBRIS. CREATE SETTLEMENT COLLECTION BASINS AND STRAIN ALL WASH WATER ABOVE LAND FEATURES AS NECESSARY TO PRODUCE VISIBLY CLEAR WATER AND COMPLY WITH CMS 514.08 AND C&MS 514.13.D FOR ANY DEBRIS.

4.0 SURFACE PREPARATION: AFTER THE PRESSURE WASHED SURFACE HAS DRIED, REMOVE EXISTING PAINT COATING TO CONTRACT LIMITS OR AS DIRECTED BY THE ENGINEER ACCORDING TO: SSPC-SP 11, POWER TOOL CLEANING TO BARE METAL, AS SHOWN ON THE PICTORIAL SURFACE PREPARATION STANDARDS FOR PAINTING STEEL SURFACES SHOWN IN SSPC-VIS 3; SSPC SP6, COMMERCIAL BLAST CLEANING, AS SHOWN ON THE PICTORIAL SURFACE PREPARATION STANDARDS FOR PAINTING STEEL SURFACES SHOWN IN SSPC-VIS 1; OR SSPC SPI2 UHP WJ-4, ULTRAHIGH-PRESSURE WATER JETTING, AS SHOWN ON THE PICTORIAL SURFACE PREPARATION STANDARDS FOR PAINTING STEEL SURFACES SHOWN IN SSPC-VIS 4. SUPPLY BLAST WATER CONTAINING A COMMERCIALY AVAILABLE RUST INHIBITOR AT A DOSAGE THAT PREVENTS FLASH RUSTING FOR 12 HOURS AND DOCUMENTED AS ACCEPTABLE TO THE COATING'S MANUFACTURER. THE ENGINEER WILL USE THE SSPC-VIS 1, SSPC-VIS 3 OR SSPC-VIS 4 TO DETERMINE THE ACCEPTANCE OF THE SURFACE PREPARATION. FEATHER THE EXISTING PAINT TO ROUGHEN A MINIMUM OF 1/2 INCH OF THE EXISTING PAINT. CONTAIN AND DISPOSE OF WASTE GENERATED BY THE CLEANING ACCORDING TO C&MS 514.13.D.



ROUND ALL EXPOSED CORNERS OF MAIN MATERIAL TO BE PAINTED AS NECESSARY TO ACHIEVE A 1/16 INCH RADIUS OR EQUIVALENT FLAT SURFACE AT A 45 DEGREE ANGLE.

5.0 FIELD PAINTING: APPLY THE PRIME COAT OF THE THREE-COAT PAINT SYSTEM SPECIFIED IN C&MS 708.02, ACCORDING TO C&MS 514.15, 514.16, 514.17, 514.19 AND 514.20 TO THE CONTRACT LIMITS OR AS DIRECTED BY THE ENGINEER. THE ENGINEER WILL DETERMINE THE PRIME COAT THICKNESS USING A TYPE 2 MAGNETIC GAGE AT SPOT LOCATIONS. DO NOT APPLY THE INTERMEDIATE OR FINISH COAT. THE PRIME COAT OF PAINT SHALL MEET THE MINIMUM DRY FILM THICKNESS REQUIREMENTS OF C&MS 514.20. APPLY PAINT AS FOLLOWS:

APPLY THE PRIME COAT ONLY TO THE PREPARED SURFACE OF THE BARE STEEL AND THE EXISTING UNKNOWN PAINT SYSTEM ROUGHENED BY FEATHERING. AT THE PERIMETER OF THE REPAIR AREA, APPLY THE PRIME COAT USING A BRUSH. IN LIEU OF BRUSHING THE CONTRACTOR MAY DOUBLE MASK THE AREAS NOT TO BE COATED AND SPRAY TO FEATHERED REMOVAL LINES.


Christopher L. Bettinger
6/17/19

DESIGN AGENCY STRUCTUREPOINT INC.	DATE	5/30/19
	REVIEWED	SJF
DRAWN	DSH	REVISER
DESIGNED	AMI	CHECKED
	CLB	
CORRECTIVE WORK PLAN - GIRDER REPAIR NOTES		
BRIDGE NO. HAM-74-1892 L/R OVER ELMORE STREET		
HAM-75-3.84	PID No. 104667	
1/2		
1	2	

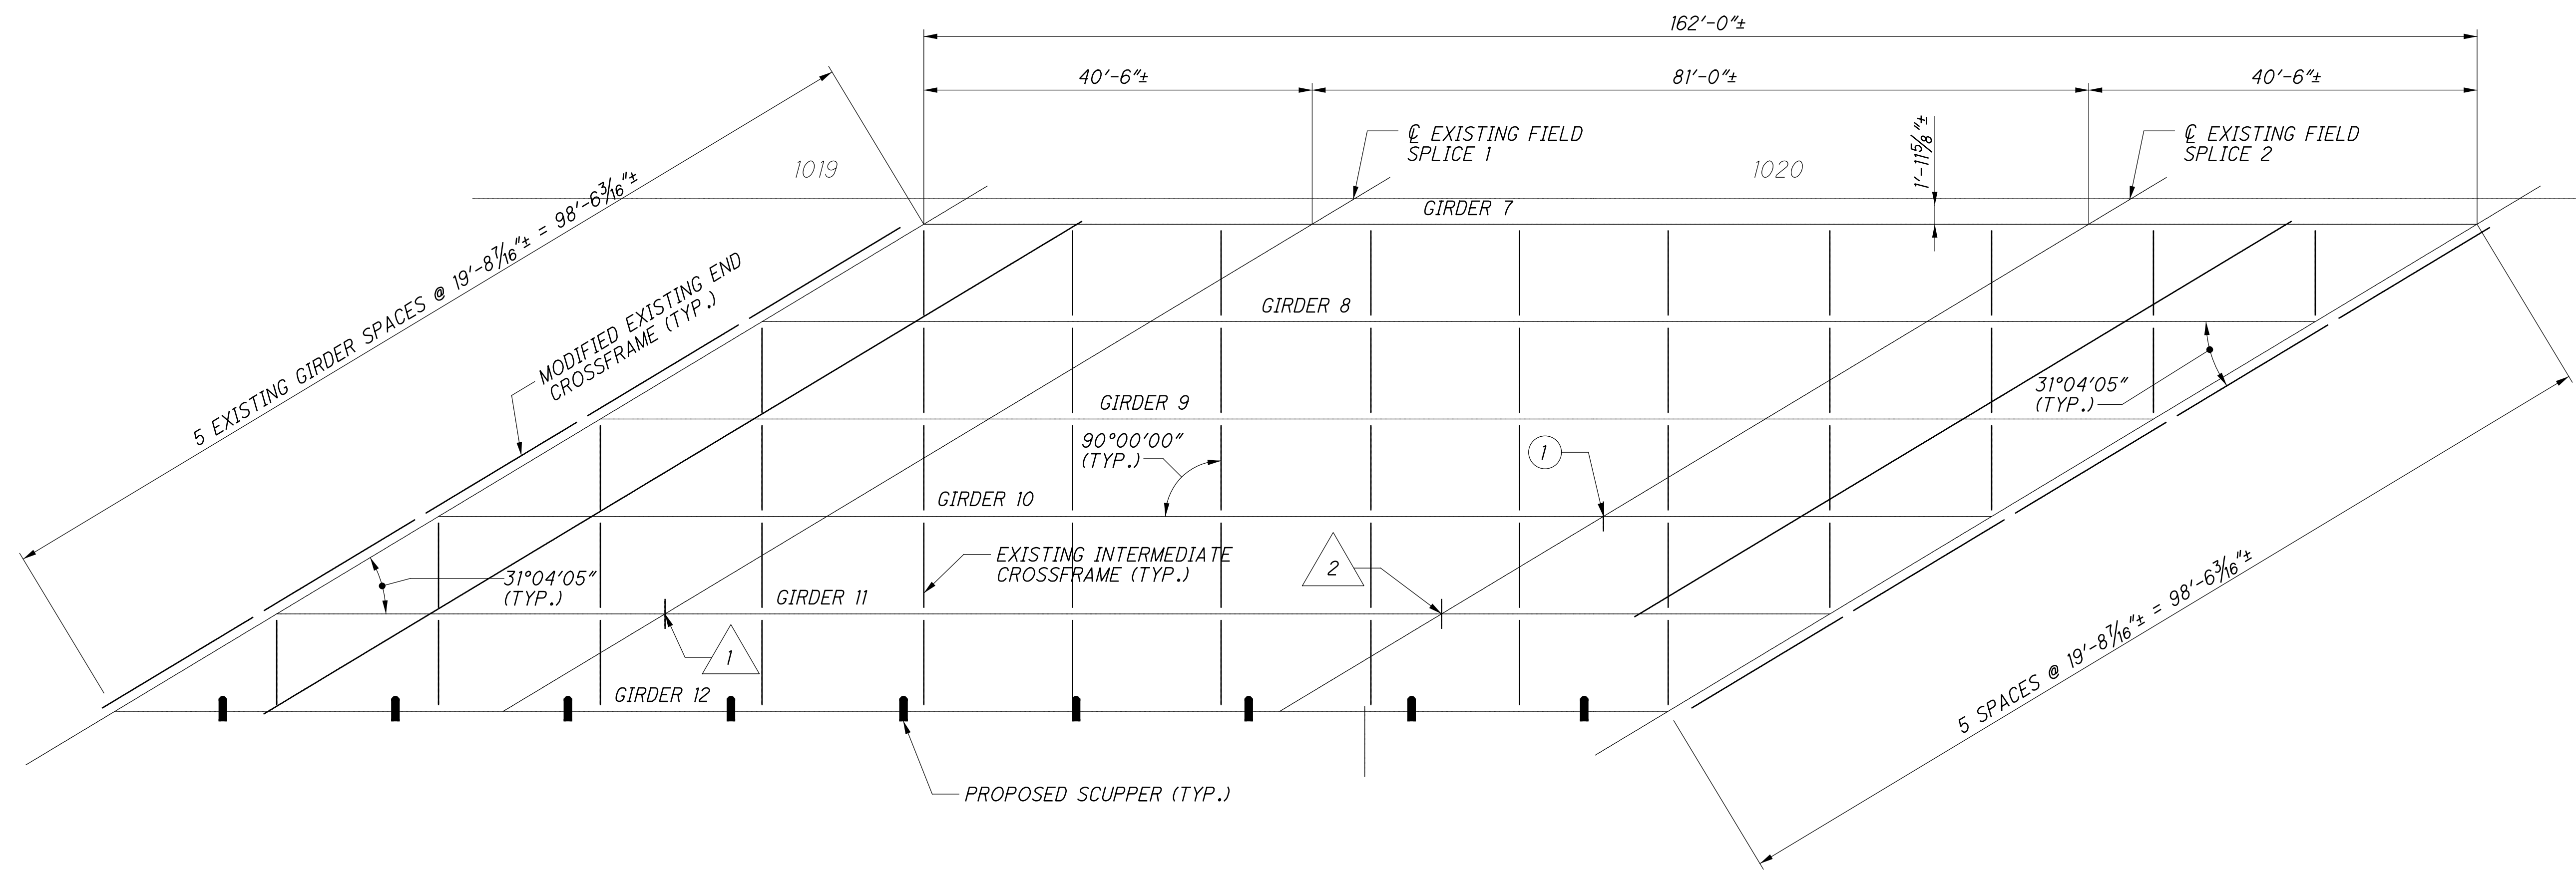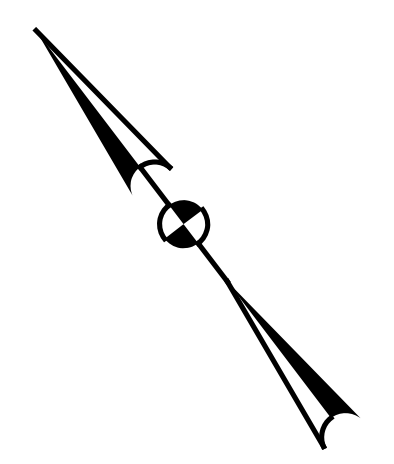


FRAMING PLAN

⊙ "X" INDICATES CUT LOCATION NUMBER
 △ "X" INDICATES CUT BOLT LOCATION NUMBER

NOTES:

AT CUT BOLT LOCATIONS NUMBER 1 AND 2, REMOVE EXISTING DAMAGED BOLTS, NUTS AND WASHERS. PLACE NEW 1" DIA. ASTM F3125 GRADE A325 HIGH STRENGTH BOLTS, NUTS AND WASHERS AS REQUIRED. (2 BOLTS AT EACH LOCATION)

CUT LOCATION	LENGTH	DEPTH	DESCRIPTION	REPAIR TYPE
1	7"	1/16"	CUT IN TOP SPLICE PLATE	GRIND

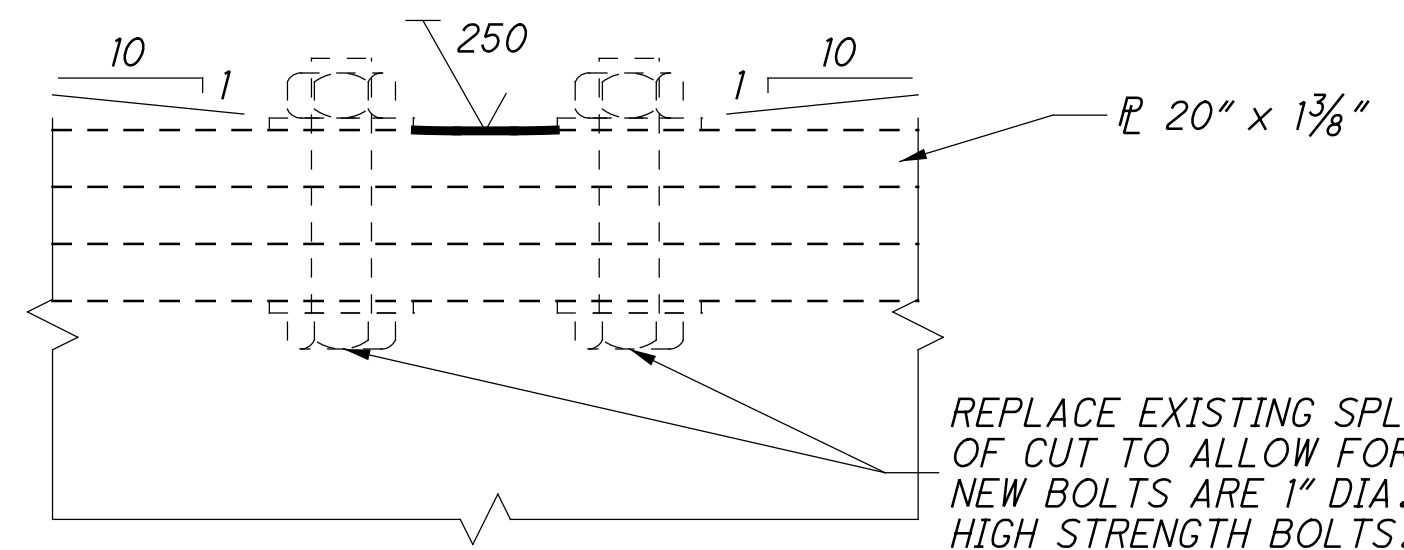

TYPICAL GRINDING REPAIR

REPLACE EXISTING SPLICE BOLTS ON EACH SIDE OF CUT TO ALLOW FOR GRINDING OPERATION. NEW BOLTS ARE 1" DIA. ASTM F3125 GRADE A325 HIGH STRENGTH BOLTS.

COSMEC INC. / DYNAMIC RUBBER

P.O. Box 2159
1501 Rocky Ridge Road
Athens, TX 75751
TEL: 903.677.2871 FAX: 903.675.4776

TRANSMITTAL SHEET

TO: WALSH CONSTRUCTION CO. II
RACE SHARRETT RSHARRETT@WALSHGROUP.ONMICROSOFT.COM
CC KATHI MILLS

DATE: 4/8/19
E170 (713) BRIDGES HAM-75-0440 L/R, HAM-74-1840 L/R,
JOB: HAM-74-1852 L/R, HAM-75-3.84
RE: SHOP DRAWING SUBMITTAL
DRP JOB NO: 15353A LOCATION: HAMILTON CO.

WE TRANSMIT TO YOU UNDER SEPARATE COVER HERE WITH THE FOLLOWING DRAWINGS:

DWG NO	REV NO	NO EACH	DESCRIPTION	REMARKS
15353A-GN1	0	1	GENERAL NOTES	
15353A-D1	0	1	SHOP DRAWING	APPROVER NOTS REQUIRE REPLY
15353A-D2	0	1	SHOP DRAWING	APPROVER NOTS REQUIRE REPLY
15353A-D3	0	1	SHOP DRAWING	
15353A-D4	0	1	SHOP DRAWING	
15353A-D5	0	1	SHOP DRAWING	
15353A-D6	0	1	SHOP DRAWING	
15353A-D7	0	1	SHOP DRAWING	

DWG NO	REV NO	NO EACH	DESCRIPTION	REMARKS
15353A-D8	0	1	SHOP DRAWING	APPROVER NOTS REQUIRE REPLY

COMMENTS: **THE ATTACHED SHOP DRAWINGS ARE**
SUBMITTED FOR APPROVAL. PLEASE FORWARD THIS
PACKAGE TO THE ENGINEER FOR REVIEW AND ADVISE
THE APPROVAL STATUS AS SOON AS POSSIBLE.

***** APPROVER NOTES REQUIRE REPLY *****

THE ABOVE PRINTS ARE SUBMITTED TO YOU FOR:

<input type="checkbox"/> (XXX) Approval	<input type="checkbox"/> Final Approval	<input type="checkbox"/> Distribution
<input type="checkbox"/> Field Use	<input type="checkbox"/> Fabrication	<input type="checkbox"/> (XXX) E-MAIL
<input type="checkbox"/> Next Day Air	<input type="checkbox"/> Second Day Air	<input type="checkbox"/> Messenger
<input type="checkbox"/> UPS	<input type="checkbox"/> First Class Mail	<input type="checkbox"/> Fax

BY:

Thank you

STEPHANIE RITZ

COSMEC INC. / DYNAMIC RUBBER PRODUCTS

WWW.COSMECINC.COM

GENERAL NOTES

GENERAL NOTES:

1. ALL BEARINGS IN ACCORDANCE WITH THE 2016 OHIO DEPARTMENT OF TRANSPORTATION STANDARD SPECIFICATION FOR CONSTRUCTION AND MAINTENANCE OF HIGHWAYS, STREETS AND BRIDGES AND SUPPLEMENTAL SPECIFICATIONS 800 DATED 10/19/18, AND 869 DATED 10/17/14.
2. SHOP TO MARK LOCATION, BEAM/GIRDER NUMBER, BEARING NUMBER, HIGH-SIDE ⊗ AND AHEAD STATION AS SHOWN. MARKS SHALL BE PERMANENT AND BE VISIBLE AFTER BEARING IS INSTALLED.
3. ALL DIMENSIONS ARE IN INCHES.
4. ALL PLATES SHALL BE SMOOTH AND STRAIGHT.
5. SHIP THE SAMPLE BEARING TO AN INDEPENDENT TESTING LABORATORY FOR TESTING PER OH DOT STANDARD SPECIFICATIONS SECTION 711.23.
6. NOTIFY THE OH DOT OFFICE OF STRUCTURAL ENGINEERING AT LEAST TWO WEEKS BEFORE STARTING SHOP FABRICATION.
7. DYNAMIC RUBBER REPRESENTATIVE:
KATHI MILLS
903-677-2871
1501 ROCKY RIDGE RD.
ATHENS, TX 75751

MATERIAL NOTES:


- BRIDGE NO.: HAM-75-0440 L/R**
1. ELASTOMER: 50 DUROMETER GRADE 3 NEOPRENE
 2. STEEL LAMINATES: ASTM A709 GRADE 36, A1011 GRADE 36, GRADE 40 OR EQUIVALENT.
 3. STEEL PLATES: ASTM A709 GRADE 50 (GALVANIZED)
 4. STEEL HP12x53 PEDESTALS: ASTM A709 GRADE 50 (GALVANIZED)
 5. RUB PLATES: ASTM A709 GRADE 50 (METALIZED)
 6. STAINLESS STEEL (RUB PLATE): ASTM A240 TYPE 304 W/#8 MIRROR FINISH ON SLIDING SURFACE
 7. PTFE (RUB PLATE): ASTM D4894 (UNFILLED) – UNDIMPLED (PER AASHTO 18.8)
 8. SHEAR STUDS: ASTM A108 GRADE 1018 (METALIZED)
- BRIDGE NO.: HAM-74-1840 L/R & HAM-74-1852 L/R**
1. ELASTOMER: 50 DUROMETER GRADE 3 NEOPRENE
 2. STEEL LAMINATES: ASTM A709 GRADE 36, A1011 GRADE 36, GRADE 40 OR EQUIVALENT.
 3. STEEL PLATES: ASTM A709 GRADE 50 (PRIME PAINTED)
 4. STEEL HP12x53 PEDESTALS: ASTM A709 GRADE 50 (PRIME PAINTED)

CONTRACTOR NOTES:



1. WHEN WELDING BEAM FLANGE TO SOLE PLATES, USE TEMPERATURE INDICATING WAX PEN OR OTHER SUITABLE MEANS TO INSURE THAT THE TEMPERATURE OF THE ELASTOMER DOES NOT EXCEED 250°F. TEMPERATURES ABOVE THIS MAY DAMAGE THE ELASTOMER.
2. HAM-74-1840 & HAM-74-1852 ARE REHABILITATION PROJECTS. THE CONTRACTOR MUST VERIFY ALL SIZES AND DIMENSIONS ON THESE SHOP DRAWINGS PRIOR TO ANY FABRICATION BY COSMEC, INC.. THE CONTRACTOR IS SOLELY RESPONSIBLE FOR THE CORRECT SIZES AND CORRECT FIT, IN THE FIELD, OF ALL COMPONENTS.

FINISH NOTES:

- BRIDGE NO.: HAM-75-0440 L/R**
1. BLAST EXPOSED STEEL SURFACES OF THE SOLE PLATES, LOAD PLATES AND HP12x53 PEDESTALS TO SSPC-SP6 (COMMERCIAL BLAST CLEANING) PRIOR TO GALVANIZING.
 2. BLAST EXPOSED STEEL SURFACES OF THE RUB PLATES & STUDS TO SSPC-SP5 (WHITE METAL BLAST CLEANING) PRIOR TO METALIZING.
 3. GALVANIZED THE SOLE PLATES, LOAD PLATES AND HP12x53 PEDESTALS ACCORDING TO SECTION 711.02.
 4. RUB PLATES & STUDS SHALL BE ZINC METALIZED AND SEAL COATED PER SUPPLEMENTAL SPECIFICATION SECTION 869.13.
- BRIDGE NO.: HAM-74-1840 L/R & HAM-74-1852 L/R**
1. BLAST EXPOSED STEEL SURFACES OF THE SOLE PLATES, LOAD PLATES AND HP12x53 PEDESTALS TO SSPC-SP10 (NEAR WHITE BLAST CLEANING) PRIOR TO PAINTING.
 2. THE SOLE PLATES, LOAD PLATES AND HP12x53 PEDESTALS SHALL BE PRIME PAINTED WITH A CONTRACTOR DESIGNATED PRIME PAINT PER SPECIFICATION SECTION 514.

STATE OF OHIO		
DEPARTMENT OF TRANSPORTATION		
BRIDGE NO.: HAM-75-0440 L/R OVER IR-74 WB		
BRIDGE NO.: HAM-74-1840 L/R OVER SB BEEKMAN ST. (U.S. 27) AND RAMP F		
BRIDGE NO. HAM-74-1852 L/R OVER NB BEEKMAN ST. (U.S. 27)		
HAM-75-3.84 CITY OF CINCINNATI		
STATE	COUNTY	PID NO.
OH	HAMILTON	104667
FED. PROJ. NO.: E170 (713)		
DYNAMIC RUBBER LAM. ELASTOMERIC BEARING ASSY.'S		
		1501 ROCKY RIDGE ROAD P.O. BOX 2159 ATHENS, TEXAS 75751
SCALE: NONE	DRAWN BY: MH	CHECKED BY: ELS
	DATE: 03/18/19	DATE: 03/29/19
SHEET GN1 OF 1		JOB NO.: 15353A
REV.	DESCRIPTION	BY DATE CK'D DATE
	CUSTOMER	DRAWING NUMBER REV.
	WALSH CONSTRUCTION CO. II	15353A-GN1 0



△					
REV.	DESCRIPTION	BY	DATE	CK'D	DATE

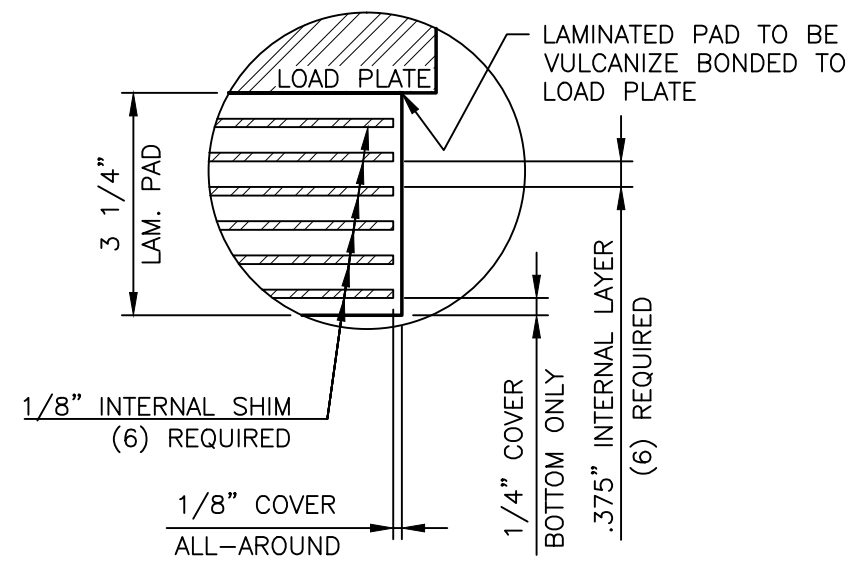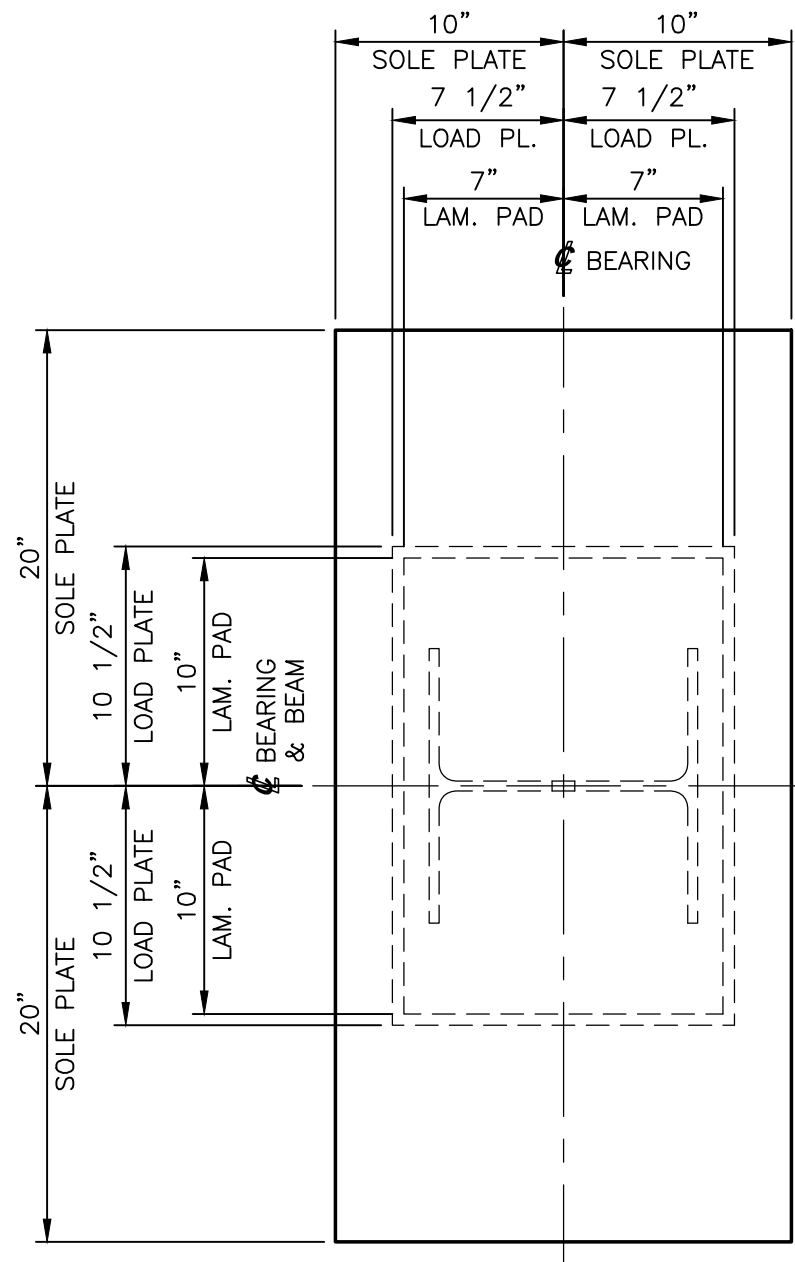


DETAIL 1
 3 1/4" x 20" x 14" LAMINATED PAD
 50 DUROMETER GRADE 3 NEOPRENE
 VULCANIZE BONDED TO LOAD PLATE
 (30) REQUIRED

TEST1-A
 3 1/4" x 20" x 14" LAMINATED PAD
 50 DUROMETER GRADE 3 NEOPRENE
 PAD ONLY FOR TESTING
 (2) REQUIRED

UNFACTORED ELASTOMERIC BEARING LOADS		
	EBA1-A (LEFT)	EBA2-A (RIGHT)
DEAD LOAD	223 KIPS	207 KIPS
LIVE LOAD	107 KIPS	101 KIPS
TOTAL LOAD (DL+LL)	330 KIPS	308 KIPS

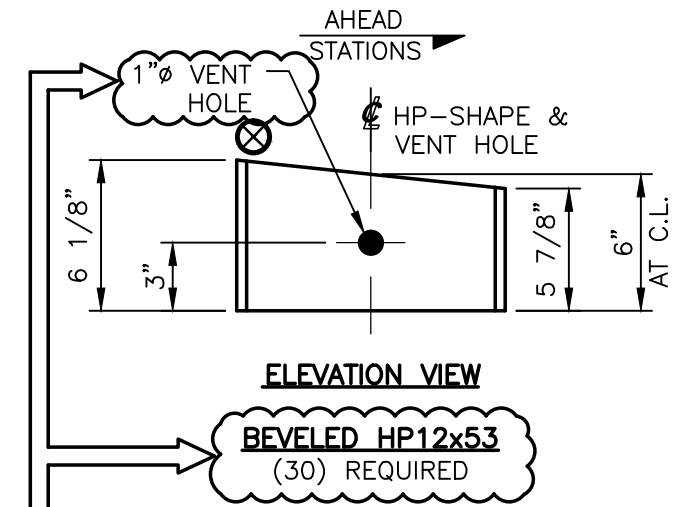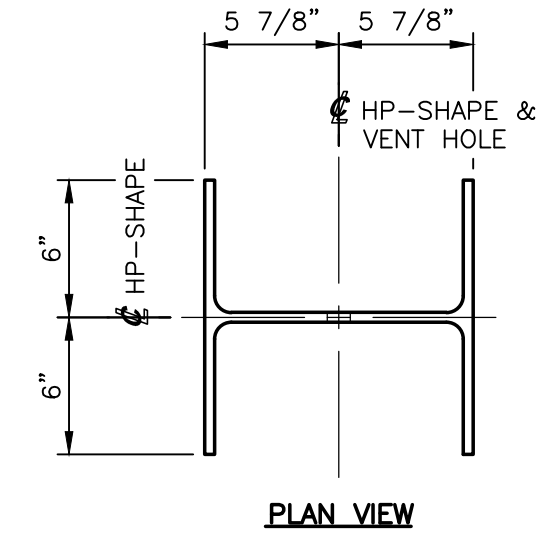

APPROVER NOTE:
 1. PER SECTIONS A-A, B-B AND ELEVATION VIEWS SHOWN ON CONTRACT SHEET 45 OF 68, THE HP12x53 IS TO BE BEVELED. IN THE PLAN AND BEARING SCHEDULE TABLE ON SHEET 45 OF 68 THE LOAD PLATE IS TO BE BEVELED. PLEASE VERIFY IF THE HP12x53 IS BEVELED AS SHOWN.
 2. A VENT HOLE IS SHOWN IN THE DETAILS ON CONTRACT SHEET 45 OF 68 BUT THE SIZE IS NOT CALLED OUT. PLEASE VERIFY IF THE 1" DIAMETER, AS SHOWN, IS ACCEPTABLE.

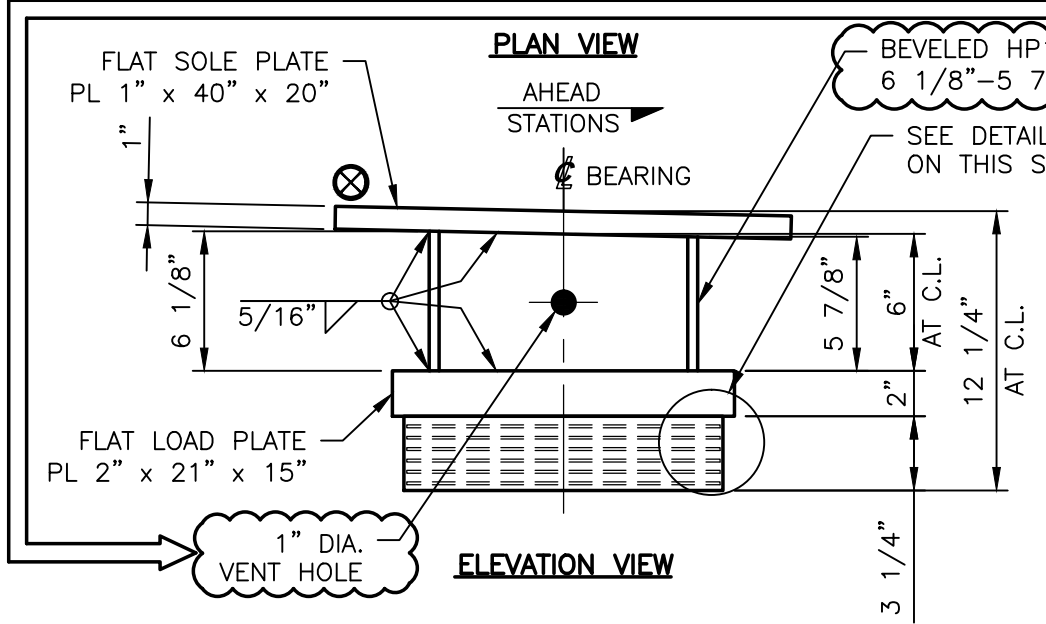


EXPANSION LAMINATED ELASTOMERIC BEARING ASSEMBLY (REF. NO.: 0039)
MARK: EBA1-A & EBA2-A
 LEFT BRIDGE (EBA1-A)
 (7) LOCATED AT REAR ABUT. (BEAMS 1-7)
 (7) LOCATED AT FORWARD ABUT. (BEAMS 1-7)
 RIGHT BRIDGE (EBA2-A)
 (8) LOCATED AT REAR ABUT. (BEAMS 8-15)
 (8) LOCATED AT FORWARD ABUT. (BEAMS 8-15)
 (30) REQUIRED

BRIDGE NO.: HAM-75-0440 L/R
 SEE NOTES ON SHEET GN1 OF 1

STATE OF OHIO
 DEPARTMENT OF TRANSPORTATION
 BRIDGE NO.: HAM-75-0440 L/R
 OVER IR-74 WB
 BRIDGE NO.: HAM-74-1840 L/R
 OVER SB BEEKMAN ST. (U.S. 27)
 AND RAMP F
 BRIDGE NO. HAM-74-1852 L/R
 OVER NB BEEKMAN ST. (U.S. 27)
 HAM-75-3.84
 CITY OF CINCINNATI

STATE	COUNTY	PID NO.
OH	HAMILTON	104667
FED. PROJ. NO.: E170 (713)		
DYNAMIC RUBBER LAM. ELASTOMERIC BEARING ASSY.'S		
Cosmee 1501 ROCKY RIDGE ROAD P.O. BOX 2159 ATHENS, TEXAS 75751		
SCALE: NONE	DRAWN BY: MH	CHECKED BY: ELS
	DATE: 03/18/19	DATE: 03/29/19
SHEET 1 OF 8	JOB NO.: 15353A	
REV.	DESCRIPTION	BY DATE CK'D DATE
	CUSTOMER WALSH CONSTRUCTION CO. II	DRAWING NUMBER 15353A-D1
		REV. 0

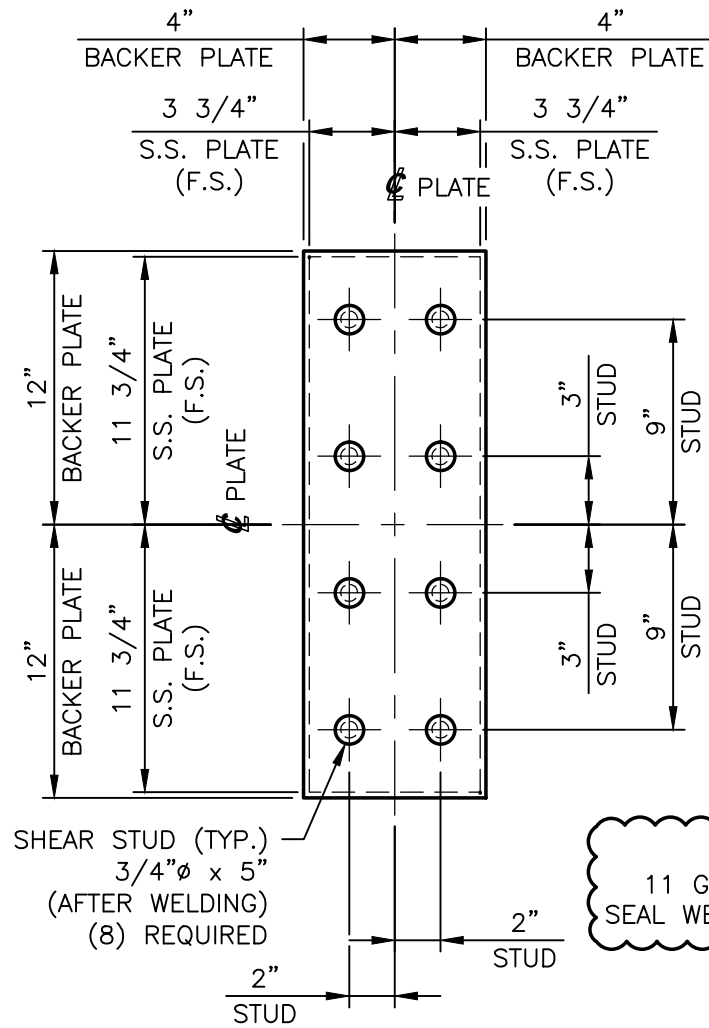

PLAN VIEW

FRONT VIEW

STAINLESS STEEL SHEET
11 GA. x 7 1/2" x 23 1/2"
SEAL WELDED TO BACKER PLATE

APPROVER NOTE:
13GA STAINLESS STEEL IS NOT
AVAILABLE WITH A MIRROR FINISH.
PLEASE VERIFY IF 11GA IS
ACCEPTABLE.


RUB PLATE ASSEMBLY (REF. NO.: 0039)

MARK NO.: RP1-A

PL 1" x 8" x 24"

ASTM A709 GRADE 50 (METALIZED)
LEFT BRIDGE

- (1) LOCATED AT REAR ABUTMENT
- (1) LOCATED AT FRONT ABUTMENT
RIGHT BRIDGE
- (1) LOCATED AT REAR ABUTMENT
- (1) LOCATED AT FRONT ABUTMENT
(4) REQUIRED

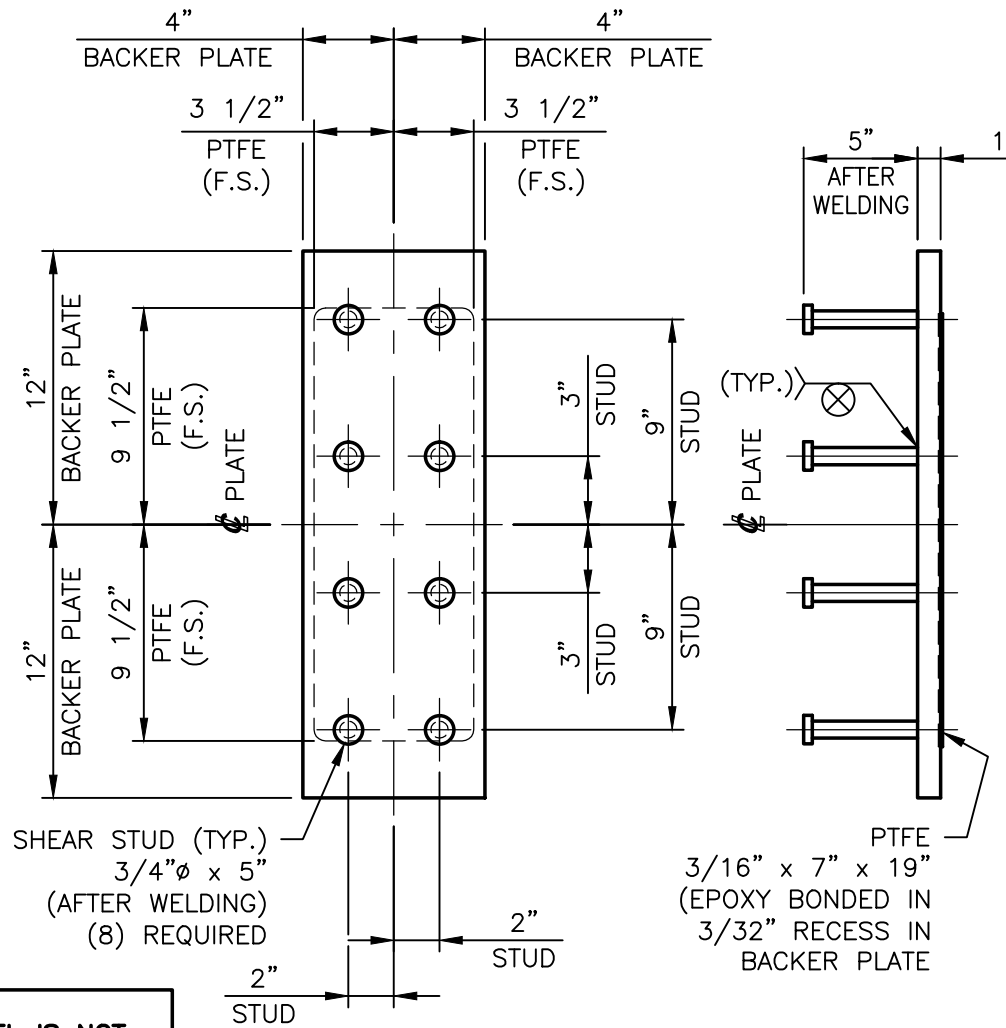

PLAN VIEW

FRONT VIEW

PTFE
3/16" x 7" x 19"
(EPOXY BONDED IN
3/32" RECESS IN
BACKER PLATE)

RUB PLATE ASSEMBLY (REF. NO.: 0039)

MARK NO.: RP2-A

PL 1" x 8" x 24"

ASTM A709 GRADE 50 (METALIZED)
LEFT BRIDGE

- (1) LOCATED AT REAR ABUTMENT
- (1) LOCATED AT FRONT ABUTMENT
RIGHT BRIDGE
- (1) LOCATED AT REAR ABUTMENT
- (1) LOCATED AT FRONT ABUTMENT
(4) REQUIRED

BRIDGE NO.: HAM-75-0440 L/R

SEE NOTES ON SHEET GN1 OF 1

STATE OF OHIO
DEPARTMENT OF TRANSPORTATION
BRIDGE NO.: HAM-75-0440 L/R
OVER IR-74 WB

BRIDGE NO.: HAM-74-1840 L/R
OVER SB BEEKMAN ST. (U.S. 27)
AND RAMP F

BRIDGE NO. HAM-74-1852 L/R
OVER NB BEEKMAN ST. (U.S. 27)

HAM-75-3.84
CITY OF CINCINNATI

STATE	COUNTY	PID NO.
OH	HAMILTON	104667

FED. PROJ. NO.: E170 (713)


**DYNAMIC RUBBER
LAM. ELASTOMERIC BEARING ASSY.'S**

Cosmee 1501 ROCKY RIDGE ROAD
P.O. BOX 2159
ATHENS, TEXAS 75751


SCALE: NONE	DRAWN BY: MH	CHECKED BY: ELS
	DATE: 03/18/19	DATE: 03/29/19

SHEET 2 OF 8 **JOB NO.: 15353A**

REV.	DESCRIPTION	BY	DATE	CK'D	DATE	CUSTOMER WALSH CONSTRUCTION CO. II	DRAWING NUMBER 15353A-D2	REV. 0
------	-------------	----	------	------	------	---------------------------------------	-----------------------------	-----------

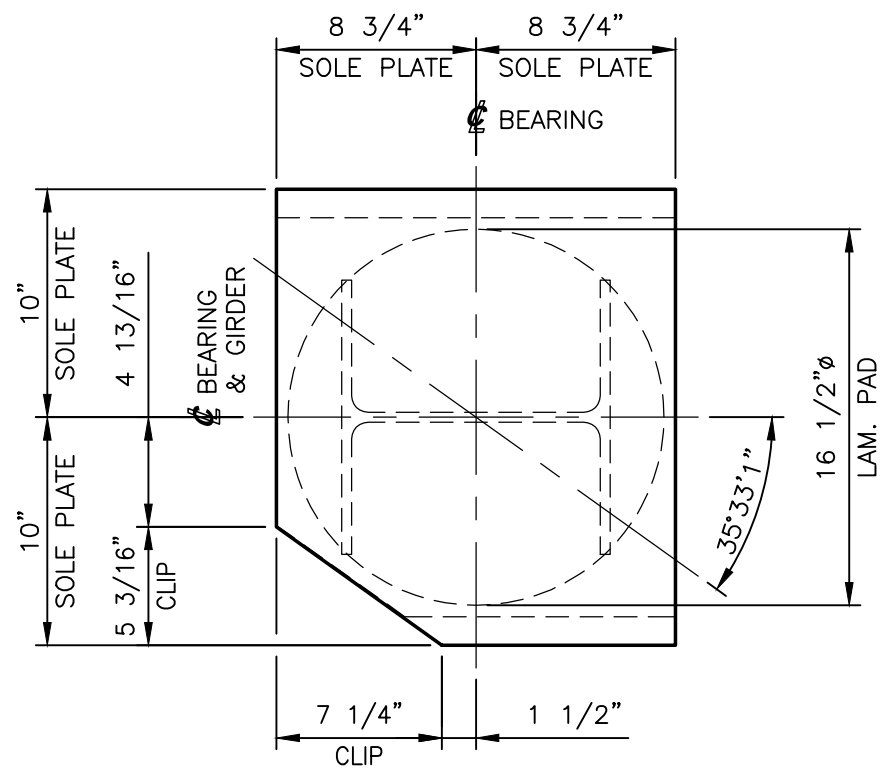


PLAN VIEW

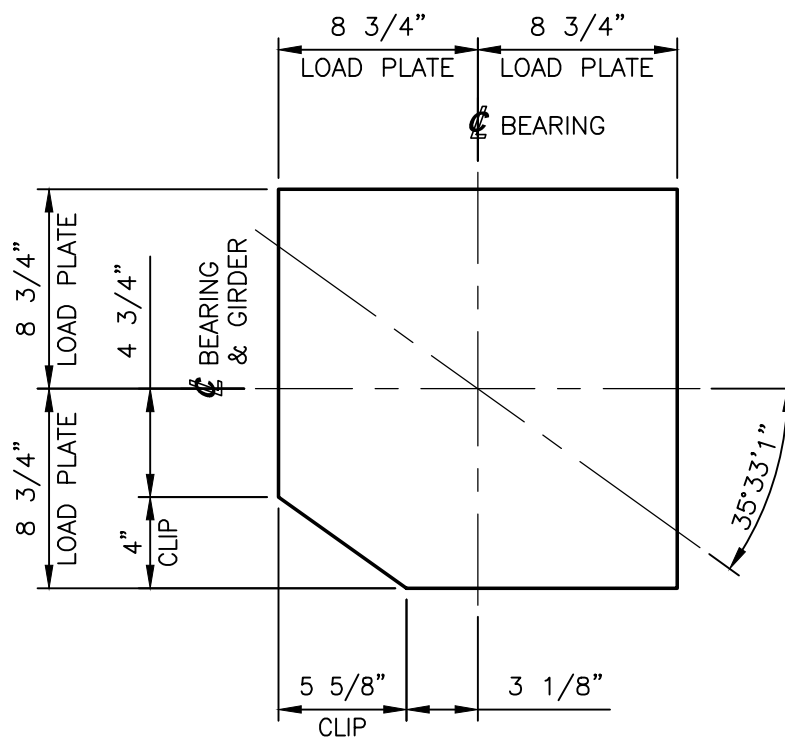

LOAD PLATE DETAIL

PL 1 1/2" x 17 1/2" x 17 1/2"
ASTM A709 GRADE 50 (PRIME PAINTED)
(10) REQUIRED

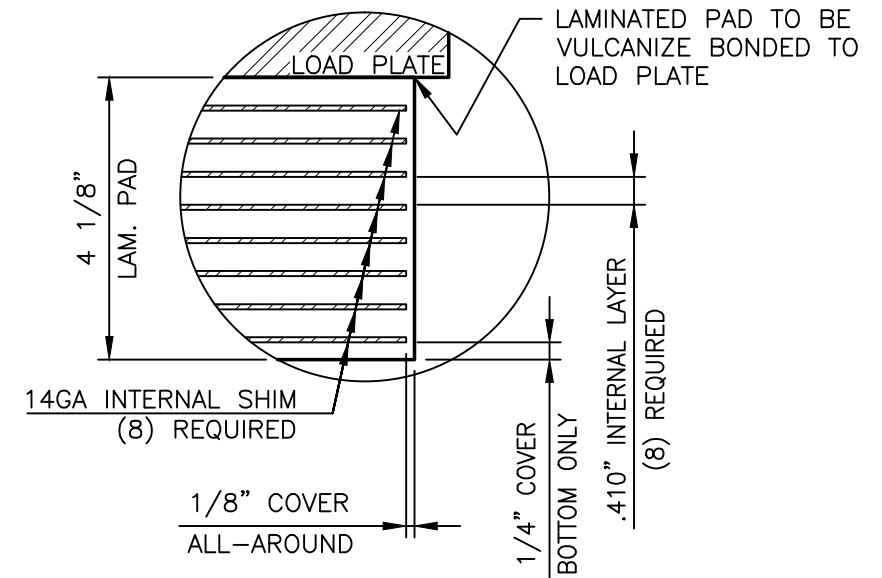

DETAIL 2


4 1/8" x 16 1/2" LAMINATED PAD
50 DUROMETER GRADE 3 NEOPRENE
VULCANIZE BONDED TO LOAD PLATE
(10) REQUIRED

TEST2-A

4 1/8" x 16 1/2" LAMINATED PAD
50 DUROMETER GRADE 3 NEOPRENE
PAD ONLY FOR TESTING
(2) REQUIRED

BRIDGE NO.: HAM-74-1840 L/R


SEE NOTES ON SHEET GN1 OF 1

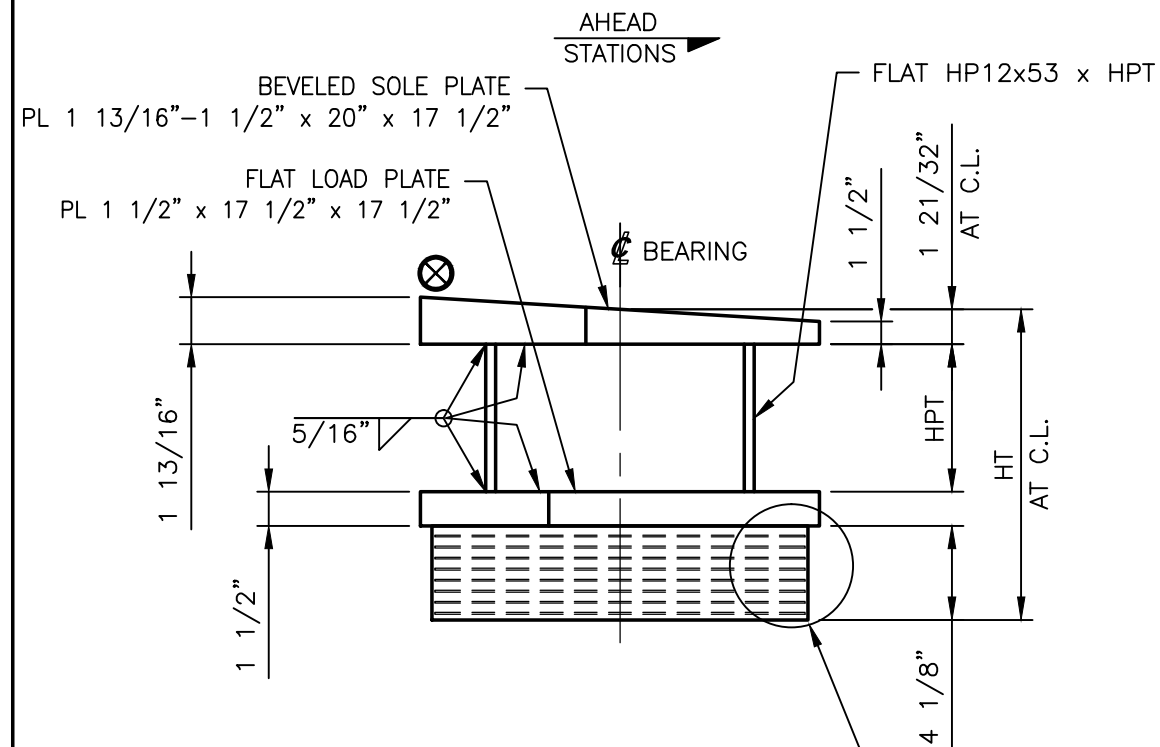


ELEVATION VIEW

EXPANSION LAMINATED ELASTOMERIC BEARING ASSEMBLY (REF. NO.: 0036) AT REAR ABUT.
SEE BEARING TABLE 1 ON SHEET 5 FOR MARK NUMBERS, QTY.'S, LOADS, LOCATIONS AND DIMENSIONS NOT SHOWN

SEE DETAIL 2 ON THIS SHEET

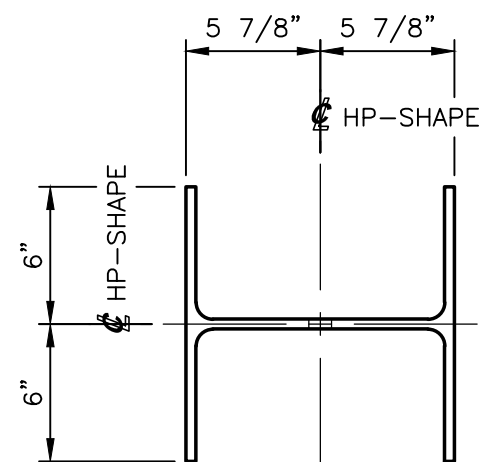

PLAN VIEW

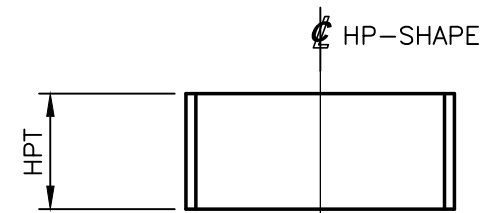

ELEVATION VIEW

FLAT HP12x53
(10) REQUIRED

STATE OF OHIO
DEPARTMENT OF TRANSPORTATION
BRIDGE NO.: HAM-75-0440 L/R
OVER IR-74 WB

BRIDGE NO.: HAM-74-1840 L/R
OVER SB BEEKMAN ST. (U.S. 27)
AND RAMP F

BRIDGE NO. HAM-74-1852 L/R
OVER NB BEEKMAN ST. (U.S. 27)

HAM-75-3.84
CITY OF CINCINNATI

STATE	COUNTY	PID NO.
OH	HAMILTON	104667

FED. PROJ. NO.: E170 (713)


DYNAMIC RUBBER LAM. ELASTOMERIC BEARING ASSY.'S

Cosmee 1501 ROCKY RIDGE ROAD
P.O. BOX 2159
ATHENS, TEXAS 75751


SCALE: NONE	DRAWN BY: MH	CHECKED BY: ELS
	DATE: 03/18/19	DATE: 03/29/19

SHEET 3 OF 8 **JOB NO.: 15353A**

REV.	DESCRIPTION	BY	DATE	CK'D	DATE	CUSTOMER WALSH CONSTRUCTION CO. II	DRAWING NUMBER 15353A-D3	REV. 0
------	-------------	----	------	------	------	---------------------------------------	-----------------------------	-----------

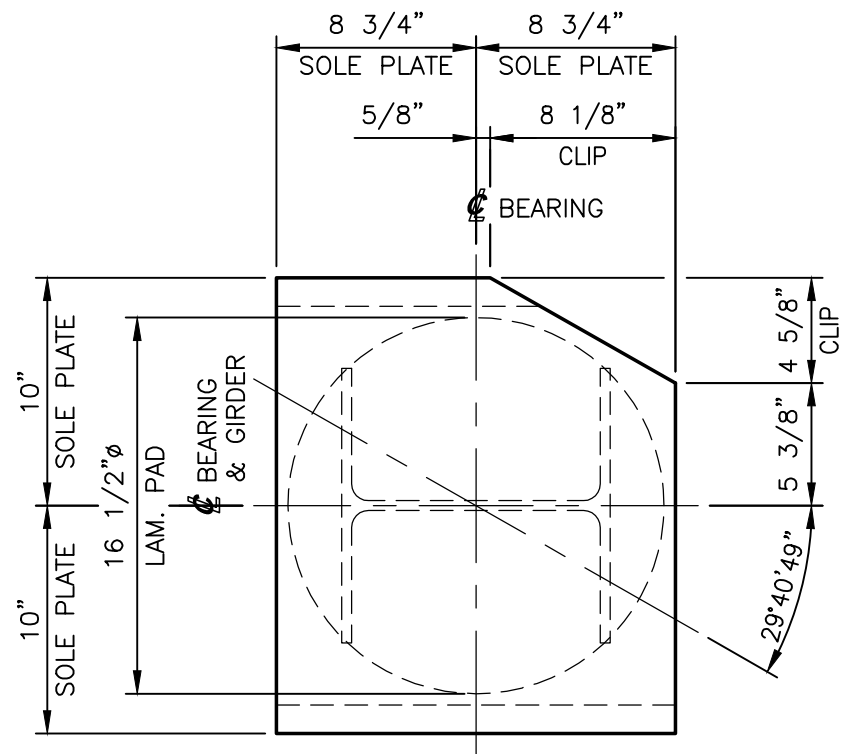


PLAN VIEW

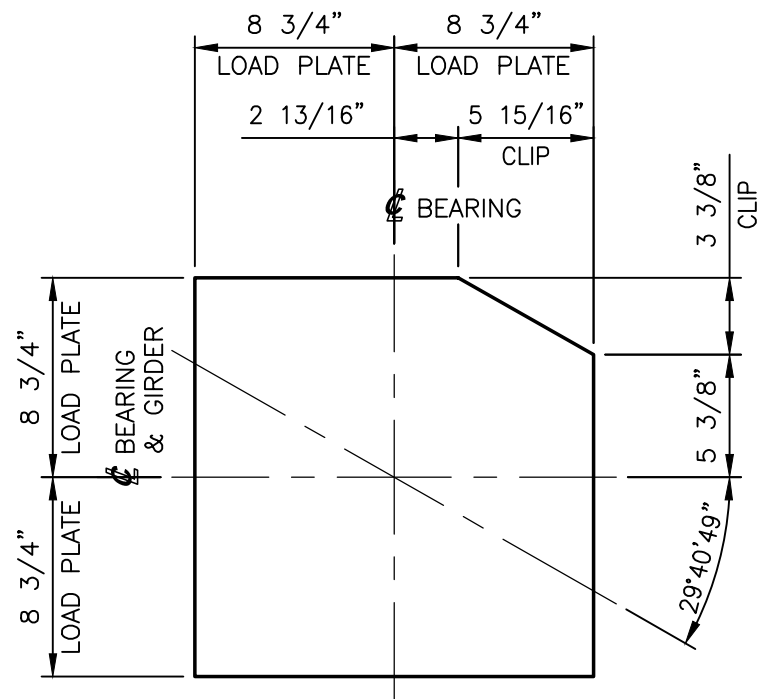


LOAD PLATE DETAIL

PL 1 1/2" x 17 1/2" x 17 1/2"
ASTM A709 GRADE 50 (PRIME PAINTED)
(10) REQUIRED

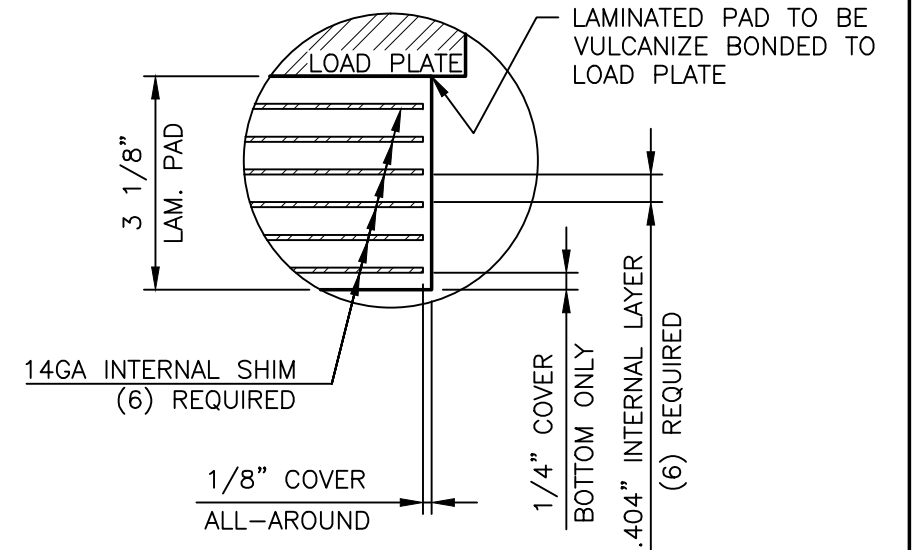


DETAIL 3

3 1/8" x 16 1/2" φ LAMINATED PAD
50 DUROMETER GRADE 3 NEOPRENE
VULCANIZE BONDED TO LOAD PLATE
(10) REQUIRED

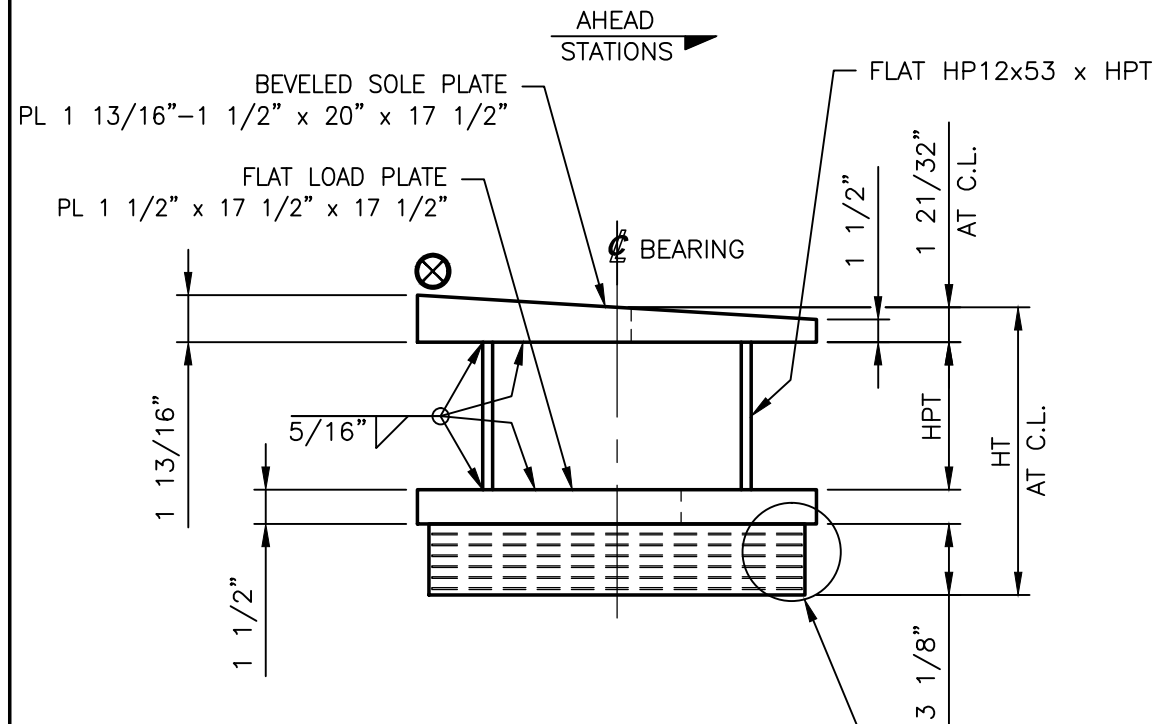


ELEVATION VIEW

EXPANSION LAMINATED ELASTOMERIC BEARING ASSEMBLY (REF. NO.: 0036) AT FORWARD ABUT.
SEE BEARING TABLE 2 ON SHEET 5 FOR MARK NUMBERS, QTY.'S, LOADS, LOCATIONS AND DIMENSIONS NOT SHOWN

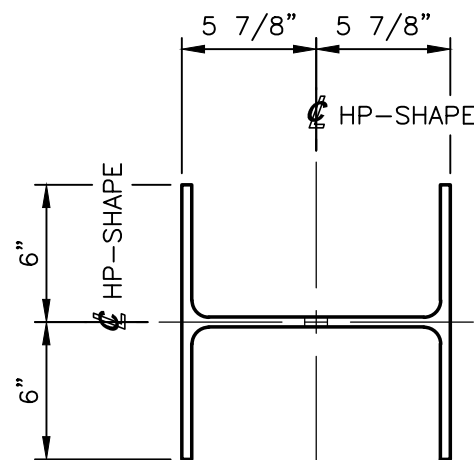

PLAN VIEW

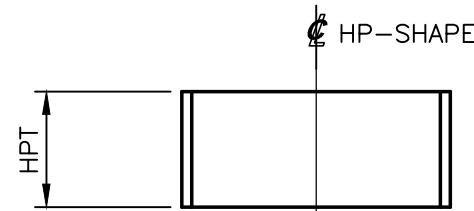

ELEVATION VIEW

FLAT HP12x53
(10) REQUIRED

BRIDGE NO.: HAM-74-1840 L/R

SEE NOTES ON SHEET GN1 OF 1

STATE OF OHIO
DEPARTMENT OF TRANSPORTATION

BRIDGE NO.: HAM-75-0440 L/R
OVER IR-74 WB

BRIDGE NO.: HAM-74-1840 L/R
OVER SB BEEKMAN ST. (U.S. 27)
AND RAMP F

BRIDGE NO. HAM-74-1852 L/R
OVER NB BEEKMAN ST. (U.S. 27)

HAM-75-3.84
CITY OF CINCINNATI

STATE	COUNTY	PID NO.
OH	HAMILTON	104667

FED. PROJ. NO.: E170 (713)

**DYNAMIC RUBBER
LAM. ELASTOMERIC BEARING ASSY.'S**

Cosmee 1501 ROCKY RIDGE ROAD
P.O. BOX 2159
ATHENS, TEXAS 75751

SCALE: NONE	DRAWN BY: MH	CHECKED BY: ELS
	DATE: 03/18/19	DATE: 03/29/19

SHEET 4 OF 8 **JOB NO.: 15353A**

REV.	DESCRIPTION	BY	DATE	CK'D	DATE	CUSTOMER WALSH CONSTRUCTION CO. II	DRAWING NUMBER 15353A-D4	REV. 0
------	-------------	----	------	------	------	---------------------------------------	-----------------------------	-----------

TABLE 1 - EXPANSION LAMINATED ELASTOMERIC BEARING ASSEMBLIES											
REF. NO.	BEARING MARK	QTY.	LOCATION			BEARING TYPE	DESIGN LOADS (KIPS)			HP12x53	HT AT C.L. (in.)
			BRIDGE	ABUTMENT	GIRDER(s)		D.L. (KIPS)	L.L. (KIPS)	TOTAL LOAD (DL+LL) (KIPS)	HPT THK. (in.)	
0036	EBA3-A	1	LEFT	REAR	G1	EXP	69	60	129	6 9/32	13 9/16
0036	EBA4-A	1	LEFT	REAR	G2	EXP	69	60	129	6.406	13 11/16
0036	EBA5-A	2	LEFT	REAR	G3 & G4	EXP	69	60	129	6 19/32	13 7/8
0036	EBA6-A	1	LEFT	REAR	G5	EXP	69	60	129	6 21/32	13 15/16
0036	EBA7-A	4	RIGHT	REAR	G6, G7, G9 & G10	EXP	69	60	129	6.639	13.92
0036	EBA8-A	1	RIGHT	REAR	G8	EXP	69	60	129	6.519	13.80

TABLE 2 - EXPANSION LAMINATED ELASTOMERIC BEARING ASSEMBLIES											
REF. NO.	BEARING MARK	QTY.	LOCATION			BEARING TYPE	DESIGN LOADS (KIPS)			HP12x53	HT AT C.L. (in.)
			BRIDGE	ABUTMENT	GIRDER(s)		D.L. (KIPS)	L.L. (KIPS)	TOTAL LOAD (DL+LL) (KIPS)	HPT THK. (in.)	
0036	EBA9-A	1	LEFT	FORWARD	G1	EXP	85	85	170	7 5/32	13 7/16
0036	EBA10-A	1	LEFT	FORWARD	G2	EXP	85	85	170	7 27/32	14 1/8
0036	EBA11-A	1	LEFT	FORWARD	G3	EXP	85	85	170	7 23/32	14
0036	EBA12-A	1	LEFT	FORWARD	G4	EXP	85	85	170	7 29/32	14 3/16
0036	EBA13-A	1	LEFT	FORWARD	G5	EXP	85	85	170	7 19/32	13 7/8
0036	EBA14-A	2	RIGHT	FORWARD	G6 & G8	EXP	85	85	170	7.519	13.80
0036	EBA15-A	3	RIGHT	FORWARD	G7, G9 & G10	EXP	85	85	170	7.639	13.92

NOTE:
REFER TO SHEETS 3 & 4 FOR BEARINGS ASSEMBLIES.

BRIDGE NO.: HAM-74-1840 L/R

SEE NOTES ON SHEET GN1 OF 1

STATE OF OHIO
DEPARTMENT OF TRANSPORTATION
BRIDGE NO.: HAM-75-0440 L/R
OVER IR-74 WB
BRIDGE NO.: HAM-74-1840 L/R
OVER SB BEEKMAN ST. (U.S. 27)
AND RAMP F
BRIDGE NO. HAM-74-1852 L/R
OVER NB BEEKMAN ST. (U.S. 27)
HAM-75-3.84
CITY OF CINCINNATI


STATE	COUNTY	PID NO.
OH	HAMILTON	104667
FED. PROJ. NO.: E170 (713)		

**DYNAMIC RUBBER
LAM. ELASTOMERIC BEARING ASSY.'S**

Cosmee 1501 ROCKY RIDGE ROAD
P.O. BOX 2159
ATHENS, TEXAS 75751


SCALE: NONE	DRAWN BY: MH	CHECKED BY: ELS
	DATE: 03/18/19	DATE: 03/29/19

△						SHEET 5 OF 8	JOB NO.: 15353A	
REV.	DESCRIPTION	BY	DATE	CK'D	DATE	CUSTOMER WALSH CONSTRUCTION CO. II	DRAWING NUMBER 15353A-D5	REV. 0

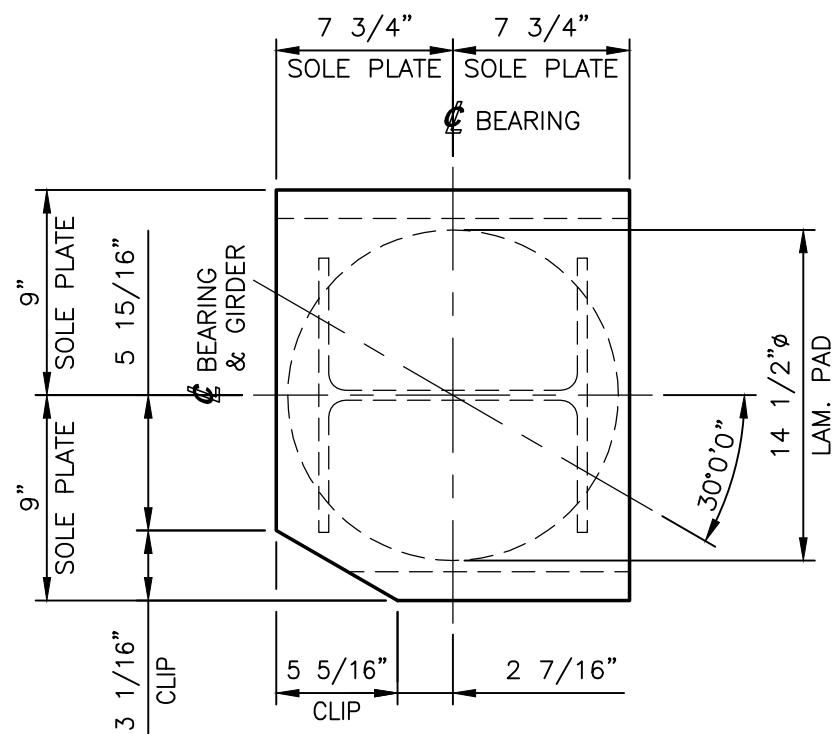


PLAN VIEW

AHEAD STATIONS

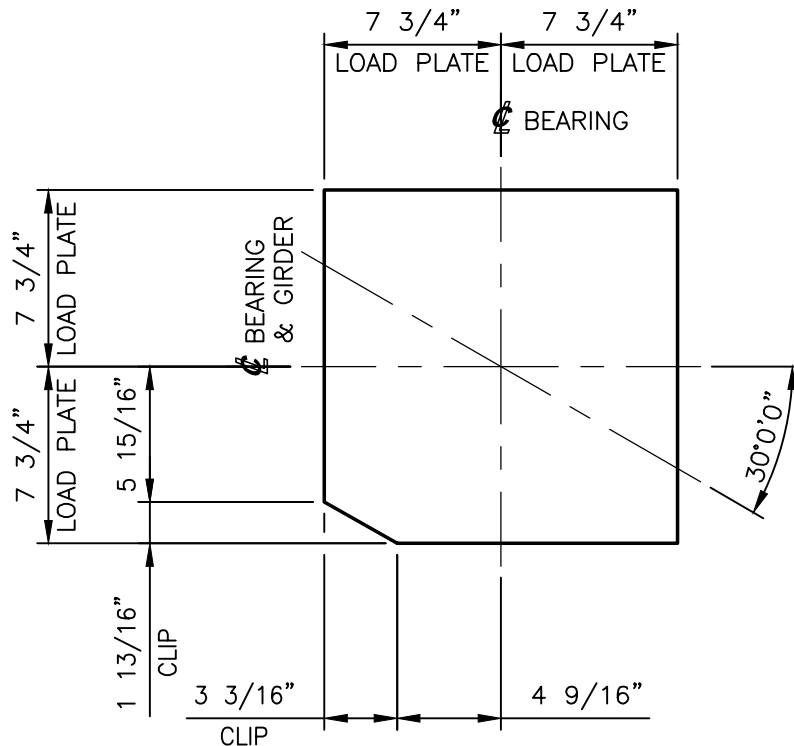

LOAD PLATE DETAIL

PL 1 1/2" x 15 1/2" x 15 1/2"
ASTM A709 GRADE 50 (PRIME PAINTED)
(10) REQUIRED

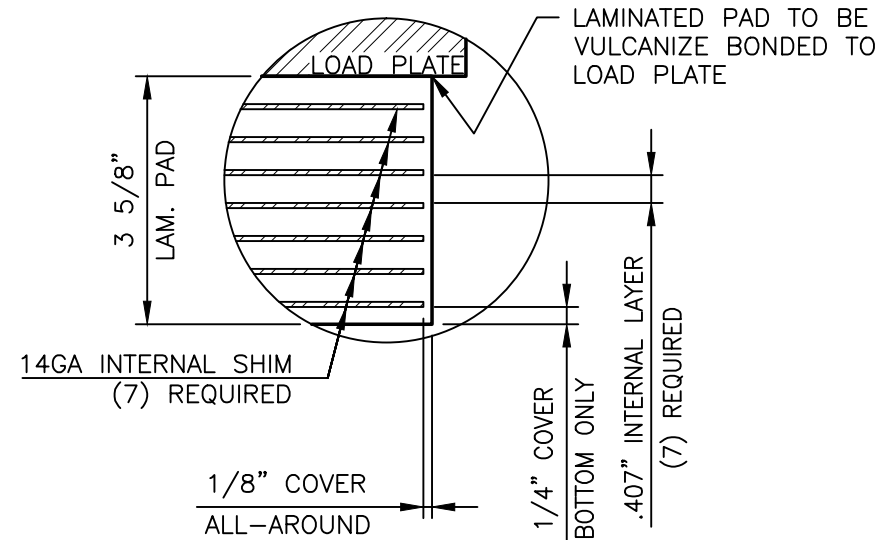


DETAIL 4

3 5/8" x 14 1/2"φ LAMINATED PAD
50 DUROMETER GRADE 3 NEOPRENE
VULCANIZE BONDED TO LOAD PLATE
(10) REQUIRED

TEST3-A

3 5/8" x 14 1/2"φ LAMINATED PAD
50 DUROMETER GRADE 3 NEOPRENE
PAD ONLY FOR TESTING
(2) REQUIRED


BRIDGE NO.: HAM-74-1852 L/R

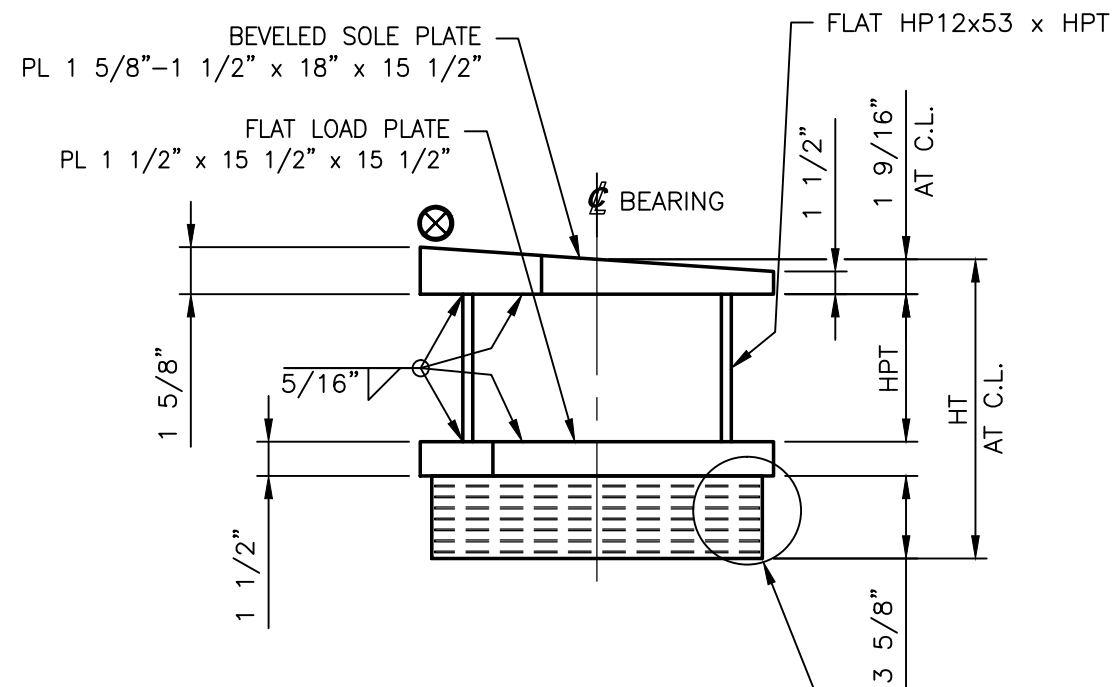


ELEVATION VIEW

EXPANSION LAMINATED ELASTOMERIC BEARING ASSEMBLY (REF. NO.: Q037) AT REAR ABUT.
SEE BEARING TABLE 3 ON SHEET 8 FOR MARK NUMBERS, QTY.'S, LOADS, LOCATIONS AND DIMENSIONS NOT SHOWN

SEE DETAIL 4 ON THIS SHEET

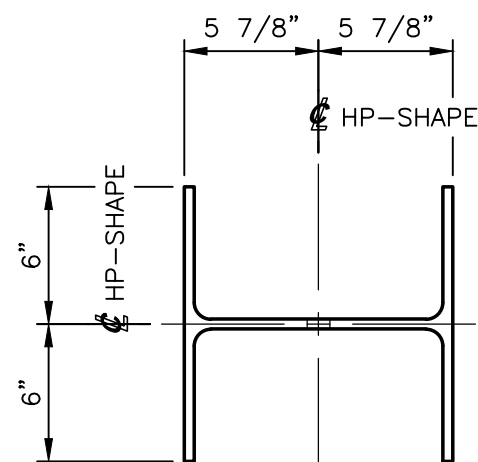

PLAN VIEW

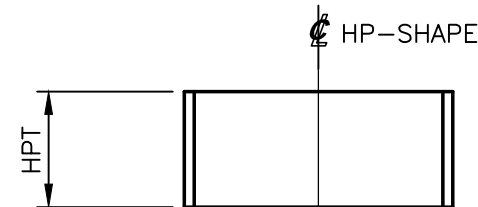

ELEVATION VIEW

FLAT HP12x53
(10) REQUIRED

SEE NOTES ON SHEET GN1 OF 1

STATE OF OHIO
DEPARTMENT OF TRANSPORTATION
BRIDGE NO.: HAM-75-0440 L/R
OVER IR-74 WB
BRIDGE NO.: HAM-74-1840 L/R
OVER SB BEEKMAN ST. (U.S. 27)
AND RAMP F
BRIDGE NO. HAM-74-1852 L/R
OVER NB BEEKMAN ST. (U.S. 27)

HAM-75-3.84
CITY OF CINCINNATI

STATE	COUNTY	PID NO.
OH	HAMILTON	104667
FED. PROJ. NO.: E170 (713)		


DYNAMIC RUBBER LAM. ELASTOMERIC BEARING ASSY.'S

Cosmee 1501 ROCKY RIDGE ROAD
P.O. BOX 2159
ATHENS, TEXAS 75751


SCALE: NONE	DRAWN BY: MH	CHECKED BY: ELS
	DATE: 03/18/19	DATE: 03/29/19

SHEET 6 OF 8 **JOB NO.: 15353A**

REV.	DESCRIPTION	BY	DATE	CK'D	DATE	CUSTOMER WALSH CONSTRUCTION CO. II	DRAWING NUMBER 15353A-D6	REV. 0
------	-------------	----	------	------	------	---------------------------------------	-----------------------------	-----------

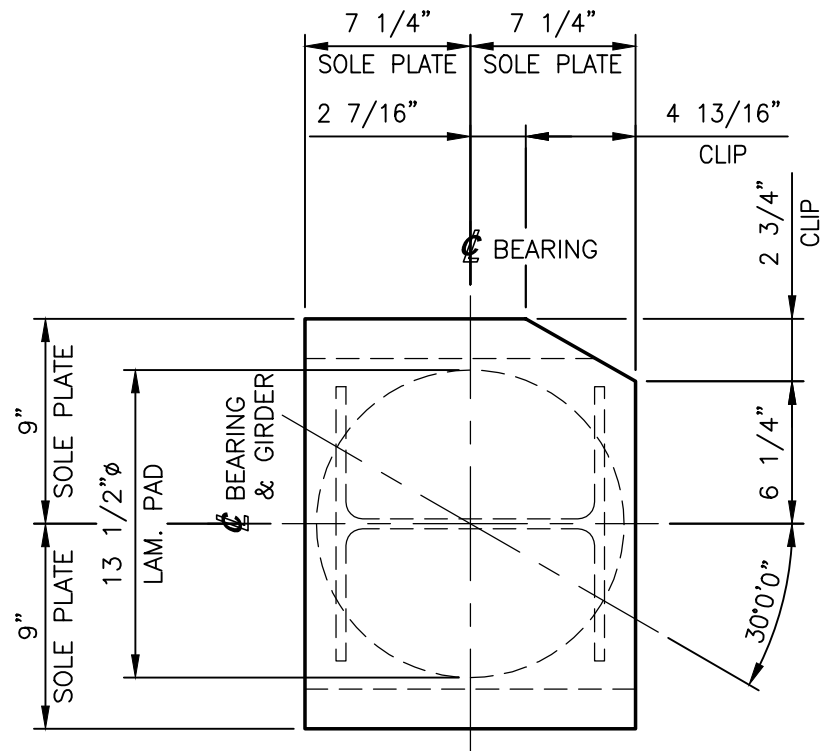


PLAN VIEW

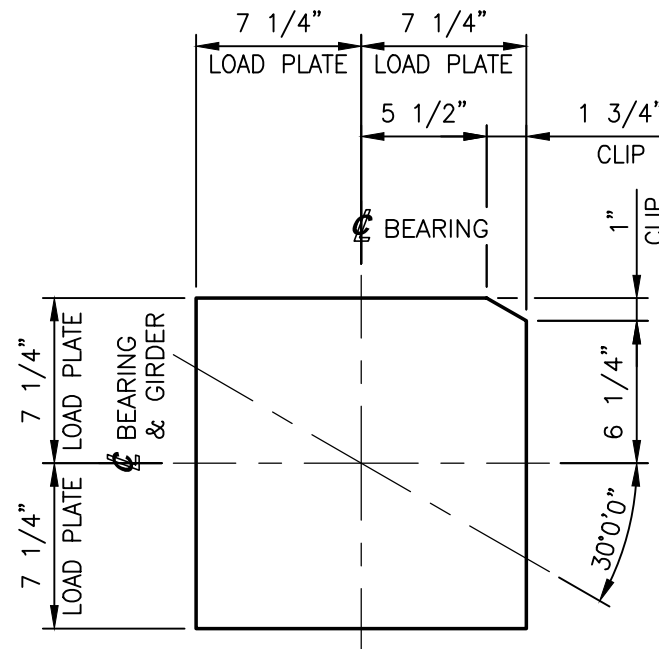


LOAD PLATE DETAIL

PL 1 1/2" x 14 1/2" x 14 1/2"
ASTM A709 GRADE 50 (PRIME PAINTED)
(10) REQUIRED

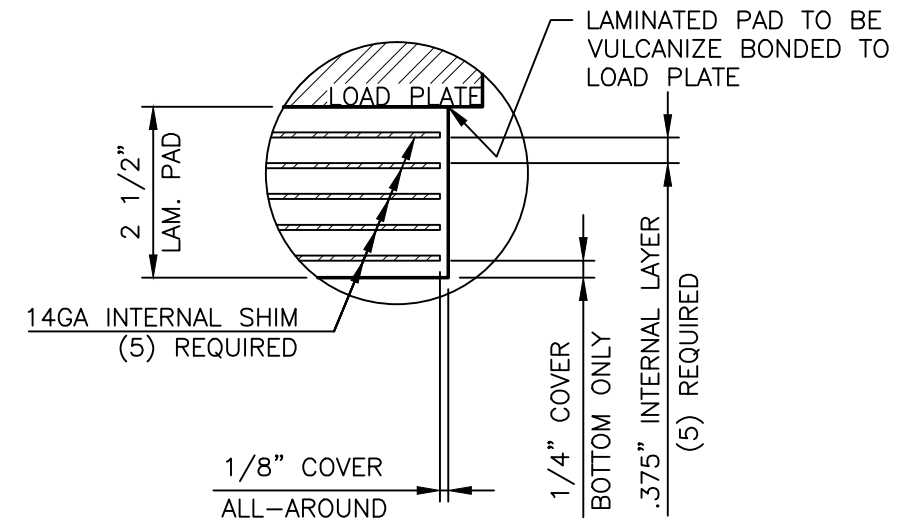

DETAIL 5


2 1/2" x 13 1/2" LAMINATED PAD
50 DUROMETER GRADE 3 NEOPRENE
VULCANIZE BONDED TO LOAD PLATE
(10) REQUIRED

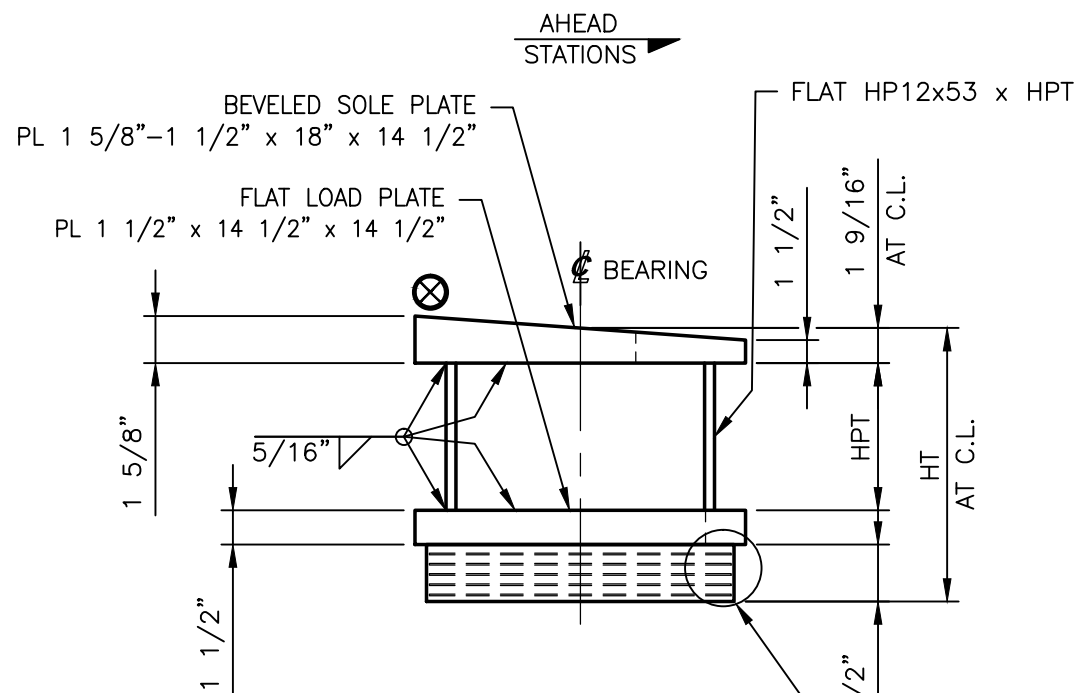


ELEVATION VIEW

EXPANSION LAMINATED ELASTOMERIC BEARING ASSEMBLY (REF. NO.: 0037) AT FORWARD ABUT.
SEE BEARING TABLE 4 ON SHEET 8 FOR MARK NUMBERS, QTY.'S, LOADS, LOCATIONS AND DIMENSIONS NOT SHOWN

SEE DETAIL 5 ON THIS SHEET

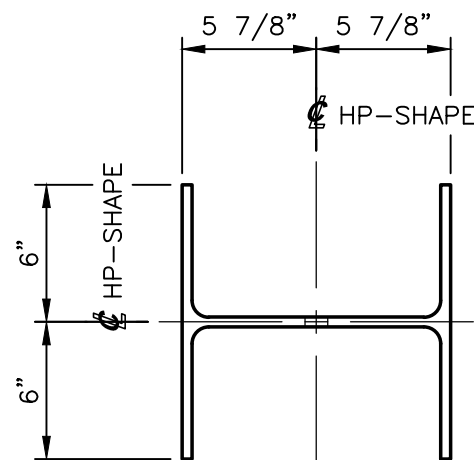

PLAN VIEW

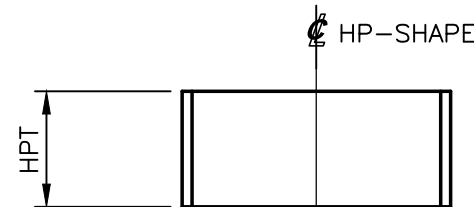

ELEVATION VIEW

FLAT HP12x53
(10) REQUIRED

BRIDGE NO.: HAM-74-1852 L/R

SEE NOTES ON SHEET GN1 OF 1

STATE OF OHIO
DEPARTMENT OF TRANSPORTATION

BRIDGE NO.: HAM-75-0440 L/R
OVER IR-74 WB

BRIDGE NO.: HAM-74-1840 L/R
OVER SB BEEKMAN ST. (U.S. 27)
AND RAMP F

BRIDGE NO. HAM-74-1852 L/R
OVER NB BEEKMAN ST. (U.S. 27)

HAM-75-3.84
CITY OF CINCINNATI

STATE	COUNTY	PID NO.
OH	HAMILTON	104667

FED. PROJ. NO.: E170 (713)

DYNAMIC RUBBER LAM. ELASTOMERIC BEARING ASSY.'S

Cosmee 1501 ROCKY RIDGE ROAD
P.O. BOX 2159
ATHENS, TEXAS 75751

SCALE: NONE	DRAWN BY: MH	CHECKED BY: ELS
	DATE: 03/18/19	DATE: 03/29/19

SHEET 7 OF 8 **JOB NO.: 15353A**

REV.	DESCRIPTION	BY	DATE	CK'D	DATE	CUSTOMER WALSH CONSTRUCTION CO. II	DRAWING NUMBER 15353A-D7	REV. 0
------	-------------	----	------	------	------	---------------------------------------	-----------------------------	-----------

TABLE 3 - EXPANSION LAMINATED ELASTOMERIC BEARING ASSEMBLIES											
REF. NO.	BEARING MARK	QTY.	LOCATION			BEARING TYPE	DESIGN LOADS (KIPS)			HP12x53	HT AT C.L. (in.)
			BRIDGE	ABUTMENT	GIRDER(s)		D.L. (KIPS)	L.L. (KIPS)	TOTAL LOAD (DL+LL) (KIPS)	HPT THK. (in.)	
0037	EBA16-A	2	LEFT	REAR	G1 & G4	EXP	56	56	112	7 13/16	14 1/2
0037	EBA17-A	2	LEFT	REAR	G2 & G3	EXP	56	56	112	8	14 11/16
0037	EBA18-A	1	LEFT	REAR	G5	EXP	56	56	112	7 11/16	14 3/8
0037	EBA19-A	1	RIGHT	REAR	G6	EXP	56	56	112	8 5/16	15
0037	EBA20-A	2	RIGHT	REAR	G7 & G9	EXP	56	56	112	8 3/16	14.88
0037	EBA21-A	1	RIGHT	REAR	G8	EXP	56	56	112	7.95	14.64
0037	EBA22-A	1	RIGHT	REAR	G9	EXP	56	56	112	8.07	14.76

APPROVER NOTE:
PLEASE VERIFY 14 3/8" IS CORRECT.
FIELD DIMENSIONS WERE SHOWN AS 14 6/16"

TABLE 4 - EXPANSION LAMINATED ELASTOMERIC BEARING ASSEMBLIES											
REF. NO.	BEARING MARK	QTY.	LOCATION			BEARING TYPE	DESIGN LOADS (KIPS)			HP12x53	HT AT C.L. (in.)
			BRIDGE	ABUTMENT	GIRDER(s)		D.L. (KIPS)	L.L. (KIPS)	TOTAL LOAD (DL+LL) (KIPS)	HPT THK. (in.)	
0037	EBA23-A	1	LEFT	FORWARD	G1	EXP	62	54	116	7 3/8	12 15/16
0037	EBA24-A	1	LEFT	FORWARD	G2	EXP	62	54	116	7	12 9/16
0037	EBA25-A	2	LEFT	FORWARD	G3 & G4	EXP	62	54	116	7 3/16	12 3/4
0037	EBA26-A	1	LEFT	FORWARD	G5	EXP	62	54	116	6 3/4	12 5/16
0037	EBA27-A	3	RIGHT	FORWARD	G6, G8 & G10	EXP	62	54	116	6.80	12.36
0037	EBA28-A	1	RIGHT	FORWARD	G7	EXP	62	54	116	7.04	12.60
0037	EBA29-A	1	RIGHT	FORWARD	G9	EXP	62	54	116	6.92	12.48

NOTE:
REFER TO SHEETS 6 & 7 FOR BEARINGS ASSEMBLIES.

BRIDGE NO.: HAM-74-1852 L/R

SEE NOTES ON SHEET GN1 OF 1

STATE OF OHIO
DEPARTMENT OF TRANSPORTATION

BRIDGE NO.: HAM-75-0440 L/R
OVER IR-74 WB

BRIDGE NO.: HAM-74-1840 L/R
OVER SB BEEKMAN ST. (U.S. 27)
AND RAMP F

BRIDGE NO. HAM-74-1852 L/R
OVER NB BEEKMAN ST. (U.S. 27)

HAM-75-3.84
CITY OF CINCINNATI

STATE	COUNTY	PID NO.
OH	HAMILTON	104667

FED. PROJ. NO.: E170 (713)


**DYNAMIC RUBBER
LAM. ELASTOMERIC BEARING ASSY.'S**

Cosmee 1501 ROCKY RIDGE ROAD
P.O. BOX 2159
ATHENS, TEXAS 75751

SCALE: NONE	DRAWN BY: MH	CHECKED BY: ELS
	DATE: 03/18/19	DATE: 03/29/19

SHEET 8 OF 8 **JOB NO.: 15353A**

REV.	DESCRIPTION	BY	DATE	CK'D	DATE	CUSTOMER WALSH CONSTRUCTION CO. II	DRAWING NUMBER 15353A-D8	REV. 0
------	-------------	----	------	------	------	---------------------------------------	-----------------------------	-----------

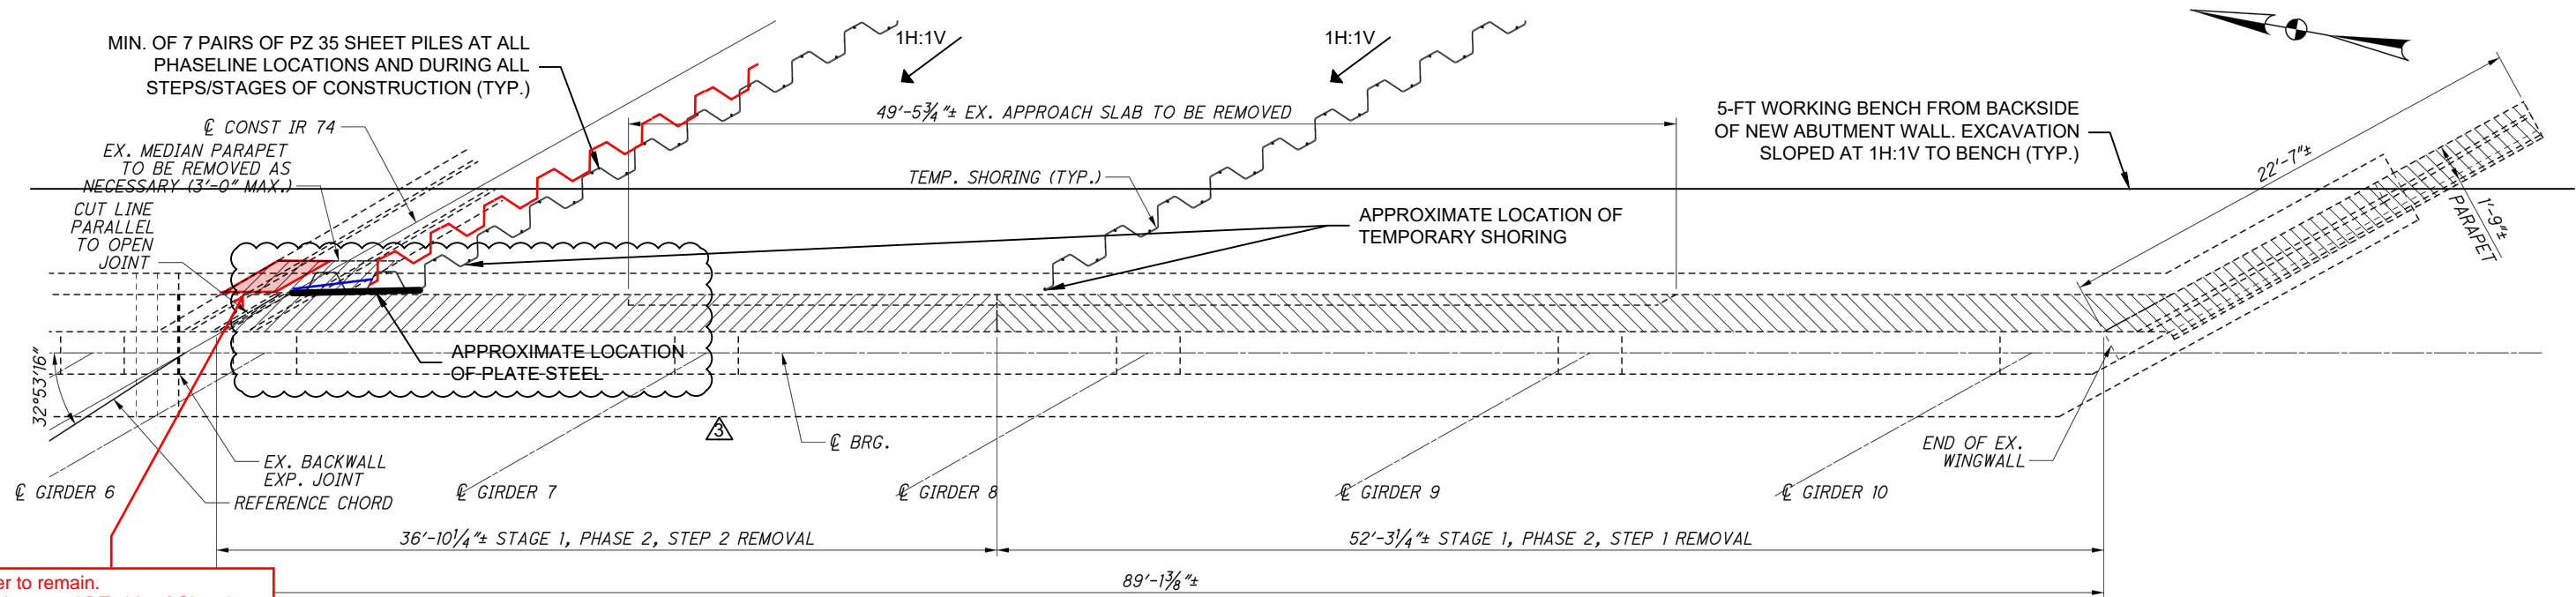


Barrier to remain.
Partial removal RT side of CL only

PLAN VIEW 1840 FORWARD ABUTMENT
SCALE: 1/8" = 1'-0"

NOTE:
USE 1-IN. THICK PLATE STEEL FOR PURPOSES OF LAGGING BETWEEN SHEETING AND ABUTMENT WHERE REQUIRED. SPAN SHALL BE NO GREATER THAN 6.5 FT BETWEEN ABUTMENT AND SHEET PILES. DRIVE PLATE STEEL INTO GROUND AND ADJACENT TO ABUTMENT WITH 2-IN. PAST CONSTRUCTION JOINT AND ATTACH PLATE STEEL TO SHEETING VIA STITCH WELDING WITH 1/4-IN. FILLET WELD. IF PLATE STEEL PROVES DIFFICULT TO DRIVE, PLATE STEEL MAY BE CUT INTO SEGMENTS AND PLACED BEHIND THE ABUTMENT AND THEN WELDED TO THE SHEETING AS THE EXCAVATION CONTINUES. OVER-EXCAVATING SHOULD BE AVOIDED WITH THIS TECHNIQUE AND THE 6.5-FT WIDE SEGMENTS SHALL NOT RETAIN MORE THAN 2 FT AT A TIME. USE A 6-IN. LONG, 1/4-IN. FILLET WELD ON TOP AND BOTTOM OF THE PLATES WHERE IN CONTACT WITH THE SHEETING.


All sheeting
left in place
and cut
below grade

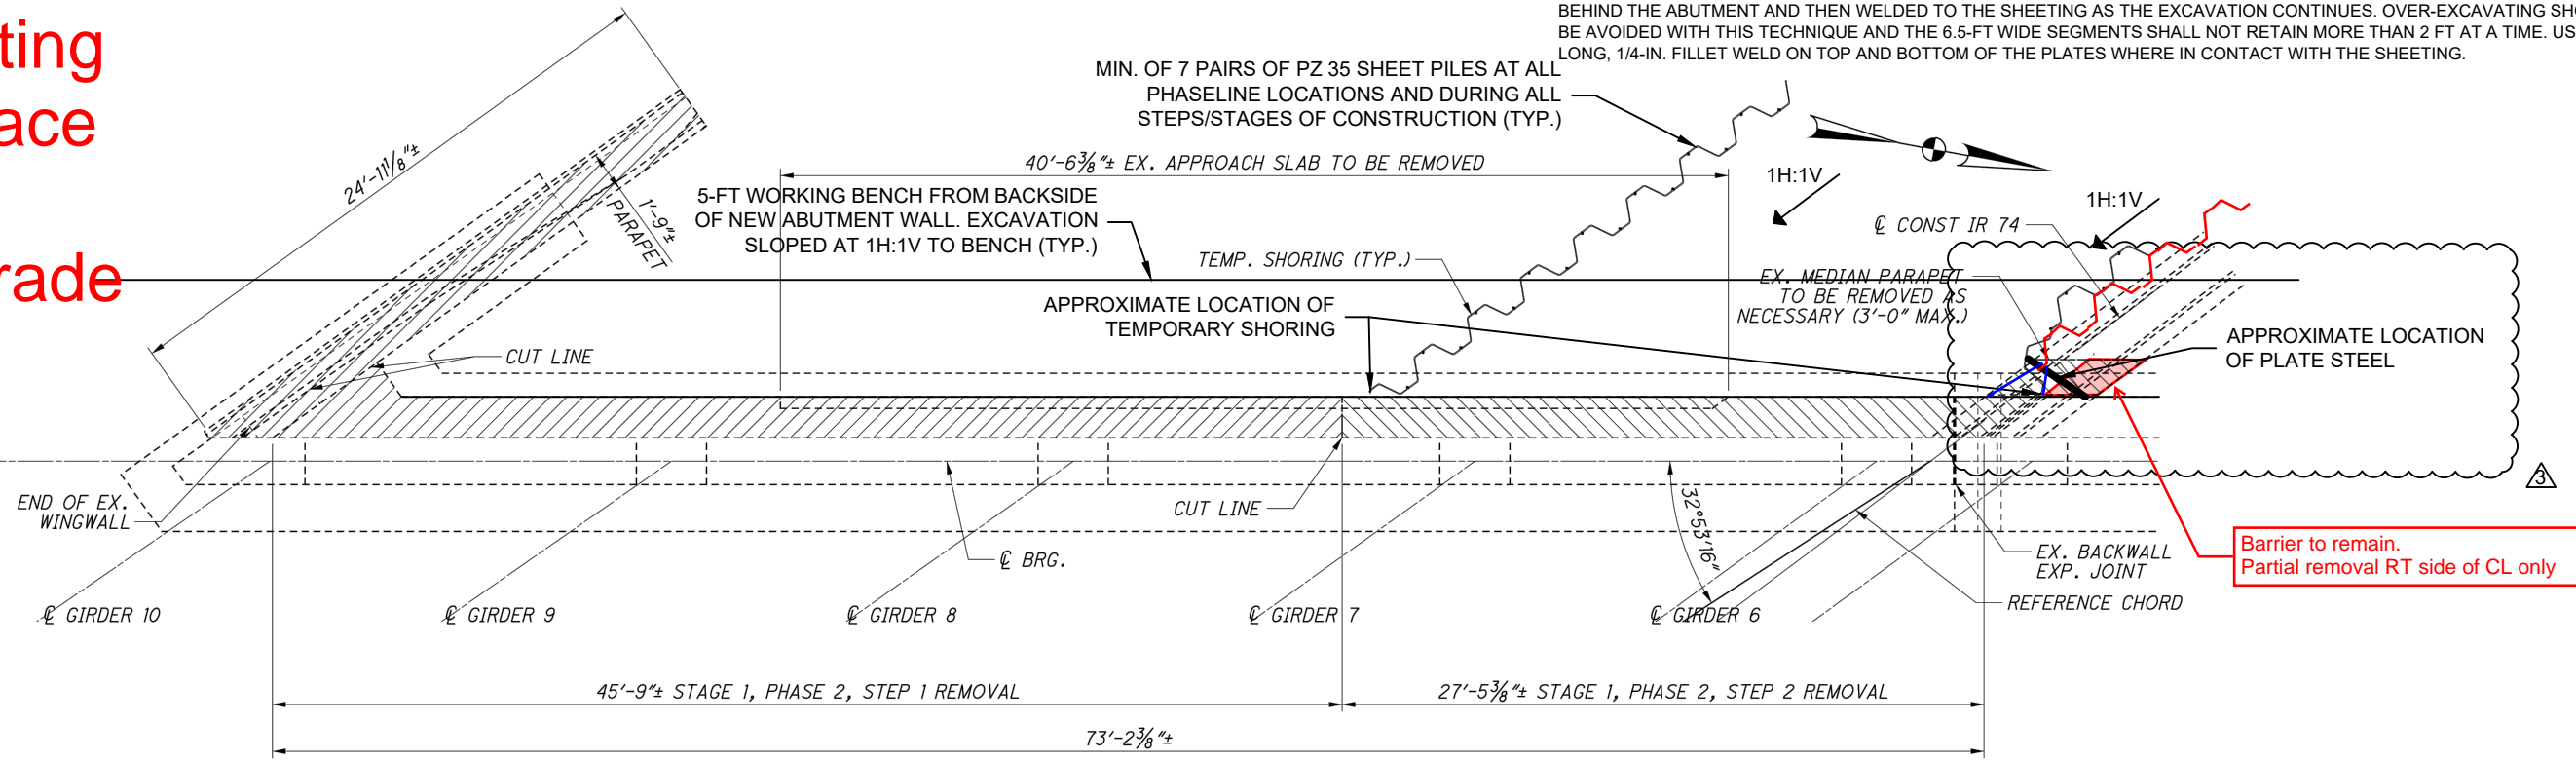

Barrier to remain.
Partial removal RT side of CL only

PLAN VIEW 1840 REAR ABUTMENT
SCALE: 1/8" = 1'-0"

REVISION No.3 FOR APPROXIMATE LOCATION OF PLATE STEEL (2-11-20)

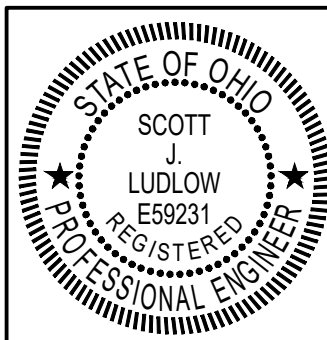

Scott J. Ludlow
DATE 2/11/20

NOTES


1. Field verify sheet pile locations in relation to existing utilities.
2. Additional sheet piles are required if earth slopes on cut side of excavation are flatter than a 1H:1V.
3. Where required, plate steel shall be installed against abutment and perpendicular to sheeting.

AS-BUILT

PLAN VIEW - 1840 FORWARD AND REAR ABUTMENTS

PROJECT: HAM-75-3.85 BU-03 - SOE PHASELINE CONSTRUCTION FOR I-74 O/ BEEKMAN ST.
 LOCATION: HAMILTON CO., OH
 CLIENT: WALSH CONSTRUCTION CO.
 SJL PROJ. NO.: 1-19-029
 SCALE: AS SHOWN

PROJECT ENG: SJL	S.J. Ludlow Consulting Engineers, Inc. 450 E. 96th St., Suite 500 Indianapolis, IN 46240 317-371-5539
APPROVED BY: SJL	
DRAWN BY: KAL	
DATE AND TIME: 2/11/20	
DRAWING NO.:	
1-19-029.B19	

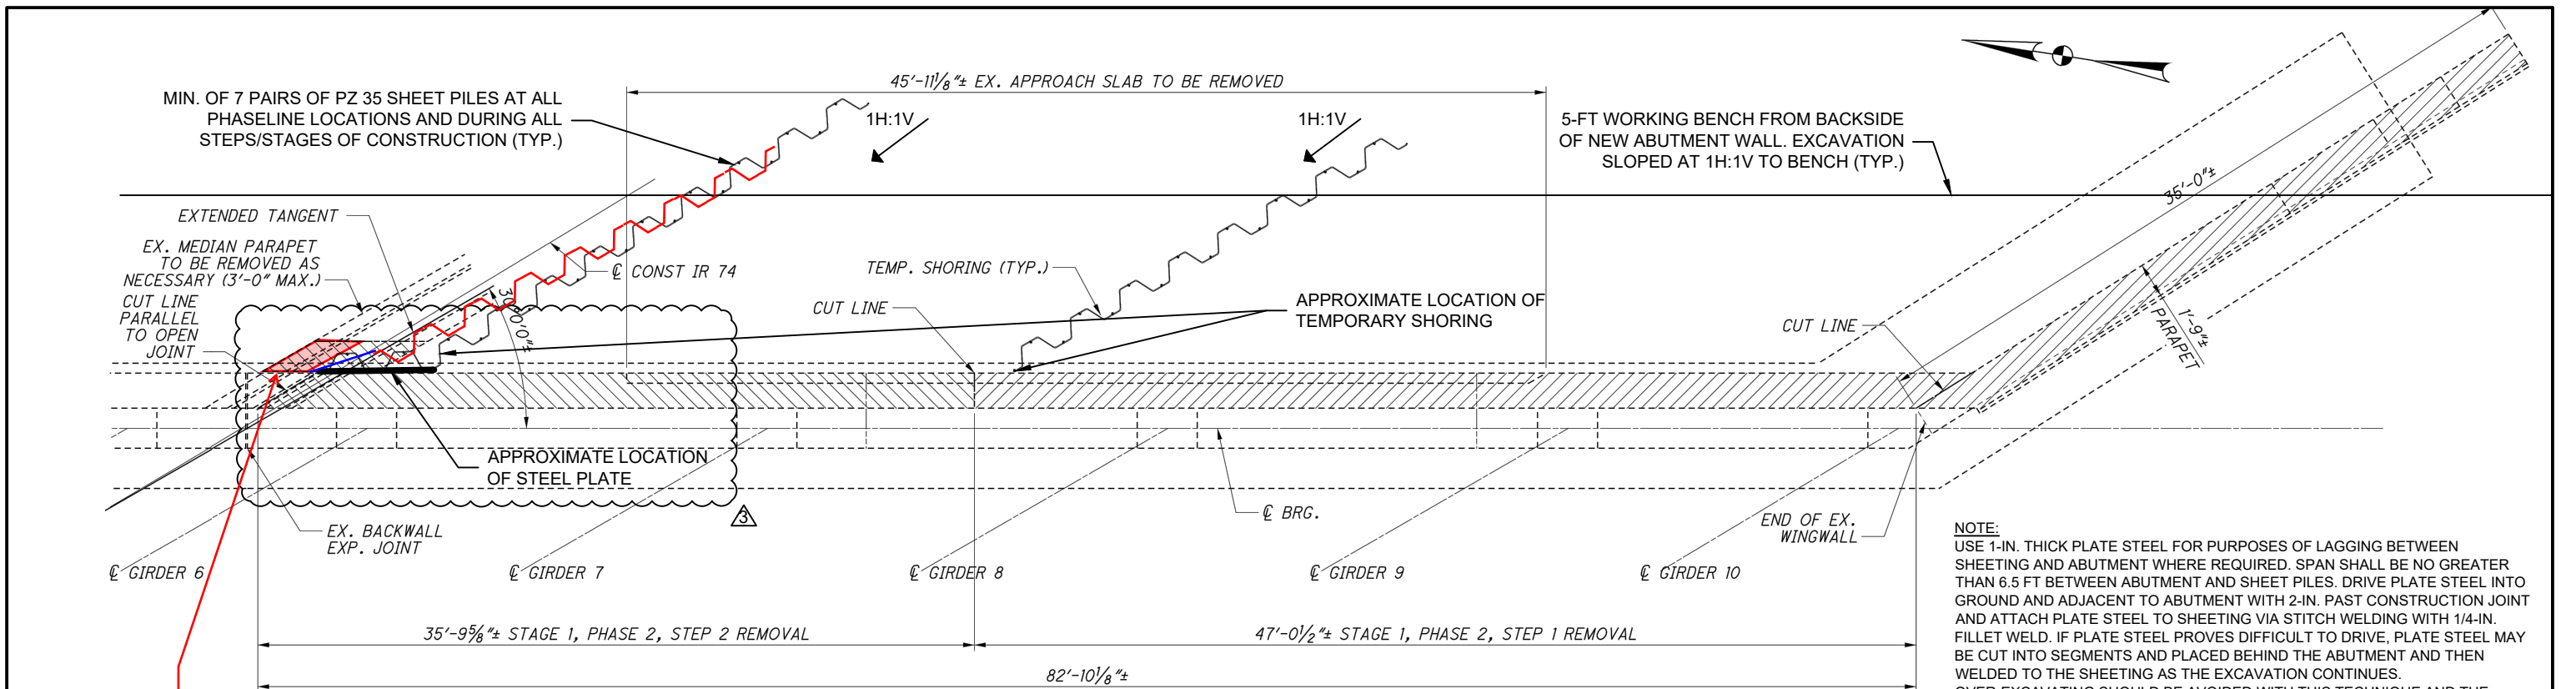


NOTE:
 USE 1-IN. THICK PLATE STEEL FOR PURPOSES OF LAGGING BETWEEN SHEETING AND ABUTMENT WHERE REQUIRED. SPAN SHALL BE NO GREATER THAN 6.5 FT BETWEEN ABUTMENT AND SHEET PILES. DRIVE PLATE STEEL INTO GROUND AND ADJACENT TO ABUTMENT WITH 2-IN. PAST CONSTRUCTION JOINT AND ATTACH PLATE STEEL TO SHEETING VIA STITCH WELDING WITH 1/4-IN. FILLET WELD. IF PLATE STEEL PROVES DIFFICULT TO DRIVE, PLATE STEEL MAY BE CUT INTO SEGMENTS AND PLACED BEHIND THE ABUTMENT AND THEN WELDED TO THE SHEETING AS THE EXCAVATION CONTINUES. OVER-EXCAVATING SHOULD BE AVOIDED WITH THIS TECHNIQUE AND THE 6.5-FT WIDE SEGMENTS SHALL NOT RETAIN MORE THAN 2 FT AT A TIME. USE A 6-IN. LONG, 1/4-IN. FILLET WELD ON TOP AND BOTTOM OF THE PLATES WHERE IN CONTACT WITH THE SHEETING.

Barrier to remain.
 Partial removal RT side of CL only

PLAN VIEW - 1852 FORWARD ABUTMENT
 SCALE: 1/8" = 1'-0"


All sheeting left in place and cut below grade

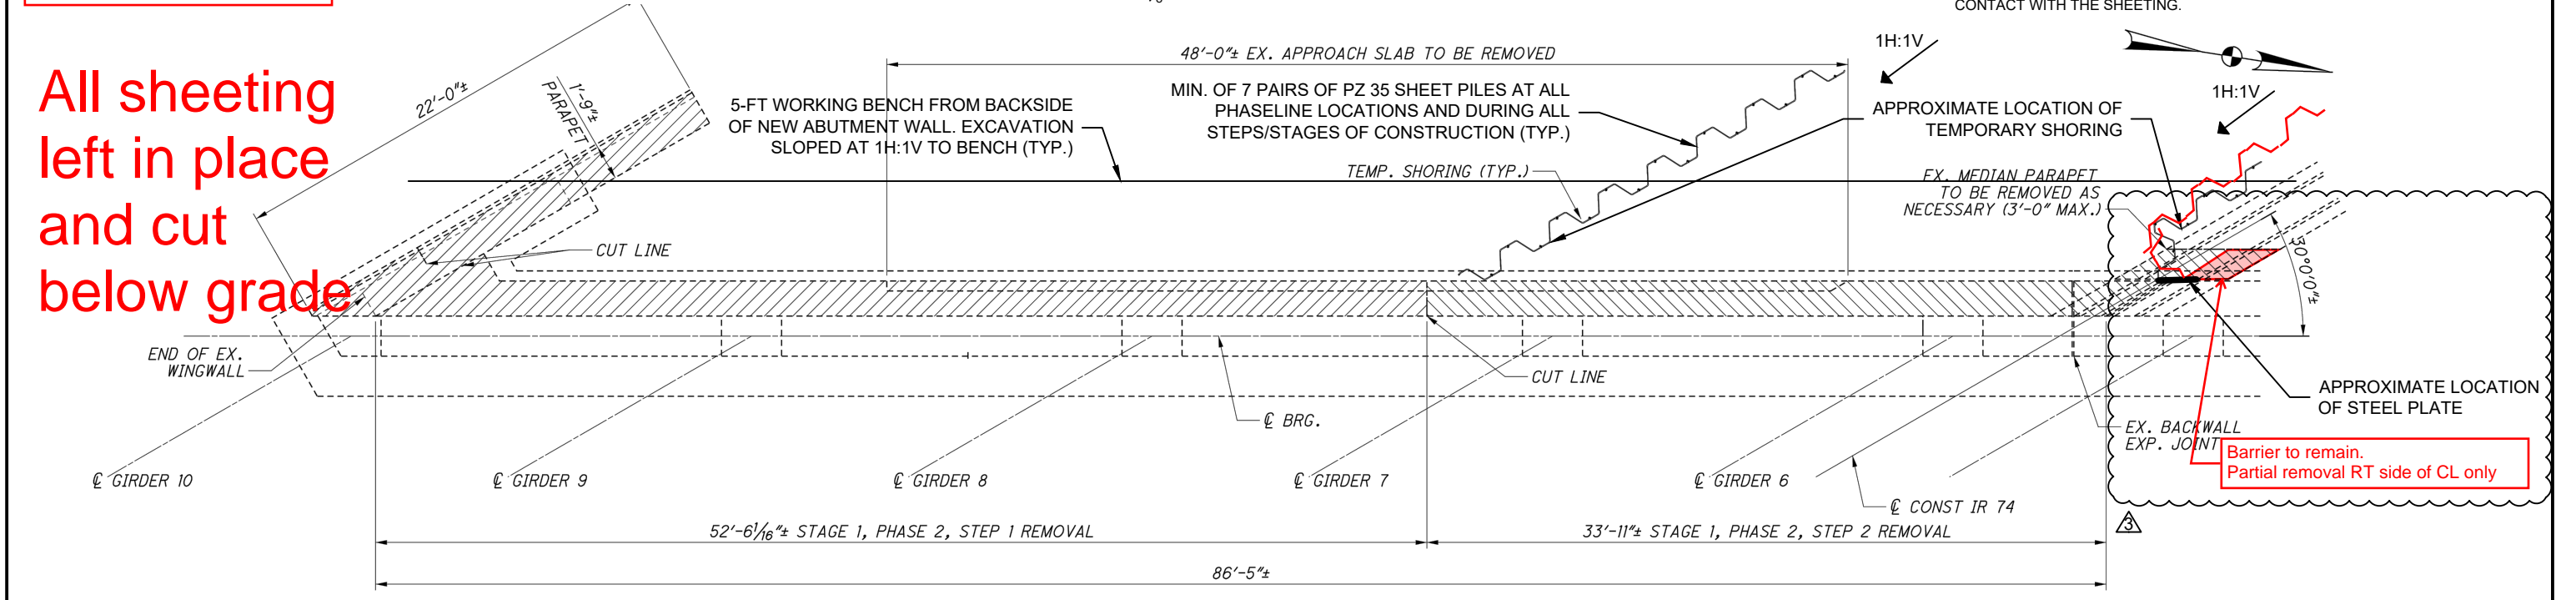

Barrier to remain.
 Partial removal RT side of CL only

PLAN VIEW 1852 REAR ABUTMENT
 SCALE: 1/8" = 1'-0"

REVISION No.3 FOR APPROXIMATE LOCATION OF PLATE STEEL (2-11-20)

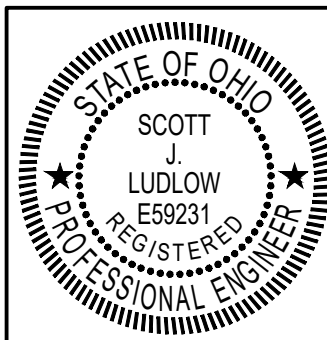

Scott J. Ludlow
 2/11/20
 DATE

NOTES

1. Field verify sheet pile locations in relation to existing utilities.
2. Additional sheet piles are required if earth slopes on cut side of excavation are flatter than a 1H:1V.
3. Where required, plate steel shall be installed against abutment and perpendicular to sheeting.


AS-BUILT

PLAN VIEW - 1852 FORWARD AND REAR ABUTMENTS

PROJECT: HAM-75-3.85 BU-03 - SOE PHASELINE CONSTRUCTION FOR I-74 O/ BEEKMAN ST.
 LOCATION: HAMILTON CO., OH
 CLIENT: WALSH CONSTRUCTION CO.
 SJL PROJ. NO.: 1-19-029
 SCALE: AS SHOWN

PROJECT ENG: SJL
 APPROVED BY: SJL
 DRAWN BY: KAL
 DATE AND TIME: 2/11/20
 DRAWING NO.: 1-19-029.B20

S.J. Ludlow
Consulting Engineers, Inc.
 450 E. 96th St., Suite 500
 Indianapolis, IN 46240
 317-371-5539

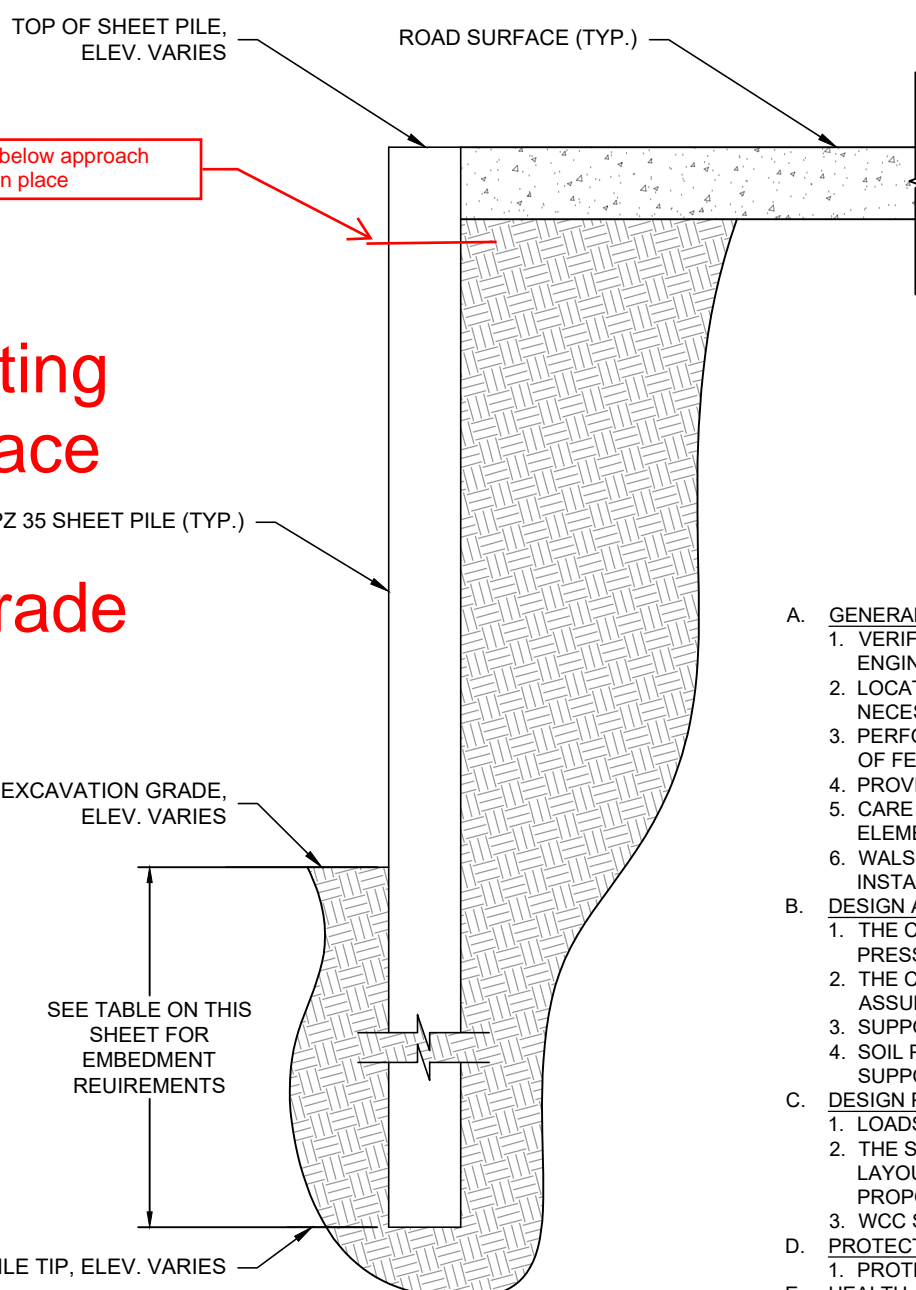


All sheeting left in place and cut below grade

SHEETING REQUIREMENTS		1840 FORWARD ABUTMENT	1840 REAR ABUTMENT	1852 FORWARD ABUTMENT	1852 REAR ABUTMENT
1 ST PAIR OF SHEETS	TOTAL SHEET LENGTH (FT)	25	25	25	25
	SHEET PILE TOP ELEV. +/-*	539	545	534	536
	SHEET PILE TIP ELEV. +/-**	515.5	521.5	513.8	514.8
	MAXIMUM RETAINED HEIGHT INCLUDING ROAD SURFACE (FT)	9.8	10.5	7.6	7.7
	EMBEDMENT (FT)	13.7	13	13.65	13.55
	SHEETING SIZE	PZ35	PZ35	PZ35	PZ35
ALL OTHER SHEETS	TOTAL SHEET LENGTH (FT)	20	20	20	20
	SHEET PILE TOP ELEV. +/-*	539	545	534	536
	SHEET PILE TIP ELEV. +/-**	520.5	526.5	517.8	519.8
	MAXIMUM RETAINED HEIGHT INCLUDING ROAD SURFACE (FT)	9.8	10.5	7.6	7.7
	EMBEDMENT (FT)	8.7	8	8.65	8.55
	SHEETING SIZE	PZ35	PZ35	PZ35	PZ35

NOTE: CONTRACTOR MAY PROVIDE ADDITIONAL LENGTH OF SHEET AS NEEDED FOR INSTALLATION.
 * SHEET PILE TOP ELEV. REPORTED DOES NOT INCLUDE PORTION ABOVE GROUND.
 ** SHEET PILE TIP ELEV. REPORTED VARIES SLIGHTLY DUE TO STEPS IN THE NEW ABUTMENT WALL. (SEE PLANS FOR EXACT ELEV. AT EACH PHASELINE)
 ALL SHEET PILES SHALL HAVE EMBEDMENT SHOWN IN THE TABLE ABOVE AS A MINIMUM REQUIREMENT.

- A. GENERAL**
- VERIFY THE CONFIGURATION AND ELEVATION OF ALL EXISTING AND ADJACENT STRUCTURAL ELEMENTS. REPORT SAME PRIOR TO START OF EXCAVATION SUPPORT CONSTRUCTION TO SJL ENGINEERS.
 - LOCATE AND IDENTIFY ALL EXISTING UNDERGROUND AND/OR OVERHEAD SERVICES AND STRUCTURES NEAR THE TEMPORARY EXCAVATION SUPPORT SYSTEMS, PROTECT AND RELOCATE AS NECESSARY. DO NOT INSTALL SHEET PILES BEFORE ALL SERVICES AND STRUCTURES HAVE BEEN LOCATED.
 - PERFORM EXCAVATION SUPPORT CONSTRUCTION IN ACCORDANCE WITH THE CONTRACT REQUIREMENTS AND CONFORM TO ALL APPLICABLE SAFETY REGULATIONS INCLUDING THE PROVISIONS OF FEDERAL OSHA.
 - PROVIDE PROTECTIVE BARRIER AROUND THE EXCAVATIONS THAT CONFORMS TO ALL APPLICABLE SAFETY REGULATIONS.
 - CARE SHALL BE TAKEN DURING THE INSTALLATION OF THE EXCAVATION SUPPORT SYSTEMS TO AVOID DAMAGE AND/OR UNINTENDED CONSEQUENCES WHILE WORKING ADJACENT TO EXISTING ELEMENTS. IF GROUND CONDITIONS FOR EMBEDMENT ARE DISTURBED, SJL ENGINEERS SHALL BE NOTIFIED SO A DETERMINATION CAN BE MADE IF ADDITIONAL SUPPORT IS REQUIRED.
 - WALSH CONSTRUCTION COMPANY TO MAINTAIN RECORDS OF DRIVING RESISTANCES AND/OR PENETRATION RATES INCLUDING FREQUENCY AND AMPLITUDE DEPENDING ON METHOD OF INSTALLATION, AND REPORT TO SJL ENGINEERS.
- B. DESIGN ASSUMPTIONS**
- THE CURRENT DESIGN SCHEME ILLUSTRATES TEMPORARY SUPPORT SYSTEMS CAPABLE OF SUPPORTING RETAINED HEIGHTS SHOWN WITH EARTH PRESSURES FROM AN EQUIVALENT FLUID PRESSURE EQUAL TO A 0.3*132PCF*HEIGHT DISTRIBUTION.
 - THE CURRENT DESIGN IS BASED UPON THE ASSUMPTIONS IN THE ENGINEERING CALCULATIONS AND LOADS INDICATED ON THE SHOP DRAWINGS ARE CORRECT. SHOULD ANY OR ALL OF THESE ASSUMPTIONS CHANGE, REDESIGN OF THE EXCAVATION SUPPORT SYSTEM MAY BE REQUIRED.
 - SUPPORT SYSTEMS ARE DESIGNED FOR A TRAFFIC SURCHARGE OF 250 PSF.
 - SOIL PARAMETERS ARE BASED ON THE INFORMATION PROVIDED IN THE STRUCTURE FOUNDATION EXPLORATION REVIEWED/DATED ON 3/13/13. FOR RESPONSE OF THE SOILS AT THE EXCAVATION SUPPORT SYSTEM, AN UNDRAINED SHEAR STRENGTH OF 2 KSF WAS USED ALONG WITH 0.3% STRAIN AT 50% PEAK SHEAR STRENGTH.
- C. DESIGN PARAMETERS**
- LOADS APPLIED TO THE EXCAVATION SUPPORT SYSTEM, OTHER THAN THAT INDICATED ON THESE DRAWINGS, ARE SUBJECT TO REVIEW BY SJL ENGINEERS.
 - THE SIZE AND DEPTH OF THE EXCAVATION SUPPORT SYSTEM ON THE DRAWINGS ARE BASED ON INFORMATION, AS PROVIDED AT THIS TIME. FIELD VERIFICATION IS TO BE PERFORMED PRIOR TO LAYOUT AND CONSTRUCTION OF THE PROPOSED EXCAVATION SUPPORT SYSTEM. IF CHANGES TO THE EXCAVATION SUPPORT SYSTEM ARE REQUIRED IN ORDER TO ACCOMMODATE THE PROPOSED STRUCTURES AND CONNECTIONS, SJL ENGINEERS SHALL BE NOTIFIED IN A TIMELY MANNER.
 - WCC SHALL VERIFY ALL CLEARANCES FOR CONSTRUCTION OF THE EXCAVATION SUPPORT SYSTEM AND PURPOSED STRUCTURE AND CONNECTIONS.
- D. PROTECTION BY CONTRACTOR**
- PROTECT ALL EXCAVATIONS FROM THE ACTIONS OF WEATHER.
- E. HEALTH AND SAFETY**
- ALL WORK TO BE CARRIED OUT IN ACCORDANCE WITH THE OCCUPATIONAL HEALTH AND SAFETY ACT LATEST REVISION, AND SITE SPECIFIC SAFETY PLANS.
- F. SHEET PILE AND PLATE STEEL LAGGING NOTES**
- MATERIALS:
 - STRUCTURAL SHAPES.....ASTM A572 OR ASTM A992, 50 KSI MIN. YIELD STRESS.
 - PLATE STEEL AS LAGGING.....ASTM A36, 36 KSI MIN. YIELD STRESS.
 - WELD ELECTRODES.....AWS E70XX LOW HYDROGEN
 - WELDS AND WELDING PERSONNEL CERTIFICATIONS SHALL MEET THE REQUIREMENTS OF AWS D1.1, "STRUCTURAL WELDING CODE." WELDING PERSONNEL SHALL BE AWS CERTIFIED FOR WELDS MADE.
 - FABRICATION AND INSTALLATION OF STRUCTURAL STEEL SHALL MEET THE REQUIREMENTS OF THE "CODE OF STANDARD PRACTICE FOR STEEL BUILDINGS AND BRIDGES," AS ADOPTED BY AISC.
 - INSTALL STRUCTURAL STEEL STRAIGHT, LEVEL AND PLUMB AS APPLICABLE.

TYPICAL CANTILEVERED SECTION
SCALE: 3/8" = 1'-0"

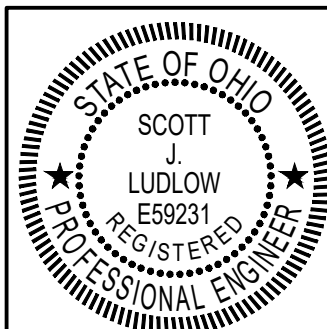

Scott J. Ludlow
2/05/20
DATE

- NOTES**
- Sheet piles may be longer than specified on these shop drawings.
 - Where required, plate steel shall be installed against abutment and perpendicular to sheeting.

AS-BUILT


TYPICAL SECTION, TABLE, AND GENERAL NOTES

PROJECT: HAM-75-3.85 BU-03 - SOE PHASELINE CONSTRUCTION FOR I-74 O/ BEEKMAN ST.
 LOCATION: HAMILTON CO., OH
 CLIENT: WALSH CONSTRUCTION CO.
 SJL PROJ. NO.: 1-19-029
 SCALE: AS SHOWN

PROJECT ENG: SJL	S.J. Ludlow Consulting Engineers, Inc. 450 E. 96th St., Suite 500 Indianapolis, IN 46240 317-371-5539
APPROVED BY: SJL	
DRAWN BY: KAL	
DATE AND TIME: 2/05/20	
DRAWING NO.: 1-19-029.B21	


NOTE:
SHEET PILE ARE DIAGRAMATIC AND
ARE NOT DRAWN TO SCALE.

NOTE A: SHEET PILES INSTALLED OVER COUNTERFORT WALLS WILL STOP SHORT OF FURNISHED PILE LENGTH

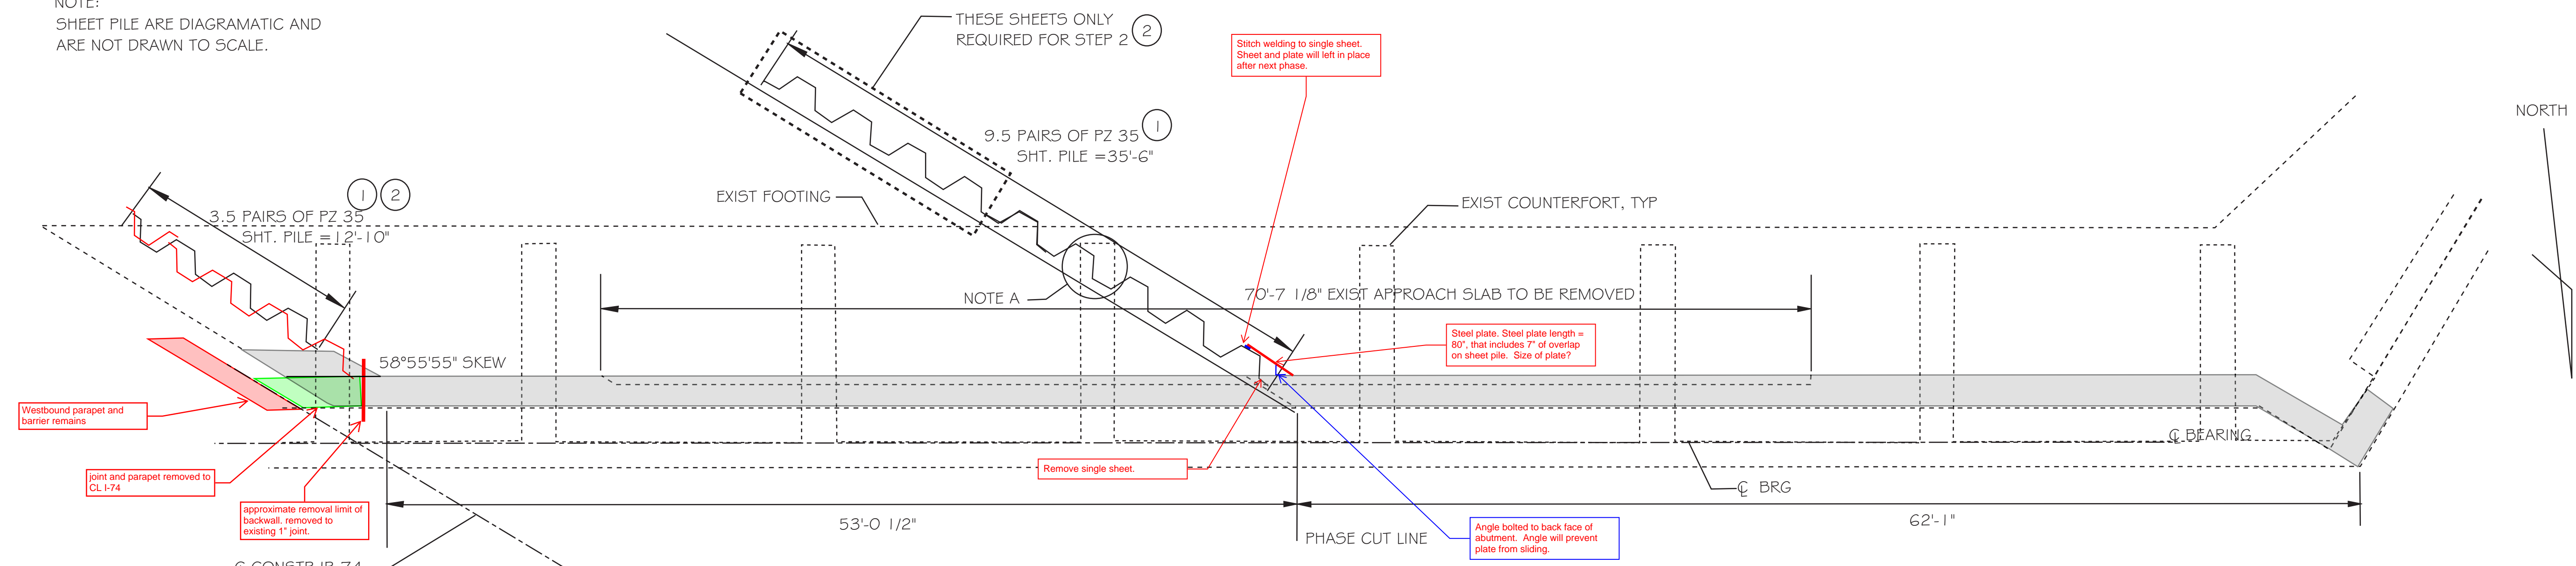

FORWARD ABUTMENT PLAN VIEW
STAGE 1, PHASE 2, STEPS 1 & 2
1"=5'-0"

All sheeting
left in place
and cut
below grade

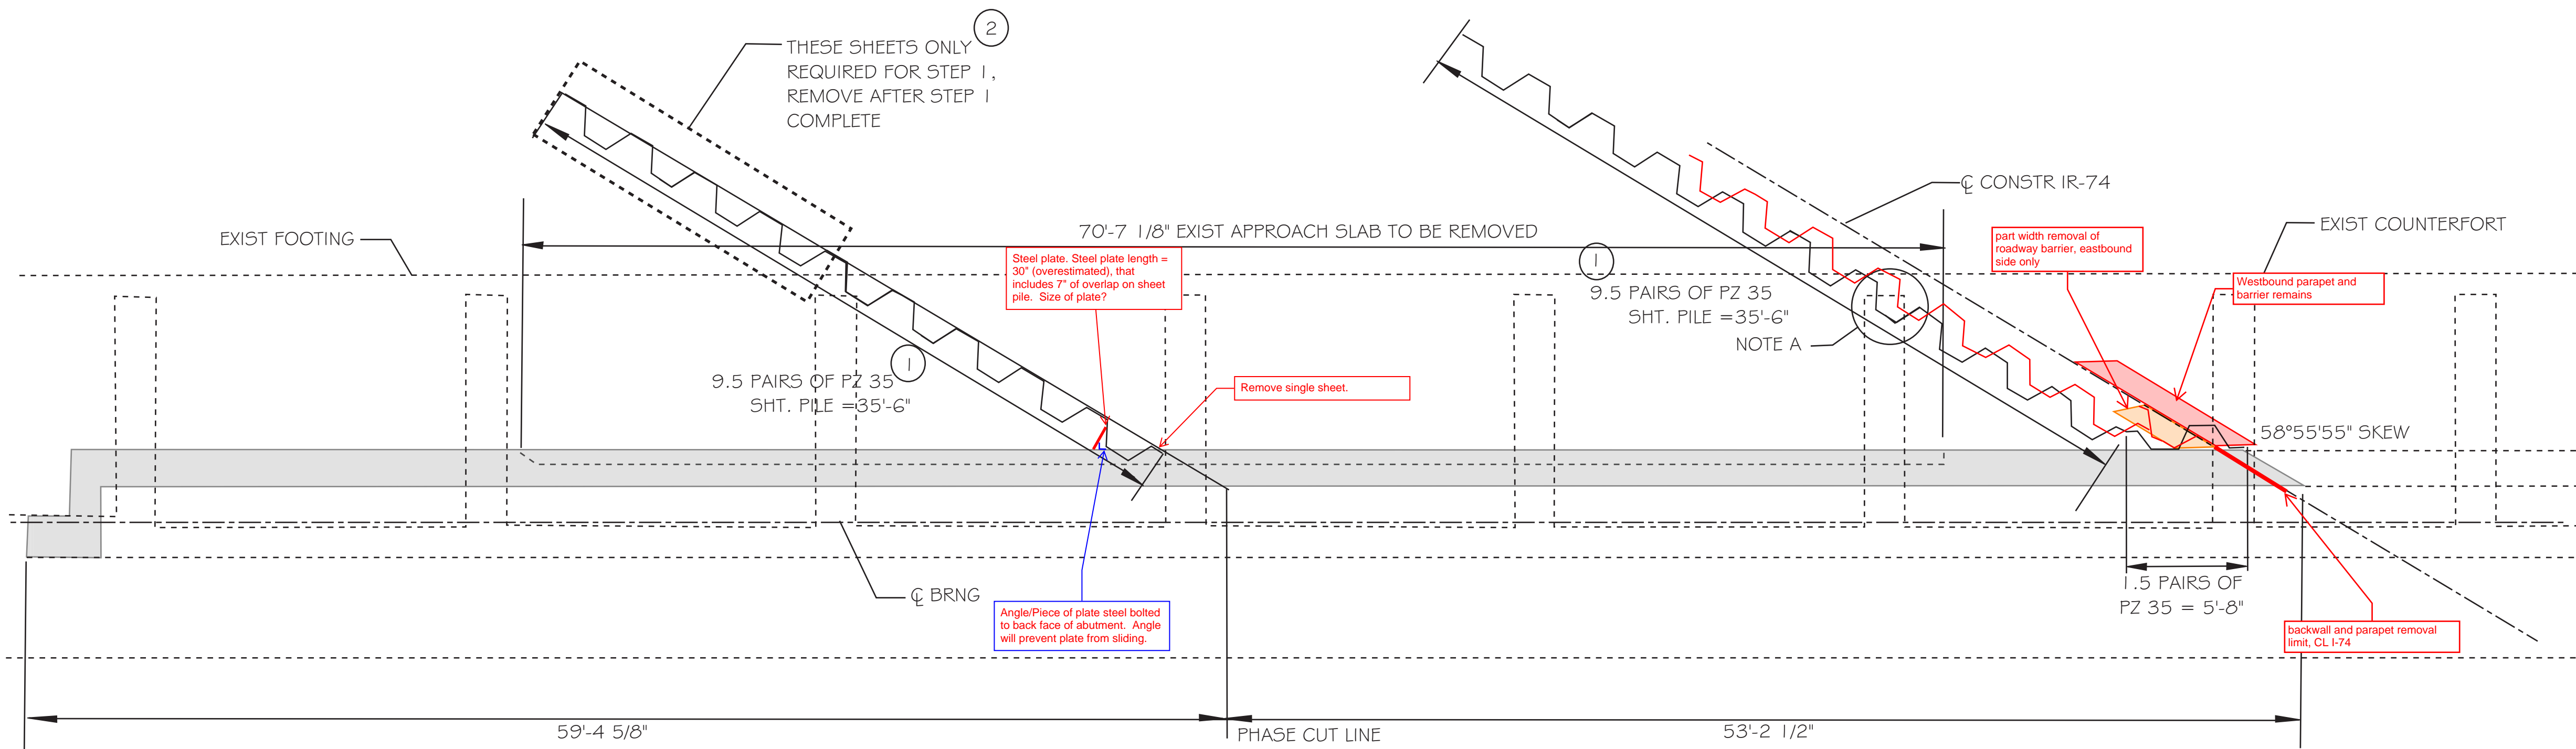

REAR ABUTMENT PLAN VIEW
STAGE 1, PHASE 2, STEPS 1 & 2
1"=5'-0"

SOE SEQUENCE OF ACTIVITIES - FORWARD ABUTMENT

1. REMOVE RIGHT LANE OF EXISTING APPROACH SLAB FOR STAGE 1 PHASE 2, STEP 1 FORWARD ABUTMENT.
2. INSTALL SOE SHEETING ON NORTH SIDE OF STAGE 1 PHASE 2, STEP 1 EXISTING APPROACH SLAB REMOVAL AREA.
3. EXCAVATE TO REQUIRED ELEVATION FOR STAGE 1 PHASE 2, STEP 1 FORWARD ABUTMENT WALL REMOVAL.
4. REMOVE AND REPLACE FORWARD ABUTMENT STAGE 1 PHASE 2, STEP 1 ABUTMENT WALL.
5. INSTALL DRAINAGE SYSTEM AND BACKFILL EXCAVATION.
6. BACKFILL TO DESIGN APPROACH SLAB SUBGRADE ELEVATION.
7. CONSTRUCT NEW FORWARD ABUTMENT STAGE 1, PHASE 2, STEP 1 APPROACH SLAB.
8. REMOVE EXISTING STAGE 1, PHASE 2, STEP 2 APPROACH SLAB.
9. INSTALL SOE SHEETING ON NORTH SIDE OF STAGE 1 PHASE 2, STEP 2 EXISTING APPROACH SLAB REMOVAL AREA.
10. EXCAVATE TO REQUIRED ELEVATION FOR FORWARD ABUTMENT STAGE 1, PHASE 2, STEP 2 WALL REMOVAL.
11. REMOVE AND REPLACE STAGE 1, PHASE 2, STEP 2 FORWARD ABUTMENT WALL.
12. INSTALL DRAINAGE SYSTEM AND BACKFILL EXCAVATION.
13. EXTRACT NORTH AND SOUTH LINES OF SHEETING.
14. CONSTRUCT NEW FORWARD ABUTMENT STAGE 1, PHASE 2, STEP 2 APPROACH SLAB.


SOE SEQUENCE OF ACTIVITIES - REAR ABUTMENT

1. REMOVE RIGHT LANE OF EXISTING APPROACH SLAB FOR STAGE 1 PHASE 2, STEP 1 REAR ABUTMENT.
2. INSTALL SOE SHEETING ON NORTH SIDE OF STAGE 1 PHASE 2, STEP 1 EXISTING APPROACH SLAB REMOVAL AREA.
3. EXCAVATE TO REQUIRED ELEVATION FOR STAGE 1 PHASE 2, STEP 1 REAR ABUTMENT WALL REMOVAL.
4. REMOVE AND REPLACE REAR ABUTMENT STAGE 1 PHASE 2, STEP 1 ABUTMENT WALL.
5. INSTALL DRAINAGE SYSTEM AND BACKFILL EXCAVATION.
6. BACKFILL TO DESIGN APPROACH SLAB SUBGRADE ELEVATION.
7. CONSTRUCT NEW REAR ABUTMENT STAGE 1, PHASE 2, STEP 1 APPROACH SLAB.
8. REMOVE EXISTING STAGE 1, PHASE 2, STEP 2 APPROACH SLAB.
9. INSTALL SOE SHEETING ON NORTH SIDE OF STAGE 1 PHASE 2, STEP 2 EXISTING APPROACH SLAB REMOVAL AREA.
10. EXCAVATE TO REQUIRED ELEVATION FOR REAR ABUTMENT STAGE 1, PHASE 2, STEP 2 WALL REMOVAL.
11. REMOVE AND REPLACE STAGE 1, PHASE 2, STEP 2 REAR ABUTMENT WALL.
12. INSTALL DRAINAGE SYSTEM AND BACKFILL EXCAVATION.
13. EXTRACT NORTH AND SOUTH LINES OF SHEETING.
14. CONSTRUCT NEW REAR ABUTMENT STAGE 1, PHASE 2, STEP 2 APPROACH SLAB.

AS-BUILT




www.sme-usa.com

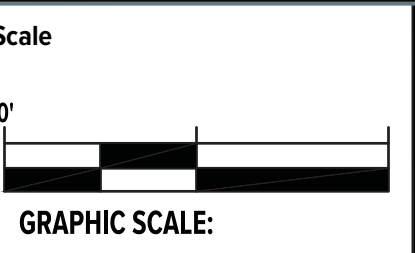

Project
HAM-75-3.84
BRIDGE NO.
HAM-74-1892 L/R
O/ELMORE ST

Project Location
HAMILTON COUNTY
CITY OF CINCINNATI
OHIO

Sheet Name
STAGE 1, PHASE 2,
SOE PLAN & DETAILS
FORWARD & REAR
ABUTMENTS

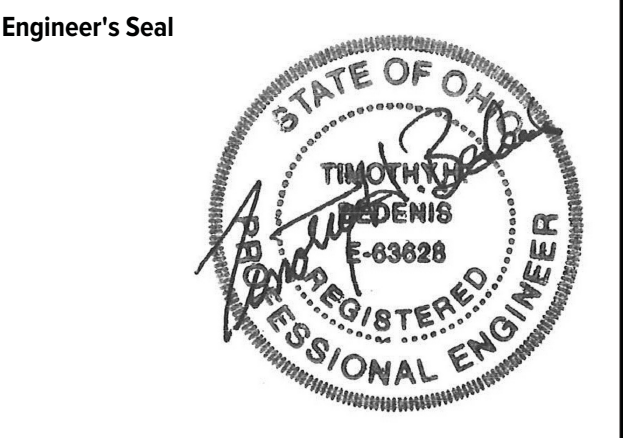

REV	ISSUED FOR	DATE	BY
1	REVISE EXCAVATION CUT SLOPE	4-23-19	DWB
2	SHEETING STAGING	5-07-19	DWB

Date
3-29-2019

SME Project No.
79059.01

Project Manager:
TH BEDENIS

Designer:
DW BIRD

CADD:
DW BIRD


Checked By:
TH BEDENIS

Sheet No.
1 OF 2

DRAWING NOTE: SCALE DIMENSIONS (6 INCHES FOR 24" X 36" AND MILL SCALE INCORRECTLY IF PRINTED ON ANY OTHER SIZE MEDIA)
NO REPRODUCTION SHALL BE MADE WITHOUT THE PRIOR CONSENT OF SME
© 2019




www.sme-usa.com

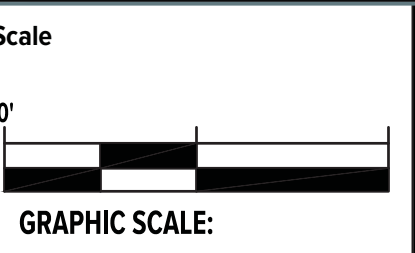

Project
HAM-75-3.84
BRIDGE NO.
HAM-74-1892 L/R
O/ELMORE ST

Project Location
HAMILTON COUNTY
CITY OF CINCINNATI
OHIO

Sheet Name
STAGE 1, PHASE 2
SOE ELEVATION
FORWARD & REAR
ABUTMENT

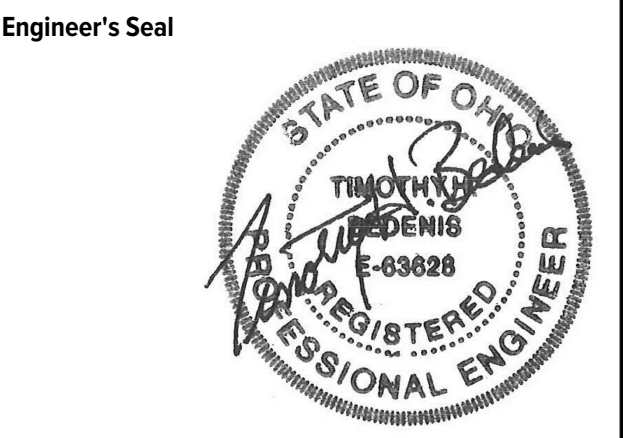

Revisions

REV	ISSUED FOR	DATE	BY
1	REVISE EXCAVATION CUT SLOPE	4-29-19	DWB
2	SHEETING STAGING	5-07-19	DWB

Date
3-29-2019

SME Project No.
79059.01


Project Manager:
TH BEDENIS

Designer:
DW BIRD

CADD:
DW BIRD

Checked By:
TH BEDENIS

Sheet No.
2 OF 2

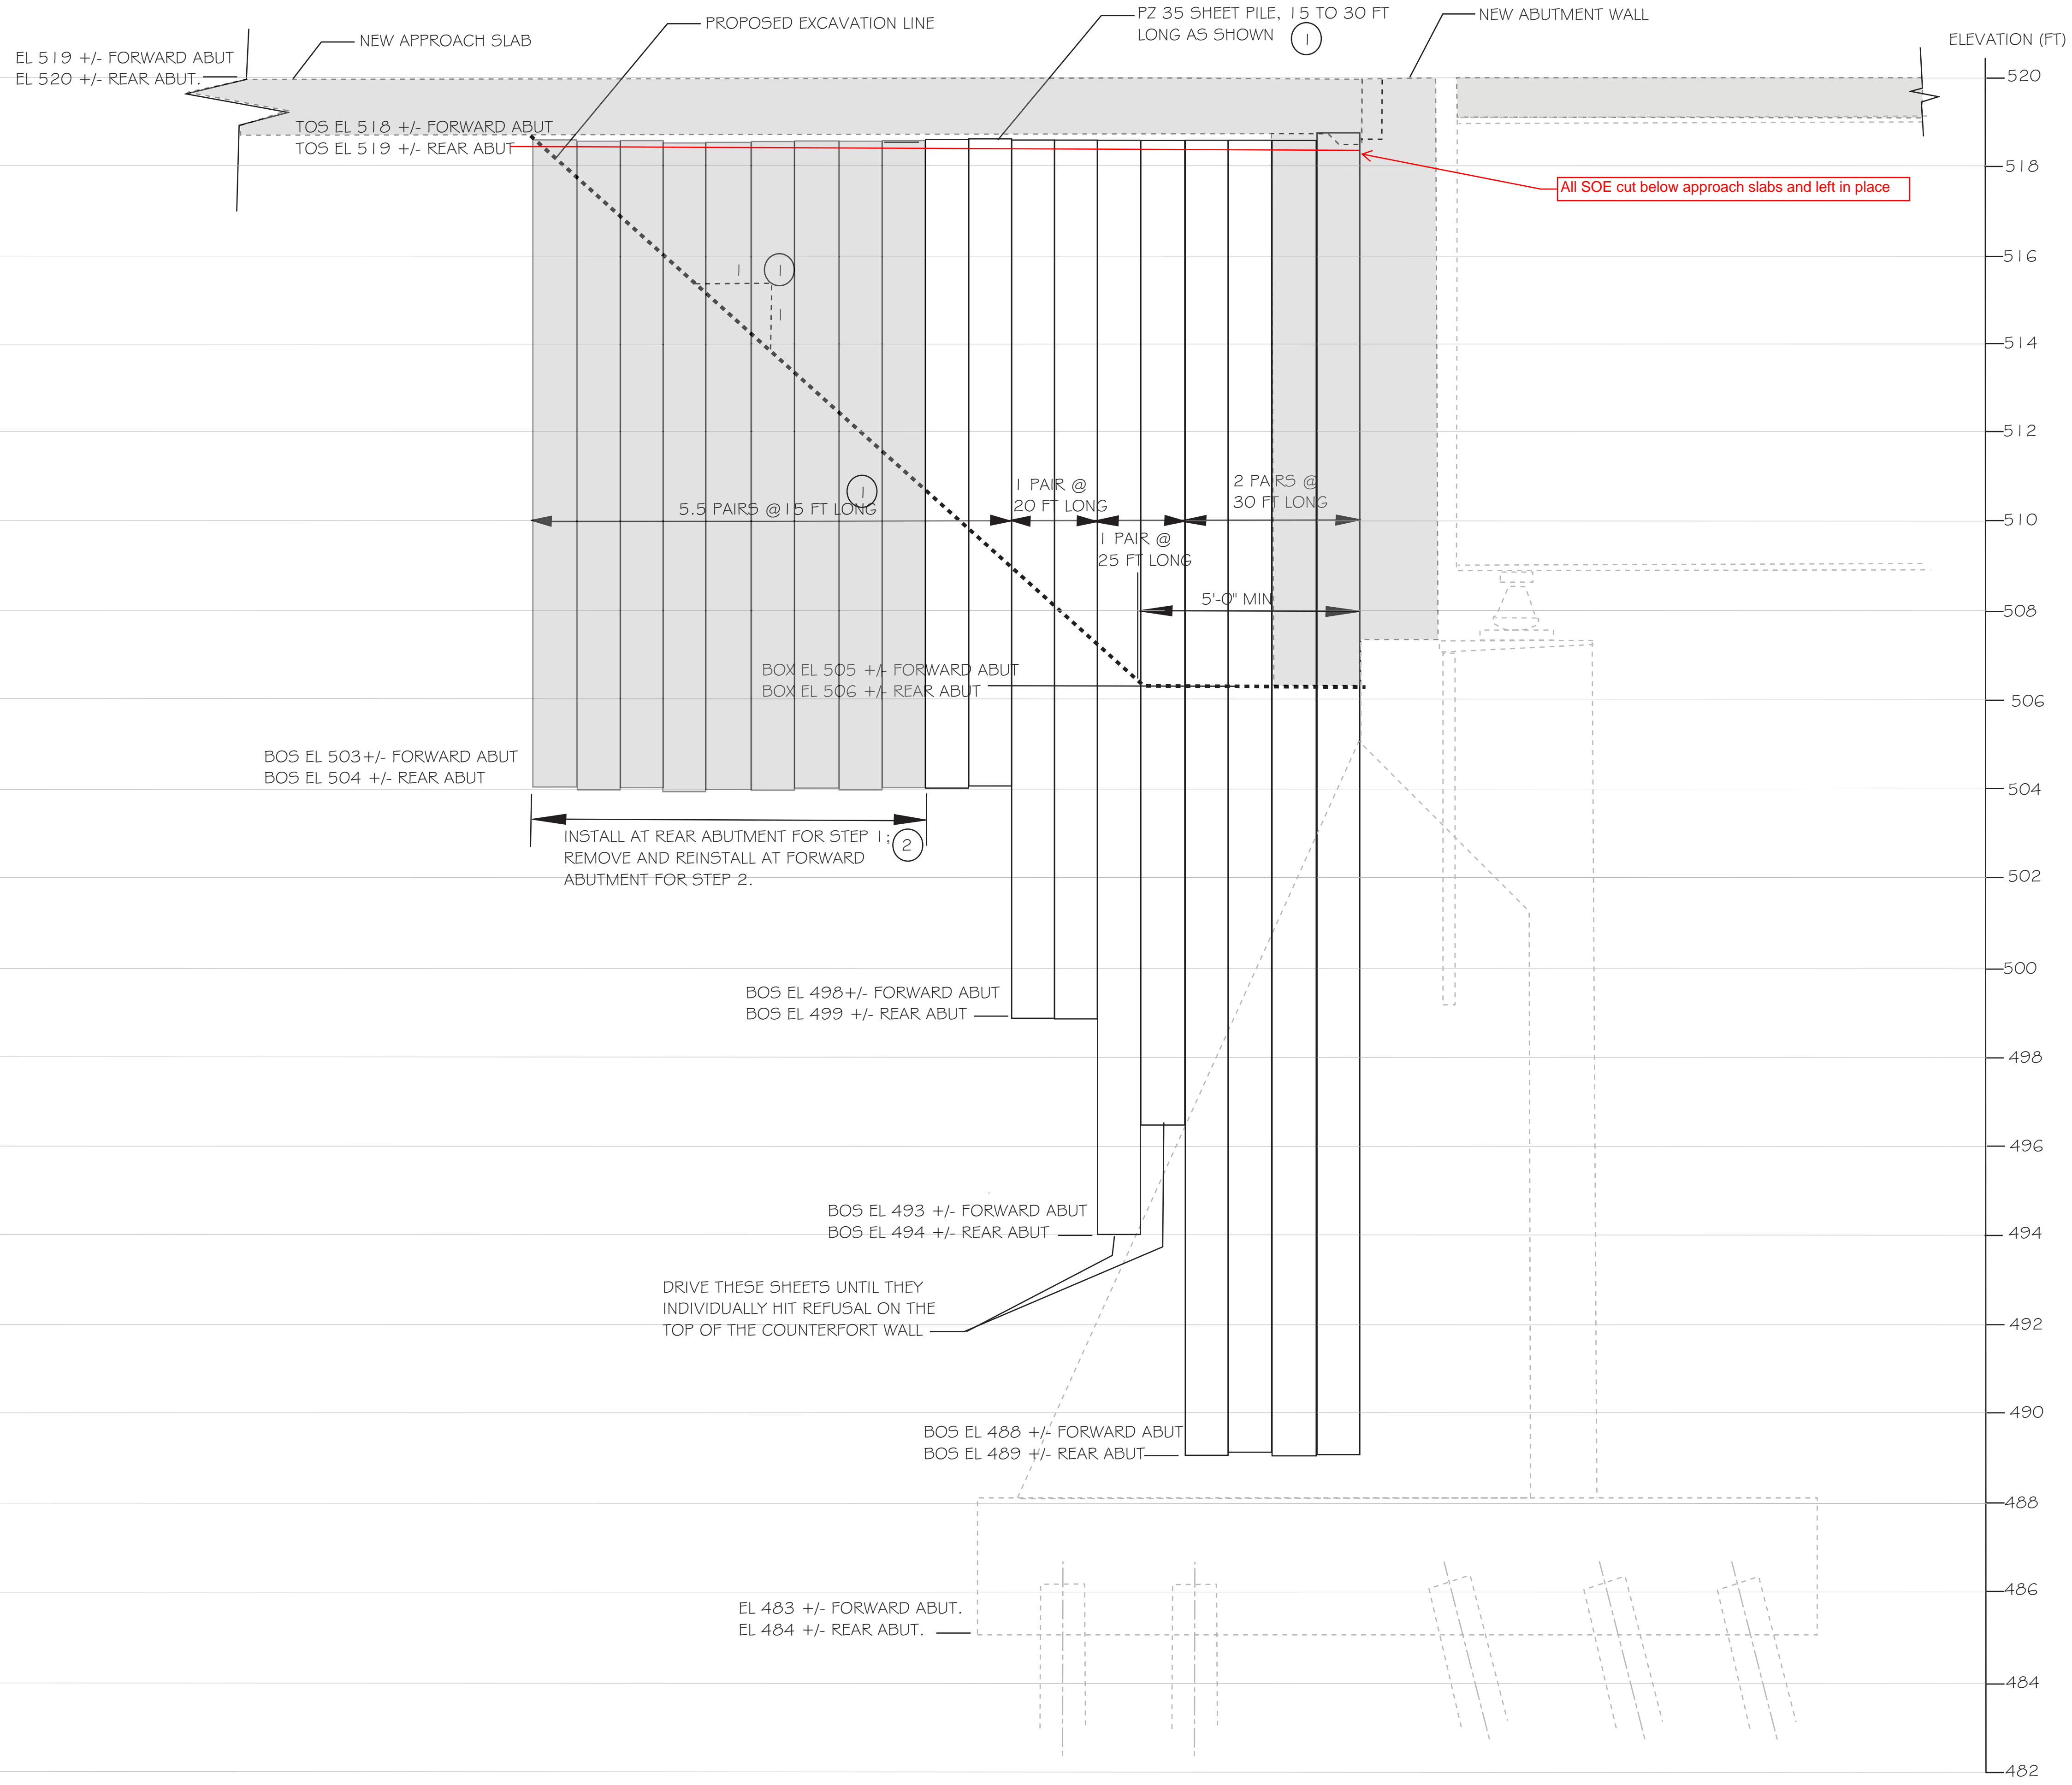

All sheeting
left in place
and cut
below grade

All SOE cut below approach slabs and left in place

1/2" = 1'-0"

NOTE:
SHEET PILES ARE SHOWN IN REDUCED WIDTH SINCE THEY ARE SKEWED WITH ABUTMENT.

AS-BUILT

DRAWING NOTE: SCALE DIMENSIONS IS MEANT FOR 24" X 36" AND WILL SCALE INACCURATELY IF PRINTED ON ANY OTHER SIZE MEDIA.
NO REPRODUCTION SHALL BE MADE WITHOUT THE PRIOR CONSENT OF SME
© 2019

Check plate steel for lagging using loading provided:

Assume lagging is simply supported between sheet pile and forward/rear abutments. Use a surcharge of 250 psf and a friction angle of 32 degrees with a unit weight of 120 pcf (as provided by others), with a reduction of 50 percent due to arching.

$H := 12.5 \text{ ft}$: Max retained height (provided by others)
$\phi := 32 \text{ deg}$: Internal angle of friction
$\gamma := 120 \text{ pcf}$: Unit weight of soil (provided by others)
$q := 250 \text{ psf}$: Surcharge (traffic surcharge, provided by others)
$K_a := \tan\left(45 \text{ deg} - \frac{\phi}{2}\right)^2 = 0.307$: Earth pressure coe. (Rankine distr., provided by others)
$LF_{EP} := 1.5$: ASSHTO load factor for earth pressure
$LF_{sur} := 1.75$: ASSHTO load factor for surcharge
Try a plate steel using ASTM Gr. A36 with a thickness of 1 in.	
$F_y := 36 \text{ ksi}$: Yield stress of plate steel
$b_p := 80 \text{ in} - 7 \text{ in} = 6.1 \text{ ft}$: Plate width
$t_p := 1 \text{ in}$: Plate thickness
$b_{eff} := 1 \text{ ft}$: Effective width
$p_{max} := LF_{EP} \cdot K_a \cdot (\gamma \cdot H) + q \cdot LF_{sur} = 1129 \text{ psf}$: Factored pressure (provided by others)
$T_{max} := p_{max} \cdot b_{eff} = 1.1 \frac{\text{kip}}{\text{ft}}$: Maximum load
$\phi_{arc} := 0.5$: Use a 50% reduction for arching effects
$M_{max} := \phi_{arc} \cdot T_{max} \cdot b_p^2 \cdot 0.125 = 2.6 \text{ ft} \cdot \text{kip}$: Maximum moment for plate steel (say simply supported and loading is constant over unit width. This is conservative and is taken at a maximum pressure)
$\phi_{bend} := 0.9$: Reduction for bending
$S_{req} := \frac{M_{max}}{\phi_{bend} \cdot F_y} = 0.97 \text{ in}^3$: Required section modulus for plate
$S_{provided} := \frac{b_{eff} \cdot t_p^2}{6} = 2 \text{ in}^3$: Provided section for plate, OK by inspection
$V_{max} := T_{max} \cdot b_p \cdot 0.5 = 3.4 \text{ kip}$: Factored shear per foot at supports (neglect arching)
$\phi_p := 0.75$: Reduction factor for shear
$\phi_p V_p := \phi_p \cdot 0.6 \cdot F_y \cdot t_p \cdot b_{eff} = 194 \text{ kip}$: Factored shear resistance of plate, OK by inspection

May use 1-in. thick plate steel, ASTM Gr. A36 for purposes of lagging. Refer to attachments for locations.