


STATE OF OHIO  
DEPARTMENT OF TRANSPORTATION

**HAM-75-3.84**  
**HAM-74-1908S**

**HAMILTON COUNTY**  
**CITY OF CINCINNATI**

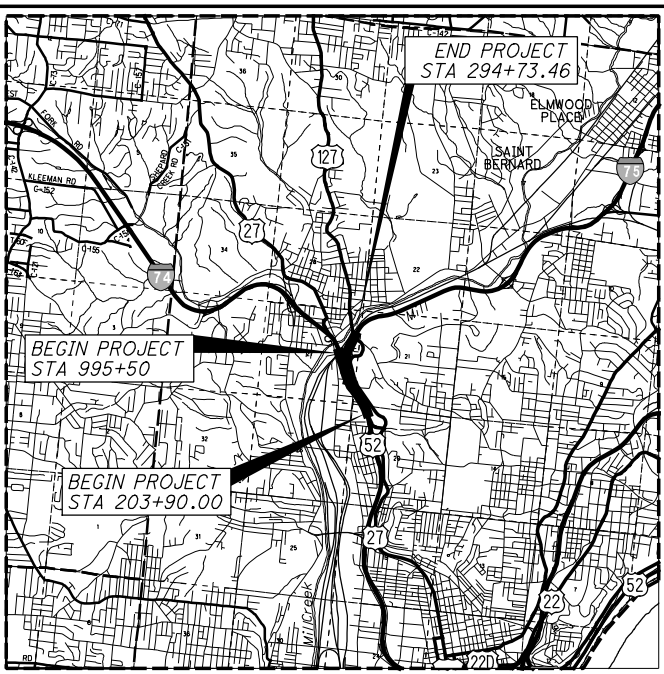

LOCATION MAP

LATITUDE: 39° 09' 03" LONGITUDE: 84° 32' 24"



PORTION TO BE IMPROVED	-----
INTERSTATE HIGHWAY	=====
FEDERAL ROUTES	=====
STATE ROUTES	=====
COUNTY & TOWNSHIP ROADS	-----
OTHER ROADS	-----

INDEX OF SHEETS:

TITLE SHEET	1	* STEEL DETAILS - UNIT 2	42-52	SOE Shop Drawings	86-89
SITE PLANS	2-3	DECK & PARAPET DETAILS - UNIT 1	53-57	Bearing Shop Drawings	90-115
GENERAL PLANS	4-5	DECK & PARAPET DETAILS - UNIT 2	58-61, 60	Structural Steel Shop Drawings	116-184
REFERENCE CHORD LAYOUT	6	DECK POURING SEQUENCE	62	Expansion Joint Shop Drawings	185-189
* GENERAL NOTES	7-9	EXPANSION JOINT DETAILS	63		
* STAGED CONSTRUCTION DETAILS	10-12	DRAINAGE DETAILS	64		
* REMOVAL DETAILS	13-16	ELEVATION TABLES	65-70		
* FOUNDATION PLANS	17-31	APPROACH SLAB AND PARAPET	71-73		
* BEARING DETAILS	32-36	REINFORCING STEEL LIST	74-79		
* STEEL DETAILS - UNIT 1	37-41	* REVIEWED IN BU-05 SUBMISSION			

DESIGN DESIGNATION

	IR 75		IR 74		DIRECTIONAL ROADWAY	
	SOUTH OF MITCHELL	SOUTH OF IR 74	WEST OF BEEKMAN	EAST OF BEEKMAN	IR 75 NB TO IR 74 WB	IR 74 EB TO IR 75 SB
CURRENT ADT (2010)	149,400	152,100	75,000	88,300	25,300	25,300
DESIGN YEAR ADT (2030)	174,300	179,200	89,300	102,000	29,800	29,800
DESIGN HOURLY VOLUME (2030)	14,640	15,050	8,040	9,180	4,100	4,380
DIRECTIONAL DISTRIBUTION	0.54	0.70	0.72	0.73	1.00	1.00
TRUCKS (24 HOUR B&C)	0.16	0.13	0.15	0.13	0.03	0.08
DESIGN SPEED	60 MPH	60 MPH	60 MPH	60 MPH	50 MPH	50 MPH
LEGAL SPEED	55 MPH	55 MPH	55 MPH	55 MPH	50 MPH	50 MPH
DESIGN FUNCTIONAL CLASSIFICATION:	URBAN INTERSTATE	URBAN INTERSTATE	URBAN INTERSTATE	URBAN INTERSTATE	URBAN INTERSTATE	URBAN INTERSTATE
NHS PROJECT	YES					

DESIGN EXCEPTIONS

DESIGN FEATURE	APPROVAL DATES	SHEET NUMBERS SEE BU-14
STOP. SIGHT DIST. - SB IR 75 (CURVE 6)	4/6/18	
SHOULDER WIDTH - IR 74-1892R BRIDGE	4/10/18	
SHOULDER WIDTH - RAMP P 1908S BRIDGE	4/11/18	
CURVE RADIUS - RAMP P 1908S BRIDGE	4/11/18	
STOP. SIGHT DIST. - RAMP P 1908S BRIDGE	4/11/18	
S.E. RATE - IR 74 EB CURVE 14, 1908R BRIDGE	4/26/18	

ENGINEERS SEAL: FOR ENTIRE PLAN EXCEPT STRUCTURES OVER 20'	ENGINEERS SEAL: FOR STRUCTURES OVER 20'
SIGNED: _____	SIGNED: _____
DATE: _____	DATE: _____

2016 SPECIFICATIONS

THE STANDARD SPECIFICATIONS OF THE STATE OF OHIO, DEPARTMENT OF TRANSPORTATION, INCLUDING SUPPLEMENTAL SPECIFICATIONS LISTED IN THE PLANS AND CHANGES LISTED IN THE PROPOSAL SHALL GOVERN THIS IMPROVEMENT.

I HEREBY APPROVE THESE PLANS AND DECLARE THAT THE MAKING OF THIS IMPROVEMENT WILL NOT REQUIRE THE CLOSING TO TRAFFIC OF THE HIGHWAY AND THAT PROVISIONS FOR THE MAINTENANCE AND SAFETY OF TRAFFIC WILL BE AS SET FORTH ON THE PLANS AND ESTIMATES.

The DBT confirms that the record drawings have been updated to incorporate all red-lined changes and have been approved by the appropriate parties. These updated drawings represent the final and accurate record of the buildable unit's design and construction.

The following sheets have been updated:  
2, 8, 9, 17, 18, 19A, 19B, 22, 24A, 24B, 25, 27, 34, 35, 35A, 35B, 36, 38, 43, 48, 53, 58, 62, 63, 64, 68, 75, and 76.

AS-BUILT PLANS

**UNDERGROUND UTILITIES**  
CONTACT BOTH SERVICES TWO WORKING DAYS BEFORE YOU DIG.

Call Before You Dig 1-800-362-2764  
(Non-members must be called directly)

**OIL & GAS PRODUCERS UNDERGROUND PROTECTION SERVICE**  
1-800-925-0988


STANDARD CONSTRUCTION DRAWINGS												SUPPLEMENTAL SPECIFICATIONS	
BP-1.1	7/28/00	I-2.4	1/15/16	MGS-5.3	7/15/16	VPF-1-90	1/19/18	MT-95.32	7/21/17	TC-21.50	7/15/16	800-2016	1/19/18
BP-2.1	7/17/15			MGS-6.1	1/19/18	HL-10.11	1/19/18	MT-95.50	7/21/17	TC-22.10	10/18/13	806	3/2/15
BP-2.2	7/18/08	MH-1.2	1/15/16			HL-10.12	1/20/17	MT-95.73	1/19/18	TC-22.20	1/17/14	808	10/16/15
BP-2.3	7/18/14			RM-1.1	7/18/14	HL-10.13	1/20/17	MT-98.30	7/21/17	TC-41.30	10/18/13	809	1/19/18
BP-2.4	7/19/13	DM-1.1	7/21/17	RM-4.1	7/21/17	HL-10.15	7/17/15	MT-99.30	1/19/18	TC-42.10	10/18/13	814	7/15/16
BP-3.1	7/18/14	DM-1.2	1/18/13	RM-4.3	7/18/14	HL-20.11	4/21/17	MT-101.70	1/17/14	TC-42.20	10/18/13	821	4/20/12
BP-6.1	7/19/13	DM-1.3	7/18/14	RM-4.4	7/21/17	HL-20.21	1/19/18	MT-101.75	7/15/16	TC-52.10	10/18/13	832	1/17/14
BP-8.1	7/18/08	DM-2.1	1/18/13	RM-4.5	7/21/17	HL-20.24	1/19/18	MT-101.80	1/16/18	TC-52.20	1/19/18	869	10/17/14
		DM-4.1	1/15/16	RM-4.6	7/19/13	HL-30.11	1/19/18	MT-101.90	7/21/17	TC-61.30	1/20/17	908	10/20/17
CB-1.1	1/15/16	DM-4.2	7/20/12	A-1-69	7/19/02	HL-30.21	1/17/14	MT-102.20	7/18/14	TC-65.10	1/17/14	914	7/15/16
CB-1.2	1/15/16	DM-4.3	1/15/16	AS-1-15	7/17/15	HL-30.22	1/17/14	MT-104.10	10/16/15	TC-65.11	7/21/17	921	4/20/12
CB-1.3	1/15/16	DM-4.4	1/15/16	AS-2-15	1/19/18	HL-30.31	1/17/14	MT-105.10	7/19/13	TC-71.10	1/19/18	939	7/17/15
CB-2.1	1/15/16			EXJ-4-87	1/19/18	HL-30.32	1/17/14			TC-72.20	7/15/16		
CB-2.2	1/15/16	MGS-1.1	1/19/18	GSD-1-96	7/19/02	HL-30.33	1/17/14	TC-7.65	1/15/16				
CB-2.3	1/15/16	MGS-2.1	1/19/18	PCB-91	1/18/13	HL-30.41	1/19/18	TC-9.10	1/19/18	ITS-13.10	7/17/15		
CB-3.1	1/15/16	MGS-3.1	1/19/18	PSID-1-13	7/15/16	HL-40.10	1/20/17	TC-9.30	1/19/18	ITS-14.10	7/17/15		
CB-3.3	1/15/16	MGS-3.2	1/18/13	RB-1-55	7/19/13	HL-40.20	1/20/17	TC-12.30	1/19/18	ITS-14.11	7/17/15		
		MGS-4.1	1/20/17	SBR-1-13	1/14/14	HL-50.11	1/16/15	TC-15.115	10/18/13	ITS-15.10	7/17/15		
I-2.1	1/15/16	MGS-4.2	7/19/13	SBR-2-13	1/14/14	HL-50.21	1/19/18	TC-16.21	1/19/18	ITS-15.11	7/17/15		
I-2.2	1/15/16	MGS-4.3	1/18/13	SICD-1-96	7/18/14	MT-95.30	7/21/17	TC-21.10	7/21/17	ITS-50.10	1/19/18		
I-2.3	1/15/16	MGS-5.2	7/15/16	SICD-2-14	7/18/14	MT-95.31	7/21/17	TC-21.20	1/19/18				

PLAN PREPARED BY:

540 WHITE POND DRIVE, STE E  
AKRON, OH 44320  
(614) 839-0250

USER: SPATES DATE: 2018/03/03 TIME: 10:03:00 PROJECT: HAM-75-03.84\04667\structures\HAM074\_1908S\sheet\074\_1908S.ctb 9/26/2023 2:44:43 PM erin.baumann

FEDERAL PROJECT NO. E170 (713)  
 PID NO. 104667  
 CONSTRUCTION PROJECT NO. 183000  
 RAILROAD INVOLVEMENT CSXT (CSX OP# OH1179) NORFOLK SOUTHERN  
 HAM-75-3.84  
 1/79

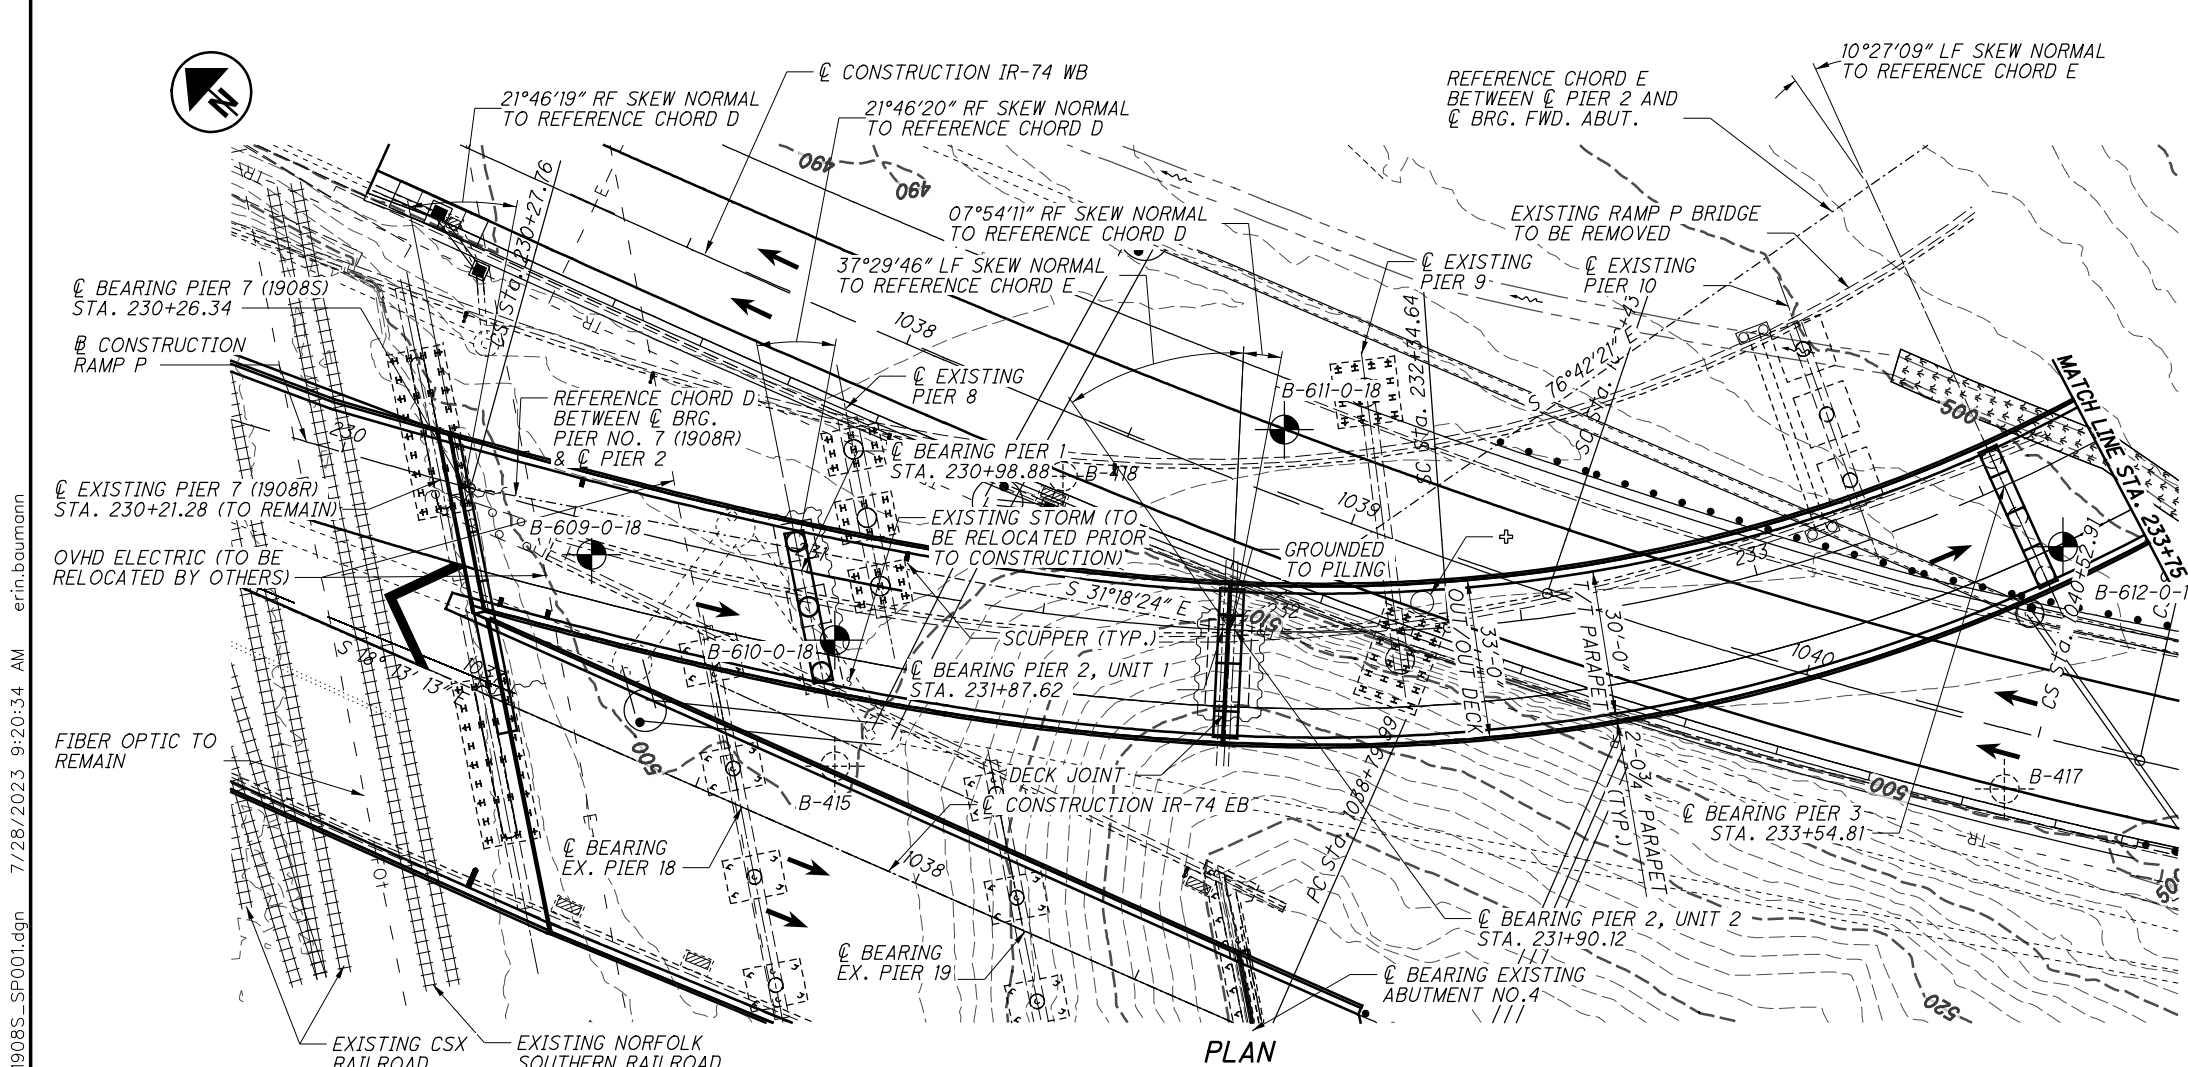


PLAN

EXISTING STRUCTURE	
TYPE:	CONTINUOUS WELDED PLATE GIRDER AND CONTINUOUS ROLLED STEEL BEAM WITH REINFORCED CONCRETE DECK AND SUBSTRUCTURE
SPANS:	UNIT 3 - 90'-0"±, 110'-0"±, 93'-0"±, 71'-3/4"± UNIT 4 - 45'-11 3/4"±, 63'-9"±, 79'-0"±, 63'-0"± UNIT 5 - 46'-7 3/8"±, 63'-4 1/4"±, 64'-0"±, 41'-0"±
ROADWAY:	VARIES
LOADING:	CF 2000 (57) AND ALTERNATE MILITARY
SKEW:	VARIES
APPROACH SLABS:	AS-1-67 (25' LONG)
ALIGNMENT:	VARIES
CROWN:	VARIES
STRUCTURAL FILE NUMBER:	3109798
DATE BUILT:	1973
DISPOSITION:	TO BE REMOVED (IN PHASES)

PROPOSED STRUCTURE	
TYPE:	CONTINUOUS 48" WEB (UNIT 1) AND 78" WEB (UNIT 2) STEEL PLATE GIRDERS WITH COMPOSITE REINFORCED CONCRETE DECK AND SUBSTRUCTURE
SPANS:	UNIT 1 - 72'-6 1/4", 88'-9 1/4" UNIT 2 - 164'-8 1/4", 170'-0 1/8", 120'-2 1/4" C/C BEARINGS MEASURED ALONG B CONSTRUCTION RAMP P
ROADWAY:	30'-0" TOE/TOE PARAPET
LOADING:	HL93 & 60 PSF FWS
WEARING SURFACE:	1" MONOLITHIC CONCRETE
SKEW:	VARIES
APPROACH SLABS:	30'-0" LONG (AS-1-15 & AS-2-15)
ALIGNMENT:	2°15'00" & 16°45'00" CURVE LEFT
SUPERELEVATION:	0.06 FT/FT MAX
COORDINATES:	LATITUDE 39°09'07.00" N LONGITUDE 84°32'28.46" W

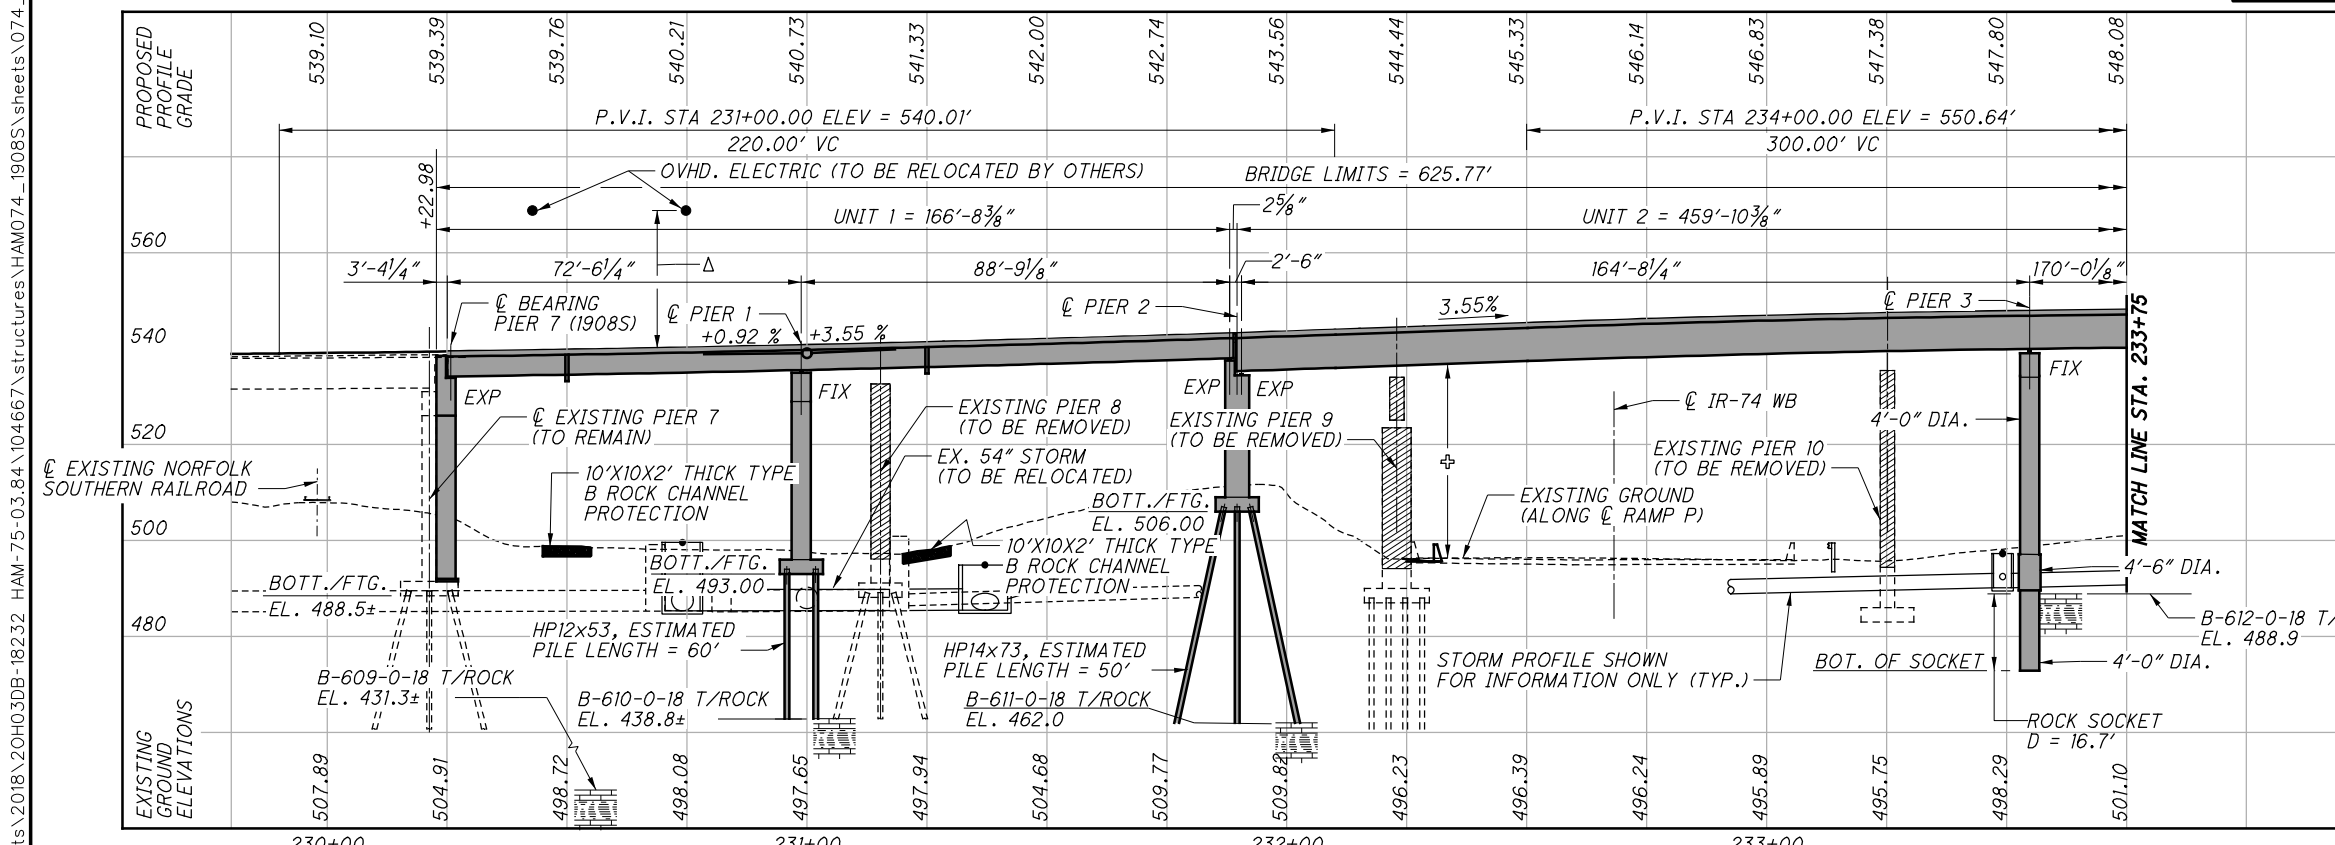

PROFILE ALONG B CONSTRUCTION RAMP P

ALL DIMENSIONS ARE ALONG B CONSTRUCTION RAMP P, UNLESS NOTED OTHERWISE

HORIZONTAL CURVE DATA RAMP P	
(C36) PI STA 228+61.19 Δ = 7° 21' 05" (LT) 45mph Dc = 2° 12' 13" R = 2,600.00' T = 167.03' L = 333.59' E = 5.36' C = 333.36' C.B. = S 22° 50' 36" E e <sub>max</sub> = 0.033	(C37) PI STA 231+58.60 Ls = 206.88' 35mph f <sub>s</sub> = 19° 36' 22" LT = 130.84' ST = 77.84' x = 204.17' y = 26.12' k = 103.04' p = 4.51' e <sub>max</sub> = 0.06

- NOTES:**
- FOR NOTES, SEE SHEET 3/79.
  - RAMP P BUILT IN STAGE 1, PHASE 2, STEP 2 CONSTRUCTION.

- LEGEND**
- [Hatched Box] - LIMITS OF SUBSTRUCTURE REMOVAL
  - [Crossed Box] - I-74 WB: REQUIRED VERTICAL CLEARANCE = 15'-6" PROPOSED VERTICAL CLEARANCE = 40'-5"
  - [Triangle] - DUKE OVHD ELECTRIC LINES: EXISTING VERTICAL CLEARANCE = 30'-6"± PROPOSED VERTICAL CLEARANCE = 29'-9"
  - [Circle with Dot] - PROP. BORING
  - [Circle with Cross] - HISTORICAL BORING LOCATION
  - [Wavy Line] - TEMPORARY SHORING

P:\Projects\2018\20H03DB-18232 HAM-75-03.84\104667\structures\HAM074\_1908S\_SFP001.dgn 7/28/2023 9:20:34 AM erin.baumann

DESIGN AGENCY  
**PRIMEW**  
540 WHITE POND DR. SUITE E  
AKRON, OH 44320

DATE 11/1/2018  
DESIGNED BY TES  
CHECKED BY CRG  
DRAWN BY KDC  
REVISED BY KDC

STRUCTURE FILE NUMBER 3109798

HAMILTON COUNTY  
STA. 230+22.98  
STA. 236+48.75


SITE PLAN (1 OF 2)  
BRIDGE NO. HAM-74-1908S  
RAMP P OVER IR-74 WESTBOUND, IR-75 AND RAMP E

HAM-75-3.84  
PID No. 104667

2 / 79

2 / 79


P:\Projects\2018\20H03DB-18232 HAM-75-03.84\104667\structures\HAM074\_1908S\_Sheet02.dgn 7/28/2023 9:22:16 AM erim.baumann

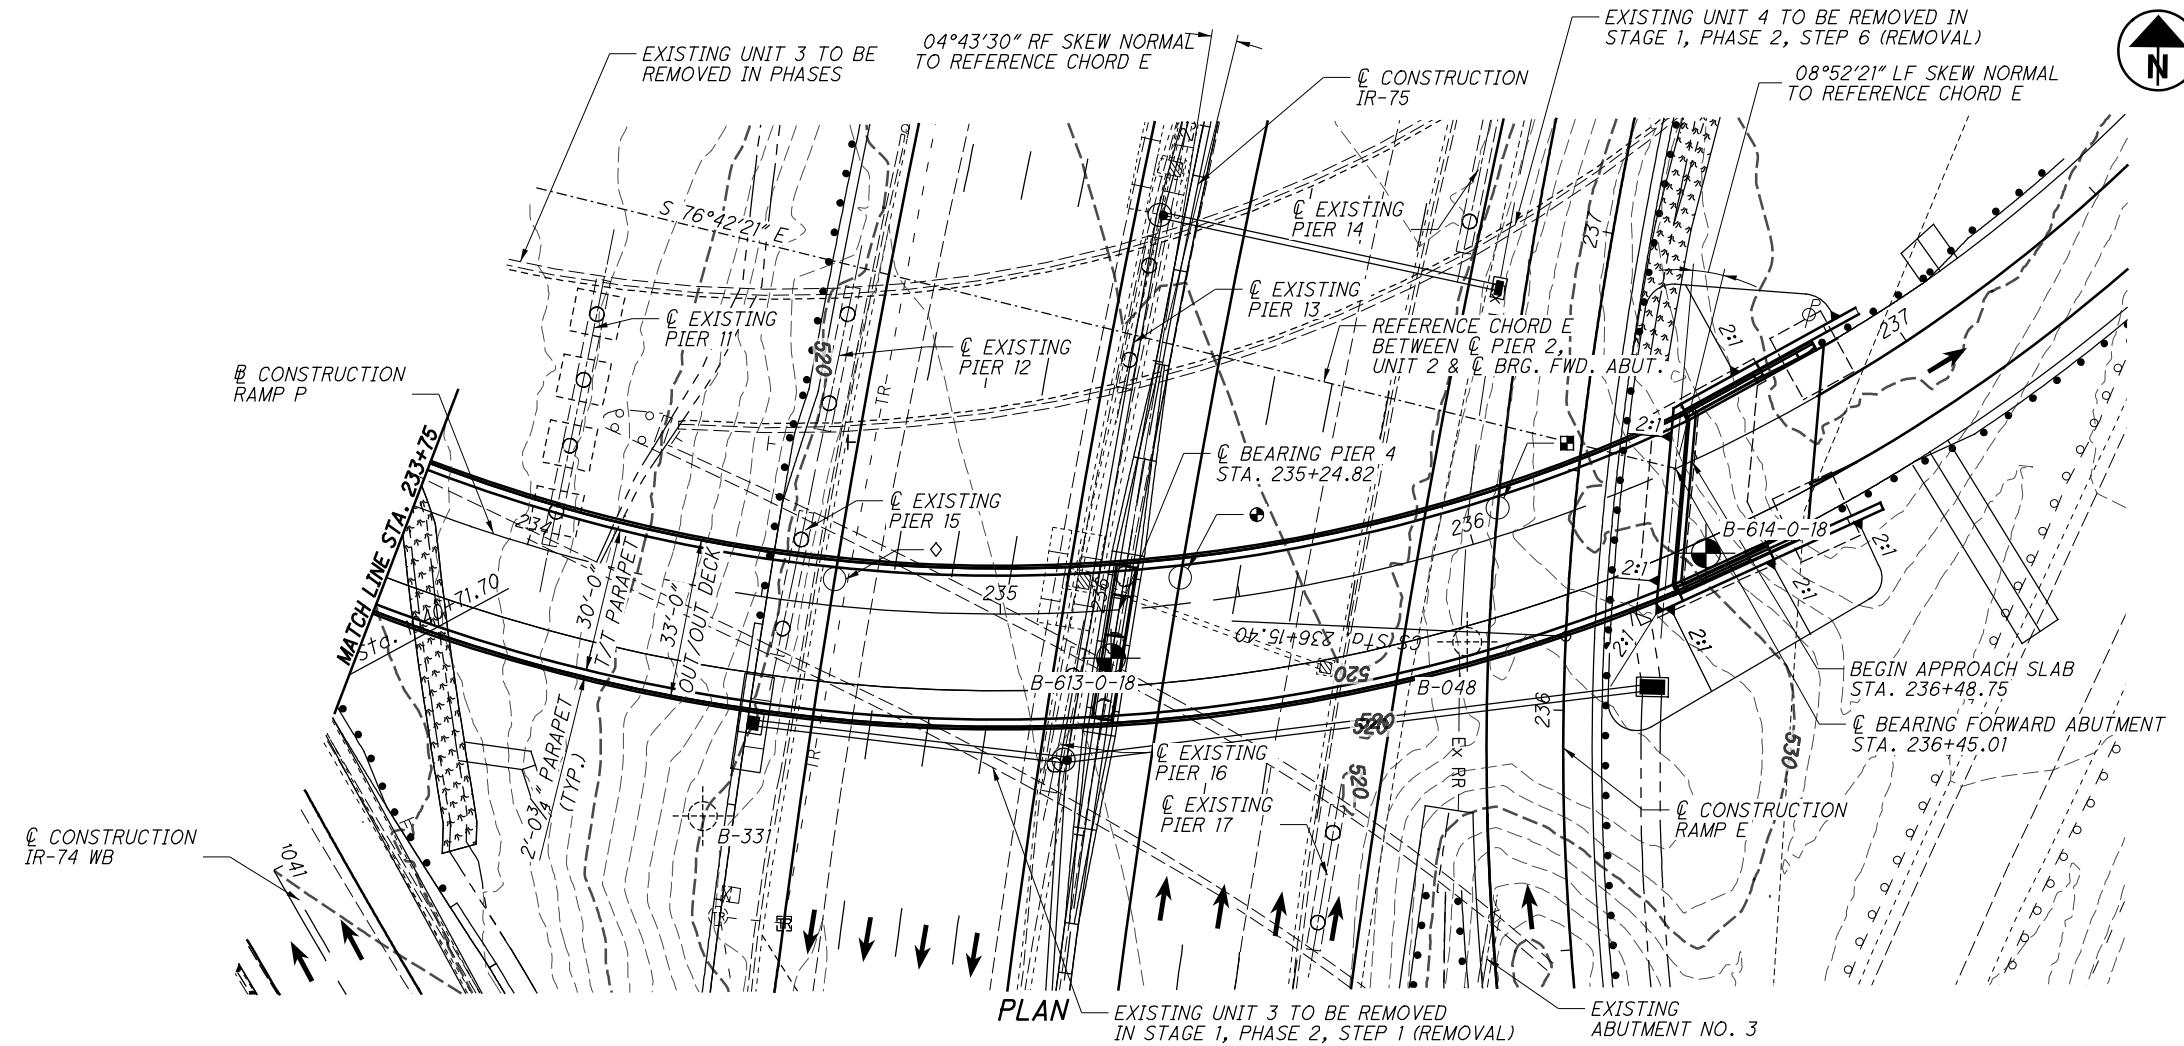

- LEGEND**
- LIMITS OF SUBSTRUCTURE REMOVAL
  - I-75 SB:  
EXISTING VERTICAL CLEARANCE = 14'-10"±  
REQUIRED VERTICAL CLEARANCE = 15'-6"  
PROPOSED VERTICAL CLEARANCE = 15'-10"
  - I-75 NB:  
EXISTING VERTICAL CLEARANCE = 17'-0"±  
REQUIRED VERTICAL CLEARANCE = 15'-6"  
PROPOSED VERTICAL CLEARANCE = 16'-4"
  - I-75 PROP. RAMP:  
REQUIRED VERTICAL CLEARANCE = 15'-6"  
PROPOSED VERTICAL CLEARANCE = 15'-10"
  - PROP. BORING
  - HISTORICAL BORING LOCATION

**BENCHMARK DATA**

FOR BENCHMARK DATA SEE BU-14

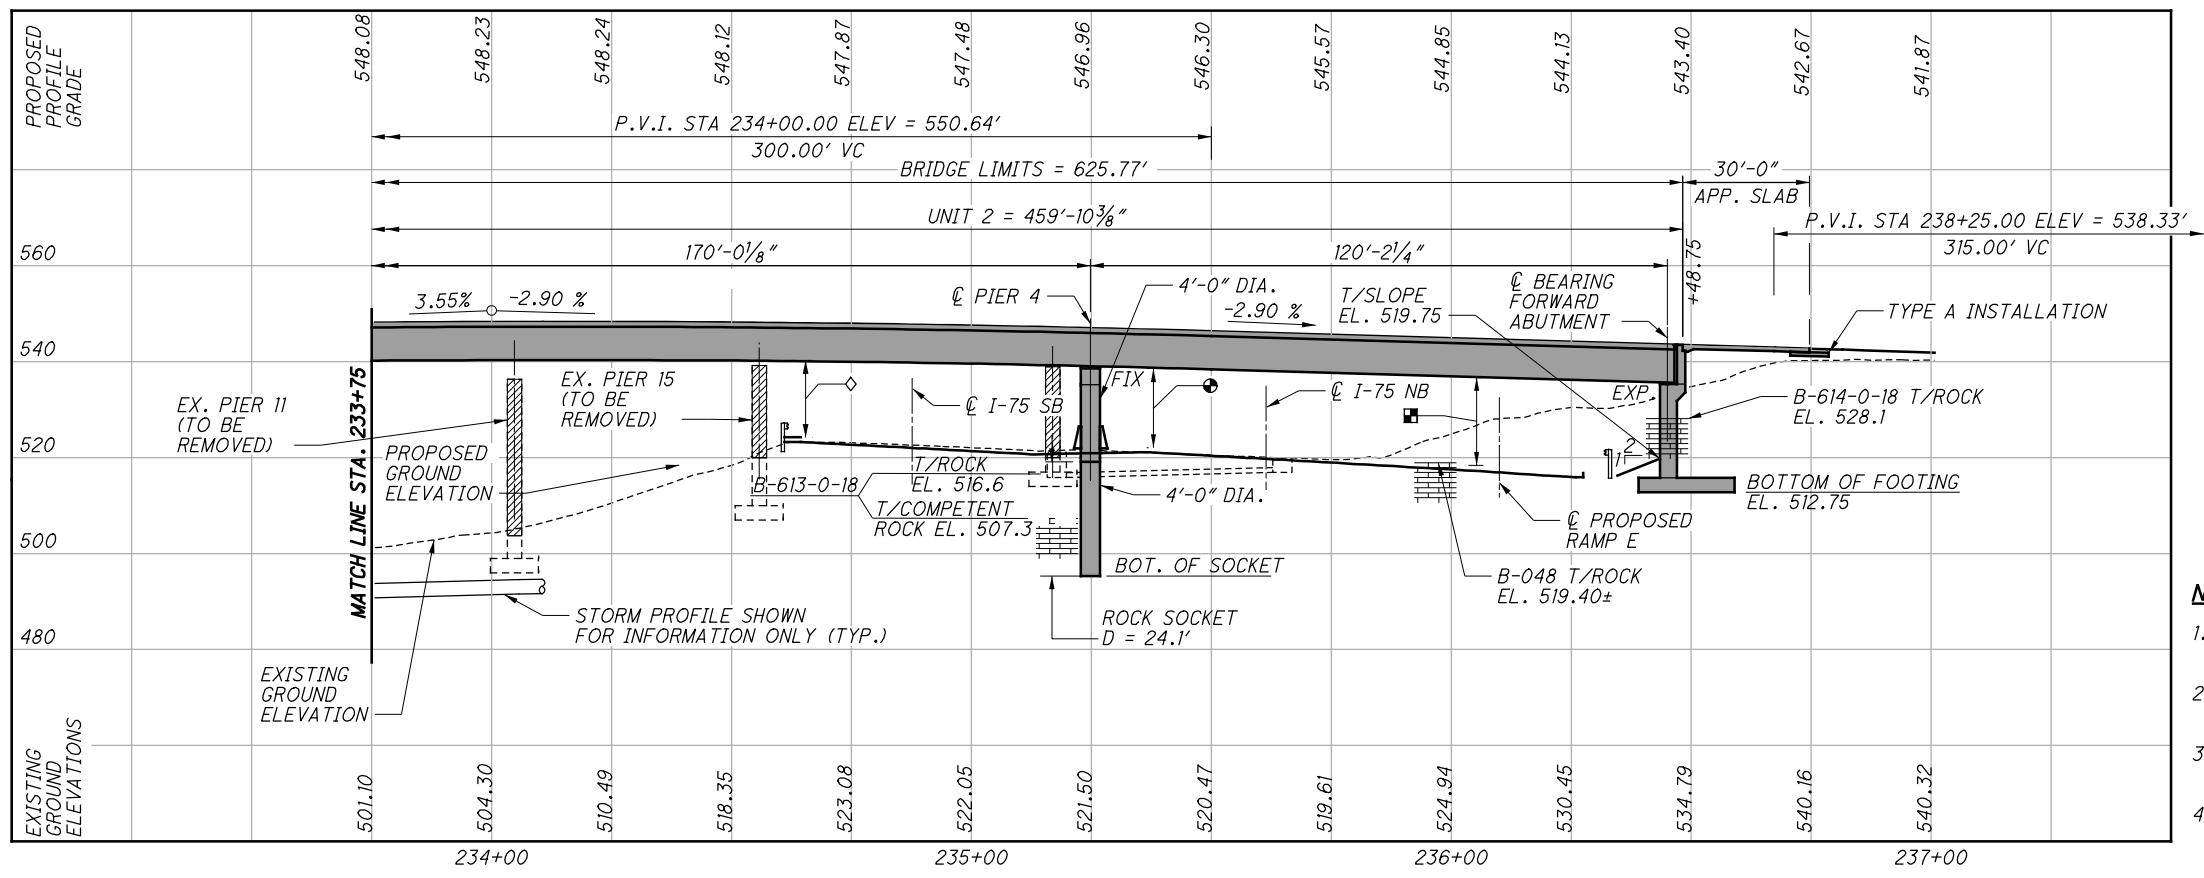

**HORIZONTAL CURVE DATA RAMP P**

(C38) PI STA 239+29.98  
 $\Delta = 127^\circ 36' 41''$  (LT)  
 35mph  $D_c = 16^\circ 45' 00''$   
 DE2  $R = 342.06'$   
 $T = 695.34'$   
 $L = 761.86'$   
 $E = 432.86'$   
 $C = 613.87'$   
 C.B. = N 70° 04' 09" E  
 $e_{max} = 0.06$

- NOTES:**
- SEE BU DS-01 FOR ADDITIONAL INFORMATION REGARDING GEOMETRICS.
  - EARTHWORK LIMITS SHOWN ARE APPROXIMATE. ACTUAL SLOPES SHALL CONFORM TO PLAN CROSS SECTIONS.
  - RAMP P BUILT IN STAGE 1, PHASE 2, STEP 2 CONSTRUCTION.
  - FOR REFERENCE CHORD DETAILS, SEE SHEET 6/79.

**PROFILE ALONG @ CONSTRUCTION RAMP P**  
 ALL DIMENSIONS ARE ALONG @ CONSTRUCTION RAMP P, UNLESS NOTED OTHERWISE


DESIGN AGENCY: **PRIMEW**  
 540 WHITE POND DR. SUITE E  
 AKRON, OH 44320

DATE: 11/1/2018  
 REVIEWED: TES  
 DRAWN: KDC  
 DESIGNED: KDC  
 CHECKED: CRG  
 HAMILTON COUNTY  
 STA. 230+22.98  
 STA. 236+48.75


SITE PLAN (2 OF 2)  
 BRIDGE NO. HAM-74-1908S  
 RAMP P OVER IR-74 WESTBOUND, IR-75 AND RAMP E

HAM-75-3.84  
 PID No. 104667

3 / 79

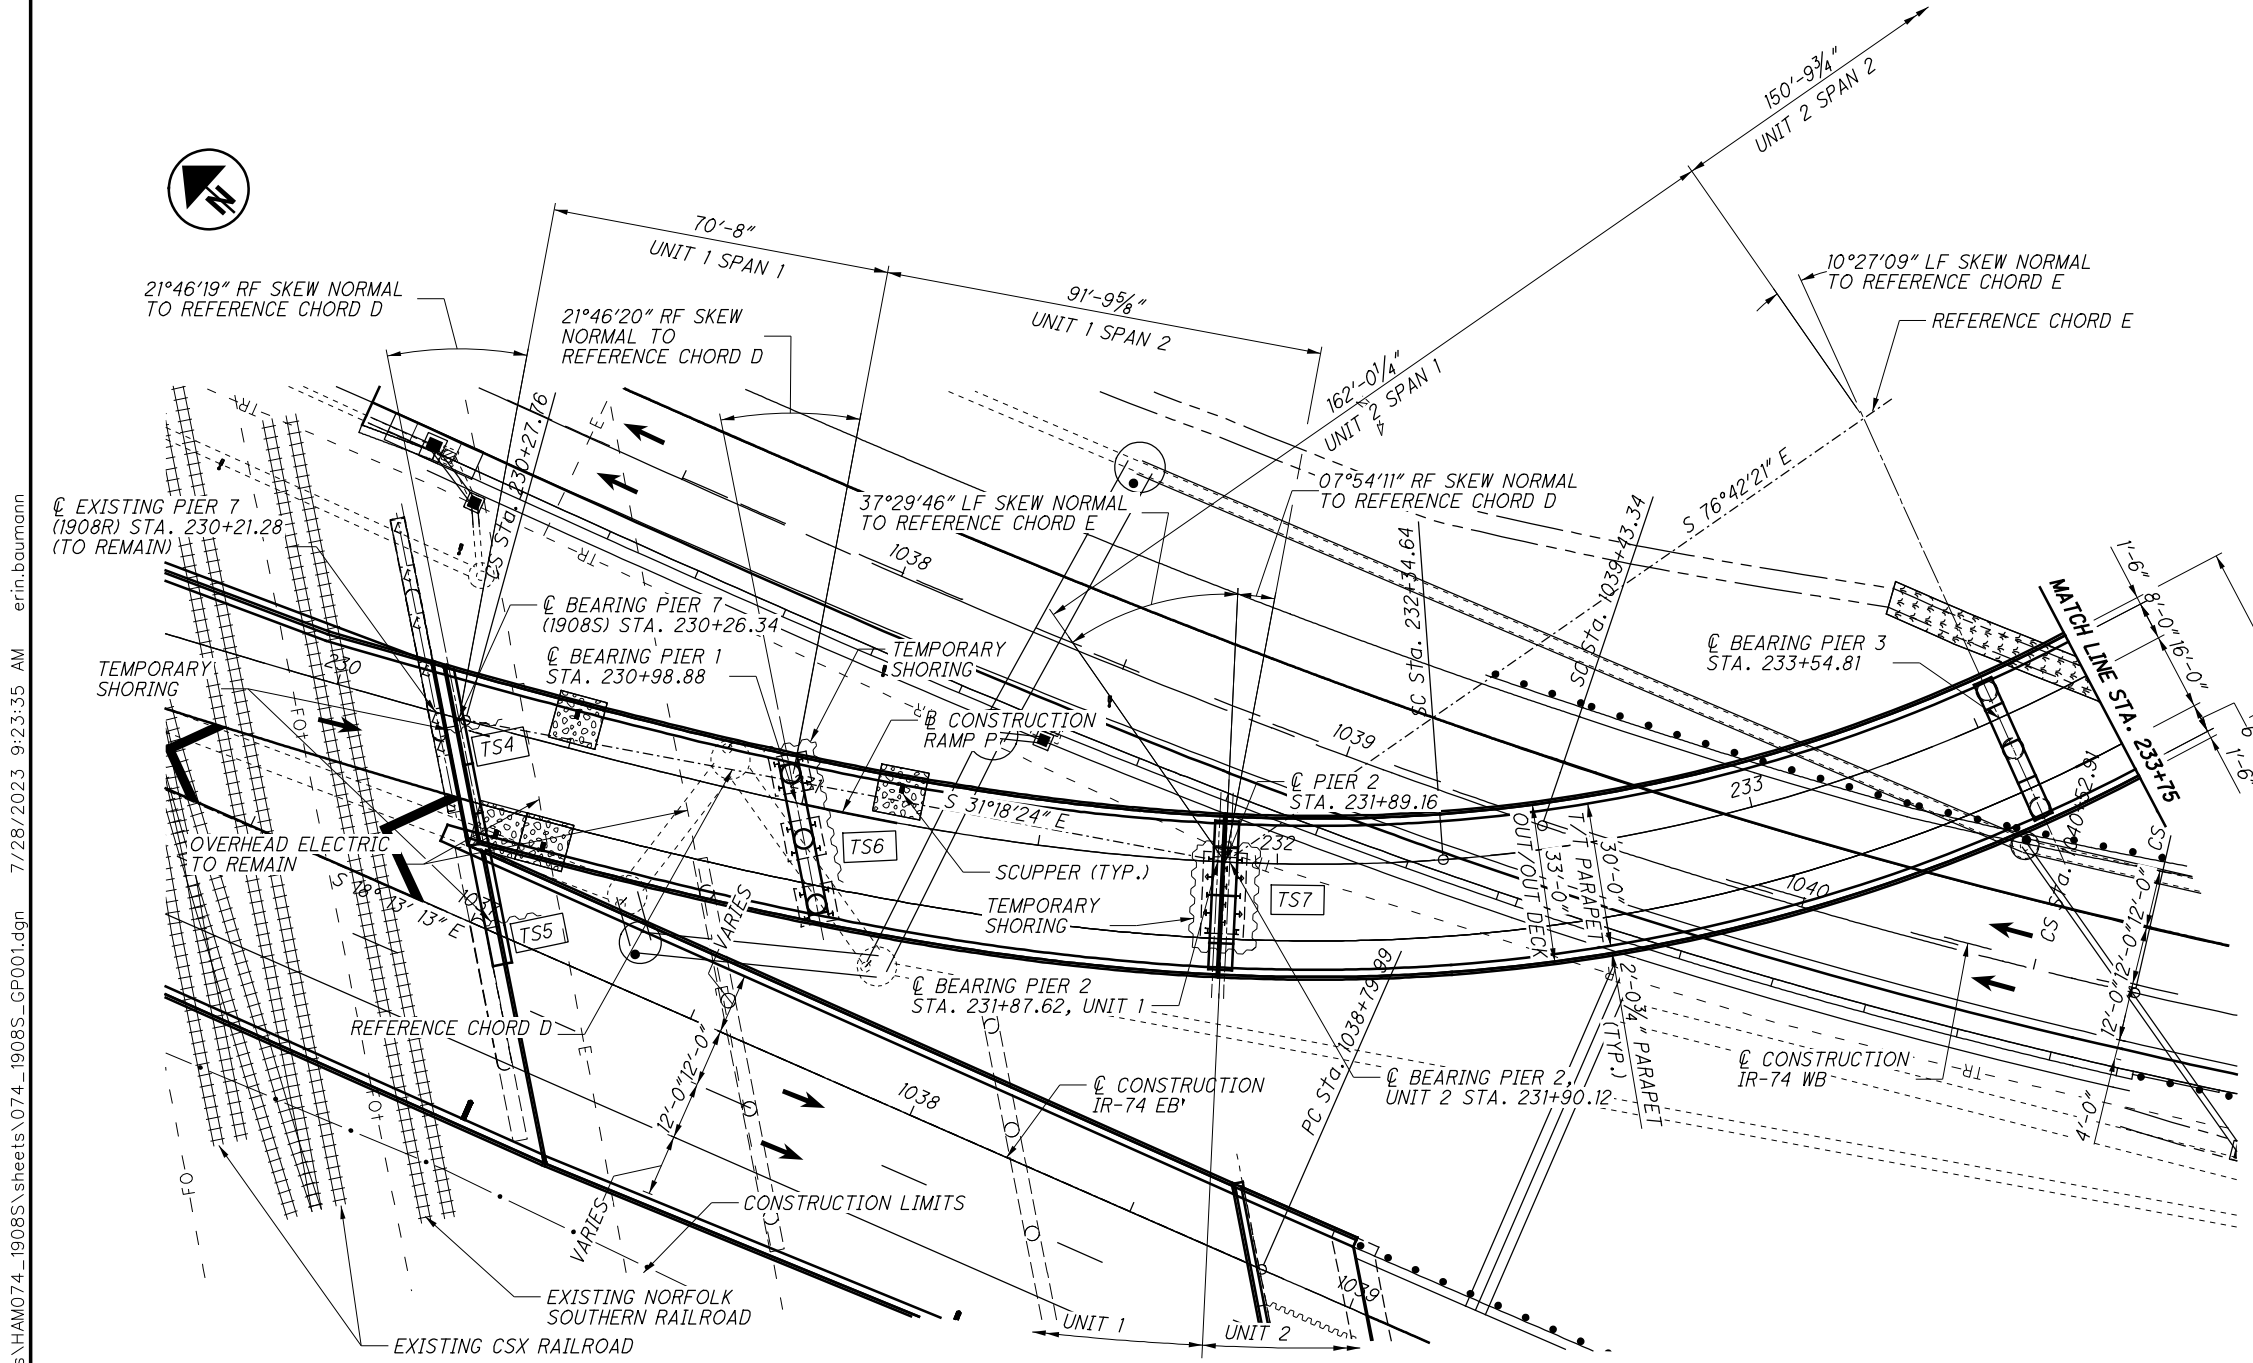

(C36) PI STA 228+61.19 45mph $\Delta = 7^\circ 21' 05''$ (LT) $D_c = 2^\circ 12' 13''$ $R = 2,600.00'$ $T = 167.03'$ $L = 333.59'$ $E = 5.36'$ $C = 333.36'$ $C.B. = S 22^\circ 50' 36'' E$ $e_{max} = 0.033$	(C37) PI STA 231+58.60 35mph $L_s = 206.88'$ $f_s = 19^\circ 36' 22''$ $LT = 130.84'$ $ST = 77.84'$ $x = 204.17'$ $y = 26.12'$ $k = 103.04'$ $p = 4.51'$ $e_{max} = 0.06$
--	--

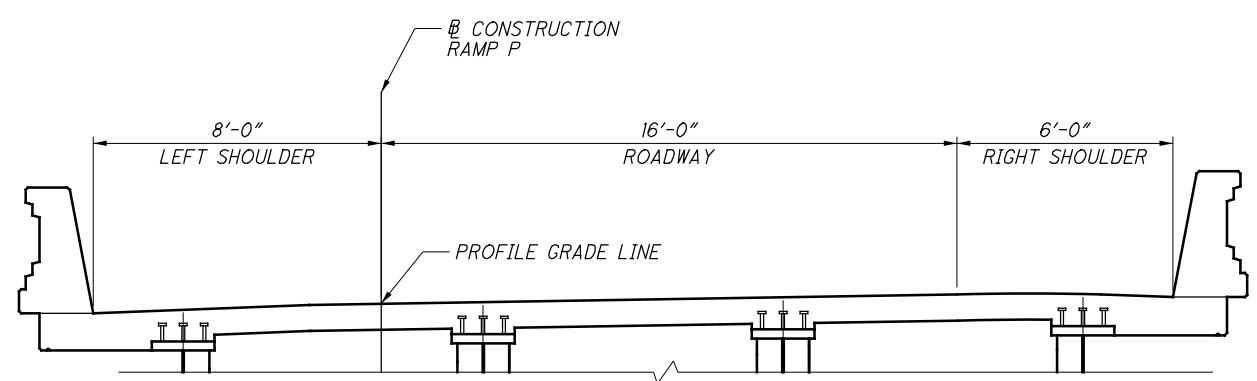

SUPERELEVATION TABLE			
STATION	LEFT SHOULDER	ROADWAY	RIGHT SHOULDER
228+13.68	0.01	0.033	-
230+27.76	0.01	0.033	0.037
232+34.64	0.06	0.06	0.01
239+59.10	0.06	0.06	0.01

**LEGEND**


- ~ - TEMPORARY SHORING
- TS# - TEMPORARY SHORING LOCATION

**NOTE:**

1. FOR DESCRIPTION OF PROPOSED WORK, SEE SHEET [7/79].

P:\Projects\2018\20H03DB-18232 HAM-75-03.84\104667\structures\HAM074\_1908S\sheets\074\_1908S\_GP001.dgn 7/28/2023 9:23:35 AM erin.baumann

P:\Projects\2018\20H03DB-18232 HAM-75-03.84\104667\structures\HAM074\_1908S\sheets\074\_1908S\_GP002.dgn 7/28/2023 9:24:39 AM erin.baumann

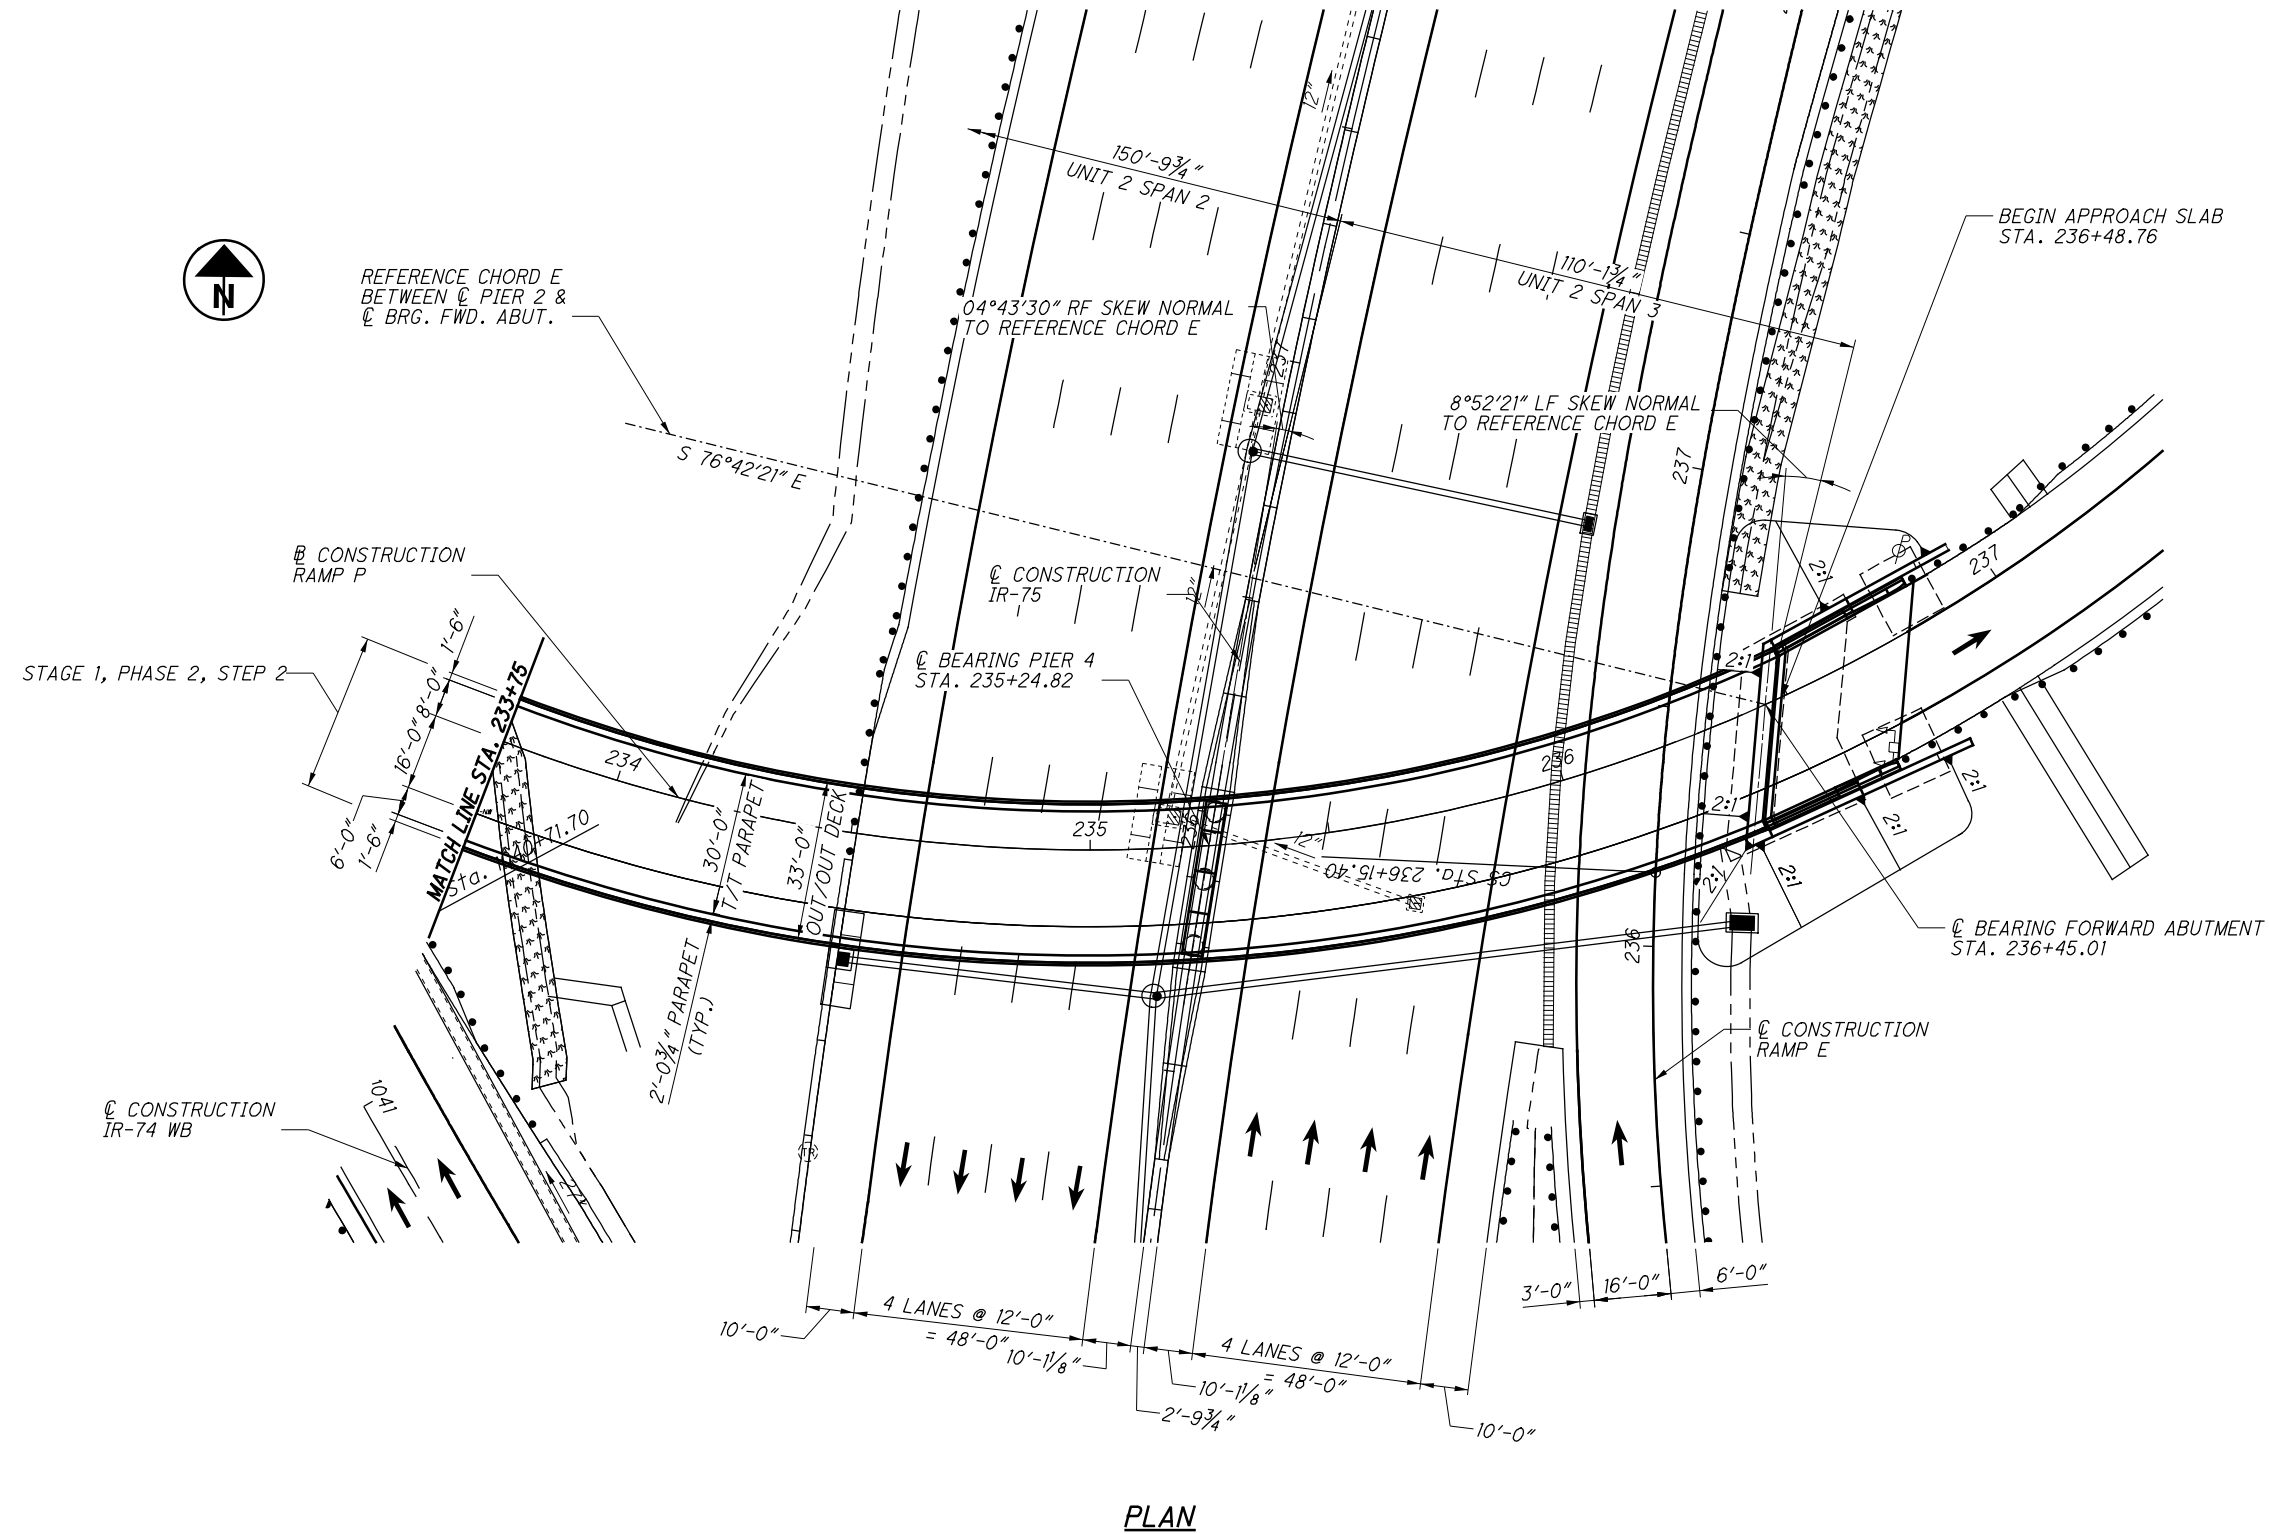


**HORIZONTAL CURVE DATA RAMP P**

(C38) PI STA 239+29.98  
 $\Delta = 127^\circ 36' 41''$  (LT)  
 35mph  $D_c = 16^\circ 45' 00''$   
 (DE2)  $R = 342.06'$   
 $T = 695.34'$   
 $L = 761.86'$   
 $E = 432.86'$   
 $C = 613.87'$   
 $C.B. = N 70^\circ 04' 09'' E$   
 $e_{max} = 0.06$


**NOTE:**  
1. FOR DESCRIPTION OF PROPOSED WORK, SEE SHEET 779.

<b>HAM-75-3.84</b> PID No. 104667	<b>GENERAL PLAN (2 OF 2)</b> BRIDGE NO. HAM-74-1908S RAMP P OVER IR-74 WESTBOUND, IR-75 AND RAMP E	HAMILTON COUNTY STA. 230+22.98 STA. 236+48.26	DESIGNED KDC CHECKED CRG	DRAWN KDC REVISED	REVIEWED TES STRUCTURE FILE NUMBER 3108798	DATE 11/1/2018	DESIGN AGENCY <b>PRIME</b> 540 WHITE POND DR. SUITE E AKRON, OH 44320
		5 / 79	79				

P:\Projects\2018\20H03DB-18232 HAM-75-03.84\104667\structures\HAM074\_1908S\sheets\074\_1908S\_DP006.dgn 7/28/2023 9:24:52 AM erin.baumann

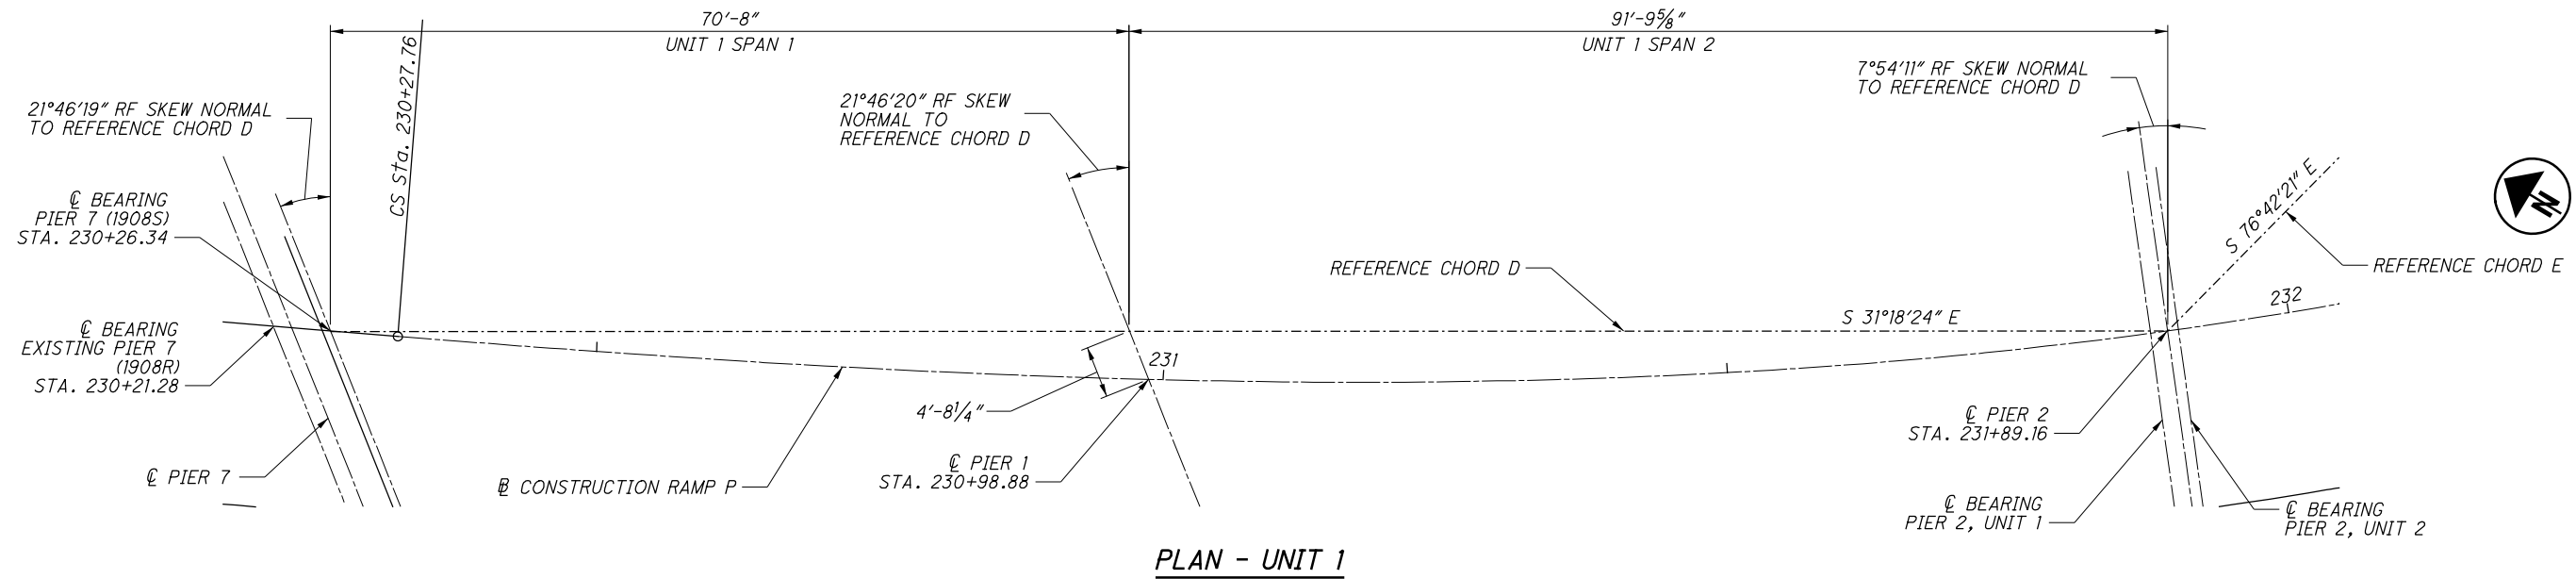

PLAN - UNIT 1

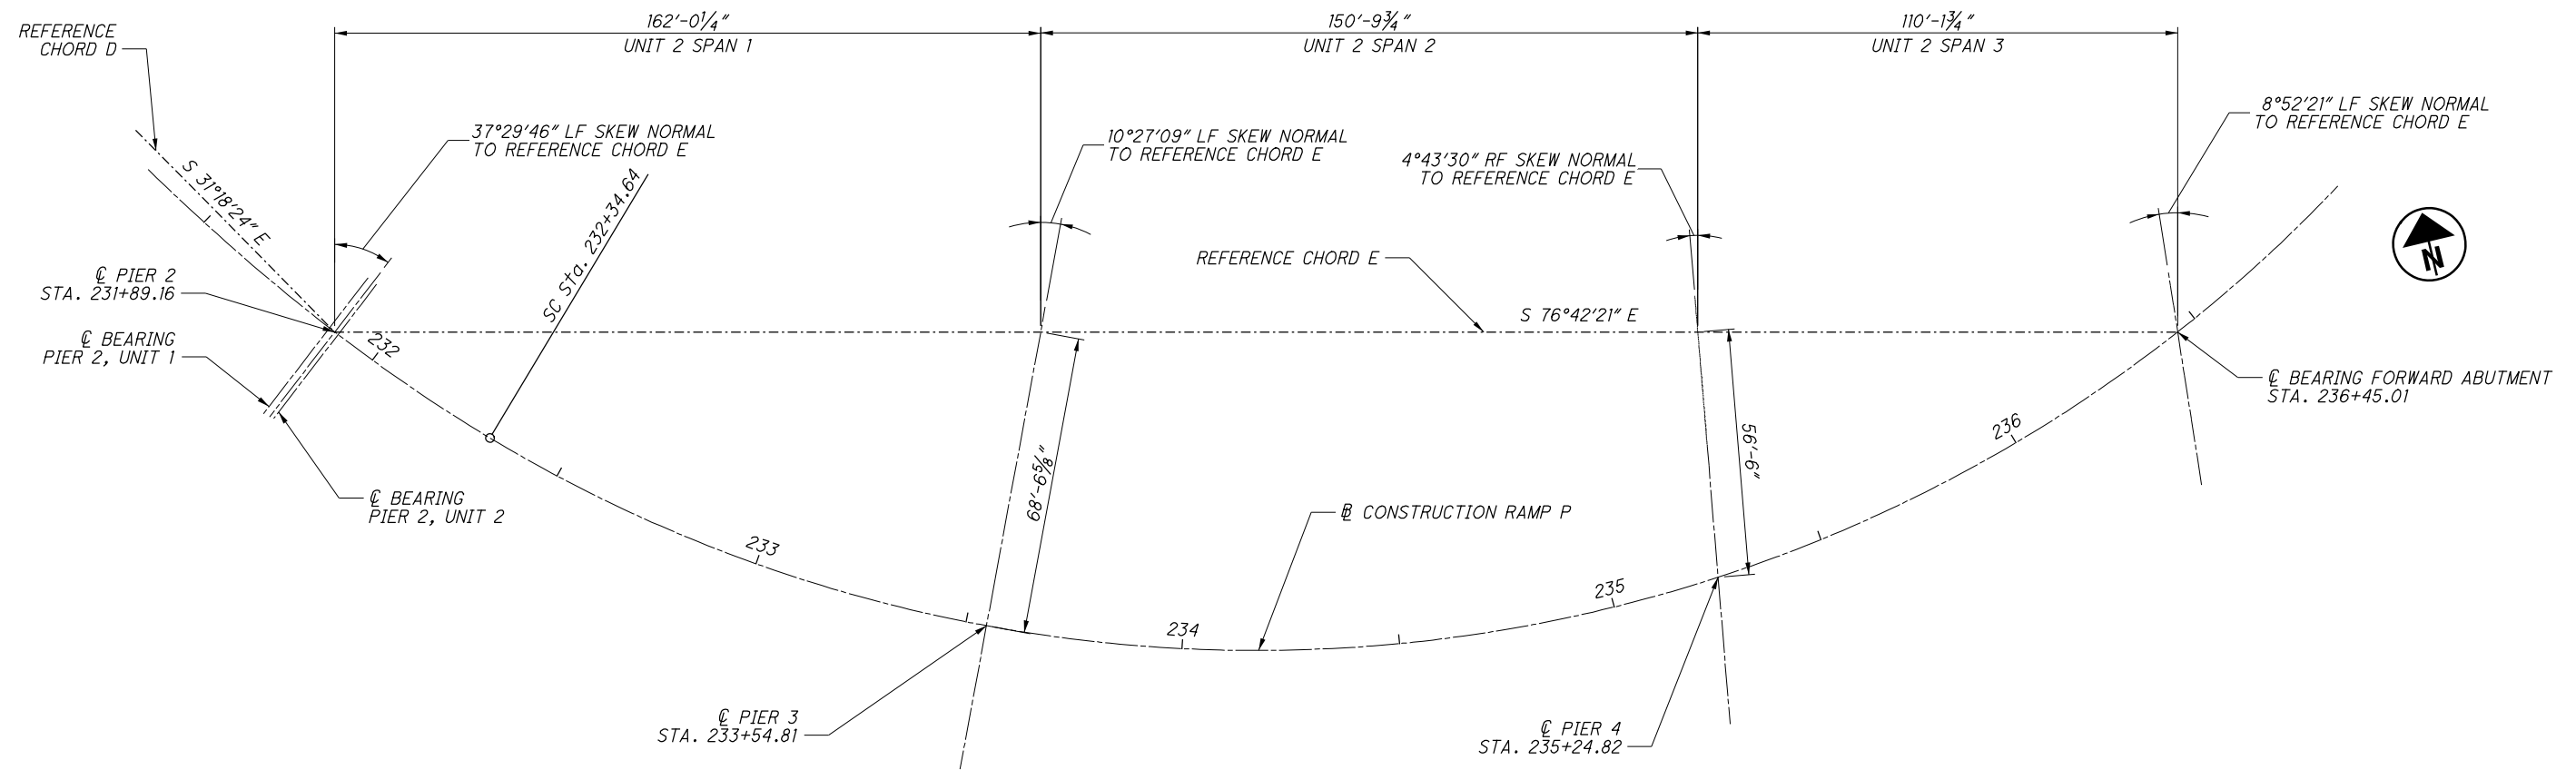

PLAN - UNIT 2

**NOTES:**

1. FOR ADDITIONAL NOTES, SEE SHEET 4/79

DESIGNED	KDC	CHECKED	CRG
DRAWN	ADS	REVISED	
REVIEWED	TES	DATE	8/22/2019
STRUCTURE FILE NUMBER	3109798		

# STRUCTURE GENERAL NOTES

## STANDARD DRAWINGS:

REFER TO THE FOLLOWING STANDARD BRIDGE DRAWINGS:  
AS-1-15 REVISED 07-17-15  
AS-2-15 REVISED 01-19-18  
VPF-1-90 REVISED 01-19-18  
SBR-1-13 REVISED 01-14-14  
EXJ-4-87 REVISED 01-19-18  
GSD-1-96 REVISED 07-19-02

AND THE FOLLOWING SUPPLEMENTAL SPECIFICATION(S):  
869 DATED 10-17-14

## DESIGN SPECIFICATIONS:

THIS STRUCTURE CONFORMS TO THE "LRFD BRIDGE DESIGN SPECIFICATIONS" ADOPTED BY THE AMERICAN ASSOCIATION OF STATE HIGHWAY AND TRANSPORTATION OFFICIALS, 8TH EDITION AND THE 2018 INTERIMS, INCLUDING THE 2018 INTERIM SPECIFICATIONS AND THE ODOT BRIDGE DESIGN MANUAL, 2007.

## SPECIAL DESIGN SPECIFICATIONS:

THIS BRIDGE REQUIRED THE USE OF A THREE DIMENSIONAL MODEL USING THE FINITE ELEMENT DESIGN METHOD TO ANALYZE THE STRUCTURE. THE COMPUTER PROGRAM USED FOR STRUCTURAL ANALYSIS WAS "MDX". THE BRIDGE COMPONENTS DESIGNED BY THIS METHOD AND THE DEAD AND LIVE LOAD DISTRIBUTIONS WERE AS FOLLOWS:

**DEAD LOAD DISTRIBUTION:** SLAB DEAD LOADS ARE DISTRIBUTED BASED ON GIRDER SPACING. FUTURE WEARING SURFACE AND PARAPET LOADS ARE DISTRIBUTED DIRECTLY TO THE SLAB.

**LIVE LOAD DISTRIBUTION:** THE DESIGN PROGRAM CREATED A LIVE LOAD INFLUENCE SURFACE OVER THE DECK SURFACE AND DISTRIBUTED THE LOADS BASED ON THE LONGITUDINAL AND TRANSVERSE STIFFNESS. THE LIVE LOAD DISTRIBUTION FACTORS VARY ALONG THE LENGTH AND WIDTH OF THE STRUCTURE.

## DESIGN DATA:

**REDUNDANCY:** THE DRILLED SHAFTS SUPPORTING THE PIERS WERE DESIGNED AS NON-REDUNDANT PER SCOPE OF SERVICES. THE SHAFT RESISTANCE WAS REDUCED TO 80% IN ACCORDANCE WITH AASHTO LRFD BRIDGE DESIGN SPECIFICATIONS, ARTICLE 10.5.5.2.3.

**OPERATIONAL IMPORTANCE:** A LOAD MODIFIER OF 1.00 HAS BEEN ASSUMED FOR THE DESIGN OF THIS STRUCTURE IN ACCORDANCE WITH THE AASHTO LRFD BRIDGE DESIGN SPECIFICATIONS, ARTICLE 1.3.5 AND THE ODOT BRIDGE DESIGN MANUAL, 2007.

## DESIGN LOADING:

HL-93  
FUTURE WEARING SURFACE (FWS) OF 0.060 KIPS/SQ. FT.

## DESIGN STRESSES:

CONCRETE CLASS QC3 WITH QC/QA-COMPRESSIVE STRENGTH 4.5 KSI (SUPERSTRUCTURE)  
CONCRETE CLASS QC3 WITH QC/QA-COMPRESSIVE STRENGTH 4.0 KSI (SUBSTRUCTURE)  
CONCRETE CLASS QC5 WITH QC/QA-COMPRESSIVE STRENGTH 4.5 KSI (DRILLED SHAFT)  
REINFORCING STEEL - MINIMUM YIELD STRENGTH 60 KSI.  
STRUCTURAL STEEL - ASTM A709 GRADE 50W - YIELD STRENGTH 50 KSI.  
STEEL H-PILES - ASTM A572 - YIELD STRENGTH 50 KSI.

## DECK PROTECTION METHOD:

EPOXY COATED REINFORCING STEEL  
2 1/2" CONCRETE COVER

## MONOLITHIC WEARING SURFACE:

MONOLITHIC WEARING SURFACE IS ASSUMED, FOR DESIGN PURPOSES, TO BE 1 INCH THICK.

## PROPOSED BRIDGE WORK:

THE PROPOSED WORK CONSISTS OF REMOVING PORTIONS OF THE EXISTING STRUCTURES AS SHOWN IN THE PLANS AND CONSTRUCTING THE PROPOSED BRIDGE.

## RAILROAD CONSTRUCTION CLEARANCE:

MAINTAIN A CONSTRUCTION CLEARANCE OF 12 FEET HORIZONTALLY FROM THE CENTER OF NEAREST TRACKS. ANY TEMPORARY VERTICAL CLEARANCE LESS THAN 23 FEET, OVER THE TRACKS, WILL REQUIRE SPECIAL PERMISSION, WITH NO GUARANTEE OF APPROVAL FROM CSX.

## ITEM 202 - PORTIONS OF STRUCTURES REMOVED, AS PER PLAN:

THE PROPOSED WORK CONSISTS OF REMOVING PORTIONS OF THE EXISTING STRUCTURES AS SHOWN IN THE PLANS AND CONSTRUCTING THE PROPOSED BRIDGE.

ALL REQUIREMENTS OF ODOT CMS 202.03 SHALL APPLY WITH THE FOLLOWING ADDITIONS. THIS WORK SHALL INCLUDE THE PHASED REMOVAL OF THE EXISTING STRUCTURES AS INDICATED IN THE PLANS AND GENERAL NOTES. THE STRUCTURE WILL BE CAREFULLY REMOVED BY PHASED CONSTRUCTION METHODS AS FURTHER DESCRIBED IN THE FOLLOWING SECTIONS. THE USE OF EXPLOSIVES AND HEADACHE BALLS WILL NOT BE PERMITTED FOR ANY DEMOLITION OF EXISTING STRUCTURES.

## PHASED CONCRETE DECK REMOVAL:

WHEN NO LONGER REQUIRED TO MAINTAIN TRAFFIC, REMOVE THE CONCRETE DECK IN ACCORDANCE WITH THE SEQUENCE OF CONSTRUCTION SHOWN IN THE PLANS. PERFORM WORK CAREFULLY DURING THE CUTTING OF THE DECK SLAB AND DURING DECK PICKING OPERATIONS TO AVOID ANY DAMAGE.

## EXISTING WELDED ATTACHMENTS:

REMOVE EXISTING WELDED ATTACHMENTS (E.G., FINISHING MACHINE AND FORM SUPPORTS; AND SUPPORTS FOR SCUPPERS AND BULB ANGLES WHICH ARE TO BE REMOVED) LOCATED IN THE DESIGNATED TENSION PORTIONS OF THE TOP FLANGES OF EXISTING STEEL MEMBERS AND GRIND THE FLANGE SURFACES SMOOTH. CAREFULLY GRIND PARALLEL TO THE FLANGES.

## CUT LINE CONSTRUCTION JOINT PREPARATION:

THOROUGHLY CLEAN THE JOINT SURFACE AND EXPOSED REINFORCEMENT OF ALL DIRT, DUST, RUST, OR OTHER FOREIGN MATERIAL BY THE USE OF WATER, AIR UNDER PRESSURE, OR OTHER METHODS THAT PRODUCE SATISFACTORY RESULTS. EXISTING REINFORCING STEEL DOES NOT HAVE TO HAVE A BRIGHT STEEL FINISH, BUT REMOVE ALL PACK AND LOOSE RUST. THOROUGHLY DRENCH EXISTING CONCRETE SURFACES WITH CLEAN WATER AND ALLOW TO DRY TO A DAMP CONDITION BEFORE PLACING CONCRETE.

## PHASED CONCRETE ABUTMENT REMOVAL:

WHEN NO LONGER REQUIRED TO MAINTAIN TRAFFIC, THE EXISTING ABUTMENT SHALL BE REMOVED TO 1'-0" BELOW FINISHED GRADE.

## PHASED CONCRETE PIER REMOVAL:

THE EXISTING PIERS SHALL BE REMOVED IN PHASES WHEN NO LONGER NEEDED TO MAINTAIN TRAFFIC. WHEN PORTIONS OF THE EXISTING STRUCTURE ARE TO REMAIN TO MAINTAIN TRAFFIC DURING PHASED CONSTRUCTION, HOE-RAM TYPE HAMMERS WILL NOT BE PERMITTED WITHIN TWO FEET OF THE PORTION TO BE TEMPORARILY PRESERVED. HAMMERS NOT EXCEEDING 90 POUNDS MAY BE USED TO REMOVE THE REMAINING TWO FOOT PORTION OF CONCRETE WITH CARE NOT TO DAMAGE THE REINFORCING STEEL AND CONCRETE OF THE PORTION OF STRUCTURE TO BE PRESERVED.

EXISTING PIERS THAT ARE NO LONGER NEEDED TO MAINTAIN TRAFFIC MAY BE REMOVED USING HOE-RAM TYPE HAMMERS AND PNEUMATIC TYPE HAMMERS. THE CONTRACTOR IS RESPONSIBLE FOR PROTECTING ADJACENT NEW AND EXISTING CONCRETE STRUCTURES DURING THE PHASED CONSTRUCTION PROCESS AND SHALL PERFORM THE DEMOLITION OPERATIONS SUCH THAT THERE IS NO DAMAGE TO THE NEW STRUCTURE OR TO PORTIONS OF THE EXISTING STRUCTURE BEING TEMPORARILY MAINTAINED.

## DECK PLACEMENT DESIGN ASSUMPTIONS:

THE FOLLOWING ASSUMPTIONS OF CONSTRUCTION MEANS AND METHODS WERE MADE FOR THE ANALYSIS AND DESIGN OF THE SUPERSTRUCTURE. THE CONTRACTOR IS RESPONSIBLE FOR THE DESIGN OF THE FALSEWORK SUPPORT SYSTEM WITHIN THESE PARAMETERS AND WILL ASSUME RESPONSIBILITY FOR SUPERSTRUCTURE ANALYSIS FOR DEVIATION FROM THESE DESIGN ASSUMPTIONS.

AN EIGHT WHEEL FINISHING MACHINE WITH A MAXIMUM WHEEL LOAD OF 2.2 KIPS.

A MAXIMUM OUT-TO-OUT WHEEL SPACING AT EACH END OF THE MACHINE OF 103".

A MAXIMUM SPACING OF OVERHANG FALSEWORK BRACKETS OF 48 INCHES.

A MAXIMUM DISTANCE FROM THE CENTERLINE OF THE FASCIA GIRDER TO THE FACE OF THE SAFETY HANDRAIL OF 77 INCHES.

## PILES TO BEDROCK:

DRIVE PILES TO REFUSAL ON BEDROCK. THE DEPARTMENT WILL CONSIDER REFUSAL TO BE OBTAINED WHEN THE PILE PENETRATION IS AN INCH OR LESS AFTER RECEIVING AT LEAST 20 BLOWS FROM THE PILE HAMMER. SELECT THE HAMMER SIZE TO ACHIEVE THE REQUIRED DEPTH TO BEDROCK AND REFUSAL.

THE TOTAL FACTORED LOAD IS 224 KIPS PER PILE FOR THE EX. PIER 7 PILES.  
THE TOTAL FACTORED LOAD IS 343 KIPS PER PILE FOR THE PIER 1 PILES.  
THE TOTAL FACTORED LOAD IS 311 KIPS PER PILE FOR THE PIER 2 PILES.

## PIER PILES:

PIER 1: HP12X53 PILES 65 FEET LONG, ORDER LENGTH  
PIER 2: HP14X73 PILES 55 FEET LONG, ORDER LENGTH

## PILE SPLICES:

IN LIEU OF USING THE FULL PENETRATION BUTT WELDS SPECIFIED IN CMS 507.09 TO SPLICE STEEL H-PILES, THE CONTRACTOR MAY USE A MANUFACTURED H-PILE SPLICER. FURNISH SPLICERS FROM THE FOLLOWING MANUFACTURER:  
ASSOCIATED PILE AND FITTING CORPORATION  
8 WOOD HOLLOW RD. PLAZA 1  
PARSIPPANY, NEW JERSEY 07054

INSTALL AND WELD THE SPLICER TO THE PILE SECTIONS IN ACCORDANCE WITH THE MANUFACTURER'S WRITTEN ASSEMBLY PROCEDURE SUPPLIED TO THE ENGINEER BEFORE THE WELDING IS PERFORMED.

## DRILLED SHAFTS:

THE MAXIMUM FACTORED LOAD TO BE SUPPORTED BY EACH DRILLED SHAFT IS 1663 KIPS AT PIER NO. 3. THIS LOAD IS RESISTED BY SIDE RESISTANCE WITHIN A PORTION OF THE BEDROCK SOCKET AND ALSO BY TIP RESISTANCE. THE FACTORED RESISTANCE DEVELOPED BY SIDE RESISTANCE IS 1206 KIPS, ASSUMED TO ACT ALONG THE BOTTOM 16 FEET OF THE BEDROCK SOCKET FOR THE PIERS. THE FACTORED RESISTANCE PROVIDED BY THE DRILLED SHAFT TIP IS 503 KIPS.

THE MAXIMUM FACTORED LOAD TO BE SUPPORTED BY EACH DRILLED SHAFT IS 1340 KIPS AT PIER NO. 4. THIS LOAD IS RESISTED BY SIDE RESISTANCE WITHIN A PORTION OF THE BEDROCK SOCKET AND ALSO BY TIP RESISTANCE. THE FACTORED RESISTANCE DEVELOPED BY SIDE RESISTANCE IS 905 KIPS, ASSUMED TO ACT ALONG THE BOTTOM 12 FEET OF THE BEDROCK SOCKET FOR THE PIERS. THE FACTORED RESISTANCE PROVIDED BY THE DRILLED SHAFT TIP IS 503 KIPS.

CONFIRM DRILL SHAFT INTEGRITY FOR ALL DRILLED SHAFTS 4-FEET. IN DIAMETER OR GREATER OR WITH A DEPTH TO BEDROCK OF MORE THAN 45-FEET. WITH CROSS-HOLE SONIC LOGGING AND THERMAL INTEGRITY. PERFORM CROSS-HOLE SONIC LOGGING AND THERMAL INTEGRITY TESTING PER THE SPECIFICATIONS OUTLINED IN APPENDIX G OF THE SCOPE OF SERVICES AND ASTM D7949 - "STANDARD TEST METHODS FOR THERMAL INTEGRITY PROFILING OF CONCRETE DEEP FOUNDATIONS".

## FOUNDATION BEARING RESISTANCE:

ABUTMENT FOOTINGS, AS DESIGNED, PRODUCE A MAXIMUM SERVICE LOAD PRESSURE OF 8.26 KIPS PER SQUARE FOOT AND A MAXIMUM STRENGTH LOAD PRESSURE OF 11.88 KIPS PER SQUARE FOOT. THE FACTORED BEARING RESISTANCE IS 18 KIPS PER SQUARE FOOT.

## SPREAD FOOTINGS:

SPREAD FOOTINGS ARE TO BE CUT NEAT WITHOUT FORMING.

## PAINTING OF STRUCTURAL STEEL:

THE OUTSIDE FASCIA GIRDER AND BOTTOM FLANGE WILL BE PAINTED IZEU FEDERAL COLOR 595B-34058 (DARK GREEN). ANY BOLTED CONNECTIONS ON THE FASCIA GIRDER WILL BE PAINTED ON ALL SIDES OF THE STEEL WITHIN THE BOLTED AREA. ALL INTERNAL BEAM/GIRDER LINES INCLUDING CROSS FRAMES, SCUPPERS, BEARINGS AND OTHER STEEL WITHIN 10 FEET OF A SUBSTRUCTURE UNIT WILL BE PAINTED. THE PRIME COAT SHALL BE 708.01. THE TOP COAT COLOR SHALL CLOSELY APPROACH FEDERAL STANDARD NO. 595B-20045 OR 20059 (THE COLOR OF WEATHERING STEEL).

AS-BUILT NOTE: SHERWIN WILLIAMS DOT HP ACRYLIC URETHANE USED ON UNIT 1 GIRDERS.

P:\Projects\2018\20H03DB-18232 HAM-75-03.84\104667\structures\HAM074\_1908S\sheets\074\_1908S\_GN001.dgn 10/26/2023 2:58:41 PM adesimone

DESIGN AGENCY  
**PRIME**  
540 WHITE POND DR. SUITE E  
AKRON, OH 44320

DESIGNED  
KDC  
CHECKED  
CRG

DRAWN  
KDC  
REVISED

REVIEWED  
TES

DATE  
8/22/2019

STRUCTURE FILE NUMBER  
3109798

GENERAL NOTES (1 OF 3)

BRIDGE NO. HAM-74-1908S

RAMP P OVER IR-74 WESTBOUND, IR-75 AND RAMP E

HAM-75-3.84

PID No. 104667

7 / 79

7  
79

## STRUCTURE GENERAL NOTES

**ITEM 512 SEALING OF CONCRETE SURFACES, AS PER PLAN, (PERMANENT GRAFFITI PROTECTION):**

APPLY A PERMANENT GRAFFITI COATING QUALIFIED ACCORDING TO SUPPLEMENT 1083 THAT IS COMPATIBLE WITH THE CONCRETE SEALER OVER WHICH IT IS APPLIED. APPLY THE GRAFFITI COATING IN ACCORDANCE WITH THE MANUFACTURER'S PRINTED INSTRUCTIONS. THE EPOXY URETHANE SEALER SHALL BE FEDERAL COLOR NUMBER 17778.

ALTERNATIVE MASONARY COATING, CHEMMASTER TEXTURRE DOT, WAS APPLIED AT PIER 3, EXISTING PIER 7, AND UNIT 1 PARAPET.

**TEMPORARY SHORING:**

ALL TEMPORARY SHORING DESIGN WILL BE PERFORMED IN ACCORDANCE WITH CMS 501 AND SUBMITTED PRIOR TO CONSTRUCTION.

**ITEM 203. EMBANKMENT, AS PER PLAN:**

PLACE AND COMPACT EMBANKMENT MATERIAL IN 6 INCH LIFTS FOR THE CONSTRUCTION OF THE APPROACH EMBANKMENT.

**EXISTING STRUCTURE VERIFICATION:**

DETAILS AND DIMENSIONS SHOWN ON THESE PLANS PERTAINING TO THE EXISTING STRUCTURE HAVE BEEN OBTAINED FROM PLANS OF THE EXISTING STRUCTURE AND FROM FIELD OBSERVATIONS AND MEASUREMENTS. CONSEQUENTLY, THEY ARE INDICATIVE OF THE EXISTING STRUCTURE AND THE PROPOSED WORK BUT THEY SHALL BE CONSIDERED TENTATIVE AND APPROXIMATE. THE CONTRACTOR IS REFERRED TO CMS SECTIONS 102.05, 105.02 AND 513.04.

**EXISTING BRIDGE PLANS:**

EXISTING AND REHABILITATION BRIDGE PLANS HAVE BEEN PROVIDED BY ODOT DISTRICT 8.

**RAILROAD RIGHT-OF-WAY REQUIREMENTS:**

ALL CONSTRUCTION WORK ON, OVER, UNDER OR ADJACENT TO THE NORFOLK-SOUTHERN (NS) OR CSX RIGHT-OF-WAY SHALL BE DONE IN ACCORDANCE WITH THE NORFOLK-SOUTHERN "SPECIAL PROVISIONS FOR THE PROTECTION OF RAILWAY INTERESTS" (NS SPECIAL PROVISIONS) OR CSX PUBLIC PROJECTS MANUAL.

**RAILROAD EXCAVATION REQUIREMENTS:**

THERE SHALL BE NO EXCAVATION ON OR AT THE TOE OF THE NORFOLK SOUTHERN OR CSX TRACK STRUCTURE SLOPES WITHOUT REVIEW AND COMPLIANCE WITH THE NORFOLK SOUTHERN AND CSX "SHORING REQUIREMENTS".

**MAINTENANCE OF TRAFFIC:**

SEE BU-04 AND BU-23 FOR MAINTENANCE OF TRAFFIC PLANS

**UTILITIES:**

THE UTILITY(IES) SHALL BORE ALL EXPENSE INVOLVED IN RELOCATING (INSTALLING) THE AFFECTED UTILITY LINES. THE CONTRACTOR AND UTILITY(IES) ARE TO COOPERATE BY ARRANGING THEIR WORK IN SUCH A MANNER THAT INCONVENIENCE TO EITHER WILL BE HELD TO A MINIMUM.

FOR A LISTING OF UTILITIES IN THE PROJECT AREA, SEE BU-14.

**STRUCTURE GROUNDING:**

STRUCTURE TO BE GROUNDED IN ACCORDANCE WITH STD. DWG. HL-50.21. SEE DETAILS ON SHEET 9779.

**LIGHTING:**

SEE BU-19 FOR REQUIRED LIGHTING WORK.

**AESTHETIC SURFACE TREATMENT:**

THE FRONT FACE OF CIP ABUTMENT AND WINGWALLS SHALL HAVE A "FRACTURED FIN" FINISH WITH A RELIEF OF 1/2" APPLIED TO THE LIMITS SHOWN IN THE PLANS. THE VERTICAL FINS AND VALLEYS IN THE FRACTURED FIN AESTHETIC TREATMENT SHALL ALIGN VERTICALLY FROM THE BOTTOM OF THE WALL TO THE TOP.

THE "FRACTURED FIN" FINISH ON THE ABUTMENT FACE AND WINGWALLS SHALL MATCH AND BE SUPPLIED BY THE SAME FORMLINER MANUFACTURER AS THAT USED ON THE RETAINING WALLS (BU-09).

**CLASS QC3 CONCRETE WITH QC/QA, SUBSTRUCTURE, AS PER PLAN**

THIS ITEM MODIFIES THE STANDARD 511 CONCRETE FOR STRUCTURES SPECIFICATION TO INCLUDE MACRO-SYNTHETIC INTO THE SUBSTRUCTURE CONCRETE. THIS ITEM SHALL CONFORM TO CMS 511 WITH THE FOLLOWING CONDITIONS AND REVISIONS:

PROVIDE MATERIALS CONFORMING TO 511.02 EXCEPT AS MODIFIED BELOW:

PORTLAND CEMENT CONCRETE 499.03, CLASS QC 3, WITH MACRO-SYNTHETIC FIBERS WITH MODIFICATION PER 511.02

FIBERS FOR CONCRETE ASTM C 1116, TYPE III

THE CLASS QC3 CONCRETE FOR THE SUBSTRUCTURE SHALL MEET THE FOLLOWING CRITERIA: WATER/CEMENT RATIO = 0.40 MAXIMUM; MINIMUM 4 LBS/CY MACRO-SYNTHETIC FIBERS (1.5 IN. MIN. TO 2.5 IN. MAX.) MEETING ASTM C1116 TYPE III SHALL BE ADDED TO THE MIX.

THE MACRO-SYNTHETIC FIBERS SHALL BE INCORPORATED INTO THE MIX IN SUCH A WAY THAT NO 'BALLING' OCCURS. UPON INSPECTION OF THE MIX AT THE TIME OF PLACEMENT, IF ANY 'BALLING' OCCURS, THE ENGINEER SHALL REJECT THE REMAINDER OF THE LOAD AT ANY TIME DURING THE POUR. IT IS IMPORTANT TO FOLLOW INDUSTRY STANDARDS AND ASTM SPECIFICATIONS ON THE PREMIXING OF THE CEMENT, AGGREGATE, AND MACRO-SYNTHETIC FIBERS PRIOR TO THE ADDITION OF WATER AND ADMIXTURES. PROVIDE MACRO-SYNTHETIC FIBERS THAT ARE MONOFILAMENT FIBERS MADE FROM VIRGIN POLYPROPYLENE, POLYETHYLENE, OR CO-POLYMERS THAT ARE INERT TO ALKALI ATTACK. ENSURE THE MACRO-SYNTHETIC FIBERS HAVE A MINIMUM TENSILE STRENGTH OF 70 KSI, A MINIMUM MODULUS OF ELASTICITY OF 800 KSI, A MINIMUM FILAMENT DIAMETER OF 0.012 INCHES, AND ASPECT RATIO BETWEEN 60 AND 100, AND ARE BETWEEN 1.5 AND 2.5 INCHES IN LENGTH. STORE THE MACRO-SYNTHETIC FIBERS ACCORDING TO THE MANUFACTURE'S RECOMMENDATION AND KEEP THE MATERIAL FREE FROM DUST, DIRT AND MOISTURE.

USE A MINIMUM DOSAGE RATE OF MACRO-SYNTHETIC FIBERS OF 4.0 LBS/CY OF CONCRETE. DETERMINE THE FINAL PROPOSED DOSAGE RATE THROUGH MIX TESTING. ENSURE THE FIBER REINFORCED CONCRETE MEETS OR EXCEEDS A MINIMUM EQUIVALENT FLEXURAL STRENGTH RATIO OF 25% ACCORDING TO ASTM C 1609. MACRO-SYNTHETIC FIBERS IS TO BE USED AS AN ADMIXTURE TO CONTROL CRACKING AND IS NOT TO BE USED TO SUPPLEMENT OR REPLACE REINFORCING STEEL IN THE DESIGN. ENSURE THE FINAL PROPOSED MIX IS WORKABLE AND ABLE TO BE PRODUCED SUCH THAT BALLING OR CLUMPING OF THE FIBERS IS NOT A PROBLEM AS DETERMINED BY THE ENGINEER. UTILIZE A LABORATORY REGULARLY INSPECTED BY THE CEMENT AND CONCRETE REFERENCE LABORATORY (CCRL) OF THE NATIONAL INSTITUTE OF STANDARDS AND TECHNOLOGY, OR OTHER APPROVED REFERENCE LABORATORY, TO PERFORM THE TESTING. BEFORE USE, SUBMIT DOCUMENTATION TO THE PROJECT ENGINEER CERTIFYING BOTH THE MACRO-SYNTHETIC FIBERS AND THE MIX MEET OR EXCEED THE REQUIRED PROPERTIES. SAMPLING WILL BE ALLOWED FOR TESTING PURPOSES. A DEMONSTRATION OF THE MIX PRODUCTION OR TRIAL MIX, WILL BE REQUIRED BY THE ENGINEER PRIOR TO PLACING ANY OF THE MIX ON THE PROJECT.

THE BATCH WEIGHTS SHALL BE CORRECTED TO COMPENSATE FOR THE MOISTURE CONTAINED IN THE AGGREGATE AT THE TIME OF USE. A CHEMICAL ADMIXTURE (705.12, TYPE A OR D) SHALL BE USED.

CONCRETE SUPPLIERS SHOULD RECOGNIZE THAT ADMIXTURES MAY HAVE AN EFFECT ON STRENGTH, ENTRAINED AIR CONTENT, WORKABILITY, ETC. OF THEIR CONCRETE MIXES. THE CONCRETE SUPPLIER'S CHOICE OF ADMIXTURES DOES NOT ALLEVIATE MEETING DESIGN REQUIREMENTS.

**CLASS QC3 CONCRETE WITH QC/QA, SUPERSTRUCTURE, AS PER PLAN**

THIS ITEM MODIFIES THE STANDARD 511 CONCRETE FOR STRUCTURES SPECIFICATION TO INCLUDE MACRO-SYNTHETIC INTO THE SUPERSTRUCTURE CONCRETE. THIS ITEM SHALL CONFORM TO CMS 511 WITH THE FOLLOWING CONDITIONS AND REVISIONS:

PROVIDE MATERIALS CONFORMING TO 511.02 EXCEPT AS MODIFIED BELOW:

PORTLAND CEMENT CONCRETE 499.03, CLASS QC3, WITH MACRO-SYNTHETIC FIBERS WITH MODIFICATION PER 511.02

FIBERS FOR CONCRETE ASTM C 1116, TYPE III

THE CLASS QC3 CONCRETE FOR THE SUPERSTRUCTURE SHALL MEET THE FOLLOWING CRITERIA: WATER/CEMENT RATIO = 0.40 MAXIMUM; MINIMUM 4 LBS/CY MACRO-SYNTHETIC FIBERS (1.5 IN. MIN. TO 2.5 IN. MAX.) MEETING ASTM C1116 TYPE III SHALL BE ADDED TO THE MIX.

THE MACRO-SYNTHETIC FIBERS SHALL BE INCORPORATED INTO THE MIX IN SUCH A WAY THAT NO 'BALLING' OCCURS. UPON INSPECTION OF THE MIX AT THE TIME OF PLACEMENT, IF ANY 'BALLING' OCCURS, THE ENGINEER SHALL REJECT THE REMAINDER OF THE LOAD AT ANY TIME DURING THE POUR. IT IS IMPORTANT TO FOLLOW INDUSTRY STANDARDS AND ASTM SPECIFICATIONS ON THE PREMIXING OF THE CEMENT, AGGREGATE, AND MACRO-SYNTHETIC FIBERS PRIOR TO THE ADDITION OF WATER AND ADMIXTURES. PROVIDE MACRO-SYNTHETIC FIBERS THAT ARE MONOFILAMENT FIBERS MADE FROM VIRGIN POLYPROPYLENE, POLYETHYLENE, OR CO-POLYMERS THAT ARE INERT TO ALKALI ATTACK. ENSURE THE MACRO-SYNTHETIC FIBERS HAVE A MINIMUM TENSILE STRENGTH OF 70 KSI, A MINIMUM MODULUS OF ELASTICITY OF 800 KSI, A MINIMUM FILAMENT DIAMETER OF 0.012 INCHES, AND ASPECT RATIO BETWEEN 60 AND 100, AND ARE BETWEEN 1.5 AND 2.5 INCHES IN LENGTH. STORE THE MACRO-SYNTHETIC FIBERS ACCORDING TO THE MANUFACTURE'S RECOMMENDATION AND KEEP THE MATERIAL FREE FROM DUST, DIRT AND MOISTURE.

USE A MINIMUM DOSAGE RATE OF MACRO-SYNTHETIC FIBERS OF 4.0 LBS/CY OF CONCRETE. DETERMINE THE FINAL PROPOSED DOSAGE RATE THROUGH MIX TESTING. ENSURE THE FIBER REINFORCED CONCRETE MEETS OR EXCEEDS A MINIMUM EQUIVALENT FLEXURAL STRENGTH RATIO OF 25% ACCORDING TO ASTM C 1609. MACRO-SYNTHETIC FIBERS IS TO BE USED AS AN ADMIXTURE TO CONTROL CRACKING AND IS NOT TO BE USED TO SUPPLEMENT OR REPLACE REINFORCING STEEL IN THE DESIGN. ENSURE THE FINAL PROPOSED MIX IS WORKABLE AND ABLE TO BE PRODUCED SUCH THAT BALLING OR CLUMPING OF THE FIBERS IS NOT A PROBLEM AS DETERMINED BY THE ENGINEER. UTILIZE A LABORATORY REGULARLY INSPECTED BY THE CEMENT AND CONCRETE REFERENCE LABORATORY (CCRL) OF THE NATIONAL INSTITUTE OF STANDARDS AND TECHNOLOGY, OR OTHER APPROVED REFERENCE LABORATORY, TO PERFORM THE TESTING. BEFORE USE, SUBMIT DOCUMENTATION TO THE PROJECT ENGINEER CERTIFYING BOTH THE MACRO-SYNTHETIC FIBERS AND THE MIX MEET OR EXCEED THE REQUIRED PROPERTIES. SAMPLING WILL BE ALLOWED FOR TESTING PURPOSES. A DEMONSTRATION OF THE MIX PRODUCTION OR TRIAL MIX, WILL BE REQUIRED BY THE ENGINEER PRIOR TO PLACING ANY OF THE MIX ON THE PROJECT.

THE BATCH WEIGHTS SHALL BE CORRECTED TO COMPENSATE FOR THE MOISTURE CONTAINED IN THE AGGREGATE AT THE TIME OF USE. A CHEMICAL ADMIXTURE (705.12, TYPE A OR D) SHALL BE USED.

CONCRETE SUPPLIERS SHOULD RECOGNIZE THAT ADMIXTURES MAY HAVE AN EFFECT ON STRENGTH, ENTRAINED AIR CONTENT, WORKABILITY, ETC. OF THEIR CONCRETE MIXES. THE CONCRETE SUPPLIER'S CHOICE OF ADMIXTURES DOES NOT ALLEVIATE MEETING DESIGN REQUIREMENTS.

APPROACH SLABS, DIAPHRAGMS, AND BRIDGE RAILING CONCRETE ARE TO USE THE SAME MIX DESIGN AS THE BRIDGE DECK (WHEN APPLICABLE). USE SELF-COMPACTING CONCRETE ON DECORATIVE RAILING SIMILAR TO TEXAS RAILING AND MACRO-SYNTHETIC CONCRETE PER THIS SPECIFICATION ON TRADITIONAL CONCRETE RAILING.

THE PLACING OF THE DECK AND THE APPROACH SLABS IN THE SAME CONCRETE POUR IS NOT PERMITTED.

P:\Projects\2018\20H03DB-18232 HAM-75-03.84\104667\structures\HAM074\_1908S\sheets\074\_1908S\_GN002.dgn 7/28/2023 9:24:56 AM erin.boumann



REVIEWED DATE 8/22/2019  
 TEST FILE NUMBER 3109798  
 STRUCTURE FILE NUMBER

DRAWN KDC  
 CHECKED CRG  
 KDC REVISED

GENERAL NOTES (2 OF 3)  
 BRIDGE NO. HAM-74-1908S  
 RAMP P OVER IR-74 WESTBOUND, IR-75 AND RAMP E

HAM-75-3.84  
 PID No. 104667



## STRUCTURE GENERAL NOTES

### ABBREVIATIONS

ABUT. - ABUTMENT  
 APPROX. - APPROXIMATELY  
 BOTT. - BOTTOM  
 BRG. - BEARING  
 BTW. - BETWEEN  
 C/C - CENTER TO CENTER  
 C.I.P. - CAST-IN-PLACE  
 C.J. - CONSTRUCTION JOINT  
 CLR. - CLEARANCE  
 CONST. - CONSTRUCTION  
 DIA. - DIAMETER  
 DWG. - DRAWING  
 EA. - EACH  
 E.F. - EACH FACE  
 EL. OR ELEV. - ELEVATION  
 EMB. - EMBEDMENT  
 EQ. - EQUAL  
 EX. - EXISTING  
 EXIST. - EXISTING  
 EXP. - EXPANSION  
 F.A. - FORWARD ABUTMENT  
 F.F. - FAR FACE  
 JT. - JOINT  
 MIN. - MINIMUM  
 MAX. - MAXIMUM  
 MOT - MAINTENANCE OF TRAFFIC  
 N.F. - NEAR FACE  
 NO. - NUMBER  
 N.P.C.P.P. - NON-PERFORATED CORRUGATED PLASTIC PIPE  
 P.C.P.P. - PERFORATED CORRUGATED PLASTIC PIPE  
 P.E.J.F. - PREFORMED EXPANSION JOINT FILLER  
 R.A. - REAR ABUTMENT  
 REQ'D. - REQUIRED  
 SPA. - SPACE(D) OR SPACING  
 STA. - STATION  
 STD. DWG. OR SCD - STANDARD CONSTRUCTION DRAWING  
 STR. - STRAIGHT  
 SQ. - SQUARE  
 T - TOP  
 T.B.D. - TO BE DETERMINED  
 T&B - TOP AND BOTTOM  
 TYP. - TYPICAL  
 U.N.O. - UNLESS NOTED OTHERWISE  
 W/ - WITH


### ASTM A490 BOLTS IN CROSSFRAME CONNECTIONS

ASTM A490 BOLTS (1 1/4" φ) SHALL ONLY BE USED FOR CROSSFRAME CONNECTIONS. ALL BOLTS SHALL BE CLEARLY MARKED TO ENSURE PROPER PLACEMENT. ADDITIONALLY, A BOLT TRACKING LOG SHALL BE USED TO TRACK ALL BOLTED CONNECTIONS, INCLUDING THE BOLT TYPE, SIZE, LENGTH AND TESTING REQUIREMENTS. A SAMPLE OF THE BOLT TRACKING LOG SHALL BE PROVIDED WITH THE STEEL ERECTION CONSTRUCTION SUBMITTAL.

A490 BOLTS CANNOT BE GALVANIZED. FOR PROTECTION, A490 BOLTS SHALL BE COATED ACCORDING TO ASTM F3125 ANNEX A1.


THE MINIMUM TEST PRETENSION FOR 1 1/4" φ A490 BOLTS SHALL BE 102K. THE MAXIMUM PERMITTED TORQUE SHALL BE 2656 FT/LBS. THE MINIMUM TEST PRETENSION AFTER ROTATION SHALL BE 117K. A BOLT ROCAP TESTING AND PRE-VERIFICATION INSTALLATION WORKSHEET TRACKING THE TESTING REQUIREMENTS FOR ALL BOLTS INCLUDING TENSIONING, TORQUE AND ROTATION REQUIREMENTS SHALL BE PROVIDED WITH THE STEEL ERECTION CONSTRUCTION SUBMITTAL.

### DETAIL B (Note 8)

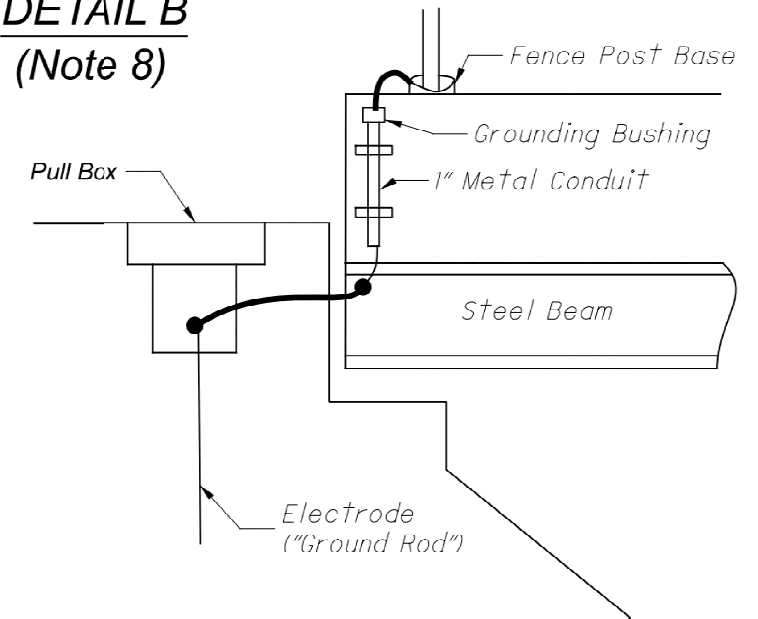


### NOTES:

1. There shall be a minimum of four (4) electrodes.
2. Wet locations shall be used rather than dry locations for electrodes.
3. No point on the structure shall be more than two spans from an electrode.
4. Provide two electrodes at each abutment.
5. Provide a grounding electrode conductor within each outside column at pier.
6. Provide grounding plates for each grounding electrode conductor.
7. Do not use surface-mounted ground conductors for new construction.
8. Alternate method at abutments: See Detail B. Route grounding conductors through one or more 1" metal conduits to an electrode located in a pull box. Assure all metal conduits enclosing grounding conductors are bonded at each end. Conduit and pullbox are incidental. Alternate method by permission of the Engineer only, or by Plan Note.

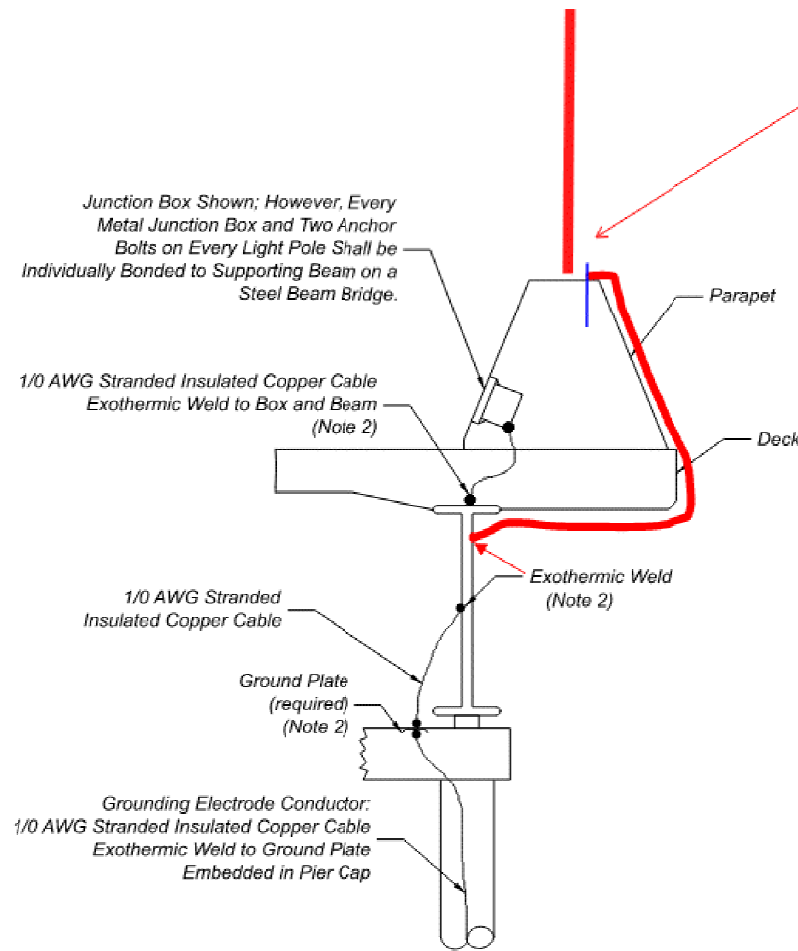

STEEL BEAM CONNECTIONS

Surface mount ground wire missed in deck and parapet. Exothermic weld to outside of steel beam and attached to VPF and/or Overhead Sign anchor bolts per Detail A on Sheet 1.

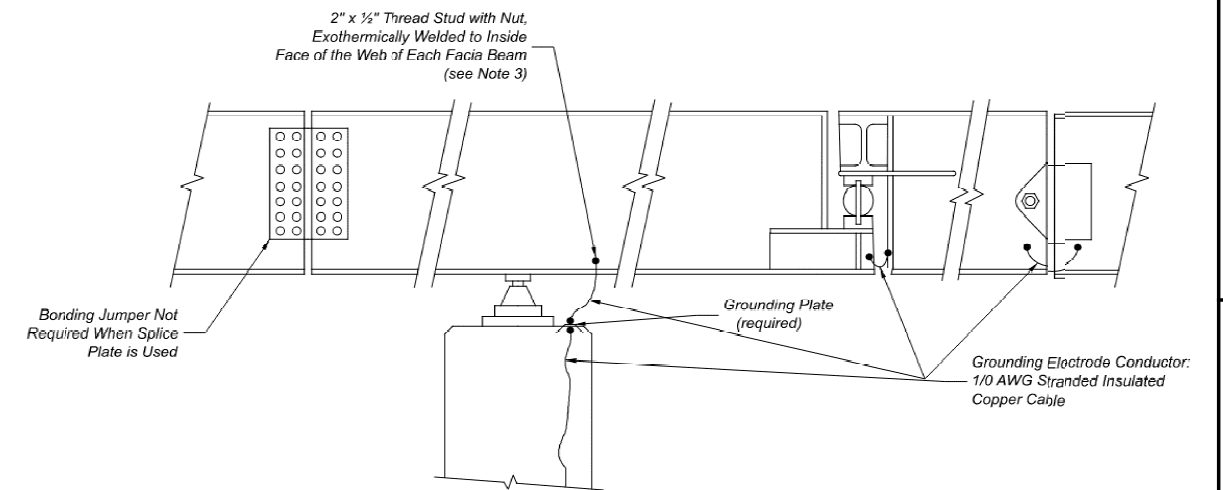

STEEL BEAM CONTINUITY (Typ.)

GENERAL NOTES (3 OF 3)

BRIDGE NO. - HAM-74-1908S

RAMP P OVER IR-74 WESTBOUND, IR-75 AND RAMP E

HAM-75-3.84

PID No. 104667

9 / 79

9 / 79


DESIGN AGENCY  
**PRIME**  
 540 WHITE POND DR. SUITE E  
 AKRON, OH 44320

REVIEWED DATE  
 TES 8/22/2019  
 STRUCTURE FILE NUMBER  
 3109798


DRAWN  
 KDC  
 REVISED

DESIGNED  
 KDC  
 CHECKED  
 CRG


P:\Projects\2018\20H03DB-18232 HAM-75-03-84 104667\structures\HAM074\_1908S\sheets\074\_1908S\_PC001.dgn 7/28/2023 9:25:47 AM erin.baumann

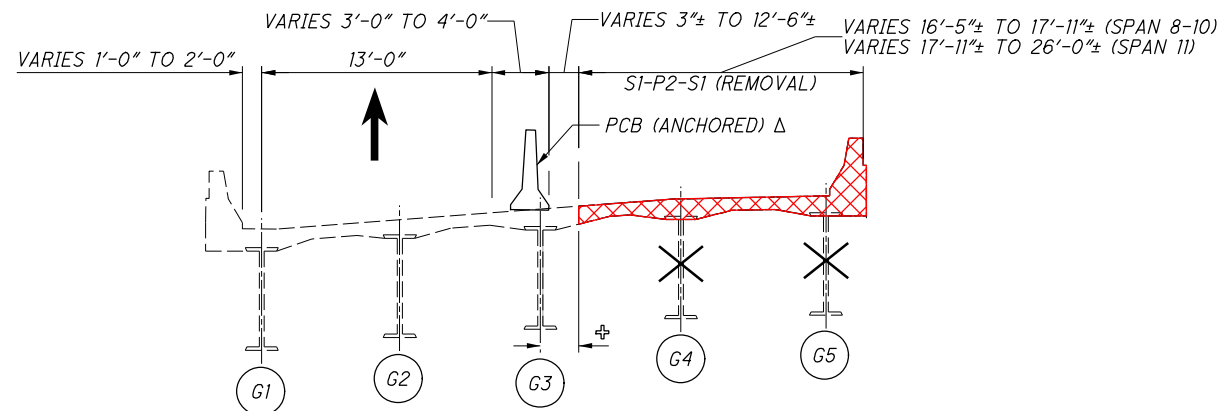

**A**  
**10** EXISTING UNIT 3 DECK REMOVAL

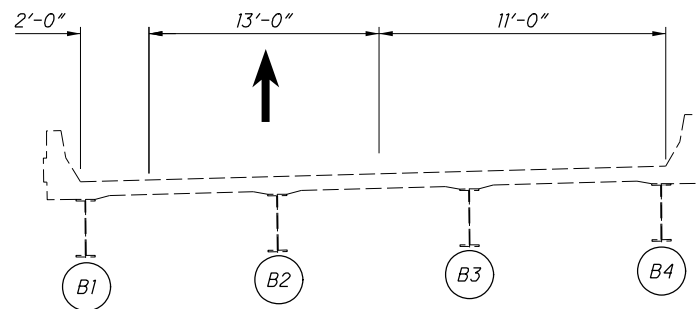

**B**  
**10** EXISTING UNIT 4 MOT

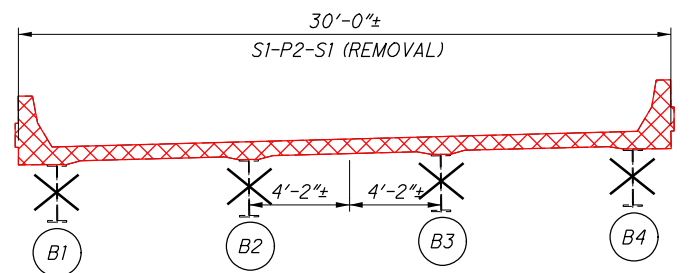

**C**  
**10** EXISTING UNIT 5 DECK REMOVAL

**DECK REMOVAL SEQUENCE:**


- 1 REMOVE PORTION OF UNIT 3 FROM EXISTING HINGE 2 TO EXISTING HINGE 3. REMOVE UNIT 5 FROM EXISTING HINGE 3 TO EXISTING ABUTMENT 3.

**NOTES:**

1. REMOVAL DETAILS ARE FOR RAMP P (HAM-74-1908S) ONLY. FOR CORRESPONDING REMOVAL DETAILS FOR I-74 EB (HAM-74-1908R), SEE BU-10.
2. THE CONTRACTOR HAS THE OPTION TO PERFORM ALL RELATED SUBSTRUCTURE REMOVAL DURING STAGE 1, PHASE 2, STEP 6 (REMOVAL).
3. PRIOR TO ANY REMOVALS OF UNIT 3, UNIT 5 OR UNIT 6, CONTRACTOR SHALL WELD PLATES TO THE BEARING LINKS AS DETAILED IN BU-05 REMOVAL SET.
4. FOR SUBSTRUCTURE REMOVAL DETAILS, SEE SHEETS 13/79 THRU 16/79.
5. FOR GENERAL NOTES AND MOT REFERENCE, SEE SHEETS 7/79 AND 8/79.


**LEGEND:**

- INDICATES LIMITS OF DECK REMOVAL (SI-P2-SI)
- SX-PX-SX - STAGE X, PHASE X, STEP X (MOT PHASING)
- INDICATES BEAM REMOVAL
- $\Delta$  - 2 ANCHORS PER SEGMENT SPANS 1 & 4  
4 ANCHORS PER SEGMENT SPANS 2 & 3
- $\oplus$  - 2'-0" SPAN 1 AND SPAN 4  
VARIES 2'-0" TO 3'-0" ON SPAN 2  
3'-0" SPAN 3
- SPAN NUMBER

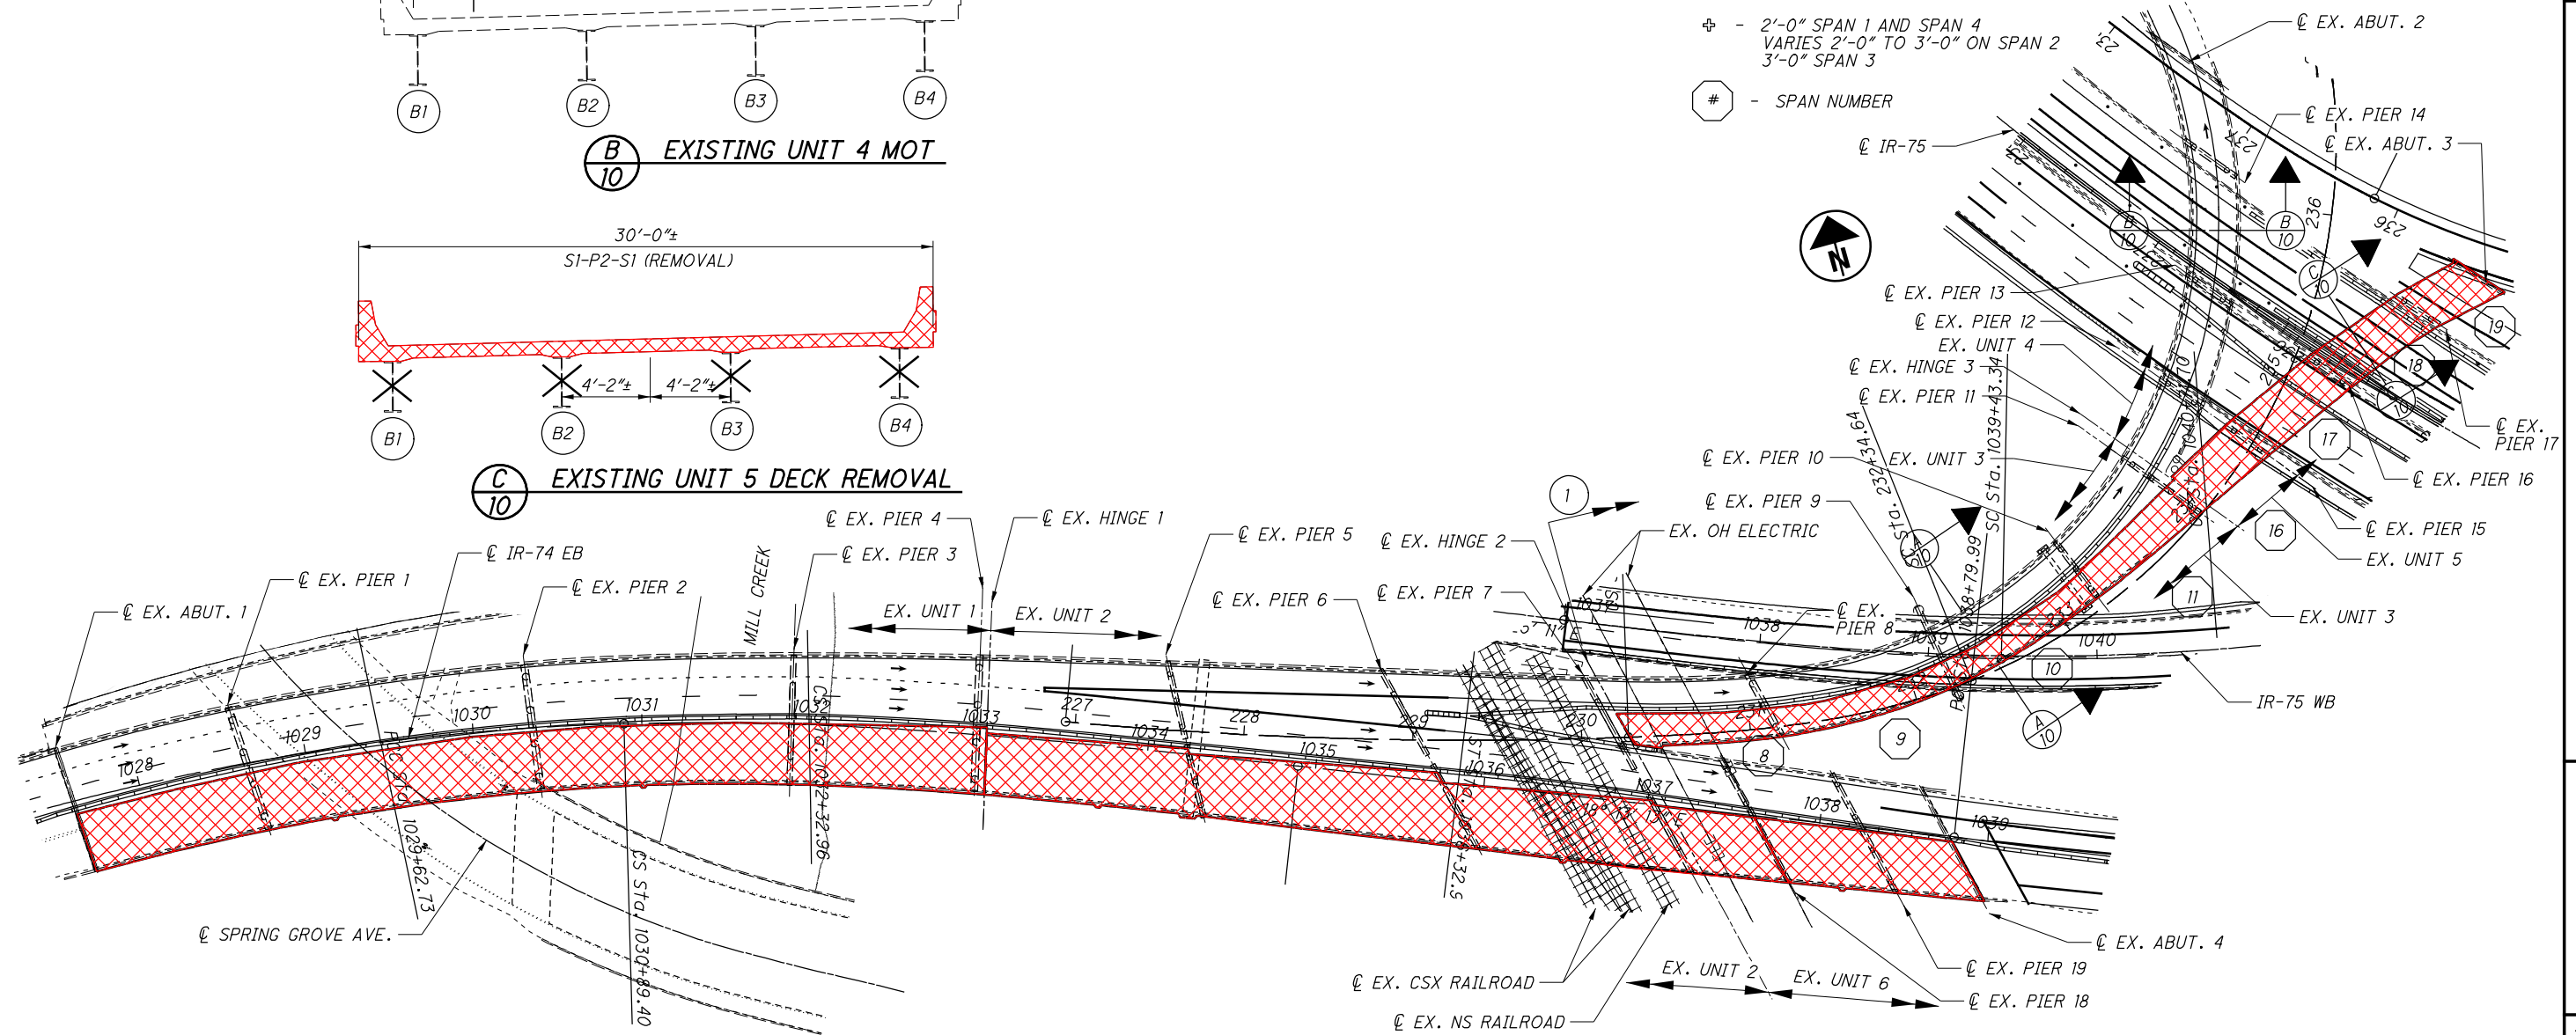


**DECK REMOVAL - STAGE 1, PHASE 2, STEP 1**

P:\Projects\2018\20H03DB-18232 HAM-75-03-84\104667\structures\HAM074\_1908S\sheets\074\_1908S\_PC002.dgn 7/28/2023 9:26:05 AM erin.baumann

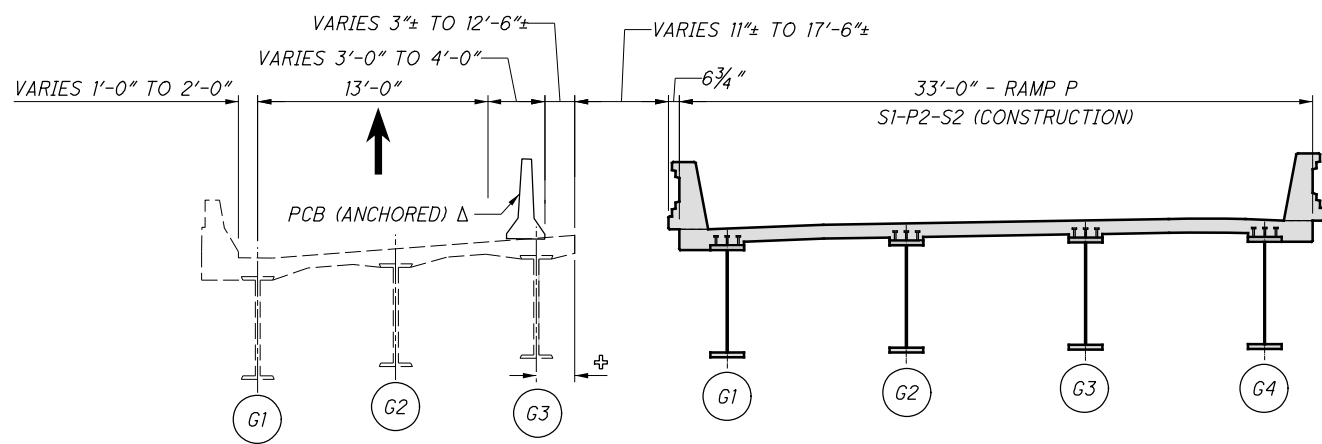

**A** 11 RAMP P CONSTRUCTION

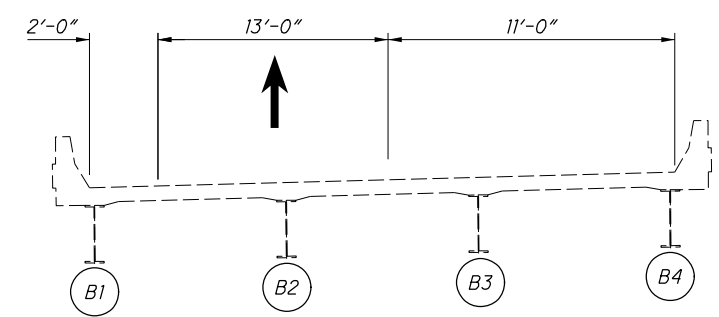


**B** 11 EXISTING UNIT 4 MOT

**NOTES:**

- CONSTRUCTION DETAILS ARE FOR RAMP P (HAM-74-1908S) ONLY. FOR CORRESPONDING CONSTRUCTION DETAILS FOR I-74 EB (HAM-74-1908R), SEE BU-10.
- FOR GENERAL NOTES AND MOT REFERENCE, SEE SHEETS **7/79** AND **8/79**.

**LEGEND:**


- INDICATES LIMITS OF DECK CONSTRUCTION (S1-P2-S2)
- SX-PX-SX - STAGE X, PHASE X, STEP X (MOT PHASING)
- Δ - 2 ANCHORS PER SEGMENT SPANS 1 & 4  
4 ANCHORS PER SEGMENT SPANS 2 & 3
- ⊕ - 2'-0" SPAN 1 AND SPAN 4  
VARIES 2'-0" TO 3'-0" ON SPAN 2  
3'-0" SPAN 3

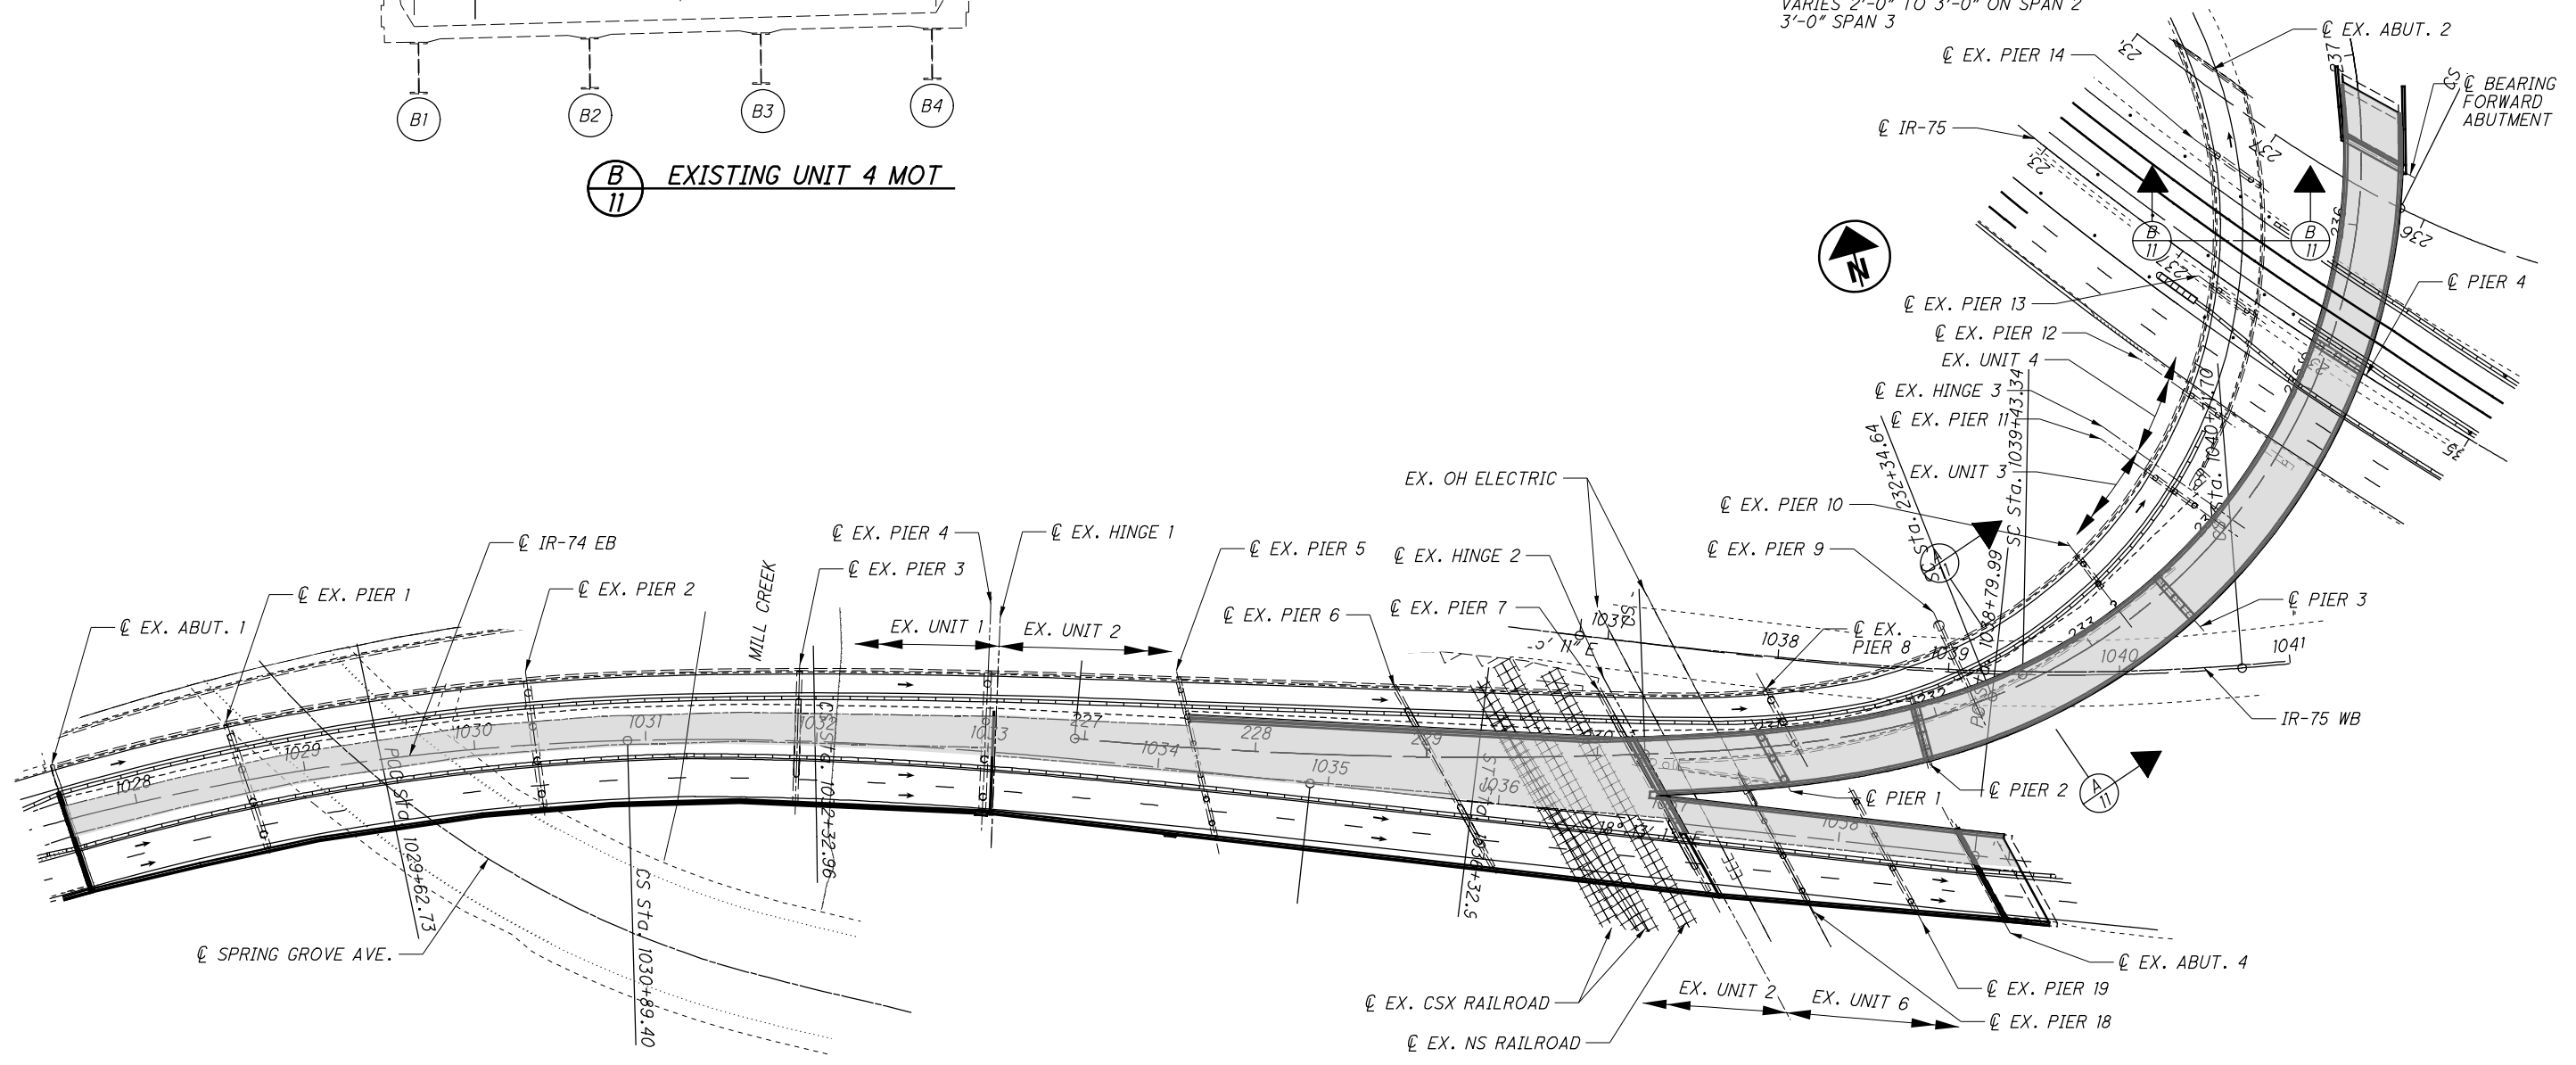


**DECK CONSTRUCTION - STAGE 1, PHASE 2, STEP 2**

<b>PRIMEW</b> <small>540 WHITE POND DR. SUITE E AKRON, OH 44320</small>	DESIGN AGENCY DATE: 8/22/2019 REVIEWED: TES DRAWN: CRG CHECKED: KDC DESIGNED: CRG STRUC. FILE NUMBER: 3109798
<b>DECK CONSTRUCTION - STAGE 1, PHASE 2, STEP 2</b> BRIDGE NO. HAM-74-1908S RAMP P OVER IR-74 WESTBOUND, IR-75 AND RAMP E	
<b>HAM-75-3.84</b> PID No. 104667	11 / 79 <div style="border: 1px solid black; width: 30px; height: 30px; display: flex; align-items: center; justify-content: center; margin: auto;">             11 79           </div>

P:\Projects\2018\20H03DB-18232 HAM-75-03-84 104667\structures\HAM074\_1908S\sheets\074\_1908S\_PC003.dgn 7/28/2023 9:26:15 AM erim.baumann

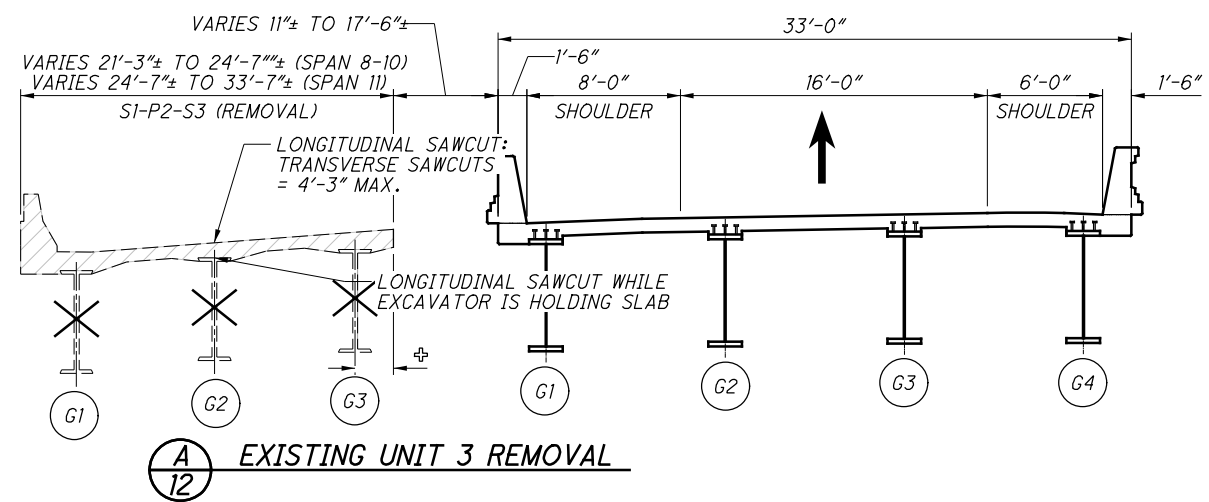

**A**  
12  
**EXISTING UNIT 3 REMOVAL**

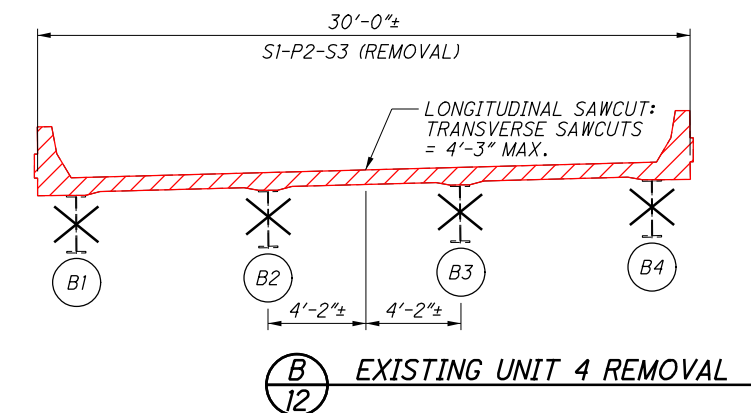


**B**  
12  
**EXISTING UNIT 4 REMOVAL**

- LEGEND:**
- INDICATES LIMITS OF SLAB OUT DECK REMOVAL (SI-P2-S3)
  - INDICATES LIMITS OF HOE RAM OR SLAB OUT DECK REMOVAL (SI-P2-S3)
  - INDICATES LIMITS OF HOE RAM DECK REMOVAL (SI-P2-S3)
  - SX-PX-SX - STAGE X, PHASE X, STEP X (MOT PHASING)
  - INDICATES BEAM REMOVAL
  - 2'-0" SPAN 1 AND SPAN 4 VARIES 2'-0" TO 3'-0" ON SPAN 2 3'-0" SPAN 3
  - SPAN NUMBER




- DECK REMOVAL SEQUENCE:**
- 1 BEFORE DEMOLITION BEGINS, THE CONTRACTOR SHALL WELD PLATES NEAR LINKS AT EXISTING HINGE 2 AND EXISTING HINGE 3. BOTH TOP AND BOTTOM AND ON EACH SIDE, TO THE BEARING PLATES PER DETAIL SHOWN ON SHEETS 1108S AND 1109S. ADDITIONALLY, THE CONTRACTOR SHALL ALSO WELD THE PLATES TO THE BEARINGS AT EXISTING PIER 8 AND EXISTING PIER 12 AS SHOWN ON SHEET 1107S.
  - 2 REMOVE 1908S FROM EXISTING ABUTMENT 2 TO EXISTING EXISTING HINGE 2.

- NOTES:**
1. REMOVAL DETAILS ARE FOR RAMP P (HAM-74-1908S) ONLY. FOR CORRESPONDING REMOVAL DETAILS FOR I-74 EB (HAM-74-1908R), SEE BU-10.
  2. PRIOR TO ANY REMOVALS OF UNIT 3, UNIT 4 OR UNIT 6, CONTRACTOR SHALL WELD PLATES TO THE BEARING LINKS AS DETAILED IN BU-05 REMOVAL SET.
  3. FOR SUBSTRUCTURE REMOVAL DETAILS, SEE SHEETS 13/79 THRU 16/79.
  4. FOR GENERAL NOTES AND MOT REFERENCE, SEE SHEETS 7/79 AND 8/79.

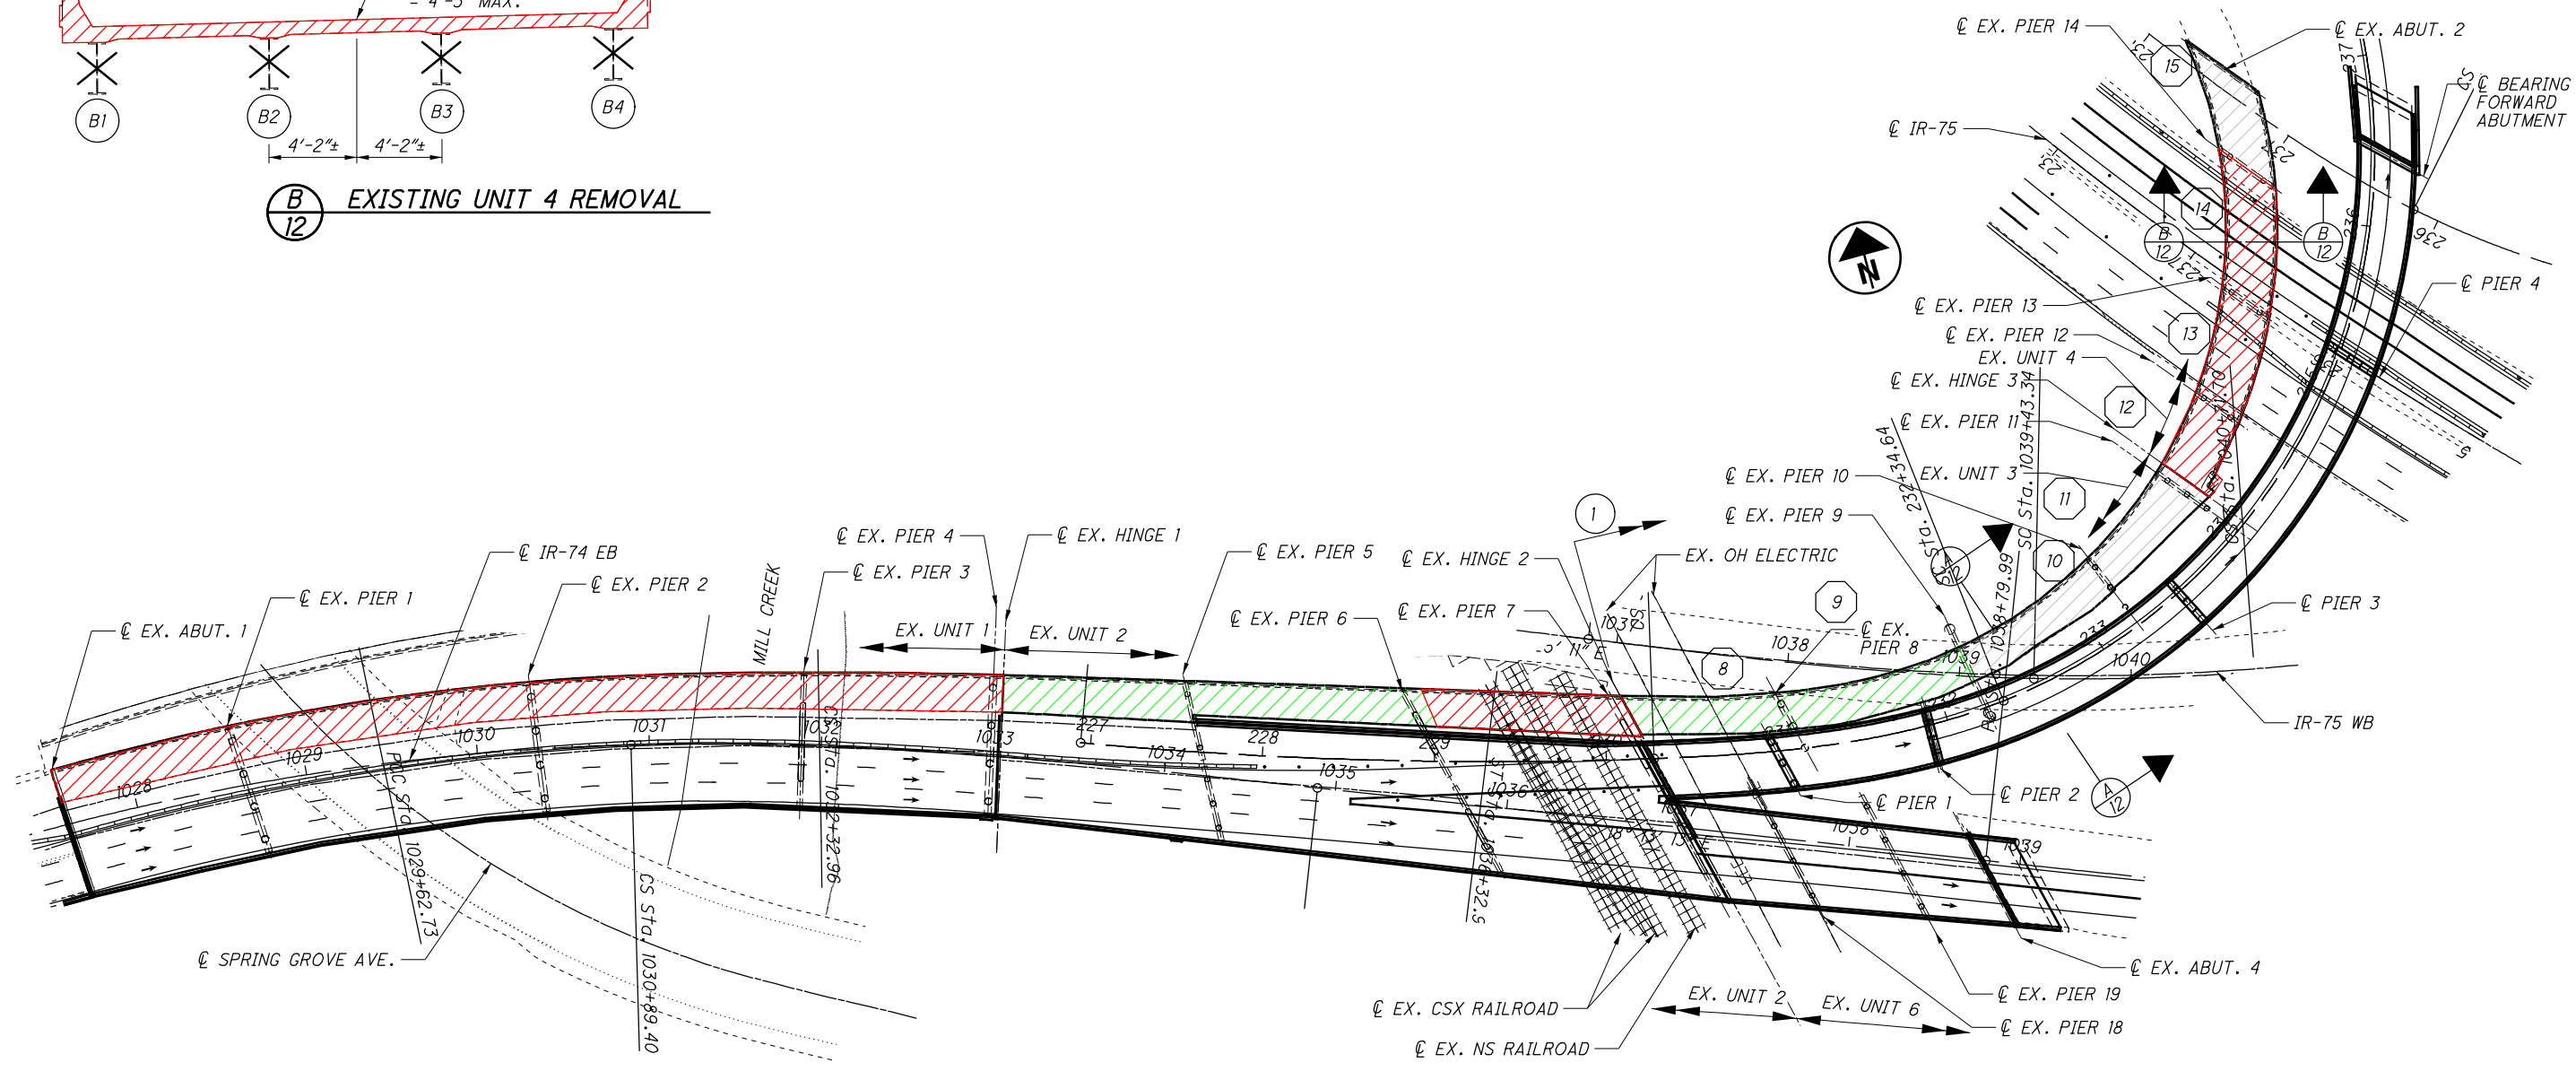


**DECK REMOVAL - STAGE 1, PHASE 2, STEP 3**

 540 WHITE POND DR. SUITE E AKRON, OH 44320
<b>DECK REMOVAL - STAGE 1, PHASE 2, STEP 3</b> BRIDGE NO. - HAM-74-1908S RAMP P OVER IR-74 WESTBOUND, IR-75 AND RAMP E
<b>HAM-75-3.84</b> PID No. 104667
12 / 79 <div style="border: 1px solid black; border-radius: 50%; width: 30px; height: 30px; display: flex; align-items: center; justify-content: center; margin: 0 auto;">             12 79           </div>
DESIGNED: CRG CHECKED: KDC DRAWN: CRG REVISED: REVIEWED: TES DATE: 8/22/2019 STRUCTURE FILE NUMBER: 3109798

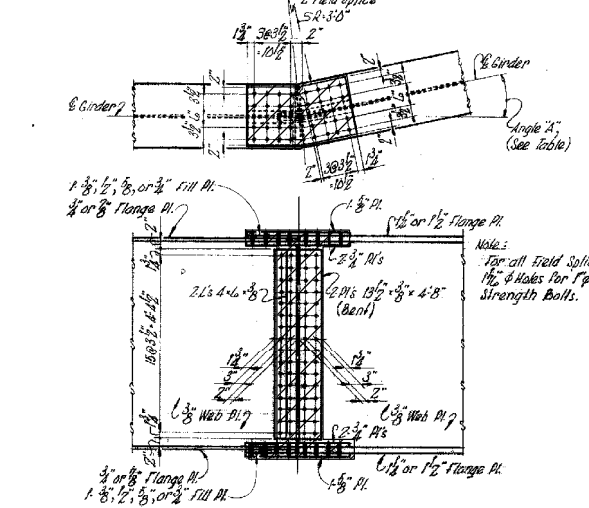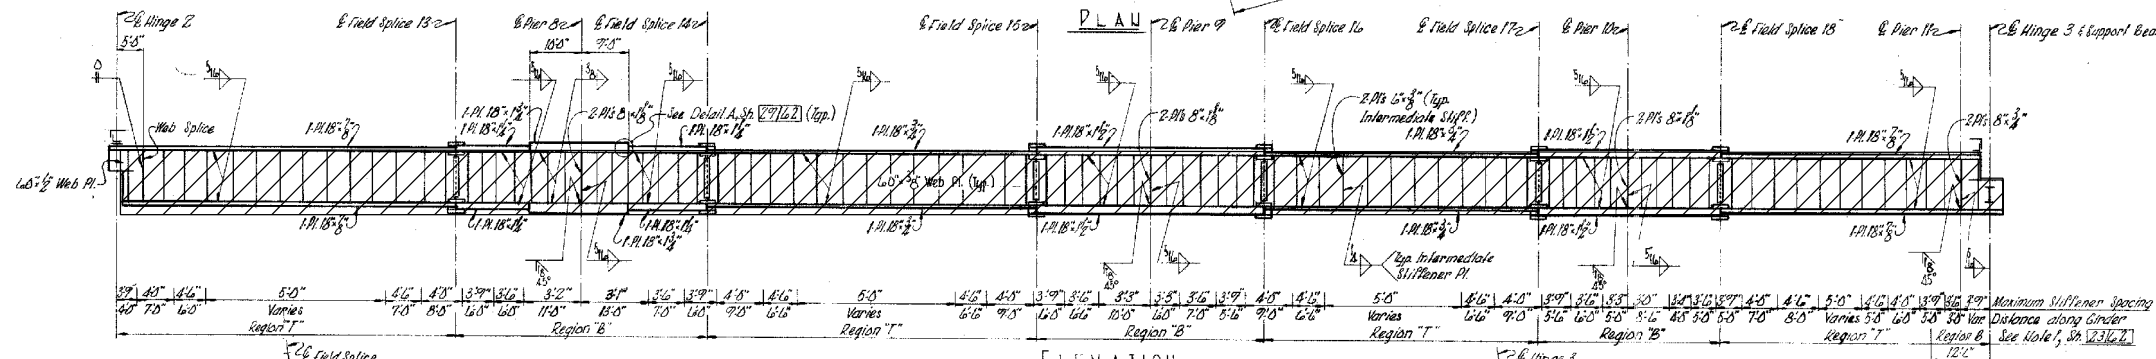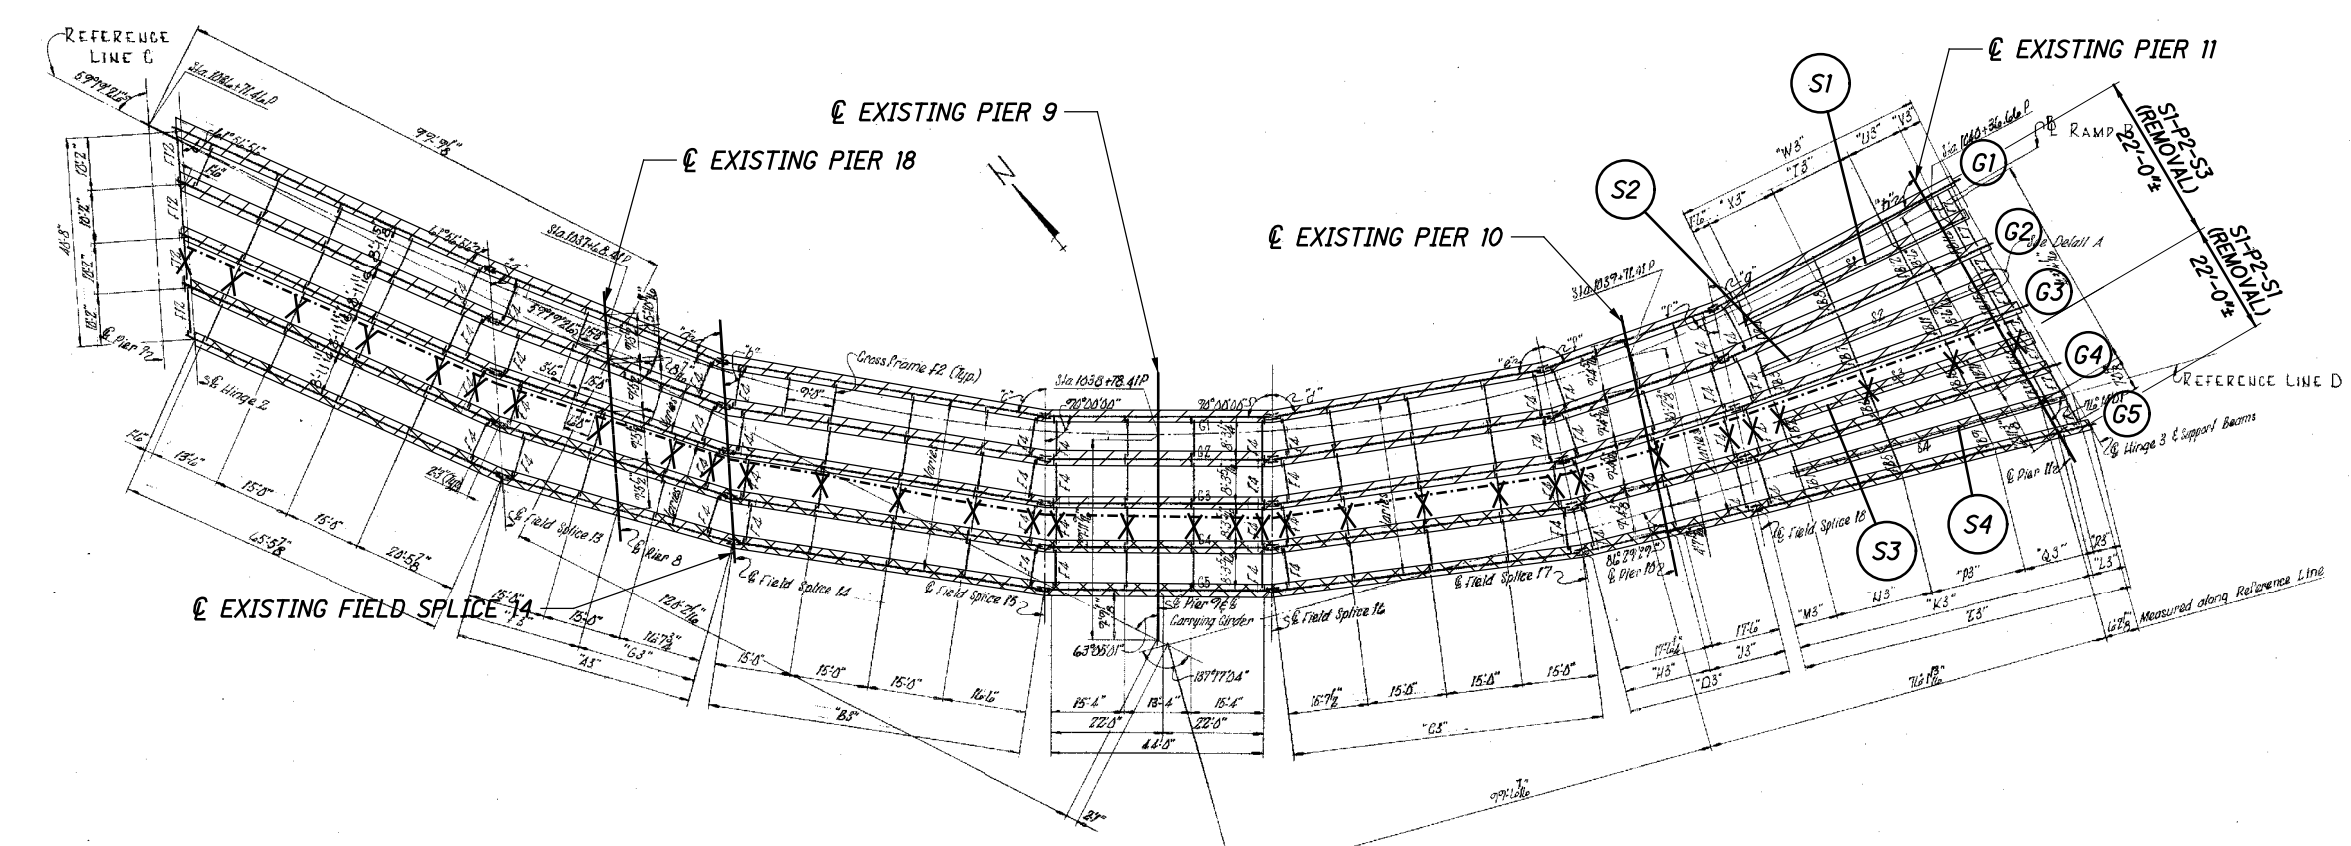

GIRDER	G1	G2	G3	G4	G5
Field Splice 13	2° 22' 54"	3° 53' 55"	5° 27' 09"	7° 02' 32"	8° 59' 59"
Field Splice 14	11° 52' 14"	11° 48' 09"	9° 26' 14"	8° 10' 34"	6° 55' 14"
Field Splice 15	16° 02' 21"	9° 45' 25"	9° 24' 06"	9° 04' 23"	8° 42' 16"
Field Splice 16	10° 18' 55"	9° 28' 59"	8° 42' 15"	7° 58' 25"	7° 17' 16"
Field Splice 17	9° 25' 35"	8° 51' 02"	8° 15' 06"	7° 35' 46"	6° 53' 39"
Field Splice 18	9° 16' 58"	5° 55' 01"	3° 01' 51"	1° 25' 33"	0° 08' 05"

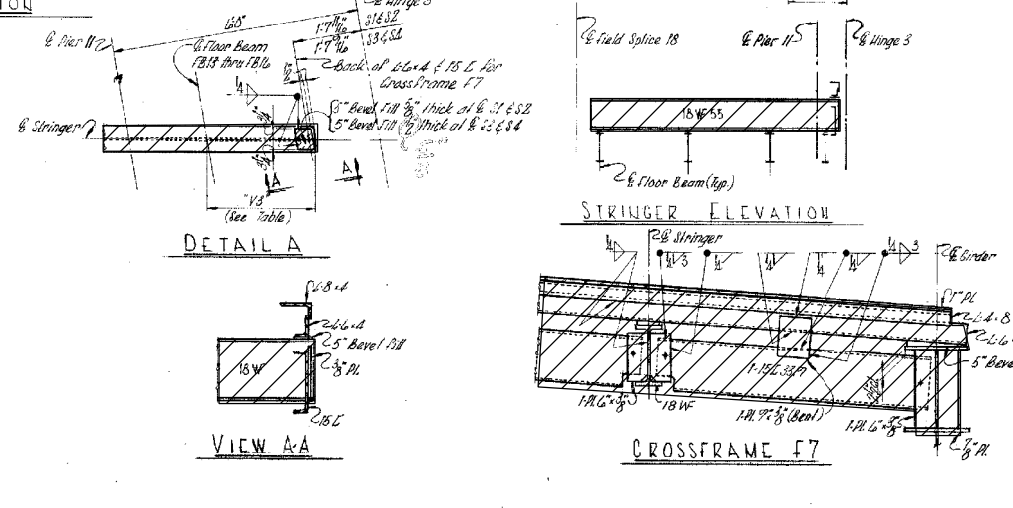


**NOTES:**  
 1. FOR ADDITIONAL DETAILS, SEE SHEET 14/79.  
 2. SEE SHEETS 10/79 THRU 12/79 FOR CONSTRUCTION SEQUENCE INFORMATION.  
 3. REMOVE G4 & G5 AND S3 & S4 DURING S1-P2-S1 AND THE CROSSFAMES CONNECTING THEM TO G3. TAKE CARE NOT TO DAMAGE G3 DURING THE REMOVAL PROCESS.  
 4. REMOVE G1-G3 AND S1-S2 DURING S1-P2-S2.


**LEGEND:**

- ⊗ - INDICATES LIMITS OF REMOVAL (S1-P2-S1)
- ⊠ - INDICATES LIMITS OF REMOVAL (S1-P2-S3)
- SX-PX-SX - STAGE X PHASE X STEP X (NOT PHASING)
- SX - STRINGER X
- ✕ - INDICATES EXISTING CROSSFRAME TO BE REMOVED IN S1-P2-S3


**EXISTING UNIT 3 REMOVAL DETAILS**

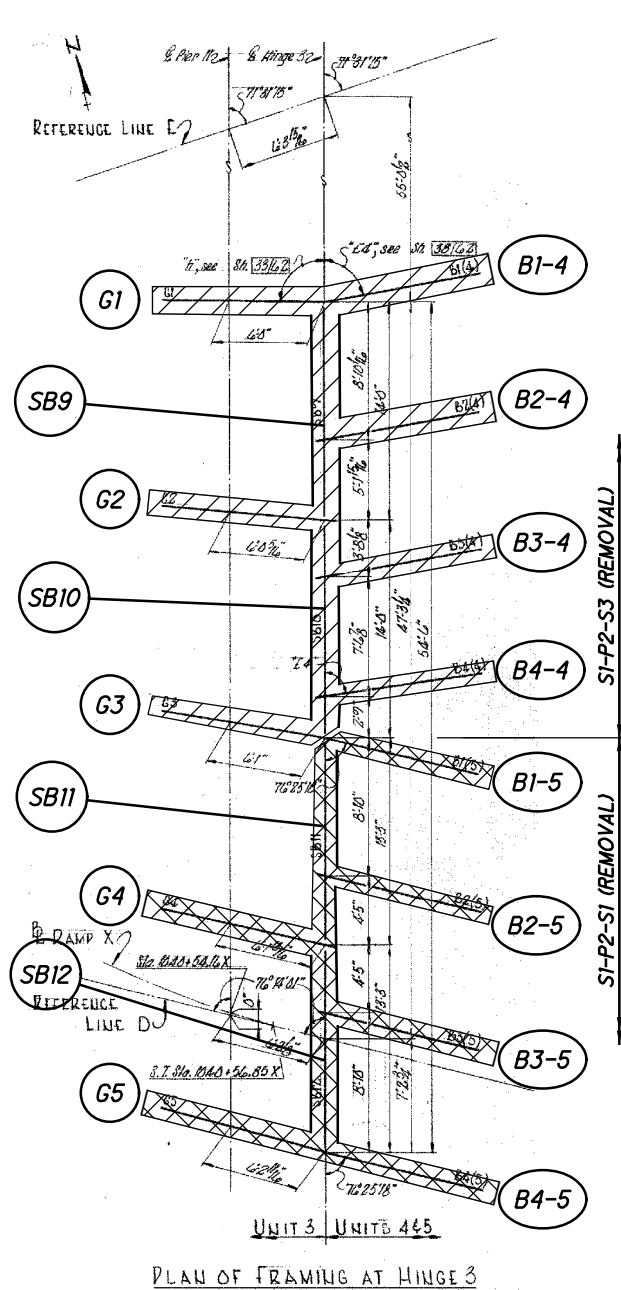


UNIT 3 UNIT 465  
PLAN OF FRAMING AT HINGE 3

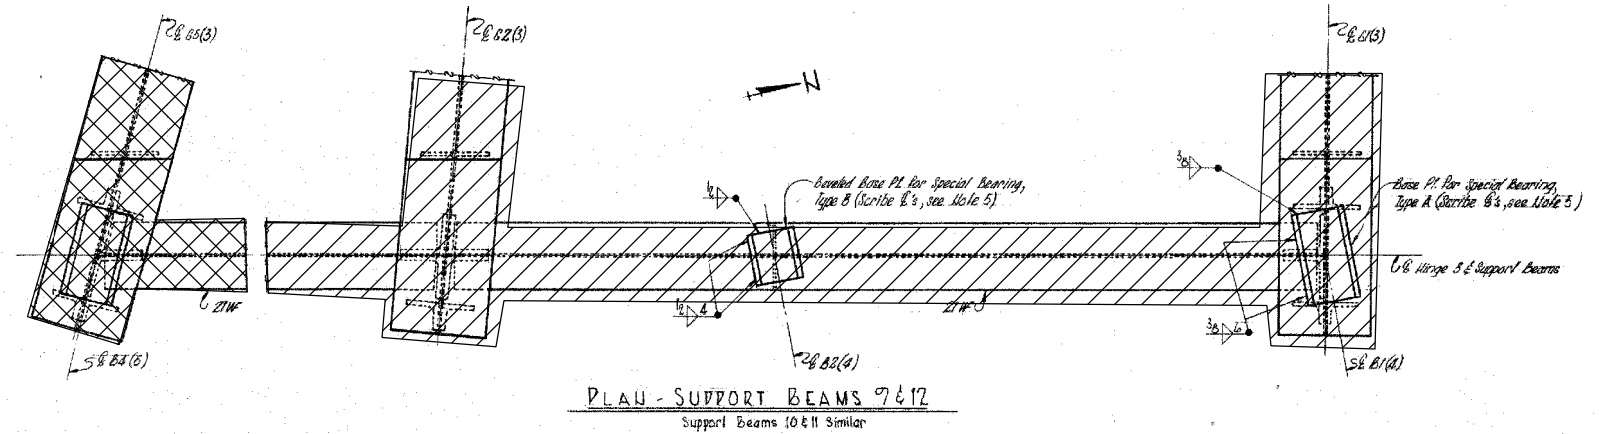


PLAU - SUPPORT BEAMS 7&12  
Support Beams 10&11 Similar

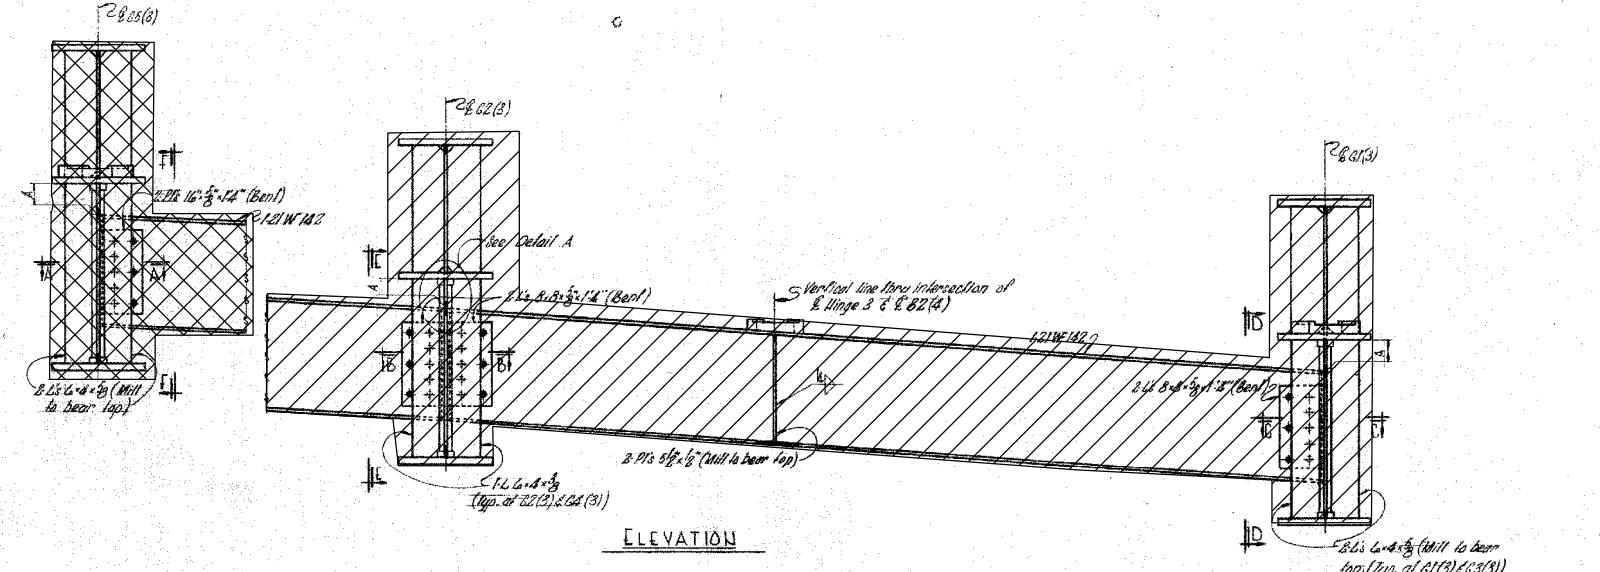


ELEVATION

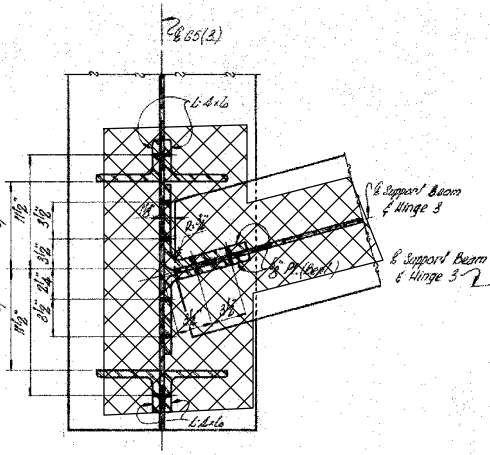


SECTION A-A

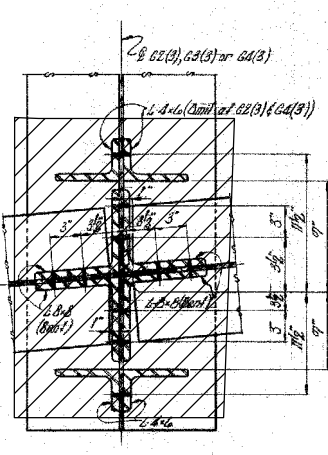

SECTION B-B

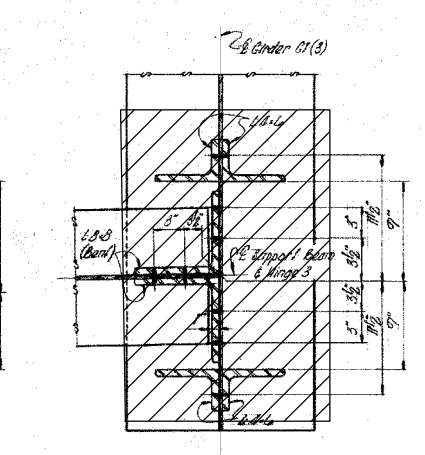


SECTION C-C

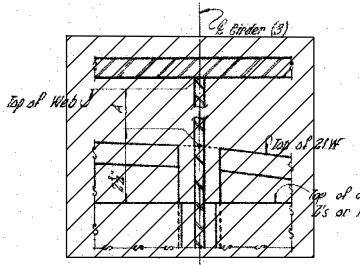


DETAIL A

Dim.	A
G1(3)	5'6"
G2(3)	5'6"
G3(3)	6'0"
G4(3)	6'0"
G5(3)	6'0"

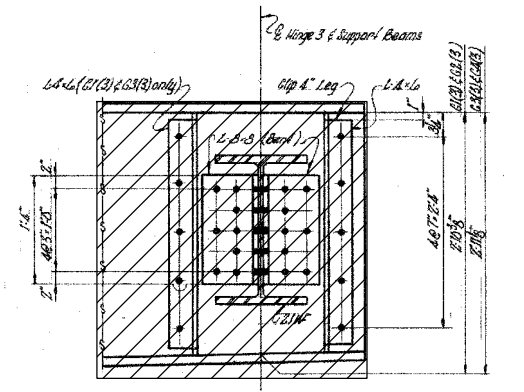

SECTION D-D  
Section C-C Similar

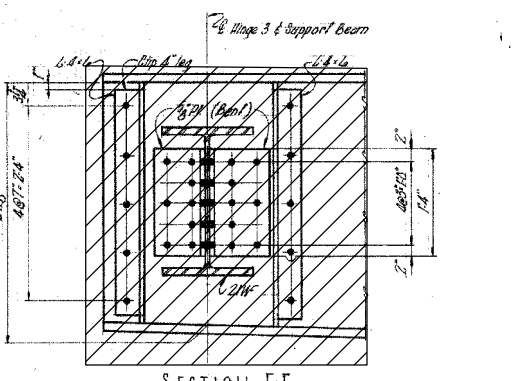

SECTION E-E  
Section C-C Similar






**LEGEND:**

- INDICATES LIMITS OF REMOVAL (SI-P2-S1)
- INDICATES LIMITS OF REMOVAL (SI-P2-S3)
- SX-PX-SX - STAGE X PHASE X STEP X (NOT PHASING)
- BX-X - BEAM X UNIT X
- SBX - SUPPORT BEAM X

**EXISTING SUPPORT BEAMS AT HINGE 3 REMOVAL DETAILS**

**NOTES:**

1. FOR ADDITIONAL DETAILS, SEE SHEET 13/79.
2. SEE SHEETS 10/79 THRU 12/79 FOR CONSTRUCTION SEQUENCE INFORMATION.
3. REMOVE G4 AND G5, B1-5 THRU B4-5, AND SB11 & SB12 DURING SI-P2-S1. CONTRACTOR SHALL TAKE CARE TO NOT DAMAGE G3 AND SB10 DURING REMOVAL.
4. REMOVE REMAINING BEAMS DURING SI-P2-S3.

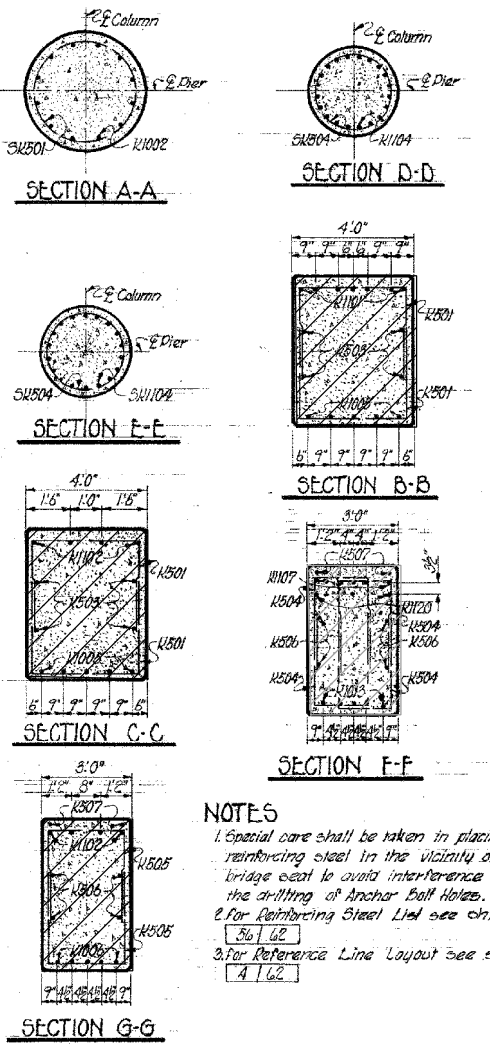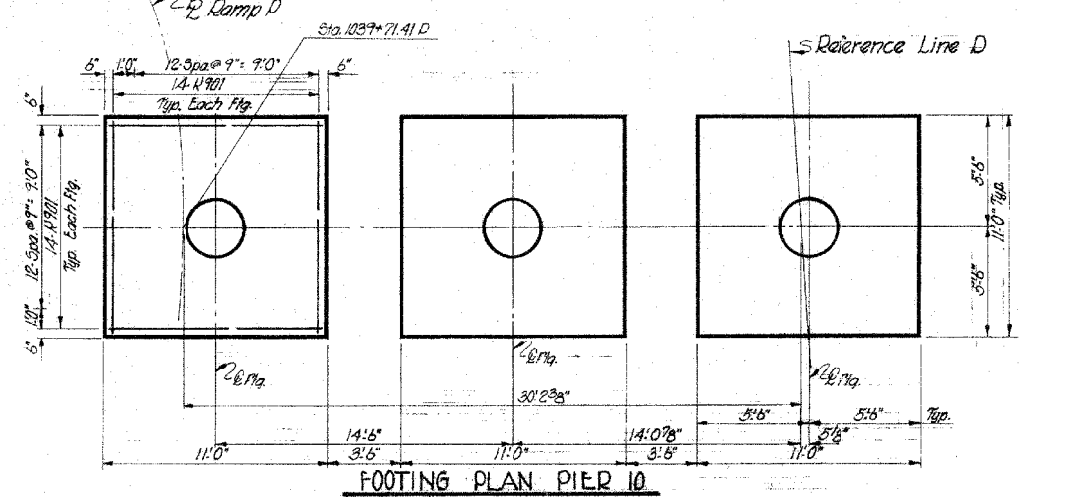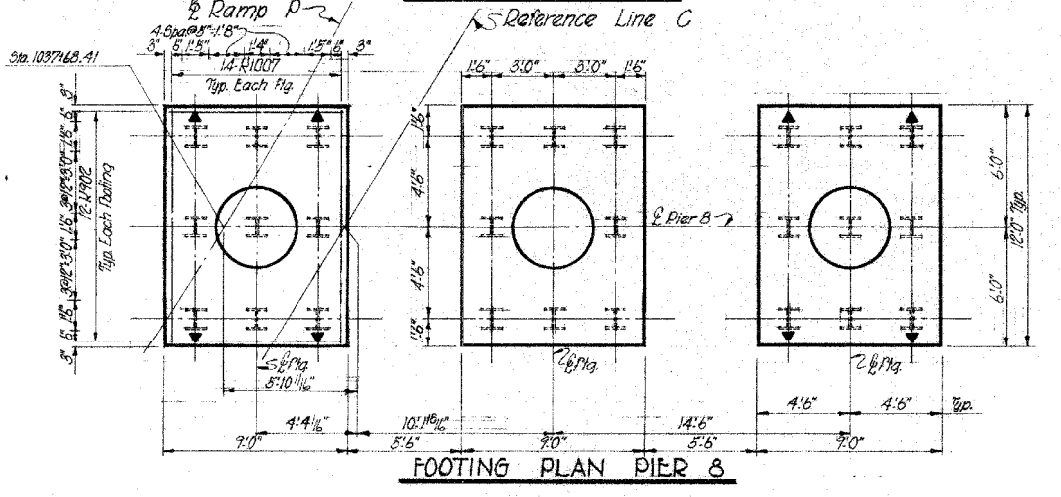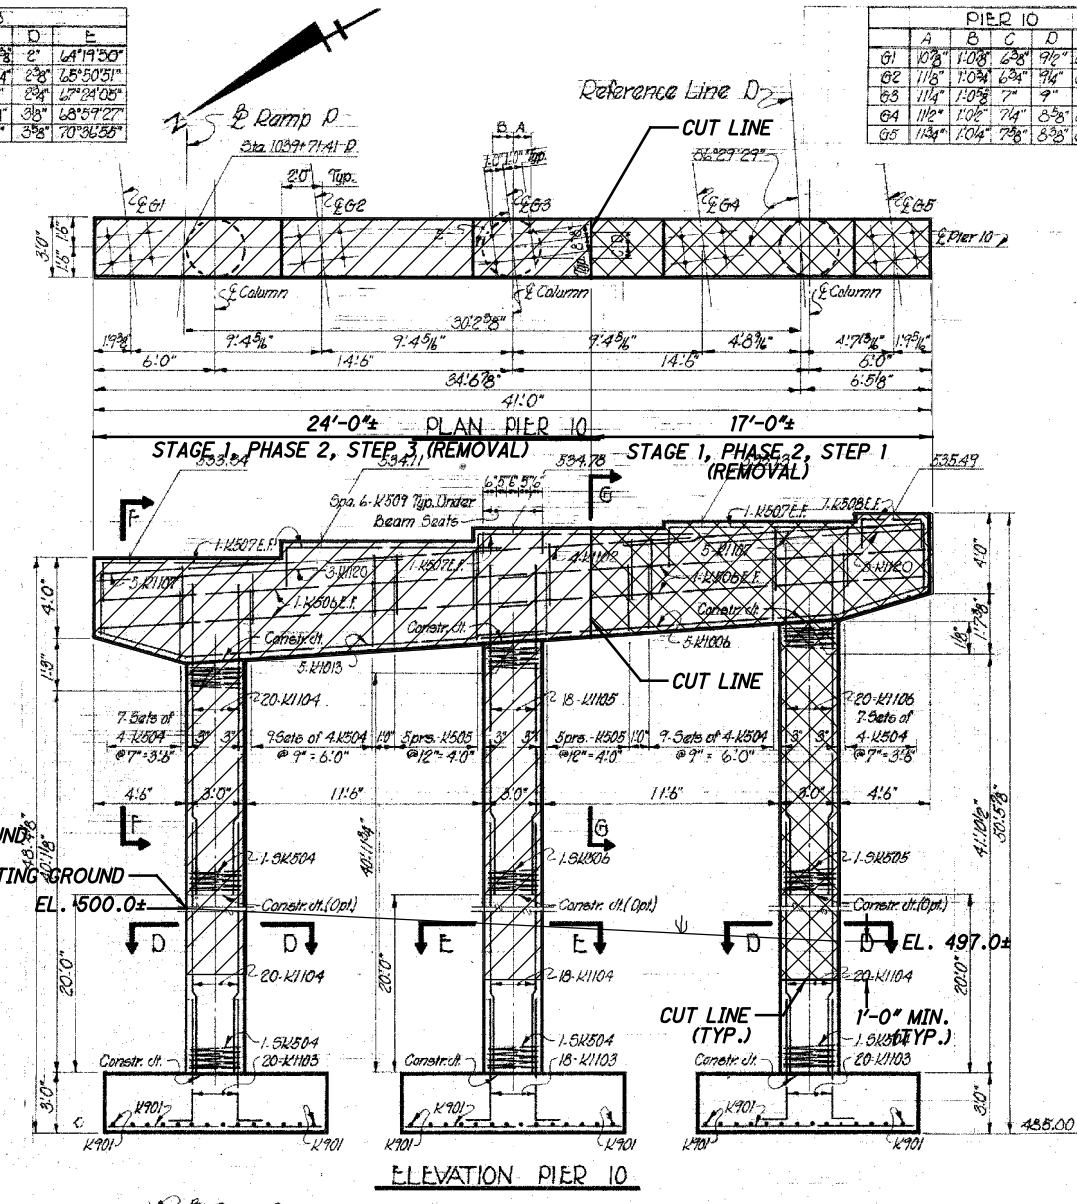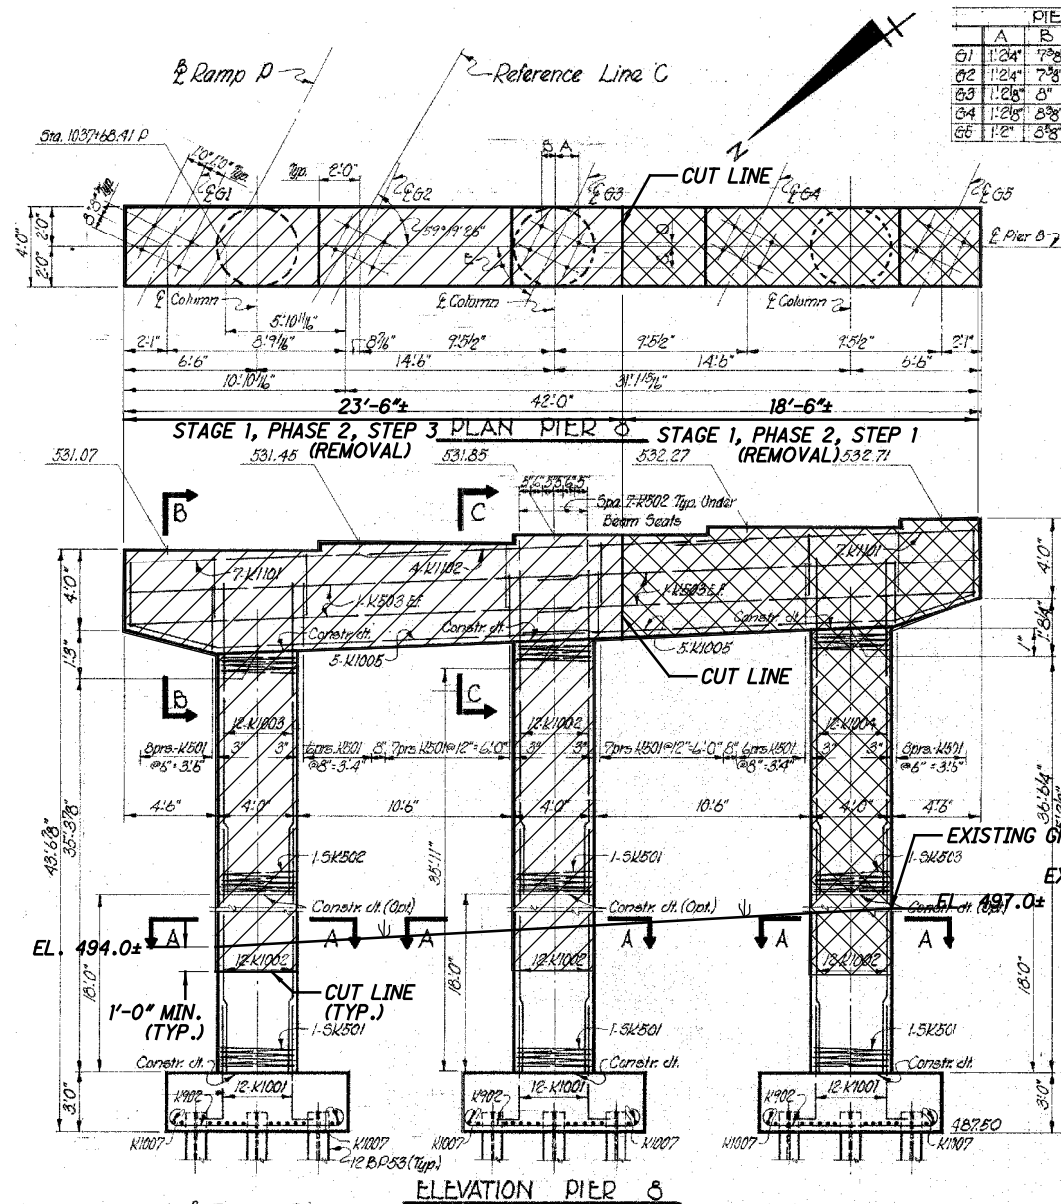


**NOTES**  
 1. Special care shall be taken in placing reinforcing steel in the vicinity of the bridge seat to avoid interference with the drilling of Anchor Bolt Holes.  
 2. For Reinforcing Steel Laid see ch. 361.62  
 3. For Reference Line Layout see ch. 41.62

**LEGEND:**  
 - INDICATES LIMITS OF REMOVAL (SI-P2-S1)  
 - INDICATES LIMITS OF REMOVAL (SI-P2-S3)  
 SX-PX-SX - STAGE X PHASE X STEP X (NOT PHASING)






**EXISTING PIERS NO. 8 & 10 REMOVAL DETAILS**

**NOTES:**  
 1. SEE SHEETS 10/79 THRU 12/79 FOR CONSTRUCTION SEQUENCE INFORMATION.  
 2. THE CONTRACTOR HAS THE OPTION TO REMOVE THE ENTIRE PIER IN SI-P2-S3.

	A	B	C	D
61	10'3"	10'3"	6'8"	6'8"
62	11'	9'8"	7'8"	5'2"
63	11'8"	9'4"	8'8"	4'8"
64	11'8"	8'8"	8'8"	4'
65	11'8"	8'8"	7'	3'8"

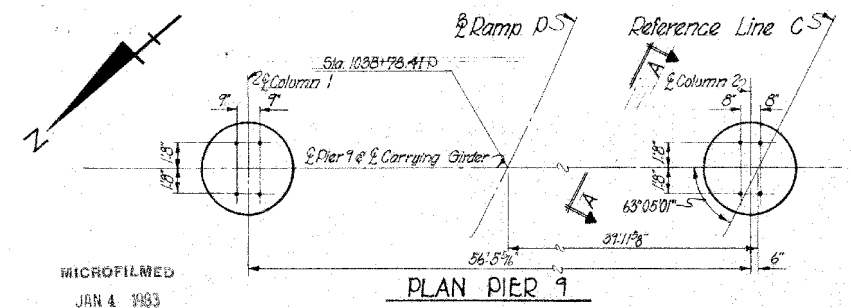

MICROFILMED  
JAN 4 1983

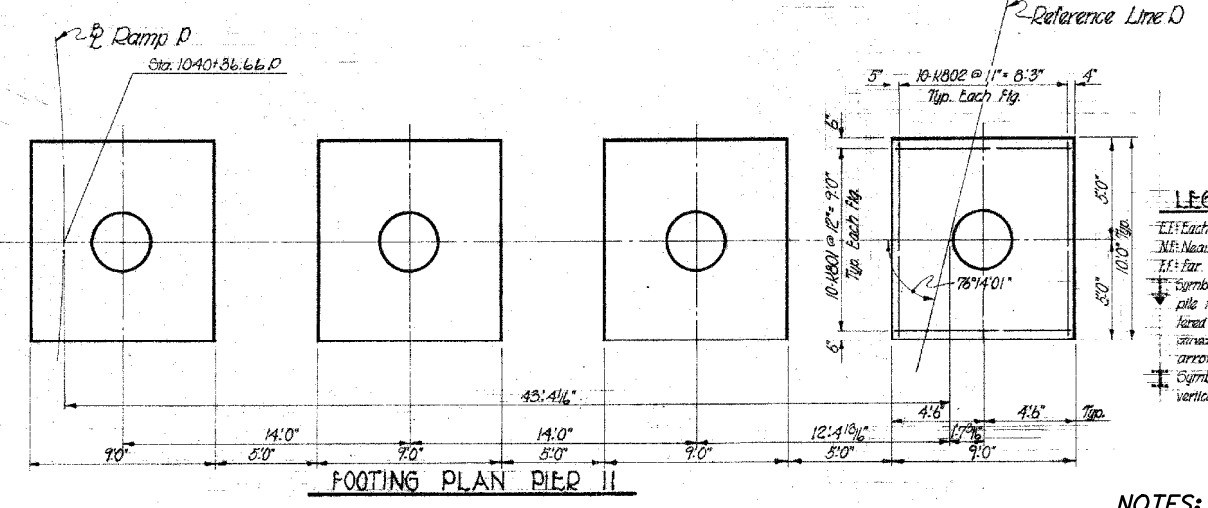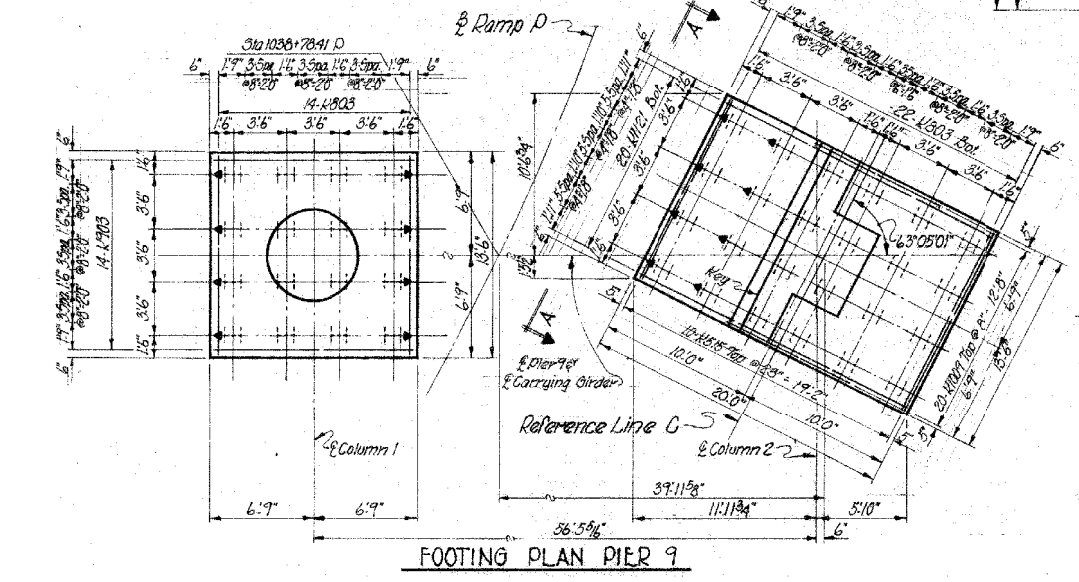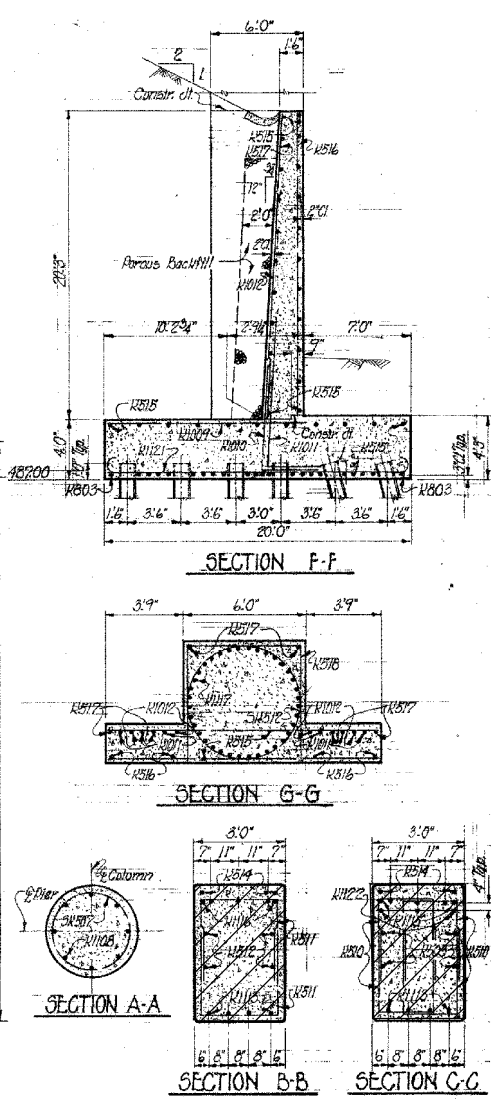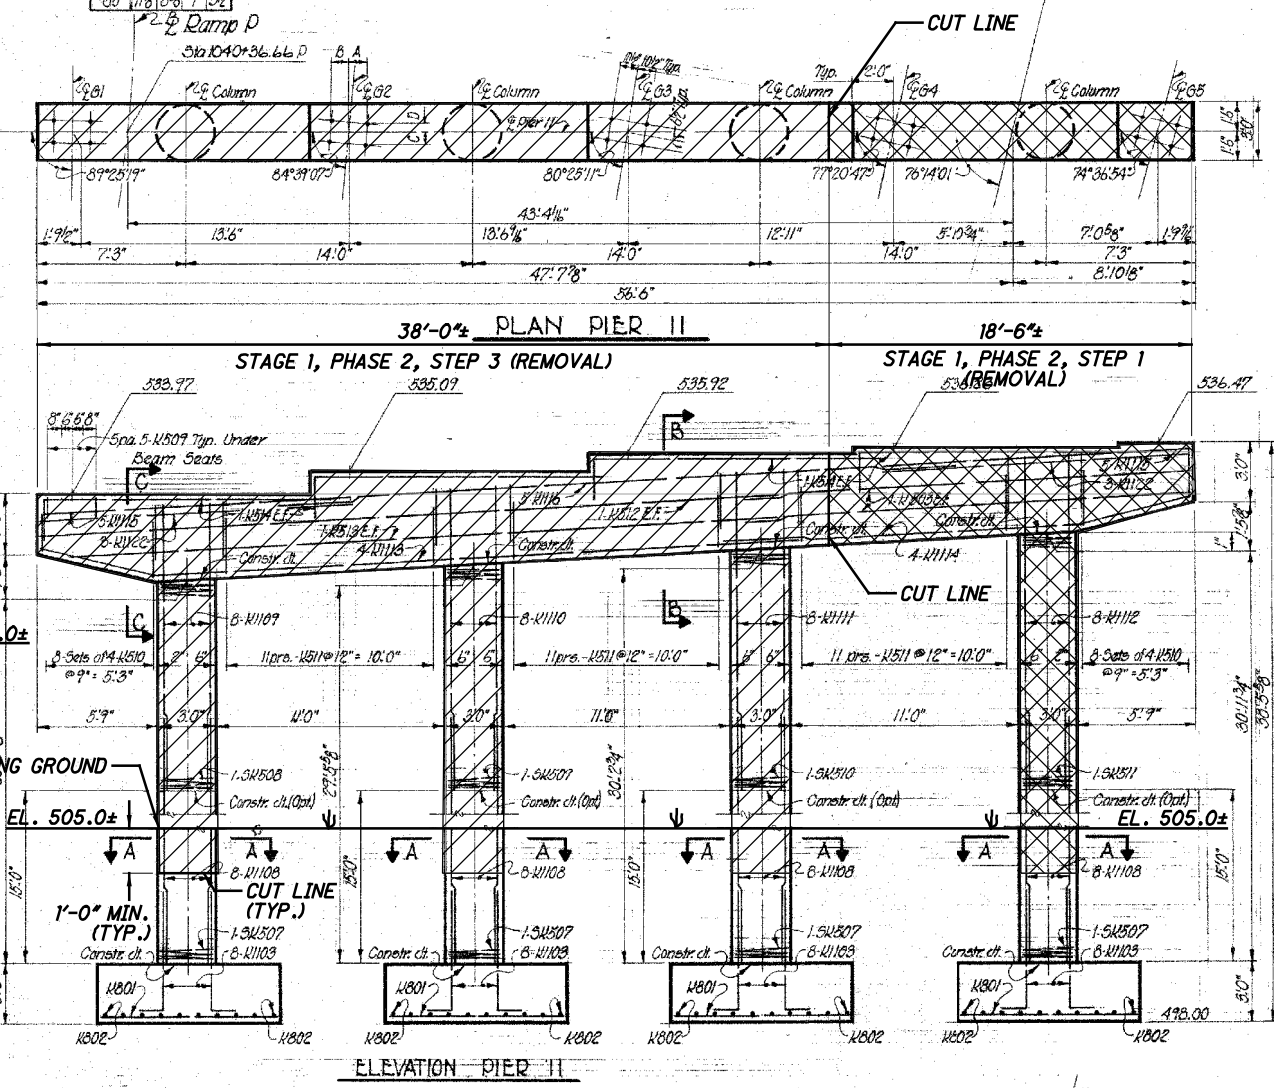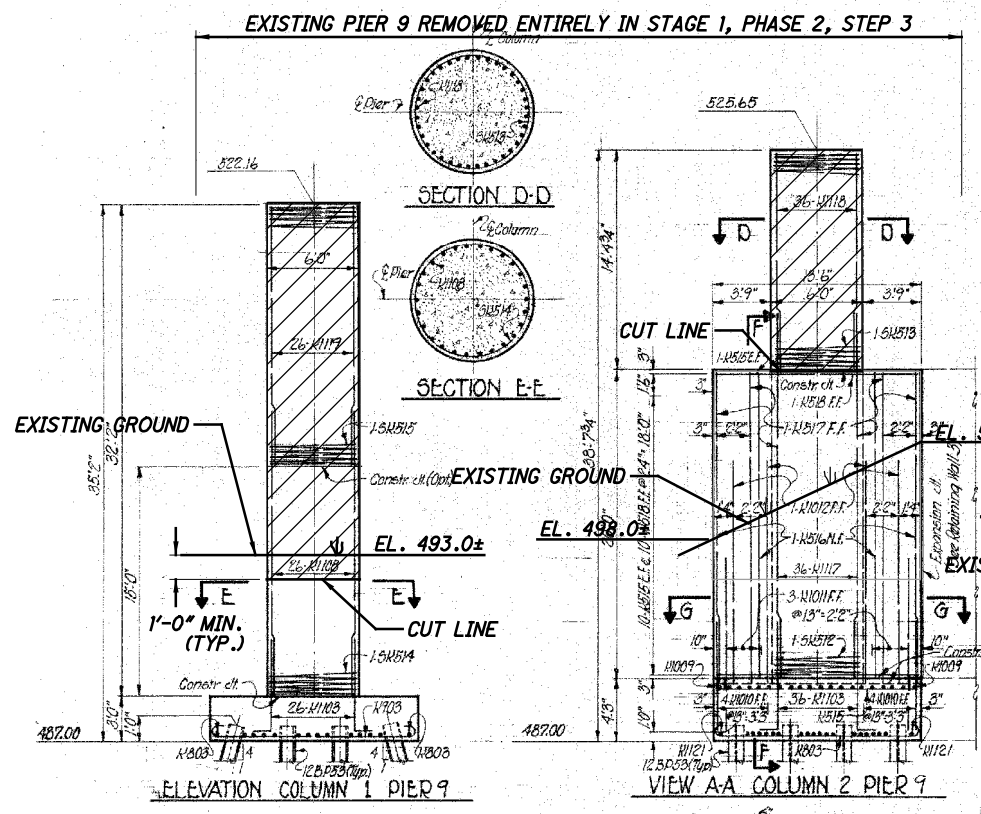

**LEGEND:**

INDICATES LIMITS OF REMOVAL (S1-P2-S1)

INDICATES LIMITS OF REMOVAL (S1-P2-S3)

SX-PX-SX - STAGE X PHASE X STEP X (NOT PHASING)

**EXISTING PIERS 9 & 11 REMOVAL DETAILS**

**LEGEND**

EE: Each face

MF: Near face

EF: Far face

Symbol indicates pile to be battered 1:4 in the direction of the arrow.


Symbol indicates vertical pile.

- NOTES:**
- SEE SHEETS 10/79 THRU 12/79 FOR CONSTRUCTION SEQUENCE INFORMATION.
  - THE CONTRACTOR HAS THE OPTION TO REMOVE THE ENTIRE PIER IN S1-P2-S3.
  - REMOVE EXISTING PIER 9 IN STAGE 1, PHASE 2, STEP 3. CONTRACTOR CANNOT REMOVE ANY PART OF EXISTING PIER 9 (INCLUDING BEARING BASE PLATE) UNTIL AFTER TRAFFIC IS SHIFTED ONTO NEW RAMP P.

P:\Projects\2018\20H03DB-18232 HAM-75-03-84-104667\structures\HAM074\_1908S\sheets\074\_1908S\_RE005.dgn 7/28/2023 9:27:00 AM erin.baumann




P:\Projects\2018\20H03DB-18232 HAM-75-03.84\104667\structures\HAM074\_1908S\sheets\074\_1908S\_FF001.dgn 7/28/2023 9:27:16 AM erin.baumann

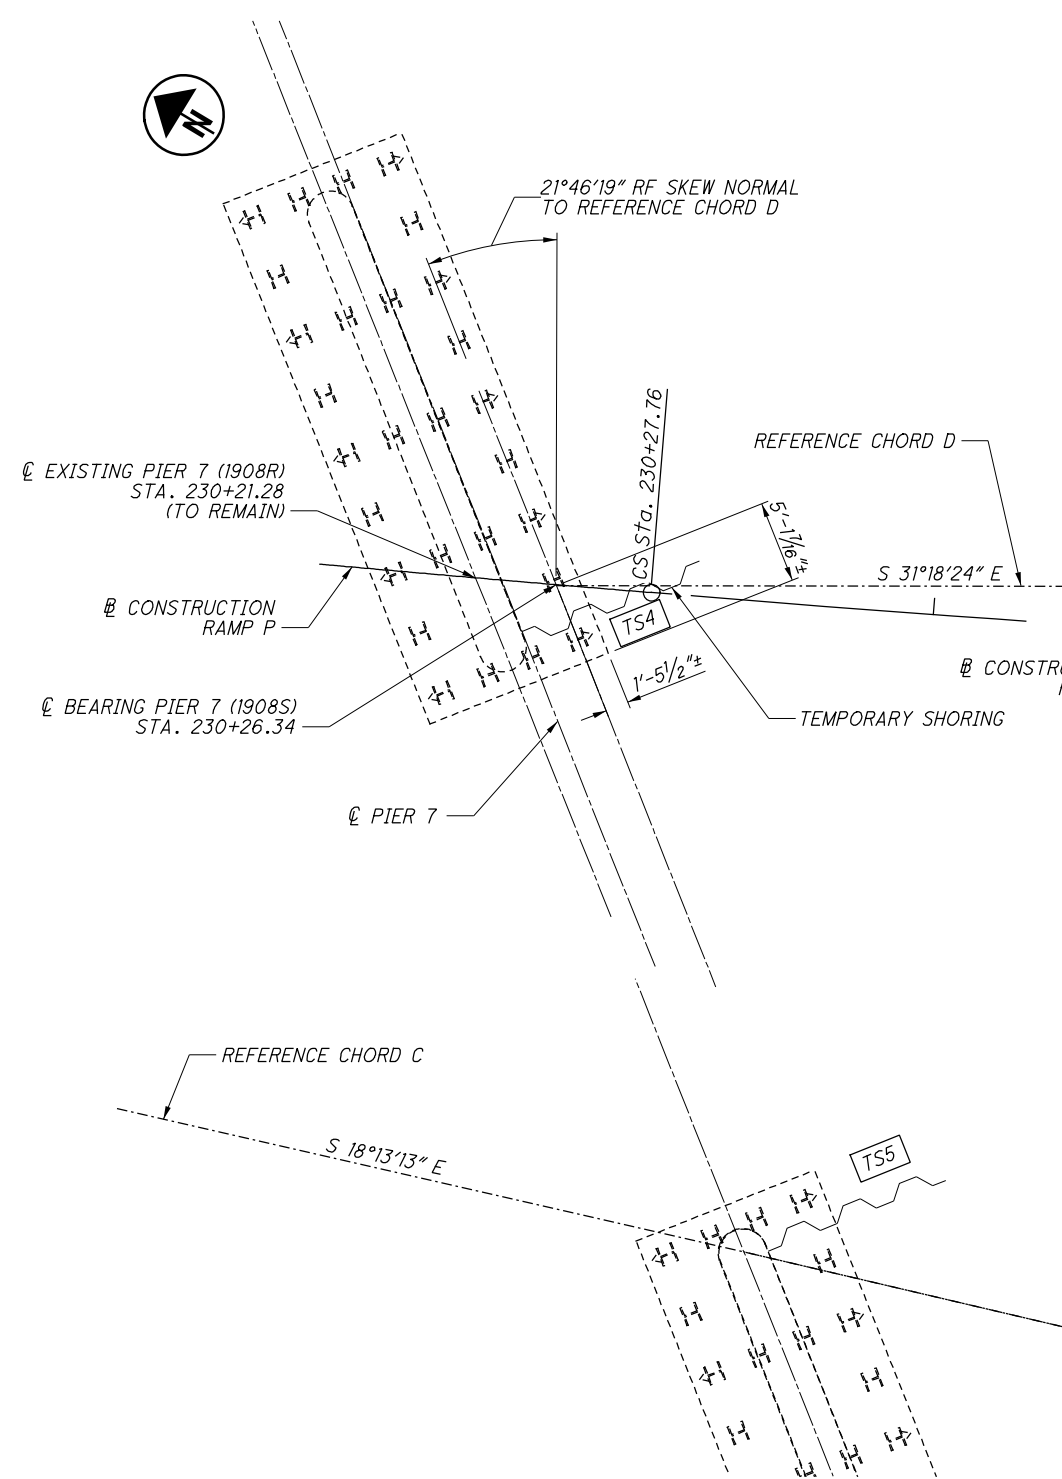

**EXISTING FOUNDATION PLAN - PIER 7 (1908S)**

NOTE: SEE AS-BUILT TABLE AT RIGHT FOR MORE INFORMATION


PILE DATA				
LOCATION	PILE TYPE	PILE NUMBER	PILE CUTOFF ELEVATION	ESTIMATED PILE LENGTH (EACH) (FEET)
PIER 1	HP12X53	1 - 12	494.0	60
PIER 2	HP14X73	13 - 26	507.0	50

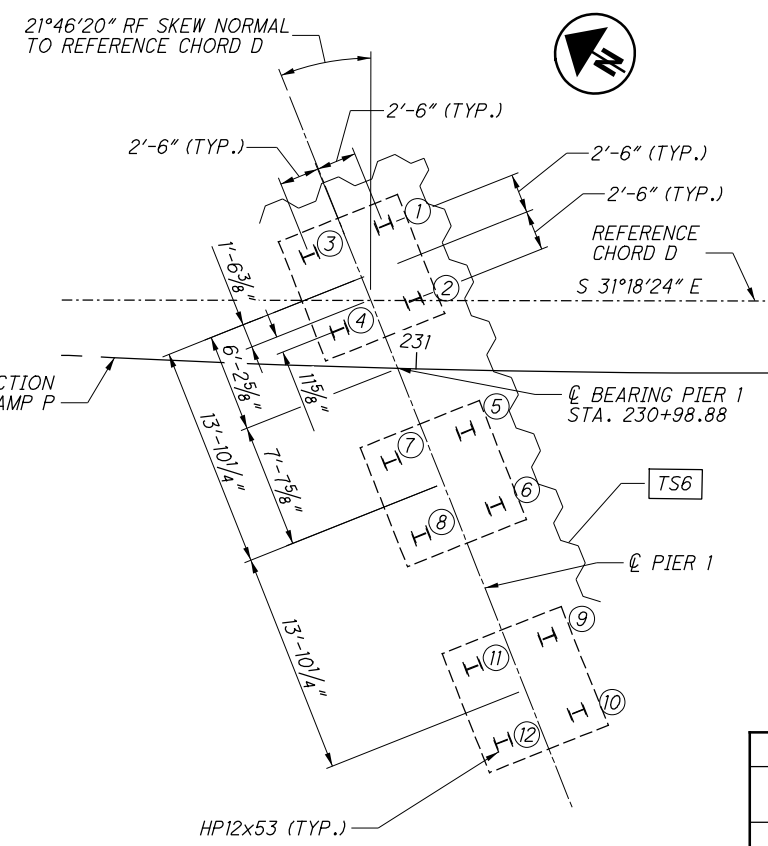

**FOUNDATION PLAN - PIER 1**

- LEGEND:**
- ① - INDICATED PILE NUMBER
  - ⊥ - INDICATES EXISTING VERTICAL PILE HP12X53 (TO REMAIN)
  - ⊥ - INDICATES EXISTING PILE HP12X53 BATTERED (H):4(V) IN THE DIRECTION SHOWN (TO REMAIN)
  - - TEMPORARY SHORING
  - TS# - TEMPORARY SHORING LOCATION
  - \* - INDICATES FURNISHED LENGTH


AS-BUILT DRIVEN PILE DATA	
PILE NUMBER	INSTALLED LENGTH (FEET)
1	54.08
2	53.75
3	55.00
4	54.50
5	54.08
6	54.25
7	54.25
8	55.00
9	54.08
10	54.08
11	65.00
12	55.25
13	48.50
14	50.25
15	48.50
16	48.25
17	55.00*
18	55.00*
19	55.00*
20	55.00*
21	55.00*
22	48.75
23	52.25
24	48.25
25	47.33
26	55.00*

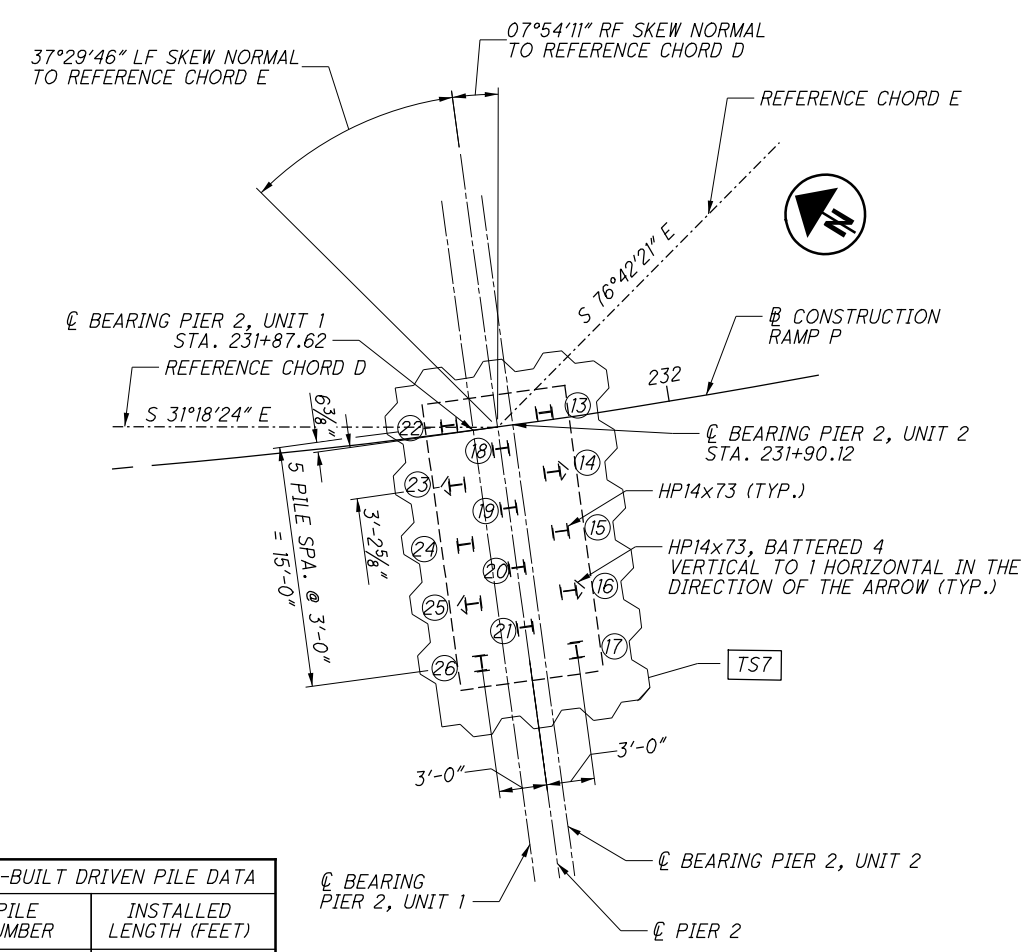

**FOUNDATION PLAN - PIER 2**

- NOTES:**
- FOR UNIT 1 GENERAL PLAN, SHEET [4/79].
  - FOR UNIT 2 GENERAL PLAN, SEE SHEETS [4/79] AND [5/79].
  - FOR REFERENCE CHORD LAYOUT, SEE SHEET [6/79].
  - FOR ADDITIONAL PILE NOTES, SEE SHEET [7/79].
  - FOR PIER 1 FOOTING DETAILS, SEE SHEET [21/79].
  - FOR PIER 2 FOOTING DETAILS, SEE SHEET [23/79].


P:\Projects\2018\20H03DB-18232 HAM-75-03.84\104667\structures\HAM074\_1908S\sheets\074\_1908S\_FF002.dgn 7/28/2023 9:27:19 AM erin.baumann

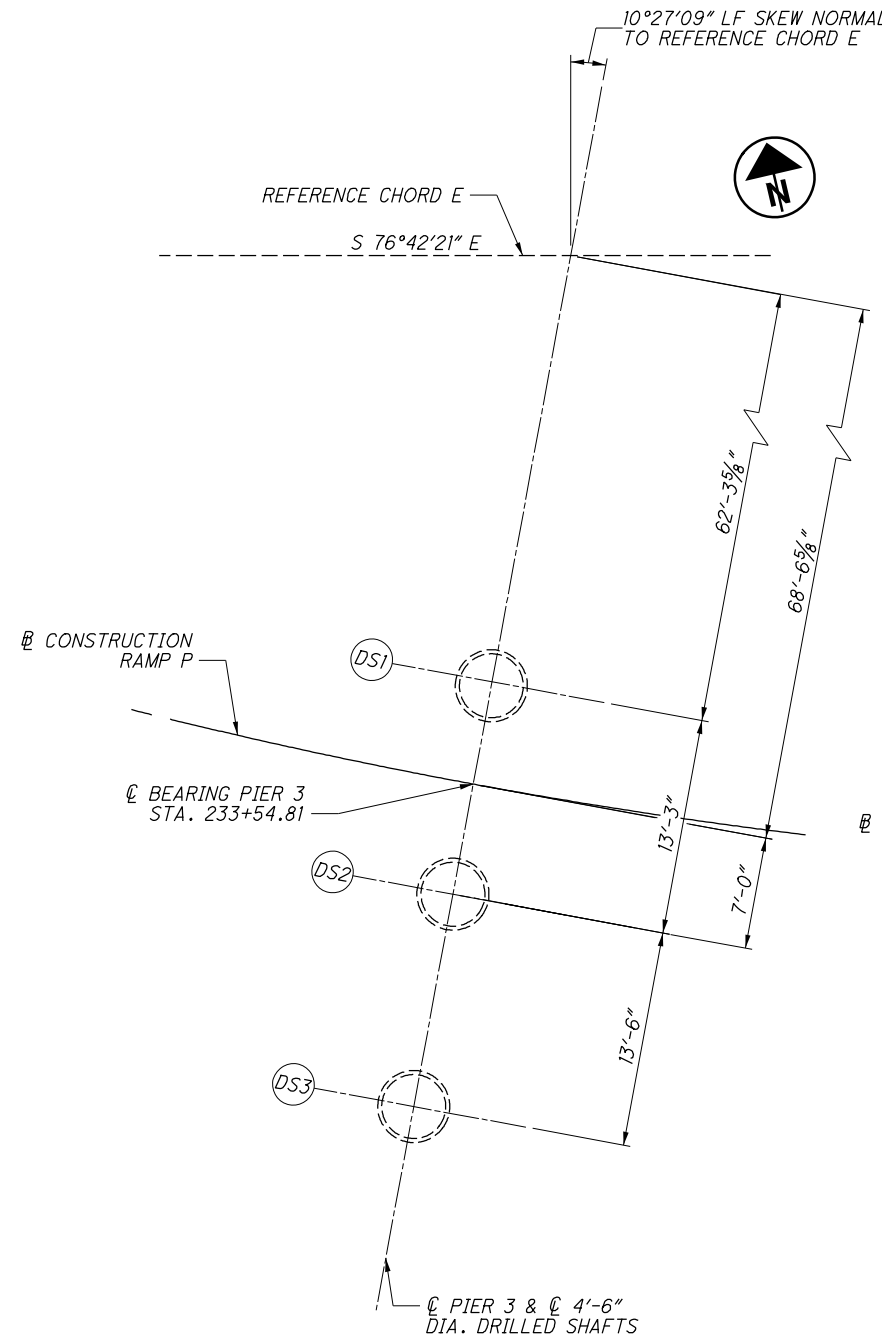

FOUNDATION PLAN - PIER 3


**LEGEND:**

(DS1) - INDICATES DRILLED SHAFT NUMBER

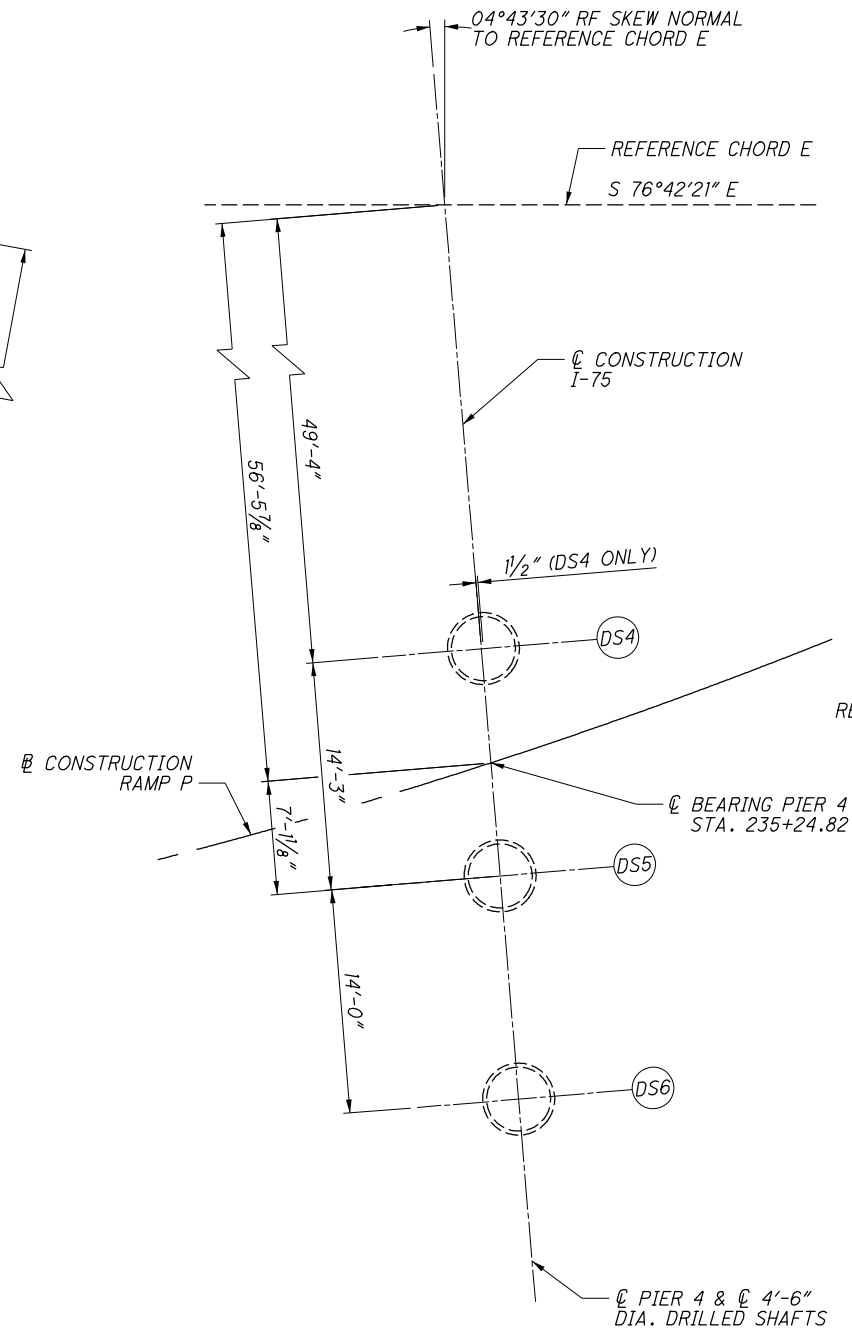

FOUNDATION PLAN - PIER 4

AS-BUILT DRILLED SHAFT TABLE									
LOCATION	DATE	DS No.	DIA. (INCHES)		TOP OF OVERBURDEN	THROUGH OVERBURDEN	ELEVATION TOP OF SOCKET	ELEVATION BOTTOM OF SOCKET	SOCKET (FT.)
			SHAFT	SOCKET					
PIER 3	5/8/19	DS1	54	48	496.7	7.5	489.6	472.9	16.7
	5/9/19	DS2	54	48	496.6	7.9	488.7	472.7	16.0
	5/14/19	DS3	54	48	496.5	7.8	488.7	474.7	16.0
PIER 4	5/21/19	DS4	48	48	0	0	519.3	495.2	24.1
	5/21/19	DS5	48	48	0	0	519.3	495.2	24.1
	5/20/19	DS6	48	48	0	0	519.3	494.9	24.1

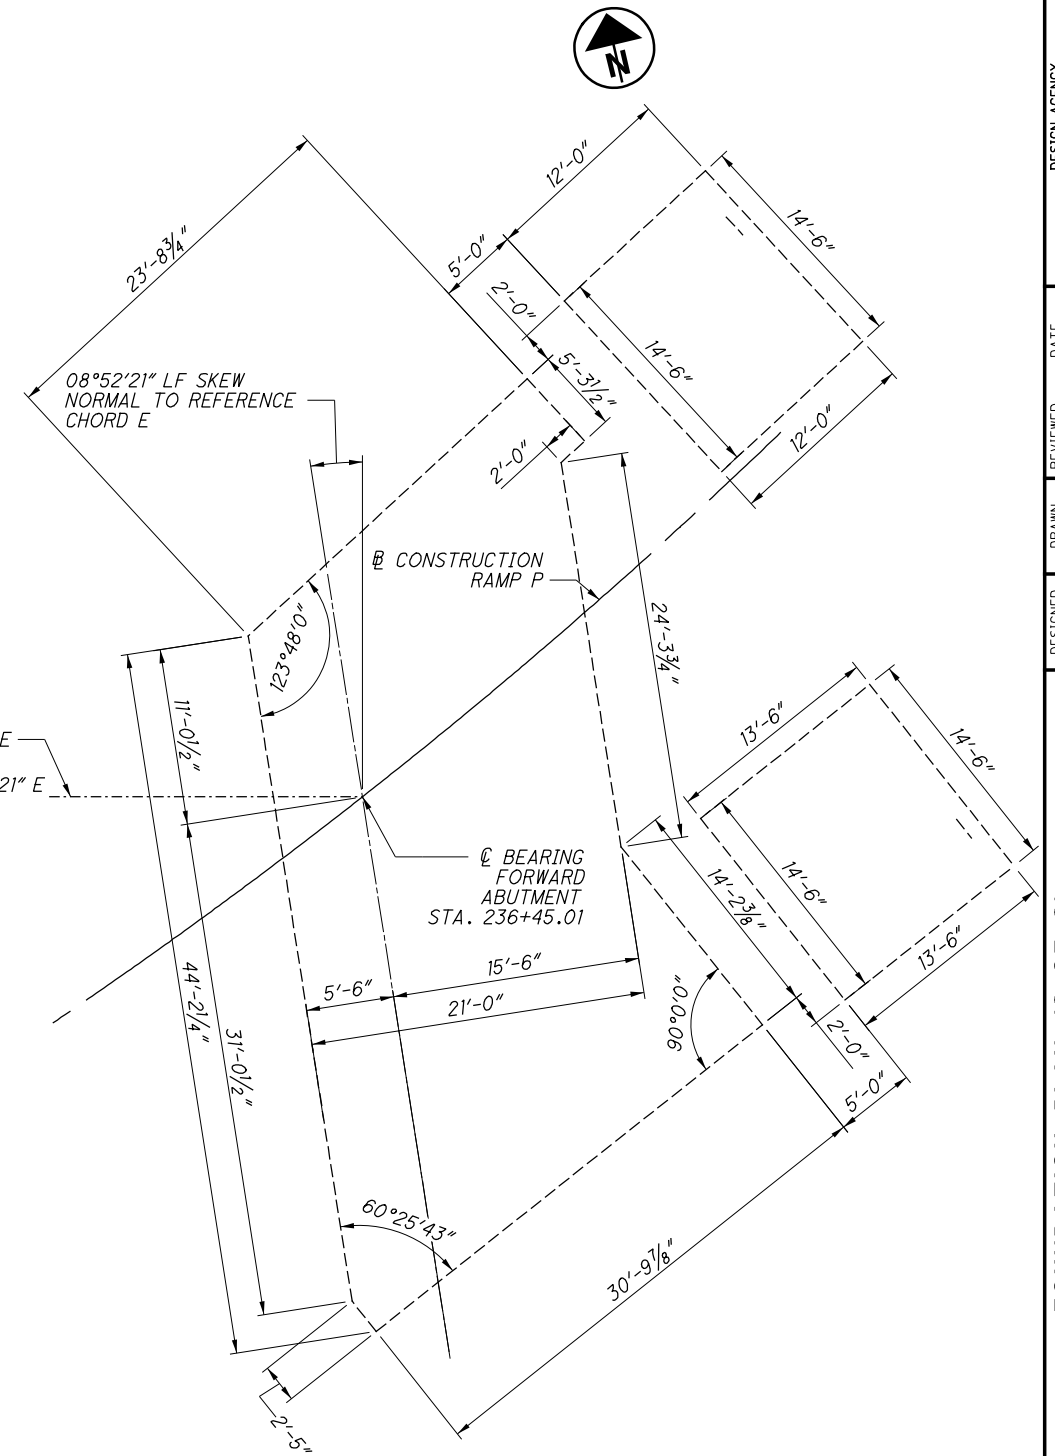


FOUNDATION PLAN - FORWARD ABUTMENT

**NOTES:**




- FOR UNIT 2 GENERAL PLAN, SEE SHEETS 4/79 AND 5/79.
- FOR REFERENCE CHORD LAYOUT, SEE SHEET 6/79.
- FOR ADDITIONAL SHAFT AND BEARING NOTES, SEE SHEET 6/79.
- FOR PIER 3 AND PIER 4 DRILLED SHAFT DETAILS, SEE SHEET 25/79.
- FOR FORWARD ABUTMENT FOOTING DETAILS, SEE SHEET 28/79.

P:\Projects\2018\20HO3DB-18232 HAM-75-03.84\104667\structures\HAM074\_1908S\sheets\074\_1908S\_P1001.dgn 7/28/2023 9:27:27 AM erin.baumann

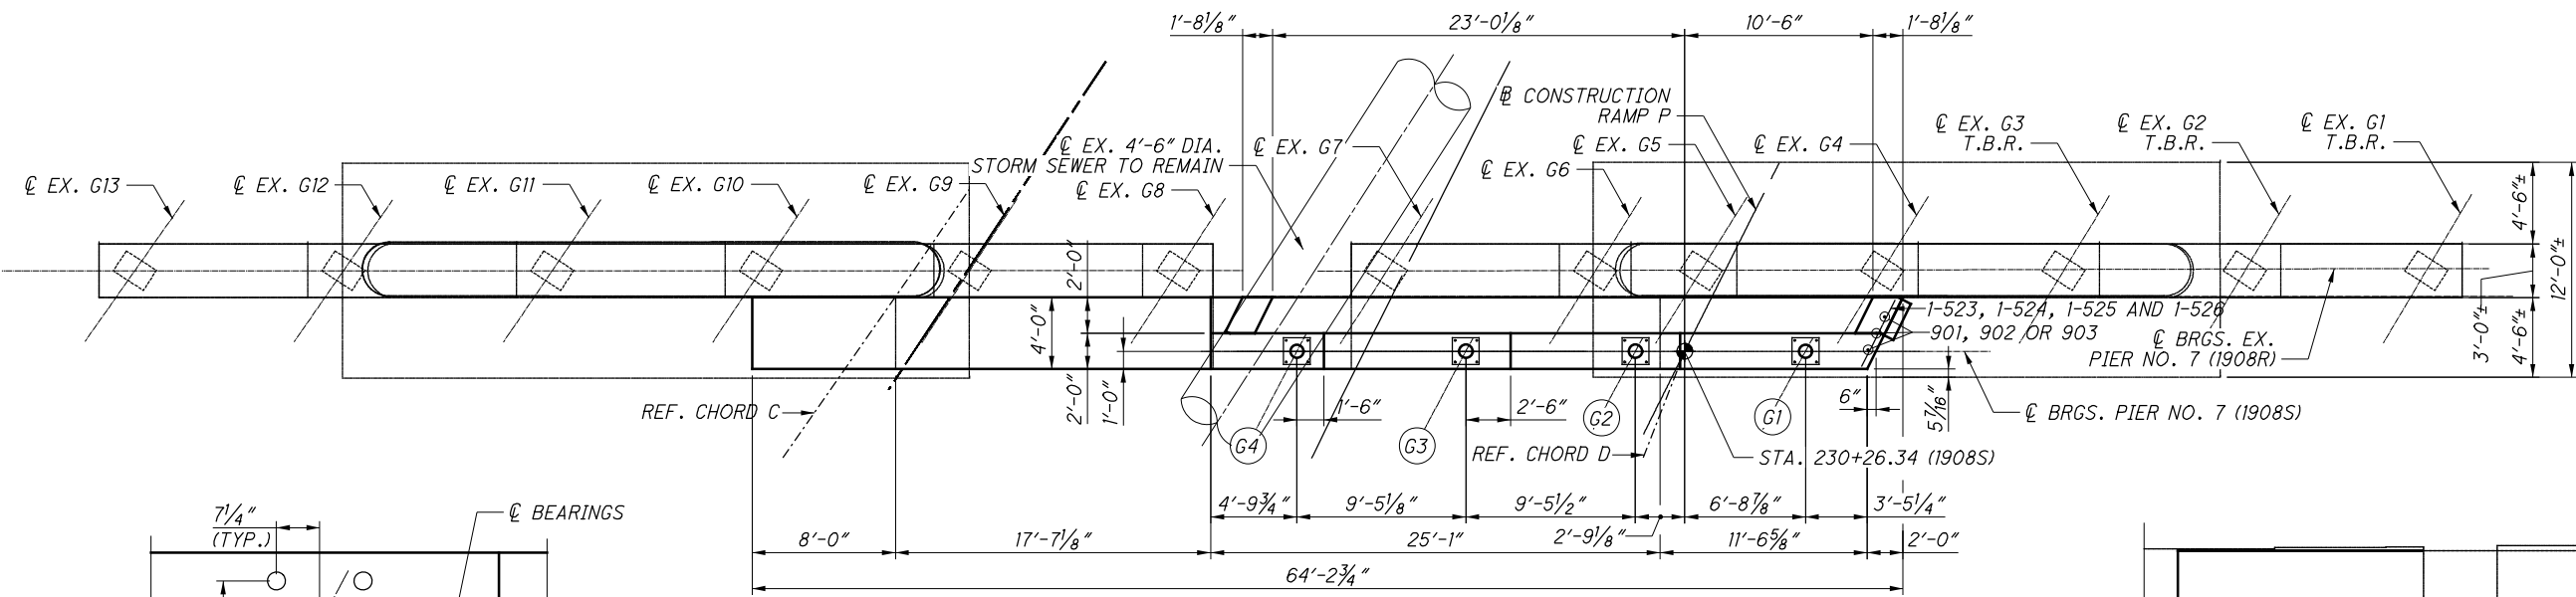


**PLAN**  
(EXISTING PILES NOT SHOWN FOR CLARITY)

**ANCHOR BOLT LOCATION PLAN (TYP.)**  
FOR ANCHOR BOLT BLOCKOUT DETAIL, SEE SHEET [35/79](#)

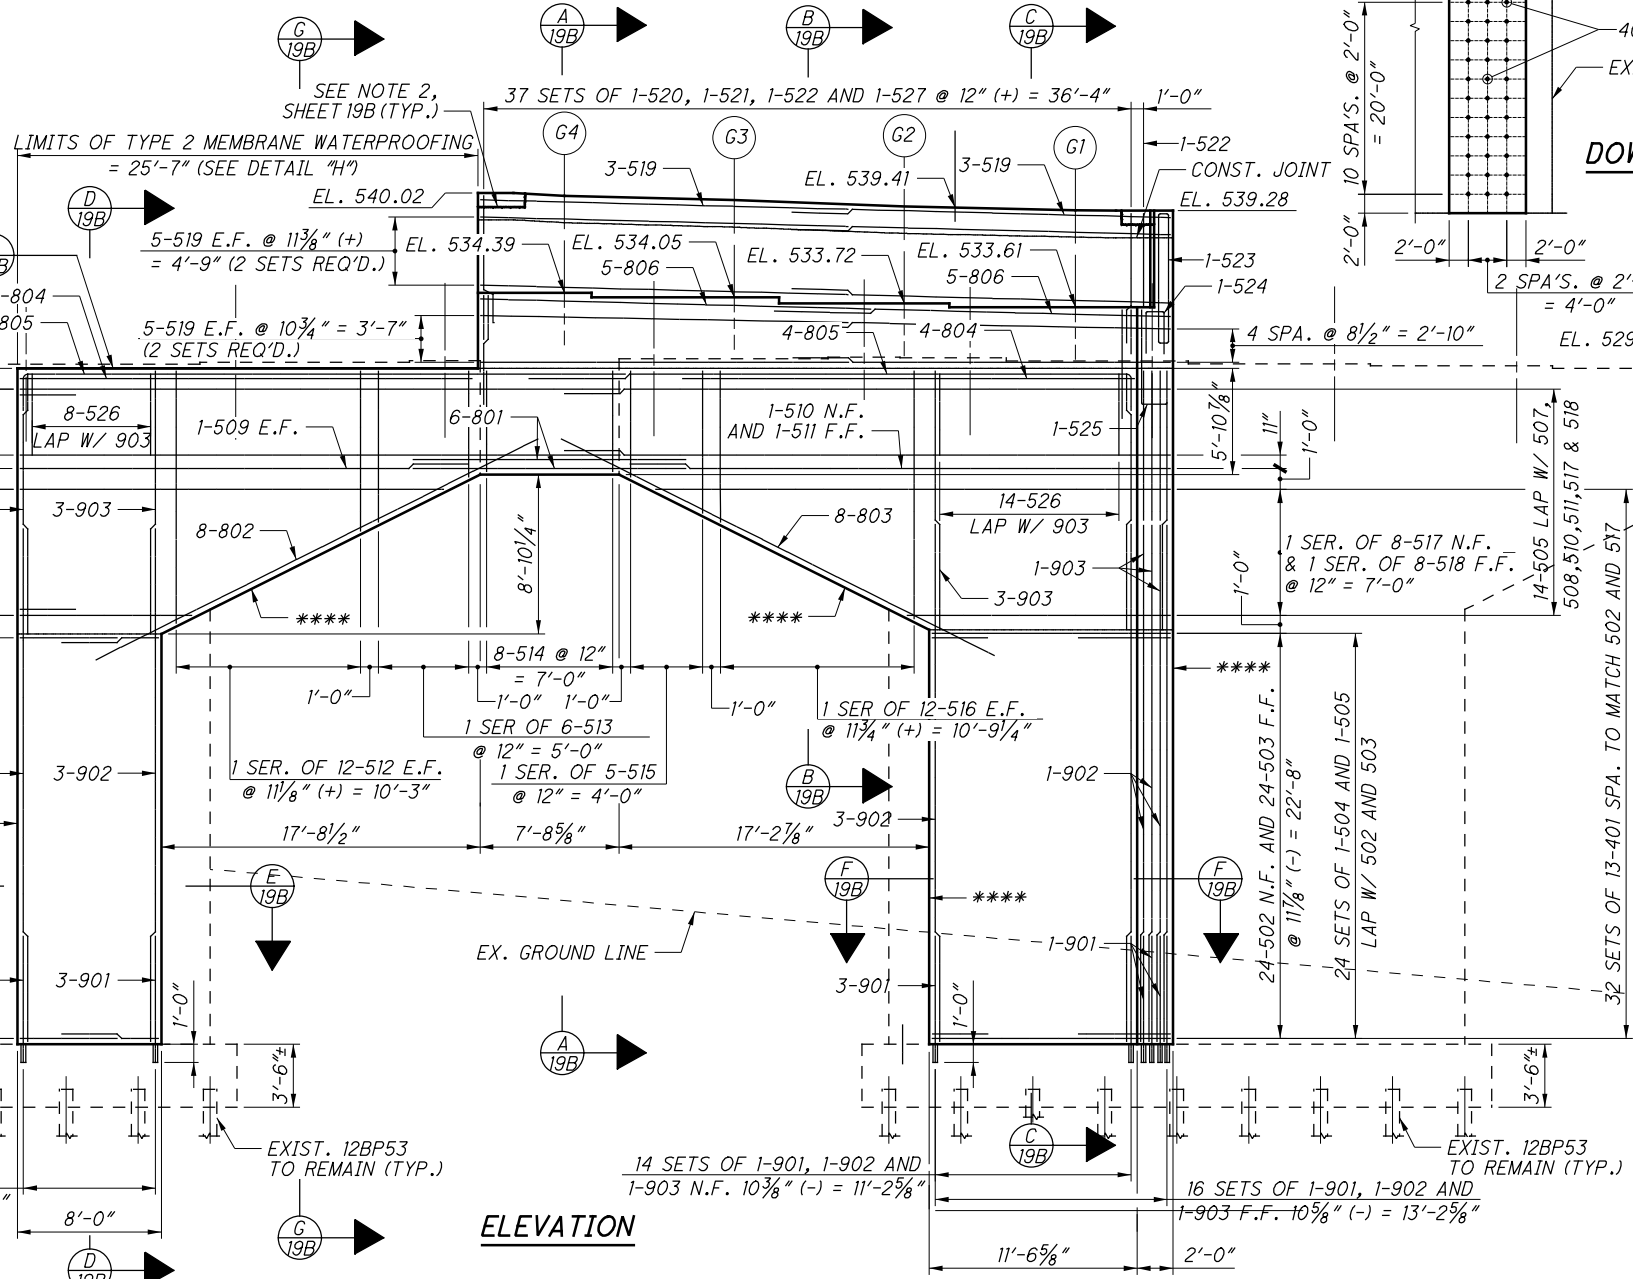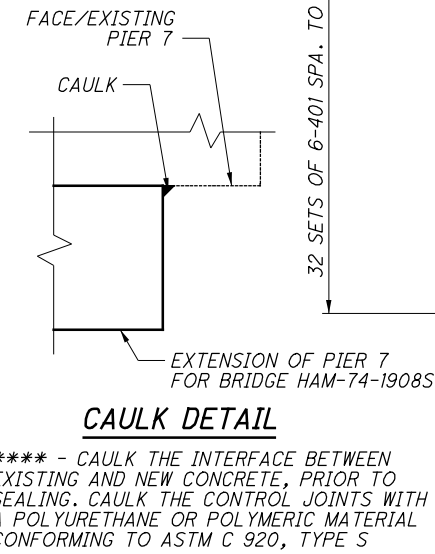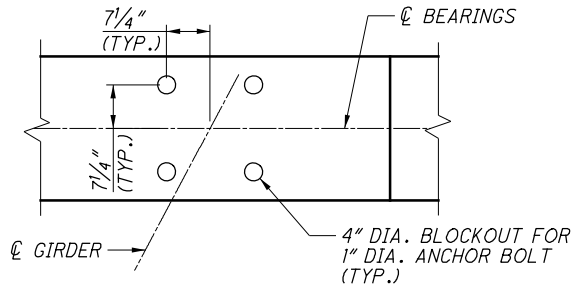

**ELEVATION**

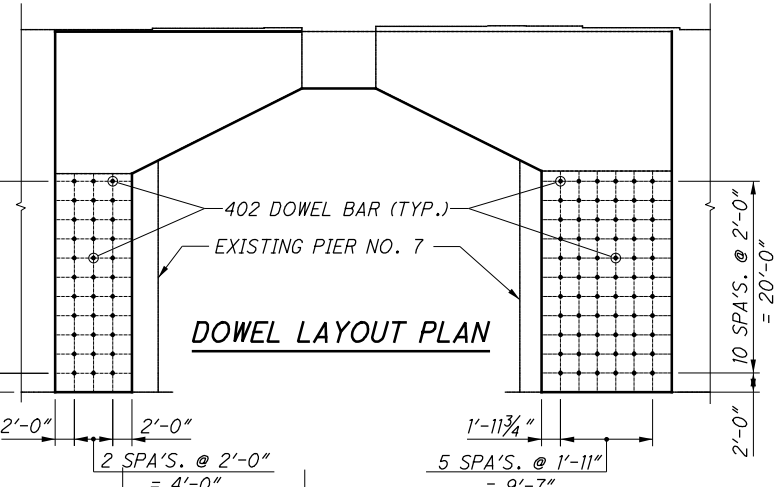

**DOWEL LAYOUT PLAN**

MIN. REQUIRED LAP LENGTH		
	VERT.	HORIZ.
#5 BARS	29"	37"
#8 BARS	57"	64"
#9 BARS	70"	79"

- NOTES:**
- SEAL ALL EXPOSED (ABOVE GROUND) CONCRETE SURFACES OF PROPOSED AND EXISTING PIER, EXCEPT BEAM SEATS, WITH EPOXY URETHANE.
  - REBAR CLEARANCE MEASURED TO THE FACE OF CONCRETE SHALL BE 2" UNLESS OTHERWISE NOTED.
  - FOR REINFORCING SCHEDULE, SEE SHEET [74/79](#)
  - REINFORCING STEEL IN THE VICINITY OF THE BEAM SEAT SHALL BE ACCURATELY PLACED TO AVOID INTERFERENCE WITH THE PRE-SETTING OR DRILLING OF BEARING ANCHORS
  - AT THE OPTION OF THE CONTRACTOR, BEARING ANCHORS (OR FORMED HOLES), LOCATED AND SUPPORTED BY TEMPLATES, MAY BE CAST-IN-PLACE
  - PRE-SET OR DRILLED ANCHOR BOLT HOLES SHALL BE GROUTED IN ACCORDANCE WITH CMS 510.
  - THE PREFIX "7P" SHALL BE ADDED TO ALL BAR MARKS FOR PIER NO. 7
  - SPACE TOP REINFORCING BARS TO MISS BEARING ANCHOR BOLTS.
  - FOR BEARING LOCATION DETAILS, SEE SHEET [36/79](#)
  - FOR GEOMETRIC REFERENCE, SEE REFERENCE CHORD LAYOUT SHEET [6/79](#).

DESIGN AGENCY: **PRIMEWAY**  
540 WHITE POND DR. SUITE E  
AKRON, OH 44320

DESIGNED: CRG  
CHECKED: KDC

DRAWN: CRG  
REVISED:


REVIEWED: TES  
DATE: 8/22/2019  
STRUCTURE FILE NUMBER: 3109798

EX. PIER 7 DETAILS  
BRIDGE NO. HAM-74-1908S  
RAMP P OVER IR-74 WESTBOUND, IR-75 AND RAMP E


HAM-75-3.84  
PID No. 104667

19 / 79  
19 / 79


P:\Projects\2018\20H03DB-18232 HAM-75-03.84\104667\structures\HAM074\_1908S\sheets\074\_1908S\_P1001.dgn 7/28/2023 9:27:28 AM erin.baumann

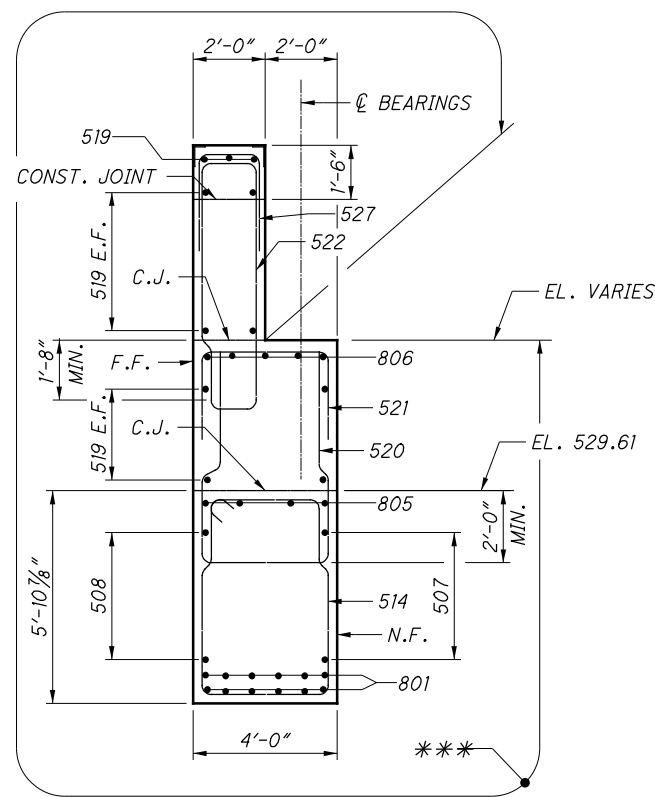


**A** SECTION THRU PIER

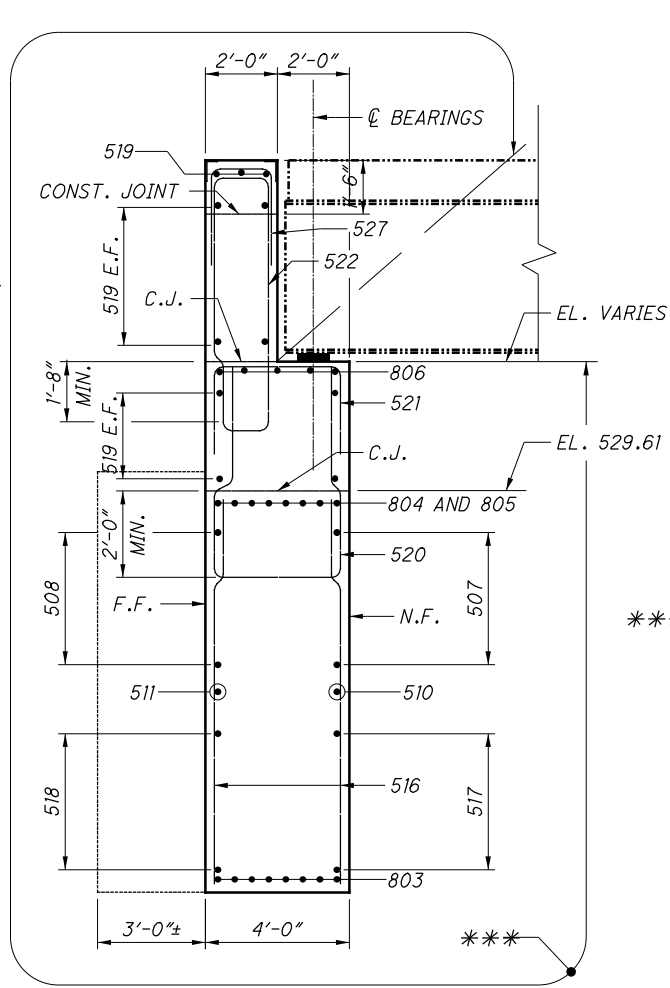


**B** SECTION THRU PIER

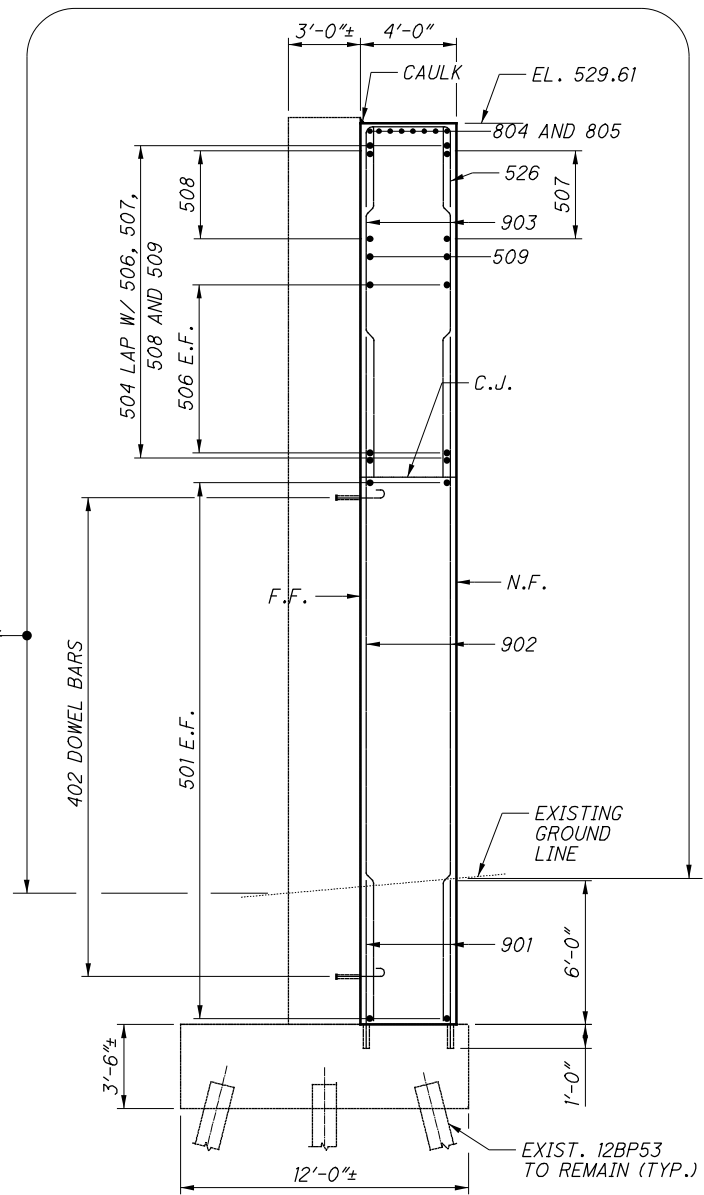


**D** SECTION THRU PIER

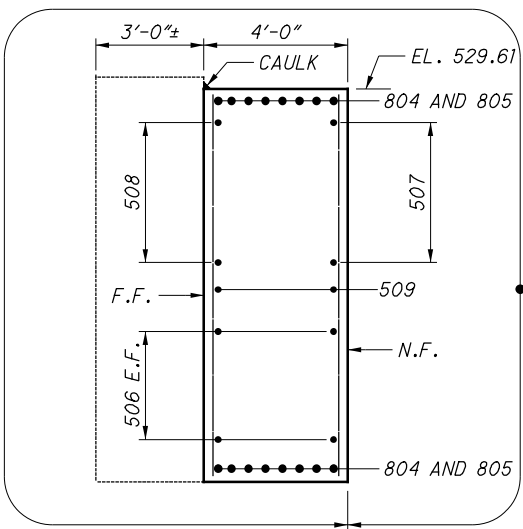

**G** SECTION THRU PIER

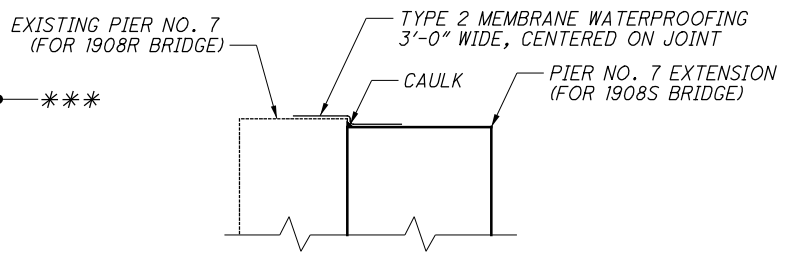


**H** DETAIL AT TOP OF PIER

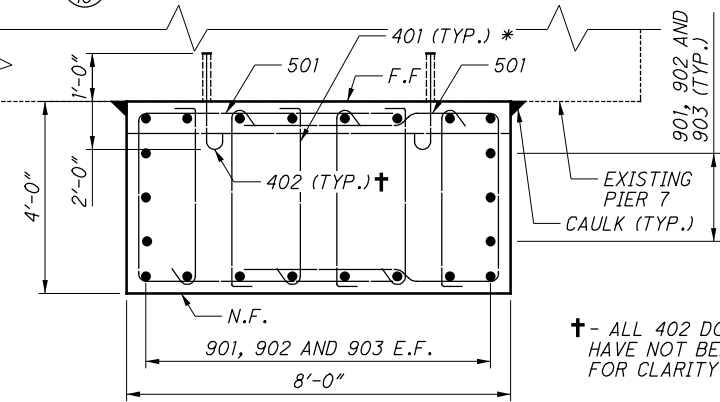


**E** SECTION THRU PIER

† - ALL 402 DOWEL BARS HAVE NOT BEEN SHOWN FOR CLARITY

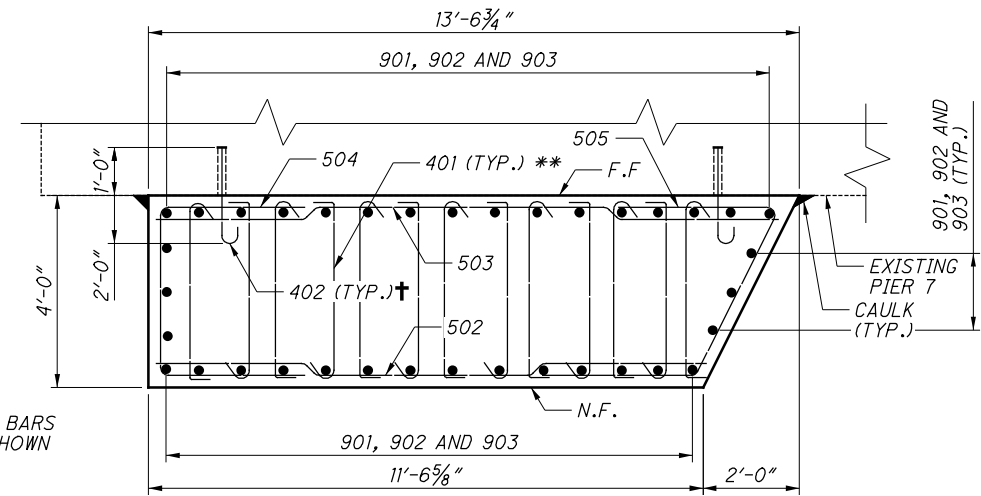

**F** SECTION THRU PIER

\*\* - SPACE TO MATCH 502 AND 503 BARS VERTICALLY

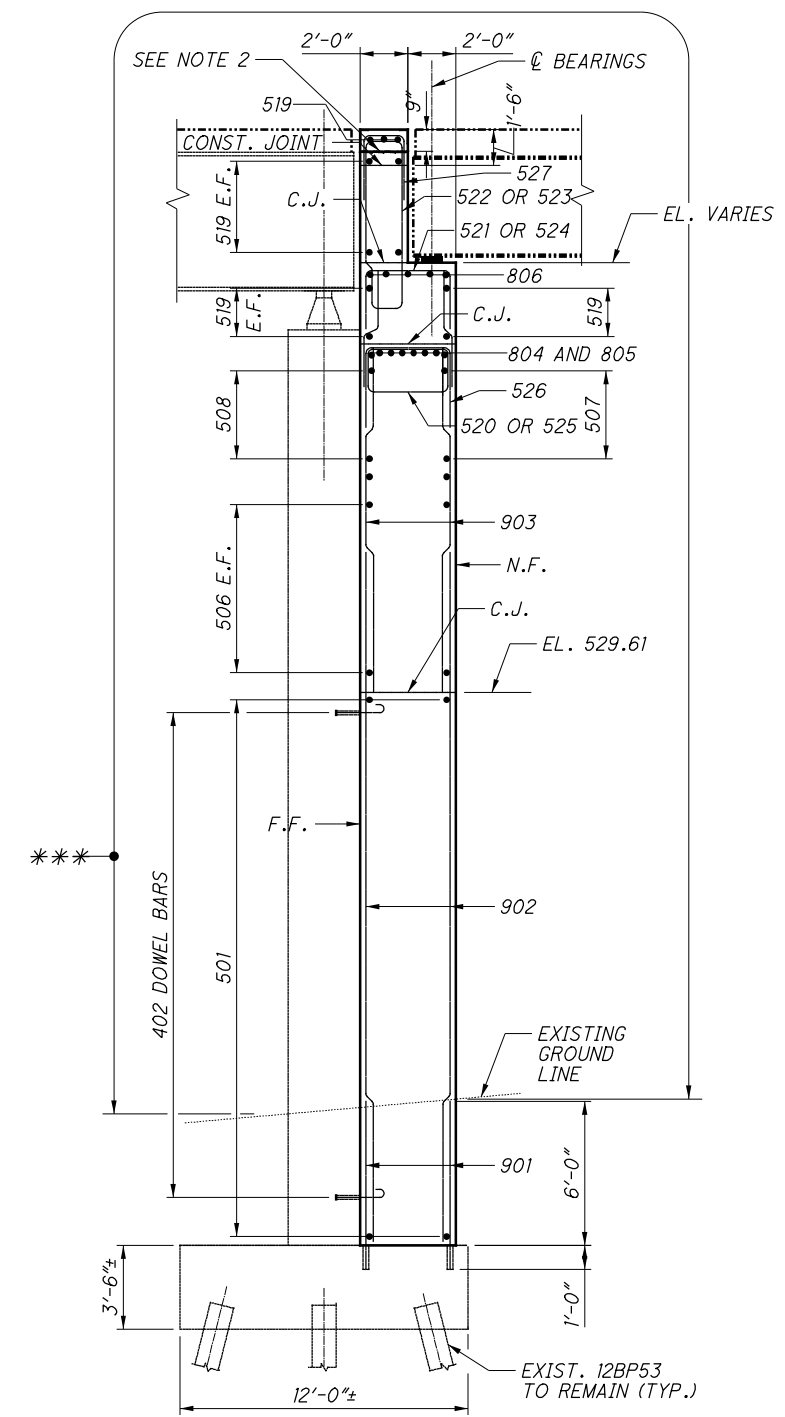

**C** SECTION THRU PIER


- LEGEND**
- \*\*\* LIMITS OF SEALING OF CONCRETE SURFACES (EPOXY-URETHANE)
- NOTES:**
- FOR NOTES, SEE SHEET 19/79.
  - REMOVE AND REPLACE TOP 9" OF BACKWALL AT EACH END OF BACKWALL FROM END OF BACKWALL TO APPROX. THE TOE OF PARAPET. PLACE HMWM AROUND JOINTS.

P:\Projects\2018\20H030B-18232 HAM-75-03.84\04667\structures\HAM074\_1908S\sheets\074\_1908S\_P1001A.dgn 7/28/2023 9:27:31 AM erin.baumann


DESIGNED	EEB	CHECKED	AMT
DRAWN	EEB	REVISED	XXX
REVIEWED	TES	DATE	8/22/2019
STRUCTURE FILE NUMBER	3109798		

**EX. PIER 7 DETAILS**  
BRIDGE NO. HAM-74-1908S  
RAMP P OVER IR-74 WESTBOUND IR-75 AND RAMP E

**HAM-75-3.84**  
**PID No. 104667**

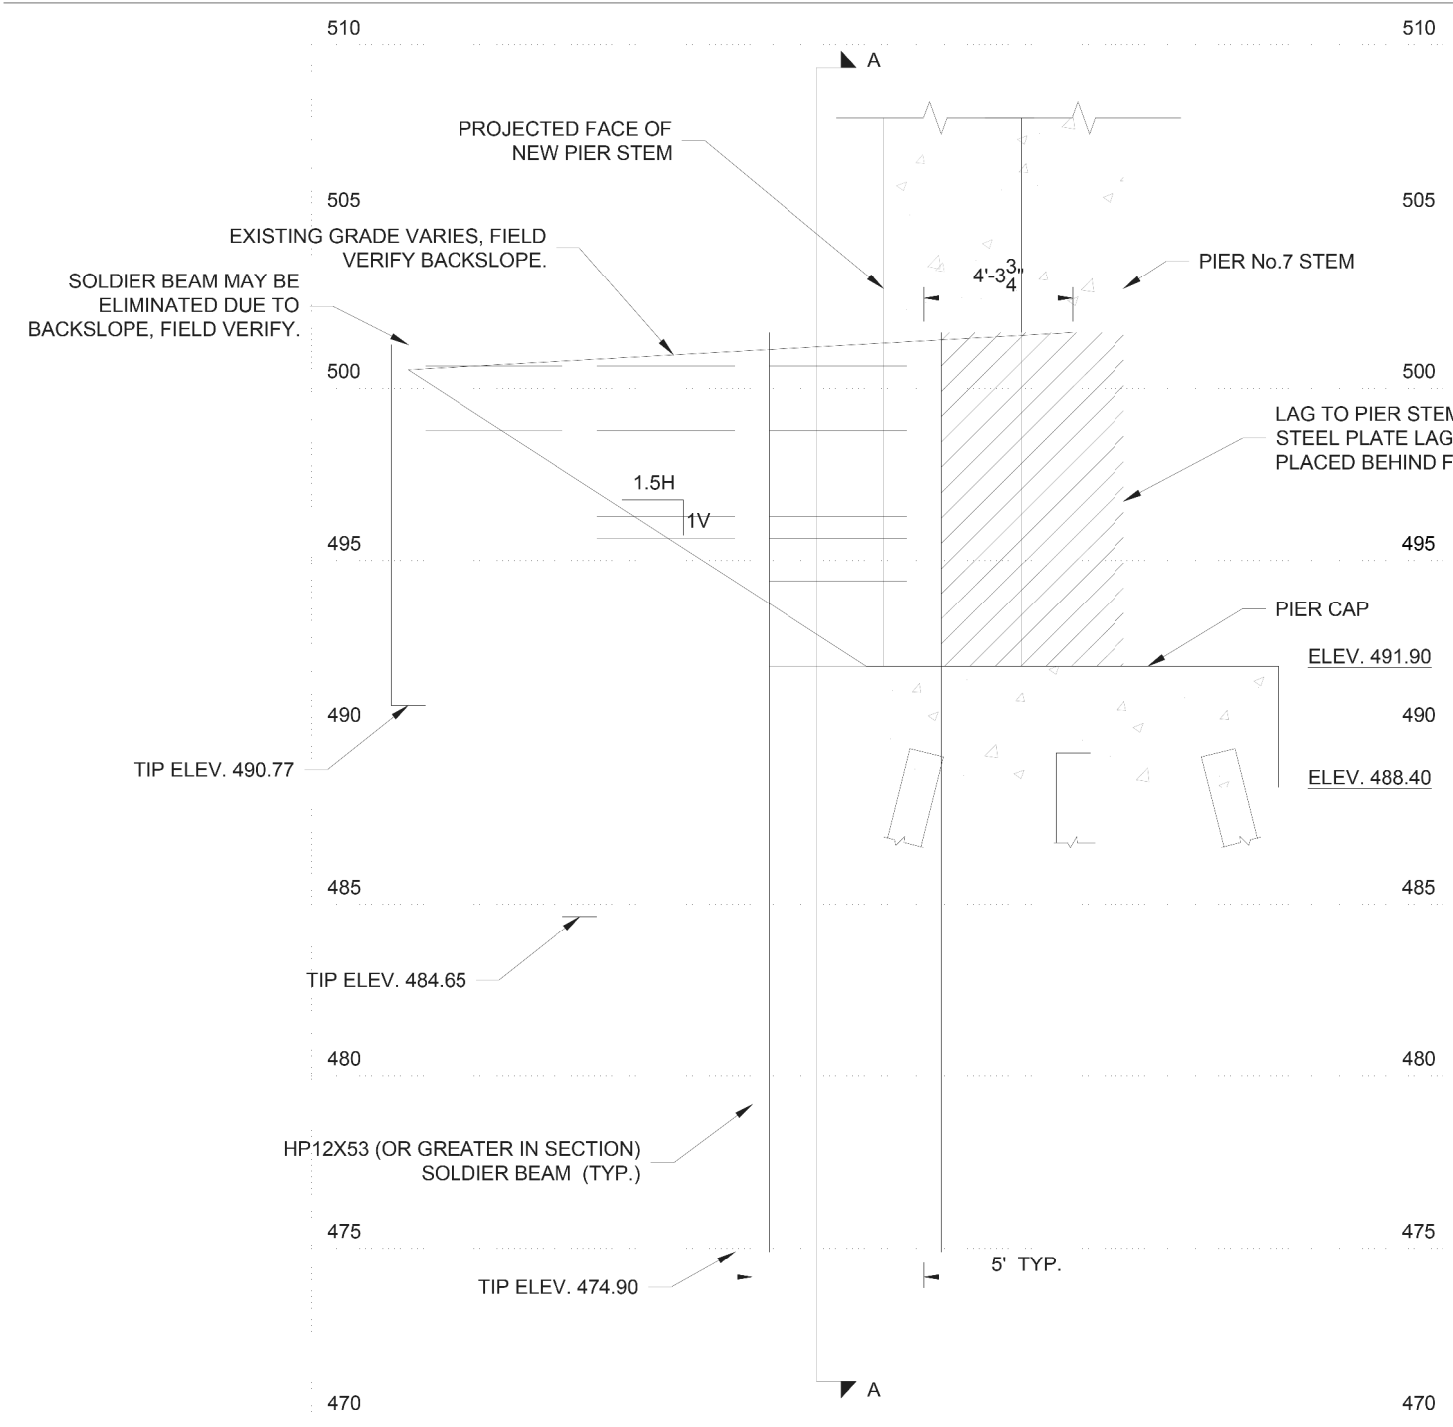

**SOUTH ELEVATION VIEW - SOE FOR PIER No. 7 (LOOKING SOUTH)**  
SCALE: 3/16" = 1'-0"

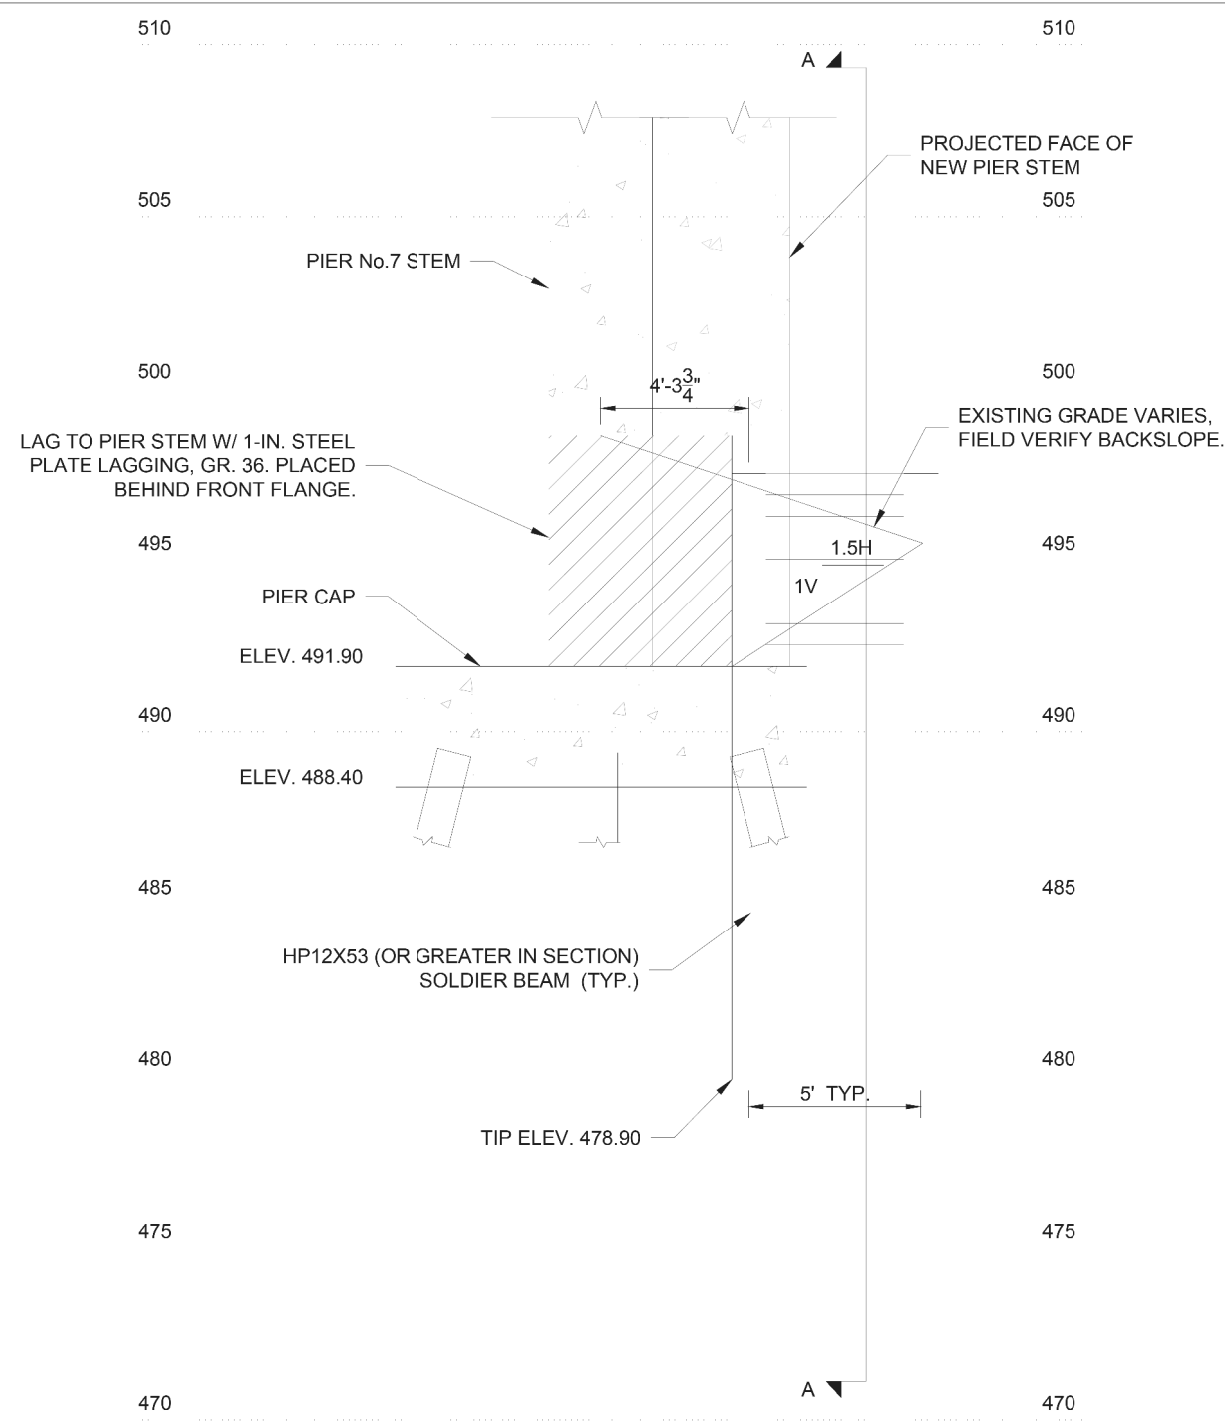

**NORTH ELEVATION VIEW - SOE FOR PIER No. 7 (LOOKING NORTH)**  
SCALE: 3/16" = 1'-0"



*Scott J. Ludlow*  
5/24/19  
DATE

**NOTES**

1. All structural steel shall be ASTM A572 or A992, Grade 50 unless noted otherwise.
2. Field verify soldier beam locations in relation to existing utilities.
3. Refer to Construction Plans for locations/orientation of existing foundations at pier.

**ELEVATION AT PIER No. 7**

PROJECT: I-75 BRIDGE STRUCTURES - HAM-75-3.85 - SOE FOR PIER No.7  
LOCATION: HAMILTON CO., OH  
CLIENT: WALSH CONSTRUCTION CO.  
SJL PROJ. NO.: 1-19-029  
SCALE: AS SHOWN

PROJECT ENG: SJL  
APPROVED BY: SJL  
DRAWN BY: KAL  
DATE AND TIME: 5/24/19  
DRAWING NO.: 1-19-029.B3



**S.J. Ludlow**  
Consulting Engineers, Inc.  
450 E. 96th St., Suite 500  
Indianapolis, IN 46240  
317-371-5539

P:\Projects\2018\20H030B-18232 HAM-75-03.84\104667\structures\HAM074\_1908S\sheets\074\_1908S\_P100B.dgn 7/28/2023 9:28:14 AM erin.baumann

DESIGNED	EEB	CHECKED	AMT
DRAWN	EEB	REVISED	XXX
REVIEWED	TES	DATE	8/22/2019
STRUCTURE FILE NUMBER	3109798		

**EX. PIER 7 DETAILS**  
BRIDGE NO. HAM-74-1908S  
RAMP P OVER IR-74 WESTBOUND IR-75 AND RAMP E


**HAM-75-3.84**  
PID No. 104667

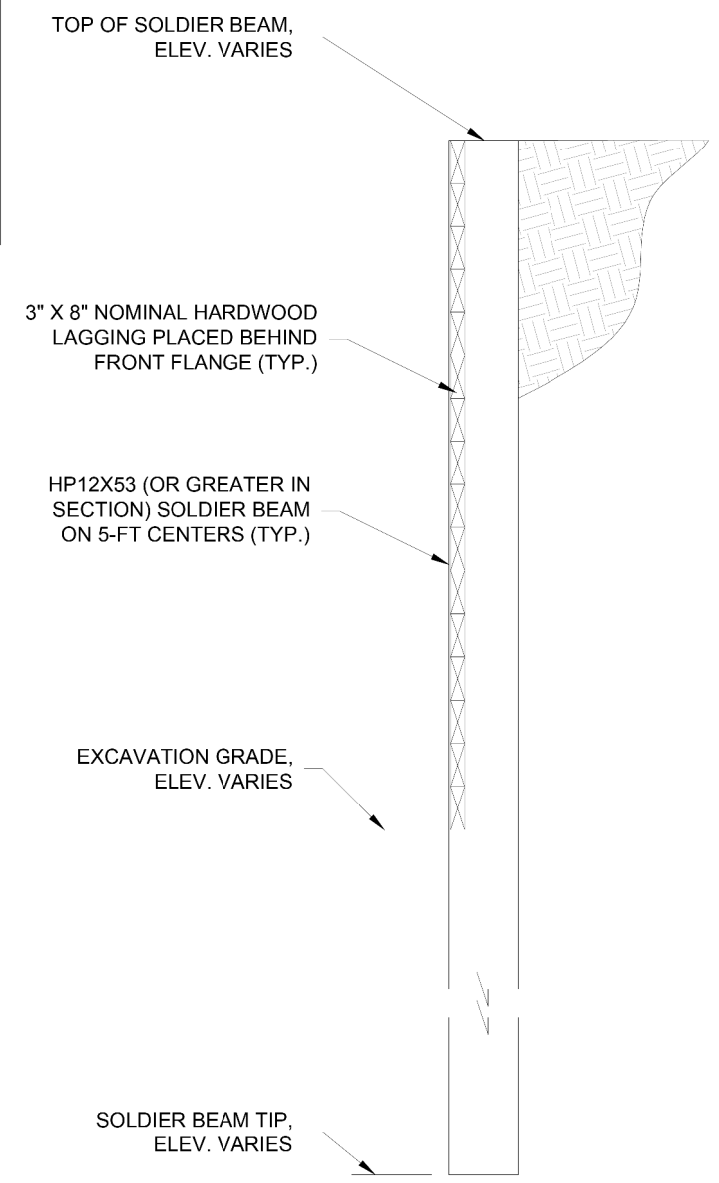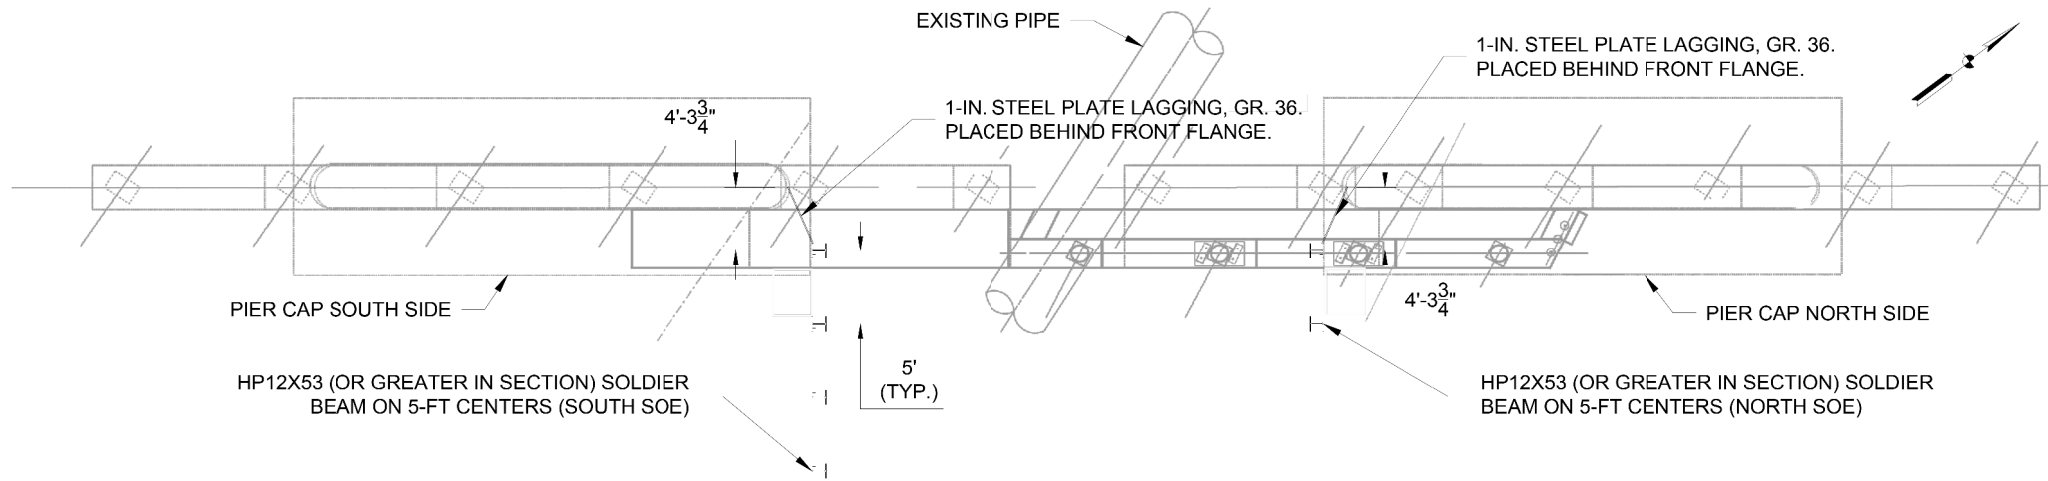

TYPICAL CANTILEVERED SECTION  
SCALE: 3/8" = 1'-0"

NOTE: PILES MAY BE FIELD SPLICED AS REQUIRED FOR LOW HEADROOM INSTALLATION.

NOTE: FIELD VERIFY LOCATION OF SOLDIER BEAMS IN RELATION TO EXISTING PIPE.

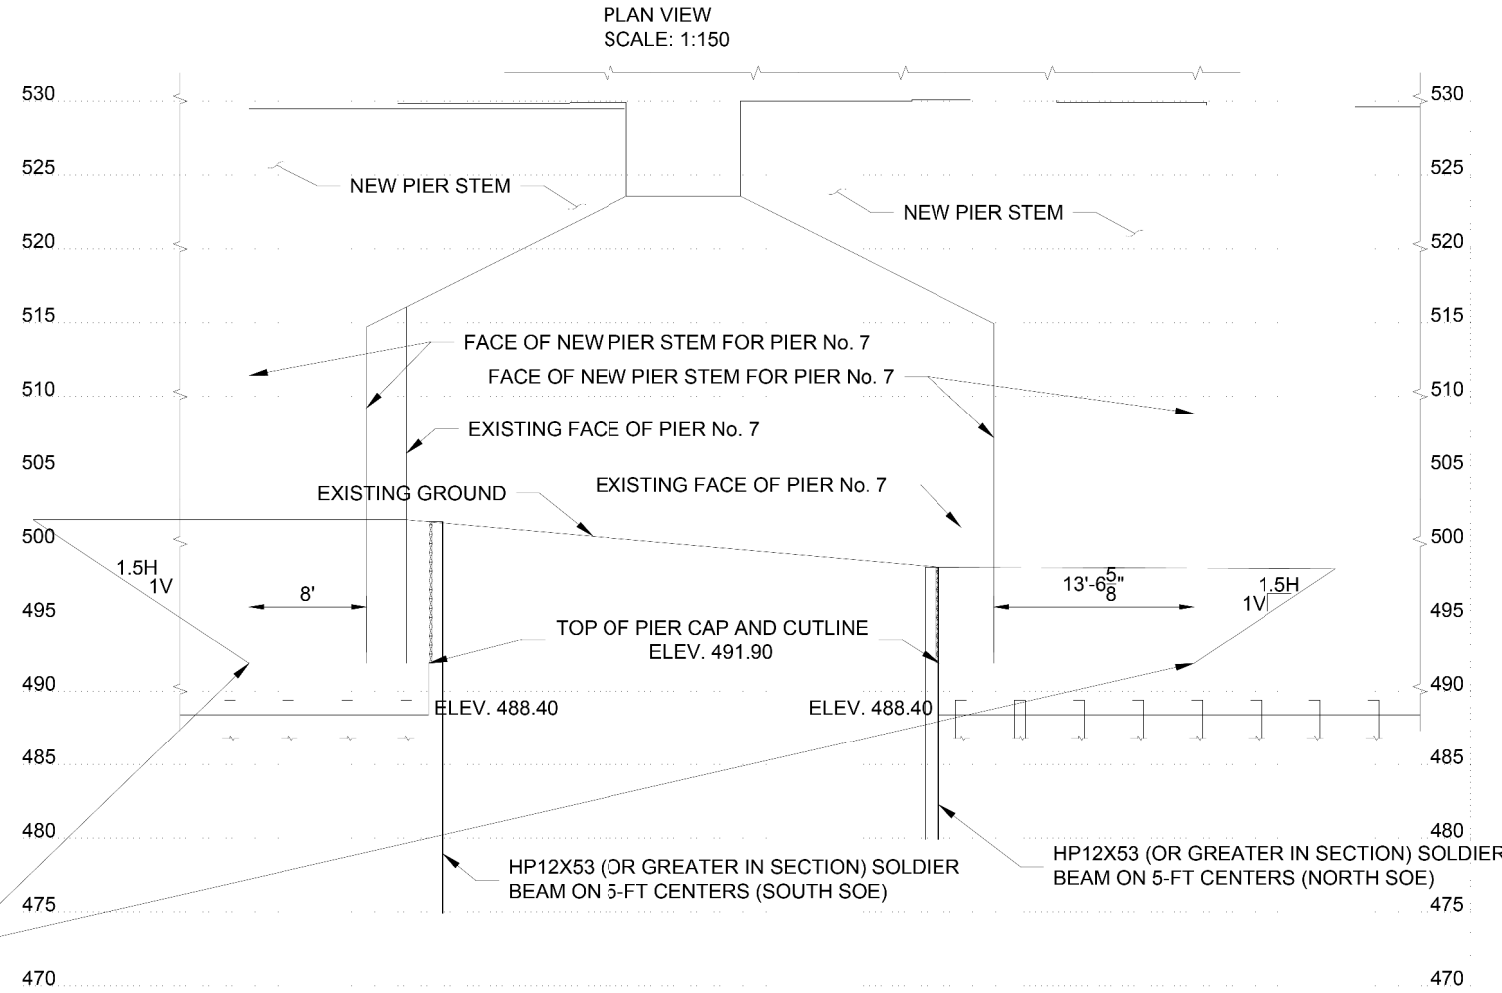

SECTION A-A - SOUTH AND NORTH SOE AT PIER No. 7 (LOOKING WEST)  
SCALE: 1:150

ADJUST OFFSET OF BACKSLOPE FROM FACE OF NEW PIER STEM AS REQUIRED AND MAINTAIN BACKSLOPE WITHIN LIMITS OF EXISTING PIER STEM



*Scott J. Ludlow*  
5/24/19  
DATE

**NOTES**

- All structural steel shall be ASTM A572 or A992, Grade 50, unless noted otherwise.
- No construction surcharge shall be applied between pier caps.
- All welds shall be E70xx electrodes according to AWS D1.1.
- Refer to Construction Plans for locations/orientation of existing foundations at pier.


**PLAN VIEW AND SECTIONS**

PROJECT: I-75 BRIDGE STRUCTURES - HAM-75-3.85 - SOE FOR PIER No.7  
LOCATION: HAMILTON CO., OH  
CLIENT: WALSH CONSTRUCTION CO.  
SJL PROJ. NO.: 1-19-029  
SCALE: AS SHOWN


PROJECT ENG: SJL  
APPROVED BY: SJL  
DRAWN BY: KAL  
DATE AND TIME: 5/24/19  
DRAWING NO.: 1-19-029.B4




P:\Projects\2018\20H03DB-18232 HAM-75-03.84\104667\structures\HAM074\_1908S\sheets\074\_1908S\_P1006.dgn 7/28/2023 9:29:04 AM erin.baumann

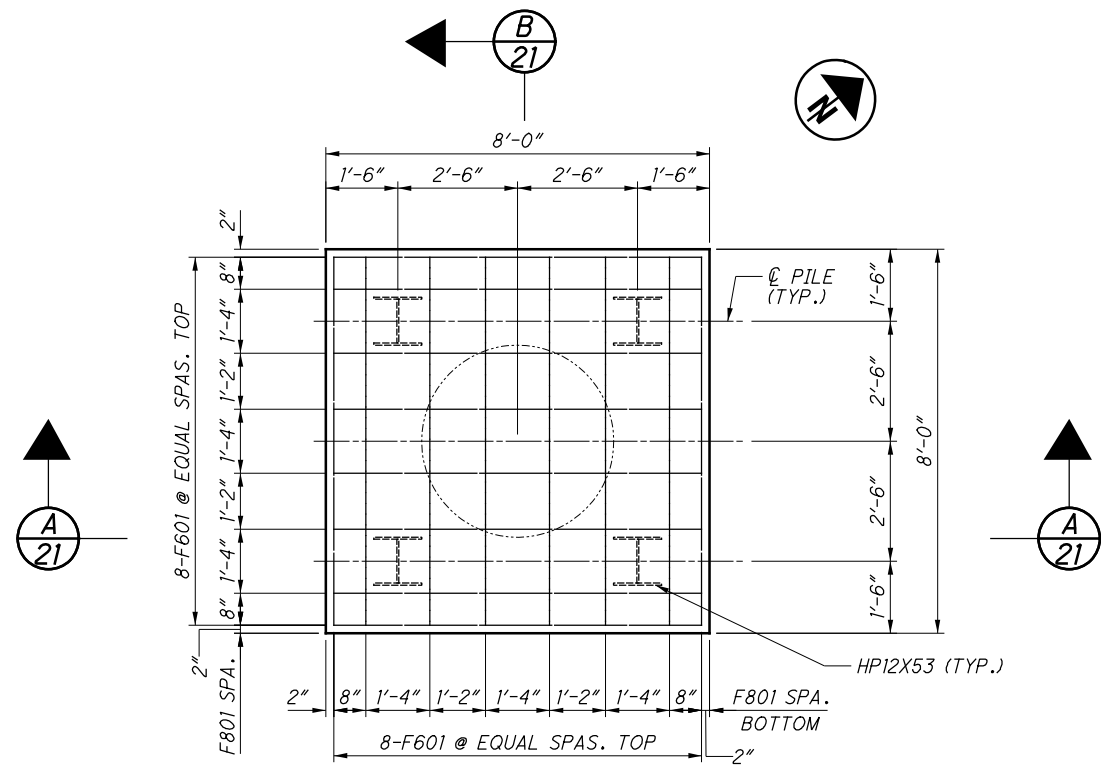


**FOOTING PLAN - PIER 1**  
(3 REQ'D)

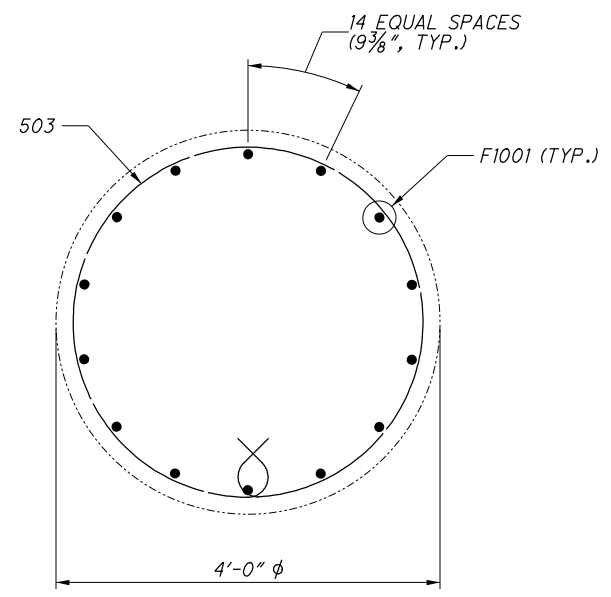

**SECTION C-C**

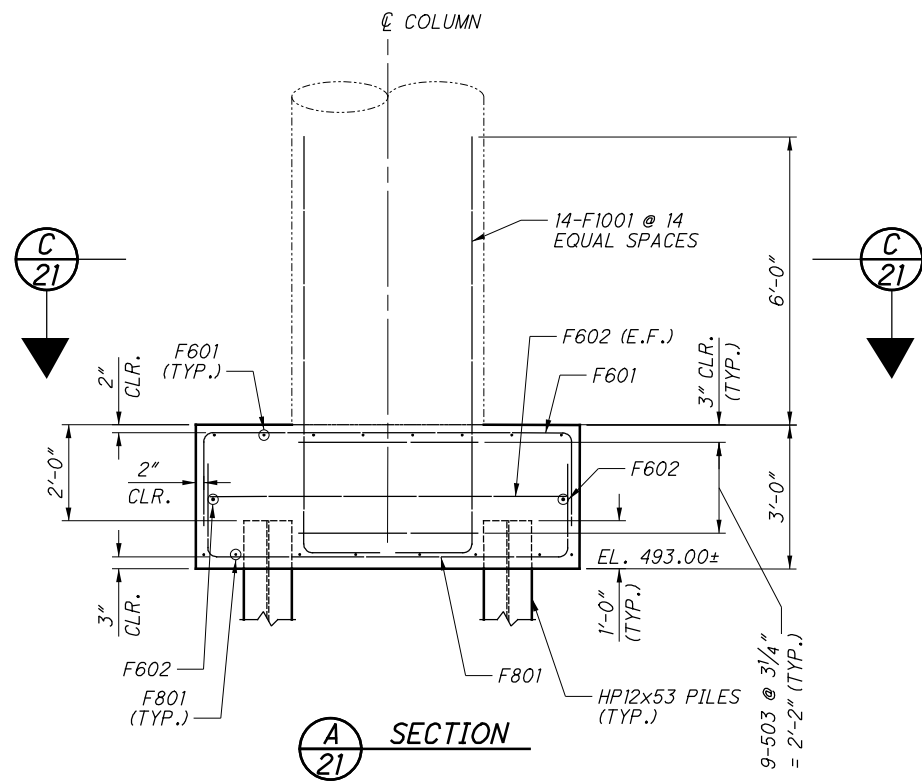

**SECTION A-A**







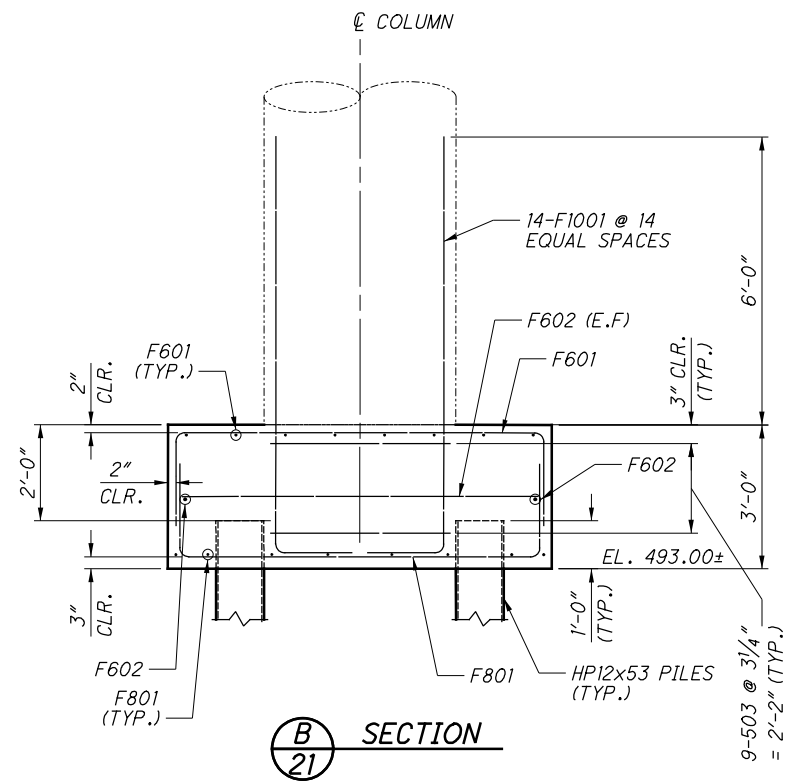


**SECTION B-B**

**NOTES:**

1. FOR REINFORCING SCHEDULE, SEE SHEETS **74/79** AND **79/79**.

P:\Projects\2018\20H03DB-18232 HAM-75-03-84\104667\structures\HAM074\_1908S\sheets\074\_1908S\_P1002.dgn 7/28/2023 9:29:20 AM er.in.baumann

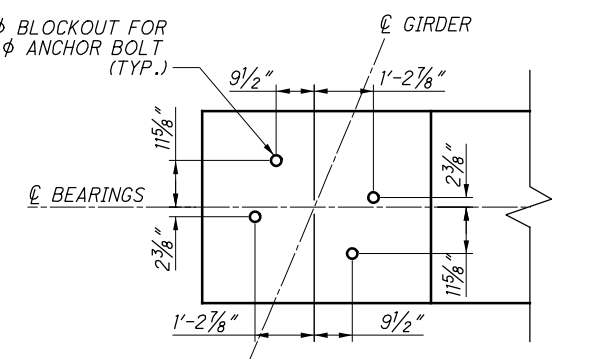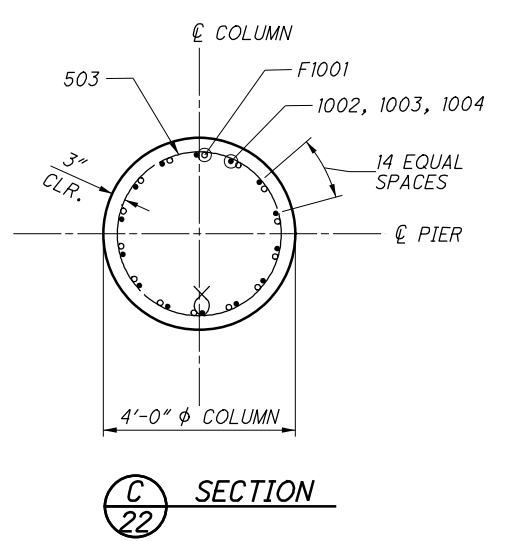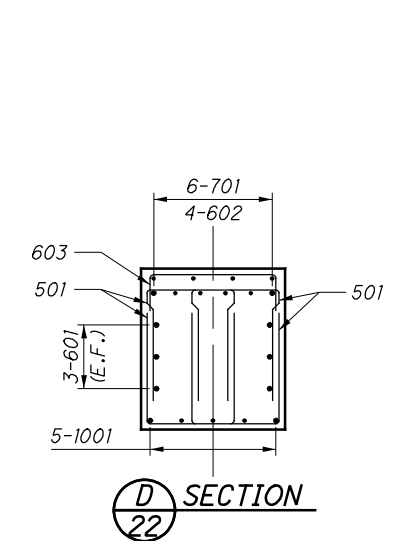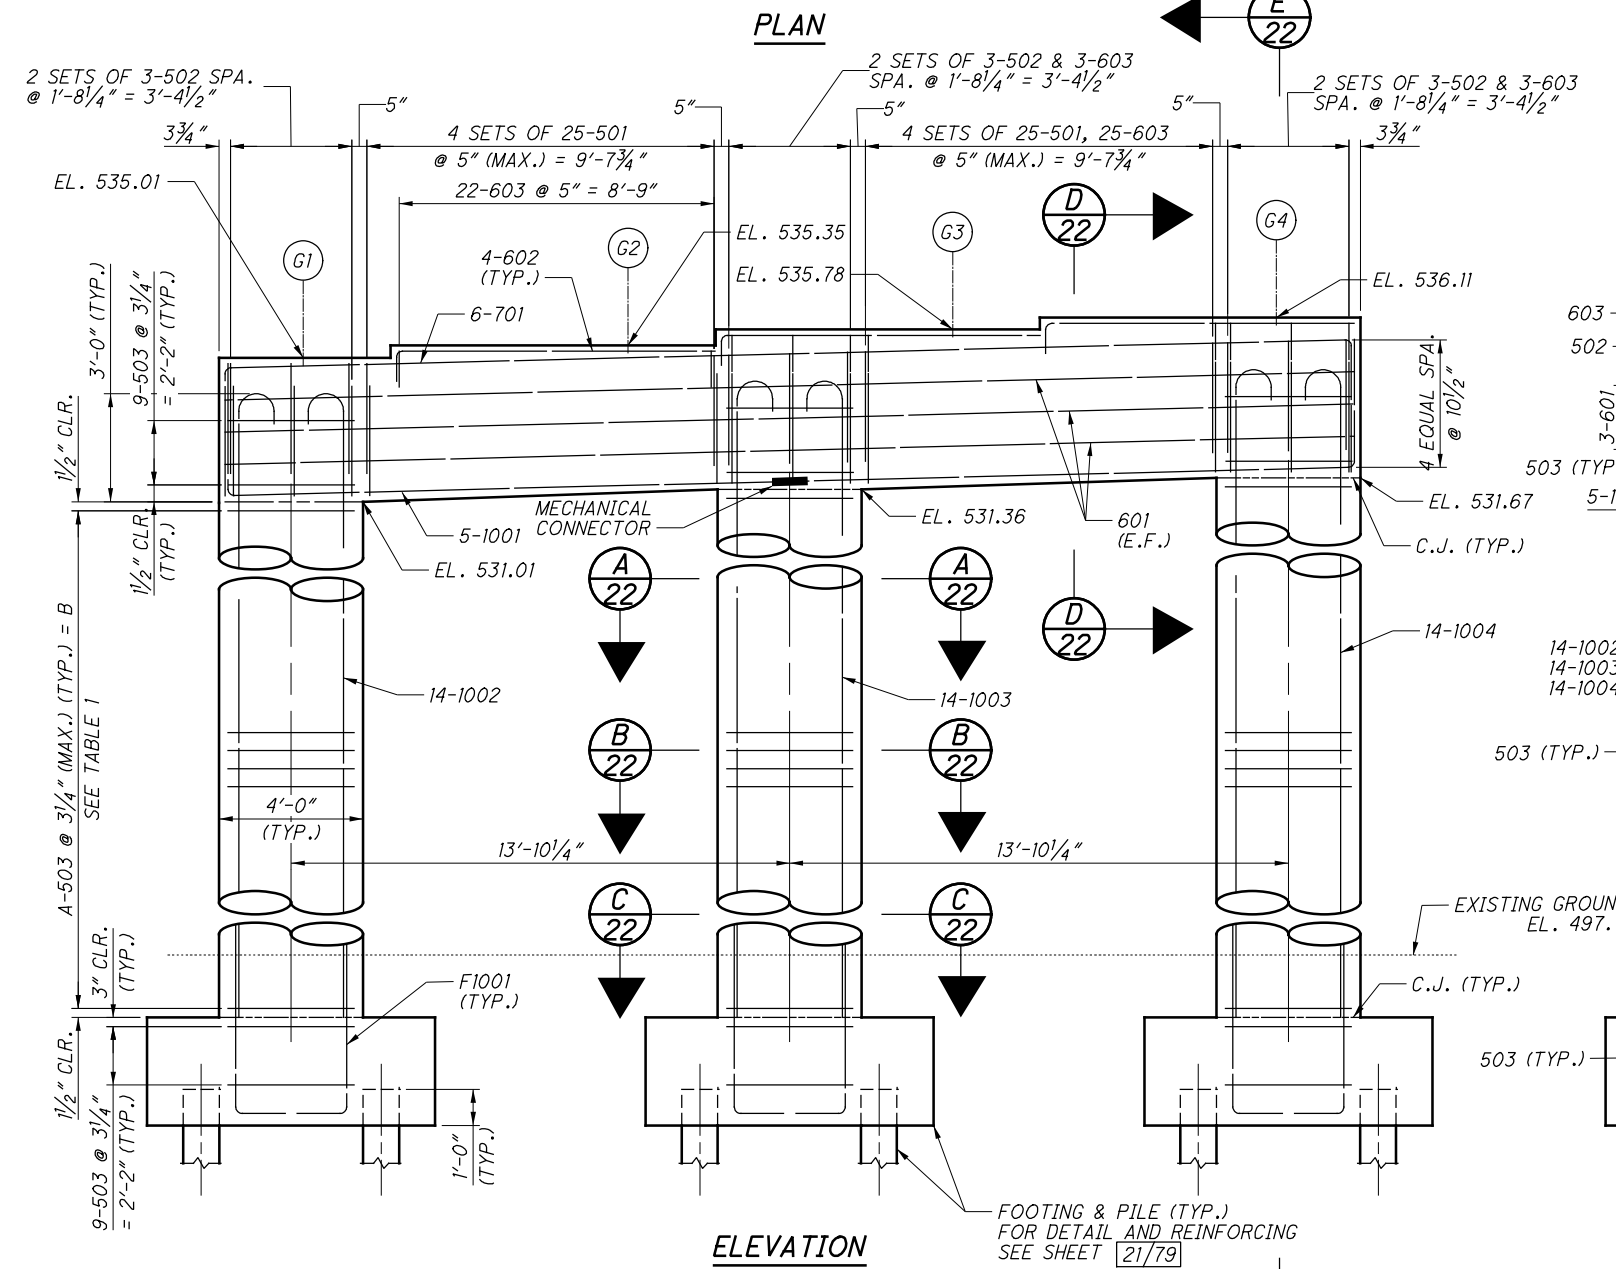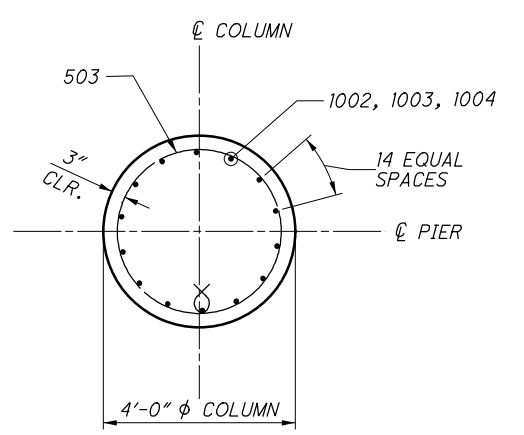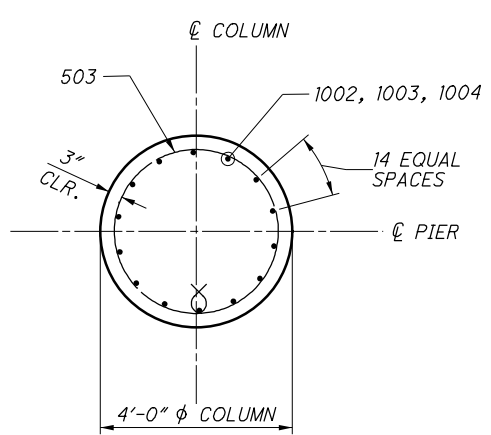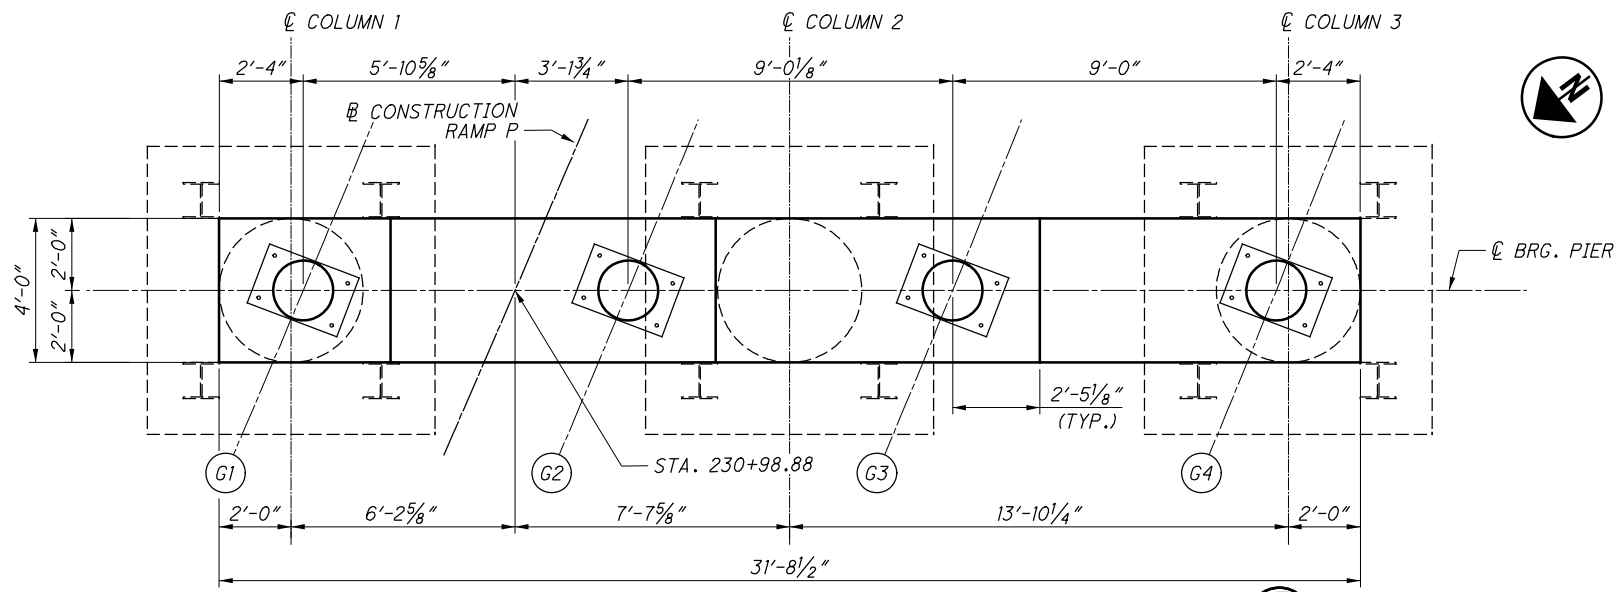

COLUMN	A	B
1	130	34'-9"
2	131	35'-1 1/4"
3	132	35'-5"


#5 VERTICAL	29"
#5 HORIZONTAL	34"
#10 VERTICAL	72"

- NOTES:**
1. SEAL ALL EXPOSED (ABOVE GROUND) CONCRETE SURFACES OF PROPOSED PIER, EXCEPT BEAM SEATS, WITH EPOXY URETHANE.
  2. FOR BEARING LOCATION DETAILS SEE SHEET [36/79].
  3. SPACE TOP REINFORCING BARS TO CLEAR BEARING ANCHOR BOLTS.
  4. FOR ANCHOR BOLT BLOCKOUT DETAILS SEE SHEET [35/79].
  5. FOR ADDITIONAL NOTES, SEE SHEET [19/79].
  6. THE PREFIX "1P" SHALL BE ADDED TO ALL BAR MARKS FOR PIER NO. 1.
  7. FOR REINFORCING SCHEDULE, SEE SHEET [74/79].
  8. FOR GEOMETRIC REFERENCE, SEE REFERENCE CHORD LAYOUT SHEET [6/79].







P:\Projects\2018\20H03DB-18232 HAM-75-03-84\104667\structures\HAM074\_1908S\PI007.dgn 7/28/2023 9:29:24 AM erin.baumann

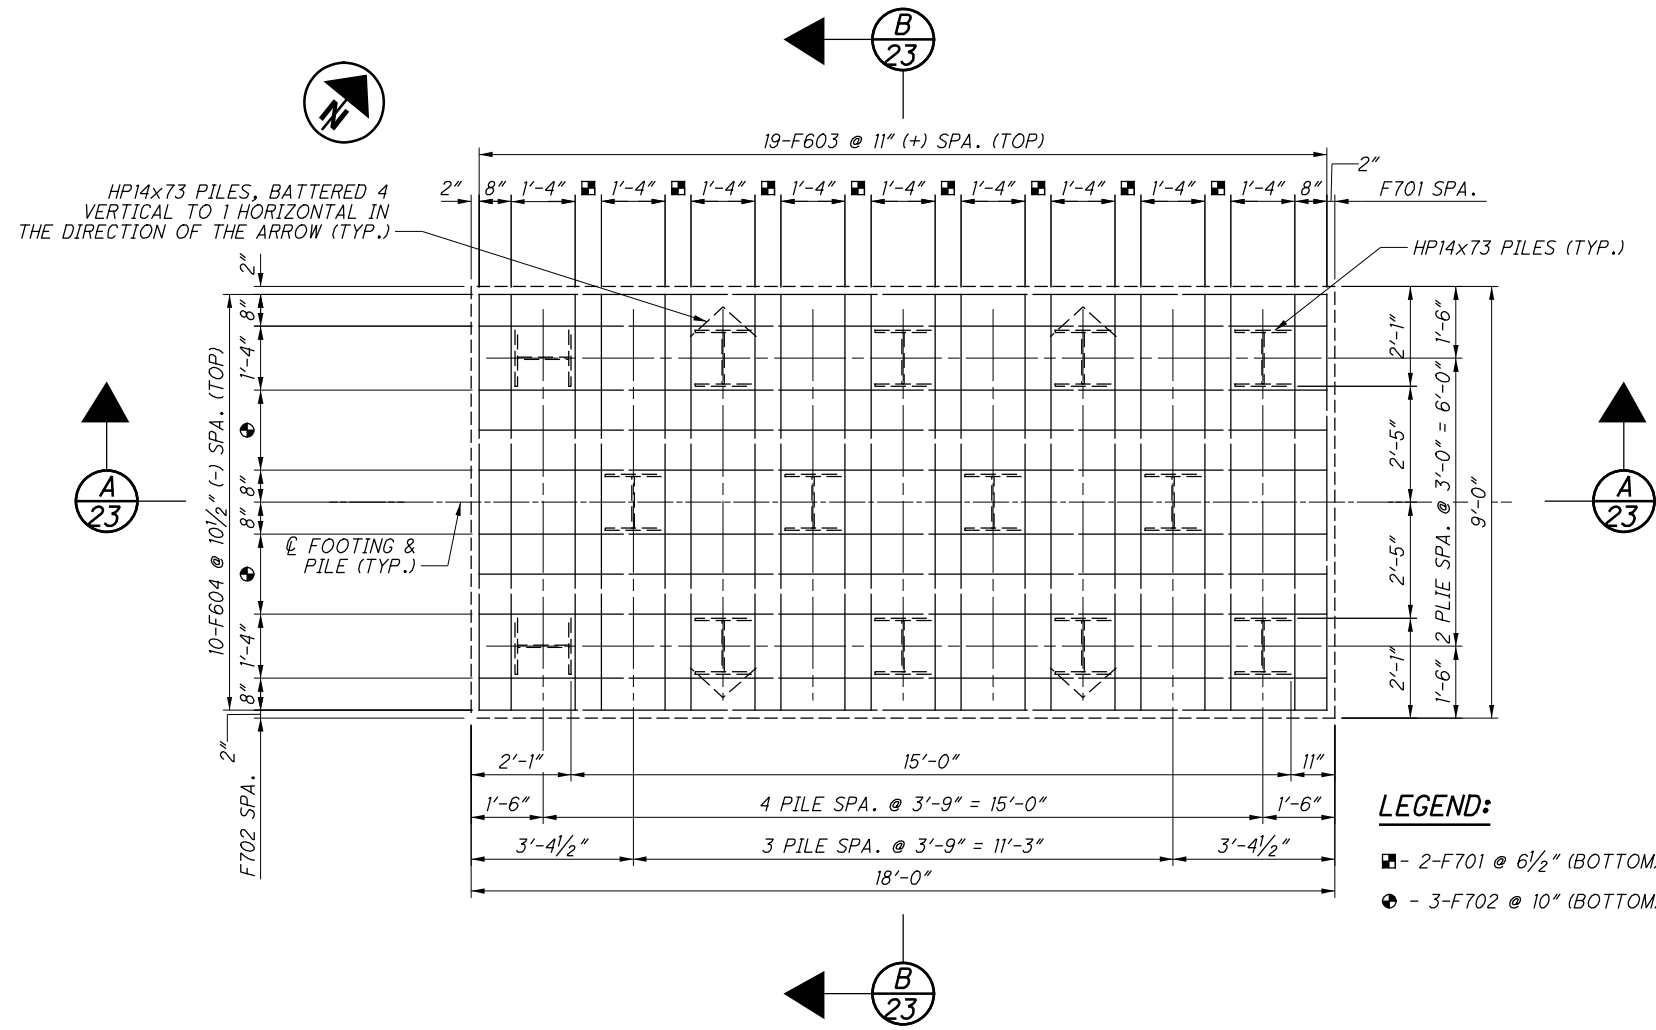


FOOTING PLAN - PIER 2

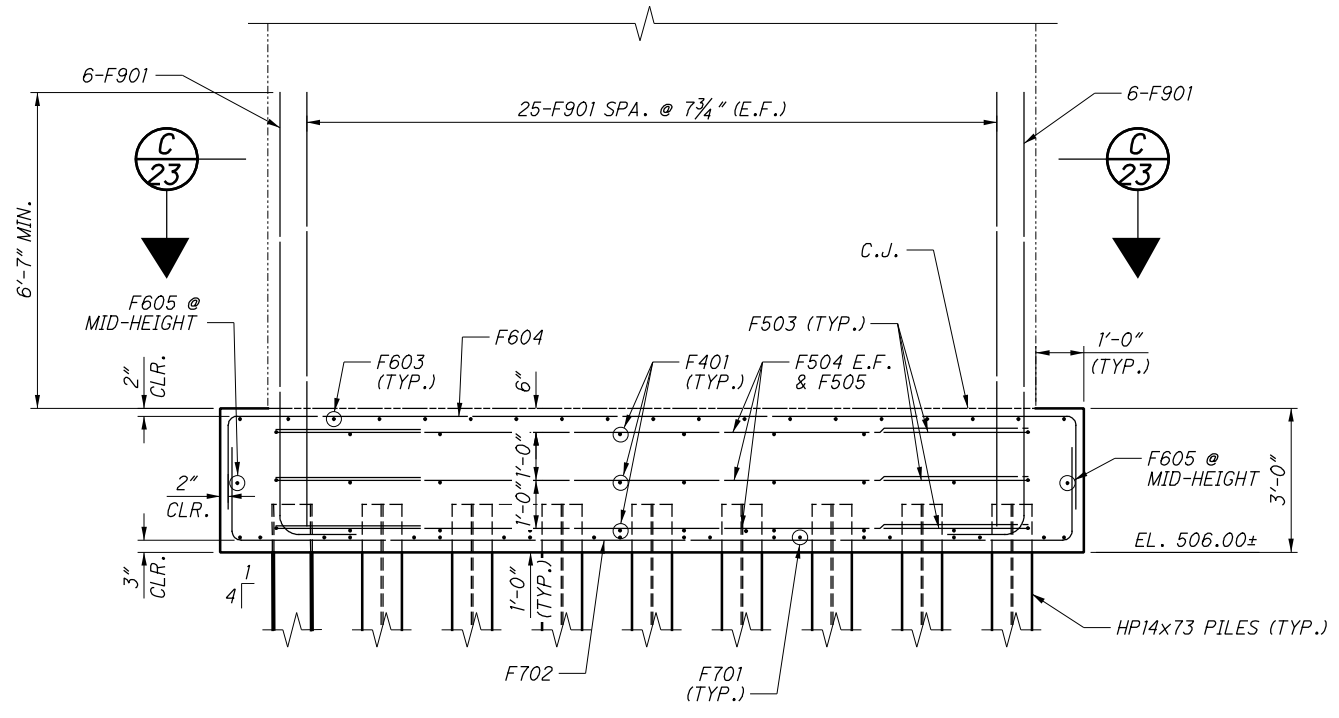

SECTION A THRU FOOTING







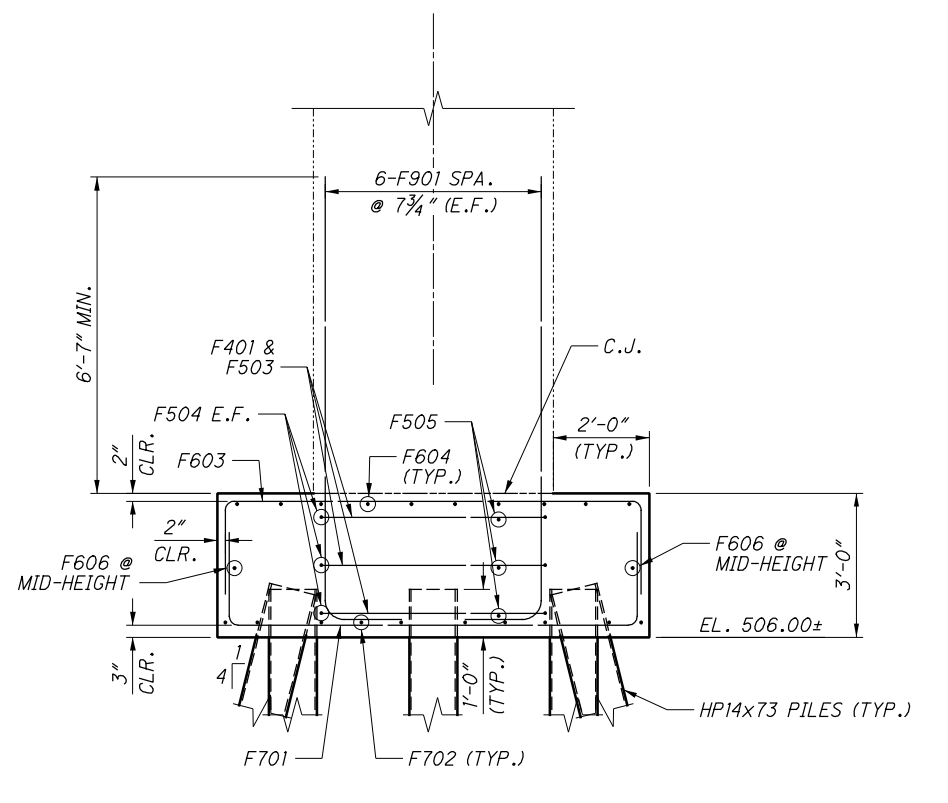


SECTION B THRU FOOTING

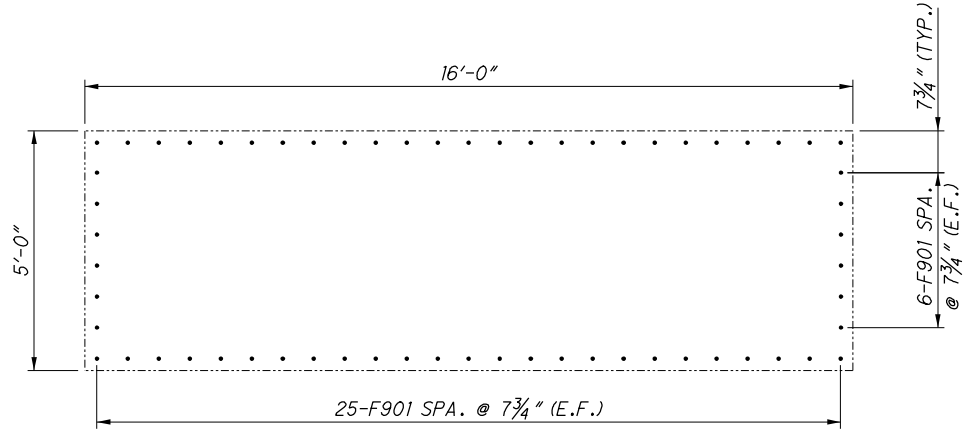

SECTION C THRU WALL

NOTES:  
1. FOR REINFORCING SCHEDULE, SEE SHEETS 74/79 AND 79/79.

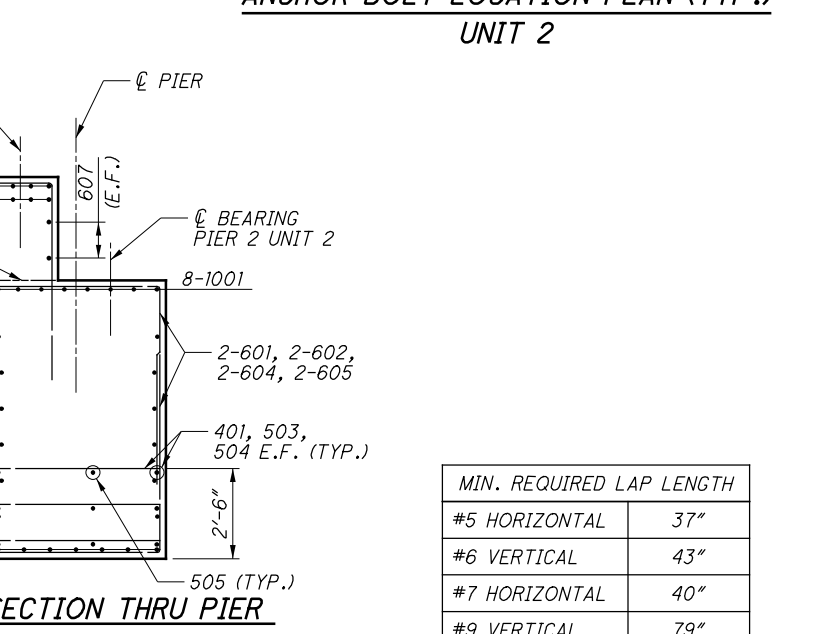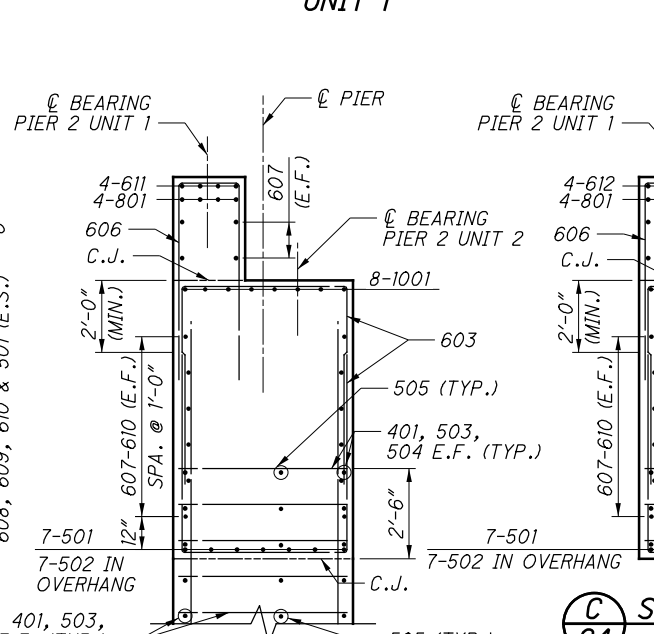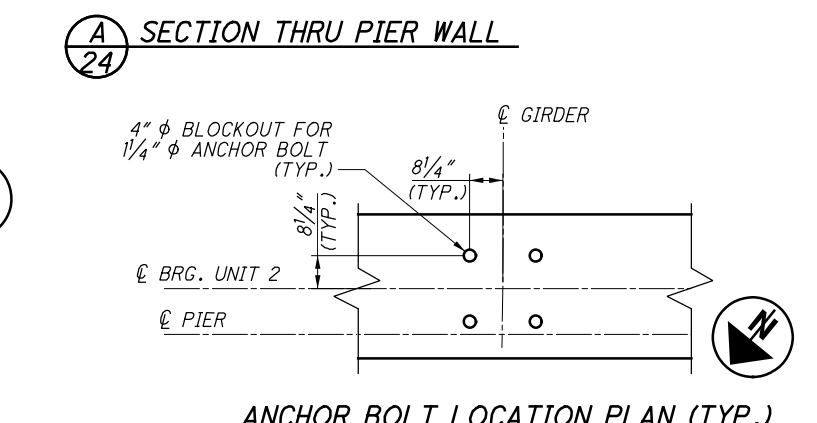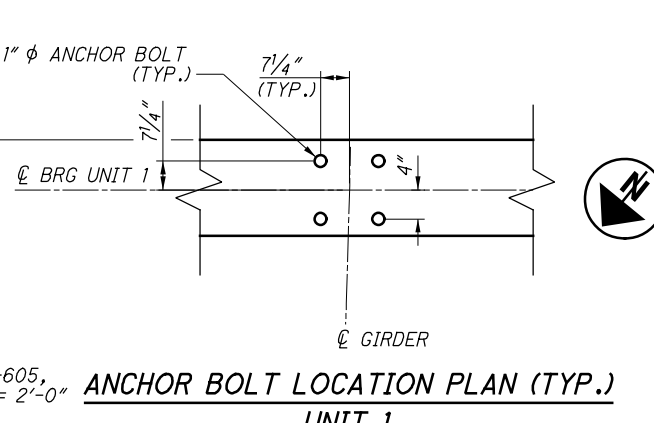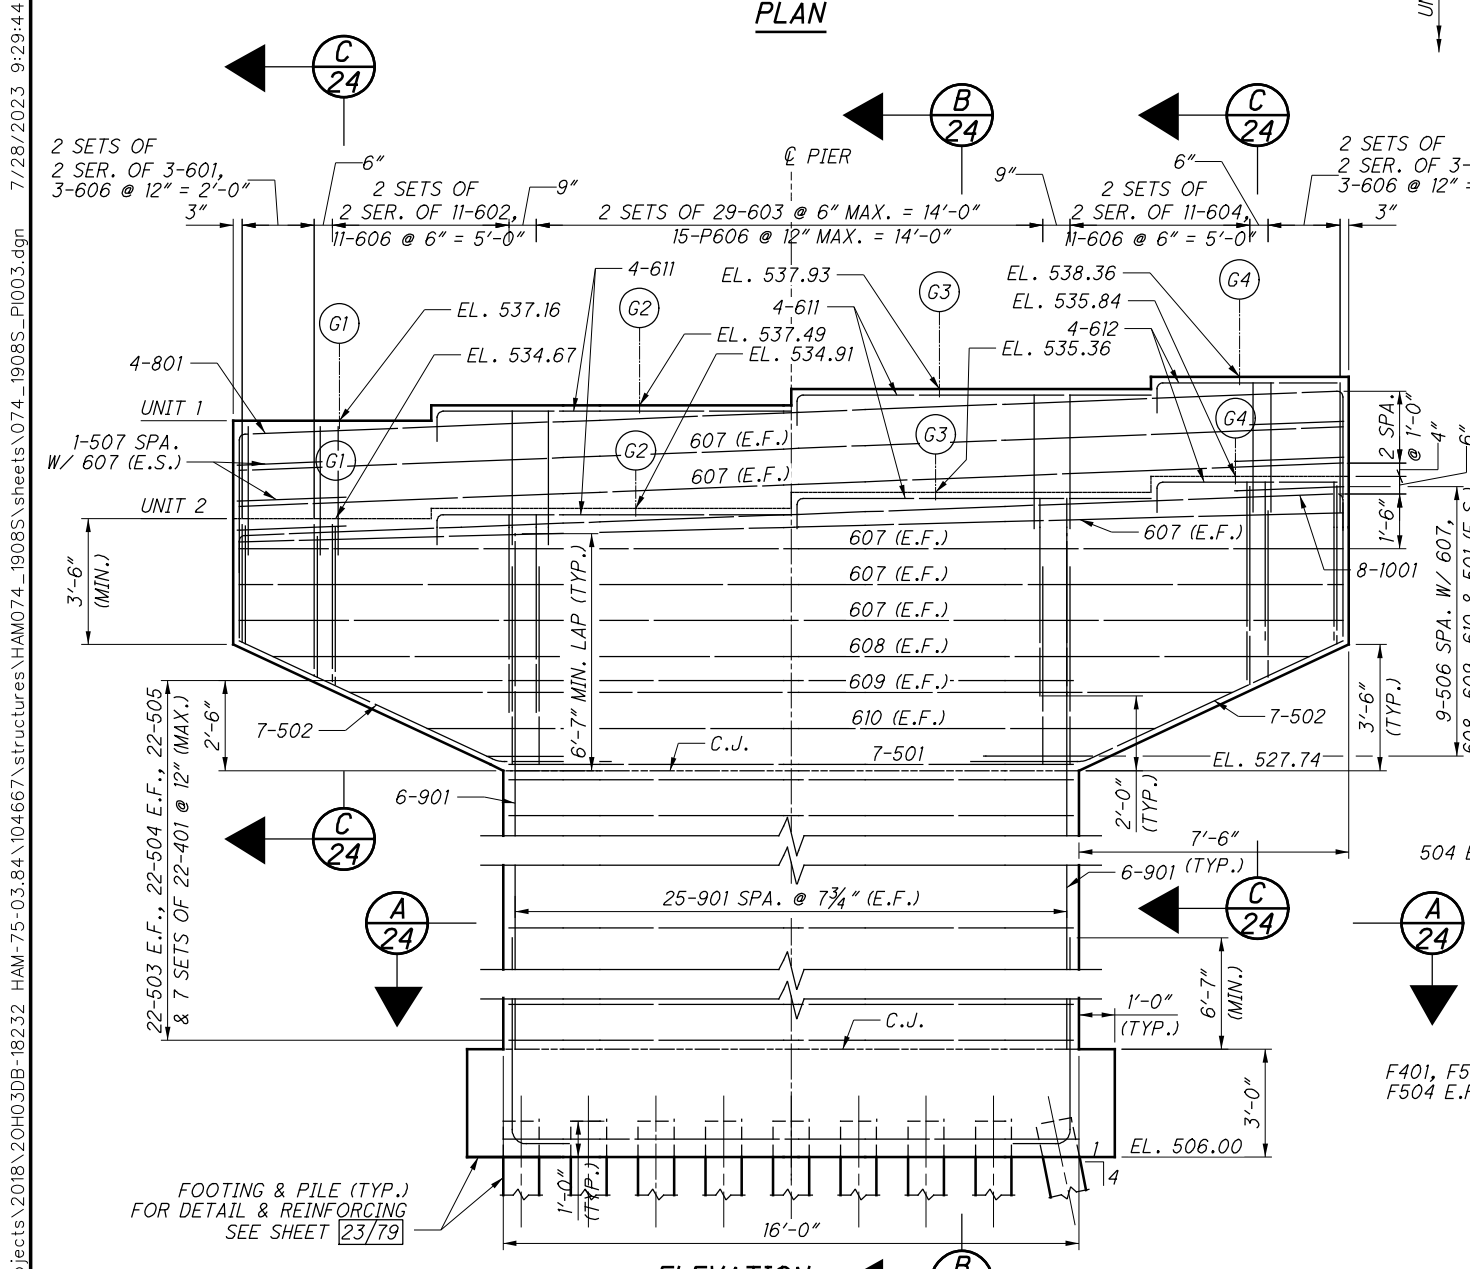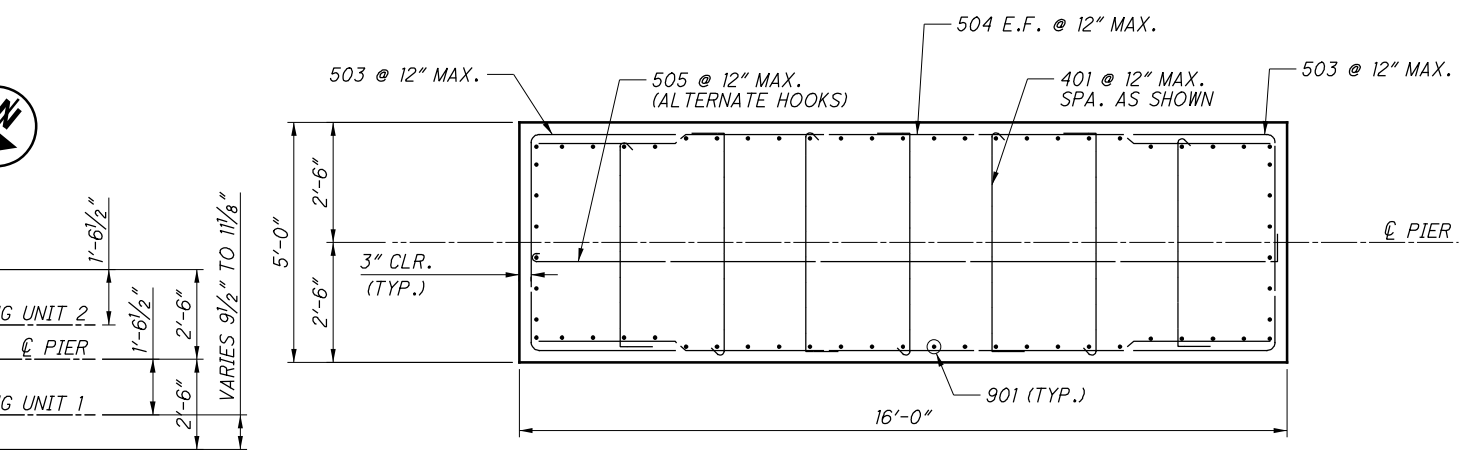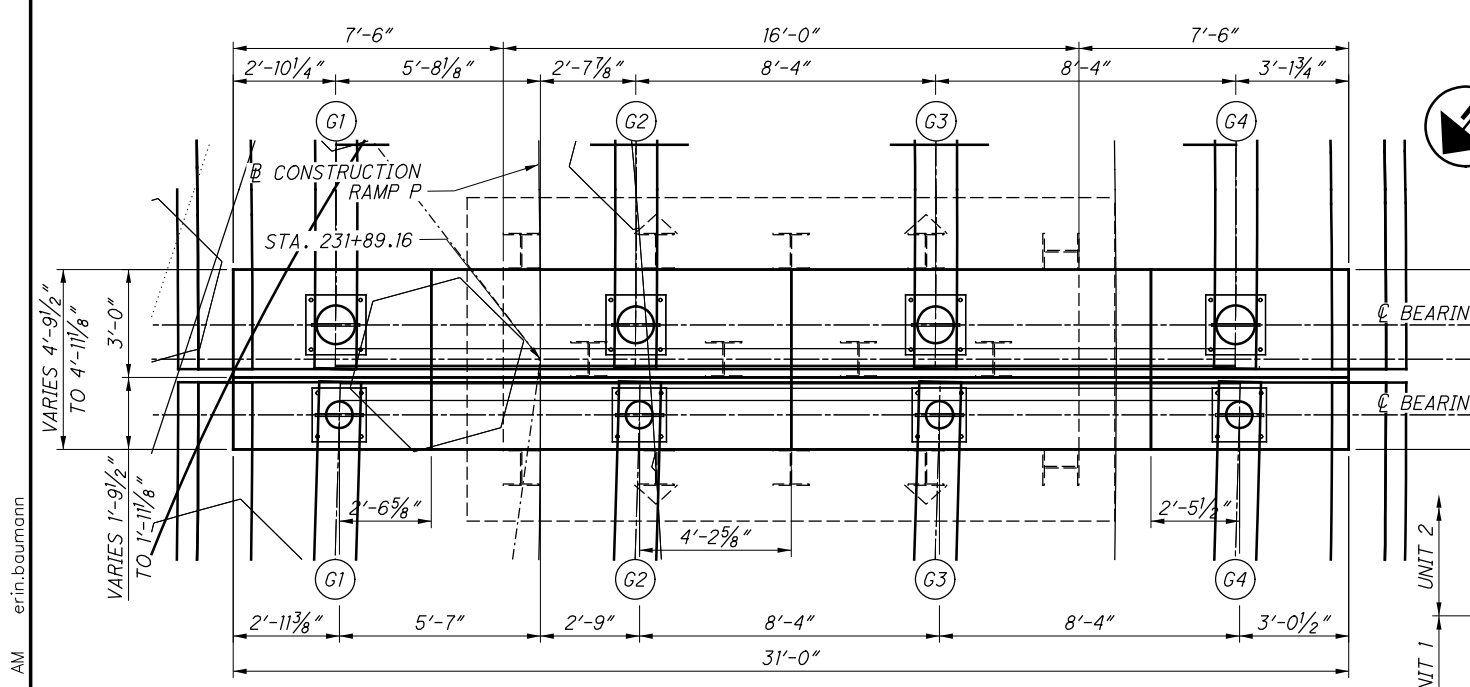

MIN. REQUIRED LAP LENGTH	
#5 HORIZONTAL	37"
#6 VERTICAL	43"
#7 HORIZONTAL	40"
#9 VERTICAL	79"

- NOTES:**
- SEAL ALL EXPOSED (ABOVE GROUND) CONCRETE SURFACES OF PROPOSED PIER, EXCEPT BEAM SEATS, WITH EPOXY URETHANE.
  - FOR BEARING LOCATION DETAILS, SEE SHEET 36/79.
  - SPACE TOP REINFORCING BARS TO CLEAR BEARING ANCHOR BOLTS.
  - FOR ANCHOR BOLT BLOCKOUT DETAILS, SEE SHEET 35/79.
  - FOR ADDITIONAL NOTES, SEE SHEET 19/79.
  - THE PREFIX "2P" SHALL BE ADDED TO ALL BAR MARKS FOR PIER NO. 2.
  - FOR REINFORCING SCHEDULE, SEE SHEET 75/79.
  - FOR GEOMETRIC REFERENCE, SEE REFERENCE CHORD LAYOUT SHEET 6/79.
  - BRIDGE SEAT ELEVATIONS HAVE BEEN ADJUSTED UPWARD 0.148 INCHES AT PIER 2 UNIT 2 TO COMPENSATE FOR THE VERTICAL DEFORMATION OF THE BEARINGS.

P:\Projects\2018\20H03DB-18232 HAM-75-03.84\104667\structures\HAM074\_1908S\PI003.dgn 7/28/2023 9:29:44 AM er.in.baumann

DESIGN AGENCY  
**PRIME**  
540 WHITE POND DR. SUITE E  
AKRON, OH 44320

DESIGNED  
KDC  
CHECKED  
CRG

DRAWN  
MIN  
REVISED

REVIEWED  
TES  
STRUCTURE FILE NUMBER  
3109798






DATE  
8/22/2019

**PIER 2 DETAILS**  
BRIDGE NO. HAM-74-1908S  
RAMP P OVER IR-74 WESTBOUND, IR-75 AND RAMP E

HAM-75-3.84  
PID No. 104667

24 / 79  
24 / 79

P:\Projects\2018\20H030B-18232 HAM-75-03-84\104667\structures\HAM074\_1908S\sheets\074\_1908S\_P1003A.dgn 7/28/2023 9:29:48 AM er.in.baumann

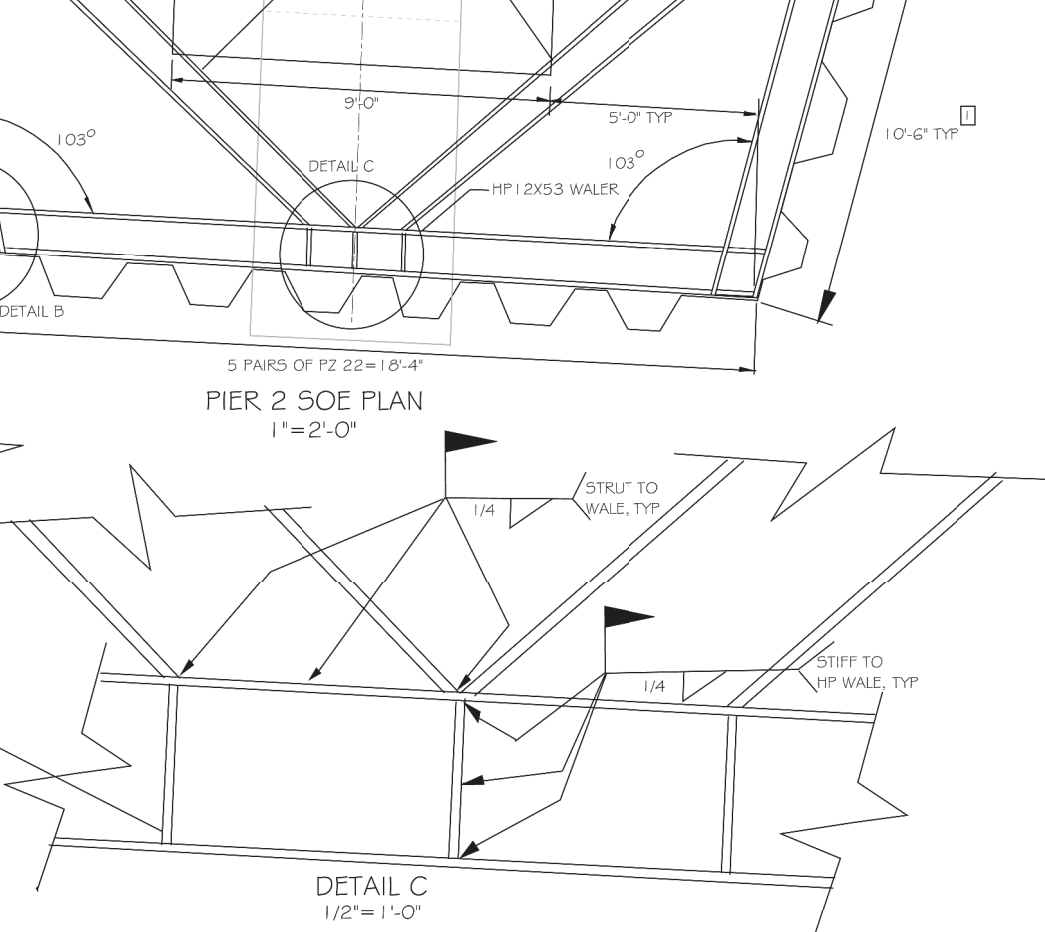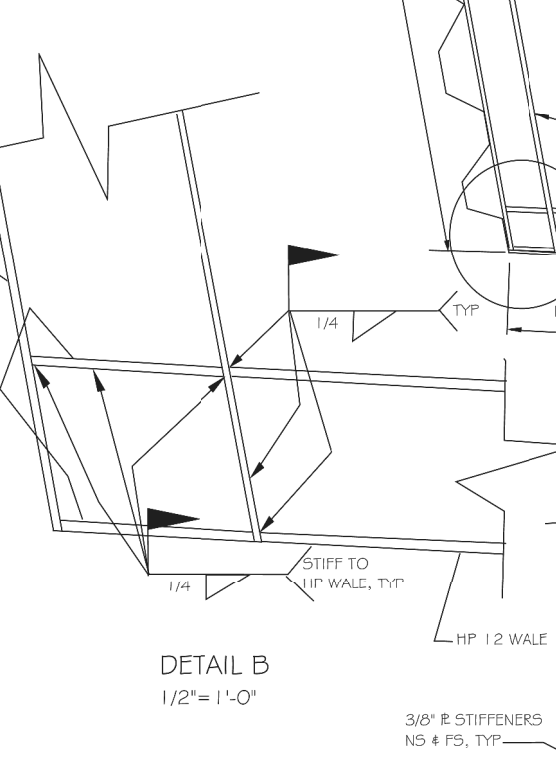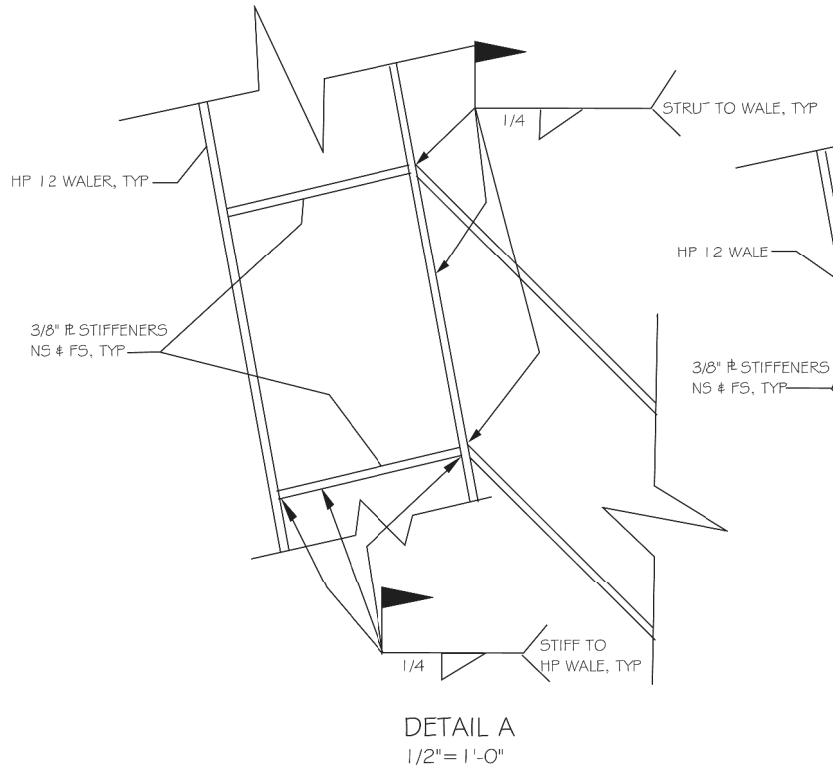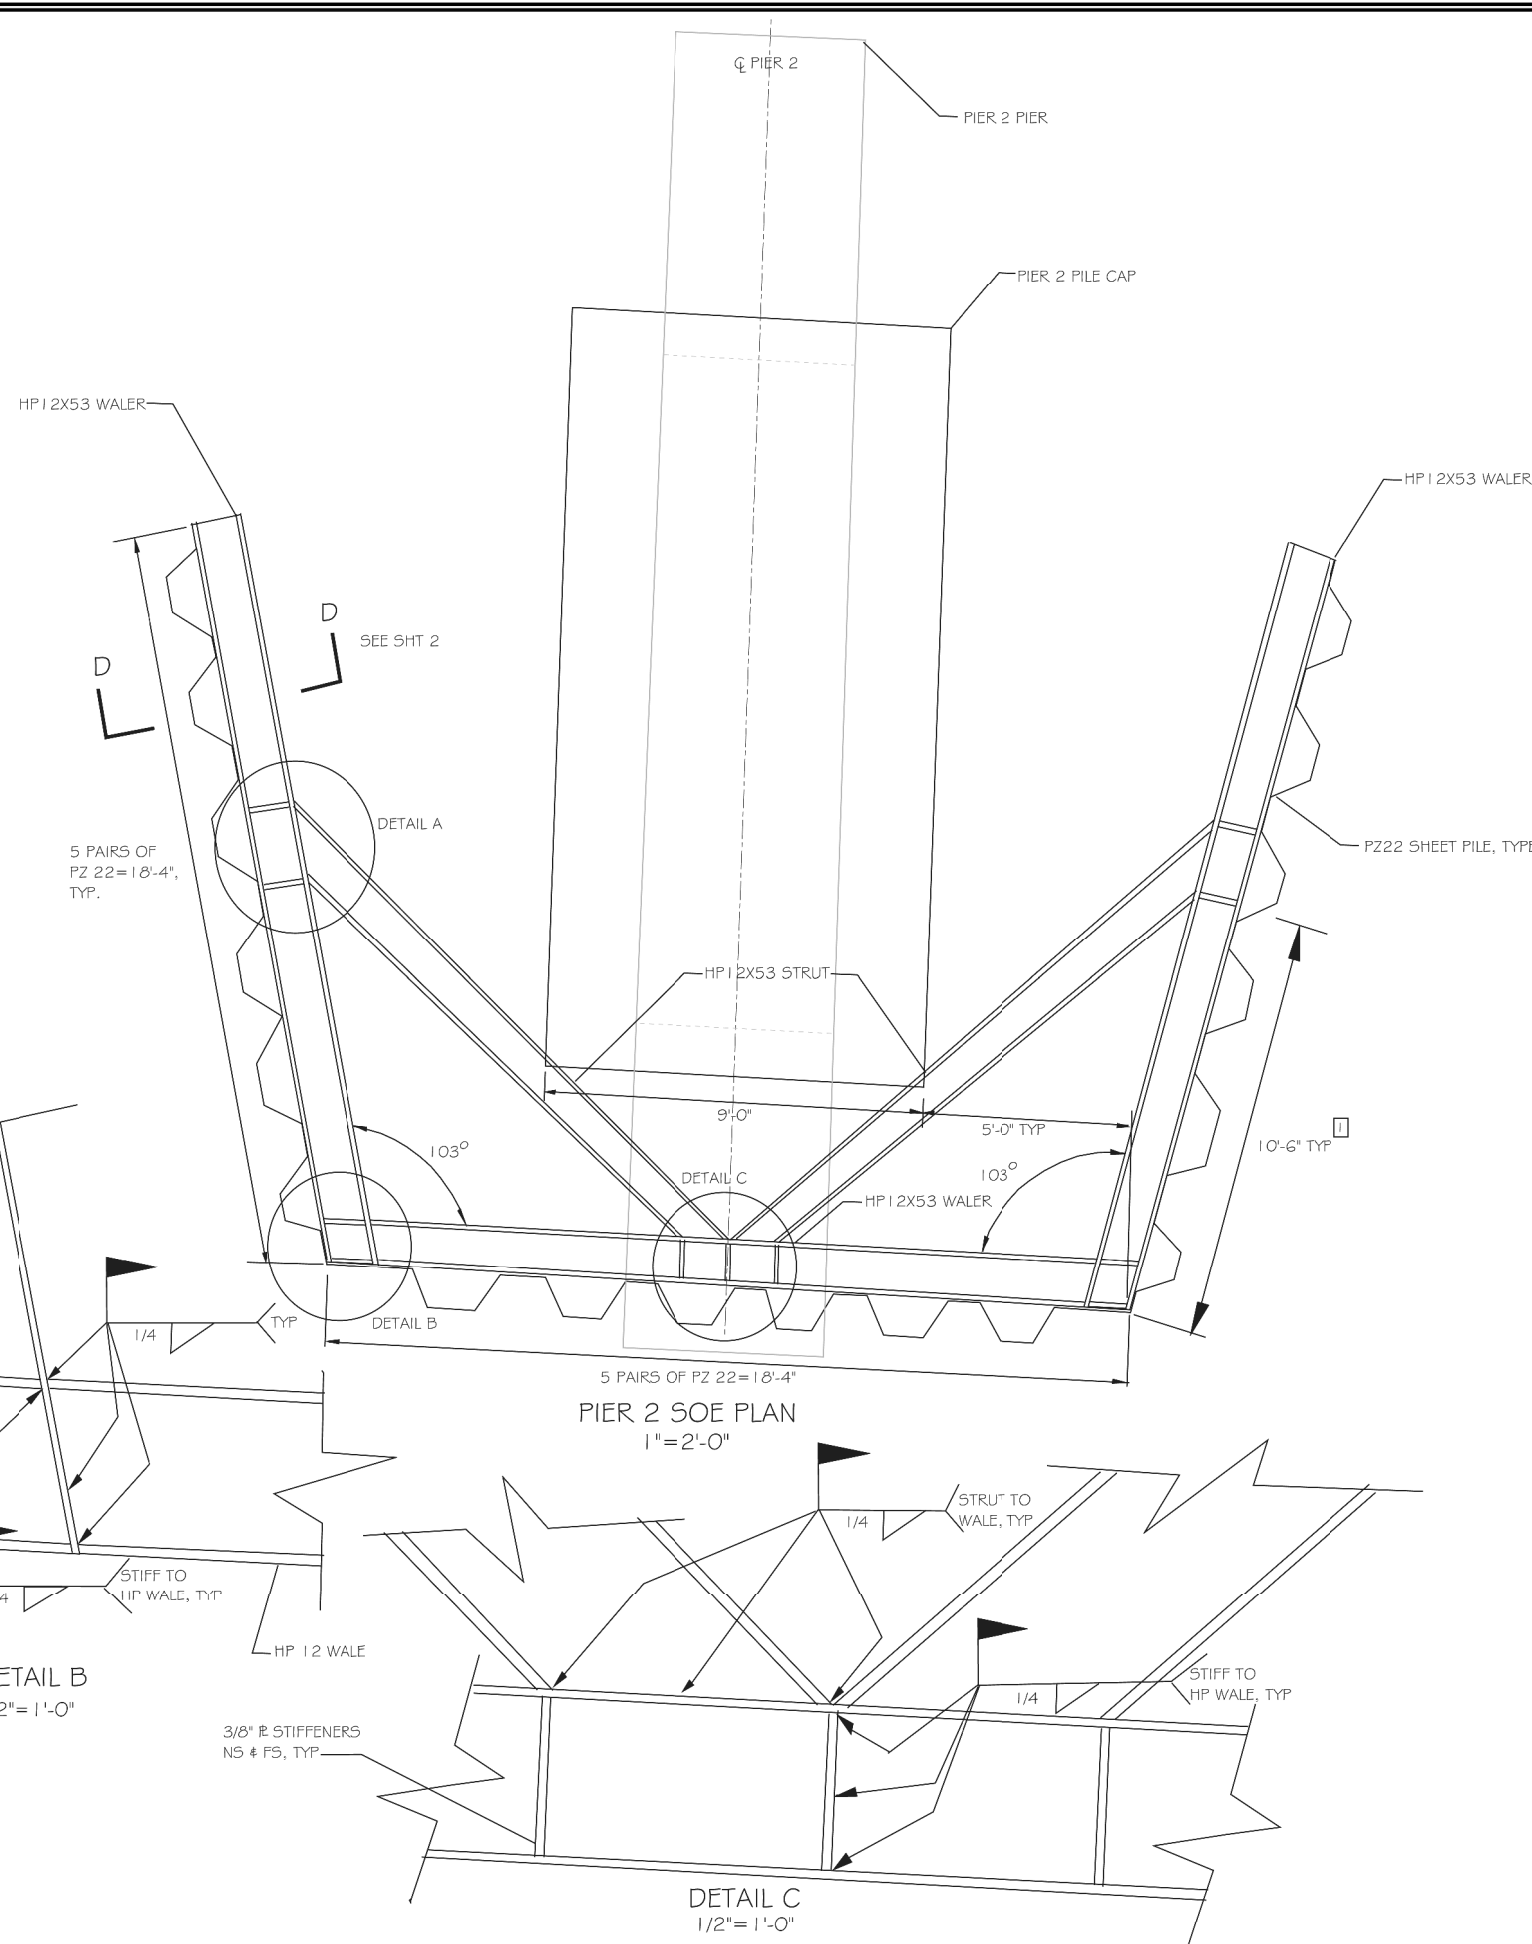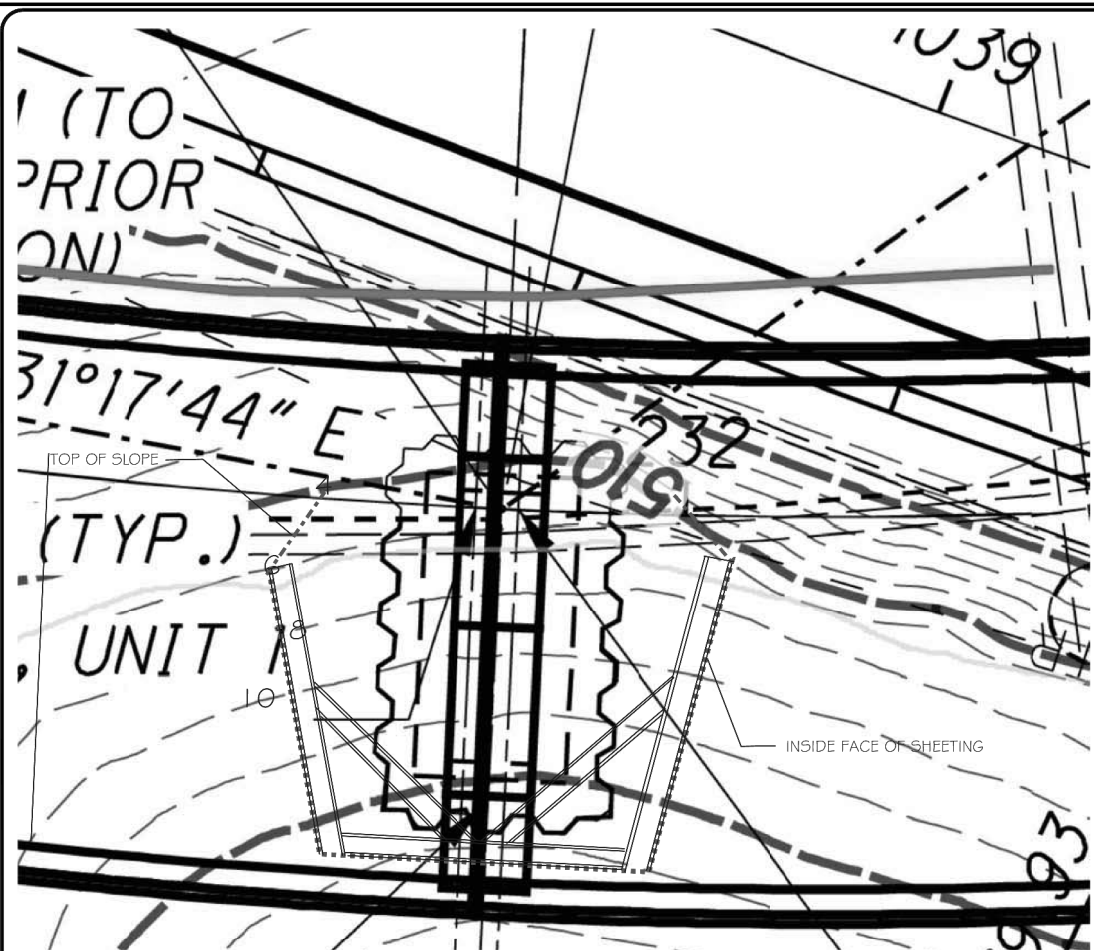

**SME**  
www.sme-usa.com

Orientation: Scale: GRAPHIC SCALE: 1" = 1"

Project: HAM-75-3.84 BRIDGE NO. HAM-74-1908 S RAMP P O/IR-74 WB & IR-75 AND RAMP E

Project Location: HAMILTON COUNTY CITY OF CINCINNATI OHIO

Sheet Name: PIER 2 SOE PLAN AND DETAILS

Engineer's Seal:

REV	ISSUED FOR	DATE	BY
1	ADDED DIMENSION	2.13.19	DWB

Date: 2-5-2019  
SME Project No. 79059.01  
Project Manager: TH BEDENIS  
Designer: DW BIRD  
CADD: DW BIRD  
Checked By: TH BEDENIS  
Sheet No. 1 OF 2

DRAWING DATE: SCALE DELETED IS MEANT FOR 24" X 36" AND WILL SCALE INCORRECTLY IF PRINTED ON ANY OTHER SIZE MEDIA. NO REPRESENTATION SHALL BE MADE THAT THIS PROJECT HAS BEEN COMPLETED BY SME. © 2019

DESIGN AGENCY: **PRIME**  
540 WHITE OAK DR. SUITE E AKRON, OH 44320

DESIGNED: EEB  
CHECKED: AMT

DRAWN: EEB  
REVISED: XXX


REVIEWED: TES  
DATE: 8/22/2019  
STRUCTURE FILE NUMBER: 3109798

**PIER 2 DETAILS**  
BRIDGE NO. HAM-74-1908S  
RAMP P OVER IR-74 WESTBOUND IR-75 AND RAMP E


HAM-75-3.84  
PID No. 104667

24A/79  
24A/79

P:\Projects\2018\20H030B-18232 HAM-75-03-84\104667\structures\HAM074\_1908S\sheets\074\_1908S\_P1003B.dgn 7/28/2023 9:30:25 AM er.in.baumann

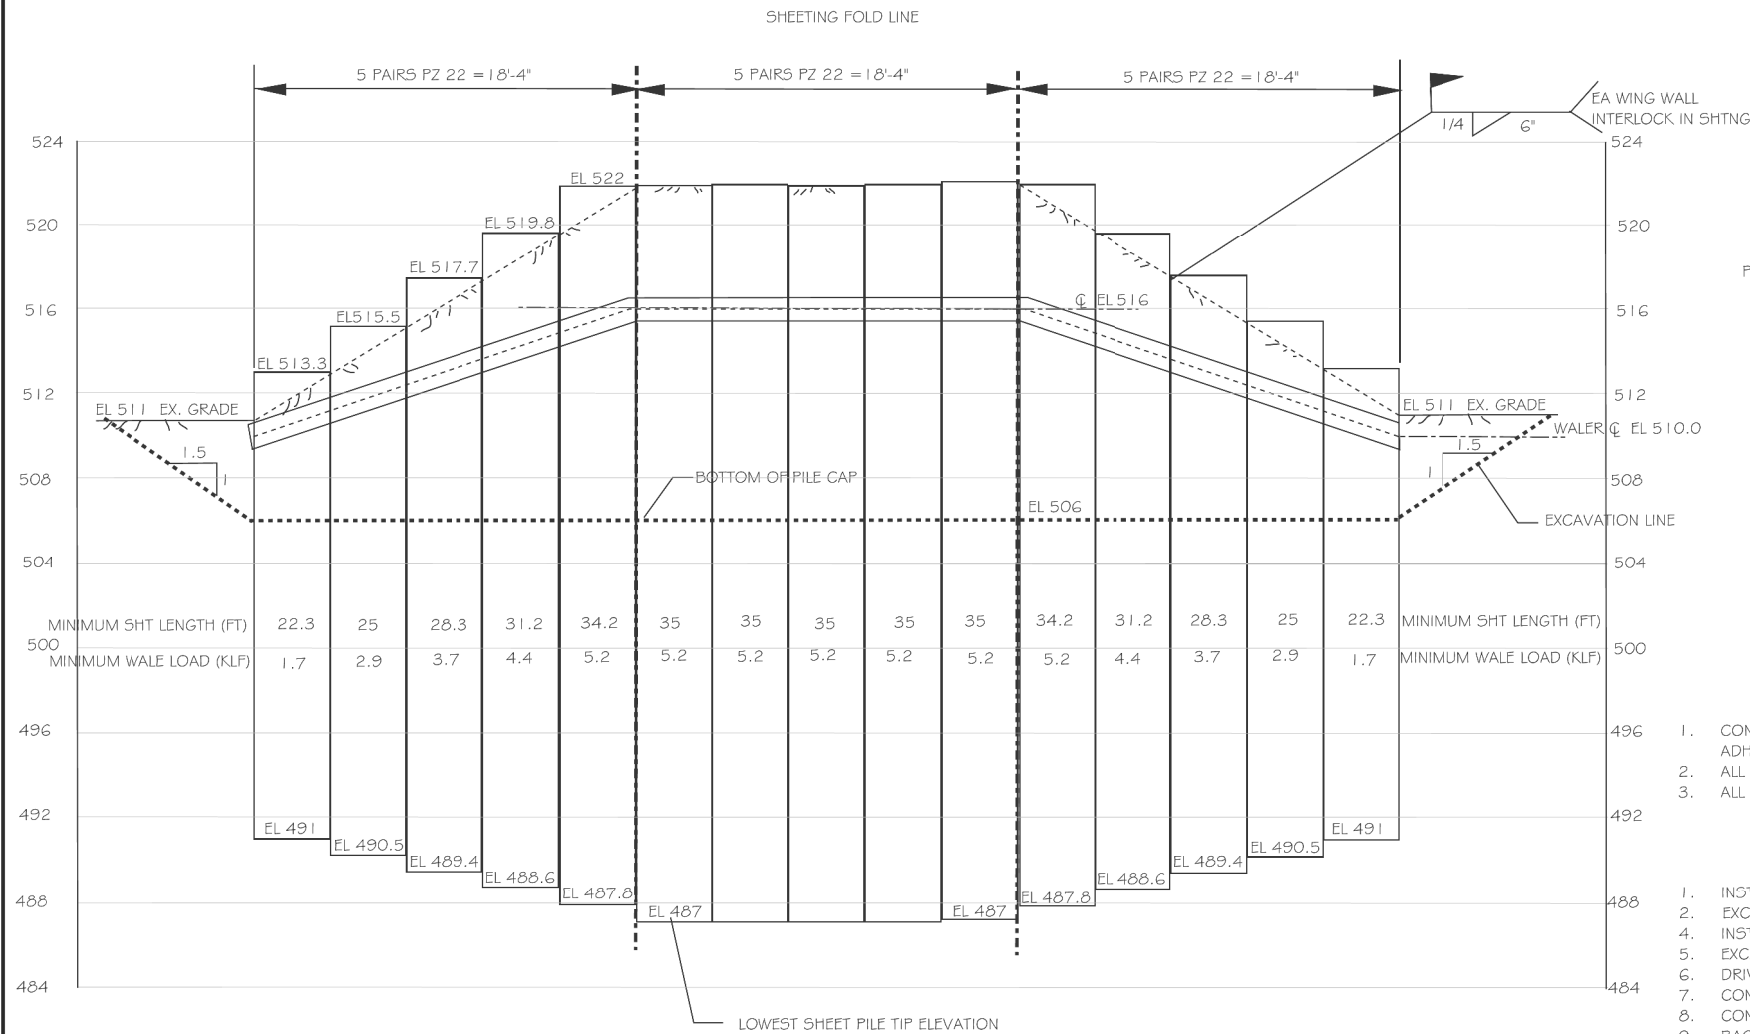

UNFOLDED SOE ELEVATION VIEW  
1/4" = 1'-0"

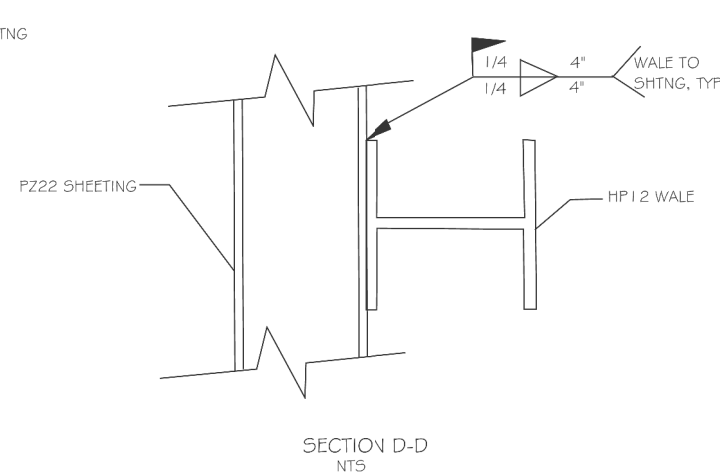

SOE INSTALLATION CONSTRUCTION NOTES:

1. CONTRACTOR IS RESPONSIBLE FOR SITE SAFETY INCLUDING INSTALLATION OF FALL PROTECTION AND ADHERENCE TO OSHA EXCAVATION SAFETY REQUIREMENTS.
2. ALL STEEL SHALL BE FURNISHED IN GR 50.
3. ALL WELDING SHALL BE WITH E70XX ELECTRODES IN ACCORDANCE WITH AWS D1.1.

SOE SEQUENCE OF ACTIVITIES

1. INSTALL SOE SHEETING.
2. EXCAVATE TO REQUIRED ELEVATION IN OPEN CUT AREA. EXCAVATE SHEETING AREA TO 2 FT BELOW WALE ELEV.
4. INSTALL WALERS AND CORNER BRACE STRUTS.
5. EXCAVATE TO ELEV 506 (BOTTOM OF PILE CAP ELEV).
6. DRIVE PILES TO REQUIRED CAPACITY/TIP ELEVATION.
7. CONSTRUCT PILE CAP.
8. CONSTRUCT PIER STEM.
9. BACKFILL EXCAVATION, REMOVING BRACING WHEN BACKFILL REACHES BRACING ELEVATION.
10. CUT THE INTERLOCK WELDS LOOSE.
11. BACKFILL TO FINAL GRADE AND EXTRACT SHEETING.




Orientation: North arrow pointing up.

Scale: GRAPHIC SCALE: 1" = 1'

Project: HAM-75-3.84 BRIDGE NO. HAM-74-1908 S RAMP P O/IR-74 WB & IR-75 AND RAMP E

Project Location: HAMILTON COUNTY CITY OF CINCINNATI OHIO

Sheet Name: PIER 2 SOE ELEVATION AND NOTES

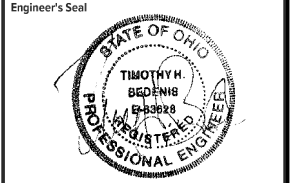

REV	ISSUED FOR	DATE	BY

Date: 2-5-2019

SME Project No. 79059.01

Project Manager: TH BEDENIS

Designer: DW BIRD

CADD: DW BIRD

Checked By: TH BEDENIS

Sheet No. 2 OF 2

DRAWING DATE SCALE CORRECTED IS MEANT FOR 24" X 36" AND ALL SCALE DIMENSIONS TO BE PRINTED ON ANY OTHER SIZE MEDIA. NO REPRODUCTION SHALL BE MADE WITHOUT THE PRIOR CONSENT OF SME. © 2019

DESIGN AGENCY: PRIMEWAY  
540 WHITE OAK DR. SUITE E  
AKRON, OH 44320

REVIEWED: TES 8/22/2019  
STRUCTURE FILE NUMBER: 3109798

DRAWN: EEB  
DESIGNED: EEB  
CHECKED: AMT  
REVISED: XXX


PIER 2 DETAILS  
BRIDGE NO. HAM-74-1908S  
RAMP P OVER IR-74 WESTBOUND IR-75 AND RAMP E

HAM-75-3.84  
PID No. 104667


24B/79

24B  
79


P:\Projects\2018\20H03DB-18232 HAM-75-03.84\104667\structures\HAM074\_1908S\sheets\074\_1908S\_DS001.dgn 7/28/2023 9:31:03 AM erin.baumann

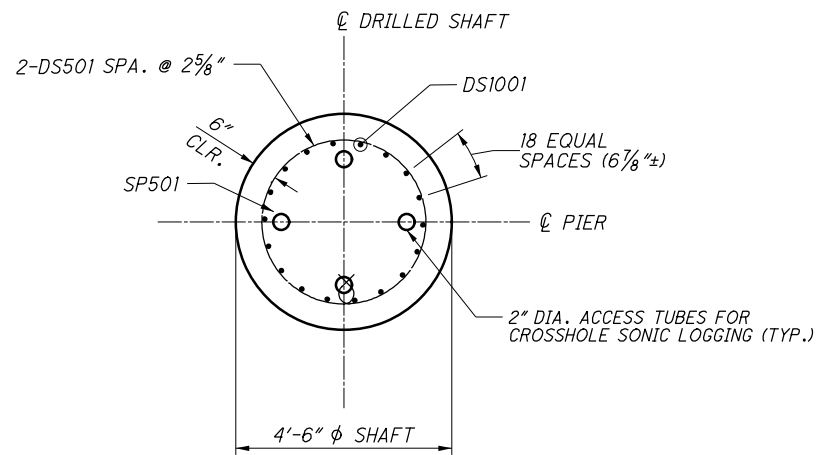


**A** SECTION THRU SHAFT  
25

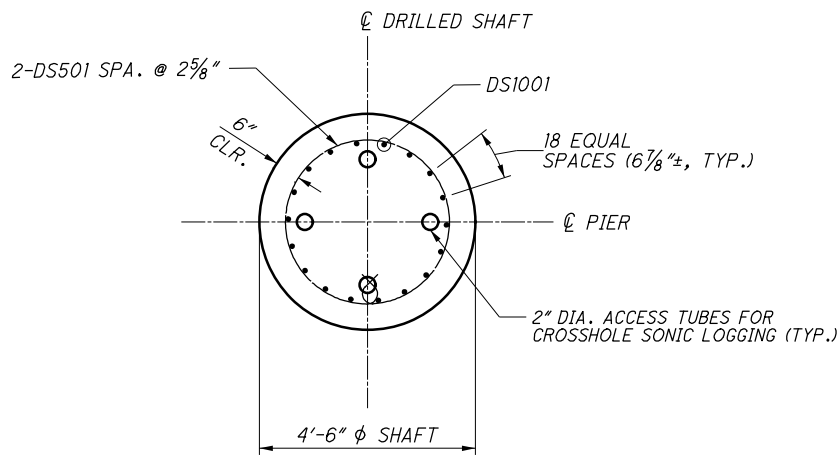


**B** SECTION THRU SHAFT  
25

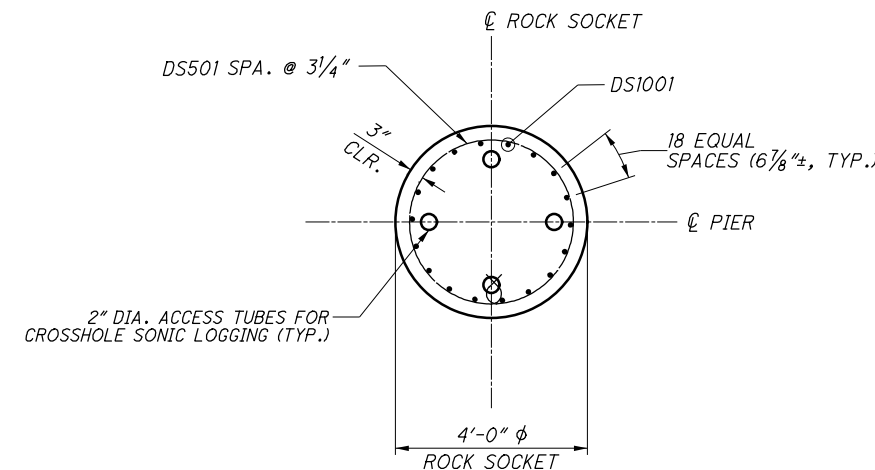

**C** SECTION THRU SOCKET  
25

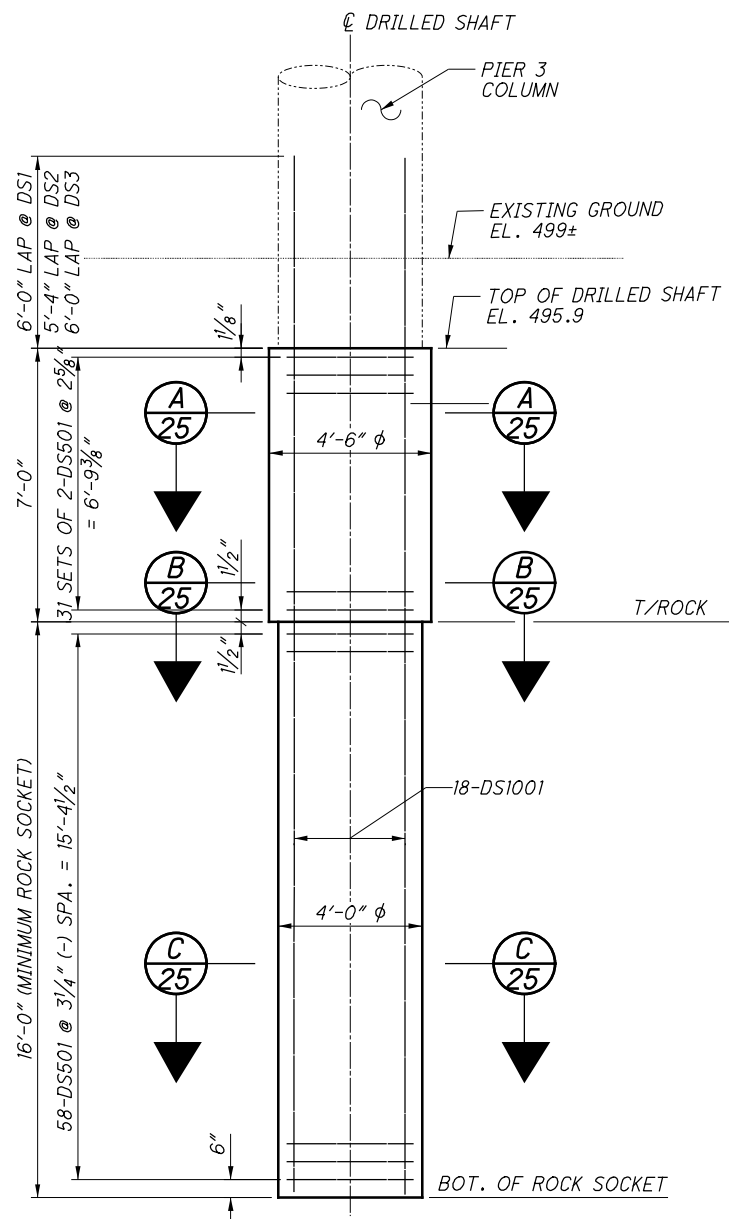

**PIER 3 DRILLED SHAFT - ELEVATION**  
(3 REQ'D)

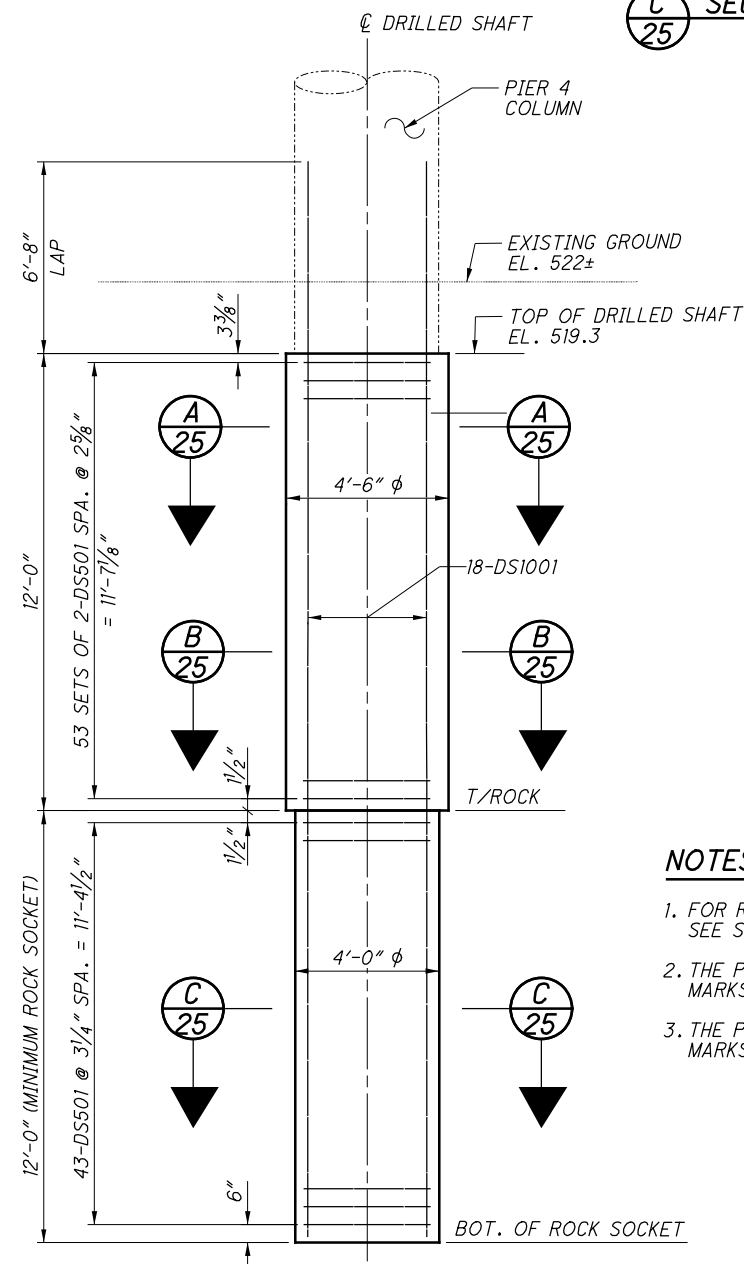

**PIER 4 DRILLED SHAFT - ELEVATION**  
(3 REQ'D)


MIN. REQUIRED LAP LENGTH	
#5 HORIZONTAL	37"

- NOTES:**
- FOR REINFORCEMENT SCHEDULE, SEE SHEETS 74/79 AND 79/79.
  - THE PREFIX "3" SHALL BE ADDED TO ALL BAR MARKS FOR PIER 3 DRILLED SHAFT.
  - THE PREFIX "4" SHALL BE ADDED TO ALL BAR MARKS FOR PIER 4 DRILLED SHAFT.


**FOUNDATION DETAILS - PIERS 3 & 4**  
BRIDGE NO. HAM-74-1908S  
RAMP P OVER IR-74 WESTBOUND, IR-75 AND RAMP E

**HAM-75-3.84**  
PID No. 104667


P:\Projects\2018\20H03DB-18232 HAM-75-03.84\104667\structures\HAM074\_1908S\sheets\074\_1908S\_P1004.dgn 7/28/2023 9:31:15 AM erin.baumann

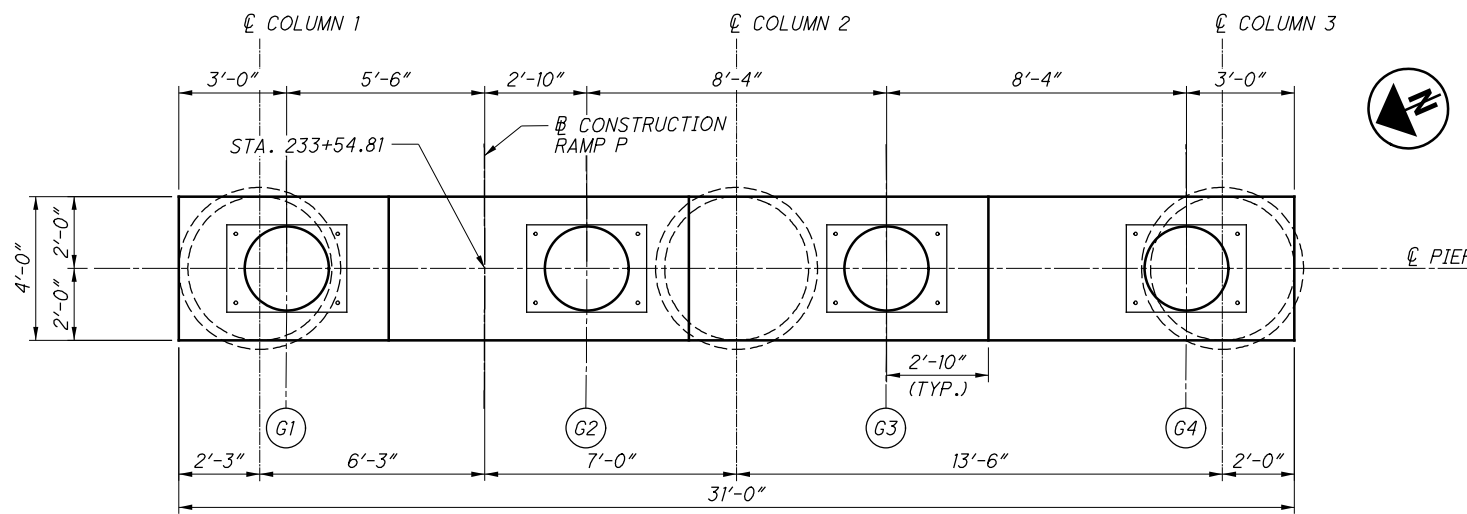


PLAN

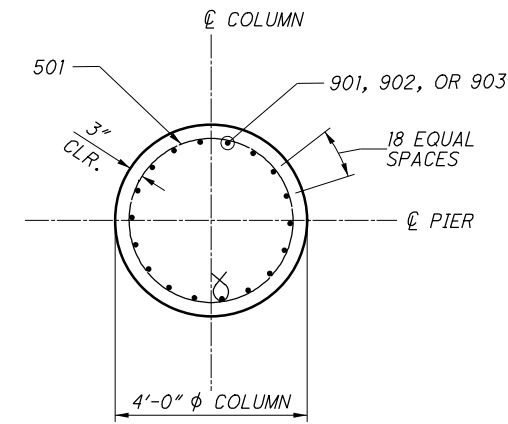


A SECTION THRU COLUMN

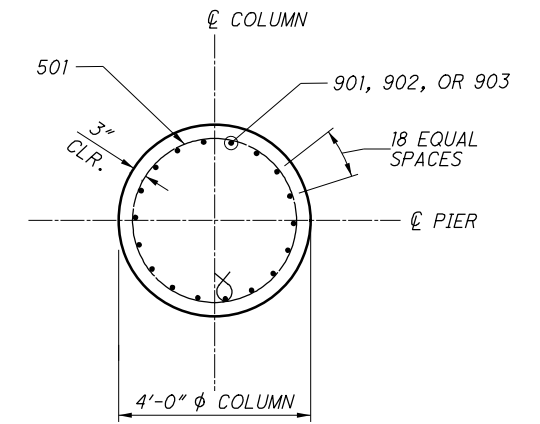


B SECTION THRU COLUMN

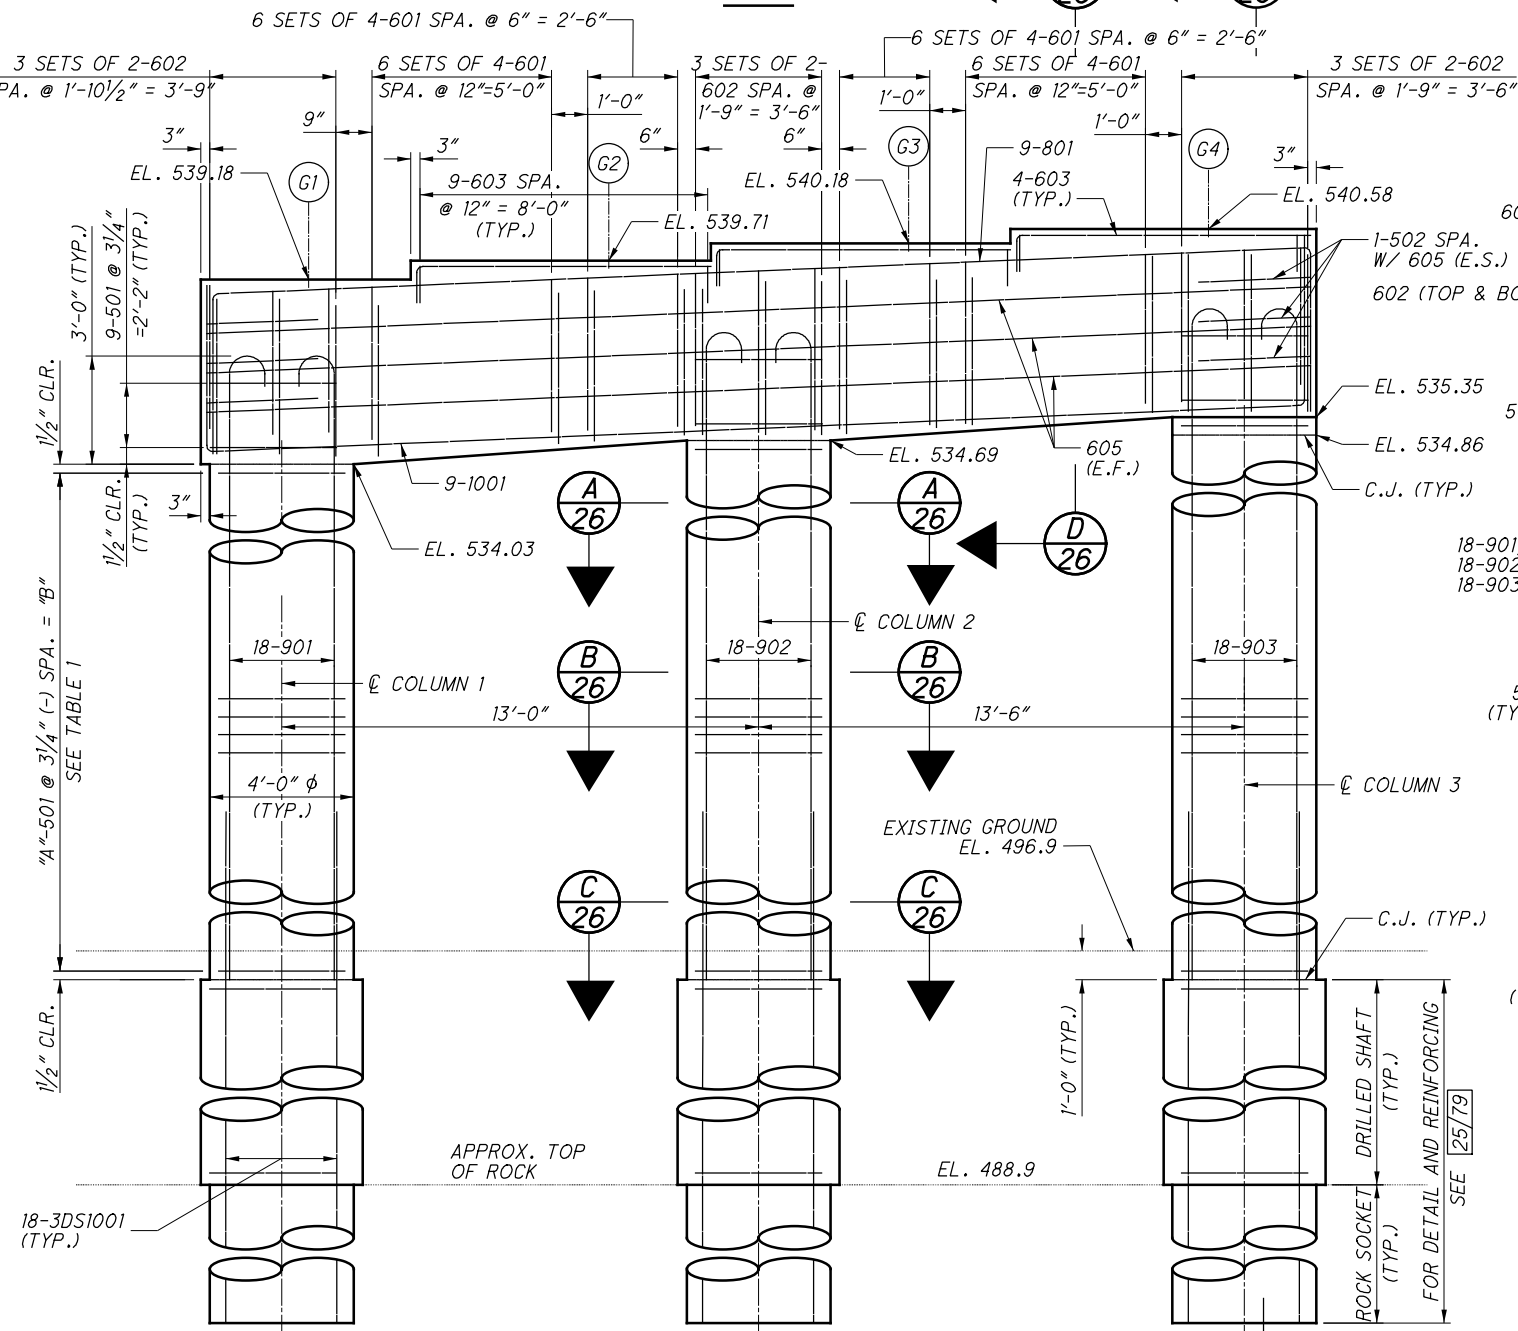


ELEVATION

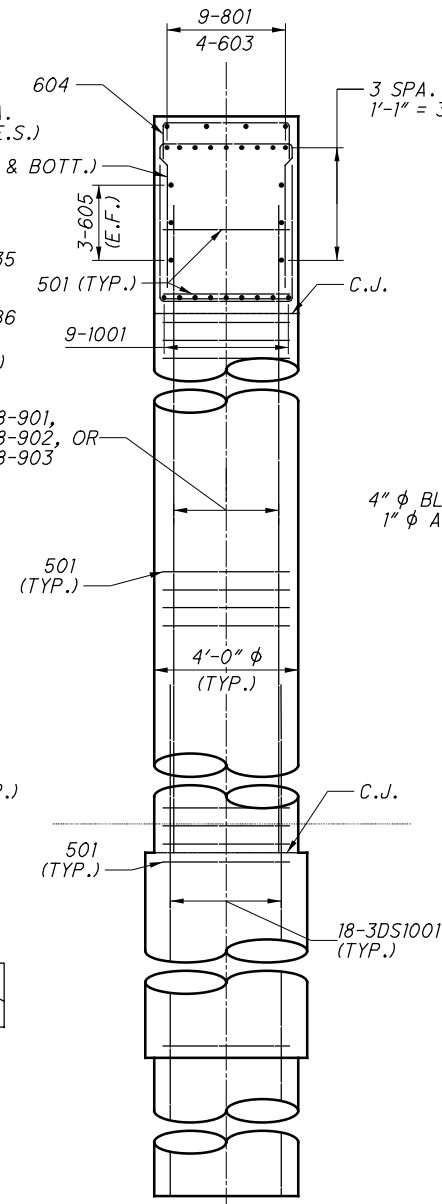


E SECTION

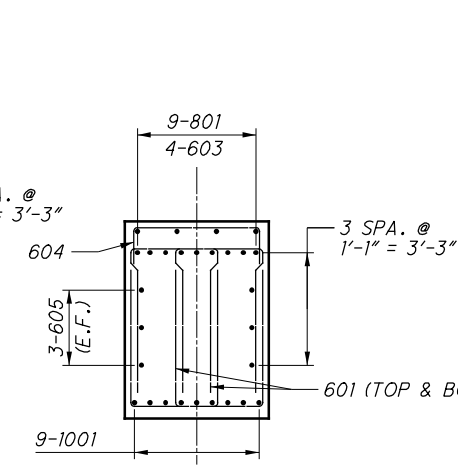

D SECTION THRU CAP

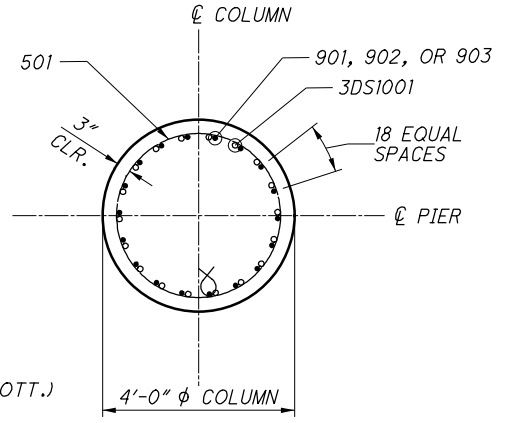

C SECTION THRU COLUMN

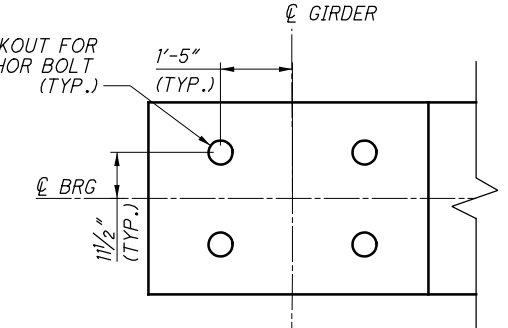








ANCHOR BOLT LOCATION PLAN (TYP.)

TABLE 1 (501 BARS)		
COLUMN	"A"	"B"
1	141	37'-10 5/8"
2	144	38'-6 5/8"
3	146	39'-2 1/2"

MIN. REQUIRED LAP LENGTH	
#5 HORIZONTAL	3'-1"
#6 VERTICAL	3'-7"
#9 VERTICAL	5'-4"

- NOTES:**
1. SEAL ALL EXPOSED (ABOVE GROUND) CONCRETE SURFACES OF PROPOSED PIER, EXCEPT BEAM SEATS, WITH EPOXY URETHANE.
  2. FOR BEARING LOCATION DETAILS SEE SHEET [36/79].
  3. SPACE TOP REINFORCING BARS IN CAP TO MISS BEARING ANCHOR BOLTS.
  4. FOR ANCHOR BOLT BLOCKOUT DETAILS SEE SHEET [35/79].
  5. FOR ADDITIONAL FOUNDATION DETAILS, SEE SHEET [17/79] & [25/79].
  6. THE PREFIX "3P" SHALL BE ADDED TO ALL BAR MARKS FOR PIER NO. 3.
  7. FOR REINFORCING SCHEDULE, SEE SHEET [75/79].
  8. FOR GEOMETRIC REFERENCE, SEE REFERENCE CHORD LAYOUT SHEET [6/79].
  9. BRIDGE SEAT ELEVATIONS HAVE BEEN ADJUSTED UPWARD 0.135 INCHES AT PIER 3 TO COMPENSATE FOR THE VERTICAL DEFORMATION OF THE BEARINGS.

P:\Projects\2018\20H03DB-18232 HAM-75-03.84\104667\structures\HAM074\_1908S\PI005.dgn 7/28/2023 9:31:19 AM erin.baumann

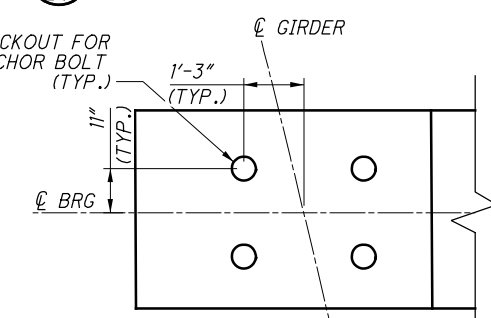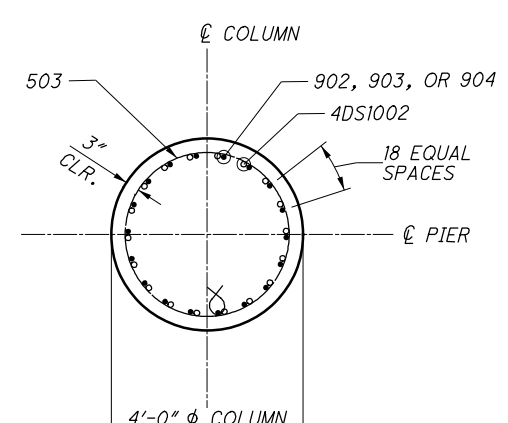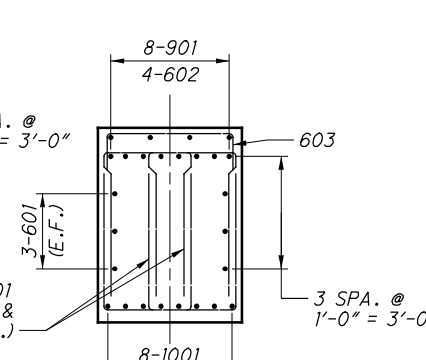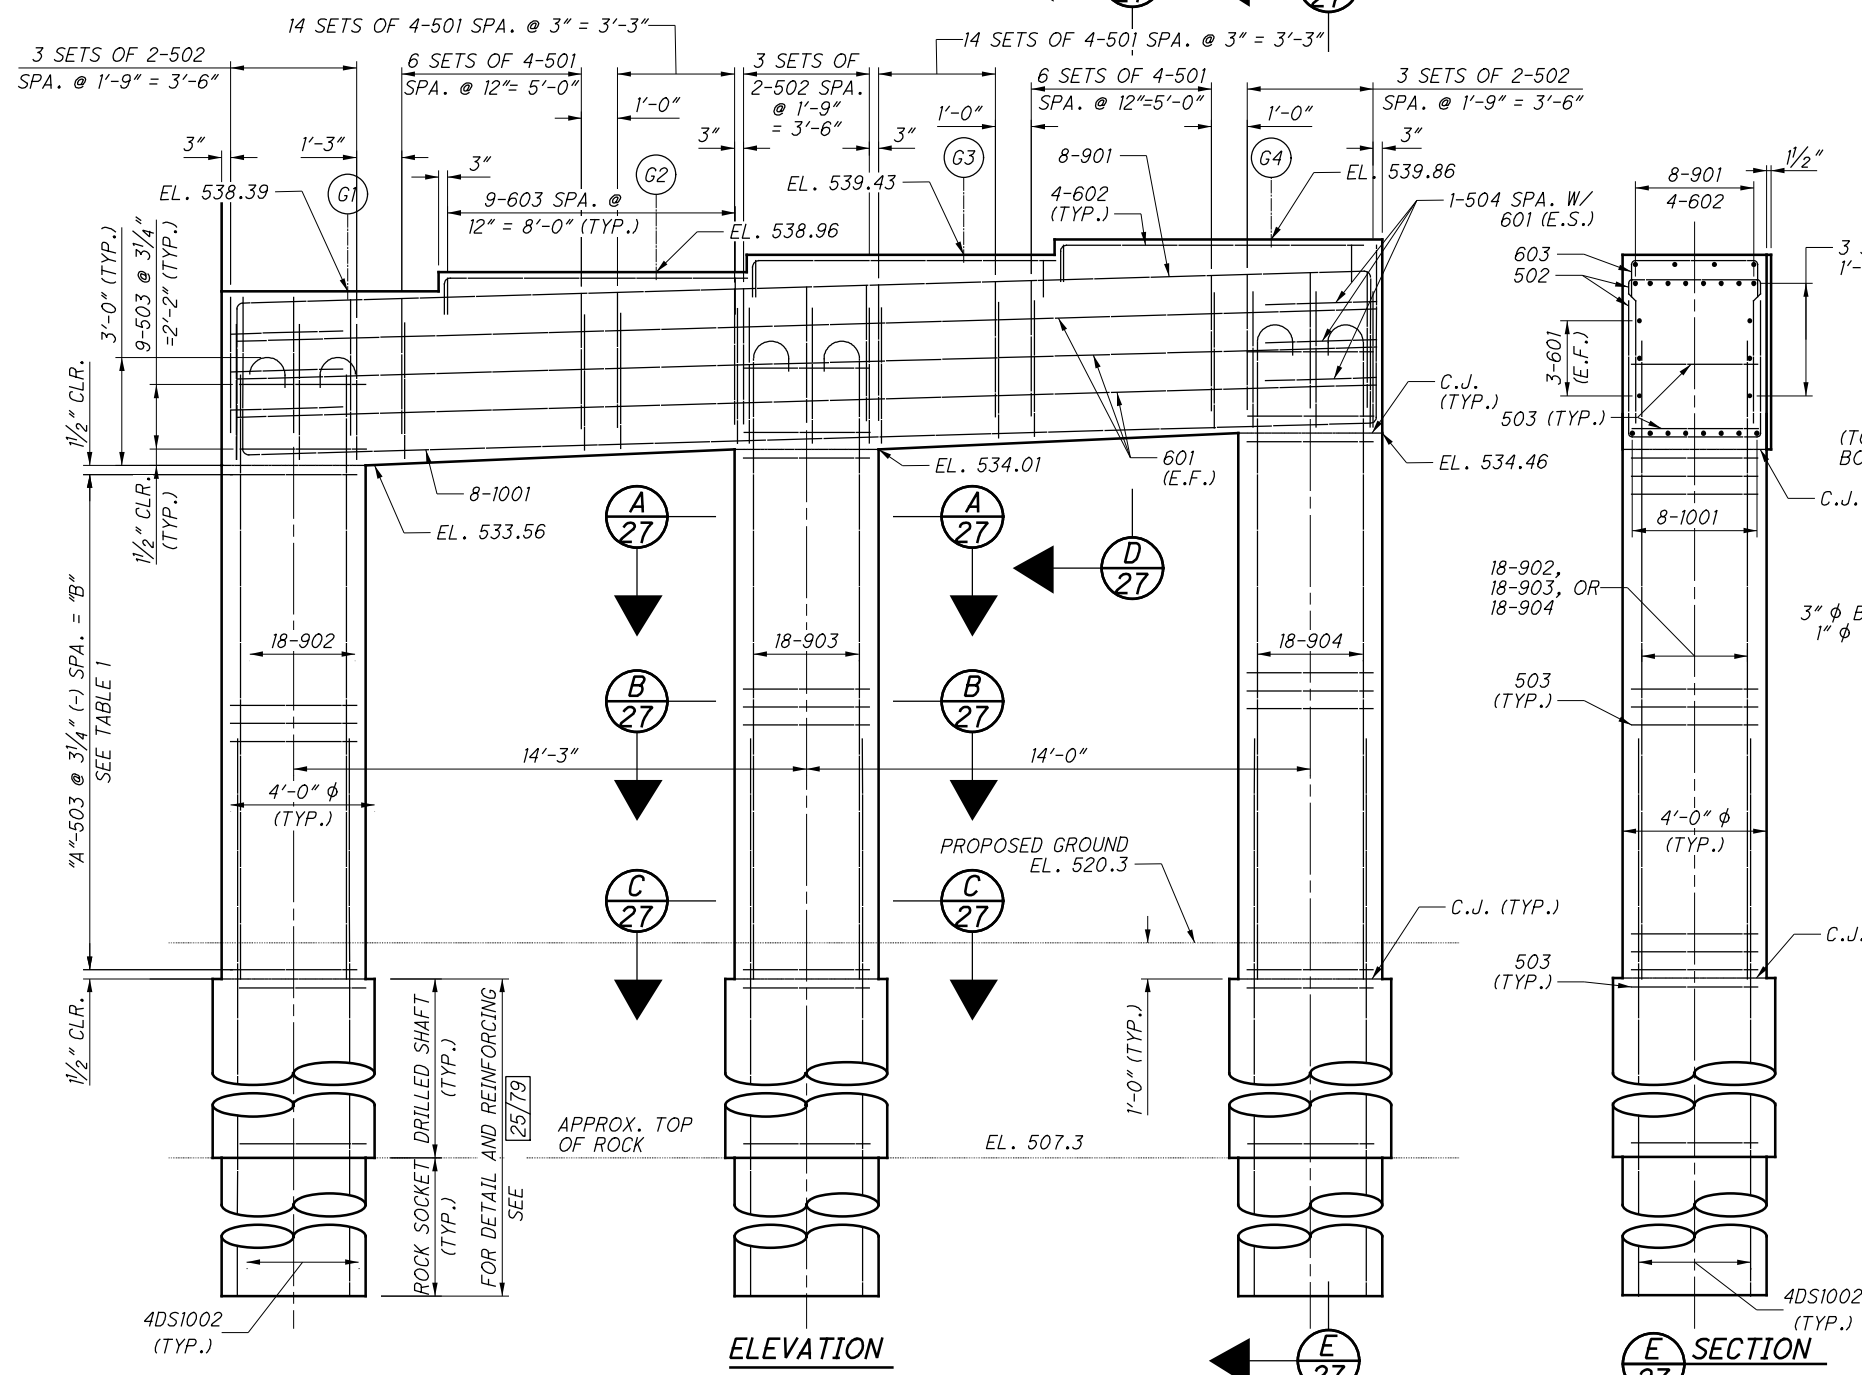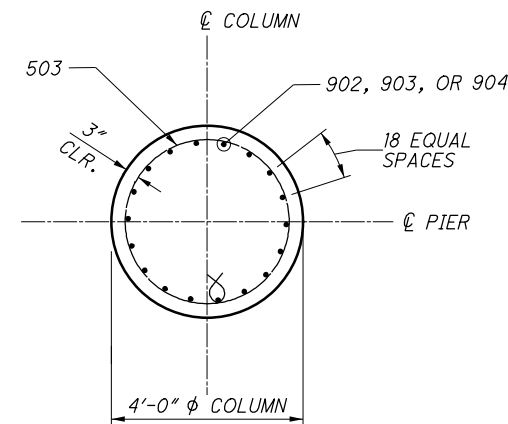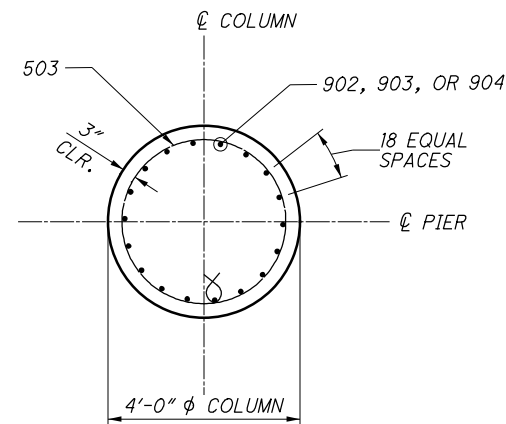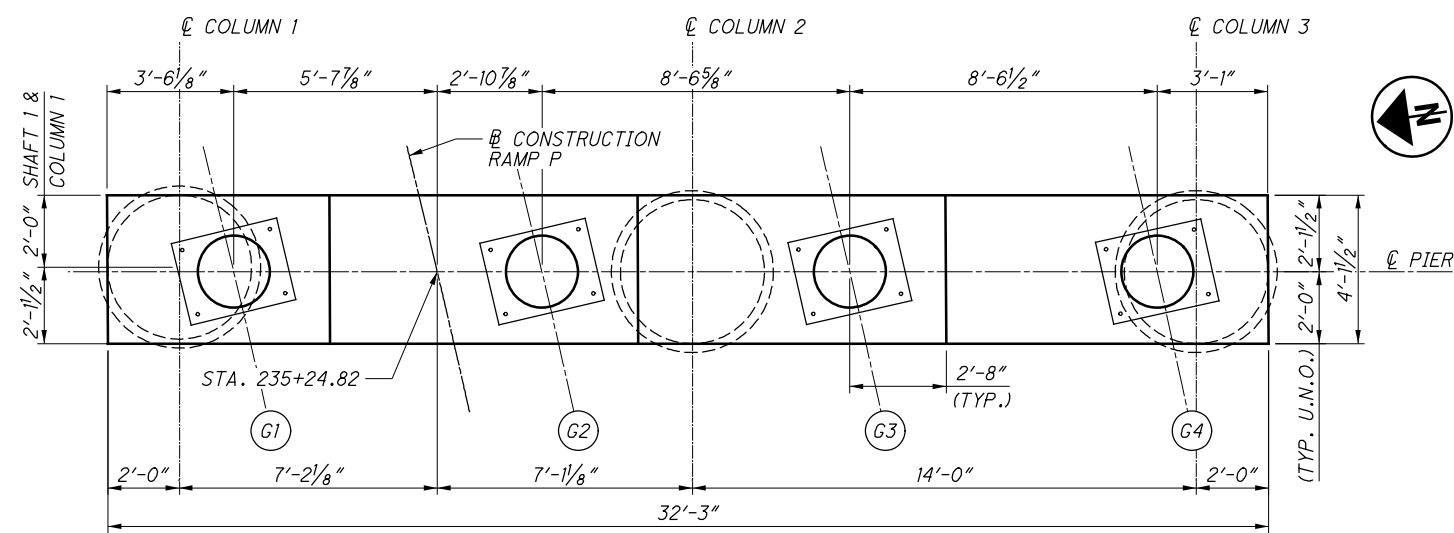

**TABLE 1 (503 BARS)**

COLUMN	"A"	"B"
1	53	14'-0 1/4"
2	55	14'-5 5/8"
3	56	14'-11"

**MIN. REQUIRED LAP LENGTH**

#5 HORIZONTAL	2'-5"
#5 HORIZONTAL	3'-1"
#9 VERTICAL	5'-4"

- NOTES:**
1. SEAL ALL EXPOSED (ABOVE GROUND) CONCRETE SURFACES OF PROPOSED PIER, EXCEPT BEAM SEATS, WITH EPOXY URETHANE.
  2. FOR BEARING LOCATION DETAILS SEE SHEET [36/79].
  3. SPACE TOP REINFORCING BARS IN CAP TO MISS BEARING ANCHOR BOLTS.
  4. FOR ANCHOR BOLT BLOCKOUT DETAILS SEE SHEET [35/79].
  5. FOR ADDITIONAL FOUNDATION DETAILS, SEE SHEET [17/79] & [25/79].
  6. THE PREFIX "4P" SHALL BE ADDED TO ALL BAR MARKS FOR PIER NO. 4.
  7. FOR REINFORCING SCHEDULE, SEE SHEET [76/79].
  8. FOR GEOMETRIC REFERENCE, SEE REFERENCE CHORD LAYOUT SHEET [6/79].
  9. BRIDGE SEAT ELEVATIONS HAVE BEEN ADJUSTED UPWARD 0.121 INCHES AT PIER 4 TO COMPENSATE FOR THE VERTICAL DEFORMATION OF THE BEARINGS.

DESIGN AGENCY: **PRIMEWAY**  
 540 WHITE POND DR. SUITE E  
 AKRON, OH 44320

DESIGNED: CRG  
 CHECKED: KDC

DRAWN: MN  
 REVISED:


REVIEWED: TES  
 DATE: 8/22/2019  
 STRUCTURE FILE NUMBER: 3109798

**PIER 4 DETAILS**  
 BRIDGE NO. HAM-74-1908S  
 RAMP P OVER IR-74 WESTBOUND, IR-75 AND RAMP E

HAM-75-3.84  
 PID No. 104667

27 / 79  
 27 / 79


P:\Projects\2018\20H03DB-18232 HAM-75-03.84\104667\structures\HAM074\_1908S\_AF001.dgn 7/28/2023 9:31:22 AM erin.baumann

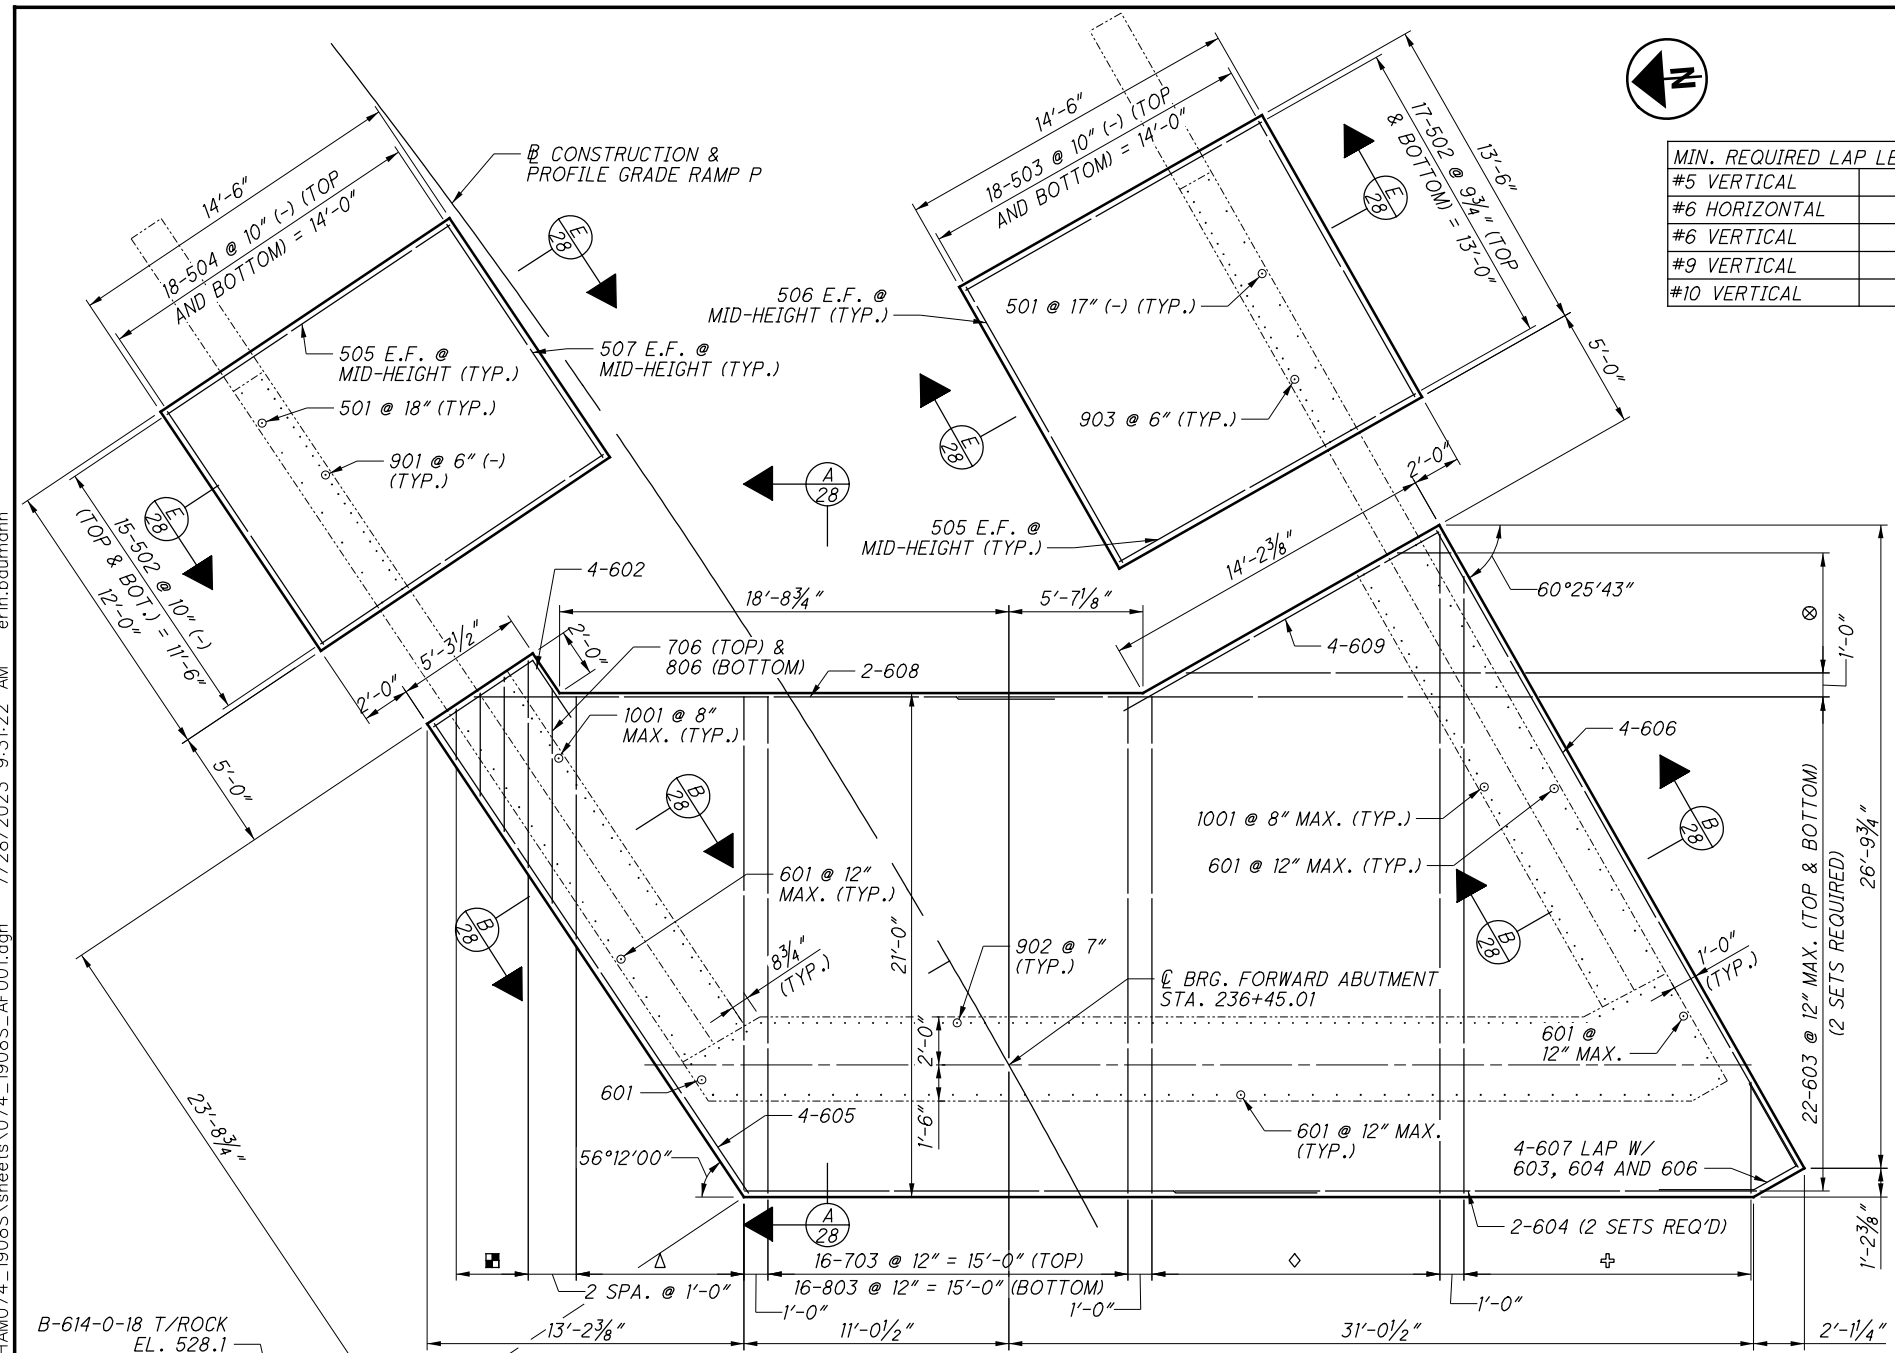


**FORWARD ABUTMENT & WINGWALLS FOUNDATION PLAN**

MIN. REQUIRED LAP LENGTH


#5 VERTICAL	29"
#6 HORIZONTAL	48"
#6 VERTICAL	34"
#9 VERTICAL	64"
#10 VERTICAL	72"

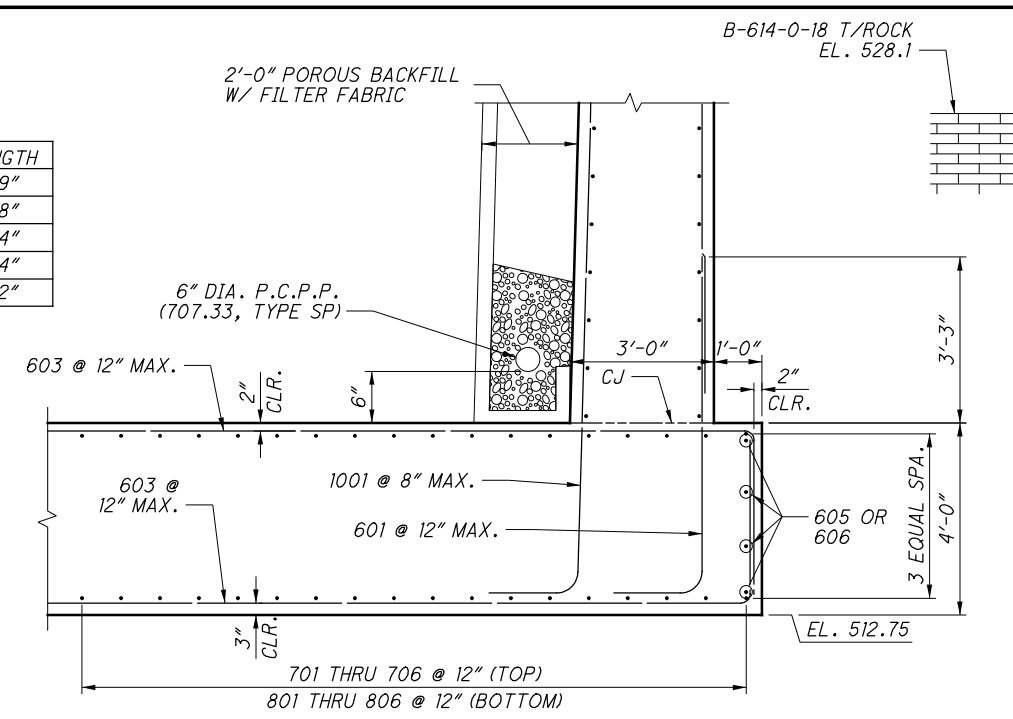

**B SECTION THRU ABUTMENT FOOTING**

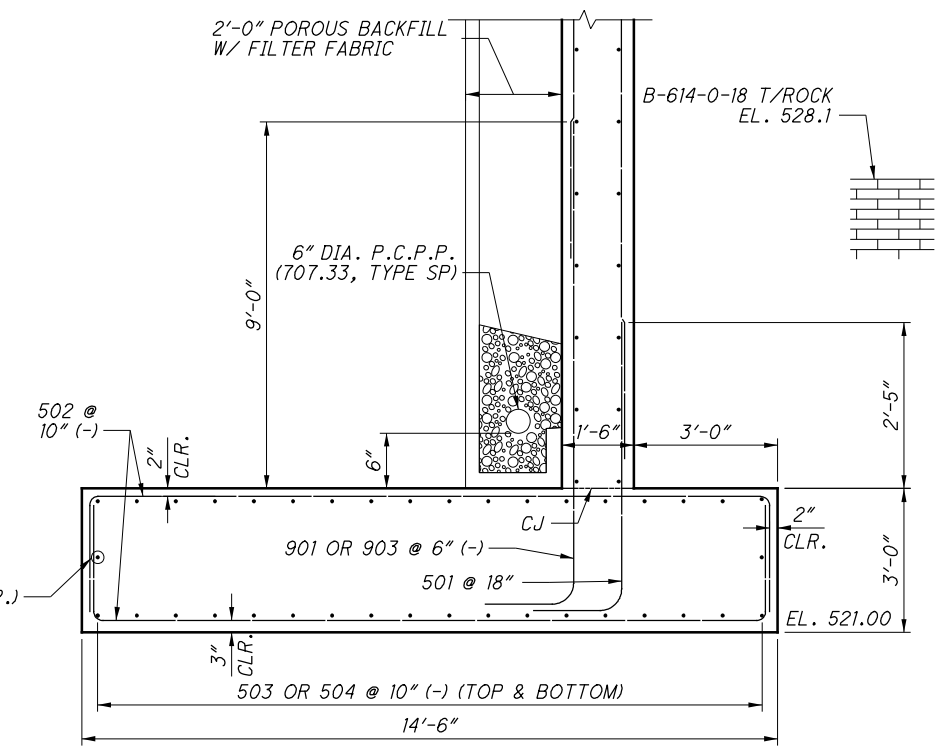

**E SECTION THRU WINGWALL FOOTING**  
NORTH WINGWALL SHOWN, SOUTH WINGWALL SIMILAR

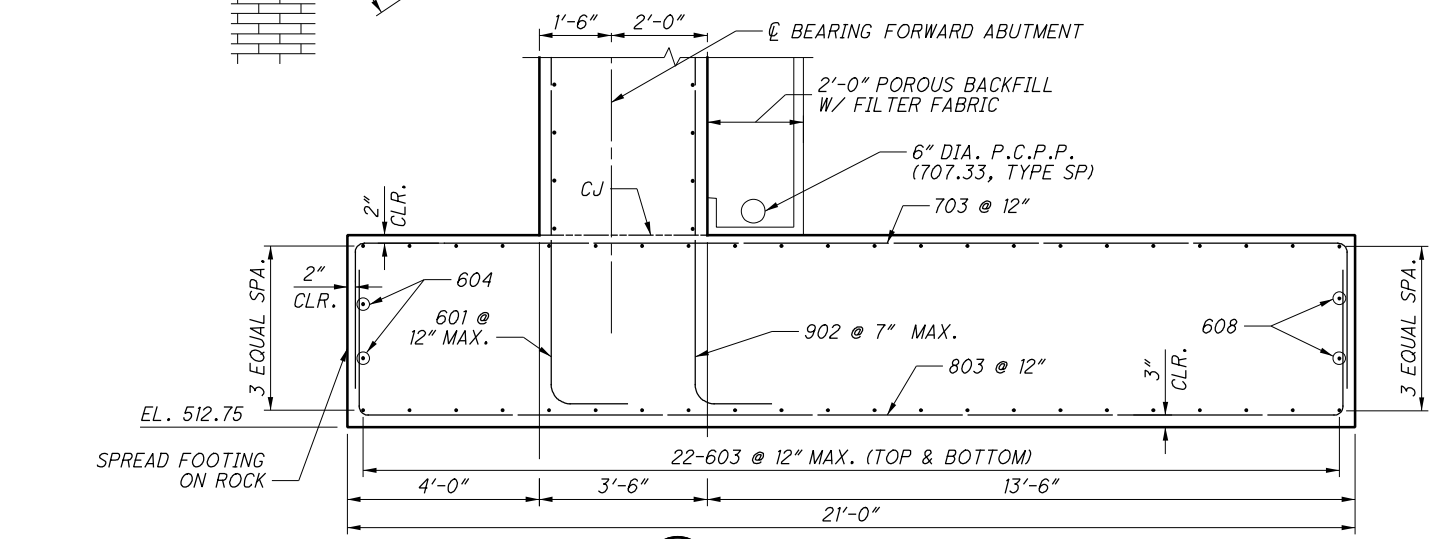

**A SECTION THRU FOOTING**

- LEGEND:**
- △ - 1 SER. OF 8-702 @ 12" (TOP),  
1 SER. OF 8-802 @ 12" (BOTTOM)
  - ⊕ - 1 SER. OF 13-705 @ 12" (TOP)  
1 SER. OF 13-805 @ 12" (BOTTOM)
  - ◇ - 1 SER. OF 13-704 @ 12" (TOP)  
1 SER. OF 13-804 @ 12" (BOTTOM)
  - ⊗ - 1 SER. OF 6-610 @ 12" (TOP)  
1 SER. OF 6-610 @ 12" (BOTTOM)
  - - 1 SER. OF 4-701 @ 12" (TOP)  
1 SER. OF 4-801 @ 12" (BOTTOM)

- NOTES:**
1. SEAL ALL EXPOSED (ABOVE GROUND) CONCRETE SURFACES OF PROPOSED ABUTMENT WITH EPOXY URETHANE.
  2. THE PREFIX "FAF" SHALL BE ADDED TO ALL BAR MARKS FOR THE FORWARD ABUTMENT FOOTINGS.
  3. FOR REINFORCING SCHEDULE, SEE SHEETS 74/79 AND 79/79.

DESIGN AGENCY  
**PRIME**  
540 WHITE POND DR. SUITE E  
AKRON, OH 44320

DATE: 8/22/2019  
REVIEWED: TES  
DESIGNED: KDC  
DRAWN: KDC  
CHECKED: CRG

BRIDGE NO. HAM-74-1908S  
RAMP P OVER IR-74 WESTBOUND, IR-75 AND RAMP E

STRUCTURE FILE NUMBER: 3109798


FORWARD ABUTMENT DETAILS (1 OF 4)

HAM-75-3.84  
PID No. 104667



28 / 79



P:\Projects\2018\20H03DB-18232 HAM-75-03.84\104667\structures\HAM074\_1908S\sheets\074\_1908S\_AF002.dgn 7/28/2023 9:31:26 AM erin.baumann

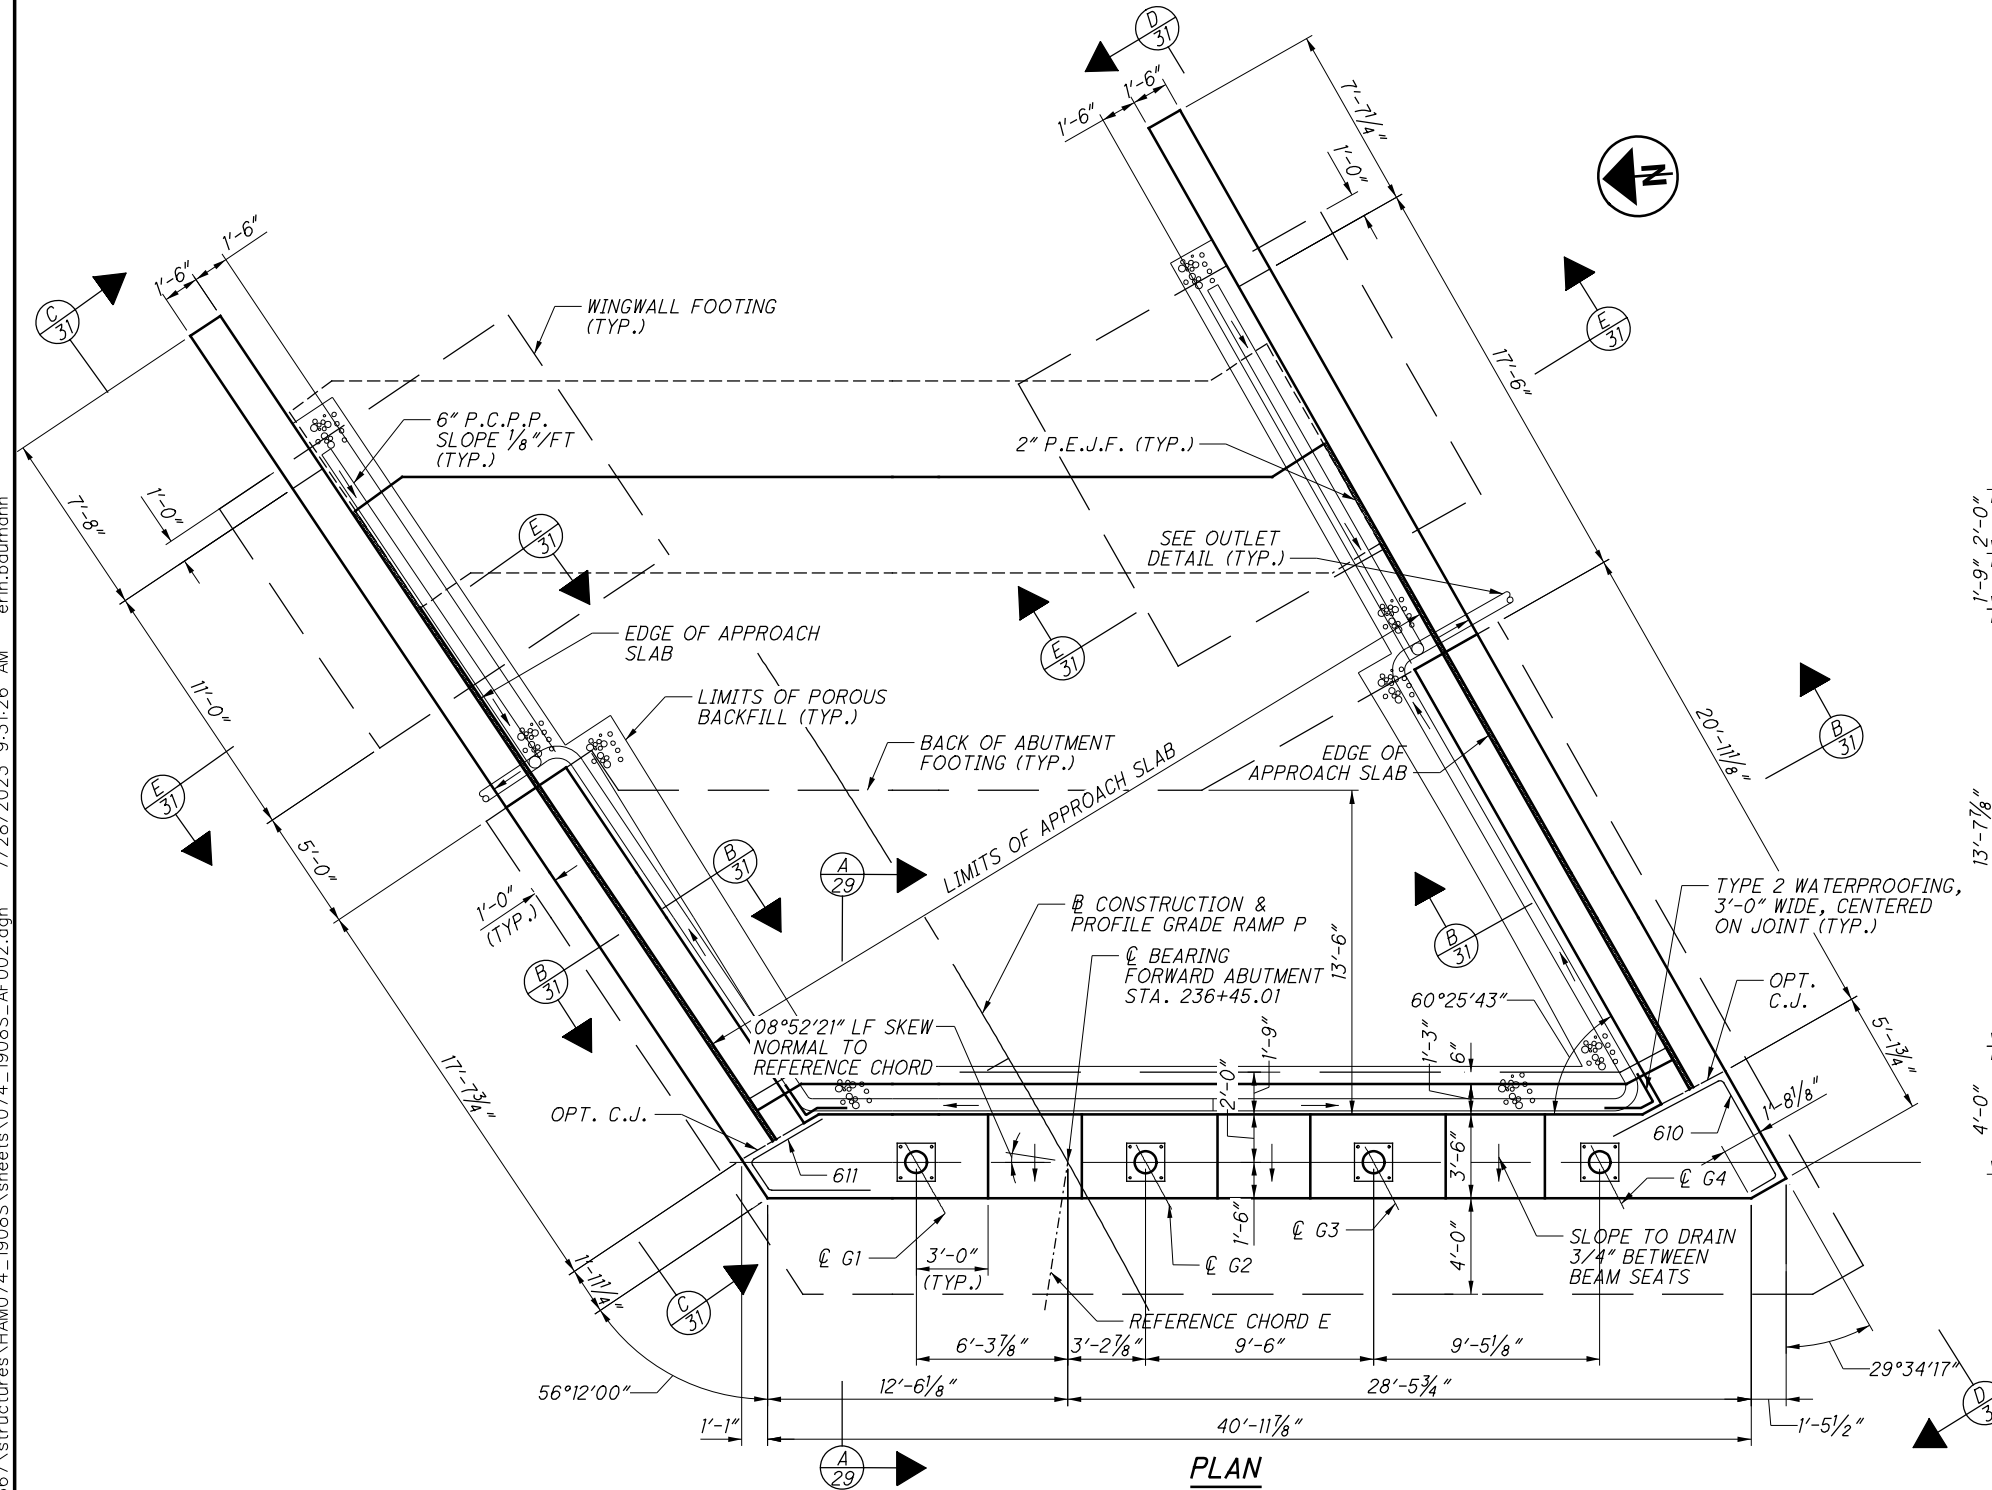

MIN. REQUIRED LAP LENGTH	
#5 VERTICAL	29"
#6 HORIZONTAL	48"
#6 VERTICAL	34"
#8 HORIZONTAL	45"

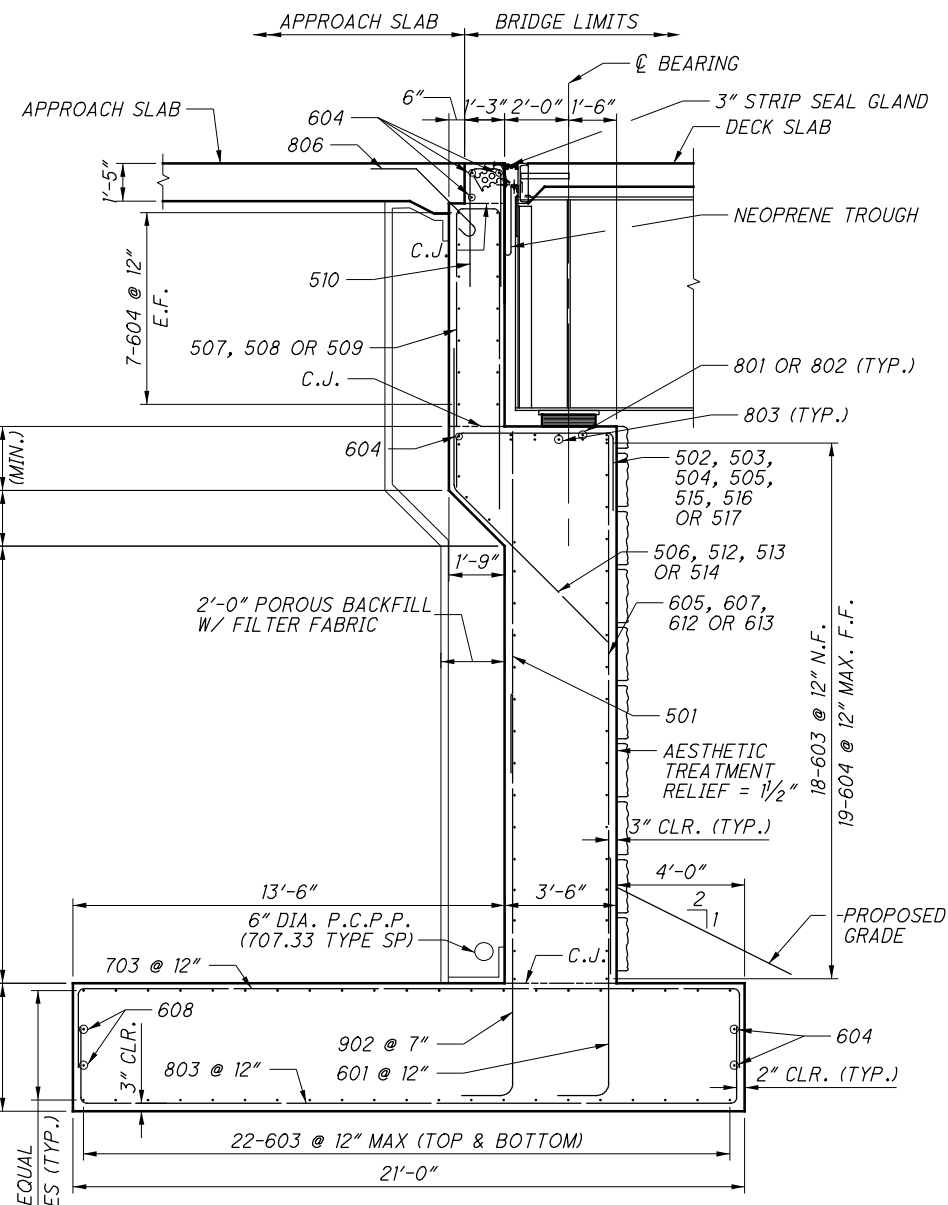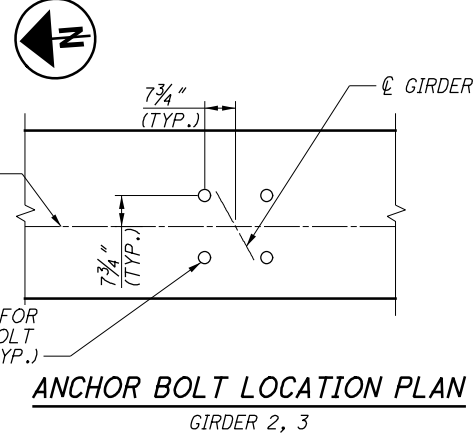

- NOTES:**
- SEAL ALL EXPOSED (ABOVE GROUND) CONCRETE SURFACES OF PROPOSED ABUTMENT WITH EPOXY URETHANE.
  - FOR BEARING LOCATION DETAILS, SEE SHEET 36/79.
  - SPACE TOP REINFORCING BARS IN CAP TO CLEAR BEARING ANCHOR BOLTS.
  - FOR ADDITIONAL FOUNDATION DETAILS, SEE SHEET 28/79 & 31/79.
  - THE PREFIX "FA" SHALL BE ADDED TO ALL BAR MARKS FOR THE FORWARD ABUTMENT. THE PREFIX "FAF" SHALL BE ADDED TO ALL BAR MARKS FOR THE FORWARD ABUTMENT FOOTING.
  - FOR REINFORCING SCHEDULE, SEE SHEETS 76/79.
  - WINGWALL ELEVATIONS GIVEN ARE TO THE FRONT FACE OF WALL.
  - LOCATE 6" P.C.P.P. AS CLOSE TO THE TOP OF FOOTING AS PRACTICAL WHILE MAINTAINING A 1/8" PER FOOT SLOPE TOWARDS THE OUTLET.

**PRIME**  
540 WHITE POND DR. SUITE E  
AKRON, OH 44320

DESIGN AGENCY

DATE 8/22/2019  
REVIEWED TES  
DRAWN CRG  
DESIGNED CRG  
CHECKED KDC


STRUCTURE FILE NUMBER 3109798  
REVISED

**FORWARD ABUTMENT DETAILS (2 OF 4)**  
BRIDGE NO. HAM-74-1908S  
RAMP P OVER IR-74 WESTBOUND, IR-75 AND RAMP E

HAM-75-3.84  
PID No. 104667

29/79  
29/79


P:\Projects\2018\20H03DB-18232 HAM-75-03.84\104667\structures\HAM074\_1908S\sheets\074\_1908S\_AF004.dgn 7/28/2023 9:31:30 AM erin.baumann

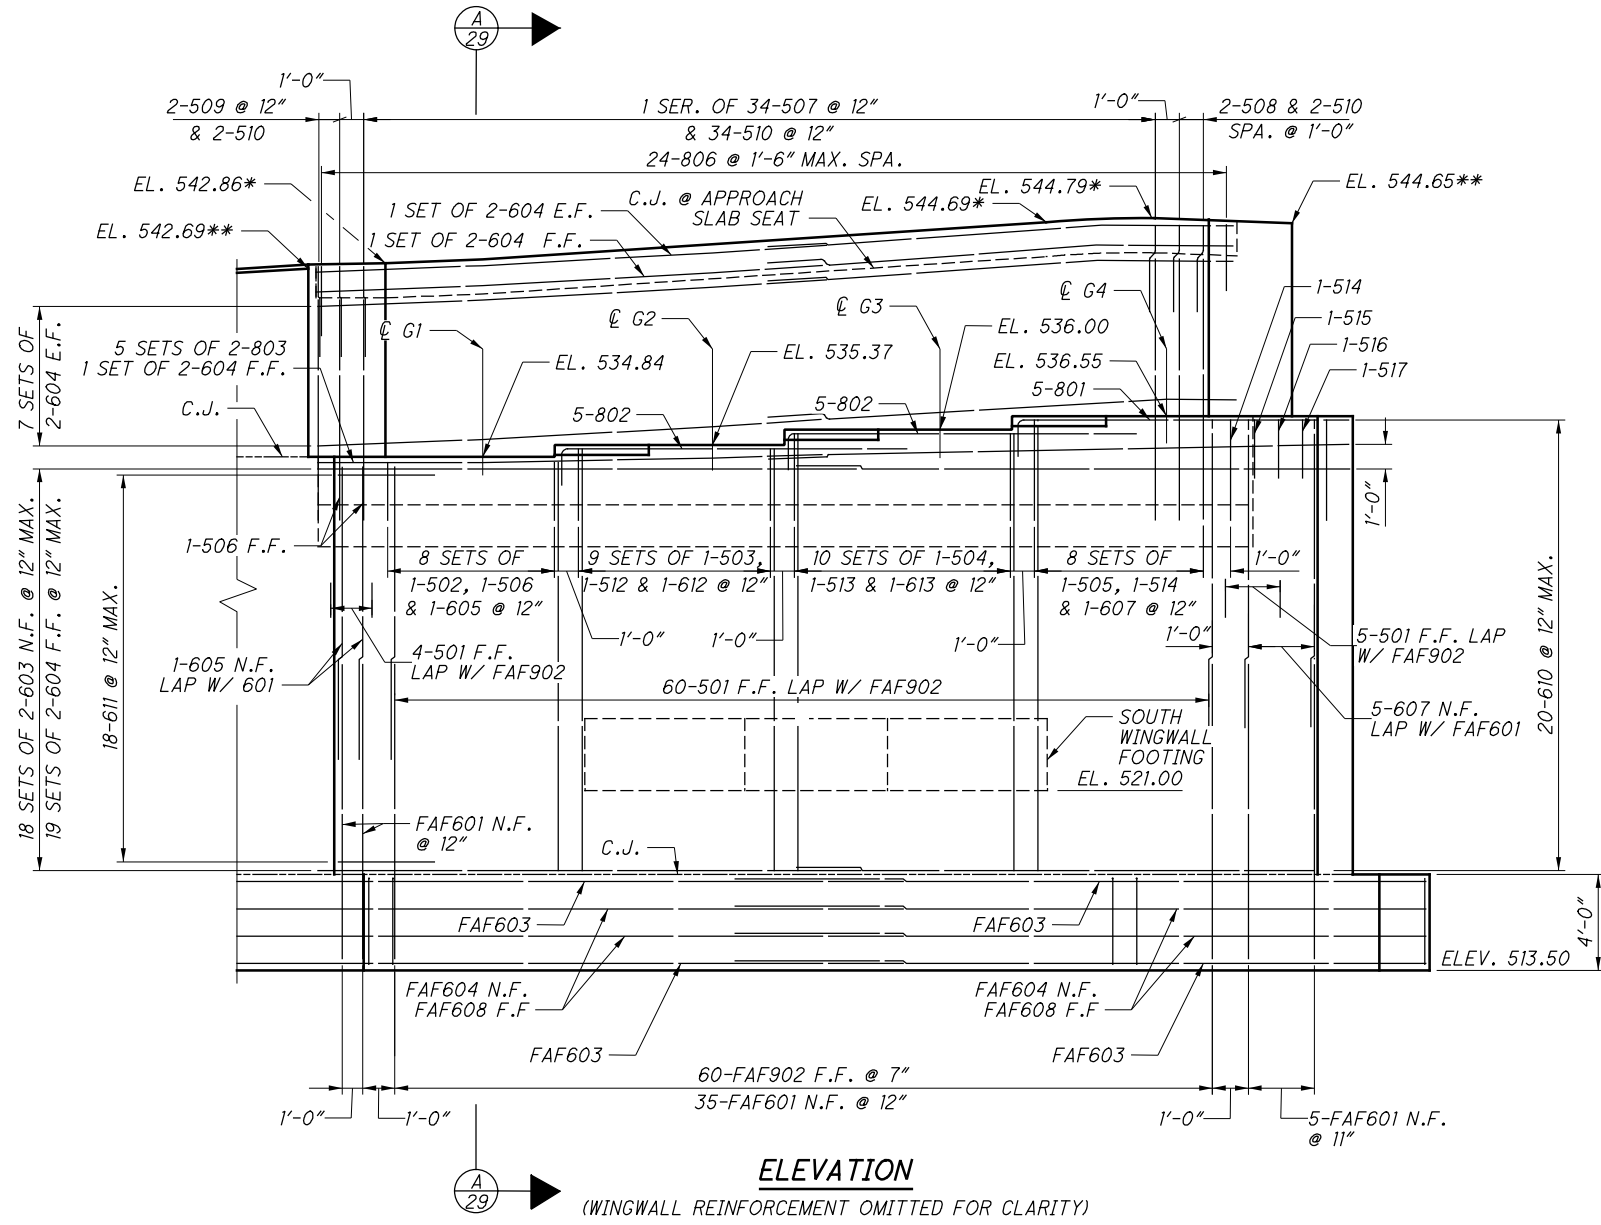

**ELEVATION**  
(WINGWALL REINFORCEMENT OMITTED FOR CLARITY)

MIN. REQUIRED LAP LENGTH	
#5 VERTICAL	29"
#6 HORIZONTAL	48"
#6 VERTICAL	34"
#8 HORIZONTAL	45"


**LEGEND:**  
 \* - ELEVATIONS ARE TO THE FRONT FACE OF BACKWALL  
 \*\* - ELEVATIONS ARE TO THE FRONT FACE OF WINGWALL

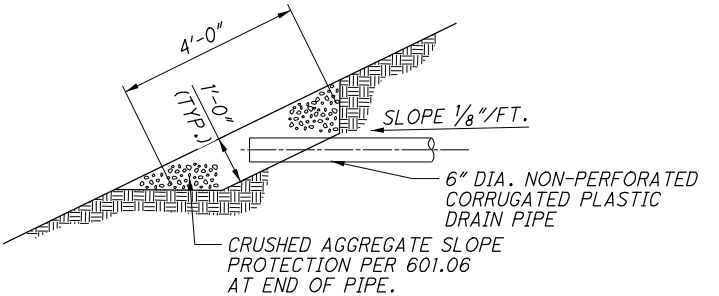


**OUTLET DETAIL**

- NOTES:**
- FOR ABUTMENT PLAN, SEE SHEET [29/79].
  - SEAL ALL EXPOSED (ABOVE GROUND) CONCRETE SURFACES OF PROPOSED ABUTMENT WITH EPOXY URETHANE.
  - FOR BEARING LOCATION DETAILS, SEE SHEET [36/79].
  - SPACE TOP REINFORCING BARS IN CAP TO CLEAR BEARING ANCHOR BOLTS.
  - FOR ADDITIONAL FOUNDATION DETAILS, SEE SHEET [28/79] & [31/79].
  - THE PREFIX "FA" SHALL BE ADDED TO ALL BAR MARKS FOR THE FORWARD ABUTMENT. THE PREFIX "FAF" SHALL BE ADDED TO ALL BAR MARKS FOR THE FORWARD ABUTMENT FOOTING.
  - FOR REINFORCING SCHEDULE, SEE SHEETS [76/79].
  - BRIDGE SEAT ELEVATIONS HAVE BEEN ADJUSTED UPWARD 0.088 INCHES AT FORWARD ABUTMENT TO COMPENSATE FOR THE VERTICAL DEFORMATION OF THE BEARINGS.


P:\Projects\2018\20H03DB-18232 HAM-75-03.84\104667\structures\HAM074\_1908S\_AF003.dgn 7/28/2023 9:31:33 AM erin.boumann

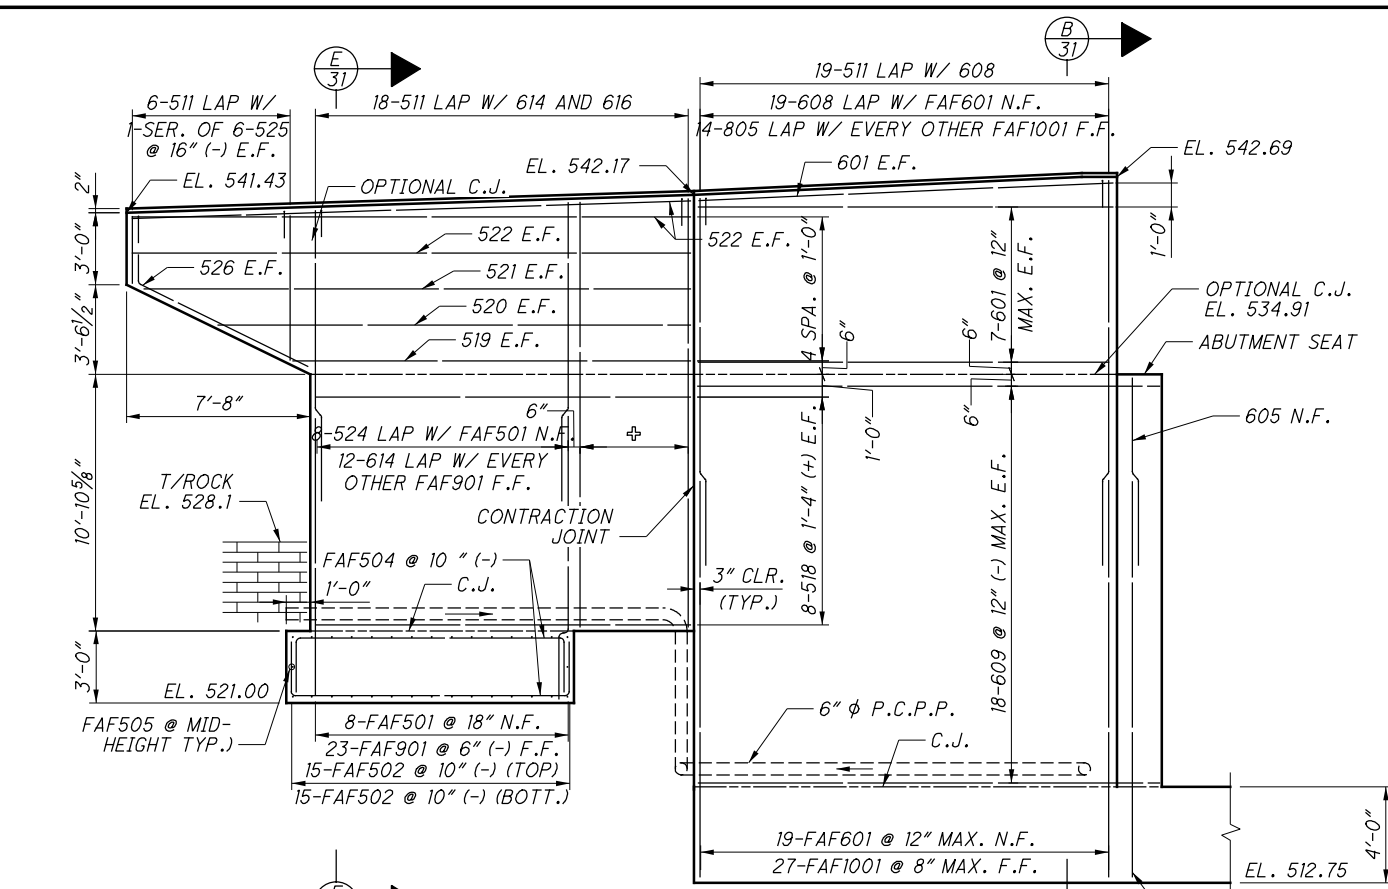


**C NORTH WINGWALL VIEW**  
29

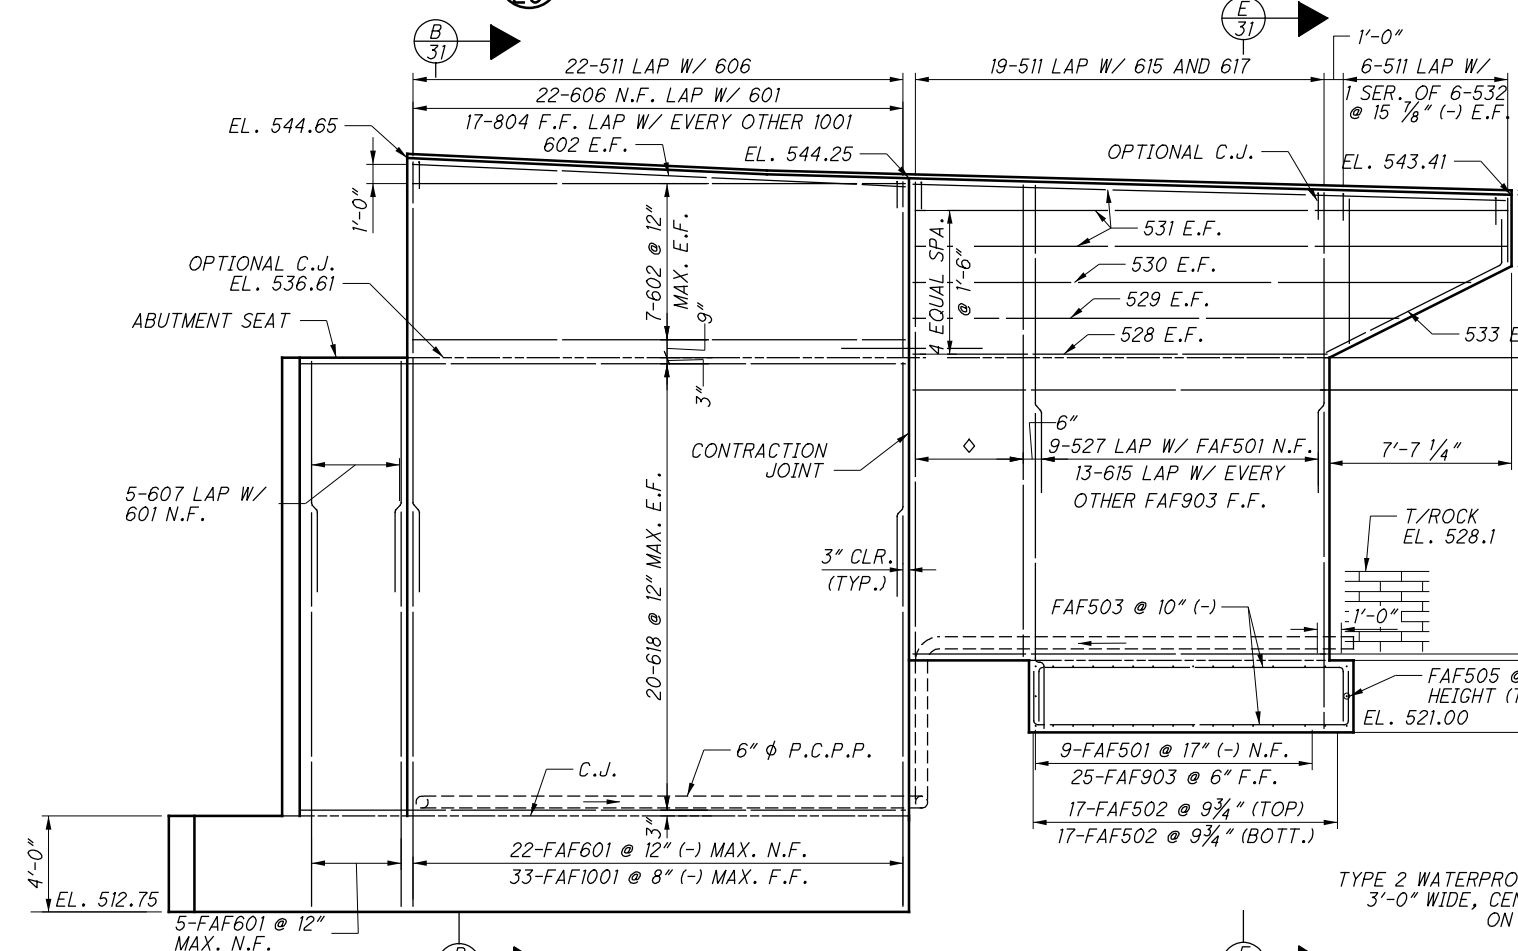

**D SOUTH WINGWALL VIEW**  
29 (ABUTMENT FOOTING REINFORCING OMITTED FOR CLARITY)

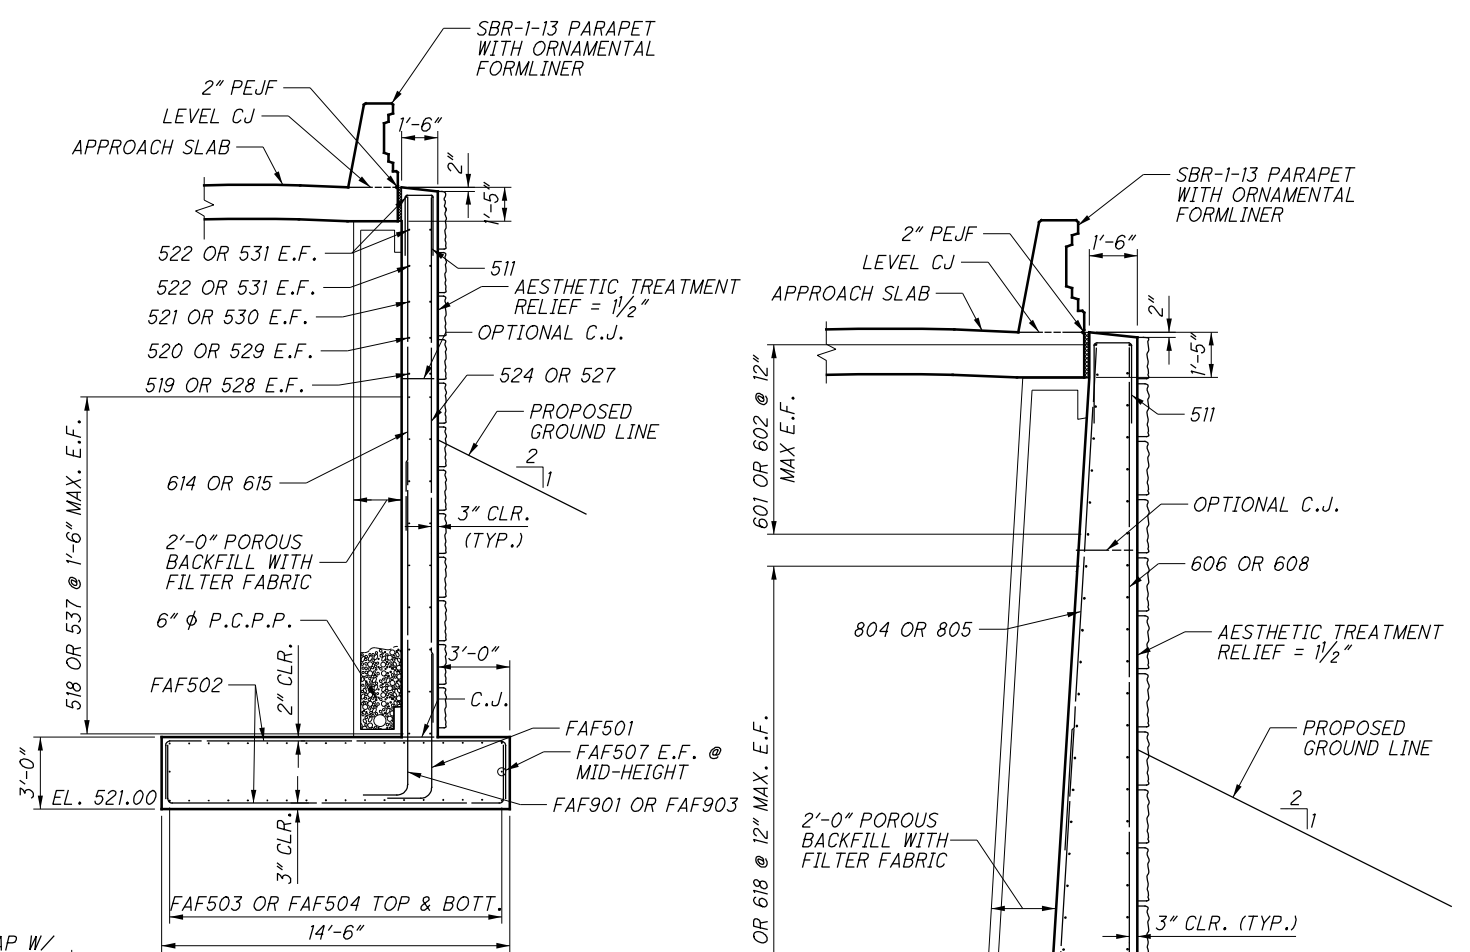


**E SECTION THROUGH WINGWALL**  
29 (NORTH WINGWALL SHOWN, SOUTH WINGWALL SIMILAR)

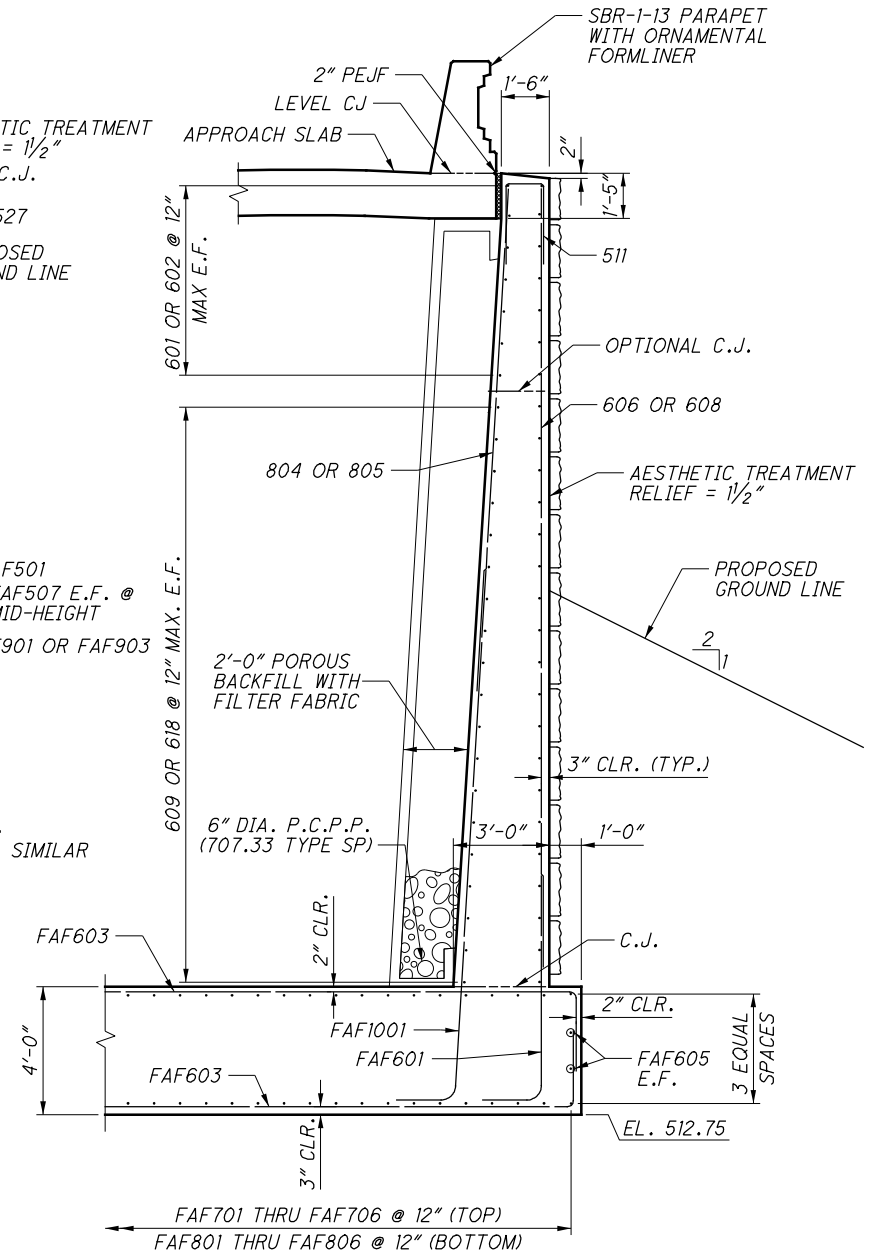

**B SECTION THROUGH WINGWALL**  
31

**LEGEND:**

- ⊕ - 4-535 N.F. @ 18" & 6-616 F.F. @ 9"
- ◇ - 4-536 N.F. @ 18" & 7-617 F.F. @ 9"

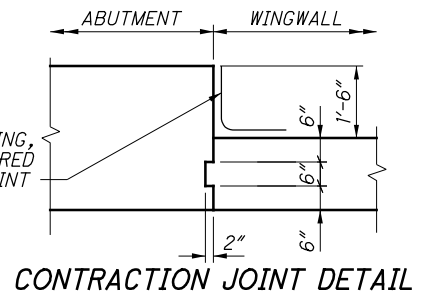


**CONTRACTION JOINT DETAIL**

**NOTES:**


1. THE PREFIX "FA" SHALL BE ADDED TO ALL BAR MARKS FOR THE FORWARD ABUTMENT. THE PREFIX "FAF" SHALL BE ADDED TO ALL BAR MARKS FOR THE FORWARD ABUTMENT FOOTINGS.
2. FOR REINFORCEMENT SCHEDULE, SEE SHEET 76/79.
3. WINGWALL ELEVATIONS SHOWN ARE TO THE FRONT FACE OF WALL.
4. SEAL ALL EXPOSED SURFACES (ABOVE GROUND) SURFACES OF PROPOSED WINGWALLS WITH EPOXY URETHANE.

MIN. REQUIRED LAP LENGTH	
#5 HORIZONTAL	35"
#5 VERTICAL	29"
#6 VERTICAL	34"
#8 VERTICAL	45"

P:\Projects\2018\20H03DB-18232 HAM-75-03.84\104667\structures\HAM074\_1908S\sheets\074\_1908S\_BR001.dgn 7/28/2023 9:31:42 AM erin.baumann

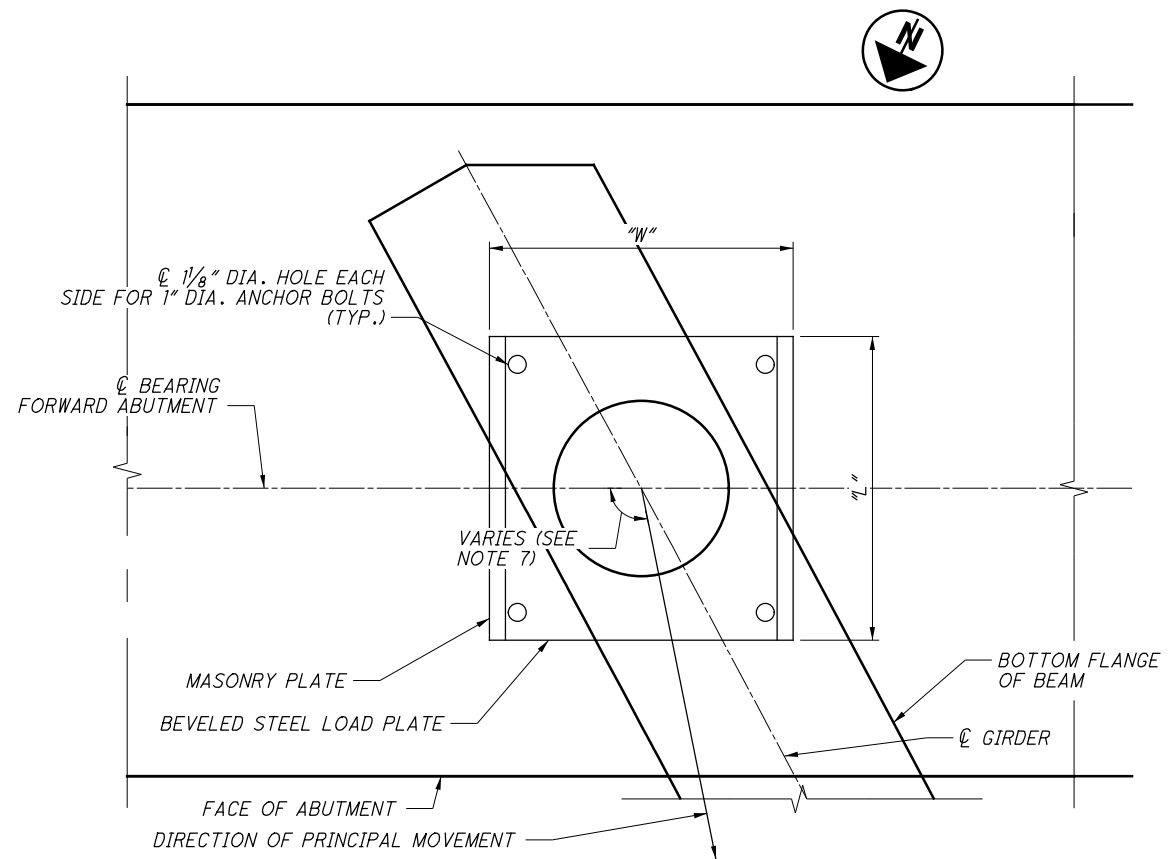

**PLAN**  
(GIRDERS 2 & 3 FORWARD ABUTMENT SHOWN, GIRDERS 2 & 3 AT: EXISTING PIER 7, UNIT 1, PIER 2 UNIT 1 & AT PIER 2 UNIT 2 SIMILAR)

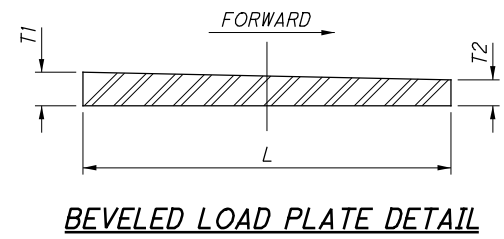


	EX. PIER 7 UNIT 1		PIER 2 UNIT 1		PIER 2 UNIT 2		FWD. ABUT. UNIT 2	
LOCATION	T1	T2	T1	T2	T1	T2	T1	T2
GIRDER 2	1.379"	1.621"	1 3/8"	1 5/8"	1"	2"	1 3/16"	1 3/16"
GIRDER 3	1 1/4"	1 3/4"	1 3/8"	1 5/8"	1"	2"	1 3/16"	1 3/16"

	EX. PIER 7 UNIT 1		PIER 2 UNIT 1		PIER 2 UNIT 2		FWD. ABUT. UNIT 2	
LOCATION	W	L	W	L	W	L	W	L
GIRDER 2	16"	16"	16"	16"	22"	24"	20"	20 1/2"
GIRDER 3	16"	16"	16"	16"	22"	24"	20"	20 1/2"

**NOTES:**

- LOAD PLATES:**  
THE STEEL LOAD AND MASONRY PLATES SHALL CONFORM TO THE REQUIREMENTS OF ASTM A709 GRADE 50 AND SHALL BE BONDED TO THE ELASTOMER BY VULCANIZATION DURING THE MOLDING PROCESS IN ACCORDANCE WITH ITEM 516. CONTROL WELDING SO THAT THE PLATE TEMPERATURE DOES NOT EXCEED 300°F AS DETERMINED BY THE USE OF PYROMETRIC SENSORS OR OTHER TEMPERATURE MONITORING DEVICES.
- COMPONENTS OF THE BEARING DEVICES SHALL MEET THE REQUIREMENTS OF ODOT SUPPLEMENTAL SPECIFICATION 869.**
- MARKINGS:**  
ALL BEARINGS SHALL BE MARKED PRIOR TO SHIPPING. THE MARKS SHALL INCLUDE THE BEARING LOCATION ON THE BRIDGE, AND A DIRECTION ARROW THAT POINTS UP-STATION. ALL MARKS SHALL BE PERMANENT AND BE VISIBLE AFTER THE BEARING IS INSTALLED.
- CORROSION PROTECTION:**  
ALL STEEL SURFACES AND COMPONENTS, EXCEPT THE TOP OF THE STEEL LOAD PLATE, STAINLESS STEEL AND PTFE SURFACES SHALL BE METALLIZED IN ACCORDANCE WITH ODOT SUPPLEMENTAL SPECIFICATION 869.
- DESIGN LOAD:**  
TOTAL DESIGN LOAD FOR BEARINGS EQUALS THE SUM OF THE DEAD LOADS AND LIVE LOADS TABULATED IN THE BEARING TABLE. LOADS SHOWN ARE WITHOUT IMPACT FACTORS INCLUDED.
- BEARING ORIENTATION:**  
FOR BEARING ORIENTATION AT SUBSTRUCTURE UNITS, SEE INDIVIDUAL PLAN SHEETS.
- THE PTFE SLIDING SURFACE SHALL BE DIMPLE LUBRICATED.**
- THE MAXIMUM COEFFICIENT OF FRICTION TO BE USED IN THE DESIGN OF THE BEARINGS SHALL BE 0.035 AT A TEMPERATURE OF -13° F.**

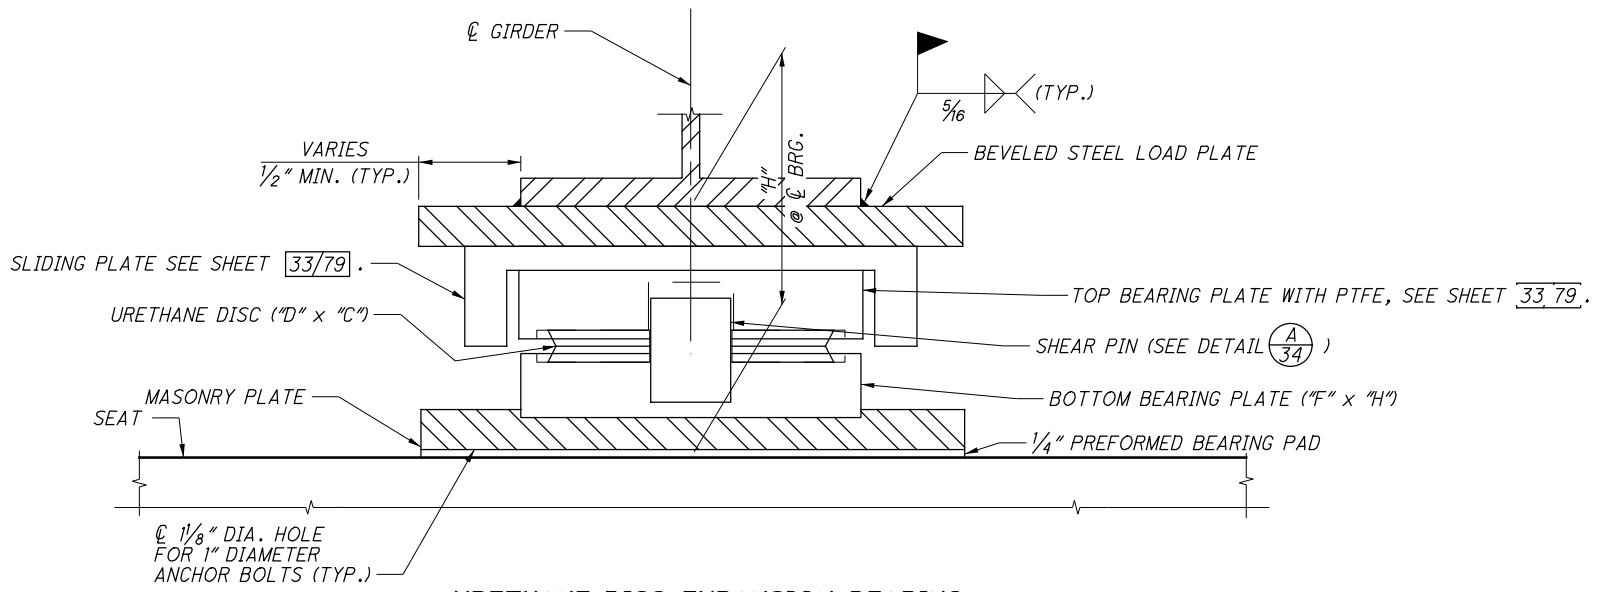


**URETHANE DISC EXPANSION BEARING**

**LEGEND:**  
\* - CLIPPED, FOR DETAIL SEE **C** CLIP DETAIL **35**


**TABLE 1 - HIGH LOAD MULTI-ROTATIONAL (HLMR) BEARINGS**

LOCATION	BEARING TYPE	NO. OF BEARINGS	TOP BEARING PLATE SIZE (KxL)	URETHANE DISC SIZE (DxC)	BOTTOM BEARING PLATE SIZE (F x H)	MASONRY PLATE SIZE (LxWxT)	SLIDING PLATE SIZE	VERTICAL LOADS (KIPS)				HORIZONTAL LOADS (KIPS)				ROTATION (RADIAN) MAX. ONE WAY MVT. (IN)	
								SERVICE LIMIT STATE		STR. LIMIT STATE	SERVICE LIMIT STATE		STR. LIMIT STATE		STR. LIMIT STATE	STR. LIMIT STATE	
								DL + FWS	LIVE LOAD	TOTAL LOAD	TOTAL LOAD	LONG.	TRANS.	LONG.	TRANS.	TOTAL	LONG.
EXISTING PIER 7 - UNIT 1	GUIDED EXP.	2	SEE SHEET 33/79	7.230" φ x 1.000"	8.930" φ x 1.969"	18"x18"x1 1/4"	SEE SHEET 33/79	51.6	68.2	119.8	187.6	5.1	8.9	4.2	11.1	0.012	0.51
PIER 2 - UNIT 1	GUIDED EXP.	2	SEE SHEET 33/79	7.230" φ x 1.000"	8.930" φ x 1.969"	18"x18"x1 1/4"	SEE SHEET 33/79	71.1	69.5	140.6	214.3	20.0	13.6	10.0	17.0	0.006	0.63
PIER 2 - UNIT 2	GUIDED EXP.	2	SEE SHEET 33/79	11.330" φ x 1.250"	13.030" φ x 2.342"	20"x20"x1 1/4"	SEE SHEET 33/79	254.1	126.1	380.2	550.6	61.2	29.0	30.6	36.6	0.019	1.79
FORWARD ABUT. - UNIT 2	GUIDED EXP.	2	SEE SHEET 33/79	9.130" φ x 1.000"	10.830" φ x 2.026"	19"x19"x1 1/2"	SEE SHEET 33/79	138.4	111.6	250.0	375.3	41.6	25.4	33.9	31.7	0.004	1.52


P:\Projects\2018\20H03DB-18232 HAM-75-03.84\104667\structures\HAM074\_1908S\sheets\074\_1908S\_BR006.dgn 7/28/2023 9:31:44 AM erin.boumann

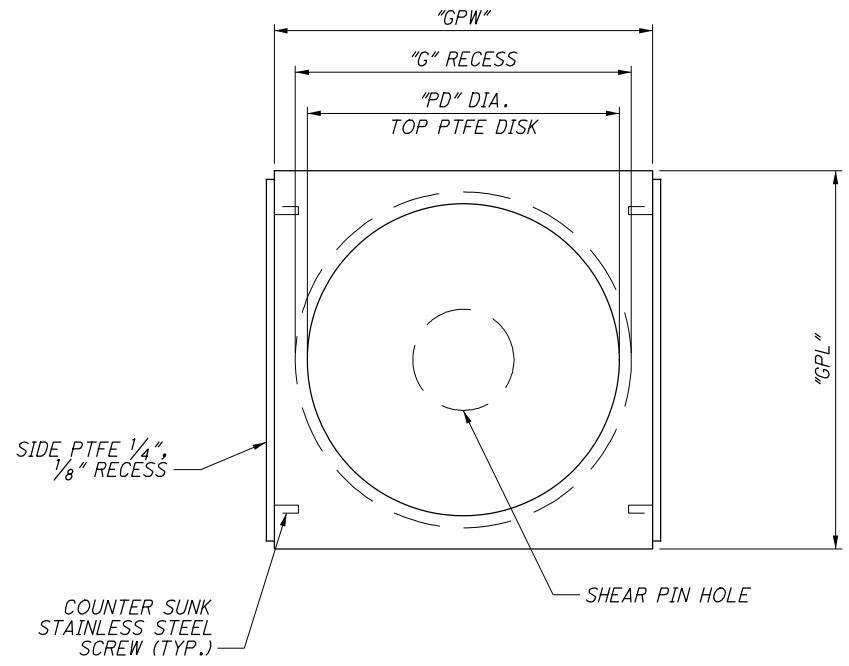


**TOP BEARING GUIDE PLAN**  
 (GIRDERS 2 & 3 FORWARD ABUTMENT SHOWN,  
 GIRDERS 2 & 3 AT: EXISTING PIER 7, UNIT 1,  
 PIER 2 UNIT 1 & AT PIER 2 UNIT 2 SIMILAR)

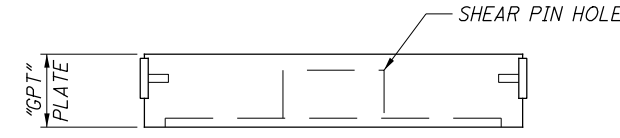


**TOP BEARING GUIDE ELEVATION**

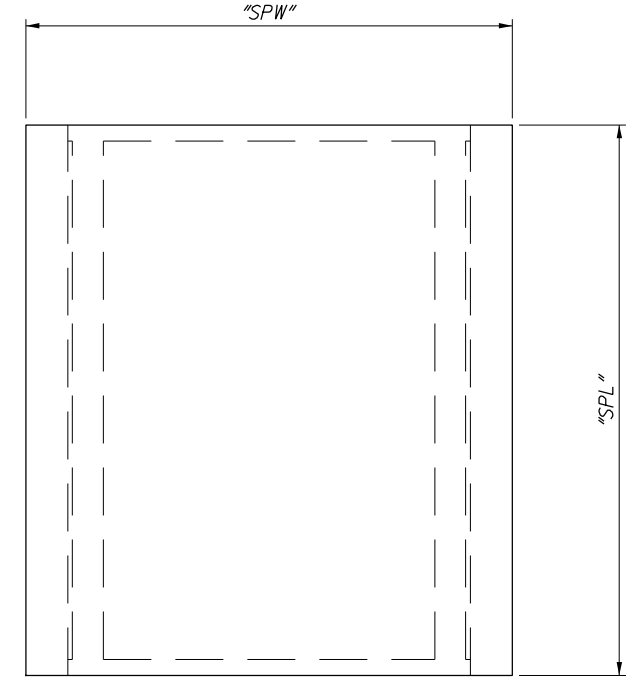

**SLIDE PLATE PLAN**  
 (GIRDERS 2 & 3 FORWARD ABUTMENT SHOWN,  
 GIRDERS 2 & 3 AT: EXISTING PIER 7, UNIT 1,  
 PIER 2 UNIT 1 & AT PIER 2 UNIT 2 SIMILAR)

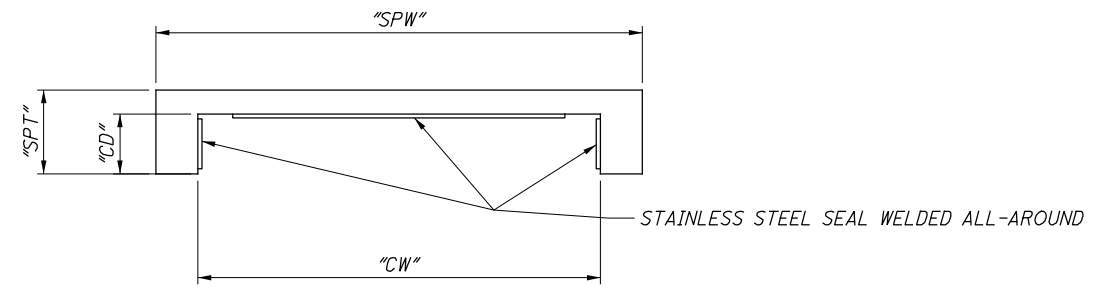


**SLIDE PLATE ELEVATION**

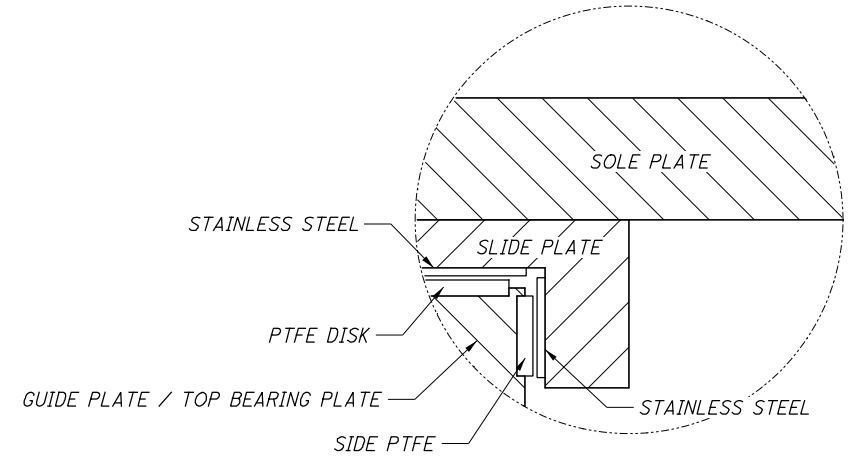


**GUIDED EXPANSION DETAILS**

TABLE 1 - TOP SLIDE AND GUIDE PLATE DIMENSIONS												
LOCATION	BEARING TYPE	NO. OF BEARINGS	TOP BEARING GUIDE PLATE					TOP BEARING GUIDE PLATE				
			GPW	GPL	GPT	G	PD	SPW	SPW	SPT	CW	CD
EXISTING PIER 7 - UNIT 1	GUIDED EXP.	2	9.930"	9.930"	2.250"	7.930"	7.500"	13.305"	13.435"	2.375"	10.680"	1.625"
PIER 2 - UNIT 1	GUIDED EXP.	2	9.930"	9.930"	2.250"	7.930"	7.500"	13.305"	13.435"	2.375"	10.680"	1.625"
PIER 2 - UNIT 2	GUIDED EXP.	2	14.030"	14.030"	2.492"	12.030"	12.000"	17.655"	19.905"	3.125"	15.030"	2.375"
FORWARD ABUT. - UNIT 2	GUIDED EXP.	2	11.830"	11.830"	2.276"	9.830"	9.750"	15.205"	17.205"	2.625"	12.580"	1.875"

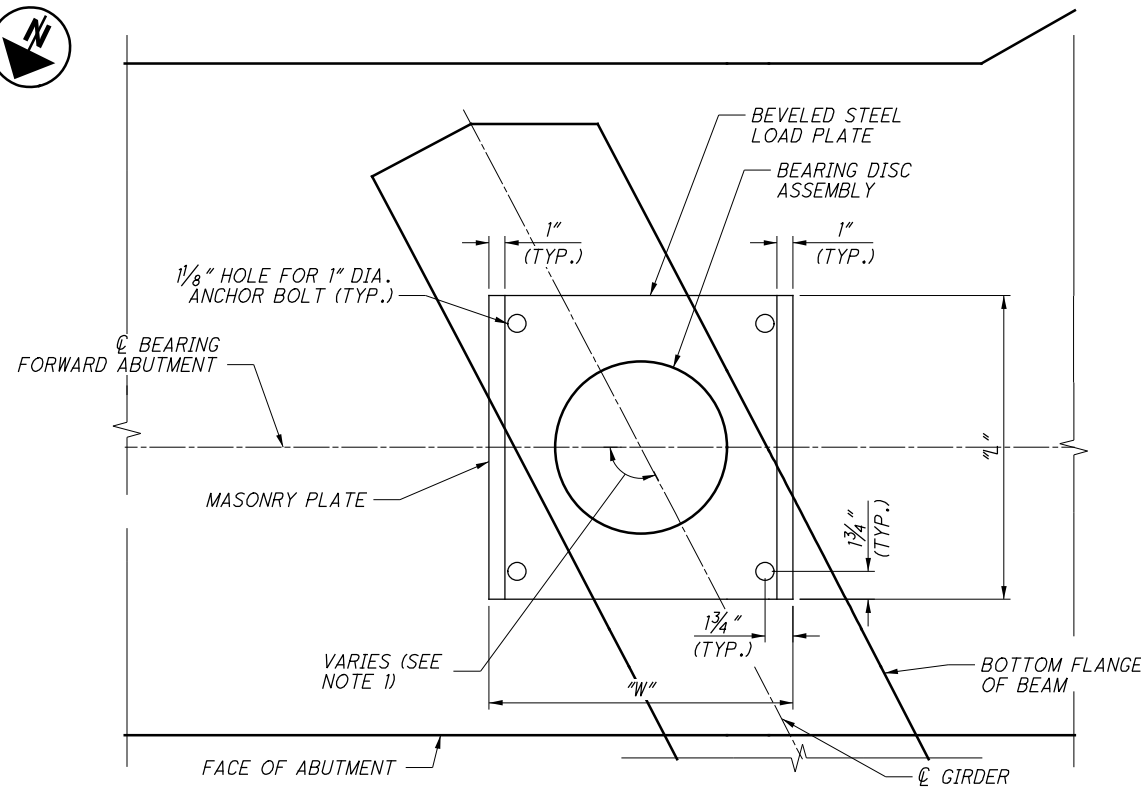


**PLAN**

(GIRDER 4 AT FORWARD ABUTMENT SHOWN)  
(TYPICAL FOR GIRDERS 1 & 4 AT EX.  
PIER 7 UNIT 1, PIER 2 UNITS 1 & 2  
& FORWARD ABUTMENT UNIT 2)

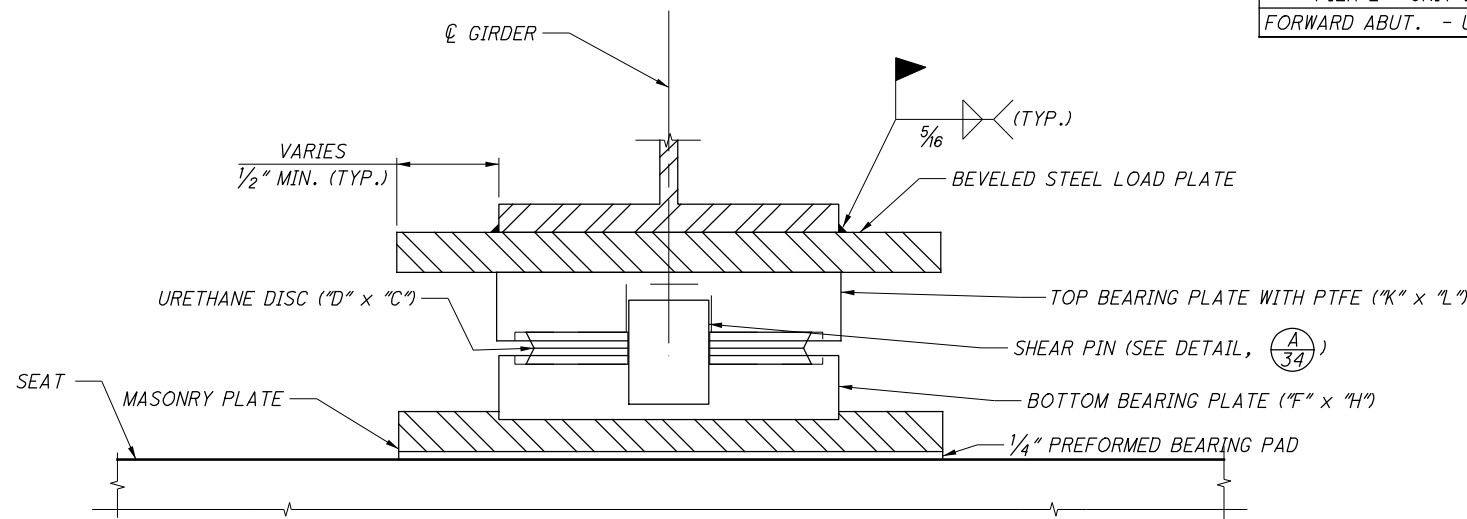

**URETHANE DISC EXPANSION BEARING**

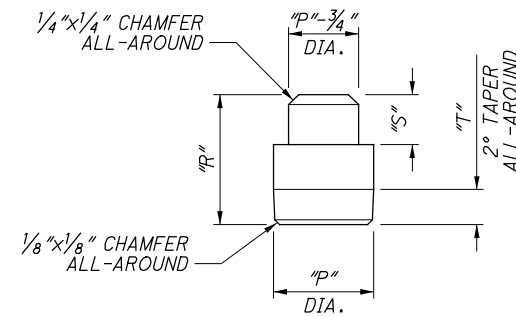


**A SHEAR PIN DETAIL**  
32,34

NON-GUIDED EXPANSION BEARINGS				
LOCATION	DIM. "P"	DIM. "R"	DIM. "S"	DIM. "T"
EXISTING PIER 7 - UNIT 1, GIRDERS 1 & 4	2.000"	3.250"	1.250"	0.875"
PIER 2 - UNIT 1, GIRDERS 1 & 4	2.000"	3.250"	1.250"	0.875"
PIER 2 - UNIT 2, GIRDERS 1 & 4	3.000"	3.375"	1.500"	0.875"
FORWARD ABUT. - UNIT 2, GIRDERS 1 & 4	2.500"	3.250"	1.250"	0.875"

AS-BUILT NOTE:  
A 1/2" THICK SHIM WAS PLACED BETWEEN BOTTOM OF BEAM  
AND TOP OF SOLE PLATE AT PIER 2 - UNIT 1, GIRDER 4,  
WELDED TO BEAM AND TO SOLE PLATE WITH 5/16" FILLET.  
THE SHIM IS 15" WIDE X 14" LONG.

GUIDED EXPANSION BEARINGS				
LOCATION	DIM. "P"	DIM. "R"	DIM. "S"	DIM. "T"
EXISTING PIER 7 - UNIT 1, GIRDERS 2 & 3	2.500"	3.250"	1.250"	0.875"
PIER 2 - UNIT 1, GIRDERS 2 & 3	2.500"	3.250"	1.250"	0.875"
PIER 2 - UNIT 2, GIRDERS 2 & 3	3.600"	3.875"	1.500"	1.000"
FORWARD ABUT. - UNIT 2, GIRDERS 2 & 3	3.000"	3.250"	1.250"	0.875"

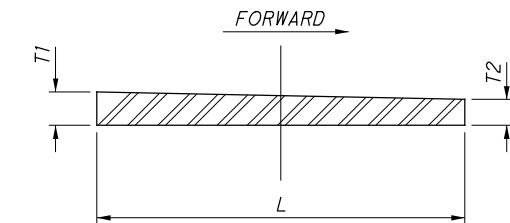

**BEVELED LOAD PLATE DETAIL**

BEVELED LOAD PLATE TABLE								
	EX. PIER 7 UNIT 1		PIER 2 UNIT 1		PIER 2 UNIT 2		FWD. ABUT. UNIT 2	
LOCATION	T1	T2	T1	T2	T1	T2	T1	T2
GIRDER 1	1 1/8"	1 3/8"	1 1/8"	1 1/8"	1 1/8"	1 5/8"	1 1/2"	1"
GIRDER 4	1 1/8"	1 3/8"	1 1/8"	1 3/8"	1"	1 1/2"	1 1/2"	1"

BEVELED LOAD PLATE TABLE								
	EX. PIER 7 UNIT 1		PIER 2 UNIT 1		PIER 2 UNIT 2		FWD. ABUT. UNIT 2	
LOCATION	W	L	W	L	W	L	W	L
GIRDER 1	16"	14"	16"	14"	19"	19"	19"	17"
GIRDER 4	16"	14"	16"	14"	29"	19"	19"	17"

**NOTE:**



1. FOR NOTES, SEE SHEET 32/79.

**TABLE 1 - NON-GUIDED EXPANSION BEARING SCHEDULE**

LOCATION	BEARING TYPE	NO. OF BEARINGS	TOP BEARING PLATE SIZE (KxL)	URETHANE DISC SIZE (DxC)	BOTTOM BEARING PLATE SIZE (F x H)	MASONRY PLATE SIZE (LxWxT)	VERTICAL LOADS (KIPS)				HORIZONTAL LOADS (KIPS)				ROTATION (RADIAN)	MAX. ONE WAY MVT. (IN)
							SERVICE LIMIT STATE		STR. LIMIT STATE		SERVICE LIMIT STATE		STR. LIMIT STATE		STR. LIMIT STATE	STR. LIMIT STATE
							DL + FWS	LIVE LOAD	TOTAL LOAD	TOTAL LOAD	LONG.	TRANS.	LONG.	TRANS.		
EXISTING PIER 7 - UNIT 1	EXP.	2	9.000" φ x 2.095"	7.730" φ x 1.000"	8.730" φ x 1.970"	18"x18"x1 1/4"	51.6	68.2	119.8	186.7	4.5	10.1	1.8	12.6	0.013	0.51
PIER 2 - UNIT 1	EXP.	2	9.000" φ x 2.095"	7.730" φ x 1.000"	8.730" φ x 1.970"	18"x18"x1 1/4"	71.1	69.5	140.6	214.3	10.0	13.9	5.0	17.4	0.006	0.63
PIER 2 - UNIT 2, GIRDER 1	EXP.	1	12.875" φ x 2.215"	11.030" φ x 1.125"	12.730" φ x 2.000"	20"x20"x1 1/4"	254.1	126.1	380.2	550.6	30.6	47.8	15.3	59.8	0.018	1.79
PIER 2 - UNIT 2, GIRDER 4	EXP.	1	12.875" φ x 2.215"	11.030" φ x 1.125"	12.730" φ x 2.000"	20"x20"x1 1/4"	254.1	126.1	380.2	550.6	30.6	47.8	15.3	59.8	0.004	1.79
FORWARD ABUT. - UNIT 2	EXP.	2	11.000" φ x 2.145"	8.930" φ x 1.000"	10.630" φ x 2.000"	19"x19"x1 1/4"	138.4	111.6	250.0	375.3	20.8	34.7	17.0	43.4	0.005	1.52



P:\Projects\2018\20H03DB-18232 HAM-75-03.84\104667\structures\HAM074\_1908S\sheets\074\_1908S\_BR003.dgn 7/28/2023 9:31:45 AM erin.baumann

P:\Projects\2018\20H03DB-18232 HAM-75-03.84\104667\structures\HAM074\_1908S\BR002.dgn 7/28/2023 9:31:49 AM erin.baumann

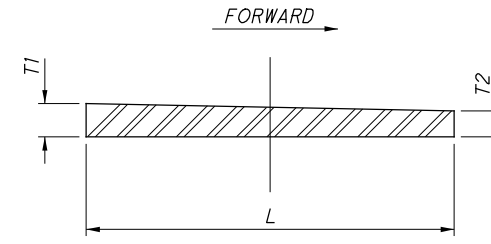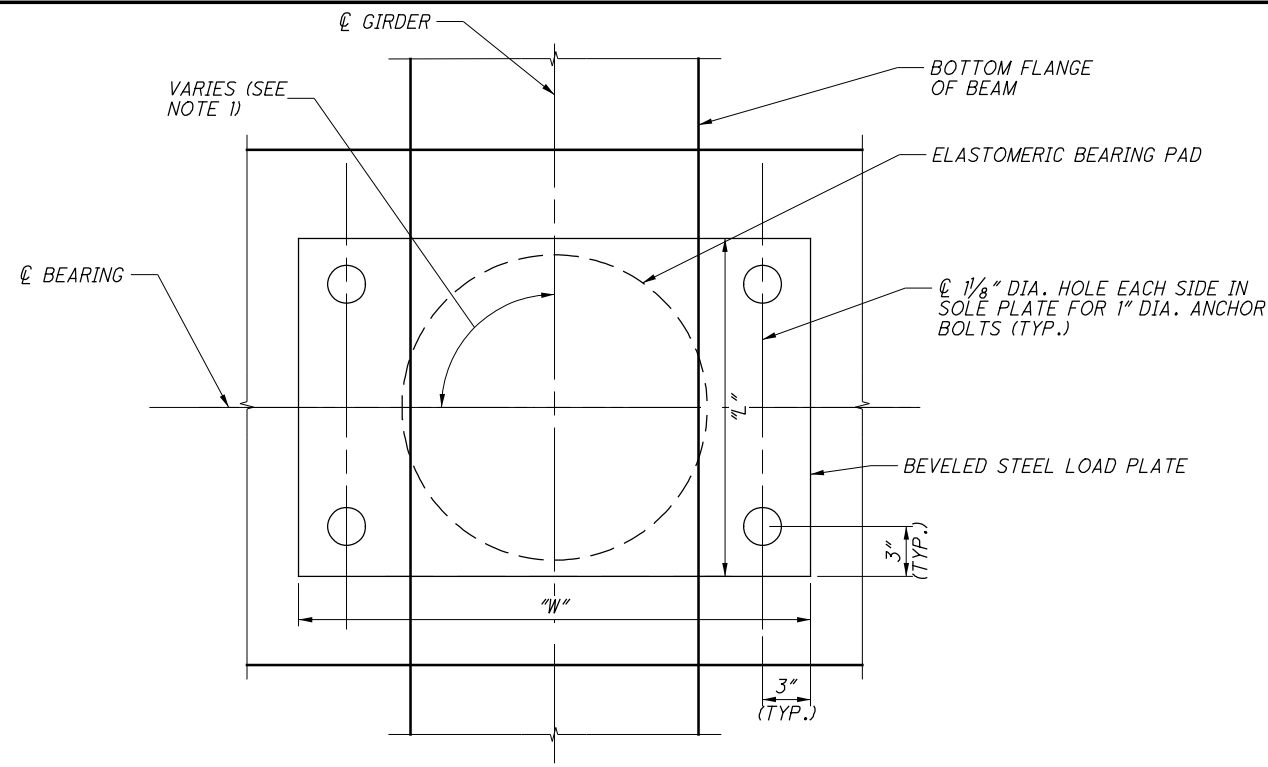

BEVELED LOAD PLATE TABLE

LOCATION	PIER 1 UNIT 1		PIER 3 UNIT 2		PIER 4 UNIT 2	
	T1	T2	T1	T2	T1	T2
GIRDER 1	1 1/4"	1 3/4"	1 3/16"	2 3/16"	1 3/4"	1 1/4"
GIRDER 2	1 1/4"	1 3/4"	1 1/8"	2 1/8"	1 3/4"	1 1/4"
GIRDER 3	1 1/4"	1 3/16"	1 7/8"	2 1/16"	1 3/4"	1 1/4"
GIRDER 4	1 3/16"	1 3/16"	1 5/16"	2 1/16"	1 3/4"	1 1/4"

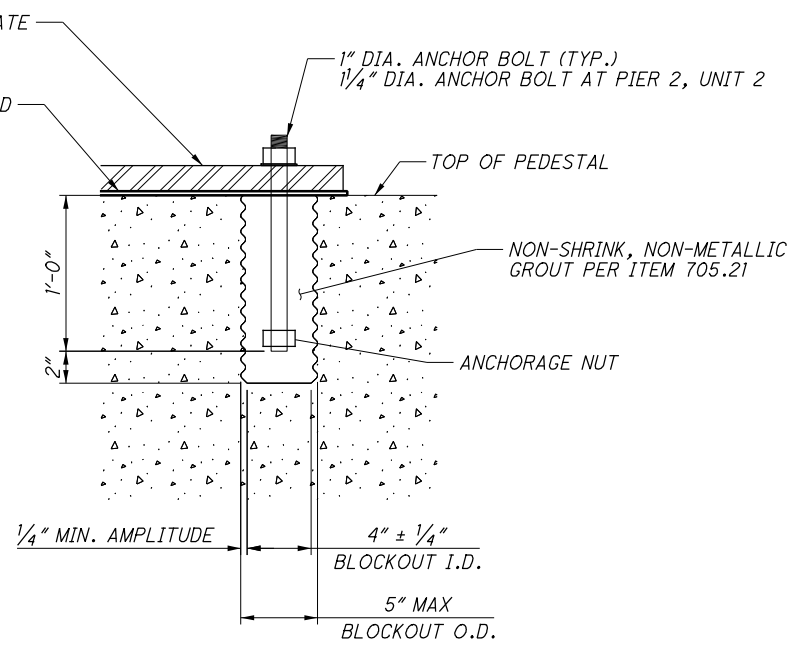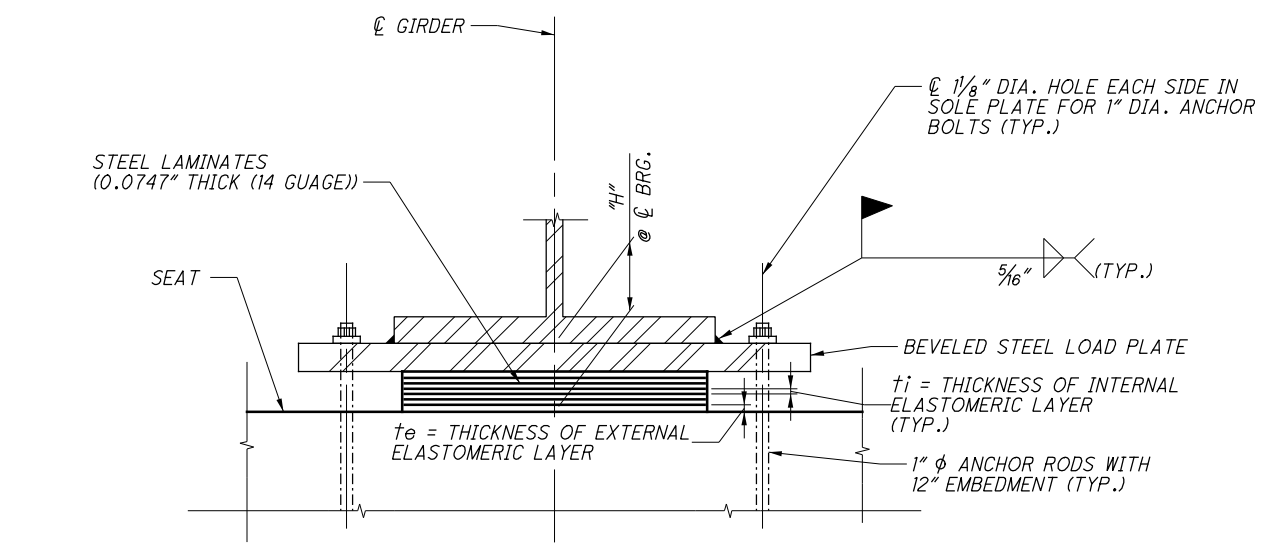

AS-BUILT NOTE:

TO DECREASE THE UNBRACED LENGTH AND THUS INCREASE THE CAPACITY OF THE 1" DIAMETER ANCHOR RODS, STEEL SHEAR BLOCKS HAVE BEEN INSTALLED AROUND EACH ROD BETWEEN THE BOTTOM OF BEVELED LOAD PLATE AND TOP OF CONCRETE PIER. THE SHEAR BLOCKS WERE INSTALLED AT FIXED BEARING LOCATIONS INDICATED IN TABLE BELOW. SEE SHEET [35A/79] AND [35B/79] FOR DETAILS.

NOTE:


- FOR BEARING NOTES, SEE SHEET [32/79].
- THE BLOCKOUT DIMENSIONS ARE BASED ON A 3 1/2" PVC PIPE THAT IS WRAPPED IN HIGH GRADE BUBBLE BUBBLE WRAP WITH 1/2" BUBBLES THAT WILL BE REMOVED AFTER THE CONCRETE HAS SET.

TABLE 2 - FIXED BEARING SCHEDULE

LOCATION	BEARING TYPE	NO. OF BEARINGS	ELASTOMERIC BEARING PAD SIZE	NO. OF STEEL LAMINATES 0.0747" THICK (14 GAGE)	EXTERNAL LAYERS (te) (#, THICK.)	INTERNAL LAYERS (ti) (#, THICK.)	"H" (IN.)	STEEL LOAD PLATE SIZE (LxWxT)	UNFACTORED DESIGN LOADS		
									DEAD LOAD (K)	LIVE LOAD (K)*	TOTAL LOAD (K)
PIER 1 - UNIT 1	FIXED	4	20" φx2.55"	4	0.250"	4 @ 0.500"	4.05"	21"x32"x1 1/2"	220.7	113.1	333.8
PIER 3 - UNIT 2	FIXED	4	28" φx4.85"	8	0.250"	8 @ 0.500"	6.85"	29"x40"x2"	525.2	200.4	725.6
PIER 4 - UNIT 2	FIXED	4	24" φx4.27"	7	0.250"	7 @ 0.500"	5.77"	28"x36"x1 1/2"	386.4	168.1	554.5

\* = LIVE LOAD WITHOUT IMPACT

P:\Projects\2018\20H03DB-18232 HAM-75-03.84\104667\structures\HAM074\_1908S\sheets\074\_1908S\_BR002A.dgn 7/28/2023 9:31:52 AM erin.baumann

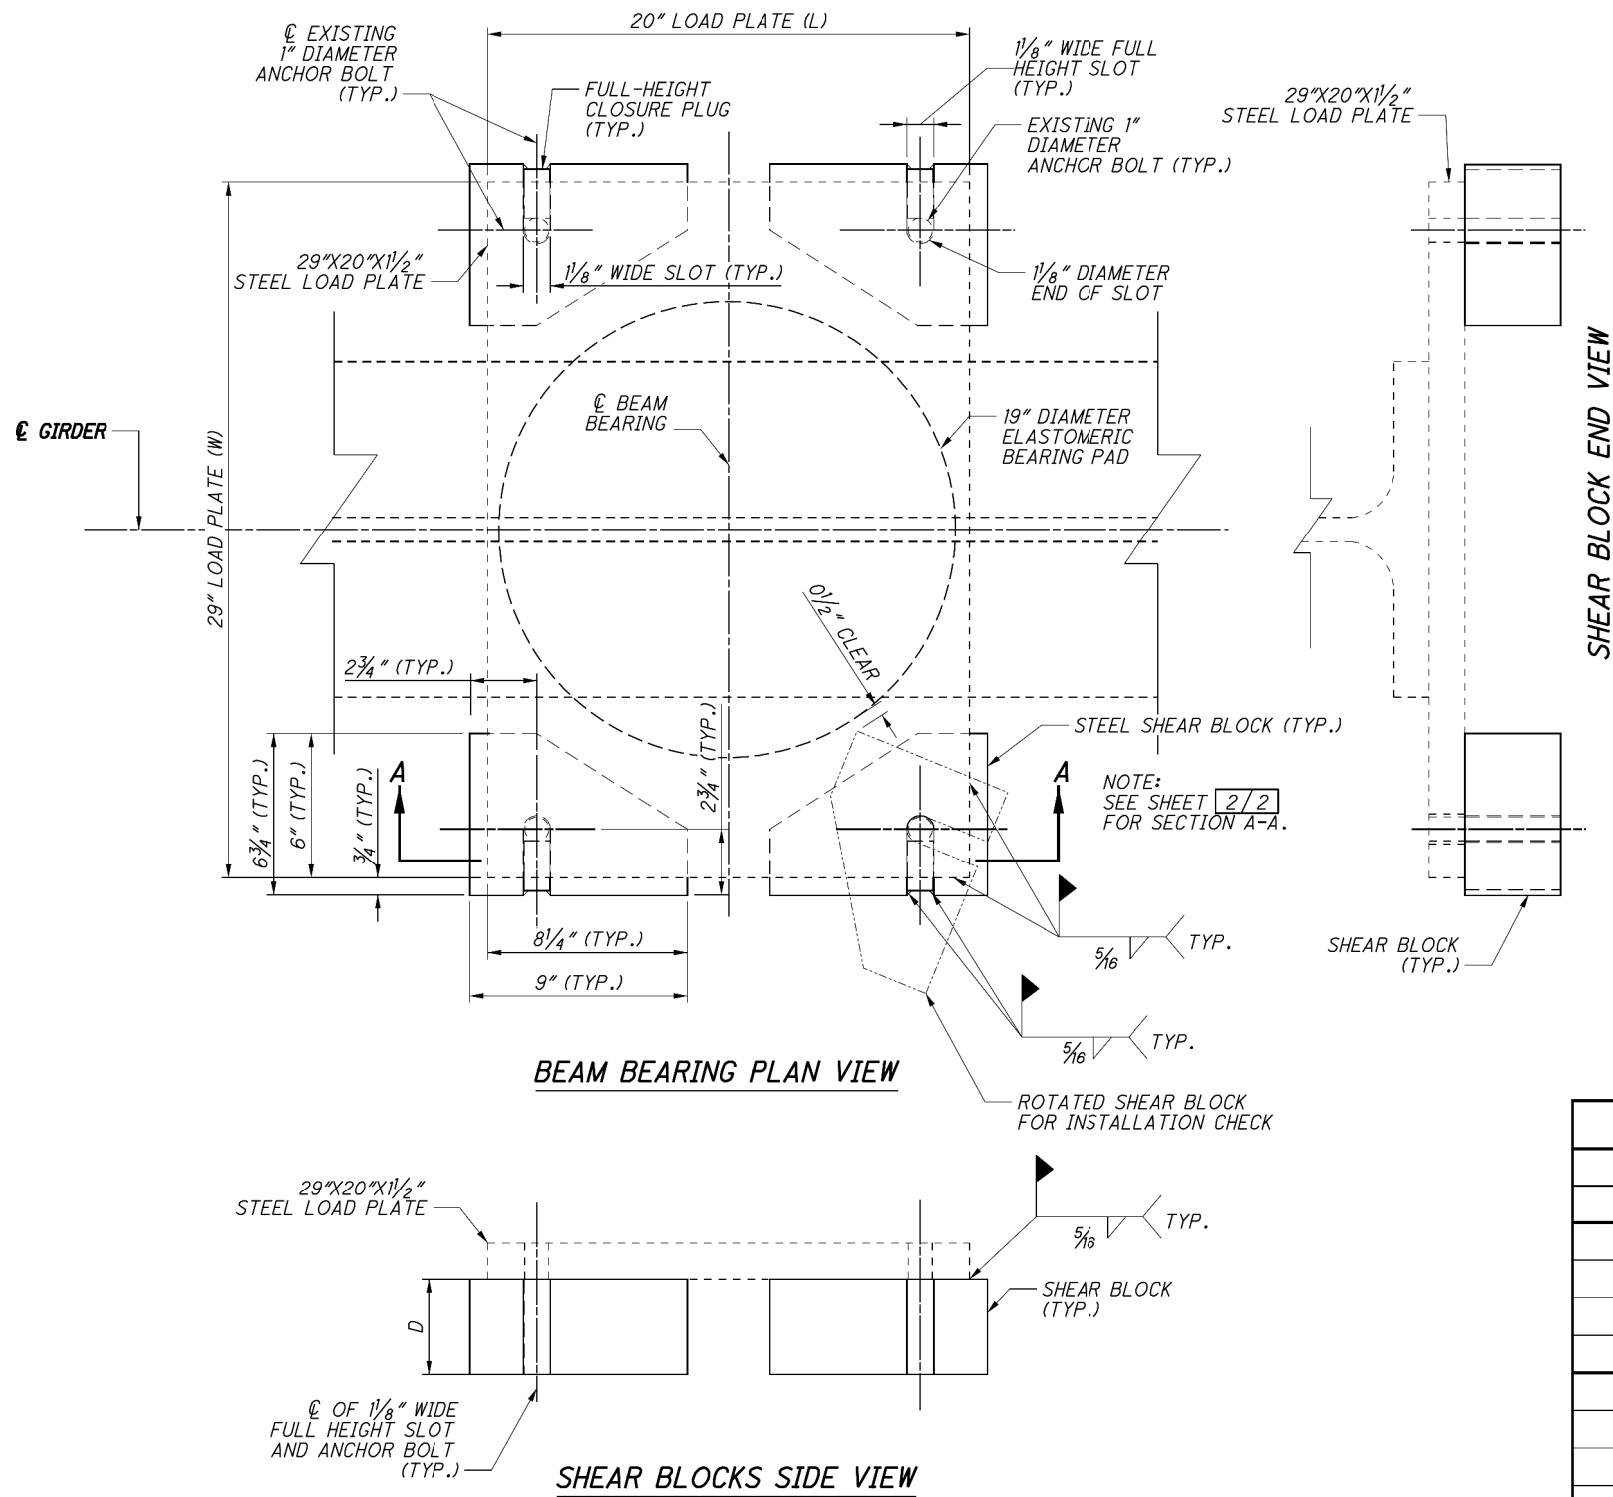

**PROPOSED WORK**

THE PURPOSE OF THESE PLANS IS IN RESPONSE TO RFI 123 1908S. THESE PLANS ARE FOR THE FABRICATION AND INSTALLATION OF STEEL SHEAR BLOCKS AROUND THE BEAM ANCHOR BOLTS AT PIERS 1, 3, AND 4.

**QUANTITIES**

- 16 EACH - 2" TALL SHEAR BLOCKS AND PLUGS FOR PIER 1
- 16 EACH - 4.25" TALL SHEAR BLOCKS AND PLUGS FOR PIER 3
- 16 EACH - 3.75" TALL SHEAR BLOCKS AND PLUGS FOR PIER 4

**GENERAL NOTES:**

1. ALL ANCHOR BOLTS WERE FIELD MEASURED AND ARE 1 INCH DIAMETER.
2. THE MEASURED ANCHOR BOLT DRIFT CAN BE IN ANY DIRECTION, THEREFORE, THE 1/8" WIDE FULL-HEIGHT SLOT AND THE FULL-HEIGHT PLUG WILL NEED TO BE ADJUSTED TO FIT IN THE FIELD BY A COMBINATION OF GRINDING AND WELD FILLER. THE INSIDE OF THE PLUG SHALL TOUCH THE BOLT FOR SNUG FIT. EACH SHEAR BLOCK SHALL BE DELIVERED TO THE FIELD GALVANIZED AND WITH THE FULL-HEIGHT SLOT CUT ASSUMING A PLUMB ANCHOR BOLT.
3. MATERIAL OF THE SHEAR BLOCKS AND FULL-HEIGHT PLUGS SHALL BE GALVANIZED A709 GRADE 50 STEEL. WELDING MATERIAL SHALL BE PER CMS 711.08. WELDING SHALL FOLLOW THE AMERICAN WELDING SOCIETY (AWS BRIDGE WELDING CODE), THE SPECIFICATIONS OF THE EXISTING BRIDGE AND CMS 513.21. GALVANIZING SHALL BE PER ASTM A 123. GALVANIZING SHALL BE REPAIRED AFTER WELDING OF SHEAR BLOCKS WITH GALVANIZING PAINT PER CMS 711.02.
4. CONTROL THE FIELD WELDING ON EXISTING ELASTOMERIC BEARING LOAD PLATES SO THAT THE TEMPERATURE OF THE ELASTOMER DOES NOT EXCEED 300°F.

SHEAR BLOCK SCHEDULE				
LOCATION		HEIGHT OF BEARING PAD (MEASURED IN FIELD)	HEIGHT OF SHEAR BLOCK DIMENSION "D"	ANCHOR BOLT DRIFT (FIELD MEASURED (IN./ 6 IN.))
PIER	GIRDER			
1	G4	2.55"	2.00"	0"
1	G3	2.55"	2.00"	0"
1	G2	2.55"	2.00"	0"
1	G1	2.55"	2.00"	0"
3	G4	4.85"	4.25"	0.125"
3	G3	4.85"	4.25"	0.125"
3	G2	4.85"	4.25"	0.125"
3	G1	4.85"	4.25"	0.125"
4	G4	4.27"	3.75"	0.125"
4	G3	4.27"	3.75"	0.480"
4	G2	4.27"	3.75"	0.125"
4	G1	4.27"	3.75"	0.360"

SIGNED: *Bradley T. Jones*
  
 DATE: 6-6-2022

NOTE: THIS PLAN IS THE PRIME AE RESPONSE TO RFI 123 1908S

DESIGN AGENCY  
**PRIME**  
 540 WHITE POND DR. SUITE E  
 AKRON, OH 44320

DATE: 8/22/2019  
 REVIEWED: TES  
 DRAWN: BTJ  
 DESIGNED: BTJ  
 CHECKED: AMT

STRUCTURE FILE NUMBER: 3109798

HAM-75-3.84  
 PID No. 104667


**SHEAR BLOCK RETROFIT AT PIER 1, 3, AND 4 (A)**  
 BRIDGE NO. HAM-74-1908S  
 RAMP P OVER IR-74 WESTBOUND, IR-75 AND RAMP E

35A/79



35A  
79



P:\Projects\2018\20H03DB-18232 HAM-75-03.84\104667\structures\HAM074\_1908S\sheets\074\_1908S\_BR002B.dgn 7/28/2023 9:32:45 AM erin.baumann

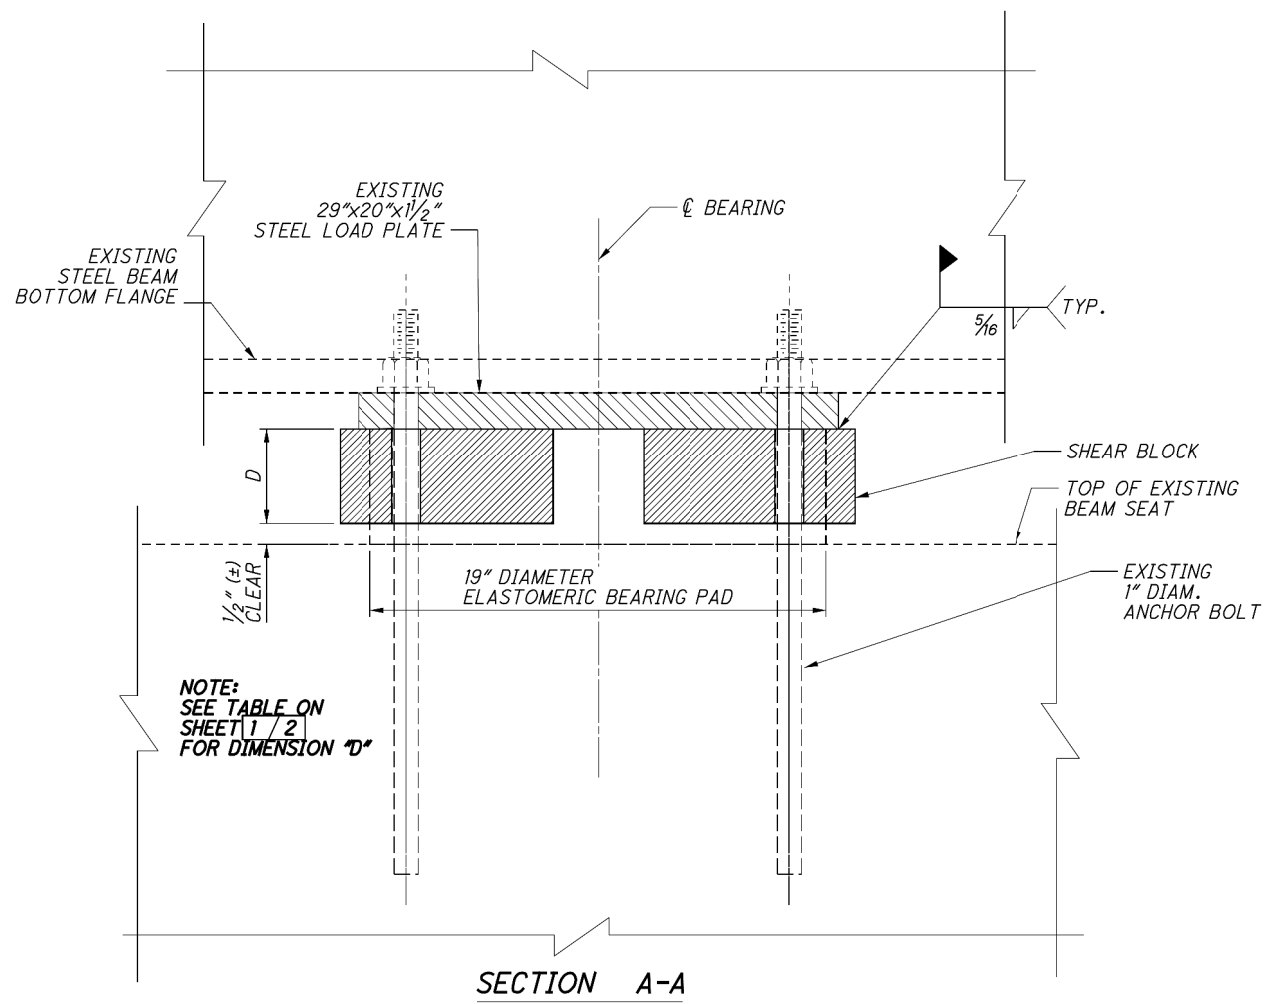


NOTE: SEE TABLE ON SHEET 1/2 FOR DIMENSION "D"

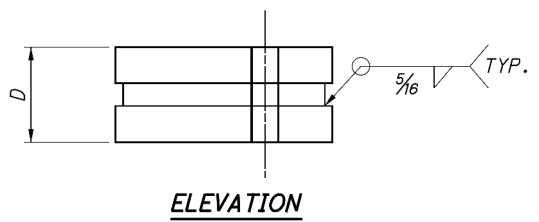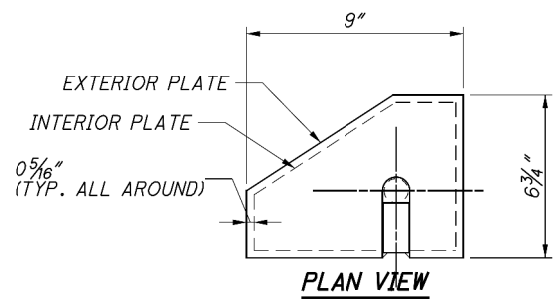

- NOTES:**
1. DETAIL SHOWN IS APPLICABLE FOR THREE PLATE SHEAR BLOCKS ONLY - TWO THICKER AND ONE THINNER. THE THICKER PLATES SHALL BE EXTERIOR PLATES.
  2. SEE SHEET 35A/79 FOR THE REQUIRED DIMENSION D.

**BUILT-UP PLATE ALTERNATIVE DETAIL**

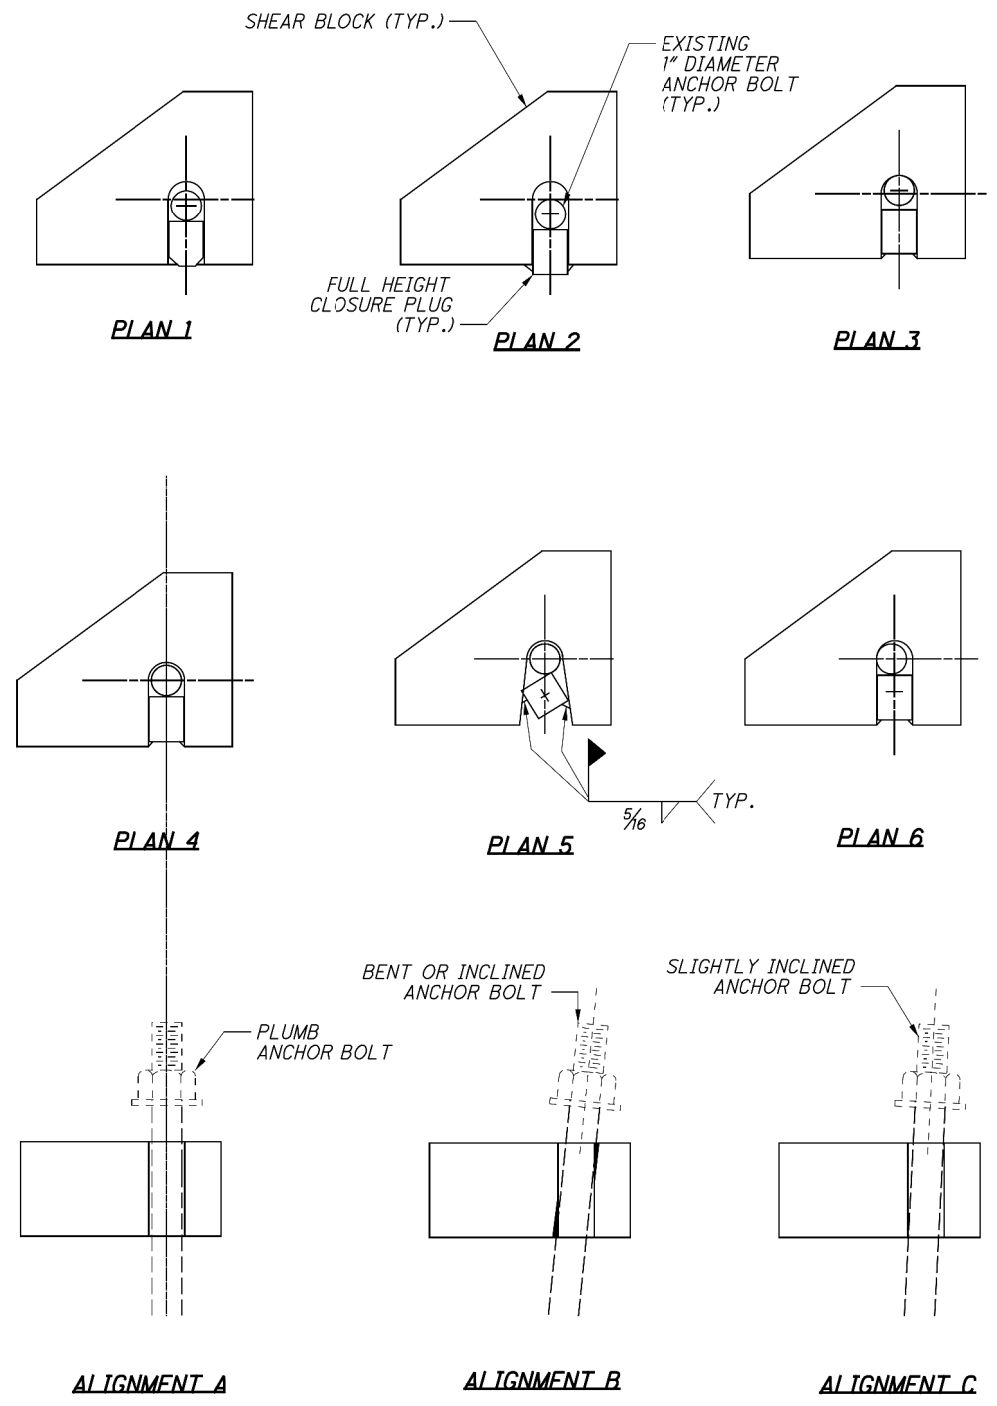








**POSSIBLE BOLT ALIGNMENT ISSUES AND CLOSURE PLUG WELDING**

THE ABOVE DETAILS INDICATE SOME POSSIBLE SCENARIOS WHEN INSTALLING THE SHEAR BLOCKS ON BENT OR MISSALIGNED ANCHOR BOLTS. DO NOT ADJUST THE EXISTING ANCHOR BOLTS IN ANY WAY. THE SHEAR BLOCK SHALL FULLY ENVELOP THE BOLT AND ENGAGE WITH A SNUG FIT. THE DETAIL NAMES ARE GIVEN FOR REFERENCE ONLY.



NOTE: THIS PLAN IS THE PRIME AE RESPONSE TO RFI 123 1908S


P:\Projects\2018\20H03DB-18232 HAM-75-03.84\104667\structures\HAM074\_1908S\sheets\074\_1908S\_BR004.dgn 7/28/2023 9:33:41 AM erin.baumann

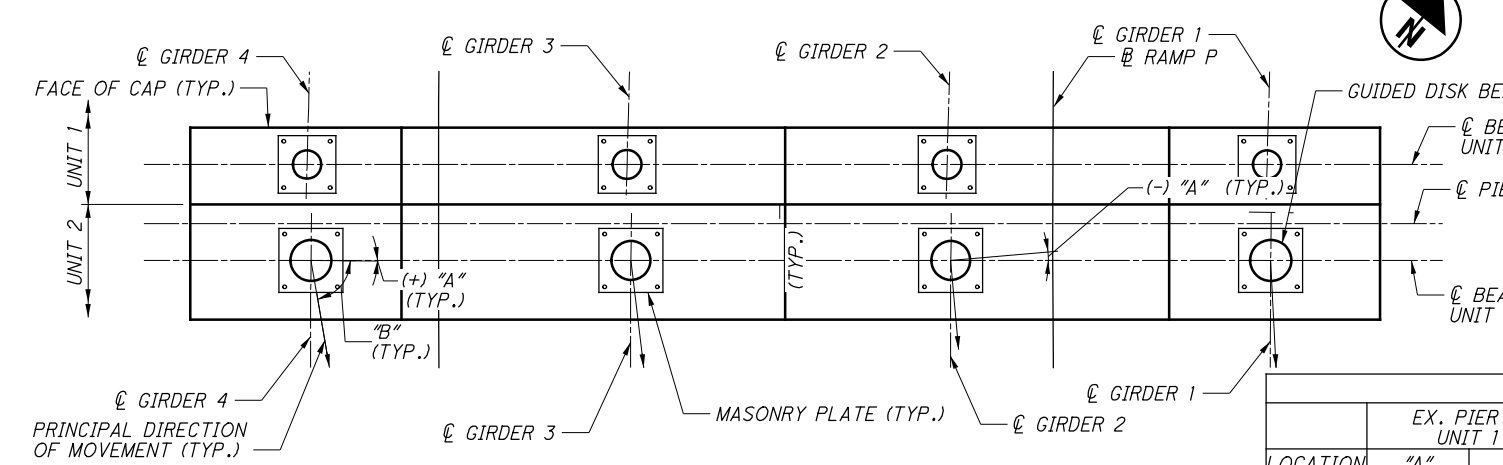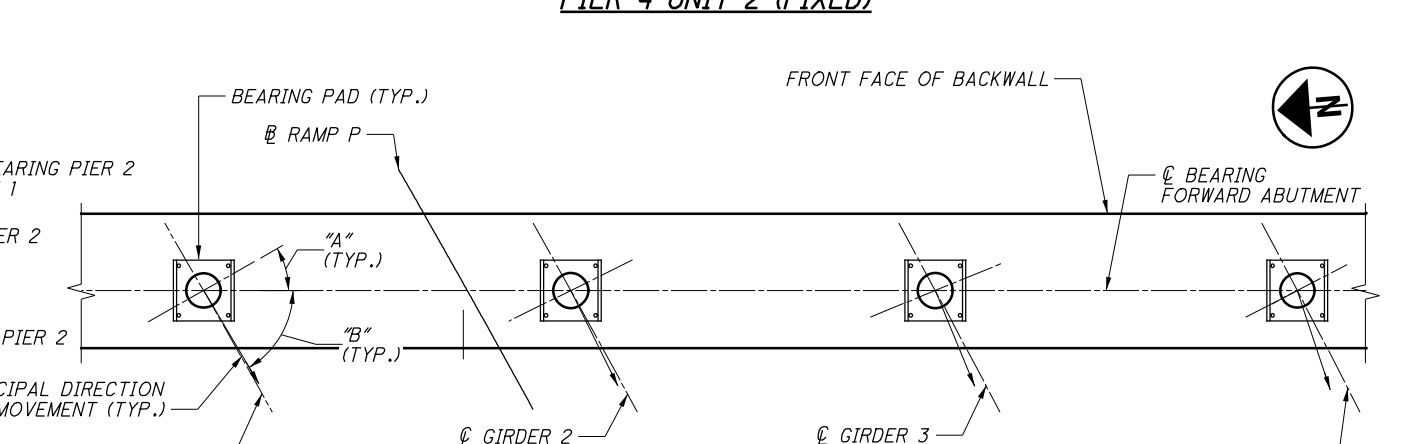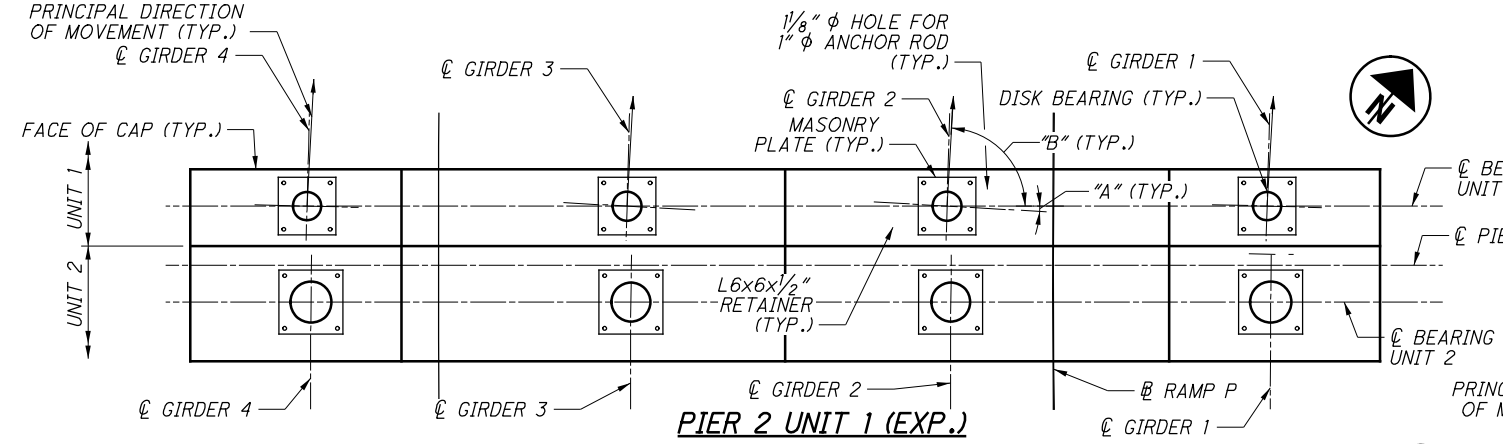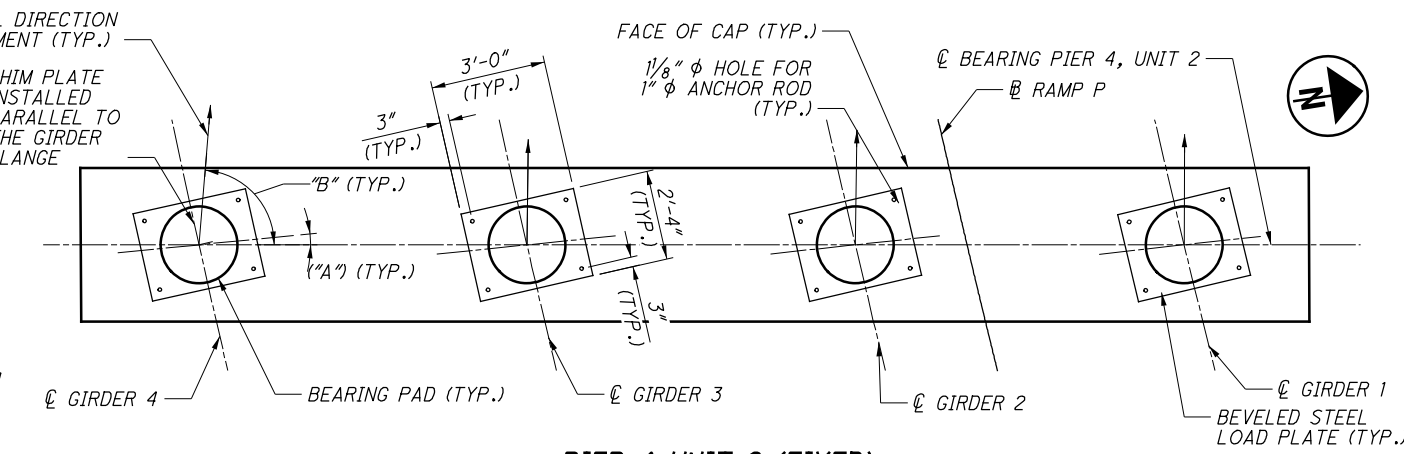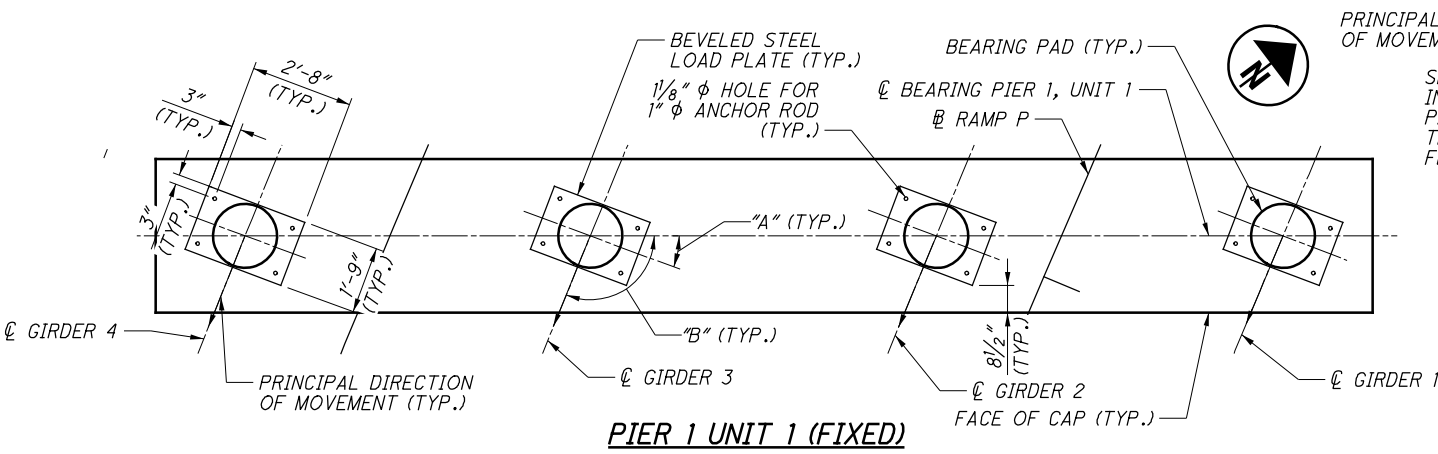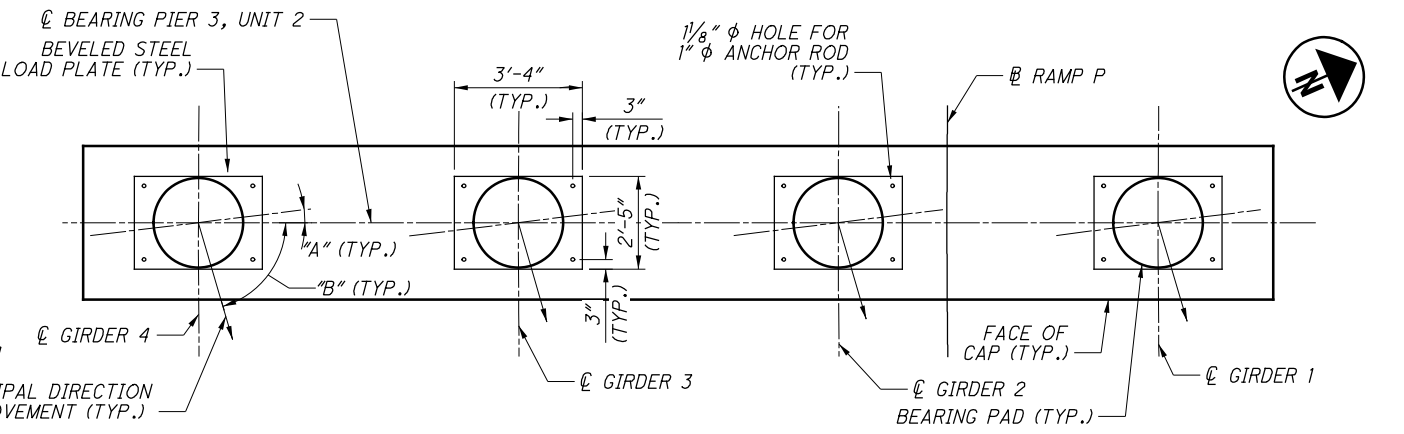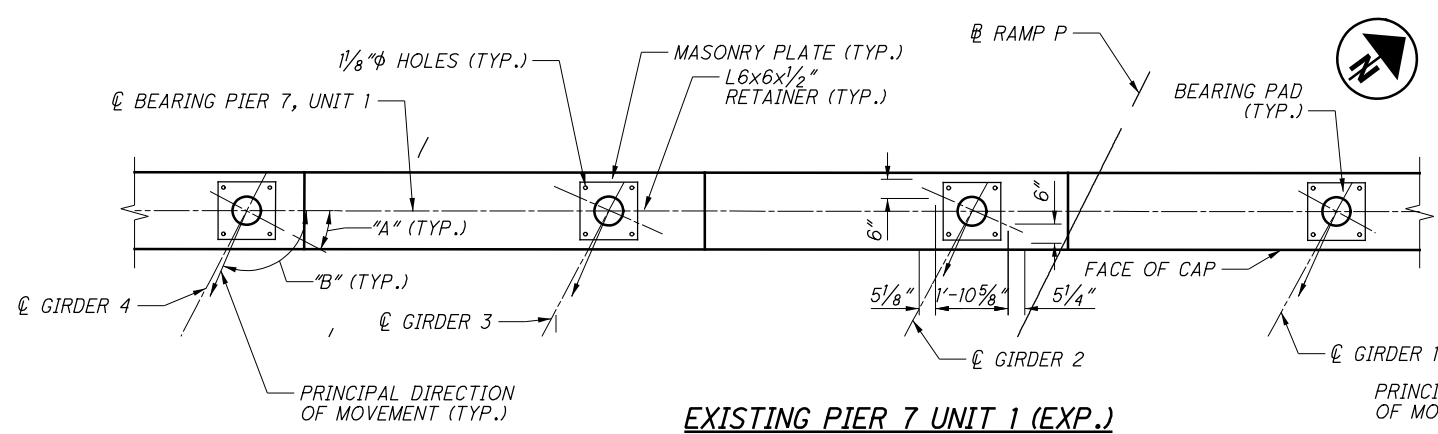

**NOTES**  
1. FOR BEARING DETAILS, SEE SHEETS 32/79 THRU 35/79.

LOCATION	BEARING ANGLES													
	EX. PIER 7 UNIT 1		PIER 1 UNIT 1		PIER 2 UNIT 1		PIER 2 UNIT 2		PIER 3 UNIT 2		PIER 4 UNIT 2		FORWARD ABUT. UNIT 2	
	"A"	"B"	"A"	"B"	"A"	"B"	"A"	"B"	"A"	"B"	"A"	"B"	"A"	"B"
GIRDER 1	28°47'05"	113°56'25"	20°56'07"	112°48'34"	01°33'03"	86°38'50"	00°26'13"	87°09'53"	07°10'29"	73°38'43"	06°20'48"	89°50'14"	29°34'58"	59°20'06"
GIRDER 2	23°40'42"	113°40'42"	20°43'02"	112°31'32"	03°16'06"	86°43'54"	-04°56'46"	85°03'14"	07°05'30"	73°56'29"	06°05'50"	89°09'09"	26°15'08"	63°44'52"
GIRDER 3	23°25'24"	113°25'24"	20°30'17"	112°14'50"	03°11'09"	86°48'51"	-06°53'39"	83°06'21"	07°00'45"	73°54'47"	05°51'35"	89°24'25"	22°14'41"	67°45'19"
GIRDER 4	27°42'17"	113°10'30"	20°17'51"	111°58'33"	01°28'58"	86°53'40"	00°24'53"	80°13'24"	06°55'59"	73°39'26"	05°37'46"	85°18'35"	27°26'59"	71°34'03"

P:\Projects\2018\20H03DB-18232 HAM-75-03.84\104667\structures\HAM074\_1908S\sheets\074\_1908S\_SDO01.dgn 7/28/2023 9:33:47 AM erin.baumann

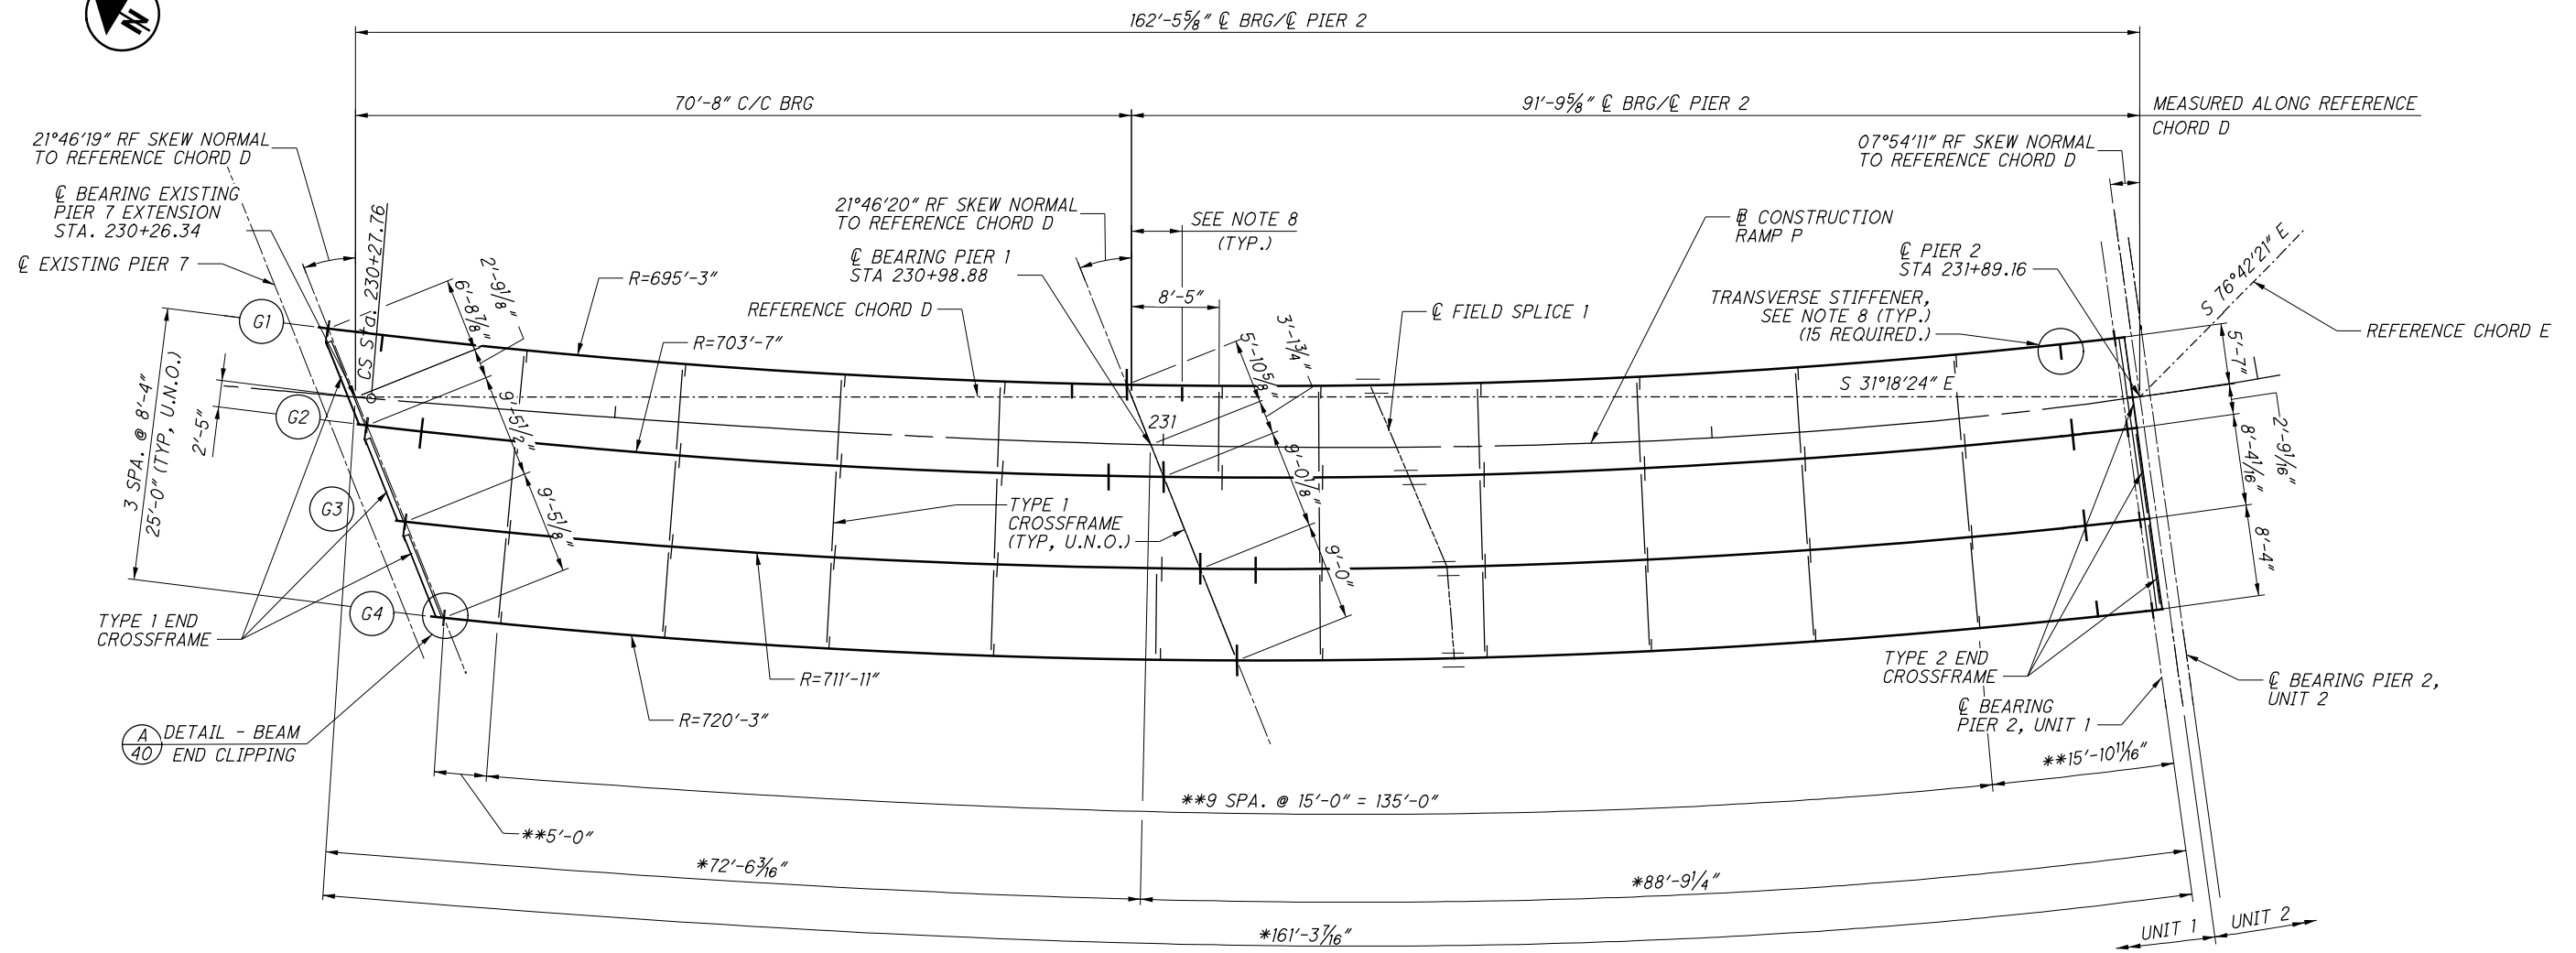


**LEGEND:**

- \* - DIMENSIONS SHOWN ARE MEASURED ALONG  
 CONSTRUCTION RAMP P
- \*\* - MEASURED ALONG  $\phi$  GIRDER 4
- TRANSVERSE STIFFENER


**NOTES:**

1. ALL CROSSFRAMES ARE TYPE 1, UNLESS NOTED OTHERWISE.
2. ALL CROSSFRAMES ARE RADIALLY CONNECTED.
3. ALL STEEL SHALL BE ASTM A709, GRADE 50W,  $F_y = 50$  KSI (CVN).
4. FOR UNIT 2 FRAMING PLAN, SEE SHEET [42/79].
5. FOR GIRDER ELEVATION, SEE SHEET [38/79].
6. FOR CROSSFRAME AND SPLICE DETAILS, SEE SHEET [39/79].
7. PARTIAL PAINTING OF A709, GRADE 50W STEEL: PAINT THE OUTSIDE FASCIA GIRDER AND BOTTOM FLANGE IZEU FEDERAL COLOR 595B-34058 (DARK GREEN). ANY BOLTED CONNECTIONS ON THE FASCIA GIRDER WILL BE PAINTED ON ALL SIDES OF THE STEEL WITHIN THE BOLTED AREA. ALL INTERNAL BEAM/GIRDER LINES INCLUDING CROSS FRAMES, SCUPPERS, BEARINGS AND OTHER STEEL WITHIN 10 FEET OF A SUBSTRUCTURE UNIT WILL BE PAINTED. THE PRIME COAT SHALL BE 708.01. THE TOP COAT COLOR SHALL CLOSELY APPROACH FEDERAL STANDARD NO. 595B-20045 OR 20059 (THE COLOR OF WEATHERING STEEL).
8. INTERMEDIATE STIFFNERS SHALL BE LOCATED 5'-0" FROM  $\phi$  SUBSTRUCTURE BEARING, PERPENDICULAR TO GIRDER.
9. FOR GENERAL NOTES, SEE SHEETS [7/79] AND [8/79].

P:\Projects\2018\20H03DB-18232 HAM-75-03-84\104667\structures\HAM074\_1908S\sheets\074\_1908S\_S0003.dgn 7/28/2023 9:33:49 AM erin.baumann

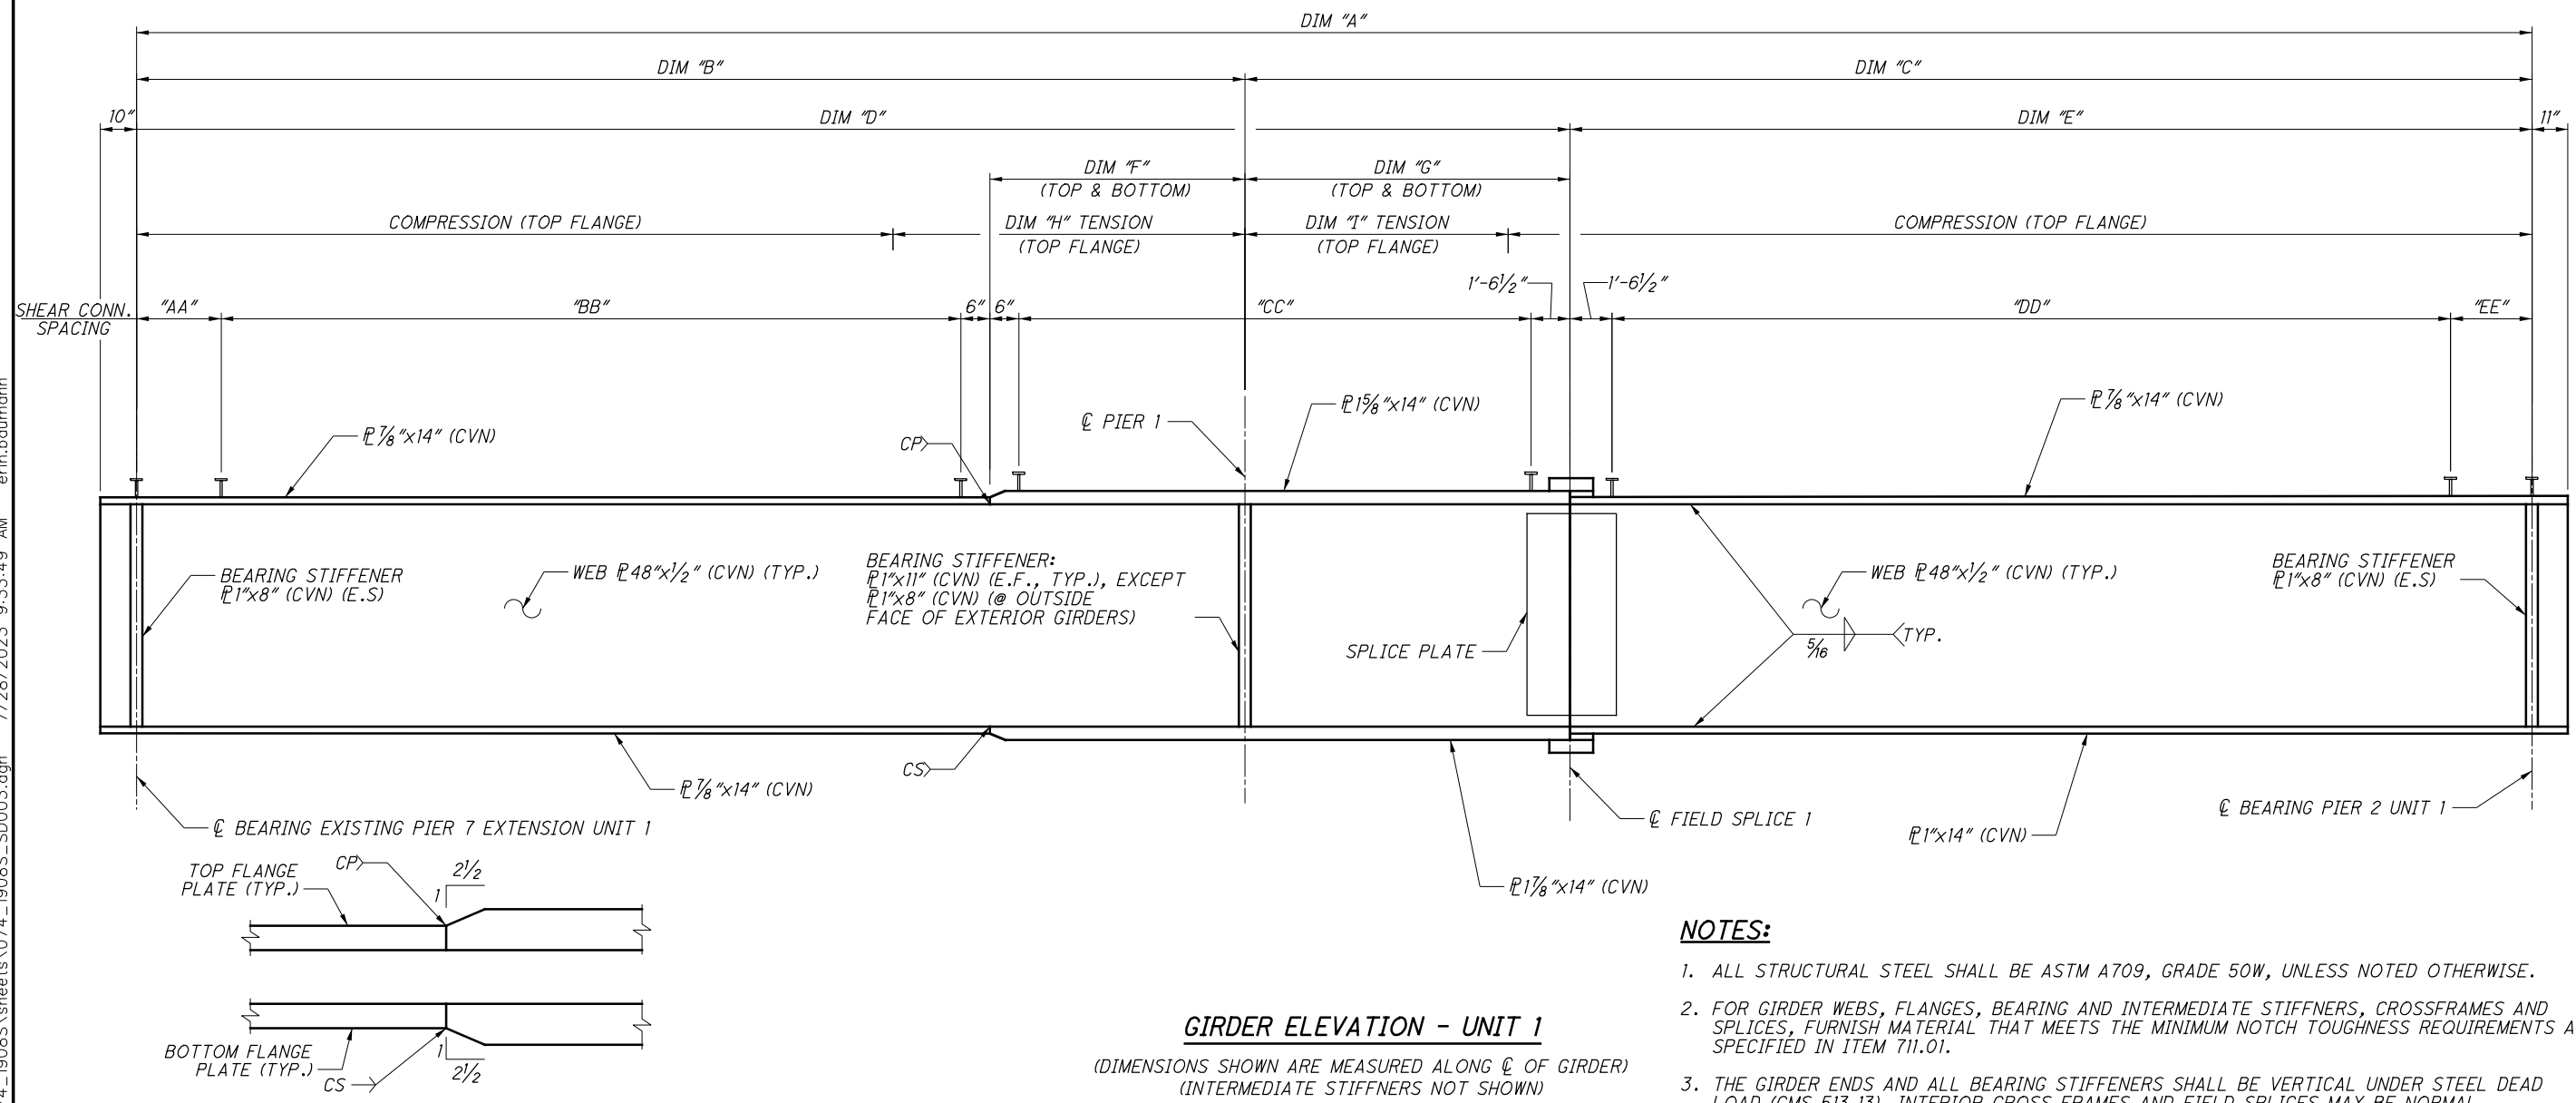

**GIRDER FLANGE THICKNESS TRANSITION DETAIL**

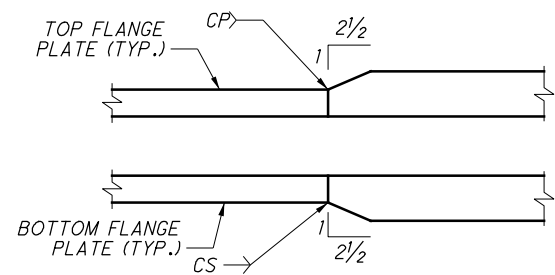

**GIRDER ELEVATION - UNIT 1**  
(DIMENSIONS SHOWN ARE MEASURED ALONG  $\phi$  OF GIRDER)  
(INTERMEDIATE STIFFENERS NOT SHOWN)


GIRDER DIMENSIONS										
GIRDER	RADIUS	SPAN LENGTHS			SEGMENT LENGTHS		DIMS. AT PIERS		TOP FLANGE TENSION AREAS	
		DIM "A"	DIM "B"	DIM "C"	DIM "D"	DIM "E"	DIM "F"	DIM "G"	DIM "H"	DIM "I"
G1	695'-3"	163'-0 <sup>5</sup> / <sub>16</sub> "	72'-11 <sup>3</sup> / <sub>16</sub> "	90'-1 <sup>1</sup> / <sub>16</sub> "	95'-0"	68'-0 <sup>5</sup> / <sub>16</sub> "	15'-11 <sup>3</sup> / <sub>16</sub> "	22'-0 <sup>13</sup> / <sub>16</sub> "	27'-3 <sup>3</sup> / <sub>8</sub> "	20'-8 <sup>1</sup> / <sub>2</sub> "
G2	703'-7"	160'-7 <sup>3</sup> / <sub>4</sub> "	72'-8 <sup>3</sup> / <sub>4</sub> "	87'-11"	95'-0"	65'-7 <sup>13</sup> / <sub>16</sub> "	15'-8 <sup>13</sup> / <sub>16</sub> "	22'-3 <sup>3</sup> / <sub>16</sub> "	28'-4 <sup>1</sup> / <sub>16</sub> "	19'-8 <sup>1</sup> / <sub>2</sub> "
G3	711'-11"	158'-3 <sup>1</sup> / <sub>8</sub> "	72'-6 <sup>3</sup> / <sub>16</sub> "	85'-8 <sup>1</sup> / <sub>16</sub> "	95'-0"	63'-3 <sup>1</sup> / <sub>8</sub> "	15'-6 <sup>1</sup> / <sub>16</sub> "	22'-5 <sup>9</sup> / <sub>16</sub> "	29'-3 <sup>9</sup> / <sub>16</sub> "	19'-0 <sup>3</sup> / <sub>8</sub> "
G4	720'-3"	155'-10 <sup>1</sup> / <sub>16</sub> "	72'-4 <sup>1</sup> / <sub>4</sub> "	83'-6 <sup>1</sup> / <sub>16</sub> "	92'-1 <sup>1</sup> / <sub>16</sub> "	63'-9"	15'-2 <sup>9</sup> / <sub>16</sub> "	19'-9 <sup>1</sup> / <sub>16</sub> "	29'-7"	18'-10 <sup>1</sup> / <sub>16</sub> "

SHEAR CONNECTOR SPACING					
GIRDER	"AA"	"BB"	"CC"	"DD"	"EE"
G1	10 SPA. @ 9" = 7'-6"	49 SPA. @ 12" = 49'-0"	40 SPA. @ 10 <sup>7</sup> / <sub>8</sub> " (-) = 35'-11 <sup>1</sup> / <sub>2</sub> "	57 SPA. @ 12" = 57'-0"	13 SPA. @ 9 <sup>1</sup> / <sub>8</sub> " = 9'-10 <sup>5</sup> / <sub>8</sub> "
G2	9 SPA. @ 10" = 7'-6"	49 SPA. @ 12" = 49'-0"	37 SPA. @ 11 <sup>5</sup> / <sub>8</sub> " (+) = 35'-11 <sup>1</sup> / <sub>2</sub> "	63 SPA @ 12" = 63'-0"	2 SPA. @ 8 <sup>7</sup> / <sub>8</sub> " (+) = 1'-5 <sup>3</sup> / <sub>16</sub> "
G3	9 SPA. @ 10" = 7'-6"	49 SPA. @ 12" = 49'-0"	37 SPA. @ 11 <sup>5</sup> / <sub>8</sub> " (+) = 35'-11 <sup>1</sup> / <sub>2</sub> "	60 SPA @ 12" = 60'-0"	2 SPA. @ 12 <sup>1</sup> / <sub>2</sub> " (+) = 2'-1 <sup>1</sup> / <sub>8</sub> "
G4	9 SPA. @ 10" = 7'-6"	49 SPA. @ 12" (+) = 49'-1 <sup>1</sup> / <sub>16</sub> "	37 SPA @ 10 <sup>5</sup> / <sub>8</sub> " (+) = 32'-11 <sup>1</sup> / <sub>2</sub> "	54 SPA @ 12" = 54'-0"	11 SPA. @ 9 <sup>1</sup> / <sub>2</sub> " (-) = 8'-7"


**NOTES:**

- ALL STRUCTURAL STEEL SHALL BE ASTM A709, GRADE 50W, UNLESS NOTED OTHERWISE.
- FOR GIRDER WEBS, FLANGES, BEARING AND INTERMEDIATE STIFFENERS, CROSSFRAMES AND SPLICES, FURNISH MATERIAL THAT MEETS THE MINIMUM NOTCH TOUGHNESS REQUIREMENTS AS SPECIFIED IN ITEM 711.01.
- THE GIRDER ENDS AND ALL BEARING STIFFENERS SHALL BE VERTICAL UNDER STEEL DEAD LOAD (CMS 513.13). INTERIOR CROSS FRAMES AND FIELD SPLICES MAY BE NORMAL TO GRADE.
- BOLTS USED FOR SPLICES SHALL BE ASTM A325, TYPE 3 HIGH STRENGTH BOLTS. ALL OTHER BOLTS SHALL BE ASTM A490, TYPE 3 HIGH STRENGTH BOLTS.
- FOR UNIT 1 FRAMING PLAN, SEE SHEET [37/79].
- THE OPENING BETWEEN GIRDER ENDS AFTER ASSEMBLY SHALL NOT EXCEED 1/4". FOR SPLICE DETAILS, SEE SHEET [39/79].
- WELD ATTACHMENT OF SUPPORTS FOR CONCRETE DECK FINISHING MACHINE TO AREAS OF THE FASCIA STRINGER FLANGES DESIGNATED "COMPRESSION". DO NOT WELD ATTACHMENTS TO AREAS DESIGNATED "TENSION". FILLET WELDS TO COMPRESSION FLANGES SHALL BE AT LEAST 1" FROM EDGE OF FLANGE, BE NO MORE THAN 2" LONG, AND BE AT LEAST 1/4" FOR THICKNESS UP TO 3/4" OR 5/16" FOR GREATER THAN 3/4" THICK.
- WHERE A WELDED BUTT JOINT IS DESIGNATED CP, THE WELD SHALL BE COMPLETE PENETRATION. WELD REINFORCEMENT SHALL BE REMOVED BY GRINDING IN THE DIRECTION OF THE MAIN STRESS.
- WHERE A WELDED BUTT JOINT WELD IS DESIGNATED CS, THE WELD IS SUBJECT TO COMPRESSIVE STRESS ONLY.
- SHEAR STUD CONNECTORS SHALL BE WELDED PER ITEM 512.22.
- FOR DEFLECTIONS AND CAMBER DIAGRAM(S), SEE SHEET [41/79].
- FOR ADDITIONAL NOTES, SEE SHEET [37/79].
- CROSS FRAMES SHALL BE DETAILED TO FIT IN THE STEEL DEAD LOAD CONDITION (CMS 513.26).
- THREADED STUDS WELDED AT 50' INCREMENT FOR HORIZONTAL LIFELINE.


P:\Projects\2018\20H03DB-18232 HAM-75-03.84\104667\structures\HAM074\_1908S\_SDO09.dgn 7/28/2023 9:33:52 AM erin.baumann

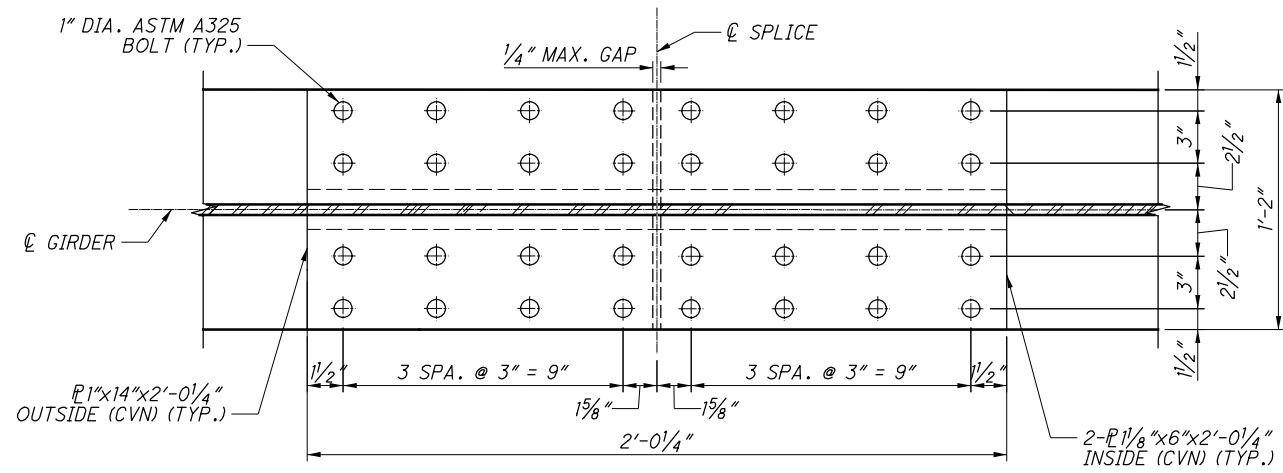


**A**  
39 SECTION

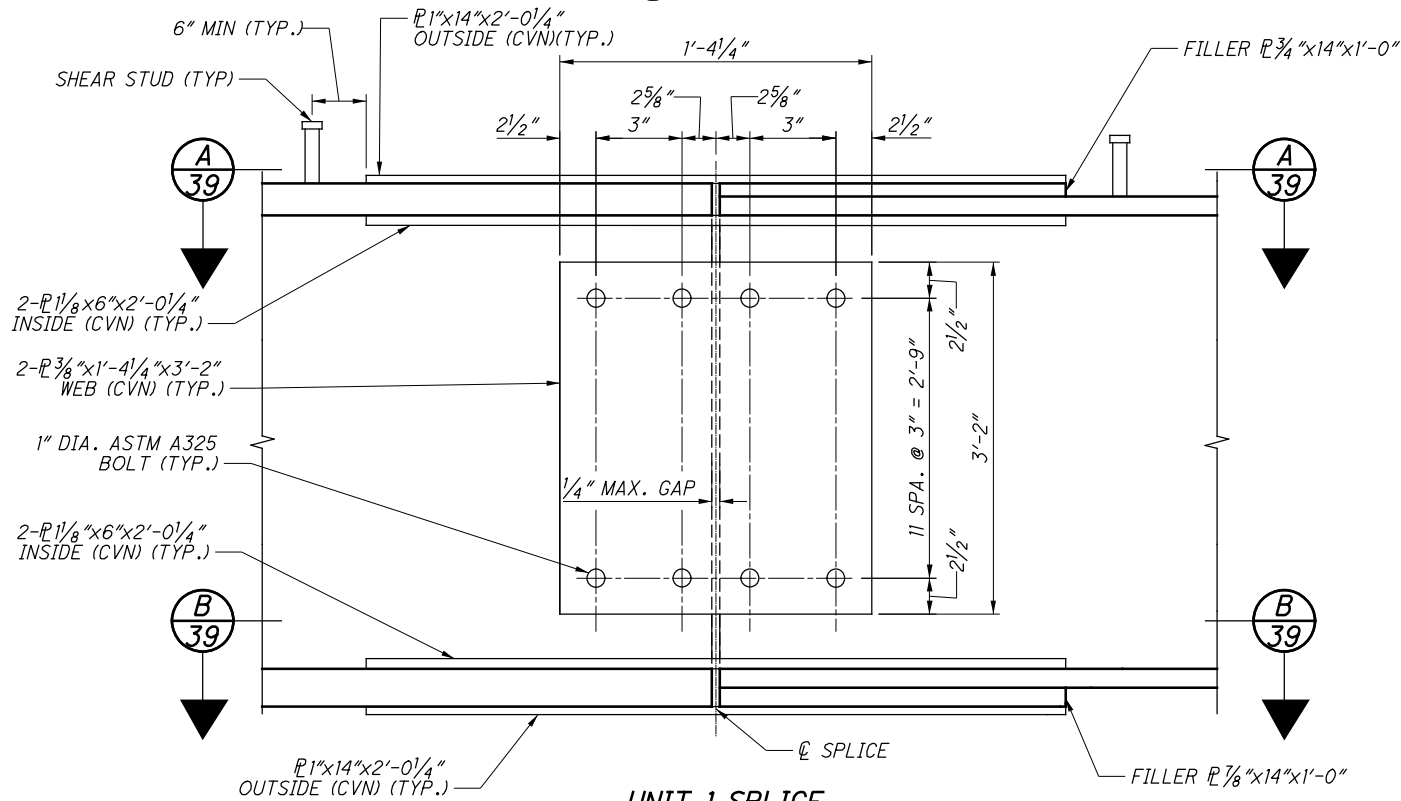


UNIT 1 SPLICE

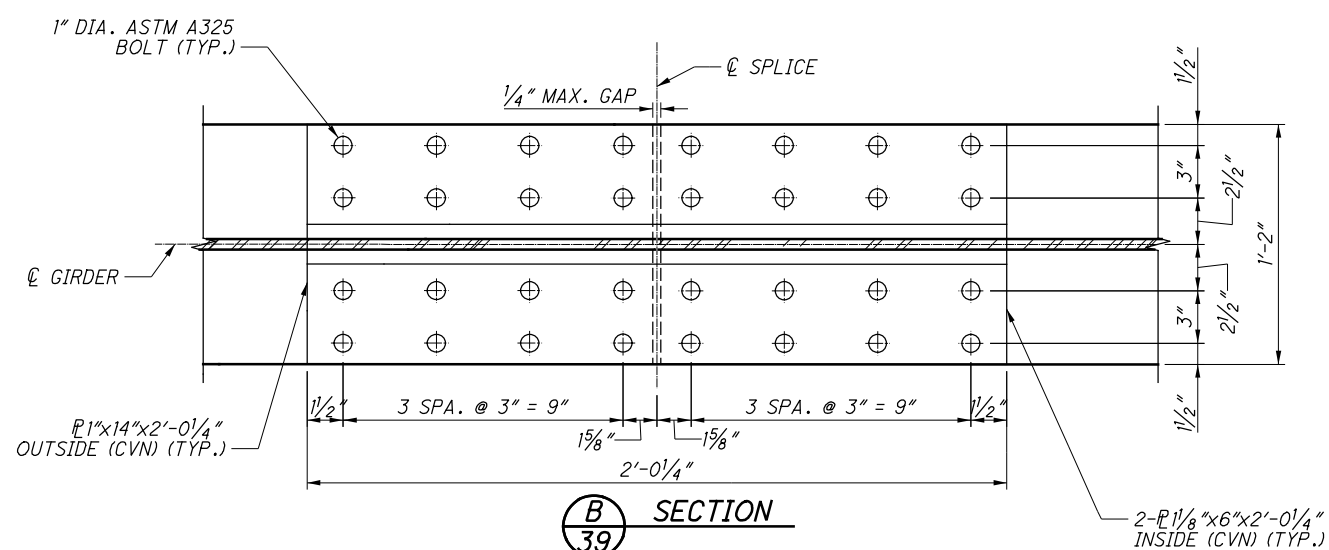


**B**  
39 SECTION

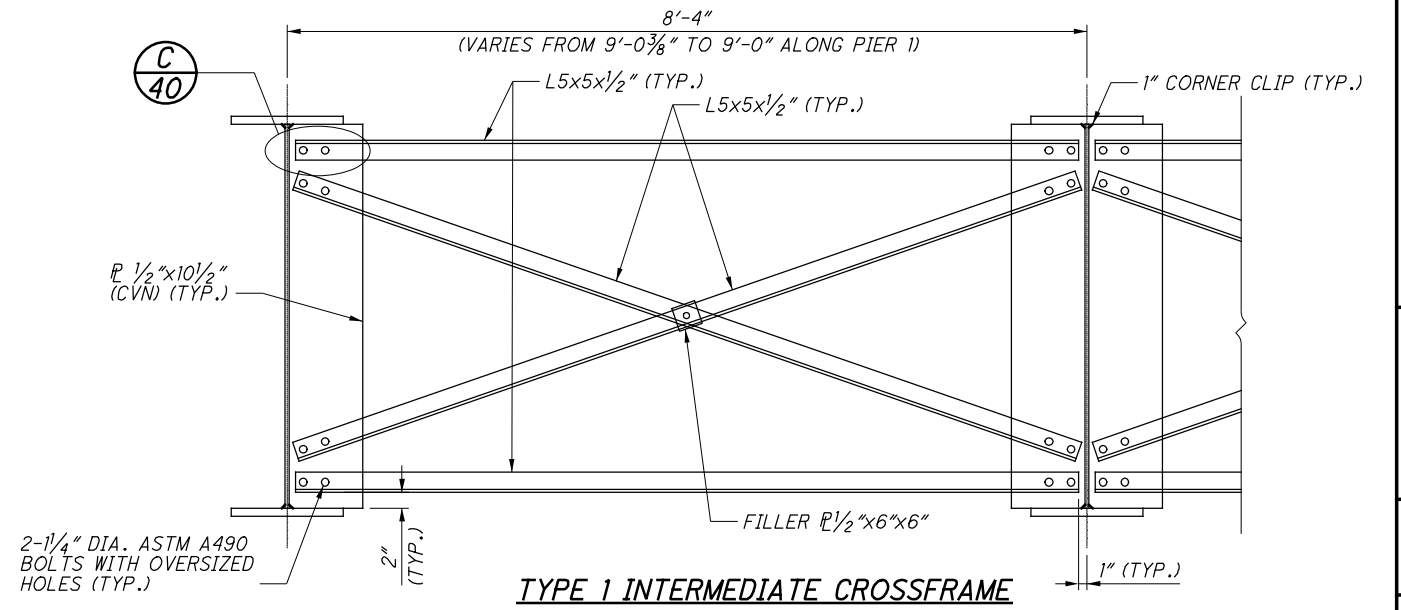

TYPE 1 INTERMEDIATE CROSSFRAME

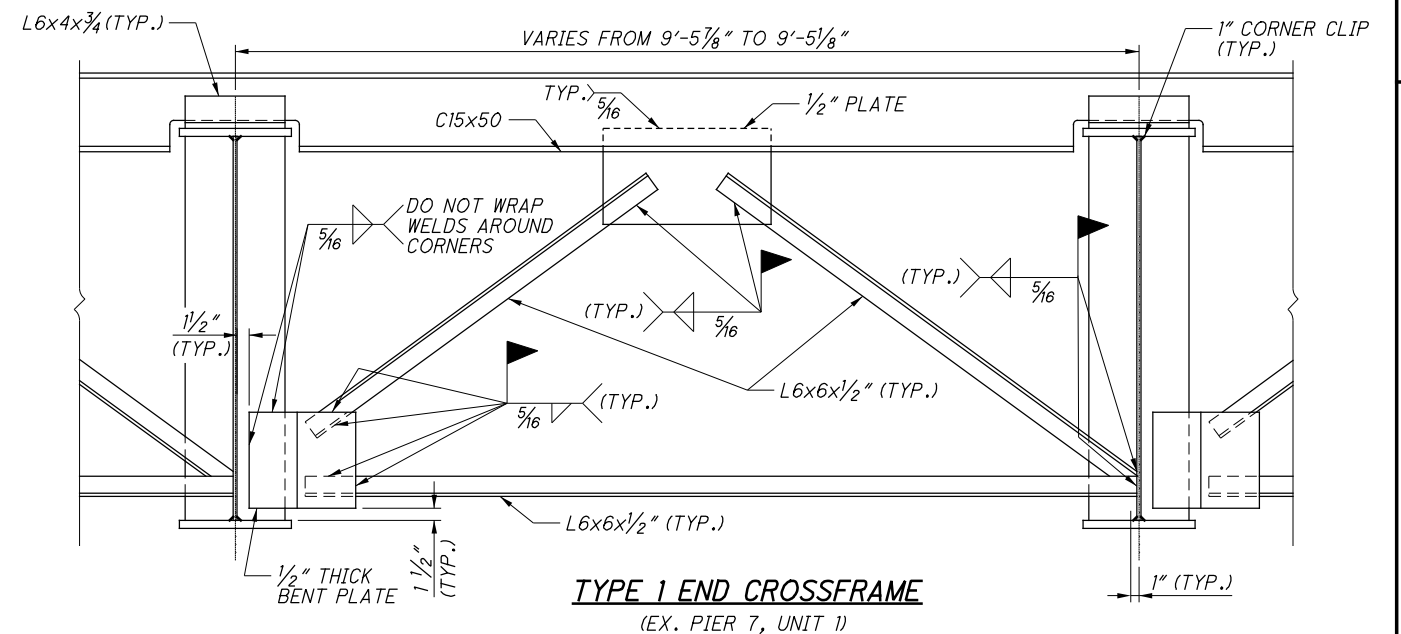

TYPE 1 END CROSSFRAME  
(EX. PIER 7, UNIT 1)

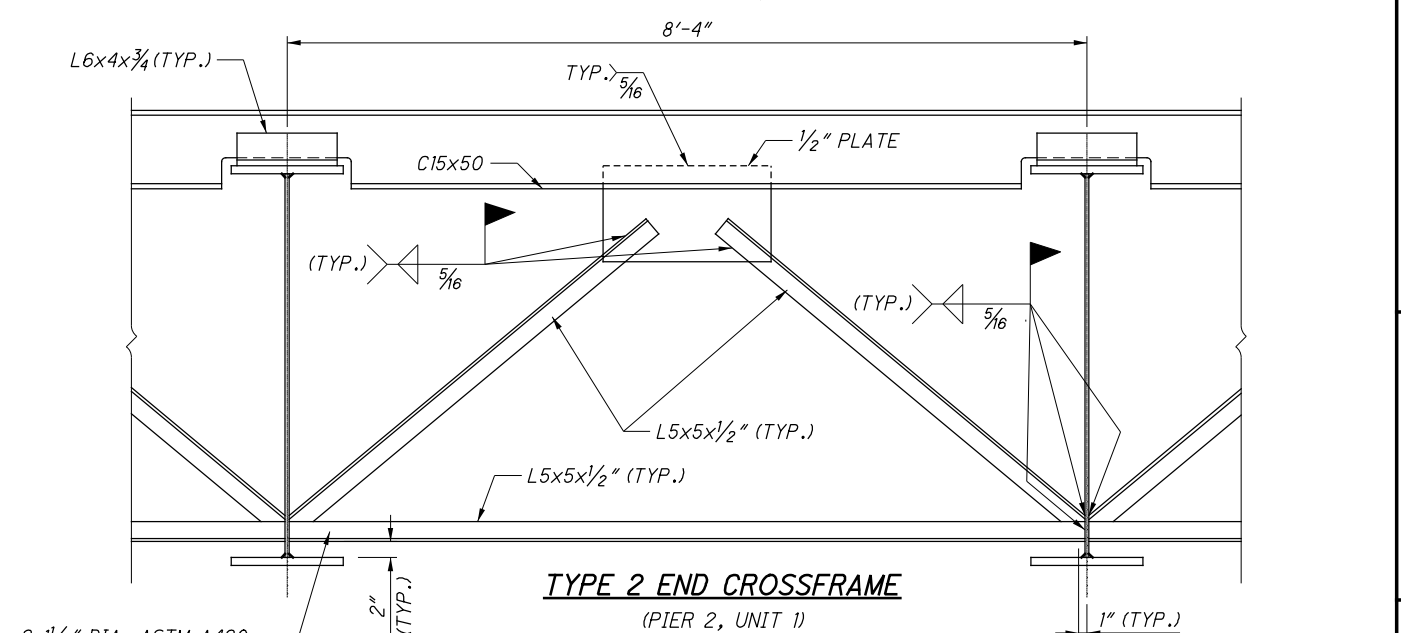

TYPE 2 END CROSSFRAME  
(PIER 2, UNIT 1)

2-1 1/4" DIA. ASTM A490 BOLTS WITH OVERSIZED HOLES (TYP.)

**NOTES:**

1. FOR NOTES, SEE SHEETS 37/79 AND 38/79.
2. FOR ADDITIONAL END FRAME DETAILS, SEE GSD-1-96.

DESIGN AGENCY: **PRIME**  
540 WHITE POND DR. SUITE E  
AKRON, OH 44320

DESIGNED: CRG  
CHECKED: KDC

DRAWN: ADS  
REVISED:


REVIEWED: TES  
DATE: 8/22/2019  
STRUCTURE FILE NUMBER: 3109798

STEEL DETAILS - UNIT 1 (1 OF 2)  
BRIDGE NO. HAM-74-1908S  
RAMP P OVER IR-74 WESTBOUND, IR-75 AND RAMP E


HAM-75-3.84  
PID No. 104667

39/79


P:\Projects\2018\20H03DB-18232 HAM-75-03.84\104667\structures\HAM074\_1908S\sheets\074\_1908S\_SD021.dgn 7/28/2023 9:33:53 AM erin.baumann

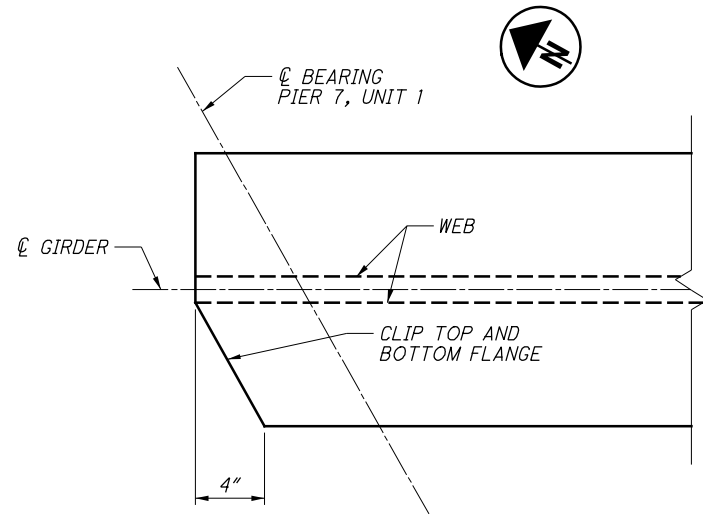


**A**  
**37** **DETAIL - BEAM END CLIPPING**  
(TYP. EXISTING PIER 7 EXTENSION)

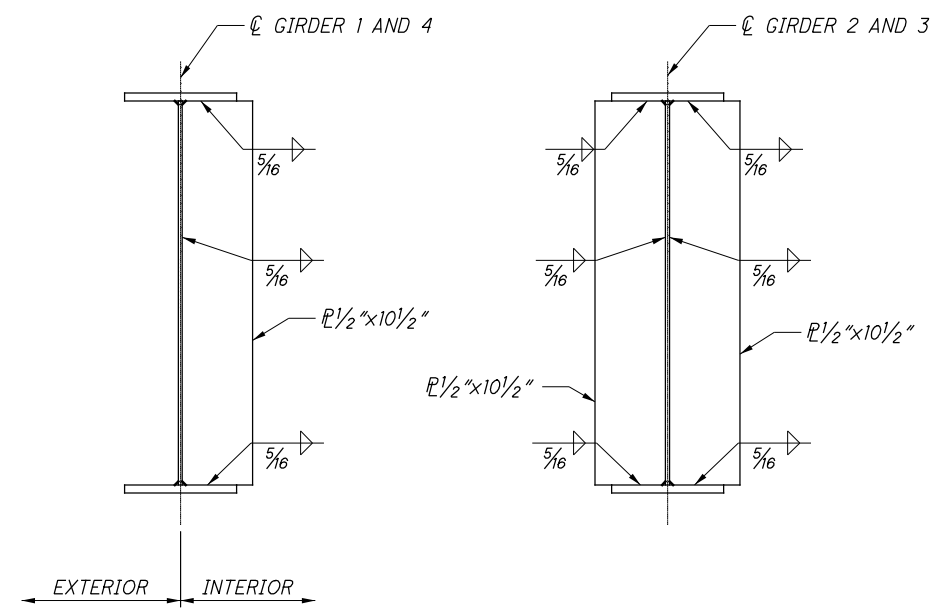


**TYPE 1 INTERMEDIATE CROSSFRAME STIFFENERS**  
(BOLTS NOT SHOWN)

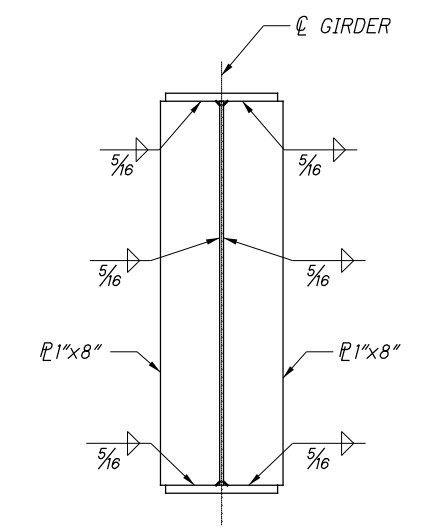


**BEARING STIFFENERS**  
(EX. PIER 7, UNIT 1 SHOWN, OTHERS SIMILAR)

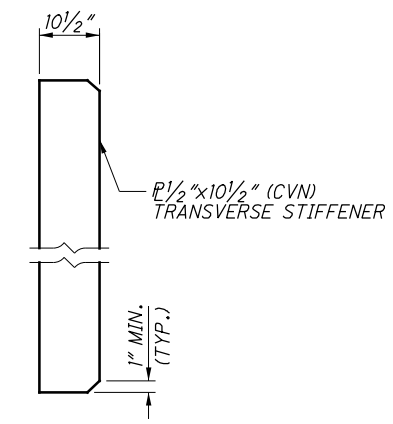


**TRANSVERSE STIFFENER DETAIL**

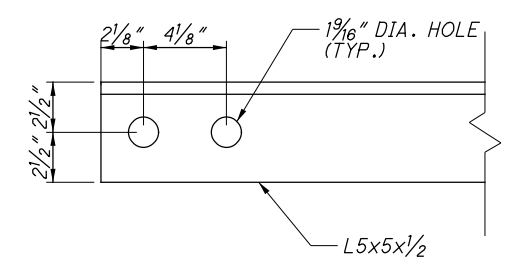

**C**  
**39,48** **DETAIL - TYPE 1 & 2 BOLT HOLE LOCATIONS (TYP.)**

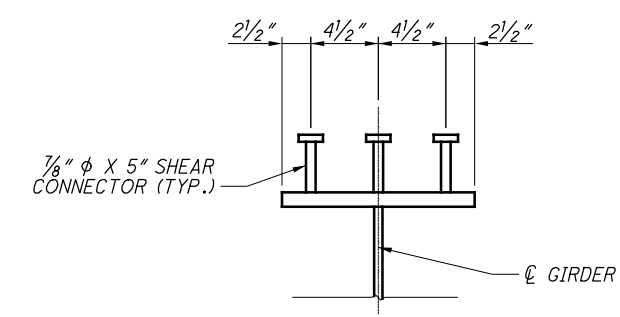

**SHEAR CONNECTOR DETAIL**

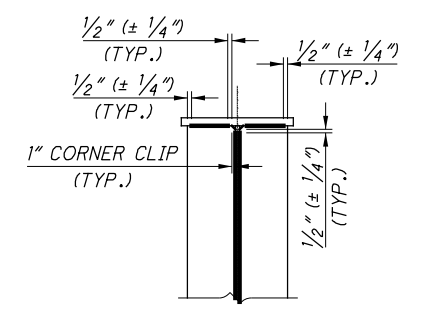


**WELD TERMINATION DETAIL**

**NOTE:**

1. FOR CROSSFRAME DETAILS, SEE SHEET **39/79**.
2. FOR CROSSFRAME NOTES, SEE SHEETS **37/79** AND **38/79**.
3. BOLT HOLE LOCATIONS IN THE TRANSVERSE STIFFENERS WILL BE DETERMINED BY THE FABRICATOR AND VERIFIED THROUGH THE SHOP DRAWING REVIEW PROCESS BY THE ENGINEER PRIOR TO FABRICATION

DESIGNED CRG		DRAWN KDC		REVIEWED TES		DATE 8/22/2019	
CHECKED KDC		REVISED		STRUCTURE FILE NUMBER 3109798		DESIGN AGENCY <b>PRIME</b> 540 WHITE POND DR. SUITE E AKRON, OH 44320	
<b>STEEL DETAILS - UNIT 1 (2 OF 2)</b>							
BRIDGE NO. HAM-74-1908S RAMP P OVER IR-74 WESTBOUND, IR-75 AND RAMP E							
HAM-75-3.84		PID No. 104667		40/79		40/79	

P:\Projects\2018\20H03DB-18232 HAM-75-03.84\104667\structures\HAM074\_1908S\sheets\074\_1908S\_S010.dgn 7/28/2023 9:33:55 AM erin.baumann

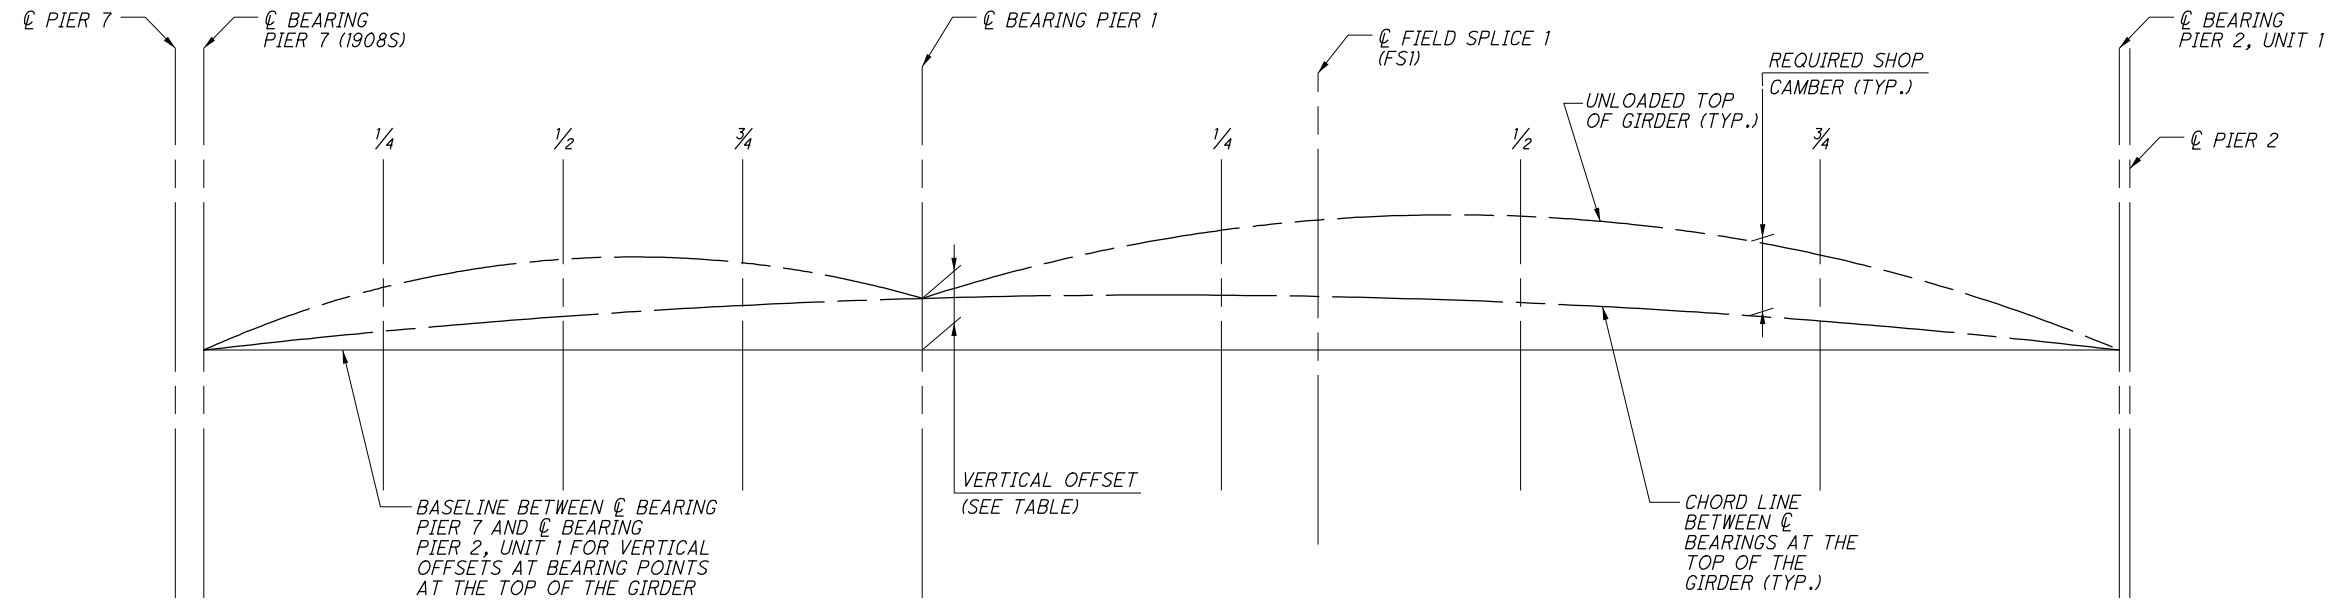

**CAMBER DIAGRAM - UNIT 1**

DEFLECTION AND CAMBER (INCHES) - GIRDER 1										
	CL BRG. PIER 7	1/4 POINT	1/2 POINT	3/4 POINT	CL BRG. PIER 1	1/4 POINT	FSI	1/2 POINT	3/4 POINT	CL BRG. PIER 2
DEFLECTION DUE TO WEIGHT OF STEEL	0"	1/16"	1/16"	-0 "	0"	1/8"	1/8"	3/16"	3/16"	0 "
DEFLECTION DUE TO REMAINING DL	0"	5/16"	1/4"	0 "	0"	5/8"	5/8"	1 1/4"	1 "	0 "
ADJUSTMENT FOR VERTICAL & HORIZONTAL CURVE	0"	- 5/8"	- 7/8"	- 11/16"	0"	-1 3/16"	-1 3/16"	-1 11/16"	-1 5/16"	0"
REQUIRED SHOP CAMBER	0"	- 1/4"	- 9/16"	- 11/16"	0"	- 7/16"	- 7/16"	- 1/4"	- 1/8"	0"

VERTICAL OFFSET (INCHES)	
	PIER 1
GIRDER 1	- 4 3/4"
GIRDER 2	- 4 7/16"
GIRDER 3	- 4 1/8"
GIRDER 4	- 3 5/16"

DEFLECTION AND CAMBER (INCHES) - GIRDER 2										
	CL BRG. PIER 7	1/4 POINT	1/2 POINT	3/4 POINT	CL BRG. PIER 1	1/4 POINT	FSI	1/2 POINT	3/4 POINT	CL BRG. PIER 2
DEFLECTION DUE TO WEIGHT OF STEEL	0"	1/16"	1/16"	-0 "	0"	1/8"	1/8"	3/16"	3/16"	0"
DEFLECTION DUE TO REMAINING DL	0"	1/4"	1/4"	0 "	0"	9/16"	9/16"	1 3/16"	15/16"	0"
ADJUSTMENT FOR VERTICAL & HORIZONTAL CURVE	0"	- 5/8"	- 13/16"	- 5/8"	0"	-1 1/8"	-1 1/8"	-1 9/16"	-1 3/16"	0"
REQUIRED SHOP CAMBER	0"	- 5/16"	- 1/2"	- 5/8"	0"	- 7/16"	- 7/16"	- 3/16"	- 1/16"	0"


DEFLECTION AND CAMBER (INCHES) - GIRDER 3										
	CL BRG. PIER 7	1/4 POINT	1/2 POINT	3/4 POINT	CL BRG. PIER 1	1/4 POINT	FSI	1/2 POINT	3/4 POINT	CL BRG. PIER 2
DEFLECTION DUE TO WEIGHT OF STEEL	0"	1/16"	1/16"	0 "	0"	1/8"	1/8"	3/16"	1/8"	0"
DEFLECTION DUE TO REMAINING DL	0"	1/4"	1/4"	1/16"	0"	9/16"	9/16"	1 1/8"	15/16"	0"
ADJUSTMENT FOR VERTICAL & HORIZONTAL CURVE	0"	- 9/16"	- 3/4"	- 9/16"	0 "	-1 1/16"	-1 1/8"	-1 7/16"	-1 1/8"	0"
REQUIRED SHOP CAMBER	0"	- 1/4"	- 7/16"	- 1/2"	0"	- 3/8"	- 7/16"	- 1/8"	- 1/16"	0"

DEFLECTION AND CAMBER (INCHES) - GIRDER 4										
	CL BRG. PIER 7	1/4 POINT	1/2 POINT	3/4 POINT	CL BRG. PIER 1	1/4 POINT	FSI	1/2 POINT	3/4 POINT	CL BRG. PIER 2
DEFLECTION DUE TO WEIGHT OF STEEL	0"	1/16"	1/16"	0 "	0"	1/16"	1/16"	3/16"	1/8"	0"
DEFLECTION DUE TO REMAINING DL	0"	5/16"	5/16"	1/16"	0"	1/2"	1/2"	1 1/16"	7/8"	0"
ADJUSTMENT FOR VERTICAL & HORIZONTAL CURVE	0"	- 3/4"	- 15/16"	- 11/16"	0 "	- 13/16"	- 13/16"	-1 1/16"	- 13/16"	0"
REQUIRED SHOP CAMBER	0"	- 3/8"	- 9/16"	- 5/8"	0"	- 1/4"	- 1/4"	3/16"	3/16"	0"

**NOTES:**

1. NEGATIVE VALUES FOR DEFLECTIONS INDICATE DEFLECTIONS UPWARD. NEGATIVE VALUES FOR VERTICAL CURVE ADJUSTMENT AND TOTAL REQUIRED SHOP CAMBER INDICATE VALUES BELOW THE CHORD.
2. DEFLECTIONS AND ADJUSTMENTS FOR VERTICAL CURVES ARE GIVEN TO THE NEAREST 1/16th INCH.
3. FOR GENERAL NOTES, SEE SHEET **7/79** AND **8/79**.
4. FOR FRAMING PLAN AND GIRDER DETAILS, SEE SHEETS **37/79** THROUGH **42/79**.

P:\Projects\2018\20H03DB-18232 HAM-75-03.84\104667\structures\HAM074\_1908S\SDD002.dgn 7/28/2023 9:34:03 AM erin.baumann

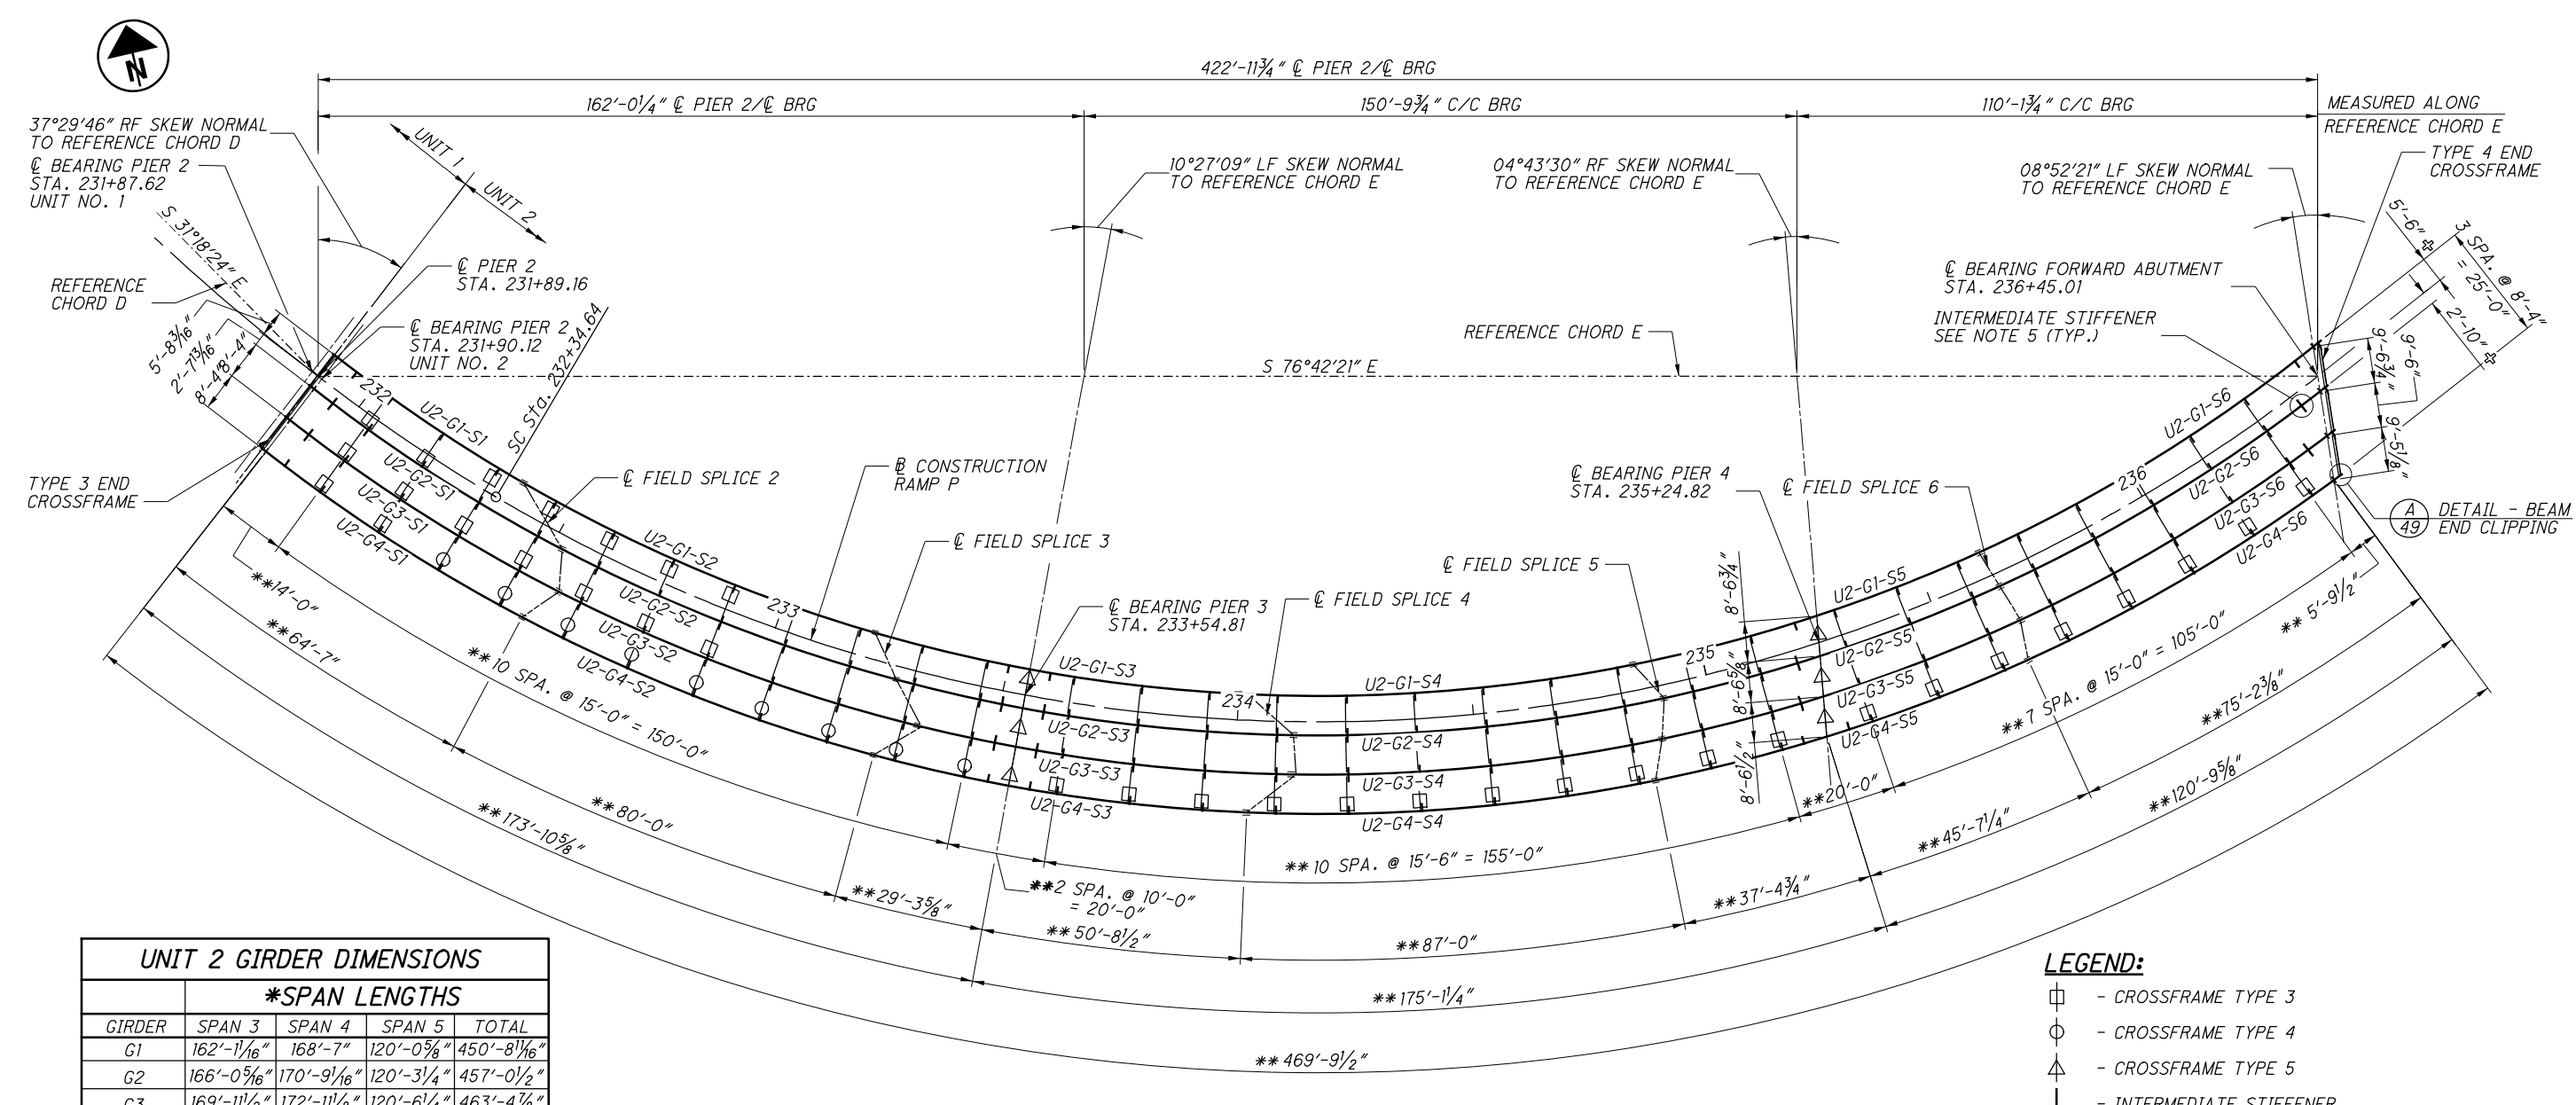

**FRAMING PLAN - UNIT 2**

UNIT 2 GIRDER DIMENSIONS				
*SPAN LENGTHS				
GIRDER	SPAN 3	SPAN 4	SPAN 5	TOTAL
G1	162'-1 1/16"	168'-7"	120'-0 9/16"	450'-8 11/16"
G2	166'-0 5/16"	170'-9 1/16"	120'-3 1/4"	457'-0 1/2"
G3	169'-11 1/2"	172'-11 1/8"	120'-6 1/4"	463'-4 7/8"
G4	173'-10 5/8"	175'-1 1/4"	120'-9 5/8"	469'-9 1/2"

\*(DIMENSIONS SHOWN ARE MEASURED ALONG CL GIRDER)

**LEGEND:**


- ⊕ - CROSSFRAME TYPE 3
- ⊙ - CROSSFRAME TYPE 4
- ⊙ - CROSSFRAME TYPE 5
- | — - INTERMEDIATE STIFFENER

U2-G1-S1 - SPLICE NAME (UNIT 2-GIRDER 1 - SECTION 1) CORRELATING TO GIRDER DIMENSION TABLE


- \*\* - MEASURED ALONG CL GIRDER 4
- ⊕ - TYPICAL UNLESS NOTED OTHERWISE

**NOTES:**


1. ALL CROSSFRAMES FOR UNIT 2 ARE TYPE 2, UNLESS NOTED OTHERWISE. CONTRACTOR SHALL SPACE CROSSFRAMES TO MAINTAIN 1'-0" CLEAR FROM END OF SPLICE PLATES.
2. ALL CROSSFRAMES ARE RADIALLY CONNECTED.
3. ALL STEEL SHALL BE ASTM A709, GRADE 50W, F<sub>y</sub> = 50 KSI (CVN).
4. FOR UNIT 1 FRAMING PLAN, SEE SHEET [37/79].
5. FOR GIRDER ELEVATIONS AND TRANSVERSE STIFFENER LOCATIONS, SEE SHEET [43/79] THRU [45/79].
6. FOR STEEL DETAILS, SEE SHEET [49/79].
7. PARTIAL PAINTING OF A709, GRADE 50W STEEL: PAINT THE OUTSIDE FASCIA GIRDER AND BOTTOM FLANGE IZEU FEDERAL COLOR 595B-34058 (DARK GREEN). ANY BOLTED CONNECTIONS ON THE FASCIA GIRDER WILL BE PAINTED ON ALL SIDES OF THE STEEL WITHIN THE BOLTED AREA. ALL INTERNAL BEAM/GIRDER LINES INCLUDING CROSS FRAMES, SCUPPERS, BEARINGS AND OTHER STEEL WITHIN 10 FEET OF A SUBSTRUCTURE UNIT WILL BE PAINTED. THE PRIME COAT SHALL BE 708.01. THE TOP COAT COLOR SHALL CLOSELY APPROACH FEDERAL STANDARD NO. 595B-20045 OR 20059 (THE COLOR OF WEATHERING STEEL).

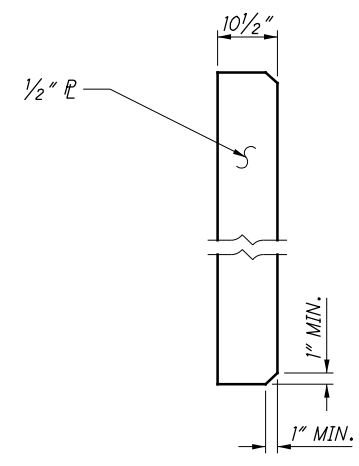

**INTERMEDIATE STIFFENER DETAIL**

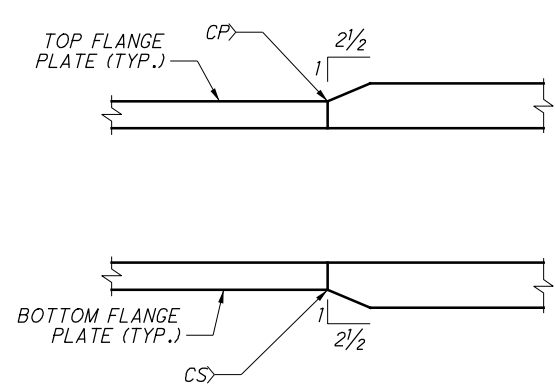


**GIRDER FLANGE THICKNESS TRANSITION DETAIL**

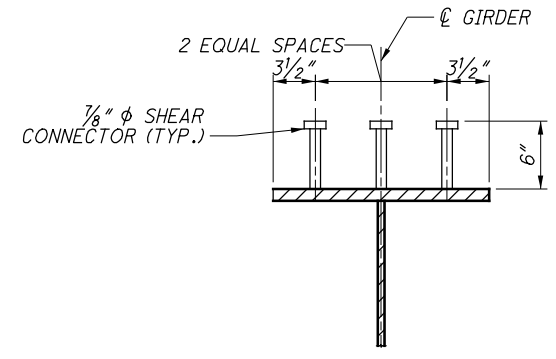


**SHEAR CONNECTOR DETAIL**



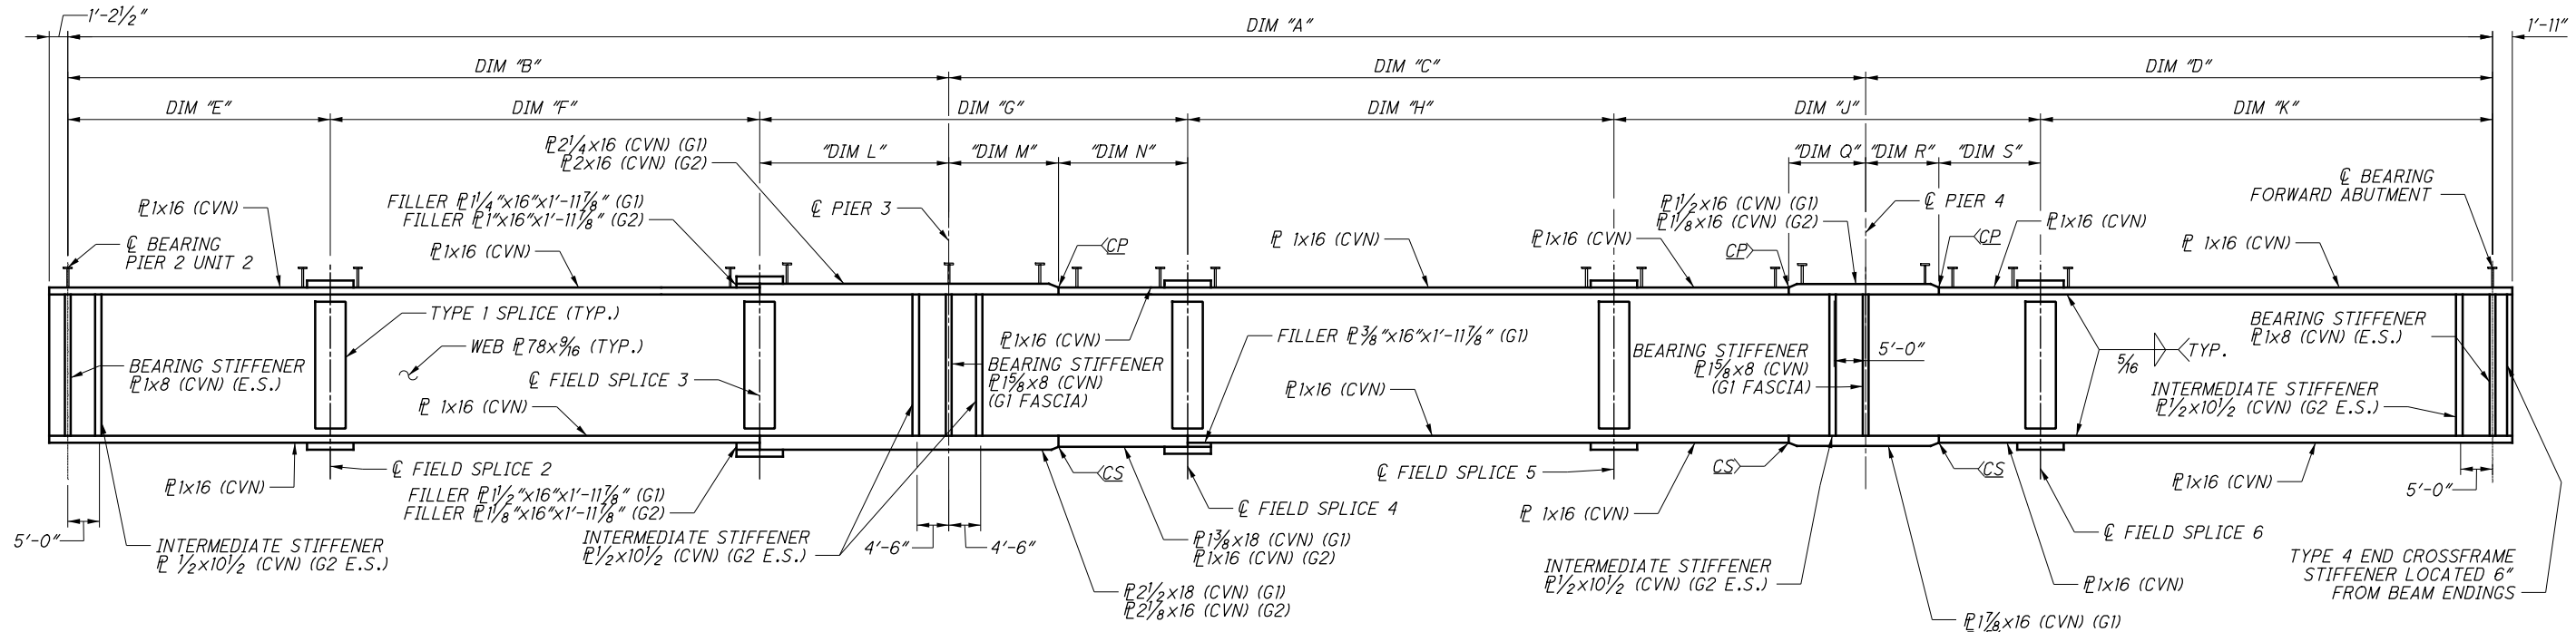

**GIRDERS 1 AND 2 ELEVATION - UNIT 2**  
(DIMENSIONS SHOWN ARE MEASURED ALONG C GIRDER)  
(INTERMEDIATE STIFFENERS NOT SHOWN FOR CLARITY)

GIRDER	RADIUS	SPAN LENGTHS				SEGMENT LENGTHS								DIMS. AT PIERS				
		DIM "A"	DIM "B"	DIM "C"	DIM "D"	DIM "E"	DIM "F"	DIM "G"	DIM "H"	DIM "J"	DIM "K"	DIM "L"	DIM "M"	DIM "N"	DIM "P"	DIM "Q"	DIM "R"	DIM "S"
G1	336'-6 3/4"	450'-8 1/16"	162'-1 1/16"	168'-7"	120'-0 5/8"	47'-5 9/16"	81'-0"	80'-0"	82'-0"	77'-0"	83'-3 3/16"	33'-7 9/16"	20'-4 1/16"	26'-0"	22'-0"	18'-2 9/16"	11'-9 1/16"	25'-0"
G2	344'-10 3/4"	457'-0 1/2"	166'-0 5/16"	170'-9 1/16"	120'-3 1/4"	62'-6 15/16"	76'-0"	85'-0"	79'-0"	75'-0"	79'-5 1/16"	27'-5 3/8"	21'-6 5/8"	36'-0"	25'-0"	9'-2 1/16"	15'-9 9/16"	25'-0"

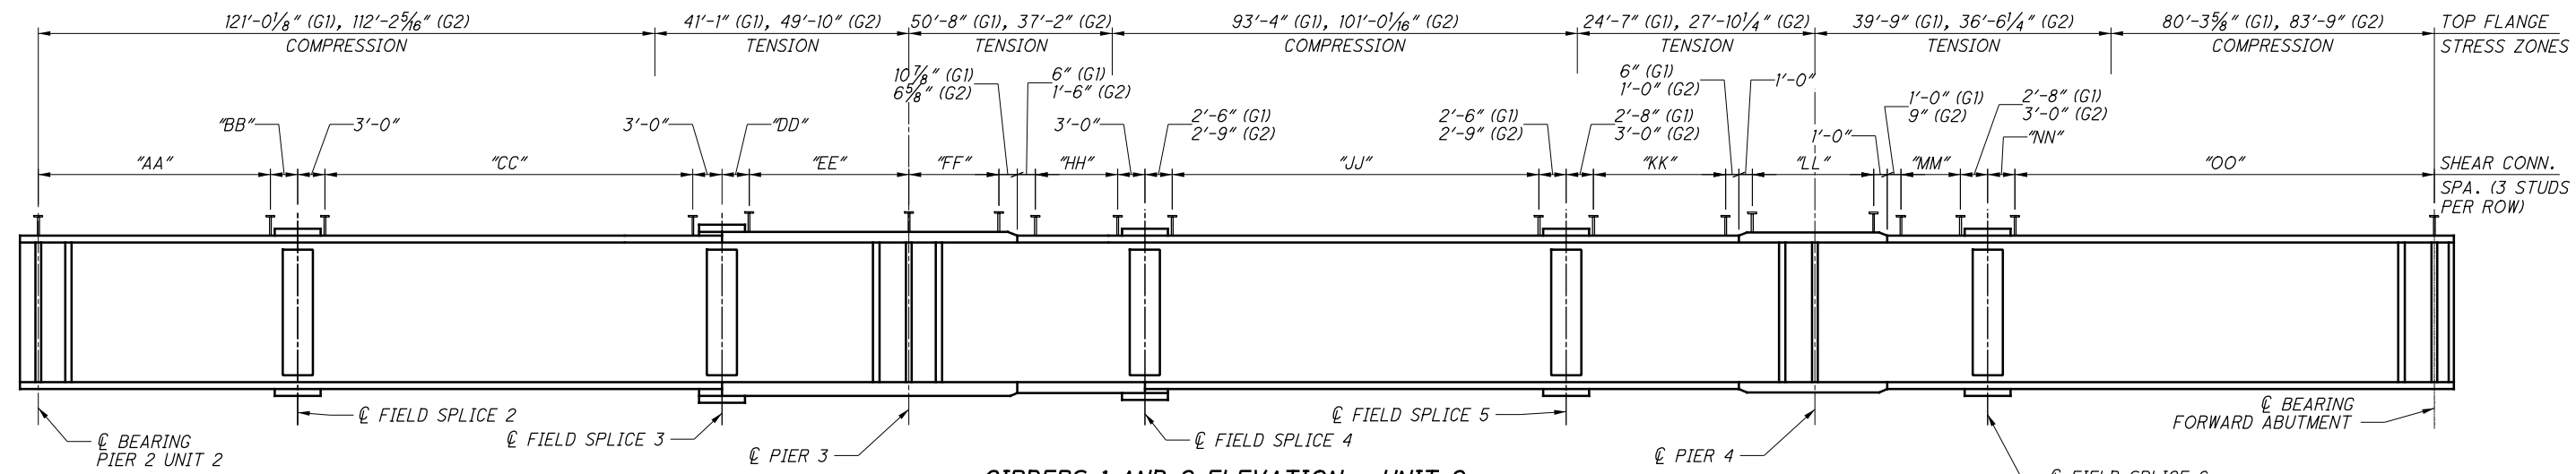

**GIRDERS 1 AND 2 ELEVATION - UNIT 2**  
(DIMENSIONS SHOWN ARE MEASURED ALONG C GIRDER)  
(INTERMEDIATE STIFFENERS NOT SHOWN FOR CLARITY)


GIRDER	SHEAR CONNECTOR SPACING										
	"AA"	"BB"	"CC"	"DD"	"EE"	"FF"	"HH"	"JJ"	"KK"	"LL"	"MM"
G1	32 SPA. @ 16 7/8" = 45'-0"	2'-5 9/16"	50 SPA. @ 18" = 75'-0"	3'-7 9/16"	20 SPA. @ 18" = 30'-0"	13 SPA. @ 18" = 19'-6"	15 SPA. @ 18" = 22'-6"	52 SPA. @ 18" = 78'-0"	14 SPA. @ 16" = 18'-8"	21 SPA. @ 16" = 28'-0"	16 SPA. @ 16" = 21'-4"
G2	40 SPA. @ 18" = 60'-0"	2'-6 15/16"	56 SPA. @ 15" = 70'-0"	3'-4 3/8"	17 SPA. @ 17" = 24'-1"	14 SPA. @ 18" = 21'-0"	21 SPA. @ 18" = 31'-6"	49 SPA. @ 18" = 73'-6"	14 SPA. @ 18" = 21'-0"	23 SPA. @ 12" = 23'-0"	17 SPA. @ 15" = 21'-3"

SHEAR CONNECTOR SPACING		
GIRDER	"NN"	"OO"
G1	3'-3 3/16"	60 SPA. @ 16" = 80'-0"
G2	2'-11 1/16"	51 SPA @ 18" = 76'-6"

- NOTES:**
- FOR NOTES AND STEEL DETAILS, SEE SHEET [48/79].
  - FOR FRAMING PLAN, SEE SHEET [42/79].
  - FOR SPLICE DETAILS, SEE SHEET [46/79].
  - THREADED STUDS WELDED AT 50' INCREMENT FOR HORIZONTAL LIFELINE.


P:\Projects\2018\20H03DB-18232 HAM-75-03.84\104667\structures\HAM074\_1908S\SD004.dgn 7/28/2023 9:34:05 AM erin.boumann

P:\Projects\2018\20H03DB-18232 HAM-75-03.84\104667\structures\HAM074\_1908S\SDD005.dgn 7/28/2023 9:34:07 AM erin.boumann

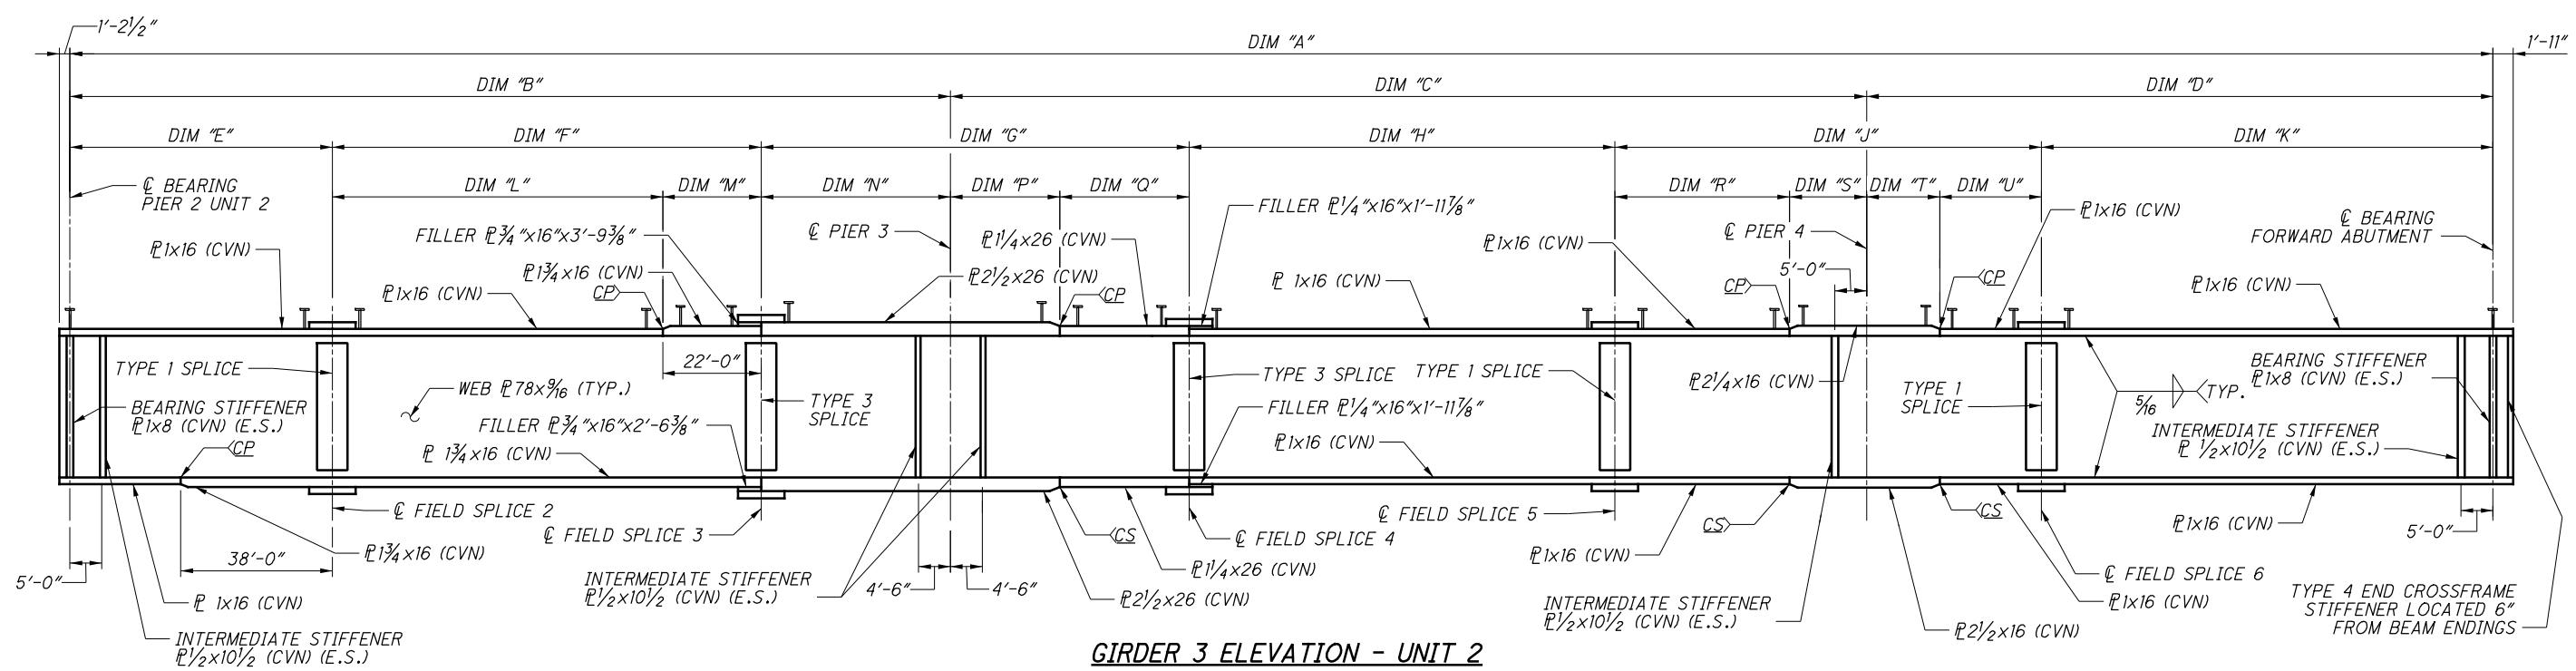

**GIRDER 3 ELEVATION - UNIT 2**  
 (DIMENSIONS SHOWN ARE MEASURED ALONG  $\phi$  GIRDER)  
 (INTERMEDIATE STIFFENERS NOT SHOWN FOR CLARITY)

GIRDER DIMENSIONS																				
GIRDER	RADIUS	SPAN LENGTHS				SEGMENT LENGTHS						DIMS. AT PIERS								
		DIM "A"	DIM "B"	DIM "C"	DIM "D"	DIM "E"	DIM "F"	DIM "G"	DIM "H"	DIM "J"	DIM "K"	DIM "L"	DIM "M"	DIM "N"	DIM "P"	DIM "Q"	DIM "R"	DIM "S"	DIM "T"	DIM "U"
G3	353'-2 $\frac{3}{4}$ "	463'-4 $\frac{7}{8}$ "	169'-11 $\frac{1}{2}$ "	172'-11 $\frac{1}{8}$ "	120'-6 $\frac{1}{4}$ "	67'-7"	82'-0"	80'-0"	78'-0"	80'-0"	75'-9 $\frac{7}{8}$ "	60'-0"	22'-0"	20'-4 $\frac{1}{2}$ "	27'-7 $\frac{1}{2}$ "	32'-0"	15'-0"	20'-3 $\frac{5}{8}$ "	19'-8 $\frac{3}{8}$ "	25'-0"

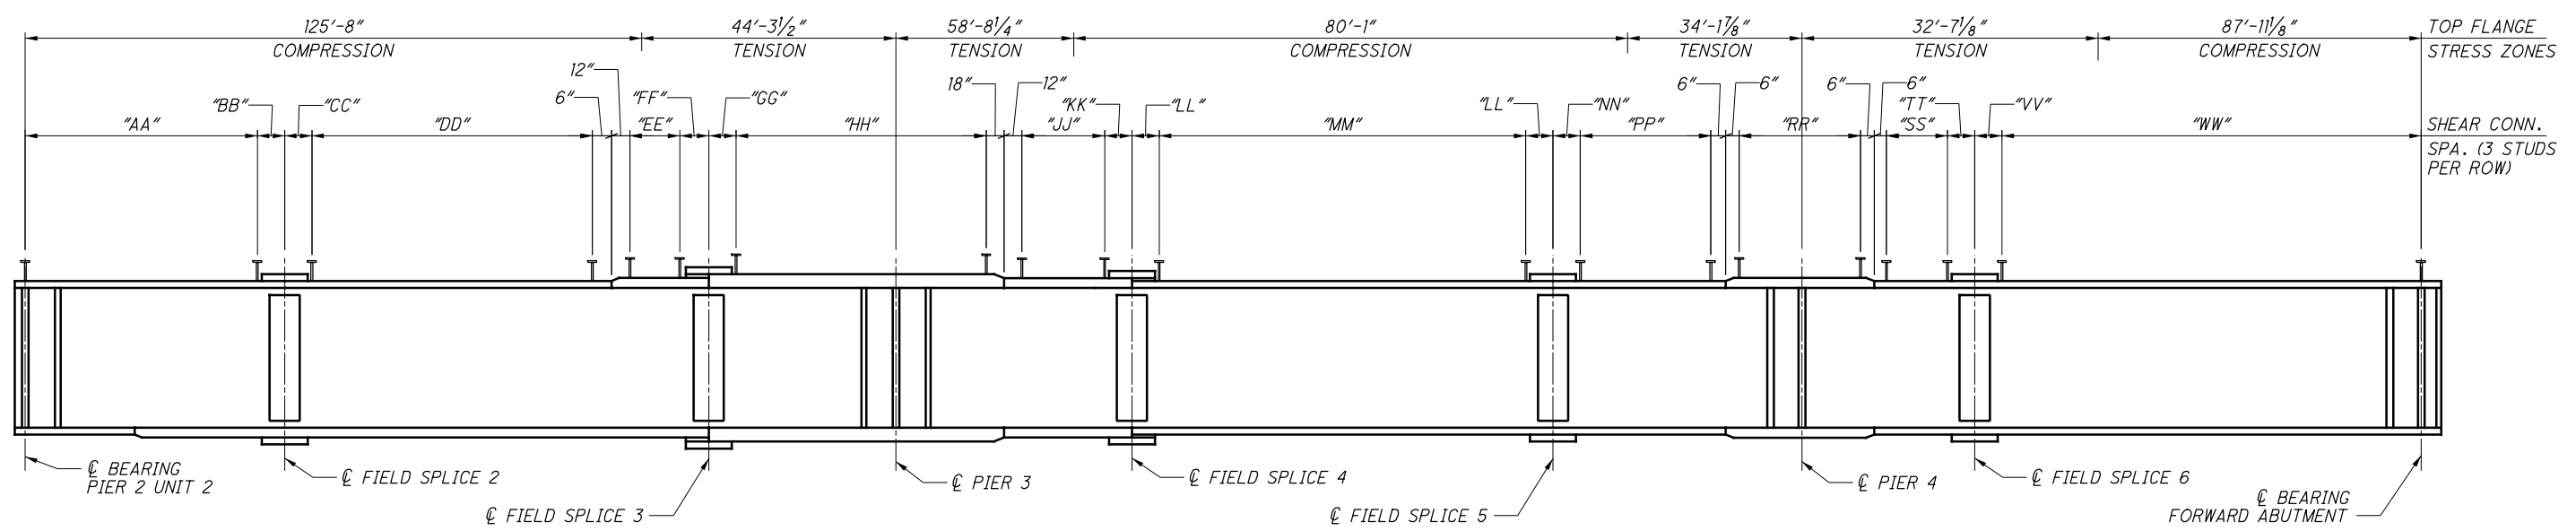

**GIRDER 3 ELEVATION - UNIT 2**  
 (DIMENSIONS SHOWN ARE MEASURED ALONG  $\phi$  GIRDER)  
 (INTERMEDIATE STIFFENERS NOT SHOWN FOR CLARITY)

SHEAR CONNECTOR SPACING															
GIRDER	"AA"	"BB"	"CC"	"DD"	"EE"	"FF"	"GG"	"HH"	"JJ"	"KK"	"LL"	"MM"	"NN"	"PP"	"RR"
G3	48 SPA. @ 16 $\frac{1}{8}$ " = 64'-6"	3'-1"	3'-3"	45 SPA. @ 15" = 56'-3"	14 SPA. @ 14" = 16'-4"	4'-8"	4'-6"	28 SPA. @ 18" = 42'-0"	18 SPA. @ 18" = 27'-0"	4'-0"	3'-0"	48 SPA. @ 18" = 72'-0"	2'-6"	12 SPA. @ 12" = 12'-0"	26 SPA. @ 18" = 39'-0"

SHEAR CONNECTOR SPACING				
GIRDER	"SS"	"TT"	"VV"	"WW"
G3	22 SPA. @ 12" = 22'-0"	2'-6"	3'-9 $\frac{7}{8}$ "	48 SPA. @ 18" = 72'-0"

- NOTES:**
- FOR NOTES AND STEEL DETAILS, SEE SHEET **48/79**.
  - FOR FRAMING PLAN, SEE SHEET **42/79**.
  - FOR SPLICE DETAILS, SEE SHEETS **46/79** AND **47/79**.

DESIGN AGENCY: **PRIME**  
540 WHITE POND DR. SUITE E  
AKRON, OH 44320

DATE: 11/1/2018  
REVISED: TKS  
STRUCTURE FILE NUMBER: 3109798

DRAWN: KDC  
KDC  
REVISED:

DESIGNED: CRG  
CRG  
CHECKED: KDC


BRIDGE NO.: HAM-74-1908S  
RAMP P OVER IR-74 WESTBOUND, IR-75 AND RAMP E

**GIRDER ELEVATION - UNIT 2 (2 OF 3)**

HAM-75-3.84  
PID No. 104667


44 / 79

44  
79

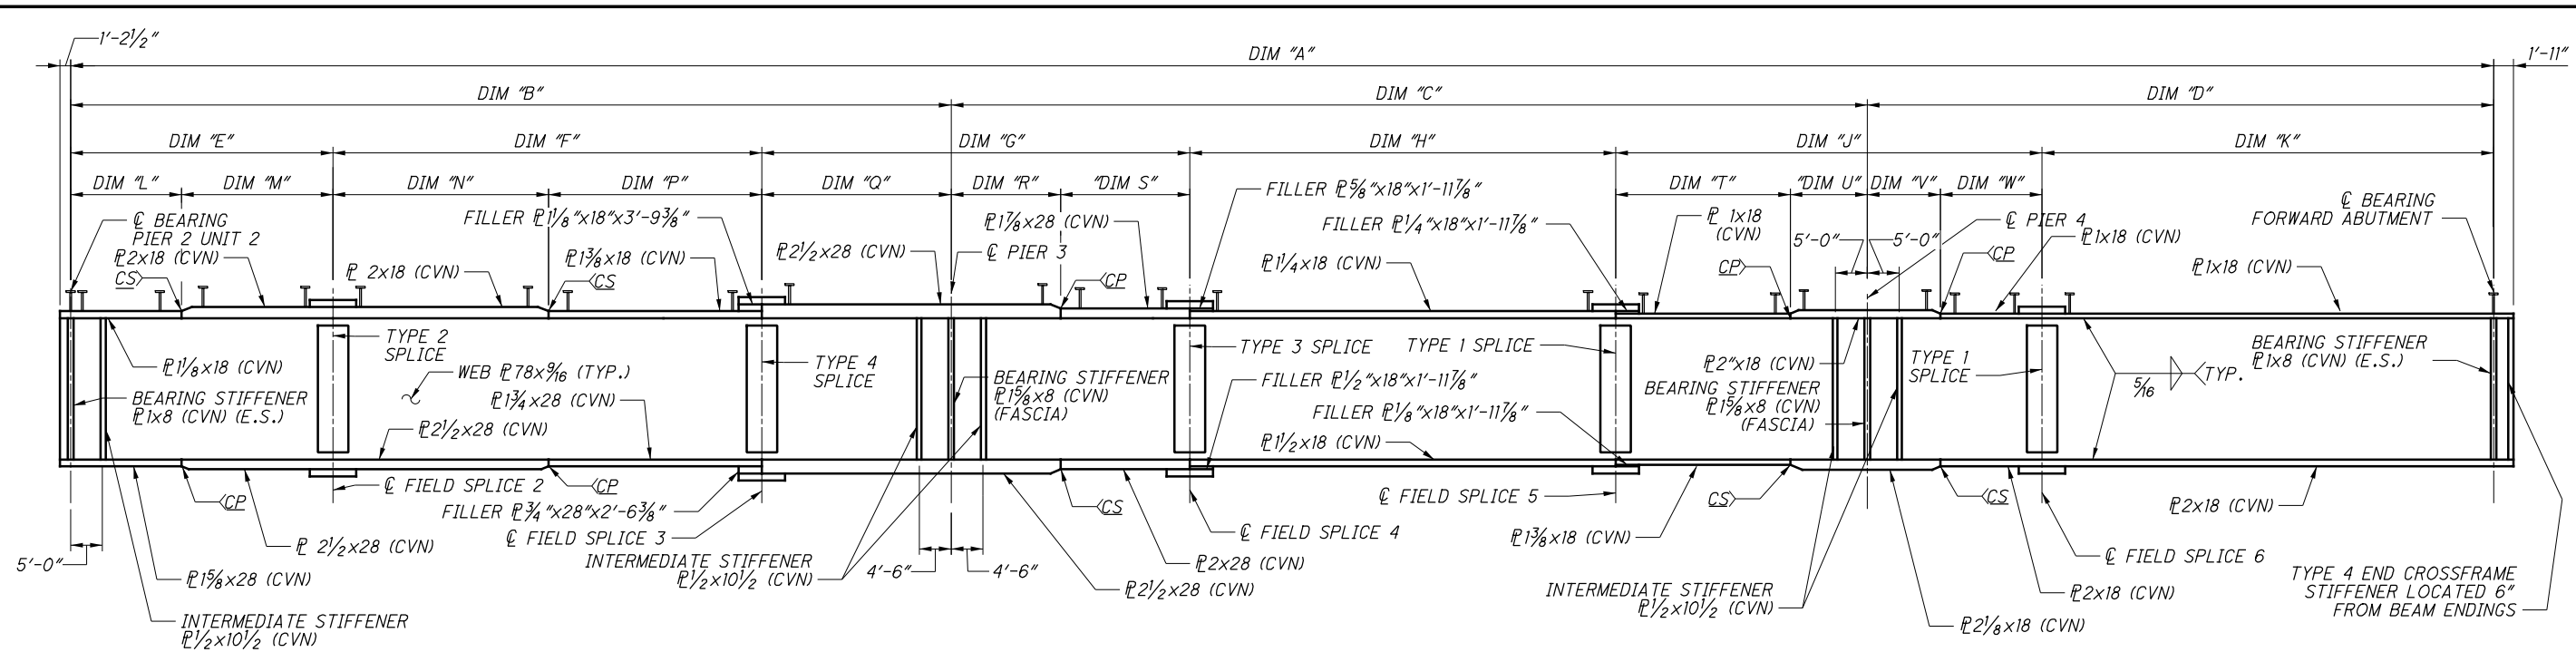

**GIRDER 4 ELEVATION - UNIT 2**  
(DIMENSIONS SHOWN ARE MEASURED ALONG C GIRDER)  
(INTERMEDIATE STIFFENERS NOT SHOWN FOR CLARITY)

GIRDER	RADIUS	SPAN LENGTHS				SEGMENT LENGTHS						DIMS. AT PIERS										
		DIM "A"	DIM "B"	DIM "C"	DIM "D"	DIM "E"	DIM "F"	DIM "G"	DIM "H"	DIM "J"	DIM "K"	DIM "L"	DIM "M"	DIM "N"	DIM "P"	DIM "Q"	DIM "R"	DIM "S"	DIM "T"	DIM "U"	DIM "V"	DIM "W"
G4	361'-6 3/4"	469'-9 1/2"	173'-10 5/8"	175'-1 1/4"	120'-9 5/8"	64'-7"	80'-0"	80'-0"	87'-0"	83'-0"	75'-2 3/8"	27'-8"	36'-11"	40'-0"	40'-0"	29'-3 1/2"	30'-8 1/2"	20'-0"	23'-0"	14'-4 3/4"	25'-7 1/4"	20'-0"

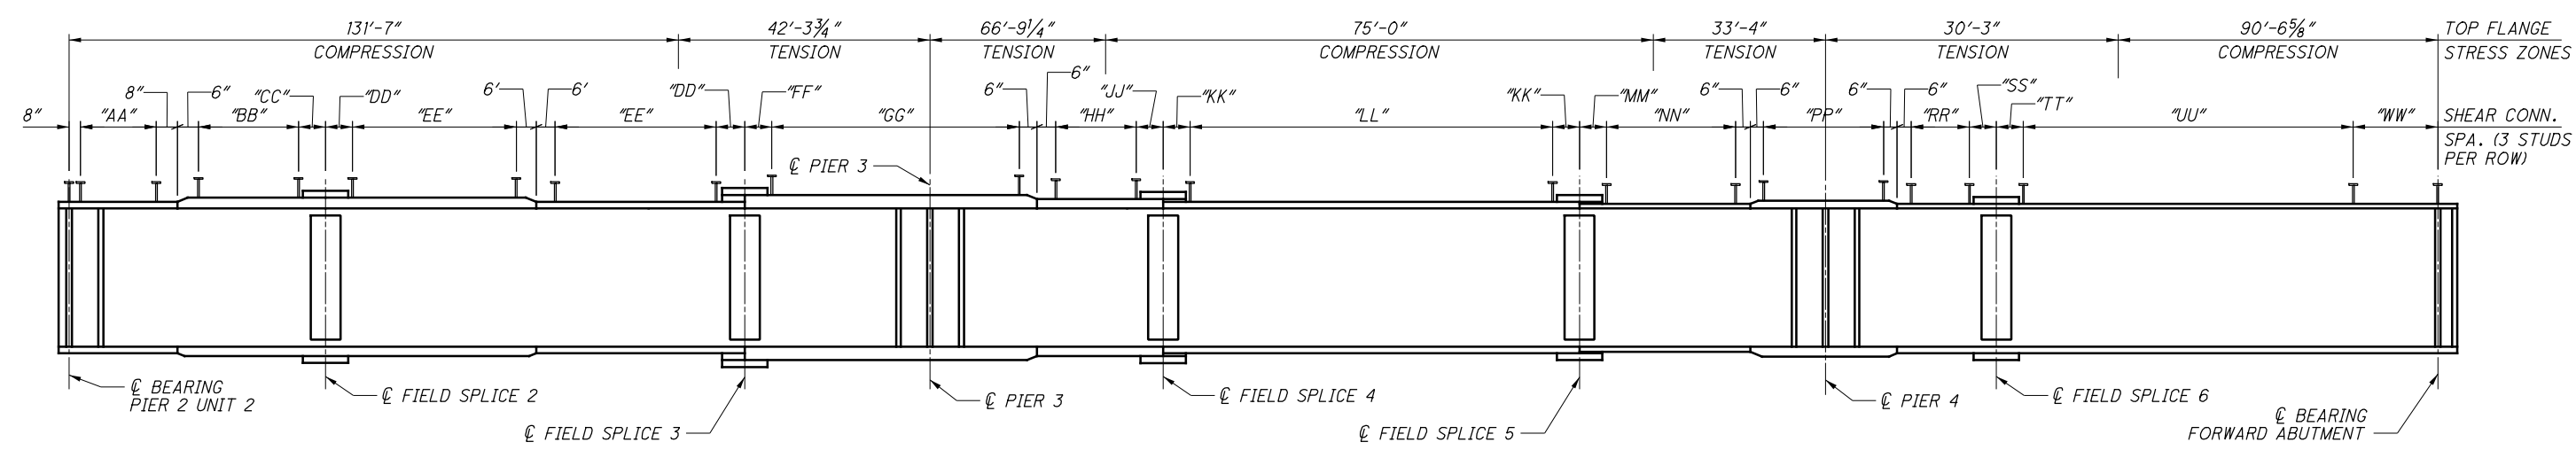

**GIRDER 4 ELEVATION - UNIT 2**  
(DIMENSIONS SHOWN ARE MEASURED ALONG C GIRDER)  
(INTERMEDIATE STIFFENERS NOT SHOWN FOR CLARITY)


GIRDER	SHEAR CONNECTOR SPACING													
	"AA"	"BB"	"CC"	"DD"	"EE"	"FF"	"GG"	"HH"	"JJ"	"KK"	"LL"	"MM"	"NN"	"PP"
G4	27 SPA. @ 12" = 27'-0"	31 SPA. @ 12" = 31'-0"	4'-9"	4'-10"	26 SPA. @ 16" = 34'-8"	4'-10"	41 SPA. @ 16" = 54'-8"	12 SPA. @ 16" = 16'-0"	3'-6"	2'-10"	61 SPA. @ 16" = 81'-4"	2'-6"	20 SPA. @ 12" = 20'-0"	36 SPA. @ 13" = 39'-0"

GIRDER	SHEAR CONNECTOR SPACING				
	"RR"	"SS"	"TT"	"UU"	"WW"
G4	13 SPA. @ 15" = 16'-3"	3'-3"	3'-2 3/8"	62 SPA. @ 12" = 62'-0"	12 SPA. @ 10" = 10'-0"


- NOTES:**
- FOR NOTES AND STEEL DETAILS, SEE SHEET 48/79.
  - FOR FRAMING PLAN, SEE SHEET 42/79.
  - FOR SPLICE DETAILS, SEE SHEETS 46/79 AND 47/79.

P:\Projects\2018\20H03DB-18232 HAM-75-03.84\104667\structures\HAM074\_1908S\SD007.dgn 7/28/2023 9:34:08 AM erin.baumann


P:\Projects\2018\20HO3DB-18232 HAM-75-03.84\104667\structures\HAM074\_1908S\SD006.dgn 7/28/2023 9:34:10 AM erim.baumann

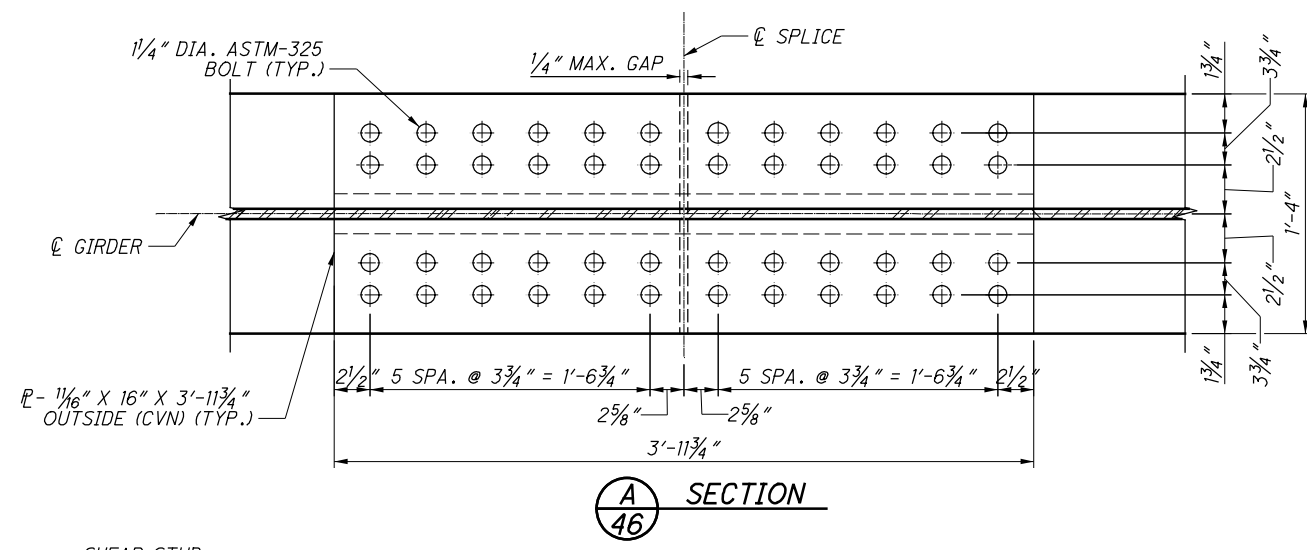


**A SECTION**

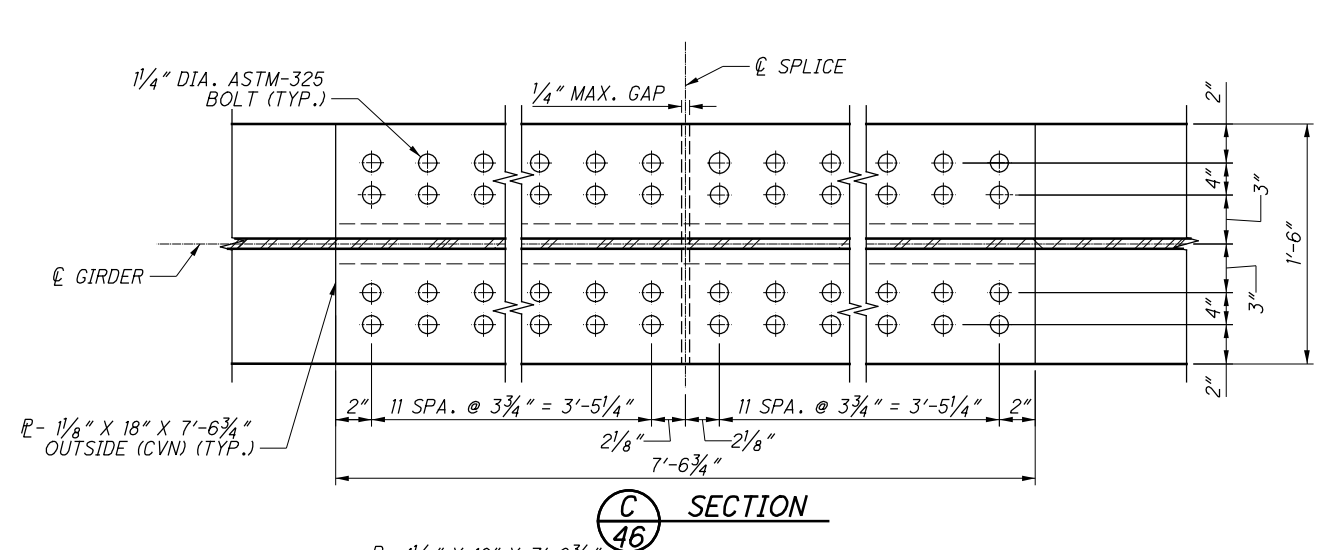


**C SECTION**

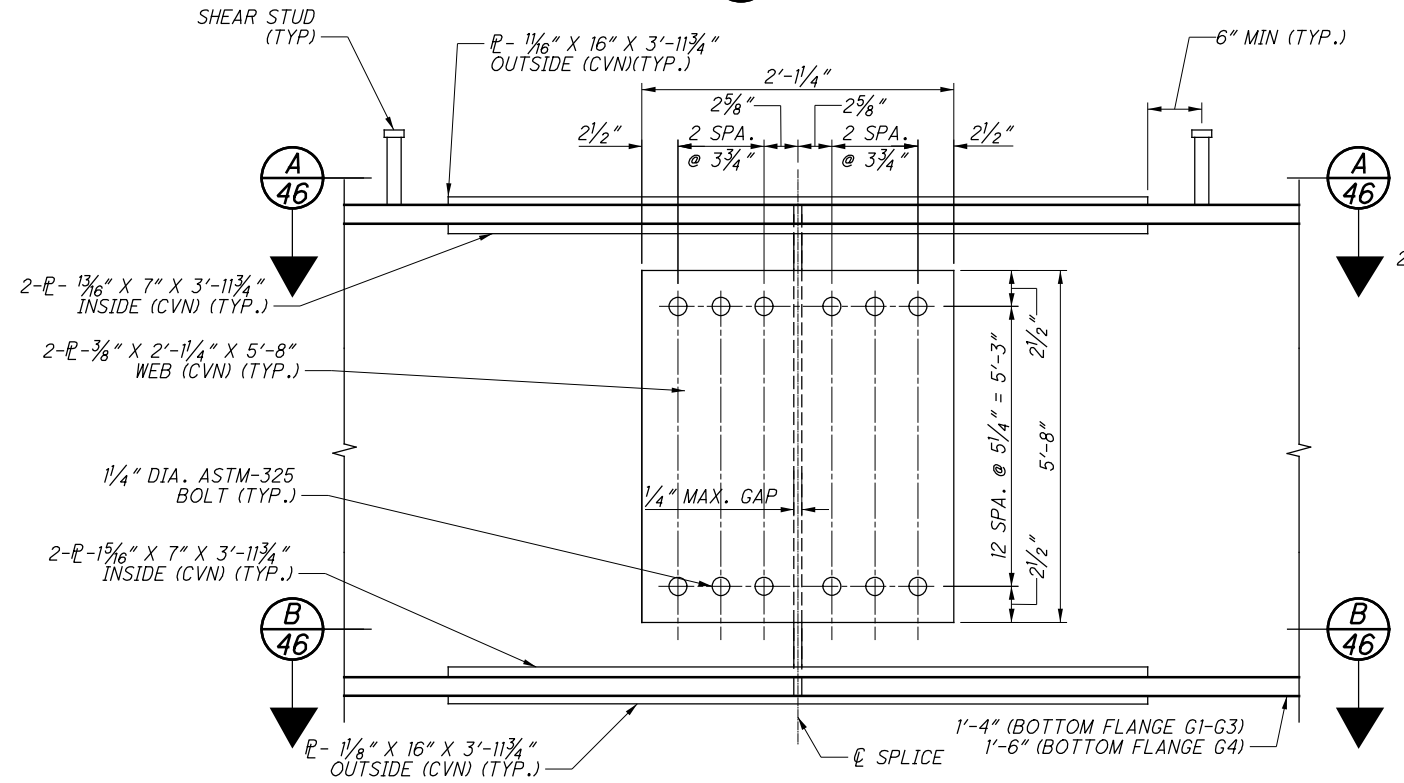


**TYPE 1 SPLICE ELEVATION**  
(FOR FILLER PLATE DETAILS, SEE NOTE 1)

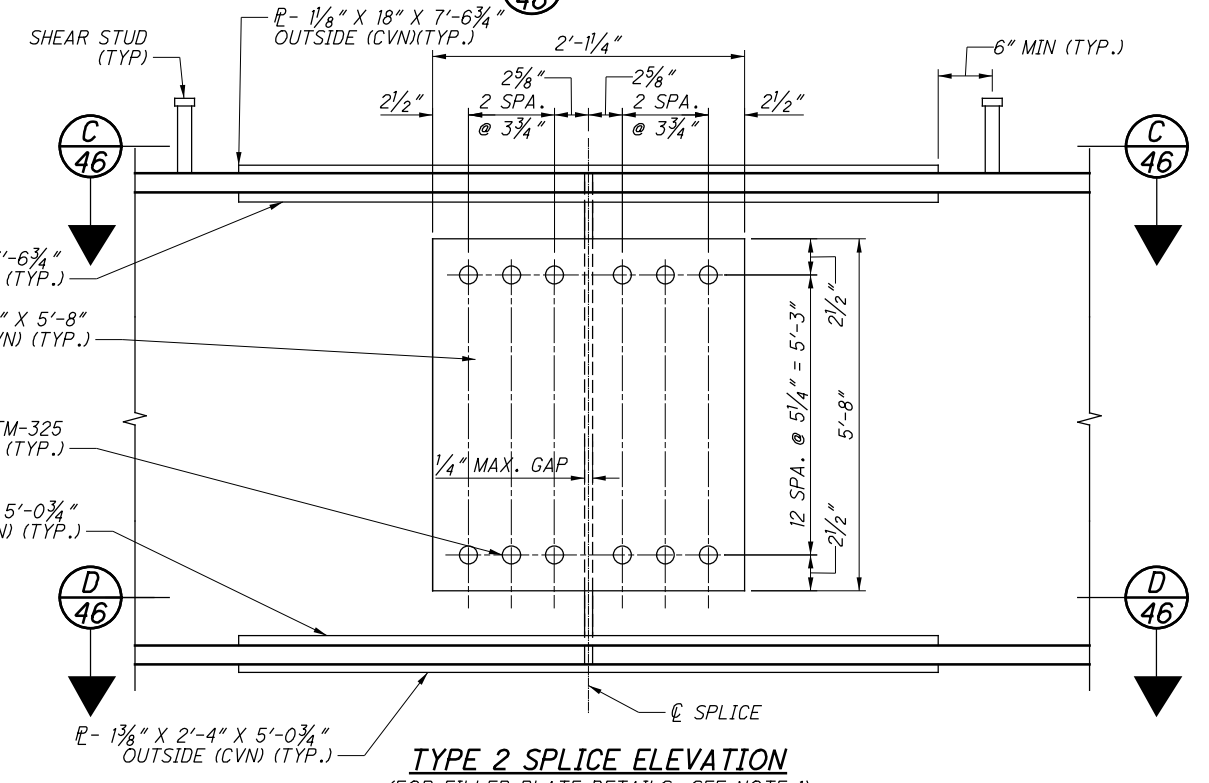

**TYPE 2 SPLICE ELEVATION**  
(FOR FILLER PLATE DETAILS, SEE NOTE 1)

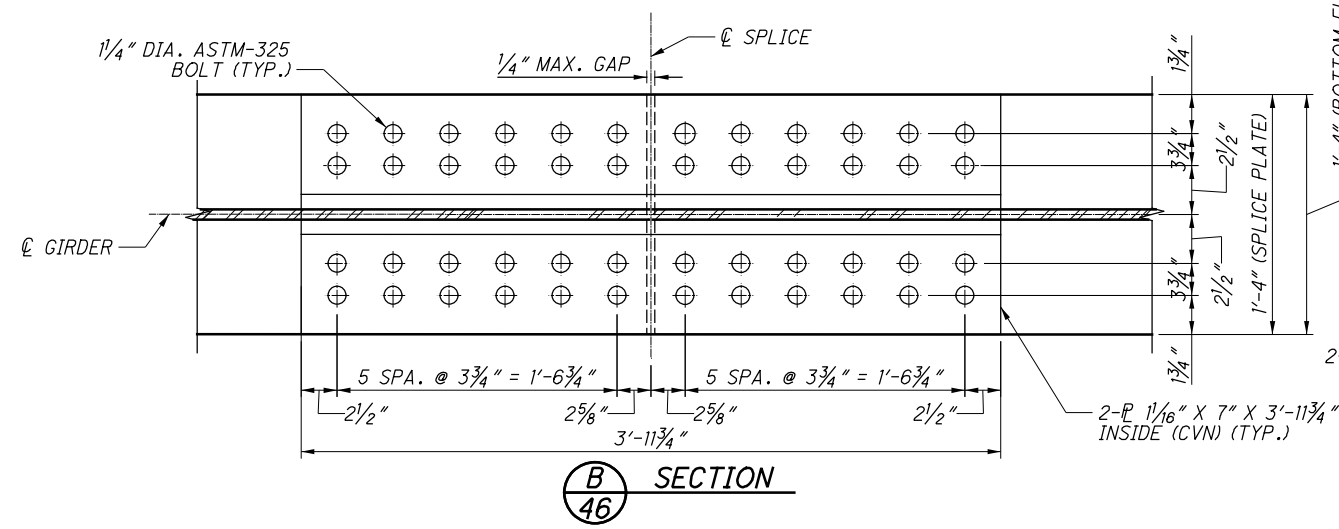

**B SECTION**

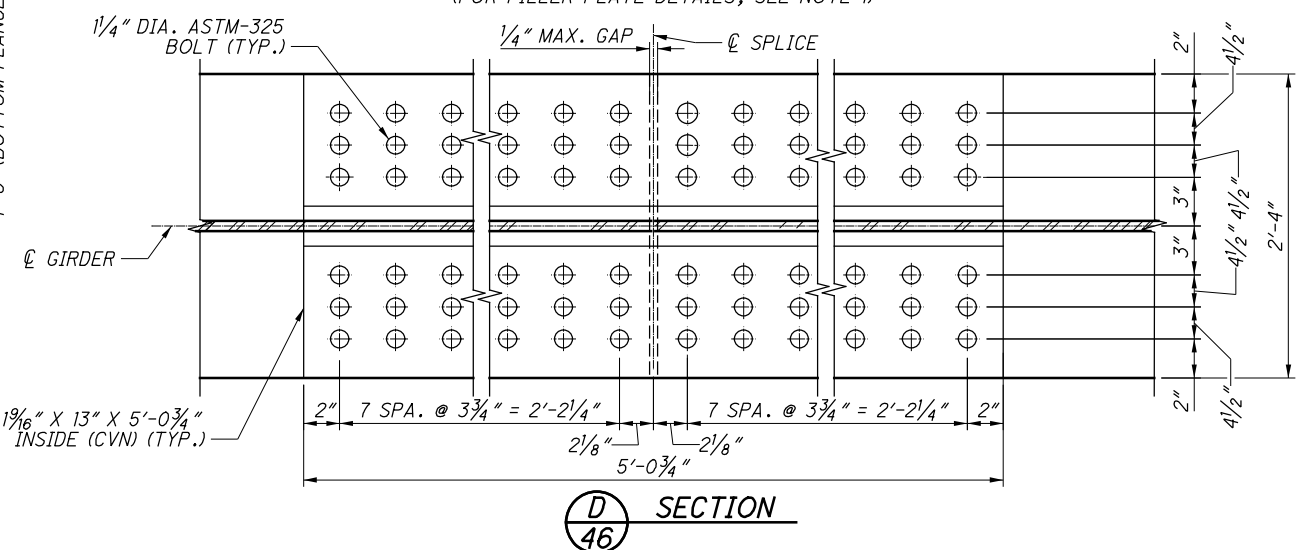

**D SECTION**

- NOTES:**
1. FILLER PLATES NOT SHOWN FOR CLARITY:  
FOR GIRDERS 1 AND 2 FILLER PLATE DETAILS, SEE SHEET 43/79.  
FOR GIRDER 3 FILLER PLATE DETAILS, SEE SHEET 44/79.  
FOR GIRDER 4 FILLER PLATE DETAILS, SEE SHEET 45/79.
  2. FOR NOTES, SEE SHEET 48/79.

DESIGN AGENCY: **PRIME**  
540 WHITE POND DR. SUITE E  
AKRON, OH 44320

DATE: 8/22/2019  
REVIEWED: TES  
STRUCTURE FILE NUMBER: 3109798

DRAWN: KDC  
KDC  
REVISED:


DESIGNED: KDC  
CHECKED: CRG

**FIELD SPLICE DETAILS - UNIT 2 (1 OF 2)**  
BRIDGE NO. HAM-74-1908S  
RAMP P OVER IR-74 WESTBOUND, IR-75 AND RAMP E


HAM-75-3.84  
PID No. 104667

46/79  
46  
79


P:\Projects\2018\20H03DB-18232 HAM-75-03.84\104667\structures\HAM074\_1908S\SD020.dgn 7/28/2023 9:34:13 AM erin.baumann

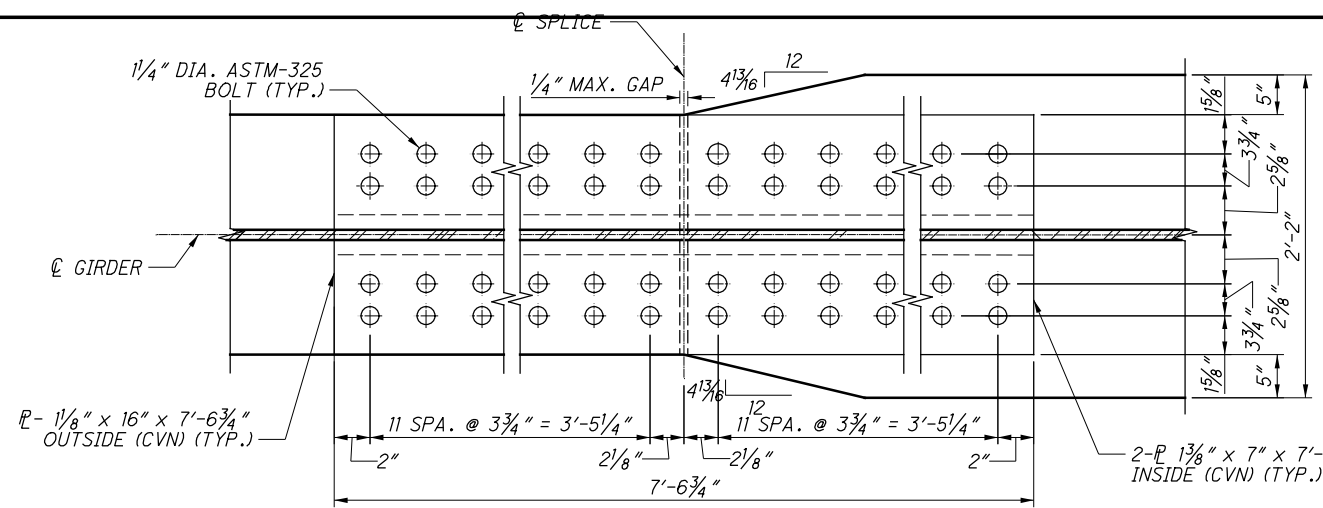


**A SECTION**  
47

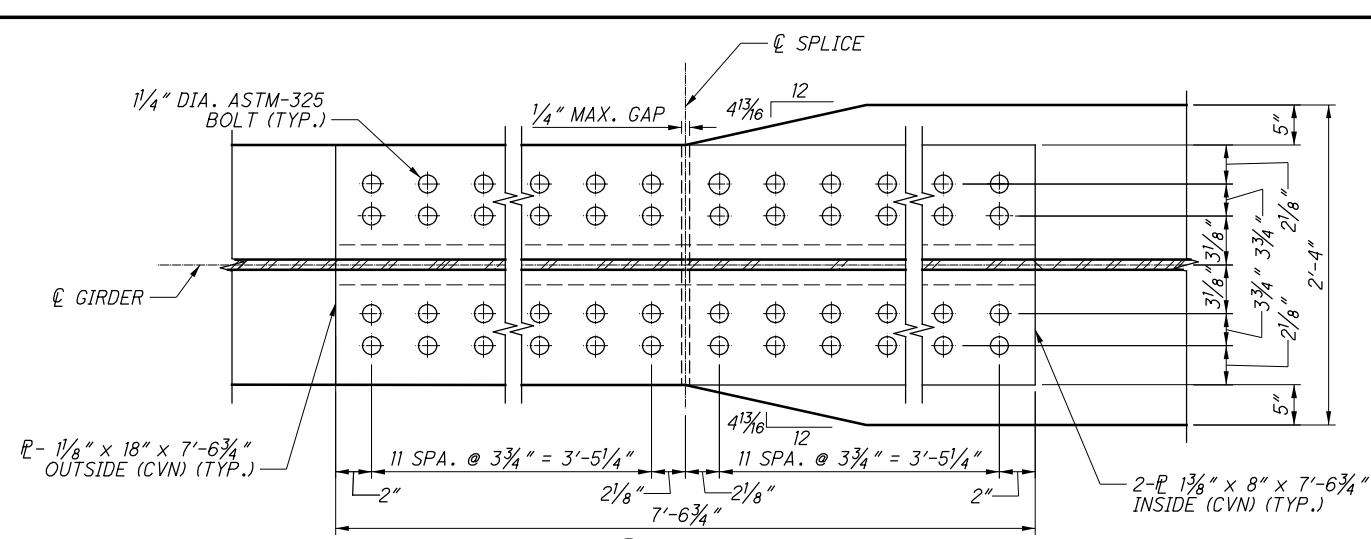


**C SECTION**  
47

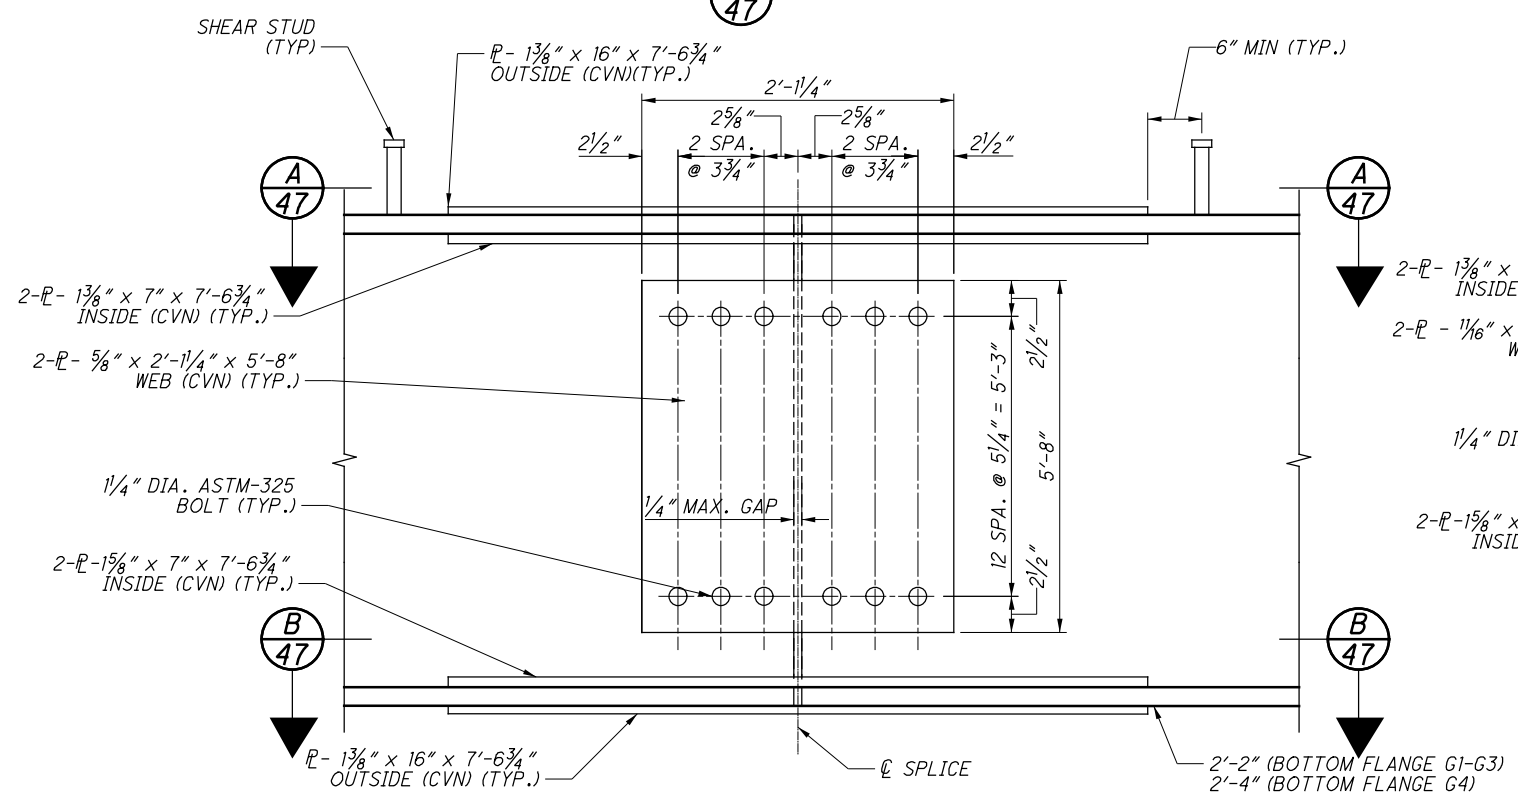


**TYPE 3 SPLICE ELEVATION**  
(FOR FILLER PLATE DETAILS, SEE NOTE 1)

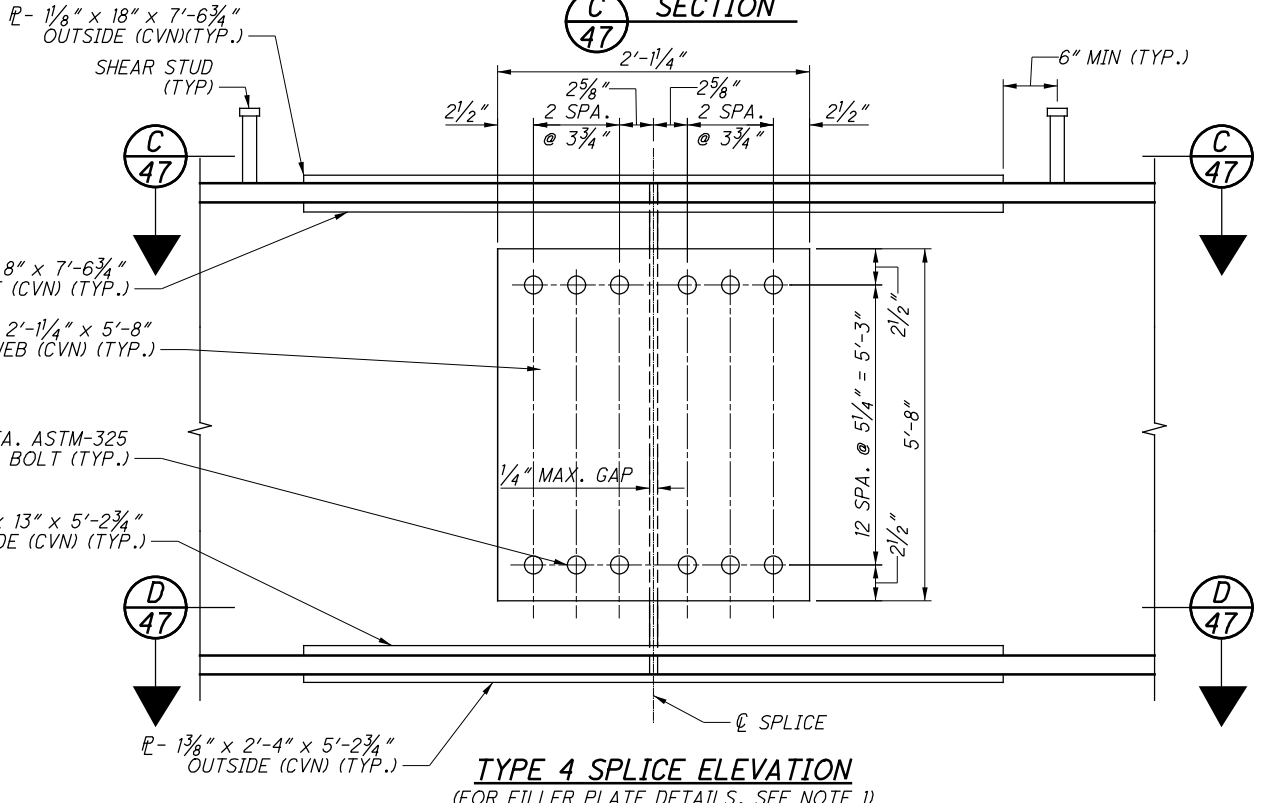

**TYPE 4 SPLICE ELEVATION**  
(FOR FILLER PLATE DETAILS, SEE NOTE 1)

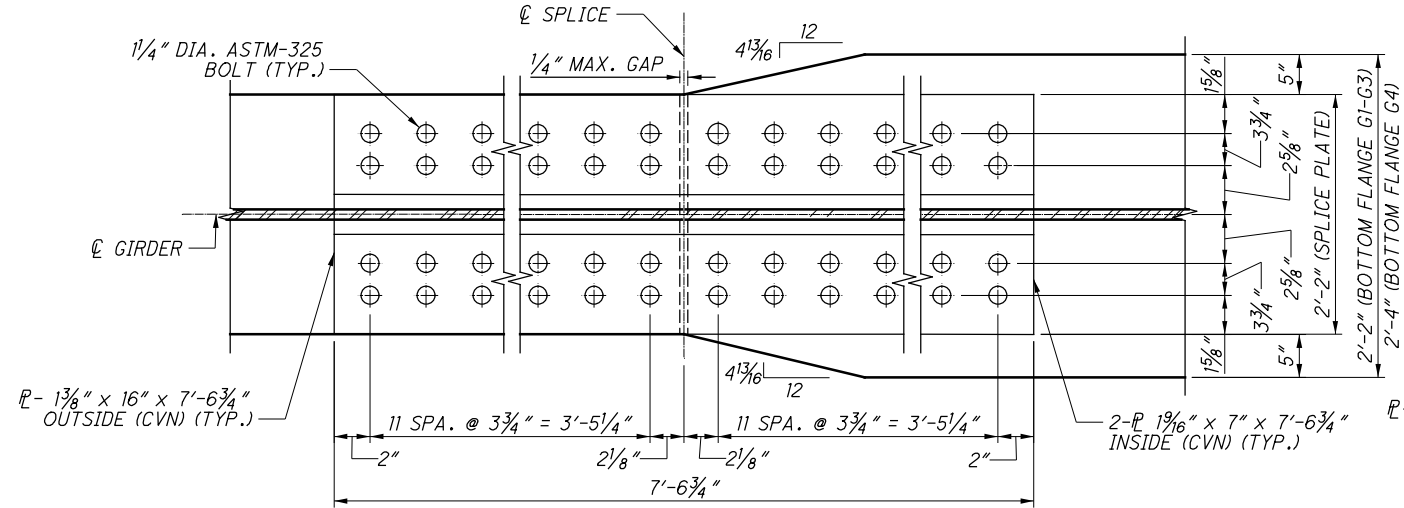

**B SECTION**  
47

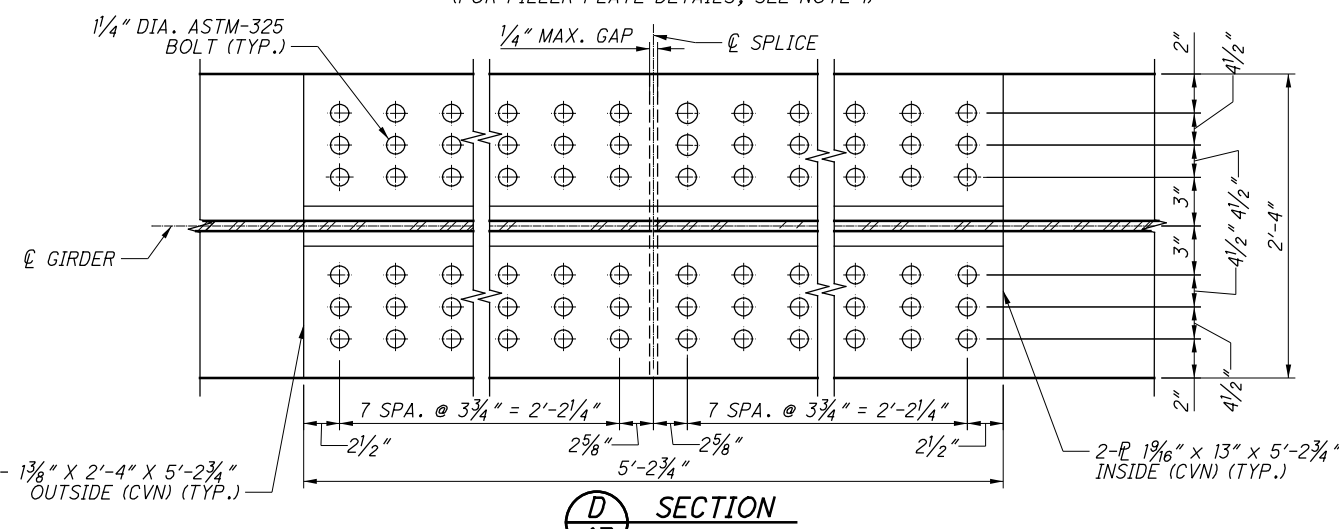

**D SECTION**  
47

**NOTES:**  
1. FILLER PLATES NOT SHOWN FOR CLARITY:  
FOR GIRDERS 1 AND 2 FILLER PLATE DETAILS, SEE SHEET 43/79.  
FOR GIRDER 3 FILLER PLATE DETAILS, SEE SHEET 44/79.  
FOR GIRDER 4 FILLER PLATE DETAILS, SEE SHEET 45/79.  
2. FOR NOTES, SEE SHEET 48/79.

DESIGN AGENCY: **PRIME**  
540 WHITE POND DR. SUITE E  
AKRON, OH 44320

DATE: 8/22/2019  
REVIEWED: TES  
STRUCTURE FILE NUMBER: 3109798

DESIGNED: KDC  
CHECKED: CRG


DRAWN: KDC  
REVISED:

**FIELD SPLICE DETAILS - UNIT 2 (2 OF 2)**  
BRIDGE NO. HAM-74-1908S  
RAMP P OVER IR-74 WESTBOUND, IR-75 AND RAMP E


HAM-75-3.84  
PID No. 104667

47/79  
47  
79


P:\Projects\2018\20H03DB-18232 HAM-75-03.84\104667\structures\HAM074\_1908S\sheets\074\_1908S\_SDO08.dgn 7/28/2023 9:34:15 AM erin.baumann

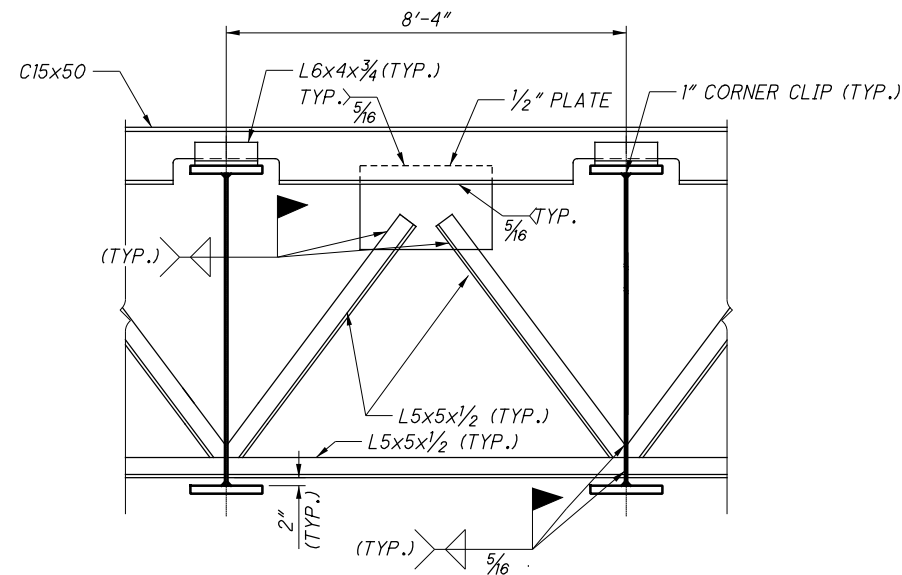


**TYPE 3 END CROSSFRAME**

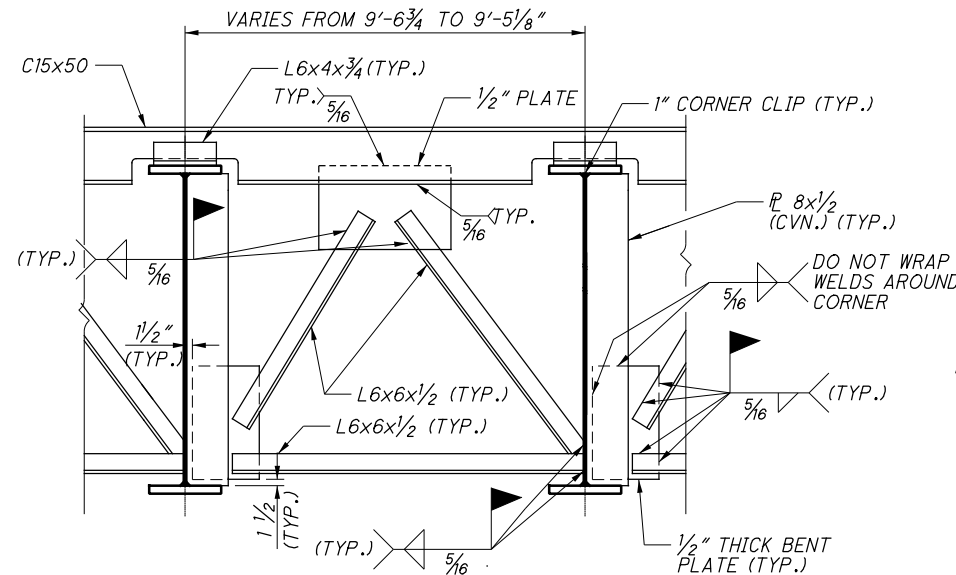


**TYPE 4 END CROSSFRAME**

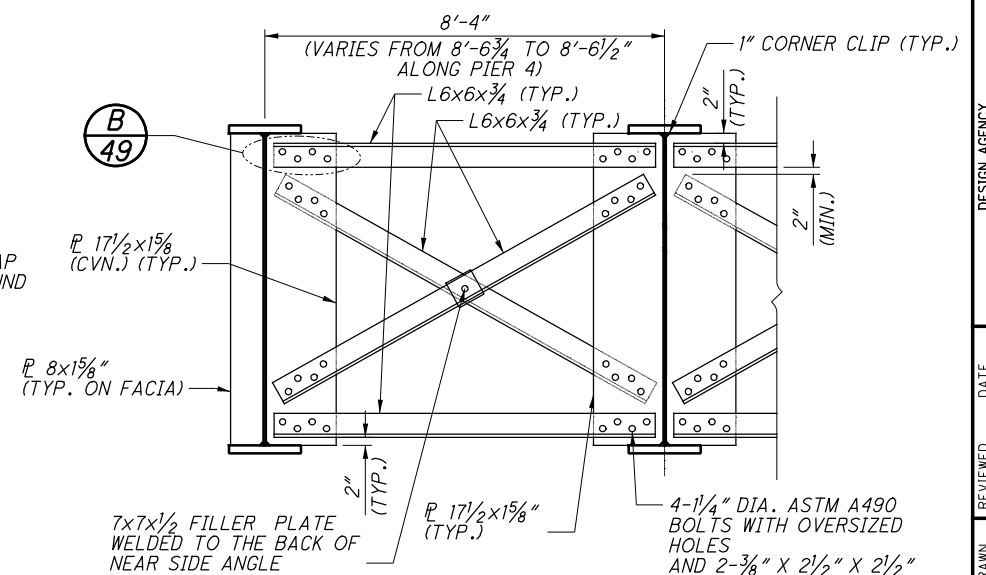


**TYPE 5 CROSSFRAME**

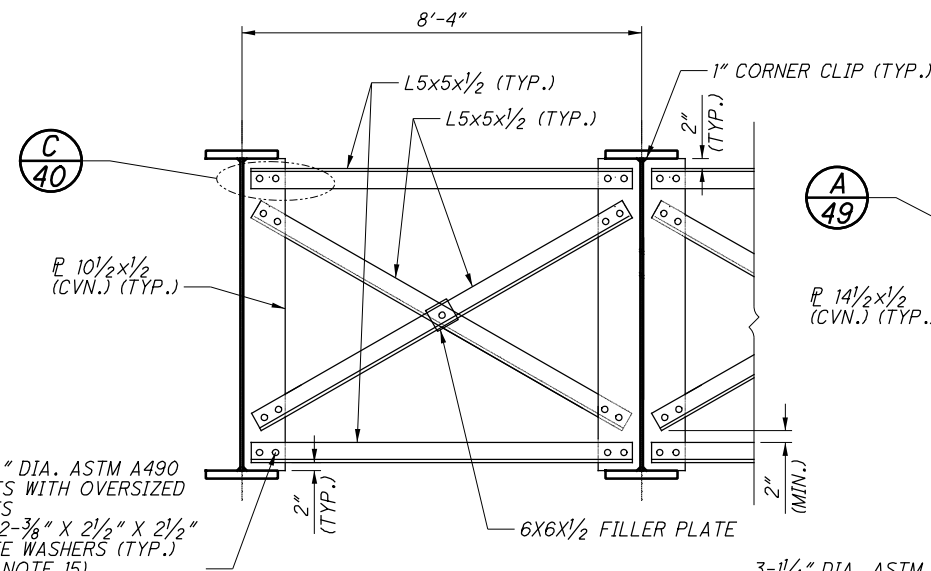

**TYPE 2 CROSSFRAME**

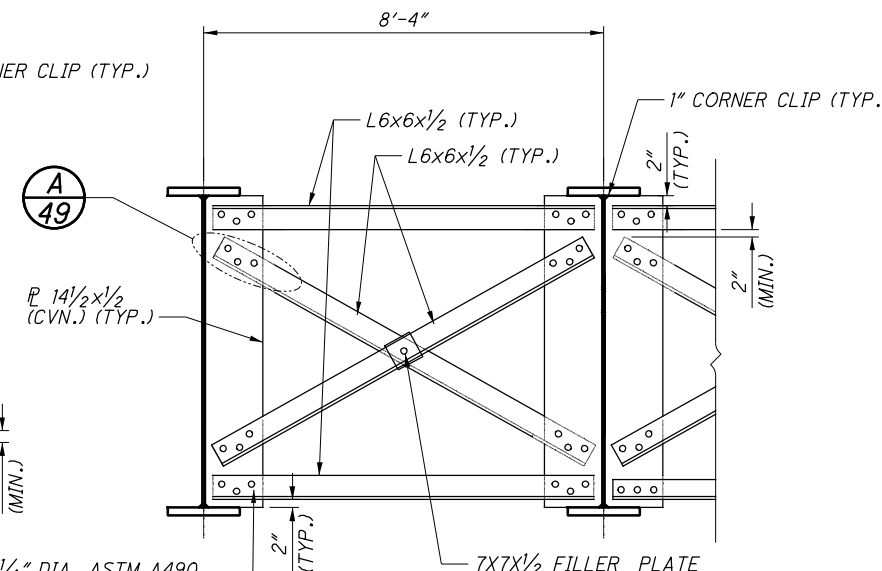

**TYPE 3 CROSSFRAME**

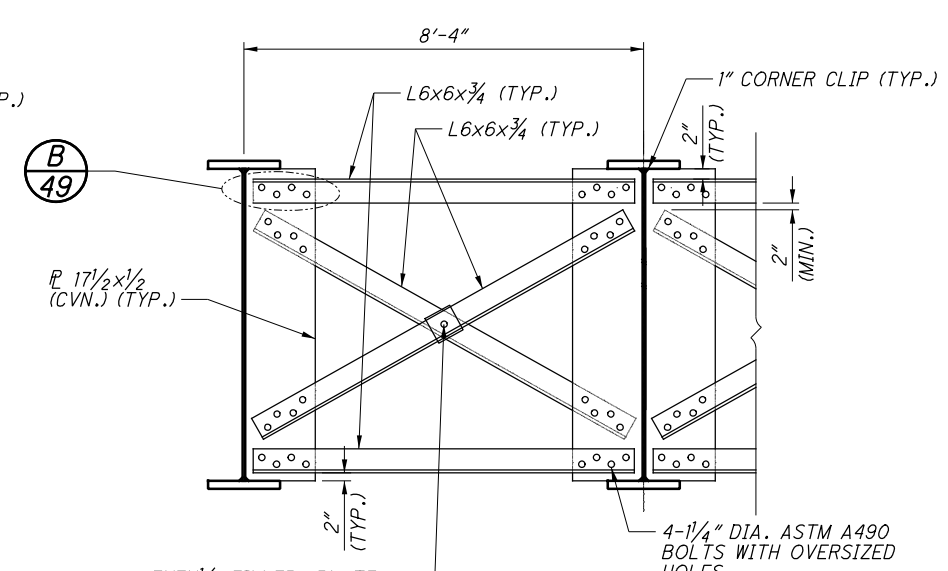


**TYPE 4 CROSSFRAME**

**NOTES:**


- ALL STRUCTURAL STEEL SHALL BE ASTM A709 GRADE 50W, UNLESS NOTED OTHERWISE.
- FOR GIRDER WEBS, FLANGES, BEARING AND INTERMEDIATE STIFFENERS, CROSSFRAMES AND SPLICES, FURNISH MATERIAL THAT MEETS THE MINIMUM NOTCH TOUGHNESS REQUIREMENTS AS SPECIFIED IN ITEM 711.01.
- THE GIRDER ENDS AND ALL BEARING STIFFENERS SHALL BE VERTICAL UNDER FULL DEAD LOAD. INTERIOR CROSS FRAMES AND FIELD SPLICES MAY BE NORMAL TO GRADE.
- BOLTS USED FOR SPLICES SHALL BE ASTM A325, TYPE 3 HIGH STRENGTH BOLTS. ALL OTHER BOLTS SHALL BE ASTM A490, TYPE 3 HIGH STRENGTH BOLTS.
- FOR UNIT 2 FRAMING PLAN, SEE SHEET 42/79.
- THE OPENING BETWEEN GIRDER ENDS AFTER ASSEMBLY SHALL NOT EXCEED 1/4".
- WELD ATTACHMENTS OF SUPPORTS FOR CONCRETE DECK FINISHING MACHINE TO AREAS OF THE FASCIA STRINGER FLANGES DESIGNATED "COMPRESSION". DO NOT WELD ATTACHMENTS TO AREAS DESIGNATED "TENSION". FILLET WELDS TO COMPRESSION FLANGES SHALL BE AT LEAST 1" FROM EDGE OF FLANGE, BE NO MORE THAN 2" LONG, AND BE AT LEAST 1/4" FOR THICKNESSES UP TO 3/4" OR 5/16" FOR GREATER THAN 3/4".
- WHERE A WELDED BUTT JOINT IS DESIGNATED CP, THE WELD SHALL BE COMPLETE PENETRATION. WELD REINFORCEMENT SHALL BE REMOVED BY GRINDING IN THE DIRECTION OF THE MAIN STRESS.
- WHERE A WELDED BUTT JOINT WELD IS DESIGNATED CS, THE WELD IS SUBJECT TO COMPRESSIVE STRESS ONLY.
- SHEAR STUD CONNECTORS SHALL BE WELDED PER ITEM 512.22.
- CROSS FRAMES SHALL BE DETAILED TO FIT IN THE STEEL DEAD LOAD CONDITION.
- FOR DEFLECTION AND CAMBER DIAGRAM, SEE SHEETS 50/79 THRU 52/79.
- FOR ADDITIONAL DETAILS, SEE SHEET 49/79.
- FOR ADDITIONAL END FRAME CONNECTION DETAILS, SEE GSD-1-96.
- WASHER DETAIL FOR 1 9/16" DIA. OVERSIZE HOLES IN CROSSFRAMES: NUT SIDE = PLATE WASHER (3/8" X 2 1/2" X 2 1/2") AND ASTM F436 WASHER BOLT HEAD SIDE = PLATE WASHER (3/8" X 2 1/2" X 2 1/2")

DESIGNED CRG	CHECKED KDC	DRAWN KDC	REVIEWED TES	DATE 8/22/2019	DESIGN AGENCY <b>PRIME</b> 540 WHITE POND DR. SUITE E AKRON, OH 44320
			STRUCTURE FILE NUMBER 3109798		
<b>CROSSFRAME DETAILS - UNIT 2</b>					
BRIDGE NO. HAM-74-1908S					
RAMP P OVER IR-74 WESTBOUND, IR-75 AND RAMP E					
HAM-75-3.84 PID No. 104667					
48 / 79					48 79


P:\Projects\2018\20H03DB-18232 HAM-75-03-84-104667\structures\HAM074\_1908S\SD022.dgn 7/28/2023 9:34:19 AM erin.baumann

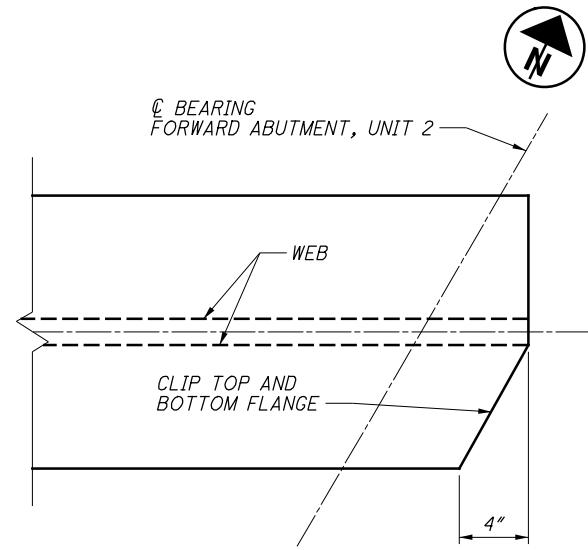




**A** 42 TYPICAL BEAM END AT FORWARD ABUTMENT

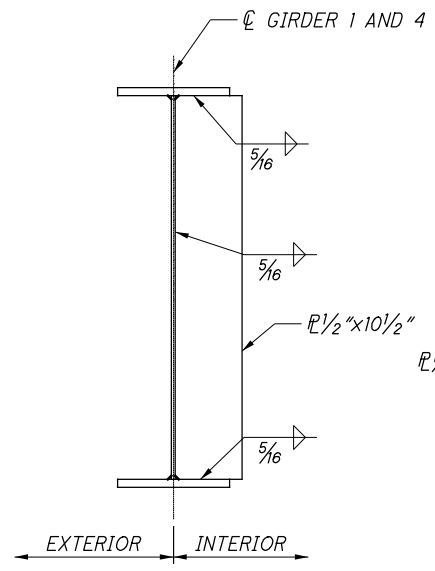


**TYPE 2 INTERMEDIATE CROSSFRAME STIFFENERS**  
(BOLTS NOT SHOWN)

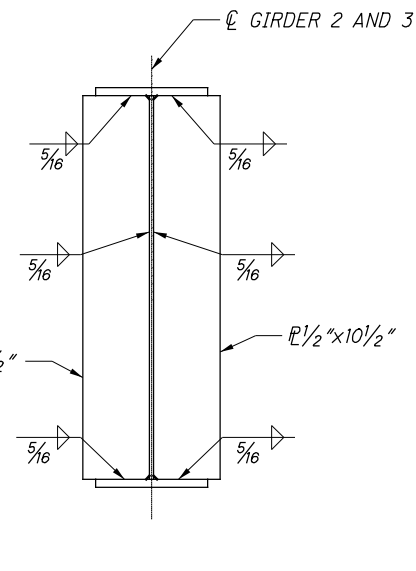


**TYPE 3 INTERMEDIATE CROSSFRAME STIFFENERS**  
(BOLTS NOT SHOWN)

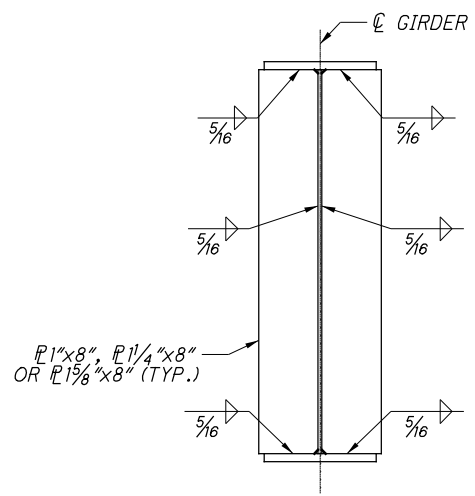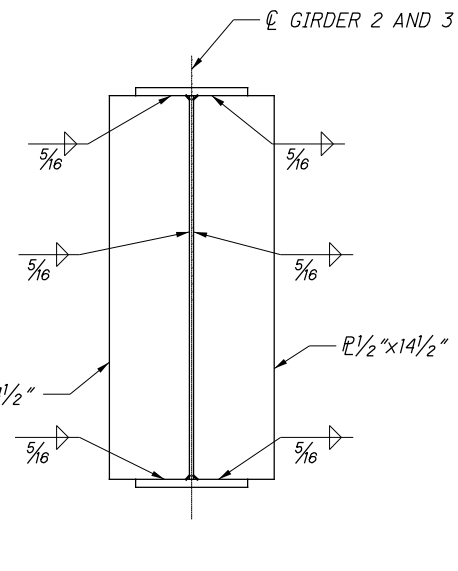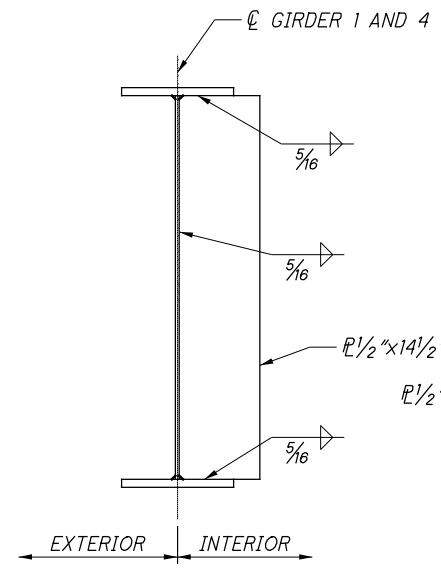



**BEARING STIFFENERS**  
(EX. PIER 7, UNIT 1 SHOWN, OTHERS SIMILAR)

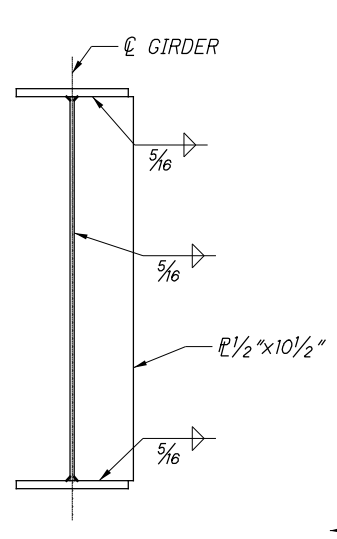



**TYPE 4 END CROSSFRAME STIFFENERS**  
(LOOKING UPSTATION)

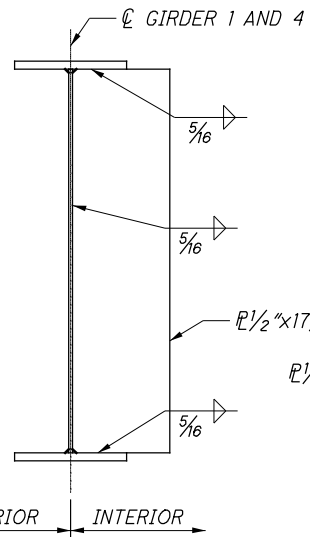


**TYPE 4 INTERMEDIATE CROSSFRAME STIFFENERS**  
(BOLTS NOT SHOWN)

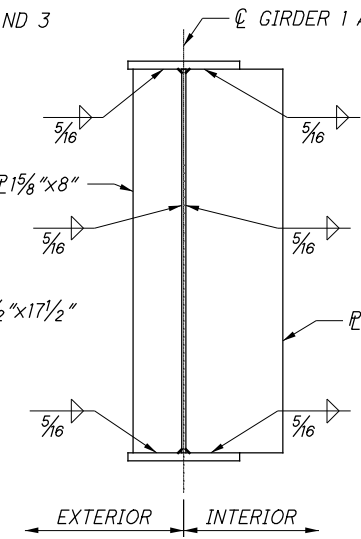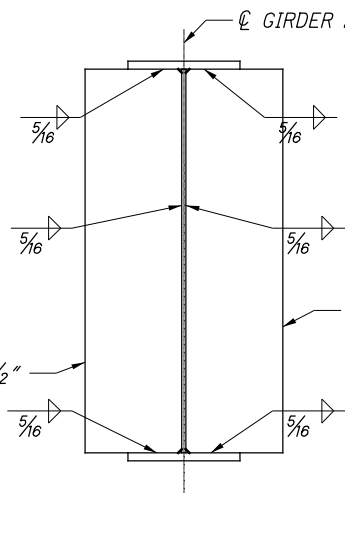


**TYPE 5 INTERMEDIATE CROSSFRAME STIFFENERS AT PIER 3 AND 4**  
(BOLTS NOT SHOWN)

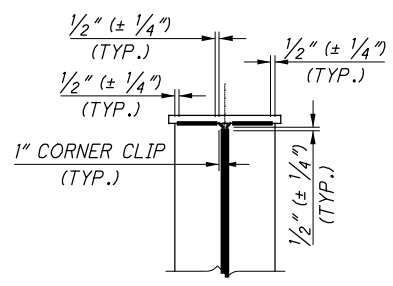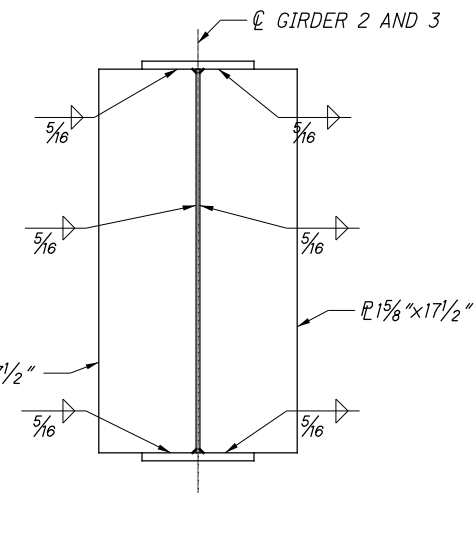

**WELD TERMINATION DETAIL**

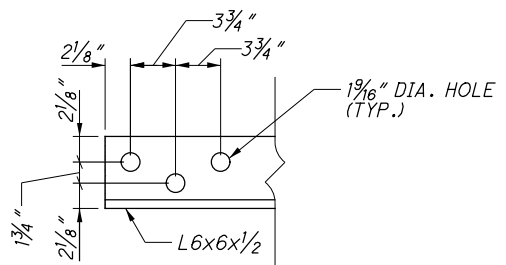

**A** 48 DETAIL - TYPE 3 BOLT HOLE LOCATIONS (TYP.)

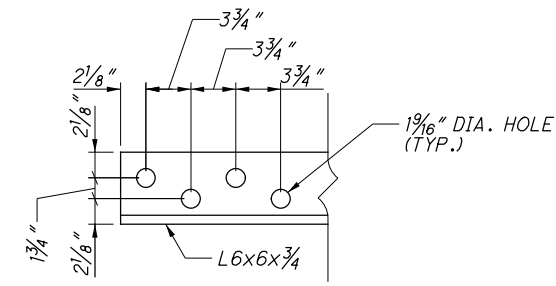


**B** 48 DETAIL - TYPE 4 BOLT HOLE LOCATIONS (TYP.)

**NOTE:**

- FOR CROSSFRAME DETAILS AND ADDITIONAL NOTES, SEE SHEET 48/79.
- BOLT HOLE LOCATIONS IN THE TRANSVERSE STIFFENERS WILL BE DETERMINED BY THE FABRICATOR AND VERIFIED THROUGH THE SHOP DRAWING REVIEW PROCESS BY THE ENGINEER PRIOR TO FABRICATION.

P:\Projects\2018\20H03DB-18232 HAM-75-03.84\104667\structures\HAM074\_1908S\sheets\074\_1908S\_S0011.dgn 7/28/2023 9:34:20 AM erin.baumann

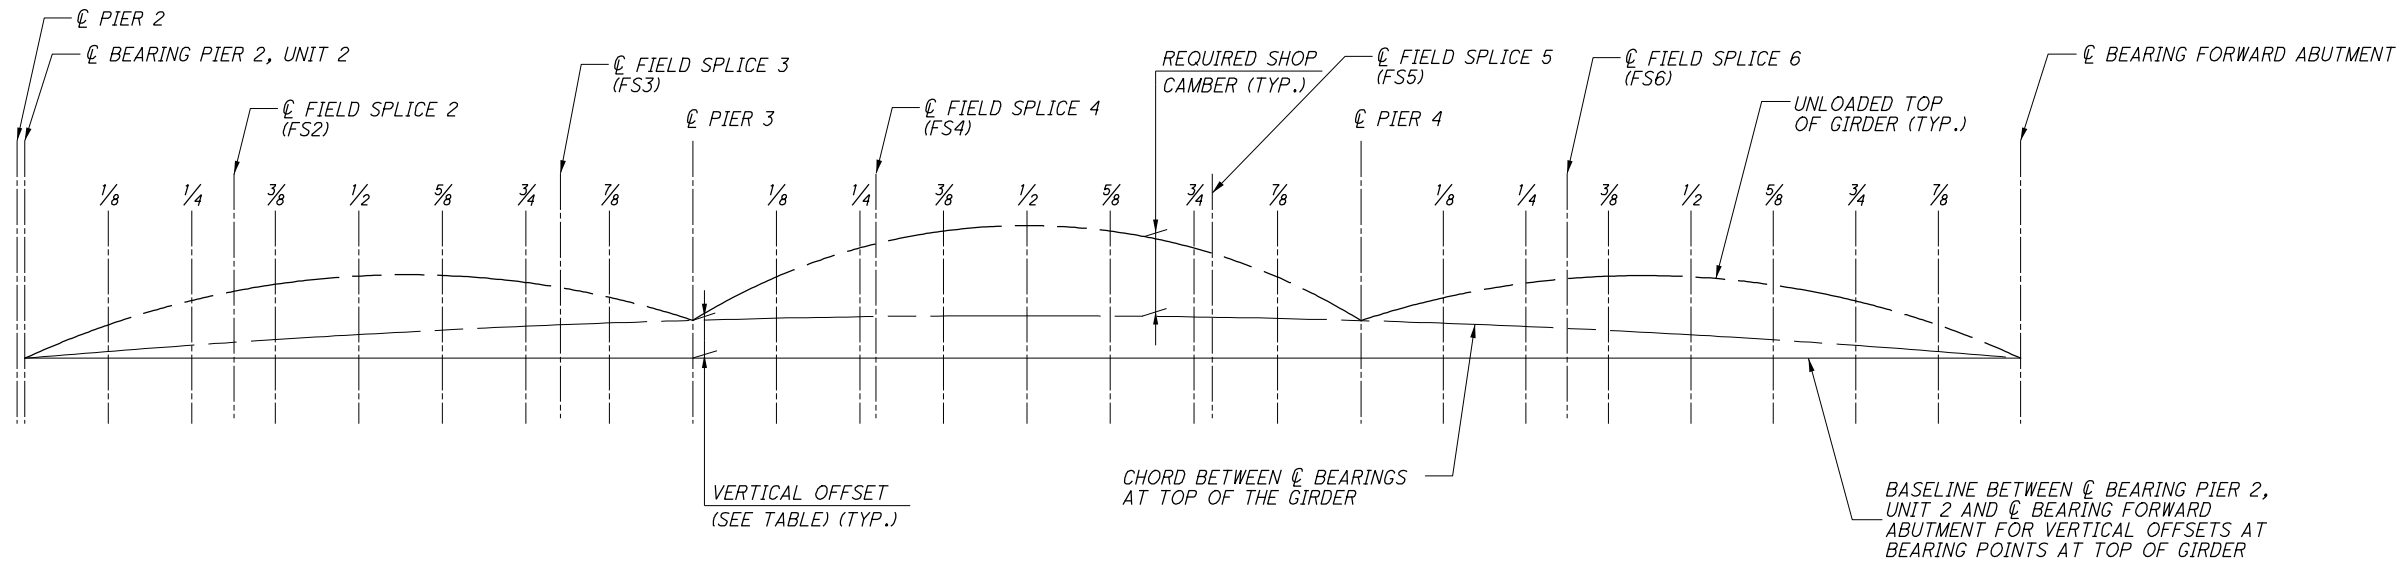

**CAMBER DIAGRAM - GIRDER 1 UNIT 2**

VERTICAL OFFSET (INCHES)		
	PIER 3	PIER 4
GIRDR 1	54 1/4"	42 1/4"

DEFLECTION AND CAMBER (INCHES) - GIRDER 1																					
	C BRG. PIER 2R	1/8 POINT	1/4 POINT	FS2	3/8 POINT	1/2 POINT	5/8 POINT	3/4 POINT	FS3	7/8 POINT	C BRG. PIER 3	1/8 POINT	1/4 POINT	FS4	3/8 POINT	1/2 POINT	5/8 POINT	3/4 POINT	FS5	7/8 POINT	C BRG. PIER 4
DEFLECTION DUE TO WEIGHT OF STEEL	0"	1/4"	3/8"	7/16"	1/2"	1/2"	3/8"	1/4"	3/16"	1/8"	0"	0 "	1/8"	1/8"	1/4"	5/16"	5/16"	3/16"	3/16"	1/16"	0 "
DEFLECTION DUE TO REMAINING DL	0"	1 1/8"	1 15/16"	2 1/8"	2 3/8"	2 3/8"	1 7/8"	1 3/16"	15/16"	7/16"	0"	1/8"	5/8"	11/16"	1 1/8"	1 7/16"	1 5/16"	7/8"	7/8"	3/8"	0 "
ADJUSTMENT FOR VERTICAL & HORIZONTAL CURVE	0"	1 5/16"	2 15/16"	3 1/2"	4 3/4"	6 "	6 1/8"	5 3/16"	4 5/8"	3 1/8"	0"	4 1/8"	7 1/16"	8 7/8"	8 7/8"	9 7/16"	8 7/8"	7 1/16"	4 1/8"	4 1/8"	0"
REQUIRED SHOP CAMBER	0"	2 11/16"	5 1/4"	6 1/16"	7 5/8"	8 7/8"	8 3/8"	6 5/8"	5 3/4"	3 11/16"	0"	4 1/4"	7 13/16"	9 11/16"	10 1/4"	11 3/16"	10 1/2"	8 1/8"	5 3/16"	4 9/16"	0"


DEFLECTION AND CAMBER (INCHES) - GIRDER 1										
	C BRG. PIER 4	1/8 POINT	1/4 POINT	FS6	3/8 POINT	1/2 POINT	5/8 POINT	3/4 POINT	7/8 POINT	C BRG. FA
DEFLECTION DUE TO WEIGHT OF STEEL	0 "	0 "	1/16"	1/8"	1/8"	3/16"	3/16"	3/16"	1/8"	0"
DEFLECTION DUE TO REMAINING DL	0 "	1/16"	5/16"	1/2"	5/8"	13/16"	7/8"	3/4"	1/2"	0"
ADJUSTMENT FOR VERTICAL & HORIZONTAL CURVE	0"	9/16"	9/16"	7/16"	7/16"	3/8"	1/4"	3/16"	1/16"	0"
REQUIRED SHOP CAMBER	0"	5/8"	15/16"	1 1/16"	1 3/16"	1 3/8"	1 5/16"	1 1/8"	11/16"	0"

**NOTES:**

1. NEGATIVE VALUES FOR DEFLECTIONS INDICATE DEFLECTIONS UPWARD. NEGATIVE VALUES FOR VERTICAL CURVE ADJUSTMENT AND TOTAL REQUIRED SHOP CAMBER INDICATE VALUES BELOW THE CHORD.
2. DEFLECTIONS AND ADJUSTMENTS FOR VERTICAL CURVES ARE GIVEN TO THE NEAREST 1/16th INCH.
3. FOR GENERAL NOTES, SEE SHEETS 7/79 AND 8/79 .
4. FOR FRAMING PLAN AND GIRDER DETAILS, SEE SHEETS 37/79 THROUGH 42/79 .



P:\Projects\2018\20H03DB-18232 HAM-75-03.84\104667\structures\HAM074\_1908S\SD012.dgn 7/28/2023 9:34:22 AM erin.baumann

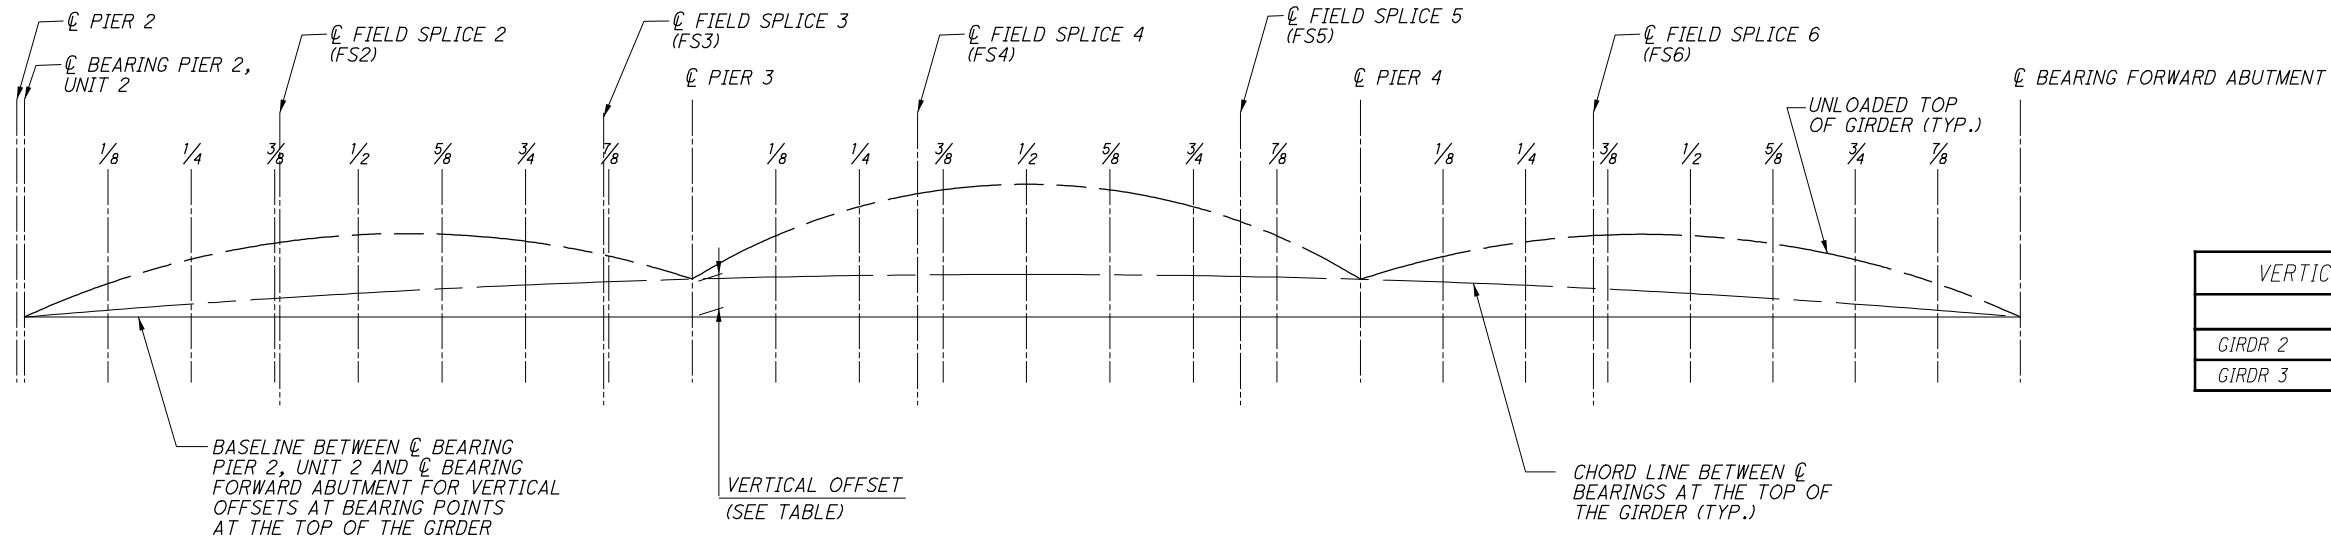

**CAMBER DIAGRAM - GIRDERS 2 AND 3 UNIT 2**

	C BRG. PIER 2R	1/8 POINT	1/4 POINT	3/8 POINT	FS2	1/2 POINT	5/8 POINT	3/4 POINT	FS3	7/8 POINT	C BRG. PIER 3	1/8 POINT	1/4 POINT	FS4	3/8 POINT	1/2 POINT	5/8 POINT	3/4 POINT	FS5	7/8 POINT	C BRG. PIER 4
DEFLECTION DUE TO WEIGHT OF STEEL	0"	7/16"	13/16"	1 1/16"	1 1/16"	1 "	13/16"	9/16"	5/16"	1/4"	0"	- 1/16"	- 1/16"	-0 "	0 "	1/8"	1/8"	1/16"	1/16"	0 "	0"
DEFLECTION DUE TO REMAINING DL	0"	1 1/2"	2 5/8"	3 9/16"	3 9/16"	3 1/4"	2 5/8"	1 5/8"	1 "	11/16"	0"	- 1/16"	1/4"	9/16"	11/16"	1 "	1 "	11/16"	1/2"	1/4"	0"
ADJUSTMENT FOR VERTICAL & HORIZONTAL CURVE	0"	1 11/16"	3 9/16"	5 5/16"	5 3/8"	6 7/16"	6 1/2"	5 7/16"	4 1/16"	3 1/4"	0"	4 1/16"	6 15/16"	8 1/4"	8 11/16"	9 1/4"	8 11/16"	6 15/16"	5 15/16"	4 1/16"	0"
REQUIRED SHOP CAMBER	0"	3 5/8"	7 "	9 15/16"	10 "	10 11/16"	9 15/16"	7 5/8"	5 3/8"	4 3/16"	0"	3 15/16"	7 1/8"	8 13/16"	9 3/8"	10 3/8"	9 13/16"	7 11/16"	6 1/2"	4 5/16"	0"

	C BRG. PIER 4	1/8 POINT	1/4 POINT	FS6	3/8 POINT	1/2 POINT	5/8 POINT	3/4 POINT	7/8 POINT	C BRG. FA
DEFLECTION DUE TO WEIGHT OF STEEL	0"	1/16"	1/8"	3/16"	1/4"	5/16"	5/16"	1/4"	1/8"	0"
DEFLECTION DUE TO REMAINING DL	0"	1/8"	7/16"	1/2"	3/4"	1 "	1 "	7/8"	1/2"	0"
ADJUSTMENT FOR VERTICAL & HORIZONTAL CURVE	0"	5/8"	5/8"	9/16"	9/16"	7/16"	5/16"	3/16"	1/8"	0 "
REQUIRED SHOP CAMBER	0"	13/16"	1 3/16"	1 1/4"	1 9/16"	1 3/4"	1 5/8"	1 5/16"	3/4"	0"

	C BRG. PIER 2R	1/8 POINT	1/4 POINT	3/8 POINT	FS2	1/2 POINT	5/8 POINT	3/4 POINT	FS3	7/8 POINT	C BRG. PIER 3	1/8 POINT	1/4 POINT	FS4	3/8 POINT	1/2 POINT	5/8 POINT	3/4 POINT	FS5	7/8 POINT	C BRG. PIER 4
DEFLECTION DUE TO WEIGHT OF STEEL	0"	11/16"	1 3/16"	1 1/2"	1 1/2"	1 1/2"	1 1/4"	13/16"	3/8"	3/8"	0"	- 3/16"	- 1/4"	- 1/4"	- 3/16"	- 1/8"	- 1/16"	- 1/16"	- 1/16"	- 1/16"	0"
DEFLECTION DUE TO REMAINING DL	0"	1 15/16"	3 3/8"	4 1/8"	4 3/16"	4 1/8"	3 3/8"	2 3/16"	15/16"	15/16"	0"	- 5/16"	- 3/16"	1/16"	3/16"	9/16"	5/8"	7/16"	5/16"	1/8"	0"
ADJUSTMENT FOR VERTICAL & HORIZONTAL CURVE	0"	1 7/8"	4 "	5 11/16"	5 15/16"	6 3/4"	6 11/16"	5 9/16"	3 5/16"	3 5/16"	0"	3 15/16"	6 3/4"	8 1/8"	8 1/2"	9 1/16"	8 7/16"	6 3/4"	5 7/8"	3 15/16"	0"
REQUIRED SHOP CAMBER	0"	4 1/2"	8 9/16"	11 5/16"	11 5/8"	12 3/8"	11 5/16"	8 9/16"	4 5/8"	4 5/8"	0"	3 7/16"	6 5/16"	7 15/16"	8 1/2"	9 1/2"	9 "	7 1/8"	6 1/8"	4 "	0"

	C BRG. PIER 4	1/8 POINT	1/4 POINT	FS6	3/8 POINT	1/2 POINT	5/8 POINT	3/4 POINT	7/8 POINT	C BRG. FA
DEFLECTION DUE TO WEIGHT OF STEEL	0"	1/8"	3/16"	5/16"	5/16"	3/8"	3/8"	5/16"	3/16"	0"
DEFLECTION DUE TO REMAINING DL	0"	3/16"	9/16"	7/8"	7/8"	1 3/16"	1 1/8"	15/16"	1/2"	0"
ADJUSTMENT FOR VERTICAL & HORIZONTAL CURVE	0"	5/8"	3/4"	5/8"	5/8"	1/2"	3/8"	1/4"	1/8"	0"
REQUIRED SHOP CAMBER	0"	15/16"	1 1/2"	1 13/16"	1 13/16"	2 1/16"	1 7/8"	1 1/2"	13/16"	0"


**NOTES:**

1. NEGATIVE VALUES FOR DEFLECTIONS INDICATE DEFLECTIONS UPWARD. NEGATIVE VALUES FOR VERTICAL CURVE ADJUSTMENT AND TOTAL REQUIRED SHOP CAMBER INDICATE VALUES BELOW THE CHORD.
2. DEFLECTIONS AND ADJUSTMENTS FOR VERTICAL CURVES ARE GIVEN TO THE NEAREST 1/16th INCH.
3. FOR GENERAL NOTES, SEE SHEETS [7/79] AND [8/79] .
4. FOR FRAMING PLAN AND GIRDER DETAILS, SEE SHEETS [37/79] THROUGH [42/79] .

CAMBER DIAGRAM AND TABLE - UNIT 2 (2 OF 3)  
BRIDGE NO. HAM-74-1908S  
RAMP P OVER IR-74 WESTBOUND, IR-75 AND RAMP E

HAM-75-3.84  
PID No. 104667

P:\Projects\2018\20H03DB-18232 HAM-75-03.84\104667\structures\HAM074\_1908S\sheets\074\_1908S\_S0013.dgn 7/28/2023 9:34:24 AM erin.baumann

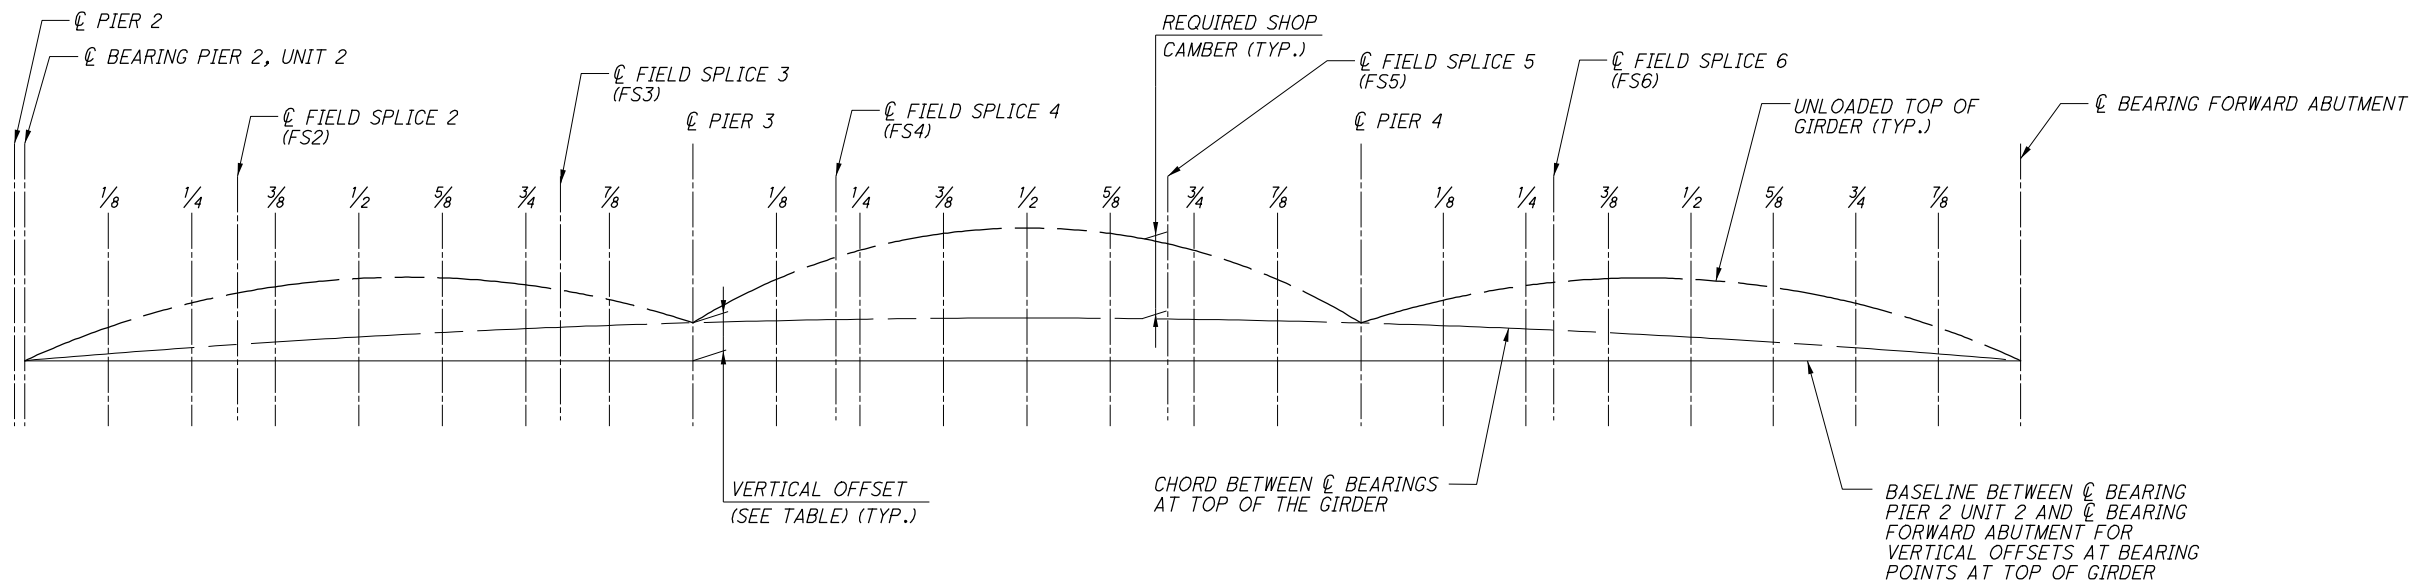

**CAMBER DIAGRAM - GIRDER 4 UNIT 2**

VERTICAL OFFSET (INCHES)		
	PIER 3	PIER 4
GIRDR 4	53 3/4"	40 7/8"

DEFLECTION AND CAMBER (INCHES) - GIRDER 4																					
	C BRG. PIER 2R	1/8 POINT	1/4 POINT	FS2	3/8 POINT	1/2 POINT	5/8 POINT	3/4 POINT	FS3	7/8 POINT	C BRG. PIER 3	1/8 POINT	1/4 POINT	FS4	3/8 POINT	1/2 POINT	5/8 POINT	3/4 POINT	FS5	7/8 POINT	C BRG. PIER 4
DEFLECTION DUE TO WEIGHT OF STEEL	0"	15/16"	1 5/8"	2 "	2 "	2 1/16"	1 11/16"	1 3/16"	3/4"	9/16"	0"	- 5/16"	- 1/2"	- 1/2"	- 1/2"	- 3/8"	- 1/4"	- 3/16"	- 1/8"	- 1/8"	0"
DEFLECTION DUE TO REMAINING DL	0"	2 3/8"	4 1/8"	5 1/16"	5 1/8"	5 1/8"	4 3/16"	2 3/4"	1 11/16"	1 3/16"	0"	- 9/16"	- 5/8"	- 9/16"	- 5/16"	1/8"	5/16"	3/16"	1/4"	-0 "	0"
ADJUSTMENT FOR VERTICAL & HORIZONTAL CURVE	0"	2 1/16"	4 5/16"	5 15/16"	6 1/16"	7 "	6 7/8"	5 11/16"	4 5/16"	3 3/8"	0"	3 7/8"	6 5/8"	7 1/8"	8 5/16"	8 13/16"	8 5/16"	6 5/8"	5 15/16"	3 7/8"	0"
REQUIRED SHOP CAMBER	0"	5 3/8"	10 1/16"	13 "	13 3/16"	14 3/16"	12 3/4"	9 5/8"	6 3/4"	5 1/8"	0"	3 "	5 1/2"	6 1/16"	7 1/2"	8 9/16"	8 3/8"	6 5/8"	6 1/16"	3 3/4"	0"

DEFLECTION AND CAMBER (INCHES) - GIRDER 4										
	C BRG. PIER 4	1/8 POINT	1/4 POINT	FS6	3/8 POINT	1/2 POINT	5/8 POINT	3/4 POINT	7/8 POINT	C BRG. FA
DEFLECTION DUE TO WEIGHT OF STEEL	0"	1/8"	5/16"	5/16"	7/16"	1/2"	1/2"	3/8"	3/16"	0"
DEFLECTION DUE TO REMAINING DL	0"	5/16"	11/16"	13/16"	1 1/8"	1 3/8"	1 5/16"	1 1/16"	5/8"	0"
ADJUSTMENT FOR VERTICAL & HORIZONTAL CURVE	0"	11/16"	13/16"	13/16"	11/16"	9/16"	7/16"	1/4"	1/8"	0"
REQUIRED SHOP CAMBER	0"	1 1/8"	1 13/16"	1 15/16"	2 1/4"	2 7/16"	2 1/4"	1 11/16"	15/16"	0"


**NOTES:**

1. NEGATIVE VALUES FOR DEFLECTIONS INDICATE DEFLECTIONS UPWARD. NEGATIVE VALUES FOR VERTICAL CURVE ADJUSTMENT AND TOTAL REQUIRED SHOP CAMBER INDICATE VALUES BELOW THE CHORD.
2. DEFLECTIONS AND ADJUSTMENTS FOR VERTICAL CURVES ARE GIVEN TO THE NEAREST 1/16th INCH.
3. FOR GENERAL NOTES, SEE SHEETS [7/79] AND [8/79].
4. FOR FRAMING PLAN AND GIRDER DETAILS, SEE SHEETS [37/79] THROUGH [42/79].


CAMBER DIAGRAM AND TABLE - UNIT 2 (3 OF 3)  
BRIDGE NO. HAM-74-1908S  
RAMP P OVER IR-74 WESTBOUND, IR-75 AND RAMP E

HAM-75-3.84  
PID No. 104667

P:\Projects\2018\20H03DB-18232 HAM-75-03.84\104667\structures\HAM074\_1908S\sheets\074\_1908S\_T5001.dgn 7/28/2023 9:34:26 AM erin.baumann

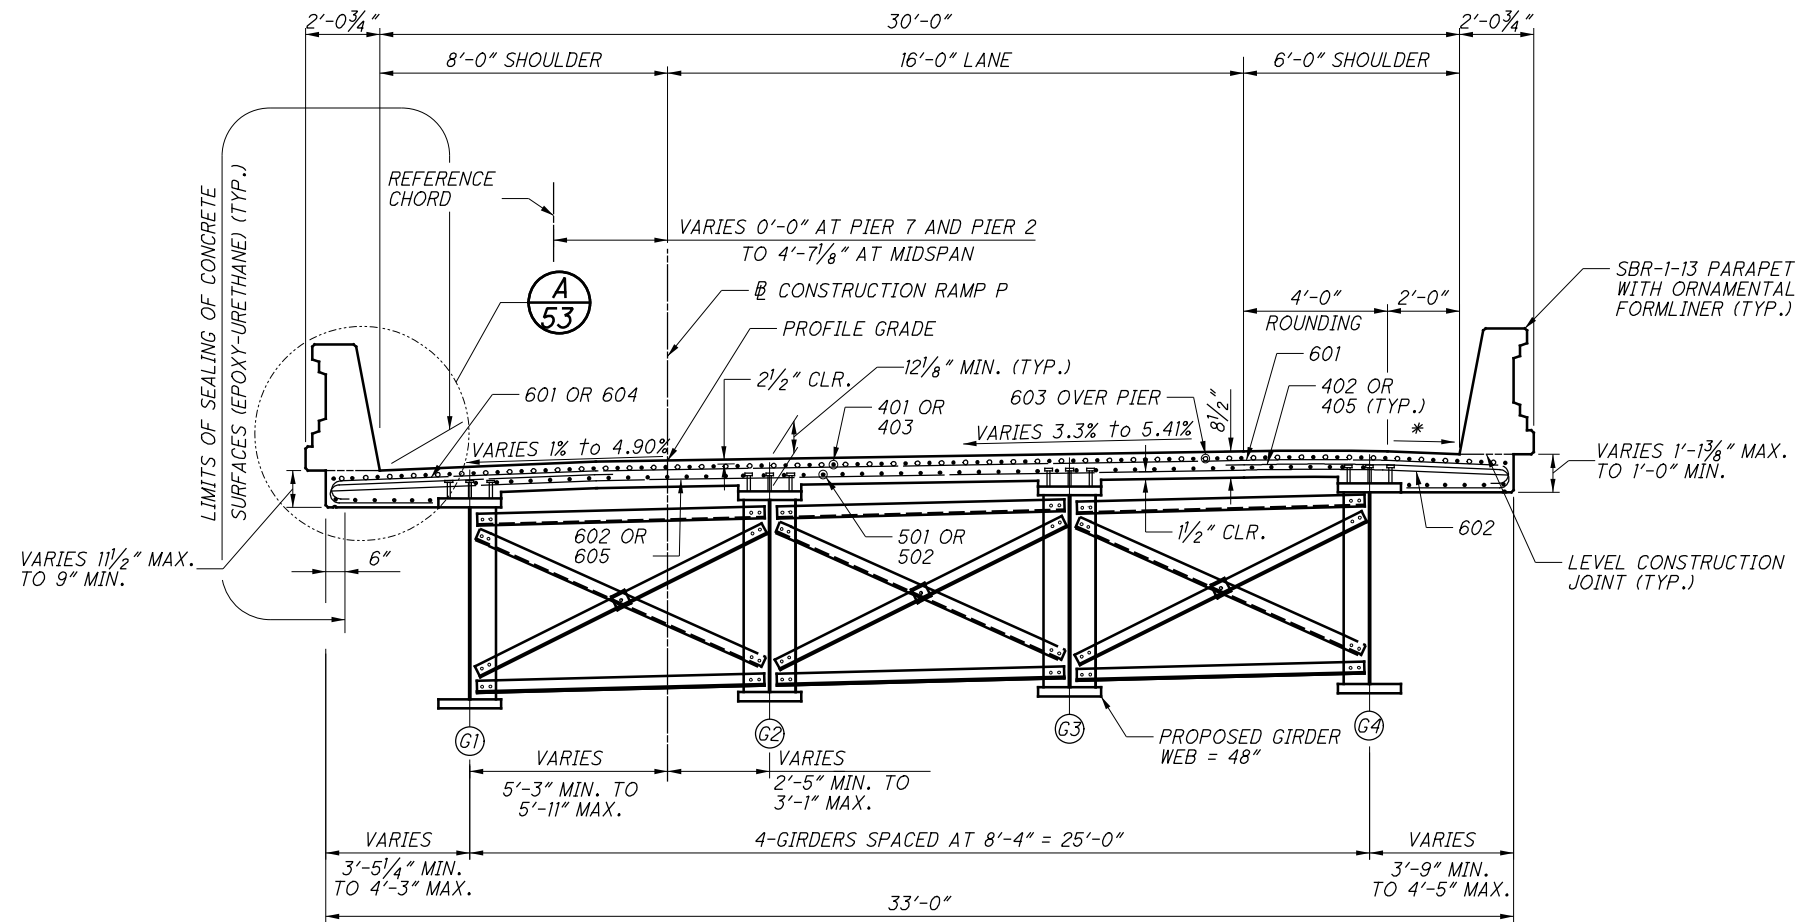

**TRANSVERSE SECTION - UNIT 1**  
(LOOKING UPSTATION)  
(PARAPET REINFORCING STEEL NOT SHOWN)

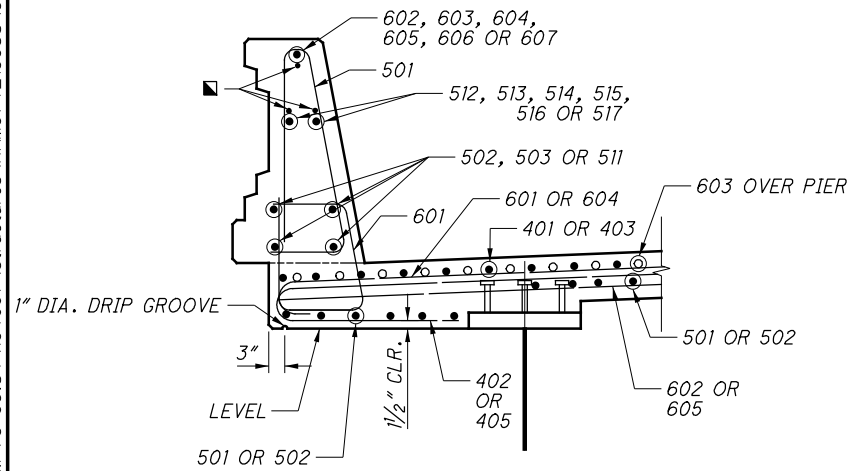

**A**  
**53** **DETAIL OF DECK OVERHANG**



**LEGEND:**

- \* - VARIES 3.70% TO 1.59%
- - 1/2" DIA. GLASS FIBER REINFORCED POLYMER (GFRP) STIFFENING REINFORCEMENT

**NOTES:**


1. FOR FRAMING PLAN, SEE SHEET 42/79.
2. FOR CROSSFRAME DETAILS, SEE SHEET 48/79.
3. THE PREFIX "1S" SHALL BE ADDED TO ALL BAR MARKS FOR UNIT 1 SLAB AND "1R" FOR UNIT 1 RAILING.
4. ADDITIONAL DECK DETAILS WILL BE INCLUDED IN BU-07.

P:\Projects\2018\20H03DB-18232 HAM-75-03.84\104667\structures\HAM074\_1908S\sheets\074\_1908S\_DP007.dgn 7/28/2023 9:34:41 AM erin.baumann

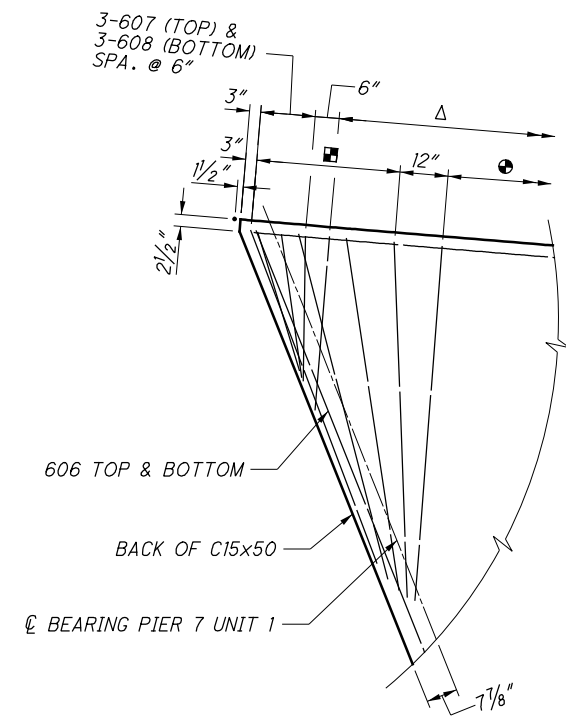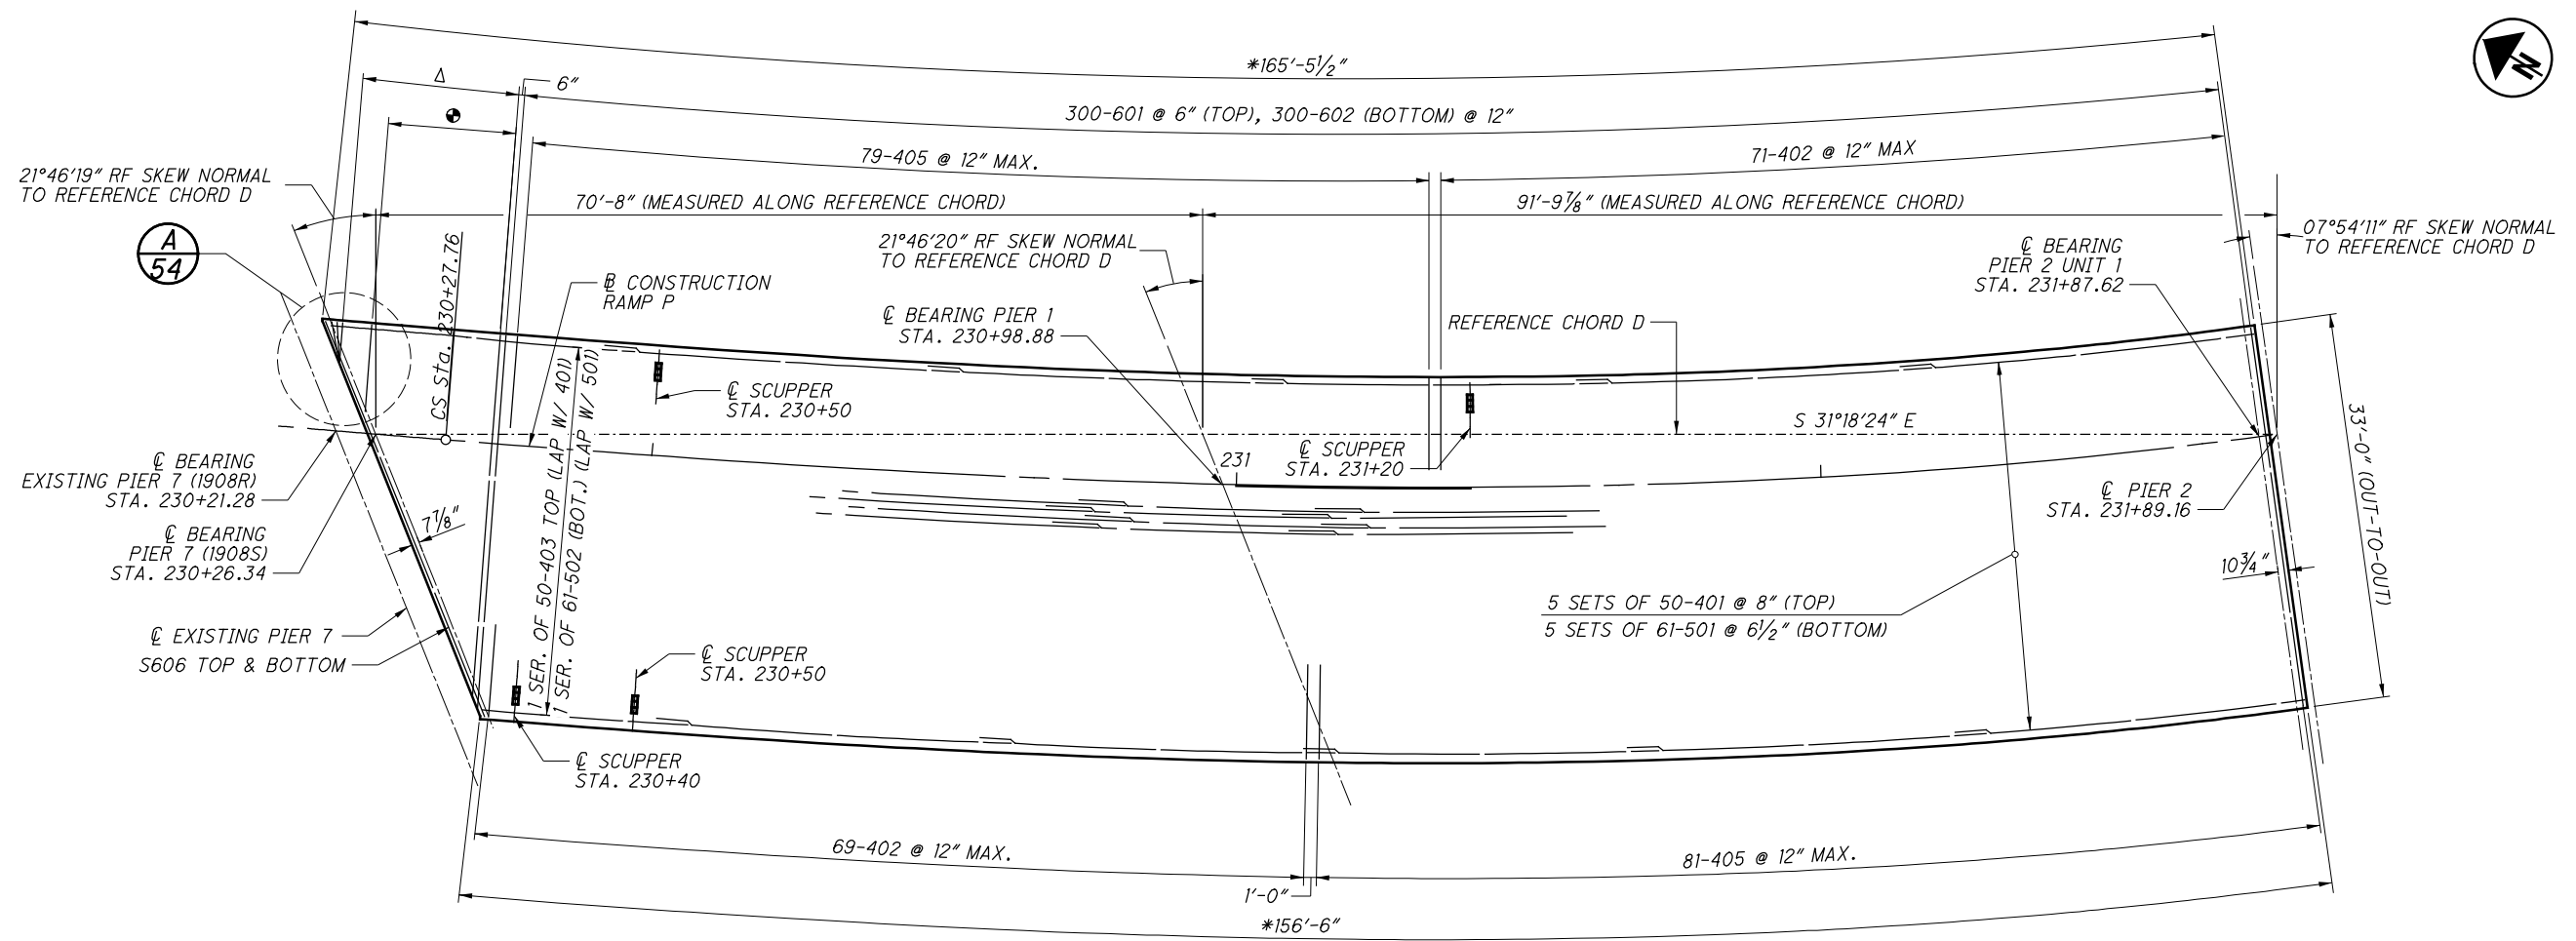


**A** 54  
DETAIL OF DECK CORNER

**SLAB PLAN - UNIT 1**  
(PARAPET NOT SHOWN)

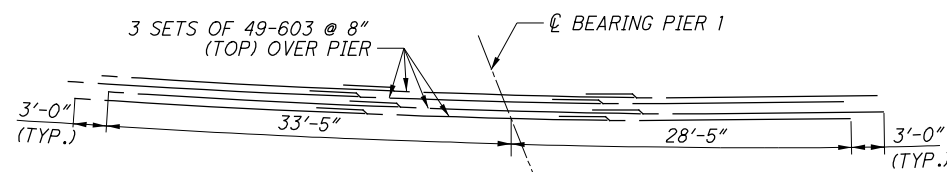

**STAGGER DIAGRAM**

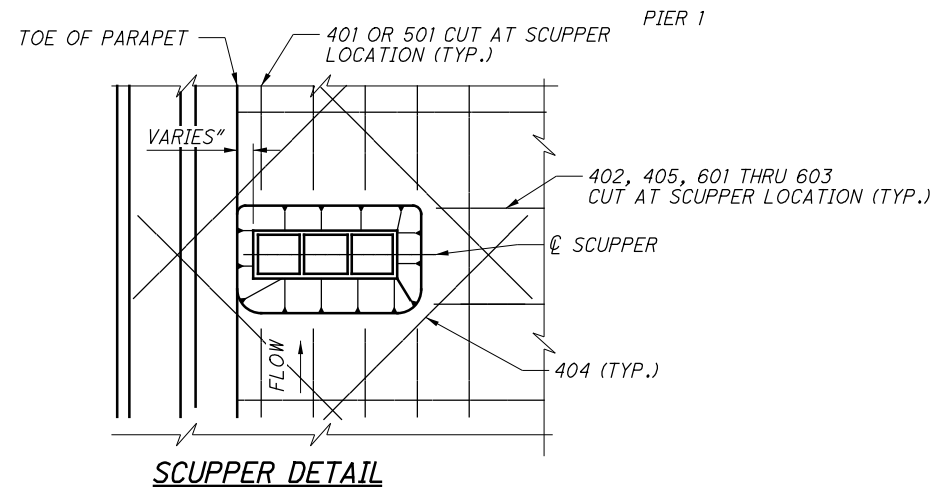

**SCUPPER DETAIL**

**LEGEND:**


- \* - MEASURED ALONG EDGE OF SLAB
- Δ - 1 SER. OF 28-604 @ 6" (TOP), 1 SER. OF 28-605 @ 6" (BOTTOM)
- ⊕ - 12-402 SPA. @ 12"
- - 4-402 SPA. @ 12"

MIN. REQUIRED LAP LENGTH	
#4 LONGITUDINAL	1'-11"
#5 LONGITUDINAL	3'-0"
#6 LONGITUDINAL	3'-7"

**NOTES:**

1. FOR TRANSVERSE SECTION, SEE SHEET 53/79.
2. FOR EXPANSION JOINT DETAIL, SEE SHEET 63/79.
3. FOR PARAPET DETAILS, SEE SHEET 57/79 THRU 57/79.
4. FOR SCREED, TOP OF HAUNCH AND FINAL DECK ELEVATIONS, SEE SHEET 66/79.
5. FOR REINFORCING STEEL LIST, SEE SHEETS 74/79 THRU 75/79.
6. REBAR CLEARANCE MEASURED TO THE FACE OF CONCRETE SHALL BE 3" UNLESS OTHERWISE NOTED.
7. FIELD BEND LONGITUDINAL BARS TO FIT CURVATURE OF ROADWAY AND TRANSVERSE BARS TO FIT CROWN. EPOXY COATED BARS DAMAGED BY FIELD BENDING SHALL BE REPAIRED IN ACCORDANCE WITH CMS 509.
8. THE PREFIX "1S" SHALL BE ADDED TO ALL BAR MARKS IN UNIT 1 SUPERSTRUCTURE.
9. FOR SCUPPER DETAILS, SEE STD. DWG. GSD-1-96.

UNIT 1 DECK OVERHANG		
LOCATION	LEFT OVERHANG	RIGHT OVERHANG
℄ BEARING PIER 7	3'-5 <sup>3</sup> / <sub>4</sub> "	4'-1 <sup>3</sup> / <sub>4</sub> "
1/8	3'-9 <sup>3</sup> / <sub>8</sub> "	3'-11 <sup>3</sup> / <sub>8</sub> "
1/4	3'-11 <sup>7</sup> / <sub>8</sub> "	3'-9 <sup>7</sup> / <sub>8</sub> "
3/8	4'-1 <sup>5</sup> / <sub>8</sub> "	3'-9 <sup>1</sup> / <sub>4</sub> "
1/2	4'-2 <sup>5</sup> / <sub>8</sub> "	3'-9 <sup>1</sup> / <sub>8</sub> "
5/8	4'-3"	3'-9 <sup>3</sup> / <sub>8</sub> "
3/4	4'-2 <sup>3</sup> / <sub>4</sub> "	3'-10 <sup>1</sup> / <sub>8</sub> "
7/8	4'-2 <sup>1</sup> / <sub>8</sub> "	3'-11 <sup>1</sup> / <sub>8</sub> "
℄ BEARING PIER 1	4'-1 <sup>1</sup> / <sub>8</sub> "	4'-1 <sup>1</sup> / <sub>4</sub> "
1/8	3'-11 <sup>5</sup> / <sub>8</sub> "	4'-1 <sup>5</sup> / <sub>8</sub> "
1/4	3'-10 <sup>1</sup> / <sub>8</sub> "	4'-2 <sup>7</sup> / <sub>8</sub> "
3/8	3'-8 <sup>5</sup> / <sub>8</sub> "	4'-4"
1/2	3'-7 <sup>5</sup> / <sub>8</sub> "	4'-4 <sup>3</sup> / <sub>4</sub> "
5/8	3'-7 <sup>1</sup> / <sub>8</sub> "	4'-5"
3/4	3'-7 <sup>1</sup> / <sub>4</sub> "	4'-4 <sup>1</sup> / <sub>2</sub> "
7/8	3'-8 <sup>5</sup> / <sub>8</sub> "	4'-3 <sup>1</sup> / <sub>8</sub> "
℄ BEARING PIER 2, UNIT 1	3'-11"	4'-1 <sup>1</sup> / <sub>8</sub> "

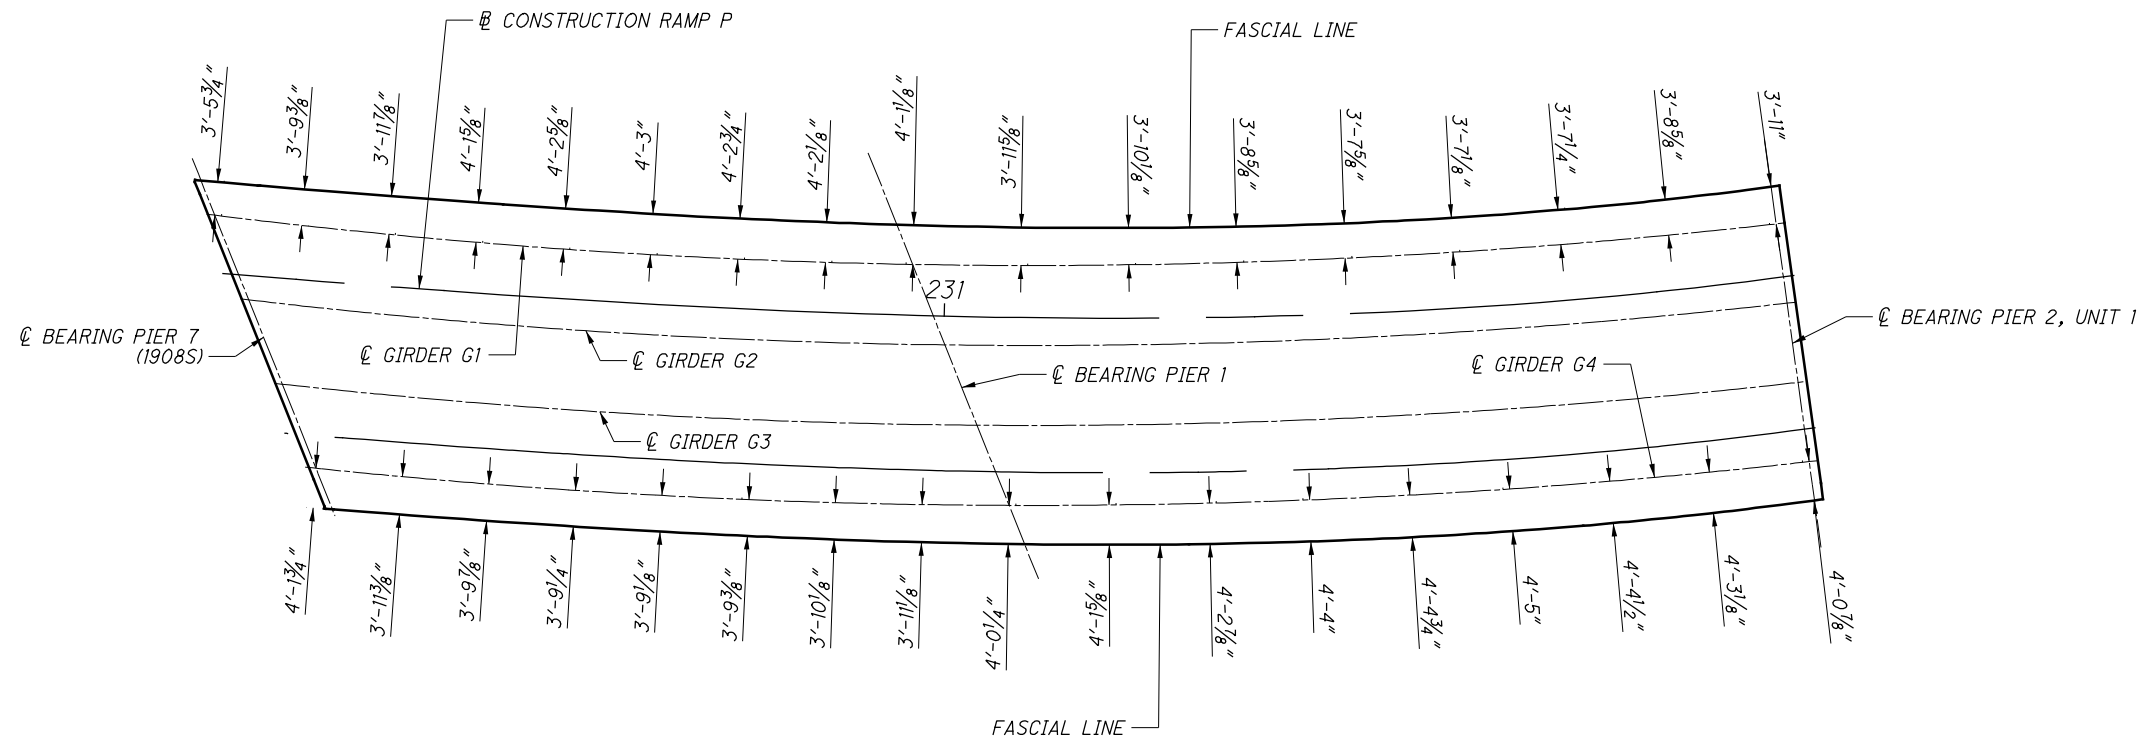


FASCIA OFFSET PLAN

NOTES:

1. FOR ADDITIONAL NOTES, SEE SHEET 54/79 .

P:\Projects\2018\20H03DB-18232 HAM-75-03.84\104667\structures\HAM074\_1908S\sheets\074\_1908S\_RA001.dgn 7/28/2023 9:34:50 AM erin.baumann

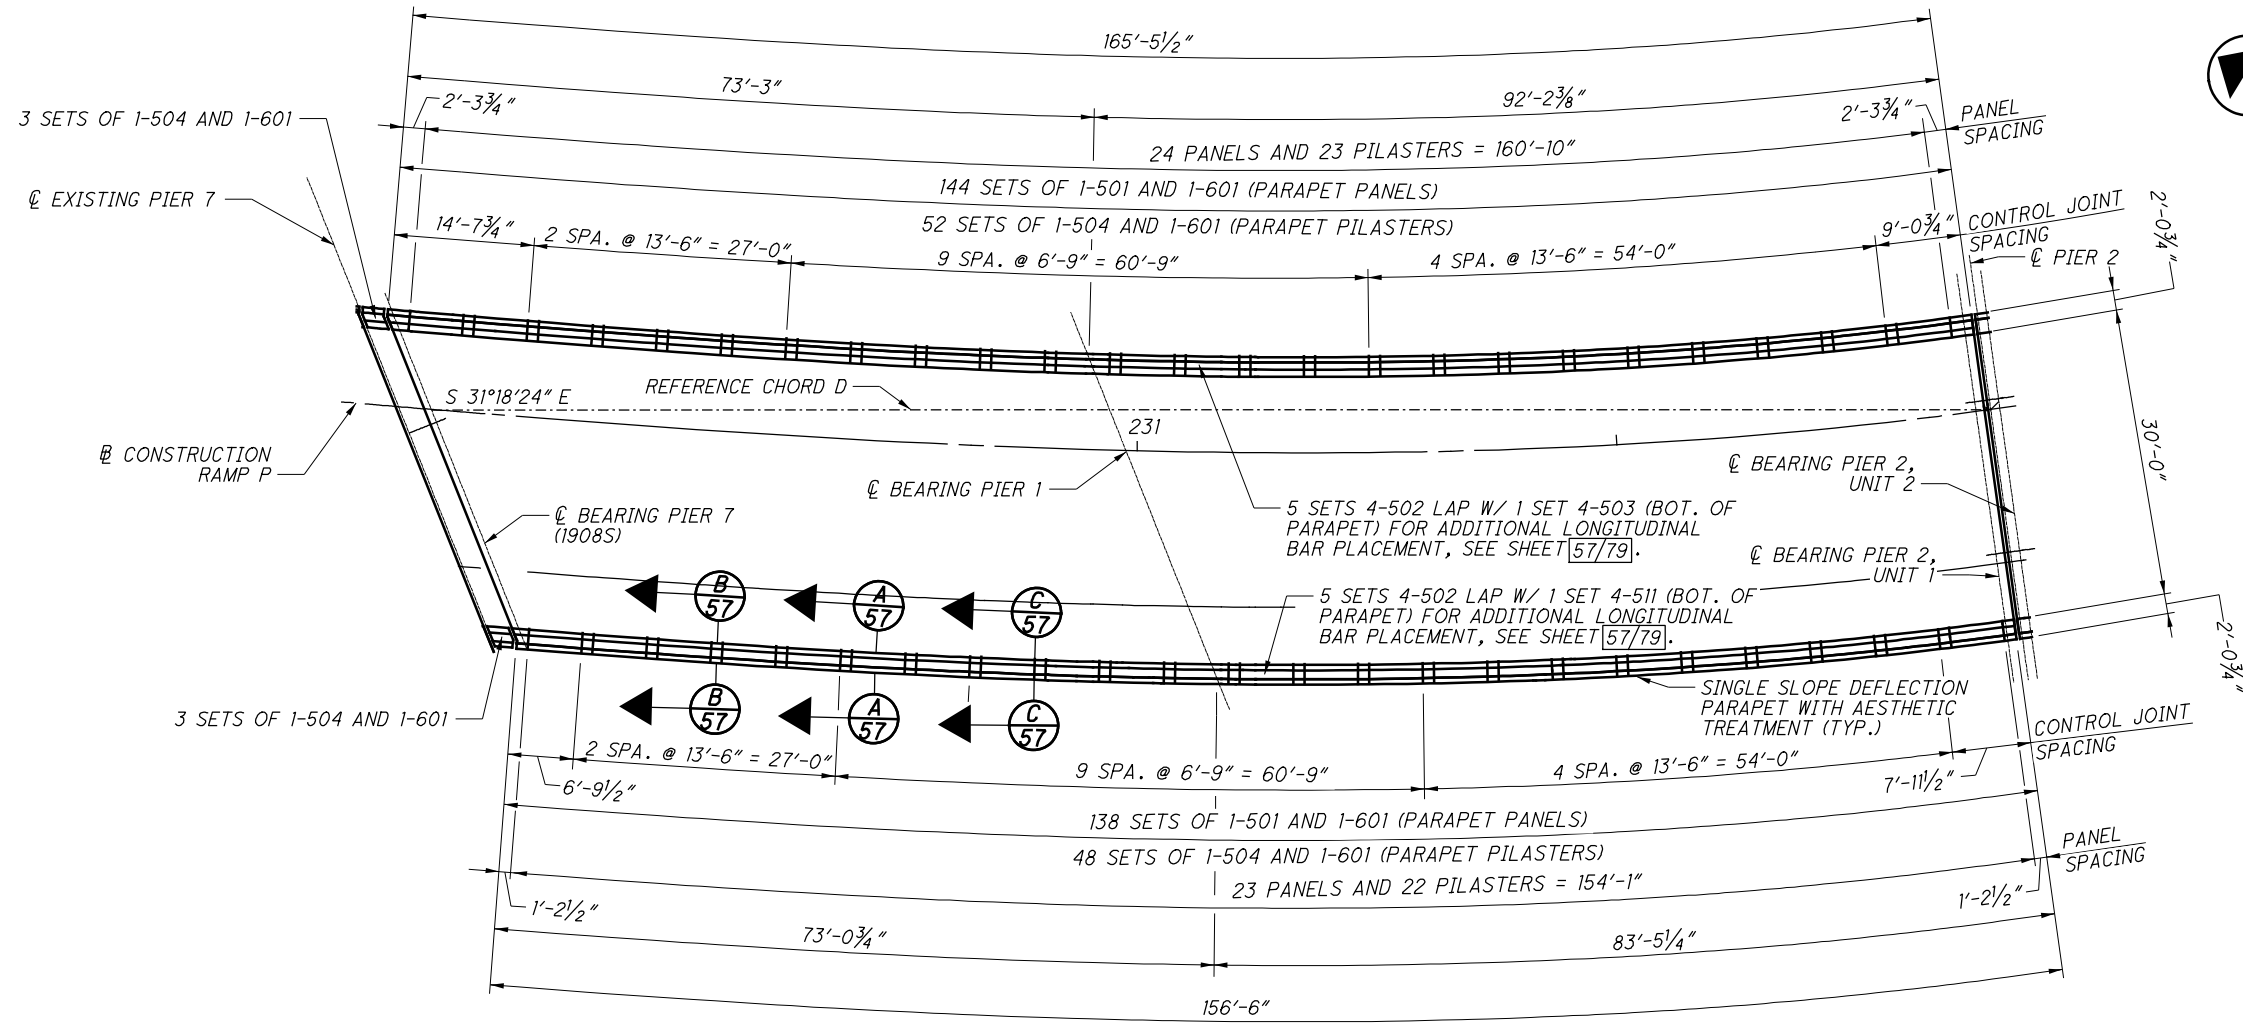

PARAPET PLAN - UNIT 1

REQUIRED MINIMUM LAP LENGTHS	
NO. 5 BAR	2'-3"
NO. 6 BAR	3'-6"

- NOTES:**
- SEE SHEET [57/79] FOR PARAPET DETAILS.
  - ALL DIMENSIONS ALONG EDGE OF SLAB UNLESS NOTED OTHERWISE.
  - THE PREFIX "R" SHALL BE ADDED TO ALL BAR MARKS FOR PARAPET DETAILS.
  - FOR REINFORCING STEEL LIST, SEE SHEET [78/79].

DESIGN AGENCY  
**PRIME**  
 540 WHITE POND DR. SUITE E  
 AKRON, OH 44320

DESIGNED BY: KDC  
 CHECKED BY: KDC

DRAWN BY: ADS  
 REVISED BY:

REVIEWED BY: TES  
 DATE: 8/22/2019  
 STRUCTURE FILE NUMBER: 3109798


BRIDGE NO. HAM-74-1908S  
 RAMP P OVER IR-74 WESTBOUND, IR-75 AND RAMP E

**HAM-75-3.84**  
**PID No. 104667**

56 / 79

56 / 79


P:\Projects\2018\20H03DB-18232 HAM-75-03.84\104667\structures\HAM074\_1908S\sheets\074\_1908S\_RA003.dgn 7/28/2023 9:34:52 AM erin.baumann

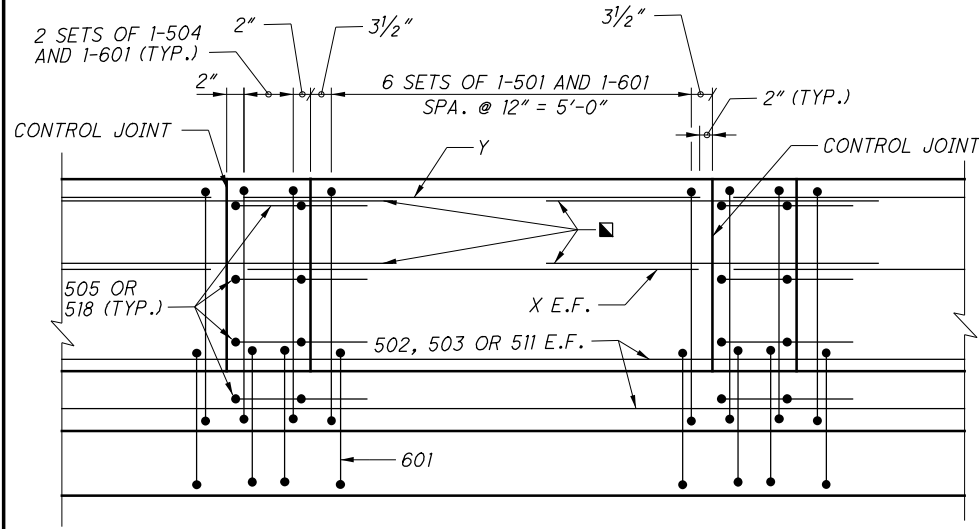

**TYPICAL ORNAMENTAL PARAPET PANEL REINFORCING**  
(SINGLE PANEL SHOWN, DOUBLE PANEL SIMILAR)

UNIT	CONTROL JT. SPA.	# PANELS	BAR X	BAR Y
1	6'-9"	18	512	602
1	13'-6"	12	513	603
1	14'-7 <sup>5</sup> / <sub>8</sub> "	1	514	604
1	9'-0 <sup>5</sup> / <sub>8</sub> "	1	515	605
1	6'-9 <sup>5</sup> / <sub>8</sub> "	1	516	606
1	7'-11 <sup>5</sup> / <sub>8</sub> "	1	517	607


UNIT	CONTROL JT. SPA.	# PANELS	BAR X	BAR Y
2	6'-9"	56	512	602
2	13'-6"	38	513	603
2	8'-4 <sup>1</sup> / <sub>2</sub> "	1	514	604
2	9'-6 <sup>1</sup> / <sub>2</sub> "	1	515	605
2	8'-2 <sup>1</sup> / <sub>8</sub> "	1	516	606
2	9'-4 <sup>1</sup> / <sub>8</sub> "	1	517	607

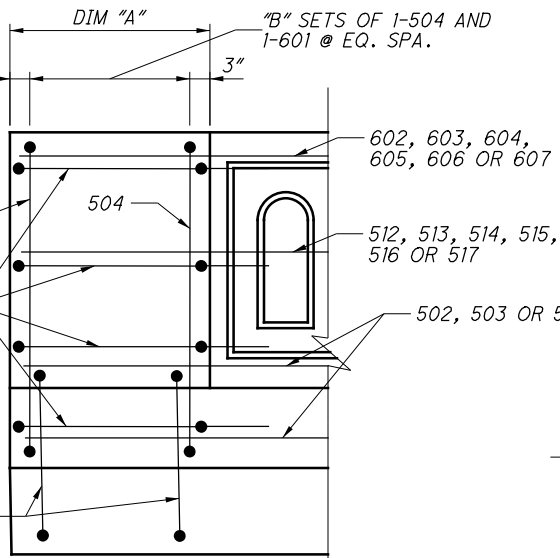

**END PILASTER DETAIL**


END PILASTERS				
UNIT	SIDE OF SLAB	DIM "A"	"B"	"C"
1	LEFT	2'-3 <sup>3</sup> / <sub>4</sub> "	3	508
1	RIGHT	1'-2 <sup>1</sup> / <sub>2</sub> "	2	509
2	LEFT	2'-9 <sup>1</sup> / <sub>2</sub> "	4	510
2	RIGHT	2'-8 <sup>1</sup> / <sub>8</sub> "	4	510

**C SECTION THRU CONTROL JOINT DETAIL**  
56,61

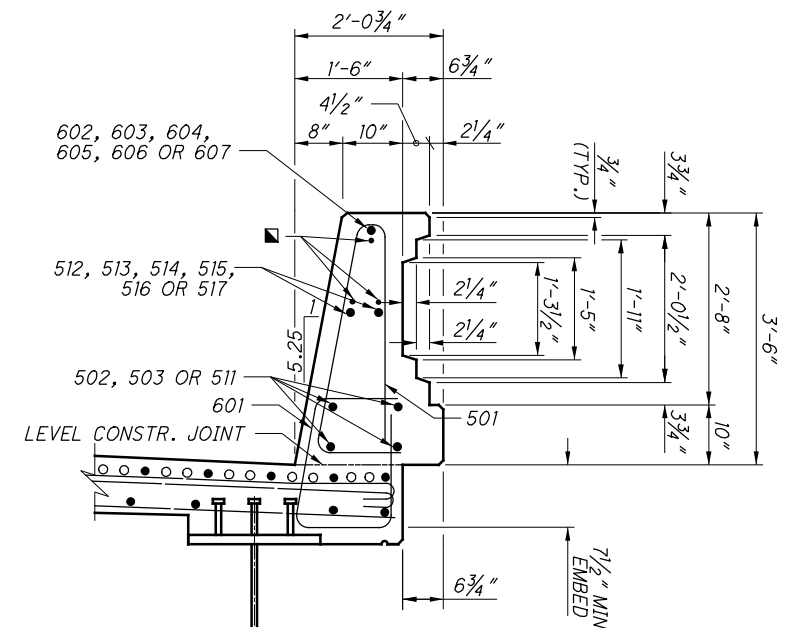


**A SECTION THRU PANEL**  
56,61


**LEGEND:**  
■ - 1/2" DIA. GLASS FIBER REINFORCED POLYMER (GFRP) STIFFENING REINFORCEMENT

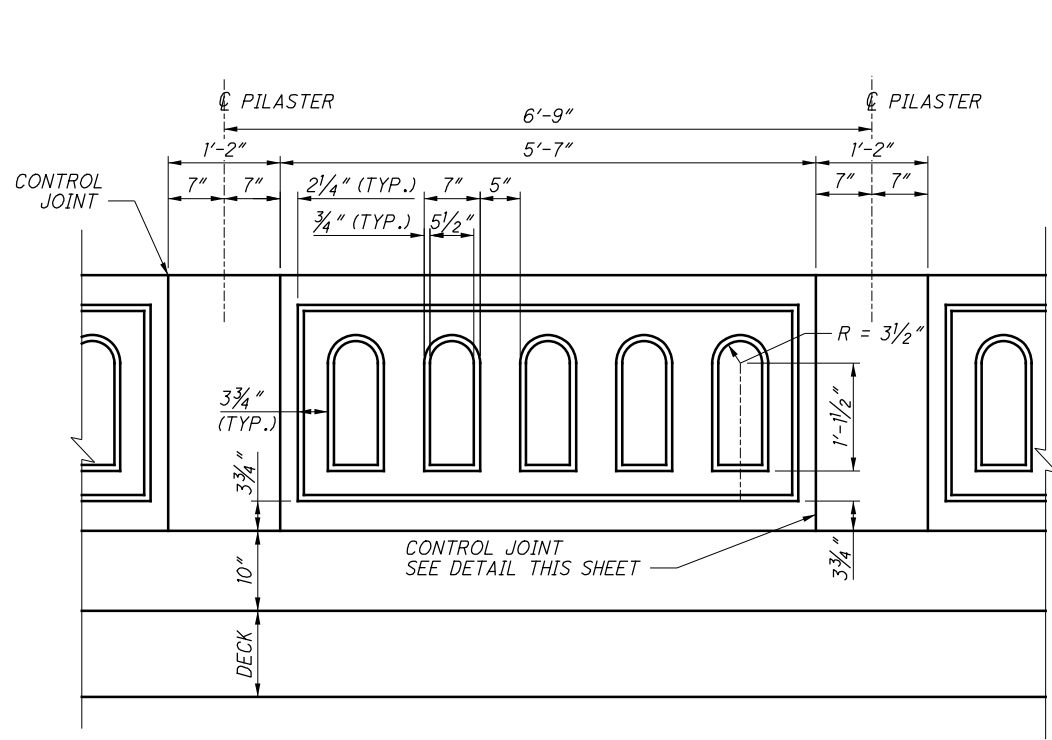

**TYPICAL ORNAMENTAL PARAPET PANEL**

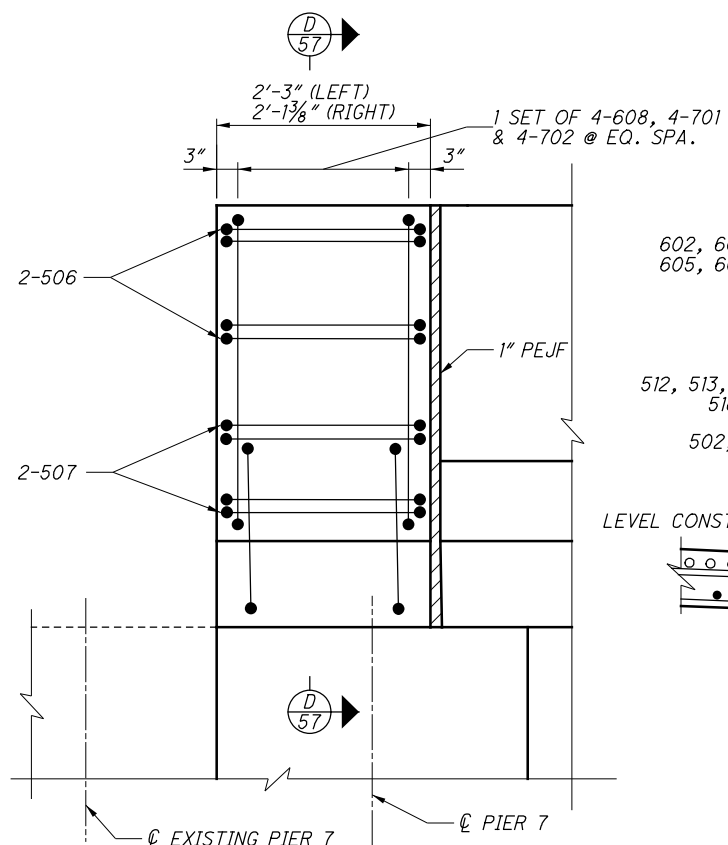

**PIER 7 PARAPET DETAIL**

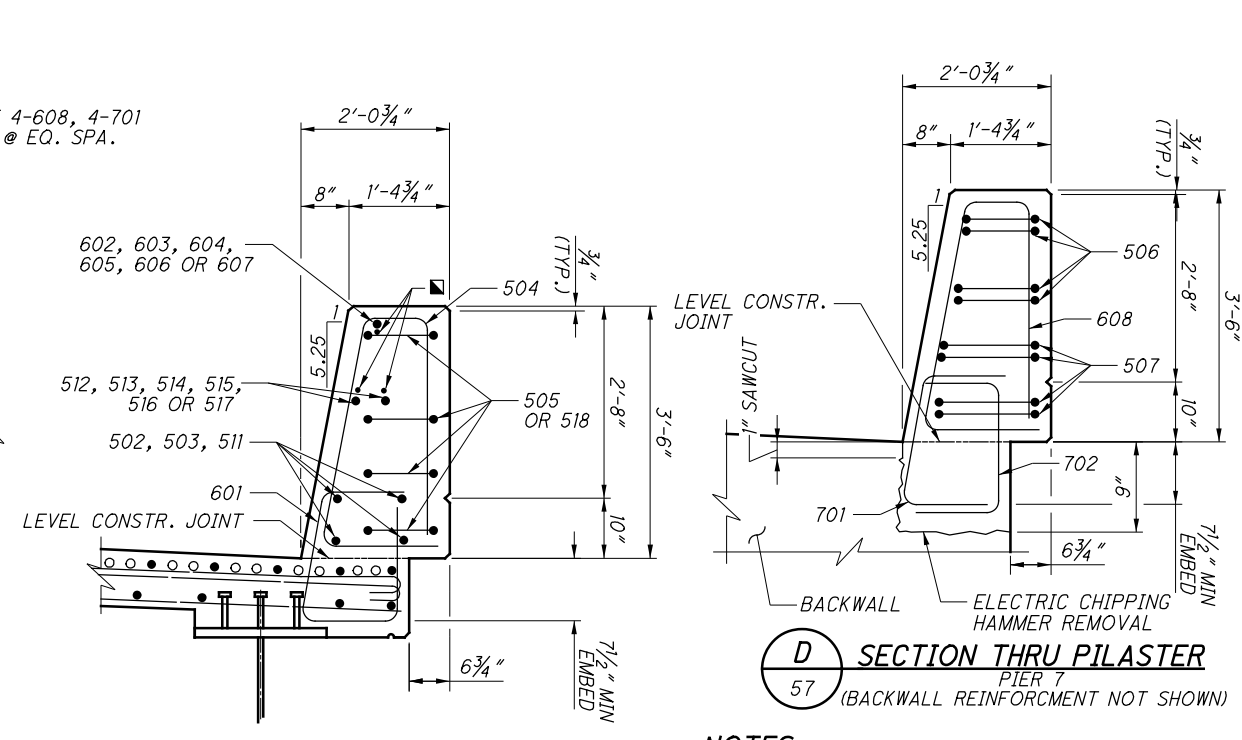


**B SECTION THRU PILASTER**  
56,61


**D SECTION THRU PILASTER**  
57  
(BACKWALL REINFORCEMENT NOT SHOWN)

**NOTES:**  
1. THE PREFIX "1R" SHALL BE ADDED TO ALL BAR MARKS FOR PARAPET DETAILS IN UNIT 1 AND "2R" SHALL BE ADDED TO ALL BAR MARKS FOR PARAPET DETAILS IN UNIT 2.  
2. FOR REINFORCING STEEL LIST, SEE SHEET 78/79.

P:\Projects\2018\20H03DB-18232 HAM-75-03.84\104667\structures\HAM074\_1908S\sheets\074\_1908S\_T5002.dgn 7/28/2023 9:34:56 AM erin.baumann

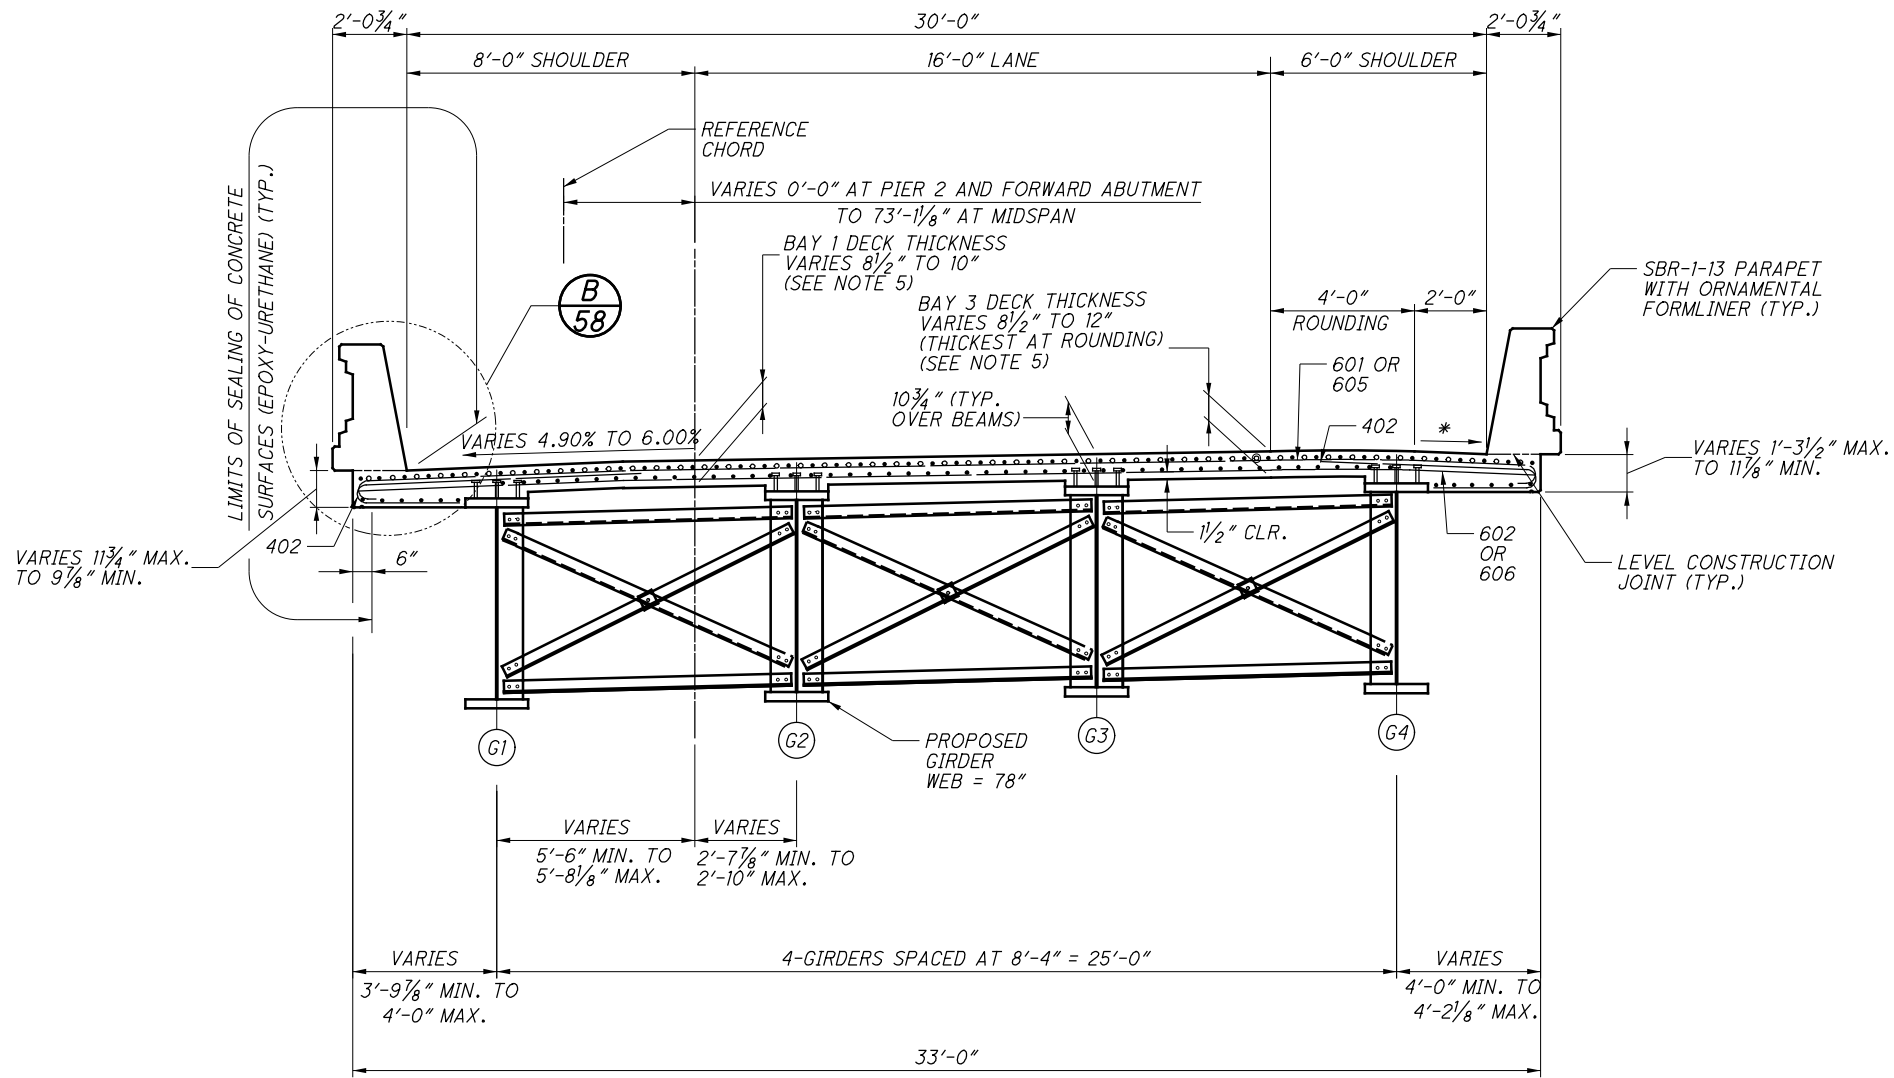

**TRANSVERSE SECTION - UNIT 2**  
(LOOKING UPSTATION)

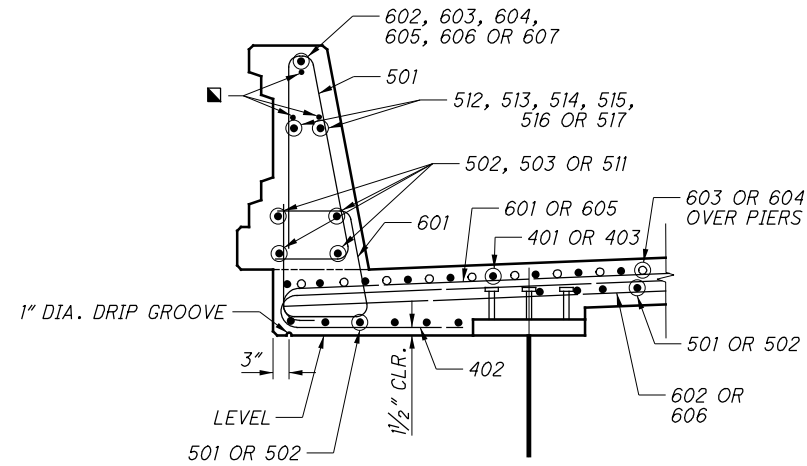

**B** 58  
**DETAIL OF DECK OVERHANG**

**LEGEND:**


- \* - VARIES 1.59% TO 1%
- - 1/2" DIA. GLASS FIBER REINFORCED POLYMER (GFRP) STIFFENING REINFORCEMENT

**NOTES:**


1. FOR FRAMING PLAN, SEE SHEET 42/79.
2. FOR CROSSFRAME DETAILS, SEE SHEET 48/79.
3. THE PREFIX "2S" SHALL BE ADDED TO ALL BAR MARKS FOR UNIT 2 SLAB AND "2R" FOR UNIT 2 RAILING.
4. ADDITIONAL DECK DETAILS WILL BE INCLUDED IN BU-07.
5. DIMENSION VARIES AT ROUNDING, VARIABILITY IS THICKEST AT THE ROUNDING AT THE GRADE BREAKS OVER BAY 1 AND BAY 3. BAY 1 VARIES FROM 8 1/2" TO 10" THICK, BAY 3 VARIES FROM 8 1/2" TO 12"





P:\Projects\2018\20H03DB-18232 HAM-75-03.84\104667\structures\HAM074\_1908S\DP010.dgn 7/28/2023 9:34:58 AM erin.boumann

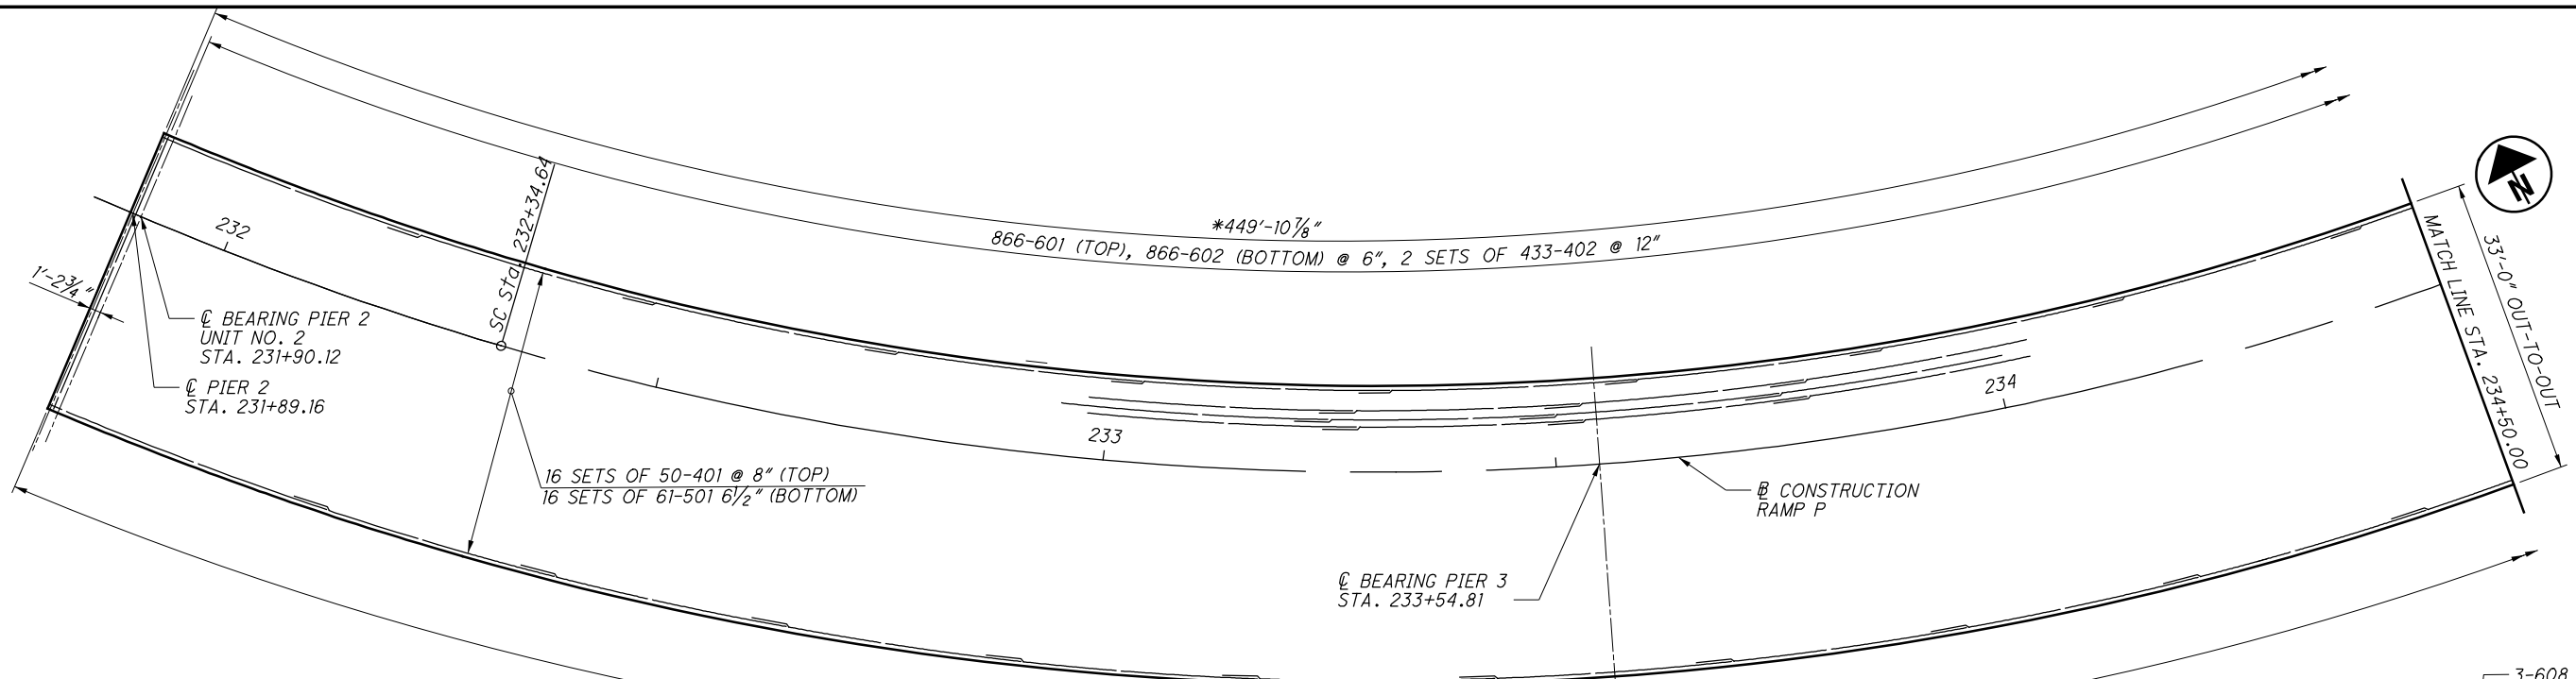


**LEGEND:**  
\* - MEASURED ALONG EDGE OF DECK  
■ - 1 SER. OF 30-S605 (TOP), 1 SER. OF 30-S606 (BOTTOM) @ 6"

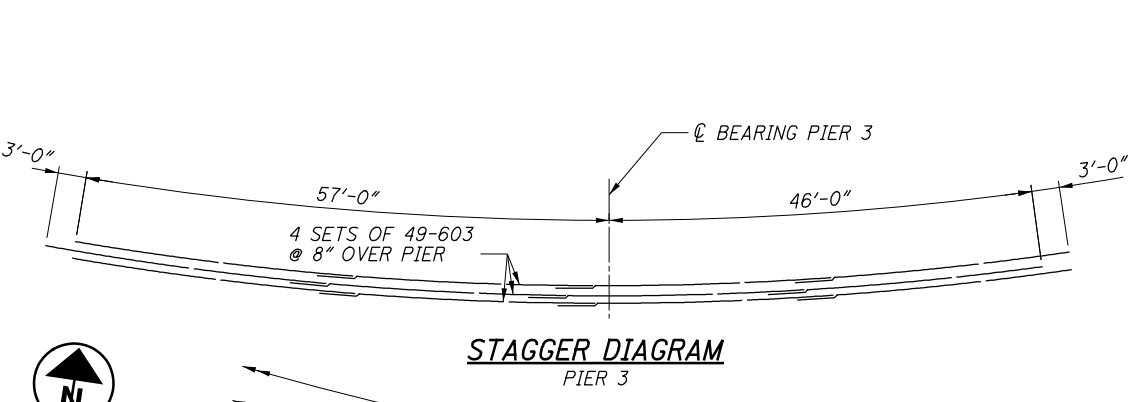

**PART SLAB PLAN - UNIT 2**  
(PARAPET AND REFERENCE CHORD NOT SHOWN)

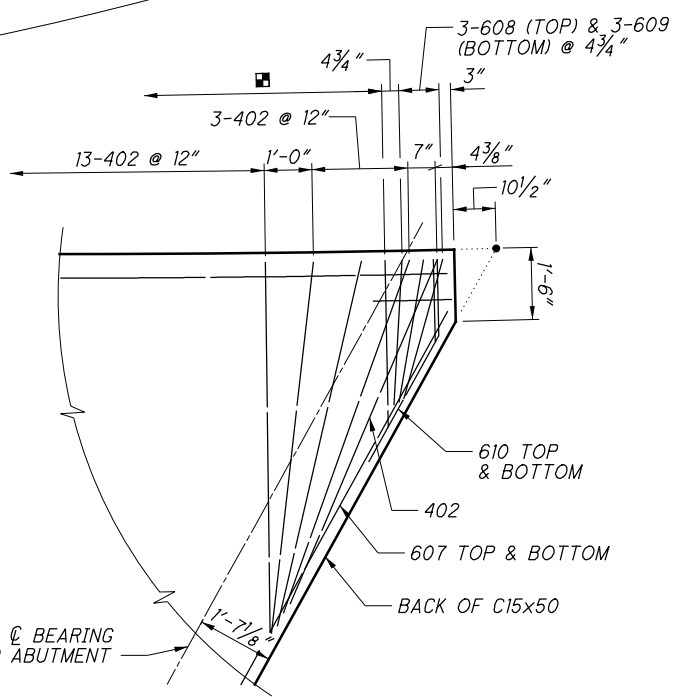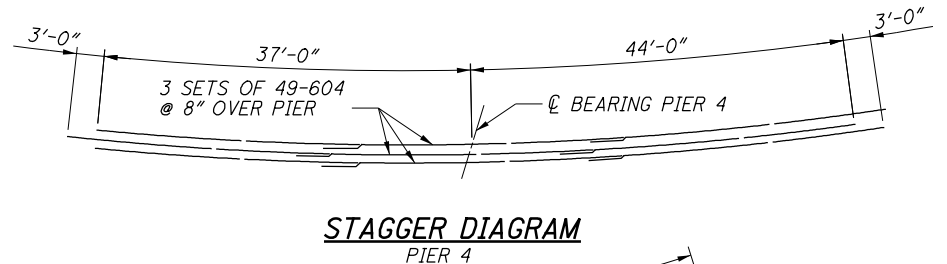

**DETAIL OF DECK CORNER**

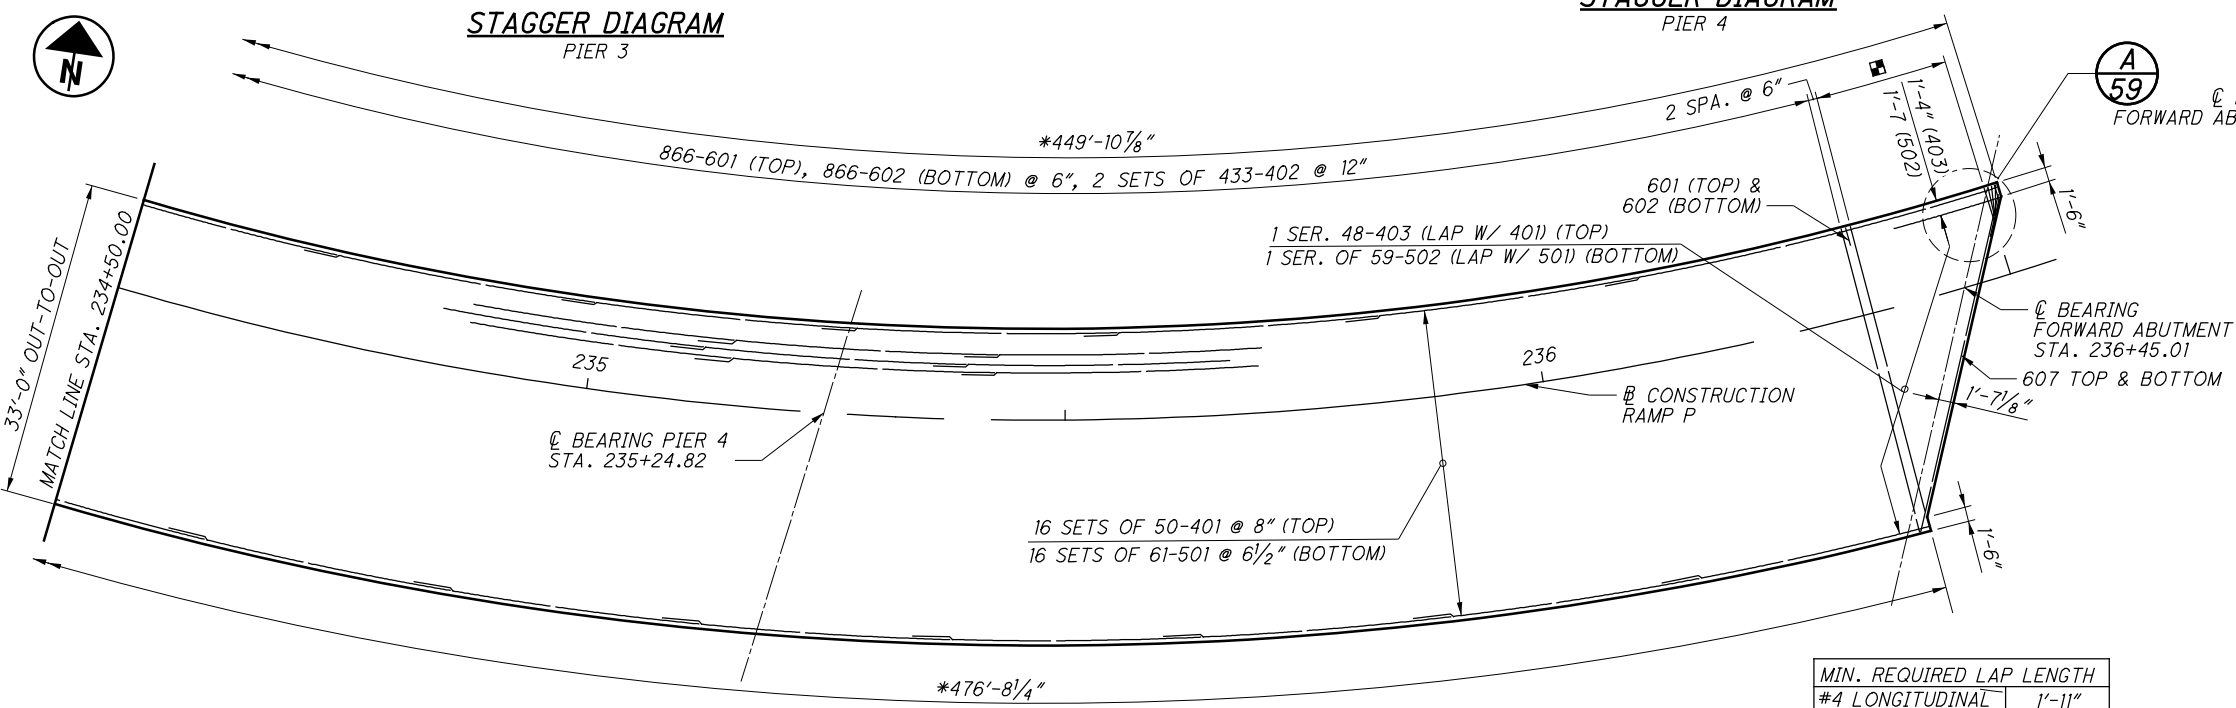


**PART SLAB PLAN - UNIT 2**  
(PARAPET AND REFERENCE CHORD NOT SHOWN)

MIN. REQUIRED LAP LENGTH	
#4 LONGITUDINAL	1'-11"
#5 LONGITUDINAL	3'-0"
#6 LONGITUDINAL	3'-7"


- NOTES:**
- FOR TRANSVERSE SECTION, SEE SHEET [53/79].
  - FOR EXPANSION JOINT DETAIL, SEE SHEET [63/79].
  - FOR PARAPET DETAILS, SEE SHEET [57/79] THRU [57/79].
  - FOR SCREED, TOP OF HAUNCH AND FINAL DECK ELEVATIONS, SEE SHEET [66/79].
  - FOR REINFORCING STEEL LIST, SEE SHEETS [74/79] THRU [75/79].
  - REBAR CLEARANCE MEASURED TO THE FACE OF CONCRETE SHALL BE 3" UNLESS OTHERWISE NOTED.
  - FIELD BEND LONGITUDINAL BARS TO FIT CURVATURE OF ROADWAY AND TRANSVERSE BARS TO FIT CROWN. EPOXY COATED BARS DAMAGED BY FIELD BENDING SHALL BE REPAIRED IN ACCORDANCE WITH CMS 509.
  - THE PREFIX "2S" SHALL BE ADDED TO ALL BAR MARKS IN UNIT 2 SUPERSTRUCTURE.
  - FOR REFERENCE CHORD LAYOUT, SEE SHEET [6/79].

P:\Projects\2018\20H03DB-18232 HAM-75-03.84\104667\structures\HAM074\_1908S\DP014.dgn 7/28/2023 9:35:01 AM erin.baumann

UNIT 2 DECK OVERHANG		
LOCATION	LEFT OVERHANG	RIGHT OVERHANG
☉ BEARING PIER 2, UNIT 2	3'-9 <sup>3</sup> / <sub>4</sub> "	4'-2 <sup>1</sup> / <sub>8</sub> "
1/8	3'-10 <sup>3</sup> / <sub>4</sub> "	4'-0 <sup>3</sup> / <sub>8</sub> "
1/4	3'-11 <sup>3</sup> / <sub>4</sub> "	3'-11 <sup>7</sup> / <sub>8</sub> "
3/8	4'-0"	4'-0"
1/2	4'-0"	4'-0"
5/8	4'-0"	4'-0"
3/4	4'-0"	4'-0"
7/8	4'-0"	4'-0"
☉ BEARING PIER 3	4'-0"	4'-0"
1/8	4'-0"	4'-0"
1/4	4'-0"	4'-0"
3/8	4'-0"	4'-0"
1/2	4'-0"	4'-0"
5/8	4'-0"	4'-0"
3/4	4'-0"	4'-0"
7/8	4'-0"	4'-0"
☉ BEARING PIER 4	4'-0"	4'-0"
1/8	4'-0"	4'-0"
1/4	4'-0"	4'-0"
3/8	4'-0"	4'-0"
1/2	4'-0"	4'-0"
5/8	4'-0"	4'-0"
3/4	4'-0"	4'-0"
7/8	4'-0"	4'-0"
☉ BEARING FWD. ABUTMENT	4'-0"	4'-0"

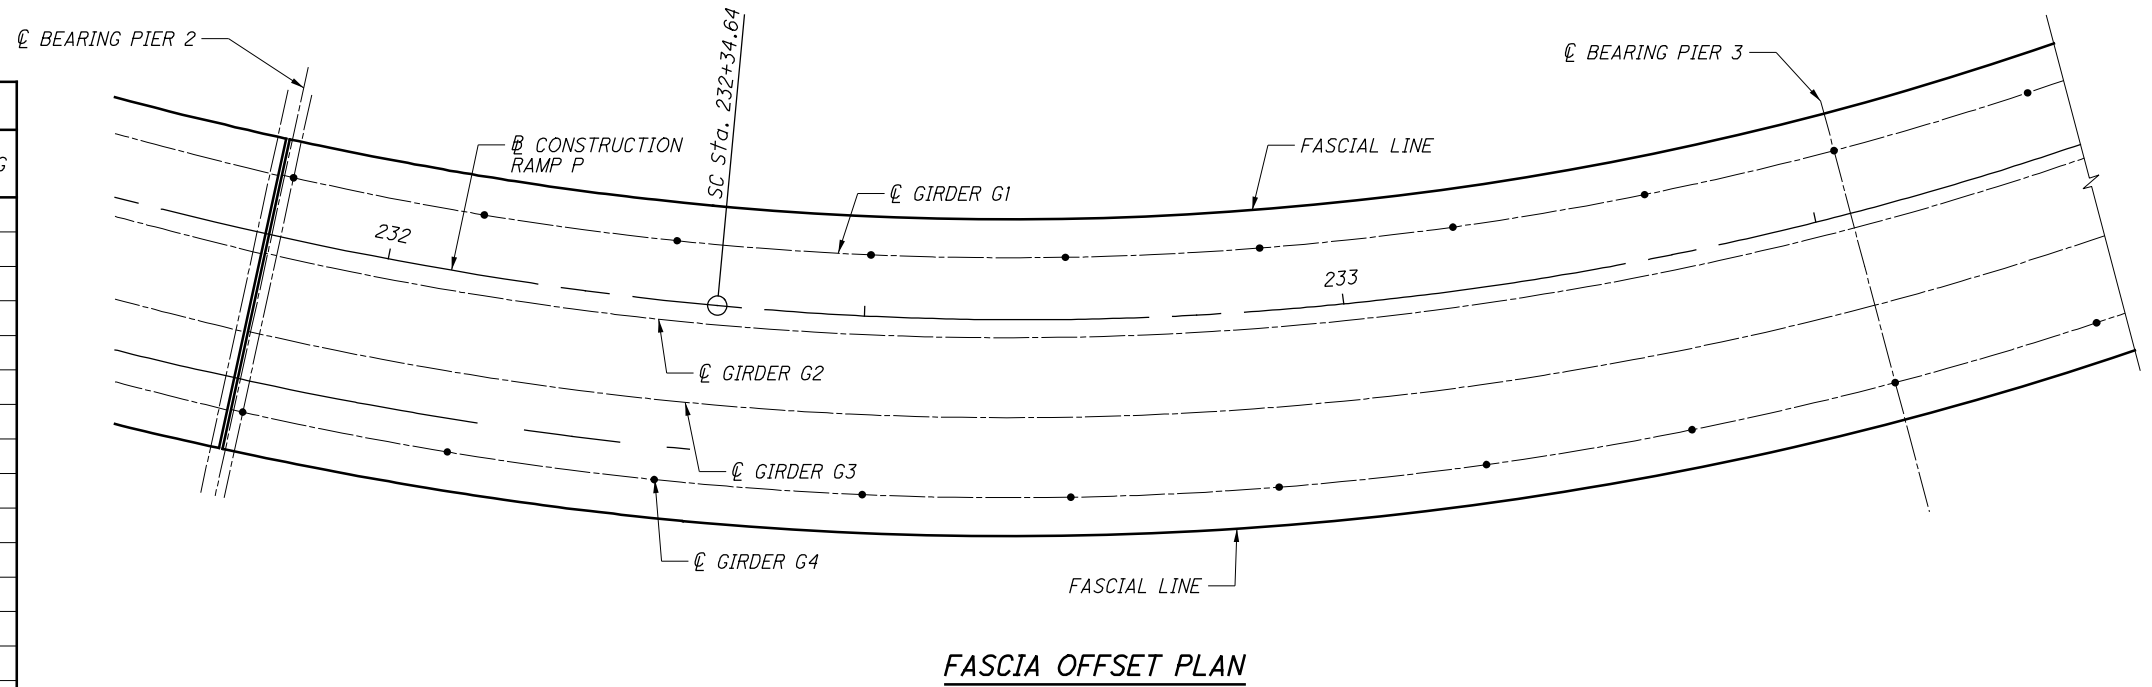

FASCIA OFFSET PLAN

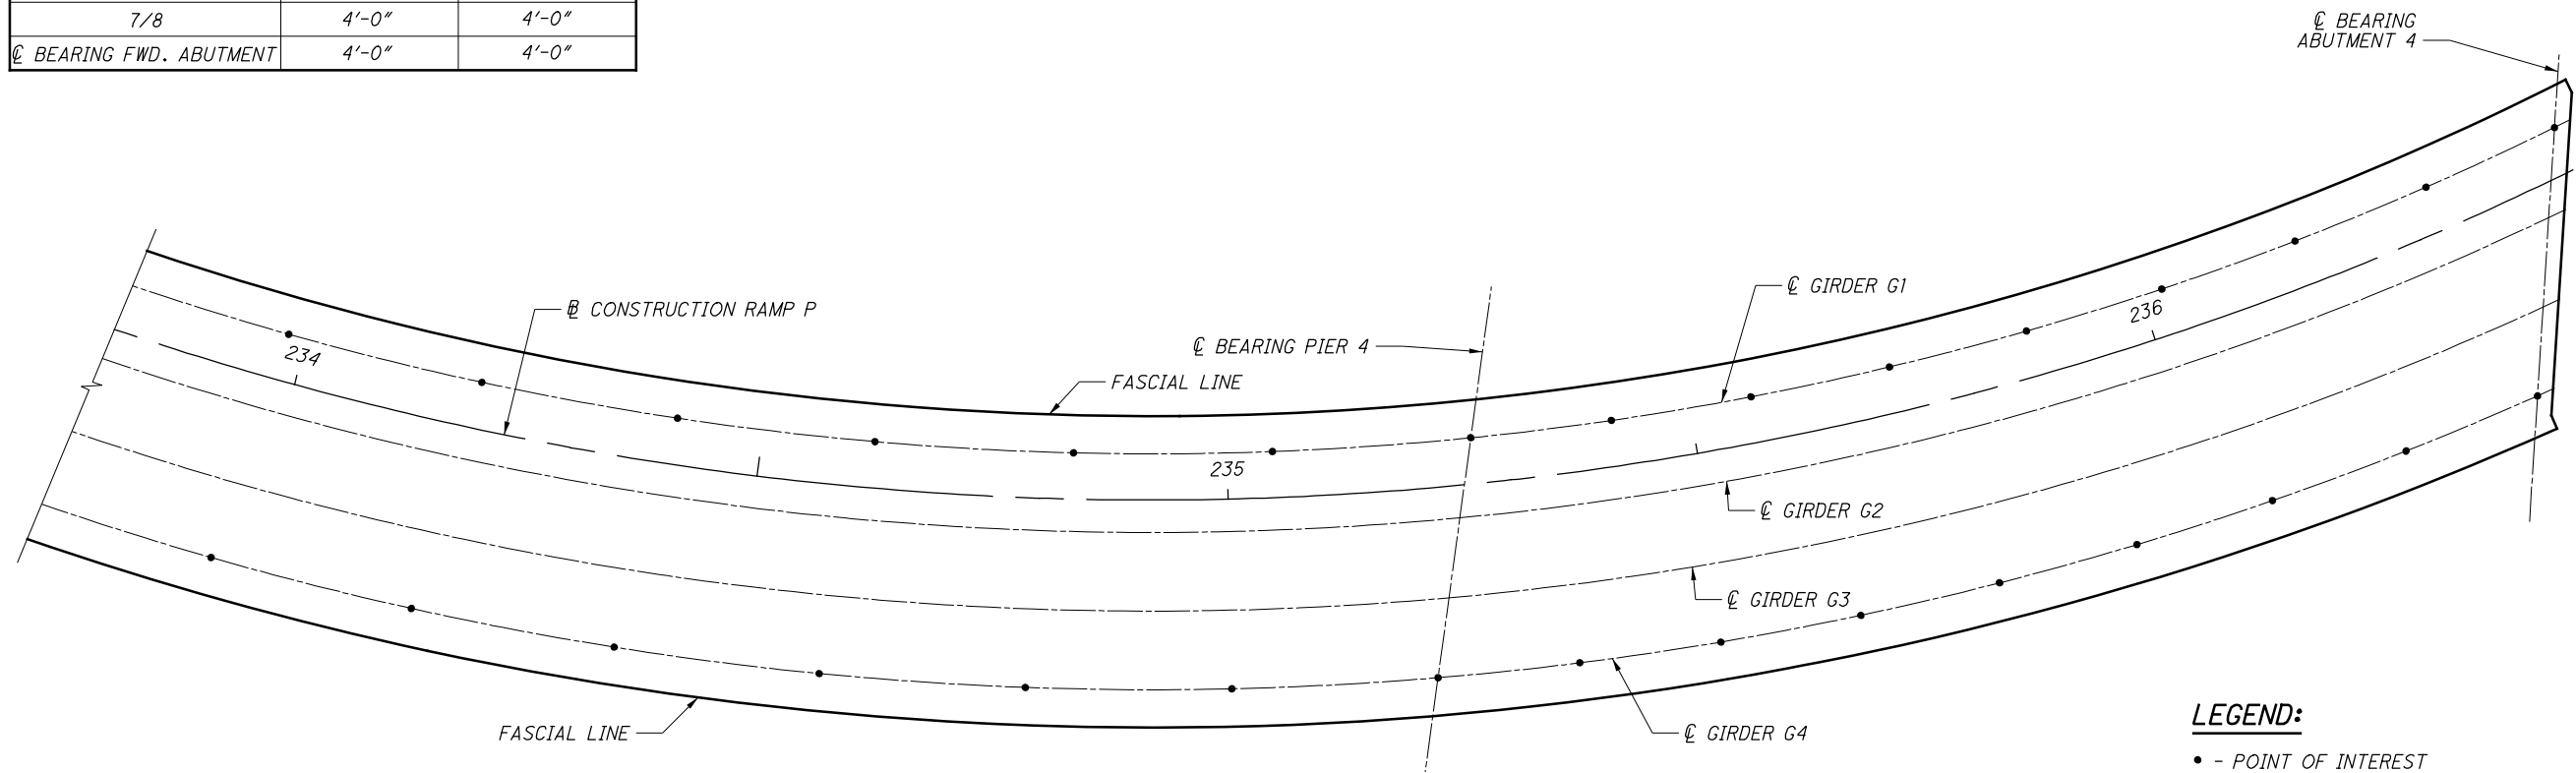


FASCIA OFFSET PLAN

**LEGEND:**  
• - POINT OF INTEREST

**NOTES:**  
1. FOR ADDITIONAL NOTES, SEE SHEET 54/79 .

P:\Projects\2018\20H03DB-18232 HAM-75-03.84\104667\structures\HAM074\_1908S\RA002.dgn 7/28/2023 9:35:06 AM erin.baumann

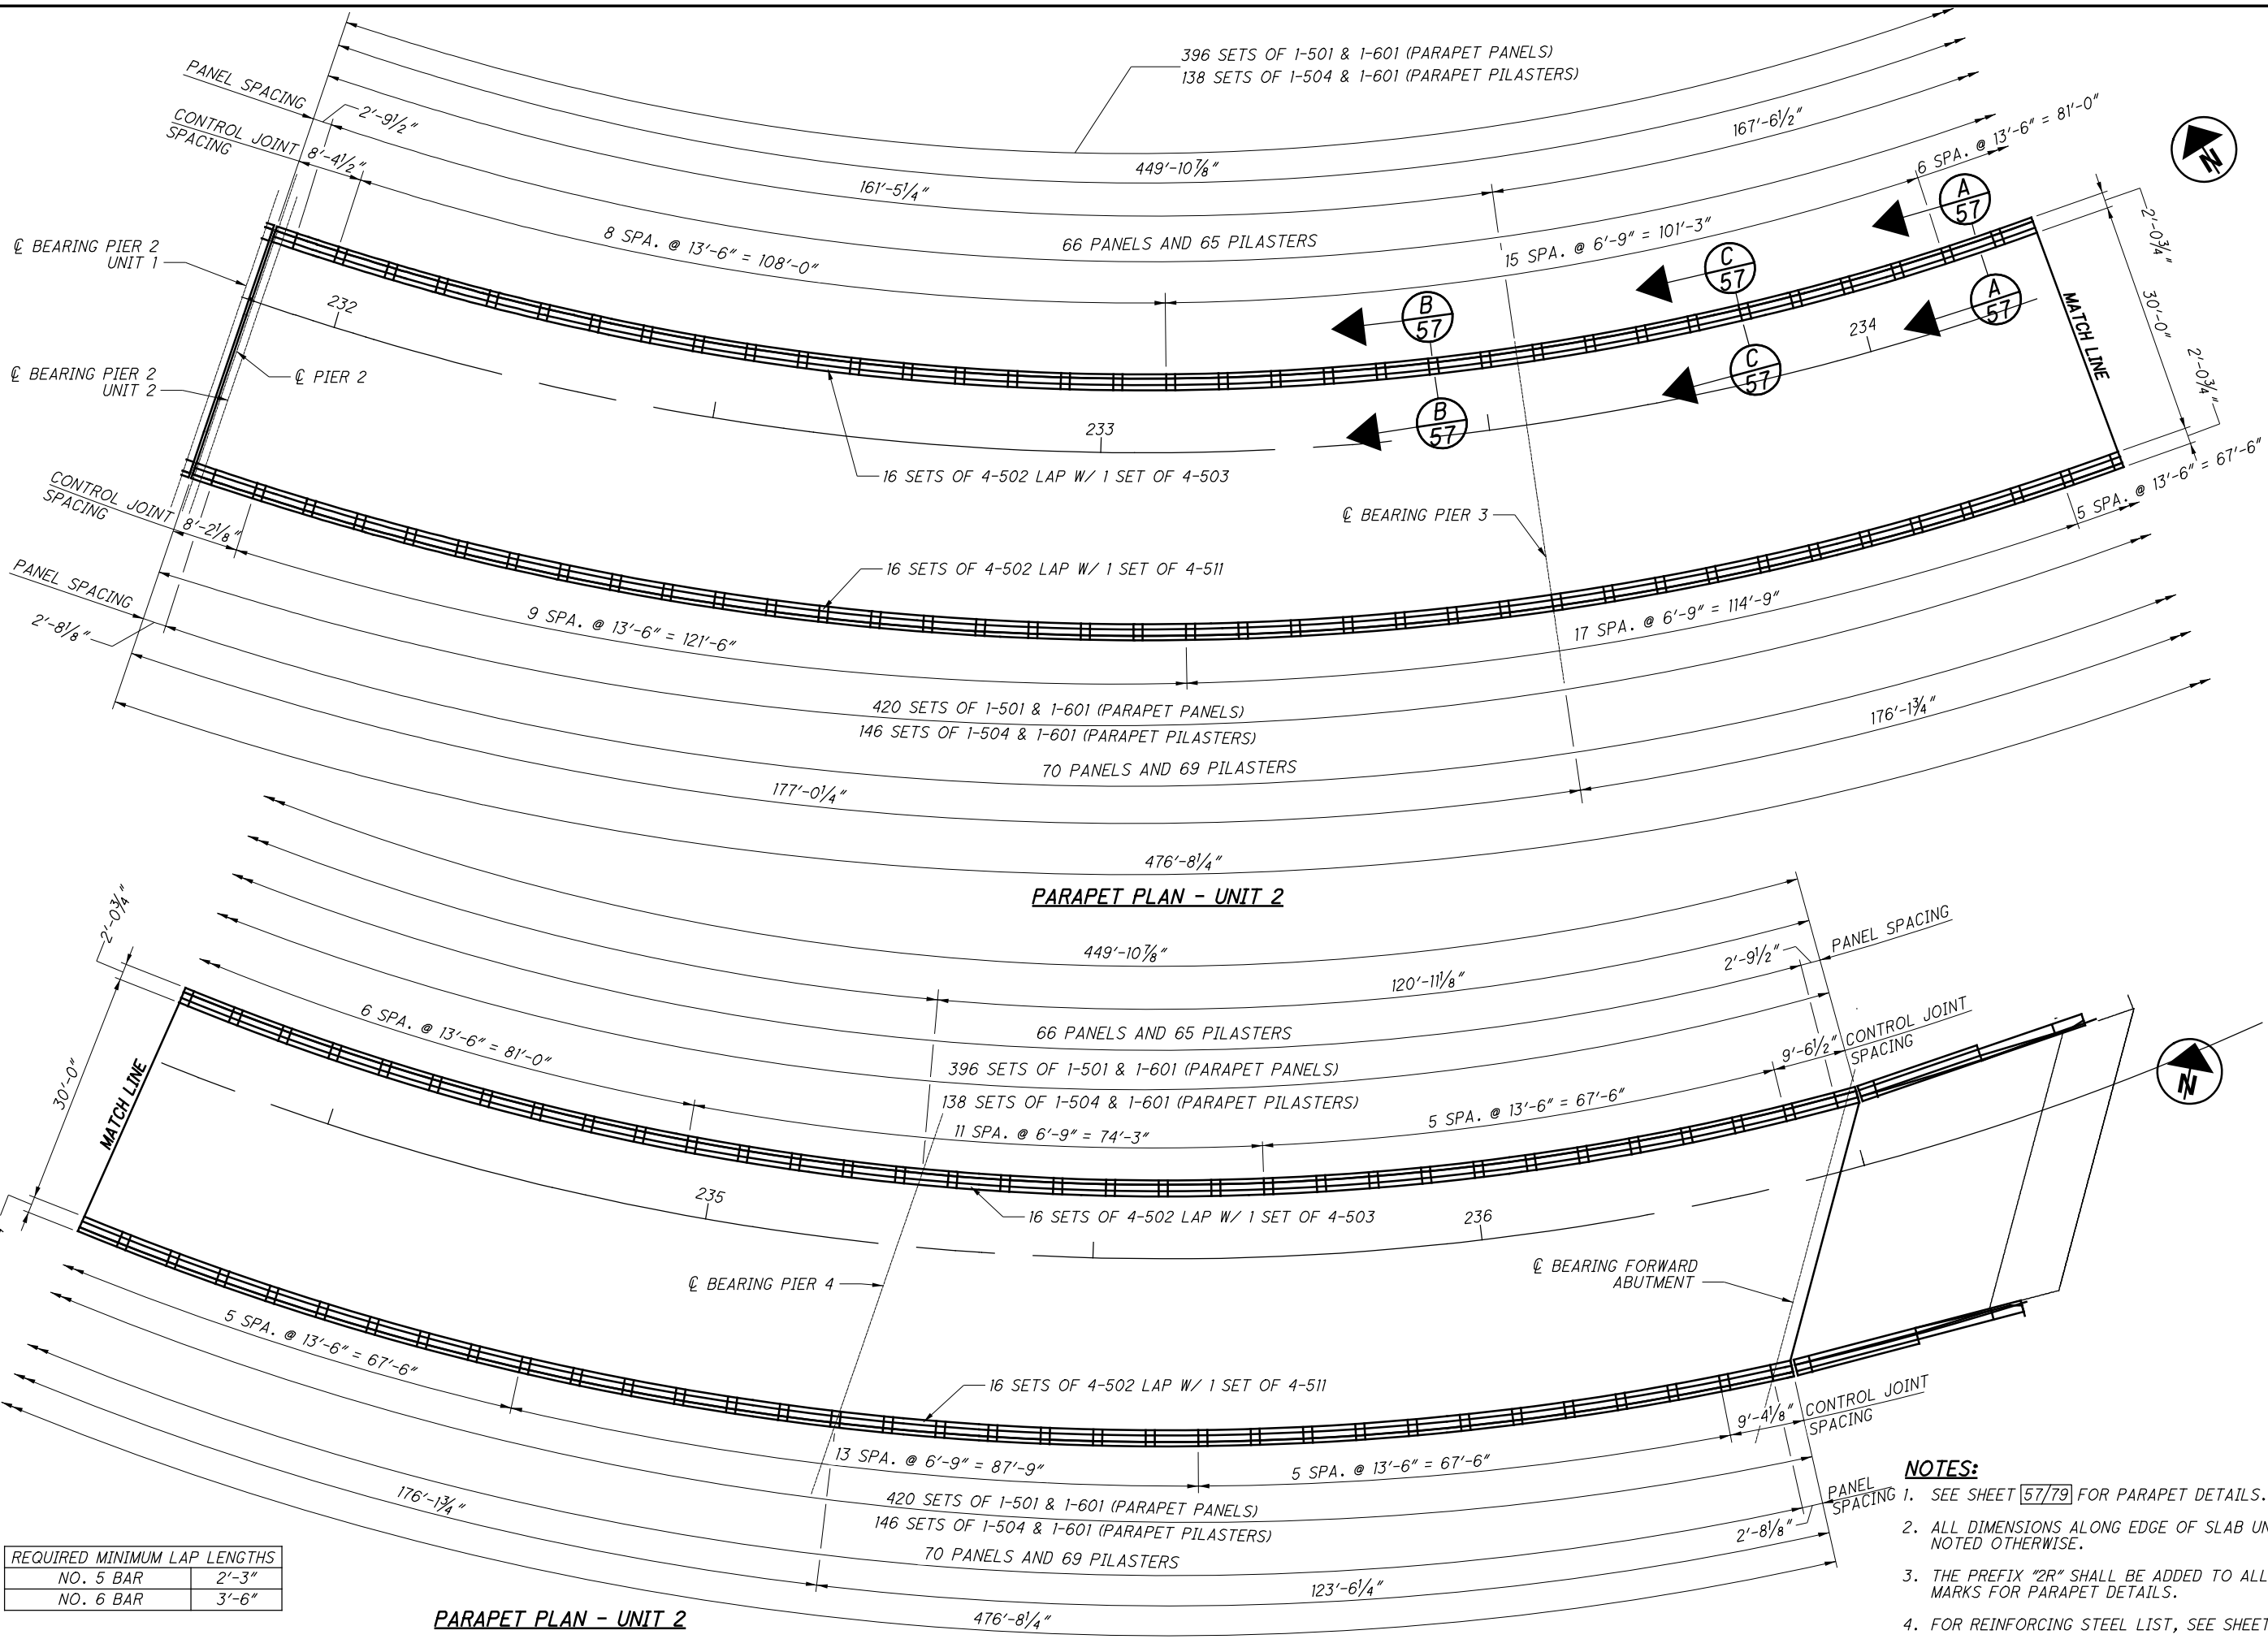

REQUIRED MINIMUM LAP LENGTHS	
NO. 5 BAR	2'-3"
NO. 6 BAR	3'-6"

- NOTES:**
- SEE SHEET [57/79] FOR PARAPET DETAILS.
  - ALL DIMENSIONS ALONG EDGE OF SLAB UNLESS NOTED OTHERWISE.
  - THE PREFIX "2R" SHALL BE ADDED TO ALL BAR MARKS FOR PARAPET DETAILS.
  - FOR REINFORCING STEEL LIST, SEE SHEET [78/79].

  
 DESIGN AGENCY  
 540 WHITE POND DR. SUITE E  
 AKRON, OH 44320

DESIGNED	CRG	CHECKED	KDC
DRAWN	ADS	REVISED	
REVIEWED	TES	STRUCTURE FILE NUMBER	3109798
DATE	8/22/2019		


**PARAPET AND MEDIAN BARRIER PLAN - UNIT 2**  
 BRIDGE NO. HAM-74-1908S  
 RAMP P OVER IR-74 WESTBOUND, IR-75 AND RAMP E

**HAM-75-3.84**  
**PID No. 104667**

61 / 79

61  
79

P:\Projects\2018\20H03DB-18232 HAM-75-03.84\104667\structures\HAM074\_1908S\sheets\074\_1908S\_DP008.dgn 7/28/2023 9:35:55 AM erin.baumann

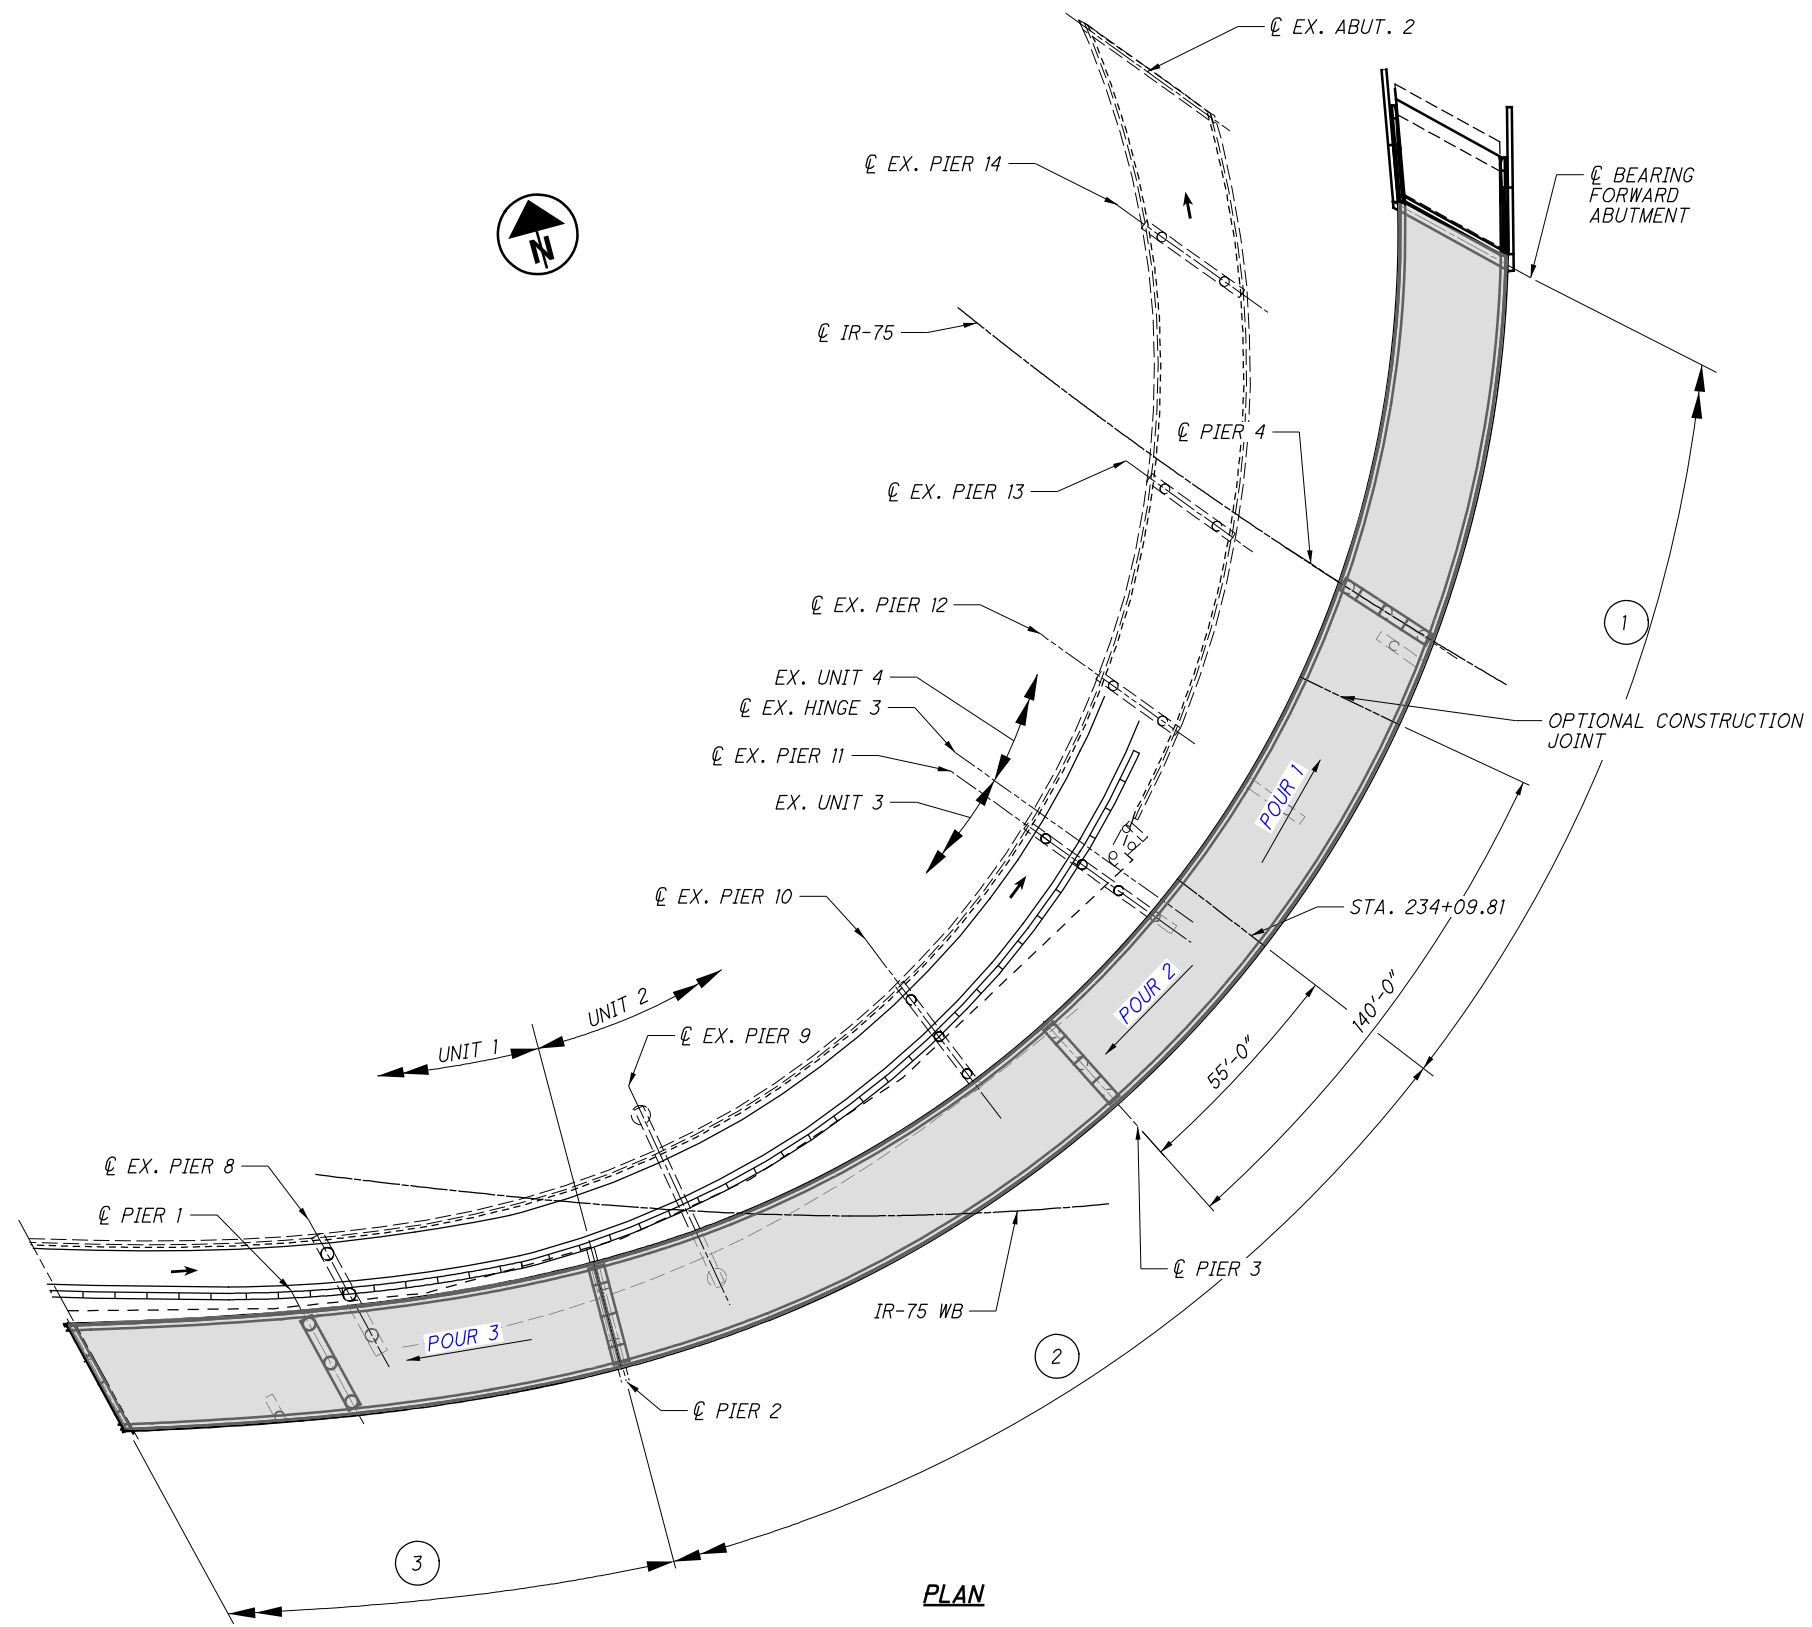

PLAN

**DECK POURING SEQUENCE:**

- ① POUR RAMP P UNIT 2 FROM STA. 234+09.81 (APPROX. FS4) TO FORWARD ABUTMENT.
- ② POUR RAMP P UNIT 2 FROM STA. 234+09.81 (APPROX. FS4) TO PIER 2.
- ③ POUR RAMP P UNIT 1 FROM PIER 2 TO PIER 7.

**NOTES:**

1. CONSTRUCTION DETAILS ARE FOR RAMP P (HAM-74-1908S) ONLY. FOR CORRESPONDING CONSTRUCTION DETAILS FOR I-74 EB (HAM-74-1908R), SEE BU-10.
2. FOR GENERAL NOTES AND MOT REFERENCE, SEE SHEETS 7/79 AND 8/79.
3. FOR SLAB PLANS, SEE SHEETS 54/79 & 59/79.

**LEGEND:**

■ - INDICATES LIMITS OF DECK CONSTRUCTION (S1-P2-S2)


SX-PX-SX - STAGE X, PHASE X, STEP X (MOT PHASING)

DESIGNED	CRG	CHECKED	KDC
DRAWN	CRG	REVISED	
REVIEWED	TES	DATE	8/22/2019
STRUCTURE FILE NUMBER	3109798		


**DECK POURING SEQUENCE**  
BRIDGE NO. HAM-74-1908S  
RAMP P OVER IR-74 WESTBOUND, IR-75 AND RAMP E

HAM-75-3.84  
PID No. 104667


P:\Projects\2018\20H03DB-18232 HAM-75-03.84\104667\structures\HAM074\_1908S\sheets\074\_1908S\_DP012.dgn 7/28/2023 9:36:01 AM erin.baumann

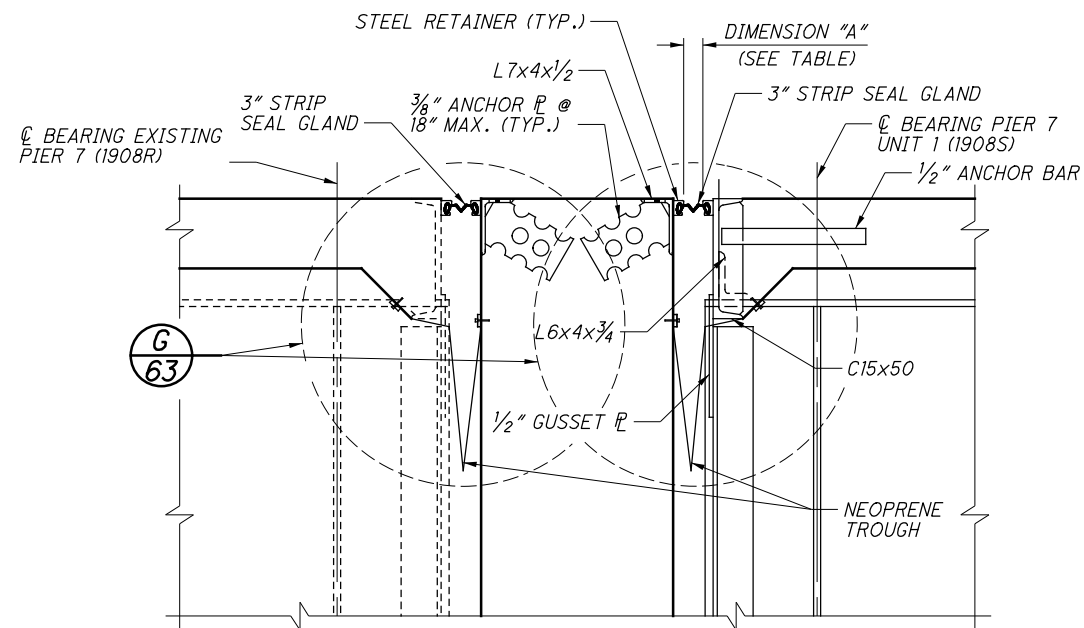


**D** SECTION THRU EXISTING PIER 7 EXPANSION JOINTS

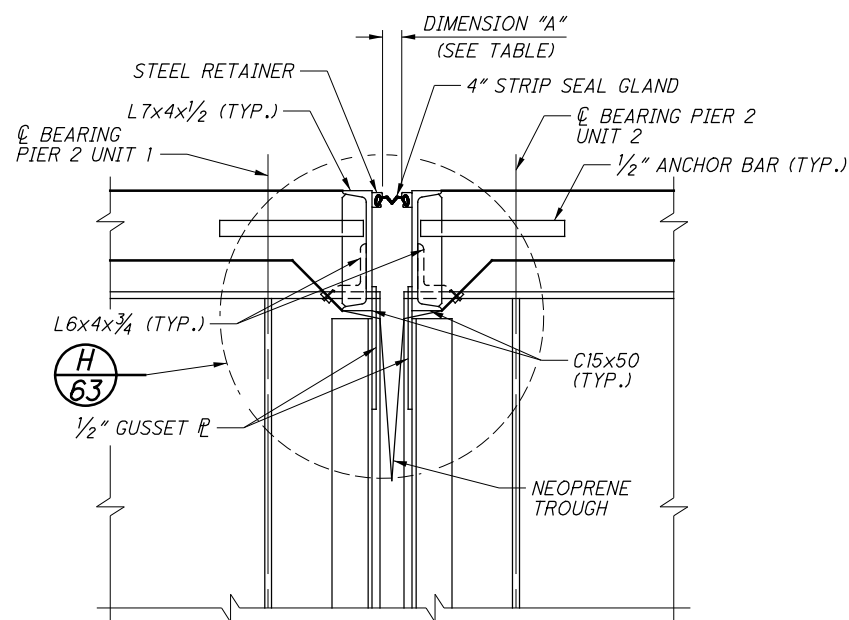

**E** SECTION THRU PIER 2 EXPANSION JOINT

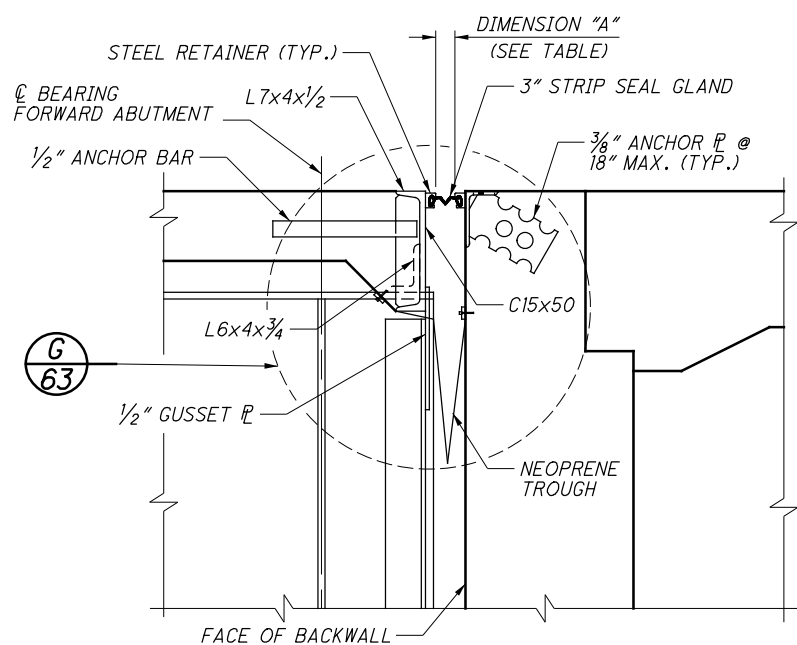


**F** SECTION THRU FORWARD ABUTMENT EXPANSION JOINT

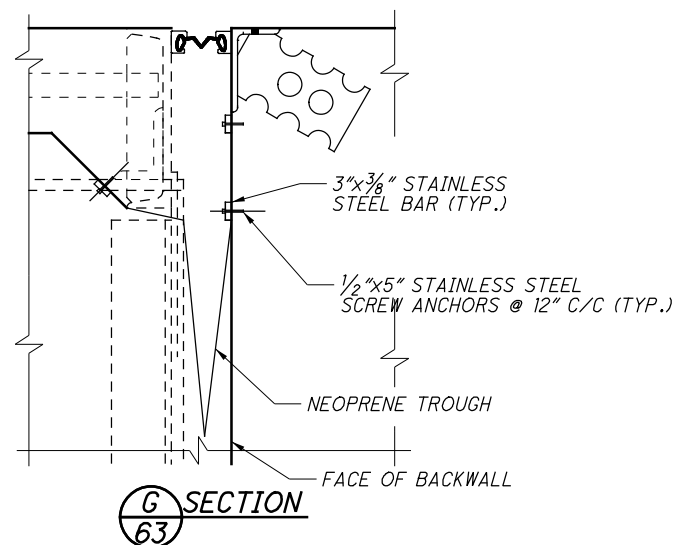

**G** SECTION

1/2"x5" STAINLESS STEEL SCREW ANCHORS @ 12" C/C (TYP.)

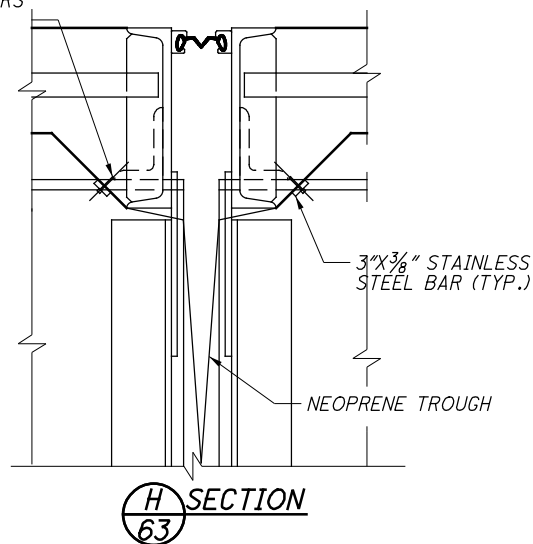

**H** SECTION

EX. PIER 7 (1908R)	
4" STRIP SEAL JOINT WIDTH	
AMBIENT TEMPERATURE	DIMENSION "A"
30° F	2 7/8"
40° F	2 5/8"
50° F	2 1/2"
60° F	2 1/4"
70° F	2"
80° F	1 13/16"
90° F	1 5/8"

PIER 7 UNIT 1	
3" STRIP SEAL JOINT WIDTH	
AMBIENT TEMPERATURE	DIMENSION "A"
30° F	1 5/16"
40° F	1 3/8"
50° F	1 3/16"
60° F	1 3/4"
70° F	1 1/16"
80° F	1 5/8"
90° F	1 1/16"

PIER 2	
4" STRIP SEAL JOINT WIDTH	
AMBIENT TEMPERATURE	DIMENSION "A"
30° F	3 1/8"
40° F	2 7/8"
50° F	2 5/8"
60° F	2 5/16"
70° F	2 1/16"
80° F	1 13/16"
90° F	1 9/16"

FORWARD ABUTMENT	
3" STRIP SEAL JOINT WIDTH	
AMBIENT TEMPERATURE	DIMENSION "A"
30° F	2 7/16"
40° F	2 1/4"
50° F	2 1/8"
60° F	1 5/16"
70° F	1 3/16"
80° F	1 5/8"
90° F	1 1/2"


**NOTES:**

- FOR ADDITIONAL EXPANSION JOINT DETAILS, SEE STANDARD DRAWING EXJ-4-87.
- THE TROUGH MATERIAL SHALL BE 3/32" THICK, HEAVY DUTY ELASTOMERIC SHEET OF NYLON FABRIC ENCASED IN A NEOPRENE POLYMER. THE MATERIAL SHALL BE "FAIRPRENE" WFP-N2N4 AS MANUFACTURED BY ALPHA ENGINEERING COMPOSITES LLC OR APPROVED EQUAL. THE MATERIAL SHALL CONFORM TO ASTM D751 AND THE FOLLOWING:

THICKNESS: 0.093 INCH ± 0.01 INCH  
 MIN. BREAKING STRENGTH: 650 LBS x 650 LBS  
 LOW TEMPERATURE: ASTM D2136


- THE SUPPORT ANGLES SHALL BE ASTM A709, GRADE 50 AND SHALL BE GALVANIZED IN ACCORDANCE WITH CMS 711.02.
- THE STAINLESS STEEL BARS SHALL BE ASTM A480, TYPE 304.

P:\Projects\2018\20H03DB-18232 HAM-75-03.84\104667\structures\HAM074\_1908S\sheets\074\_1908S\_MD007.dgn 7/28/2023 9:36:05 AM erin.baumann

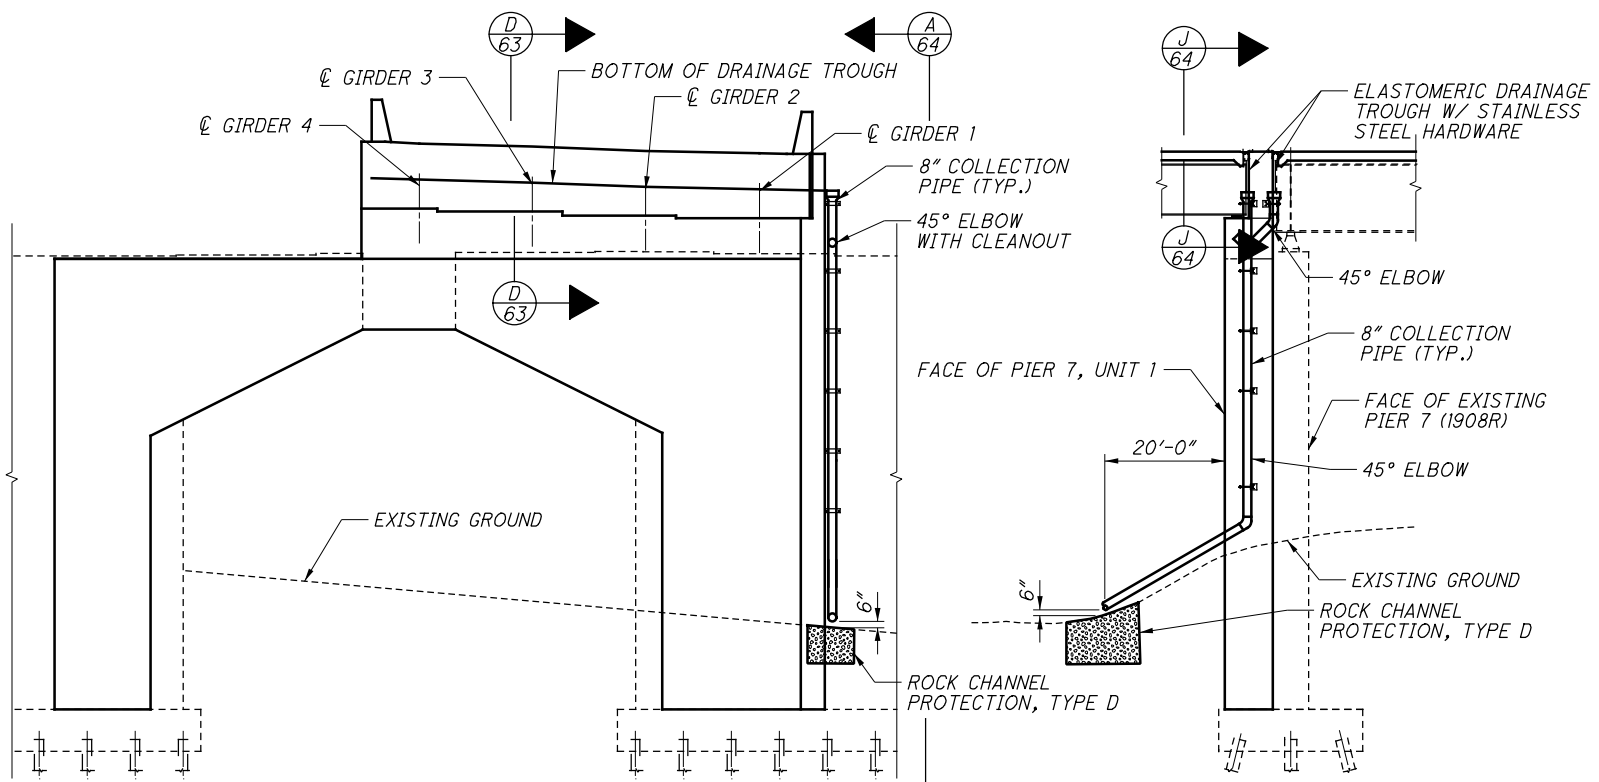


**PIER 7 PLAN**


**PIER 7 DRAINAGE DETAIL**

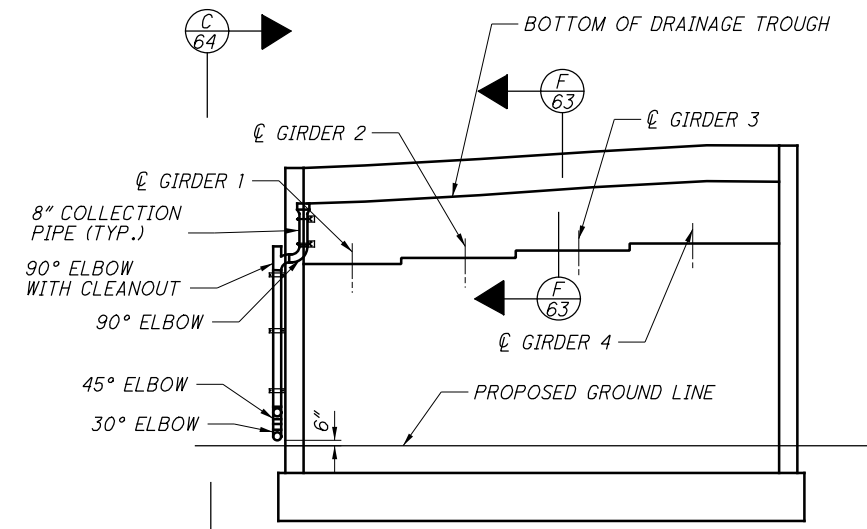


**FORWARD ABUTMENT PLAN**

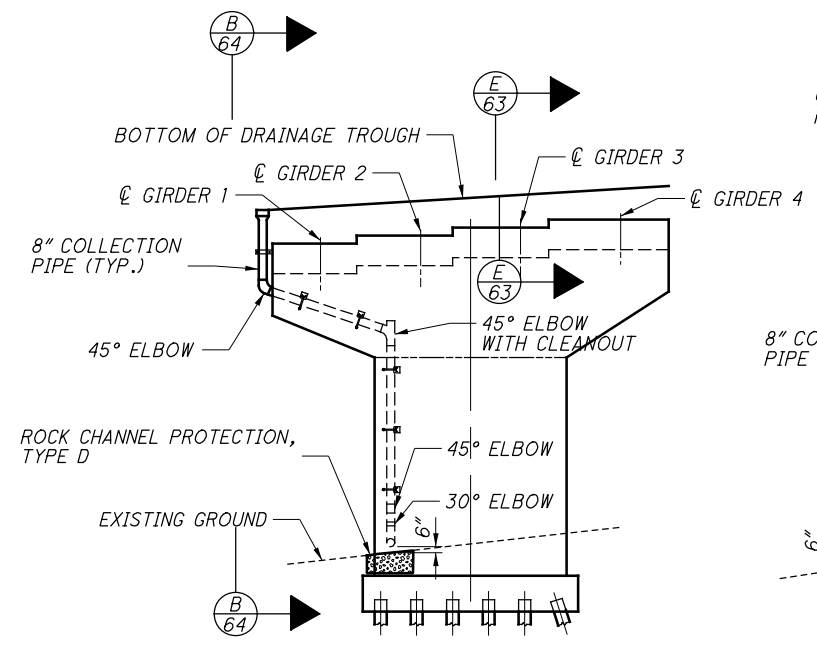


**PIER 2 PLAN**

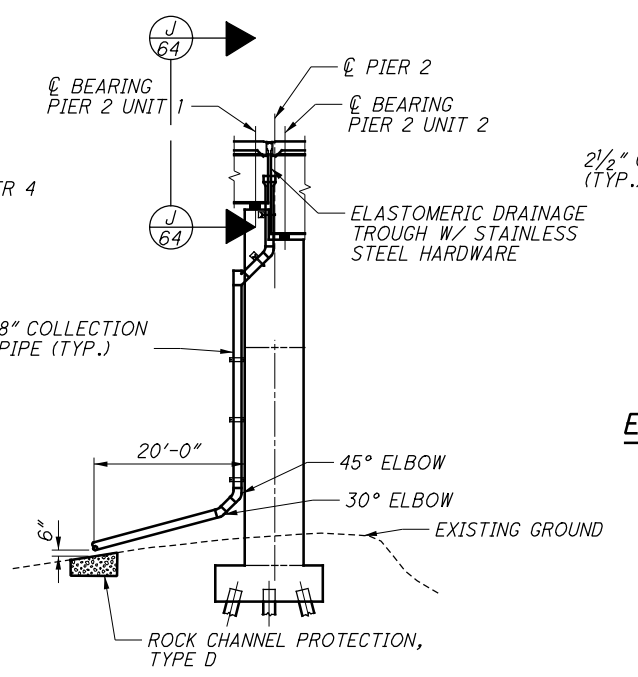


**PIER 2 DRAINAGE DETAIL**

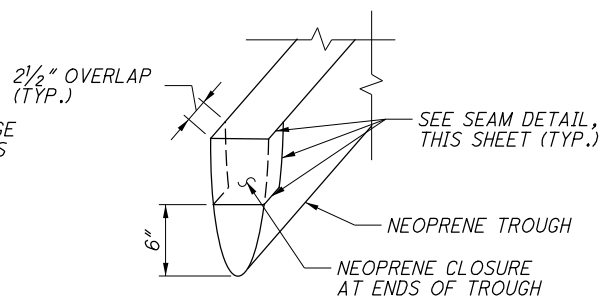


**END OF TROUGH CLOSURE DETAIL**

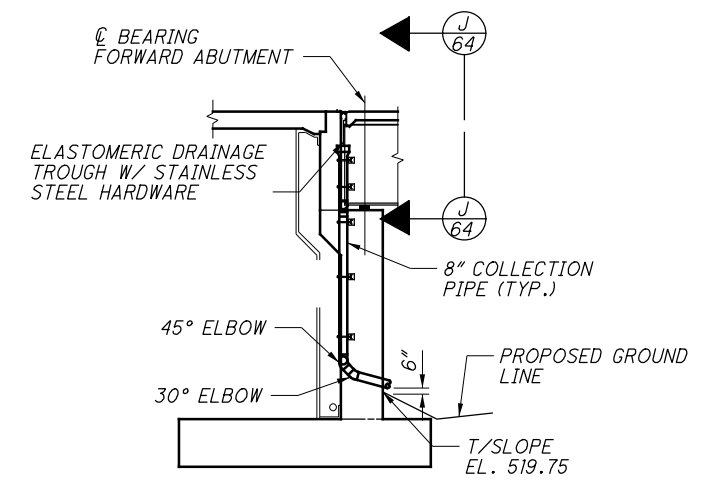


**FORWARD ABUTMENT DRAINAGE DETAIL**

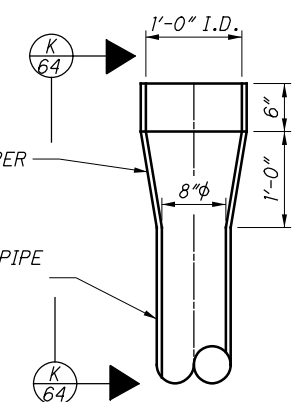


**J SECTION**

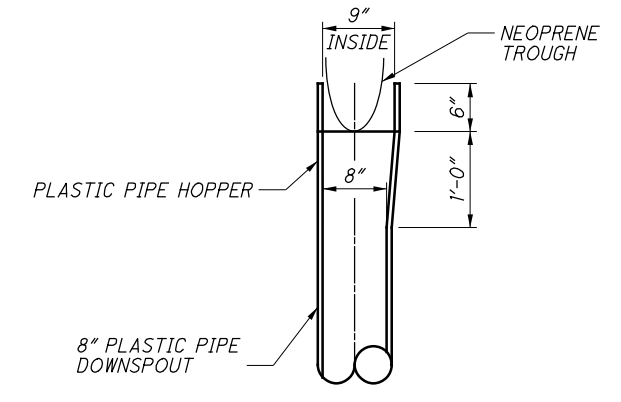

**K SECTION**

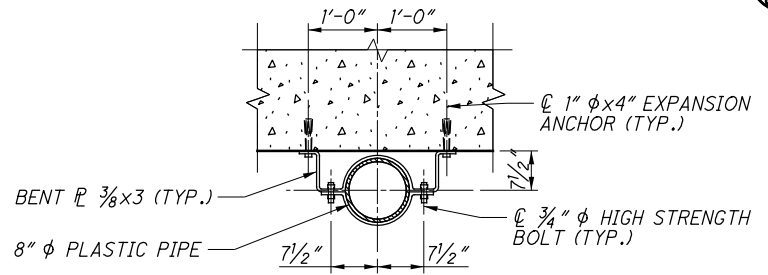

**DOWNSPOUT SUPPORT BRACKET**

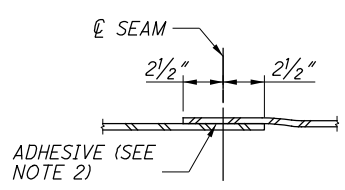

**SEAM DETAIL**

**NOTES:**

- FOR EXPANSION JOINT DETAILS, SEE SHEET [63/79].
- AT THE ENDS OF THE NEOPRENE DRAINAGE TROUGHS, OVERLAP THE ENDS OF THE NEOPRENE AND SEAL WITH 3M SCOTCH-WELD HP 1357 NEOPRENE CONTACT ADHESIVE OR APPROVED EQUAL.
- ALL BRACKETS SHALL BE ASTM A709, GRADE 50 AND SHALL BE GALVANIZED PER CMS 711.02.
- ALL MATERIALS FOR THE DOWNSPOUTS AND ELBOWS SHALL BE PLASTIC PIPE IN ACCORDANCE WITH CMS 707.45.

DESIGN AGENCY: **PRIMEW**  
 540 WHITE POND DR. SUITE E  
 AKRON, OH 44320

DESIGNED: KDC  
 CHECKED: CRG

DRAWN: KDC  
 REVISED:

REVIEWED: TES  
 DATE: 8/22/2019  
 STRUCTURE FILE NUMBER: 3109798


BRIDGE NO.: HAM-74-1908S  
 RAMP P OVER IR-74 WESTBOUND, IR-75 AND RAMP E

**DRAINAGE DETAILS**


HAM-75-3.84  
 PID No. 104667

64/79

P:\Projects\2018\20H03DB-18232 HAM-75-03.84\104667\structures\HAM074\_1908S\sheets\074\_1908S\_MD001.dgn 7/28/2023 9:36:14 AM erin.baumann

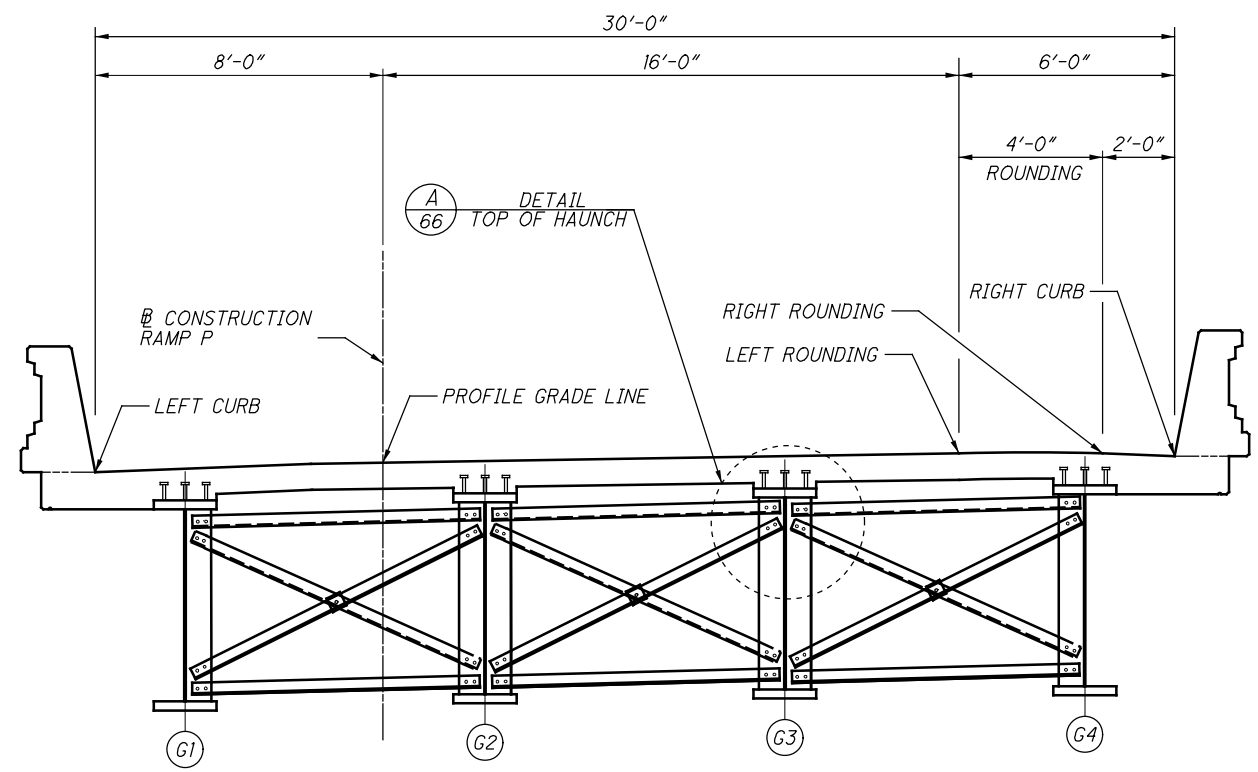

**TRANSVERSE SECTION - UNIT 1**

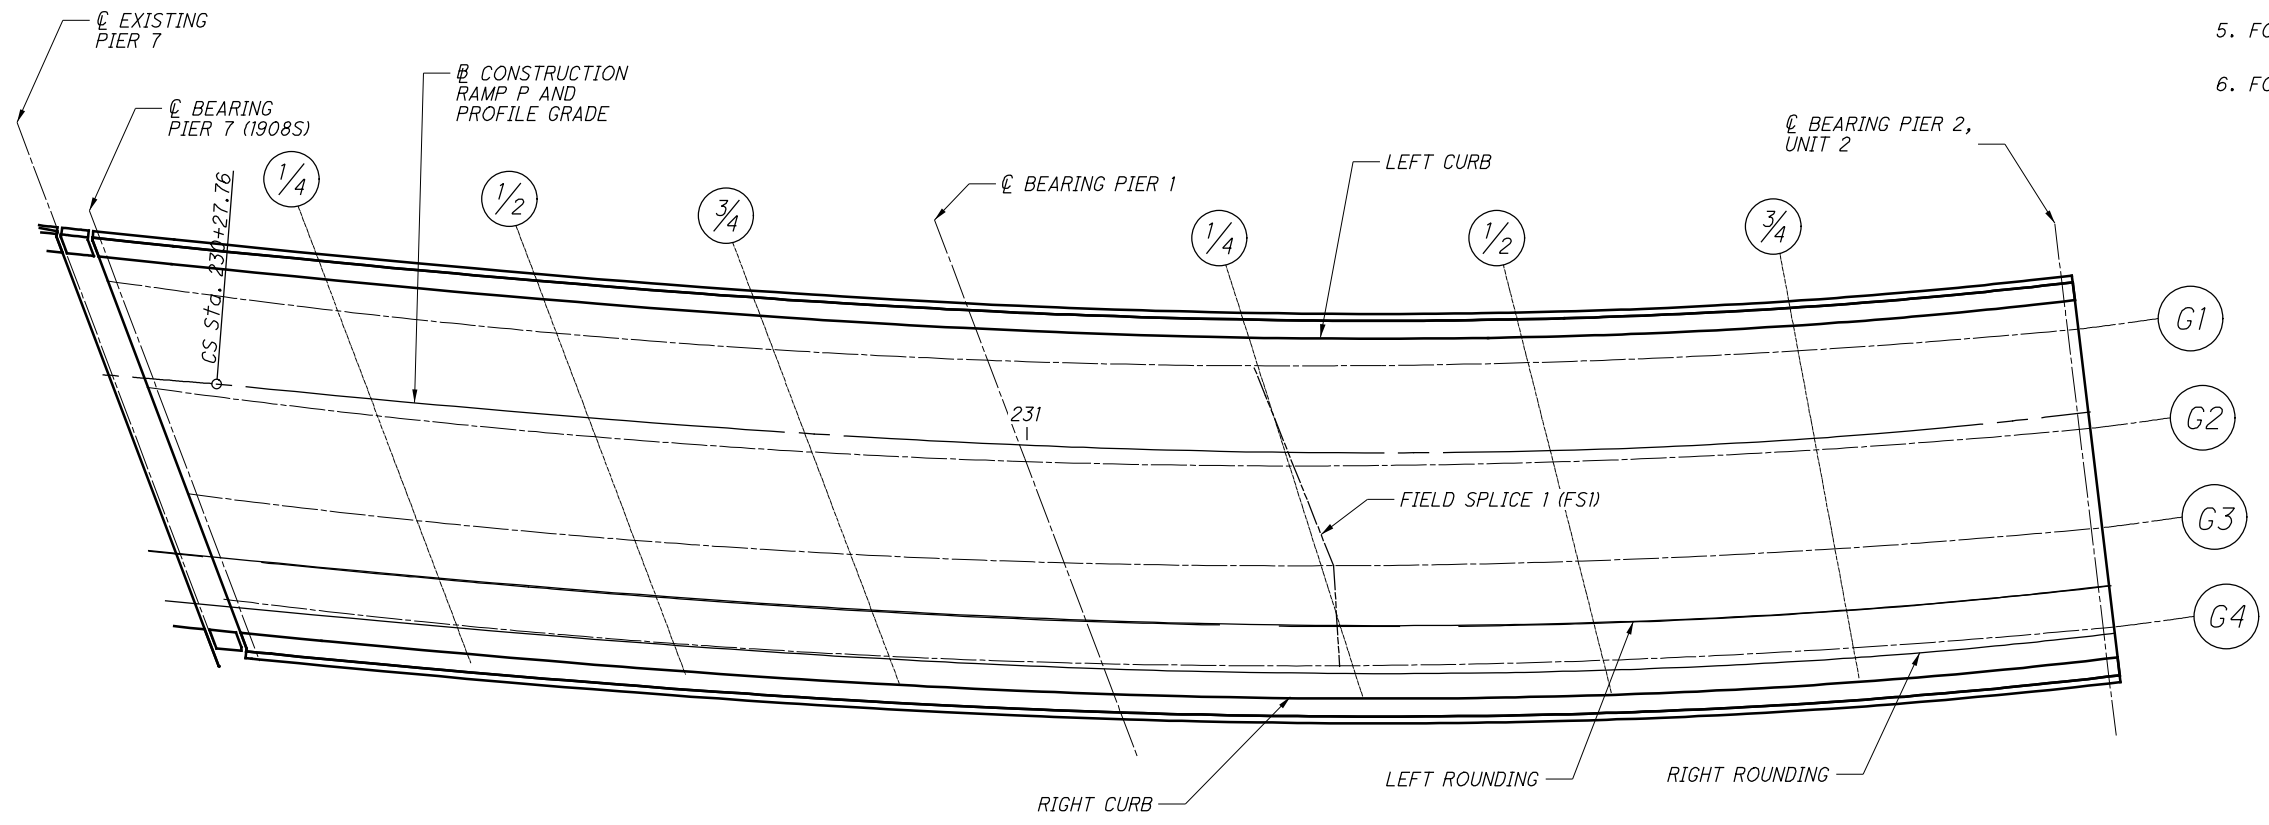

**ELEVATION LOCATION PLAN - UNIT 1**

**NOTES:**


1. FOR SCREED ELEVATIONS, SEE SHEET **66/79**.
2. FOR TOP OF HAUNCH ELEVATIONS, SEE SHEET **66/79**.
3. FOR FINAL DECK ELEVATIONS, SEE SHEET **66/79**.
4. FOR DECK PLAN, SEE SHEET **54/79**.
5. FOR TRANSVERSE SECTION, SEE SHEET **53/79**.
6. FOR FRAMING PLAN, SEE SHEET **37/79**.

<b>DESIGN AGENCY</b> <b>PRIME</b> <small>540 WHITE POND DR. SUITE E AKRON, OH 44320</small>
<b>ELEVATION LOCATION PLAN - UNIT 1</b> <small>BRIDGE NO. HAM-74-1908S RAMP P OVER IR-74 WESTBOUND, IR-75 AND RAMP E</small>
<b>HAM-75-3.84</b> <b>PID No. 104667</b>
DESIGNED: KDC CHECKED: CRG DRAWN: ADS REVISED:
REVIEWED: TES DATE: 8/22/2019 STRUCTURE FILE NUMBER: 3109798
65 / 79
<div style="border: 1px solid black; border-radius: 50%; width: 30px; height: 30px; display: flex; align-items: center; justify-content: center;"> <div style="border-right: 1px solid black; width: 15px; height: 15px; border-radius: 50%;"></div> <div style="width: 15px; height: 15px; border-radius: 50%;"></div> </div>

P:\Projects\2018\20H03DB-18232 HAM-75-03.84\104667\structures\HAM074\_1908S\sheets\074\_1908S\_MD002.dgn 7/28/2023 9:36:15 AM erin.baumann

SCREED ELEVATIONS - UNIT 1											
		¢ BRG. PIER 7 (1908S)	1/4 POINT	1/2 POINT	3/4 POINT	¢ BRG. PIER 1	1/4 POINT	FSI POINT	1/2 POINT	3/4 POINT	¢ BRG. PIER 2, UNIT 2
LEFT CURB	STATION	230+22.32	230+40.55	230+58.80	230+77.09	230+95.41	231+18.38	231+18.88	231+41.39	231+64.47	231+87.59
	ELEV.	539.28	539.53	539.79	540.08	540.42	540.96	540.97	541.56	542.16	542.75
PROFILE GRADE	STATION	230+26.34	230+44.47	230+62.61	230+80.75	230+98.88	231+21.07	231+22.34	231+43.25	231+65.43	231+87.62
	ELEV.	539.41	539.70	540.00	540.32	540.71	541.28	541.31	541.91	542.53	543.14
LEFT ROUNDING	STATION	230+34.30	230+52.21	230+70.07	230+87.86	231+05.59	231+26.23	231+26.25	231+46.79	231+67.27	231+87.67
	ELEV.	540.05	540.39	540.74	541.11	541.53	542.12	542.12	542.76	543.38	543.99
RIGHT ROUNDING	STATION	230+36.26	230+54.11	230+71.89	230+89.59	231+07.22	231+27.48	231+26.25	231+47.64	231+67.71	231+87.68
	ELEV.	540.08	540.43	540.79	541.17	541.61	542.20	543.38	542.83	543.46	544.07
RIGHT CURB	STATION	230+37.23	230+55.06	230+72.70	230+90.45	231+08.03	231+28.10	231+26.25	231+48.06	231+67.92	231+87.68
	ELEV.	540.02	540.38	540.75	541.14	541.57	542.17	542.11	542.80	543.43	544.04

TOP OF HAUNCH ELEVATIONS - UNIT 1											
		¢ BRG. PIER 7 (1908S)	1/4 POINT	1/2 POINT	3/4 POINT	¢ BRG. PIER 1	1/4 POINT	FSI **	1/2 POINT	3/4 POINT	¢ BRG. PIER 2, UNIT 2
EX. GIRDER 1	STATION	230+23.32	230+41.59	230+59.88	230+78.20	230+96.55	231+19.25	231+18.88	231+41.99	231+64.78	231+87.60
	ELEV.	538.60	538.87	539.15	539.45	539.80	540.34	540.34	540.95	541.55	542.16
EX. GIRDER 2	STATION	230+27.57	230+45.72	230+63.87	230+82.00	231+00.12	231+22.01	231+22.34	231+43.90	231+65.77	231+87.62
	ELEV.	538.80	539.11	539.43	539.76	540.14	540.71	540.72	541.33	541.95	542.58
EX. GIRDER 3	STATION	230+31.78	230+49.80	230+67.78	230+85.71	231+03.61	231+24.70	231+25.71	231+45.74	231+66.73	231+87.65
	ELEV.	539.13	539.47	539.81	540.17	540.57	541.15	541.18	541.77	542.40	543.02
EX. GIRDER 4	STATION	230+35.95	230+53.83	230+71.63	230+89.36	231+07.01	231+27.31	231+26.25	231+47.53	231+67.65	231+87.68
	ELEV.	539.38	539.73	540.09	540.47	540.90	541.50	541.46	542.13	542.76	543.37

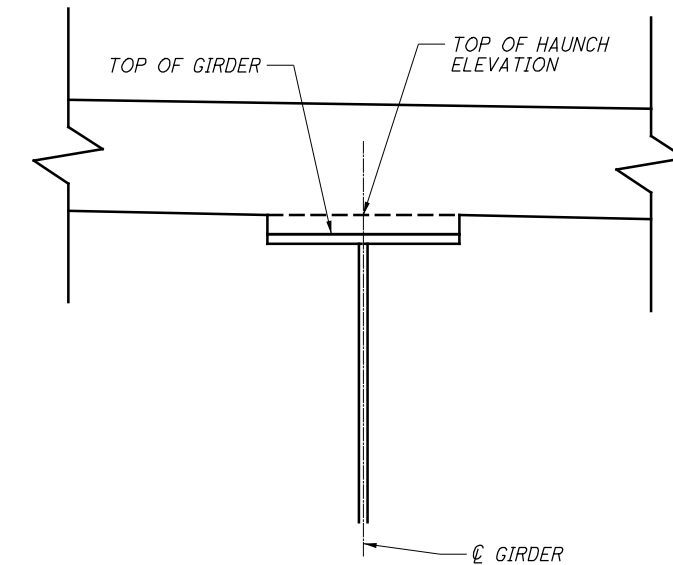

(A) 66 **DETAIL - TOP OF HAUNCH**

FINAL DECK SURFACE ELEVATIONS - UNIT 1											
		¢ BRG. EX. PIER 7	1/4 POINT	1/2 POINT	3/4 POINT	¢ BRG. PIER 1	1/4 POINT	FSI **	1/2 POINT	3/4 POINT	¢ BRG. PIER 2, UNIT 1
LEFT CURB	STATION	230+22.32	230+40.55	230+58.80	230+77.09	230+95.41	231+18.38	231+18.88	231+41.39	231+64.47	231+87.59
	ELEV.	539.28	539.51	539.77	540.08	540.42	540.91	540.92	541.46	542.07	542.75
GIRDER 1	STATION	230+23.32	230+41.59	230+59.88	230+78.20	230+96.55	231+19.25	231+18.88	231+41.99	231+64.78	231+87.60
	ELEV.	539.31	539.56	539.84	540.16	540.51	541.00	540.99	541.55	542.17	542.87
PROFILE GRADE	STATION	230+26.34	230+44.47	230+62.61	230+80.75	230+98.88	231+21.07	231+22.34	231+43.25	231+65.43	231+87.62
	ELEV.	539.41	539.68	539.98	540.32	540.71	541.23	541.26	541.81	542.45	543.14
GIRDER 2	STATION	230+27.57	230+45.72	230+63.87	230+82.00	231+00.12	231+22.01	231+22.34	231+43.90	231+65.77	231+87.62
	ELEV.	539.51	539.79	540.12	540.47	540.85	541.37	541.38	541.94	542.58	543.29
GIRDER 3	STATION	230+31.78	230+49.80	230+67.78	230+85.71	231+03.61	231+24.70	231+25.71	231+45.74	231+66.73	231+87.65
	ELEV.	539.84	540.16	540.50	540.87	541.28	541.81	541.83	542.39	543.03	543.73
LEFT ROUNDING	STATION	230+34.30	230+52.21	230+70.07	230+87.86	231+05.59	231+26.23	231+26.25	231+46.79	231+67.27	231+87.67
	ELEV.	540.05	540.37	540.72	541.11	541.53	542.08	542.08	542.67	543.31	543.99
GIRDER 4	STATION	230+35.95	230+53.83	230+71.63	230+89.36	231+07.01	231+27.31	231+26.25	231+47.53	231+67.65	231+87.68
	ELEV.	540.09	540.41	540.77	541.17	541.61	542.16	542.13	542.75	543.39	544.07
RIGHT ROUNDING	STATION	230+36.26	230+54.11	230+71.89	230+89.59	231+07.22	231+27.48	231+26.25	231+47.64	231+67.71	231+87.68
	ELEV.	540.08	540.40	540.77	541.17	541.61	542.15	542.12	542.75	543.38	544.07
RIGHT CURB	STATION	230+37.23	230+55.06	230+72.70	230+90.45	231+08.03	231+28.10	231+26.25	231+48.06	231+67.92	231+87.68
	ELEV.	540.02	540.36	540.72	541.13	541.57	542.07	542.12	542.72	543.35	544.04

**LEGEND:**


\*\* - FIELD SPLICE 1 LOCATED BEFORE 1/4 POINT FOR: GIRDER 1, GIRDER 4, RIGHT ROUNDING & RIGHT CURB

**NOTES:**


1. SCREED ELEVATIONS SHOWN REPRESENT THE THEORETICAL DECK SURFACE LOCATION PRIOR TO DEFLECTIONS CAUSED BY DECK PLACEMENT AND OTHER ANTICIPATED DEAD LOADS.
2. TOP OF HAUNCH ELEVATIONS SHOWN REPRESENT THE THEORETICAL LOCATION OF THE BOTTOM OF THE DECK ABOVE THE BEAM HAUNCH PRIOR TO DEFLECTIONS CAUSED BY DECK PLACEMENT AND OTHER ANTICIPATED DEAD LOADS.
3. FINAL DECK SURFACE ELEVATIONS SHOWN REPRESENT THE DECK SURFACE LOCATION AFTER ALL ANTICIPATED DEAD LOAD DEFLECTIONS HAVE OCCURRED.
4. FOR ELEVATION DIAGRAM DEPICTING DECK SURFACE LOACTIONS IN TRANSVERSE SECTION AND PLAN VIEW, SEE SHEET 65/79.
5. FOR DECK POURING SEQUENCE, SEE SHEET 62/79.
6. FOR ADDITIONAL NOTES, SEE SHEET 65/79.



P:\Projects\2018\20H03DB-18232 HAM-75-03.84\104667\structures\HAM074\_1908S\sheets\074\_1908S\_MD003.dgn 7/28/2023 9:36:21 AM erin.boumann

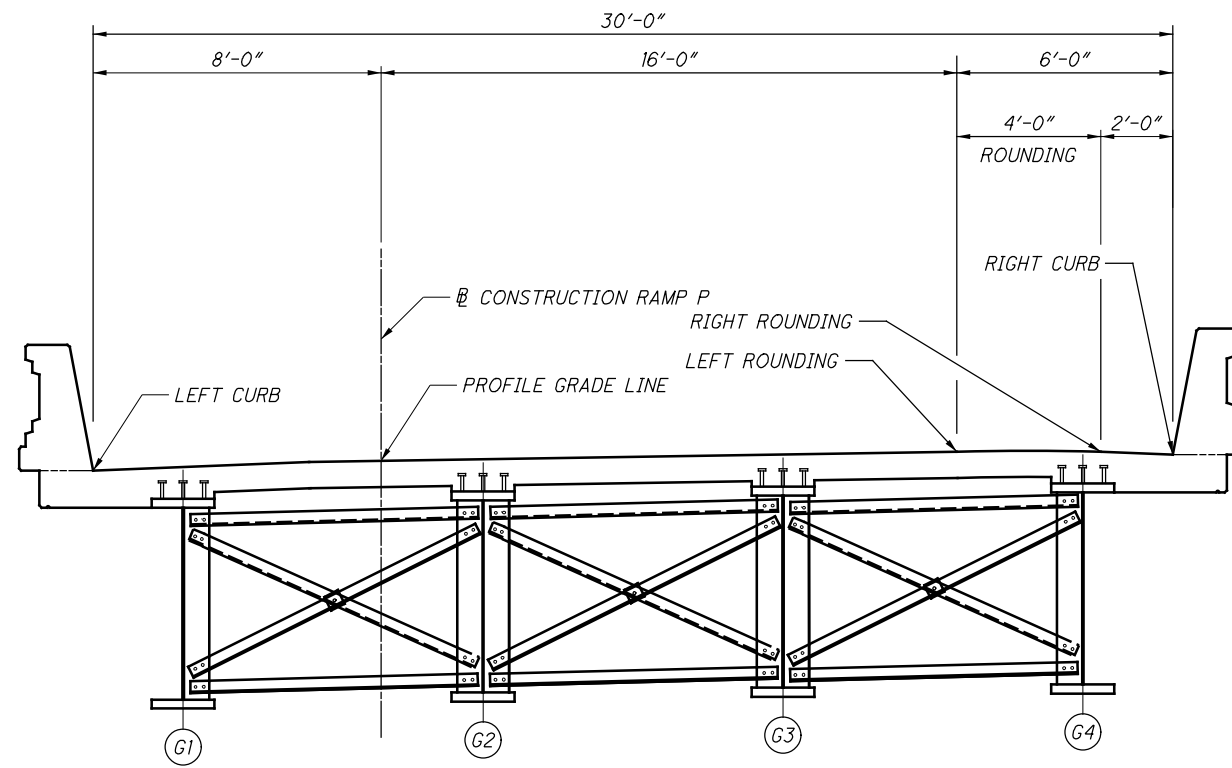

**TRANSVERSE SECTION - UNIT 2**

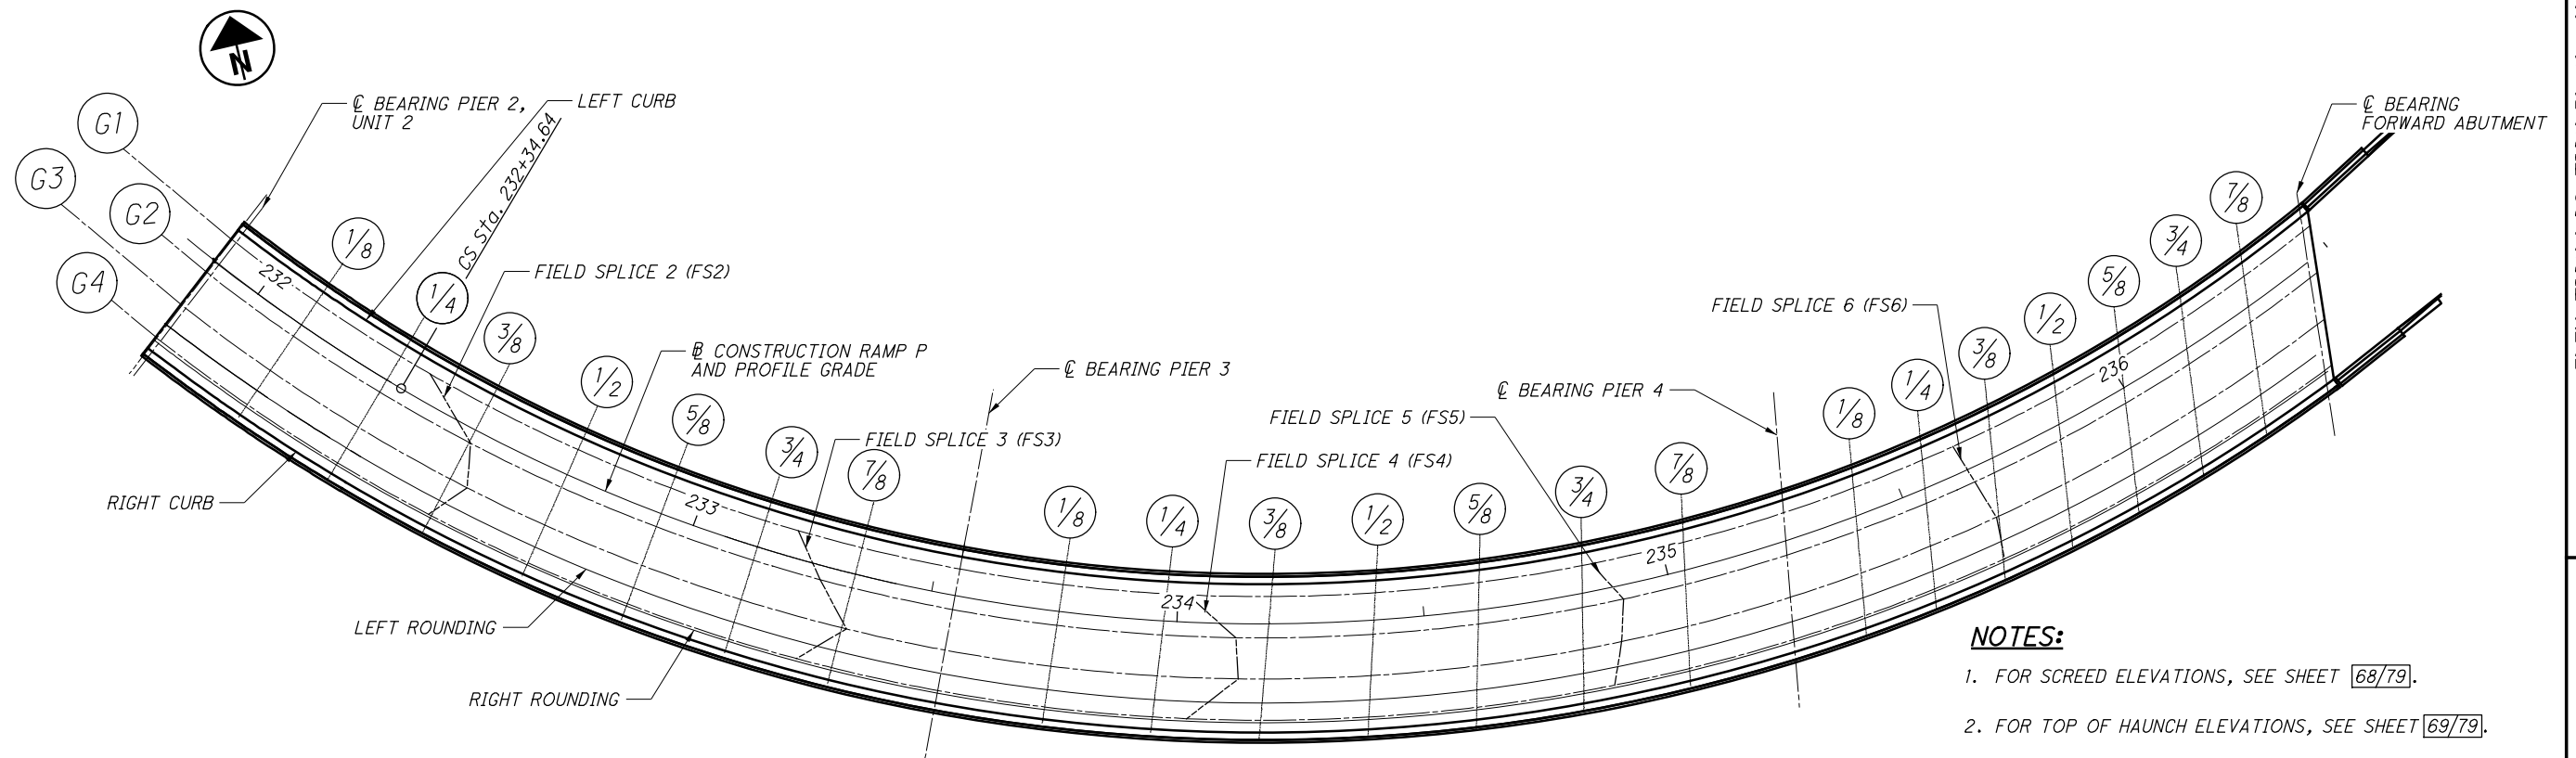

**PLAN - UNIT 2**

**NOTES:**

1. FOR SCREED ELEVATIONS, SEE SHEET 68/79.
2. FOR TOP OF HAUNCH ELEVATIONS, SEE SHEET 69/79.
3. FOR FINAL DECK ELEVATIONS, SEE SHEET 70/79.
4. FOR DECK PLAN, SEE SHEET 59/79.
5. FOR TRANSVERSE SECTIONS, SEE SHEET 58/79.
6. FOR FRAMING PLAN, SEE SHEET 42/79.

P:\Projects\2018\20H03DB-18232 HAM-75-03.84\104667\structures\HAM074\_1908S\sheets\074\_1908S\_MD004.dgn 7/28/2023 9:36:22 AM erin.boumann

SCREED ELEVATIONS - UNIT 2

		℄ BRG. PIER 3	1/8 POINT	1/4 POINT	FS4	3/8 POINT	1/2 POINT	5/8 POINT	3/4 POINT	FS5	7/8 POINT	℄ BRG. PIER 4	1/8 POINT	1/4 POINT	FS6	3/8 POINT	1/2 POINT	5/8 POINT	3/4 POINT	7/8 POINT	℄ BRG. FA
LEFT CURB	STATION	233+54.81	233+76.30	233+97.80	234+01.94	234+19.29	234+40.79	234+62.28	234+83.77	234+85.28	235+05.27	235+26.76	235+42.12	235+57.48	235+63.53	235+72.83	235+88.19	236+03.55	236+18.91	236+34.26	236+49.62
	ELEV.	547.38	547.62	547.79	547.81	547.87	547.82	547.64	547.34	547.32	546.93	546.43	546.04	545.63	545.46	545.21	544.78	544.34	543.89	543.42	542.93
PROFILE GRADE	STATION	233+54.81	233+76.06	233+97.31	234+11.94	234+18.56	234+39.82	234+61.07	234+82.32	234+90.24	235+03.57	235+24.82	235+39.84	235+57.87	235+64.26	235+69.89	235+84.92	235+99.94	236+14.96	236+29.99	236+45.01
	ELEV.	547.86	548.08	548.24	548.30	548.31	548.27	548.11	547.82	547.69	547.43	546.96	546.59	546.19	545.94	545.79	545.37	544.94	544.49	544.02	543.55
LEFT ROUNDING	STATION	233+54.81	233+75.61	233+96.41	234+02.78	234+17.21	234+38.01	234+58.81	234+79.61	234+85.09	235+00.41	235+21.21	235+35.63	235+50.04	235+63.61	235+64.45	235+78.86	235+93.27	236+07.68	236+22.09	236+36.50
	ELEV.	548.82	548.99	549.12	549.15	549.19	549.17	549.04	548.78	548.71	548.43	548.00	547.68	547.32	546.97	546.94	546.55	546.13	545.69	545.23	544.75
RIGHT ROUNDING	STATION	233+54.81	233+75.50	233+96.20	234+38.01	234+16.89	234+37.58	234+58.28	234+78.97	235+21.21	234+99.67	235+20.36	235+34.63	235+48.90	235+78.86	235+63.17	235+77.44	235+91.70	236+05.97	236+20.24	236+34.51
	ELEV.	548.92	549.09	549.22	549.25	549.29	549.27	549.14	548.89	548.81	548.54	548.12	547.81	547.45	547.07	547.08	546.69	546.27	545.84	545.38	544.91
RIGHT CURB	STATION	233+54.81	233+75.45	233+96.09	234+02.78	234+16.73	234+37.38	234+58.02	234+78.66	234+85.09	234+99.30	235+19.94	235+34.14	235+48.34	235+63.61	235+62.54	235+76.74	235+90.93	236+05.13	236+19.33	236+33.53
	ELEV.	548.90	549.07	549.20	549.23	549.27	549.25	549.12	548.88	548.79	548.53	548.11	547.80	547.45	547.05	547.08	546.69	546.28	545.84	545.39	544.92

**LEGEND:**

\*\* - FIELD SPLICE 2 LOCATED AFTER 3/8 POINT FOR: PROFILE GRADE

**NOTES:**

1. SCREED ELEVATIONS SHOWN REPRESENT THE THEORETICAL DECK SURFACE LOCATION PRIOR TO DEFLECTIONS CAUSED BY DECK PLACEMENT AND OTHER ANTICIPATED DEAD LOADS.
2. FOR DECK PLAN, SEE SHEET [59/79].
3. FOR TOP OF HAUNCH ELEVATIONS, SEE SHEET [69/79].
4. FOR FINAL DECK SURFACE ELEVATIONS, SEE SHEET [70/79].
5. FOR ELEVATION DIAGRAM DEPICTING DECK SURFACE LOACTIONS IN TRANSVERSE SECTION AND PLAN VIEW, SEE SHEET [67/79].
6. FOR DECK POURING SEQUENCE, SEE SHEET [62/79].

DESIGN AGENCY  
**PRIME**  
540 WHITE POND DR. SUITE E  
AKRON, OH 44320

**SCREED ELEVATIONS - UNIT 2**  
BRIDGE NO. HAM-74-1908S  
RAMP P OVER IR-74 WESTBOUND, IR-75 AND RAMP E

DESIGNED: KDC  
CHECKED: CRG

DRAWN: ADS  
REVISED:

REVIEWED: TES  
DATE: 8/22/2019  
STRUCTURE FILE NUMBER: 3109798

HAM-75-3.84  
PID No. 104667

68 / 79

68  
79

P:\Projects\2018\20H03DB-18232 HAM-75-03.84\104667\structures\HAM074\_1908S\_MD005.dgn 7/28/2023 9:36:24 AM erin.boumann

**TOP OF HAUNCH ELEVATIONS - UNIT 2**

		⊕ BRG. PIER 2, UNIT 2	1/8 POINT	1/4 POINT	FS2	3/8 POINT	1/2 POINT	5/8 POINT	3/4 POINT	FS3	7/8 POINT	⊕ BRG. PIER 3	1/8 POINT	1/4 POINT	FS4	3/8 POINT	1/2 POINT	5/8 POINT
GIRDER 1	STATION	231+90.13	232+10.68	232+31.26	232+38.31	232+51.85	232+72.45	232+93.04	233+13.62	233+20.63	233+34.22	233+54.81	233+76.23	233+97.64	234+00.92	234+19.06	234+40.48	234+61.89
	ELEV.	542.24	543.02	543.79	544.05	544.55	545.23	545.77	546.21	546.33	546.55	546.82	547.06	547.23	547.25	547.31	547.26	547.09
GIRDER 4	STATION	231+90.07	232+10.80	232+31.40	232+51.39	232+52.00	232+72.56	232+93.11	233+13.70	233+27.09	233+34.26	233+54.81	233+75.52	233+96.23	234+85.09	234+16.93	234+37.64	234+58.35
	ELEV.	543.47	544.43	545.36	546.15	546.18	546.85	547.36	547.73	547.92	548.01	548.22	548.39	548.52	548.10	548.58	548.56	548.43

**TOP OF HAUNCH ELEVATION - UNIT 2**


		3/4 POINT	FS5	7/8 POINT	⊕ BRG. PIER 4	1/8 POINT	1/4 POINT	FS6	3/8 POINT	1/2 POINT	5/8 POINT	3/4 POINT	7/8 POINT	⊕ BRG. FA
GIRDER 1	STATION	234+83.31	234+85.28	235+04.73	235+26.15	235+41.40	235+56.65	235+63.53	235+71.90	235+87.15	236+02.40	236+17.65	236+32.90	236+48.16
	ELEV.	546.79	546.76	546.38	545.89	545.50	545.09	544.90	544.68	544.25	543.82	543.36	542.90	542.42
GIRDER 4	STATION	234+79.06	234+85.09	234+99.76	235+20.47	235+34.76	235+49.04	235+53.33	235+63.33	235+77.61	235+91.90	236+06.18	236+20.47	236+34.75
	ELEV.	548.18	548.10	547.84	547.41	547.09	546.74	546.63	546.36	545.96	545.55	545.11	544.66	544.20

**TOP OF HAUNCH ELEVATIONS - UNIT 2**

		⊕ BRG. PIER 2, UNIT 2	1/8 POINT	1/4 POINT	3/8 POINT	FS2	1/2 POINT	5/8 POINT	3/4 POINT	FS3	7/8 POINT	⊕ BRG. PIER 3	1/8 POINT	1/4 POINT	FS4	3/8 POINT	1/2 POINT	5/8 POINT
GIRDER 2	STATION	231+90.10	232+10.72	232+31.31	232+51.89	232+52.21	232+72.48	232+93.07	233+13.64	233+27.59	233+34.23	233+54.81	233+75.98	233+97.15	234+11.94	234+18.31	234+39.48	234+60.65
	ELEV.	542.66	543.51	544.34	545.15	545.16	545.80	546.33	546.75	546.97	547.07	547.32	547.54	547.70	547.76	547.77	547.73	547.57
GIRDER 3	STATION	231+90.09	232+10.76	232+31.35	232+51.94	232+55.67	232+72.52	232+93.09	233+13.66	233+34.11	233+34.24	233+54.81	233+75.74	233+96.67	234+11.58	234+17.61	234+38.54	234+59.47
	ELEV.	543.11	544.02	544.90	545.70	545.84	546.38	546.90	547.29	547.59	547.59	547.82	548.02	548.16	548.22	548.23	548.20	548.06

**TOP OF HAUNCH ELEVATION - UNIT 2**

		3/4 POINT	FS5	7/8 POINT	⊕ BRG. PIER 4	1/8 POINT	1/4 POINT	FS6	3/8 POINT	1/2 POINT	5/8 POINT	3/4 POINT	7/8 POINT	⊕ BRG. FA
GIRDER 2	STATION	234+81.82	234+90.24	235+02.99	235+24.16	235+39.07	235+53.98	235+64.62	235+68.89	235+83.80	235+98.71	236+13.62	236+28.53	236+43.44
	ELEV.	547.29	547.15	546.91	546.44	546.07	545.68	545.39	545.27	544.86	544.43	543.99	543.52	543.05
GIRDER 3	STATION	234+80.40	234+88.08	235+01.34	235+22.27	235+36.86	235+51.45	235+65.56	235+66.03	235+80.62	235+95.21	236+09.80	236+24.39	236+38.98
	ELEV.	547.79	547.67	547.43	546.98	546.64	546.26	545.88	545.87	545.47	545.05	544.60	544.15	543.68

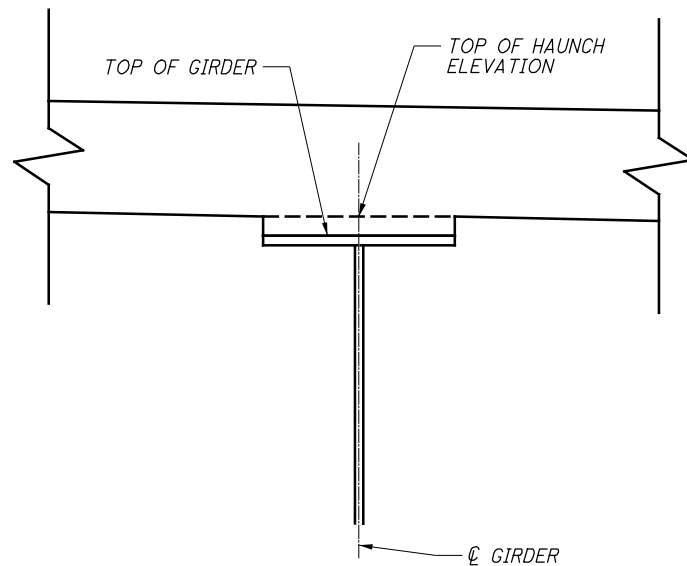

**TOP OF HAUNCH DETAIL**

**LEGEND:**

\*\* - FIELD SPLICE 2 LOCATED AFTER 3/8 POINT FOR PROFILE GRADE

**NOTES:**

1. TOP OF HAUNCH ELEVATIONS SHOWN REPRESENT THE THEORETICAL LOCATION OF THE BOTTOM OF THE DECK ABOVE THE BEAM HAUNCH PRIOR TO DEFLECTIONS CAUSED BY DECK PLACEMENT AND OTHER ANTICIPATED DEAD LOADS.
2. FOR DECK PLAN, SEE SHEET [59/79].
3. FOR SCREED ELEVATIONS, SEE SHEET [68/79].
4. FOR FINAL DECK SURFACE ELEVATIONS, SEE SHEET [70/79].
5. FOR ELEVATION DIAGRAM DEPICTING DECK SURFACE LOACTIONS IN TRANSVERSE SECTION AND PLAN VIEW, SEE SHEET [67/79].
6. FOR DECK POURING SEQUENCE, SEE SHEET [67/79].

FINAL DECK SURFACE ELEVATIONS - UNIT 2

Table with columns for stationing, elevation, and various points (1/8, 1/4, FS2, 3/8, 1/2, 5/8, 3/4, FS3, 7/8, 1/1, 1/8, 1/4, FS4, 3/8, 1/2, 5/8). Rows include LEFT CURB, GIRDER 1, PROFILE GRADE, GIRDER 2, GIRDER 3, LEFT ROUNDING, GIRDER 4, RIGHT ROUNDING, and RIGHT CURB.

FINAL DECK SURFACE ELEVATIONS - UNIT 2

Table with columns for stationing, elevation, and various points (3/4, FS5, 7/8, 1/1, 1/8, 1/4, FS6, 3/8, 1/2, 5/8, 3/4, 7/8, 1/8, FA). Rows include LEFT CURB, GIRDER 1, PROFILE GRADE, GIRDER 2, GIRDER 3, LEFT ROUNDING, GIRDER 4, RIGHT ROUNDING, and RIGHT CURB.

LEGEND:

\*\* - FIELD SPLICE 2 LOCATED AFTER 3/8 POINT FOR: PROFILE GRADE, GIRDER 1 & GIRDER 2

NOTES:

- 1. FINAL DECK SURFACE ELEVATIONS SHOWN REPRESENT THE DECK SURFACE LOCATION AFTER ALL ANTICIPATED DEAD LOAD DEFLECTIONS HAVE OCCURRED.
2. FOR DECK PLAN, SEE SHEET [59/79].
3. FOR SCREED ELEVATIONS, SEE SHEET [68/79].
4. FOR TOP OF HAUNCH ELEVATIONS, SEE SHEET [69/79].
5. FOR ELEVATION DIAGRAM DEPICTING DECK SURFACE LOACTIONS IN TRANSVERSE SECTION AND PLAN VIEW, SEE SHEET [67/79].
6. FOR DECK POURING SEQUENCE, SEE SHEET [62/79].

FINAL DECK SURFACE ELEVATIONS - UNIT 2

BRIDGE NO. HAM-74-1908S
RAMP P OVER IR-74 WESTBOUND, IR-75 AND RAMP E

HAM-75-3.84
PID No. 104667


70/79

70/79




DESIGNED: KDC
CHECKED: CRG
DRAWN: ADS
REVISED:
REVIEWED: TES
DATE: 8/22/2019
STRUCTURE FILE NUMBER: 3109798


P:\Projects\2018\20H03DB-18232 HAM-75-03.84\104667\structures\HAM074\_1908S\sheets\074\_1908S\_MD008.dgn 7/28/2023 9:36:39 AM erin.baumann

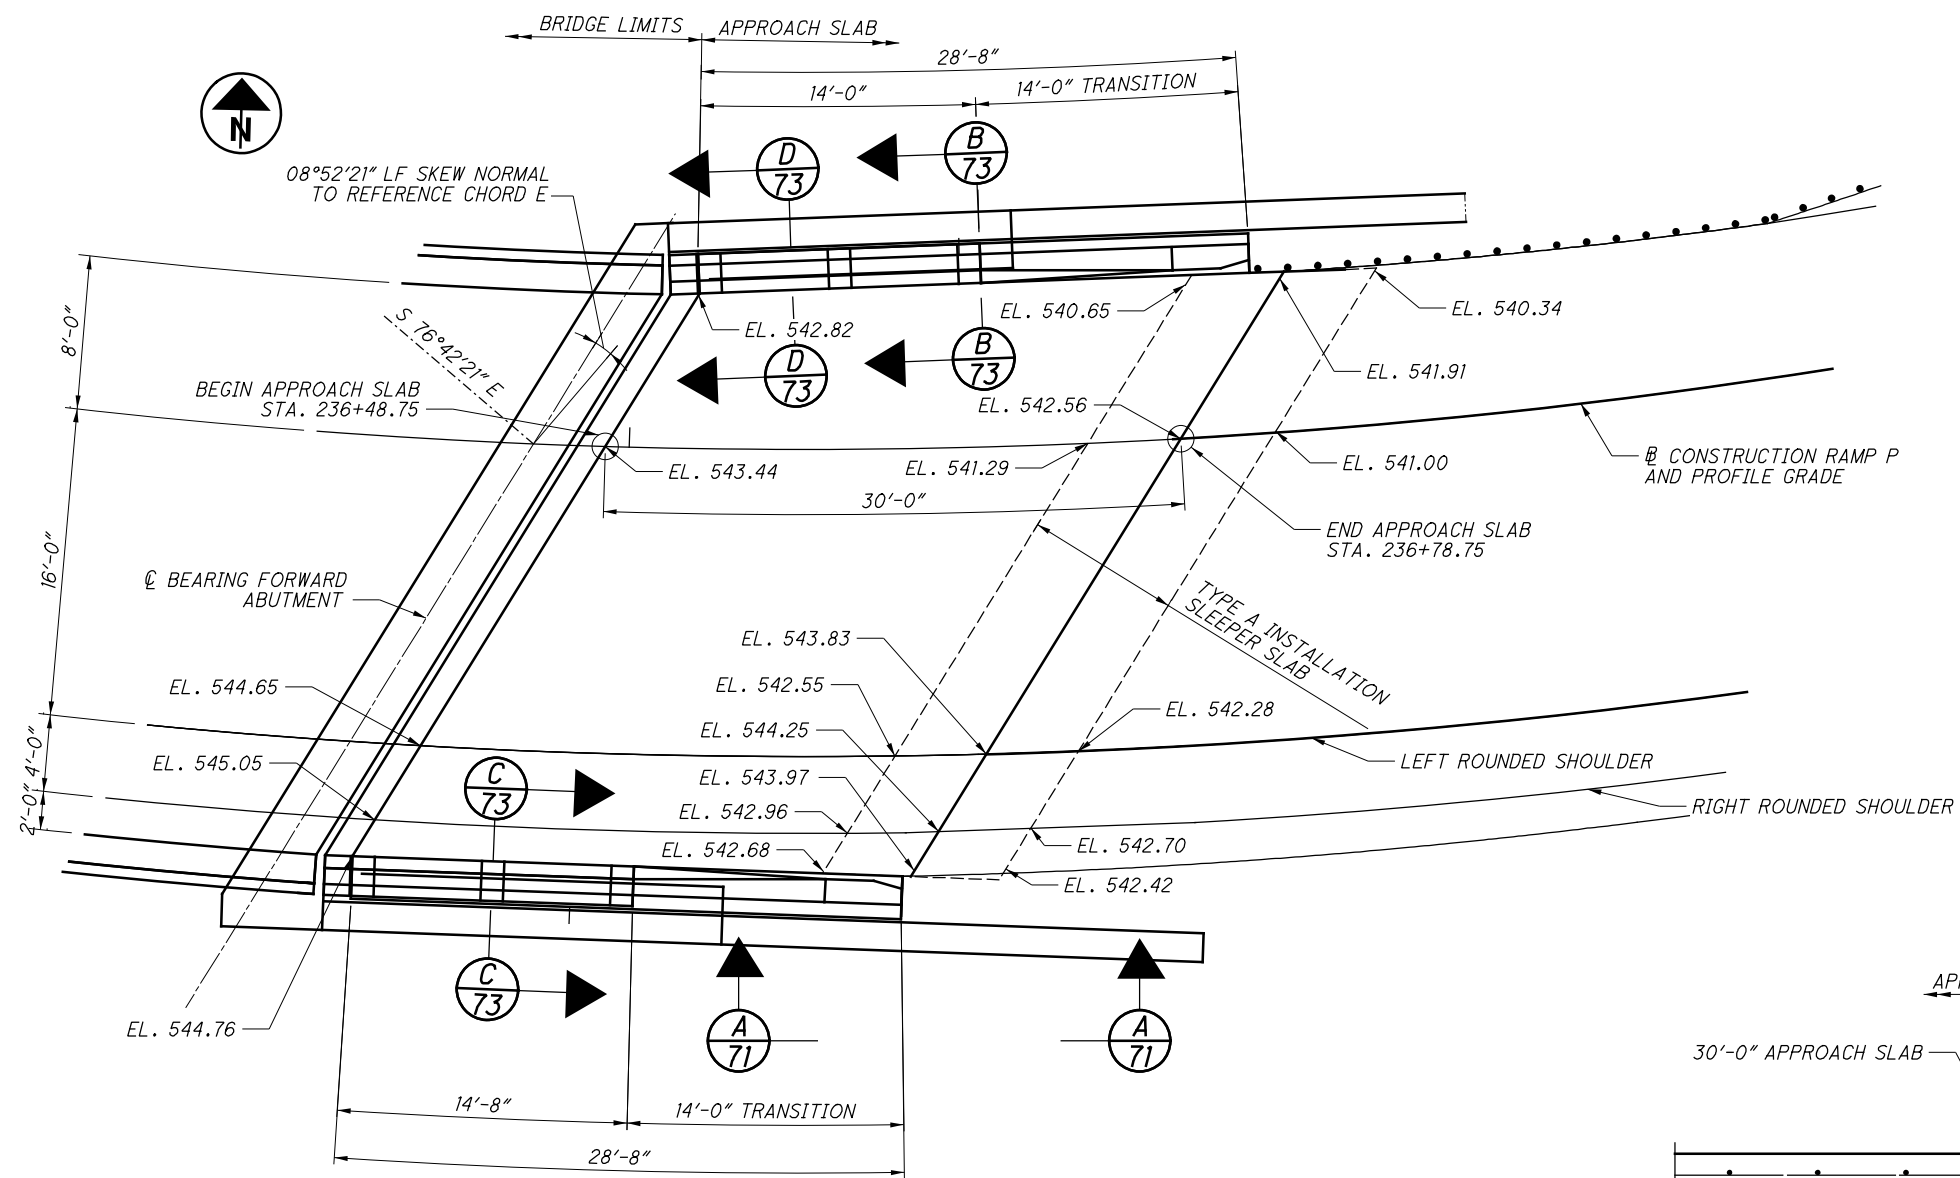

**APPROACH SLAB PLAN**

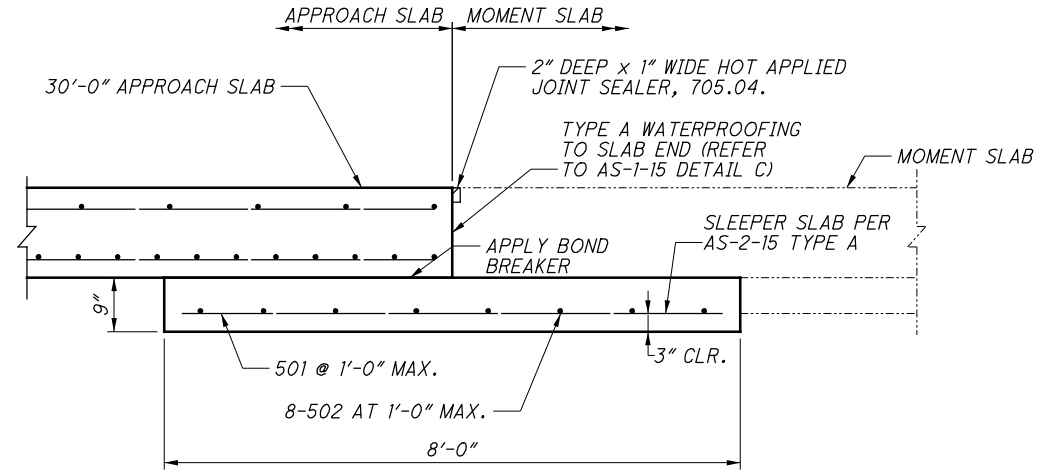

**A SECTION**

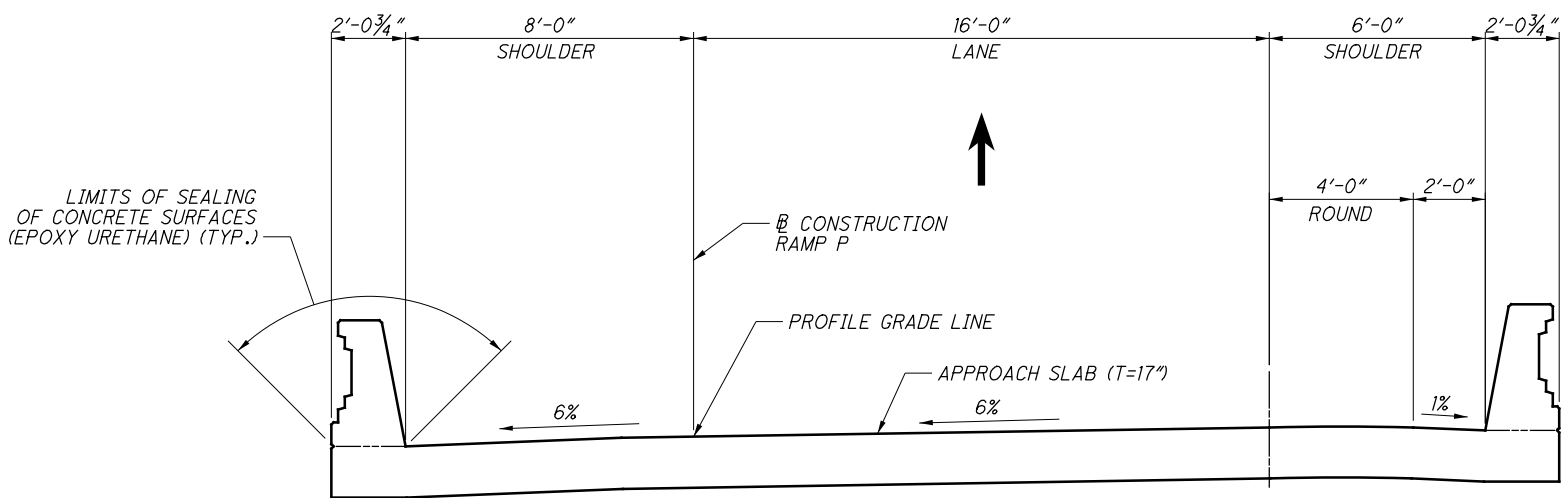

**APPROACH SLAB SECTION**

**NOTES:**

1. ALL CONCRETE SURFACES OF THE ORNAMENTAL PARAPET SHALL RECEIVE A RUBBED FINISH. SAW CUTTING AND TEXTURED FINISH ARE INCLUDED WITH ITEM 511 - CONCRETE CLASS QC3 WITH QC/QA-COMPRESSIVE STRENGTH 4.5 KSI, BRIDGE DECK (PARAPET), AS PER PLAN, FOR PAYMENT.
2. FOR MORE DETAILS, SEE STANDARD DRAWINGS AS-1-15 AND AS-2-15.
3. PARAPET DIMENSIONS ALONG OUTSIDE EDGE OF APPROACH SLAB.
4. FOR APPROACH PARAPET DETAILS, SEE SHEETS 72/79 AND 73/79.
5. THE PREFIX "AS" SHALL BE ADDED TO ALL BAR MARKS FOR APPROACH SLAB.

**APPROACH SLAB PLAN AND DETAILS (1 OF 3)**  
 BRIDGE NO. HAM-74-1908S  
 RAMP P OVER IR-74 WESTBOUND, IR-75 AND RAMP E


**HAM-75-3.84**  
**PID No. 104667**

71 / 79


71  
79

DESIGNED	KDC	CHECKED	CRG
DRAWN	ADS	REVISED	
REVIEWED	TES	DATE	8/22/2019
STRUCTURE FILE NUMBER	3109798		


P:\Projects\2018\20H03DB-18232 HAM-75-03.84\104667\structures\HAM074\_1908S\MD009.dgn 7/28/2023 9:36:44 AM erin.boumann

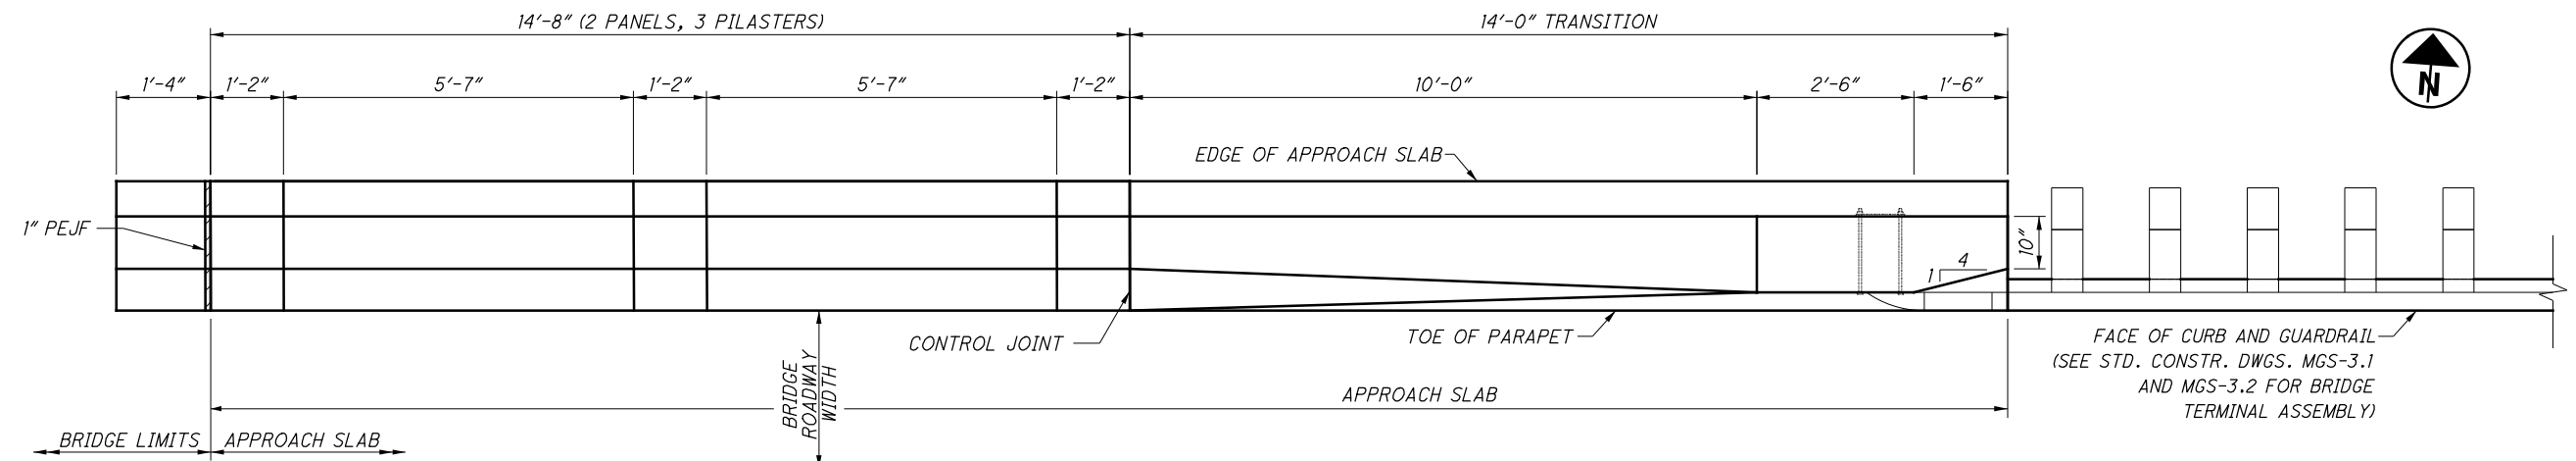

**APPROACH SLAB PARAPET PLAN**

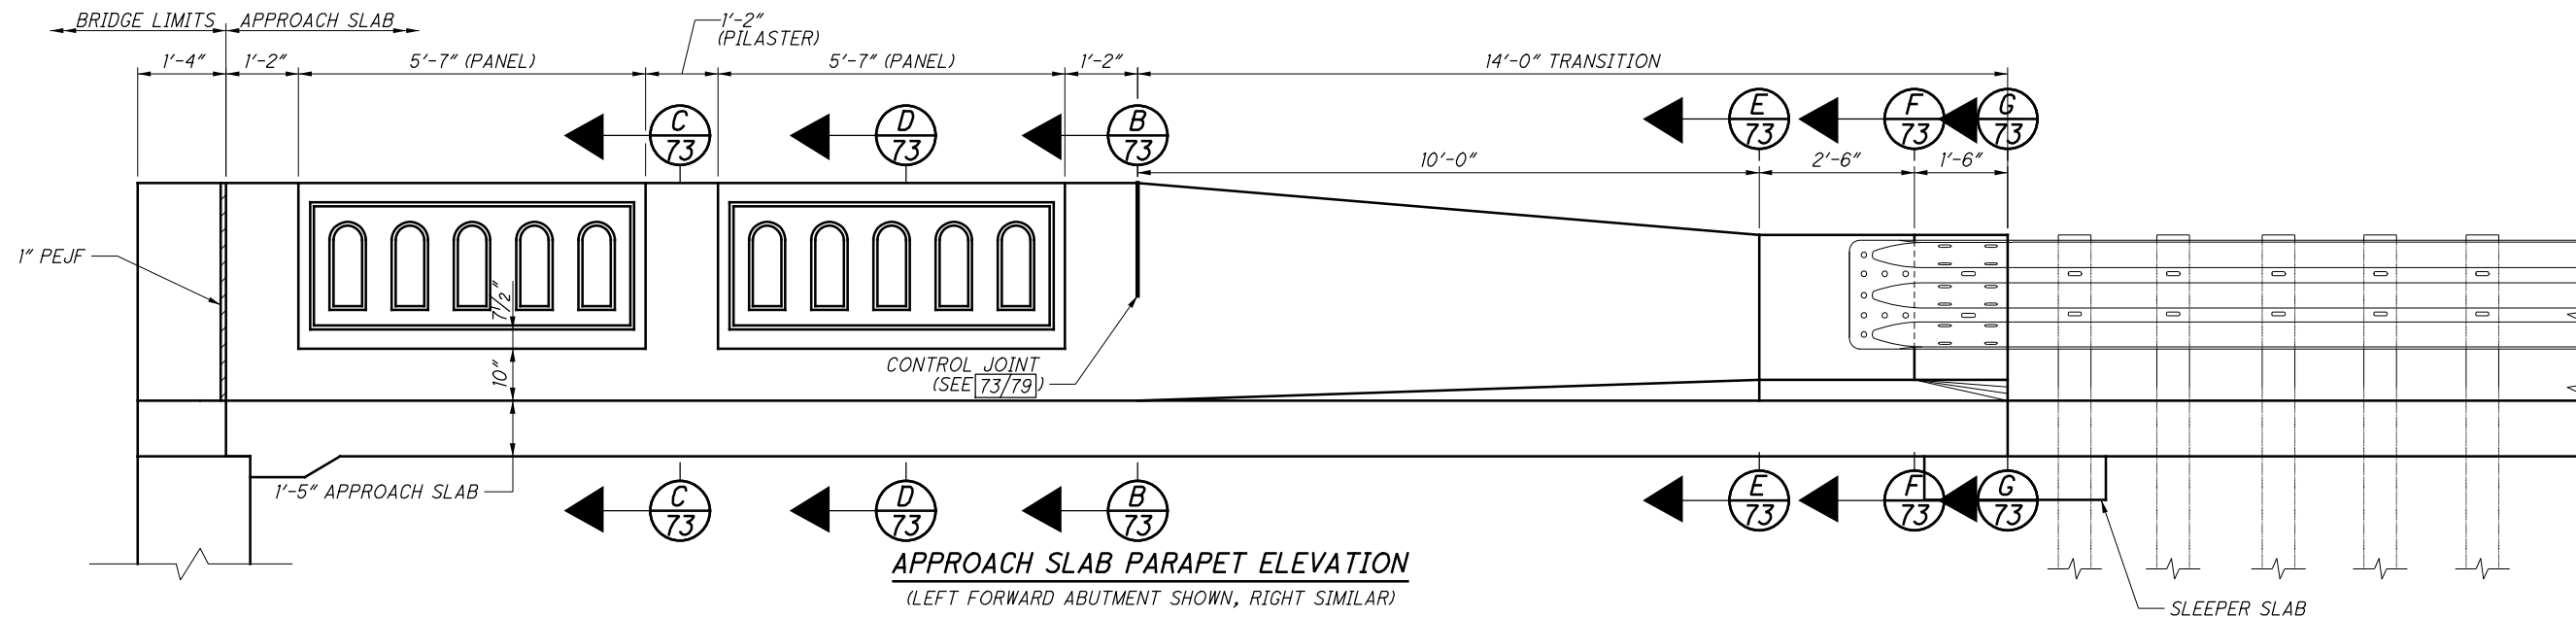

**APPROACH SLAB PARAPET ELEVATION**  
(LEFT FORWARD ABUTMENT SHOWN, RIGHT SIMILAR)

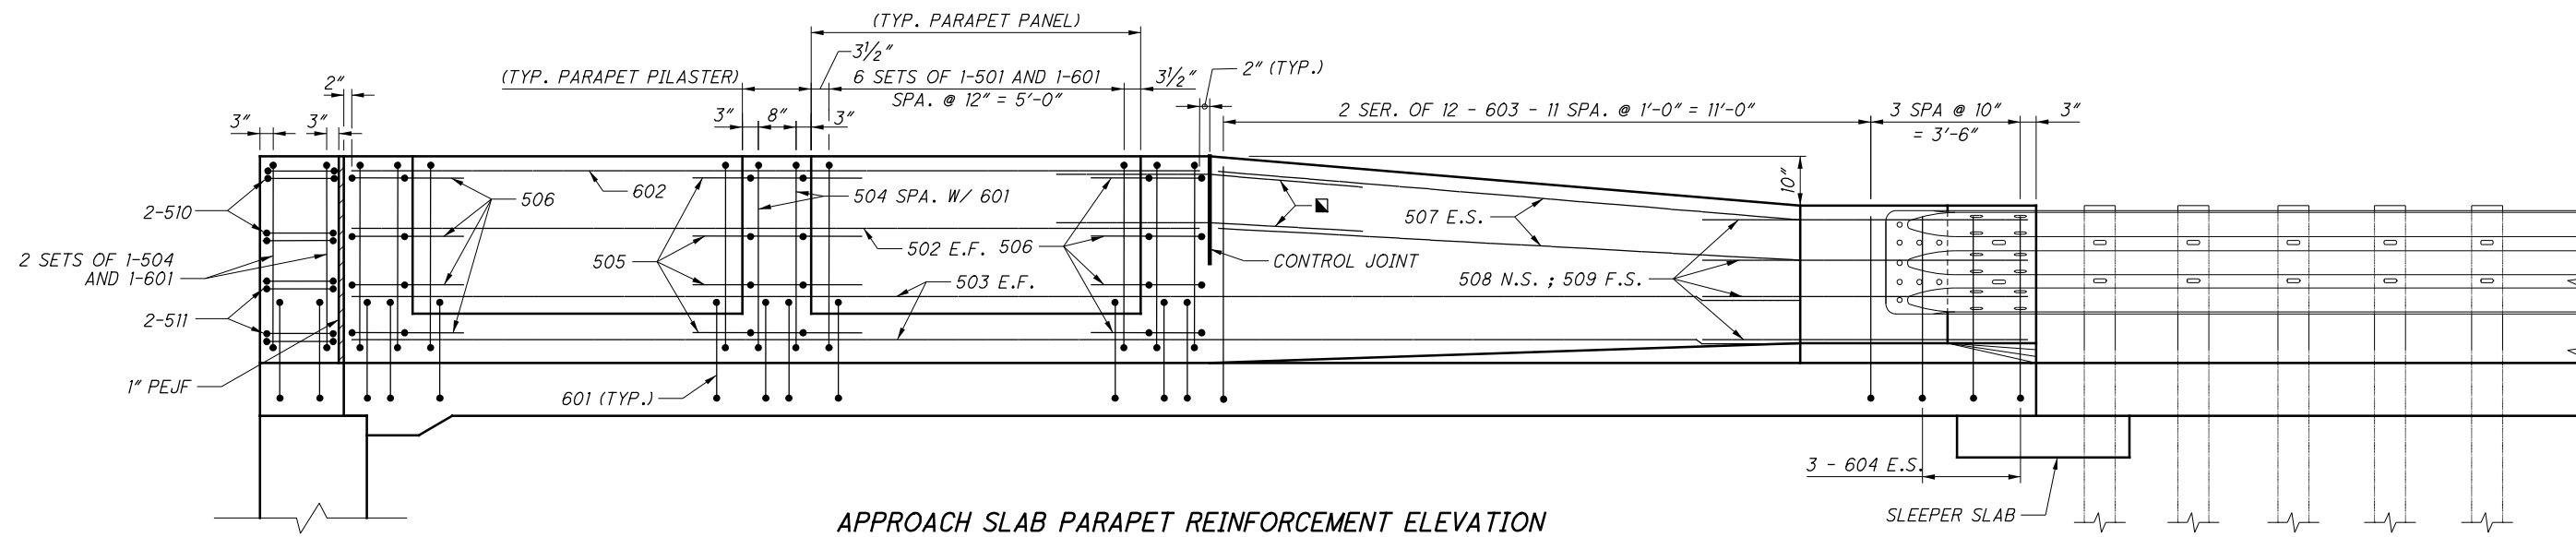


**APPROACH SLAB PARAPET REINFORCEMENT ELEVATION**


**LEGEND:**  
 ■ - 1/2" DIA. GLASS FIBER REINFORCED POLYMER (GFRP) STIFFENING REINFORCEMENT

**NOTES:**  
 1. FOR ADDITIONAL DETAILS AND NOTES, SEE SHEET [73/79].  
 2. FOR PANEL DETAILS, SEE SHEET [57/79].


P:\Projects\2018\20H03DB-18232 HAM-75-03.84\104667\structures\HAM074\_1908S\sheets\074\_1908S\_MD010.dgn 7/28/2023 9:36:47 AM erin.baumann

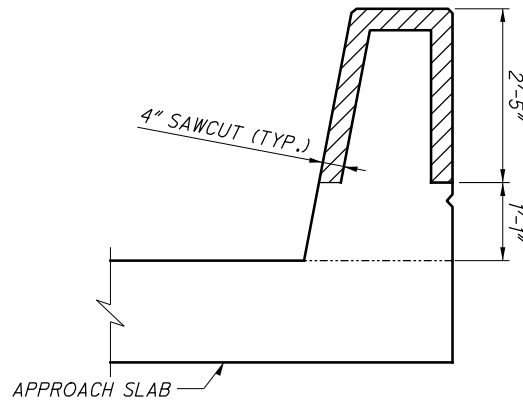


**B** CONTROL JOINT DETAIL  
71,72 (SECTION THROUGH SAWCUT)  
(SEE SBR-1-99)

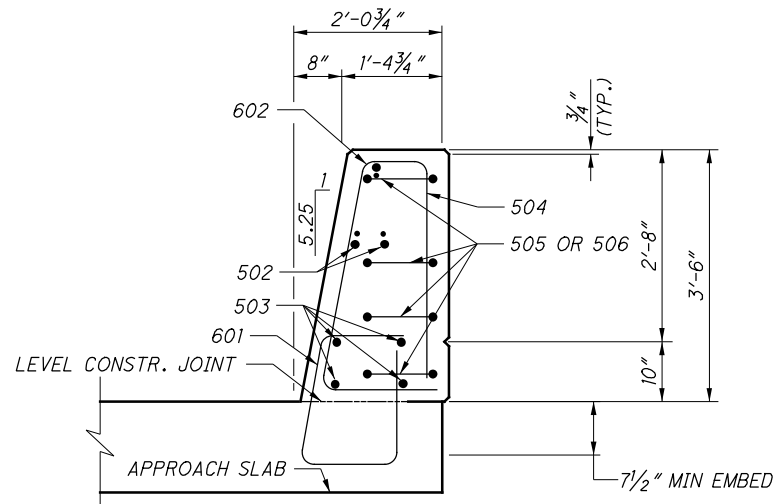


**C** SECTION THRU PILASTER  
71,72

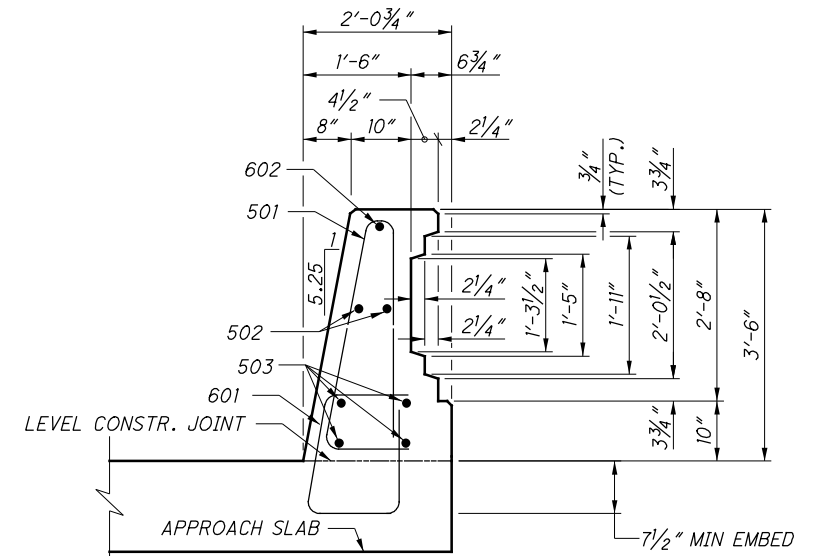


**D** SECTION THRU PANEL  
71,72

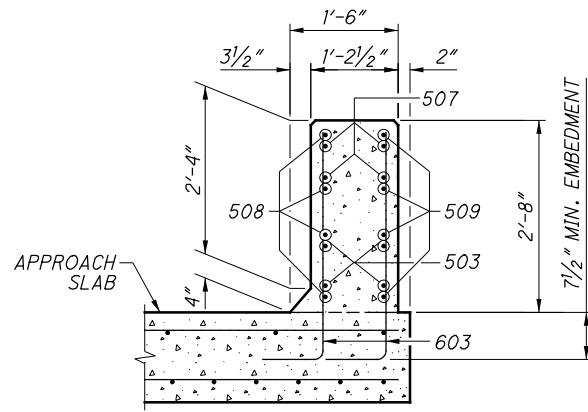

**E** SECTION  
71,72

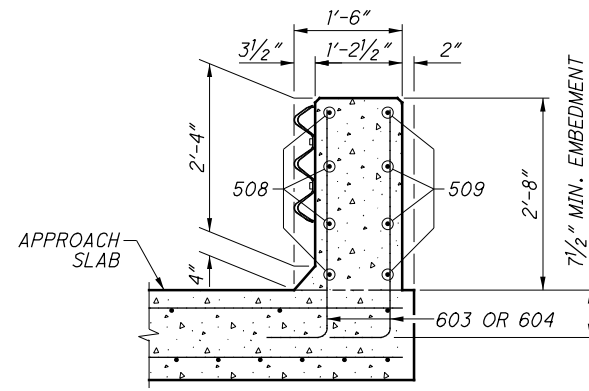

**F** SECTION  
71,72

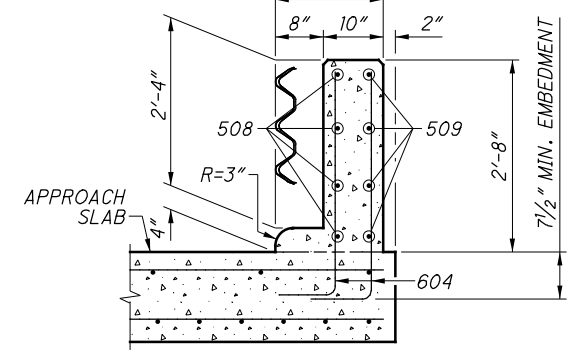

**G** SECTION  
71,72

**NOTES:**

1. FOR NOTES, SEE SHEET 71/79.

**LEGEND:**


■ - 1/2" DIA. GLASS FIBER REINFORCED POLYMER (GFRP) STIFFENING REINFORCEMENT

DESIGNED	CRG	CHECKED	KDC
DRAWN	ADS	REVISED	
REVIEWED	TES	STRUCTURE FILE NUMBER	3109798
DATE	8/22/2019		

P:\Projects\2018\20H03DB-18232 HAM-75-03-84\104667\structures\HAM074\_1908S\sheets\074\_1908S\_RL001.dgn 7/28/2023 9:36:51 AM erin.baumann

MARK	NUMBER		LENGTH	WEIGHT	TYPE	DIMENSIONS					
	TOTAL					A	B	C	D	E	R
<b>EXISTING PIER 7</b>											
7P401	608		4'-8"	1878	37	3'-8"					
7P402	99		3'-6"	231	16	3'-0"					
7P501	48		14'-3"	713	1	5'-5"	3'-8"	5'-5"			
7P502	24		11'-3"	282	STR						
7P503	24		13'-3"	332	STR						
7P504	38		9'-7"	380	2	3'-1"	3'-8"	3'-1"			
7P505	38		9'-7"	380	28	3'-8"	3'-1"				
7P506	1 OF		9'-6"								
	8		23'-6"	138	STR						2'-0"
7P507	10		32'-4"	337	STR						
7P508	10		33'-4"	348	STR						
7P509	2		25'-0"	52	STR						
7P510	1		28'-0"	29	STR						
7P511	1		30'-0"	31	STR						
7P512	2 SR		8'-10"								
	OF		TO	286	STR						5 3/4"
	12		14'-0"								
	1 SR		19'-8"				5'-10"				
7P513	OF		TO	139	3	3'-8"	TO				6"
	6		24'-8"				8'-4"				
7P514	8		19'-0"	159	3	3'-8"	5'-6"				
	1 SR		19'-8"				5'-10"				
7P515	OF		TO	113	3	3'-8"	TO				6"
	5		23'-8"				7'-10"				
	2 SR		8'-4"								
7P516	OF		TO	276	STR						6"
	12		13'-9"								
	1 SR		12'-7"								
7P517	OF		TO	163	STR						2'-0"
	8		26'-7"								
	1 SR		14'-7"								
7P518	OF		TO	180	STR						2'-0"
	8		28'-7"								
7P519	46		20'-8"	992	STR						
7P520	37		15'-5"	595	2	6'-0"	3'-8"	6'-0"			
7P521	37		9'-9"	376	2	3'-2"	3'-8"	3'-2"			
7P522	37		18'-0"	695	3	1'-8"	7'-0"				
7P523	1		18'-8"	19	3	1'-10"	7'-2"				
7P524	1		8'-8"	9	2	2'-5"	4'-1"	2'-5"			
7P525	1		15'-10"	17	2	6'-0"	4'-1"	6'-0"			
7P526	23		10'-4"	248	2	3'-6"	3'-7"	3'-6"			
7P527	37		6'-8"	504	2	2'-8"	1'-8"	2'-8"			
7P801	12		15'-1"	483	STR						
7P802	8		27'-5"	586	STR						
7P803	8		26'-10"	573	STR						
7P804	8		25'-0"	534	STR						
7P805	8		35'-5"	757	1	2'-0"	33'-8"				
7P806	10		21'-9"	581	STR						
7P901	58		7'-0"	1380	STR						
7P902	58		28'-5"	5604	STR						
7P903	58		14'-7"	2876	STR						
SUB-TOTAL			23,276								

**BAR BENDING DETAILS**

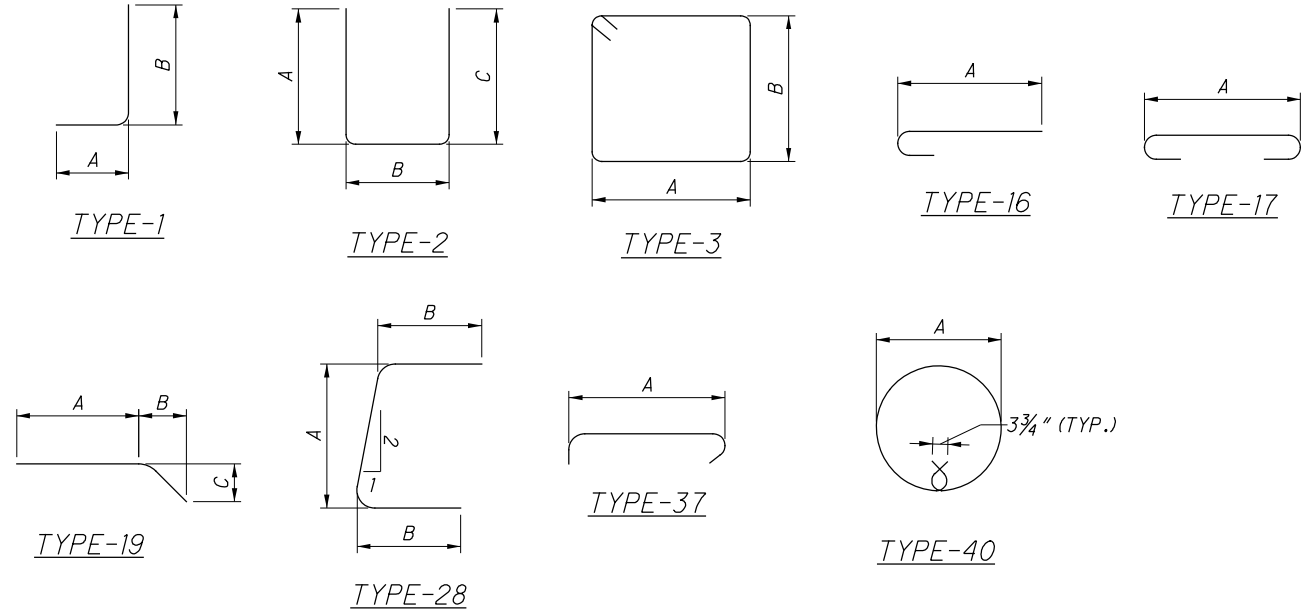

MARK	NUMBER		LENGTH	WEIGHT	TYPE	DIMENSIONS					
	TOTAL					A	B	C	D	E	R
<b>PIER 1</b>											
IP501	200		8'-4"	1738	2	3'-1"	2'-5"	3'-1"			
IP502	18		9'-7"	180	2	3'-1"	3'-8"	3'-1"			
IP503	420		11'-11"	5220	40	3'-6"					
IP601	6		31'-4"	282	STR						
IP602	12		9'-5"	170	1	1'-1"	8'-6"				
IP603	53		4'-7"	365	2	1'-1"	3'-8"	1'-1"			
IP701	6		37'-11"	465	2	3'-7"	31'-2"	3'-7"			
IP1001	5		37'-8"	810	2	3'-7"	31'-2"	3'-7"			
IP1002	14		39'-5"	2375	16	38'-0"					
IP1003	14		39'-10"	2400	16	38'-5"					
IP1004	14		40'-2"	2420	16	38'-9"					
SUB-TOTAL			16,425								

MARK	NUMBER		LENGTH	WEIGHT	TYPE	DIMENSIONS					
	TOTAL					A	B	C	D	E	R
<b>PIER 1 FOOTINGS</b>											
F503	27		11'-11"	336	40	3'-6"					
F601	48		11'-3"	811	2	1'-11 1/4"	7'-8"	2'-0"			
F602	12		7'-8"	138	STR						
F801	48		11'-2"	1431	2	1'-11 1/4"	7'-8"	2'-0"			
F1001	42		9'-5"	1702	1	1'-0"	8'-9"				
SUB-TOTAL			4,418								

**NOTES:**  
SEE SHEET [79/79] FOR NOTES.




P:\Projects\2018\20H03DB-18232 HAM-75-03.84\104667\structures\HAM074\_1908S\104667\sheets\074\_1908S\_RL002.dgn 7/28/2023 9:36:54 AM erin.baumann

MARK	NUMBER TOTAL	LENGTH	WEIGHT	TYPE	DIMENSIONS						
					A	B	C	D	E	R	INC
<b>PIER 2</b>											
2P401	154	5'-7"	574	60	4'-8"	8"				1"	
2P501	7	15'-8"	114	STR							
2P502	14	11'-0"	161	19	7'-9"	3'-0"	1'-4"				
2P503	44	10'-9"	493	2	3'-3"	4'-6"	3'-3"				
2P504	44	15'-8"	719	STR							
2P505	22	16'-6"	379	60	15'-6"	8"				1/4"	
2P505	22	16'-6"	379	60	15'-6"	8"				1/4"	
2P506	18	10'-5"	196	2	3'-1"	4'-6"	3'-1"				
2P507	4	7'-5"	31	2	3'-1"	1'-6"	3'-1"				
2P601	4 SER OF	10'-8"			3'-3"	3'-3"					
	3	12'-0"	204	2	TO	4'-6"	TO				4"
					3'-11"	3'-11"					
	4 SER	12'-2"			4'-0"	4'-0"					
2P602	OF	TO	892	2	TO	4'-6"	TO				1/2"
	11	14'-10"			5'-4"	5'-4"					
2P603	60	15'-4"	1382	2	5'-7"	4'-6"	5'-7"				
	4 SER	13'-4"			4'-7"	4'-7"					
2P604	OF	TO	947	2	TO	4'-6"	TO				1/4"
	11	15'-4"			5'-7"	5'-7"					
	4 SER	12'-2"			4'-0"	4'-0"					
2P605	OF	TO	228	2	TO	4'-6"	TO				3"
	3	13'-2"			4'-6"	4'-6"					
2P606	43	11'-10"	764	2	5'-4"	1'-6"	5'-4"				
2P607	12	30'-8"	553	STR							
2P608	2	28'-9"	86	STR							
2P609	2	24'-6"	74	STR							
2P610	2	20'-2"	61	STR							
2P611	16	10'-11"	262	1	1'-1"	10'-0"					
2P612	8	5'-11"	71	1	1'-1"	5'-0"					
2P801	4	37'-9"	403	2	3'-10"	30'-6"	3'-10"				
2P901	62	25'-4"	5340	STR							
2P1001	8	36'-8"	1262	2	2'-10"	30'-6"	4'-0"				
SUB-TOTAL			15,196								

MARK	NUMBER TOTAL	LENGTH	WEIGHT	TYPE	DIMENSIONS						
					A	B	C	D	E	R	INC
<b>PIER 2 FOOTING</b>											
F401	21	5'-7"	78	60	4'-8"	8"				1"	
F503	6	10'-9"	67	2	3'-3"	4'-6"	3'-3"				
F504	6	15'-8"	98	STR							
F505	3	16'-6"	52	60	15'-6"	8"				1/4"	
F603	19	12'-4"	352	2	2'-0"	8'-8"	2'-0"				
F604	10	21'-4"	320	2	2'-0"	17'-8"	2'-0"				
F605	2	8'-8"	26	STR							
F606	2	17'-8"	53	STR							
F701	19	12'-3"	476	2	2'-0"	8'-8"	2'-0"				
F702	10	21'-3"	434	2	2'-0"	17'-8"	2'-0"				
F901	62	10'-6"	2213	1	1'-7"	9'-3"					
SUB-TOTAL			4,169								

**BAR BENDING DETAILS**

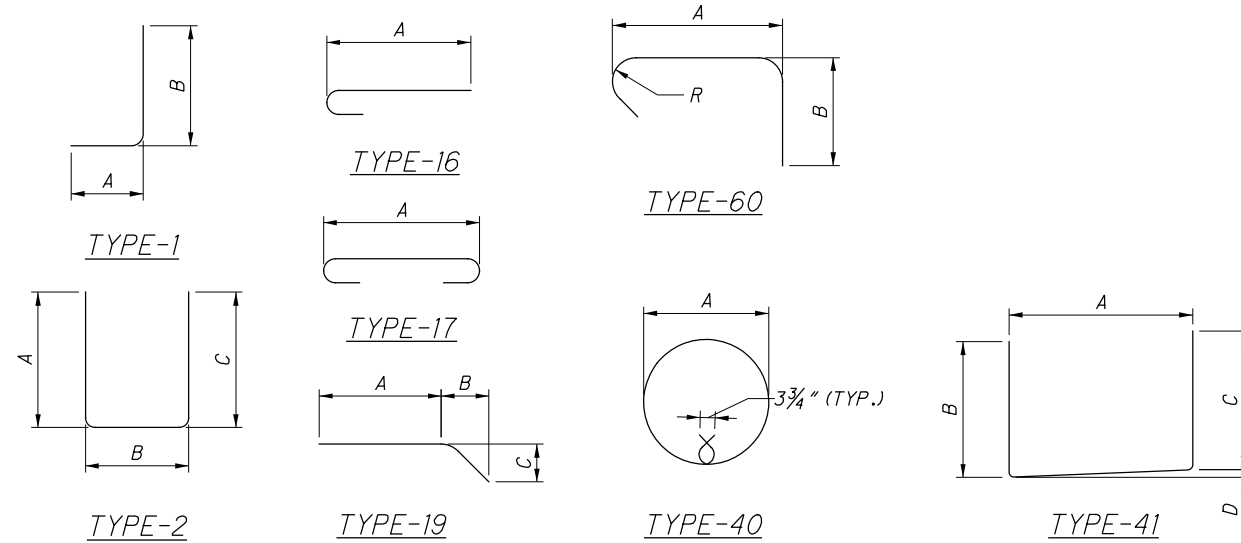

MARK	NUMBER TOTAL	LENGTH	WEIGHT	TYPE	DIMENSIONS						
					A	B	C	D	E	R	INC
<b>PIER 3</b>											
3P501	458	11'-11"	5693	40	3'-6"						
3P502	6	9'-6"	59	2	3'-1"	3'-7"	3'-1"				
3P601	96	10'-9"	1550	2	4'-4"	2'-5"	4'-4"				
3P602	18	12'-0"	324	2	4'-4"	3'-8"	4'-4"				
3P603	12	9'-0"	162	1	1'-0"	8'-2"					
3P604	27	5'-4"	216	2	1'-0"	3'-8"	1'-0"				
3P605	6	30'-7"	276	STR							
3P801	9	33'-7"	807	41	1'-6"	30'-7"	1'-6"	1'-3 1/2"			
3P901	18	42'-5"	2596	16	41'-1 1/2"						
3P902	18	43'-1"	2637	16	41'-9 3/4"						
3P903	18	43'-9"	2672	16	42'-5 1/2"						
3P1001	9	34'-7"	1340	41	2'-0"	30'-7"	2'-0"	1'-3 1/2"			
SUB-TOTAL			18,332								

MARK	NUMBER TOTAL	LENGTH	WEIGHT	TYPE	DIMENSIONS						
					A	B	C	D	E	R	INC
<b>PIER 3 DRILLED SHAFTS</b>											
3DS501	360	12'-8"	4756	40	3'-6"						
3DS1001	54	29'-6"	6855	STR							
SUB-TOTAL			11,611								


**NOTES:**  
SEE SHEET 79/79 FOR NOTES.



P:\Projects\2018\20H03DB-18232 HAM-75-03.84\104667\structures\HAM074\_1908S\sheets\074\_1908S\_RL008.dgn 7/28/2023 9:37:02 AM erin.baumann

MARK	NUMBER	LENGTH	WEIGHT	TYPE	DIMENSIONS						
	TOTAL				A	B	C	D	E	R	INC
<b>FORWARD ABUTMENT FOOTING</b>											
FAF501	17	6'-0"	106	1	1'-0"	5'-2"					
FAF502	64	18'-8"	1246	2	2'-5"	14'-1"	2'-5"				
FAF503	36	17'-8"	663	2	2'-5"	13'-1"	2'-5"				
FAF504	36	16'-2"	607	2	2'-5"	11'-7"	2'-5"				
FAF505	4	14'-2"	59	STR							
FAF506	2	13'-2"	27	STR							
FAF507	2	11'-8"	24	STR							
FAF601	89	7'-11"	1058	1	1'-1"	7'-0"					
FAF602	4	7'-9"	47	1	4'-11"	3'-0"					
FAF603	88	27'-1"	3580	1	3'-0"	24'-3"					
FAF604	4	23'-1"	137	STR							
FAF605	4	23'-6"	141	STR							
FAF606	4	30'-5"	183	STR							
FAF607	4	8'-6"	51	9	3'-5 <sup>3</sup> / <sub>4</sub> "	1'-11 <sup>3</sup> / <sub>4</sub> "	2'-0"	4'-0"			
FAF608	2	28'-0"	84	STR							
FAF609	4	15'-1"	91	STR							
	2 SR	7'-10"				2'-2"					
FAF610	OF	TO	246	2	3'-0"	TO	3'-0"				2'-4"
	6	19'-6"				13'-10"					
	1 SR	7'-9"				2'-2"					
FAF701	OF	TO	90	2	3'-0"	TO	3'-0"				2'-2"
	4	14'-2"				8'-7"					
	1 SR	15'-8"				10'-1"					
FAF702	OF	TO	342	2	3'-0"	TO	3'-0"				1'-6"
	8	26'-2"				20'-7"					
FAF703	16	26'-3"	858	2	3'-0"	20'-8"	3'-0"				
	1 SR	26'-3"				20'-8"					
FAF704	OF	TO	788	2	3'-0"	TO	3'-0"				6 <sup>3</sup> / <sub>4</sub> "
	13	33'-0"				27'-5"					
	1 SR	10'-2"				4'-7"					
FAF705	OF	TO	551	2	3'-0"	TO	3'-0"				1'-9"
	13	31'-3"				25'-8"					
FAF706	1	14'-6"	30	2	3'-0"	8'-11"	3'-0"				
	1 SR	7'-9"				2'-2"					
FAF801	OF	TO	117	2	3'-0"	TO	3'-0"				2'-2"
	4	14'-2"				8'-7"					
	1 SR	15'-8"				10'-1"					
FAF802	OF	TO	447	2	3'-0"	TO	3'-0"				1'-6"
	8	26'-2"				20'-8"					
FAF803	16	26'-3"	1121	2	3'-0"	20'-8"	3'-0"				
	1 SR	26'-3"				20'-8"					
FAF804	OF	TO	1027	2	3'-0"	TO	3'-0"				6 <sup>3</sup> / <sub>4</sub> "
	13	33'-0"				27'-5"					
	1 SR	10'-2"				4'-7"					
FAF805	OF	TO	717	2	3'-0"	TO	3'-0"				1'-9"
	13	31'-3"				25'-8"					
FAF806	1	14'-6"	39	2	3'-0"	8'-11"	3'-0"				
FAF901	23	13'-2"	1030	1	1'-8"	11'-9"					
FAF902	69	14'-8"	3441	1	1'-8"	13'-3"					
FAF903	25	14'-2"	1204	1	1'-8"	12'-9"					
FAF1001	48	19'-4"	3993	1	1'-11"	17'-9"					
SUB-TOTAL			24,105								

**BAR BENDING DETAILS**

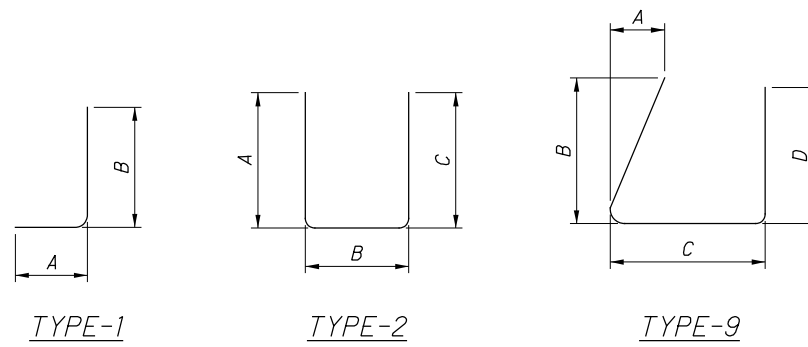

**NOTES:**  
SEE SHEET 79/79 FOR NOTES.

**REINFORCING STEEL LIST ( 4 OF 6 )**  
BRIDGE NO. HAM-74-1908S  
RAMP P OVER IR-74 WESTBOUND, IR-75 AND RAMP E

**HAM-75-3.84**  
PID No. 104667

DESIGNED: KDC  
CHECKED: CRG

DRAWN: ADS  
REVISED:

REVIEWED: TES  
STRUCTURE FILE NUMBER: 3109798

DATE: 8/22/2019

DESIGN AGENCY: **PRIME**  
540 WHITE POND DR. SUITE E  
AKRON, OH 44320

77 / 79


77  
79



P:\Projects\2018\20H03DB-18232 HAM-75-03.84\104667\structures\HAM074\_1908S\sheets\074\_1908S\_RL005.dgn 7/28/2023 9:37:09 AM erin.baumann

MARK	NUMBER	LENGTH	WEIGHT	TYPE	DIMENSIONS						
	TOTAL				A	B	C	D	E	R	INC
<b>APPROACH SLAB PARAPET</b>											
ASR501	24	7'-4"	184	23	11"	3'-3"	3'-0"			2 3/4"	
ASR502	4	14'-4"	60	STR							
ASR503	8	24'-6"	204	STR							
ASR504	16	8'-7"	143	45	1'-0"	1'-8"	3'-3"	3'-0"			
ASR505	8	4'-5"	37	6	11"	1'-0"	1'-0"				
ASR506	16	4'-2"	70	44	11"	1'-0"	1'-0"				
ASR507	8	9'-10"	82	STR							
ASR508	8	5'-9"	48	25	1'-10"	2'-5"	1'-5"	1 1/2"	5"		
ASR509	8	5'-8"	47	STR							
ASR510	8	3'-1"	26	2	1'-2"	1'-0"	1'-2"				
ASR511	8	3'-9"	31	2	1'-6"	1'-0"	1'-6"				
ASR601	40	4'-9"	285	29	11"	1'-2 1/2"	1'-7"	1'-6"			
ASR602	2	14'-4"	43	STR							
	4 SR	3'-11"				3'-0 1/2"					
ASR603	OF	TO	312	1	1'-0"	TO				1"	
	12	4'-10"				3'-11 1/2"					
ASR604	12	4'-0"	72	1	1'-0"	3'-1 1/2"					
SUB-TOTAL			1644								

**BAR BENDING DETAILS**

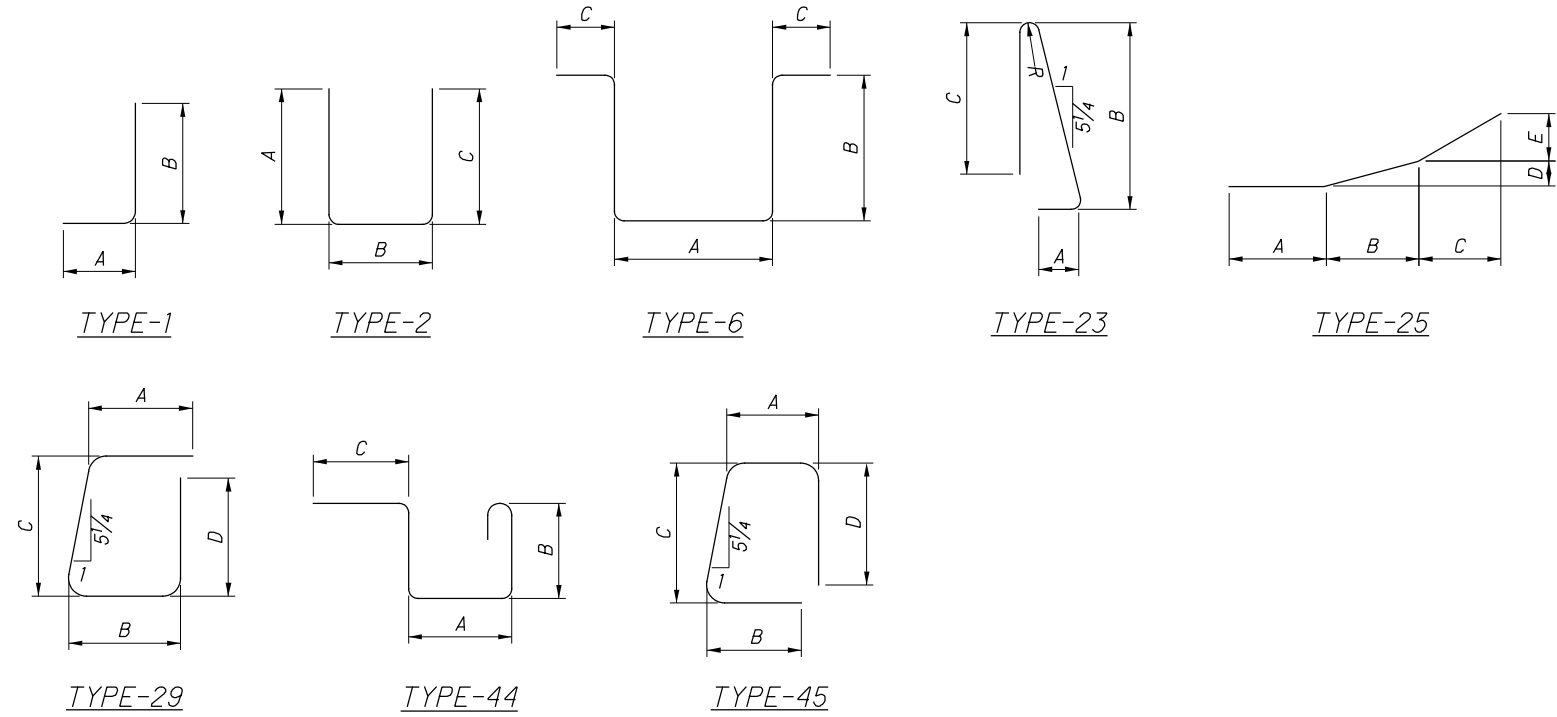

**NOTES:**


1. ALL REINFORCING BARS SHALL BE EPOXY COATED.
2. ALL DIMENSIONS ARE OUT TO OUT, EXCEPT WHERE NOTED.
3. DIMENSION 'R' IS TO THE INSIDE OF THE BAR.
4. STANDARD BENDS ARE TO BE PROVIDED, EXCEPT WHERE NOTED.
5. ALL DIMENSIONS SHOWN ARE FINISHED DIMENSIONS.
6. SPIRAL REINFORCING BARS:

THE LENGTH SHOWN IN THE STEEL LIST FOR SPIRAL BARS IS THE LENGTH OF THE SPIRAL ALONG THE AXIS OF THE SPIRAL. ONE AND ONE-HALF CLOSED-COIL TURNS SHALL BE PROVIDED AT ENDS OF EACH SPIRAL UNIT.


**SPACERS:**

CONCRETE SPACERS OR OTHER APPROVED NON-CORROSIVE SPACING DEVICES SHALL BE USED AT SUFFICIENT INTERVALS (NEAR BOTTOM AND AT INTERVALS NOT EXCEEDING 10 FEET) TO INSURE CONCENTRIC SPACING FOR THE ENTIRE CAGE LENGTH. SPACERS SHALL BE CONSTRUCTED OF APPROVED MATERIAL EQUAL IN QUANTITY AND DURABILITY TO THE CONCRETE SPECIFIED. THE SPACERS SHALL HAVE ADEQUATE DIMENSIONS TO ENSURE A MINIMUM COVER BETWEEN THE OUTSIDE OF THE REINFORCING CAGE AND THE DESIGN DIMENSION PER GENERAL NOTES.


7. FOR FIELD CUT BARS THE EPOXY COATING SHALL BE REPAIRED AT THE CUT.

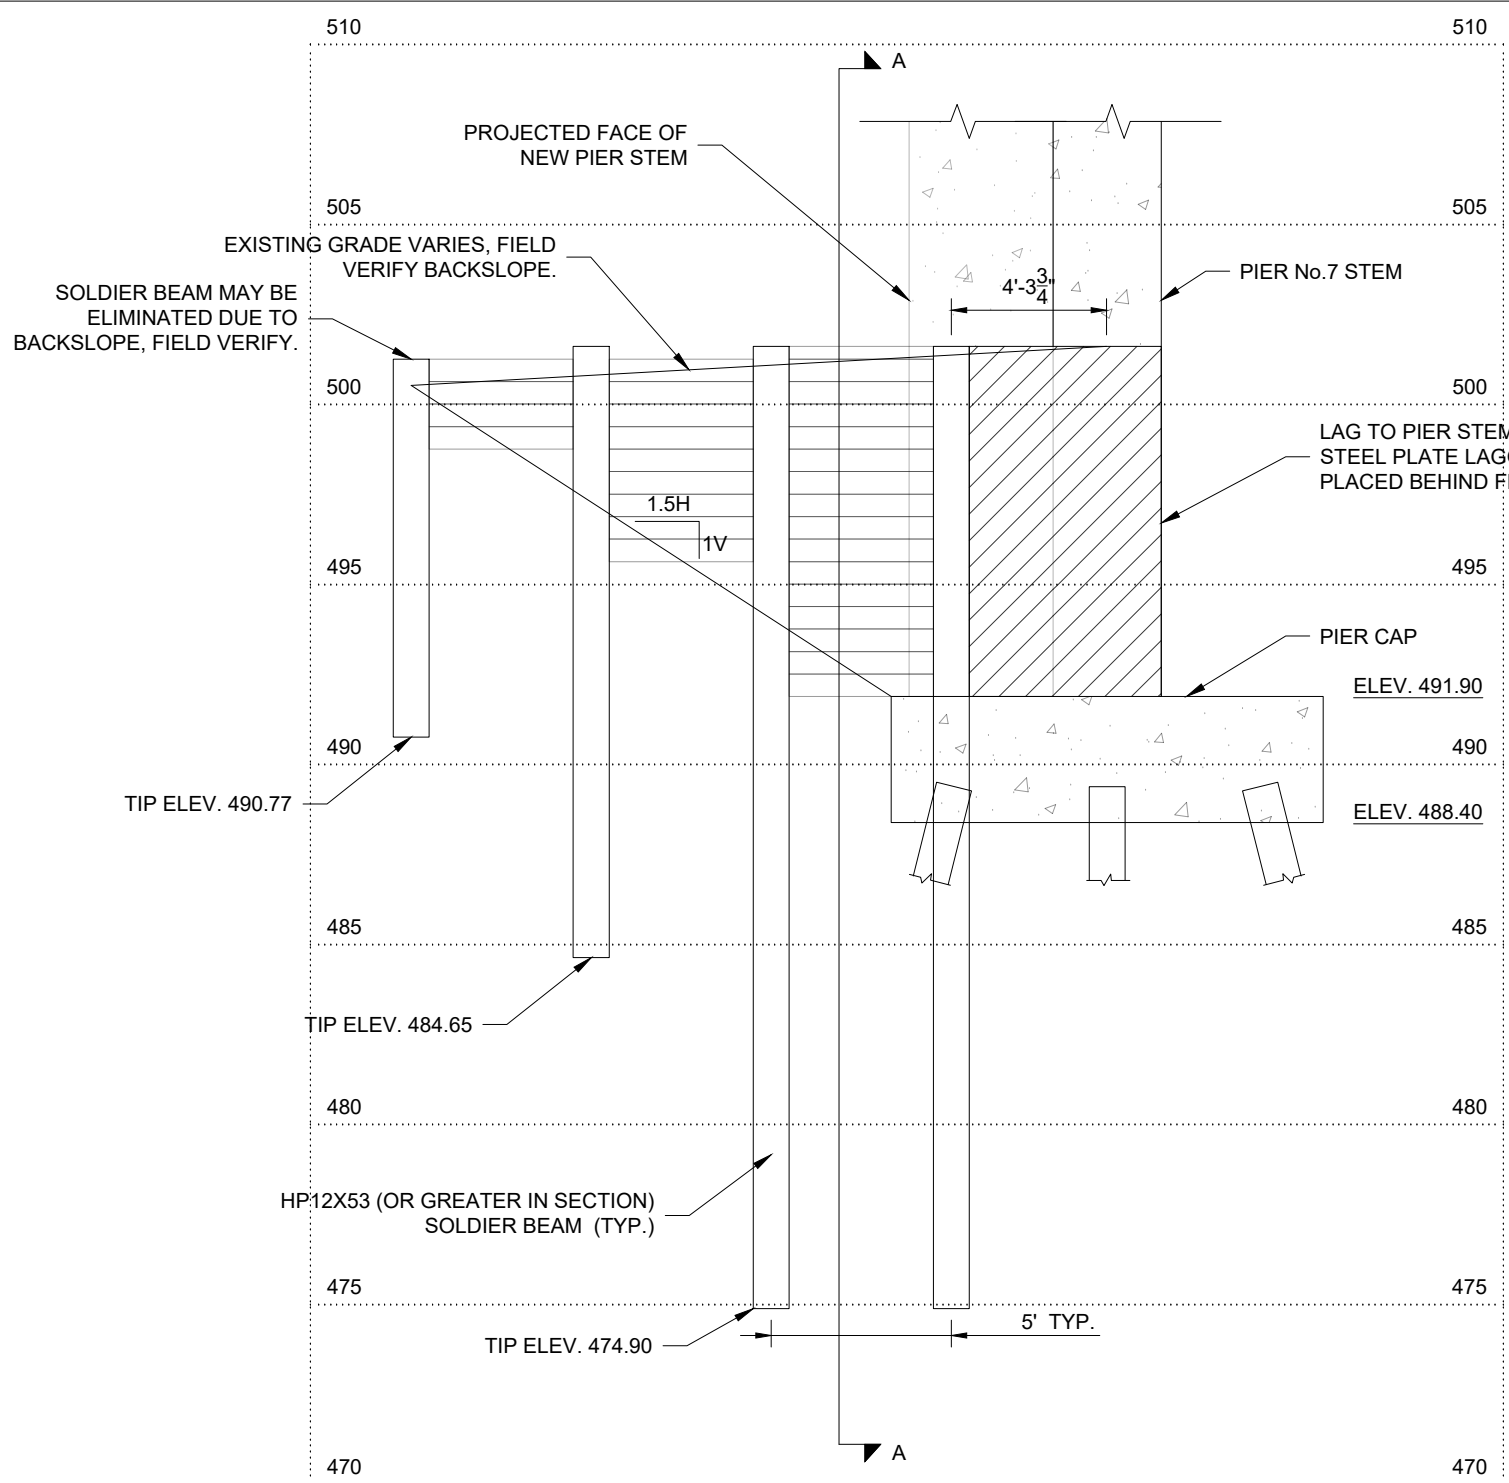

SOUTH ELEVATION VIEW - SOE FOR PIER No. 7 (LOOKING SOUTH)  
SCALE: 3/16" = 1'-0"

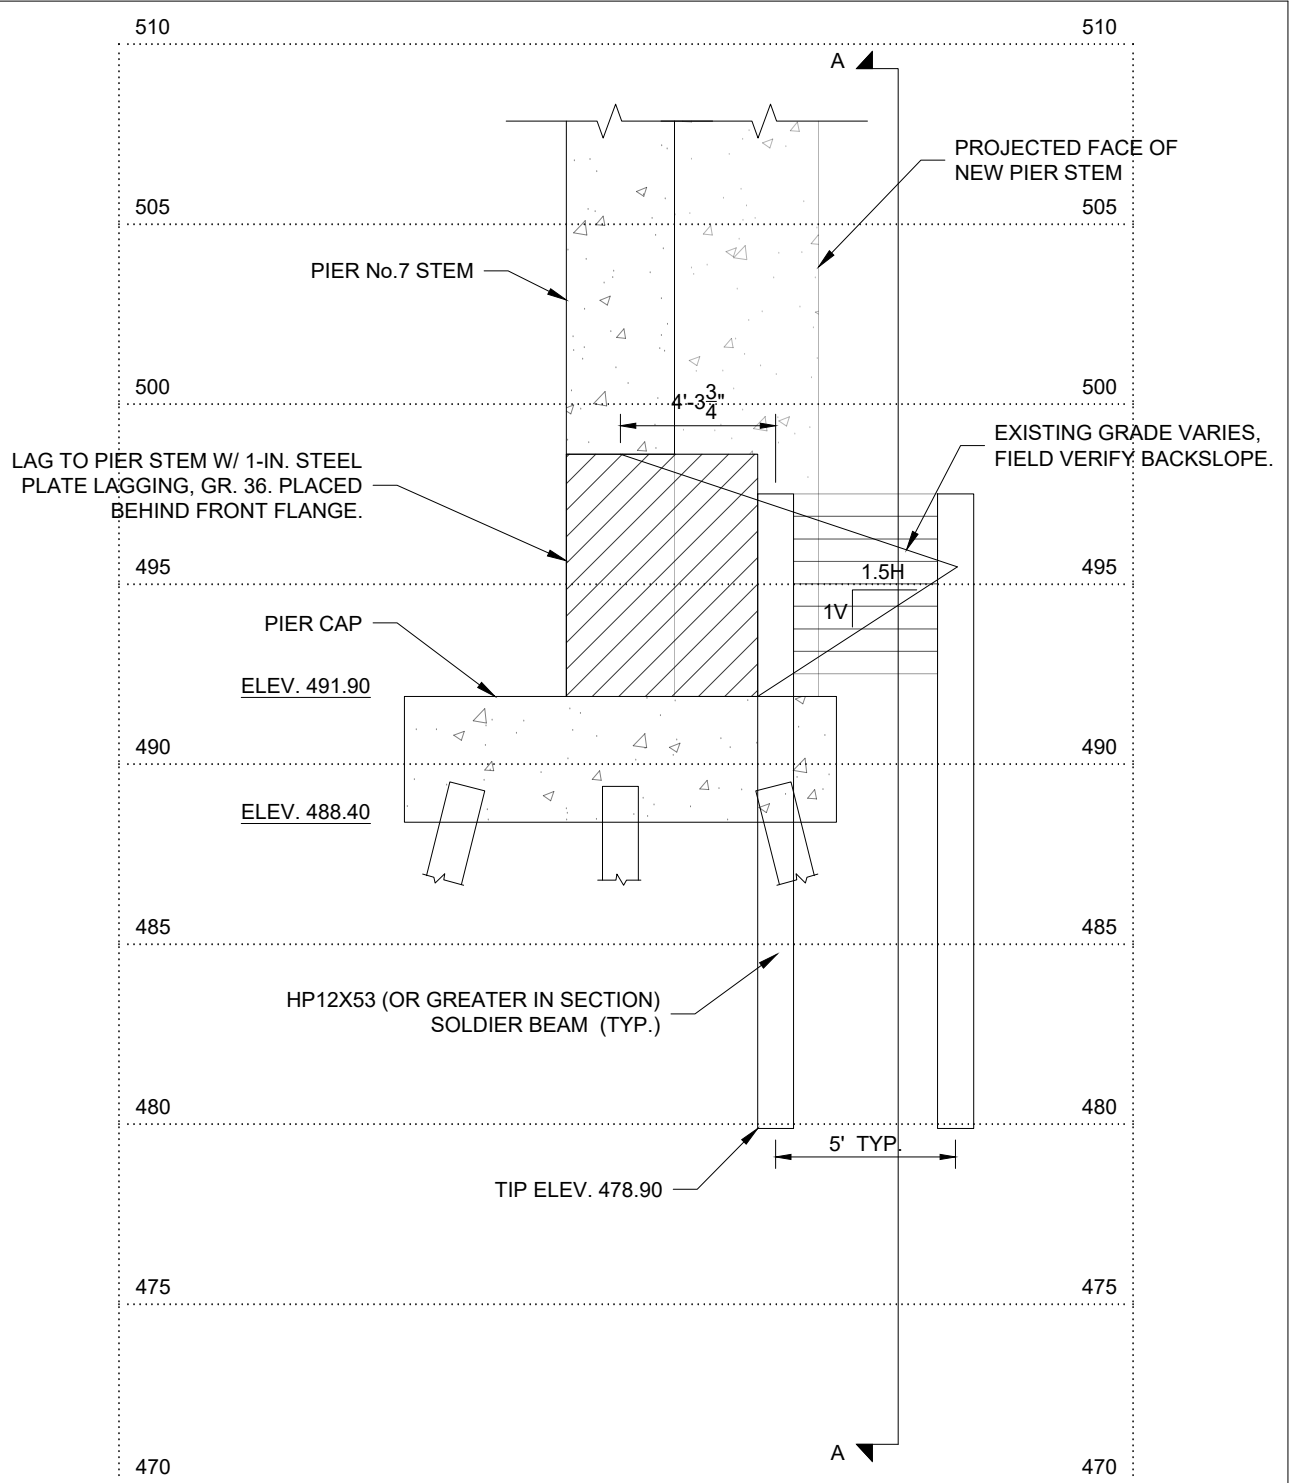

NORTH ELEVATION VIEW - SOE FOR PIER No. 7 (LOOKING NORTH)  
SCALE: 3/16" = 1'-0"

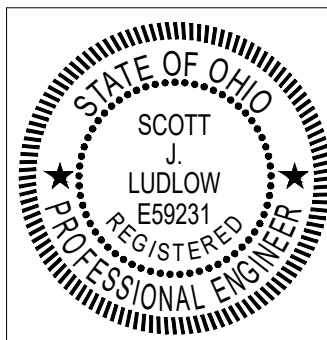

*Scott J. Ludlow*  
5/24/19  
DATE



- NOTES**
- All structural steel shall be ASTM A572 or A992, Grade 50, unless noted otherwise.
  - Field verify soldier beam locations in relation to existing utilities.
  - Refer to Construction Plans for locations/orientation of existing foundations at pier.

**ELEVATION AT PIER No. 7**


PROJECT: I-75 BRIDGE STRUCTURES - HAM-75-3.85 - SOE FOR PIER No.7  
 LOCATION: HAMILTON CO., OH  
 CLIENT: WALSH CONSTRUCTION CO.  
 SJL PROJ. NO.: 1-19-029  
 SCALE: AS SHOWN

PROJECT ENG: SJL  
 APPROVED BY: SJL  
 DRAWN BY: KAL  
 DATE AND TIME: 5/24/19  
 DRAWING NO.: 1-19-029.B3

**S.J. Ludlow**  
*Consulting Engineers, Inc.*  
 450 E. 96th St., Suite 500  
 Indianapolis, IN 46240  
 317-371-5539

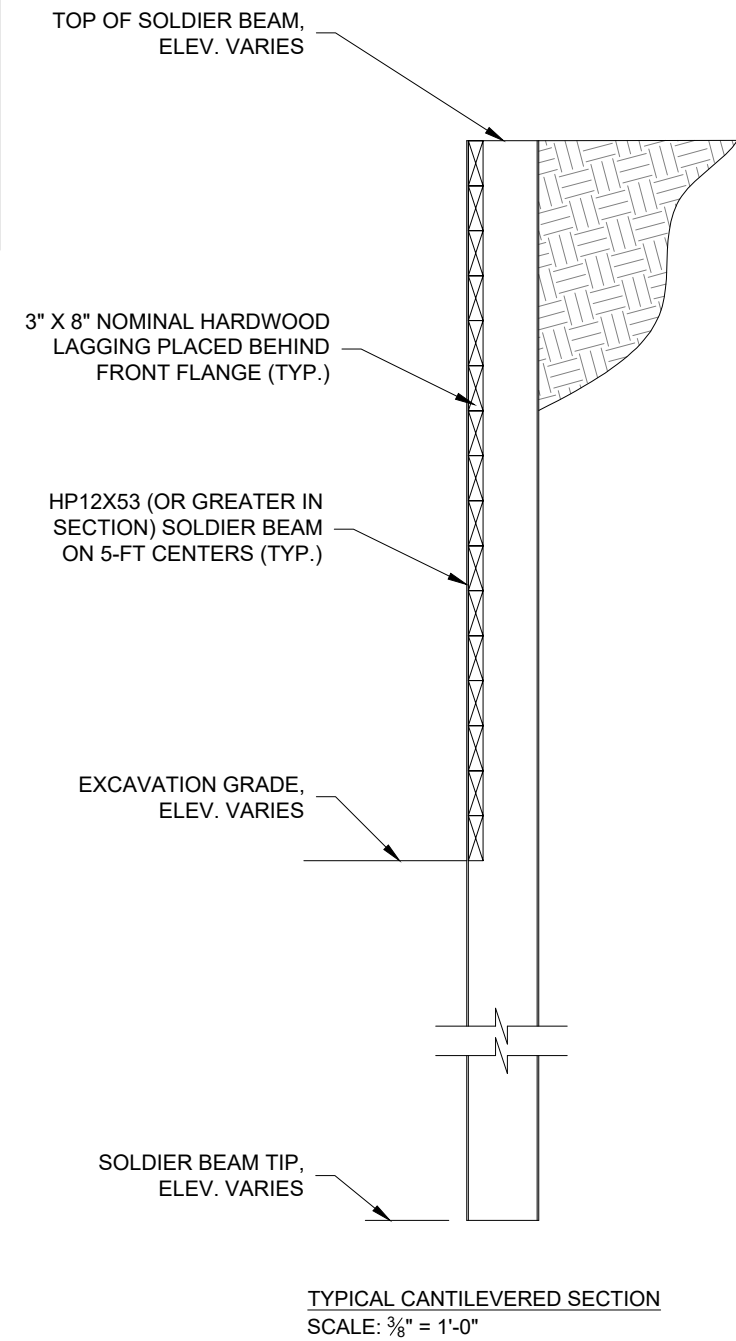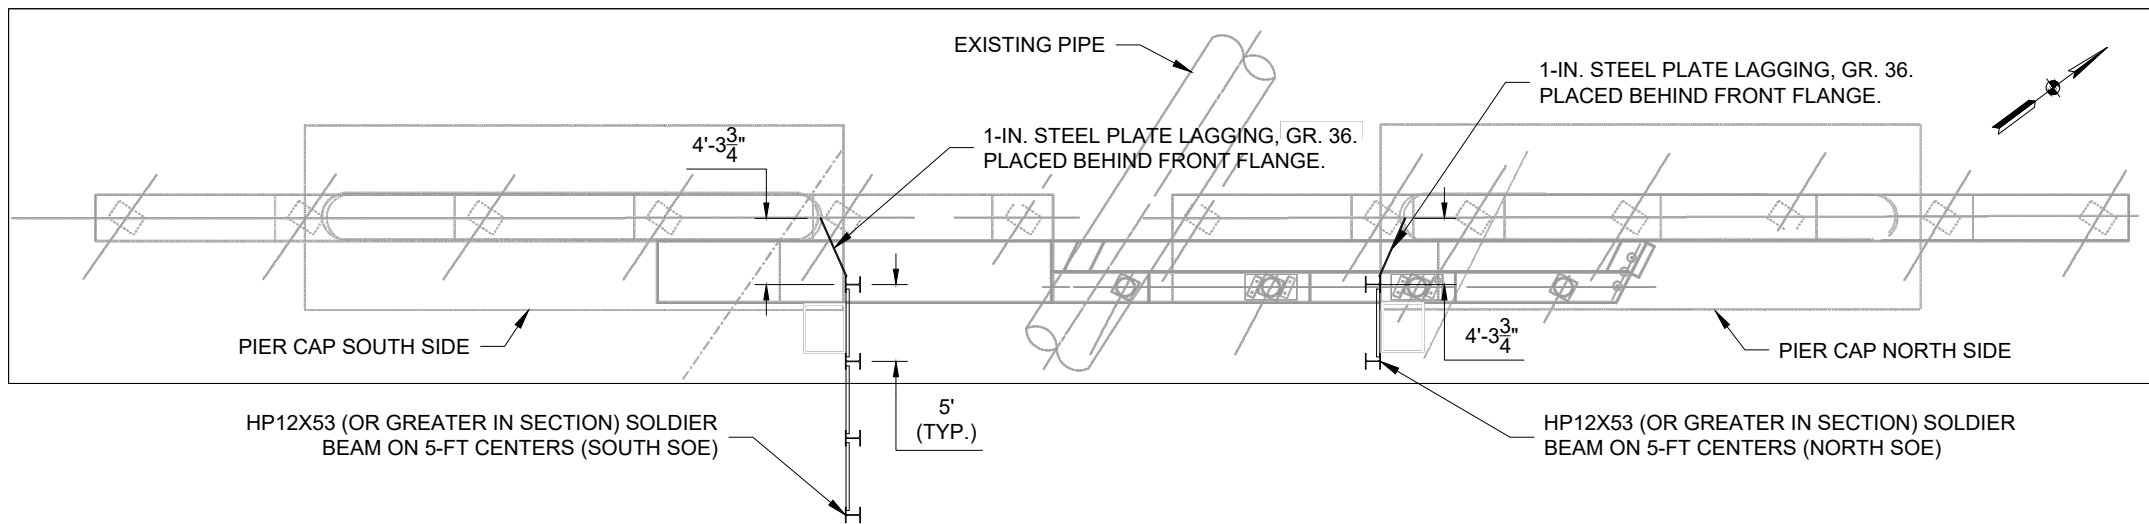


NOTE:  
FIELD VERIFY LOCATION OF SOLDIER BEAMS IN RELATION TO EXISTING PIPE.

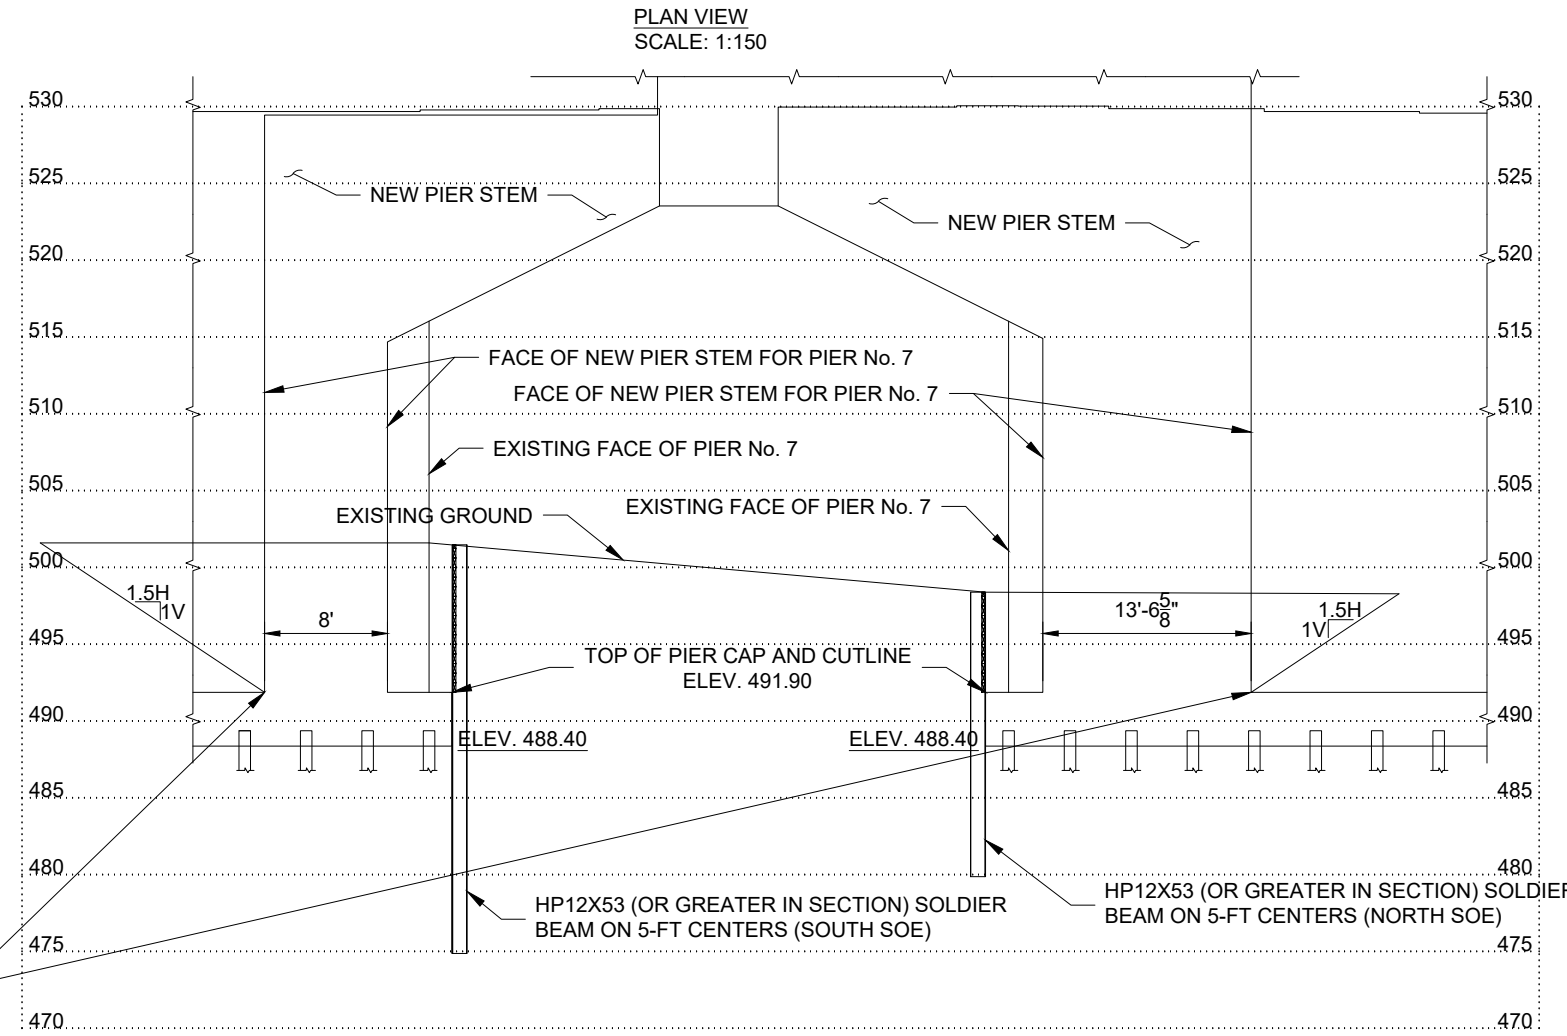

ADJUST OFFSET OF BACKSLOPE FROM FACE OF NEW PIER STEM AS REQUIRED AND MAINTAIN BACKSLOPE WITHIN LIMITS OF EXISTING PIER STEM

NOTE:  
PILES MAY BE FIELD SPLICED AS REQUIRED FOR LOW HEADROOM INSTALLATION.



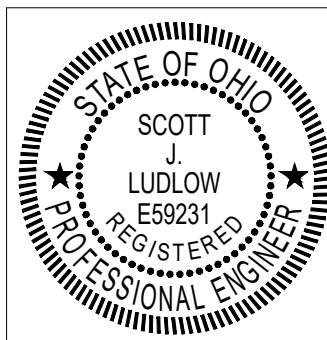


*Scott J. Ludlow*  
5/24/19  
DATE


NOTES
<ol style="list-style-type: none"> <li>All structural steel shall be ASTM A572 or A992, Grade 50, unless noted otherwise.</li> <li>No construction surcharge shall be applied between pier caps.</li> <li>All welds shall be E70xx electrodes according to AWS D1.1.</li> <li>Refer to Construction Plans for locations/orientation of existing foundations at pier.</li> </ol>

PLAN VIEW AND SECTIONS	
PROJECT:	I-75 BRIDGE STRUCTURES - HAM-75-3.85 - SOE FOR PIER No.7
LOCATION:	HAMILTON CO., OH
CLIENT:	WALSH CONSTRUCTION CO.
SJL PROJ. NO.:	1-19-029
SCALE:	AS SHOWN


PROJECT ENG: SJL	<b>S.J. Ludlow</b> <i>Consulting Engineers, Inc.</i> 450 E. 96th St., Suite 500 Indianapolis, IN 46240 317-371-5539
APPROVED BY: SJL	
DRAWN BY: KAL	
DATE AND TIME: 5/24/19	
DRAWING NO.:	
1-19-029.B4	

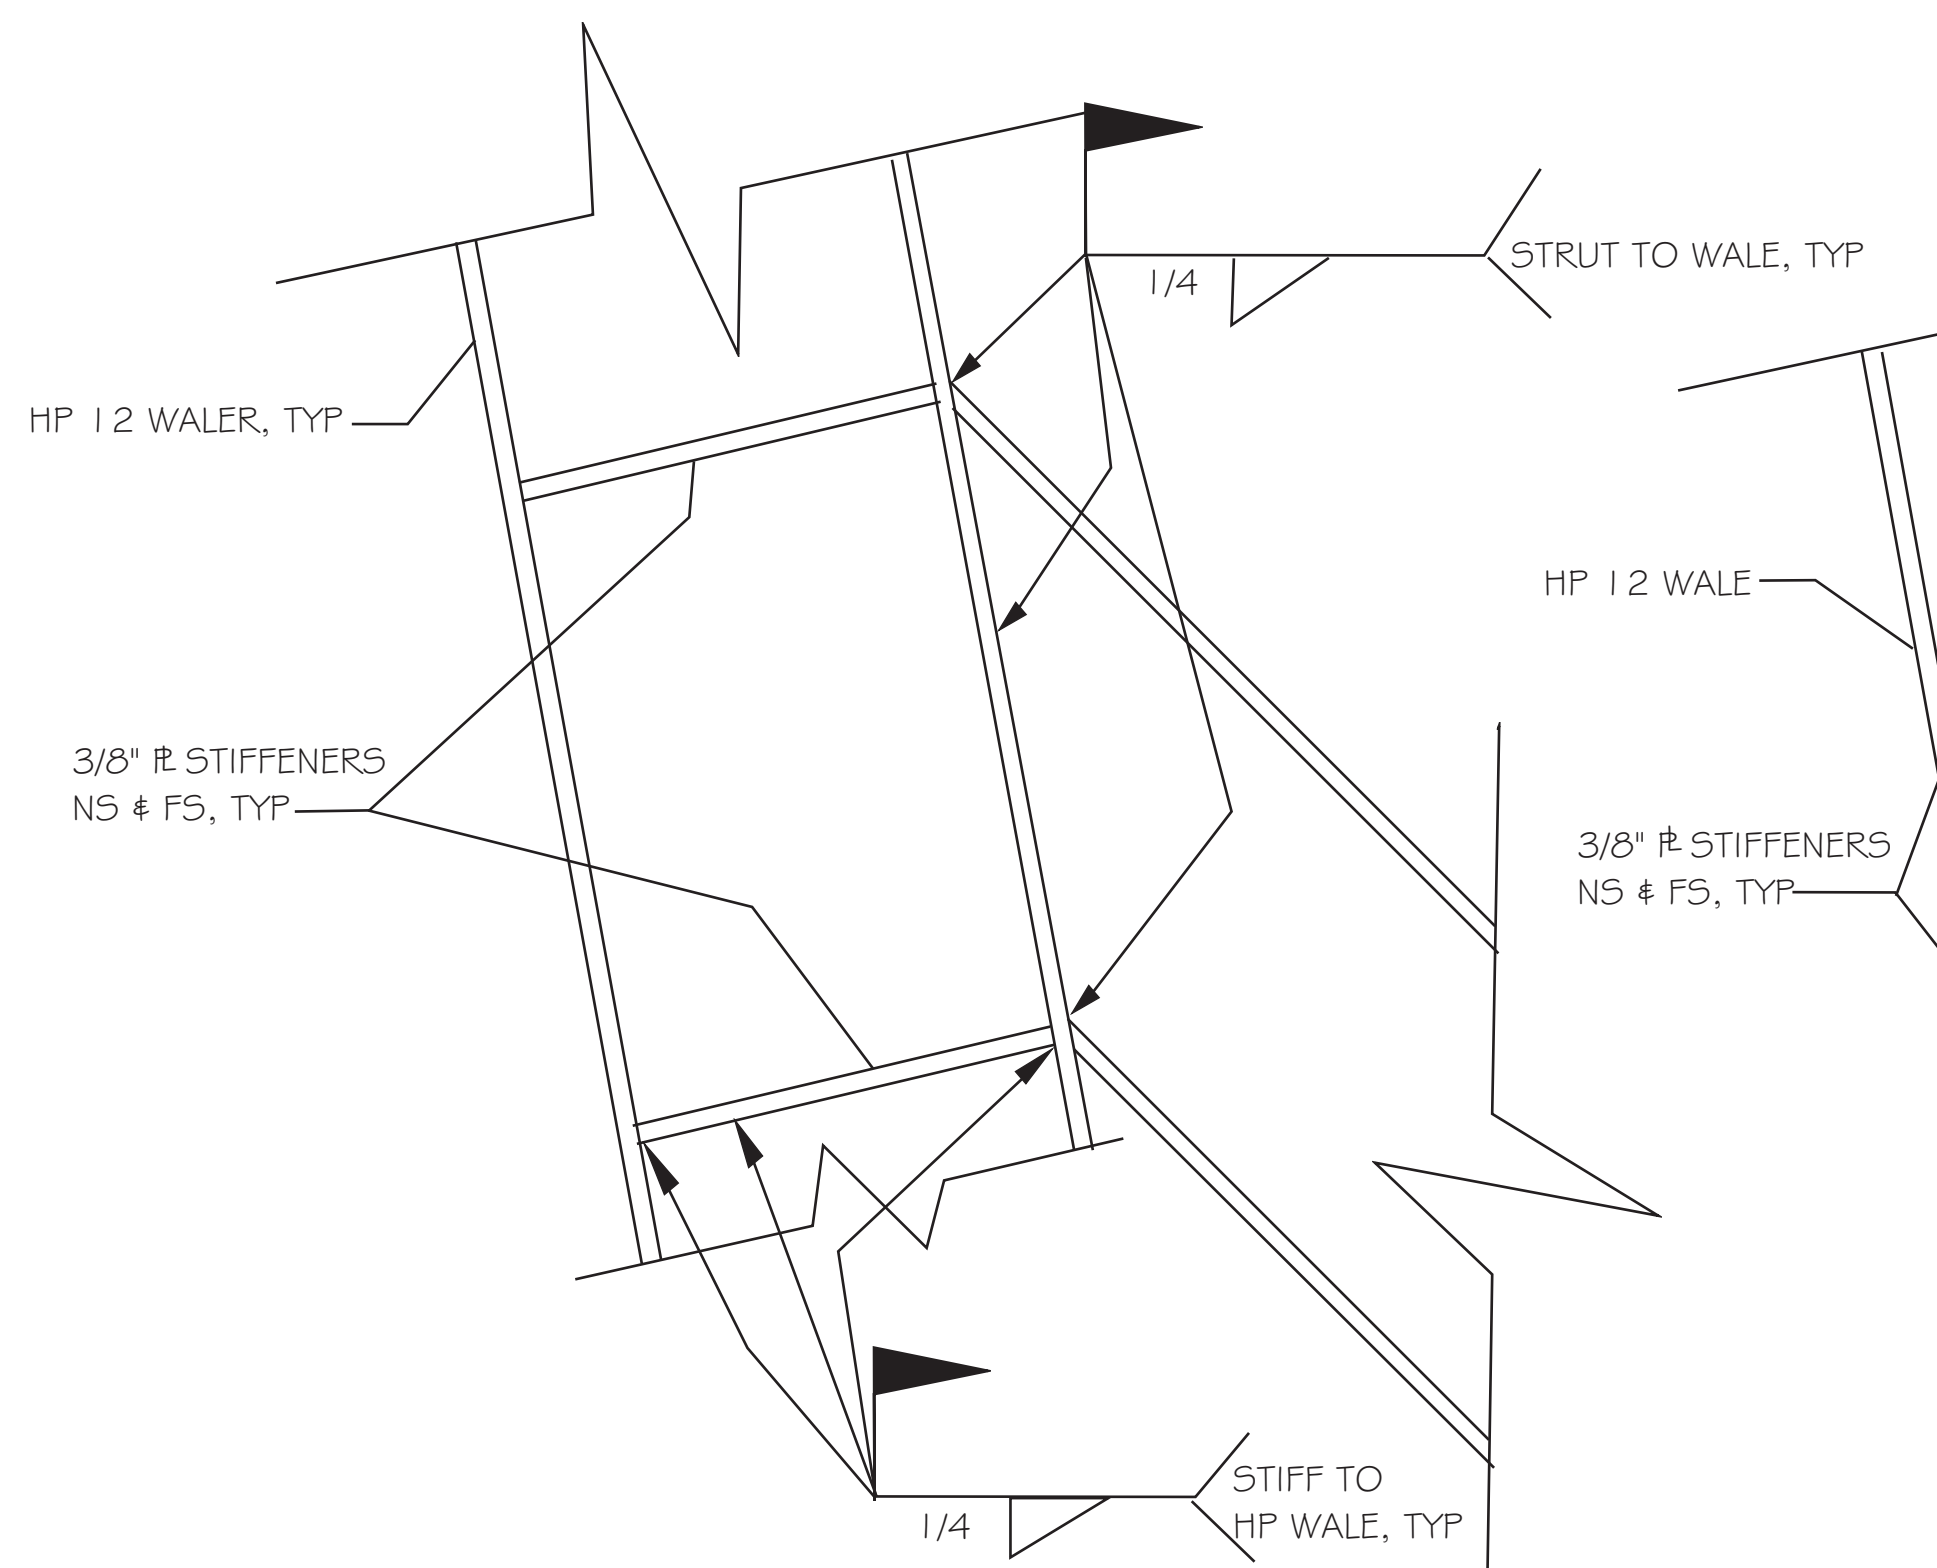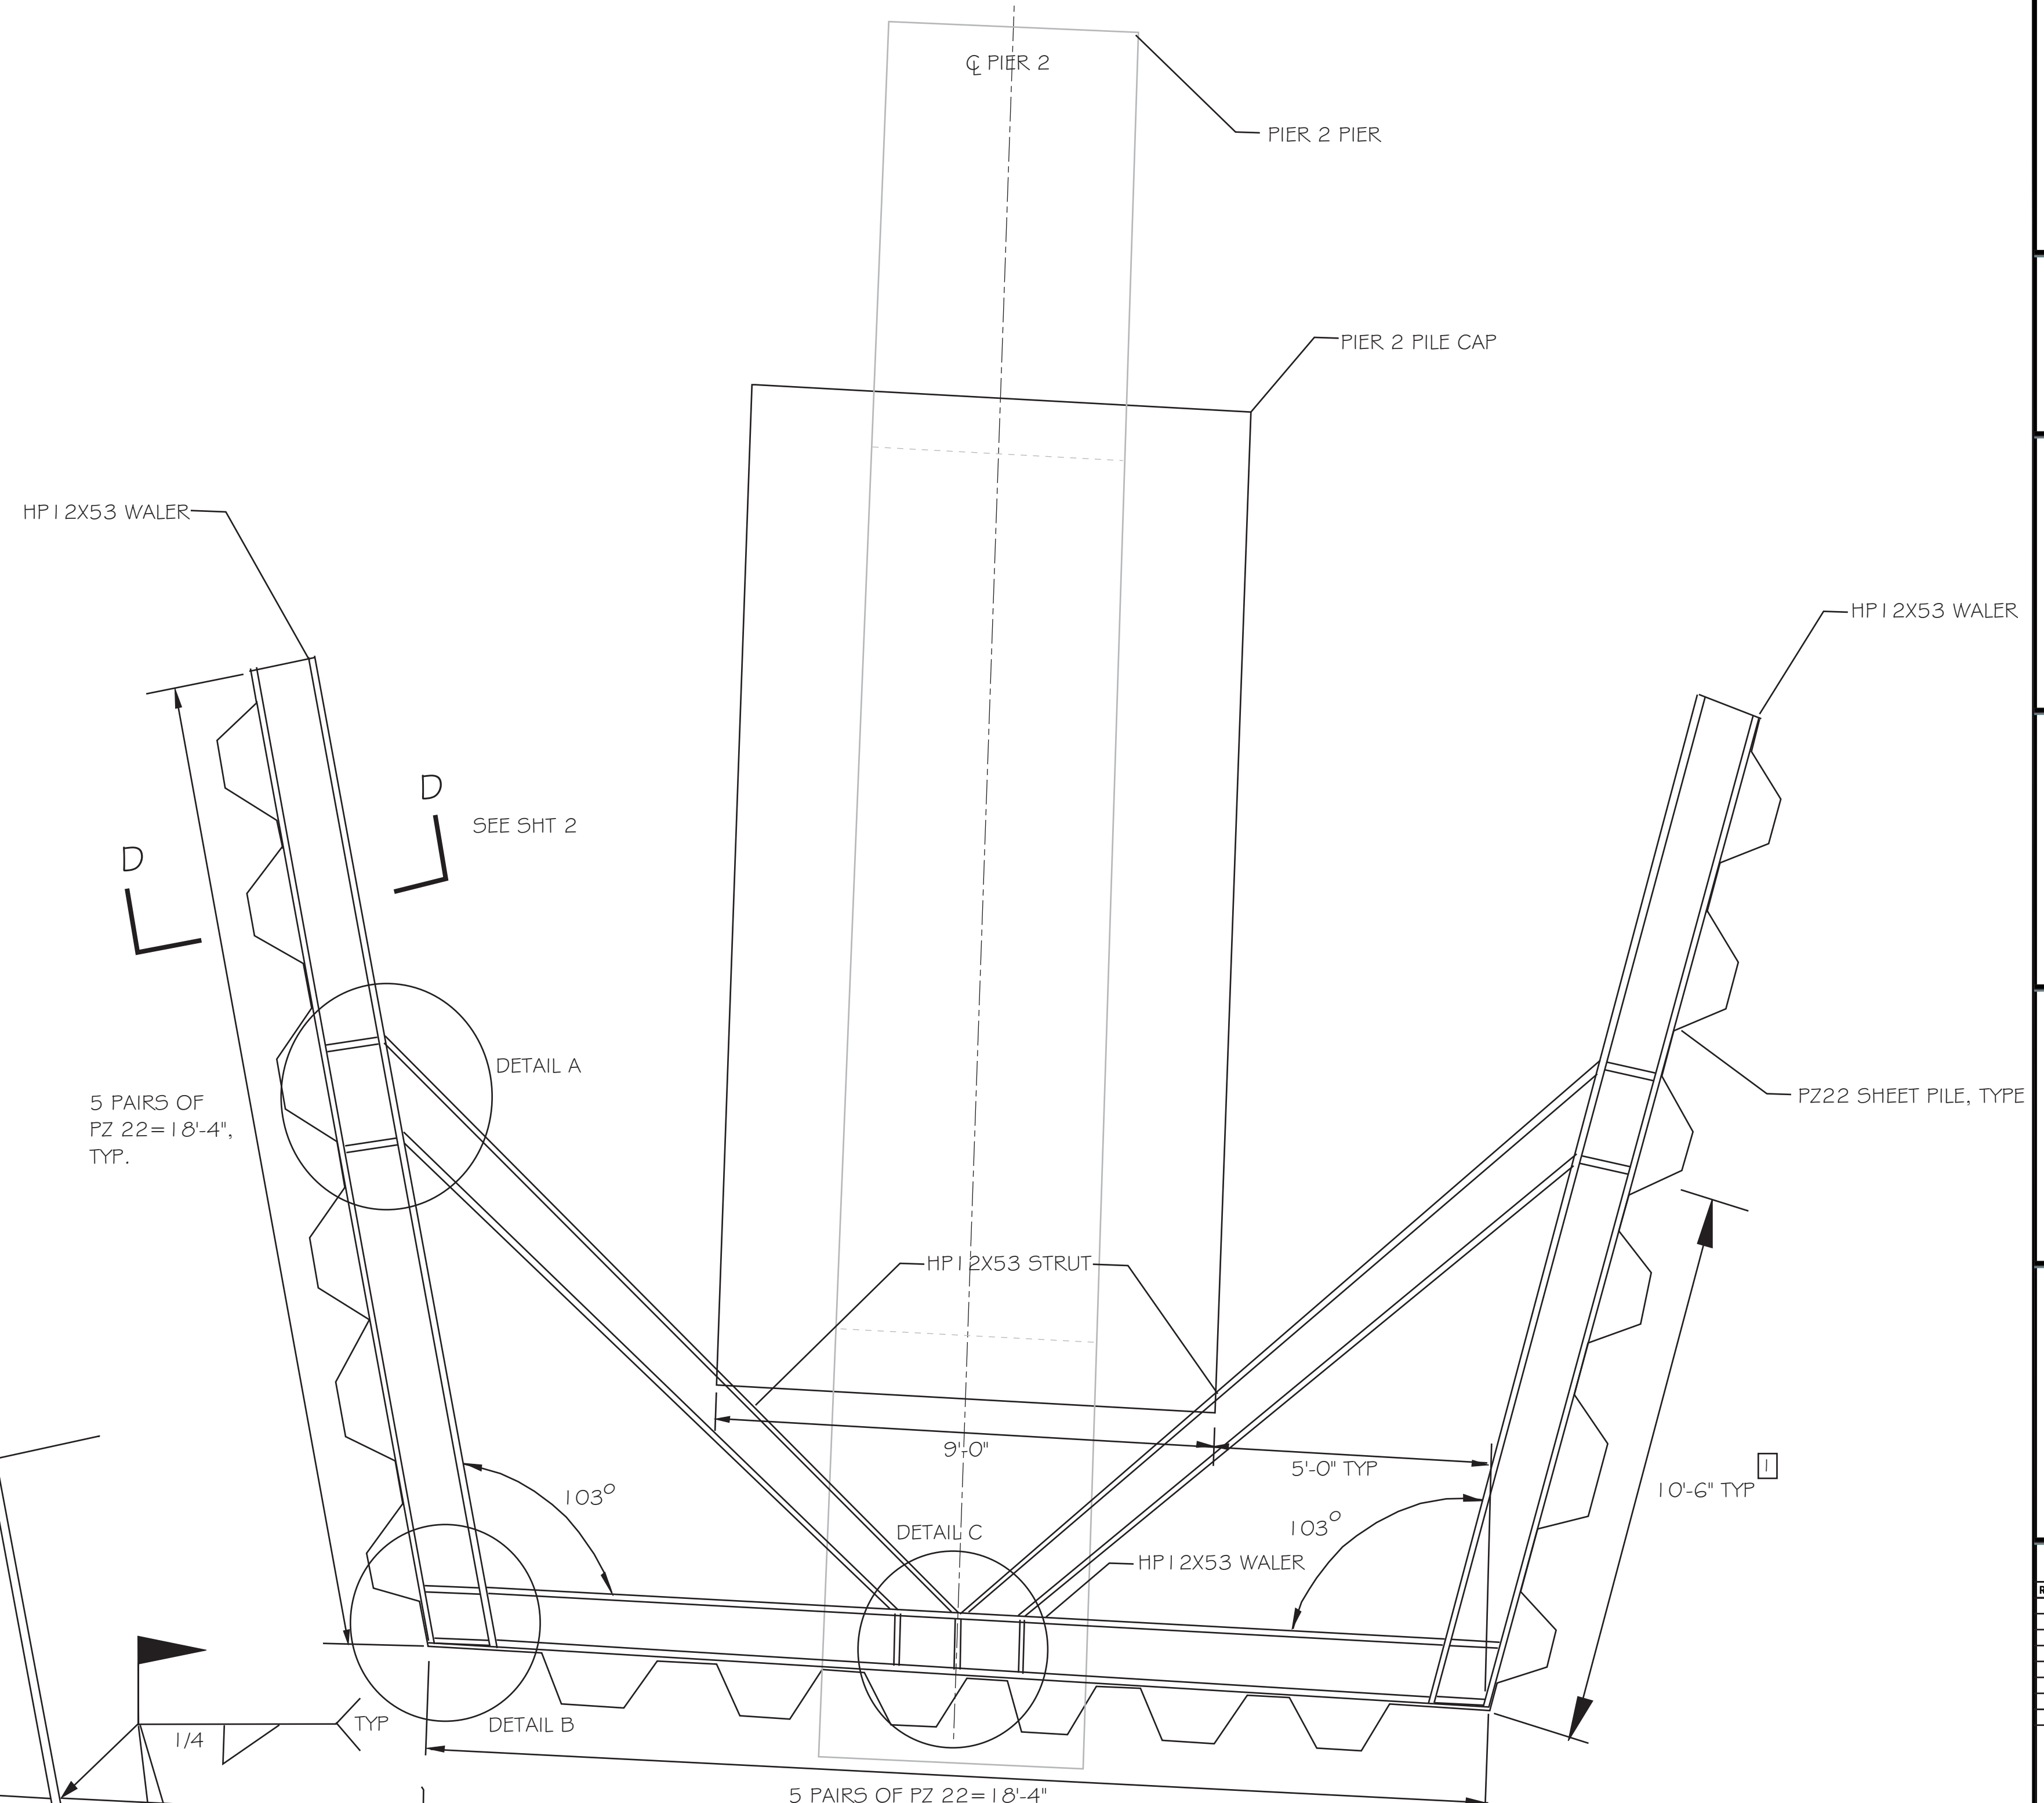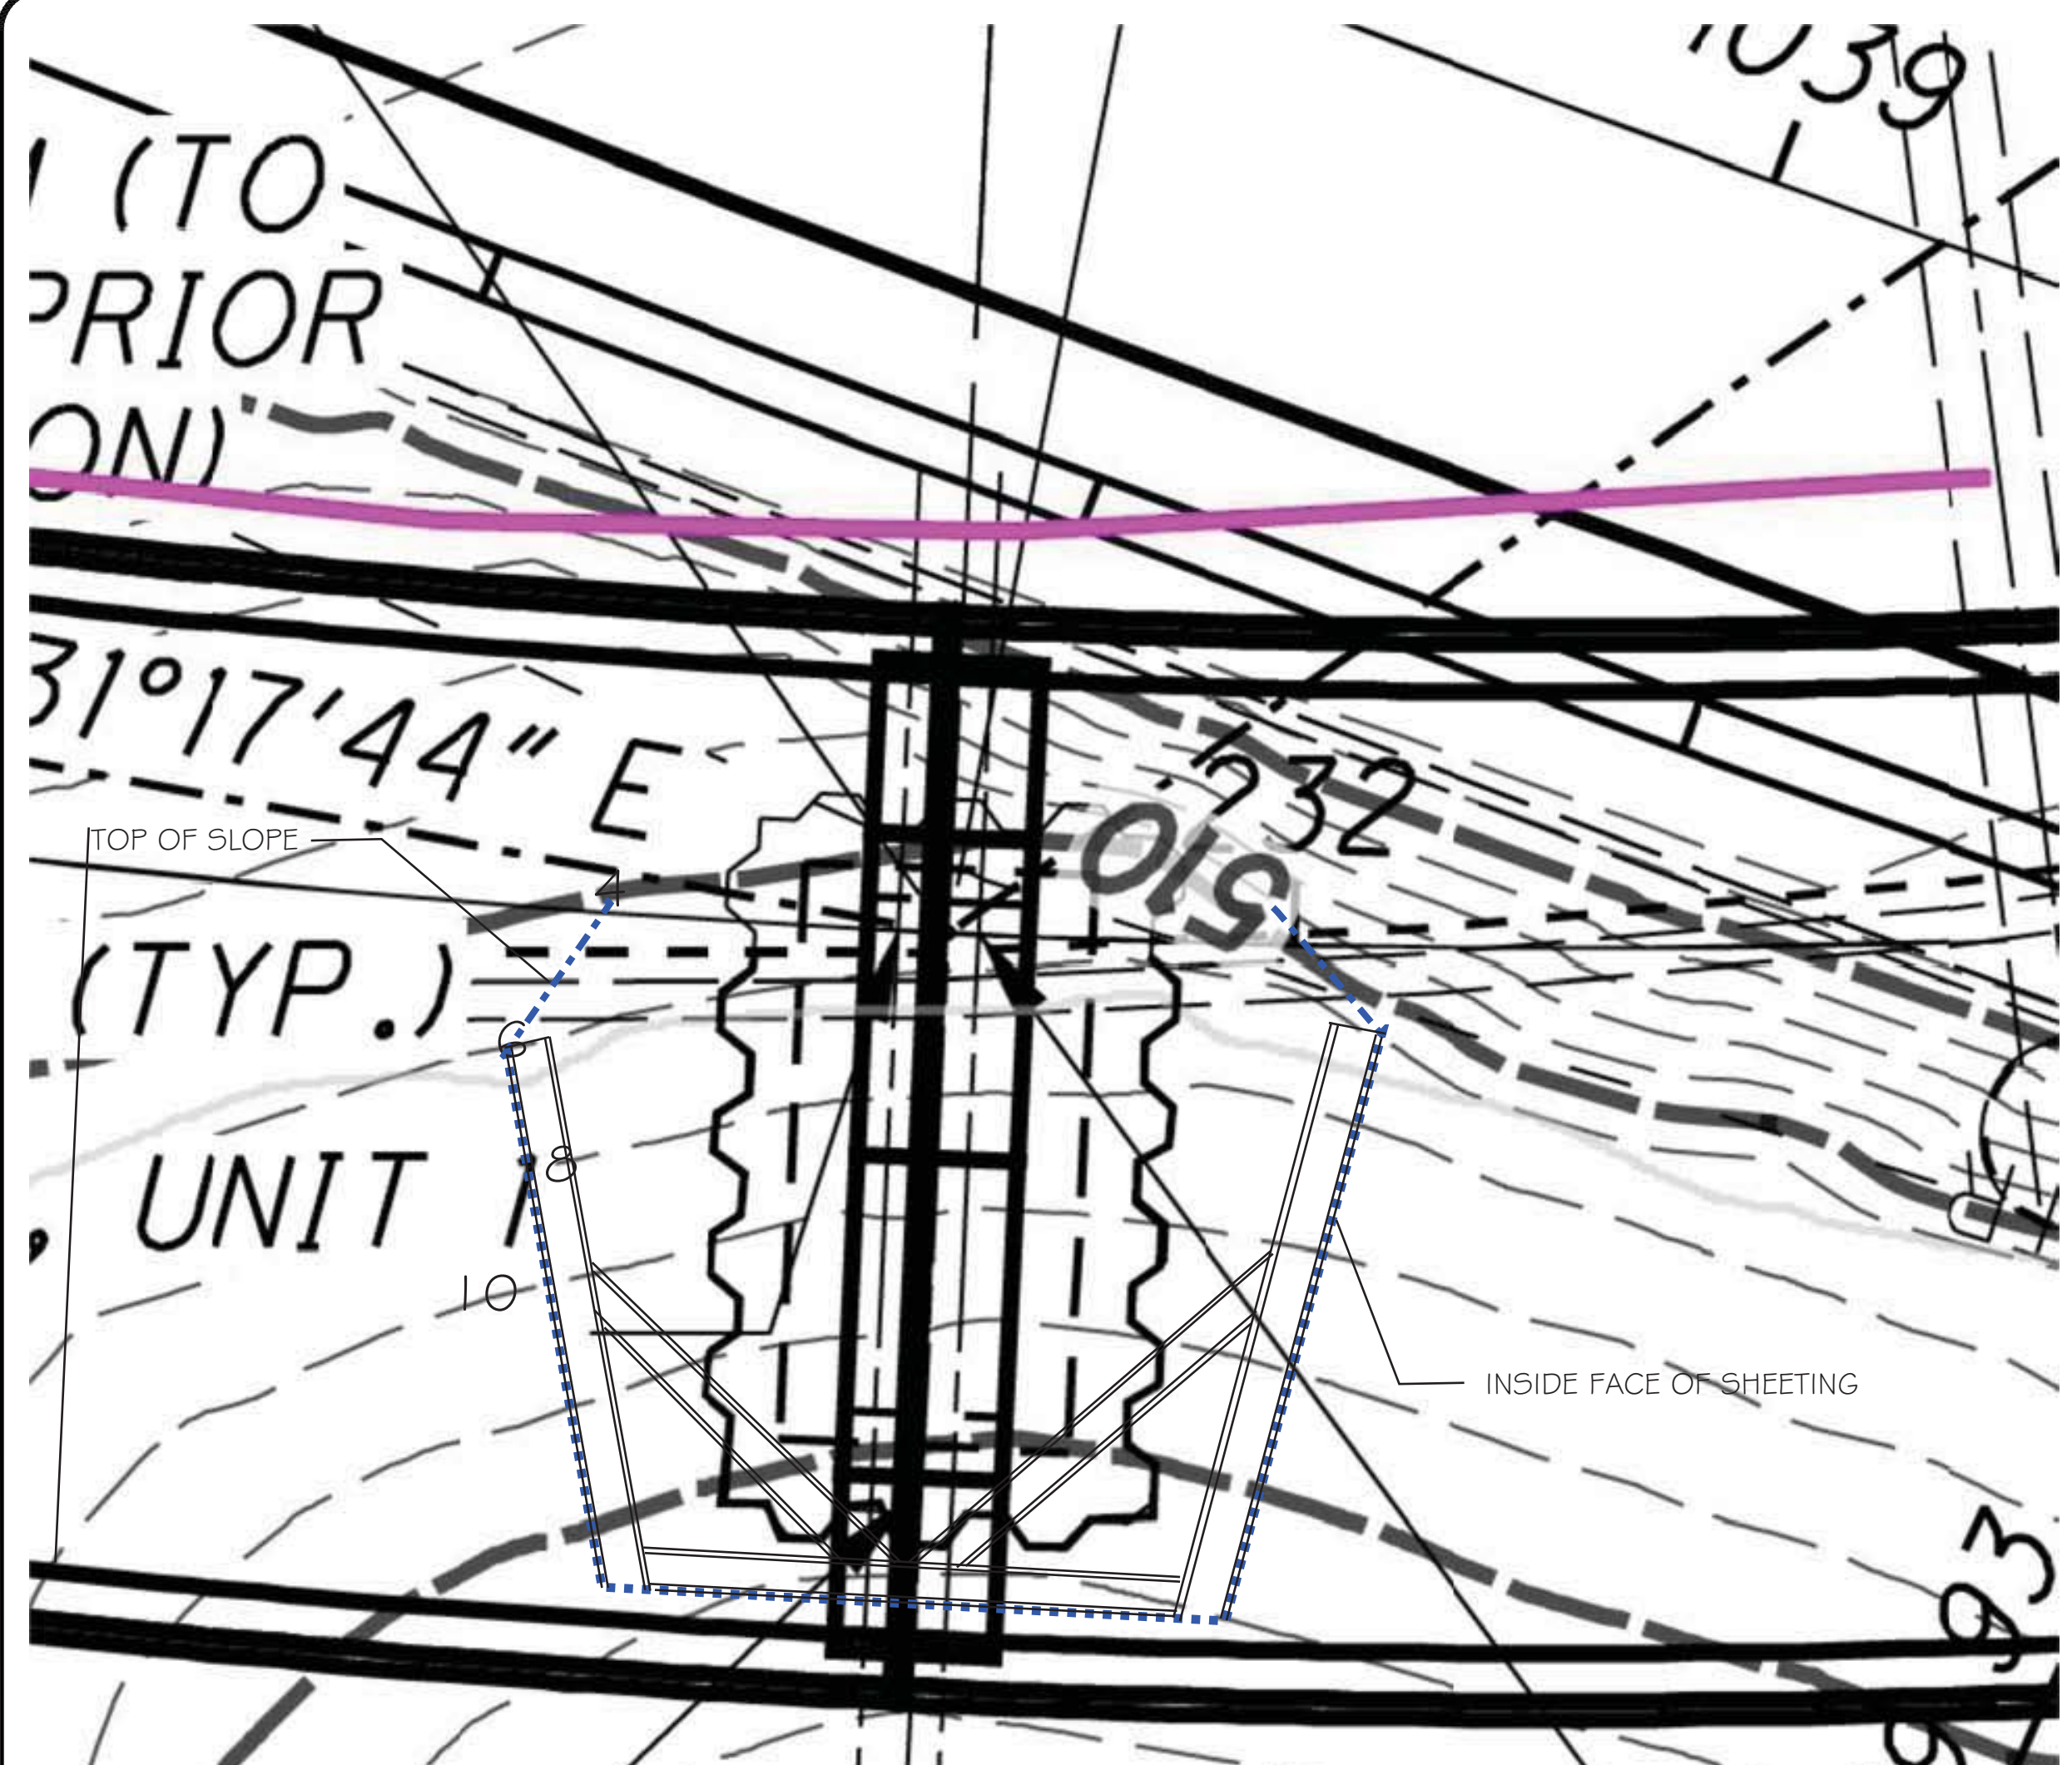

DETAIL A  
1/2" = 1'-0"

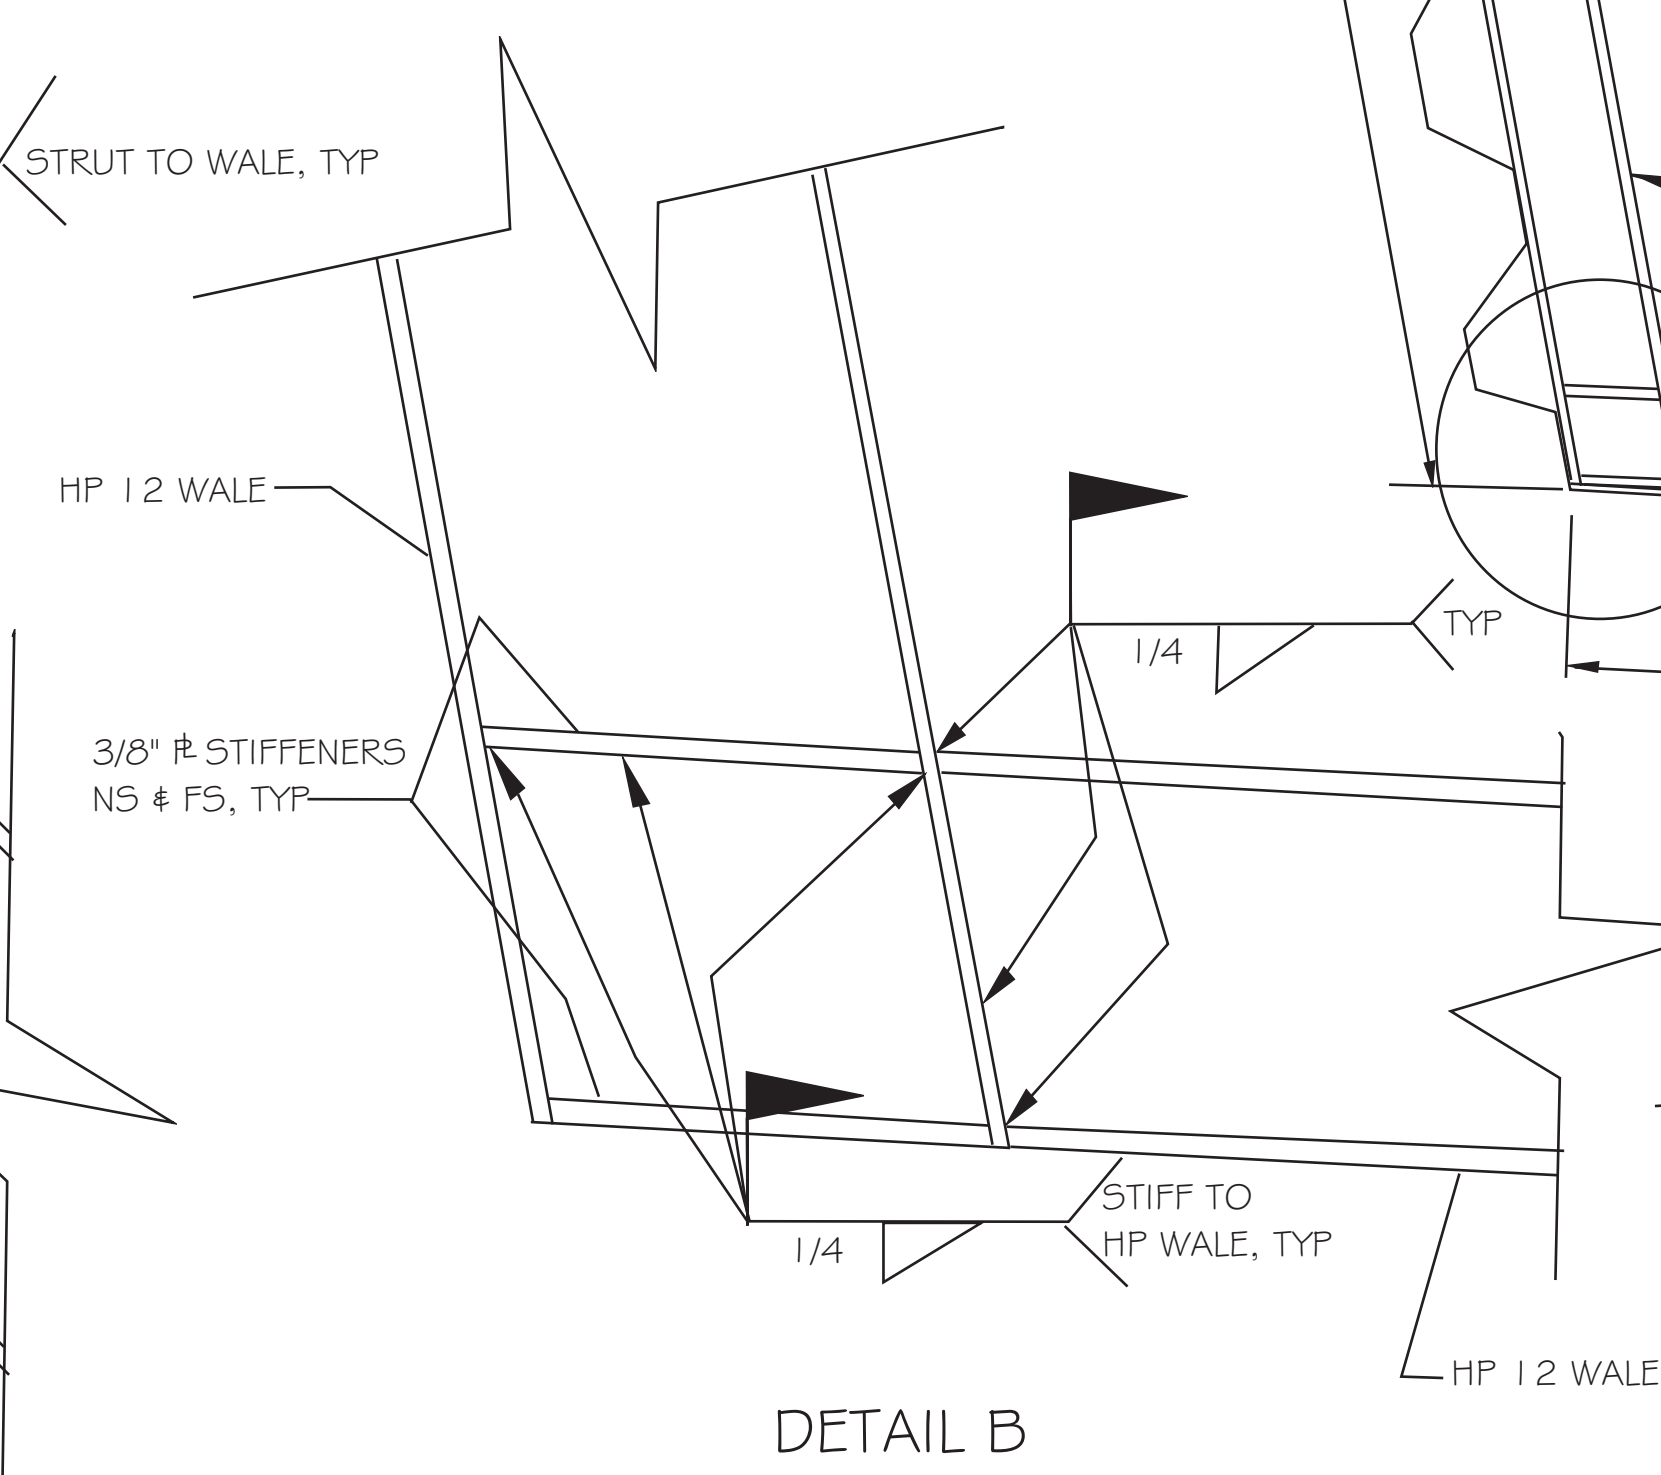

DETAIL B  
1/2" = 1'-0"

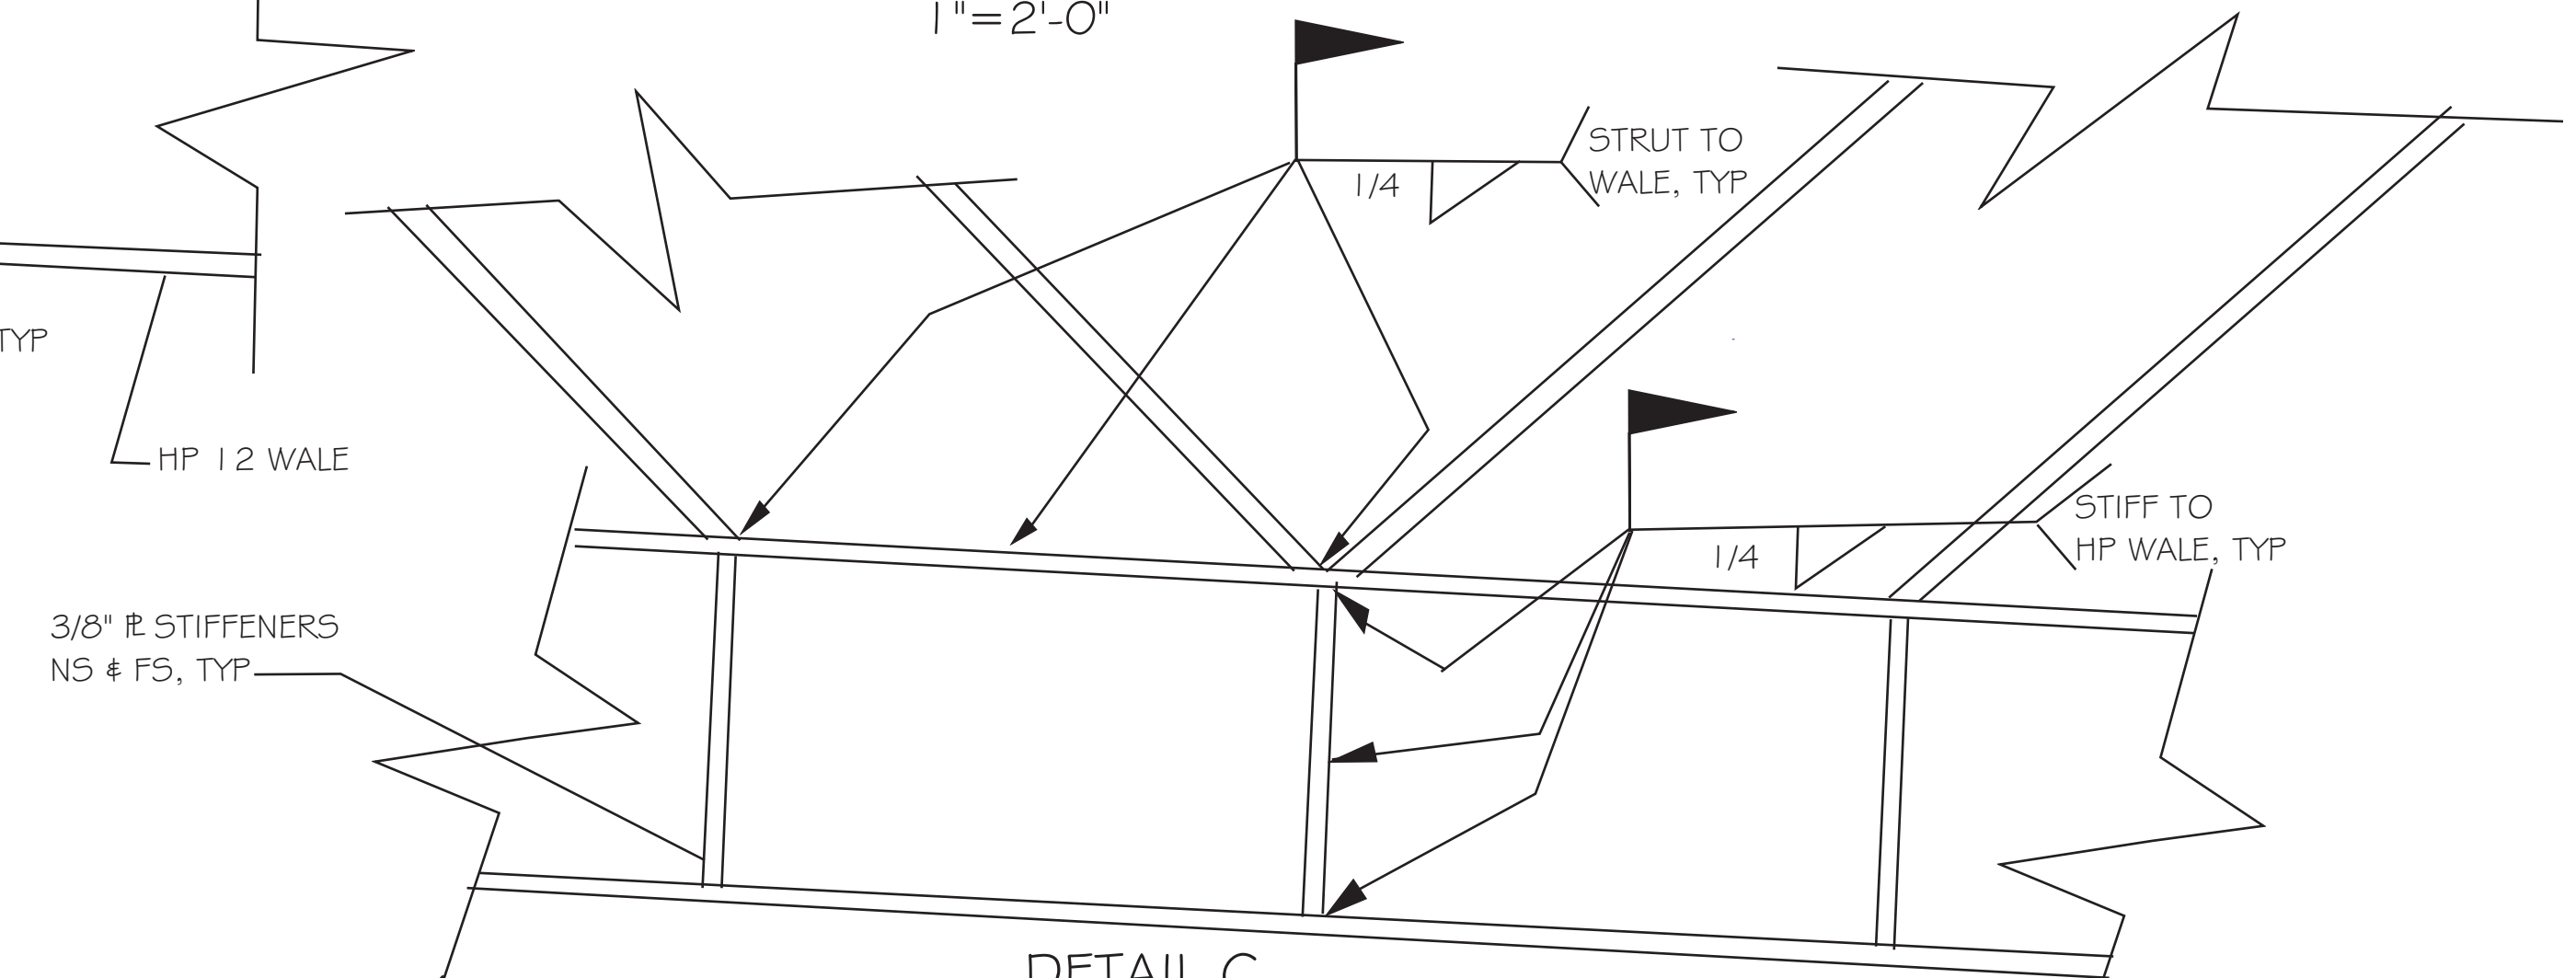


DETAIL C  
1/2" = 1'-0"

PIER 2 SOE PLAN  
1" = 2'-0"




www.sme-usa.com

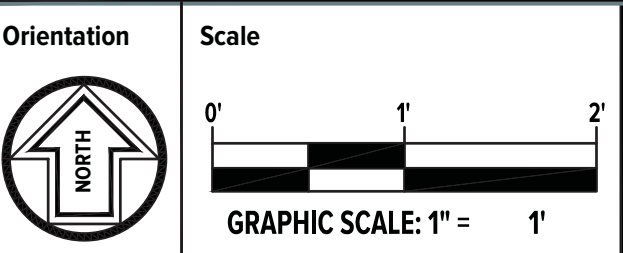

Project  
HAM-75-3.84  
BRIDGE NO.  
HAM-74-1908 S  
RAMP P O/IR-74 WB  
& IR-75 AND RAMP E

Project Location  
HAMILTON COUNTY  
CITY OF CINCINNATI  
OHIO

Sheet Name  
PIER 2  
SOE PLAN  
AND DETAILS

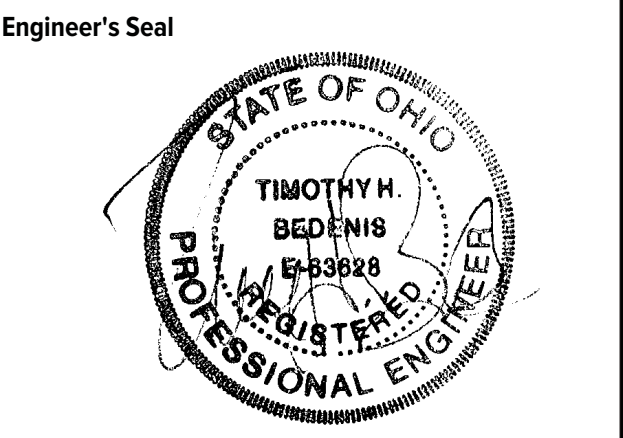

REV	ISSUED FOR	DATE	BY
1	ADDED DIMENSION	2-13-19	DWB

Date  
2-5-2019

SME Project No.  
79059.01

Project Manager:  
TH BEDENIS

Designer:  
DW BIRD


CADD:  
DW BIRD

Checked By:  
TH BEDENIS


Sheet No.  
1 OF 2

DRAWING NOTE: SCALE DIMENSIONS MEANT FOR 24" X 36" AND WILL SCALE INCORRECTLY IF PRINTED ON ANY OTHER SIZE MEDIA.  
NO REPRODUCTION SHALL BE MADE WITHOUT THE PRIOR CONSENT OF SME  
© 2019



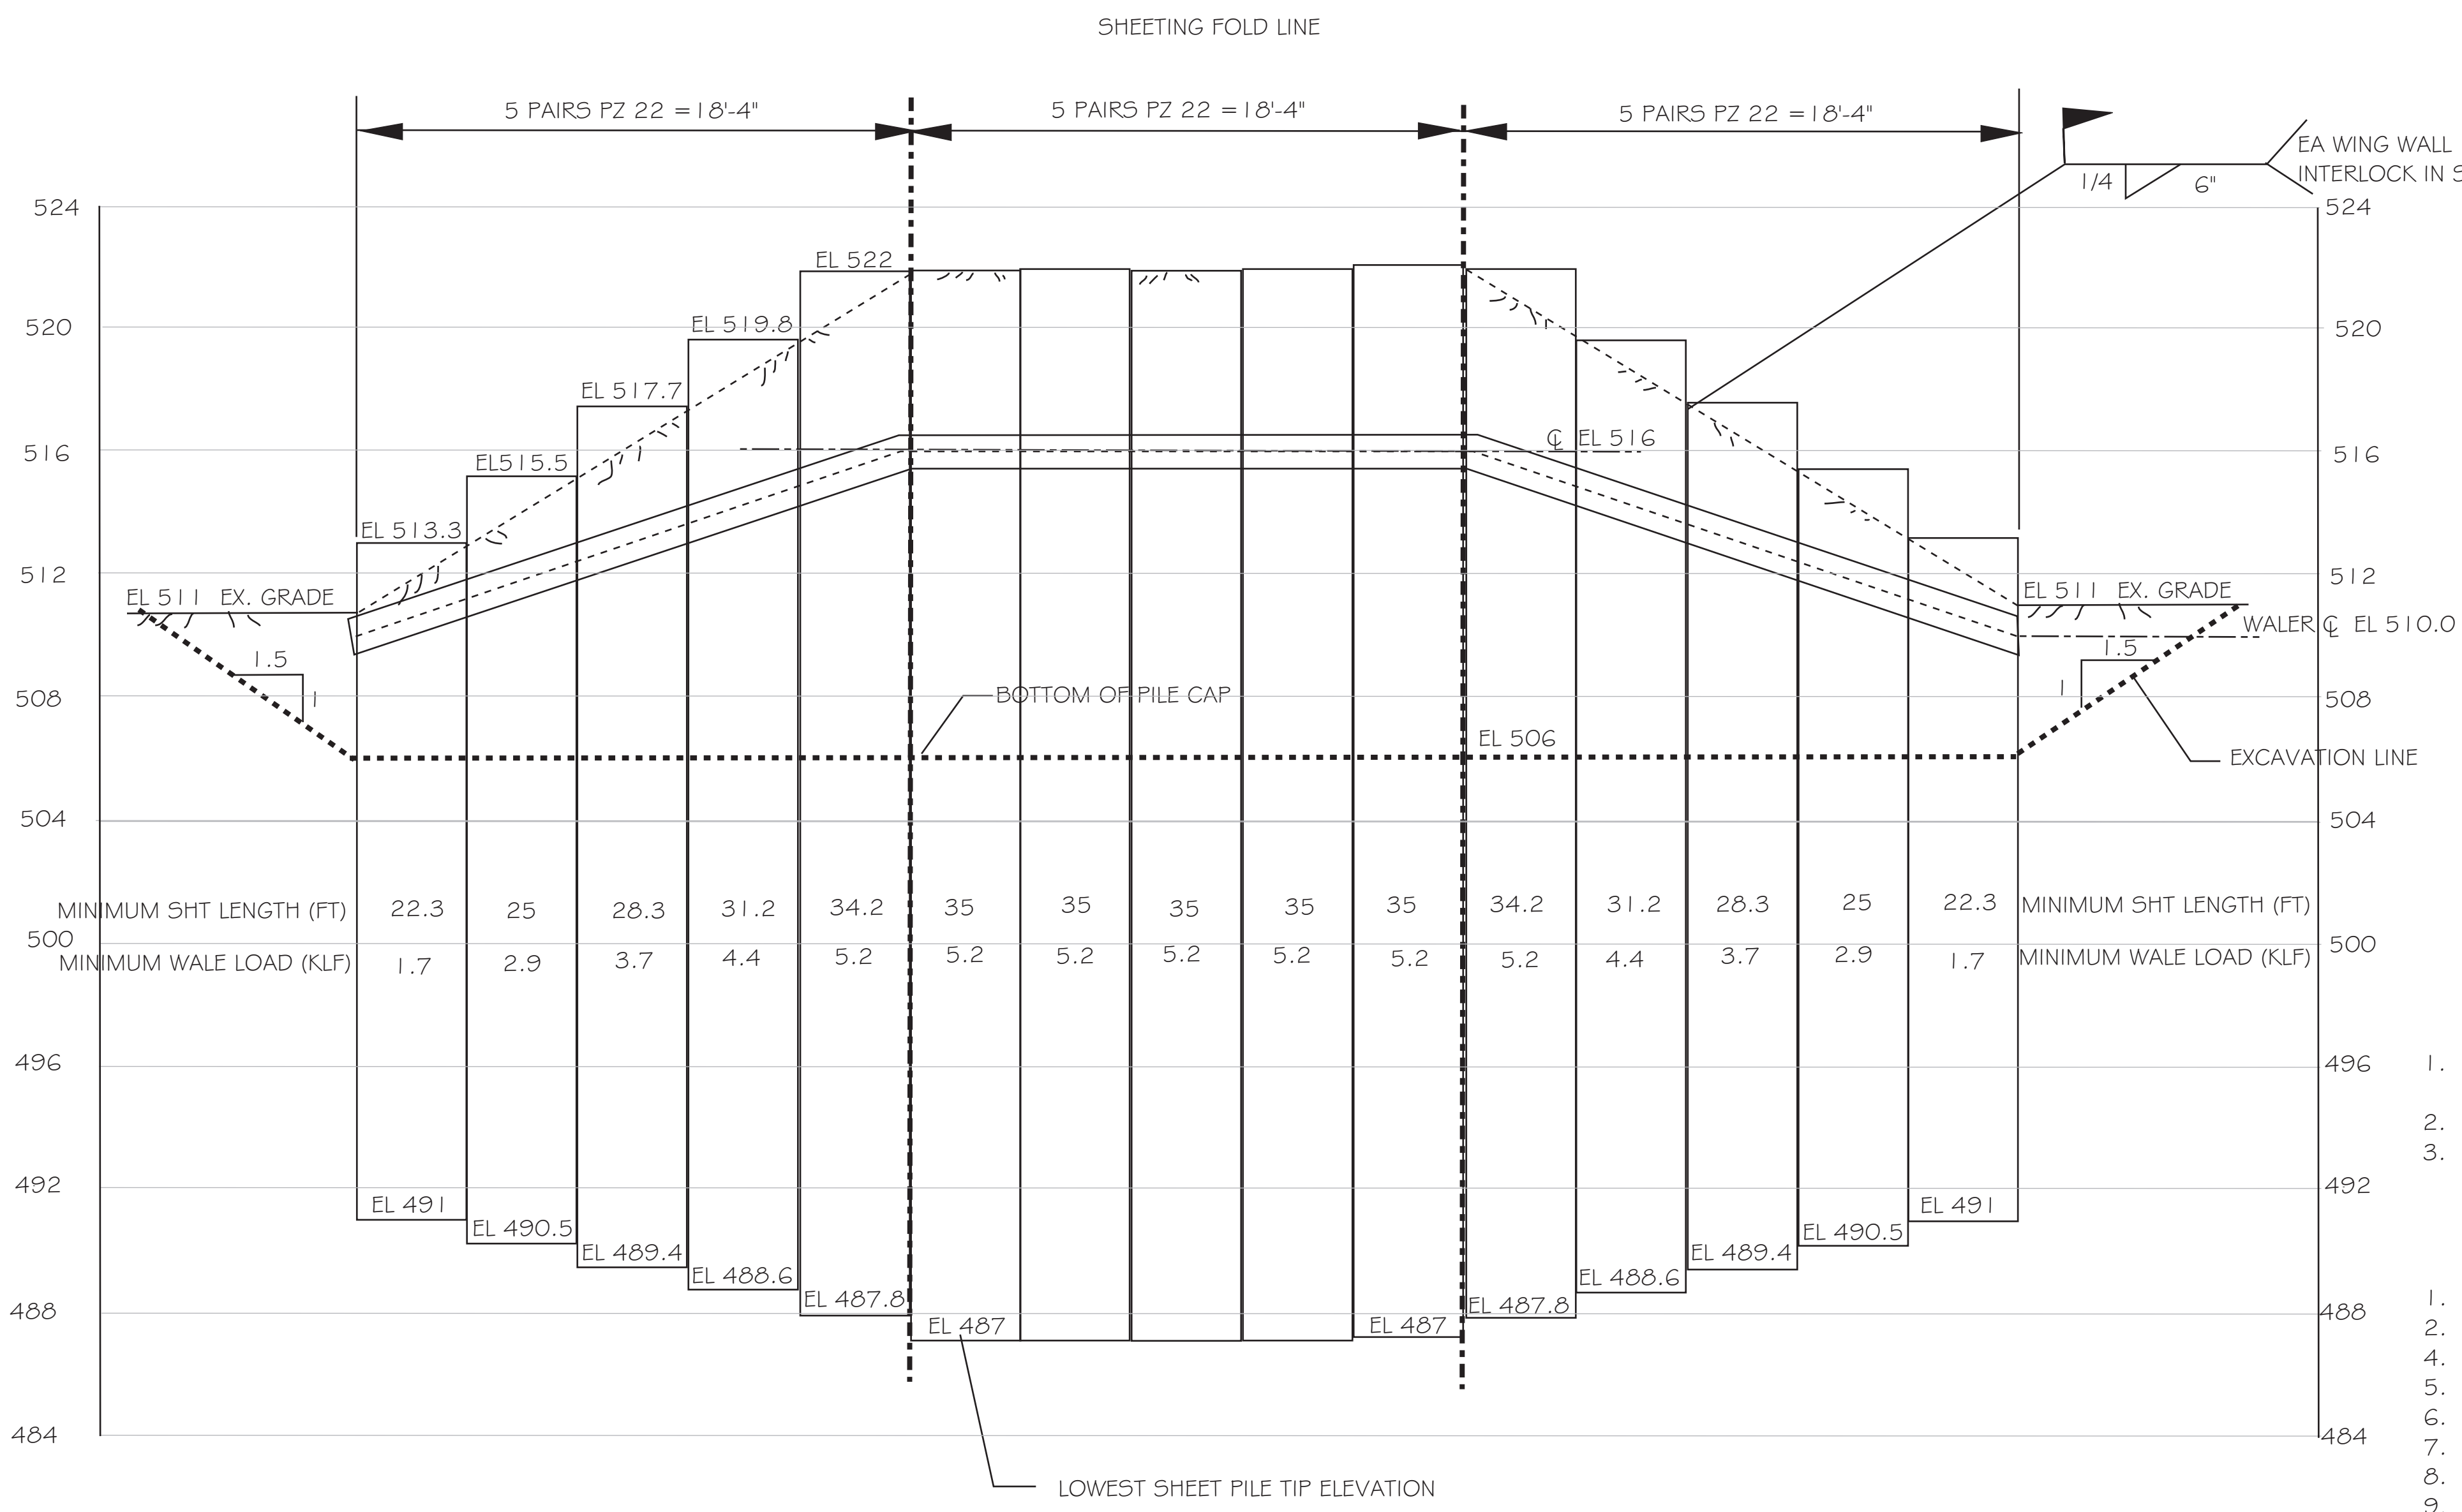

UNFOLDED SOE ELEVATION VIEW  
1/4" = 1'-0"

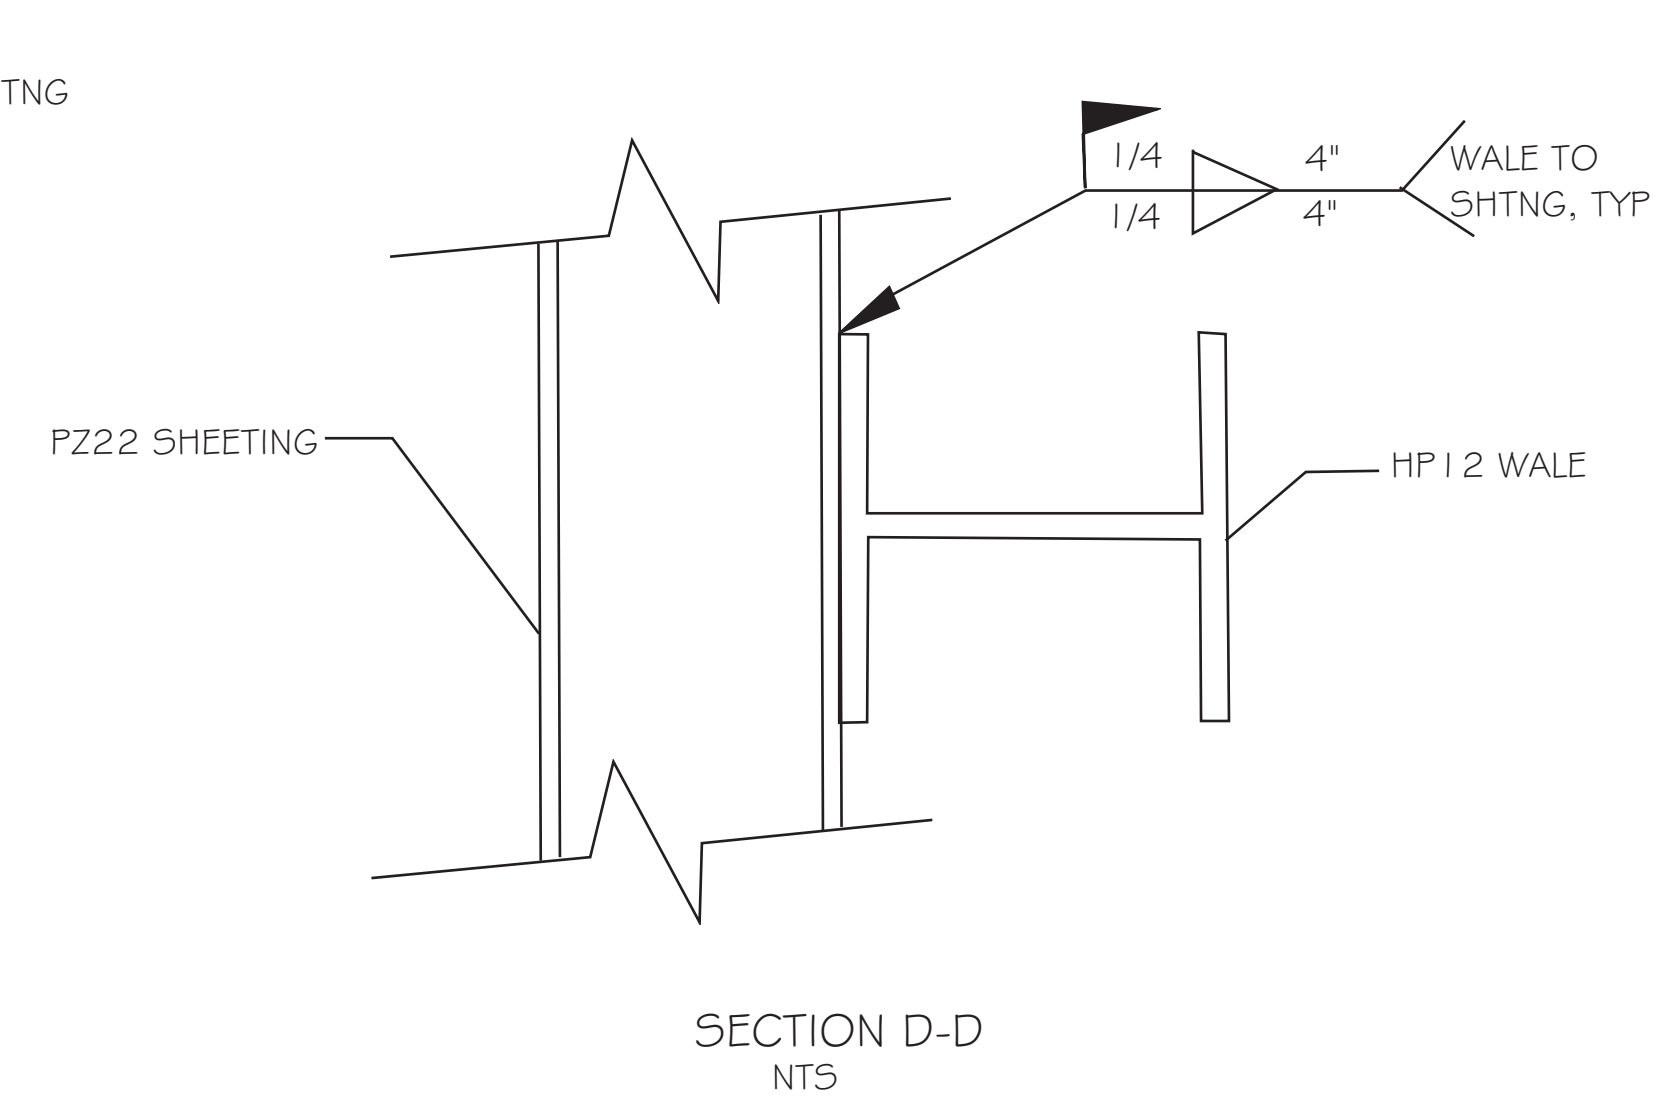

SOE INSTALLATION CONSTRUCTION NOTES:

1. CONTRACTOR IS RESPONSIBLE FOR SITE SAFETY INCLUDING INSTALLATION OF FALL PROTECTION AND ADHERENCE TO OSHA EXCAVATION SAFETY REQUIREMENTS.
2. ALL STEEL SHALL BE FURNISHED IN GR 50.
3. ALL WELDING SHALL BE WITH E70XX ELECTRODES IN ACCORDANCE WITH AWS D1.1.

SOE SEQUENCE OF ACTIVITIES

1. INSTALL SOE SHEETING.
2. EXCAVATE TO REQUIRED ELEVATION IN OPEN CUT AREA. EXCAVATE SHEETING AREA TO 2 FT BELOW WALE ELEV.
4. INSTALL WALERS AND CORNER BRACE STRUTS.
5. EXCAVATE TO ELEV 506 (BOTTOM OF PILE CAP ELEV).
6. DRIVE PILES TO REQUIRED CAPACITY/TIP ELEVATION.
7. CONSTRUCT PILE CAP.
8. CONSTRUCT PIER STEM.
9. BACKFILL EXCAVATION, REMOVING BRACING WHEN BACKFILL REACHES BRACING ELEVATION.
10. CUT THE INTERLOCK WELDS LOOSE.
11. BACKFILL TO FINAL GRADE AND EXTRACT SHEETING.



www.sme-usa.com

Orientation:

Scale:

GRAPHIC SCALE: 1" = 1'

Project  
HAM-75-3.84  
BRIDGE NO.  
HAM-74-1908 S  
RAMP P O/IR-74 WB  
IR-75 AND RAMP E

Project Location  
HAMILTON COUNTY  
CITY OF CINCINNATI  
OHIO

Sheet Name  
PIER 2  
SOE ELEVATION  
AND NOTES

Engineer's Seal

Revisions

REV	ISSUED FOR	DATE	BY

Date: 2-5-2019

SME Project No.: 79059.01

Project Manager: TH BEDENIS

Designer: DW BIRD

CADD: DW BIRD


Checked By: TH BEDENIS

Sheet No.: 2 OF 2

DRAWING NOTE: SCALE DIMENSIONS MEANT FOR 24" X 36" AND WILL SCALE INCORRECTLY IF PRINTED ON ANY OTHER SIZE MEDIA.  
NO REPRODUCTION SHALL BE MADE WITHOUT THE PRIOR CONSENT OF SME  
© 2019

**COSMEC INC. / DYNAMIC RUBBER**

P.O. Box 2159  
 1501 Rocky Ridge Road  
 Athens, TX 75751  
 TEL: 903.677.2871 FAX: 903.675.4776

<b>PRIME AE, Group, Inc</b>		<b>RELEASED FOR FABRICATION</b>	
DATE REC'D: <b>8/19/2019</b>	BUILDABLE UNIT NO.: <b>7</b>		
Review conforms that the shop drawings meet the intent of the contract.			
<input checked="" type="checkbox"/> CONFORMS AS-IS	<input type="checkbox"/> CONFORMS AS NOTED		
	<input type="checkbox"/> REVISE AND RESEND		
<b>1908S - FIXED BEARINGS</b>			
By: <b>Conrad Gagnon</b>		By:	
Date: <b>8/20/2019</b>		Date:	

**TRANSMITTAL SHEET**

TO: WALSH CONSTRUCTION CO. II  
ZACHARY WIRRIG ZWIRRIG@WALSHGROUP.COM  
CC KATHI MILLS

DATE: 8/19/19  
 JOB: 183000 BRIDGE HAM-74-1908S  
 RE: FINAL DRAWING DISTRIBUTION

DRP JOB NO: 15353B1 LOCATION: HAMILTON COUNTY

WE TRANSMIT TO YOU UNDER SEPARATE COVER HERE WITH THE FOLLOWING DRAWINGS:

DWG NO	REV NO	NO EACH	DESCRIPTION	REMARKS
15353B1-GN1	1	1	GENERAL NOTES	
15353B1-D1	2	1	SHOP DRAWINGS	
15353B1-D2	2	1	SHOP DRAWINGS	
15353B1-D3	2	1	SHOP DRAWINGS	
15353B1-D4	2	1	SHOP DRAWINGS	

DWG NO	REV NO	NO EACH	DESCRIPTION	REMARKS

COMMENTS: **THE ATTACHED SHOP DRAWINGS ARE PROVIDED FOR FINAL DISTRIBUTION, NO ACTION REQUIRED ON YOUR PART.**


THE ABOVE PRINTS ARE SUBMITTED TO YOU FOR:

( ) Approval	( ) Final Approval	(XXX) Distribution
( ) Field Use	( ) Fabrication	(XXX) E-MAIL
BY: ( ) Next Day Air	( ) Second Day Air	( ) Messenger
( ) UPS	( ) First Class Mail	( ) Fax

Thank you  
 STEPHANIE RITZ  
 COSMEC INC. / DYNAMIC RUBBER PRODUCTS  
[WWW.COSMECINC.COM](http://WWW.COSMECINC.COM)

# GENERAL NOTES


**GENERAL NOTES:**

1. ALL BEARINGS IN ACCORDANCE WITH THE 2016 OHIO DEPARTMENT OF TRANSPORTATION STANDARD SPECIFICATION FOR CONSTRUCTION AND MAINTENANCE OF HIGHWAYS, STREETS AND BRIDGES AND SUPPLEMENTAL SPECIFICATIONS 800 DATED 10/19/18, AND 869 DATED 10/17/14.
2. SHOP TO MARK LOCATION, BEAM/GIRDER NUMBER, BEARING NUMBER, HIGH-SIDE  AND AHEAD STATION AS SHOWN. MARKS SHALL BE PERMANENT AND BE VISIBLE AFTER BEARING IS INSTALLED.
3. ALL DIMENSIONS ARE IN INCHES.
4. ALL PLATES SHALL BE SMOOTH AND STRAIGHT.
5. SHIP THE SAMPLE BEARING TO AN INDEPENDENT TESTING LABORATORY FOR TESTING PER OH DOT STANDARD SPECIFICATIONS SECTION 711.23.
6. NOTIFY THE OH DOT OFFICE OF STRUCTURAL ENGINEERING AT LEAST TWO WEEKS BEFORE STARTING SHOP FABRICATION.
7. DYNAMIC RUBBER REPRESENTATIVE:  
KATHI MILLS  
903-677-2871  
1501 ROCKY RIDGE RD.  
ATHENS, TX 75751


**MATERIAL NOTES:**


1. ELASTOMER: 50 DUROMETER GRADE 3 NEOPRENE
2. STEEL LAMINATES: ASTM A709 GRADE 36, A1011 GRADE 36, GRADE 40 OR EQUIVALENT.
3. STEEL PLATES: ASTM A709 GRADE 50 (METALIZED)
4. ALL-THREAD ANCHOR ROD: ASTM F1554 GRADE 55 (HOT-DIPPED GALVANIZED)
5. HVY. HEX NUT: ASTM A563-DH (HOT-DIPPED GALVANIZED)
6. HD WASHER: ASTM F436 (HOT-DIPPED GALVANIZED)

**CONTRACTOR NOTES:**


1. WHEN WELDING BEAM FLANGE TO SOLE PLATES, USE TEMPERATURE INDICATING WAX PEN OR OTHER SUITABLE MEANS TO INSURE THAT THE TEMPERATURE OF THE ELASTOMER DOES NOT EXCEED 250°F. TEMPERATURES ABOVE THIS MAY DAMAGE THE ELASTOMER.
2. REPAIR DAMAGED OR FIELD WELDED METALIZED COATINGS BY METALIZING AND SEALING IN ACCORDANCE TO SUPPLEMENTAL SPECIFICATION 869.  PROTECT AND MASK NON-DAMAGED OR NON-FIELD WELDED METALIZED SURFACES AND ELASTOMERIC PARTS DURING ALL REPAIRS TO PREVENT DAMAGE OR CONTAMINATION.


**FINISH NOTES:**

1. BLAST EXPOSED STEEL SURFACES OF THE LOAD PLATES TO SSPC-SP5 (WHITE METAL BLAST CLEANING) PRIOR TO METALIZING.
2. THE LOAD PLATES SHALL BE METALIZED (12 MILS MIN. DFT) PER SUPPLEMENTAL SPECIFICATION 869. 


<b>PRIME AE, Group, Inc</b>		<b>RELEASED FOR FABRICATION</b>  
DATE REC'D: <b>8/19/2019</b>	BUILDABLE UNIT NO.: <b>7</b>	
Review conforms that the shop drawings meet the intent of the contract.		
<input checked="" type="checkbox"/> CONFORMS AS-IS <input type="checkbox"/> CONFORMS AS NOTED <input type="checkbox"/> REVISE AND RESEND		
<b>1908S - FIXED BEARINGS</b>		
By: <b>Conrad Gagnon</b>		By:
Date: <b>8/20/2019</b>		Date:

STATE OF OHIO DEPARTMENT OF TRANSPORTATION  BRIDGE NO.: HAM-74-1908S OVER IR-74 WB, IR-75 & RAMP E  HAM-75-3.84 CITY OF CINCINNATI		
STATE	COUNTY	PID NO.
OH	HAMILTON	104667
FED. PROJ. NO.: E170 (713)		
<b>DYNAMIC RUBBER LAM. ELASTOMERIC BEARING ASSY.'S</b>		
		1501 ROCKY RIDGE ROAD P.O. BOX 2159 ATHENS, TEXAS 75751
SCALE: NONE	DRAWN BY: <b>MH</b>	CHECKED BY: <b>RB</b>
	DATE: 06/11/19	DATE: 07/02/19

	REVISED FINISH NOTE #2 AND ADDED CONTRACTOR NOTE #2.	MH	07/19/19	ELS	07/19/19	SHEET GN1 OF 1	<b>JOB NO.: 15353B1</b>
REV.	DESCRIPTION	BY	DATE	CK'D	DATE	CUSTOMER WALSH CONSTRUCTION CO. II	DRAWING NUMBER 15353B1-GN1

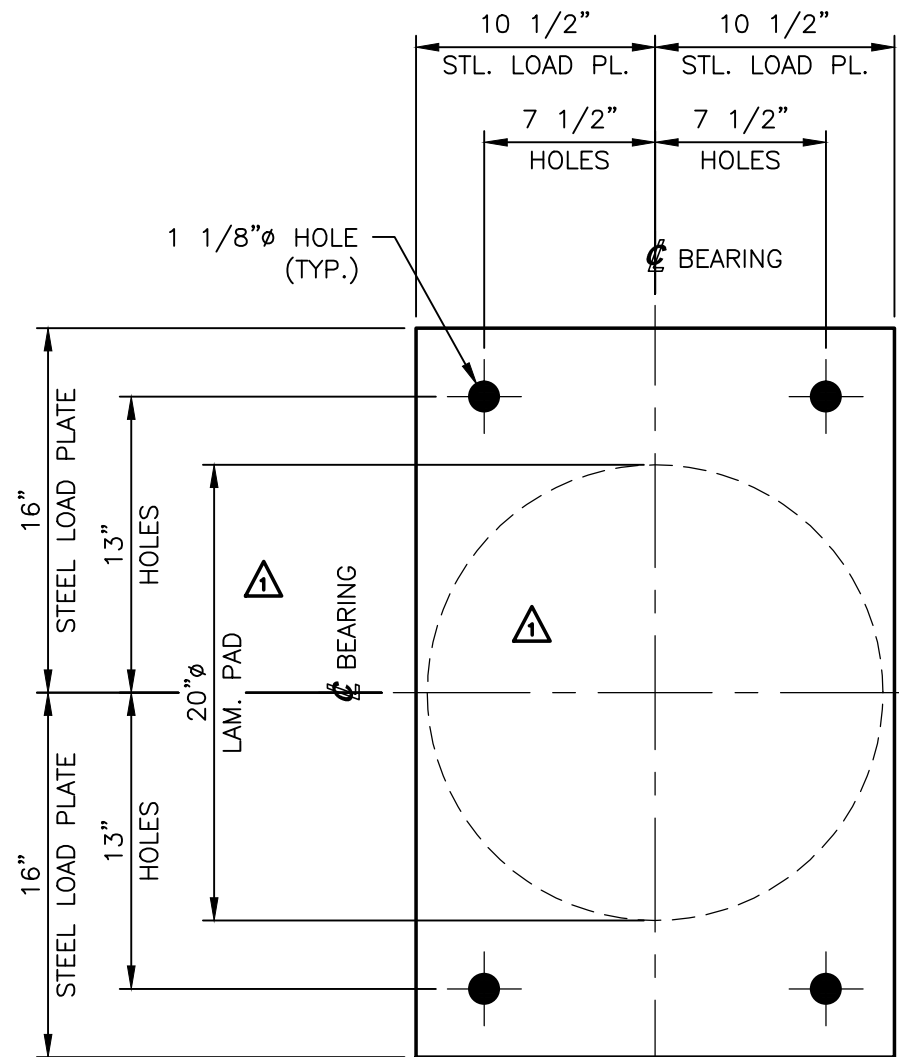

**PLAN VIEW**

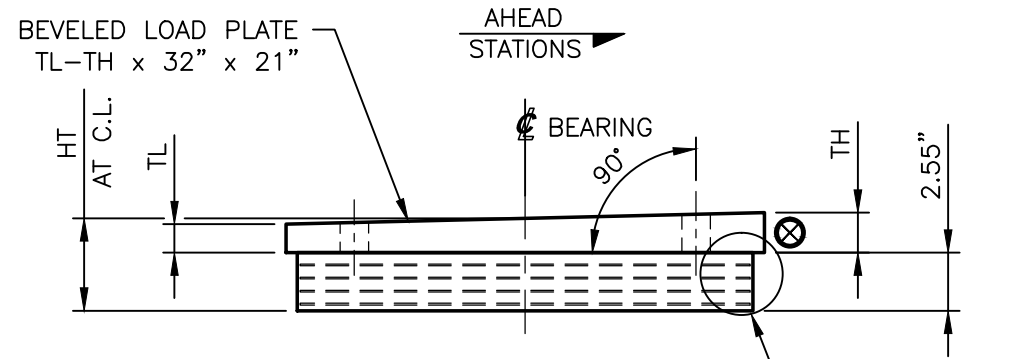


**ELEVATION VIEW**

**FIXED LAMINATED ELASTOMERIC BEARING ASSEMBLY (REF. NO.: 0034)**  
 (REFER TO BEARING TABLE ON THIS SHEET FOR MARK NO.'s, LOCATIONS, DIMENSIONS & QUANTITIES)

**CONTRACTOR NOTE:**  
 AREAS FOR FIELD WELDING SHALL BE GROUND DOWN, IN THE FIELD, FOR WELDING THE GIRDER FLANGE TO THE TOP OF THE LOAD PLATES. THE CONTRACTOR SHALL BE RESPONSIBLE FOR FIELD TOUCH-UP OF THE BEARING ASSEMBLIES AFTER INSTALLATION FOR ANY DAMAGE TO THE COATED AREAS. REFER TO CONTRACTOR NOTE #2 ON THE GN1 SHEET.

BEARING TABLE						
BEARING MARK	QTY.	LOCATION		TL LOW SIDE (in.)	TH HIGH SIDE (in.)	HT AT C.L. (in.)
		PIER	GIRDER(s)			
FBA1-B1	1	PIER 1	G1	1 1/4	1 3/4	4.05
FBA2-B1	1	PIER 1	G2	1 1/4	1 3/4	4.05
FBA3-B1	1	PIER 1	G3	1 1/4	1 13/16	4.08
FBA4-B1	1	PIER 1	G4	1 3/16	1 13/16	4.05

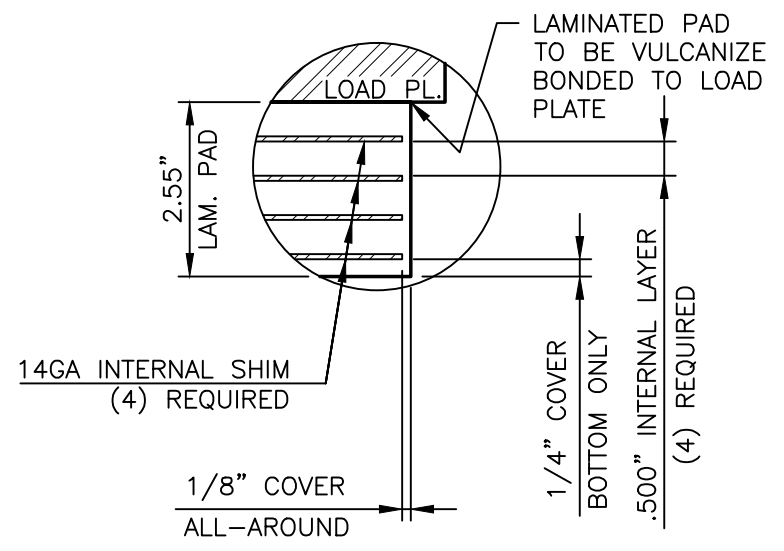

**DETAIL 7**  
 2.55" x 20"Ø LAMINATED PAD  
 50 DUROMETER GRADE 3 NEOPRENE  
 VULCANIZE BONDED TO LOAD PLATE  
 (4) REQUIRED

UNFACTORED ELASTOMERIC BEARING LOADS	
DEAD LOAD	220.7 KIPS
LIVE LOAD	113.1 KIPS
TOTAL LOAD (DL+LL)	333.8 KIPS

**PRIME AE, Group, Inc**

DATE REC'D: 8/19/2019 BUILDABLE UNIT NO.: 7

Review conforms that the shop drawings meet the intent of the contract.

CONFORMS AS-IS     CONFORMS AS NOTED  
 REVISE AND RESEND

**1908S - FIXED BEARINGS**

By: Conrad Gagnon    Date: 8/20/2019

**RELEASED FOR FABRICATION**

**WALSH**

SEE NOTES ON SHEET GN1 OF 1

STATE OF OHIO  
 DEPARTMENT OF TRANSPORTATION

BRIDGE NO.: HAM-74-1908S  
 OVER IR-74 WB, IR-75 & RAMP E

HAM-75-3.84  
 CITY OF CINCINNATI


STATE	COUNTY	PID NO.
OH	HAMILTON	104667

FED. PROJ. NO.: E170 (713)


**DYNAMIC RUBBER LAM. ELASTOMERIC BEARING ASSY.'S**

**Cosmee** 1501 ROCKY RIDGE ROAD  
 P.O. BOX 2159  
 ATHENS, TEXAS 75751

ADDED 1 AT THE END OF THE MARK NUMBERS.	MH	08/13/19	ELS	08/19/19	SCALE: NONE	DRAWN BY: MH	CHECKED BY: RB
REMOVED NO METALIZING AREAS AND ANGLE COLUMN IN TABLE. ADDED CONTRACTOR NOTE.	MH	07/19/19	ELS	07/19/19	SHEET 1 OF 4	DATE: 06/11/19	DATE: 07/01/19
REV.	DESCRIPTION	BY	DATE	CK'D	DATE	JOB NO.: 15353B1	
						CUSTOMER: WALSH CONSTRUCTION CO. II	DRAWING NUMBER: 15353B1-D1
							REV. 2

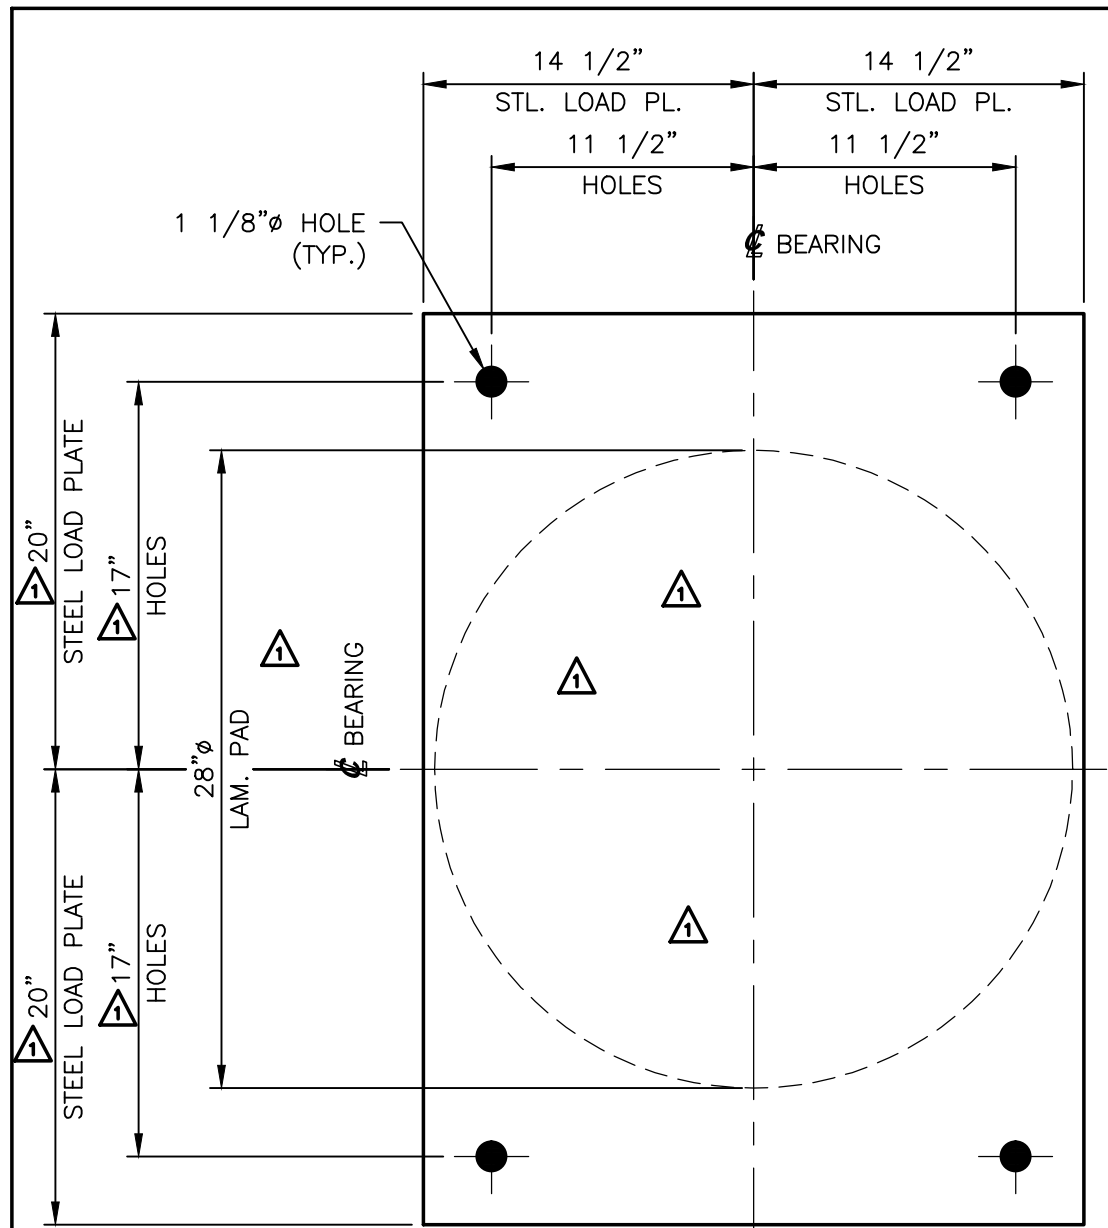

**PLAN VIEW**

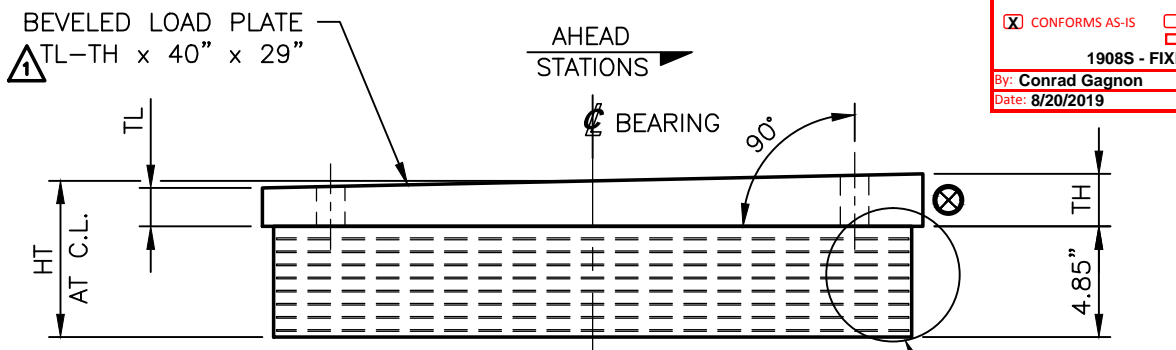


**ELEVATION VIEW**

**FIXED LAMINATED ELASTOMERIC BEARING ASSEMBLY (REF. NO.: 0034)**  
 (REFER TO BEARING TABLE ON THIS SHEET FOR MARK NO.'s, LOCATIONS, DIMENSIONS & QUANTITIES)

**CONTRACTOR NOTE:**  
 AREAS FOR FIELD WELDING SHALL BE GROUND DOWN, IN THE FIELD, FOR WELDING THE GIRDER FLANGE TO THE TOP OF THE LOAD PLATES. THE CONTRACTOR SHALL BE RESPONSIBLE FOR FIELD TOUCH-UP OF THE BEARING ASSEMBLIES AFTER INSTALLATION FOR ANY DAMAGE TO THE COATED AREAS. REFER TO CONTRACTOR NOTE #2 ON THE GN1 SHEET.

BEARING MARK	QTY.	LOCATION		TL LOW SIDE (in.)	TH HIGH SIDE (in.)	HT AT C.L. (in.)
		PIER	GIRDER(s)			
FBA5-B1	1	PIER 3	1	1 13/16	2 3/16	6.85
FBA6-B1	1	PIER 3	2	1 7/8	2 1/8	6.85
FBA7-B1	1	PIER 3	3	1 7/8	2 1/16	6.82
FBA8-B1	1	PIER 3	4	1 15/16	2 1/16	6.85

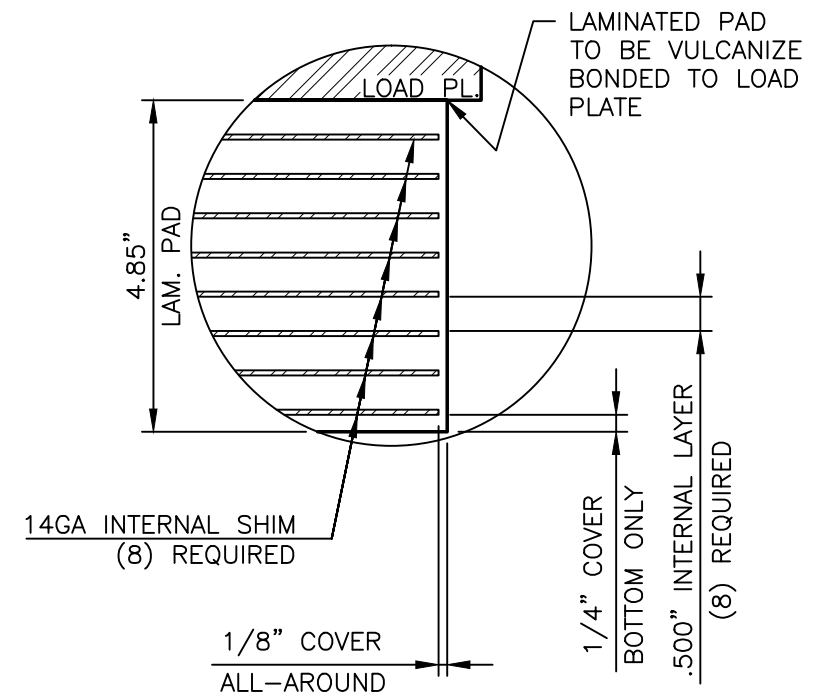

**DETAIL 8**  
 4.85" x 28"Ø LAMINATED PAD  
 50 DUROMETER GRADE 3 NEOPRENE  
 VULCANIZE BONDED TO LOAD PLATE  
 (4) REQUIRED

**TEST2-B1**  
 4.85" x 28"Ø LAMINATED PAD  
 50 DUROMETER GRADE 3 NEOPRENE  
 PAD ONLY FOR TESTING  
 (1) REQUIRED

UNFACTORED ELASTOMERIC BEARING LOADS	
DEAD LOAD	525.2 KIPS
LIVE LOAD	200.4 KIPS
TOTAL LOAD (DL+LL)	725.6 KIPS

**PRIME AE, Group, Inc**  
 DATE REC'D: 8/19/2019 BUILDABLE UNIT NO.: 7  
 Review conforms that the shop drawings meet the intent of the contract.  
 CONFORMS AS-IS  CONFORMS AS NOTED  
 REVISE AND RESEND  
**1908S - FIXED BEARINGS**  
 By: Conrad Gagnon Date: 8/20/2019

**RELEASED FOR FABRICATION**  
**WALSH**

SEE NOTES ON SHEET GN1 OF 1  
**STATE OF OHIO**  
 DEPARTMENT OF TRANSPORTATION  
**BRIDGE NO.: HAM-74-1908S**  
**OVER IR-74 WB, IR-75 & RAMP E**

**HAM-75-3.84**  
**CITY OF CINCINNATI**


STATE	COUNTY	PID NO.
OH	HAMILTON	104667

FED. PROJ. NO.: E170 (713)

**DYNAMIC RUBBER LAM. ELASTOMERIC BEARING ASSY.'S**

**Cosmee** 1501 ROCKY RIDGE ROAD  
 P.O. BOX 2159  
 ATHENS, TEXAS 75751


ADDED 1 AT THE END OF THE MARK NUMBERS.	MH	08/13/19	ELS	08/19/19	SCALE: NONE	DRAWN BY: MH	CHECKED BY: RB
REMOVED NO METALIZING AREAS AND ANGLE & NM COLUMNS IN TABLE. REVISED LOAD PLATE DIMENSIONS ADDED CONTRACTOR NOTE.	MH	07/19/19	ELS	07/19/19	DATE: 06/11/19	DATE: 07/01/19	
REV.	DESCRIPTION	BY	DATE	CK'D	DATE	SHEET 2 OF 4 <b>JOB NO.: 15353B1</b>	
						CUSTOMER: WALSH CONSTRUCTION CO. II	DRAWING NUMBER: 15353B1-D2 REV. 2

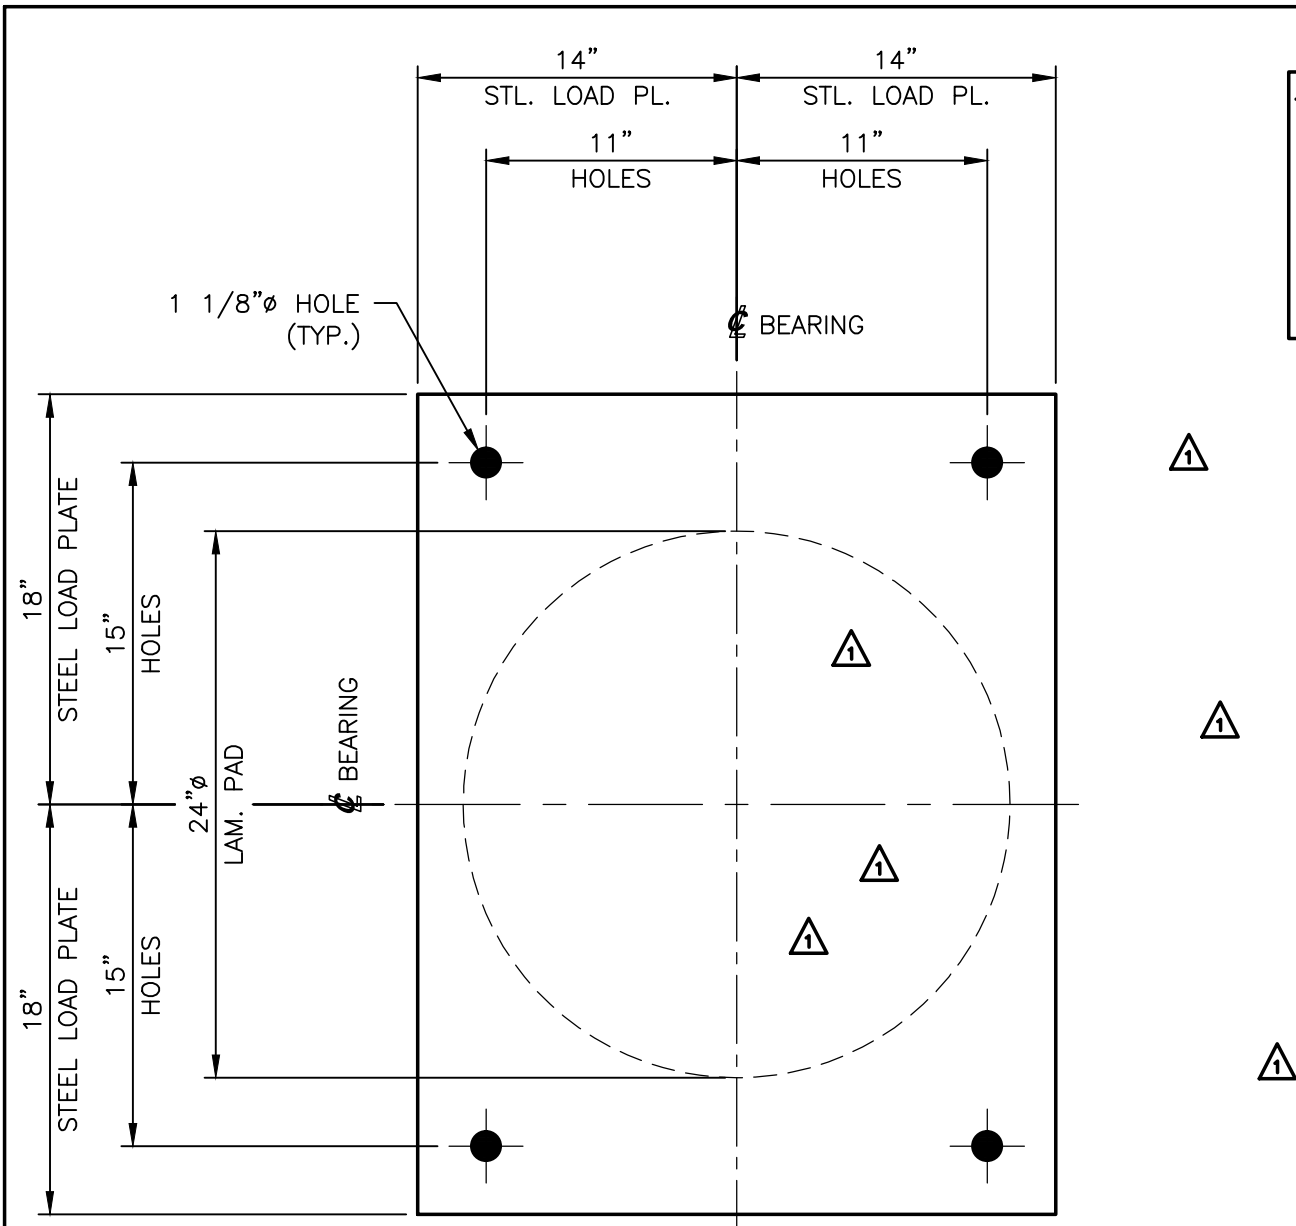

**PLAN VIEW**


**CONTRACTOR NOTE:**  
 AREAS FOR FIELD WELDING SHALL BE GROUND DOWN, IN THE FIELD, FOR WELDING THE GIRDER FLANGE TO THE TOP OF THE LOAD PLATES. THE CONTRACTOR SHALL BE RESPONSIBLE FOR FIELD TOUCH-UP OF THE BEARING ASSEMBLIES AFTER INSTALLATION FOR ANY DAMAGE TO THE COATED AREAS. REFER TO CONTRACTOR NOTE #2 ON THE GN1 SHEET.

BEARING TABLE						
BEARING MARK	QTY.	LOCATION		TH HIGH SIDE (in.)	TL LOW SIDE (in.)	HT AT C.L. (in.)
		PIER	GIRDER(s)			
FBA9-B1	1	PIER 4	1	1 3/4	1 1/4	5.77
FBA10-B1	1	PIER 4	2	1 3/4	1 1/4	5.77
FBA11-B1	1	PIER 4	3	1 3/4	1 1/4	5.77
FBA12-B1	1	PIER 4	4	1 3/4	1 1/4	5.77

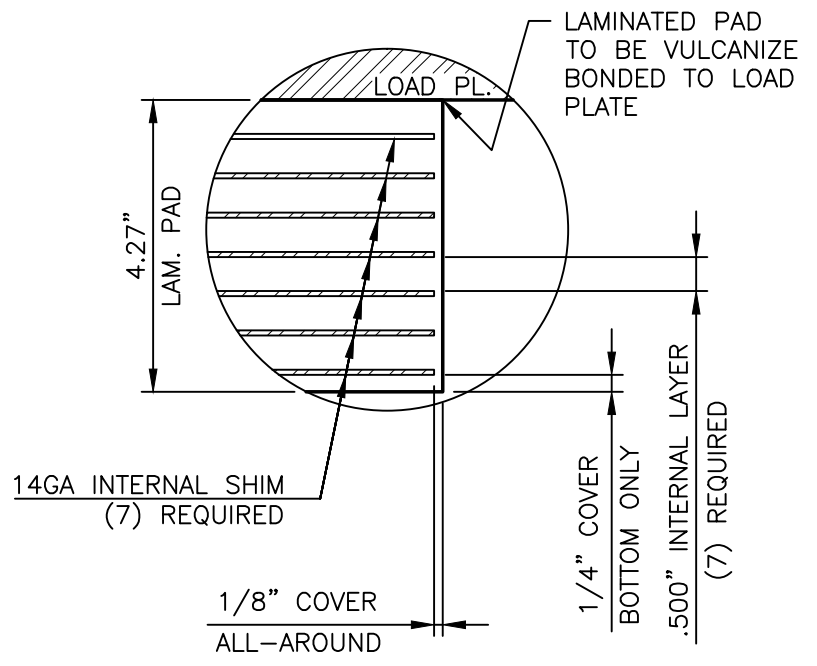

**DETAIL 9**  
 4.27" x 24"Ø LAMINATED PAD  
 50 DUROMETER GRADE 3 NEOPRENE  
 VULCANIZE BONDED TO LOAD PLATE  
 (4) REQUIRED

UNFACTORED ELASTOMERIC BEARING LOADS	
DEAD LOAD	386.4 KIPS
LIVE LOAD	168.1 KIPS
TOTAL LOAD (DL+LL)	554.5 KIPS

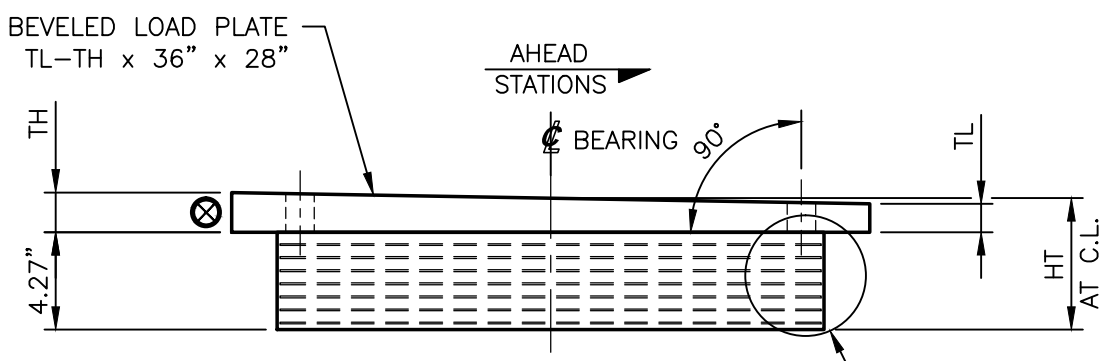

**ELEVATION VIEW**

**FIXED LAMINATED ELASTOMERIC BEARING ASSEMBLY (REF. NO.: 0034)**  
 (REFER TO BEARING TABLE ON THIS SHEET FOR MARK NO.'s, LOCATIONS, DIMENSIONS & QUANTITIES)

SEE NOTES ON SHEET GN1 OF 1  
**STATE OF OHIO**  
 DEPARTMENT OF TRANSPORTATION  
**BRIDGE NO.: HAM-74-1908S**  
**OVER IR-74 WB, IR-75 & RAMP E**  
**HAM-75-3.84**  
**CITY OF CINCINNATI**


STATE	COUNTY	PID NO.
OH	HAMILTON	104667

FED. PROJ. NO.: E170 (713)  
**DYNAMIC RUBBER LAM. ELASTOMERIC BEARING ASSY.'S**

**Cosmee** 1501 ROCKY RIDGE ROAD  
 P.O. BOX 2159  
 ATHENS, TEXAS 75751

**PRIME AE, Group, Inc**  
 DATE REC'D: 8/19/2019 BUILDABLE UNIT NO.: 7  
 Review conforms that the shop drawings meet the intent of the contract.  
 CONFORMS AS-IS  CONFORMS AS NOTED  
 REVISE AND RESEND  
**1908S - FIXED BEARINGS**  
 By: Conrad Gagnon Date: 8/20/2019  
 RELEASED FOR FABRICATION  
**WALSH**

ADDED 1 AT THE END OF THE MARK NUMBERS.	MH	08/13/19	ELS	08/19/19	SCALE: NONE	DRAWN BY: MH	CHECKED BY: RB
REMOVED NO METALIZING AREAS AND ANGLE & NM COLUMNS IN TABLE. ADDED CONTRACTOR NOTE.	MH	07/19/19	ELS	07/19/19	SHEET 3 OF 4	DATE: 06/11/19	DATE: 07/01/19
REV. DESCRIPTION	BY	DATE	CK'D	DATE	JOB NO.: 15353B1		CUSTOMER: WALSH CONSTRUCTION CO. II
					DRAWING NUMBER: 15353B1-D3		REV. 2

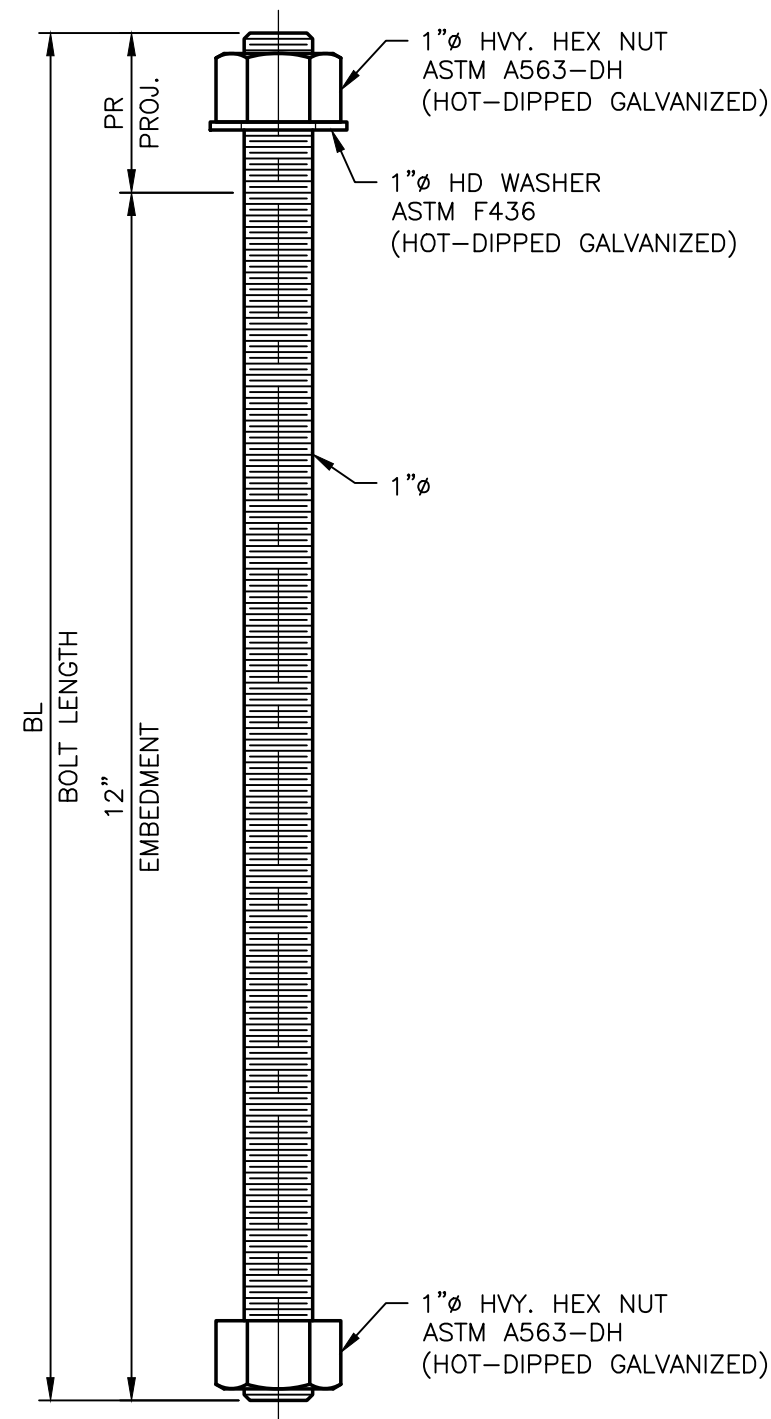

**ALL-THREAD ANCHOR ROD ASSEMBLY**

1"Ø x BL

ASTM F1554 GRADE 55 (HOT-DIPPED GALV.)  
(SEE ANCHOR BOLT TABLE ON THIS SHEET FOR  
MARK NO.'s, LOCATIONS, DIMENSIONS & QUANTITIES)

ANCHOR BOLT TABLE						
BEARING MARK	ANCHOR MARK	QTY.	LOCATION		PR PROJECTION (in.)	BL LENGTH (in.)
			PIER	GIRDER(s)		
FBA1-B1 <sup>2</sup>	AB2-B1 <sup>2</sup> (HIGH SIDE)	2	PIER 1	G1	6 1/2 <sup>1</sup>	18 1/2 <sup>1</sup>
FBA2-B1 <sup>2</sup>		G2				
FBA3-B1 <sup>2</sup>		G3				
FBA4-B1 <sup>2</sup>		G4				
FBA1-B1 <sup>2</sup>	<sup>1</sup> AB3-B1 <sup>2</sup> (LOW SIDE)	2	PIER 1	G1	6 <sup>1</sup>	18 <sup>1</sup>
FBA2-B1 <sup>2</sup>		G2				
FBA3-B1 <sup>2</sup>		G3				
FBA4-B1 <sup>2</sup>		G4				
FBA5-B1 <sup>2</sup>	<sup>1</sup> AB4-B1 <sup>2</sup> (HIGH SIDE)	2	PIER 3	G1	9 <sup>1</sup>	21 <sup>1</sup>
FBA6-B1 <sup>2</sup>		G2				
FBA7-B1 <sup>2</sup>		G3				
FBA8-B1 <sup>2</sup>		G4				
FBA5-B1 <sup>2</sup>	<sup>1</sup> AB5-B1 <sup>2</sup> (LOW SIDE)	2	PIER 3	G1	8 3/4 <sup>1</sup>	20 3/4 <sup>1</sup>
FBA6-B1 <sup>2</sup>		G2				
FBA7-B1 <sup>2</sup>		G3				
FBA8-B1 <sup>2</sup>		G4				
FBA9-B1 <sup>2</sup>	<sup>1</sup> AB6-B1 <sup>2</sup> (HIGH SIDE)	2	PIER 4	G1	8 <sup>1</sup>	20 <sup>1</sup>
FBA10-B1 <sup>2</sup>		G2				
FBA11-B1 <sup>2</sup>		G3				
FBA12-B1 <sup>2</sup>		G4				
FBA9-B1 <sup>2</sup>	<sup>1</sup> AB7-B1 <sup>2</sup> (LOW SIDE)	2	PIER 4	G1	7 1/2 <sup>1</sup>	19 1/2 <sup>1</sup>
FBA10-B1 <sup>2</sup>		G2				
FBA11-B1 <sup>2</sup>		G3				
FBA12-B1 <sup>2</sup>		G4				

**PRIME AE, Group, Inc**  
 DATE REC'D: 8/19/2019 BUILDABLE UNIT NO.: 7  
 Review conforms that the shop drawings meet the intent of the contract.

CONFORMS AS-IS     CONFORMS AS NOTED  
 REVISE AND RESEND

**1908S - FIXED BEARINGS**

By: Conrad Gagnon    Date: 8/20/2019

**RELEASED FOR FABRICATION**

**WALSH**

By: \_\_\_\_\_ Date: \_\_\_\_\_

SEE NOTES ON SHEET GN1 OF 1  
 STATE OF OHIO  
 DEPARTMENT OF TRANSPORTATION  
 BRIDGE NO.: HAM-74-1908S  
 OVER IR-74 WB, IR-75 & RAMP E

HAM-75-3.84  
 CITY OF CINCINNATI

STATE	COUNTY	PID NO.
OH	HAMILTON	104667

FED. PROJ. NO.: E170 (713)  
**DYNAMIC RUBBER LAM. ELASTOMERIC BEARING ASSY.'S**


**Cosmee** 1501 ROCKY RIDGE ROAD  
 P.O. BOX 2159  
 ATHENS, TEXAS 75751

<sup>1</sup>	ADDED 1 AT THE END OF THE MARK NUMBERS.	MH	08/13/19	ELS	08/19/19	SCALE: NONE	DRAWN BY: MH	CHECKED BY: RB
<sup>2</sup>	REVISED DIMENSIONS PER CONTRACTOR.	MH	07/19/19	ELS	07/19/19	SHEET 4 OF 4	JOB NO.: 15353B1	
REV.	DESCRIPTION	BY	DATE	CK'D	DATE	CUSTOMER: WALSH CONSTRUCTION CO. II	DRAWING NUMBER: 15353B1-D4	REV. 2

**COSMEC INC. / DYNAMIC RUBBER**

P.O. Box 2159  
1501 Rocky Ridge Road  
Athens, TX 75751  
TEL: 903.677.2871 FAX: 903.675.4776

**TRANSMITTAL SHEET**

<b>PRIME AE, Group, Inc</b>		<b>RELEASED FOR FABRICATION</b>	
DATE REC'D: <b>8/19/2019</b>	BUILDABLE UNIT NO.: <b>7</b>		
Review conforms that the shop drawings meet the intent of the contract.			
<input checked="" type="checkbox"/> CONFORMS AS-IS	<input type="checkbox"/> CONFORMS AS NOTED		
	<input type="checkbox"/> REVISE AND RESEND		
<b>1908S - DISC BEARINGS</b>			
By: <b>Conrad Gagnon</b>		By:	
Date: <b>8/19/2019</b>		Date:	

TO: WALSH CONSTRUCTION CO. II  
RACE SHARRETT RSHARRETT@WALSHGROUP.ONMICROSOFT.COM  
CC KATHI MILLS

DATE: 8/19/19  
JOB: 183000 BRIDGE HAM-74-1908S  
RE: SHOP DRAWING RE-SUBMITTAL  
DRP JOB NO: 15353C LOCATION: HAMILTON COUNTY

WE TRANSMIT TO YOU UNDER SEPARATE COVER HERE WITH THE FOLLOWING DRAWINGS:

DWG NO	REV NO	NO EACH	DESCRIPTION	REMARKS
15353C-GN1	1	1	GENERAL NOTES	
15353C-CAP1	1	1	CAPACITY SHEET	
15353C-E1	1	1	ERECTION SHEET	
15353C-D1	1	1	SHOP DRAWING	
15353C-D2	0	1	SHOP DRAWING	
15353C-D3	1	1	SHOP DRAWING	
15353C-D4	1	1	SHOP DRAWING	
15353C-D5	1	1	SHOP DRAWING	
15353C-D6	1	1	SHOP DRAWING	
15353C-D7	1	1	SHOP DRAWING	
15353C-D8	0	1	SHOP DRAWING	
15353C-D9	0	1	SHOP DRAWING	
15353C-D10	1	1	SHOP DRAWING	
15353C-D11	1	1	SHOP DRAWING	
15353C-D12	1	1	SHOP DRAWING	

DWG NO	REV NO	NO EACH	DESCRIPTION	REMARKS
15353C-D13	1	1	SHOP DRAWING	
15353C-D14	1	1	SHOP DRAWING	
153535C-D15	1	1	SHOP DRAWING	
153535C-D16	0	1	SHOP DRAWING	
	1	13	150K NGE CALCS	
	1	13	250K NGE CALCS	
	1	13	390K NGE CALCS	
	1	20	150K GE CALCS	
	1	20	250K GE CALCS	
	1	20	390K GE CALCS	
	1	1	ANCHOR BOLT CALCS	
	1	1	ANCHOR BOLT LENGTHS	

COMMENTS: **THE ATTACHED SHOP DRAWINGS ARE RE-SUBMITTED FOR APPROVAL. PLEASE FORWARD THIS PACKAGE TO THE ENGINEER FOR REVIEW AND ADVISE THE APPROVAL STATUS AS SOON AS POSSIBLE.**

THE ABOVE PRINTS ARE SUBMITTED TO YOU FOR:

(XXX) Approval	( ) Final Approval	( ) Distribution
( ) Field Use	( ) Fabrication	(XXX) E-MAIL
( ) Next Day Air	( ) Second Day Air	( ) Messenger
( ) UPS	( ) First Class Mail	( ) Fax

Thank you  
STEPHANIE RITZ  
COSMEC INC. / DYNAMIC RUBBER PRODUCTS  
[WWW.COSMECINC.COM](http://WWW.COSMECINC.COM)



**GENERAL SHOP NOTES:**

1. BEARING IS TO BE PROTECTED FROM MOISTURE AND DUST DURING SHIPMENT, STORAGE, AND ERECTION.
2. ALL STEEL BEARING COMPONENTS SHALL BE BLAST CLEANED TO SSPC-SP10 (NEAR-WHITE METAL BLAST CLEAN) AND THEN METALLIZED & SEAL COATED PER ODOT SUPPLEMENTAL SPEC. 869.13. AREAS NOTED AS "NO COATING" OR "DO NOT COAT" SHALL NOT BE METALLIZED. INTERNAL UNEXPOSED SURFACES DO NOT NEED METALLIZING EXCEPT AS NOTED ON THESE SHOP DRAWINGS.
3. ALL FREE EDGES OF PLATES TO BE COATED SHALL BE ROUNDED TO A 1/16 INCH RADIUS, OR SHALL HAVE THE EQUIVALENT FLAT SURFACE AT A SUITABLE ANGLE.
4. RECESS IN MASONRY PLATE FOR THE BOTTOM BEARING PLATE IS TO BE SHOP SEALED ALL-AROUND WITH A SILICONE CAULK AS SHOWN IN DETAIL "AA", THIS SHEET.
5. ALL MATERIALS & FABRICATION SHALL BE IN ACCORDANCE WITH ODOT SUPPLEMENTAL SPECIFICATION 869.
6. ALL DIMENSIONS ARE IN INCHES UNLESS OTHERWISE NOTED.
7. ALL TESTING SHALL BE IN ACCORDANCE WITH ODOT SUPPLEMENTAL SPECIFICATION 869.
8. COSMEC, INC. REPRESENTATIVES: KATHI MILLS - (903) 677-2871 (kmills@cosmecinc.com)  
JOHN A. RITZ - (903) 677-2871 (jritz@cosmecinc.com)  
(WEBSITE: www.cosmecinc.com)


**GENERAL INSTALLATION NOTES:**

- CONTRACTOR NOTE →
1. BEARING ASSEMBLIES SHALL NOT BE LIFTED BY THEIR TOP OR SOLE PLATES. ANY HANDLING SHALL SUPPORT THE BEARING UNIT FROM THE MASONRY PLATE AND BE LIFTED AND SET FLAT AND LEVEL AT ALL TIMES. THE CONTRACTOR IS SOLELY RESPONSIBLE FOR THE SAFE AND PROPER LIFTING, SETTING, AND INSTALLATION OF THE BEARING ASSEMBLIES AND ANCHOR BOLTS.
  2. REMOVE CLAMPING BANDS AFTER THE BEARING HAS BEEN POSITIONED AT ITS PERMANENT LOCATION AND PRIOR TO ERECTION OF THE SUPERSTRUCTURE.
  3. THE CONTRACTOR IS TO ROTATE THE SOLE PLATE AFTER THE BEARING ASSEMBLY HAS BEEN SET ON THE BEARING SEAT SO THAT THE SOLE PLATE IS PARALLEL WITH THE GIRDER BOTTOM FLANGE. CONTRACTOR IS TO MAKE SURE THE AHEAD STATION ARROWS ON THE SOLE PLATES ARE ORIENTED IN THE CORRECT DIRECTION. PROPER SETTING OF THE BEARING ASSEMBLIES IS SOLELY THE CONTRACTOR'S RESPONSIBILITY.
  4. DISASSEMBLY OF BEARING UNITS SHALL NOT BE DONE WITHOUT WRITTEN AUTHORIZATION FROM COSMEC INC. UNAUTHORIZED DISASSEMBLY COULD RESULT IN FAILURE OF THE BEARING UNIT.
  5. THE CONTRACTOR IS SOLELY RESPONSIBLE FOR THE CORRECT BEARING SEAT ELEVATIONS. CONTRACTOR SHALL ADJUST BEARING SEAT ELEVATIONS TO ACCURATELY REFLECT HEIGHTS OF BEARINGS SUPPLIED.
  6. THE CONTRACTOR IS RESPONSIBLE FOR THE FIELD TOUCH UP OF THE BEARING ASSEMBLIES AFTER INSTALLATION FOR ANY DAMAGE TO THE COATED SURFACES DURING INSTALLATION.
  7. DO NOT ALLOW WELDING CURRENT TO PASS THRU THE INTERNAL COMPONENTS OF THE BEARINGS. MAKE SURE THAT THE GROUNDING LEADS ARE POSITIONED FOR THE FIELD WELDING TO PREVENT THIS. CURRENT PASSING THRU THE INTERNAL COMPONENTS WILL DAMAGE THE BEARING.
  8. DO NOT ALLOW THE BEARING SOLE PLATE TO EXCEED 250°F OR DAMAGE TO THE PTFE OR URETHANE DISC MAY RESULT. CHECK THE TEMPERATURE WHEN FIELD WELDING TO INSURE THIS TEMPERATURE IS NOT EXCEEDED.
  9. CONTRACTOR TO KEEP THE BEARINGS PROTECTED FROM MOISTURE AND DUST DURING STORAGE AND ERECTION.

MATERIALS	SPECIFICATIONS
STRUCTURAL STEEL	ASTM A709 GR.50 (UNO)
STAINLESS STEEL	11 GA. ASTM A240 TYPE 304 w/POLISHED #8 MIRROR FINISH
PRIMARY PTFE	AASHTO 1/4" VIRGIN UNFILLED CONFORMING TO AASHTO 18.8.2 "MATERIALS"
GUIDE PTFE	AASHTO 1/4" VIRGIN UNFILLED CONFORMING TO AASHTO 18.8.2 "MATERIALS"
POLYETHER URETHANE DISC	COMPOUND SHALL CONFORM TO THE REQUIREMENTS OF AASHTO LRFD BRIDGE CONSTRUCTION TABLE 18.3.2.8-1
SHEAR PIN	ASTM A240/A276 UNS S21800 STEEL (OR EQUIVALENT)
ANCHOR BOLTS	ASTM F1554 GRADE 55, GALV.
PREFORMED BEARING PADS	<b>⚠ 1/4" THICK PREFORMED FABRIC PAD PER C&amp;MS 711.21</b>

SEE SHEETS 1 THRU 16 FOR BEARING DETAILS  
SEE SHEET E1 FOR ERECTION TABLE  
SEE SHEET CAP1 FOR BEARING CAPACITY DETAILS

**GENERAL NOTES SHEET**

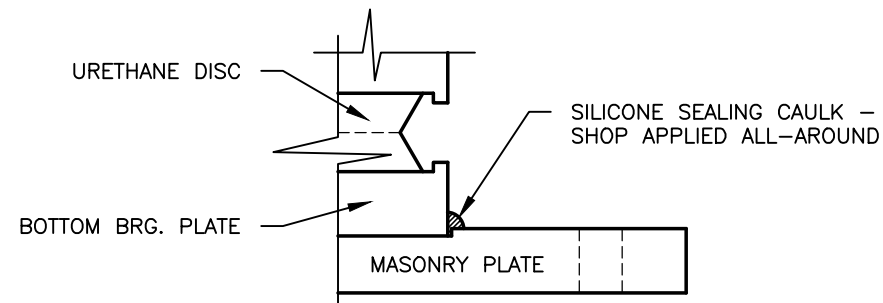

**DETAIL "AA"**

SEE GENERAL SHOP NOTE #4, THIS SHEET

checked 2019-08-16

Roaring Brook Consultants, Inc.  
Engineering a Better Future  
15 Sewall Road, South Berwick, Maine 03908  
Phone: (877) 722-2643 FAX: (207) 384-5383

<b>PRIME AE, Group, Inc</b>		<b>RELEASED FOR FABRICATION</b>	
DATE REC'D: 8/19/2019	BUILDABLE UNIT NO.: 7	<b>WALSH</b>	
Review conforms that the shop drawings meet the intent of the contract.			
<input checked="" type="checkbox"/> CONFORMS AS-IS	<input type="checkbox"/> CONFORMS AS NOTED		
	<input type="checkbox"/> REVISE AND RESEND		
<b>1908S - DISC BEARINGS</b>			
By: Conrad Gagnon	By:		
Date: 8/19/2019	Date:		

P.E. SEAL

INCREASE BRG. PAD THK. PER CONTR. & APPROVER.	JR	8/8/19	ELS	8/12/19
REV.	DESCRIPTION	BY	DATE	CK'D DATE

STATE OF OHIO  
DEPARTMENT OF TRANSPORTATION

BRIDGE NO.  
HAM-74-1908S  
RAMP P  
HAMILTON COUNTY, OH

STATE	COUNTY	PID NO.
OH	HAMILTON	104667

FED. AID PROJ. NO.: E170 (713)

**COSMEC INC.:**  
**DISC BEARINGS ASSEMBLIES**

**Cosmee** 1501 ROCKY RIDGE ROAD  
P.O. BOX 2159  
ATHENS, TEXAS 75751

SCALE: NONE	DRAWN BY: JR	CHECKED BY: MCM
	DATE: 6/26/19	DATE: 7/5/19

SHEET GN1 OF 1

**JOB NO.: 15353C**

CUSTOMER: WALSH CONSTRUCTION	DRAWING NUMBER: 15353C-GN1	REV. 1
------------------------------	----------------------------	--------

CAPACITY TABLE		150 kip GUIDED EXP. BEARING	250 kip GUIDED EXP. BEARING	390 kip GUIDED EXP. BEARING
DESIGN VERTICAL LOAD (MAX.)		150 kips	250 kips	390 kips
DESIGN LATERAL LOAD (MAX.)		<b>Δ 38 kips</b>	<b>Δ 63 kips</b>	<b>Δ 98 kips</b>
DESIGN MOVEMENT	LONGITUDINAL	1.38 in.	3.25 in.	3.75 in.
	TRANSVERSE	0.25 in.	0.25 in.	0.50 in.
DESIGN ROTATION (rads)		0.030 rads	0.030 rads	0.030 rads
DESIGN COEFFICIENT OF FRICTION		3.5% MAX.	3.5% MAX.	3.5% MAX.
COMPRESSIVE STRESS ON PRIMARY PTFE @ DESIGN CAPACITY		3.40 ksi	3.35 ksi	3.45 ksi
COMPRESSIVE STRESS ON URETHANE DISC @ DESIGN CAPACITY		4.90 ksi	<b>Δ 4.87 ksi</b>	<b>Δ 4.91 ksi</b>
CAPACITY TABLE		150 kip NON-GUIDED EXP. BEARING	250 kip NON-GUIDED EXP. BEARING	390 kip NON-GUIDED EXP. BEARING
DESIGN VERTICAL LOAD (MAX.)		150 kips	250 kips	390 kips
DESIGN LATERAL LOAD (MAX.)		15 kips	25 kips	40 kips
DESIGN MOVEMENT	LONGITUDINAL	1.50 in.	3.25 in.	3.75 in.
	TRANSVERSE	1.50 in.	1.50 in.	1.50 in.
DESIGN ROTATION (rads)		0.030 rads	0.030 rads	0.030 rads
DESIGN COEFFICIENT OF FRICTION		3.5% MAX.	3.5% MAX.	3.5% MAX.
COMPRESSIVE STRESS ON PRIMARY PTFE @ DESIGN CAPACITY		3.40 ksi	3.35 ksi	3.45 ksi
COMPRESSIVE STRESS ON URETHANE DISC @ DESIGN CAPACITY		4.95 ksi	4.92 ksi	4.96 ksi



SEE SHEET GN1 FOR GENERAL NOTES AND MATERIAL SPECIFICATIONS

**CAPACITY TABLES**

checked 2019-08-16

<b>PRIME AE, Group, Inc</b>		<b>RELEASED FOR FABRICATION</b>  <b>WALSH</b>
DATE REC'D: <b>8/19/2019</b>	BUILDABLE UNIT NO.: <b>7</b>	
Review conforms that the shop drawings meet the intent of the contract.		
<input checked="" type="checkbox"/> CONFORMS AS-IS	<input type="checkbox"/> CONFORMS AS NOTED	
<input type="checkbox"/> REVISE AND RESEND		
<b>1908S - DISC BEARINGS</b>		
By: <b>Conrad Gagnon</b>	By:	
Date: <b>8/19/2019</b>	Date:	

 **Roaring Brook Consultants, Inc.**  
Engineering & Better Future  
15 Sewall Road, South Berwick, Maine 03908  
Phone: (877) 722-2643 FAX: (207) 384-5383

P.E. SEAL		STATE OF OHIO DEPARTMENT OF TRANSPORTATION	
		BRIDGE NO. <b>HAM-74-1908S</b>	
		RAMP P HAMILTON COUNTY, OH	
STATE	COUNTY	PID NO.	
OH	HAMILTON	104667	
FED. AID PROJ. NO.: E170 (713)			
<b>COSMEC INC.:</b> <b>DISC BEARINGS ASSEMBLIES</b>			
		1501 ROCKY RIDGE ROAD P.O. BOX 2159 ATHENS, TEXAS 75751	
SCALE: NONE	DRAWN BY: JR	CHECKED BY: MCM	
	DATE: 6/26/19	DATE: 7/5/19	
<b>Δ</b> REDESIGN FOR HIGHER GE HORIZ. LOADS PER APPROVER.	JR	8/8/19	ELS 8/12/19
REV.	DESCRIPTION	BY	DATE
SHEET CAP1 OF 1		JOB NO.: 15353C	
CUSTOMER: WALSH CONSTRUCTION		DRAWING NUMBER	REV.
		15353C-CAP1	1

**TABLE "HT1" - Bearing Marks, Locations, Heights and Bearing Seat Elevation Changes**

Bearing Description										Height			Bearing Seat Elevation Changes Required		
Bearing Mark	Pier or Abutment	Unit	Girder	Qty.	Design Vertical Load (kips)	Design Horizontal Load (kips)	Max. Design Rotation (rads)	TOTAL Design Longit. Mvmnt. (in.)	TOTAL Design Transv. Mvmnt. (in.)	Dim. "EH"	Dim. "TH"	Dim. "H"	NOTE: CONTRACTOR AND EOR TO REVIEW AND VERIFY ALL BEARING SEAT ELEVATION CHANGES.		
										Total Brg. Height (excl. Brg. Pad) (in.)	Total Brg. Height (in.)	Height as per EOR (Original Design Plans) (in.)	Difference ("TH" - "H") (in.)	Bearing Seat Elevation Change Required (in.)	Bearing Seat Elevation Change Required (ft.)
NGE1C	Exist. Pier 7	Unit 1	G1	1	150	15	0.030	1.500	1.500	7.125	7.375 $\Delta$	3.720	3.655	-3.655	-0.305
GE1C	Exist. Pier 7	Unit 1	G2	1	150	38 $\Delta$	0.030	1.380	0.250	8.281	8.531 $\Delta$	5.834	2.697	-2.697	-0.225
GE2C	Exist. Pier 7	Unit 1	G3	1	150	38 $\Delta$	0.030	1.380	0.250	8.281	8.531 $\Delta$	5.834	2.697	-2.697	-0.225
NGE2C	Exist. Pier 7	Unit 1	G4	1	150	15	0.030	1.500	1.500	7.125	7.375 $\Delta$	3.720	3.655	-3.655	-0.305
NGE3C	Pier 2	Unit 1	G1	1	150	15	0.030	1.500	1.500	7.125	7.375 $\Delta$	3.720	3.655	-3.655	-0.305
GE3C	Pier 2	Unit 1	G2	1	150	38 $\Delta$	0.030	1.380	0.250	8.281	8.531 $\Delta$	5.834	2.697	-2.697	-0.225
GE4C	Pier 2	Unit 1	G3	1	150	38 $\Delta$	0.030	1.380	0.250	8.281	8.531 $\Delta$	5.834	2.697	-2.697	-0.225
NGE4C	Pier 2	Unit 1	G4	1	150	15	0.030	1.500	1.500	7.125	7.375 $\Delta$	3.720	3.655	-3.655	-0.305
NGE5C	Pier 2	Unit 2	G1	1	390	40	0.030	3.750	1.500	7.160	7.410 $\Delta$	6.660	0.750	-0.750	-0.063
GE5C	Pier 2	Unit 2	G2	1	390	98 $\Delta$	0.030	3.750	0.500	9.250 $\Delta$	9.500 $\Delta$	8.714	0.786	-0.786	-0.066
GE6C	Pier 2	Unit 2	G3	1	390	98 $\Delta$	0.030	3.750	0.500	9.250 $\Delta$	9.500 $\Delta$	8.714	0.786	-0.786	-0.066
NGE6C	Pier 2	Unit 2	G4	1	390	40	0.030	3.750	1.500	7.160	7.410 $\Delta$	6.660	0.750	-0.750	-0.063
NGE7C	Fwd. Abut.	Unit 2	G1	1	250	25	0.030	3.250	1.500	7.105	7.355 $\Delta$	6.020	1.335	-1.335	-0.111
GE7C	Fwd. Abut.	Unit 2	G2	1	250	63 $\Delta$	0.030	3.250	0.250	8.450 $\Delta$	8.700 $\Delta$	8.714	-0.014	+0.014	+0.001
GE8C	Fwd. Abut.	Unit 2	G3	1	250	63 $\Delta$	0.030	3.250	0.250	8.450 $\Delta$	8.700 $\Delta$	8.714	-0.014	+0.014	+0.001
NGE8C	Fwd. Abut.	Unit 2	G4	1	250	25	0.030	3.250	1.500	7.105	7.355 $\Delta$	6.020	1.335	-1.335	-0.111

<b>PRIME AE, Group, Inc</b>		<b>RELEASED FOR FABRICATION</b>  <b>WALSH</b>
DATE REC'D: 8/19/2019	BUILDABLE UNIT NO.: 7	
Review conforms that the shop drawings meet the intent of the contract.		
<input checked="" type="checkbox"/> CONFORMS AS-IS	<input type="checkbox"/> CONFORMS AS NOTED	
<b>1908S - DISC BEARINGS</b>		
By: Conrad Gagnon	By:	
Date: 8/19/2019	Date:	


**BEARING MARKS, LOCATIONS & ELEVATION CHANGES REQUIRED**

SEE SHEET GN1 FOR NOTES & MATERIAL SPECIFICATIONS

$\Delta$  SEE SHEET 15 FOR ANCHOR BOLT MARKS & LOCATIONS

**CONTRACTOR AND EOR NOTE:**  
PLEASE REVIEW AND VERIFY ALL BEARING HEIGHT DIFFERENCES AND REQUIRED BEARING SEAT ELEVATION CHANGES NOTED IN TABLE "HT1". CONTRACTOR IS SOLELY RESPONSIBLE FOR INSURING THE BEARINGS SEAT ELEVATIONS AND ANCHOR BOLT LAYOUTS ARE CORRECT FOR THE BEARINGS SUPPLIED AT ALL THE LOCATIONS GIVEN.

checked 2019-08-16

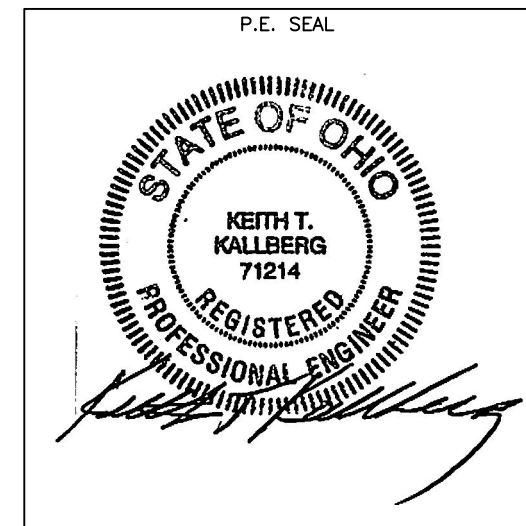

STATE OF OHIO  
DEPARTMENT OF TRANSPORTATION  
BRIDGE NO.  
HAM-74-1908S  
RAMP P  
HAMILTON COUNTY, OH

STATE	COUNTY	PID NO.
OH	HAMILTON	104667
FED. AID PROJ. NO.: E170 (713)		

**COSMEC INC.:**  
**DISC BEARINGS ASSEMBLIES**

**Cosmec** 1501 ROCKY RIDGE ROAD  
P.O. BOX 2159  
ATHENS, TEXAS 75751

SCALE: NONE	DRAWN BY: JR	CHECKED BY: MCM
	DATE: 6/27/19	DATE: 7/5/19


SHEET E1 OF 1 **JOB NO.: 15353C**

CUSTOMER: WALSH CONSTRUCTION	DRAWING NUMBER: 15353C-E1	REV. 1
------------------------------	---------------------------	--------

$\Delta$	REVISE BRG. SEAT ELEV. DUE TO DESIGN CHANGES & INCREASE IN BRG. PAD THK..	JR	8/8/19	ELS	8/12/19
REV.	DESCRIPTION	BY	DATE	CK'D	DATE

**PRIME AE, Group, Inc**  
 DATE REC'D: 8/19/2019 BUILDABLE UNIT NO.: 7  
 Review conforms that the shop drawings meet the intent of the contract.  
 CONFORMS AS-IS     CONFORMS AS NOTED  
 REVISIONS     REVISE AND RESEND  
**1908S - DISC BEARINGS**  
 By: Conrad Gagnon    Date: 8/19/2019

**RELEASED FOR FABRICATION**  
**WALSH**

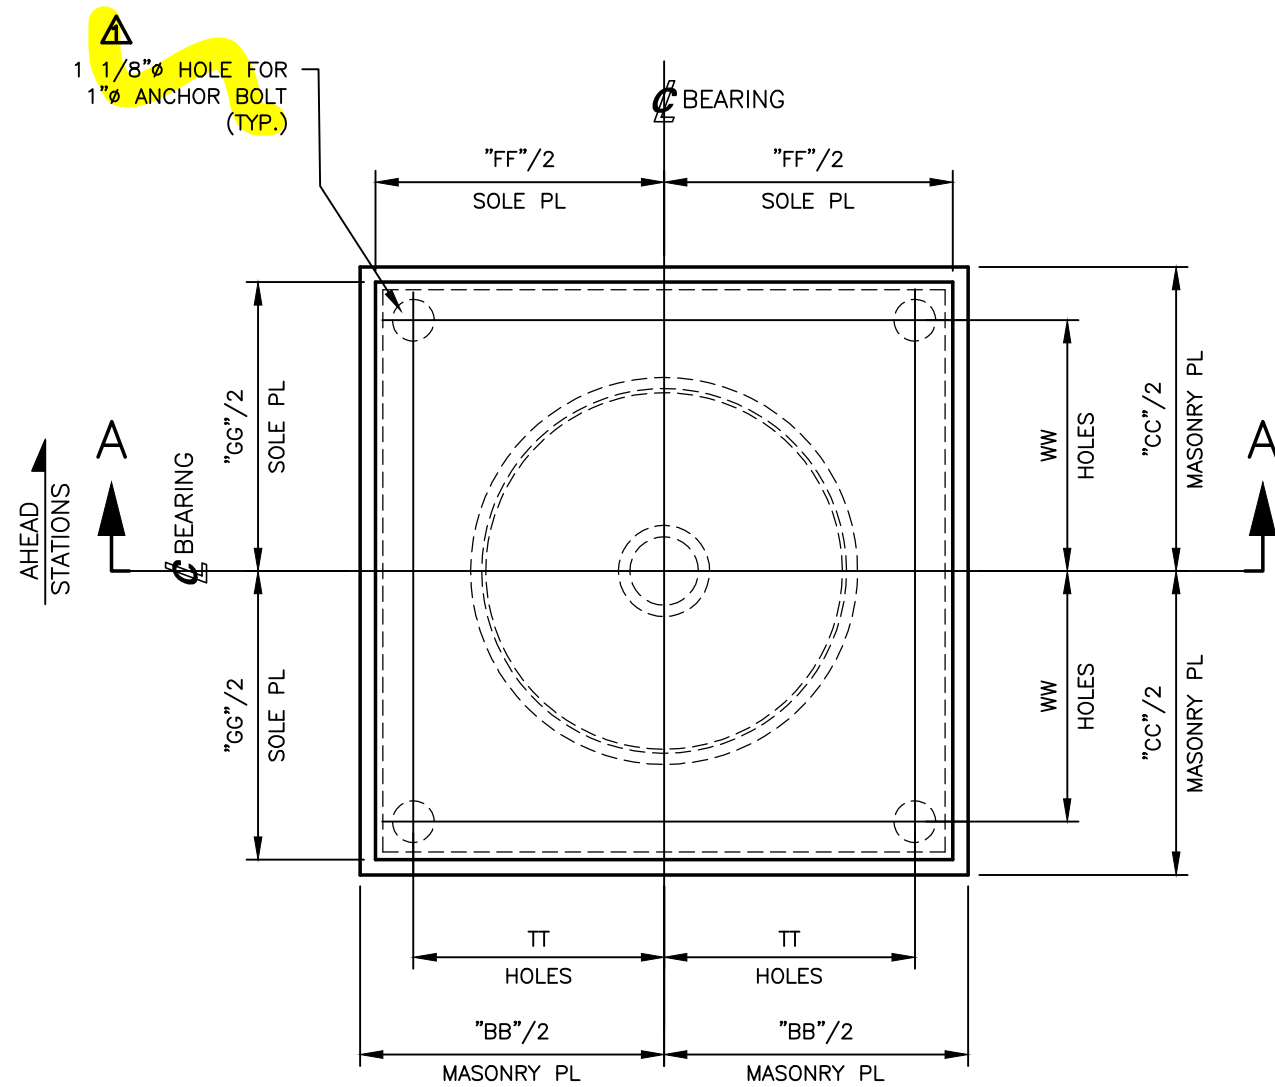


**PLAN VIEW**


**(8) NON-GUIDED EXPANSION BEARINGS  
 MKS. NGE1C thru NGE8C**

SEE SHEETS 2 thru 6 FOR COMPONENT DETAILS;  
 TABLES WITH MARKS, LOCATIONS, AND DIMENSIONS

**CONTRACTOR NOTE:** SOLE PLATE WILL HAVE TO BE ROTATED IN THE FIELD TO ALIGN THE SOLE PLATE WITH THE BOTTOM FLANGE OF THE GIRDER. MASONRY PLATE SHALL BE ALIGNED WITH THE CENTERLINE OF BEARING OF SUBSTRUCTURE. CONTRACTOR SHALL TAKE CARE NOT TO MOVE THE MASONRY PLATE WHILE ALIGNING THE SOLE PLATE.

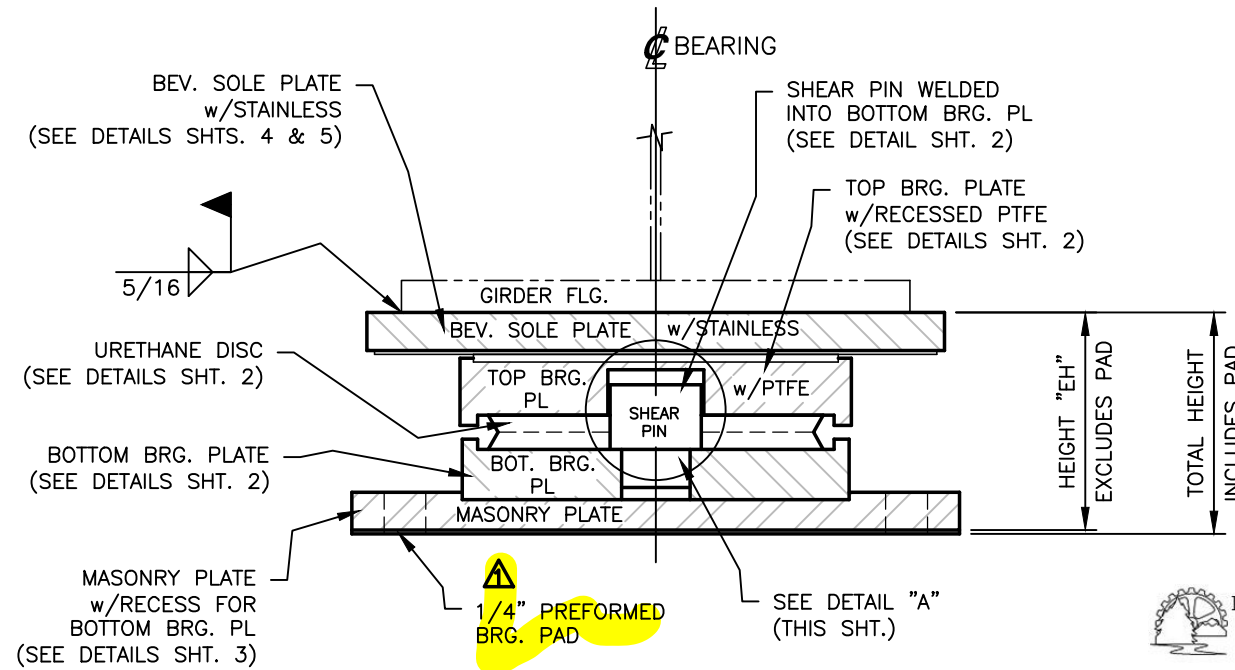

**SECTION A-A**

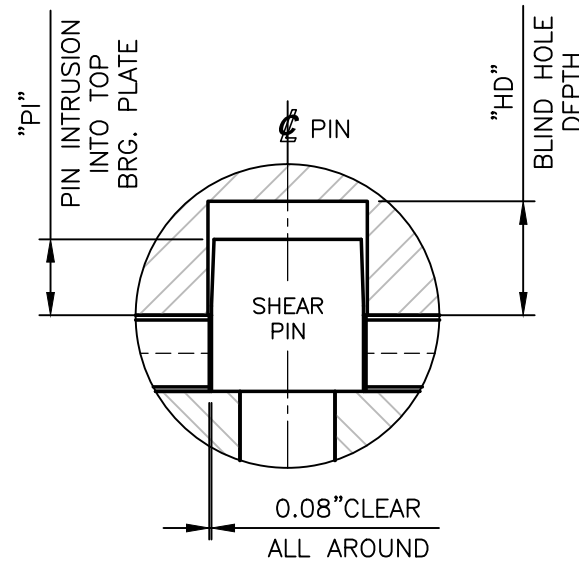

**DETAIL A**

SHOWING SHEAR PIN INTRUSION INTO THE TOP BEARING PLATE  
 (SEE TABLE NGE1C, SHT. 6 FOR DIMS.)

checked 2019-08-16

**Roaring Brook Consultants, Inc.**  
 Engineering & Better Future  
 15 Sewall Road, South Berwick, Maine 03908  
 Phone: (877) 722-2643 FAX: (207) 384-5383

P.E. SEAL  
  
 KEITH T. KALLBERG  
 71214  
 REGISTERED PROFESSIONAL ENGINEER

STATE OF OHIO  
 DEPARTMENT OF TRANSPORTATION  
 BRIDGE NO.  
 HAM-74-1908S  
 RAMP P  
 HAMILTON COUNTY, OH

STATE	COUNTY	PID NO.
OH	HAMILTON	104667

FED. AID PROJ. NO.: E170 (713)

**COSMEC INC.**  
**DISC BEARINGS ASSEMBLIES**  
  
 1501 ROCKY RIDGE ROAD  
 P.O. BOX 2159  
 ATHENS, TEXAS 75751


SCALE: NONE    DRAWN BY: JR    CHECKED BY: MCM  
 DATE: 6/12/19    DATE: 7/5/19

SEE SHEET GN1 FOR NOTES & MATERIAL SPECIFICATIONS  
 SEE SHTS. 2 thru 6 FOR DISC BEARING COMPONENT DETAILS & TABLES


REV.	DESCRIPTION	BY	DATE	CK'D	DATE	SHEET 1 OF 16	JOB NO.: 15353C	DRAWING NUMBER 15353C-D1	REV. 1
------	-------------	----	------	------	------	---------------	-----------------	--------------------------	--------

**PRIME AE, Group, Inc**  
 DATE REC'D: 8/19/2019 BUILDABLE UNIT NO.: 7  
 Review conforms that the shop drawings meet the intent of the contract.  
 CONFORMS AS-IS  CONFORMS AS NOTED  
 REVISE AND RESEND  
 By: Conrad Gagnon Date: 8/19/2019


**RELEASED FOR FABRICATION**  
**WALSH**  
 By: \_\_\_\_\_ Date: \_\_\_\_\_

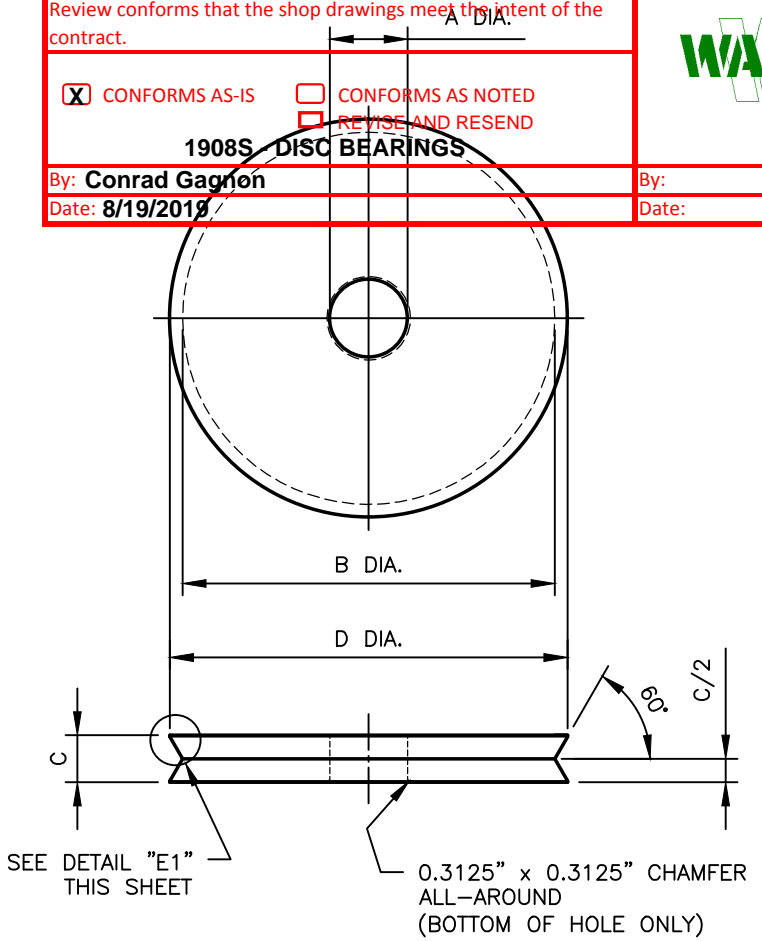

**POLYETHER URETHANE DISC**  
**DO NOT COAT**  
 DISC "C" x "D" DIA.  
 (SEE SHEET GN1 FOR MATERIAL SPECS.)

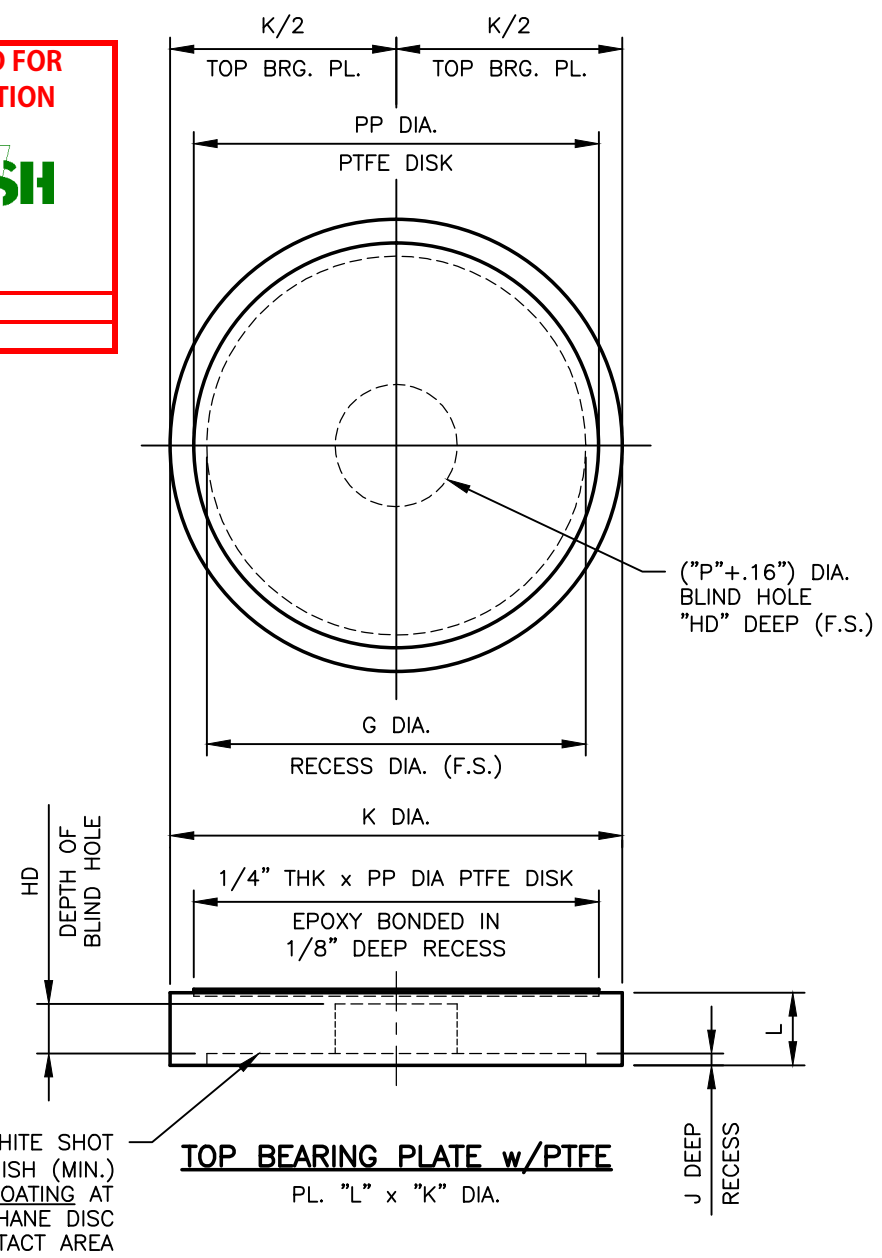


**NON-GUIDED EXPANSION BEARING - INTERNAL COMPONENTS**  
 FOR BEARING MARKS NGE1C thru NGE8C  
 (SEE TABLE NGE1C ON SHEET 6 FOR DIMENSIONS)


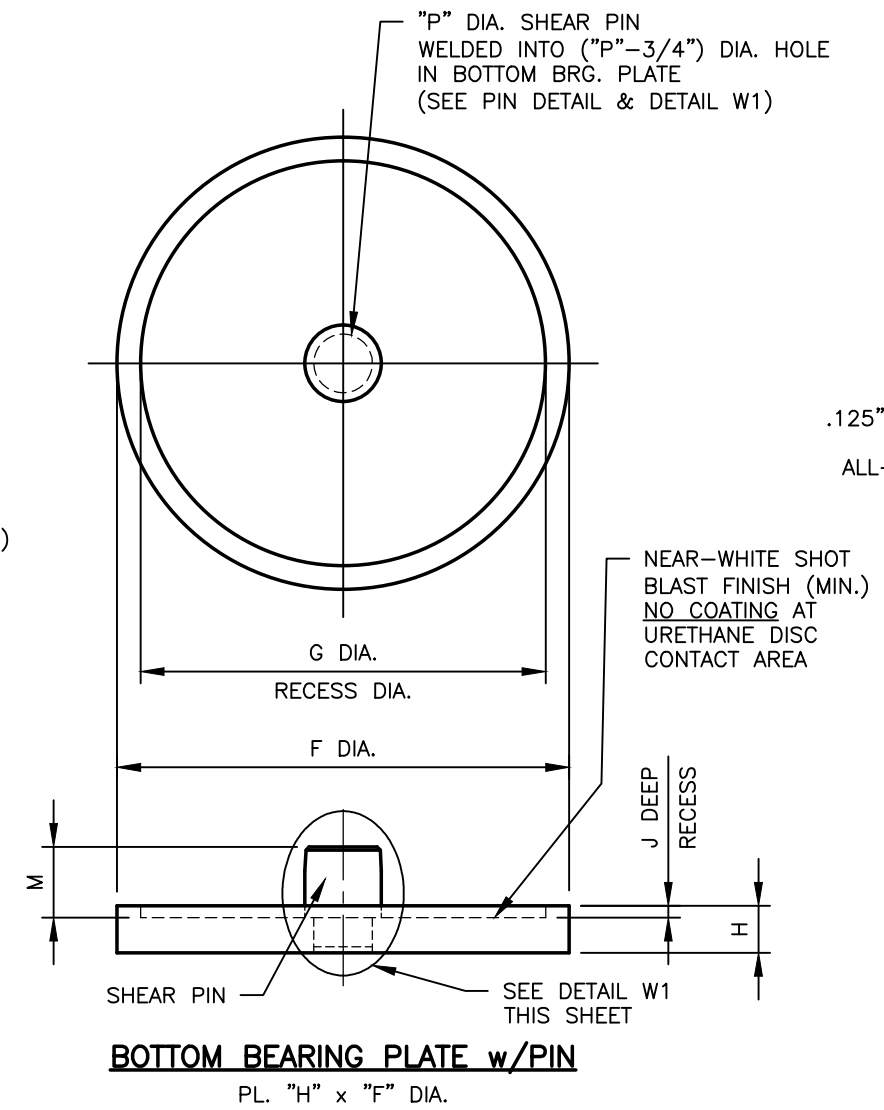


checked 2019-08-16

Roaring Brook Consultants, Inc.  
 Engineering A Better Future  
 15 Sewall Road, South Berwick, Maine 03908  
 Phone: (877) 722-2643 FAX: (207) 384-5383

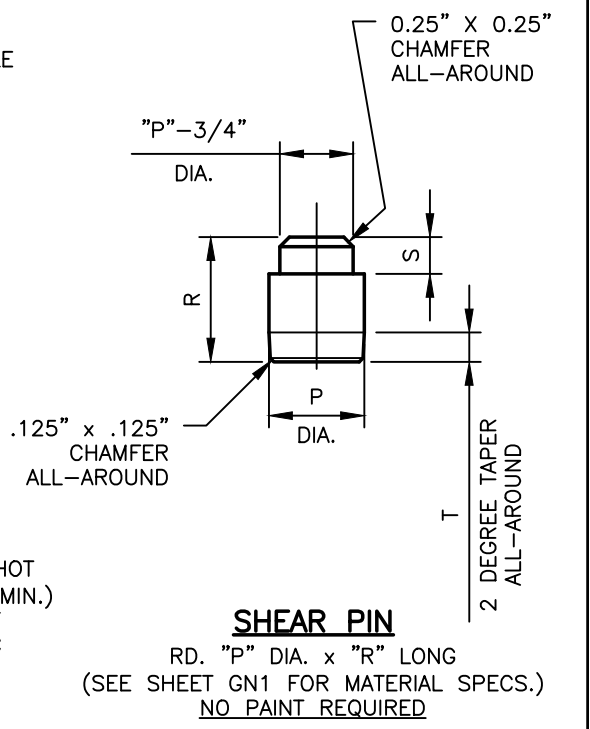

SEE SHEET GN1 FOR NOTES & MATERIAL SPECIFICATIONS  
 SEE SHEET 1 FOR NGE DISC BEARING ASSEMBLY DETAILS  
 SEE TABLE NGE1C ON SHEET 6 FOR DIMENSIONS

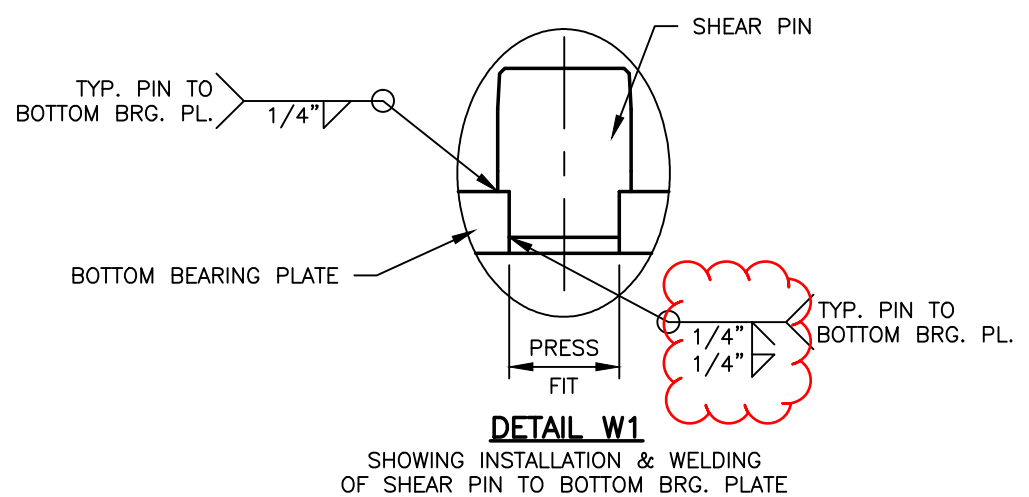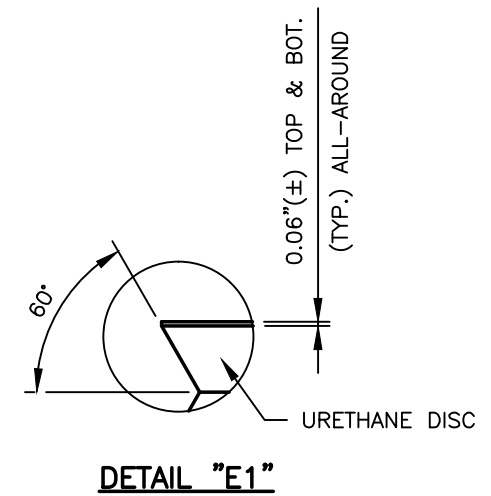


P.E. SEAL

STATE OF OHIO  
 KEITH T. KALLBERG  
 71214  
 REGISTERED PROFESSIONAL ENGINEER

STATE OF OHIO DEPARTMENT OF TRANSPORTATION		
BRIDGE NO. HAM-74-1908S RAMP P		
HAMILTON COUNTY, OH		
STATE	COUNTY	PID NO.
OH	HAMILTON	104667
FED. AID PROJ. NO.: E170 (713)		
COSMEC INC.: DISC BEARINGS ASSEMBLIES		
1501 ROCKY RIDGE ROAD P.O. BOX 2159 ATHENS, TEXAS 75751		
SCALE: NONE	DRAWN BY: JR	CHECKED BY: MCM
	DATE: 6/13/19	DATE: 7/5/19
SHEET 2 OF 16		JOB NO.: 15353C
REV.	DESCRIPTION	CUSTOMER: WALSH CONSTRUCTION
	BY	DRAWING NUMBER: 15353C-D2
	DATE	REV. 0
	CK'D	
	DATE	

**TABLE MP1 - Masonry Plates for Non-Guided Exp. Bearings: Marks, Locations & Dimensions**

Bearing Mark	Pier or Abutment	Unit	Girder	Qty.	Bearing Description					Masonry Plate							
					Design Vertical Load (kips)	Design Horizontal Load (kips)	Max. Design Rotation (rads)	TOTAL Design Longit. Mvmnt. (in.)	TOTAL Design Transv. Mvmnt. (in.)	Dim. "AA"	Dim. "AA1"	Dim. "BB"	Dim. "CC"	Dim. "TT"	Dim. "WW"	Dim. "MPRD"	Dim. "RD"
										Mas. PL Thk. (in.)	Total Mas. PL Thk. (Incl. Recess) (in.)	Mas. PL Width (in.)	Mas. PL Length (in.)	Mas. PL Anchor Bolt Hole Location (in.)	Mas. PL Anchor Bolt Hole Location (in.)	Mas. PL Recess Depth (in.)	Mas. PL Recess Dia. (in.)
NGE1C	Exist. Pier 7	Unit 1	G1	1	150	15	0.030	1.500	1.500	1.000	1.250	18.000	18.000	7.250	7.250	0.250	8.855
NGE2C	Exist. Pier 7	Unit 1	G4	1	150	15	0.030	1.500	1.500	1.000	1.250	18.000	18.000	7.250	7.250	0.250	8.855
NGE3C	Pier 2	Unit 1	G1	1	150	15	0.030	1.500	1.500	1.000	1.250	18.000	18.000	7.250	7.250	0.250	8.855
NGE4C	Pier 2	Unit 1	G4	1	150	15	0.030	1.500	1.500	1.000	1.250	18.000	18.000	7.250	7.250	0.250	8.855
NGE5C	Pier 2	Unit 2	G1	1	390	40	0.030	3.750	1.500	1.000	1.250	20.000	20.000	8.250	8.250	0.250	12.855
NGE6C	Pier 2	Unit 2	G4	1	390	40	0.030	3.750	1.500	1.000	1.250	20.000	20.000	8.250	8.250	0.250	12.855
NGE7C	Fwd. Abut.	Unit 2	G1	1	250	25	0.030	3.250	1.500	1.000	1.250	19.000	19.000	7.750	7.750	0.250	10.755
NGE8C	Fwd. Abut.	Unit 2	G4	1	250	25	0.030	3.250	1.500	1.000	1.250	19.000	19.000	7.750	7.750	0.250	10.755

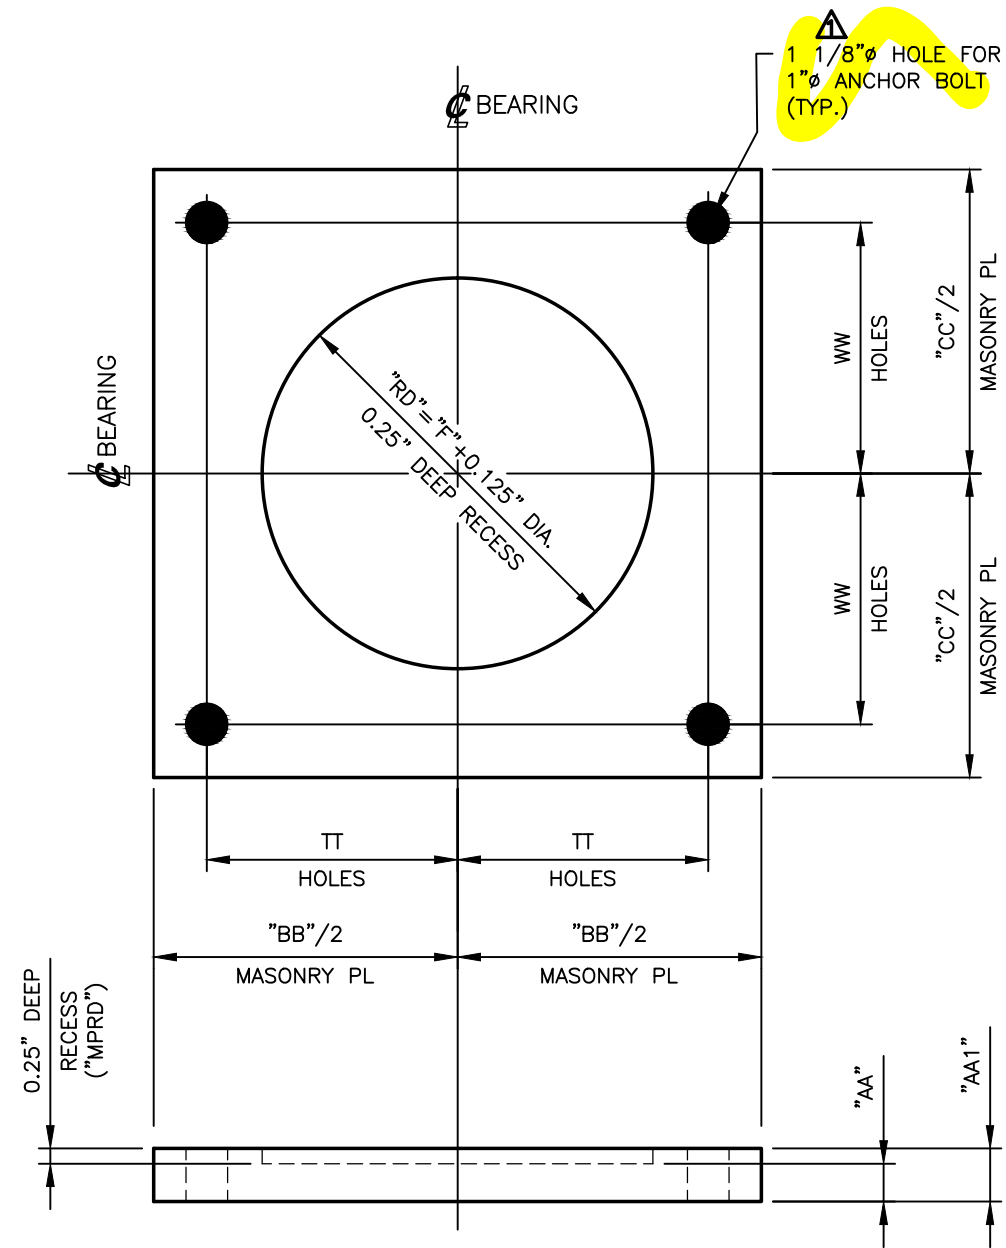

**PRIME AE, Group, Inc**

DATE REC'D: 8/19/2019 BUILDABLE UNIT NO.: 7

Review conforms that the shop drawings meet the intent of the contract.

CONFORMS AS-IS  CONFORMS AS NOTED  
 REVISE AND RESEND

**1908S - DISC BEARINGS**

By: Conrad Gagnon Date: 8/19/2019

By: \_\_\_\_\_ Date: \_\_\_\_\_


**RELEASED FOR FABRICATION**

**WALSH**

SEE SHEET GN1 FOR NOTES & MATERIAL SPECIFICATIONS  
 SEE SHEET 1 FOR NGE DISC BEARING ASSEMBLY DETAILS

checked 2019-08-16

**Roaring Brook Consultants, Inc.**  
 Engineering & Better Future  
 15 Sewall Road, South Berwick, Maine 03908  
 Phone: (877) 722-2643 FAX: (207) 384-5383

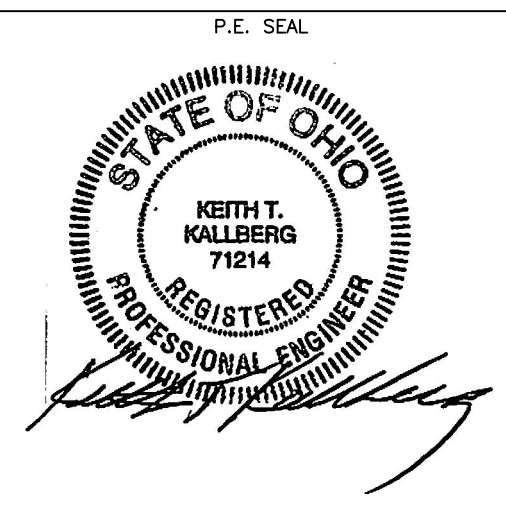

STATE OF OHIO  
 DEPARTMENT OF TRANSPORTATION

BRIDGE NO.  
 HAM-74-1908S  
 RAMP P

HAMILTON COUNTY, OH

STATE	COUNTY	PID NO.
OH	HAMILTON	104667

FED. AID PROJ. NO.: E170 (713)

**COSMEC INC.**  
**DISC BEARINGS ASSEMBLIES**

**Cosmec** 1501 ROCKY RIDGE ROAD  
 P.O. BOX 2159  
 ATHENS, TEXAS 75751


SCALE: NONE	DRAWN BY: JR DATE: 6/17/19	CHECKED BY: MCM DATE: 7/5/19
-------------	-------------------------------	---------------------------------

**(8) NON-GUIDED EXP. (NGE) BEARING MASONRY PLATES**  
 PL "AA1" x "BB" x "CC"  
 SEE TABLE MP1 ON THIS SHEET  
 FOR MARKS, LOCATIONS, AND DIMENSIONS

REVISED PER APPROVER COMMENTS & REMOVE NOTES.	JR	8/7/19	ELS	8/12/19	SHEET 3 OF 16	JOB NO.: 15353C
REV.	DESCRIPTION	BY	DATE	CK'D	DATE	CUSTOMER: WALSH CONSTRUCTION
						DRAWING NUMBER: 15353C-D3 REV. 1

**TABLE NGSP1 - Sole Plates (POS. Slope) for Non-Guided Exp. Bearings: Marks, Locations & Dimensions**

Bearing Description										Sole Plate						
Bearing Mark	Pier or Abutment	Unit	Girder	Qty.	Design Vertical Load (kips)	Design Horizontal Load (kips)	Max. Design Rotation (rads)	TOTAL Design Longit. Mvmnt. (in.)	TOTAL Design Transv. Mvmnt. (in.)	Dim. "FF"	Dim. "GG"	Dim. "SPCLT"	Dim. "SSW"	Dim. "SSL"	Dim. "T1"	Dim. "T2"
										Sole PL Width (in.)	Sole PL Length (in.)	Sole PL Center-Line Thk. (in.)	Stainless Steel Width (in.)	Stainless Steel Length (in.)	Sole PL Side Thk. (in.)	Sole PL Side Thk. (in.)
NGE1C	Exist. Pier 7	Unit 1	G1	1	150	15	0.030	1.500	1.500	16.000	14.000	1.250	15.500	13.500	1.125	1.375
NGE2C	Exist. Pier 7	Unit 1	G4	1	150	15	0.030	1.500	1.500	16.000	14.000	1.250	15.500	13.500	1.125	1.375
NGE3C	Pier 2	Unit 1	G1	1	150	15	0.030	1.500	1.500	16.000	14.000	1.250	15.500	13.500	1.063	1.438
NGE4C	Pier 2	Unit 1	G4	1	150	15	0.030	1.500	1.500	16.000	14.000	1.250	15.500	13.500	1.125	1.375
NGE5C	Pier 2	Unit 2	G1	1	390	40	0.030	3.750	1.500	19.000	19.000	1.250	18.500	18.500	0.875	1.625
NGE6C	Pier 2	Unit 2	G4	1	390	40	0.030	3.750	1.500	29.000	19.000	1.250	28.500	18.500	1.000	1.500

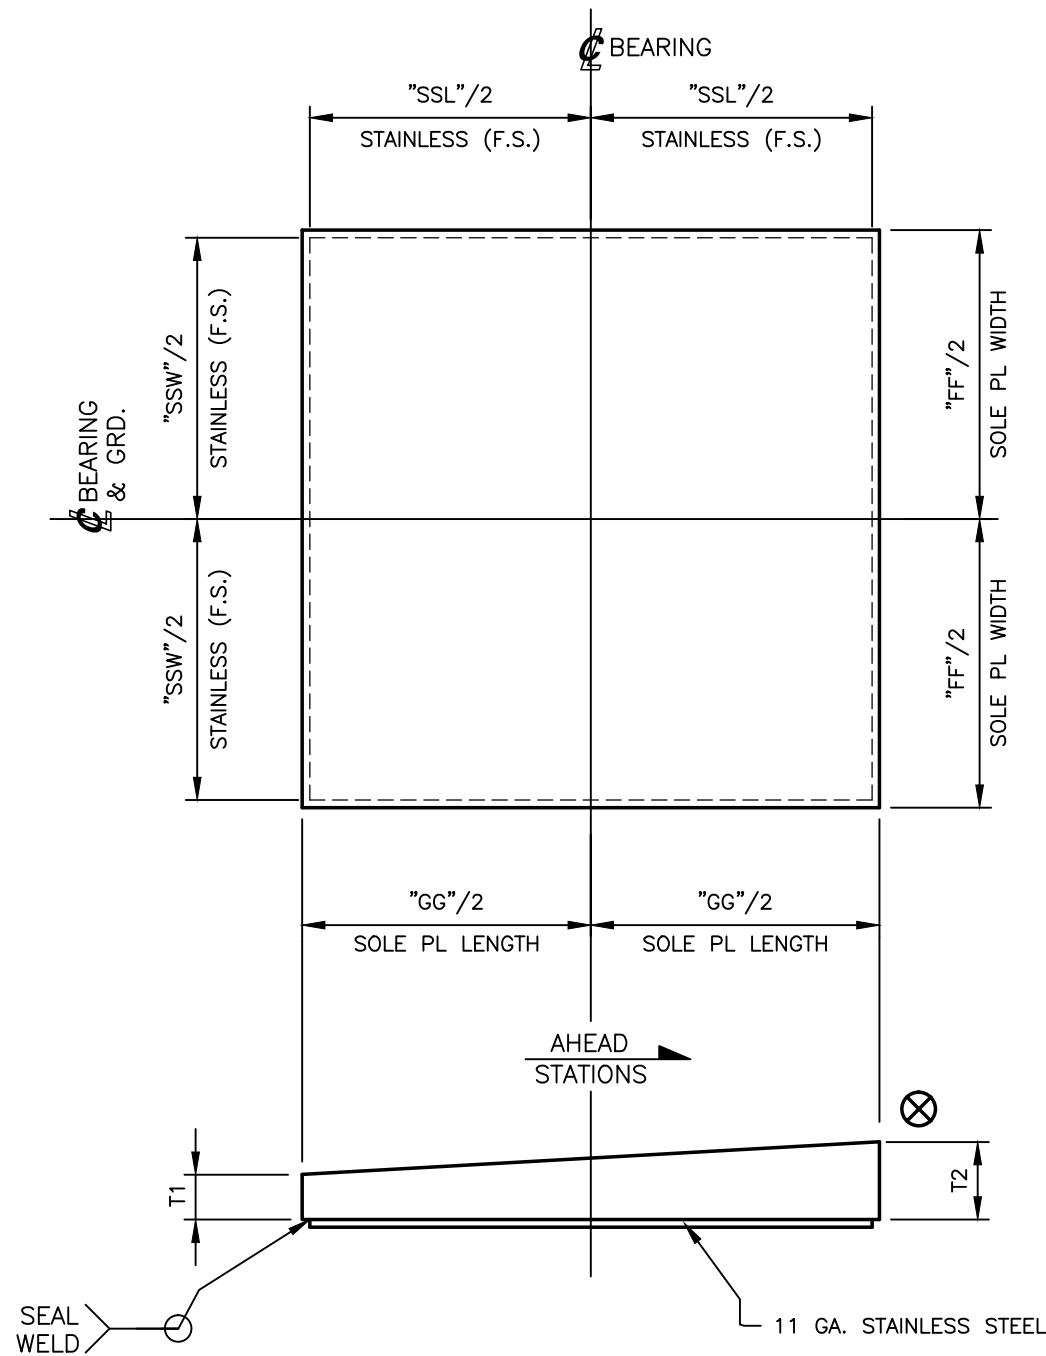

**(6) NON-GUIDED EXP. (NGE) BEARING BEVELED SOLE PLATES w/STAINLESS STEEL - POSITIVE SLOPE**

PL "T2" x "FF" x "GG"  
SEE TABLE NGSP1 ON THIS SHEET FOR MARKS, LOCATIONS, AND DIMENSIONS

**CONTRACTOR & APPROVER NOTE:** ENOUGH STAINLESS STEEL SLIDING SURFACE IS PROVIDED TO ALLOW MOVEMENT ALONG A SKEWED LINE PLUS AN ADDITIONAL 2 in. OF MOVEMENT BOTH LONGITUDINALLY & TRANSVERSELY.



- SHOP TO MARK HIGH SIDE OF BEVELED PLATE AND AHEAD STATION ARROW AS SHOWN.

checked 2019-08-16

**Roaring Brook Consultants, Inc.**  
Engineering & Better Future  
15 Sewall Road, South Berwick, Maine 03908  
Phone: (877) 722-2643 FAX: (207) 384-5383


<b>PRIME AE, Group, Inc</b>		<b>RELEASED FOR FABRICATION</b>
DATE REC'D: 8/19/2019	BUILDABLE UNIT NO.: 7	
Review conforms that the shop drawings meet the intent of the contract.		
<input checked="" type="checkbox"/> CONFORMS AS-IS	<input type="checkbox"/> CONFORMS AS NOTED	
<input type="checkbox"/> REVISE AND RESEND		
<b>1908S - DISC BEARINGS</b>		
By: Conrad Gagnon	By:	
Date: 8/19/2019	Date:	

SEE SHEET GN1 FOR NOTES & MATERIAL SPECIFICATIONS  
SEE SHEET 1 FOR NGE DISC BEARING ASSEMBLY DETAILS

P.E. SEAL			STATE OF OHIO DEPARTMENT OF TRANSPORTATION		
			BRIDGE NO. HAM-74-1908S		
			RAMP P		
			HAMILTON COUNTY, OH		
STATE	COUNTY	PID NO.			
OH	HAMILTON	104667			
FED. AID PROJ. NO.: E170 (713)			COSMEC INC.: DISC BEARINGS ASSEMBLIES		
			1501 ROCKY RIDGE ROAD P.O. BOX 2159 ATHENS, TEXAS 75751		
SCALE: NONE	DRAWN BY: JR	CHECKED BY: MCM			
	DATE: 6/17/19	DATE: 7/5/19			
	REVISED PER APPROVER & REMOVE APPR./CONTR. NOTE	JR	8/7/19	ELS	8/12/19
SHEET 4 OF 16			JOB NO.: 15353C		
REV.	DESCRIPTION	BY	DATE	CK'D	DATE
CUSTOMER: WALSH CONSTRUCTION			DRAWING NUMBER: 15353C-D4 REV. 1		

**TABLE NGSP2 - Sole Plates (NEG. Slope) for Non-Guided Exp. Bearings: Marks, Locations & Dimensions**

Bearing Description										Sole Plate						
Bearing Mark	Pier or Abutment	Unit	Girder	Qty.	Design Vertical Load (kips)	Design Horizontal Load (kips)	Max. Design Rotation (rads)	TOTAL Design Longit. Mvmnt. (in.)	TOTAL Design Transv. Mvmnt. (in.)	Dim. "FF"	Dim. "GG"	Dim. "SPCLT"	Dim. "SSW"	Dim. "SSL"	Dim. "T1"	Dim. "T2"
										Sole PL Width (in.)	Sole PL Length (in.)	Sole PL Center-Line Thk. (in.)	Stainless Steel Width (in.)	Stainless Steel Length (in.)	Sole PL Side Thk. (in.)	Sole PL Side Thk. (in.)
NGE7C	Fwd. Abut.	Unit 2	G1	1	250	25	0.030	3.250	1.500	19.000	17.000	1.250	18.500	16.500	1.500	1.000
NGE8C	Fwd. Abut.	Unit 2	G4	1	250	25	0.030	3.250	1.500	19.000	17.000	1.250	18.500	16.500	1.500	1.000

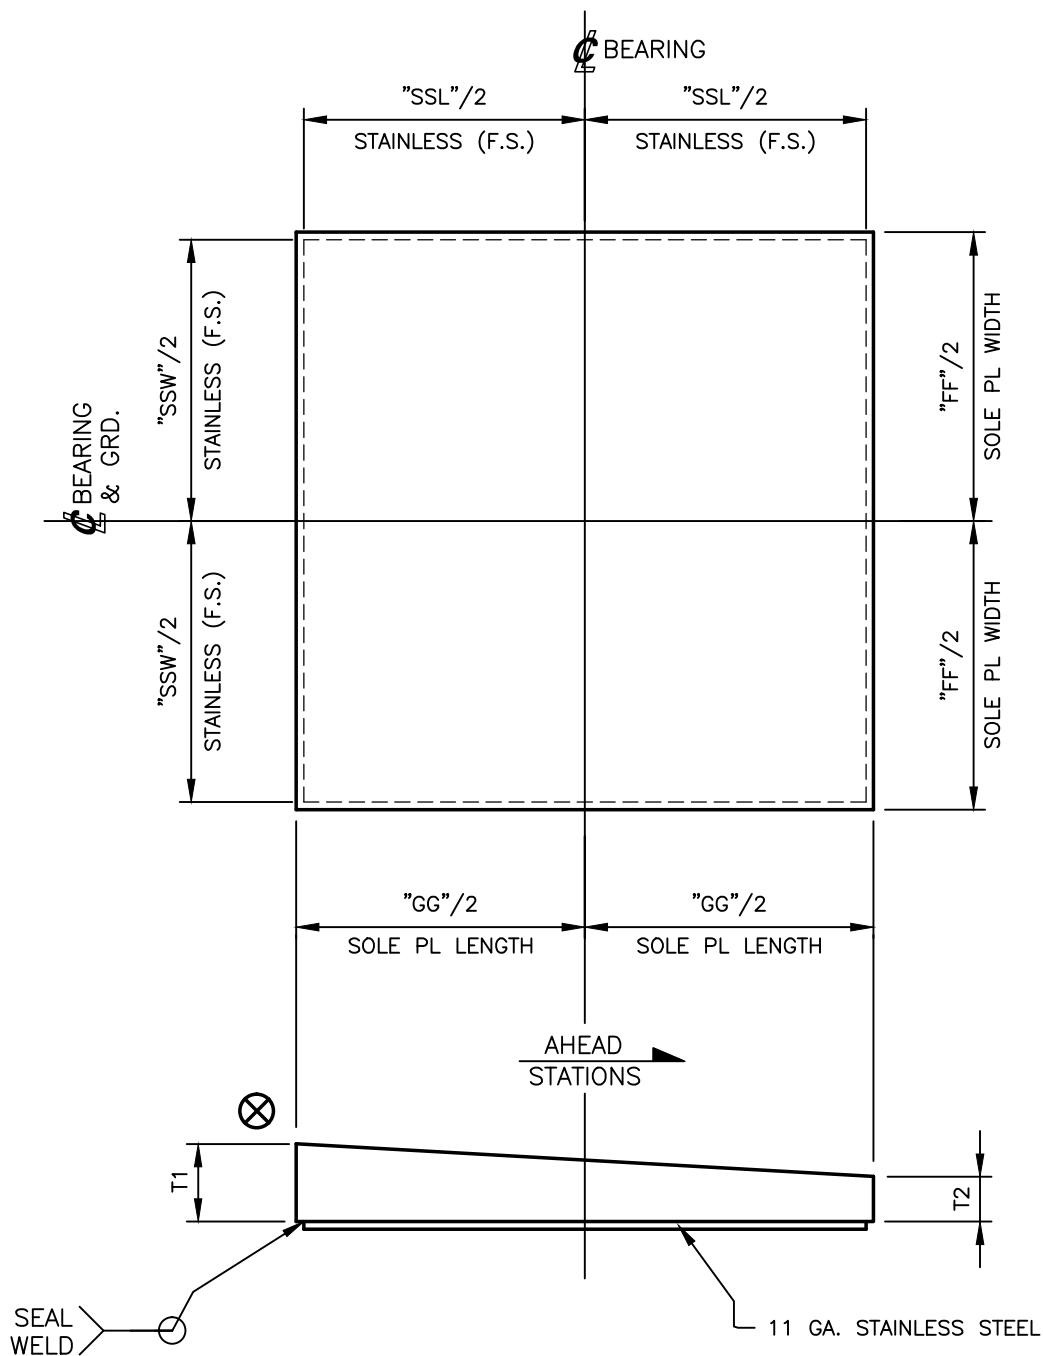

- SHOP TO MARK HIGH SIDE OF BEVELED PLATE AND AHEAD STATION ARROW AS SHOWN.

<b>PRIME AE, Group, Inc</b>		<b>RELEASED FOR FABRICATION</b>
DATE REC'D: 8/19/2019	BUILDABLE UNIT NO.: 7	
Review conforms that the shop drawings meet the intent of the contract.		
<input checked="" type="checkbox"/> CONFORMS AS-IS	<input type="checkbox"/> CONFORMS AS NOTED	
<input type="checkbox"/> REVISE AND RESEND		
<b>1908S - DISC BEARINGS</b>		
By: Conrad Gagnon	By:	
Date: 8/19/2019	Date:	

SEE SHEET GN1 FOR NOTES & MATERIAL SPECIFICATIONS  
SEE SHEET 1 FOR NGE DISC BEARING ASSEMBLY DETAILS

checked 2019-08-16

**Roaring Brook Consultants, Inc.**  
Engineering & Better Future  
15 Sewall Road, South Berwick, Maine 03908  
Phone: (877) 722-2643 FAX: (207) 384-5383

P.E. SEAL		
STATE OF OHIO DEPARTMENT OF TRANSPORTATION		
BRIDGE NO. HAM-74-1908S RAMP P HAMILTON COUNTY, OH		
STATE	COUNTY	PID NO.
OH	HAMILTON	104667
FED. AID PROJ. NO.: E170 (713)		
COSMEC INC.: <b>DISC BEARINGS ASSEMBLIES</b>		
1501 ROCKY RIDGE ROAD P.O. BOX 2159 ATHENS, TEXAS 75751		
SCALE: NONE	DRAWN BY: JR DATE: 6/19/19	CHECKED BY: MCM DATE: 7/5/19
SHEET 5 OF 16 <b>JOB NO.: 15353C</b>		
	REVISED PER APPROVER & REMOVE APPR./CONTR. NOTE	JR 8/7/19 ELS 8/12/19
REV.	DESCRIPTION	BY DATE CK'D DATE
CUSTOMER: WALSH CONSTRUCTION		DRAWING NUMBER: 15353C-D5 REV. 1

**(2) NON-GUIDED EXP. (NGE) BEARING BEVELED SOLE PLATES w/STAINLESS STEEL - NEGATIVE SLOPE**

PL "T1" x "FF" x "GG"  
SEE TABLE NGSP2 ON THIS SHEET FOR MARKS, LOCATIONS, AND DIMENSIONS

**CONTRACTOR & APPROVER NOTE:** ENOUGH STAINLESS STEEL SLIDING SURFACE IS PROVIDED TO ALLOW MOVEMENT ALONG A SKEWED LINE PLUS AN ADDITIONAL 2 in. OF MOVEMENT BOTH LONGITUDINALLY & TRANSVERSELY.



**TABLE NGE1C - Internal Components of Non-Guided Exp. Bearings: Brg. Marks, Locations & Dimensions**

Bearing Description					Urethane Disc				Top & Bottom Bearing Plates										Shear Pin						Height				
Bearing Mark	Pier or Abutment	Unit	Girder	Qty.	Design Vertical Load (kips)	Design Horizontal Load (kips)	Max. Design Rotation (rads)	TOTAL Design Longit. Mvmnt. (in.)	TOTAL Design Transv. Mvmnt. (in.)	Dim. "A"	Dim. "B"	Dim. "C"	Dim. "D"	Dim. "F"	Dim. "G"	Dim. "H"	Dim. "J"	Dim. "K"	Dim. "L"	Dim. "HD"	Dim. "PP"	Dim. "M"	Dim. "P"	Dim. "R"	Dim. "S"	Dim. "T"	Dim. "PI"	Dim. "EH"	Dim. "TH"
										Disc Hole Dia. (in.)	Eff. Disc Dia. (in.)	Disc Thk. (in.)	Disc O.D. (in.)	Bot. Brg. PL O.D. (in.)	Top & Bot. Brg. PL Recess Dia. (in.) (+/- 0.125")	Total Bot. Brg. PL Thk. (in.)	Top & Bot. Brg. PL Recess Depth (in.)	Top Brg. PL Dia. (in.)	Total Top Brg. PL Thk. (in.)	Top Brg. PL Depth of Hole (in.)	Top Brg. PL PTFE Dia. (in.)	Proj. of Pin (in.)	Shear Pin Dia. (in.)	Shear Pin Length (in.)	Pin Intrusion Into Bottom Brg. PL (in.)	Pin Taper Length (in.)	Pin Intrusion Into Top PL (in.)	Total Brg. Height (excl. Brg. Pad) (in.)	Total Brg. Height w/Brg. Pad (in.)
NGE1C	Exist. Pier 7	Unit 1	G1	1	150	15	0.030	1.500	1.500	2.063	6.523	1.000	7.030	8.730	7.730	1.970	0.220	9.000	2.095	1.500	7.500	2.000	2.000	3.250	1.250	0.875	1.000	7.125	7.375
NGE2C	Exist. Pier 7	Unit 1	G4	1	150	15	0.030	1.500	1.500	2.063	6.523	1.000	7.030	8.730	7.730	1.970	0.220	9.000	2.095	1.500	7.500	2.000	2.000	3.250	1.250	0.875	1.000	7.125	7.375
NGE3C	Pier 2	Unit 1	G1	1	150	15	0.030	1.500	1.500	2.063	6.523	1.000	7.030	8.730	7.730	1.970	0.220	9.000	2.095	1.500	7.500	2.000	2.000	3.250	1.250	0.875	1.000	7.125	7.375
NGE4C	Pier 2	Unit 1	G4	1	150	15	0.030	1.500	1.500	2.063	6.523	1.000	7.030	8.730	7.730	1.970	0.220	9.000	2.095	1.500	7.500	2.000	2.000	3.250	1.250	0.875	1.000	7.125	7.375
NGE5C	Pier 2	Unit 2	G1	1	390	40	0.030	3.750	1.500	3.063	10.450	1.125	11.030	12.730	11.730	2.000	0.340	12.875	2.215	1.500	12.000	2.125	3.000	3.375	1.250	0.875	1.000	7.160	7.410
NGE6C	Pier 2	Unit 2	G4	1	390	40	0.030	3.750	1.500	3.063	10.450	1.125	11.030	12.730	11.730	2.000	0.340	12.875	2.215	1.500	12.000	2.125	3.000	3.375	1.250	0.875	1.000	7.160	7.410
NGE7C	Fwd. Abut.	Unit 2	G1	1	250	25	0.030	3.250	1.500	2.563	8.423	1.000	8.930	10.630	9.630	2.000	0.270	11.000	2.145	1.500	9.750	2.000	2.500	3.250	1.250	0.875	1.000	7.105	7.355
NGE8C	Fwd. Abut.	Unit 2	G4	1	250	25	0.030	3.250	1.500	2.563	8.423	1.000	8.930	10.630	9.630	2.000	0.270	11.000	2.145	1.500	9.750	2.000	2.500	3.250	1.250	0.875	1.000	7.105	7.355




<b>PRIME AE, Group, Inc</b>		<b>RELEASED FOR FABRICATION</b>
DATE REC'D: 8/19/2019	BUILDABLE UNIT NO.: 7	
Review conforms that the shop drawings meet the intent of the contract.		
<input checked="" type="checkbox"/> CONFORMS AS-IS	<input type="checkbox"/> CONFORMS AS NOTED	<b>WALSH</b>
<input type="checkbox"/> REVISE AND RESEND		
<b>1908S - DISC BEARINGS</b>		
By: Conrad Gagnon	By:	
Date: 8/19/2019	Date:	

SEE SHEET GN1 FOR NOTES & MATERIAL SPECIFICATIONS  
 SEE SHEET 1 FOR NGE DISC BEARING ASSEMBLY DETAILS  
 SEE SHEET 2 FOR NGE DISC BEARING INTERNAL COMPONENT DETAILS

checked 2019-08-16

**Roaring Brook Consultants, Inc.**  
 Engineering & Better Future  
 15 Sewall Road, South Berwick, Maine 03908  
 Phone: (877) 722-2643 FAX: (207) 384-5383

P.E. SEAL		
STATE OF OHIO DEPARTMENT OF TRANSPORTATION BRIDGE NO. HAM-74-1908S RAMP P HAMILTON COUNTY, OH		
STATE	COUNTY	PID NO.
OH	HAMILTON	104667
FED. AID PROJ. NO.: E170 (713)		
<b>COSMEC INC.:</b> <b>DISC BEARINGS ASSEMBLIES</b>		
1501 ROCKY RIDGE ROAD P.O. BOX 2159 ATHENS, TEXAS 75751		
SCALE: NONE	DRAWN BY: JR DATE: 6/18/19	CHECKED BY: MCM DATE: 7/5/19
SHEET 6 OF 16 <b>JOB NO.: 15353C</b>		
REV. DESCRIPTION BY DATE CK'D DATE	CUSTOMER: WALSH CONSTRUCTION	
DRAWING NUMBER: 15353C-D6		REV. 1

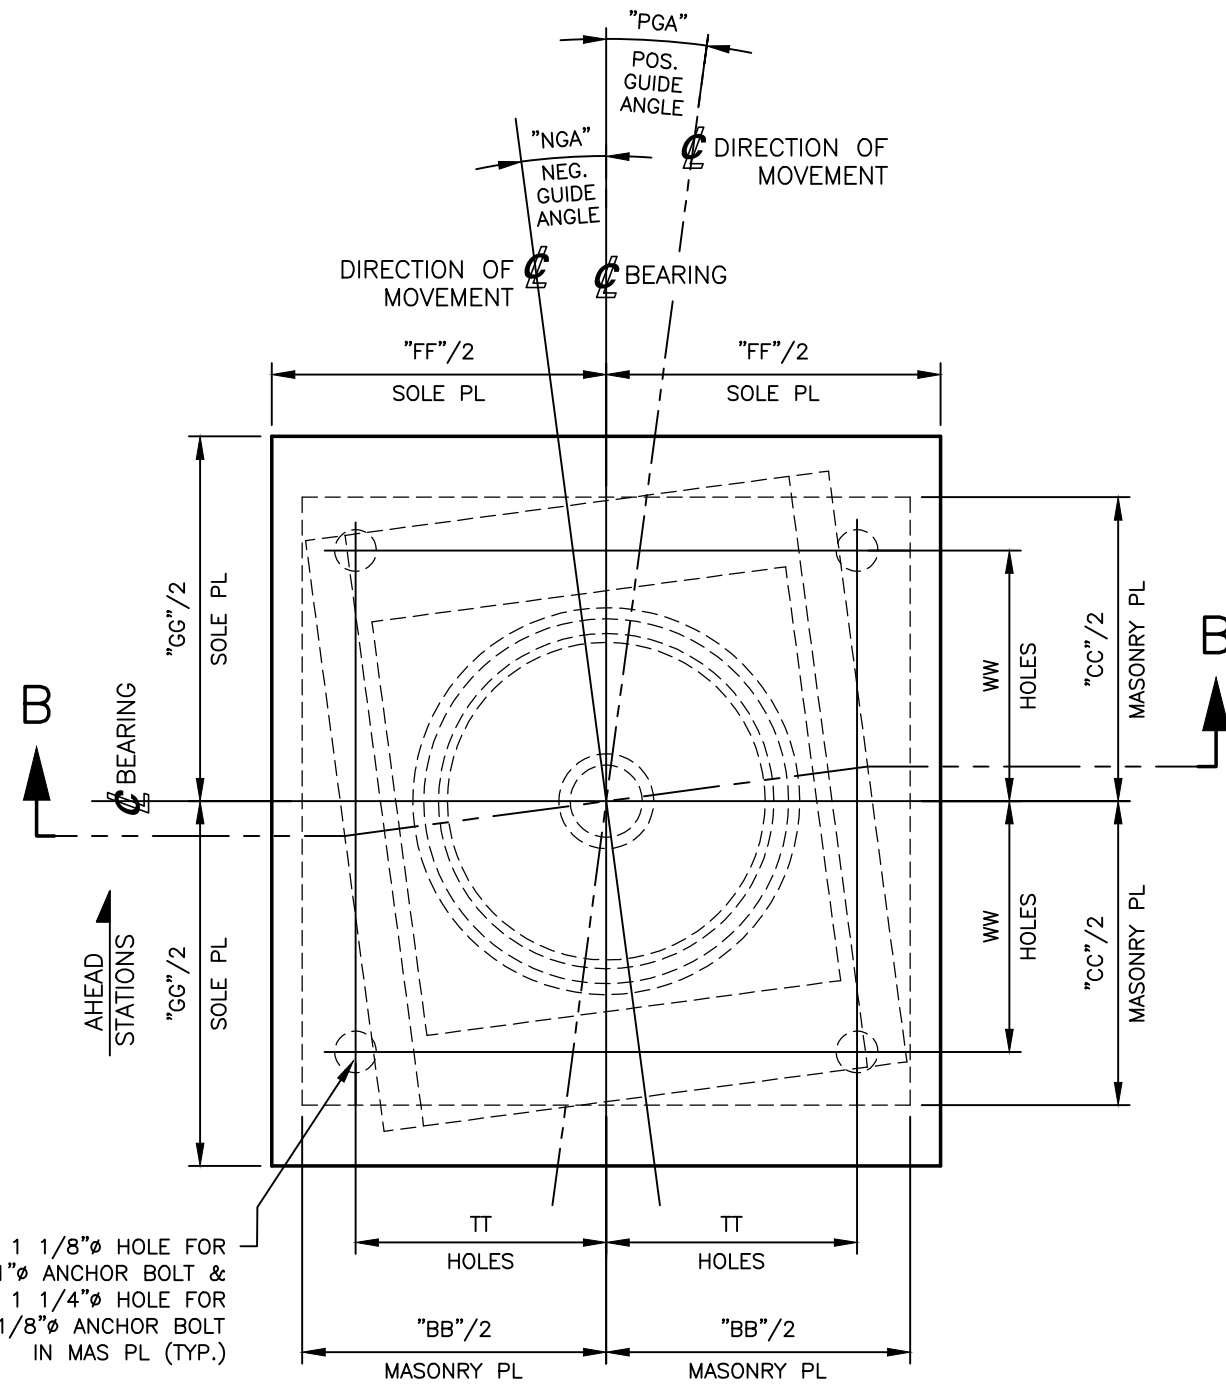


**PLAN VIEW**

**(8) GUIDED EXPANSION BEARINGS  
MKS. GE1C thru GE8C**


(BEARING WITH NEGATIVE GUIDE ANGLE ["NGA"] SHOWN – POSITIVE GUIDE ANGLE ["PGA"] SIMILAR w/CENTERLINE OF DIRECTION OF MOVEMENT AS REPRESENTED ABOVE)

SEE SHEETS 8 thru 14 FOR COMPONENT DETAILS; TABLES WITH MARKS, LOCATIONS, AND DIMENSIONS

**CONTRACTOR NOTE:** SOLE PLATE MAY HAVE TO BE ROTATED IN THE FIELD TO ALIGN THE SOLE PLATE WITH THE BOTTOM FLANGE OF THE GIRDER. MASONRY PLATE SHALL BE ALIGNED WITH THE CENTERLINE OF BEARING OF SUBSTRUCTURE. CONTRACTOR SHALL TAKE CARE NOT TO MOVE THE MASONRY PLATE WHILE ALIGNING THE SOLE PLATE.

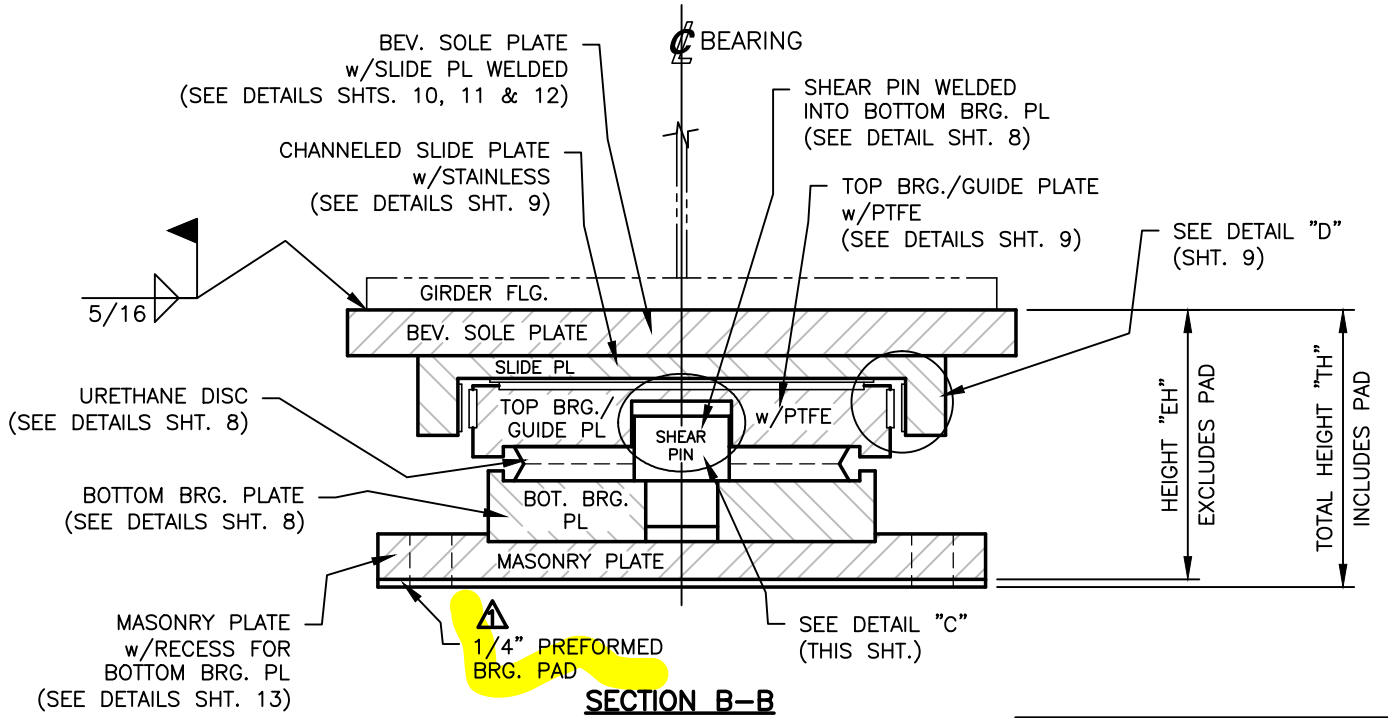

**SECTION B-B**

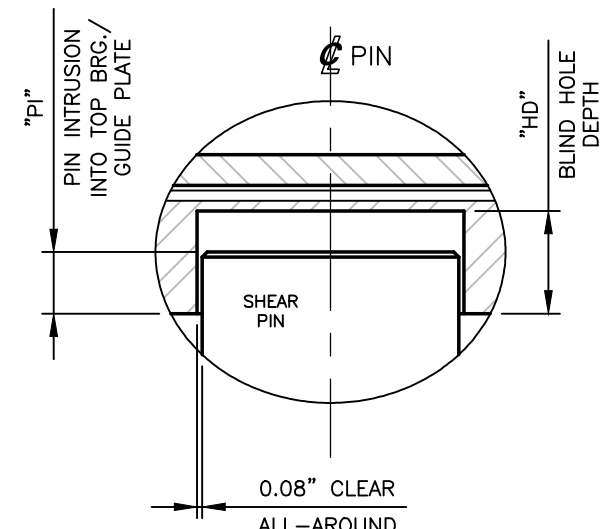


**DETAIL C**

SHOWING SHEAR PIN INTRUSION INTO GUIDE/TOP BRG. PLATE (SEE TABLES GE1A & GE1B ON SHT. 14)

**Roaring Brook Consultants, Inc.**  
Engineering & Better Future  
15 Sewall Road, South Berwick, Maine 03908  
Phone: (877) 722-2643 FAX: (207) 384-5383

checked 2019-08-16

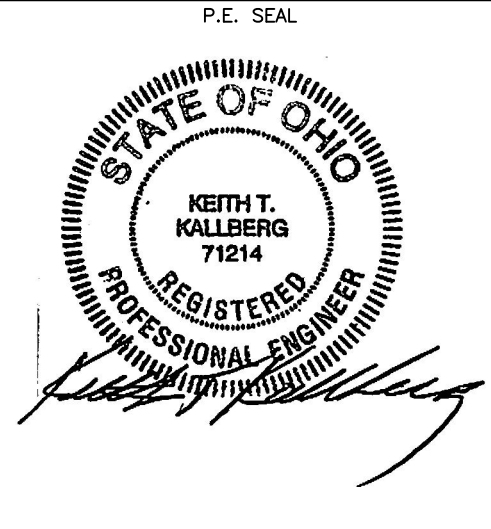

STATE OF OHIO  
DEPARTMENT OF TRANSPORTATION  
**BRIDGE NO. HAM-74-1908S**  
**RAMP P**  
HAMILTON COUNTY, OH

STATE	COUNTY	PID NO.
OH	HAMILTON	104667

FED. AID PROJ. NO.: E170 (713)  
**COSMEC INC.:**  
**DISC BEARINGS ASSEMBLIES**

**Cosmec** 1501 ROCKY RIDGE ROAD  
P.O. BOX 2159  
ATHENS, TEXAS 75751


SCALE: NONE	DRAWN BY: JR	CHECKED BY: MCM
	DATE: 6/19/19	DATE: 7/5/19

SHEET 7 OF 16 **JOB NO.: 15353C**


<b>PRIME AE, Group, Inc</b>		<b>RELEASED FOR FABRICATION</b>	
DATE REC'D: 8/19/2019	BUILDABLE UNIT NO.: 7	<b>WALSH</b>	
Review conforms that the shop drawings meet the intent of the contract.			
<input checked="" type="checkbox"/> CONFORMS AS-IS	<input type="checkbox"/> CONFORMS AS NOTED		
<input type="checkbox"/> CONFORMS AS NOTED	<input type="checkbox"/> REVISE AND RESEND		
<b>1908S - DISC BEARINGS</b>			
By: Conrad Gagnon	By:		
Date: 8/19/2019	Date:		

SEE SHEET GN1 FOR NOTES & MATERIAL SPECIFICATIONS  
SEE SHTS. 8 thru 14 FOR DISC BEARING COMPONENT DETAILS & TABLES


<b>REVISION</b>	REVISION DESCRIPTION	BY	DATE	CK'D	DATE	CUSTOMER: WALSH CONSTRUCTION	DRAWING NUMBER: 15353C-D7	REV. 1
Δ	REVISED ANC. BOLT HOLES & BRG. PAD PER APPROVER	JR	8/6/19	ELS	8/12/19			

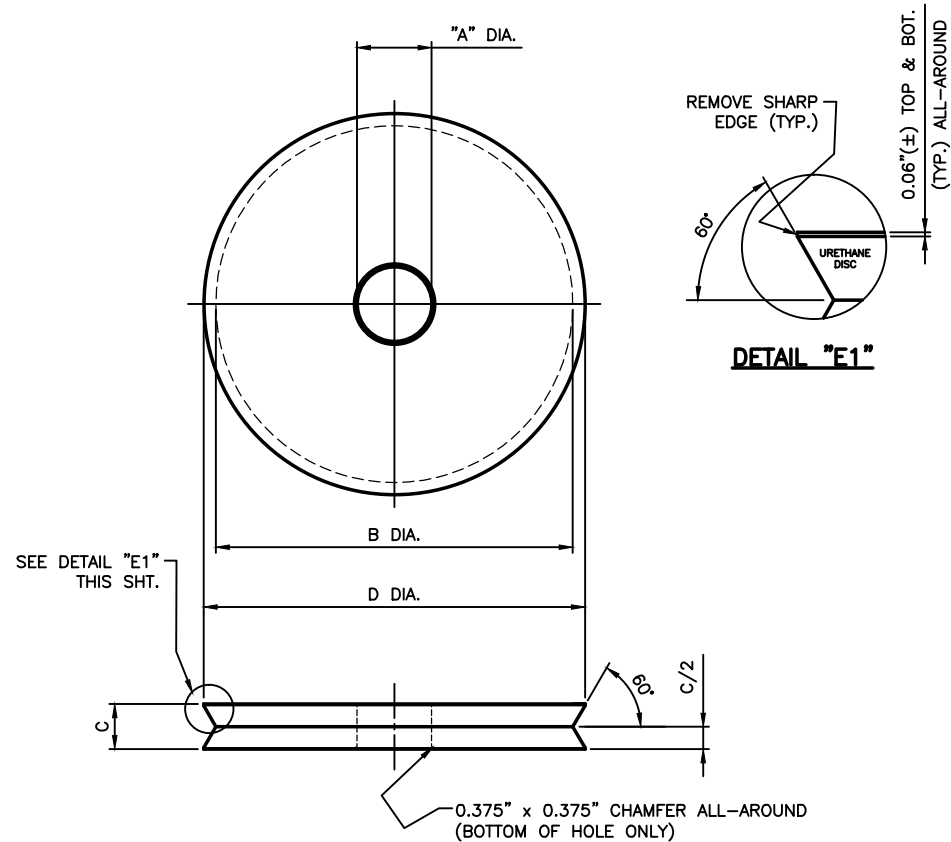

**POLYETHER URETHANE DISC**  
DO NOT COAT  
DISC "C" x "D" DIA.  
(SEE SHT. GN1 FOR MATERIAL SPECS.)

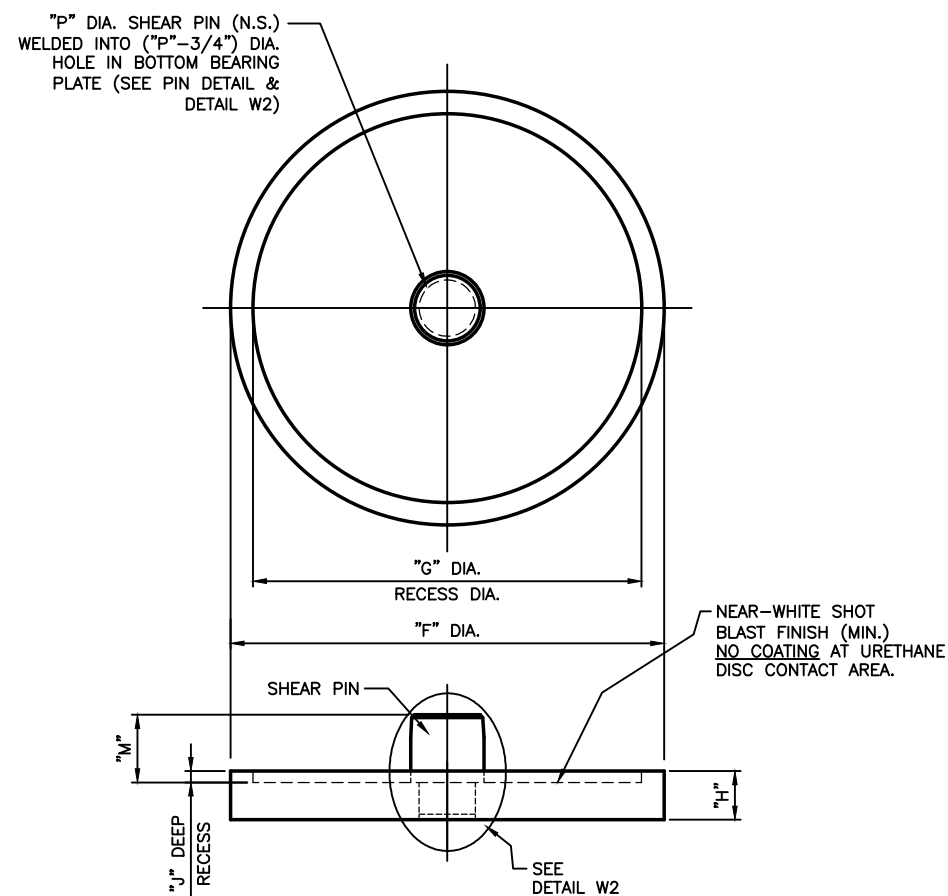


**BOTTOM BEARING PLATE w/SHEAR PIN**  
PL "H" x "F" DIA.  
(SEE SHT. GN1 FOR MATERIAL SPECS.)

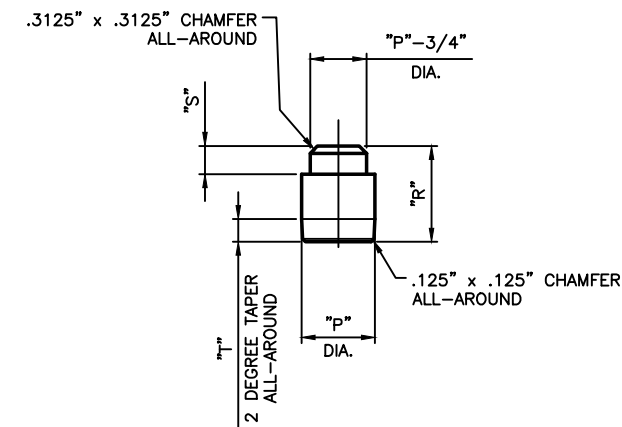

**SHEAR PIN**  
RD. "P" DIA. x "R"  
(SEE SHT. GN1 FOR MATERIAL SPECS.)  
NO PAINT REQUIRED

**GUIDED EXP. DISC BEARING – INTERNAL COMPONENTS**  
(SEE TABLES GE1A & GE1B SHEET 14 FOR DIMENSIONS)

SEE SHEET GN1 FOR NOTES & MATERIAL SPECIFICATIONS  
SEE SHEET 7 FOR GUIDED EXPANSION BEARING ASSEMBLY DETAILS  
SEE TABLES ON SHT. 14 FOR DIMENSIONS

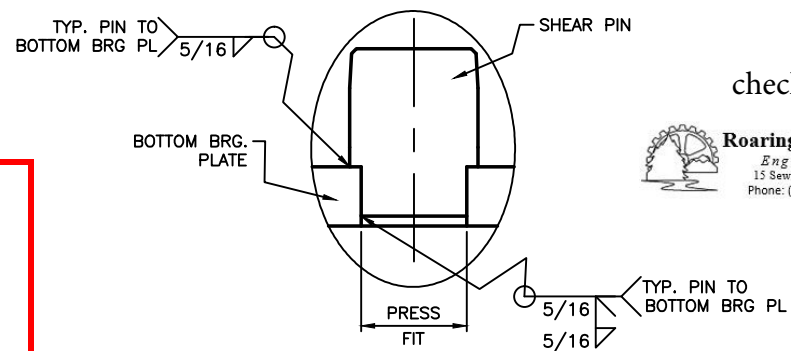



**DETAIL W2**  
SHOWING INSTALLATION & WELDING OF SHEAR PIN TO BOTTOM BRG. PLATE

checked 2019-08-16

Roaring Brook Consultants, Inc.  
Engineering & Better Future  
15 Sewall Road, South Berwick, Maine 03908  
Phone: (877) 722-2643 FAX: (207) 384-5383

<b>PRIME AE, Group, Inc</b>		<b>RELEASED FOR FABRICATION</b>
DATE REC'D: 8/19/2019	BUILDABLE UNIT NO.: 7	
Review conforms that the shop drawings meet the intent of the contract.		<b>WALSH</b>
<input checked="" type="checkbox"/> CONFORMS AS-IS	<input type="checkbox"/> CONFORMS AS NOTED	
1908S - DISC BEARINGS		
By: Conrad Gagnon	By:	
Date: 8/19/2019	Date:	


P.E. SEAL		
STATE	COUNTY	PID NO.
OH	HAMILTON	104667
FED. AID PROJ. NO.: E170 (713)		
COSMEC INC.: <b>DISC BEARINGS ASSEMBLIES</b>		
1501 ROCKY RIDGE ROAD P.O. BOX 2159 ATHENS, TEXAS 75751		
SCALE: NONE	DRAWN BY: JR	CHECKED BY: MCM
	DATE: 6/24/19	DATE: 7/5/19
SHEET 8 OF 16	JOB NO.: 15353C	
REV.	DESCRIPTION	BY DATE CK'D DATE
	CUSTOMER: WALSH CONSTRUCTION	DRAWING NUMBER: 15353C-DB
		REV. 0

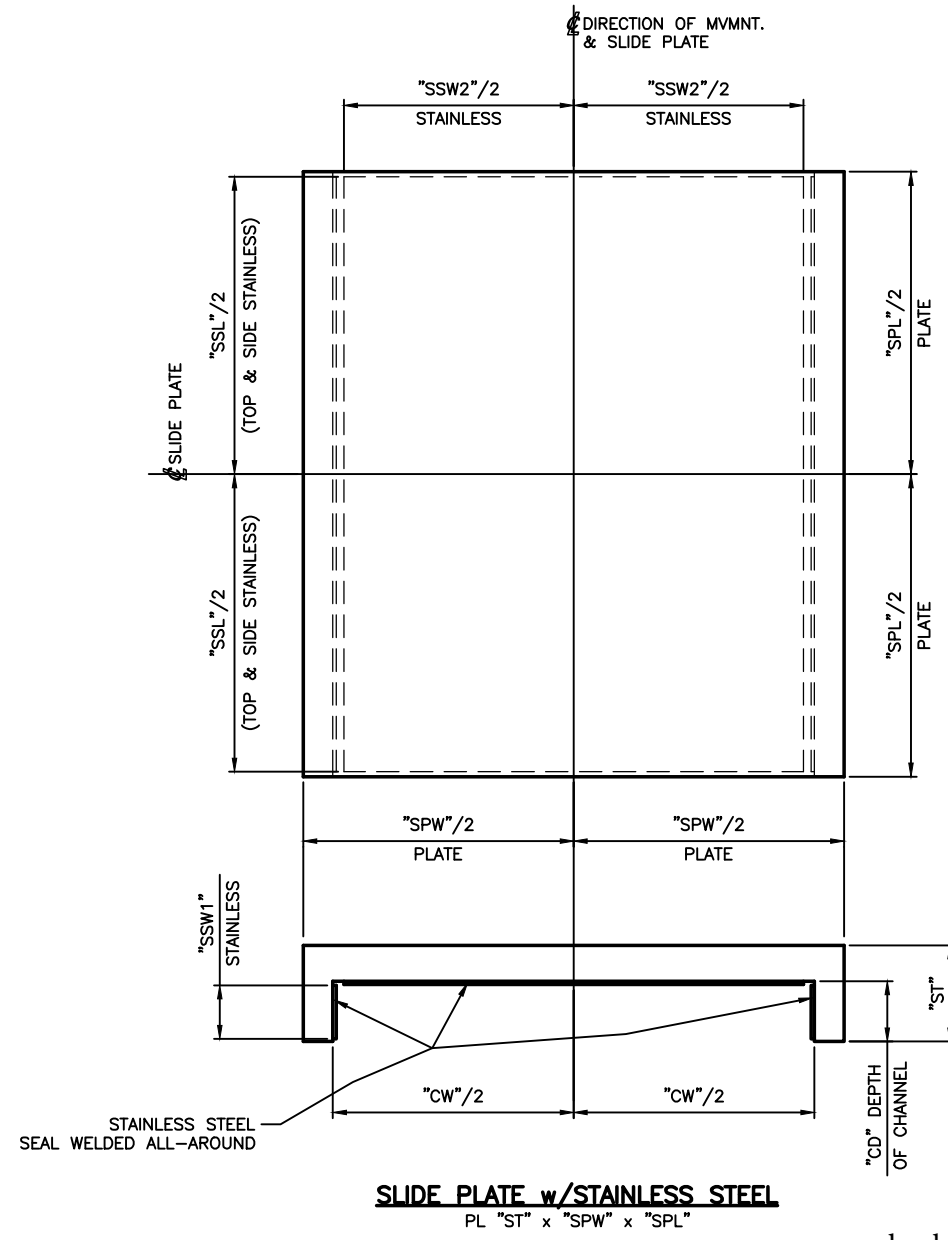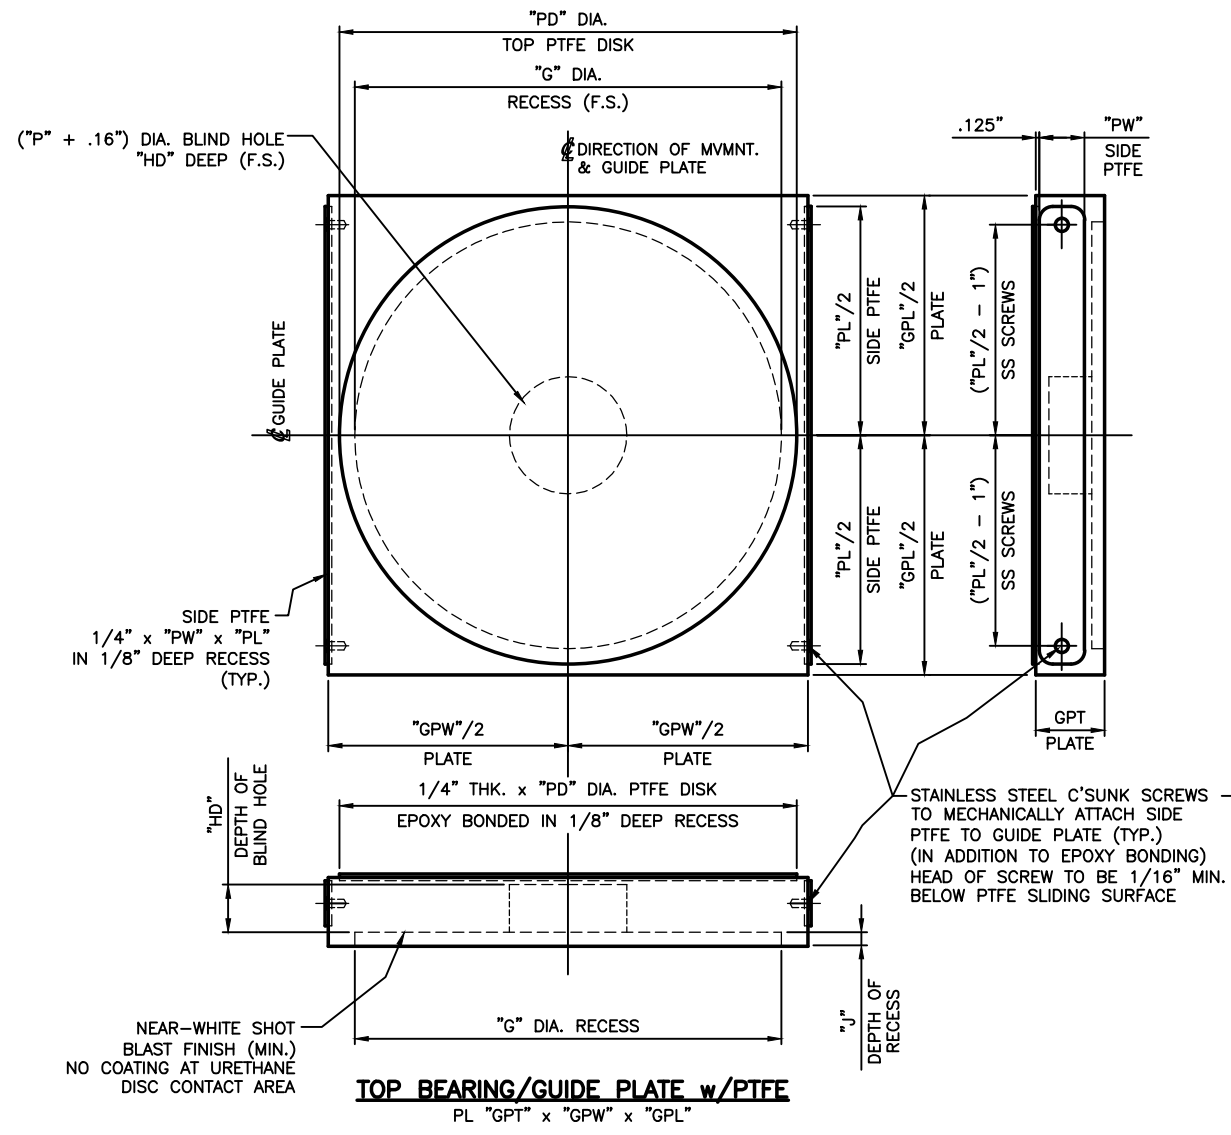

SEE SHEET GN1 FOR NOTES & MATERIAL SPECIFICATIONS  
 SEE SHT. 7 FOR GUIDED EXPANSION DISC BEARING ASSEMBLY DETAILS  
 SEE SHT. 14 FOR TABLES

P.E. SEAL

checked 2019-08-16

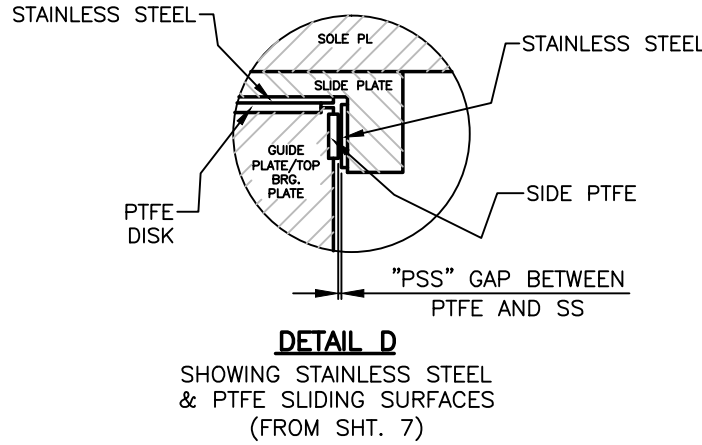

**GUIDED EXP. DISC BEARINGS -  
 SLIDE & GUIDE COMPONENTS**  
 (SEE TABLES GE1A & GE1B ON SHEET 14 FOR DIMENSIONS)

**Roaring Brook Consultants, Inc.**  
 Engineering & Better Future  
 15 Sewall Road, South Berwick, Maine 03908  
 Phone: (877) 722-2643 FAX: (207) 384-5383

<b>PRIME AE, Group, Inc</b>		<b>RELEASED FOR FABRICATION</b>
DATE REC'D: 8/19/2019	BUILDABLE UNIT NO.: 7	
Review conforms that the shop drawings meet the intent of the contract.		
<input checked="" type="checkbox"/> CONFORMS AS-IS	<input type="checkbox"/> CONFORMS AS NOTED	<b>WALSH</b>
<input type="checkbox"/> REVISIONS	<input type="checkbox"/> REVISE AND RESEND	
<b>1908S - DISC BEARINGS</b>		
By: Conrad Gagnon	By:	
Date: 8/19/2019	Date:	

STATE OF OHIO  
 DEPARTMENT OF TRANSPORTATION

BRIDGE NO.  
 HAM-74-1908S  
 RAMP P  
 HAMILTON COUNTY, OH

STATE	COUNTY	PID NO.
OH	HAMILTON	104667

FED. AID PROJ. NO.: E170 (713)

**COSMEC INC.:**  
**DISC BEARINGS ASSEMBLIES**

**Cosmec** 1501 ROCKY RIDGE ROAD  
 P.O. BOX 2159  
 ATHENS, TEXAS 75751

SCALE: NONE	DRAWN BY: JR	CHECKED BY: MCM
	DATE: 6/24/19	DATE: 7/5/19



SHEET 9 OF 16 **JOB NO.: 15353C**

REV.	DESCRIPTION	BY	DATE	CK'D	DATE

CUSTOMER: WALSH CONSTRUCTION DRAWING NUMBER: 15353C-D9 REV: 0

**TABLE GESP1 - Bev. Sole Plates for Guided Exp. Bearings w/"NEG." Guide Angles; "POS." Slope: Marks, Locations & Dimensions**

Bearing Mark	Pier or Abutment	Unit	Girder	Qty.	Design Vertical Load (kips)	Design Horizontal Load (kips)	Max. Design Rotation (rads)	TOTAL Design Longit. Mvmnt. (in.)	TOTAL Design Transv. Mvmnt. (Double the Gap "PSS") (in.)	Sole Plate w/Slide Plate Weld Attached								
										Dim. "FF"	Dim. "GG"	Dim. "SPCLT"	Dim. "SPW"	Dim. "SPL"	Dim. "ST"	Guide Angle "NGA"	Dim. "T1"	Dim. "T2"
										Sole PL Width (in.)	Sole PL Length (in.)	Sole PL Center-Line Thk. (in.)	Slide Plate Width (in.)	Slide Plate Length (in.)	Slide Plate Thickness (in.)	Negative Guide Angle (degrees)	Sole PL Side Thk. (in.)	Sole PL Side Thk. (in.)
GE1C	Exist. Pier 7	Unit 1	G2	1	150	38	0.030	1.380	0.250	16.000	16.000	1.500	13.305	13.435	2.375	4.77	1.379	1.621
GE2C	Exist. Pier 7	Unit 1	G3	1	150	38	0.030	1.380	0.250	16.000	16.000	1.500	13.305	13.435	2.375	4.66	1.250	1.750
GE5C	Pier 2	Unit 2	G2	1	390	98	0.030	3.750	0.500	22.000	24.000	1.500	17.355	19.605	2.625	5.64	1.000	2.000
GE6C	Pier 2	Unit 2	G3	1	390	98	0.030	3.750	0.500	22.000	24.000	1.500	17.355	19.605	2.625	7.41	1.000	2.000

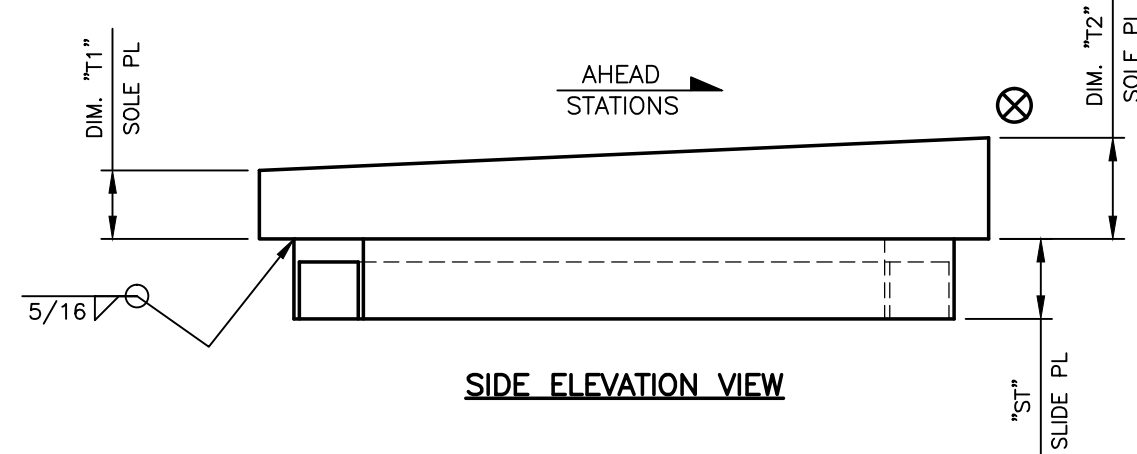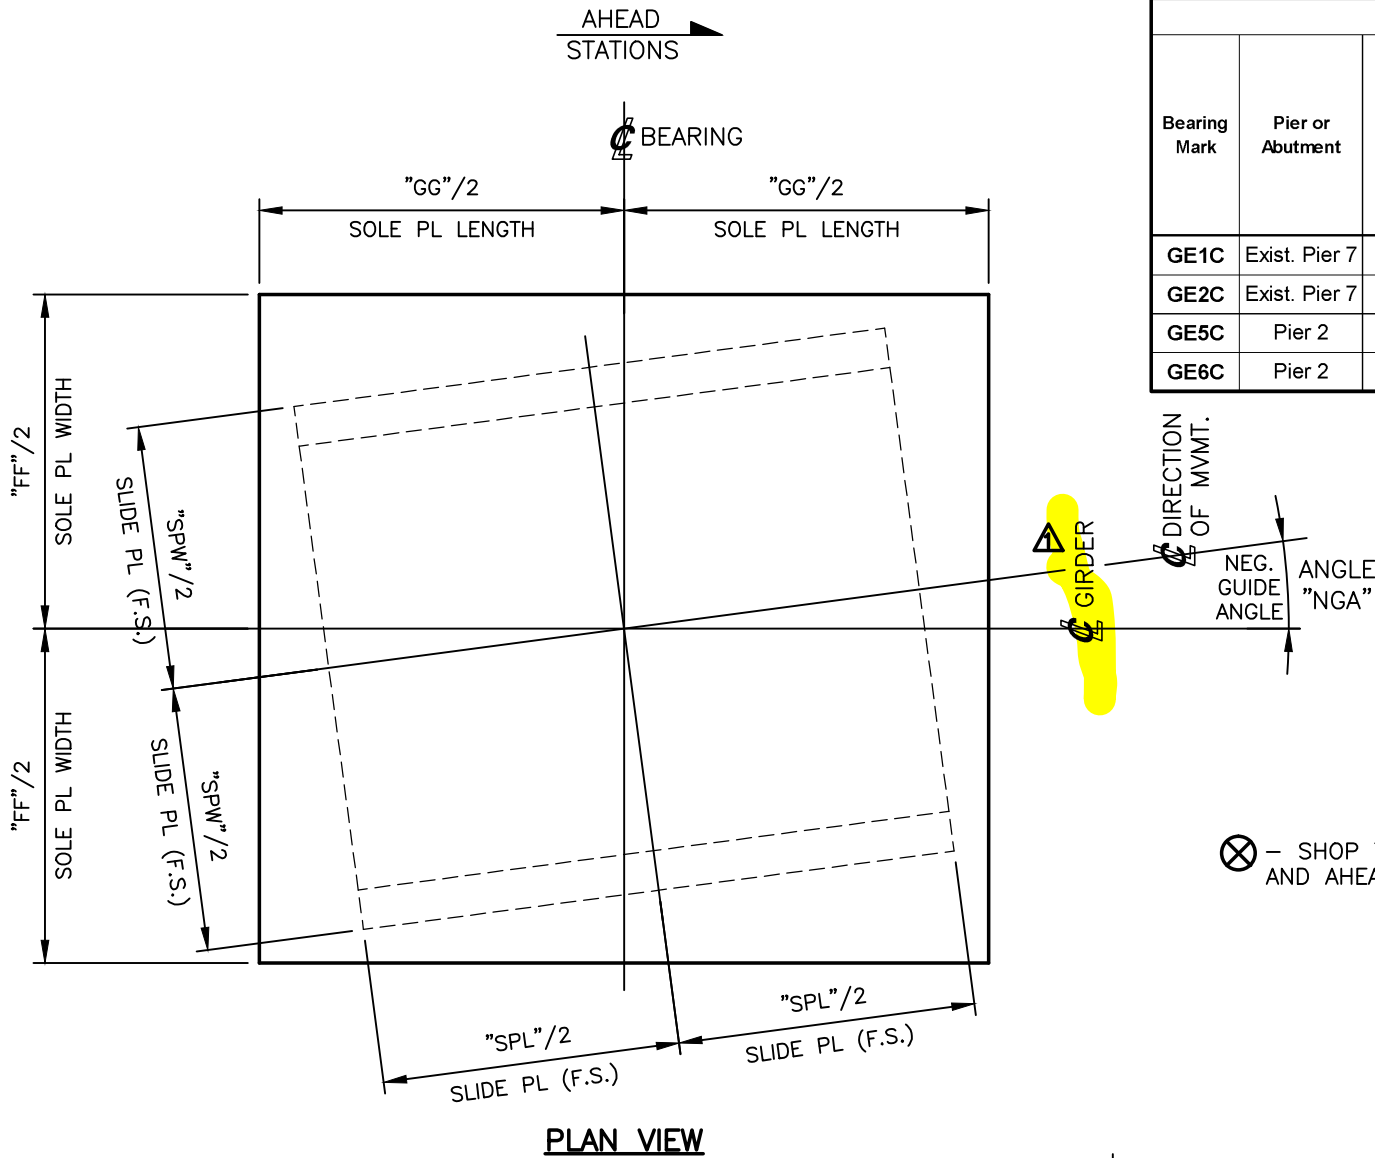


CONTRACTOR NOTE: SOLE PLATE MAY HAVE TO BE ROTATED IN THE FIELD TO ALIGN THE SOLE PLATE WITH THE BOTTOM FLANGE OF THE GIRDER

⊗ - SHOP TO MARK HIGH SIDE OF BEVELED PLATE AND AHEAD STATION ARROW AS SHOWN.

checked 2019-08-16

Roaring Brook Consultants, Inc.  
Engineering a Better Future  
15 Sewall Road, South Berwick, Maine 03908  
Phone: (677) 722-2643 FAX: (207) 384-5383

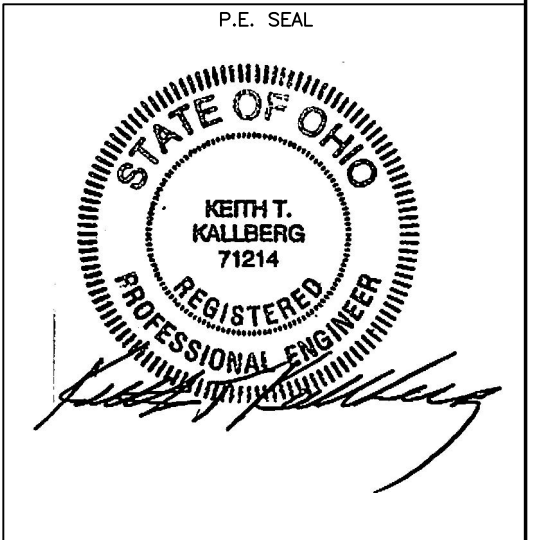

<b>PRIME AE, Group, Inc</b>		<b>RELEASED FOR FABRICATION</b>
DATE REC'D: 8/19/2019	BUILDABLE UNIT NO.: 7	
Review conforms that the shop drawings meet the intent of the contract.		
<input checked="" type="checkbox"/> CONFORMS AS-IS	<input type="checkbox"/> CONFORMS AS NOTED	
<b>1908S - DISC BEARINGS</b>		<b>WALSH</b>
<input type="checkbox"/> REVISE AND RESEND		
By: Conrad Gagnon	By:	
Date: 8/19/2019	Date:	

STATE OF OHIO  
DEPARTMENT OF TRANSPORTATION  
BRIDGE NO.  
HAM-74-1908S  
RAMP P  
HAMILTON COUNTY, OH

STATE	COUNTY	PID NO.
OH	HAMILTON	104667

FED. AID PROJ. NO.: E170 (713)  
**COSMEC INC.:**  
**DISC BEARINGS ASSEMBLIES**

**Cosmec** 1501 ROCKY RIDGE ROAD  
P.O. BOX 2159  
ATHENS, TEXAS 75751

SCALE: NONE	DRAWN BY: JR	CHECKED BY: MCM
	DATE: 6/25/19	DATE: 7/5/19

SHEET 10 OF 16 **JOB NO.: 15353C**

SEE SHEET GN1 FOR NOTES & MATERIAL SPECIFICATIONS  
SEE SHT. 7 FOR GE BEARING ASSEMBLY DETAILS

**(4) GUIDED EXPANSION BRG. BEVELED SOLE PLATES w/"NEGATIVE" GUIDE ANGLES & SLIDE PLATE WELDED**

**MKS. GE1C, GE2C, GE5C & GE6C**


SEE TABLE GESP1 THIS SHEET FOR MARKS, ANGLES AND DIMENSIONS

REMOVE APPROVER NOTES & REVISE HL BEVELS & GUIDE ANGLES PER APPROVER.	JR	8/6/19	ELS	8/12/19
REV. DESCRIPTION	BY	DATE	CK'D	DATE
CUSTOMER: WALSH CONSTRUCTION				DRAWING NUMBER: 15353C-D10
				REV. 1


**TABLE GESP2 - Bev. Sole Plates for Guided Exp. Bearings w/"POS." Guide Angles & "POS." Slope: Marks, Locations & Dimensions**

Bearing Description										Sole Plate w/Slide Plate Weld Attached								
Bearing Mark	Pier or Abutment	Unit	Girder	Qty.	Design Vertical Load (kips)	Design Horizontal Load (kips)	Max. Design Rotation (rads)	TOTAL Design Longit. Mvmt. (in.)	TOTAL Design Transv. Mvmt. (Double the Gap "PSS") (in.)	Dim. "FF"	Dim. "GG"	Dim. "SPCLT"	Dim. "SPW"	Dim. "SPL"	Dim. "ST"	Guide Angle "PGA"	Dim. "T1"	Dim. "T2"
										Sole PL Width (in.)	Sole PL Length (in.)	Sole PL Center-Line Thk. (in.)	Slide Plate Width (in.)	Slide Plate Length (in.)	Slide Plate Thickness (in.)	Positive Guide Angle (degrees)	Sole PL Side Thk. (in.)	Sole PL Side Thk. (in.)
GE3C	Pier 2	Unit 1	G2	1	150	38	0.030	1.380	0.250	16.000	16.000	1.500	13.305	13.435	2.375	1.76	1.3125	1.6875
GE4C	Pier 2	Unit 1	G3	1	150	38	0.030	1.380	0.250	16.000	16.000	1.500	13.305	13.435	2.375	1.71	1.3125	1.6875

CONTRACTOR NOTE: SOLE PLATE MAY HAVE TO BE ROTATED IN THE FIELD TO ALIGN THE SOLE PLATE WITH THE BOTTOM FLANGE OF THE GIRDER

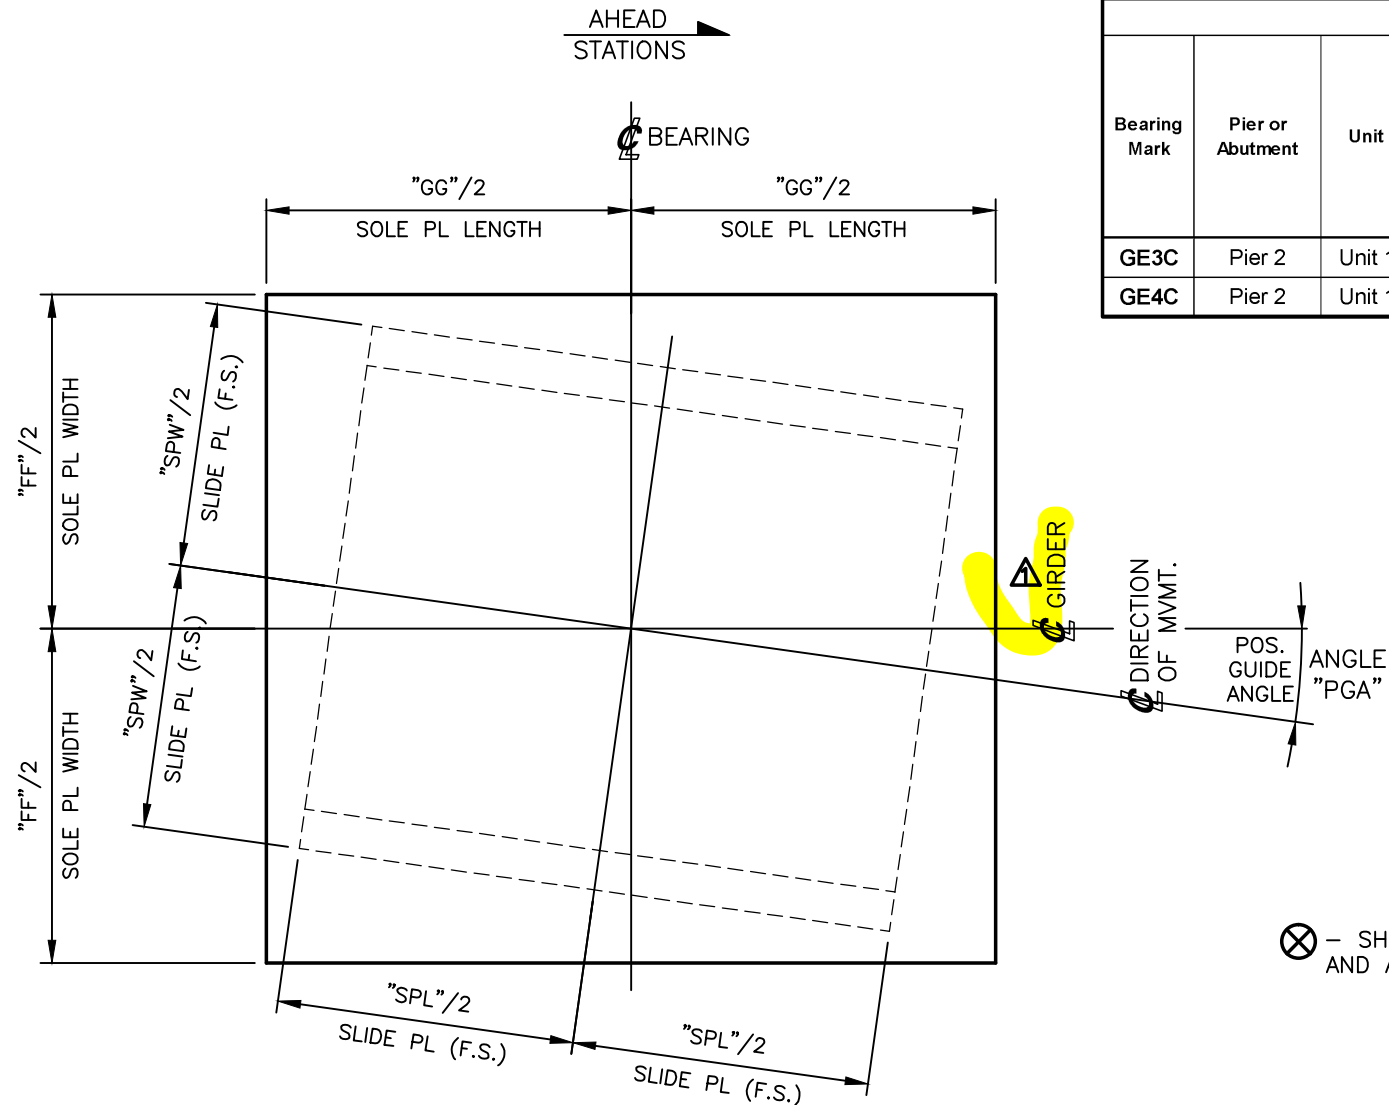

**PLAN VIEW**

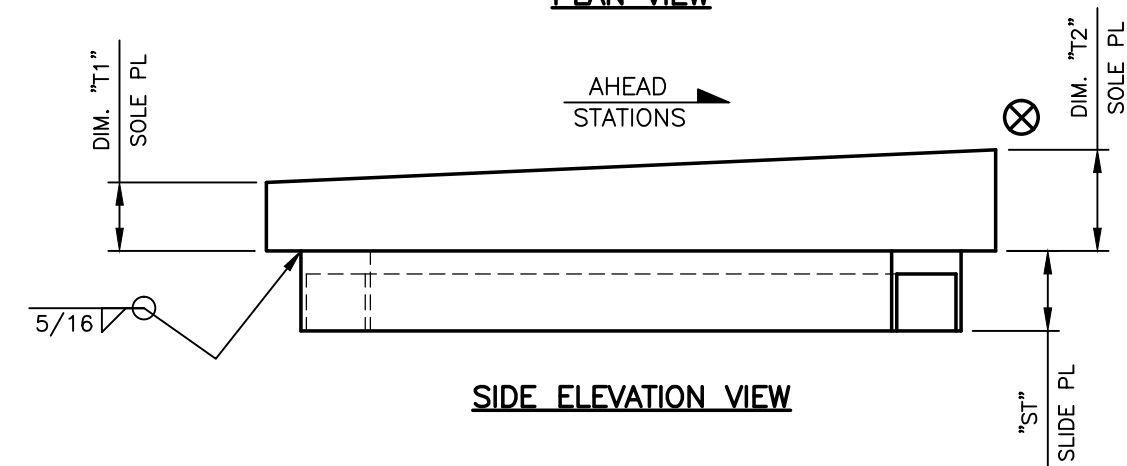

**SIDE ELEVATION VIEW**


**(2) GUIDED EXPANSION BRG. BEVELED SOLE PLATES w/"POSITIVE" GUIDE ANGLES & SLIDE PLATE WELDED**

**MKS. GE3C & GE4C**

SEE TABLE GESP2 THIS SHEET FOR MARKS, ANGLES AND DIMENSIONS

⊗ - SHOP TO MARK HIGH SIDE OF BEVELED PLATE AND AHEAD STATION ARROW AS SHOWN.

checked 2019-08-16  
 Roaring Brook Consultants, Inc.  
 Engineering A Better Future  
 15 Sewall Road, South Berwick, Maine 03908  
 Phone: (877) 722-2643 FAX: (207) 384-5383

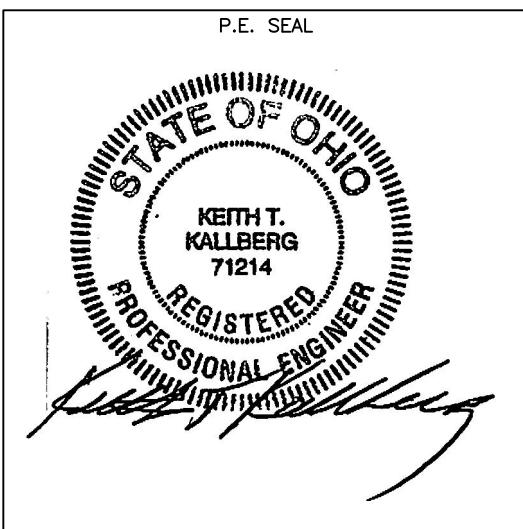

<b>PRIME AE, Group, Inc</b>		<b>RELEASED FOR FABRICATION</b>
DATE REC'D: 8/19/2019	BUILDABLE UNIT NO.: 7	
Review conforms that the shop drawings meet the intent of the contract.		<b>WALSH</b>
<input checked="" type="checkbox"/> CONFORMS AS-IS	<input type="checkbox"/> CONFORMS AS NOTED	
<input type="checkbox"/> REVISE AND RESEND		
<b>1908S - DISC BEARINGS</b>		
By: Conrad Gagnon	By:	
Date: 8/19/2019	Date:	

SEE SHEET GN1 FOR NOTES & MATERIAL SPECIFICATIONS  
 SEE SHT. 7 FOR GE BEARING ASSEMBLY DETAILS

STATE OF OHIO  
 DEPARTMENT OF TRANSPORTATION  
 BRIDGE NO.  
 HAM-74-1908S  
 RAMP P  
 HAMILTON COUNTY, OH

STATE	COUNTY	PID NO.
OH	HAMILTON	104667

FED. AID PROJ. NO.: E170 (713)

**COSMEC INC.:**  
**DISC BEARINGS ASSEMBLIES**


**Cosmec** 1501 ROCKY RIDGE ROAD  
 P.O. BOX 2159  
 ATHENS, TEXAS 75751

REMOVE APPROVER NOTES & REVISE BEVELS, HL & GUIDE ANGLES PER APPROVER.	JR	8/6/19	ELS	8/12/19	SHEET 11 OF 16	JOB NO.: 15353C
SCALE: NONE	DRAWN BY: JR	CHECKED BY: MCM	DATE: 6/25/19	DATE: 7/5/19	CUSTOMER: WALSH CONSTRUCTION	DRAWING NUMBER: 15353C-D11
REV.	DESCRIPTION	BY	DATE	CK'D	DATE	REV.


**TABLE GESP3 - Bev. Sole Plates for Guided Exp. Bearings w/"POS." Guide Angles & "NEG." Slope: Marks, Locations & Dimensions**

Bearing Description										Sole Plate w/Slide Plate Weld Attached								
Bearing Mark	Pier or Abutment	Unit	Girder	Qty.	Design Vertical Load (kips)	Design Horizontal Load (kips)	Max. Design Rotation (rads)	TOTAL Design Longit. Mvmt. (in.)	TOTAL Design Transv. Mvmt. (Double the Gap "PSS") (in.)	Dim. "FF"	Dim. "GG"	Dim. "SPCLT"	Dim. "SPW"	Dim. "SPL"	Dim. "ST"	Guide Angle "PGA"	Dim. "T1"	Dim. "T2"
										Sole PL Width (in.)	Sole PL Length (in.)	Sole PL Center-Line Thk. (in.)	Slide Plate Width (in.)	Slide Plate Length (in.)	Slide Plate Thickness (in.)	Positive Guide Angle (degrees)	Sole PL Side Thk. (in.)	Sole PL Side Thk. (in.)
GE7C	Fwd. Abut.	Unit 2	G2	1	250	63 $\Delta$	0.030	3.250	0.250	20.000	20.500	1.500	15.205	17.205	2.500	2.78	1.8125 $\Delta$	1.1875 $\Delta$
GE8C	Fwd. Abut.	Unit 2	G3	1	250	63 $\Delta$	0.030	3.250	0.250	20.000	20.500	1.500	15.205	17.205	2.500	6.04	1.8125 $\Delta$	1.1875 $\Delta$

CONTRACTOR NOTE: SOLE PLATE MAY HAVE TO BE ROTATED IN THE FIELD TO ALIGN THE SOLE PLATE WITH THE BOTTOM FLANGE OF THE GIRDER

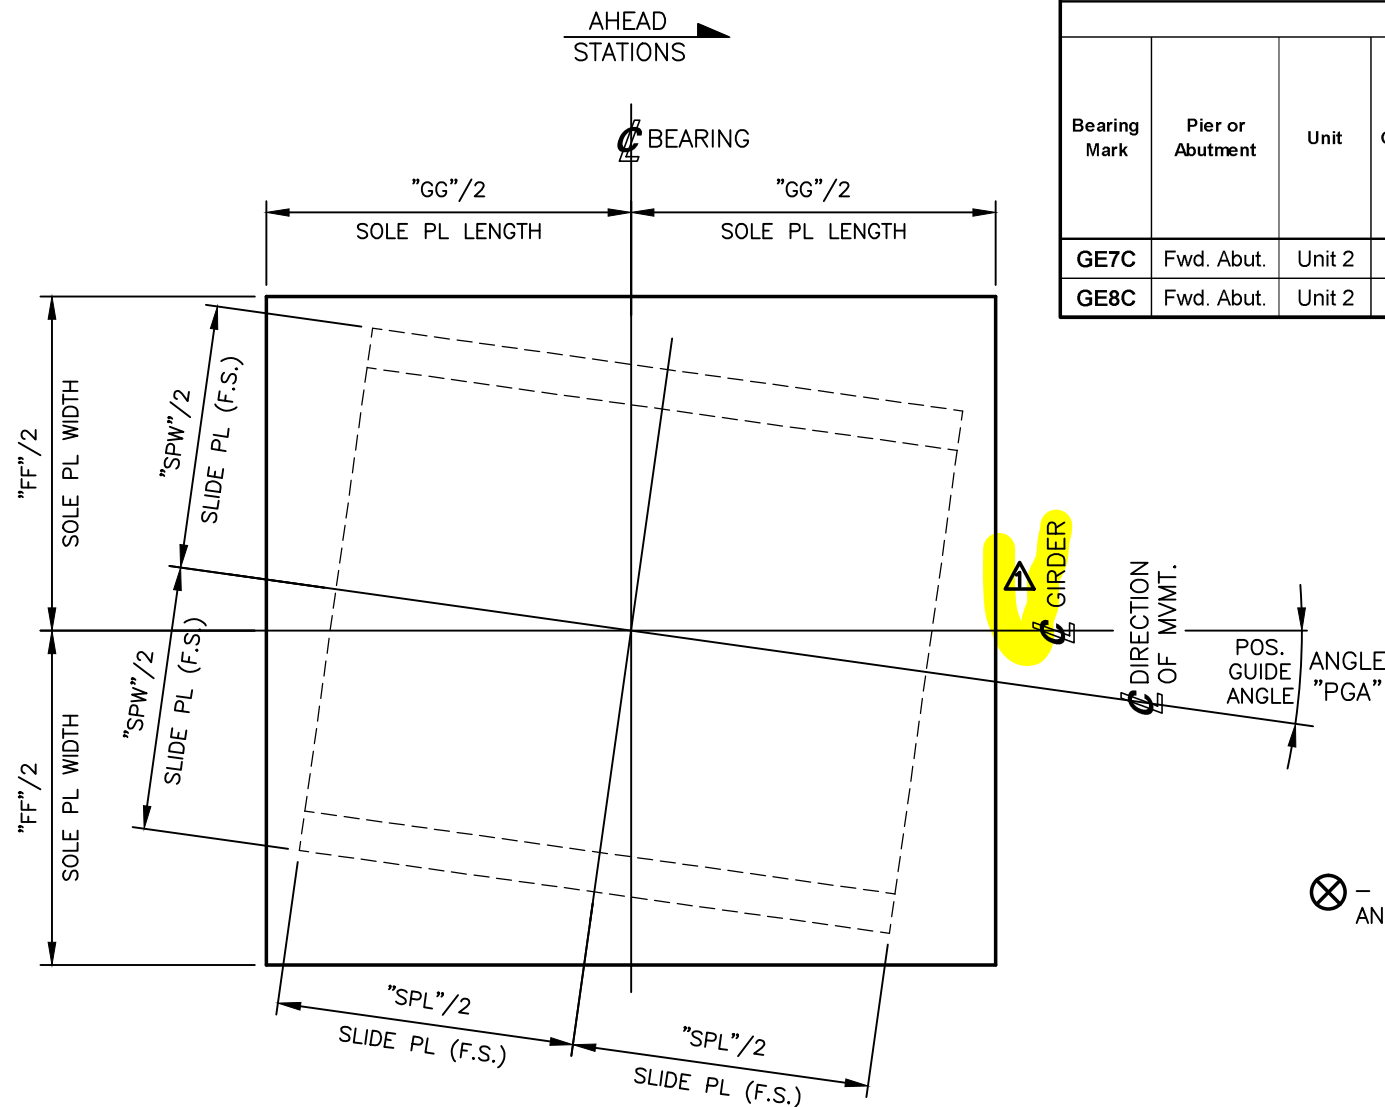

**PLAN VIEW**

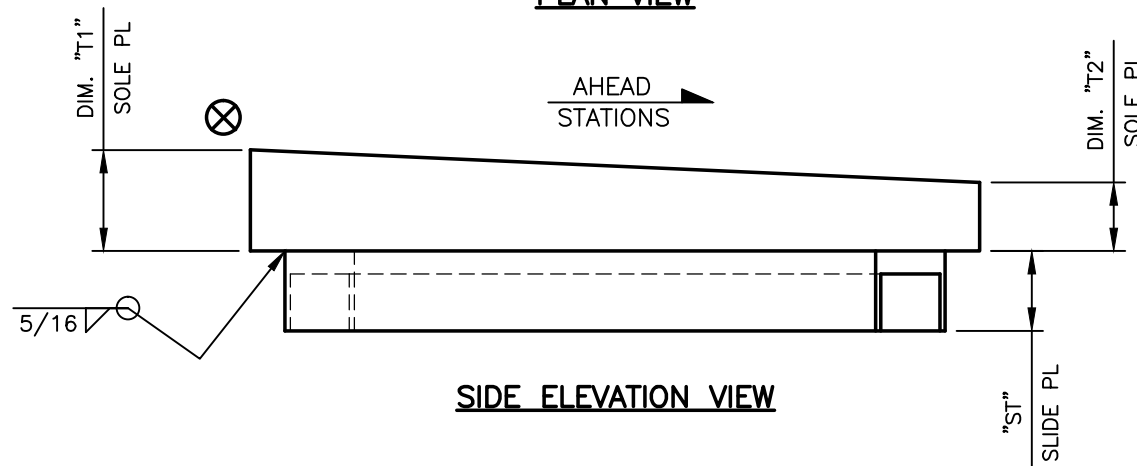

**SIDE ELEVATION VIEW**

**(2) GUIDED EXPANSION BRG. BEVELED SOLE PLATES w/"POSITIVE" GUIDE ANGLES & SLIDE PLATE WELDED**

**MKS. GE7C & GE8C**

SEE TABLE GESP3 THIS SHEET FOR MARKS, ANGLES AND DIMENSIONS


checked 2019-08-16



$\otimes$  - SHOP TO MARK HIGH SIDE OF BEVELED PLATE AND AHEAD STATION ARROW AS SHOWN.

<b>PRIME AE, Group, Inc</b>		<b>RELEASED FOR FABRICATION</b>
DATE REC'D: 8/19/2019	BUILDABLE UNIT NO.: 7	
Review conforms that the shop drawings meet the intent of the contract.		<b>WALSH</b>
<input checked="" type="checkbox"/> CONFORMS AS-IS	<input type="checkbox"/> CONFORMS AS NOTED	
<input type="checkbox"/> REVISE AND RESEND		
1908S - DISC BEARINGS		
By: Conrad Gagnon	By:	
Date: 8/19/2019	Date:	

SEE SHEET GN1 FOR NOTES & MATERIAL SPECIFICATIONS  
SEE SHT. 7 FOR GE BEARING ASSEMBLY DETAILS

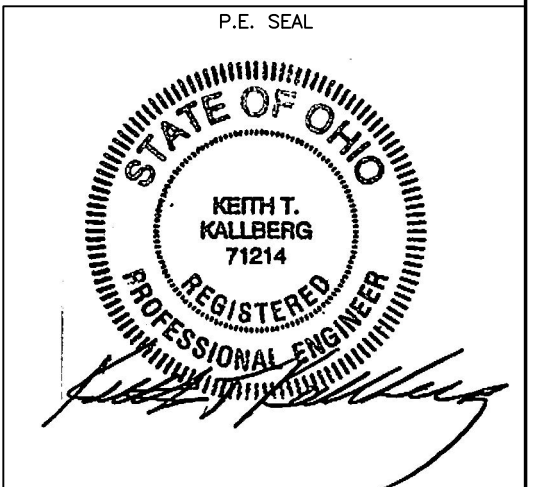

STATE OF OHIO  
DEPARTMENT OF TRANSPORTATION  
BRIDGE NO.  
HAM-74-1908S  
RAMP P  
HAMILTON COUNTY, OH

STATE	COUNTY	PID NO.
OH	HAMILTON	104667

FED. AID PROJ. NO.: E170 (713)  
**COSMEC INC.: DISC BEARINGS ASSEMBLIES**

**Cosmec** 1501 ROCKY RIDGE ROAD  
P.O. BOX 2159  
ATHENS, TEXAS 75751


SCALE: NONE	DRAWN BY: JR	CHECKED BY: MCM
	DATE: 6/25/19	DATE: 7/5/19

SHEET 12 OF 16 **JOB NO.: 15353C**

$\Delta$	REMOVE APPROVER NOTES & REVISE BEVELS & HL PER APPROVER.	JR	8/6/19	ELS	8/12/19	CUSTOMER: WALSH CONSTRUCTION	DRAWING NUMBER: 15353C-D12	REV. 1
----------	--	----	--------	-----	---------	------------------------------	----------------------------	--------

**TABLE MP2 - Masonry Plates for Guided Expansion Bearings: Marks, Locations & Dimensions**

Bearing Mark	Pier or Abutment	Unit	Girder	Qty.	Bearing Description					Masonry Plate							
					Design Vertical Load (kips)	Design Horizontal Load (kips)	Max. Design Rotation (rads)	TOTAL Design Longit. Mvmnt. (in.)	TOTAL Design Transv. Mvmnt. (Double the Gap "PSS") (in.)	Dim. "AA"	Dim. "AA1"	Dim. "BB"	Dim. "CC"	Dim. "TT"	Dim. "WW"	Dim. "MPRD"	Dim. "RD"
										Mas. PL Thk. (in.)	Total Mas. PL Thk. (Incl. Recess) (in.)	Mas. PL Width (in.)	Mas. PL Length (in.)	Mas. PL Anchor Bolt Hole Location (in.)	Mas. PL Anchor Bolt Hole Location (in.)	Mas. PL Recess Depth (in.)	Mas. PL Recess Dia. (in.)
GE1C	Exist. Pier 7	Unit 1	G2	1	150	38	0.030	1.380	0.250	1.000	1.250	18.000	18.000	7.250	7.250	0.250	9.055
GE2C	Exist. Pier 7	Unit 1	G3	1	150	38	0.030	1.380	0.250	1.000	1.250	18.000	18.000	7.250	7.250	0.250	9.055
GE3C	Pier 2	Unit 1	G2	1	150	38	0.030	1.380	0.250	1.000	1.250	18.000	18.000	7.250	7.250	0.250	9.055
GE4C	Pier 2	Unit 1	G3	1	150	38	0.030	1.380	0.250	1.000	1.250	18.000	18.000	7.250	7.250	0.250	9.055
GE5C	Pier 2	Unit 2	G2	1	390	98	0.030	3.750	0.500	1.350	1.750	20.000	20.000	8.250	8.250	0.400	12.155
GE6C	Pier 2	Unit 2	G3	1	390	98	0.030	3.750	0.500	1.350	1.750	20.000	20.000	8.250	8.250	0.400	12.155
GE7C	Fwd. Abut.	Unit 2	G2	1	250	63	0.030	3.250	0.250	1.200	1.500	19.000	19.000	7.750	7.750	0.300	10.955
GE8C	Fwd. Abut.	Unit 2	G3	1	250	63	0.030	3.250	0.250	1.200	1.500	19.000	19.000	7.750	7.750	0.300	10.955

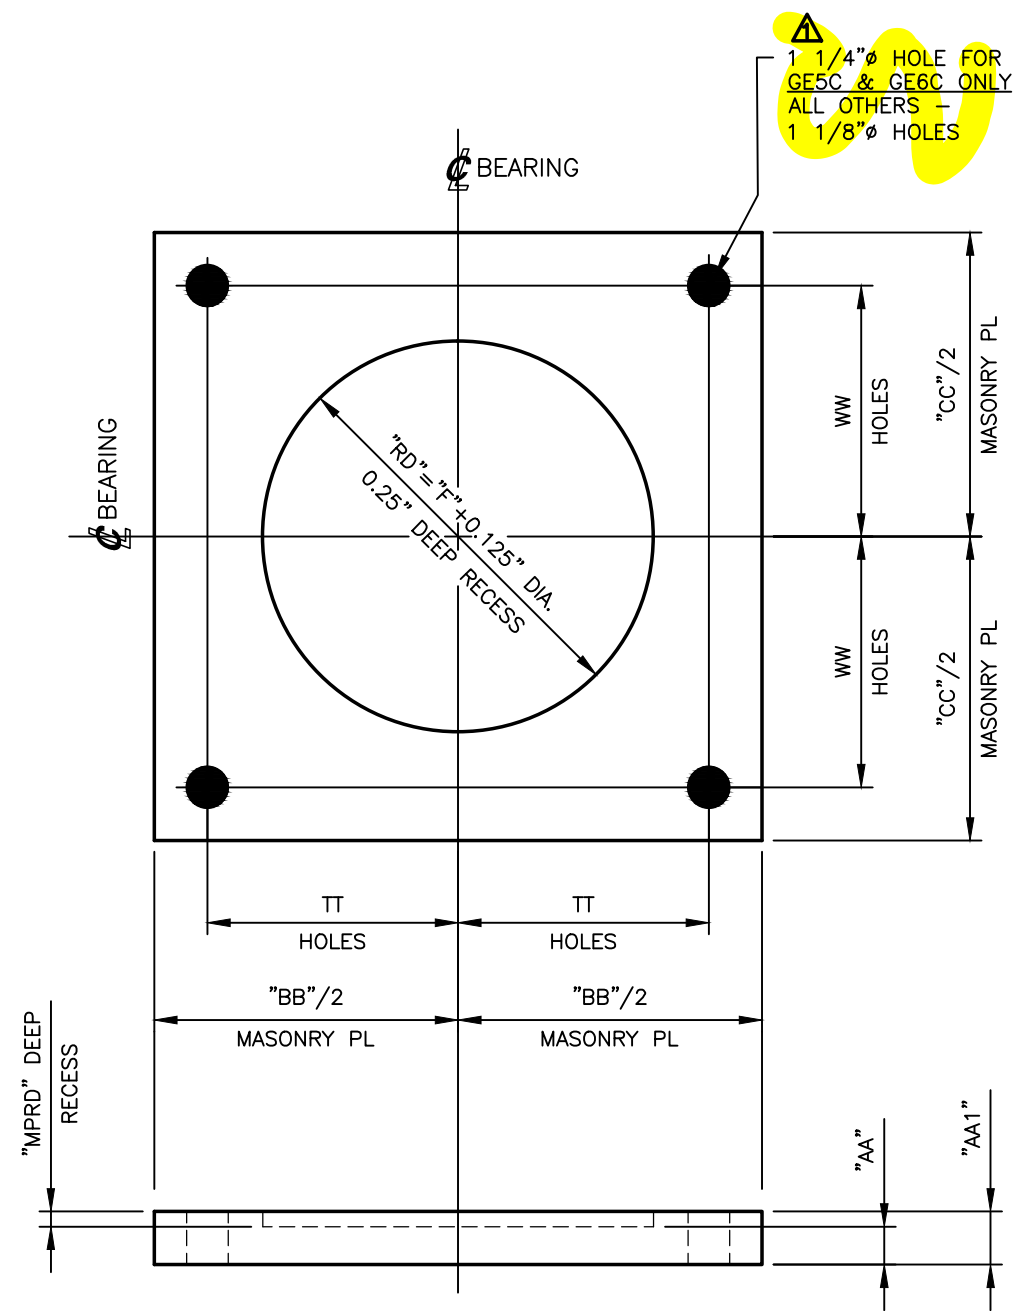

**(8) GUIDED EXP. (GE) BEARING MASONRY PLATES**  
 PL "AA1" x "BB" x "CC"  
 SEE TABLE MP2 ON THIS SHEET FOR MARKS, LOCATIONS, AND DIMENSIONS

**PRIME AE, Group, Inc**  
 DATE REC'D: 8/19/2019 BUILDABLE UNIT NO.: 7  
 Review conforms that the shop drawings meet the intent of the contract.

CONFORMS AS-IS     CONFORMS AS NOTED  
 REVISE AND RESEND


**1908S - DISC BEARINGS**

By: Conrad Gagnon    Date: 8/19/2019

**RELEASED FOR FABRICATION**

**WALSH**

checked 2019-08-16  
**Roaring Brook Consultants, Inc.**  
 Engineering & Better Future  
 15 Sewall Road, South Berwick, Maine 03908  
 Phone: (877) 722-2643 FAX: (207) 384-5383

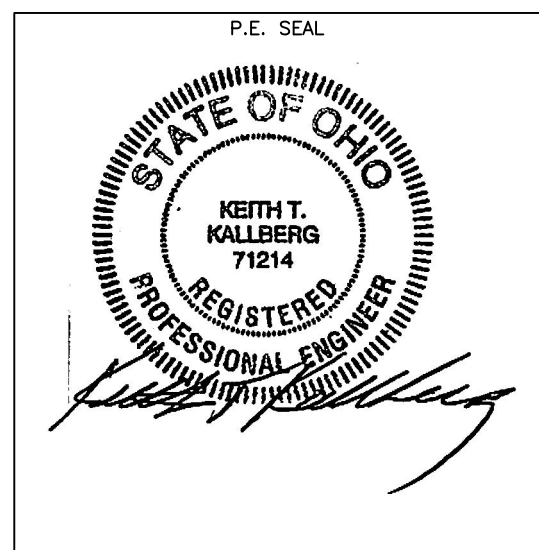

SEE SHEET GN1 FOR NOTES & MATERIAL SPECIFICATIONS  
 SEE SHEET 7 FOR GE DISC BEARING ASSEMBLY DETAILS

STATE OF OHIO  
 DEPARTMENT OF TRANSPORTATION  
 BRIDGE NO. HAM-74-1908S  
 RAMP P  
 HAMILTON COUNTY, OH

STATE	COUNTY	PID NO.
OH	HAMILTON	104667
FED. AID PROJ. NO.: E170 (713)		

**COSMEC INC.:**  
**DISC BEARINGS ASSEMBLIES**

**Cosmec** 1501 ROCKY RIDGE ROAD  
 P.O. BOX 2159  
 ATHENS, TEXAS 75751

SCALE: NONE	DRAWN BY: JR	CHECKED BY: MCM
	DATE: 6/25/19	DATE: 7/5/19

REVISE TABLE & ANC. BOLT HOLES; REMOVE APPR./CONTR. NOTE ALL PER APPROVER.	JR	8/7/19	ELS	8/12/19	SHEET 13 OF 16	JOB NO.: 15353C
CUSTOMER: WALSH CONSTRUCTION	DRAWING NUMBER: 15353C-D13	REV. 1				



**TABLE GE1A - Internal Components of Guided Exp. Bearings: Brg. Marks, Locations & Dimensions**

Bearing Description										Urethane Disc				Bottom Bearing Plate					Shear Pin						Top Slide Plate							
Bearing Mark	Pier or Abutment	Unit	Girder	Qty.	Design Vertical Load (kips)	Design Horizontal Load (kips)	Max. Design Rotation (rads)	TOTAL Design Longit. Mvmnt. (in.)	TOTAL Design Transv. Mvmnt. (Double the Gap "PSS") (in.)	Dim. "A"	Dim. "B"	Dim. "C"	Dim. "D"	Dim. "E"	Dim. "F"	Dim. "G"	Dim. "H"	Dim. "J"	Dim. "M"	Dim. "P"	Dim. "R"	Dim. "S"	Dim. "T"	Dim. "PJ"	Dim. "SPW"	Dim. "SPL"	Dim. "ST"	Dim. "CD"	Dim. "CW"	Dim. "SSL"	Dim. "SSW1"	Dim. "SSW2"
										Disc Hole Dia. (in.)	Eff. Disc Dia. (in.)	Disc Thk. (in.)	Disc O.D. (in.)	Bottom Brg. PL Hole Dia. (in.)	Bottom Brg. PL O.D. (in.)	Bottom Brg. PL Recess Dia. (in.)	Total Bot. Brg. PL Thk. (in.)	Bottom Brg. PL Recess Depth (in.)	Proj. of Pin (in.)	Shear Pin Dia. (in.)	Shear Pin Length (in.)	Pin Intrusion Into Bottom Brg. PL (in.)	Pin Taper Length (in.)	Pin Intrusion Into Top PL. (in.)	Slide PL Width (in.)	Slide PL Length (in.)	Slide PL Thk. (in.)	Depth of Channel (in.)	Width of Channel (in.)	Stainless Length (All) (in.)	Side Stainless Width (in.)	Top Stainless Width (in.)
GE1C	Exist. Pier 7	Unit 1	G2	1	150	38	0.030	1.380	0.250	2.563	6.720	1.000	7.230	1.750	8.930	7.930	1.969	0.219	2.000	2.500	3.250	1.250	0.875	1.000	13.305	13.435	2.375	1.625	10.680	13.060	1.313	8.125
GE2C	Exist. Pier 7	Unit 1	G3	1	150	38	0.030	1.380	0.250	2.563	6.720	1.000	7.230	1.750	8.930	7.930	1.969	0.219	2.000	2.500	3.250	1.250	0.875	1.000	13.305	13.435	2.375	1.625	10.680	13.060	1.313	8.125
GE3C	Pier 2	Unit 1	G2	1	150	38	0.030	1.380	0.250	2.563	6.720	1.000	7.230	1.750	8.930	7.930	1.969	0.219	2.000	2.500	3.250	1.250	0.875	1.000	13.305	13.435	2.375	1.625	10.680	13.060	1.313	8.125
GE4C	Pier 2	Unit 1	G3	1	150	38	0.030	1.380	0.250	2.563	6.720	1.000	7.230	1.750	8.930	7.930	1.969	0.219	2.000	2.500	3.250	1.250	0.875	1.000	13.305	13.435	2.375	1.625	10.680	13.060	1.313	8.125
GE5C	Pier 2	Unit 2	G2	1	390	98	0.030	3.750	0.500	3.663	10.680	1.250	11.330	2.850	13.030	12.030	2.342	0.342	2.375	3.600	3.875	1.500	1.000	1.125	17.655	19.905	3.125	2.375	15.030	19.530	2.063	12.625
GE6C	Pier 2	Unit 2	G3	1	390	98	0.030	3.750	0.500	3.663	10.680	1.250	11.330	2.850	13.030	12.030	2.342	0.342	2.375	3.600	3.875	1.500	1.000	1.125	17.655	19.905	3.125	2.375	15.030	19.530	2.063	12.625
GE7C	Fwd. Abut.	Unit 2	G2	1	250	63	0.030	3.250	0.250	3.063	8.620	1.000	9.130	2.250	10.830	9.830	2.026	0.276	2.000	3.000	3.250	1.250	0.875	1.000	15.205	17.205	2.625	1.875	12.580	16.830	1.563	10.375
GE8C	Fwd. Abut.	Unit 2	G3	1	250	63	0.030	3.250	0.250	3.063	8.620	1.000	9.130	2.250	10.830	9.830	2.026	0.276	2.000	3.000	3.250	1.250	0.875	1.000	15.205	17.205	2.625	1.875	12.580	16.830	1.563	10.375

**TABLE GE1B - Internal Components of Guided Exp. Bearings: Brg. Marks, Locations & Dimensions**


Bearing Description										Guide Plate/Top Bearing Plate										Height	
Bearing Mark	Pier or Abutment	Unit	Girder	Qty.	Design Vertical Load (kips)	Design Horizontal Load (kips)	Max. Design Rotation (rads)	TOTAL Design Longit. Mvmnt. (in.)	TOTAL Design Transv. Mvmnt. (Double the Gap "PSS") (in.)	Dim. "PSS"	Dim. "GPW"	Dim. "GPL"	Dim. "GPT"	Dim. "PD"	Dim. "PL"	Dim. "PW"	Dim. "HD"	Dim. "G"	Dim. "J"	Dim. "EH"	Dim. "TH"
										Gap between SS & PTFE on Guides (in.)	Guide PL Width (in.)	Guide PL Length (in.)	Guide PL Thk. (in.)	Top PTFE Dia. (in.)	Side PTFE Length (in.)	Side PTFE Width (in.)	Depth of Blind Hole (in.)	Top Brg. PL Recess Dia. (in.)	Top Brg. PL Recess Depth (in.)	Total Brg. Height (excl. Brg. Pad) (in.)	Total Brg. Height (in.)
GE1C	Exist. Pier 7	Unit 1	G2	1	150	38	0.030	1.380	0.250	0.125	9.930	9.930	2.250	7.500	9.680	1.000	1.500	7.930	0.219	8.281	8.531
GE2C	Exist. Pier 7	Unit 1	G3	1	150	38	0.030	1.380	0.250	0.125	9.930	9.930	2.250	7.500	9.680	1.000	1.500	7.930	0.219	8.281	8.531
GE3C	Pier 2	Unit 1	G2	1	150	38	0.030	1.380	0.250	0.125	9.930	9.930	2.250	7.500	9.680	1.000	1.500	7.930	0.219	8.281	8.531
GE4C	Pier 2	Unit 1	G3	1	150	38	0.030	1.380	0.250	0.125	9.930	9.930	2.250	7.500	9.680	1.000	1.500	7.930	0.219	8.281	8.531
GE5C	Pier 2	Unit 2	G2	1	390	98	0.030	3.750	0.500	0.250	14.030	14.030	2.492	12.000	13.780	1.750	1.650	12.030	0.342	9.250	9.500
GE6C	Pier 2	Unit 2	G3	1	390	98	0.030	3.750	0.500	0.250	14.030	14.030	2.492	12.000	13.780	1.750	1.650	12.030	0.342	9.250	9.500
GE7C	Fwd. Abut.	Unit 2	G2	1	250	63	0.030	3.250	0.250	0.125	11.830	11.830	2.276	9.750	11.580	1.250	1.500	9.830	0.276	8.450	8.700
GE8C	Fwd. Abut.	Unit 2	G3	1	250	63	0.030	3.250	0.250	0.125	11.830	11.830	2.276	9.750	11.580	1.250	1.500	9.830	0.276	8.450	8.700

<b>PRIME AE, Group, Inc</b>		<b>RELEASED FOR FABRICATION</b>	
DATE REC'D: 8/19/2019	BUILDABLE UNIT NO.: 7		
Review conforms that the shop drawings meet the intent of the contract.			
<input checked="" type="checkbox"/> CONFORMS AS-IS		<input type="checkbox"/> CONFORMS AS NOTED	
		<input type="checkbox"/> REVISE AND RESEND	
<b>1908S - DISC BEARINGS</b>			
By: Conrad Gagnon		By:	
Date: 8/19/2019		Date:	

SEE SHEET GN1 FOR NOTES & MATERIAL SPECIFICATIONS  
SEE SHEET 7 FOR GE DISC BEARING ASSEMBLY DETAILS


checked 2019-08-16

**Roaring Brook Consultants, Inc.**  
Engineering & Better Future  
15 Sewall Road, South Berwick, Maine 03908  
Phone: (877) 722-2643 FAX: (207) 384-5383

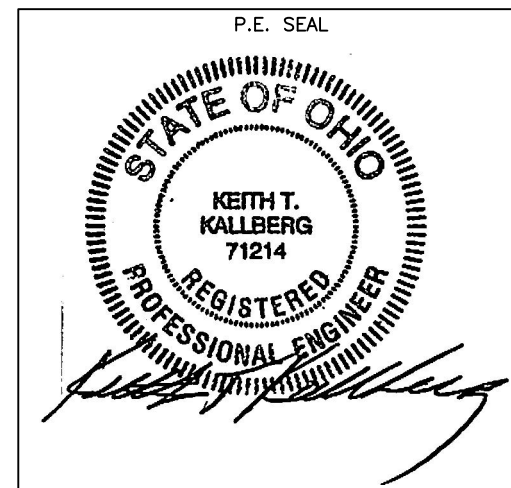

STATE OF OHIO DEPARTMENT OF TRANSPORTATION		
BRIDGE NO. HAM-74-1908 RAMP P		
HAMILTON COUNTY, OH		
STATE	COUNTY	PID NO.
OH	HAMILTON	104667
FED. AID PROJ. NO.: E170 (713)		
<b>COSMEC INC.:</b> <b>DISC BEARINGS ASSEMBLIES</b>		
<b>Cosmec</b> 1501 ROCKY RIDGE ROAD P.O. BOX 2159 ATHENS, TEXAS 75751		
SCALE: NONE	DRAWN BY: JR DATE: 6/26/19	CHECKED BY: MCM DATE: 7/5/19
SHEET 14 OF 16		<b>JOB NO.: 15353C</b>
REV.	DESCRIPTION	BY DATE CK'D DATE
CUSTOMER: WALSH CONSTRUCTION		DRAWING NUMBER: 15353C-D14 REV. 1

<b>REVISED TABLES PER RE-DESIGN AS PER APPROVER.</b>	JR	8/7/19	ELS	8/12/19
--	----	--------	-----	---------

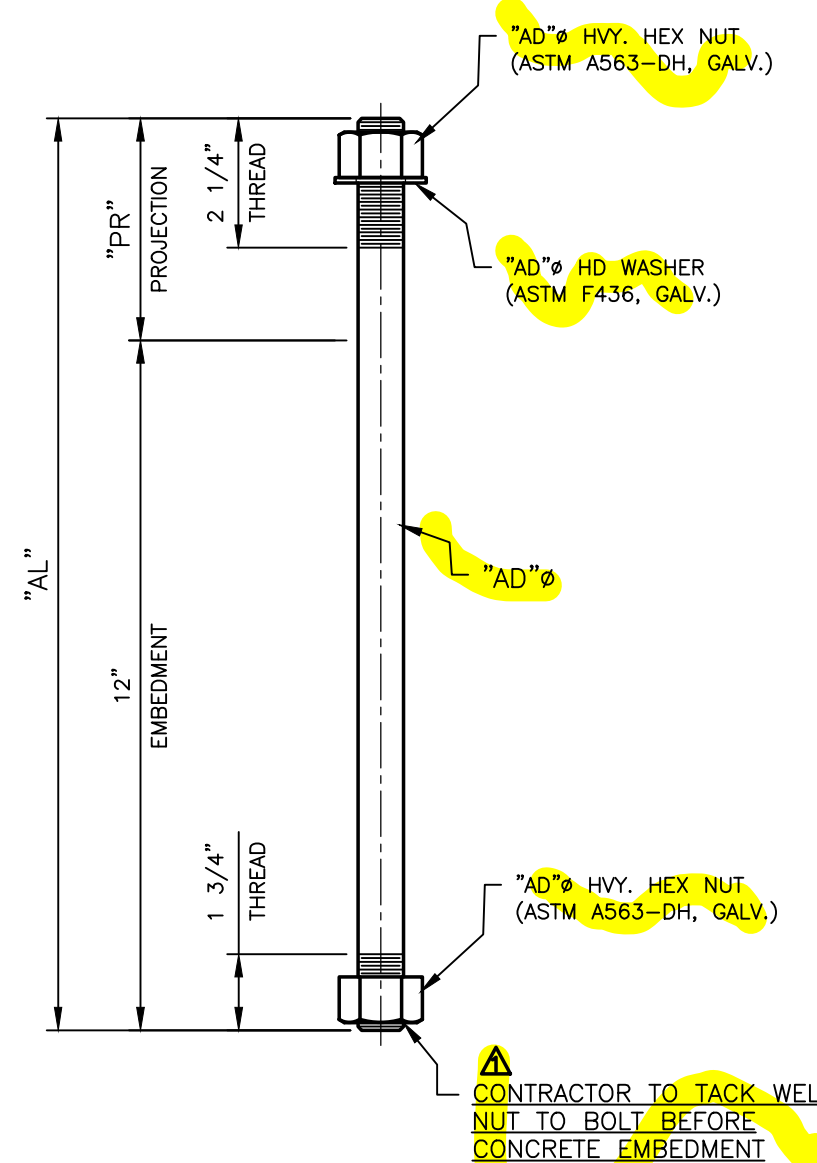

**⚠ (64) ANCHOR BOLTS, MKS. AB1-C; AB2-C & AB3-C**

ANCHOR BOLT "AD" DIA. x "AL" LONG  
 ASTM F1554 GRADE 55, GALV.  
 SEE ANCHOR BOLT TABLE (THIS SHT.) FOR  
 MARKS, DIMENSIONS AND LOCATIONS

**⚠ ANCHOR BOLT TABLE FOR SIZES AND LOCATIONS**

Bearing Mark	Pier or Abutment	Unit	Girder	Bearing Design Vertical Load (kips)	Qty.	Anchor Bolt Mark	Anchor Bolt Dia. "AD" (in.)	* Anchor Bolt Projection Req'd "PR" (in.)	Anchor Bolt TOTAL Length "AL" (in.)
NGE1C	Exist. Pier 7	Unit 1	G1	150	4	AB1-C	1.000	3.000	15.000
GE1C	Exist. Pier 7	Unit 1	G2	150	4	AB1-C	1.000	3.000	15.000
GE2C	Exist. Pier 7	Unit 1	G3	150	4	AB1-C	1.000	3.000	15.000
NGE2C	Exist. Pier 7	Unit 1	G4	150	4	AB1-C	1.000	3.000	15.000
NGE3C	Pier 2	Unit 1	G1	150	4	AB1-C	1.000	3.000	15.000
GE3C	Pier 2	Unit 1	G2	150	4	AB1-C	1.000	3.000	15.000
GE4C	Pier 2	Unit 1	G3	150	4	AB1-C	1.000	3.000	15.000
NGE4C	Pier 2	Unit 1	G4	150	4	AB1-C	1.000	3.000	15.000
NGE5C	Pier 2	Unit 2	G1	390	4	AB1-C	1.000	3.000	15.000
GE5C	Pier 2	Unit 2	G2	390	4	AB2-C	1.125	3.625	15.625
GE6C	Pier 2	Unit 2	G3	390	4	AB2-C	1.125	3.625	15.625
NGE6C	Pier 2	Unit 2	G4	390	4	AB1-C	1.000	3.000	15.000
NGE7C	Fwd. Abut.	Unit 2	G1	250	4	AB1-C	1.000	3.000	15.000
GE7C	Fwd. Abut.	Unit 2	G2	250	4	AB3-C	1.000	3.250	15.250
GE8C	Fwd. Abut.	Unit 2	G3	250	4	AB3-C	1.000	3.250	15.250
NGE8C	Fwd. Abut.	Unit 2	G4	250	4	AB1-C	1.000	3.000	15.000


\* = CONTRACTOR MUST EXERCISE CAUTION TO KEEP THE ANCHOR BOLT PROJECTIONS AS SHOWN. HIGHER PROJECTIONS COULD INTERFERE WITH BEARING COMPONENTS.

**CONTRACTOR NOTE:**  
 THE PROJECTION DIMENSIONS SHOWN FOR THE ANCHOR BOLTS MUST BE MAINTAINED IN THE FIELD WHEN CASTING IN THE BOLTS. THIS IS NEEDED TO INSURE THAT THE ANCHOR BOLT PROJECTIONS WILL NOT INTERFERE WITH ANY UPPER BEARING COMPONENTS.

<b>PRIME AE, Group, Inc</b>		<b>RELEASED FOR FABRICATION</b>
DATE REC'D: 8/19/2019	BUILDABLE UNIT NO.: 7	
Review conforms that the shop drawings meet the intent of the contract.		<b>WALSH</b>
<input checked="" type="checkbox"/> CONFORMS AS-IS	<input type="checkbox"/> CONFORMS AS NOTED	
<input type="checkbox"/> REVISE AND RESEND		
<b>1908S - DISC BEARINGS</b>		
By: Conrad Gagnon	By:	
Date: 8/19/2019	Date:	

SEE SHEET GN1 FOR NOTES & MATERIAL SPECIFICATIONS

checked 2019-08-16

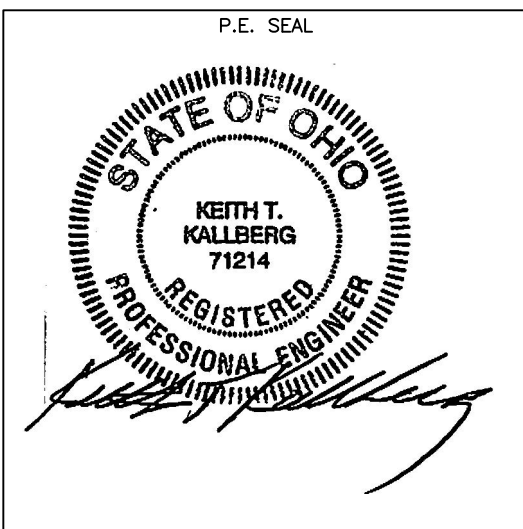

STATE OF OHIO  
 DEPARTMENT OF TRANSPORTATION  
 BRIDGE NO.  
 HAM-74-1908S  
 RAMP P  
 HAMILTON COUNTY, OH


STATE	COUNTY	PID NO.
OH	HAMILTON	104667
FED. AID PROJ. NO.: E170 (713)		

**COSMEC INC.:**  
**DISC BEARINGS ASSEMBLIES**

**Cosmec** 1501 ROCKY RIDGE ROAD  
 P.O. BOX 2159  
 ATHENS, TEXAS 75751

SCALE: NONE	DRAWN BY: JR	CHECKED BY: MCM
	DATE: 6/26/19	DATE: 7/5/19

<b>⚠</b> GENERAL REVISIONS TO ANC. BOLTS AS PER APPROVER.	JR	8/8/19	ELS	8/12/19	SHEET 15 OF 16	<b>JOB NO.: 15353C</b>
REV.	DESCRIPTION	BY	DATE	CK'D	DATE	CUSTOMER: WALSH CONSTRUCTION
						DRAWING NUMBER: 15353C-D15
						REV. 1

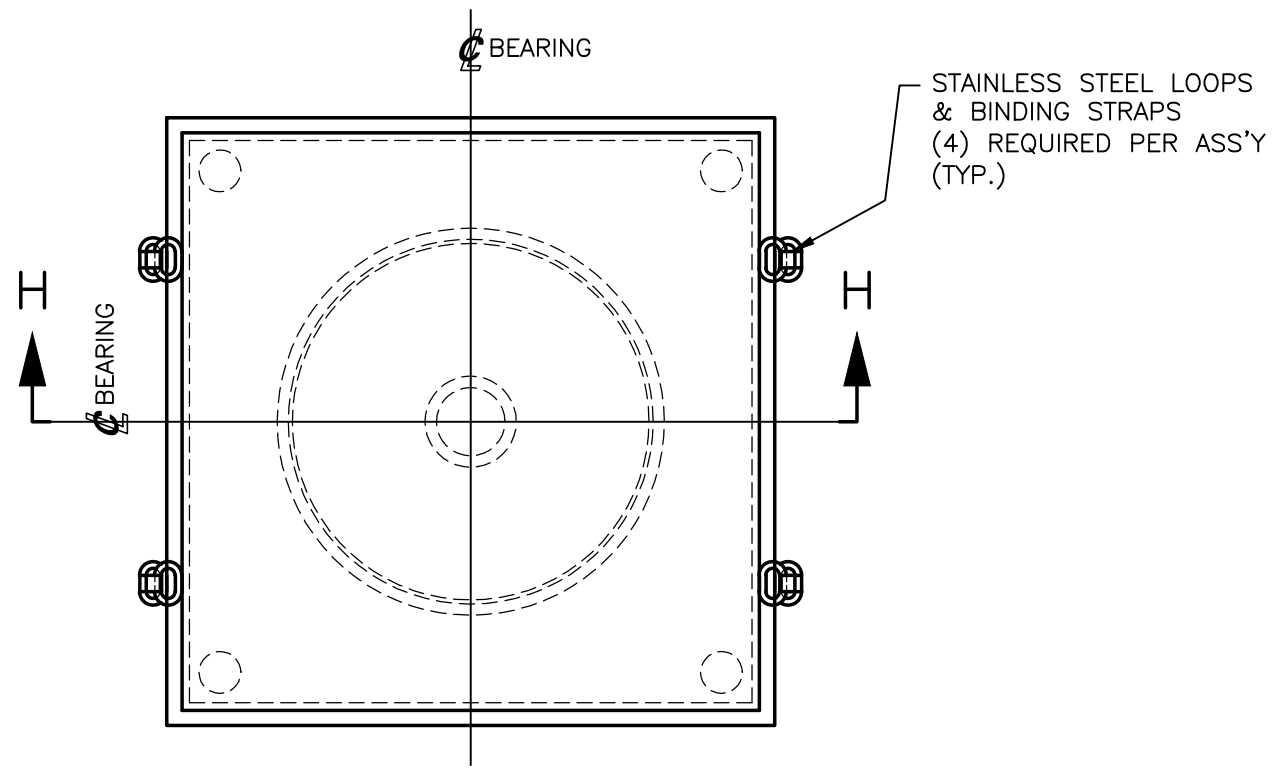


**PLAN VIEW**

**STAINLESS STEEL LOOPS AND BINDING STRAPS TO AID IN SHIPPING AND HANDLING OF BEARING ASSEMBLIES**

NON-GUIDED EXP. BEARING ASSEMBLY SHOWN  
 GUIDED EXPANSION BEARING ASSEMBLIES SIMILAR  
 LOOPS TO BE COATED THE SAME AS THE BEARING.

**CONTRACTOR NOTE:**


STAINLESS STEEL LOOPS TO REMAIN A PERMANENT PART OF THE BEARING ASSEMBLY – BINDING STRAPS TO BE REMOVED BY CONTRACTOR WHEN BEARING IS SET IN PERMANENT POSITION. THE CONTRACTOR IS TO TURN THE TOP OF THE BEARING ASSEMBLY TO BRING THE SOLE PLATE PARALLEL WITH THE GIRDER BOTTOM FLANGE DURING ERECTION.

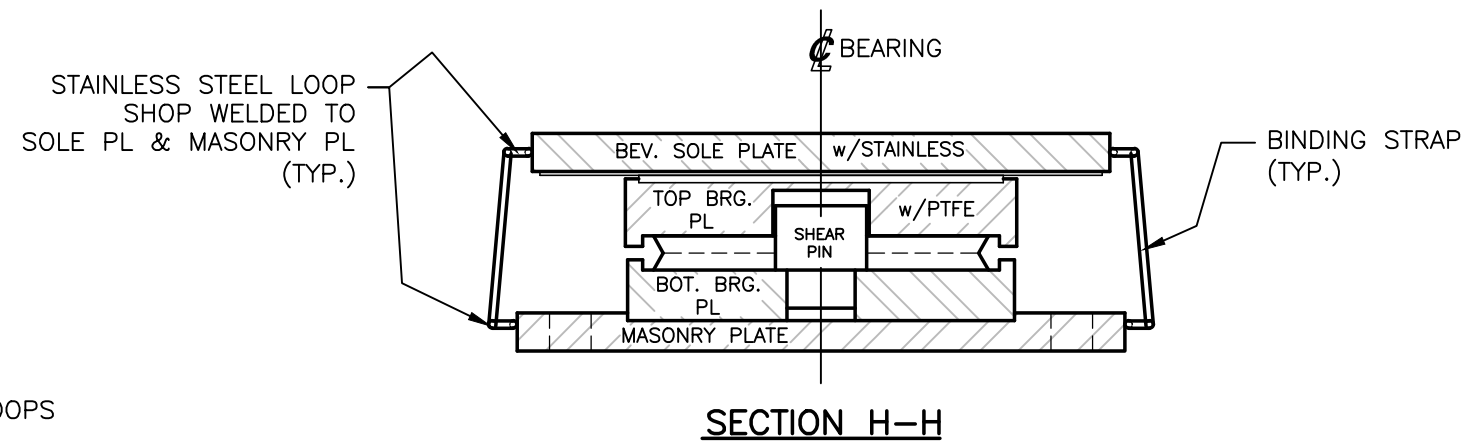


**SECTION H-H**

<b>PRIME AE, Group, Inc</b>		<b>RELEASED FOR FABRICATION</b>
DATE REC'D: <b>8/19/2019</b>	BUILDABLE UNIT NO.: <b>7</b>	
Review conforms that the shop drawings meet the intent of the contract.		<b>WALSH</b>
<input checked="" type="checkbox"/> CONFORMS AS-IS	<input type="checkbox"/> CONFORMS AS NOTED	
<input type="checkbox"/> REVISE AND RESEND		
<b>1908S - DISC BEARINGS</b>		
By: <b>Conrad Gagnon</b>	By:	
Date: <b>8/19/2019</b>	Date:	

SEE SHEET GN1 FOR NOTES & MATERIAL SPECIFICATIONS

checked 2019-08-16  
 **Roaring Brook Consultants, Inc.**  
 Engineering & Better Future  
 15 Sewall Road, South Berwick, Maine 03908  
 Phone: (877) 722-2643 FAX: (207) 384-5383

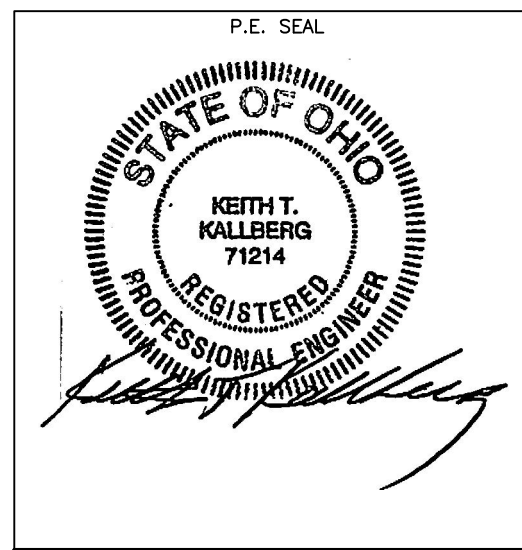

STATE OF OHIO  
 DEPARTMENT OF TRANSPORTATION

**BRIDGE NO.  
 HAM-74-1908S  
 RAMP P**

**HAMILTON COUNTY, OH**

STATE	COUNTY	PID NO.
OH	HAMILTON	104667



FED. AID PROJ. NO.: E170 (713)

**COSMEC INC.:  
 DISC BEARINGS ASSEMBLIES**







**Cosmec** 1501 ROCKY RIDGE ROAD  
 P.O. BOX 2159  
 ATHENS, TEXAS 75751

SCALE: NONE	DRAWN BY: JR	CHECKED BY: MCM
	DATE: 6/27/19	DATE: 7/5/19

△						SHEET 16 OF 16	<b>JOB NO.: 15353C</b>
REV.	DESCRIPTION	BY	DATE	CK'D	DATE	CUSTOMER: WALSH CONSTRUCTION	DRAWING NUMBER 15353C-D16 REV. 0

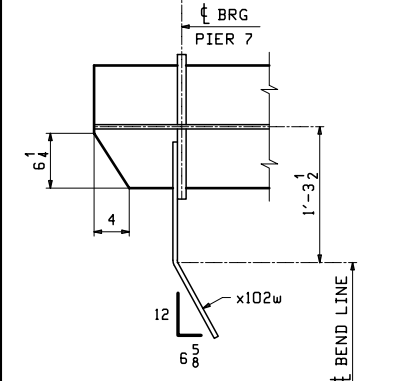
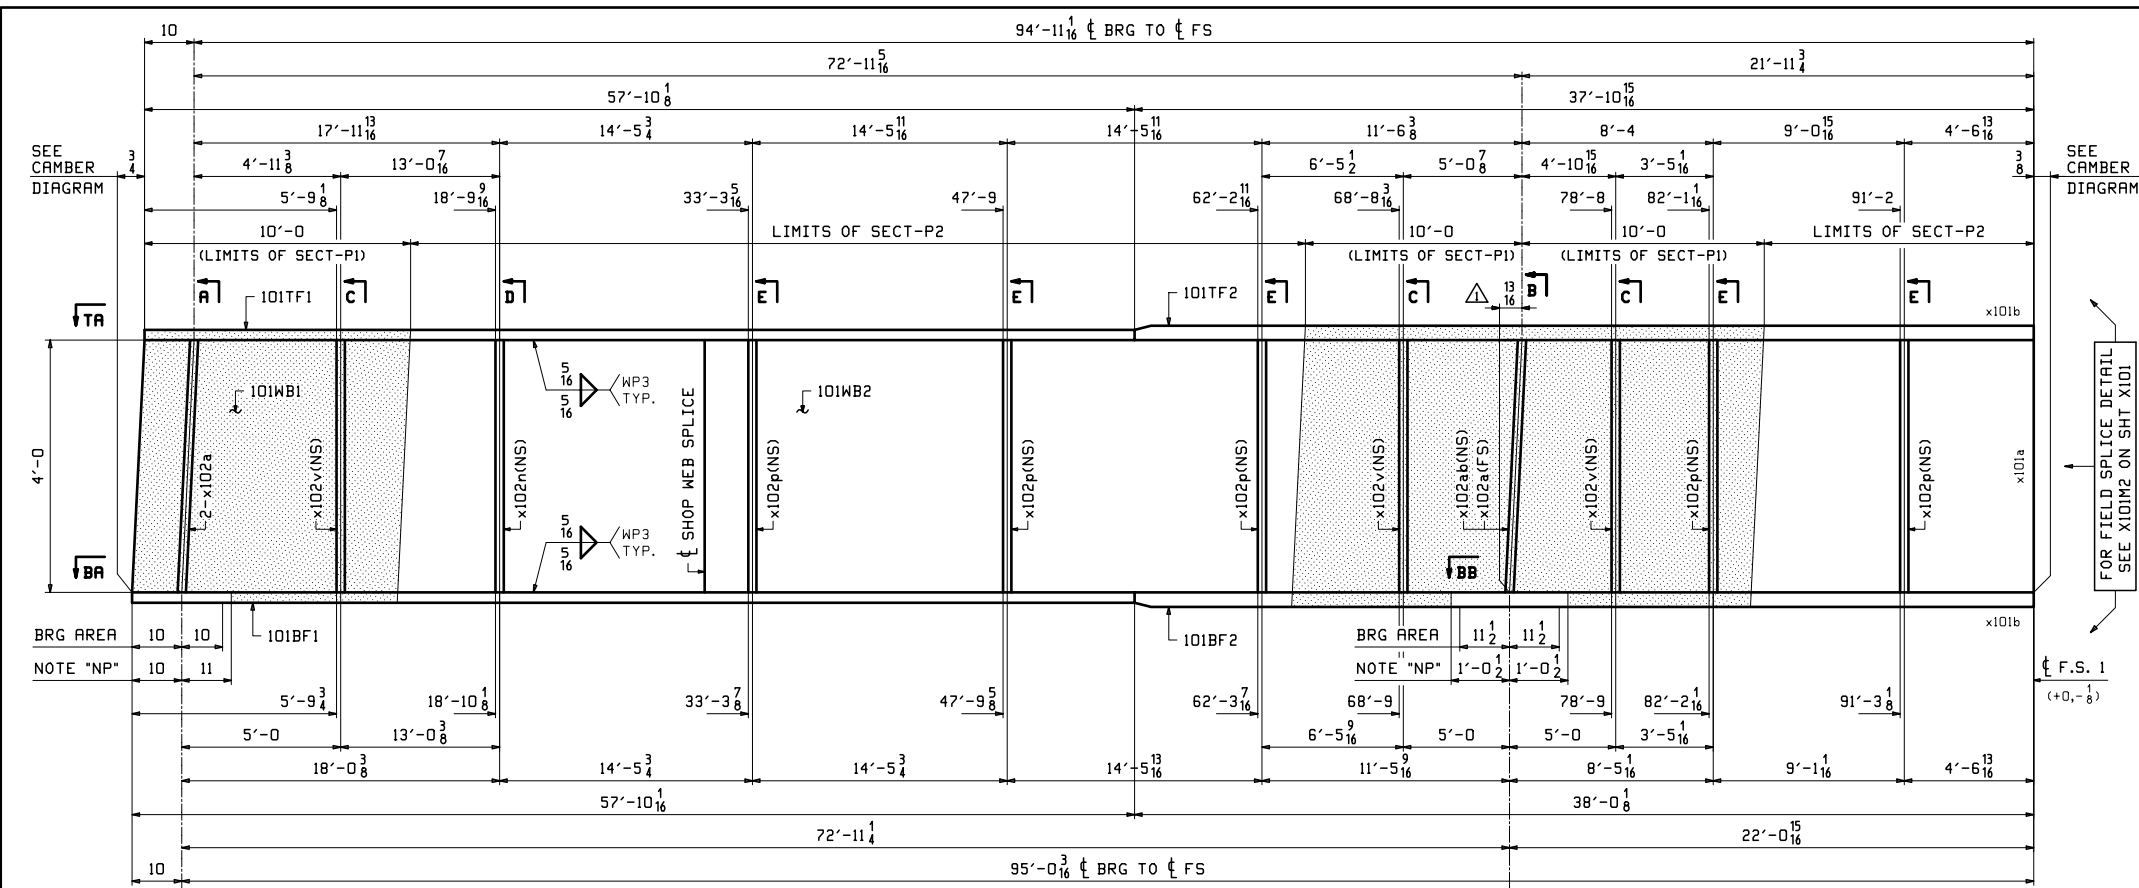


- ONE - GIRDER - 10IA1 (DEVELOPED)**
1. FOR GENERAL NOTES SEE SHEET GNI.
  2. FOR PAINT NOTES SEE SHEET PI.
  3. FOR FIELD SPLICE DETAIL SEE SHEET X101.
  4. FOR GIRDER STANDARD DETAILS SEE SHEET X102.
  5. FOR CAMBER & FLANGE DIAGRAMS SEE SHEET BG101.
  6. "T2" DENOTES MATERIAL SUBJECT TO CHARPY V-NOTCH TESTING.
  7. BRG AREA - DENOTES FLANGE TO BE FLAT & TRUE.
  8. SEE SHEET P101 FOR SECT-P1, SECT-P2 & NOTE "NP".

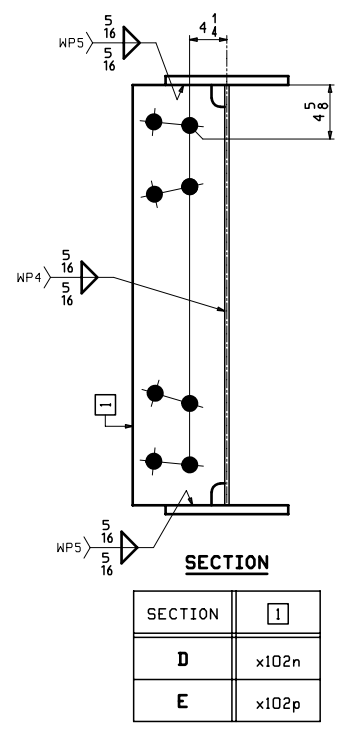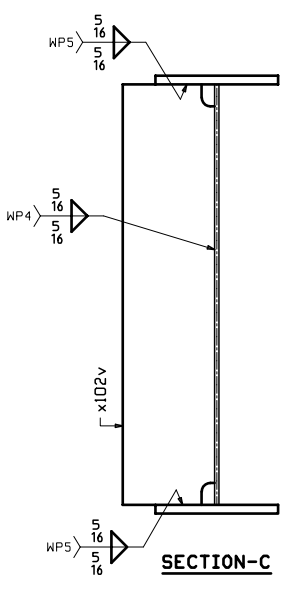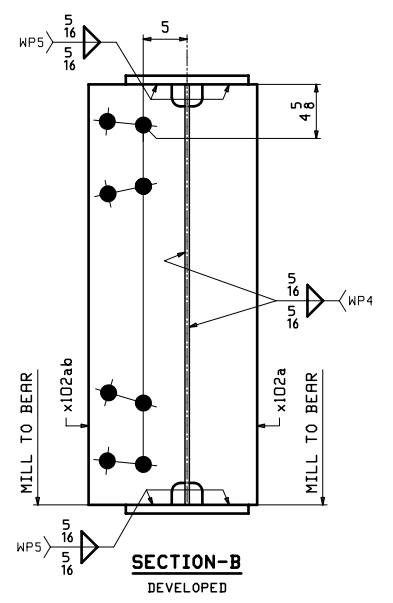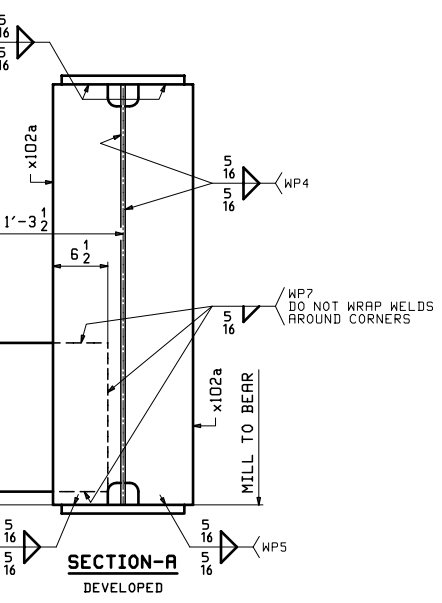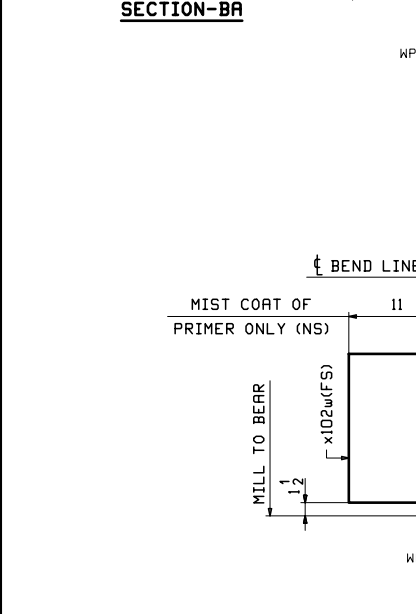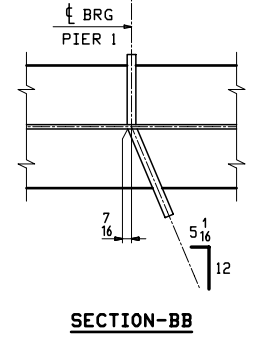


SECTION	1
D	x102n
E	x102p

L	SHIP MARK	NO. OF PCS.	ASS'Y MARK	MATERIAL				REMARKS
				SHAPE	LENGTH FT. IN.	MATERIAL SPEC.	ITEM NO.	
1	10IA1	1		GIRDER				2015B
2								
3		1	10IWB1	PL 2x48	32 0	A709-50WT2	101-28	FP-20
4		1	10IWB2	PL 2x48	63 10 3/4	A709-50WT2	101-29	FP-20
5		1	10ITF1	PL 7/8x14	57 10 1/2	A709-50WT2	101-25	FP-20
6		1	10ITF2	PL 7/8x14	37 10 1/2	A709-50WT2	101-26	FP-20
7		1	10IBF1	PL 5/8x14	57 10 1/2	A709-50WT2	101-26	FP-20
8		1	10IBF2	PL 5/8x14	38 0 1/8	A709-50WT2	101-26	FP-20
9		3	x102a	PL 1x8	4 0	A709-50WT2	104-2	MIE FP-20
11		1	x102ab	PL 1x11	4 0 1/2	A709-50WT2	104-3	MIE FP-20
12		1	x102n	PL 2x10 1/2	4 0	A709-50WT2	104-3	FP-20
13		5	x102p	PL 2x10 1/2	4 0	A709-50WT2	104-3	FP-20
14		3	x102v	PL 2x10 1/2	4 0	A709-50WT2	104-4	FP-20
15		1	x102w	PL 2x17	1 11 1/2	A709-50WT2	104-6	BENT FP-20
16								

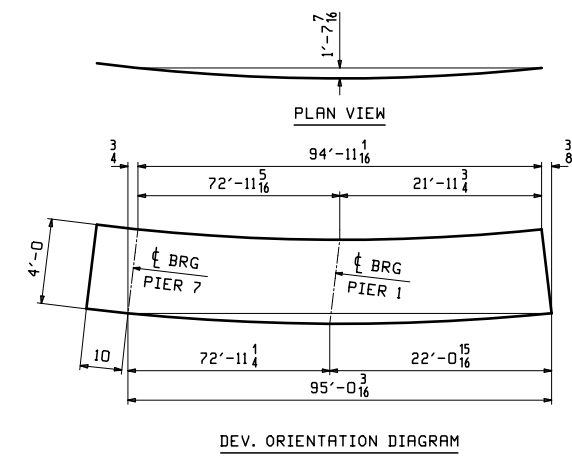
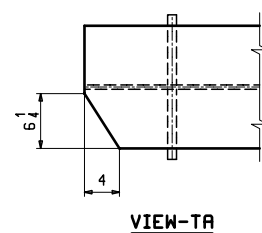


NO.	05/13/19	ADDED BRG LEAN DIMENSION	EEO	WJL
REVISIONS				
2-EAU CLAIRE, WI 3-WAUSAU, WI 4-PALATKA, FL				
STRUCTURE	RAMP P OVER IR-74 WB, IR-75 & RAMP E - UNIT 1			
LOCATION	CINCINNATI, OH (HAMILTON COUNTY) STA. 230+22.98			
PROJECT NO.	HAM-75-3.84, PID NO. 104667, BRIDGE NO. HAM-74-19085			
ENGINEER	PRIME RE GROUP			
CONTRACTOR	WALSH GROUP			
GIRDER ~ 10IA1				
ITEM				
SURFACE PREP.	SEE P1 OPEN HOLES 1 3/8" OVS FOR 1 1/4" HSB (U.N.)			
PAINT	SEE P1 & AS NOTED			
PRELIMINARY	DRAWN	EEO 03/26/19	SHEET NO.	PLANT
FOR APPROVAL	CHECKED	WJL 04/03/19	101	3
			18060A	20






HLL, Rev. 15, 2018 08/08/2018 BR...

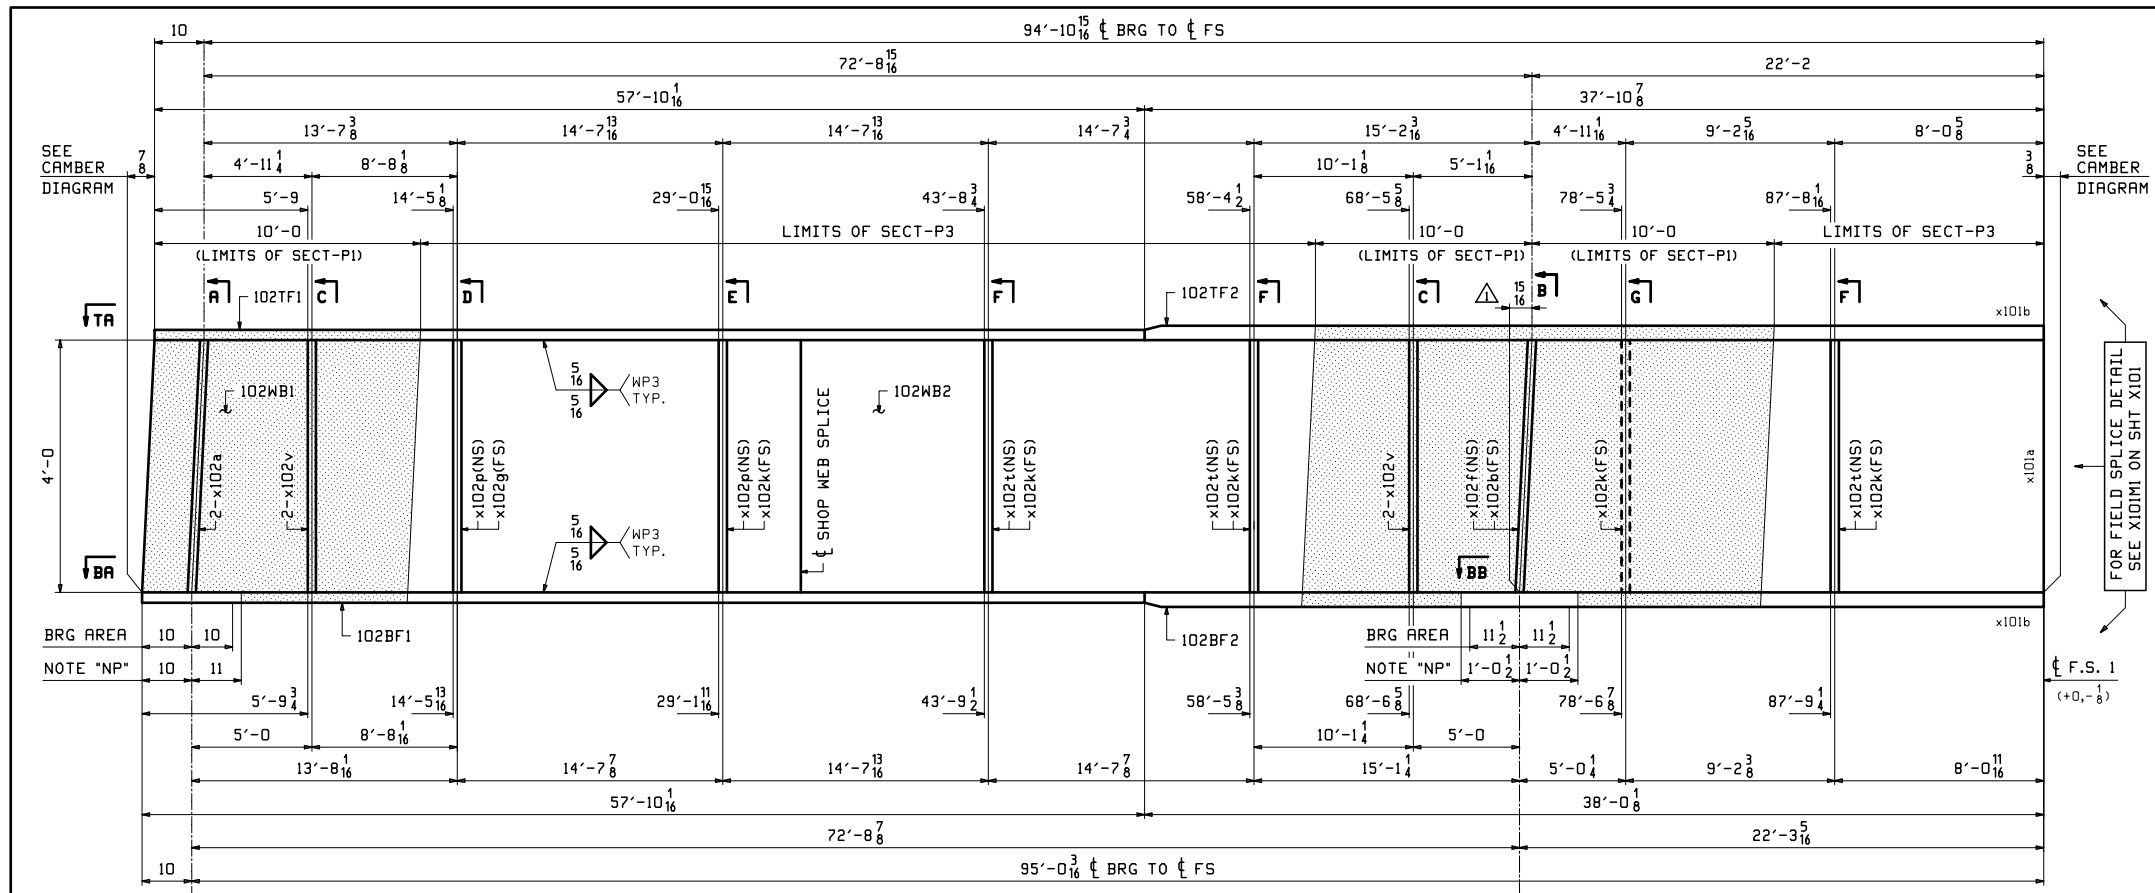

L	SHIP MARK	NO. OF PCS.	ASS'Y MARK	MATERIAL			REMARKS
				SHAPE	LENGTH FT. IN.	MATERIAL SPEC.	
1	102B1	1		GIRDER			20625
2							
3		1	102WB1	PL 2x48	32 0	A709-50WT2	DP 8
4		1	102WB2	PL 2x48	63 10 3/8	A709-50WT2	DP 28
5		1	102TF1	PL 7/8x14	57 10 1/4	A709-50WT2	DP 25
6		1	102TF2	PL 7/8x14	37 10 3/8	A709-50WT2	DP 5
7		1	102BF1	PL 7/8x14	57 10 1/4	A709-50WT2	DP 26
8		1	102BF2	PL 7/8x14	38 0 1/8	A709-50WT2	DP 2
9		2	x102a	PL 1x8	4 0	A709-50WT2	DP 2
10		1	x102b	PL 1x11	4 0 8	A709-50WT2	DP 5
11		1	x102f	PL 1x11	4 0 8	A709-50WT2	DP 5
12		1	x102g	PL 1x10 1/2	4 0	A709-50WT2	DP 3
13		5	x102k	PL 2x10 2	4 0	A709-50WT2	DP 3
14		2	x102p	PL 2x10 2	4 0	A709-50WT2	DP 3
15		3	x102t	PL 2x10 2	4 0	A709-50WT2	DP 4
16		4	x102v	PL 2x10 2	4 0	A709-50WT2	DP 4
17		1	x102y	PL 2x17	1 11 1/2	A709-50WT2	DP 6
18							BENT
19							

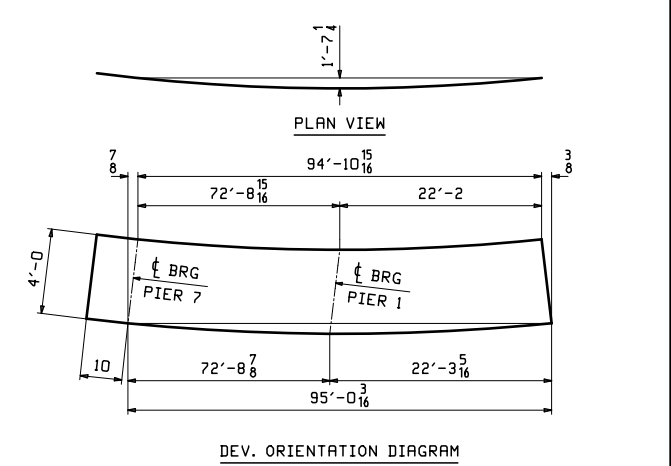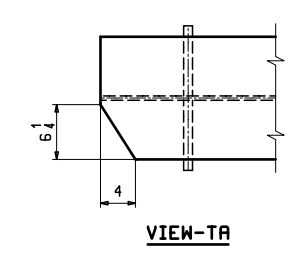


- ONE - GIRDER - 102B1 (DEVELOPED)**
- FOR GENERAL NOTES SEE SHEET GNI.
  - FOR PAINT NOTES SEE SHEET PI.
  - FOR FIELD SPlice DETAIL SEE SHEET X101.
  - FOR GIRDER STANDARD DETAILS SEE SHEET X102.
  - FOR CAMBER & FLANGE DIAGRAMS SEE SHEET BG101.
  - "T2" DENOTES MATERIAL SUBJECT TO CHARPY V-NOTCH TESTING.
  - BRG AREA - DENOTES FLANGE TO BE FLAT & TRUE.
  - SEE SHEET P101 FOR SECT-P1, SECT-P2 & NOTE "NP".

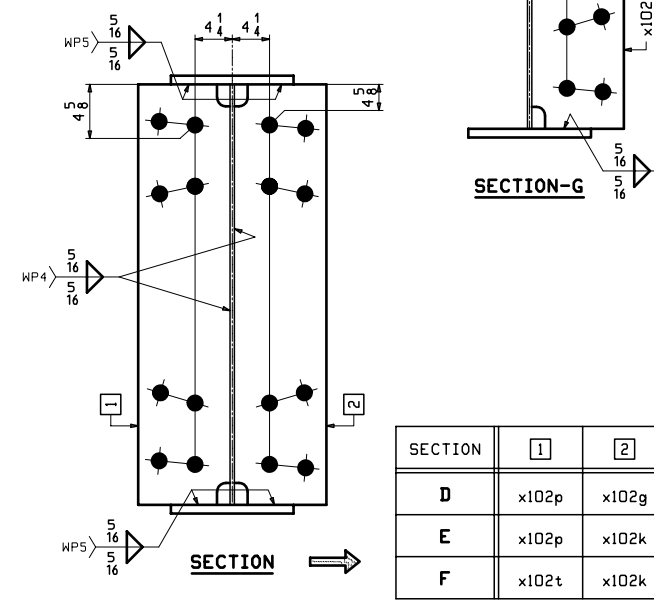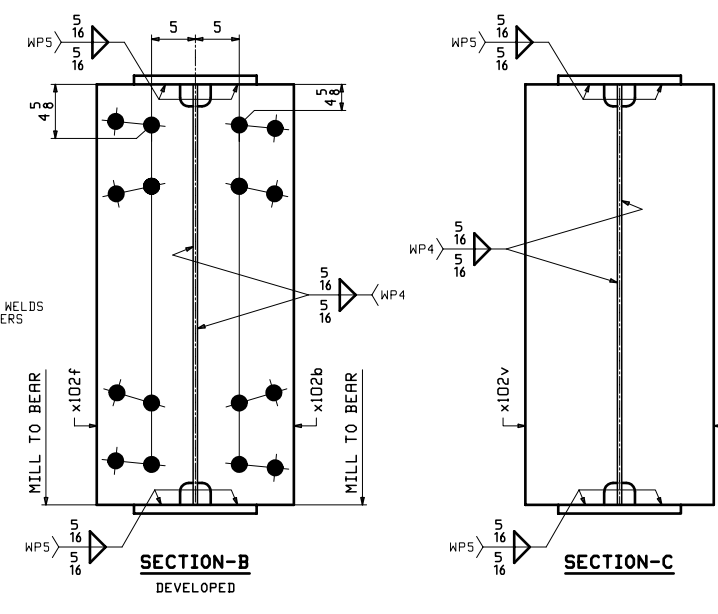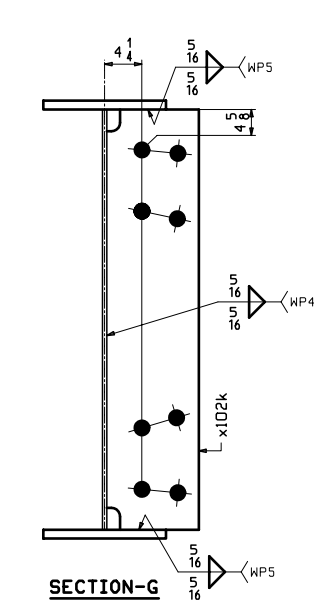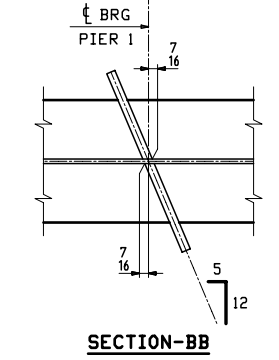
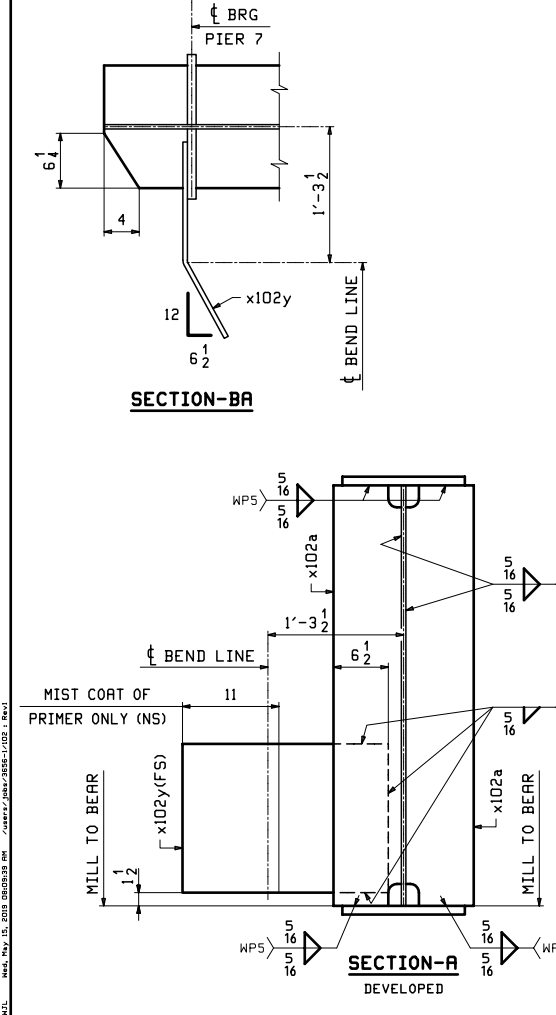


SECTION	1	2
D	x102p	x102g
E	x102p	x102k
F	x102t	x102k

NO.	DATE	REVISIONS	REMARKS	BY
	05/13/19		ADDED BRG LEAN DIMENSION	EEO
STRUCTURE: RAMP P OVER IR-74 WB, IR-75 & RAMP E - UNIT 1 LOCATION: CINCINNATI, OH (HAMILTON COUNTY) STA. 230+22.98 PROJECT NO.: HAM-75-3.84, PID NO. 104667, BRIDGE NO. HAM-74-19085 ENGINEER: PRIME RE GROUP CONTRACTOR: WALSH GROUP				
<b>GIRDER ~ 102B1</b>				
ITEM: GIRDER ~ 102B1 SURFACE PREP: SEE P1 PAINT: SEE P1 & AS NOTED				
PRELIMINARY	DRAWN	EEO 04/01/19	SHEET NO.	PLANT
FOR APPROVAL	CHECKED	WJL 04/03/19	102	3
		ORDER NO.	18060A	FP. NO.
				20







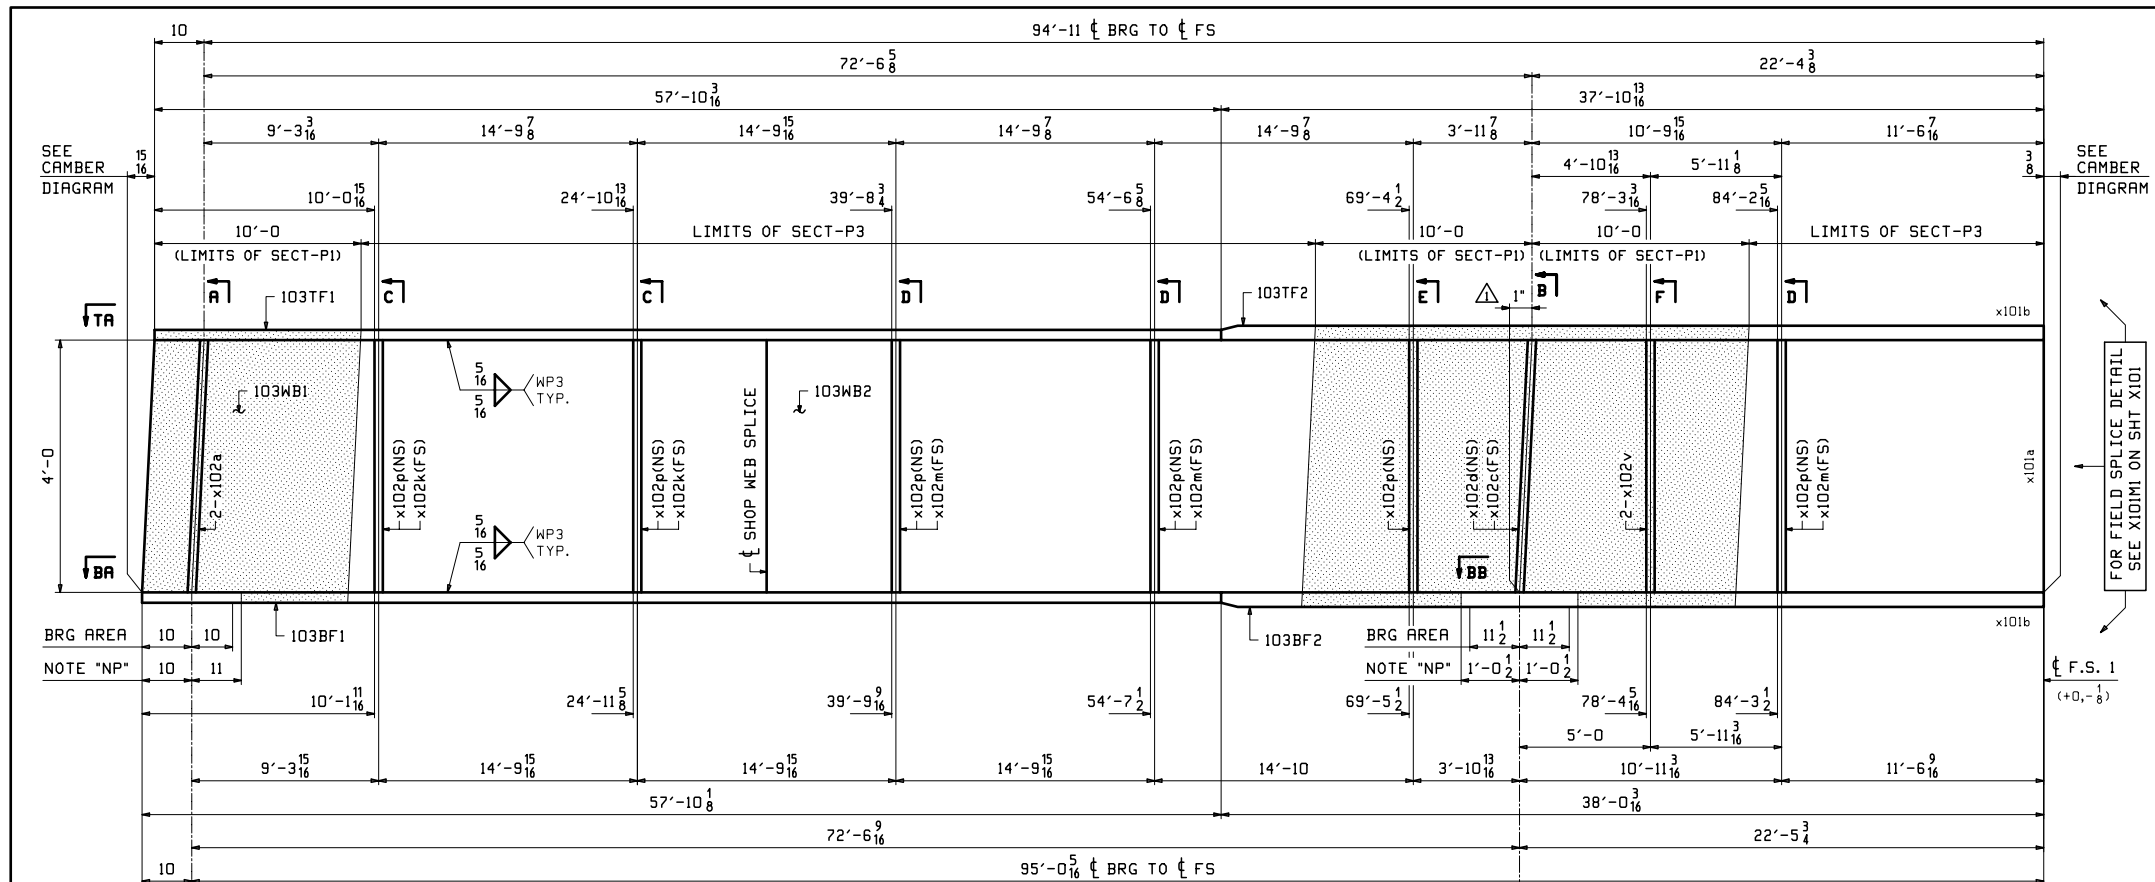


L	M	SHIP MARK	NO. OF PCS.	ASS'Y MARK	MATERIAL			REMARKS
					SHAPE	LENGTH FT. IN.	ITEM NO.	
1		103C1	1		GIRDER			20484
2								
3		103WB1	1		PL 2x48	32 0	A709-S0WT2	103
4		103WB2	1		PL 2x48	63 10 5/8	A709-S0WT2	101
5		103TF1	1		PL 7/8x14	57 10 3/8	A709-S0WT2	101
6		103TF2	1		PL 7/8x14	37 10 3/8	A709-S0WT2	101
7		103BF1	1		PL 7/8x14	57 10 3/8	A709-S0WT2	101
8		103BF2	1		PL 7/8x14	38 0 3/8	A709-S0WT2	101
9								
10		2 x102a	2		PL 1x8	4 0	A709-S0WT2	104
11		1 x102aa	1		PL 2x17	1 11 2	A709-S0WT2	104
12		1 x102c	1		PL 1x11	4 0 8	A709-S0WT2	104
13		1 x102d	1		PL 1x11	4 0 8	A709-S0WT2	104
14		2 x102k	2		PL 2x10 1/2	4 0	A709-S0WT2	104
15		3 x102m	3		PL 2x10 1/2	4 0	A709-S0WT2	104
16		6 x102p	6		PL 2x10 1/2	4 0	A709-S0WT2	104
17		2 x102v	2		PL 2x10 1/2	4 0	A709-S0WT2	104
18								

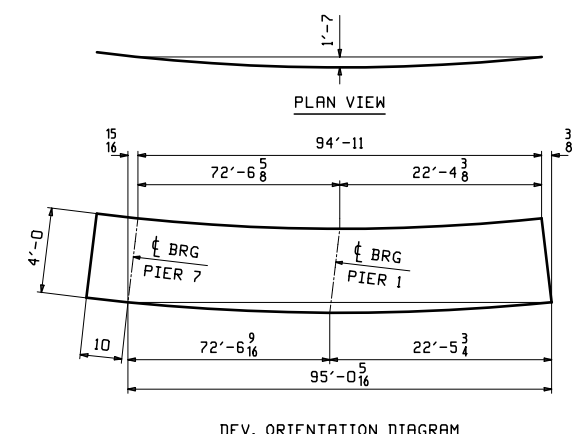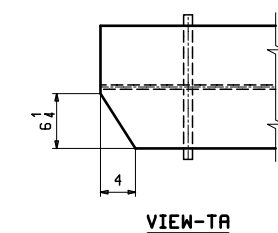



**ONE - GIRDER - 103C1 (DEVELOPED)**

1. FOR GENERAL NOTES SEE SHEET GNI.
2. FOR PAINT NOTES SEE SHEET PI.
3. FOR FIELD SPLICE DETAIL SEE SHEET X101.
4. FOR GIRDER STANDARD DETAILS SEE SHEET X102.
5. FOR CAMBER & FLANGE DIAGRAMS SEE SHEET BG101.
6. "T2" DENOTES MATERIAL SUBJECT TO CHARPY V-NOTCH TESTING.
7. BRG AREA - DENOTES FLANGE TO BE FLAT & TRUE.
8. SEE SHEET P101 FOR SECT-P1, SECT-P2 & NOTE "NP".

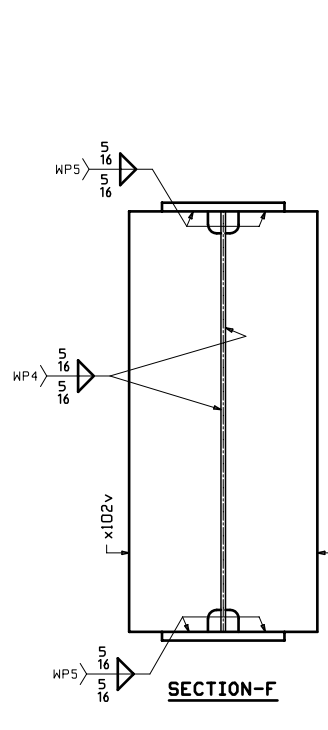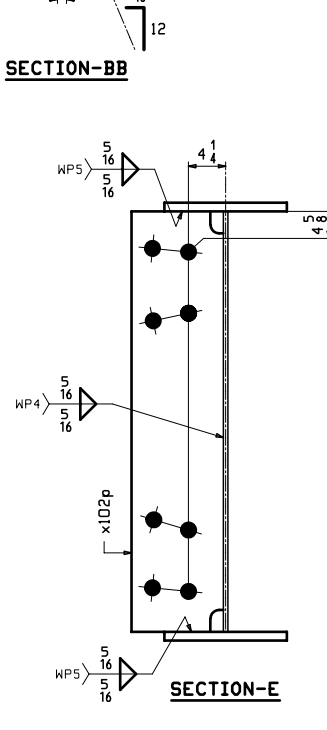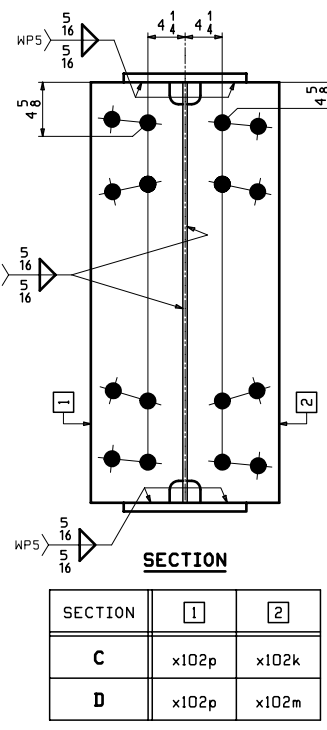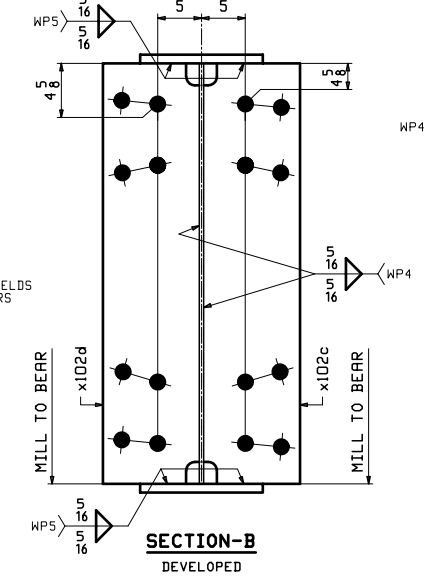
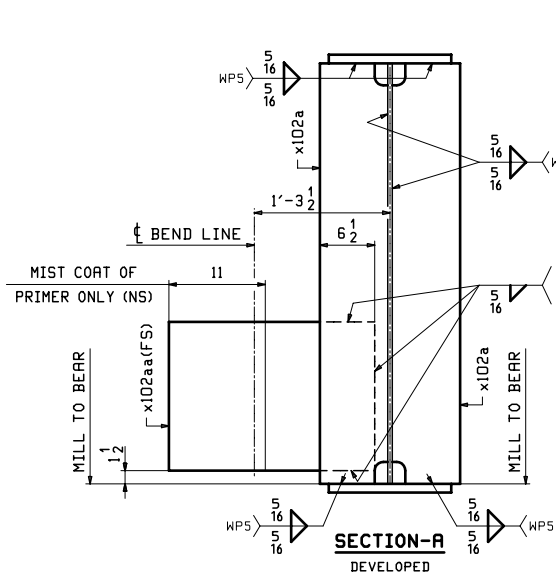
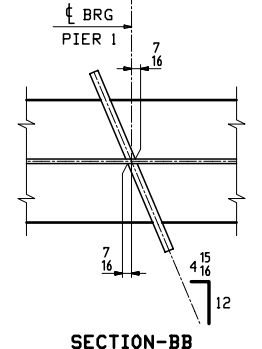
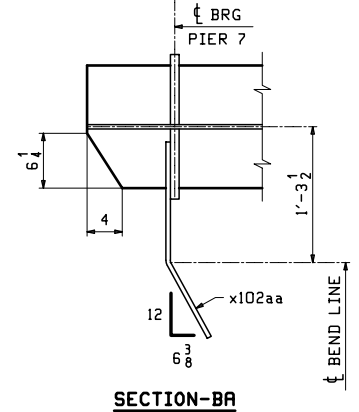


SECTION	1	2
C	x102p	x102k
D	x102p	x102m



NO.	05/13/19	ADDED BRG LEAN DIMENSION	EEO	HJL
REVISIONS				
2-EAU CLAIRE, WI 3-WAUSAU, WI 4-PALATKA, FL				
STRUCTURE	RAMP P OVER IR-74 WB, IR-75 & RAMP E - UNIT 1			
LOCATION	CINCINNATI, OH (HAMILTON COUNTY) STA. 230+22.98			
PROJECT NO.	HAM-75-3.84, PID NO. 104667, BRIDGE NO. HAM-74-19085			
ENGINEER	PRIME RE GROUP			
CONTRACTOR	WALSH GROUP			
GIRDER ~ 103C1				
ITEM	SEE P1			
SURFACE PREP.	OPEN HOLES 1 3/8" OVS FOR 1 1/4" HSB (U.N.)			
PAINT	SEE P1 & AS NOTED			
PRELIMINARY	DRAWN	EEO 04/02/19	SHEET NO.	PLANT
FOR APPROVAL	CHECKED	HJL 04/03/19	103	3
			18060A	20

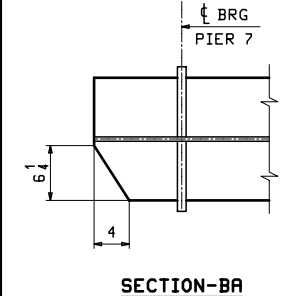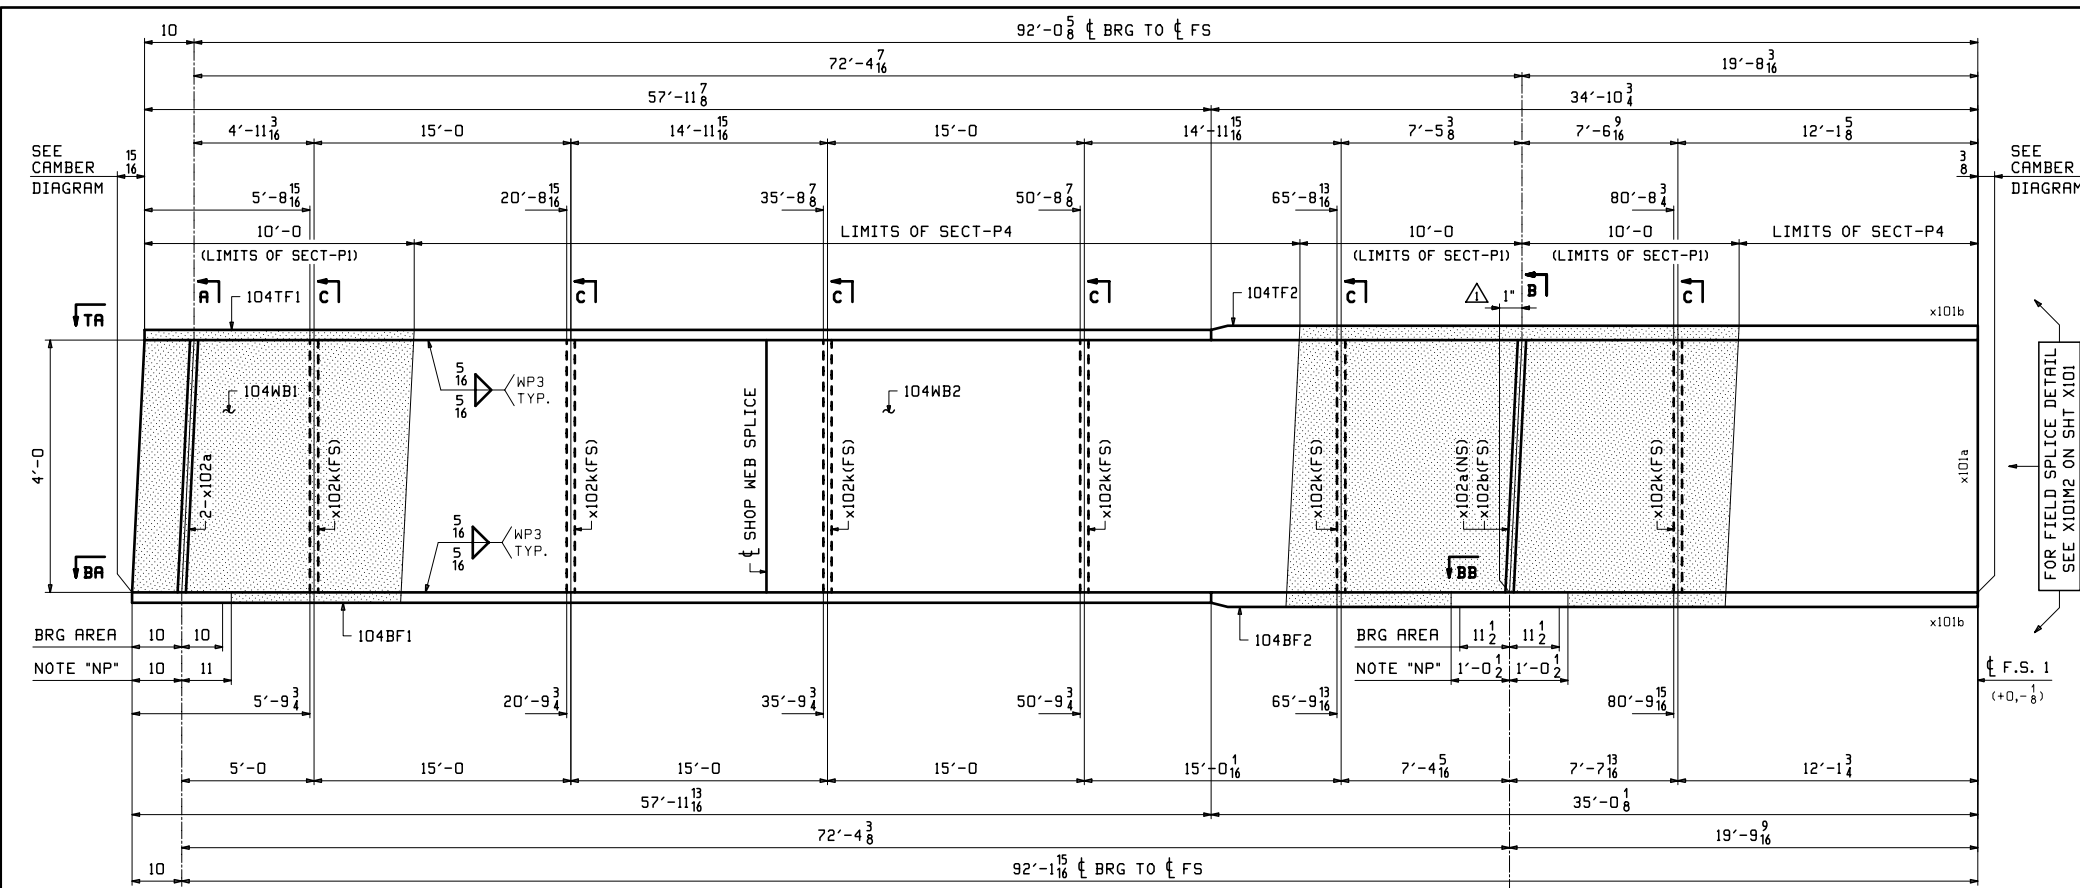

- ONE - GIRDER - 104D1 (DEVELOPED)**
1. FOR GENERAL NOTES SEE SHEET GNI.
  2. FOR PAINT NOTES SEE SHEET PI.
  3. FOR FIELD SPlice DETAIL SEE SHEET X101.
  4. FOR GIRDER STANDARD DETAILS SEE SHEET X102.
  5. FOR CAMBER & FLANGE DIAGRAMS SEE SHEET BG101.
  6. "T2" DENOTES MATERIAL SUBJECT TO CHARPY V-NOTCH TESTING.
  7. BRG AREA - DENOTES FLANGE TO BE FLAT & TRUE.
  8. SEE SHEET P101 FOR SECT-P1, SECT-P2 & NOTE "NP".

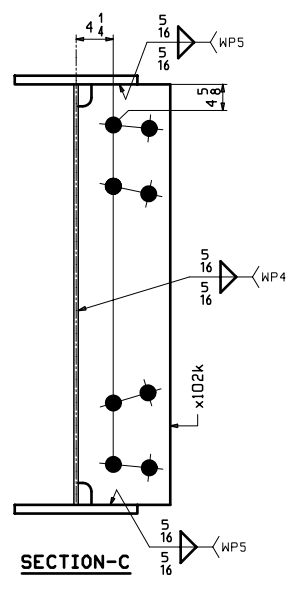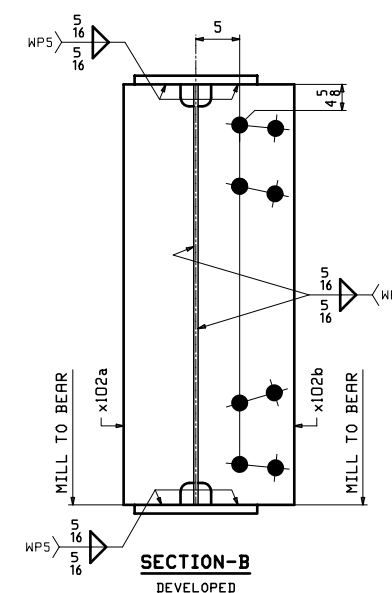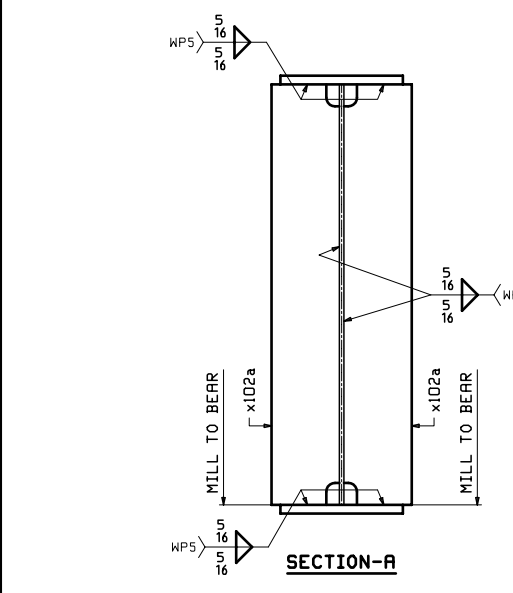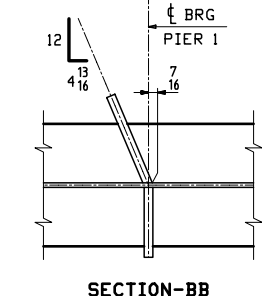


QTY	SHIP MARK	NO. OF PCS.	ASS'Y MARK	MATERIAL			REMARKS
				SHAPE	LENGTH FT. IN.	MATERIAL SPEC.	
1	104D1	1		GIRDER			19163
2							
3		1	104WB1	PL 2x48	32 0	A709-SOWT2	DP 8
4		1	104WB2	PL 2x48	60 11 15	A709-SOWT2	DP 10
5		1	104TF1	PL 7/8x14	57 11 8	A709-SOWT2	DP 25
6		1	104TF2	PL 7/8x14	34 10 3	A709-SOWT2	DP 8
7		1	104BF1	PL 7/8x14	57 11 8	A709-SOWT2	DP 26
8		1	104BF2	PL 7/8x14	35 0 1/8	A709-SOWT2	DP 4
9		3	x102a	PL 1x8	4 0	A709-SOWT2	DP 2
10		1	x102b	PL 1x11	4 0 8	A709-SOWT2	DP 5
11		6	x102k	PL 1/2x10 1/2	4 0	A709-SOWT2	DP 3
12							
13							

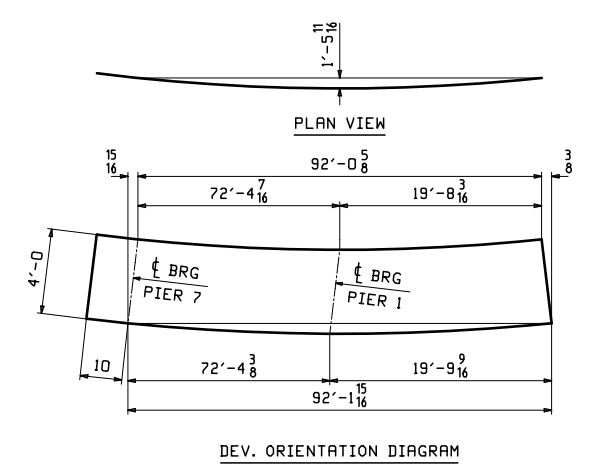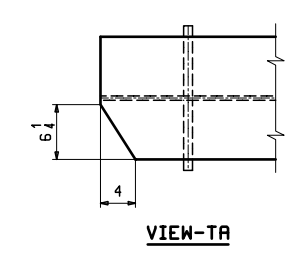


05/13/19	ADDED BRG LEAN DIMENSION	EEO	HJL
REVISIONS			
STRUCTURE: RAMP P OVER IR-74 WB, IR-75 & RAMP E - UNIT 1 LOCATION: CINCINNATI, OH (HAMILTON COUNTY) STA. 230+22.98 PROJECT NO.: HAM-75-3.84, PID NO. 104667, BRIDGE NO. HAM-74-19085 ENGINEER: PRIME RE GROUP CONTRACTOR: WALSH GROUP			
GIRDER ~ 104D1			
SURFACE PREP. SEE P1 OPEN HOLES 1 3/8" Ø OVS FOR 1 1/4" HSB (U.N.)			
PAINT SEE P1 & AS NOTED			
PRELIMINARY	DRAWN EEO 04/02/19	SHEET NO. 104	PLANT ORDER NO. 3 18060A 20
FOR APPROVAL	CHECKED WJL 04/08/19		


HJL: Rev. 15, 2018 20180505.DWG: 104D1-1 (REV. 1)

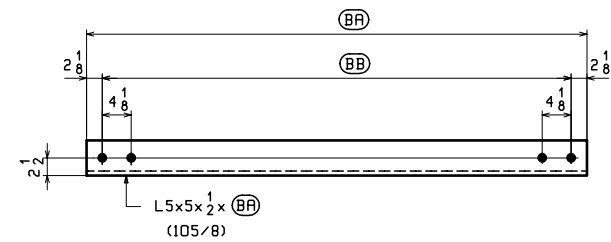

**CROSSFRAME TOP & BTM STRUTS ~ MARK "A"**

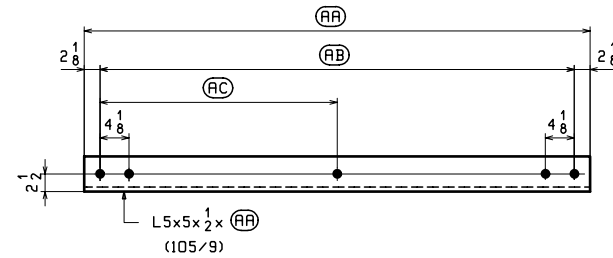

**CROSSFRAME DIAGONALS ~ MARK "B"**  
(LOW END @ LEFT LOOKING UP-STATION)

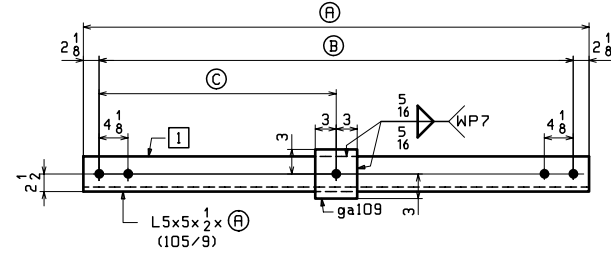

**CROSSFRAME DIAGONALS ~ MARK "C"**  
(LOW END @ LEFT LOOKING UP-STATION)

MARK	QTY	(BA)	(BB)
109C1A	2	7'-11 <sup>13</sup> / <sub>16</sub>	7'-7 <sup>9</sup> / <sub>16</sub>
109C2A	10	7'-11 <sup>13</sup> / <sub>16</sub>	7'-7 <sup>9</sup> / <sub>16</sub>
109C2AP	2	7'-11 <sup>13</sup> / <sub>16</sub>	7'-7 <sup>9</sup> / <sub>16</sub>
109C3A	△ 8	7'-11 <sup>13</sup> / <sub>16</sub>	7'-7 <sup>9</sup> / <sub>16</sub>
109C3AP	△ 6	7'-11 <sup>13</sup> / <sub>16</sub>	7'-7 <sup>9</sup> / <sub>16</sub>
109C4A	14	7'-11 <sup>7</sup> / <sub>8</sub>	7'-7 <sup>5</sup> / <sub>8</sub>
109C5A	12	7'-11 <sup>7</sup> / <sub>8</sub>	7'-7 <sup>5</sup> / <sub>8</sub>
109C6A	4	7'-11 <sup>15</sup> / <sub>16</sub>	7'-7 <sup>11</sup> / <sub>16</sub>


PRIME COATED (SEE SHT P1)

MARK	QTY	(AA)	(AB)	(AC)
109C1B	1	8'-2 <sup>9</sup> / <sub>16</sub>	7'-10 <sup>5</sup> / <sub>16</sub>	3'-11 <sup>3</sup> / <sub>16</sub>
109C2B	5	8'-2 <sup>7</sup> / <sub>16</sub>	7'-10 <sup>3</sup> / <sub>16</sub>	3'-11 <sup>1</sup> / <sub>8</sub>
109C2BP	1	8'-2 <sup>7</sup> / <sub>16</sub>	7'-10 <sup>3</sup> / <sub>16</sub>	3'-11 <sup>1</sup> / <sub>8</sub>
109C3B	△ 4	8'-2 <sup>5</sup> / <sub>16</sub>	7'-10 <sup>1</sup> / <sub>16</sub>	3'-11 <sup>1</sup> / <sub>16</sub>
109C3BP	△ 3	8'-2 <sup>5</sup> / <sub>16</sub>	7'-10 <sup>1</sup> / <sub>16</sub>	3'-11 <sup>1</sup> / <sub>16</sub>
109C4B	7	8'-2 <sup>3</sup> / <sub>16</sub>	7'-9 <sup>15</sup> / <sub>16</sub>	3'-11
109C5B	6	8'-2	7'-9 <sup>3</sup> / <sub>4</sub>	3'-10 <sup>7</sup> / <sub>8</sub>
109C6B	2	8'-1 <sup>7</sup> / <sub>8</sub>	7'-9 <sup>5</sup> / <sub>8</sub>	3'-10 <sup>13</sup> / <sub>16</sub>

PRIME COATED (SEE SHT P1)


MARK	QTY	(A)	(B)	(C)	(I)
109C1C	1	8'-3 <sup>9</sup> / <sub>16</sub>	7'-11 <sup>5</sup> / <sub>16</sub>	3'-11 <sup>11</sup> / <sub>16</sub>	a109
109C2C	5	8'-3 <sup>3</sup> / <sub>4</sub>	7'-11 <sup>1</sup> / <sub>2</sub>	3'-11 <sup>3</sup> / <sub>4</sub>	b109
109C2CP	1	8'-3 <sup>3</sup> / <sub>4</sub>	7'-11 <sup>1</sup> / <sub>2</sub>	3'-11 <sup>3</sup> / <sub>4</sub>	b109
109C3C	△ 4	8'-3 <sup>15</sup> / <sub>16</sub>	7'-11 <sup>11</sup> / <sub>16</sub>	3'-11 <sup>7</sup> / <sub>8</sub>	c109
109C3CP	△ 3	8'-3 <sup>15</sup> / <sub>16</sub>	7'-11 <sup>11</sup> / <sub>16</sub>	3'-11 <sup>7</sup> / <sub>8</sub>	c109
109C4C	7	8'-4 <sup>1</sup> / <sub>8</sub>	7'-11 <sup>7</sup> / <sub>8</sub>	3'-11 <sup>15</sup> / <sub>16</sub>	d109
109C5C	6	8'-4 <sup>5</sup> / <sub>16</sub>	8'-0 <sup>1</sup> / <sub>16</sub>	4'-0 <sup>1</sup> / <sub>16</sub>	f109
109C6C	2	8'-4 <sup>1</sup> / <sub>2</sub>	8'-0 <sup>1</sup> / <sub>4</sub>	4'-0 <sup>1</sup> / <sub>8</sub>	g109

PRIME COATED (SEE SHT P1)

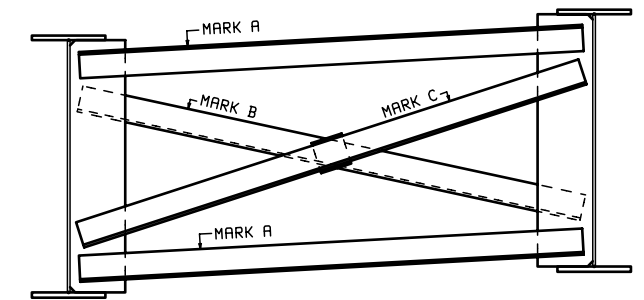

**CROSSFRAME MARK LOCATION**  
(LOOKING UP-STATION)

- NOTES:
1. FOR GENERAL NOTES SEE SHEET GNI.
  2. ALL MATERIAL SHALL BE A709-50WT2, UN.
  3. T2 DENOTES CHARPY V-NOTCH TESTING REQUIRED.

△	05/15/19	REV'D QTY	DPS/WJL
NO.	DATE	REMARKS	BY
REVISIONS			
			
STRUCTURE	RAMP P OVER IR-74 WB, IR-75 & RAMP E - UNIT 1		
LOCATION	CINCINNATI, OH (HAMILTON COUNTY) STA. 230+22.98		
PROJECT NO.	HAM-75-3.84, PID NO. 104667, BRIDGE NO. HAM-74-1908S		
ENGINEER	PRIME AE GROUP		
CONTRACTOR	WALSH GROUP		
INT CROSSFRAMES			
ITEM			
SURFACE PREP.	SEE SHEET P1 OPEN HOLES 9/16" Ø FOR 1 1/4" Ø HSB		
PAINT	SEE SHEET P1		
PRELIMINARY	DRAWN DPS 03/18/19	SHEET NO.	PLANT ORDER NO. FP. NO.
FOR APPROVAL	CHECKED WJL 04/05/19	109AB	3 18060A 37

WORK THIS SHEET WITH SHEET 109B




LINE	SHIP MARK	NO. OF PCS.	ASS'Y MARK	MATERIAL				REMARKS	
				SHAPE	LENGTH FT. IN.	MATERIAL SPEC.	ITEM NO.		
35	109C1C	1		DIAGONALS					139
36		1	a109	L 5x5x $\frac{1}{2}$	8 3 $\frac{1}{4}$	A709-50WT2	105 g		
37		1	ga109	PL $\frac{1}{2}$ x6	0 6	A709-50WT2	105 10		
38									
39	109C2C	5		DIAGONALS					139
40		5	b109	L 5x5x $\frac{1}{2}$	8 3 $\frac{1}{4}$	A709-50WT2	105 g		
41		5	ga109	PL $\frac{1}{2}$ x6	0 6	A709-50WT2	105 10		
42									
43	109C2CP	1		DIAGONALS				PRINTED	139
44		1	b109	L 5x5x $\frac{1}{2}$	8 3 $\frac{1}{4}$	A709-50WT2	105 g		
45		1	ga109	PL $\frac{1}{2}$ x6	0 6	A709-50WT2	105 10		
46									
47	109C3C	4		DIAGONALS					140
48		4	c109	L 5x5x $\frac{1}{2}$	8 3 $\frac{1}{4}$	A709-50WT2	105 g		
49		4	ga109	PL $\frac{1}{2}$ x6	0 6	A709-50WT2	105 10		
50									
51	109C3CP	3		DIAGONALS				PRINTED	140
52		3	c109	L 5x5x $\frac{1}{2}$	8 3 $\frac{1}{4}$	A709-50WT2	105 g		
53		3	ga109	PL $\frac{1}{2}$ x6	0 6	A709-50WT2	105 10		
54									
55	109C4C	7		DIAGONALS					140
56		7	d109	L 5x5x $\frac{1}{2}$	8 4 $\frac{1}{8}$	A709-50WT2	105 g		
57		7	ga109	PL $\frac{1}{2}$ x6	0 6	A709-50WT2	105 10		
58									
59	109C5C	6		DIAGONALS					140
60		6	f109	L 5x5x $\frac{1}{2}$	8 4 $\frac{1}{8}$	A709-50WT2	105 g		
61		6	ga109	PL $\frac{1}{2}$ x6	0 6	A709-50WT2	105 10		
62									
63	109C6C	2		DIAGONALS					140
64		2	g109	L 5x5x $\frac{1}{2}$	8 4 $\frac{1}{8}$	A709-50WT2	105 g		
65		2	ga109	PL $\frac{1}{2}$ x6	0 6	A709-50WT2	105 10		
66									
67									
68									

LINE	SHIP MARK	NO. OF PCS.	ASS'Y MARK	MATERIAL				REMARKS	
				SHAPE	LENGTH FT. IN.	MATERIAL SPEC.	ITEM NO.		
1	109C1A	2		L 5x5x $\frac{1}{2}$	7 11 $\frac{1}{16}$	A709-50WT2	105 g		129
2									
3	109C2A	10		L 5x5x $\frac{1}{2}$	7 11 $\frac{1}{16}$	A709-50WT2	105 g		129
4									
5	109C2AP	2		L 5x5x $\frac{1}{2}$	7 11 $\frac{1}{16}$	A709-50WT2	105 g	PRINTED	129
6									
7	109C3A	8		L 5x5x $\frac{1}{2}$	7 11 $\frac{1}{16}$	A709-50WT2	105 g		129
8									
9	109C3AP	6		L 5x5x $\frac{1}{2}$	7 11 $\frac{1}{16}$	A709-50WT2	105 g	PRINTED	129
10									
11	109C4A	14		L 5x5x $\frac{1}{2}$	7 11 $\frac{1}{16}$	A709-50WT2	105 g		129
12									
13	109C5A	12		L 5x5x $\frac{1}{2}$	7 11 $\frac{1}{16}$	A709-50WT2	105 g		129
14									
15	109C6A	4		L 5x5x $\frac{1}{2}$	7 11 $\frac{1}{16}$	A709-50WT2	105 g		129
16									
17									
18	109C1B	1		L 5x5x $\frac{1}{2}$	8 2 $\frac{9}{16}$	A709-50WT2	105 g		133
19									
20	109C2B	5		L 5x5x $\frac{1}{2}$	8 2 $\frac{7}{16}$	A709-50WT2	105 g		133
21									
22	109C2BP	1		L 5x5x $\frac{1}{2}$	8 2 $\frac{7}{16}$	A709-50WT2	105 g	PRINTED	133
23									
24	109C3B	4		L 5x5x $\frac{1}{2}$	8 2 $\frac{5}{16}$	A709-50WT2	105 g		132
25									
26	109C3BP	3		L 5x5x $\frac{1}{2}$	8 2 $\frac{5}{16}$	A709-50WT2	105 g	PRINTED	132
27									
28	109C4B	7		L 5x5x $\frac{1}{2}$	8 2 $\frac{3}{16}$	A709-50WT2	105 g		132
29									
30	109C5B	6		L 5x5x $\frac{1}{2}$	8 2	A709-50WT2	105 g		132
31									
32	109C6B	2		L 5x5x $\frac{1}{2}$	8 1 $\frac{7}{8}$	A709-50WT2	105 g		132
33									
34									


- NOTES:  
1. FOR GENERAL NOTES SEE SHEET GNI.  
2. ALL MATERIAL SHALL BE A709-50WT2, UN.  
3. T2 DENOTES CHARPY V-NOTCH TESTING REQUIRED.

WORK THIS SHEET WITH SHEET 109AB

	05/15/19	REV'D QTY		DPS/WJL
NO.	DATE	REMARKS		BY
REVISIONS				
		<b>Veritas STEEL</b>		
2-EAU CLAIRE, WI		3-WAUSAU, WI 4-PALATKA, FL		
STRUCTURE	RAMP P OVER IR-74 WB, IR-75 & RAMP E - UNIT 1			
LOCATION	CINCINNATI, OH (HAMILTON COUNTY) STA. 230+22.98			
PROJECT NO.	HAM-75-3.84, PID NO. 104667, BRIDGE NO. HAM-74-1908S			
ENGINEER	PRIME AE GROUP			
CONTRACTOR	WALSH GROUP			
INT CROSSFRAMES				
ITEM				
SURFACE PREP.	SEE SHEET P1 OPEN HOLES			
PAINT	SEE SHEET P1			
PRELIMINARY	DRAWN	DPS 03/18/19	SHEET NO.	PLANT
FOR APPROVAL	CHECKED	WJL 04/05/19	109B	3
			ORDER NO.	FP. NO.
			18060A	37

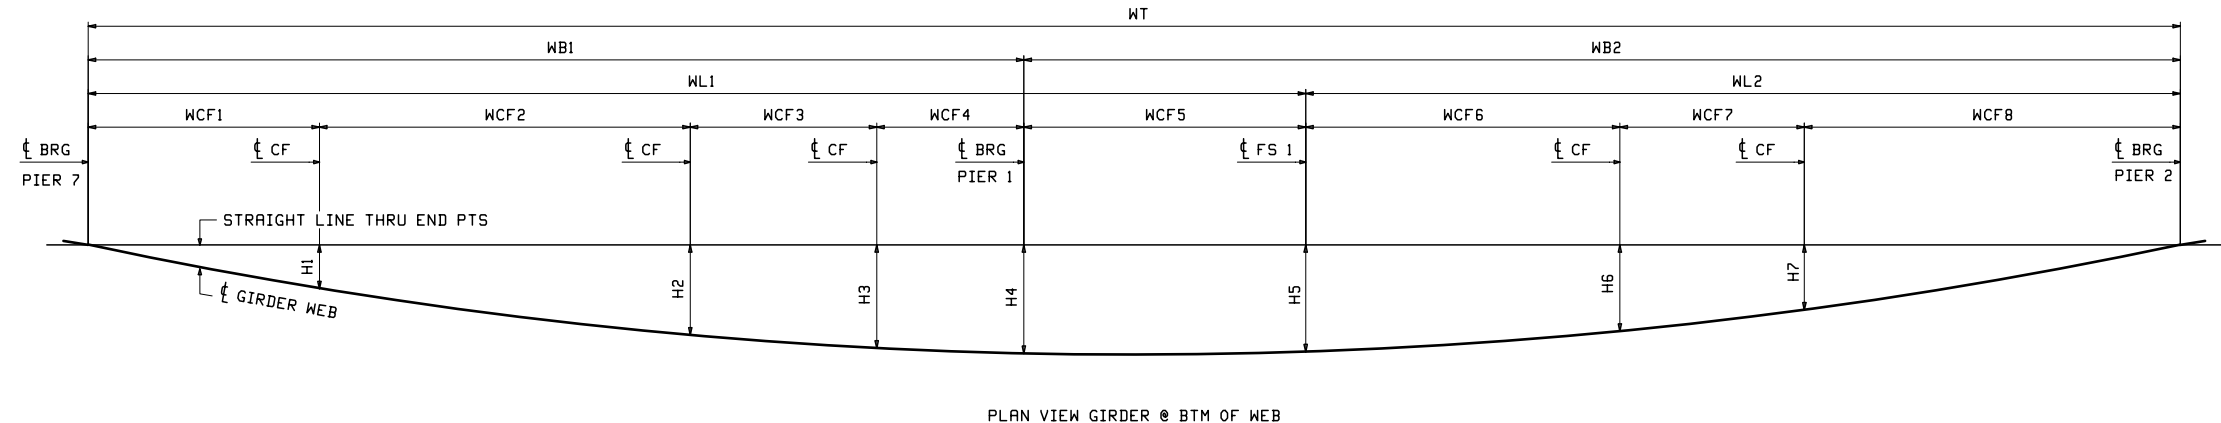

PLAN VIEW GIRDER @ BTM OF WEB

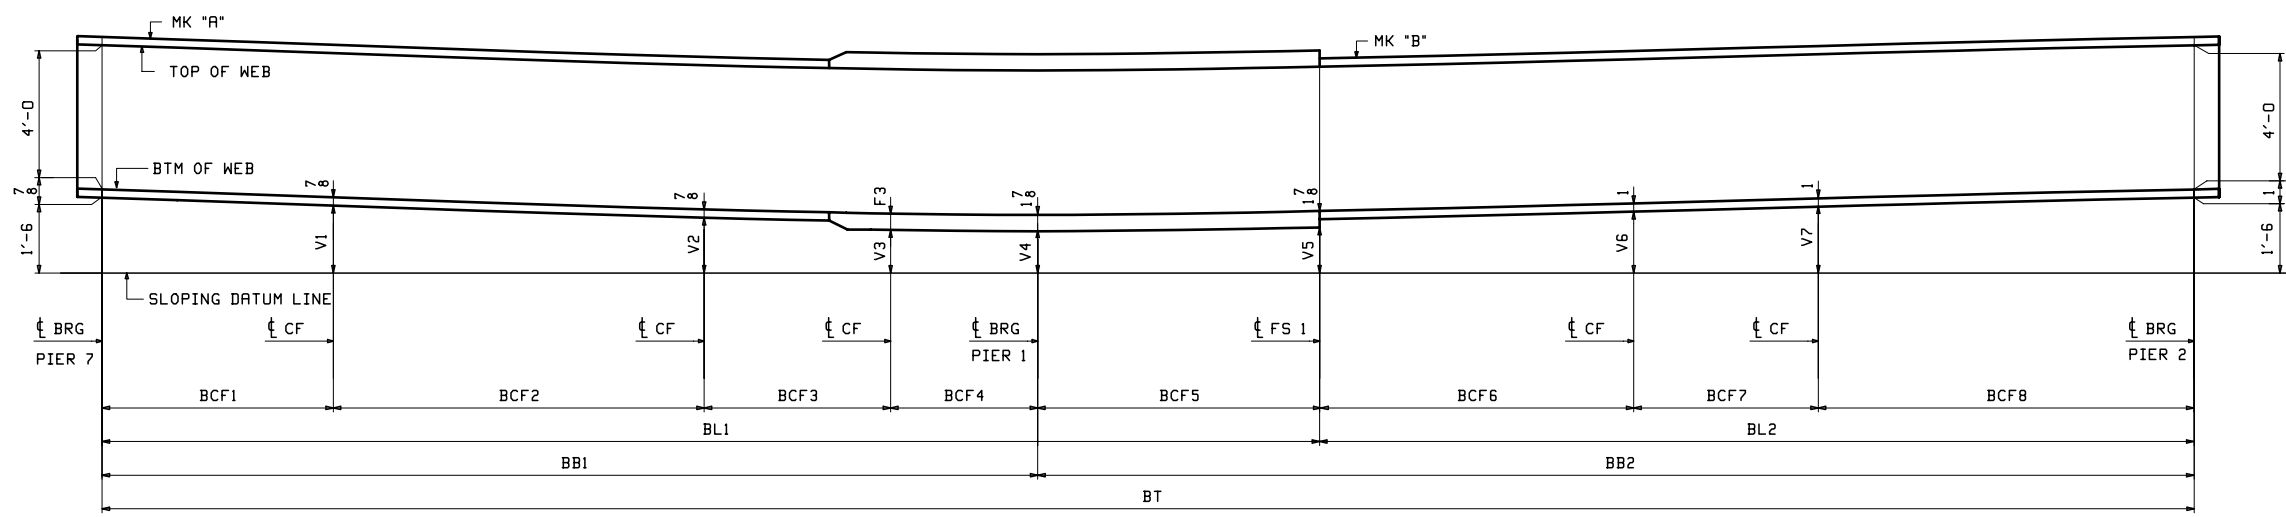


DEVELOPED SECTION A-A  
DIMENSIONS GIVEN ALONG  $\bar{c}$  WEB


LINE	A	B	BT	BL1	BL2	V1	V2	V3	V4	V5	V6	V7	BB1	BB2	BCF1	BCF2	BCF3	BCF4	BCF5	BCF6	BCF7	BCF8	F3
1	101A1	105A2	163'-0 <sup>7</sup> / <sub>8</sub>	95'-0 <sup>3</sup> / <sub>16</sub>	68'-0 <sup>11</sup> / <sub>16</sub>	1'-3 <sup>3</sup> / <sub>4</sub>	1'-1 <sup>7</sup> / <sub>16</sub>	11 <sup>5</sup> / <sub>8</sub>	11 <sup>7</sup> / <sub>16</sub>	1'-0 <sup>1</sup> / <sub>8</sub>	1'-2 <sup>7</sup> / <sub>16</sub>	1'-3 <sup>5</sup> / <sub>16</sub>	72'-11 <sup>1</sup> / <sub>4</sub>	90'-1 <sup>5</sup> / <sub>8</sub>	18'-0 <sup>3</sup> / <sub>8</sub>	28'-11 <sup>1</sup> / <sub>2</sub>	14'-5 <sup>13</sup> / <sub>16</sub>	11'-5 <sup>9</sup> / <sub>16</sub>	22'-0 <sup>15</sup> / <sub>16</sub>	24'-4 <sup>3</sup> / <sub>4</sub>	14'-5 <sup>3</sup> / <sub>4</sub>	29'-2 <sup>3</sup> / <sub>16</sub>	1 <sup>7</sup> / <sub>8</sub>
2	102B1	106B2	160'-8 <sup>1</sup> / <sub>8</sub>	95'-0 <sup>3</sup> / <sub>16</sub>	65'-7 <sup>15</sup> / <sub>16</sub>	1'-4 <sup>1</sup> / <sub>16</sub>	1'-2	1'-0 <sup>1</sup> / <sub>16</sub>	11 <sup>3</sup> / <sub>4</sub>	1'-0 <sup>7</sup> / <sub>16</sub>	1'-2 <sup>9</sup> / <sub>16</sub>	1'-3 <sup>7</sup> / <sub>16</sub>	72'-8 <sup>7</sup> / <sub>8</sub>	87'-11 <sup>1</sup> / <sub>4</sub>	13'-8 <sup>1</sup> / <sub>8</sub>	29'-3 <sup>5</sup> / <sub>8</sub>	14'-7 <sup>7</sup> / <sub>8</sub>	15'-1 <sup>1</sup> / <sub>4</sub>	22'-3 <sup>5</sup> / <sub>16</sub>	21'-3 <sup>1</sup> / <sub>16</sub>	14'-7 <sup>7</sup> / <sub>8</sub>	29'-9	1 <sup>7</sup> / <sub>8</sub>
3	103C1	107C2	158'-3 <sup>9</sup> / <sub>16</sub>	95'-0 <sup>5</sup> / <sub>16</sub>	63'-3 <sup>1</sup> / <sub>4</sub>	1'-4 <sup>1</sup> / <sub>2</sub>	1'-2 <sup>7</sup> / <sub>16</sub>	1'-1 <sup>9</sup> / <sub>16</sub>	1'-0	1'-0 <sup>11</sup> / <sub>16</sub>	1'-2 <sup>11</sup> / <sub>16</sub>	1'-3 <sup>7</sup> / <sub>16</sub>	72'-6 <sup>9</sup> / <sub>16</sub>	85'-9	9'-3 <sup>15</sup> / <sub>16</sub>	29'-7 <sup>7</sup> / <sub>8</sub>	14'-9 <sup>15</sup> / <sub>16</sub>	18'-8 <sup>13</sup> / <sub>16</sub>	22'-5 <sup>3</sup> / <sub>4</sub>	18'-1 <sup>7</sup> / <sub>16</sub>	14'-9 <sup>7</sup> / <sub>8</sub>	30'-3 <sup>15</sup> / <sub>16</sub>	7 <sup>7</sup> / <sub>8</sub>
4	104D1	108D2	155'-11 <sup>1</sup> / <sub>8</sub>	92'-1 <sup>15</sup> / <sub>16</sub>	63'-9 <sup>3</sup> / <sub>8</sub>	1'-4 <sup>3</sup> / <sub>4</sub>	1'-2 <sup>11</sup> / <sub>16</sub>	1'-1 <sup>3</sup> / <sub>4</sub>	1'-0 <sup>3</sup> / <sub>8</sub>	1'-0 <sup>7</sup> / <sub>8</sub>	1'-2 <sup>15</sup> / <sub>16</sub>	1'-3 <sup>3</sup> / <sub>4</sub>	72'-4 <sup>3</sup> / <sub>8</sub>	83'-6 <sup>3</sup> / <sub>4</sub>	5'-0	30'-0	15'-0	22'-4 <sup>3</sup> / <sub>8</sub>	19'-9 <sup>9</sup> / <sub>16</sub>	17'-10 <sup>7</sup> / <sub>16</sub>	15'-0	30'-10 <sup>3</sup> / <sub>4</sub>	7 <sup>7</sup> / <sub>8</sub>

LINE	A	B	WT	WL1	WL2	H1	H2	H3	H4	H5	H6	H7	WB1	WB2	WCF1	WCF2	WCF3	WCF4	WCF5	WCF6	WCF7	WCF8
1	101A1	105A2	162'-8 <sup>3</sup> / <sub>8</sub>	94'-9 <sup>15</sup> / <sub>16</sub>	67'-10 <sup>7</sup> / <sub>16</sub>	1'-10 <sup>1</sup> / <sub>2</sub>	3'-11	4'-5 <sup>13</sup> / <sub>16</sub>	4'-8 <sup>5</sup> / <sub>8</sub>	4'-7 <sup>11</sup> / <sub>16</sub>	3'-8 <sup>15</sup> / <sub>16</sub>	2'-9 <sup>5</sup> / <sub>8</sub>	72'-9	89'-11 <sup>3</sup> / <sub>8</sub>	17'-11 <sup>1</sup> / <sub>4</sub>	28'-10 <sup>9</sup> / <sub>16</sub>	14'-5 <sup>11</sup> / <sub>16</sub>	11'-5 <sup>1</sup> / <sub>2</sub>	22'-0 <sup>15</sup> / <sub>16</sub>	24'-4 <sup>9</sup> / <sub>16</sub>	14'-5 <sup>3</sup> / <sub>8</sub>	29'-0 <sup>1</sup> / <sub>2</sub>
2	102B1	106B2	160'-3 <sup>15</sup> / <sub>16</sub>	94'-10 <sup>1</sup> / <sub>8</sub>	65'-5 <sup>13</sup> / <sub>16</sub>	1'-5 <sup>1</sup> / <sub>8</sub>	3'-7 <sup>1</sup> / <sub>16</sub>	4'-2 <sup>9</sup> / <sub>16</sub>	4'-6 <sup>7</sup> / <sub>16</sub>	4'-5 <sup>1</sup> / <sub>8</sub>	3'-7 <sup>15</sup> / <sub>16</sub>	2'-9 <sup>1</sup> / <sub>8</sub>	72'-6 <sup>13</sup> / <sub>16</sub>	87'-9 <sup>1</sup> / <sub>8</sub>	13'-7 <sup>3</sup> / <sub>16</sub>	29'-2 <sup>11</sup> / <sub>16</sub>	14'-7 <sup>3</sup> / <sub>4</sub>	15'-1 <sup>3</sup> / <sub>8</sub>	22'-3 <sup>5</sup> / <sub>16</sub>	21'-2 <sup>7</sup> / <sub>8</sub>	14'-7 <sup>1</sup> / <sub>2</sub>	29'-7 <sup>7</sup> / <sub>16</sub>
3	103C1	107C2	157'-11 <sup>5</sup> / <sub>8</sub>	94'-10 <sup>5</sup> / <sub>16</sub>	63'-1 <sup>5</sup> / <sub>16</sub>	11 <sup>11</sup> / <sub>16</sub>	3'-3 <sup>1</sup> / <sub>8</sub>	3'-11 <sup>5</sup> / <sub>16</sub>	4'-4 <sup>5</sup> / <sub>16</sub>	4'-2 <sup>9</sup> / <sub>16</sub>	3'-7	2'-8 <sup>5</sup> / <sub>8</sub>	72'-4 <sup>5</sup> / <sub>8</sub>	85'-7	9'-3 <sup>3</sup> / <sub>8</sub>	29'-6 <sup>3</sup> / <sub>4</sub>	14'-9 <sup>3</sup> / <sub>4</sub>	18'-8 <sup>3</sup> / <sub>4</sub>	22'-5 <sup>11</sup> / <sub>16</sub>	18'-1 <sup>5</sup> / <sub>16</sub>	14'-9 <sup>5</sup> / <sub>8</sub>	30'-2 <sup>3</sup> / <sub>8</sub>
4	104D1	108D2	155'-7 <sup>1</sup> / <sub>2</sub>	92'-0 <sup>1</sup> / <sub>8</sub>	63'-7 <sup>3</sup> / <sub>8</sub>	6 <sup>1</sup> / <sub>4</sub>	2'-11 <sup>3</sup> / <sub>16</sub>	3'-8 <sup>1</sup> / <sub>16</sub>	4'-2 <sup>5</sup> / <sub>16</sub>	4'-0 <sup>7</sup> / <sub>8</sub>	3'-6	2'-8 <sup>1</sup> / <sub>8</sub>	72'-2 <sup>9</sup> / <sub>16</sub>	83'-4 <sup>15</sup> / <sub>16</sub>	4'-11 <sup>11</sup> / <sub>16</sub>	29'-10 <sup>13</sup> / <sub>16</sub>	14'-11 <sup>3</sup> / <sub>4</sub>	22'-4 <sup>5</sup> / <sub>16</sub>	19'-9 <sup>9</sup> / <sub>16</sub>	17'-10 <sup>5</sup> / <sub>16</sub>	14'-11 <sup>11</sup> / <sub>16</sub>	30'-9 <sup>3</sup> / <sub>8</sub>



NOTES  
FOR GENERAL NOTES SEE DWG GNI  
ALL DIMENSIONS GIVEN AT BTM OF BTM FLG  
DIMS @ FIELD SPLICES ARE TAKEN TO BTM  
OF THICKER FLG

NO.	DATE	REVISIONS	REMARKS	DPS/W.JL
	5/13/19		REVISED PER APPROVAL COMMENTS	
REVISIONS				
				
STRUCTURE RAMP P OVER IR-74 WB, IR-75 & RAMP E - UNIT 1				
LOCATION CINCINNATI, OH (HAMILTON COUNTY) STR. 230+22.98				
PROJECT NO. HRM-75-3.84, PID NO. 104667, BRIDGE NO. HRM-74-19085				
ENGINEER PRIME AE GROUP				
CONTRACTOR WALSH GROUP				
SHOP ASSEMBLY				
ITEM _____				
SURFACE PREP. _____ OPEN HOLES _____				
PAINT _____				
PRELIMINARY	DRAWN	DPS 03/20/19	SHEET NO.	PLANT
FOR APPROVAL	CHECKED	WJL 04/04/19	BD101	3
			ORDER NO.	FP. NO.
			18060A	

07/11/19 10:28:32 AM C:\Users\jwalsh\OneDrive\Documents\18060A.dwg

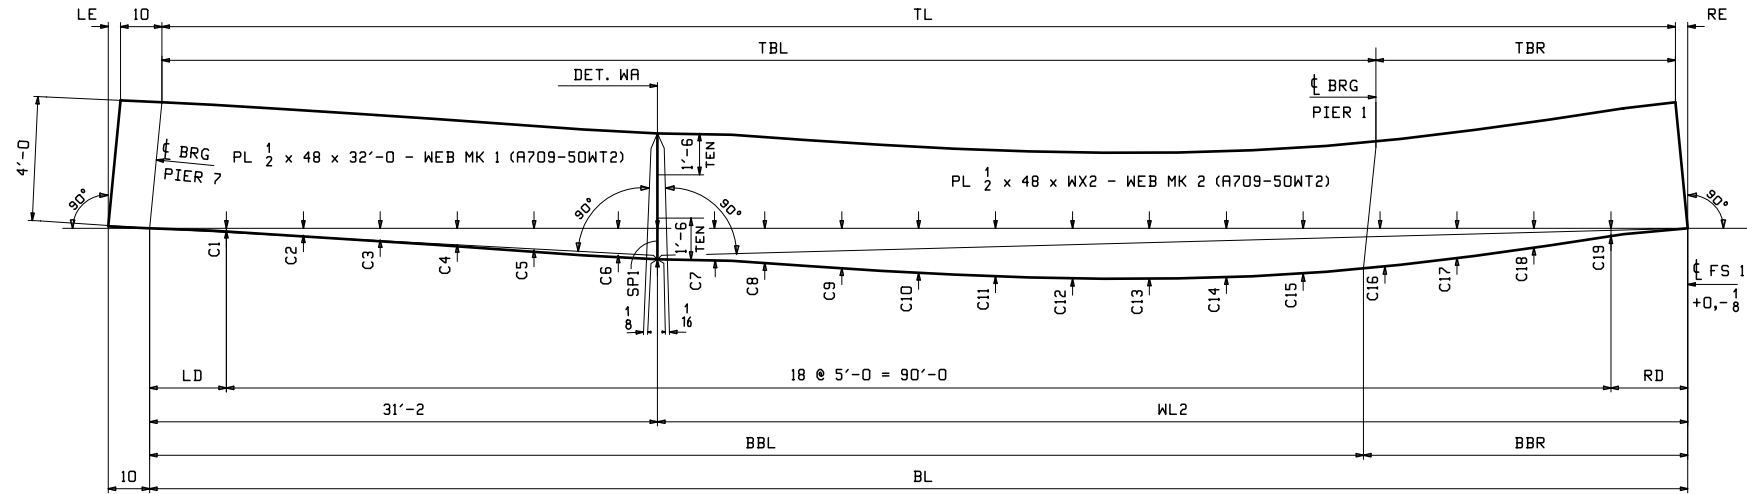


MARK	TL	BL	LE	RE	WL2	WX2	SP1	TBL	TBR	BBL	BBR	LD	RD	C1	C2	C3	C4	C5	C6	C7	C8	C9	C10	C11	C12	C13	C14	C15	C16	C17	C18	C19	WEB MK 1	PG/LINE	WEB MK 2	PG/LINE	
101A1	94'-11 <sup>1</sup> / <sub>16</sub>	95'-0 <sup>3</sup> / <sub>16</sub>	3/4	3/8	63'-10 <sup>3</sup> / <sub>16</sub>	63'-10 <sup>3</sup> / <sub>16</sub>	1 <sup>3</sup> / <sub>16</sub>	72'-11 <sup>5</sup> / <sub>16</sub>	21'-11 <sup>3</sup> / <sub>4</sub>	72'-11 <sup>1</sup> / <sub>4</sub>	22'-0 <sup>15</sup> / <sub>16</sub>	2'-6 <sup>1</sup> / <sub>8</sub>	2'-6 <sup>1</sup> / <sub>16</sub>	1/16	1/4	7/16	5/8	13/16	1/16	1/4	7/16	5/8	1/4	7/8	15/16	15/16	13/16	11/16	11/16	13/8	1/16	11/16	1/4	101WB1	102/8	101WB2	101/28
102B1	94'-10 <sup>15</sup> / <sub>16</sub>	95'-0 <sup>3</sup> / <sub>16</sub>	7/8	3/8	63'-10 <sup>3</sup> / <sub>16</sub>	63'-10 <sup>3</sup> / <sub>16</sub>	1/8	72'-8 <sup>15</sup> / <sub>16</sub>	22'-2	72'-8 <sup>7</sup> / <sub>8</sub>	22'-3 <sup>5</sup> / <sub>16</sub>	2'-6 <sup>1</sup> / <sub>8</sub>	2'-6 <sup>1</sup> / <sub>16</sub>	1/8	5/16	1/2	11/16	13/16	1	1/16	5/16	1/2	5/8	1/4	13/16	13/16	11/16	9/16	5/16	1	5/8	3/16	102WB1	102/8	102WB2	101/28	
103C1	94'-11	95'-0 <sup>5</sup> / <sub>16</sub>	15/16	3/8	63'-10 <sup>5</sup> / <sub>16</sub>	63'-10 <sup>5</sup> / <sub>16</sub>	1/16	72'-6 <sup>5</sup> / <sub>8</sub>	22'-4 <sup>3</sup> / <sub>8</sub>	72'-6 <sup>9</sup> / <sub>16</sub>	22'-5 <sup>3</sup> / <sub>4</sub>	2'-6 <sup>1</sup> / <sub>8</sub>	2'-6 <sup>3</sup> / <sub>16</sub>	1/16	1/4	7/16	5/8	3/4	15/16	1/16	1/4	13/8	1/2	5/8	11/16	11/16	15/8	1/2	5/16	1	5/8	3/16	103WB1	102/10	103WB2	101/28	
104D1	92'-0 <sup>5</sup> / <sub>8</sub>	92'-1 <sup>15</sup> / <sub>16</sub>	15/16	3/8	60'-11 <sup>15</sup> / <sub>16</sub>	60'-11 <sup>15</sup> / <sub>16</sub>	1/8	72'-4 <sup>7</sup> / <sub>16</sub>	19'-8 <sup>3</sup> / <sub>16</sub>	72'-4 <sup>3</sup> / <sub>8</sub>	19'-9 <sup>9</sup> / <sub>16</sub>	1'-1	1'-0 <sup>15</sup> / <sub>16</sub>	1/16	1/4	7/16	5/8	13/16	1	1/8	1/4	13/8	1/2	5/8	15/8	5/8	11/16	13/16	7/8	1/2	1/16	1	104WB1	102/8	104WB2	101/30	

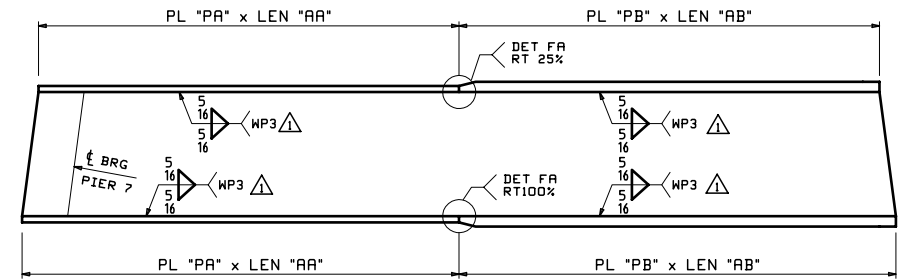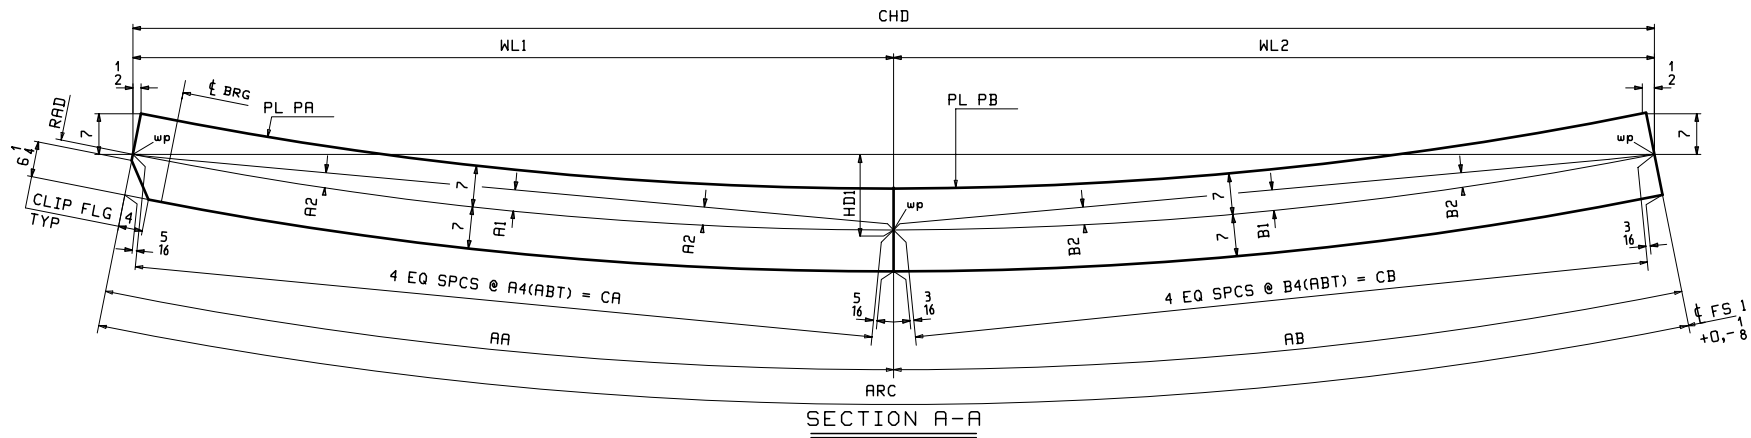


FLANGE DIAGRAM FOR 101A1 - 104D1


LOCATION	RAD	ARC	CHD	AA	AB	A1	A2	A4	CA	B1	B2	B4	CB	WL1	WL2	HD1	PL PA (A709-50WT2)	PL PB (A709-50WT2)
101A1 TOP FLG	695.25	95'-9 <sup>1</sup> / <sub>16</sub>	95'-8 <sup>1</sup> / <sub>8</sub>	57'-10 <sup>1</sup> / <sub>8</sub>	37'-10 <sup>15</sup> / <sub>16</sub>	7 <sup>3</sup> / <sub>16</sub>	5 <sup>7</sup> / <sub>16</sub>	14'-5 <sup>1</sup> / <sub>2</sub>	57'-9 <sup>15</sup> / <sub>16</sub>	3 <sup>1</sup> / <sub>8</sub>	2 <sup>5</sup> / <sub>16</sub>	9'-5 <sup>3</sup> / <sub>4</sub>	37'-10 <sup>7</sup> / <sub>8</sub>	57'-9 <sup>5</sup> / <sub>8</sub>	37'-10 <sup>1</sup> / <sub>2</sub>	1'-6 <sup>15</sup> / <sub>16</sub>	PL 7/8 x 14-101TF1 (101/26)	PL 1 5/8 x 14-101TF2 (101/6)
101A1 BTM FLG	695.25	95'-10 <sup>3</sup> / <sub>16</sub>	95'-9 <sup>1</sup> / <sub>4</sub>	57'-10 <sup>1</sup> / <sub>16</sub>	38'-0 <sup>8</sup> / <sub>8</sub>	7 <sup>3</sup> / <sub>16</sub>	5 <sup>7</sup> / <sub>16</sub>	14'-5 <sup>7</sup> / <sub>16</sub>	57'-9 <sup>7</sup> / <sub>8</sub>	3 <sup>1</sup> / <sub>8</sub>	2 <sup>5</sup> / <sub>16</sub>	9'-6	38'-0 <sup>1</sup> / <sub>16</sub>	57'-9 <sup>9</sup> / <sub>8</sub>	37'-11 <sup>11</sup> / <sub>16</sub>	1'-6 <sup>15</sup> / <sub>16</sub>	PL 7/8 x 14-101BF1 (101/26)	PL 1 7/8 x 14-101BF2 (101/2)
102B1 TOP FLG	703.58	95'-8 <sup>15</sup> / <sub>16</sub>	95'-8 <sup>1</sup> / <sub>16</sub>	57'-10 <sup>1</sup> / <sub>16</sub>	37'-10 <sup>7</sup> / <sub>8</sub>	7 <sup>1</sup> / <sub>8</sub>	5 <sup>3</sup> / <sub>8</sub>	14'-5 <sup>7</sup> / <sub>16</sub>	57'-9 <sup>7</sup> / <sub>8</sub>	3 <sup>1</sup> / <sub>16</sub>	2 <sup>5</sup> / <sub>16</sub>	9'-5 <sup>11</sup> / <sub>16</sub>	37'-10 <sup>13</sup> / <sub>16</sub>	57'-9 <sup>5</sup> / <sub>8</sub>	37'-10 <sup>7</sup> / <sub>16</sub>	1'-6 <sup>11</sup> / <sub>16</sub>	PL 7/8 x 14-102TF1 (101/26)	PL 1 5/8 x 14-102TF2 (101/6)
102B1 BTM FLG	703.58	95'-10 <sup>3</sup> / <sub>16</sub>	95'-9 <sup>5</sup> / <sub>16</sub>	57'-10 <sup>1</sup> / <sub>16</sub>	38'-0 <sup>8</sup> / <sub>8</sub>	7 <sup>1</sup> / <sub>8</sub>	5 <sup>3</sup> / <sub>8</sub>	14'-5 <sup>7</sup> / <sub>16</sub>	57'-9 <sup>7</sup> / <sub>8</sub>	3 <sup>1</sup> / <sub>16</sub>	2 <sup>5</sup> / <sub>16</sub>	9'-6	38'-0 <sup>1</sup> / <sub>16</sub>	57'-9 <sup>5</sup> / <sub>8</sub>	37'-11 <sup>11</sup> / <sub>16</sub>	1'-6 <sup>3</sup> / <sub>4</sub>	PL 7/8 x 14-102BF1 (101/26)	PL 1 7/8 x 14-102BF2 (101/2)
103C1 TOP FLG	711.92	95'-9	95'-8 <sup>1</sup> / <sub>8</sub>	57'-10 <sup>3</sup> / <sub>16</sub>	37'-10 <sup>13</sup> / <sub>16</sub>	7 <sup>1</sup> / <sub>16</sub>	5 <sup>5</sup> / <sub>16</sub>	14'-5 <sup>1</sup> / <sub>2</sub>	57'-10	3	2 <sup>1</sup> / <sub>4</sub>	9'-5 <sup>11</sup> / <sub>16</sub>	37'-10 <sup>3</sup> / <sub>4</sub>	57'-9 <sup>3</sup> / <sub>4</sub>	37'-10 <sup>3</sup> / <sub>8</sub>	1'-6 <sup>7</sup> / <sub>16</sub>	PL 7/8 x 14-103TF1 (101/26)	PL 1 5/8 x 14-103TF2 (101/6)
103C1 BTM FLG	711.92	95'-10 <sup>5</sup> / <sub>16</sub>	95'-9 <sup>7</sup> / <sub>16</sub>	57'-10 <sup>1</sup> / <sub>16</sub>	38'-0 <sup>3</sup> / <sub>16</sub>	7 <sup>1</sup> / <sub>16</sub>	5 <sup>5</sup> / <sub>16</sub>	14'-5 <sup>1</sup> / <sub>2</sub>	57'-9 <sup>15</sup> / <sub>16</sub>	3 <sup>1</sup> / <sub>16</sub>	2 <sup>5</sup> / <sub>16</sub>	9'-6 <sup>1</sup> / <sub>16</sub>	38'-0 <sup>8</sup> / <sub>8</sub>	57'-9 <sup>11</sup> / <sub>16</sub>	37'-11 <sup>3</sup> / <sub>4</sub>	1'-6 <sup>2</sup> / <sub>2</sub>	PL 7/8 x 14-103BF1 (101/26)	PL 1 7/8 x 14-103BF2 (101/2)
104D1 TOP FLG	720.25	92'-10 <sup>5</sup> / <sub>8</sub>	92'-9 <sup>7</sup> / <sub>8</sub>	57'-11 <sup>7</sup> / <sub>8</sub>	34'-10 <sup>3</sup> / <sub>4</sub>	7	5 <sup>1</sup> / <sub>4</sub>	14'-5 <sup>15</sup> / <sub>16</sub>	57'-11 <sup>11</sup> / <sub>16</sub>	2 <sup>9</sup> / <sub>16</sub>	1 <sup>8</sup> / <sub>8</sub>	8'-8 <sup>11</sup> / <sub>16</sub>	34'-10 <sup>11</sup> / <sub>16</sub>	57'-11 <sup>1</sup> / <sub>2</sub>	34'-10 <sup>3</sup> / <sub>8</sub>	1'-4 <sup>13</sup> / <sub>16</sub>	PL 7/8 x 14-104TF1 (101/26)	PL 1 5/8 x 14-104TF2 (101/8)
104D1 BTM FLG	720.25	92'-11 <sup>15</sup> / <sub>16</sub>	92'-11 <sup>3</sup> / <sub>16</sub>	57'-11 <sup>13</sup> / <sub>16</sub>	35'-0 <sup>1</sup> / <sub>8</sub>	7	5 <sup>1</sup> / <sub>4</sub>	14'-5 <sup>15</sup> / <sub>16</sub>	57'-11 <sup>5</sup> / <sub>8</sub>	2 <sup>9</sup> / <sub>16</sub>	1 <sup>15</sup> / <sub>16</sub>	8'-9	35'-0 <sup>1</sup> / <sub>16</sub>	57'-11 <sup>7</sup> / <sub>16</sub>	34'-11 <sup>3</sup> / <sub>4</sub>	1'-4 <sup>7</sup> / <sub>8</sub>	PL 7/8 x 14-104BF1 (101/26)	PL 1 7/8 x 14-104BF2 (101/4)

NOTES:  
 1. FOR GENERAL NOTES SEE DRAWING GN1001.  
 2. T2 DENOTES MATERIAL SUBJECT TO CHARPY V-NOTCH TEST AT H FREQ. FOR ZONE 2


NO.	04/19/19	REV WELD PROCEDURE NUMBER. ADD F.P.NO.	WJL
NO.	DATE	REMARKS	BY
REVISIONS			
 <b>Veritas STEEL</b> 2-EAU CLAIRE, WI 3-WAUSAU, WI 4-PALATKA, FL TENSOR 3536-1			
STRUCTURE	RAMP P OVER IR-74 WB, IR-75 & RAMP E - UNIT 1		
LOCATION	CINCINNATI, OH (HAMILTON COUNTY) STA. 230+22.98		
PROJECT NO.	HAM-75-3.84, PID NO. 104667, BRIDGE NO. HAM-74-1908S		
ENGINEER	PRIME AE GROUP		
CONTRACTOR	WALSH GROUP		
WEB & FLANGE CUTTING			
ITEM			
SURFACE PREP.	OPEN HOLES		
PAINT			
PRELIMINARY	DRAWN	ELG 02/12/19	SHEET NO. PLANT ORDER NO. F.P. NO.
FOR APPROVAL	CHECKED	WJL 04/01/19	<b>BG101</b> 3 18060A 20

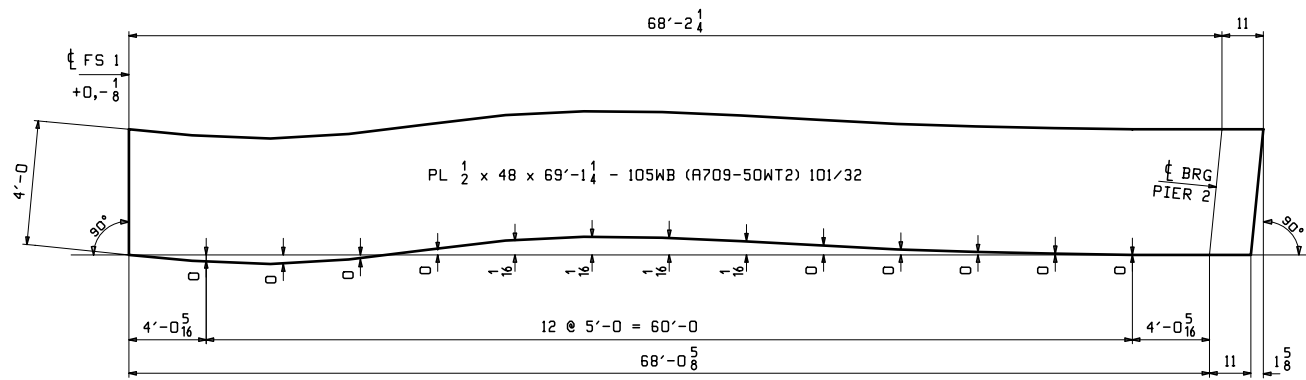


**CAMBER DIAGRAM FOR 105A2**

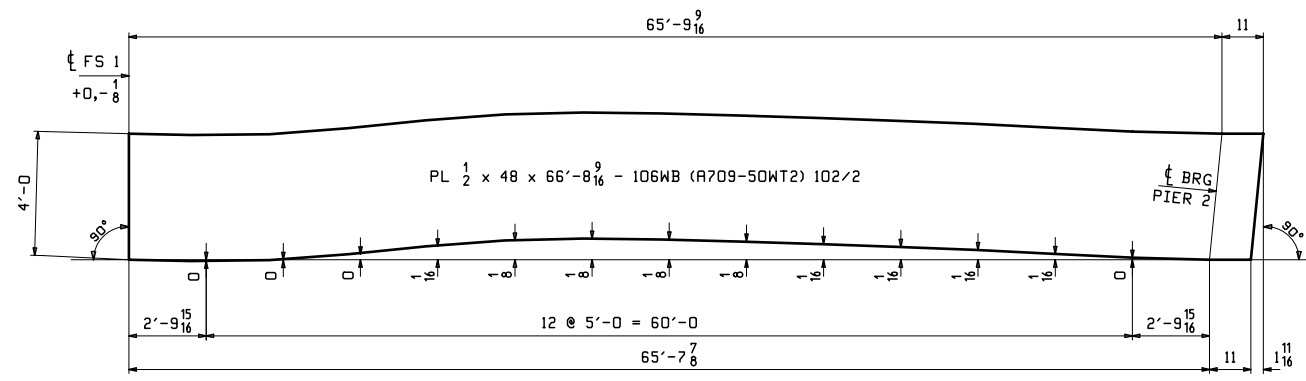


**CAMBER DIAGRAM FOR 106B2**

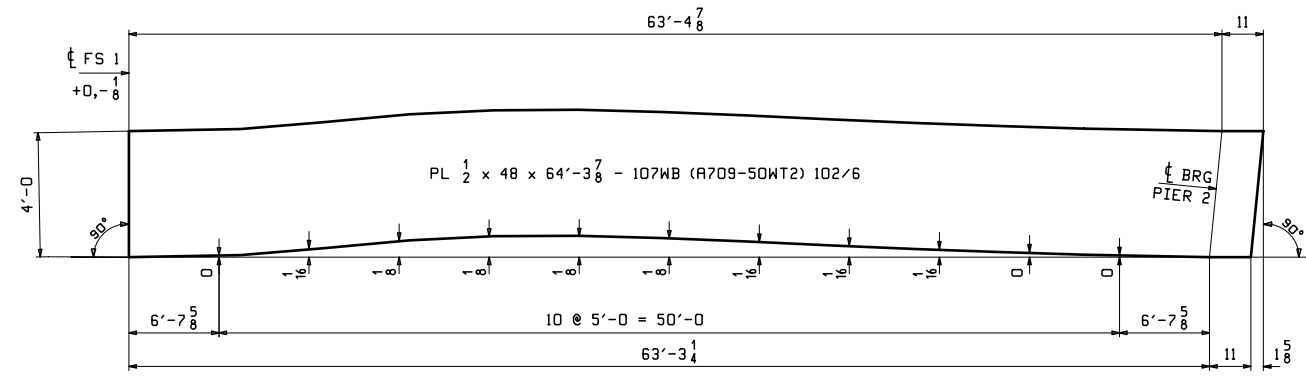


**CAMBER DIAGRAM FOR 107C2**

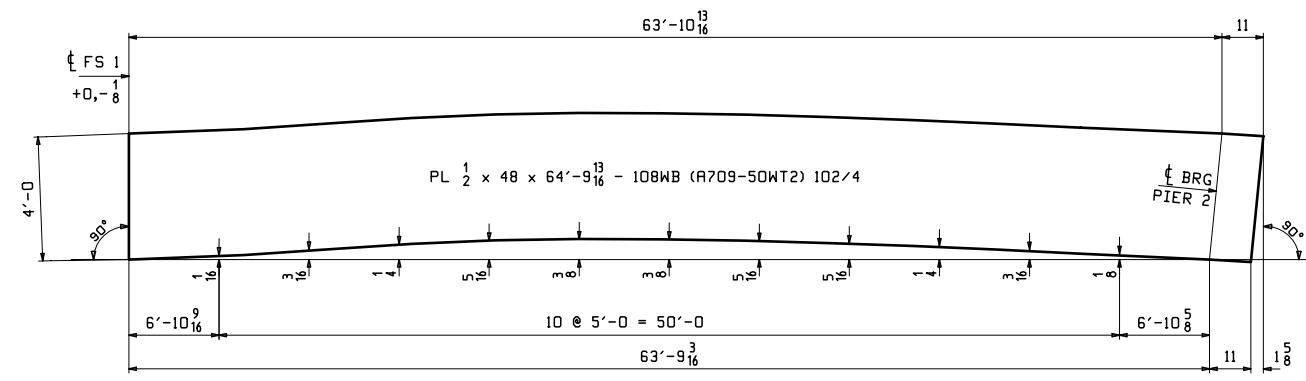

**CAMBER DIAGRAM FOR 108D2**

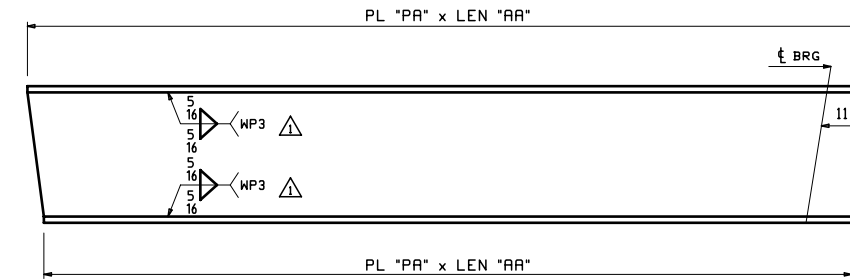


**FLANGE DIAGRAM FOR 105A2 - 108D2**

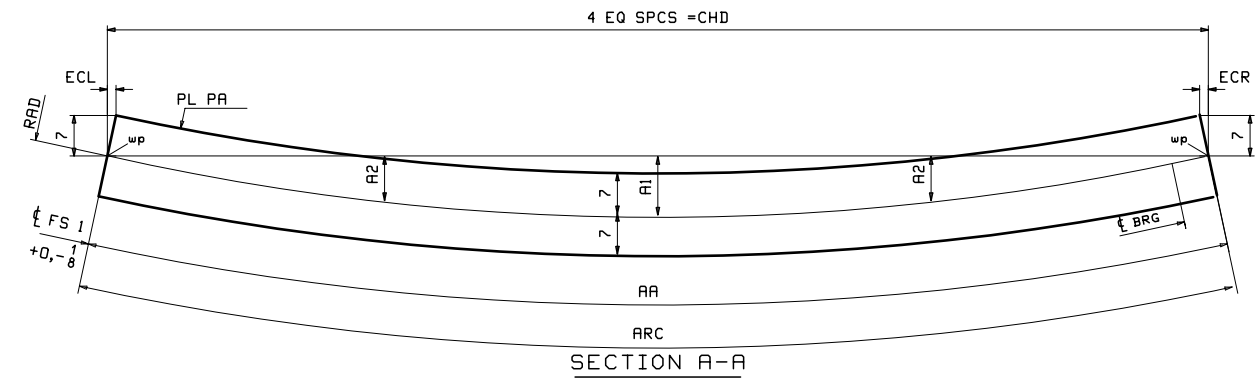


LOCATION	RAD	ARC	CHD	AA	A1	A2	ECL	ECR	PL PA (A709-50WT2)
105A2 TOP FLG	695.25	69'-1 1/4	69'-0 15/16	69'-1 1/4	10 5/16	7 3/4	3/8	3/8	PL 7/8 x 14-105TF (101/18)
105A2 BTM FLG	695.25	68'-11 5/8	68'-11 5/8	68'-11 5/8	10 1/4	7 11/16	3/8	3/8	PL 1 x 14-105BF (101/10)
106B2 TOP FLG	703.58	66'-8 9/16	66'-8 1/4	66'-8 9/16	9 1/2	7 1/8	5/16	5/16	PL 7/8 x 14-106TF (101/20)
106B2 BTM FLG	703.58	66'-6 7/8	66'-6 9/16	66'-6 7/8	9 7/16	7 1/16	5/16	5/16	PL 1 x 14-106BF (101/12)
107C2 TOP FLG	711.92	64'-3 7/8	64'-3 5/8	64'-3 7/8	8 11/16	6 1/2	5/16	5/16	PL 7/8 x 14-107TF (101/24)
107C2 BTM FLG	711.92	64'-2 1/4	64'-2	64'-2 1/4	8 11/16	6 1/2	5/16	5/16	PL 1 x 14-107BF (101/16)
108D2 TOP FLG	720.25	64'-9 13/16	64'-9 9/16	64'-9 13/16	8 3/4	6 9/16	5/16	5/16	PL 7/8 x 14-108TF (101/22)
108D2 BTM FLG	720.25	64'-8 3/8	64'-7 15/16	64'-8 3/8	8 11/16	6 1/2	5/16	5/16	PL 1 x 14-108BF (101/14)

- NOTES:**
- FOR GENERAL NOTES SEE DRAWING GN1001.
  - T2 DENOTES MATERIAL SUBJECT TO CHARNY V-NOTCH TEST AT H FREQ. FOR ZONE 2

NO.	DATE	REVISIONS	REMARKS	BY
	04/19/19		REV WELD PROCEDURE NUMBER. ADD F.P.NO.	WJL
				
STRUCTURE	RAMP P OVER IR-74 WB, IR-75 & RAMP E - UNIT 1			
LOCATION	CINCINNATI, OH (HAMILTON COUNTY) STA. 230+22.98			
PROJECT NO.	HAM-75-3.84, PID NO. 104667, BRIDGE NO. HAM-74-19085			
ENGINEER	PRIME AE GROUP			
CONTRACTOR	WALSH GROUP			
ITEM	WEB & FLANGE CUTTING			
SURFACE PREP.	OPEN HOLES			
PAIN				
PRELIMINARY	DRAWN	ELG 02/12/19	SHEET NO.	PLANT
FOR APPROVAL	CHECKED	WJL 04/01/19	BG102	3 18060A
				FF. NO. 20


ECD: F:\\_Proj\_18\_2018\_08\545450.DWG 7/24/2019 10:55:11 AM 1/28/2019 10:55:11 AM 1/28/2019 10:55:11 AM

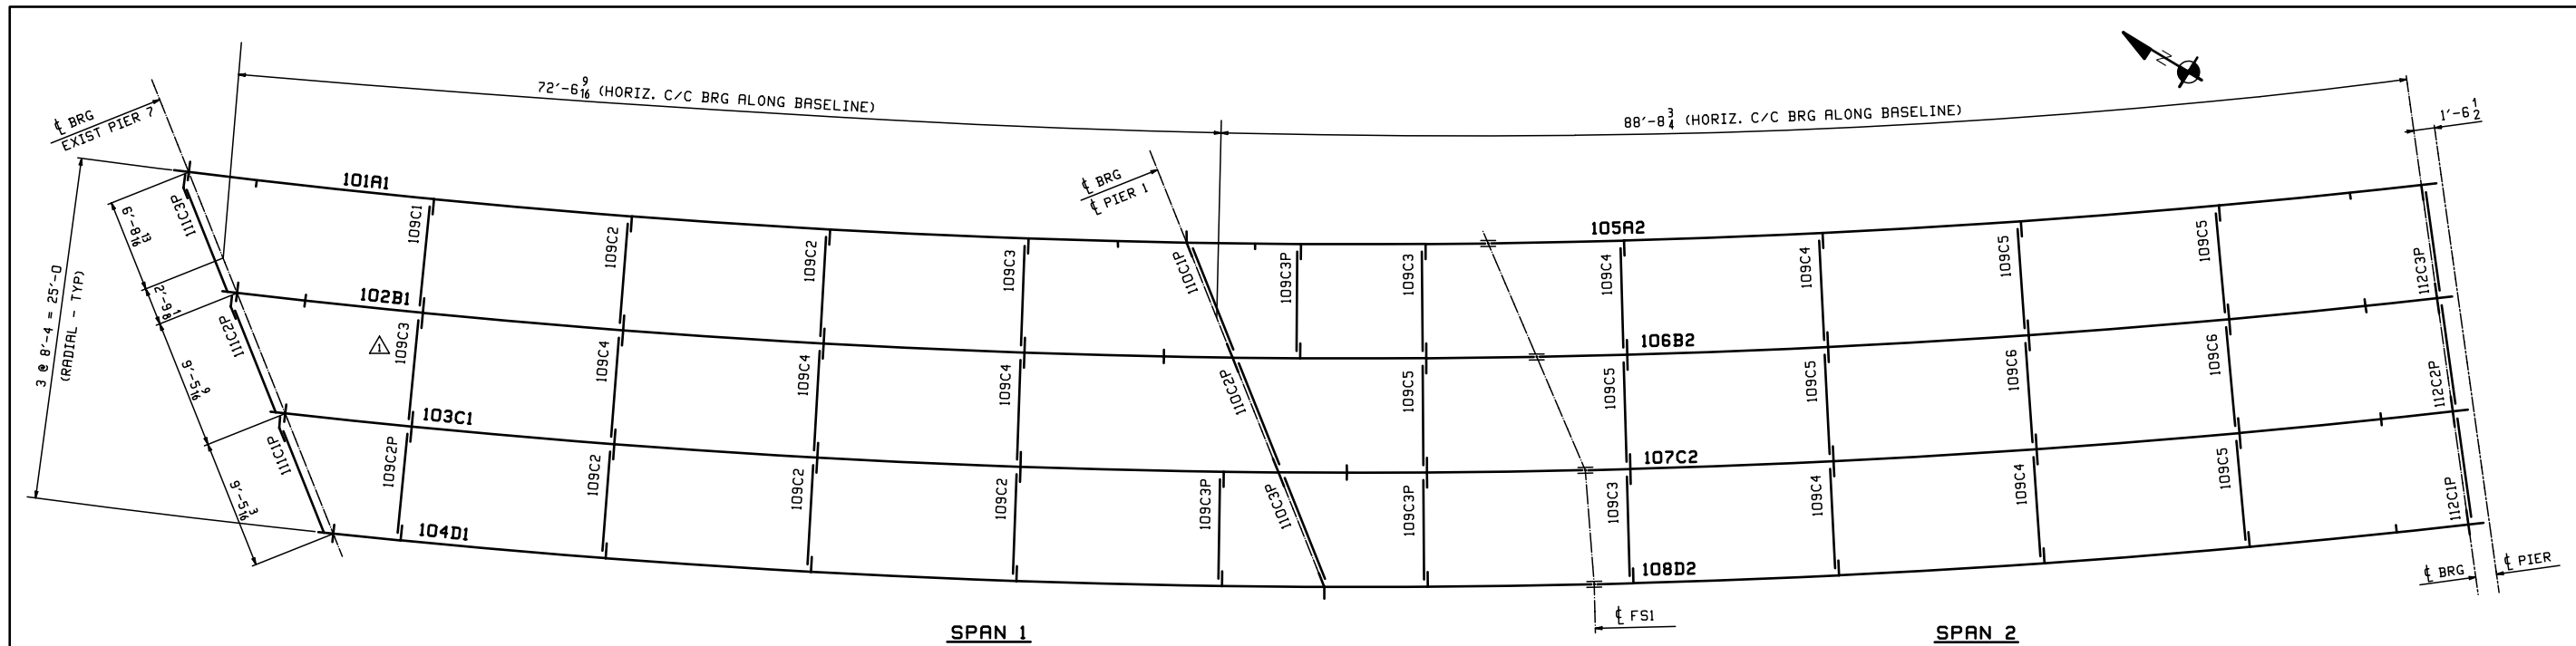

**FRAMING PLAN**

SAMPLE CROSSFRAME MARK ON FRAMING PLAN → 109C1 P  
 CORRESPONDING STRUT AND DIAGONAL MARKS  
 STRUT MARK → 109C1AP  
 DIAGONAL MARK → 109C1BP  
 DIAGONAL MARK → 109C1CP  
 SHEET NUMBER (VARIES) TYPICAL  
 P INDICATES PRIME COATED MEMBER  
 SUFFIX (SEE DETAILS BELOW FOR PLACEMENT)  
 FRAME NUMBER (VARIES)

**SAMPLE INT. CROSSFRAME MARK**

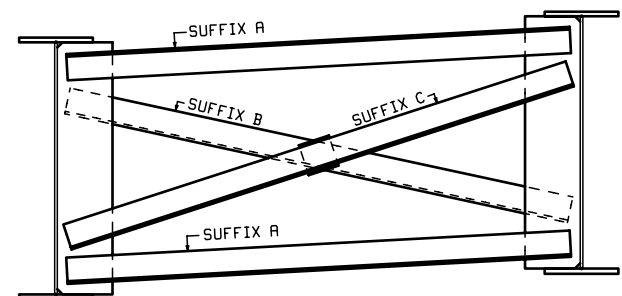


**INT CROSSFRAME MARK LOCATION**

(LOOKING UP-STATION)

SAMPLE CROSSFRAME MARK ON FRAMING PLAN → 110C1 P  
 CORRESPONDING STRUT AND DIAGONAL MARKS  
 TOP STRUT MARK → 110C1AP  
 BTM STRUT MARK → 110C1DP  
 DIAGONAL MARK → 110C1BP  
 DIAGONAL MARK → 110C1CP  
 SHEET NUMBER (VARIES) TYPICAL  
 P INDICATES PRIME COATED MEMBER  
 SUFFIX (SEE DETAILS BELOW FOR PLACEMENT)  
 FRAME NUMBER (VARIES)

**SAMPLE PIER 1 CROSSFRAME MARK**

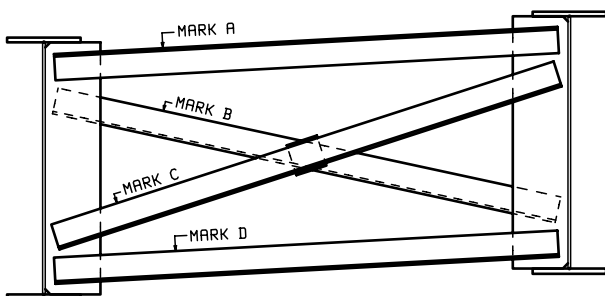

**PIER 1 CROSSFRAME MARK LOCATION**

(LOOKING UP-STATION)

**NOTES:**

1. ALL DIMENSIONS SHOWN ARE IN THE HORIZONTAL PLANE.
2. ALL STEEL SHALL BE ERECTED WITH THE SHIPPING MARK IN THE SAME RELATIVE POSITION AS SHOWN ON THE ERECTION PLANS.
3. IN WEB SPLICE PLATES, BOLT HEADS SHALL BE PLACED ON THE EXPOSED SIDE OF THE FASCIA GIRDERS. IN BOTTOM FLANGE SPLICE, BOLT HEADS SHALL BE PLACED ON THE BOTTOM SURFACE OF THE BOTTOM FLANGE SPLICE PLATES.

**NOTICE TO ERECTOR**

BACKCHARGES FOR CORRECTIVE WORK OR REPLACED MATERIALS WILL NOT BE ACCEPTED UNLESS EXPRESSLY AUTHORIZED BY VERITAS STEEL BEFORE ANY SUCH COSTS ARE INCURRED.

WORK THIS SHEET WITH SHEET E102

INDEX OF SHEETS			
E101	FRAMING PLAN	BD101 & BD102	BLOCKING DIAGRAMS
E102	FRAMING DETAILS	FB101	FIELD BOLTS
GN101	GENERAL NOTES	SB101	SHIPPING BOLTS
PI01	PAINT NOTES	X101	FIELD SPLICE DETAILS
TD101 & TD102	TYPICAL LAYOUTS	X102	GIRDER STANDARDS
WS101	CALCULATION PLAN	101 - 108	GIRDER DETAILS
BG101 & BG102	CAMBER/FLANGE DIAGRAMS	109AB - 110	INT./PIER CROSSFRAMES
R101	RADIOGRAPH SHEET	111 & 112	END CROSSFRAMES

5/15/19		REVISED CROSSFRAME MARK	DPS/WJL
NO.	DATE	REMARKS	BY
REVISIONS			
 2-EAU CLAIRE, WI 3-WAUSAU, WI 4-PALATKA, FL			
STRUCTURE	RAMP P OVER IR-74 WB, IR-75 & RAMP E - UNIT 1		
LOCATION	CINCINNATI, OH (HAMILTON COUNTY) STA. 230+22.98		
PROJECT NO.	HAM-75-3.84, PID NO. 104667, BRIDGE NO. HAM-74-19085		
ENGINEER	PRIME AE GROUP		
CONTRACTOR	WALSH GROUP		
ITEM	FRAMING PLAN		
SURFACE PREP.	OPEN HOLES		
PAINT			
PRELIMINARY	DRAWN DPS 03/20/19	SHEET NO.	PLANT ORDER NO. FP. NO.
FOR APPROVAL	CHECKED WJL 04/05/19	E101	3 18060A

DATE: MAY 15, 2019 10:40:04 AM C:\p1\ham75\384\19085-1\CROSS 1.DWG

FIELD BOLT LIST							A325 Type 3 BOLTS				WASHER CODES	PIECES CONNECTED AND REMARKS
LINE	NO. REQ'D.	BOLT DIAH.	BOLT LEN.	BOLTS # OF CONN.	GRIP	THICKNESS OF PCS. CONNECTED						
1												FIELD SPLICE 1
2	128	1	5 1/2	32	4	3 1/2	1	1 1/8	1 1/8			1 TOP FLANGE SPLICE
3	192	1	2 3/4	48	4	1 1/4	3	1 1/2	3			1 WEB SPLICE
4	128	1	5 1/2	32	4	4	1	1 1/8	1 1/8			1 BOTTOM FLANGE SPLICE
5												

1: 1 Hard Flat Washer

FIELD BOLT LIST							A490 Type 3 BOLTS				WASHER CODES	PIECES CONNECTED AND REMARKS
LINE	NO. REQ'D.	BOLT DIAH.	BOLT LEN.	BOLTS # OF CONN.	GRIP	THICKNESS OF PCS. CONNECTED						
6												INT CROSSFRAME - CF1
7	200	1 1/4	3	8	25	1	1 1/2	1 1/2				2 TOP/BTM STRUT-STIFF
8	200	1 1/4	3	8	25	1	1 1/2	1 1/2				2 DIAG-STIFF
9	25	1 1/4	3 1/2	1	25	1 1/2	1 1/2	1 1/2				2 DIAG-FILL PL-DIAG
10												

2: 2 Hard Flat Washers

FIELD BOLT LIST							A490 Type 3 F1136 ANNEX A1				WASHER CODES	PIECES CONNECTED AND REMARKS
LINE	NO. REQ'D.	BOLT DIAH.	BOLT LEN.	BOLTS # OF CONN.	GRIP	THICKNESS OF PCS. CONNECTED						
11												INT CROSSFRAME - CF1
12	32	1 1/4	3	8	4	1	1 1/2	1 1/2				2 TOP/BTM STRUT-STIFF
13	32	1 1/4	3	8	4	1	1 1/2	1 1/2				2 DIAG-STIFF
14	4	1 1/4	3 1/2	1	4	1 1/2	1 1/2	1 1/2				2 DIAG-FILL PL-DIAG
15												
16												PIER CROSSFRAME - CF1
17	24	1 1/4	3 1/2	8	3	1 1/2	1 1/2	1				2 TOP/BTM STRUT-STIFF
18	24	1 1/4	3 1/2	8	3	1 1/2	1 1/2	1				2 DIAG-STIFF
19	3	1 1/4	4	1	3	2	1 1/2	1 1/2				2 DIAG-FILL PL-DIAG


2: 2 Hard Flat Washers

(CONNECTIONS TO PAINTED GIRDER CONNECTION PLATES ONLY)


ROT'L CAPACITY TEST REQ'D

LINE	SHIP MARK	NO. OF PCS.	ASS'Y MARK	MATERIAL				REMARKS
				SHAPE	LENGTH FT. IN.	MATERIAL SPEC.	ITEM NO.	
1				FIELD BOLTS				5x + 5 ADDED (ACTUAL COUNT)
2								
3		72	bpk6	1 1/4 HSB	0 3	A490-3	DB 5	(64)RSTM F1136 ANNEX A1
4		60	bpn6	1 1/4 HSB	0 3 1/2	A490-3	DB 7	(52)RSTM F1136 ANNEX A1
5		8	bpt6	1 1/4 HSB	0 4	A490-3	DB 9	(3)RSTM F1136 ANNEX A1
6		80	wg6	1 1/4 HSW		F436-3	DB 28	(238)RSTM F1136 ANNEX A1
7		140	ng6	1 1/4 HHN		A563	DB 29	(119)RSTM F1136 ANNEX A1
8								
9		425	bpk6	1 1/4 HSB	0 3	A490-3	DB 5	(400) FP-88
10		31	bpn6	1 1/4 HSB	0 3 1/2	A490-3	DB 7	(25) FP-88
11		912	wg6	1 1/4 HSW		F436-3	DB 28	(850) FP-88
12		456	ng6	1 1/4 HHN		A563	DB 29	(425) FP-88
13								
14		207	bgg3	1 HSB	0 2 1/4	A325-3	DB 4	(192) FP-88
15		274	bkc3	1 HSB	0 5 1/2	A325-3	DB 7	(256) FP-88
16		481	wd3	1 HSW		F436-3	DB 28	(448) FP-88
17		481	nd3	1 HHN		A563	DB 29	(448) FP-88
18								
19								
NOTE: FOR GENERAL NOTES SEE SHEET GNI.

NO.	DATE	REMARKS	BY
REVISIONS			
			
STRUCTURE	RAMP P OVER IR-74 WB, IR-75 & RAMP E - UNIT 1		
LOCATION	CINCINNATI, OH (HAMILTON COUNTY) STA. 230+22.98		
PROJECT NO.	HAM-75-3.84, PID NO. 104667, BRIDGE NO. HAM-74-19085		
ENGINEER	PRIME AE GROUP		
CONTRACTOR	WALSH GROUP		
FIELD BOLTS			
ITEM			
SURFACE PREP.	OPEN HOLES		
PAIN			
PRELIMINARY	DRAWN	DPS 03/20/19	SHEET NO. PLANT ORDER NO. FP. NO.
FOR APPROVAL	CHECKED	WJL 04/05/19	FB101 3 18060A 86

DPS Wed, Nov 15, 2018 10:08:42 PM C:\msd\18060A\FB101\_1.dwg


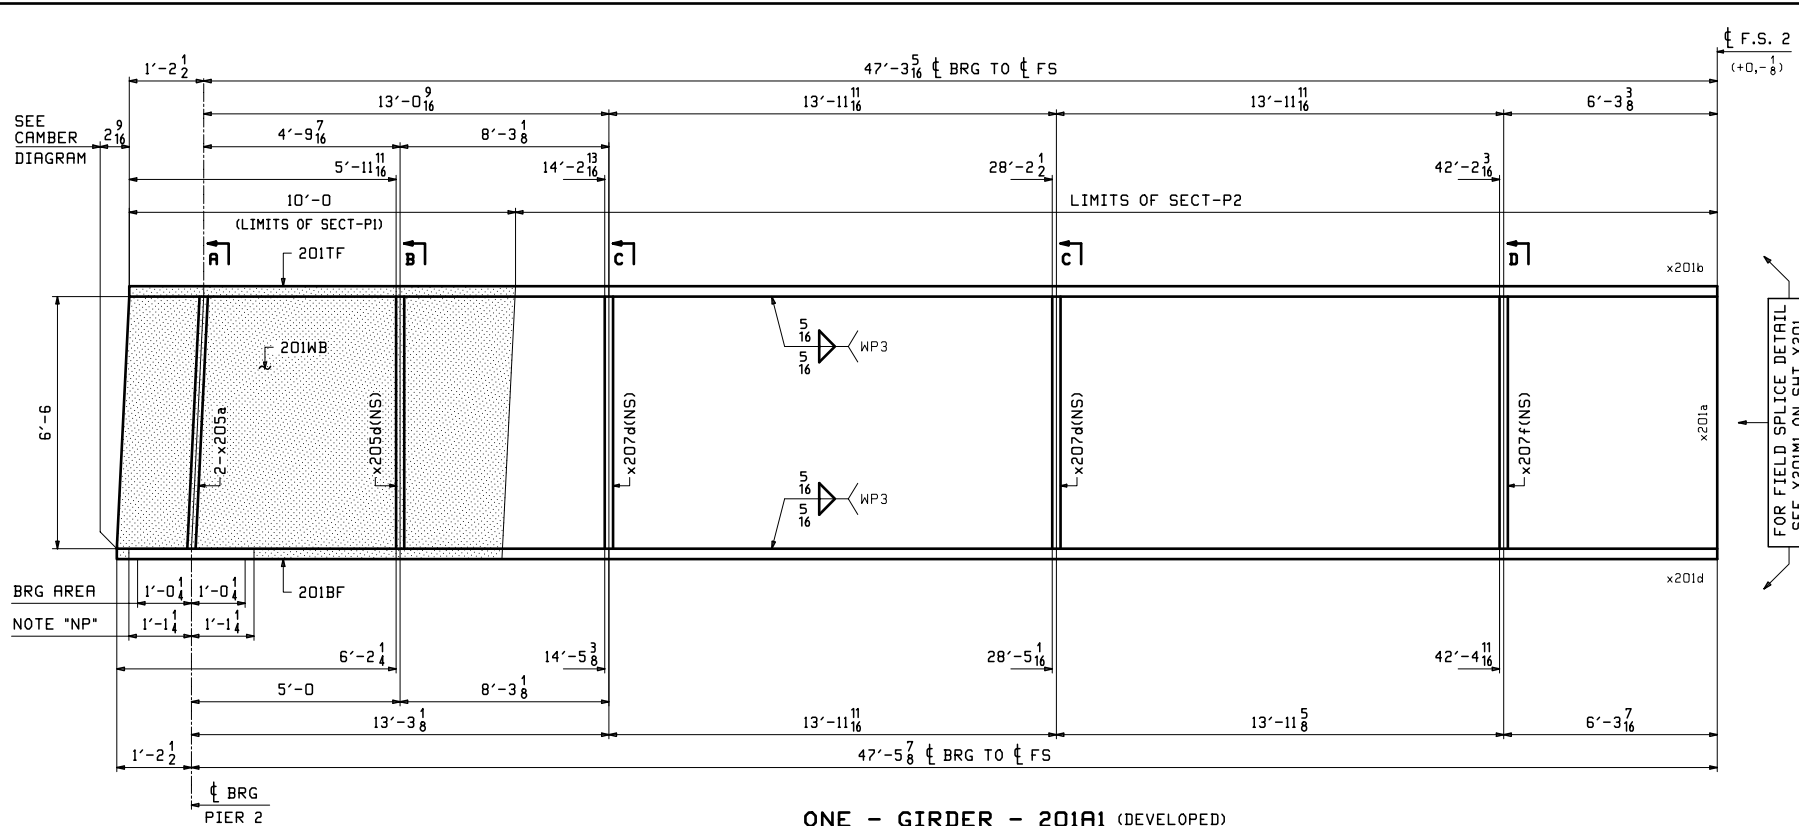


ONE - GIRDER - 201A1 (DEVELOPED)

1. FOR GENERAL NOTES SEE SHEET GNI.
2. FOR PAINT NOTES SEE SHEET P1.
3. FOR FIELD SPLICE DETAIL SEE SHEET X201.
4. FOR GIRDER STANDARD DETAILS SEE SHEETS X205-X207.
5. FOR CAMBER & FLANGE DIAGRAMS SEE SHEET BG201 & BG202.
6. "T2" DENOTES MATERIAL SUBJECT TO CHARPY V-NOTCH TESTING.
7. BRG AREA - DENOTES FLANGE TO BE FLAT & TRUE.
8. SEE SHEET P1 FOR SECT-P1, SECT-P2 & NOTE "NP".


ITEM	SHIP MARK	NO. OF PCS.	ASS'Y MARK	MATERIAL				REMARKS
				SHAPE	LENGTH FT. IN.	MATERIAL SPEC.	ITEM NO.	
1	201A1	1		GIRDER				13513
2								
3		1	201WB	PL 1/2x78	48 8 3/8	A709-50WT2	205-2	FP:20
4		1	201TF	PL 1x16	48 5 1/2	A709-50WT2	204-3	FP:20
5		1	201BF	PL 1x16	48 8 3/8	A709-50WT2	204-5	FP:20
6								
7		2	x205a	PL 1x8	6 6 1/2	A709-50WT2	208-2	MIE FP:20
8		1	x205d	PL 1/2x10 1/2	6 6	A709-50WT2	208-3	FP:20
9		2	x207d	PL 1/2x14 1/2	6 6	A709-50WT2	208-3	FP:20
10		1	x207f	PL 2x14 1/2	6 6	A709-50WT2	208-7	FP:20
11								

FOR FIELD SPLICE DETAIL SEE X201 ON SHIT X201

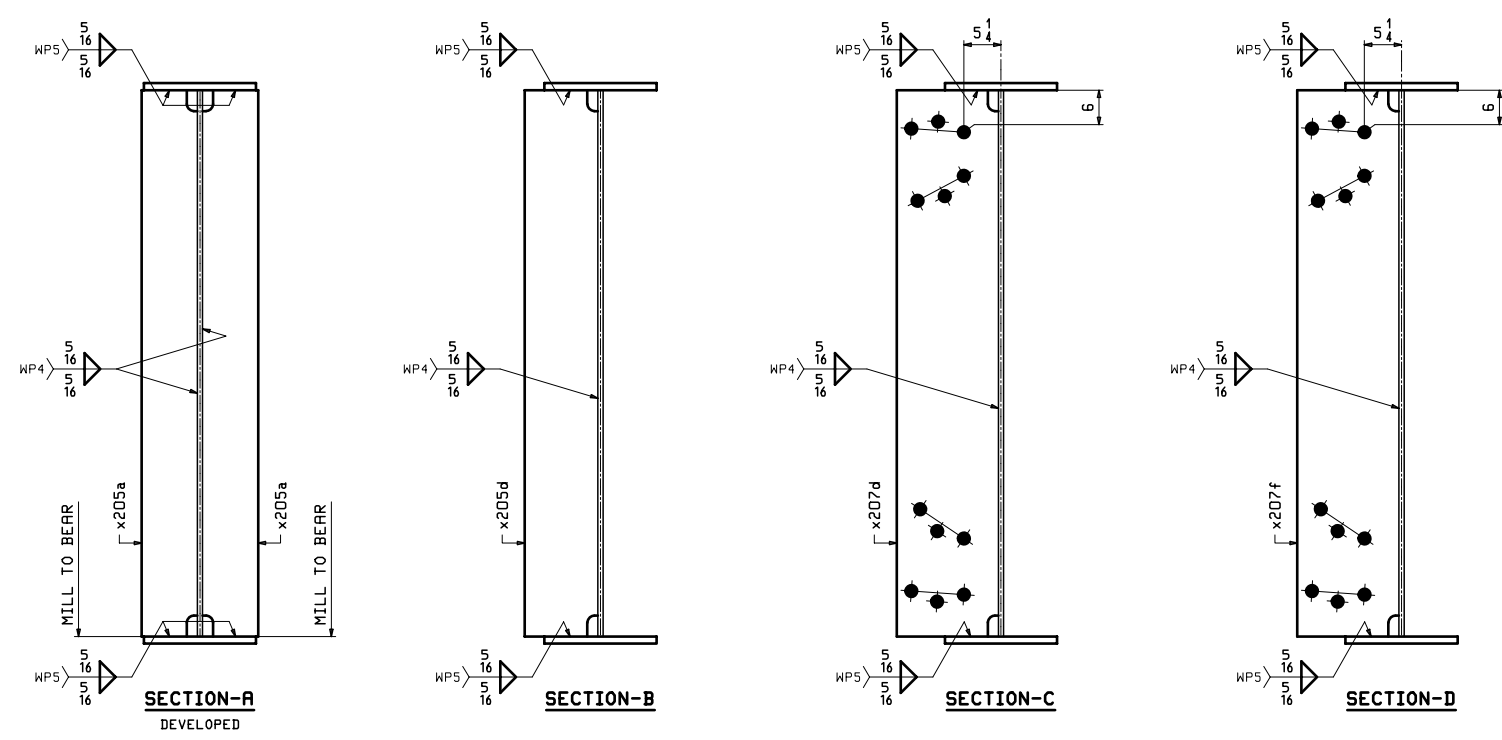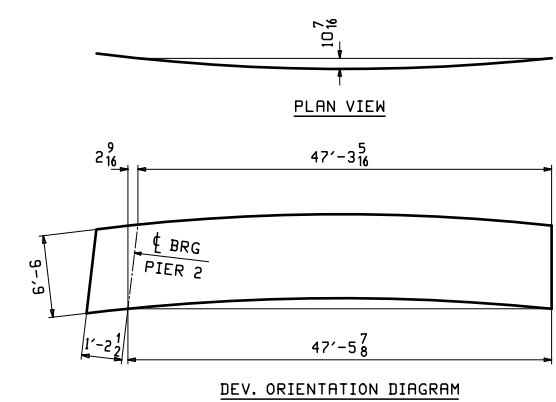

NO.	DATE	REMARKS	BY
REVISIONS			
STRUCTURE RAMP P OVER IR-74 WB, IR-75 & RAMP E - UNIT 2 LOCATION CINCINNATI, OH (HAMILTON COUNTY) STA. 230+22.98 PROJECT NO. HAM-75-3.84, PID NO. 104667, BRIDGE NO. HAM-74-19085 ENGINEER PRIME RE GROUP CONTRACTOR WALSH GROUP			
GIRDER ~ 201A1			
ITEM SEE P1			
SURFACE PREP. SEE P1 & AS NOTED			
PAINT SEE P1 & AS NOTED			
PRELIMINARY	DRAWN EEO 04/09/19	SHEET NO. 201	PLANT ORDER NO. 180608
FOR APPROVAL	CHECKED WJL 04/15/19		FP. NO. 20

EEO: FTA, Apr. 18, 2018 03:00:18 PM C:\msd17\share\2019-2\2011\_RWP.D


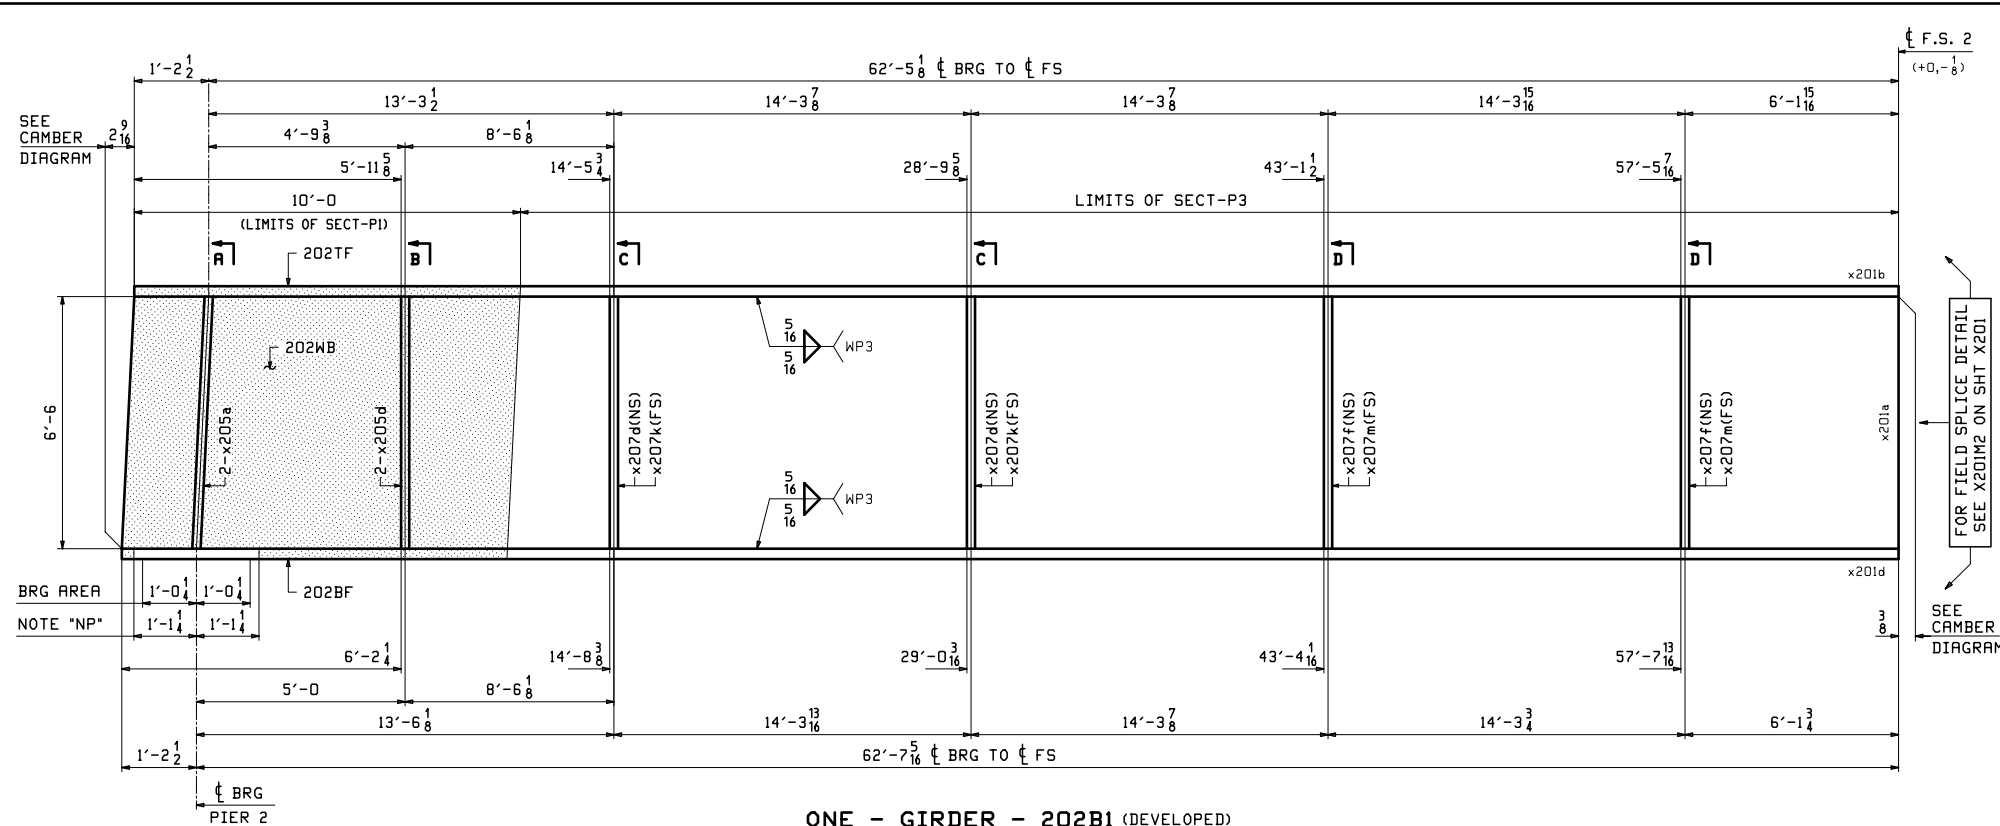


ONE - GIRDER - 202B1 (DEVELOPED)

1. FOR GENERAL NOTES SEE SHEET GNI.
2. FOR PAINT NOTES SEE SHEET P1.
3. FOR FIELD SPLICE DETAIL SEE SHEET X201.
4. FOR GIRDER STANDARD DETAILS SEE SHEETS X205-X207.
5. FOR CAMBER & FLANGE DIAGRAMS SEE SHEET BG201 & BG202.
6. "T2" DENOTES MATERIAL SUBJECT TO CHARPY V-NOTCH TESTING.
7. BRG AREA - DENOTES FLANGE TO BE FLAT & TRUE.
8. SEE SHEET P1 FOR SECT-P1, SECT-P3 & NOTE "NP".

M.Z.L.	SHIP MARK	NO. OF PCS.	ASS'Y MARK	MATERIAL			REMARKS	
				SHAPE	LENGTH FT. IN.	MATERIAL SPEC.		ITEM NO.
1	202B1	1		GIRDER			18341	
2								
3		1	202WB	PL 1/2x78	63 10 3/4	A709-50WT2	205-30	FP:20
4		1	202TF	PL 1x16	63 7 5/8	A709-50WT2	204-2	FP:20
5		1	202BF	PL 1x16	63 9 1/4	A709-50WT2	204-2	FP:20
6								
7		2	x205a	PL 1x8	6 6 1/4	A709-50WT2	208-2	MIE FP:20
8		2	x205d	PL 1/2x10 1/2	6 6	A709-50WT2	208-2	FP:20
9		2	x207d	PL 1/2x14 1/2	6 6	A709-50WT2	208-2	FP:20
10		2	x207f	PL 1/2x14 1/2	6 6	A709-50WT2	208-2	FP:20
11		2	x207k	PL 1/2x14 1/2	6 6	A709-50WT2	208-2	FP:20
12		2	x207m	PL 1/2x14 1/2	6 6	A709-50WT2	208-2	FP:20
13								


FOR FIELD SPLICE DETAIL SEE X201M2 ON SHT X201  
SEE CAMBER DIAGRAM

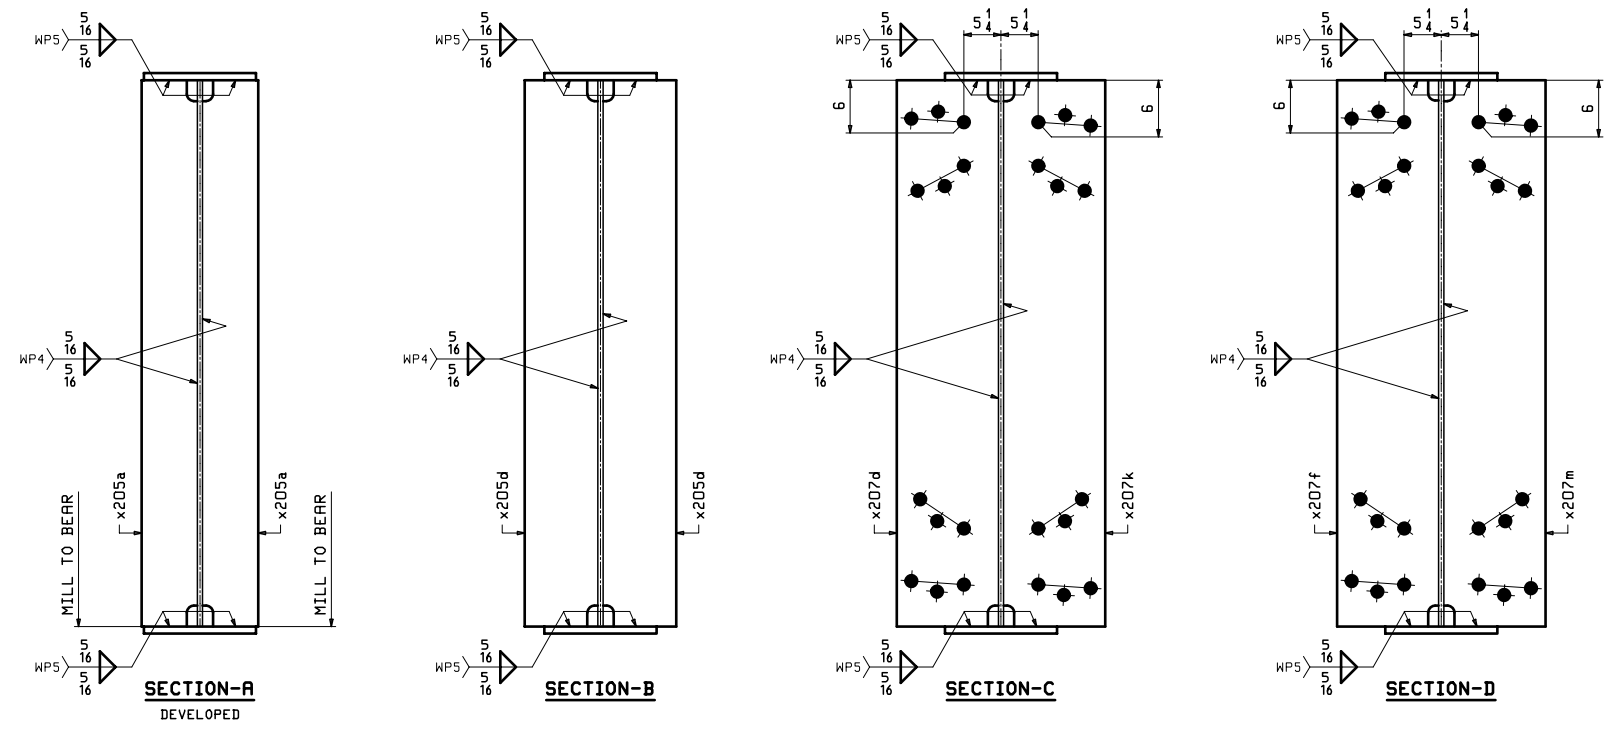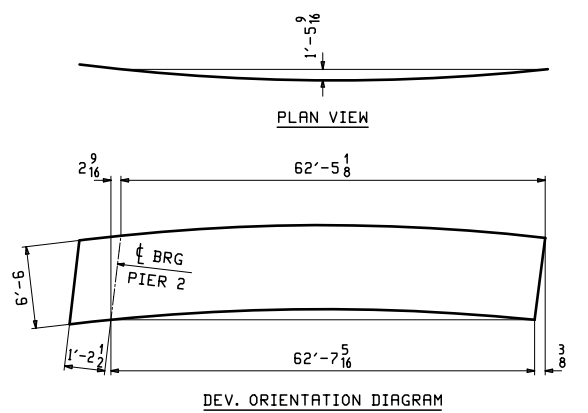

NO.	DATE	REMARKS	BY
REVISIONS			
STRUCTURE RAMP P OVER IR-74 WB, IR-75 & RAMP E - UNIT 2 LOCATION CINCINNATI, OH (HAMILTON COUNTY) STA. 230+22.98 PROJECT NO. HAM-75-3.84, PID NO. 104667, BRIDGE NO. HAM-74-19085 ENGINEER PRIME RE GROUP CONTRACTOR WALSH GROUP			
GIRDER ~ 202B1			
ITEM	SEE P1		
SURFACE PREP.	OPEN HOLES 1 3/8\"/>		
PAINT	SEE P1 & AS NOTED		
PRELIMINARY	DRAWN EEO 04/06/19	SHEET NO. 202	PLANT ORDER NO. 180608
FOR APPROVAL	CHECKED WJL 04/15/19		FP. NO. 20

EEO: F:\18\_0208\_020854.PM 7/24/19 10:08:54 AM 202011180608-2021.1 Rev.0




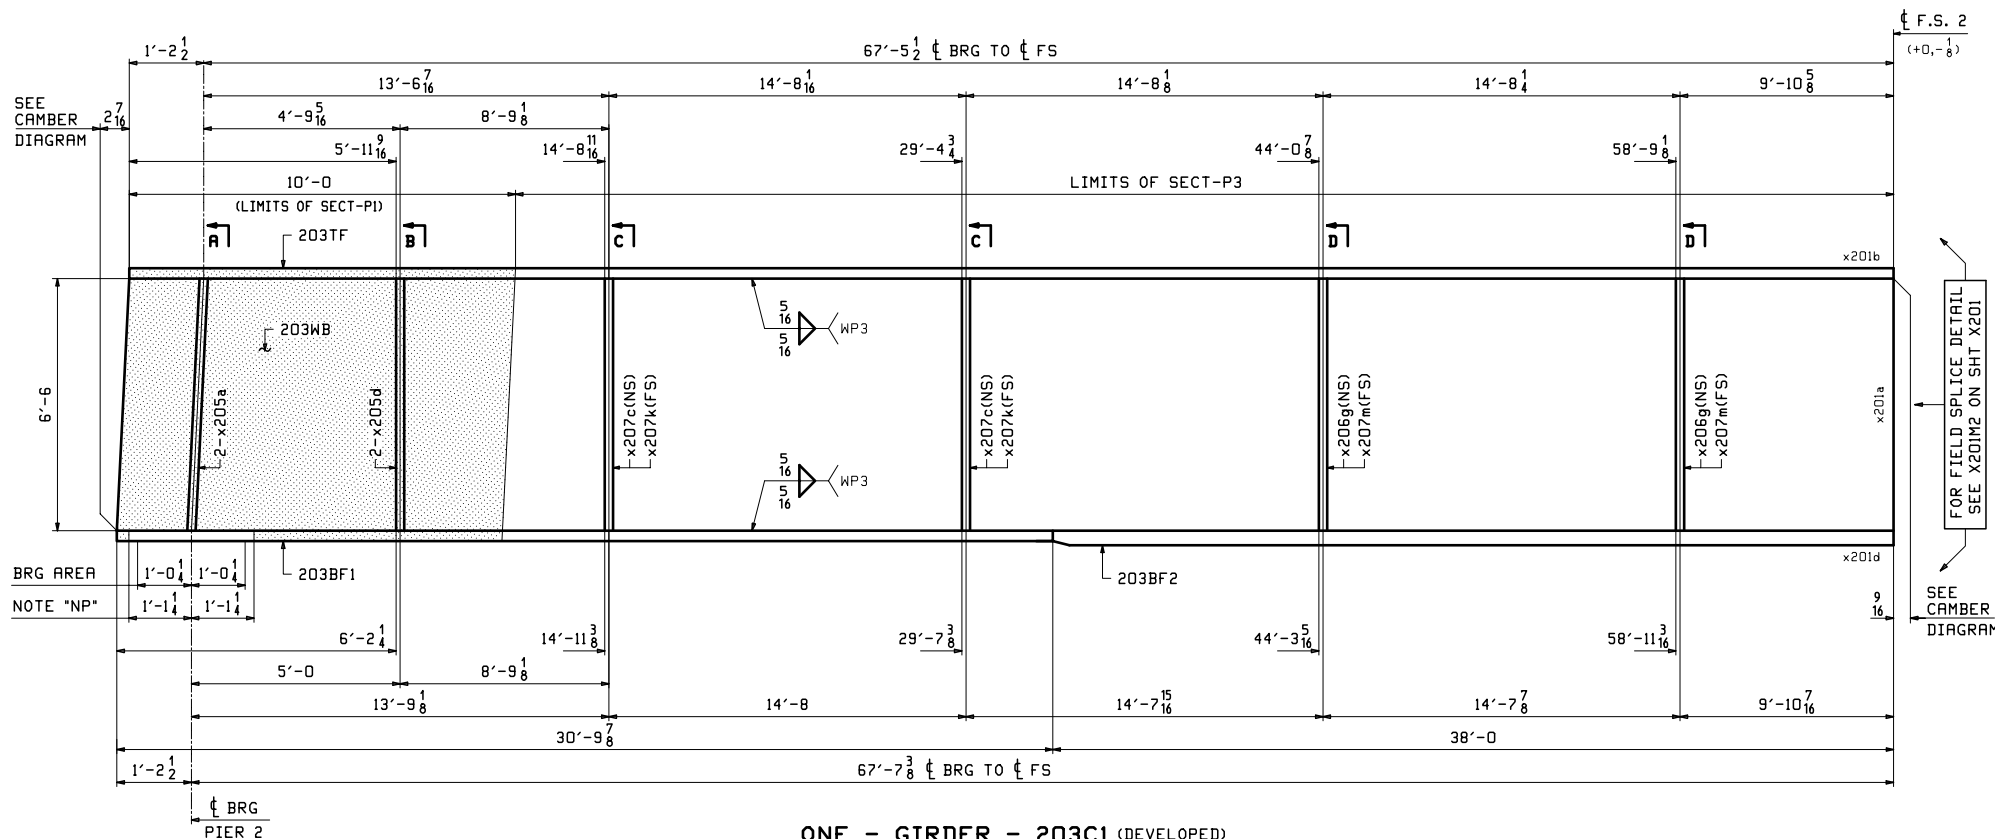


**ONE - GIRDER - 203C1 (DEVELOPED)**

1. FOR GENERAL NOTES SEE SHEET GNI.
2. FOR PAINT NOTES SEE SHEET P1.
3. FOR FIELD SPLICE DETAIL SEE SHEET X201.
4. FOR GIRDER STANDARD DETAILS SEE SHEETS X205-X207.
5. FOR CAMBER & FLANGE DIAGRAMS SEE SHEET BG201 & BG202.
6. "T2" DENOTES MATERIAL SUBJECT TO CHARPY V-NOTCH TESTING.
7. BRG AREA - DENOTES FLANGE TO BE FLAT & TRUE.
8. SEE SHEET P1 FOR SECT-P1, SECT-P3 & NOTE "NP".


MATERIAL	SHIP MARK	NO. OF PCS.	ASS'Y MARK	MATERIAL				REMARKS
				SHAPE	LENGTH FT. IN.	MATERIAL SPEC.	ITEM NO.	
1	203C1	1		GIRDER				21255
2								
3		1	203WB	PL 1/2x78	58 10 1/4	A708-S0WT2	205-14	FP:20
4		1	203TF	PL 1x16	58 8	A708-S0WT2	203-2	FP:20
5		1	203BF1	PL 1x16	30 9 7/8	A708-S0WT2	204-12	FP:20
6		1	203BF2	PL 1 1/4x16	38 0	A708-S0WT2	202-10	FP:20
7								
8		2	x205a	PL 1x8	6 6 1/8	A708-S0WT2	208-2	MIC FP:20
9		2	x205d	PL 1/2x10 1/2	6 6	A708-S0WT2	208-5	FP:20
10		2	x205g	PL 2x17 1/2	6 6	A708-S0WT2	208-8	FP:20
11		2	x207c	PL 2x14 1/2	6 6	A708-S0WT2	208-7	FP:20
12		2	x207k	PL 2x14 1/2	6 6	A708-S0WT2	208-7	FP:20
13		2	x207m	PL 2x14 1/2	6 6	A708-S0WT2	208-7	FP:20
14								

FOR FIELD SPLICE DETAIL SEE X201M2 ON SHT X201  
SEE CAMBER DIAGRAM

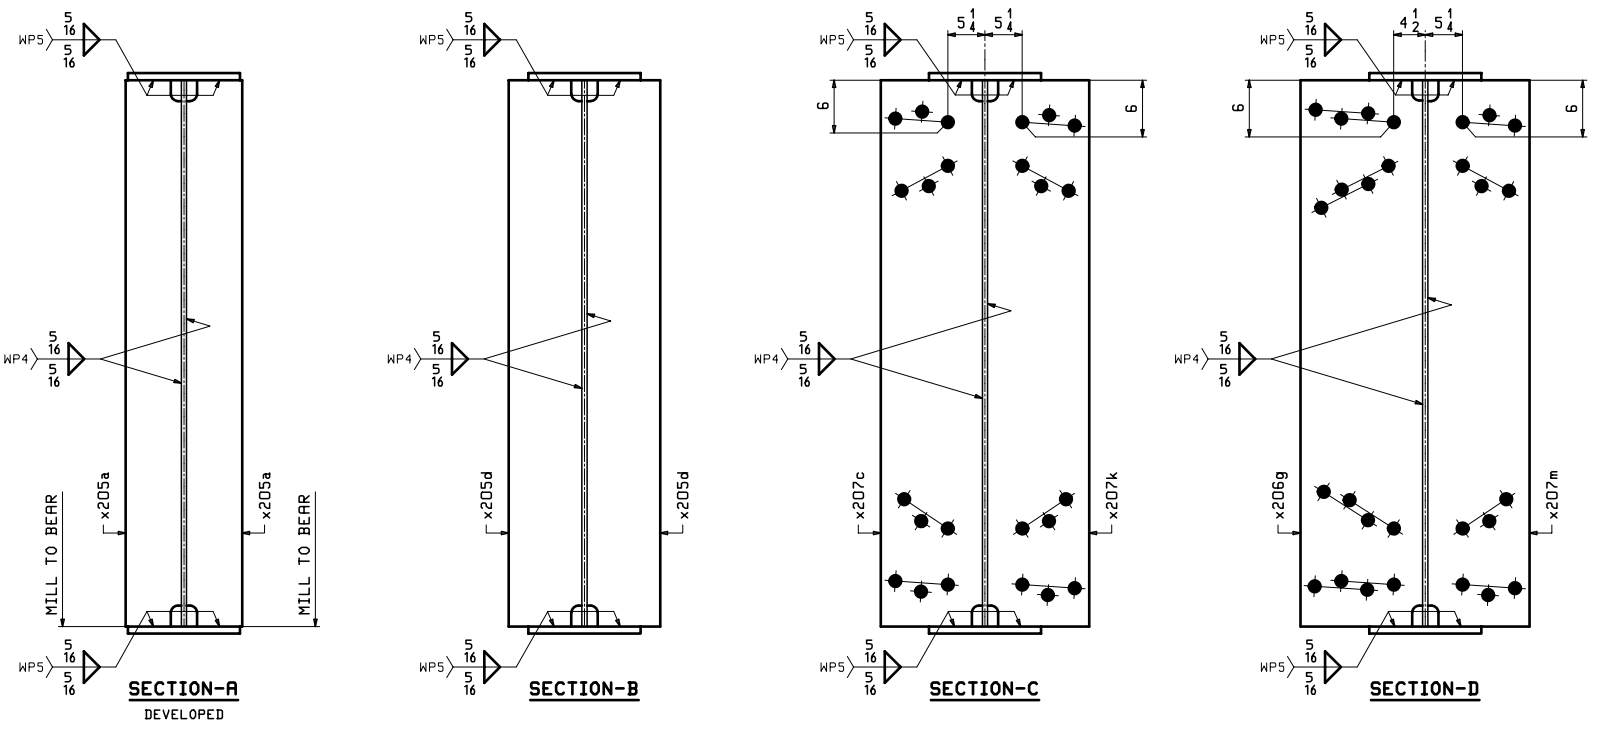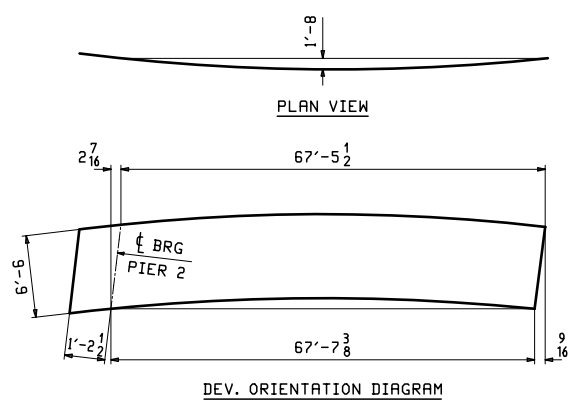

NO.	DATE	REMARKS	BY
REVISIONS			
STRUCTURE RAMP P OVER IR-74 WB, IR-75 & RAMP E - UNIT 2 LOCATION CINCINNATI, OH (HAMILTON COUNTY) STA. 230+22.98 PROJECT NO. HAM-75-3.84, PID NO. 104667, BRIDGE NO. HAM-74-19085 ENGINEER PRIME RE GROUP CONTRACTOR WALSH GROUP			
GIRDER ~ 203C1			
ITEM		SEE P1	
SURFACE PREP.		OPEN HOLES 1 3/8" Ø OVS FOR 1 1/4" Ø HSB (U.N.)	
PAINT		SEE P1 & AS NOTED	
PRELIMINARY	DRAWN EEO 04/06/19	SHEET NO. 203	PLANT ORDER NO. 180608
FOR APPROVAL	CHECKED WJL 04/15/19		FP. NO. 20



EEO: FTA, Rev. 18, 2018 03/05/18 PM - 2/2021.1 Rev.0

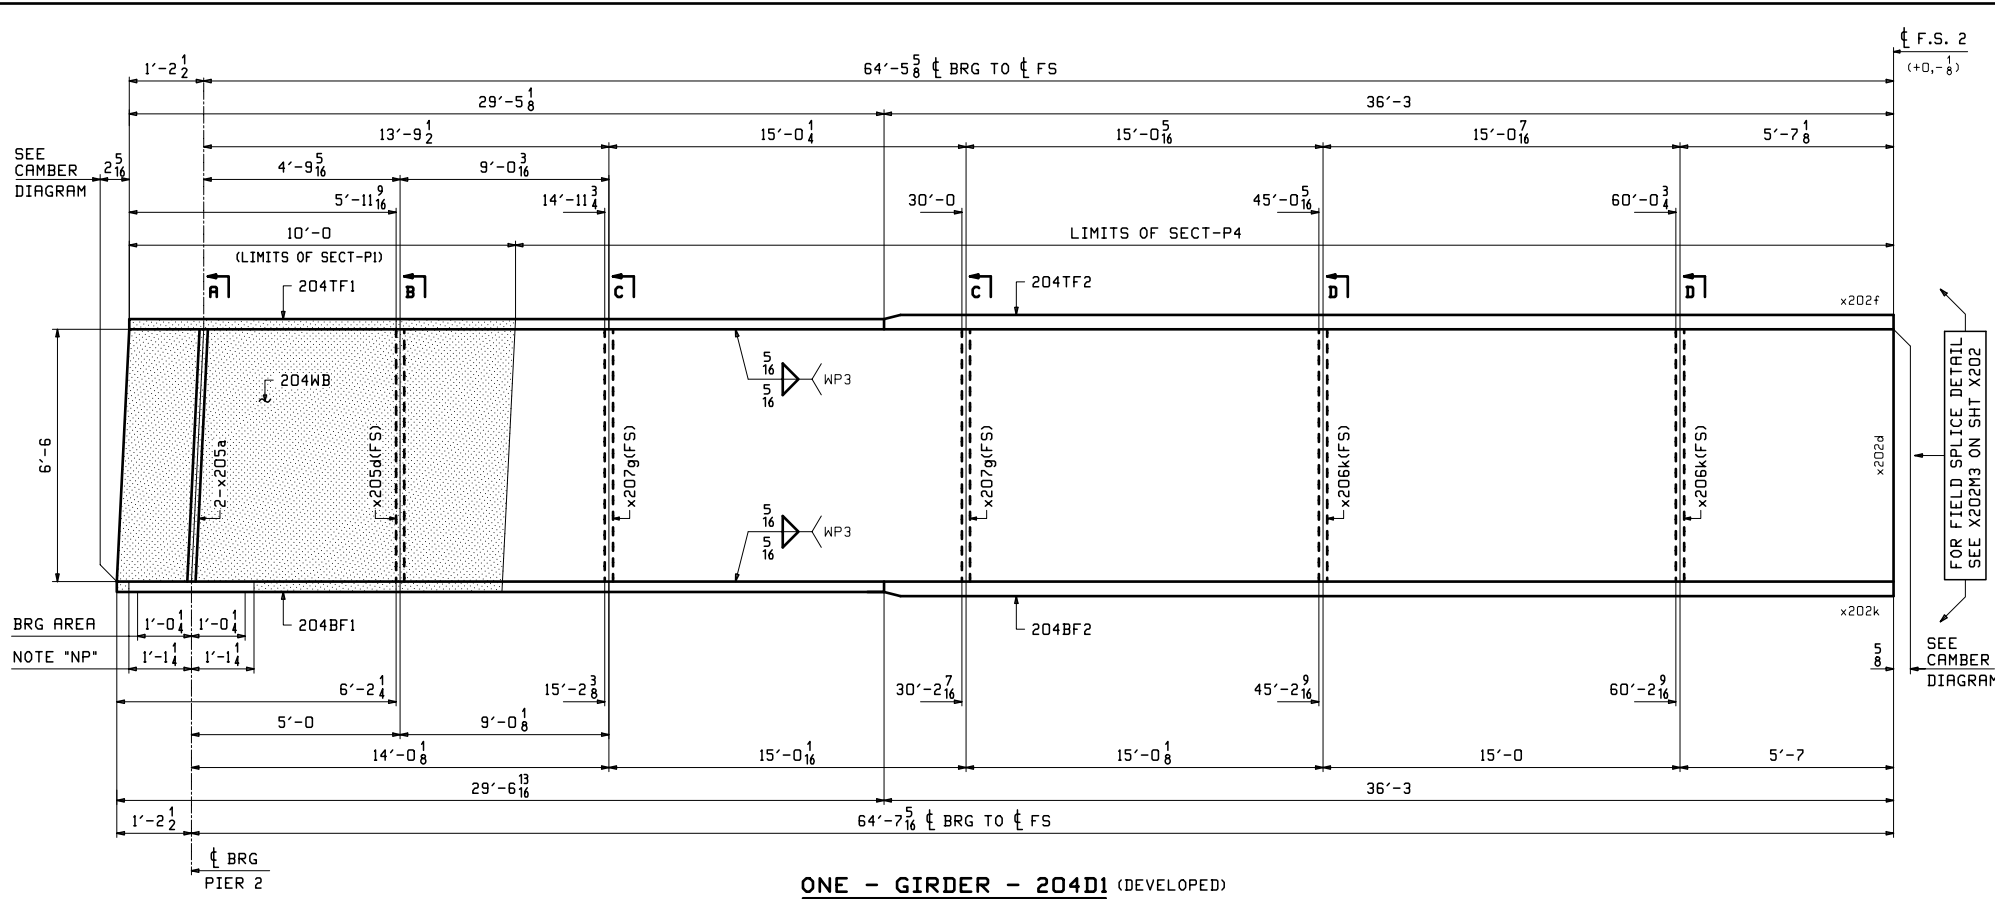

**ONE - GIRDER - 204D1 (DEVELOPED)**

1. FOR GENERAL NOTES SEE SHEET GNI.
2. FOR PAINT NOTES SEE SHEET P1.
3. FOR FIELD SPLICE DETAIL SEE SHEET X202.
4. FOR GIRDER STANDARD DETAILS SEE SHEETS X205-X207.
5. FOR CAMBER & FLANGE DIAGRAMS SEE SHEET BG201 & BG202.
6. "T2" DENOTES MATERIAL SUBJECT TO CHARPY V-NOTCH TESTING.
7. BRG AREA - DENOTES FLANGE TO BE FLAT & TRUE.
8. SEE SHEET P1 FOR SECT-P1, SECT-P4 & NOTE "NP".


MATERIAL	SHIP MARK	NO. OF PCS.	ASS'Y MARK	MATERIAL			REMARKS
				SHAPE	LENGTH FT. IN.	MATERIAL SPEC.	
1	204D1	1		GIRDER			30693
2							
3		1	204WB	PL 1/2x78	65 10 7/8	A709-50WT2	205 16
4		1	204TF1	PL 1 1/2x18	29 5 1/8	A709-50WT2	203 4
5		1	204TF2	PL 2x18	36 3	A709-50WT2	201 28
6		1	204BF1	PL 1 1/2x28	29 6 1/8	A709-50WT2	202 14
7		1	204BF2	PL 2 1/2x28	36 3	A709-50WT2	201 6
8							
9		2	x205a	PL 1x8	6 6 1/4	A709-50WT2	208 2
10		1	x205d	PL 2x10 1/2	6 6	A709-50WT2	208 5
11		2	x206k	PL 2x17 1/2	6 6	A709-50WT2	208 9
12		2	x207g	PL 2x14 1/2	6 6	A709-50WT2	208 7
13							

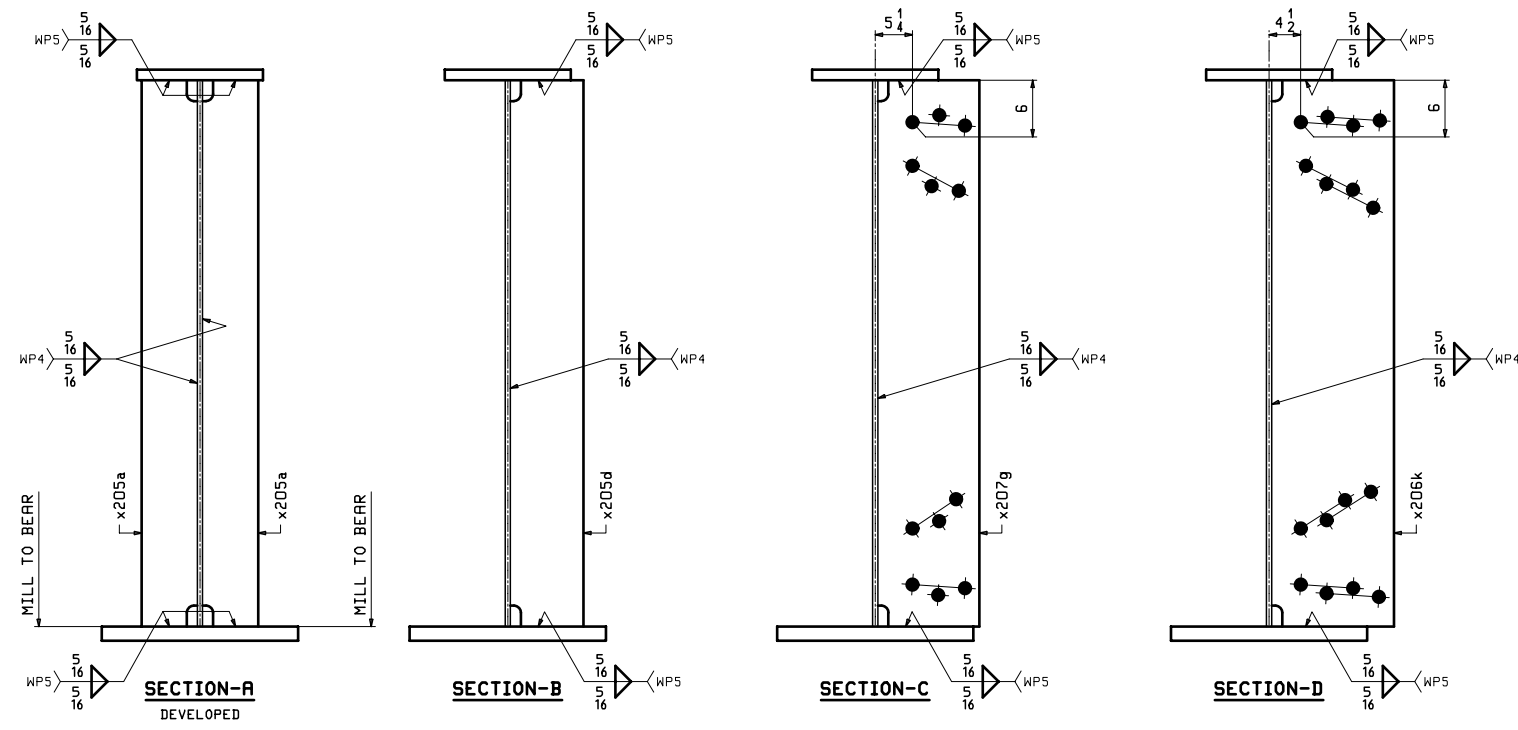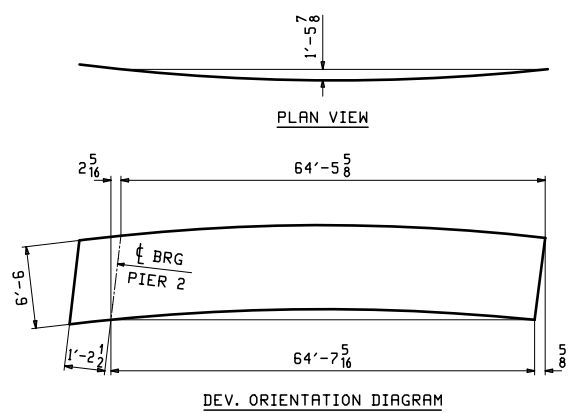

NO.	DATE	REMARKS	BY
REVISIONS			
STRUCTURE: RAMP P OVER IR-74 WB, IR-75 & RAMP E - UNIT 2 LOCATION: CINCINNATI, OH (HAMILTON COUNTY) STA. 230+22.98 PROJECT NO.: HAM-75-3.84, PID NO. 104667, BRIDGE NO. HAM-74-19085 ENGINEER: PRIME RE GROUP CONTRACTOR: WALSH GROUP			
GIRDER ~ 204D1			
ITEM: SEE P1		OPEN HOLES: 1 3/8" OVS FOR 1 1/4" HSB (U.N.)	
SURFACE PREP: SEE P1 & AS NOTED		PAINT: SEE P1 & AS NOTED	
PRELIMINARY	DRAWN: EEO 04/06/19	SHEET NO.: 204	PLANT: 3
FOR APPROVAL	CHECKED: WJL 04/15/19	ORDER NO.: 180608	FP. NO.: 20



EEO: FTA, MFL, IS, 2018 03/05/20 PM 7:00:41 AM / 2018/03/05/20/204D1 Rev 0

L	SHIP MARK	NO. OF PCS.	ASS'Y MARK	MATERIAL				REMARKS
				SHAPE	LENGTH FT. IN.	MATERIAL SPEC.	ITEM NO.	
1	205A2	1		GIRDER				21819
2								
3		1	205WB	PL 1/2x78	81 1/8	A708-S0MT2	204	FP-20
4		1	205TF	PL 1x16	81 1/8	A708-S0MT2	203	FP-20
5		1	205BF	PL 1x16	81 1/8	A708-S0MT2	203	FP-20
6								
7		2	x207a	PL 1/2x10 1/2	6 6	A708-S0MT2	208	FP-20
8		4	x207f	PL 1/2x14 1/2	6 6	A708-S0MT2	208	FP-20
9								

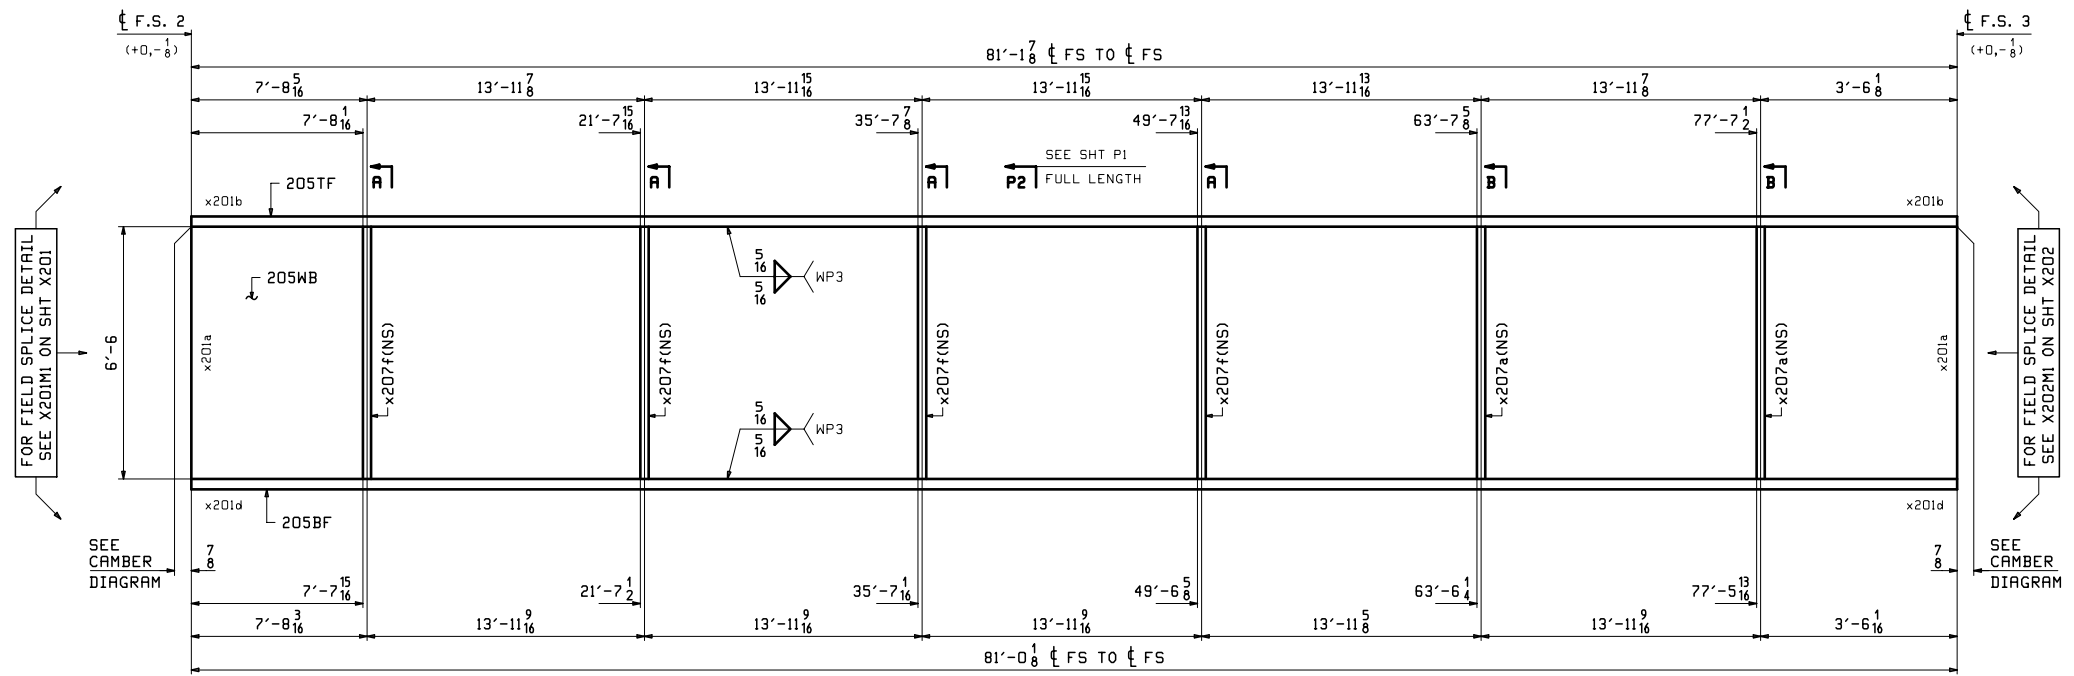

**ONE - GIRDER - 205A2 (DEVELOPED)**


1. FOR GENERAL NOTES SEE SHEET GNI.
2. FOR PAINT NOTES SEE SHEET P1.
3. FOR FIELD SPLICE DETAIL SEE SHEET X201 & X202.
4. FOR GIRDER STANDARD DETAILS SEE SHEETS X205-X207.
5. FOR CAMBER & FLANGE DIAGRAMS SEE SHEET BG203.
6. "T2" DENOTES MATERIAL SUBJECT TO CHARPY V-NOTCH TESTING.
7. SEE SHEET P1 FOR SECT-P2.

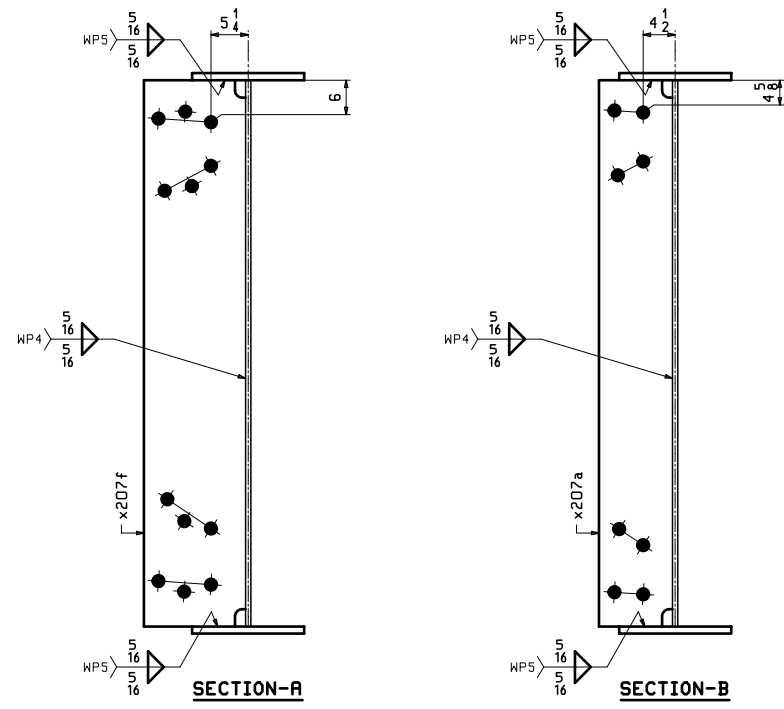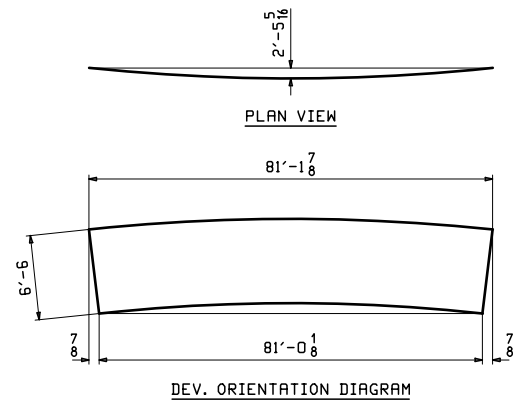

NO.	DATE	REMARKS	BY
REVISIONS			
STRUCTURE RAMP P OVER IR-74 WB, IR-75 & RAMP E - UNIT 2			
LOCATION CINCINNATI, OH (HAMILTON COUNTY) STA. 230+22.98			
PROJECT NO. HAM-75-3.84, PID NO. 104667, BRIDGE NO. HAM-74-19085			
ENGINEER PRIME RE GROUP			
CONTRACTOR WALSH GROUP			
GIRDER ~ 205A2			
ITEM SEE P1			
SURFACE PREP. OPEN HOLES 1 3/16" Ø OVS FOR 1 1/4" Ø HSB (U.N.)			
PAINT SEE P1 & AS NOTED			
PRELIMINARY	DRAWN EEO 04/05/19	SHEET NO. 205	PLANT ORDER NO. 180608
FOR APPROVAL	CHECKED WJL 04/15/19		FP. NO. 20




EEO: P1, Rev. 18, 02/01/2019 PM 7:44:41 AM / 2019-02-01 1 Rev.0

L PZLT	SHIP MARK	NO. OF PCS.	ASS'Y MARK	MATERIAL				REMARKS
				SHAPE	LENGTH FT. IN.	MATERIAL SPEC.	ITEM NO.	
1	206B2	1		GIRDER				21078
2								
3		1	206WB	PL 1/2x78	76 1/2	A709-50WT2	205-4	FP-20
4		1	206TF	PL 1x16	76 1/2	A709-50WT2	203-10	FP-20
5		1	206BF	PL 1x16	76 0	A709-50WT2	203-30	FP-20
6								
7		2	x207a	PL 1/2x10 1/2	6 6	A709-50WT2	208-6	FP-20
8		2	x207b	PL 1/2x10 1/2	6 6	A709-50WT2	208-6	FP-20
9		3	x207f	PL 1/2x14 1/2	6 6	A709-50WT2	208-7	FP-20
10		3	x207m	PL 1/2x14 1/2	6 6	A709-50WT2	208-7	FP-20
11								

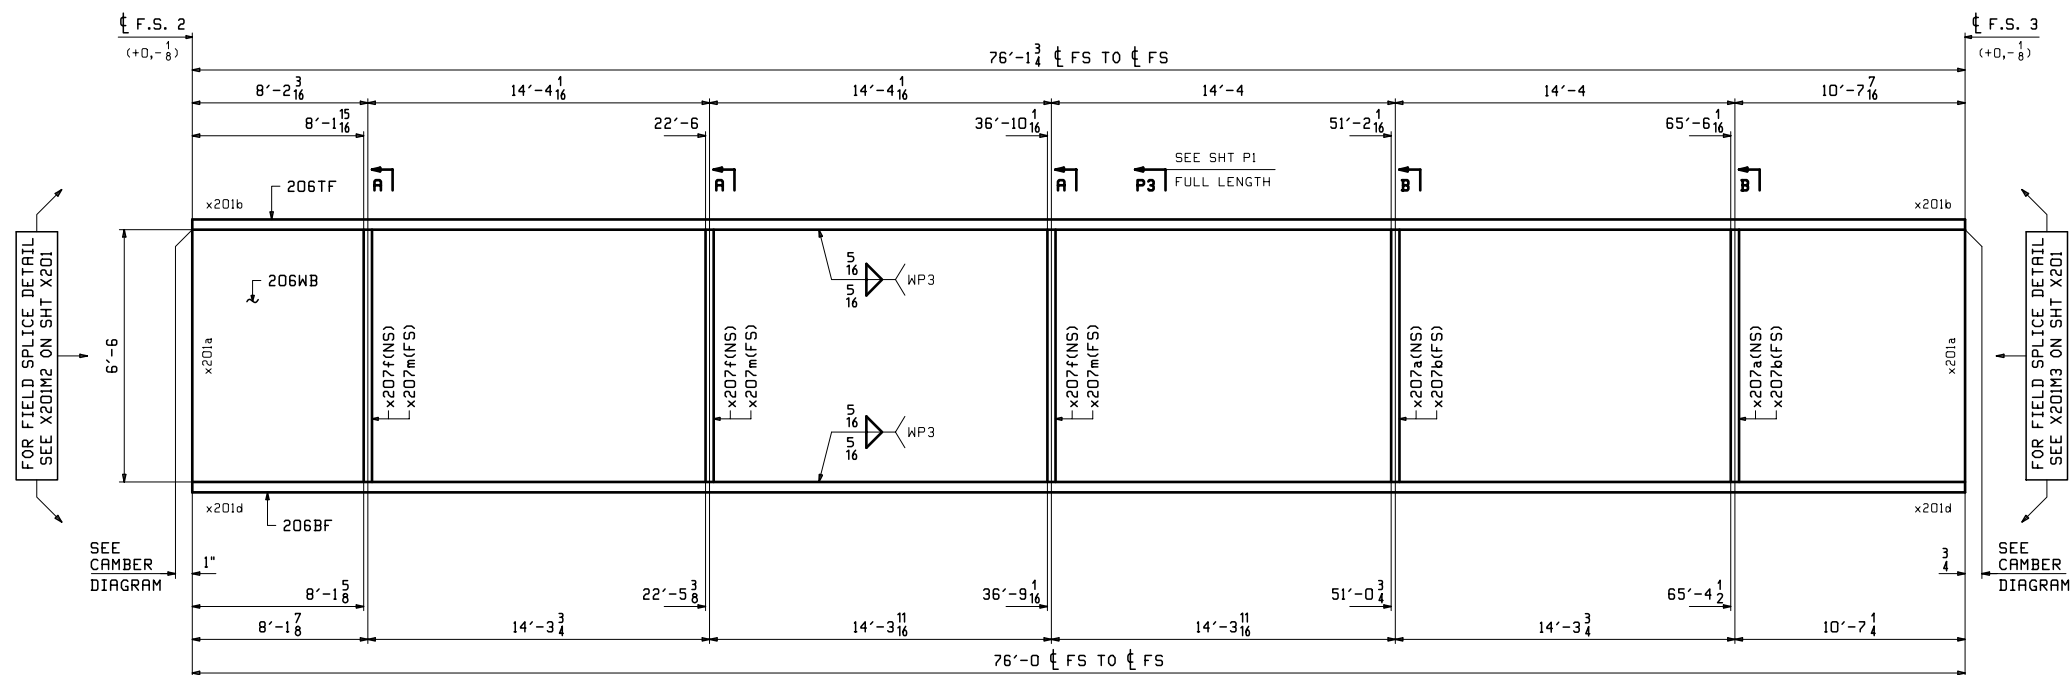


**ONE - GIRDER - 206B2 (DEVELOPED)**

1. FOR GENERAL NOTES SEE SHEET GNI.
2. FOR PAINT NOTES SEE SHEET P1.
3. FOR FIELD SPLICE DETAIL SEE SHEET X201.
4. FOR GIRDER STANDARD DETAILS SEE SHEETS X205-X207.
5. FOR CAMBER & FLANGE DIAGRAMS SEE SHEET BG203.
6. "T2" DENOTES MATERIAL SUBJECT TO CHARPY V-NOTCH TESTING.
7. SEE SHEET P1 FOR SECT-P3.

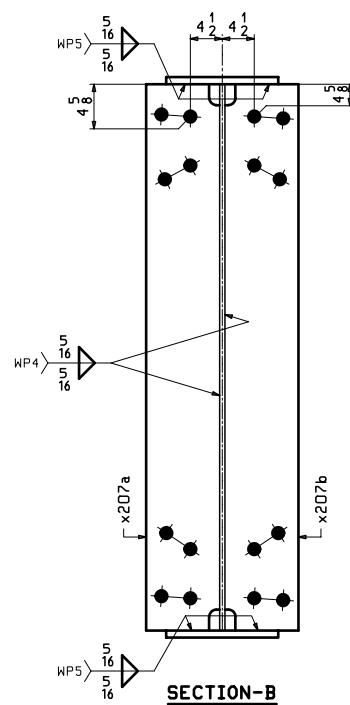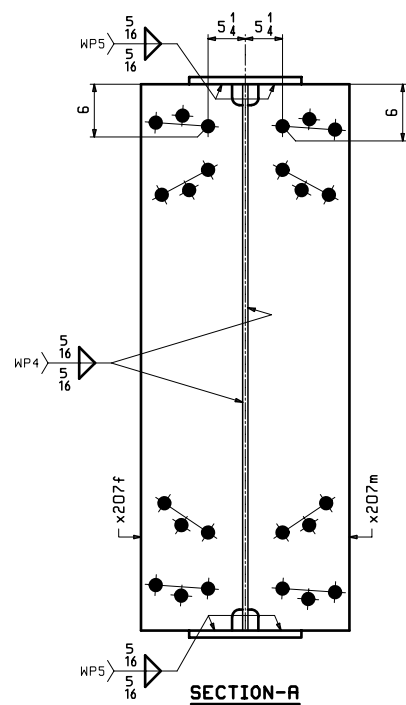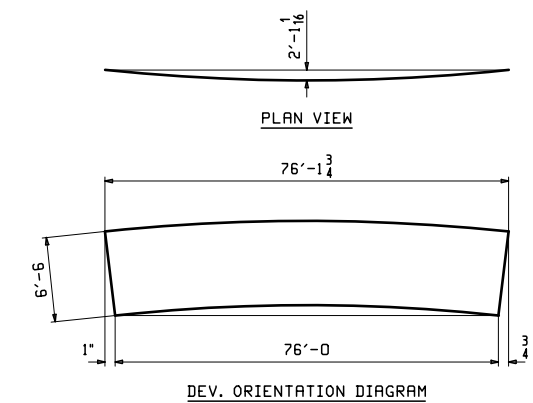



NO.	DATE	REMARKS	BY
REVISIONS			
STRUCTURE RAMP P OVER IR-74 WB, IR-75 & RAMP E - UNIT 2			
LOCATION CINCINNATI, OH (HAMILTON COUNTY) STA. 230+22.98			
PROJECT NO. HAM-75-3.84, PID NO. 104667, BRIDGE NO. HAM-74-19085			
ENGINEER PRIME RE GROUP			
CONTRACTOR WALSH GROUP			
GIRDER ~ 206B2			
ITEM			
SURFACE PREP. SEE P1 OPEN HOLES 1 3/8" Ø OVS FOR 1 1/4" Ø HSB (U.N.)			
PAINT SEE P1 & AS NOTED			
PRELIMINARY	DRAWN EEO 04/06/19	SHEET NO. 206	PLANT ORDER NO. 180608
FOR APPROVAL	CHECKED WJL 04/15/19		FP. NO. 20

L	SHIP MARK	NO. OF PCS.	ASS'Y MARK	MATERIAL				REMARKS
				SHAPE	LENGTH FT. IN.	MATERIAL SPEC.	ITEM NO.	
1	207C2	1		GIRDER				27438
2								
3		1	207WB	PL 1/2x78	82 1/16	A709-50WT2	204-26	FP-20
4		1	207TF1	PL 1x16	60 1/16	A709-50WT2	204-4	FP-20
5		1	207TF2	PL 1 3/4x16	22 0	A709-50WT2	202-12	FP-20
6		1	207BF	PL 1 1/4x16	81 11/8	A709-50WT2	202-8	FP-20
7								
8		6	x206g	PL 1/2x17 1/2	6 6	A709-50WT2	208-3	FP-20
9		3	x207b	PL 1/2x10 1/2	6 6	A709-50WT2	208-6	FP-20
10		3	x207m	PL 1/2x14 1/2	6 6	A709-50WT2	208-7	FP-20
11								

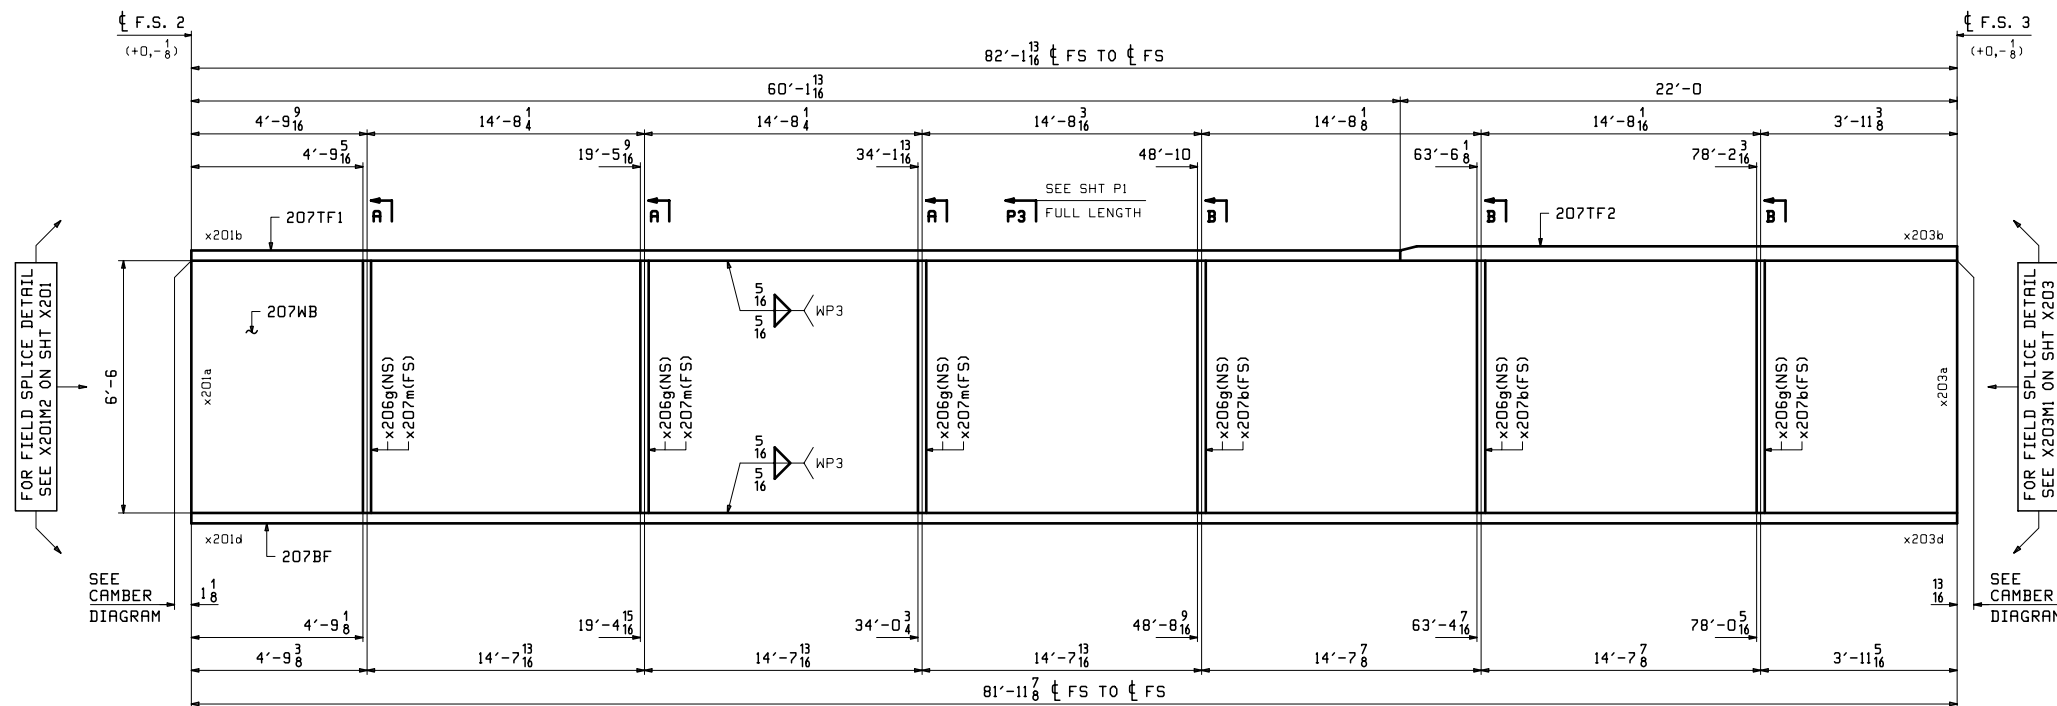

**ONE - GIRDER - 207C2 (DEVELOPED)**


1. FOR GENERAL NOTES SEE SHEET GNI.
2. FOR PAINT NOTES SEE SHEET PI.
3. FOR FIELD SPLICE DETAIL SEE SHEET X201 & X203.
4. FOR GIRDER STANDARD DETAILS SEE SHEETS X205-X207.
5. FOR CAMBER & FLANGE DIAGRAMS SEE SHEET BG203.
6. "T2" DENOTES MATERIAL SUBJECT TO CHARPY V-NOTCH TESTING.
7. SEE SHEET PI FOR SECT-P2.

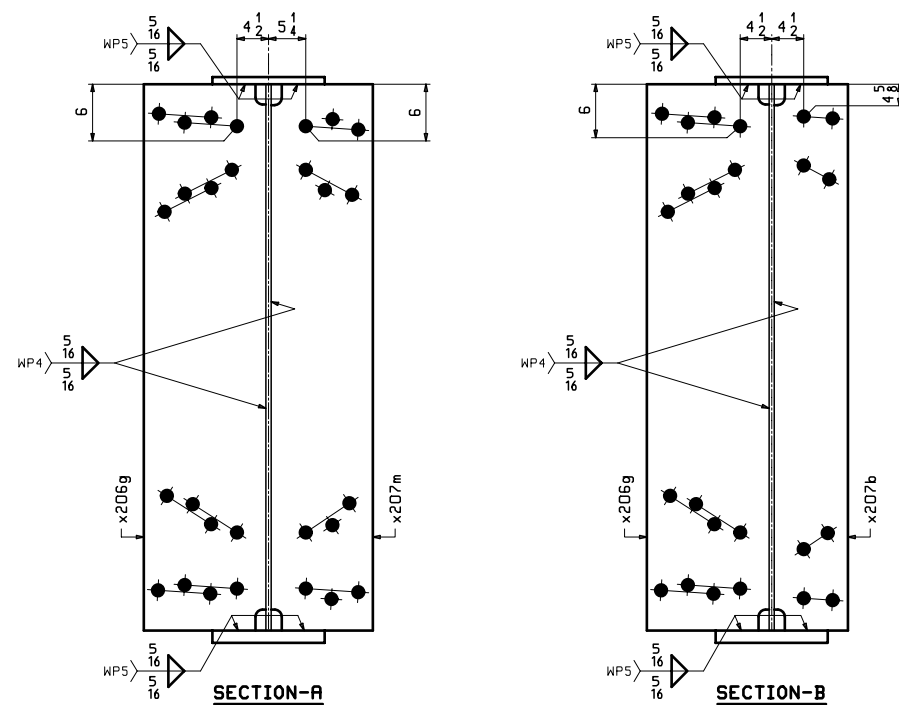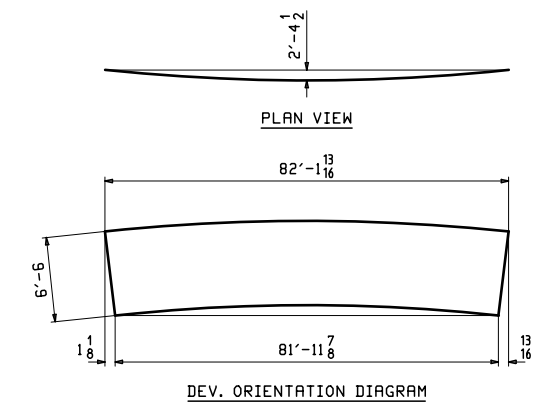

NO.	DATE	REMARKS	BY
REVISIONS			
STRUCTURE: RAMP P OVER IR-74 WB, IR-75 & RAMP E - UNIT 2 LOCATION: CINCINNATI, OH (HAMILTON COUNTY) STA. 230+22.98 PROJECT NO.: HAM-75-3.84, PID NO. 104667, BRIDGE NO. HAM-74-19085 ENGINEER: PRIME RE GROUP CONTRACTOR: WALSH GROUP			
GIRDER ~ 207C2			
ITEM: SEE P1			
SURFACE PREP: SEE P1 & AS NOTED			
PAINT: SEE P1 & AS NOTED			
PRELIMINARY	DRAWN EEO 04/06/19	SHEET NO. 207	PLANT ORDER NO. 180608
FOR APPROVAL	CHECKED WJL 04/15/19		FP. NO. 20



EEO: F:\\_Rev 18\_2018\_0310155 PM - 2018-03-15 10:58:22 AM - 2017-1 Rev 0

L PZLT	SHIP MARK	NO. OF PCS.	ASS'Y MARK	MATERIAL				REMARKS
				SHAPE	LENGTH FT. IN.	MATERIAL SPEC.	ITEM NO.	
1	208D2	1		GIRDER				37420
2								
3		1	208WB	PL 3/8x78	80 1/8	A709-50WT2	204	FP:20
4		1	208TF1	PL 2x18	40 1	A709-50WT2	204	FP:20
5		1	208TF2	PL 3/8x18	40 0 7/8	A709-50WT2	202	FP:20
6		1	208BF1	PL 2 1/2x28	40 1	A709-50WT2	201	FP:20
7		1	208BF2	PL 1 1/2x28	39 10 1/4	A709-50WT2	202	FP:20
8								
9		5	x206k	PL 1/2x17 1/2	6 6	A709-50WT2	208	FP:20
10								

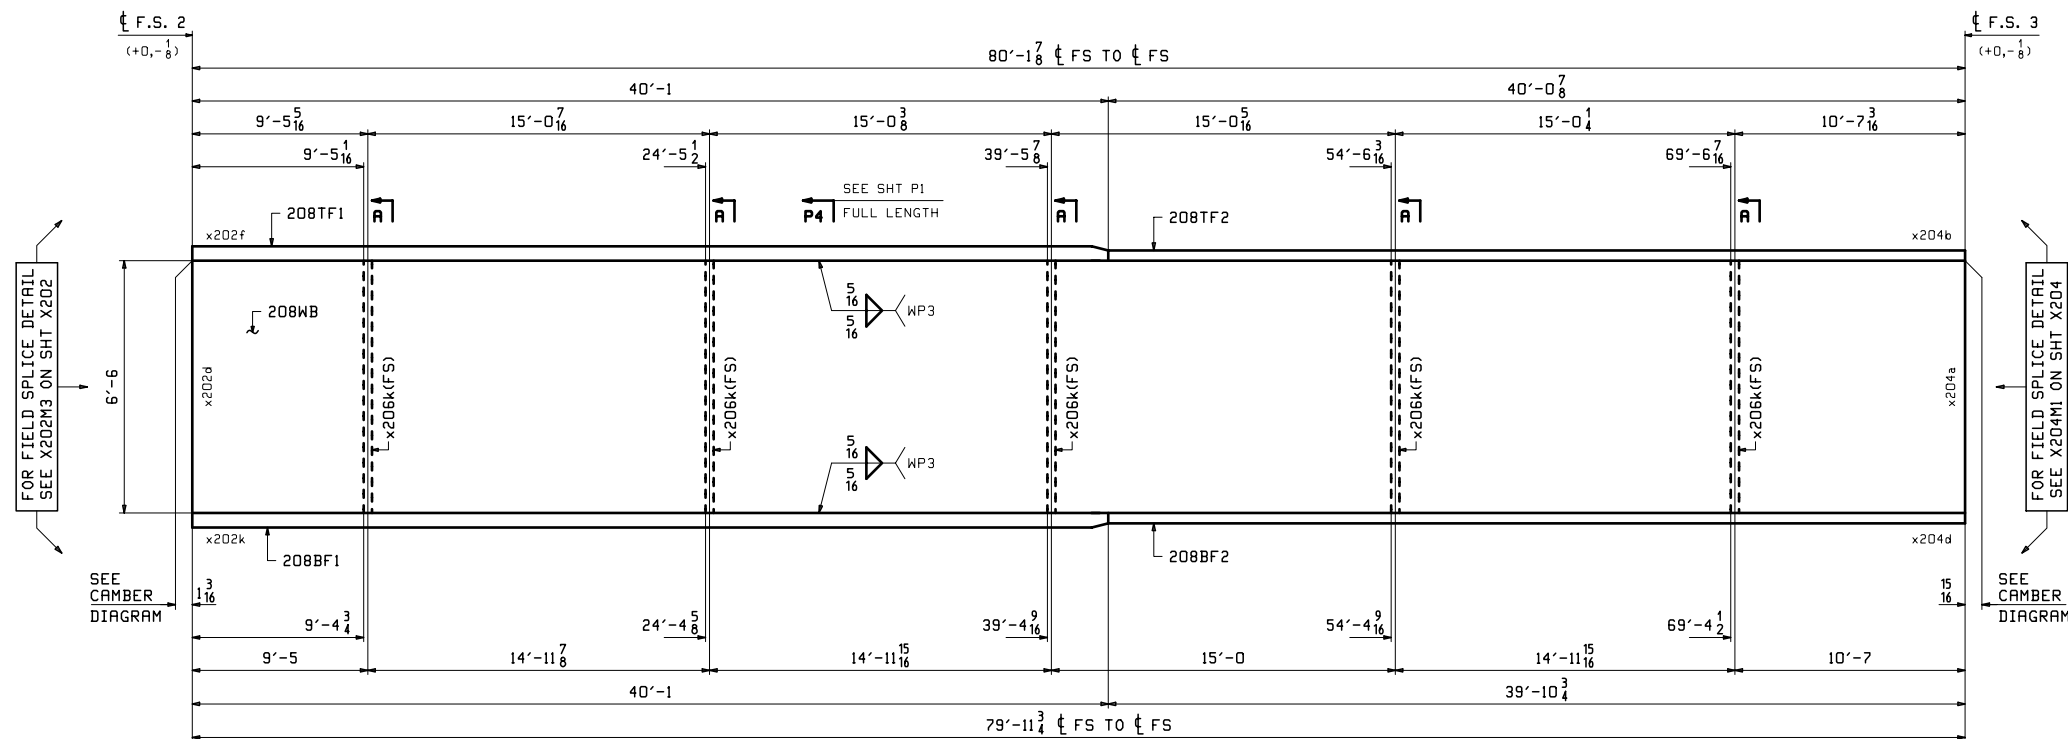


**ONE - GIRDER - 208D2 (DEVELOPED)**

1. FOR GENERAL NOTES SEE SHEET GNI.
2. FOR PAINT NOTES SEE SHEET P1.
3. FOR FIELD SPLICE DETAIL SEE SHEET X203 & X204.
4. FOR GIRDER STANDARD DETAILS SEE SHEETS X205-X207.
5. FOR CAMBER & FLANGE DIAGRAMS SEE SHEET BG203.
6. \*T2\* DENOTES MATERIAL SUBJECT TO CHARPY V-NOTCH TESTING.
7. SEE SHEET P1 FOR SECT-P3.

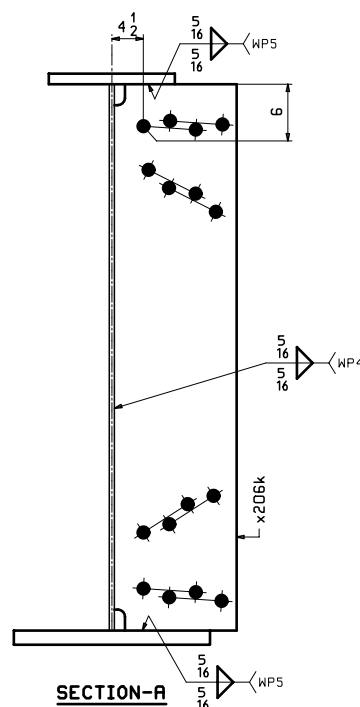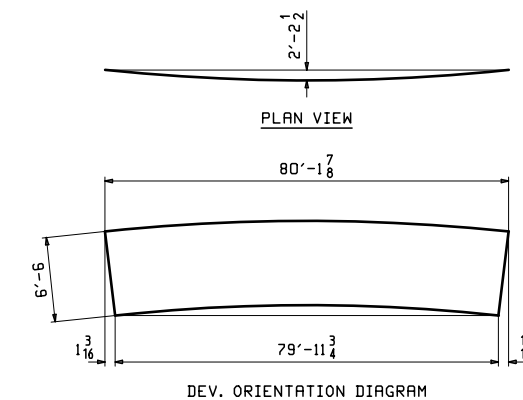

NO.	DATE	REMARKS	BY
REVISIONS			
STRUCTURE <b>RAMP P OVER IR-74 WB, IR-75 &amp; RAMP E - UNIT 2</b> LOCATION <b>CINCINNATI, OH (HAMILTON COUNTY) STA. 230+22.98</b> PROJECT NO. <b>HAM-75-3.84, PID NO. 104667, BRIDGE NO. HAM-74-19085</b> ENGINEER <b>PRIME RE GROUP</b> CONTRACTOR <b>WALSH GROUP</b>			
<b>GIRDER ~ 208D2</b>			
ITEM _____			
SURFACE PREP. <b>SEE P1</b> OPEN HOLES <b>1 3/8" Ø OVS FOR 1 1/4" Ø HSB (U.N.)</b>			
PAINT <b>SEE P1 &amp; AS NOTED</b>			
PRELIMINARY	DRAWN <b>EEO 04/06/19</b>	SHEET NO. <b>208</b>	PLANT <b>3</b>
FOR APPROVAL	CHECKED <b>WJL 04/15/19</b>	ORDER NO. <b>180608</b>	FP. NO. <b>20</b>

EEO: P1, Rev. 18, 2018 03/14/2018 PM 7:00:47 AM 2018/03/14/2018 1 Rev.0

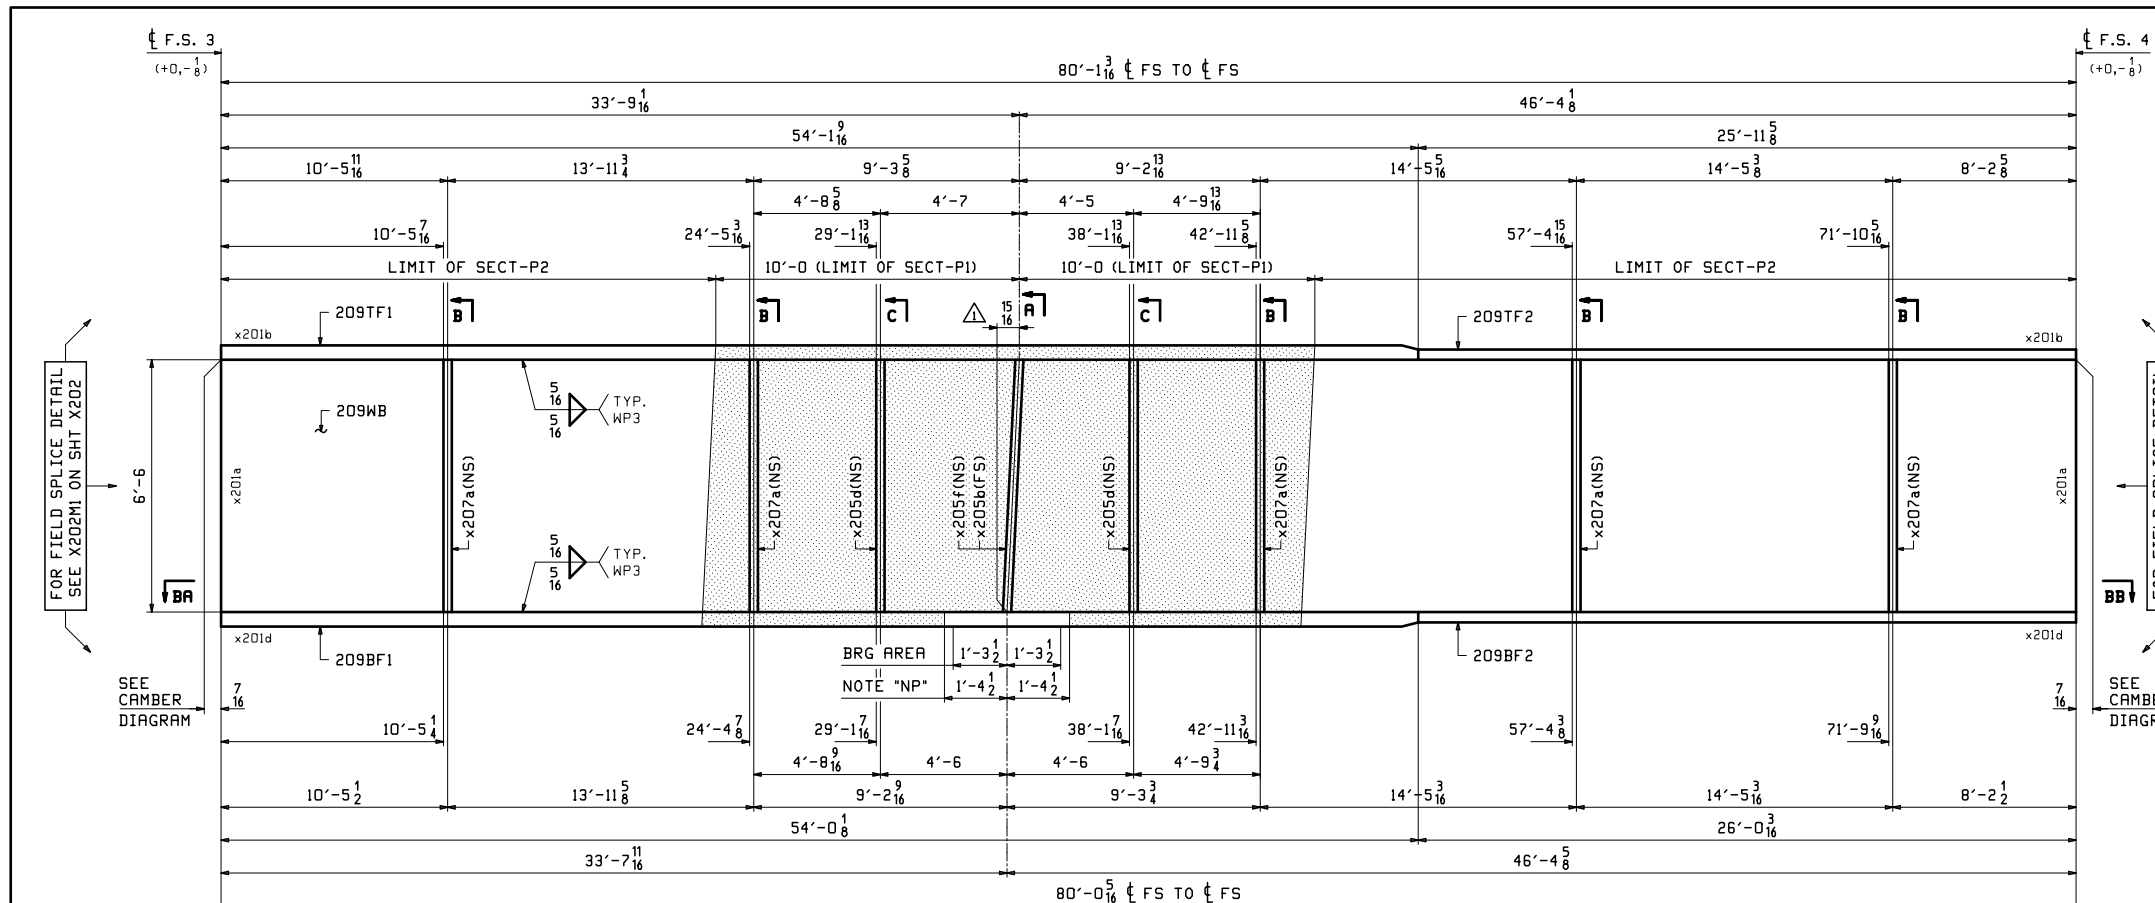

L	MATERIAL	NO. OF PCS.	ASS'Y MARK	SHAPE	LENGTH FT. IN.	MATERIAL SPEC.	ITEM NO.	REMARKS
1	209A3	1		GIRDER				32194
2								
3		1	209WB	PL 1/2x78	80	A708-S0WT2	205-10	FP-20
4		1	209TF1	PL 2 1/4x16	54	A708-S0WT2	201-14	FP-20
5		1	209TF2	PL 1x16	25	A708-S0WT2	204-14	FP-20
6		1	209BF1	PL 2 1/2x18	54	A708-S0WT2	201-10	FP-20
7		1	209BF2	PL 1 1/2x18	26	A708-S0WT2	202-26	FP-20
8								
9		1	x205b	PL 5/8x8	6	A708-S0WT2	208-4	MIE FP-20
10		2	x205d	PL 1/2x10 1/2	6	A708-S0WT2	208-5	FP-20
11		1	x205f	PL 1 1/2x17 1/2	6	A708-S0WT2	208-3	MIE FP-20
12		5	x207a	PL 1 1/2x10 1/2	6	A708-S0WT2	208-6	FP-20
13								

FOR FIELD SPLICE DETAIL SEE X202M1 ON SHT X202







FOR FIELD SPLICE DETAIL SEE X204M2 ON SHT X204

SEE CAMBER DIAGRAM

SEE CAMBER DIAGRAM


**ONE - GIRDER - 209A3 (DEVELOPED)**

1. FOR GENERAL NOTES SEE SHEET GNI.
2. FOR PRINT NOTES SEE SHEET P1.
3. FOR FIELD SPLICE DETAIL SEE SHEET X202 & X204.
4. FOR GIRDER STANDARD DETAILS SEE SHEETS X205-X207.
5. FOR CAMBER & FLANGE DIAGRAMS SEE SHEET BG205 & BG206.
6. \*T2\* DENOTES MATERIAL SUBJECT TO CHARPY V-NOTCH TESTING.
7. BRG AREA - DENOTES FLANGE TO BE FLAT & TRUE.
8. SEE SHEET P1 FOR SECT-P1, SECT-P2 & NOTE \*NP\*.

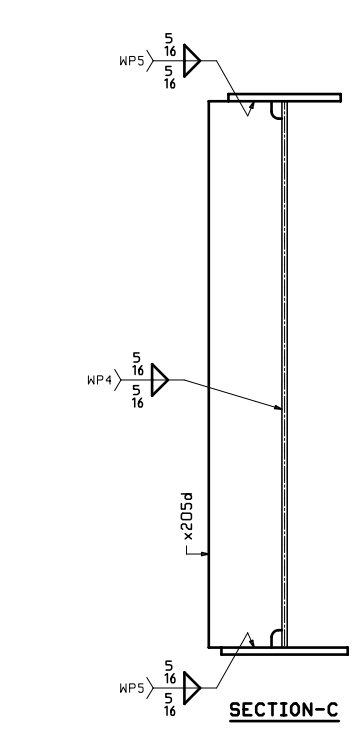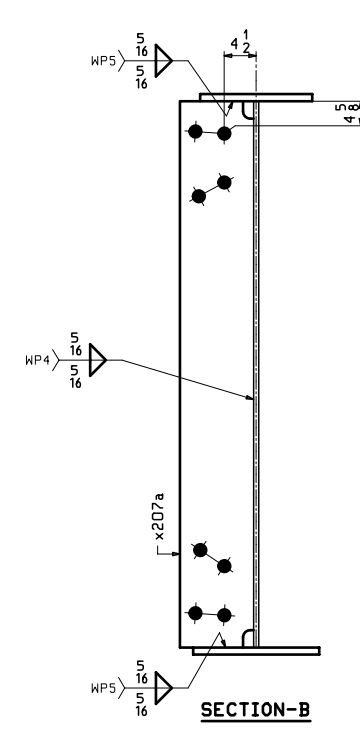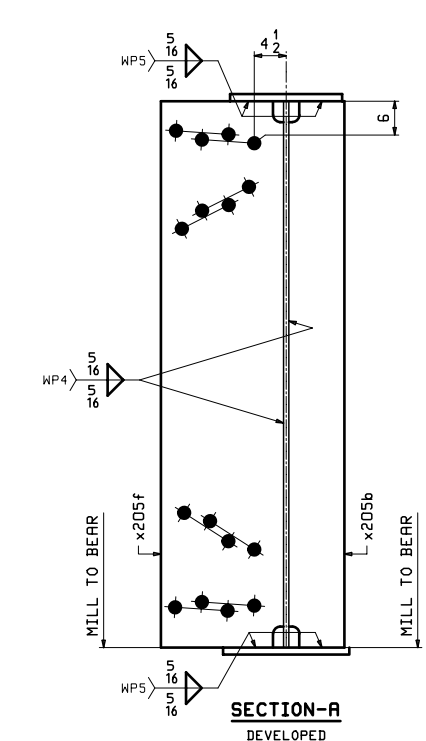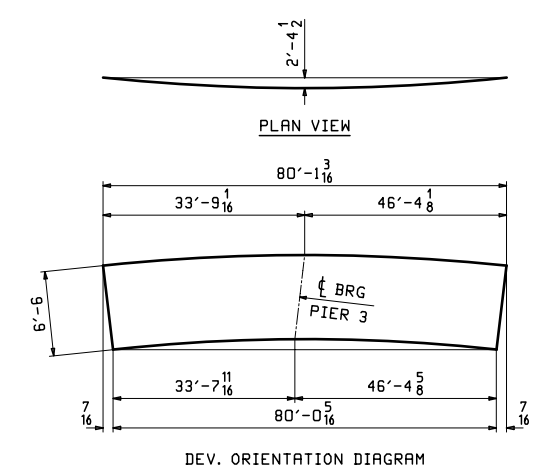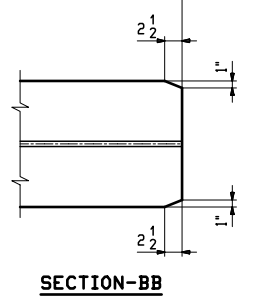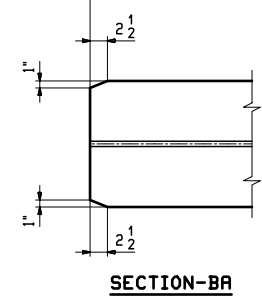


NO.	DATE	REMARKS	BY
1	05/13/19	ADDED BRG LEAN DIMENSION	EEO/WJL
REVISIONS			
STRUCTURE: RAMP P OVER IR-74 WB, IR-75 & RAMP E - UNIT 2 LOCATION: CINCINNATI, OH (HAMILTON COUNTY) STA. 230+22.98 PROJECT NO.: HAM-75-3.84, PID NO. 104667, BRIDGE NO. HAM-74-1908S ENGINEER: PRIME AE GROUP CONTRACTOR: WALSH GROUP			
GIRDER ~ 209A3			
ITEM: SEE P1			
SURFACE PREP: SEE P1 & AS NOTED			
PAINT: SEE P1 & AS NOTED			
PRELIMINARY	DRAWN EEO 04/05/19	SHEET NO. 209	PLANT ORDER NO. 180608
FOR APPROVAL	CHECKED WJL 04/15/19		FP. NO. 20


HJL, Inc., May 15, 2019 02:16:49 PM, C:\msd11\work\2019-2\209A3.dwg

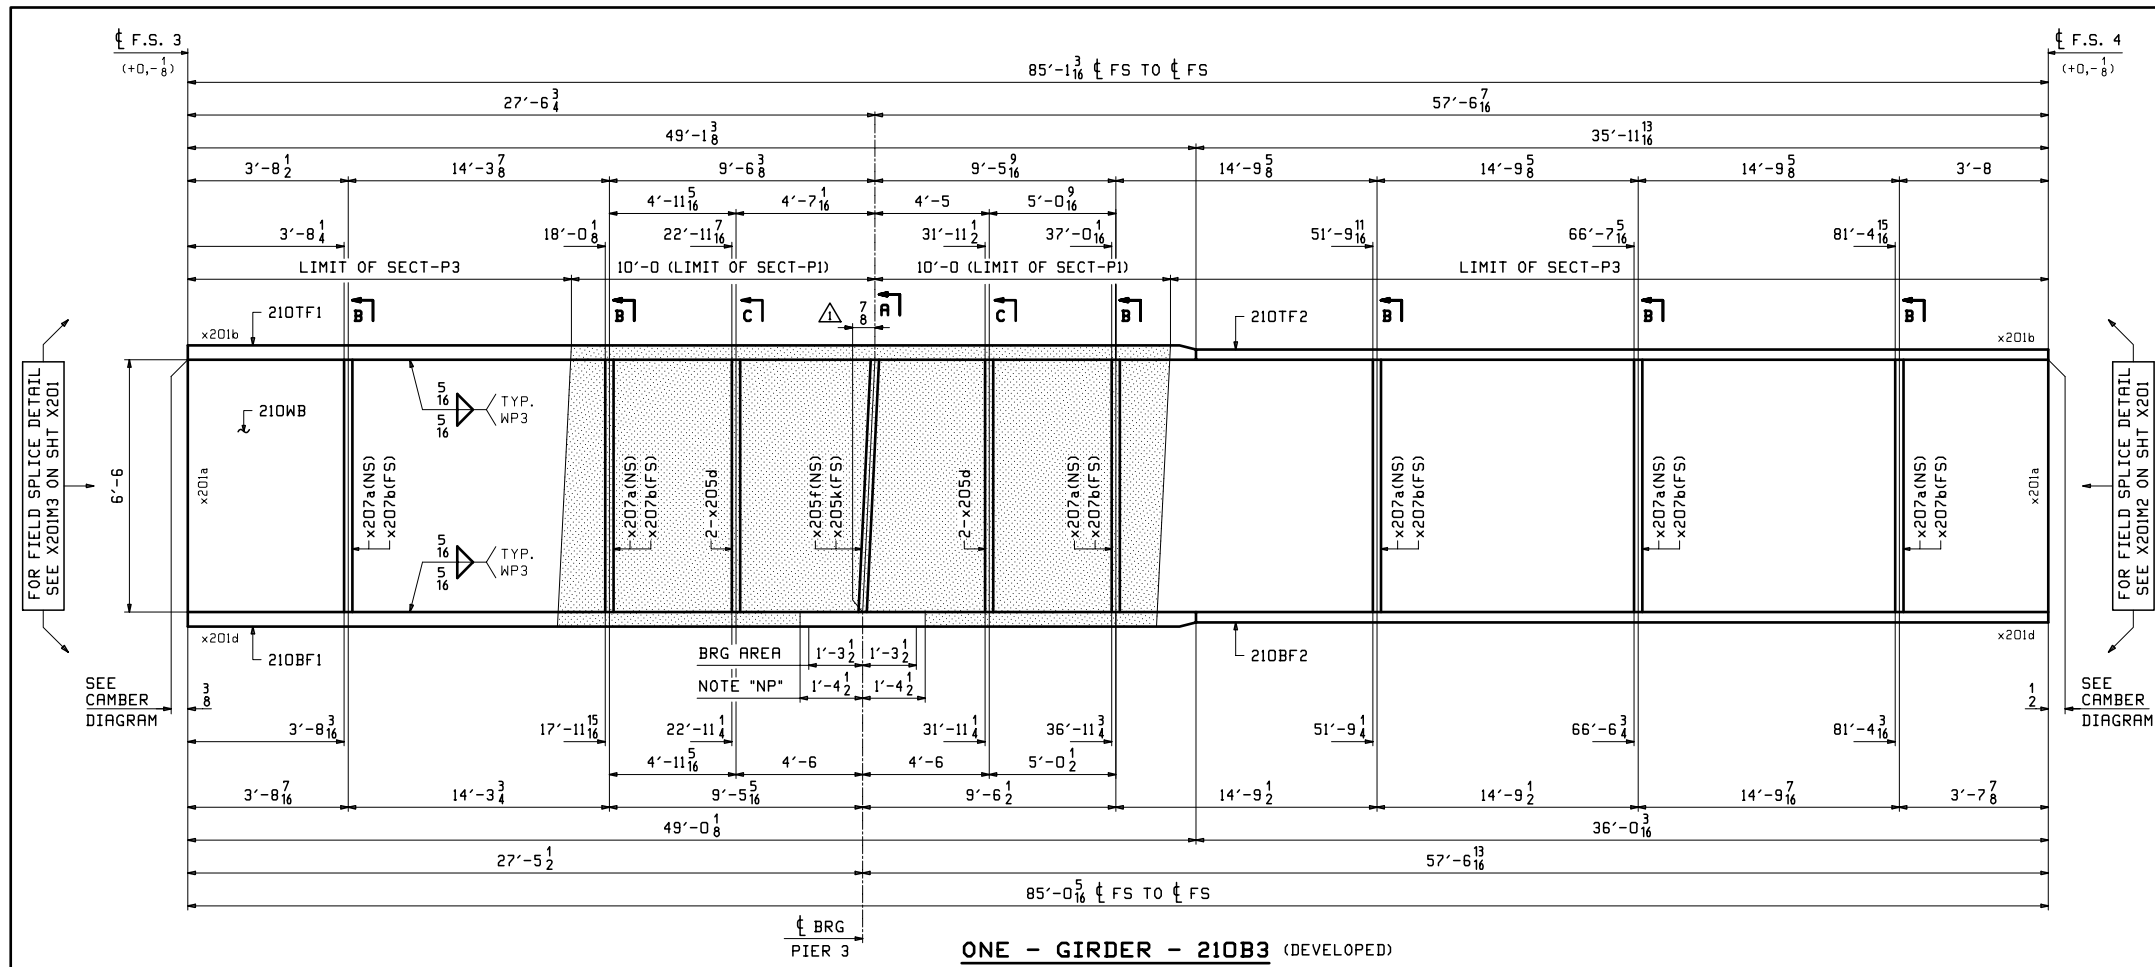

1. FOR GENERAL NOTES SEE SHEET GNI.
2. FOR PRINT NOTES SEE SHEET P1.
3. FOR FIELD SPLICE DETAIL SEE SHEET X201.
4. FOR GIRDER STANDARD DETAILS SEE SHEETS X205-X207.
5. FOR CAMBER & FLANGE DIAGRAMS SEE SHEET BG205 & BG206.
6. "T2" DENOTES MATERIAL SUBJECT TO CHARPY V-NOTCH TESTING.
7. BRG AREA - DENOTES FLANGE TO BE FLAT & TRUE.
8. SEE SHEET P1 FOR SECT-P1, SECT-P3 & NOTE "NP".

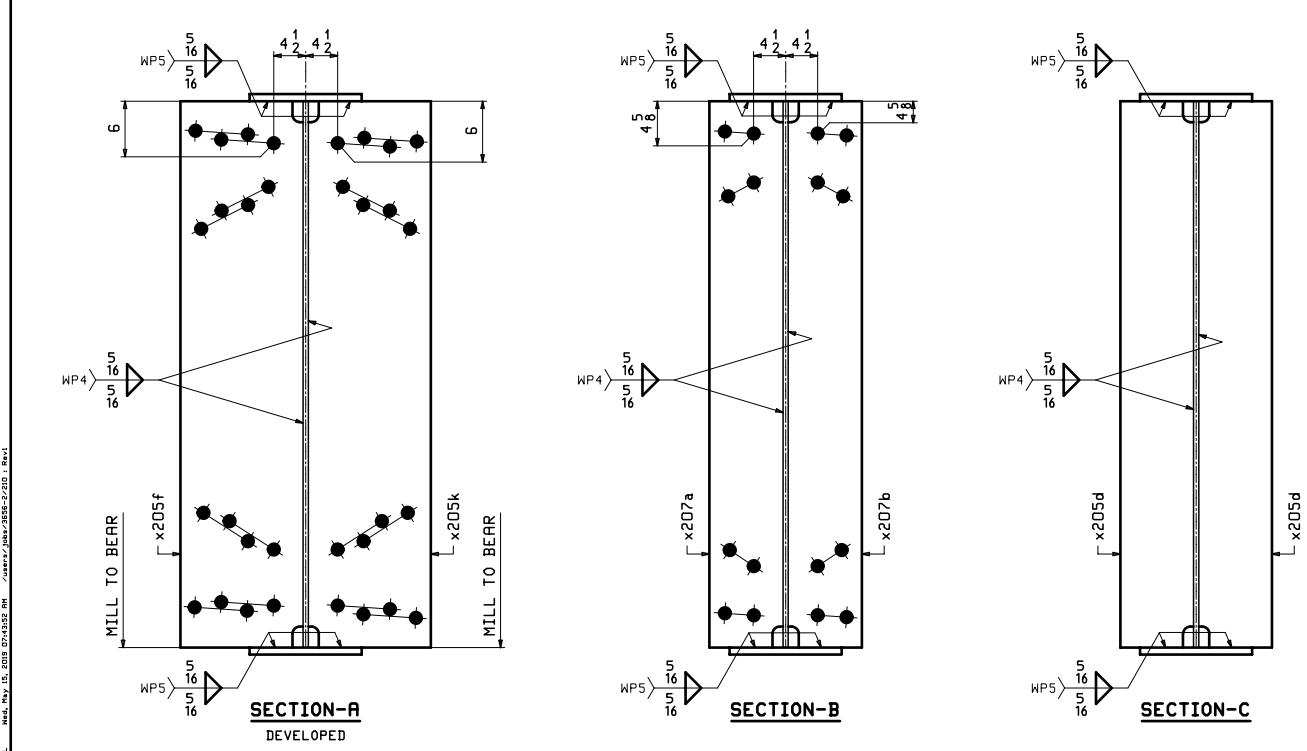


L	SHIP MARK	NO. OF PCS.	ASS'Y MARK	MATERIAL				REMARKS
				SHAPE	LENGTH FT. IN.	MATERIAL SPEC.	ITEM NO.	
1	210B3	1		GIRDER				30753
2								
3		1	210WB	PL 1/2x78	85 13/16	A709-S0W72	205-6	FP-20
4		1	210TF1	PL 2x16	49 13/8	A709-S0W72	201-2	FP-20
5		1	210TF2	PL 1x16	35 11/16	A709-S0W72	204-10	FP-20
6		1	210BF1	PL 2 1/8x16	49 0 1/8	A709-S0W72	201-20	FP-20
7		1	210BF2	PL 1x16	36 0 1/8	A709-S0W72	201-10	FP-20
8								
9		4	x205d	PL 1/2x10 1/2	6 6	A709-S0W72	208-3	FP-20
10		1	x205f	PL 1 1/8x17 1/2	6 6	A709-S0W72	208-3	MIE FP-20
11		1	x205k	PL 1 1/8x17 1/2	6 6	A709-S0W72	208-3	MIE FP-20
12		6	x207a	PL 1/2x10 1/2	6 6	A709-S0W72	208-6	FP-20
13		6	x207b	PL 1/2x10 1/2	6 6	A709-S0W72	208-6	FP-20
14								

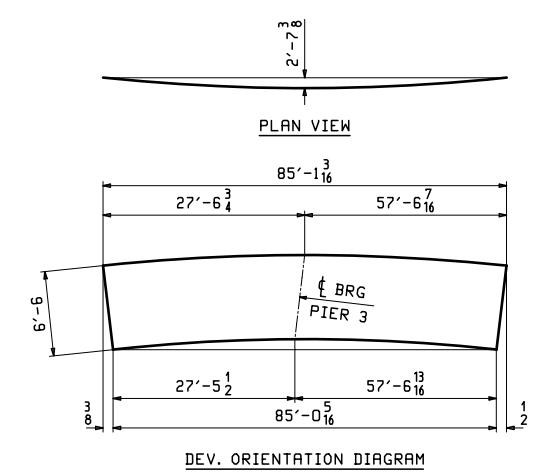


NO.	DATE	REMARKS	BY
	05/13/19	ADDED BRG LEAN DIMENSION	EEO
REVISIONS			
STRUCTURE RAMP P OVER IR-74 WB, IR-75 & RAMP E - UNIT 2			
LOCATION CINCINNATI, OH (HAMILTON COUNTY) STA. 230+22.98			
PROJECT NO. HAM-75-3.84, PID NO. 104667, BRIDGE NO. HAM-74-19085			
ENGINEER PRIME RE GROUP			
CONTRACTOR WALSH GROUP			
GIRDER ~ 210B3			
ITEM	SEE P1		
SURFACE PREP.	OPEN HOLES 1 3/8" OVS FOR 1 1/4" HSB (U.N.)		
PAINT	SEE P1 & AS NOTED		
PRELIMINARY	DRAWN EEO 04/06/19	SHEET NO. 210	PLANT ORDER NO. 3 180608
FOR APPROVAL	CHECKED WJL 04/15/19		FP. NO. 20





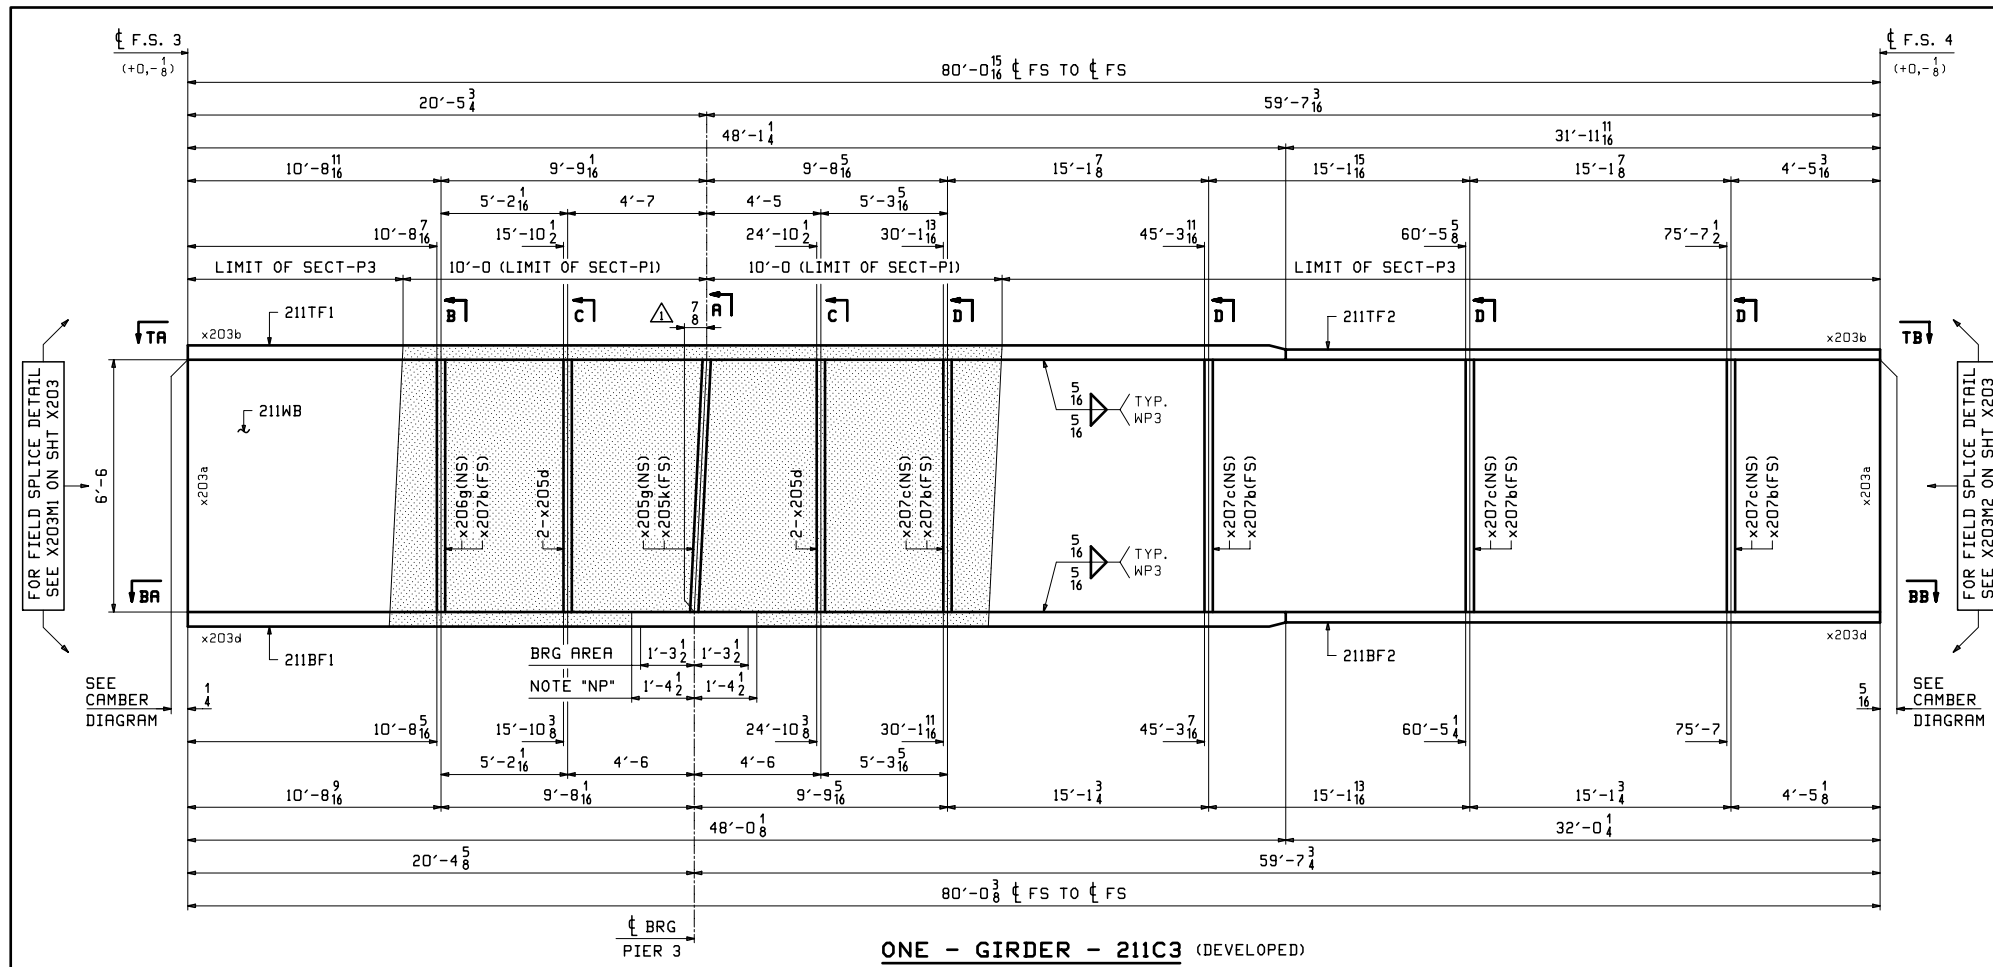


ONE - GIRDER - 211C3 (DEVELOPED)


1. FOR GENERAL NOTES SEE SHEET GNI.
2. FOR PRINT NOTES SEE SHEET P1.
3. FOR FIELD SPLICE DETAIL SEE SHEET X203.
4. FOR GIRDER STANDARD DETAILS SEE SHEETS X205-X207.
5. FOR CAMBER & FLANGE DIAGRAMS SEE SHEET BG205 & BG206.
6. "T2" DENOTES MATERIAL SUBJECT TO CHAPPY V-NOTCH TESTING.
7. BRG AREA - DENOTES FLANGE TO BE FLAT & TRUE.
8. SEE SHEET P1 FOR SECT-P1, SECT-P3 & NOTE "NP".

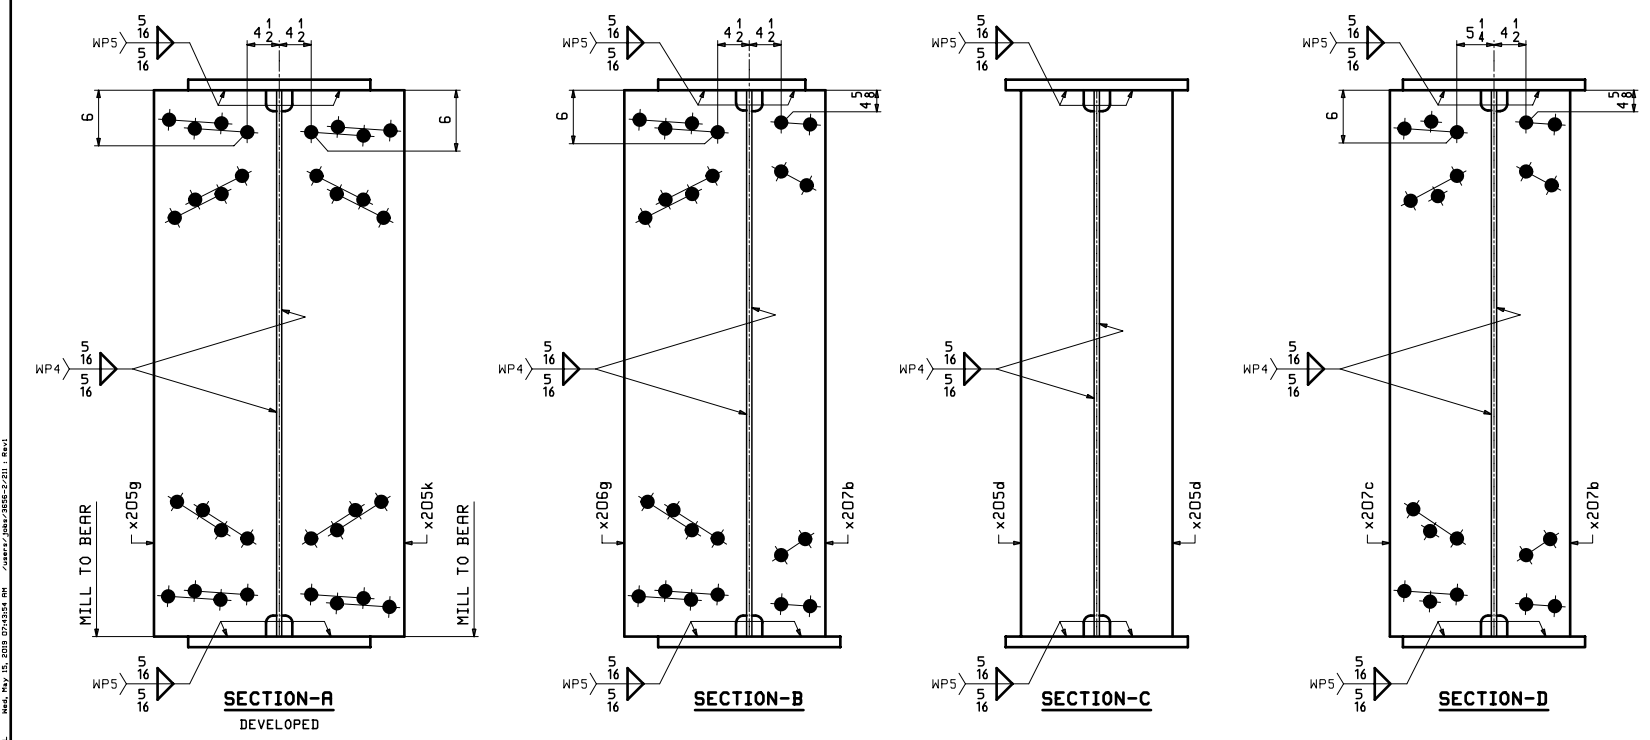

L	SHIP MARK	NO. OF PCS.	ASS'Y MARK	MATERIAL			REMARKS
				SHAPE	LENGTH FT. IN.	MATERIAL SPEC.	
1	211C3	1		GIRDER			43423
2		1	211WB	PL 1/2 x 78	80	A709-50WT2	205-22
3		1	211TF1	PL 2 1/2 x 26	48	A709-50WT2	201-9
4		1	211TF2	PL 1 1/2 x 26	31	A709-50WT2	202-30
5		1	211BF1	PL 2 1/2 x 26	48	A709-50WT2	201-8
6		1	211BF2	PL 1 1/2 x 26	32	A709-50WT2	202-30
7		4	x205d	PL 1/2 x 10 1/2	6	A709-50WT2	208-3
8		1	x205g	PL 5/8 x 17 1/2	6	A709-50WT2	208-3
9		1	x205k	PL 1 1/8 x 17 1/2	6	A709-50WT2	208-3
10		1	x206g	PL 1/2 x 17 1/2	6	A709-50WT2	208-3
11		5	x207b	PL 2 x 10 1/2	6	A709-50WT2	208-3
12		4	x207c	PL 2 x 14 1/2	6	A709-50WT2	208-3

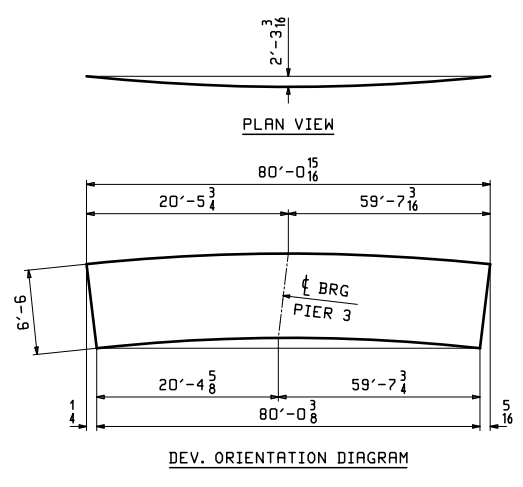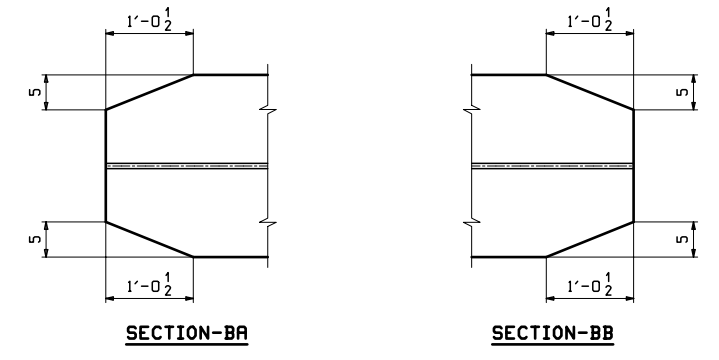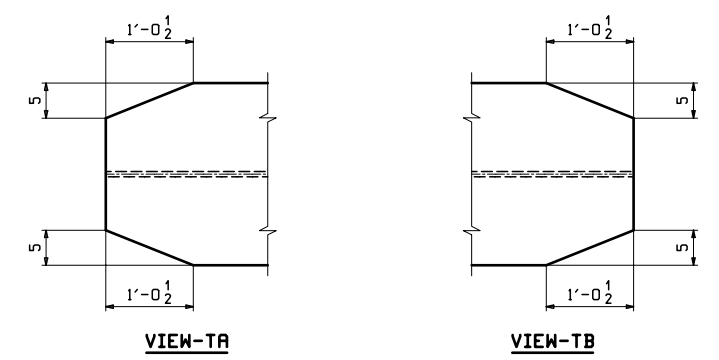

NO.	05/13/19	ADDED BRG LEAN DIMENSION	EEO
DATE		REMARKS	BY
REVISIONS			
2-EAU CLAIRE, WI 3-WAUSAU, WI 4-PALATKA, FL			
STRUCTURE	RAMP P OVER IR-74 WB, IR-75 & RAMP E - UNIT 2		
LOCATION	CINCINNATI, OH (HAMILTON COUNTY) STA. 230+22.98		
PROJECT NO.	HAM-75-3.84, PID NO. 104667, BRIDGE NO. HAM-74-19085		
ENGINEER	PRIME AE GROUP		
CONTRACTOR	WALSH GROUP		
ITEM	GIRDER ~ 211C3		
SURFACE PREP.	SEE P1	OPEN HOLES	1 3/8" OVS FOR 1 1/4" HSB (U.N.)
PAINT	SEE P1 & AS NOTED		
PRELIMINARY	DRAWN EEO 04/06/19	SHEET NO.	PLANT ORDER NO. FP. NO.
FOR APPROVAL	CHECKED WJL 04/15/19	211	3 180608 20

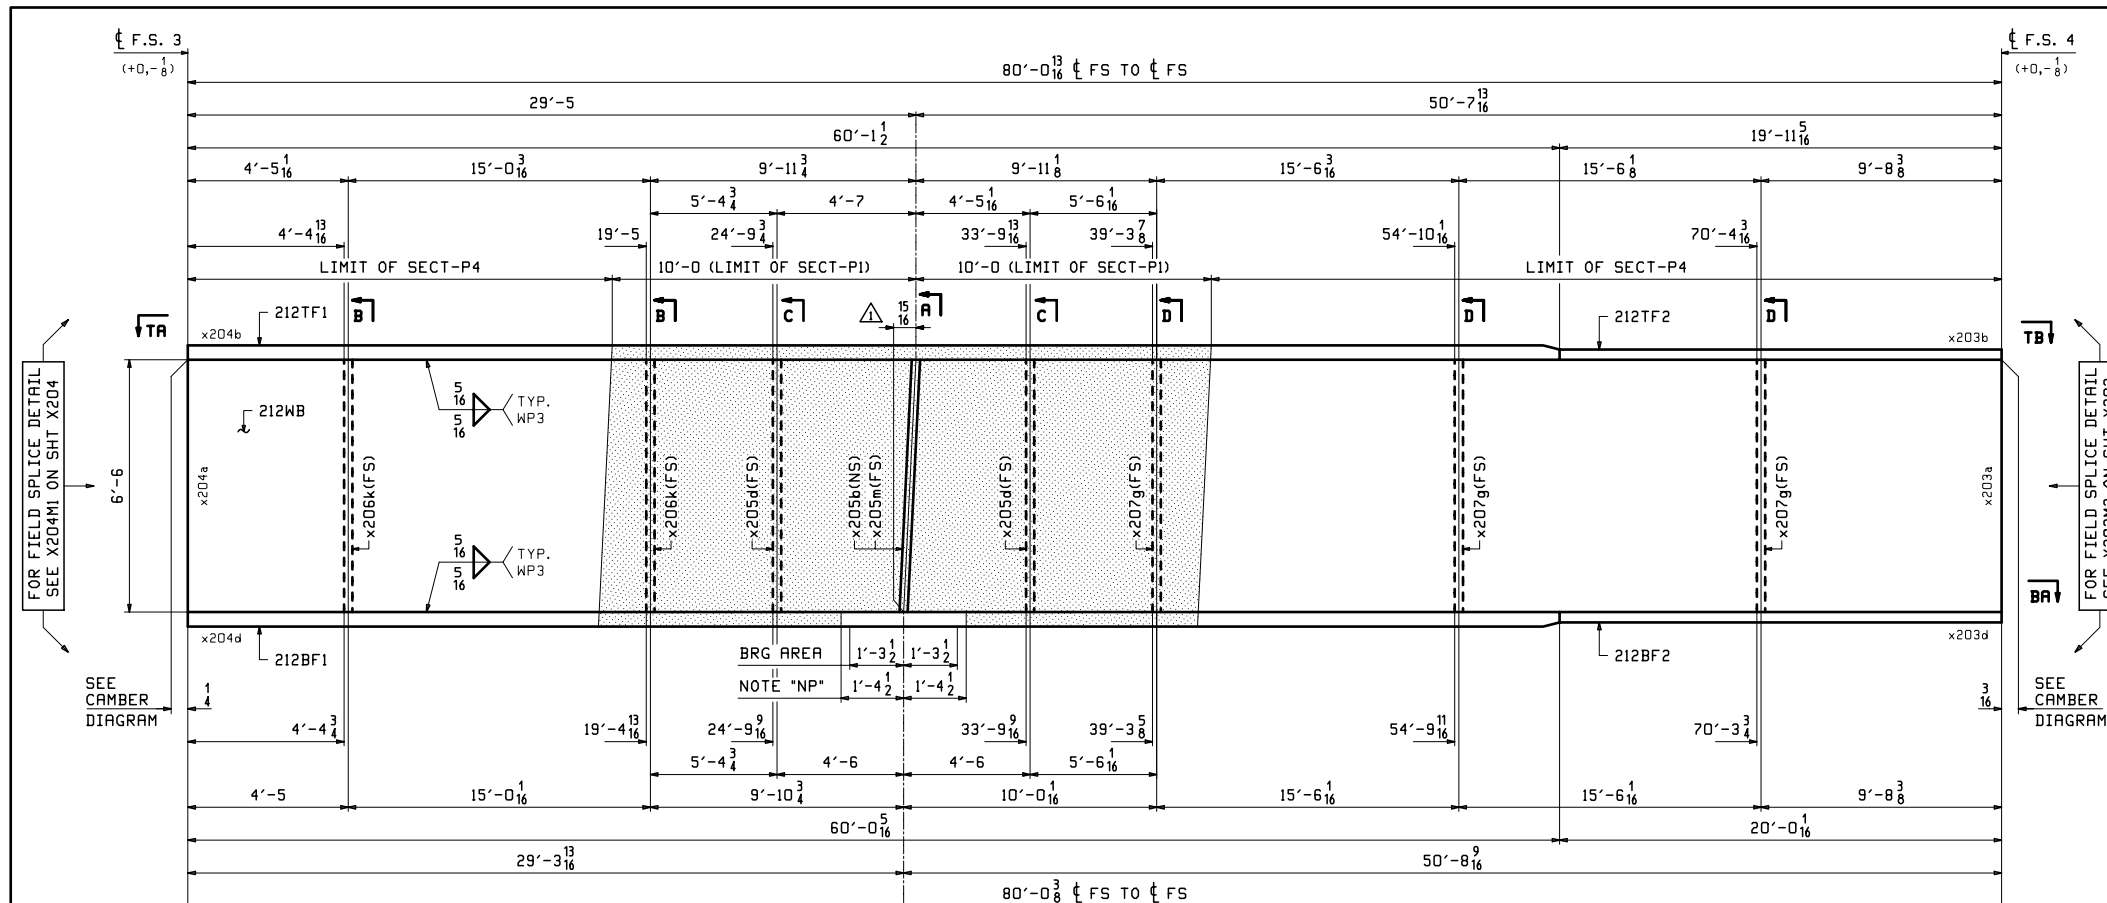

FOR FIELD SPLICE DETAIL  
SEE X204M1 ON SHT X204

FOR FIELD SPLICE DETAIL  
SEE X203M3 ON SHT X203


SEE CAMBER  
DIAGRAM

SEE CAMBER  
DIAGRAM

ONE - GIRDER - 212D3 (DEVELOPED)  
PIER 3


1. FOR GENERAL NOTES SEE SHEET GNI.
2. FOR PAINT NOTES SEE SHEET P1.
3. FOR FIELD SPLICE DETAIL SEE SHEET X203 & X204.
4. FOR GIRDER STANDARD DETAILS SEE SHEETS X205-X207.
5. FOR CAMBER & FLANGE DIAGRAMS SEE SHEET BG205 & BG206.
6. "T2" DENOTES MATERIAL SUBJECT TO CHARPY V-NOTCH TESTING.
7. BRG AREA - DENOTES FLANGE TO BE FLAT & TRUE.
8. SEE SHEET P1 FOR SECT-P1, SECT-P4 & NOTE "NP".

L	SHIP MARK	NO. OF PCS.	ASS'Y MARK	MATERIAL			REMARKS
				SHAPE	LENGTH FT. IN.	MATERIAL SPEC.	
1	212D3	1		GIRDER			49955
2							
3		1	212WB	PL 1/2 x 7/8	80	A709-SOWT2	205-22
4		1	212TF1	PL 2 1/2 x 2B	60	A709-SOWT2	201-2
5		1	212TF2	PL 1 1/2 x 2B	19	A709-SOWT2	202-2
6		1	212BF1	PL 2 x 2B	60	A709-SOWT2	201-2
7		1	212BF2	PL 2 x 2B	20	A709-SOWT2	201-2
8							
9		1	x205b	PL 5/8 x 8	6	A709-SOWT2	208-4
10		2	x205d	PL 2 x 10 1/2	6	A709-SOWT2	208-5
11		1	x205m	PL 1 1/2 x 17 1/2	6	A709-SOWT2	208-3
12		2	x206k	PL 2 x 17 1/2	6	A709-SOWT2	208-8
13		3	x207g	PL 2 x 14 1/2	6	A709-SOWT2	208-7
14							

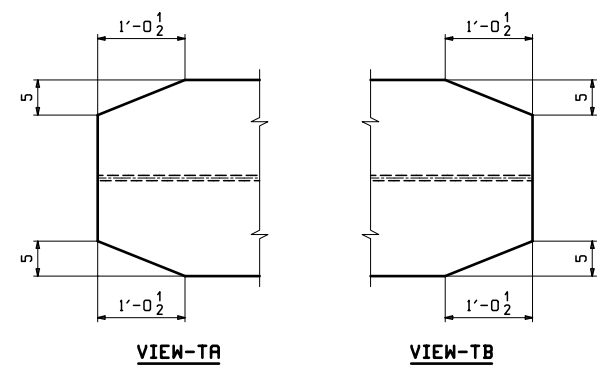


VIEW-TA

VIEW-TB

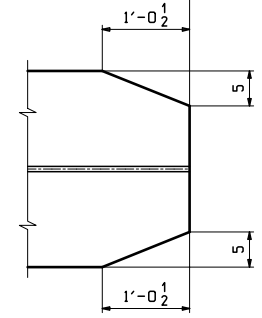


SECTION-BA

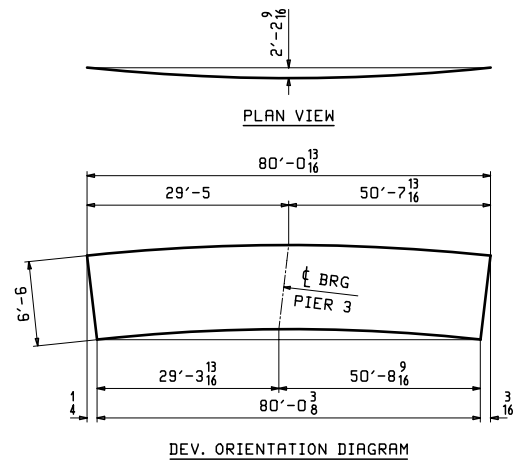


PLAN VIEW


DEV. ORIENTATION DIAGRAM

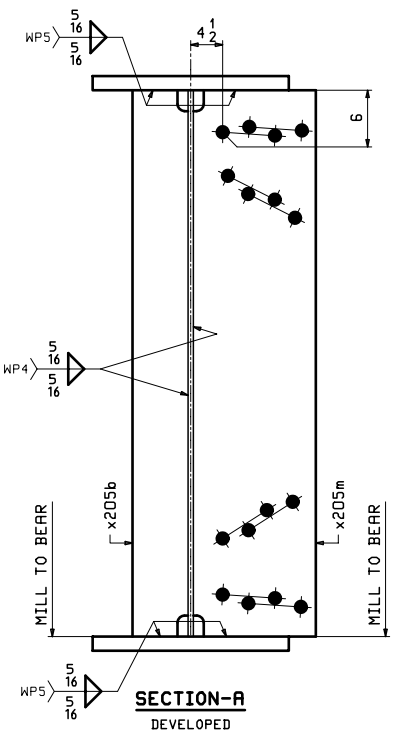


SECTION-A DEVELOPED

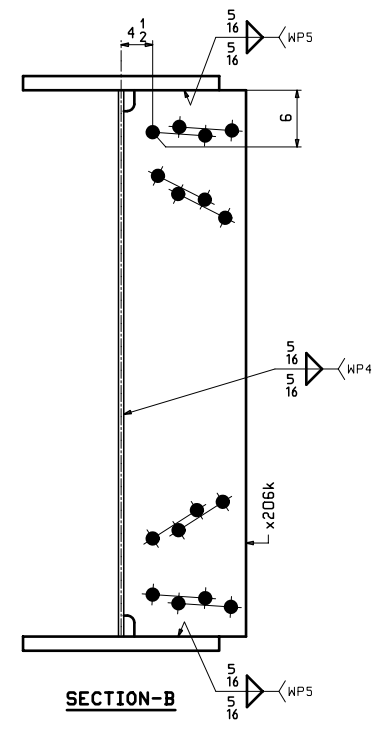

SECTION-B

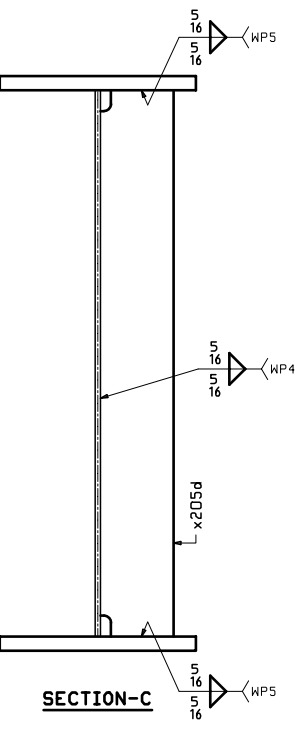

SECTION-C

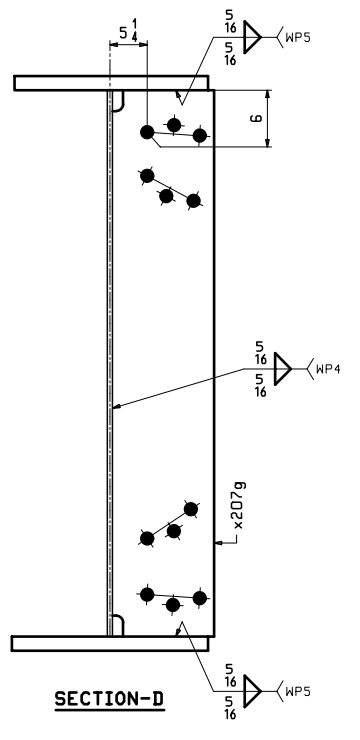


SECTION-D

NO.	DATE	REVISIONS	BY
05/13/19		ADDED BRG LEAN DIMENSION	EEO
			WJL
STRUCTURE RAMP P OVER IR-74 WB, IR-75 & RAMP E - UNIT 2 LOCATION CINCINNATI, OH (HAMILTON COUNTY) STA. 230+22.98 PROJECT NO. HAM-75-3.84, PID NO. 104667, BRIDGE NO. HAM-74-1908S ENGINEER PRIME RE GROUP CONTRACTOR WALSH GROUP			
GIRDER ~ 212D3			
ITEM	SEE P1		
SURFACE PREP.	OPEN HOLES 1 3/8" OVS FOR 1 1/4" HSB (U.N.)		
PAIN	SEE P1 & AS NOTED		
PRELIMINARY	DRAWN EEO 04/06/19	SHEET NO. 212	PLANT ORDER NO. 3 180608
FOR APPROVAL	CHECKED WJL 04/15/19		FP. NO. 20



HLL Mod. Rev. 15, 2018 07/10/19 19:00:00 2018-07-20 11:00:00

L	SHIP MARK	NO. OF PCS.	ASS'Y MARK	MATERIAL				REMARKS
				SHAPE	LENGTH FT. IN.	MATERIAL SPEC.	ITEM NO.	
1	213A4	1		GIRDER				21895
2								
3		1	213WB	PL 1/2x78	82 1 5/8	A709-50WT2	204 26	FP:20
4		1	213TF	PL 1x16	82 1 5/8	A709-50WT2	203 16	FP:20
5		1	213BF	PL 1x16	81 11 1/16	A709-50WT2	203 16	FP:20
6								
7		6	x207a	PL 1/2x10 1/2	6 6	A709-50WT2	208 6	FP:20
8								

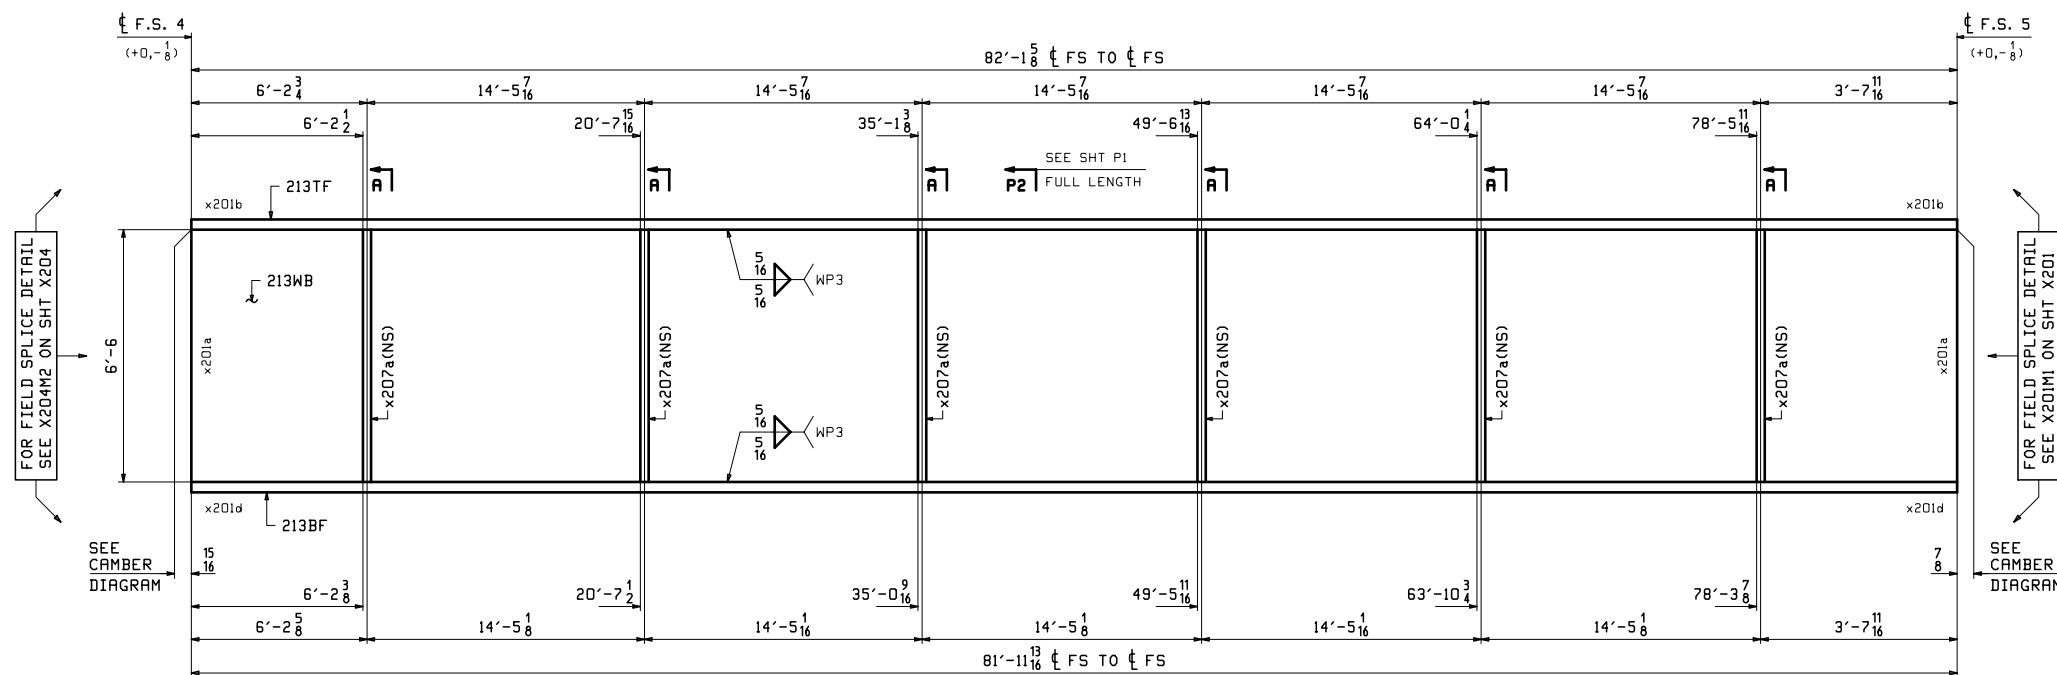


**ONE - GIRDER - 213A4 (DEVELOPED)**

1. FOR GENERAL NOTES SEE SHEET GNI.
2. FOR PAINT NOTES SEE SHEET P1.
3. FOR FIELD SPLICE DETAIL SEE SHEET X201 & X204.
4. FOR GIRDER STANDARD DETAILS SEE SHEETS X205-X207.
5. FOR CAMBER & FLANGE DIAGRAMS SEE SHEETS BG206 & BG207.
6. "T2" DENOTES MATERIAL SUBJECT TO CHARPY V-NOTCH TESTING.
7. SEE SHEET P1 FOR SECT-P2.

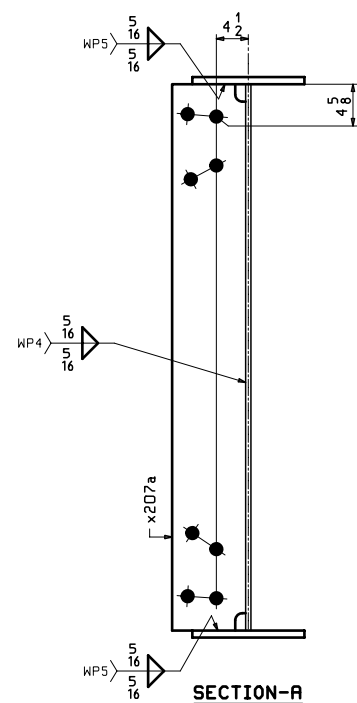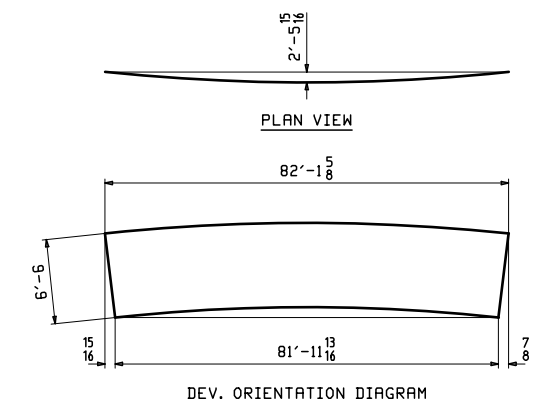



NO.	DATE	REMARKS	BY
REVISIONS			
STRUCTURE <b>RAMP P OVER IR-74 WB, IR-75 &amp; RAMP E - UNIT 2</b> LOCATION <b>CINCINNATI, OH (HAMILTON COUNTY) STA. 230+22.98</b> PROJECT NO. <b>HAM-75-3.84, PID NO. 104667, BRIDGE NO. HAM-74-19085</b> ENGINEER <b>PRIME RE GROUP</b> CONTRACTOR <b>WALSH GROUP</b>			
<b>GIRDER ~ 213A4</b>			
ITEM <b>SEE P1</b>			
SURFACE PREP. <b>SEE P1 &amp; AS NOTED</b>			
PAINT <b>SEE P1 &amp; AS NOTED</b>			
PRELIMINARY	DRAWN <b>EE0 04/05/19</b>	SHEET NO. <b>213</b>	PLANT <b>3</b>
FOR APPROVAL	CHECKED <b>WJL 04/15/19</b>	ORDER NO. <b>180608</b>	FP. NO. <b>20</b>

QTY	SHIP MARK	NO. OF PCS.	ASS'Y MARK	MATERIAL				REMARKS	
				SHAPE	LENGTH FT. IN.	MATERIAL SPEC.	ITEM NO.		
1	214B4	1		GIRDER				215B3	
2									
3	1	214WB		PL 1/2x78	79	1 1/2	A709-50WT2	204-32	FP-20
4	1	214TF		PL 1x16	79	1 1/2	A709-50WT2	203-24	FP-20
5	1	214BF		PL 1x16	78	11 7/8	A709-50WT2	203-24	FP-20
6									
7	5	x207a		PL 1/2x10 1/2	6	6	A709-50WT2	208-6	FP-20
8	5	x207b		PL 1/2x10 1/2	6	6	A709-50WT2	208-6	FP-20
9									

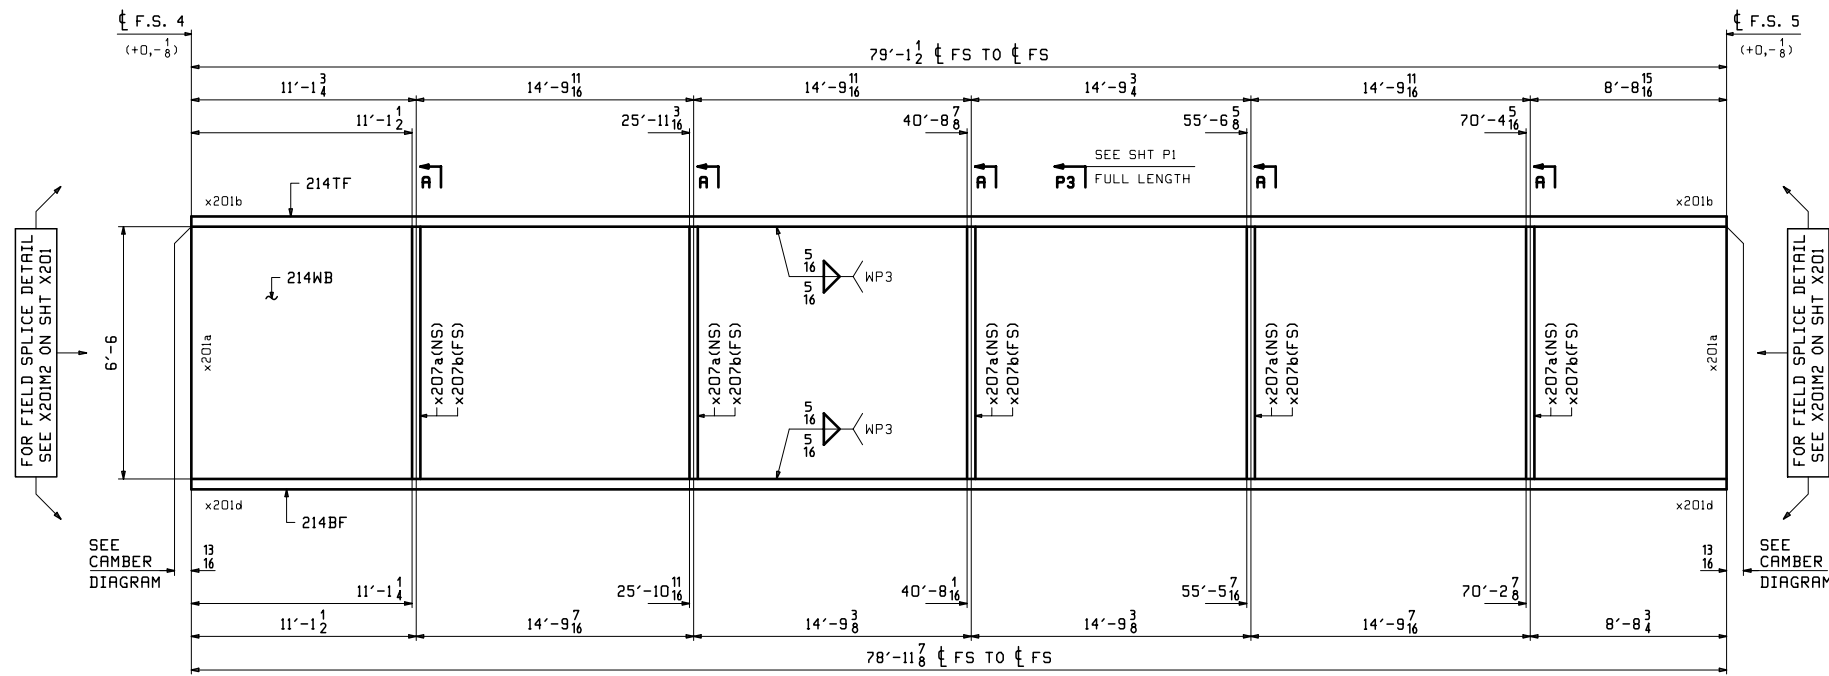

**ONE - GIRDER - 214B4 (DEVELOPED)**


1. FOR GENERAL NOTES SEE SHEET GNI.
2. FOR PAINT NOTES SEE SHEET P1.
3. FOR FIELD SPLICE DETAIL SEE SHEET X201.
4. FOR GIRDER STANDARD DETAILS SEE SHEETS X205-X207.
5. FOR CAMBER & FLANGE DIAGRAMS SEE SHEET BG206 & BG207.
6. "T2" DENOTES MATERIAL SUBJECT TO CHARPY V-NOTCH TESTING.
7. SEE SHEET P1 FOR SECT-P3.

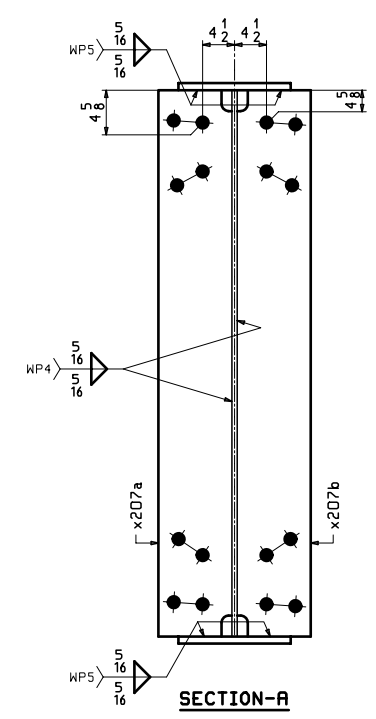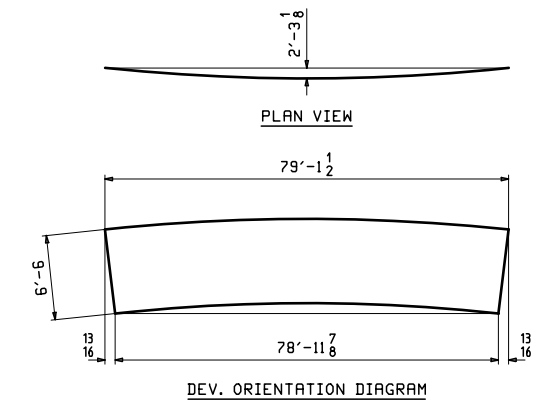

NO.	DATE	REMARKS	BY
REVISIONS			
STRUCTURE <u>RAMP P OVER IR-74 WB, IR-75 &amp; RAMP E - UNIT 2</u> LOCATION <u>CINCINNATI, OH (HAMILTON COUNTY) STA. 230+22.98</u> PROJECT NO. <u>HAM-75-3.84, PID NO. 104667, BRIDGE NO. HAM-74-19085</u> ENGINEER <u>PRIME RE GROUP</u> CONTRACTOR <u>WALSH GROUP</u>			
<b>GIRDER ~ 214B4</b>			
ITEM	<u>SEE P1</u>		
SURFACE PREP.	<u>SEE P1 &amp; AS NOTED</u>		
PAINT	<u>SEE P1 &amp; AS NOTED</u>		
PRELIMINARY	DRAWN <u>EEO 04/07/19</u>	SHEET NO. <u>214</u>	PLANT <u>3</u> ORDER NO. <u>180608</u> FP. NO. <u>20</u>
FOR APPROVAL	CHECKED <u>WJL 04/15/19</u>		



EEO: P1, Rev. 18, 2018 03:00:00 PM C:\msd\180608\214B4.dwg

ITEM	SHIP MARK	NO. OF PCS.	ASS'Y MARK	MATERIAL				REMARKS
				SHAPE	LENGTH FT. IN.	MATERIAL SPEC.	ITEM NO.	
1	215C4	1		GIRDER				21544
2								
3		1	215WB	PL 1/2x78	78 1/8	A709-50WT2	205-2	FP:20
4		1	215TF	PL 1x16	78 1/8	A709-50WT2	203-25	FP:20
5		1	215BF	PL 1x16	77 11/8	A709-50WT2	203-26	FP:20
6								
7		5	x207b	PL 1/2x10 1/2	6 6	A709-50WT2	208-6	FP:20
8		5	x207c	PL 1/2x14 1/2	6 6	A709-50WT2	208-7	FP:20
9								

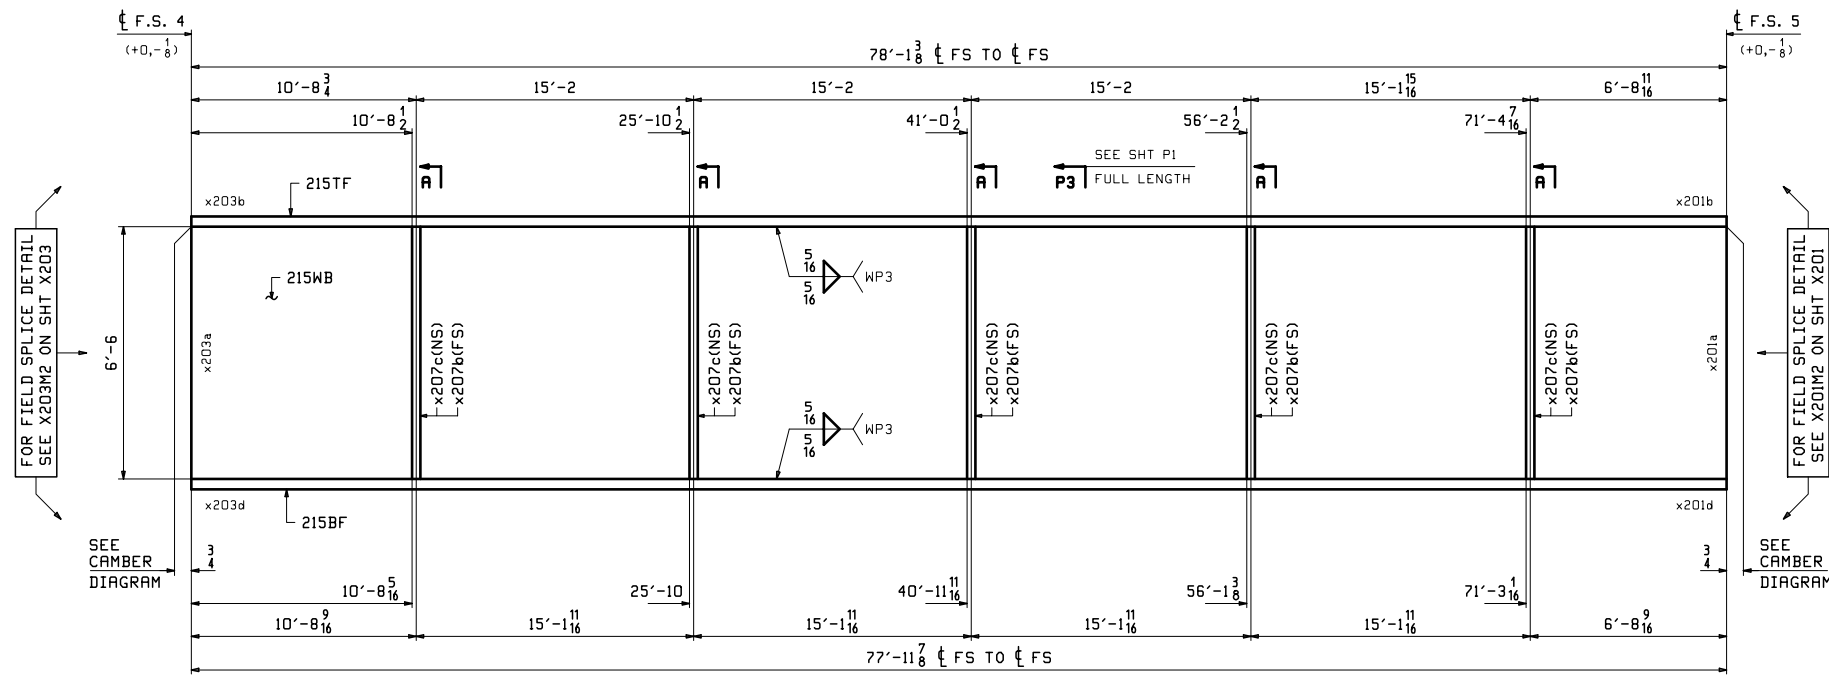

**ONE - GIRDER - 215C4 (DEVELOPED)**


1. FOR GENERAL NOTES SEE SHEET GNI.
2. FOR PAINT NOTES SEE SHEET P1.
3. FOR FIELD SPLICE DETAIL SEE SHEET X201 & X203.
4. FOR GIRDER STANDARD DETAILS SEE SHEETS X205-X207.
5. FOR CAMBER & FLANGE DIAGRAMS SEE SHEET BG206 & BG207.
6. "T2" DENOTES MATERIAL SUBJECT TO CHARPY V-NOTCH TESTING.
7. SEE SHEET P1 FOR SECT-P3.

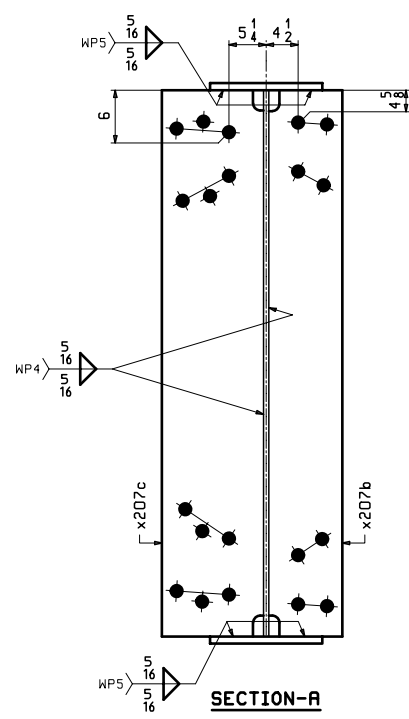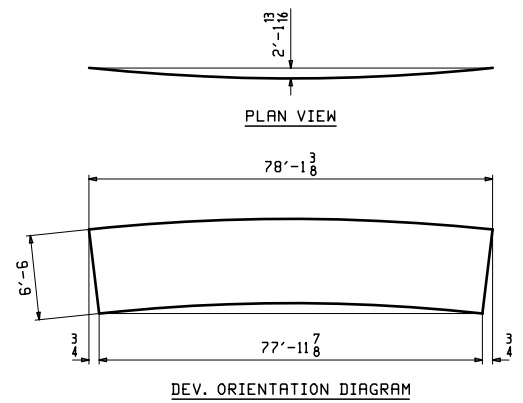

NO.	DATE	REMARKS	BY
REVISIONS			
STRUCTURE <b>RAMP P OVER IR-74 WB, IR-75 &amp; RAMP E - UNIT 2</b>			
LOCATION <b>CINCINNATI, OH (HAMILTON COUNTY) STA. 230+22.98</b>			
PROJECT NO. <b>HAM-75-3.84, PID NO. 104667, BRIDGE NO. HAM-74-19085</b>			
ENGINEER <b>PRIME RE GROUP</b>			
CONTRACTOR <b>WALSH GROUP</b>			
<b>GIRDER ~ 215C4</b>			
ITEM <b>SEE P1</b>			
SURFACE PREP. <b>SEE P1</b> OPEN HOLES <b>1 3/8" Ø OVS FOR 1 1/4" Ø HSB (U.N.)</b>			
PAINT <b>SEE P1 &amp; AS NOTED</b>			
PRELIMINARY	DRAWN <b>EEO 04/07/19</b>	SHEET NO. <b>215</b>	PLANT <b>3</b>
FOR APPROVAL	CHECKED <b>WJL 04/15/19</b>	ORDER NO. <b>180608</b>	FP. NO. <b>20</b>



EEO: P1, Rev. 18, 2018 03:25:30 PM, C:\Users\jwalsh\OneDrive\Documents\2018\180608-2019\1 Rev 0

L	SHIP MARK	NO. OF PCS.	ASS'Y MARK	MATERIAL				REMARKS
				SHAPE	LENGTH FT. IN.	MATERIAL SPEC.	ITEM NO.	
1	216D4	1		GIRDER				28830
2								
3		1	216WB1	PL 3/8x78	58 0 11/16	A709-50WT2	205-32	FP-20
4		1	216WB2	PL 3/8x78	29 0 11/16	A709-50WT2	206-4	FP-20
5		1	216TF1	PL 1/4x18	29 1 3/8	A709-50WT2	203-2	FP-20
6		1	216TF2	PL 1/4x18	58 0	A709-50WT2	202-32	FP-20
7		1	216BF1	PL 1/2x18	28 11 5/16	A709-50WT2	202-20	FP-20
8		1	216BF2	PL 1/2x18	58 0	A709-50WT2	202-16	FP-20
9								
10		6	x207g	PL 1/2x14 1/2	6 6	A709-50WT2	208-7	FP-20
11								

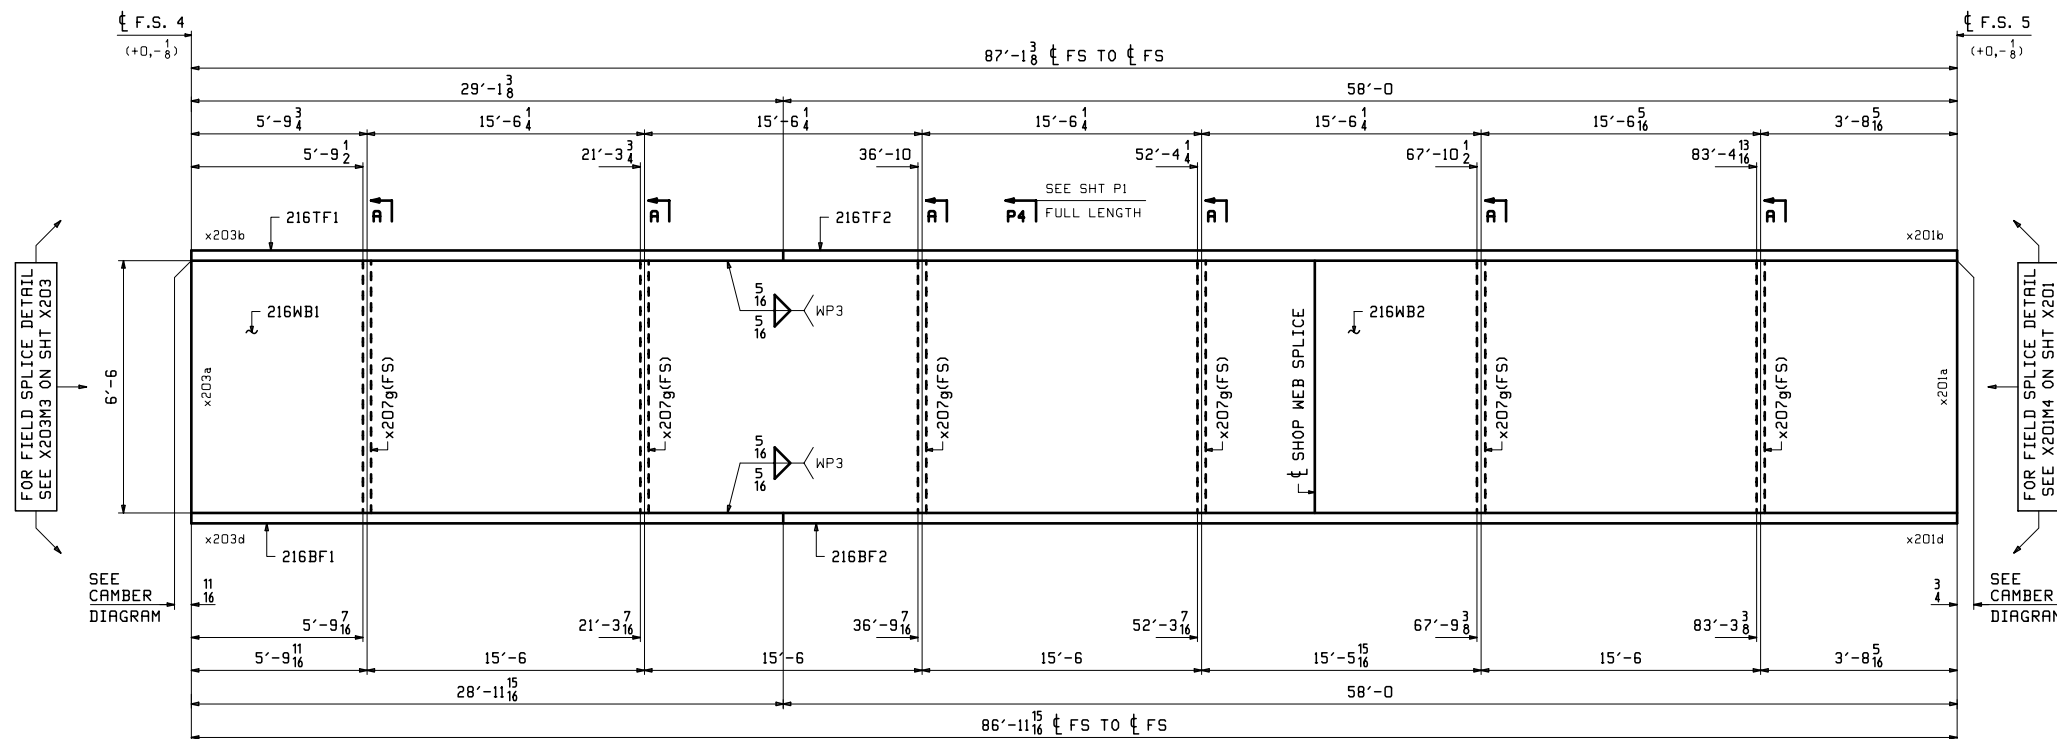


**ONE - GIRDER - 216D4 (DEVELOPED)**

1. FOR GENERAL NOTES SEE SHEET GNI.
2. FOR PAINT NOTES SEE SHEET P1.
3. FOR FIELD SPLICE DETAIL SEE SHEET X201 & X203.
4. FOR GIRDER STANDARD DETAILS SEE SHEETS X205-X207.
5. FOR CAMBER & FLANGE DIAGRAMS SEE SHEET BG206 & BG207.
6. "T2" DENOTES MATERIAL SUBJECT TO CHARPY V-NOTCH TESTING.
7. SEE SHEET P1 FOR SECT-P4.

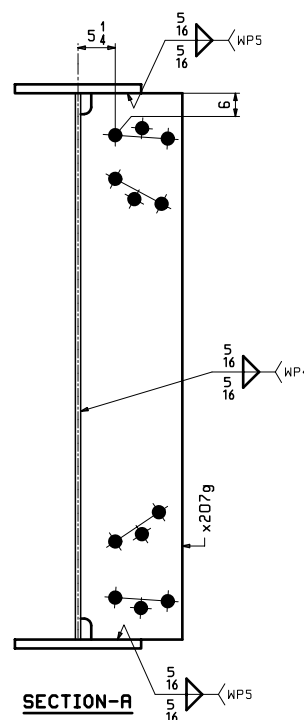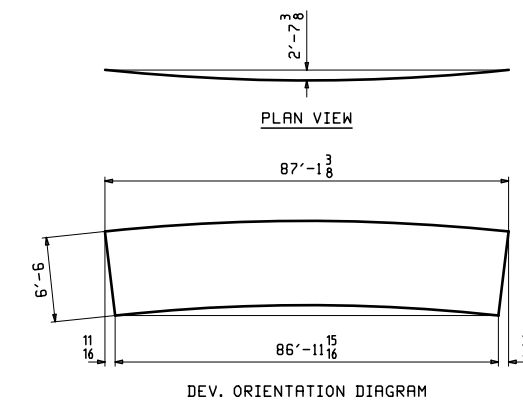

NO.	DATE	REMARKS	BY			
REVISIONS						
STRUCTURE <u>RAMP P OVER IR-74 WB, IR-75 &amp; RAMP E - UNIT 2</u>						
LOCATION <u>CINCINNATI, OH (HAMILTON COUNTY) STA. 230+22.98</u>						
PROJECT NO. <u>HAM-75-3.84, PID NO. 104667, BRIDGE NO. HAM-74-19085</u>						
ENGINEER <u>PRIME AE GROUP</u>						
CONTRACTOR <u>WALSH GROUP</u>						
GIRDER ~ 216D4						
ITEM <u>SEE P1</u>						
SURFACE PREP. <u>SEE P1</u> OPEN HOLES <u>1 3/8" Ø OVS FOR 1 1/4" Ø HSB (U.N.)</u>						
PAINT <u>SEE P1 &amp; AS NOTED</u>						
PRELIMINARY	DRAWN	EEO 04/07/19	SHEET NO.	PLANT	ORDER NO.	FP. NO.
FOR APPROVAL	CHECKED	WJL 04/15/19	216	3	180608	20




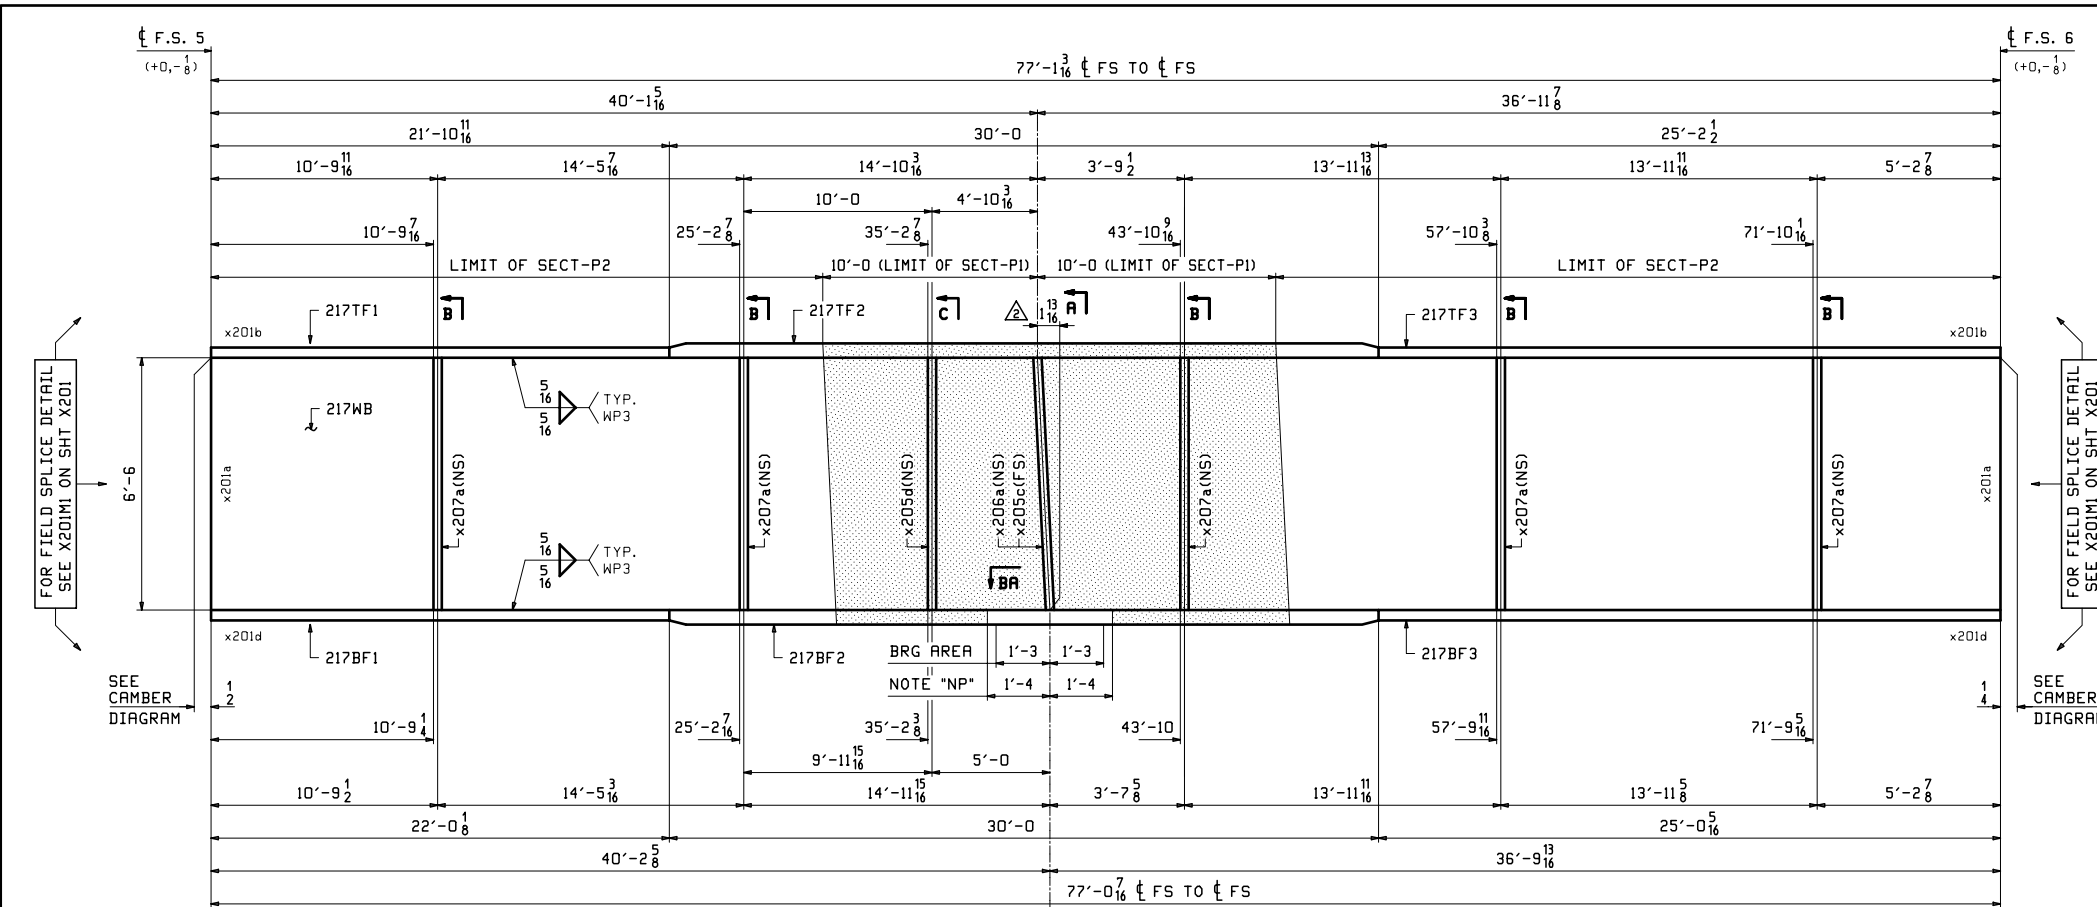


FOR FIELD SPLICE DETAIL  
SEE X201M1 ON SHT X201


FOR FIELD SPLICE DETAIL  
SEE X201M1 ON SHT X201

**ONE - GIRDER - 217A5 (DEVELOPED)**

1. FOR GENERAL NOTES SEE SHEET GNI.
2. FOR PAINT NOTES SEE SHEET P1.
3. FOR FIELD SPLICE DETAIL SEE SHEET X201.
4. FOR GIRDER STANDARD DETAILS SEE SHEETS X205-X207.
5. FOR CAMBER & FLANGE DIAGRAMS SEE SHEET BG208.
6. \*T2\* DENOTES MATERIAL SUBJECT TO CHARPY V-NOTCH TESTING.
7. BRG AREA - DENOTES FLANGE TO BE FLAT & TRUE.
8. SEE SHEET P1 FOR SECT-P1, SECT-P2 & NOTE \*NP\*.

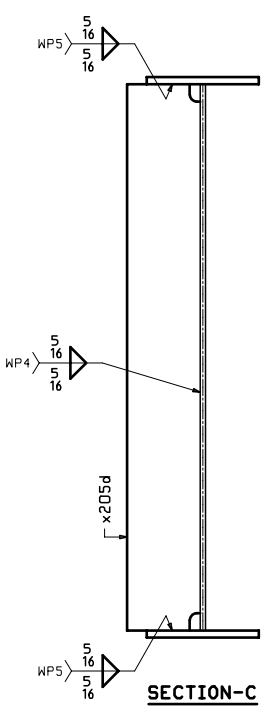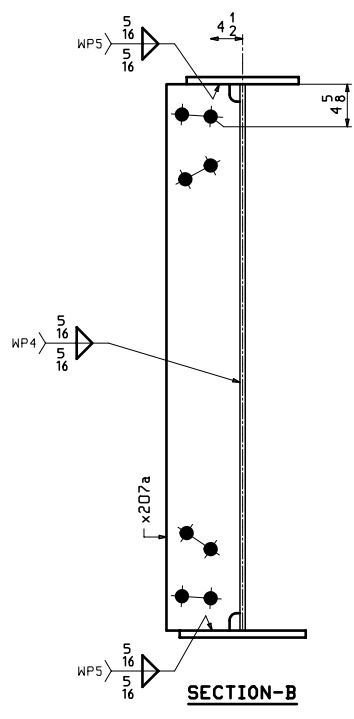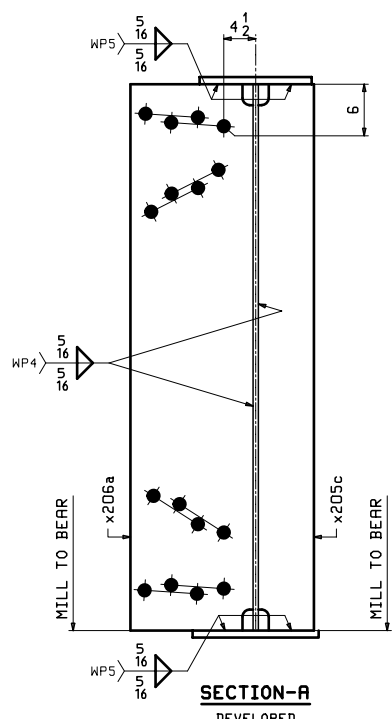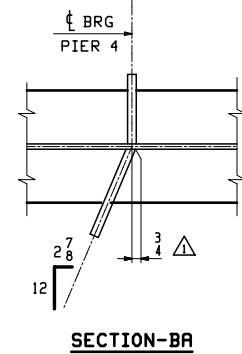

L PZT	SHIP MARK	NO. OF PCS.	ASS'Y MARK	MATERIAL			REMARKS	
				SHAPE	LENGTH FT. IN.	MATERIAL SPEC.		ITEM NO.
1	217A5	1		GIRDER			237E3	
2								
3		1	217WB	PL 1/2x78	77 13/16	A709-SOWT2	205-12	FP-20
4		1	217TF1	PL 1x16	21 10 1/4	A709-SOWT2	204-22	FP-20
5		1	217TF2	PL 1 1/2x16	30 0	A709-SOWT2	202-22	FP-20
6		1	217TF3	PL 1x16	25 2 1/2	A709-SOWT2	204-16	FP-20
7		1	217BF1	PL 1x16	22 0 8	A709-SOWT2	204-20	FP-20
8		1	217BF2	PL 1 1/2x16	30 0	A709-SOWT2	202-16	FP-20
9		1	217BF3	PL 1x16	25 0 1/2	A709-SOWT2	204-16	FP-20
10								
11		1	x205c	PL 1 1/2x8	6 6	A709-SOWT2	208-14	MIE FP-20
12		1	x205d	PL 2x10 1/2	6 6	A709-SOWT2	208-3	FP-20
13		1	x206a	PL 1 1/2x17 1/2	6 6 1/8	A709-SOWT2	208-13	MIE FP-20
14		5	x207a	PL 2x10 2	6 6	A709-SOWT2	208-5	FP-20
15								

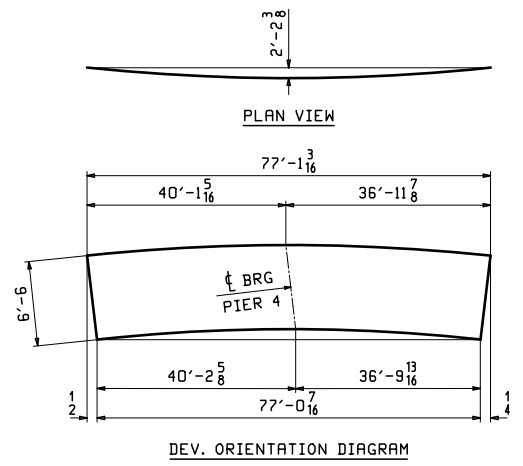

NO.	DATE	REVISIONS	BY
1	05/13/19	ADDED BRG LEAN DIMENSION	EEO WJL
2	04/24/19	REV'D BRG STIFF THICKNESS @ PIER 4	EEO WJL


2-EAU CLAIRE, WI 3-WAUSAU, WI 4-PALATKA, FL

STRUCTURE: RAMP P OVER IR-74 WB, IR-75 & RAMP E - UNIT 2  
 LOCATION: CINCINNATI, OH (HAMILTON COUNTY) STA. 230+22.98  
 PROJECT NO.: HAM-75-3.84, PID NO. 104667, BRIDGE NO. HAM-74-19085  
 ENGINEER: PRIME RE GROUP  
 CONTRACTOR: WALSH GROUP

ITEM: GIRDER ~ 217A5  
 SURFACE PREP.: SEE P1 OPEN HOLES 1 3/8" Ø OVS FOR 1 1/4" Ø HSB (U.N.)  
 PAINT: SEE P1 & AS NOTED





PRELIMINARY	DRAWN EEO 04/05/19	SHEET NO. 217	PLANT 3	ORDER NO. 180608	FP. NO. 20
FOR APPROVAL	CHECKED WJL 04/15/19				

JNL, Mod, Nov 15, 2018 02:43:05 PM, C:\msd17\work\2018-2017-1\_Rn2

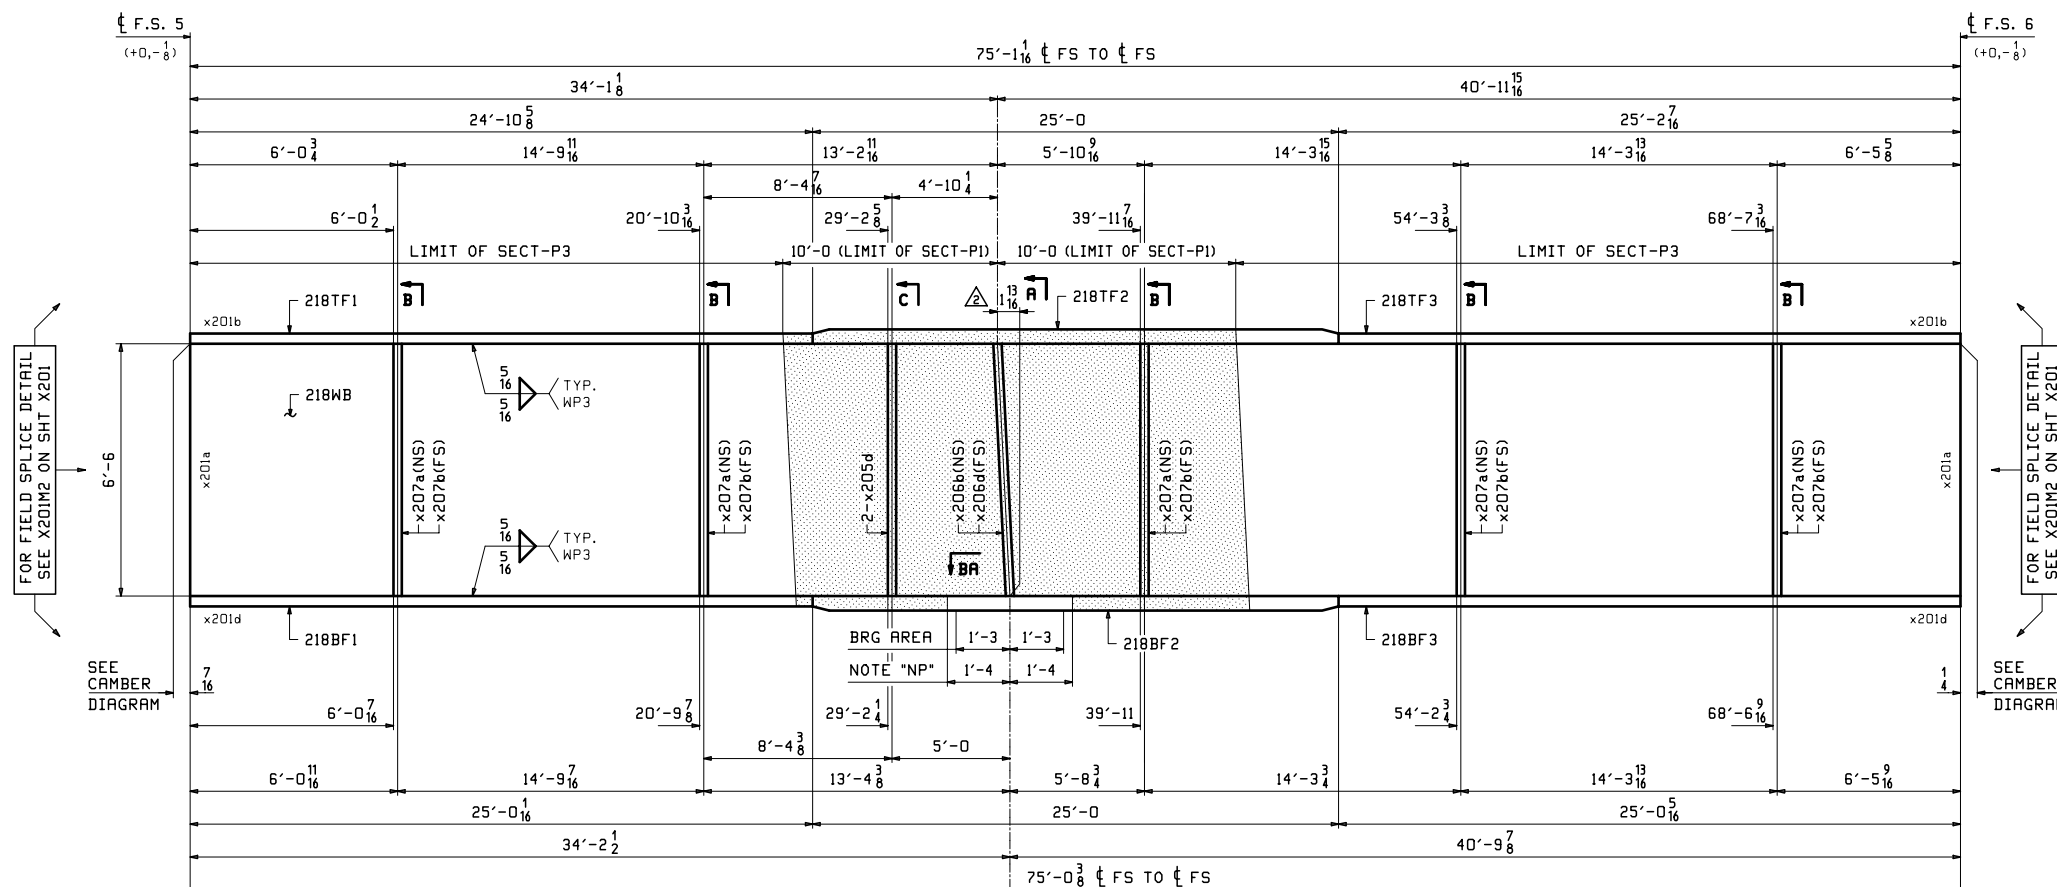


**ONE - GIRDER - 218B5 (DEVELOPED)**

1. FOR GENERAL NOTES SEE SHEET GNI.
2. FOR PAINT NOTES SEE SHEET P1.
3. FOR FIELD SPLICE DETAIL SEE SHEET X201.
4. FOR GIRDER STANDARD DETAILS SEE SHEETS X205-X207.
5. FOR CAMBER & FLANGE DIAGRAMS SEE SHEET BG208 & BG209.
6. "T2" DENOTES MATERIAL SUBJECT TO CHARPY V-NOTCH TESTING.
7. BRG AREA - DENOTES FLANGE TO BE FLAT & TRUE.
8. SEE SHEET P1 FOR SECT-P1, SECT-P3 & NOTE "NP".

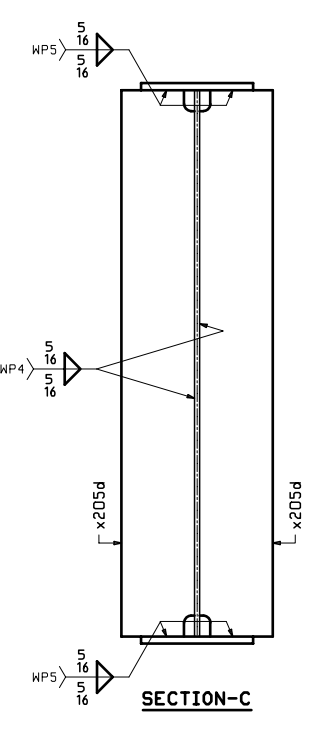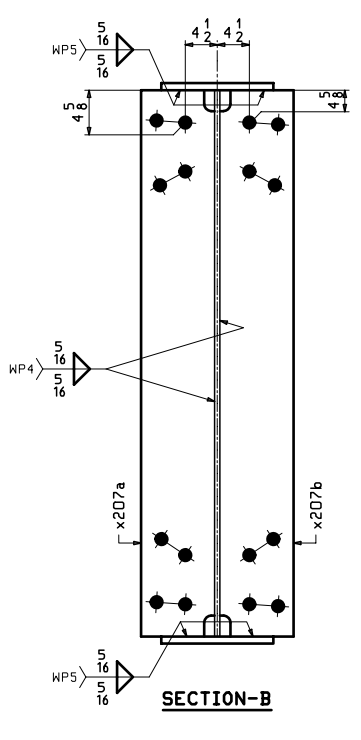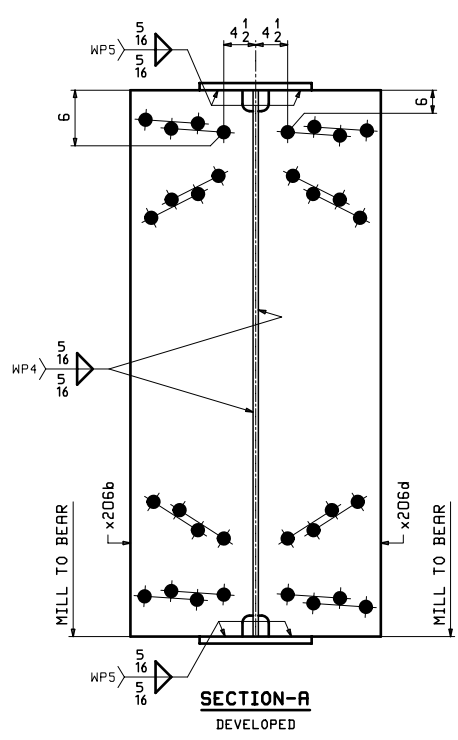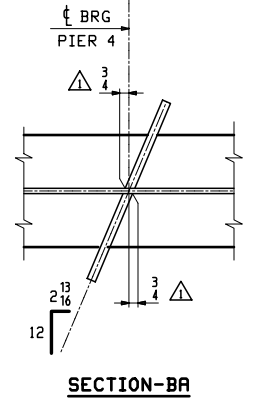

L	SHIP MARK	NO. OF PCS.	ASS'Y MARK	MATERIAL			REMARKS
				SHAPE	LENGTH FT. IN.	MATERIAL SPEC.	
1	218B5	1		GIRDER			23058
2							
3		1	218WB	PL 1/2x78	75 1 1/8	A709-S0WT2	205-28
4		1	218TF1	PL 1x16	24 10 5/8	A709-S0WT2	203-18
5		1	218TF2	PL 1 1/8x16	25 0	A709-S0WT2	203-5
6		1	218TF3	PL 1x16	25 2 1/4	A709-S0WT2	204-16
7		1	218BF1	PL 1x16	25 0 1/4	A709-S0WT2	204-16
8		1	218BF2	PL 1 1/8x16	25 0	A709-S0WT2	203-5
9		1	218BF3	PL 1x16	25 0 1/4	A709-S0WT2	204-16
10							
11		2	x205d	PL 1/2x10 1/2	6 6	A709-S0WT2	208-5
12		1	x206b	PL 1 1/8x17 1/2	6 6 8	A709-S0WT2	208-13
13		1	x206d	PL 1 1/8x17 1/2	6 6 8	A709-S0WT2	208-13
14		5	x207a	PL 1/2x10 1/2	6 6	A709-S0WT2	208-5
15		5	x207b	PL 1/2x10 1/2	6 6	A709-S0WT2	208-5
16							

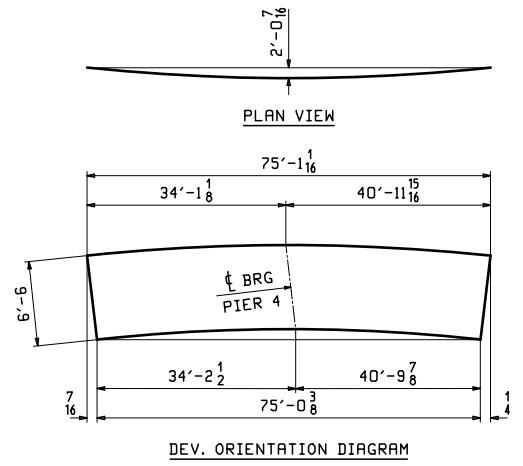

NO.	DATE	REVISIONS	REMARKS	BY
1	05/13/19	ADDED BRG LEAN DIMENSION		EEO WJL
2	04/24/19	REV'D BRG STIFF THICKNESS @ PIER 4		EEO WJL

2-EAU CLAIRE, WI 3-WAUSAU, WI 4-PALATKA, FL


STRUCTURE	RAMP P OVER IR-74 WB, IR-75 & RAMP E - UNIT 2
LOCATION	CINCINNATI, OH (HAMILTON COUNTY) STA. 230+22.98
PROJECT NO.	HAM-75-3.84, PID NO. 104667, BRIDGE NO. HAM-74-19085
ENGINEER	PRIME RE GROUP
CONTRACTOR	WALSH GROUP

ITEM	GIRDER ~ 218B5
SURFACE PREP.	SEE P1 OPEN HOLES 1 3/8" Ø OVS FOR 1 1/4" Ø HSB (U.N.)
PAINT	SEE P1 & AS NOTED

PRELIMINARY	DRAWN EEO 04/07/19	SHEET NO.	PLANT	ORDER NO.	FP. NO.
FOR APPROVAL	CHECKED WJL 04/15/19	218	3	180608	20

192111.dwg, Rev. 15, 2019 07/14/2019, 11:00 AM, 2019 07/14/2019, 11:00 AM, 2019 07/14/2019, 11:00 AM, 2019 07/14/2019, 11:00 AM








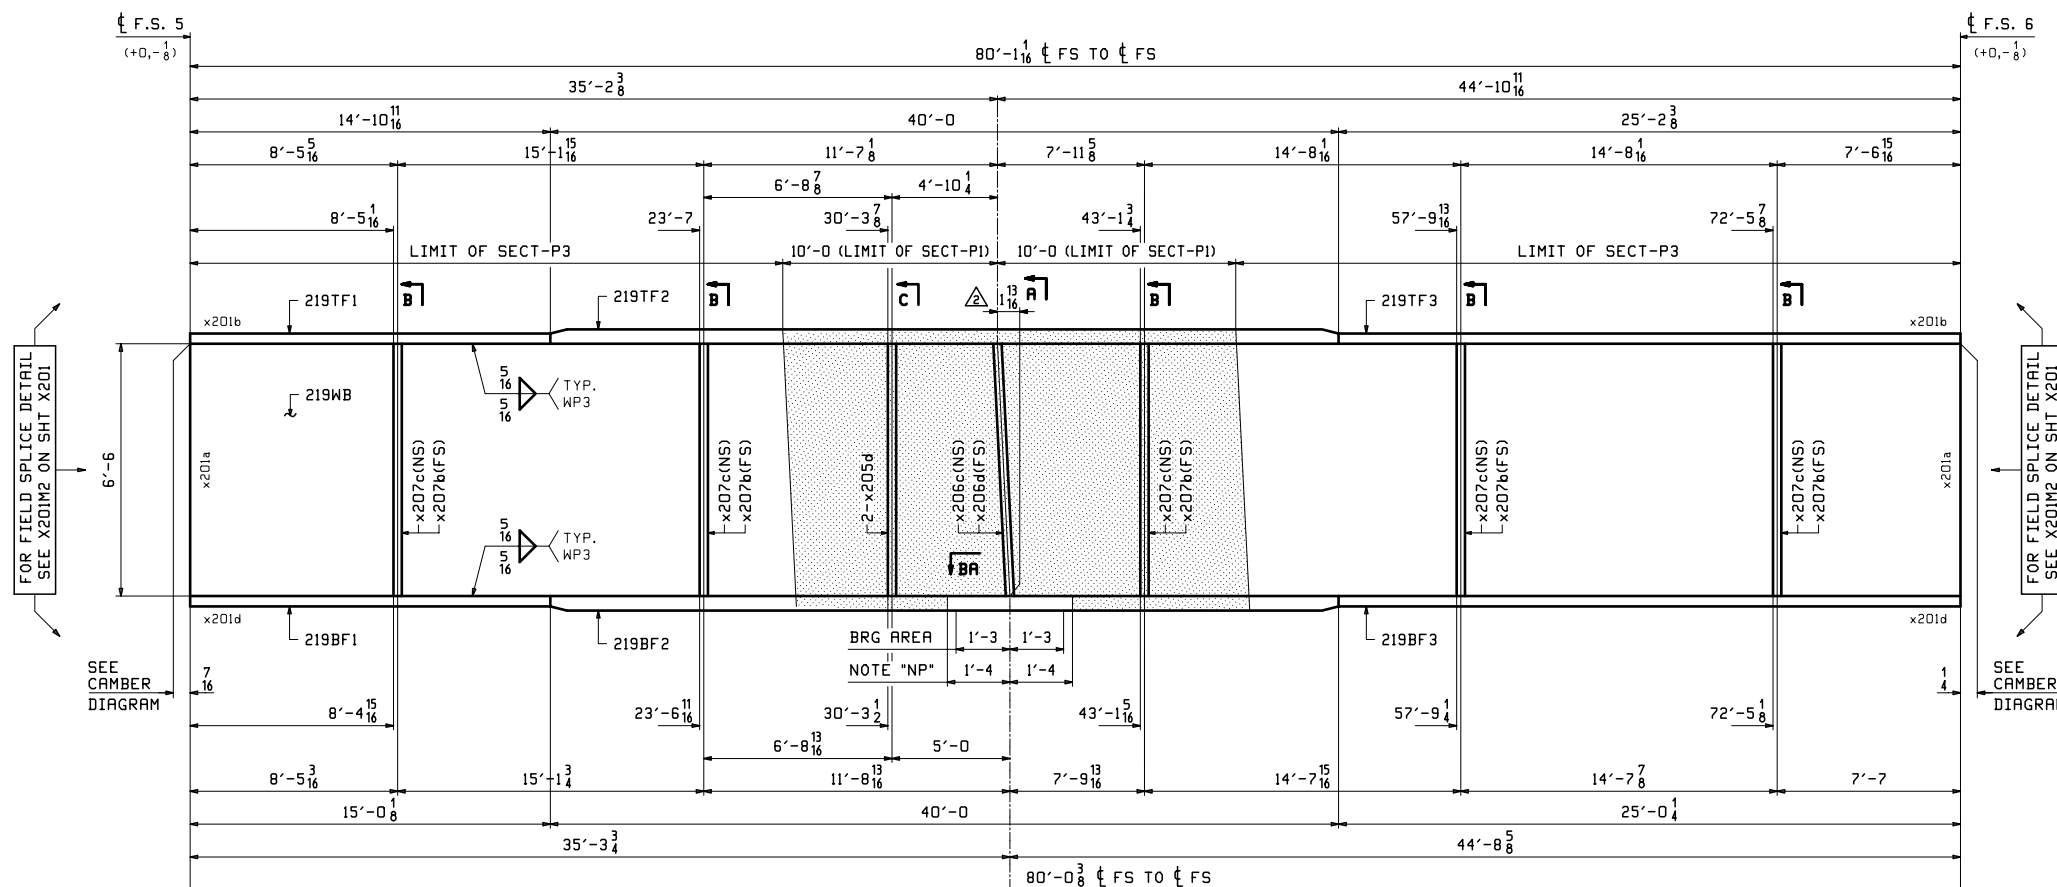

L	SHIP MARK	NO. OF PCS.	ASS'Y MARK	MATERIAL			REMARKS
				SHAPE	LENGTH FT. IN.	MATERIAL SPEC.	
1	219C5	1		GIRDER			29538
2							
3		1	219WB	PL 1/2x78	80 1 1/2	A709-50WT2	205 10
4		1	219TF1	PL 1x16	14 10 1/2	A709-50WT2	204 24
5		1	219TF2	PL 2 1/4x16	40 0	A709-50WT2	201 16
6		1	219TF3	PL 1x16	25 2 3/8	A709-50WT2	204 16
7		1	219BF1	PL 1x16	15 0 8	A709-50WT2	204 24
8		1	219BF2	PL 2 1/2x16	40 0	A709-50WT2	201 12
9		1	219BF3	PL 1x16	25 0 1/4	A709-50WT2	204 16
10							
11		2	x205d	PL 1/2x10 1/2	6 6	A709-50WT2	208 5
12		1	x206c	PL 1 1/8x17 1/2	6 6 1/8	A709-50WT2	208 13
13		1	x206d	PL 1 1/8x17 1/2	6 6 1/8	A709-50WT2	208 13
14		5	x207e	PL 2x10 1/2	6 6	A709-50WT2	208 5
15		5	x207c	PL 2x14 1/2	6 6	A709-50WT2	208 7
16							

**ONE - GIRDER - 219C5 (DEVELOPED)**

1. FOR GENERAL NOTES SEE SHEET GNI.
2. FOR PAINT NOTES SEE SHEET P1.
3. FOR FIELD SPLICE DETAIL SEE SHEET X201.
4. FOR GIRDER STANDARD DETAILS SEE SHEETS X205-X207.
5. FOR CAMBER & FLANGE DIAGRAMS SEE SHEET BG208.
6. "T2" DENOTES MATERIAL SUBJECT TO CHARPY V-NOTCH TESTING.
7. BRG AREA - DENOTES FLANGE TO BE FLAT & TRUE.
8. SEE SHEET P1 FOR SECT-P1, SECT-P3 & NOTE "NP".

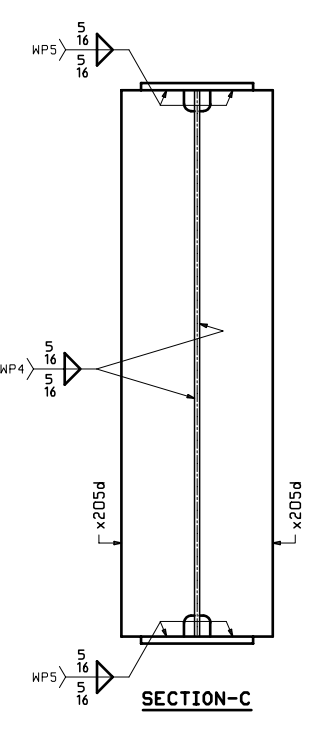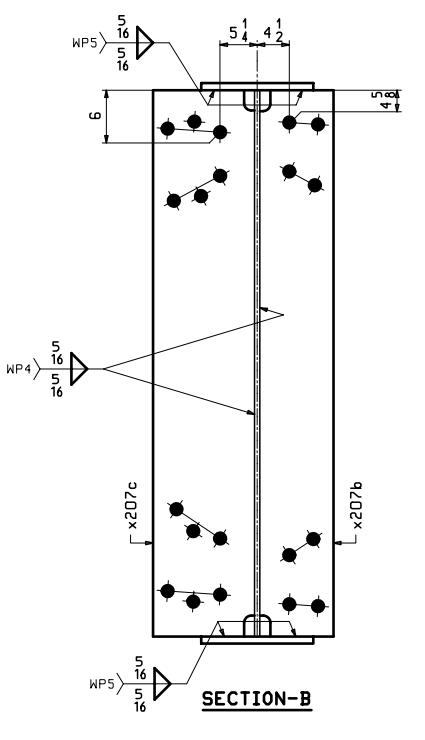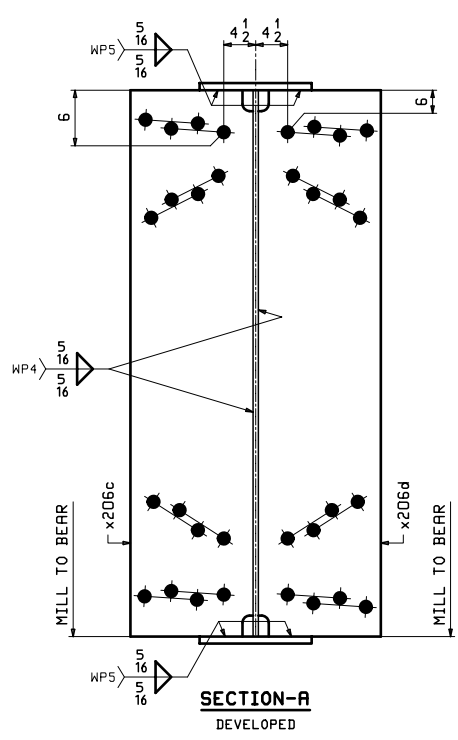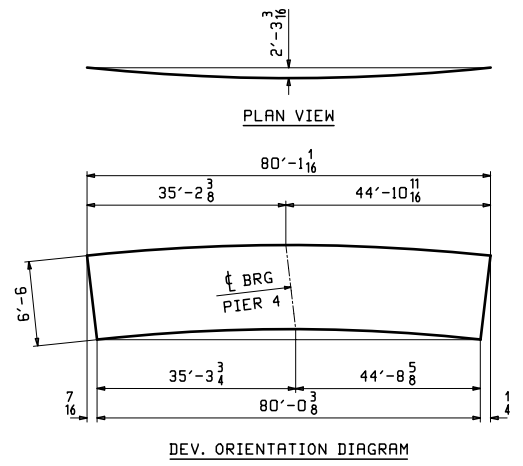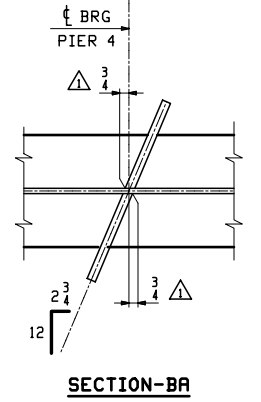


NO.	DATE	REVISIONS	REMARKS	BY
1	05/13/19	ADDED BRG LEAN DIMENSION		EEO WJL
2	04/24/19	REV'D BRG STIFF THICKNESS @ PIER 4		EEO WJL

STRUCTURE	RAMP P OVER IR-74 WB, IR-75 & RAMP E - UNIT 2				
LOCATION	CINCINNATI, OH (HAMILTON COUNTY) STA. 230+22.98				
PROJECT NO.	HAM-75-3.84, PID NO. 104667, BRIDGE NO. HAM-74-19085				
ENGINEER	PRIME RE GROUP				
CONTRACTOR	WALSH GROUP				
ITEM	GIRDER ~ 219C5				
SURFACE PREP.	SEE P1				
PAINT	SEE P1 & AS NOTED				
PRELIMINARY	DRAWN EEO 04/07/19	SHEET NO. 219	PLANT 3	ORDER NO. 180608	FP. NO. 20
FOR APPROVAL	CHECKED WJL 04/15/19				






JNL: Mod. Nov. 15, 2018 02:44:04 PM C:\msdcs\apps\2018\20181\_Rn2

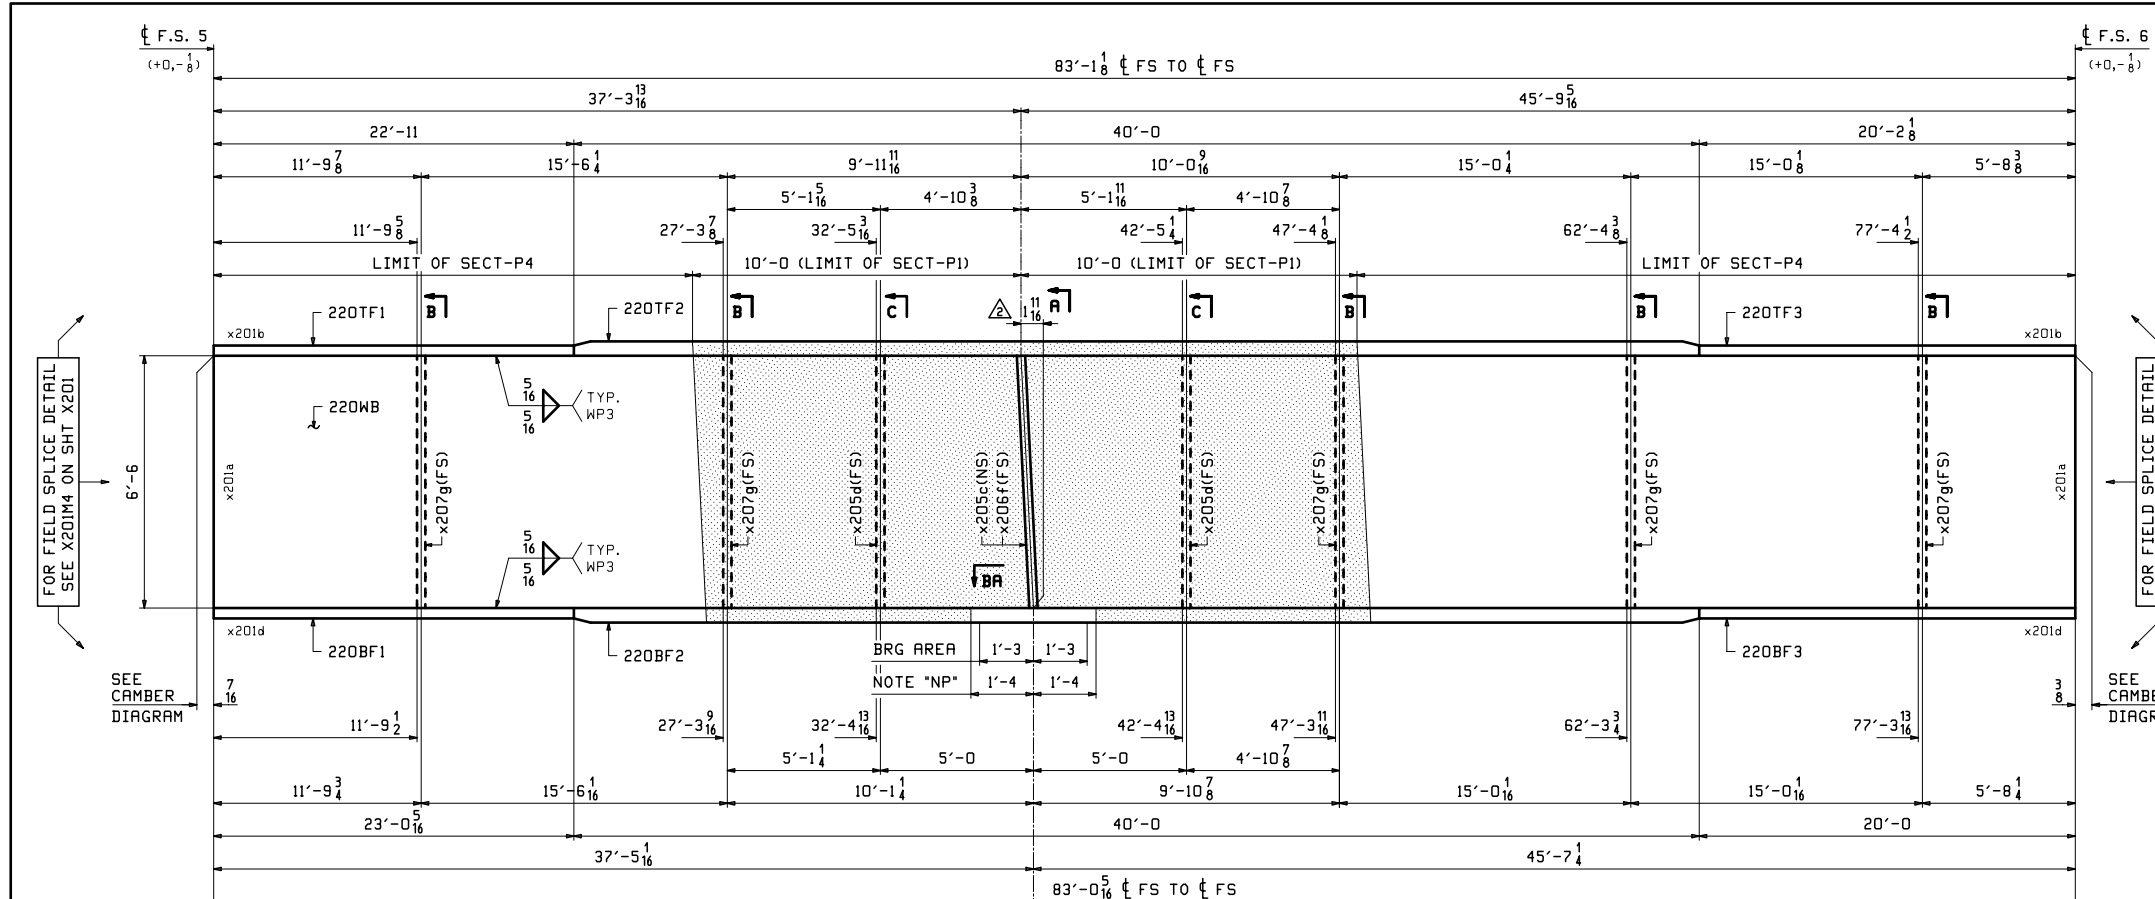

L	ITEM	SHIP MARK	NO. OF PCS.	ASS'Y MARK	MATERIAL				REMARKS	
					SHAPE	LENGTH FT. IN.	MATERIAL SPEC.	ITEM NO.		
1	220D5		1		GIRDER				31492	
2										
3			1	220WB	PL 3/8x78	83	18	A709-S0M72	205-8	FP-20
4			1	220TF1	PL 1x18	22	11	A709-S0M72	203-10	FP-20
5			1	220TF2	PL 2x18	40	0	A709-S0M72	201-26	FP-20
6			1	220TF3	PL 1x18	20	2 1/2	A709-S0M72	203-12	FP-20
7			1	220BF1	PL 1 3/8x18	23	0 5/8	A709-S0M72	203-28	FP-20
8			1	220BF2	PL 2 1/8x18	40	0	A709-S0M72	201-18	FP-20
9			1	220BF3	PL 2x18	20	0	A709-S0M72	201-30	FP-20
10										
11			1	x205c	PL 1 3/8x8	6	6	A709-S0M72	208-11	MIE FP-20
12			2	x205d	PL 1/2x10 1/2	6	6	A709-S0M72	208-3	FP-20
13			1	x206f	PL 1 3/8x17 1/2	6	6 1/8	A709-S0M72	208-13	MIE FP-20
14			5	x207g	PL 1/2x14 1/2	6	6	A709-S0M72	208-7	FP-20
15										

**ONE - GIRDER - 220D5 (DEVELOPED)**

- FOR GENERAL NOTES SEE SHEET GNI.
- FOR PAINT NOTES SEE SHEET P1.
- FOR FIELD SPLICE DETAIL SEE SHEET X201.
- FOR GIRDER STANDARD DETAILS SEE SHEETS X205-X207.
- FOR CAMBER & FLANGE DIAGRAMS SEE SHEET BG208 & BG209.
- \*T2 DENOTES MATERIAL SUBJECT TO CHARPY V-NOTCH TESTING.
- BRG AREA - DENOTES FLANGE TO BE FLAT & TRUE.
- SEE SHEET P1 FOR SECT-P1, SECT-P4 & NOTE "NP".

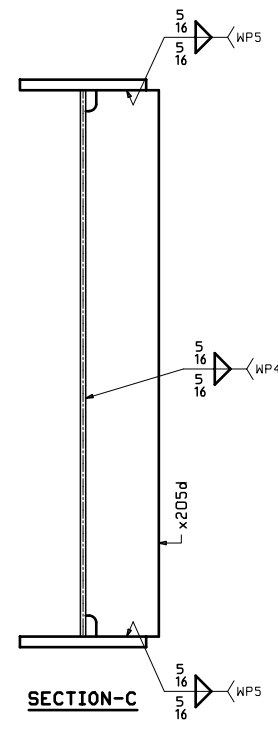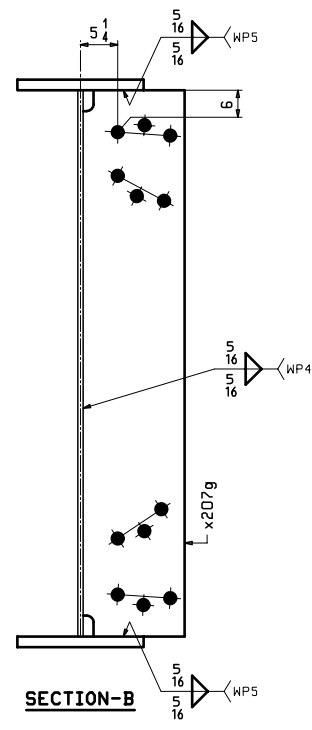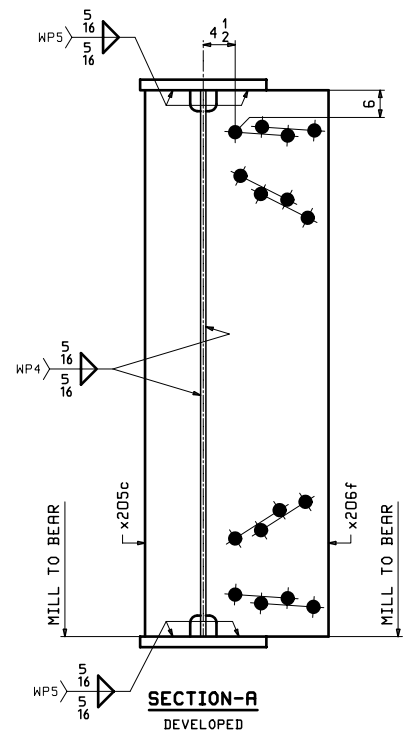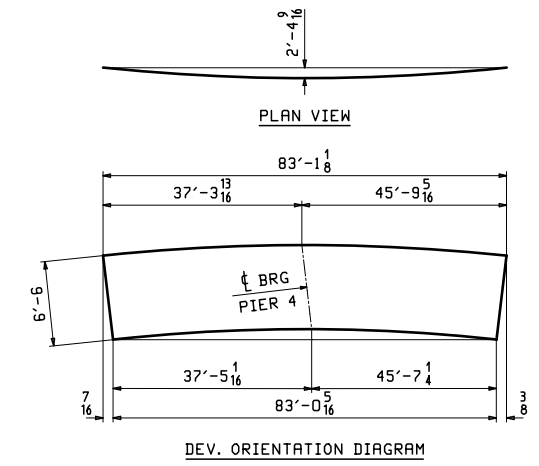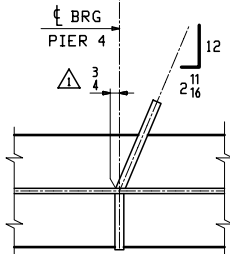

NO.	DATE	REVISIONS	REMARKS	BY
2	05/13/19	ADDED BRG LEAN DIMENSION		EEO
1	04/24/19	REV'D BRG STIFF THICKNESS @ PIER 4		EEO


2-EAU CLAIRE, WI 3-WAUSAU, WI 4-PALATKA, FL

STRUCTURE	RAMP P OVER IR-74 WB, IR-75 & RAMP E - UNIT 2
LOCATION	CINCINNATI, OH (HAMILTON COUNTY) STA. 230+22.98
PROJECT NO.	HAM-75-3.84, PID NO. 104667, BRIDGE NO. HAM-74-19085
ENGINEER	PRIME AE GROUP
CONTRACTOR	WALSH GROUP




**GIRDER ~ 220D5**

ITEM	SEE P1	OPEN HOLES	1 3/8" Ø OVS FOR 1 1/4" Ø HSB (U.N.)
SURFACE PREP.	SEE P1 & AS NOTED		
PAIN	SEE P1 & AS NOTED		

PRELIMINARY	DRAWN	EEO	04/07/19	SHEET NO.	PLANT	ORDER NO.	FP. NO.
FOR APPROVAL	CHECKED	WJL	04/15/19	220	3	180608	20




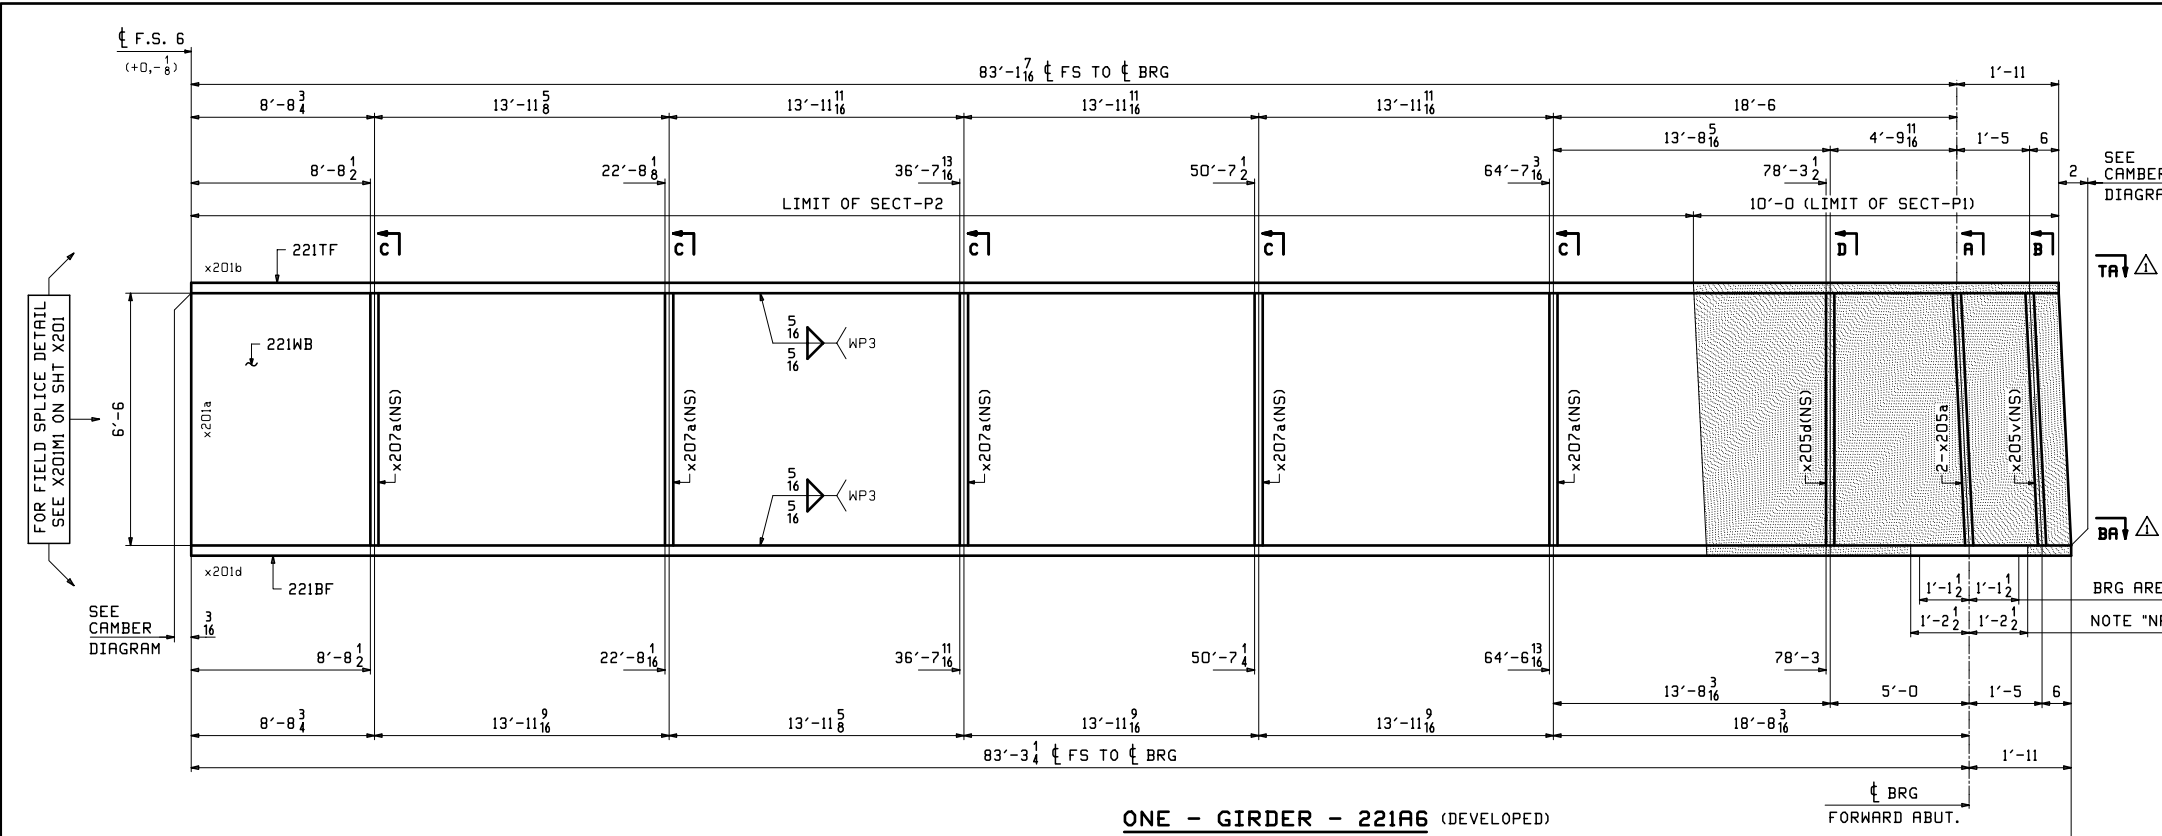


L	MATERIAL	SHIP MARK	NO. OF PCS.	ASS'Y MARK	SHAPE	LENGTH FT. IN.	MATERIAL SPEC.	ITEM NO.	REMARKS
1	221A6		1		GIRDER				23178
2									
3			1	221WB	PL 3/8x78	85 2/4	A709-50WT2	205-18	FP-20
4			1	221TF	PL 1x16	85 0 3/4	A709-50WT2	203-14	FP-20
5			1	221BF	PL 1x16	85 2 1/4	A709-50WT2	203-14	FP-20
6									
7			2	x205a	PL 1x8	6 6 1/4	A709-50WT2	208-2	MIE FP-20
8			1	x205d	PL 1/2x10 1/2	6 6	A709-50WT2	208-3	FP-20
9			1	x205n	PL 1/2x18	1 6 3/4	A709-50WT2	208-10	BENT FP-20
10			1	x205v	PL 1/2x8	6 6 1/4	A709-50WT2	208-16	FP-20
11			5	x207a	PL 1/2x10 1/2	6 6	A709-50WT2	208-6	FP-20
12									

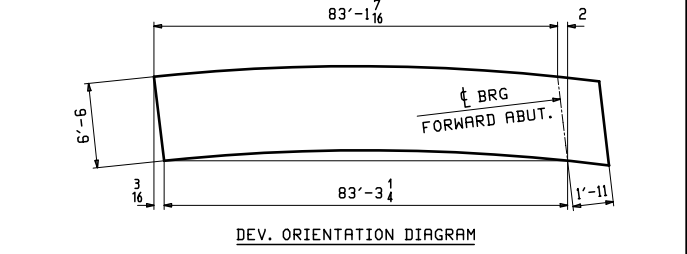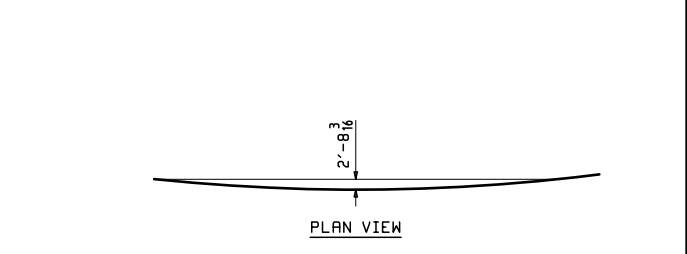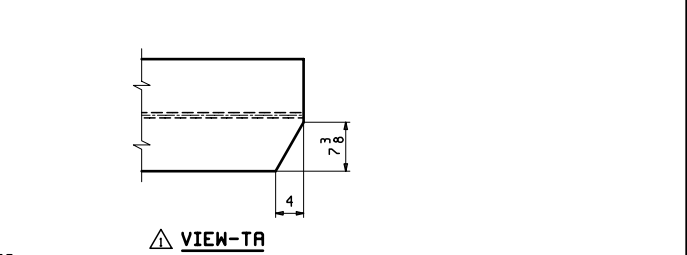


**ONE - GIRDER - 221A6 (DEVELOPED)**

1. FOR GENERAL NOTES SEE SHEET GNI.
2. FOR PAINT NOTES SEE SHEET P1.
3. FOR FIELD SPLICE DETAIL SEE SHEET X201.
4. FOR GIRDER STANDARD DETAILS SEE SHEETS X205-X207.
5. FOR CAMBER & FLANGE DIAGRAMS SEE SHEET BG209.
6. "T2" DENOTES MATERIAL SUBJECT TO CHARPY V-NOTCH TESTING.
7. BRG AREA - DENOTES FLANGE TO BE FLAT & TRUE.
8. SEE SHEET P1 FOR SECT-P1, SECT-P2 & NOTE "NP".

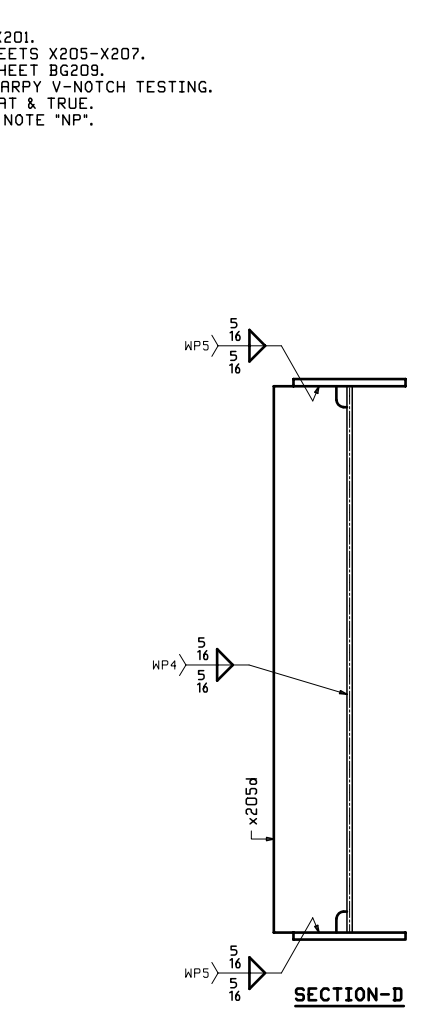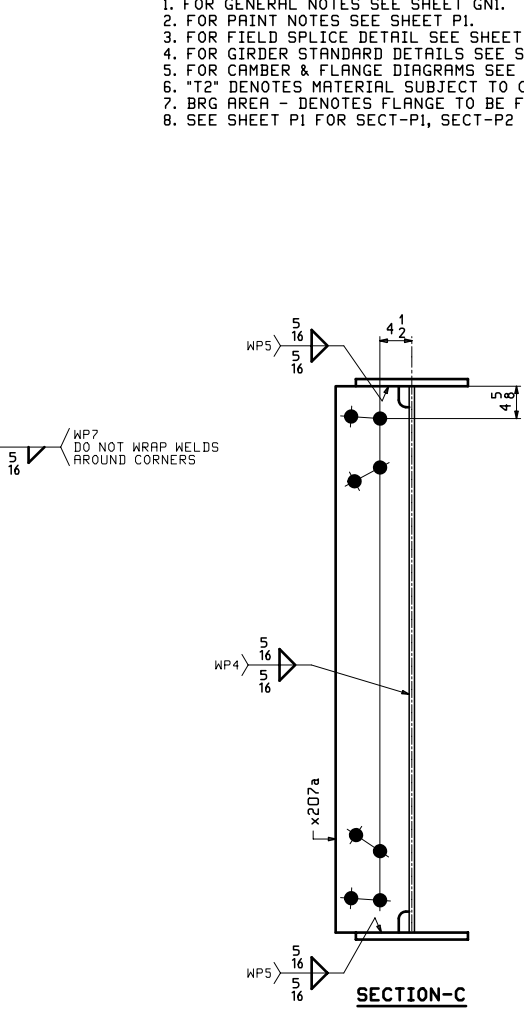
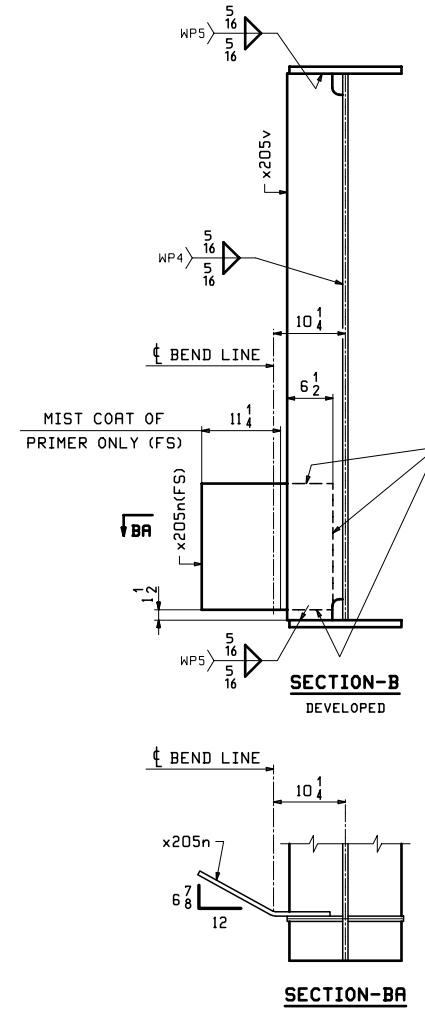
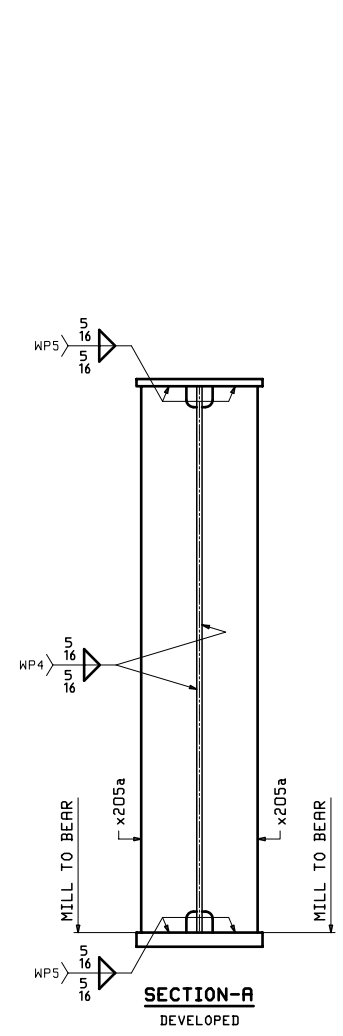


NO.	DATE	REVISIONS	REMARKS	BY
	05/13/19		ADDED FLANGE CLIPS	EEO
				WJL
STRUCTURE: RAMP P OVER IR-74 WB, IR-75 & RAMP E - UNIT 2 LOCATION: CINCINNATI, OH (HAMILTON COUNTY) STA. 230+22.98 PROJECT NO.: HAM-75-3.84, PID NO. 104667, BRIDGE NO. HAM-74-19085 ENGINEER: PRIME AE GROUP CONTRACTOR: WALSH GROUP				
GIRDER ~ 221A6				
ITEM: SEE P1				
SURFACE PREP: SEE P1 & AS NOTED				
PAINT: SEE P1 & AS NOTED				
PRELIMINARY	DRAWN	EEO 04/05/19	SHEET NO.	PLANT
FOR APPROVAL	CHECKED	WJL 04/15/19	221	3
		ORDER NO.	FP. NO.	
		180608	20	

15: Rev. 15: 2018 07/14/03 DM 7/2018/15: 2018/05/22/2018 1 Rev. 1




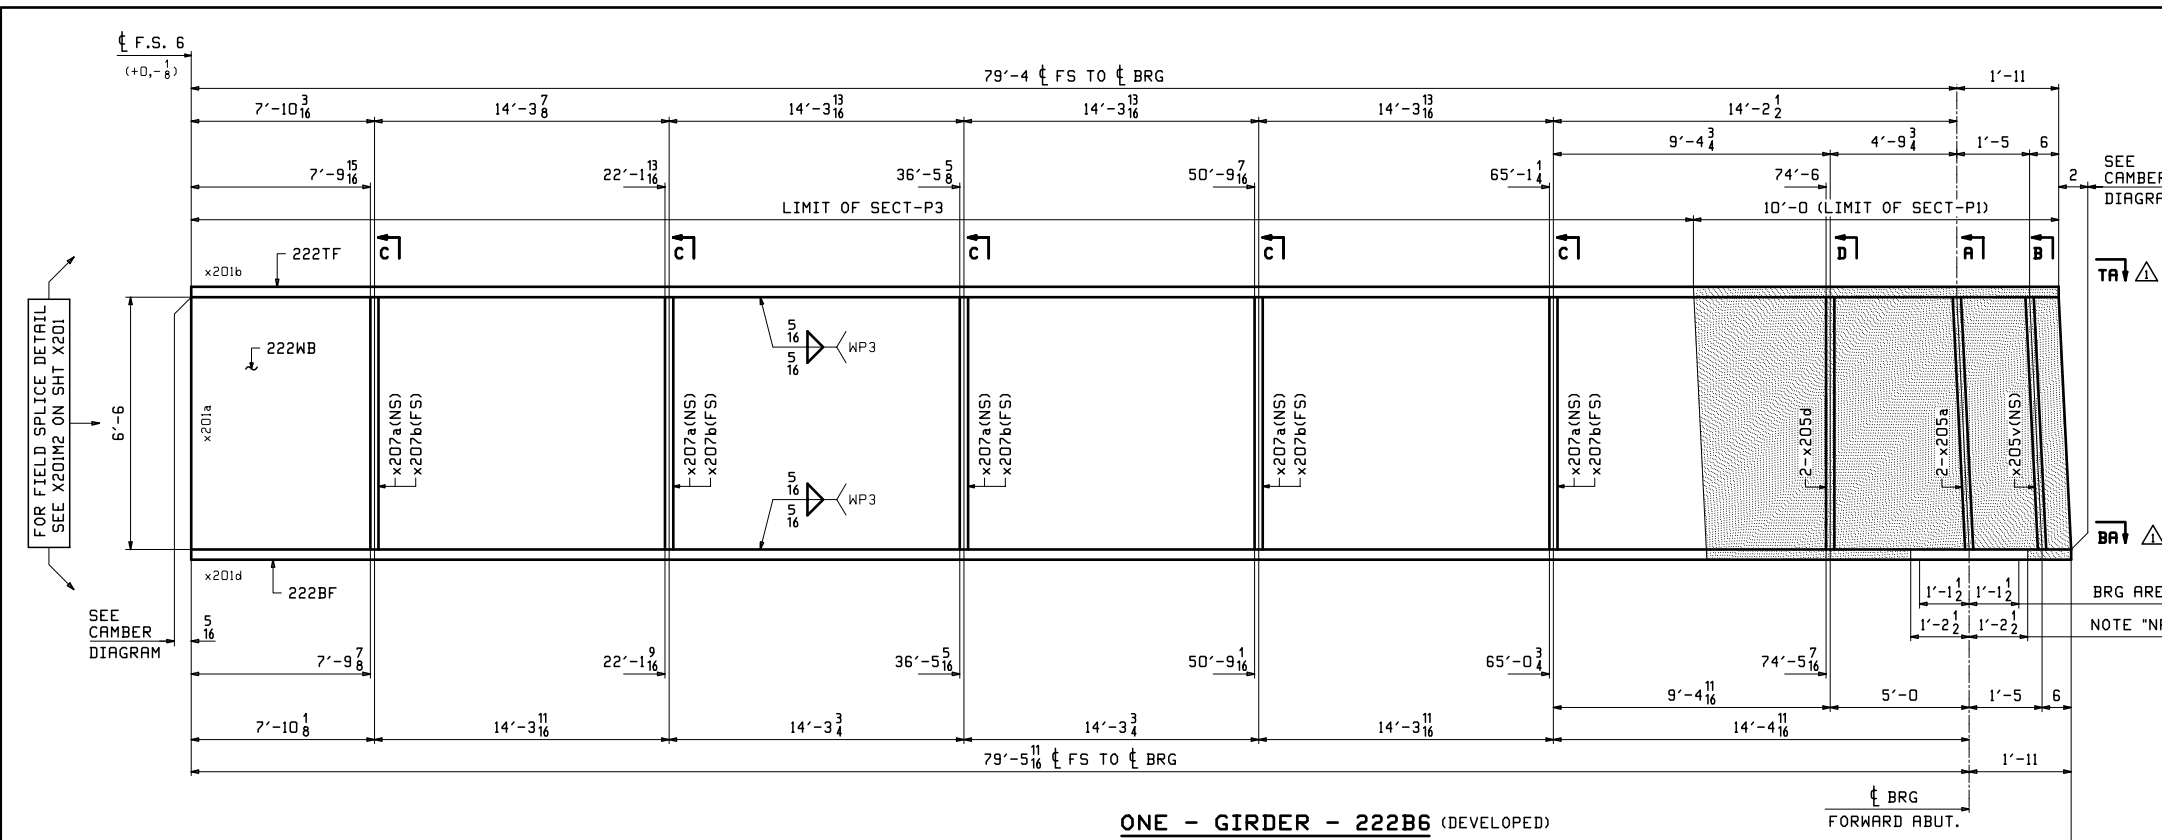


L	MATERIAL	SHIP MARK	NO. OF PCS.	ASS'Y MARK	SHAPE	LENGTH FT. IN.	MATERIAL SPEC.	ITEM NO.	REMARKS
1	222B6		1		GIRDER				22894
2									
3			1	222WB	PL 1/2 x 78	81 5	A709-S0WT2	205-20	FP-20
4			1	222TF	PL 1x16	81 3	A709-S0WT2	203-22	FP-20
5			1	222BF	PL 1x16	81 4 1/2	A709-S0WT2	203-22	FP-20
6									
7			2	x205a	PL 1x8	6 6 1/2	A709-S0WT2	208-2	MIE FP-20
8			2	x205d	PL 1/2 x 10 1/2	6 6	A709-S0WT2	208-3	FP-20
9			1	x205b	PL 1/2 x 18	1 6 3/4	A709-S0WT2	208-10	BENT FP-20
10			1	x205v	PL 2x8	6 6 1/2	A709-S0WT2	208-16	FP-20
11			5	x207a	PL 1/2 x 10 1/2	6 6	A709-S0WT2	208-5	FP-20
12			5	x207b	PL 1/2 x 10 1/2	6 6	A709-S0WT2	208-6	FP-20
13									

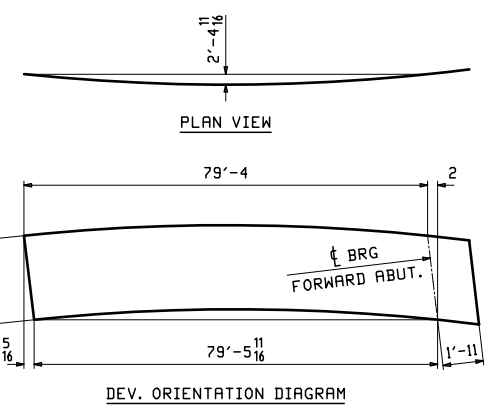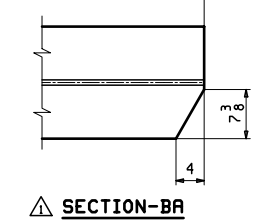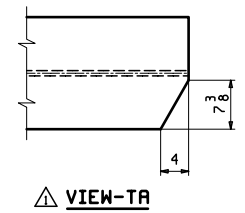


**ONE - GIRDER - 222B6 (DEVELOPED)**

1. FOR GENERAL NOTES SEE SHEET GNI.
2. FOR PAINT NOTES SEE SHEET P1.
3. FOR FIELD SPLICE DETAIL SEE SHEET X201.
4. FOR GIRDER STANDARD DETAILS SEE SHEETS X205-X207.
5. FOR CAMBER & FLANGE DIAGRAMS SEE SHEET BG209.
6. "T2" DENOTES MATERIAL SUBJECT TO CHARPY V-NOTCH TESTING.
7. BRG AREA - DENOTES FLANGE TO BE FLAT & TRUE.
8. SEE SHEET P1 FOR SECT-P1, SECT-P3 & NOTE "NP".

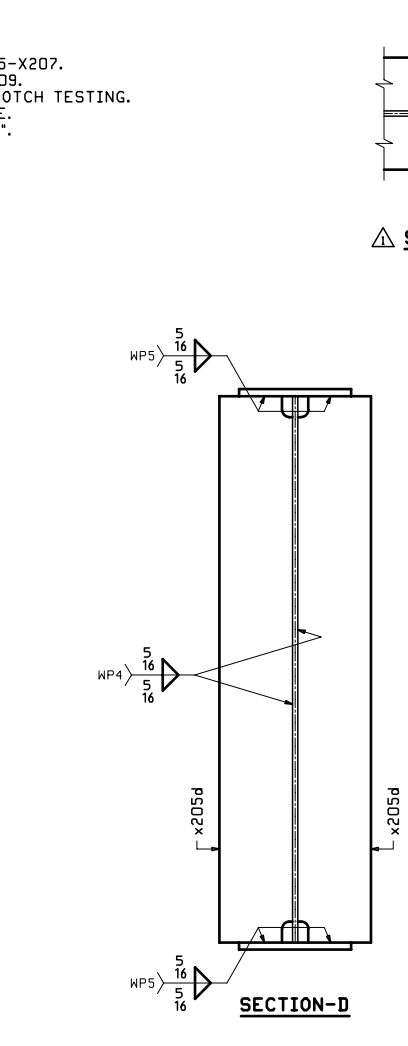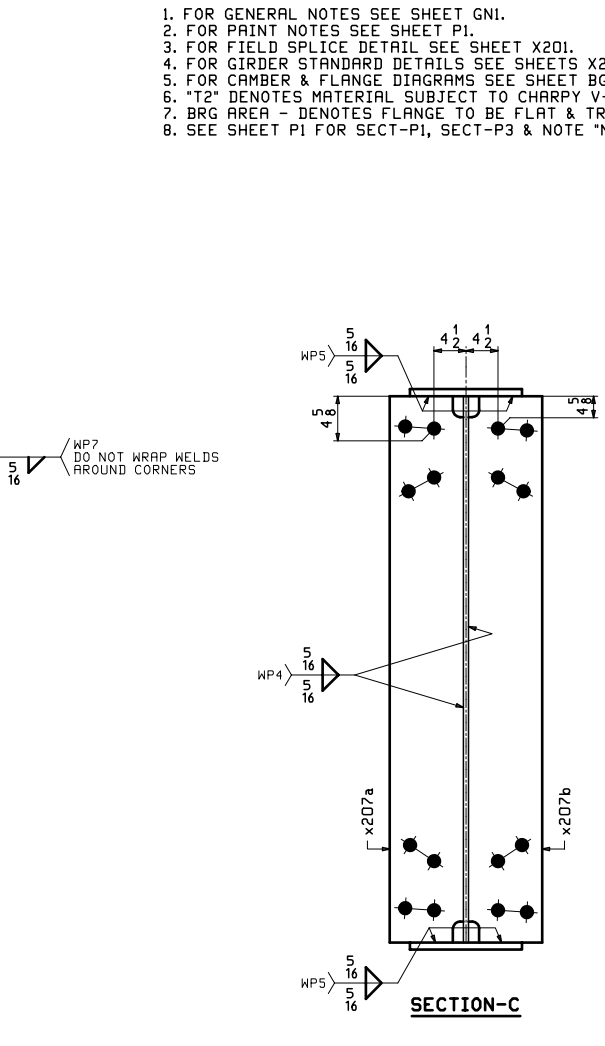
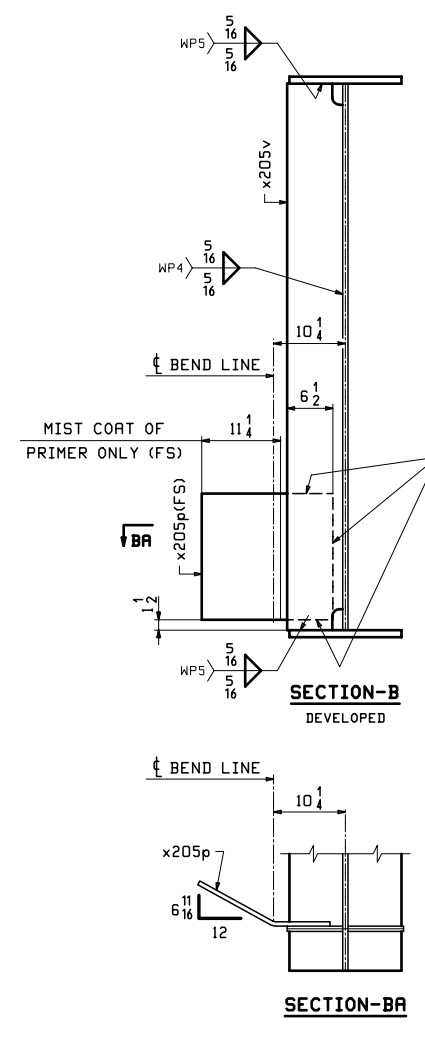
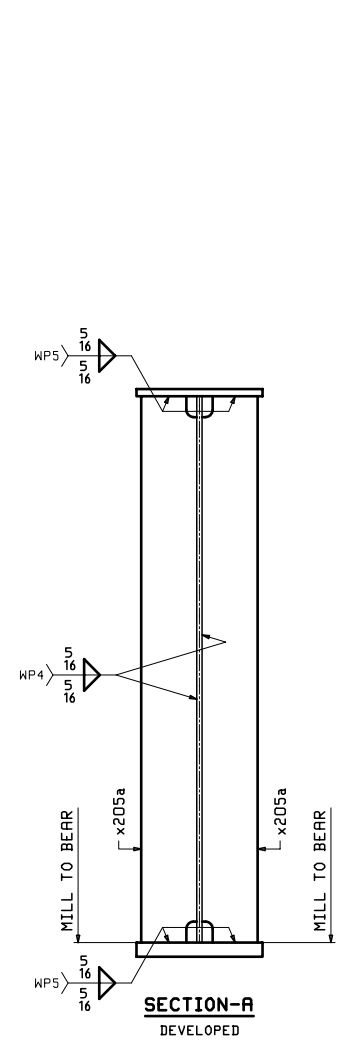


05/13/19		ADDED FLANGE CLIPS	EEO	HJL
NO.	DATE	REMARKS	BY	
REVISIONS				
STRUCTURE: RAMP P OVER IR-74 WB, IR-75 & RAMP E - UNIT 2 LOCATION: CINCINNATI, OH (HAMILTON COUNTY) STA. 230+22.98 PROJECT NO.: HAM-75-3.84, PID NO. 104667, BRIDGE NO. HAM-74-19085 ENGINEER: PRIME AE GROUP CONTRACTOR: WALSH GROUP				
GIRDER ~ 222B6				
ITEM	SEE P1			
SURFACE PREP.	SEE P1 & AS NOTED			
PAIN	SEE P1 & AS NOTED			
PRELIMINARY	DRAWN	EEO 04/08/19	SHEET NO.	PLANT
FOR APPROVAL	CHECKED	WJL 04/15/19	222	3
			180608	20

H:\\_New\_Net\_15\_2018\2744101.DWG    4/24/19 10:58:22 AM    2/22/19 1:00:01 PM




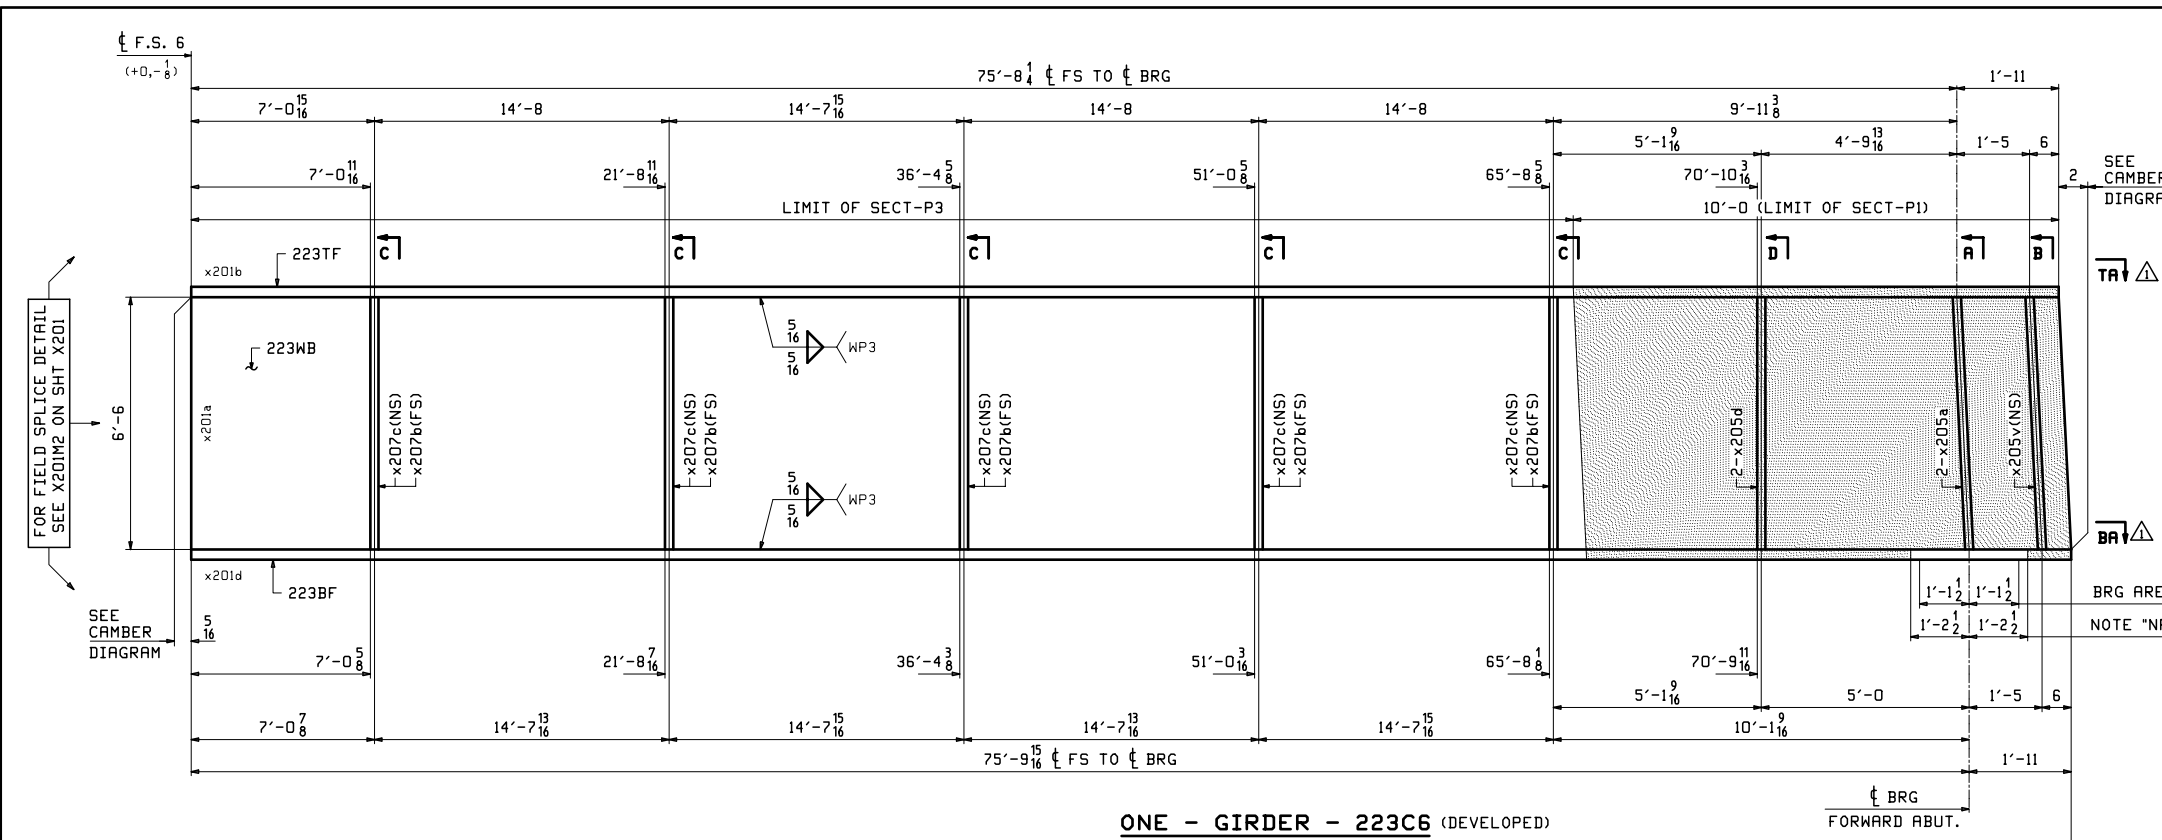


L	SHIP MARK	NO. OF PCS.	ASS'Y MARK	MATERIAL			REMARKS
				SHAPE	LENGTH FT. IN.	MATERIAL SPEC.	
1	223C6	1		GIRDER			22174
2							
3		1	223WB	PL 1/2x78	77 9/4	A709-50WT2	205-24
4		1	223TF	PL 1x16	77 7/4	A709-50WT2	205-28
5		1	223BF	PL 1x16	77 8/16	A709-50WT2	203-28
6							
7		2	x205a	PL 1x8	6 6 1/16	A709-50WT2	208-2
8		2	x205d	PL 1/2x10 1/2	6 6	A709-50WT2	208-3
9		1	x205l	PL 1/2x18	1 6 3/4	A709-50WT2	208-10
10		1	x205v	PL 2x8	6 6 1/16	A709-50WT2	208-16
11		5	x207b	PL 1/2x10 1/2	6 6	A709-50WT2	208-5
12		5	x207c	PL 1/2x14 1/2	6 6	A709-50WT2	208-7
13							

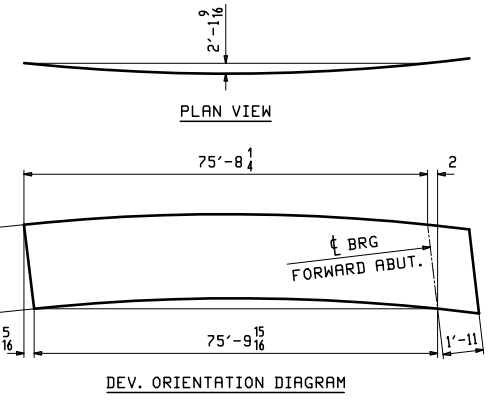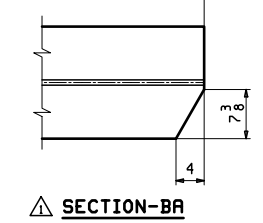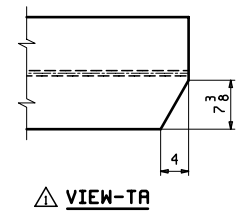

ONE - GIRDER - 223C6 (DEVELOPED)


1. FOR GENERAL NOTES SEE SHEET GNI.
2. FOR PAINT NOTES SEE SHEET P1.
3. FOR FIELD SPLICE DETAIL SEE SHEET X201.
4. FOR GIRDER STANDARD DETAILS SEE SHEETS X205-X207.
5. FOR CAMBER & FLANGE DIAGRAMS SEE SHEET BG209.
6. "T2" DENOTES MATERIAL SUBJECT TO CHARPY V-NOTCH TESTING.
7. BRG AREA - DENOTES FLANGE TO BE FLAT & TRUE.
8. SEE SHEET P1 FOR SECT-P1, SECT-P3 & NOTE "NP".

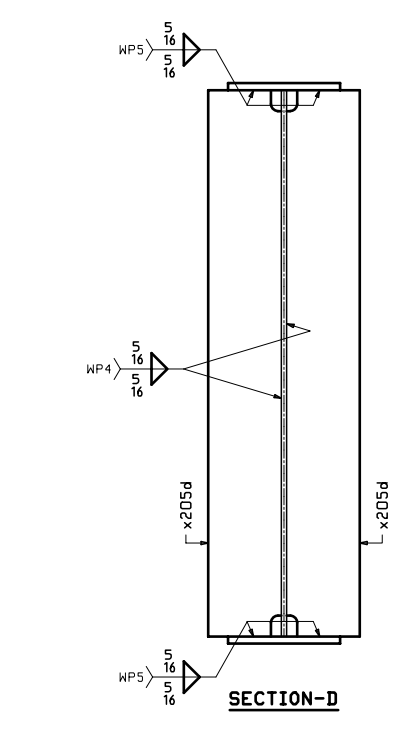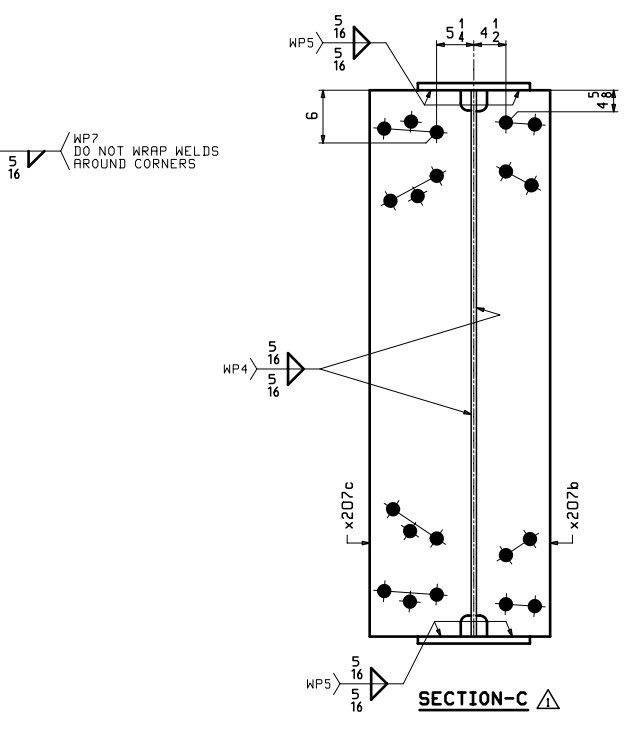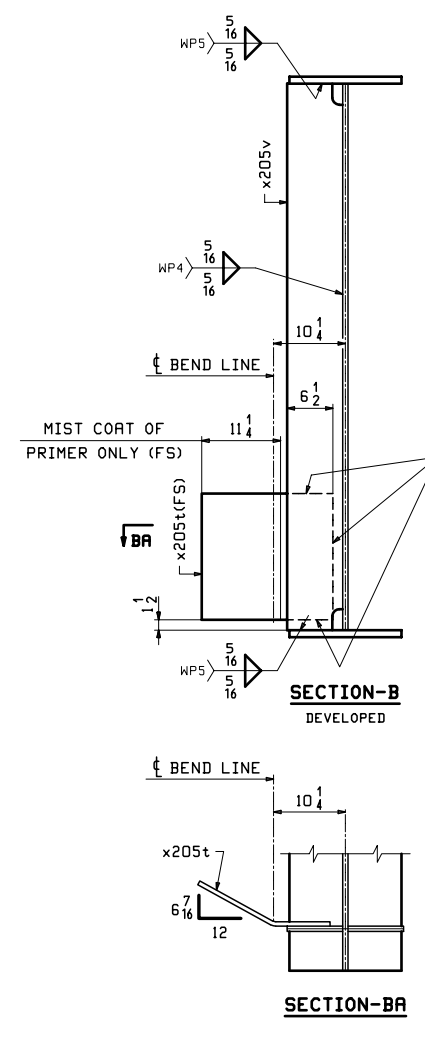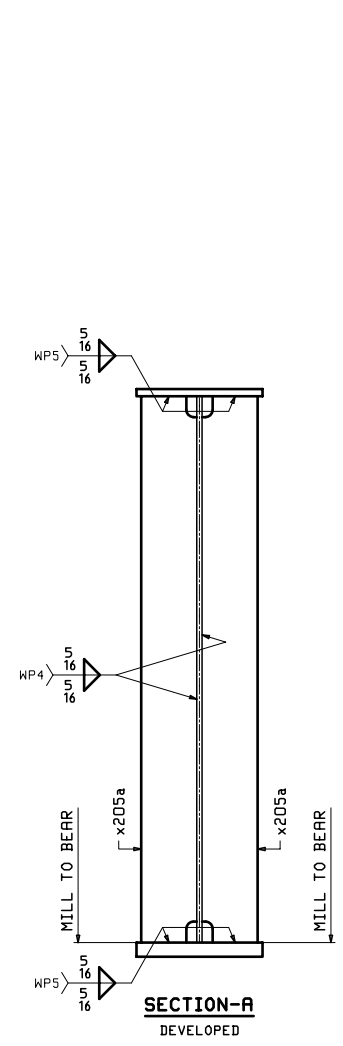

05/13/19		ADDED FLANGE CLIPS & MISC	EEO
NO.	DATE	REMARKS	BY
REVISIONS			
STRUCTURE RAMP P OVER IR-74 WB, IR-75 & RAMP E - UNIT 2 LOCATION CINCINNATI, OH (HAMILTON COUNTY) STA. 230+22.98 PROJECT NO. HAM-75-3.84, PID NO. 104667, BRIDGE NO. HAM-74-19085 ENGINEER PRIME AE GROUP CONTRACTOR WALSH GROUP			
GIRDER ~ 223C6			
ITEM			
SURFACE PREP. SEE P1 OPEN HOLES 1 3/8" Ø OVS FOR 1 1/4" HSB (U.N.)			
PAINT SEE P1 & AS NOTED			
PRELIMINARY	DRAWN EEO 04/08/19	SHEET NO. 223	PLANT ORDER NO. 180608
FOR APPROVAL	CHECKED WJL 04/15/19		FP. NO. 20

HJL, May 15, 2019 07:41:03 AM, C:\msd\1\2019\05\22\223C6.dwg

QTY	SHIP MARK	NO. OF PCS.	ASS'Y MARK	MATERIAL				REMARKS	
				SHAPE	LENGTH FT. IN.	MATERIAL SPEC.	ITEM NO.		
1	224D6	1		GIRDER				25841	
2									
3		1	224WB	PL 1/2x78	77	15/16	A709-50WT2	205-26	FP-20
4		1	224TF	PL 1x18	77	0	A709-50WT2	203-8	FP-20
5		1	224BF	PL 2x18	77	1/16	A709-50WT2	201-24	FP-20
6									
7		2	x205a	PL 1x8	6	1/16	A709-50WT2	208-2	MIE FP-20
8		5	x207g	PL 1/2x14 1/2	6	6	A709-50WT2	208-7	FP-20
9									

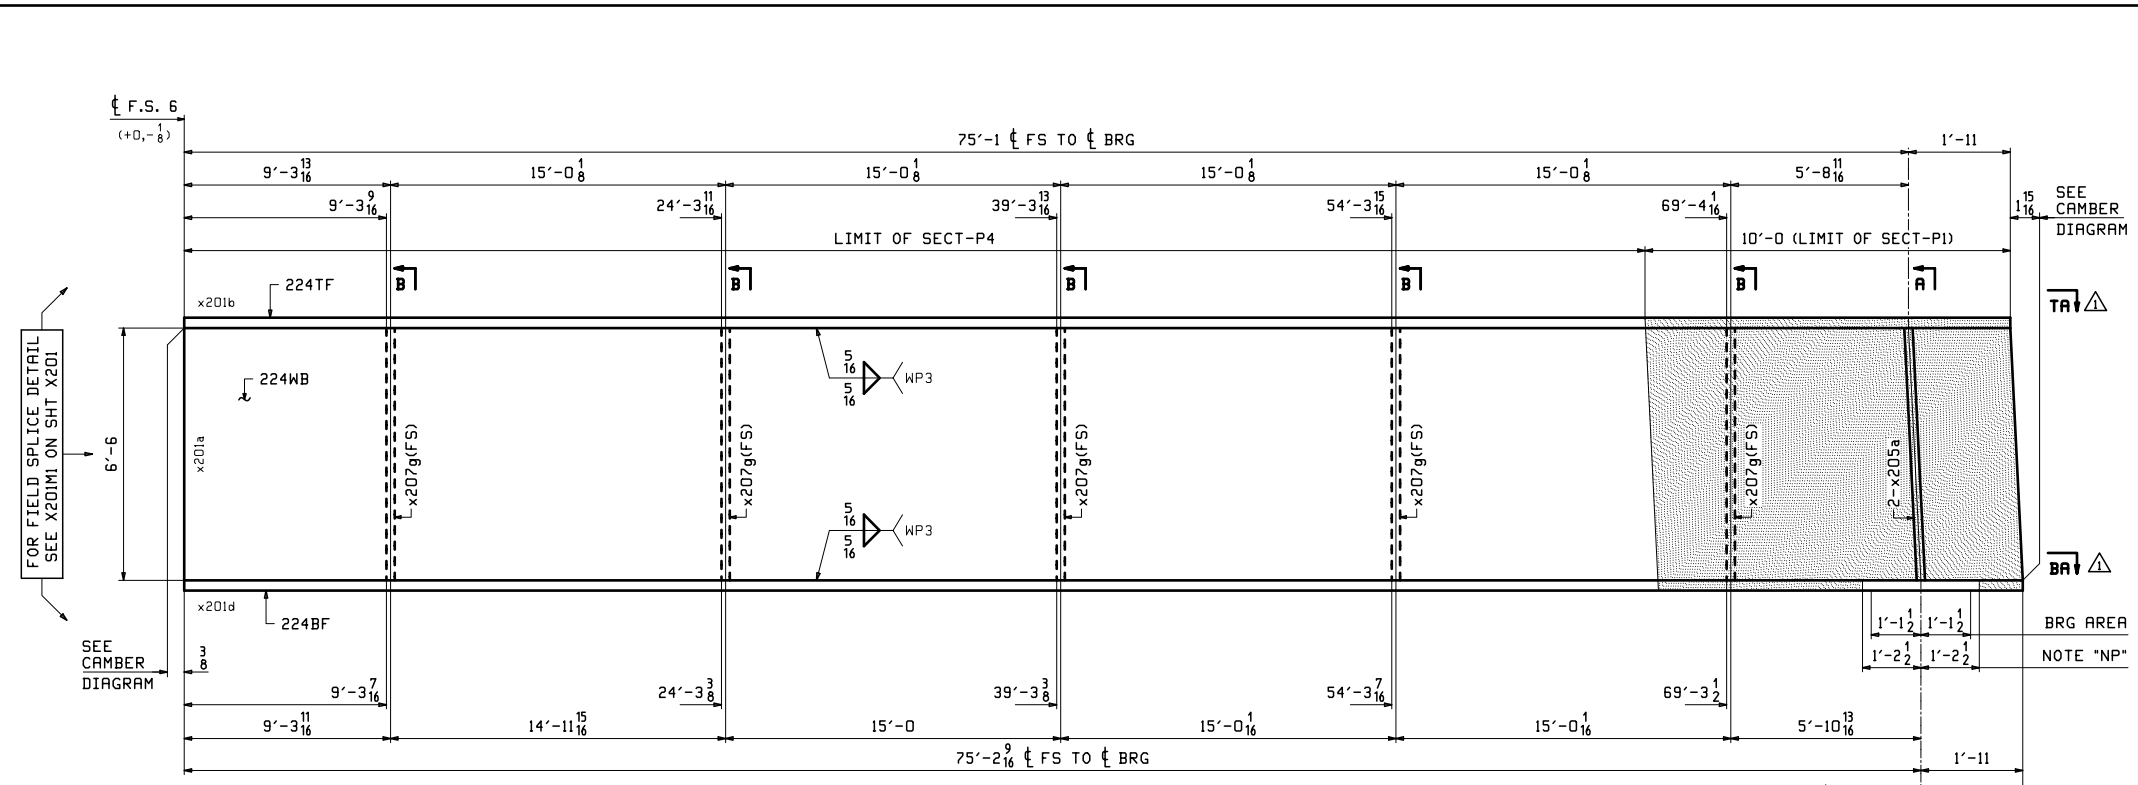

FOR FIELD SPLICE DETAIL SEE X201M ON SHT X201

SEE CAMBER DIAGRAM

SEE CAMBER DIAGRAM

TR


BR

BRG AREA  
NOTE "NP"


**ONE - GIRDER - 224D6 (DEVELOPED)**

1. FOR GENERAL NOTES SEE SHEET GNI.
2. FOR PAINT NOTES SEE SHEET P1.
3. FOR FIELD SPLICE DETAIL SEE SHEET X201.
4. FOR GIRDER STANDARD DETAILS SEE SHEETS X205-X207.
5. FOR CAMBER & FLANGE DIAGRAMS SEE SHEET BG209.
6. "T2" DENOTES MATERIAL SUBJECT TO CHARPY V-NOTCH TESTING.
7. BRG AREA - DENOTES FLANGE TO BE FLAT & TRUE.
8. SEE SHEET P1 FOR SECT-PI, SECT-P4 & NOTE "NP".


BRG FORWARD ABUT.

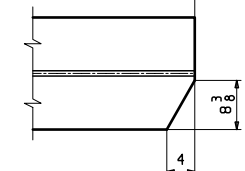


**SECTION-BR**

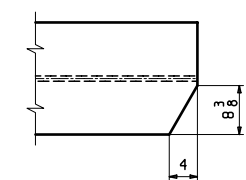


**VIEW-TA**

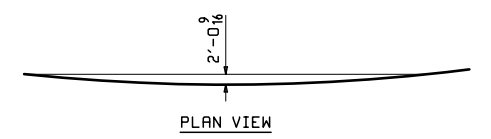


**PLAN VIEW**

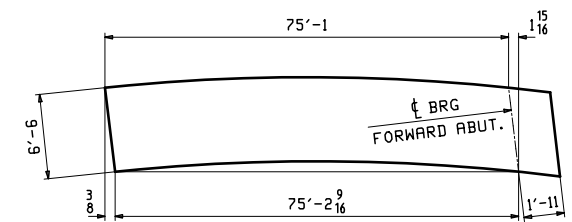

**DEV. ORIENTATION DIAGRAM**

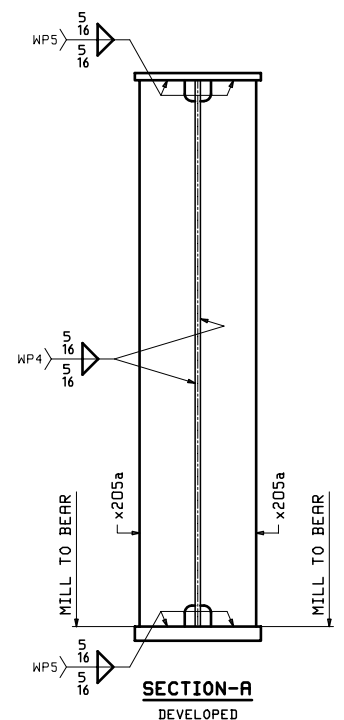

**SECTION-A DEVELOPED**

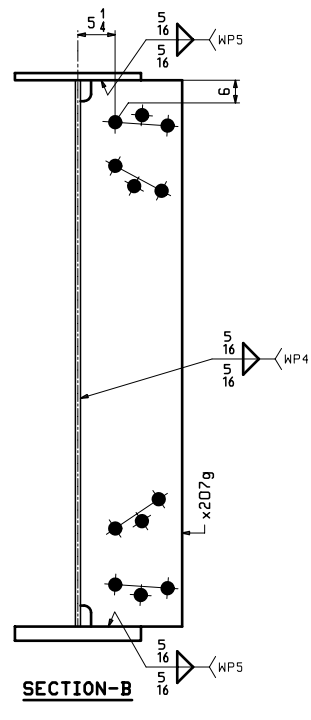

**SECTION-B DEVELOPED**

NO.		DATE		REVISIONS		BY	
		05/13/19		ADDED FLANGE CLIPS		EEO WJL	
<b>2-EAU CLAIRE, WI 3-WAUSAU, WI 4-PALATKA, FL</b>							
<b>STRUCTURE</b> RAMP P OVER IR-74 WB, IR-75 & RAMP E - UNIT 2							
<b>LOCATION</b> CINCINNATI, OH (HAMILTON COUNTY) STA. 230+22.98							
<b>PROJECT NO.</b> HAM-75-3.84, PID NO. 104667, BRIDGE NO. HAM-74-1908S							
<b>ENGINEER</b> PRIME RE GROUP							
<b>CONTRACTOR</b> WALSH GROUP							
<b>GIRDER ~ 224D6</b>							
<b>ITEM</b> SEE P1							
<b>SURFACE PREP.</b> SEE P1 & AS NOTED							
<b>PAINT</b> SEE P1 & AS NOTED							
<b>PRELIMINARY</b> DRAWN EEO 04/08/19 SHEET NO. 224 PLANT ORDER NO. 18060B							
<b>FOR APPROVAL</b> CHECKED WJL 04/15/19							


JNL, May 15, 2019 10:41:05 AM, C:\msd17\work\224D6-2\224D6\_1.dwg



CROSSFRAME TOP & BTM STRUTS ~ MARK "A"  
(209/2)

MARK	QTY	(BA)	(BB)
225C1A	30	7'-11 7/16	7'-7 3/16
225C2A	18	7'-11 1/2	7'-7 1/4
225C2AP	8	7'-11 1/2	7'-7 1/4
225C3A	24	7'-11 1/2	7'-7 1/4
225C3AP	4	7'-11 1/2	7'-7 1/4
225C4A	8	7'-11 1/2	7'-7 1/4


PRIME COATED (SEE SHT P1)

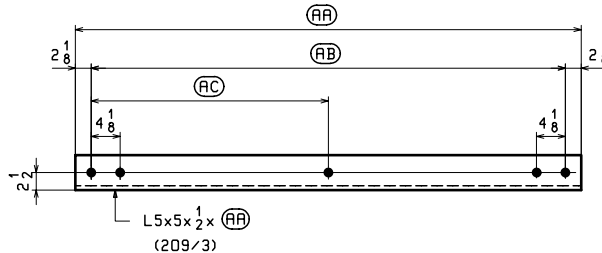

CROSSFRAME DIAGONALS ~ MARK "B"  
(LOW END @ LEFT LOOKING UP-STATION)

MARK	QTY	(AA)	(AB)	(AC)
225C1B	15	8'-11 3/4	8'-7 1/2	4'-3 3/4
225C2B	9	8'-11 9/16	8'-7 5/16	4'-3 11/16
225C2BP	4	8'-11 9/16	8'-7 5/16	4'-3 11/16
225C3B	12	8'-11 7/16	8'-7 3/16	4'-3 5/8
225C3BP	2	8'-11 7/16	8'-7 3/16	4'-3 5/8
225C4B	4	8'-11 1/4	8'-7	4'-3 1/2

PRIME COATED (SEE SHT P1)

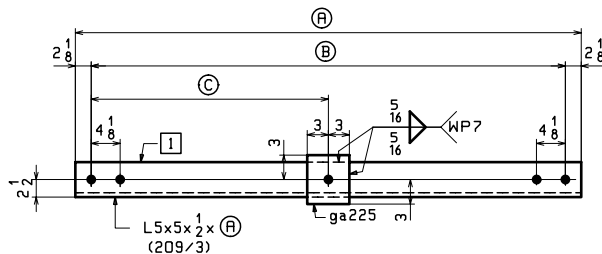


CROSSFRAME DIAGONALS ~ MARK "C"  
(LOW END @ LEFT LOOKING UP-STATION)

MARK	QTY	(A)	(B)	(C)	(I)
225C1C	15	9'-5 7/16	9'-1 3/16	4'-6 5/8	a225
225C2C	9	9'-5 5/8	9'-1 3/8	4'-6 11/16	b225
225C2CP	4	9'-5 5/8	9'-1 3/8	4'-6 11/16	b225
225C3C	12	9'-5 3/4	9'-1 1/2	4'-6 3/4	c225
225C3CP	2	9'-5 3/4	9'-1 1/2	4'-6 3/4	c225
225C4C	4	9'-6	9'-1 3/4	4'-6 7/8	d225

PRIME COATED (SEE SHT P1)

LINE	SHIP MARK	NO. OF PCS.	ASS'Y MARK	MATERIAL			REMARKS
				SHAPE	LENGTH FT. IN.	MATERIAL SPEC.	
41	225C1C	15		DIAGONALS			158
42		15	a225	L 5x5x 1/2	9 5/8	A709-50WT2	209 3
43		15	ga225	PL 1/2x6	0 6	A709-50WT2	209 4
44							
45	225C2C	9		DIAGONALS			158
46		9	b225	L 5x5x 1/2	9 5/8	A709-50WT2	209 3
47		9	ga225	PL 1/2x6	0 6	A709-50WT2	209 4
48							
49	225C2CP	4		DIAGONALS			158 PRINTED
50		4	b225	L 5x5x 1/2	9 5/8	A709-50WT2	209 3
51		4	ga225	PL 1/2x6	0 6	A709-50WT2	209 4
52							
53	225C3C	12		DIAGONALS			158
54		12	c225	L 5x5x 1/2	9 5/8	A709-50WT2	209 3
55		12	ga225	PL 1/2x6	0 6	A709-50WT2	209 4
56							
57	225C3CP	2		DIAGONALS			158 PRINTED
58		2	c225	L 5x5x 1/2	9 5/8	A709-50WT2	209 3
59		2	ga225	PL 1/2x6	0 6	A709-50WT2	209 4
60							
61	225C4C	4		DIAGONALS			158
62		4	d225	L 5x5x 1/2	9 6	A709-50WT2	209 3
63		4	ga225	PL 1/2x6	0 6	A709-50WT2	209 4
64							
65							
LINE	SHIP MARK	NO. OF PCS.	ASS'Y MARK	MATERIAL			REMARKS
				SHAPE	LENGTH FT. IN.	MATERIAL SPEC.	
1	225C1A	30		L 5x5x 1/2	7 11/16	A709-50WT2	209 2 129
2							
3	225C2A	18		L 5x5x 1/2	7 11/2	A709-50WT2	209 2 129
4							
5	225C2AP	8		L 5x5x 1/2	7 11/2	A709-50WT2	209 2 PRINTED 129
6							
7	225C3A	24		L 5x5x 1/2	7 11/2	A709-50WT2	209 2 129
8							
9	225C3AP	4		L 5x5x 1/2	7 11/2	A709-50WT2	209 2 PRINTED 129
10							
11	225C4A	8		L 5x5x 1/2	7 11/2	A709-50WT2	209 2 129
12							
13							
14	225C1B	15		L 5x5x 1/2	8 11/4	A709-50WT2	209 3 145
15							
16	225C2B	9		L 5x5x 1/2	8 9/16	A709-50WT2	209 3 145
17							
18	225C2BP	4		L 5x5x 1/2	8 9/16	A709-50WT2	209 3 PRINTED 145
19							
20	225C3B	12		L 5x5x 1/2	8 7/16	A709-50WT2	209 3 145
21							
22	225C3BP	2		L 5x5x 1/2	8 7/16	A709-50WT2	209 3 PRINTED 145
23							
24	225C4B	4		L 5x5x 1/2	8 11/4	A709-50WT2	209 3 144
25							
26							
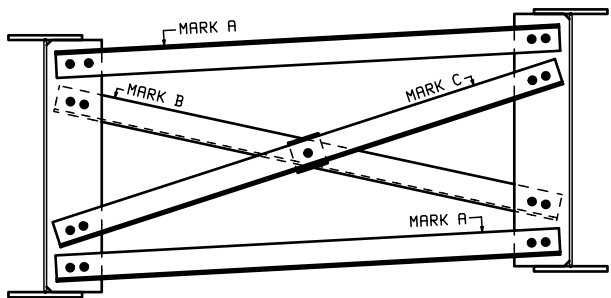

CROSSFRAME MARK LOCATION  
(LOOKING UP-STATION)

- NOTES:
- FOR GENERAL NOTES SEE SHEET GNI.
  - ALL MATERIAL SHALL BE A709-50WT2, UN.
  - T2 DENOTES CHARPY V-NOTCH TESTING REQUIRED.


5/13/19	REVISED CROSSFRAME QTY	DPS/
NO.	DATE	REMARKS
		BY
REVISIONS		
<b>2-EAU CLAIRE, WI 3-WAUSAU, WI 4-PALATKA, FL</b>		
STRUCTURE	RAMP P OVER IR-74 WB, IR-75 & RAMP E - UNIT 2	
LOCATION	CINCINNATI, OH (HAMILTON COUNTY) STA. 230+22.98	
PROJECT NO.	HAM-75-3.84, PID NO. 104667, BRIDGE NO. HAM-74-19085	
ENGINEER	PRIME AE GROUP	
CONTRACTOR	WALSH GROUP	
ITEM	CROSSFRAMES	
SURFACE PREP.	SEE SHEET P1	OPEN HOLES 9/16" Ø FOR 1 1/4" Ø HSB
PAINT	SEE SHEET P1	
PRELIMINARY	DRAWN DPS 03/22/19	SHEET NO. 180608
FOR APPROVAL	CHECKED WJL 04/17/19	PLANT ORDER NO. 37

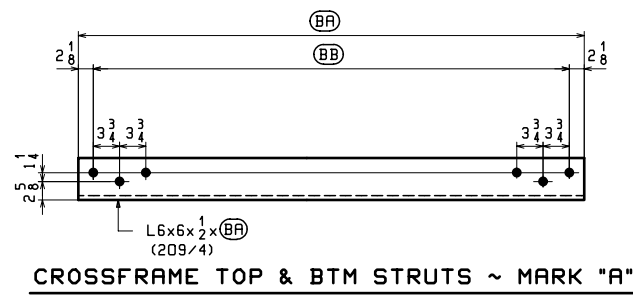

CROSSFRAME TOP & BTM STRUTS ~ MARK "A"  
(LOW END @ LEFT LOOKING UP-STATION)

MARK	QTY	(AA)	(BB)
226C1A	14	7'-9 7/8	7'-5 5/8
226C2A	10	7'-9 7/8	7'-5 5/8
226C2AP	4	7'-9 7/8	7'-5 5/8
226C3A	10	7'-9 15/16	7'-5 11/16
226C3AP	2	7'-9 15/16	7'-5 5/8
226C4A	2	7'-9 15/16	7'-5 11/16
226C5A	4	7'-9 15/16	7'-5 11/16
226C6A	4	7'-10	7'-5 3/4
226C7A	16	7'-10 1/16	7'-5 13/16
226C8A	4	7'-10 1/16	7'-5 13/16


PRIME COATED (SEE SHT P1)

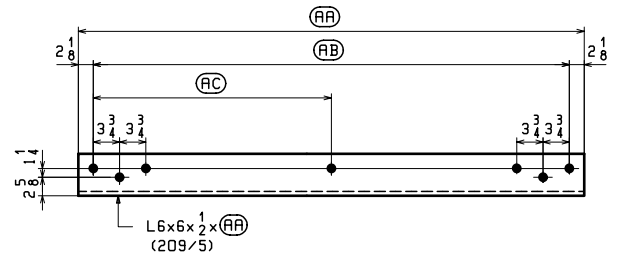

CROSSFRAME DIAGONALS ~ MARK "B"  
(LOW END @ LEFT LOOKING UP-STATION)

MARK	QTY	(AA)	(AB)	(AC)
226C1B	7	8'-9 11/16	8'-5 7/16	4'-2 3/4
226C2B	5	8'-9 1/2	8'-5 1/4	4'-2 5/8
226C2BP	2	8'-9 1/2	8'-5 1/4	4'-2 5/8
226C3B	5	8'-9 5/8	8'-5 1/8	4'-2 9/16
226C3BP	1	8'-9 5/8	8'-5 1/8	4'-2 9/16
226C4B	1	8'-9 1/4	8'-5	4'-2 1/2
226C5B	2	8'-8 11/16	8'-4 11/16	4'-2 3/8
226C6B	2	8'-8 11/16	8'-4 7/16	4'-2 1/4
226C7B	8	8'-8 7/16	8'-4 3/16	4'-2 1/8
226C8B	2	8'-8 5/16	8'-4 1/16	4'-2 1/16

PRIME COATED (SEE SHT P1)

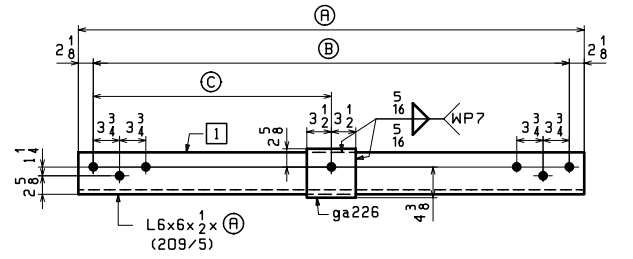


CROSSFRAME DIAGONALS ~ MARK "C"  
(LOW END @ LEFT LOOKING UP-STATION)

MARK	QTY	(A)	(B)	(C)	(I)
226C1C	7	9'-1 13/16	8'-9 9/16	4'-4 13/16	a226
226C2C	5	9'-1 15/16	8'-9 11/16	4'-4 7/8	b226
226C2CP	2	9'-1 15/16	8'-9 11/16	4'-4 7/8	b226
226C3C	5	9'-2 1/8	8'-9 7/8	4'-4 15/16	c226
226C3CP	1	9'-2 1/8	8'-9 7/8	4'-4 15/16	c226
226C4C	1	9'-2 1/4	8'-10	4'-5	d226
226C5C	2	9'-2 5/8	8'-10 3/8	4'-5 3/16	f226
226C6C	2	9'-2 15/16	8'-10 11/16	4'-5 5/16	g226
226C7C	8	9'-3 1/4	8'-11	4'-5 1/2	k226
226C8C	2	9'-3 7/16	8'-11 3/16	4'-5 5/8	m226

PRIME COATED (SEE SHT P1)

LINE	SHIP MARK	NO. OF PCS.	ASSY MARK	MATERIAL				REMARKS
				SHAPE	LENGTH FT. IN.	MATERIAL SPEC.	ITEM NO.	
53	226C1C	7		DIAGONALS				186
54		7	a226	L 6x6x 1/2	9 1 11/16	A709-50MT2	209 5	
55		7	ga226	PL 1/2x7	0 7	A709-50MT2	209 15	
56								
57	226C2C	5		DIAGONALS				186
58		5	b226	L 6x6x 1/2	9 1 11/16	A709-50MT2	209 5	
59		5	ga226	PL 1/2x7	0 7	A709-50MT2	209 15	
60								
61	226C2CP	2		DIAGONALS				186
62		2	b226	L 6x6x 1/2	9 1 11/16	A709-50MT2	209 5	
63		2	ga226	PL 1/2x7	0 7	A709-50MT2	209 15	
64								
65	226C3C	5		DIAGONALS				187
66		5	c226	L 6x6x 1/2	9 2 8	A709-50MT2	209 5	
67		5	ga226	PL 1/2x7	0 7	A709-50MT2	209 15	
68								
69	226C3CP	1		DIAGONALS				187
70		1	c226	L 6x6x 1/2	9 2 8	A709-50MT2	209 5	
71		1	ga226	PL 1/2x7	0 7	A709-50MT2	209 15	
72								
73	226C4C	1		DIAGONALS				187
74		1	d226	L 6x6x 1/2	9 2 4	A709-50MT2	209 5	
75		1	ga226	PL 1/2x7	0 7	A709-50MT2	209 15	
76								
77	226C5C	2		DIAGONALS				187
78		2	f226	L 6x6x 1/2	9 2 8	A709-50MT2	209 5	
79		2	ga226	PL 1/2x7	0 7	A709-50MT2	209 15	
80								
81	226C6C	2		DIAGONALS				188
82		2	g226	L 6x6x 1/2	9 2 5	A709-50MT2	209 5	
83		2	ga226	PL 1/2x7	0 7	A709-50MT2	209 15	
84								
85	226C7C	8		DIAGONALS				188
86		8	k226	L 6x6x 1/2	9 3 1	A709-50MT2	209 5	
87		8	ga226	PL 1/2x7	0 7	A709-50MT2	209 15	
88								
89	226C8C	2		DIAGONALS				189
90		2	m226	L 6x6x 1/2	9 3 5	A709-50MT2	209 5	
91		2	ga226	PL 1/2x7	0 7	A709-50MT2	209 15	
92								
93								
LINE	SHIP MARK	NO. OF PCS.	ASSY MARK	MATERIAL				REMARKS
				SHAPE	LENGTH FT. IN.	MATERIAL SPEC.	ITEM NO.	
1	226C1A	14		L 6x6x 1/2	7 9 7/8	A709-50MT2	209 4	153
2								
3	226C2A	10		L 6x6x 1/2	7 9 7/8	A709-50MT2	209 4	153
4								
5	226C2AP	4		L 6x6x 1/2	7 9 7/8	A709-50MT2	209 4	153
6								
7	226C3A	10		L 6x6x 1/2	7 9 15/16	A709-50MT2	209 4	153
8								
9	226C3AP	2		L 6x6x 1/2	7 9 15/16	A709-50MT2	209 4	153
10								
11	226C4A	2		L 6x6x 1/2	7 9 15/16	A709-50MT2	209 4	153
12								
13	226C5A	4		L 6x6x 1/2	7 9 15/16	A709-50MT2	209 4	153
14								
15	226C6A	4		L 6x6x 1/2	7 10	A709-50MT2	209 4	153
16								
17	226C7A	16		L 6x6x 1/2	7 10 1/16	A709-50MT2	209 4	153
18								
19	226C8A	4		L 6x6x 1/2	7 10 1/16	A709-50MT2	209 4	153
20								
21								
22	226C1B	7		L 6x6x 1/2	8 9 11/16	A709-50MT2	209 5	172
23								
24	226C2B	5		L 6x6x 1/2	8 9 1/2	A709-50MT2	209 5	172
25								
26	226C2BP	2		L 6x6x 1/2	8 9 1/2	A709-50MT2	209 5	172
27								
28	226C3B	5		L 6x6x 1/2	8 9 5/8	A709-50MT2	209 5	172
29								
30	226C3BP	1		L 6x6x 1/2	8 9 5/8	A709-50MT2	209 5	172
31								
32	226C4B	1		L 6x6x 1/2	8 9 1/4	A709-50MT2	209 5	172
33								
34	226C5B	2		L 6x6x 1/2	8 8 15/16	A709-50MT2	209 5	171
35								
36	226C6B	2		L 6x6x 1/2	8 8 11/16	A709-50MT2	209 5	171
37								
38	226C7B	8		L 6x6x 1/2	8 7 1/16	A709-50MT2	209 5	170
39								
40	226C8B	2		L 6x6x 1/2	8 8 5/16	A709-50MT2	209 5	170
41								
42								
43								
44								
45								
46								
47								
48								
49								
50								
51								
52								

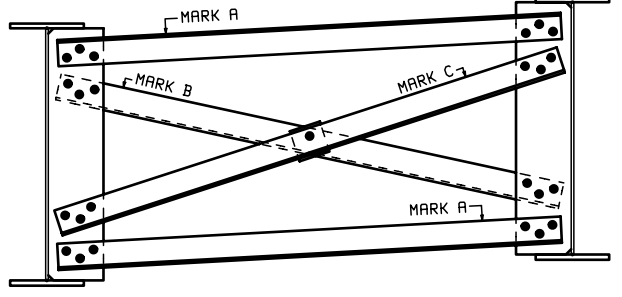

CROSSFRAME MARK LOCATION  
(LOOKING UP-STATION)

- NOTES:  
1. FOR GENERAL NOTES SEE SHEET GNI.  
2. ALL MATERIAL SHALL BE A709-50MT2, UN.  
3. T2 DENOTES CHARPY V-NOTCH TESTING REQUIRED.

NO. \_\_\_\_\_ DATE \_\_\_\_\_ REMARKS \_\_\_\_\_ BY \_\_\_\_\_

REVISIONS

**Veritas STEEL**

2-EAU CLAIRE, WI 3-WAUSAU, WI 4-PALATKA, FL TENSOR 3656-2

STRUCTURE: RAMP P OVER IR-74 WB, IR-75 & RAMP E - UNIT 2

LOCATION: CINCINNATI, OH (HAMILTON COUNTY) STA. 230+22.98

PROJECT NO.: HAM-75-3.84, PID NO. 104667, BRIDGE NO. HAM-74-19085

ENGINEER: PRIME AE GROUP

CONTRACTOR: WALSH GROUP


ITEM: CROSSFRAMES

SURFACE PREP.: SEE SHEET P1 OPEN HOLES: 9/16" Ø FOR 1 1/4" Ø HSB

PAINT: SEE SHEET P1

PRELIMINARY	DRAWN	DPS	03/22/19	SHEET NO.	PLANT	ORDER NO.	FP. NO.
FOR APPROVAL	CHECKED	WJL	04/17/19	226	3	18060B	37




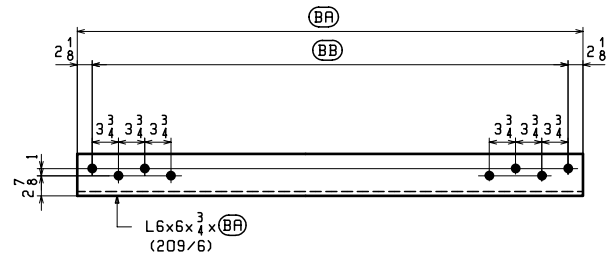

CROSSFRAME TOP & BTM STRUTS ~ MARK "A"

MARK	QTY	(BA)	(BB)
227C1A	2	7'-11 3/8	7'-7 1/8
227C1AP	2	7'-11 3/8	7'-7 1/8
227C2A	6	7'-11 7/16	7'-7 3/16
227C3A	6	7'-11 7/16	7'-7 3/16
227C4A	2	7'-11 7/16	7'-7 3/16

PRIME COATED (SEE SHT P1)

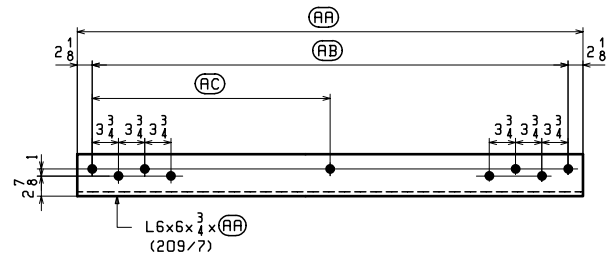


CROSSFRAME DIAGONALS ~ MARK "B"

(LOW END @ LEFT LOOKING UP-STATION)

MARK	QTY	(AA)	(AB)	(AC)
227C1B	1	8'-10	8'-5 3/4	4'-2 3/8
227C1BP	1	8'-10	8'-5 3/4	4'-2 3/8
227C2B	3	8'-9 13/16	8'-5 9/16	4'-2 5/16
227C3B	3	8'-9 11/16	8'-5 7/16	4'-2 1/4
227C4B	1	8'-9 5/8	8'-5 3/8	4'-2 1/4

PRIME COATED (SEE SHT P1)

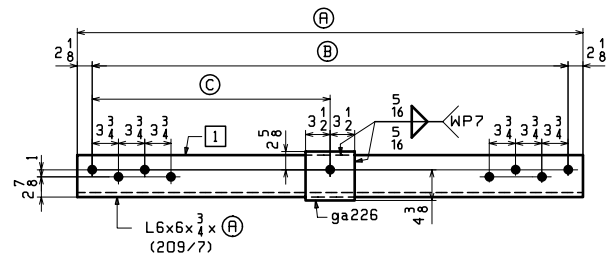


CROSSFRAME DIAGONALS ~ MARK "C"

(LOW END @ LEFT LOOKING UP-STATION)

MARK	QTY	(A)	(B)	(C)	(I)
227C1C	1	9'-2 13/16	8'-10 9/16	4'-4 7/8	a227
227C1CP	1	9'-2 13/16	8'-10 9/16	4'-4 7/8	a227
227C2C	3	9'-3	8'-10 3/4	4'-4 15/16	b227
227C3C	3	9'-3 3/16	8'-10 15/16	4'-5 1/16	c227
227C4C	1	9'-3 1/4	8'-11	4'-5 1/16	d227

PRIME COATED (SEE SHT P1)

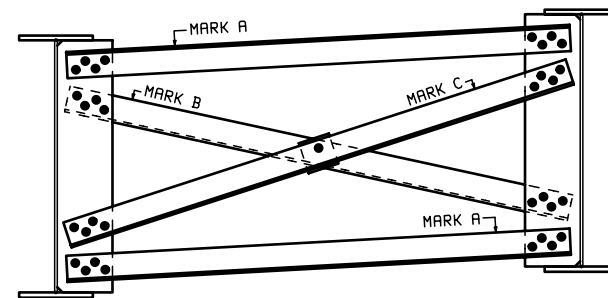


CROSSFRAME MARK LOCATION

(LOOKING UP-STATION)

- NOTES:
- FOR GENERAL NOTES SEE SHEET GNI.
  - ALL MATERIAL SHALL BE A709-50WT2, UN.
  - T2 DENOTES CHARPY V-NOTCH TESTING REQUIRED.

L I N E	SHIP MARK	NO. OF PCS.	ASS'Y MARK	MATERIAL				REMARKS
				SHAPE	LENGTH FT. IN.	MATERIAL SPEC.	ITEM NO.	
1	227C1A	2		L 6x6x 3/4	7 11 3/8	A709-50WT2	209 6	228
2								
3	227C1AP	2		L 6x6x 3/4	7 11 3/8	A709-50WT2	209 6	PRINTED 228
4								
5	227C2A	6		L 6x6x 3/4	7 11 7/16	A709-50WT2	209 6	228
6								
7	227C3A	6		L 6x6x 3/4	7 11 7/16	A709-50WT2	209 6	228
8								
9	227C4A	2		L 6x6x 3/4	7 11 7/16	A709-50WT2	209 6	228
10								
11								
12	227C1B	1		L 6x6x 3/4	8 10	A709-50WT2	209 7	254
13								
14	227C1BP	1		L 6x6x 3/4	8 10	A709-50WT2	209 7	PRINTED 254
15								
16	227C2B	3		L 6x6x 3/4	8 9 13/16	A709-50WT2	209 7	253
17								
18	227C3B	3		L 6x6x 3/4	8 9 11/16	A709-50WT2	209 7	253
19								
20	227C4B	1		L 6x6x 3/4	8 9 5/8	A709-50WT2	209 7	253
21								
22								
23	227C1C	1		DIAGONALS				272
24		1	a227	L 6x6x 3/4	9 2 13/16	A709-50WT2	209 7	
25		1	ga226	PL 2x7	0 7	A709-50WT2	209 15	
26								
27	227C1CP	1		DIAGONALS				PRINTED 272
28		1	a227	L 6x6x 3/4	9 2 13/16	A709-50WT2	209 7	
29		1	ga226	PL 2x7	0 7	A709-50WT2	209 15	
30								
31	227C2C	3		DIAGONALS				273
32		3	b227	L 6x6x 3/4	9 3	A709-50WT2	209 7	
33		3	ga226	PL 2x7	0 7	A709-50WT2	209 15	
34								
35	227C3C	3		DIAGONALS				273
36		3	c227	L 6x6x 3/4	9 3 3/16	A709-50WT2	209 7	
37		3	ga226	PL 2x7	0 7	A709-50WT2	209 15	
38								
39	227C4C	1		DIAGONALS				273
40		1	d227	L 6x6x 3/4	9 3 1/4	A709-50WT2	209 7	
41		1	ga226	PL 2x7	0 7	A709-50WT2	209 15	
42								
43								
44								
45								
46								
47								
48								
49								
50								


NO.	DATE	REMARKS	BY
REVISIONS			
2-EAU CLAIRE, WI 3-WAUSAU, WI 4-PALATKA, FL TENSOR 3656-2			
STRUCTURE	RAMP P OVER IR-74 WB, IR-75 & RAMP E - UNIT 2		
LOCATION	CINCINNATI, OH (HAMILTON COUNTY) STA. 230+22.98		
PROJECT NO.	HAM-75-3.84, PID NO. 104667, BRIDGE NO. HAM-74-19085		
ENGINEER	PRIME AE GROUP		
CONTRACTOR	WALSH GROUP		
CROSSFRAMES			
ITEM			
SURFACE PREP.	SEE SHEET P1 OPEN HOLES 9/16" Ø FOR 1 1/4" Ø HSB		
PAINT	SEE SHEET P1		
PRELIMINARY	DRAWN	DPS 03/22/19	SHEET NO. 3
FOR APPROVAL	CHECKED	WJL 04/17/19	PLANT ORDER NO. 180608
			FP. NO. 37

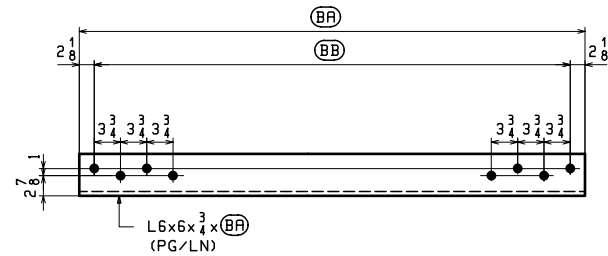

**CROSSFRAME TOP & BTM STRUTS ~ MARK "A"**

MARK	QTY	(BA)	(BB)	PG/LN
228C1AP	2	7'-11 <sup>3</sup> / <sub>8</sub>	7'-7 <sup>1</sup> / <sub>8</sub>	209/6
228C2AP	4	7'-11 <sup>1</sup> / <sub>2</sub>	7'-7 <sup>1</sup> / <sub>4</sub>	209/6
228C3AP	2	8'-1 <sup>15</sup> / <sub>16</sub>	7'-9 <sup>11</sup> / <sub>16</sub>	209/8
228C4AP	2	8'-2 <sup>1</sup> / <sub>8</sub>	7'-9 <sup>7</sup> / <sub>8</sub>	209/8
228C5AP	2	8'-2 <sup>5</sup> / <sub>16</sub>	7'-10 <sup>1</sup> / <sub>16</sub>	209/8

PRIME COATED (SEE SHT P1)

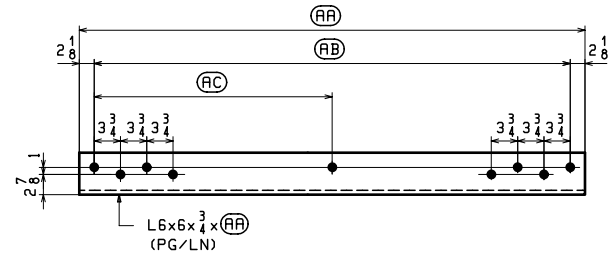


**CROSSFRAME DIAGONALS ~ MARK "B"**

(LOW END @ LEFT LOOKING UP-STATION)

MARK	QTY	(AA)	(AB)	(AC)	PG/LN
228C1BP	1	8'-10 <sup>1</sup> / <sub>8</sub>	8'-5 <sup>7</sup> / <sub>8</sub>	4'-2 <sup>1</sup> / <sub>2</sub>	209/7
228C2BP	2	8'-9 <sup>7</sup> / <sub>16</sub>	8'-5 <sup>3</sup> / <sub>16</sub>	4'-2 <sup>1</sup> / <sub>8</sub>	209/7
228C3BP	1	9'-0 <sup>1</sup> / <sub>8</sub>	8'-7 <sup>7</sup> / <sub>8</sub>	4'-3 <sup>1</sup> / <sub>2</sub>	209/9
228C4BP	1	8'-11 <sup>9</sup> / <sub>16</sub>	8'-7 <sup>5</sup> / <sub>16</sub>	4'-3 <sup>3</sup> / <sub>16</sub>	209/9
228C5BP	1	8'-11 <sup>3</sup> / <sub>4</sub>	8'-7 <sup>1</sup> / <sub>2</sub>	4'-3 <sup>5</sup> / <sub>16</sub>	209/9

PRIME COATED (SEE SHT P1)

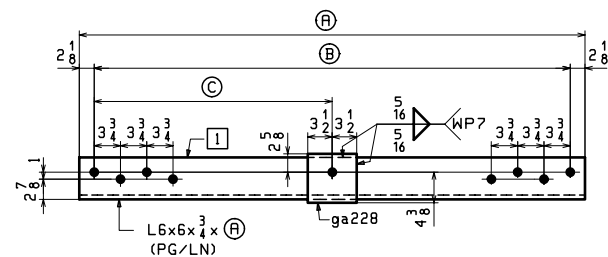


**CROSSFRAME DIAGONALS ~ MARK "C"**

(LOW END @ LEFT LOOKING UP-STATION)

MARK	QTY	(A)	(B)	(C)	(I)	PG/LN
228C1CP	1	9'-2 <sup>11</sup> / <sub>16</sub>	8'-10 <sup>7</sup> / <sub>16</sub>	4'-4 <sup>13</sup> / <sub>16</sub>	a228	209/7
228C2CP	2	9'-3 <sup>7</sup> / <sub>16</sub>	8'-11 <sup>3</sup> / <sub>16</sub>	4'-5 <sup>3</sup> / <sub>16</sub>	b228	209/7
228C3CP	1	9'-5 <sup>1</sup> / <sub>16</sub>	9'-0 <sup>13</sup> / <sub>16</sub>	4'-6	c228	209/9
228C4CP	1	9'-5 <sup>15</sup> / <sub>16</sub>	9'-1 <sup>11</sup> / <sub>16</sub>	4'-6 <sup>7</sup> / <sub>16</sub>	d228	209/9
228C5CP	1	9'-6 <sup>1</sup> / <sub>8</sub>	9'-1 <sup>7</sup> / <sub>8</sub>	4'-6 <sup>1</sup> / <sub>2</sub>	f228	209/9

PRIME COATED (SEE SHT P1)

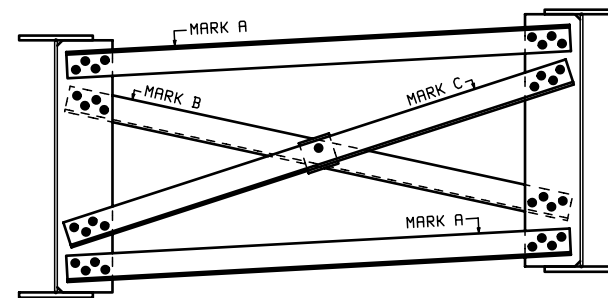

**CROSSFRAME MARK LOCATION**


(LOOKING UP-STATION)

- NOTES:
- FOR GENERAL NOTES SEE SHEET GNI.
  - ALL MATERIAL SHALL BE A709-50WT2, UN.
  - T2 DENOTES CHARTY V-NOTCH TESTING REQUIRED.

L I N E	SHIP MARK	NO. OF PCS.	ASS'Y MARK	MATERIAL				REMARKS
				SHAPE	LENGTH FT. IN.	MATERIAL SPEC.	ITEM NO.	
1	228C1AP	2		L 6x6x <sup>3</sup> / <sub>4</sub>	7 11 <sup>3</sup> / <sub>8</sub>	A709-50WT2	209/6	PRINTED 228
2	228C2AP	4		L 6x6x <sup>3</sup> / <sub>4</sub>	7 11 <sup>1</sup> / <sub>2</sub>	A709-50WT2	209/6	PRINTED 228
3	228C3AP	2		L 6x6x <sup>3</sup> / <sub>4</sub>	8 1 <sup>15</sup> / <sub>16</sub>	A709-50WT2	209/8	PRINTED 234
4	228C4AP	2		L 6x6x <sup>3</sup> / <sub>4</sub>	8 2 <sup>1</sup> / <sub>8</sub>	A709-50WT2	209/8	PRINTED 235
5	228C5AP	2		L 6x6x <sup>3</sup> / <sub>4</sub>	8 2 <sup>5</sup> / <sub>16</sub>	A709-50WT2	209/8	PRINTED 235
6								
7	228C1BP	1		L 6x6x <sup>3</sup> / <sub>4</sub>	8 10 <sup>1</sup> / <sub>8</sub>	A709-50WT2	209/7	PRINTED 254
8	228C2BP	2		L 6x6x <sup>3</sup> / <sub>4</sub>	8 9 <sup>7</sup> / <sub>16</sub>	A709-50WT2	209/7	PRINTED 252
9	228C3BP	1		L 6x6x <sup>3</sup> / <sub>4</sub>	9 0 <sup>1</sup> / <sub>8</sub>	A709-50WT2	209/9	PRINTED 259
10	228C4BP	1		L 6x6x <sup>3</sup> / <sub>4</sub>	8 11 <sup>9</sup> / <sub>16</sub>	A709-50WT2	209/9	PRINTED 257
11	228C5BP	1		L 6x6x <sup>3</sup> / <sub>4</sub>	8 11 <sup>3</sup> / <sub>4</sub>	A709-50WT2	209/9	PRINTED 258
12								
13	228C1CP	1		DIAGONALS				PRINTED 287
14	1 a228			L 6x6x <sup>3</sup> / <sub>4</sub>	9 2 <sup>11</sup> / <sub>16</sub>	A709-50WT2	209/7	
15	1 ga228			PL 1 <sup>5</sup> / <sub>8</sub> x7	0 7	A709-50WT2	209/16	
16								
17	228C2CP	2		DIAGONALS				PRINTED 289
18	2 b228			L 6x6x <sup>3</sup> / <sub>4</sub>	9 3 <sup>7</sup> / <sub>16</sub>	A709-50WT2	209/7	
19	2 ga228			PL 1 <sup>5</sup> / <sub>8</sub> x7	0 7	A709-50WT2	209/16	
20								
21	228C3CP	1		DIAGONALS				PRINTED 293
22	1 c228			L 6x6x <sup>3</sup> / <sub>4</sub>	9 5 <sup>1</sup> / <sub>16</sub>	A709-50WT2	209/9	
23	1 ga228			PL 1 <sup>5</sup> / <sub>8</sub> x7	0 7	A709-50WT2	209/16	
24								
25	228C4CP	1		DIAGONALS				PRINTED 295
26	1 d228			L 6x6x <sup>3</sup> / <sub>4</sub>	9 5 <sup>15</sup> / <sub>16</sub>	A709-50WT2	209/9	
27	1 ga228			PL 1 <sup>5</sup> / <sub>8</sub> x7	0 7	A709-50WT2	209/16	
28								
29	228C5CP	1		DIAGONALS				PRINTED 296
30	1 f228			L 6x6x <sup>3</sup> / <sub>4</sub>	9 6 <sup>1</sup> / <sub>8</sub>	A709-50WT2	209/9	
31	1 ga228			PL 1 <sup>5</sup> / <sub>8</sub> x7	0 7	A709-50WT2	209/16	
32								
33								
NO.	DATE	REMARKS	BY
REVISIONS			
STRUCTURE <u>RAMP P OVER IR-74 WB, IR-75 &amp; RAMP E - UNIT 2</u>			
LOCATION <u>CINCINNATI, OH (HAMILTON COUNTY) STA. 230+22.98</u>			
PROJECT NO. <u>HAM-75-3.84, PID NO. 104667, BRIDGE NO. HAM-74-19085</u>			
ENGINEER <u>PRIME AE GROUP</u>			
CONTRACTOR <u>WALSH GROUP</u>			
PIER CROSSFRAMES			
ITEM _____			
SURFACE PREP. <u>SEE SHEET P1</u> OPEN HOLES <u>9/16" Ø FOR 1 1/4" Ø HSB</u>			
PAINT <u>SEE SHEET P1</u>			
PRELIMINARY	DRAWN <u>DPS 03/22/19</u>	SHEET NO. <u>228</u>	PLANT <u>3</u> ORDER NO. <u>18060B</u> FP. NO. <u>37</u>
FOR APPROVAL	CHECKED <u>WJL 04/17/19</u>		

ECD Rev. 20, 2019 03/22/19 BR 7/2019/19/03/22/19 228-1 Rev.0

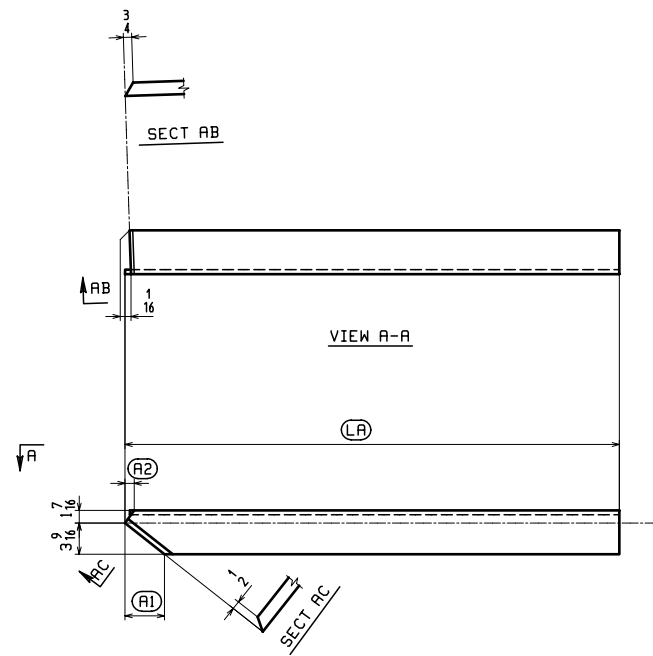


CROSSFRAME DIAGONALS ~ MARK "A"

MARK "A"	QTY	(LA)	(A1)	(A2)	PG/LN
229C1AP	1	6'-7 <sup>13</sup> / <sub>16</sub>	2 <sup>3</sup> / <sub>4</sub>	2	209/11
229C2AP	1	6'-8 <sup>5</sup> / <sub>16</sub>	2 <sup>13</sup> / <sub>16</sub>	2 <sup>1</sup> / <sub>16</sub>	209/11
229C3AP	1	6'-7 <sup>3</sup> / <sub>8</sub>	2 <sup>13</sup> / <sub>16</sub>	2 <sup>1</sup> / <sub>16</sub>	209/11

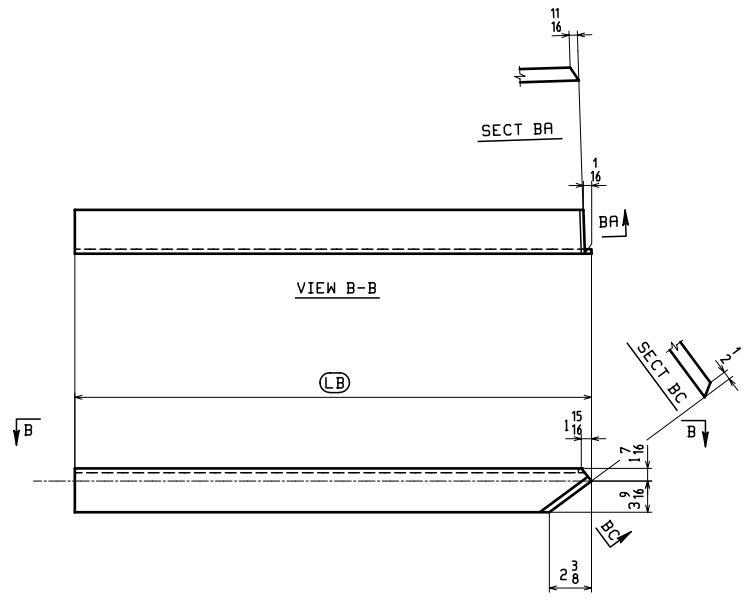

CROSSFRAME DIAGONALS ~ MARK "B"


MARK "B"	QTY	(LB)	PG/LN
229C1BP	1	6'-4 <sup>1</sup> / <sub>2</sub>	209/11
229C2BP	1	6'-3 <sup>15</sup> / <sub>16</sub>	209/11
229C3BP	1	6'-3 <sup>5</sup> / <sub>16</sub>	209/11

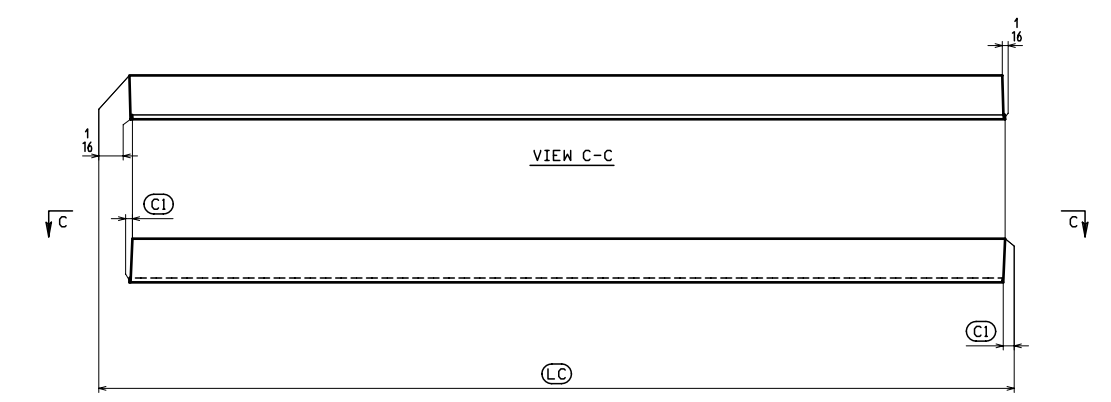

CROSSFRAME STRUTS ~ MARK "C"

MARK "C"	QTY	(LC)	(C1)	PG/LN
229C1CP	1	8'-3 <sup>9</sup> / <sub>16</sub>	3 <sup>3</sup> / <sub>16</sub>	209/10
229C2CP	1	8'-3 <sup>5</sup> / <sub>8</sub>	1 <sup>1</sup> / <sub>4</sub>	209/10
229C3CP	1	8'-3 <sup>9</sup> / <sub>16</sub>	1 <sup>1</sup> / <sub>4</sub>	209/10

LT LN	SHIP MARK	NO. OF PCS.	ASS'Y MARK	MATERIAL				REMARKS
				SHAPE	LENGTH FT. IN.	MATERIAL SPEC.	ITEM NO.	
1	229C1AP	1		L 5x5x <sup>1</sup> / <sub>2</sub>	6 7 <sup>13</sup> / <sub>16</sub>	A709-50WT2	209/11	PRINTED 108
2	229C2AP	1		L 5x5x <sup>1</sup> / <sub>2</sub>	6 8 <sup>5</sup> / <sub>16</sub>	A709-50WT2	209/11	PRINTED 108
3	229C3AP	1		L 5x5x <sup>1</sup> / <sub>2</sub>	6 7 <sup>3</sup> / <sub>8</sub>	A709-50WT2	209/11	PRINTED 107
4	229C1BP	1		L 5x5x <sup>1</sup> / <sub>2</sub>	6 4 <sup>1</sup> / <sub>2</sub>	A709-50WT2	209/11	PRINTED 103
5	229C2BP	1		L 5x5x <sup>1</sup> / <sub>2</sub>	6 3 <sup>15</sup> / <sub>16</sub>	A709-50WT2	209/11	PRINTED 102
6	229C3BP	1		L 5x5x <sup>1</sup> / <sub>2</sub>	6 3 <sup>5</sup> / <sub>16</sub>	A709-50WT2	209/11	PRINTED 101
7	229C1CP	1		L 5x5x <sup>1</sup> / <sub>2</sub>	8 3 <sup>9</sup> / <sub>16</sub>	A709-50WT2	209/10	PRINTED 134
8	229C2CP	1		L 5x5x <sup>1</sup> / <sub>2</sub>	8 3 <sup>5</sup> / <sub>8</sub>	A709-50WT2	209/10	PRINTED 134
9	229C3CP	1		L 5x5x <sup>1</sup> / <sub>2</sub>	8 3 <sup>9</sup> / <sub>16</sub>	A709-50WT2	209/10	PRINTED 134
10								
11								
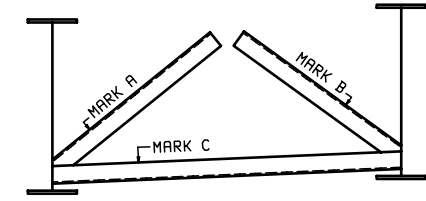


CROSSFRAME MARK LOCATION  
(LOOKING UP-STATION)

NO.	DATE	REMARKS	BY
REVISIONS			
		TENSOR 3656-2	
STRUCTURE	RAMP P OVER IR-74 WB, IR-75 & RAMP E - UNIT 2		
LOCATION	CINCINNATI, OH (HAMILTON COUNTY) STA. 230+22.98		
PROJECT NO.	HAM-75-3.84, PID NO. 104667, BRIDGE NO. HAM-74-1908S		
ENGINEER	PRIME AE GROUP		
CONTRACTOR	WALSH GROUP		
END CROSSFRAMES			
ITEM			
SURFACE PREP.	SEE SHEET P1 OPEN HOLES		
PAINT	SEE SHEET P1		
PRELIMINARY	DRAWN	DPS 03/25/19	SHEET NO. 3
FOR APPROVAL	CHECKED	WJL 04/18/19	PLANT ORDER NO. 18060B 37


- NOTES:
- FOR GENERAL NOTES SEE SHEET GNI.
  - ALL MATERIAL SHALL BE A709-50WT2.
  - T2 DENOTES CHARPY V-NOTCH TESTING REQUIRED.
  - ALL MATERIAL PRIME COATED (SEE SHT P1)

ECD Rev. 20 2019 07/26/19 BR 7/26/19 10:58:27 2/2019 1 Rev 0

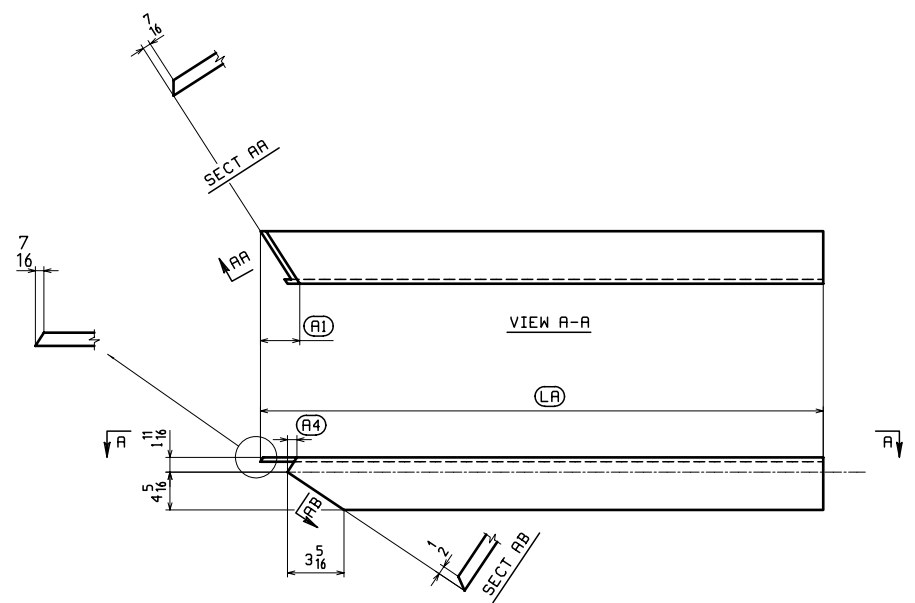


**CROSSFRAME DIAGONALS ~ MARK "A"**

MARK "A"	QTY	(LA)	(A1)	(A3)	(A4)	PG/LN
230C1AP	1	6'-10 1/8	5 5/16	3 5/16	1 15/16	209/13
230C2AP	1	6'-9 15/16	5 7/16	3 5/16	1 7/8	209/13
230C3AP	1	6'-10 1/4	5 1/4	3 5/16	1 7/8	209/13

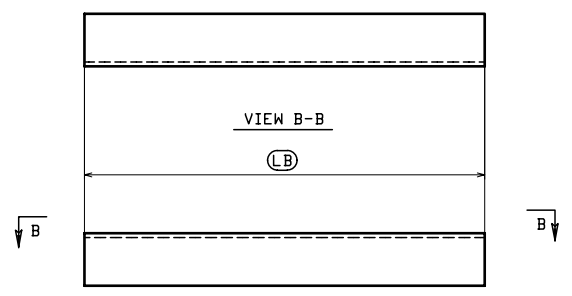

**CROSSFRAME DIAGONALS ~ MARK "B"**


MARK "B"	QTY	(LB)	PG/LN
230C1BP	1	5'-11 3/8	209/13
230C2BP	1	6'-0 3/16	209/13
230C3BP	1	6'-0 5/16	209/13

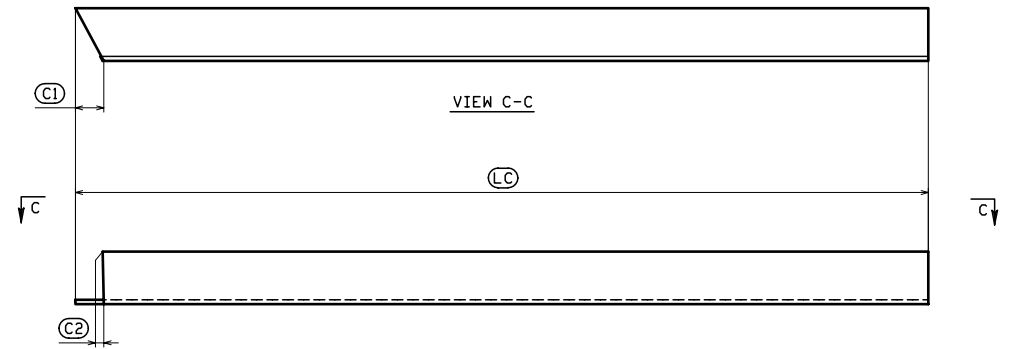

**CROSSFRAME STRUTS ~ MARK "C"**

MARK "C"	QTY	(LC)	(C1)	(C2)	PG/LN
230C1CP	1	8'-5 13/16	3 1/8	3/8	209/12
230C2CP	1	8'-6 9/16	3 3/16	7/16	209/12
230C3CP	1	8'-7 5/8	3 5/16	7/16	209/12

LN	SHIP MARK	NO. OF PCS.	ASS'Y MARK	MATERIAL				REMARKS
				SHAPE	LENGTH FT. IN.	MATERIAL SPEC.	ITEM NO.	
1	230C1AP	1		L 6x6x 1/2	6 10 8	A709-50WT2	209/13	PRINTED 134
2								
3	230C2AP	1		L 6x6x 1/2	6 9 5/8	A709-50WT2	209/13	PRINTED 134
4								
5	230C3AP	1		L 6x6x 1/2	6 10 4	A709-50WT2	209/13	PRINTED 134
6								
7	230C1BP	1		L 6x6x 1/2	5 11 8	A709-50WT2	209/13	PRINTED 115
8								
9	230C2BP	1		L 6x6x 1/2	6 0 3/4	A709-50WT2	209/13	PRINTED 118
10								
11	230C3BP	1		L 6x6x 1/2	6 0 5/8	A709-50WT2	209/13	PRINTED 118
12								
13	230C1CP	1		L 6x6x 1/2	8 5 1/4	A709-50WT2	209/12	PRINTED 155
14								
15	230C2CP	1		L 6x6x 1/2	8 6 9/16	A709-50WT2	209/12	PRINTED 157
16								
17	230C3CP	1		L 6x6x 1/2	8 7 5/8	A709-50WT2	209/12	PRINTED 159
18								
19								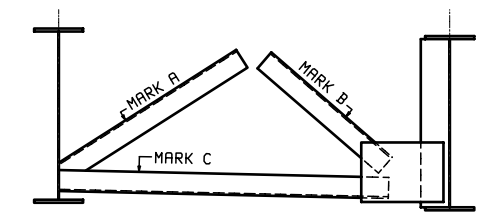
**CROSSFRAME MARK LOCATION**  
(LOOKING DOWNSTATION)


- NOTES:**
- FOR GENERAL NOTES SEE SHEET GNI.
  - ALL MATERIAL SHALL BE A709-50WT2.
  - T2 DENOTES CHARPY V-NOTCH TESTING REQUIRED.
  - ALL MATERIAL PRIME COATED (SEE SHT P1)

NO.	DATE	REMARKS	BY
REVISIONS			
		2-EAU CLAIRE, WI 3-WAUSAU, WI 4-PALATKA, FL TENSOR 3656-2	
STRUCTURE	RAMP P OVER IR-74 WB, IR-75 & RAMP E - UNIT 2		
LOCATION	CINCINNATI, OH (HAMILTON COUNTY) STA. 230+22.98		
PROJECT NO.	HAM-75-3.84, PID NO. 104667, BRIDGE NO. HAM-74-19085		
ENGINEER	PRIME AE GROUP		
CONTRACTOR	WALSH GROUP		
END CROSSFRAMES			
ITEM			
SURFACE PREP.	SEE SHEET P1 OPEN HOLES		
PAINT	SEE SHEET P1		
PRELIMINARY	DRAWN DPS 03/25/19	SHEET NO. 230	PLANT ORDER NO. 180608
FOR APPROVAL	CHECKED WJL 04/18/19		FP. NO. 37

ECD - Rev. 23, 2019 07/28/2019, BM - 7/28/2019, 230+22.98-2+2301.1 Rev.0

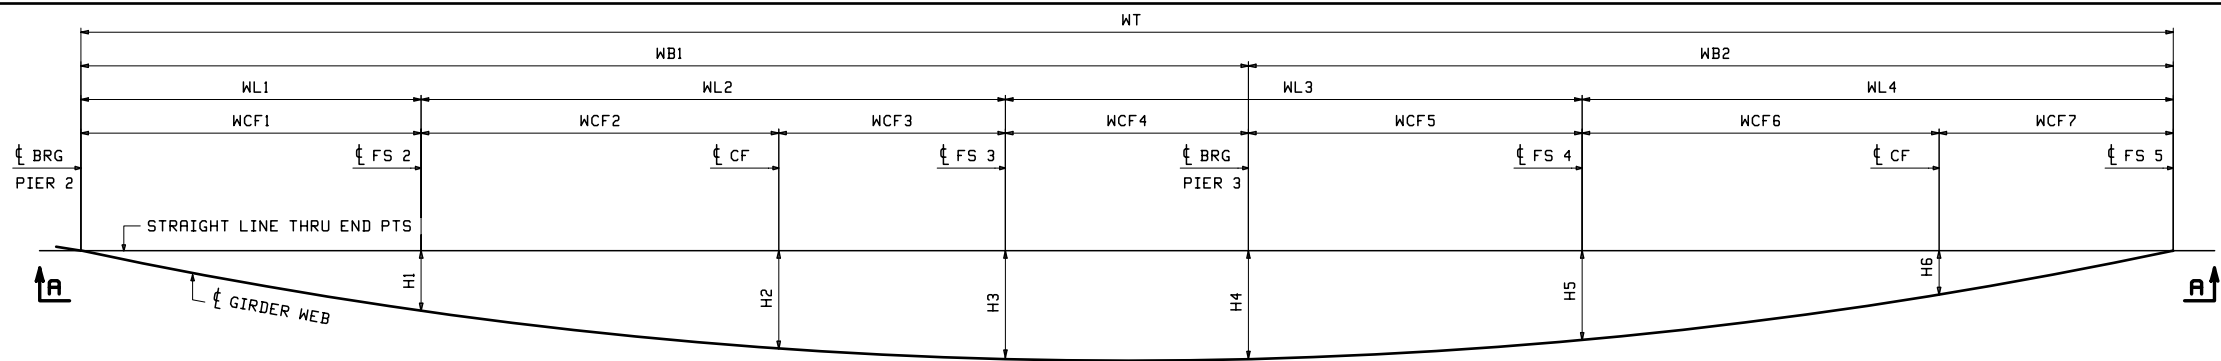

PLAN VIEW GIRDER @ TOP OF WEB

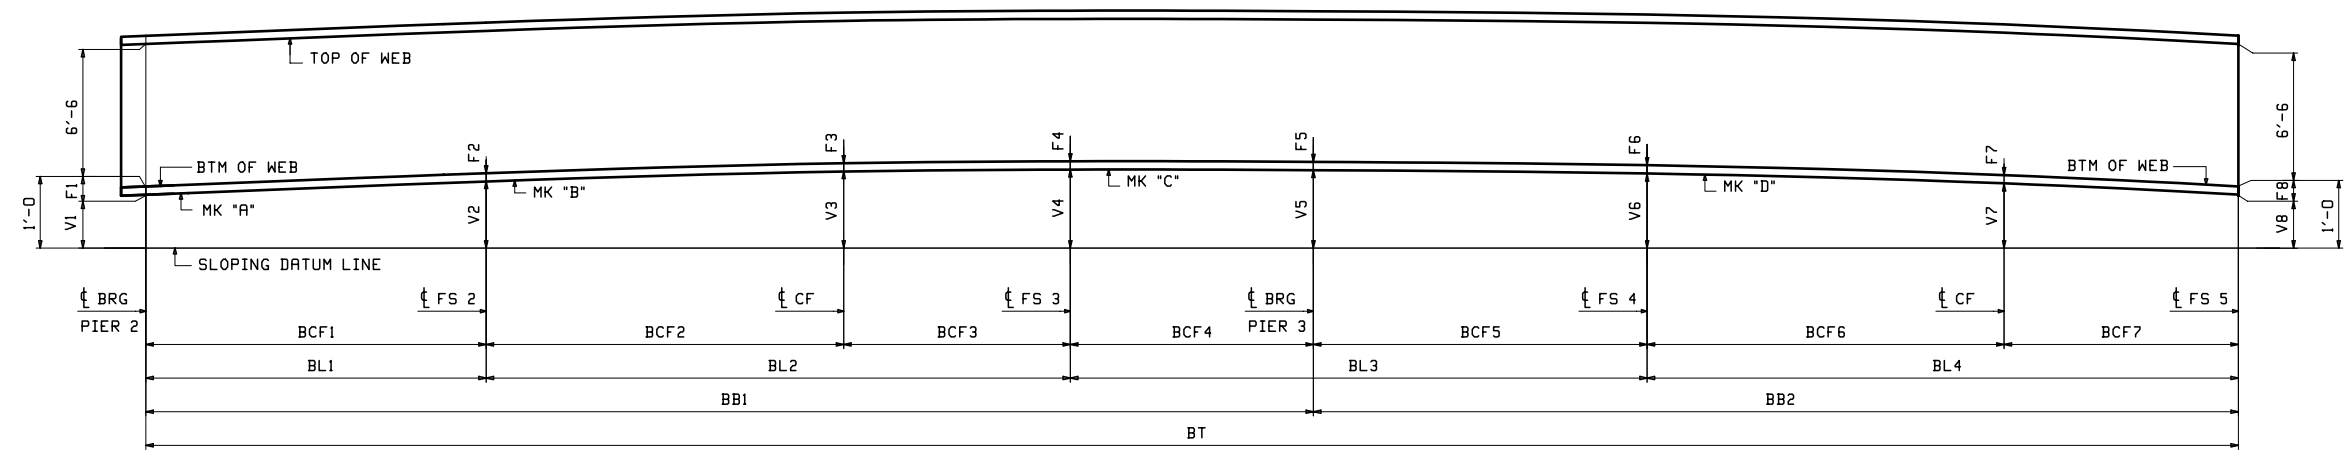


DEVELOPED SECTION A-A  
DIMENSIONS GIVEN ALONG  $\bar{C}$  WEB


LINE	MK A	MK B	MK C	MK D	BT	BL1	BL2	BL3	BL4	V1	V2	V3	V4	V5	V6	V7	V8	BB1	BB2	BCF1	BCF2	BCF3	BCF4	BCF5	BCF6	BCF7	F1	F2	F3	F4	F5	F6	F7	F8
1	201A1	205A2	209A3	213A4	290'-5 <sup>5</sup> / <sub>8</sub>	47'-5 <sup>11</sup> / <sub>16</sub>	81'-0 <sup>1</sup> / <sub>16</sub>	80'-0 <sup>5</sup> / <sub>16</sub>	81'-11 <sup>9</sup> / <sub>16</sub>	11	2'-0 <sup>5</sup> / <sub>8</sub>	2'-10 <sup>5</sup> / <sub>8</sub>	2'-10 <sup>7</sup> / <sub>8</sub>	2'-10 <sup>1</sup> / <sub>8</sub>	2'-7 <sup>11</sup> / <sub>16</sub>	1'-10 <sup>1</sup> / <sub>8</sub>	11	162'-1 <sup>7</sup> / <sub>16</sub>	128'-4 <sup>3</sup> / <sub>16</sub>	47'-5 <sup>11</sup> / <sub>16</sub>	49'-6 <sup>7</sup> / <sub>8</sub>	31'-5 <sup>3</sup> / <sub>16</sub>	33'-7 <sup>11</sup> / <sub>16</sub>	46'-4 <sup>5</sup> / <sub>8</sub>	49'-5 <sup>7</sup> / <sub>8</sub>	32'-5 <sup>11</sup> / <sub>16</sub>	1	1	1	2 <sup>1</sup> / <sub>2</sub>	2 <sup>1</sup> / <sub>2</sub>	1 <sup>3</sup> / <sub>8</sub>	1	1
2	202B1	206B2	210B3	214B4	302'-6 <sup>15</sup> / <sub>16</sub>	62'-7 <sup>1</sup> / <sub>16</sub>	75'-11 <sup>15</sup> / <sub>16</sub>	85'-0 <sup>5</sup> / <sub>16</sub>	78'-11 <sup>5</sup> / <sub>8</sub>	11	2'-7 <sup>1</sup> / <sub>4</sub>	3'-1 <sup>1</sup> / <sub>4</sub>	3'-1 <sup>3</sup> / <sub>8</sub>	3'-0 <sup>3</sup> / <sub>16</sub>	2'-8	1'-11 <sup>11</sup> / <sub>16</sub>	11	166'-0 <sup>1</sup> / <sub>2</sub>	136'-6 <sup>7</sup> / <sub>16</sub>	62'-7 <sup>1</sup> / <sub>16</sub>	36'-9 <sup>1</sup> / <sub>4</sub>	39'-2 <sup>11</sup> / <sub>16</sub>	27'-5 <sup>1</sup> / <sub>2</sub>	57'-6 <sup>13</sup> / <sub>16</sub>	40'-8 <sup>3</sup> / <sub>16</sub>	38'-3 <sup>7</sup> / <sub>16</sub>	1	1	1	2 <sup>1</sup> / <sub>8</sub>	2 <sup>1</sup> / <sub>8</sub>	1	1	1
3	203C1	207C2	211C3	215C4	307'-6 <sup>15</sup> / <sub>16</sub>	67'-7 <sup>1</sup> / <sub>16</sub>	81'-11 <sup>7</sup> / <sub>8</sub>	80'-0 <sup>5</sup> / <sub>16</sub>	77'-11 <sup>11</sup> / <sub>16</sub>	11	2'-8 <sup>3</sup> / <sub>4</sub>	3'-2	3'-1 <sup>3</sup> / <sub>16</sub>	2'-11 <sup>13</sup> / <sub>16</sub>	2'-6 <sup>13</sup> / <sub>16</sub>	1'-10 <sup>11</sup> / <sub>16</sub>	11	169'-11 <sup>9</sup> / <sub>16</sub>	137'-7 <sup>3</sup> / <sub>8</sub>	67'-7 <sup>1</sup> / <sub>16</sub>	34'-1	47'-10 <sup>7</sup> / <sub>8</sub>	20'-4 <sup>5</sup> / <sub>8</sub>	59'-7 <sup>11</sup> / <sub>16</sub>	40'-11 <sup>7</sup> / <sub>8</sub>	36'-11 <sup>13</sup> / <sub>16</sub>	1	1 <sup>3</sup> / <sub>4</sub>	1 <sup>3</sup> / <sub>4</sub>	2 <sup>1</sup> / <sub>2</sub>	2 <sup>1</sup> / <sub>2</sub>	1 <sup>1</sup> / <sub>4</sub>	1	1
4	204D1	208D2	212D3	216D4	311'-6 <sup>13</sup> / <sub>16</sub>	64'-7	79'-11 <sup>11</sup> / <sub>16</sub>	80'-0 <sup>3</sup> / <sub>8</sub>	86'-11 <sup>3</sup> / <sub>4</sub>	10 <sup>3</sup> / <sub>8</sub>	2'-8 <sup>5</sup> / <sub>8</sub>	3'-2 <sup>9</sup> / <sub>16</sub>	3'-2 <sup>1</sup> / <sub>16</sub>	2'-11 <sup>1</sup> / <sub>2</sub>	2'-6 <sup>1</sup> / <sub>4</sub>	1'-9	10 <sup>1</sup> / <sub>2</sub>	173'-10 <sup>9</sup> / <sub>16</sub>	137'-8 <sup>1</sup> / <sub>4</sub>	64'-7	39'-4 <sup>1</sup> / <sub>4</sub>	40'-6 <sup>15</sup> / <sub>16</sub>	29'-3 <sup>7</sup> / <sub>8</sub>	50'-8 <sup>1</sup> / <sub>2</sub>	52'-3 <sup>5</sup> / <sub>8</sub>	34'-8 <sup>1</sup> / <sub>8</sub>	1 <sup>5</sup> / <sub>8</sub>	2 <sup>1</sup> / <sub>2</sub>	2 <sup>1</sup> / <sub>2</sub>	2 <sup>1</sup> / <sub>2</sub>	2 <sup>1</sup> / <sub>2</sub>	2	1 <sup>1</sup> / <sub>2</sub>	1 <sup>1</sup> / <sub>2</sub>

LINE	MK A	MK B	MK C	MK D	WT	WL1	WL2	WL3	WL4	H1	H2	H3	H4	H5	H6	WB1	WB2	WCF1	WCF2	WCF3	WCF4	WCF5	WCF6	WCF7
1	201A1	205A2	209A3	213A4	281'-6 <sup>1</sup> / <sub>2</sub>	44'-4 <sup>9</sup> / <sub>16</sub>	79'-7 <sup>3</sup> / <sub>4</sub>	79'-7 <sup>3</sup> / <sub>4</sub>	77'-10 <sup>7</sup> / <sub>16</sub>	16'-8 <sup>15</sup> / <sub>16</sub>	27'-4 <sup>3</sup> / <sub>4</sub>	30'-5 <sup>1</sup> / <sub>8</sub>	30'-5 <sup>1</sup> / <sub>16</sub>	24'-11 <sup>1</sup> / <sub>16</sub>	12'-1 <sup>11</sup> / <sub>16</sub>	157'-7 <sup>13</sup> / <sub>16</sub>	123'-10 <sup>11</sup> / <sub>16</sub>	44'-4 <sup>9</sup> / <sub>16</sub>	48'-4 <sup>3</sup> / <sub>8</sub>	31'-3 <sup>3</sup> / <sub>8</sub>	33'-7 <sup>1</sup> / <sub>2</sub>	46'-0 <sup>1</sup> / <sub>4</sub>	47'-9 <sup>3</sup> / <sub>16</sub>	30'-1 <sup>1</sup> / <sub>4</sub>
2	202B1	206B2	210B3	214B4	292'-11 <sup>5</sup> / <sub>8</sub>	58'-9 <sup>1</sup> / <sub>8</sub>	75'-0 <sup>1</sup> / <sub>4</sub>	84'-5 <sup>15</sup> / <sub>16</sub>	74'-8 <sup>5</sup> / <sub>16</sub>	21'-3 <sup>9</sup> / <sub>16</sub>	28'-8 <sup>7</sup> / <sub>8</sub>	32'-4 <sup>15</sup> / <sub>16</sub>	32'-4	25'-1 <sup>3</sup> / <sub>16</sub>	14'-3 <sup>11</sup> / <sub>16</sub>	161'-2 <sup>13</sup> / <sub>16</sub>	131'-8 <sup>13</sup> / <sub>16</sub>	58'-9 <sup>1</sup> / <sub>8</sub>	35'-11 <sup>7</sup> / <sub>8</sub>	39'-0 <sup>3</sup> / <sub>8</sub>	27'-5 <sup>7</sup> / <sub>16</sub>	57'-0 <sup>1</sup> / <sub>2</sub>	39'-2 <sup>1</sup> / <sub>2</sub>	35'-5 <sup>13</sup> / <sub>16</sub>
3	203C1	207C2	211C3	215C4	297'-11 <sup>1</sup> / <sub>2</sub>	63'-7 <sup>9</sup> / <sub>16</sub>	81'-1 <sup>11</sup> / <sub>16</sub>	79'-5 <sup>5</sup> / <sub>16</sub>	73'-8 <sup>15</sup> / <sub>16</sub>	22'-5 <sup>11</sup> / <sub>16</sub>	29'-1 <sup>1</sup> / <sub>4</sub>	32'-11 <sup>1</sup> / <sub>16</sub>	32'-6 <sup>15</sup> / <sub>16</sub>	24'-10 <sup>3</sup> / <sub>16</sub>	13'-9 <sup>13</sup> / <sub>16</sub>	165'-1 <sup>3</sup> / <sub>4</sub>	132'-9 <sup>3</sup> / <sub>4</sub>	63'-7 <sup>9</sup> / <sub>16</sub>	33'-5 <sup>1</sup> / <sub>16</sub>	47'-8 <sup>5</sup> / <sub>8</sub>	20'-4 <sup>1</sup> / <sub>2</sub>	59'-0 <sup>13</sup> / <sub>16</sub>	39'-5 <sup>7</sup> / <sub>16</sub>	34'-3 <sup>1</sup> / <sub>2</sub>
4	204D1	208D2	212D3	216D4	302'-0 <sup>1</sup> / <sub>4</sub>	60'-9 <sup>5</sup> / <sub>16</sub>	79'-0 <sup>3</sup> / <sub>16</sub>	79'-7 <sup>5</sup> / <sub>16</sub>	82'-7 <sup>7</sup> / <sub>16</sub>	21'-7 <sup>1</sup> / <sub>8</sub>	29'-3 <sup>15</sup> / <sub>16</sub>	32'-10 <sup>3</sup> / <sub>8</sub>	32'-7 <sup>1</sup> / <sub>16</sub>	26'-6 <sup>3</sup> / <sub>16</sub>	12'-11 <sup>7</sup> / <sub>16</sub>	169'-1 <sup>3</sup> / <sub>16</sub>	132'-11 <sup>1</sup> / <sub>16</sub>	60'-9 <sup>5</sup> / <sub>16</sub>	38'-7 <sup>5</sup> / <sub>16</sub>	40'-4 <sup>7</sup> / <sub>8</sub>	29'-3 <sup>11</sup> / <sub>16</sub>	50'-3 <sup>5</sup> / <sub>8</sub>	50'-5 <sup>5</sup> / <sub>8</sub>	32'-1 <sup>13</sup> / <sub>16</sub>


NOTES  
FOR GENERAL NOTES SEE DWG GNI  
ALL DIMENSIONS GIVEN AT BTM OF BTM FLG  
DIMS @ FIELD SPLICES ARE TAKEN TO BTM OF THICKER FLG

5/13/19		REVISED DIMS TO BTM OF BTM FLG	DPS/
NO.	DATE	REMARKS	BY
REVISIONS			
			
STRUCTURE	RAMP P OVER IR-74 WB, IR-75 & RAMP E - UNIT 2		
LOCATION	CINCINNATI, OH (HAMILTON COUNTY) STR. 230+22.98		
PROJECT NO.	HAM-75-3.84, PID NO. 104667, BRIDGE NO. HAM-74-19085		
ENGINEER	PRIME RE GROUP		
CONTRACTOR	WALSH GROUP		
ITEM	SHOP ASSEMBLY		
SURFACE PREP.	OPEN HOLES		
PAIN			
PRELIMINARY	DRAWN	DPS 03/26/19	SHEET NO.
FOR APPROVAL	CHECKED	WJL 04/12/19	BD201
	PLANT	ORDER NO.	FP. NO.
	3	180608	

WJL - Mod. May 15, 2019 02:41:21 PM C:\users\jwalsh\appdata\local\temp\1\104667-2\BD201 - Rev1

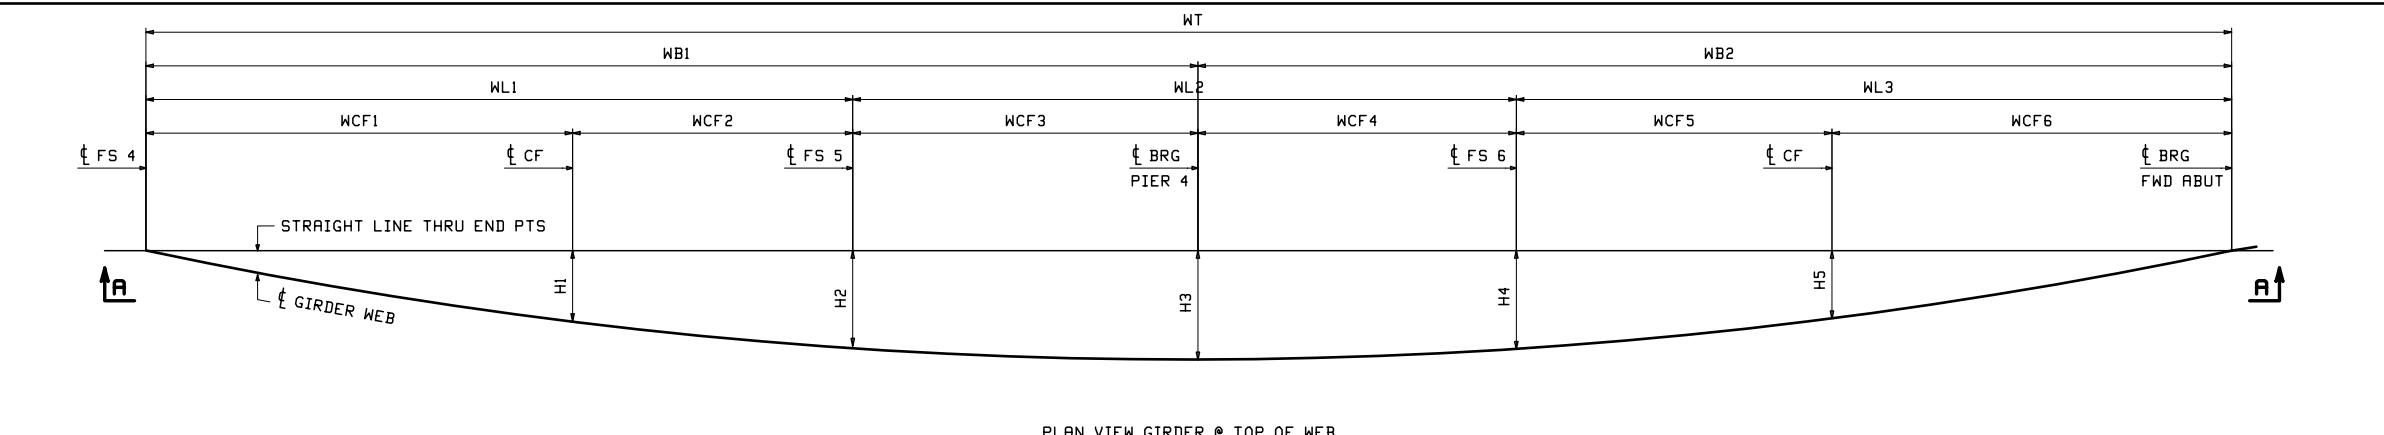

PLAN VIEW GIRDER @ TOP OF WEB

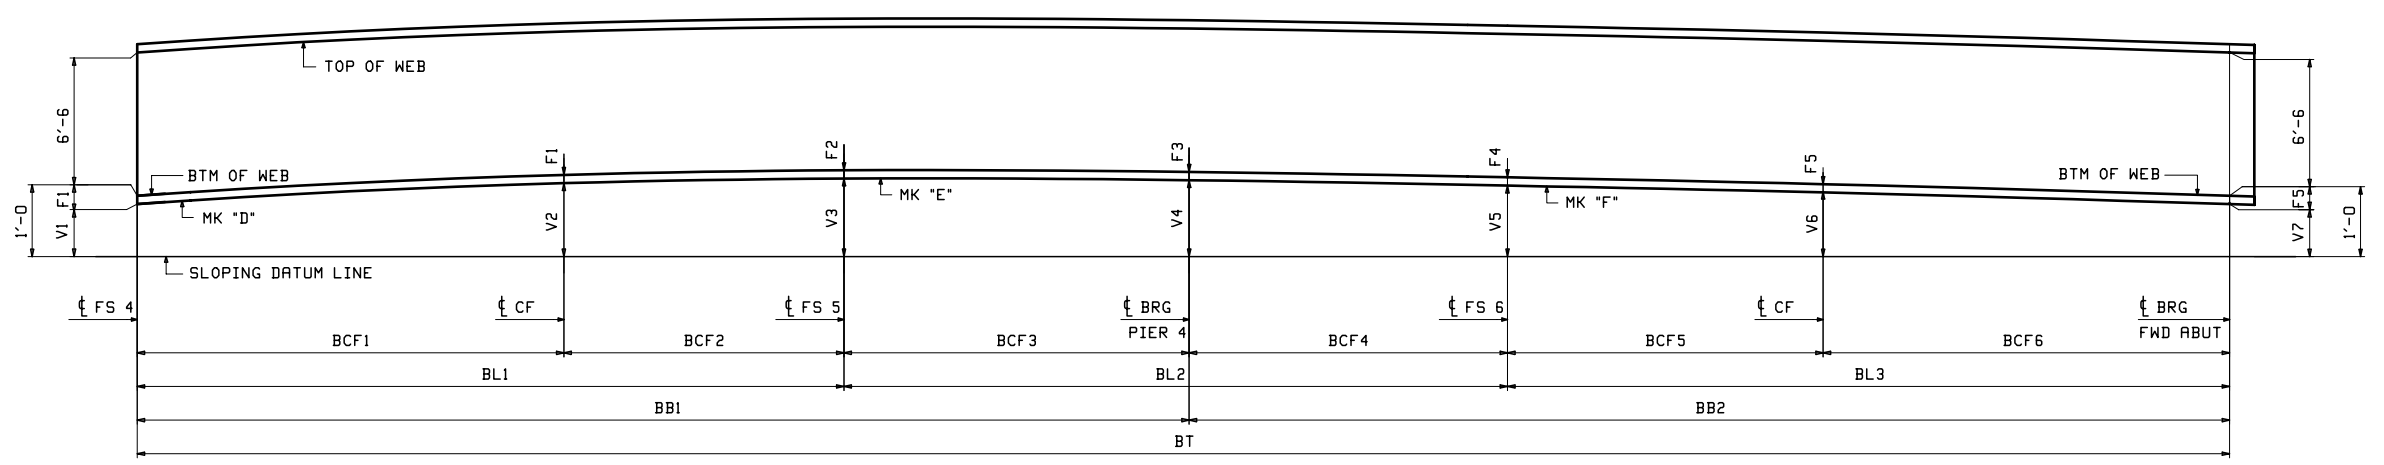

DEVELOPED SECTION A-A  
DIMENSIONS GIVEN ALONG CL WEB


LINE	D	E	F	BT	BL1	BL2	BL3	V1	V2	V3	V4	V5	V6	V7	BB1	BB2	BCF1	BCF2	BCF3	BCF4	BCF5	BCF6	F1	F2	F3	F4	F5
1	213A4	217A5	221A6	242'-3 <sup>3</sup> / <sub>8</sub>	81'-11 <sup>11</sup> / <sub>16</sub>	77'-0 <sup>7</sup> / <sub>16</sub>	83'-3 <sup>1</sup> / <sub>4</sub>	11	1'-9 <sup>15</sup> / <sub>16</sub>	2'-0 <sup>1</sup> / <sub>2</sub>	1'-10 <sup>15</sup> / <sub>16</sub>	1'-9 <sup>1</sup> / <sub>8</sub>	1'-5 <sup>9</sup> / <sub>16</sub>	11	122'-2 <sup>3</sup> / <sub>8</sub>	120'-1	49'-5 <sup>7</sup> / <sub>8</sub>	32'-5 <sup>13</sup> / <sub>16</sub>	40'-2 <sup>11</sup> / <sub>16</sub>	36'-9 <sup>3</sup> / <sub>4</sub>	36'-7 <sup>15</sup> / <sub>16</sub>	46'-7 <sup>5</sup> / <sub>16</sub>	1	1	1 <sup>7</sup> / <sub>8</sub>	1	1
2	214B4	218B5	222B6	233'-5 <sup>15</sup> / <sub>16</sub>	78'-11 <sup>13</sup> / <sub>16</sub>	75'-0 <sup>3</sup> / <sub>8</sub>	79'-5 <sup>3</sup> / <sub>4</sub>	11	1'-7 <sup>1</sup> / <sub>2</sub>	1'-10 <sup>11</sup> / <sub>16</sub>	1'-9 <sup>7</sup> / <sub>8</sub>	1'-8 <sup>3</sup> / <sub>16</sub>	1'-4 <sup>15</sup> / <sub>16</sub>	11	113'-2 <sup>5</sup> / <sub>16</sub>	120'-3 <sup>5</sup> / <sub>8</sub>	40'-8 <sup>1</sup> / <sub>4</sub>	38'-3 <sup>9</sup> / <sub>16</sub>	34'-2 <sup>1</sup> / <sub>2</sub>	40'-9 <sup>7</sup> / <sub>8</sub>	36'-5 <sup>5</sup> / <sub>8</sub>	43'-0 <sup>1</sup> / <sub>8</sub>	1	1	1 <sup>5</sup> / <sub>8</sub>	1	1
3	215C4	219C5	223C6	233'-10 <sup>1</sup> / <sub>8</sub>	77'-11 <sup>13</sup> / <sub>16</sub>	80'-0 <sup>3</sup> / <sub>8</sub>	75'-9 <sup>15</sup> / <sub>16</sub>	11	1'-7 <sup>3</sup> / <sub>16</sub>	1'-10 <sup>7</sup> / <sub>16</sub>	1'-9 <sup>1</sup> / <sub>16</sub>	1'-8 <sup>1</sup> / <sub>4</sub>	1'-4 <sup>3</sup> / <sub>4</sub>	11	113'-3 <sup>9</sup> / <sub>16</sub>	120'-6 <sup>9</sup> / <sub>16</sub>	40'-11 <sup>7</sup> / <sub>8</sub>	36'-11 <sup>15</sup> / <sub>16</sub>	35'-3 <sup>3</sup> / <sub>4</sub>	44'-8 <sup>5</sup> / <sub>8</sub>	36'-4 <sup>5</sup> / <sub>8</sub>	39'-5 <sup>5</sup> / <sub>16</sub>	1	1	2 <sup>1</sup> / <sub>2</sub>	1	1
4	216D4	220D5	224D6	245'-2 <sup>11</sup> / <sub>16</sub>	86'-11 <sup>7</sup> / <sub>8</sub>	83'-0 <sup>5</sup> / <sub>16</sub>	75'-2 <sup>1</sup> / <sub>2</sub>	10 <sup>1</sup> / <sub>2</sub>	1'-8 <sup>13</sup> / <sub>16</sub>	1'-11 <sup>9</sup> / <sub>16</sub>	1'-11	1'-8 <sup>5</sup> / <sub>8</sub>	1'-4	10	124'-4 <sup>15</sup> / <sub>16</sub>	120'-9 <sup>3</sup> / <sub>4</sub>	52'-3 <sup>5</sup> / <sub>8</sub>	34'-8 <sup>1</sup> / <sub>4</sub>	37'-5 <sup>1</sup> / <sub>16</sub>	45'-7 <sup>1</sup> / <sub>4</sub>	39'-3 <sup>11</sup> / <sub>16</sub>	35'-10 <sup>13</sup> / <sub>16</sub>	1 <sup>1</sup> / <sub>2</sub>	1 <sup>1</sup> / <sub>2</sub>	2 <sup>1</sup> / <sub>8</sub>	2	2

LINE	D	E	F	WT	WL1	WL2	WL3	H1	H2	H3	H4	H5	WB1	WB2	WCF1	WCF2	WCF3	WCF4	WCF5	WCF6
1	213A4	217A5	221A6	237'-1 <sup>1</sup> / <sub>8</sub>	79'-5 <sup>5</sup> / <sub>8</sub>	76'-10 <sup>3</sup> / <sub>8</sub>	80'-9 <sup>1</sup> / <sub>16</sub>	13'-11 <sup>5</sup> / <sub>8</sub>	19'-3 <sup>7</sup> / <sub>16</sub>	21'-6 <sup>11</sup> / <sub>16</sub>	19'-5 <sup>1</sup> / <sub>8</sub>	13'-4 <sup>1</sup> / <sub>8</sub>	119'-7 <sup>3</sup> / <sub>16</sub>	117'-5 <sup>7</sup> / <sub>8</sub>	47'-5 <sup>1</sup> / <sub>8</sub>	32'-0 <sup>1</sup> / <sub>2</sub>	40'-1 <sup>9</sup> / <sub>16</sub>	36'-8 <sup>13</sup> / <sub>16</sub>	36'-1 <sup>9</sup> / <sub>16</sub>	44'-7 <sup>1</sup> / <sub>2</sub>
2	214B4	218B5	222B6	229'-0 <sup>3</sup> / <sub>4</sub>	76'-10 <sup>1</sup> / <sub>8</sub>	74'-10 <sup>5</sup> / <sub>8</sub>	77'-4	11'-2 <sup>5</sup> / <sub>8</sub>	17'-6	19'-6 <sup>9</sup> / <sub>16</sub>	17'-6 <sup>5</sup> / <sub>8</sub>	11'-8 <sup>9</sup> / <sub>16</sub>	110'-11 <sup>3</sup> / <sub>4</sub>	118'-1	39'-1	37'-9 <sup>1</sup> / <sub>8</sub>	34'-1 <sup>5</sup> / <sub>8</sub>	40'-9	35'-11 <sup>3</sup> / <sub>4</sub>	41'-4 <sup>1</sup> / <sub>4</sub>
3	215C4	219C5	223C6	229'-7 <sup>3</sup> / <sub>8</sub>	75'-11 <sup>5</sup> / <sub>16</sub>	79'-10 <sup>5</sup> / <sub>16</sub>	73'-9 <sup>9</sup> / <sub>16</sub>	11'-0 <sup>1</sup> / <sub>2</sub>	17'-0 <sup>5</sup> / <sub>16</sub>	19'-1 <sup>13</sup> / <sub>16</sub>	16'-9 <sup>3</sup> / <sub>8</sub>	10'-8 <sup>1</sup> / <sub>2</sub>	111'-2 <sup>1</sup> / <sub>16</sub>	118'-5 <sup>1</sup> / <sub>8</sub>	39'-5 <sup>3</sup> / <sub>8</sub>	36'-5 <sup>15</sup> / <sub>16</sub>	35'-2 <sup>3</sup> / <sub>4</sub>	44'-7 <sup>9</sup> / <sub>16</sub>	35'-10 <sup>1</sup> / <sub>4</sub>	37'-11 <sup>5</sup> / <sub>16</sub>
4	216D4	220D5	224D6	240'-6 <sup>11</sup> / <sub>16</sub>	84'-8 <sup>1</sup> / <sub>2</sub>	82'-10 <sup>1</sup> / <sub>16</sub>	73'-0 <sup>1</sup> / <sub>8</sub>	13'-9 <sup>5</sup> / <sub>16</sub>	18'-10	20'-7	17'-5 <sup>3</sup> / <sub>4</sub>	10'-2 <sup>7</sup> / <sub>8</sub>	122'-0 <sup>7</sup> / <sub>8</sub>	118'-5 <sup>13</sup> / <sub>16</sub>	50'-4 <sup>7</sup> / <sub>8</sub>	34'-3 <sup>5</sup> / <sub>8</sub>	37'-4 <sup>3</sup> / <sub>8</sub>	45'-5 <sup>11</sup> / <sub>16</sub>	38'-7 <sup>5</sup> / <sub>16</sub>	34'-4 <sup>13</sup> / <sub>16</sub>


NOTES  
 FOR GENERAL NOTES SEE DWG GNI  
 ALL DIMENSIONS GIVEN AT BTM OF BTM FLG  
 DIMS @ FIELD SPLICES ARE TAKEN TO BTM  
 OF THICKER FLG

NO.	5/13/19	REVISED DIMS TO BTM OF BTM FLG	DPS/
REVISIONS		REMARKS	BY
STRUCTURE RAMP P OVER IR-74 WB, IR-75 & RAMP E - UNIT 2 LOCATION CINCINNATI, OH (HAMILTON COUNTY) STA. 230+22.98 PROJECT NO. HAM-75-3.84, PID NO. 104667, BRIDGE NO. HAM-74-1908S ENGINEER PRIME AE GROUP CONTRACTOR WALSH GROUP			
SHOP ASSEMBLY			
SURFACE PREP. OPEN HOLES			
PAIN			
PRELIMINARY	DRAWN	DPS 03/26/19	SHEET NO. PLANT ORDER NO. FP. NO.
FOR APPROVAL	CHECKED	WJL 04/12/19	BD202 3 180608


WJL\_HAM\_NW\_19\_200\_02744323\_DM\_7/20/19/1908-2/0502\_1\_Rv1

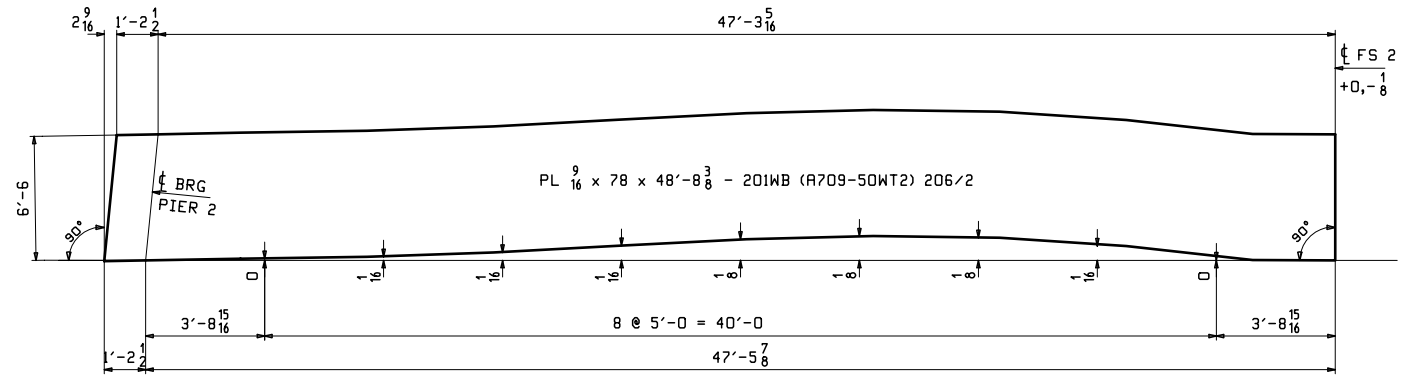

**CAMBER DIAGRAM FOR 201A1**

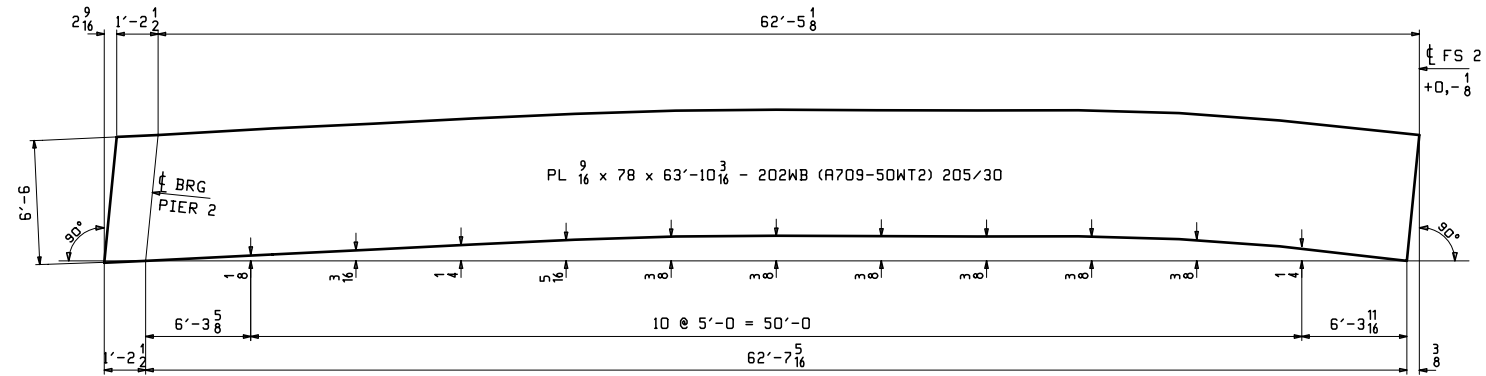

**CAMBER DIAGRAM FOR 202B1**

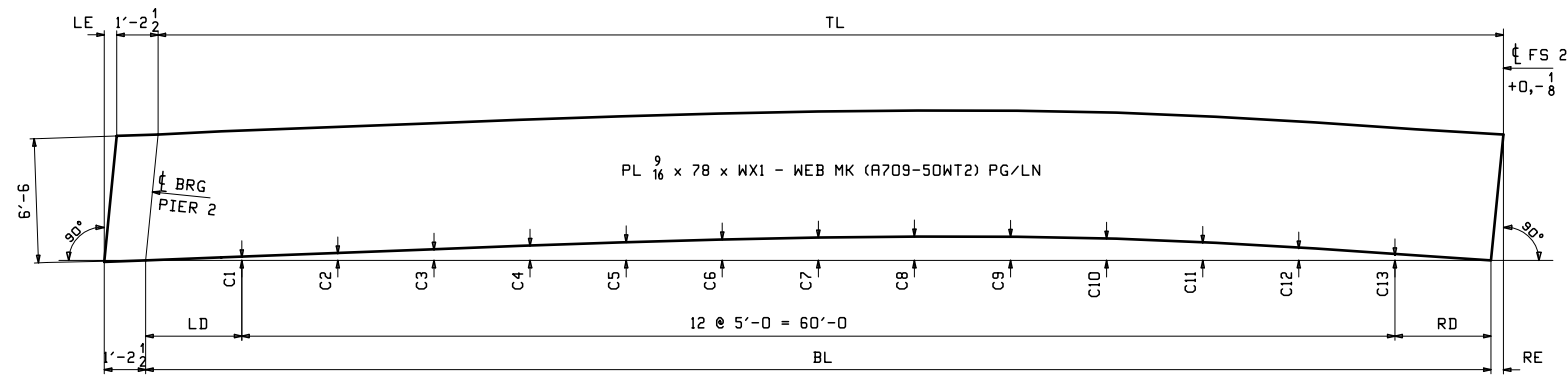


**CAMBER DIAGRAM FOR 203C1,204D1**

MARK	TL	BL	LE	RE	WX1	LD	RD	C1	C2	C3	C4	C5	C6	C7	C8	C9	C10	C11	C12	C13	WEB MK	PG/LINE
203C1	$67'-5\frac{1}{2}$	$67'-7\frac{3}{8}$	$2\frac{7}{16}$	$\frac{9}{16}$	$68'-10\frac{7}{16}$	$3'-9\frac{11}{16}$	$3'-9\frac{11}{16}$	$\frac{3}{16}$	$\frac{3}{8}$	$\frac{9}{16}$	$\frac{3}{4}$	$\frac{15}{16}$	$\frac{1}{16}$	$\frac{3}{16}$	$\frac{1}{4}$	$\frac{3}{16}$	$\frac{1}{8}$	$\frac{7}{8}$	$\frac{5}{8}$	$\frac{1}{4}$	203WB	205/14
204D1	$64'-5\frac{5}{8}$	$64'-7\frac{5}{16}$	$2\frac{5}{16}$	$\frac{5}{8}$	$65'-10\frac{7}{16}$	$2'-3\frac{11}{16}$	$2'-3\frac{5}{8}$	$\frac{1}{8}$	$\frac{3}{8}$	$\frac{5}{8}$	$\frac{13}{16}$	1	$\frac{1}{8}$	$\frac{3}{16}$	$\frac{1}{4}$	$\frac{1}{4}$	$\frac{3}{16}$	$\frac{15}{16}$	$\frac{9}{16}$	$\frac{3}{16}$	204WB	205/16

- NOTES:  
 1. FOR GENERAL NOTES SEE DRAWING GNI.  
 2. T2 DENOTES MATERIAL SUBJECT TO CHARPY V-NOTCH TEST AT H FREQ. FOR ZONE 2


NO.	DATE	REMARKS	BY
REVISIONS			
STRUCTURE: RAMP P OVER IR-74 WB, IR-75 & RAMP E - UNIT 2 LOCATION: CINCINNATI, OH (HAMILTON COUNTY) STA. 230+22.98 PROJECT NO.: HAM-75-3.84, PID NO. 104667, BRIDGE NO. HAM-74-19085 ENGINEER: PRIME RE GROUP CONTRACTOR: WALSH GROUP			
WEB & FLANGE CUTTING			
ITEM: _____			
SURFACE PREP: _____ OPEN HOLES _____			
PAINT: _____			
PRELIMINARY	DRAWN ELG 02/22/19	SHEET NO. B6201	PLANT ORDER NO. 3 180608
FOR APPROVAL	CHECKED WJL 04/10/19		FP. NO. 20

ECD: P1, Rev. 18, 2018 09/25/18 DWG: 180608-2-00001 Rev. 0

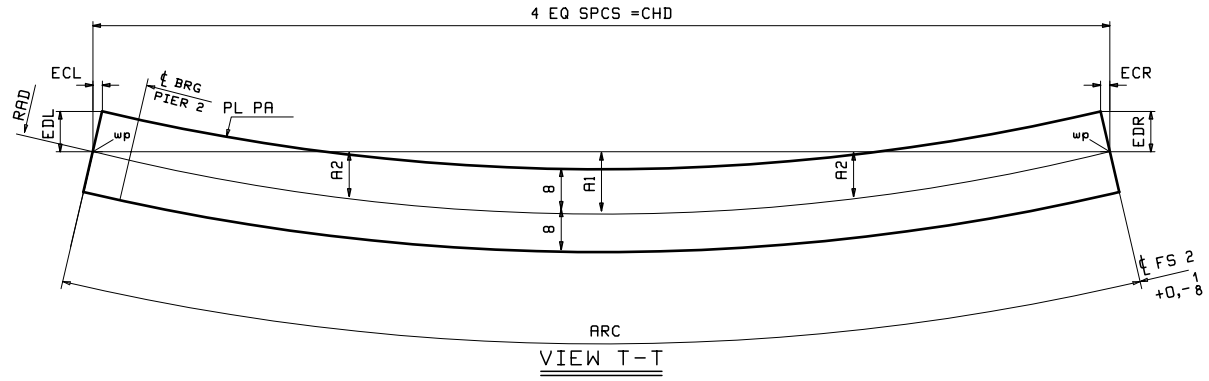


VIEW T-T  
SECTION B-B


LOCATION	RAD	ARC	CHD	R1	R2	ECL	ECR	EDL	EDR	PL PA (A709-50WT2)
201A1 TOP FLG	336.56	48'-5 <sup>13</sup> / <sub>16</sub>	48'-5 <sup>5</sup> / <sub>16</sub>	10 <sup>7</sup> / <sub>16</sub>	7 <sup>13</sup> / <sub>16</sub>	9 <sup>9</sup> / <sub>16</sub>	9 <sup>9</sup> / <sub>16</sub>	8	8	PL 1 x 16-201TF (204/8)
201A1 BTM FLG	336.56	48'-8 <sup>3</sup> / <sub>8</sub>	48'-7 <sup>7</sup> / <sub>8</sub>	10 <sup>9</sup> / <sub>16</sub>	7 <sup>15</sup> / <sub>16</sub>	9 <sup>9</sup> / <sub>16</sub>	9 <sup>9</sup> / <sub>16</sub>	8	8	PL 1 x 16-201BF (204/6)
202B1 TOP FLG	344.89	63'-7 <sup>5</sup> / <sub>8</sub>	63'-6 <sup>9</sup> / <sub>16</sub>	1'-5 <sup>9</sup> / <sub>16</sub>	1'-1 <sup>3</sup> / <sub>16</sub>	3 <sup>3</sup> / <sub>4</sub>	3 <sup>3</sup> / <sub>4</sub>	7 <sup>15</sup> / <sub>16</sub>	7 <sup>15</sup> / <sub>16</sub>	PL 1 x 16-202TF (204/2)
202B1 BTM FLG	344.89	63'-9 <sup>13</sup> / <sub>16</sub>	63'-8 <sup>3</sup> / <sub>4</sub>	1'-5 <sup>11</sup> / <sub>16</sub>	1'-1 <sup>1</sup> / <sub>4</sub>	3 <sup>3</sup> / <sub>4</sub>	3 <sup>3</sup> / <sub>4</sub>	7 <sup>15</sup> / <sub>16</sub>	7 <sup>15</sup> / <sub>16</sub>	PL 1 x 16-202BF (204/2)

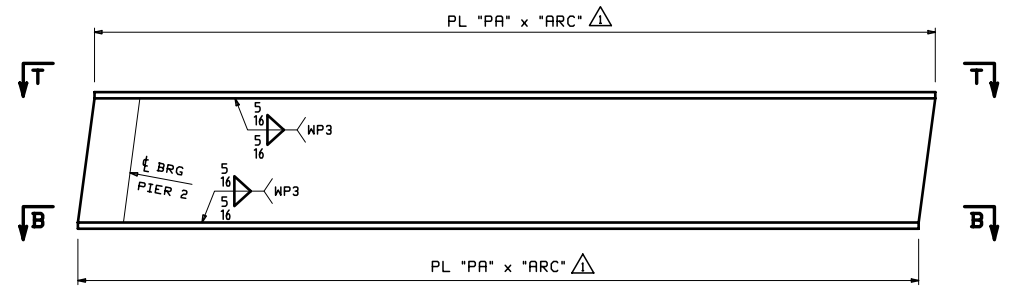


FLANGE DIAGRAM FOR 201A1 & 202B1

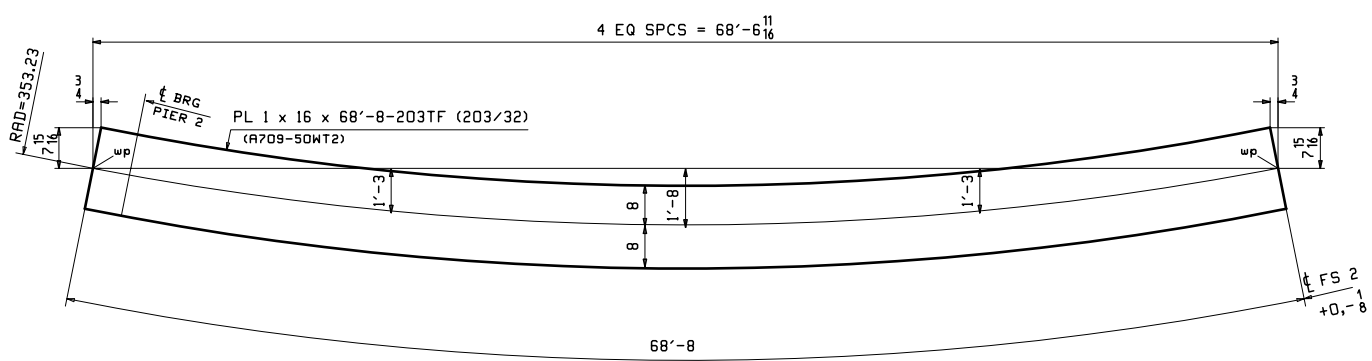

VIEW T-T FOR 203C1 TOP FLG

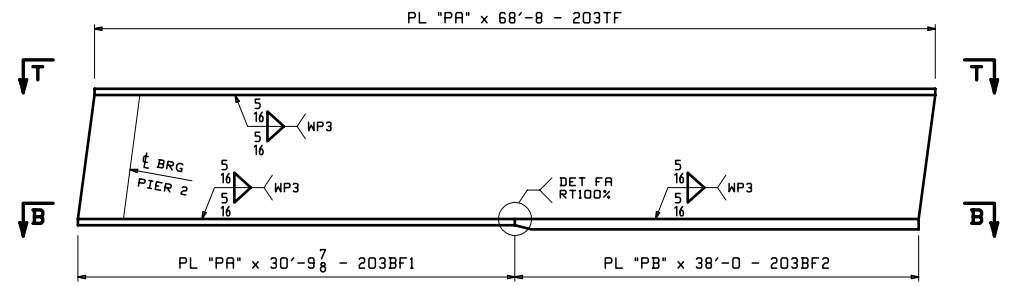

FLANGE DIAGRAM FOR 203C1

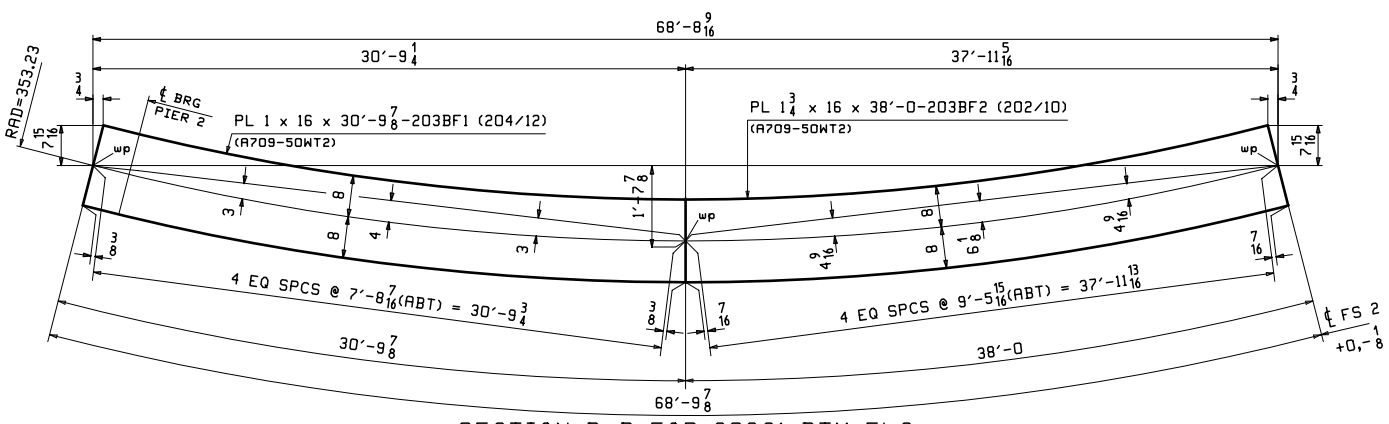


SECTION B-B FOR 203C1 BTM FLG

- NOTES:  
 1. FOR GENERAL NOTES SEE DRAWING GNI.  
 2. T2 DENOTES MATERIAL SUBJECT TO CHARPY V-NOTCH TEST AT H FREQ. FOR ZONE 2  
 3. FOR WELD DETAIL 'FA', SEE GNI.


NO.	DATE	REVISIONS	BY
△	05/06/19	APPROVAL COMMENTS	ELG/WJL
REVISIONS			
STRUCTURE: RAMP P OVER IR-74 WB, IR-75 & RAMP E - UNIT 2 LOCATION: CINCINNATI, OH (HAMILTON COUNTY) STA. 230+22.98 PROJECT NO.: HAM-75-3.84, PID NO. 104667, BRIDGE NO. HAM-74-19085 ENGINEER: PRIME AE GROUP CONTRACTOR: WALSH GROUP			
WEB & FLANGE CUTTING			
ITEM			
SURFACE PREP.	OPEN HOLES		
PAIN			
PRELIMINARY	DRAWN	ELG 02/22/19	SHEET NO. PLANT ORDER NO. FP. NO.
FOR APPROVAL	CHECKED	WJL 04/10/19	BG202 3 180608 20



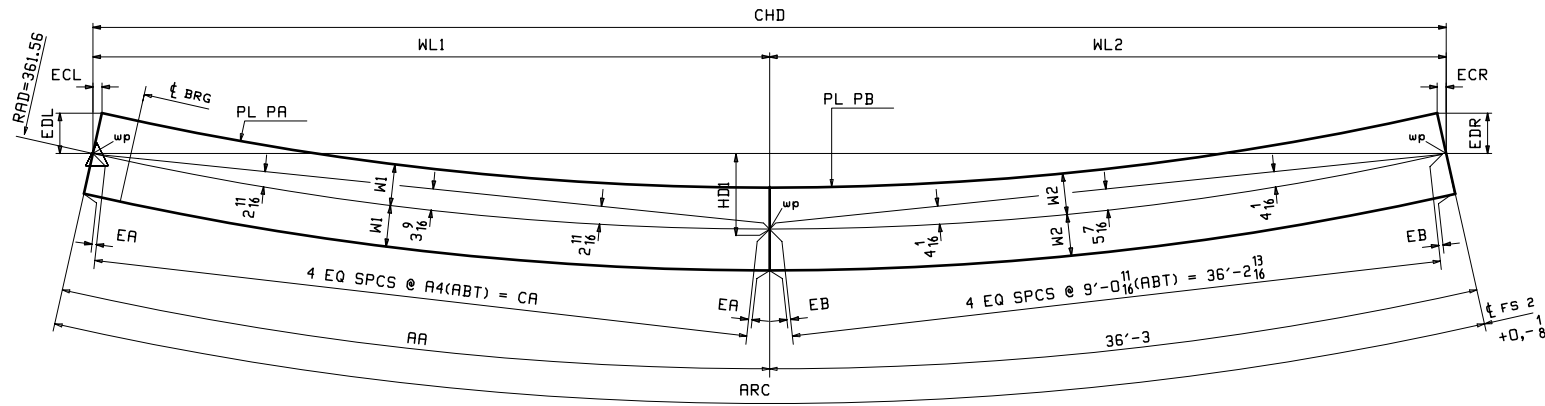


VIEW T-T  
SECTION B-B

LOCATION	ARC	CHD	AA	EA	A4	CA	EB	ECL	ECR	EDL	EDR	WL1	WL2	HDI	WI	W2	PL PA (A709-50WT2)	PL PB (A709-50WT2)
204D1 TOP FLG	65'-0 1/8	65'-7 1/16	29'-5 1/8	3/8	7'-4 1/4	29'-5	7/16	13/16	13/16	8 15/16	8 15/16	29'-4 5/8	36'-2 7/16	1'-5 5/8	9	9	PL 1 1/8 x 18-204TF1 (203/4)	PL 2 x 18-204TF2 (201/28)
204D1 BTM FLG	65'-9 13/16	65'-8 3/4	29'-6 13/16	9/16	7'-4 11/16	29'-6 11/16	1 1/4	1 1/4	1'-1 15/16	1'-1 15/16	1'-1 15/16	29'-6 1/4	36'-2 1/2	1'-5 3/4	1'-2	1'-2	PL 1 5/8 x 28-204BF1 (202/14)	PL 2 1/2 x 28-204BF2 (201/6)

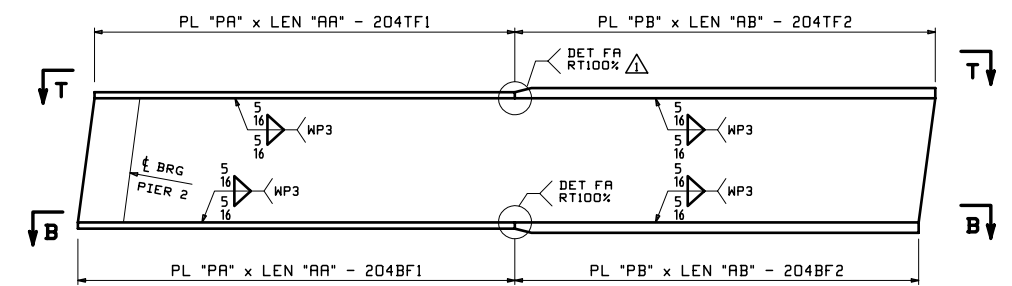


FLANGE DIAGRAM FOR 204D1

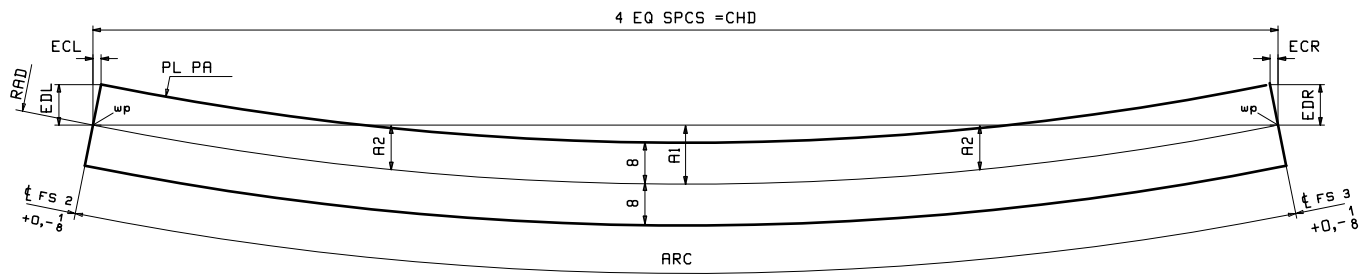


VIEW T-T  
SECTION B-B

LOCATION	RAD	ARC	CHD	AA	A1	A2	ECL	ECR	EDL	EDR	PL PA (A709-50WT2)
205A2 TOP FLG	336.56	81'-1 7/8	80'-11 1/2	81'-1 7/8	2'-5 5/16	1'-10	15/16	15/16	7 15/16	7 15/16	PL 1 x 16-205TF (203/18)
205A2 BTM FLG	336.56	81'-0 1/8	80'-9 13/16	81'-0 1/8	2'-5 3/16	1'-9 15/16	15/16	15/16	7 15/16	7 15/16	PL 1 x 16-205BF (203/20)
206B2 TOP FLG	344.89	76'-1 3/4	75'-11 7/8	76'-1 3/4	2'-1 3/16	1'-6 7/8	7/8	7/8	7 15/16	7 15/16	PL 1 x 16-206TF (203/30)
206B2 BTM FLG	344.89	76'-0	75'-10 3/16	76'-0	2'-1 1/16	1'-6 13/16	7/8	7/8	7 15/16	7 15/16	PL 1 x 16-206BF (203/30)

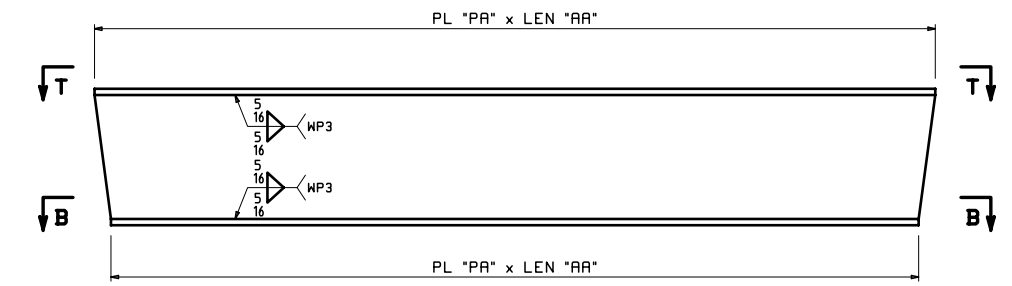

FLANGE DIAGRAM FOR 205A2 & 206B2

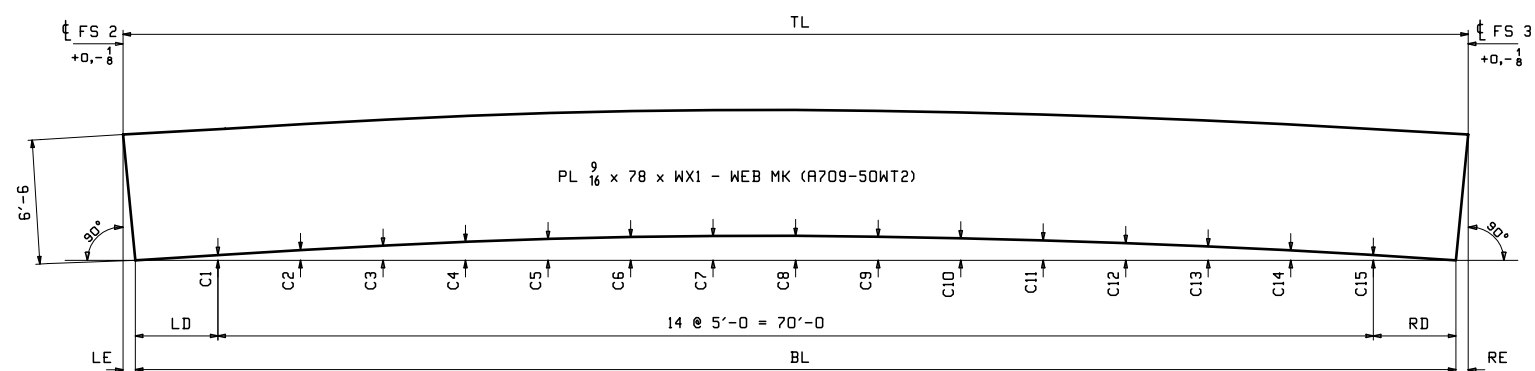


CAMBER DIAGRAM FOR 205A2, 206B2, 207C2, 208D2

MARK	TL	BL	LE	RE	WX1	LD	RD	C1	C2	C3	C4	C5	C6	C7	C8	C9	C10	C11	C12	C13	C14	C15	WEB MK	PG/LINE
205A2	81'-1 7/8	81'-0 1/8	7/8	7/8	81'-1 7/8	5'-6 1/16	5'-6 1/16	11/16	1 1/4	1 13/16	2 1/4	2 5/8	2 13/16	2 15/16	2 15/16	2 7/8	2 11/16	2 7/16	2 1/8	1 3/4	1 1/4	11/16	205WB	204/30
206B2	76'-1 3/4	76'-0	1	3/4	76'-1 3/4	3'-0	3'-0	3/8	1	1 1/2	1 1/16	2 1/16	2 1/16	2 7/16	2 2	2 7/16	2 4	2	1 1/16	1 1/16	7/8	5/16	206WB	205/4
207C2	82'-1 13/16	81'-11 7/8	1 1/8	13/16	82'-1 13/16	5'-11 15/16	5'-11 15/16	15/16	9/16	2 1/8	2 1/2	2 13/16	3	3 1/16	3	2 15/16	2 11/16	2 7/16	2 1/16	1 1/16	1 3/16	11/16	207WB	204/26
208D2	80'-1 7/8	79'-11 3/4	3/16	15/16	80'-1 7/8	4'-11 7/8	4'-11 7/8	13/16	9/16	2 3/16	2 5/8	3	3 3/16	3 1/4	3 3/16	3 1/16	2 7/8	2 5/8	2 1/4	1 13/16	1 1/4	11/16	208WB	204/28

- NOTES:  
 1. FOR GENERAL NOTES SEE DRAWING GNI.  
 2. T2 DENOTES MATERIAL SUBJECT TO CHARPY V-NOTCH TEST AT H FREQ. FOR ZONE 2  
 3. FOR WELD DETAIL "FA", SEE GNI.


NO.	05/06/19	APPROVAL COMMENTS	ELG
REVISIONS	DATE	REMARKS	BY
STRUCTURE: RAMP P OVER IR-74 WB, IR-75 & RAMP E - UNIT 2 LOCATION: CINCINNATI, OH (HAMILTON COUNTY) STA. 230+22.98 PROJECT NO.: HAM-75-3.84, PID NO. 104667, BRIDGE NO. HAM-74-19085 ENGINEER: PRIME RE GROUP CONTRACTOR: WALSH GROUP			
WEB & FLANGE CUTTING			
ITEM: _____			
SURFACE PREP: _____ OPEN HOLES _____			
PAINT: _____			
PRELIMINARY	DRAWN ELG 02/22/19	SHEET NO.	PLANT ORDER NO.
FOR APPROVAL	CHECKED WJL 04/10/19	BG203	3 180608 20

1.000 - Rev. 11. 2018 02/22/19 08:00 AM - 1.000 - Rev. 11. 2018 02/22/19 08:00 AM - 1.000 - Rev. 11. 2018 02/22/19 08:00 AM

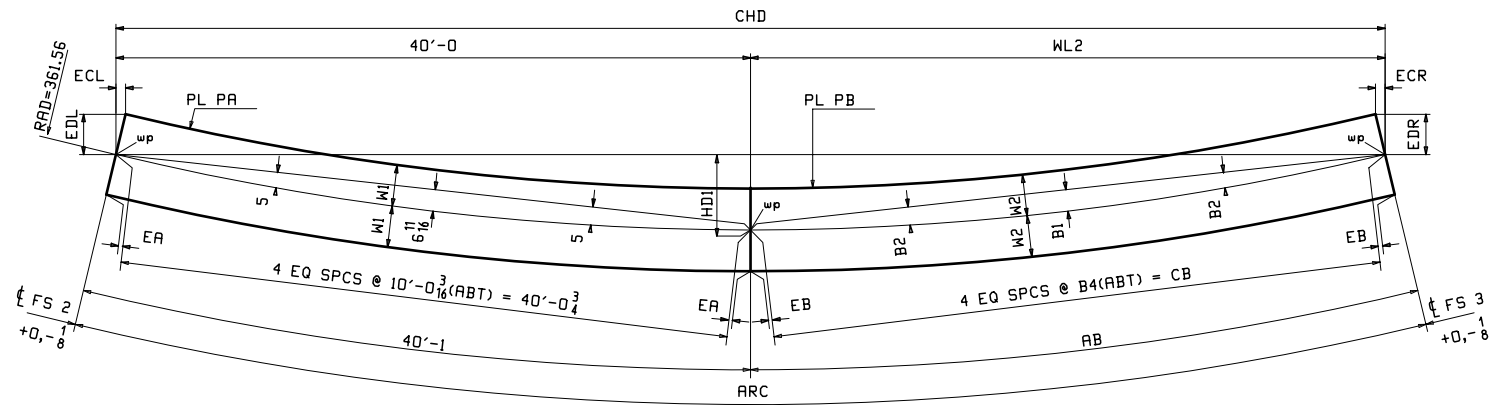


VIEW T-T  
SECTION B-B


LOCATION	ARC	CHD	AB	EA	EB	B1	B2	B4	CB	ECL	ECR	EDL	EDR	WL2	HDI	WI	W2	PL PA (A709-50WT2)	PL PB (A709-50WT2)
208D2 TOP FLG	80'-1 <sup>7</sup> / <sub>8</sub>	79'-11 <sup>15</sup> / <sub>16</sub>	40'-0 <sup>7</sup> / <sub>8</sub>	1 <sup>2</sup> / <sub>2</sub>	1 <sup>2</sup> / <sub>2</sub>	6 <sup>11</sup> / <sub>16</sub>	5	10'-0 <sup>3</sup> / <sub>16</sub>	40'-0 <sup>5</sup> / <sub>8</sub>	1	1	8 <sup>15</sup> / <sub>16</sub>	8 <sup>15</sup> / <sub>16</sub>	39'-11 <sup>15</sup> / <sub>16</sub>	2'-2 <sup>5</sup> / <sub>8</sub>	9	9	PL 2 x 18-208TF1 (201/26)	PL 1 <sup>3</sup> / <sub>8</sub> x 18-208TF2 (202/24)
208D2 BTM FLG	79'-11 <sup>3</sup> / <sub>4</sub>	79'-9 <sup>13</sup> / <sub>16</sub>	39'-10 <sup>3</sup> / <sub>4</sub>	3 <sup>3</sup> / <sub>4</sub>	3 <sup>3</sup> / <sub>4</sub>	6 <sup>5</sup> / <sub>8</sub>	4 <sup>15</sup> / <sub>16</sub>	9'-11 <sup>5</sup> / <sub>8</sub>	39'-10 <sup>1</sup> / <sub>2</sub>	1 <sup>9</sup> / <sub>16</sub>	1 <sup>9</sup> / <sub>16</sub>	1'-1 <sup>15</sup> / <sub>16</sub>	1'-1 <sup>15</sup> / <sub>16</sub>	39'-9 <sup>13</sup> / <sub>16</sub>	2'-2 <sup>1</sup> / <sub>2</sub>	1'-2	1'-2	PL 2 <sup>1</sup> / <sub>2</sub> x 28-208BF1 (201/4)	PL 1 <sup>3</sup> / <sub>4</sub> x 28-208BF2 (202/6)

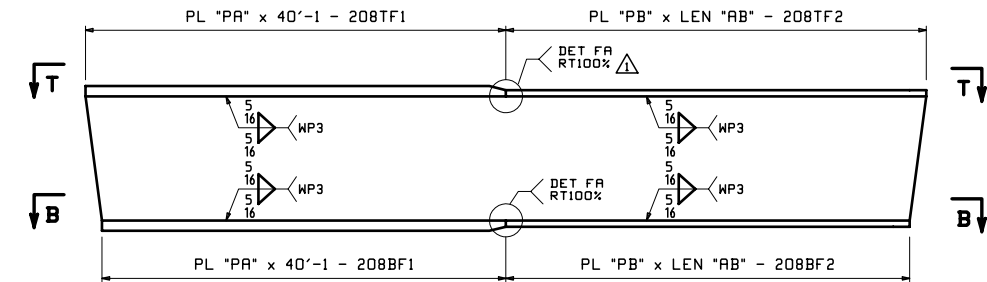


FLANGE DIAGRAM FOR 208D2

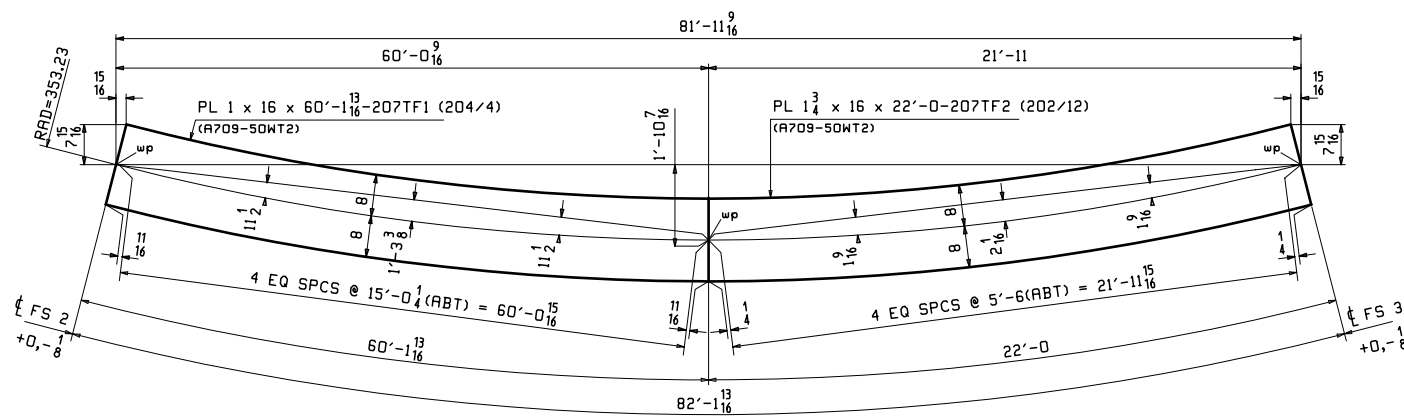

VIEW T-T FOR 207C2 TOP FLG

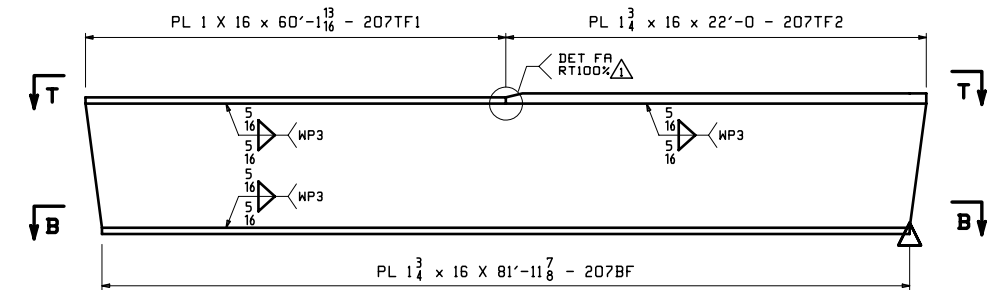


FLANGE DIAGRAM FOR 207C2

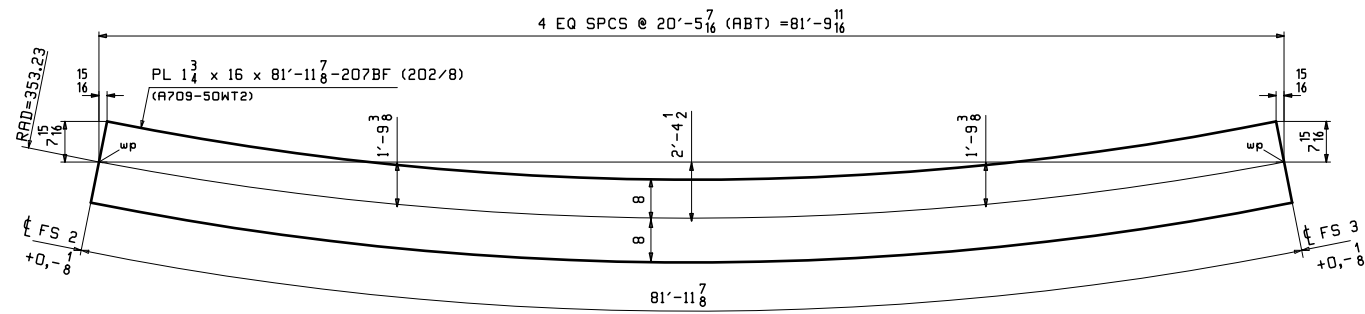


SECTION B-B FOR 207C2 BTM FLG

- NOTES:  
 1. FOR GENERAL NOTES SEE DRAWING GNI.  
 2. T2 DENOTES MATERIAL SUBJECT TO CHARPY V-NOTCH TEST AT H FREQ. FOR ZONE 2  
 3. FOR WELD DETAIL 'FA', SEE GNI.


NO.	DATE	APPROVAL COMMENTS	ELG
	05/06/19		WJL
REVISIONS			
STRUCTURE: RAMP P OVER IR-74 WB, IR-75 & RAMP E - UNIT 2 LOCATION: CINCINNATI, OH (HAMILTON COUNTY) STA. 230+22.98 PROJECT NO.: HAM-75-3.84, PID NO. 104667, BRIDGE NO. HAM-74-19085 ENGINEER: PRIME AE GROUP CONTRACTOR: WALSH GROUP			
ITEM: WEB & FLANGE CUTTING			
SURFACE PREP: OPEN HOLES			
PAINT:			
PRELIMINARY	DRAWN	ELG 02/22/19	SHEET NO.
FOR APPROVAL	CHECKED	WJL 04/10/19	BG204
PLANT	ORDER NO.	FP. NO.	
3	180608	20	

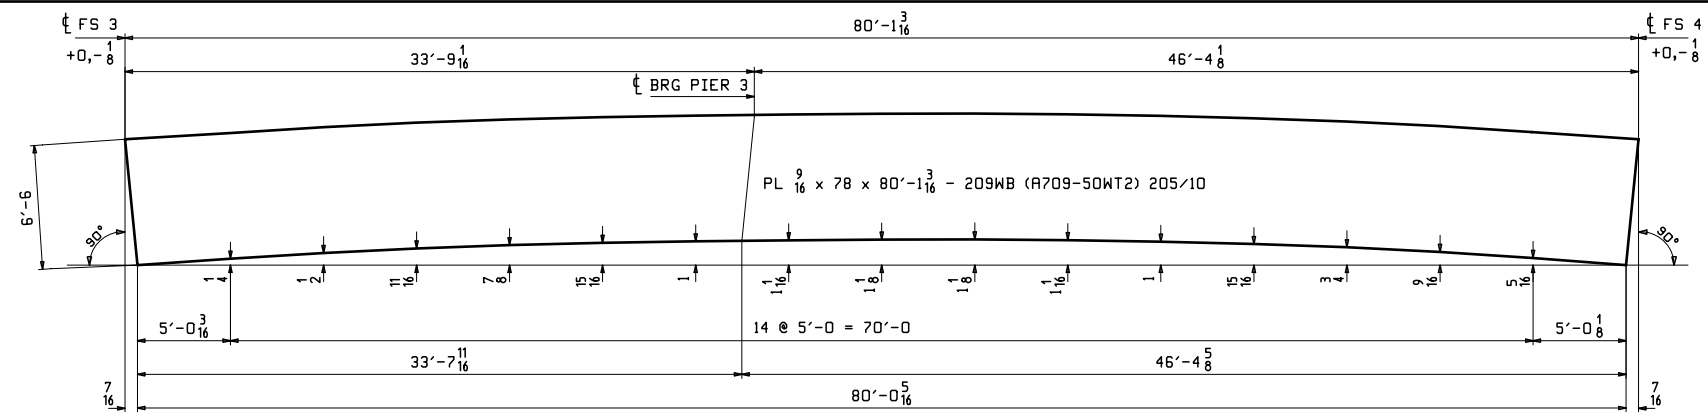


CAMBER DIAGRAM FOR 209A3

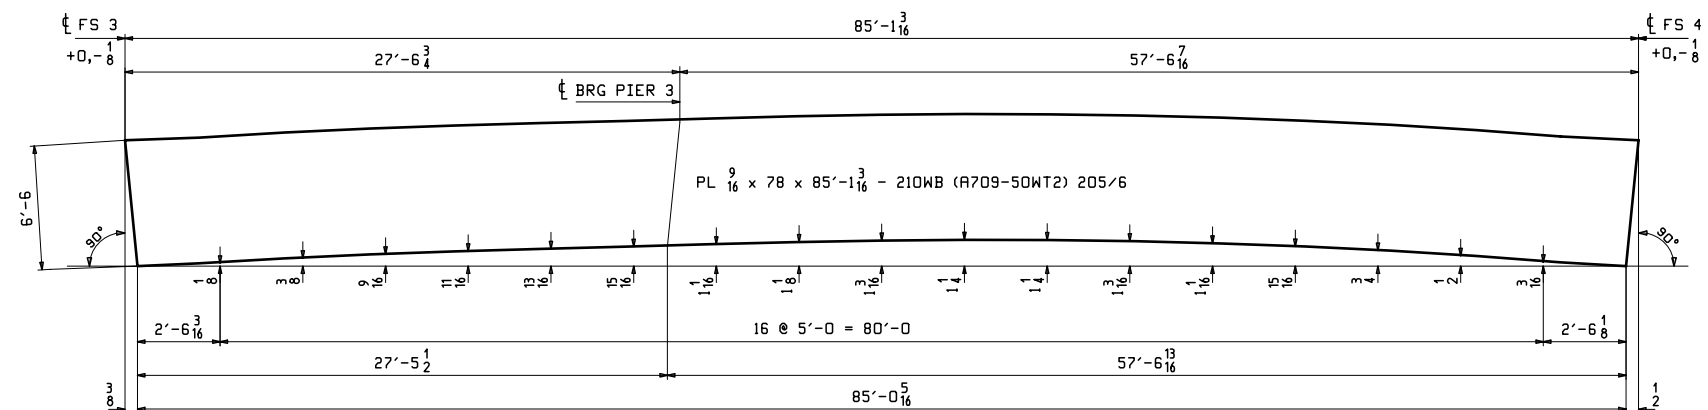

CAMBER DIAGRAM FOR 210B3

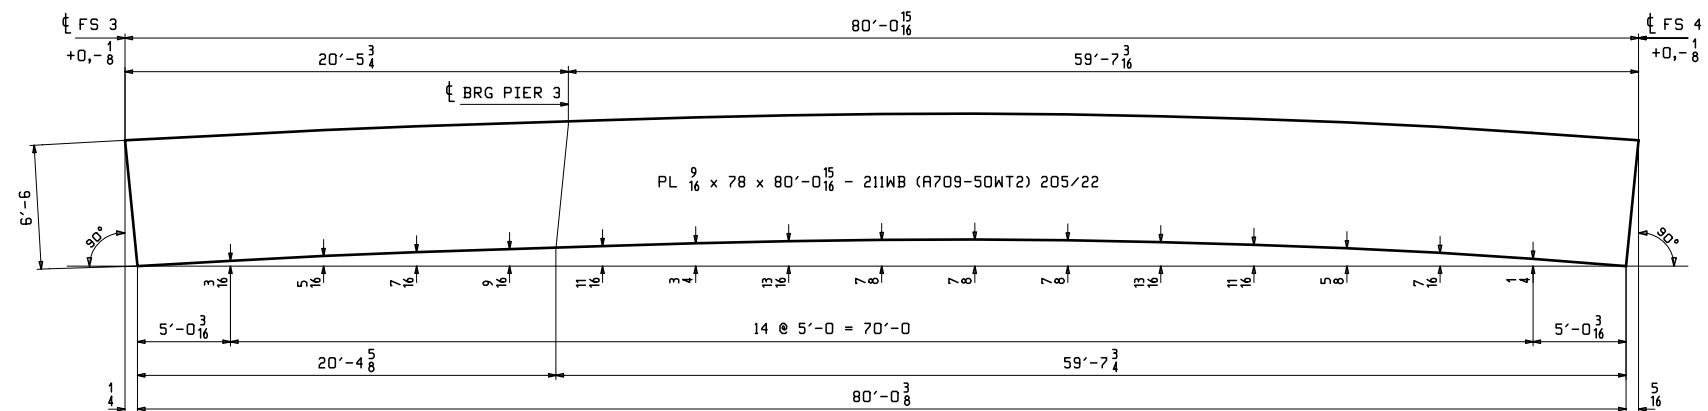

CAMBER DIAGRAM FOR 211C3


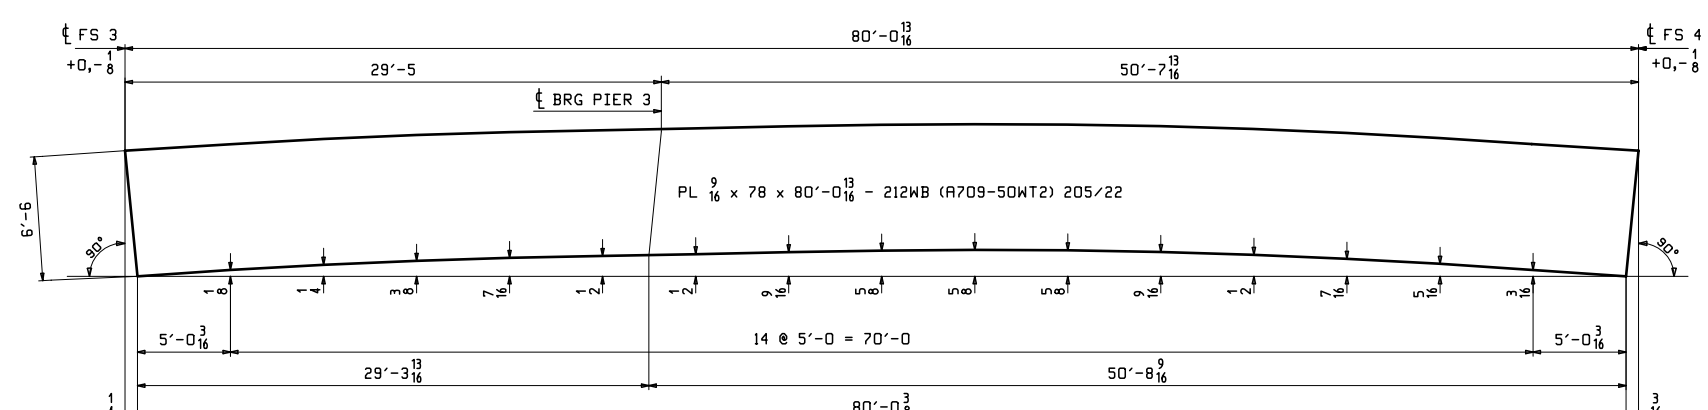


CAMBER DIAGRAM FOR 212D3

- NOTES:  
 1. FOR GENERAL NOTES SEE DRAWING GNI.  
 2. T2 DENOTES MATERIAL SUBJECT TO CHARPY V-NOTCH TEST AT H FREQ. FOR ZONE 2


NO.	DATE	REMARKS	BY
REVISIONS			
STRUCTURE RAMP P OVER IR-74 WB, IR-75 & RAMP E - UNIT 2			
LOCATION CINCINNATI, OH (HAMILTON COUNTY) STA. 230+22.98			
PROJECT NO. HAM-75-3.84, PID NO. 104667, BRIDGE NO. HAM-74-1908S			
ENGINEER PRIME RE GROUP			
CONTRACTOR WALSH GROUP			
WEB CUTTING DIAGRAMS			
ITEM _____			
SURFACE PREP. _____ OPEN HOLES _____			
PAINT _____			
PRELIMINARY _____	DRAWN ELG 02/22/19	SHEET NO. _____	PLANT ORDER NO. _____
FOR APPROVAL _____	CHECKED WJL 04/10/19	BG205	3 180608 20

C:\p1\p1\_18\_2018\_08\5503.dwg 7/22/2018 10:52:23 AM 20180822 10:52:23 AM

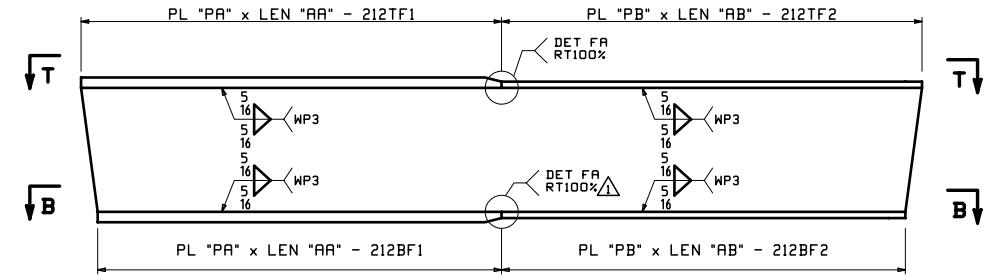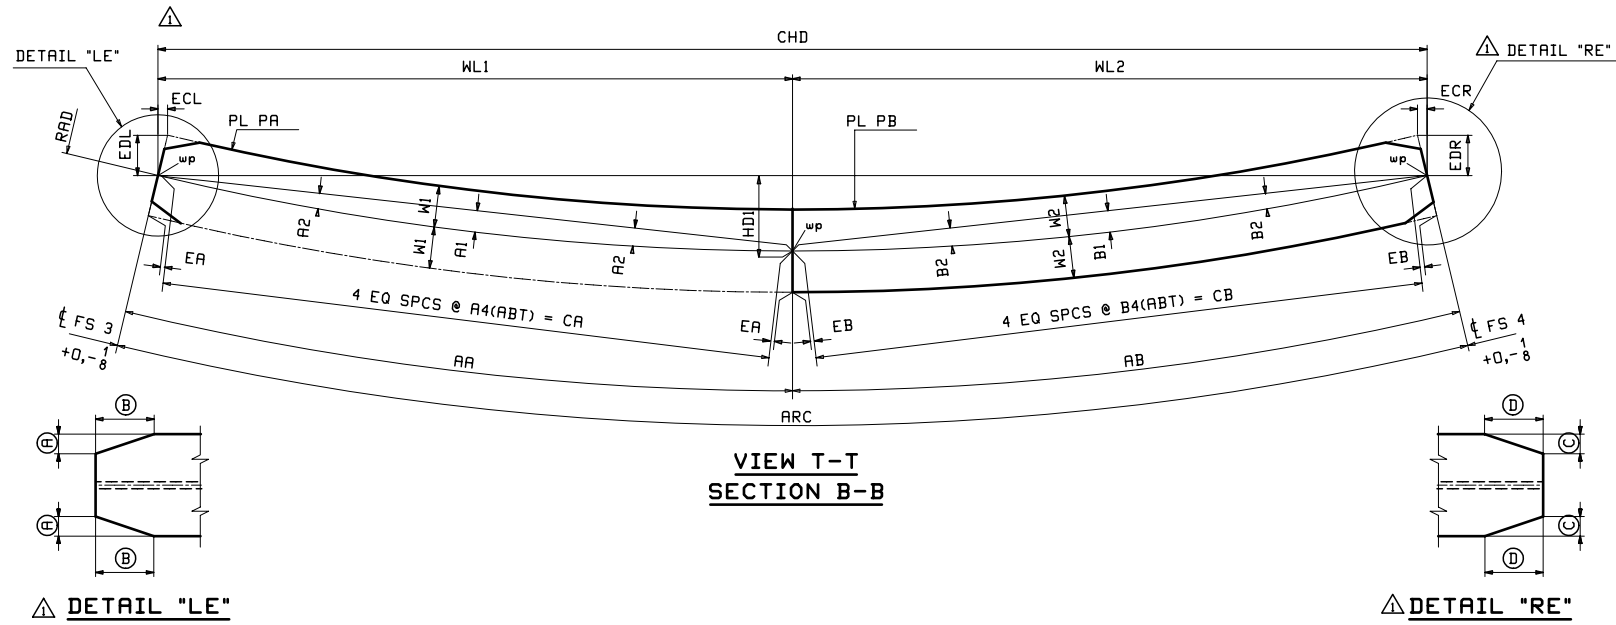

FLANGE DIAGRAM FOR 209A3, 210B3, 211C3, 212D3

LOCATION	RAD	ARC	CHD	AA	AB	EA	A1	A2	A4	CA	EB	B1	B2	B4	CB	ECL	ECR	EDL	EDR	WL1	WL2	HDI	W1	W2	(A)	(B)	(C)	(D)	PL PA (A709-50WT2)	PL PB (A709-50WT2)
209A3 TOP FLG	336.56	80'-1 <sup>3</sup> / <sub>16</sub>	79'-10 <sup>15</sup> / <sub>16</sub>	54'-1 <sup>9</sup> / <sub>16</sub>	25'-11 <sup>5</sup> / <sub>8</sub>	5/8	1'-1 <sup>1</sup> / <sub>16</sub>	9 <sup>13</sup> / <sub>16</sub>	13'-6 <sup>3</sup> / <sub>16</sub>	54'-0 <sup>7</sup> / <sub>8</sub>	5/8	3	2 <sup>1</sup> / <sub>4</sub>	6'-5 <sup>7</sup> / <sub>8</sub>	25'-11 <sup>9</sup> / <sub>16</sub>	1 <sup>15</sup> / <sub>16</sub>	1 <sup>15</sup> / <sub>16</sub>	7 <sup>15</sup> / <sub>16</sub>	7 <sup>15</sup> / <sub>16</sub>	54'-0 <sup>3</sup> / <sub>8</sub>	25'-10 <sup>9</sup> / <sub>16</sub>	2'-1	8	8	0	0	0	0	PL 2 <sup>1</sup> / <sub>4</sub> x 16-209TF1 (201/14)	PL 1 x 16-209TF2 (204/14)
209A3 BTM FLG	336.56	80'-0 <sup>5</sup> / <sub>16</sub>	79'-10 <sup>1</sup> / <sub>16</sub>	54'-0 <sup>1</sup> / <sub>16</sub>	26'-0 <sup>3</sup> / <sub>16</sub>	3/4	1'-1	9 <sup>3</sup> / <sub>4</sub>	13'-5 <sup>7</sup> / <sub>8</sub>	53'-11 <sup>7</sup> / <sub>16</sub>	3/8	3	2 <sup>1</sup> / <sub>4</sub>	6'-6	26'-0 <sup>1</sup> / <sub>8</sub>	1 <sup>1</sup> / <sub>16</sub>	1 <sup>1</sup> / <sub>16</sub>	8 <sup>15</sup> / <sub>16</sub>	8 <sup>15</sup> / <sub>16</sub>	53'-10 <sup>15</sup> / <sub>16</sub>	25'-11 <sup>8</sup> / <sub>16</sub>	2'-1	9	9	1	2 <sup>1</sup> / <sub>2</sub>	1	2 <sup>1</sup> / <sub>2</sub>	PL 2 <sup>1</sup> / <sub>2</sub> x 18-209BF1 (201/10)	PL 1 <sup>3</sup> / <sub>8</sub> x 18-209BF2 (202/26)
210B3 TOP FLG	344.89	85'-1 <sup>3</sup> / <sub>16</sub>	84'-10 <sup>5</sup> / <sub>8</sub>	49'-1 <sup>3</sup> / <sub>8</sub>	35'-11 <sup>13</sup> / <sub>16</sub>	9/16	10 <sup>1</sup> / <sub>2</sub>	7 <sup>7</sup> / <sub>8</sub>	12'-3 <sup>1</sup> / <sub>4</sub>	49'-0 <sup>7</sup> / <sub>8</sub>	7/8	5 <sup>5</sup> / <sub>8</sub>	4 <sup>1</sup> / <sub>4</sub>	8'-11 <sup>7</sup> / <sub>8</sub>	35'-11 <sup>5</sup> / <sub>8</sub>	1	1	7 <sup>15</sup> / <sub>16</sub>	7 <sup>15</sup> / <sub>16</sub>	49'-0 <sup>1</sup> / <sub>16</sub>	35'-10 <sup>9</sup> / <sub>16</sub>	2'-6 <sup>11</sup> / <sub>16</sub>	8	8	0	0	0	0	PL 2 x 16-210TF1 (201/32)	PL 1 x 16-210TF2 (204/10)
210B3 BTM FLG	344.89	85'-0 <sup>5</sup> / <sub>16</sub>	84'-9 <sup>3</sup> / <sub>4</sub>	49'-0 <sup>1</sup> / <sub>8</sub>	36'-0 <sup>3</sup> / <sub>16</sub>	9/16	10 <sup>7</sup> / <sub>16</sub>	7 <sup>13</sup> / <sub>16</sub>	12'-2 <sup>15</sup> / <sub>16</sub>	48'-11 <sup>5</sup> / <sub>8</sub>	7/8	5 <sup>5</sup> / <sub>8</sub>	4 <sup>1</sup> / <sub>4</sub>	9'-0	36'-0	1	1	7 <sup>15</sup> / <sub>16</sub>	7 <sup>15</sup> / <sub>16</sub>	48'-10 <sup>13</sup> / <sub>16</sub>	35'-10 <sup>15</sup> / <sub>16</sub>	2'-6 <sup>11</sup> / <sub>16</sub>	8	8	0	0	0	0	PL 2 <sup>1</sup> / <sub>8</sub> x 16-210BF1 (201/20)	PL 1 x 16-210BF2 (204/10)
211C3 TOP FLG	353.23	80'-0 <sup>15</sup> / <sub>16</sub>	79'-10 <sup>7</sup> / <sub>8</sub>	48'-1 <sup>1</sup> / <sub>4</sub>	31'-11 <sup>13</sup> / <sub>16</sub>	7/8	9 <sup>13</sup> / <sub>16</sub>	7 <sup>3</sup> / <sub>8</sub>	12'-0 <sup>3</sup> / <sub>16</sub>	48'-0 <sup>13</sup> / <sub>16</sub>	9/16	4 <sup>5</sup> / <sub>16</sub>	3 <sup>1</sup> / <sub>4</sub>	7'-11 <sup>7</sup> / <sub>8</sub>	31'-11 <sup>9</sup> / <sub>16</sub>	1 <sup>1</sup> / <sub>2</sub>	1 <sup>1</sup> / <sub>2</sub>	1'-0 <sup>15</sup> / <sub>16</sub>	1'-0 <sup>15</sup> / <sub>16</sub>	48'-0 <sup>3</sup> / <sub>16</sub>	31'-10 <sup>11</sup> / <sub>16</sub>	2'-2 <sup>8</sup> / <sub>16</sub>	1'-1	1'-1	5	1'-0 <sup>1</sup> / <sub>2</sub>	5	1'-0 <sup>1</sup> / <sub>2</sub>	PL 2 <sup>1</sup> / <sub>2</sub> x 26-211TF1 (201/8)	PL 1 <sup>1</sup> / <sub>4</sub> x 26-211TF2 (202/30)
211C3 BTM FLG	353.23	80'-0 <sup>3</sup> / <sub>8</sub>	79'-10 <sup>5</sup> / <sub>16</sub>	48'-0 <sup>1</sup> / <sub>8</sub>	32'-0 <sup>1</sup> / <sub>4</sub>	7/8	9 <sup>13</sup> / <sub>16</sub>	7 <sup>5</sup> / <sub>16</sub>	11'-11 <sup>15</sup> / <sub>16</sub>	47'-11 <sup>11</sup> / <sub>16</sub>	9/16	4 <sup>3</sup> / <sub>8</sub>	3 <sup>1</sup> / <sub>4</sub>	8'-0	32'-0 <sup>1</sup> / <sub>8</sub>	1 <sup>1</sup> / <sub>2</sub>	1 <sup>1</sup> / <sub>2</sub>	1'-0 <sup>15</sup> / <sub>16</sub>	1'-0 <sup>15</sup> / <sub>16</sub>	47'-11 <sup>1</sup> / <sub>16</sub>	31'-11 <sup>4</sup> / <sub>16</sub>	2'-2 <sup>1</sup> / <sub>16</sub>	1'-1	1'-1	5	1'-0 <sup>1</sup> / <sub>2</sub>	5	1'-0 <sup>1</sup> / <sub>2</sub>	PL 2 <sup>1</sup> / <sub>2</sub> x 26-211BF1 (201/8)	PL 1 <sup>1</sup> / <sub>4</sub> x 26-211BF2 (202/30)
212D3 TOP FLG	361.56	80'-0 <sup>13</sup> / <sub>16</sub>	79'-10 <sup>7</sup> / <sub>8</sub>	60'-1 <sup>1</sup> / <sub>2</sub>	19'-11 <sup>5</sup> / <sub>16</sub>	1 <sup>3</sup> / <sub>16</sub>	1'-3	11 <sup>1</sup> / <sub>4</sub>	15'-0 <sup>3</sup> / <sub>16</sub>	60'-0 <sup>11</sup> / <sub>16</sub>	3/8	1 <sup>5</sup> / <sub>8</sub>	1 <sup>1</sup> / <sub>4</sub>	4'-11 <sup>13</sup> / <sub>16</sub>	19'-11 <sup>5</sup> / <sub>16</sub>	9/16	9/16	1'-1 <sup>15</sup> / <sub>16</sub>	1'-1 <sup>15</sup> / <sub>16</sub>	60'-0 <sup>7</sup> / <sub>16</sub>	19'-10 <sup>7</sup> / <sub>16</sub>	1'-7 <sup>7</sup> / <sub>8</sub>	1'-2	1'-2	5	1'-0 <sup>1</sup> / <sub>2</sub>	5	1'-0 <sup>1</sup> / <sub>2</sub>	PL 2 <sup>1</sup> / <sub>2</sub> x 28-212TF1 (201/2)	PL 1 <sup>7</sup> / <sub>8</sub> x 28-212TF2 (202/2)
212D3 BTM FLG	361.56	80'-0 <sup>3</sup> / <sub>8</sub>	79'-10 <sup>7</sup> / <sub>16</sub>	60'-0 <sup>5</sup> / <sub>16</sub>	20'-0 <sup>1</sup> / <sub>16</sub>	1 <sup>3</sup> / <sub>16</sub>	1'-2 <sup>15</sup> / <sub>16</sub>	11 <sup>3</sup> / <sub>16</sub>	14'-11 <sup>7</sup> / <sub>8</sub>	59'-11 <sup>1</sup> / <sub>2</sub>	3/8	1 <sup>1</sup> / <sub>16</sub>	1 <sup>1</sup> / <sub>4</sub>	5'-0	20'-0 <sup>1</sup> / <sub>16</sub>	1 <sup>9</sup> / <sub>16</sub>	1 <sup>9</sup> / <sub>16</sub>	1'-1 <sup>15</sup> / <sub>16</sub>	1'-1 <sup>15</sup> / <sub>16</sub>	59'-11 <sup>1</sup> / <sub>16</sub>	19'-11 <sup>3</sup> / <sub>16</sub>	1'-7 <sup>7</sup> / <sub>8</sub>	1'-2	1'-2	0	0	5	1'-0 <sup>1</sup> / <sub>2</sub>	PL 2 <sup>1</sup> / <sub>2</sub> x 28-212BF1 (201/2)	PL 2 x 28-212BF2 (201/22)

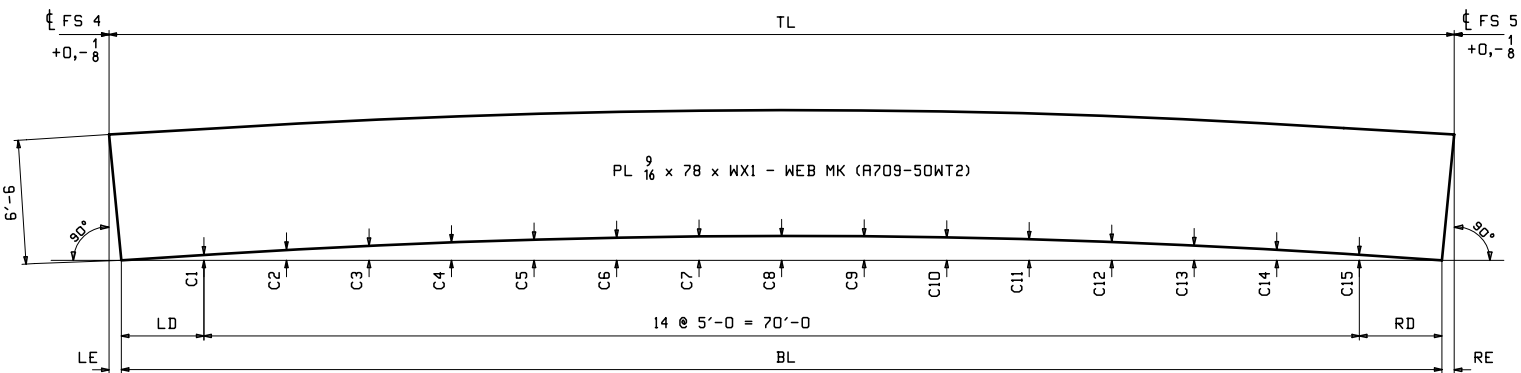


CAMBER DIAGRAM FOR 213A4, 214B4, 215C4

MARK	TL	BL	LE	RE	WX1	LD	RD	C1	C2	C3	C4	C5	C6	C7	C8	C9	C10	C11	C12	C13	C14	C15	WEB MK	PG/LINE
213A4	82'-1 <sup>5</sup> / <sub>8</sub>	81'-11 <sup>13</sup> / <sub>16</sub>	15/16	7/8	82'-1 <sup>5</sup> / <sub>8</sub>	5'-11 <sup>7</sup> / <sub>8</sub>	5'-11 <sup>15</sup> / <sub>16</sub>	13/16	1/8	1/8	2 <sup>5</sup> / <sub>16</sub>	2 <sup>5</sup> / <sub>8</sub>	2 <sup>7</sup> / <sub>8</sub>	3	3 <sup>1</sup> / <sub>16</sub>	3 <sup>1</sup> / <sub>16</sub>	2 <sup>7</sup> / <sub>8</sub>	2 <sup>11</sup> / <sub>16</sub>	2 <sup>3</sup> / <sub>8</sub>	1 <sup>15</sup> / <sub>16</sub>	1 <sup>7</sup> / <sub>16</sub>	1 <sup>13</sup> / <sub>16</sub>	213WB	204/26
214B4	79'-1 <sup>1</sup> / <sub>2</sub>	78'-11 <sup>7</sup> / <sub>8</sub>	13/16	13/16	79'-1 <sup>1</sup> / <sub>2</sub>	4'-5 <sup>15</sup> / <sub>16</sub>	4'-5 <sup>15</sup> / <sub>16</sub>	1/2	1 <sup>1</sup> / <sub>16</sub>	1 <sup>9</sup> / <sub>16</sub>	1 <sup>15</sup> / <sub>16</sub>	2 <sup>1</sup> / <sub>4</sub>	2 <sup>7</sup> / <sub>16</sub>	2 <sup>19</sup> / <sub>16</sub>	2 <sup>5</sup> / <sub>8</sub>	2 <sup>9</sup> / <sub>16</sub>	2 <sup>7</sup> / <sub>16</sub>	2 <sup>1</sup> / <sub>4</sub>	1 <sup>15</sup> / <sub>16</sub>	1 <sup>9</sup> / <sub>16</sub>	1 <sup>1</sup> / <sub>16</sub>	1 <sup>1</sup> / <sub>2</sub>	214WB	204/32
215C4	78'-1 <sup>3</sup> / <sub>8</sub>	77'-11 <sup>7</sup> / <sub>8</sub>	3/4	3/4	78'-1 <sup>3</sup> / <sub>8</sub>	3'-11 <sup>15</sup> / <sub>16</sub>	3'-11 <sup>15</sup> / <sub>16</sub>	7/16	1 <sup>15</sup> / <sub>16</sub>	1 <sup>3</sup> / <sub>8</sub>	1 <sup>11</sup> / <sub>16</sub>	2	2 <sup>3</sup> / <sub>16</sub>	2 <sup>5</sup> / <sub>16</sub>	2 <sup>5</sup> / <sub>16</sub>	2 <sup>1</sup> / <sub>4</sub>	2 <sup>8</sup> / <sub>16</sub>	1 <sup>15</sup> / <sub>16</sub>	1 <sup>11</sup> / <sub>16</sub>	1 <sup>5</sup> / <sub>16</sub>	1 <sup>15</sup> / <sub>16</sub>	7/16	215WB	205/2


- NOTES:  
 1. FOR GENERAL NOTES SEE DRAWING GNI.  
 2. T2 DENOTES MATERIAL SUBJECT TO CHARPY V-NOTCH TEST AT H FREQ. FOR ZONE 2  
 3. FOR WELD DETAIL "FA", SEE GNI.

APPROVAL COMMENTS		ELG WJL	
NO.	DATE	REMARKS	BY
REVISIONS			
STRUCTURE RAMP P OVER IR-74 WB, IR-75 & RAMP E - UNIT 2			
LOCATION CINCINNATI, OH (HAMILTON COUNTY) STA. 230+22.98			
PROJECT NO. HAM-75-3.84, PID NO. 104667, BRIDGE NO. HAM-74-19085			
ENGINEER PRIME AE GROUP			
CONTRACTOR WALSH GROUP			
WEB & FLANGE CUTTING			
ITEM _____			
SURFACE PREP. _____ OPEN HOLES _____			
PAINT _____			
PRELIMINARY	DRAWN	SHEET NO.	PLANT
FOR APPROVAL	CHECKED	BG206	3
DATE	DATE		
02/22/19	04/10/19		
ORDER NO.	FF. NO.		
180608	20		

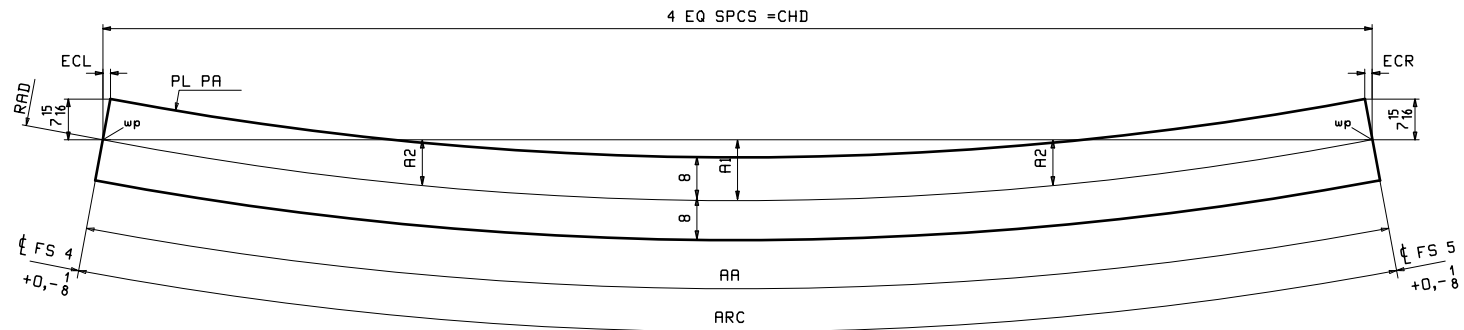


**VIEW T-T  
SECTION B-B**

LOCATION	RAD	ARC	CHD	AA	AI	A2	ECL	ECR	PL PA (A709-50WT2)
213A4 TOP FLG	336.56	82'-1 <sup>5</sup> / <sub>8</sub>	81'-11 <sup>3</sup> / <sub>16</sub>	82'-1 <sup>5</sup> / <sub>8</sub>	2'-6	1'-10 <sup>9</sup> / <sub>16</sub>	1	1	PL 1 x 16-213TF (203/16)
213A4 BTM FLG	336.56	81'-11 <sup>13</sup> / <sub>16</sub>	81'-9 <sup>3</sup> / <sub>8</sub>	81'-11 <sup>13</sup> / <sub>16</sub>	2'-5 <sup>15</sup> / <sub>16</sub>	1'-10 <sup>7</sup> / <sub>16</sub>	1	1	PL 1 x 16-213BF (203/16)
214B4 TOP FLG	344.89	79'-1 <sup>1</sup> / <sub>2</sub>	78'-11 <sup>7</sup> / <sub>16</sub>	79'-1 <sup>1</sup> / <sub>2</sub>	2'-3 <sup>3</sup> / <sub>16</sub>	1'-8 <sup>7</sup> / <sub>16</sub>	15 <sup>15</sup> / <sub>16</sub>	15 <sup>15</sup> / <sub>16</sub>	PL 1 x 16-214TF (203/24)
214B4 BTM FLG	344.89	78'-11 <sup>7</sup> / <sub>8</sub>	78'-9 <sup>13</sup> / <sub>16</sub>	78'-11 <sup>7</sup> / <sub>8</sub>	2'-3 <sup>1</sup> / <sub>8</sub>	1'-8 <sup>3</sup> / <sub>8</sub>	15 <sup>15</sup> / <sub>16</sub>	15 <sup>15</sup> / <sub>16</sub>	PL 1 x 16-214BF (203/24)
215C4 TOP FLG	353.23	78'-1 <sup>3</sup> / <sub>8</sub>	77'-11 <sup>7</sup> / <sub>16</sub>	78'-1 <sup>3</sup> / <sub>8</sub>	2'-1 <sup>7</sup> / <sub>8</sub>	1'-7 <sup>7</sup> / <sub>16</sub>	7 <sup>7</sup> / <sub>8</sub>	7 <sup>7</sup> / <sub>8</sub>	PL 1 x 16-215TF (203/26)
215C4 BTM FLG	353.23	77'-11 <sup>7</sup> / <sub>8</sub>	77'-10	77'-11 <sup>7</sup> / <sub>8</sub>	2'-1 <sup>13</sup> / <sub>16</sub>	1'-7 <sup>3</sup> / <sub>8</sub>	7 <sup>7</sup> / <sub>8</sub>	7 <sup>7</sup> / <sub>8</sub>	PL 1 x 16-215BF (203/26)

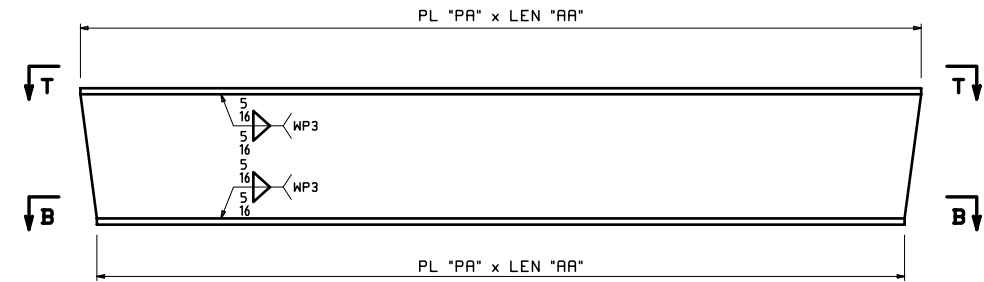


**FLANGE DIAGRAM FOR 213A4,214B4,215C4**

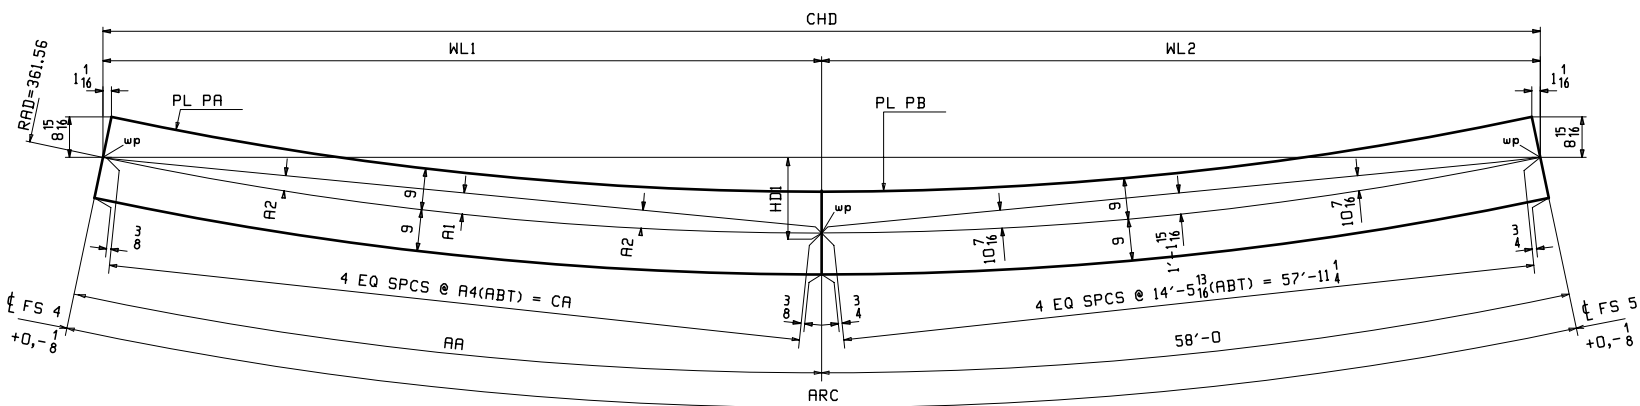


**VIEW T-T  
SECTION B-B**

LOCATION	ARC	CHD	AA	AI	A2	A4	CA	WL1	WL2	HD1	PL PA (A709-50WT2)	PL PB (A709-50WT2)
216D4 TOP FLG	87'-1 <sup>3</sup> / <sub>8</sub>	86'-10 <sup>7</sup> / <sub>8</sub>	29'-1 <sup>3</sup> / <sub>8</sub>	3 <sup>1</sup> / <sub>2</sub>	2 <sup>5</sup> / <sub>8</sub>	7'-3 <sup>5</sup> / <sub>16</sub>	29'-1 <sup>5</sup> / <sub>16</sub>	29'-0 <sup>3</sup> / <sub>16</sub>	57'-10 <sup>11</sup> / <sub>16</sub>	2'-4	PL 1 <sup>1</sup> / <sub>4</sub> x 18-216TF1 (203/2)	PL 1 <sup>1</sup> / <sub>4</sub> x 18-216TF2 (202/32)
216D4 BTM FLG	86'-11 <sup>15</sup> / <sub>16</sub>	86'-9 <sup>7</sup> / <sub>16</sub>	28'-11 <sup>15</sup> / <sub>16</sub>	3 <sup>1</sup> / <sub>2</sub>	2 <sup>5</sup> / <sub>8</sub>	7'-2 <sup>15</sup> / <sub>16</sub>	28'-11 <sup>7</sup> / <sub>8</sub>	28'-10 <sup>3</sup> / <sub>4</sub>	57'-10 <sup>11</sup> / <sub>16</sub>	2'-3 <sup>7</sup> / <sub>8</sub>	PL 1 <sup>1</sup> / <sub>2</sub> x 18-216BF1 (202/20)	PL 1 <sup>1</sup> / <sub>2</sub> x 18-216BF2 (202/18)

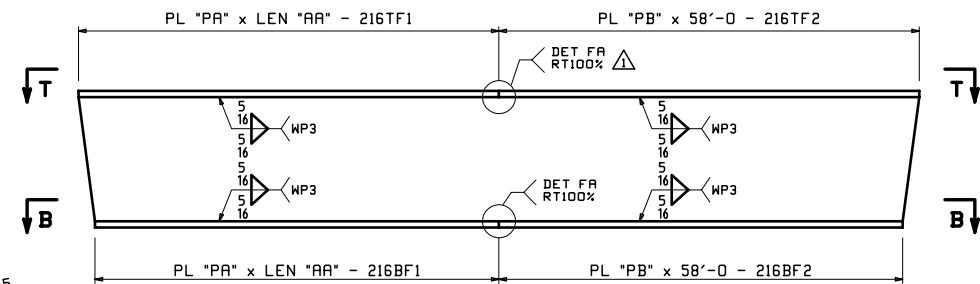



**FLANGE DIAGRAM FOR 216D4**

- NOTES:**
1. FOR GENERAL NOTES SEE DRAWING GNI.
  2. T2 DENOTES MATERIAL SUBJECT TO CHARPY V-NOTCH TEST AT H FREQ. FOR ZONE 2
  3. FOR WELD DETAILS 'FA' & 'WA', SEE GNI.

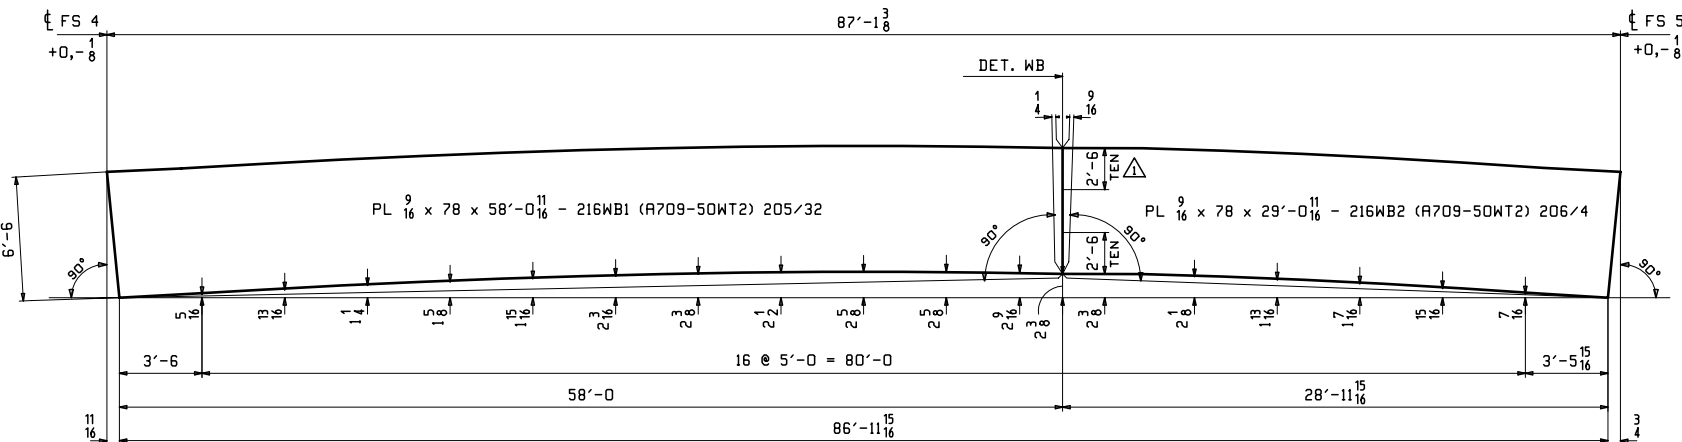

**CAMBER DIAGRAM FOR 216D4**

NO.	DATE	REVISIONS	REMARKS	BY
05/06/19			APPROVAL COMMENTS	ELG/WJL
<b>Veritas STEEL</b>				
2-EAU CLAIRE, WI 3-WAUSAU, WI 4-PALATKA, FL				
STRUCTURE	RAMP P OVER IR-74 WB, IR-75 & RAMP E - UNIT 2			
LOCATION	CINCINNATI, OH (HAMILTON COUNTY) STA. 230+22.98			
PROJECT NO.	HAM-75-3.84, PID NO. 104667, BRIDGE NO. HAM-74-19085			
ENGINEER	PRIME AE GROUP			
CONTRACTOR	WALSH GROUP			
ITEM	WEB & FLANGE CUTTING			
SURFACE PREP.	OPEN HOLES			
PAIN				
PRELIMINARY	DRAWN	ELG 02/22/19	SHEET NO.	PLANT
FOR APPROVAL	CHECKED	WJL 04/10/19	<b>BG207</b>	<b>3</b>
			ORDER NO.	FP. NO.
			<b>180608</b>	<b>20</b>

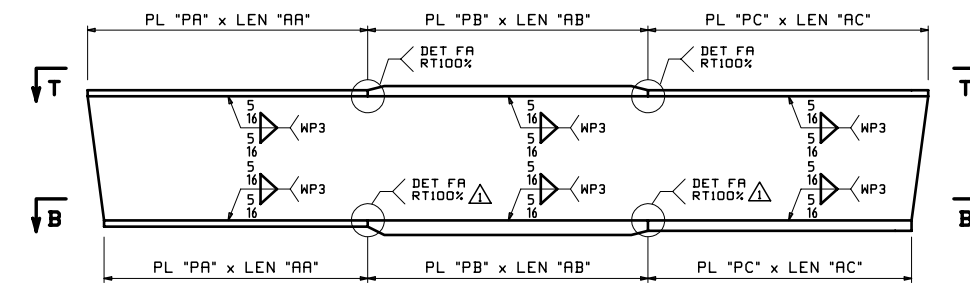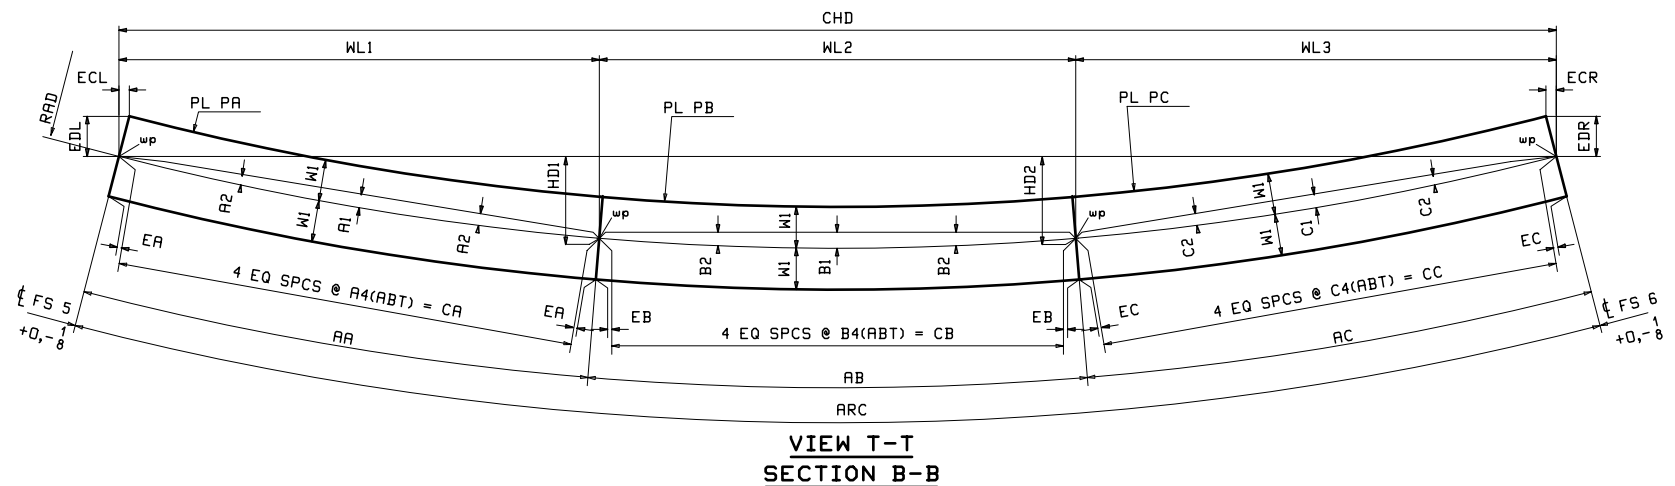


FLANGE DIAGRAM FOR 217A5, 218B5, 219C5, & 220D5

LOCATION	RAD	ARC	CHD	AA	AB	AC	EA	EA	EA	EA	EA	EA	EA	EA	EA	EA	EA	EA	EA	EA	ECL	ECR	EDL	EDR	WL1	WL2	WL3	HD1	HD2	W1	
217A5 TOP FLG	336.56	77'-1 3/16	76'-11 3/16	21'-10 11/16	30'-0	25'-2 1/2	1/4	2 3/8	1 5/8	5'-5 11/16	21'-10 5/8	3/8	4	3	7'-6	29'-11 7/8	5/16	2 13/16	2 1/8	6'-3 5/8	25'-2 7/16	15/16	15/16	7 15/16	7 15/16	21'-9 3/4	29'-11 7/8	25'-1 9/16	1'-9 1/2	1'-11 1/4	8
217A5 BTM FLG	336.56	77'-0 7/16	76'-10 7/16	22'-0 8/16	30'-0	25'-0 5/16	1/4	2 3/16	1 5/8	5'-6	22'-0 1/16	3/8	4	3	7'-6	29'-11 7/8	5/16	2 13/16	2 1/8	6'-3 1/16	25'-0 1/4	15/16	15/16	7 15/16	7 15/16	21'-11 3/8	29'-11 7/8	24'-11 3/8	1'-9 9/16	1'-11 3/16	8
218B5 TOP FLG	344.89	75'-1 1/16	74'-11 5/16	24'-10 5/8	25'-0	25'-2 7/16	5/16	2 11/16	2	6'-2 5/8	24'-10 9/16	5/16	2 11/16	2 1/16	6'-3	24'-11 15/16	5/16	2 3/4	2 1/8	6'-3 5/8	25'-2 3/8	7/8	7/8	7 15/16	7 15/16	24'-9 3/4	24'-11 15/16	25'-1 5/8	1'-9 11/16	1'-9 13/16	8
218B5 BTM FLG	344.89	75'-0 3/8	74'-10 5/8	25'-0 1/16	25'-0	25'-0 5/16	5/16	2 11/16	2 1/16	6'-3	25'-0	5/16	2 11/16	2 1/16	6'-3	24'-11 15/16	5/16	2 3/4	2 1/8	6'-3 1/16	25'-0 1/4	7/8	7/8	7 15/16	7 15/16	24'-11 3/16	24'-11 15/16	24'-11 1/2	1'-9 3/4	1'-9 3/4	8
219C5 TOP FLG	353.23	80'-1 1/16	79'-11	14'-10 11/16	40'-0	25'-2 3/8	3/16	15/16	11/16	3'-8 11/16	14'-10 11/16	7/16	6 13/16	5 1/16	9'-11 15/16	39'-11 3/4	5/16	2 11/16	2	6'-3 9/8	25'-2 5/16	7/8	7/8	7 15/16	7 15/16	14'-9 15/16	39'-11 11/16	25'-1 3/8	1'-4 7/16	1'-11 7/16	8
219C5 BTM FLG	353.23	80'-0 3/8	79'-10 5/16	15'-0 8/16	40'-0	25'-0 1/4	3/16	15/16	11/16	3'-9	15'-0 8/16	7/16	6 13/16	5 1/16	9'-11 15/16	39'-11 3/4	5/16	2 11/16	2	6'-3 1/16	25'-0 3/16	7/8	7/8	7 15/16	7 15/16	14'-11 5/16	39'-11 11/16	24'-11 5/16	1'-4 9/16	1'-11 5/16	8
220D5 TOP FLG	361.56	83'-1 1/8	82'-10 15/16	22'-11	40'-0	20'-2 1/8	5/16	2 3/16	1 5/8	5'-8 3/4	22'-10 15/16	1/2	6 5/8	5	9'-11 15/16	39'-11 3/4	1/4	1 11/16	1 1/4	5'-0 1/2	20'-2 1/16	1 1/16	1 1/16	8 15/16	8 15/16	22'-10	39'-11 3/4	20'-1 3/16	1'-10 7/8	1'-9	9
220D5 BTM FLG	361.56	83'-0 5/16	82'-10 1/8	23'-0 5/16	40'-0	20'-0	5/16	2 3/16	1 5/8	5'-9 1/16	23'-0 1/4	1/2	6 5/8	5	9'-11 15/16	39'-11 3/4	1/4	1 11/16	1 1/4	5'-0	20'-0	1	1	8 15/16	8 15/16	22'-11 5/16	39'-11 3/4	19'-11 1/16	1'-10 7/8	1'-8 7/8	9

LOCATION	PL PA (A709-50WT2)	PL PB (A709-50WT2)	PL PC (A709-50WT2)
217A5 TOP FLG	PL 1 x 16-217TF1 (204/22)	PL 1 1/2 x 16-217TF2 (202/22)	PL 1 x 16-217TF3 (204/16)
217A5 BTM FLG	PL 1 x 16-217BF1 (204/20)	PL 7/8 x 16-217BF2 (202/4)	PL 1 x 16-217BF3 (204/16)
218B5 TOP FLG	PL 1 x 16-218TF1 (204/18)	PL 1 1/8 x 16-218TF2 (203/6)	PL 1 x 16-218TF3 (204/16)
218B5 BTM FLG	PL 1 x 16-218BF1 (204/16)	PL 5/8 x 16-218BF2 (202/16)	PL 1 x 16-218BF3 (204/16)

LOCATION	PL PA (A709-50WT2)	PL PB (A709-50WT2)	PL PC (A709-50WT2)
219C5 TOP FLG	PL 1 x 16-219TF1 (204/24)	PL 2 1/4 x 16-219TF2 (201/16)	PL 1 x 16-219TF3 (204/16)
219C5 BTM FLG	PL 1 x 16-219BF1 (204/24)	PL 2 1/2 x 16-219BF2 (201/12)	PL 1 x 16-219BF3 (204/16)
220D5 TOP FLG	PL 1 x 18-220TF1 (203/10)	PL 2 x 18-220TF2 (201/26)	PL 1 x 18-220TF3 (203/12)
220D5 BTM FLG	PL 1 3/8 x 18-220BF1 (202/28)	PL 2 1/8 x 18-220BF2 (201/18)	PL 2 x 18-220BF3 (201/30)

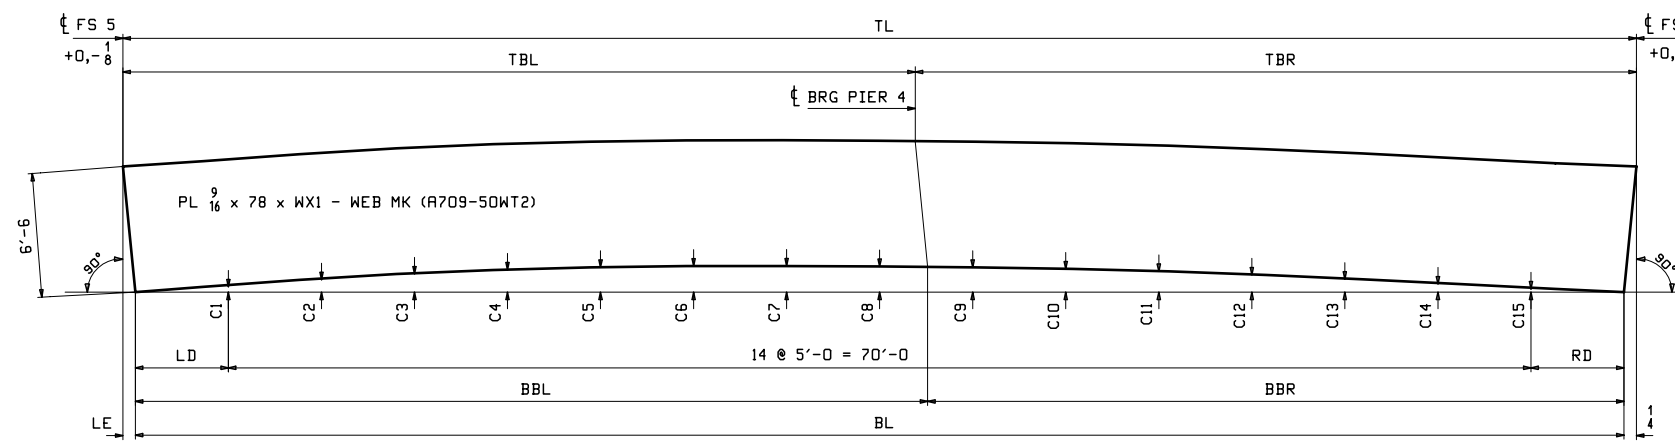

CAMBER DIAGRAM FOR 217A5 & 219C5

MARK	TL	BL	LE	WX1	TBL	TBR	BBL	BBR	LD	RD	C1	C2	C3	C4	C5	C6	C7	C8	C9	C10	C11	C12	C13	C14	C15	WEB MK	PG/LINE
217A5	77'-1 3/16	77'-0 7/16	1/2	77'-1 3/16	40'-1 5/16	36'-11 7/8	40'-2 5/8	36'-9 13/16	3'-6 1/4	3'-6 3/16	1/4	9/16	3/4	15/16	1 1/16	1 1/8	1 1/8	1 1/8	1 1/16	1	7/8	3/4	9/16	3/8	1/8	217WB	205/12
219C5	80'-1 1/16	80'-0 3/8	7/16	80'-1 1/16	35'-2 3/8	44'-10 11/16	35'-3 3/4	44'-8 5/8	5'-0 3/16	5'-0 3/16	5/16	9/16	3/4	7/8	1	1 1/16	1 1/8	1 1/8	1 1/8	1 1/16	1	7/8	11/16	7/16	1/4	219WB	205/10

- NOTES:  
 1. FOR GENERAL NOTES SEE DRAWING GNI.  
 2. T2 DENOTES MATERIAL SUBJECT TO CHARPY V-NOTCH TEST AT H FREQ. FOR ZONE 2  
 3. FOR WELD DETAIL "FA", SEE GNI.

NO.	DATE	REMARKS	BY
Δ	05/06/19	APPROVAL COMMENTS	ELG / WJL

REVISIONS



**Veritas STEEL**  
 2-EAU CLAIRE, WI 3-WAUSAU, WI 4-PALATKA, FL  
 TENSOR 3636-2

STRUCTURE: RAMP P OVER IR-74 WB, IR-75 & RAMP E - UNIT 2  
 LOCATION: CINCINNATI, OH (HAMILTON COUNTY) STA. 230+22.98  
 PROJECT NO.: HAM-75-3.84, PID NO. 104667, BRIDGE NO. HAM-74-19085  
 ENGINEER: PRIME AE GROUP  
 CONTRACTOR: WALSH GROUP

ITEM: WEB & FLANGE CUTTING  
 SURFACE PREP: OPEN HOLES


PRELIMINARY: DRAWN ELG 02/22/19 SHEET NO. PLANT ORDER NO. FF. NO.  
 FOR APPROVAL: CHECKED WJL 04/10/19 **BG208** **3** **180608** **20**

217A5, 219C5, 220D5 BRIDGE - 202008 - 1 Rev. 1  
 Date: May 13, 2019 10:43:09 AM  
 C:\Users\jwalsh\OneDrive\Documents\202008\_1 Rev. 1

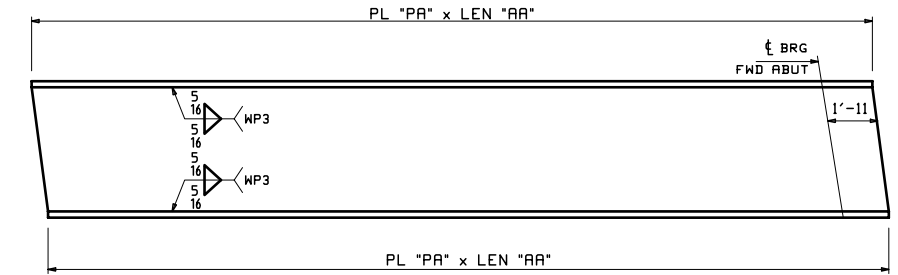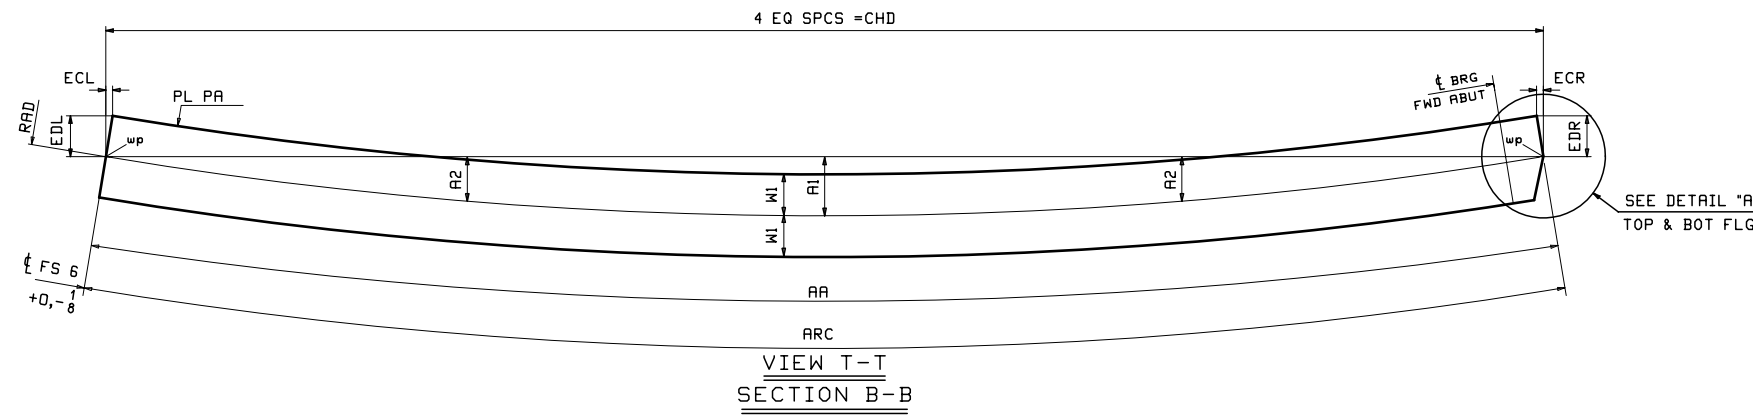


FLANGE DIAGRAM FOR 221A6, 222B6, 223C6, & 224D6

LOCATION	RAD	ARC	CHD	AA	AI	A2	ECL	ECR	EDL	EDR	WI	PL PA (A709-50WT2)
221A6 TOP FLG	336.56	85'-0 <sup>7</sup> / <sub>16</sub>	84'-9 <sup>3</sup> / <sub>4</sub>	85'-0 <sup>7</sup> / <sub>16</sub>	2'-8 <sup>3</sup> / <sub>16</sub>	2'-0 <sup>1</sup> / <sub>8</sub>	1	1	7 <sup>15</sup> / <sub>16</sub>	7 <sup>15</sup> / <sub>16</sub>	8	PL 1 x 16-221TF (203/14)
221A6 BTM FLG	336.56	85'-2 <sup>1</sup> / <sub>4</sub>	84'-11 <sup>1</sup> / <sub>2</sub>	85'-2 <sup>1</sup> / <sub>4</sub>	2'-8 <sup>1</sup> / <sub>4</sub>	2'-0 <sup>1</sup> / <sub>4</sub>	1	1	7 <sup>15</sup> / <sub>16</sub>	7 <sup>15</sup> / <sub>16</sub>	8	PL 1 x 16-221BF (203/14)
222B6 TOP FLG	344.89	81'-3	81'-0 <sup>3</sup> / <sub>4</sub>	81'-3	2'-4 <sup>5</sup> / <sub>8</sub>	1'-9 <sup>1</sup> / <sub>2</sub>	15 <sup>15</sup> / <sub>16</sub>	15 <sup>15</sup> / <sub>16</sub>	7 <sup>15</sup> / <sub>16</sub>	7 <sup>15</sup> / <sub>16</sub>	8	PL 1 x 16-222TF (203/22)
222B6 BTM FLG	344.89	81'-4 <sup>11</sup> / <sub>16</sub>	81'-2 <sup>7</sup> / <sub>16</sub>	81'-4 <sup>11</sup> / <sub>16</sub>	2'-4 <sup>3</sup> / <sub>4</sub>	1'-9 <sup>9</sup> / <sub>16</sub>	15 <sup>15</sup> / <sub>16</sub>	15 <sup>15</sup> / <sub>16</sub>	7 <sup>15</sup> / <sub>16</sub>	7 <sup>15</sup> / <sub>16</sub>	8	PL 1 x 16-222BF (203/22)
223C6 TOP FLG	353.23	77'-7 <sup>1</sup> / <sub>4</sub>	77'-5 <sup>3</sup> / <sub>8</sub>	77'-7 <sup>1</sup> / <sub>4</sub>	2'-1 <sup>1</sup> / <sub>2</sub>	1'-7 <sup>1</sup> / <sub>8</sub>	7 <sup>8</sup> / <sub>8</sub>	7 <sup>8</sup> / <sub>8</sub>	7 <sup>15</sup> / <sub>16</sub>	7 <sup>15</sup> / <sub>16</sub>	8	PL 1 x 16-223TF (203/28)
223C6 BTM FLG	353.23	77'-8 <sup>15</sup> / <sub>16</sub>	77'-7 <sup>1</sup> / <sub>16</sub>	77'-8 <sup>15</sup> / <sub>16</sub>	2'-1 <sup>5</sup> / <sub>8</sub>	1'-7 <sup>1</sup> / <sub>4</sub>	7 <sup>8</sup> / <sub>8</sub>	7 <sup>8</sup> / <sub>8</sub>	7 <sup>15</sup> / <sub>16</sub>	7 <sup>15</sup> / <sub>16</sub>	8	PL 1 x 16-223BF (203/28)
224D6 TOP FLG	361.56	77'-0	76'-10 <sup>1</sup> / <sub>4</sub>	77'-0	2'-0 <sup>9</sup> / <sub>16</sub>	1'-6 <sup>7</sup> / <sub>16</sub>	15 <sup>15</sup> / <sub>16</sub>	15 <sup>15</sup> / <sub>16</sub>	8 <sup>15</sup> / <sub>16</sub>	8 <sup>15</sup> / <sub>16</sub>	9	PL 1 x 18-224TF (203/8)
224D6 BTM FLG	361.56	77'-1 <sup>9</sup> / <sub>16</sub>	76'-11 <sup>13</sup> / <sub>16</sub>	77'-1 <sup>9</sup> / <sub>16</sub>	2'-0 <sup>5</sup> / <sub>8</sub>	1'-6 <sup>1</sup> / <sub>2</sub>	15 <sup>15</sup> / <sub>16</sub>	15 <sup>15</sup> / <sub>16</sub>	8 <sup>15</sup> / <sub>16</sub>	8 <sup>15</sup> / <sub>16</sub>	9	PL 2 x 18-224BF (201/24)

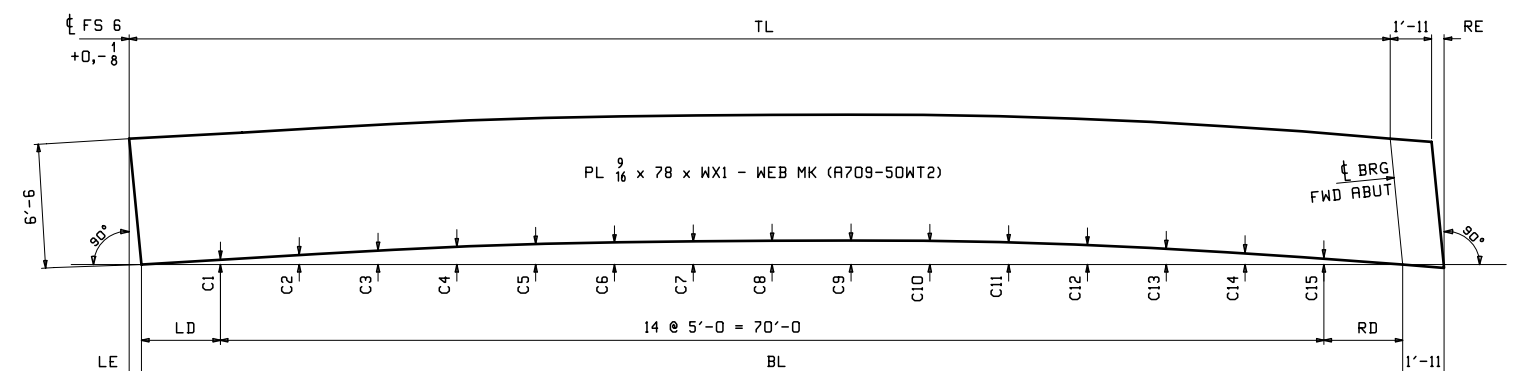


CAMBER DIAGRAM FOR 221A6, 222B6, 223C6, & 224D6

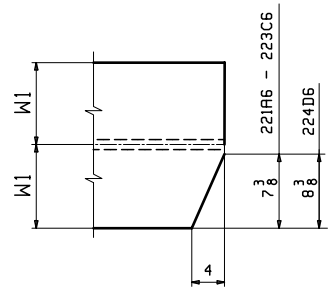

DETAIL "A"

MARK	TL	BL	LE	RE	WX1	LD	RD	C1	C2	C3	C4	C5	C6	C7	C8	C9	C10	C11	C12	C13	C14	C15	WEB MK	PG/LINE
221A6	83'-1 <sup>7</sup> / <sub>16</sub>	83'-3 <sup>1</sup> / <sub>4</sub>	3 <sup>3</sup> / <sub>16</sub>	2	85'-2 <sup>7</sup> / <sub>16</sub>	6'-7 <sup>5</sup> / <sub>8</sub>	6'-7 <sup>5</sup> / <sub>8</sub>	3 <sup>3</sup> / <sub>16</sub>	5 <sup>5</sup> / <sub>16</sub>	1 <sup>1</sup> / <sub>2</sub>	9 <sup>9</sup> / <sub>16</sub>	11 <sup>11</sup> / <sub>16</sub>	11 <sup>11</sup> / <sub>16</sub>	3 <sup>3</sup> / <sub>4</sub>	3 <sup>3</sup> / <sub>4</sub>	3 <sup>3</sup> / <sub>4</sub>	3 <sup>3</sup> / <sub>4</sub>	11 <sup>11</sup> / <sub>16</sub>	5 <sup>5</sup> / <sub>8</sub>	9 <sup>9</sup> / <sub>16</sub>	3 <sup>3</sup> / <sub>8</sub>	1 <sup>1</sup> / <sub>4</sub>	221WB	205/18
222B6	79'-4	79'-5 <sup>11</sup> / <sub>16</sub>	5 <sup>5</sup> / <sub>16</sub>	2	81'-5	4'-8 <sup>7</sup> / <sub>8</sub>	4'-8 <sup>13</sup> / <sub>16</sub>	3 <sup>3</sup> / <sub>16</sub>	3 <sup>3</sup> / <sub>8</sub>	9 <sup>9</sup> / <sub>16</sub>	5 <sup>5</sup> / <sub>8</sub>	3 <sup>3</sup> / <sub>4</sub>	3 <sup>3</sup> / <sub>4</sub>	13 <sup>13</sup> / <sub>16</sub>	13 <sup>13</sup> / <sub>16</sub>	13 <sup>13</sup> / <sub>16</sub>	3 <sup>3</sup> / <sub>4</sub>	11 <sup>11</sup> / <sub>16</sub>	9 <sup>9</sup> / <sub>16</sub>	7 <sup>7</sup> / <sub>16</sub>	5 <sup>5</sup> / <sub>16</sub>	3 <sup>3</sup> / <sub>16</sub>	222WB	205/20
223C6	75'-8 <sup>1</sup> / <sub>4</sub>	75'-9 <sup>15</sup> / <sub>16</sub>	5 <sup>5</sup> / <sub>16</sub>	2	77'-9 <sup>1</sup> / <sub>4</sub>	2'-11	2'-10 <sup>15</sup> 11 <sup>11</sup> / <sub>16</sub>	13 <sup>13</sup> / <sub>16</sub>	7 <sup>7</sup> / <sub>8</sub>	7 <sup>7</sup> / <sub>8</sub>	7 <sup>7</sup> / <sub>8</sub>	13 <sup>13</sup> / <sub>16</sub>	3 <sup>3</sup> / <sub>4</sub>	11 <sup>11</sup> / <sub>16</sub>	9 <sup>9</sup> / <sub>16</sub>	7 <sup>7</sup> / <sub>16</sub>	1 <sup>1</sup> / <sub>4</sub>	1 <sup>1</sup> / <sub>8</sub>	224WB	205/26

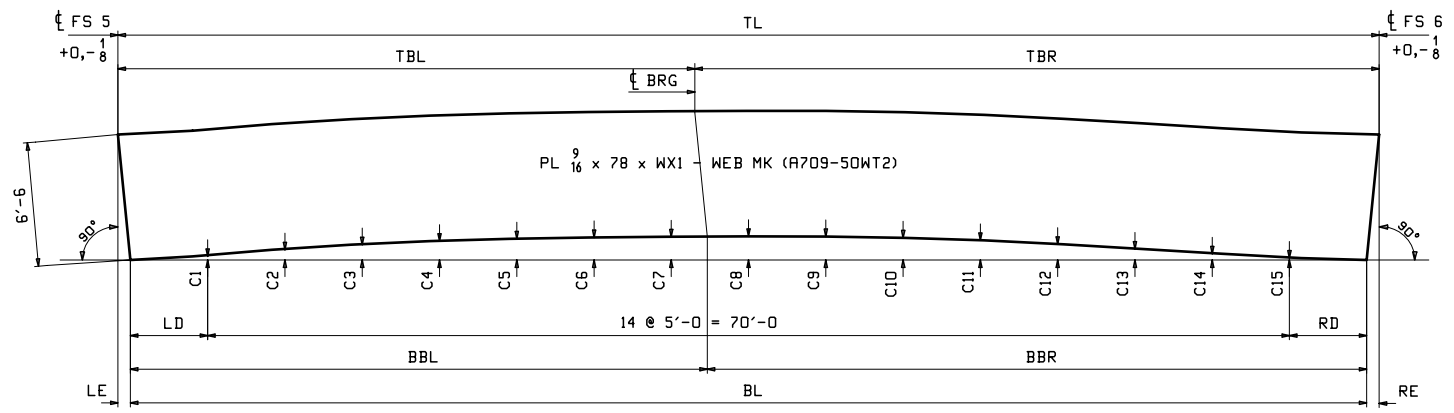


CAMBER DIAGRAM FOR 218B5 & 220D5

MARK	TL	BL	LE	RE	WX1	TBL	TBR	BBL	BBR	LD	RD	C1	C2	C3	C4	C5	C6	C7	C8	C9	C10	C11	C12	C13	C14	C15	WEB MK	PG/LINE
218B5	75'-1 <sup>1</sup> / <sub>16</sub>	75'-0 <sup>3</sup> / <sub>8</sub>	7 <sup>7</sup> / <sub>16</sub>	1 <sup>1</sup> / <sub>4</sub>	75'-1 <sup>1</sup> / <sub>16</sub>	34'-1 <sup>1</sup> / <sub>8</sub>	40'-11 <sup>15</sup> / <sub>16</sub>	34'-2 <sup>1</sup> / <sub>2</sub>	40'-9 <sup>7</sup> / <sub>8</sub>	2'-6 <sup>3</sup> / <sub>16</sub>	2'-6 <sup>3</sup> / <sub>16</sub>	1 <sup>1</sup> / <sub>8</sub>	7 <sup>7</sup> / <sub>16</sub>	5 <sup>5</sup> / <sub>8</sub>	3 <sup>3</sup> / <sub>4</sub>	13 <sup>13</sup> / <sub>16</sub>	7 <sup>7</sup> / <sub>8</sub>	15 <sup>15</sup> / <sub>16</sub>	15 <sup>15</sup> / <sub>16</sub>	7 <sup>7</sup> / <sub>8</sub>	3 <sup>3</sup> / <sub>4</sub>	5 <sup>5</sup> / <sub>8</sub>	7 <sup>7</sup> / <sub>16</sub>	1 <sup>1</sup> / <sub>4</sub>	1 <sup>1</sup> / <sub>16</sub>	218WB	205/28	
220D5	83'-1 <sup>1</sup> / <sub>8</sub>	83'-0 <sup>5</sup> / <sub>16</sub>	7 <sup>7</sup> / <sub>16</sub>	3 <sup>3</sup> / <sub>8</sub>	83'-1 <sup>1</sup> / <sub>8</sub>	37'-3 <sup>13</sup> / <sub>16</sub>	45'-9 <sup>5</sup> / <sub>16</sub>	37'-5 <sup>1</sup> / <sub>16</sub>	45'-7 <sup>1</sup> / <sub>4</sub>	6'-6 <sup>3</sup> / <sub>16</sub>	6'-6 <sup>1</sup> / <sub>8</sub>	3 <sup>3</sup> / <sub>8</sub>	5 <sup>5</sup> / <sub>8</sub>	13 <sup>13</sup> / <sub>16</sub>	1	1 <sup>1</sup> / <sub>16</sub>	1 <sup>1</sup> / <sub>8</sub>	1 <sup>1</sup> / <sub>16</sub>	1 <sup>1</sup> / <sub>16</sub>	1 <sup>1</sup> / <sub>16</sub>	1 <sup>1</sup> / <sub>16</sub>	1 <sup>1</sup> / <sub>16</sub>	15 <sup>15</sup> / <sub>16</sub>	3 <sup>3</sup> / <sub>4</sub>	9 <sup>9</sup> / <sub>16</sub>	5 <sup>5</sup> / <sub>16</sub>	220WB	205/8

NOTES:  
 1. FOR GENERAL NOTES SEE DRAWING GNI.  
 2. T2 DENOTES MATERIAL SUBJECT TO CHARPY V-NOTCH TEST AT H FREQ. FOR ZONE 2

NO.	DATE	REMARKS	BY
REVISIONS			
2-EAU CLAIRE, WI 3-WAUSAU, WI 4-PALATKA, FL			
STRUCTURE	RAMP P OVER IR-74 WB, IR-75 & RAMP E - UNIT 2		
LOCATION	CINCINNATI, OH (HAMILTON COUNTY) STA. 230+22.98		
PROJECT NO.	HAM-75-3.84, PID NO. 104667, BRIDGE NO. HAM-74-19085		
ENGINEER	PRIME RE GROUP		
CONTRACTOR	WALSH GROUP		
WEB & FLANGE CUTTING			
ITEM	OPEN HOLES		
SURFACE PREP.	OPEN HOLES		
PAIN			
PRELIMINARY	DRAWN ELG 02/22/19	SHEET NO.	PLANT ORDER NO. FP. NO.
FOR APPROVAL	CHECKED WJL 04/10/19	180608	3 180608 20

ECD P1, Rev. 18, 2019 10:00:35 AM C:\Users\james.walsh\OneDrive\Documents\2019\180608\_1\_Rev.0

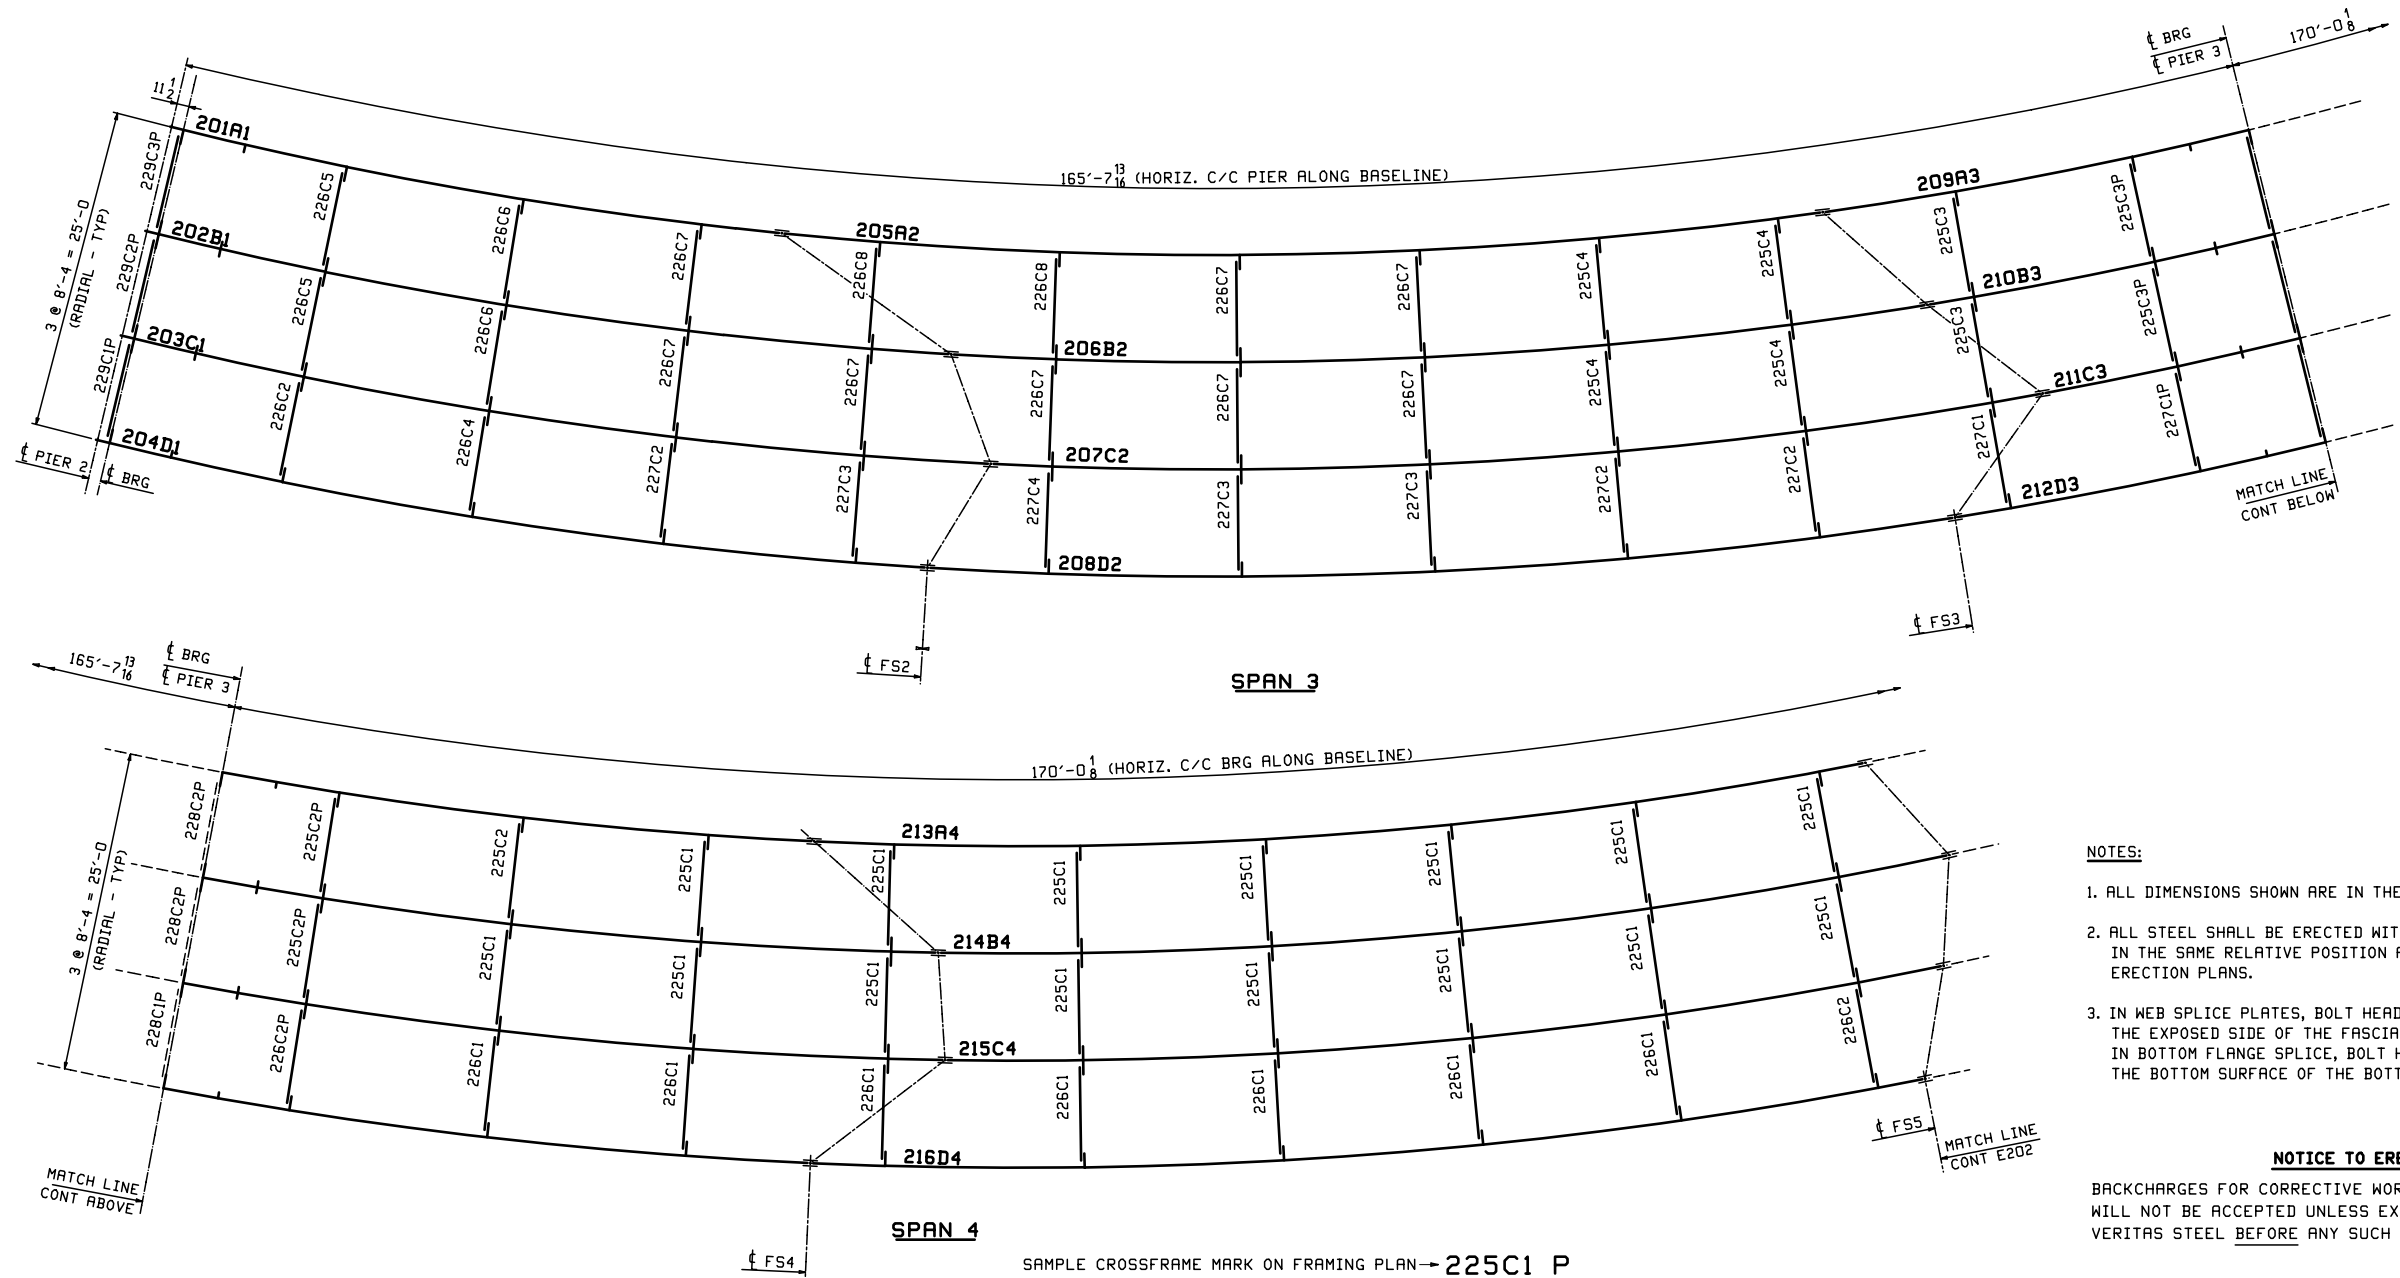

- NOTES:**
1. ALL DIMENSIONS SHOWN ARE IN THE HORIZONTAL PLANE.
  2. ALL STEEL SHALL BE ERECTED WITH THE SHIPPING MARK IN THE SAME RELATIVE POSITION AS SHOWN ON THE ERECTION PLANS.
  3. IN WEB SPLICE PLATES, BOLT HEADS SHALL BE PLACED ON THE EXPOSED SIDE OF THE FASCIA GIRDERS. IN BOTTOM FLANGE SPLICE, BOLT HEADS SHALL BE PLACED ON THE BOTTOM SURFACE OF THE BOTTOM FLANGE SPLICE PLATES.


**NOTICE TO ERECTOR**  
 BACKCHARGES FOR CORRECTIVE WORK OR REPLACED MATERIALS WILL NOT BE ACCEPTED UNLESS EXPRESSLY AUTHORIZED BY VERITAS STEEL BEFORE ANY SUCH COSTS ARE INCURRED.

WORK THIS SHEET WITH SHEET E202

**FRAMING PLAN**

SAMPLE CROSSFRAME MARK ON FRAMING PLAN → 225C1 P  
 CORRESPONDING STRUT AND DIAGONAL MARKS  
 STRUT MARK → 225C1AP  
 DIAGONAL MARK → 225C1BP  
 DIAGONAL MARK → 225C1CP

SHEET NUMBER (VARIES) TYPICAL → P INDICATES PRIME COATED MEMBER  
 SUFFIX (SEE DETAILS BELOW FOR PLACEMENT)  
 FRAME NUMBER (VARIES)

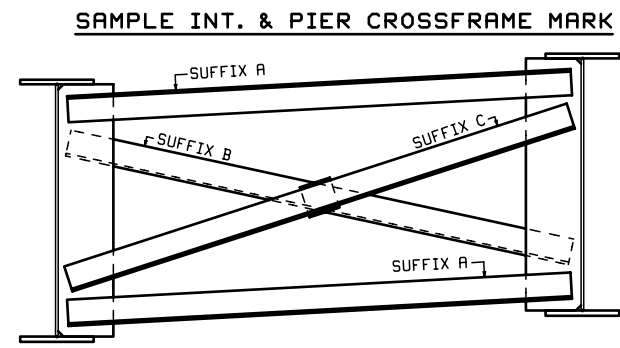


**INT CROSSFRAME MARK LOCATION**  
 (LOOKING UP-STATION)


INDEX OF SHEETS			
E201 & E202	FRAMING PLAN	BD201 - BD202	SHOP ASSEMBLY
GNI	GENERAL NOTES	FB201	FIELD BOLTS
P1	PAINT NOTES	SB201	SHIPPING BOLTS
TD201 - TD203	TYPICAL LAYOUTS	X201 - X204	FIELD SPLICE DETAILS
WS201 & WS202	CALCULATION PLAN	X205 - X207	GIRDER STANDARDS
BG201 - BG209	CAMBER/FLANGE DIAGRAMS	201 - 224	GIRDER DETAILS
R201	RADIOGRAPH SHEET	225 - 228	INT./PIER CROSSFRAMES
		229 & 230	END CROSSFRAMES

NO.	DATE	REMARKS	BY
REVISIONS			
STRUCTURE: RAMP P OVER IR-74 WB, IR-75 & RAMP E - UNIT 2 LOCATION: CINCINNATI, OH (HAMILTON COUNTY) STA. 230+22.98 PROJECT NO.: HAM-75-3.84, PID NO. 104667, BRIDGE NO. HAM-74-19085 ENGINEER: PRIME AE GROUP CONTRACTOR: WALSH GROUP			
FRAMING PLAN			
ITEM: _____			
SURFACE PREP: _____ OPEN HOLES _____			
PAINT: _____			
PRELIMINARY	DRAWN	DPS 03/25/19	SHEET NO.
FOR APPROVAL	CHECKED	WJL 04/18/19	E201
		PLANT	ORDER NO.
		3	180608
		FF. NO.	



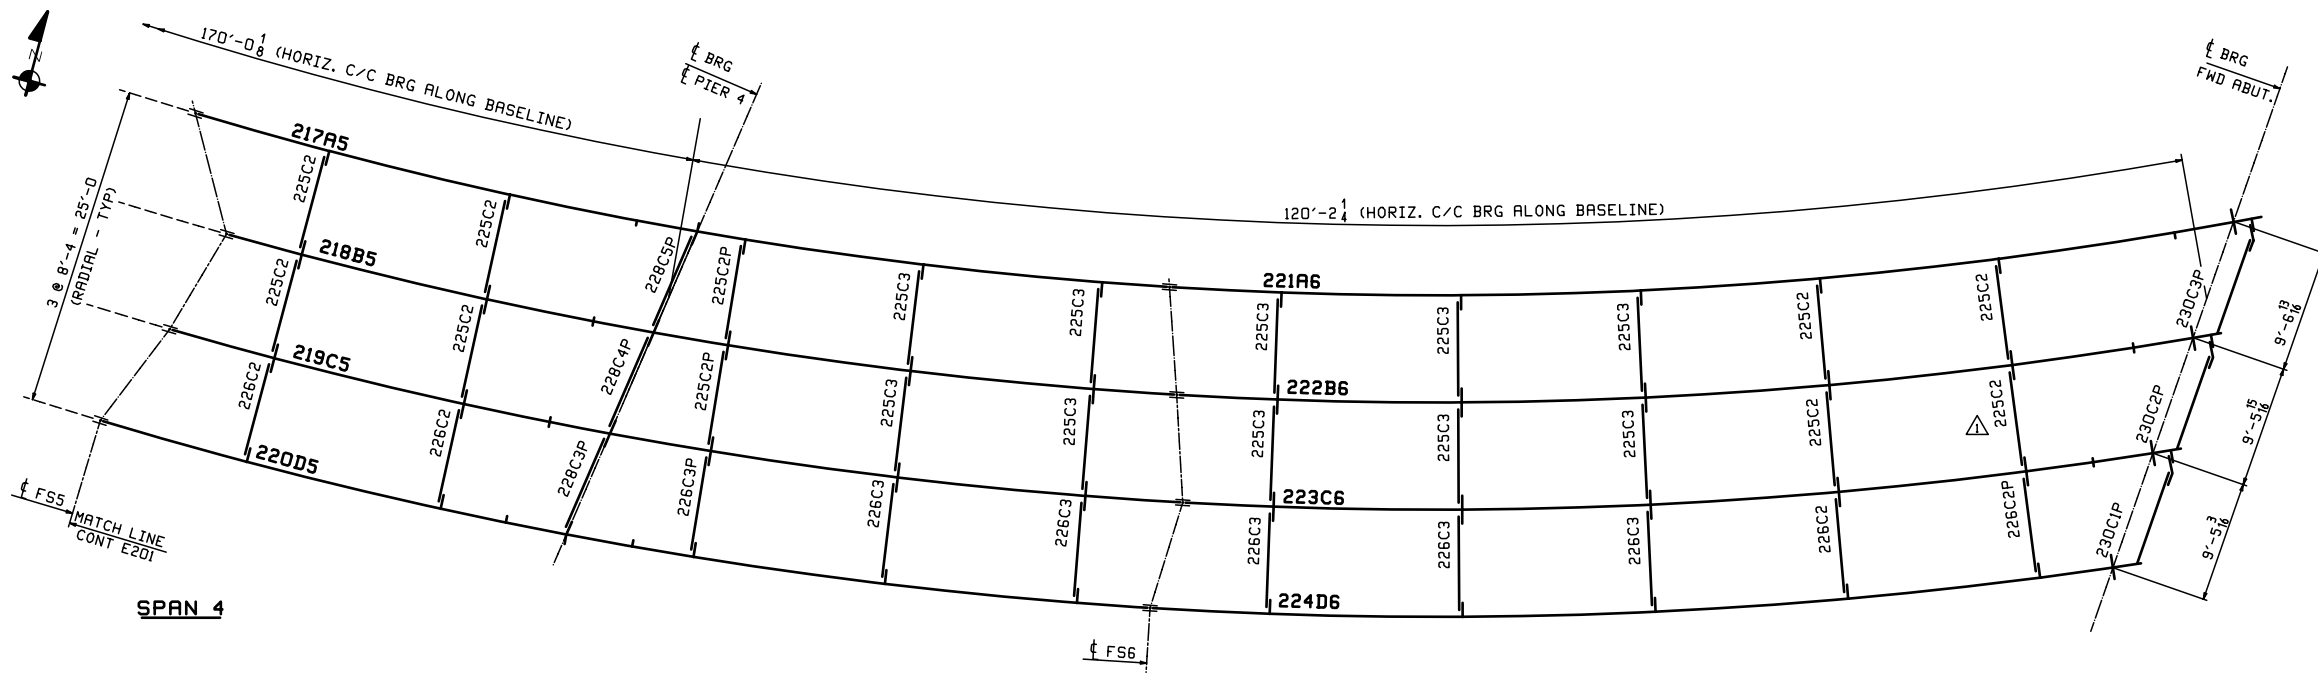


**FRAMING PLAN**

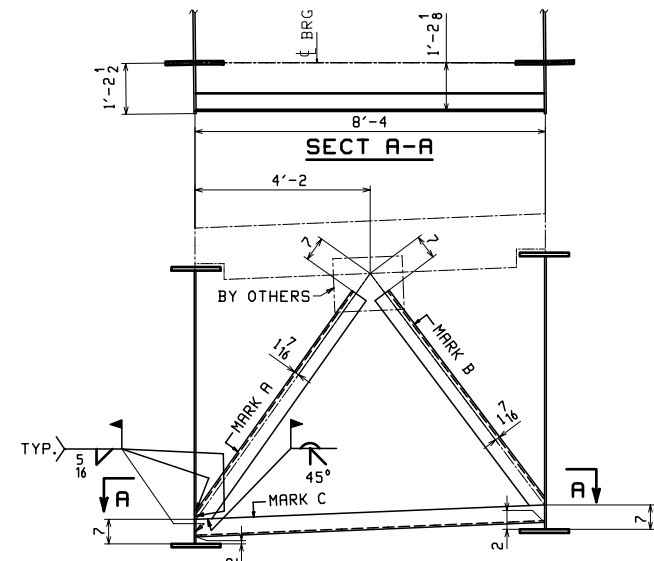

**END CROSSFRAME LAYOUT @ PIER 2**  
(LOOKING UP-STATION)

TERMINATE ALL WELDS  $\frac{1}{4} \pm \frac{1}{8}$ " FROM PLATE EDGES

MARK	MARK "A"	MARK "B"	MARK "C"
229C1P	229C1AP	229C1BP	229C1CP
229C2P	229C2AP	229C2BP	229C2CP
229C3P	229C3AP	229C3BP	229C3CP

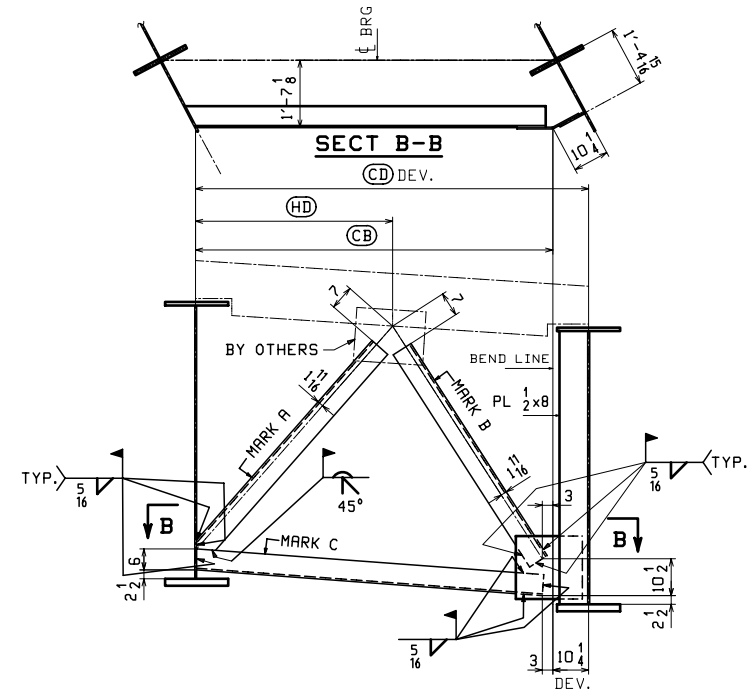

**END CROSSFRAME LAYOUT @ FORWARD ABUTMENT**  
(LOOKING BACKSTATION)  
(DEVELOPED)

TERMINATE ALL WELDS  $\frac{1}{4} \pm \frac{1}{8}$ " FROM PLATE EDGES


MARK	MARK "A"	MARK "B"	MARK "C"	(CD)	(CB)	(HD)
230C1P	230C1AP	230C1BP	230C1CP	9'-4"	8'-5 <sup>3</sup> / <sub>4</sub> "	4'-8 <sup>5</sup> / <sub>8</sub> "
230C2P	230C2AP	230C2BP	230C2CP	9'-4 <sup>11</sup> / <sub>16</sub> "	8'-6 <sup>7</sup> / <sub>16</sub> "	4'-9"
230C3P	230C3AP	230C3BP	230C3CP	9'-5 <sup>3</sup> / <sub>16</sub> "	8'-6 <sup>15</sup> / <sub>16</sub> "	4'-9 <sup>7</sup> / <sub>16</sub> "

WORK THIS SHEET WITH SHEET E201

5/13/19		REVISED CROSSFRAME MARK	DPS/
NO.	DATE	REMARKS	BY
REVISIONS			
STRUCTURE RAMP P OVER IR-74 WB, IR-75 & RAMP E - UNIT 2			
LOCATION CINCINNATI, OH (HAMILTON COUNTY) STA. 230+22.98			
PROJECT NO. HAM-75-3.84, PID NO. 104667, BRIDGE NO. HAM-74-19085			
ENGINEER PRIME AE GROUP			
CONTRACTOR WALSH GROUP			
FRAMING PLAN			
ITEM	SURFACE PREP. OPEN HOLES		
PAIN			
PRELIMINARY	DRAWN	DPS 03/25/19	SHEET NO. PLANT ORDER NO. FF. NO.
FOR APPROVAL	CHECKED		E202 3 18060B


DATE: 05/13/19 11:20:00 AM  
 FILE: \\s01\proj\18060B\18060B-24\CD01.dwg  
 PLOT: 05/13/19 11:20:00 AM



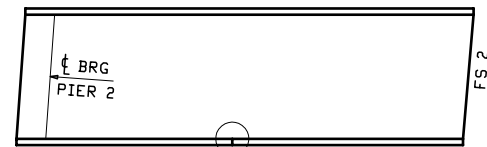


GIRDER	TEST	FILM NO.
203C1	TEN	

**DIAGRAM FOR 203C1**

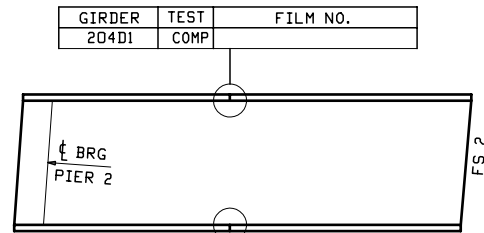


GIRDER	TEST	FILM NO.
204D1	TEN	

**DIAGRAM FOR 204D1**

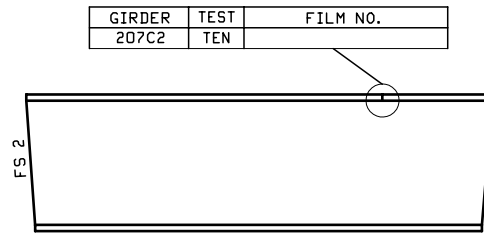

GIRDER	TEST	FILM NO.
207C2	TEN	


**DIAGRAM FOR 207C2**

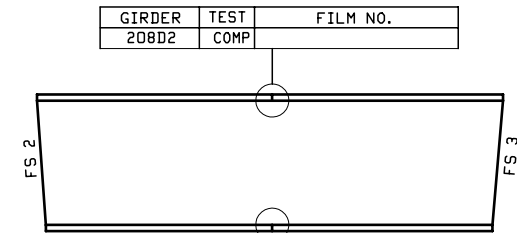

GIRDER	TEST	FILM NO.
208D2	COMP	

GIRDER	TEST	FILM NO.
208D2	TEN	


**DIAGRAM FOR 208D2**

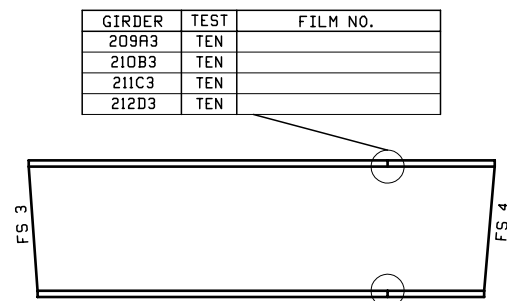

GIRDER	TEST	FILM NO.
209A3	TEN	
210B3	TEN	
211C3	TEN	
212D3	TEN	

GIRDER	TEST	FILM NO.
209A3	COMP	
210B3	COMP	
211C3	COMP	
212D3	COMP	

**DIAGRAM FOR 209A3, 210B3, 211C3, 212D3**

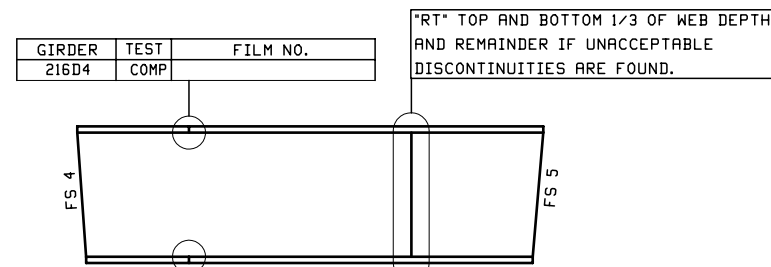


GIRDER	TEST	FILM NO.
216D4	COMP	

GIRDER	TEST	FILM NO.
216D4	TEN	

GIRDER	TEST	FILM NO.
216D4	TOP	
	BTM	

**DIAGRAM FOR 216D4**

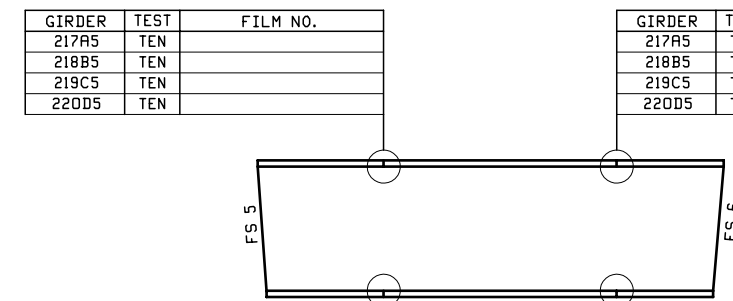

GIRDER	TEST	FILM NO.
217A5	TEN	
218B5	TEN	
219C5	TEN	
220D5	TEN	


GIRDER	TEST	FILM NO.
217A5	TEN	
218B5	TEN	
219C5	TEN	
220D5	TEN	

GIRDER	TEST	FILM NO.
217A5	COMP	
218B5	COMP	
219C5	COMP	
220D5	COMP	

GIRDER	TEST	FILM NO.
217A5	COMP	
218B5	COMP	
219C5	COMP	
220D5	COMP	

**DIAGRAM FOR 217A5, 218B5, 219C5, 220D5**

**GENERAL NOTES:**  
 RADIOGRAPHY SHALL BE DONE IN ACCORDANCE WITH THE SPECIAL PROVISIONS, STANDARD SPECIFICATIONS AND CURRENT A.W.S. D1.5


NO.	DATE	REMARKS	BY
REVISIONS			
			
STRUCTURE <u>RAMP P OVER IR-74 WB, IR-75 &amp; RAMP E - UNIT 2</u>			
LOCATION <u>CINCINNATI, OH (HAMILTON COUNTY) STA. 230+22.98</u>			
PROJECT NO. <u>HAM-75-3.84, PID NO. 104667, BRIDGE NO. HAM-74-19085</u>			
ENGINEER <u>PRIME AE GROUP</u>			
CONTRACTOR <u>WALSH GROUP</u>			
RADIOGRAPH SHEET			
ITEM _____			
SURFACE PREP. _____ OPEN HOLES _____			
PAINT _____			
PRELIMINARY	DRAWN <u>DPS 04/02/19</u>	SHEET NO. <u>R201</u>	PLANT <u>3</u> ORDER NO. <u>18060B</u>
FOR APPROVAL	CHECKED <u>WJL 04/18/19</u>		

S.43750


FIELD BOLT LIST								A325 Type 3 BOLTS			WASHER CODE	PIECES CONNECTED AND REMARKS
LINE	NO. REQ'D.	BOLT DIA.	BOLT LEN.	BOLTS /CONN.	# OF CONN.	GRIP	THICKNESS OF PCS. CONNECTED					
1											FIELD SPLICE 5,6 @ G1-3,	
2											2 @ G1-2, 4 @ G2	
3	54	7/8	4	6	9	2 1/2	11/16	1	13/16	2	Top Flg Splice	
4	36	7/8	2 3/4	4	9	1 5/8	3/8	9	3/8	2	Web Splice	
5	54	7/8	5	6	9	3 7/8	1 5/16	1	1 1/8	2	Btm Flg Splice	
6												
7											FIELD SPLICE 3 @ G2	
8	6	7/8	5	6	1	3 3/4	11/16	2	13/16	2	Top Flg Splice	
9	4	7/8	2 3/4	4	1	1 5/8	3/8	9	3/8	2	Web Splice	
10	6	7/8	6	6	1	4 9/16	1 5/16	2 8/8	1 1/8	2	Btm Flg Splice	
11												
12											FIELD SPLICE 5 @ G4	
13	6	7/8	4 1/4	6	1	2 3/4	11/16	1 1/4	13/16	2	Top Flg Splice	
14	4	7/8	2 3/4	4	1	1 5/8	3/8	9	3/8	2	Web Splice	
15	6	7/8	5 1/2	6	1	3 15/16	1 5/16	1 1/2	1 1/8	2	Btm Flg Splice	
16												
17											FIELD SPLICE 3 @ G1	
18	6	7/8	5 1/2	6	1	3 3/4	11/16	2 1/4	13/16	2	Top Flg Splice	
19	4	7/8	2 3/4	4	1	1 5/8	3/8	9	3/8	2	Web Splice	
20	6	7/8	6 1/2	6	1	4 15/16	1 5/16	2 1/2	1 1/8	2	Btm Flg Splice	
21												
22											FIELD SPLICE 4 @ G1	
23	6	7/8	4	6	1	2 1/2	11/16	1	13/16	2	Top Flg Splice	
24	4	7/8	2 3/4	4	1	1 5/8	3/8	9	3/8	2	Web Splice	
25	6	7/8	5 1/2	6	1	3 15/16	1 5/16	1 3/8	1 1/8	2	Btm Flg Splice	
26												
27											FIELD SPLICE 2 @ G4	
28	6	7/8	6	6	1	4 1/2	1 5/8	2	1 3/8	2	Top Flg Splice	
29	4	7/8	3 1/4	4	1	1 11/16	5/8	9	5/8	2	Web Splice	
30	6	7/8	7	6	1	5 1/2	1 5/8	2 1/2	1 3/8	2	Btm Flg Splice	
31												
32											FIELD SPLICE 3 @ G3	
33	6	7/8	7	6	1	5 1/4	1 3/8	2 1/2	1 3/8	2	Top Flg Splice	
34	4	7/8	3 1/4	4	1	1 13/16	5/8	9	5/8	2	Web Splice	
35	6	7/8	7	6	1	5 1/2	1 5/8	2 1/2	1 3/8	2	Btm Flg Splice	
36												
37											FIELD SPLICE 4 @ G3	
38	6	7/8	5 1/2	6	1	4	1 3/8	1 1/4	1 3/8	2	Top Flg Splice	
39	4	7/8	3 1/4	4	1	1 13/16	5/8	9	5/8	2	Web Splice	
40	6	7/8	6	6	1	4 1/4	1 5/8	1 1/4	1 3/8	2	Btm Flg Splice	
41												
42											FIELD SPLICE 4 @ G4	
43	6	7/8	6 1/2	6	1	4 5/8	1 3/8	1 3/8	1 3/8	2	Top Flg Splice	
44	4	7/8	3 1/4	4	1	1 13/16	5/8	9	5/8	2	Web Splice	
45	6	7/8	6 1/2	6	1	5	1 5/8	2	1 3/8	2	Btm Flg Splice	
46												
47											FIELD SPLICE 3 @ G4	
48	6	7/8	6 1/2	6	1	5	1 5/8	2 1/2	1 3/8	2	Top Flg Splice	
49	4	7/8	3 1/2	4	1	1 15/16	11/16	9	11/16	2	Web Splice	
50	6	7/8	7	6	1	5 1/2	1 5/8	2 1/2	1 3/8	2	Btm Flg Splice	
51												
52											FIELD SPLICE 2 @ G3	
53	6	7/8	4	6	1	2 1/2	11/16	1	13/16	2	Top Flg Splice	
54	4	7/8	2 3/4	4	1	1 5/8	3/8	9	3/8	2	Web Splice	
55	6	7/8	6	6	1	4 3/4	1 5/16	1 3/4	1 1/8	2	Btm Flg Splice	
56												
57											FIELD SPLICE 6 @ G4	
58	6	7/8	4	6	1	2 1/2	11/16	1	13/16	2	Top Flg Splice	
59	4	7/8	2 3/4	4	1	1 5/8	3/8	9	3/8	2	Web Splice	
60	6	7/8	6	6	1	4 7/8	1 5/16	2	1 1/8	2	Btm Flg Splice	

WASHER CODES  
2: 2 Hard Flat Washers

LINE	SHIP MARK	NO. OF PCS.	ASS'Y MARK	MATERIAL				REMARKS
				SHAPE	LENGTH FT. IN.	MATERIAL SPEC.	ITEM NO.	
1				SHIPPING BOLTS				EXACT COUNT
2		60	bog7	7/8 # MB	0 2 3/4	A307	213 4	ZINC-PLATED
3		16	bom7	7/8 # MB	0 3 1/4	A307	213 6	ZINC-PLATED
4		4	bom7	7/8 # MB	0 3 1/2	A307	213 7	ZINC-PLATED
5		72	bdt7	7/8 # MB	0 4	A307	213 9	ZINC-PLATED
6		6	bav7	7/8 # MB	0 4 1/4	A307	213 10	ZINC-PLATED
7		60	bfa7	7/8 # MB	0 5	A307	213 13	ZINC-PLATED
8		24	bfc7	7/8 # MB	0 5 1/2	A307	213 15	ZINC-PLATED
9		30	bff7	7/8 # MB	0 6	A307	213 17	ZINC-PLATED
10		24	bfg7	7/8 # MB	0 6 1/2	A307	213 18	ZINC-PLATED
11		24	bfk7	7/8 # MB	0 7	A307	213 19	ZINC-PLATED
12		320	hc7	7/8 # HEX NUT		A563	213 26	ZINC-PLATED
13		640	wc7	STD. WASH FOR 7/8 # BPLT		F436	213 28	ZINC-PLATED
14								
15								
16								
17								
18								
19								
20								

NO.	DATE	REMARKS	BY
REVISIONS			
			
STRUCTURE		RAMP P OVER IR-74 WB, IR-75 & RAMP E - UNIT 2	
LOCATION		CINCINNATI, OH (HAMILTON COUNTY) STA. 230+22.98	
PROJECT NO.		HAM-75-3.84, PID NO. 104667, BRIDGE NO. HAM-74-19085	
ENGINEER		PRIME RE GROUP	
CONTRACTOR		WALSH GROUP	
SHIPPING BOLTS			
ITEM			
SURFACE PREP.			
PAINT			
PRELIMINARY	DRAWN	DPS 04/19/19	SHEET NO. 3
FOR APPROVAL	CHECKED	WJL 04/18/19	SB201 180608


E:\0 - New Proj 2019\10181933.DWG  
 C:\Users\j\AppData\Local\Temp\1\10181933.DWG

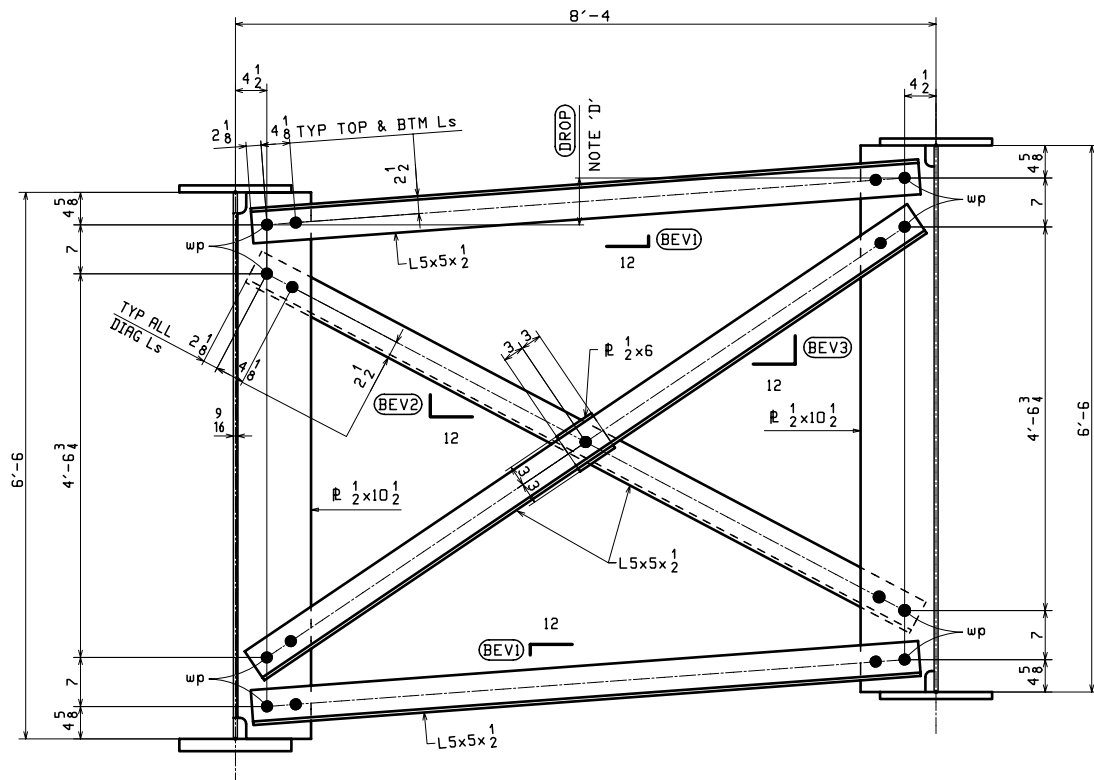

**INT CROSSFRAME CF2**  
(LOOKING UP-STATION)

TYPE	(DROP)	(BEV1)	(BEV2)	(BEV3)
INT CF2	5 5/8	3/4	6 1/2	7 15/16
	5 15/16	13/16	6 7/16	8
	6 1/4	13/16	6 3/8	8 1/16
	6 9/16	7/8	6 3/8	8 1/16

NOTE D:  
- DROP VARIES IN MAGNITUDE - SEE "WS" SHEETS.

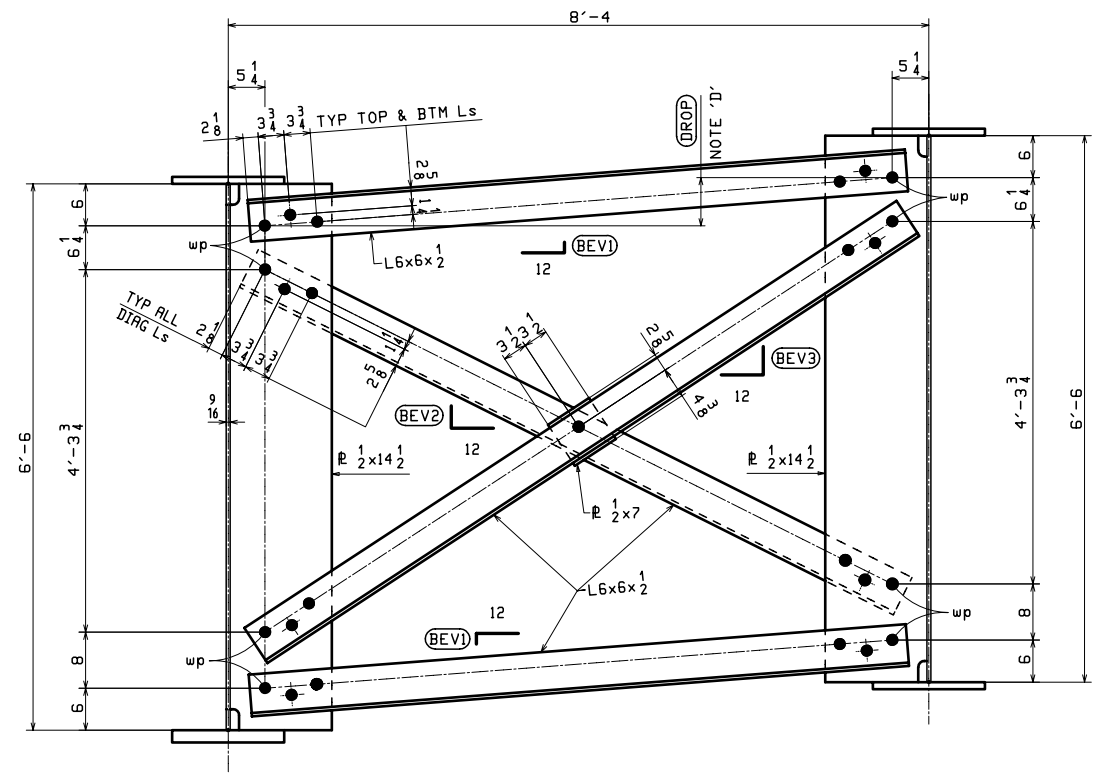


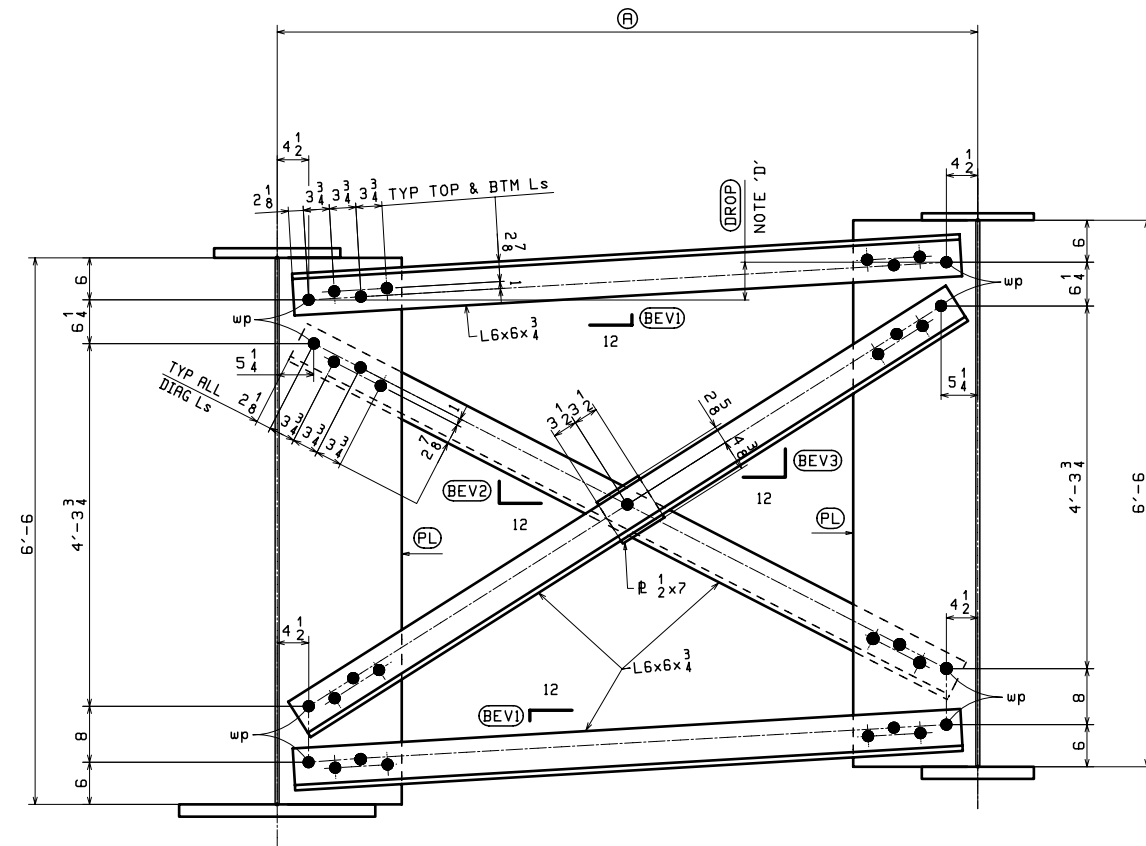
**INT CROSSFRAME CF3**  
(LOOKING UP-STATION)

TYPE	(DROP)	(BEV1)	(BEV2)	(BEV3)
INT CF3	4 6/8	9/16	6 3/8	7 1/2
	4 7/16	5/8	6 5/16	7 9/16
	4 3/4	5/8	6 5/16	7 9/16
	5	11/16	6 1/4	7 5/8
	5 3/4	3/4	6 3/16	7 11/16
	6 1/4	13/16	6 1/8	7 3/4
	6 13/16	15/16	6	7 7/8
	7 1/8	15/16	6	7 7/8

- NOTES:
- CROSSFRAMES & CONN. PLATES SHALL BE ASTM A709-50W.
  - STRUT & CONN. PLATE MATERIAL SHALL MEET CHARPY V-NOTCH TESTING REQUIREMENTS.
  - FIELD BOLTS SHALL BE 1 1/4" Ø ASTM A490.
  - HOLES SHALL BE 1 9/16" Ø (OVS).

**\*\* NOTE \*\***  
THE PURPOSE OF THIS DRAWING IS TO COORDINATE GEOMETRIC CONTROL INFORMATION AND CONNECTION SPACING. THIS DWG IS SUBMITTED FOR INFORMATION ONLY & IS NOT INTENDED FOR SHOP FABRICATION. DETAIL DWGS WILL SHOW ALL WELDING AND DIMENSIONS REQ'D FOR FABRICATION.

NO.	DATE	REMARKS	BY
REVISIONS			
			
STRUCTURE	RAMP P OVER IR-74 WB, IR-75 & RAMP E - UNIT 2		
LOCATION	CINCINNATI, OH (HAMILTON COUNTY) STR. 230+22.98		
PROJECT NO.	HAM-75-3.84, PID NO. 104667, BRIDGE NO. HAM-74-19085		
ENGINEER	PRIME AE GROUP		
CONTRACTOR	WALSH GROUP		
ITEM	LAYOUTS		
SURFACE PREP.	OPEN HOLES		
PAIN			
PRELIMINARY	DRAWN DPS 03/08/19	SHEET NO. TD201	PLANT ORDER NO. 3 180608
FOR APPROVAL	CHECKED WJL 04/08/19		



**INT & PIER CROSSFRAME CF4**  
(LOOKING UP-STATION)


TYPE	(PL)	(DROP)	(A)	(BEV1)	(BEV2)	(BEV3)
INT CF4	ϕ 1 1/2 x 17 1/2	4 13/16	8'-4"	5/8	6 1/4	7 1/2
		5 3/16	8'-4"	11/16	6 3/16	7 9/16
		5 1/2	8'-4"	3/4	6 1/8	7 5/8
		5 11/16	8'-4"	3/4	6 1/8	7 5/8
PIER 3 CF4	ϕ 1 5/8 x 17 1/2	4 9/16	8'-4"	5/8	6 1/4	7 1/2
		6	8'-4"	13/16	6 1/16	7 11/16
PIER 4 CF4	ϕ 1 5/8 x 17 1/2 ⚠	5 1/16	8'-6 1/2"	5/8	6 1/16	7 3/8
		6 9/16	8'-6 5/8"	13/16	5 13/16	7 9/16
		9 9/16	8'-6 13/16"	13/16	5 13/16	7 1/2

NOTE D:  
- DROP VARIES IN MAGNITUDE - SEE "WS" SHEETS.

- NOTES:
- CROSSFRAMES & CONN. PLATES SHALL BE ASTM A709-50W.
  - STRUT & CONN. PLATE MATERIAL SHALL MEET CHARPY V-NOTCH TESTING REQUIREMENTS.
  - FIELD BOLTS SHALL BE 1 1/4" Ø ASTM A490.
  - HOLES SHALL BE 1 9/16" Ø (OVS).

**\*\* NOTE \*\***  
THE PURPOSE OF THIS DRAWING IS TO COORDINATE GEOMETRIC CONTROL INFORMATION AND CONNECTION SPACING. THIS DWG IS SUBMITTED FOR INFORMATION ONLY & IS NOT INTENDED FOR SHOP FABRICATION. DETAIL DWGS WILL SHOW ALL WELDING AND DIMENSIONS REQ'D FOR FABRICATION.

NO.	DATE	REVISIONS	REMARKS	BY
⚠	04/24/19		REV'D BRG STIFF THICKNESS @ PIER 4	ECO WJL
<b>Veritas STEEL</b>				
2-EAU CLAIRE, WI 3-WAUSAU, WI 4-PALATKA, FL				
STRUCTURE RAMP P OVER IR-74 WB, IR-75 & RAMP E - UNIT 2				
LOCATION CINCINNATI, OH (HAMILTON COUNTY) STA. 230+22.98				
PROJECT NO. HAM-75-3.84, PID NO. 104667, BRIDGE NO. HAM-74-1908S				
ENGINEER PRIME AE GROUP				
CONTRACTOR WALSH GROUP				
LAYOUTS				
ITEM _____				
SURFACE PREP. _____ OPEN HOLES _____				
PAINT _____				
PRELIMINARY	DRAWN	DPS 03/13/19	SHEET NO.	PLANT
FOR APPROVAL	CHECKED	WJL 04/09/19	<b>TD202</b>	<b>3</b>
		ORDER NO.	FP. NO.	
		<b>180608</b>		

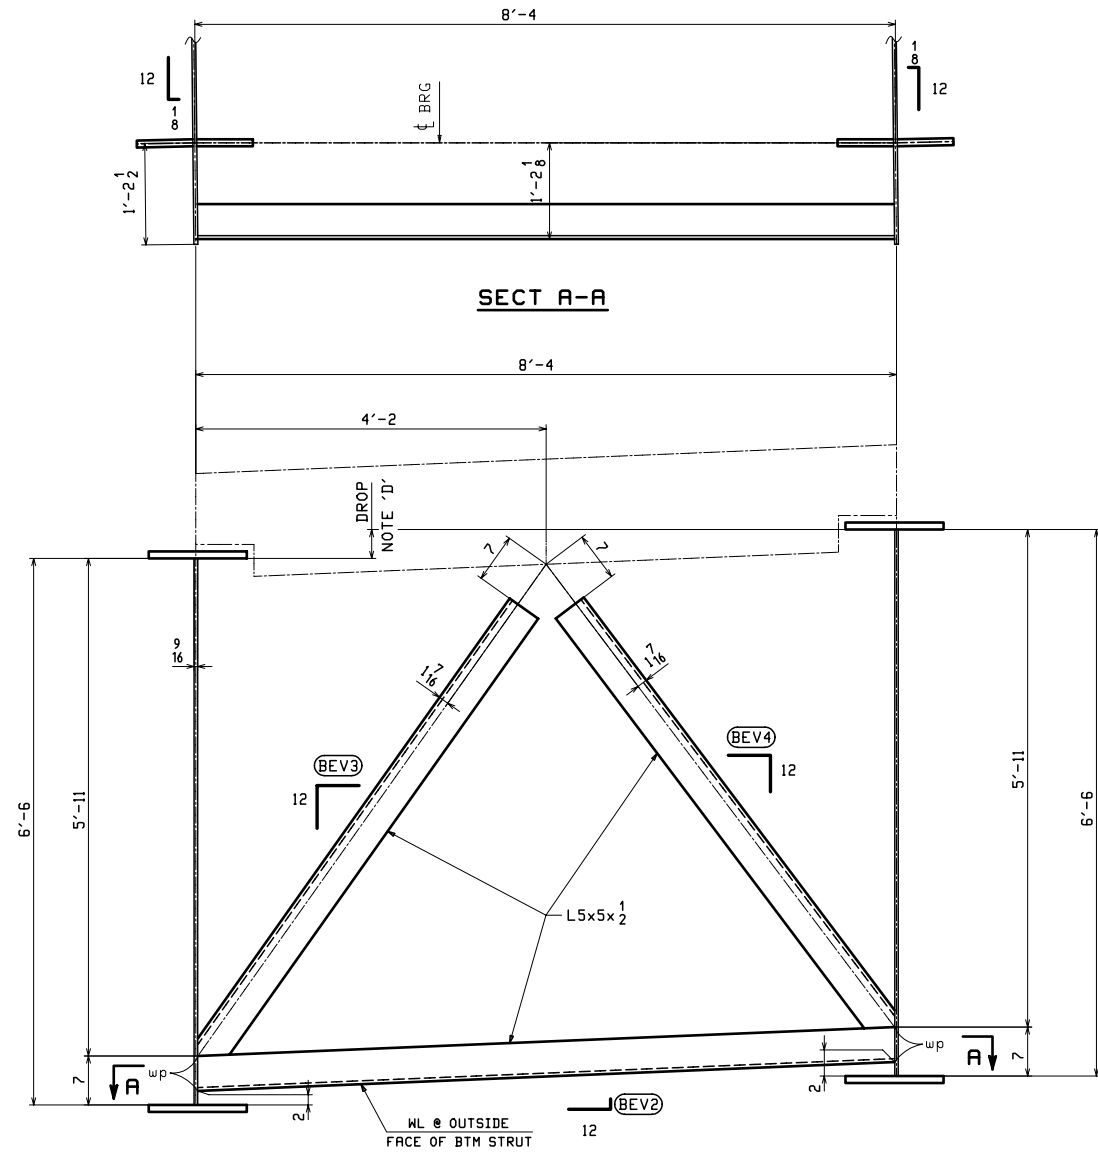


**END CROSSFRAME LAYOUT @ PIER 2**  
(LOOKING UP-STATION)

BETWEEN GIRDS	DROP	BEV2	BEV3	BEV4
1-2	5 1/16	5/8	5 5/16	8 15/16
2-3	5 3/8	5/8	5 5/16	9
3-4	4 1/8	1/2	5 3/8	7 7/8

NOTE D:  
- DROP VARIES IN MAGNITUDE - SEE "WS" SHEETS.

- NOTES:
- CROSSFRAMES & CONN. PLATES SHALL BE ASTM A709-50W.
  - STRUT & CONN. PLATE MATERIAL SHALL MEET CHARPY V-NOTCH TESTING REQUIREMENTS.


**\*\* NOTE \*\***  
THE PURPOSE OF THIS DRAWING IS TO COORDINATE GEOMETRIC CONTROL INFORMATION AND CONNECTION SPACING. THIS DWG IS SUBMITTED FOR INFORMATION ONLY & IS NOT INTENDED FOR SHOP FABRICATION. DETAIL DWGS WILL SHOW ALL WELDING AND DIMENSIONS REQ'D FOR FABRICATION.

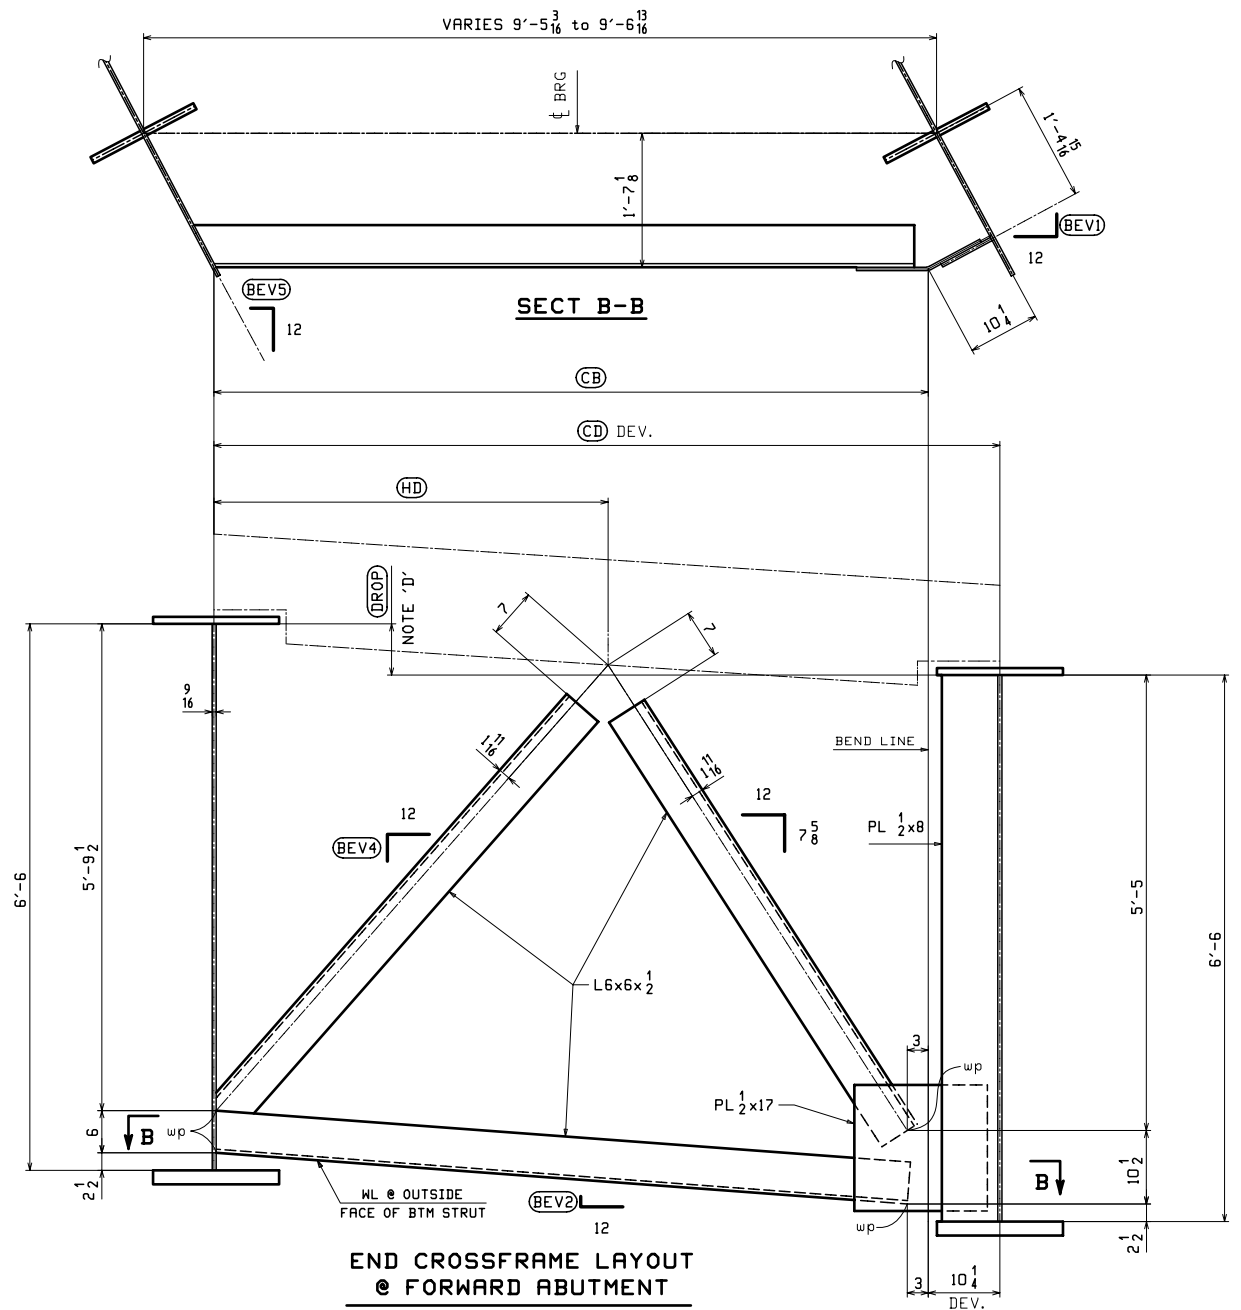

**END CROSSFRAME LAYOUT @ FORWARD ABUTMENT**  
(LOOKING BACKSTATION)  
(DEVELOPED)

BETWEEN GIRDS	DROP	CD	CB	HD	BEV1	BEV2	BEV4	BEV5
1-2	7 5/8	9'-5 3/16	8'-6 15/16	4'-9 7/16	6 7/8	15 1/16	10 13/16	6 11/16
2-3	7 9/16	9'-4 11/16	8'-6 7/16	4'-9	6 11/16	15 1/16	10 11/16	6 7/16
3-4	6	9'-4	8'-5 3/4	4'-8 5/8	6 7/16	3 4	10 1/2	6 4

NO.	DATE	REMARKS	BY
REVISIONS			
STRUCTURE: RAMP P OVER IR-74 WB, IR-75 & RAMP E - UNIT 2			
LOCATION: CINCINNATI, OH (HAMILTON COUNTY) STA. 230+22.98			
PROJECT NO.: HAM-75-3.84, PID NO. 104667, BRIDGE NO. HAM-74-19085			
ENGINEER: PRIME AE GROUP			
CONTRACTOR: WALSH GROUP			
LAYOUTS			
ITEM: _____			
SURFACE PREP: _____ OPEN HOLES _____			
PAINT: _____			
PRELIMINARY	DRAWN DPS 03/13/19	SHEET NO. TD203	PLANT ORDER NO. 3 180608
FOR APPROVAL	CHECKED WJL 04/10/19		

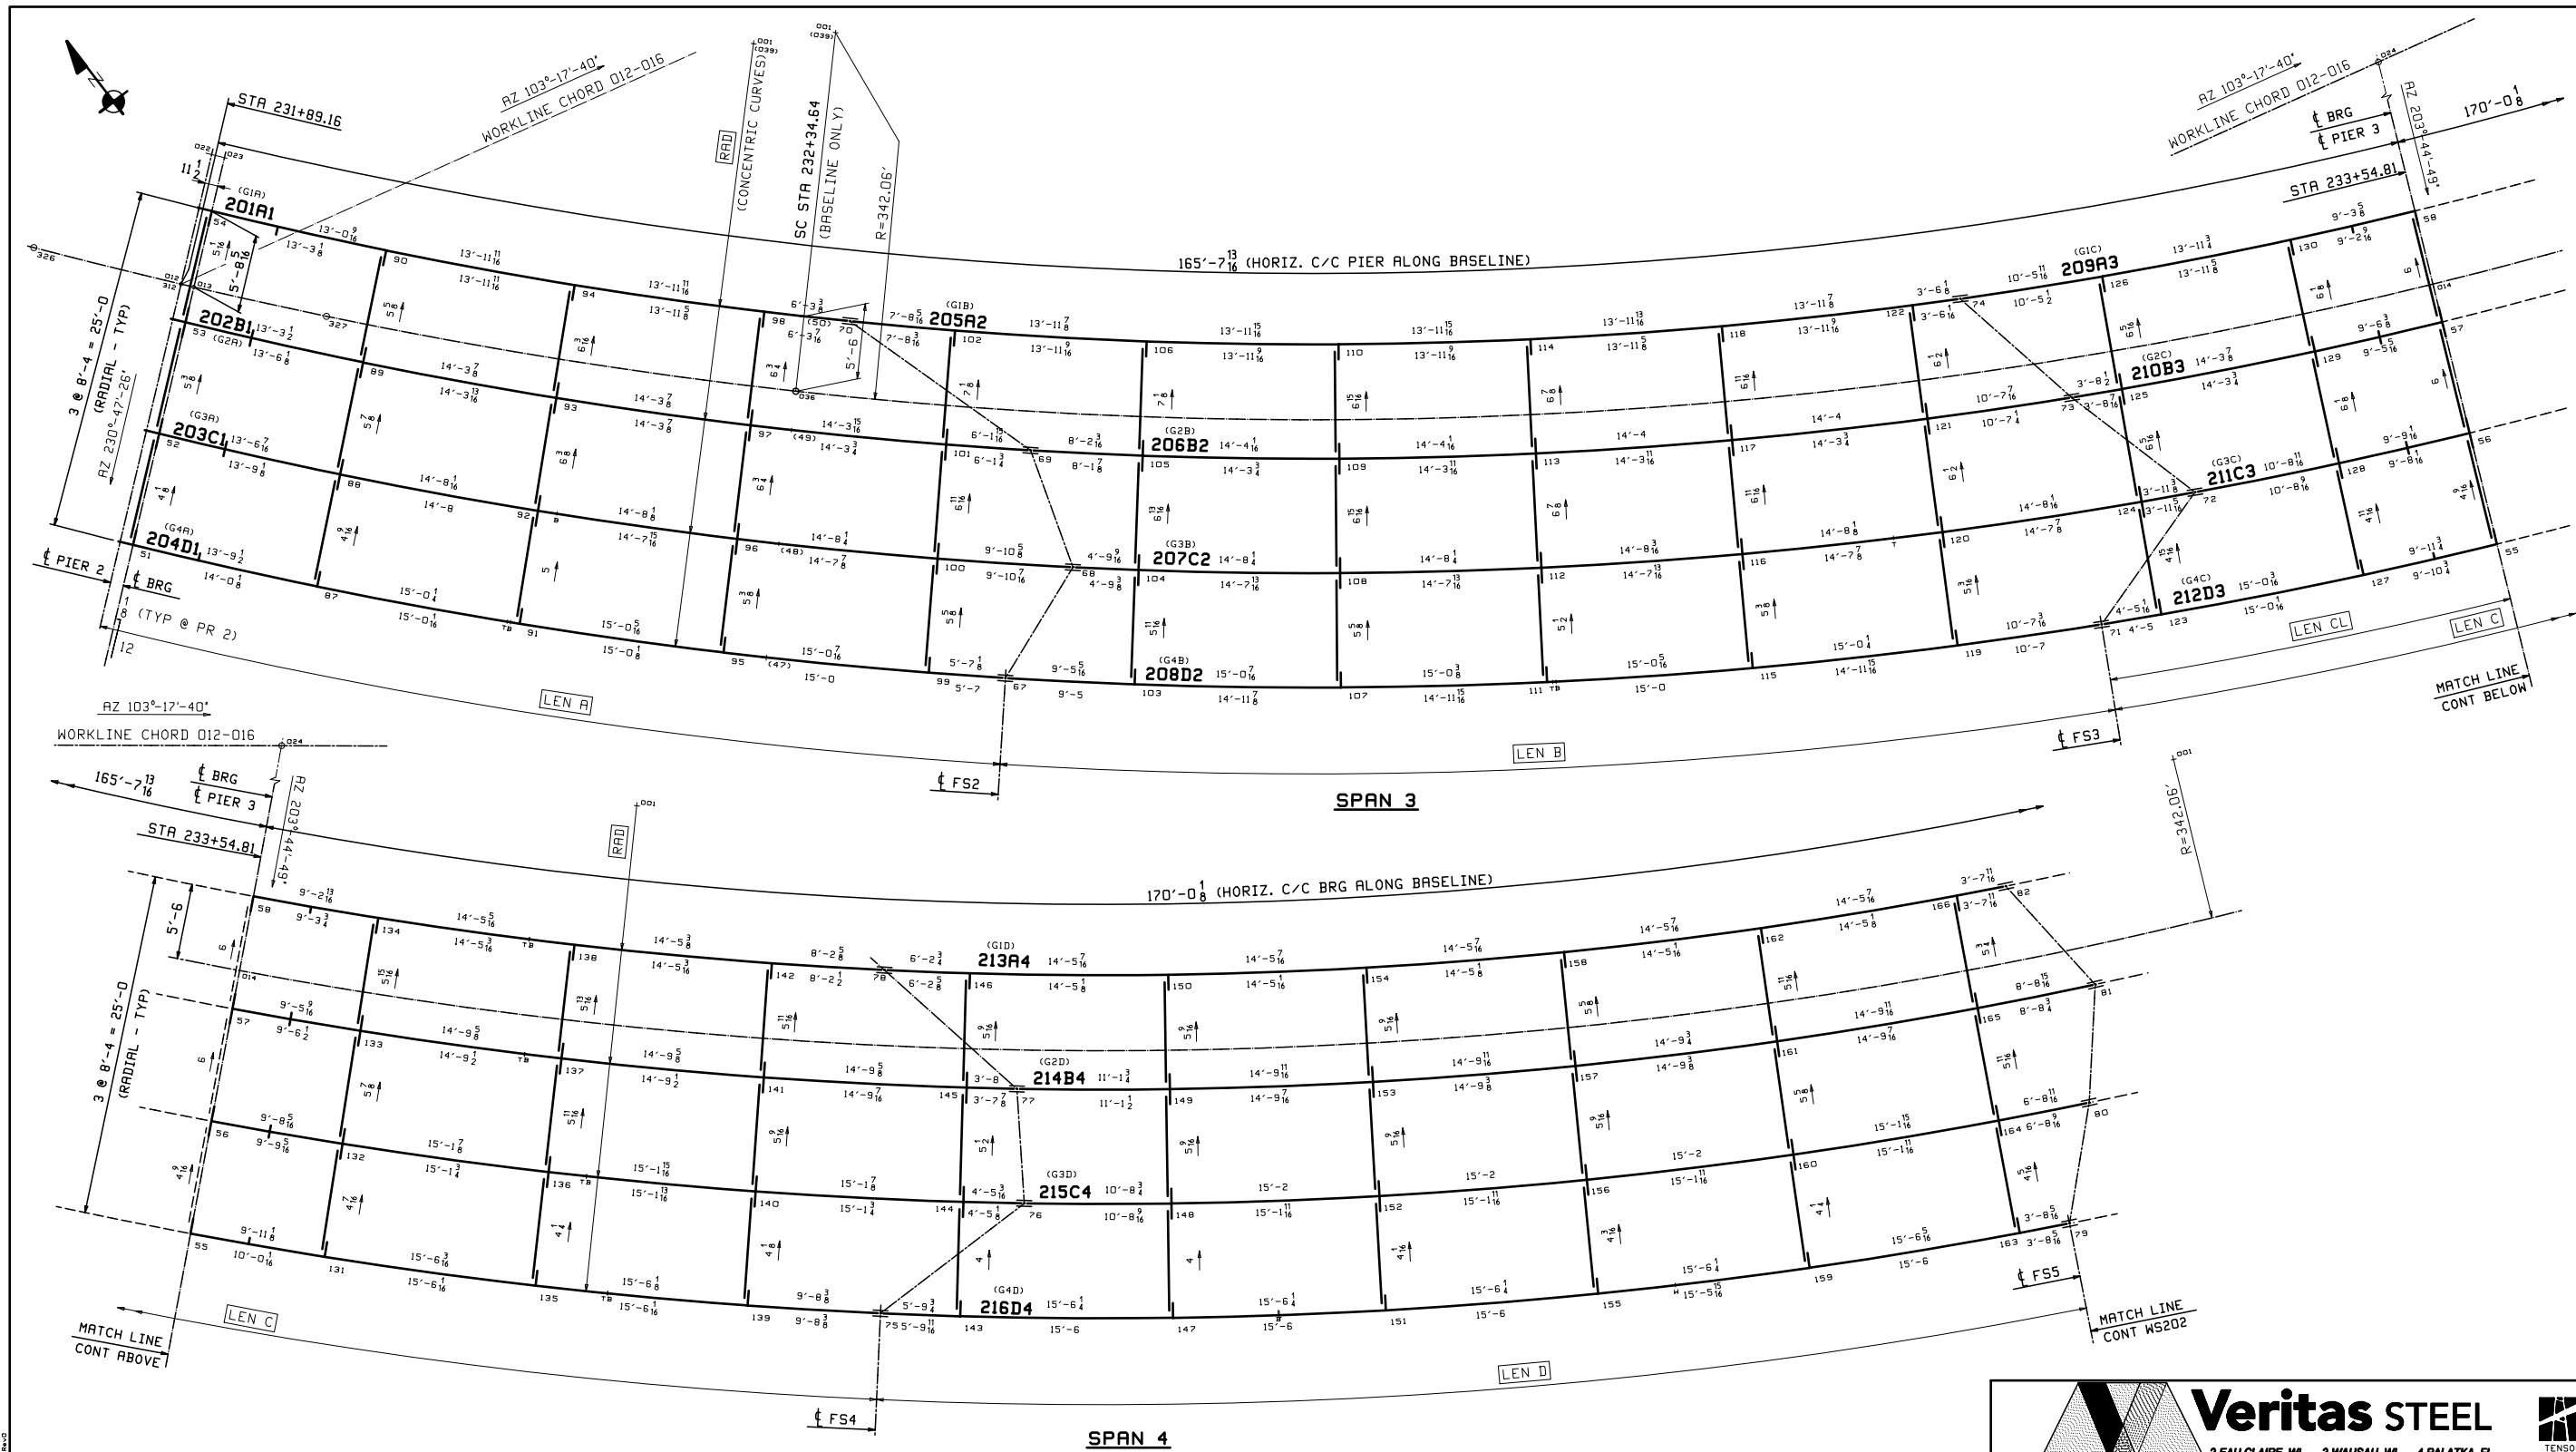

Line	SLOPING LENGTHS					GRADE		RADI
	LEN A	LEN B	LEN CL	LEN C	LEN D	PIER 2	PIER 3	
1	T	47'-3 1/8	81'-1 7/8	33'-9 1/16	80'-1 1/8	0.0327	0.0131	336'-6 3/4
	B	47'-5 7/8	81'-0 1/8	33'-7 11/16	80'-0 5/16			
2	T	62'-9 5/8	76'-1 1/4	27'-6 3/4	85'-1 1/8	0.0339	0.0128	344'-10 3/4
	B	62'-7 5/16	76'-0	27'-5 1/2	85'-0 5/16			
3	T	67'-5 1/2	82'-1 1/8	20'-5 1/4	80'-0 1/16	0.0343	0.0125	353'-2 3/4
	B	67'-7 3/8	81'-11 7/8	20'-4 5/8	80'-0 3/8			
4	T	64'-5 5/8	80'-1 5/8	29'-5	80'-0 1/16	0.0340	0.0122	361'-6 3/4
	B	64'-7 5/16	79'-11 3/4	29'-3 1/16	80'-0 3/8			

**\*\* NOTE \*\***  
 THE PURPOSE OF THIS DRAWING IS TO COORDINATE GEOMETRIC CONTROL INFORMATION. THIS DWG IS SUBMITTED FOR INFORMATION ONLY AND IS NOT INTENDED FOR SHOP FABRICATION.

- NOTES
- LONGITUDINAL DIMENSIONS ARE SLOPING ALONG TOP & BOT OF WEB WITH CORRECTIONS MADE FOR VERTICAL CURVE, GRADE & DL CAMBER (UN).
  - TRANSVERSE DIMENSIONS ARE IN A HORIZ. PLANE (UN).
  - DROP ARROW POINTS TOWARDS LOW END OF MEMBER.
  - ENDS OF GIRDERS AND BRG. STIFF'S ARE VERTICAL AFTER DL ROTATION.
  - CF STIFF, INT STIFF & FIELD SPLICES ARE NORMAL TO GRADE.
  - BOTT PT NUMBERS = TOP PT NUMBERS + 300.
  - FOR LAYOUTS SEE "TD" SHEETS.
  - COMBINE INT. CROSSFRAMES FOR DIFF IN DROPS OF +/- 1/8".
  - CROSSFRAME DROPS ARE CALCULATED IN THE STEEL DEAD LOAD POSITION.

**CALCULATION PLAN**

NO.	DATE	REMARKS	BY

2-EAU CLAIRE, WI 3-WAUSAU, WI 4-PALATKA, FL  
 TENSOR 3656-2

STRUCTURE	RAMP P OVER IR-74 WB, IR-75 & RAMP E - UNIT 2
LOCATION	CINCINNATI, OH (HAMILTON COUNTY) STA. 230+22.98
PROJECT NO.	HAM-75-3.84, PID NO. 104667, BRIDGE NO. HAM-74-19085
ENGINEER	PRIME AE GROUP
CONTRACTOR	WALSH GROUP


**CALCULATION PLAN**

ITEM	
SURFACE PREP.	OPEN HOLES
PAINT	

NO.	DATE	REMARKS	BY

PRELIMINARY	DRAWN	WL	03/13/19	SHEET NO.	PLANT	ORDER NO.	FP. NO.
FOR APPROVAL	CHECKED	RLA	03/19/19	WS201	3	180608	



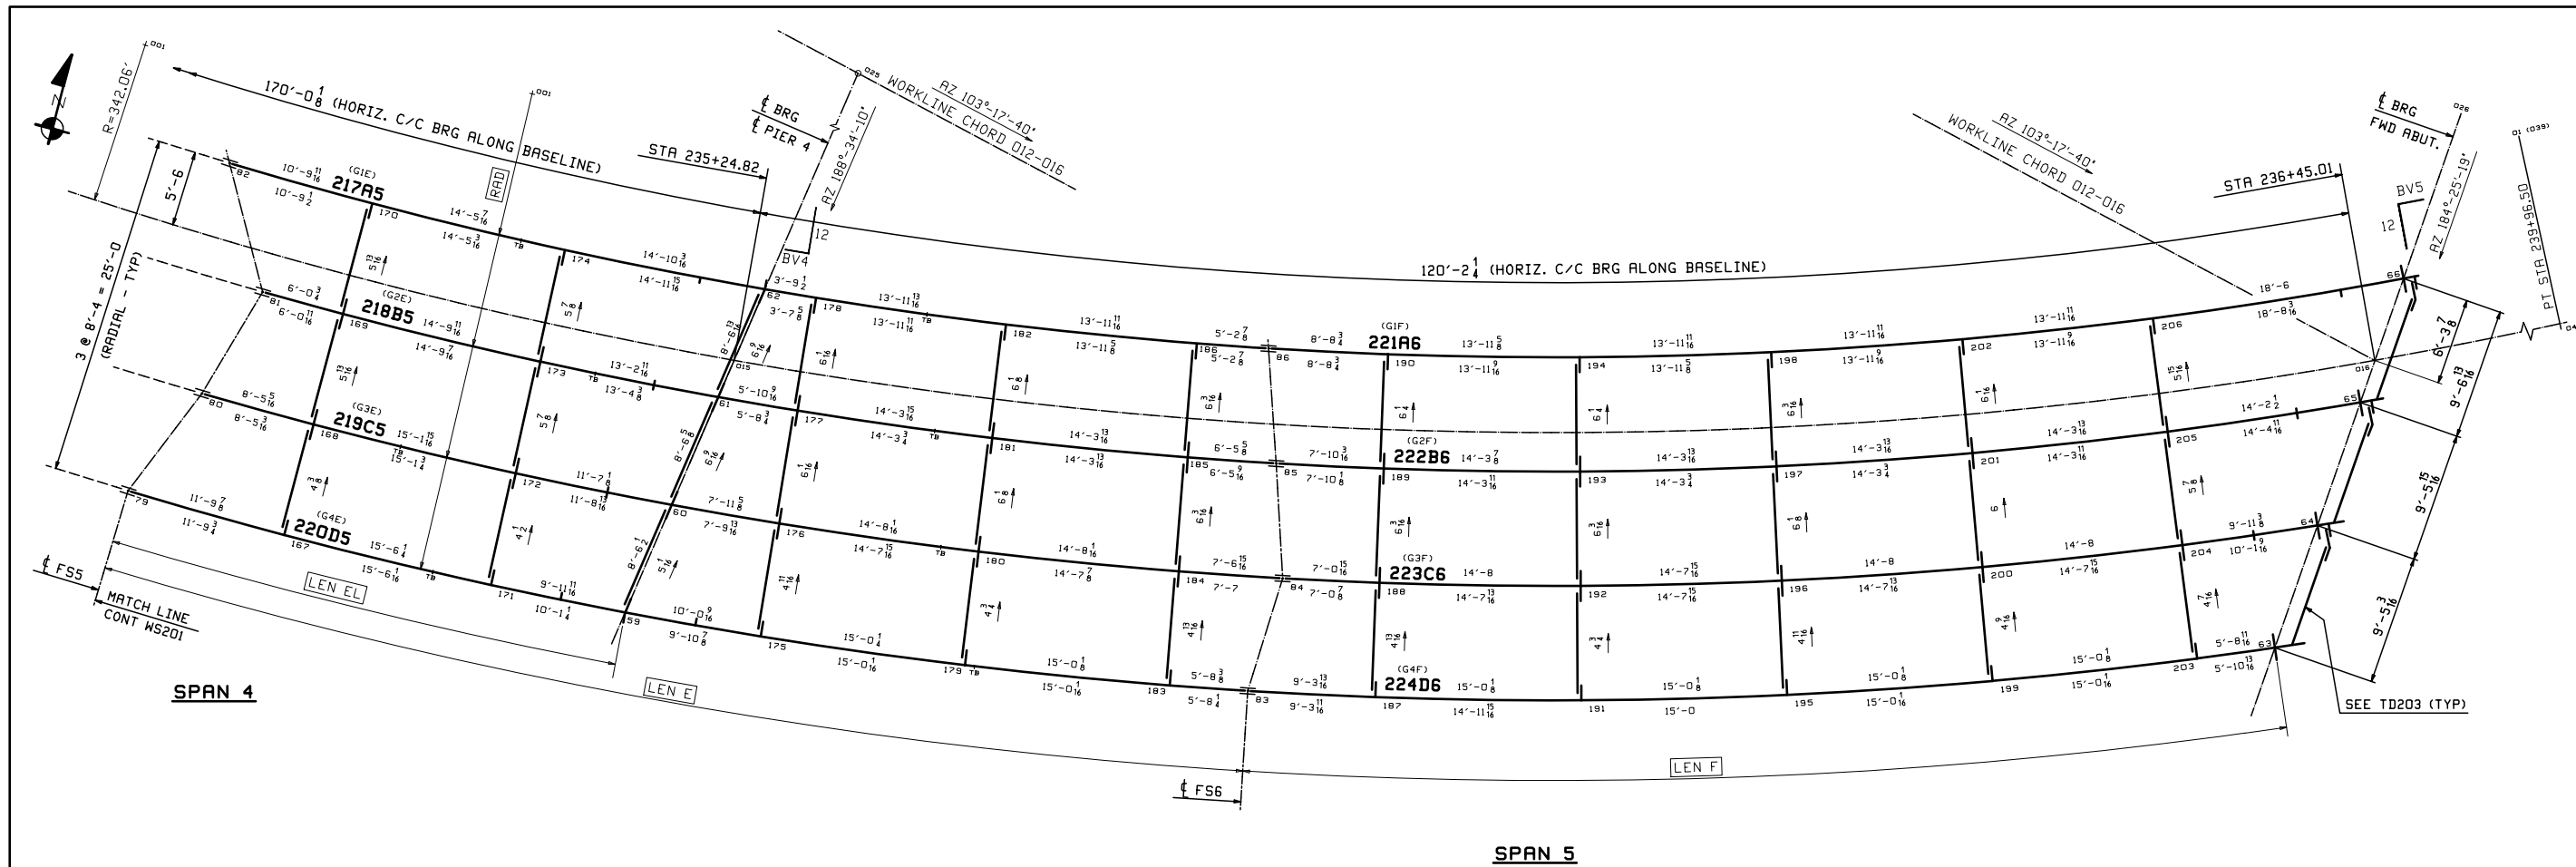


**CALCULATION PLAN**







Line	SLOPING LENGTHS			GRADE		RADII	BEVELS @ PIERS		
	LEN EL	LEN E	LEN F	PIER 4	F ABUT	RAD	BV4	BV5	
1	T 40'-1 <sup>5</sup> / <sub>16</sub>	77'-1 <sup>3</sup> / <sub>16</sub>	83'-1 <sup>7</sup> / <sub>16</sub>	-.0242	-.0294	336'-6 <sup>3</sup> / <sub>4</sub>	2 <sup>7</sup> / <sub>8</sub>	6 <sup>7</sup> / <sub>8</sub>	
	B 40'-2 <sup>0</sup> / <sub>16</sub>	77'-0 <sup>16</sup> / <sub>16</sub>	83'-3 <sup>1</sup> / <sub>16</sub>						
2	T 34'-1 <sup>1</sup> / <sub>8</sub>	75'-1 <sup>1</sup> / <sub>16</sub>	79'-4	-.0232	-.0287	344'-10 <sup>3</sup> / <sub>4</sub>	2 <sup>13</sup> / <sub>16</sub>	6 <sup>11</sup> / <sub>16</sub>	
	B 34'-2 <sup>2</sup> / <sub>16</sub>	75'-0 <sup>8</sup> / <sub>16</sub>	79'-5 <sup>15</sup> / <sub>16</sub>						
3	T 35'-2 <sup>3</sup> / <sub>8</sub>	80'-1 <sup>1</sup> / <sub>16</sub>	75'-8 <sup>1</sup> / <sub>16</sub>	-.0223	-.0281	353'-2 <sup>3</sup> / <sub>4</sub>	2 <sup>3</sup> / <sub>4</sub>	6 <sup>7</sup> / <sub>16</sub>	
	B 35'-3 <sup>2</sup> / <sub>16</sub>	80'-0 <sup>8</sup> / <sub>16</sub>	75'-9 <sup>15</sup> / <sub>16</sub>						
4	T 37'-3 <sup>13</sup> / <sub>16</sub>	83'-1 <sup>1</sup> / <sub>8</sub>	75'-1	-.0214	-.0274	361'-6 <sup>3</sup> / <sub>4</sub>	2 <sup>11</sup> / <sub>16</sub>	6 <sup>1</sup> / <sub>4</sub>	
	B 37'-5 <sup>1</sup> / <sub>16</sub>	83'-0 <sup>16</sup> / <sub>16</sub>	75'-2 <sup>5</sup> / <sub>16</sub>						

**\*\* NOTE \*\***  
 THE PURPOSE OF THIS DRAWING IS TO COORDINATE GEOMETRIC CONTROL INFORMATION. THIS DMG IS SUBMITTED FOR INFORMATION ONLY AND IS NOT INTENDED FOR SHOP FABRICATION.

- NOTES
1. LONGITUDINAL DIMENSIONS ARE SLOPING ALONG TOP & BOTT OF WEB WITH CORRECTIONS MADE FOR VERTICAL CURVE, GRADE & DL CAMBER (UN).
  2. TRANSVERSE DIMENSIONS ARE IN A HORIZ. PLANE (UN).
  3. DROP ARROW POINTS TOWARDS LOW END OF MEMBER.
  4. ENDS OF GIRDERS AND BRG. STIFF'S ARE VERTICAL AFTER DL ROTATION.
  5. CF STIFF, INT STIFF & FIELD SPLICES ARE NORMAL TO GRADE.
  6. BOTT PT NUMBERS =TOP PT NUMBERS + 300.
  7. FOR LAYOUTS SEE "TD" SHEETS.
  8. COMBINE INT. CROSSFRAMES FOR DIFF IN DROPS OF +/- 1/8.
  9. CROSSFRAME DROPS ARE CALCULATED IN THE STEEL DEAD LOAD POSITION.

NO.	DATE	REMARKS	BY
REVISIONS			
			
STRUCTURE	RAMP P OVER IR-74 WB, IR-75 & RAMP E - UNIT 2		
LOCATION	CINCINNATI, OH (HAMILTON COUNTY) STA. 230+22.98		
PROJECT NO.	HAM-75-3.84, PID NO. 104667, BRIDGE NO. HAM-74-19085		
ENGINEER	PRIME AE GROUP		
CONTRACTOR	WALSH GROUP		
CALCULATION PLAN			
ITEM	SURFACE PREP. _____ OPEN HOLES _____		
PRELIMINARY	DRAWN	WL 03/13/19	SHEET NO. PLANT ORDER NO. FP. NO.
FOR APPROVAL	CHECKED	RLA 03/19/19	WS202 3 180608

DWG: F:\\_Proj\_18\_2018\_04\4667\_PN\_Crossing\Drawings\2-240522\_1\_R.dwg  
 Date: 03/19/19 10:46:08 AM

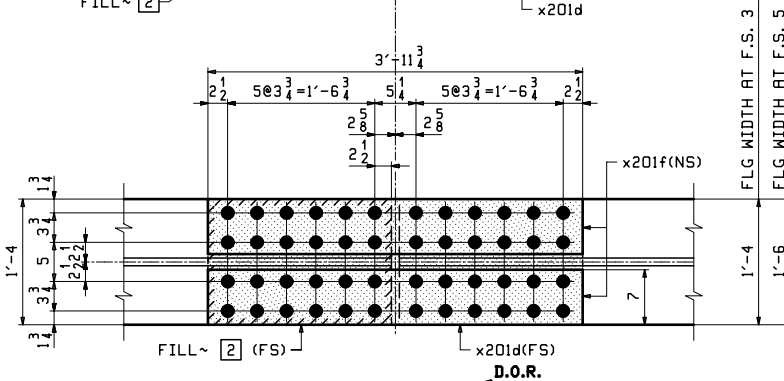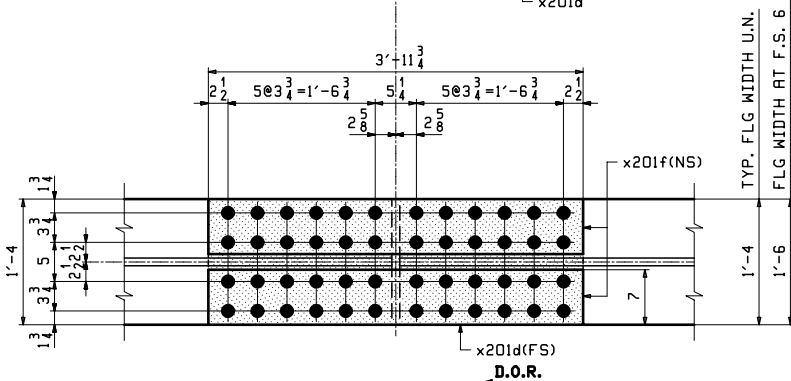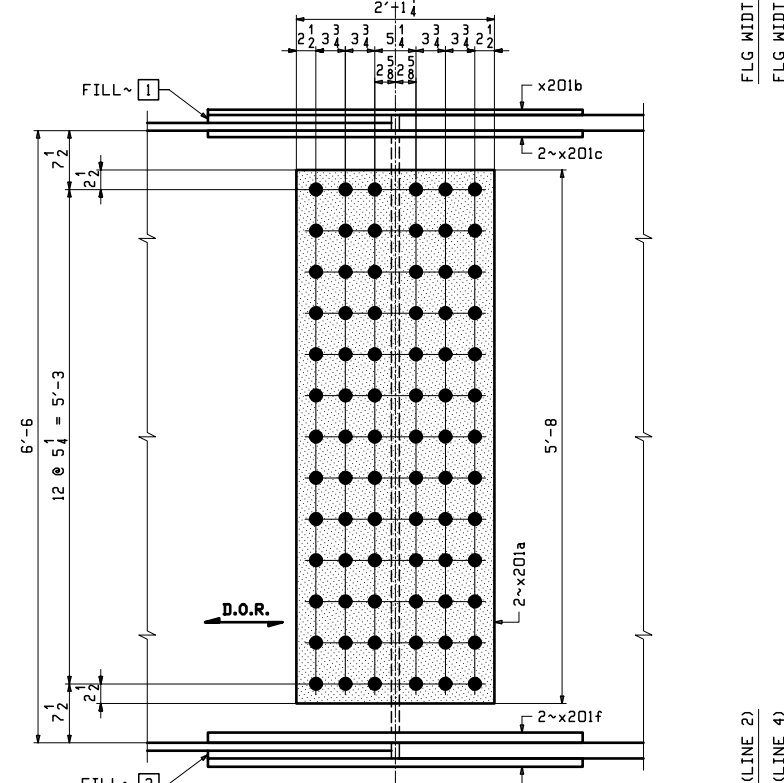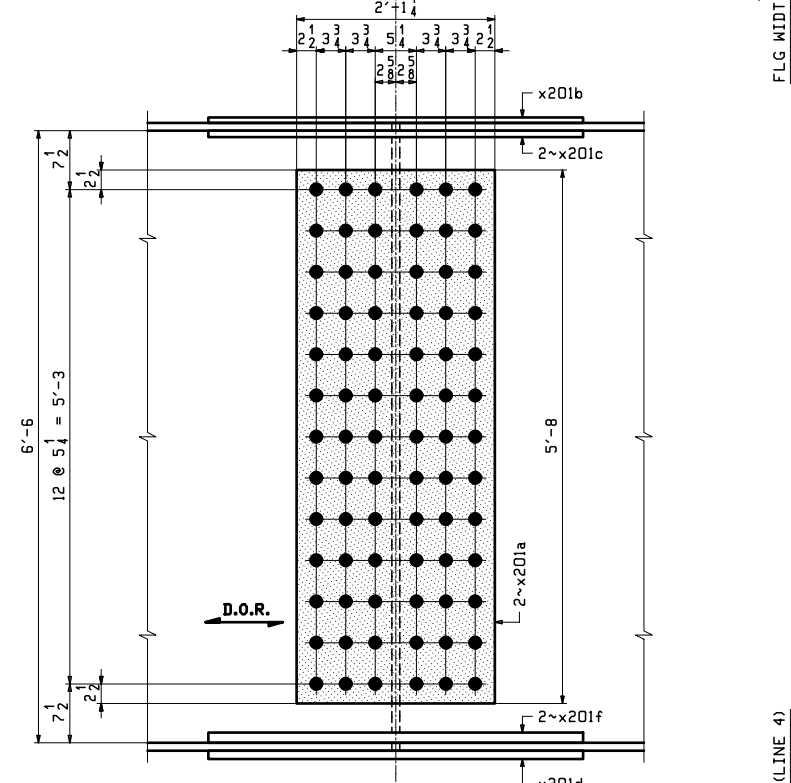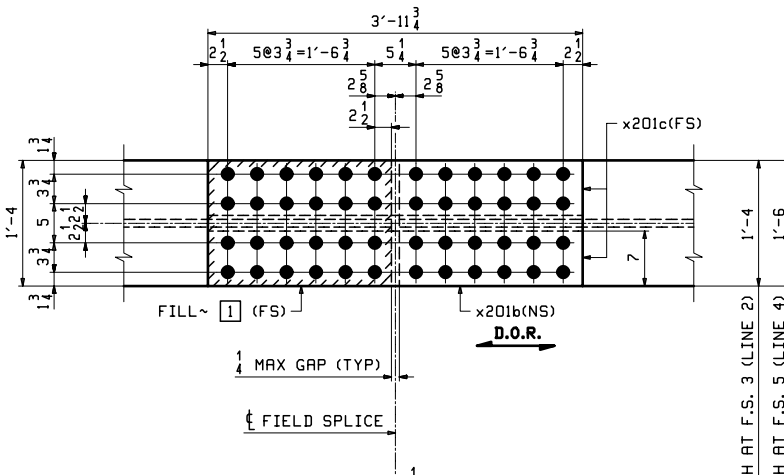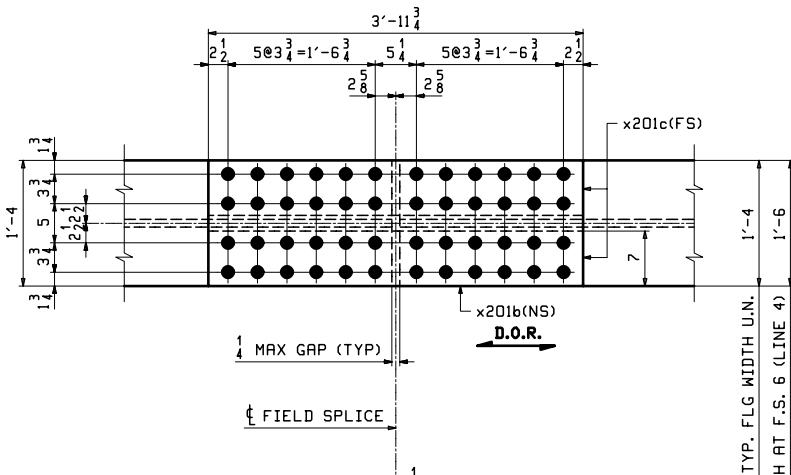

**4 ~ FIELD SPLICE DETAIL ~ X201M1 (PAINT AS NOTED)**  
 F.S. 2, 5 & 6 (LINE 1)  
 F.S. 6 (LINE 4)

**7 ~ FIELD SPLICE DETAIL ~ X201M2 (NO PAINT)**  
 F.S. 2, 5 & 6 (LINES 2 & 3)  
 F.S. 4 (LINE 2)

**ONE ~ FIELD SPLICE DETAIL ~ X201M3 (NO PAINT)**  
 F.S. 3 (LINE 2)

**ONE ~ FIELD SPLICE DETAIL ~ X201M4 (ROTATE 180°) (PAINT AS NOTED)**  
 F.S. 5 (LINE 4)

MARK	1	2
X201M3	x201g	x201k
X201M4	x201m	x201n




L	SHIP MARK	NO. OF PCS.	ASS'Y MARK	MATERIAL				REMARKS
				SHAPE	LENGTH FT. IN.	MATERIAL SPEC.	ITEM NO.	
1								
2	X201M1	4		FIELD SPLICE DETAIL				1161
3		8	x201a	PL 8x68	2 1/4	A709-50WT2	207-2	FP:31
4		4	x201b	PL 1/2x16	3 11/4	A709-50WT2	207-4	FP:31
5		8	x201c	PL 1/2x7	3 11/4	A709-50WT2	207-5	FP:31
6		4	x201d	PL 1/2x16	3 11/4	A709-50WT2	207-3	FP:31
7		8	x201f	PL 1/2x7	3 11/4	A709-50WT2	207-5	FP:31
8								
9	X201M2	7		FIELD SPLICE DETAIL				1161
10		14	x201a	PL 8x68	2 1/4	A709-50WT2	207-2	FP:31
11		7	x201b	PL 1/2x16	3 11/4	A709-50WT2	207-4	FP:31
12		14	x201c	PL 1/2x7	3 11/4	A709-50WT2	207-5	FP:31
13		7	x201d	PL 1/2x16	3 11/4	A709-50WT2	207-3	FP:31
14		14	x201f	PL 1/2x7	3 11/4	A709-50WT2	207-5	FP:31
15								
16	X201M3	1		FIELD SPLICE DETAIL				1390
17		2	x201a	PL 8x68	2 1/4	A709-50WT2	207-2	FP:31
18		1	x201b	PL 1/2x16	3 11/4	A709-50WT2	207-4	FP:31
19		2	x201c	PL 1/2x7	3 11/4	A709-50WT2	207-5	FP:31
20		1	x201d	PL 1/2x16	3 11/4	A709-50WT2	207-3	FP:31
21		2	x201f	PL 1/2x7	3 11/4	A709-50WT2	207-5	FP:31
22		1	x201g	PL 1x16	1 11/4	A709-50W	207-21	FILL FP:31
23		1	x201k	PL 1/2x16	1 11/4	A709-50W	207-23	FILL FP:31
24								
25	X201M4	1		FIELD SPLICE DETAIL				1202
26		2	x201a	PL 8x68	2 1/4	A709-50WT2	207-2	FP:31
27		1	x201b	PL 1/2x16	3 11/4	A709-50WT2	207-4	FP:31
28		2	x201c	PL 1/2x7	3 11/4	A709-50WT2	207-5	FP:31
29		1	x201d	PL 1/2x16	3 11/4	A709-50WT2	207-3	FP:31
30		2	x201f	PL 1/2x7	3 11/4	A709-50WT2	207-5	FP:31
31		1	x201m	PL 1x16	1 11/4	A709-50W	207-21	FILL FP:31
32		1	x201n	PL 10GA x 16	1 11/4	A606-4	207-32	FILL FP:31
33								

- DENOTES PRIME COAT PER SHEET P1 ON ALL SURFACES OF SPLICE PLATES, GIRDER WEB, AND GIRDER FLANGE.




**FOR SHOP USE ONLY**

- NOTES:  
 1. FOR GENERAL NOTES SEE SHEET GNI.  
 2. ALL FIELD SPLICE HOLES ARE **DA**.  
 3. **D.O.R.** - DENOTES DIRECTION OF MILL ROLLING.  
 4. T2 - DENOTES CHARPY V-NOTCH TESTING REQUIRED.

NO.	DATE	REMARKS	BY
REVISIONS			
STRUCTURE: RAMP P OVER IR-74 WB, IR-75 & RAMP E - UNIT 2 LOCATION: CINCINNATI, OH (HAMILTON COUNTY) STA. 230+22.98 PROJECT NO.: HAM-75-3.84, PID NO. 104667, BRIDGE NO. HAM-74-19085 ENGINEER: PRIME AE GROUP CONTRACTOR: WALSH GROUP			
FIELD SPLICE DETAIL			
ITEM: SEE P1			
SURFACE PREP: SEE P1 & AS NOTED			
PAINT: SEE P1 & AS NOTED			
PRELIMINARY	DRAWN EEO 04/03/19	SHEET NO. X201	PLANT ORDER NO. 180608
FOR APPROVAL	CHECKED WJL 04/11/19		FP. NO. 31

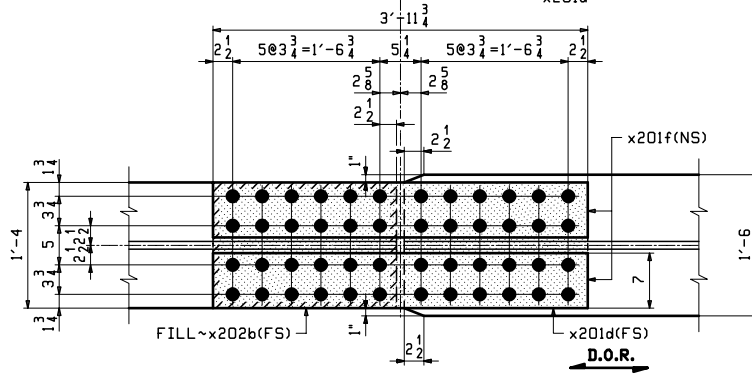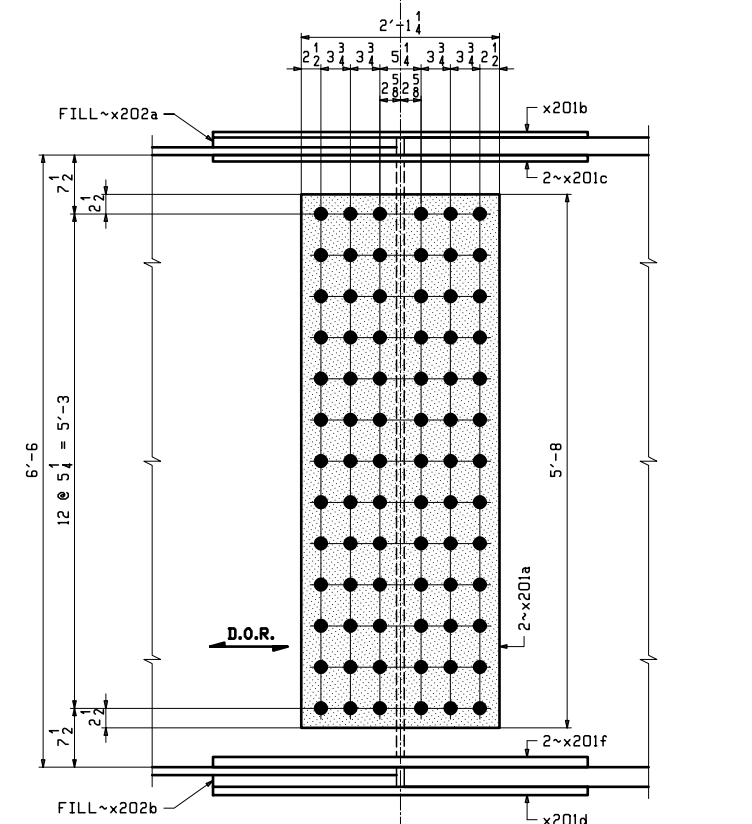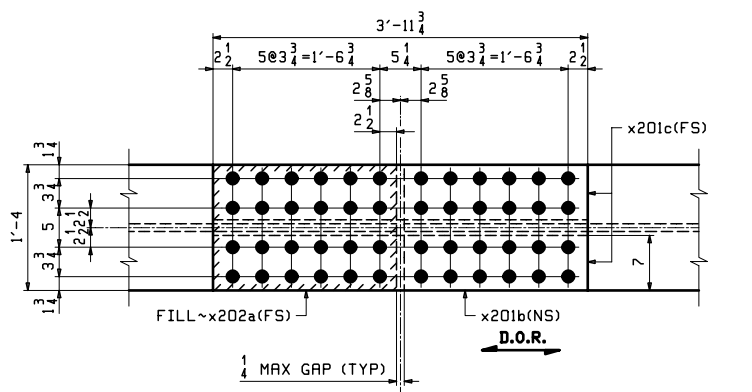

ONE ~ FIELD SPLICE DETAIL ~ X202M1 (PRINT AS NOTED)  
F.S. 3 (LINE 1)

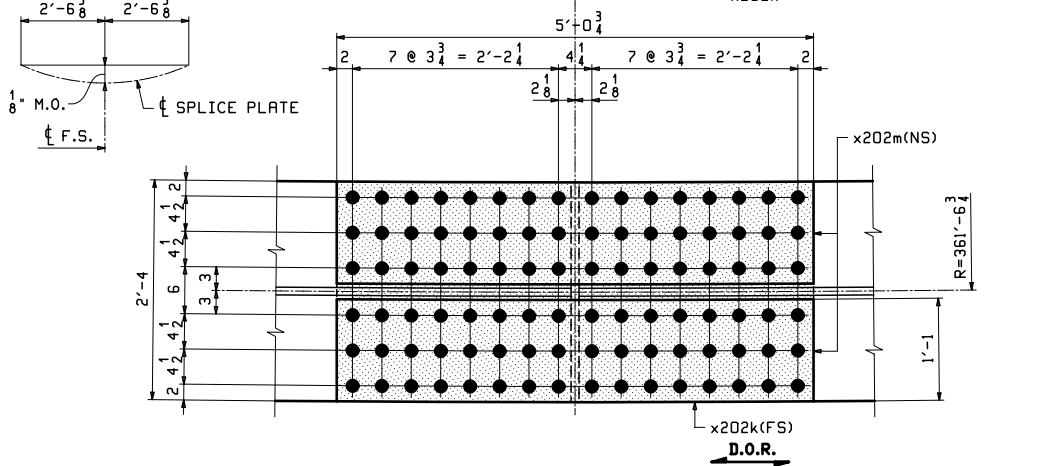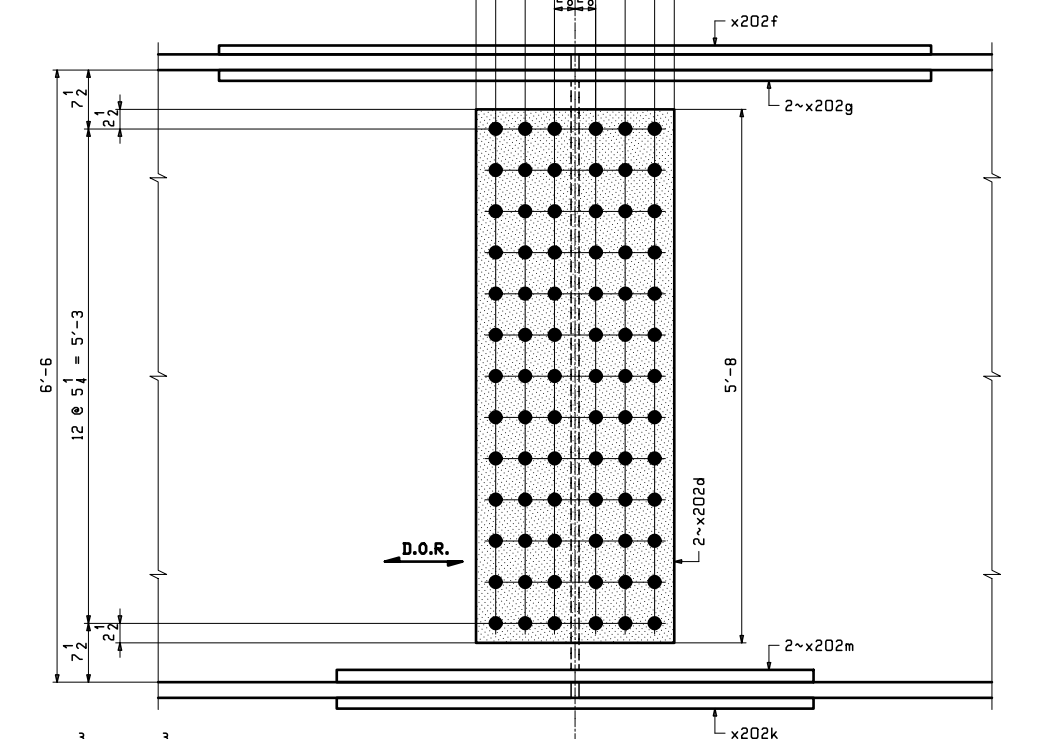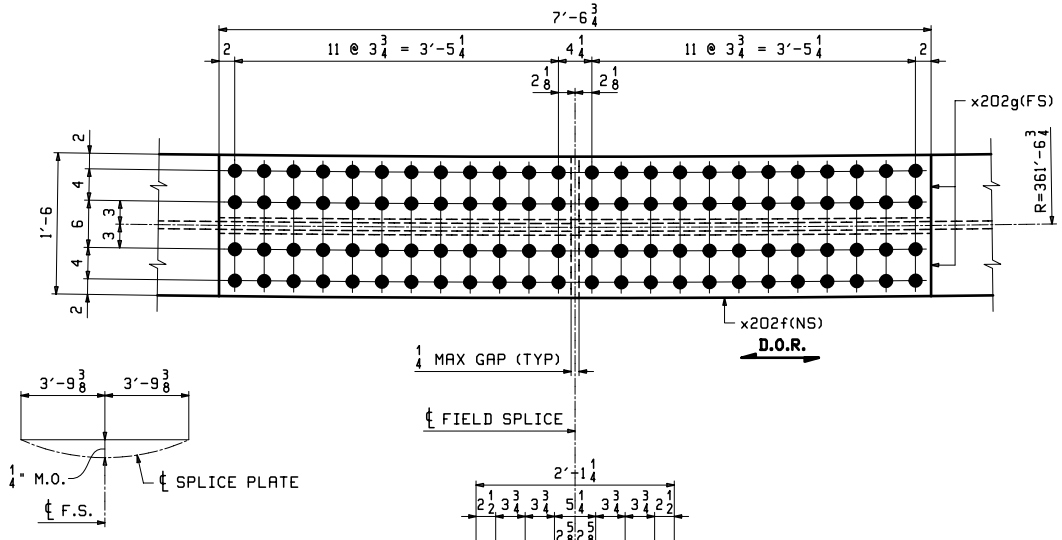

ONE ~ FIELD SPLICE DETAIL ~ X202M3 (PRINT AS NOTED)  
F.S. 2 (LINE 4)


PZLT	SHIP MARK	NO. OF PCS.	ASS'Y MARK	MATERIAL				REMARKS
				SHAPE	LENGTH FT. IN.	MATERIAL SPEC.	ITEM NO.	
1	X202M1	1		FIELD SPLICE DETAIL				1457
2	X201a	2		PL 3/8x68	2 1/4	A709-50WT2	207 2	FP:31
3	X201b	1		PL 1/2x16	3 11/4	A709-50WT2	207 4	FP:31
4	X201c	2		PL 1/2x7	3 11/4	A709-50WT2	207 6	FP:31
5	X201d	1		PL 1/2x16	3 11/4	A709-50WT2	207 3	FP:31
6	X201e	2		PL 1/2x7	3 11/4	A709-50WT2	207 5	FP:31
7	X201f	1		PL 1/2x16	1 11/4	A709-50W	207 20	FILL FP:31
8	X201g	1		PL 1/2x16	1 11/4	A709-50W	207 22	FILL FP:31
9	X201h	2		PL 3/8x68	2 1/4	A709-50WT2	207 7	FP:31
10	X201i	1		PL 1/2x18 1/4	7 6/4	A709-50WT2	207 9	FP:31
11	X201j	2		PL 1/2x8 1/4	7 6/4	A709-50WT2	207 11	FP:31
12	X201k	1		PL 1/2x28 1/2	5 0 3/4	A709-50WT2	207 8	FP:31
13	X201l	2		PL 1/2x13 1/2	5 0 3/4	A709-50WT2	207 10	FP:31

▨ - DENOTES PRIME COAT PER SHEET P1 ON ALL SURFACES OF SPLICE PLATES, GIRDER WEB, AND GIRDER FLANGE.

**FOR SHOP USE ONLY**

- NOTES:  
 1. FOR GENERAL NOTES SEE SHEET GNI.  
 2. ALL FIELD SPLICE HOLES ARE **DR**.  
 3. **D.O.R.** - DENOTES DIRECTION OF MILL ROLLING.  
 4. T2 - DENOTES CHARPY V-NOTCH TESTING REQUIRED.

NO.	DATE	REMARKS	BY
REVISIONS			
2-EAU CLAIRE, WI 3-WAUSAU, WI 4-PALATKA, FL TENSOR 3656-2			
STRUCTURE	RAMP P OVER IR-74 WB, IR-75 & RAMP E - UNIT 2		
LOCATION	CINCINNATI, OH (HAMILTON COUNTY) STA. 230+22.98		
PROJECT NO.	HAM-75-3.84, PID NO. 104667, BRIDGE NO. HAM-74-19085		
ENGINEER	PRIME RE GROUP		
CONTRACTOR	WALSH GROUP		
FIELD SPLICE DETAIL			
ITEM	SEE P1		
SURFACE PREP.	SEE P1 & AS NOTED		
PAINT	SEE P1 & AS NOTED		
PRELIMINARY	DRAWN EEO 04/03/19	SHEET NO. X202	PLANT ORDER NO. 180608
FOR APPROVAL	CHECKED WJL 04/11/19	3	FP. NO. 31

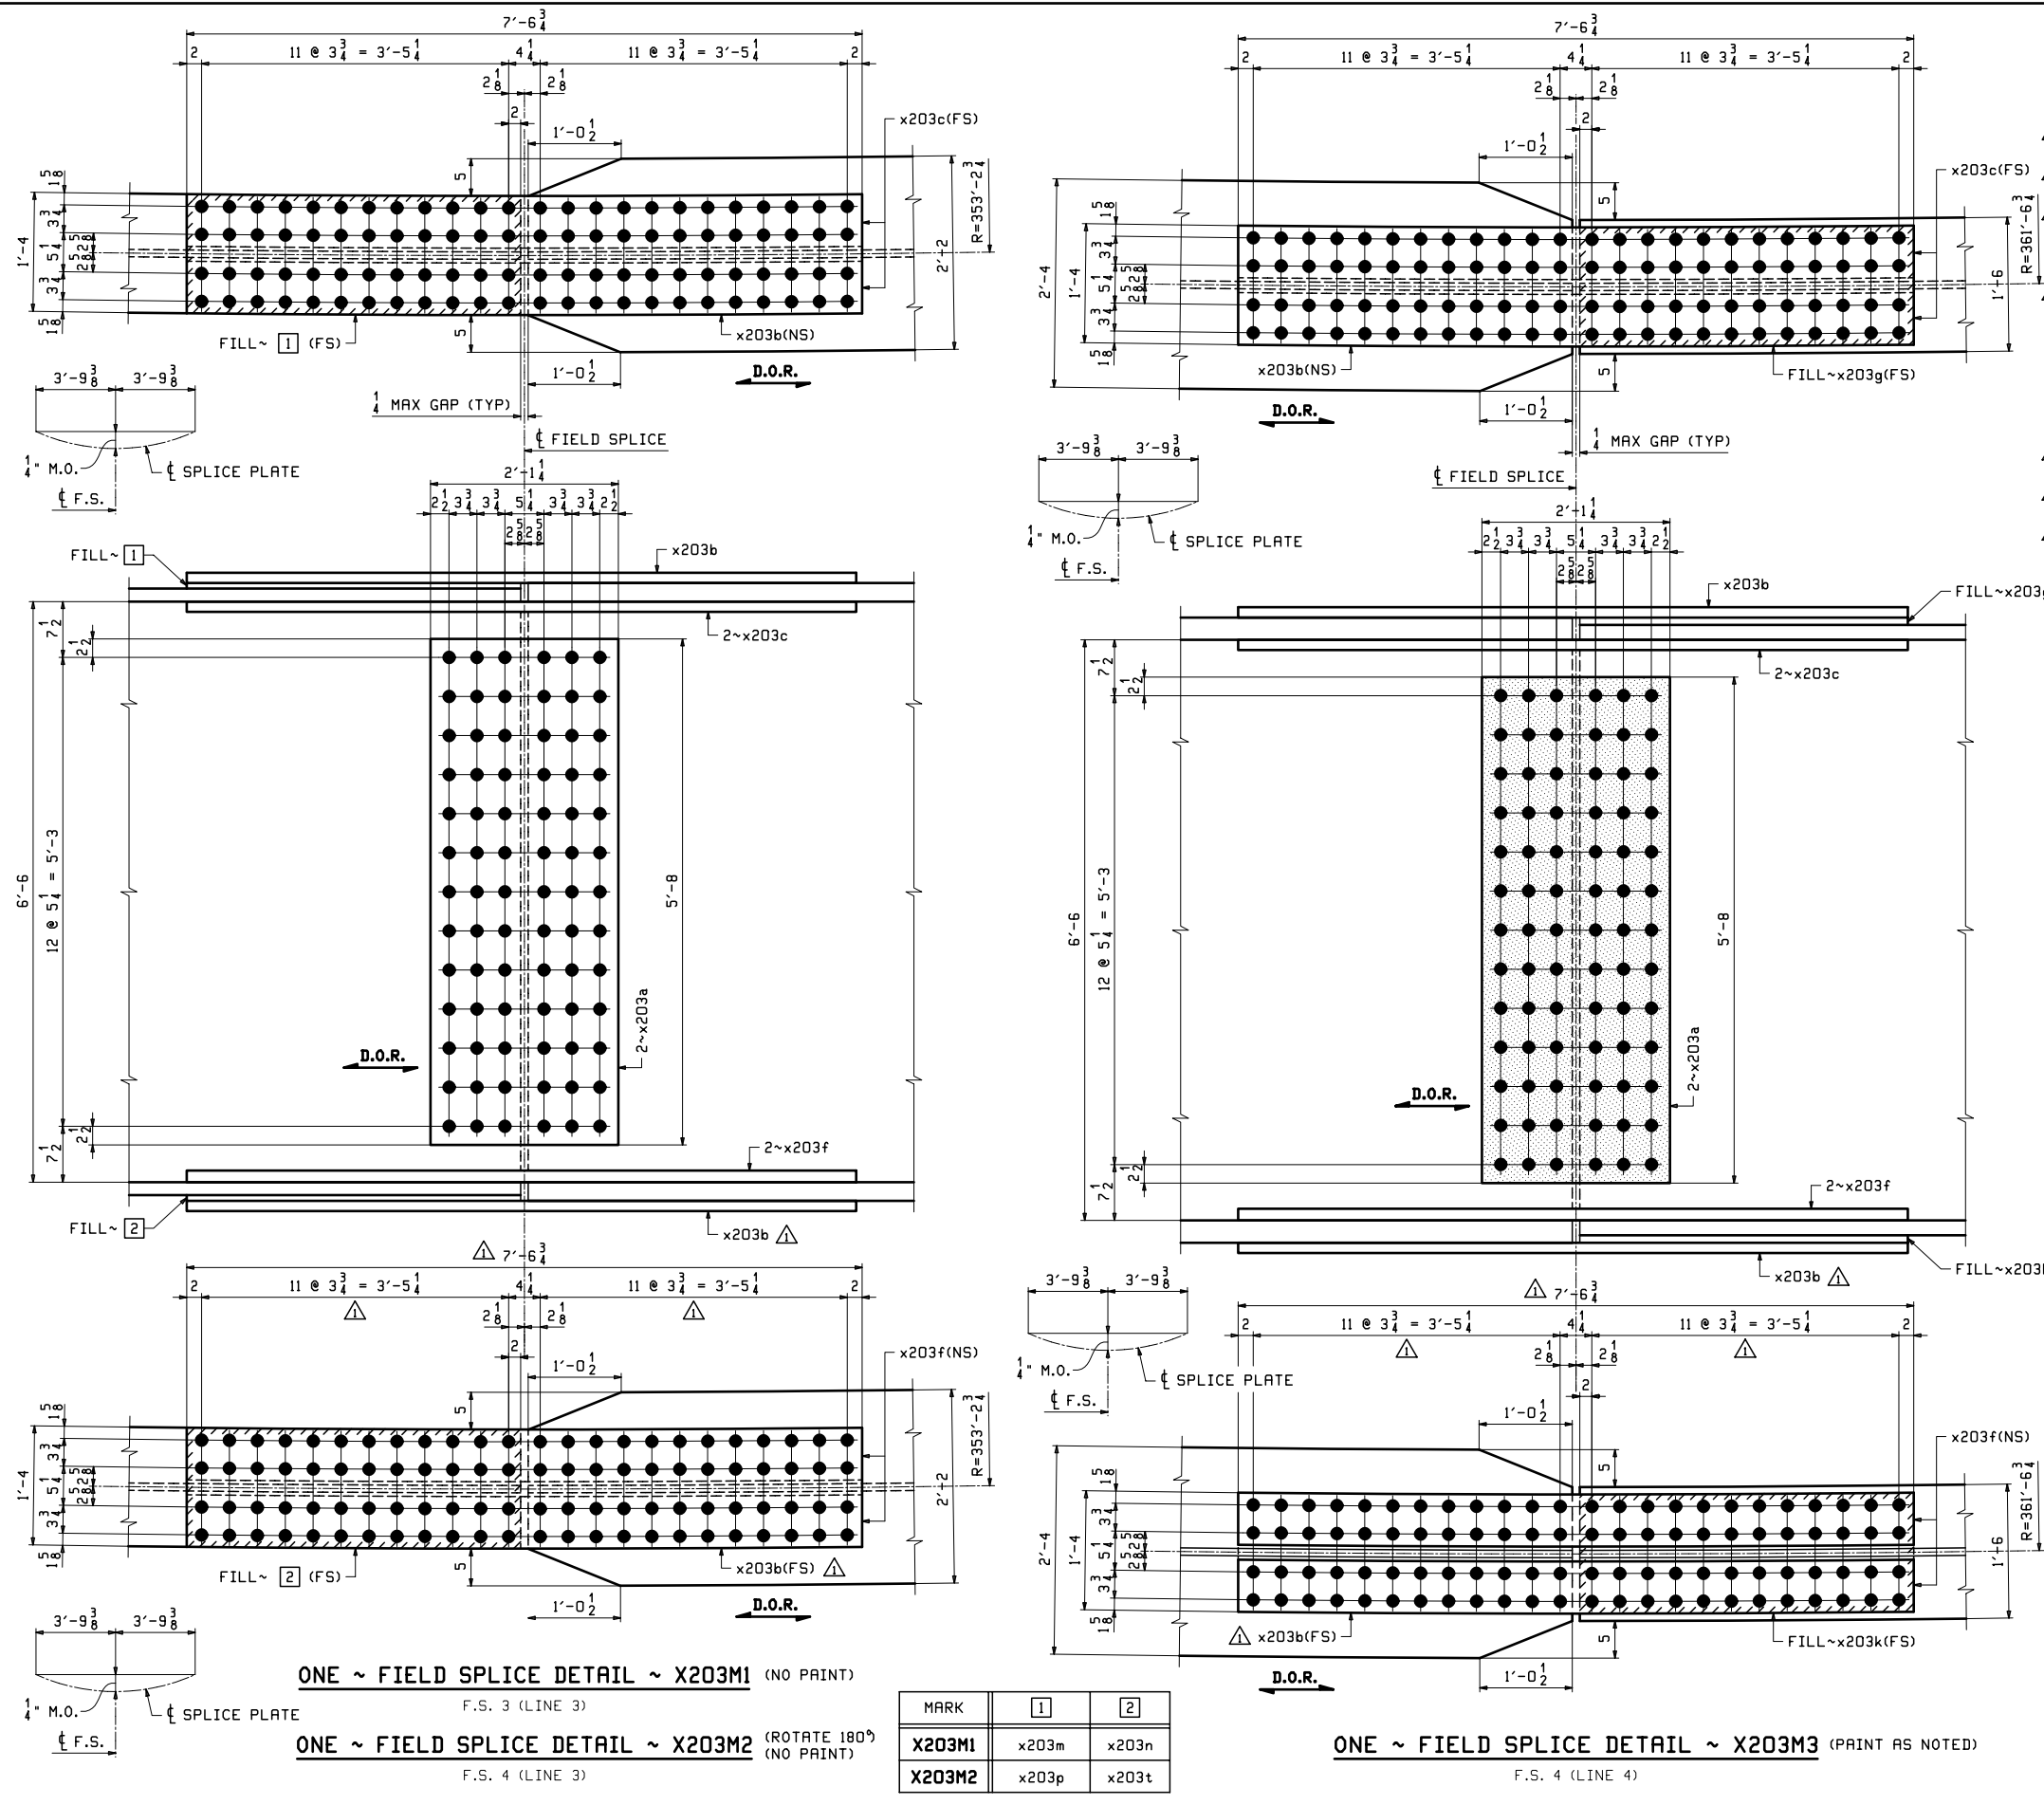

L	SHIP MARK	NO. OF PCS.	ASS'Y MARK	MATERIAL			REMARKS
				SHAPE	LENGTH FT. IN.	MATERIAL SPEC.	
1				FIELD SPlice DETAIL			3155
2	X203M1	1		PL 8x68	2 1/4	A709-50WT2	207-12
3		2	x203a	PL 1/2x16 1/4	7 6/4	A709-50WT2	207-14
4		2	x203b	PL 1/2x7 1/4	7 6/4	A709-50WT2	207-15
5		2	x203c	PL 1/2x7 1/4	7 6/4	A709-50WT2	207-16
6		2	x203f	PL 1/2x7 1/4	7 6/4	A709-50WT2	207-15
7		1	x203m	PL 1/2x16	3 9/4	A709-50W	207-25
8		1	x203n	PL 1/2x16	3 9/4	A709-50W	207-25
9							
10	X203M2	1		FIELD SPlice DETAIL			2950
11		2	x203a	PL 8x68	2 1/4	A709-50WT2	207-12
12		2	x203b	PL 1/2x16 1/4	7 6/4	A709-50WT2	207-14
13		2	x203c	PL 1/2x7 1/4	7 6/4	A709-50WT2	207-15
14		2	x203f	PL 1/2x7 1/4	7 6/4	A709-50WT2	207-15
15		1	x203p	PL 1/2x16	3 9/4	A709-50W	207-25
16		1	x203t	PL 1/2x16	3 9/4	A709-50W	207-25
17							
18	X203M3	1		FIELD SPlice DETAIL			3088
19		2	x203a	PL 8x68	2 1/4	A709-50WT2	207-12
20		2	x203b	PL 1/2x16 1/4	7 6/4	A709-50WT2	207-14
21		2	x203c	PL 1/2x7 1/4	7 6/4	A709-50WT2	207-15
22		2	x203f	PL 1/2x7 1/4	7 6/4	A709-50WT2	207-15
23		1	x203g	PL 1/2x16	3 9/4	A709-50W	207-25
24		1	x203k	PL 1/2x16	3 9/4	A709-50W	207-25
25							

- DENOTES PRIME COAT PER SHEET P1 ON ALL SURFACES OF SPLICE PLATES, GIRDER WEB, AND GIRDER FLANGE.

**FOR SHOP USE ONLY**

- NOTES:
- FOR GENERAL NOTES SEE SHEET GNI.
  - ALL FIELD SPlice HOLES ARE **DR**.
  - D.O.R.** - DENOTES DIRECTION OF MILL ROLLING.
  - T2 - DENOTES CHARPY V-NOTCH TESTING REQUIRED.


NO.	DATE	REV'D BOTTOM FLG SPLICE PLATES	BY
05/13/19			EEO HJL
REVISIONS			
STRUCTURE RAMP P OVER IR-74 WB, IR-75 & RAMP E - UNIT 2 LOCATION CINCINNATI, OH (HAMILTON COUNTY) STA. 230+22.98 PROJECT NO. HAM-75-3.84, PID NO. 104667, BRIDGE NO. HAM-74-19085 ENGINEER PRIME AE GROUP CONTRACTOR WALSH GROUP			
FIELD SPlice DETAIL			
ITEM	SEE P1		
SURFACE PREP.	SEE P1 & AS NOTED		
PAINT	SEE P1 & AS NOTED		
PRELIMINARY	DRAWN EEO 04/04/19	SHEET NO. X203	PLANT ORDER NO. 180608
FOR APPROVAL	CHECKED WJL 04/11/19		FF. NO. 31

ONE ~ FIELD SPlice DETAIL ~ X203M1 (NO PAINT)  
 F.S. 3 (LINE 3)  
 ONE ~ FIELD SPlice DETAIL ~ X203M2 (ROTATE 180°)  
 (NO PAINT)  
 F.S. 4 (LINE 3)

ONE ~ FIELD SPlice DETAIL ~ X203M3 (PAINT AS NOTED)  
 F.S. 4 (LINE 4)


MARK	1	2
X203M1	x203m	x203n
X203M2	x203p	x203t

19/05/19 10:20:24 AM 20190513 10:20:24 AM 20190513 10:20:24 AM

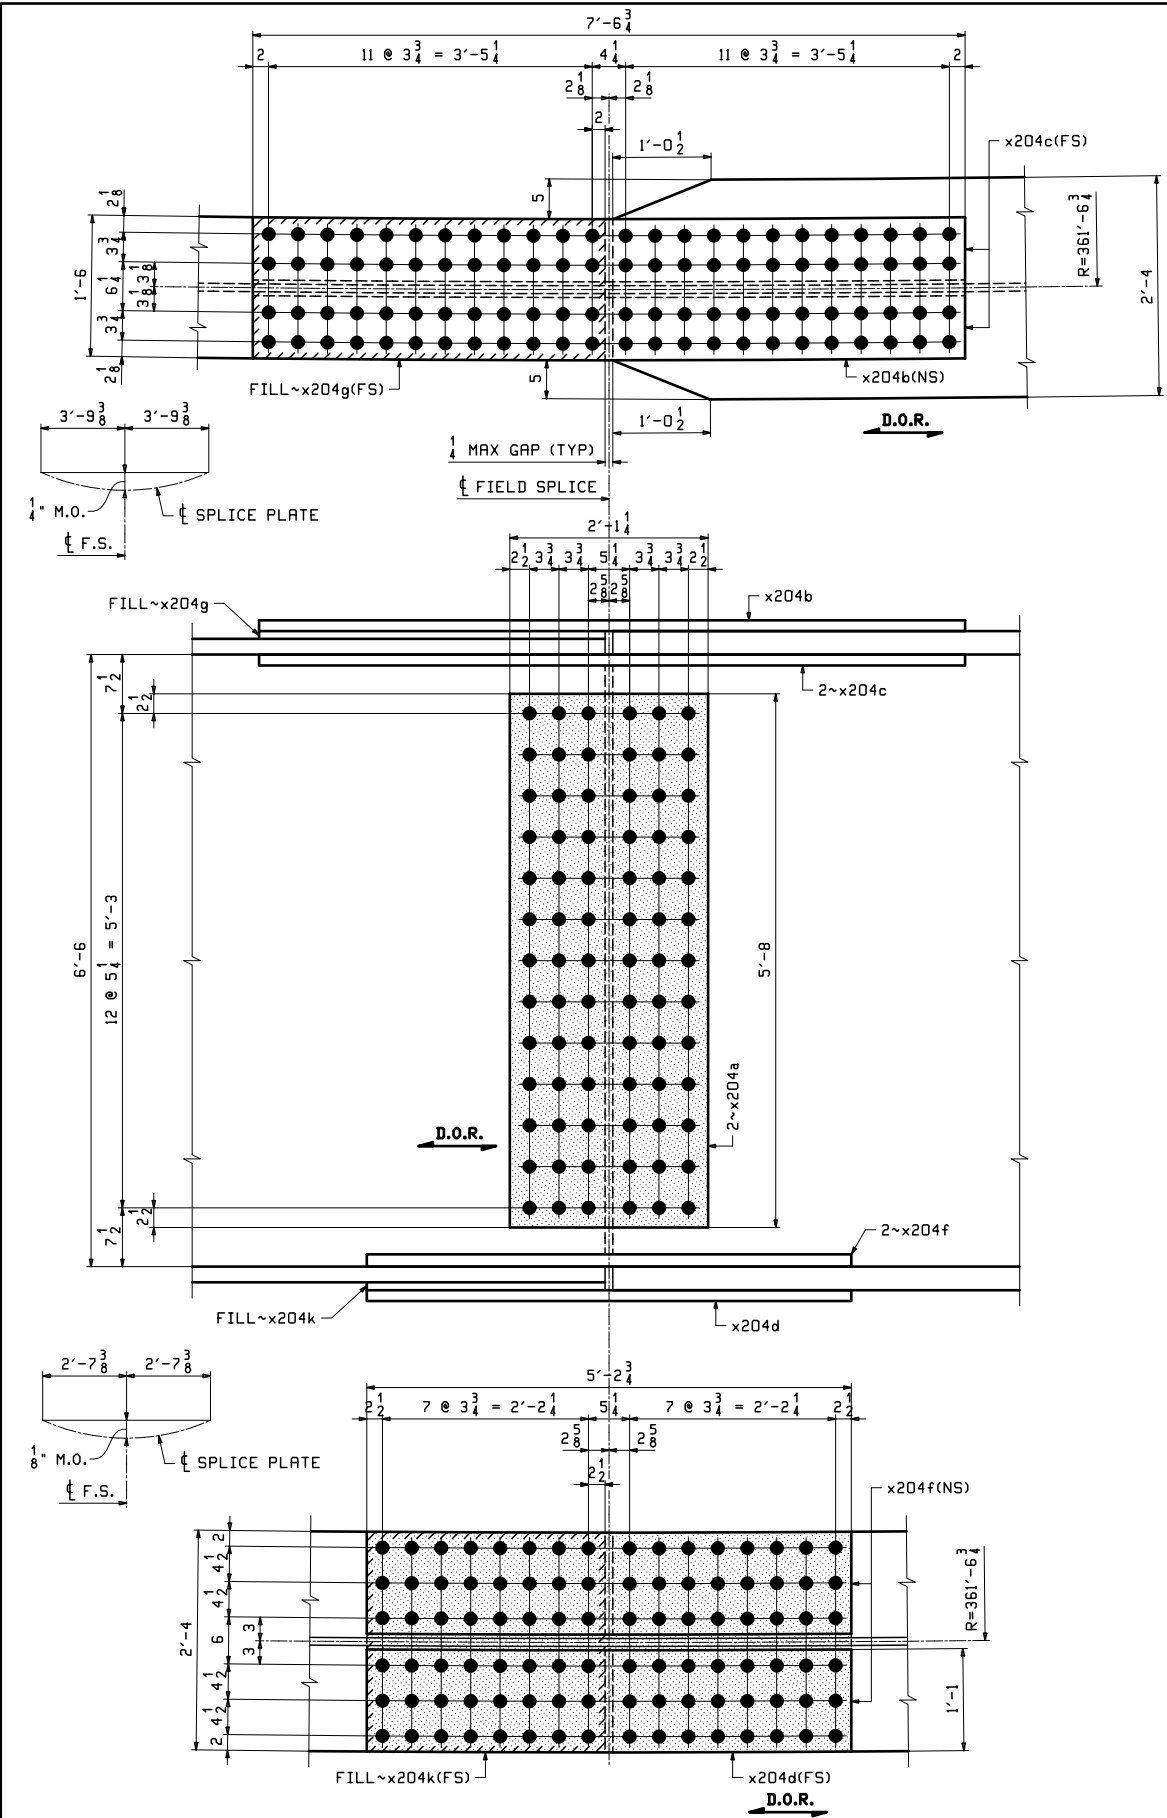

ONE ~ FIELD SPLICE DETAIL ~ X204M1 (PRINT AS NOTED)

F.S. 3 (LINE 4)

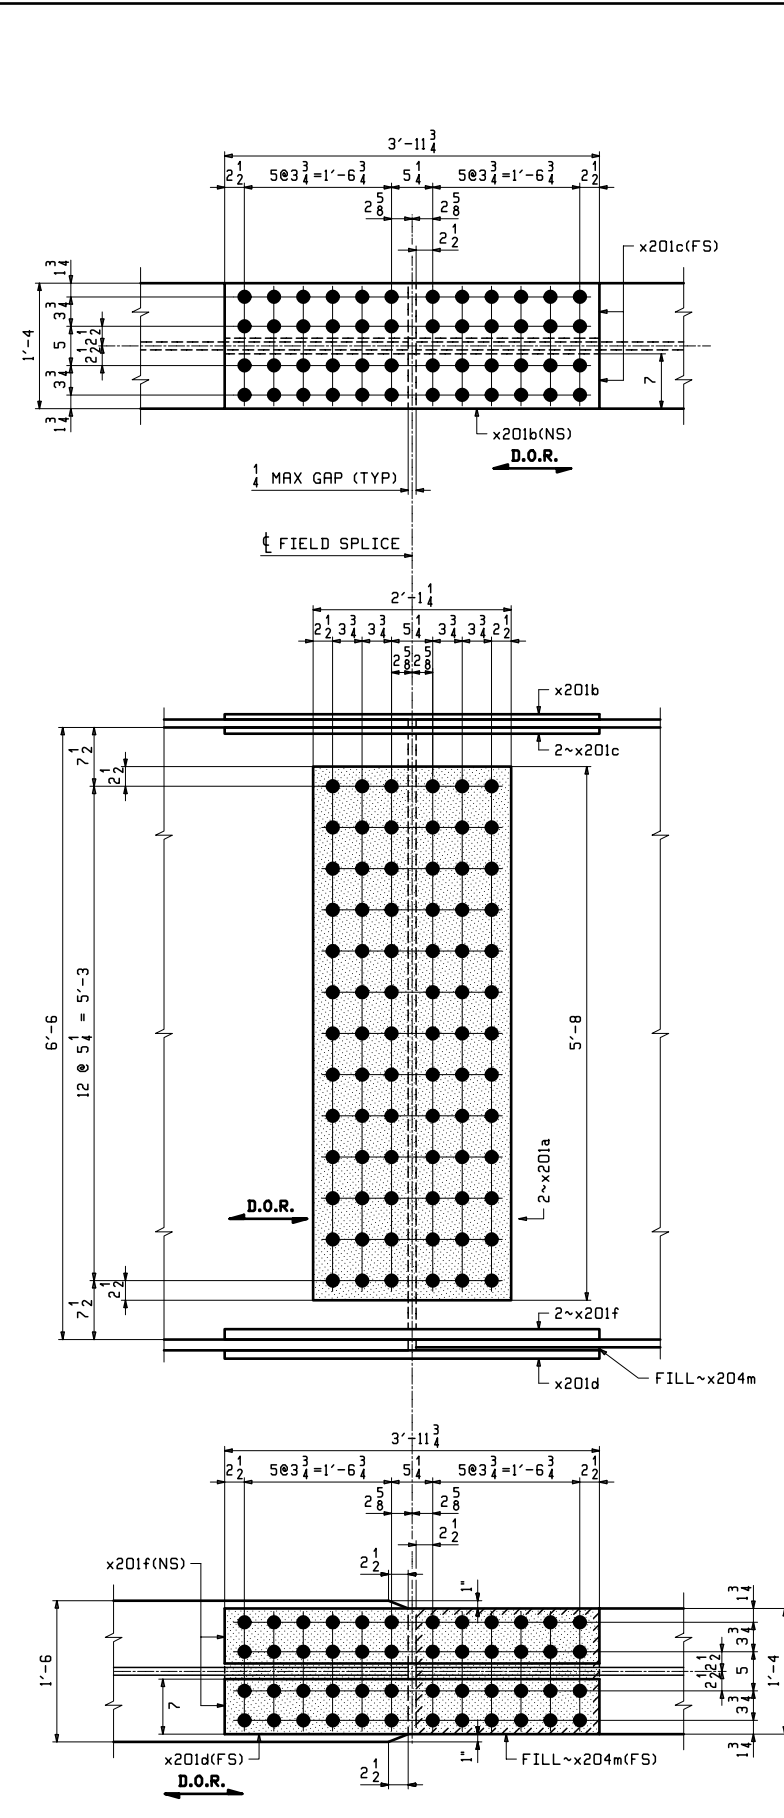

ONE ~ FIELD SPLICE DETAIL ~ X204M2 (PRINT AS NOTED)

F.S. 4 (LINE 1)

LINE	SHIP MARK	NO. OF PCS.	ASS'Y MARK	MATERIAL			REMARKS	
				SHAPE	LENGTH FT. IN.	MATERIAL SPEC.		
1				FIELD SPLICE DETAIL			3675	
2	X204M1	1						
3		2	x204a	PL 1/2 x 68	2 1/4	A709-50WT2	207-2	FP:31
4		1	x204b	PL 1/2 x 18 1/4	7 6/8	A709-50WT2	207-3	FP:31
5		2	x204c	PL 3/8 x 8 1/4	7 6/8	A709-50WT2	207-11	FP:31
6		1	x204d	PL 3/8 x 28 1/8	5 2/4	A709-50WT2	207-18	FP:31
7		2	x204f	PL 1/2 x 13 1/8	5 2/4	A709-50WT2	207-19	FP:31
8		1	x204g	PL 1/2 x 18	3 9/4	A709-50W	207-22	FP:31
9		1	x204k	PL 3/4 x 28	2 7/4	A709-50W	207-28	FP:31
10				FIELD SPLICE DETAIL				1201
11	X204M2	1						
12		2	x201a	PL 3/8 x 68	2 1/4	A709-50WT2	207-2	FP:31
13		1	x201b	PL 1/2 x 15	3 11/4	A709-50WT2	207-4	FP:31
14		2	x201c	PL 3/8 x 7	3 11/4	A709-50WT2	207-5	FP:31
15		1	x201d	PL 1/2 x 15	3 11/4	A709-50WT2	207-1	FP:31
16		2	x201f	PL 1/2 x 7	3 11/4	A709-50WT2	207-3	FP:31
17		1	x204m	PL 3/8 x 15	1 11/4	A709-50W	207-24	FILL FP:31
18								


- DENOTES PRIME COAT PER SHEET P1 ON ALL SURFACES OF SPLICE PLATES, GIRDER WEB, AND GIRDER FLANGE.

**FOR SHOP USE ONLY**


- NOTES:  
 1. FOR GENERAL NOTES SEE SHEET GNI.  
 2. ALL FIELD SPLICE HOLES ARE **DA**.  
 3. **D.O.R.** - DENOTES DIRECTION OF MILL ROLLING.  
 4. T2 - DENOTES CHARPY V-NOTCH TESTING REQUIRED.

NO.	DATE	REMARKS	BY
REVISIONS			
2-EAU CLAIRE, WI    3-WAUSAU, WI    4-PALATKA, FL			
STRUCTURE	RAMP P OVER IR-74 WB, IR-75 & RAMP E - UNIT 2		
LOCATION	CINCINNATI, OH (HAMILTON COUNTY) STA. 230+22.98		
PROJECT NO.	HAM-75-3.84, PID NO. 104667, BRIDGE NO. HAM-74-19085		
ENGINEER	PRIME AE GROUP		
CONTRACTOR	WALSH GROUP		
FIELD SPLICE DETAIL			
ITEM	SEE P1		
SURFACE PREP.	SEE P1 & AS NOTED		
PAINT	SEE P1 & AS NOTED		
PRELIMINARY	DRAWN EEO 04/05/19	SHEET NO. X204	PLANT ORDER NO. 180608
FOR APPROVAL	CHECKED WJL 04/11/19		FP. NO. 31


EEO - Non-Disc. Act. 2018 11/02/19 0M - 00001/180608-2/2024 - 1 Rev.0

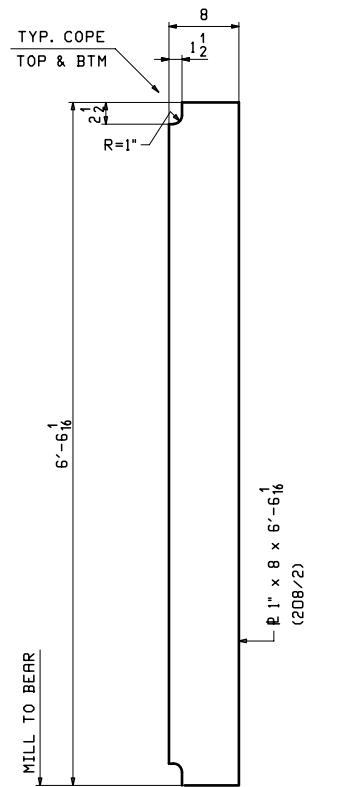


**16 ~ BRG STIFFENERS ~ x205a**  
PIER 2 & FORWARD ABUT. (NS & FS)

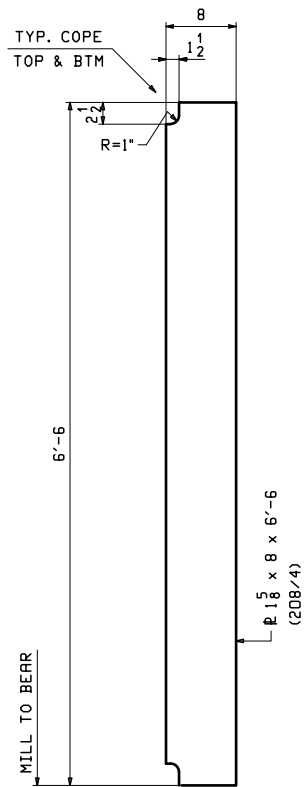


**2 ~ BRG STIFFENERS ~ x205b**  
PIER 3 (FASCIA)

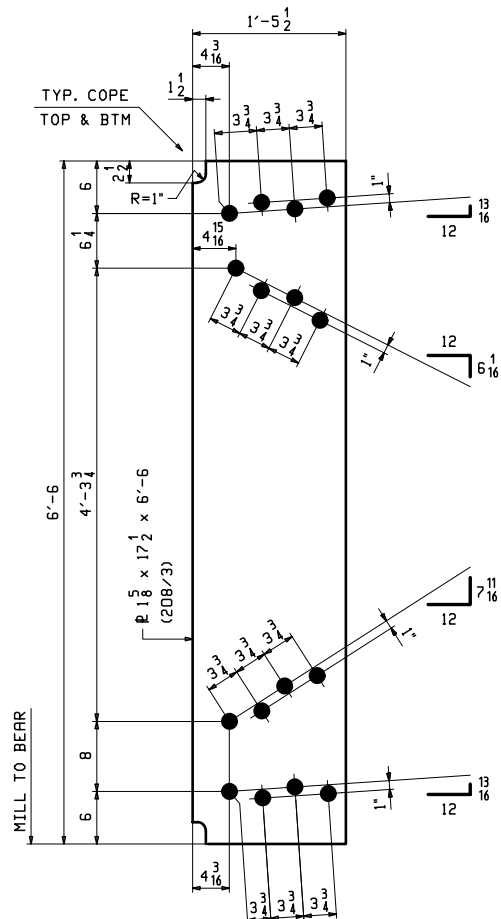


**2 ~ BRG STIFFENERS ~ x205f**  
PIER 3 (6" DROP, LOW SIDE)

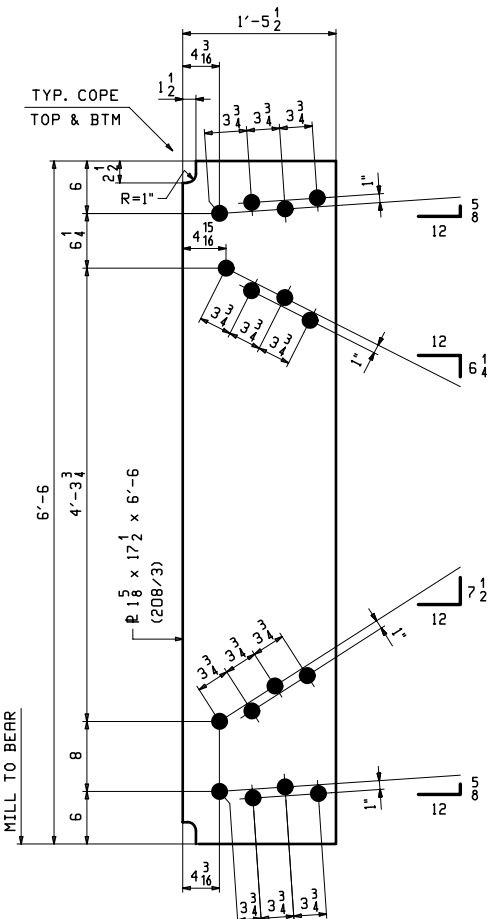


**ONE ~ BRG STIFFENERS ~ x205g**  
PIER 3 (4 1/16" DROP, LOW SIDE)

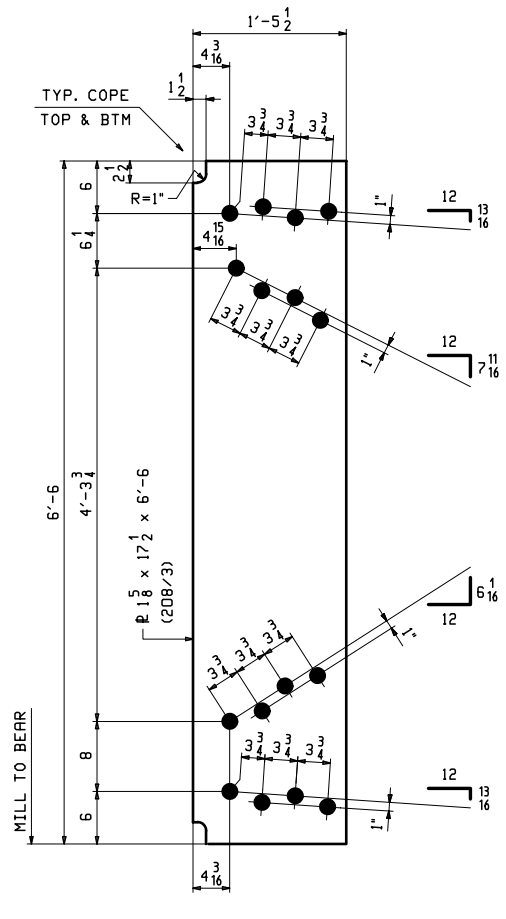


**2 ~ BRG STIFFENERS ~ x205k**  
PIER 3 (6" DROP, HIGH SIDE)

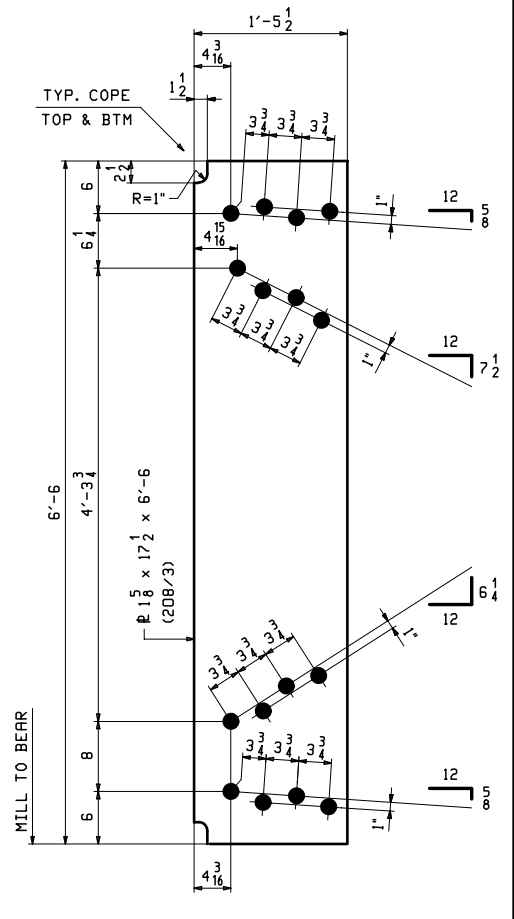


**ONE ~ BRG STIFFENERS ~ x205m**  
PIER 3 (4 1/16" DROP, HIGH SIDE)

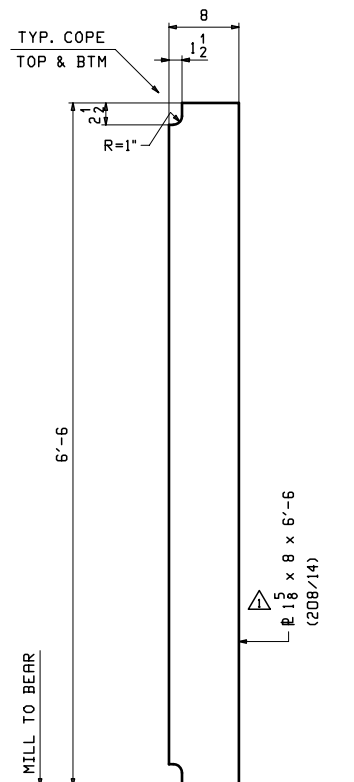

**2 ~ BRG STIFFENERS ~ x205c**  
PIER 4 (FASCIA)

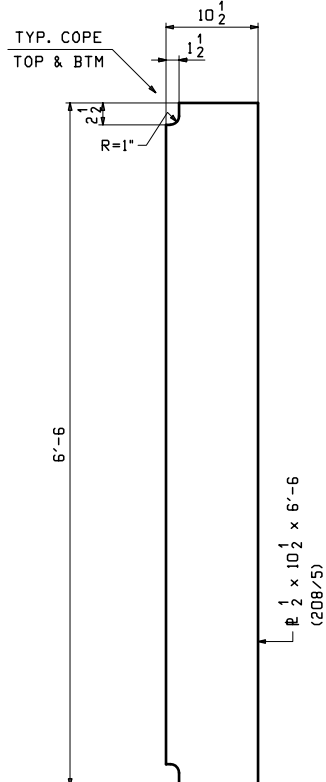


**30 ~ STIFFENER ~ x205d**  
TYP. TRANSVERSE STIFFENER

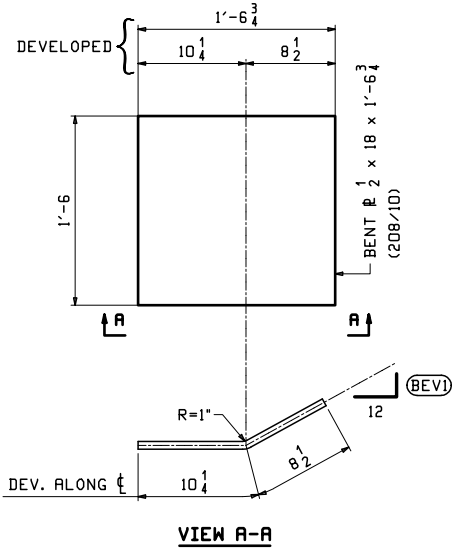

**GUSSET PLATE ~ MARK**  
FORWARD ABUT. BTM GUSSET

MARK	QTY	(BEV)
x205n	ONE	6 7/8
x205p	ONE	6 11/16
x205t	ONE	6 7/16

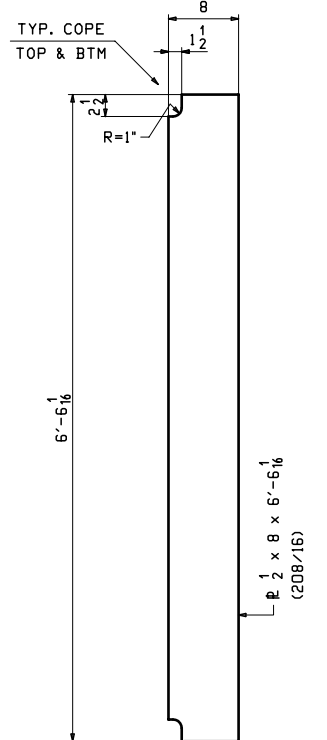


**3 ~ STIFFENER ~ x205v**  
FORWARD ABUT. CF CONN. PLATE

- NOTES:  
 1. FOR GENERAL NOTES SEE SHEET GNI.  
 2. ALL MATERIAL TO BE A709-50WT2.  
 3. T2 - DENOTES CHARPY V-NOTCH TESTING REQ'D.


NO.	DATE	REMARKS	BY
1	04/24/19	REV'D BRG STIFF THICKNESS @ PIER 4	EEO/WJL
REVISIONS			
STRUCTURE: RAMP P OVER IR-74 WB, IR-75 & RAMP E - UNIT 2 LOCATION: CINCINNATI, OH (HAMILTON COUNTY) STA. 230+22.98 PROJECT NO.: HAM-75-3.84, PID NO. 104667, BRIDGE NO. HAM-74-1908S ENGINEER: PRIME AE GROUP CONTRACTOR: WALSH GROUP			
GIRDER STANDARDS			
ITEM	SEE P1		
SURFACE PREP.	SEE P1		
PAINT	SEE P1		
PRELIMINARY	DRAWN EEO 04/08/19	SHEET NO. X205	PLANT ORDER NO. 180608
FOR APPROVAL	CHECKED WJL 04/12/19		FP. NO. 20

EEO, Rev. 25, 2018 03/31/13 PM, 1 Rev.1

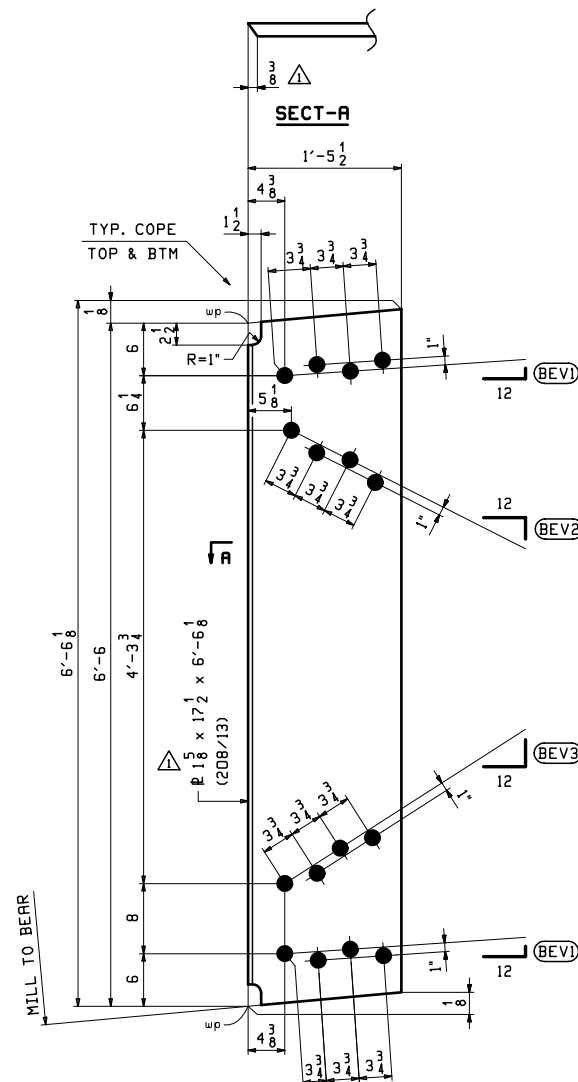


**BRG STIFFENERS ~ MARK**  
PIER 4 CONN. PLATES (LOW SIDE)

MARK	QTY	(BEV1)	(BEV2)	(BEV3)
62	x206a	ONE	13/16	7 1/2
61	x206b	ONE	13/16	7 9/16
60	x206c	ONE	5/8	7 3/8

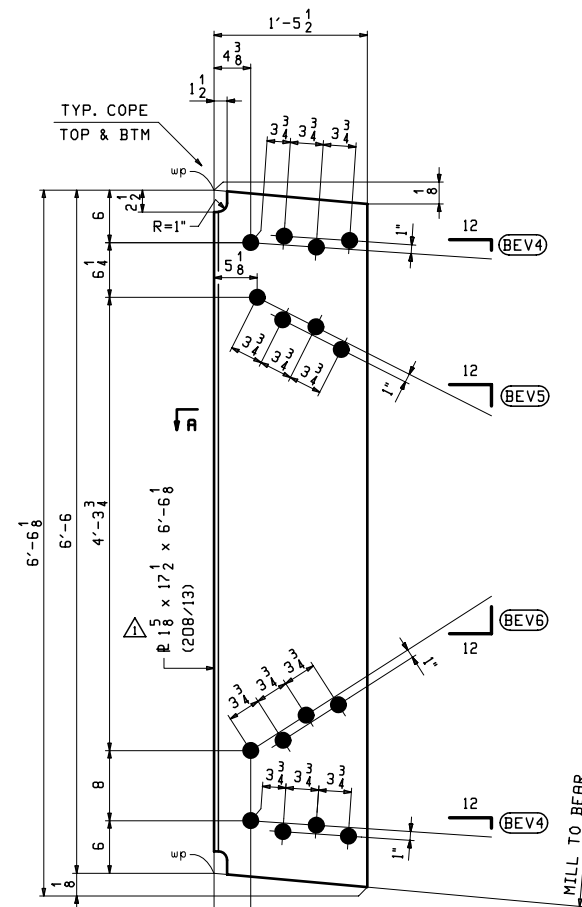


**BRG STIFFENERS ~ MARK**  
PIER 4 CONN. PLATES (HIGH SIDE)

MARK	QTY	(BEV4)	(BEV5)	(BEV6)
61,60	x206d	2	13/16	7 9/16
59	x206e	ONE	5/8	7 3/8
	x206f	ONE	5/8	6 1/16

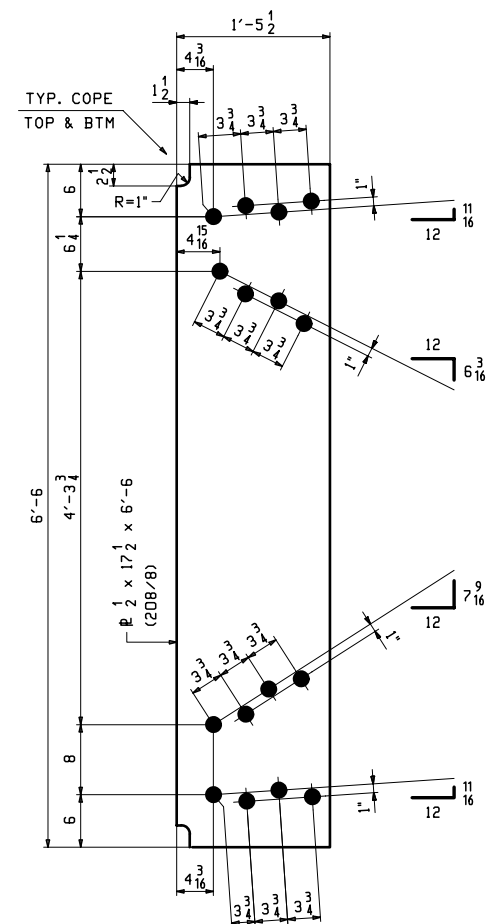


**9 ~ CONN. PLATES ~ x206g**  
INT. CF TYPE 4 (LOW SIDE)

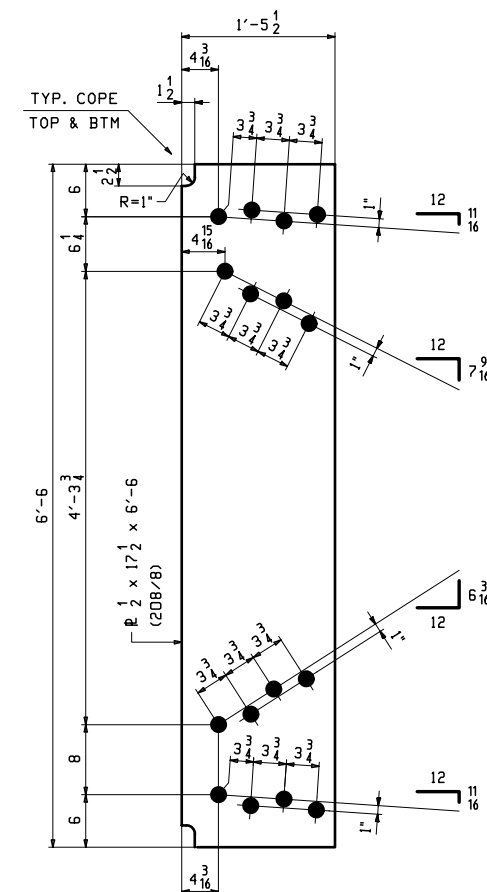


**9 ~ CONN. PLATES ~ x206k**  
INT. CF TYPE 4 (HIGH SIDE)

- NOTES:  
 1. FOR GENERAL NOTES SEE SHEET GNI.  
 2. ALL MATERIAL TO BE A709-50WT2.  
 3. T2 - DENOTES CHARPY V-NOTCH TESTING REQ'D.


NO.	DATE	REMARKS	BY
	04/24/19	REV'D BRG STIFF THICKNESS @ PIER 4	EEO/WJL
REVISIONS			
STRUCTURE: RAMP P OVER IR-74 WB, IR-75 & RAMP E - UNIT 2 LOCATION: CINCINNATI, OH (HAMILTON COUNTY) STA. 230+22.98 PROJECT NO.: HAM-75-3.84, PID NO. 104667, BRIDGE NO. HAM-74-1908S ENGINEER: PRIME AE GROUP CONTRACTOR: WALSH GROUP			
GIRDER STANDARDS			
ITEM: SEE P1			
SURFACE PREP: SEE P1			
PAINT: SEE P1			
PRELIMINARY	DRAWN EEO 04/08/19	SHEET NO. X206	PLANT ORDER NO. 180608
FOR APPROVAL	CHECKED WJL 04/12/19		FP. NO. 20

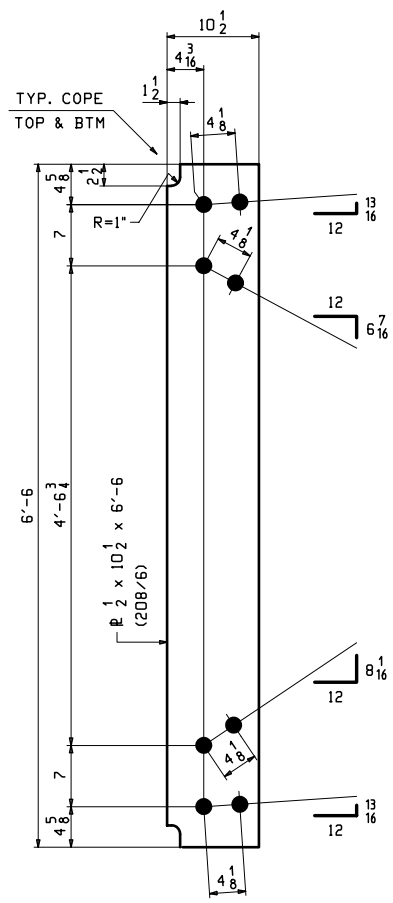

**46 ~ CONN. PLATES ~ x207a**  
INT. CF TYPE 2 (LOW SIDE)

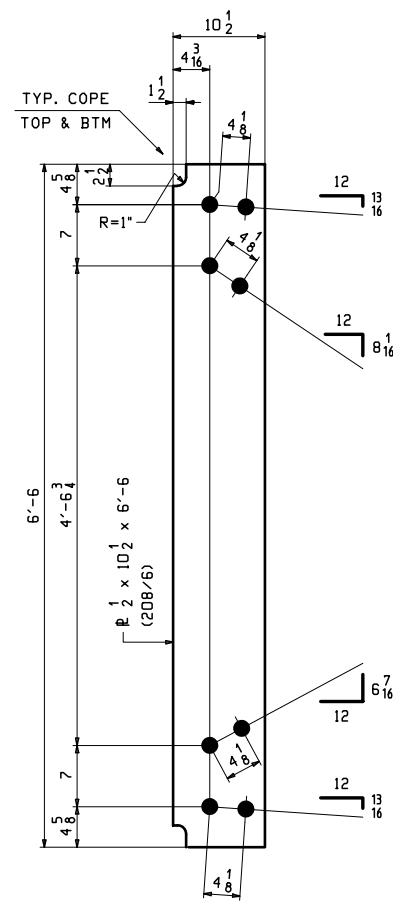


**46 ~ CONN. PLATES ~ x207b**  
INT. CF TYPE 2 (HIGH SIDE)

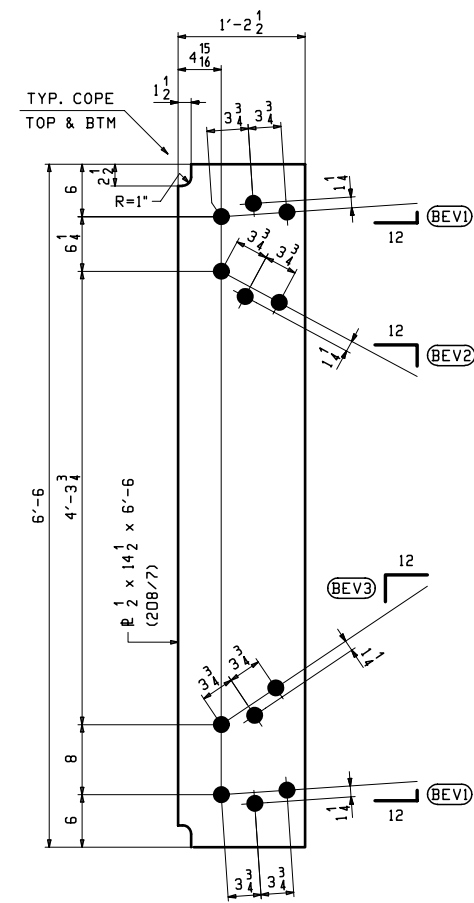

**CONN. PLATES ~ MARK**  
INT. CF TYPE 3 (LOW SIDE)

MARK	QTY	(BEV1)	(BEV2)	(BEV3)	
4-5 DROPS	<b>x207c</b>	21	5/8	6 5/16	7 9/16
5 5/8 - 6 3/8 DROPS	<b>x207d</b>	4	13/16	6 8/8	7 3/4
6 11/16 - 7 1/8 DROPS	<b>x207f</b>	10	15/16	6	7 7/8

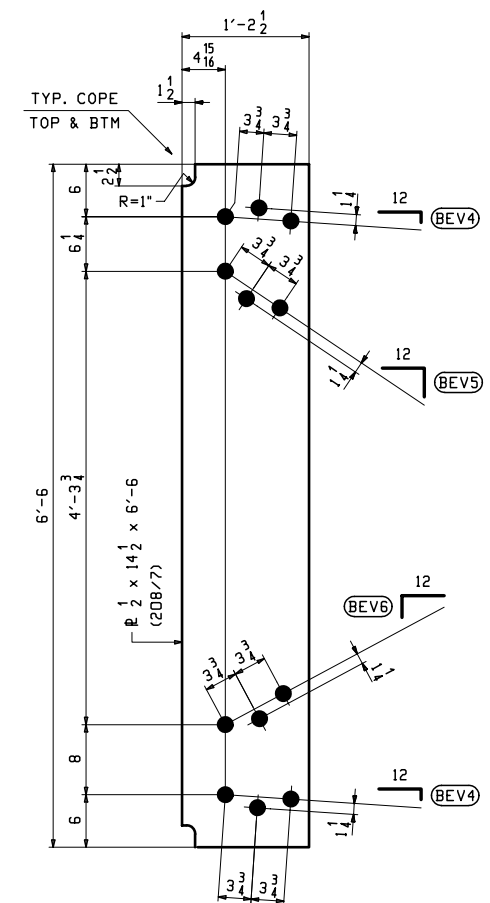

**CONN. PLATES ~ MARK**  
INT. CF TYPE 3 (HIGH SIDE)


MARK	QTY	(BEV4)	(BEV5)	(BEV6)	
4-5 DROPS	<b>x207g</b>	21	5/8	7 9/16	6 5/16
5 5/8 - 6 3/8 DROPS	<b>x207k</b>	4	13/16	7 3/4	6 8/8
6 11/16 - 7 1/8 DROPS	<b>x207m</b>	10	15/16	7 7/8	6

- NOTES:  
 1. FOR GENERAL NOTES SEE SHEET GNI.  
 2. ALL MATERIAL TO BE A709-50WT2.  
 3. T2 - DENOTES CHARPY V-NOTCH TESTING REQ'D.

NO.	DATE	REMARKS	BY
REVISIONS			
		2-EAU CLAIRE, WI 3-WAUSAU, WI 4-PALATKA, FL TENSOR 3656-2	
STRUCTURE	RAMP P OVER IR-74 WB, IR-75 & RAMP E - UNIT 2		
LOCATION	CINCINNATI, OH (HAMILTON COUNTY) STA. 230+22.98		
PROJECT NO.	HAM-75-3.84, PID NO. 104667, BRIDGE NO. HAM-74-1908S		
ENGINEER	PRIME AE GROUP		
CONTRACTOR	WALSH GROUP		
GIRDER STANDARDS			
ITEM	SEE P1		
SURFACE PREP.	SEE P1		
PAINT	SEE P1		
PRELIMINARY	DRAWN EEO 04/08/19	SHEET NO. X207	PLANT ORDER NO. 180608
FOR APPROVAL	CHECKED WJL 04/12/19		FP. NO. 20

EEO - Nov. 20, 2019 11:02:18 AM C:\Users\johnd\OneDrive\Documents\2019-2020\1 Rev 0



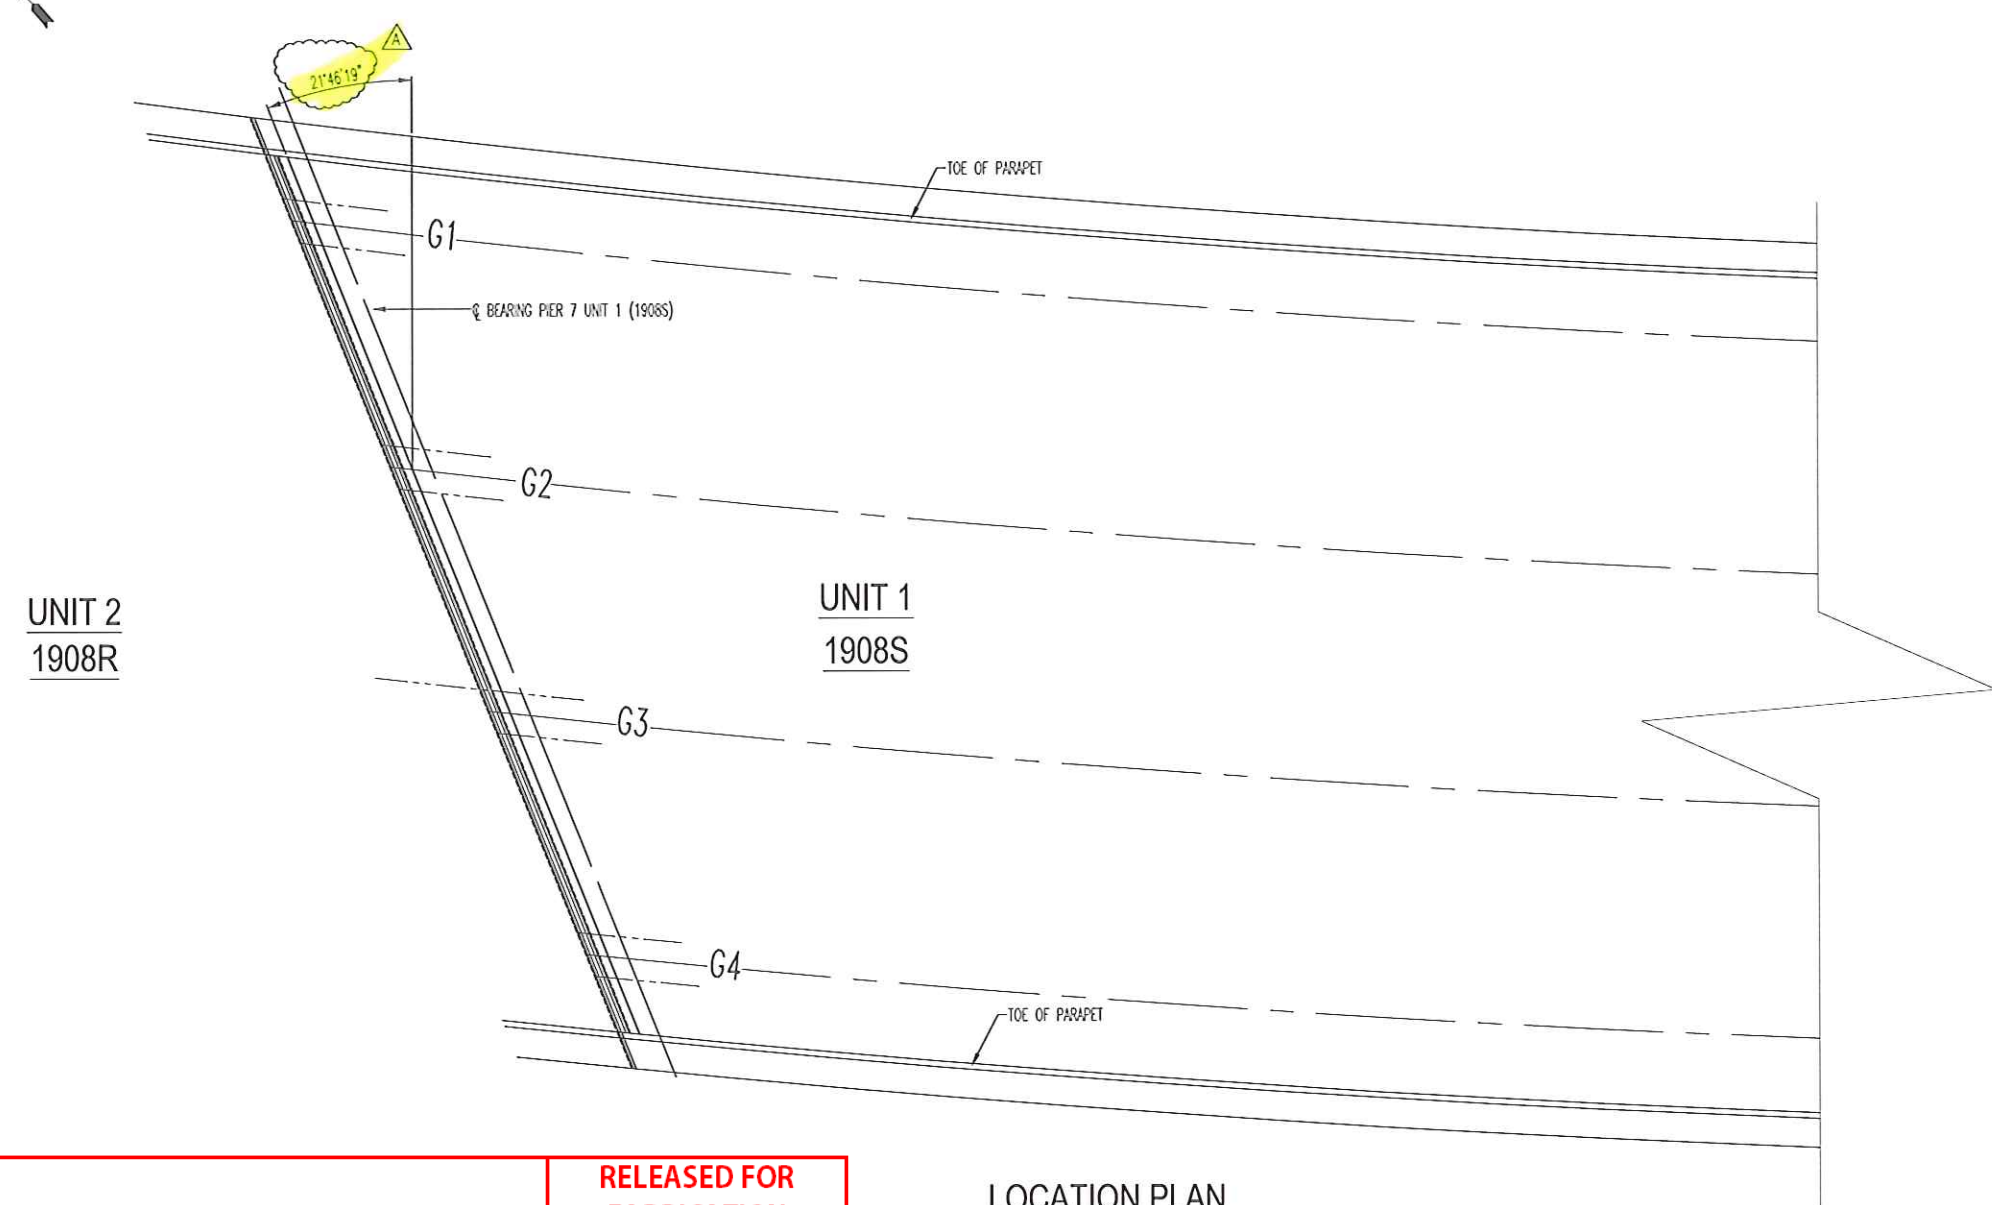

<b>PRIME AE, Group, Inc</b>		<b>RELEASED FOR FABRICATION</b>	
DATE REC'D: 5/1/2020	BUILDABLE UNIT NO.: 7		
Review conforms that the shop drawings meet the intent of the contract.			
<input checked="" type="checkbox"/> CONFORMS AS-IS	<input type="checkbox"/> CONFORMS AS NOTED	By: Kelly Chrisman	By:
<input type="checkbox"/> INCOMPLETE	<input type="checkbox"/> DOES NOT CONFORM	Date: 5/1/2020	Date:

**LOCATION PLAN**




APPROVAL

<b>OHIO STRUCTURES INC.</b> 4030 BOARDMAN-CANFIELD RD. SUITE 200D CANFIELD, OHIO 44406 (330) 533-0084 FAX: (330) 533-0191		
<b>OHIO DEPARTMENT OF TRANSPORTATION</b> BRIDGE: HAM-74-1908S RAMP P OVER IR-74 WB, IR-75 AND RAMP E		
SCALE: N.T.S.	<b>WALSH CONSTRUCTION</b>	DRAWN: LF
DATE: 4/20	LOCATION PLAN 1908S PIER 7 UNIT 1	CHECK: MI
REF NO: 0034		ITEM NO: 516
ODOT PROJ. NO: 183000	HAMILTON COUNTY	DWG. NO: E1
OSI PROJ. NO: 00-18	PID NO: 104667	SFN: 3109798
		1 OF 3


NOTES:  
 SEE SHEET 2 FOR EXPANSION JOINT DETAILS  
 SEE SHEET 3 FOR GENERAL NOTES & BILL OF MATERIAL

REV. No.	REVISION
A	Per Contractors Review 4/30/20



SHOP INSPECTED BY:

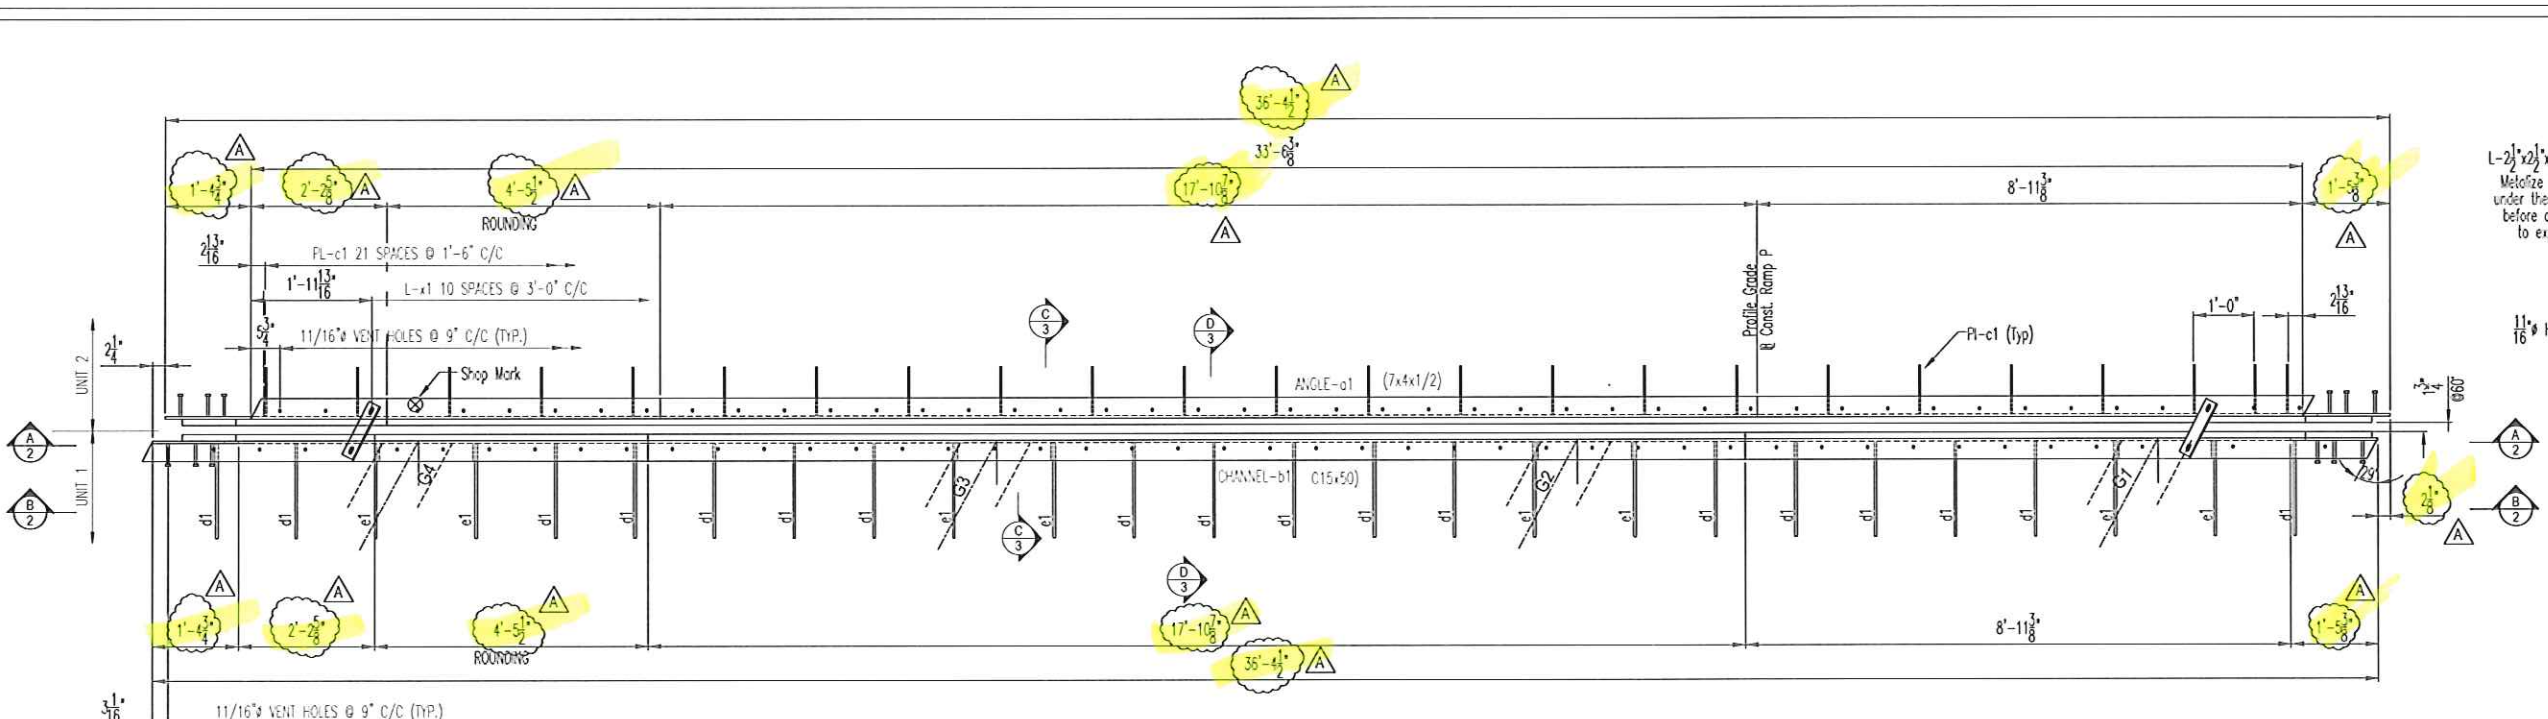

**PIER 7 - EXPANSION JOINT - 1908S**

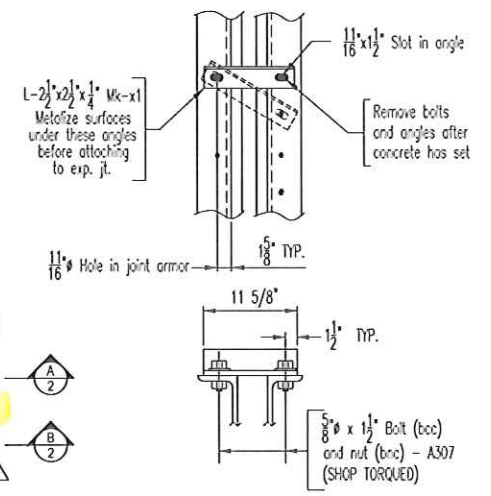


**SHIPPING ANGLE DETAIL**

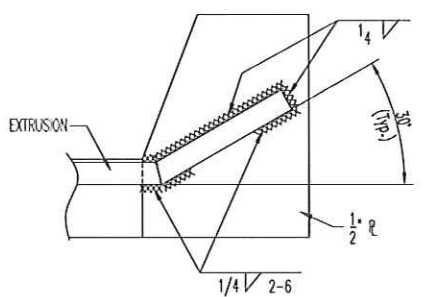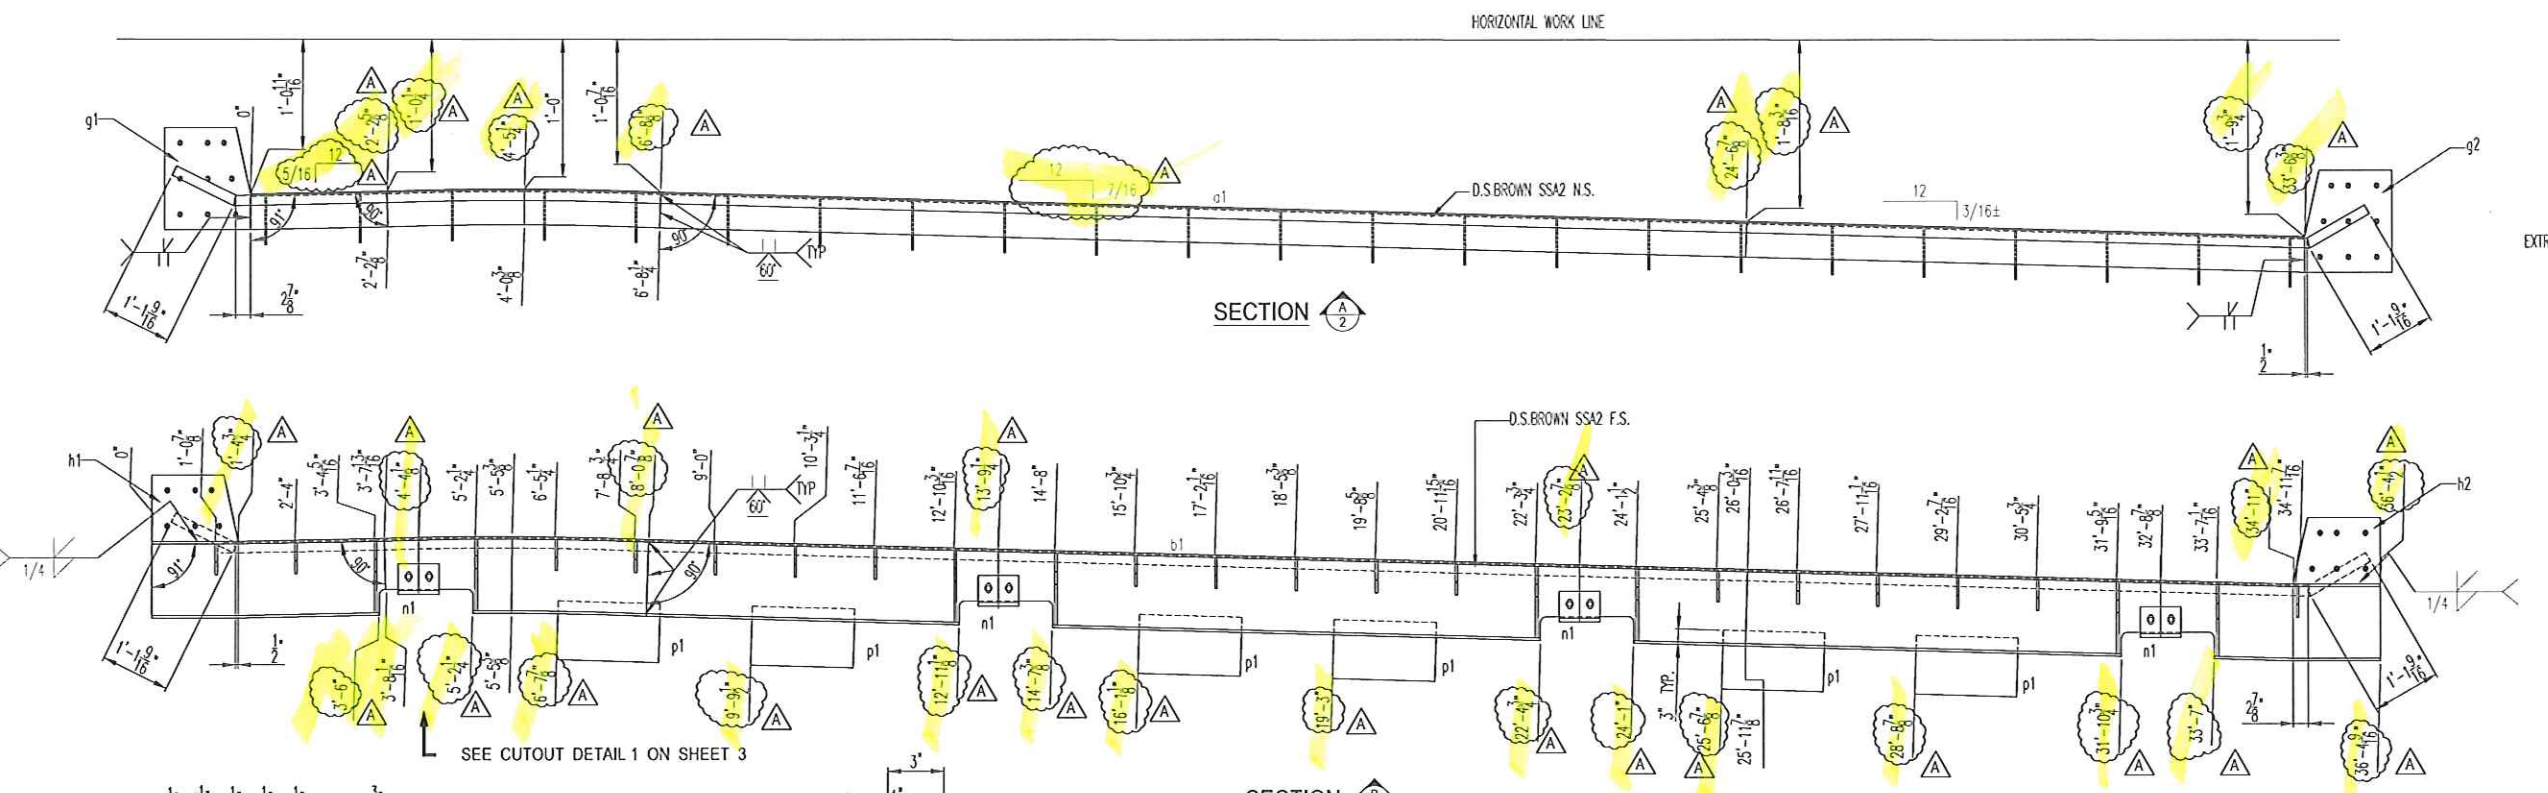


**PARAPET PL DETAIL**

PAY LENGTH: 36.4 FT.

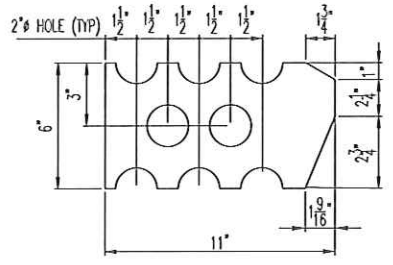

**DETAIL PL-c1**  
MATERIAL: 3/8\"/>

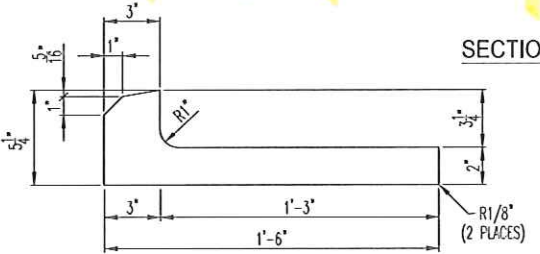

**DETAIL d1**  
MATERIAL: 1/2\"/>

**NOTES:**  
SEE SHEET 1 FOR EXPANSION JOINT LOCATION PLAN  
SEE SHEET 3 FOR SECTION VIEWS, DETAILS  
SEE SHEET 3 FOR DETAILS, GENERAL NOTES & BILL OF MATERIAL



REV. No.	REVISION
A	Per Contractors Review 4/30/20

SHOP INSPECTED BY:

APPROVAL

**OHIO STRUCTURES INC.**  
4030 BOARDMAN - CANFIELD RD. SUITE 200D  
CANFIELD, OHIO 44406  
(330) 533-0084 FAX: (330) 533-0191

**OHIO DEPARTMENT OF TRANSPORTATION**  
BRIDGE: HAM-74-1908S  
RAMP P OVER I-74 WB, IR-75 AND RAMP E

SCALE: N.T.S.	DATE: 4/20	WALSH CONSTRUCTION	DRAWN: LF
		PIER 7 UNIT 1 EXPANSION JOINT 1908S	CHECK: MI
REF NO: 0034	ODOT PROJ NO: 183000	HAMILTON COUNTY	ITEM NO: 516
	OSI PROJ NO: 00-18	PID NO: 104667	SN: 3109798

1908S PIER 7 UNIT 1 EXPANSION JOINT

**MATERIALS ONLY:**

LINE	PO#	QTY	MARK	SECTION	LENGTH (FEET)	LENGTH (INCHES)	STL SPEC	PC WT (N LBS)	NET WT (N LBS)	HEAT #	REMARKS
1		1	a1	ANGLE 7x4x1/2	33	8 3/4	A709-50	603.75	603.75		
2		11	--	ANGLE 2-1/2x2-1/2x1/4	0	11 5/8	A709-36	3.97	43.69		SHIPPING
3		1	b1	C15x50	36	6 3/4	A709-50	1,828.13	1,828.13		
4		4	n1	ANGLE 6x4x3/4	0	8	A709-50	15.73	62.93		
5		24	c1	PLATE 3/8 x 6	0	11	A709-36	5.02	120.48		
6		8	e1	PLATE 1/2 x 14 3/16	1	6	A709-36	10.02	80.16		
7		18	d1	PLATE 1/2 x 5 1/4	1	6	A709-36	7.68	138.28		
8		6	p1	PLATE 1/2 20	1	0	A709-50	34.03	204.18		
9		1	g1	PLATE 1/2 20	1	4 3/4	A709-36	47.28	47.28		
10		1	g2	PLATE 1/2 20	1	4 3/4	A709-36	48.64	48.64		
11		1	h1	PLATE 1/2 13 5/16	1	5 3/8	A709-36	30.35	30.35		
12		1	h2	PLATE 1/2 x 13 1/4	1	5 3/8	A709-36	31.67	31.67		
								SUB TOTAL	3,239.54		










**HARDWARE ONLY:**

LINE	QTY	MARK	DESCRIPTION	STL SPEC	WT PER (N LBS)	NET WT (N LBS)	HEAT #	REMARKS
13	30	--	1/2" x 4" STUD	A108	0.29	8.70		
14	8	dh	3/4x2-3/4 HEX HEAD BOLT	A325 Galv	0.48	3.85		
15	8	nd	3/4 HEAVY HEX NUT	A563 Galv	0.20	1.60		
16	8	wd	3/4 FLAT WASHER	F436 Galv	0.04	0.33		
17	22	boc	5/8x1-1/2 HEX HEAD BOLT	A307	0.22	4.77		
18	22	bnc	5/8 HEAVY HEX NUT	A307	0.12	2.64		
					SUB TOTAL	21.89		

**MISC:**

LINE	QTY	MARK	DESCRIPTION	STL SPEC	WT PER (N LBS)	NET WT (N LBS)	HEAT #	REMARKS
19	3.15	--	SSA2 EXTRUSION (D.S. BROWN) x 23'-0"	A709-36	121.90	383.99		
20	1	*	3" AZR STRIP SEAL x 37'-0" (D.S. BROWN)		0.00	0.00		
21	1	*	GALLON OF GLUE		0.00	0.00		
					SUB TOTAL	383.99		
					<b>TOTAL WT</b>	<b>3,645.41</b>		

\* INDICATES AN ITEM THAT WILL BE SHIPPED LOOSE

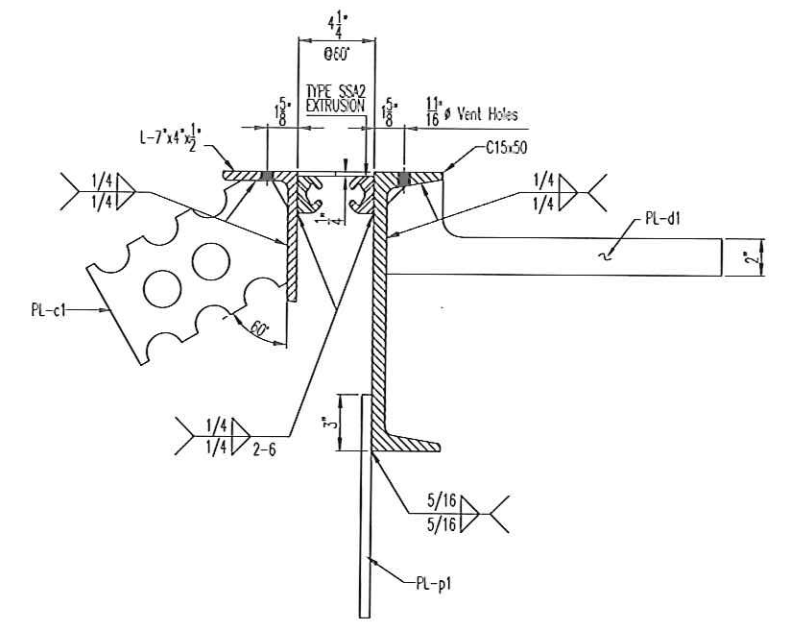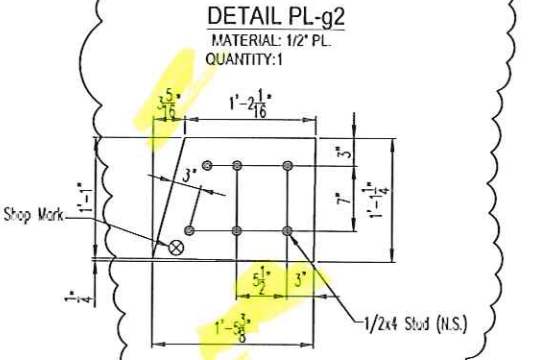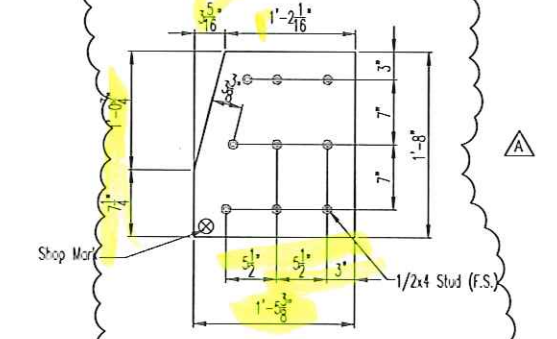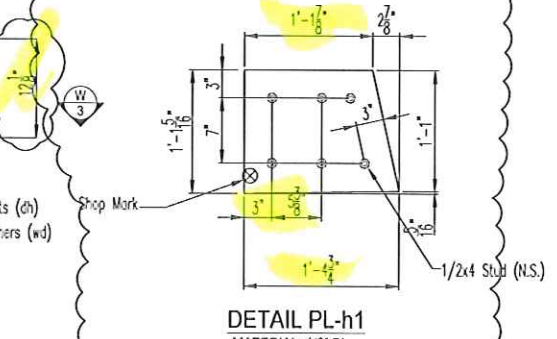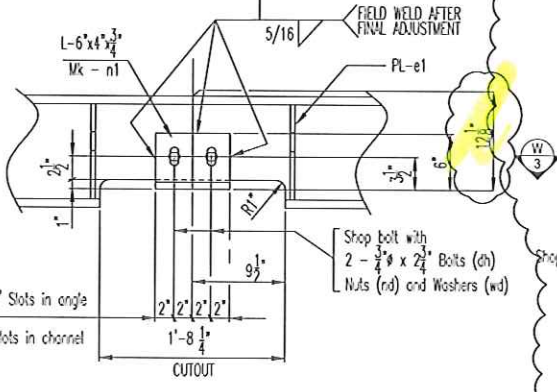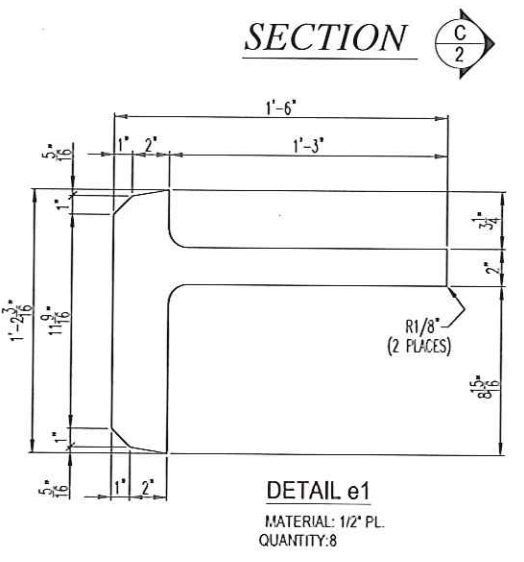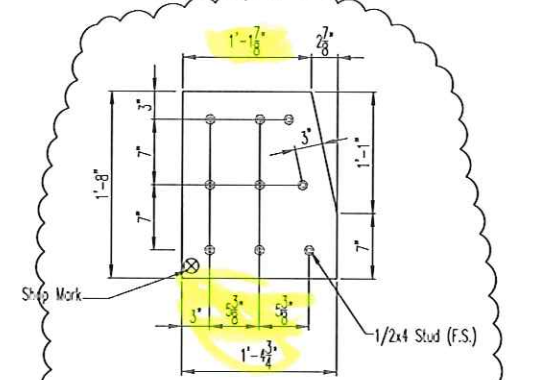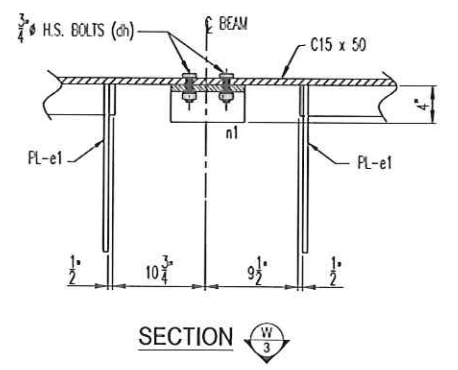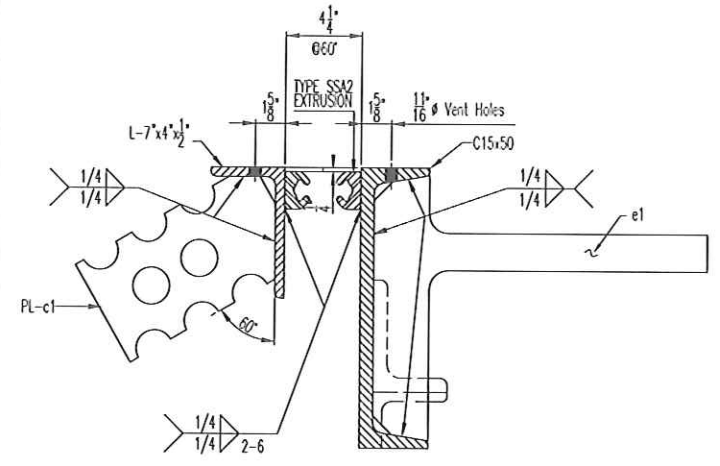

- GENERAL NOTES:**
- \* ALL MATERIAL SHALL BE ASTM A709 GR50/36.
  - \* MATERIAL AND WORKMANSHIP SHALL BE IN ACCORDANCE WITH ODOT-CMS-2019.
  - \* WELDING SHALL BE IN ACCORDANCE WITH AWS/AASHTO D1.5-15 AND ODOT 1011.
  - \* ALL MATERIAL TO BE METALIZED IN CONFORMANCE WITH O.D.O.T. STANDARD DRAWING EXJ-4-87 DATED 7/19/02.
  - \* ALL INFORMATION & DIMENSIONS ARE TO BE APPROVED BY THE CONTRACTOR PRIOR TO COMMENCING FABRICATION.
  - \* GENERAL TOLERANCE ±1/8" UNLESS NOTED.



**NOTES:**  
SEE SHEET 1 FOR EXPANSION JOINT LOCATION PLAN  
SEE SHEET 2 FOR EXPANSION JOINT DETAILS

REV. No.	REVISION
A	Per Contractors Review 4/30/20


SHOP INSPECTED BY:

APPROVAL

**OHIO STRUCTURES INC.**  
4030 BOARDMAN - CANFIELD RD, SUITE 200D  
CANFIELD, OHIO 44406  
(330) 533-0084 FAX: (330) 533-0191

**OHIO DEPARTMENT OF TRANSPORTATION**  
BRIDGE: HAM-74-1908S  
RAMP P OVER I-74 WB, IR-75 AND RAMP E

SCALE: N.T.S.	DRAWN: LF
DATE: 4/20	CHECK: MI
DETAILS, GENERAL NOTES, MATERIAL LIST	
REF. NO.: 0034	ITEM NO.: 516
ODOT PROJ. NO.: 183000	HAMILTON COUNTY DWG. NO.: 02
OSI PROJ. NO.: 00-18	PID NO.: 104687 SFN: 3109798 3 OF 3

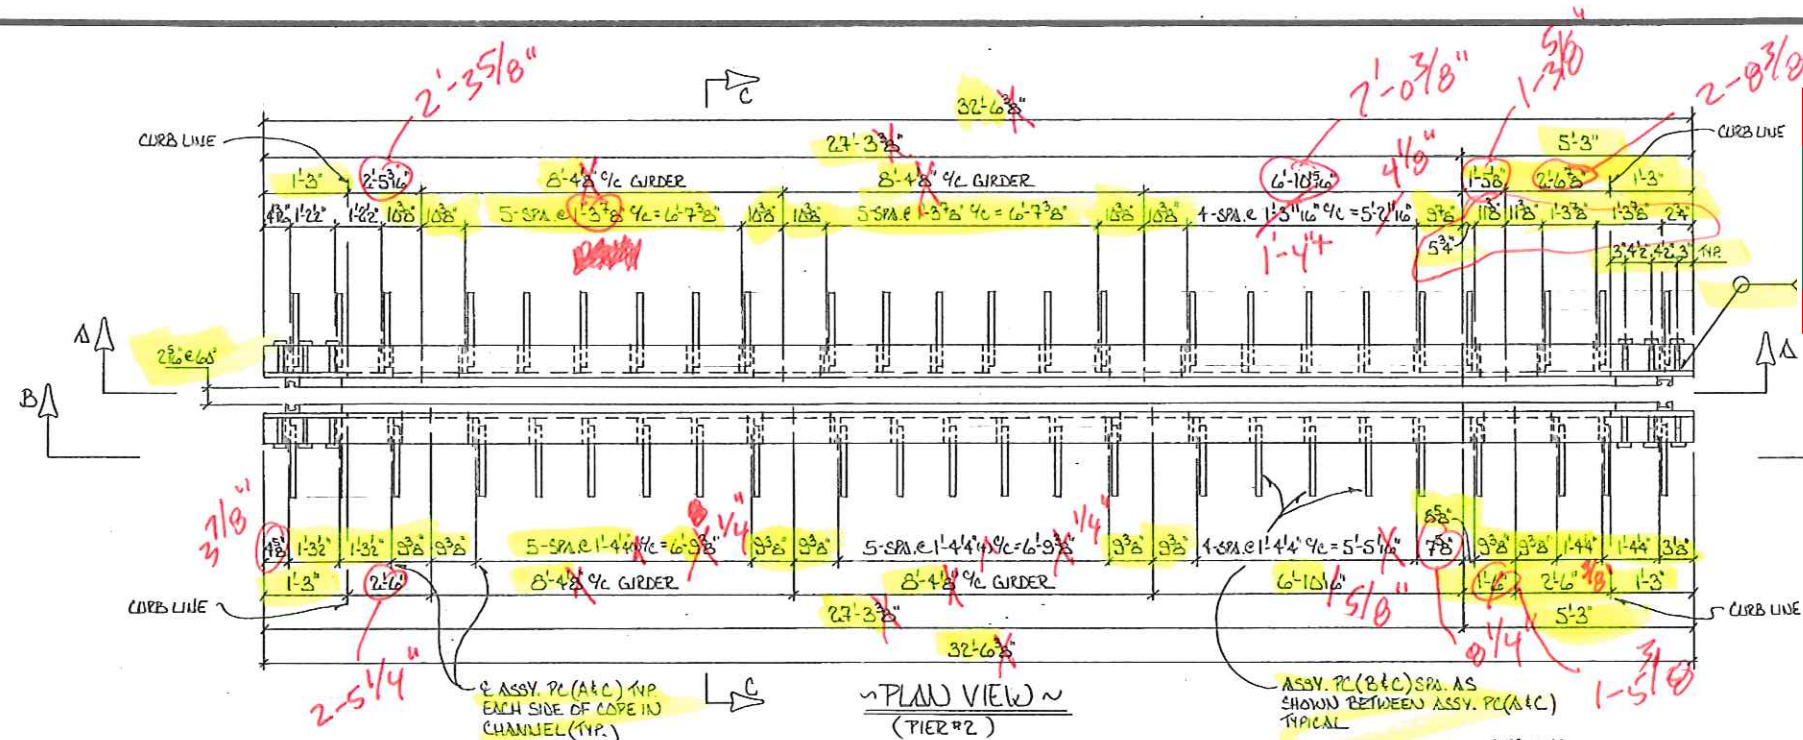

**PRIME AE, Group, Inc**

DATE REC'D: 3/26/2020 BUILDABLE UNIT NO.: 11

Review conforms that the shop drawings meet the intent of the contract.

CONFORMS AS-IS  CONFORMS AS NOTED  DOES NOT CONFORM




INCOMPLETE

By: Kelly Chrisman Date: 3/10/2020

STATE OF OHIO PROFESSIONAL ENGINEER Kelly D. Chrisman E-68020

RELEASED FOR FABRICATION

**WALSH**


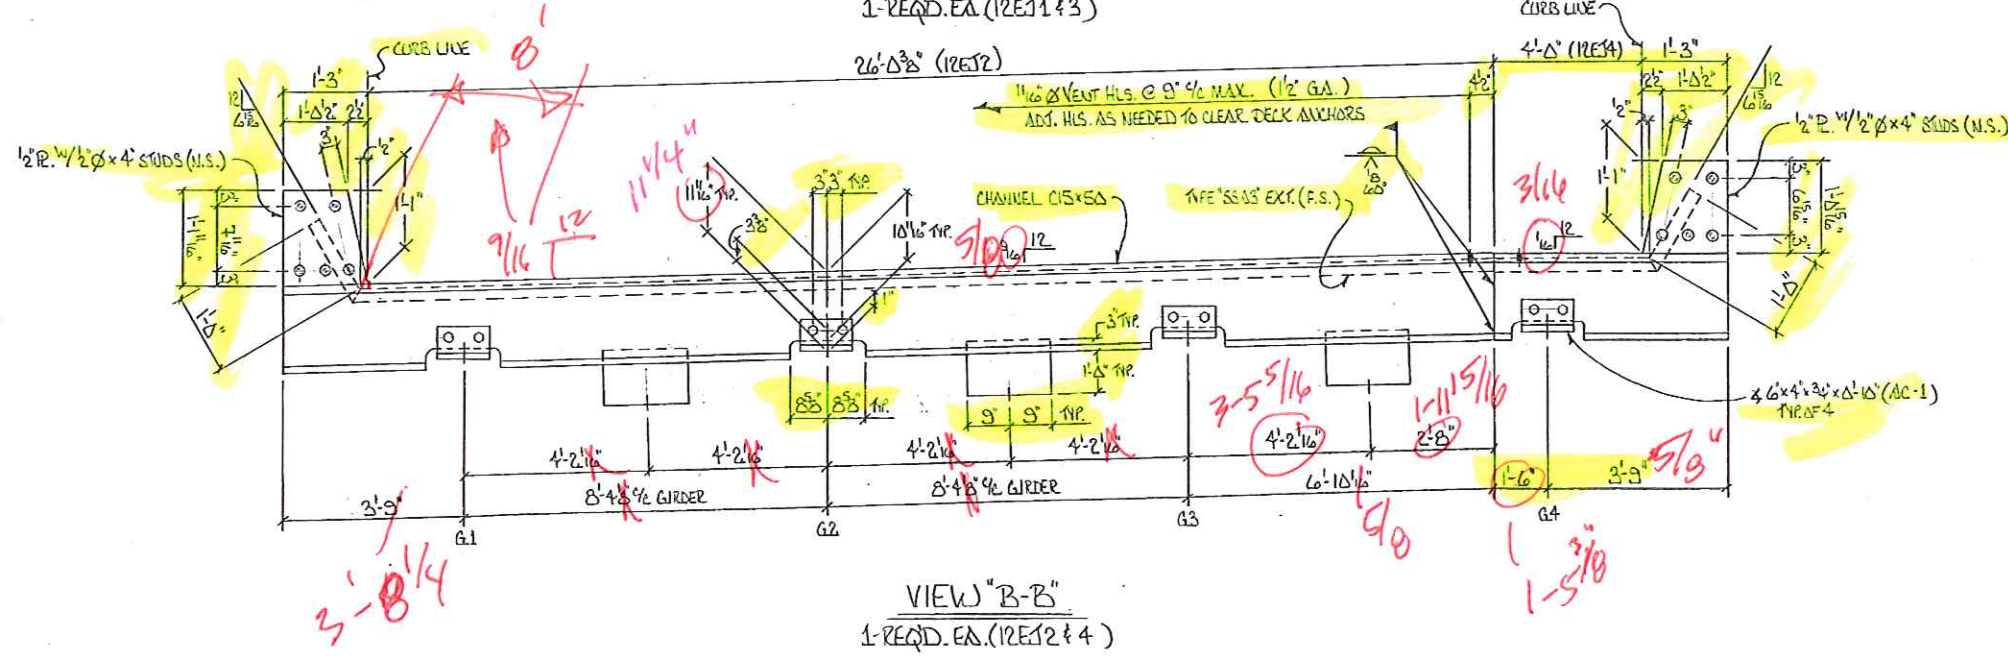
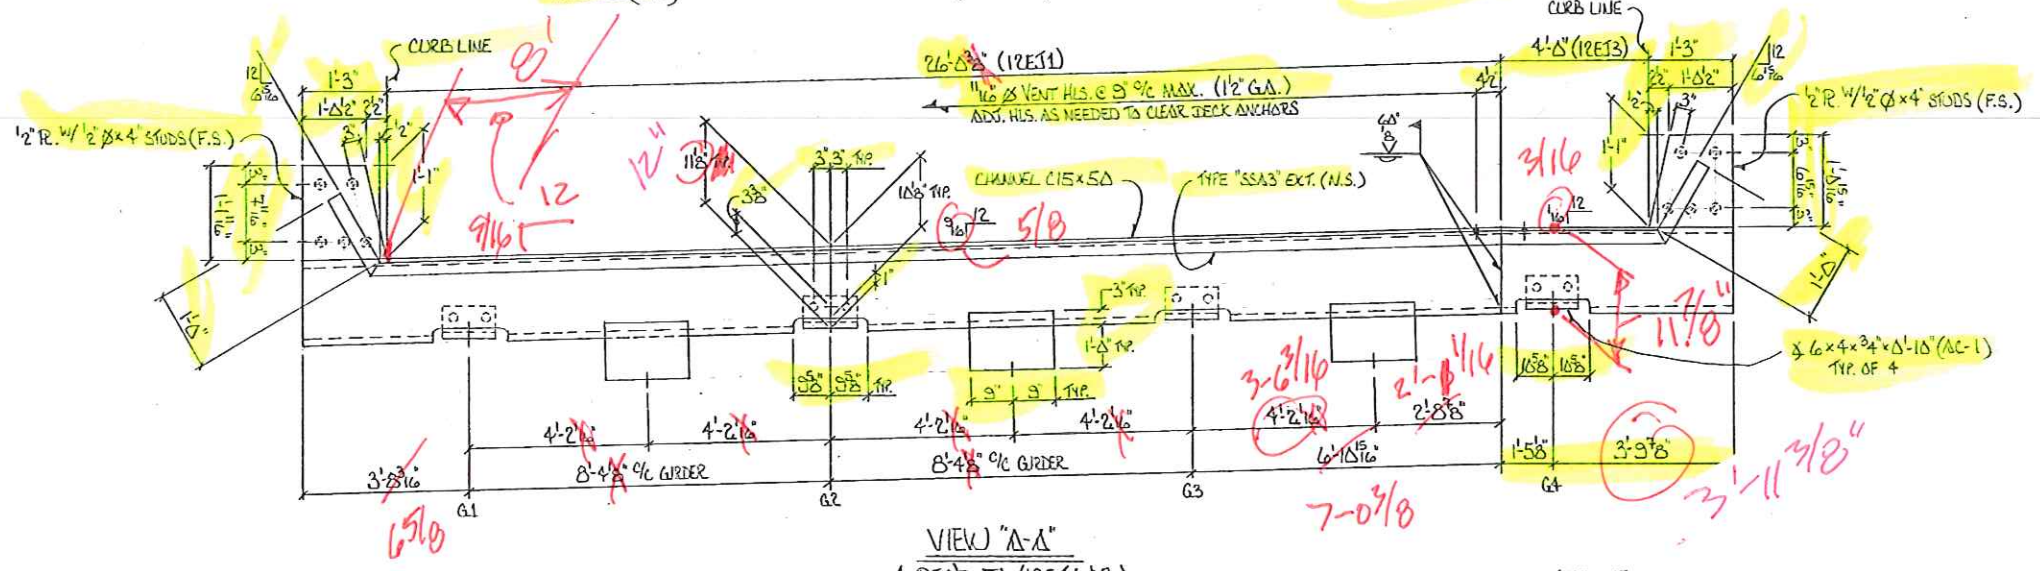
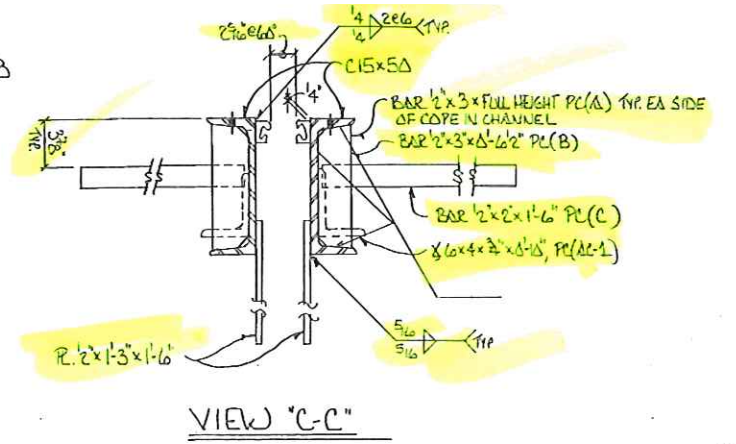


Note:


There is another grade break @ B' from left toe/parapet slope is 9/16 which is only 1/16 Δ from slope in middle.

O.D.D.T. PROJ. 3000-18  
 COUNTY: HAMILTON  
 BRIDGE No. HAM-74-1908S  
 REF. No.

		799 North Court Street, Suite 9 Medina, Ohio 44256-3160 Office: (330) 721-0131 Fax: (330) 721-0161 E-mail: contact@marbri.net	
NO	USE	DATE	FABRICATOR
1	APP	12-5-19	
1	REV	3-23-20	
PROJECT		O.D.D.T. PROJ. 3000-18	
CONTRACTOR		WALSH CONSTRUCTION	
LOCATION		HAMILTON COUNTY	
DESCRIPTION		EXP. JT. DETAILS ~ PIER #2	
DETAILED ADS.		DATE 12-1-19	JOB NUMBER
CHECKED R.M.S.		DATE 12-4-19	3000
FINISH		METALLIZED	DETAILS
			12

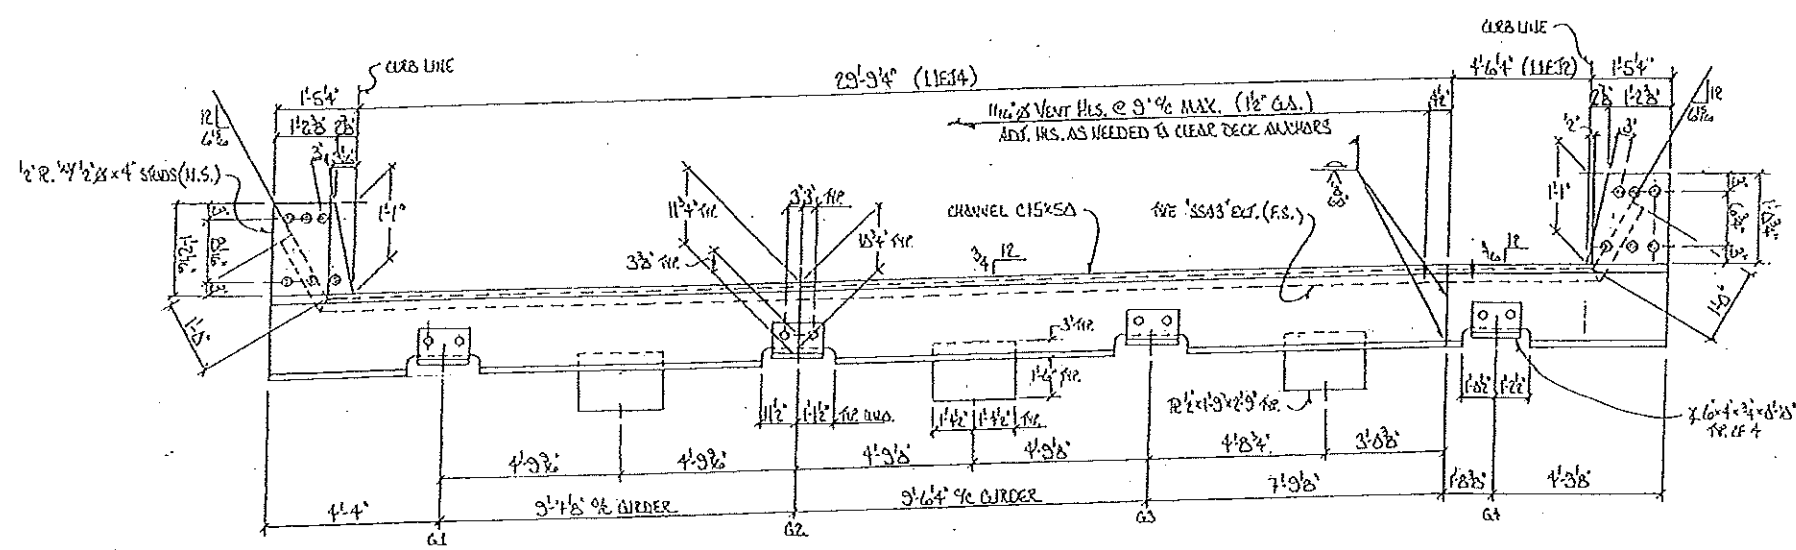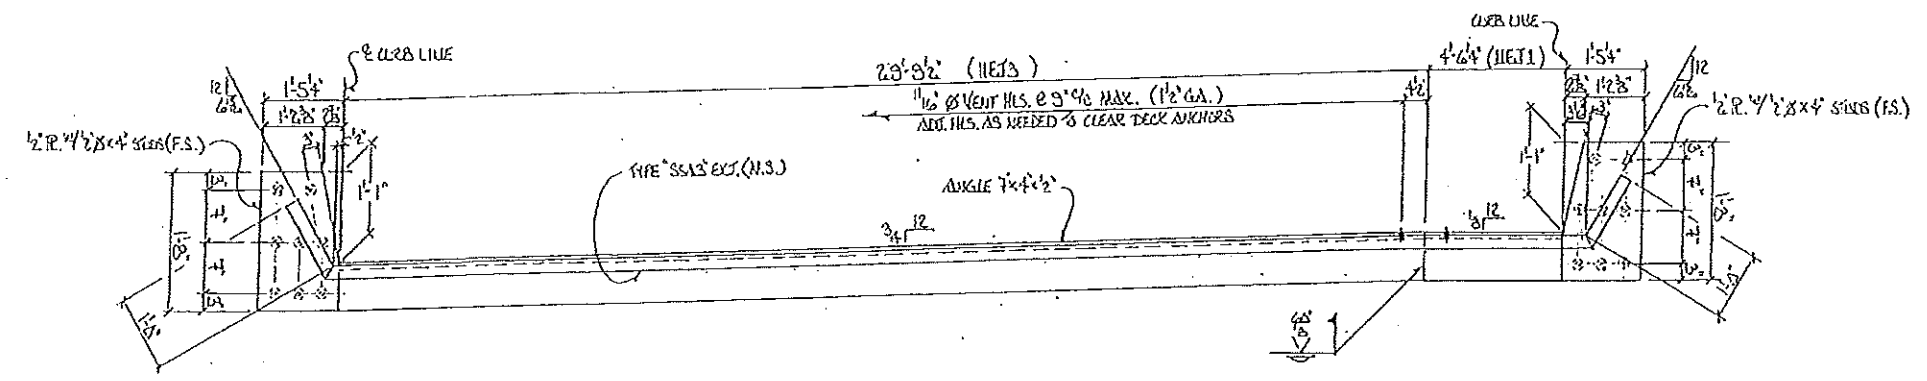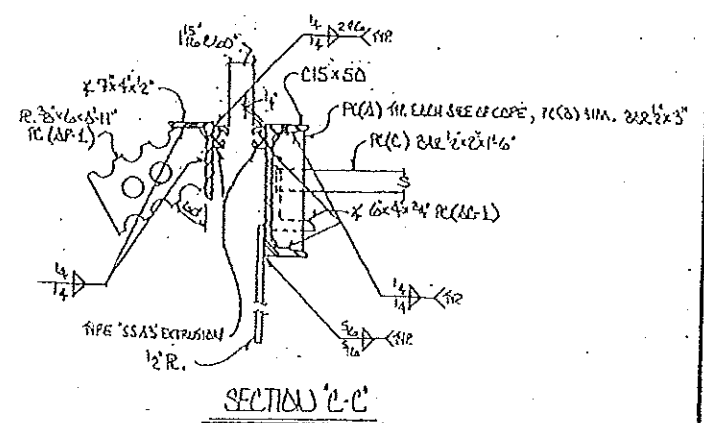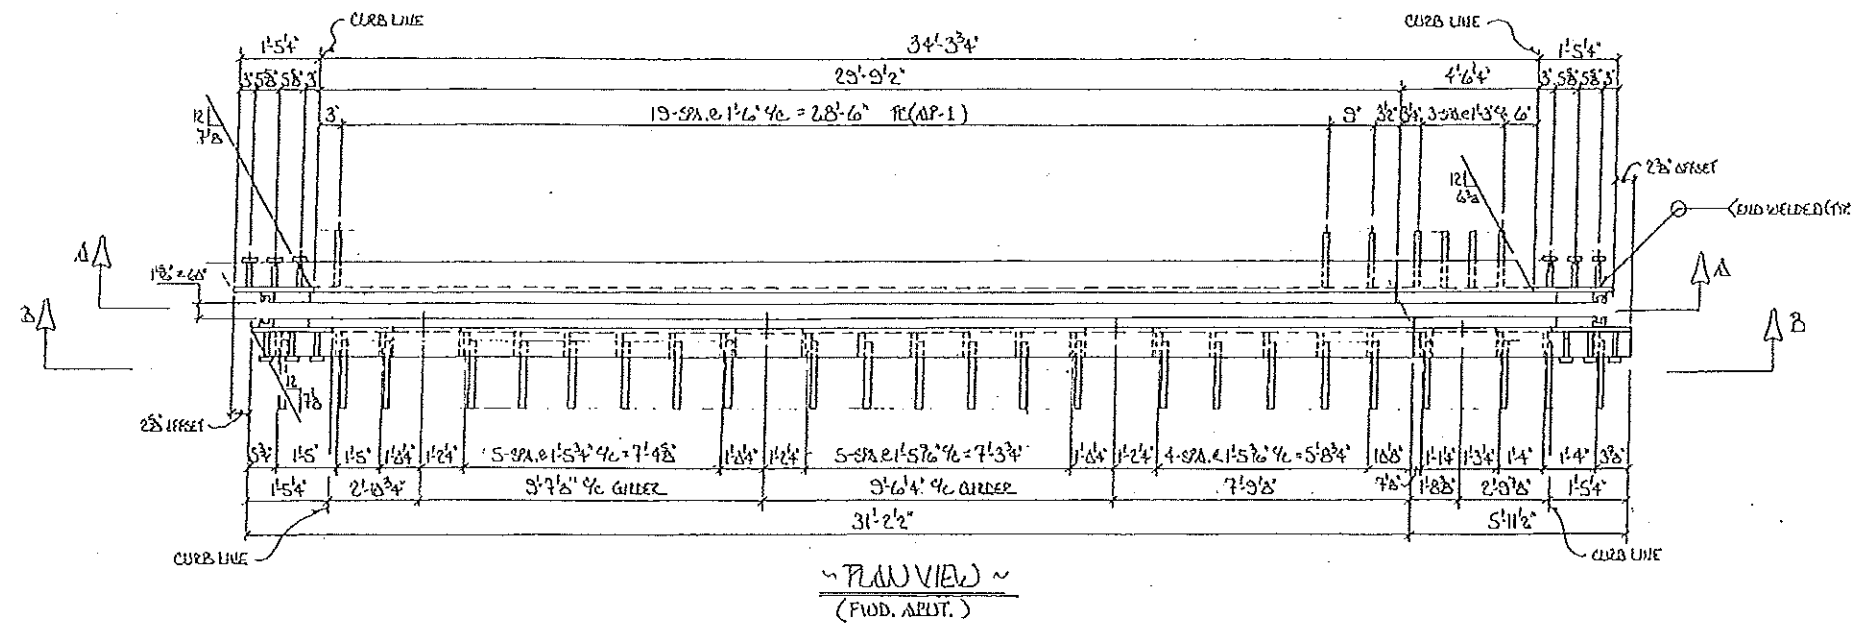

O.D.O.T. PROJ. 3000-18  
 COUNTY: HAMILTON  
 BRIDGE No. HAM-74-1908S  
 REF. No.

 100 Highland Drive, Suite 3 Medina, Ohio 44256-3160 Office: (330) 721-0131 Fax: (330) 721-0181 E-mail: contact@marbel.net		NO. DATE REVISION	
		1 11-13-18	1 11-25-19
1 11-27-19	CONTRACTOR WALSH CONSTRUCTION	1 1-6-20	LOCATION HAMILTON COUNTY
DESCRIPTION EXP. ST. DETAILS / F.U.D. ABUT. P.O.B.S.		DESIGNED A.D.S. DATE 10-20-19	REVISION NUMBER 3000
DRAWN R.M.S. DATE 11-3-19		SCALE METRIC	11