

STATE OF OHIO
DEPARTMENT OF TRANSPORTATION
HAM-75-3.84
RETAINING WALLS
(BU-9)

HAMILTON COUNTY
CITY OF CINCINNATI

PROJECT DESCRIPTION

THIS IS PHASE 5A OF THE HAMILTON 75 CORRIDOR PROJECTS (MCE). THE PROJECT ADDS A LANE TO IR 75 SB, PROVIDES 4-LANE CONTINUITY NB, AND RECONFIGURES IR 74 EB RAMP TO IR 75. THE PROJECT ALSO INCLUDES SURFACE COURSE AND ADDITIONAL PAVEMENT WORK TO THE SOUTH AND IMPROVEMENTS TO RAMP A AT THE HOPPLE ST INTERCHANGE.

BUILDABLE UNIT 9 DESCRIPTION

THIS BUILDABLE UNIT INCLUDES THE CONSTRUCTION OF RETAINING WALLS NO. 4, 5 AND 7 ALONG IR 75 SB AND RETAINING WALLS NO. 2 AND 21 ALONG IR 75 NB.


LIMITED ACCESS

THIS IMPROVEMENT IS ESPECIALLY DESIGNED FOR THROUGH TRAFFIC AND HAS BEEN DECLARED A LIMITED ACCESS HIGHWAY OR FREEWAY BY ACTION OF THE DIRECTOR IN ACCORDANCE WITH THE PROVISIONS OF SECTION 5511.02 OF THE OHIO REVISED CODE.

2016 SPECIFICATIONS

THE STANDARD SPECIFICATIONS OF THE STATE OF OHIO, DEPARTMENT OF TRANSPORTATION, INCLUDING SUPPLEMENTAL SPECIFICATIONS LISTED IN THE PLANS AND CHANGES LISTED IN THE PROPOSAL SHALL GOVERN THIS IMPROVEMENT.

I HEREBY APPROVE THESE PLANS AND DECLARE THAT THE MAKING OF THIS IMPROVEMENT WILL NOT REQUIRE THE CLOSING TO TRAFFIC OF THE HIGHWAY AND THAT PROVISIONS FOR THE MAINTENANCE AND SAFETY OF TRAFFIC WILL BE AS SET FORTH ON THE PLANS AND ESTIMATES.

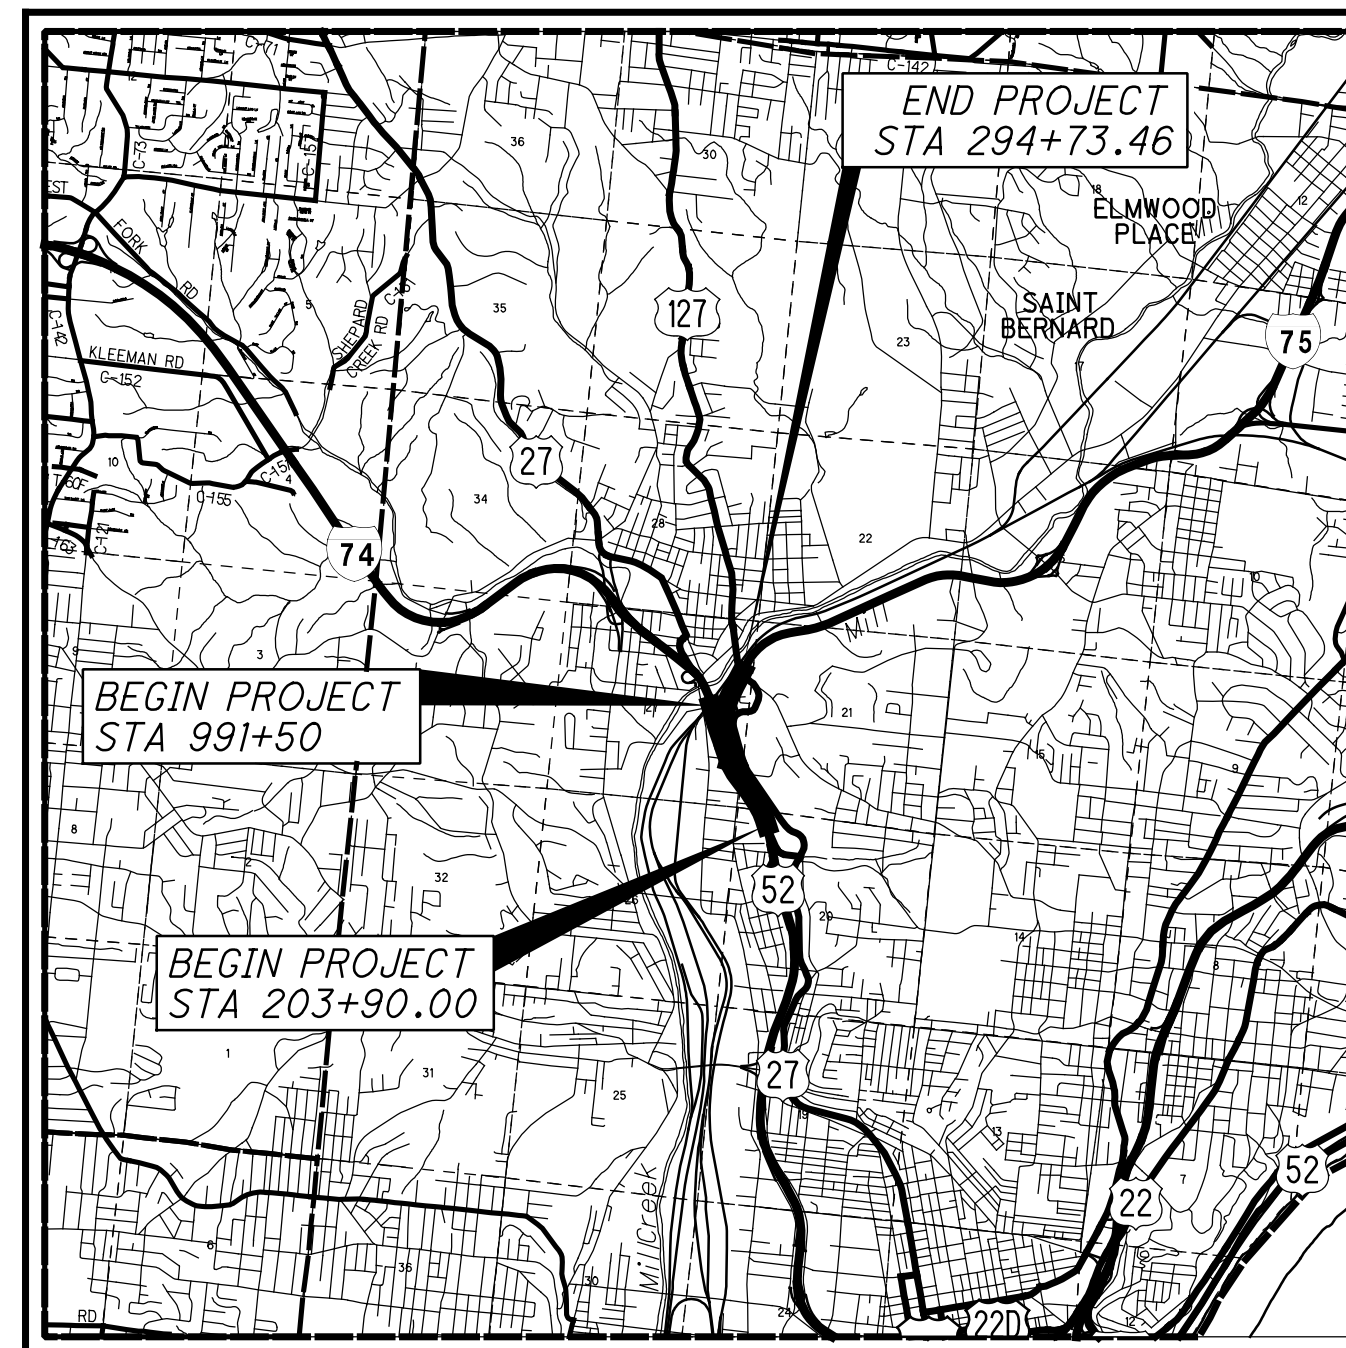

LOCATION MAP

LATITUDE: 39° 09' 03" LONGITUDE: -84° 32' 24"



PORTION TO BE IMPROVED	—————
INTERSTATE HIGHWAY	—————
FEDERAL ROUTES	—————
STATE ROUTES	—————
COUNTY & TOWNSHIP ROADS	—————
OTHER ROADS	—————

ENGINEERS SEAL: FOR ENTIRE PLAN EXCEPT STRUCTURES OVER 20'	ENGINEERS SEAL: FOR STRUCTURES OVER 20'
SIGNED: <i>Bruce Fraser</i> DATE: 2/19/2019	SIGNED: <i>Sage J. Flannagan</i> DATE: 2/19/2019

INDEX OF SHEETS:

TITLE SHEET	1
GENERAL NOTES	2-3
RETAINING WALL NO. 2	4-14
RETAINING WALL NO. 4	15-25
RETAINING WALL NO. 5	26-28
RETAINING WALL NO. 7	29-35
RETAINING WALL NO. 21	36-48
RETAINING WALL RELIABLE CASTINGS	48A-48C
STRUCTURE FOUNDATION EXPLORATION	1-54

DESIGN DESIGNATION

	IR 75		IR 74		DIRECTIONAL ROADWAY	
	SOUTH OF MITCHELL	SOUTH OF IR 74	WEST OF BEEKMAN	EAST OF BEEKMAN	IR 75 NB TO IR 74 WB	IR 74 EB TO IR 75 SB
CURRENT ADT (2010)	149,400	152,100	75,000	88,300	25,300	25,300
DESIGN YEAR ADT (2030)	174,300	179,200	89,300	102,000	29,800	29,800
DESIGN HOURLY VOLUME (2030)	14,640	15,050	8,040	9,180	4,100	4,380
DIRECTIONAL DISTRIBUTION	0.54	0.70	0.72	0.73	1.00	1.00
TRUCKS (24 HOUR B&C)	0.16	0.13	0.15	0.13	0.03	0.08
DESIGN SPEED	60 MPH	60 MPH	60 MPH	60 MPH	50 MPH	50 MPH
LEGAL SPEED	55 MPH	55 MPH	55 MPH	55 MPH	50 MPH	50 MPH
DESIGN FUNCTIONAL CLASSIFICATION:	03 URBAN INTERSTATE	03 URBAN INTERSTATE	03 URBAN INTERSTATE	03 URBAN INTERSTATE	03 URBAN INTERSTATE	03 URBAN INTERSTATE

NHS PROJECT ----- YES

DESIGN EXCEPTIONS

DESIGN FEATURE	APPROVAL DATES	SHEET NUMBERS
STOP. SIGHT DIST. - SB IR 75 (CURVE 6)	4/6/18	SEE BU-14
SHOULDER WIDTH - IR 74-1892R BRIDGE	4/10/18	
SHOULDER WIDTH - RAMP P 1908S BRIDGE	12/12/18	
CURVE RADIUS - RAMP P 1908S BRIDGE	12/12/18	
STOP. SIGHT DIST. - RAMP P 1908S BRIDGE	12/12/18	
S.E. RATE - IR 74 EB CURVE 13, 1908R BRIDGE	4/26/18	

SUPPLEMENTAL SPECIFICATIONS

800-2016	1/19/18	814	7/15/16	866	4/21/17	914	7/15/16
804	1/15/16	821	4/20/12	867	4/15/16	921	4/20/12
806	3/2/15	832	1/17/14	902	12/31/12	939	7/17/15
808	10/16/15	839	7/17/15	904	7/15/16		
809	1/19/18	840	4/15/16	908	10/20/17		

STANDARD CONSTRUCTION DRAWINGS

BP-1.1	7/28/00	MH-1.1	1/15/16	RM-1.1	7/18/14	HL-10.11	1/19/18	MT-95.30	7/21/17	TC-7.65	1/15/16	ITS-10.10	7/17/15
BP-2.1	7/17/15	MH-1.2	1/15/16	RM-4.1	7/21/17	HL-10.12	1/20/17	MT-95.31	7/21/17	TC-9.10	1/19/18	ITS-10.11	1/19/18
BP-2.2	7/18/08			RM-4.3	7/18/14	HL-10.13	1/20/17	MT-95.32	7/21/17	TC-9.30	1/19/18	ITS-13.10	7/17/15
BP-2.3	7/18/14	DM-1.1	7/21/17	RM-4.4	7/21/17	HL-10.15	7/17/15	MT-95.40	1/20/17	TC-12.30	1/19/18	ITS-14.10	7/17/15
BP-2.4	7/19/13	DM-1.2	1/18/13	RM-4.5	7/21/17	HL-10.31	1/19/18	MT-95.45	7/21/17	TC-15.115	10/18/13	ITS-14.11	7/17/15
BP-3.1	7/18/14	DM-1.3	7/18/14	RM-4.6	7/19/13	HL-20.11	4/21/17	MT-95.50	7/21/17	TC-16.21	1/19/18	ITS-15.10	7/17/15
BP-6.1	7/19/13	DM-2.1	1/18/13			HL-20.13	1/19/18	MT-95.73	1/19/18	TC-21.10	7/21/17	ITS-15.11	7/17/15
BP-8.1	7/18/08	DM-4.1	1/15/16	A-1-69	7/19/02	HL-20.21	1/19/18	MT-98.10	1/20/17	TC-21.20	1/19/18	ITS-50.10	1/19/18
		DM-4.2	7/20/12	AS-1-15	7/17/15	HL-20.24	1/19/18	MT-98.11	1/20/17	TC-21.50	7/15/16	ITS-50.11	1/15/16
CB-1.1	1/15/16	DM-4.3	1/15/16	AS-2-15	1/19/18	HL-30.11	1/19/18	MT-98.20	7/18/14	TC-22.10	10/18/13	ITS-50.12	1/19/18
CB-1.2	1/15/16	DM-4.4	1/15/16	EXJ-4-87	1/17/14	HL-30.21	1/17/14	MT-98.21	7/18/14	TC-22.20	1/17/14	ITS-60.10	7/15/16
CB-1.3	1/15/16			GSD-1-96	7/19/02	HL-30.22	1/17/14	MT-98.29	1/20/17	TC-41.30	10/18/13		
CB-2.1	1/15/16	MGS-1.1	1/19/18	PCB-91	1/18/13	HL-30.31	1/17/14	MT-98.30	7/21/17	TC-42.10	10/18/13		
CB-2.2	1/15/16	MGS-2.1	1/19/18	PSID-1-13	7/15/16	HL-30.32	1/17/14	MT-99.30	1/19/18	TC-42.20	10/18/13		
CB-2.3	1/15/16	MGS-3.1	1/19/18	RB-1-55	7/19/13	HL-30.33	1/17/14	MT-99.60	7/15/16	TC-52.10	10/18/13		
CB-3.1	1/15/16	MGS-3.2	1/18/13	SBR-1-13	1/14/14	HL-30.41	1/19/18	MT-101.70	1/17/14	TC-52.20	1/19/18		
CB-3.3	1/15/16	MGS-4.2	7/19/13	SBR-2-13	1/14/14	HL-40.10	1/20/17	MT-101.75	7/15/16	TC-61.30	1/20/17		
		MGS-4.3	1/18/13	SICD-1-96	7/18/14	HL-40.20	1/20/17	MT-101.80	1/16/18	TC-65.10	1/17/14		
I-2.1	1/15/16	MGS-5.2	7/15/16	SICD-2-14	7/18/14	HL-50.11	1/16/15	MT-101.90	7/21/17	TC-65.11	7/21/17		
I-2.2	1/15/16	MGS-5.3	7/15/16	VPF-1-90	1/19/18	HL-50.21	1/19/18	MT-102.10	1/20/17	TC-71.10	1/19/18		
I-2.3	1/15/16	MGS-6.1	1/19/18			HL-60.12	7/15/16	MT-102.20	7/18/14	TC-72.20	7/15/16		
I-2.4	1/15/16					HL-60.21	1/16/15	MT-103.10	1/19/18	TC-73.20	7/21/17		
						HL-60.31	7/21/17	MT-104.10	10/16/15				
								MT-105.10	7/19/13				

SPECIAL PROVISIONS

AS BUILT PLANS
8/23/2022

UNDERGROUND UTILITIES
Contact Two Working Days
Before You Dig



OHIO811, 8-1-1, or 1-800-362-2764
(Non-members must be called directly)

jwade
 8/22/2022 9:13:53 AM
 O:\2017\01113\C.Design\104667-HAM-75-3.84.Design\Structures\Walls\Sheets\104667_W00GN001.dgn

GENERAL NOTES - MSE RETAINING WALLS
(WALL 5)

STANDARD DRAWINGS AND SUPPLEMENTAL SPECIFICATIONS:
REFER TO THE FOLLOWING SUPPLEMENTAL SPECIFICATIONS:

840 REVISED 07-20-18

DESIGN SPECIFICATIONS:

THE STRUCTURE CONFORMS TO THE "LRFD BRIDGE DESIGN SPECIFICATIONS" ADOPTED BY THE AMERICAN ASSOCIATION OF STATE HIGHWAY AND TRANSPORTATION OFFICIALS, 8TH EDITION, AND THE ODOT BRIDGE DESIGN MANUAL, 2007.

SEALING OF CONCRETE SURFACES
(PERMANENT GRAFFITI PROTECTION):

APPLY A PERMANENT GRAFFITI COATING QUALIFIED ACCORDING TO SUPPLEMENT 1083 THAT IS COMPATIBLE WITH THE CONCRETE SEALER OVER WHICH IT IS APPLIED. APPLY THE GRAFFITI COATING IN ACCORDANCE WITH THE MANUFACTURER'S PRINTED INSTRUCTIONS.

FOUNDATION BEARING RESISTANCE:

THE FOUNDATION BEARING RESISTANCE IS LISTED IN THE TABLE BELOW.

FOUNDATION BEARING RESISTANCE			
WALL NUMBER	WALL LIMITS		FACTORED BEARING RESISTANCE
	FROM STA.	TO STA.	
5	265+35.00	260+58.32	4.5

SEALING OF CONCRETE SURFACES
(EPOXY-URETHANE):

THE FINISH COAT COLOR SHALL BE FEDERAL COLOR NO. 595B-17778, LIGHT NEUTRAL.

AESTHETIC SURFACE TREATMENT:

ALL MSE PANELS SHALL HAVE A "FRACTURED FIN" FINISH WITH A RELIEF OF 1/2". THE MANUFACTURER SHALL FABRICATE AND THE CONTRACTOR INSTALL THE PANELS SUCH THAT THE VERTICAL FINNS AND VALLEYS IN THE FRACTURED FIN AESTHETIC TREATMENT ALIGN VERTICALLY ACROSS ADJACENT PANELS FROM THE BOTTOM OF THE WALL TO THE TOP.

THE "FRACTURED FIN" FINISH ON ALL THE WALLS SHALL MATCH AND SHALL BE SUPPLIED BY THE SAME FORMLINER MANUFACTURER.

GENERAL NOTES - CIP CONCRETE RETAINING WALLS
(WALLS 2A, 4 AND 7)

DESIGN DATA:

CONCRETE, CLASS QC1 - COMPRESSIVE STRENGTH 4.0 KSI (RETAINING WALL)

REINFORCING STEEL - MINIMUM YIELD STRENGTH 60 KSI EPOXY COATED PER CMS 509

DESIGN SPECIFICATIONS:

THE STRUCTURE CONFORMS TO THE "LRFD BRIDGE DESIGN SPECIFICATIONS" ADOPTED BY THE AMERICAN ASSOCIATION OF STATE HIGHWAY AND TRANSPORTATION OFFICIALS, 8TH EDITION, AND THE ODOT BRIDGE DESIGN MANUAL, 2007.

SEALING OF CONCRETE SURFACES
(PERMANENT GRAFFITI PROTECTION):

APPLY A PERMANENT GRAFFITI COATING QUALIFIED ACCORDING TO SUPPLEMENT 1083 THAT IS COMPATIBLE WITH THE CONCRETE SEALER OVER WHICH IT IS APPLIED. APPLY THE GRAFFITI COATING IN ACCORDANCE WITH THE MANUFACTURER'S PRINTED INSTRUCTIONS.

FOUNDATION BEARING RESISTANCE:

FOOTINGS, AS DESIGNED, PRODUCE A MAXIMUM SERVICE BEARING PRESSURE AND STRENGTH BEARING PRESSURE AS LISTED IN THE TABLE BELOW.

FOUNDATION BEARING RESISTANCE			
WALL NUMBER	SERVICE BEARING PRESSURE (KSF)	STRENGTH BEARING PRESSURE (KSF)	FACTORED BEARING RESISTANCE (KSF)
2A	1.22	1.36	7.1
4	2.03	2.44	4.25
7	1.65	2.11	4.40

SEALING OF CONCRETE SURFACES
(EPOXY-URETHANE):

THE FINISH COAT COLOR SHALL BE FEDERAL COLOR NO. 595B-17778, LIGHT NEUTRAL.

AESTHETIC SURFACE TREATMENT:

THE FRONT FACE OF CIP RETAINING WALLS SHALL HAVE A "FRACTURED FIN" FINISH WITH A RELIEF OF 1/2" APPLIED TO THE LIMITS SHOWN IN THE PLANS. THE VERTICAL FINNS AND VALLEYS IN THE FRACTURED FIN AESTHETIC TREATMENT SHALL ALIGN VERTICALLY FROM THE BOTTOM OF THE WALL TO THE TOP.

THE "FRACTURED FIN" FINISH ON ALL THE WALLS SHALL MATCH AND SHALL BE SUPPLIED BY THE SAME FORMLINER MANUFACTURER.

GENERAL NOTES - SOLDIER PILE RETAINING WALLS
(WALLS 2B AND 2I)

STANDARD DRAWINGS AND SUPPLEMENTAL SPECIFICATIONS:
REFER TO THE FOLLOWING SUPPLEMENTAL SPECIFICATIONS:

866 REVISED 04-21-17

DESIGN DATA:

CONCRETE, CLASS QC1 - COMPRESSIVE STRENGTH 4.0 KSI (CIP FACING)

CONCRETE, CLASS QC MISC. - COMPRESSIVE STRENGTH 4.0 KSI (LEVELING PAD)

REINFORCING STEEL - MINIMUM YIELD STRENGTH 60 KSI EPOXY COATED PER CMS 509

STRUCTURAL STEEL - ASTM A 709 GRADE 50 - YIELD STRENGTH 50 KSI (MISC. STEEL ATTACHMENTS)
ASTM A 53 GRADE B - YIELD STRENGTH 35 KSI (ANCHOR ASSEMBLY PIPE)

STEEL H-PILES - ASTM A572 - YIELD STRENGTH 50 KSI

TIMBER LAGGING - BENDING STRENGTH (Fb) 950 PSI

DESIGN SPECIFICATIONS:

THE STRUCTURE CONFORMS TO THE "LRFD BRIDGE DESIGN SPECIFICATIONS" ADOPTED BY THE AMERICAN ASSOCIATION OF STATE HIGHWAY AND TRANSPORTATION OFFICIALS, 8TH EDITION, AND THE ODOT BRIDGE DESIGN MANUAL, 2007.

SEALING OF CONCRETE SURFACES
(PERMANENT GRAFFITI PROTECTION):

APPLY A PERMANENT GRAFFITI COATING QUALIFIED ACCORDING TO SUPPLEMENT 1083 THAT IS COMPATIBLE WITH THE CONCRETE SEALER OVER WHICH IT IS APPLIED. APPLY THE GRAFFITI COATING IN ACCORDANCE WITH THE MANUFACTURER'S PRINTED INSTRUCTIONS.

SEALING OF CONCRETE SURFACES
(EPOXY-URETHANE):

THE FINISH COAT COLOR SHALL BE FEDERAL COLOR NO. 595B-17778, LIGHT NEUTRAL.

AESTHETIC SURFACE TREATMENT:

THE FRONT FACE OF CIP FACING SHALL HAVE A "FRACTURED FIN" FINISH WITH A RELIEF OF 1/2" APPLIED TO THE LIMITS SHOWN IN THE PLANS. THE VERTICAL FINNS AND VALLEYS IN THE FRACTURED FIN AESTHETIC TREATMENT SHALL ALIGN VERTICALLY FROM THE BOTTOM OF THE WALL TO THE TOP.

THE "FRACTURED FIN" FINISH ON ALL THE WALLS SHALL MATCH AND SHALL BE SUPPLIED BY THE SAME FORMLINER MANUFACTURER.

DRILLED SHAFTS ABOVE BEDROCK:
DRILLED SHAFTS INTO BEDROCK:


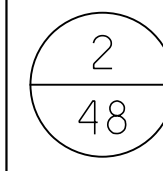
THIS WORK CONSISTS OF FURNISHING AND INSTALLING DRILLED SHAFTS FOR SOLDIER PILE AND LAGGING WALLS. THE DRILLED SHAFTS ARE REINFORCED WITH SOLDIER PILES INSTEAD OF REINFORCING STEEL CAGES. THE SOLDIER PILES EXTEND ABOVE THE TOP OF THE DRILLED SHAFT. FURNISH AND INSTALL THE DRILLED SHAFTS IN ACCORDANCE WITH CMS 524 EXCEPT AS MODIFIED AND SUPPLEMENTED BELOW.

EXCAVATE THE HOLE FOR THE DRILLED SHAFT WITHIN 3 INCHES OF THE PLAN LOCATION. PLACE THE SOLDIER PILE WITHIN THE HOLE SO IT IS VERTICAL AND NOT INCLINED MORE THAN 1/4 INCH PER FOOT. PLACE THE SOLDIER PILE SO THAT THE FLANGES ARE PARALLEL TO THE CENTERLINE OF THE ROW OF DRILLED SHAFTS. DO NOT ALLOW THE ORIENTATION OF THE FLANGES TO VARY BY MORE THAN 10 DEGREES. SUPPORT THE SOLDIER PILE SO THAT IT DOES NOT MOVE DURING CONCRETE PLACEMENT.

USE CLASS QC1 CONCRETE ACCORDING TO CMS 511. PLACE CONCRETE TO THE ELEVATION FOR THE TOP OF THE DRILLED SHAFT. THE CONTRACTOR MAY PLACE CONCRETE USING THE FREE FALL METHOD PROVIDED THE DEPTH OF WATER IS LESS THAN 6 INCHES AND THE CONCRETE FALLS WITHOUT STRIKING THE SIDES OF THE HOLE. POURING CONCRETE ALONG THE WEB OF THE SOLDIER PILE IS ACCEPTABLE.

CHECK THE POSITION, THE VERTICAL ALIGNMENT AND ORIENTATION OF THE SOLDIER PILE IMMEDIATELY AFTER CONCRETE PLACEMENT. MAKE CORRECTIONS AS NECESSARY TO MEET THE ABOVE TOLERANCES. AS SHOWN ON THE PLANS, FILL THE HOLE ABOVE THE BOTTOM OF THE LAGGING TO THE EXISTING GROUND SURFACE WITH ITEM C&MS 613 LOW STRENGTH MORTAR BACKFILL (LSM).

REMOVE CONCRETE AND LSM AS NECESSARY FROM AROUND THE SOLDIER PILE IN ORDER TO PLACE THE LAGGING. PLACE LAGGING SO THAT THE SOLDIER PILE FLANGE OVERLAPS THE END OF THE LAGGING BY AT LEAST 3 INCHES AT BOTH ENDS OF THE LAGGING. WAIT AT LEAST 12 HOURS AFTER PLACING CONCRETE BEFORE PLACING LAGGING.

	DESIGN AGENCY STRUCTUREPOINT	DATE 01/18/19	REVIEWED MDS STRUCTURE FILE NUMBER
DESIGNED SUJ CHECKED CLB	DRAWN SUJ REVISED	GENERAL NOTES - 1 RETAINING WALLS NO. 2, 4, 5, 7 & 21	
HAM-75-3.84 PID No. 104667		1 / 2	

GENERAL NOTES - SOLDIER PILE RETAINING
(WALLS 2B AND 2I)

TIMBER LAGGING:

THIS ITEM CONSISTS OF FURNISHING AND PLACING TIMBER LAGGING AS TEMPORARY SUPPORT FOR THE RETAINED SOIL. FURNISH TIMBER LAGGING CONSISTING OF CONSTRUCTION GRADE, UNTREATED HARDWOOD WITH A MINIMUM THICKNESS OF 3 INCHES. TO PERMIT DRAINAGE, PROVIDE 1/4 TO 1/2 SPACES BETWEEN LAGGING BOARDS USING 3/8 SPACER BLOCKS OR OTHER MEANS ACCEPTABLE TO THE ENGINEER. EXCAVATION FOR PLACEMENT OF THE LAGGING SHALL BE PERFORMED IN SUCH A MANNER THAT THE LAGGING IS TIGHT AGAINST THE EXCAVATION CUT FACE. ANY VOIDS BEHIND THE LAGGING SHALL BE BACKFILLED WITH NO. 57 STONE. THE COST OF ANY SUCH BACKFILLING REQUIRED, INCLUDING MATERIAL, PLACEMENT AND COMPACTION, SHALL BE INCIDENTAL TO THE COST OF LAGGING.

PREFABRICATED GEOCOMPOSITE DRAIN (J-DRAIN 400/420):

THIS WORK CONSISTS OF FURNISHING AND PLACING PREFABRICATED GEOCOMPOSITE DRAIN (PGD) STRIPS AGAINST TIMBER LAGGING.

FURNISH PGD STRIPS CONSISTING OF A POLYMERIC CORE WRAPPED IN A FABRIC CONFORMING TO C&MS 712.09, TYPE A. USE CORE MATERIAL THAT IS RESISTANT TO PETROLEUM-BASED CHEMICALS, NATURALLY OCCURRING SOIL CHEMICALS, AND ROAD DE-ICING SALTS. THE CORE MATERIAL SHALL HAVE SUFFICIENT FLEXIBILITY TO WITHSTAND BENDING AND HANDLING DURING INSTALLATION WITHOUT DAMAGE. THE REQUIRED MINIMUM COMPRESSIVE STRENGTH OF THE CORE IS 40 POUNDS PER SQUARE INCH ACCORDING TO ASTM D 1621 PROCEDURE A. THE MINIMUM (SINGLE SIDE) CORE FLOW CAPACITY IS 10 GALLONS PER MINUTE PER FOOT OF WIDTH FOR A 0.1 GRADIENT AT 10 POUNDS PER SQUARE INCH BLADDER LOAD ACCORDING TO ASTM D 4716. FURNISH THE MANUFACTURER'S CERTIFIED TEST DATA.

PLACE PGD STRIPS BETWEEN THE SOLDIER PILES, FROM EDGE OF SOLDIER PILE TO EDGE OF SOLDIER PILE. PLACE THE SIDE FACED WITH GEOTEXTILE AGAINST THE TIMBER LAGGING, FACING TOWARDS THE RETAINED GROUND, AND SECURE THE DRAIN TO THE LAGGING. USE NAILS AND WASHERS AT LEAST 1-INCH DIAMETER IN SIZE TO SECURE THE PGD ALONG THE EDGES OF THE PGD AND AT A MAXIMUM SPACING OF 3 FEET. REPAIR ANY DAMAGE TO THE GEOTEXTILE FABRIC BY COVERING WITH A PATCH WHICH OVERLAPS THE DAMAGED AREA BY AT LEAST 12 INCHES. IF THE CORE OF THE PGD IS DAMAGED, REPLACE IT WITH A NEW SECTION OF PGD AND SPLICE THE NEW SECTION WITH AT LEAST A 12-INCH OVERLAP SUCH THAT THE FLOW OF WATER IS NOT IMPEDED WITHIN THE DRAIN. TAPE ALL JOINTS IN THE PGD STRIP TO PREVENT CONCRETE INTRUSION DURING PLACEMENT.

INSTALL POROUS BACKFILL AT THE BASE OF THE SOLDIER PILE WALL AS SHOWN IN THE PLANS. ENSURE THE BOTTOM OF EACH PGD STRIP EXTENDS INTO THE POROUS BACKFILL SO THAT WATER FLOW IS NOT INTERRUPTED.

WELDED STUD SHEAR CONNECTORS:

WELD HEADED STEEL STUDS TO THE FLANGES OF THE SOLDIER PILE IN ORDER TO CONNECT THE CONCRETE WALL FACING TO THE SOLDIER PILE. ATTACH HEADED STUDS ACCORDING TO C&MS 513.22 AND AS SHOWN IN THE PLANS. THE CONTRACTOR MAY ATTACH THE STUDS EITHER IN A TOP DOWN MANNER AS EXCAVATION PROGRESSES OR AFTER EXCAVATION IN FRONT OF THE WALL IS COMPLETE. PROTECT THE HEADED STUDS FROM DAMAGE UNTIL THE CONCRETE WALL FACING IS POURED. REPAIR OR REPLACE DAMAGED HEADED STUDS AT NO EXPENSE TO THE DEPARTMENT.

SOLDIER PILES:

THIS WORK CONSISTS OF FURNISHING AND PLACING STEEL SOLDIER PILES INTO DRILLED HOLES. FURNISH SOLDIER PILES CONSISTING OF STRUCTURAL STEEL MEMBERS THAT MEET THE PLAN REQUIREMENTS AND CONFORM TO ASTM A572, GRADE 50. DO NOT FIELD WELD OR SPLICE STEEL SOLDIER PILES.

GENERAL NOTES - ALL WALLS


DUKE ENERGY ELECTRIC:

AT NO TIME SHOULD WORKERS VIOLATE THE CLEARANCE DISTANCE ESTABLISHED BY OSHA OR THEIR OWN COMPANY'S SAFETY STANDARDS IN REGARDS TO DUKE'S ELECTRIC LINES AND SAFE WORKING DISTANCE. ANY COVER UP REQUIRED FROM DUKE ELECTRIC IS ONLY GOOD FOR VISUAL IDENTIFICATION ONLY AND NOT TO BE USED FOR INSULATION PURPOSES. TO REQUEST COVER UP, THE CONTRACTOR MUST CALL 1-800-544-6900 AT LEAST FIVE (5) WORKING DAYS IN ADVANCE OF NEEDING THIS SERVICE. PROCEED WITH CAUTION WHEN WORKING IN CLOSE PROXIMITY TO ELECTRIC OVERHEAD AND/OR UNDERGROUND FACILITIES. THE CONTRACTOR SHOULD ALSO BE INFORMED TO CALL OUPS AT 811 BEFORE DIGGING TO HAVE UNDERGROUND FACILITIES LOCATED AND MARKED).


ABBREVIATION LIST:

THE FOLLOWING STANDARD ABBREVIATIONS ARE USED THROUGHOUT THE RETAINING WALL PLANS.


- ABUT. = ABUTMENT
- ACT. = ACTUAL
- APP. = APPROACH
- BRG. = BEARING
- BOT. = BOTTOM
- BTA. = BRIDGE TERMINAL ASSEMBLY
- BTW. = BETWEEN
- CB = CATCH BASIN
- C.I.P. = CAST-IN-PLACE
- C.J. = CONSTRUCTION JOINT
- CLR. = CLEARANCE
- CONST = CONSTRUCTION
- CONT. = CONTINUOUS
- DIA. = DIAMETER
- DIM. = DIMENSION
- DWG. = DRAWING
- E.F. = EACH FACE
- EL. = ELEVATION
- EQ. = EQUAL
- EST. = ESTIMATED
- EX. = EXISTING
- EXP. = EXPANSION
- F.A. = FORWARD ABUTMENT
- F.D.S. = FINAL DECK SURFACE
- F.F. = FRONT FACE
- FTG. = FOOTING
- FWD. = FORWARD
- GR. = GUARDRAIL
- HMWM = HIGH MOLECULAR WEIGHT METHACRYLATE
- INT. = INTERIOR
- INV. = INVERT
- NPCCP = NON-PERFORATED CORRUGATED PLASTIC PIPE
- O.C.J. = OPTIONAL CONSTRUCTION JOINT
- PCCP = PERFORATED CORRUGATED PLASTIC PIPE
- PEJF = PREFORMED EXPANSION JOINT FILLER
- PERP. = PERPENDICULAR
- PROP. = PROPOSED
- PT. = POINT
- R.A. = REAR ABUTMENT
- R.F. = REAR FACE
- REQD. = REQUIRED
- SER. = SERIES
- SHLD. = SHOULDER
- SPA. = SPACES
- STA. = STATION
- STD. = STANDARD
- STM = STORM SEWER LINE
- T&B = TOP AND BOTTOM
- T.O.H. = TOP OF HAUNCH
- T/S = TOP OF SLOPE
- TYP. = TYPICAL
- U.N. = UNLESS NOTED

	DESIGN AGENCY STRUCTUREPOINT	DATE 01/18/19	REVIEWED MDS
DESIGNED SUJ	DRAWN SUJ	FILE NUMBER 104667	REVISIONS REVISED CLB
GENERAL NOTES - 2 RETAINING WALLS NO. 2, 4, 5, 7 & 21			
HAM-75-3.84 PID No. 104667		2 / 2	

I:\wade 8/22/2022 9:14:00 AM O:\2017\01113\C.Design\104667_HAM-75-3.84.Design\Structures\Walls_Sheets\104667_WD02.dgn

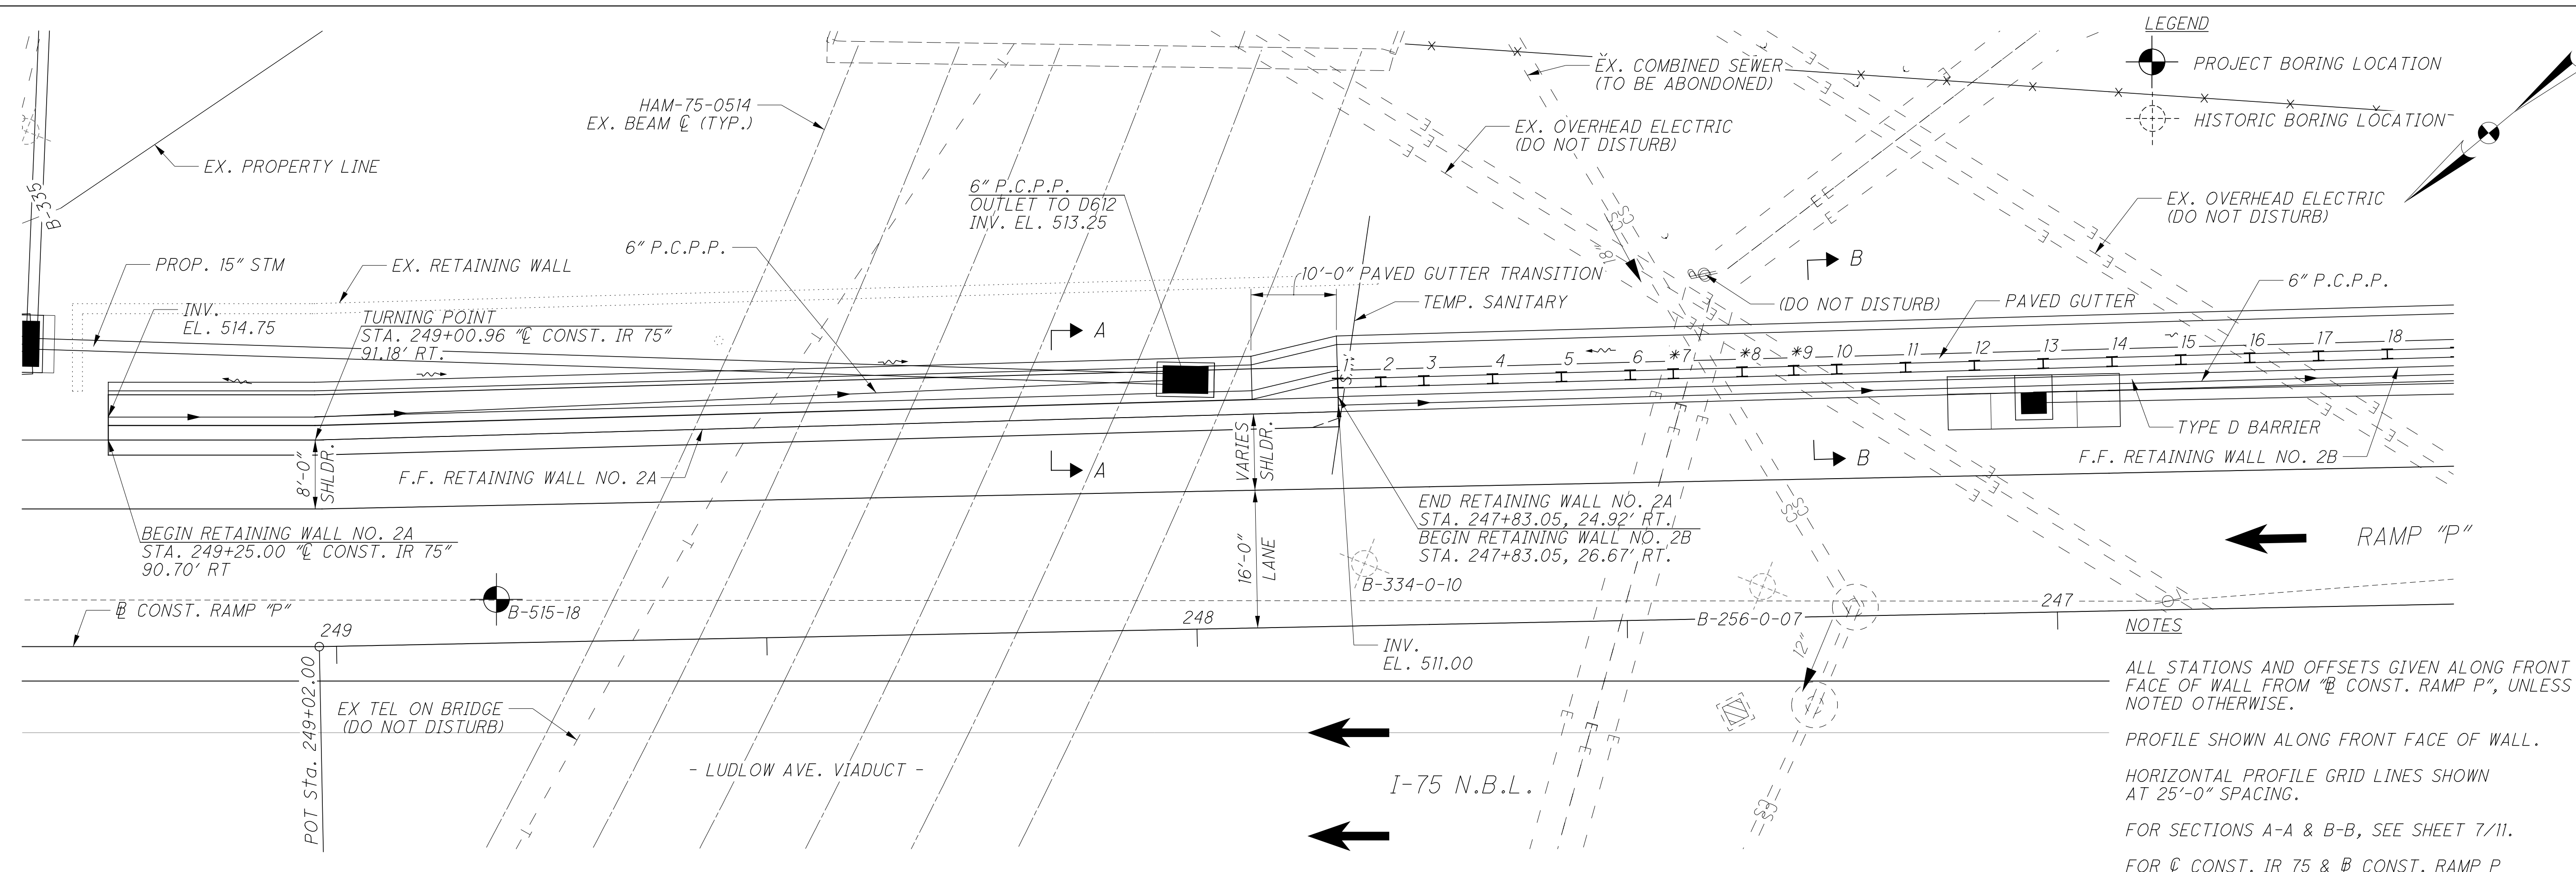

PLAN

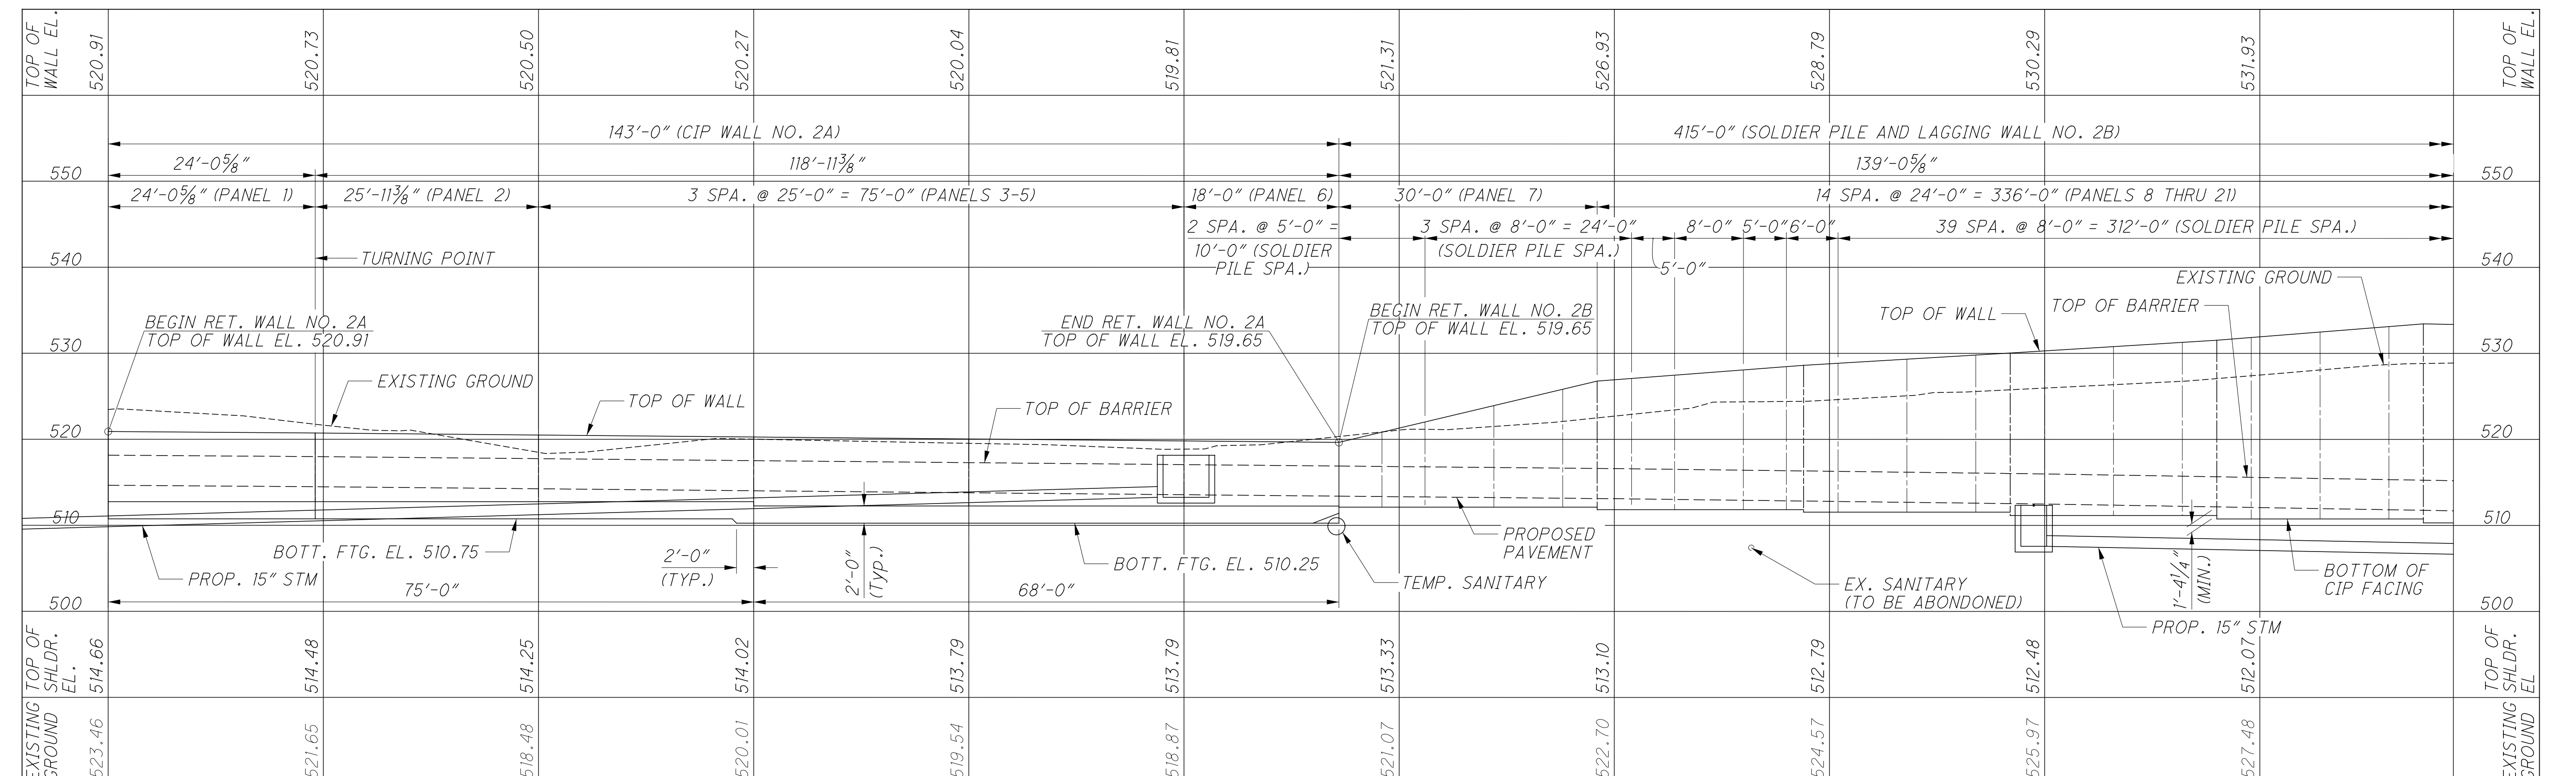

PROFILE
ALONG F.F. RETAINING WALL NO. 2

LEGEND

- PROJECT BORING LOCATION
- HISTORIC BORING LOCATION

NOTES

ALL STATIONS AND OFFSETS GIVEN ALONG FRONT FACE OF WALL FROM @ CONST. RAMP P, UNLESS NOTED OTHERWISE.

PROFILE SHOWN ALONG FRONT FACE OF WALL.

HORIZONTAL PROFILE GRID LINES SHOWN AT 25'-0" SPACING.


FOR SECTIONS A-A & B-B, SEE SHEET 7/11.

FOR @ CONST. IR 75 & @ CONST. RAMP P SPIRAL DATA SEE BU-14.


* ADJUST PILE SPACING AS NECESSARY TO AVOID UTILITY IMPACTS (8'-0" MAX.)

DESIGN AGENCY: STRUCTUREPOINT
 DATE: 01/18/19
 REVIEWED: MDS
 DRAWN: BMP
 DESIGNED: SUJ
 CHECKED: CLB
 RETAINING WALL NO. 2 DETAILS
 ALONG RAMP "P" AND IR 75 NB
 HAM-75-3.84
 PID No. 104667
 1 / 11
 4 / 48

8/22/2022 9:14:02 AM
 O:\2017\01113.C. Design\104667_HAM-75-3.84.Design\Structures\Walls_Sheets\104667_WD03.dgn

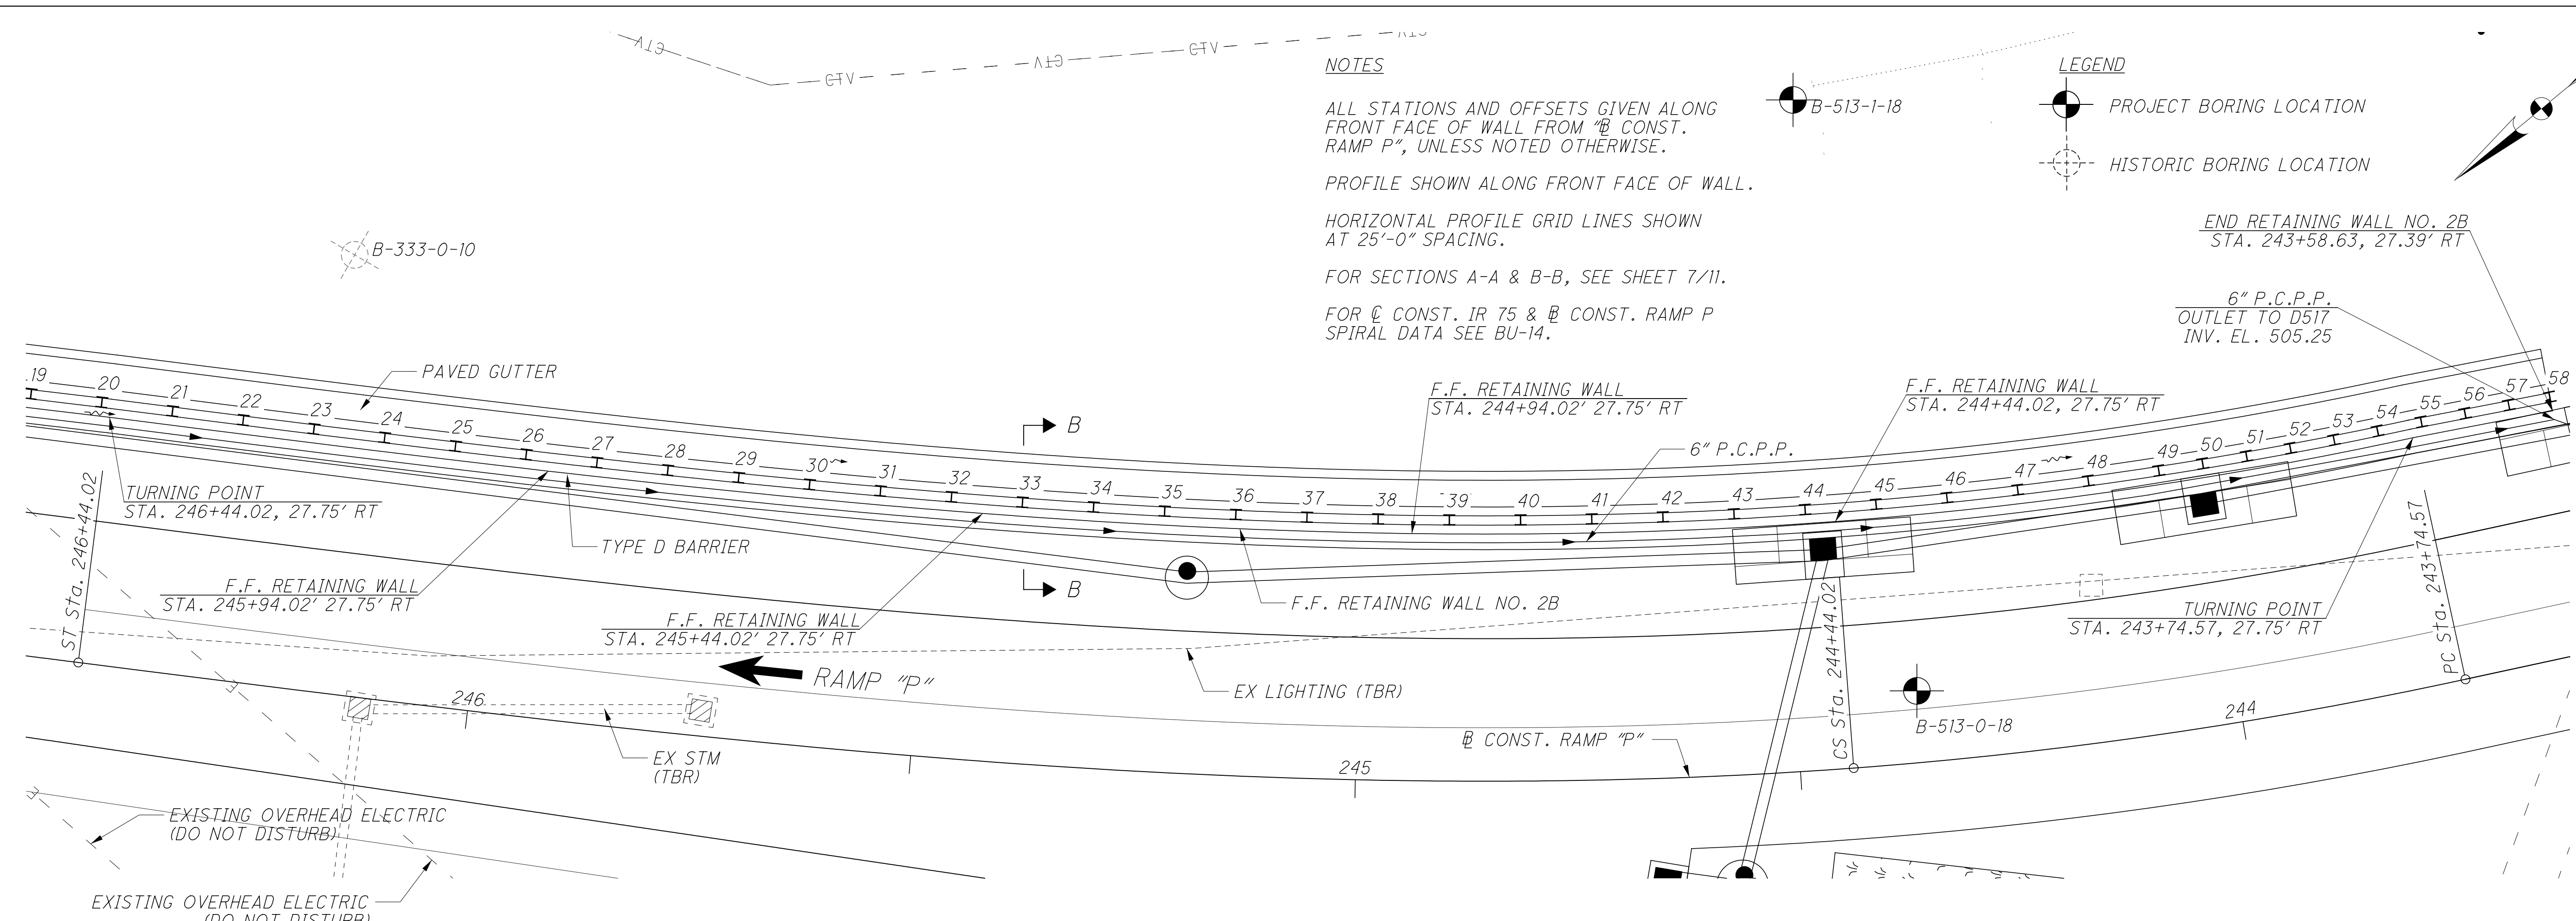

PLAN

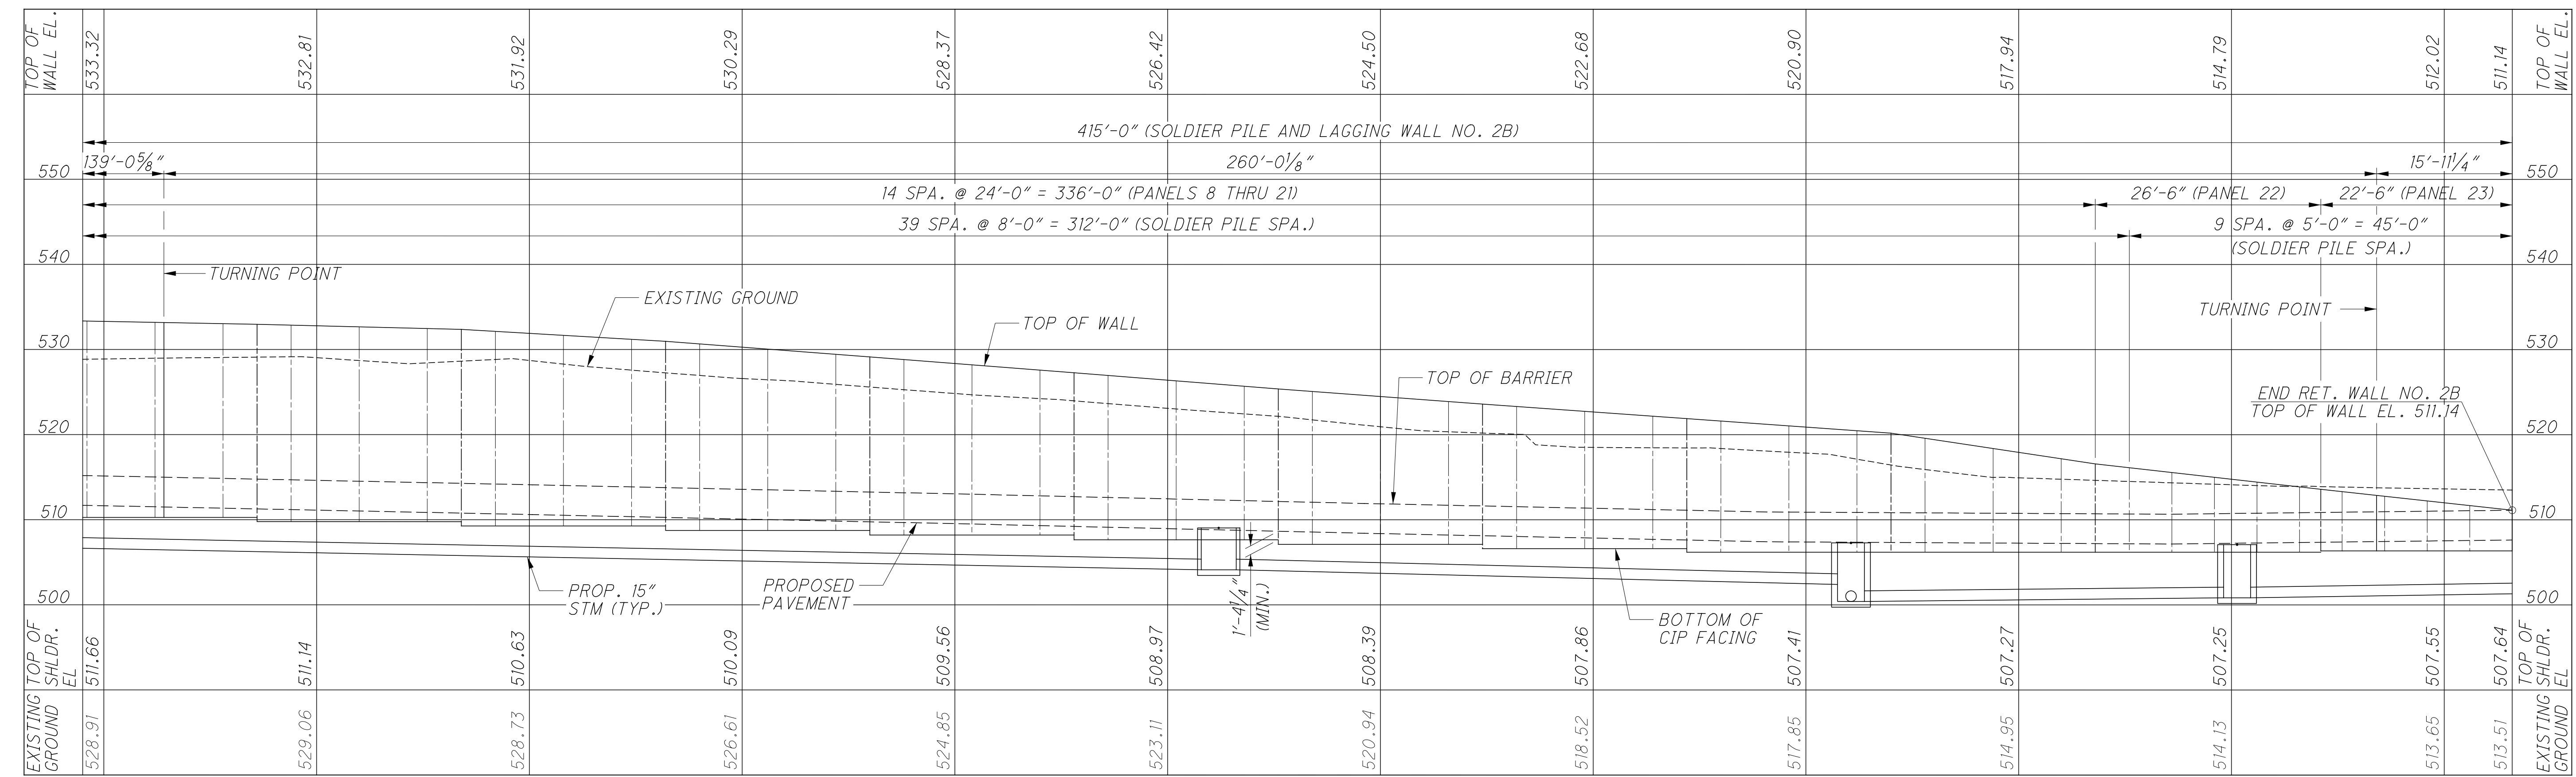

PROFILE
ALONG F.F. RETAINING WALL NO. 2


DESIGN AGENCY: STRUCTUREPOINT
 DATE: 01/18/19
 REVIEWED: MDS
 DRAWN: BMP
 DESIGNED: SUJ
 CHECKED: CLB

RETAINING WALL NO. 2 DETAILS
 ALONG RAMP "P" AND IR 75 NB


HAM-75-3.84
 PID No. 104667

2 / 11
 5 / 48

i:\wade 8/22/2022 9:14:03 AM 0...2017\01113.C. Design\104667_HAM-75-3.84.Design\Structures\Walls_Sheets\104667_WD04.dgn

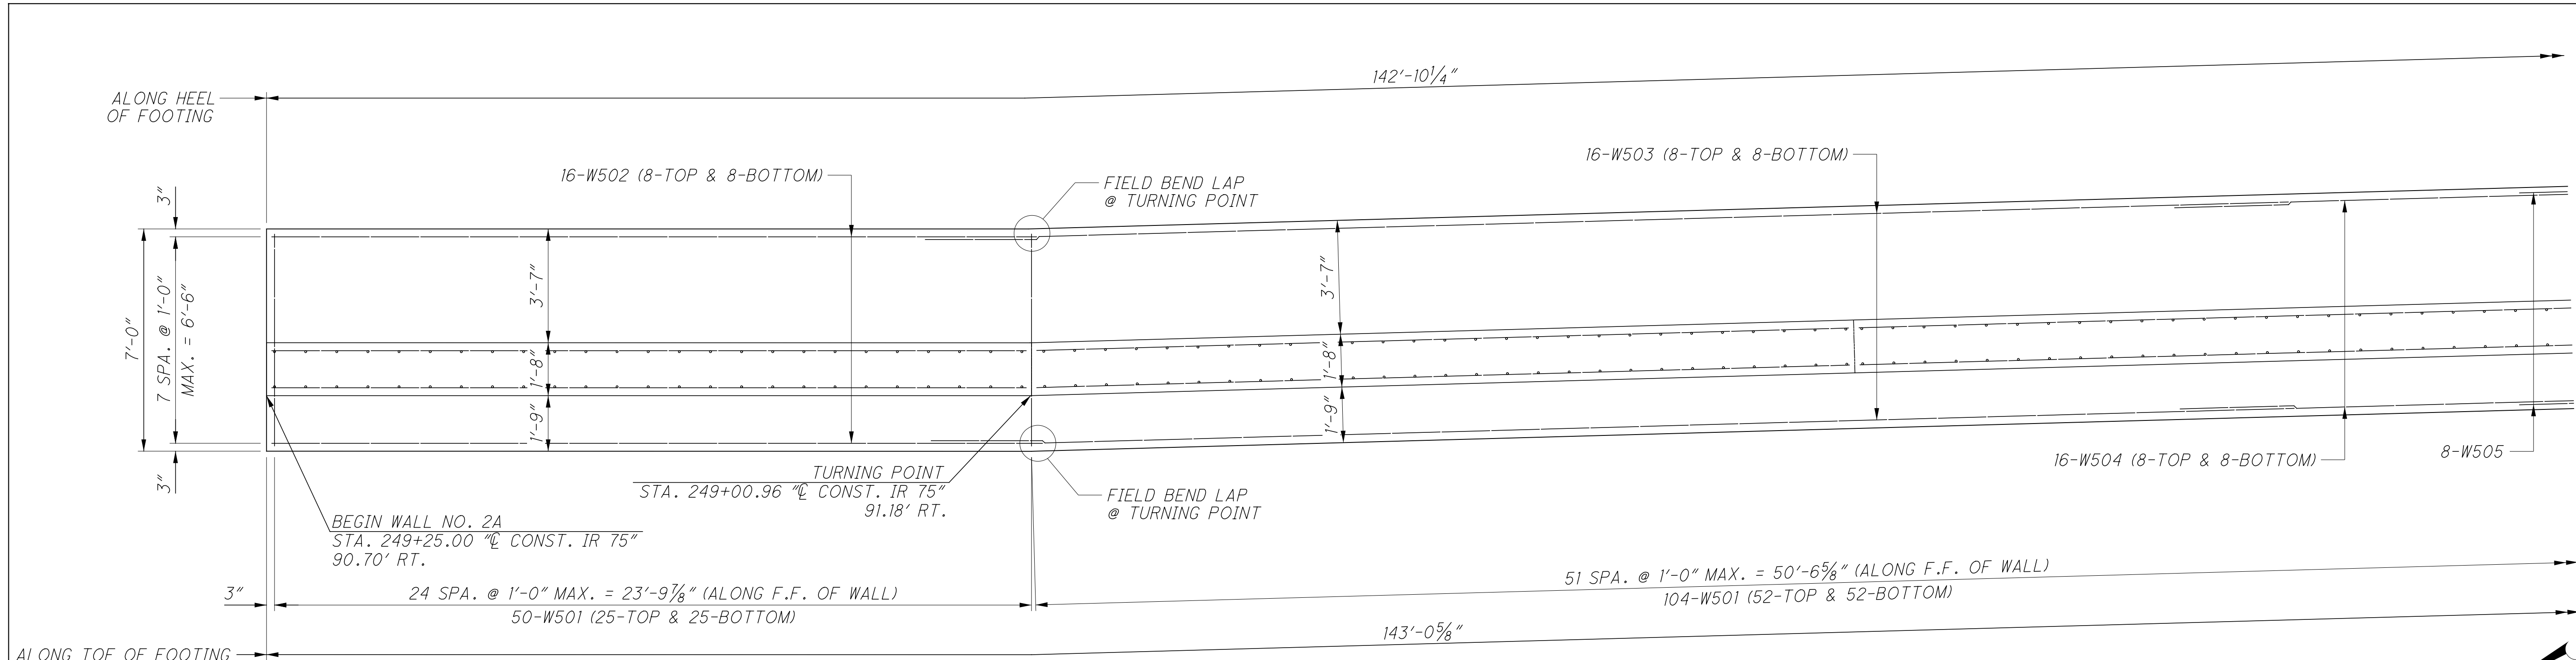

PARTIAL PLAN

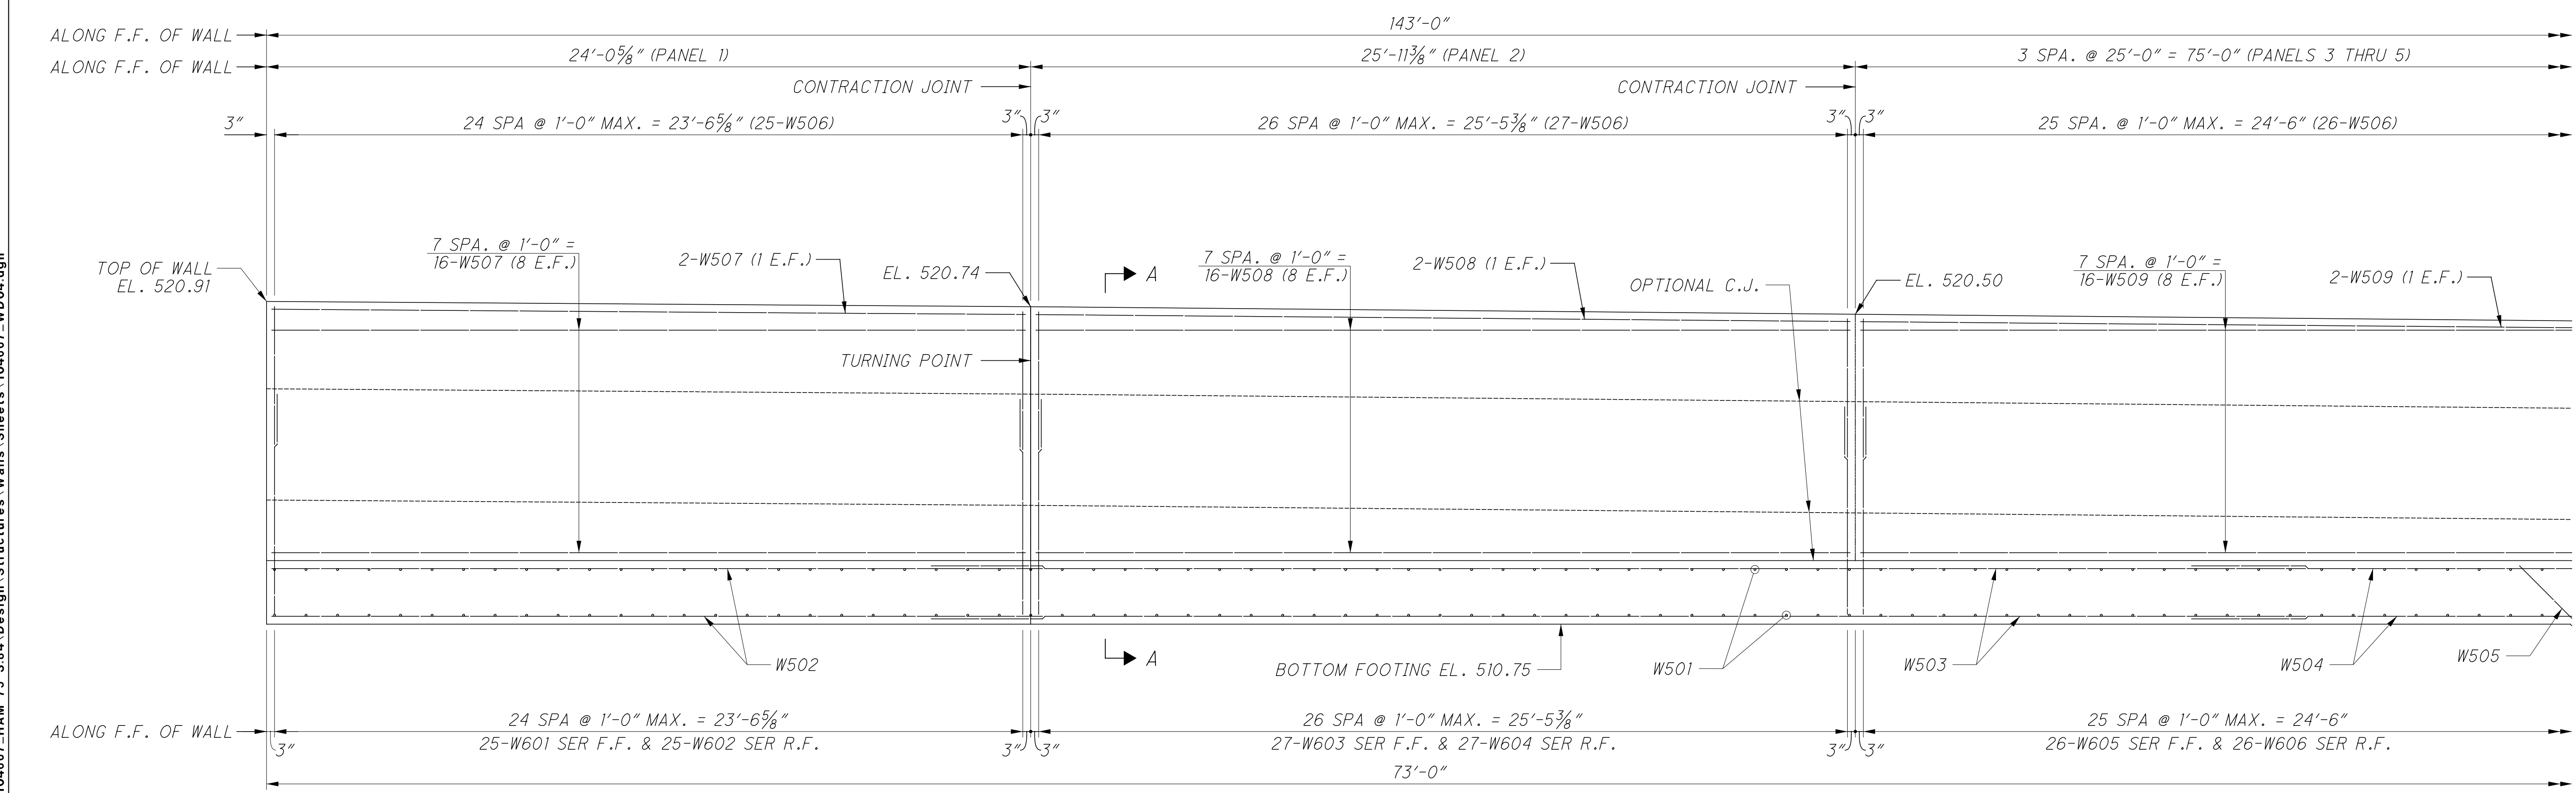


PARTIAL ELEVATION

MINIMUM BAR LAP	
#5 (VERTICAL)	2'-7"
#5 (HORIZONTAL)	3'-7"


NOTES
 FOR SECTION A-A, SEE SHEET 7/11.
 FOR CONTRACTION AND EXPANSION JOINT DETAILS, SEE SHEET 7/11.

DESIGN AGENCY: STRUCTUREPOINT
 DATE: 01/18/19
 REVIEWED: MDS
 DRAWN: BMP
 DESIGNED: SUJ
 CHECKED: CLB
 RETAINING WALL NO. 2A DETAILS
 ALONG RAMP "P" AND IR 75 NB
 HAM-75-3.84
 PID No. 104667
 3 / 11
 6 / 48

Wads
 8/22/2022 9:14:04 AM
 O:\2017\01113\C.Design\104667-HAM-75-3.84\Design\Structures\Walls\Sheets\104667-WD05.dgn

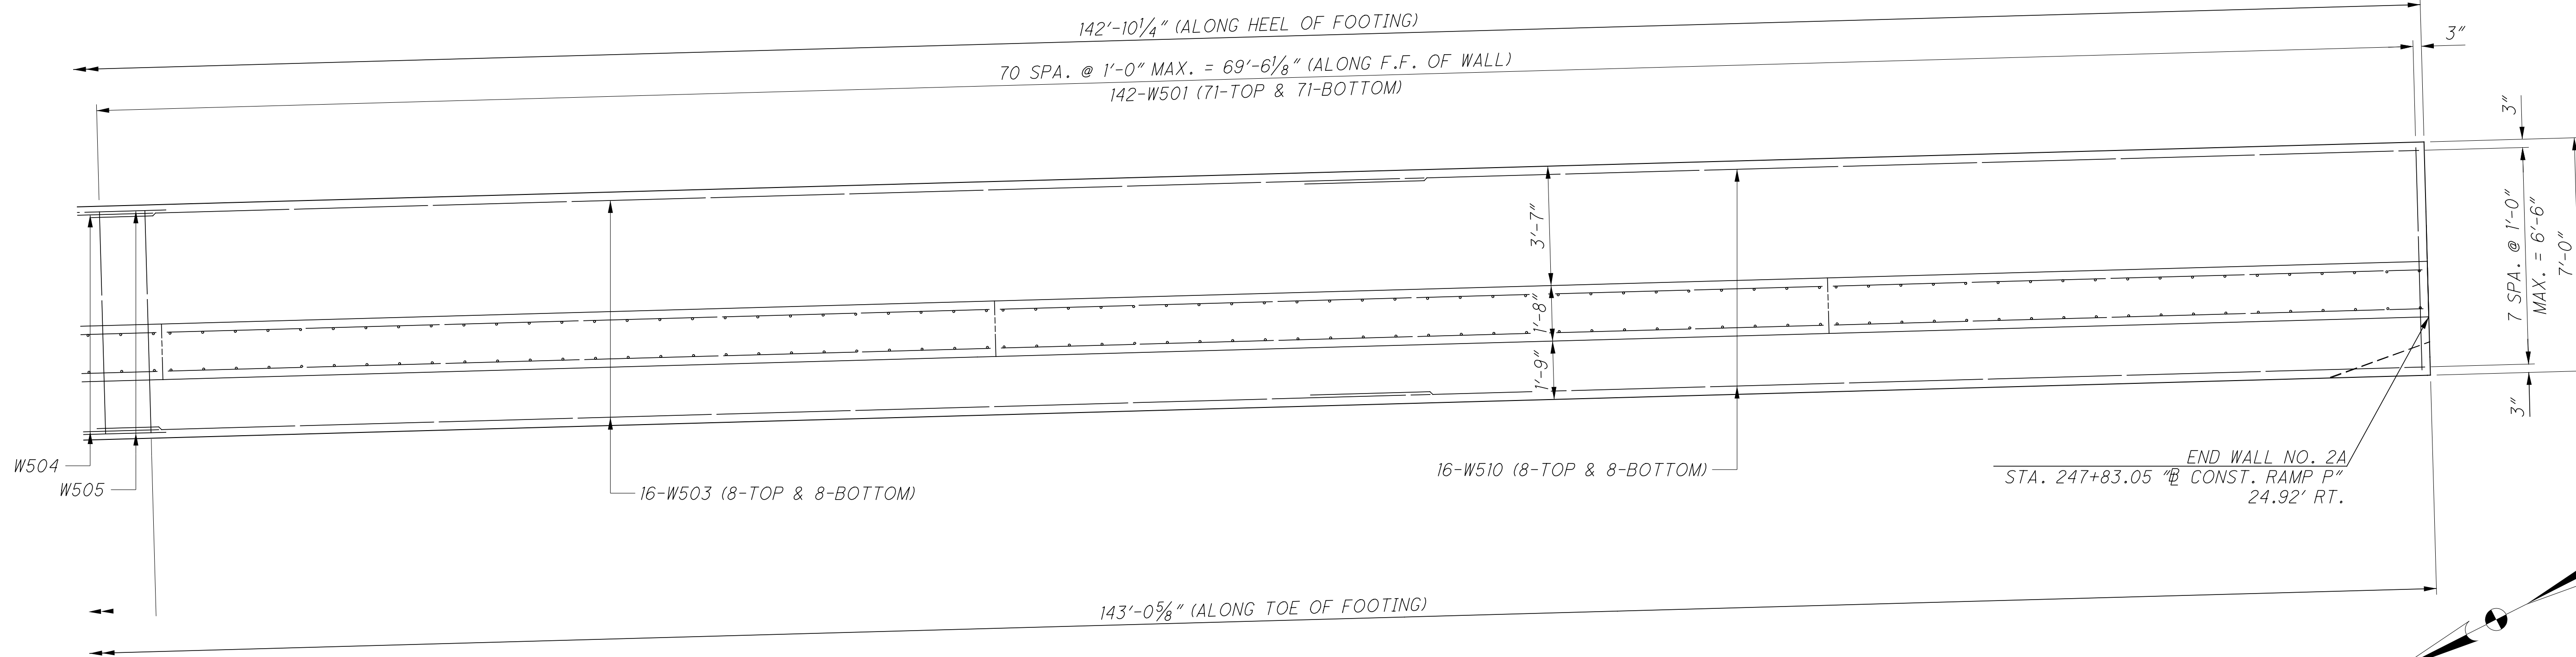

PARTIAL PLAN

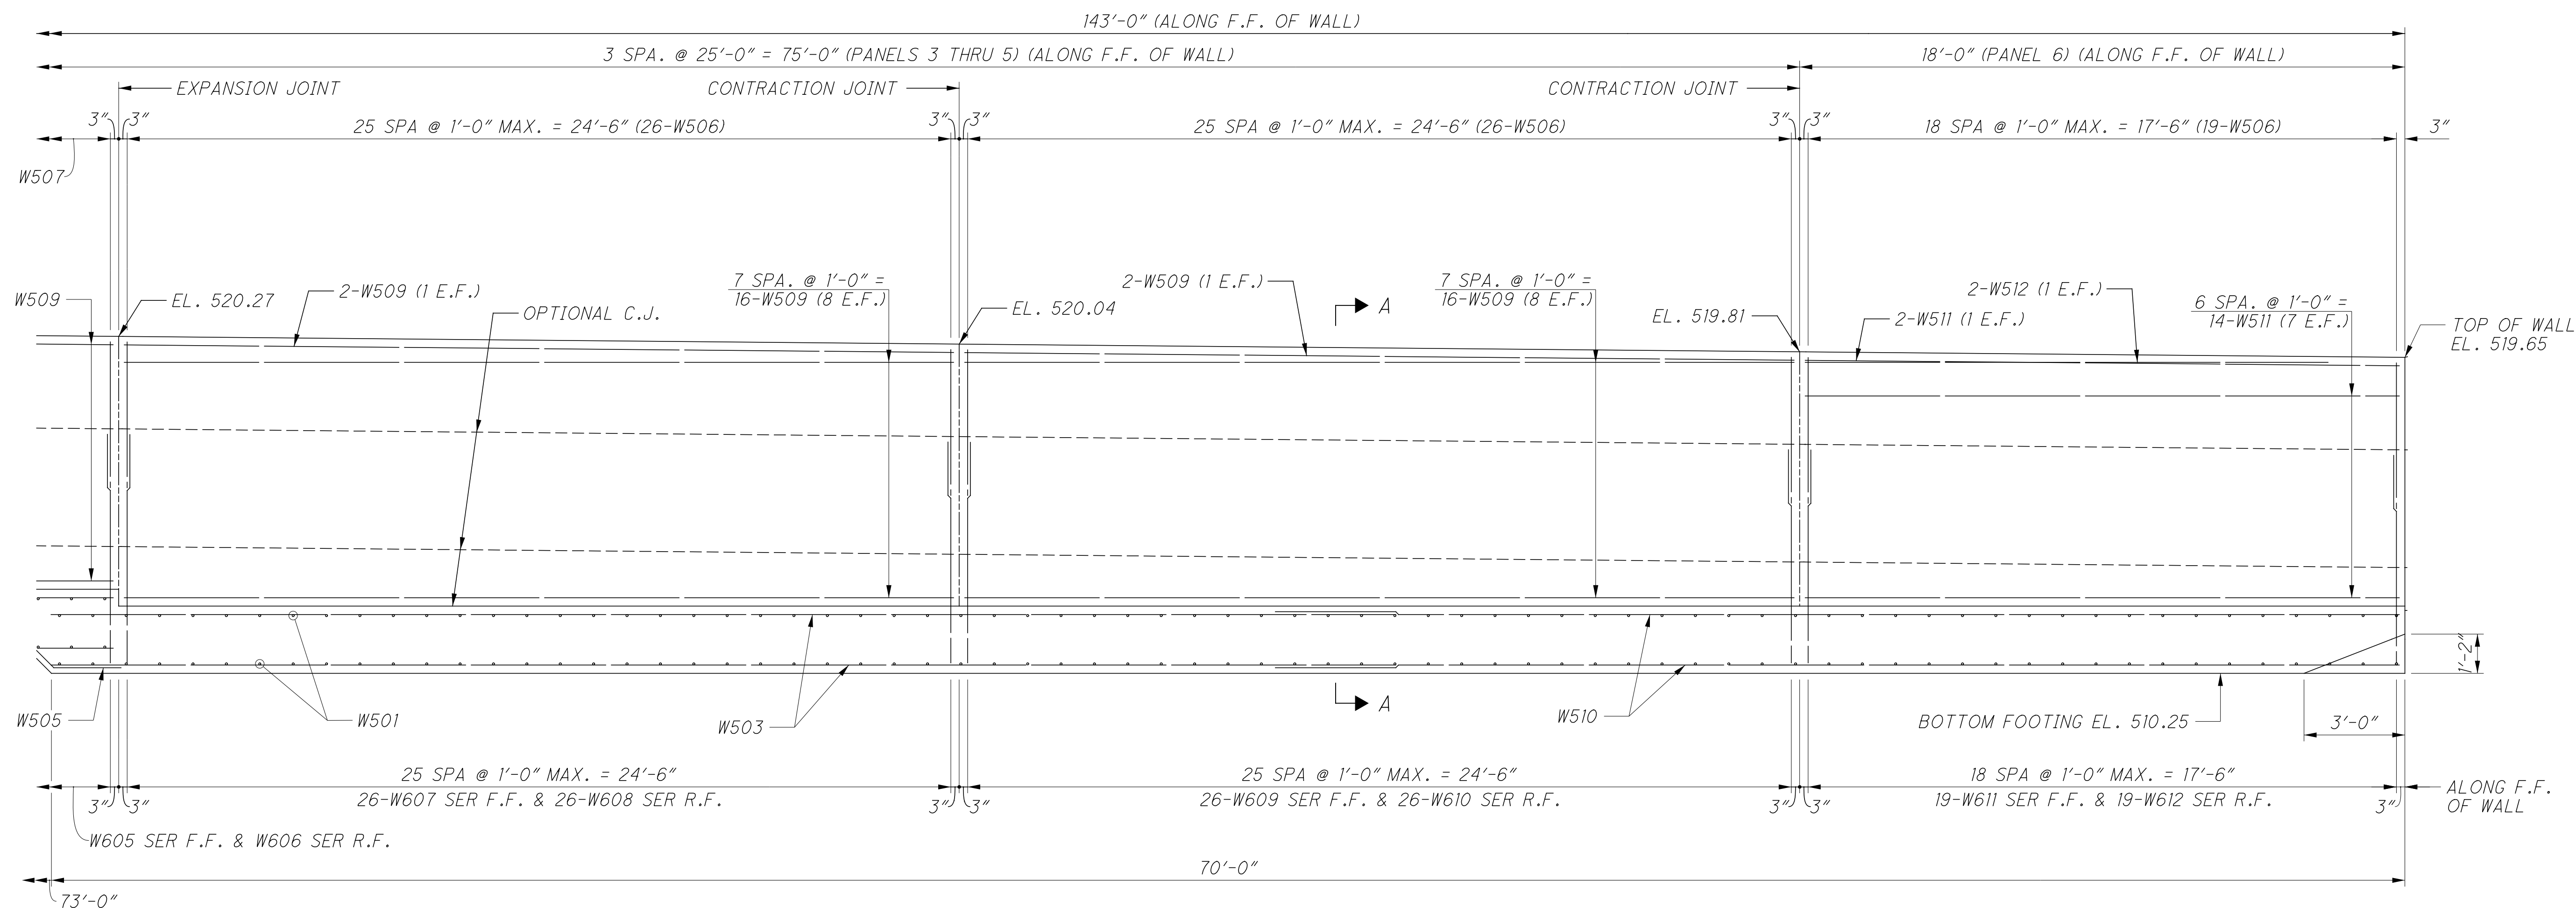

PARTIAL ELEVATION

MINIMUM BAR LAP	
#5 (VERTICAL)	2'-7"
#5 (HORIZONTAL)	3'-7"

NOTES
 FOR SECTION A-A, SEE SHEET 7/11.
 FOR CONTRACTION AND EXPANSION
 JOINT DETAILS, SEE SHEET 7/11.

DESIGN AGENCY
 STRUCTUREPOINT
 2000 CORPORATION CENTER DR., 17TH FL.
 ST. LOUIS, MO 63103
 TEL: 314.433.3300 FAX: 314.433.3300
 WWW.STRUCTUREPOINT.COM


DESIGNED	SUF	CHECKED	CLB
DRAWN	BMP	REVISED	
REVIEWED	MDS	STRUCTURE POINT FILE NUMBER	
DATE	01/18/19		

RETAINING WALL NO. 2A DETAILS
 ALONG RAMP "P" AND IR 75 NB


HAM-75-3.84
PID No. 104667

4 / 11
 7
 48

i:\wade 8/22/2022 9:14:04 AM 0:\2017\01113.C.Design\104667-HAM-75-384.Design\Structures\Walls_Sheets\104667-WD06.dgn

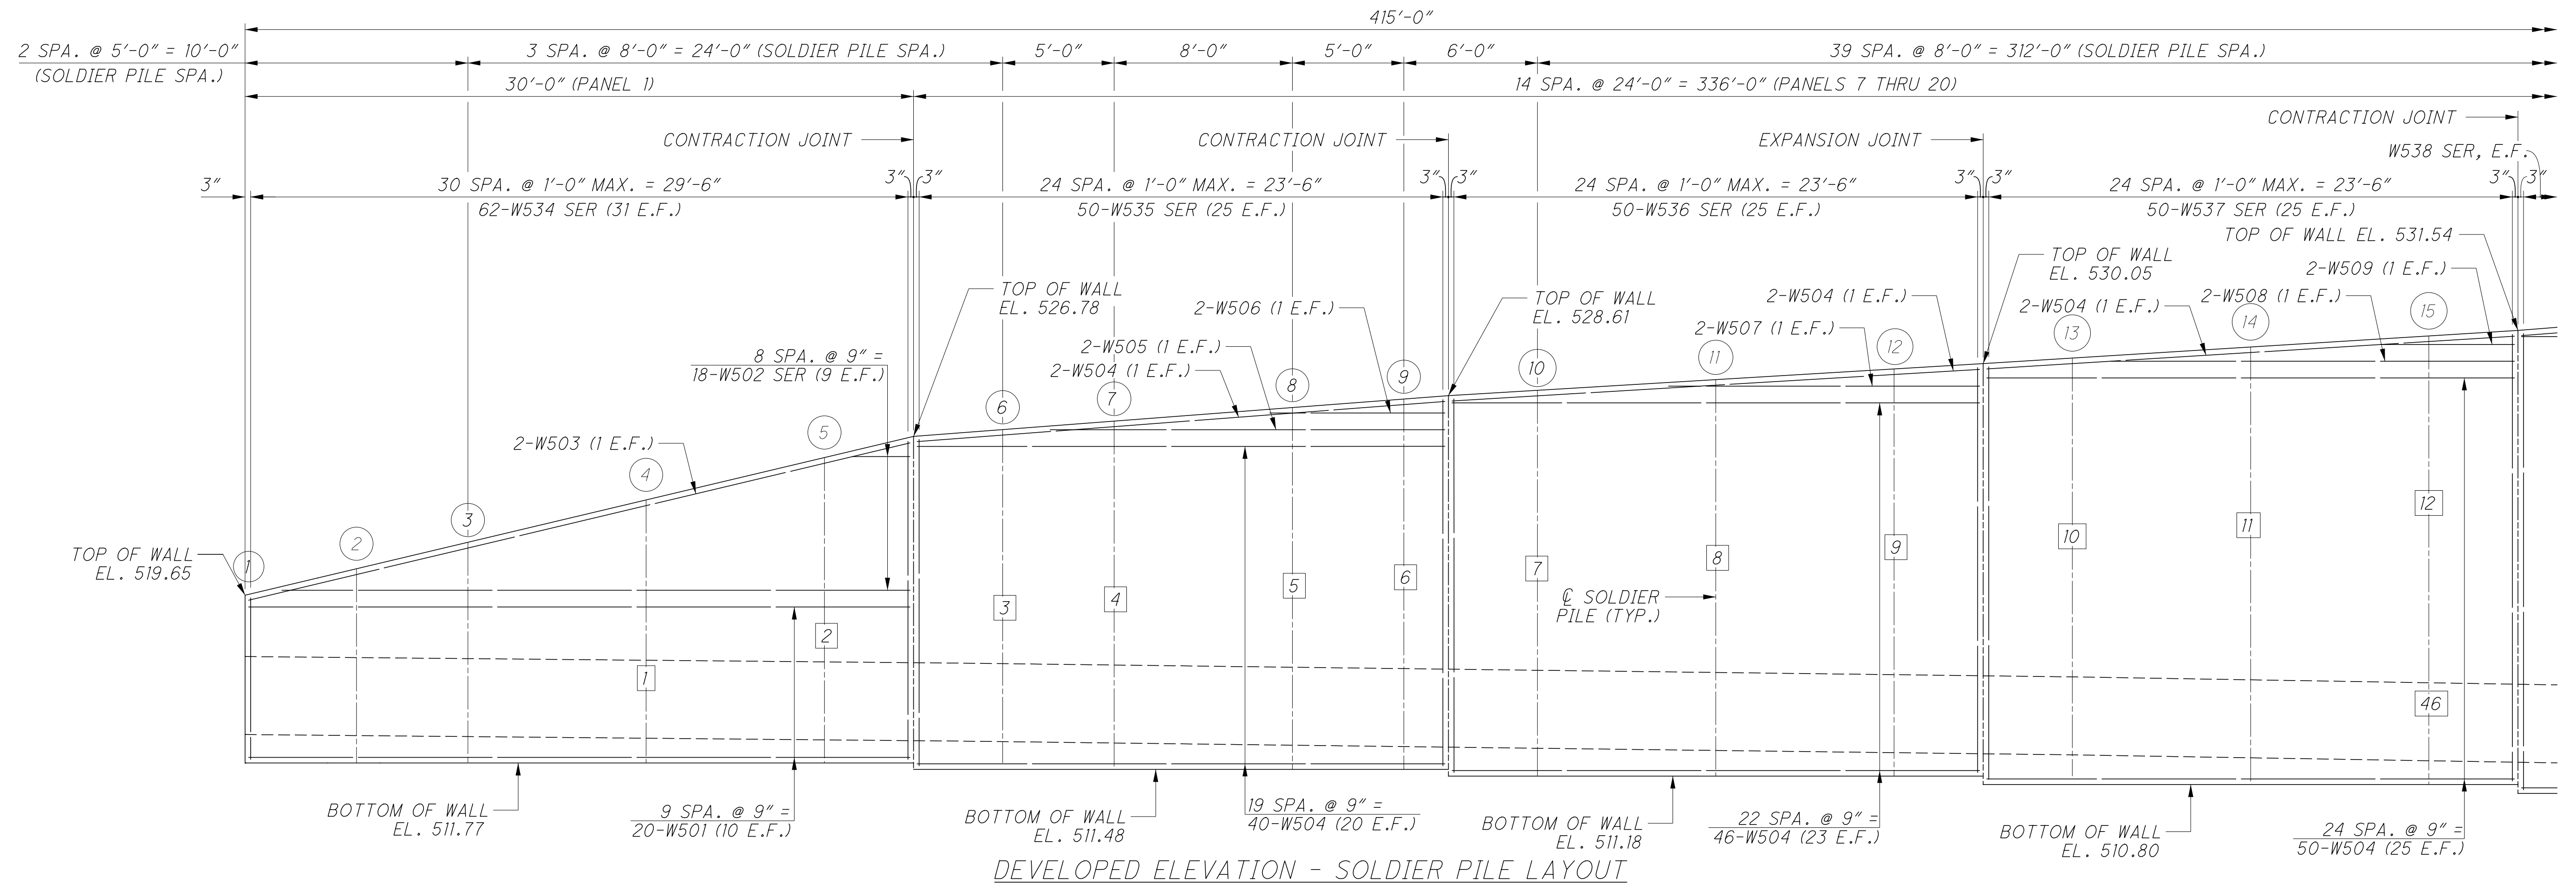

DEVELOPED ELEVATION - SOLDIER PILE LAYOUT

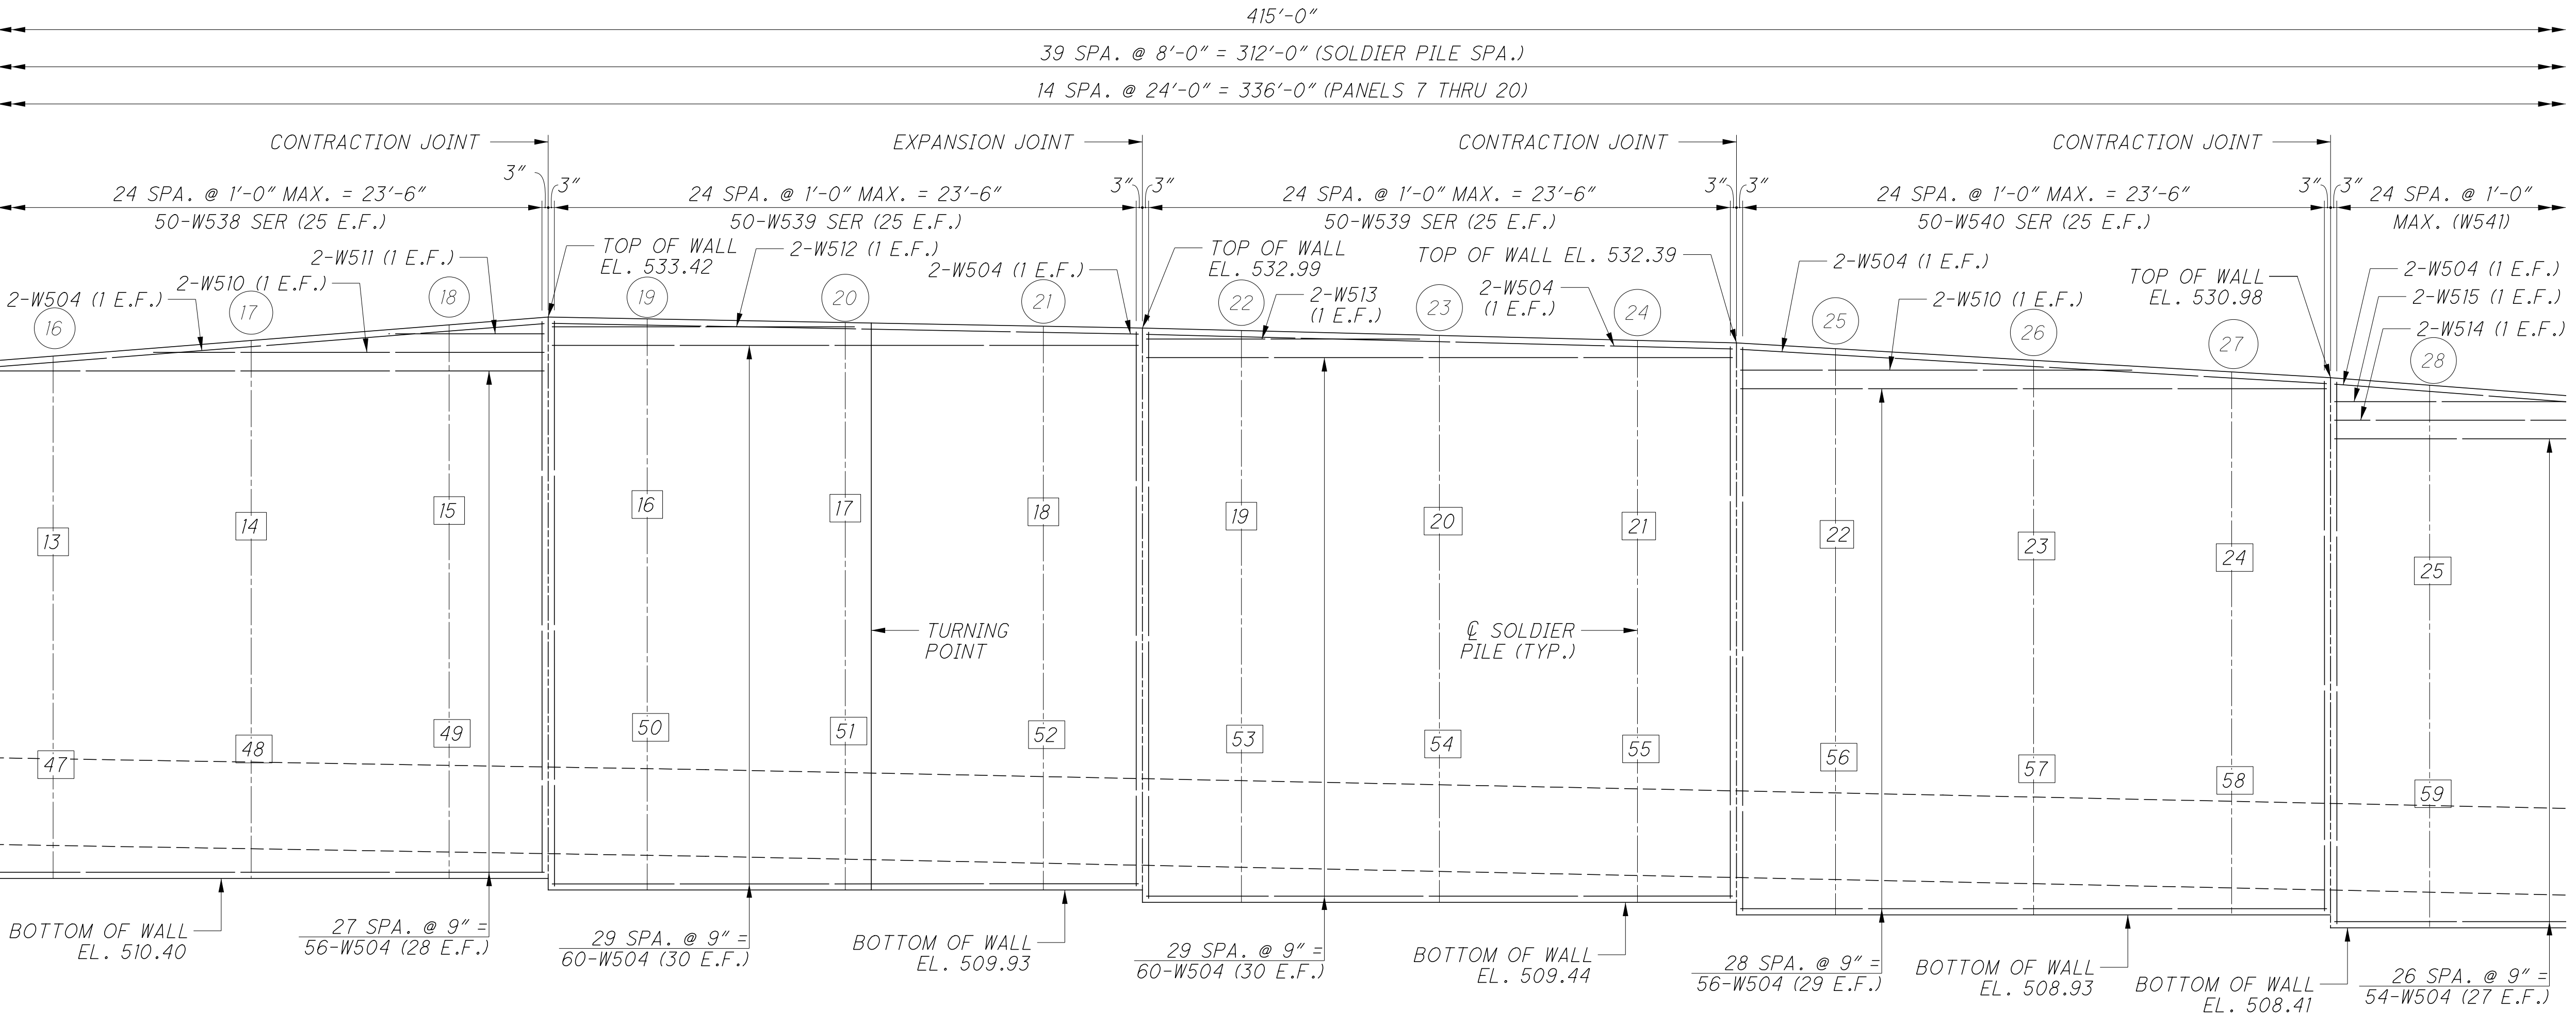


DEVELOPED ELEVATION - SOLDIER PILE LAYOUT


NOTES
 ALL DIMENSIONS GIVEN ALONG FRONT FACE OF WALL.
 FOR ADDITIONAL WALL DETAILS, SEE SHEETS 7 THRU 9.
 (X) - SOLDIER PILE NUMBER.
 [X] - ANCHOR NUMBER

DESIGN AGENCY	DATE	REVIEWED	DRAWN	DESIGNED
STRUCTUREPOINT	01/18/19	MDS	BMP	SUF
	STRUCTURE FILE NUMBER	REVISED	CHECKED	CLB
RETAINING WALL NO. 2B DETAILS ALONG RAMP "P" AND IR 75 NB				
HAM-75-3.84 PID No. 104667				
5 / 11				
8 48				

Wades 8/22/2022 9:14:05 AM
 O:\2017\01113\C.Design\104667_HAM-75-3.84\Design\Structures\Walls\Sheets\104667-WD07.dgn

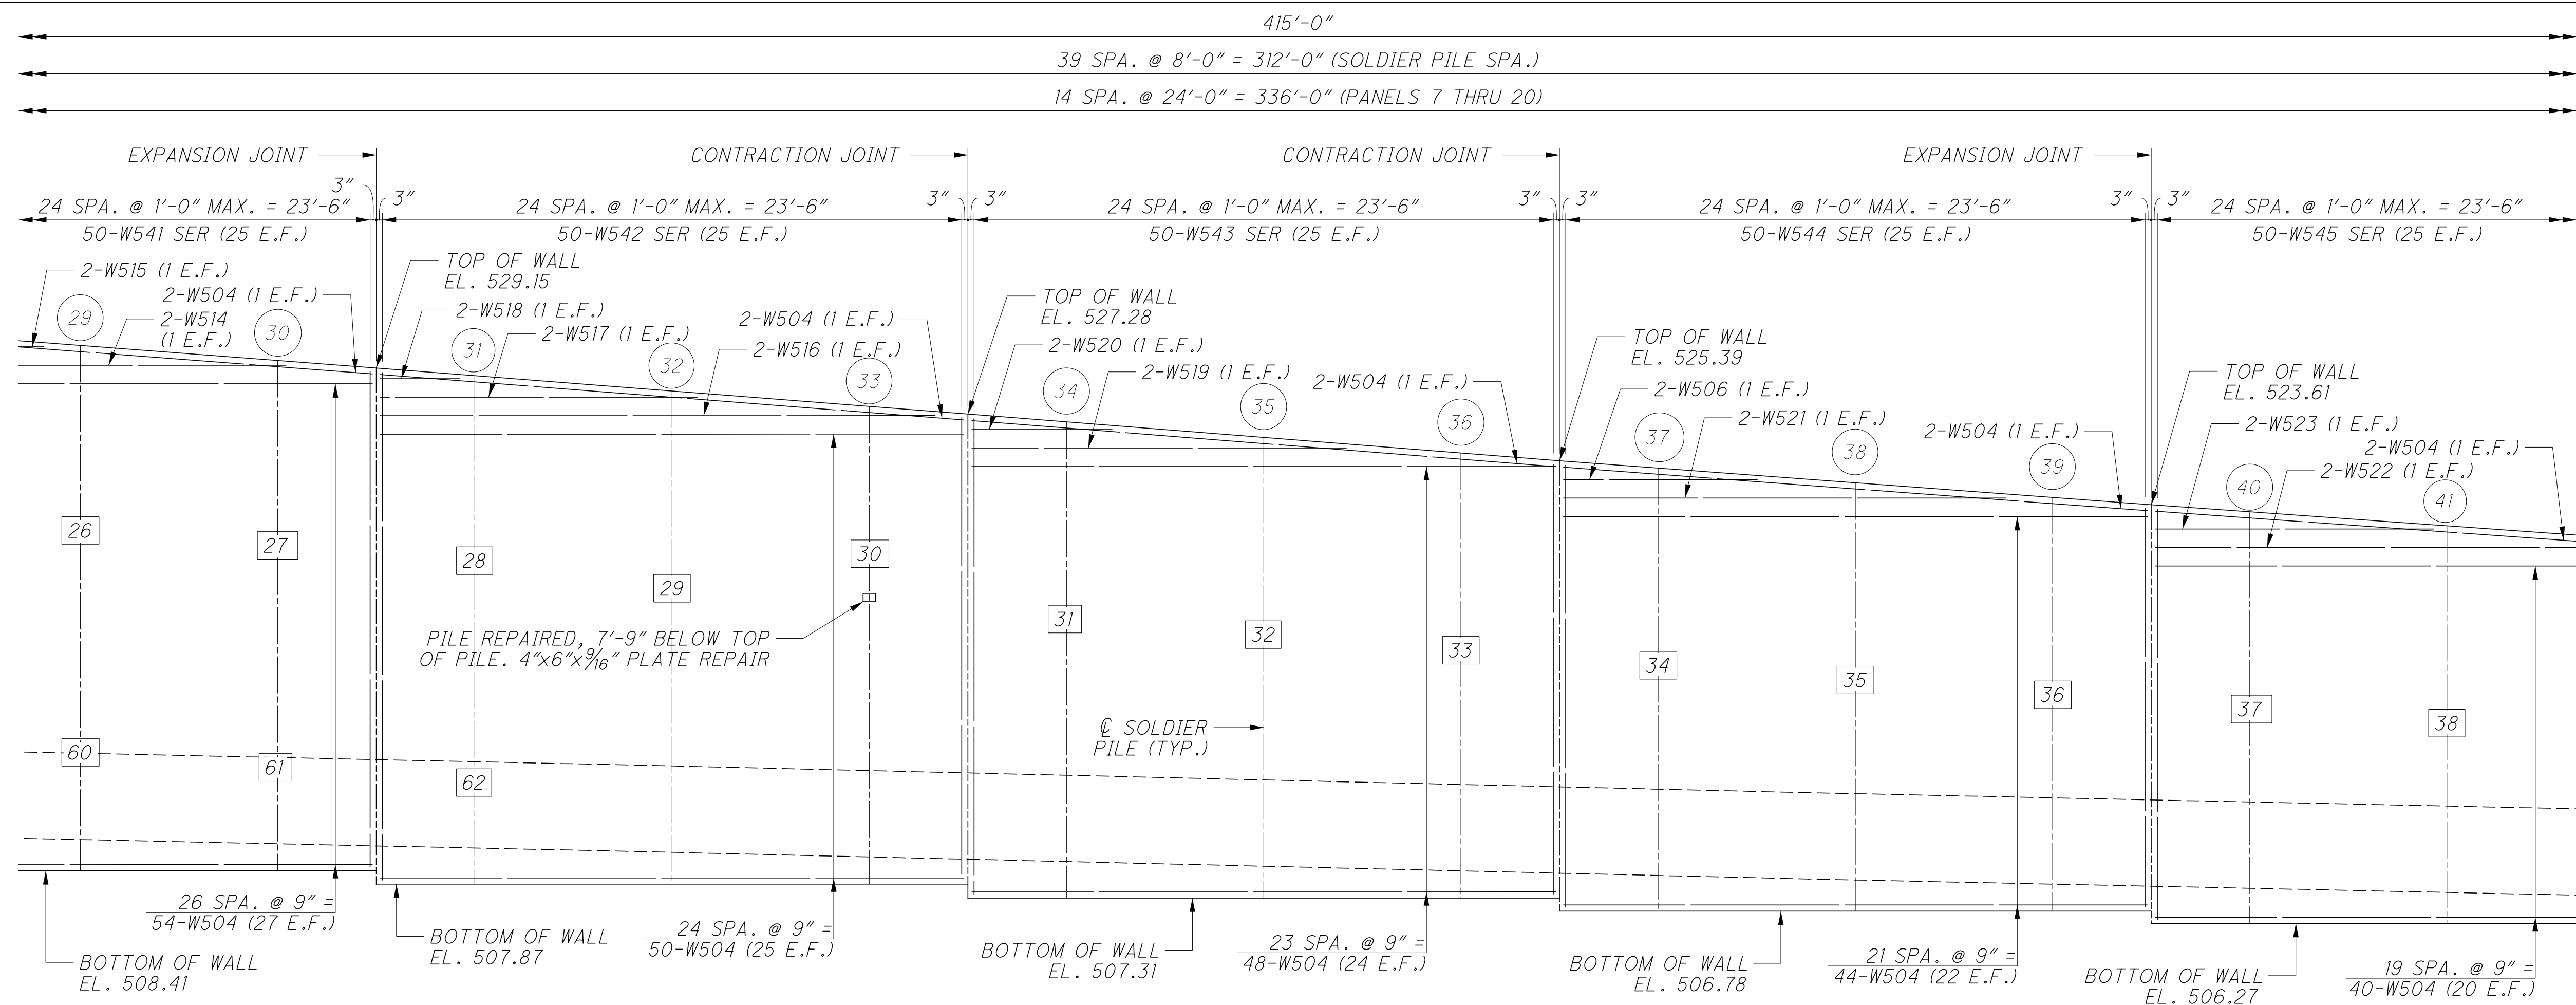

DEVELOPED ELEVATION - SOLDIER PILE LAYOUT

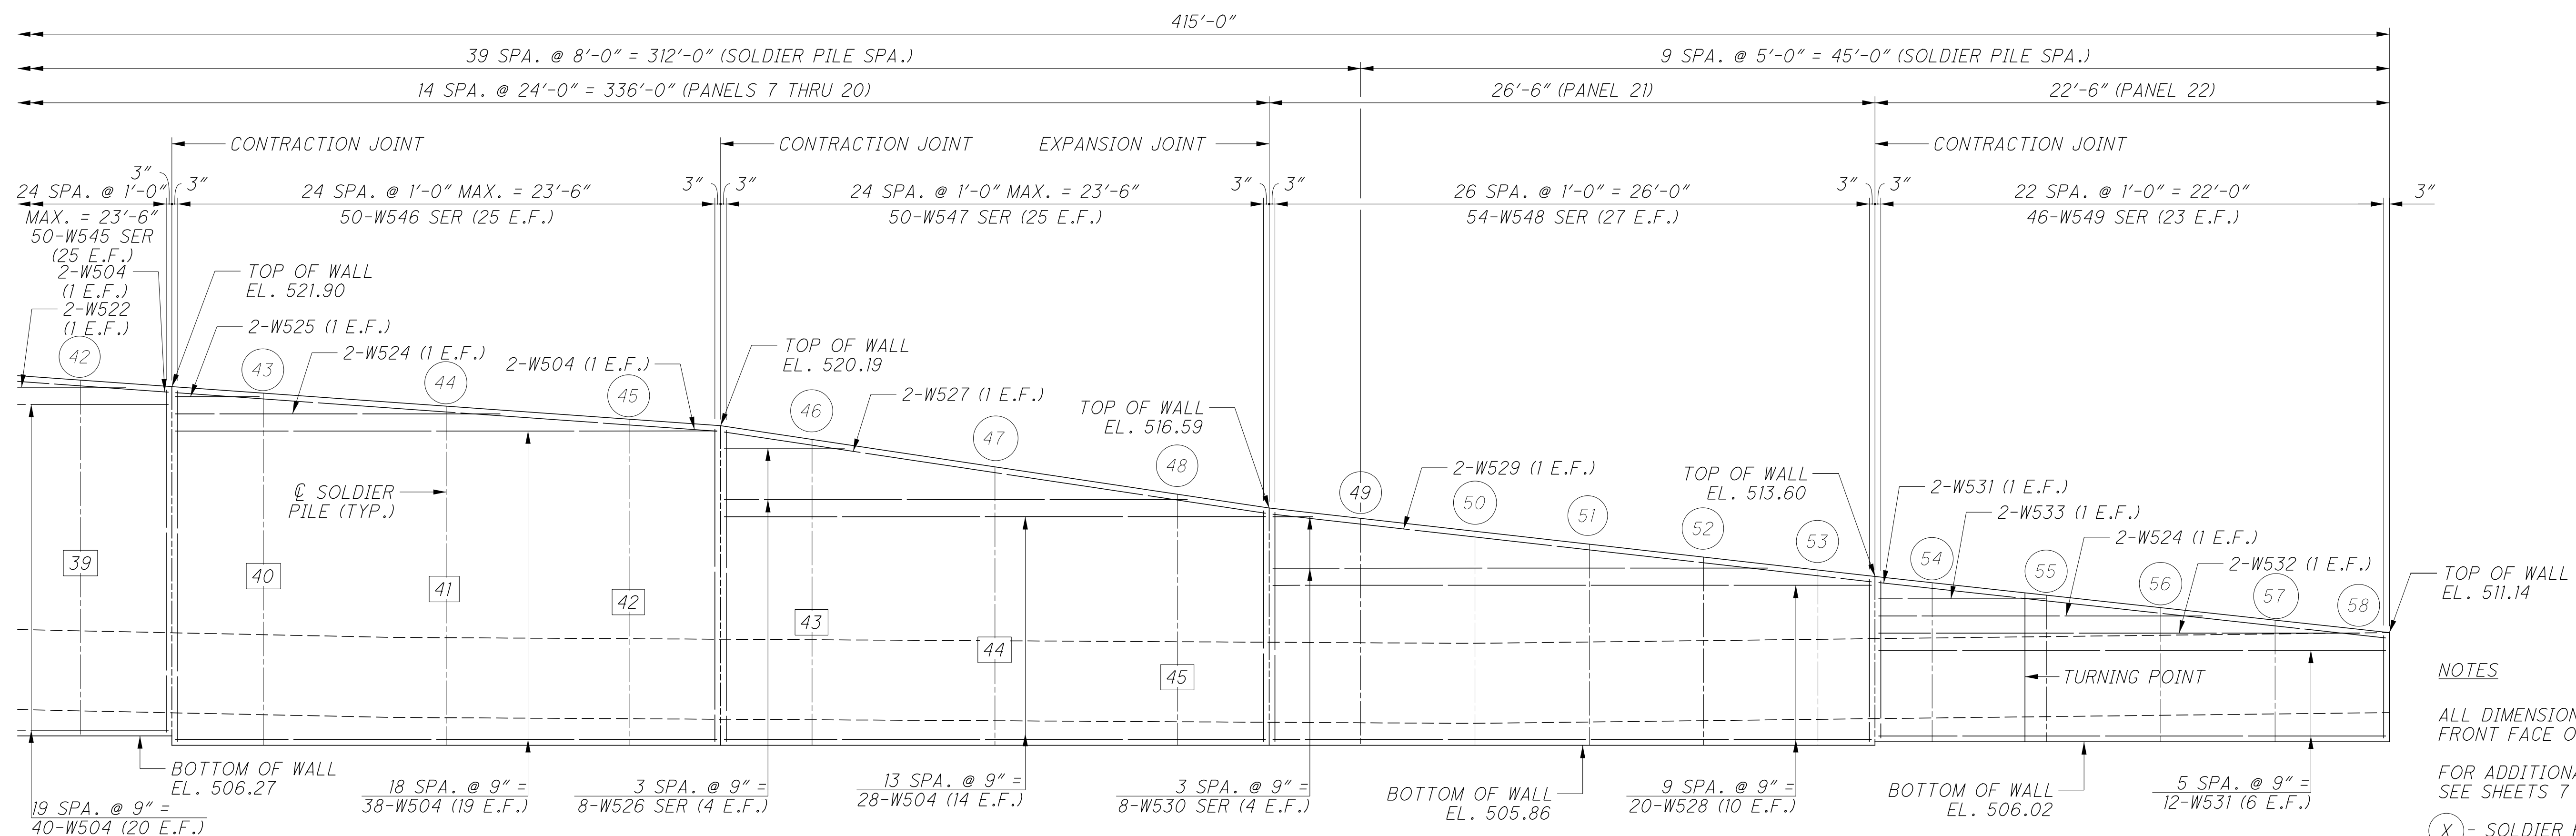

DEVELOPED ELEVATION - SOLDIER PILE LAYOUT


NOTES

ALL DIMENSIONS GIVEN ALONG FRONT FACE OF WALL.
 FOR ADDITIONAL WALL DETAILS, SEE SHEETS 7 THRU 9.


- (X) - SOLDIER PILE NUMBER.
- [X] - ANCHOR NUMBER

DESIGN AGENCY DATE 01/18/19 REVIEWED MDS DRAWN BMP DESIGNED SJF CHECKED CLB
RETAINING WALL NO. 2B DETAILS ALONG RAMP "P" AND IR 75 NB
HAM-75-3.84 PID No. 104667
6 / 11
9 48


jwade 8/22/2022 9:14:06 AM O:\2017\01113\C.Design\104667_HAM-75-3.84.Design\Structures\Walls\Sheets\104667_WD08.dgn

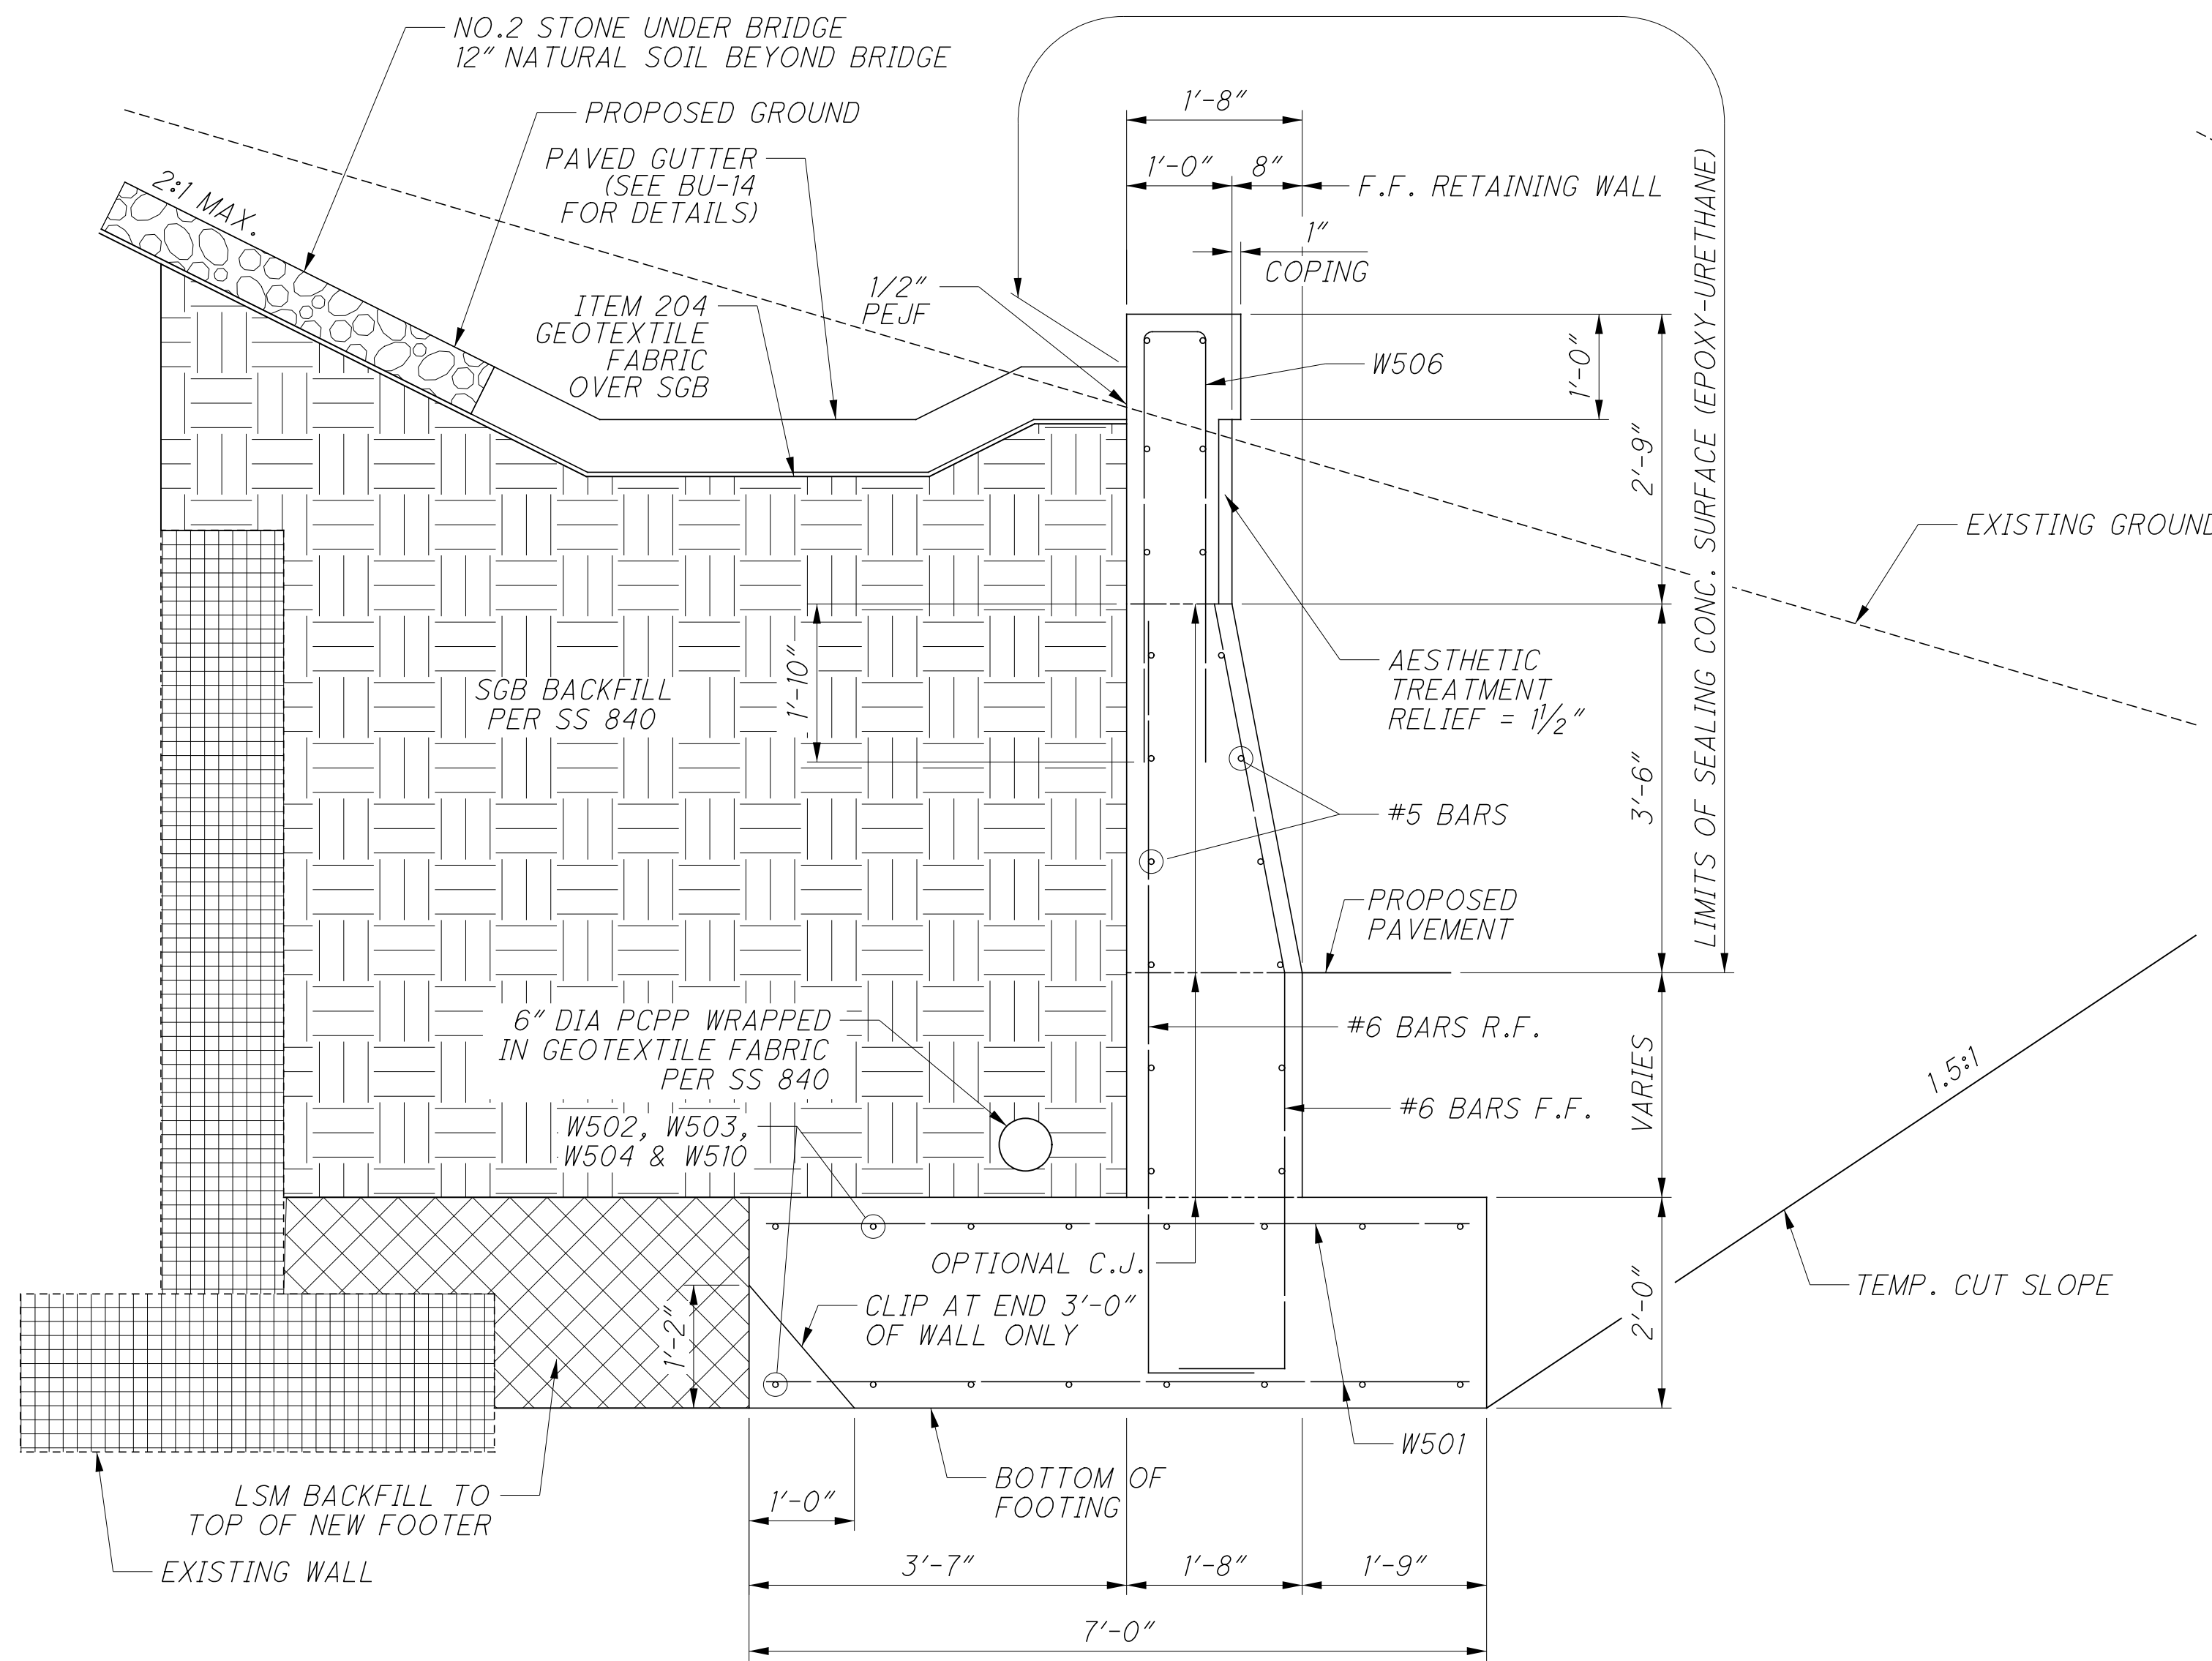


SECTION A-A
(WALL 2A)

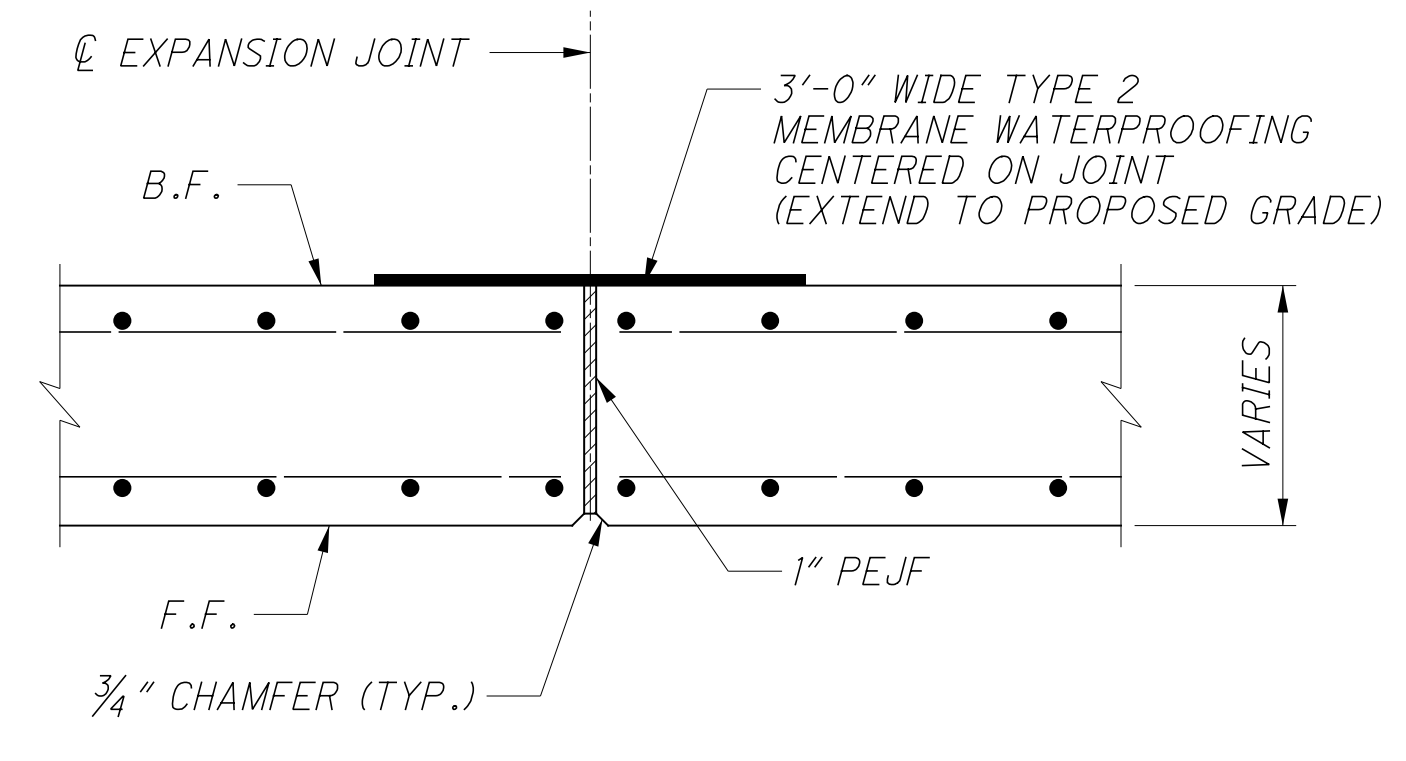

EXPANSION JOINT DETAIL
(WALL 2A)

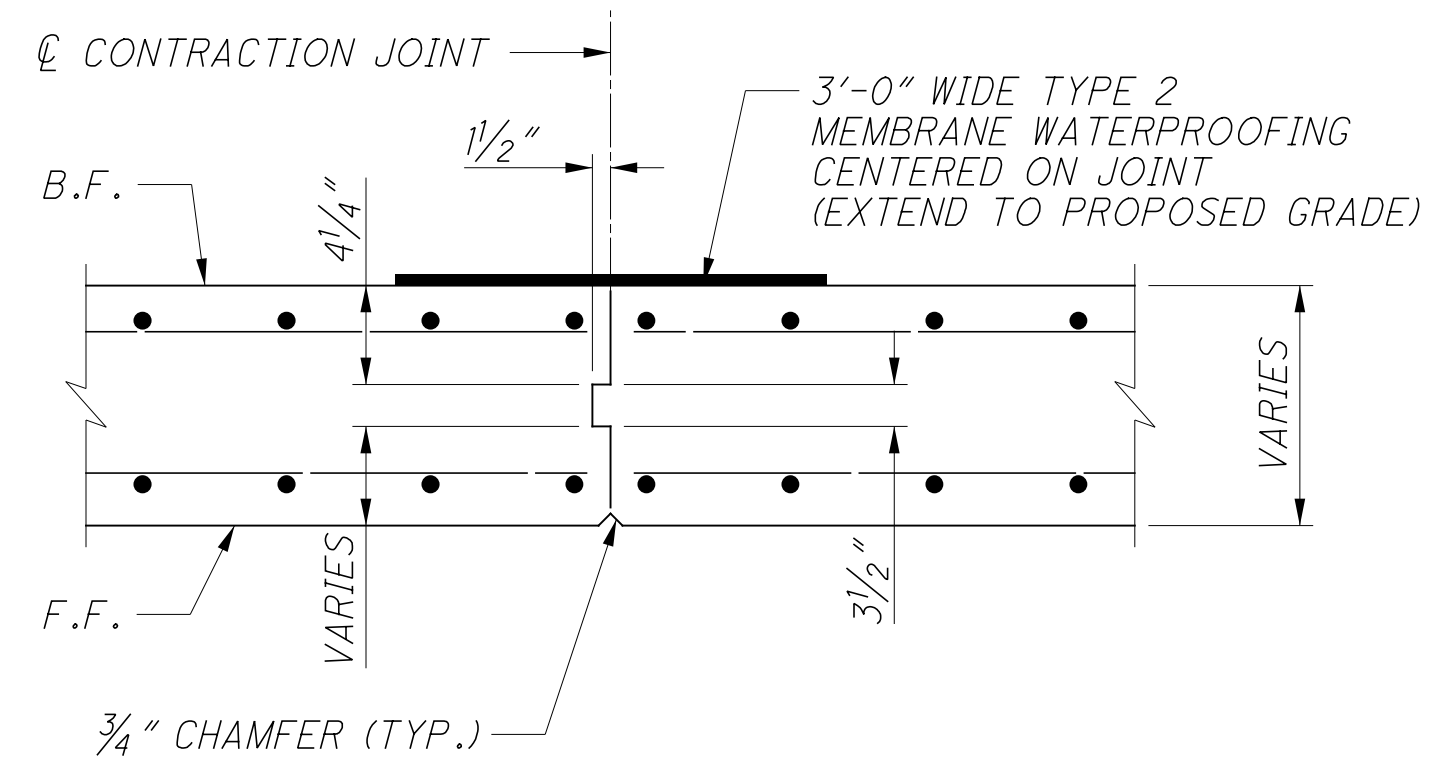

CONTRACTION JOINT DETAIL
(WALL 2A)

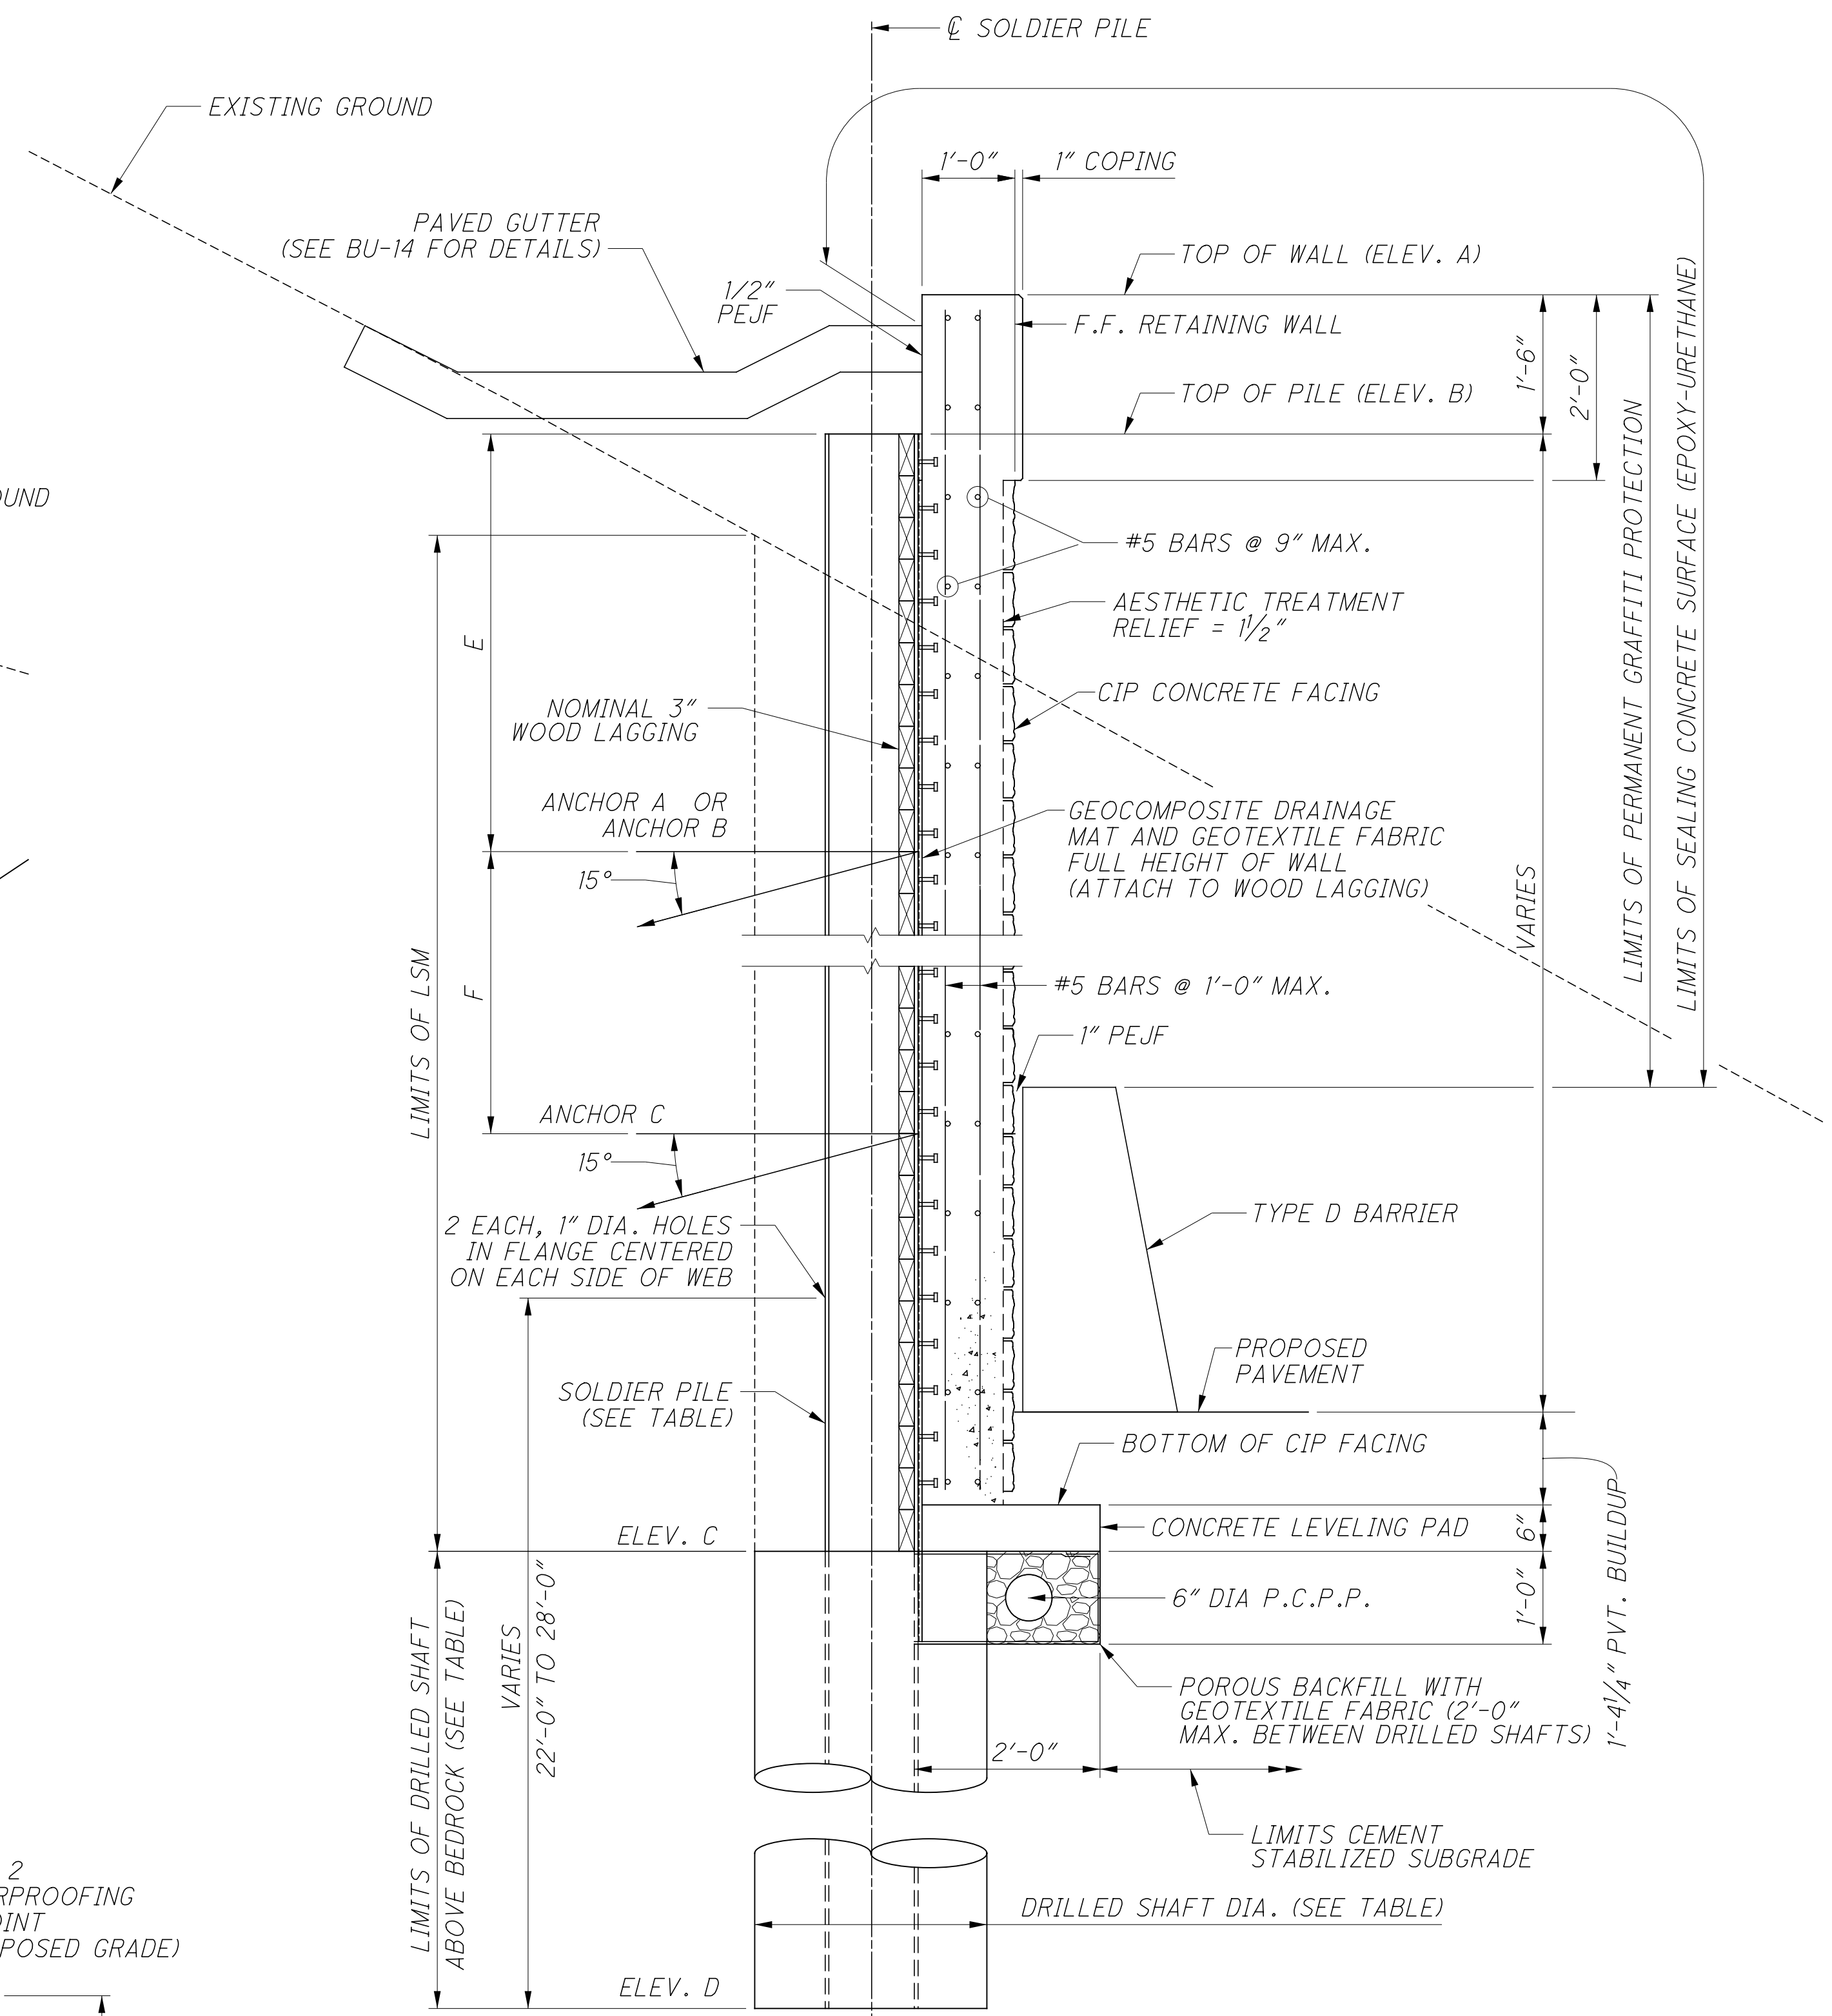


SECTION B-B
(WALL 2B)


ANCHOR DESIGN DATA TABLE					
ANCHOR #	ANCHOR	DESIGN LOAD (K)	LOCK OFF LOAD (K)	MIN. UNBONDED LENGTH (FT)	MIN. BONDED LENGTH (FT)
1-11, 29-45	A	150	105	15	15
12-28	B	133	93	15	20
46-62	C	103	72	15	15

DESIGN AGENCY: STRUCTUREPOINT
 DATE: 01/18/19
 REVIEWED: MDS
 DRAWN: BMP
 DESIGNED: SUJ
 CHECKED: CLB
 RETAINING WALL NO. 2A & 2B DETAILS
 ALONG RAMP "P" AND IR 75 NB
 HAM-75-3.84
 PID No. 104667
 7 / 11
 10 / 48


i:\wade 8/22/2022 9:14:07 AM
 O:\2017\01113\C.Design\104667-HAM-75-384.Design\Structures\Walls\Sheets\104667-WD06.dgn

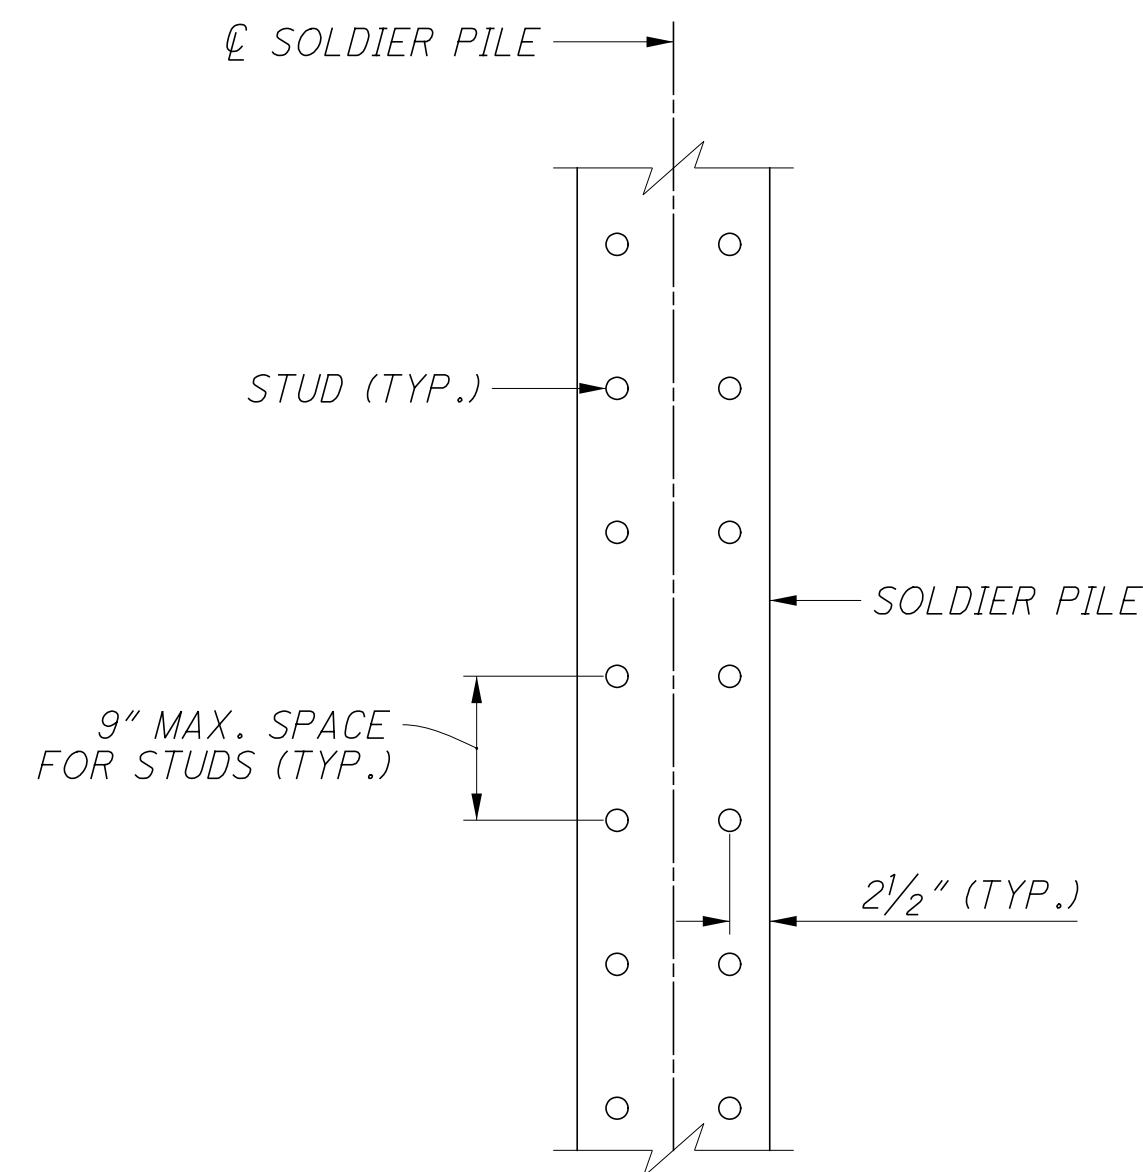


**SOLDIER PILE
PARTIAL ELEVATION**

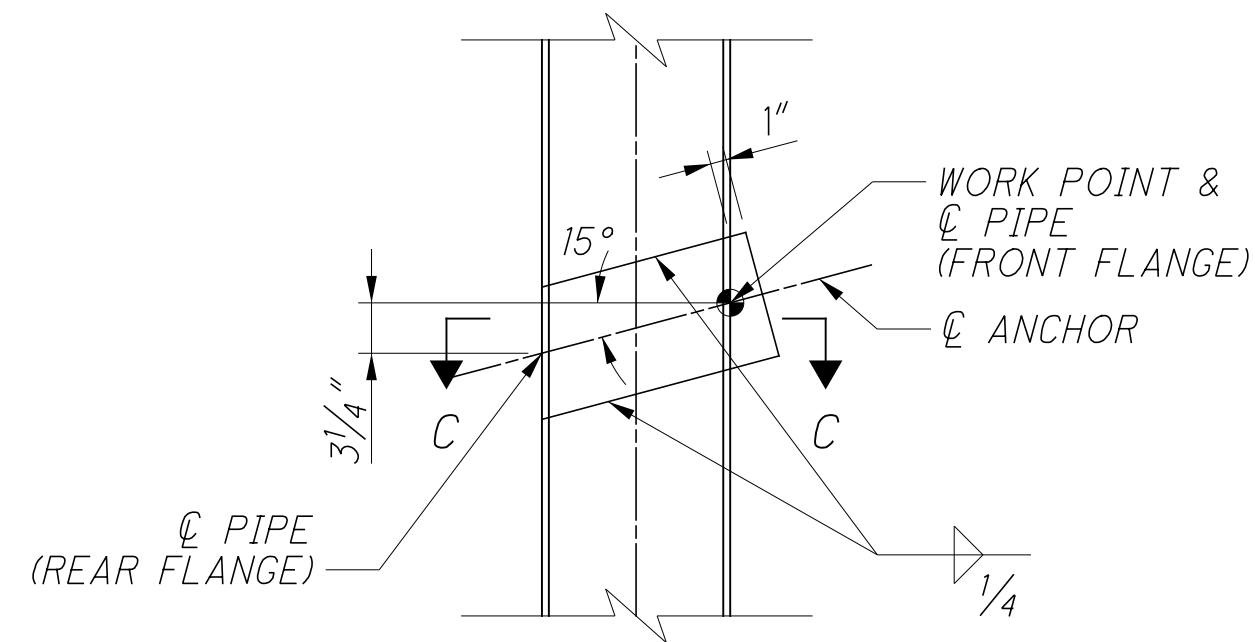


**AT ANCHOR LOCATION
PARTIAL SECTION**

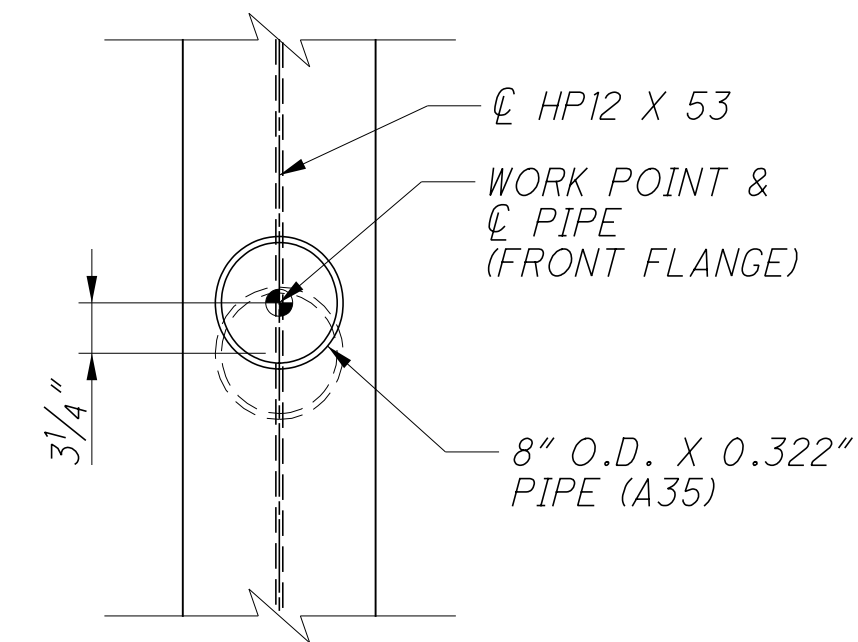


**AT ANCHOR LOCATION
PARTIAL ELEVATION**

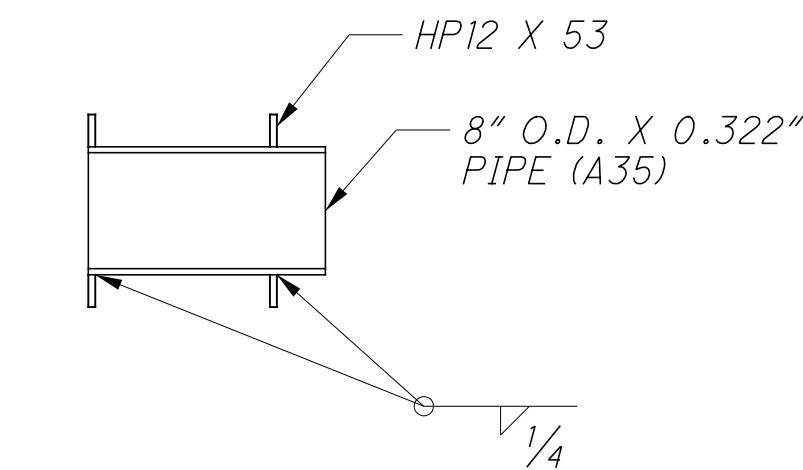


SECTION C-C

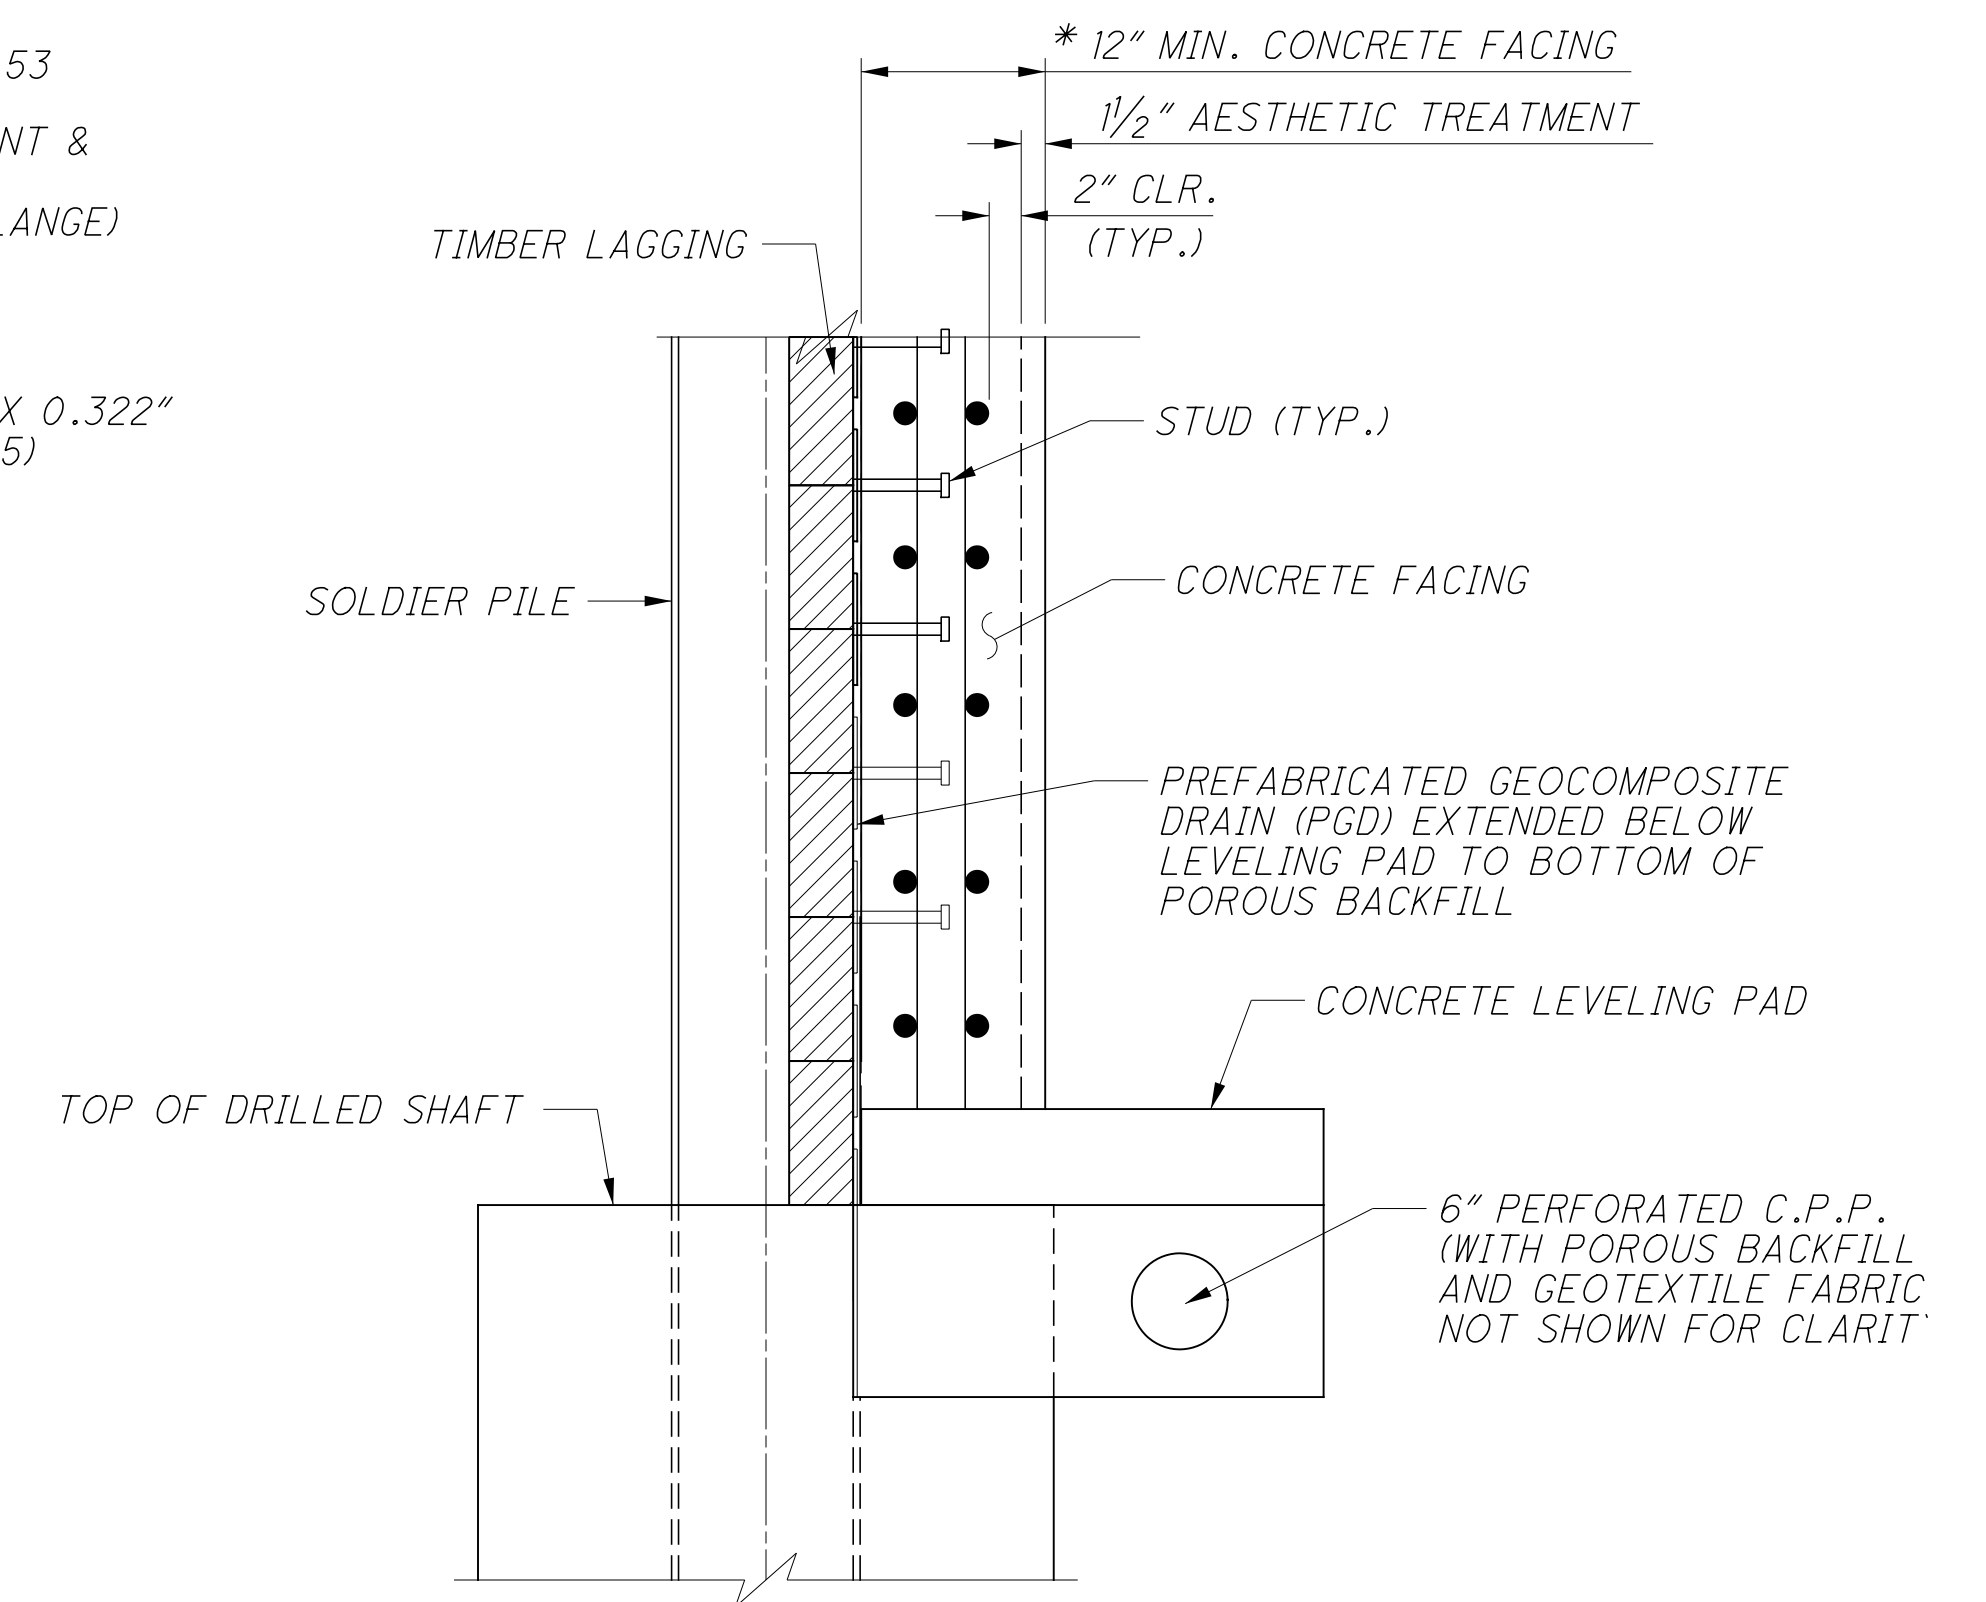


WALL DRAINAGE DETAIL
 *PILE LOCATIONS TOLERANCE RESULTS IN VARIABLE THICKNESS

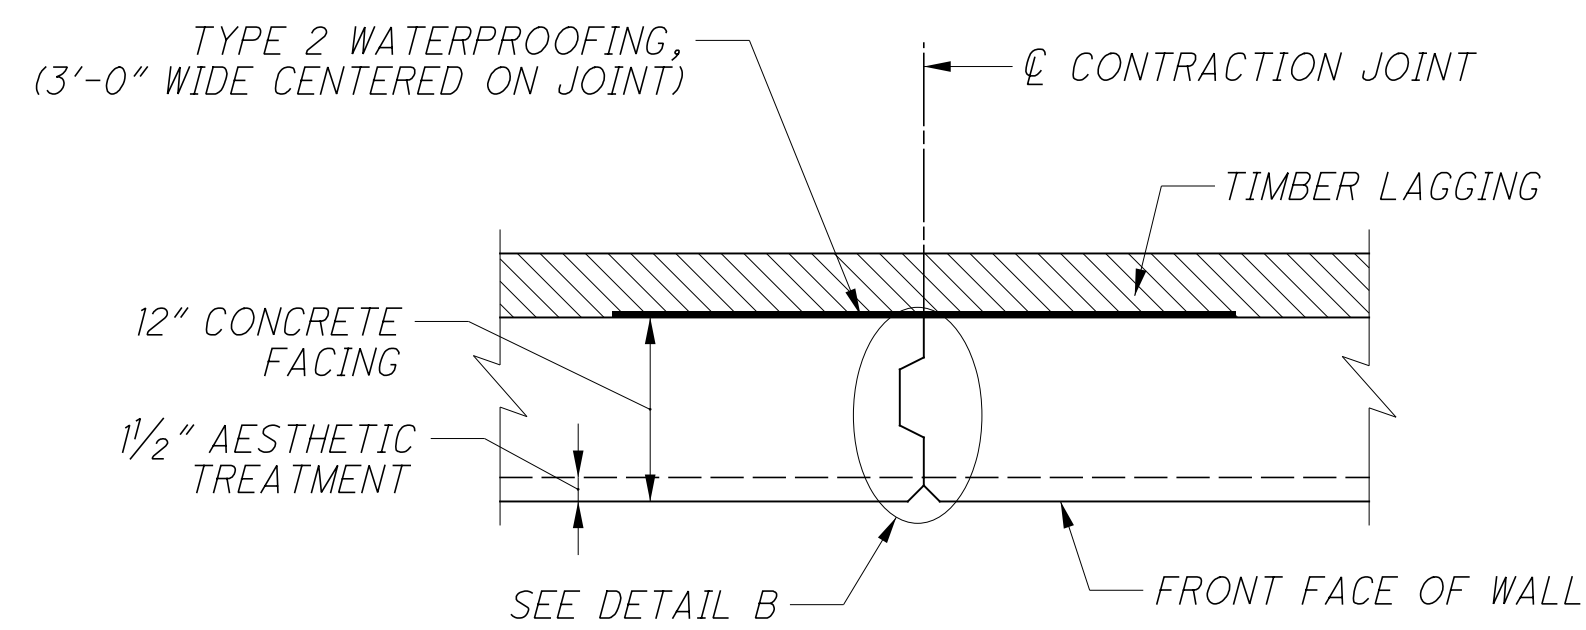


CONTRACTION JOINT DETAIL

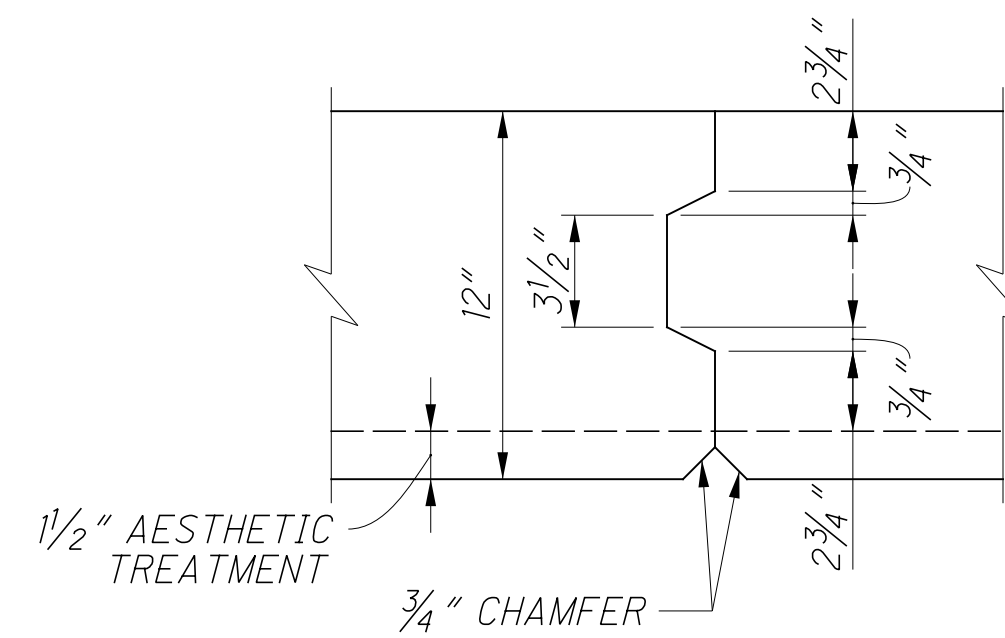


DETAIL B

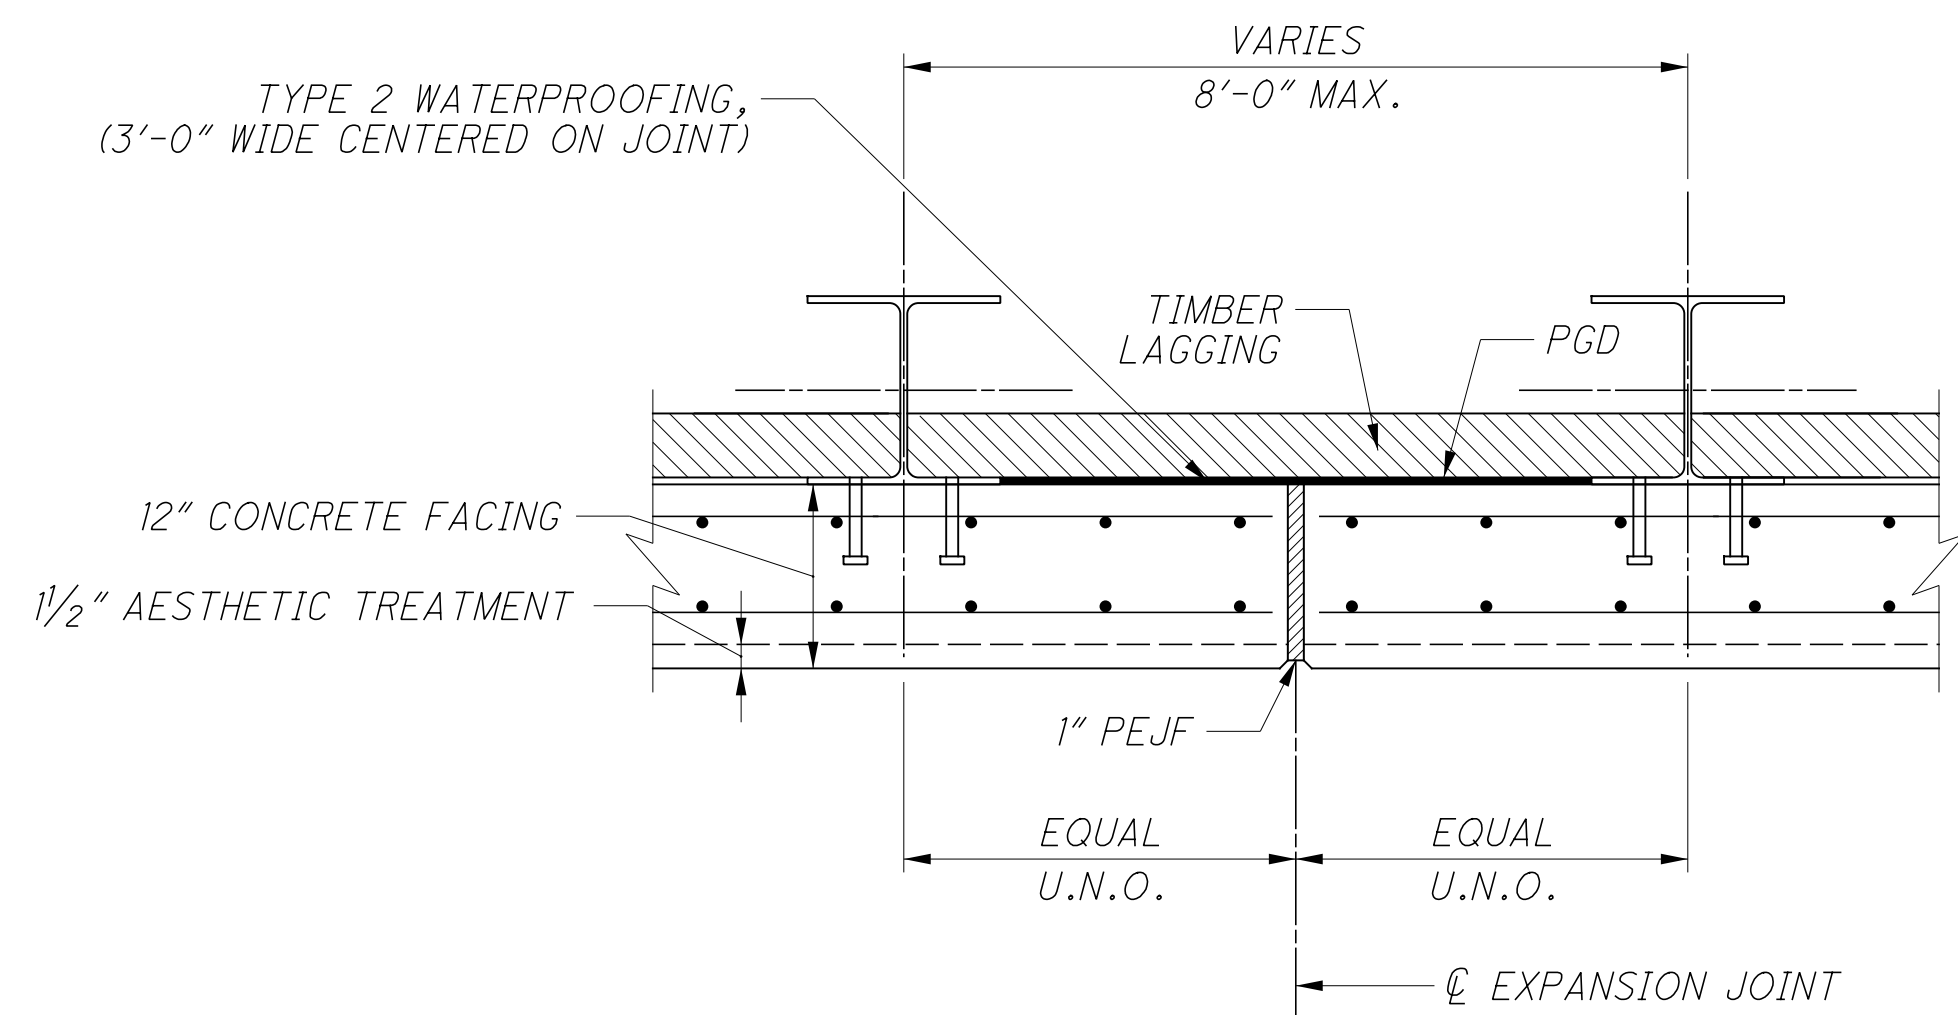

EXPANSION JOINT DETAIL

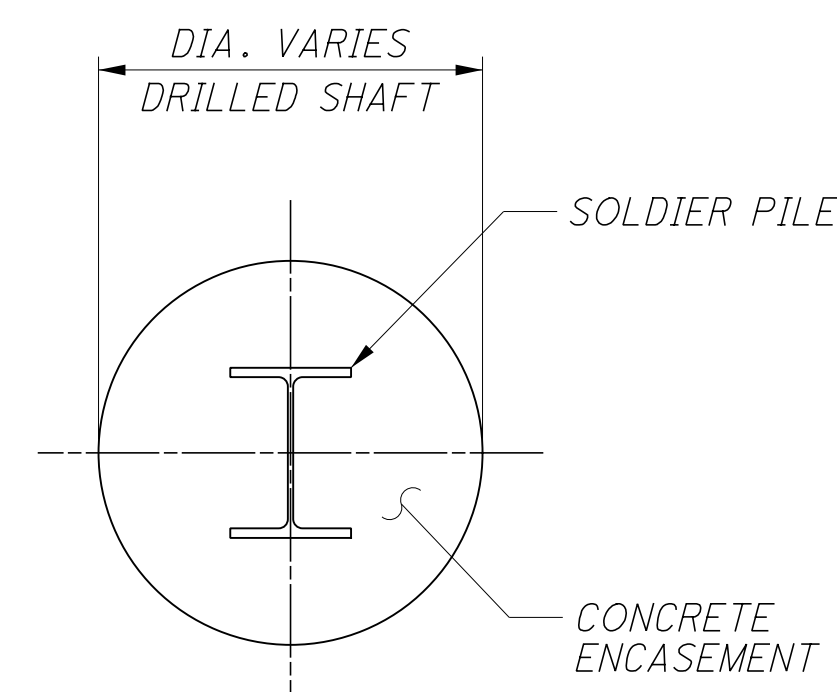

SECTION A-A

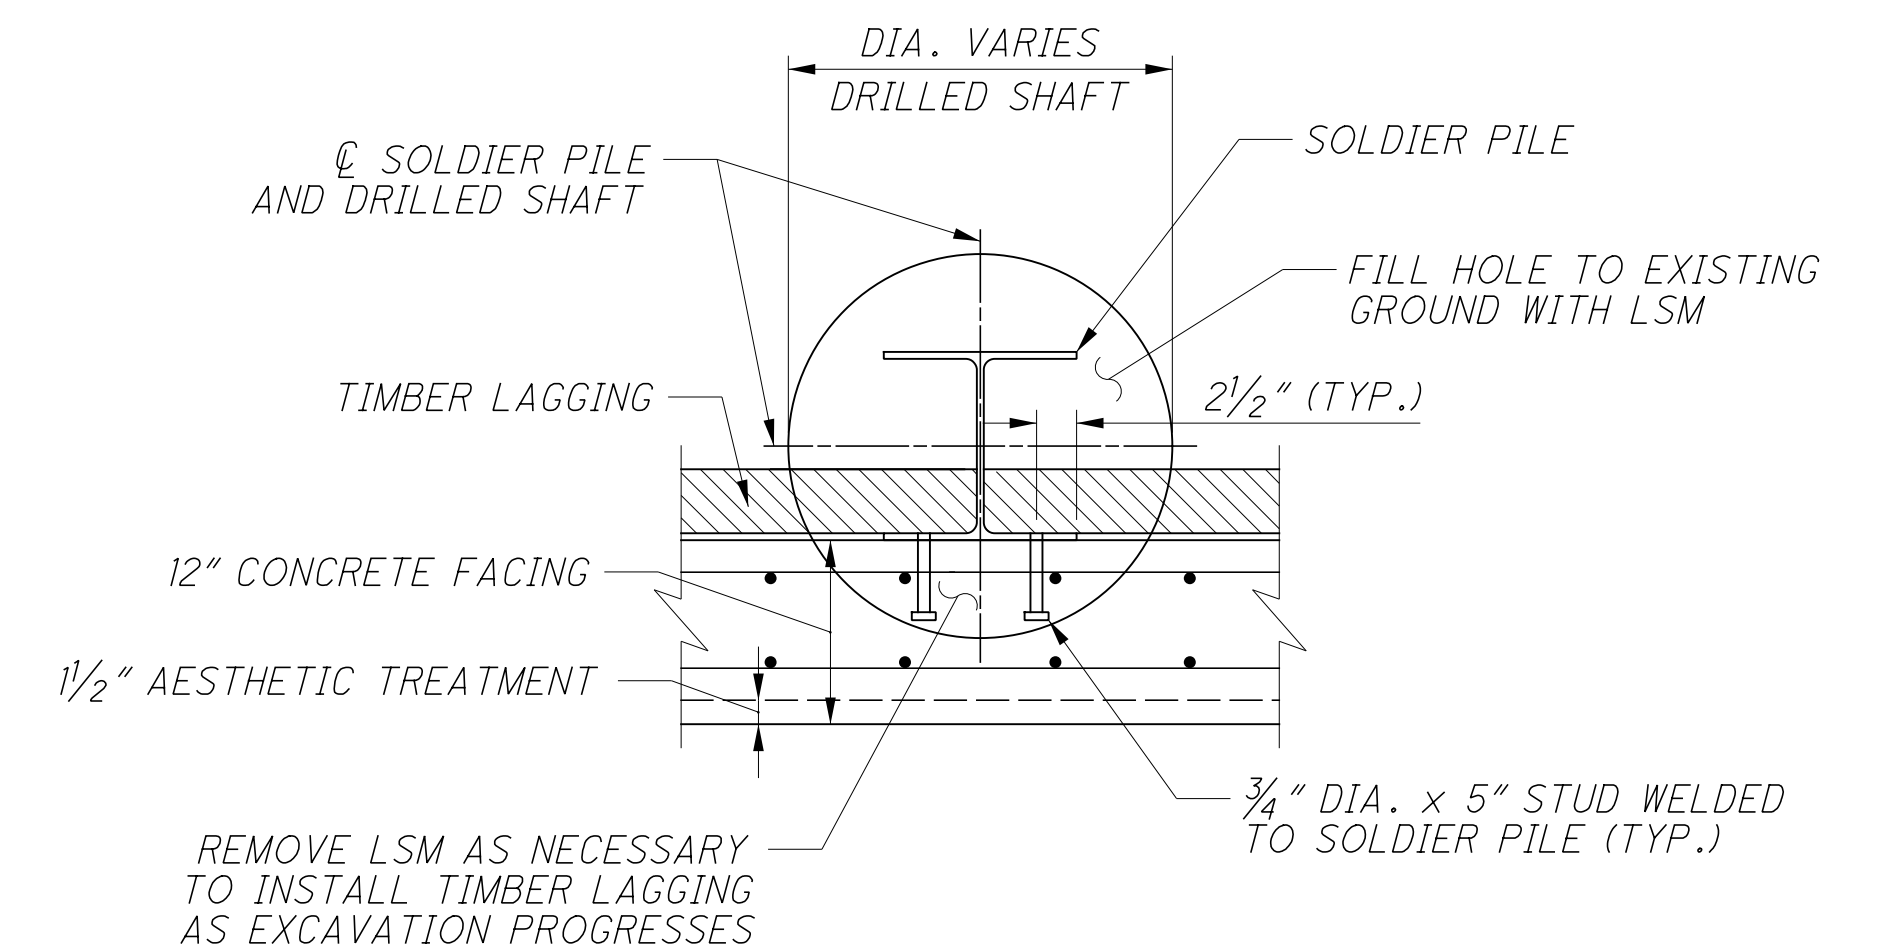


SECTION B-B

DESIGN AGENCY STRUCTUREPOINT	DATE 01/18/19	DESIGNED SUF	DRAWN DSH	REVIEWED MDS	DATE 01/18/19	DESIGN AGENCY STRUCTUREPOINT
FILE NUMBER 104667	STRUCTURE FILE NUMBER	CHECKED CLB	REVISED	FILE NUMBER	STRUCTURE FILE NUMBER	DESIGNED SUF
RETAINING WALL NO. 2 DETAILS ALONG RAMP "P" AND IR-75 NB			HAM-75-3.84 PID No. 104667			8 / 11
						11 / 48

ESTIMATED RETAINING WALL NO. 2B DETAIL TABLE





AS- BUILT
INFORMATION

SOLDIER PILE NUMBER	PILE STATION	PILE SIZE	TOP OF WALL EL. A	TOP OF PILE EL. B	TOP OF DRILLED SHAFT EL. C	DRILLED SHAFT ABOVE BEDROCK	PILE TIP EL. D	DRILLED SHAFT DIA. (FT)	DISTANCE TO TOP ANCHOR "E"	DISTANCE BETWEEN ANCHORS "F"	DRILLED SHAFT LENGTH MEASURED (FT)	PILE LENGTH MEASURED (FT)
1	247+83.07	HP12x53	519.65	518.15	511.77	20.00	491.77	2.00	-	-	26.08	26.50
2	247+78.07	HP12x53	520.84	519.34	511.77	20.00	491.77	2.00	-	-	26.33	27.60
3	247+73.07	HP12x53	522.02	520.52	511.77	20.00	491.77	2.00	-	-	26.50	29.75
4	247+65.07	HP12x53	523.93	522.43	511.77	16.00	495.77	3.00	6.50	-	23.17	27.00
5	247+57.07	HP12x53	525.83	524.33	511.77	16.00	495.77	3.00	6.50	-	25.75	28.60
6	247+49.07	HP12x53	527.08	525.58	511.48	16.00	495.48	3.00	6.50	-	25.20	33.20
7	247+44.07	HP12x53	527.47	525.97	511.48	16.00	495.48	3.00	6.50	-	25.20	31.50
8	247+36.07	HP12x53	528.07	526.57	511.48	16.00	495.48	3.00	6.50	-	26.75	31.20
9	247+30.07	HP12x53	528.46	526.96	511.48	16.00	495.48	3.00	6.50	-	26.40	31.50
10	247+25.07	HP12x53	528.85	527.35	511.18	16.00	495.18	3.00	6.50	-	27.83	32.20
11	247+17.07	HP12x53	529.33	527.83	511.18	16.00	495.18	3.00	6.50	-	29.50	32.75
12	247+09.07	HP12x53	529.81	528.31	511.18	16.00	495.18	3.00	6.50	-	29.17	33.75
13	247+01.07	HP12x53	530.29	528.79	510.80	16.00	494.80	3.00	6.50	-	N/A	N/A
14	246+93.07	HP12x53	530.79	529.29	510.80	16.00	494.80	3.00	6.50	-	N/A	N/A
15	246+85.07	HP12x53	531.29	529.79	510.80	20.00	490.80	3.00	6.00	9.00	N/A	N/A
16	246+77.07	HP12x53	531.85	530.35	510.40	20.00	490.40	3.00	6.00	9.00	N/A	N/A
17	246+69.07	HP12x53	532.48	530.98	510.40	20.00	490.40	3.00	6.00	9.00	N/A	N/A
18	246+61.07	HP12x53	533.11	531.61	510.40	20.00	490.40	3.00	6.00	9.00	N/A	N/A
19	246+53.07	HP12x53	533.36	531.86	509.93	20.00	489.93	3.00	6.00	9.00	37.67	42.25
20	246+45.07	HP12x53	533.21	531.71	509.93	20.00	489.93	3.00	6.00	9.00	37.00	42.25
21	246+37.07	HP12x53	533.06	531.56	509.93	20.00	489.93	3.00	6.00	9.00	38.42	42.00
22	246+29.05	HP12x53	532.89	531.39	509.44	20.00	489.44	3.00	6.00	9.00	38.43	42.25
23	246+21.00	HP12x53	532.69	531.19	509.44	20.00	489.44	3.00	6.00	9.00	39.17	42.00
24	246+12.94	HP12x53	532.49	530.99	509.44	20.00	489.44	3.00	6.00	9.00	38.83	41.75
25	246+04.86	HP12x53	532.15	530.65	508.93	20.00	488.93	3.00	6.00	9.00	39.50	42.25
26	245+96.75	HP12x53	531.68	530.18	508.93	20.00	488.93	3.00	6.00	9.00	39.67	42.00
27	245+88.63	HP12x53	531.22	529.72	508.93	20.00	488.93	3.00	6.00	9.00	37.83	34.30
28	245+80.49	HP12x53	530.68	529.18	508.41	20.00	488.41	3.00	6.00	9.00	38.50	40.80
29	245+72.33	HP12x53	530.07	528.57	508.41	20.00	488.41	3.00	6.00	9.00	39.50	40.20
30	245+64.16	HP12x53	529.46	527.96	508.41	20.00	488.41	3.00	6.00	9.00	37.00	39.60
31	245+55.96	HP12x53	528.84	527.34	507.87	20.00	487.87	3.00	6.00	9.00	32.50	39.50
32	245+47.74	HP12x53	528.22	526.72	507.87	16.00	491.87	3.00	6.50	-	32.50	34.90
33	245+39.50	HP12x53	527.60	526.10	507.87	16.00	491.87	3.00	6.50	-	32.33	34.30
34	245+31.24	HP12x53	526.97	525.47	507.31	16.00	491.31	3.00	6.50	-	32.50	34.20
35	245+22.96	HP12x53	526.34	524.84	507.31	16.00	491.31	3.00	6.50	-	31.50	33.60
36	245+14.66	HP12x53	525.71	524.21	507.31	16.00	491.31	3.00	6.50	-	31.33	33.00
37	245+06.34	HP12x53	525.09	523.59	506.78	16.00	490.78	3.00	6.50	-	31.10	32.90
38	244+98.00	HP12x53	524.50	523.00	506.78	16.00	490.78	3.00	6.50	-	31.25	32.30
39	244+89.64	HP12x53	523.90	522.40	506.78	16.00	490.78	3.00	6.50	-	29.75	31.70
40	244+81.25	HP12x53	523.32	521.82	506.27	16.00	490.27	3.00	6.50	-	30.20	31.60
41	244+72.85	HP12x53	522.75	521.25	506.27	16.00	490.27	3.00	6.50	-	30.10	31.00
42	244+64.42	HP12x53	522.18	520.68	506.27	16.00	490.27	3.00	6.50	-	30.58	30.50
43	244+55.97	HP12x53	521.61	520.11	505.86	16.00	489.86	3.00	6.50	-	29.92	30.30
44	244+47.51	HP12x53	521.04	519.54	505.86	16.00	489.86	3.00	6.50	-	29.00	29.70
45	244+39.02	HP12x53	520.48	518.98	505.86	16.00	489.86	3.00	6.50	-	28.30	29.20
46	244+30.53	HP12x53	519.59	518.09	505.86	16.00	489.86	3.00	6.50	-	29.50	28.30
47	244+22.04	HP12x53	518.39	516.89	505.86	16.00	489.86	3.00	6.50	-	26.00	27.10
48	244+13.55	HP12x53	517.19	515.69	505.86	16.00	489.86	3.00	6.50	-	25.00	25.90
49	244+05.06	HP12x53	516.14	514.64	505.86	20.00	485.86	2.00	-	-	27.25	28.80
50	243+99.75	HP12x53	515.58	514.08	505.86	20.00	485.86	2.00	-	-	27.83	28.30
51	243+94.44	HP12x53	515.01	513.51	505.86	20.00	485.86	2.00	-	-	26.40	27.70
52	243+89.14	HP12x53	514.45	512.95	505.86	20.00	485.86	2.00	-	-	25.92	27.10
53	243+83.83	HP12x53	513.88	512.38	505.86	20.00	485.86	2.00	-	-	26.10	26.50
54	243+78.52	HP12x53	513.32	511.82	506.02	20.00	486.02	2.00	-	-	24.30	25.80
55	243+73.32	HP12x53	512.78	511.28	506.02	20.00	486.02	2.00	-	-	24.20	25.30
56	243+68.32	HP12x53	512.23	510.73	506.02	20.00	486.02	2.00	-	-	22.10	24.80
57	243+63.32	HP12x53	511.69	510.19	506.02	20.00	486.02	2.00	-	-	22.10	23.70
58	243+58.63	HP12x53	511.14	509.64	506.02	20.00	486.02	2.00	-	-	20.40	N/A

	DESIGN AGENCY STRUCTUREPOINT
REVIEWED MDS	DATE 01/18/19
DRAWN BMP	STRUCTURE POINT FILE NUMBER
DESIGNED SJF	CHECKED CLB
RETAINING WALL NO. 2B DETAIL TABLE ALONG RAMP "P" AND IR 75 NB	
HAM - 75 - 3.84 PID No. 104667	
9 / 11	12 48

LEGEND
N/A - NOT AVAILABLE


MARK	NUMBER	LENGTH	WEIGHT	TYPE	DIMENSIONS						
	TOTAL				A	B	C	D	E	R	INC
WALL NO. 2A											
W501	296	6'-8"	2058	STR							
W502	16	24'-3"	405	STR							
W503	32	40'-0"	1335	STR							
W504	16	17'-8"	295	STR							
W505	8	5'-7"	47	19	2'-7"	2'-2"	2'-2"				
W506	149	9'-2"	1425	2	4'-5"	0'-7"	4'-5"				
W507	18	23'-8"	444	STR							
W508	18	25'-7"	480	STR							
W509	54	24'-8"	1389	STR							
W510	16	33'-5"	558	STR							
W511	16	17'-8"	295	STR							
W512	2	15'-6"	32	STR							
	1 SR	7'-9"					3'-5"				
W601	OF	TO	294	37	0'-8"	3'-4"	TO	1'-0"			1/8"
	25	7'-11"					3'-7"				
	1 SR	7'-7"				6'-9"					
W602	OF	TO	288	1	1'-0"	TO					1/8"
	25	7'-9"				6'-11"					
	1 SR	7'-6"					3'-2"				
W603	OF	TO	309	37	0'-8"	3'-4"	TO	1'-0"			1/4"
	27	7'-9"					3'-5"				
	1 SR	7'-4"				6'-6"					
W604	OF	TO	304	1	1'-0"	TO					1/4"
	27	7'-7"				6'-9"					
	1 SR	7'-3"					2'-11"				
W605	OF	TO	288	37	0'-8"	3'-4"	TO	1'-0"			1/4"
	26	7'-6"					3'-2"				
	1 SR	7'-2"				6'-4"					
W606	OF	TO	286	1	1'-0"	TO					1/4"
	26	7'-5"				6'-7"					
	1 SR	7'-6"					3'-2"				
W607	OF	TO	298	37	0'-8"	3'-4"	TO	1'-0"			1/4"
	26	7'-9"					3'-5"				
	1 SR	7'-4"				6'-6"					
W608	OF	TO	293	1	1'-0"	TO					1/4"
	26	7'-7"				6'-9"					
	1 SR	7'-4"					3'-0"				
W609	OF	TO	292	37	0'-8"	3'-4"	TO	1'-0"			1/4"
	26	7'-6"					3'-2"				
	1 SR	7'-2"				6'-4"					
W610	OF	TO	283	1	1'-0"	TO					1/4"
	26	7'-4"				6'-6"					
	1 SR	7'-2"					2'-10"				
W611	OF	TO	207	37	0'-8"	3'-4"	TO	1'-0"			1/4"
	19	7'-4"					3'-0"				
	1 SR	7'-0"				6'-2"					
W612	OF	TO	202	1	1'-0"	TO					1/8"
	19	7'-2"				6'-4"					
	SUB-TOTAL		12,107								

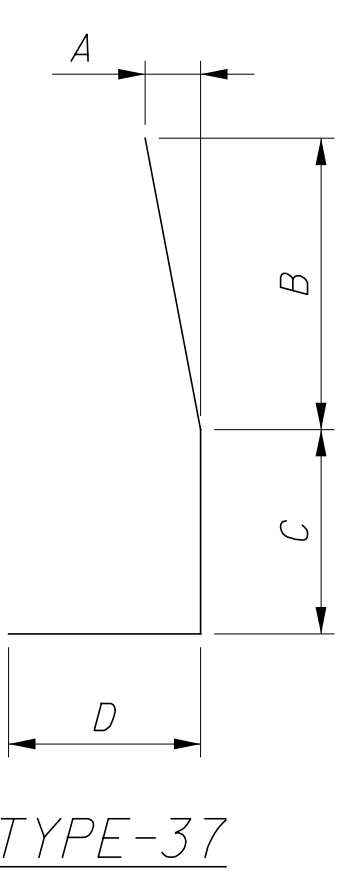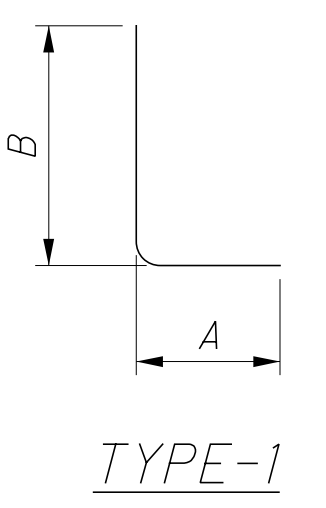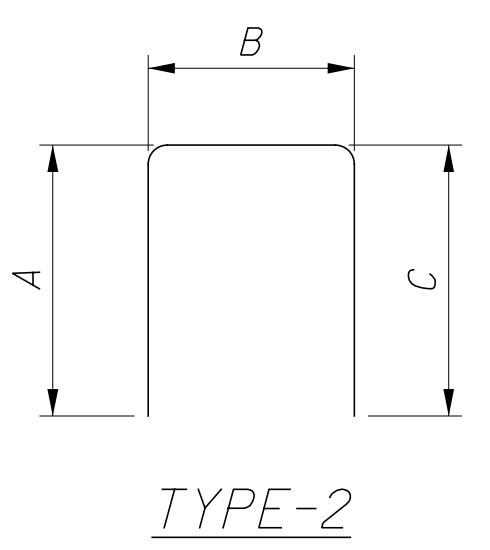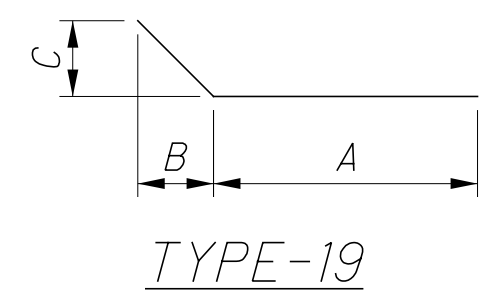


MARK	NUMBER		LENGTH	WEIGHT	TYPE	DIMENSIONS					
	TOTAL					A	B	C	D	E	R
WALL NO. 2B											
W501	20		29'-8"	619	STR						
	2 SR		2'-7"								
W502	OF		TO	289	STR						3'-2 1/2"
	9		28'-2"								
W503	2		30'-5"	63	STR						
W504	696		23'-8"	17181	STR						
W505	2		17'-8"	37	STR						
W506	4		7'-10"	33	STR						
W507	2		13'-11"	29	STR						
W508	2		18'-1"	38	STR						
W509	2		5'-11"	12	STR						
W510	4		15'-9"	66	STR						
W511	2		6'-3"	13	STR						
W512	2		12'-1"	25	STR						
W513	2		11'-0"	23	STR						
W514	2		20'-2"	42	STR						
W515	2		10'-4"	22	STR						
W516	2		22'-6"	47	STR						
W517	2		12'-1"	25	STR						
W518	2		3'-2"	7	STR						
W519	2		15'-2"	32	STR						
W520	2		5'-8"	12	STR						
W521	2		17'-11"	37	STR						
W522	2		21'-9"	45	STR						
W523	2		11'-3"	23	STR						
W524	4		14'-2"	59	STR						
W525	2		3'-6"	7	STR						
	2 SR		5'-3"								
W526	OF		TO	106	STR						5'-0"
	4		20'-3"								
W527	2		23'-11"	50	STR						
W528	20		26'-2"	546	STR						
W529	2		26'-4"	55	STR						
	2 SR		1'-9"								
W530	OF		TO	98	STR						6'-7 3/4"
	4		21'-8"								
W531	14		22'-2"	324	STR						
W532	2		21'-0"	44	STR						
W533	2		7'-3"	15	STR						
	2 SR		7'-3"								
W534	OF		TO	695	STR						2 3/4"
	31		14'-3"								
	2 SR		14'-8"								
W535	OF		TO	810	STR						1"
	25		16'-5"								

MARK	NUMBER		LENGTH	WEIGHT	TYPE	DIMENSIONS					
	TOTAL					A	B	C	D	E	R
WALL NO. 2B CONTINUED											
	2 SR		16'-9"								
W536	OF		TO	910	STR						3/4"
	25		18'-2"								
	2 SR		18'-6"								
W537	OF		TO	1004	STR						3/4"
	25		20'-0"								
	2 SR		20'-6"								
W538	OF		TO	1115	STR						7/8"
	25		22'-3"								
	4 SR		22'-3"								
W539	OF		TO	2351	STR						1/4"
	25		22'-10"								
	2 SR		21'-5"								
W540	OF		TO	1152	STR						3/4"
	25		22'-9"								
	2 SR		20'-1"								
W541	OF		TO	1093	STR						7/8"
	25		21'-10"								
	2 SR		18'-9"								
W542	OF		TO	1023	STR						7/8"
	25		20'-6"								
	2 SR		17'-5"								
W543	OF		TO	956	STR						1"
	25		19'-3"								
	2 SR		16'-2"								
W544	OF		TO	889	STR						7/8"
	25		17'-11"								
	2 SR		14'-11"								
W545	OF		TO	824	STR						7/8"
	25		16'-8"								
	2 SR		13'-8"								
W546	OF		TO	756	STR						3/4"
	25		15'-4"								
	2 SR		10'-1"								
W547	OF		TO	617	STR						1 3/4"
	25		13'-7"								
	2 SR		7'-1"								
W548	OF		TO	481	STR						1 3/8"
	27		10'-0"								
	2 SR		4'-6"								
W549	OF		TO	272	STR						1 1/4"
	23		6'-10"								
	SUB-TOTAL			34,972							

Wads 8/22/2022 9:14:11 AM
 O:\2017\01113\C.Design\104667_HAM-75-3.84\Design\Structures\Walls\Sheets\104667_WD40.dgn

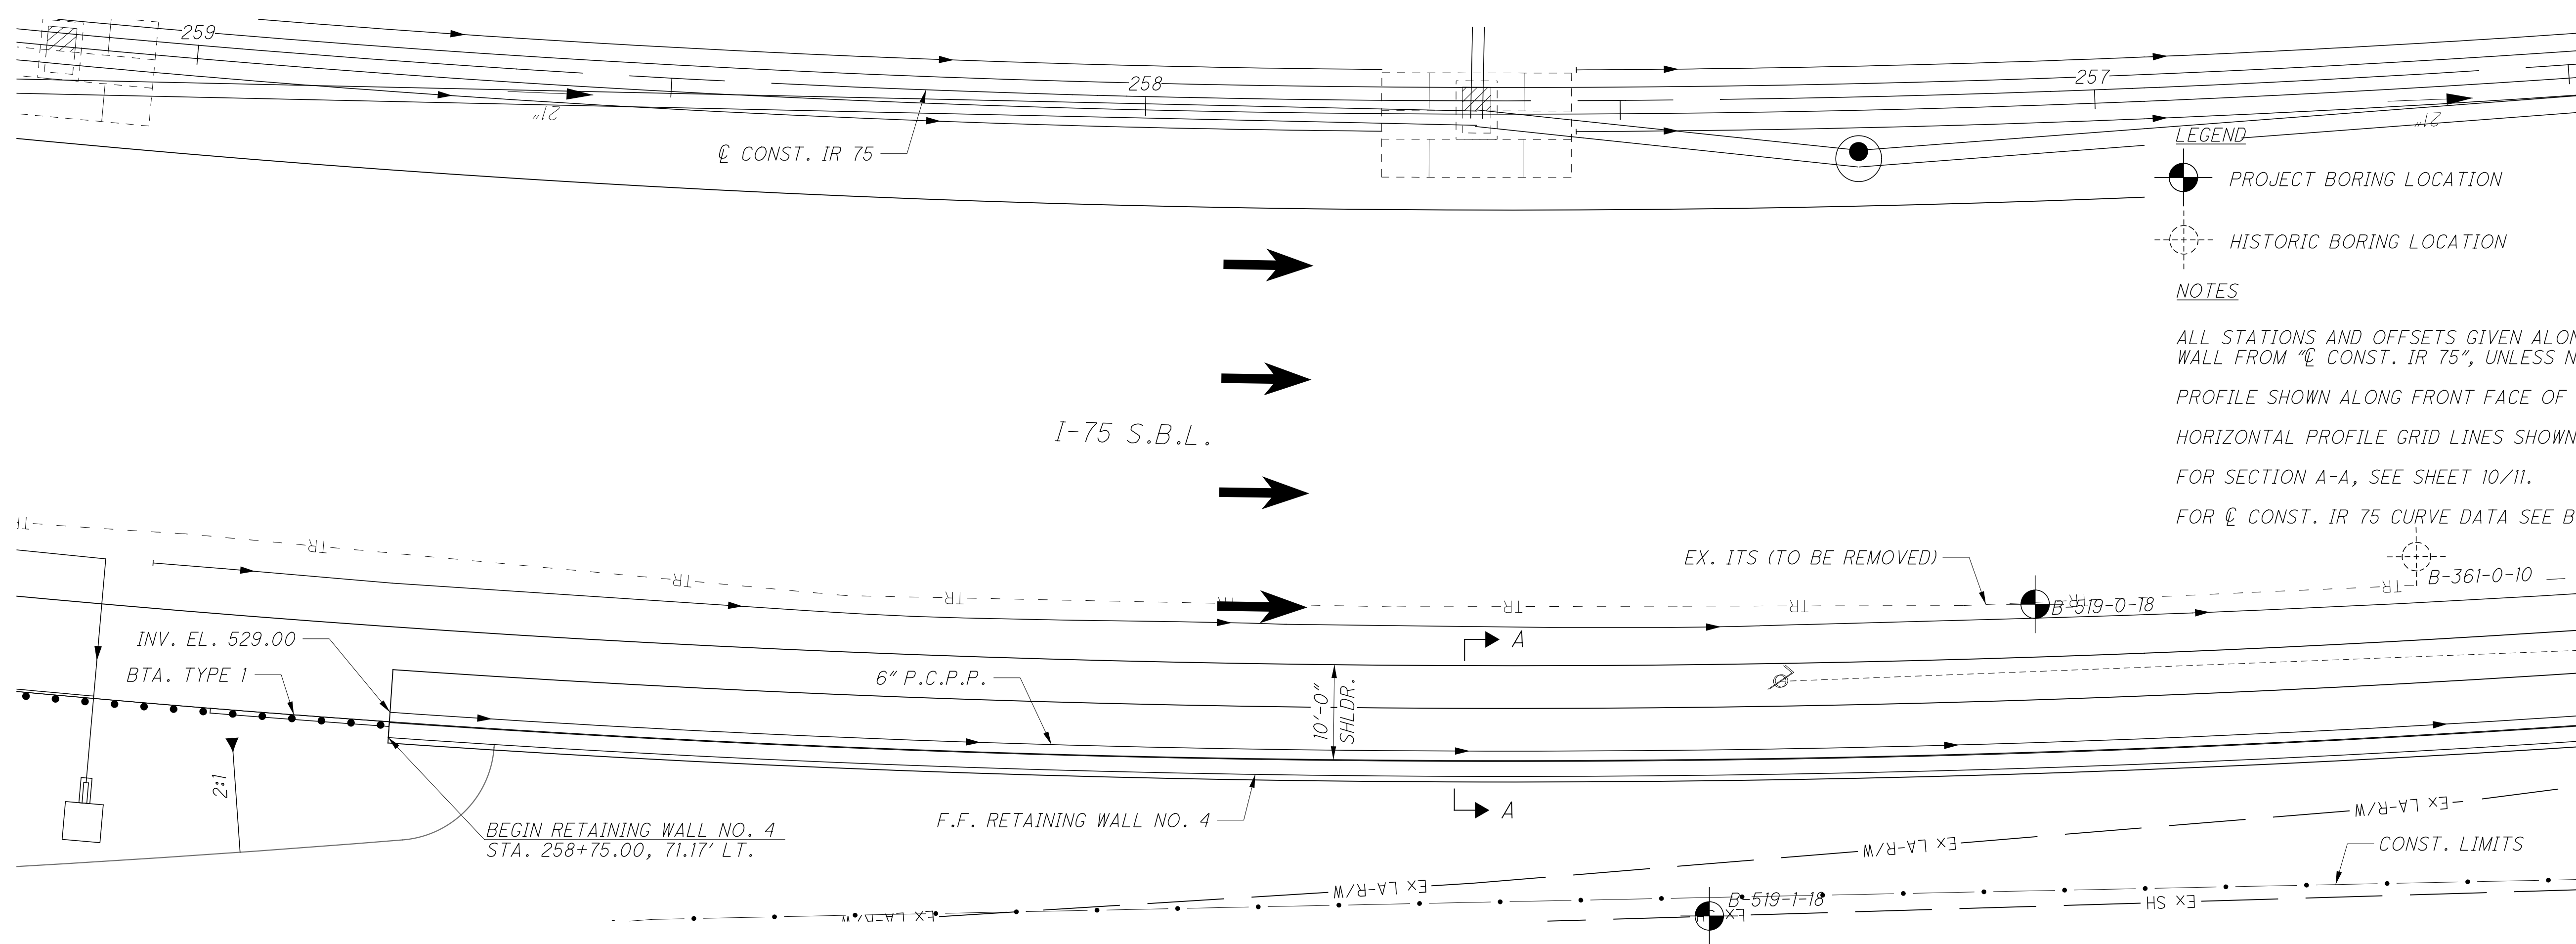

LEGEND
 PROJECT BORING LOCATION
 HISTORIC BORING LOCATION
NOTES
 ALL STATIONS AND OFFSETS GIVEN ALONG FRONT FACE OF WALL FROM "C CONST. IR 75", UNLESS NOTED OTHERWISE.
 PROFILE SHOWN ALONG FRONT FACE OF WALL.
 HORIZONTAL PROFILE GRID LINES SHOWN AT 25'-0" SPACING.
 FOR SECTION A-A, SEE SHEET 10/11.
 FOR C CONST. IR 75 CURVE DATA SEE BU-14.

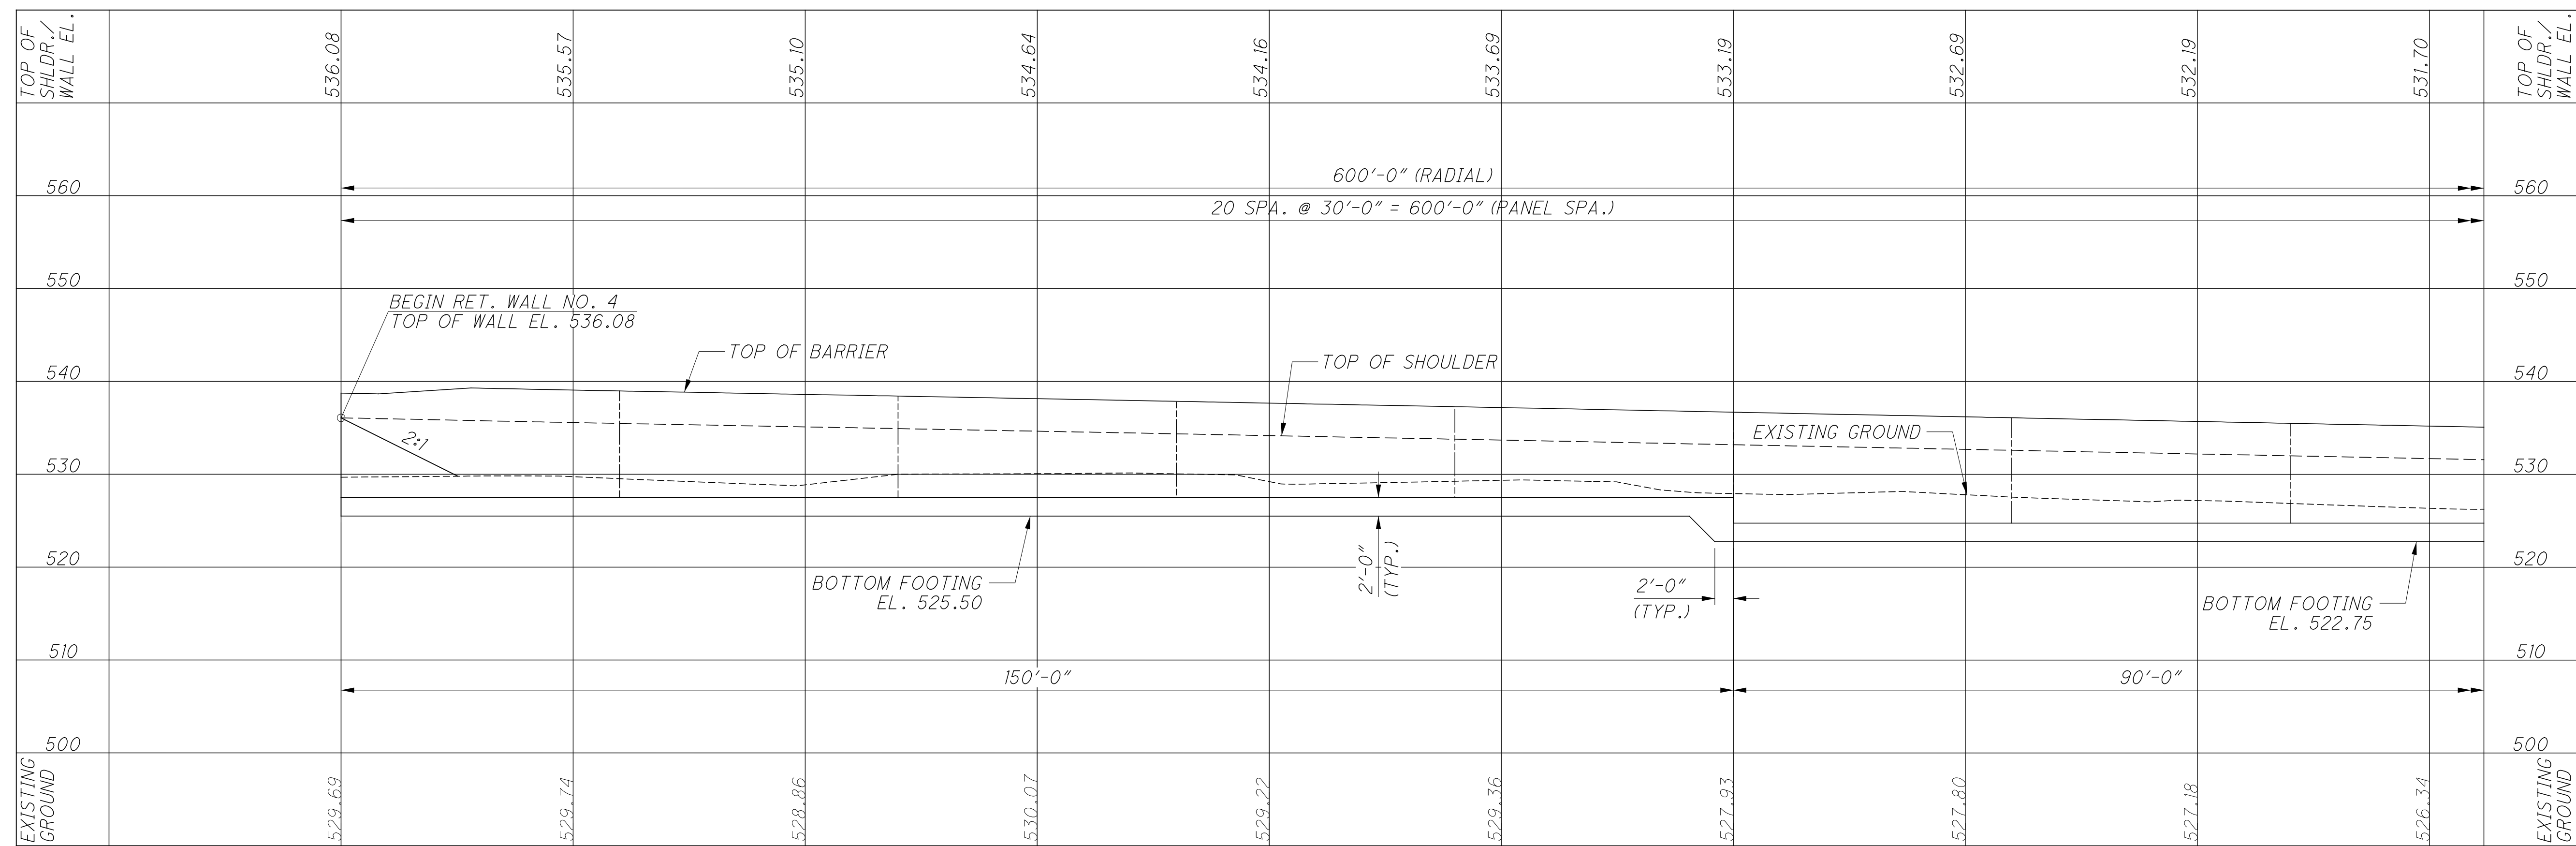

DESIGN AGENCY
 STRUCTUREPOINT
 2000 CORPORATE CENTER DR., 10TH FLOOR
 1000 EAST 17TH AVENUE, SUITE 1000
 DENVER, CO 80202
 TEL: 303.733.8800 FAX: 303.733.8801
 WWW.STRUCTUREPOINT.COM



DESIGNED	SUF	CHECKED	CLB
DRAWN	BMP	REVISED	
REVIEWED	MDS	STRUCTURE POINT FILE NUMBER	
DATE	01/18/19		

RETAINING WALL NO. 4 DETAILS
 ALONG IR 75 SB

HAM-75-3.84
PID No. 104667

1 / 11
 15 / 48

8/22/2022 9:14:12 AM
 O:\2017\01113.C.Design\104667_HAM-75-3.84.Design\Structures\Walls_Sheets\104667_WD41.dgn

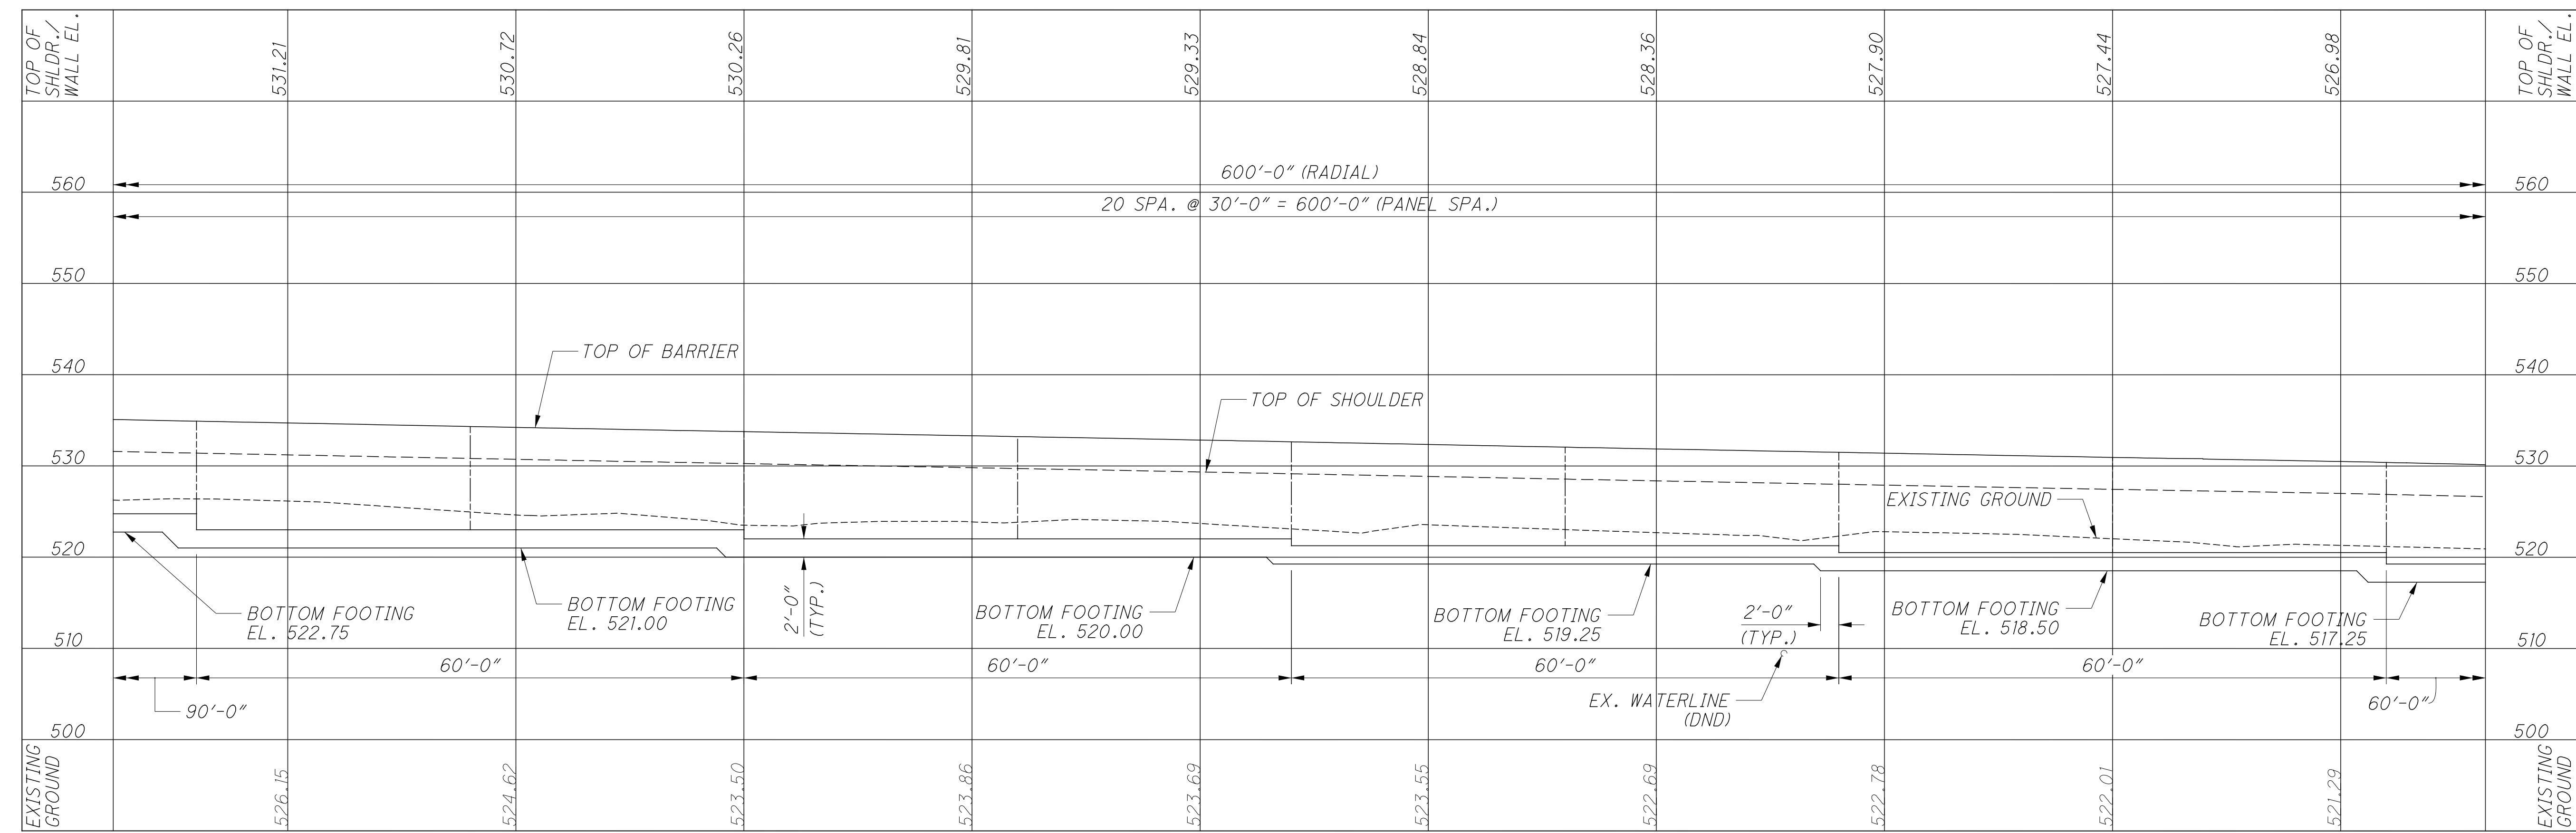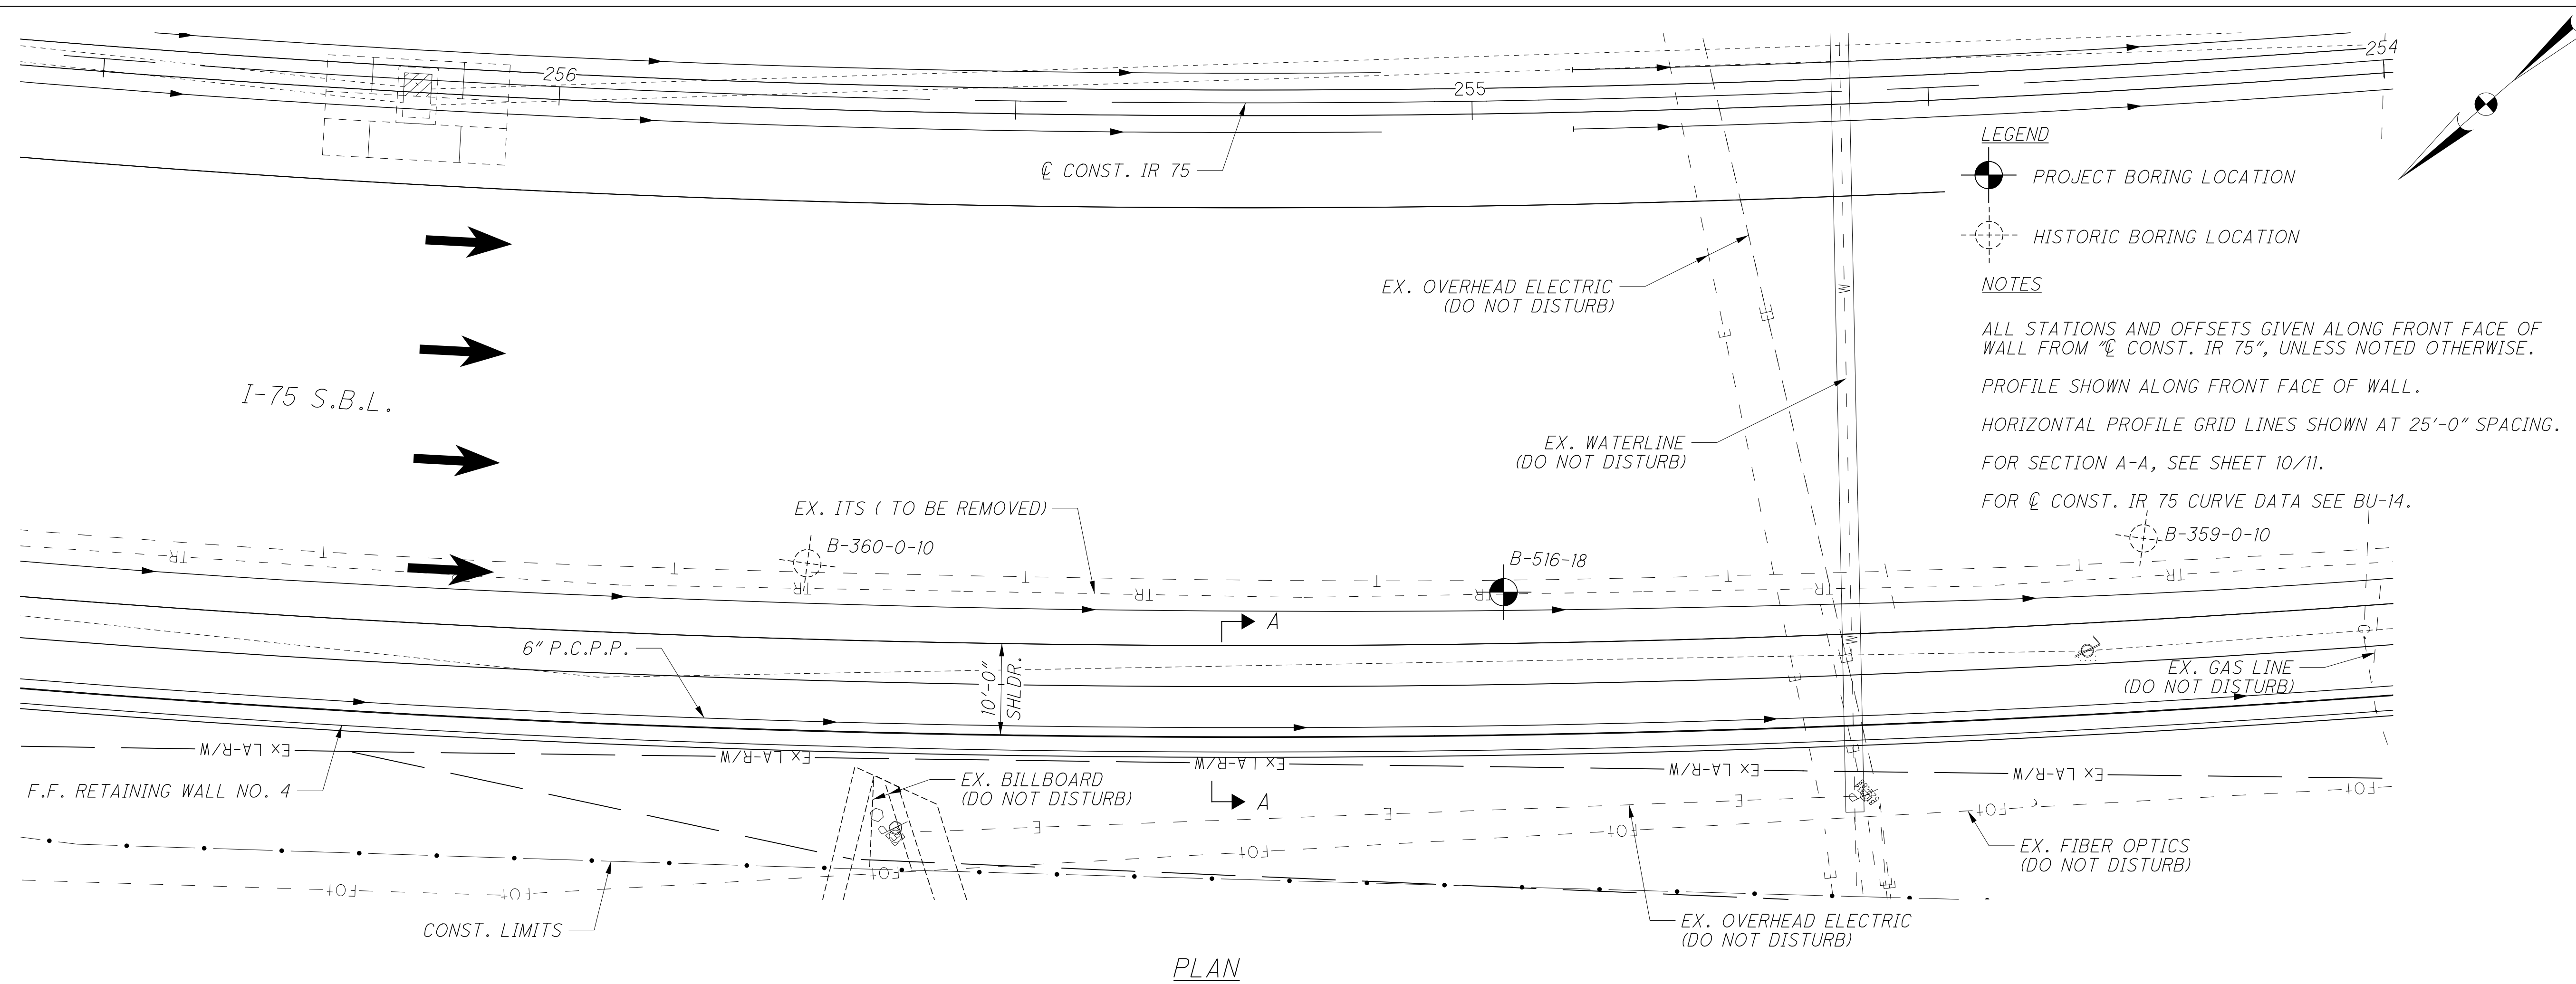

PROFILE
ALONG F.F. RETAINING WALL NO. 4

DESIGN AGENCY: **STRUCTUREPOINT**
 2000 CORPORATION CENTER DR., 17TH FLOOR
 1000 W. 10TH AVENUE, SUITE 1000
 DENVER, CO 80202
 TEL: 303.733.8800 FAX: 303.733.8801

DESIGNED	SJF	CHECKED	CLB
DRAWN	BMP	REVISED	
REVIEWED	MDS	STRUCTURE POINT FILE NUMBER	
DATE	01/18/19		


RETAINING WALL NO. 4 DETAILS
 ALONG IR 75 SB

HAM-75-3.84
PID No. 104667

2 / 11

16
48

jwade 8/22/2022 9:14:12 AM
 O:\2017\01113.C.Design\104667-HAM-75-3.84.Design\Structures\Walls_Sheets\104667_WD42.dgn

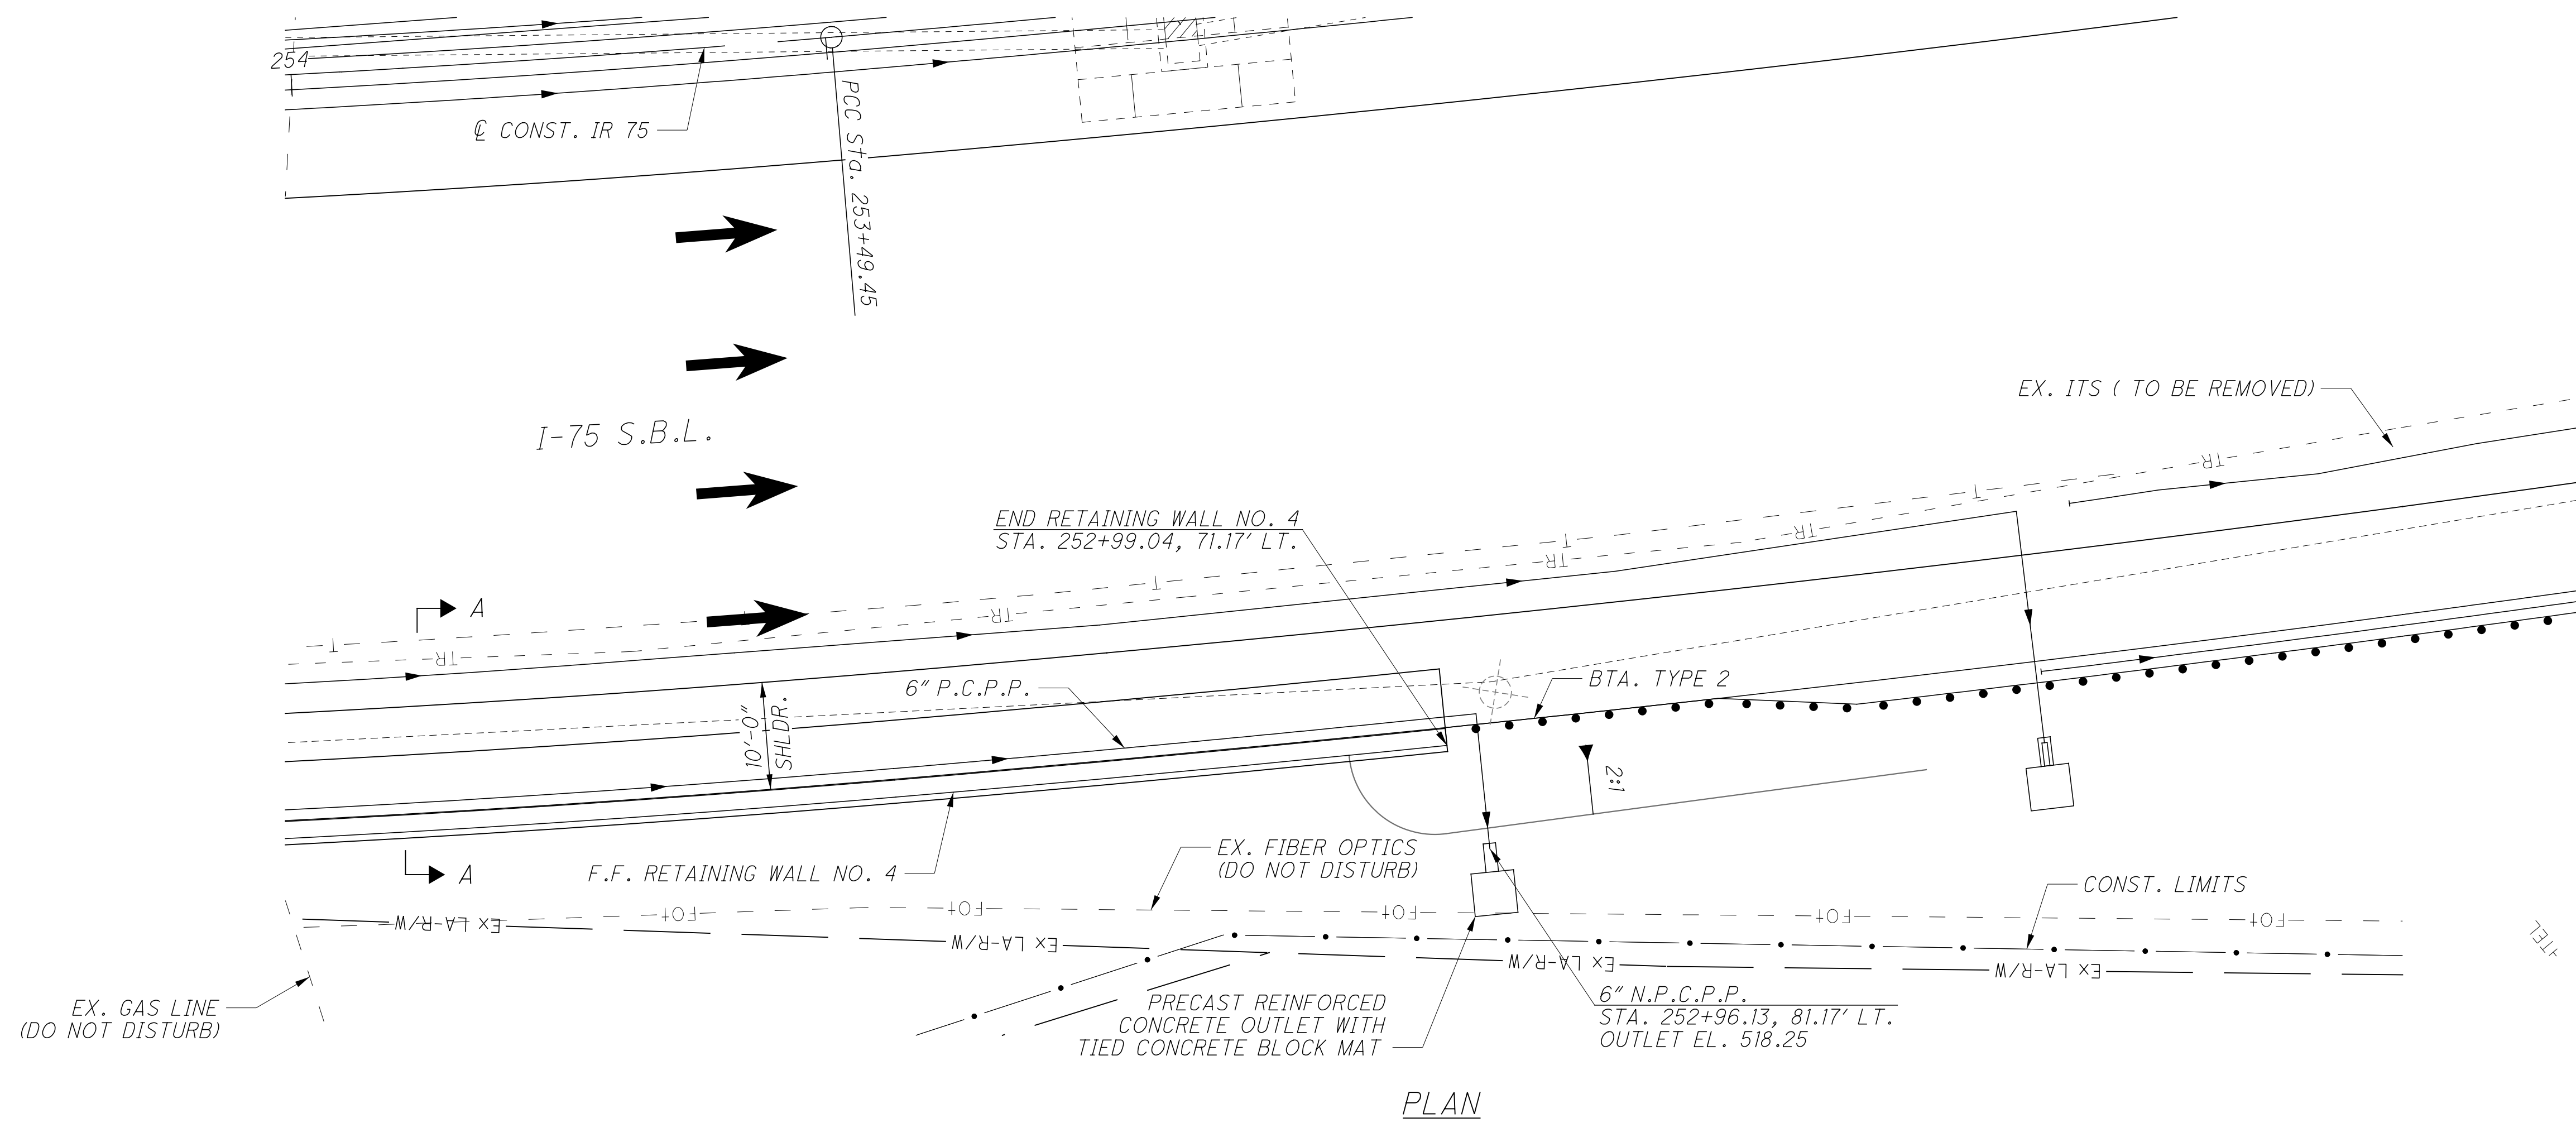

TOP OF SHLDR./ WALL EL.	526.42	525.81	525.19	524.58	523.97	TOP OF SHLDR./ WALL EL.
560						560
550	600'-0" (RADIAL) 20 SPA. @ 30'-0" = 600'-0" (PANEL SPA.)					550
540						540
530	TOP OF BARRIER		TOP OF SHOULDER			530
520	EXISTING GROUND 2:1					520
510	BOTTOM FOOTING EL. 517.25	2'-0" (TYP.)	BOTTOM FOOTING EL. 516.25	2'-0" (TYP.)		510
500	60'-0" EX. GAS LINE 60'-0"					500
EXISTING GROUND	520.72	520.21	520.18	520.13	519.74	EXISTING GROUND

PROFILE
 ALONG F.F. RETAINING WALL NO. 4

LEGEND

- PROJECT BORING LOCATION
- HISTORIC BORING LOCATION

NOTES

- ALL STATIONS AND OFFSETS GIVEN ALONG FRONT FACE OF WALL FROM "C" CONST. IR 75", UNLESS NOTED OTHERWISE.
- PROFILE SHOWN ALONG FRONT FACE OF WALL.
- HORIZONTAL PROFILE GRID LINES SHOWN AT 25'-0" SPACING.
- FOR SECTION A-A, SEE SHEET 10/11.
- FOR C CONST. IR 75 CURVE DATA SEE BU-14.

RETAINING WALL NO. 4 DETAILS
 ALONG IR 75 SB

HAM-75-3.84
PID No. 104667

3 / 11


17
 48




DESIGNED	SJF	CHECKED	CLB
DRAWN	BMP	REVISED	
REVIEWED	MDS	STRUCTURE POINT FILE NUMBER	
DATE	01/18/19		

DESIGN AGENCY
STRUCTUREPOINT
 2000 CORPORATION CENTER DR., STE. 200
 WESTMINSTER, CO 80057
 TEL: 303.440.2300 FAX: 303.440.2302
 WWW.STRUCTUREPOINT.COM

WJW 8/22/2022 9:14:14 AM
 O:\2017\01113\C.Design\104667-HAM-75-3.84\Design\Structures\Walls\Sheets\104667-WD43.dgn

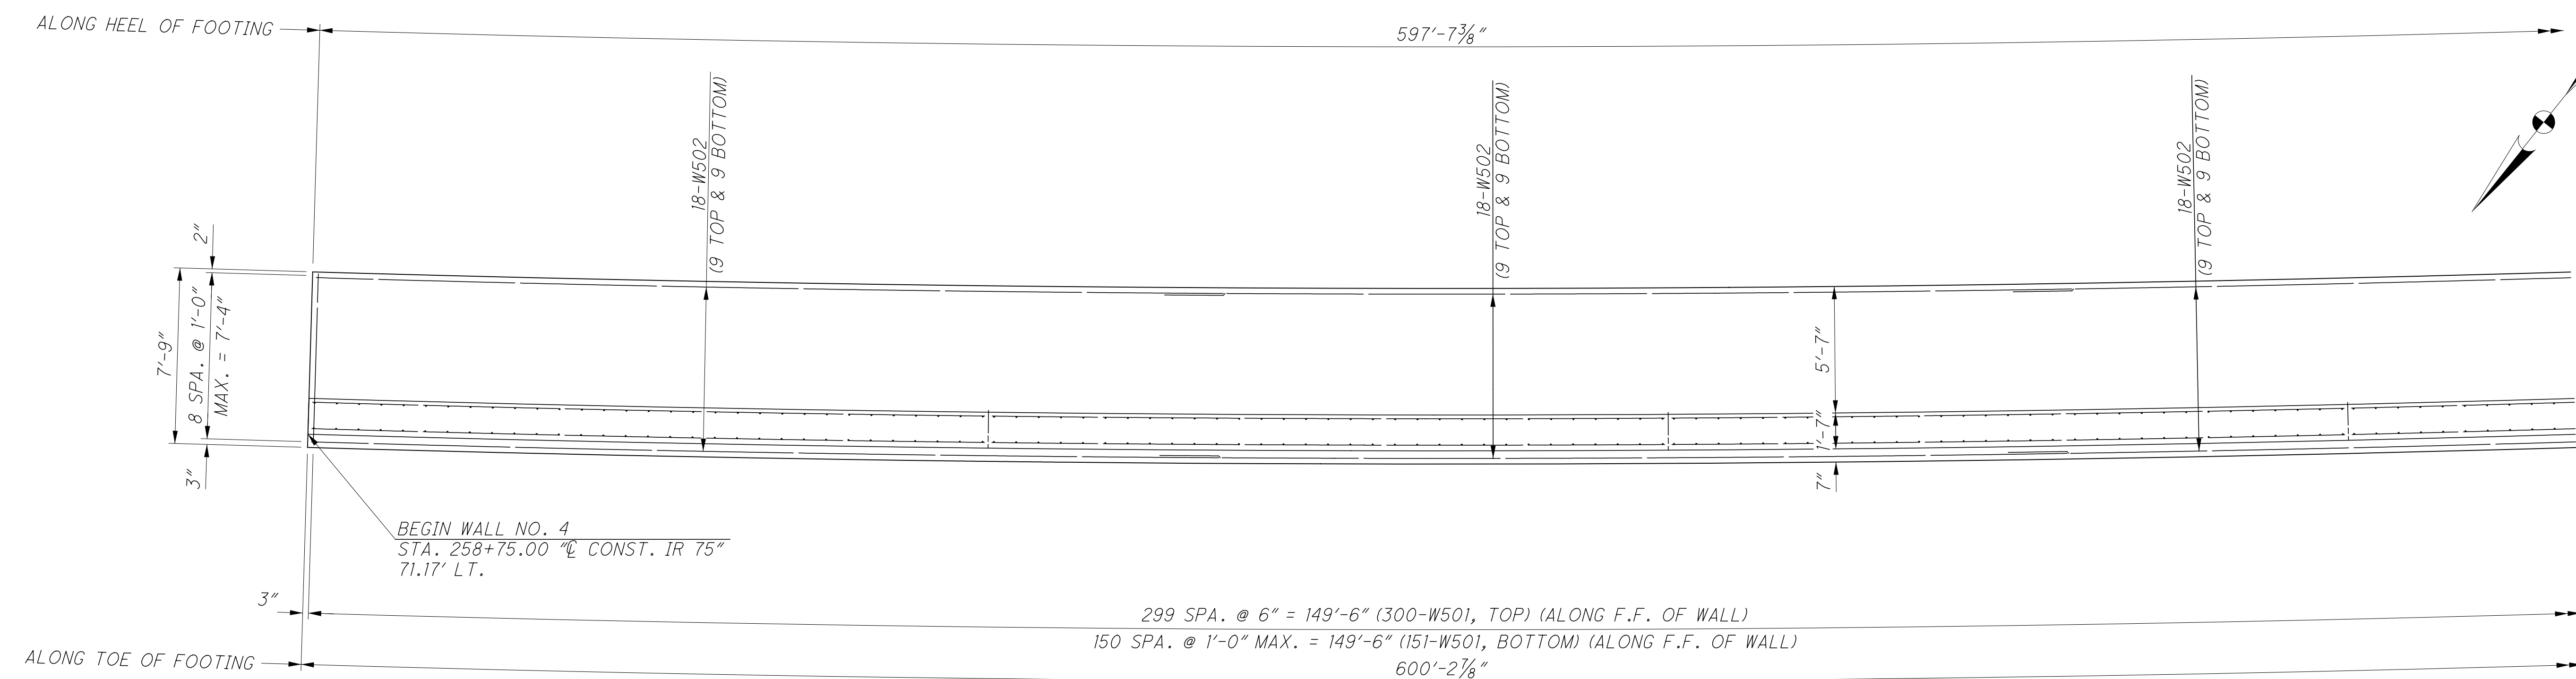

PARTIAL PLAN

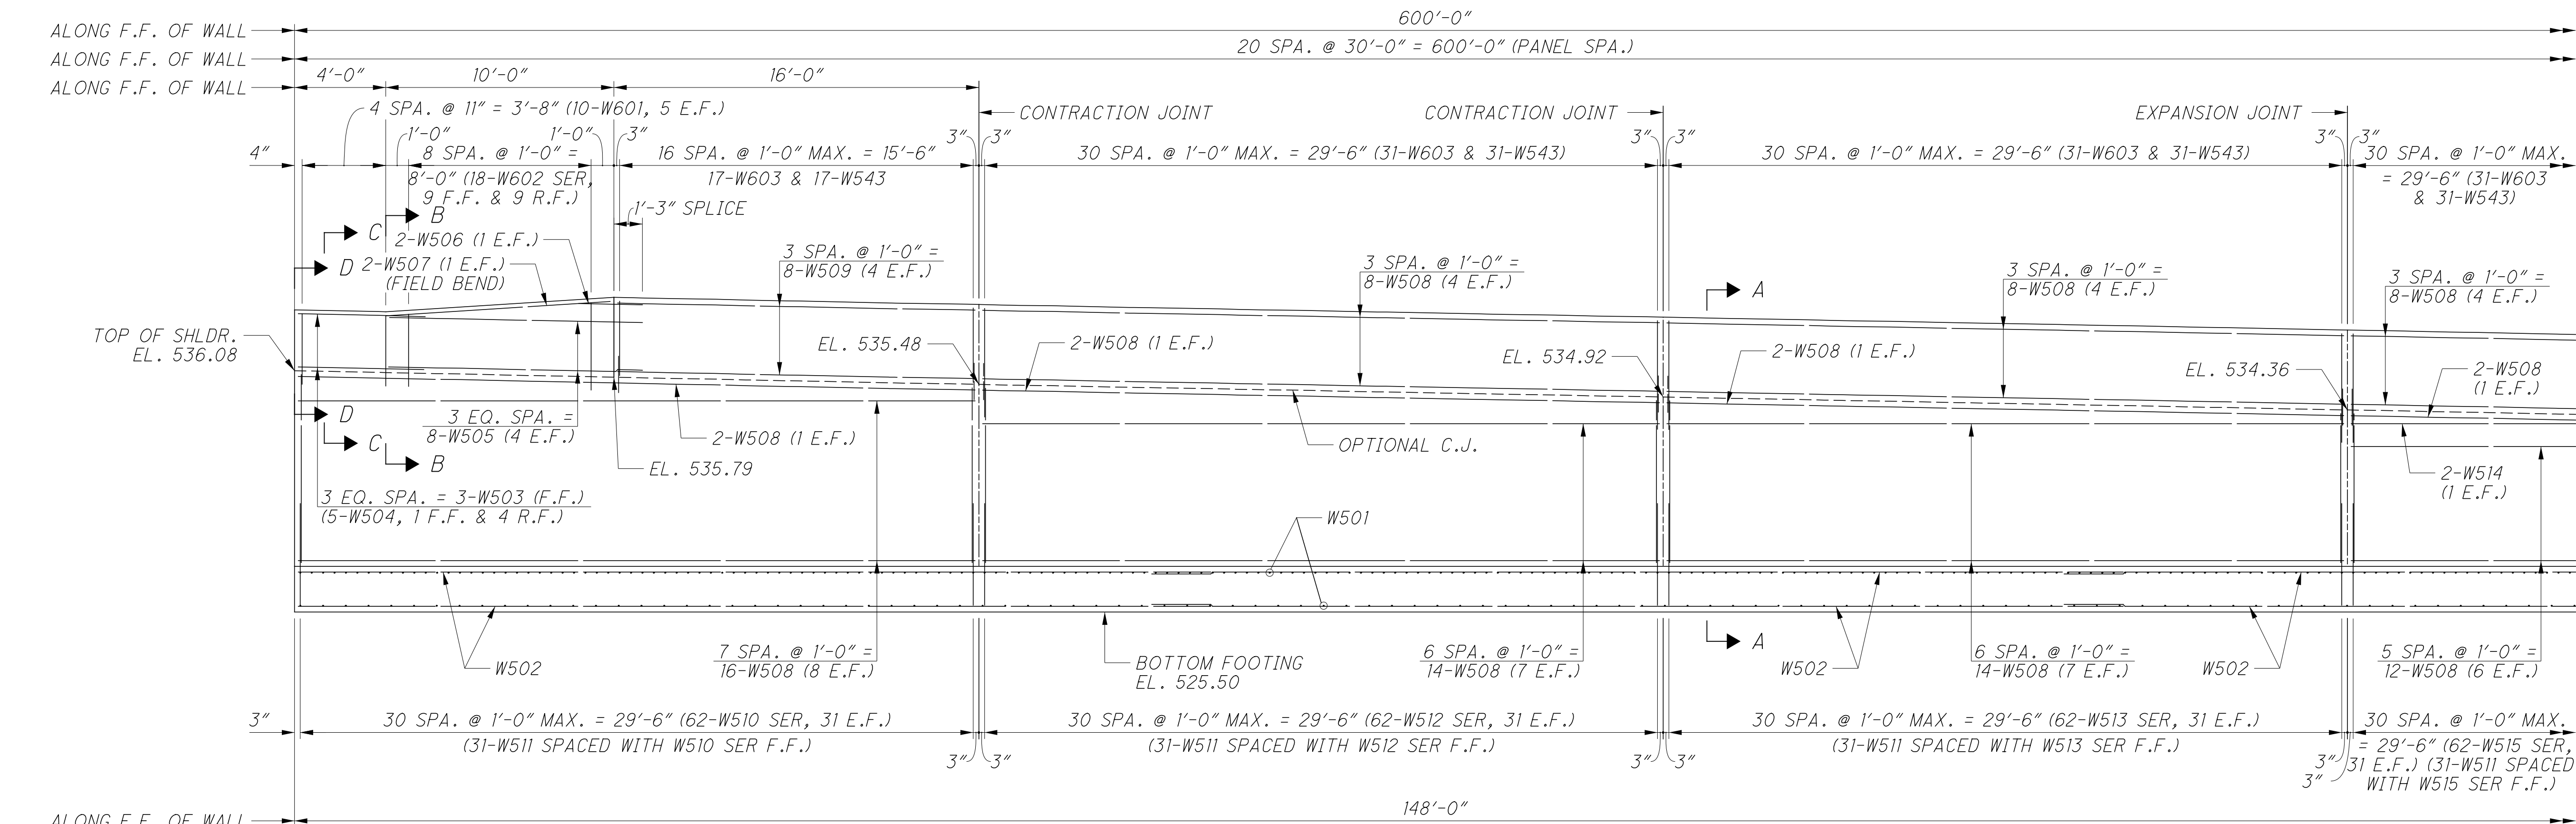

PARTIAL ELEVATION

MINIMUM BAR LAP	
#5 (VERTICAL)	2'-7"
#5 (HORIZONTAL)	3'-7"

NOTES
 FOR SECTIONS A-A THRU D-D, SEE SHEET 10/11.
 FOR CONTRACTION AND EXPANSION JOINT DETAILS, SEE SHEET 10/11.

DESIGN AGENCY
STRUCTUREPOINT
INCORPORATED

DATE
 01/18/19

REVIEWED
 MDS

DRAWN
 BMP

DESIGNED
 SUJ

STRUCTURE POINT FILE NUMBER

STRUCTURE FILE NUMBER

CHECKED
 CLB

REVISED

RETAINING WALL NO. 4 DETAILS

ALONG IR 75 SB


HAM-75-3.84

PID No. 104667


4 / 11

18
48

Wads
 8/22/2022 9:14:15 AM
 O:\2017\01113\C.Design\104667-HAM-75-3.84\Design\Structures\Walls\Sheets\104667-WD44.dgn

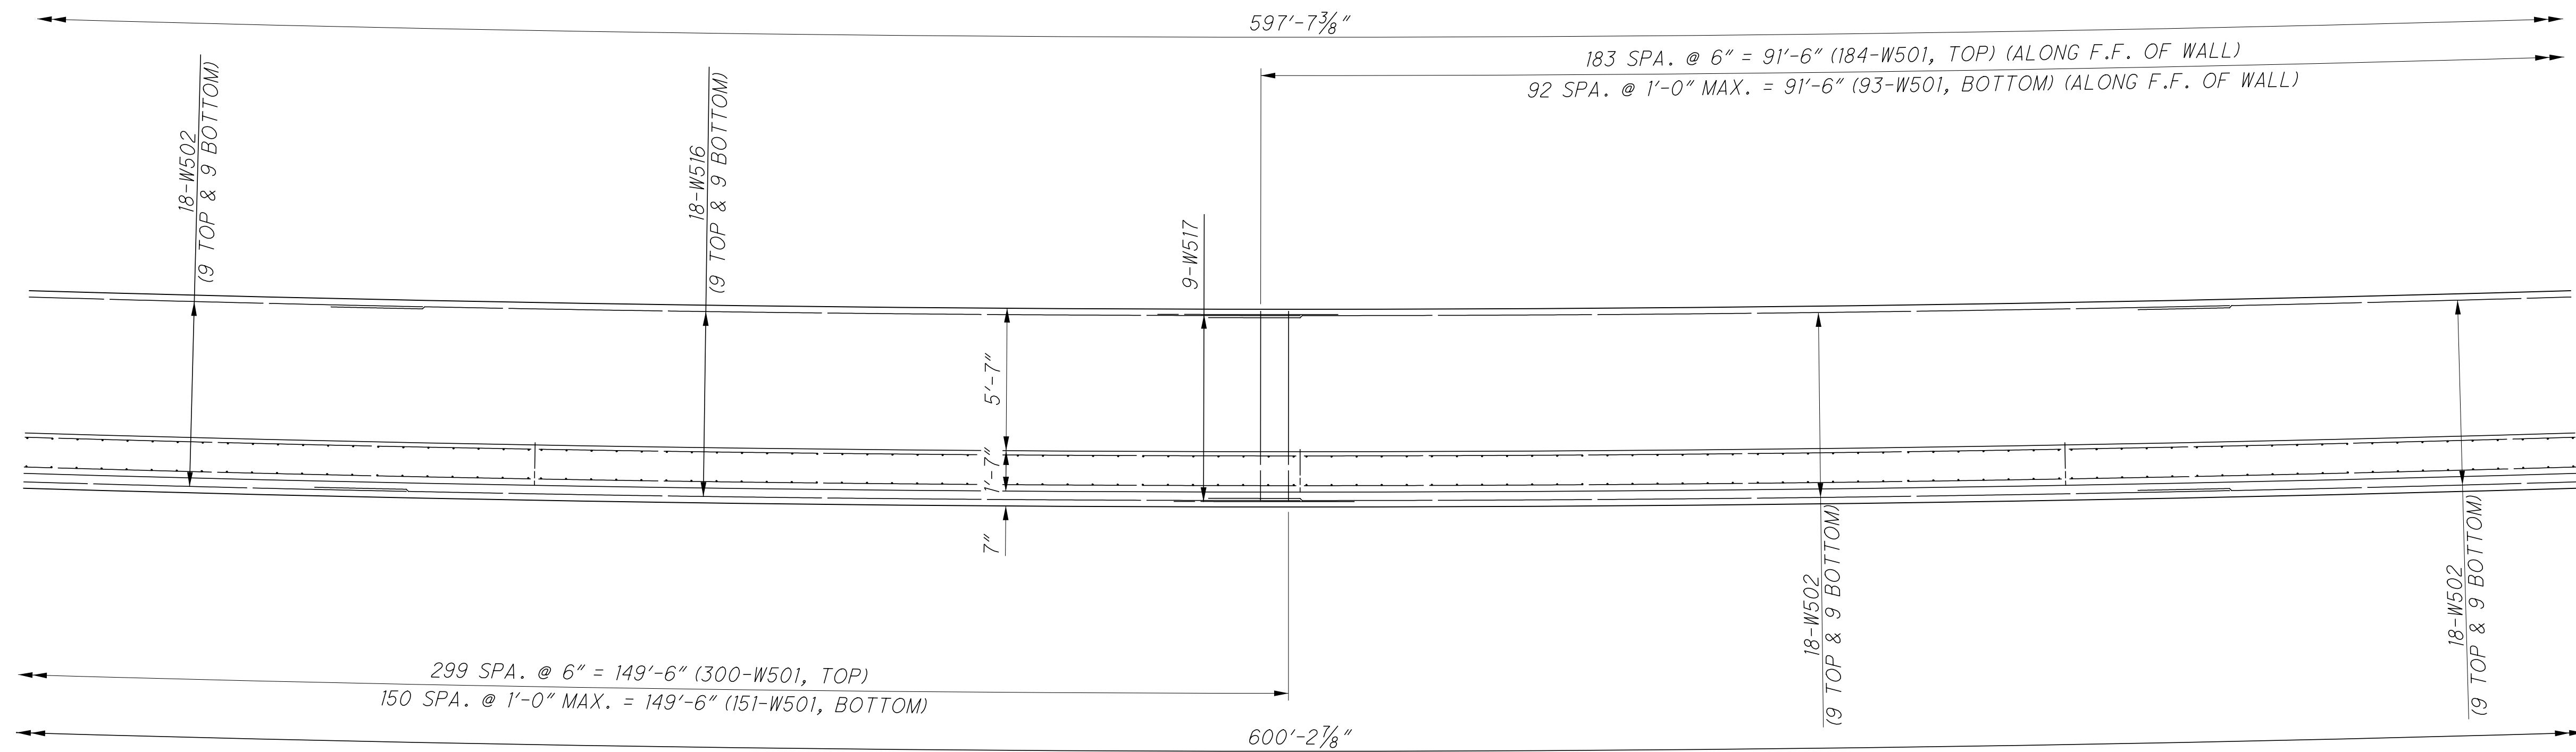


PARTIAL PLAN

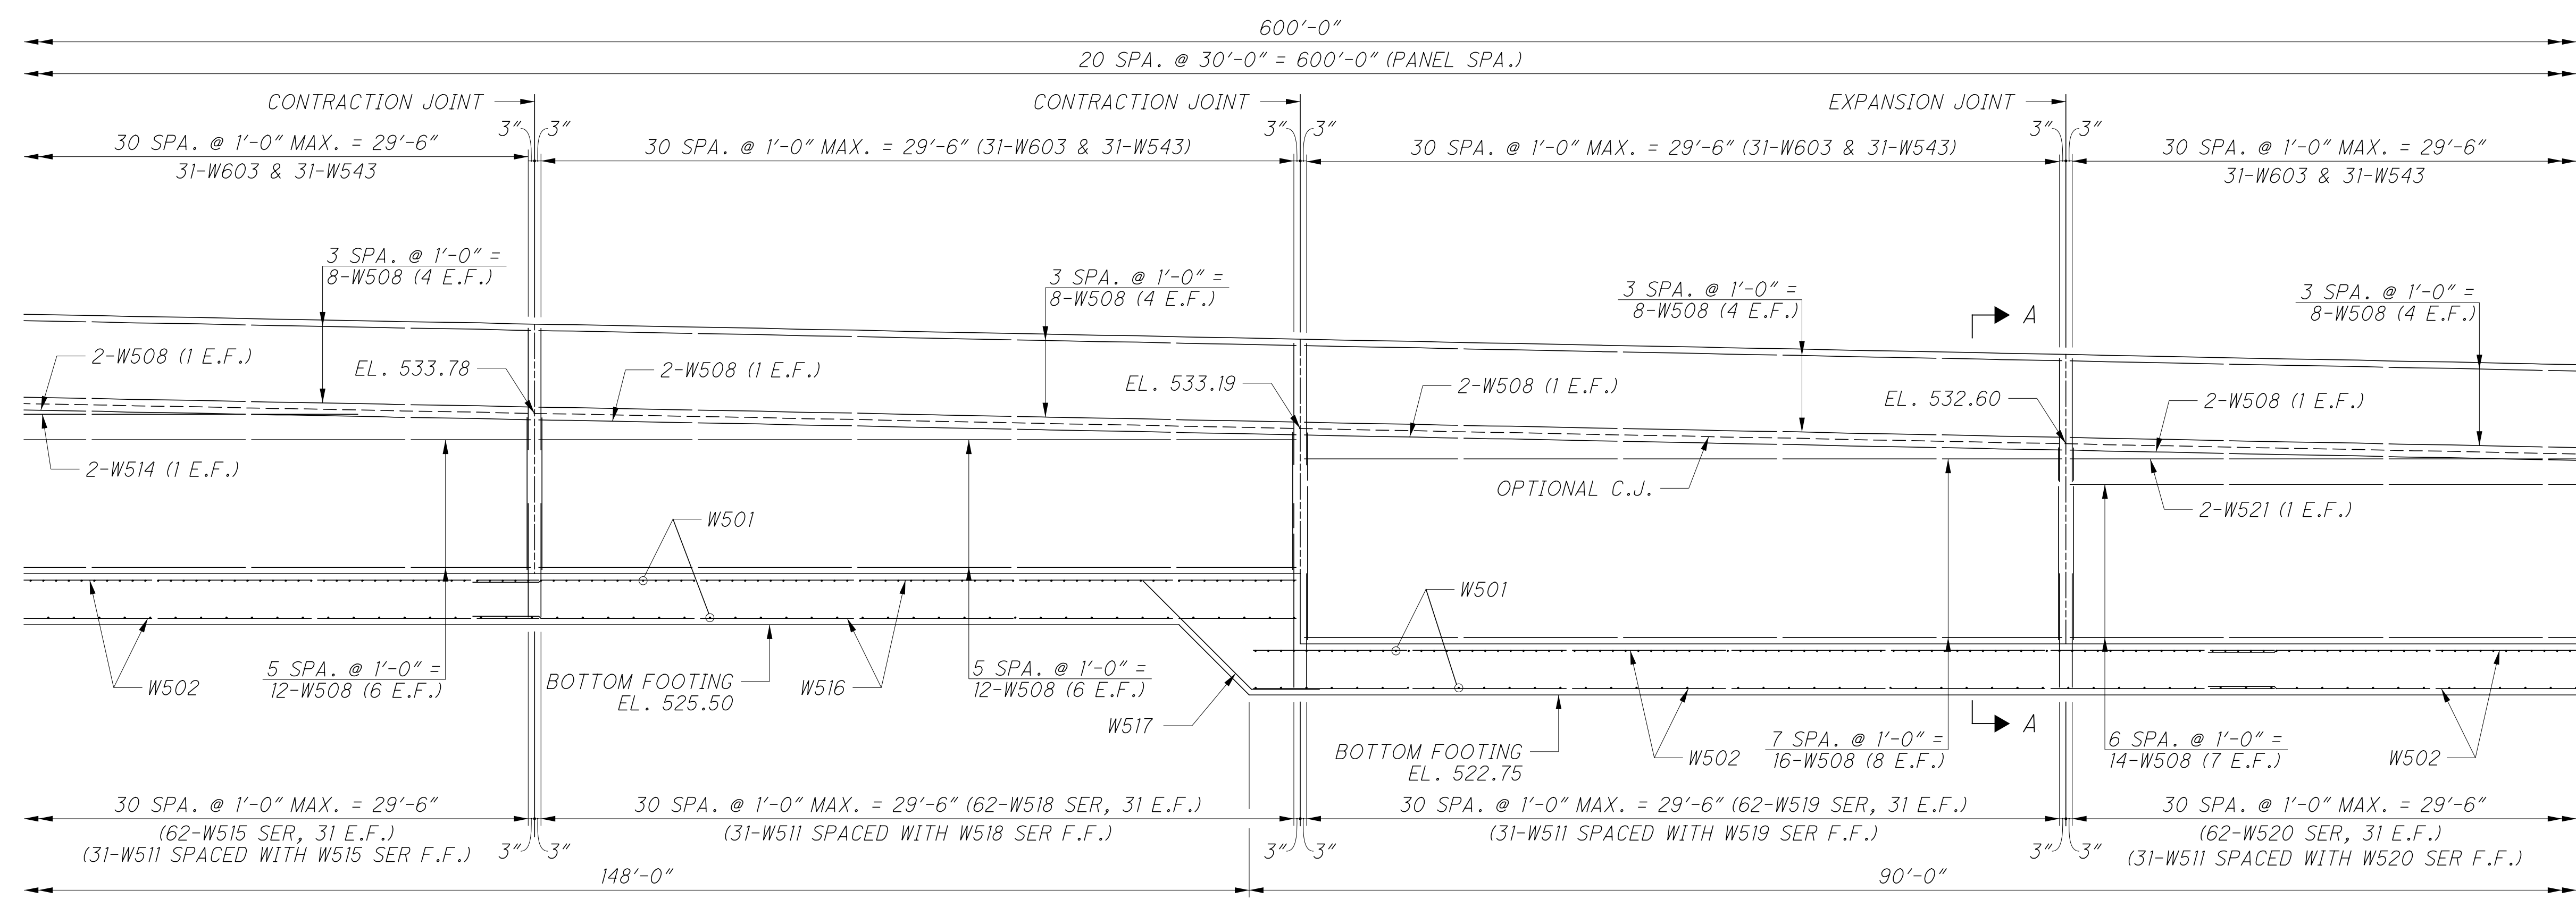

PARTIAL ELEVATION

MINIMUM BAR LAP	
#5 (VERTICAL)	2'-7"
#5 (HORIZONTAL)	3'-7"

NOTES
 FOR SECTION A-A, SEE SHEET 10/11.
 FOR CONTRACTION AND EXPANSION JOINT DETAILS, SEE SHEET 10/11.

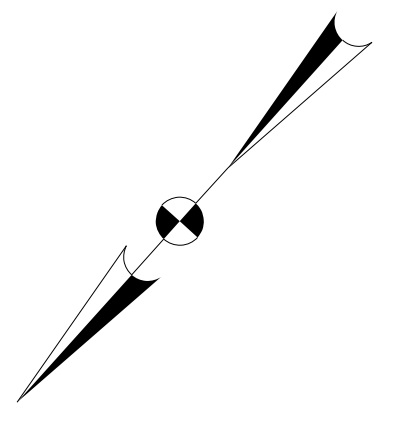

RETAINING WALL NO. 4 DETAILS
ALONG IR 75 SB


DESIGNED	SUF	CHECKED	CLB	DRAWN	BMP	REVISED	FILE NUMBER
REVIEWED	MDS	DATE	01/18/19	STRUCTURE	FILE NUMBER		

DESIGN AGENCY
STRUCTUREPOINT
INCORPORATED
 2000 CORPORATE PARKWAY SUITE 100
 FARMINGTON, CT 06030
 TEL: 860.633.7800 FAX: 860.633.7801
 WWW.STRUCTUREPOINT.COM


HAM-75-3.84
PID No. 104667

5 / 11
19
48

Wads
 8/22/2022 9:14:16 AM
 O:\2017\01113\C.Design\104667-HAM-75-3.84\Design\Structures\Walls\Sheets\104667-WD45.dgn

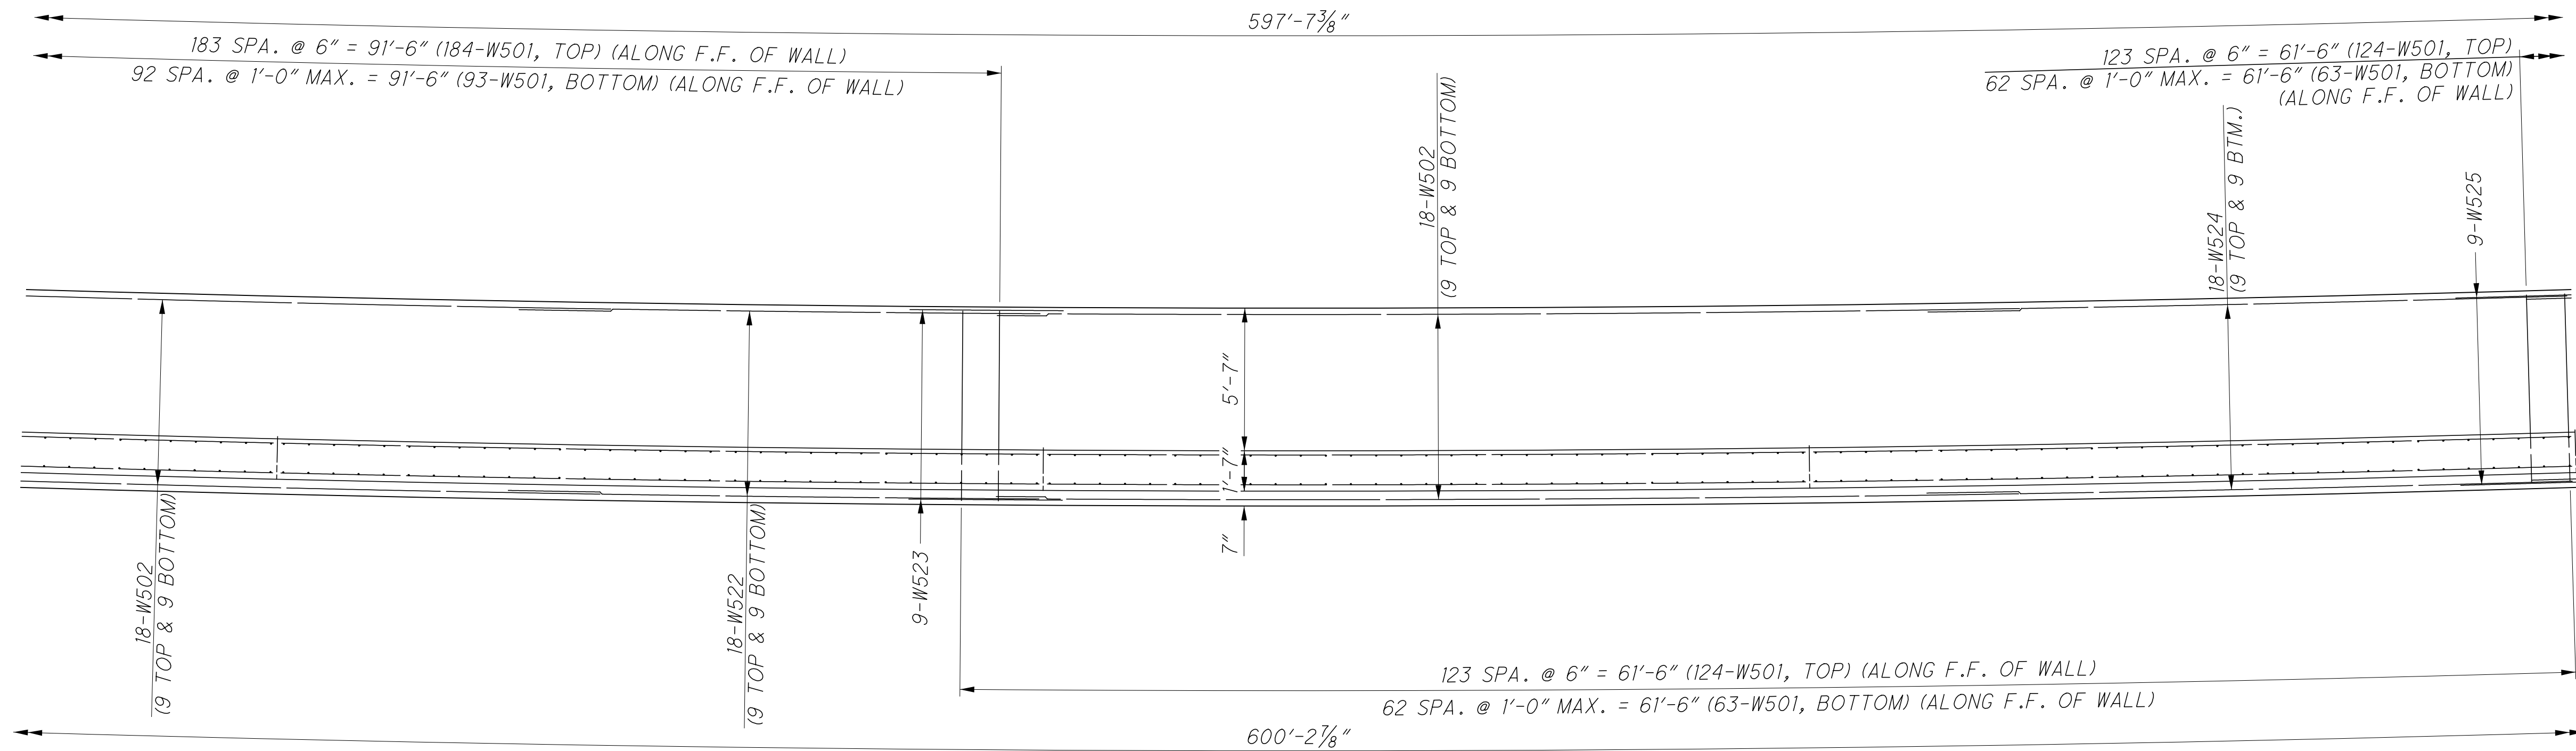


PARTIAL PLAN

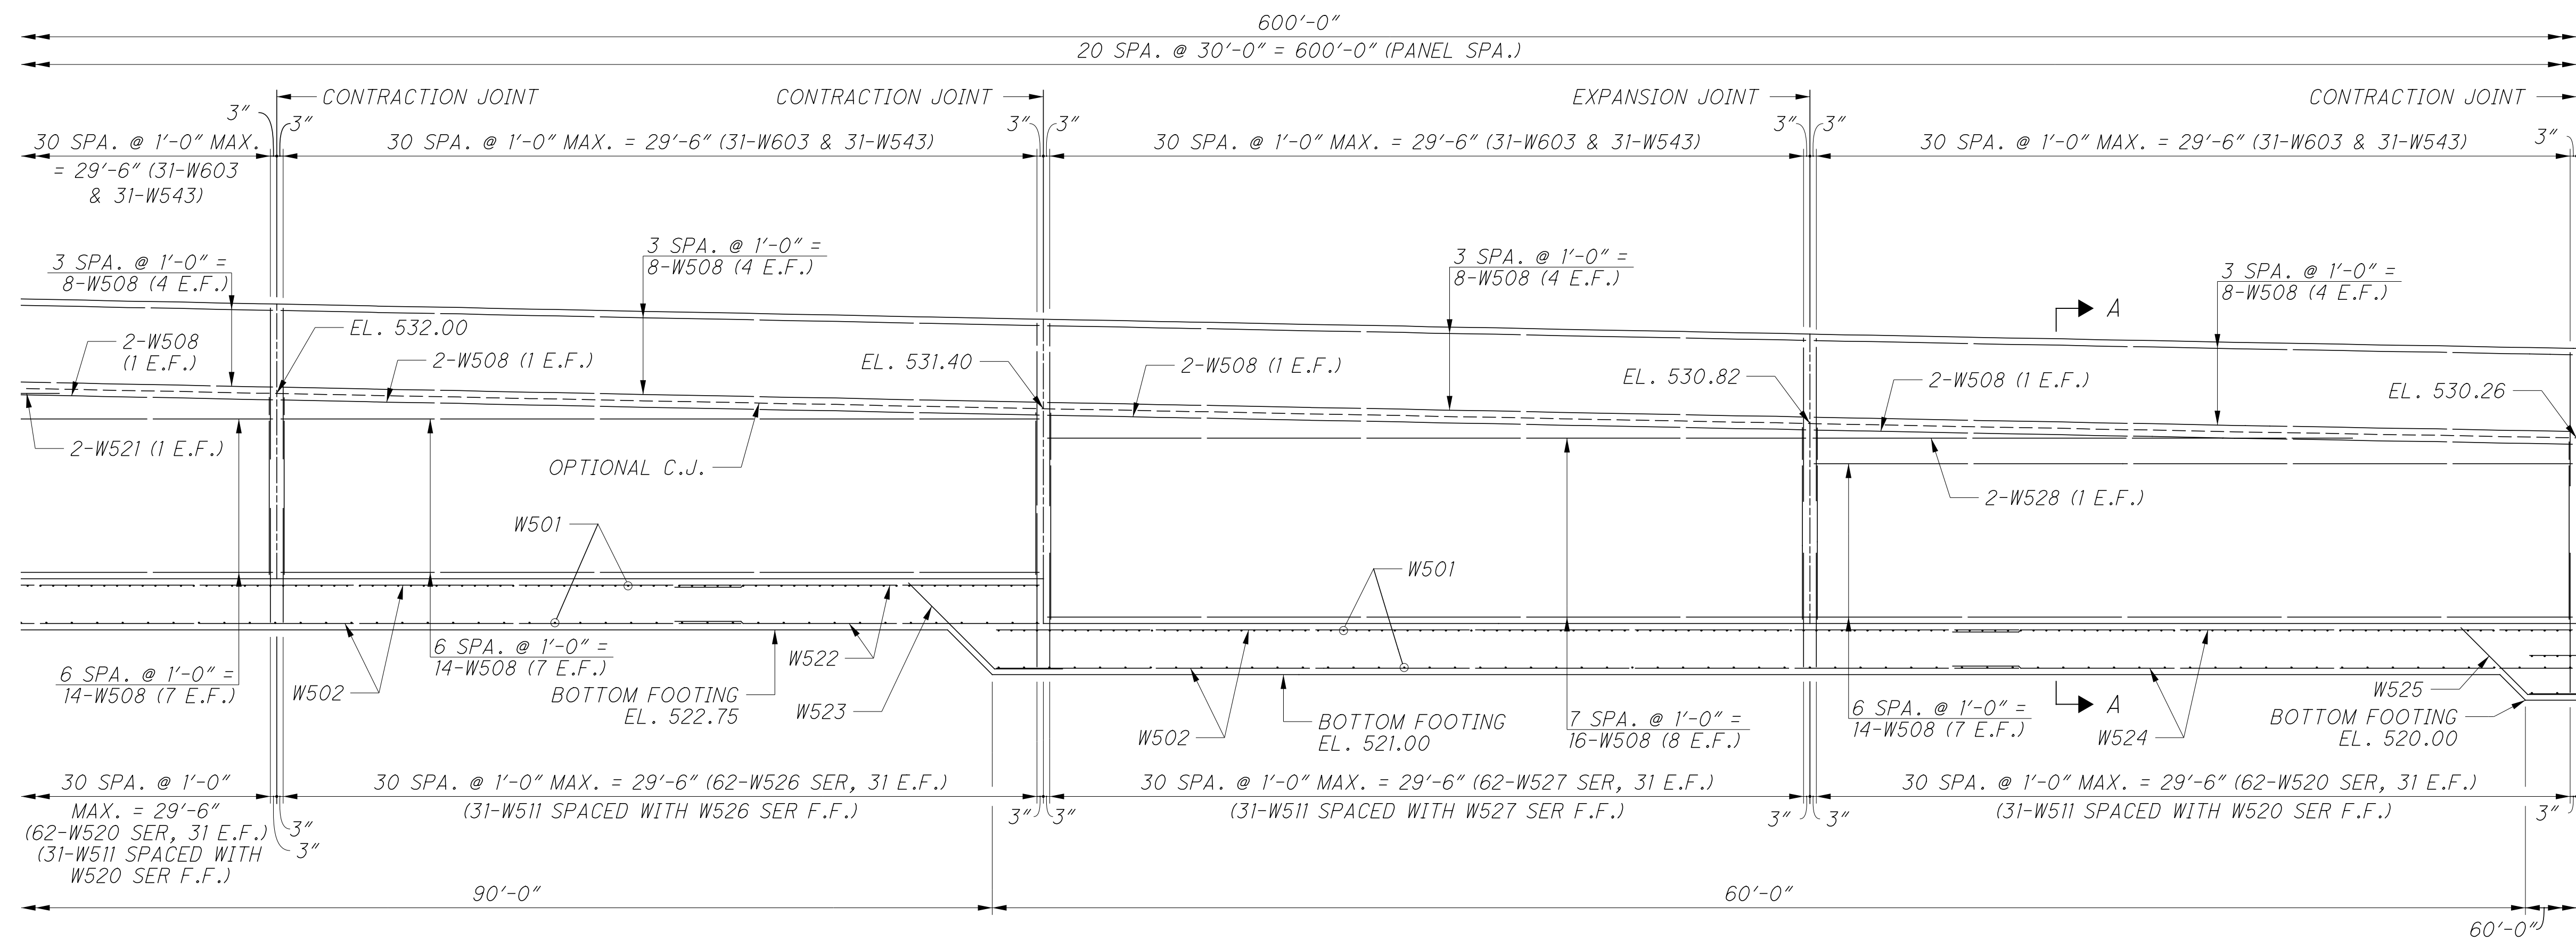

PARTIAL ELEVATION

MINIMUM BAR LAP	
#5 (VERTICAL)	2'-7"
#5 (HORIZONTAL)	3'-7"

NOTES
 FOR SECTION A-A, SEE SHEET 10/11.
 FOR CONTRACTION AND EXPANSION
 JOINT DETAILS, SEE SHEET 10/11.

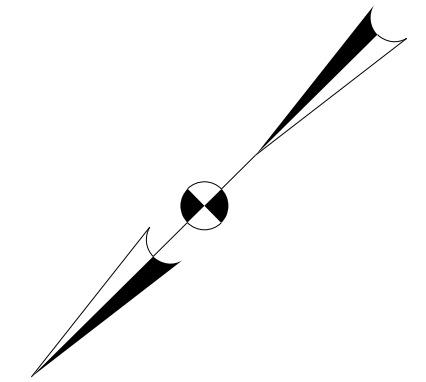


RETAINING WALL NO. 4 DETAILS
ALONG IR 75 SB

DESIGNED	SUF	CHECKED	CLB	DRAWN	BMP	REVISED
REVIEWED	MDS	DATE	01/18/19	STRUCTURE	FILE NUMBER	DESIGN AGENCY


HAM-75-3.84
 PID No. 104667

6 / 11
20
48

Wads
 8/22/2022 9:14:17 AM
 O:\2017\01113\C.Design\104667-HAM-75-3.84\Design\Structures\Walls\Sheets\104667-WD46.dgn

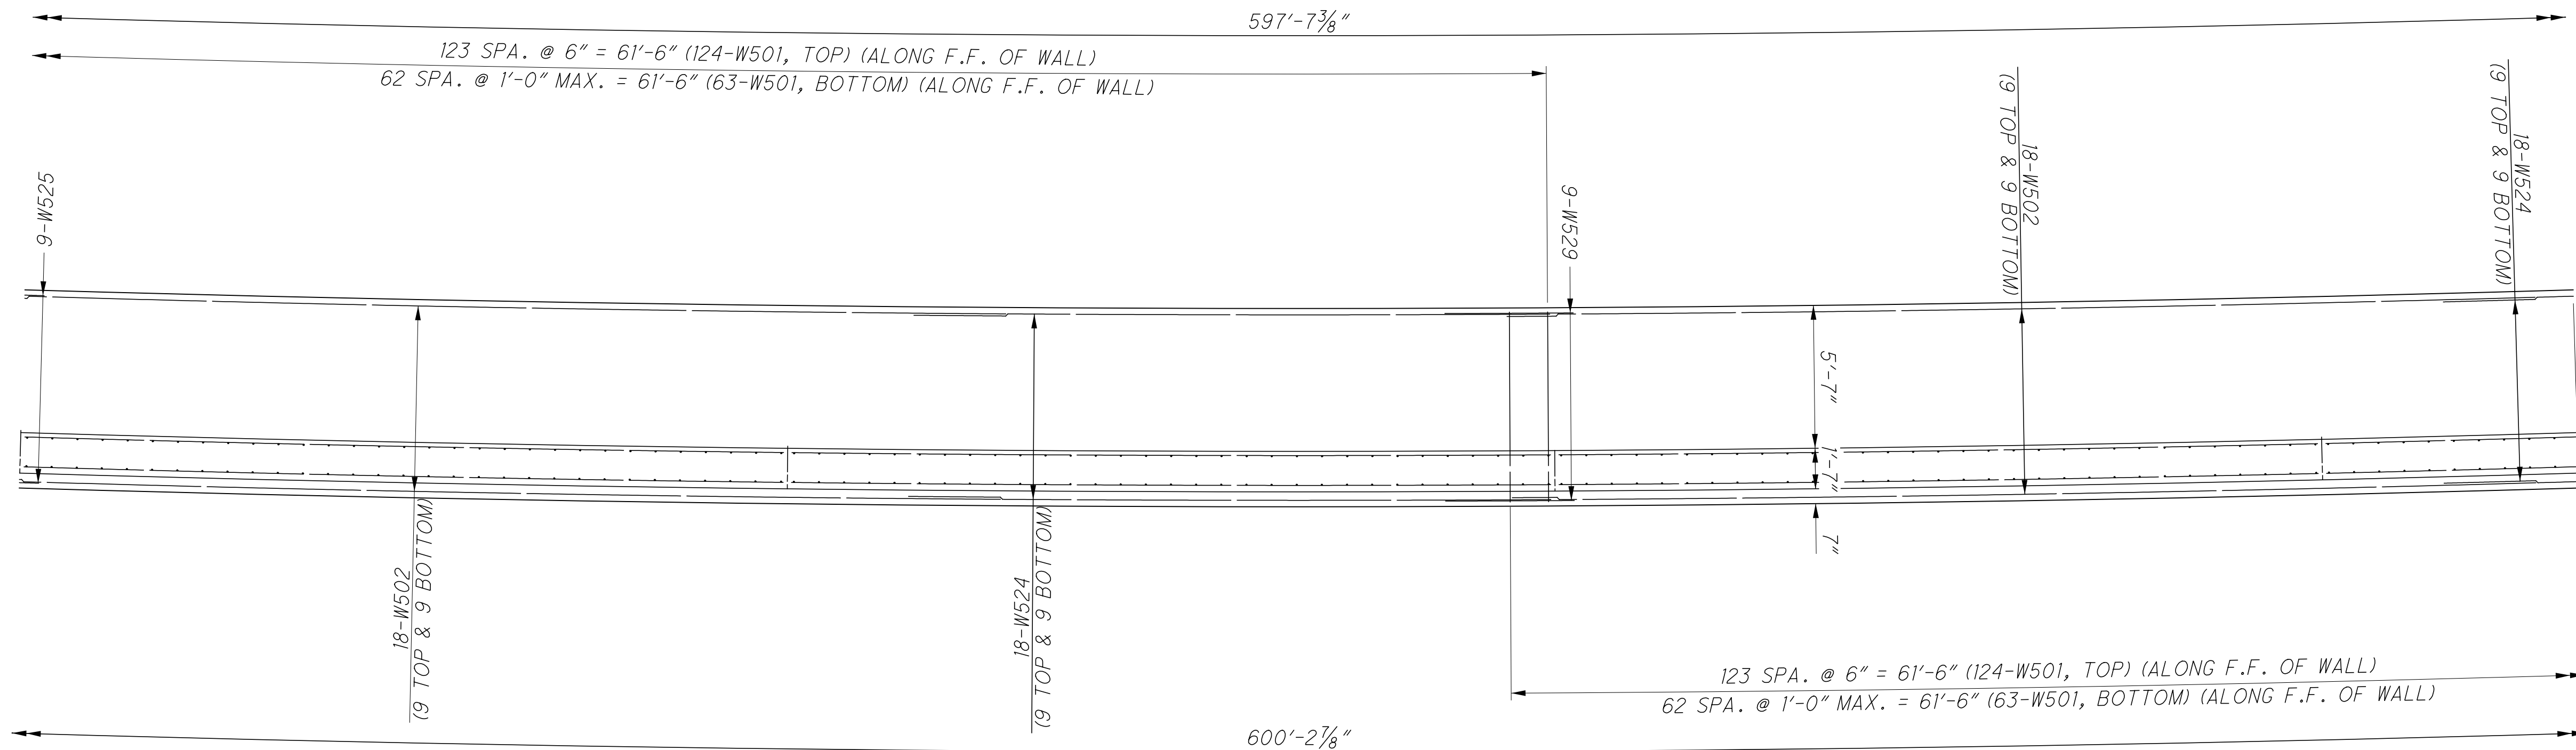


PARTIAL PLAN

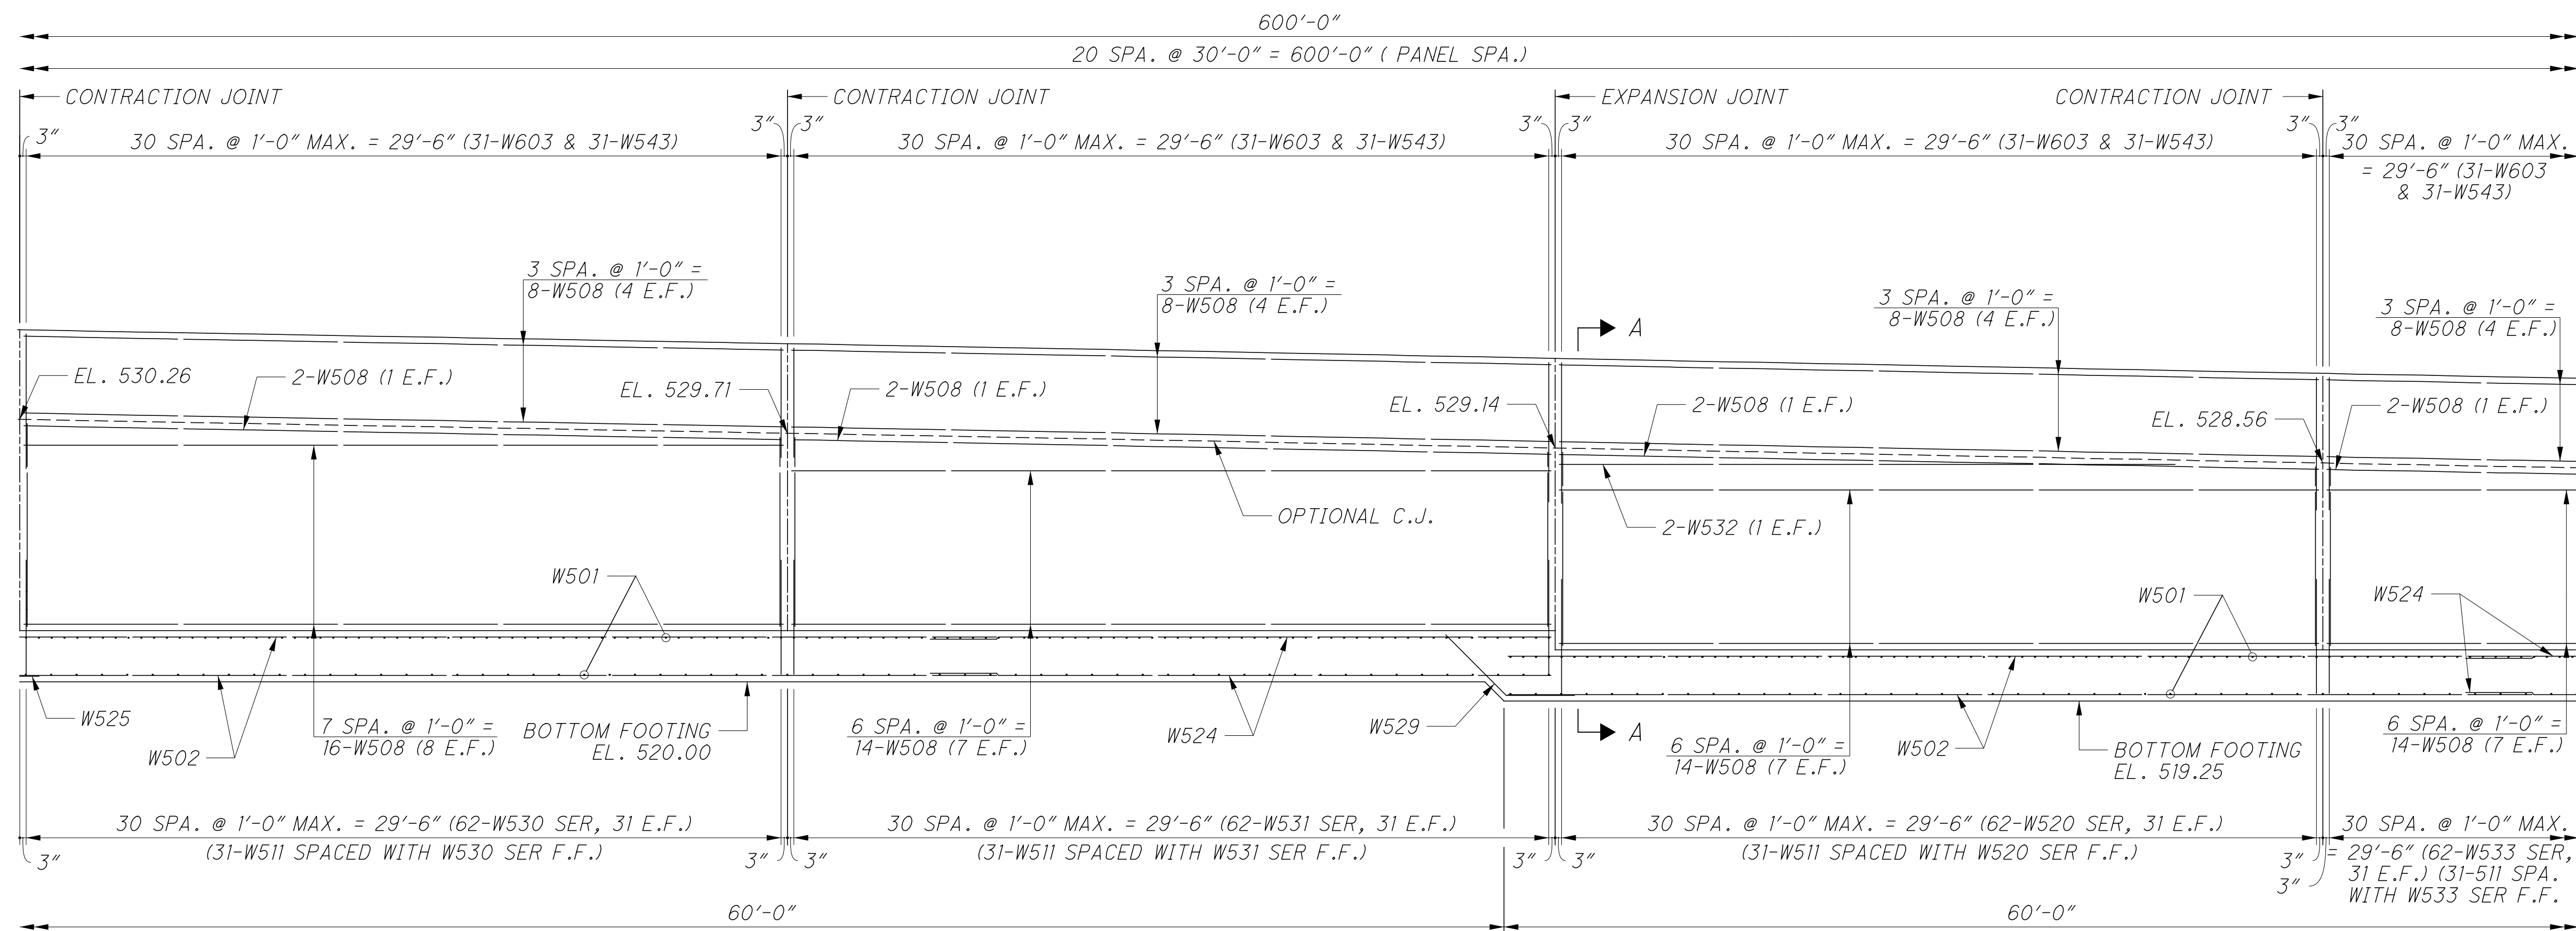

PARTIAL ELEVATION


MINIMUM BAR LAP	
#5 (VERTICAL)	2'-7"
#5 (HORIZONTAL)	3'-7"

NOTES
 FOR SECTION A-A, SEE SHEET 10/11.
 FOR CONTRACTION AND EXPANSION JOINT DETAILS, SEE SHEET 10/11.

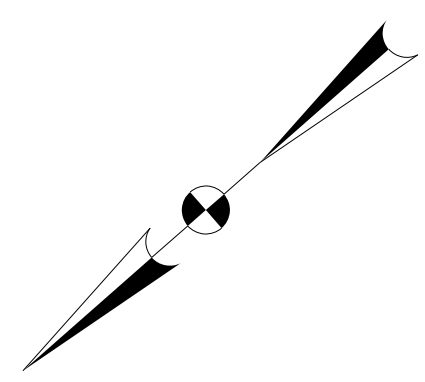


 DESIGN AGENCY STRUCTUREPOINT 2000 COMPANYSITE SQUARE DR. STE. 200 HOUSTON, TX 77056 TEL: 281.416.1000 FAX: 281.416.1002 WWW.STRUCTUREPOINT.COM
REVIEWED: MDS DATE: 01/18/19 STRUCTURE FILE NUMBER:
DRAWN: BMP REVISED:
DESIGNED: SUJ CHECKED: CLB
RETAINING WALL NO. 4 DETAILS ALONG IR 75 SB
HAM-75-3.84 PID No. 104667
7 / 11 <div style="border: 1px solid black; border-radius: 50%; width: 30px; height: 30px; display: flex; align-items: center; justify-content: center; margin: 0 auto;"> 21 48 </div>

Wads
 8/22/2022 9:14:18 AM
 O:\2017\01113\C.Design\104667_HAM-75-3.84\Design\Structures\Walls\Sheets\104667_WD47.dgn

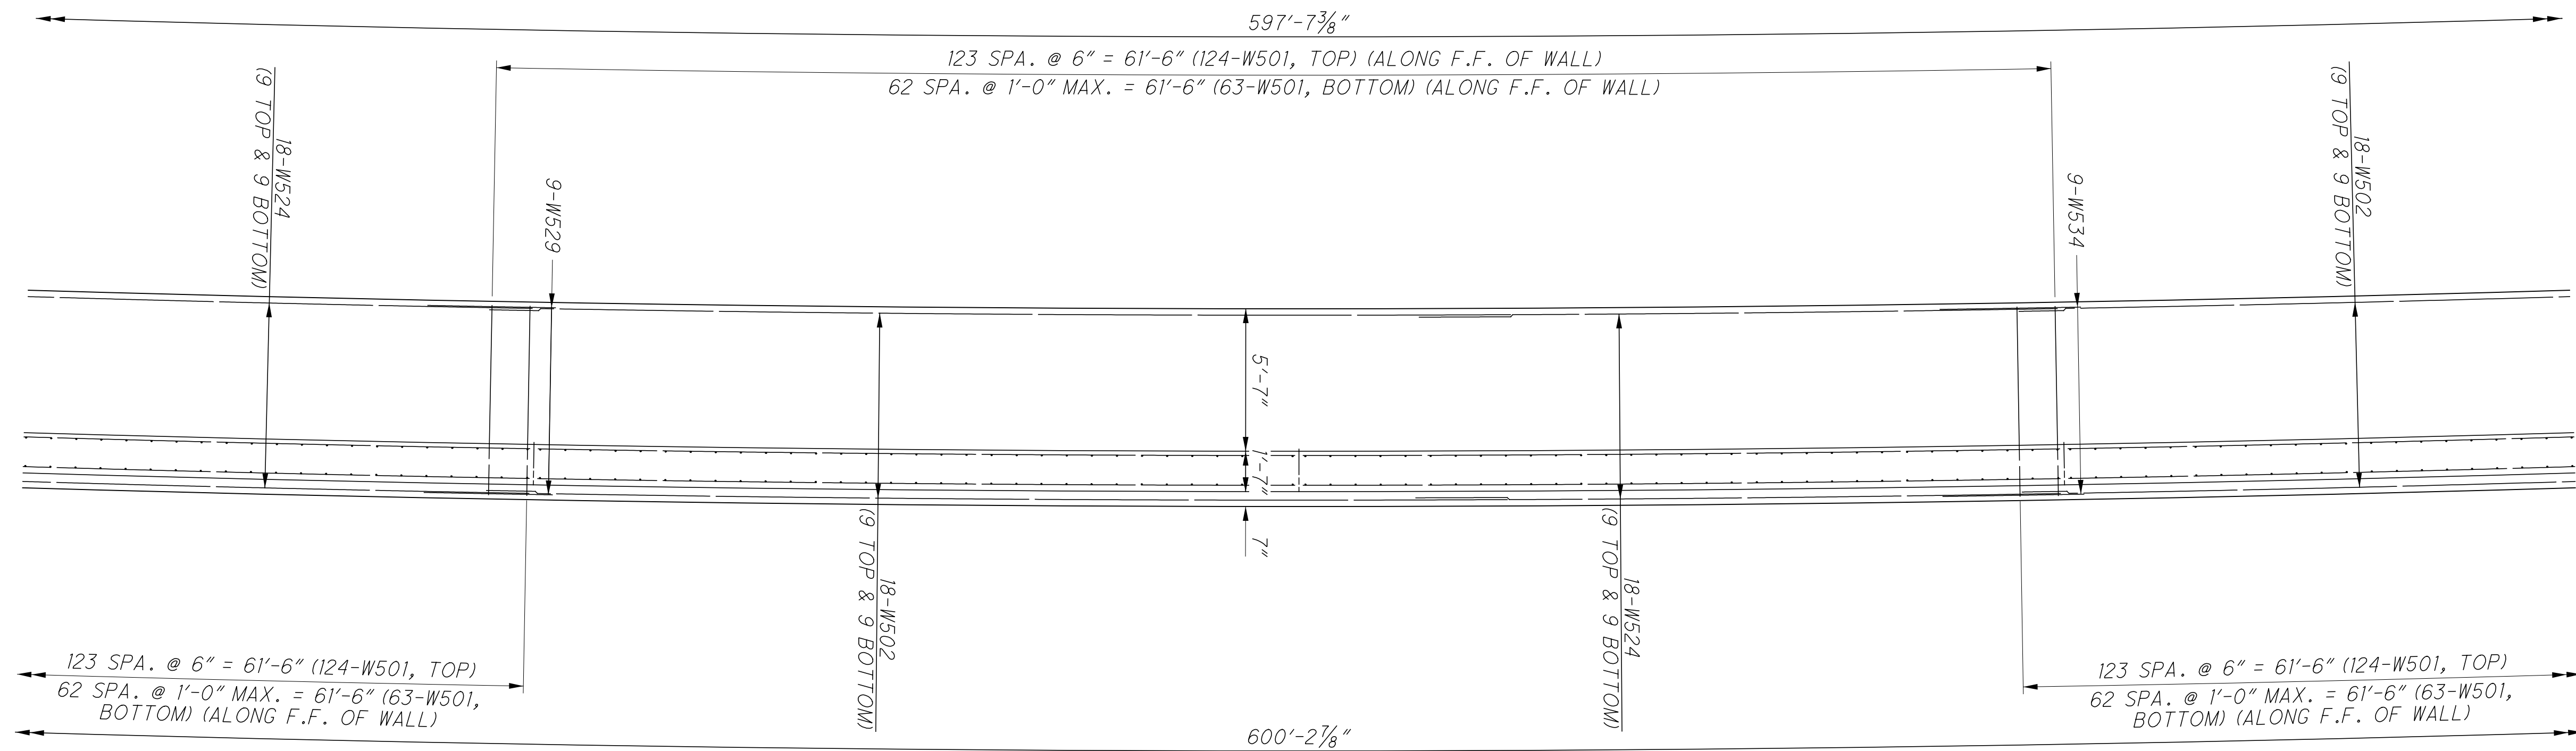

PARTIAL PLAN

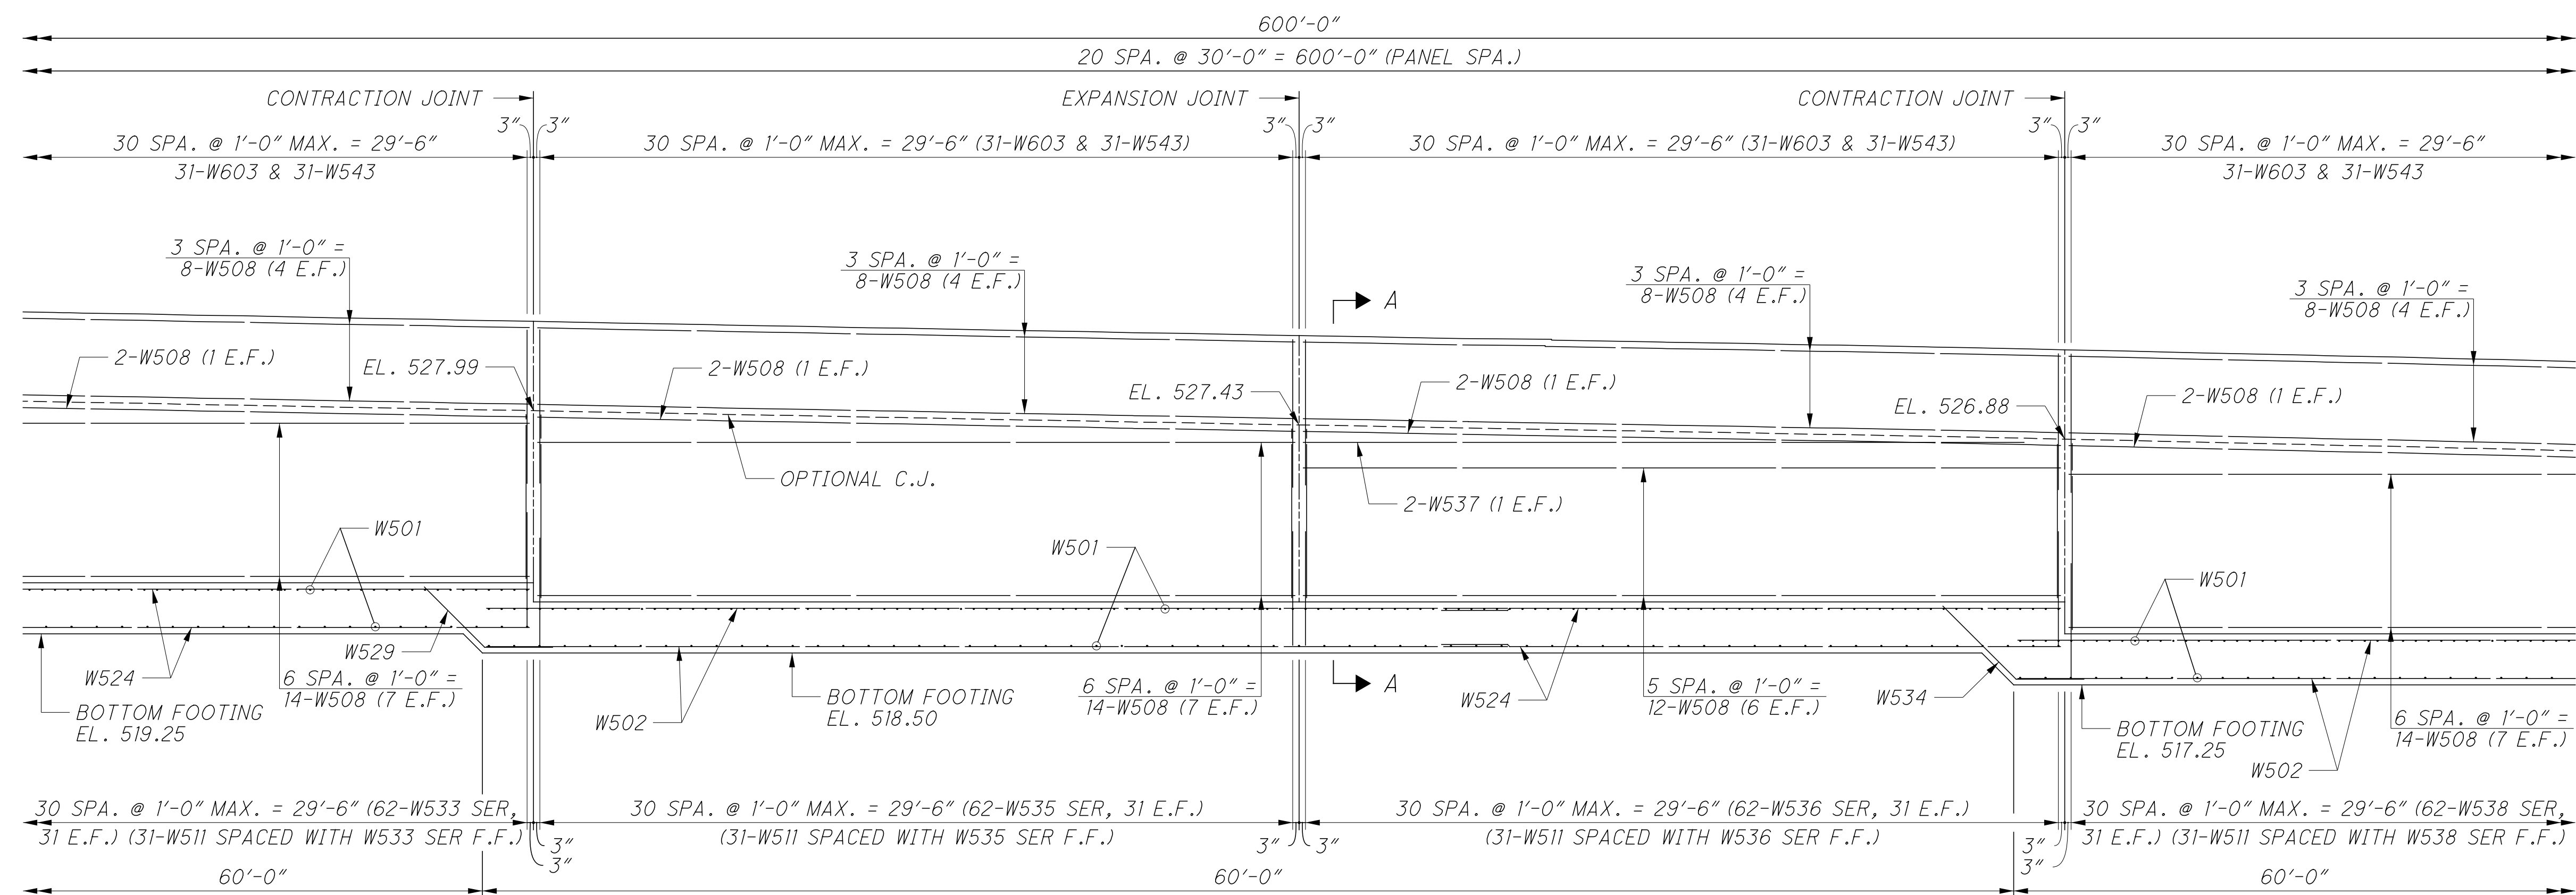

PARTIAL ELEVATION

MINIMUM BAR LAP	
#5 (VERTICAL)	2'-7"
#5 (HORIZONTAL)	3'-7"

NOTES
 FOR SECTION A-A, SEE SHEET 10/11.
 FOR CONTRACTION AND EXPANSION JOINT DETAILS, SEE SHEET 10/11.

RETAINING WALL NO. 4 DETAILS
 ALONG IR 75 SB

HAM-75-3.84
 PID No. 104667

8 / 11


22
48

DESIGN AGENCY
STRUCTUREPOINT
 2000 CORPORATE CENTER DR., STE. 200
 FORT WORTH, TX 76102
 TEL: 817.339.8800 FAX: 817.339.8801
 WWW.STRUCTUREPOINT.COM


REVIEWED
 MDS
 DATE
 01/18/19
 STRUCTURE FILE NUMBER

DRAWN
 BMP
 REVISIONS
 DESIGNED
 SUJ
 CHECKED
 CLB

Wades
 8/22/2022 9:14:19 AM
 O:\2017\01113\C.Design\104667_HAM-75-3.84\Design\Structures\Walls\Sheets\104667_WD48.dgn

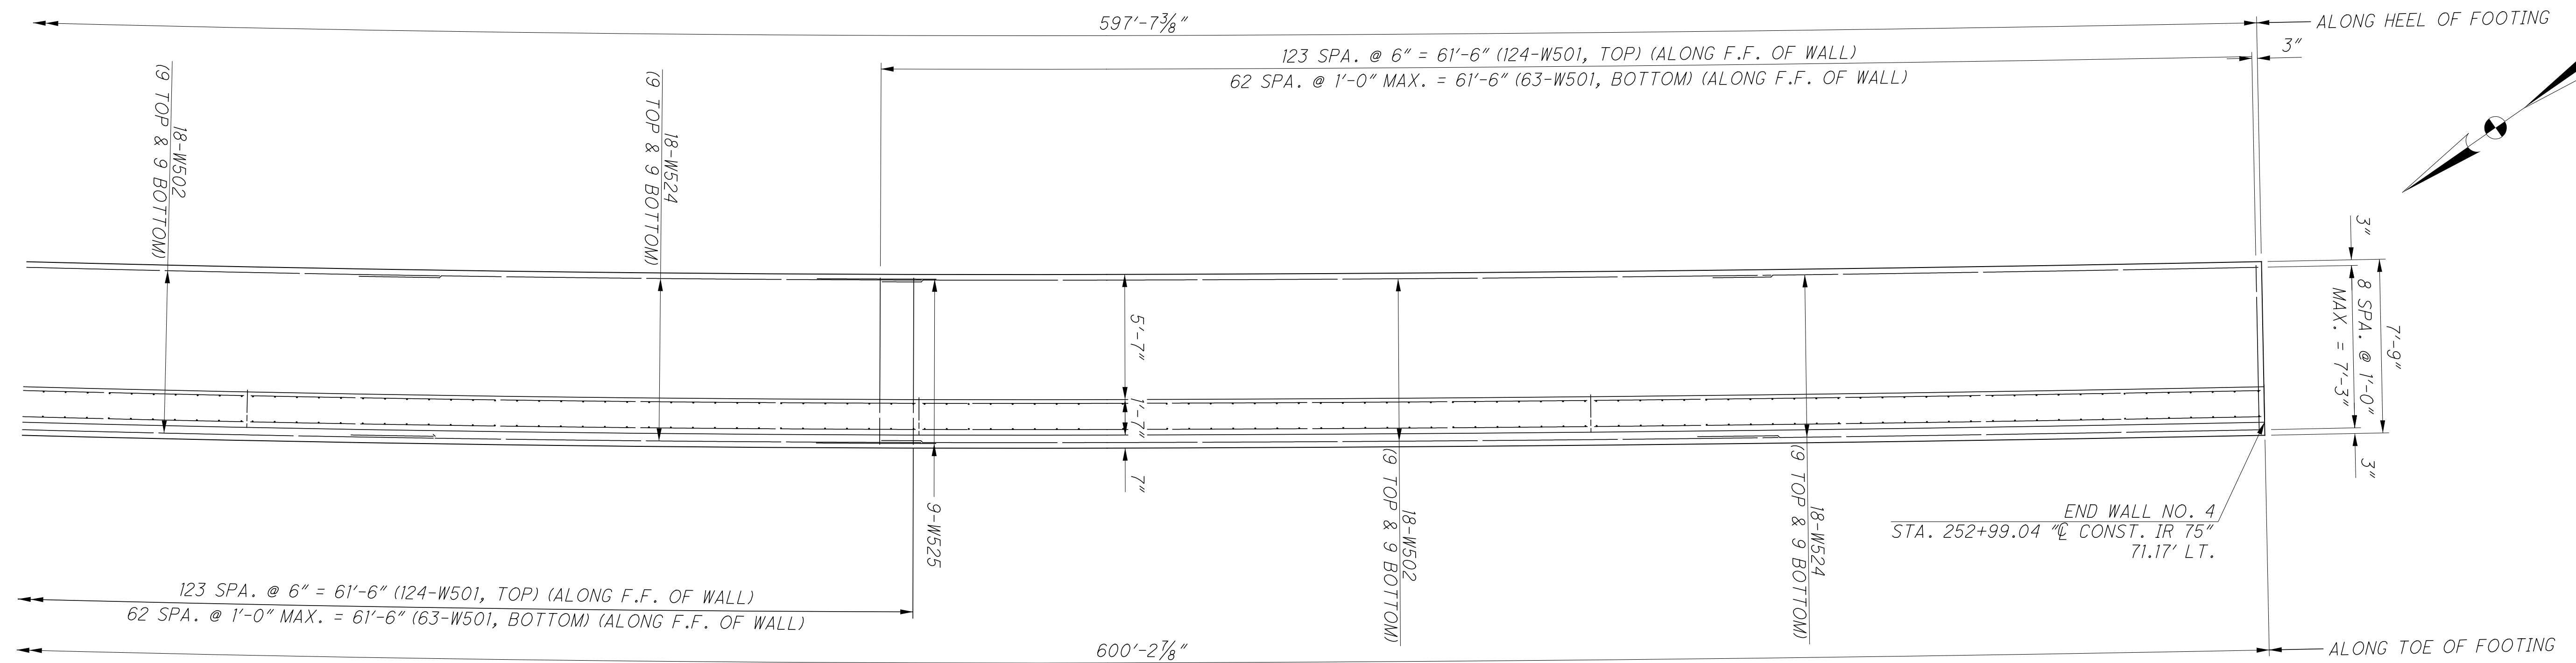

PARTIAL PLAN

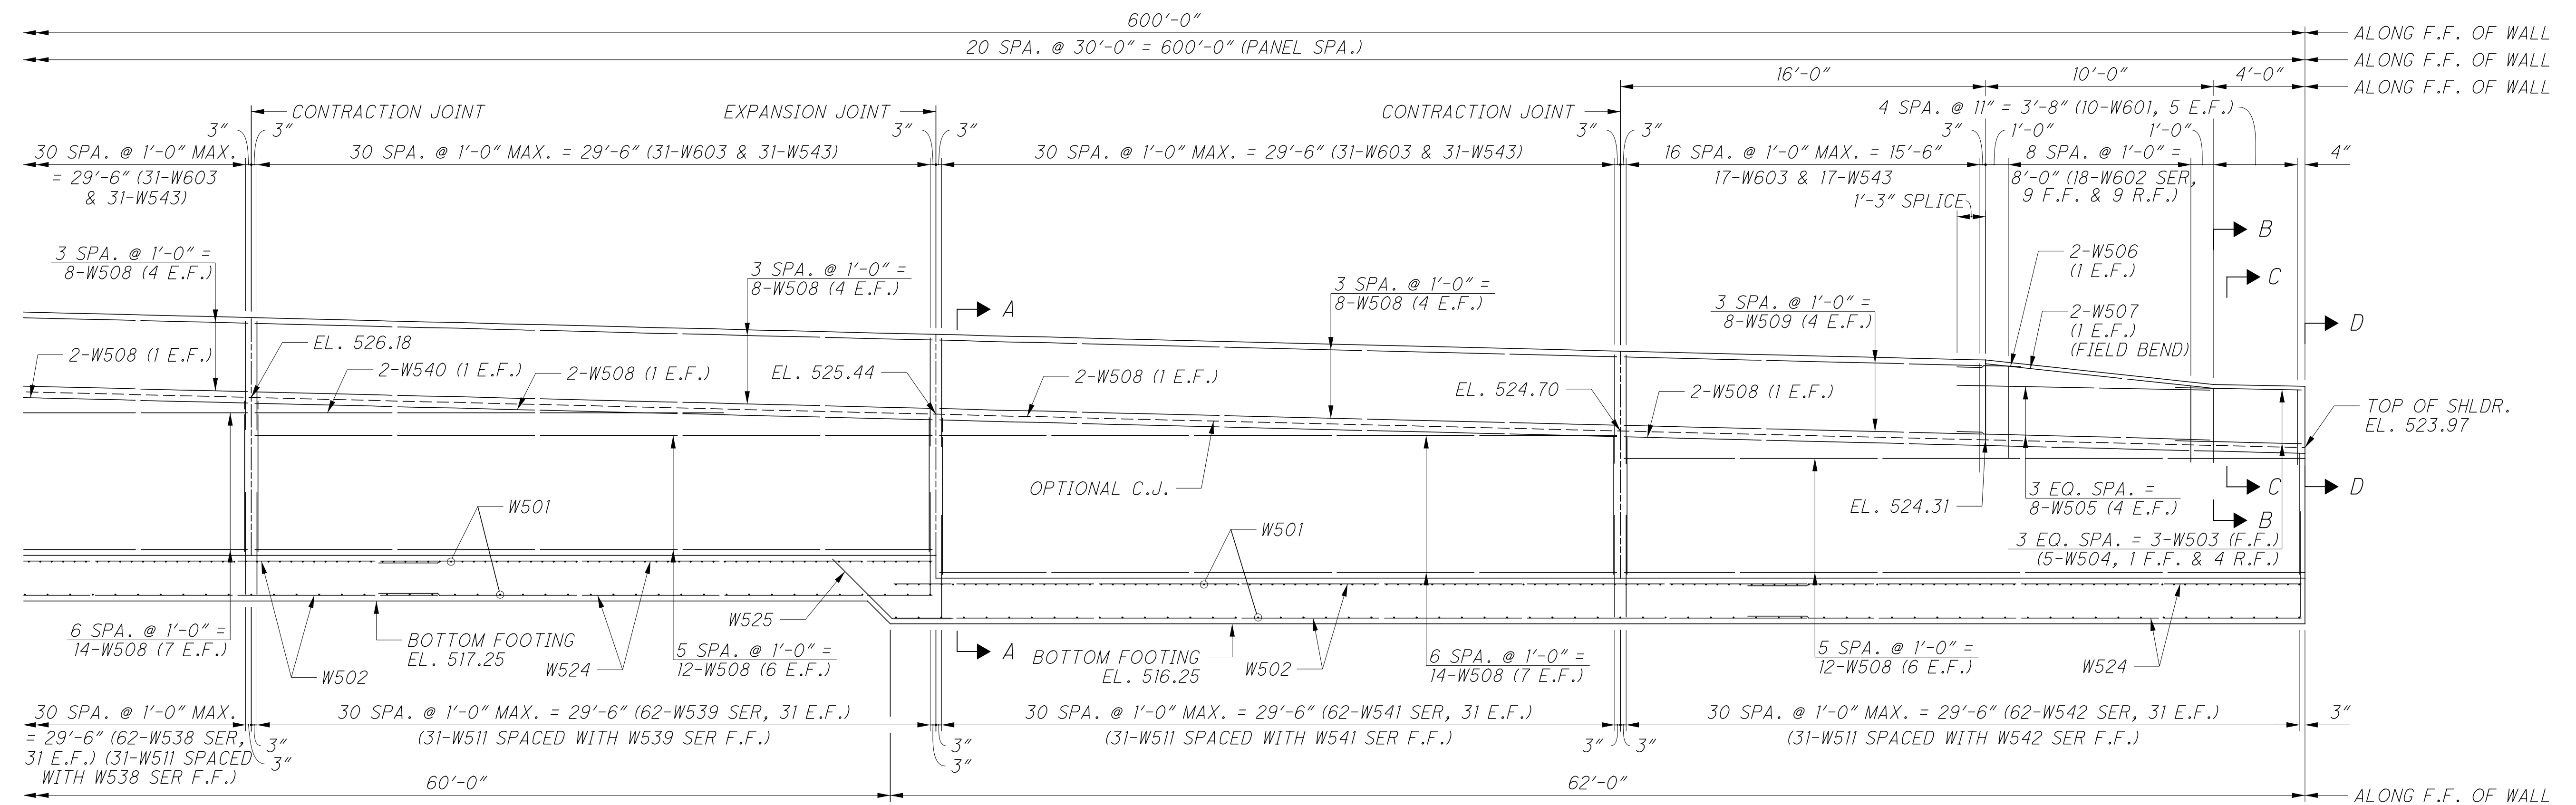


PARTIAL ELEVATION

MINIMUM BAR LAP	
#5 (VERTICAL)	2'-7"
#5 (HORIZONTAL)	3'-7"


NOTES
 FOR SECTIONS A-A THRU D-D, SEE SHEET 10/11.
 FOR CONTRACTION AND EXPANSION JOINT DETAILS, SEE SHEET 10/11.

	DESIGN AGENCY STRUCTUREPOINT
DRAWN BMP	REVISIONS REVISED
DESIGNED SUJ	CHECKED CLB
DATE 01/18/19	STRUCTURE FILE NUMBER
RETAINING WALL NO. 4 DETAILS ALONG IR 75 SB	
HAM-75-3.84 PID No. 104667	
9 / 11	<div style="border: 1px solid black; border-radius: 50%; width: 30px; height: 30px; display: flex; align-items: center; justify-content: center;"> 23 48 </div>


jwade 8/22/2022 9:14:21 AM O:\2017\01113\C.Design\104667_HAM-75-3.84\Design\Structures\Walls\Sheets\104667_WD49.dgn

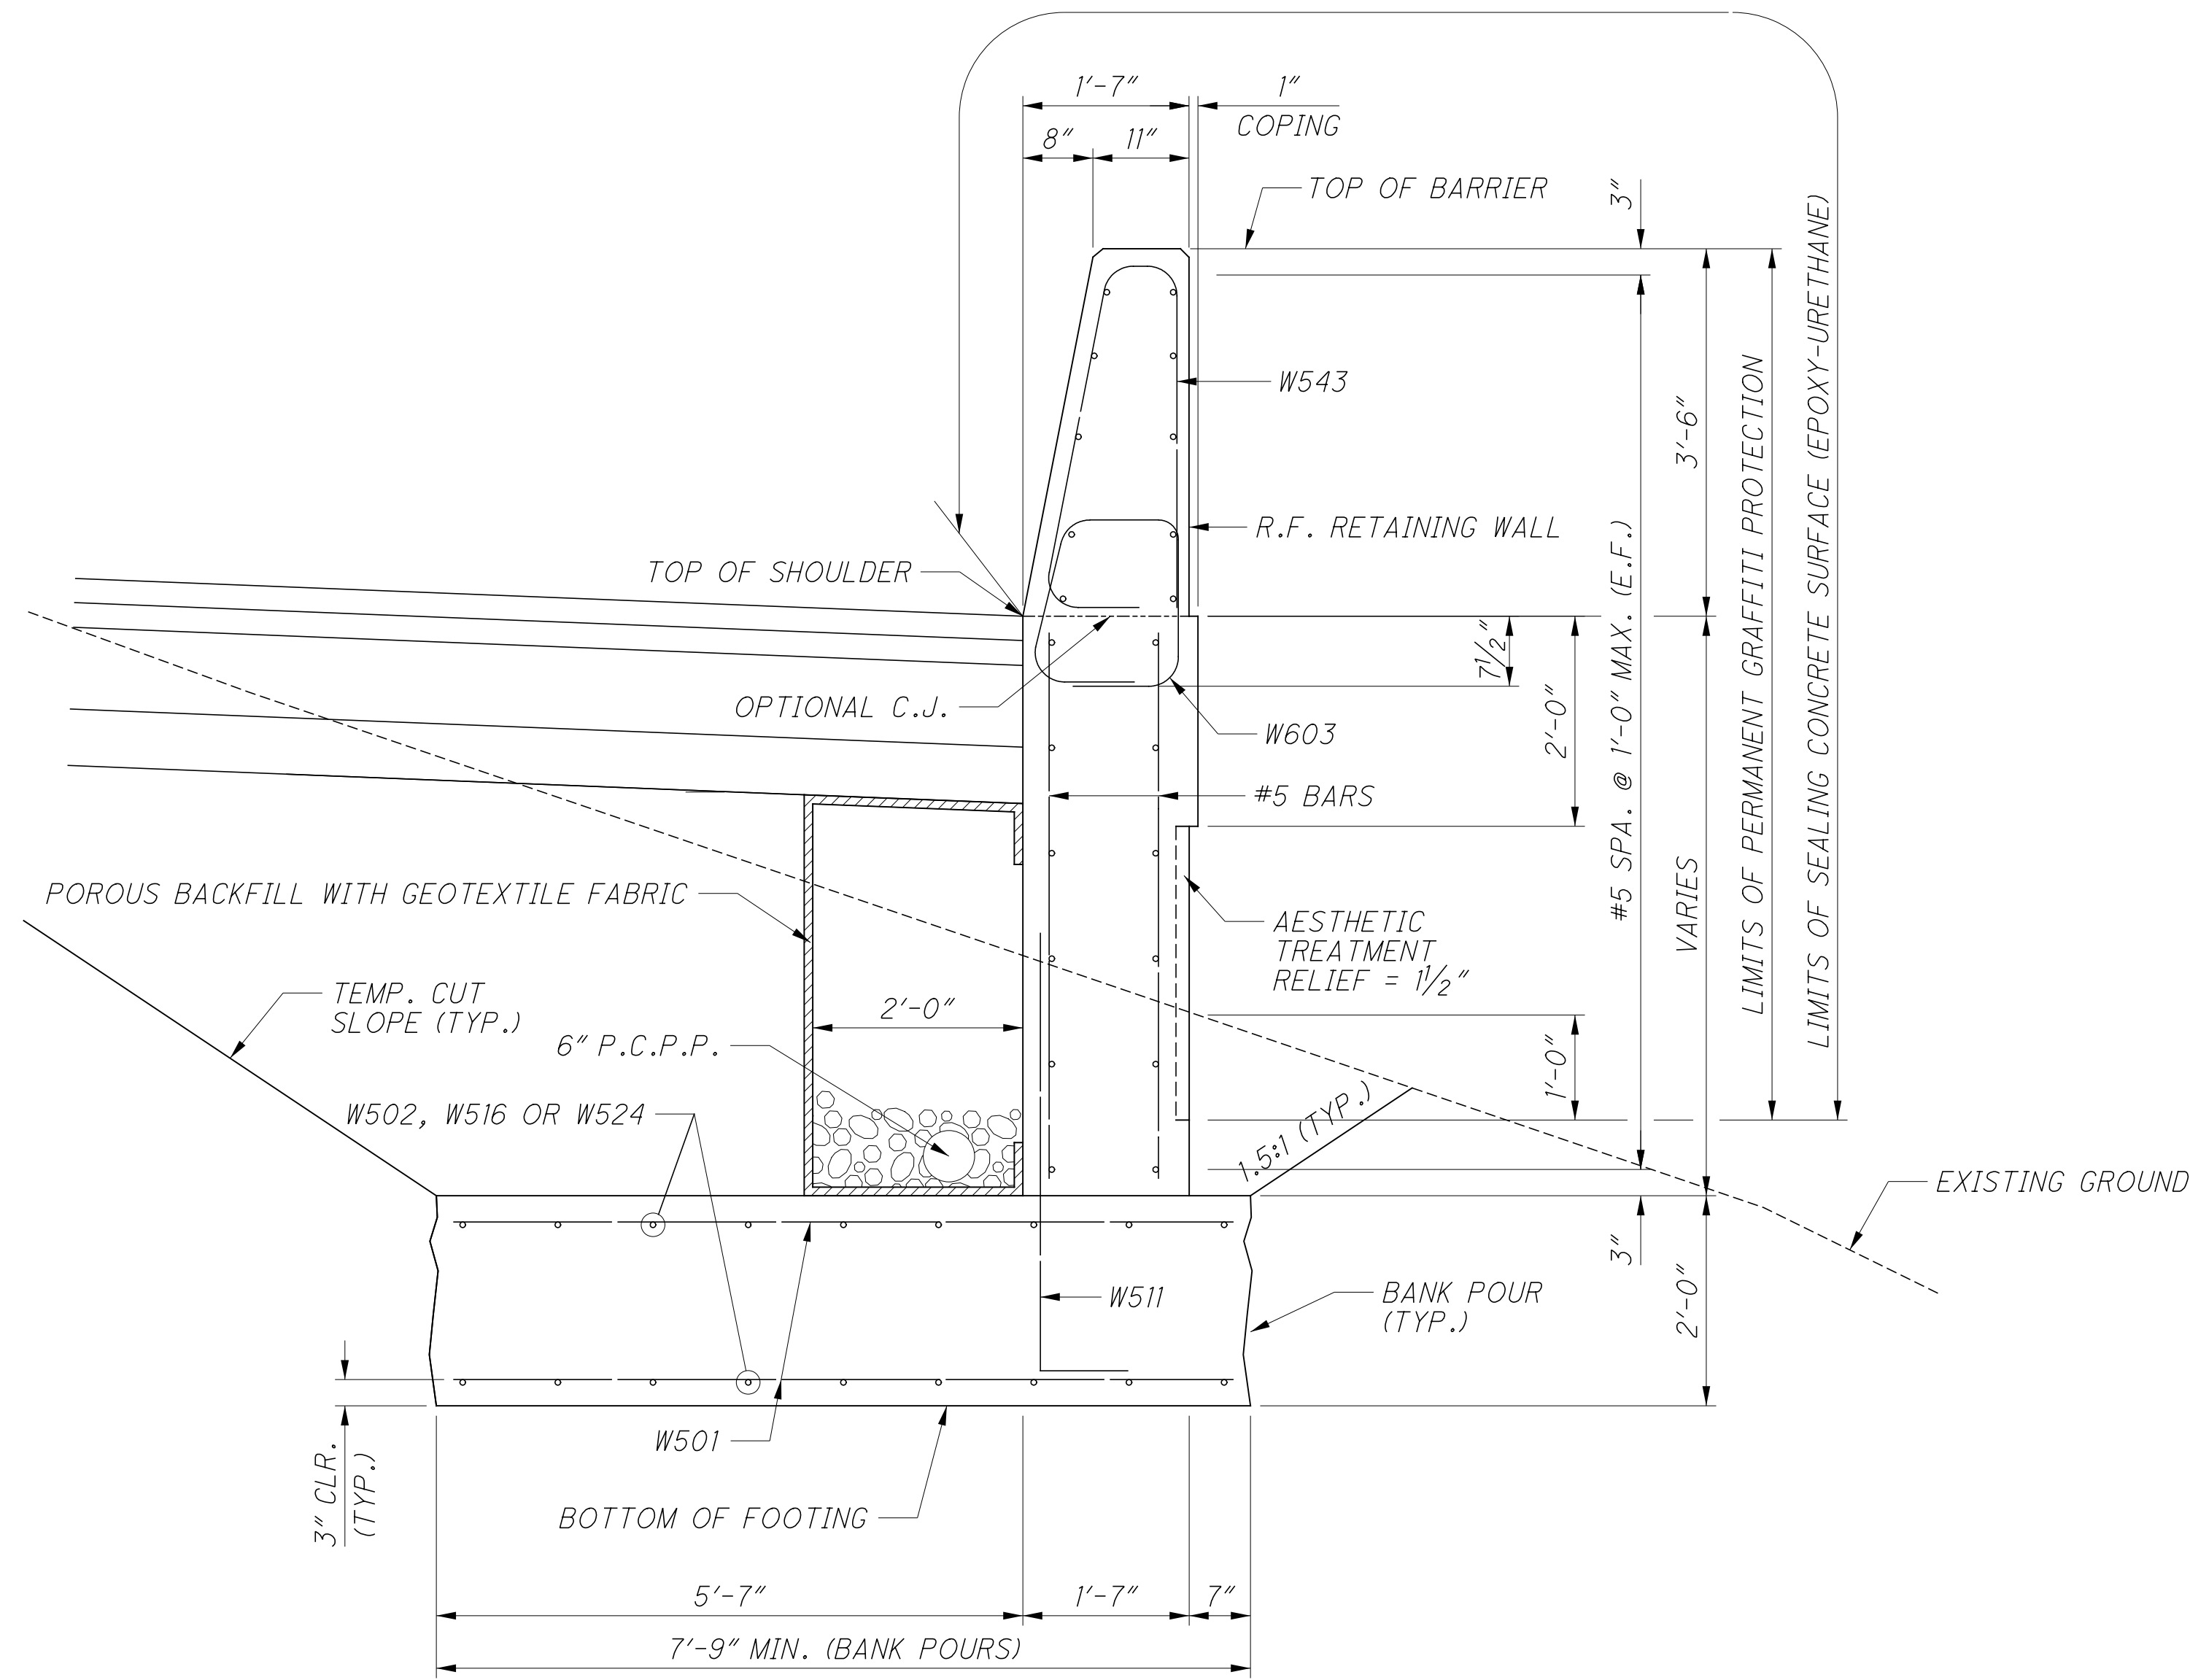


SECTION A-A

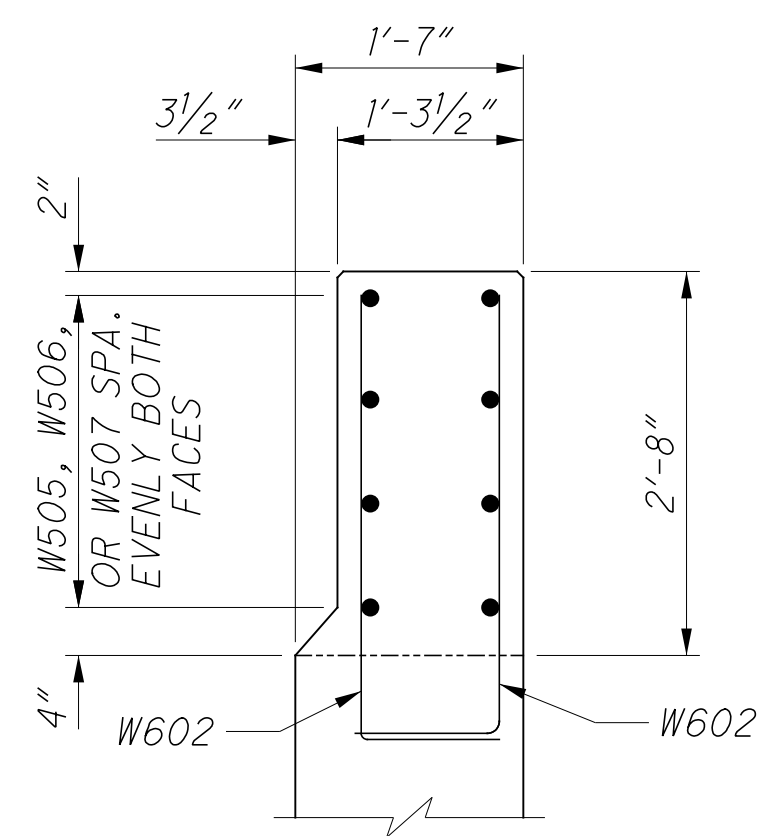


SECTION B-B

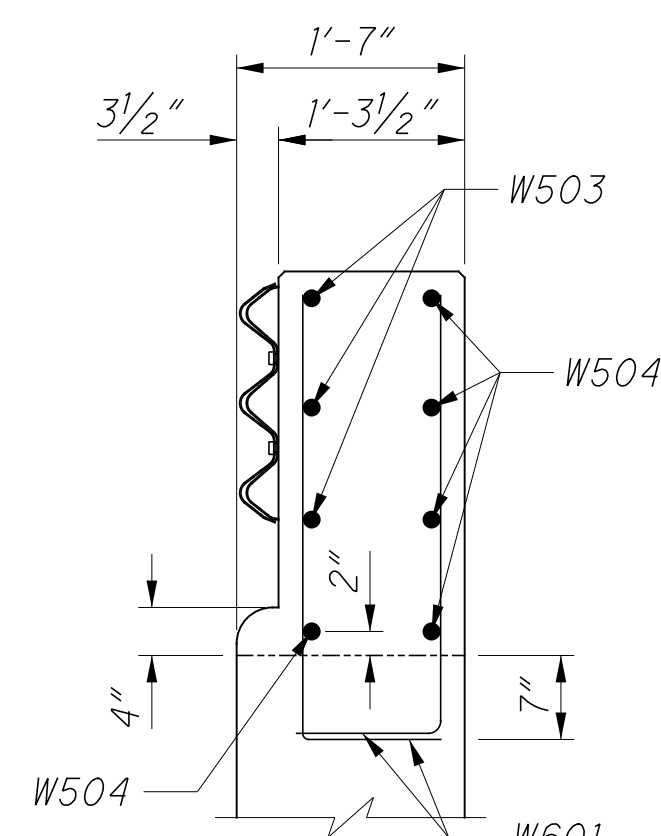


SECTION C-C

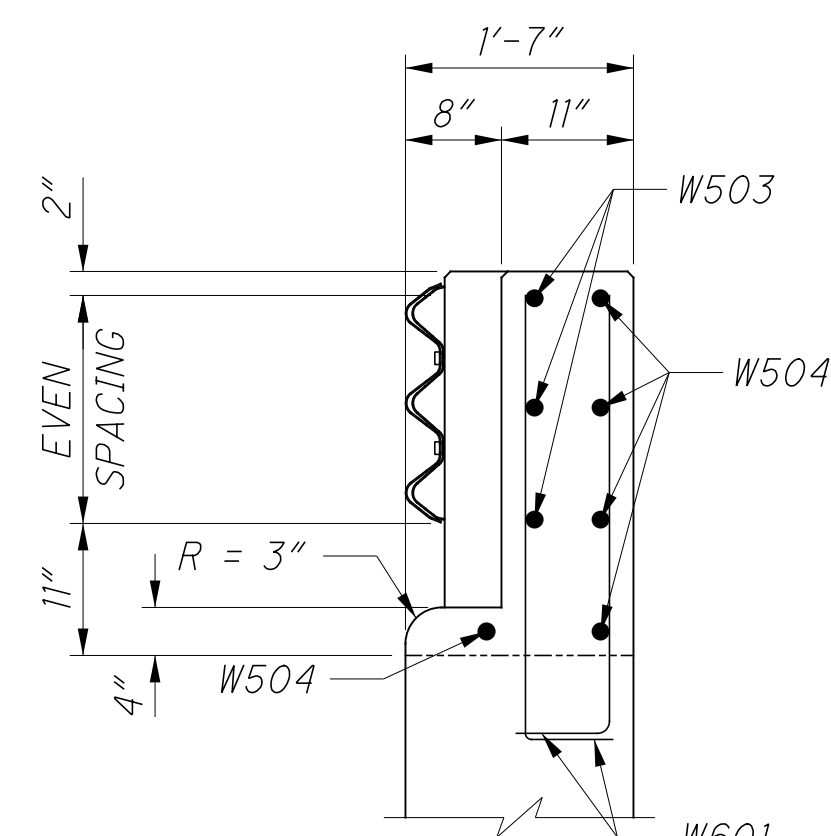


SECTION D-D

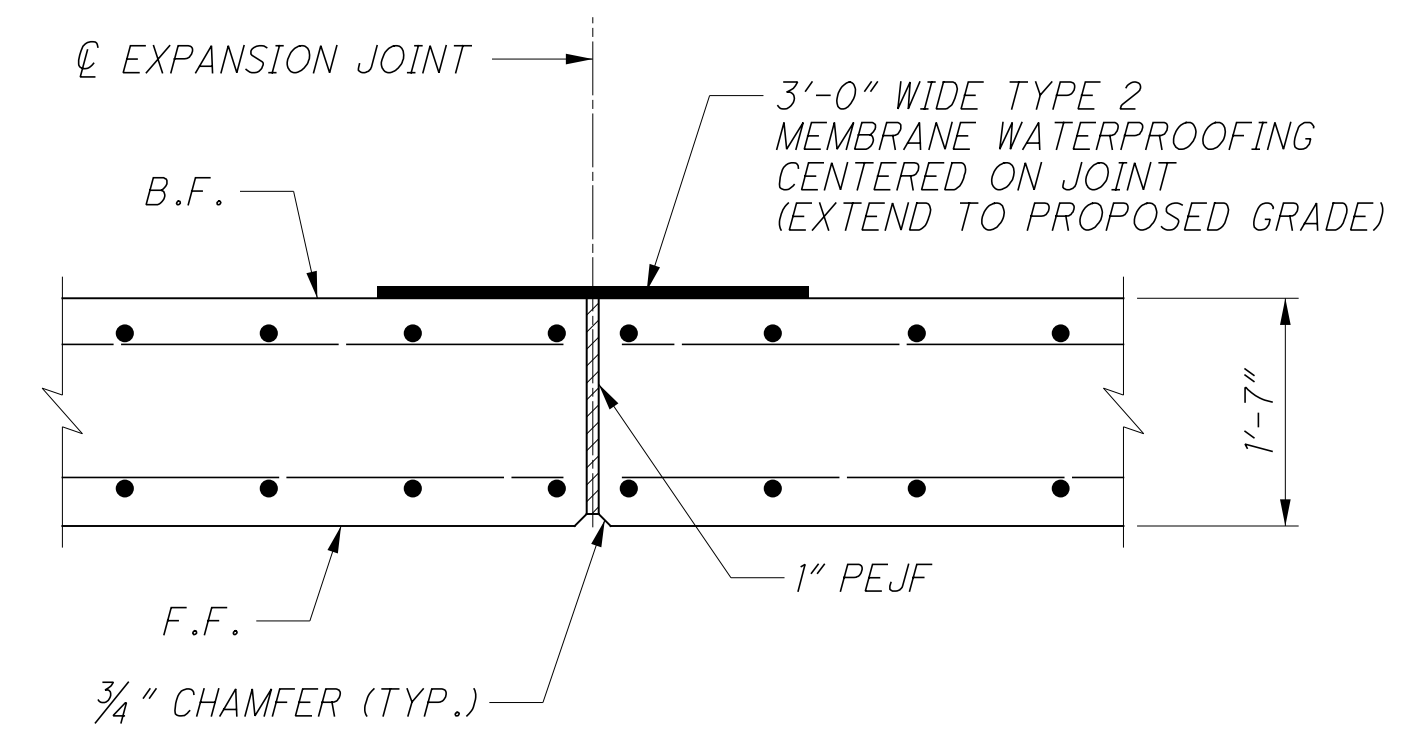

EXPANSION JOINT DETAIL

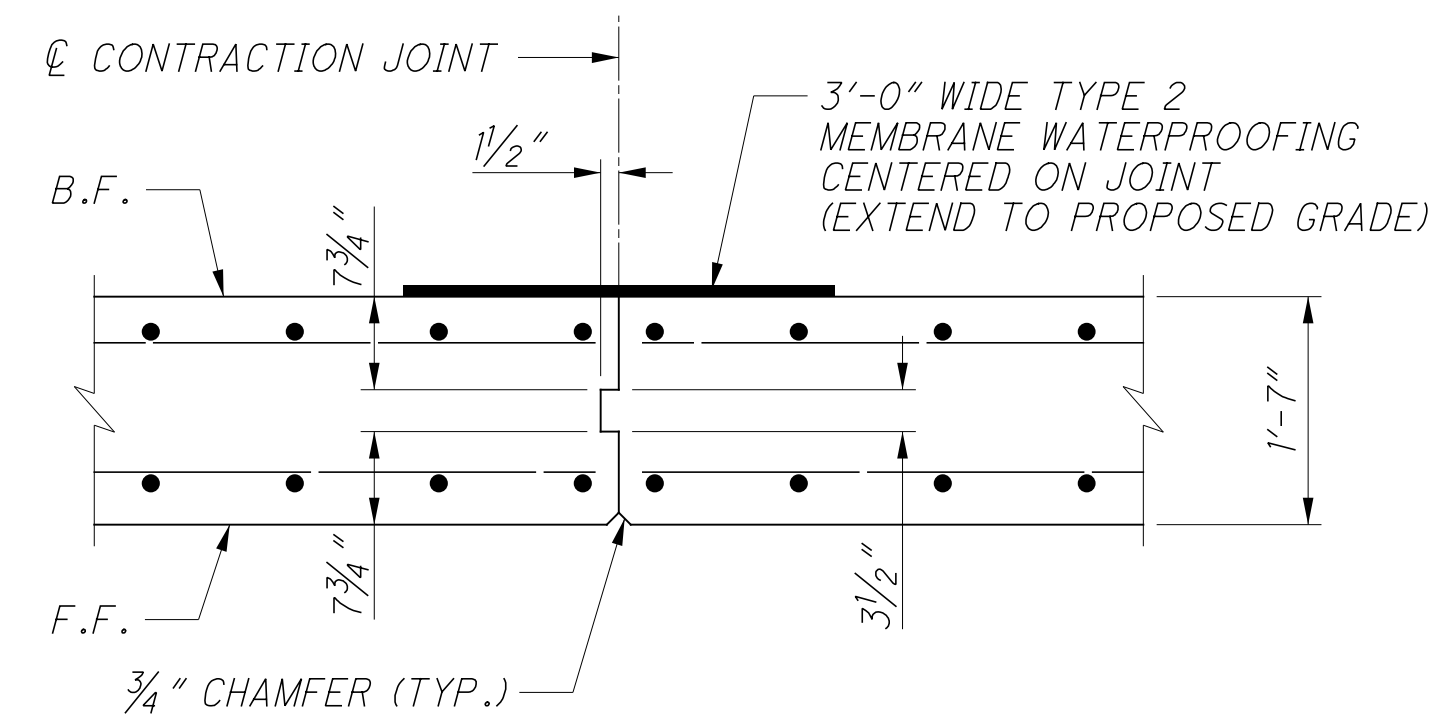

CONTRACTION JOINT DETAIL

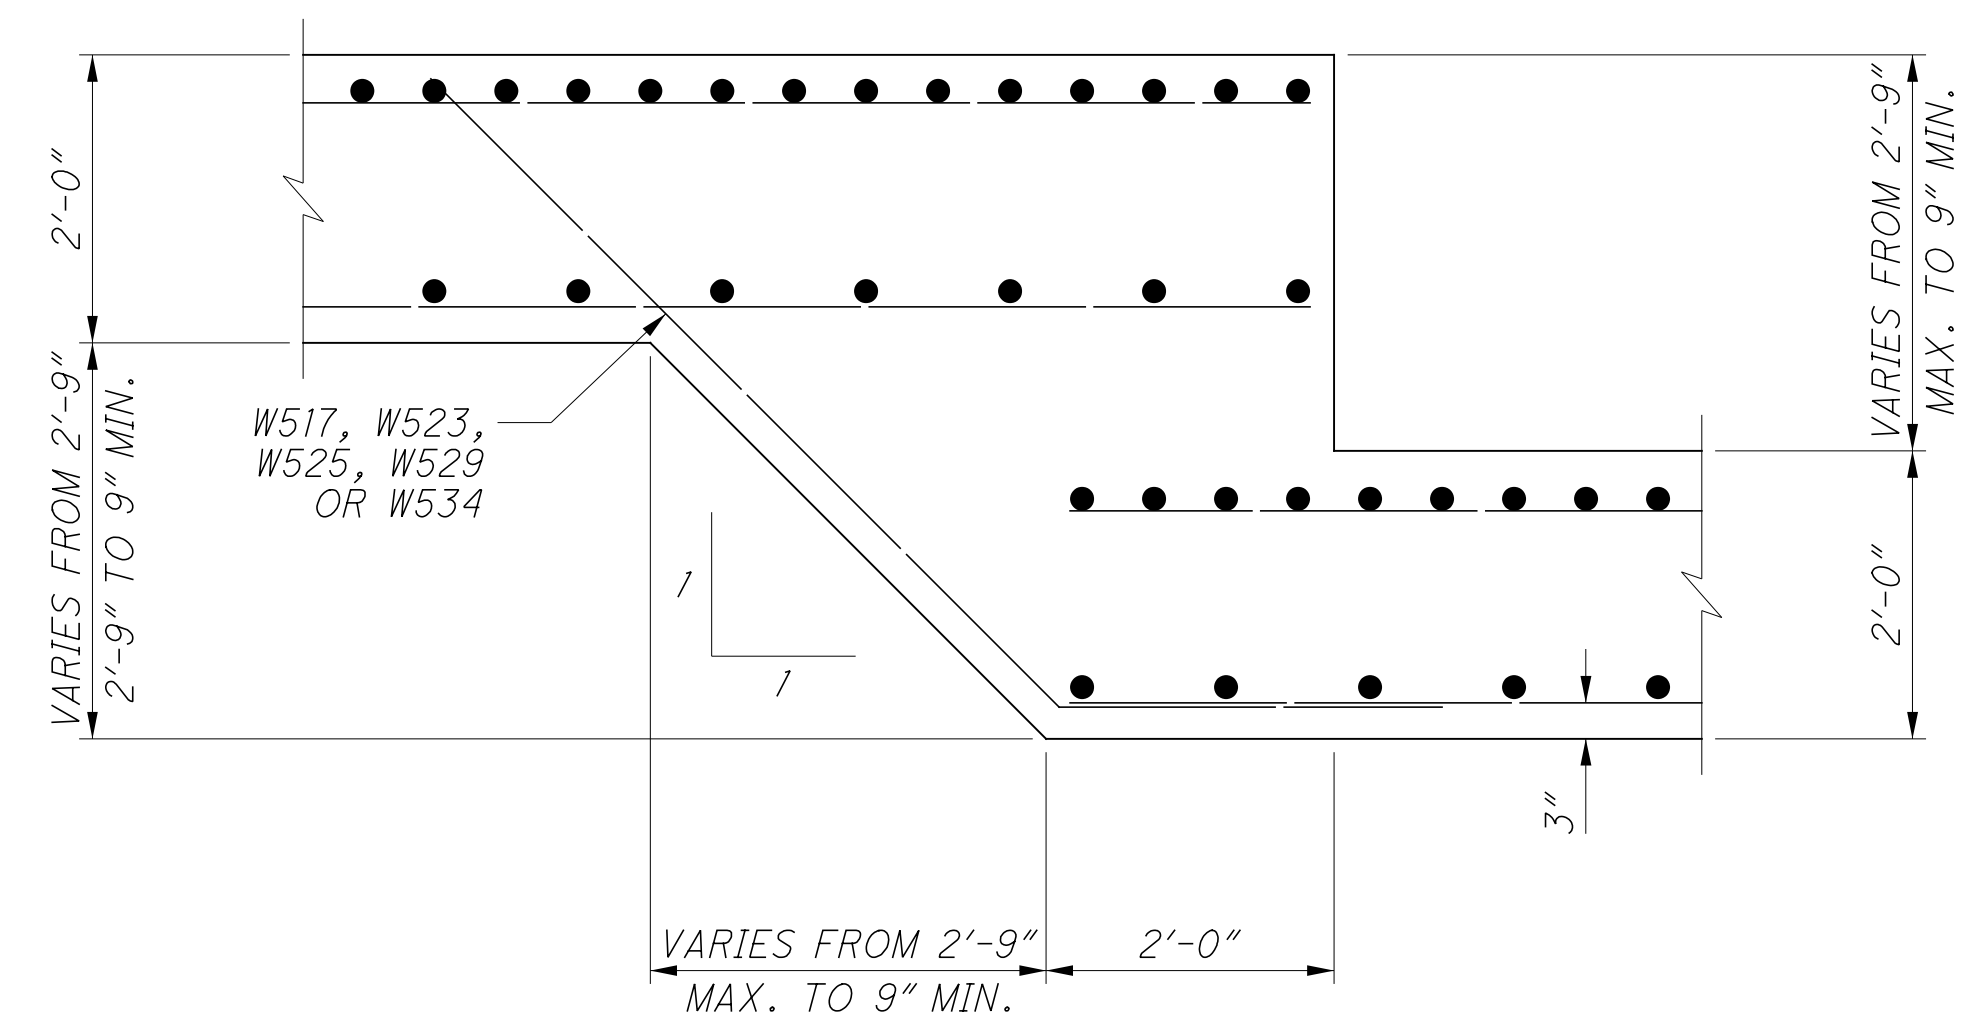






FOOTING STEP

NOTES
 FOR BRIDGE TERMINAL ASSEMBLY,
 SEE STANDARD CONSTRUCTION
 DRAWING MSG 3.1 AND 3.2.


DESIGN AGENCY STRUCTUREPOINT <small>INCORPORATED</small>	
DATE 01/18/19	FILE NUMBER
REVIEWED MDS	STRUCTURE
DRAWN BMP	REVISED
DESIGNED SUJ	CHECKED CLB
RETAINING WALL NO. 4 DETAILS ALONG IR 75 SB	
HAM-75-3.84 PID No. 104667	
10 / 11	
24 48	

MARK	NUMBER	LENGTH	WEIGHT	TYPE	DIMENSIONS					
	TOTAL				A	B	C	D	E	R
WALL NO. 4										
W501	1850	7'-5"	14311	STR						
W502	198	40'-0"	8261	STR						
W503	6	5'-7"	35	25	1'-8"	2'-5"	1'-5"	1 1/2"	6 1/2"	
W504	10	5'-6"	57	STR						
W505	16	11'-1"	185	STR						
W506	4	3'-6"	15	STR						
W507	4	11'-3"	47	STR						
W508	462	29'-8"	14296	STR						
W509	16	15'-8"	261	STR						
	2 SR	7'-7"								
W510	OF	TO	509	STR						1/4"
	31	8'-2"								
W511	620	5'-1"	3287	1	0'-10"	4'-5"				
	2 SR	7'-1"								
W512	OF	TO	474	STR						1/4"
	31	7'-7"								
	2 SR	6'-6"								
W513	OF	TO	440	STR						1/4"
	31	7'-1"								
W514	2	22'-10"	48	STR						
	2 SR	5'-11"								
W515	OF	TO	401	STR						1/4"
	31	6'-6"								
W516	18	40'-5"	759	STR						
W517	9	8'-9"	82	19	2'-8"	4'-4"	4'-4"			
	2 SR	5'-4"								
W518	OF	TO	364	STR						1/4"
	31	5'-11"								
	2 SR	7'-6"								
W519	OF	TO	505	STR						1/4"
	31	8'-1"								
	6 SR	6'-11"								
W520	OF	TO	1398	STR						1/4"
	31	7'-6"								
W521	2	21'-4"	45	STR						
W522	18	18'-10"	354	STR						
W523	9	7'-4"	69	19	2'-8"	3'-4"	3'-4"			
W524	108	25'-3"	2844	STR						
W525	18	6'-3"	117	19	2'-8"	2'-7"	2'-7"			
	2 SR	6'-3"								
W526	OF	TO	423	STR						1/4"
	31	6'-10"								
	2 SR	7'-5"								
W527	OF	TO	498	STR						1/4"
	31	8'-0"								
W528	2	21'-1"	44	STR						
W529	18	5'-11"	111	19	2'-8"	2'-4"	2'-4"			
	2 SR	7'-4"								
W530	OF	TO	493	STR						1/4"
	31	7'-11"								
	2 SR	6'-9"								
W531	OF	TO	455	STR						1/4"
	31	7'-4"								
W532	2	24'-0"	50	STR						
	2 SR	6'-4"								
W533	OF	TO	428	STR						1/4"
	31	6'-11"								
W534	9	6'-8"	63	19	2'-8"	2'-10"	2'-10"			
	2 SR	6'-7"								
W535	OF	TO	445	STR						1/4"
	31	7'-2"								
	2 SR	6'-0"								
W536	OF	TO	407	STR						1/4"
	31	6'-7"								

MARK	NUMBER	LENGTH	WEIGHT	TYPE	DIMENSIONS					
	TOTAL				A	B	C	D	E	R
WALL NO. 4 CONT.										
W537	2	28'-2"	59	STR						
	2 SR	6'-7"								
W538	OF	TO	447	STR						1/4"
	31	7'-3"								
	2 SR	5'-9"								
W539	OF	TO	399	STR						1/4"
	31	6'-7"								
W540	2	20'-6"	43	STR						
	2 SR	6'-1"								
W541	OF	TO	415	STR						1/4"
	31	6'-9"								
	2 SR	5'-3"								
W542	OF	TO	366	STR						1/4"
	31	6'-1"								
W543	592	10'-4"	6380	23	0'-11"	4'-9"	4'-6"			3 1/2"
W601	20	4'-1"	123	1	1'-0"	3'-3"				
	4 SR	4'-0"				3'-2"				
W602	OF	TO	234	1	1'-0"	TO				1"
	9	4'-8"				3'-10"				
W603	592	5'-8"	5042	40	1'-2"	1'-0"	1'-7"	1'-7"		
SUB-TOTAL			66,089							

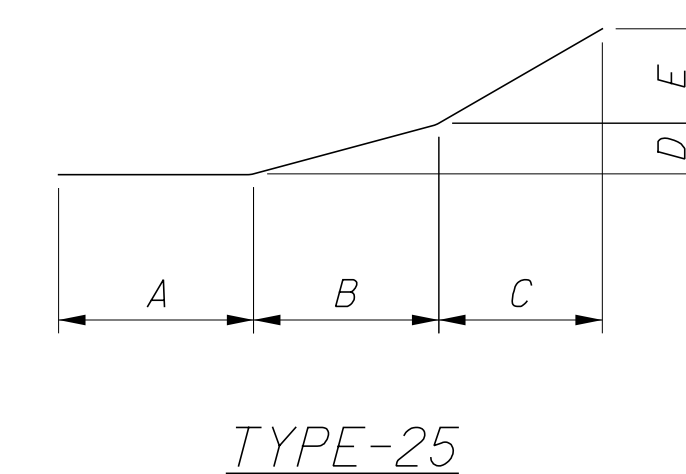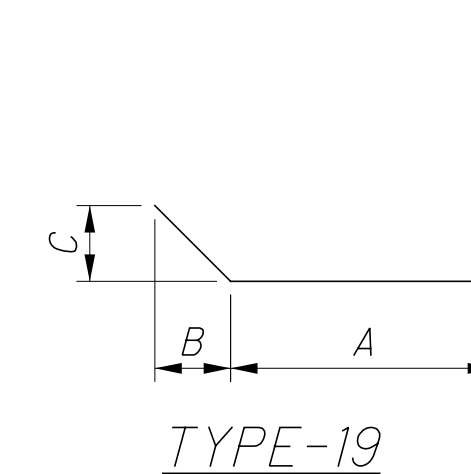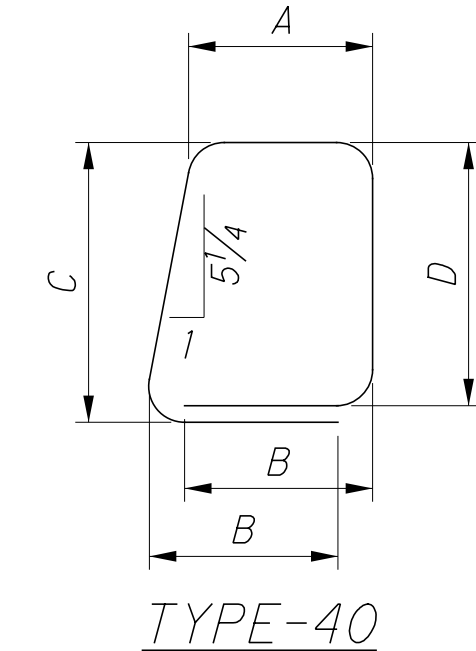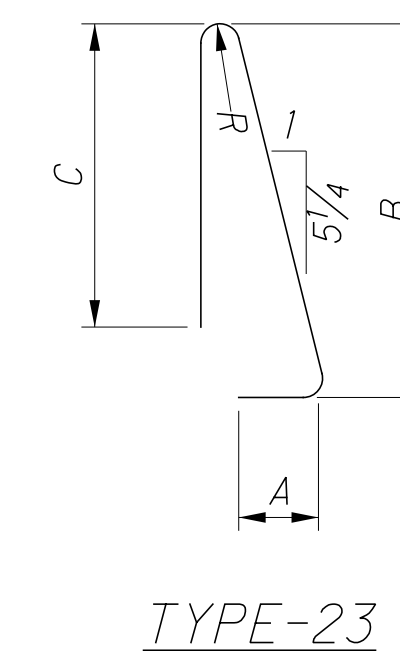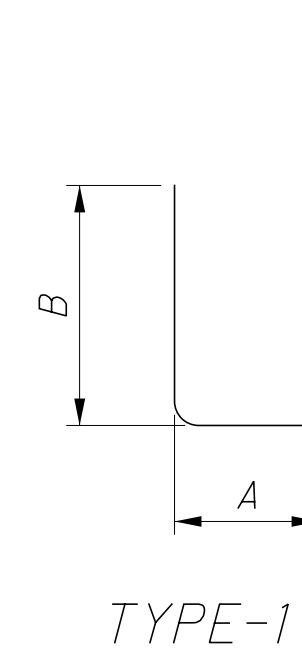

iwade 8/22/2022 9:14:23 AM
 O:\2017\01113.C.Design\104667_HAM-75-3.84.Design\Structures\Walls_Sheets\104667_WD55.dgn

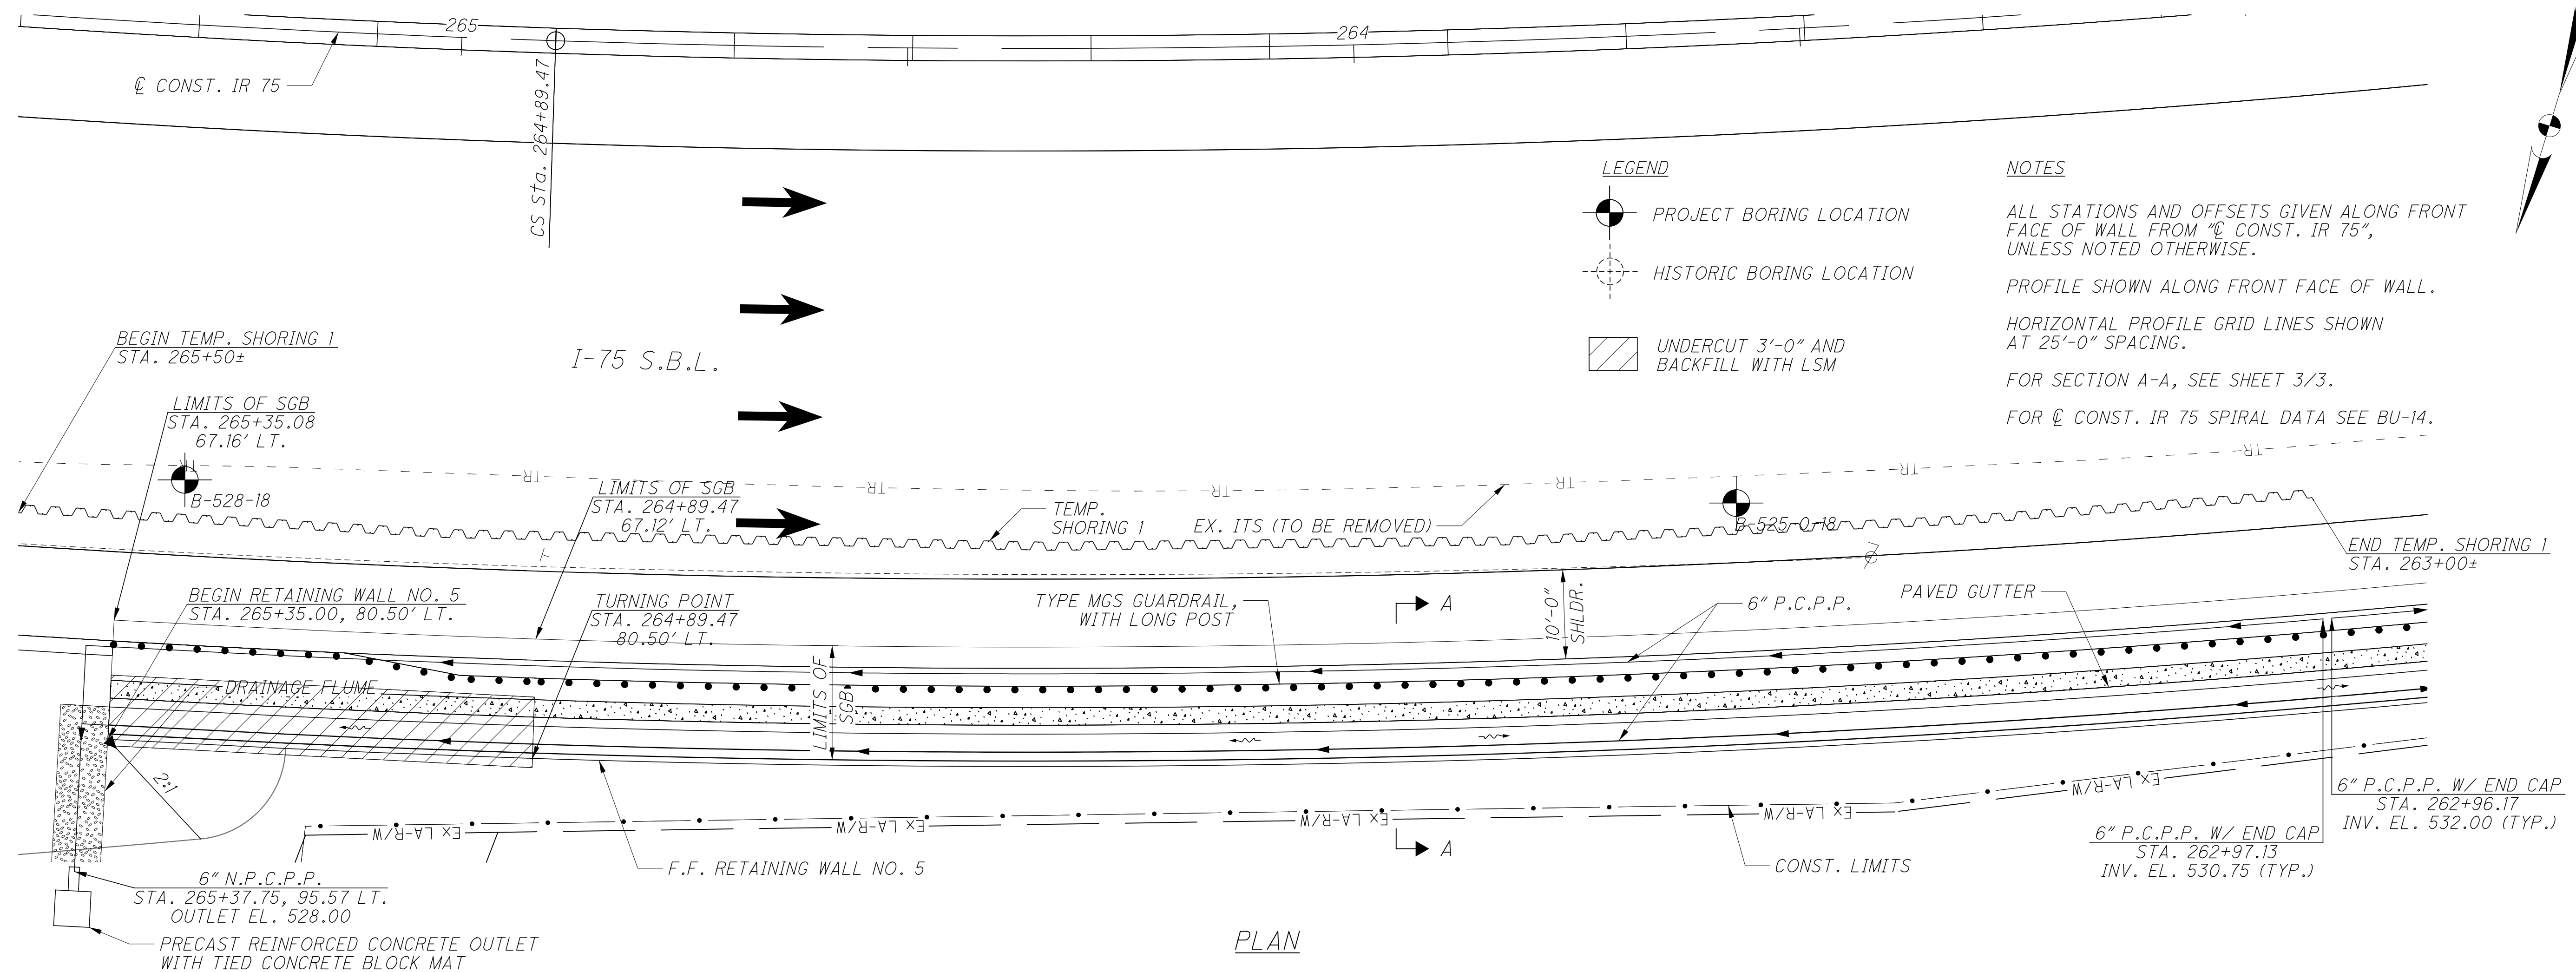


EXISTING GROUND	530.00	530.85	532.16	532.13	532.19	532.10	531.97	532.12	532.26	532.13	532.17	EXISTING GROUND
510												510
520												520
530												530
1000												1000

PROFILE
ALONG F.F. RETAINING WALL NO. 5

DESIGN AGENCY: STRUCTUREPOINT
 DATE: 01/18/19
 REVIEWED: MDS
 DRAWN: BMP
 DESIGNED: SUJ
 CHECKED: CLB
 STRUCTURE POINT FILE NUMBER:
 RETAINING WALL NO. 5 DETAILS
 ALONG IR 75 SB
 HAM-75-3.84
 PID No. 104667
 1 / 3
 26 / 48

iwade 8/22/2022 9:14:24 AM
 O:\2017\01113.C.Design\104667_HAM-75-3.84.Design\Structures\Walls_Sheets\104667_WD56.dgn

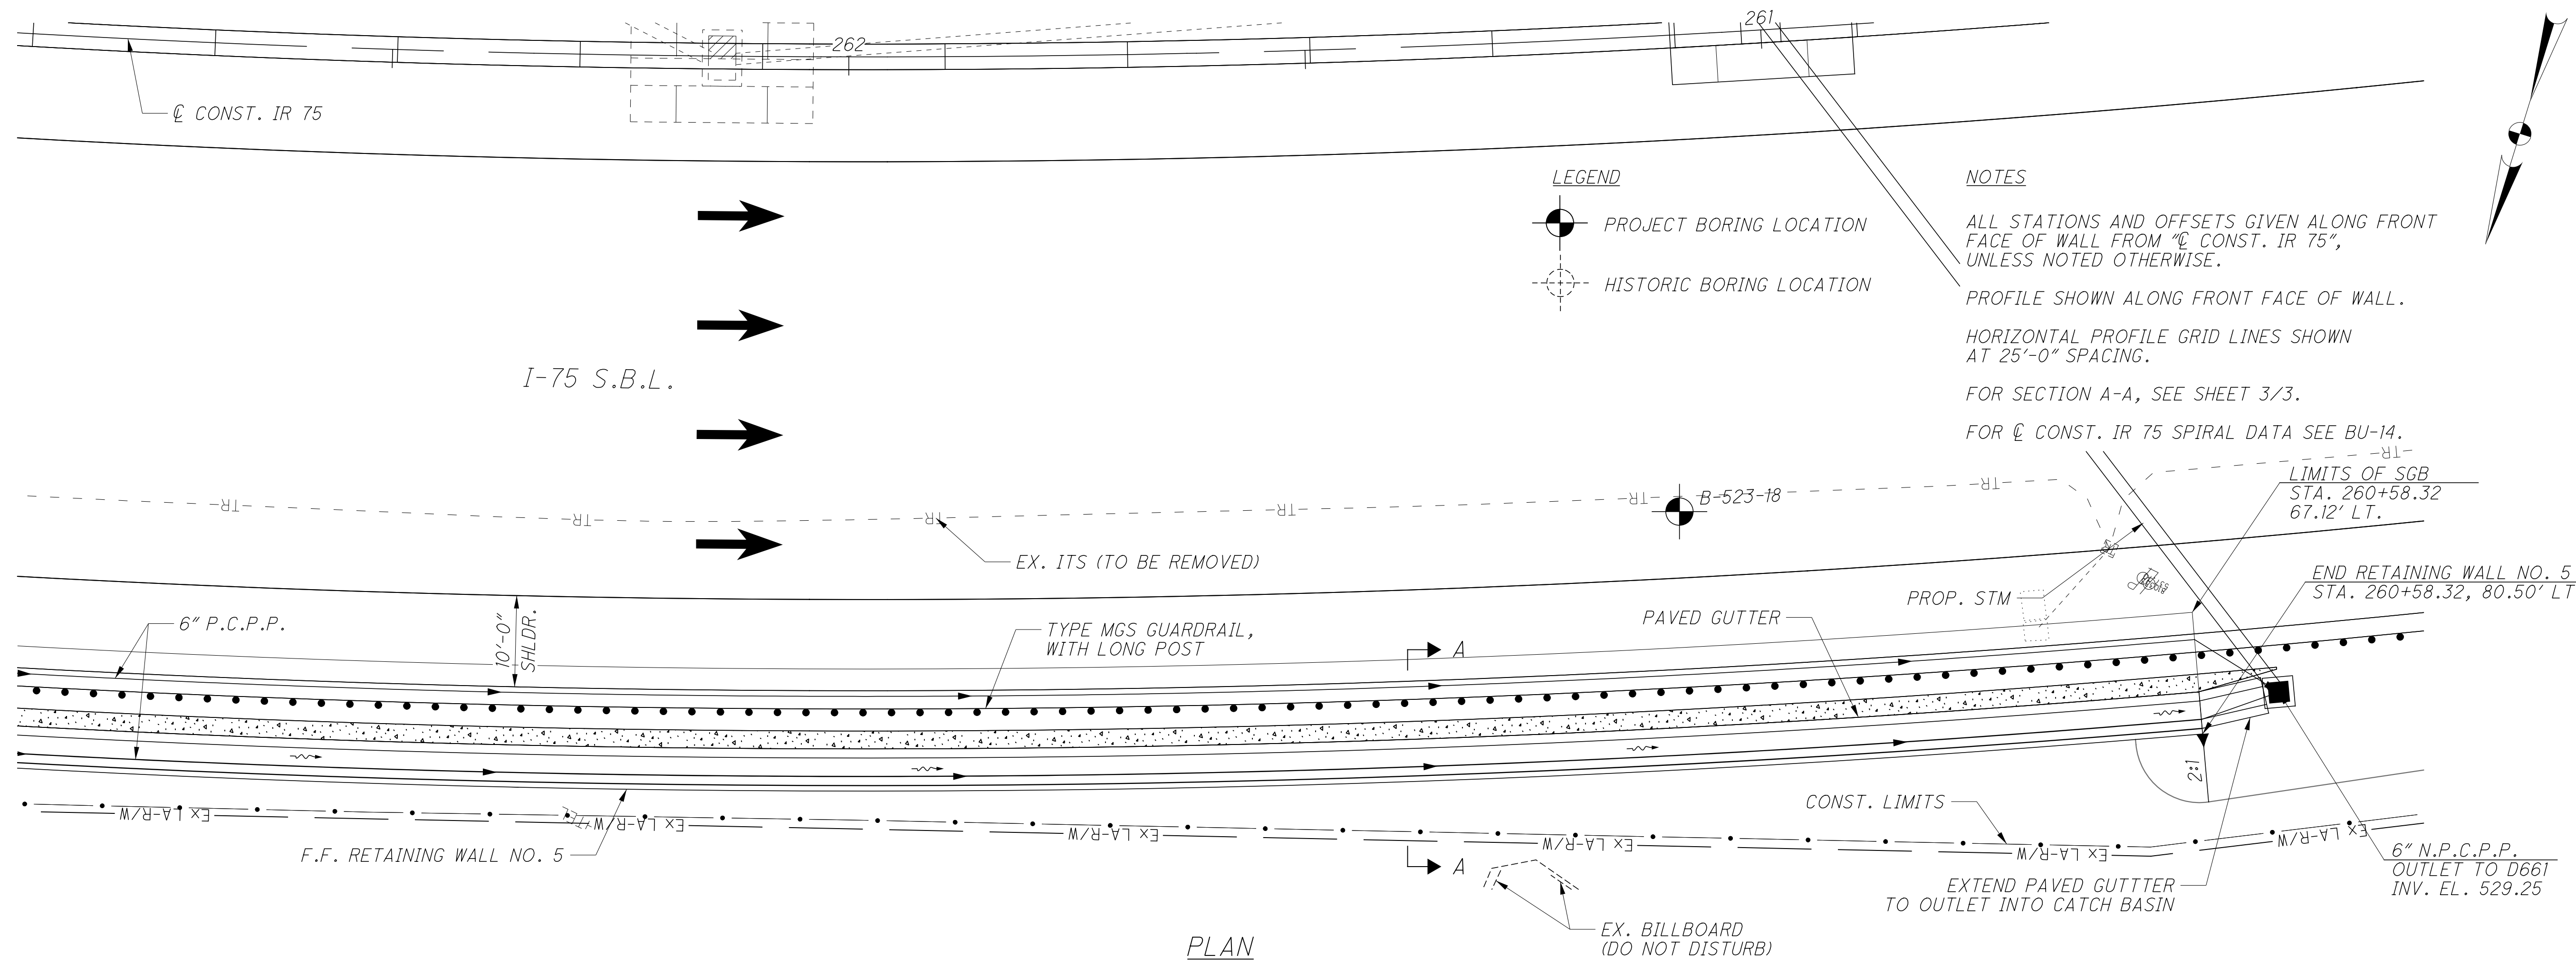

NOTES

ALL STATIONS AND OFFSETS GIVEN ALONG FRONT FACE OF WALL FROM "C" CONST. IR 75", UNLESS NOTED OTHERWISE.

PROFILE SHOWN ALONG FRONT FACE OF WALL.

HORIZONTAL PROFILE GRID LINES SHOWN AT 25'-0" SPACING.

FOR SECTION A-A, SEE SHEET 3/3.

FOR "C" CONST. IR 75 SPIRAL DATA SEE BU-14.

EXISTING GROUND	532.34	532.70	532.96	532.87	532.82	532.51	532.62	532.58	532.36	532.03	EXISTING GROUND
510											510
520											520
530											530
540											540
550											550
560											560
570											570
TOP OF COPING EL.	542.50	542.20	541.83	541.46	541.06	540.67	540.21	539.75	539.26	538.76	TOP OF COPING EL.
					500'-0"	452'-4 1/4"					

PROFILE
ALONG F.F. RETAINING WALL NO. 5

DESIGN AGENCY
STRUCTUREPOINT
INCORPORATED

DATE
 01/18/19

REVIEWED
 MDS

DRAWN
 BMP

DESIGNED
 SUJ

CHECKED
 CLB

FILE NUMBER
 STRUCTURE POINT

RETAINING WALL NO. 5 DETAILS

ALONG IR 75 SB


HAM-75-3.84

PID No. 104667


2 / 3

27
48


jwade
 8/22/2022 9:14:25 AM
 O:\2017\01113\C.Design\104667_HAM-75-3.84.Design\Structures\Walls\Sheets\104667_WD57.dgn

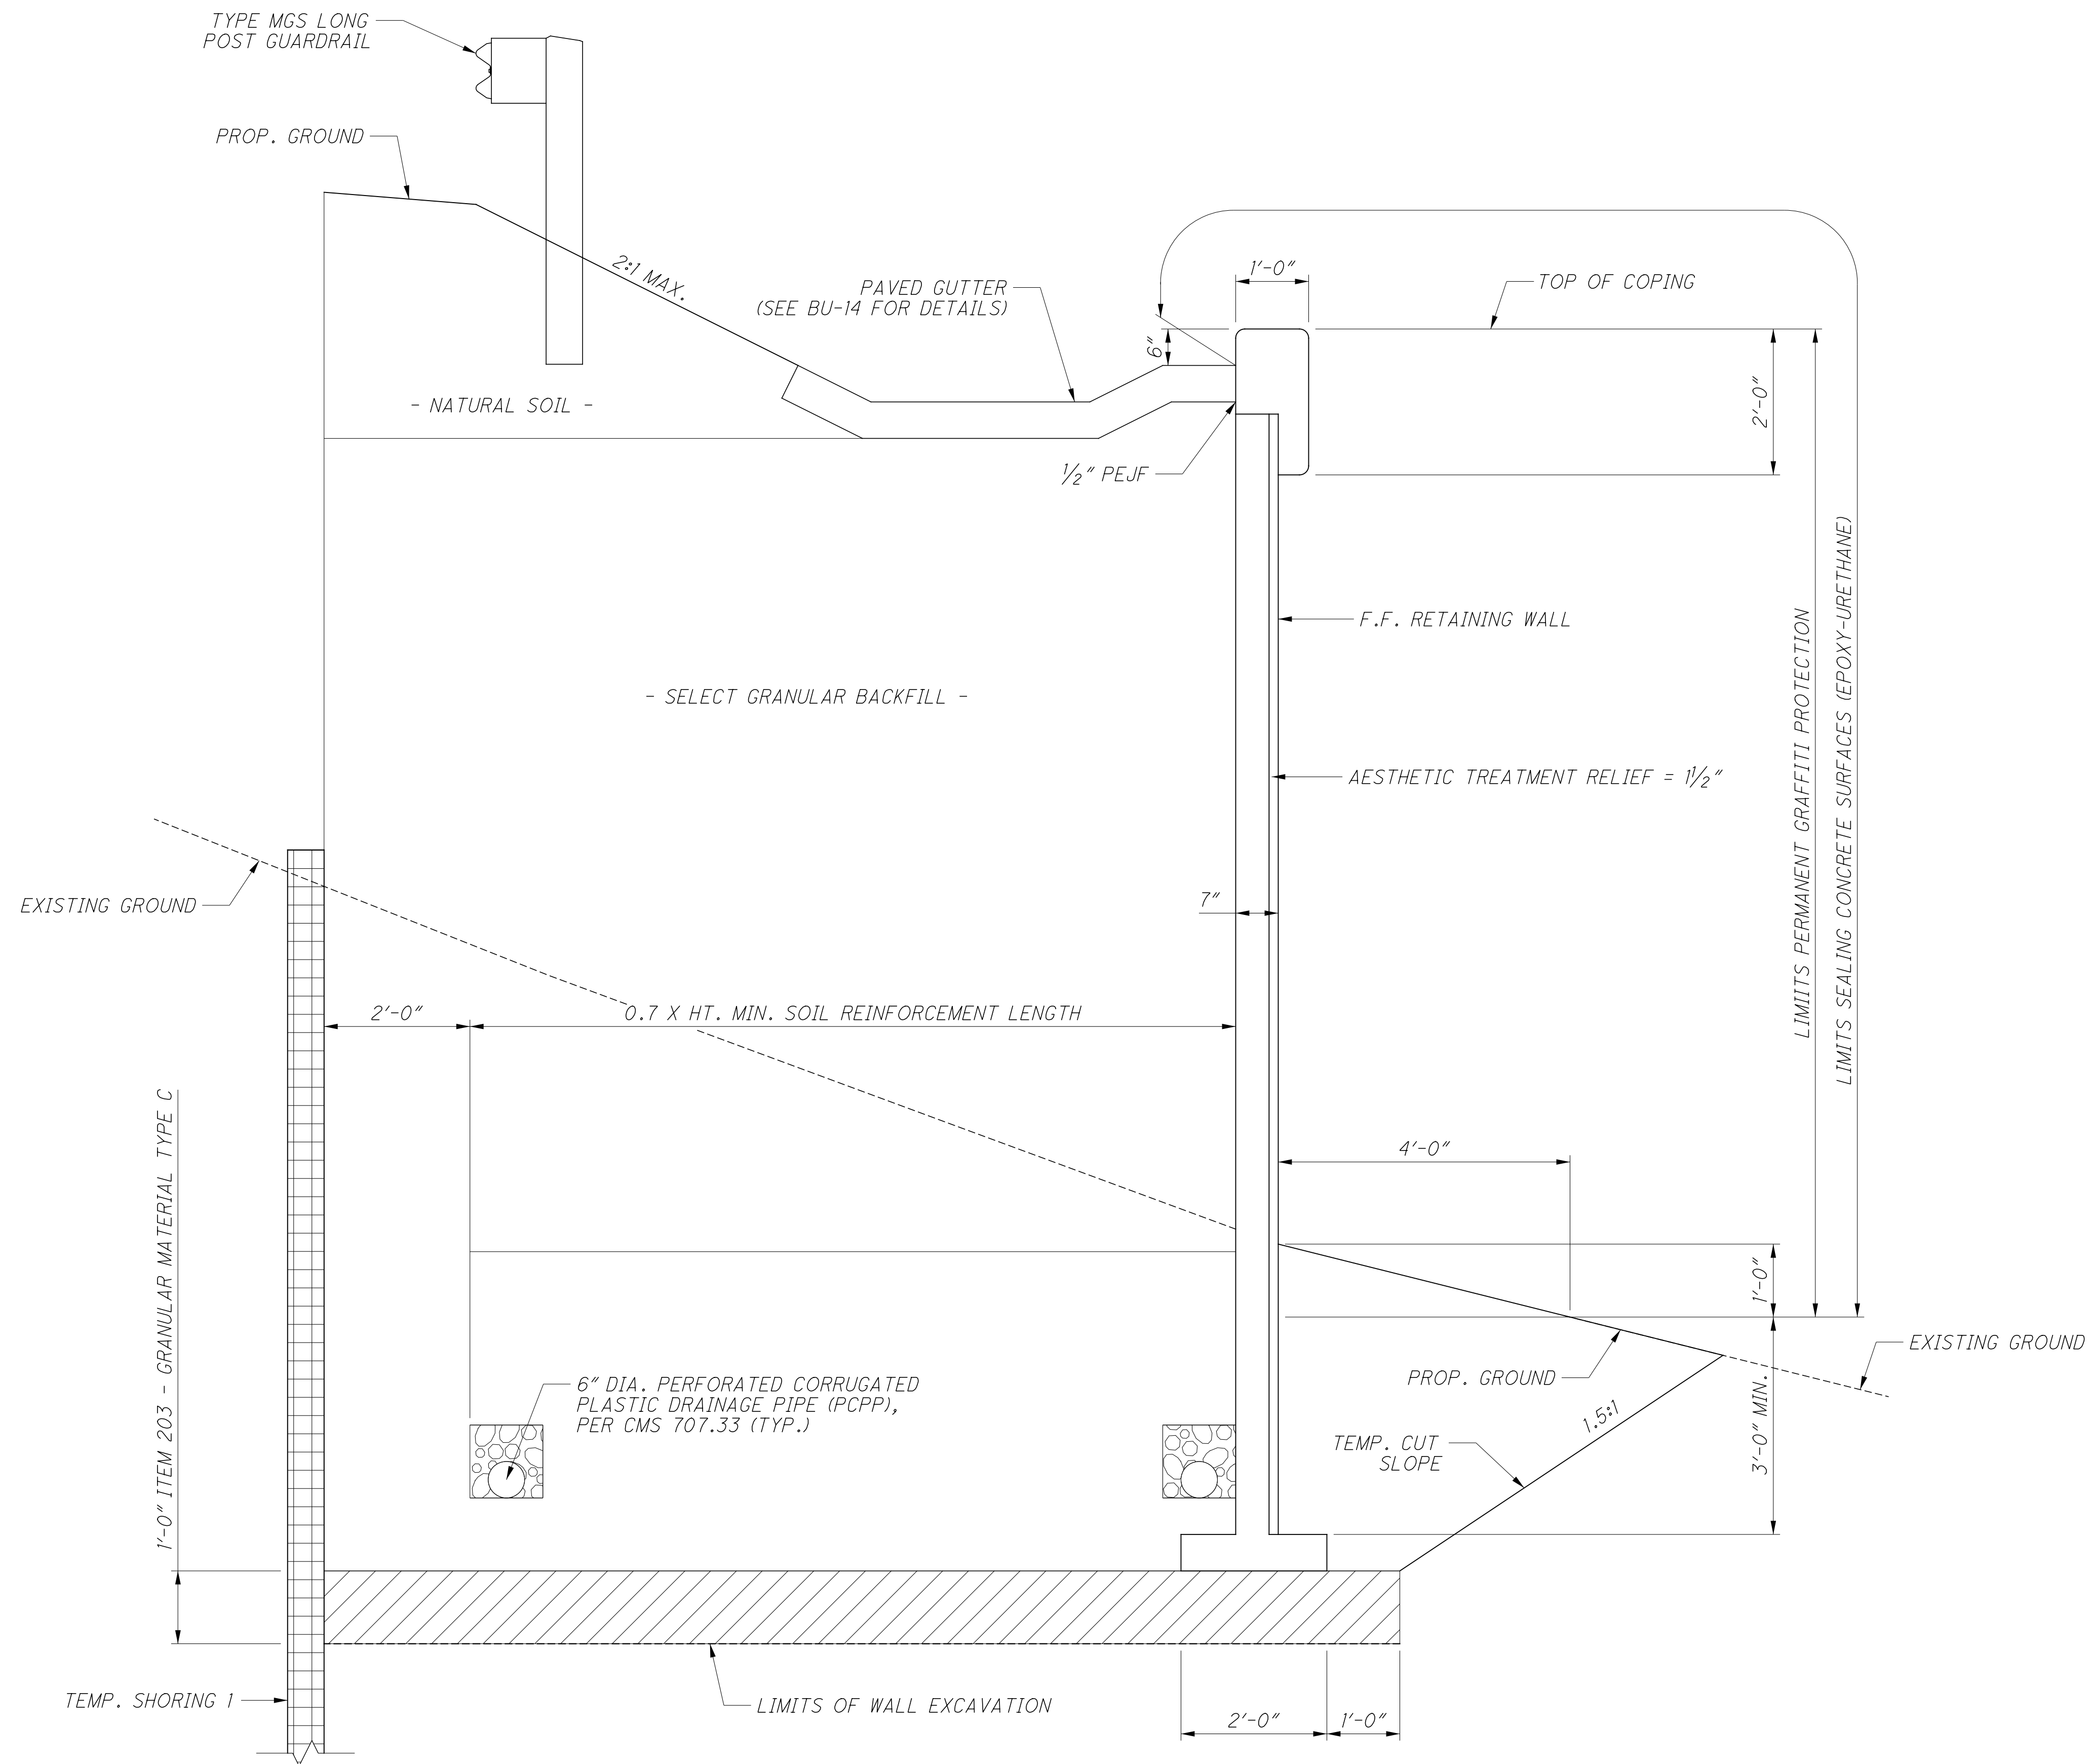


SECTION A-A

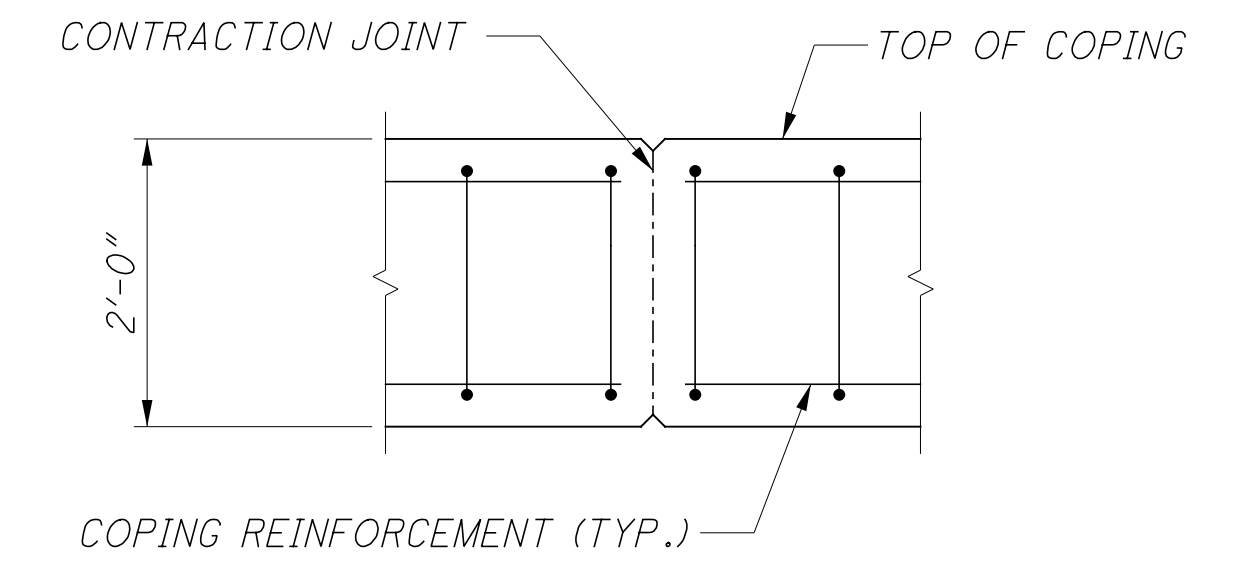

COPING CONTRACTION JOINT

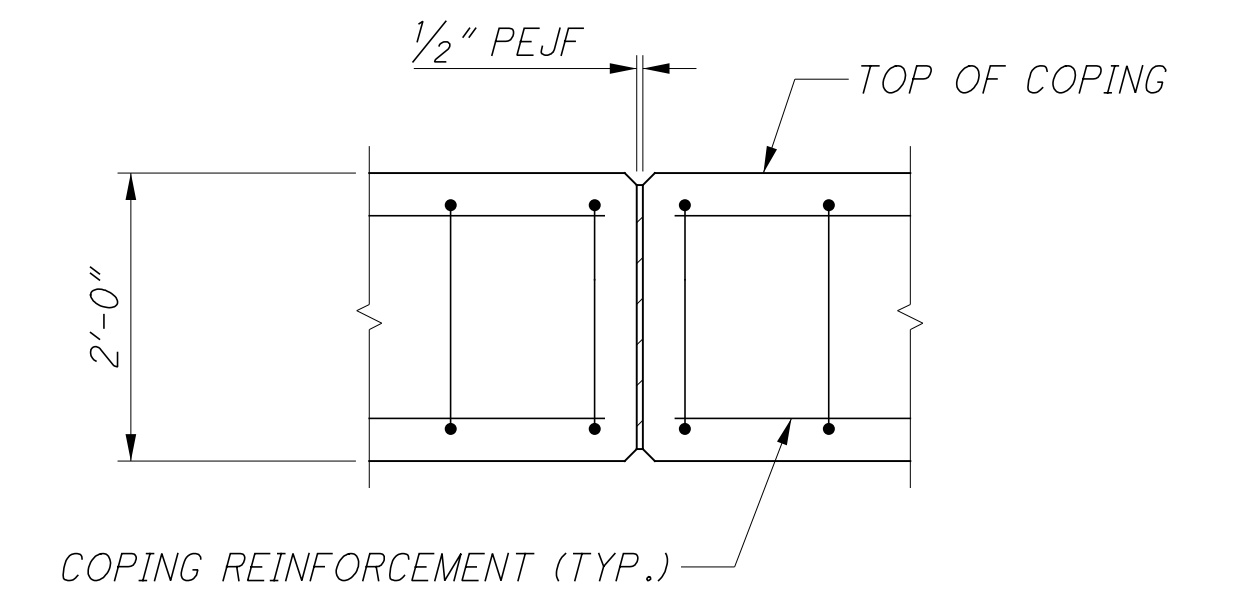


COPING EXPANSION JOINT

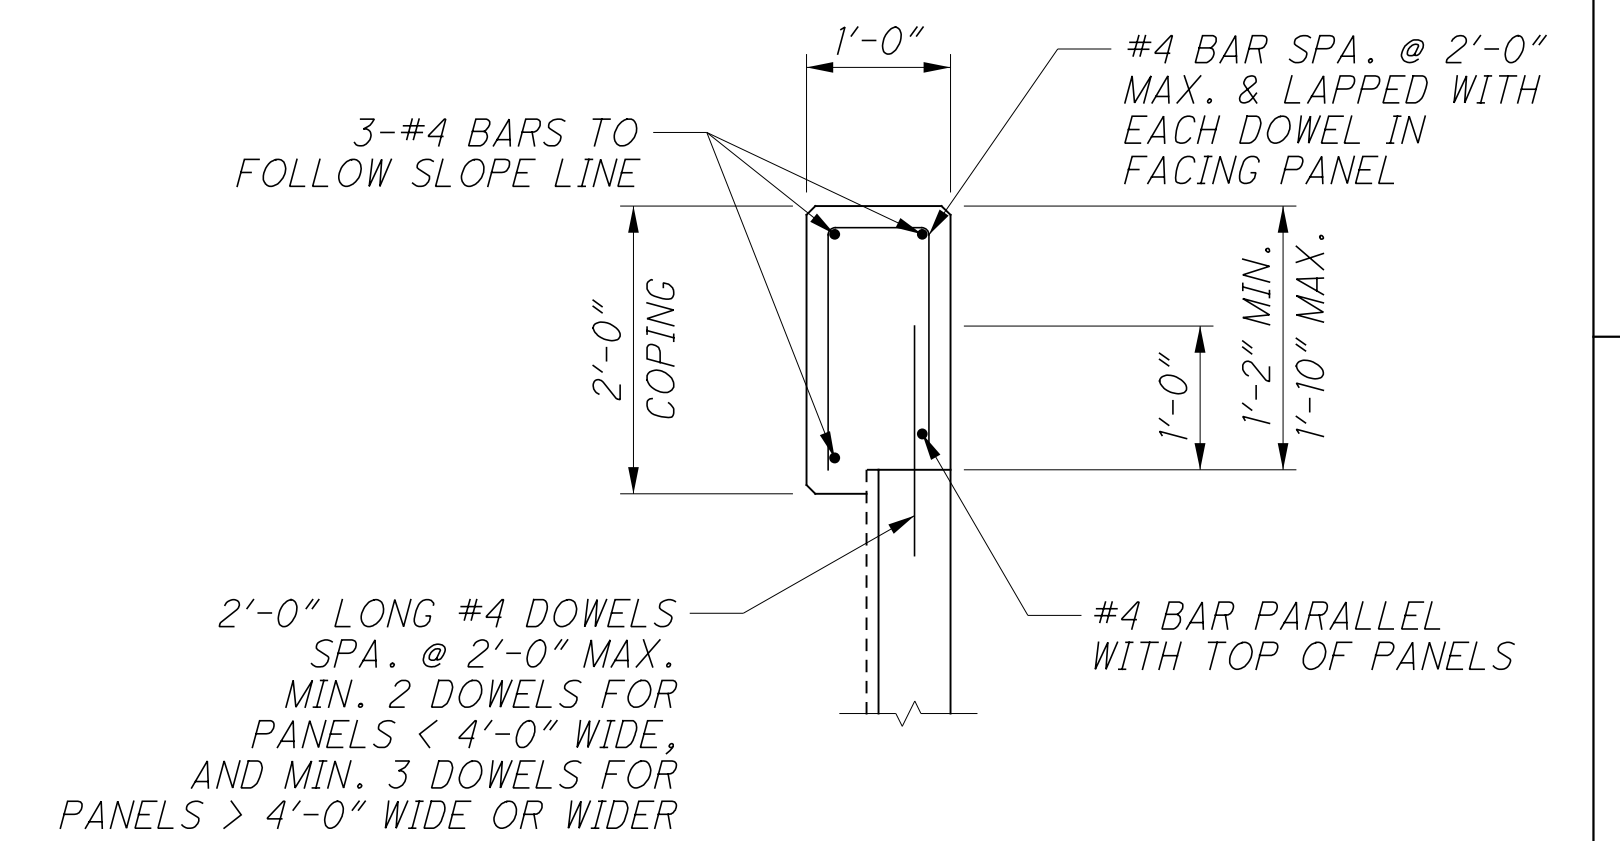

COPING DETAIL

DESIGN AGENCY		DATE	
STRUCTUREPOINT		01/18/19	
DESIGNED	REVIEWED	STRUCTURE FILE NUMBER	
SJF	MDS		
CHECKED	DRAWN	REVISED	
CLB	BMP		
RETAINING WALL NO. 5 DETAILS			
ALONG IR-75 SB			
HAM-75-3.84		PID No. 104667	
3 / 3			
28			
48			

iwade 8/22/2022 9:14:26 AM
 O:\2017\01113.C.Design\104667_HAM-75-3.84.Design\Structures\Walls_Sheets\104667_WD70.dgn

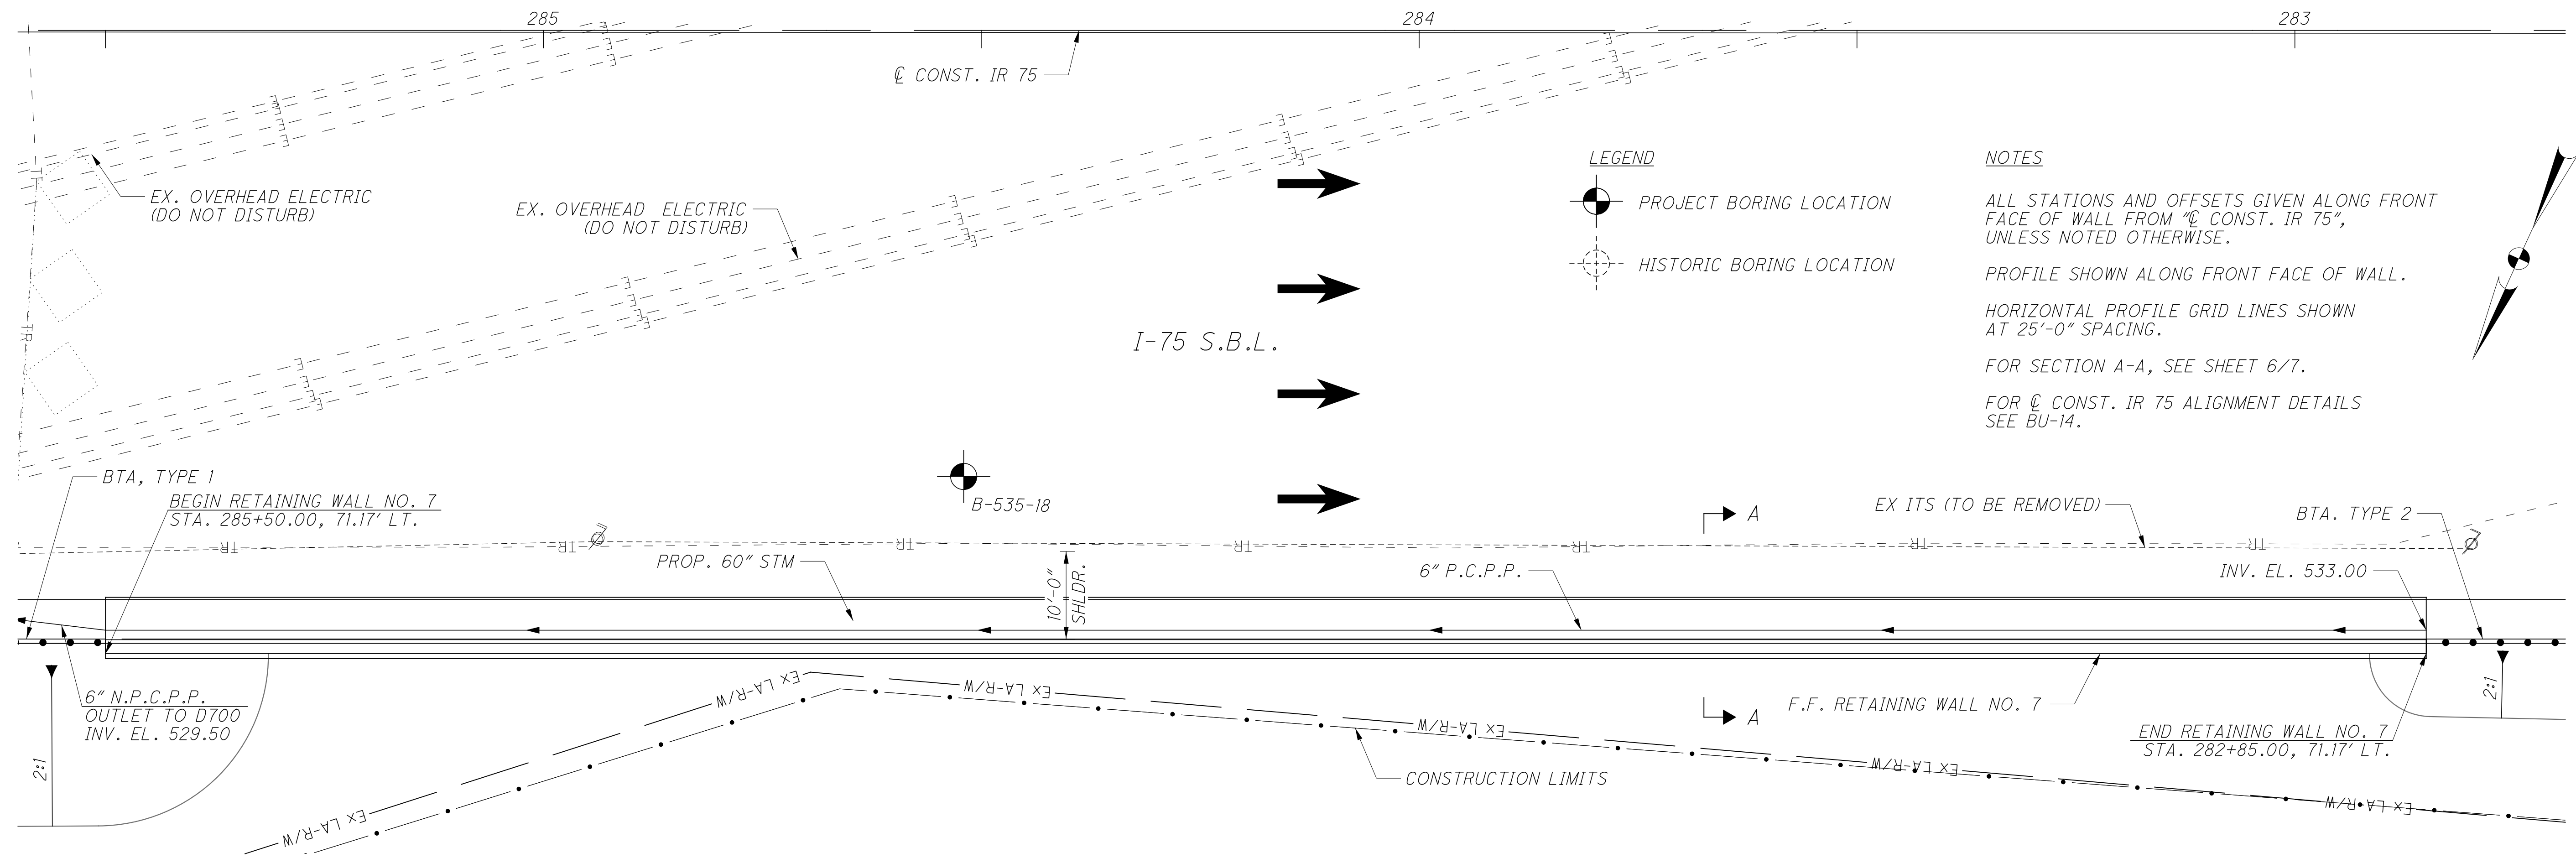

PLAN


EXISTING GROUND	534.72	533.49	534.14	534.47	534.47	533.72	534.00	533.03	532.84	532.82	534.96	536.57	EXISTING GROUND
500													500
510													510
520													520
530													530
540													540
550													550
560													560
TOP OF SHLDR./ WALL EL.	538.45	538.52	538.59	538.62	538.66	538.63	538.60	538.55	538.50	538.39	538.28	538.18	TOP OF SHLDR./ WALL EL.

PROFILE


ALONG F.F. RETAINING WALL NO. 7

DESIGN AGENCY: STRUCTUREPOINT
 DATE: 01/18/19
 REVIEWED: MDS
 DRAWN: BMP
 DESIGNED: SJF
 CHECKED: CLB
 FILE NUMBER:
 RETAINING WALL NO. 7 DETAILS
 ALONG IR 75 SB
 HAM-75-3.84
 PID No. 104667
 1 / 7
 29 / 48

W:\2017\01113\C.Design\104667_HAM-75-3.84\Design\Structures\Walls\Sheets\104667_WD71.dgn
 8/22/2022 9:14:27 AM
 O:\2017\01113\C.Design\104667_HAM-75-3.84\Design\Structures\Walls\Sheets\104667_WD71.dgn

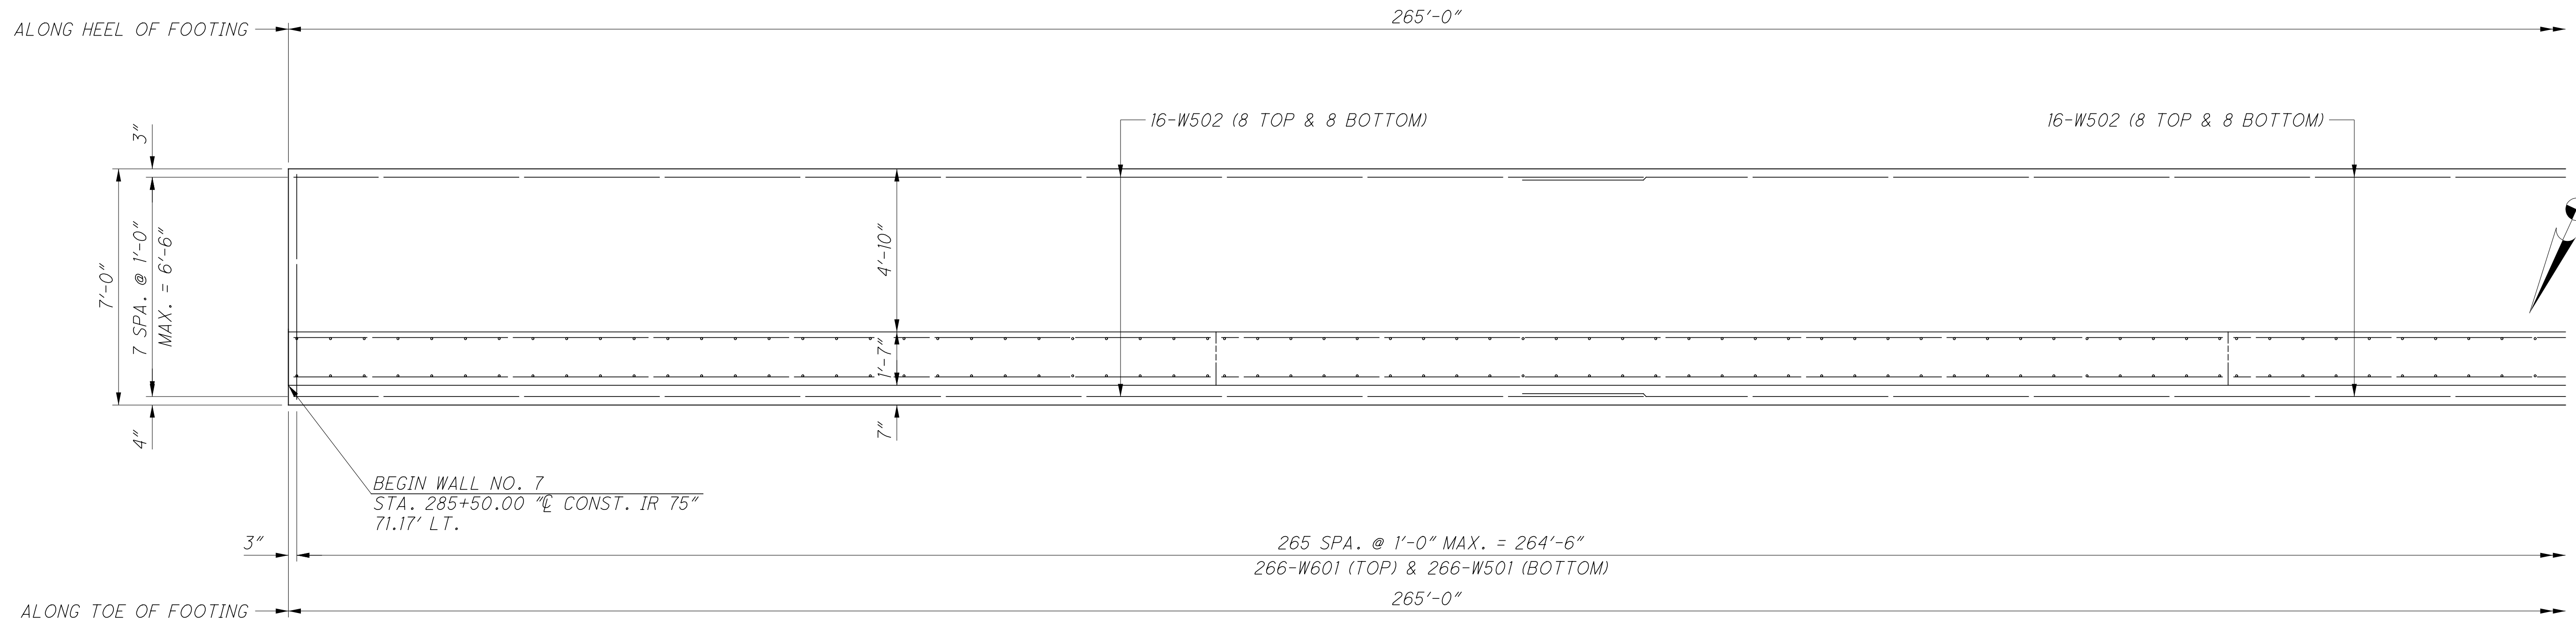

PARTIAL PLAN

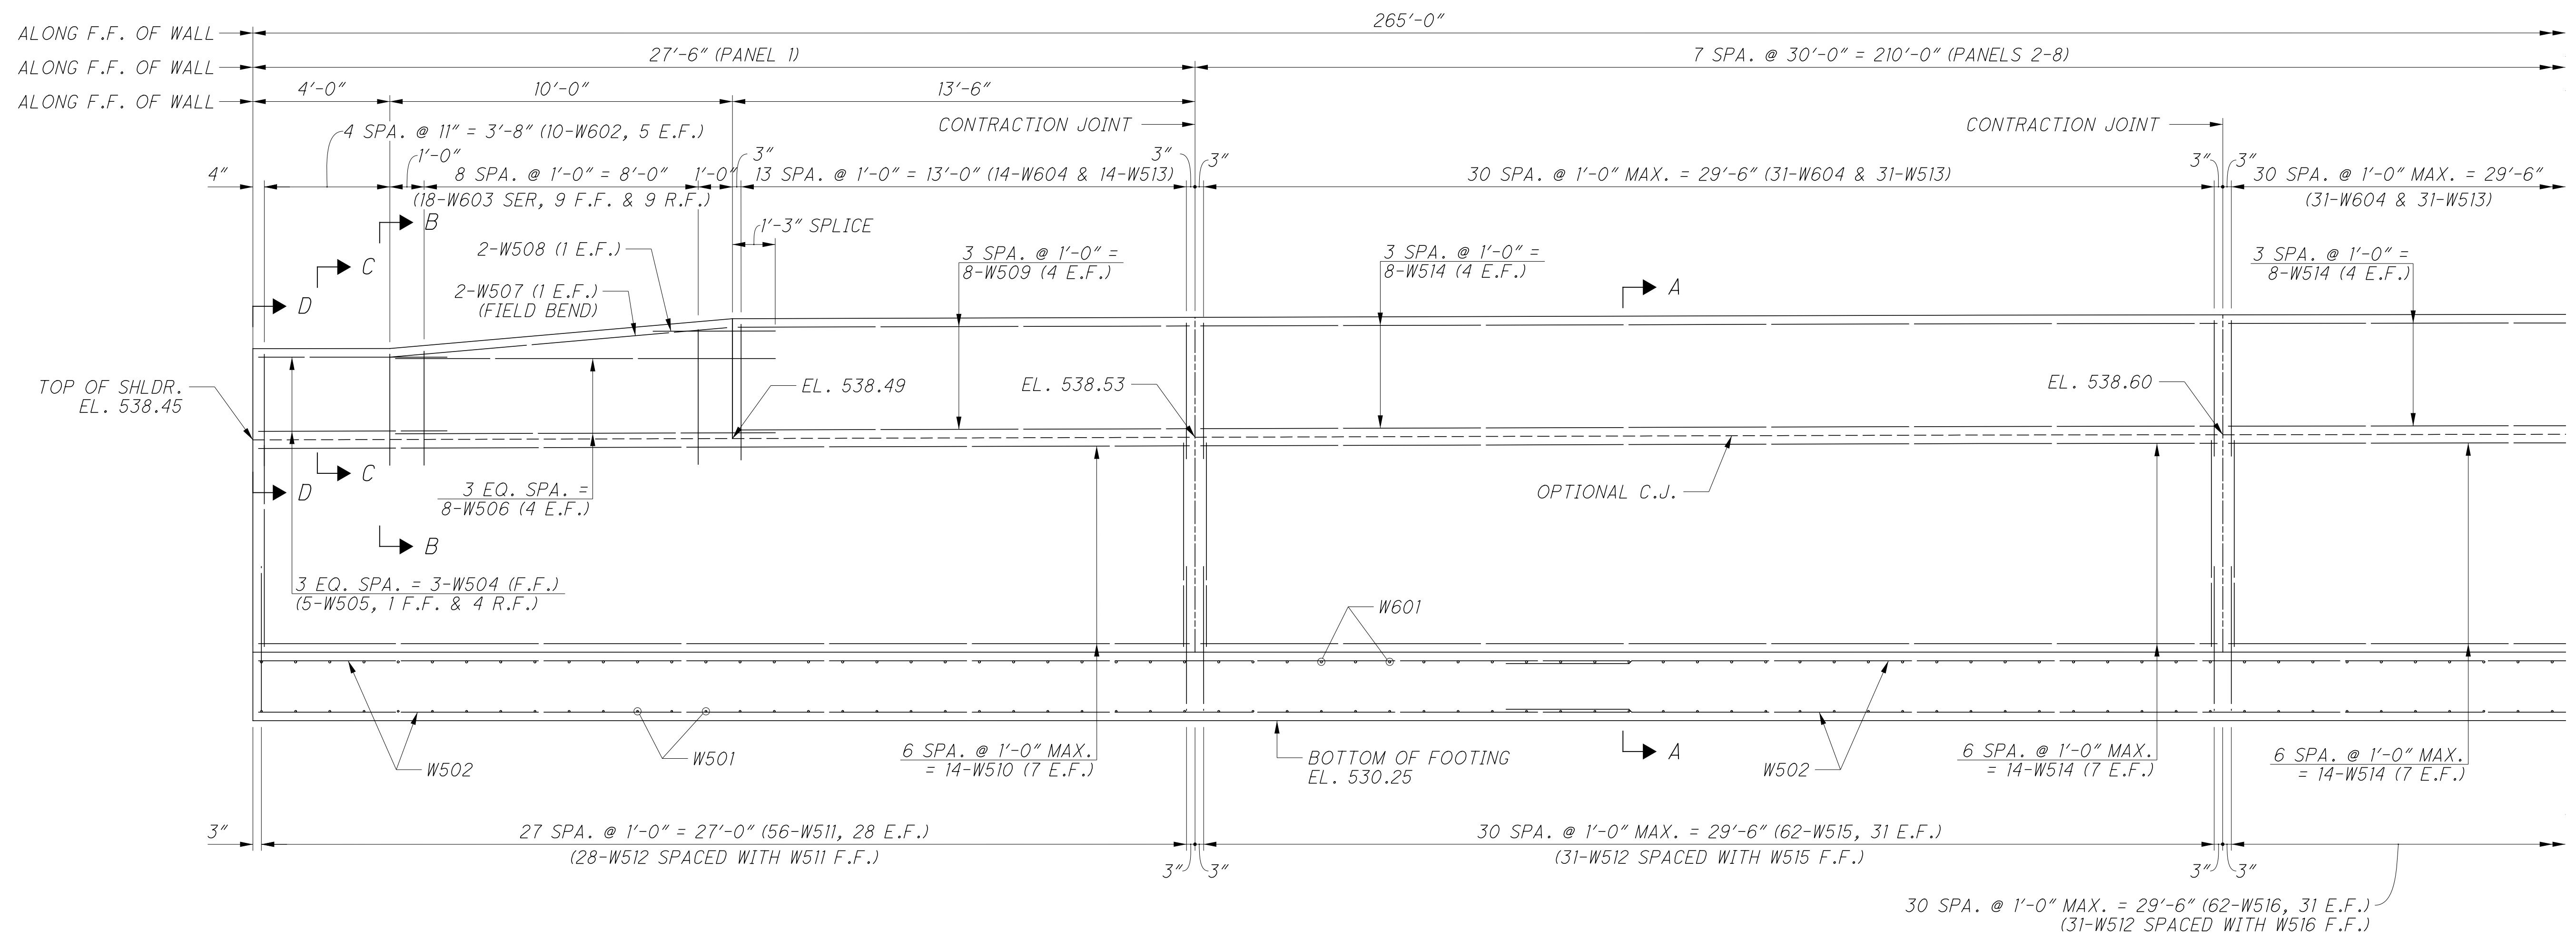


PARTIAL ELEVATION

MINIMUM BAR LAP	
#5 (VERTICAL)	2'-7"
#5 (HORIZONTAL)	3'-7"


NOTES
 FOR SECTIONS A-A THRU D-D, SEE SHEET 6/7.
 FOR CONTRACTION AND EXPANSION JOINT DETAILS, SEE SHEET 6/7.

DESIGN AGENCY: STRUCTUREPOINT
 DATE: 01/18/19
 REVIEWED: MDS
 DRAWN: BMP
 DESIGNED: SUJ
 CHECKED: CLB
 RETAINING WALL NO. 7 DETAILS
 ALONG IR 75 SB
 HAM-75-3.84
 PID No. 104667
 2 / 7
 30
 48

Wads
 8/22/2022 9:14:28 AM
 O:\2017\01113\C.Design\104667_HAM-75-3.84\Design\Structures\Walls\Sheets\104667_WD72.dgn

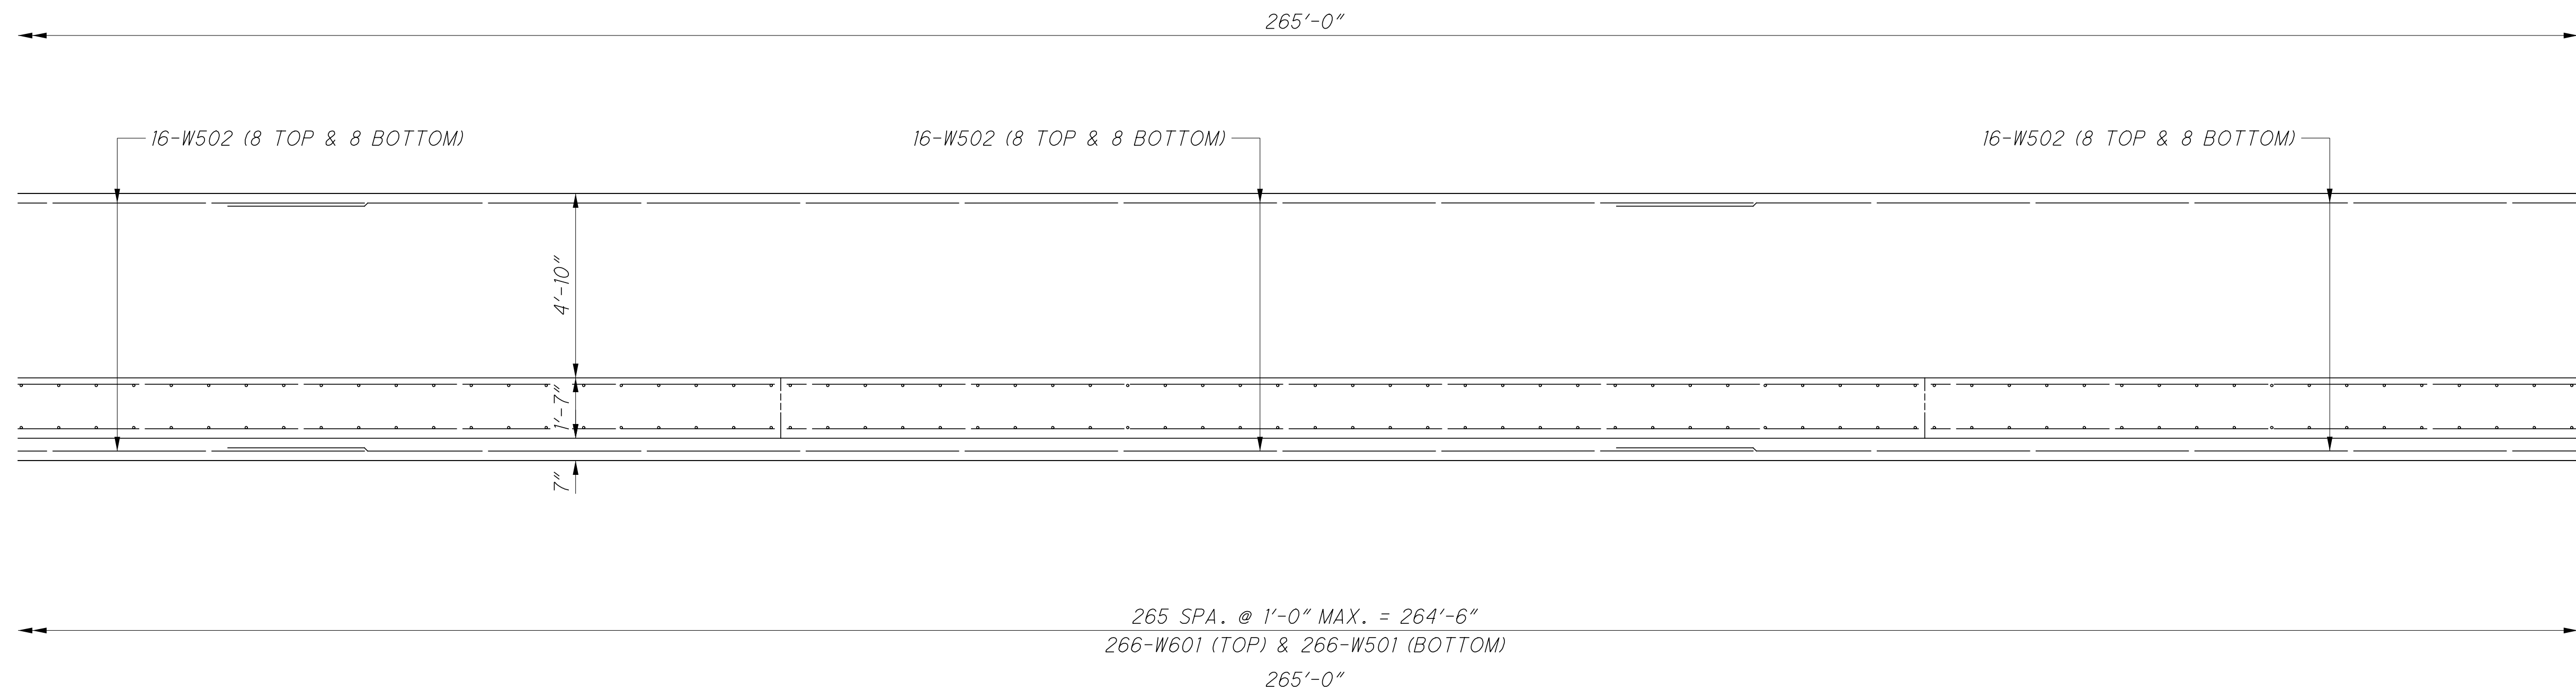


PARTIAL PLAN

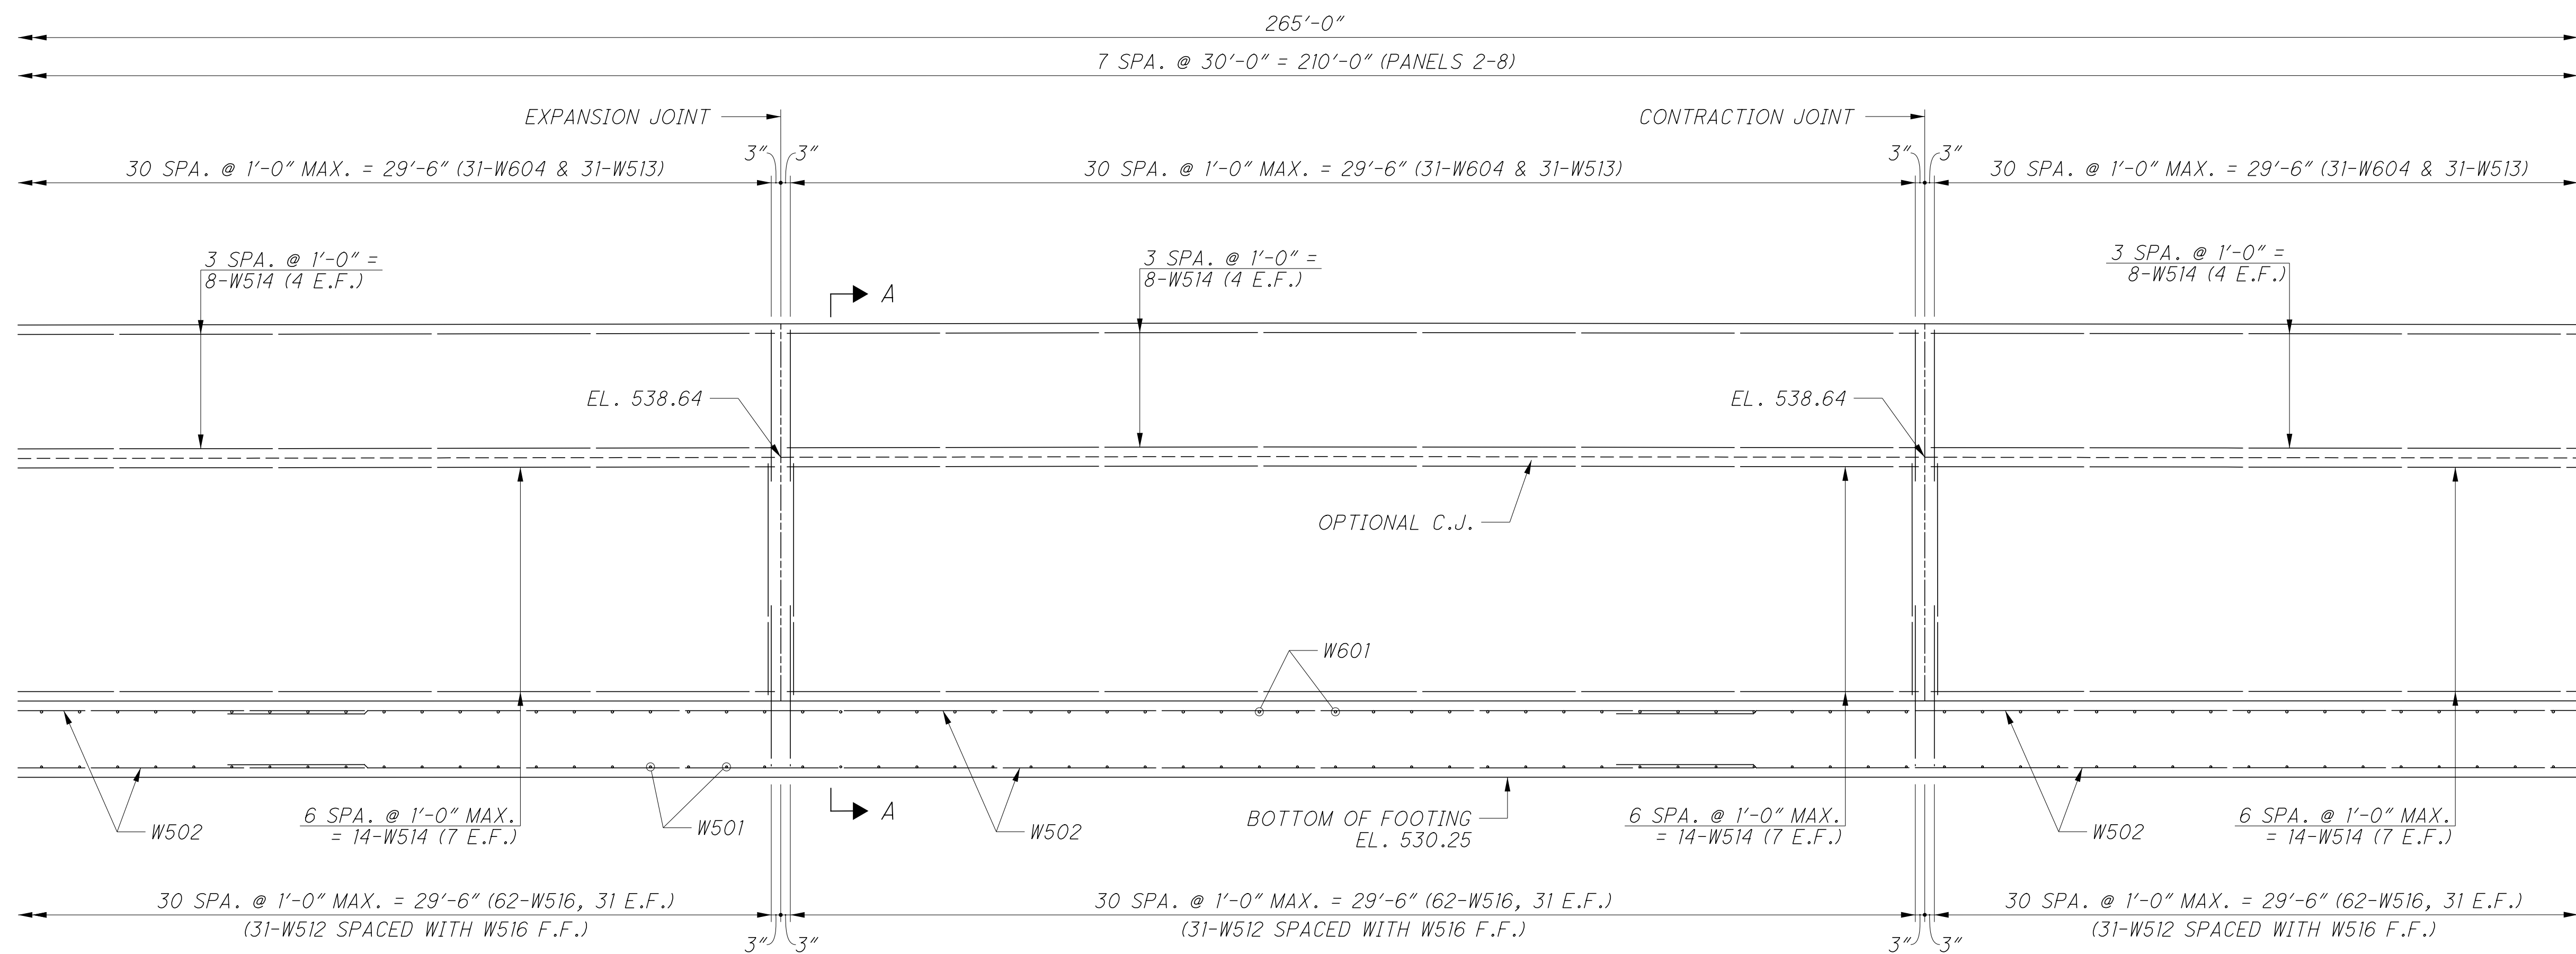

PARTIAL ELEVATION


MINIMUM BAR LAP	
#5 (VERTICAL)	2'-7"
#5 (HORIZONTAL)	3'-7"

NOTES
 FOR SECTIONS A-A THRU D-D, SEE SHEET 6/7.
 FOR CONTRACTION AND EXPANSION
 JOINT DETAILS, SEE SHEET 6/7.

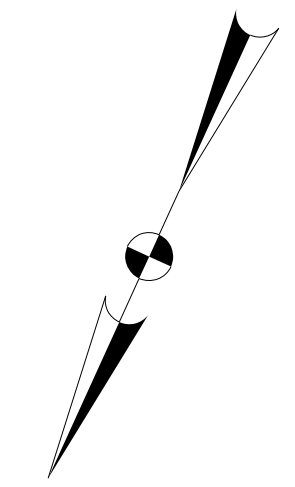


 DESIGN AGENCY 2000 CORPORATION CENTER DR. STE. 200 FORT WORTH, TX 76102 TEL: 817.339.8800 FAX: 817.339.8801 WWW.STRUCTUREPOINT.COM	
DESIGNED	DATE
SUF	01/18/19
CHECKED	STRUCTURE FILE NUMBER
CLB	
RETAINING WALL NO. 7 DETAILS ALONG IR 75 SB	
HAM-75-3.84 PID No. 104667	
3 / 7	
31 48	

jwade 8/22/2022 9:14:29 AM
 O:\2017\01113.C. Design\104667_HAM-75-3.84.Design\Structures\Walls_Sheets\104667_WD73.dgn

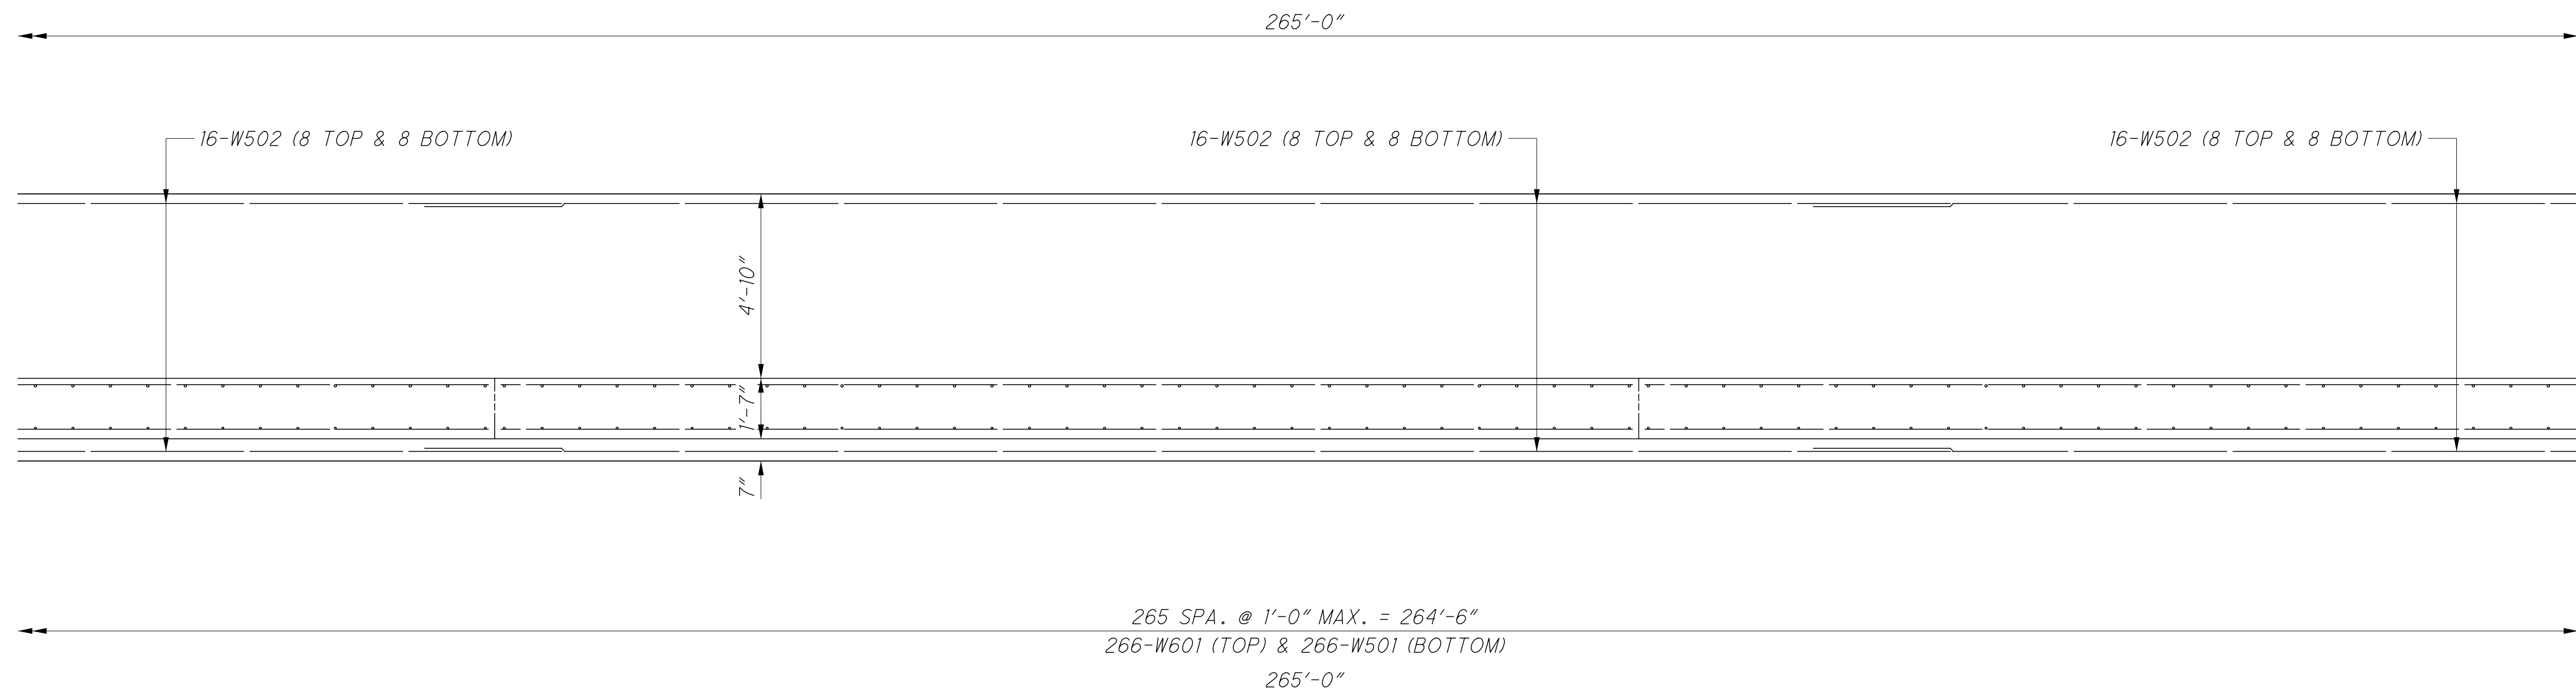

PARTIAL PLAN

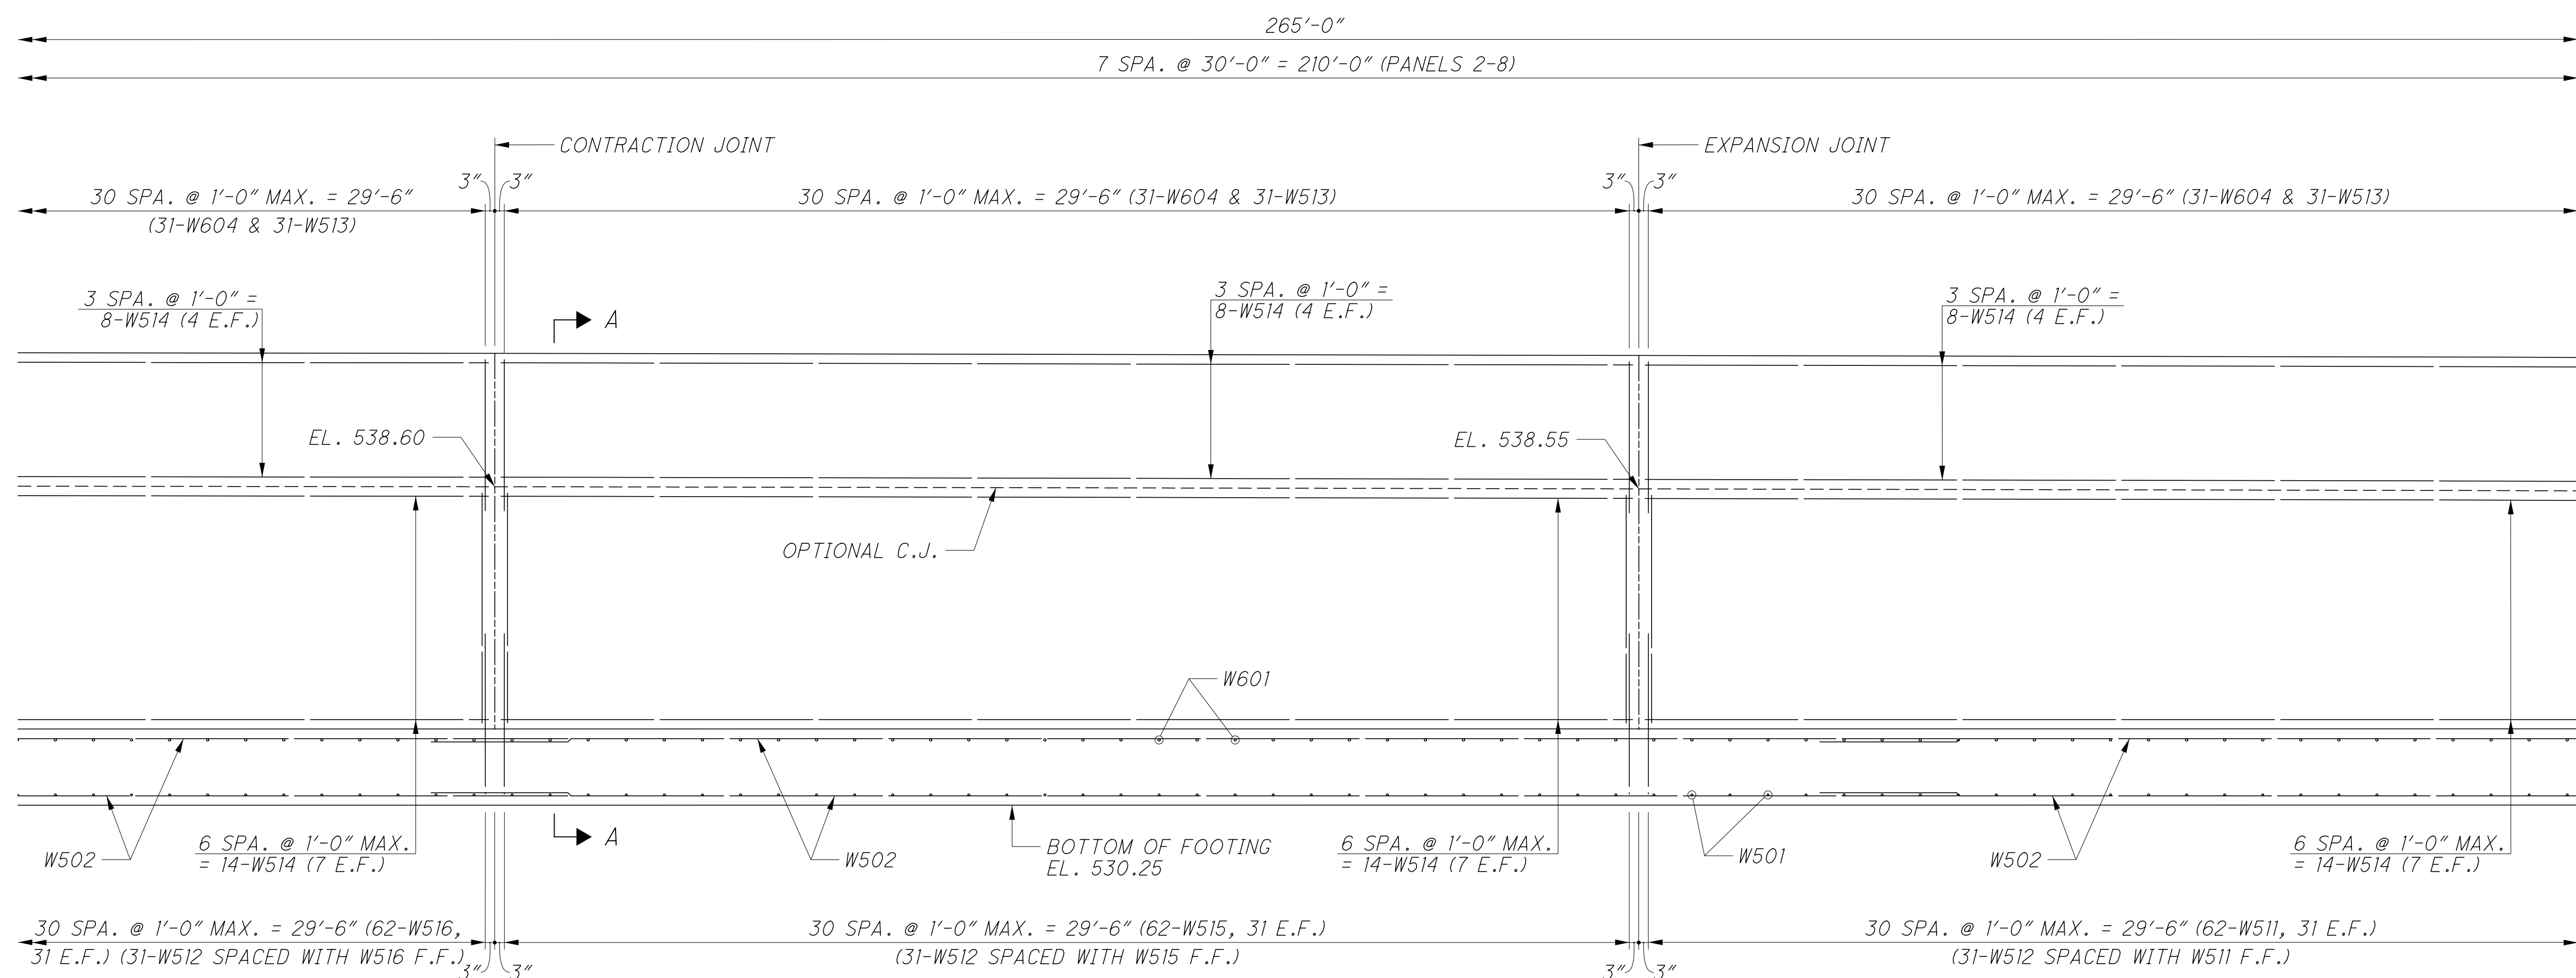


PARTIAL ELEVATION

MINIMUM BAR LAP	
#5 (VERTICAL)	2'-7"
#5 (HORIZONTAL)	3'-7"


NOTES
 FOR SECTIONS A-A THRU D-D, SEE SHEET 6/7.
 FOR CONTRACTION AND EXPANSION JOINT DETAILS, SEE SHEET 6/7.

 DESIGN AGENCY STRUCTUREPOINT 2000 CORPORATE CENTER DR., STE. 200 FORT WORTH, TX 76102 TEL: 817.339.8300 FAX: 817.339.8301 WWW.STRUCTUREPOINT.COM		
REVIEWED: MDS DATE: 01/18/19 STRUCTURE FILE NUMBER:		
DRAWN: BMP REVISIONS:		
DESIGNED: SUJ CHECKED: CLB		
RETAINING WALL NO. 7 DETAILS ALONG IR 75 SB		
HAM-75-3.84 PID No. 104667		
4 / 7		
<table border="1" style="margin: auto;"> <tr> <td style="width: 20px; height: 20px; text-align: center;">32</td> </tr> <tr> <td style="width: 20px; height: 20px; text-align: center;">48</td> </tr> </table>	32	48
32		
48		

Wads
 8/22/2022 9:14:30 AM
 O:\2017\01113\C.Design\104667_HAM-75-3.84\Design\Structures\Walls\Sheets\104667_WD74.dgn

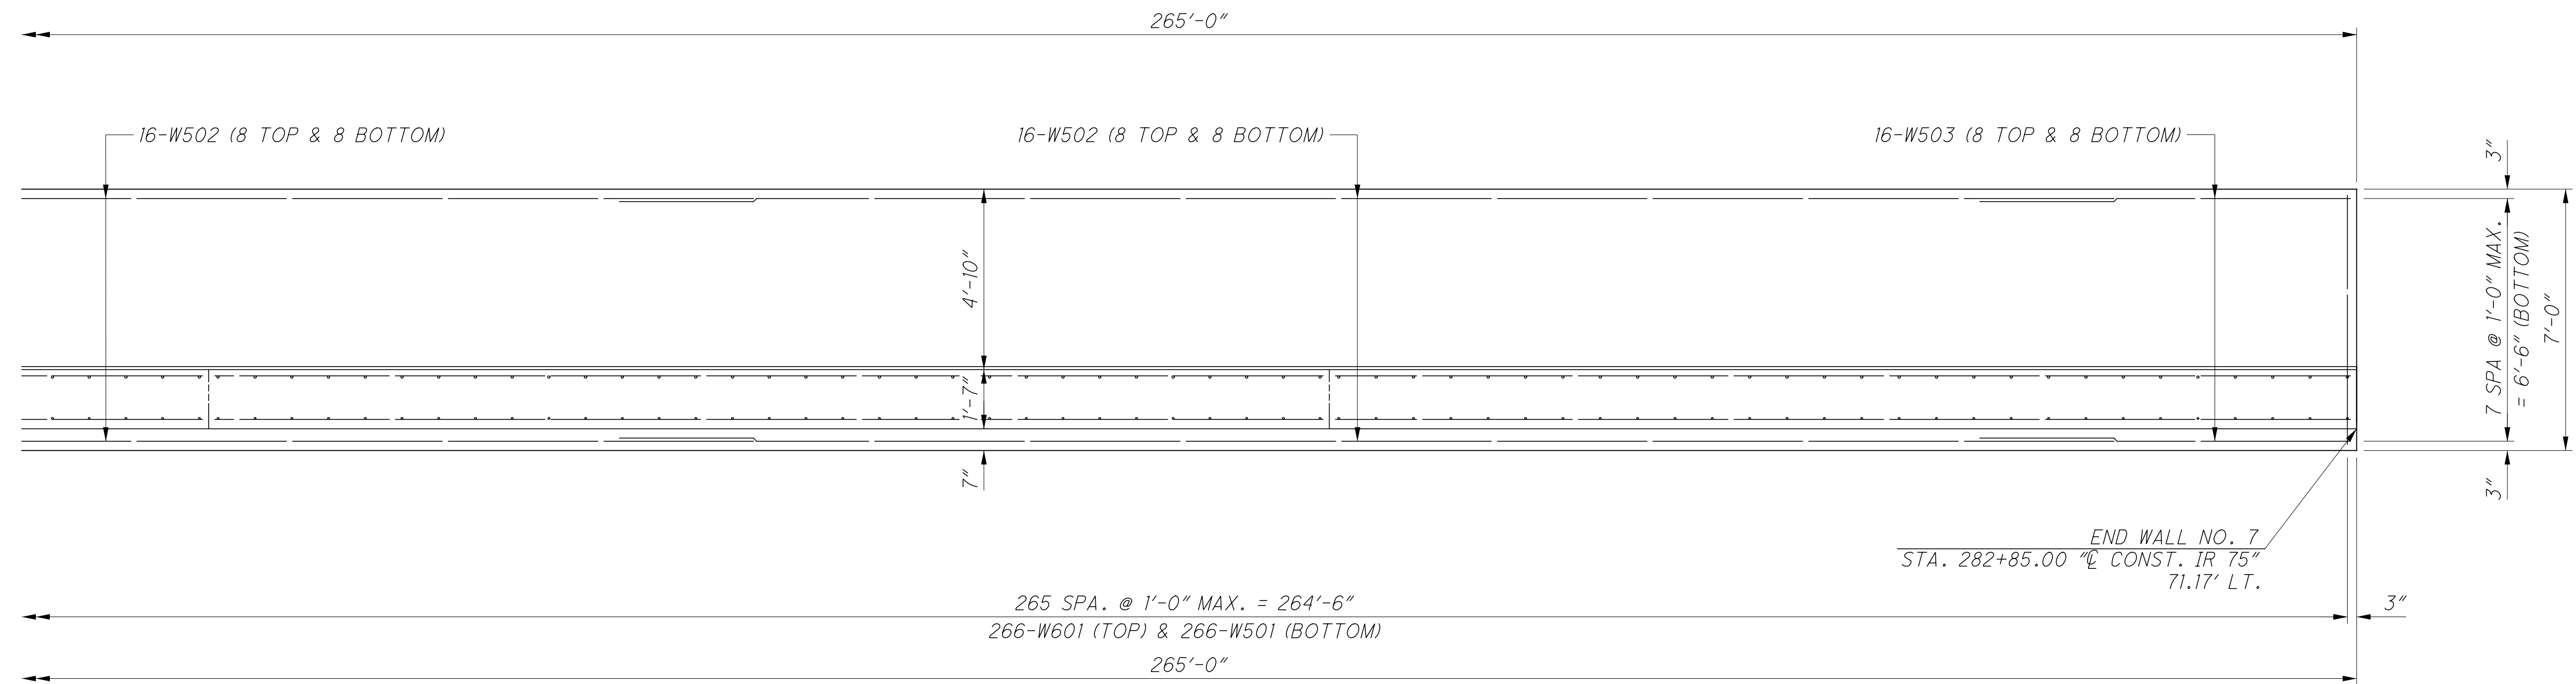

PARTIAL PLAN

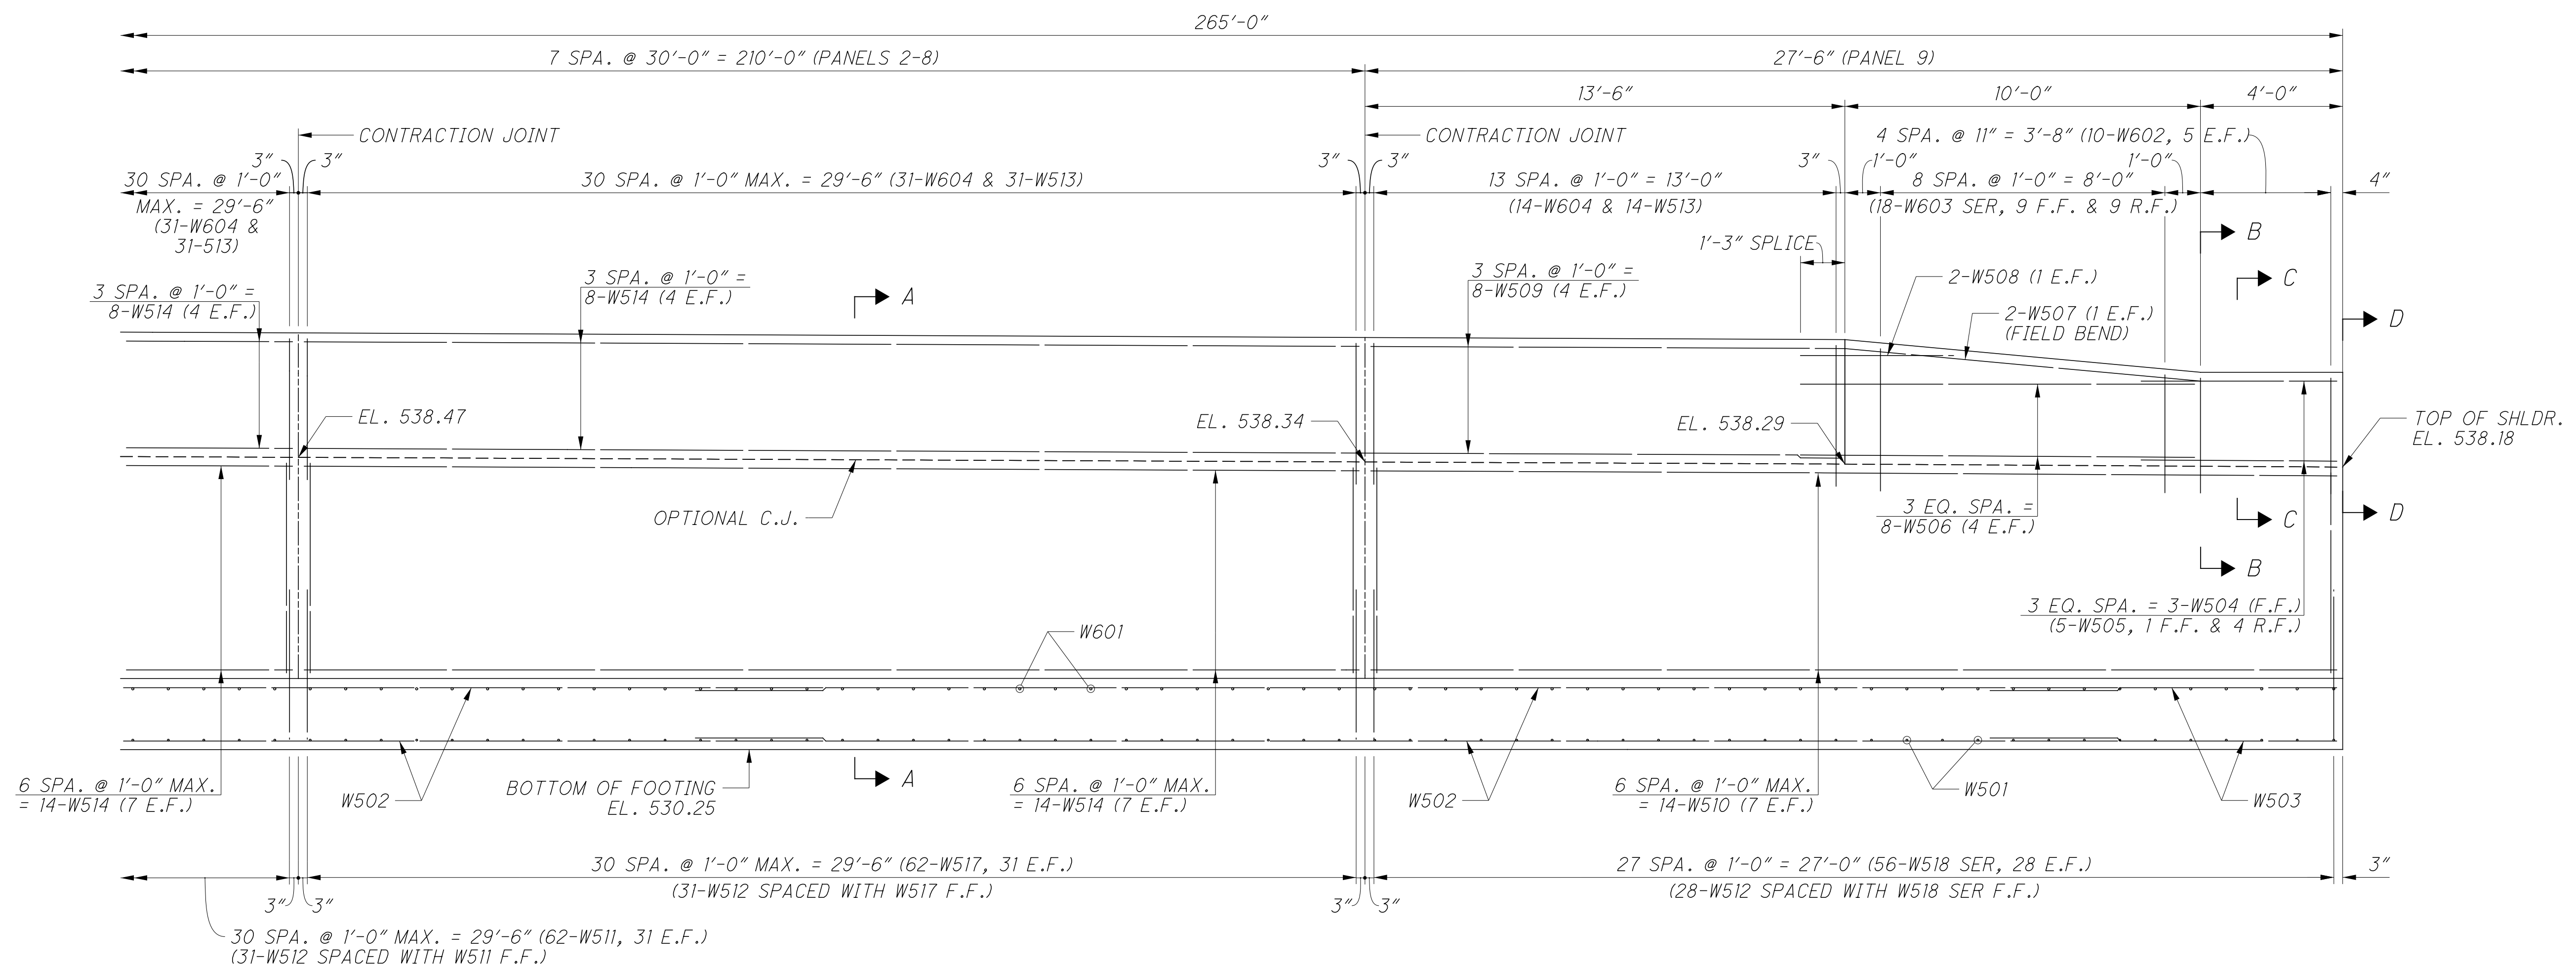

PARTIAL ELEVATION

MINIMUM BAR LAP	
#5 (VERTICAL)	2'-7"
#5 (HORIZONTAL)	3'-7"


NOTES
 FOR SECTIONS A-A THRU D-D, SEE SHEET 6/7.
 FOR CONTRACTION AND EXPANSION JOINT DETAILS, SEE SHEET 6/7.


RETAINING WALL NO. 7 DETAILS
 ALONG IR 75 SB

HAM-75-3.84
 PID No. 104667


5 / 7

33
48

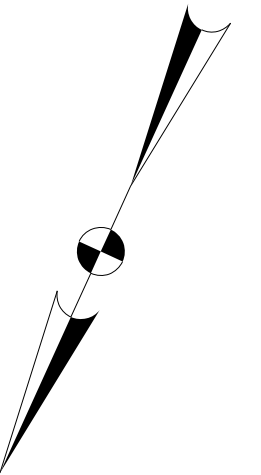


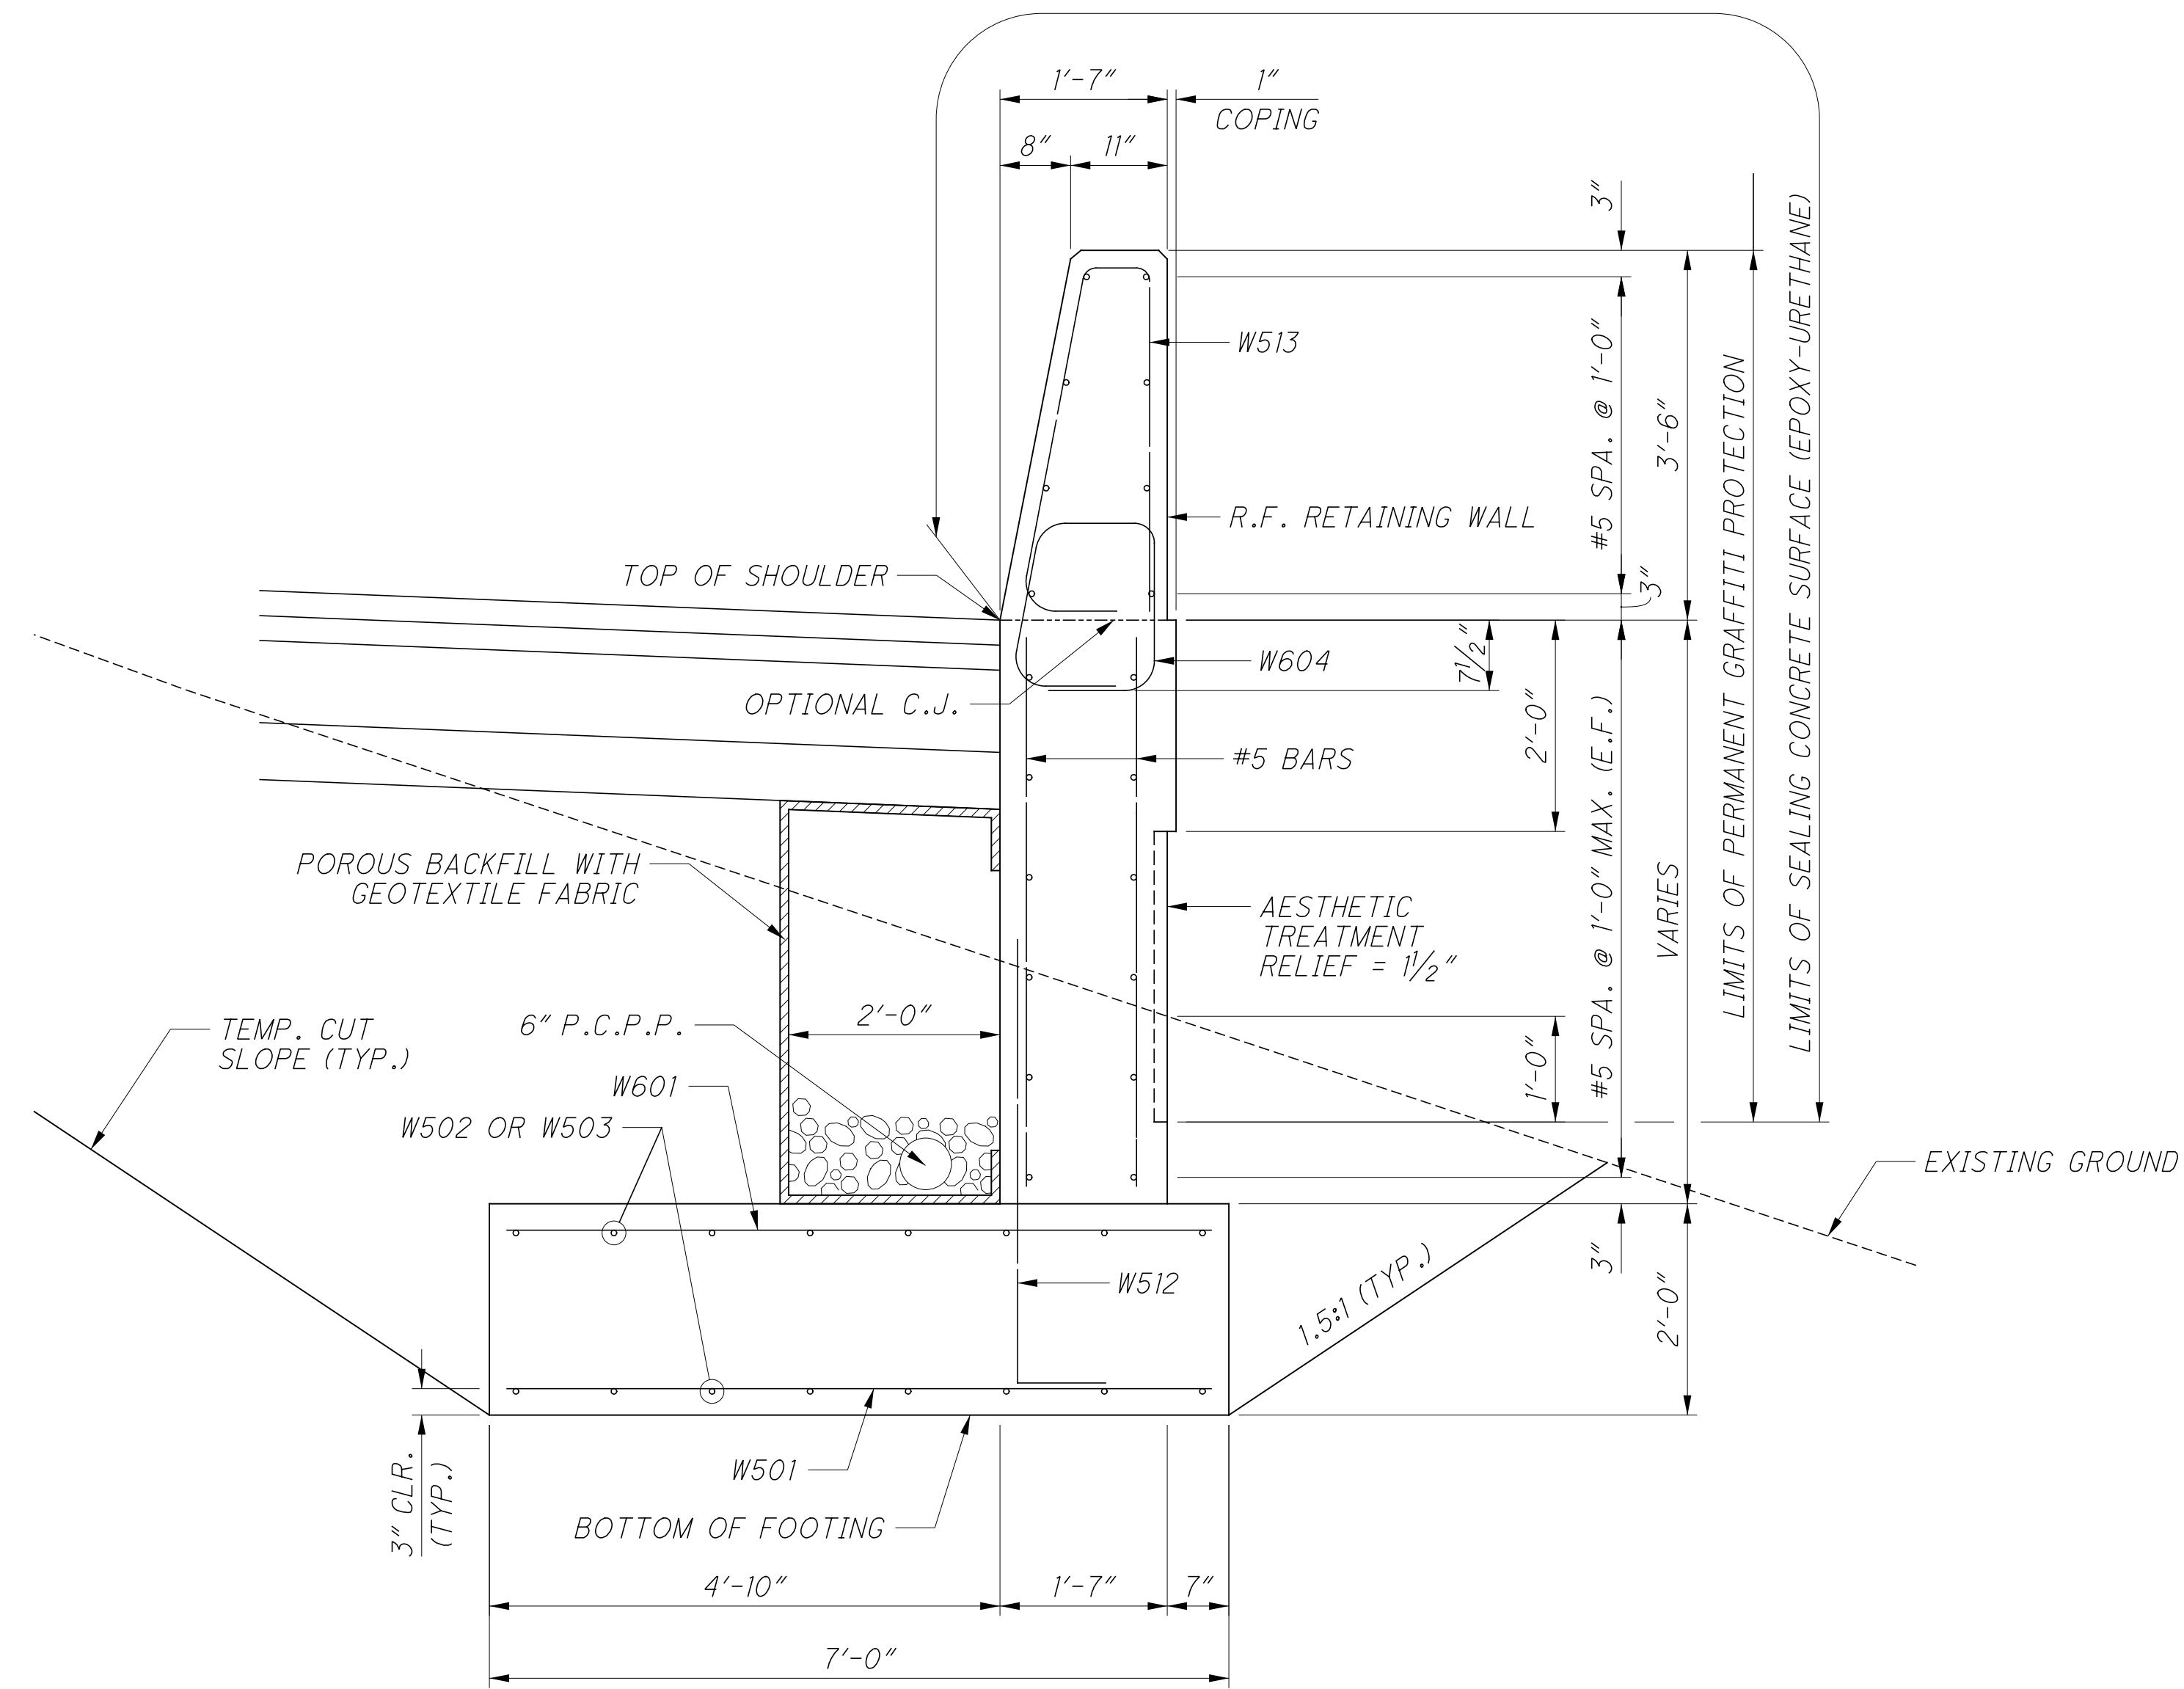


SECTION A-A

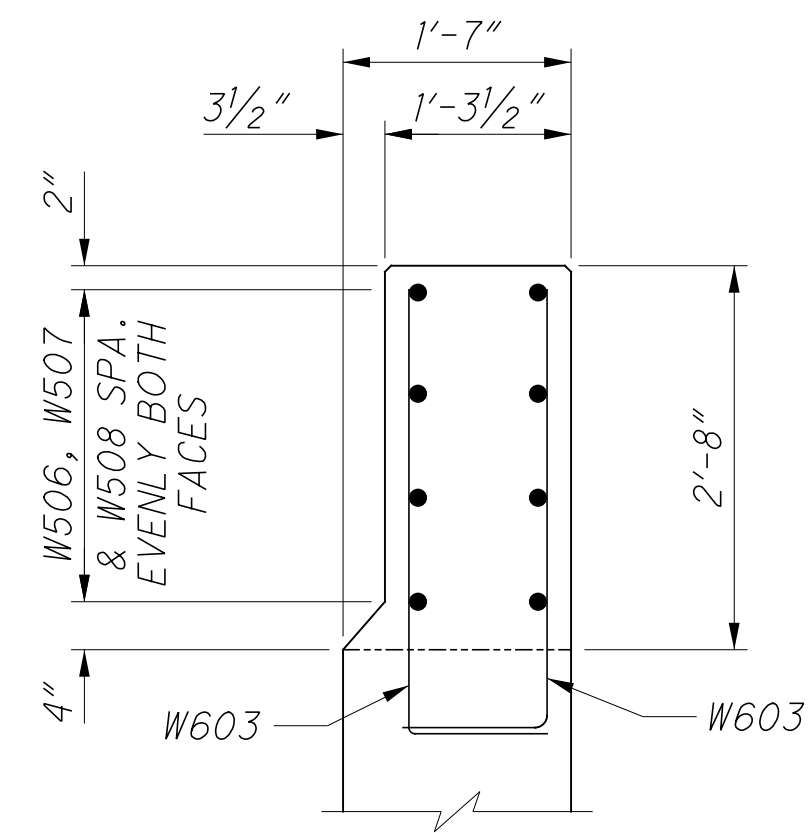


SECTION B-B

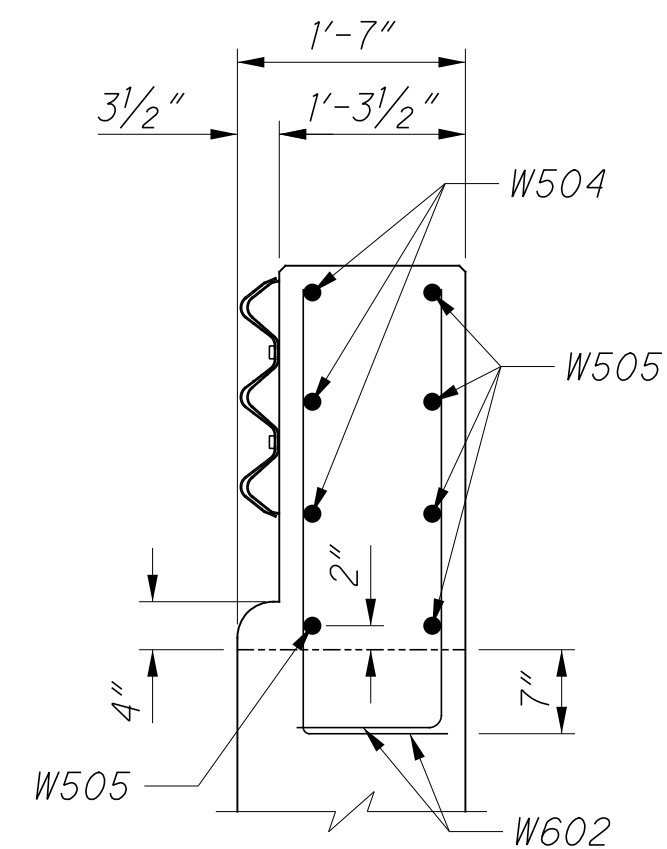


SECTION C-C

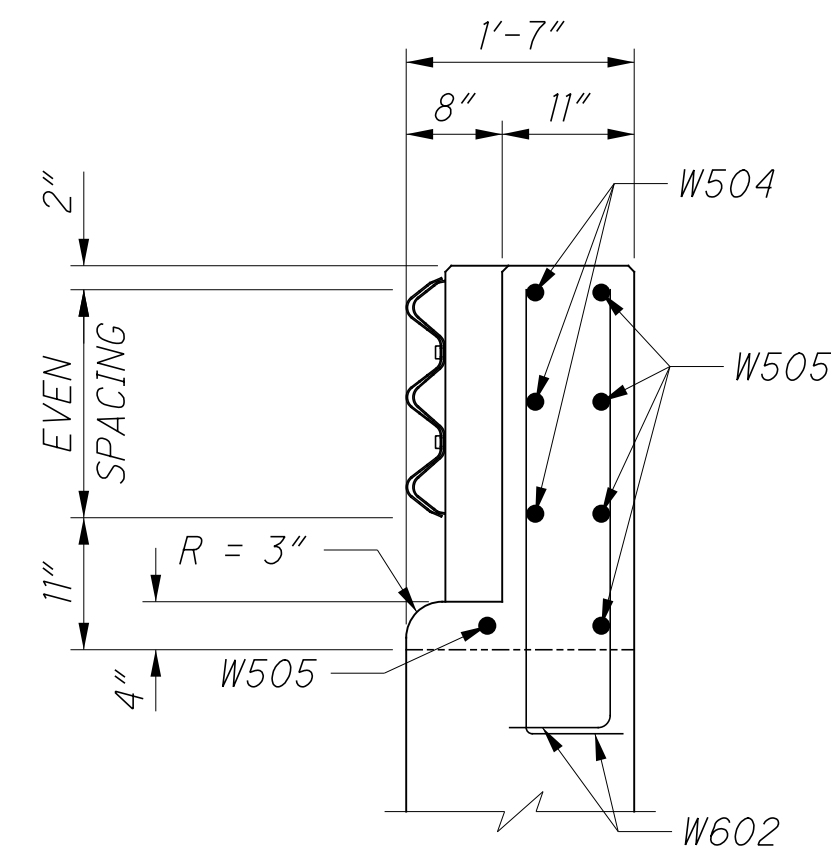

SECTION D-D

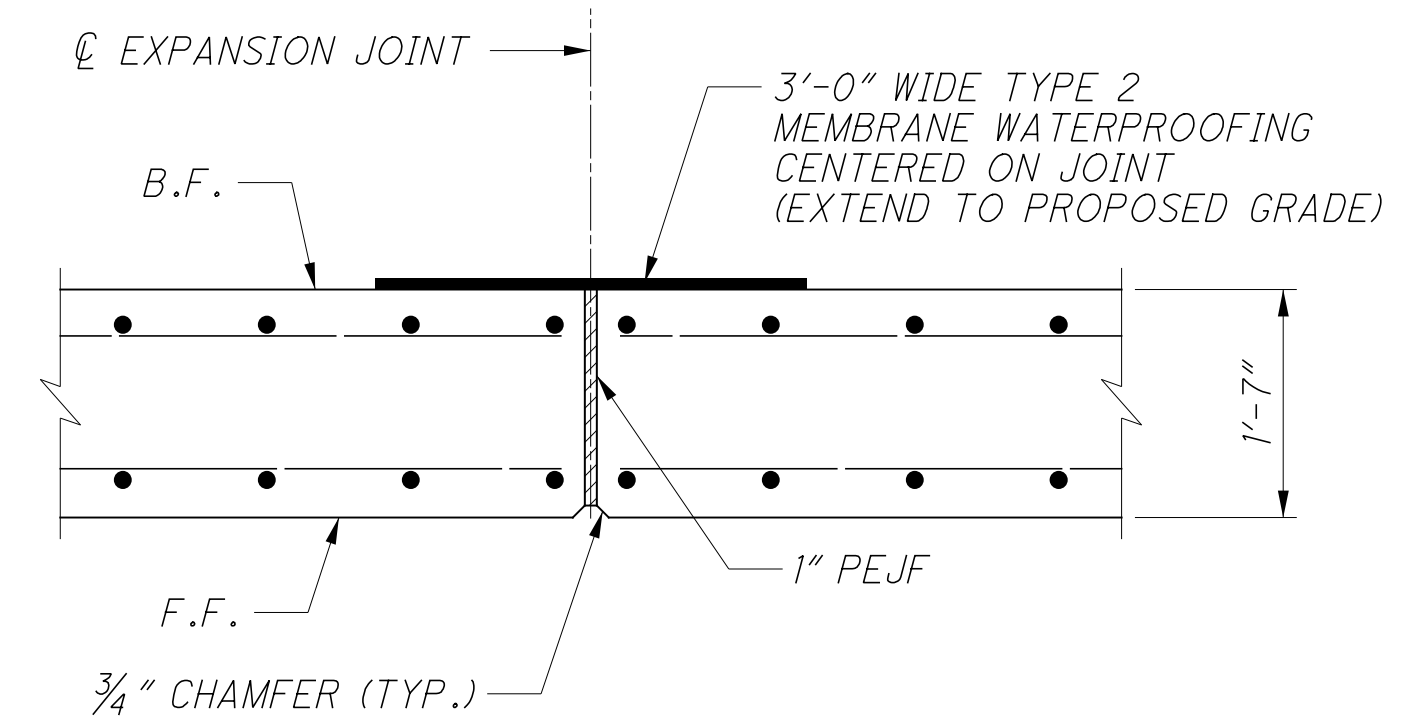


EXPANSION JOINT DETAIL

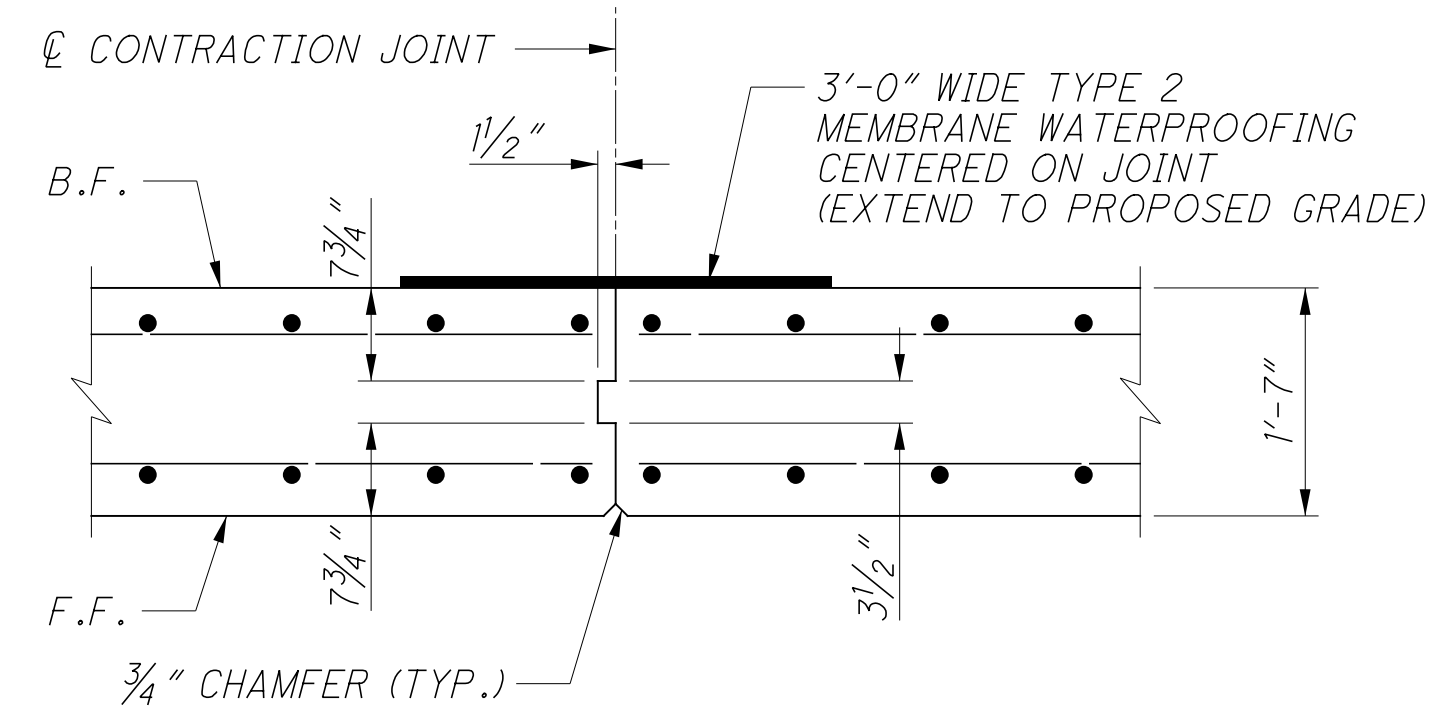


CONTRACTION JOINT DETAIL

NOTES
 FOR BRIDGE TERMINAL ASSEMBLY,
 SEE STANDARD CONSTRUCTION
 DRAWING MSG 3.1 AND 3.2.


MARK	NUMBER		LENGTH	WEIGHT	TYPE	DIMENSIONS					
	TOTAL					A	B	C	D	E	R
WALL NO. 7											
W501	266		6'-8"	1850	STR						
W502	112		40'-0"	4673	STR						
W503	16		9'-11"	165	STR						
W504	6		5'-7"	35	25	1'-8"	2'-5"	1'-5"	1 1/2"	6 1/2"	
W505	10		5'-6"	57	STR						
W506	16		11'-1"	185	STR						
W507	4		11'-3"	47	STR						
W508	4		3'-6"	15	STR						
W509	16		13'-2"	220	STR						
W510	28		27'-2"	793	STR						
W511	118		5'-10"	718	STR						
W512	273		5'-1"	1447	1	0'-10"	4'-5"				
W513	245		7'-4"	1874	23	0'-11"	3'-3"	3'-0"		3 1/2"	
W514	154		29'-8"	4765	STR						
W515	124		5'-11"	765	STR						
W516	186		6'-0"	1164	STR						
W517	62		5'-9"	372	STR						
	2 SR		5'-6"								
W518	OF	TO		329	STR						1/8"
	28		5'-9"								
W601	266		6'-8"	2664	STR						
W602	20		4'-1"	123	1	1'-0"	3'-3"				
	4 SR		4'-2"				3'-4"				
W603	OF	TO		243	1	1'-0"	TO				1/8"
	9		4'-9"				3'-11"				
W604	245		5'-8"	2085	40	1'-2"	1'-0"	1'-7"	1'-7"		
SUB-TOTAL				24,589							

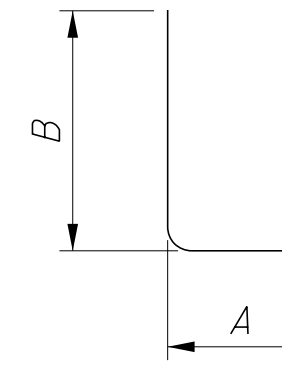


TYPE-1

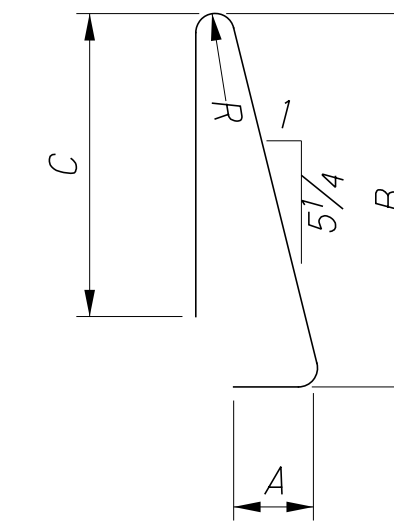

TYPE-23

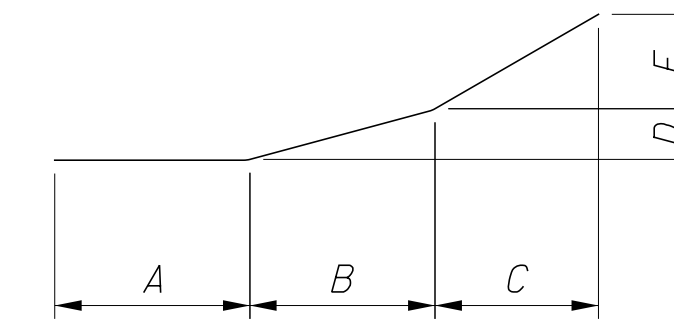


TYPE-25

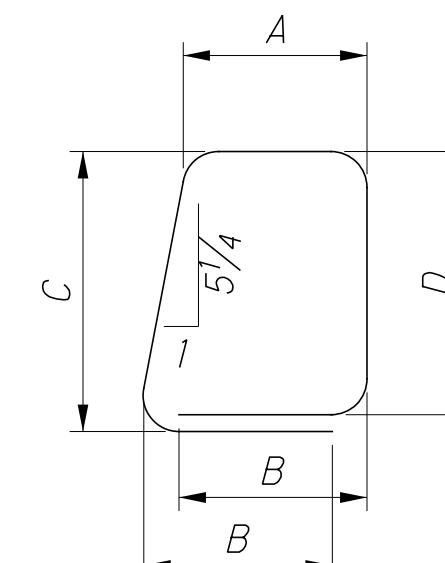

TYPE-40

8/22/2022 9:14:32 AM
 O:\2017\01113.C.Design\104667.HAM-75-3.84.Design\Structures\Walls_Sheets\104667_WD21.dgn

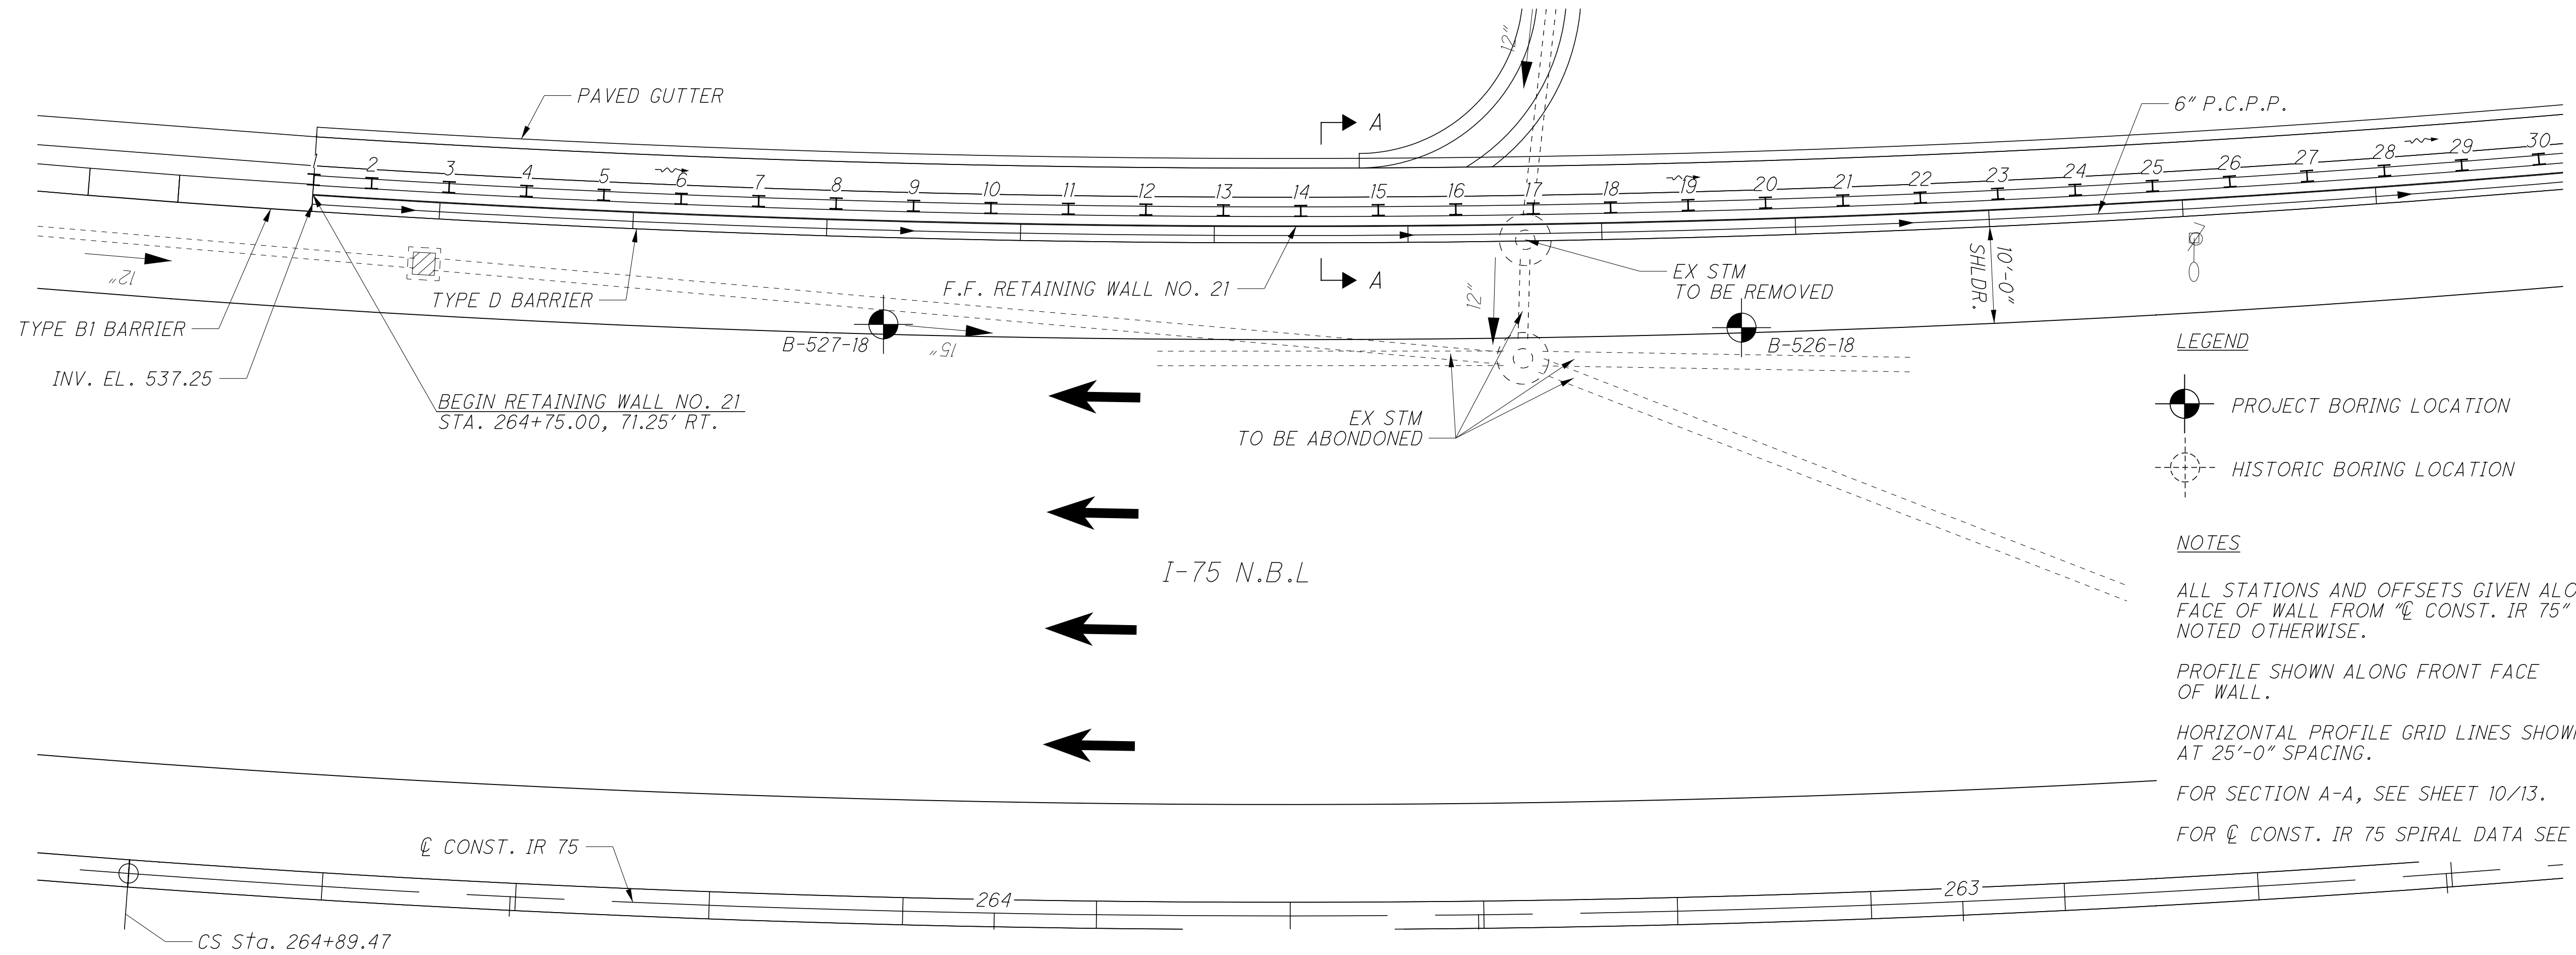

- LEGEND**
- PROJECT BORING LOCATION
 - HISTORIC BORING LOCATION

- NOTES**
- ALL STATIONS AND OFFSETS GIVEN ALONG FRONT FACE OF WALL FROM "C" CONST. IR 75" UNLESS NOTED OTHERWISE.
 - PROFILE SHOWN ALONG FRONT FACE OF WALL.
 - HORIZONTAL PROFILE GRID LINES SHOWN AT 25'-0" SPACING.
 - FOR SECTION A-A, SEE SHEET 10/13.
 - FOR "C" CONST. IR 75 SPIRAL DATA SEE BU-14.


PLAN

EXISTING GROUND EL.	EXISTING TOP OF SHLDR. EL.	520	530	540	550	560	570	TOP OF WALL EL.
543.18	539.59							543.56
543.28	539.44							544.80
543.35	539.22							546.03
543.40	538.98							547.07
543.47	538.64							547.10
542.88	538.29							547.03
542.85	537.94							546.68
542.40	537.56							546.38
542.32	537.21							546.18
542.32	536.87							546.12
EXISTING GROUND EL.	TOP OF SHLDR. EL.	520	530	540	550	560	570	TOP OF WALL EL.

PROFILE
ALONG F.F. RETAINING WALL NO. 21


DESIGN AGENCY: **STRUCTUREPOINT**
 DATE: 01/18/19
 REVIEWED: MDS
 DRAWN: BMP
 DESIGNED: SUJ
 CHECKED: CLB
 RETAINING WALL NO. 21 DETAILS
 ALONG IR 75 NB
 HAM-75-3.84
 PID No. 104667
 1 / 13
 36 / 48

8/22/2022 9:14:33 AM
 O:\2017\01113.C.Design\104667.HAM-75-3.84.Design\Structures\Walls_Sheets\104667_WD22.dgn

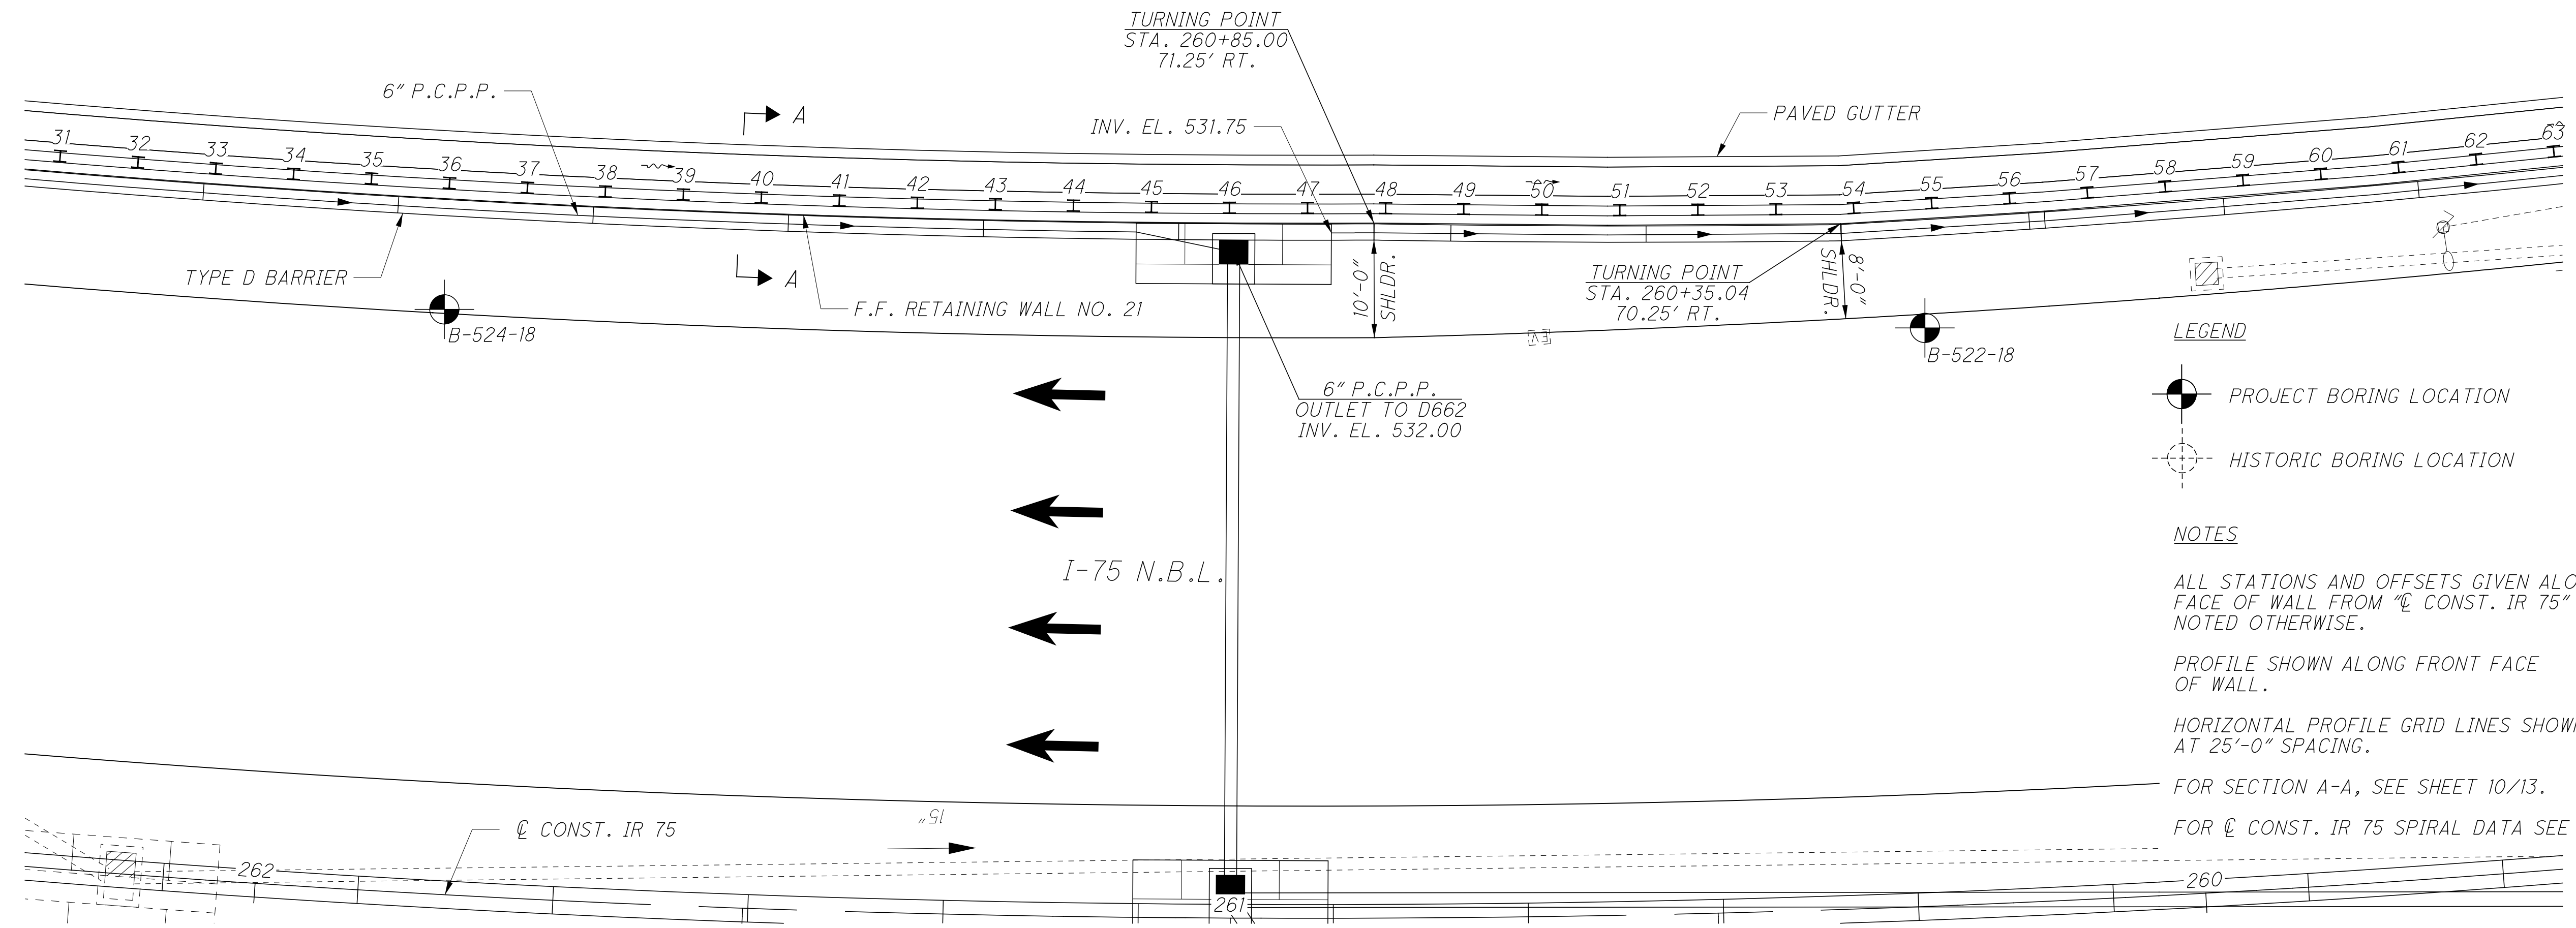


- LEGEND**
- PROJECT BORING LOCATION
 - HISTORIC BORING LOCATION

- NOTES**
- ALL STATIONS AND OFFSETS GIVEN ALONG FRONT FACE OF WALL FROM "C" CONST. IR 75" UNLESS NOTED OTHERWISE.
 - PROFILE SHOWN ALONG FRONT FACE OF WALL.
 - HORIZONTAL PROFILE GRID LINES SHOWN AT 25'-0" SPACING.
 - FOR SECTION A-A, SEE SHEET 10/13.
 - FOR "C" CONST. IR 75 SPIRAL DATA SEE BU-14.

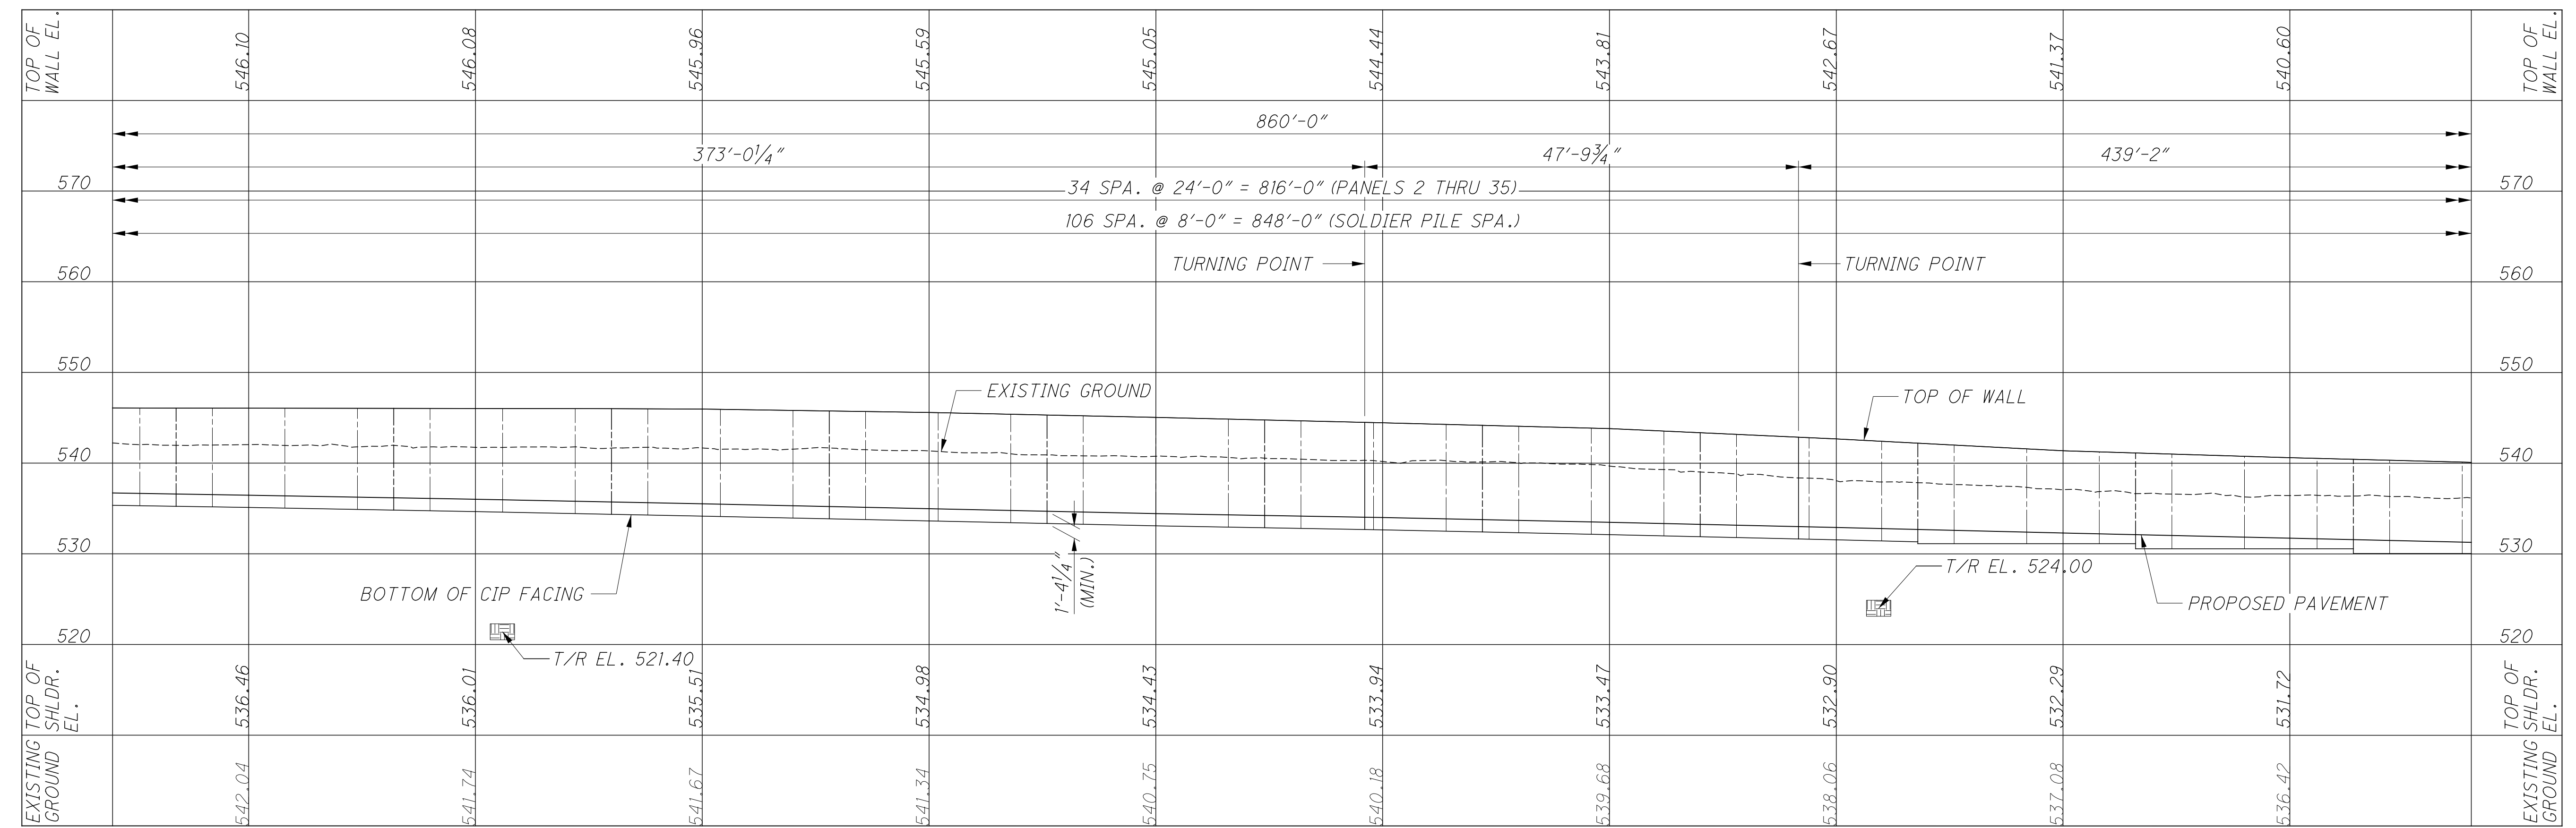

PROFILE
 ALONG F.F. RETAINING WALL NO. 21

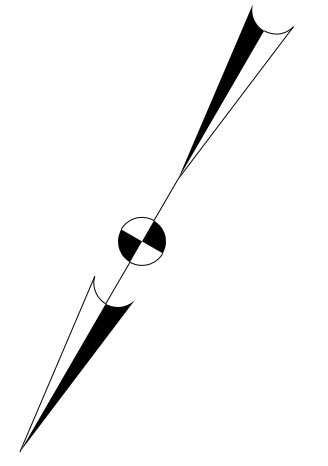

DESIGN AGENCY
 STRUCTUREPOINT
 2000 CORPORATE CENTER DR., 17TH FL.
 HOUSTON, TX 77056
 TEL: 713.861.3333 FAX: 713.861.3335
 WWW.STRUCTUREPOINT.COM


DESIGNED	SJF	CHECKED	CLB
DRAWN	BMP	REVISED	
REVIEWED	MDS	STRUCTURE FILE NUMBER	
DATE	01/18/19		

RETAINING WALL NO. 21 DETAILS
 ALONG IR 75 NB

HAM-75-3.84
PID No. 104667

2 / 13

37
 48

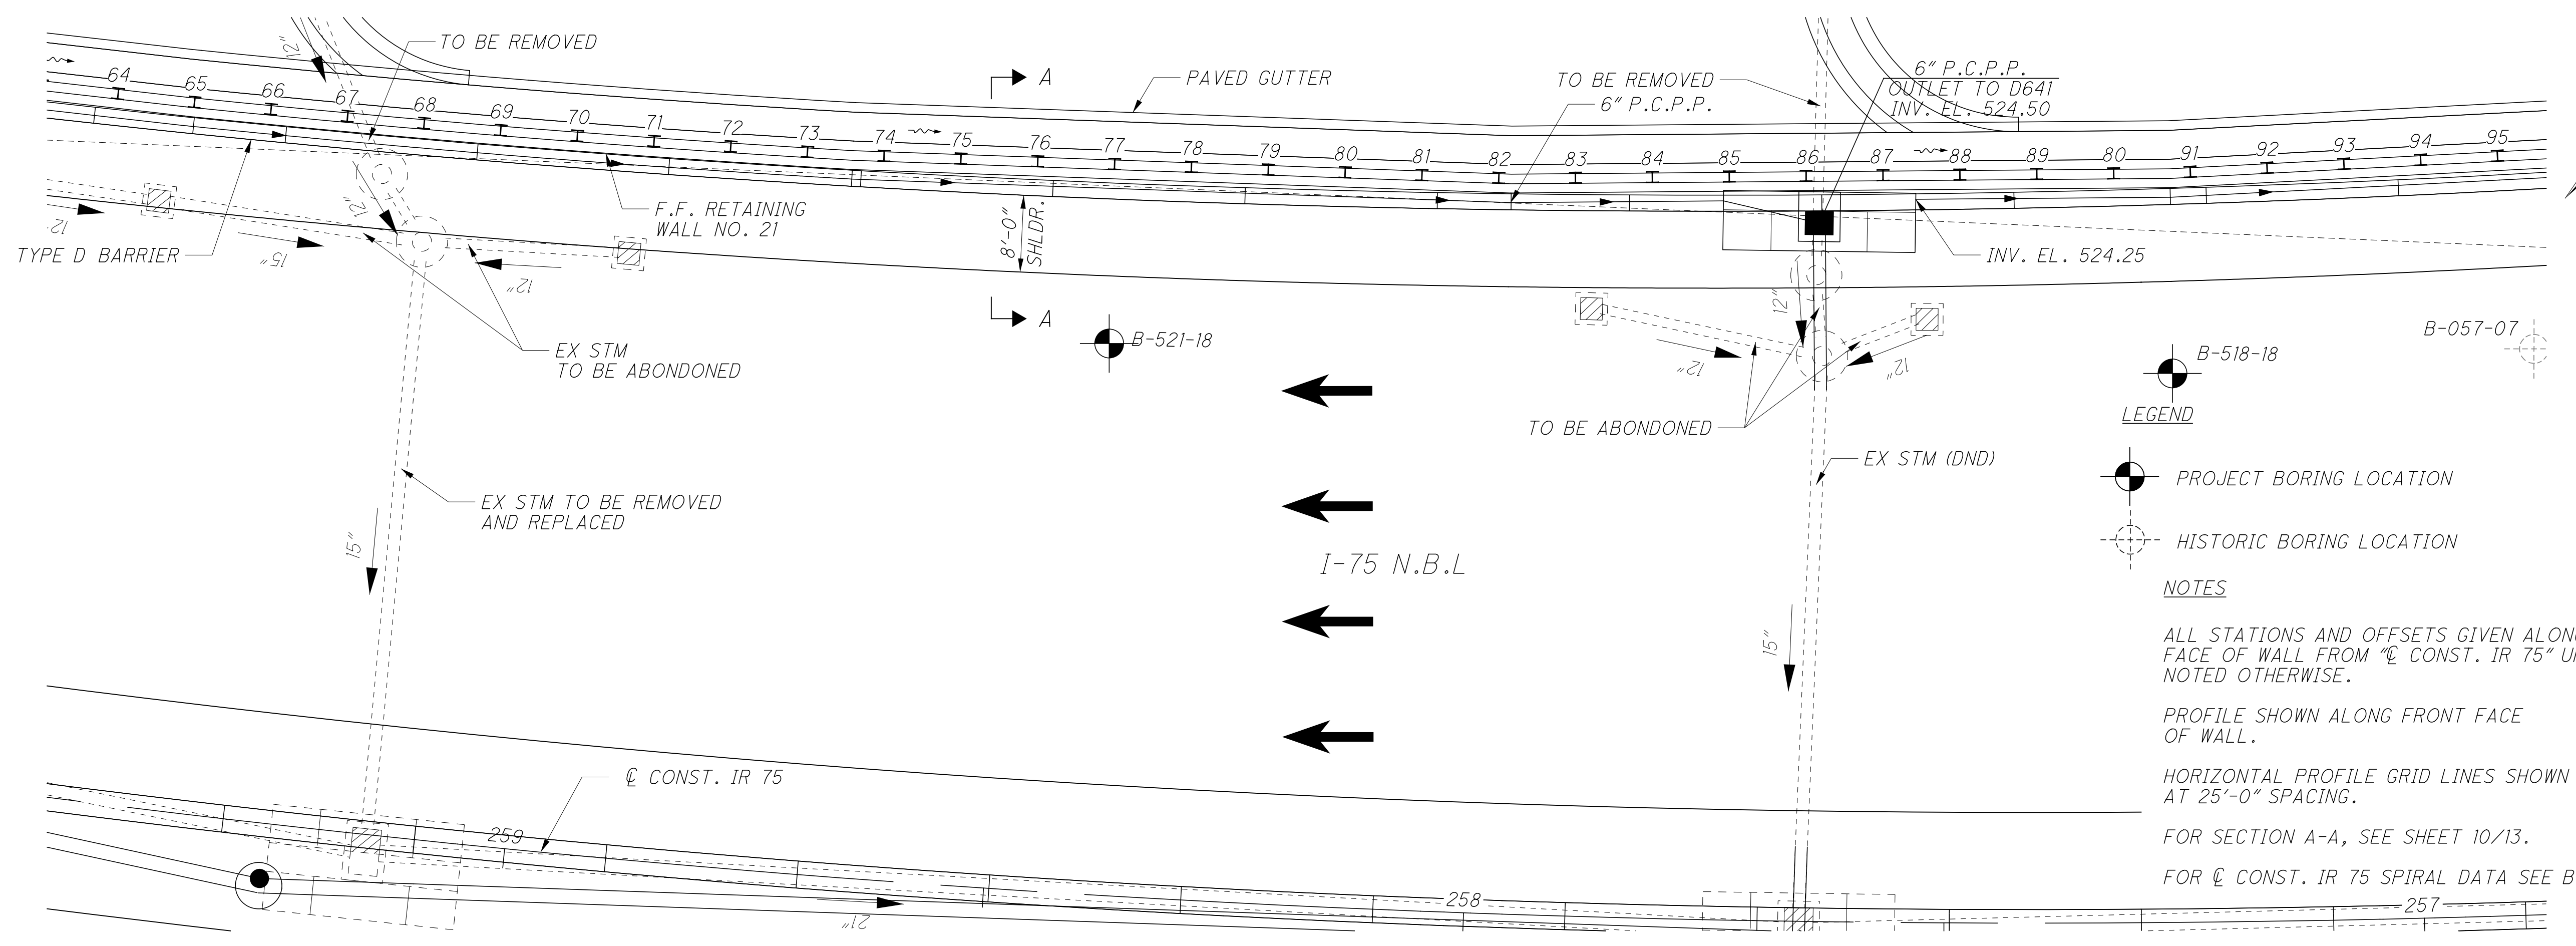

PLAN

EXISTING TOP OF GROUND EL.	535.98	535.78	535.50	535.03	535.10	535.22	534.19	533.81	533.45	532.61	532.39	TOP OF EXISTING SHLDR. EL.
TOP OF WALL EL.	539.95	539.89	539.88	539.55	539.20	538.74	538.26	537.69	537.16	536.72	536.28	TOP OF WALL EL.
570	↑↑	↑↑	↑↑	↑↑	↑↑	↑↑	↑↑	↑↑	↑↑	↑↑	↑↑	570
560	↑↑	↑↑	↑↑	↑↑	↑↑	↑↑	↑↑	↑↑	↑↑	↑↑	↑↑	560
550												550
540												540
530												530
520												520
EXISTING TOP OF SHLDR. EL.	531.15	530.62	530.09	529.57	529.04	528.48	527.92	527.31	526.73	526.23	525.71	TOP OF EXISTING SHLDR. EL.
EXISTING GROUND												
BOTTOM OF CIP FACING												
T/R EL. 521.20												
PROPOSED PAVEMENT												
T/R EL. 522.70												

PROFILE
ALONG F.F. RETAINING WALL NO. 21

LEGEND

- PROJECT BORING LOCATION
- HISTORIC BORING LOCATION

NOTES

ALL STATIONS AND OFFSETS GIVEN ALONG FRONT FACE OF WALL FROM "C" CONST. IR 75" UNLESS NOTED OTHERWISE.


PROFILE SHOWN ALONG FRONT FACE OF WALL.

HORIZONTAL PROFILE GRID LINES SHOWN AT 25'-0" SPACING.


FOR SECTION A-A, SEE SHEET 10/13.

FOR "C" CONST. IR 75 SPIRAL DATA SEE BU-14.

Jwade 8/22/2022 9:14:35 AM
 O:\2017\01113.C.Design\104667.HAM-75-3.84.Design\Structures\Walls_Sheets\104667_WD24.dgn

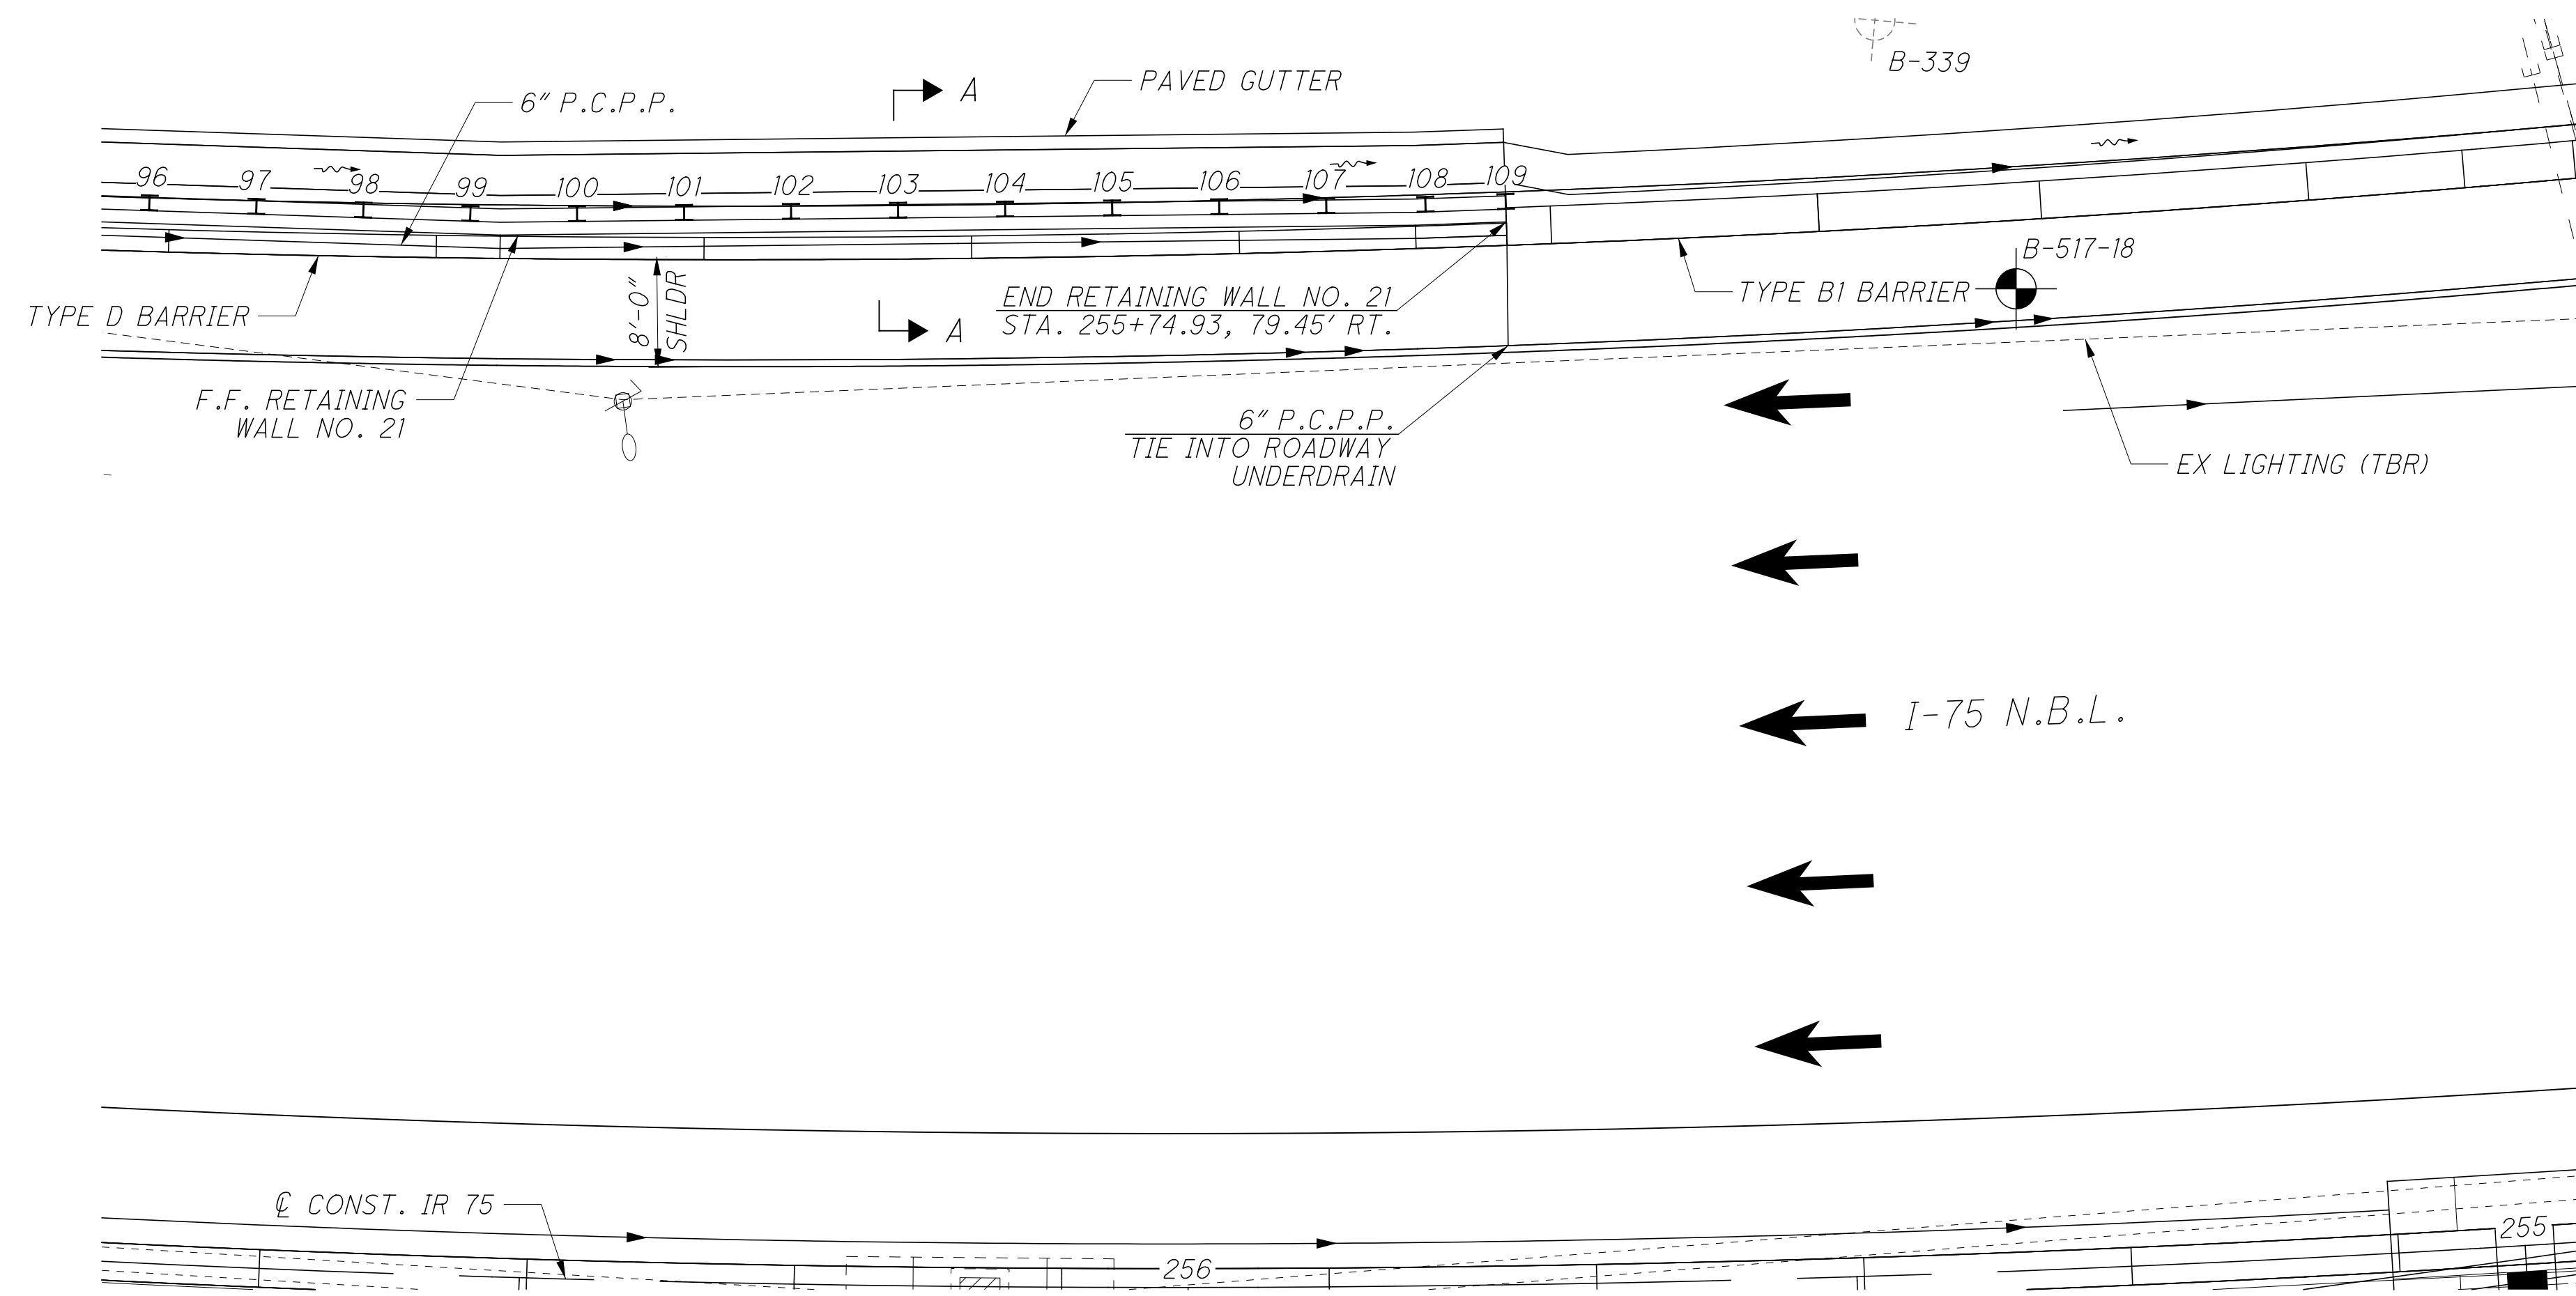

PLAN

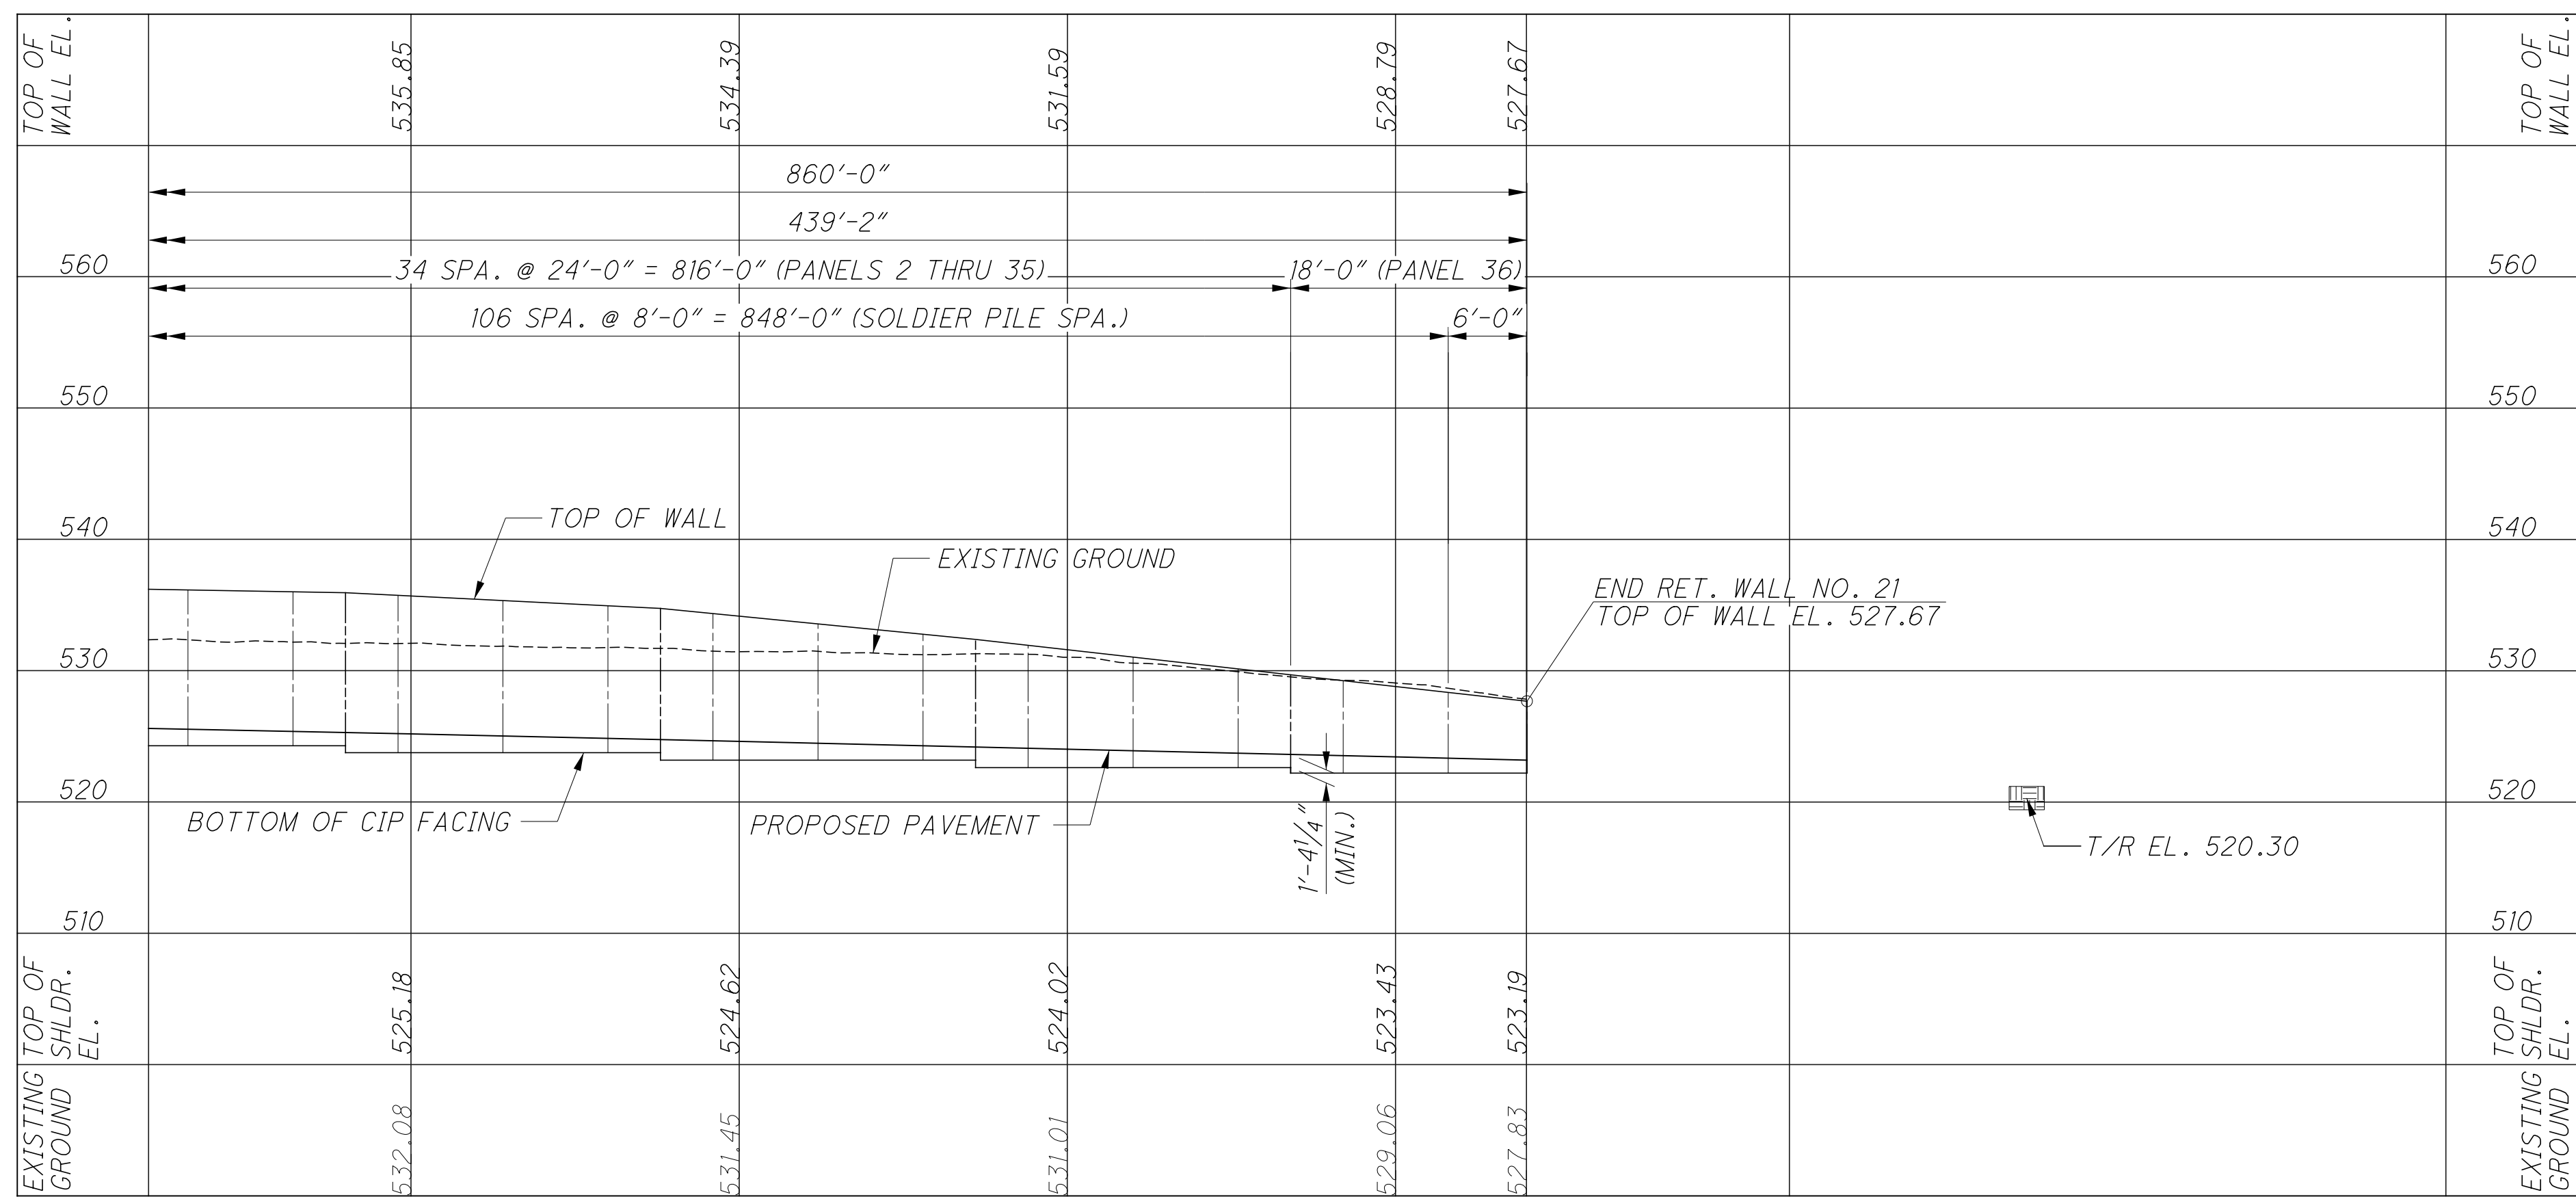


PROFILE
ALONG F.F. RETAINING WALL NO. 21

LEGEND

- PROJECT BORING LOCATION
- HISTORIC BORING LOCATION


NOTES

ALL STATIONS AND OFFSETS GIVEN ALONG FRONT FACE OF WALL FROM "Q CONST. IR 75" UNLESS NOTED OTHERWISE.
 PROFILE SHOWN ALONG FRONT FACE OF WALL.
 HORIZONTAL PROFILE GRID LINES SHOWN AT 25'-0" SPACING.
 FOR SECTION A-A, SEE SHEET 10/13.
 FOR Q CONST. IR 75 SPIRAL DATA SEE BU-14.

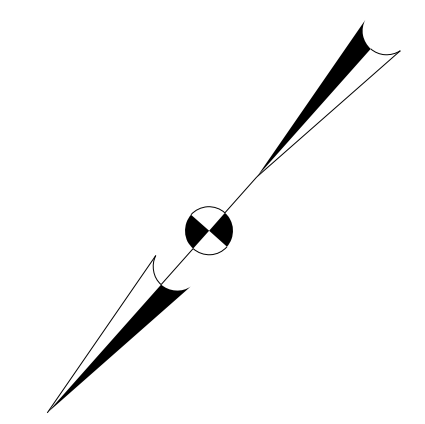


DESIGN AGENCY: STRUCTUREPOINT
 REVIEWED: MDS 01/18/19
 DRAWN: BMP
 DESIGNED: SUJ
 CHECKED: CLB
 DATE: 01/18/19
 STRUCTURE FILE NUMBER:
 REVISIONS:
 RETAINING WALL NO. 21 DETAILS
 ALONG IR 75 NB
 HAM-75-3.84
 PID No. 104667
 4 / 13
 39 / 48

jwade 8/22/2022 9:14:36 AM
 O:\2017\01113.C.Design\104667.HAM-75-3.84.Design\Structures\Walls_Sheets\104667_WD25.dgn

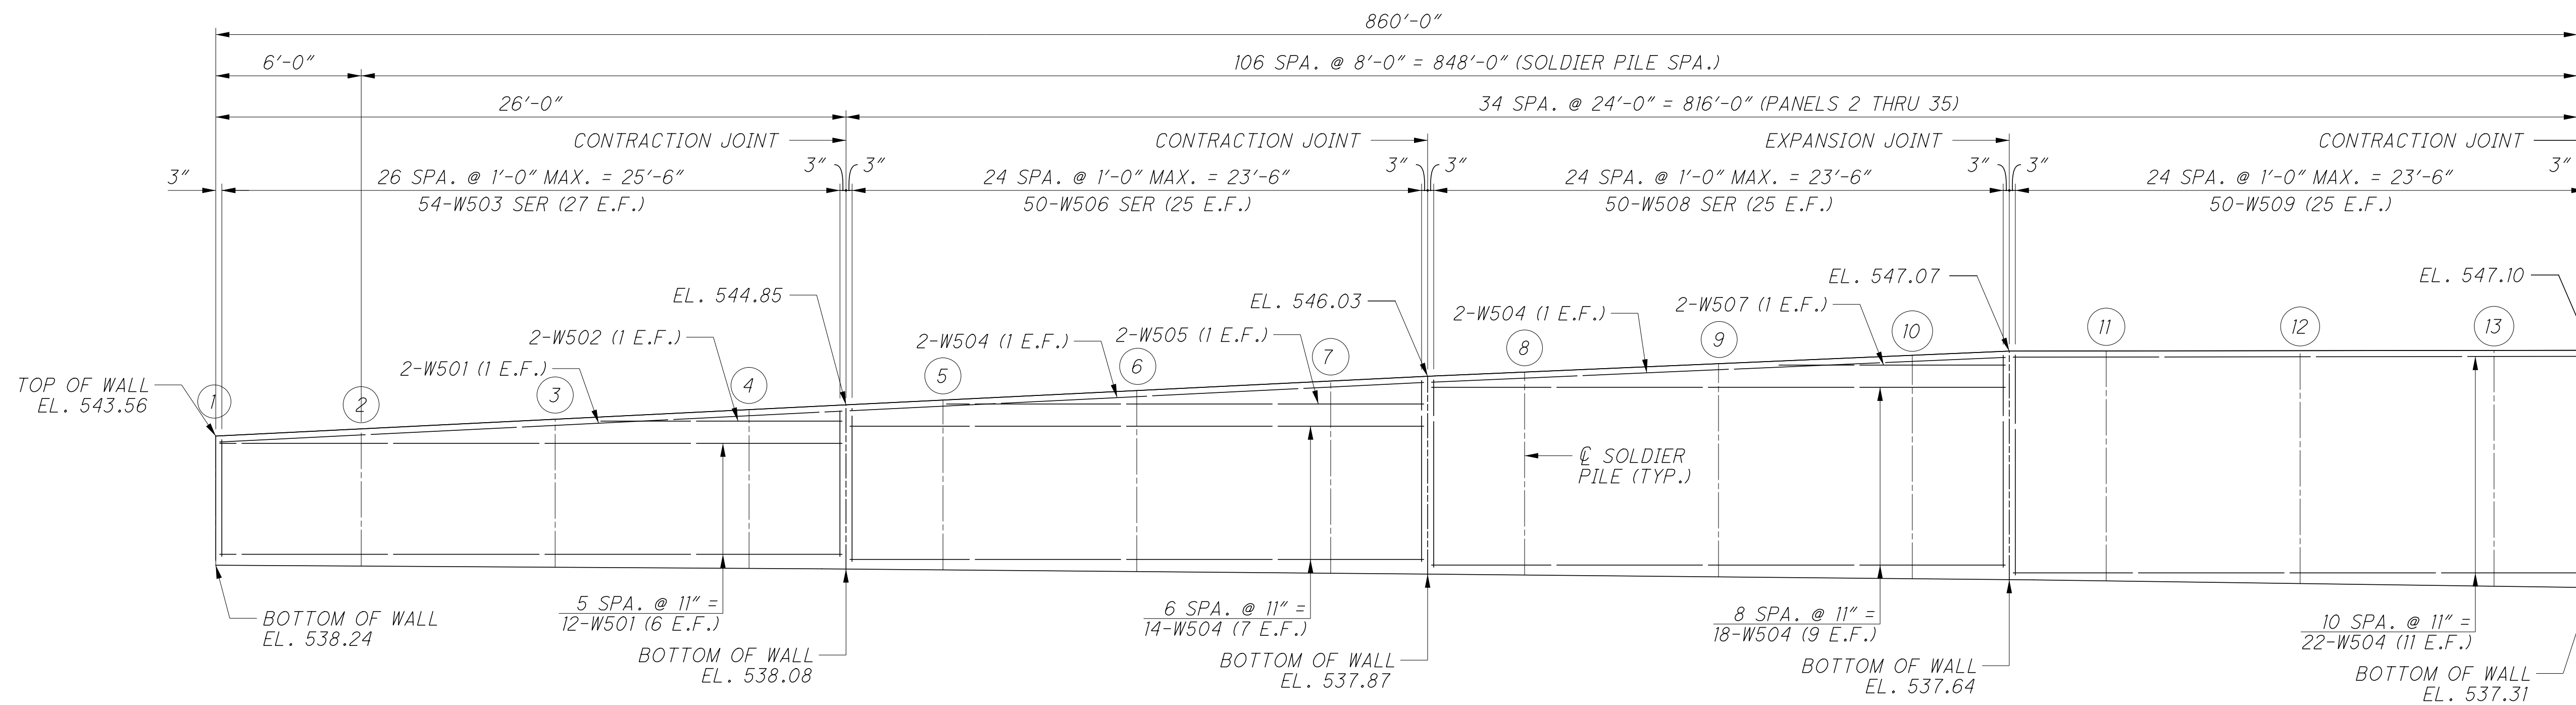

DEVELOPED ELEVATION - SOLDIER PILE LAYOUT

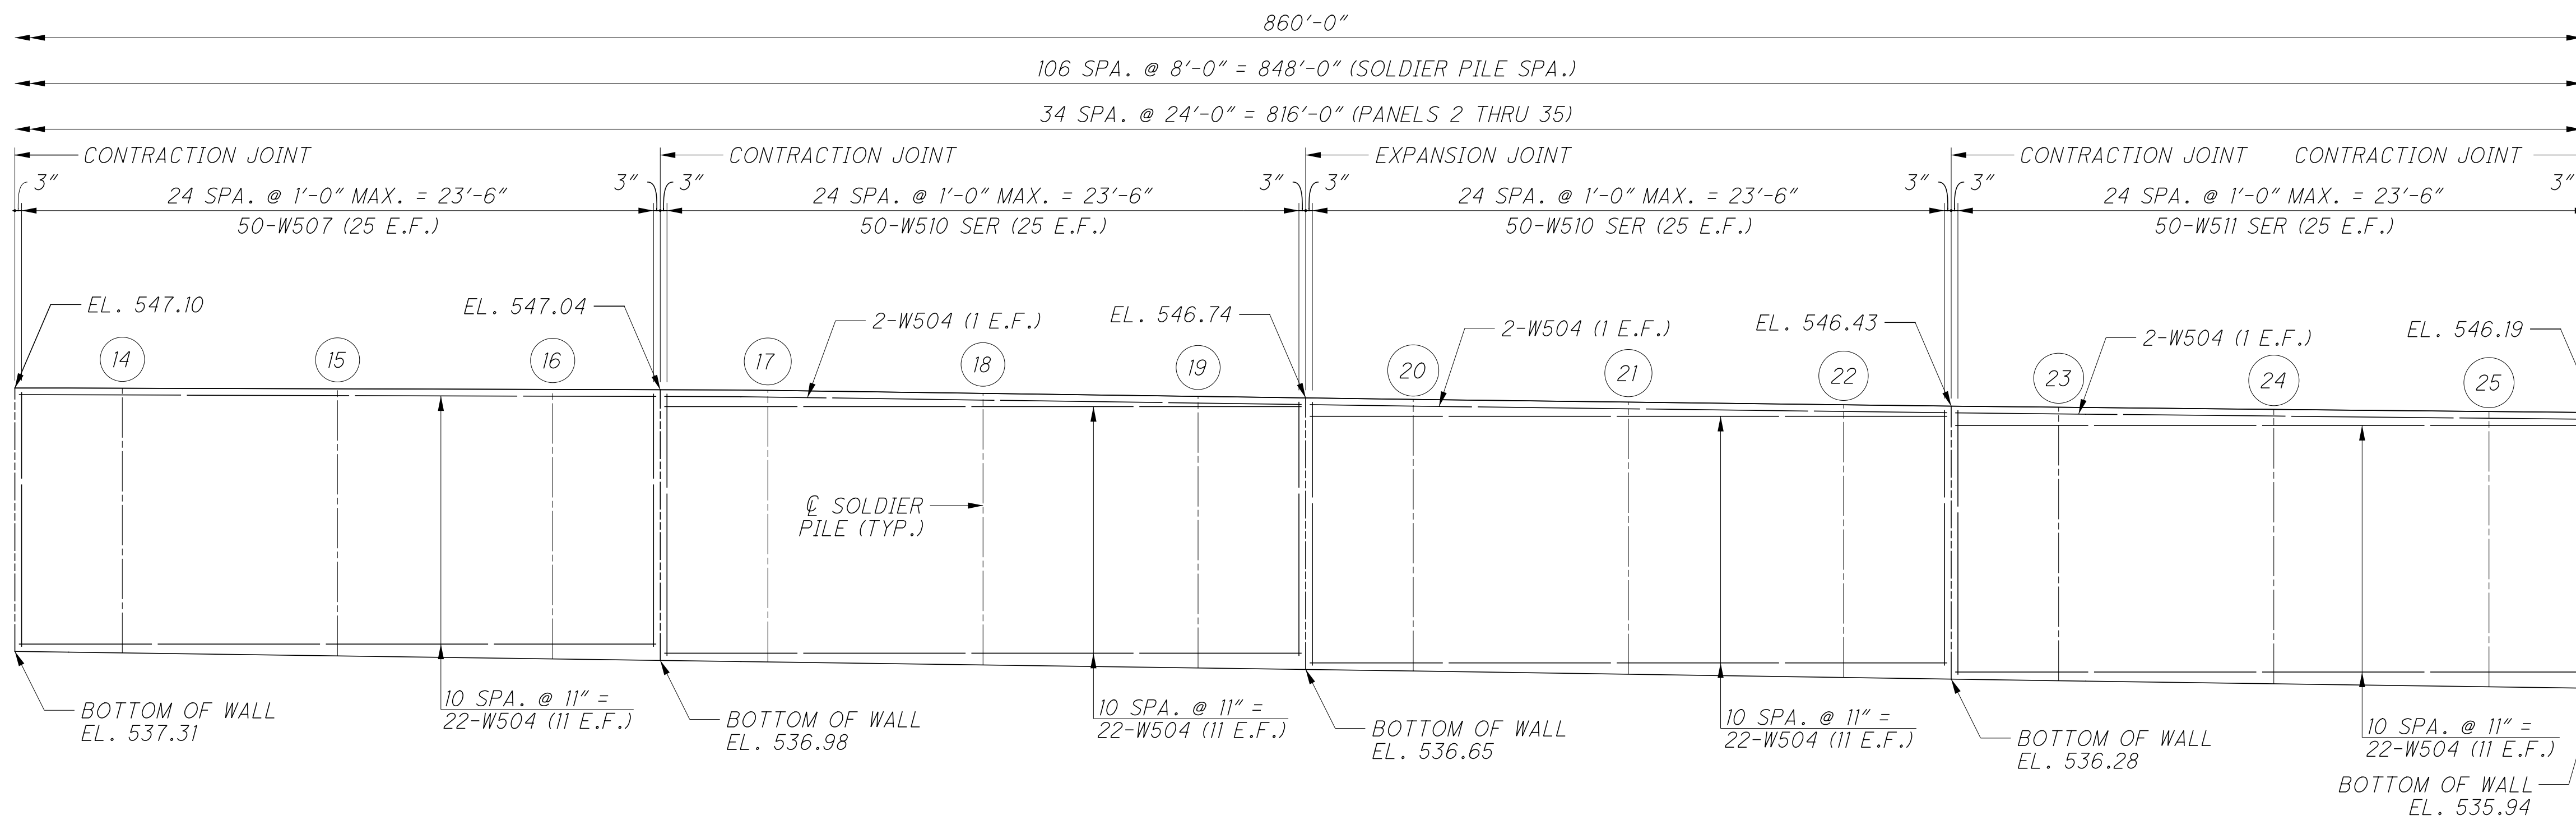

DEVELOPED ELEVATION - SOLDIER PILE LAYOUT

NOTES


ALL DIMENSIONS GIVEN ALONG FRONT FACE OF WALL.

FOR ADDITIONAL WALL DETAILS, SEE SHEETS 10 THRU 12.


(X) - SOLDIER PILE NUMBER.

 DESIGN AGENCY STRUCTUREPOINT 2000 CORPORATE CENTER DRIVE, SUITE 200 FORT WORTH, TEXAS 76102 TEL: 817.339.3333 FAX: 817.339.3333 WWW.STRUCTUREPOINT.COM
DATE: 01/18/19 REVIEWED: MDS DRAWN: BMP DESIGNED: CLB CHECKED: SUF
STRUCTURE FILE NUMBER REVISED
RETAINING WALL NO. 21 DETAILS ALONG IR 75 NB
HAM-75-3.84 PID No. 104667
5 / 13 <div style="border: 1px solid black; border-radius: 50%; width: 30px; height: 30px; display: flex; align-items: center; justify-content: center; margin: 0 auto;"> 40 48 </div>

jwade
 8/22/2022 9:14:37 AM
 O:\2017\01113.C.Design\104667_HAM-75-3.84.Design\Structures\Walls_Sheets\104667_WD26.dgn

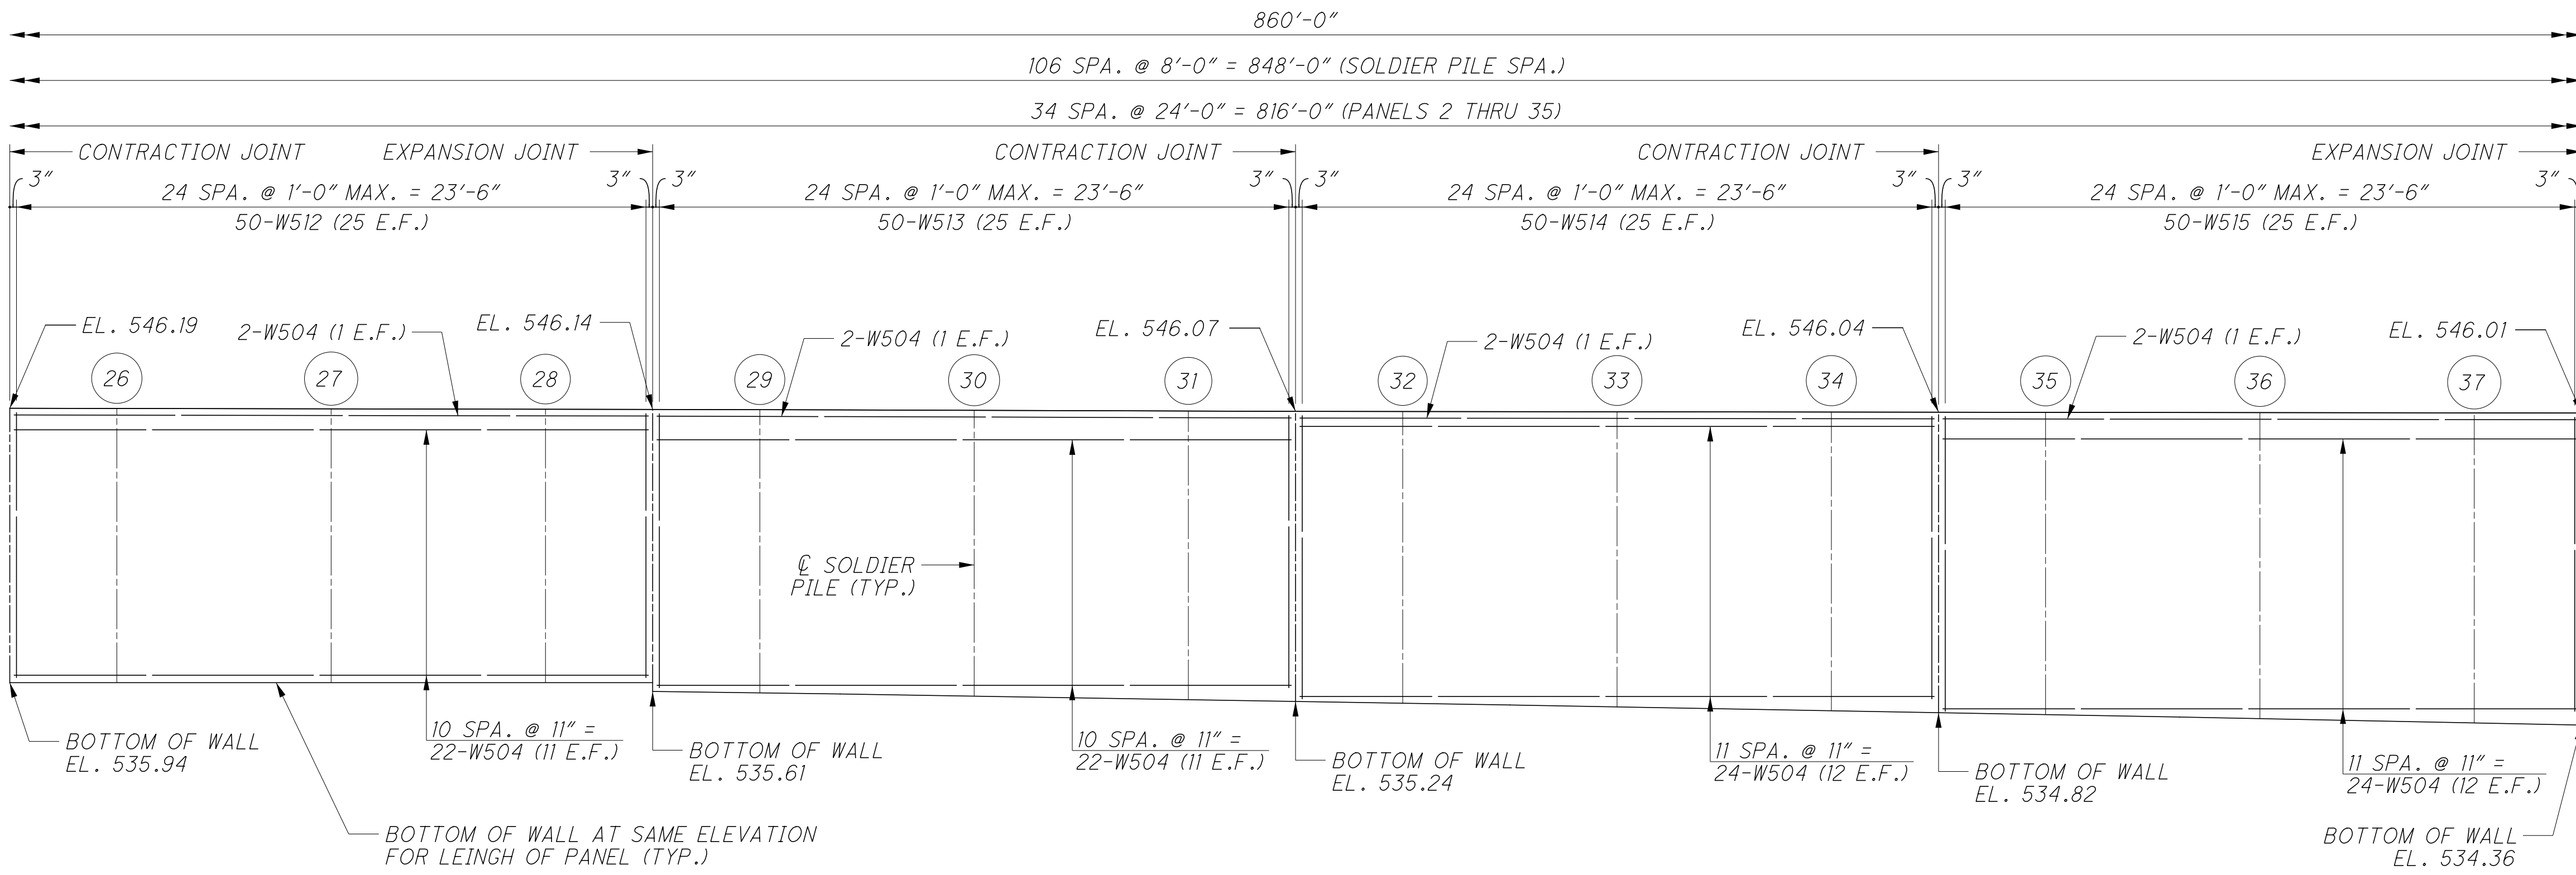

DEVELOPED ELEVATION - SOLDIER PILE LAYOUT

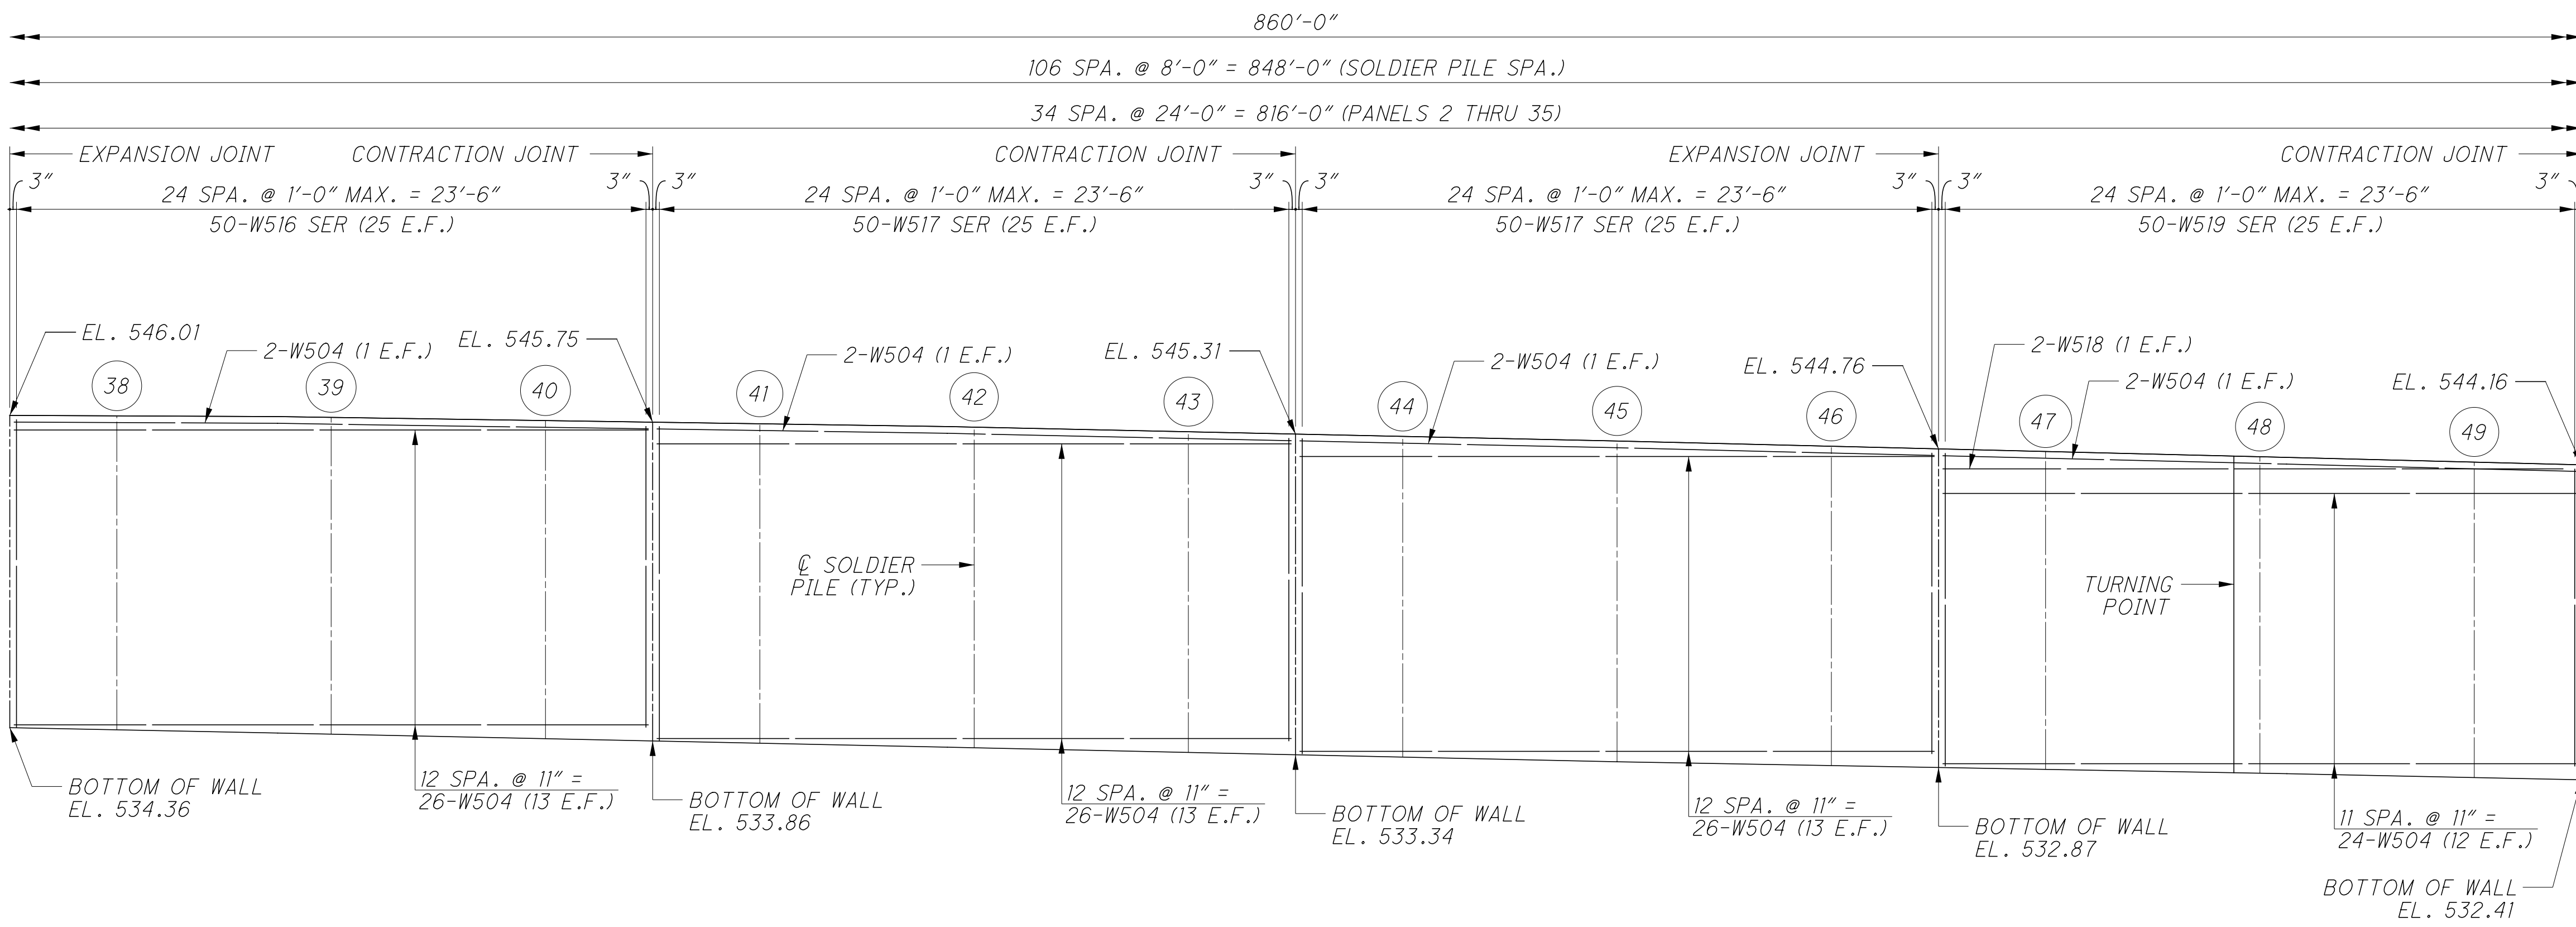


DEVELOPED ELEVATION - SOLDIER PILE LAYOUT

NOTES
 ALL DIMENSIONS GIVEN ALONG FRONT FACE OF WALL.
 FOR ADDITIONAL WALL DETAILS, SEE SHEETS 10 THRU 12.


(X) - SOLDIER PILE NUMBER.

 DESIGN AGENCY 2000 CORPORATE CENTER DR., STE. 200 FORT WORTH, TX 76102 TEL: 817.339.2222 FAX: 817.339.2222
REVIEWED DATE 01/18/19 MDS STRUCTURE FILE NUMBER
DRAWN BMP REVISSED
DESIGNED CLB CHECKED SJF
RETAINING WALL NO. 21 DETAILS ALONG IR 75 NB
HAM-75-3.84 PID No. 104667
6 / 13
41 48

jwade
 8/22/2022 9:14:38 AM
 O:\2017\01113.C.Design\104667_HAM-75-3.84.Design\Structures\Walls_Sheets\104667_WD27.dgn

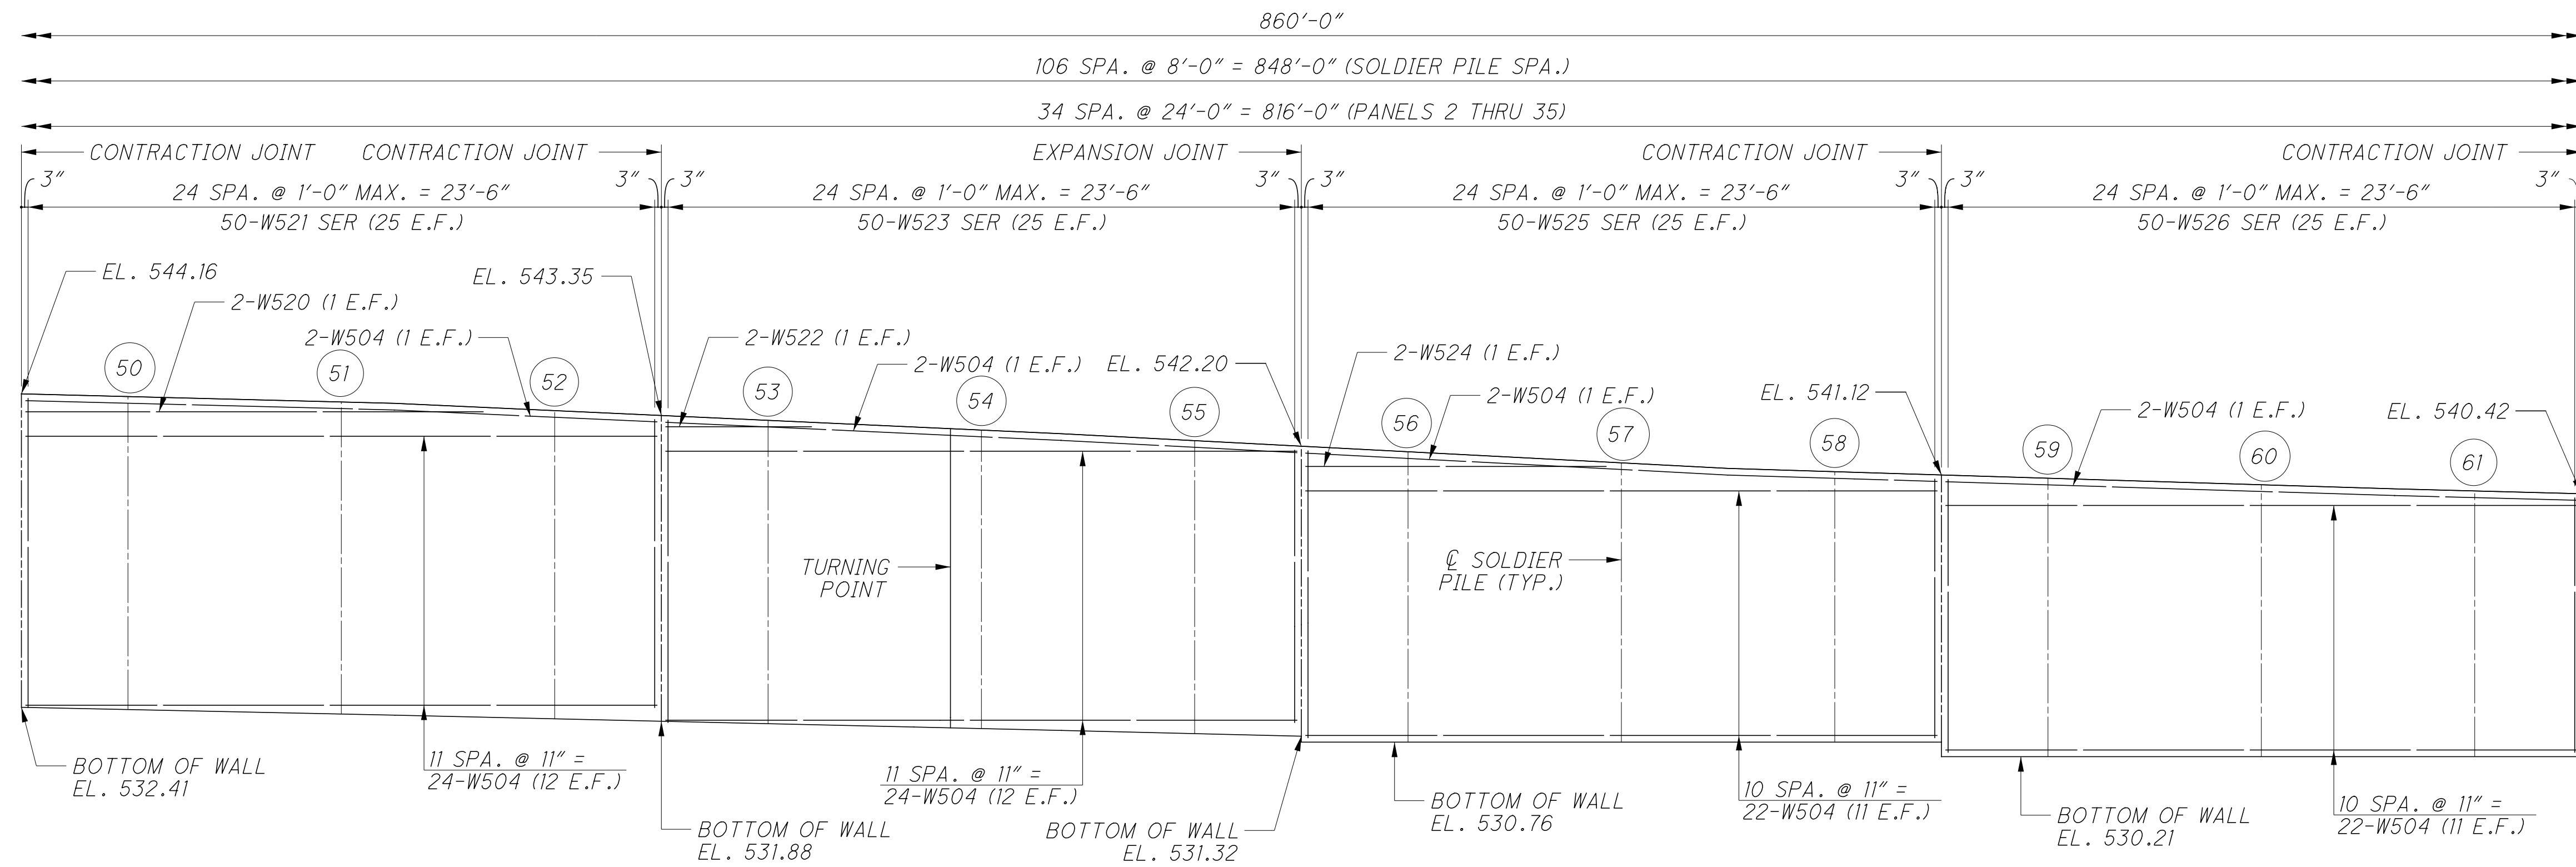

DEVELOPED ELEVATION - SOLDIER PILE LAYOUT

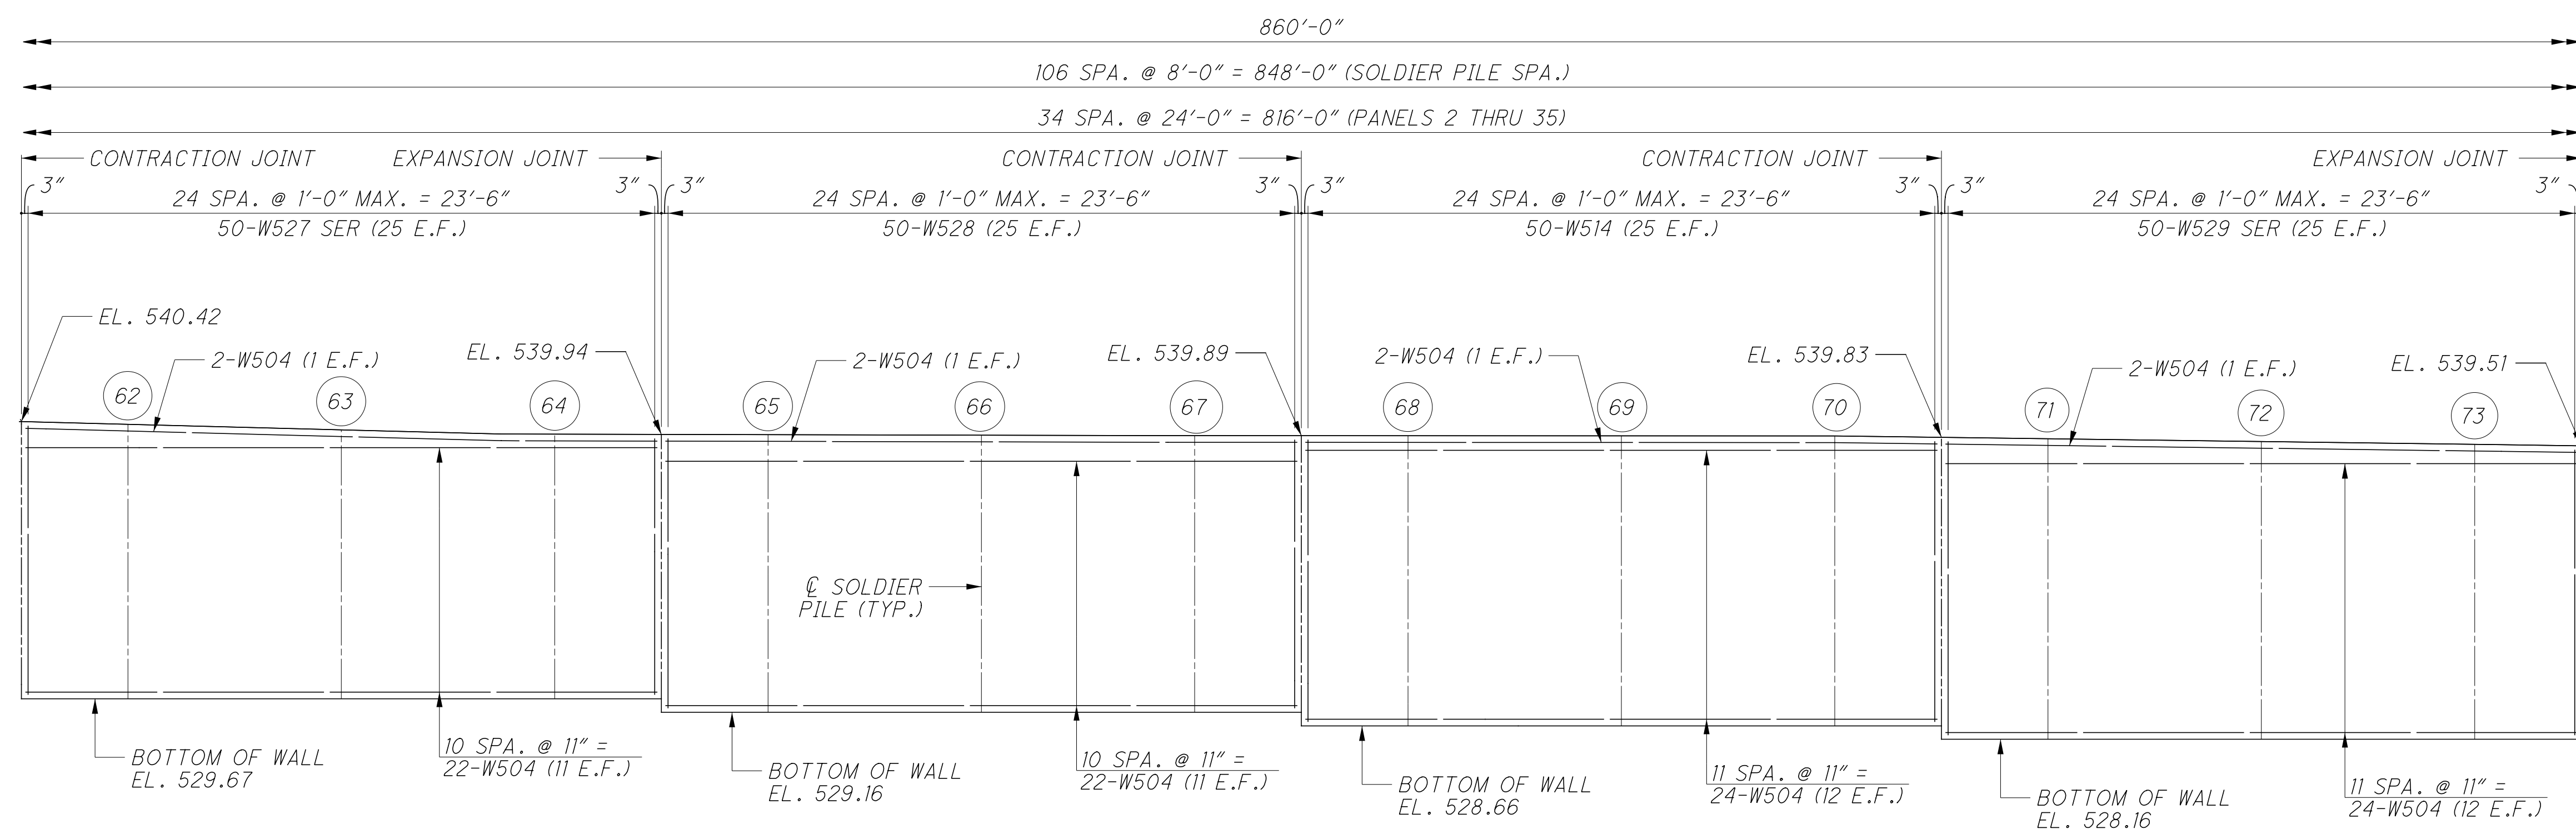


DEVELOPED ELEVATION - SOLDIER PILE LAYOUT


NOTES
 ALL DIMENSIONS GIVEN ALONG FRONT FACE OF WALL.
 FOR ADDITIONAL WALL DETAILS, SEE SHEETS 10 THRU 12.
 (X) - SOLDIER PILE NUMBER.

 DESIGN AGENCY 2000 CORPORATE CENTER DR., STE. 200 HOUSTON, TX 77056 TEL: 713.462.1200 FAX: 713.462.1202 WWW.STRUCTUREPOINT.COM
REVIEWED DATE 01/18/19 MDS STRUCTURE FILE NUMBER
DRAWN BMP REVISIONS
DESIGNED CLB CHECKED SUF
RETAINING WALL NO. 21 DETAILS ALONG IR 75 NB
HAM-75-3.84 PID No. 104667
7 / 13 <div style="border: 1px solid black; border-radius: 50%; width: 30px; height: 30px; display: flex; align-items: center; justify-content: center; margin: 0 auto;"> 42 48 </div>

8/22/2022 9:14:39 AM
 O:\2017\01113.C.Design\104667_HAM-75-3.84.Design\Structures\Walls_Sheets\104667_WD28.dgn

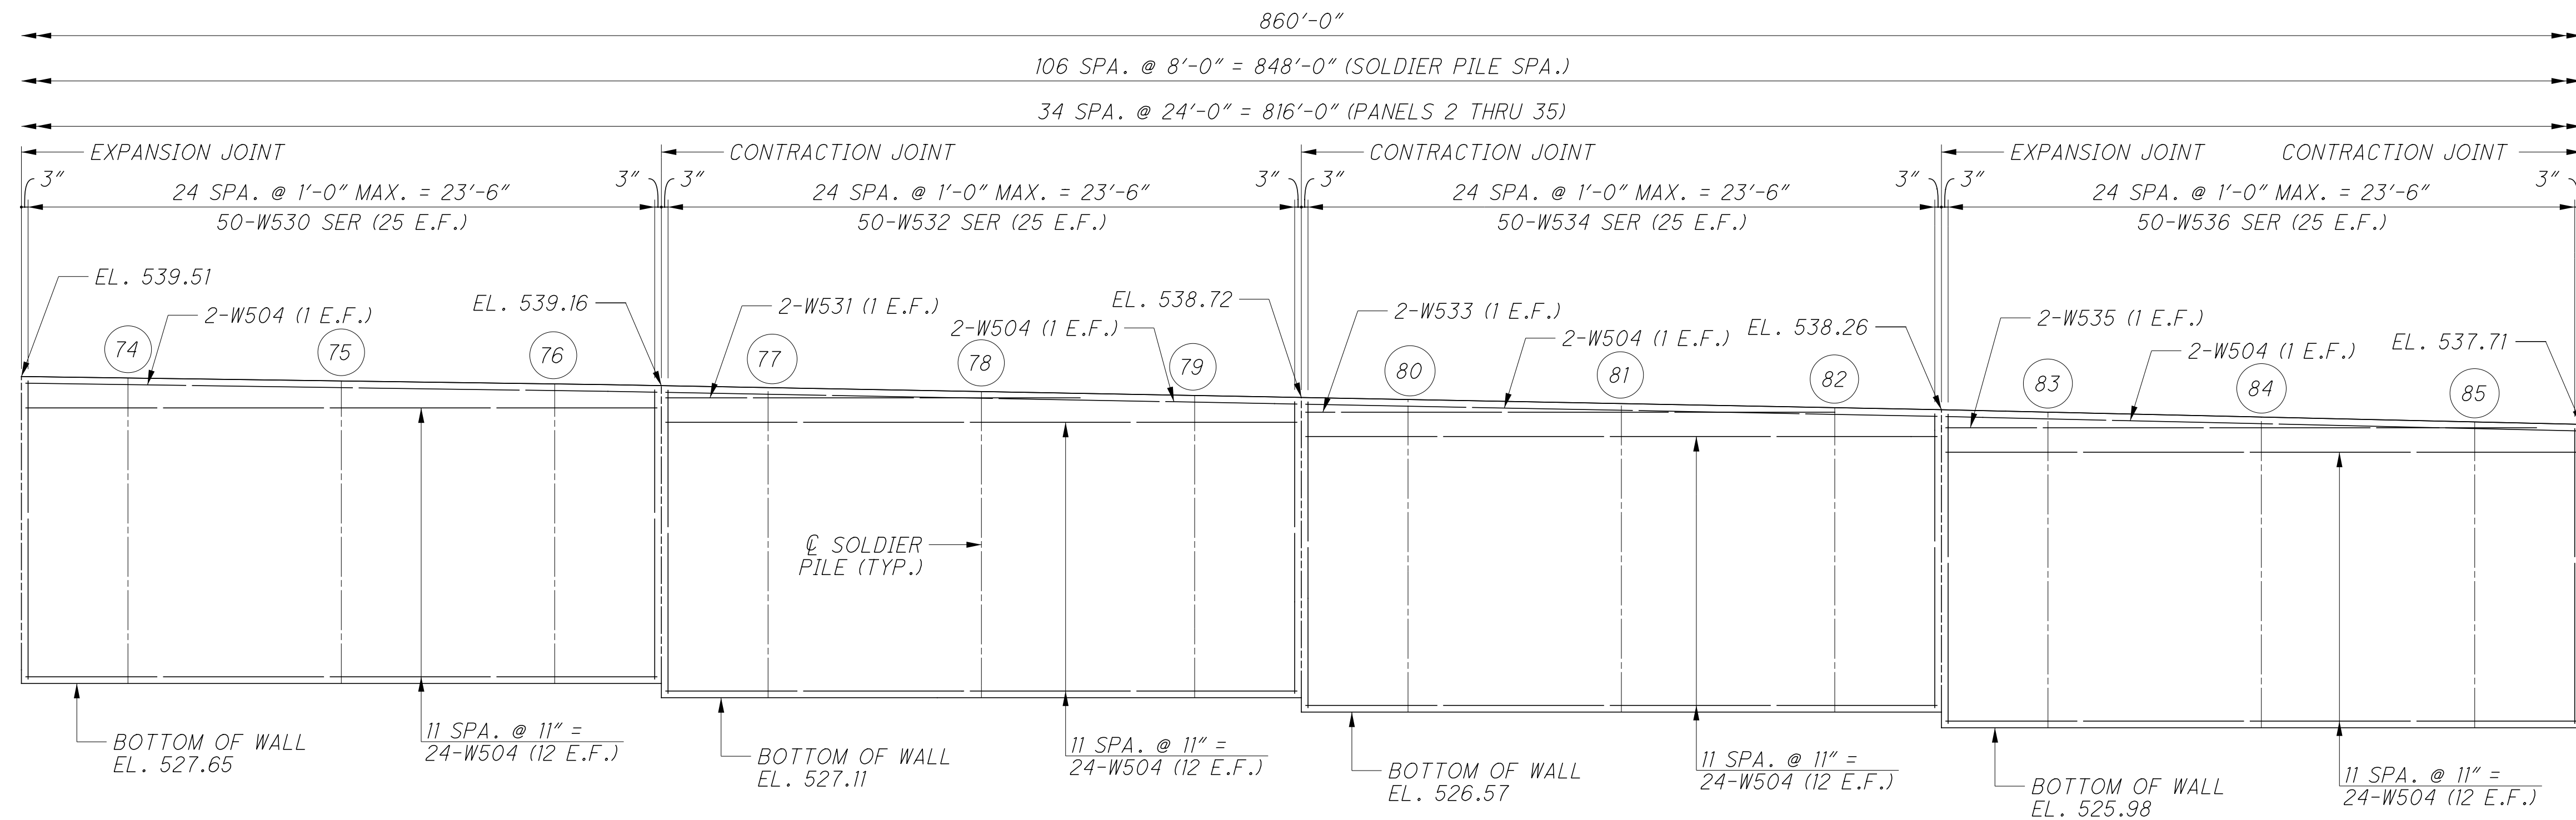

DEVELOPED ELEVATION - SOLDIER PILE LAYOUT

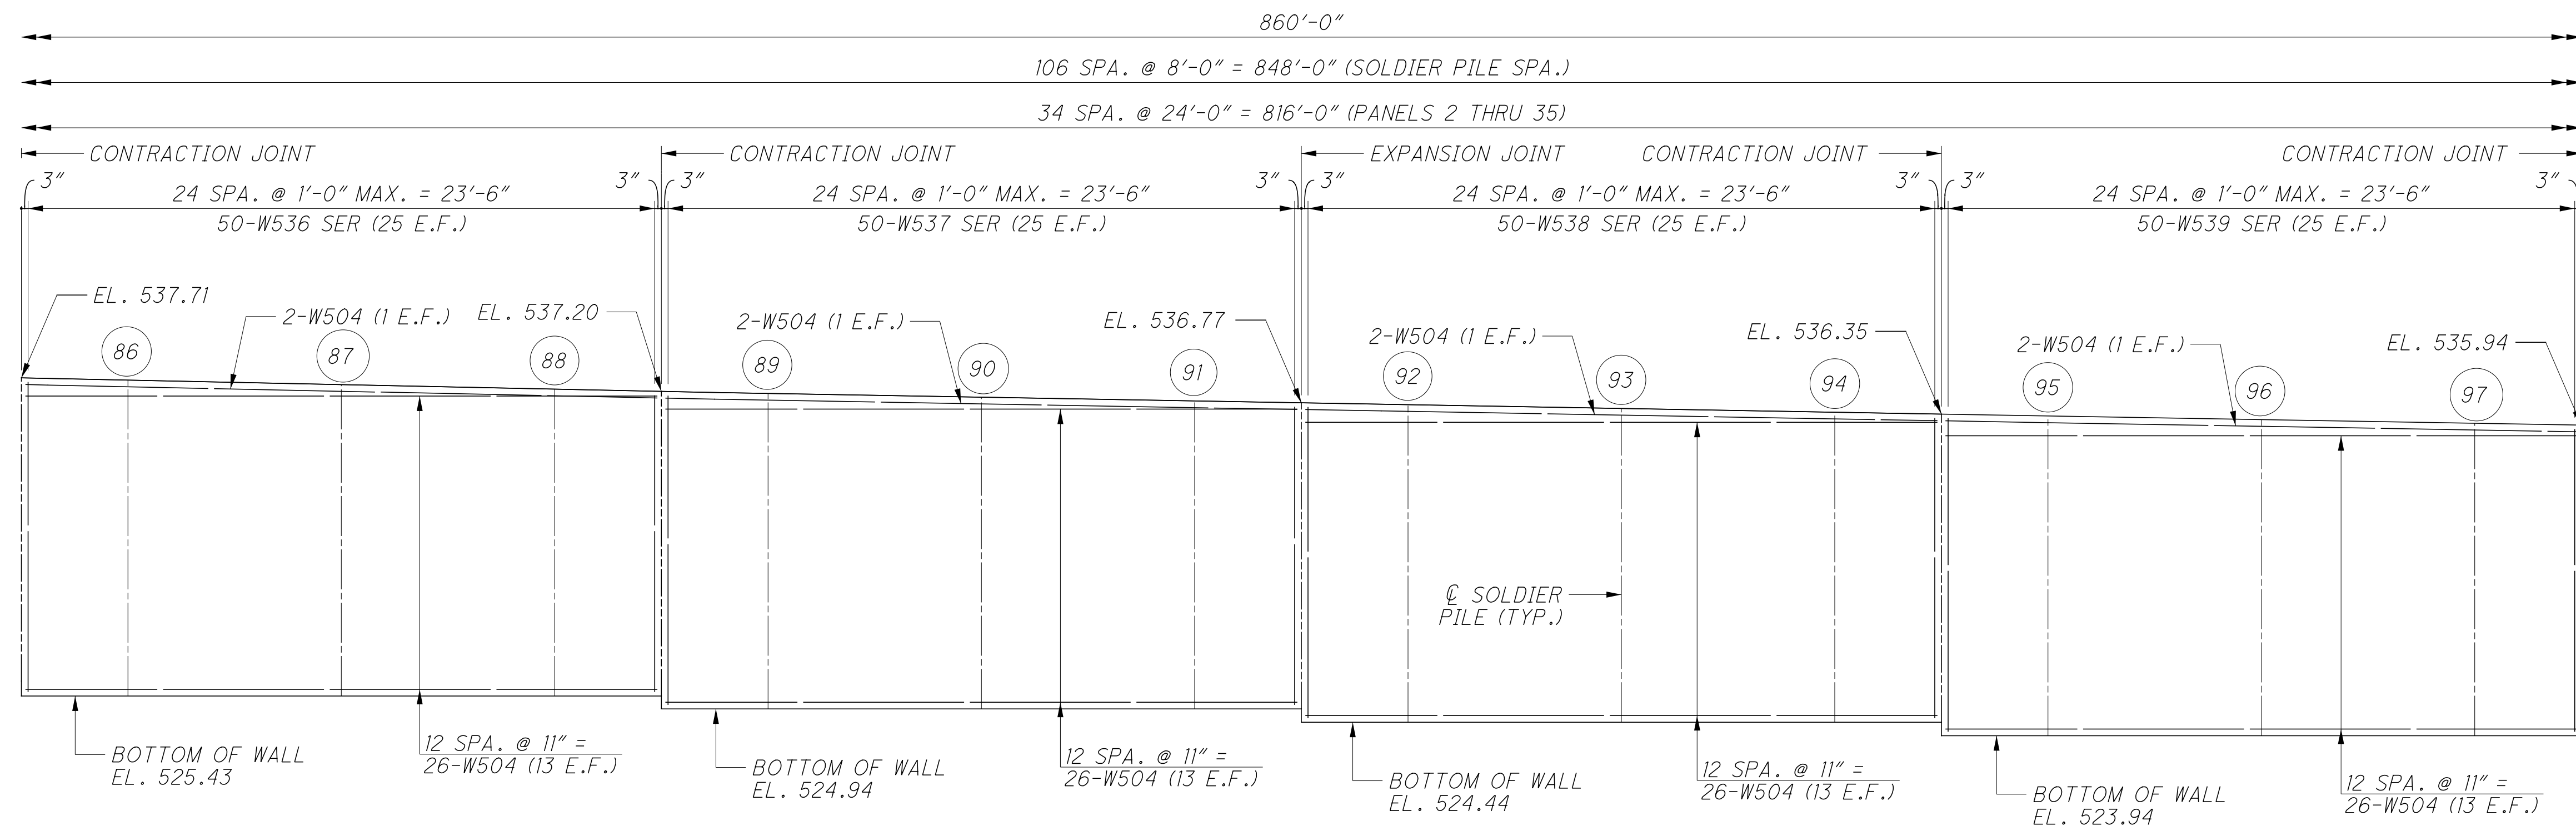

DEVELOPED ELEVATION - SOLDIER PILE LAYOUT

NOTES


ALL DIMENSIONS GIVEN ALONG FRONT FACE OF WALL.

FOR ADDITIONAL WALL DETAILS, SEE SHEETS 10 THRU 12.

(X) - SOLDIER PILE NUMBER.

DESIGN AGENCY DATE 01/18/19 REVIEWED MDS DRAWN BMP DESIGNED CLB CHECKED SUF
RETAINING WALL NO. 21 DETAILS ALONG IR 75 NB
HAM-75-3.84 PID No. 104667
8 / 13 <div style="border: 1px solid black; border-radius: 50%; width: 30px; height: 30px; display: flex; align-items: center; justify-content: center; margin: 0 auto;"> 43 48 </div>

jwade
 8/22/2022 9:14:39 AM
 O:\2017\01113.C.Design\104667_HAM-75-3.84.Design\Structures\Walls_Sheets\104667_WD25.dgn

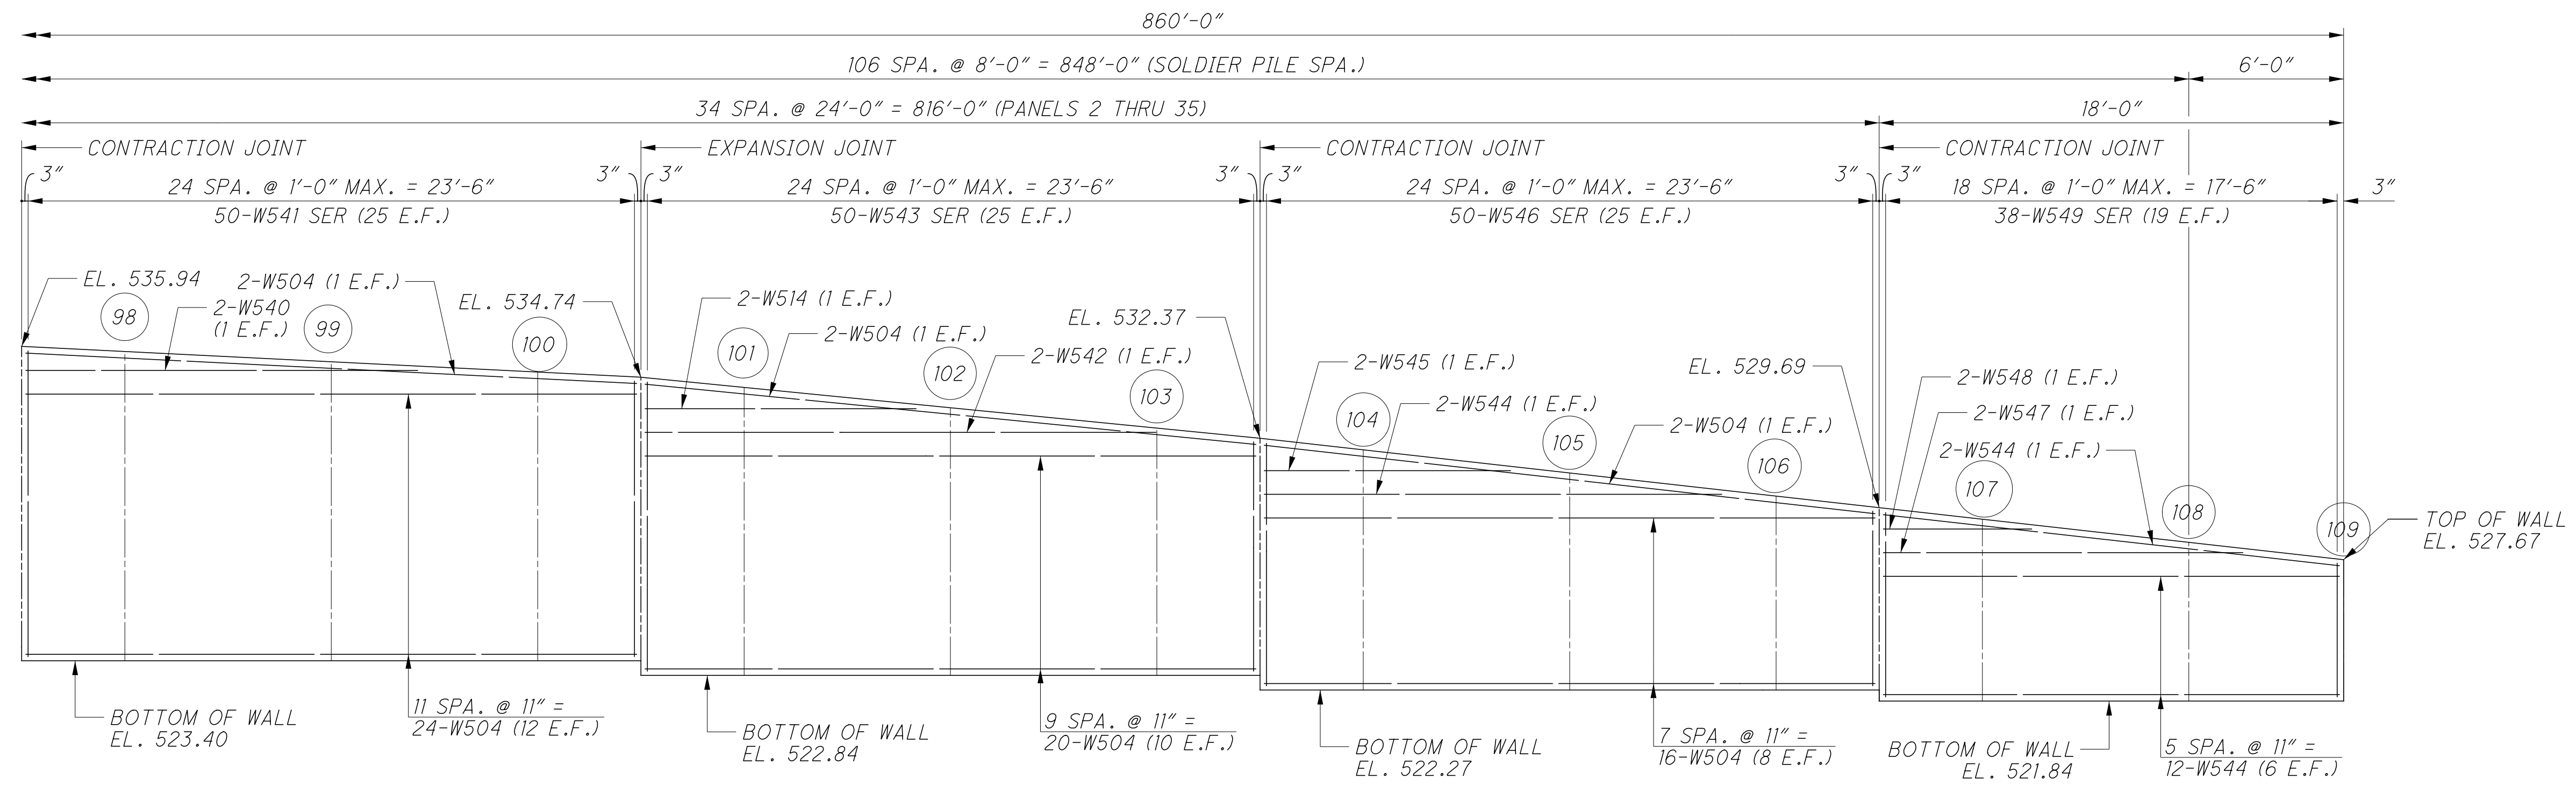

DEVELOPED ELEVATION - SOLDIER PILE LAYOUT

NOTES

ALL DIMENSIONS GIVEN ALONG FRONT FACE OF WALL.

FOR ADDITIONAL WALL DETAILS, SEE SHEETS 10 THRU 12.

(X) - SOLDIER PILE NUMBER.

RETAINING WALL NO. 21 DETAILS
 ALONG IR 75 NB

HAM-75-3.84
PID No. 104667

9 / 13

44
 48


DESIGNED
 CLB
 CHECKED
 SUF

DRAWN
 BMP
 REVISED


REVIEWED
 MDS
 STRUCTURE FILE NUMBER

DATE
 01/18/19


DESIGN AGENCY
STRUCTUREPOINT
 2000 CORPORATE CENTER DR., STE. 200
 FORT WORTH, TX 76102
 TEL: 817.339.8800 FAX: 817.339.8801
 WWW.STRUCTUREPOINT.COM

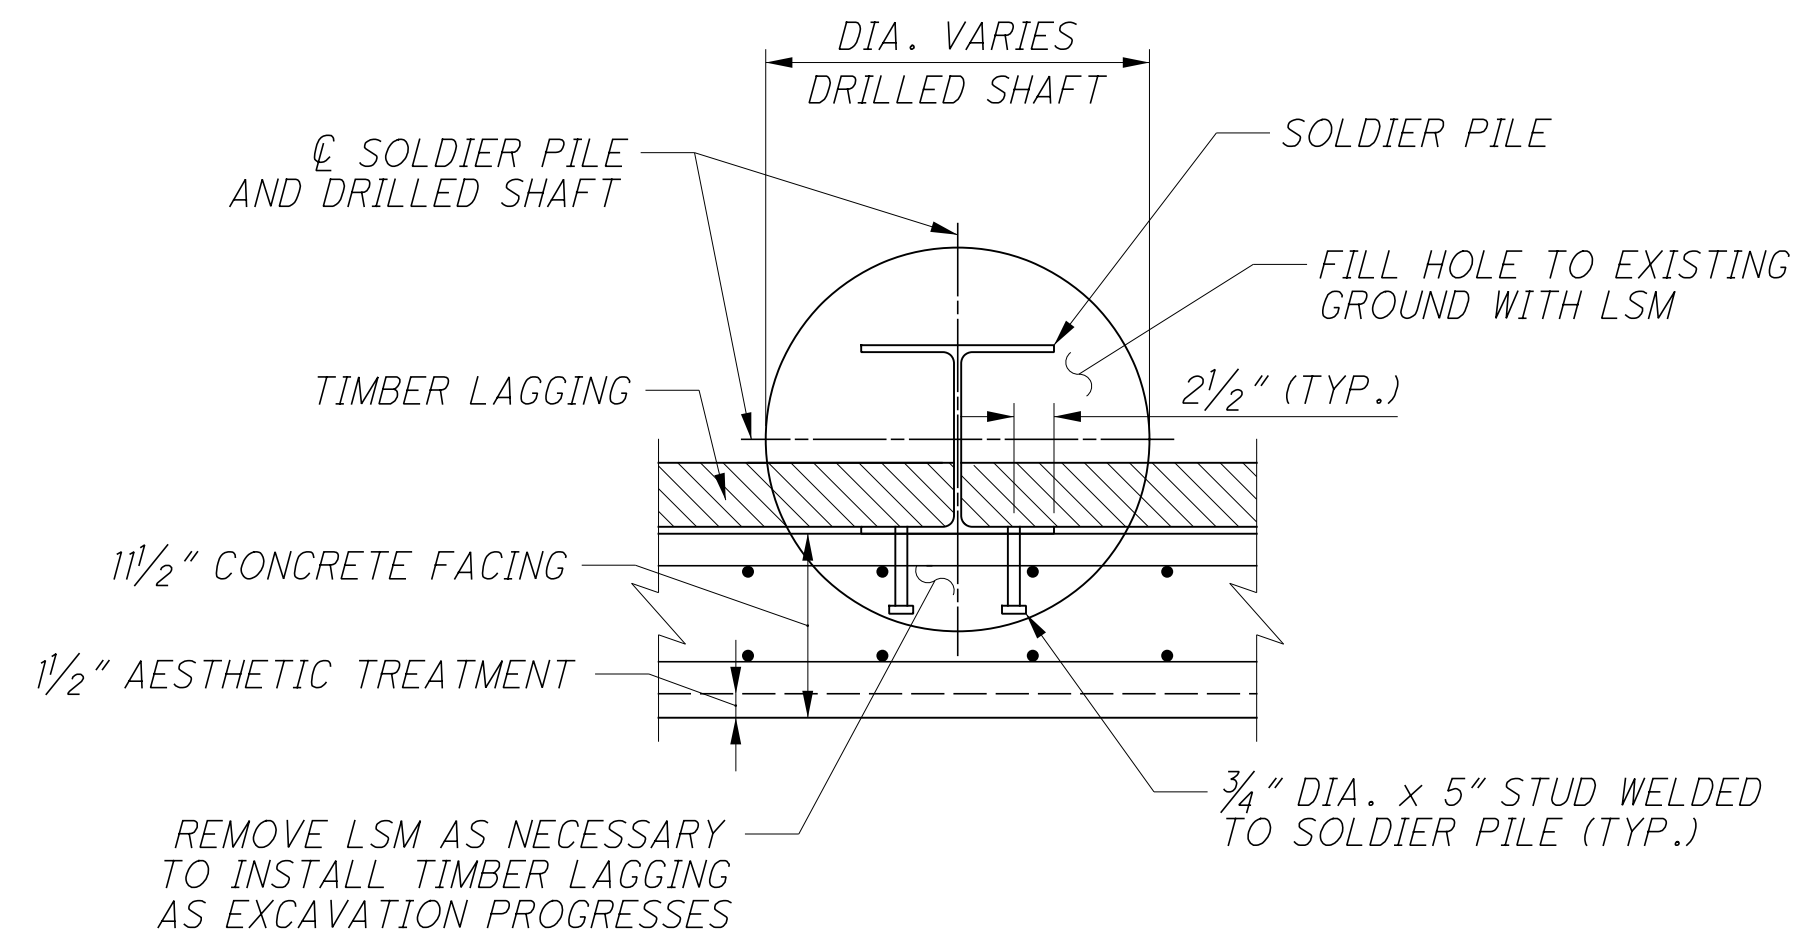

SECTION B-B

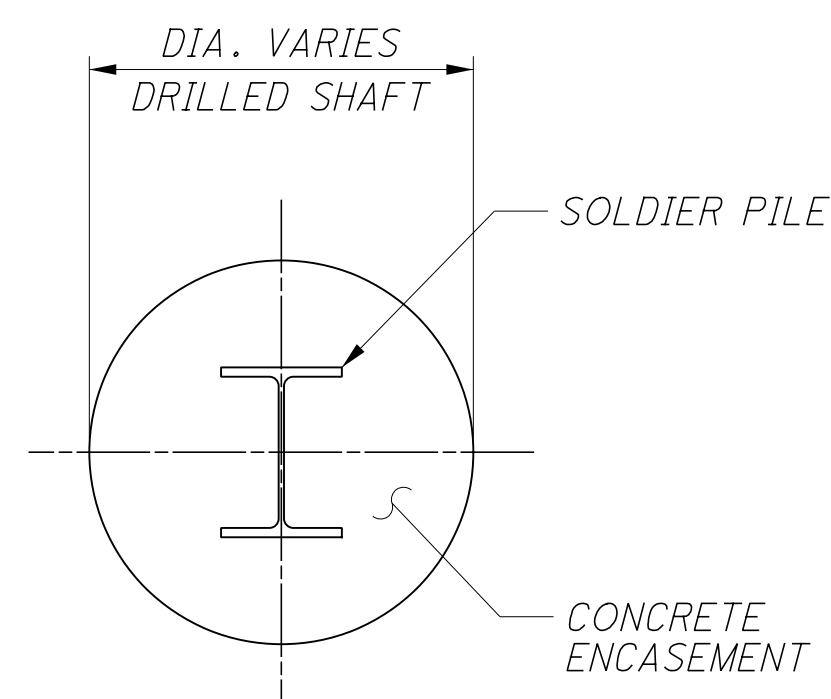

SECTION C-C

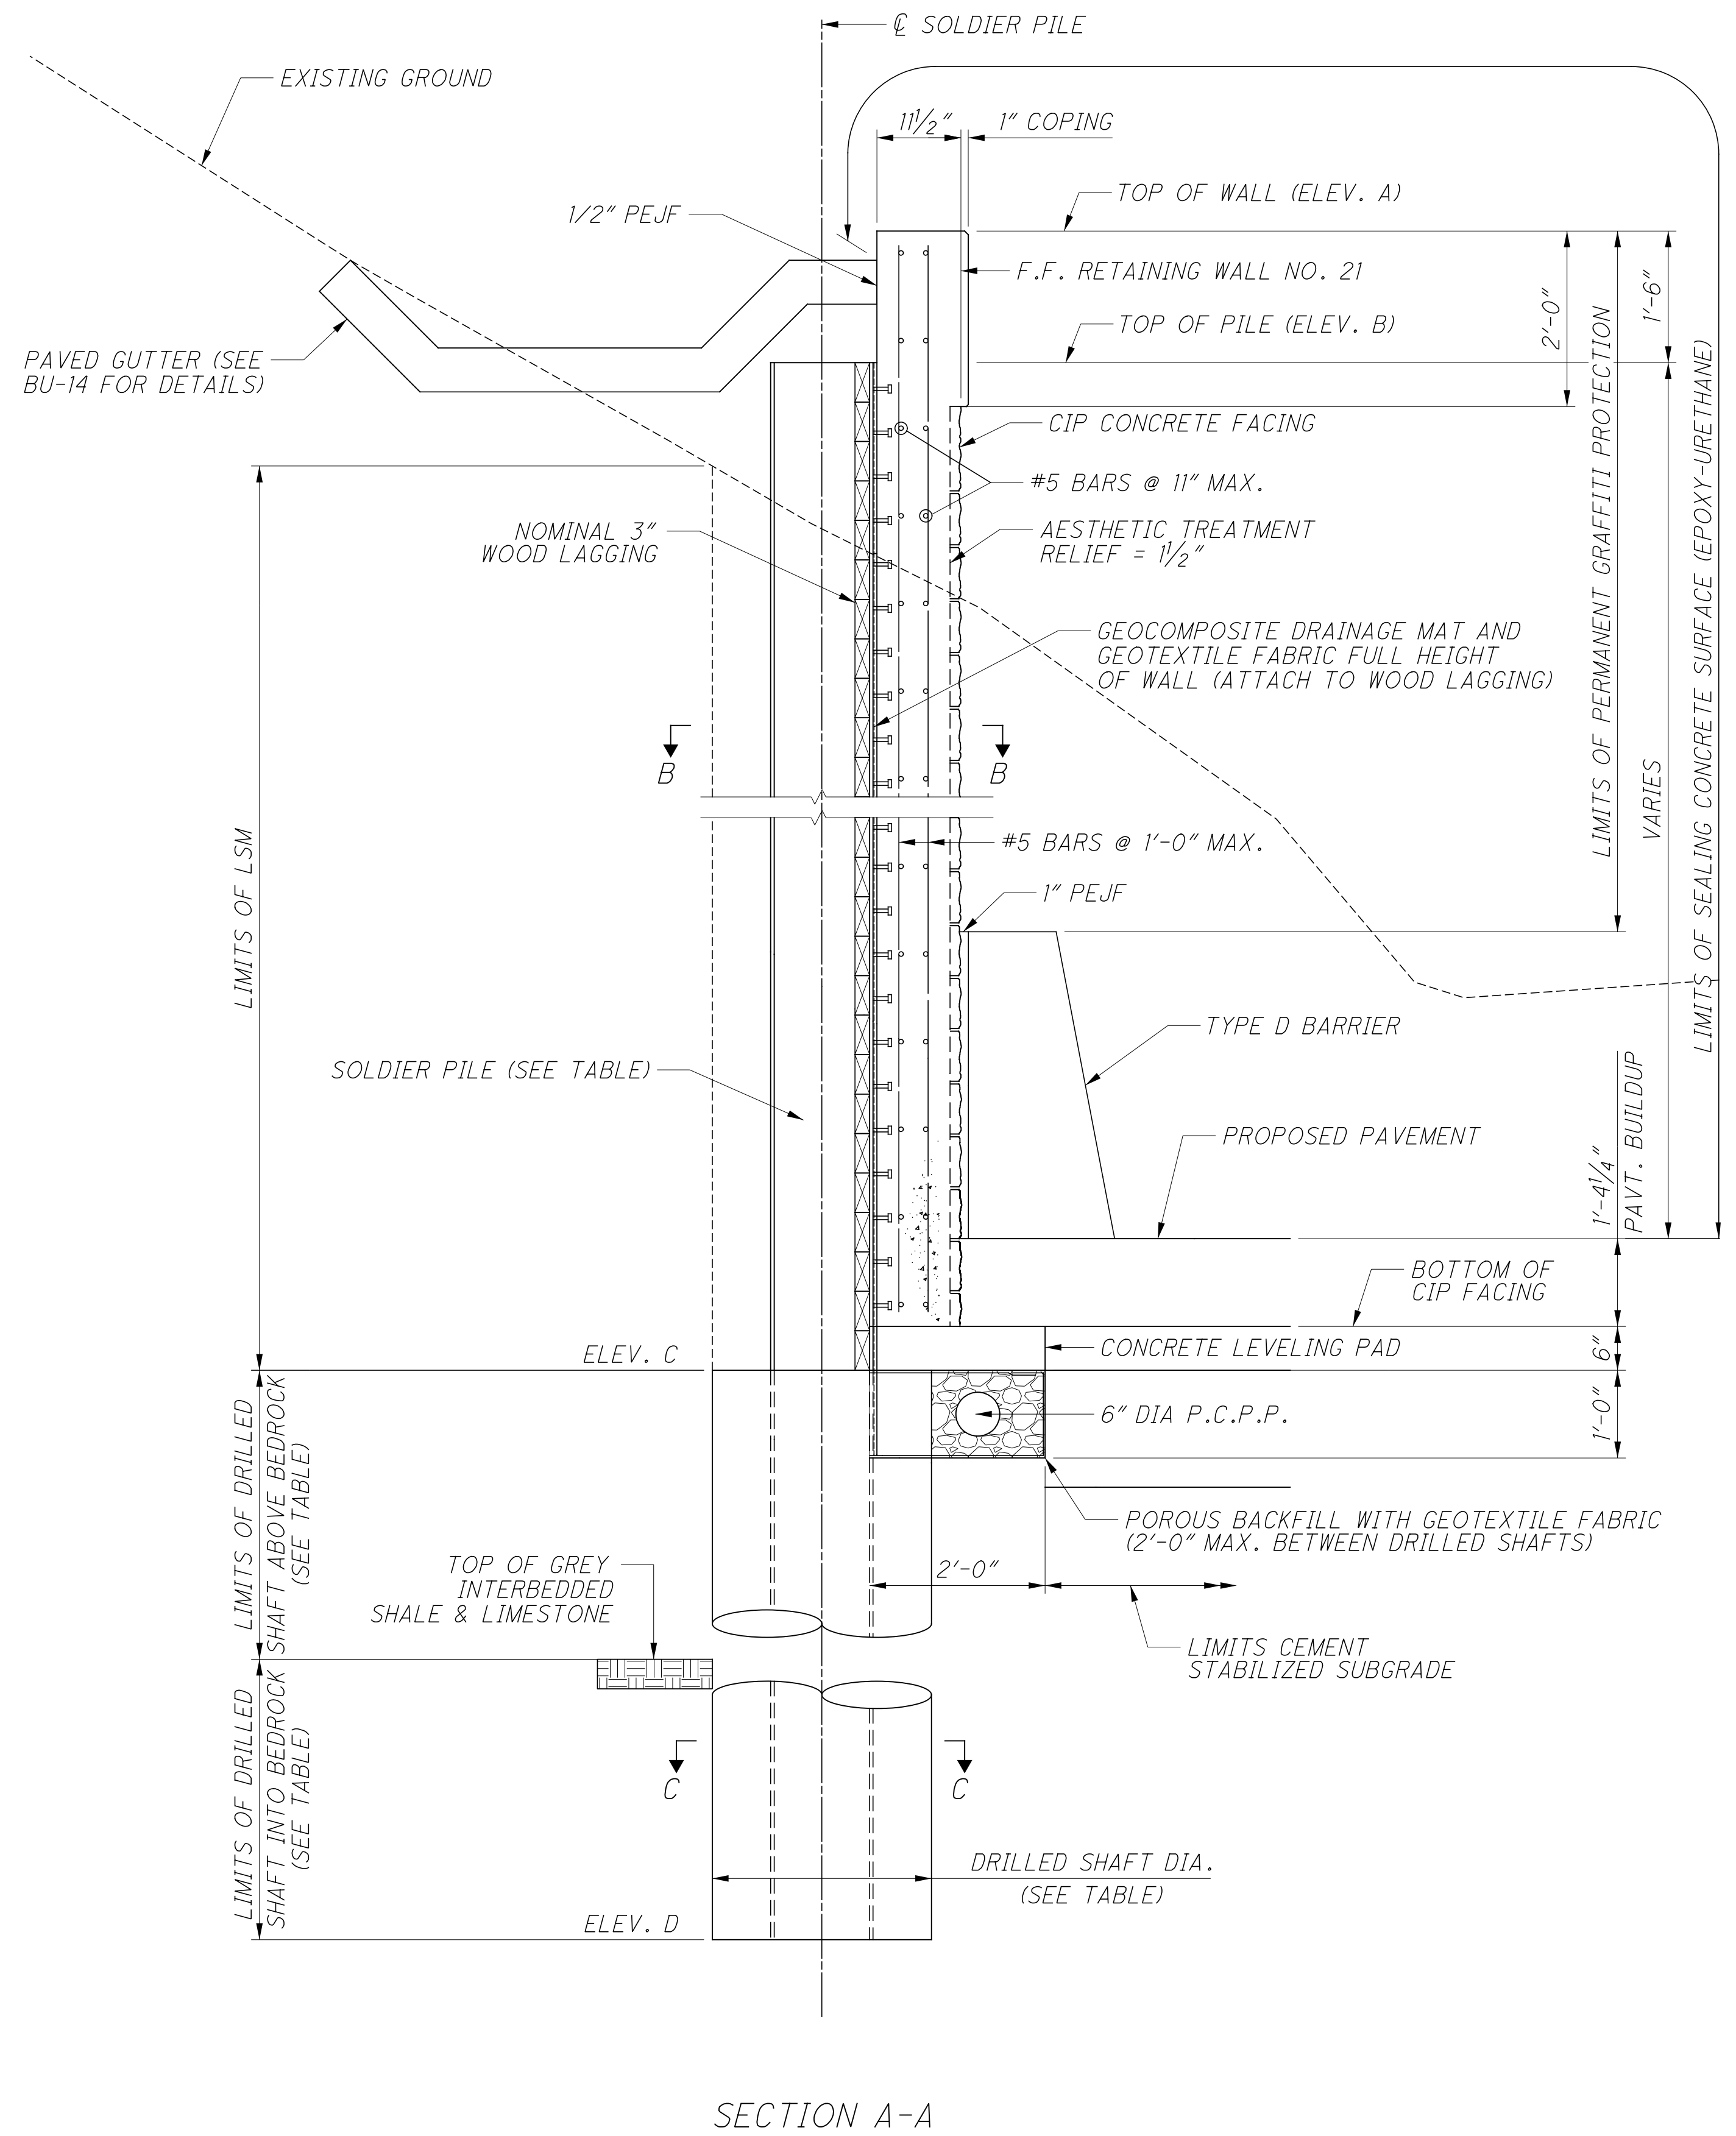

SECTION A-A






NOTE
FOR SOLDIER PILE DESIGN DATA TABLE SEE SHEET 12/13.

	DESIGN AGENCY STRUCTUREPOINT	DATE 01/18/19	REVIEWED MDS
DRAWN BMP	DESIGNED SUJ	FILE NUMBER STRUCTURE	STRUCTURE FILE NUMBER
CHECKED CLB	REVISIONS		

RETAINING WALL NO. 21 DETAILS
 ALONG IR 75 NB

HAM-75-3.84
PID No. 00000

i:\wade 8/22/2022 9:14:41 AM 0:\2017\01113.C.Design\104667-HAM-75-384.Design\Structures\Walls_Sheets\104667_WD31.dgn

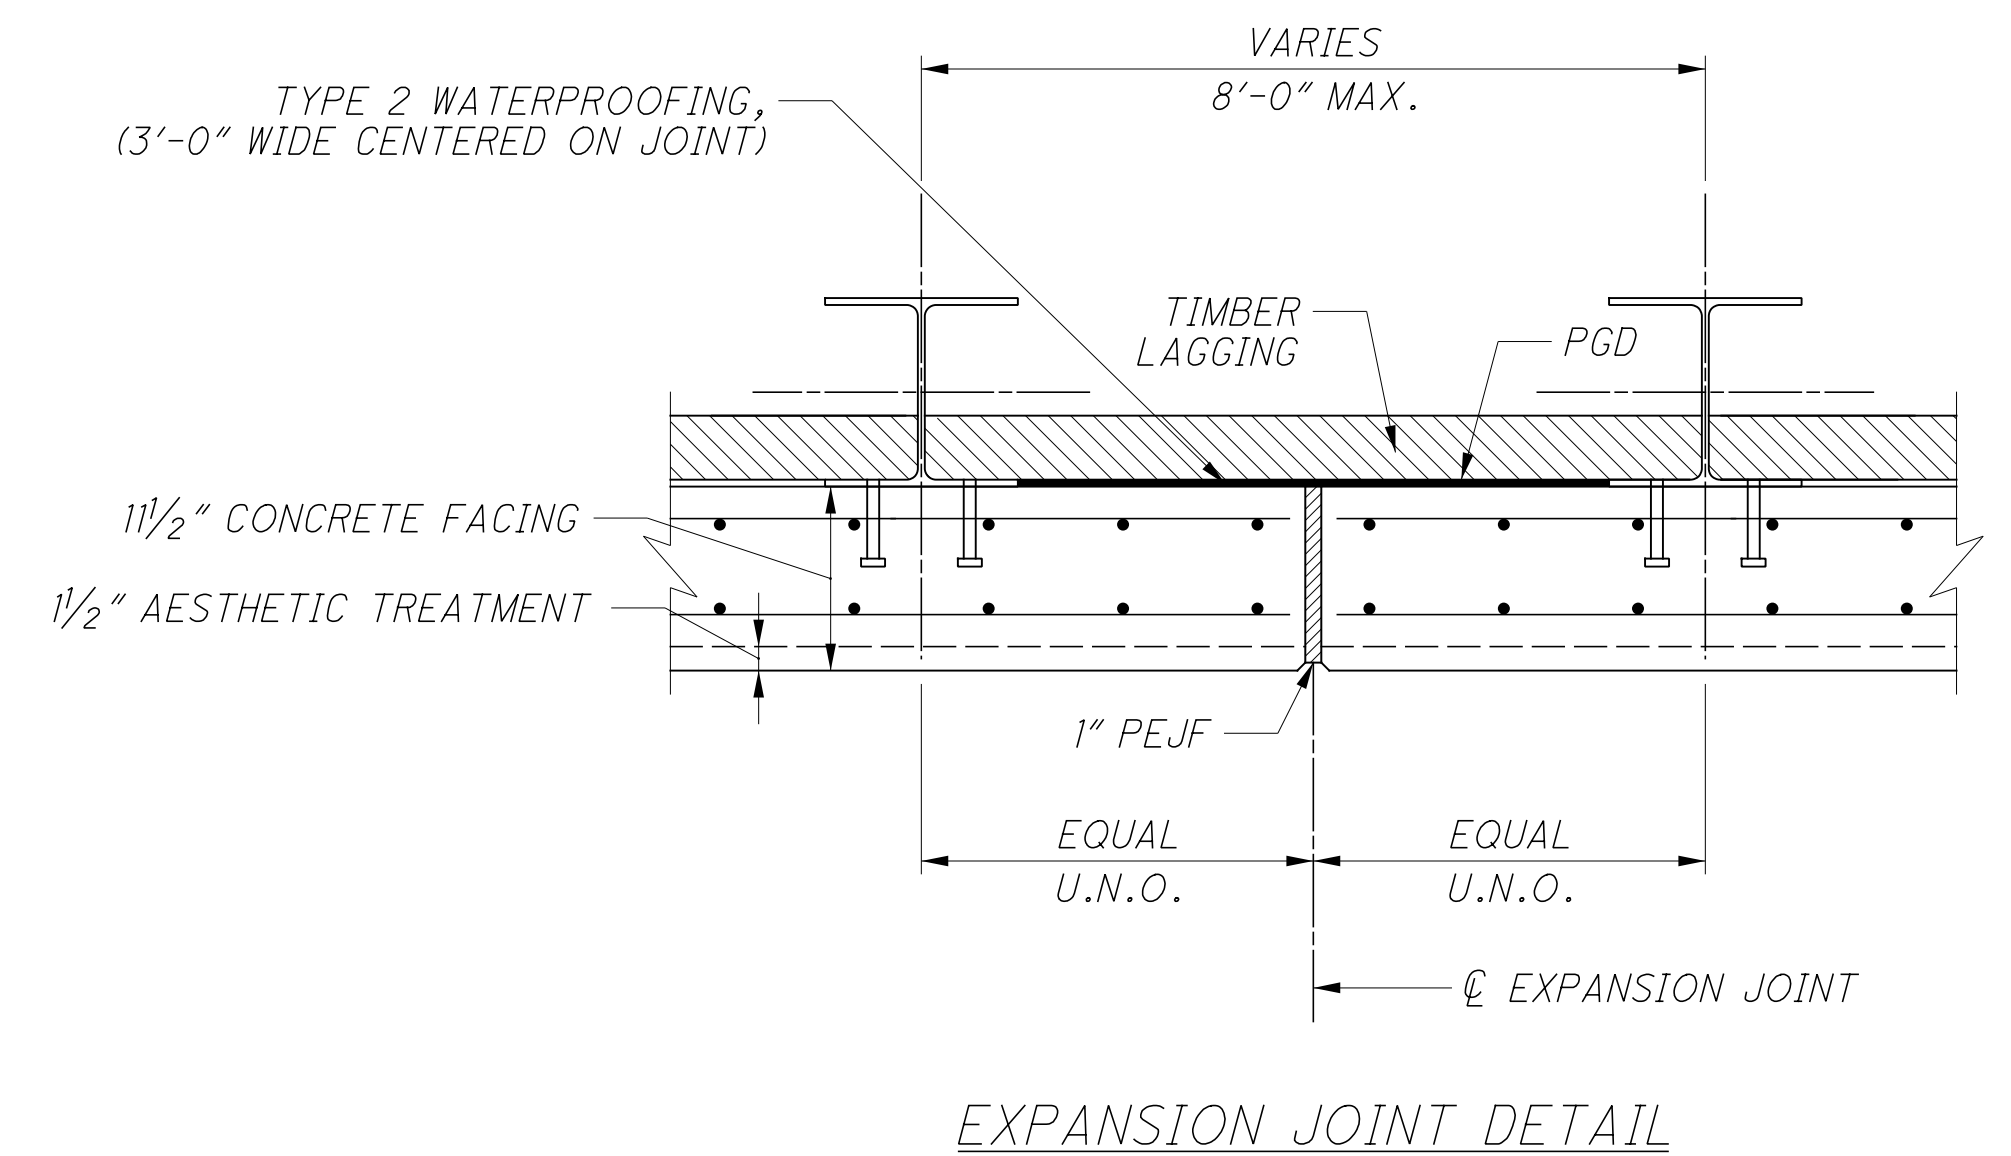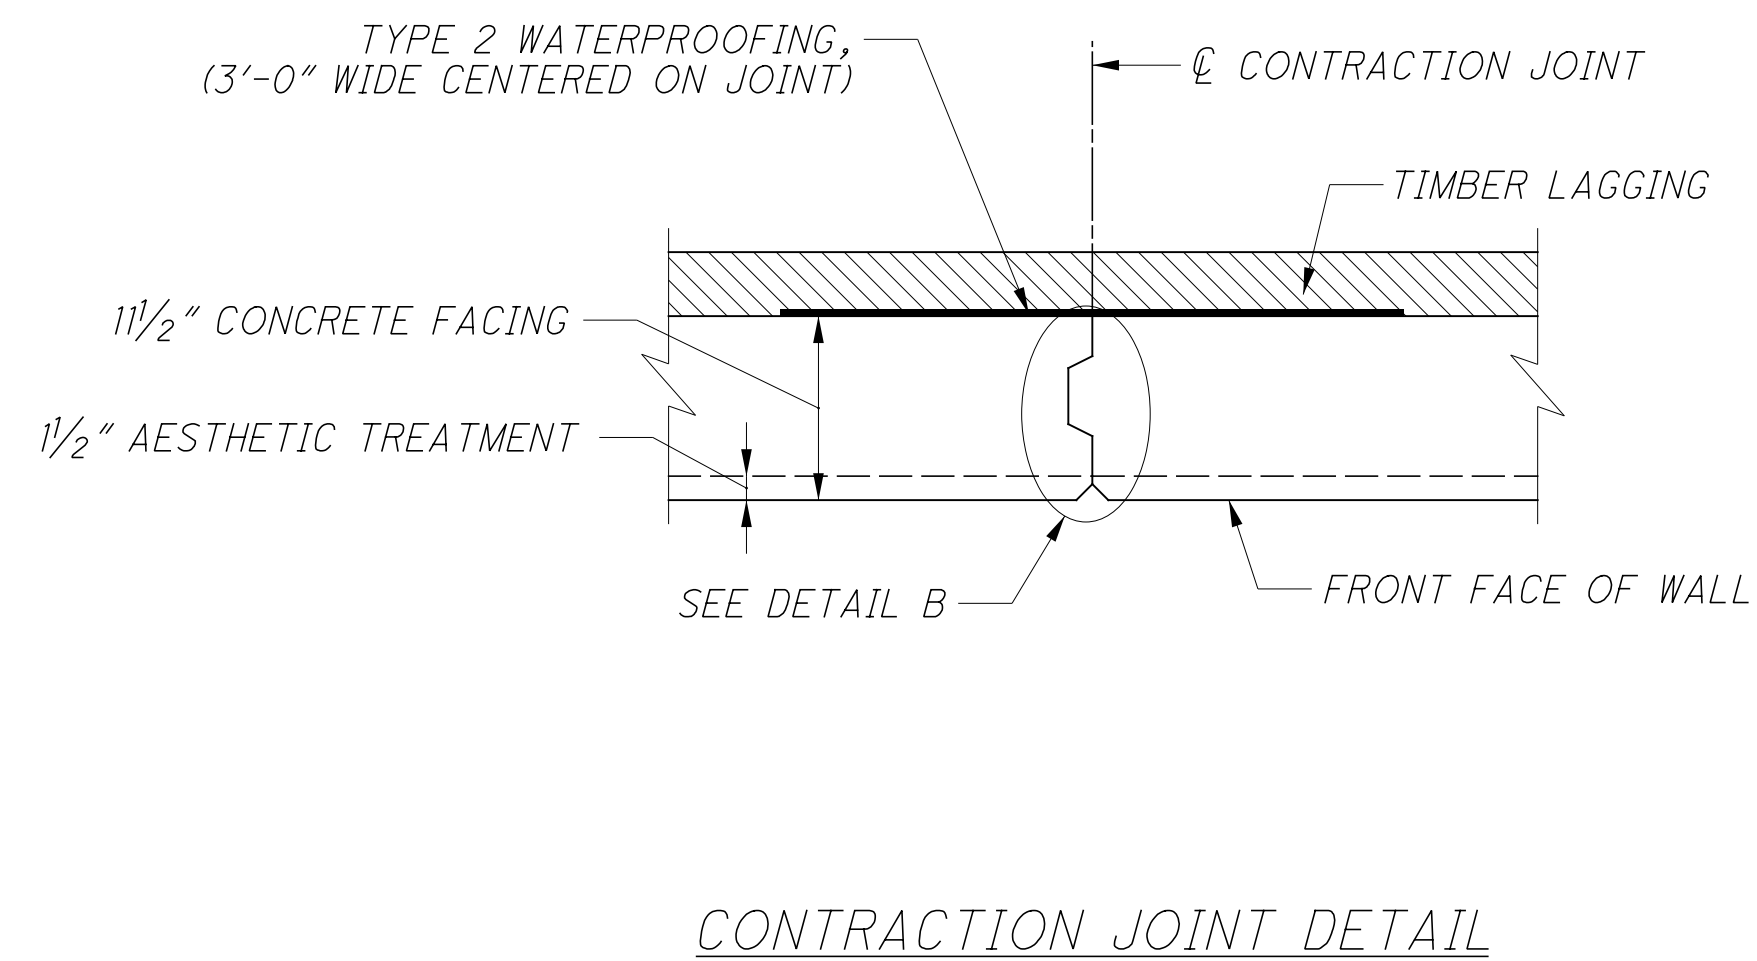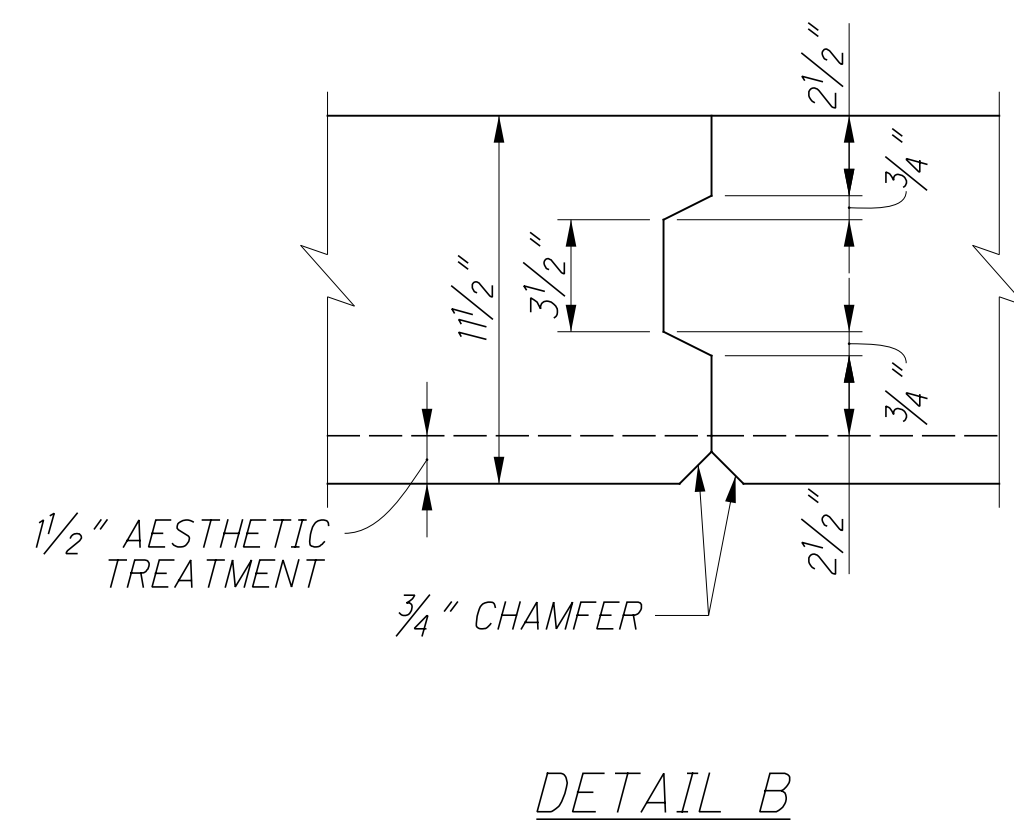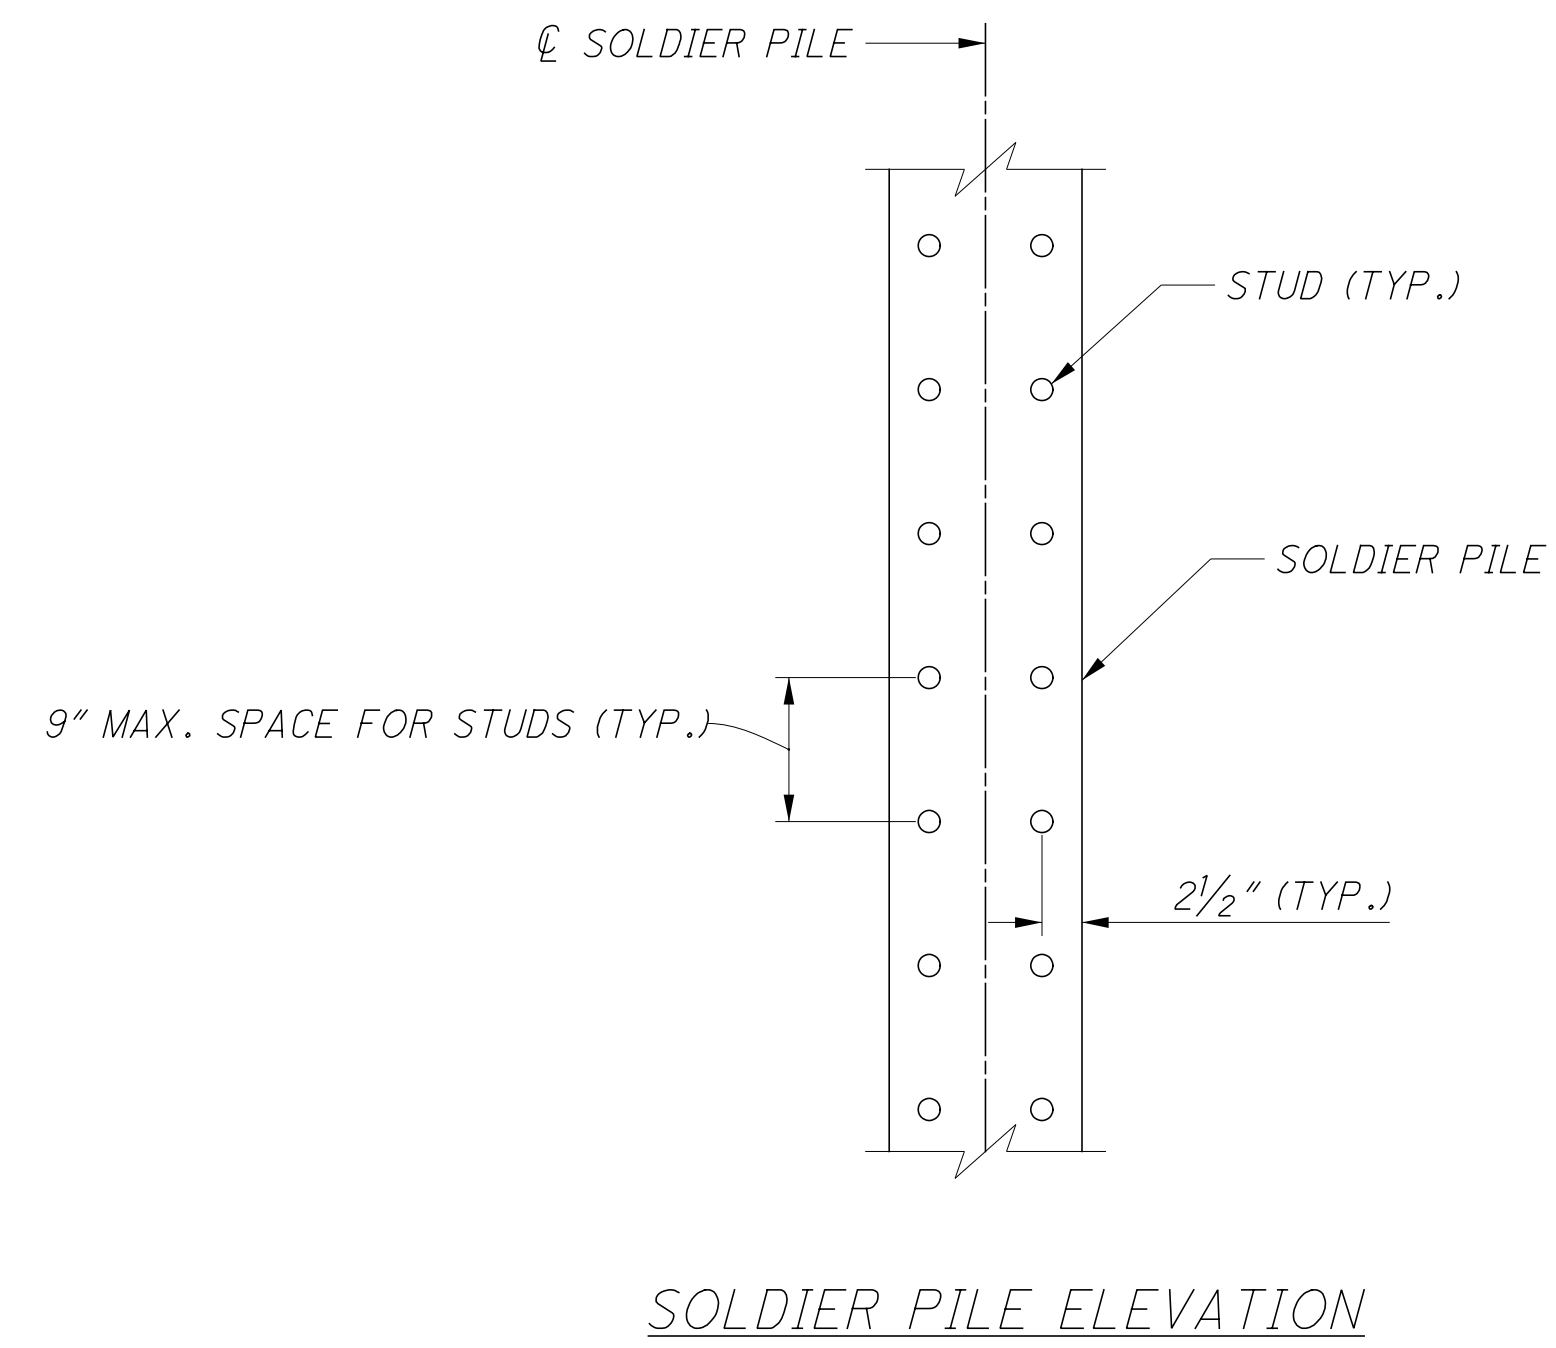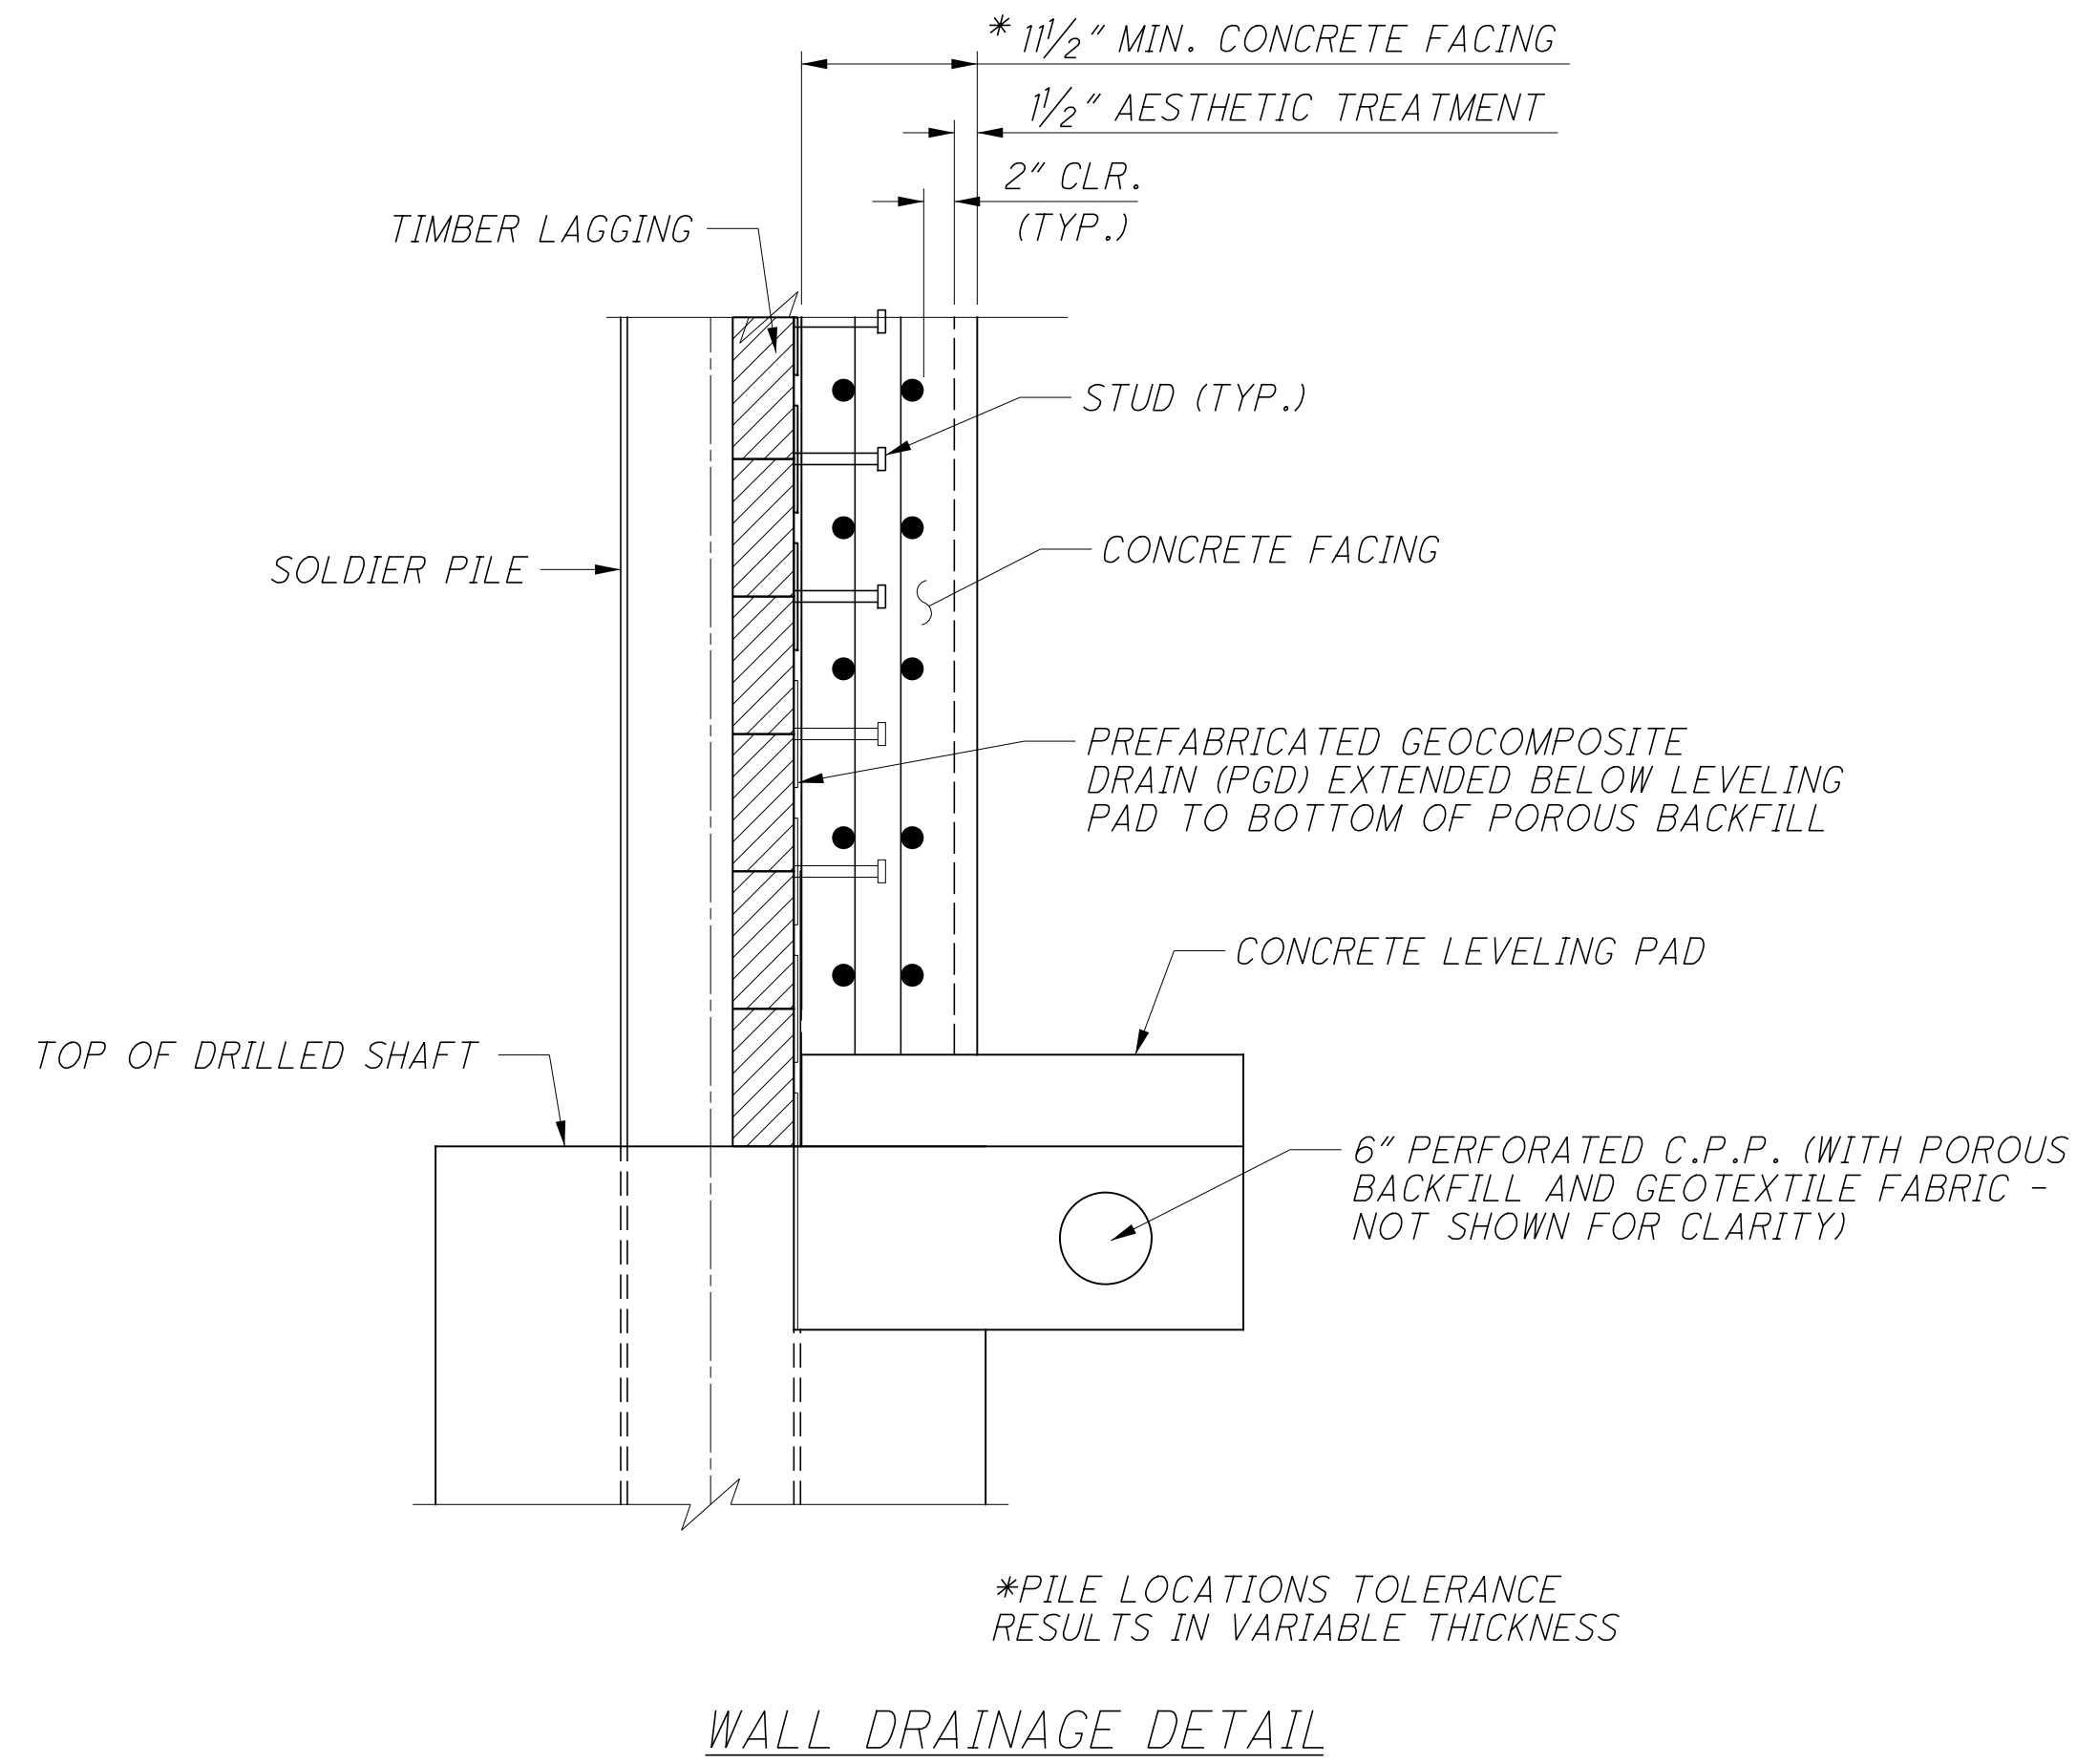

DESIGN AGENCY	DATE	REVIEWED	DRAWN	DESIGNED
STRUCTUREPOINT	01/18/19	MDS	BMP	SUF
	FILE NUMBER	STRUCTURE	REVISED	CHECKED
				CLB
RETAINING WALL NO. 21 DETAILS				
ALONG IR 75 NB				
HAM-75-3.84		PID No. 104667		
11 / 13				
46				
48				

MARK	NUMBER	LENGTH	WEIGHT	TYPE	DIMENSIONS						
	TOTAL				A	B	C	D	E	R	INC
WALL NO. 21											
W501	14	25'-8"	375	STR							
W502	2	9'-11"	21	STR							
	2 SR	4'-9"									
W503	OF	TO	303	STR							1/2"
	27	6'-0"									
W504	844	23'-8"	20834	STR							
W505	2	19'-8"	41	STR							
	2 SR	6'-3"									
W506	OF	TO	356	STR							1/2"
	25	7'-5"									
W507	52	9'-4"	506	STR							
	2 SR	7'-8"									
W508	OF	TO	426	STR							1/2"
	25	8'-8"									
W509	50	9'-0"	469	STR							
	4 SR	9'-4"									
W510	OF	TO	991	STR							1/4"
	25	9'-8"									
	2 SR	9'-6"									
W511	OF	TO	502	STR							1/8"
	25	9'-9"									
W512	50	9'-10"	513	STR							
W513	50	10'-1"	526	STR							
W514	102	10'-6"	1117	STR							
W515	50	10'-11"	569	STR							
	2 SR	11'-2"									
W516	OF	TO	589	STR							1/8"
	25	11'-5"									
	4 SR	11'-3"									
W517	OF	TO	1195	STR							1/4"
	25	11'-8"									
W518	2	23'-1"	48	STR							
	2 SR	11'-0"									
W519	OF	TO	589	STR							1/4"
	25	11'-7"									
W520	2	17'-1"	36	STR							
	2 SR	10'-9"									
W521	OF	TO	583	STR							1/2"
	25	11'-7"									
W522	2	5'-5"	11	STR							
	2 SR	10'-2"									
W523	OF	TO	558	STR							1/2"
	25	11'-3"									
W524	2	11'-3"	23	STR							
	2 SR	9'-8"									
W525	OF	TO	533	STR							1/2"
	25	10'-9"									
	2 SR	9'-6"									
W526	OF	TO	513	STR							1/4"
	25	10'-2"									
	2 SR	9'-7"									
W527	OF	TO	511	STR							1/4"
	25	10'-0"									
W528	50	10'-0"	522	STR							
	2 SR	10'-8"									
W529	OF	TO	563	STR							1/8"
	25	10'-11"									
	2 SR	10'-10"									
W530	OF	TO	574	STR							1/4"
	25	11'-2"									
W531	2	15'-6"	32	STR							
	2 SR	10'-11"									
W532	OF	TO	582	STR							1/4"
	25	11'-4"									

MARK	NUMBER	LENGTH	WEIGHT	TYPE	DIMENSIONS						
	TOTAL				A	B	C	D	E	R	INC
WALL NO. 21 CONT.											
W533	2	19'-10"	41	STR							
	2 SR	11'-0"									
W534	OF	TO	585	STR							1/4"
	25	11'-5"									
W535	2	22'-1"	46	STR							
	4 SR	11'-0"									
W536	OF	TO	1178	STR							1/4"
	25	11'-7"									
	2 SR	11'-1"									
W537	OF	TO	589	STR							1/4"
	25	11'-6"									
	2 SR	11'-2"									
W538	OF	TO	593	STR							1/4"
	25	11'-7"									
	2 SR	11'-3"									
W539	OF	TO	598	STR							1/4"
	25	11'-8"									
W540	2	15'-2"	32	STR							
	2 SR	10'-8"									
W541	OF	TO	587	STR							1/2"
	25	11'-10"									
W542	2	19'-9"	41	STR							
	2 SR	8'-10"									
W543	OF	TO	522	STR							1/4"
	25	11'-2"									
W544	16	17'-8"	295	STR							
W545	2	9'-6"	20	STR							
	2 SR	6'-9"									
W546	OF	TO	419	STR							1/4"
	25	9'-4"									
W547	2	13'-11"	29	STR							
W548	2	5'-8"	12	STR							
	2 SR	5'-2"									
W549	OF	TO	243	STR							1/4"
	19	7'-1"									
SUB-TOTAL			40,841								

RETAINING WALL NO. 21 REINFORCING STEEL LIST
 ALONG IR 75 NB

HAM-75-3.84
PID No. 104667


DESIGN AGENCY
STRUCTUREPOINT
 2000 CORPORATE CENTER DR., 17TH FL.
 ST. LOUIS, MO 63103
 TEL: 636.321.3300 FAX: 636.321.3305
 WWW.STRUCTUREPOINT.COM

REVIEWED
 MBS
 DATE
 01/18/19
 STRUCTURE FILE NUMBER


DRAWN
 BMP
 REVISSED

DESIGNED
 BMP
 CHECKED
 SJF

iwade 8/22/2022 9:14:49 AM
 O:\2017\01113.C.Design\104667_HAM-75-3.84.Design\104667_Releable_Castings01.dgn

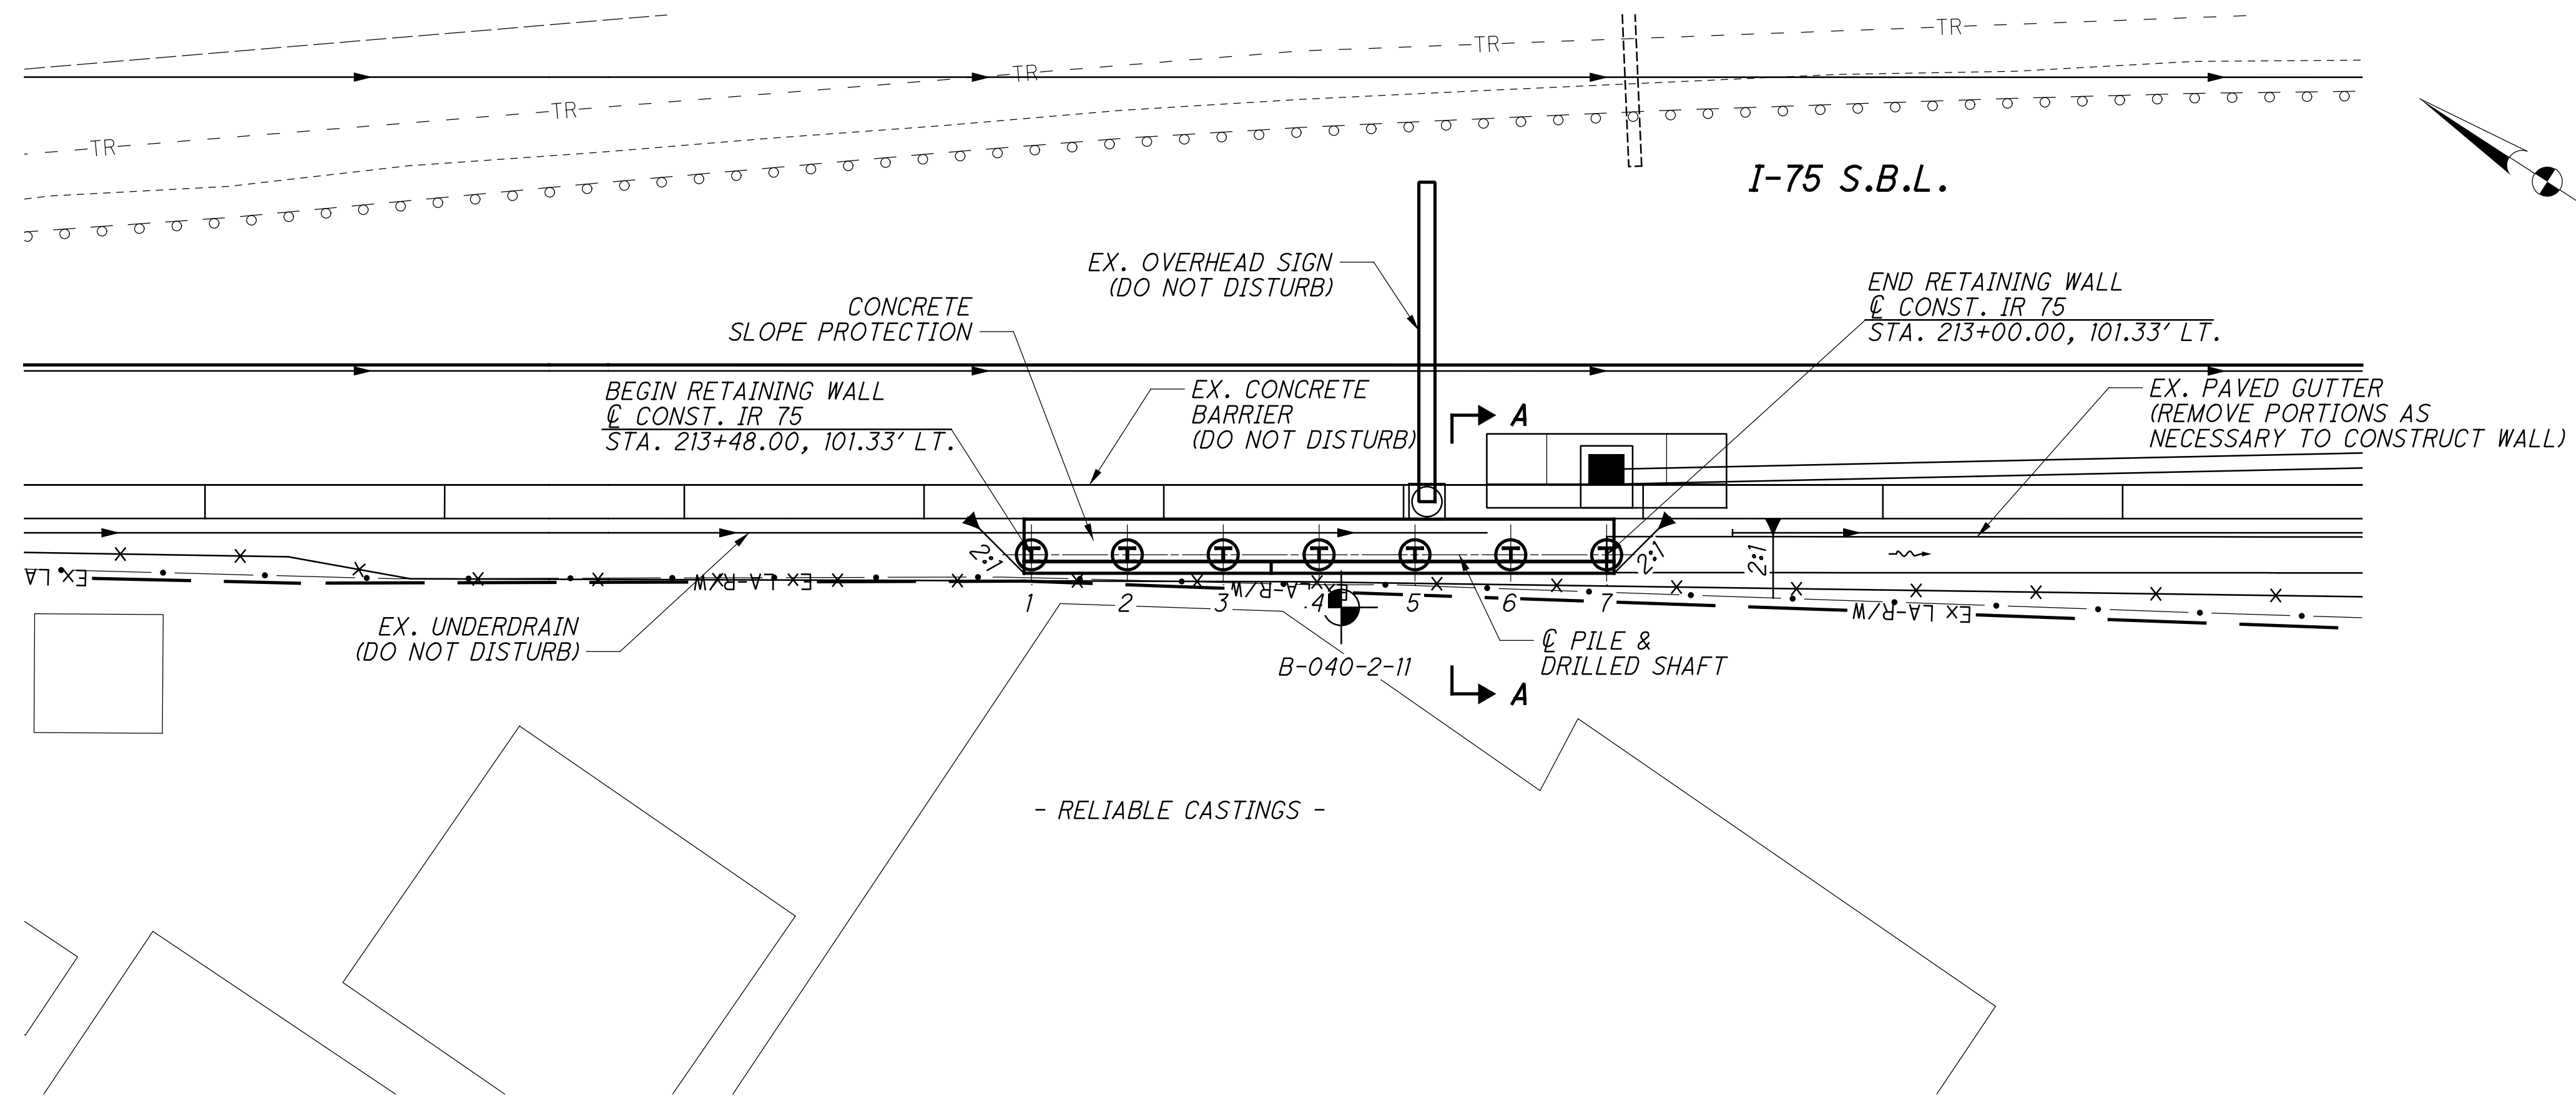

PLAN

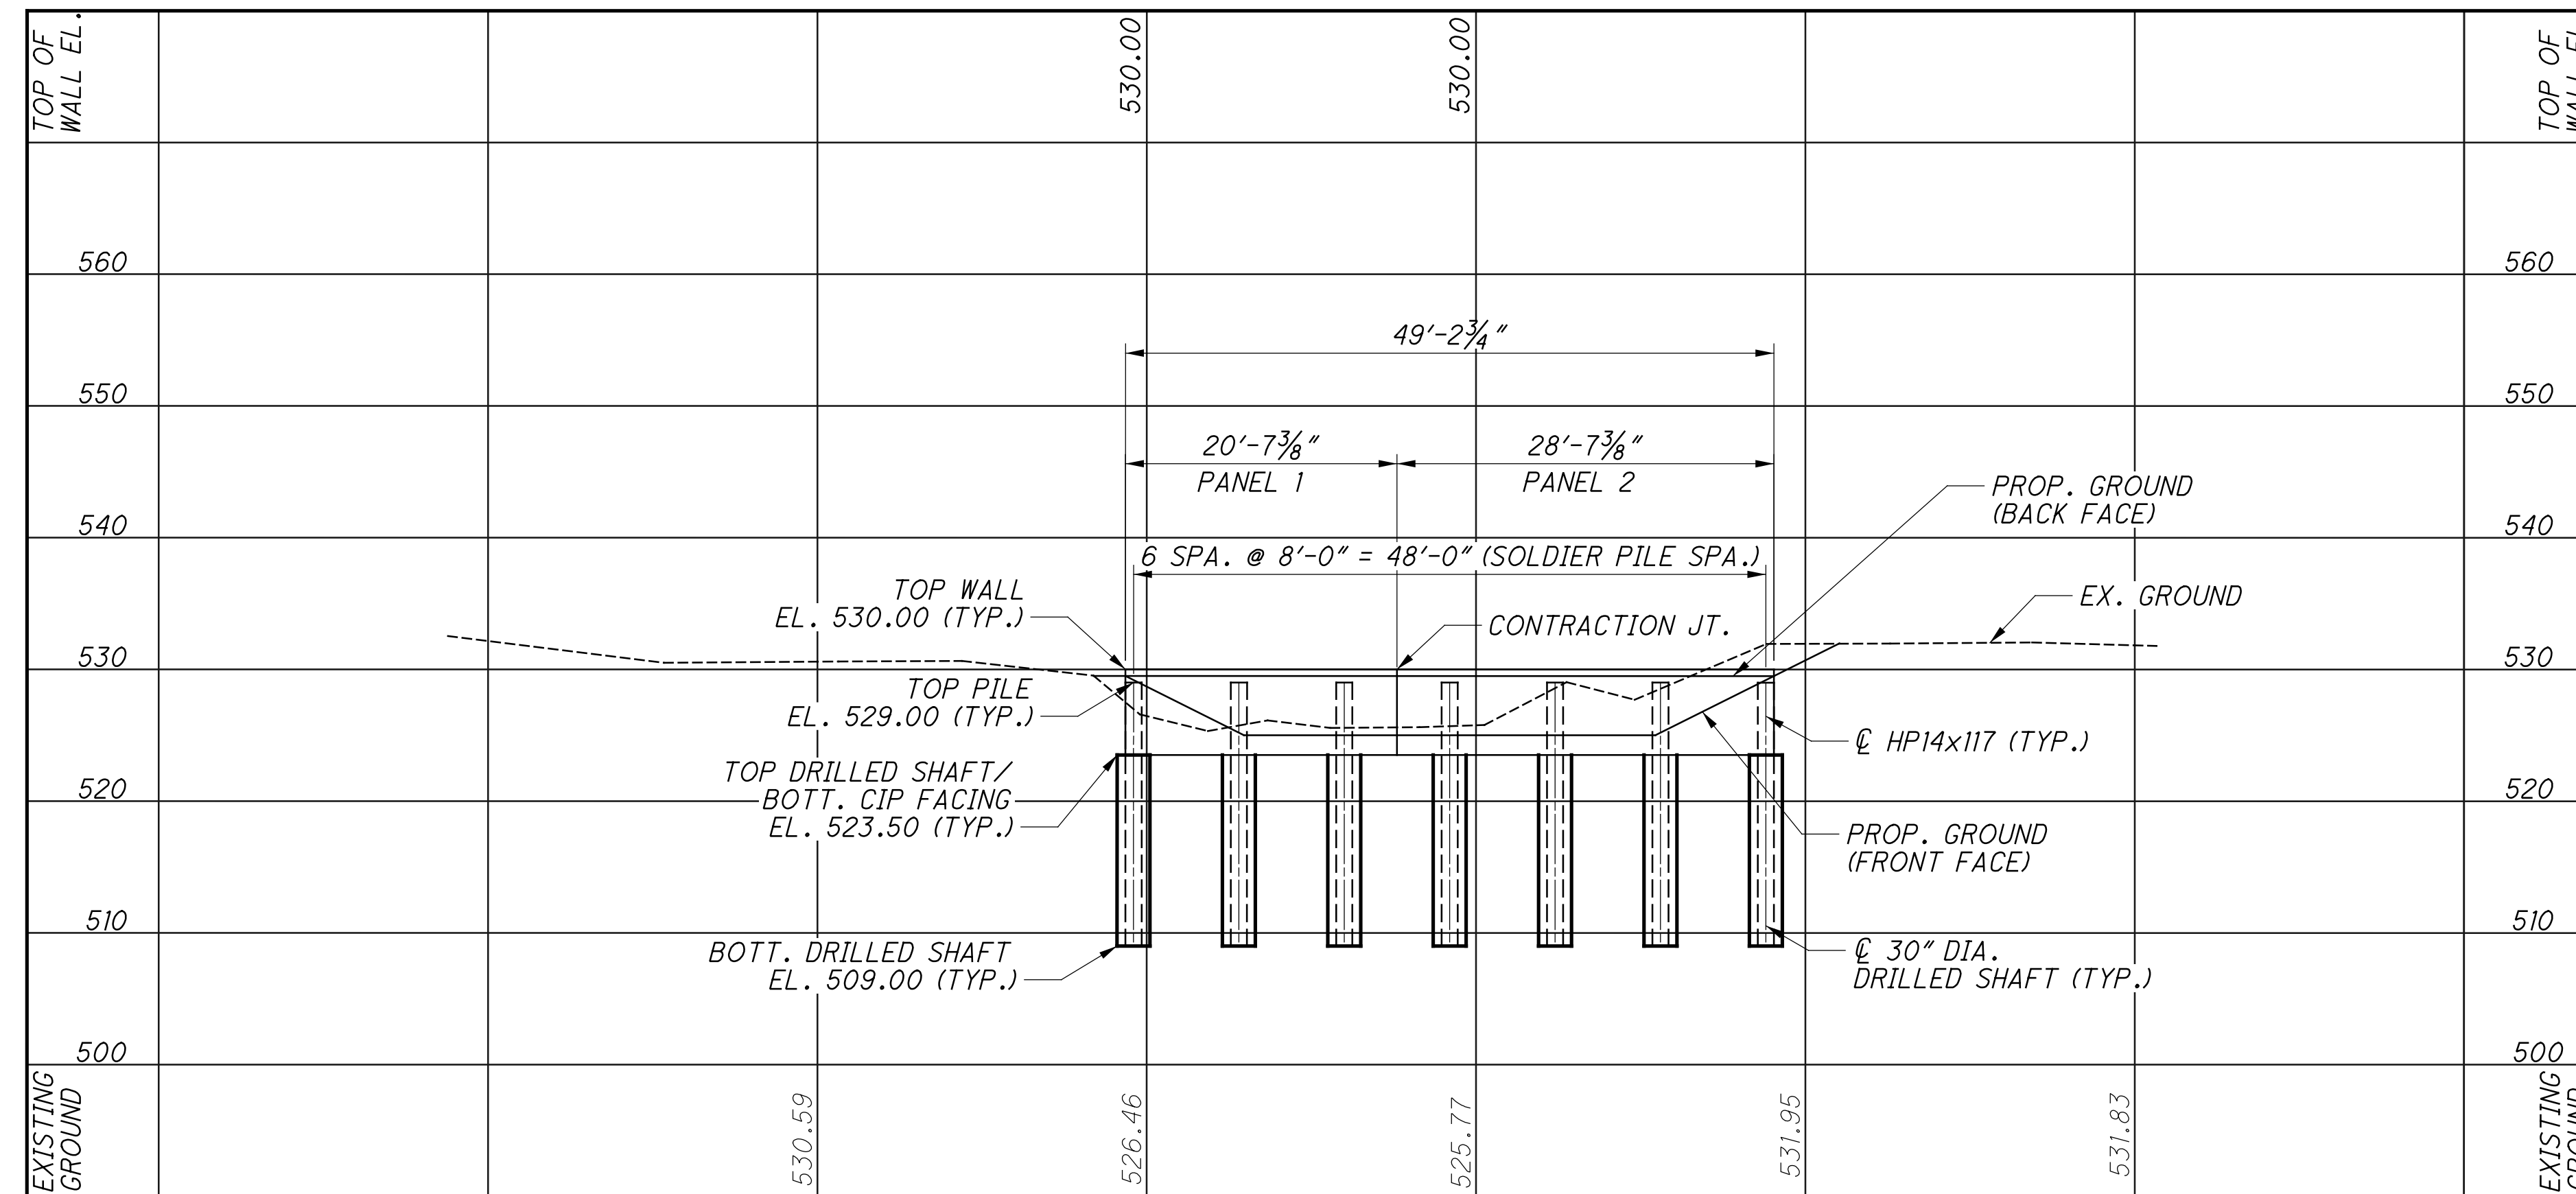

NOTES

ALL STATIONS AND OFFSETS GIVEN ALONG FRONT FACE OF WALL FROM @ CONST. IR 75, UNLESS NOTED OTHERWISE.

PROFILE SHOWN ALONG FRONT FACE OF WALL.

HORIZONTAL PROFILE GRID LINES SHOWN AT 25'-0" SPACING.

FOR SECTION A-A, SEE SHEET 2/3.

FOR @ CONST. IR 75 ALIGNMENT DETAILS SEE BU-14.

FOR GENERAL NOTES SEE BU-9, SHEETS 2&3/48.

RETAINING WALL (RELIABLE CASTINGS) DETAILS
 ALONG IR 75 SB


DESIGNED	SJF	CHECKED	CLB
DRAWN	SJF	REVISED	
REVIEWED	-	STRUCTURE FILE NUMBER	
DATE	06/25/21	STRUCTURE FILE NUMBER	

DESIGN AGENCY
STRUCTUREPOINT
2020 CORPORATE HEADQUARTERS: 1400 EAST 17TH AVENUE, SUITE 1000, DENVER, CO 80202
 TEL: 303.440.3333 FAX: 303.440.3334
 WWW.STRUCTUREPOINT.COM


HAM-75-3.84
PID No. 104667

1 / 3
 48A
 48


iwade 8/22/2022 9:14:58 AM O:\2017\01113.C.Design\104667_HAM-75-3.84.Design\Structures\Walls_Sheets\104667_Reliable_Castings02.dgn

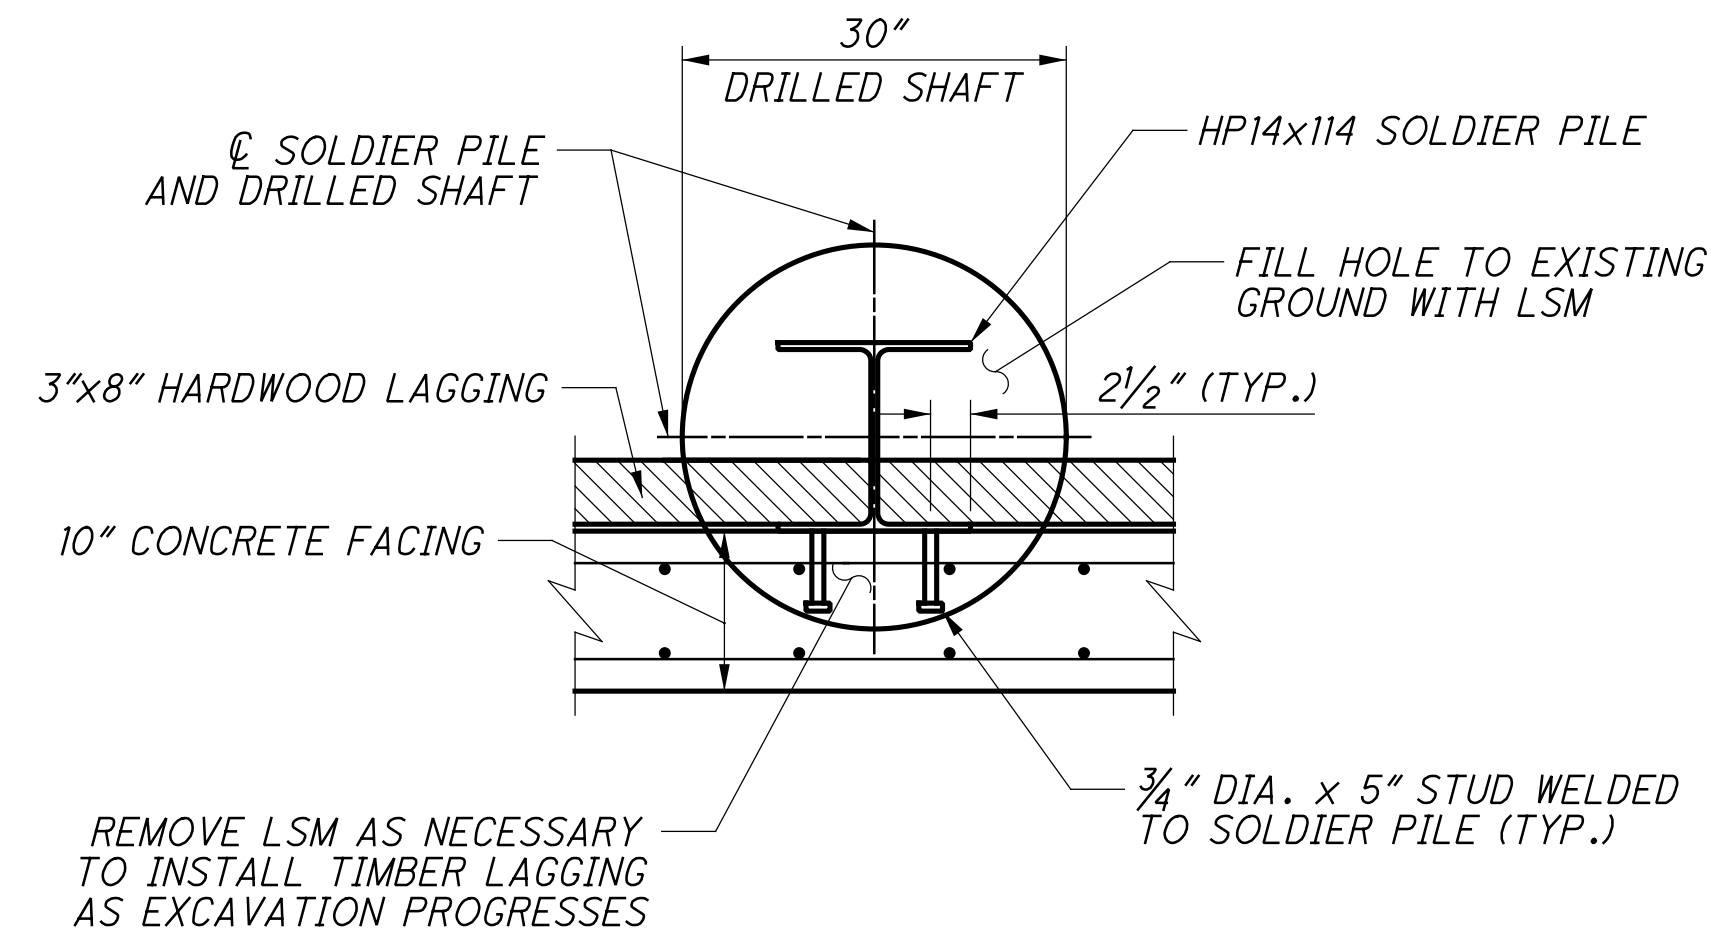

SECTION B-B

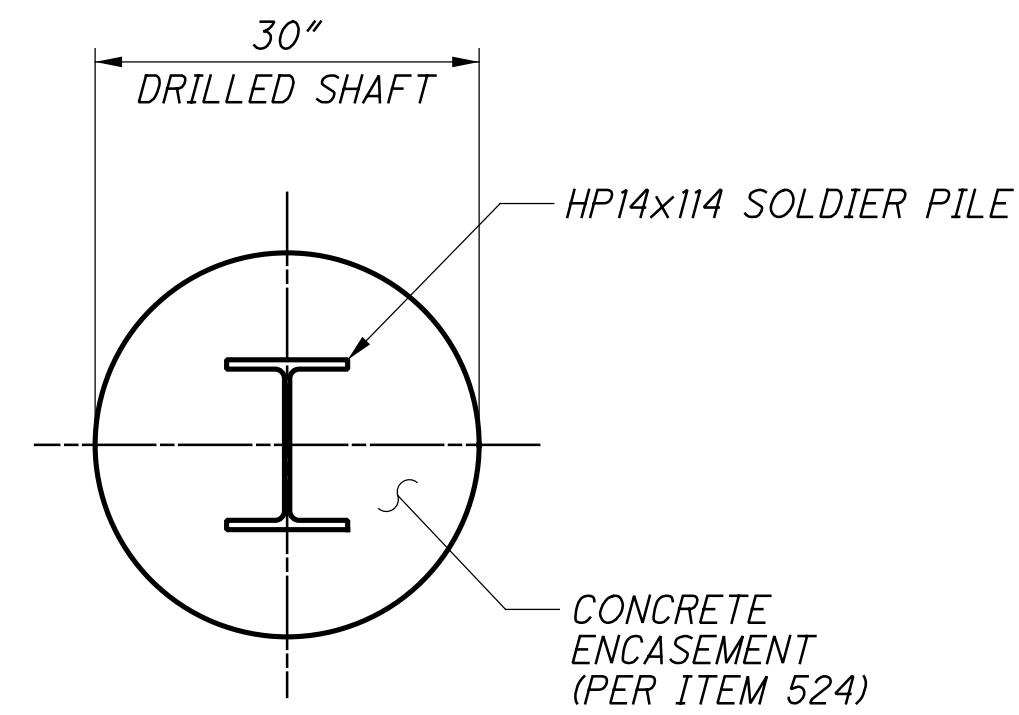

SECTION C-C

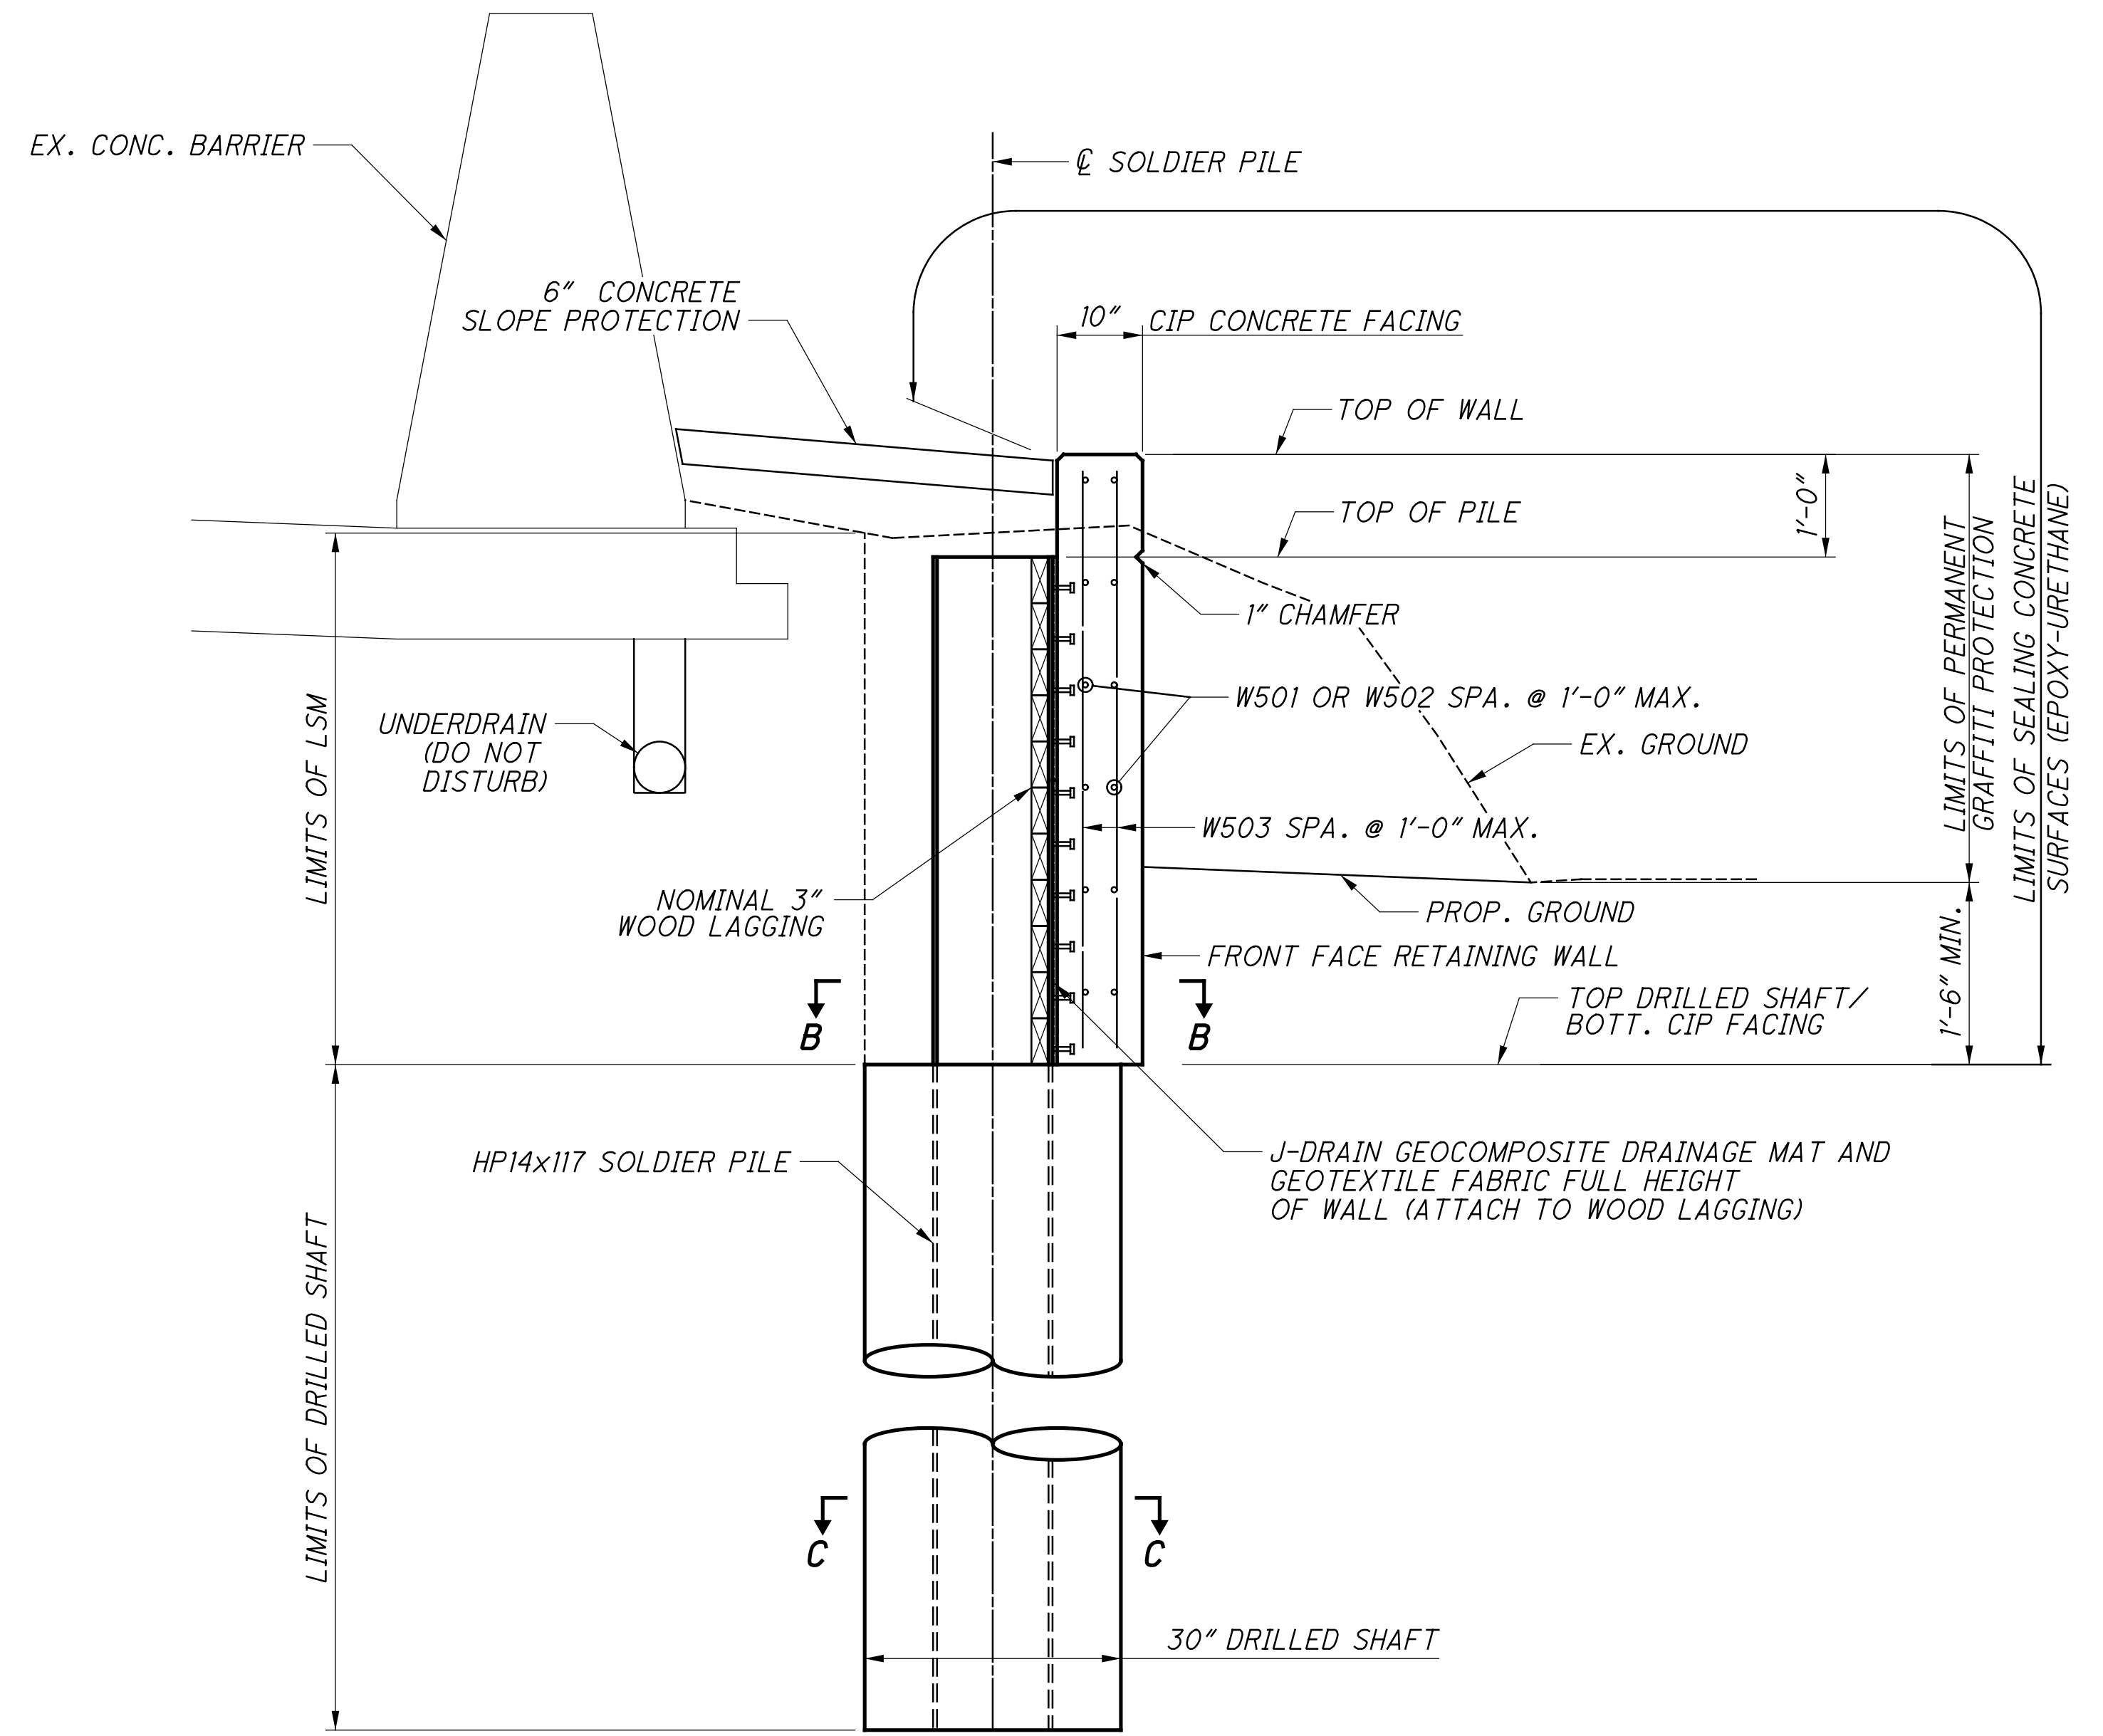

SECTION A-A

MARK	NUMBER	LENGTH	WEIGHT	TYPE	DIMENSIONS						
	TOTAL				A	B	C	D	E	R	INC
RELIABLE CASTINGS WALL											
W501	14	20'-1"	294	STR							
W502	14	28'-1"	411	STR							
W503	100	6'-0"	626	STR							
		SUB-TOTAL	1,331								


RETAINING WALL (RELIABLE CASTINGS) DETAILS
ALONG IR 75 SB

HAM-75-3.84
PID No. 104667


2 / 3
 48B
 48

DESIGN AGENCY: STRUCTUREPOINT
 DATE: 06/25/21
 REVIEWED: SUJ
 DRAWN: SUJ
 DESIGNED: SUJ
 CHECKED: CLB
 STRUCTURE FILE NUMBER:


8/22/2022 9:14:59 AM
 O:\2017\01113.C.Design\104667.Design\HAM-75-3.84.Design\Structures\Walls_Sheets\104667_Reliable_Castings03.dgn

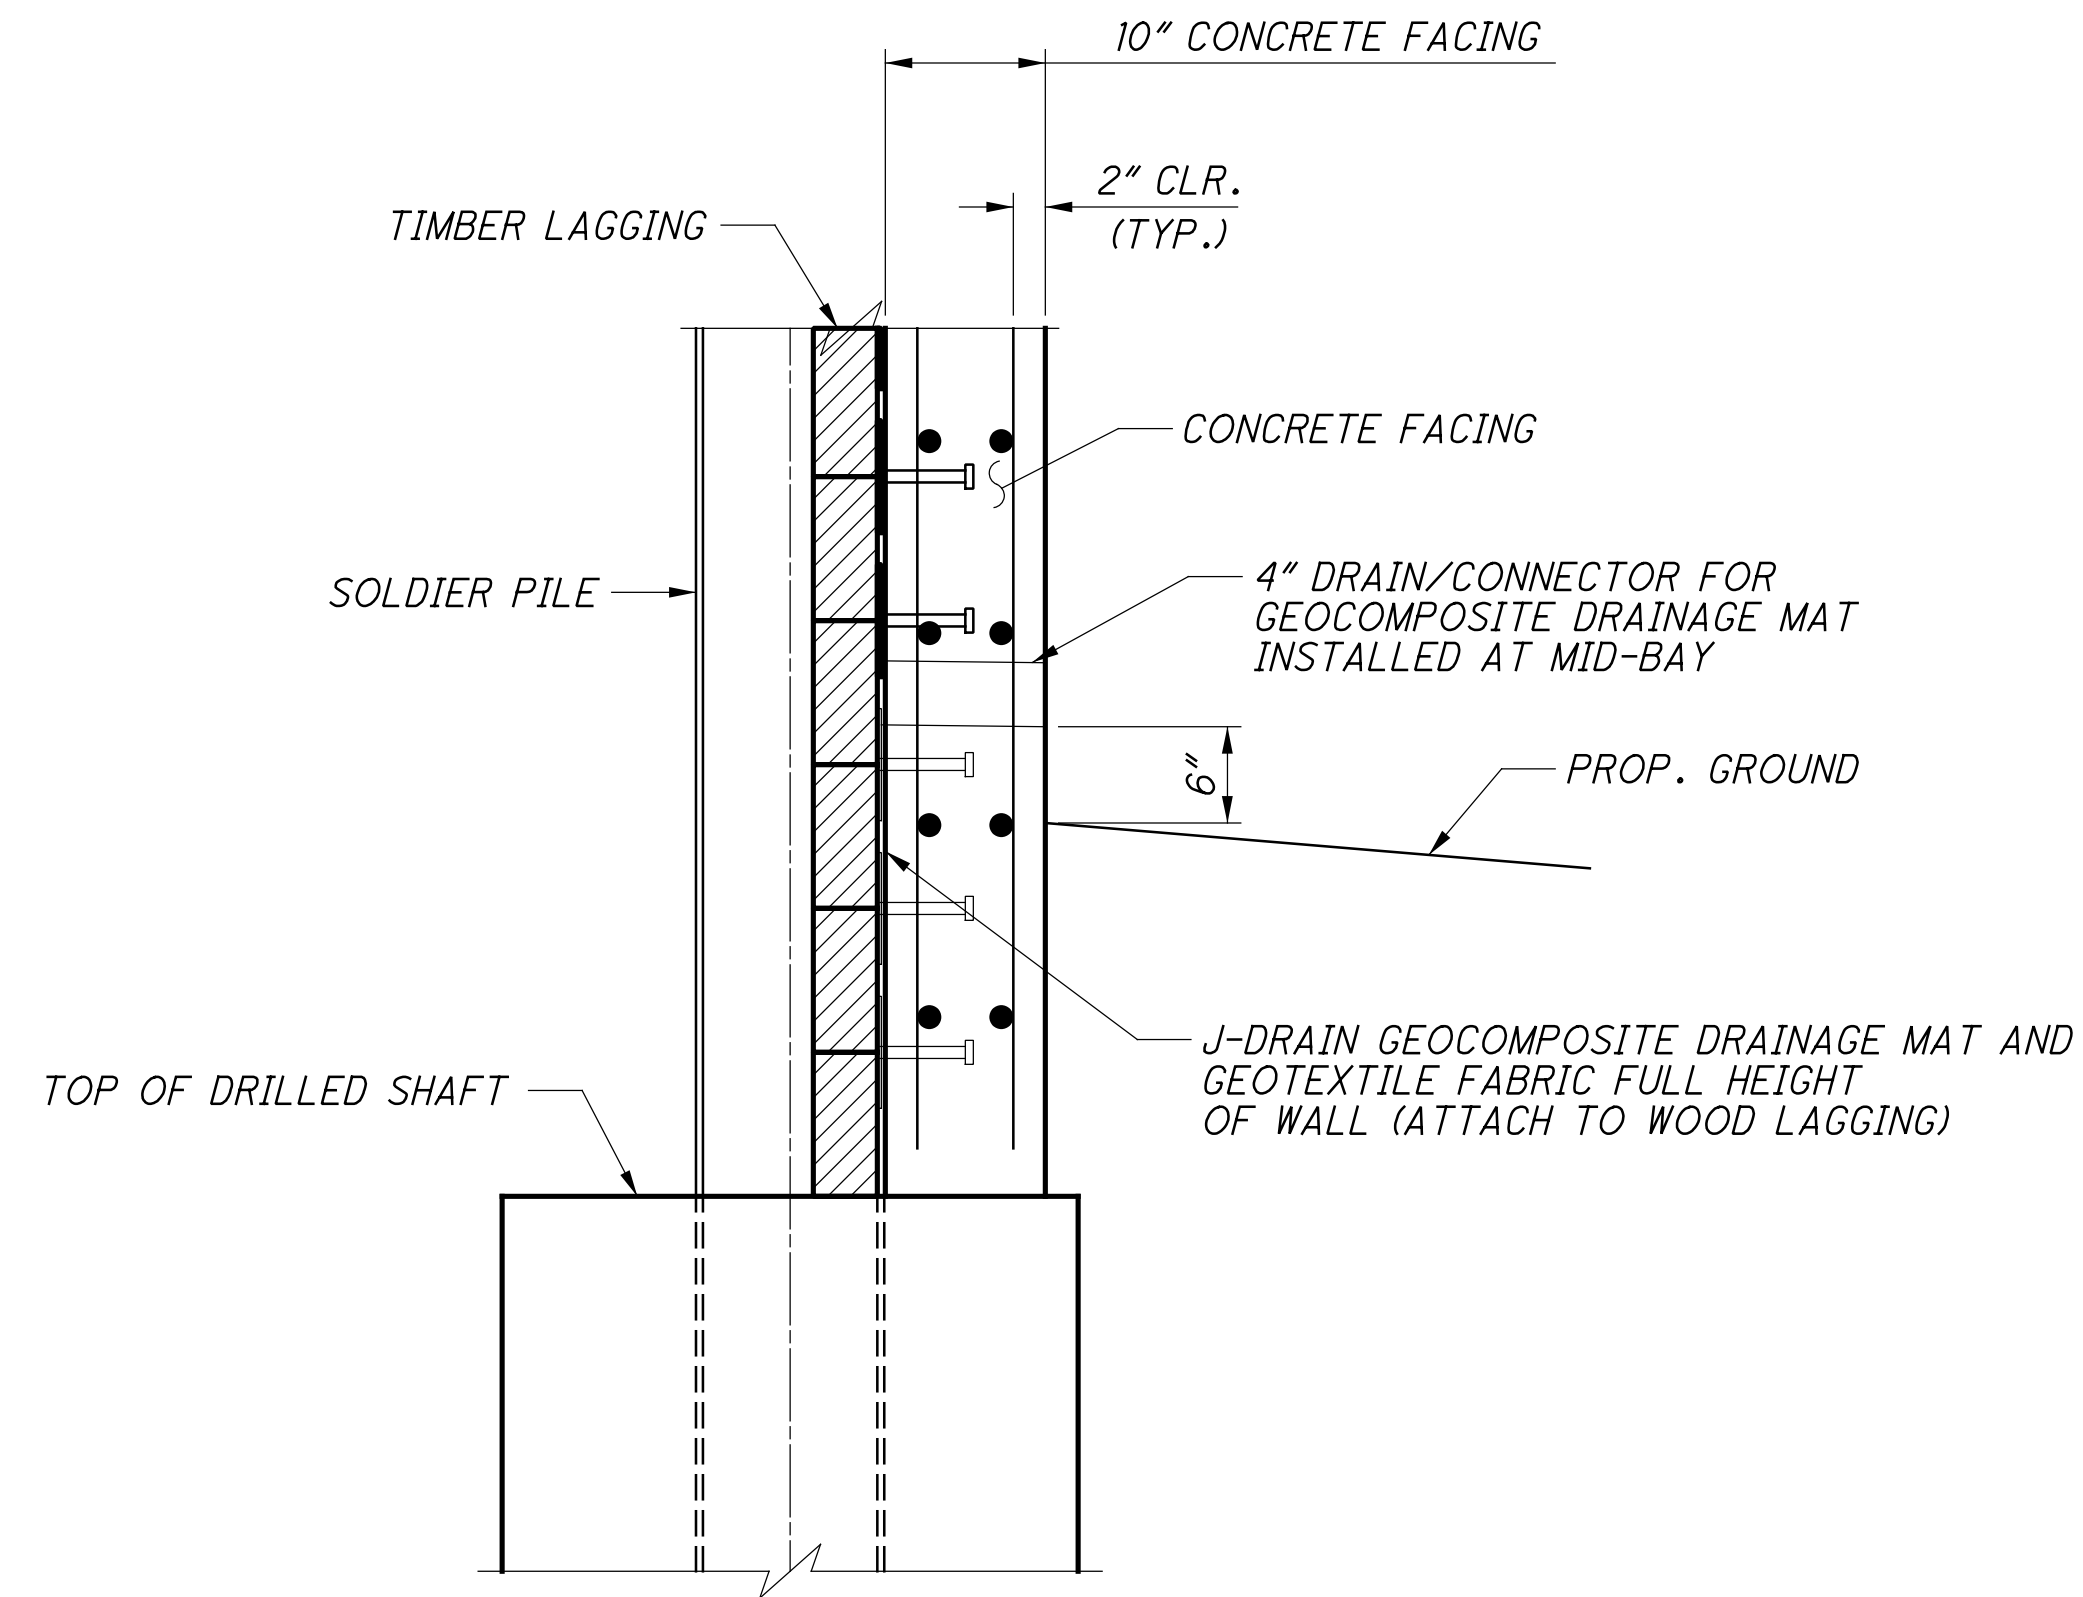


WALL DRAINAGE DETAIL

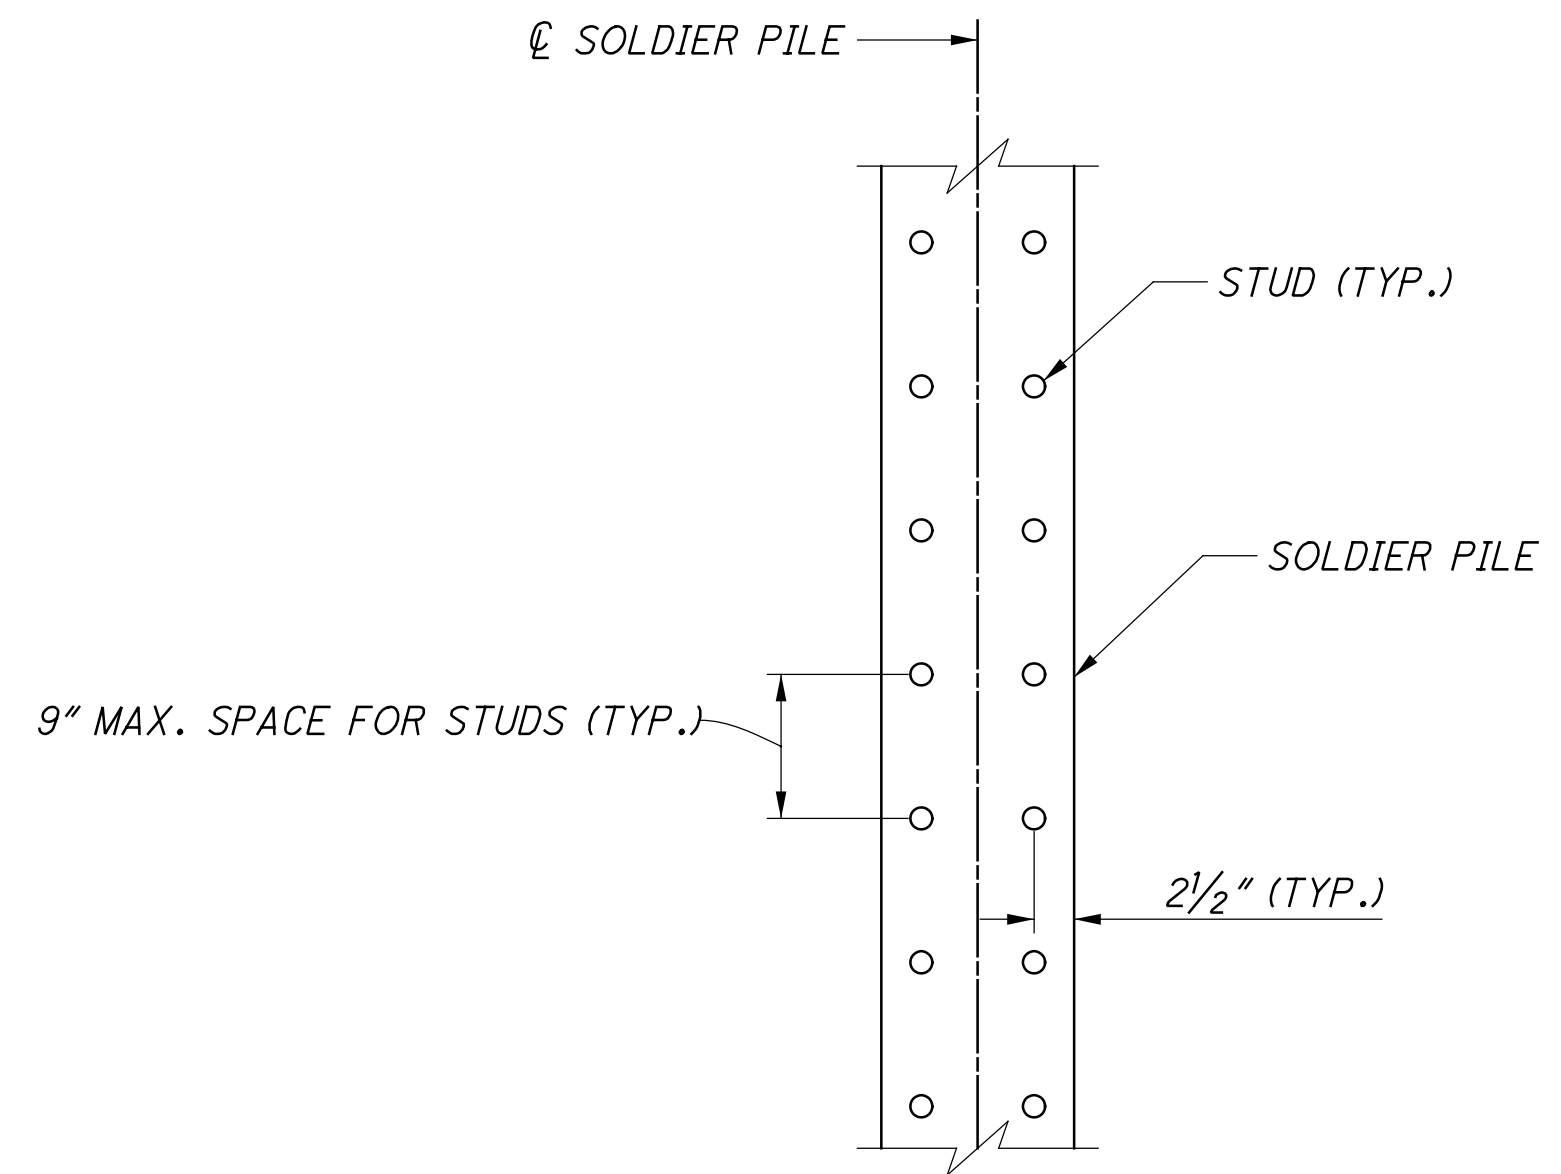

SOLDIER PILE ELEVATION

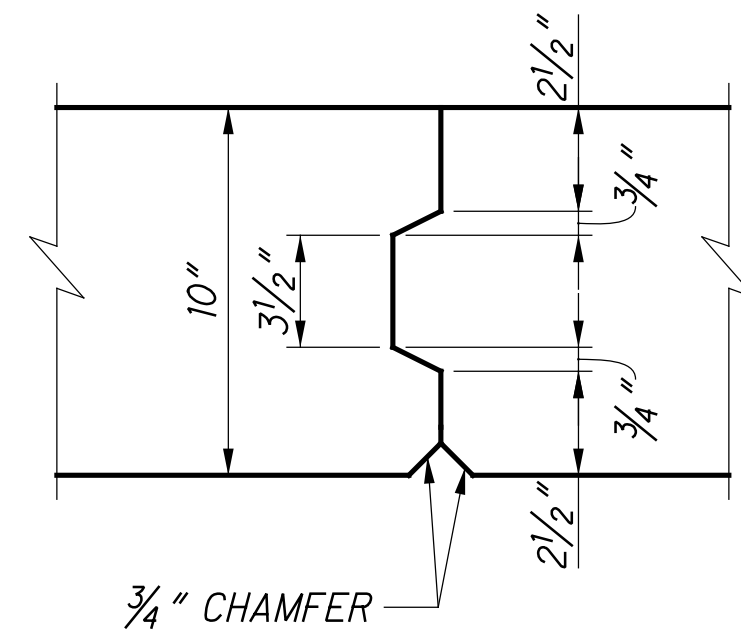

DETAIL B

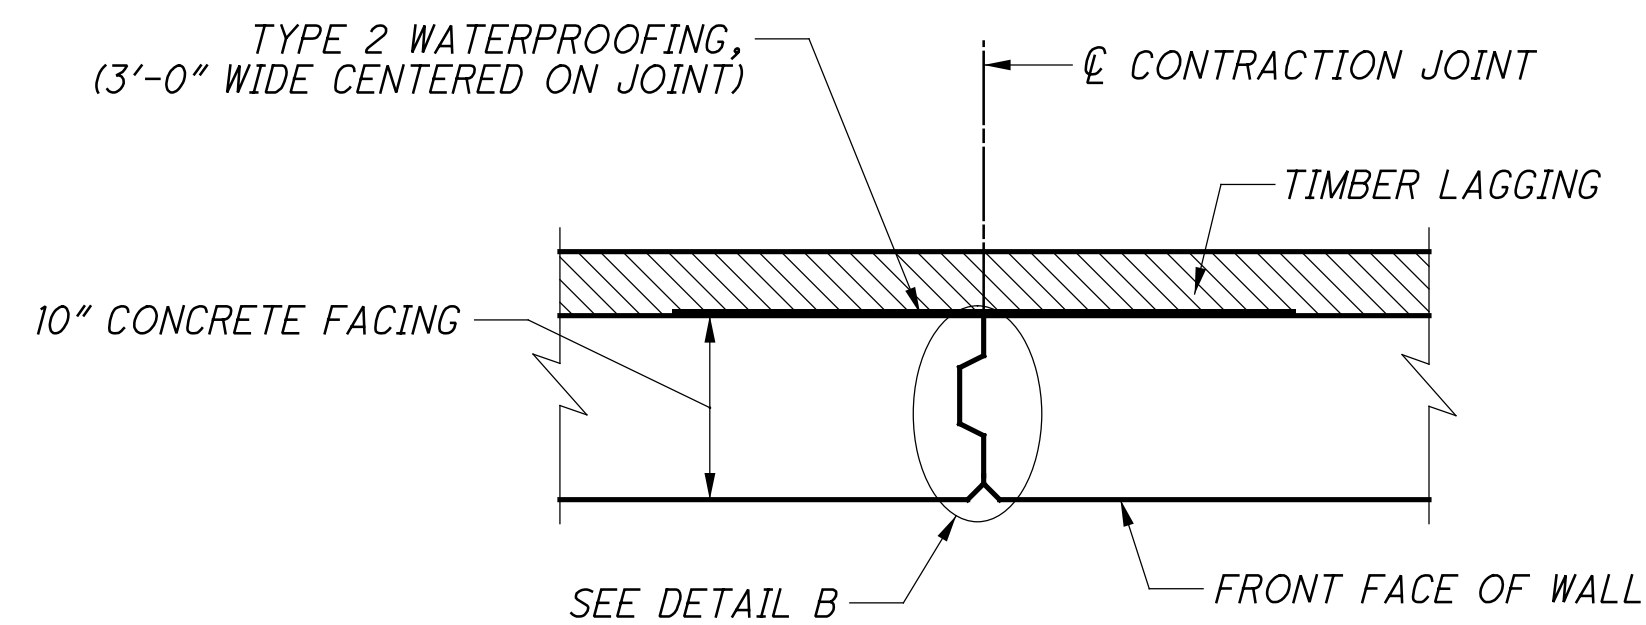

CONTRACTION JOINT DETAIL

DESIGNED	DATE	REVIEWED	DATE
SJF	06/25/21	SJF	06/25/21
CHECKED	FILE NUMBER	REVISED	FILE NUMBER
CLB			

RETAINING WALL (RELIABLE CASTINGS) DETAILS
 ALONG IR 75 SB

HAM-75-3.84
PID No. 104667

R:\Projects\2018\GEO\178-18-006_Am_StructurePt_HAM-75-3.84\CAD\001_Deliverables\SoilProfile_Sheets\104667_HAM-75-3.84\Design\Roadway\Sheets\BU 9_Retaining_Walls\104667_ZC001.dgn Sheet 2/25/20

PROJECT DESCRIPTION

AS PART OF THE HAM-75-3.84 WIDENING AND REALIGNMENT PROJECT, TWO (2) RETAINING WALLS WILL BE ADDED ALONG NORTHBOUND I-75 AND THREE (3) WALLS ALONG SOUTHBOUND I-75. THE PROPOSED RETAINING WALLS WILL CONSIST OF EITHER CAST-IN-PLACE (CIP), SOLDIER PILE AND LAGGING (SPL), OR MECHANICALLY STABILIZED EARTH (MSE) RETAINING WALLS BASED ON VARIATIONS IN THE DEPTH TO BEDROCK, THE ANTICIPATED LOADS, AND SPACE CONSTRAINTS AT EACH PROPOSED RETAINING WALL LOCATION.

HISTORIC RECORDS

THE ON-LINE ODOT TRANSPORTATION INFORMATION MAPPING SYSTEM (TIMS) RECORDS WERE SEARCHED FOR HISTORIC BORING INFORMATION FOR THE EXISTING BRIDGE. ADDITIONALLY, ODOT PROVIDED S&ME WITH BORING INFORMATION FROM THE HAM-75-3.85 PROJECT. HISTORIC BORING INFORMATION IS SHOWN ON THE STRUCTURE FOUNDATION EXPLORATION SHEETS.

GEOLOGY

GEOLOGIC REFERENCES INDICATE THAT THIS PROJECT SITE IS LOCATED WITHIN THE ILLINOIAN TILL PLAIN PHYSIOGRAPHIC REGION OF OHIO. SURFICIAL GEOLOGY MAPPING INDICATES THAT INTERLAYERED SILT AND CLAY ARE PREDOMINANT WITH INTERBEDS OF FINE SAND, GENERALLY OF WISCONSINAN-AGE, ALSO BEING PRESENT. ALLUVIAL MATERIALS WITHIN THE MILL CREEK VALLEY ARE ALSO PRESENT. GEOLOGIC BEDROCK MAPPING (BEDROCK GEOLOGY OF THE CINCINNATI WEST, OHIO QUADRANGLE, OHIO DEPARTMENT OF NATURAL RESOURCES (ODNR)) INDICATES THE UPPERMOST BEDROCK CONSISTS OF THE KOPE AND POINT PLEASANT FORMATIONS OF THE ORDOVICIAN SYSTEM, WHICH ARE COMPOSED OF INTERLAYERED SHALE (40 TO 75 PERCENT) AND LIMESTONE (25 TO 60 PERCENT). SURFICIAL GEOLOGY MAPPING INDICATES THE TOP OF BEDROCK RANGES FROM ELEVATION 400 TO ELEVATION 500 (MSL) IN THIS AREA. BORINGS PERFORMED FOR THIS PROJECT ENCOUNTERED SHALE AND SHALE INTERBEDDED WITH LIMESTONE BEDROCK AT DEPTHS RANGING FROM 1.5 TO 57 FEET BELOW THE EXISTING GROUND SURFACE.

A REVIEW OF THE ODNR "OHIO KARST AREAS" MAP INDICATES THE SITE LIES IN AN AREA NOT KNOWN TO CONTAIN KARST FEATURES. A REVIEW OF THE ODNR "LANDSLIDES IN OHIO" MAP REVEALS THE SITE IS IN AN AREA SUSCEPTIBLE TO LANDSLIDES DUE TO THE KOPE FORMATION, AND THE ODNR "ABANDONED UNDERGROUND MINES OF OHIO" MAP INDICATES THESE SITES LIE IN AREAS WITH NO MAPPED ABANDONED MINES NEAR THE AREA OF THE PROJECT SITE.

RECONNAISSANCE

FROM JULY 17 TO 26, 2018, S&ME PERFORMED A SITE RECONNAISSANCE OF THE PROJECT SITE TO OBSERVE CURRENT CONDITIONS AND TO STAKE THE PLANNED BORING LOCATIONS. THE SITE CONSISTS OF SEVERAL INTERSTATE HIGHWAY RAMPS FOR I-74 AND I-75, THE NORTHBOUND AND SOUTHBOUND LANES OF I-75, AND OFF ROAD SECTIONS COVERED WITH GRASS, SHRUBS, AND TREES. DURING THESE RECONNAISSANCE VISITS, NO SIGNS OF SLOPE INSTABILITY WERE OBSERVED AT ANY OF THE FIVE (5) PLANNED RETAINING WALL LOCATIONS.

SUBSURFACE EXPLORATION

BETWEEN AUGUST 2 AND 30, 2018 AND JANUARY 25, 2018, TWENTY-FOUR (24) BORINGS WERE PERFORMED FOR THE RETAINING WALLS EXPLORATION FOR THE PROJECT. THE BORINGS WERE NUMBERED B-513-0-18, B-513-1-18, B-514-0-18, B-514-1-18, B-515-0-18 THROUGH B-519-0-18, B-519-1-18, B-520-0-18 THROUGH B-525-0-18, B-525-1-18, B-526-0-18 THROUGH B-528-0-18, AND B-533-0-18 THROUGH B-535-0-18. THE LOCATIONS OF THE BORINGS ARE SHOWN ON THE PLAN OF BORINGS INCLUDED AS FIGURES 2A THROUGH 2E OF APPENDIX A. THE SURVEYED LOCATIONS AND ELEVATIONS WERE PROVIDED BY ASI.

THESE BORINGS WERE PERFORMED BY EITHER AN ATV-MOUNTED OR A TRUCK-MOUNTED DRILLING RIG USING A 3/4-INCH OR 4/4-INCH I.D. HOLLOW-STEM AUGER TO ADVANCE THE BORINGS BETWEEN SAMPLING ATTEMPTS. DISTURBED BUT REPRESENTATIVE SOIL SAMPLES WERE OBTAINED BY LOWERING A 2-INCH O.D. SPLIT-BARREL SAMPLER THROUGH THE AUGER STEM TO THE BOTTOM OF THE BORING AND THEN DRIVING THE SAMPLER INTO THE SOIL WITH BLOWS FROM A 140-POUND HAMMER FREELY FALLING 30 INCHES (ASTM D1586 - STANDARD PENETRATION TEST). SPT SAMPLES WERE EXAMINED IMMEDIATELY AFTER RECOVERY AND REPRESENTATIVE PORTIONS WERE PRESERVED IN AIRTIGHT GLASS JARS. AT SELECTED LOCATIONS, UNDISTURBED SAMPLES WERE OBTAINED HYDRAULICALLY PRESSING A SEAMLESS STEEL (SHELBY) TUBE INTO THE SOIL. THE RECOVERED SHELBY TUBES WERE SEALED WITH WAX IN THE FIELD. ADDITIONALLY, 5 TO 28.9 FEET OF BEDROCK WAS CORED IN TWELVE BORINGS USING AN NQ2 CORE BARREL WITH A DIAMOND BIT UTILIZING WATER AS A CIRCULATING FLUID.

IN ACCORDANCE WITH THE CURRENT ODOT SPECIFICATIONS FOR GEOTECHNICAL EXPLORATIONS (SGE), THE HAMMER SYSTEM ON THE DRILL RIG HAD BEEN CALIBRATED IN ACCORDANCE WITH ASTM D4633 TO DETERMINE THE DRILL ROD ENERGY RATIO (75.5 AND 81.8%). SAMPLING INTERVALS RANGED FROM 2.5 TO 5-FOOT INTERVALS AS REQUIRED BY THE ODOT SGE.

EXPLORATION FINDINGS

BENEATH THE SURFICIAL MATERIALS, THE BORINGS GENERALLY ENCOUNTERED EXISTING EMBANKMENT FILL OVER RESIDUAL SOIL OVERLYING BEDROCK. THE SUBSURFACE CONDITIONS ENCOUNTERED IN THE BORINGS PERFORMED FOR THE CURRENT EXPLORATION AT THIS SITE MAY BE DESCRIBED, IN DESCENDING ORDER AS FOLLOWS:

EXISTING FILL FOR THE RETAINING WALL BORINGS RANGED IN THICKNESS FROM 1.5 TO 47 FEET AND CONSISTED OF BOTH NON-COHESIVE AND COHESIVE SOILS.

NATURAL SOILS ENCOUNTERED BELOW THE SURFICIAL MATERIALS AND/OR THE EXISTING FILL CONSISTED MAINLY OF SANDY SILT (A-4A), SILT (A-4B), SILT AND CLAY (A-6A), SILTY CLAY (A-6B), AND CLAY (A-7-6).

TEN OF THE BORINGS WERE TERMINATED AFTER AUGERING INTO WEATHERED SHALE BEDROCK AND TWELVE OF THE BORINGS WERE TERMINATED AFTER CORING 5 TO 28.9 FEET OF INTERBEDDED SHALE AND LIMESTONE. GROUNDWATER WAS ENCOUNTERED WHILE DRILLING OR PRIOR TO COMPLETION IN TEN BORINGS.

SPECIFICATIONS

THIS GEOTECHNICAL EXPLORATION WAS PERFORMED IN ACCORDANCE WITH THE STATE OF OHIO, DEPARTMENT OF TRANSPORTATION, OFFICE OF GEOTECHNICAL ENGINEERING, SPECIFICATIONS FOR GEOTECHNICAL EXPLORATIONS, DATED JULY 2017.



LEGEND

DESCRIPTION	ODOT CLASS	CLASSIFIED MECH./VISUAL	
GRAVEL	A-1-a	4	7
GRAVEL W/ SAND AND SILT	A-2-4	1	0
COARSE AND FINE SAND	A-3a	0	2
SANDY SILT	A-4a	4	4
SILT	A-4b	2	2
SILT AND CLAY	A-6a	7	22
SILTY CLAY	A-6b	3	47
CLAY	A-7-6	25	40
TOTAL	TOTAL	47	124
SHALE			
LIMESTONE			
INTERBEDDED SHALE AND LIMESTONE			
PAVEMENT OR BASE = X = APPROXIMATE THICKNESS	VISUAL		
UNCONTROLLED FILL	VISUAL		
SOD AND TOPSOIL = X = APPROXIMATE THICKNESS	VISUAL		
BORING LOCATION - PLAN VIEW.			
HISTORIC BORING LOCATION - PLAN VIEW.			
DRIVE SAMPLE AND/OR ROCK CORE BORING PLOTTED TO VERTICAL SCALE ONLY. HORIZONTAL BAR INDICATES A CHANGE IN STRATIGRAPHY.			
WC	INDICATES WATER CONTENT IN PERCENT.		
N₆₀	INDICATES STANDARD PENETRATION RESISTANCE NORMALIZED TO 60% DRILL ROD ENERGY RATIO.		
X/Y/Z	NUMBER OF BLOWS FOR STANDARD PENETRATION TEST (SPT): X= NUMBER OF BLOWS FOR FIRST 6 INCHES. Y= NUMBER OF BLOWS FOR SECOND 6 INCHES. Z= NUMBER OF BLOWS FOR THIRD 6 INCHES.		
X/Y/D"	NUMBER OF BLOWS FOR STANDARD PENETRATION TEST (SPT): X= NUMBER OF BLOWS FOR FIRST 6 INCHES (UNCORRECTED). Y/D"= NUMBER OF BLOWS (UNCORRECTED) FOR D" OF PENETRATION AT REFUSAL.		
W	INDICATES FREE WATER ELEVATION.		
	INDICATES A PLASTIC MATERIAL WITH A MOISTURE CONTENT EQUAL TO OR GREATER THAN THE LIQUID LIMIT MINUS 3.		
	INDICATES A NON-PLASTIC MATERIAL WITH A MOISTURE CONTENT GREATER THAN 25 % OR GREATER THAN 19 % WITH A WET APPEARANCE.		
*	INDICATES A SAMPLE TAKEN WITHIN 3 FT OF PROPOSED GRADE.		
SS	INDICATES A SPLIT SPOON SAMPLE.		
NP	INDICATES A NON-PLASTIC SAMPLE.		
- FILL	INDICATES BOTTOM OF EXISTING FILL		
-TR	INDICATES TOP OF BEDROCK.		

Ben Dusina
 Feb 25 2019 4:30 PM

AVAILABLE INFORMATION

ALL AVAILABLE SOIL AND BEDROCK INFORMATION THAT CAN BE CONVENIENTLY SHOWN ON THE GEOTECHNICAL EXPLORATION SHEETS HAS BEEN SO REPORTED. ADDITIONAL EXPLORATIONS MAY HAVE BEEN MADE TO STUDY SOME SPECIAL ASPECT OF THE PROJECT. COPIES OF THIS DATA, IF ANY, MAY BE INSPECTED IN THE DISTRICT DEPUTY DIRECTOR'S OFFICE OR THE OFFICE OF GEOTECHNICAL ENGINEERING AT 1980 WEST BROAD STREET.

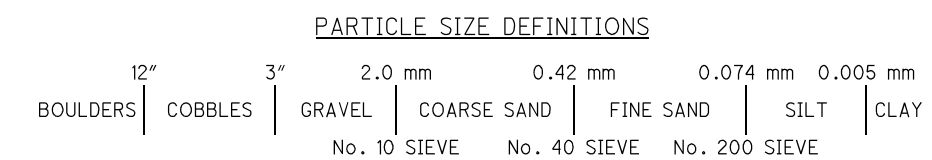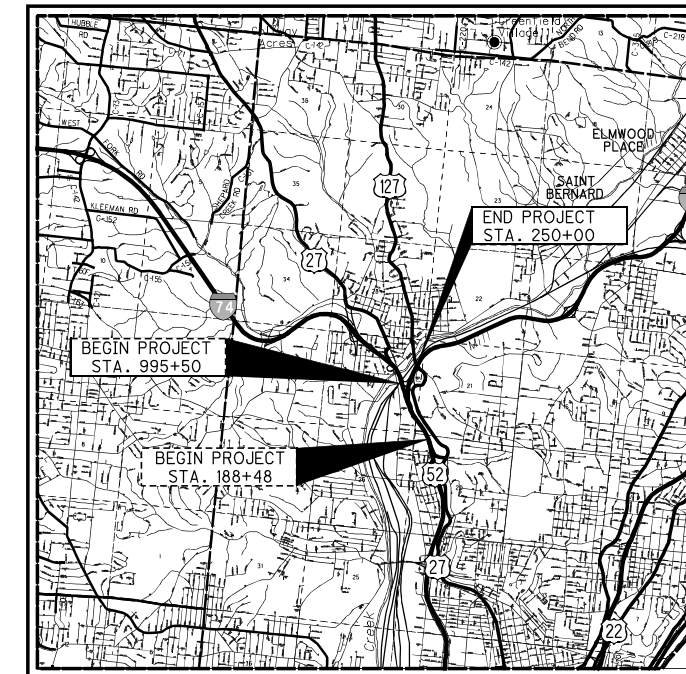

	ODOT CLASS	CLASSIFIED MECH./VISUAL	
HISTORIC BORINGS			
GRAVEL	A-1-a	1	--
GRAVEL W/ SAND	A-1-b	4	7
GRAVEL W/ SAND AND SILT	A-2-4	3	10
GRAVEL W/ SAND, SILT AND CLAY	A-2-7	3	1
FINE SAND	A-3	--	1
COURSE AND FINE SAND	A-3a	2	2
SANDY SILT	A-4a	12	9
SILT	A-4b	7	4
SILT AND CLAY	A-6a	14	25
SILTY CLAY	A-6b	14	64
CLAY	A-7-6	31	47
TOTAL	TOTAL	91	170
SEVERELY WEATHERED SHALE			
SHALE			
INTERBEDDED SHALE AND LIMESTONE			

RECON.	- BCD / REP	7/17/18 TO 7/26/18
DRILLING	- S&ME	8/2/18 TO 8/30/18, 11/11/18
DRAWN	- DWM, KAH	3/30/18, 10/22/18, 1/22/19
REVIEWED	- BCD	8/31/18, 10/22/18, 1/22/19




PID NO. **104667**


**STRUCTURE FOUNDATION EXPLORATION *
HAM-75 RETAINING WALLS**

HAM-75-3.85




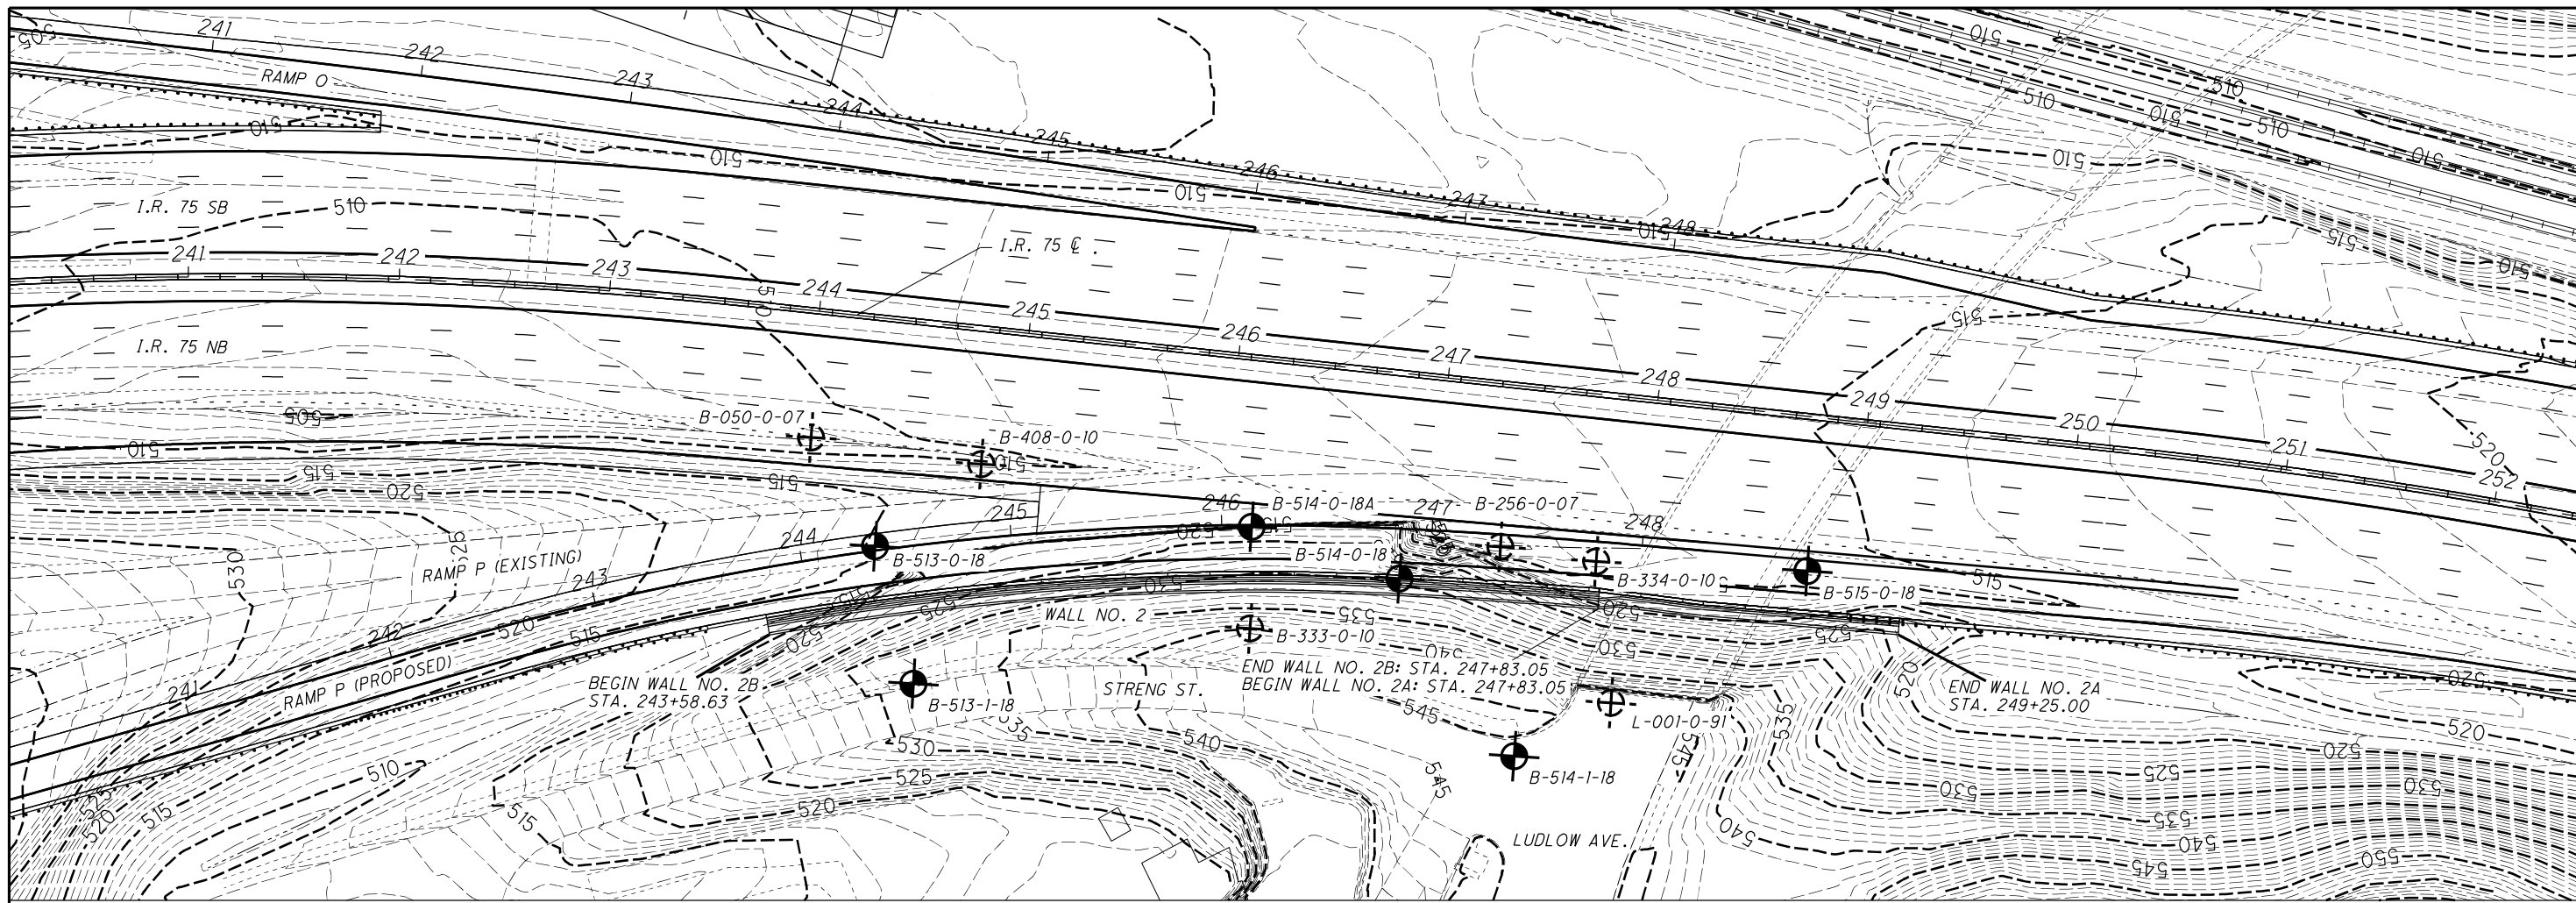

DRAWN: KAH
 CHECKED: BCD
**STRUCTURE FOUNDATION EXPLORATION
 RETAINING WALL NO. 2**

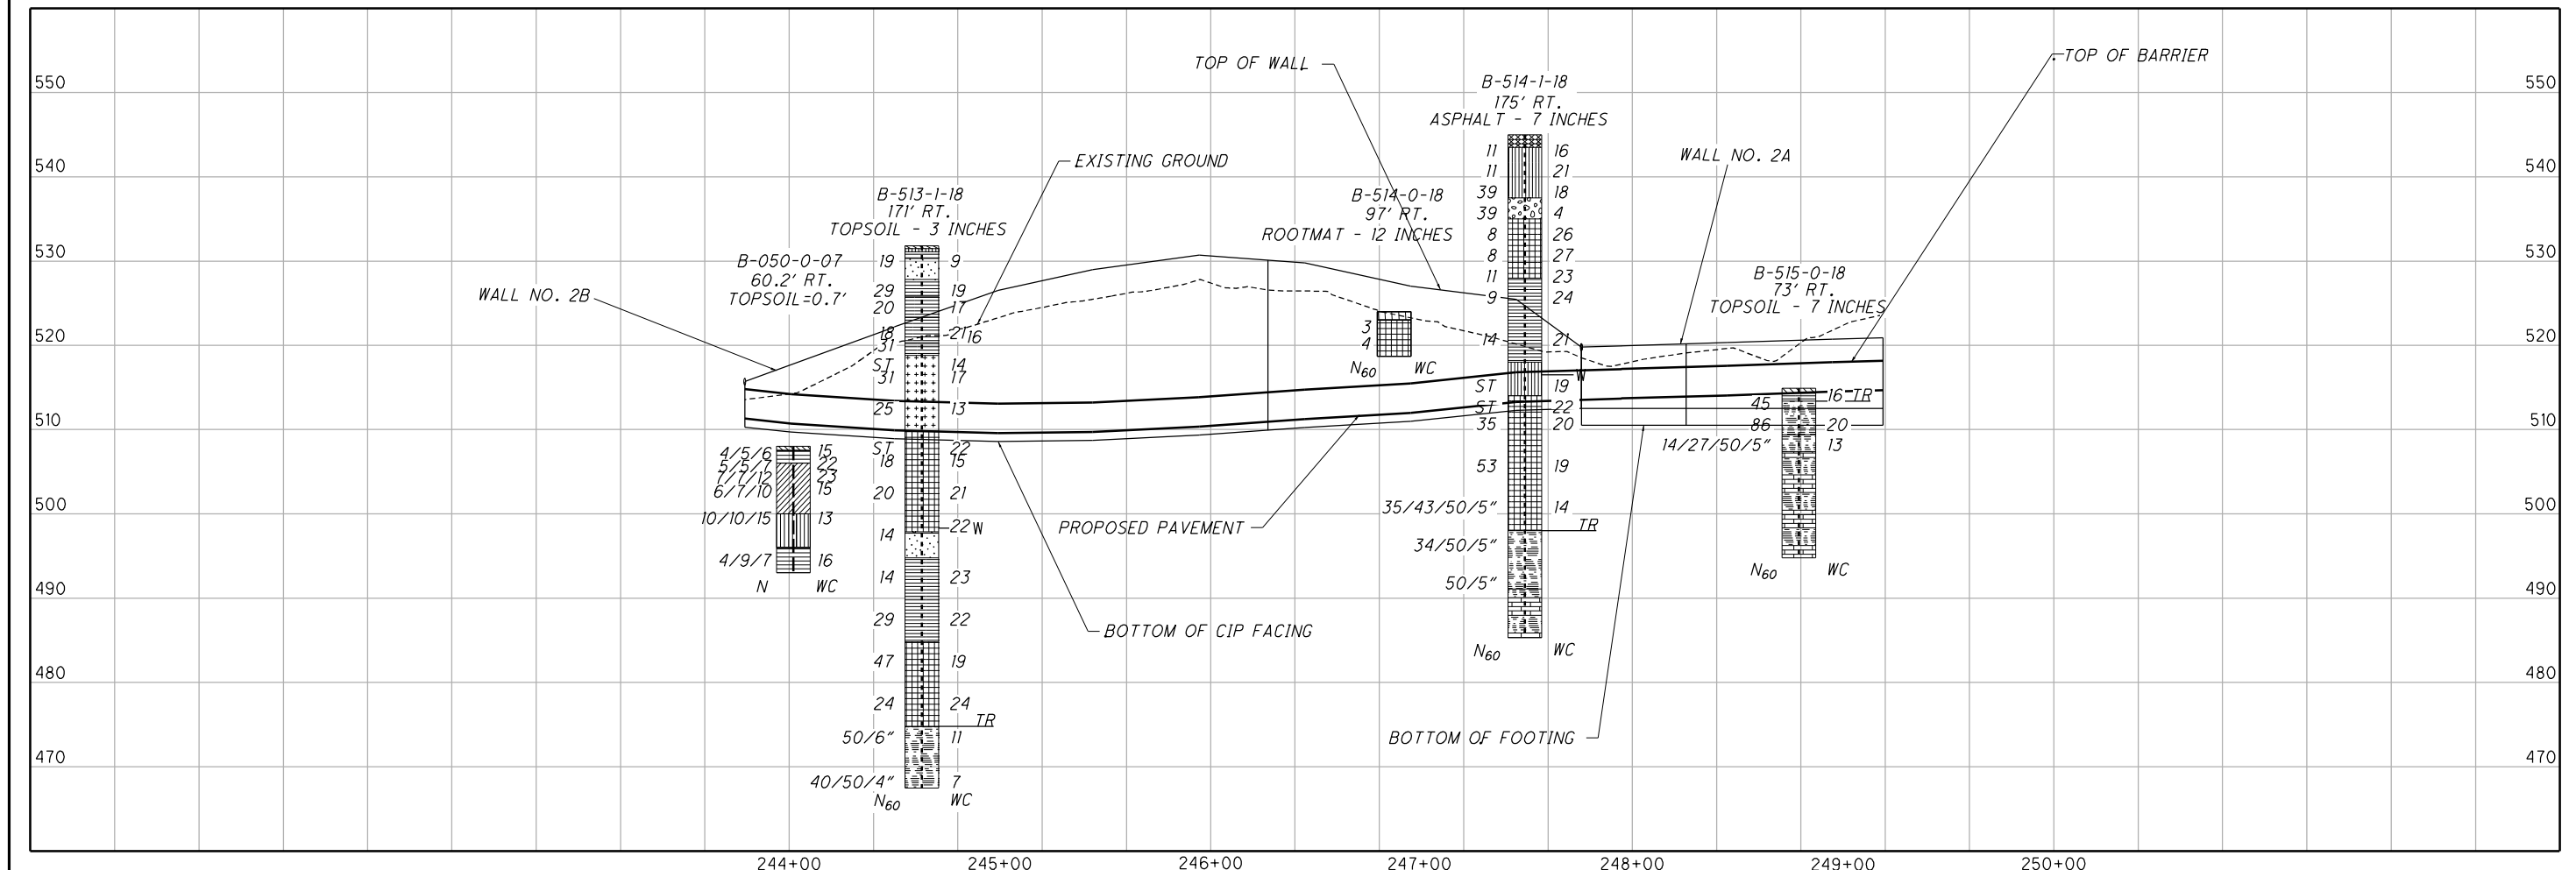

HAM-75-3.84

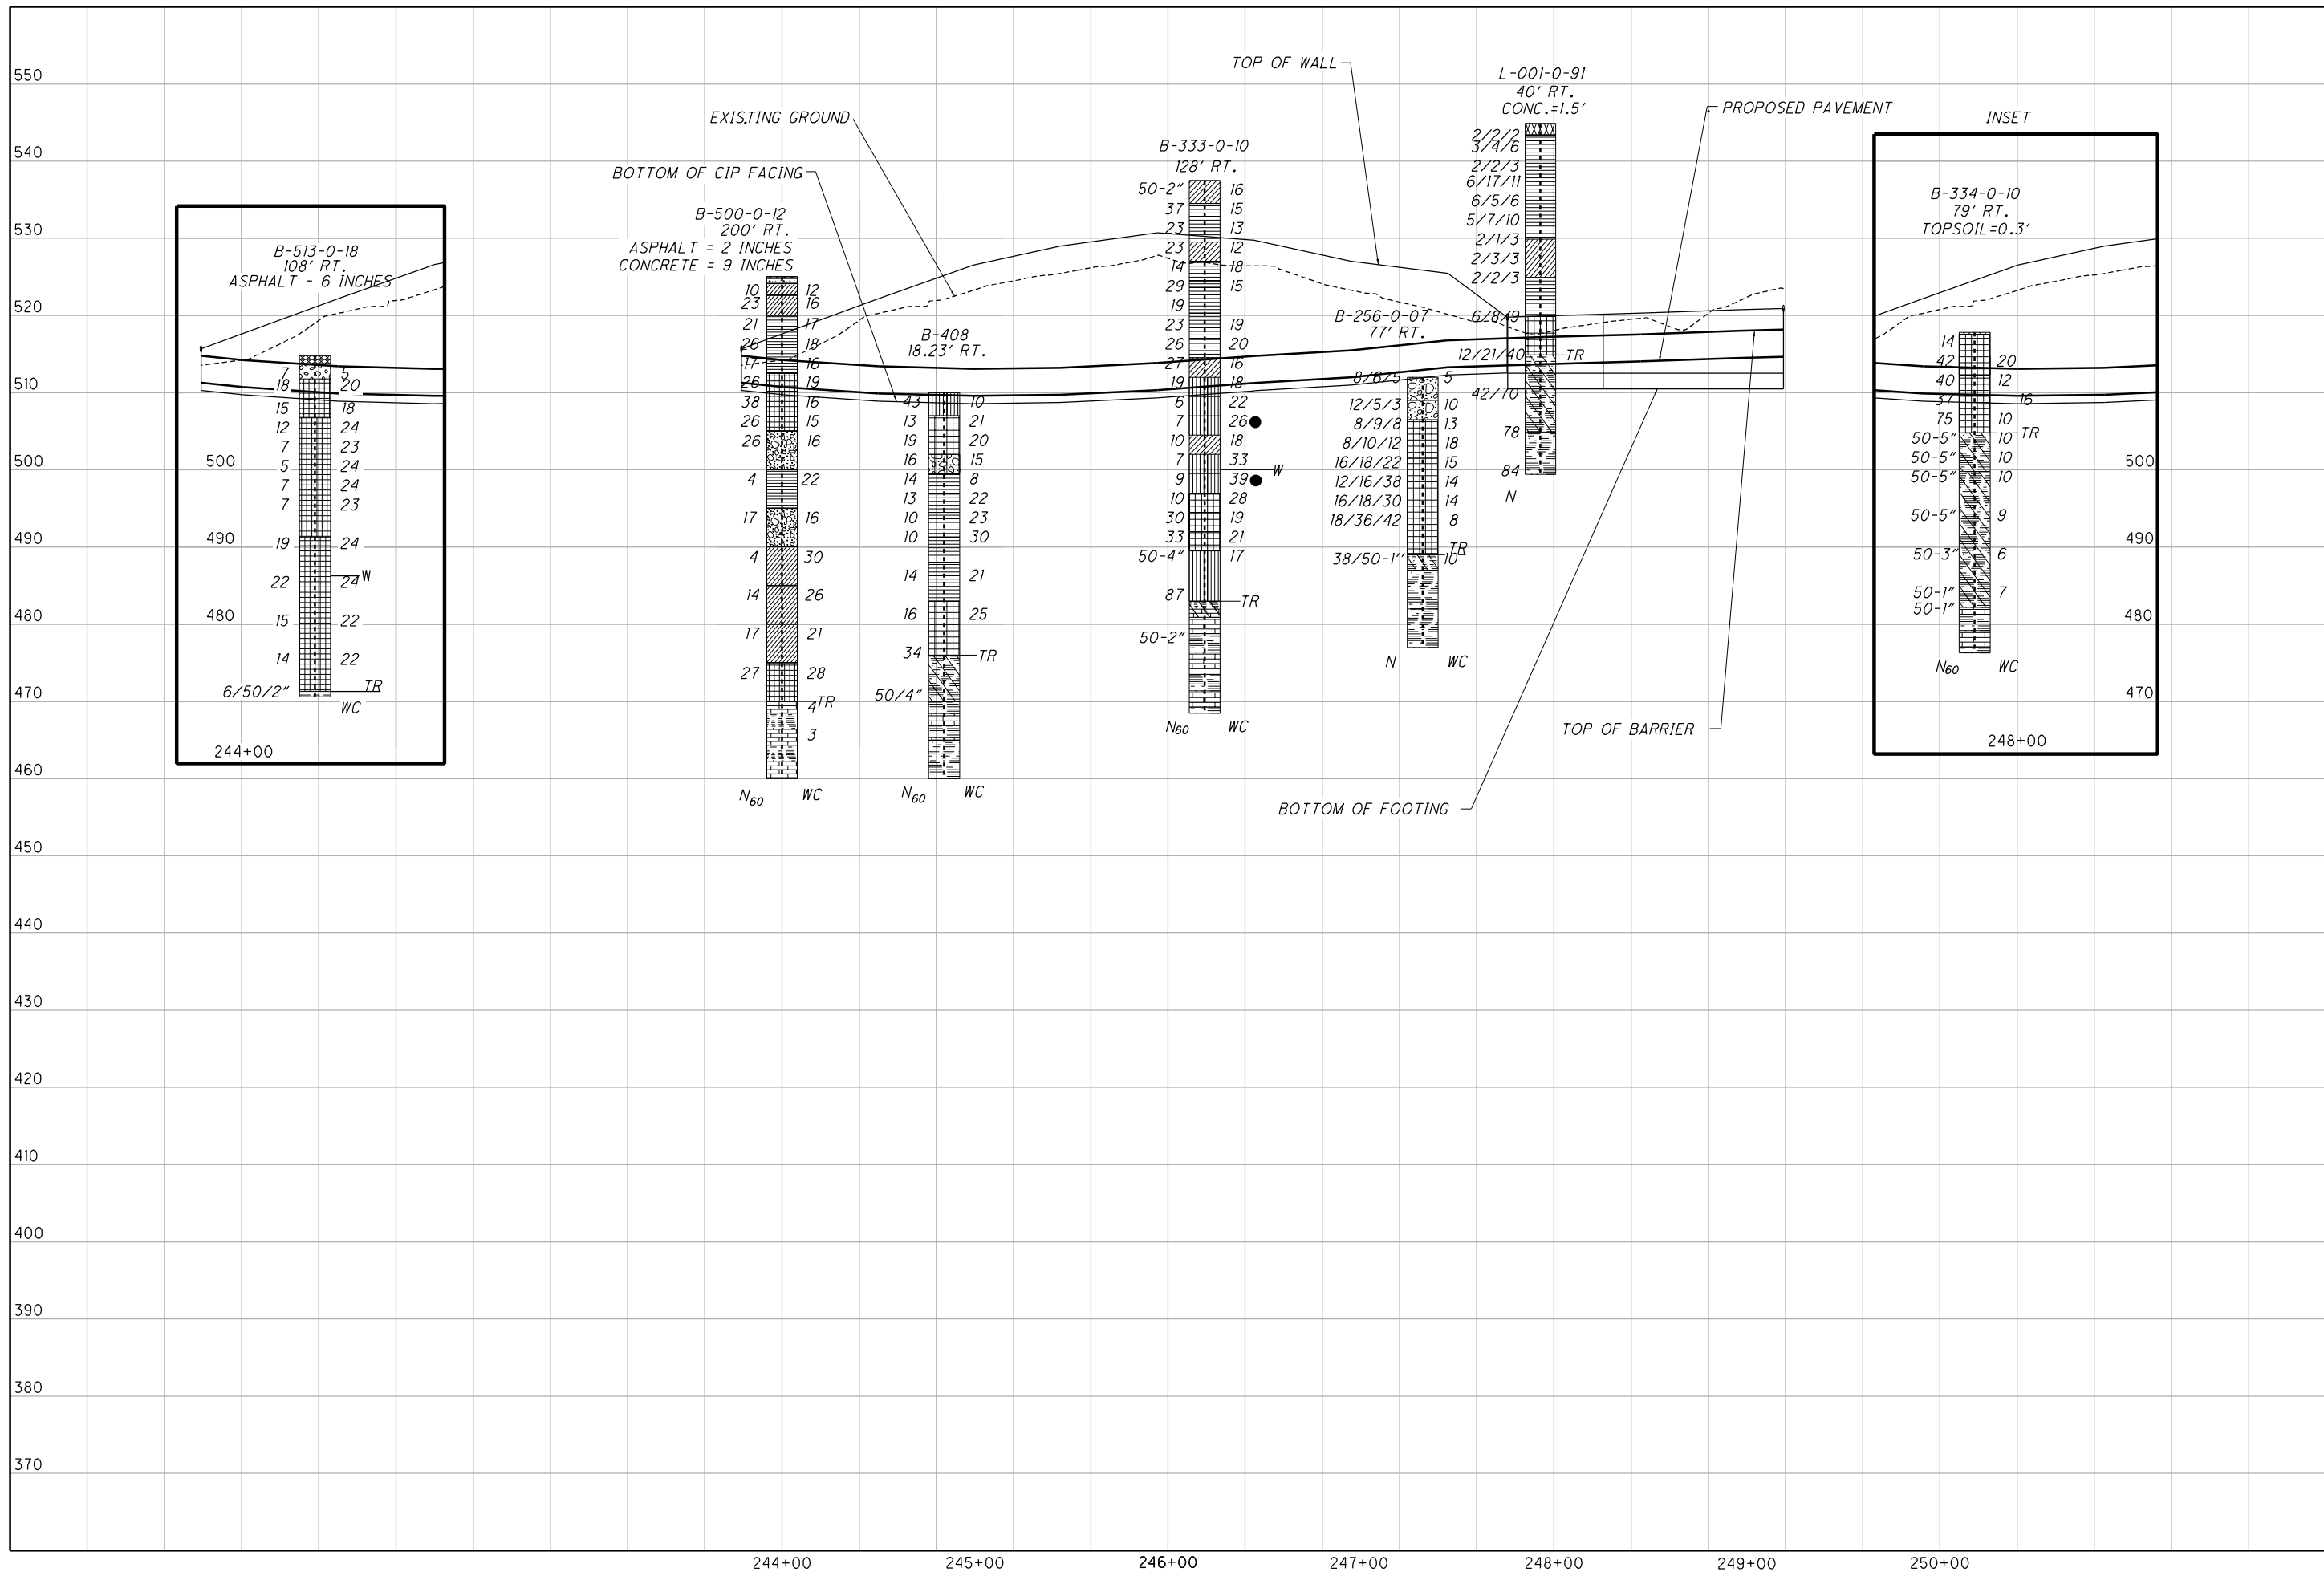


80
40
0
DRAWN: KAH
CHECKED: BCD
HORIZONTAL SCALE: IN FEET


**STRUCTURE FOUNDATION EXPLORATION
RETAINING WALL NO. 2**

HAM-75-3.84

N:\Projects\2018\GEO\1178-18-006_Am StructurePt_HAM-75-3.84\CAD\0001 Deliverables\SoilProfile Sheets\104667_HAM-75-3.84\Design\Roadway\Sheets\BU 9 Retaining Walls\104667_ZP002.dgn Sheet 1/22/21

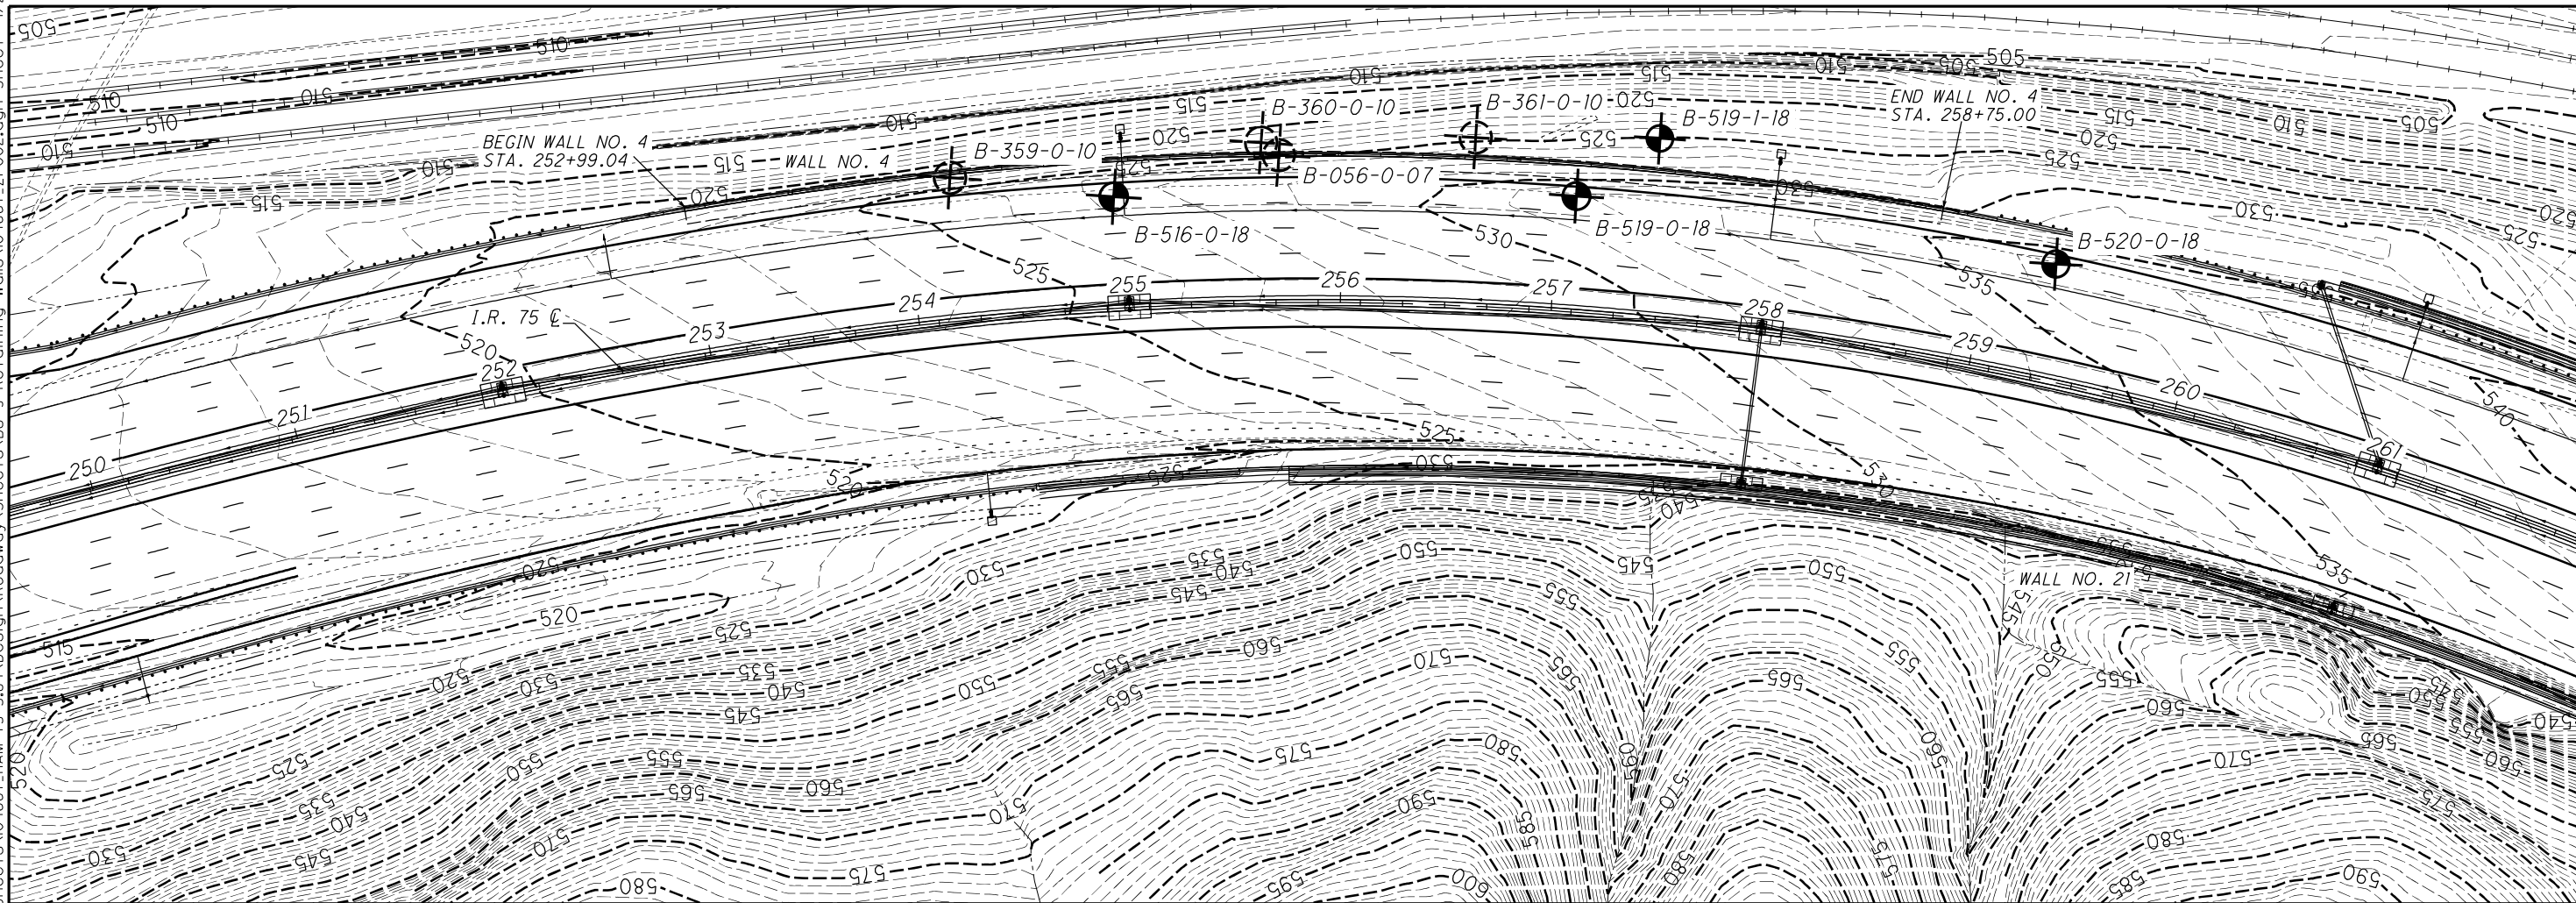


STRUCTURE FOUNDATION EXPLORATION
RETAINING WALL NO. 4

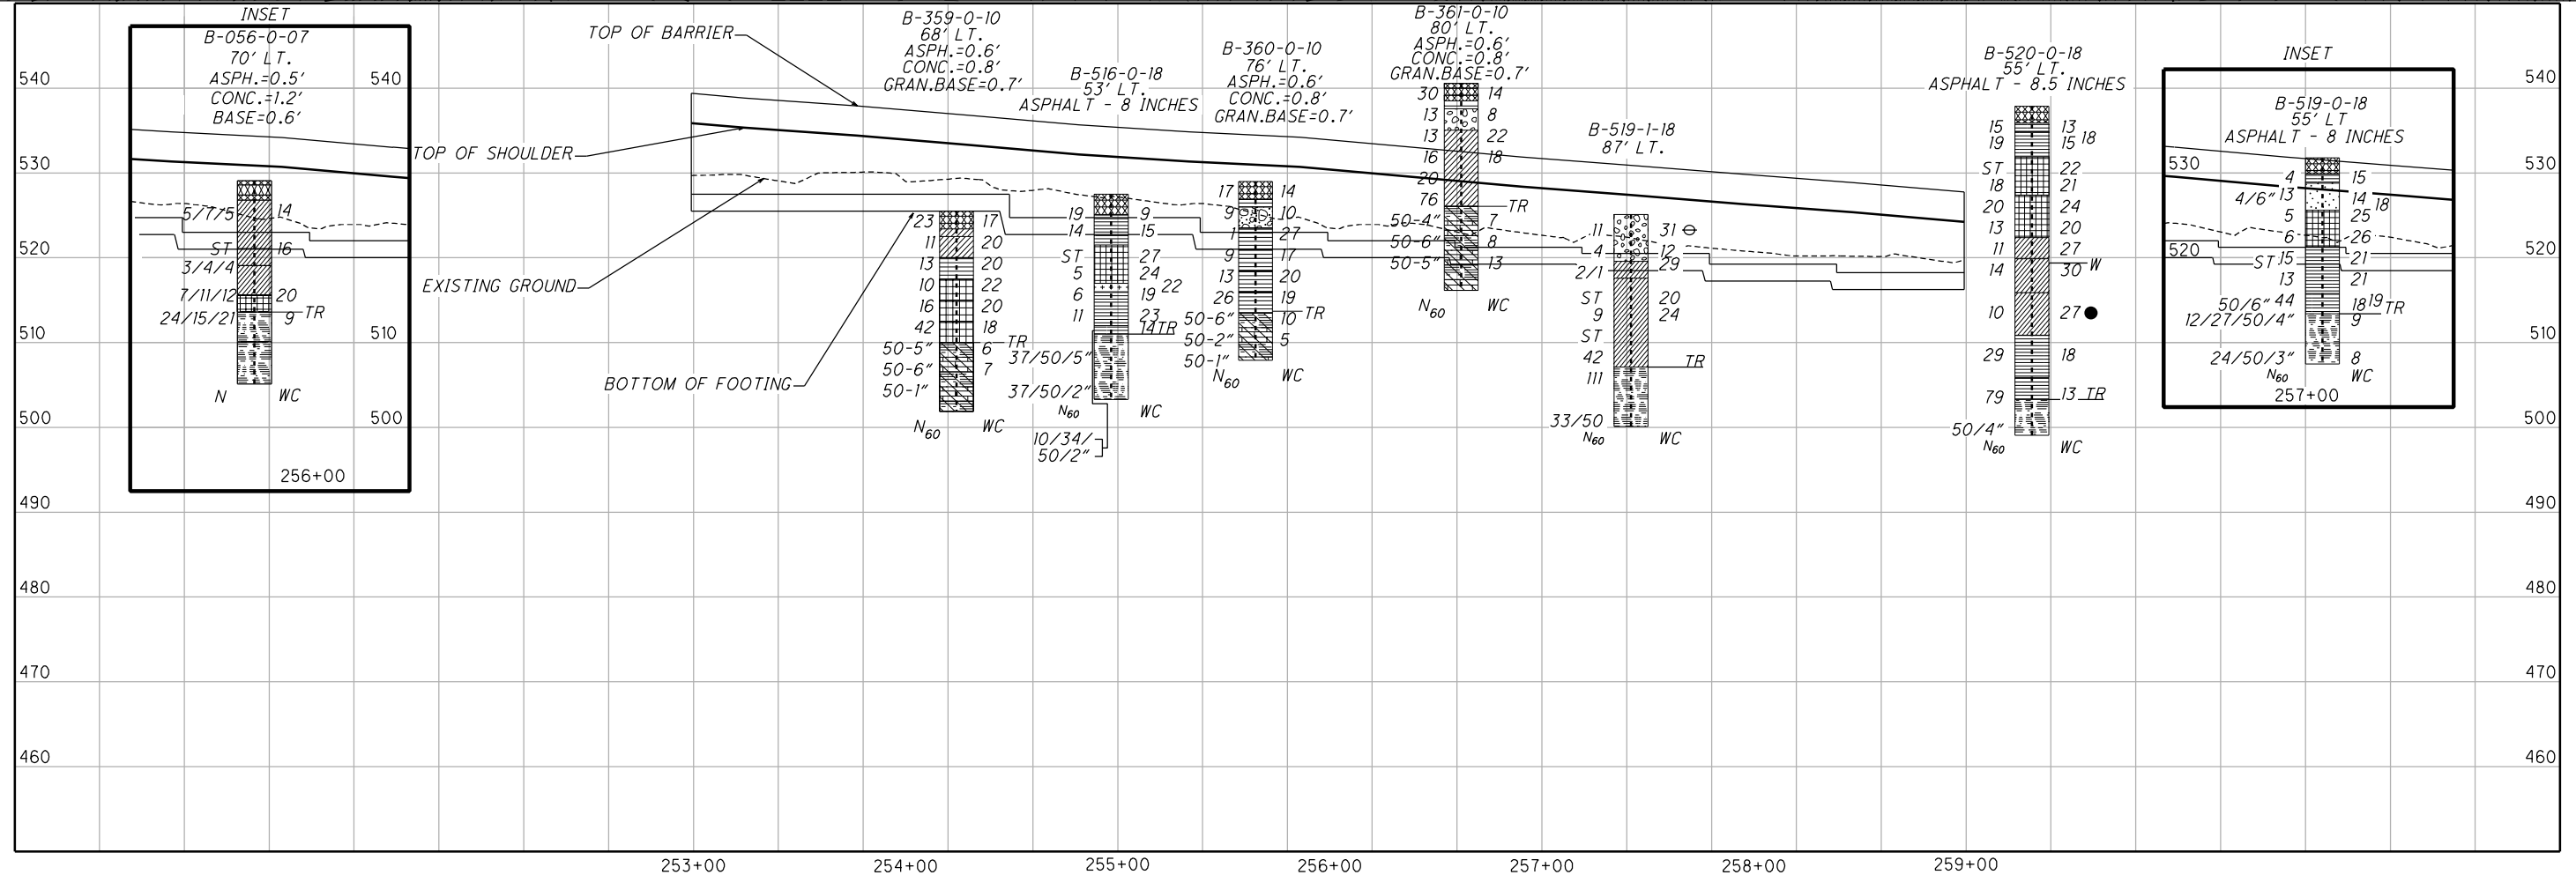


HAM-75-3.84

N:\Projects\2018\GEO\178-18-006_Am StructurePt_HAM-75-3.84\CAD\0001 Deliverables\SoilProfile Sheets\104667_HAM-75-3.84\Design\Roadway\Sheets\BU 9 Retaining Walls\104667_ZP003.dgn Sheet 2/25


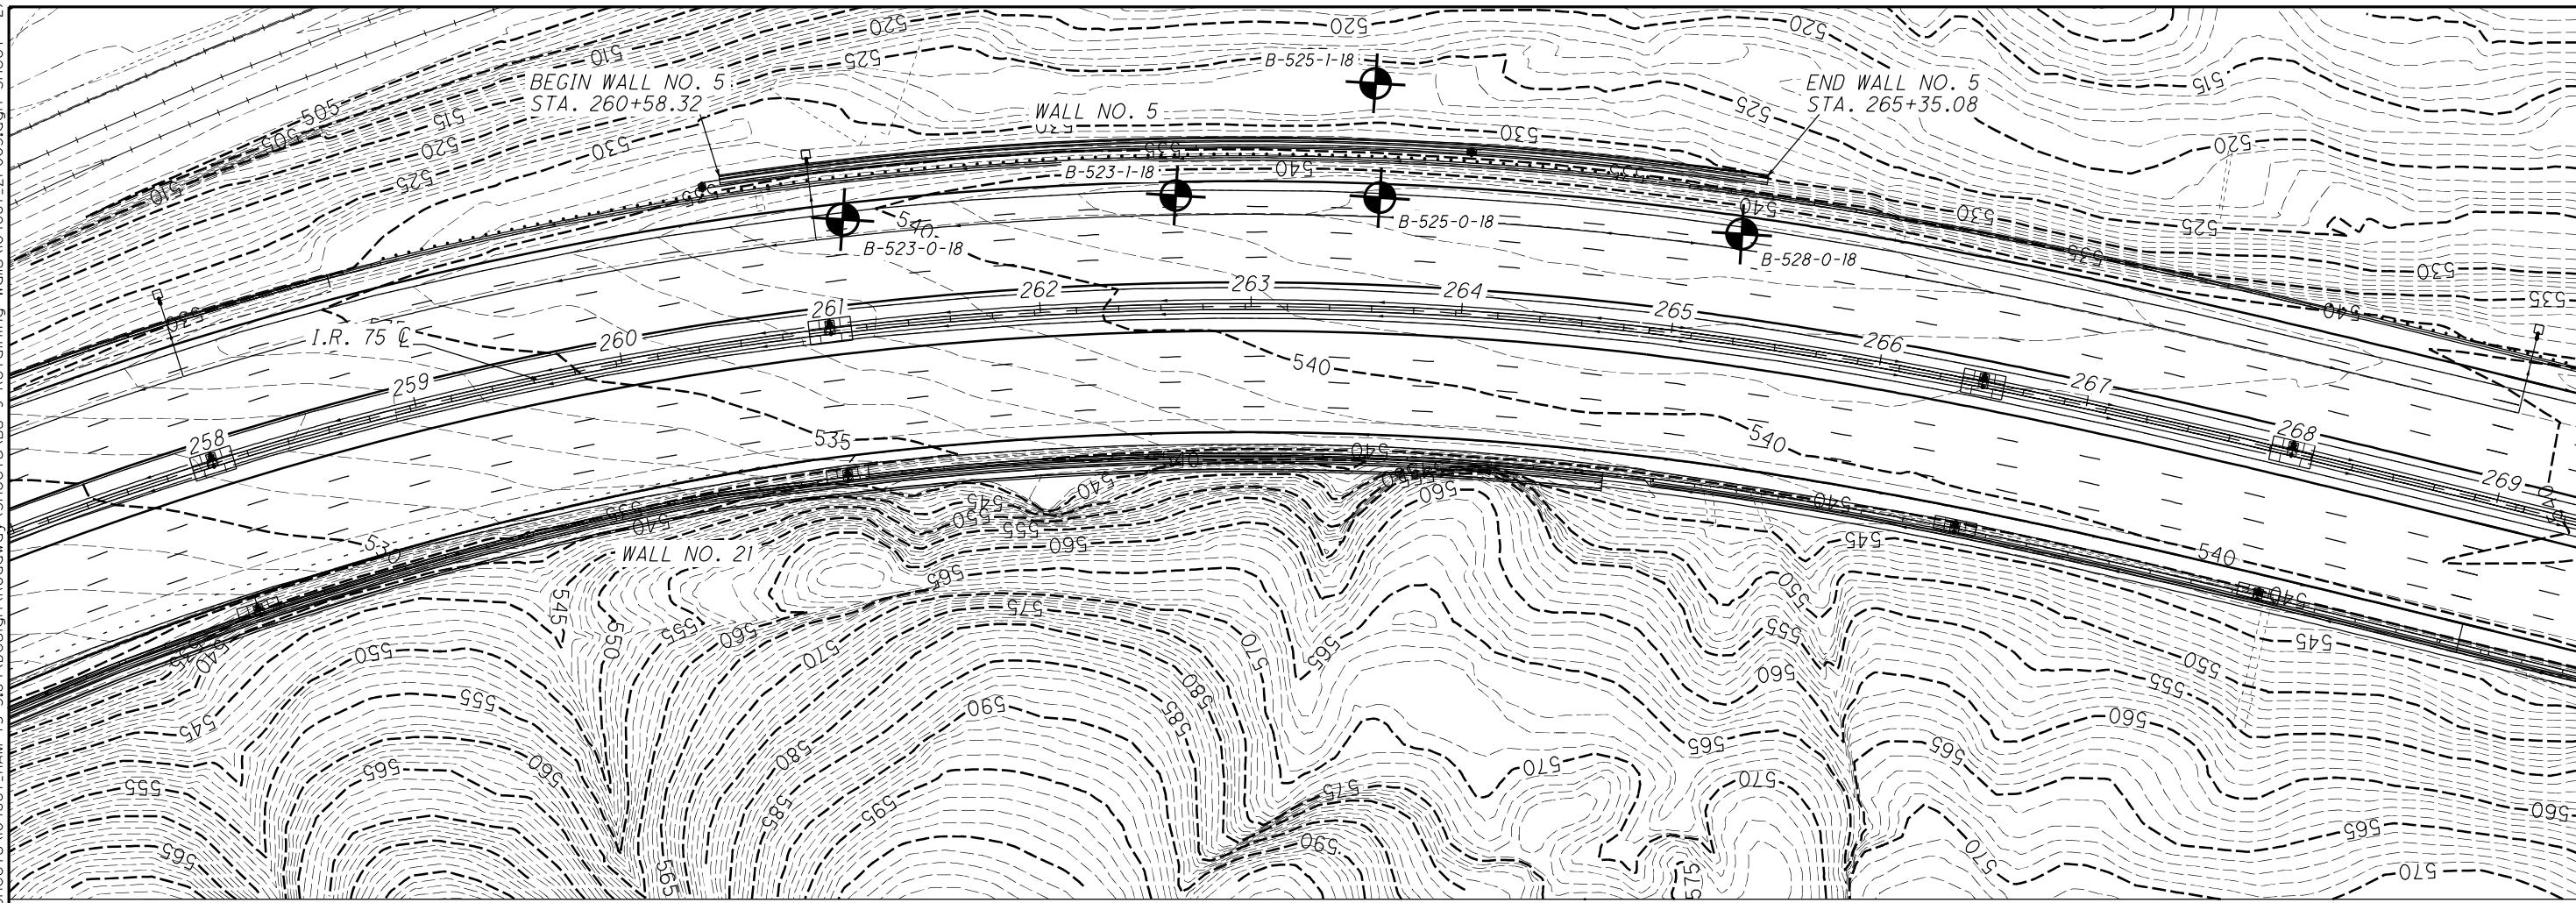


STRUCTURE FOUNDATION EXPLORATION
RETAINING WALL NO. 5

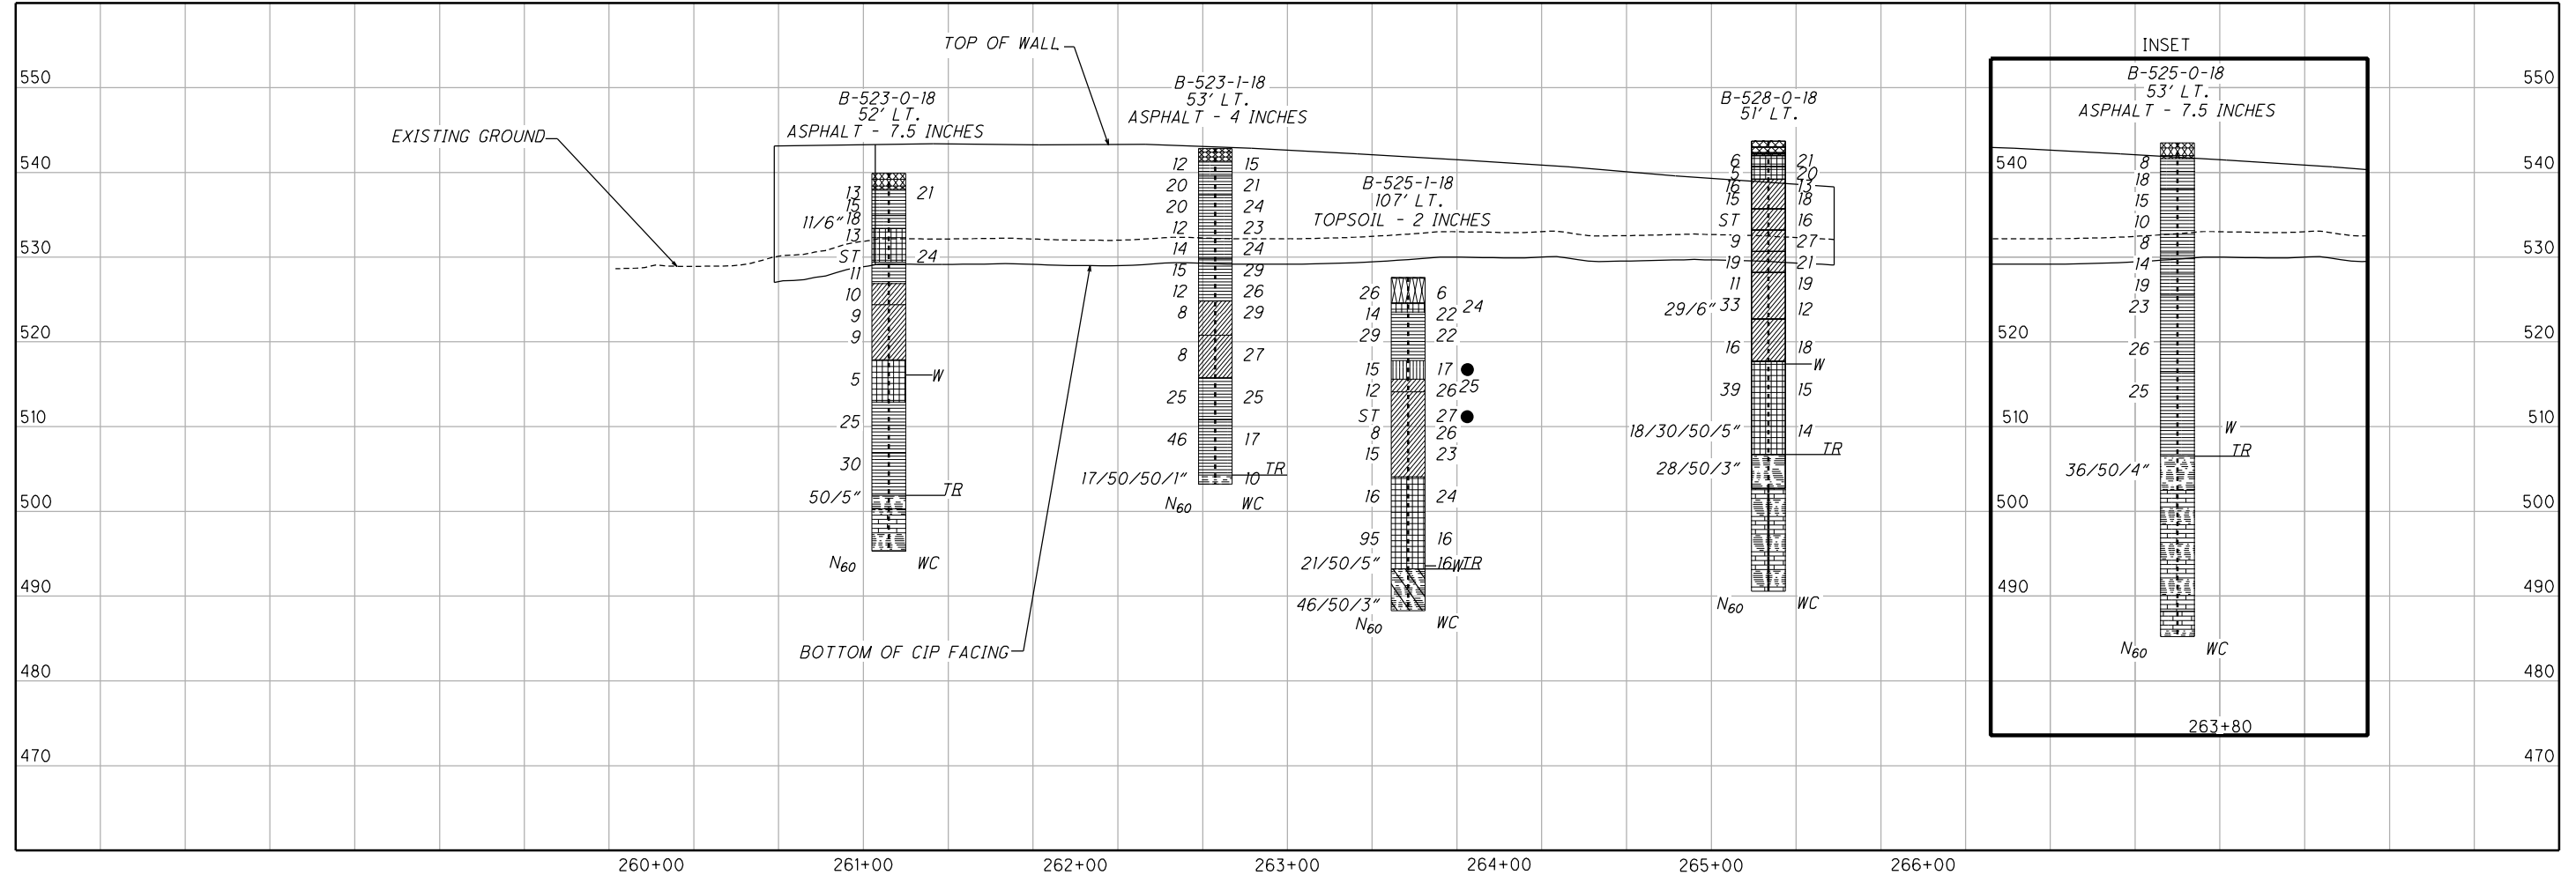

HAM-75-3.84



N:\Projects\2018\GEO\1178-18-006_Am StructurePt_HAM-75-3.84\CAD\000T Deliverables\SoilProfile Sheets\104667_HAM-75-3.84\Design\Roadway\Sheets\BU 9 Retaining Walls\104667_ZP004.dgn Sheet 1/22

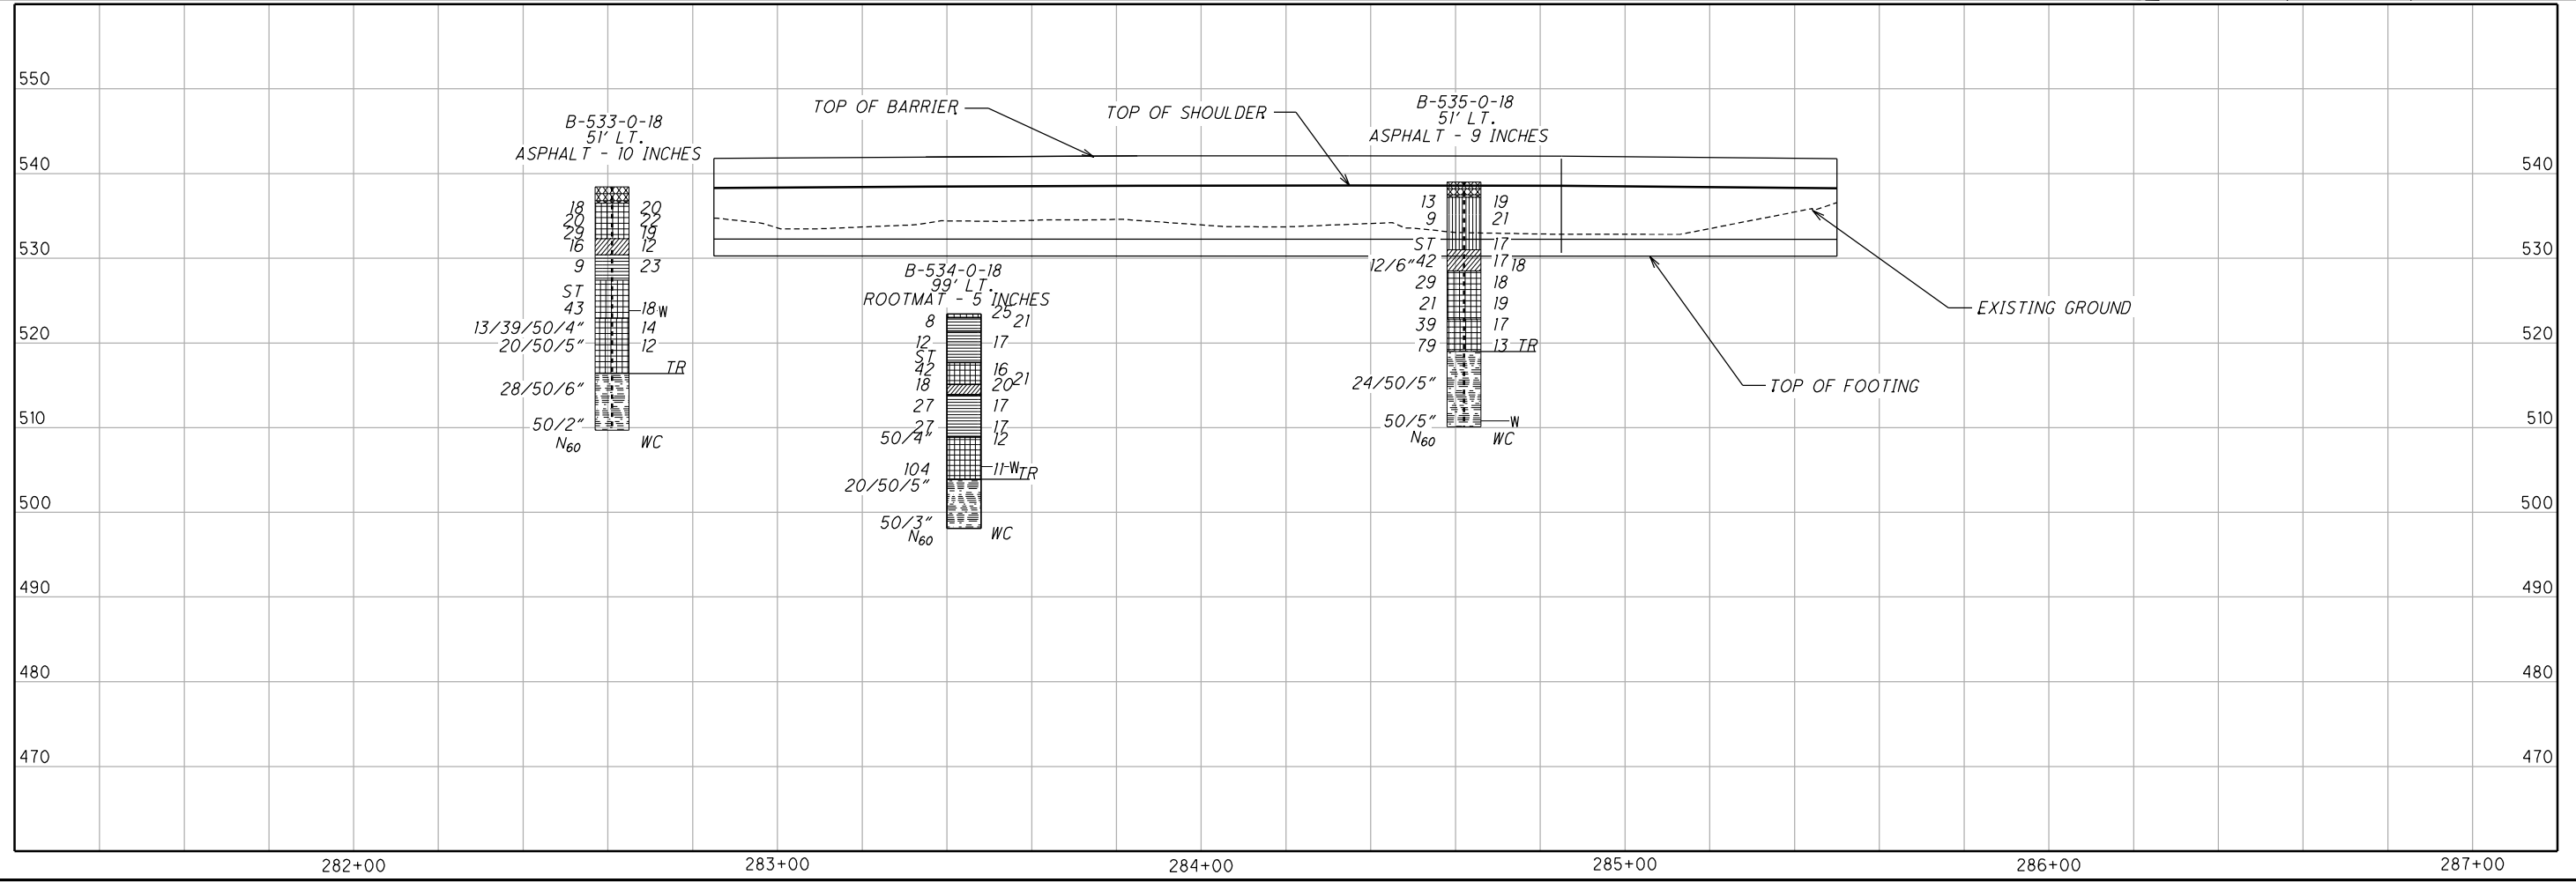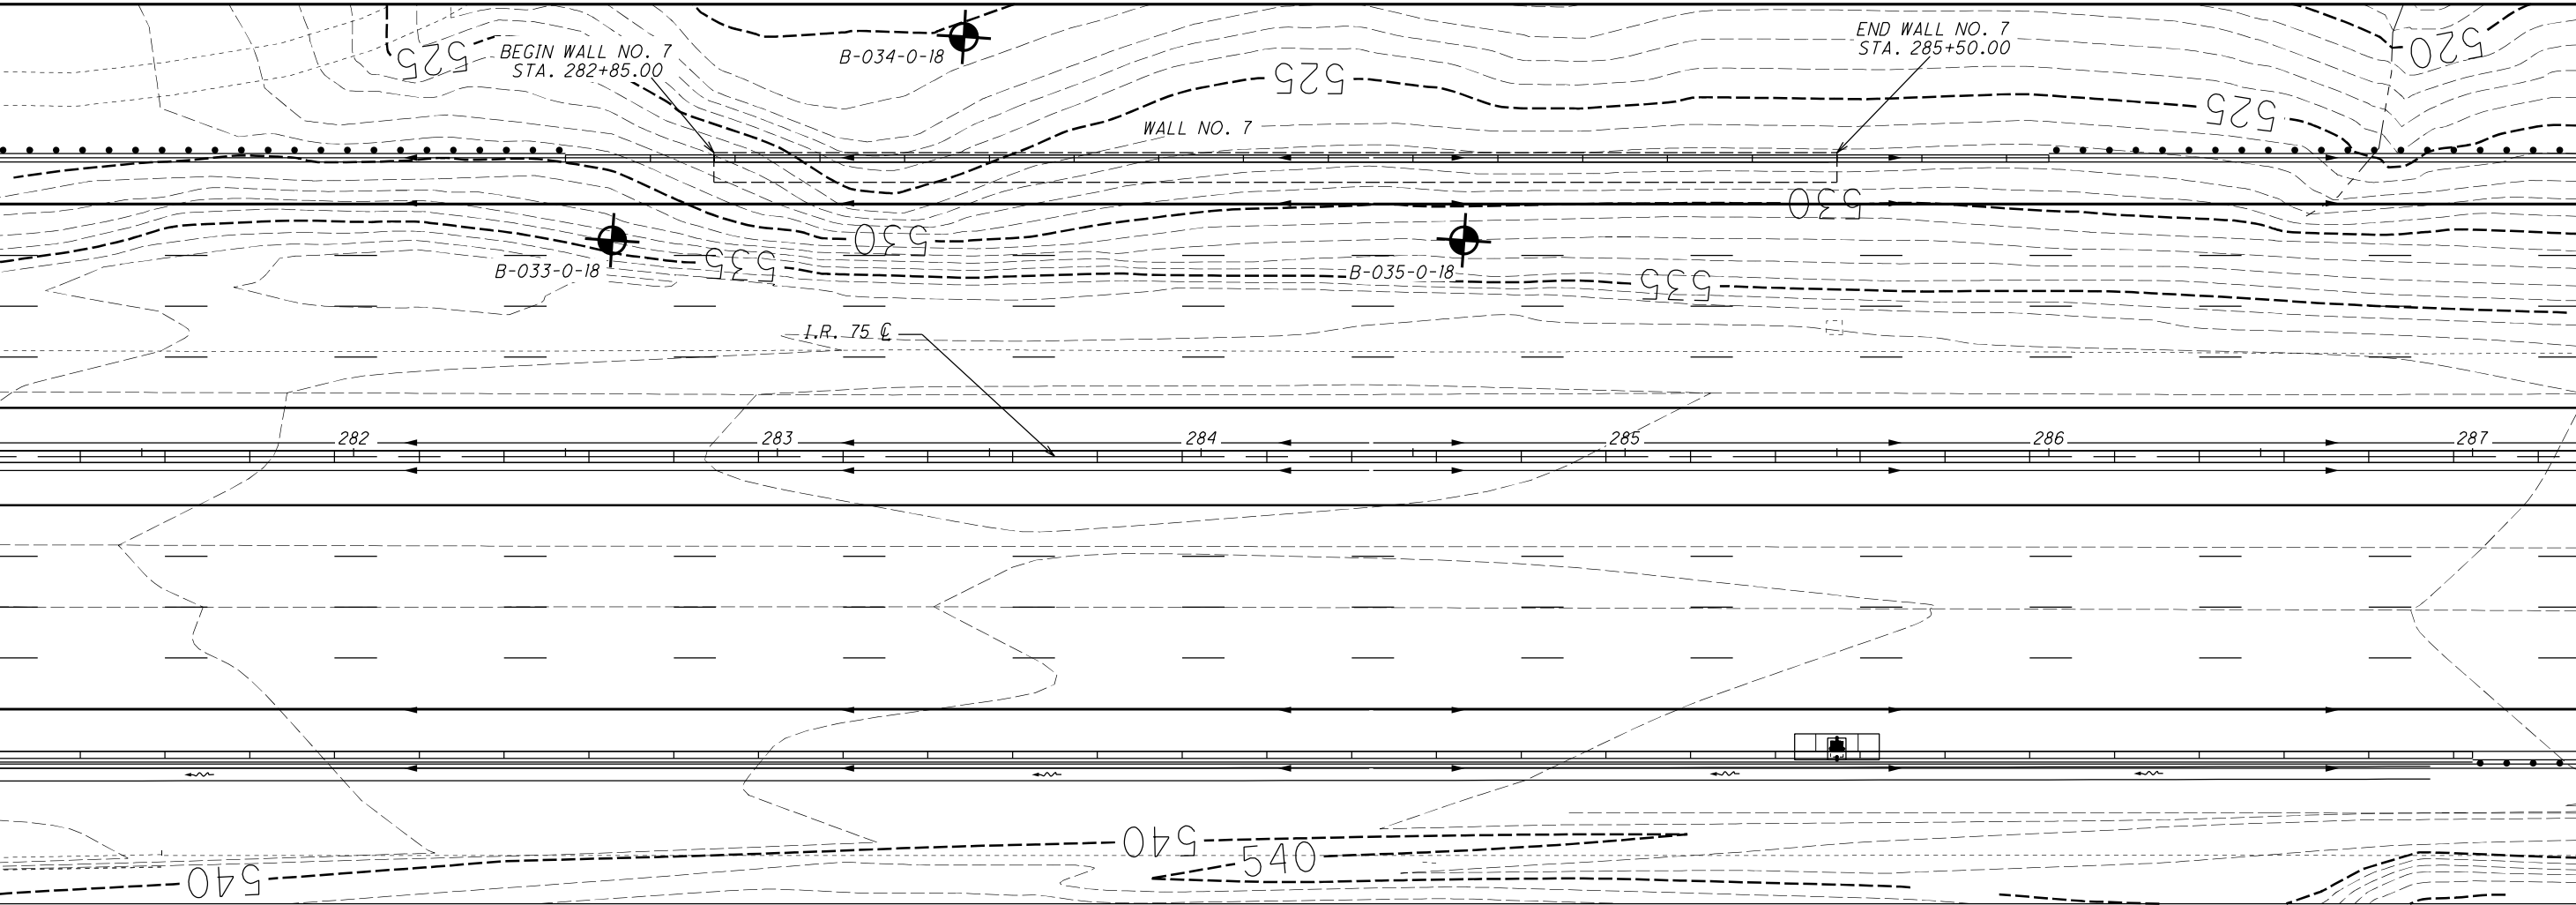

STRUCTURE FOUNDATION EXPLORATION
RETAINING WALL NO. 7
HAM-75-3.84
 6 / 54

DRAWN: DWM
 CHECKED: BCD
 HORIZONTAL SCALE IN FEET

N:\Projects\2018\GEO\1178-1B-006_Am StructurePt_HAM-75-3.84\CAD\0D0T Deliverables\SoilProfile Sheets\104667_HAM-75-3.84\Design\Roadway\Sheets\BU 9 Retaining Walls\104667_ZP005.dgn Sheet 1/22

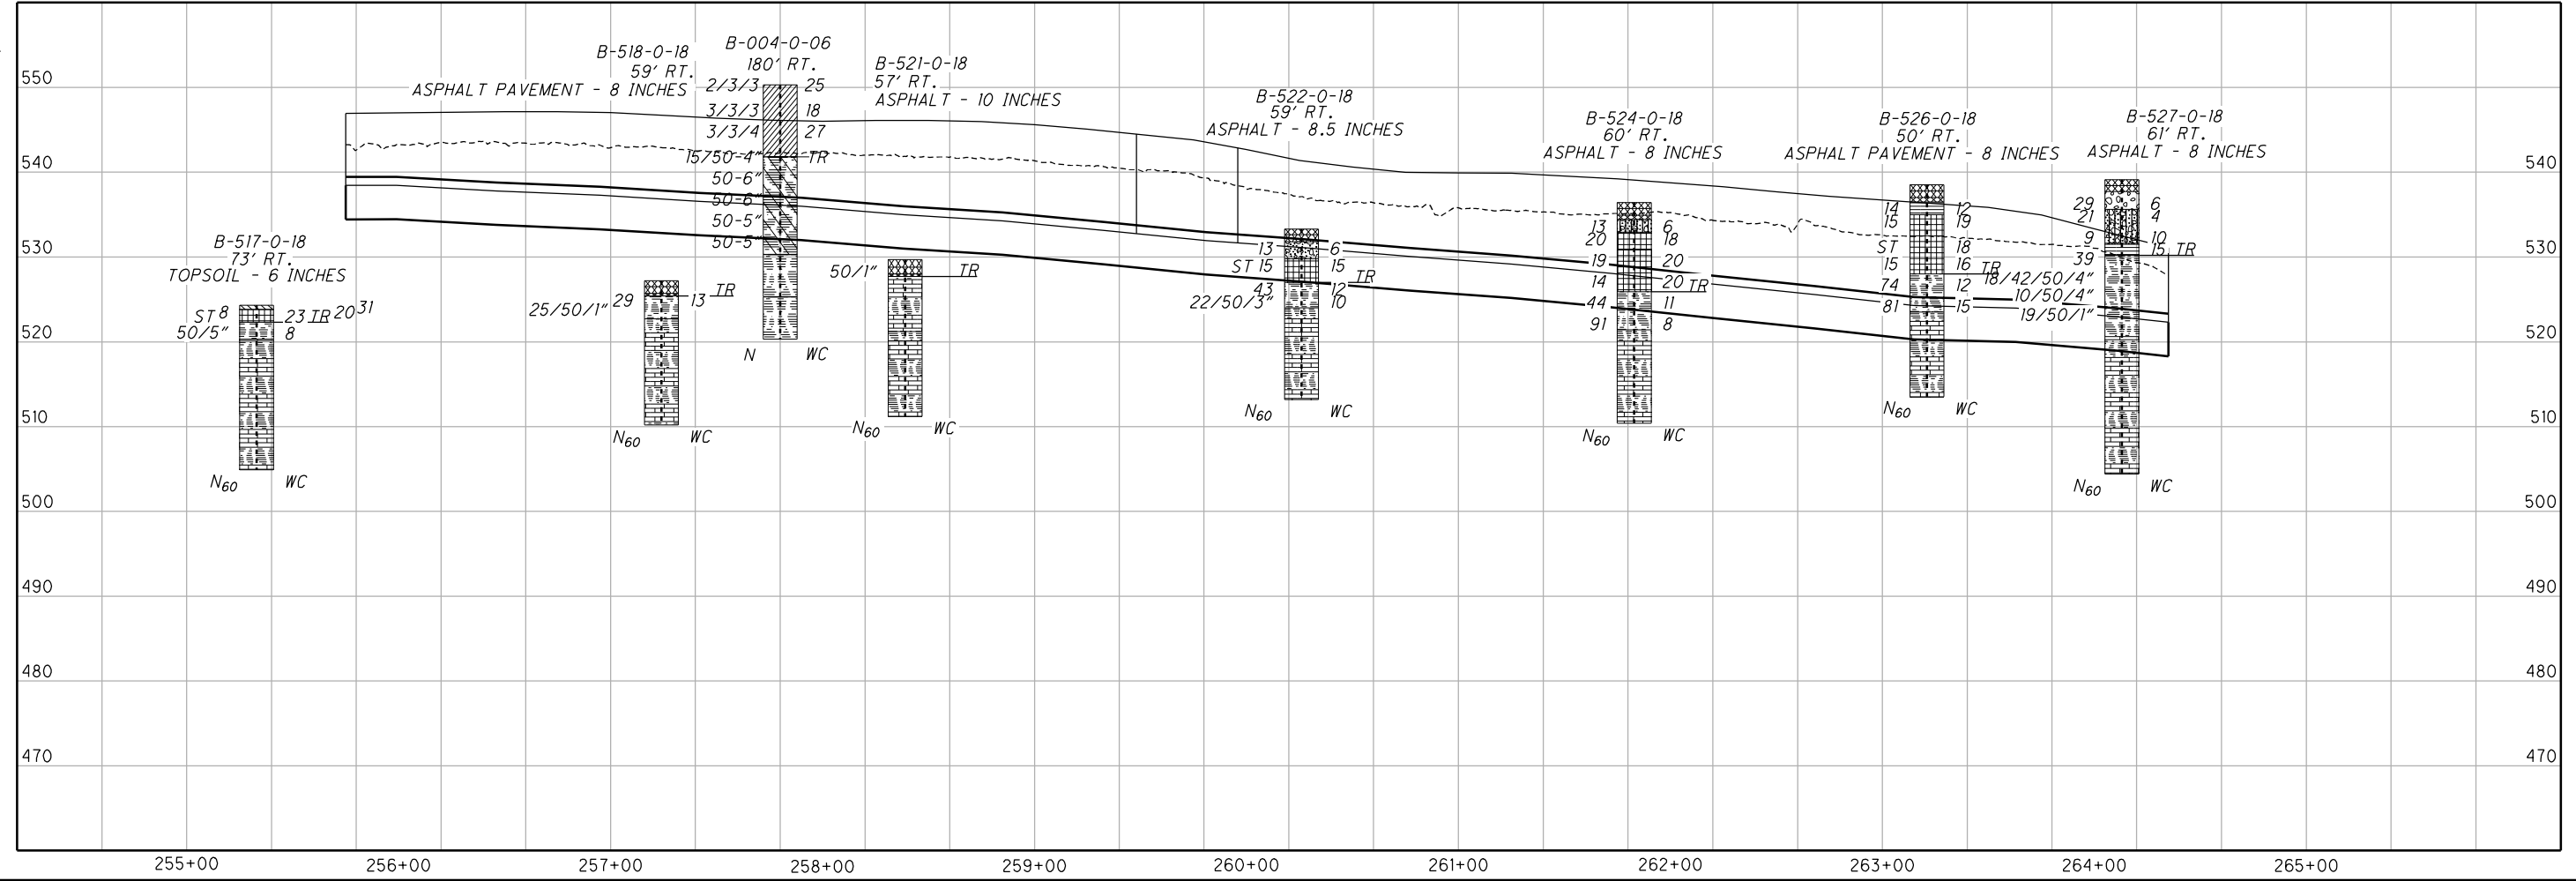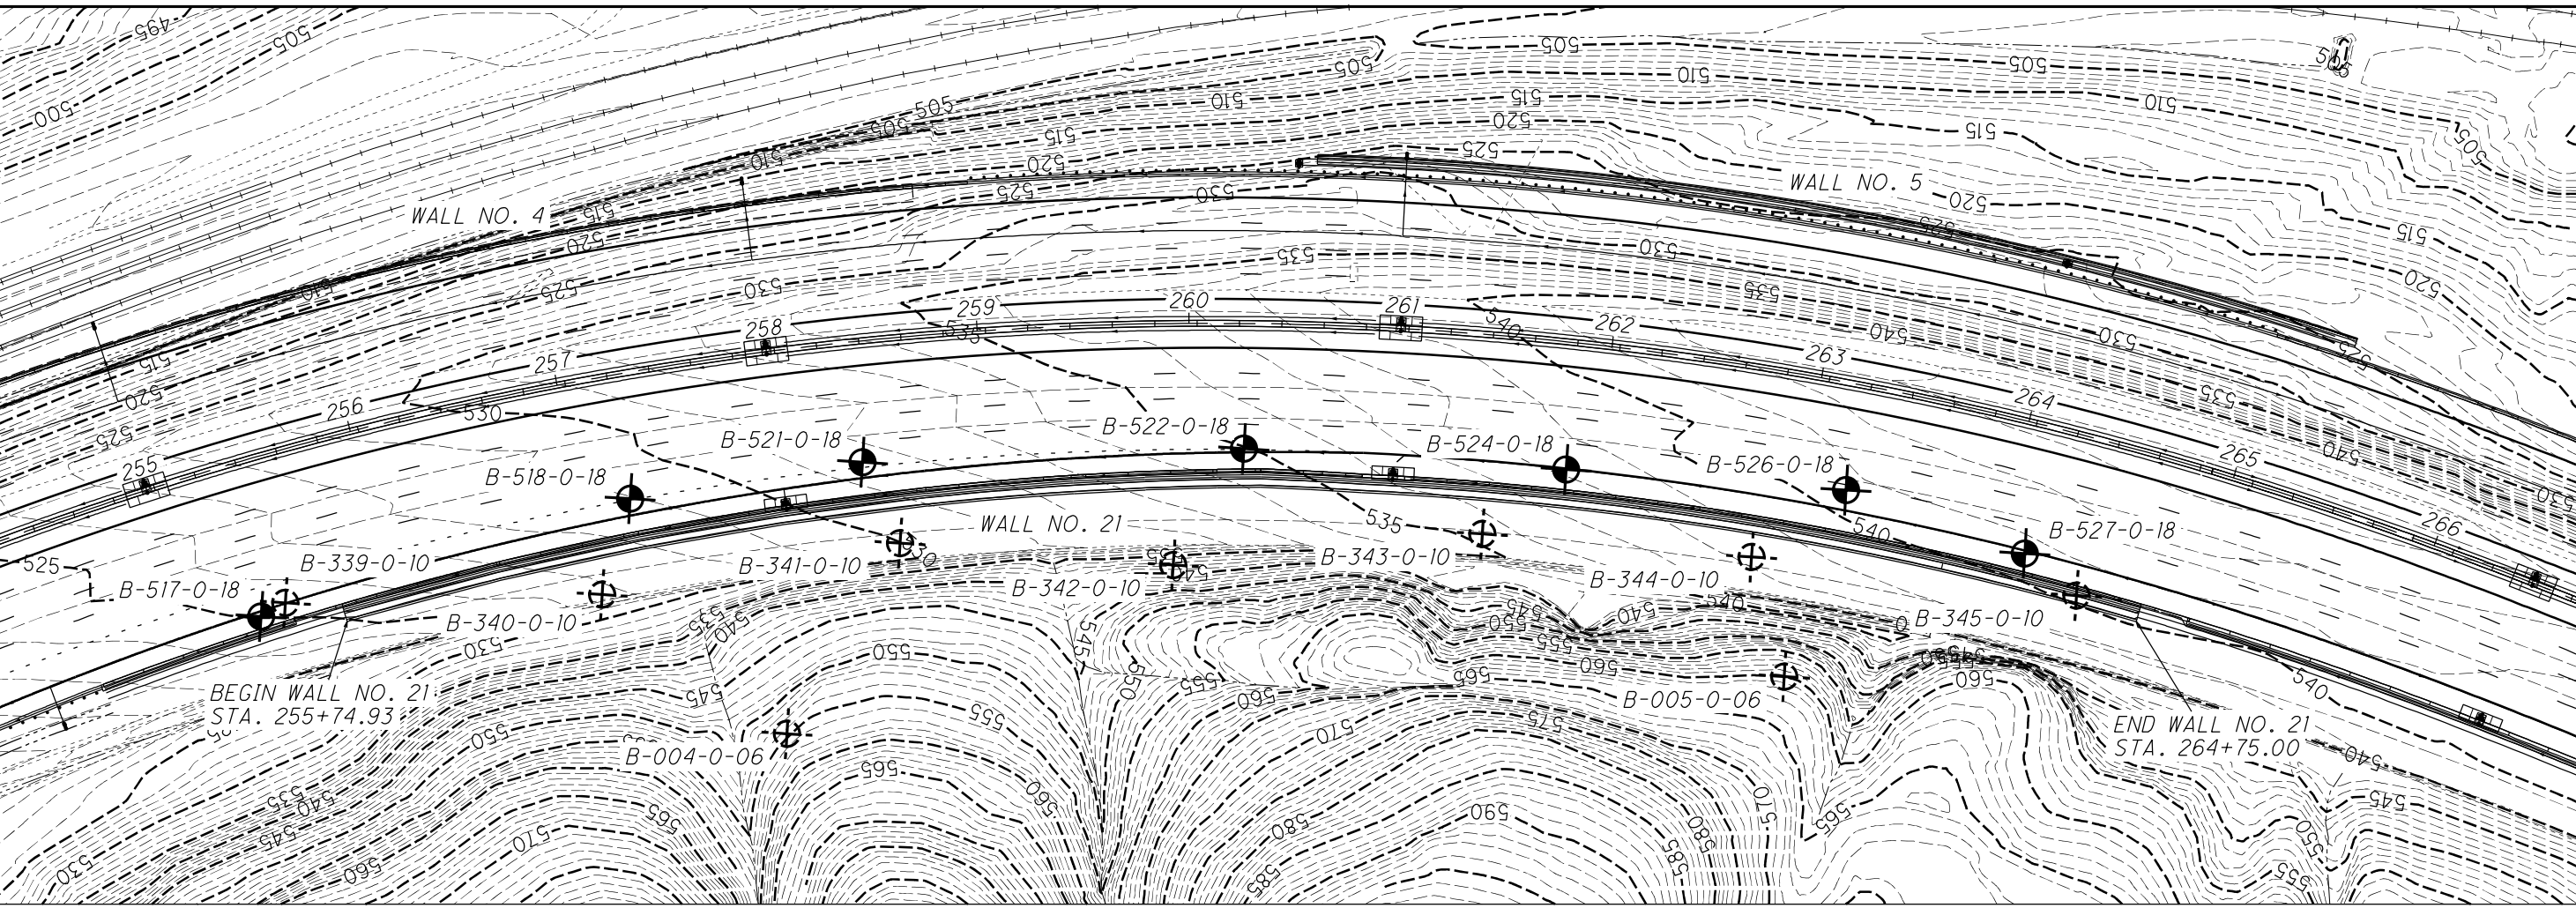


STRUCTURE FOUNDATION EXPLORATION
RETAINING WALL NO. 21

HAM-75-3.84

7/54

Scale: HORIZONTAL SCALE IN FEET (0, 20, 40, 80)

Checked: BCD, Drawn: DWM

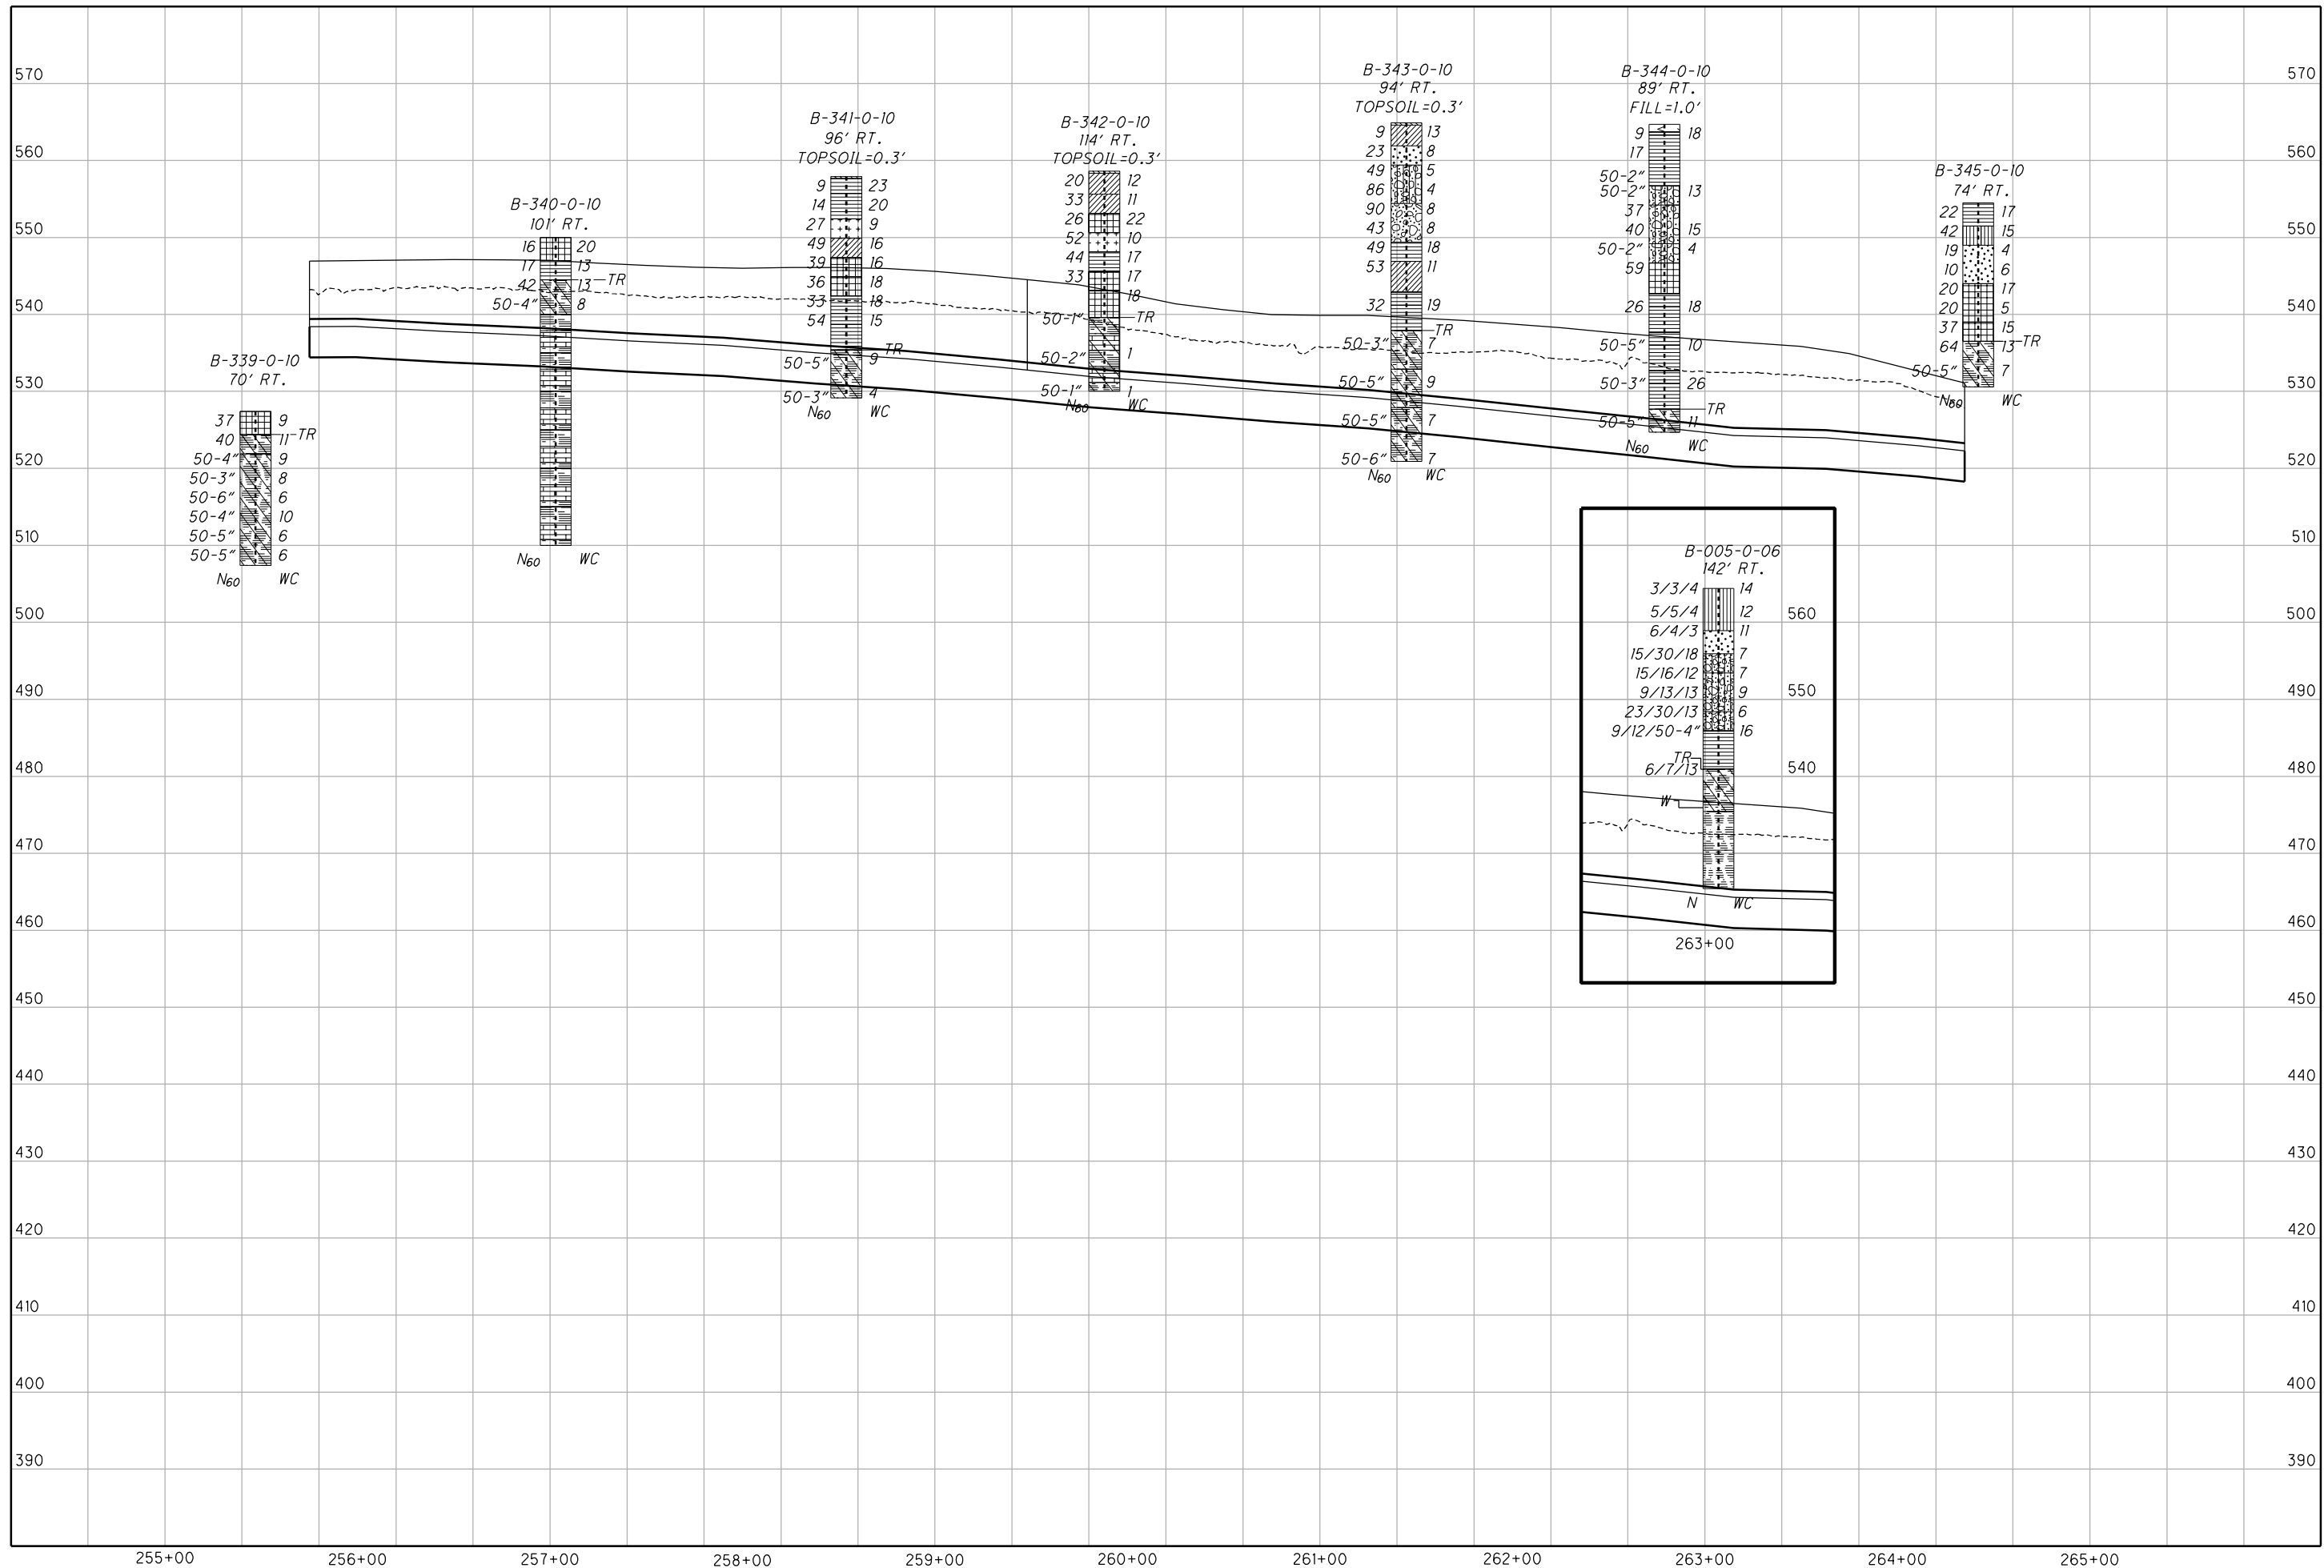

**STRUCTURE FOUNDATION EXPLORATION
RETAINING WALL NO. 21**

HAM-75-3.84



S&ME JOB: 1178-18-006

PROJECT: HAM-75-3.84 RETAINING WALL
 TYPE: RETAINING WALL
 PID: 104667 BR ID: N/A
 START: 8/24/18 END: 8/24/18
 DRILLING FIRM / OPERATOR: S&ME / S&ME
 SAMPLING FIRM / LOGGER: S&ME / J. HAYDU
 DRILLING METHOD: 3.25" HSA
 SAMPLING METHOD: SPT
 DRILL RIG: S&ME TRK 55 (R-44)
 HAMMER: CME AUTOMATIC
 CALIBRATION DATE: 12/13/17
 ENERGY RATIO (%): 81.8
 STATION / OFFSET: 244+38, 108' RT
 ALIGNMENT: 1-75 CENTERLINE
 ELEVATION: 514.8 (MSL) EOB: 44.2 ft.
 COORD: 39.153245 N, -84.538641 W
 EXPLORATION ID: B-513-0-18
 PAGE: 1 OF 1

DEPTH	ELEV.	MATERIAL DESCRIPTION AND NOTES	SPT/ROD	REC (%)	N60	SAMPLE ID	HP (tsf)	GRADATION (%)										WC	HOLE SEALED
								GR	CS	FS	SI	CL	LL	PL	PI				
1	514.8	ASPHALT - 6 inches																	
2	514.3	AGGREGATE BASE - 6 inches																	
3	513.8	FILL: Loose gray GRAVEL, some fine to coarse sand, trace silt, trace clay, dry.	3	7	44	SS-1	-	82	9	3	4	2	-	-	-	-	-	5	A-1-a (V)
4	511.8	FILL: Stiff gray and brown CLAY, some silt, little fine to coarse sand, trace fine gravel, damp.	8	18	33	SS-2	1.5	-	-	-	-	-	-	-	-	-	-	20	A-7-6 (V)
5																			
6																			
7																			
8	506.8																		
9																			
10																			
24	491.3	Very-stiff brown and gray CLAY, some silt, trace to little fine to coarse sand, trace fine gravel, moist.	3	19	83	SS-9	-	8	4	5	29	54	46	20	26	24	24	A-7-6 (16)	
25																			
26																			
43	471.3																		
44	470.6																		
45																			

SHALE, gray, highly weathered, very weak.
 - Boring caved at 11.8 feet after augers pulled.
 - Encountered groundwater at 28.5 feet while drilling.
 - Groundwater at 37.9 feet after drilling.
 - Auger Refusal at 44.2 feet.

NOTES: SEE ABOVE.
 ABANDONMENT METHODS, MATERIALS, QUANTITIES: ASPHALT PATCH; 20 LB. BENTONITE CHIPS; 2 BAGS CEMENT; 100 GAL. WATER



HAM-75-3.84

STRUCTURE FOUNDATION EXPLORATION
 RETAINING WALL NO. 2
 BORING LOG B-513-0-18

DRAWN: DWM
 CHECKED: BCD

S&ME JOB: 1178-18-006

PROJECT: HAM-75-3.84 RETAINING WALL
 TYPE: RETAINING WALL
 PID: 104667 BR ID: N/A
 START: 8/7/18 END: 8/7/18
 DRILLING FIRM / OPERATOR: S&ME / S&ME
 SAMPLING FIRM / LOGGER: S&ME / J. HAYDU
 DRILLING METHOD: 3.25" HSA
 SAMPLING METHOD: SPT / ST
 DRILL RIG: S&ME ATV D50 (SN226)
 HAMMER: AUTOMATIC
 CALIBRATION DATE: 8/1/18
 ENERGY RATIO (%): 75.5
 STATION / OFFSET: 244+63.171' RT
 ALIGNMENT: 1-75 CENTERLINE
 ELEVATION: 531.8 (MSL) EOB: 64.33 ft.
 LAT / LONG: 39.153228 N, -84.538403 W
 EXPLORATION ID: B-513-1-18
 PAGE: 1 OF 1

DEPTH (ft)	S&ME / S&ME	ELEV.	MATERIAL DESCRIPTION AND NOTES	GRADATION (%)										HP (tsf)	REC (%)	SPT / ROD	HOLE SEALED	
				GR	CS	FS	SI	CL	LL	PL	PI	WC	ODT CLASS (at)					
1		531.8	TOPSOIL - 3 inches															
2		531.1	FILL: Loose brown SANDY SILT, damp.															
3		530.3	FILL: Very-stiff brown SILTY CLAY "and" fine to coarse sand, trace fine to coarse gravel, damp.															
4		527.8	FILL: Medium-dense brown COARSE AND FINE SAND, little silt, trace clay, damp. - Encountered cobbles from 3.5 to 4.5 feet.															
5		525.8	FILL: Very-stiff gray becoming brown SILTY CLAY, little fine to coarse sand, little fine to coarse gravel, damp.															
6		523.3	FILL: Very-stiff olive and gray SILTY CLAY, little fine to coarse sand, little fine to coarse gravel, damp.															
7		520.3	FILL: Very-stiff brown, gray, and olive SILTY CLAY, little fine to coarse sand, little fine to coarse gravel, contains shale fragments, moist.															
8		518.8	FILL: Very-stiff gray to dark gray SILTY CLAY, little fine to coarse sand, slightly organic, moist.															
9		509.8	FILL: Hard gray and olive SILT, some clay, little fine to coarse sand, trace fine to coarse gravel, contains shale and brick fragments, damp to moist.															
10			FILL: Hard becoming very-stiff gray and olive CLAY, some silt, trace fine to coarse sand, trace fine to coarse gravel, contains shale and brick fragments, damp.															
11																		
12																		
34		497.9	FILL: Red brick fragments.															
35		497.7	FILL: Medium-dense brown COARSE AND FINE SAND, trace fine to coarse gravel, trace silt, trace clay, wet.															
36																		
37		494.8	FILL: Very-stiff brown and gray SILTY CLAY, little fine to coarse sand, little fine to coarse gravel, contains decayed wood and brick fragments, moist to wet.															
38																		
39																		
64		467.5	SHALE, gray, highly weathered, very weak.															

NOTES:
 - Encountered groundwater at 33.5 feet.
 - Water had accumulated to 28.9 feet inside HSA at completion.
 SEE ABOVE.
 ABANDONMENT METHODS, MATERIALS, QUANTITIES: 20 LB. BENTONITE CHIPS; 2 BAGS CEMENT; 100 GAL. WATER

S&ME JOB: 1178-18-006

PROJECT: HAM-75-3.84
 TYPE: RETAINING WALL
 PID: 104667 BR ID: N/A
 START: 8/7/18 END: 8/7/18

DRILLING FIRM / OPERATOR: S&ME / S&ME
 SAMPLING FIRM / LOGGER: S&ME / J. HAYDU
 DRILLING METHOD: 3.25" HSA / NQ2
 SAMPLING METHOD: SPT / ST / NQ2

DRILL RIG: S&ME ATV D50 (SN226)
 HAMMER: AUTOMATIC
 CALIBRATION DATE: 8/1/18
 ENERGY RATIO (%): 75.5

STATION / OFFSET: 247+50.175' RT
 ALIGNMENT: 1-75 CENTERLINE
 ELEVATION: 545.0 (MSL) EOB: 59.7 ft.
 LAT / LONG: 39.153908 N, -84.537946 W

EXPLORATION ID
 B-514-1-18
 PAGE
 1 OF 1

DEPTH	ELEV.	MATERIAL DESCRIPTION AND NOTES	SPT/RQD	N60 (%)	REC (%)	SAMPLE ID	HP (tsf)	GRADATION (%)							ATTERBERG			WC	HOLE SEALED			
								GR	CS	FS	SI	CL	LL	PL	PI	NP	NP			NP		
1	545.0	ASPHALT - 7 inches																				
2	544.4	CONCRETE - 6 inches																				
3	543.9	AGGREGATE BASE - 5 inches																				
4	543.5	FILL: Very-stiff to hard brown and gray SANDY SILT, some clay, trace fine to coarse gravel, moist.	4	11	100	SS-1A	-													Visual (V)		
5			5			SS-1B	-	8	16	22	27	25	15	10						16 A-4a (4)		
6																						
7	537.5	FILL: Dense brown GRAVEL, some fine to coarse sand, trace silt, trace clay, damp.	3	11	100	SS-2	3.5-4.5+														21 A-4a (V)	
8																						
9																						
10																						
11																						
12																						
13																						
14																						
15																						
16																						
17	528.0	FILL: Very-stiff brown SILTY CLAY, trace fine to coarse sand, trace fine to coarse gravel, moist.	2	4	100	SS-7	2.5															23 A-7-6 (V)
18																						
19																						
20																						
21																						
22																						
23																						
24																						
25																						
26																						
27	518.0	FILL: Very-stiff brown SANDY SILT, some clay, trace fine gravel, damp to moist.																				
28																						
29																						
30																						
31																						
32	514.0	FILL: Very-stiff to hard brown and gray CLAY, some silt, trace fine to coarse sand, trace fine to coarse gravel, contains limestone fragments, moist.	ST	67	67	ST-10	2.0	1	5	22	38	34	29	20	9							19 A-4a (7)
33																						
34																						
48	498.0	SHALE, gray, highly weathered, very weak.																				
49																						
50																						
51																						
52																						
53																						
54	491.1	Interbedded SHALE (90%) and LIMESTONE (10%), RQD 55%, REC 98%. SHALE, gray, moderately weathered, very weak to weak, thinly laminated, fractured to moderately fractured; LIMESTONE, light gray, slightly weathered, moderately strong, ranges in thickness from 0.5 to 2.0 inches.	34	53	67	SS-13	4.5+															
55																						
56																						
57																						
58																						
59	485.3	FILL: Interbedded SHALE (90%) and LIMESTONE (10%), RQD 55%, REC 98%. SHALE, gray, moderately weathered, very weak to weak, thinly laminated, fractured to moderately fractured; LIMESTONE, light gray, slightly weathered, moderately strong, ranges in thickness from 0.5 to 2.0 inches.	50-5"	0	80	SS-16	NQ2-17															

NOTES: SEE ABOVE.

S&MB JOB: 1178-18-006

PROJECT: TYPE: PID: START:	HAM-75-3.84 RETAINING WALL N/A 8/10/18	DRILLING FIRM / OPERATOR: S&M&E / J. HAYDU	S&M&E / S&M&E S&M&E / J. HAYDU	DRILL RIG: HAMMER: CALIBRATION DATE: ENERGY RATIO (%):	S&M&E ATV D50 (SN226) AUTOMATIC 8/1/18 75.5	STATION / OFFSET:											EXPLORATION ID B-515-0-18				
						ALIGNMENT: ELEVATION: LAT / LONG:															
		MATERIAL DESCRIPTION AND NOTES		ELEV.		SPT / RQD		REC (%)		SAMPLE ID		HP (tsf)		GRADATION (%)					ATTERBERG		BACK FILL
		TOPSOIL - 7 inches		514.9 513.4		5 10		45 7		SS-1A SS-1B		4.5+		GR					WC		
		FILL: Hard brown and gray SILTY CLAY, little fine to coarse sand, damp.		514.3		2		26		-		-		-					16		A-6b (V)
		SHALE, brown and gray, severely weathered, very weak, contains thin limestone layers.		513.4		3		-		-		-		-					-		
		SHALE, gray and brown, highly weathered, very weak, contains limestone layers.		509.4		4		86		SS-2		-		-					20		Rock (V)
		Interbedded SHALE (92%) and LIMESTONE (8%), RQD 56%, REC 82%;		507.4		5		-		-		-		-					13		
		SHALE, gray, moderately weathered, very weak to weak, thinly laminated, fractured to moderately fractured;				6		-		-		-		-					-		CORE
		LIMESTONE, light gray, slightly weathered, moderately strong, ranges in thickness from 1.0 to 2.0 inches.				7		82		SS-3		-		-					-		
						8		23		NQ2-4		-		-					-		CORE
						9		95		NQ2-5		-		-					-		
						10		-		-		-		-					-		CORE
						11		-		-		-		-					-		
						12		-		-		-		-					-		CORE
						13		-		-		-		-					-		
						14		-		-		-		-					-		CORE
						15		-		-		-		-					-		
						16		-		-		-		-					-		CORE
						17		-		-		-		-					-		
						18		-		-		-		-					-		CORE
						19		-		-		-		-					-		
						20		-		-		-		-					-		CORE
				494.8		600		-		-		-		-					-		
								-		-		-		-					-		CORE

- No seepage noted.

NOTES: SEE ABOVE.
ABANDONMENT METHODS, MATERIALS, QUANTITIES: PLASTIC HOLE PLUG DEVICE; SOIL CUTTINGS MIXED WITH BENTONITE

S&MB JOB: 1178-18-006

PROJECT: TYPE: PID: START:	HAM-75-3.84 RETAINING WALL N/A 8/22/18	DRILLING FIRM / OPERATOR: S&M&E / J. HAYDU	S&M&E / S&M&E S&M&E / J. HAYDU	DRILL RIG: HAMMER: CALIBRATION DATE: ENERGY RATIO (%):	S&M&E ATV D50 (SN226) AUTOMATIC 8/1/18 75.5	STATION / OFFSET:											EXPLORATION ID B-516-0-18				
						ALIGNMENT: ELEVATION: LAT / LONG:															
		MATERIAL DESCRIPTION AND NOTES		ELEV.		SPT / RQD		REC (%)		SAMPLE ID		HP (tsf)		GRADATION (%)					ATTERBERG		BACK FILL
		ASPHALT - 8 inches		527.5		1 <td colspan="2"></td> <td colspan="2"></td> <td colspan="2"></td> <td colspan="5"></td> <td colspan="2"></td> <td rowspan="2">Visual (V)</td>															
		CONCRETE - 10 inches		526.8		2		19		SS-1A		-		-					-		A-6b (V)
		AGGREGATE BASE - 10 inches		526.0		3		8		SS-1B		-		-					9		
		FILL: Very-stiff brown and gray SILTY CLAY some fine to coarse sand, some fine to coarse gravel, contains few brick and limestone fragments, moist.		525.1		4		14		SS-2		4.0		-					15		A-6b (V)
		Possible Fill: Very-stiff becoming stiff brown and gray CLAY, some silt, little fine to coarse sand, trace fine to coarse gravel, moist.		521.5		5		7		ST-3		2.5		3 5 15 34 43					17 30		
		Medium-stiff brown and gray SILT, some clay, trace fine to coarse sand, trace fine gravel, moist.		517.0		6		2		SS-4		1.0		-					24		A-7-6 (V)
		Very-stiff brown and gray SILTY CLAY, little fine to coarse sand, little fine to coarse gravel, contains few limestone fragments, moist.		516.0		7		6		SS-5A SS-5B		0.5- 1.0/ 2.0		2 3 5 68 22 27 19 8					22		
		Hard olive and gray SILTY CLAY, little fine to coarse sand, trace fine to coarse gravel, contains limestone layers, relic bedding, damp.		512.0		8		11		SS-6		3.0		-					23		A-6b (V)
		SHALE, brown and gray, highly weathered, very weak, contains few limestone layers.		511.0		9		-		SS-7A SS-7B		4.5+		-					14		
				511.0		10		-		SS-7B		-		-					-		Rock (V)
				503.3 <td colspan="2">11</td> <td colspan="2">89</td> <td colspan="2">SS-8</td> <td colspan="2">-</td> <td colspan="5">-</td> <td colspan="2">-</td> <td rowspan="2">Rock (V)</td>		11		89		SS-8		-		-					-		
				<td colspan="2">12</td> <td colspan="2">-</td> <td colspan="2">-</td> <td colspan="2">-</td> <td colspan="5">-</td> <td colspan="2">-</td> <td rowspan="2">Rock (V)</td>		12		-		-		-		-					-		Rock (V)
				<td colspan="2">13</td> <td colspan="2">-</td> <td colspan="2">-</td> <td colspan="2">-</td> <td colspan="5">-</td> <td colspan="2">-</td> <td rowspan="2">Rock (V)</td>		13		-		-		-		-					-		
				<td colspan="2">14</td> <td colspan="2">-</td> <td colspan="2">-</td> <td colspan="2">-</td> <td colspan="5">-</td> <td colspan="2">-</td> <td rowspan="2">Rock (V)</td>		14		-		-		-		-					-		Rock (V)
				<td colspan="2">15</td> <td colspan="2">-</td> <td colspan="2">-</td> <td colspan="2">-</td> <td colspan="5">-</td> <td colspan="2">-</td> <td rowspan="2">Rock (V)</td>		15		-		-		-		-					-		
				<td colspan="2">24</td> <td colspan="2">-</td> <td colspan="2">-</td> <td colspan="2">-</td> <td colspan="5">-</td> <td colspan="2">-</td> <td rowspan="2">Rock (V)</td>		24		-		-		-		-					-		Rock (V)
				503.3 <td colspan="2">600</td> <td colspan="2">-</td> <td colspan="2">-</td> <td colspan="2">-</td> <td colspan="5">-</td> <td colspan="2">-</td> <td rowspan="2">Rock (V)</td>		600		-		-		-		-					-		
				<td colspan="2"></td> <td colspan="2">-</td> <td colspan="2">-</td> <td colspan="2">-</td> <td colspan="5">-</td> <td colspan="2">-</td> <td rowspan="2">Rock (V)</td>				-		-		-		-					-		Rock (V)

- No seepage noted.

NOTES: SEE ABOVE.
ABANDONMENT METHODS, MATERIALS, QUANTITIES: ASPHALT PATCH; PLASTIC HOLE PLUG DEVICE; SOIL CUTTINGS MIXED WITH BENTONITE

S&M JOB: 1178-18-006

PROJECT: HAM-75-3.84 TYPE: RETAINING WALL	DRILLING FIRM / OPERATOR: S&M / S&M SAMPLING FIRM / LOGGER: S&M / J. HAYDU	DRILL RIG: S&M ATV D50 (SN226) HAMMER: AUTOMATIC	STATION / OFFSET: 255+33, 73' RT	EXPLORATION ID B-517-0-18									
PID: 104667 BR ID: N/A	DRILLING METHOD: 3.25" HSA / NQ2	CALIBRATION DATE: 8/1/18	ALIGNMENT: 1-75 CENTERLINE										
START: 8/23/18 END: 8/23/18	SAMPLING METHOD: SPT / ST / NQ2	ENERGY RATIO (%): 75.5	ELEVATION: 524.3 (MSL) EOB: 19.4 ft.	PAGE 1 OF 1									
MATERIAL DESCRIPTION AND NOTES		GRADATION (%)											
TOPSOIL - 6 inches		GR	CS	FS	SI	CL	LL	PL	PI	WC	ODOT CLASS (qt)	BACK FILL	
Very-stiff brown mottled with gray CLAY, some to "and" silt, trace to little fine to coarse sand, trace fine gravel, damp. - Sample ST-1 obtained from 1.0 to 3.0 feet in offset boring. SHALE, brown and gray, severely weathered, very weak. Interbedded SHALE (85%) and LIMESTONE (15%), ROD 59%, REC 82%; SHALE, gray, moderately weathered, very weak to weak, thinly laminated, blocky/disturbed/seamy, good to fair; LIMESTONE, light gray, moderately to slightly weathered, moderately strong, blocky/disturbed/seamy, good, ranges in thickness from 1.0 to 5.0 inches.		SPT / ROD			REC (%)			SAMPLE ID			HP (tsf)		
		2			8			SS-1A			-		
		4			6			SS-1B			3.0		
		ST			5			ST-1			-		
		50-5"			100			SS-2			-		
		0			40			NQ2-3			-		
		10			50			NQ2-4			-		
		90			98			NQ2-5			-		
		82			100			NQ2-6			-		
		19			504.9								

- No groundwater noted prior to coring rock.

NOTES: SEE ABOVE.

ABANDONMENT METHODS, MATERIALS, QUANTITIES: PLASTIC HOLE PLUG DEVICE; SOIL CUTTINGS MIXED WITH BENTONITE

S&M JOB: 1178-18-006

PROJECT: HAM-75-3.84 TYPE: RETAINING WALL	DRILLING FIRM / OPERATOR: S&M / S&M SAMPLING FIRM / LOGGER: S&M / J. HAYDU	DRILL RIG: S&M ATV D50 (SN226) HAMMER: AUTOMATIC	STATION / OFFSET: 257+24, 59' RT	EXPLORATION ID B-518-0-18									
PID: 104667 BR ID: N/A	DRILLING METHOD: 3.25" HSA / NQ2	CALIBRATION DATE: 8/1/18	ALIGNMENT: 1-75 CENTERLINE										
START: 8/2/18 END: 8/2/18	SAMPLING METHOD: SPT / NQ2	ENERGY RATIO (%): 75.5	ELEVATION: 527.2 (MSL) EOB: 17.0 ft.	PAGE 1 OF 1									
MATERIAL DESCRIPTION AND NOTES		GRADATION (%)											
ASPHALT PAVEMENT - 8 inches CONCRETE - 10 inches AGGREGATE BASE - 3 inches SHALE, brown and gray, severely weathered, very weak. Interbedded SHALE (85%) and LIMESTONE (15%), ROD 58%, REC 88%; SHALE, gray, moderately weathered, very weak to weak, thinly laminated, blocky/disturbed/seamy, good to fair; LIMESTONE, light gray, highly to slightly weathered, moderately strong, blocky/disturbed/seamy, good, ranges in thickness from 1.0 to 5.0 inches.		SPT / ROD			REC (%)			SAMPLE ID			HP (tsf)		
		7			29			SS-1			-		
		15			100			SS-2			-		
		25			100			SS-3			-		
		30-1"			67			SS-4			-		
		0			80			SS-5			-		
		52			93			SS-6			-		
		100			100			SS-7			-		
		17			510.2								

- No groundwater noted prior to coring rock.

NOTES: SEE ABOVE.

ABANDONMENT METHODS, MATERIALS, QUANTITIES: ASPHALT PATCH; PLASTIC HOLE PLUG DEVICE; SOIL CUTTINGS MIXED WITH BENTONITE

S&MB JOB: 1178-18-006

PROJECT: HAM-75-3.84 TYPE: RETAINING WALL		DRILLING FIRM / OPERATOR: S&M E / J. HAYDU		STATION / OFFSET: 257+08, 55' LT		EXPLORATION ID	
PID: 104667 BR ID: N/A		SAMPLING FIRM / LOGGER: S&M E / J. HAYDU		ALIGNMENT: 1-75 CENTERLINE		B-519-0-18	
START: 8/22/18 END: 8/22/18		DRILLING METHOD: 3.25" HSA / NQ2		ELEVATION: 531.8 (MSL) EOB: 24.3 ft.		PAGE	
SAMPLING METHOD: SPT / ST / NQ2		ENERGY RATIO (%): 75.5		LAT / LONG: 39.156450 N, -84.536804 W		1 OF 1	
MATERIAL DESCRIPTION AND NOTES							
ELEV.	DEPTHS	SPT / ROD	REC (%)	SAMPLE ID	HP (tsf)	GRADATION (%)	ATTEMBERG
						GR CS FS SI CL	LL PL PI WC
531.8	1						
531.1	2	5	44	SS-1A	-		Visual (V)
529.9	3	1	4	SS-1B	1.0		15 A-6b (V)
528.8	4	6	13	--	-		
	5	4	-	SS-2	-	62 13 12 9 4	14 A-1-a (V)
525.6	6	2	5	SS-3A	-		18 A-1-a (V)
	7	2	67	SS-3B	1.0		25 A-7-6 (V)
	8						
	9	2	6	SS-4	1.0-1.5	2 3 6 40 49 43 18 25	26 A-7-6 (15)
521.3	10	2	100				
	11	3	15	SS-5	3.0		21 A-6b (V)
	12	5	33	SS-5	3.0		
	13	7	50	ST-11	3.5-4.0		A-6b (V)
	14	4	13	SS-6	3.5		21 A-6b (V)
	15	5	78	SS-6	3.5		
515.8	16	10	44	SS-7	-		19 A-6b (V)
	17	15	17	SS-7	-		
	18	20	100	SS-8	4.5+		18 A-6b (V)
513.4	19	12	100	SS-9	-		9 Rock (V)
	20	27	-		-		
	21	50-4"	-		-		
	22						
	23						
507.5	24	24	100	SS-10	-		8 Rock (V)
	25	50-3"	-		-		

- No seepage noted.

NOTES: SEE ABOVE.

ABANDONMENT METHODS, MATERIALS, QUANTITIES: ASPHALT PATCH; PLASTIC HOLE PLUG DEVICE; SOIL CUTTINGS MIXED WITH BENTONITE

S&MB JOB: 1178-18-006

PROJECT: HAM-75-3.84 TYPE: RETAINING WALL		DRILLING FIRM / OPERATOR: S&M E / J. JONES		STATION / OFFSET: 257+42, 87' LT		EXPLORATION ID	
PID: 104667 BR ID: N/A		SAMPLING FIRM / LOGGER: S&M E / J. HAYDU		ALIGNMENT: 1-75 CENTERLINE		B-519-1-18	
START: 8/30/18 END: 8/30/18		DRILLING METHOD: 3.25" HSA		ELEVATION: 525.1 (MSL) EOB: 25.0 ft.		PAGE	
SAMPLING METHOD: SPT / ST		ENERGY RATIO (%): 75.5		LAT / LONG: 39.156581 N, -84.536792 W		1 OF 1	
MATERIAL DESCRIPTION AND NOTES							
ELEV.	DEPTHS	SPT / ROD	REC (%)	SAMPLE ID	HP (tsf)	GRADATION (%)	ATTEMBERG
						GR CS FS SI CL	LL PL PI WC
525.1	1	5	11	SS-1	-		
	2	4	89	SS-1	-	66 16 9 7 2	NP NP 31 A-1-a (0)
	3						
	4	2	4	SS-2	-		12 A-1-a (V)
519.6	5	1	94	SS-2	-		
	6	2	89	SS-3A	-		29 A-6a (V)
517.6	7	1	-	SS-3B	-		A-6a (V)
	8						
	9	ST	33	ST-1	-	0 3 13 48 36	20 A-6a (V)
	10						
	11	2	9	SS-4	-	5 4 3 58 30 34 20 14	24 A-6a (10)
	12	3	94	SS-4	-		
	13	4					
	14	ST	0	ST	-		A-6a (V)
	15						
	16	7	42	SS-5	-		A-6a (V)
	17	13	89	SS-5	-		
507.1	18	20					
	19	38	111	SS-6	-		Rock (V)
	20	50					
	21						
	22						
	23						
500.1	24	33	50	SS-7	-		Rock (V)
	25	50					

- No seepage noted.

NOTES: SEE ABOVE.

ABANDONMENT METHODS, MATERIALS, QUANTITIES: PLASTIC HOLE PLUG DEVICE; SOIL CUTTINGS MIXED WITH BENTONITE

HAM-75-3.84

STRUCTURE FOUNDATION EXPLORATION
RETAINING WALL NO. 4
BORING LOGS B-519-0-18, B-519-1-18

DRAWN
DWM
CHECKED
BCD

S&ME JOB: 1178-18-006

PROJECT: HAM-75-3.84 RETAINING WALL
 TYPE: 104667 BR ID: N/A
 START: 8/21/18 END: 8/21/18
 DRILLING FIRM / OPERATOR: S&ME / S&ME
 SAMPLING FIRM / LOGGER: S&ME / J. HAYDU
 DRILLING METHOD: 3.25" HSA / NQ2
 SAMPLING METHOD: SPT / ST / NQ2

DRILL RIG: S&ME ATV D50 (SN226)
 HAMMER: AUTOMATIC
 CALIBRATION DATE: 8/1/18
 ENERGY RATIO (%): 75.5

STATION / OFFSET: 259+31, 55' LT
 ALIGNMENT: 1-75 CENTERLINE
 ELEVATION: 536.3 (MSL) EOB: 38.8 ft.
 LAT / LONG: 39.156857 N, -84.536185 W

EXPLORATION ID: B-520-0-18
 PAGE: 1 OF 1

DEPTH	ELEV.	MATERIAL DESCRIPTION AND NOTES	SPT/ROD	REC (%)	SAMPLE ID	HP (tsf)	GRADATION (%)							WC	HOLE SEALED
							GR	CS	FS	SI	CL	LL	PL		
1	536.3	ASPHALT - 8.5 inches													
2	535.6	CONCRETE - 10.5 inches													
3	534.7	AGGREGATE BASE - 5 inches	3	89	SS-1A	-	-	-	-	-	-	-	-	-	Visual (V)
4	534.3	FILL: Hard gray SILTY CLAY, some fine to coarse sand, some fine to coarse gravel, damp.	5	15	SS-1B	4.5+	-	-	-	-	-	-	-	-	13 A-6b (V)
5	533.3	FILL: Very-stiff dark gray SILTY CLAY, some fine to coarse sand, some fine to coarse gravel, contains brick and cinder fragments, damp.	7	19	SS-2A	4.0	-	-	-	-	-	-	-	-	18 A-6b (V)
6	530.3	Possible Fill: Very-stiff brown and gray CLAY, "and" silt, little fine to coarse sand, trace fine to coarse gravel, contains iron oxide stains, moist.	8	78	SS-2B	4.0	-	-	-	-	-	-	-	-	15 A-6b (V)
7		Very-stiff to hard brown and gray CLAY, "and" silt, trace fine to coarse sand, trace fine gravel, moist.	ST	92	ST-3	2.5-3.5	2	3	11	46	38	53	17	36	22 A-7-6 (19)
8			4	18	SS-4	3.0-4.0	-	-	-	-	-	-	-	-	21 A-7-6 (V)
9			5	100											
10	525.8		7	20	SS-5	4.0-4.5	3	2	1	36	58	43	21	22	24 A-7-6 (13)
11			9												
12			3	13	SS-6	3.5	-	-	-	-	-	-	-	-	20 A-7-6 (V)
13			4	6											
14	520.8	Stiff gray SILT AND CLAY, little fine to coarse sand, trace fine gravel, (varved), moist.	3	11	SS-7	2.0	-	-	-	-	-	-	-	-	27 A-6a (V)
15			4	5											
16	518.3	Stiff to very-stiff gray SILT AND CLAY, some fine to coarse sand, contains fine sand and silt seams, (varved), moist to wet.	4	14	SS-8	1.5-2.5	-	-	-	-	-	-	-	-	30 A-6a (V)
17			5	72											
18	514.3	Stiff gray SILT AND CLAY, trace fine gravel, contains decayed wood, (varved), wet.	4	10	SS-9	1.5-2.0	1	0	0	58	41	29	18	11	27 A-6a (8)
19			3	89											
20			4	4											
21			8	29	SS-10	4.0	-	-	-	-	-	-	-	-	18 A-6b (V)
22			9	56											
23			14												
24	509.3	Very-stiff brown and gray SILTY CLAY, little fine to coarse sand, trace fine gravel, contains fossils, damp.	10	79	SS-11A	4.5+	-	-	-	-	-	-	-	-	13 A-6b (V)
25			15	100	SS-11B	-	-	-	-	-	-	-	-	-	Rock (V)
26			48												
27	504.3	Hard olive and gray SILTY CLAY, little fine to coarse sand, trace fine gravel, contains few limestone fragments, relic bedding, damp.	10	79											
28			15												
29	501.7	SHALE, brown and gray, highly weathered, very weak.	48												
30			50-4'	100	SS-12	-	-	-	-	-	-	-	-	-	Rock (V)
31															
32															
33															
34															
35															
36															
37															
38	497.5														

NOTES:
 - Slight seepage at 18.5 feet.
 - Boring "dry" at completion.

SEE ABOVE.

ABANDONMENT METHODS, MATERIALS, QUANTITIES: ASPHALT PATCH; PLASTIC HOLE PLUG DEVICE; SOIL CUTTINGS MIXED WITH BENTONITE

S&MB JOB: 1178-18-006

PROJECT: HAM-75-3.84 TYPE: RETAINING WALL	DRILLING FIRM / OPERATOR: S&M / S&M SAMPLING FIRM / LOGGER: S&M / J. HAYDU	STATION / OFFSET: 258+39, 57' RT ALIGNMENT: 1-75 CENTERLINE	EXPLORATION ID B-521-0-18
PID: 104667 BR ID: N/A	DRILLING METHOD: 3.25" HSA / NQ2	ELEVATION: 529.7 (MSL) EOB: 18.5 ft.	PAGE 1 OF 1
START: 8/22/18 END: 8/23/18	SAMPLING METHOD: SPT / NQ2	LAT / LONG: 39.156464 N, -84.536195 W	
MATERIAL DESCRIPTION AND NOTES ASPHALT - 10 inches CONCRETE - 10 inches AGGREGATE BASE - 4 inches Interbedded SHALE (97%) and LIMESTONE (3%), RQD 7%, REC 12%. SHALE, gray, moderately weathered, very weak to weak, thinly laminated, blocky/disturbed/seamy, poor; LIMESTONE, light gray, slightly weathered, moderately strong, blocky/disturbed/seamy, good, ranges in thickness from 0.5 to 2.0 inches.		SPT / RQD 50-1" --- 0 7 58 63	GRADATION (%) GR CS FS SI CL --- -- -- -- -- --- -- -- -- -- --- -- -- -- --
Interbedded SHALE (90%) and LIMESTONE (10%), RQD 61%, REC 95%. SHALE, gray, moderately weathered, very weak to weak, thinly laminated, blocky/disturbed/seamy, good to fair; LIMESTONE, light gray, slightly weathered, moderately strong, blocky/disturbed/seamy, good, ranges in thickness from 0.5 to 3.0 inches.		HP (tsf) --- --- ---	ATTERBERG LL PL PI --- -- -- --- -- -- --- -- --
Interbedded SHALE (90%) and LIMESTONE (10%), RQD 61%, REC 95%. SHALE, gray, moderately weathered, very weak to weak, thinly laminated, blocky/disturbed/seamy, good to fair; LIMESTONE, light gray, slightly weathered, moderately strong, blocky/disturbed/seamy, good, ranges in thickness from 0.5 to 3.0 inches.		12 NQ2-1 97 NQ2-2 93 NQ2-3	CORE CORE CORE
ELEV. 529.7 528.8 528.0 527.7 521.2 511.2		DEPTHS 1 2 TR 3 4 5 6 7 8 9 10 11 12 13 14 15 16 17 18	HOLE SEALED HOLE SEALED HOLE SEALED

- No groundwater noted prior to coring rock.
- Boring caved at 12.1 feet after augers pulled.

NOTES: SEE ABOVE.

ABANDONMENT METHODS, MATERIALS, QUANTITIES: ASPHALT PATCH; PLASTIC HOLE PLUG DEVICE; SOIL CUTTINGS MIXED WITH BENTONITE

S&MB JOB: 1178-18-006

PROJECT: HAM-75-3.84 TYPE: RETAINING WALL	DRILLING FIRM / OPERATOR: S&M / S&M SAMPLING FIRM / LOGGER: S&M / J. HAYDU	STATION / OFFSET: 258+39, 57' RT ALIGNMENT: 1-75 CENTERLINE	EXPLORATION ID B-521-0-18A
PID: 104667 BR ID: N/A	DRILLING METHOD: 3.25" HSA / NQ2	ELEVATION: 529.7 (MSL) EOB: 17.4 ft.	PAGE 1 OF 1
START: 8/23/18 END: 8/23/18	SAMPLING METHOD: SPT / NQ2	LAT / LONG: 39.156464 N, -84.536195 W	
MATERIAL DESCRIPTION AND NOTES ASPHALT - 10.5 inches CONCRETE - 10 inches AGGREGATE BASE - 4 inches Interbedded SHALE (90%) and LIMESTONE (10%), RQD 61%, REC 95%. SHALE, gray, moderately weathered, very weak to weak, thinly laminated, fractured to moderately fractured; LIMESTONE, light gray, highly to slightly weathered, moderately strong, ranges in thickness from 1.0 to 3.0 inches.		SPT / RQD 50-1" --- 0 58 63	GRADATION (%) GR CS FS SI CL --- -- -- -- -- --- -- -- -- -- --- -- -- -- --
Interbedded SHALE (90%) and LIMESTONE (10%), RQD 61%, REC 95%. SHALE, gray, moderately weathered, very weak to weak, thinly laminated, fractured to moderately fractured; LIMESTONE, light gray, highly to slightly weathered, moderately strong, ranges in thickness from 1.0 to 3.0 inches.		HP (tsf) --- --- ---	ATTERBERG LL PL PI --- -- -- --- -- -- --- -- --
Interbedded SHALE (90%) and LIMESTONE (10%), RQD 61%, REC 95%. SHALE, gray, moderately weathered, very weak to weak, thinly laminated, fractured to moderately fractured; LIMESTONE, light gray, highly to slightly weathered, moderately strong, ranges in thickness from 1.0 to 3.0 inches.		97 NQ2-2 93 NQ2-3	CORE CORE
ELEV. 529.7 528.8 528.0 527.6 512.3		DEPTHS 1 2 TR 3 4 5 6 7 8 9 10 11 12 13 14 15 16 17	HOLE SEALED HOLE SEALED HOLE SEALED

- Boring "dry" prior to coring rock
- Boring caved at 8.8 feet after augers pulled.

NOTES: SEE ABOVE.

ABANDONMENT METHODS, MATERIALS, QUANTITIES: ASPHALT PATCH; PLASTIC HOLE PLUG DEVICE; SOIL CUTTINGS MIXED WITH BENTONITE

S&ME JOB: 1178-18-006

PROJECT: HAM-75-3.84 TYPE: RETAINING WALL		DRILLING FIRM / OPERATOR: S&ME / S&ME SAMPLING FIRM / LOGGER: S&ME / J. HAYDU		STATION / OFFSET: 260+26, 59' RT		EXPLORATION ID B-522-0-18	
PID: 104667 BR ID: N/A		DRILLING METHOD: 3.25" HSA / NQ2		ALIGNMENT: 1-75 CENTERLINE		PAGE 1 OF 1	
START: 8/2/18 END: 8/2/18		SAMPLING METHOD: SPT / NQ2		ELEVATION: 533.3 (MSL) EOB: 20.1 ft.		PAGE 1 OF 1	
MATERIAL DESCRIPTION AND NOTES		ELEV.		GRADATION (%)		ODOT CLASS (g)	
ASPHALT - 8.5 inches		533.3		GR CS FS SI CL		WC	
CONCRETE - 9.5 inches		532.6		GR CS FS SI CL		WC	
FILL: Medium-dense gray GRAVEL WITH SAND, trace silt, trace clay, dry.		531.8		GR CS FS SI CL		WC	
Very-stiff brown mottled with gray CLAY, some silt, trace fine to coarse sand, trace fine gravel, damp.		529.8		GR CS FS SI CL		WC	
SHALE, brown and gray, severely weathered, very weak.		527.0		GR CS FS SI CL		WC	
Interbedded SHALE (91%) and LIMESTONE (9%), ROD 50%, REC 93%;		524.0		GR CS FS SI CL		WC	
SHALE, gray, moderately weathered, very weak to weak, thinly laminated, blocky/disturbed/seamy, good to fair;				GR CS FS SI CL		WC	
LIMESTONE, light gray, slightly weathered, moderately strong, blocky/disturbed/seamy, good, ranges in thickness from 1.0 to 4.0 inches.				GR CS FS SI CL		WC	

- No groundwater noted prior to coring rock.
- Attempted Shelby tube at 5 feet. Crushed tube.

NOTES: SEE ABOVE.

ABANDONMENT METHODS, MATERIALS, QUANTITIES: ASPHALT PATCH; PLASTIC HOLE PLUG DEVICE; SOIL CUTTINGS MIXED WITH BENTONITE

S&ME JOB: 1178-18-006

PROJECT: HAM-75-3.84 TYPE: RETAINING WALL		DRILLING FIRM / OPERATOR: S&ME / S&ME SAMPLING FIRM / LOGGER: S&ME / J. HAYDU		STATION / OFFSET: 261+83, 60' RT		EXPLORATION ID B-524-0-18	
PID: 104667 BR ID: N/A		DRILLING METHOD: 3.25" HSA / NQ2		ALIGNMENT: 1-75 CENTERLINE		PAGE 1 OF 1	
START: 8/23/18 END: 8/23/18		SAMPLING METHOD: SPT / NQ2		ELEVATION: 536.4 (MSL) EOB: 26.0 ft.		PAGE 1 OF 1	
MATERIAL DESCRIPTION AND NOTES		ELEV.		GRADATION (%)		ODOT CLASS (g)	
ASPHALT - 8 inches		536.4		GR CS FS SI CL		WC	
CONCRETE - 10.5 inches		535.7		GR CS FS SI CL		WC	
AGGREGATE BASE - 6 inches		534.9		GR CS FS SI CL		WC	
FILL: Medium-dense gray GRAVEL WITH SAND AND SILT, trace clay, dry.		534.4		GR CS FS SI CL		WC	
- Attempted ST from 3.0 to 5.0 feet in offset boring, no recovery.		532.9		GR CS FS SI CL		WC	
Hard brown mottled with gray CLAY, some silt, trace fine to coarse sand, trace fine gravel, damp.		530.9		GR CS FS SI CL		WC	
Hard olive-brown CLAY, some silt, little fine to coarse sand, trace fine to coarse gravel, moist.				GR CS FS SI CL		WC	
SHALE, brown and gray, severely weathered, very weak.		525.9		GR CS FS SI CL		WC	
Interbedded SHALE (93%) and LIMESTONE (7%), ROD 53%, REC 85%;		521.4		GR CS FS SI CL		WC	
SHALE, gray, moderately weathered, very weak to weak, thinly laminated, blocky/disturbed/seamy, good to fair;				GR CS FS SI CL		WC	
LIMESTONE, light gray, slightly weathered, moderately strong, blocky/disturbed/seamy, good, ranges in thickness from 1.0 to 3.0 inches.				GR CS FS SI CL		WC	

- No groundwater noted prior to coring rock.
- Boring caved at 14.1 feet after augers pulled.

NOTES: SEE ABOVE.

ABANDONMENT METHODS, MATERIALS, QUANTITIES: ASPHALT PATCH; PLASTIC HOLE PLUG DEVICE; SOIL CUTTINGS MIXED WITH BENTONITE



S&ME JOB: 1178-18-006

PROJECT: HAM-75-3.84 RETAINING WALL
 TYPE: 104667 BR ID: N/A
 START: 8/21/18 END: 8/21/18
 DRILLING FIRM / OPERATOR: S&ME / S&ME
 SAMPLING FIRM / LOGGER: S&ME / J. HAYDU
 DRILLING METHOD: 3.25" HSA / NQ2
 SAMPLING METHOD: SPT / ST / NQ2

DRILL RIG: S&ME ATV D50 (SN226)
 HAMMER: AUTOMATIC
 CALIBRATION DATE: 8/1/18
 ENERGY RATIO (%): 75.5

STATION / OFFSET: 261+12, 52' LT
 ALIGNMENT: 1-75 CENTERLINE
 ELEVATION: 539.9 (MSL) EOB: 44.6 ft.
 LAT / LONG: 39.157134 N, -84.535630 W

EXPLORATION ID: B-523-0-18
 PAGE: 1 OF 1

DEPTH (ft)	S&ME / S&ME	ELEV.	MATERIAL DESCRIPTION AND NOTES	SPT / ROD	REC (%)	N60	SAMPLE ID	HP (tsf)	GRADATION (%)										WC	BACK FILL
									GR	CS	FS	SI	CL	LL	PL	PI				
1		539.9	ASPHALT - 7.5 inches																	
2		539.2	CONCRETE - 10.5 inches																	
3		538.4	AGGREGATE BASE - 5 inches																	
4		538.0	FILL: Very-stiff dark gray and olive SILTY CLAY, little fine to coarse sand, trace fine to coarse gravel, moist.	4	72	13	SS-1A												Visual (V)	
5		534.9	FILL: Very-stiff brown SILTY CLAY, little fine to coars sand, trace fine to coarse gravel, moist.	7	72	15	SS-1B	4.0											A-6b (V)	
6		533.4	Possible Fill: Very-stiff brown CLAY, some silt, trace fine to coarse sand, trace fine gravel, damp.	8	0	18	SS-2	3.5-4.0											A-6b (V)	
7		529.4	Very-stiff brown SILTY CLAY, little to some fine to coarse sand, contains many 0.5 to 1" silt seams (varved), moist.	11	100		SS-3	3.0-3.5											A-6b (V)	
8		526.9	Stiff brown to gray SILT AND CLAY, little fine to coarse sand, trace fine to coarse gravel, moist.	2	100	13	SS-4	2.0-3.0											A-7-6 (V)	
9		524.4	Stiff gray SILT AND CLAY, little fine to coarse sand, trace fine to coarse gravel, slightly organic, moist.	6	67	ST	ST-5	2.0-3.0											A-7-6 (14)	
10		517.9	Stiff gray CLAY, some silt, little fine to coarse sand, trace fine to coarse gravel, contains 2" fine sand and silt seams (varved), moist.	3	100	11	SS-6	2.0-2.5											A-6b (V)	
11		512.9	Very-stiff mottled olive and gray SILTY CLAY, little fine to coarse sand, trace fine to coarse gravel, contains limestone fragments, damp to moist.	3	100	10	SS-7	1.5-2.0											A-6a (V)	
12		506.9	Hard olive and gray SILTY CLAY, little fine to coarse sand, trace fine to coarse gravel, contains limestone fragments, damp to dry.	3	89	9	SS-8	1.5-2.0											A-6a (V)	
13		501.9	SHALE, gray, highly weathered, very weak.	3	100	9	SS-9	1.5-2.0											A-6a (V)	
14		500.3	Interbedded SHALE (90%) and LIMESTONE (10%), RQD 60%, REC 97%. SHALE, gray, moderately weathered, very weak to weak, thinly laminated, moderately fractured; LIMESTONE, light gray, slightly weathered, moderately strong, ranges in thickness from 1.0 to 2.0 inches.	3	100	5	SS-10	1.0-1.5											A-7-6 (V)	
15		495.3		5	89	25	SS-11	4.0											A-6b (V)	
16				9	61	30	SS-12	4.5+											A-6b (V)	
17				15																
18				50-5"	100		SS-13												Rock (V)	
19																				
20																				
NOTES:
 - Sample SS-1B: Sulfate Content = 81 ppm.
 - Slight seepage at 23.8 feet.
 - No groundwater noted prior to coring rock.

SEE ABOVE.

ABANDONMENT METHODS, MATERIALS, QUANTITIES: ASPHALT PATCH; PLASTIC HOLE PLUG DEVICE; SOIL CUTTINGS MIXED WITH BENTONITE

S&ME JOB: 1178-18-006

PROJECT: HAM-75-3.84 RETAINING WALL
 TYPE: 104667 BR ID: N/A
 START: 1/25/19 END: 1/25/19
 DRILLING FIRM / OPERATOR: S&ME / S&ME
 SAMPLING FIRM / LOGGER: S&ME / J. HAYDU
 DRILLING METHOD: 3.25" HSA
 SAMPLING METHOD: SPT

DRILL RIG: S&ME TRK 55 (R-44)
 HAMMER: CME AUTOMATIC
 CALIBRATION DATE: 12/13/17
 ENERGY RATIO (%): 81.8

STATION / OFFSET: 262+66, 53' LT
 ALIGNMENT: I-75 CENTERLINE
 ELEVATION: 542.8 (MSL) EOB: 39.6 ft.
 COORD: 39.157338 N, -84.535129 W

EXPLORATION ID: B-523-1-18
 PAGE: 1 OF 1

DEPTH (ft)	SPT / RQD	REC (%)	SAMPLE ID	HP (1st)	GRADATION (%)			ATTERBERG			WC	ODOT CLASS (g)	BACK FILL
					GR	CS	FS	SI	CL	LL			
1	8												
2	4	12	SS-1	-	-	-	-	-	-	-	15	Visual (V)	
3	5												
4	2	20	SS-2	-	-	-	-	-	-	-	21	A-6b (V)	
5	4	11											
6	3	7	8										
7	3	20	100	SS-3	-	-	-	-	-	-	24	A-6b (V)	
8	8												
9	3	4	12	100	SS-4	-	-	-	-	-	23	A-6b (V)	
10	4	5											
11	3	4	14	56	SS-5	-	-	-	-	-	24	A-6b (V)	
12	4	6											
13	13												
14	3	4	15	100	SS-6	-	-	-	-	-	29	A-6b (V)	
15	4	7											
16	2	4	12	100	SS-7	-	-	-	-	-	26	A-6b (V)	
17	4	5											
18	18												
19	1	2	8	100	SS-8	-	-	-	-	-	29	A-6a (V)	
20	2	4											
21	21												
22	22												
23	23												
24	1	3	8	100	SS-9	-	-	-	-	-	27	A-6a (V)	
25	3												
26	26												
27	27												
28	28												
29	7	25	17	SS-10	-	-	-	-	-	-	25	A-6b (V)	
30	11												
31	31												
32	32												
33	33												
34	10	46	44	SS-11	-	-	-	-	-	-	17	A-6b (V)	
35	12	22											
36	36												
37	37												
38	38												
39	17	50	92	SS-12	-	-	-	-	-	-	10	Rock (V)	
	50	1"											

SHALE, gray, highly weathered, very weak.
 - Encountered cobbles at 21.0 feet, 27.0 feet, and 27.9 feet.
 - Slight seepage at 28.5 feet.

NOTES: SEE ABOVE.

ABANDONMENT METHODS, MATERIALS, QUANTITIES: ASPHALT PATCH; PLASTIC HOLE PLUG DEVICE; SOIL CUTTINGS MIXED WITH BENTONITE

S&ME JOB: 1178-18-006

PROJECT: HAM-75-3.84 RETAINING WALL
 TYPE: RETAINING WALL
 PID: 104667 BR ID: N/A
 START: 8/20/18 END: 8/21/18
 DRILLING FIRM / OPERATOR: S&ME / S&ME
 SAMPLING FIRM / LOGGER: S&ME / J. HAYDU
 DRILLING METHOD: 3.25" HSA / NQ2
 SAMPLING METHOD: SPT / NQ2
 DRILL RIG: S&ME ATV D50 (SN226)
 HAMMER: AUTOMATIC
 CALIBRATION DATE: 8/1/18
 ENERGY RATIO (%): 75.5
 STATION / OFFSET: 263+60, 53' LT
 ALIGNMENT: 1-75 CENTERLINE
 ELEVATION: 543.5 (MSL) EOB: 58.3 ft.
 LAT / LONG: 39.157438 N, -84.534818 W
 EXPLORATION ID: B-525-0-18
 PAGE: 1 OF 1

DEPTH	ELEV.	MATERIAL DESCRIPTION AND NOTES	SPT/RQD	REC (%)	SAMPLE ID	HP (tsf)	GRADATION (%)							WC	HOLE SEALED
							GR	CS	FS	SI	CL	LL	PL		
1	543.5	ASPHALT - 7.5 inches													
2	542.9	CONCRETE - 10.5 inches													
3	542.0	AGGREGATE BASE - 5 inches	3	8	SS-1A	2.0-									Visual (V)
4	541.6	FILL: Silt to very-stiff brown, gray, and black SILTY CLAY, little fine to coarse sand, little fine to coarse gravel, contains roots, damp.	3	61	SS-1B	3.0									A-6b (V)
5	538.0	FILL: Silt to very-stiff reddish-brown and brown SILTY CLAY, some fine to coarse sand, some fine to coarse gravel, damp.	4	18	SS-2	1.5-3.5									A-6b (V)
6			5	6											
7			6	15	SS-3	2.0-3.0									A-6b (V)
8															
9			3	4	SS-4	1.5-2.5									A-6b (V)
10			4	10											
11			3	8	SS-5	1.5									A-6b (V)
12	530.5	Possible Fill: Very-stiff brown mottled with gray and reddish-brown SILTY CLAY, little fine to coarse sand, contains iron oxide stains, damp. - Encountered cobbles from 13.0 to 18.0 feet.	3	8											
13															
14			5	14	SS-6	2.0-3.0									A-6b (V)
15			6												
16			5	7	SS-7	3.0-4.0									A-6b (V)
17			8	19											
18															
19			15	23	SS-8	-									A-6b (V)
20			12												
21															
22															
23															
24			5	26	SS-9	4.5+									A-6b (V)
25			12												
26															
27	516.5	Hard brown and gray SILTY CLAY, little fine to coarse sand, little fine to coarse gravel, contains limestone fragments, relic bedding, damp.													
28															
29			4	25	SS-10	4.5+									A-6b (V)
30			12												
31															
32															
33															
34			9	72	SS-11	4.5+									A-6b (V)
35			24												
36			33												
37	506.5	SHALE, brown and gray, severely weathered, very weak.													
38															
39			36												Rock (V)
40			50-4"												
41	502.5	Interbedded SHALE (93%) and LIMESTONE (7%), RQD 36%, REC 71%; SHALE, gray, moderately weathered, very weak to weak, thinly laminated, moderately fractured; LIMESTONE, light gray, slightly weathered, moderately strong, ranges in thickness from 0.5 to 1.0 inches.													CORE
42															
43			0	12	NQ2-13										CORE
44															
45															
46															
47															
48			63	93	NQ2-14										CORE
49															
50															
51															
52															
53			40	100	NQ2-15										CORE
54															
55	488.2	Interbedded SHALE (70%) and LIMESTONE (30%), RQD 85%, REC 100%; SHALE, gray, moderately weathered, very weak to weak, thinly laminated, moderately fractured; LIMESTONE, light gray, slightly weathered, moderately strong, ranges in thickness from 2.0 to 4.0 inches.													CORE
56															
57			86	100	NQ2-16										CORE
58	485.2	- Slight seepage at 16.5 feet. - Encountered groundwater at 33.5 feet. - Groundwater at 29.3 feet prior to coring rock and after heavy overnight rain.													

NOTES: SEE ABOVE.
 ABANDONMENT METHODS, MATERIALS, QUANTITIES: ASPHALT PATCH; 20 LB. BENTONITE CHIPS; 94 LB. CEMENT; 100 GAL. WATER

S&ME JOB: 1178-18-006

PROJECT: HAM-75-3.84 RETAINING WALL
 TYPE: 104667 BR ID: N/A
 START: 8/27/18 END: 8/28/18
 DRILLING FIRM / OPERATOR: S&ME / S&ME
 SAMPLING FIRM / LOGGER: S&ME / J. HAYDU
 DRILLING METHOD: 3.25" HSA
 SAMPLING METHOD: SPT / ST
 DRILL RIG: S&ME TRK 55 (R-44)
 HAMMER: CME AUTOMATIC
 CALIBRATION DATE: 12/13/17
 ENERGY RATIO (%): 81.8
 STATION / OFFSET: 263+57.107' LT
 ALIGNMENT: 1-75 CENTERLINE
 ELEVATION: 527.6 (MSL) EOB: 39.3 ft.
 LAT / LONG: 39.157574 N, -84.534897 W
 EXPLORATION ID: B-525-1-18
 PAGE: 1 OF 1

DEPTH	ELEV.	MATERIAL DESCRIPTION AND NOTES	SPT / ROD	REC (%)	SAMPLE ID	HP (tsf)	GRADATION (%)				ATTERBERG				WC	HOLE CLASS (a)	HOLE SEALED
							GR	CS	FS	SI	CL	LL	PL	PI			
1	527.5	FILL: 304 stone	7	39	SS-1	-	-	-	-	-	-	-	-	-	-	-	-
2	524.6		8	26	SS-1	-	-	-	-	-	-	-	-	-	-	-	-
3	523.5	FILL: Hard black and reddish-brown CLAY, "and" silt, some fine to coarse sand, trace fine to coarse gravel, moist.	3	14	SS-2A	4.5+	4	8	17	44	27	47	24	23	24	A-7-6 (14)	
4		FILL: Hard reddish-brown and gray SILTY CLAY, some fine to coarse sand, little fine to coarse gravel, damp to moist.	4	6	SS-2B	4.5+	-	-	-	-	-	-	-	-	-	22	A-6b (V)
5		- Encountered cobbles at 5.5 and 6.0 feet.															
6			7	29	SS-3	-	-	-	-	-	-	-	-	-	-	22	A-6b (V)
7		- Encountered cobbles at 8.0 feet and from 8.4 to 9.9 feet.	8	13													
8	517.8																
9																	
10		Very-stiff brown SANDY SILT, little clay, trace fine to coarse gravel, contains 2" fine sand seams, moist to wet.	6	15	SS-4	2.5	1	16	22	43	18	18	15	3	17	A-4a (5)	
11			5	6													
12	515.6	Very-stiff brown SILT AND CLAY, little fine to coarse sand, trace fine to coarse gravel, moist.	3	12	SS-5A	2.5	-	-	-	-	-	-	-	-	-	25	A-6a (V)
13	514.1	Stiff to very-stiff gray SILT AND CLAY, trace fine sand, (varved), moist.	4	5	SS-5B	2.5-3.0	-	-	-	-	-	-	-	-	-	26	A-6a (V)
14																	
15		Limestone floater at 21.0 ft															
16			ST	100	ST-6	2.5-3.0	0	0	2	62	36	30	19	11	27	A-6a (8)	
17																	
18			2	8	SS-7	1.0-1.5	-	-	-	-	-	-	-	-	-	26	A-6a (V)
19			3	3													
20			3	15	SS-8	2.5-3.0	-	-	-	-	-	-	-	-	-	23	A-6a (V)
21			5	6													
22																	
23																	
24	504.1	Very-stiff to hard brown and gray CLAY, "and" silt, trace fine to coarse sand, contains limestone fragments, moist to damp.															
25			3	16	SS-9	2.0-4.5+	0	1	1	41	57	49	23	26	24	A-7-6 (16)	
26			5	7													
27																	
28																	
29																	
30			12	95	SS-10	4.5+	1	1	1	39	58	47	22	25	16	A-7-6 (15)	
31			28	42													
32																	
33																	
34	493.2	SHALE, brown and gray, highly weathered, very weak.	21	-	SS-11	4.5+	-	-	-	-	-	-	-	-	-	16	A-7-6 (V)
35			30-5"														
36																	
37																	
38																	
39	488.3		46	-	SS-12	-	-	-	-	-	-	-	-	-	-	-	Rock (V)
			30-3"	67													

- Slight seepage at 34.0 feet.
 - Boring "dry" at completion.
 NOTES: SEE ABOVE.
 ABANDONMENT METHODS, MATERIALS, QUANTITIES: 20 LB. BENTONITE CHIPS; 94 LB. CEMENT; 100 GAL. WATER

S&ME JOB: 1178-18-006

PROJECT: HAM-75-3.84 RETAINING WALL
 TYPE: 104667 BR ID: N/A
 START: 8/24/18 END: 8/24/18
 DRILLING FIRM / OPERATOR: S&ME / S&ME
 SAMPLING FIRM / LOGGER: S&ME / J. HAYDU
 DRILLING METHOD: 3.25" HSA / NQ2
 SAMPLING METHOD: SPT / ST / NQ2

DRILL RIG: S&ME ATV D50 (SN226)
 HAMMER: AUTOMATIC
 CALIBRATION DATE: 8/1/18
 ENERGY RATIO (%): 75.5

STATION / OFFSET: 263+21, 50' RT
 ALIGNMENT: 1-75 CENTERLINE
 ELEVATION: 538.5 (MSL) EOB: 25.0 ft.
 LAT / LONG: 39.157111 N, -84.534795 W

EXPLORATION ID: B-526-0-18
 PAGE: 1 OF 1

SPT / ROD	REC (%)	SAMPLE ID	HP (tsf)	GRADATION (%)				ATTERBERG				ODOT CLASS (qt)	WC	HOLE SEALED
				GR	CS	FS	SI	CL	LL	PL	PI			
3	56	SS-1	2.5	50	8	4	17	21	36	18	18	12	A-6b (2)	
3	89	SS-2	4.0-4.5+	-	-	-	-	-	-	-	-	19	A-7-6 (V)	
ST	67	ST-3	4.5+	7	2	2	38	51	44	22	22	18	A-7-6 (14)	
3	89	SS-4	4.5+	-	-	-	-	-	-	-	-	16	A-7-6 (V)	
7	74	SS-5	-	-	-	-	-	-	-	-	-	12	Rock (V)	
15	81	SS-6	-	-	-	-	-	-	-	-	-	15	Rock (V)	
57	87	NQ2-7	-	-	-	-	-	-	-	-	-	-	CORE	
78	100	NQ2-8	-	-	-	-	-	-	-	-	-	-	CORE	

ELEV. 538.5
 537.8
 537.0
 536.5
 535.0
 528.0
 523.5
 513.5

DEPTHS 1-25
 TR
 600

MATERIAL DESCRIPTION AND NOTES
 ASPHALT PAVEMENT - 8 inches
 CONCRETE - 9 inches
 AGGREGATE BASE - 6 inches
 FILL: Very-stiff gray SILTY CLAY, "and" fine to coarse gravel, little fine to coarse sand, damp.
 Hard brown mottled with gray CLAY, "and" silt, trace fine to coarse sand, trace fine to coarse gravel, damp.
 SHALE, brown and gray, severely weathered, very weak.
 Interbedded SHALE (91%) and LIMESTONE (9%), RQD 67%, REC 93%.
 SHALE, gray, moderately weathered, very weak to weak, thinly laminated, blocky/disturbed/seamy, good to fair;
 LIMESTONE, light gray, slightly weathered, moderately strong, blocky/disturbed/seamy, good, ranges in thickness from 1.0 to 2.0 inches.

NOTES: SEE ABOVE.
 ABANDONMENT METHODS, MATERIALS, QUANTITIES: ASPHALT PATCH; PLASTIC HOLE PLUG DEVICE; SOIL CUTTINGS MIXED WITH BENTONITE

S&ME JOB: 1178-18-006

PROJECT: HAM-75-3.84
 TYPE: RETAINING WALL
 PID: 104667 BR ID: N/A
 START: 8/24/18 END: 8/24/18

DRILLING FIRM / OPERATOR: S&ME / S&ME
 SAMPLING FIRM / LOGGER: S&ME / J. HAYDU
 DRILLING METHOD: 3.25" HSA / NQ2
 SAMPLING METHOD: SPT / NQ2

DRILL RIG: S&ME ATV D50 (SN226)
 HAMMER: AUTOMATIC
 CALIBRATION DATE: 8/1/18
 ENERGY RATIO (%): 75.5

STATION / OFFSET: 264+13, 61' RT
 ALIGNMENT: 1-75 CENTERLINE
 ELEVATION: 539.1 (MSL) EOB: 34.7 ft.
 LAT / LONG: 39.157197 N, -84.534502 W

EXPLORATION ID
 B-527-0-18
 PAGE
 1 OF 1

DEPTH (ft)	SPT / RQD	REC (%)	N60	SAMPLE ID	HP (tsf)	GRADATION (%)						ATTERBERG				HOLE SEALED	
						GR	CS	FS	SI	CL	LL	PL	PI	WC	ODOT CLASS (qt)		
1																	
2																	
3	6	29	50	SS-1	-	52	22	11	10	5	NP	NP	NP	6	A-1-a (0)		
4	15	21	33	SS-2	-	67	16	7	8	2	-	-	-	4	A-2-4 (V)		
5	8																
6	6	4	9	SS-3	-	-	-	-	-	-	-	-	-	10	A-2-4 (V)		
7	4	3															
8																	
9	11	39	39	SS-4A	4.5+	19	2	2	42	35	39	20	19	15	A-6b (12)		
10	20			SS-4B	-	-	-	-	-	-	-	-	-	-	Rock (V)		
11																	
12	18		19	SS-5	-	-	-	-	-	-	-	-	-	-	Rock (V)		
13	42																
14	50-4"		40	SS-6	-	-	-	-	-	-	-	-	-	-	Rock (V)		
15																	
16	19		100	SS-7	-	-	-	-	-	-	-	-	-	-	Rock (V)		
17	30-1"																
18																	
19	0	0	0	NQ2-8	-	-	-	-	-	-	-	-	-	-	CORE		
20																	
21																	
22	10	30	30	NQ2-9	-	-	-	-	-	-	-	-	-	-	CORE		
23																	
24																	
25																	
26																	
27	63	88	88	NQ2-10	-	-	-	-	-	-	-	-	-	-	CORE		
28																	
29																	
30																	
31																	
32	58	100	100	NQ2-11	-	-	-	-	-	-	-	-	-	-	CORE		
33																	
34																	

MATERIAL DESCRIPTION AND NOTES

ASPHALT - 8 inches

CONCRETE - 8 inches

FILL: Medium-dense gray GRAVEL, some fine to coarse sand, little silt, trace clay, damp.

FILL: Loose to medium-dense brown and gray GRAVEL WITH SAND, SILT, trace clay, contains limestone fragments, damp.

Hard olive-brown SILTY CLAY, little fine to coarse gravel, trace fine to coarse sand, contains limestone fragments, damp.

SHALE, brown and gray, severely weathered, very weak.

- Encountered cobbles from 11.0 to 12.5 feet.

Interbedded SHALE (85%) and LIMESTONE (15%), RQD 41%, REC 67%;

SHALE, gray, moderately weathered, very weak to weak, thinly laminated, blocky/disturbed/seamy, good to fair;

LIMESTONE, light gray, slightly weathered, moderately strong, blocky/disturbed/seamy, good, ranges in thickness from 1.0 to 3.0 inches.

NOTES:
 - Encountered seepage at 6.0 feet.
 - No groundwater noted prior to coring rock.
 - Boring caved at 6.4 feet after augers pulled.

SEE ABOVE.

ABANDONMENT METHODS, MATERIALS, QUANTITIES: ASPHALT PATCH; PLASTIC HOLE PLUG DEVICE; SOIL CUTTINGS MIXED WITH BENTONITE



S&ME JOB: 1178-18-006

PROJECT: HAM-75-3.84 ROADWAY/RETAINING WALL
 TYPE: ROADWAY/RETAINING WALL
 PID: 104667 BR ID: N/A
 START: 8/15/18 END: 8/17/18

DRILLING FIRM / OPERATOR: S&ME / S&ME
 SAMPLING FIRM / LOGGER: S&ME / J. HAYDU
 DRILLING METHOD: 3.25" HSA / NQ2
 SAMPLING METHOD: SPT / ST / NQ2

DRILL RIG: S&ME ATV D50 (SN226)
 HAMMER: AUTOMATIC
 CALIBRATION DATE: 8/1/18
 ENERGY RATIO (%): 75.5

STATION / OFFSET: 265+27, 51' LT
 ALIGNMENT: 1-75 CENTERLINE
 ELEVATION: 543.7 (MSL) EOB: 53.1 ft.
 COORD: 39.157584 N, -84.534233 W

EXPLORATION ID: B-528-0-18
 PAGE: 1 OF 1

DEPTH (ft)	SPT / ROD	REC (%)	SAMPLE ID	HP (tsf)	GR	GRADATION (%)					ATTERBERG					HOLE SEALED	
						FS	SI	CL	LL	PL	PI	WC	ODOT CLASS (a)				
1																	
2	2	6	SS-1A	4.0													
3	3	39	SS-1B	4.0													
4	0	5	SS-2	1.5-2.0	1	5	3	28	63	43	22	21	20				
5	3	2	SS-3	4.5+													
6	6	16	SS-3	4.5+													
7	4	7	SS-4	4.5+	4	19	14	29	34	33	20	13	18				
8	5	15	SS-4	4.5+													
9	ST	79	ST-5	-	5	3	9	41	42	31	18	13	16				
10																	
11	3	9	SS-6	1.5-2.0													
12	3	4	SS-6	1.5-2.0													
13	5	19	SS-7	3.0													
14	3	10	SS-7	3.0													
15	5	4	SS-8	2.5													
16	5	11	SS-8	2.5													
17	4	5	SS-8	2.5													
18																	
19	10	12															
20	12	33															
21	14	0															
22	29	-	SS-9	-													
23																	
24	4	5	SS-10	3.0-3.5													
25	5	16	SS-10	3.0-3.5													
26	8	100	SS-10	3.0-3.5													
27																	
28																	
29	6	12	SS-11	4.5+													
30	19	39	SS-11	4.5+													
31																	
32																	
33																	
34	18	-	SS-12	4.5+													
35	30	-	SS-12	4.5+													
36	50-5"	100	SS-12	4.5+													
37																	
38																	
39	28	-	SS-13	-													
40	30-3"	78	SS-13	-													
41																	
42																	
43	72	100	NQ2-14	-													
44																	
45																	
46																	
47																	
48	78	100	NQ2-15	-													
49																	
50																	
51																	
52	61	100	NQ2-16	-													
53																	

Material Descriptions:
 1-8 inches ASPHALT
 8-12 inches CONCRETE
 12-18 inches ASPHALT
 18-24 inches AGGREGATE BASE
 24-30 inches FILL: Very-stiff gray CLAY, some silt, little fine to coarse sand, trace fine to coarse gravel, damp.
 30-36 inches FILL: Stiff brown and gray CLAY, some silt, trace fine to coarse sand, trace fine to coarse gravel, contains shale fragments, damp.
 36-42 inches FILL: Hard gray and brown SILT AND CLAY, some fine to coarse sand, trace fine to coarse gravel, contains many limestone fragments, contains decayed wood, damp.
 42-48 inches FILL: Hard gray SILT AND CLAY, little fine to coarse sand, trace fine gravel, damp.
 48-54 inches FILL: Stiff dark gray and black SILT AND CLAY, some fine to coarse sand, some fine to coarse gravel, contains organics, moist.
 54-60 inches FILL: Very-stiff brown and gray SILT AND CLAY, little fine to coarse sand, little fine to coarse gravel, contains limestone fragments and hair roots, moist.
 60-66 inches FILL: Very-stiff brown, gray, and reddish-brown SILT AND CLAY, little fine to coarse sand, little fine to coarse gravel, contains limestone fragments, moist.
 66-72 inches Very-stiff brown and gray SILT AND CLAY, little fine to coarse sand, little fine to coarse gravel, contains limestone fragments, moist.
 72-78 inches Hard olive and gray CLAY "and" silt, little fine sand, little fine to coarse gravel, trace coarse sand, contains limestone fragments and fossils, contains relic bedding, moist to damp.
 78-84 inches SHALE, brown and gray, highly weathered, very weak.
 84-90 inches Interbedded SHALE (90%) and LIMESTONE (10%), ROD 72%, REC 100%. SHALE, gray, moderately weathered, very weak to weak, thinly laminated, fractured to moderately fractured; LIMESTONE, light gray, slightly weathered, moderately strong, ranges in thickness from 0.5 to 2.0 inches.

NOTES:
 - Sample SS-3: Sulfate Content = 452 ppm.
 - Groundwater noted at 26.3 feet on 8/17/18 after recent heavy rains.
 SEE ABOVE.
 ABANDONMENT METHODS, MATERIALS, QUANTITIES: ASPHALT PATCH; 20 LB. BENTONITE CHIPS; 1 BAG CEMENT; 90 GAL. WATER

S&ME JOB: 1178-18-006

PROJECT: HAM-75-3.84 ROADWAY/RETAINING WALL
 TYPE: ROADWAY/RETAINING WALL
 PID: 104667 BR ID: N/A
 START: 8/14/18 END: 8/14/18
 DRILLING FIRM / OPERATOR: S&ME / S&ME
 SAMPLING FIRM / LOGGER: S&ME / J. HAYDU
 DRILLING METHOD: 3.25" HSA
 SAMPLING METHOD: SPT / ST

DRILL RIG: S&ME ATV D50 (SN226)
 HAMMER: AUTOMATIC
 CALIBRATION DATE: 8/1/18
 ENERGY RATIO (%): 75.5
 STATION / OFFSET: 282+61, 51' LT
 ALIGNMENT: 1-75 CENTERLINE
 ELEVATION: 538.4 (MSL) EOB: 28.7 ft.
 COORD: 39.159015 N, -84.528479 W

DEPTH	ELEV.	MATERIAL DESCRIPTION AND NOTES	SPT / ROD	REC (%)	SAMPLE ID	HP (tsf)	GRADATION (%)							WC	BACK FILL
							GR	CS	FS	SI	CL	LL	PL		
1	538.4	ASPHALT - 10 inches													
2	537.6	CONCRETE - 10 inches													
3	536.8	AGGREGATE BASE - 4 inches													
4	536.5	FILL: Very-stiff to hard brown to reddish-brown CLAY, some silt, little fine to coarse sand, trace fine to coarse gravel, contains limestone fragments, moist.	5	18	SS-1A	-	-	-	-	-	-	-	-	-	Visual (V)
5			6	20	SS-1B	4.5+	-	-	-	-	-	-	-	-	A-7-6 (V)
6			6	20	SS-2	3.0	0	2	12	29	57	46	19	27	A-7-6 (16)
7	532.3	FILL: Very-stiff brown to reddish-brown SILT AND CLAY, little fine to coarse sand, trace fine gravel, damp.	6	29	SS-3	3.0	-	-	-	-	-	-	-	-	A-7-6 (V)
8			4	16	SS-4	4.0	7	6	13	35	39	29	17	12	A-6a (9)
9	530.4	FILL: Stiff brown SILTY CLAY, little fine to coarse sand, little fine to coarse gravel, damp to moist.	2	9	SS-5	1.0-1.5	-	-	-	-	-	-	-	-	A-6b (V)
10			3	67											
11	527.4	Possible Fill: Hard brown and gray CLAY, some fine to coarse gravel, some silt, trace fine to coarse sand, damp.	ST	71	ST-6	4.5+	-	-	-	-	-	-	-	-	A-7-6 (V)
12															
13															
14			12	43	SS-7	4.5+	27	7	3	25	38	41	23	18	A-7-6 (9)
15	522.9	Hard brown and gray CLAY, some silt, little fine to coarse sand, trace fine to coarse gravel, contains few limestone floaters, contains relic bedding, damp to dry.	15	19											
16			13	39	SS-8	4.5+	-	-	-	-	-	-	-	-	A-7-6 (V)
17			50-4"	69											
18															
19			20	64	SS-9	-	-	-	-	-	-	-	-	-	A-7-6 (V)
20			50-5"												
21															
22	516.4	SHALE, brown and gray, highly weathered, very weak, contains occasional limestone layers.													
23															
24			28	58	SS-10	-	-	-	-	-	-	-	-	-	Rock (V)
25															
26															
27															
28	509.7		50-2"	50	SS-11	-	-	-	-	-	-	-	-	-	Rock (V)

NOTES:
 - Sample SS-1B: Sulfate Content = 162 ppm.
 - Slight seepage at 14.6 feet.
 - Boring "dry" at completion.

ABANDONMENT METHODS, MATERIALS, QUANTITIES: ASPHALT PATCH; PLASTIC HOLE PLUG DEVICE; SOIL CUTTINGS MIXED WITH BENTONITE

LOG OF BORING

Date Started 7/23/07 Sampler: Type SS / ST Dia. 1.375" Project Identification: HAM-75-2.30 PID 76257
 Date Completed 7/23/07 Casing: Length 15ft Dia. 3.25" Hamilton County, Ohio

Boring No. B-050 Station & Offset 244+01.9, 60.2 RT Water Elev. Dry CTL Project No. 04050070C.IN
 Surface Elev. 508.0ft

Elev. (ft)	Depth (ft)	Std. Pen./RQD	Rec. (ft)	Loss (ft)	Description	Sample No.	Physical Characteristics						ODOT Class							
							% Agg	% C.S.	% F.S.	% Silt	% Clay	L.L.		P.I.	W.C.					
508.0	0																			
508.0		AUGERED			TOPSOIL (0.7')	1	3	5	10	41	41	38	18	15	VISUAL					
507.5		4/5/6			STIFF, BROWN SILTY CLAY, LITTLE SAND, TRACE GRAVEL, MOIST															
506.0	2	5/5/7			VERY STIFF, BROWN SILT AND CLAY, TRACE GRAVEL, TRACE SAND, DAMP	2	4	3	7	26	60	36	14	22	A-6a					
504.5	4	7/7/12				3								23	VISUAL					
503.0	6	6/7/10				4								15	VISUAL					
500.0	8	10/10/15			VERY STIFF, GRAY SANDY SILT, SOME CLAY, TRACE GRAVEL, DAMP	5	8	6	15	46	25	21	6	13	A-4a					
499.5	10																			
496.0	12																			
494.5	14	4/9/7			VERY STIFF, GRAY AND BROWN MOTTLED, SILTY CLAY, LITTLE GRAVEL, TRACE SAND, MOIST	6														
493.0	15.0'				BOTTOM OF BORING = 15.0'									16	VISUAL					

Particle Sizes: Agg => 2.00mm, Coarse Sand = 2.00-0.42mm, Fine Sand = 0.42-0.074mm, Silt = 0.074-0.005mm, Clay =< 0.005mm.

PLATE 50

PROJECT: HAM-75-03.85 TYPE: STRUCTURE PID: 83723 SFN: N/A START: 9/14/10 END: 9/14/10		DRILLING FIRM / OPERATOR: CTL / MF SAMPLING FIRM / LOGGER: CTL / MF DRILLING METHOD: 3.25" HSA / NX SAMPLING METHOD: SPT / NX		DRILL RIG: CTL CME 550 TRACK HAMMER: AUTOMATIC HAMMER CALIBRATION DATE: 10/13/09 ENERGY RATIO (%): 86		STATION / OFFSET: 244+84.64' RT. ALIGNMENT: IR-75 ELEVATION: 510.2 (MSL) EOB: 50.0 ft. COORD: 428652.6200 N, 1390536.2500 E										EXPLORATION ID B-408							
MATERIAL DESCRIPTION AND NOTES				ELEV.	DEPTHS	SPT/ ROD	N ₆₀	REC (%)	HP ID	GR	CS	FS	SI	CL	LL	PL	PI	WC	ODOT CLASS(GI)	HOLE SEALED			
HARD, BROWN, SANDY SILT, LITTLE GRAVEL, DAMP				510.2		10																	
STIFF TO VERY STIFF, GRAY, CLAY, TRACE SAND, DAMP				507.2		15	43	83	SS-1														
MEDIUM DENSE, BLACK, GRAVEL AND/OR STONE FRAGMENTS WITH SAND AND SILT, LITTLE CLAY, SOME WOOD FRAGMENTS, DAMP				502.2		4	13	78	SS-2	3	3	4	-	90	48	24	24	21			A-7-6 (15)		
STIFF, GRAY, SILTY CLAY, TRACE GRAVEL, TRACE SAND, DAMP				499.7		10	19	67	SS-3														
STIFF, BROWN AND GRAY, SILTY CLAY, TRACE SAND, DAMP				497.2		7	6																
STIFF, GRAY, SILTY CLAY, TRACE GRAVEL, TRACE SAND, MOIST				494.7		3	10	72	SS-4	25	18	24	19	14	NP	NP	NP	15				A-2-4 (0)	
STIFF, BROWN, SILTY CLAY, "AND" GRAVEL, DAMP				488.2		3	4	72	SS-6														
VERY STIFF, GRAY, CLAY, TRACE GRAVEL, TRACE SAND, "AND" SILT, MOIST				483.2		3	14	56	SS-5														
VERY WEAK, GRAY, SEVERELY WEATHERED SHALE				476.2		2	10	83	SS-8														
INTERBEDDED SHALE (97%) AND LIMESTONE (3%), ROD 13%, REC. 87%; SHALE, GRAY, SEVERELY WEATHERED, VERY WEAK, VERY THICK BEDDED; LIMESTONE LIGHT GRAY, SLIGHTLY WEATHERED, STRONG, THIN BEDDED.				470.2		3	16	-	SS-10	1	1	3	54	41	43	23	20	25					A-6b (V)
SHALE, GRAY, SEVERELY WEATHERED, VERY WEAK, VERY THICK BEDDED; ROD 22%, REC 100%.				465.2		7	34	0	SS-11														
ABANDONMENT METHODS, MATERIALS, QUANTITIES: BACKFILLED WITH CEMENT				460.2		30	-	80	SS-12														Rock (V)
CORE						13		87	NX-1													CORE	
CORE						22		100	NX-2														CORE

NOTES: NONE
ABANDONMENT METHODS, MATERIALS, QUANTITIES: BACKFILLED WITH CEMENT

PLATE 91

PROJECT: HAM-75-03.85		DRILLING FIRM / OPERATOR: CTL / MF		STATION / OFFSET: 246+19.128 RT		EXPLORATION ID		
TYPE: STRUCTURE		SAMPLING FIRM / LOGGER: CTL / MF		ALIGNMENT: IR-75		B-333		
PID: 83723 BR ID: N/A		DRILLING METHOD: 3.25" HSA / NX		ELEVATION: 537.5 (MSL) EOB: 69.0 ft.		PAGE		
START: 12/10/10 END: 12/10/10		SAMPLING METHOD: SPT / NX		COORD: 426741.820 N, 1390655.900 E		1 OF 3		
MATERIAL DESCRIPTION		DEPTHS		GRADATION (%)		ODOT CLASS (GI)		
AND NOTES		ELEV.		REC SAMPLE HP		HOLE		
		537.5		ID (tsf)		SEALED		
		534.5		N ₆₀				
HARD, BROWN, SILT AND CLAY, LITTLE GRAVEL, TRACE SAND, WITH COBBLES, DAMP (FILL)		1	60/2"	100	SS-1		16	A-6a (V)
		2						
		3						
VERY STIFF TO HARD, BROWN, SILTY CLAY, TRACE GRAVEL, TRACE SAND, DAMP		4	10	37	SS-2		15	A-6b (V)
		5	16					
		6	7	6	SS-3		40	A-6b (V)
		7	10	23	SS-3		21	A-6b (V)
		8						
VERY STIFF, GRAY, SILT AND CLAY, TRACE GRAVEL, LITTLE SAND, DAMP		9	6	23	SS-4		12	A-6a (V)
		10	9					
		11	4	14	SS-5		18	A-6b (V)
		12	6					
		13						
VERY STIFF, BROWN AND GRAY, SILTY CLAY, LITTLE GRAVEL, LITTLE SAND, DAMP		14	9	29	SS-6		34	A-6b (11)
		15	12				39	A-6b (11)
		16	5	6	SS-7			
		17	7	19	SS-7			
		18						
		19	5	23	SS-8		19	A-6b (V)
		20	9					
VERY STIFF, BROWN, SILTY CLAY, LITTLE GRAVEL, TRACE SAND, DAMP		21	7	8	SS-9		20	A-6b (V)
		22	10	26	SS-9			
		23						
VERY STIFF, BROWN, SILT AND CLAY, LITTLE GRAVEL, LITTLE SAND, DAMP		24	6	27	SS-10		16	A-6a (V)
		25	11					
MEDIUM DENSE, BROWN AND GRAY, SANDY SILT, TRACE GRAVEL, TRACE CLAY, MOIST		26	5	19	SS-11		10	A-4a (2)
		27	6					
MEDIUM STIFF, BROWN AND GRAY, SANDY SILT, SOME CLAY, MOIST		28	2	6	SS-12			
		29	2					

STANDARD ODOT SOIL BORING LOG (8.5 X 11) - OH DOT.GDT - 8/31/12 10:16 - K:\04050070CIND-HAM-75-3.85\REPORTS\LOGS AND GINT\04050070CIND-IR-74-IR-75 INTERCHANGE.GPJ

PLATE 58

PID: 83723 BR ID: N/A		PROJECT: HAM-75-03.85		STATION / OFFSET: 246+19.128 RT		PG 2 OF 3		B-333	
MATERIAL DESCRIPTION		DEPTHS		GRADATION (%)		ODOT CLASS (GI)		HOLE	
AND NOTES		ELEV.		REC SAMPLE HP		SEALED			
		507.5		ID (tsf)					
		507.0		N ₆₀					
MEDIUM STIFF, GRAY, SANDY SILT, TRACE GRAVEL, SOME CLAY, MOIST		31	1	7	SS-13		26	A-4a (7)	
		32	2						
		33	3						
STIFF, GRAY, SILT AND CLAY, TRACE GRAVEL, LITTLE SAND, MOIST		34	1	10	SS-14		18	A-6a (V)	
		35	4						
MEDIUM STIFF, GRAY AND BLACK, SANDY SILT, SOME GRAVEL, LITTLE CLAY, MOIST		36	2	7	SS-15		33	A-4a (V)	
		37	3						
STIFF, GRAY, SANDY SILT, LITTLE GRAVEL, LITTLE CLAY, WET		38							
		39	2	9	SS-16		8	A-4a (3)	
		40	3						
STIFF, GRAY, CLAY, TRACE GRAVEL, TRACE SAND, SOME SILT, MOIST		41	1	10	SS-17		28	A-7-6 (V)	
		42	4						
VERY STIFF, BROWN AND GRAY, CLAY, TRACE GRAVEL, TRACE SAND, "AND" SILT, DAMP		43							
		44	5	8	SS-18		19	A-7-6 (V)	
		45	13						
HARD, BROWN, CLAY, TRACE GRAVEL, TRACE SAND, "AND" SILT, DAMP		46	14	11	SS-19		21	A-7-6 (11)	
		47	12	33	SS-19		41	A-7-6 (11)	
HARD, BROWN, SANDY SILT, LITTLE GRAVEL, LITTLE CLAY, WITH LIMESTONE FRAGMENTS, MOIST		48							
		49	50/4"	75	SS-20		17	A-4a (V)	
		50							
		51							
		52							
		53							
		54	18	87	SS-21				
@53.5: LIMESTONE COBBLE ENCOUNTERED		55	25						
VERY WEAK, GRAY, SEVERELY WEATHERED INTERBEDDED SHALE AND LIMESTONE		56	36						
		57							
		58							
		59	60/2"	100	SS-22			Rock (V)	
		60							
		61	48	97	NX-1			CORE	

STANDARD ODOT SOIL BORING LOG (8.5 X 11) - OH DOT.GDT - 8/31/12 10:16 - K:\04050070CIND-HAM-75-3.85\REPORTS\LOGS AND GINT\04050070CIND-IR-74-IR-75 INTERCHANGE.GPJ

PLATE 59

STRUCTURE FOUNDATION EXPLORATION
RETAINING WALL NO. 2
HISTORIC BORING LOG B-333-0-10

HAM-75-3.84

PID: 83723	BR ID:	N/A	PROJECT:	HAM-75-03.85	STATION / OFFSET:	246+19.128 RT	START:	12/10/10	END:	12/10/10	PG 3 OF 3	B-333						
MATERIAL DESCRIPTION AND NOTES				ELEV.	DEPTHS	SPT/ RQD	REC (%)	HP (tsf)	GRADATION (%)			HOLE SEALED						
INTERBEDDED SHALE (97%) AND LIMESTONE (3%), SHALE, GRAY, HIGHLY WEATHERED, VERY WEAK TO WEAK, MEDIUM BEDDED; LIMESTONE LIGHT GRAY, SLIGHTLY WEATHERED, STRONG, THIN BEDDED. (continued)			475.4	63					GR	CS	FS	SI	CL	LL	PL	PT	WC	ODOT CLASS (GI)
			473.5	64														
INTERBEDDED SHALE (77%) AND LIMESTONE (23%), SHALE, GRAY, HIGHLY WEATHERED, VERY WEAK TO WEAK, MEDIUM BEDDED; LIMESTONE LIGHT GRAY AND GRAY, SLIGHTLY WEATHERED, STRONG, THIN BEDDED.			468.5	65	40	52												
				66														
				67														
				68														
				69														
				EOB														

NOTES: NONE
 ABANDONMENT METHODS, MATERIALS, QUANTITIES: BACKFILLED WITH CEMENT

PLATE 60

LOG OF BORING

Date Started 9/10/07 Sampler: Type SS / ST Dia. 1.375" Northing: 426865.4 Easting: 1390664.8
 Date Completed 9/10/07 Casing: Length 35.0ft Dia. 3.25" Project Identification: HAM-75-2.30 PID 76257
 Boring No. B-256 Alignment I-75 Station & Offset 247+32.6, 77.4 RT Water Elev. Dry CTL Project No. 04050070CIN
 Hamilton County, Ohio

Elev. (ft)	Depth (ft)	Std. Pen./RQD	Rec. (ft)	Loss (ft)	Description	Sample No.	Physical Characteristics							ODOT Class					
							% Agg	% C.S.	% F.S.	% Silt	% Clay	L.L.	P.I.		W.C.				
510.5	0																		
510.5	2	8/6/5			MEDIUM DENSE, BROWN GRAVEL AND/OR STONE FRAGMENTS WITH SAND, LITTLE CLAY, TRACE SILT, CONCRETE FRAGMENTS, DAMP -FILL	1										5			
507.0	4	12/5/3		3.0'	LOOSE, BROWN TO GRAY GRAVEL AND/OR STONE FRAGMENTS WITH SAND, TRACE CLAY, LITTLE SILT	2	29	33	19	16	3	NP	NP			10			
504.5	6	8/9/8		5.5'	VERY STIFF, LIGHT BROWN AND GRAY, MOTTLED CLAY, SOME SILT, TRACE SAND, LITTLE GRAVEL, DAMP (FILL)	3										13			
502.0	8	8/10/12				4	12	3	2	27	56	52	27			18			
499.5	10					5													
499.5	12	16/18/22		10.5'	HARD, LIGHT BROWN TO DARK BROWN AND GRAY, MOTTLED CLAY, AND SILT, TRACE SAND, LITTLE GRAVEL, DAMP	5										15			
497.0	14	12/16/38				6										14			
494.5	16	16/18/30				7	11	5	5	39	40	46	22			14			
492.0	18	18/36/42				8										8			
487.0	24	38/60-1*		23.0'	SHALE, LIGHT BROWN AND GRAY HIGHLY WEATHERED, DAMP	9										10			
485.5	26			25.0'	SHALE, MODERATE TO HIGHLY WEATHERED, LAMINATED TO THIN BEDDED, WEAK TO SLIGHTLY STRONG, INTERBEDDED 2"-4" LIMESTONE, STRONG FOSSILIFEROUS - UNIT RQD = 15% - % LOSS = 40%	10													
480.5	30			30.0'	SHALE, SLIGHTLY WEATHERED, VERY THIN TO LAMINATED, SLIGHTLY STRONG, INTERBEDDED 2"-4" LIMESTONE, STRONG FOSSILIFEROUS - UNIT RQD = 65% - % LOSS = 15%	11													
475.5	34			35.0'															

BOTTOM OF BORING = 35.0'

Particle Sizes: Agg => 2.00mm, Coarse Sand = 2.00-0.42mm, Fine Sand = 0.42-0.074mm, Silt = 0.074-0.005mm, Clay =< 0.005mm.

PLATE 57

PROJECT: HAM-75-03.85		DRILLING FIRM / OPERATOR: CTL / ZF		STATION / OFFSET: 247+79.79 RT		EXPLORATION ID	
TYPE: STRUCTURE		SAMPLING FIRM / LOGGER: CTL / ZF		ALIGNMENT: IR-75		B-334	
PID: 83723 BR ID: N/A		DRILLING METHOD: 3.25" HSA / NX		ELEVATION: 513.9 (MSL) EOB: 41.5 ft.		PAGE	
START: 10/26/10 END: 10/26/10		SAMPLING METHOD: SPT / NX		COORD: 426905.450 N, 1390688.110 E		1 OF 2	
SPT/ROD		REC SAMPLE ID		GRADATION (%)		HOLE	
N ₆₀		ID (tsf)		GR CS FS SI CL LL PL PI WC		ODOT CLASS (GI) SEALED	
DEPTHS		ELEV.		MATERIAL DESCRIPTION			
1	4	513.9					
2	5	513.7	SS-1				
3	5						
4	10	508.4	SS-2	1 1 2 30 66 49 24 25	20	A-7-6 (16)	
5	20						
6	13		SS-3			12	A-7-6 (V)
7	16						
8							
9	11		SS-4	15 2 3 30 50 47 24 23	16	A-7-6 (15)	
10	15						
11	12		SS-5				
12	19	500.9				10	A-7-6 (V)
13	35						
14	28		SS-6				Rock (V)
15	50/5'						
16	34		SS-7				Rock (V)
17	50/5'						
18							
19	39		SS-8				Rock (V)
20	50/5'						
21							
22							
23							
24	36		SS-9				Rock (V)
25	50/5'						
26							
27							
28							
29	29		SS-10				Rock (V)
	50/3'						

PLATE 61

PROJECT: HAM-75-03.85		DRILLING FIRM / OPERATOR: CTL / ZF		STATION / OFFSET: 247+79.79 RT		EXPLORATION ID	
TYPE: STRUCTURE		SAMPLING FIRM / LOGGER: CTL / ZF		ALIGNMENT: IR-75		B-334	
PID: 83723 BR ID: N/A		DRILLING METHOD: 3.25" HSA / NX		ELEVATION: 483.9		PAGE	
START: 10/26/10 END: 10/26/10		SAMPLING METHOD: SPT / NX		COORD: 426905.450 N, 1390688.110 E		1 OF 2	
SPT/ROD		REC SAMPLE ID		GRADATION (%)		HOLE	
N ₆₀		ID (tsf)		GR CS FS SI CL LL PL PI WC		ODOT CLASS (GI) SEALED	
DEPTHS		ELEV.		MATERIAL DESCRIPTION			
31		483.9					
32							
33		480.4					
34			SS-11				Rock (V)
35							
36		477.4	SS-12				Rock (V)
37							
38							
39			NX-1				CORE
40							
41		472.4					

NOTES: NONE

ABANDONMENT METHODS, MATERIALS, QUANTITIES: BACKFILLED WITH CEMENT

PLATE 62

L-001-0-91 LOG OF BORING
 DATE STARTED 3-4-91 SAMPLER: TYPE SPLIT SPOON DIA. 2.0" O.D. WATER ELEVATION:
 DATE COMPLETED 3-5-91 CASING: LENGTH HOLLOW STEM AUGER DIA. 3.25" I.D. IMMEDIATE 530.9
 BORING NUMBER L-1 CORE BARREL: TYPE _____ SIZE _____ AFTER COMP. HRS. 529.9
 STATION & OFFSET 2+88, 11'Lt. SURFACE ELEVATION 544.9

ELEV.	DEPTH	STD. PEN. (N)	DESCRIPTION	SA. NO.	PHYSICAL CHARACTERISTICS *													
					% AGG	% CS	% FS	% SILT	% CLAY	% LL	% PI	% WC	SHTL CLASS					
544.9	0		CONCRETE															
543.4	2		BROWN SILTY CLAY, SAND AND GRAVEL (FILL), MOIST - LOOSE	1	V	I	S	U	A	L								
541.9	4	2-2-2	BROWN AND GRAY SILTY CLAY AND CLAY, TRACE OF TOPSOIL, WOOD AND ROCK FRAGMENTS (FILL), MOIST - STIFF	2	V	I	S	U	A	L								
539.9	6	3-4-6	BROWN AND GRAY SILTY CLAY WITH LIMESTONE FRAGMENTS AND FLOATERS, TRACE OF TOPSOIL (FILL), MOIST - MEDIUM STIFF TO STIFF	3	V	I	S	U	A	L								
534.9	8	2-2-3	BROWN AND GRAY SILTY CLAY WITH LIMESTONE FRAGMENTS AND FLOATERS, TRACE OF TOPSOIL (FILL), MOIST - MEDIUM STIFF TO STIFF	4	V	I	S	U	A	L								
	10	8-17-11		5	V	I	S	U	A	L								
529.9	12	6-5-6	BROWN AND GRAY CLAY AND SILTY CLAY WITH LIMESTONE FRAGMENTS, TRACE OF SHALE FRAGMENTS (FILL), MOIST - STIFF	6	V	I	S	U	A	L								
	14	5-7-10		7	V	I	S	U	A	L								
524.9	16	2-1-3	BROWN AND GRAY SILT AND CLAY WITH ROCK FRAGMENTS (FILL), VERY MOIST - SOFT TO MEDIUM STIFF	8	V	I	S	U	A	L								
	18	2-3-3		9	V	I	S	U	A	L								
519.9	20	-2-2-3	GRAY SILTY CLAY, TRACE OF ROCK FRAGMENTS (FILL), VERY MOIST - MEDIUM STIFF	10	V	I	S	U	A	L								A-7-6
	22			11	V	I	S	U	A	L								
	24			12	V	I	S	U	A	L								
	26	6-8-9	BROWN CLAY, MOIST - VERY STIFF	13	V	I	S	U	A	L								
	28			14	V	I	S	U	A	L								
514.9	30	12-21-40	BROWN VERY SOFT HIGHLY WEATHERED SHALE															
	32																	
	34																	
509.9	36	42-70	BROWN VERY SOFT WEATHERED SHALE															
	38																	
504.9	40	-78-	GRAY SOFT SHALE															
	42																	
499.4	44	-84-																

BORING COMPLETED

PLATE 46

PROJECT: HAM-75-03.85	DRILLING FIRM / OPERATOR: CTL / MF	STATION / OFFSET: 254+24, 68 LT	EXPLORATION ID												
TYPE: STRUCTURE	SAMPLING FIRM / LOGGER: CTL / MF	ALIGNMENT: IR-75	B-359												
PID: 83723 BR ID: N/A	DRILLING METHOD: 3.25" HSA	ELEVATION: 525.5 (MSL) EOB: 23.6 ft.	PAGE												
START: 10/20/10 END: 10/20/10	SAMPLING METHOD: SPT	COORD: 427532.010 N, 1390909.860 E	1 OF 1												
MATERIAL DESCRIPTION AND NOTES															
ELEV.	DEPTHS	SPT/ RQD	REC SAMPLE ID	HP (tsf)	GR	CS	FS	SI	CL	LL	PL	PI	WC	ODOT CLASS (GI)	HOLE SEALED
525.5	1	8	SS-1	-	-	-	-	-	-	-	-	-	-	17	A-6a (V)
524.9	2	5	SS-1	-	-	-	-	-	-	-	-	-	-	-	-
524.1	3	11	SS-2	-	-	-	-	-	-	-	-	-	-	-	-
523.4	4	3	SS-2	-	-	-	-	-	-	-	-	-	-	-	-
523.4	5	5	SS-2	-	-	-	-	-	-	-	-	-	-	-	-
522.5	6	2	SS-3	-	-	-	-	-	-	-	-	-	-	-	-
520.0	7	6	SS-3	-	-	-	-	-	-	-	-	-	-	-	-
517.5	8	3	SS-4	-	-	-	-	-	-	-	-	-	-	-	-
515.0	9	3	SS-4	-	-	-	-	-	-	-	-	-	-	-	-
515.0	10	4	SS-5	-	-	-	-	-	-	-	-	-	-	-	-
512.5	11	3	SS-5	-	-	-	-	-	-	-	-	-	-	-	-
512.5	12	4	SS-5	-	-	-	-	-	-	-	-	-	-	-	-
510.0	13	7	SS-6	-	-	-	-	-	-	-	-	-	-	-	-
510.0	14	6	SS-6	-	-	-	-	-	-	-	-	-	-	-	-
510.0	15	22	SS-7	-	-	-	-	-	-	-	-	-	-	-	-
510.0	16	19	SS-7	-	-	-	-	-	-	-	-	-	-	-	-
510.0	17	50/5	SS-8	-	-	-	-	-	-	-	-	-	-	-	-
501.9	18	50	SS-8	-	-	-	-	-	-	-	-	-	-	-	-
501.9	19	50	SS-9	-	-	-	-	-	-	-	-	-	-	-	-
501.9	20	50	SS-9	-	-	-	-	-	-	-	-	-	-	-	-
501.9	21	50	SS-9	-	-	-	-	-	-	-	-	-	-	-	-
501.9	22	50	SS-9	-	-	-	-	-	-	-	-	-	-	-	-
501.9	23	50	SS-9	-	-	-	-	-	-	-	-	-	-	-	-

NOTES: NONE
 ABANDONMENT METHODS, MATERIALS, QUANTITIES: BACKFILLED WITH CEMENT

PLATE 88

PROJECT: HAM-75-03.85	DRILLING FIRM / OPERATOR: CTL / MF	STATION / OFFSET: 255+65, 76 LT	EXPLORATION ID												
TYPE: STRUCTURE	SAMPLING FIRM / LOGGER: CTL / MF	ALIGNMENT: IR-75	B-360												
PID: 83723 BR ID: N/A	DRILLING METHOD: 3.25" HSA	ELEVATION: 529.1 (MSL) EOB: 21.1 ft.	PAGE												
START: 10/20/10 END: 10/20/10	SAMPLING METHOD: SPT	COORD: 427644.670 N, 1391003.470 E	1 OF 1												
MATERIAL DESCRIPTION AND NOTES															
ELEV.	DEPTHS	SPT/ RQD	REC SAMPLE ID	HP (tsf)	GR	CS	FS	SI	CL	LL	PL	PI	WC	ODOT CLASS (GI)	HOLE SEALED
529.1	1	6	SS-1	-	-	-	-	-	-	-	-	-	-	14	A-6b (V)
528.5	2	5	SS-1	-	-	-	-	-	-	-	-	-	-	-	-
527.6	3	7	SS-2	-	-	-	-	-	-	-	-	-	-	-	-
527.0	4	8	SS-2	-	-	-	-	-	-	-	-	-	-	-	-
526.1	5	4	SS-2	-	-	-	-	-	-	-	-	-	-	-	-
526.1	6	2	SS-3	-	-	-	-	-	-	-	-	-	-	-	-
523.6	7	0	SS-3	-	-	-	-	-	-	-	-	-	-	-	-
521.1	8	0	SS-3	-	-	-	-	-	-	-	-	-	-	-	-
521.1	9	2	SS-4	-	-	-	-	-	-	-	-	-	-	-	-
518.6	10	3	SS-4	-	-	-	-	-	-	-	-	-	-	-	-
518.6	11	4	SS-5	-	-	-	-	-	-	-	-	-	-	-	-
516.1	12	4	SS-5	-	-	-	-	-	-	-	-	-	-	-	-
516.1	13	5	SS-6	-	-	-	-	-	-	-	-	-	-	-	-
513.6	14	3	SS-6	-	-	-	-	-	-	-	-	-	-	-	-
513.6	15	6	SS-6	-	-	-	-	-	-	-	-	-	-	-	-
513.6	16	12	SS-7	-	-	-	-	-	-	-	-	-	-	-	-
508.0	17	50	SS-7	-	-	-	-	-	-	-	-	-	-	-	-
508.0	18	28	SS-8	-	-	-	-	-	-	-	-	-	-	-	-
508.0	19	50/2	SS-8	-	-	-	-	-	-	-	-	-	-	-	-
508.0	20	50	SS-8	-	-	-	-	-	-	-	-	-	-	-	-
508.0	21	50	SS-9	-	-	-	-	-	-	-	-	-	-	-	-

NOTES: NONE
 ABANDONMENT METHODS, MATERIALS, QUANTITIES: BACKFILLED WITH CEMENT

PLATE 89

LOG OF BORING

Date Started 10/25/07 Sampler: Type SS / ST Dia. 1.375" Project Identification: HAM-75-2.30 PID 76257
 Date Completed 10/25/07 Casing: Length 24.0ft Dia. 3.25" Hamilton County, Ohio
 Boring No. B-056 Station & Offset 255+73.3, 69.7 LT Water Elev. Dry CTL Project No. 04050070C.IN
 Surface Elev. 529.1ft

Elev. (ft)	Depth (ft)	Std. Pen./ RQD	Rec. (ft)	Loss (ft)	Description	Sample No.	Physical Characteristics							ODOT Class	
							% Agg	% C.S.	% F.S.	% Silt	% Clay	L.L.	P.I.		W.C.
529.1	0				ASPHALT (.5')										VISUAL
528.6		AUGERED			CONCRETE (1.2')										VISUAL
527.4	2	AUGERED			BASE (.6')										VISUAL
525.6	4	5/7/5			STIFF, BROWNISH GRAY SILT AND CLAY, LITTLE SAND, LITTLE GRAVEL, ASPHALT FRAGMENTS, DAMP -FILL	1	12	5	11	35	37	33	14	14	A-6a
521.1	8	Undisturbed tube 8-10'				8	6	8	53	25	30	12	16	16	A-6a
519.1	10	3/4/4				2									VISUAL
515.6	14	7/11/12			MEDIUM STIFF, BROWNISH GRAY SILT AND CLAY, LITTLE SAND, LITTLE GRAVEL, ASPHALT FRAGMENTS, DAMP -FILL	3	1	1	1	47	50	50	27	20	A-7-6
513.1	16	24/15/21				4								9	VISUAL
510.1	20				VERY STIFF, LIGHT BROWN AND GRAY, MOTTLED CLAY, AND SILT, TRACE SAND, TRACE GRAVEL, DAMP										VISUAL
	22														
	24				SHALE, GRAY, SLIGHTLY WEATHERED										
					SHALE, GRAY, SLIGHTLY WEATHERED; CONTAINS FOSSILIFEROUS DEPOSITS, INTERBEDDED CRYSTALLINE LIMESTONE, STRONG UNIT ROD = 40% % LOSS = 0										

Particle Sizes: Agg => 2.00mm, Coarse Sand = 2.00-0.42mm, Fine Sand = 0.42-0.074mm, Silt = 0.074-0.005mm, Clay =< 0.005mm.

PLATE 51

PROJECT: HAM-75-03.85		DRILLING FIRM / OPERATOR: CTL / MF		STATION / OFFSET: 256+62, 80 LT		EXPLORATION ID										
TYPE: STRUCTURE		SAMPLING FIRM / LOGGER: CTL / MF		ALIGNMENT: IR-75		B-361										
PID: 83723 BR ID: N/A		DRILLING METHOD: 3.25" HSA		ELEVATION: 531.0 (MSL) EOB: 24.4 ft.		PAGE										
START: 10/20/10 END: 10/20/10		SAMPLING METHOD: SPT		COORD: 427716.480 N, 1391073.840 E		1 OF 1										
		SAMPLING METHOD: SPT		ENERGY RATIO (%): 86												
MATERIAL DESCRIPTION AND NOTES				GRADATION (%)												
				GR	CS	FS	SI	CL	LL	PL	PI	WC				
SPT / RQD	N ₆₀	REC (%)	SAMPLE ID	HP (tsf)	GR	CS	FS	SI	CL	LL	PL	PI	WC	ODOT CLASS (G)	HOLE SEALED	
1	10															
2	13	30	SS-1	-	-	-	-	-	-	-	-	-	-	14	A-6b (V)	
3	8															
4	9	5	13	56	SS-2	-	59	18	16	5	2	NP	NP	8	A-1-a (0)	
5	4															
6	6	13	67	SS-3	-	-	-	-	-	-	-	-	-	22	A-6a (V)	
7	3															
8																
9	3	5	16	83	SS-4	-	1	3	10	52	34	32	19	13	18	A-6a (9)
10	6															
11	5	5	20	0	SS-5	-	-	-	-	-	-	-	-	-	-	A-6a (V)
12	9															
13																
14	9	18	76	6	SS-6	-	-	-	-	-	-	-	-	-	-	A-6a (V)
15	35															
16	38	50/4"	-	100	SS-7	-	-	-	-	-	-	-	-	7	Rock (V)	
17																
18																
19	50	-	100	SS-8	-	-	-	-	-	-	-	-	-	8	Rock (V)	
20																
21																
22																
23																
24	50/5"	-	100	SS-9	-	-	-	-	-	-	-	-	-	13	Rock (V)	
				-EOB												

NOTES: NONE
 ABANDONMENT METHODS, MATERIALS, QUANTITIES: BACKFILLED WITH CEMENT

PLATE 90

PROJECT: HAM-75-03.85 STRUCTURE N/A PID: 83723 BR ID: N/A START: 11/22/10 END: 11/22/10		DRILLING FIRM / OPERATOR: CTL / MF SAMPLING FIRM / LOGGER: CTL / MF DRILLING METHOD: 3.25" HSA SAMPLING METHOD: SPT		STATION / OFFSET: 255+47.70 RT ALIGNMENT: IR-75 ELEVATION: 527.4 (MSL) EOB: 20.0 ft. COORD: 427528.640 N, 1391094.140 E		EXPLORATION ID B-339			
MATERIAL DESCRIPTION AND NOTES		ELEV.	DEPTHS	SPT/ ROD	REC SAMPLE ID	HP (tsf)	GRADATION (%) GR CS FS SI CL LL PL PI WC	ODOT CLASS (G)	HOLE SEALED
HARD, GRAY, CLAY, TRACE GRAVEL, TRACE SAND, SOME SILT, DAMP VERY WEAK, BROWN AND GRAY, SEVERELY WEATHERED SHALE VERY WEAK, GRAY, SEVERELY WEATHERED SHALE	527.4	1	6	37	SS-1	-	4 1 2 - 93 - 43 23 20 9	A-7-6 (13)	
	524.4	2	6	20					
	521.9	3	8	10	40	SS-2	-	11	Rock (V)
		4	18						
		5	20						
		6	50/4"		100	SS-3	-	9	Rock (V)
		7							
		8	60/3"		100	SS-4	-	8	Rock (V)
		9							
		10							
		11	50		83	SS-5	-	6	Rock (V)
		12							
		13							
		14	50/4"		100	SS-6	-	10	Rock (V)
		15							
		16	50/5"		100	SS-7	-	6	Rock (V)
		17							
		18	50/5"		100	SS-8	-	6	Rock (V)
		19							
		20	507.4						

NOTES: NONE
ABANDONMENT METHODS, MATERIALS, QUANTITIES: BACKFILLED WITH CEMENT

PLATE 64

PROJECT: HAM-75-03.85 STRUCTURE N/A PID: 83723 BR ID: N/A START: 11/22/10 END: 11/22/10		DRILLING FIRM / OPERATOR: CTL / MF SAMPLING FIRM / LOGGER: CTL / MF DRILLING METHOD: 3.25" HSA / NX SAMPLING METHOD: SPT/NX		STATION / OFFSET: 257+03.101 RT ALIGNMENT: IR-75 ELEVATION: 550.1 (MSL) EOB: 40.0 ft. COORD: 427608.180 N, 1391224.070 E		EXPLORATION ID B-340			
MATERIAL DESCRIPTION AND NOTES		ELEV.	DEPTHS	SPT/ ROD	REC SAMPLE ID	HP (tsf)	GRADATION (%) GR CS FS SI CL LL PL PI WC	ODOT CLASS (G)	HOLE SEALED
VERY STIFF, BROWN, CLAY, TRACE GRAVEL, SOME SAND, LITTLE SILT, DAMP VERY STIFF, BROWN, SILTY CLAY, TRACE SAND, DAMP VERY WEAK, GRAY, SEVERELY WEATHERED SHALE INTERBEDDED SHALE (84% AND LIMESTONE (16%), ROD 38%, REC. 96%; SHALE, GRAY, SEVERELY WEATHERED, VERY WEAK, THICK BEDDED; LIMESTONE, LIGHT GRAY, SLIGHTLY WEATHERED, STRONG, THIN BEDDED. INTERBEDDED SHALE (89% AND LIMESTONE (11%), ROD 50%, REC. 98%; SHALE, GRAY, SEVERELY WEATHERED, VERY WEAK, THICK BEDDED; LIMESTONE, LIGHT GRAY, SLIGHTLY WEATHERED, STRONG, THIN BEDDED. INTERBEDDED SHALE (90% AND LIMESTONE (10%), ROD 51%, REC. 97%; SHALE, GRAY, HIGHLY WEATHERED, VERY WEAK, THICK BEDDED; LIMESTONE, LIGHT GRAY, SLIGHTLY WEATHERED, STRONG, THIN BEDDED. INTERBEDDED SHALE (95% AND LIMESTONE (5%), ROD 57%, REC. 100%; SHALE, GRAY, HIGHLY WEATHERED, VERY WEAK, THICK BEDDED; LIMESTONE, LIGHT GRAY, SLIGHTLY WEATHERED, STRONG, THIN BEDDED.	550.1	1	6	78	SS-1	-	8 14 17 17 44 61 27 34 20	A-7-6 (16)	
	547.1	2	6						
	544.6	3	6	17	67	SS-2	-	13	Rock (V)
		4							
		5							
		6							
		7			42	SS-3	-	8	Rock (V)
		8							
		9			40	SS-4	-	8	Rock (V)
		10	540.1						
		11							
		12			38	NX-1	-		CORE
		13							
		14							
		15	535.1						
		16							
		17			50	NX-2	-		CORE
		18							
		19							
		20	530.1						
	21								
	22								
	23			51	NX-3	-		CORE	
	24								
	25	525.1							
	26								
	27								
	28			57	NX-4	-		CORE	
	29	520.1							

NOTES: NONE
ABANDONMENT METHODS, MATERIALS, QUANTITIES: BACKFILLED WITH CEMENT

PLATE 65

PID	BR ID	N/A	PROJECT	HAM-75-03.85	STATION / OFFSET		257+03.101 RT	START: 11/22/10	END: 11/22/10	PG 2 OF 2		B-340
					GR	CS				FS	SI	
MATERIAL DESCRIPTION AND NOTES												
INTERBEDDED SHALE (91%) AND LIMESTONE (9%), ROD 55%, REC. 100%; SHALE, GRAY, SEVERELY TO HIGHLY WEATHERED, VERY WEAK, THICK BEDDED; LIMESTONE LIGHT GRAY, SEVERELY TO HIGHLY WEATHERED, STRONG, THIN BEDDED.												
INTERBEDDED SHALE (95%) AND LIMESTONE (5%), ROD 13%, REC. 97%; SHALE, GRAY, SEVERELY TO HIGHLY WEATHERED, VERY WEAK, THICK BEDDED; LIMESTONE LIGHT GRAY, SLIGHTLY WEATHERED, STRONG, THIN BEDDED.												
				520.1		DEPTHS						
						31						
						32						
						33						
				515.1		34						
						35						
						36						
						37						
						38						
						39						
				510.1		40						
EOB												
SPT/ RQD N ₆₀ REC SAMPLE ID HP (tsf) GRADATION (%) ATTERBERG 55 100 NX-5 13 97 NX-6												

NOTES: NONE
 ABANDONMENT METHODS, MATERIALS, QUANTITIES: BACKFILLED WITH CEMENT

PLATE 66

PROJECT	TYPE	PID	START	END	OPERATOR	CTL / MF	DEPTHS	SPT/ RQD	N ₆₀	REC SAMPLE ID	HP (tsf)	GR	CS	FS	SI	CL	LL	PL	PI	WC	ODOT CLASS (GI)	HOLE SEALED
PROJECT: HAM-75-03.85 TYPE: STRUCTURE PID: 83723 BR ID: N/A START: 12/23/10 END: 12/23/10 DRILLING FIRM / OPERATOR: CTL / MF SAMPLING FIRM / LOGGER: CTL / MF DRILLING METHOD: 3.25" HSA SAMPLING METHOD: SPT DRILL RIG: CTL CME 550 TRACK HAMMER: AUTOMATIC HAMMER CALIBRATION DATE: 10/13/09 ENERGY RATIO (%): 86 STATION / OFFSET: 258+54.96 RT ALIGNMENT: IR-75 ELEVATION: 557.9 (MSL) EOB: 28.75 ft. COORD: 427701.060 N, 1391332.750 E																						
MATERIAL DESCRIPTION AND NOTES																						
TOPSOIL (3')																						
STIFF, BROWN, SILTY CLAY, SOME SAND, MOIST																						
VERY STIFF, BROWN, SILT, TRACE GRAVEL, SOME SAND, SOME CLAY, DAMP																						
HARD, BROWN, SILT AND CLAY, TRACE SAND, WITH COBBLES, DAMP																						
HARD, GRAY, CLAY, LITTLE GRAVEL, DAMP																						
HARD, BROWN, CLAY, TRACE GRAVEL, TRACE SAND, *AND* SILT, DAMP																						
HARD, BROWN, SILTY CLAY, WITH WEATHERED SHALE FRAGMENTS, DAMP																						
VERY WEAK, GRAY, SEVERELY WEATHERED SHALE																						

NOTES: NONE
 ABANDONMENT METHODS, MATERIALS, QUANTITIES: BACKFILLED WITH CEMENT

PLATE 69

PID: 83723	BR ID: N/A	PROJECT: HAM-75-03.85	STATION / OFFSET: 261+45.94 RT		START: 12/29/10		END: 12/29/10		PG 2 OF 2		B-343		
			REC (%)	N ₆₀	HP (tsf)	GR	CS	FS	SI	CL		LL	PL
MATERIAL DESCRIPTION AND NOTES		ELEV.	SPT / RQD		GRADATION (%)		ATTERBERG		ATTERBERG		HOLE SEALED		
VERY WEAK, GRAY, SEVERELY WEATHERED SHALE (continued)		534.9	31										
VERY WEAK, BROWN, SEVERELY WEATHERED SHALE		532.9	32										
			33										
			34	50/5"	100	SS-11						9 Rock (V)	
			35										
			36										
			37										
VERY WEAK, GRAY, SEVERELY WEATHERED SHALE		527.9	38										
			39	50/5"	100	SS-12						7 Rock (V)	
			40										
			41										
			42										
			43										
			44	50	100	SS-13						7 Rock (V)	
		520.9	EOB										

NOTES: NONE
 ABANDONMENT METHODS, MATERIALS, QUANTITIES: BACKFILLED WITH CEMENT

PLATE 75

PROJECT: HAM-75-03.85	STRUCTURE	BR ID: N/A	END: 1/4/11	SAMPLING METHOD: SPT	DRILLING FIRM / OPERATOR: CTL / MF	SPT / RQD	REC (%)	N ₆₀	HP (tsf)	GR	CS	FS	SI	CL	LL	PL	PI	WC	ODOT CLASS (GI)	HOLE SEALED											
																					GRADATION (%)	ATTERBERG	ATTERBERG	ATTERBERG							
MATERIAL DESCRIPTION AND NOTES		ELEV.		DEPTHS		SPT / RQD		REC (%)		GR		CS		FS		SI		CL		LL		PL		PI		WC		ODOT CLASS (GI)		HOLE SEALED	
FILL (12")		564.7		1																											
STIFF TO VERY STIFF, BROWN, SILTY CLAY, TRACE GRAVEL, MOIST		563.7		2		3		78		SS-1																18		A-6b (V)			
				3																											
		560.2		4		5		17		0		SS-2																			
				5		6		12				18		7		14		41		20		38		19		19		-		A-6b (9)	
				7		8		50/2"																							
		556.7		9		10		100		SS-4																13		A-2-4 (V)			
				11		12		37		56		SS-5		49		12		11		15		13		NP		NP		-		A-2-4 (0)	
				13		14		40		67		SS-6																15		A-2-4 (V)	
		549.2		15		16		43		50		SS-7																4		A-2-4 (V)	
				17		18		26		59		SS-8																			
		546.7		19		20		18		33		SS-8																			
				21		22																									
		542.7		23		24		8		26		SS-9																18		A-6b (V)	
				25		26		10		56		SS-9																			
				27		28																									
		537.7		29		30		50/5"		100		SS-10														10		A-6b (V)			

PLATE 78

PID: 83723	BR ID:	N/A	PROJECT:	HAM-75-03.85	STATION / OFFSET:	262+79.89 RT		START: 1/4/11			END: 1/4/11			PG 2 OF 2	B-344
						REC (%)	N ₆₀	HP (tsf)	GR	CS	FS	SI	CL		
MATERIAL DESCRIPTION AND NOTES		ELEV.	DEPTH		SPT/ RQD	REC SAMPLE ID		GRADATION (%)			ATTERBERG			ODOT CLASS (GI)	HOLE SEALED
HARD, GRAY, SILTY CLAY, WITH WEATHERED SHALE FRAGMENTS, MOIST (continued)		534.7	31												
HARD, GRAY, SILTY CLAY, SOME GRAVEL, WET		532.7	32												
			33												
			34		60/3"	SS-11								26	A-6b (V)
			35												
			36												
			37												
VERY WEAK, GRAY, SEVERELY WEATHERED SHALE		527.7	38												
			39		50/5"	SS-12								11	Rock (V)
		524.7	40												

NOTES: NONE
 ABANDONMENT METHODS, MATERIALS, QUANTITIES: BACKFILLED WITH CEMENT

PLATE 79

LOG OF BORING

Date Started 5/16/06 Sampler Type SS / ST Dia. 1.375" Project Identification: HAM-75-2.30 PID 76257
 Date Completed 5/16/06 Casing Length 23.5ft Dia. 3.25" Hamilton County, Ohio

Boring No. B-005-2006 Location & Offset N 427857.1, E 1391575.9 Water Elev. 535.9ft
CTL Project No. 04050070CIN Surface Elev. 564.4ft

Elev. (ft)	Depth (ft)	Std. Pen./RQD	Rec. (ft)	Loss (ft)	Description	Sample No.	Physical Characteristics							ODOT Class		
							% Agg	% C.S.	% F.S.	% Silt	% Clay	L.L.	P.I.		W.C.	
564.4	0					1									14	VIS.
561.4	2	3/3/4			Brown, medium stiff, SANDY SILT, trace gravel, trace clay, damp	2									12	VIS.
558.9	4	5/5/4			Brown, stiff, SANDY SILT, little gravel, trace clay, damp	3									11	VIS.
555.9	6	6/4/3		5.5'	Brown, loose, COARSE AND FINE SAND, trace silt, damp	4									7	VIS.
553.4	8	15/30/18		8.5'	Brown, dense, GRAVEL AND/OR STONE FRAGMENTS WITH SAND AND SILT, little clay, with limestone fragments, wet	5									7	VIS.
550.9	10	15/16/12		11.0'	Brown, medium dense, GRAVEL AND/OR STONE FRAGMENTS WITH SAND AND SILT, little clay, with limestone fragments, wet	6									9	VIS.
548.4	12	9/13/13		16.0'	Brown, medium dense, GRAVEL AND/OR STONE FRAGMENTS WITH SAND AND SILT, little clay, with limestone fragments, wet	7									6	VIS.
545.9	14	23/30/13		18.5'	Brown, dense, GRAVEL AND/OR STONE FRAGMENTS WITH SAND AND SILT, little clay, with limestone fragments, wet	8									16	A-6b
540.9	16	9/12/50-4"		23.5'	Brown and gray, hard, SILTY CLAY, little gravel, trace sand, with limestone fragments, damp	9										VIS.
535.4	18	6/7/13		29.0'	SHALE, gray, very soft, augered	RC-1										VIS.
530.4	20	58%	4.3	0.7	SHALE (85%) gray, soft, thick bedded, with interbedded LIMESTONE (15%), gray, fossiliferous, thin bedded, hard	RC-2										VIS.
530.4	22	42%	4.8	0.2	SHALE (73%) gray, soft, thick bedded, with interbedded LIMESTONE (27%), gray.											VIS.

Particle Sizes: Agg => 2.00mm, Coarse Sand = 2.00-0.42mm, Fine Sand = 0.42-0.074mm, Silt = 0.074-0.005mm, Clay =< 0.005mm.

PLATE 48

LOG OF BORING (Continued)

Boring No. B-005-2006

Project Identification: HAM-75-2.30 PID 76257
Hamilton County, Ohio

Elev. (ft)	Depth (ft)	Std. Pen./RQD	Rec. (ft)	Loss (ft)	Description	Sample No.	Physical Characteristics					ODOT Class			
							% Agg	% C.S.	% F.S.	% Silt	% Clay		L.L.	P.I.	W.C.
529.4	.36				fossiliferous, thin bedded, hard										
525.4	.38														



39.0'

BOTTOM OF BORING

OH DOT 2 CTL OH DOT.GDT ODOT LIBRARY BY DM 6-27-08 (TESTING).GLB 04120070G HAM-75 B BORINGS.GPJ 12/1/08


PLATE 49

PROJECT: HAM-75-03.85		DRILLING FIRM / OPERATOR: CTL / MF		STATION / OFFSET: 264+42, 74 RT		EXPLORATION ID								
TYPE: STRUCTURE		SAMPLING FIRM / LOGGER: CTL / MF		ALIGNMENT: IR-75		B-345								
PID: 83723 BR ID: N/A		DRILLING METHOD: 3.25" HSA		ELEVATION: 554.5 (MSL) EOB: 23.9 ft.		PAGE								
START: 12/30/10 END: 12/30/10		SAMPLING METHOD: SPT		COORD: 427979.610 N, 1391819.450 E		1 OF 1								
SPT/ RQD		REC SAMPLE ID		GRADATION (%)		HOLE CLASS (GI)								
N ₆₀		HP (tsf)		GR CS FS SI CL LL PL FI WC		SEAL								
DEPTHS		ELEV.		MATERIAL DESCRIPTION		HOLE CLASS (GI)								
1	4	22	61	SS-1	-	-	-	17	A-6b (V)					
2	5													
3	10													
4	11	42	22	SS-2	-	-	-	15	A-4a (V)					
5	18													
6	8	19	61	SS-3	0	1	83	14	2	NP	NP	4	A-3a (0)	
7	6													
8														
9	5	3	10	67	SS-4	-	-	-	-	-	-	6	A-3a (V)	
10	4													
11	5	7	20	61	SS-5	-	-	-	-	-	-	17	A-7-6 (V)	
12	7													
13														
14	5	6	20	50	SS-6	3	2	2	50	43	24	25	5	A-7-6 (16)
15	8													
16	5	10	37	67	SS-7	-	-	-	-	-	-	15	A-7-6 (V)	
17	16													
18														
19	11	18	64	67	SS-8	-	-	-	-	-	-	13	Rock (V)	
20	27													
21														
22														
23	50'5"													
E-O-B														

NOTES: NONE
 ABANDONMENT METHODS, MATERIALS, QUANTITIES: BACKFILLED WITH CEMENT


PLATE 80

C and phi are not test results but an interpretation of the test results. The designer is responsible for interpreting test data as provided by S&ME.

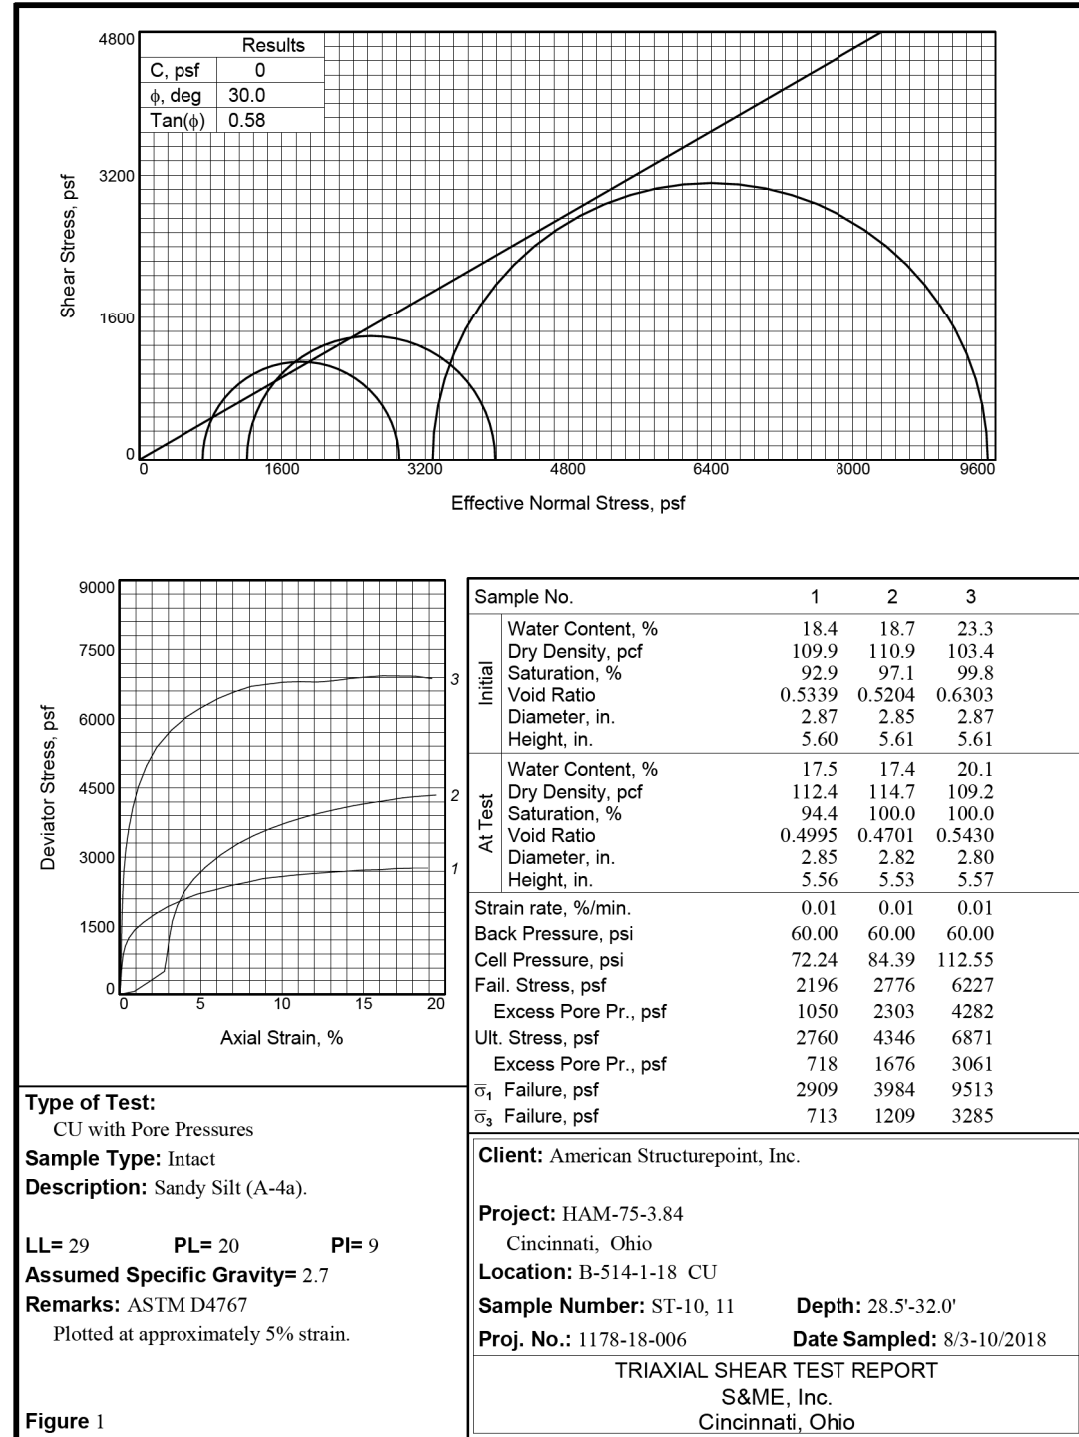

Tested By: PJM Checked By: NRR


C and phi are not test results but an interpretation of the test results. The designer is responsible for interpreting test data as provided by S&ME.

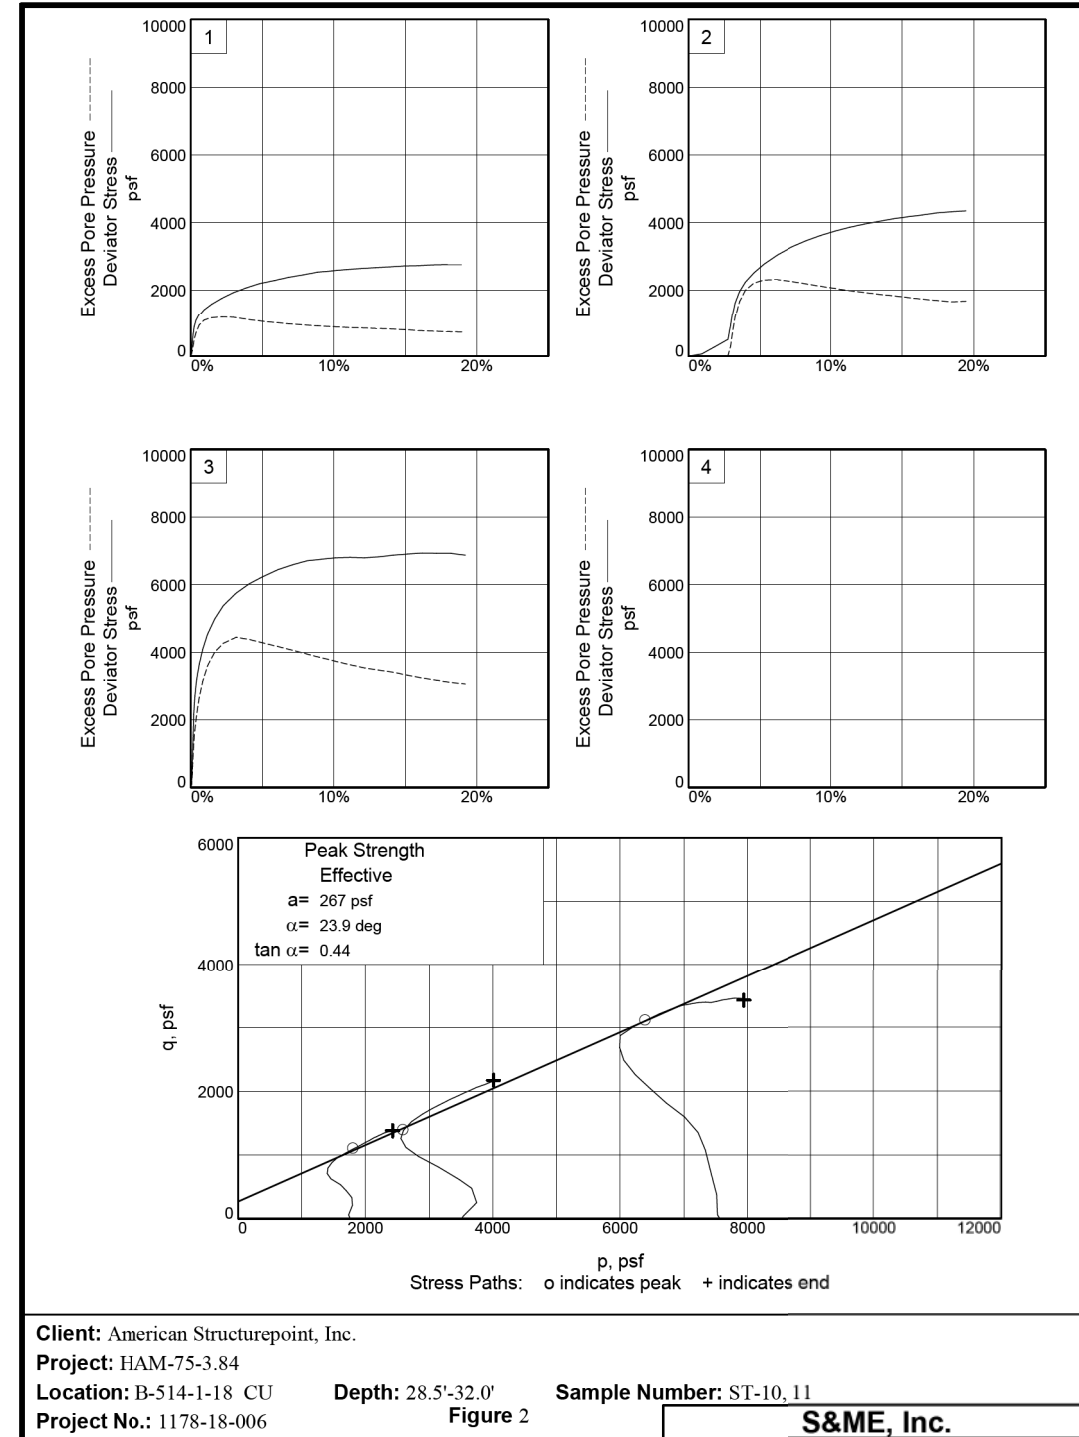

Tested By: PJM Checked By: NRR




C & phi are not test results but an interpretation of the test results. The designer is responsible for interpreting test data as provided by S&ME.

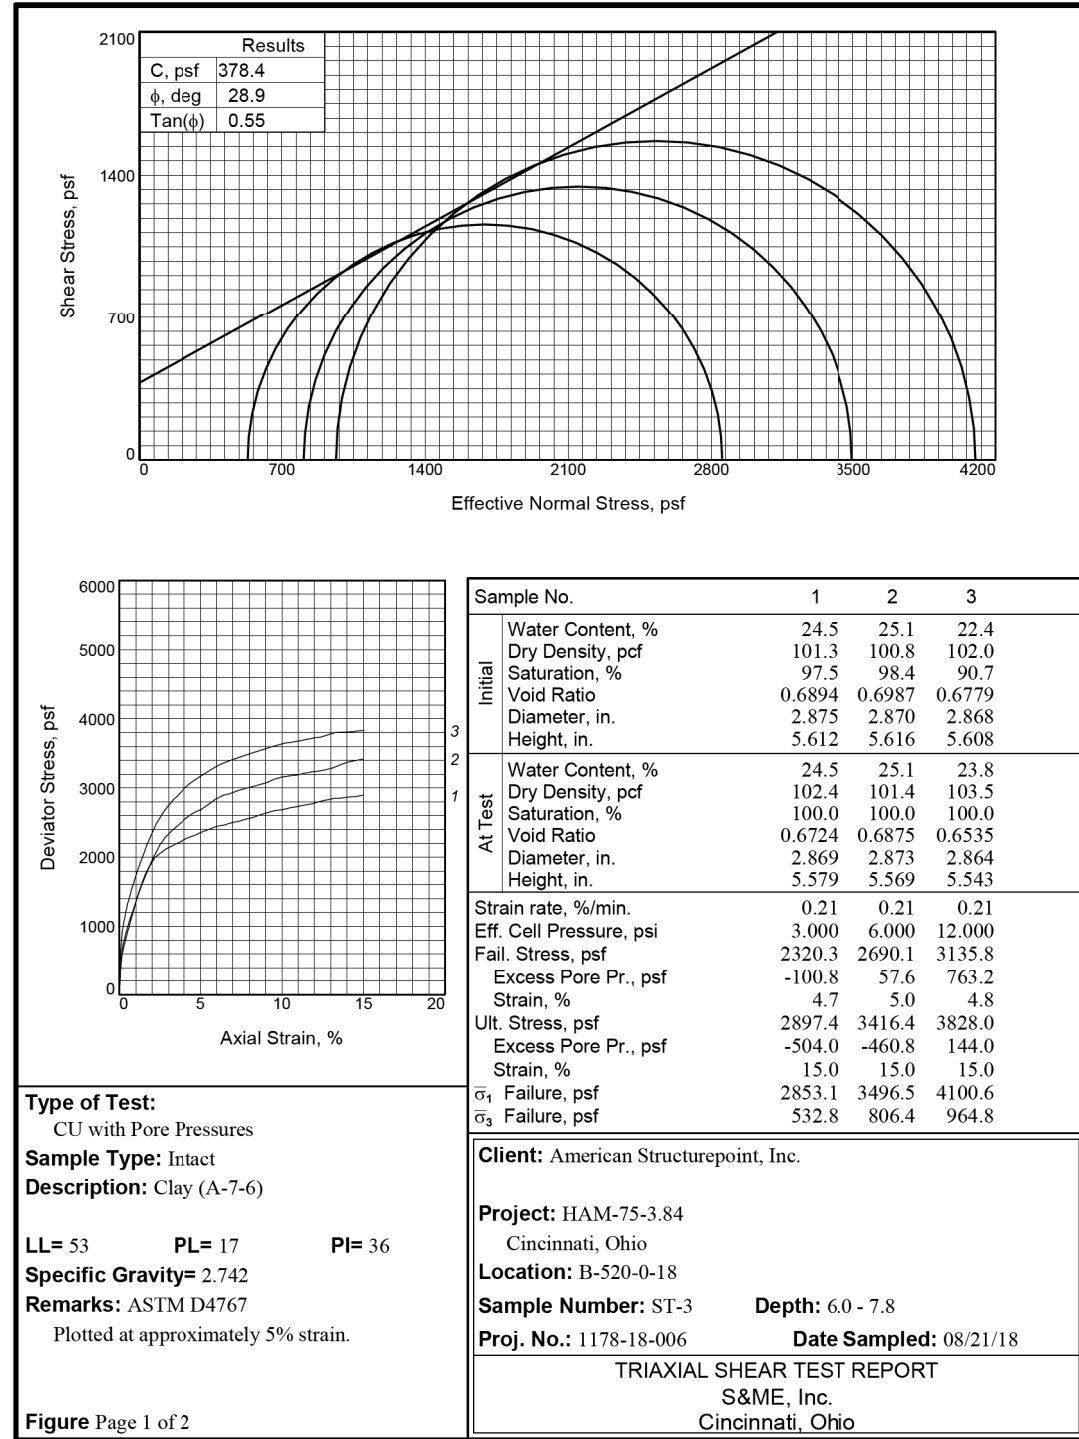

Tested By: M. Weber

Figure Page 1 of 2

C & phi are not test results but an interpretation of the test results. The designer is responsible for interpreting test data as provided by S&ME.

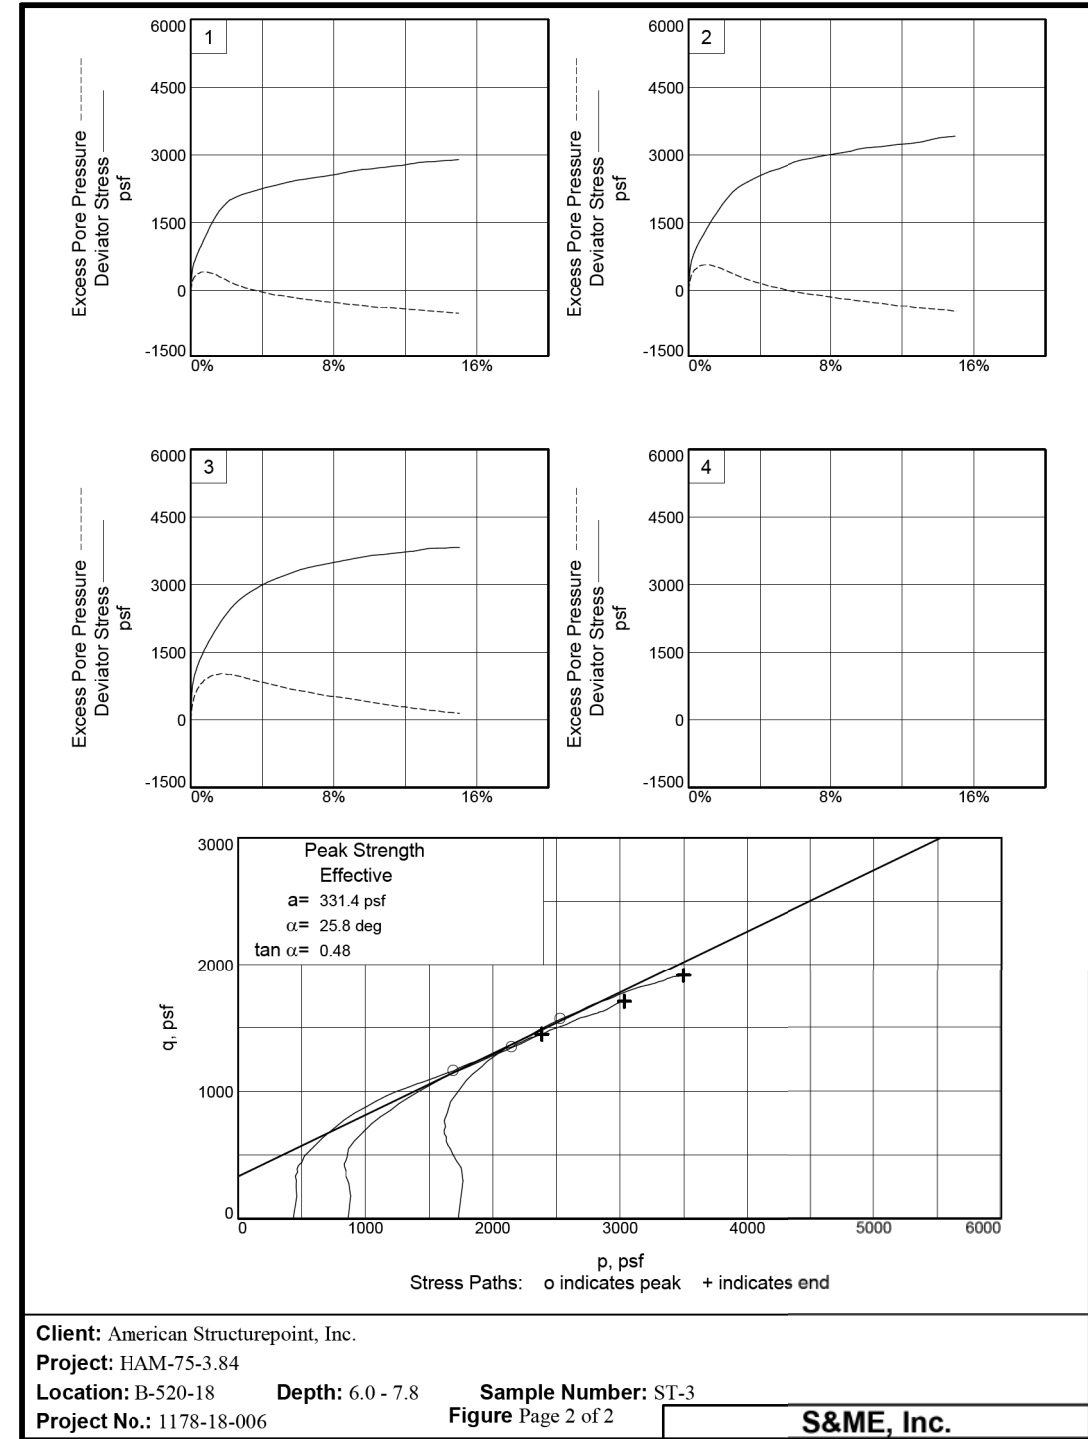


Tested By: M. Weber

Figure Page 2 of 2




C and phi are not test results but an interpretation of the test results. The designer is responsible for interpreting test data as provided by S&ME.

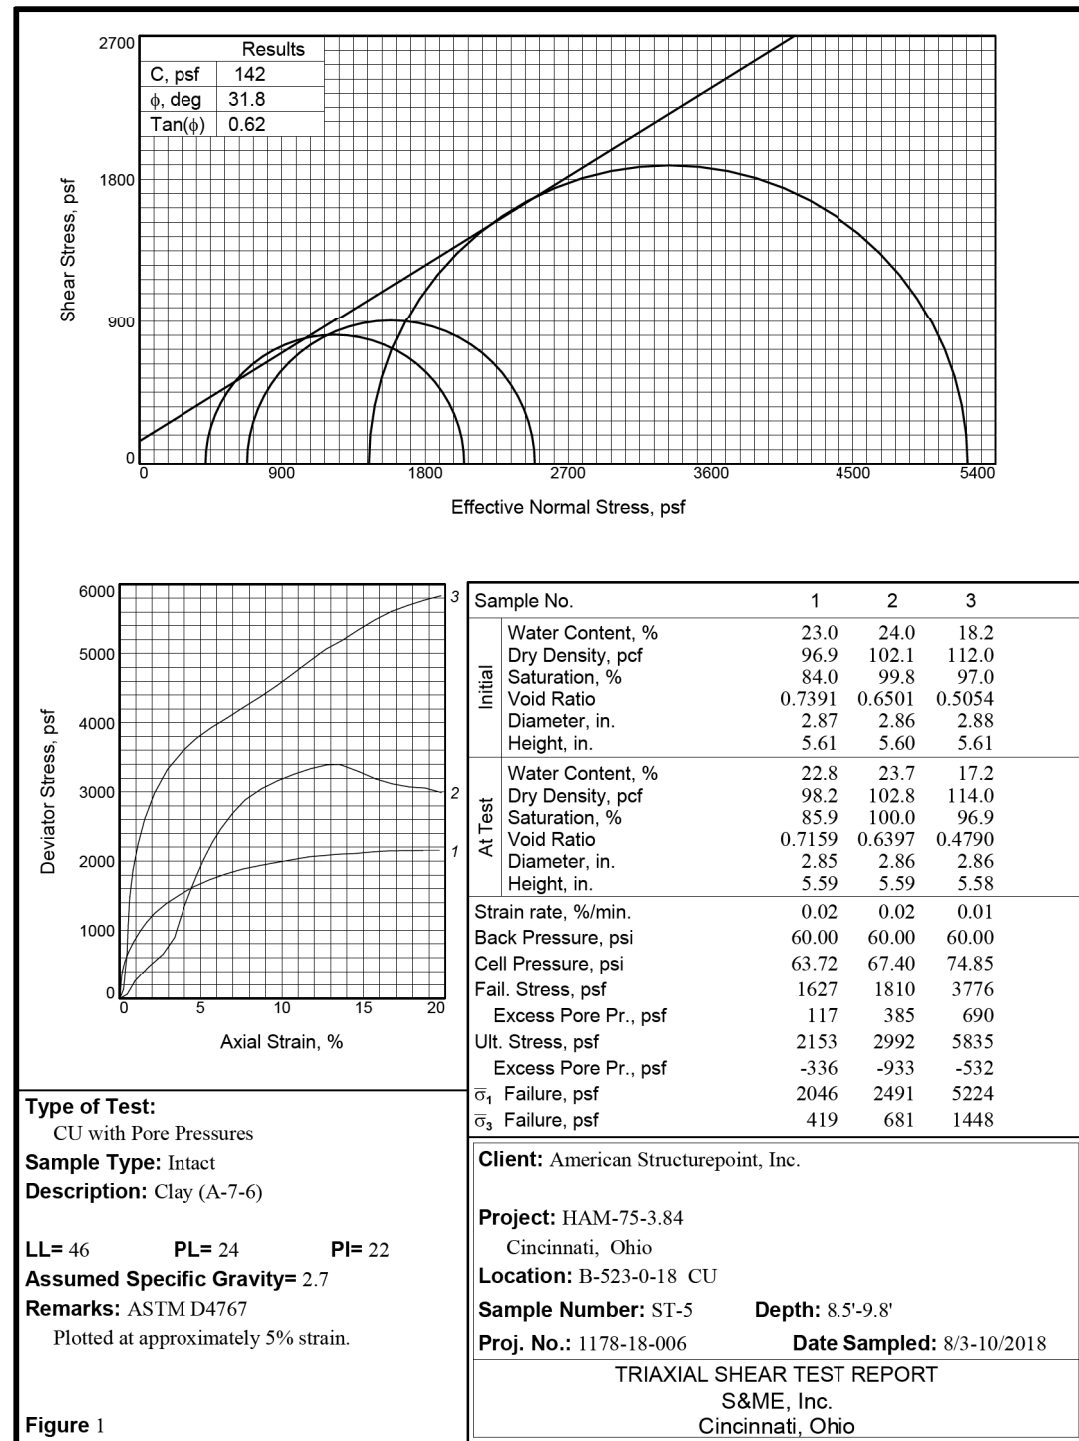


Tested By: PJM Checked By: NRR


C and phi are not test results but an interpretation of the test results. The designer is responsible for interpreting test data as provided by S&ME.

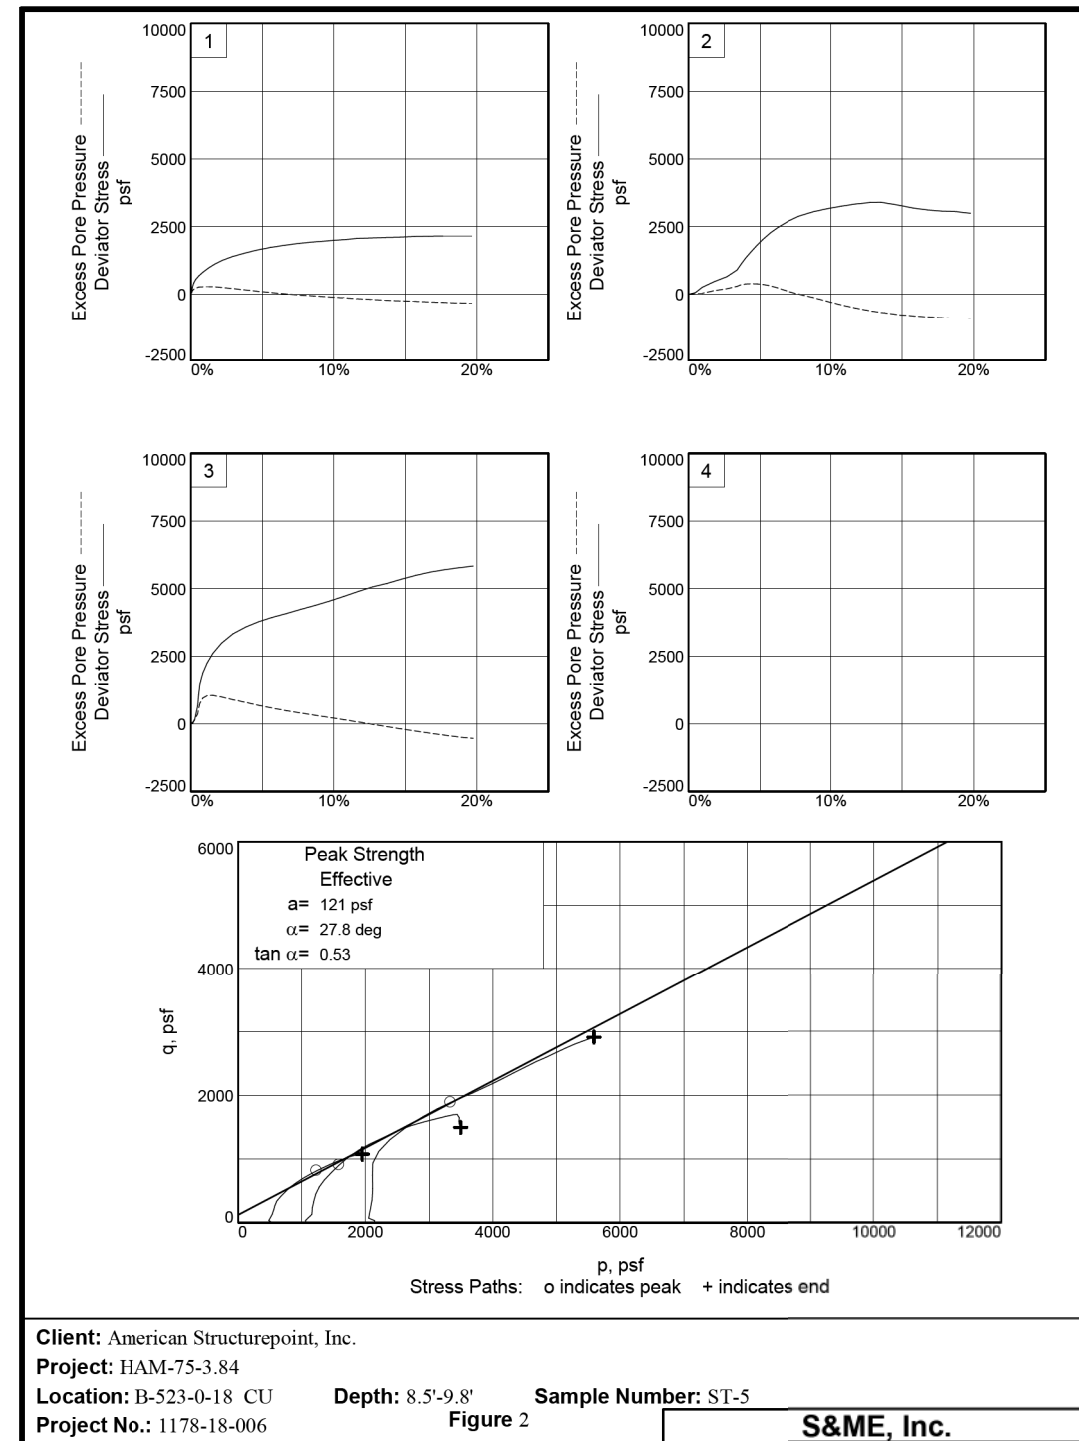

Tested By: PJM Checked By: NRR

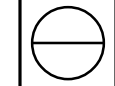


C and phi are not test results but an interpretation of the test results. The designer is responsible for interpreting test data as provided by S&ME.

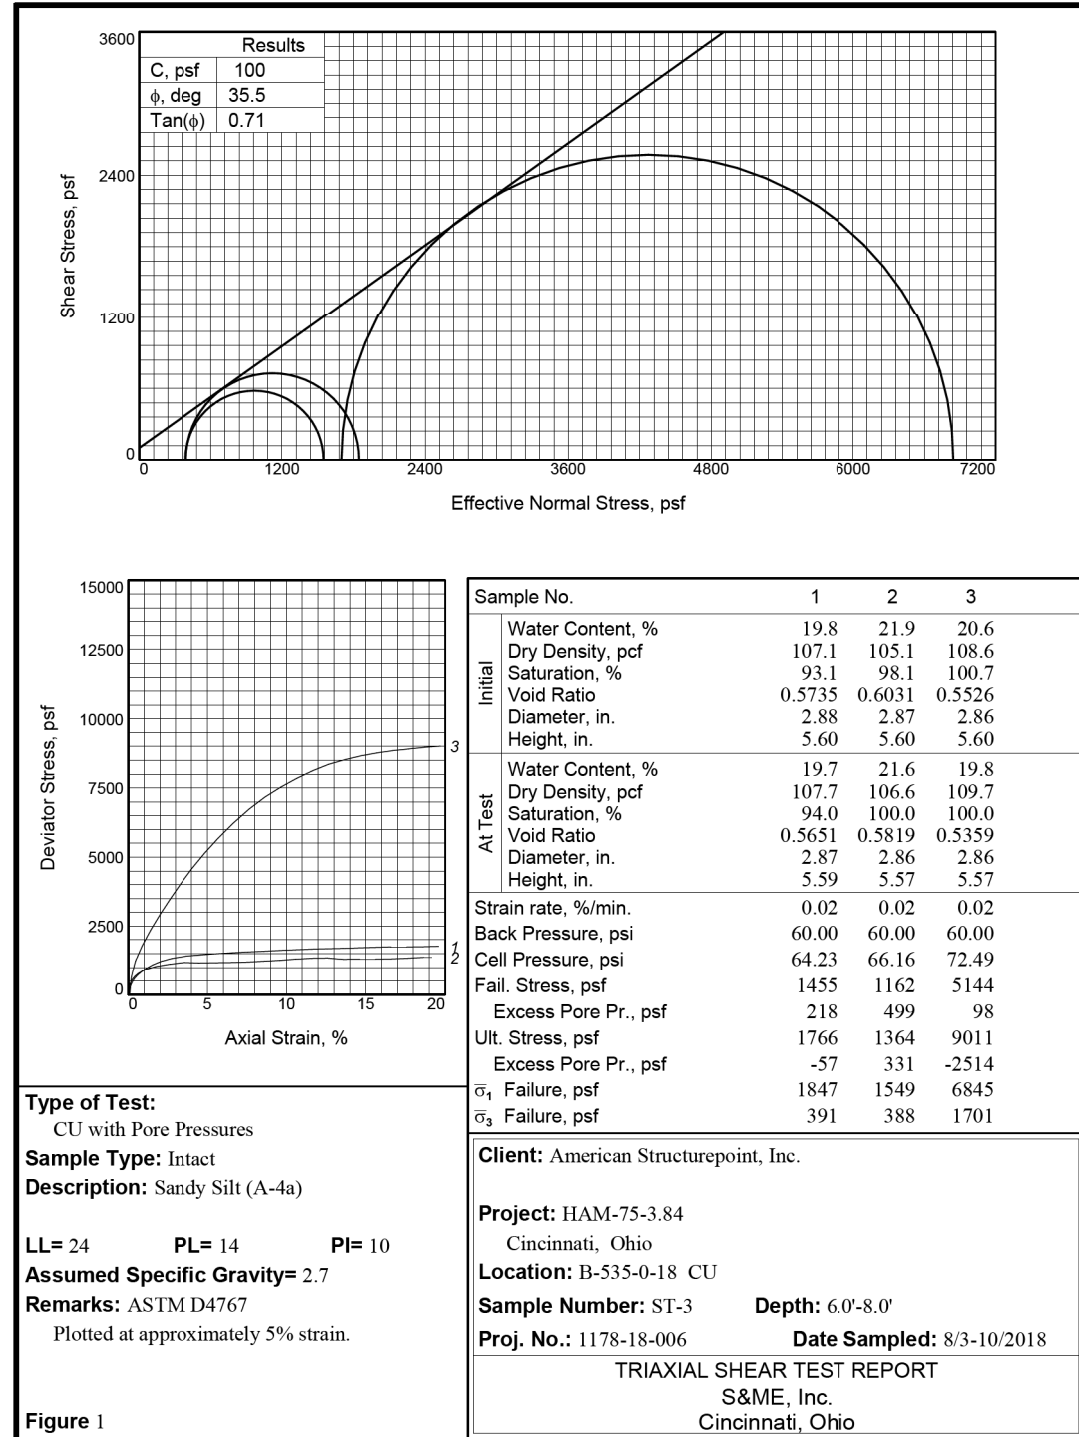

Tested By: PJM Checked By: NRR

C and phi are not test results but an interpretation of the test results. The designer is responsible for interpreting test data as provided by S&ME.

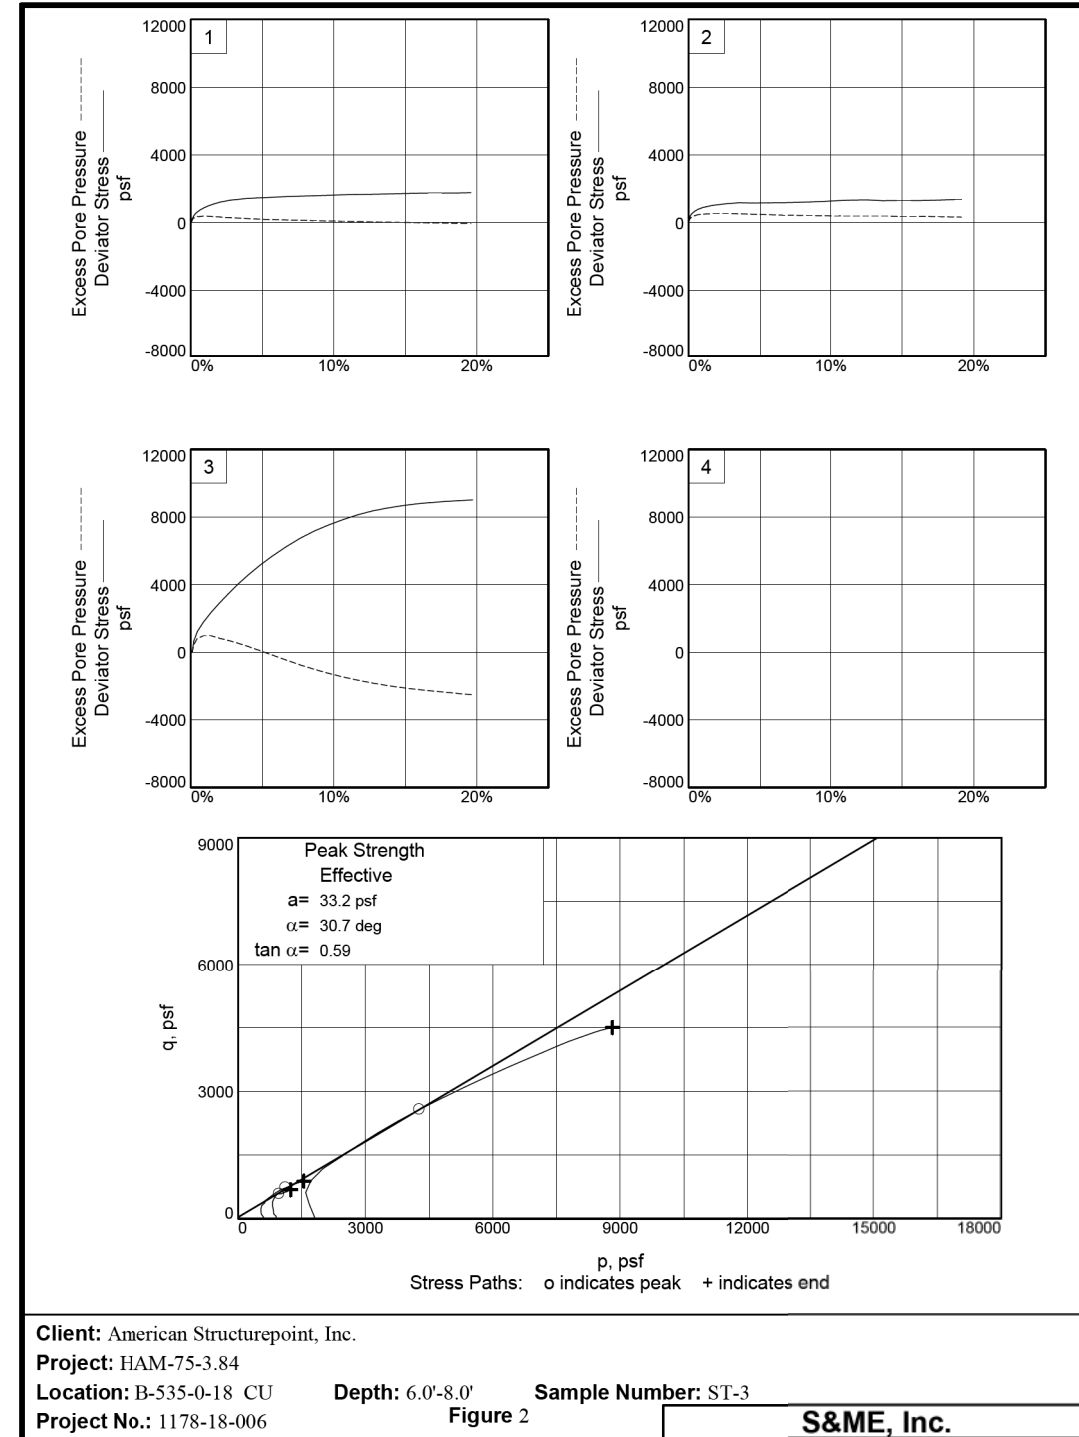




Tested By: PJM Checked By: NRR



DIRECT SHEAR TEST REPORT



Results: C (ksf) = 0 ϕ (deg) = 28.0

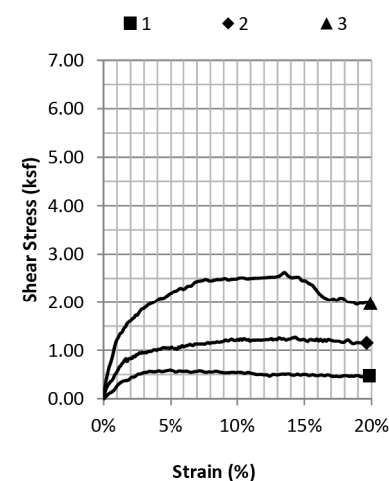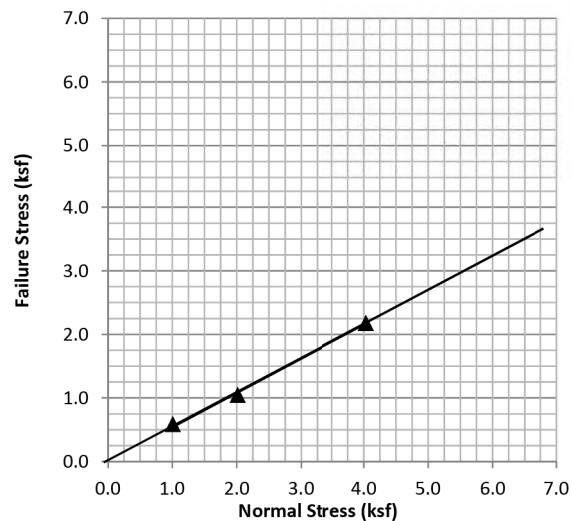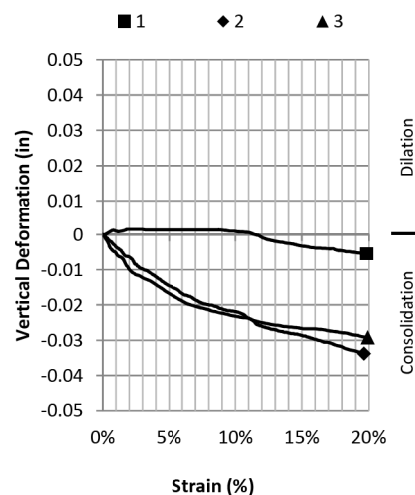

Sample No.	1	2	3
Moisture Content (%)	19.86%	20.92%	20.26%
Dry Density (pcf)	103.33	99.69	100.03
Saturation (%)	86.6%	83.2%	81.3%
Void Ratio	0.6125	0.6712	0.6656
Diameter (in)	2.50	2.50	2.50
Height (in)	1.00	1.00	1.00
Moisture Content (%)	22.83%	22.31%	20.73%
Dry Density (pcf)	102.37	100.69	104.37
Saturation (%)	97.2%	91.0%	92.8%
Void Ratio	0.6275	0.6546	0.5964
Diameter (in)	2.499	2.499	2.501
Height (in)	0.99	0.98	0.96
Normal Stress (ksf)	1.01	2.02	4.03
Failure Stress (ksf)	0.59	1.05	2.18
- Strain at Failure (%)	4.95%	4.78%	4.93%
Ultimate Stress (ksf)	0.47	1.15	1.98
- Strain at Ultimate (%)	19.84%	19.64%	19.92%
Avg. Strain Rate (in/min)	0.0018	0.0010	0.0020

Sample Type: Shelby Tube
Sample Description: Stiff brown CLAY (A-7-6(15))

Comments:
 ASTM D3080
 Plotted near 5% strain.

LL = 43 PI = 25
 Specific Gravity = 2.670

Client: American Structurepoint, Inc.
Project Name: HAM-75-3.84
Project Location: Cincinnati, Ohio
Project No.: 1178-18-006

Boring ID: B-519-18
Sample ID: ST-1
Sample Depth: 8.5'-9.2' Section T
Date(s) Tested: 9/27-10-2/2018

Tested By: PJM Checked By: BKS


Summary of Unconfined Compressive Tests on Bedrock

Boring	Specimen Depth (feet)	Specimen Elevation	Unconfined Compressive Strength (psi)	Bedrock Description
B-517-0-18	9.5 to 9.6	514.8 to 514.7	244	SHALE, gray, very weak
B-518-0-18	5.4 to 5.8	521.8 to 521.4	135	SHALE, gray, very weak
B-521-0-18	16.7 to 17.1	513.0 to 512.6	2,642	SHALE, gray, slightly strong
B-522-0-18	13.4 to 13.8	519.9 to 519.5	113	SHALE, gray, very weak
B-522-0-18	19.2 to 19.9	514.1 to 513.4	255	SHALE, gray, very weak
B-524-0-18	19.4 to 19.8	517.0 to 516.6	602	SHALE, gray, very weak
B-525-0-18	46.4 to 47.0	497.1 to 496.5	618	SHALE, gray, very weak
B-525-0-18	57.7 to 58.1	485.8 to 485.4	1,125	SHALE, gray, weak
B-526-0-18	16.2 to 16.7	522.3 to 521.8	181	SHALE, gray, very weak
B-527-0-18	25.9 to 26.6	513.2 to 512.5	439	SHALE, gray, very weak
B-527-0-18	26.8 to 27.3	512.3 to 511.8	492	SHALE, gray, very weak


Summary of Point Load Tests on Bedrock

Boring	Specimen Depth (feet)	Specimen Elevation	Point Load, $I_{s(50)}$ (psi)*	Bedrock Description
B-518-0-18	5.4 to 5.8	521.8 to 521.4	19	SHALE, gray, very weak
B-525-0-18	46.4 to 47.0	497.1 to 496.5	6	SHALE, gray, very weak
B-525-0-18	57.7 to 58.1	485.8 to 485.4	100	SHALE, gray, slightly strong
B-526-0-18	16.2 to 16.7	522.3 to 521.8	15	SHALE, gray, very weak
B-527-0-18	25.9 to 26.6	513.2 to 512.5	788	LIMESTONE, gray, very strong
B-527-0-18	25.9 to 26.6	513.2 to 512.5	18	SHALE, gray, very weak
B-527-0-18	26.8 to 27.3	512.3 to 511.8	62	SHALE, gray, weak

* Testing performed parallel to the plane of weakness

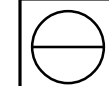


C and phi are not test results but an interpretation of the test results. The designer is responsible for interpreting test data as provided by S&ME.

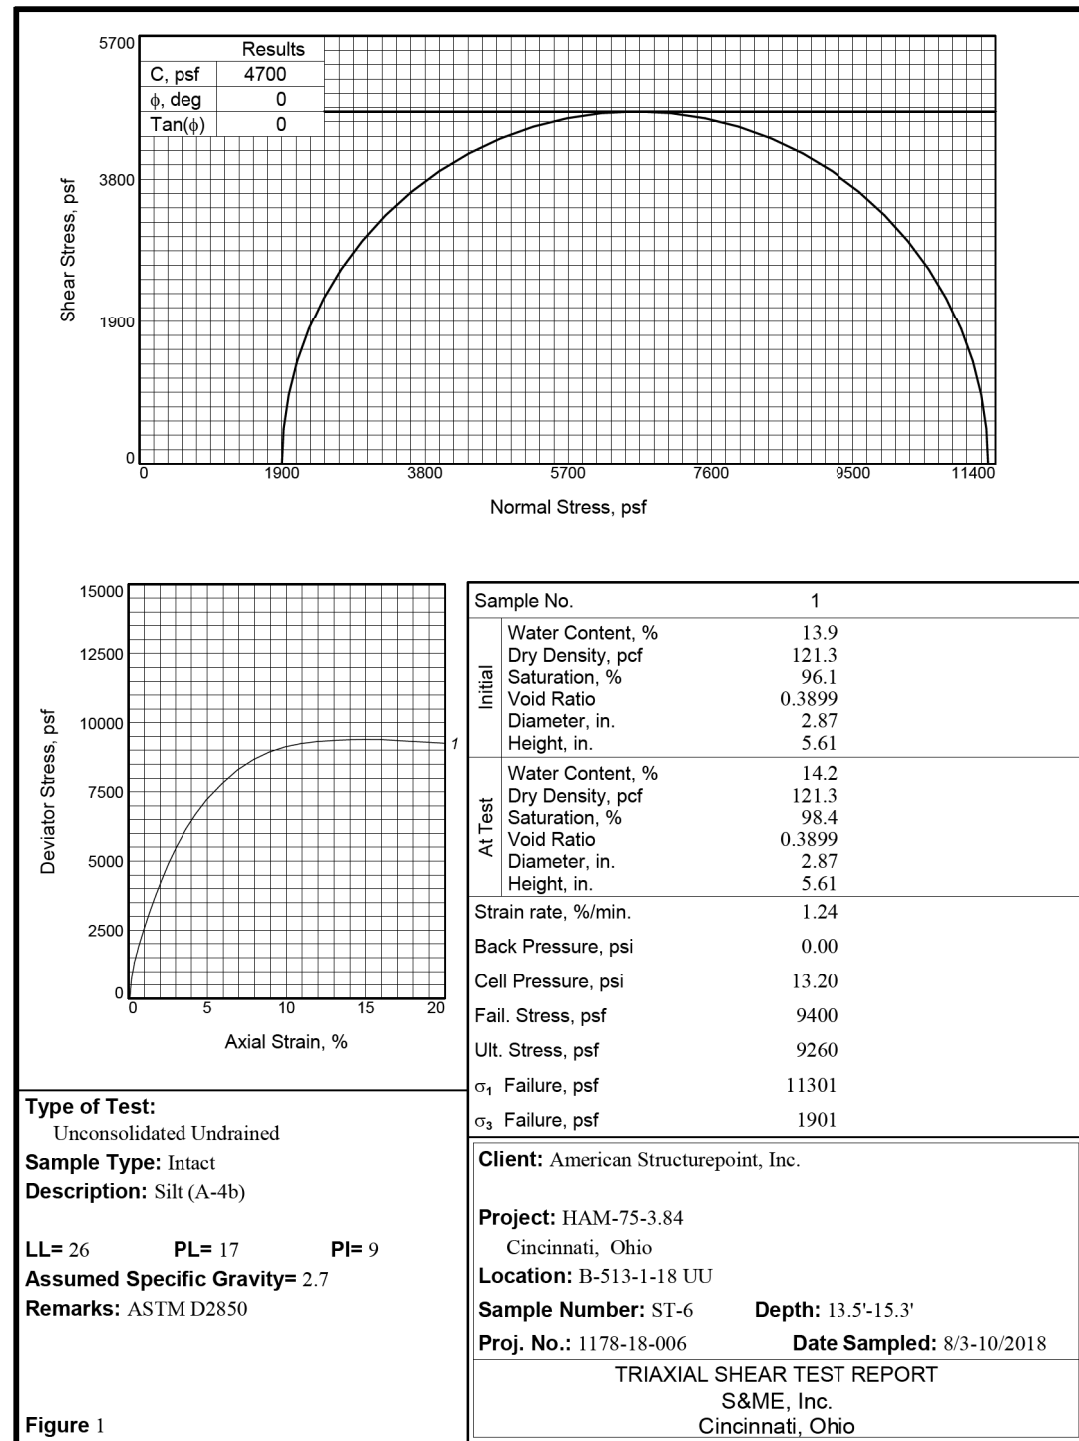


Tested By: PJM Checked By: NRR


C and phi are not test results but an interpretation of the test results. The designer is responsible for interpreting test data as provided by S&ME.

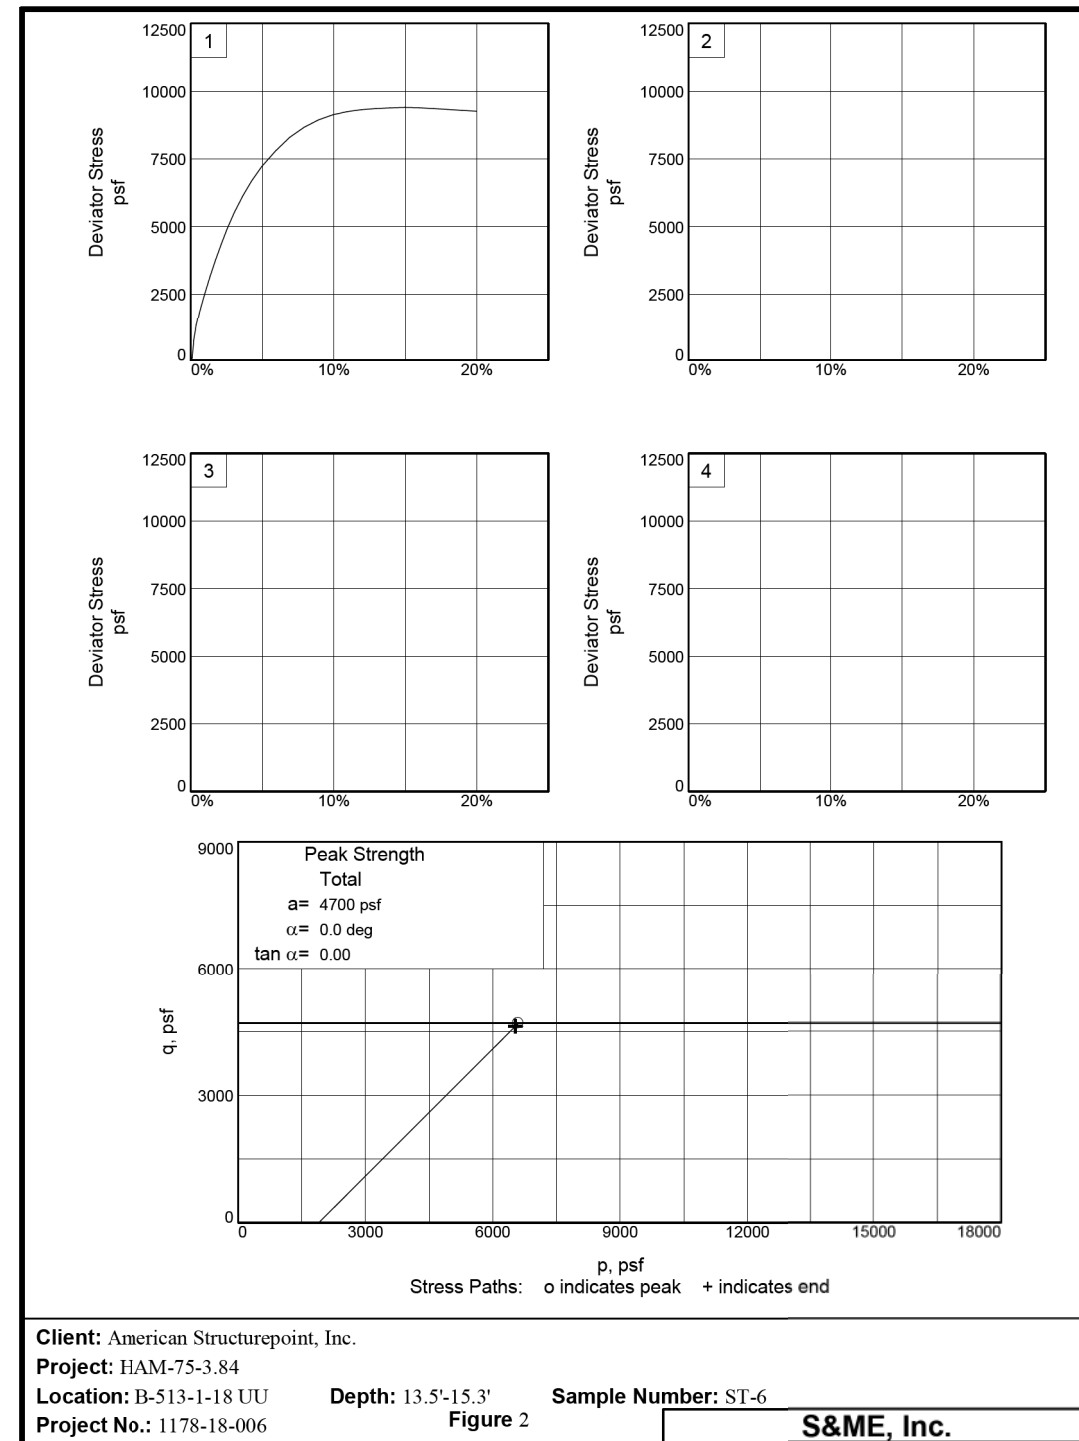

Tested By: PJM Checked By: NRR

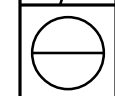


C and phi are not test results but an interpretation of the test results. The designer is responsible for interpreting test data as provided by S&ME.

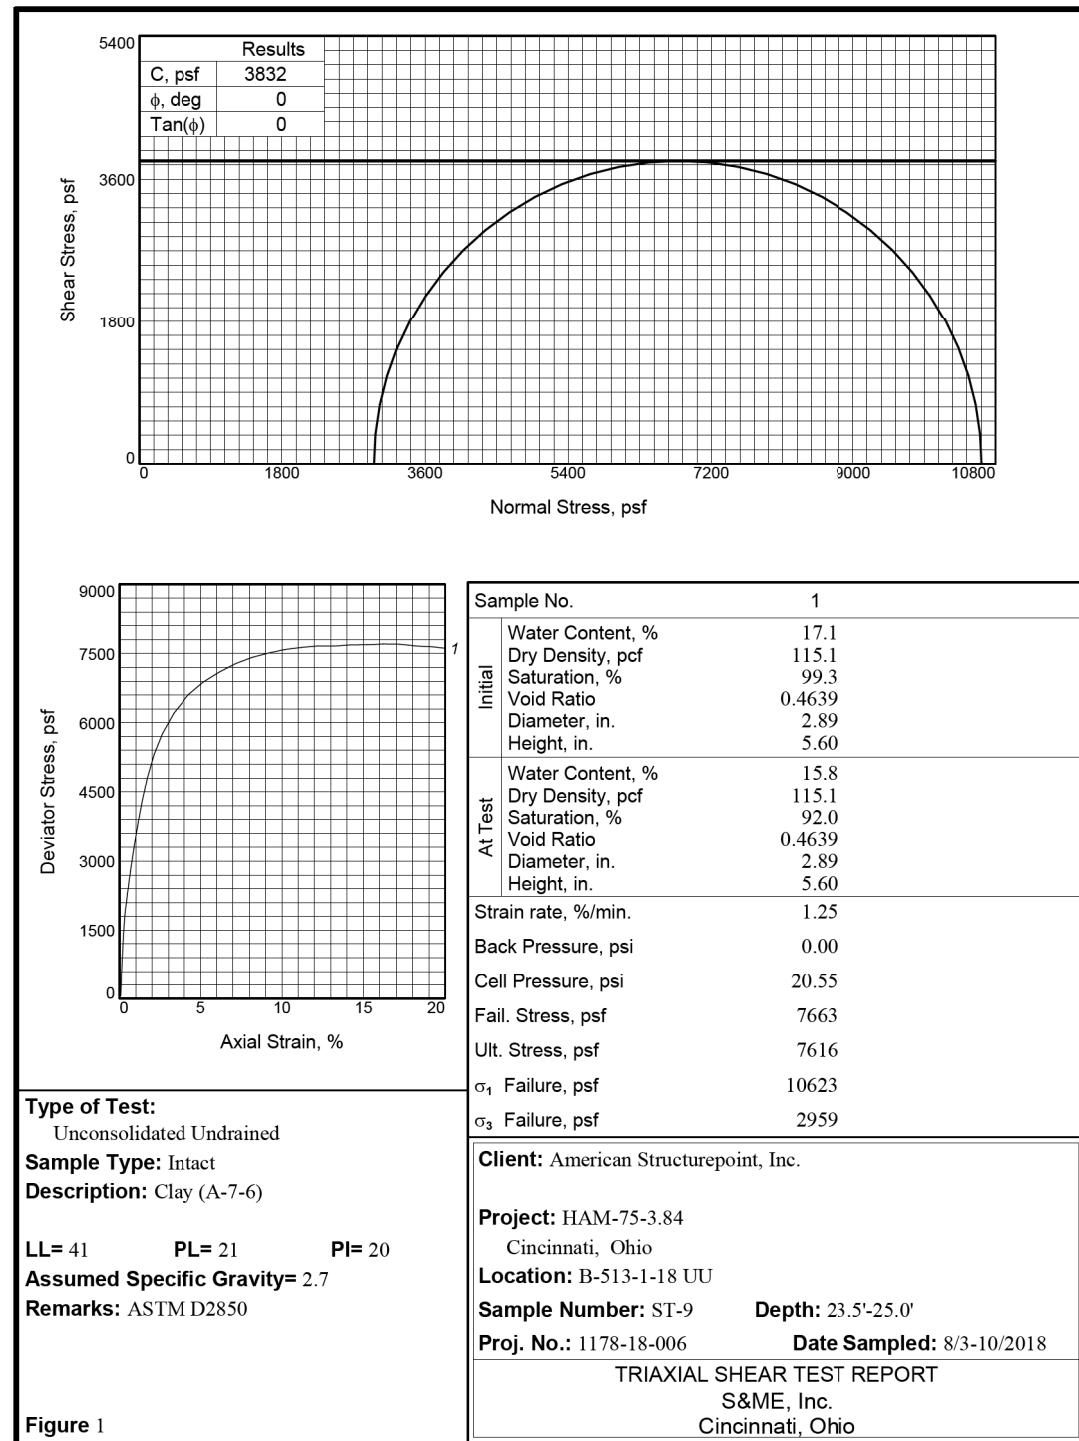


Tested By: PJM Checked By: NRR


C and phi are not test results but an interpretation of the test results. The designer is responsible for interpreting test data as provided by S&ME.

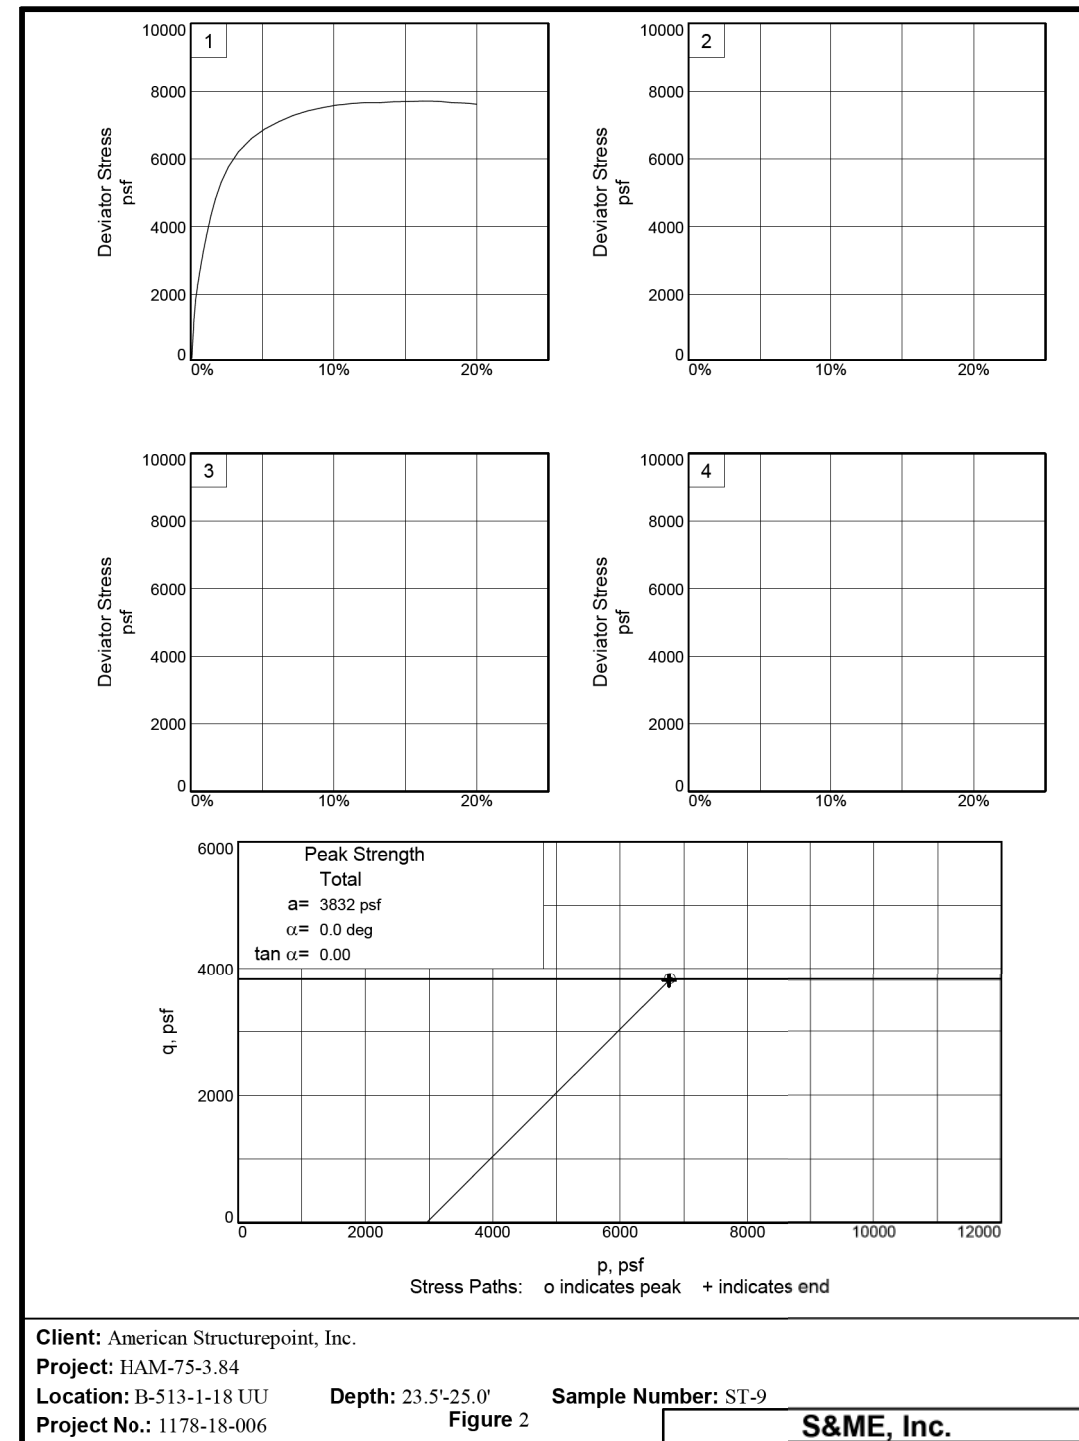

Tested By: PJM Checked By: NRR

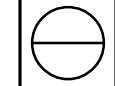


C & phi are not test results but an interpretation of the test results. The designer is responsible for interpreting test data as provided by S&ME.

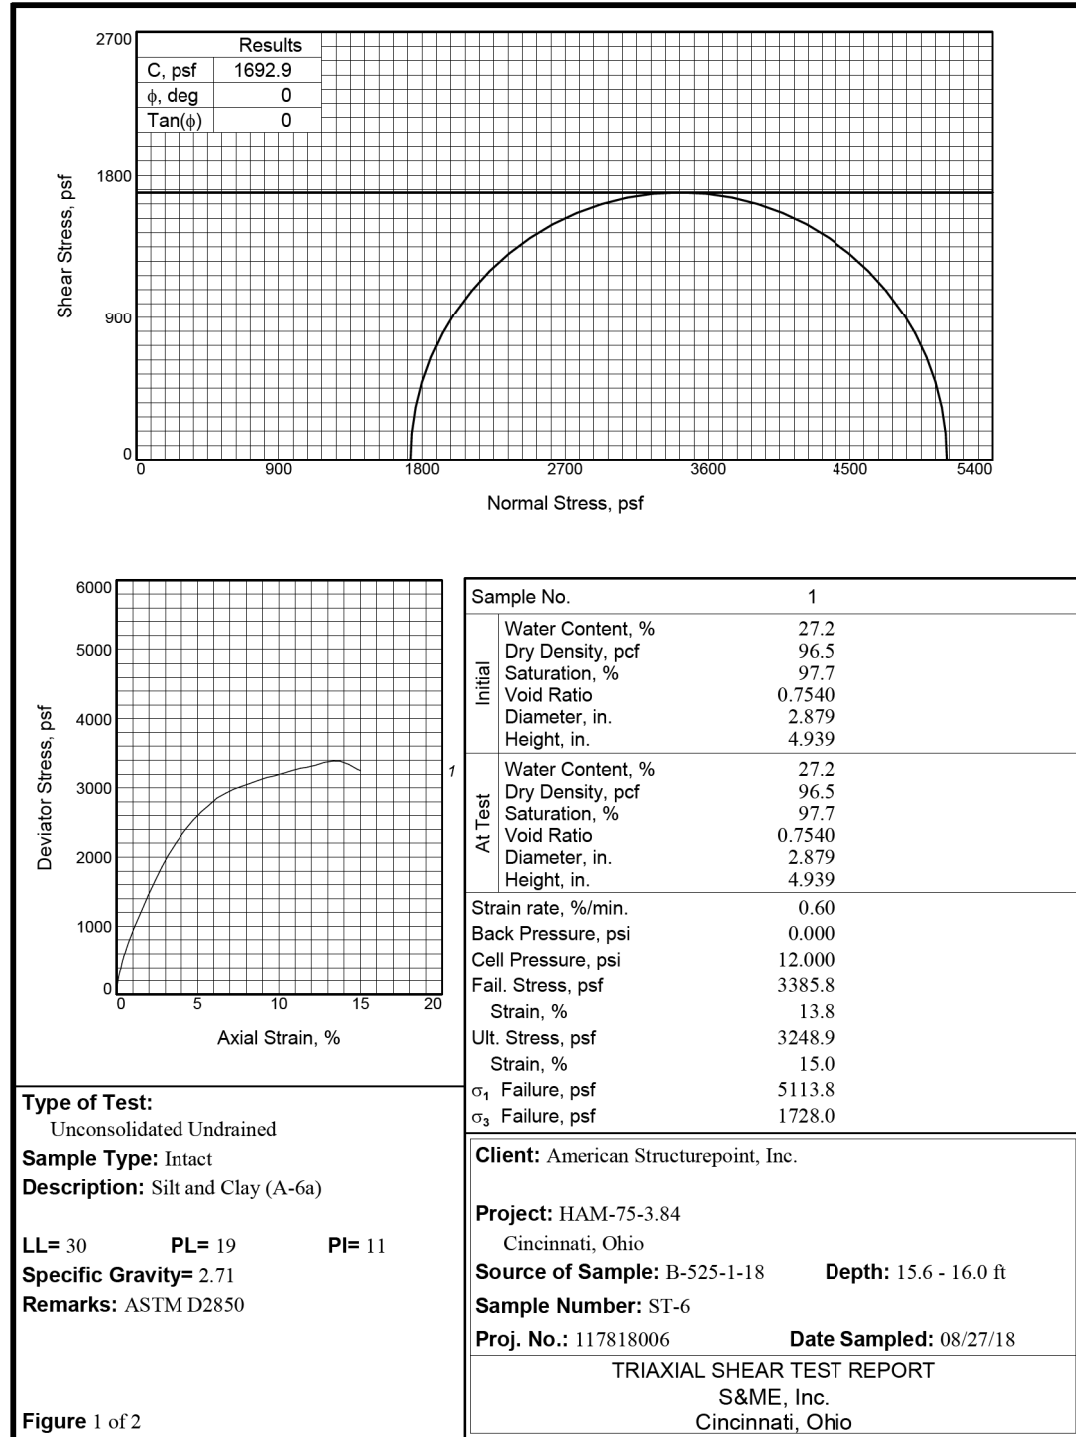

Tested By: M. Weber

Checked By: J. Folsom

C & phi are not test results but an interpretation of the test results. The designer is responsible for interpreting test data as provided by S&ME.

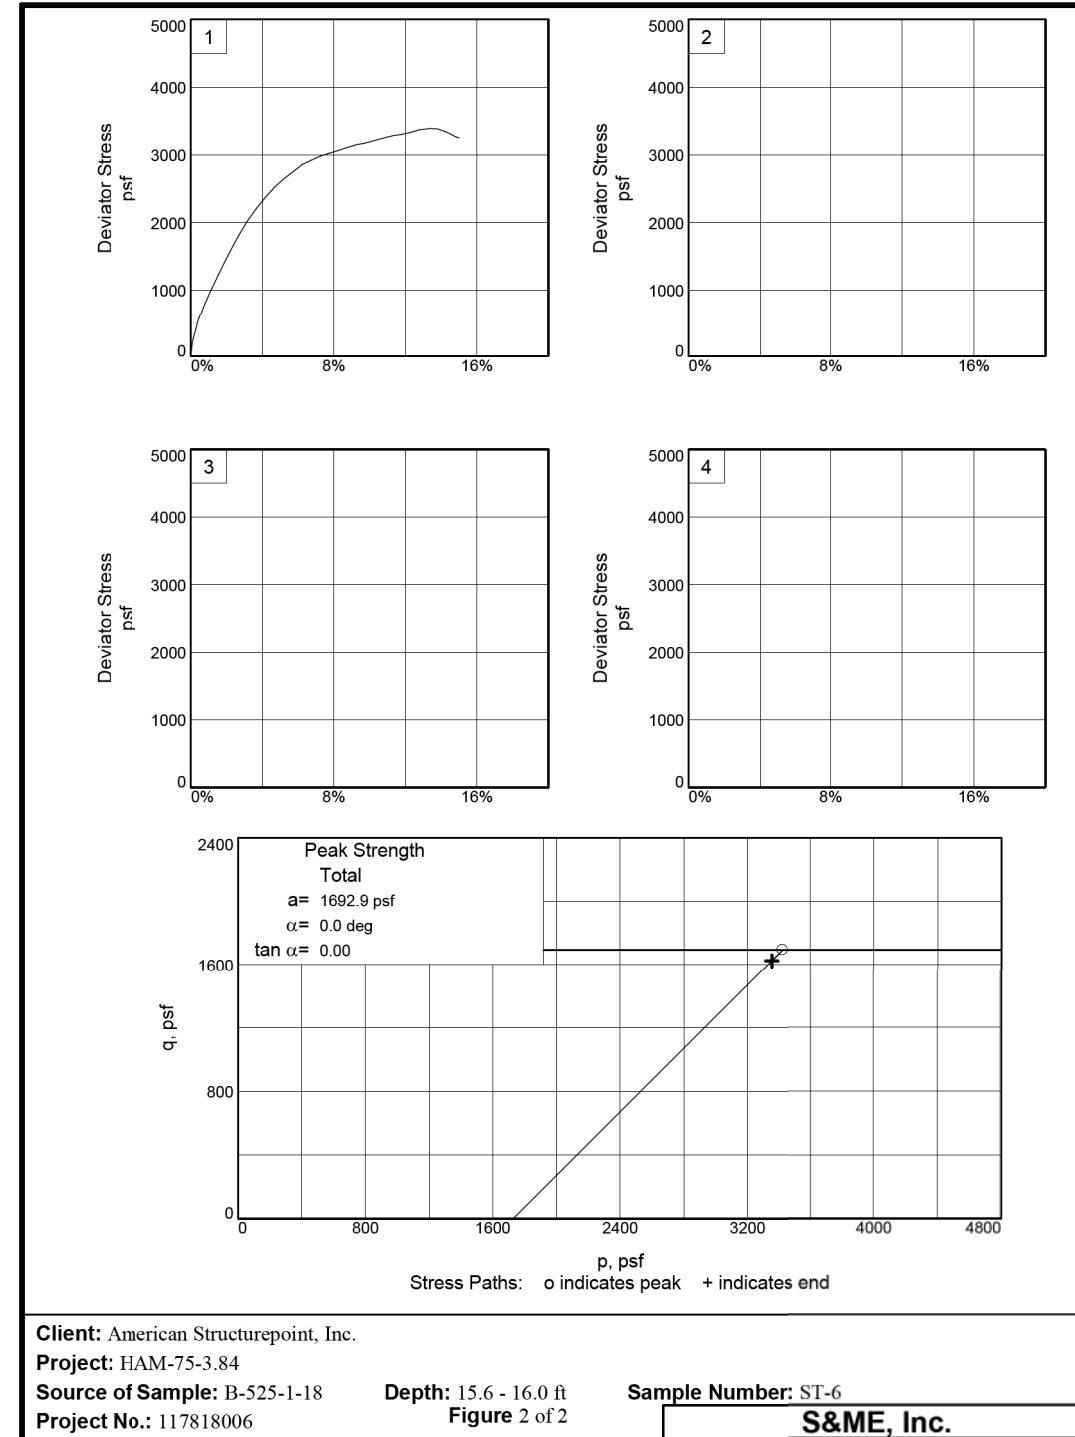


Tested By: M. Weber

Checked By: J. Folsom




C & phi are not test results but an interpretation of the test results. The designer is responsible for interpreting test data as provided by S&ME.

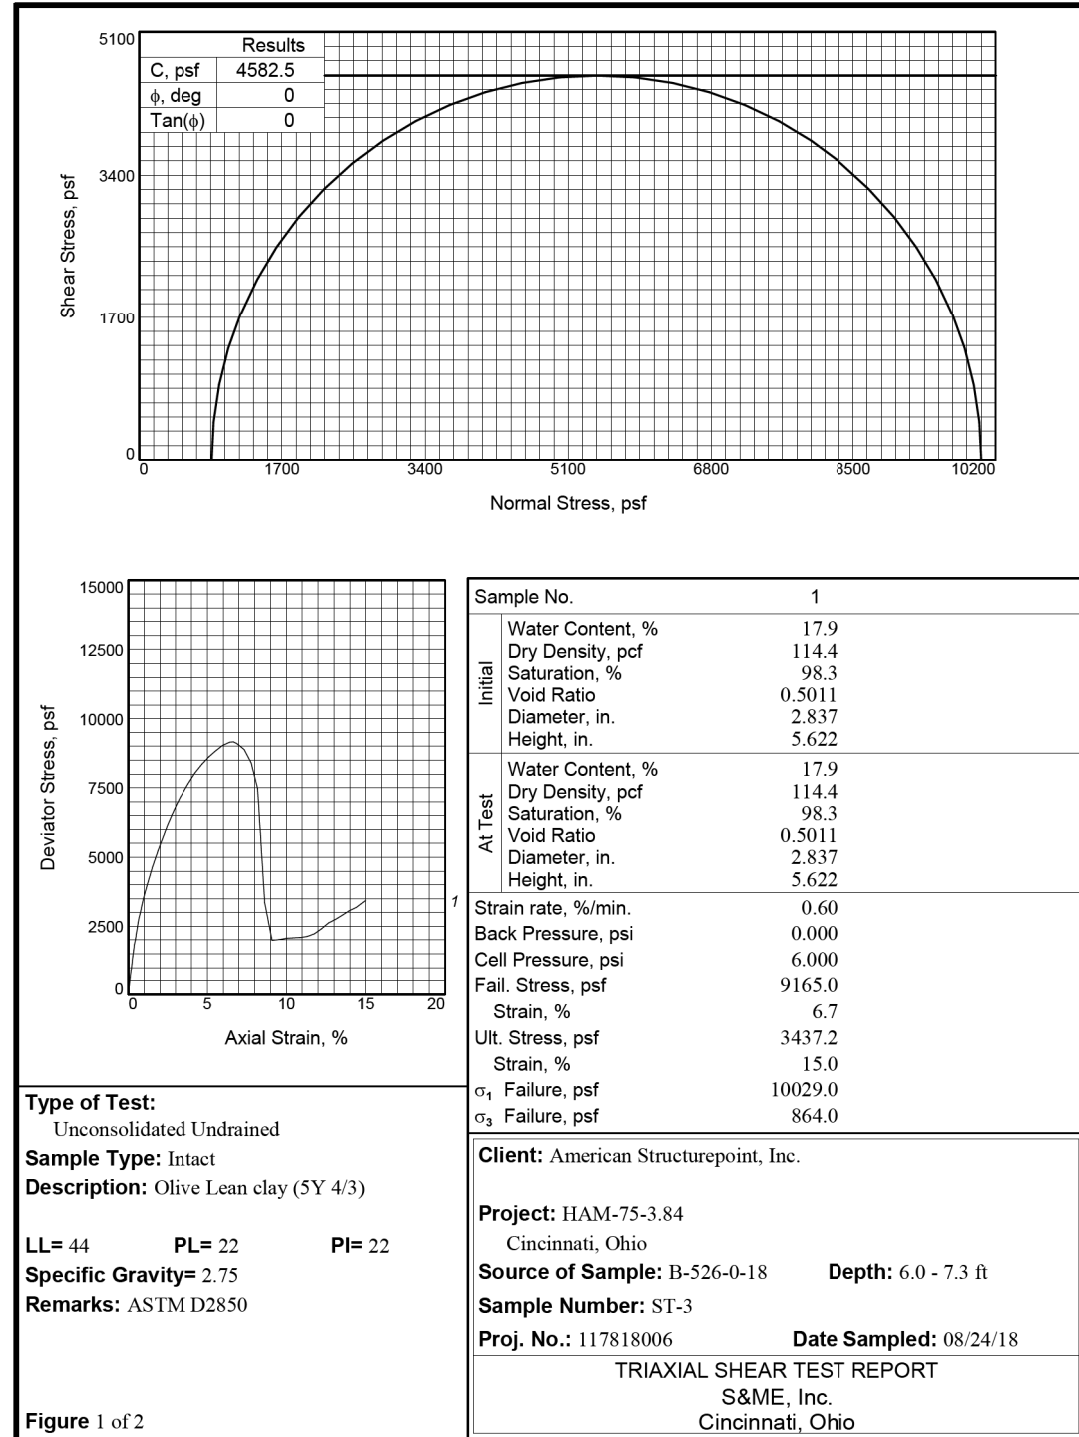

Tested By: M. Weber Checked By: J. Folsom


C & phi are not test results but an interpretation of the test results. The designer is responsible for interpreting test data as provided by S&ME.

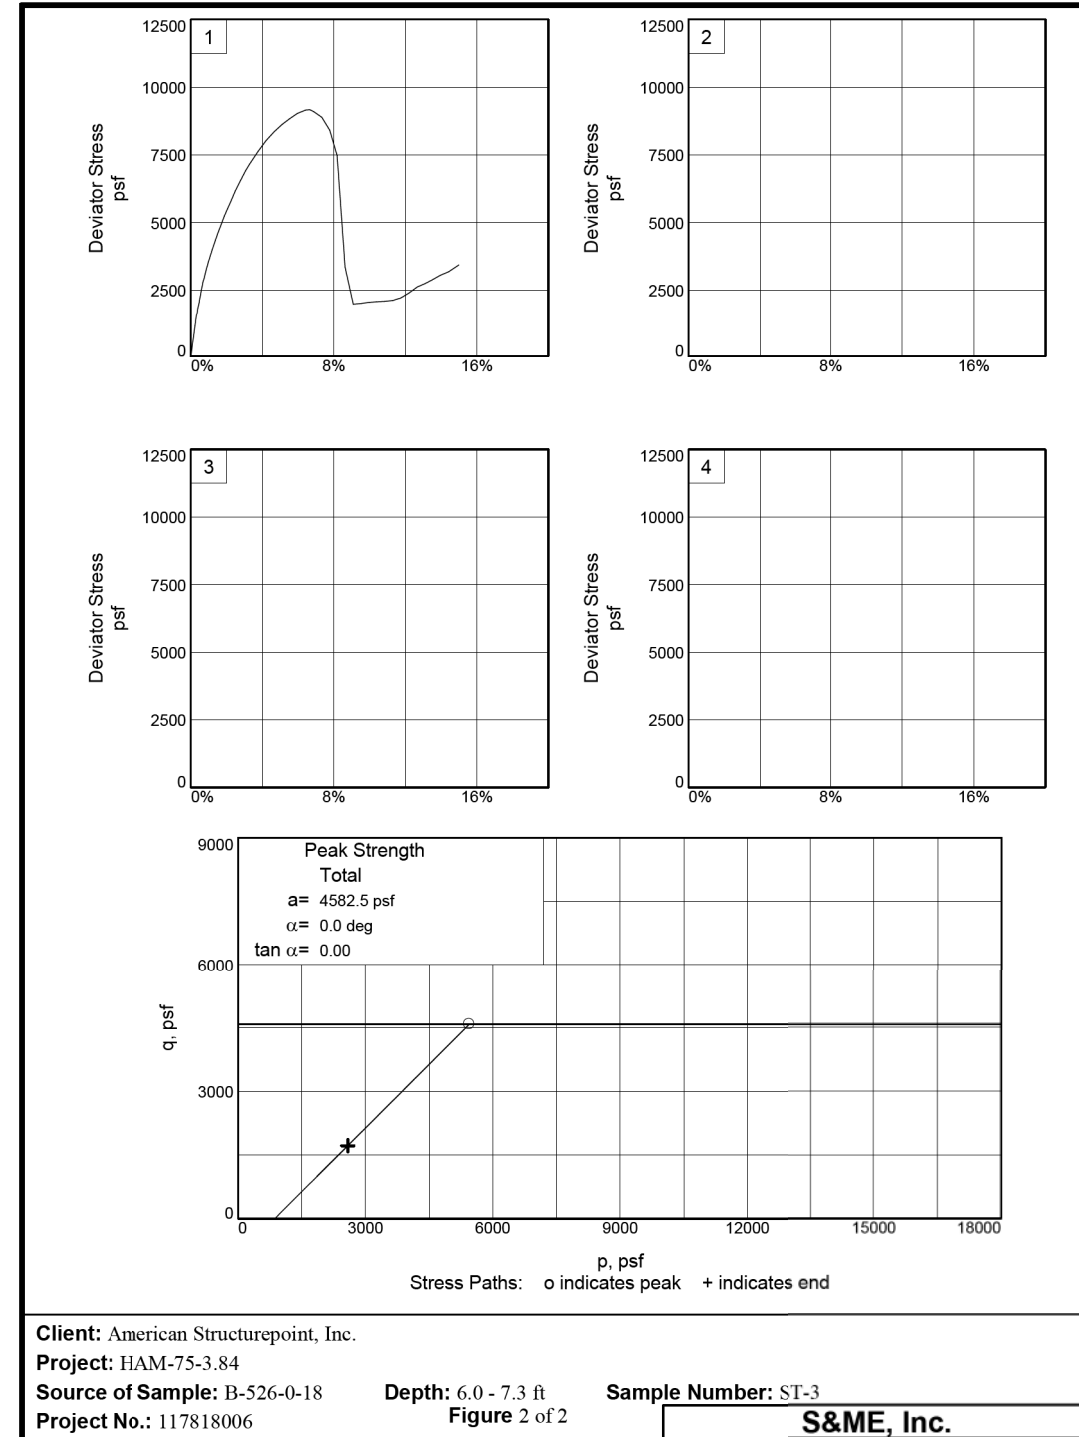

Tested By: M. Weber Checked By: J. Folsom




C and phi are not test results but an interpretation of the test results. The designer is responsible for interpreting test data as provided by S&ME.

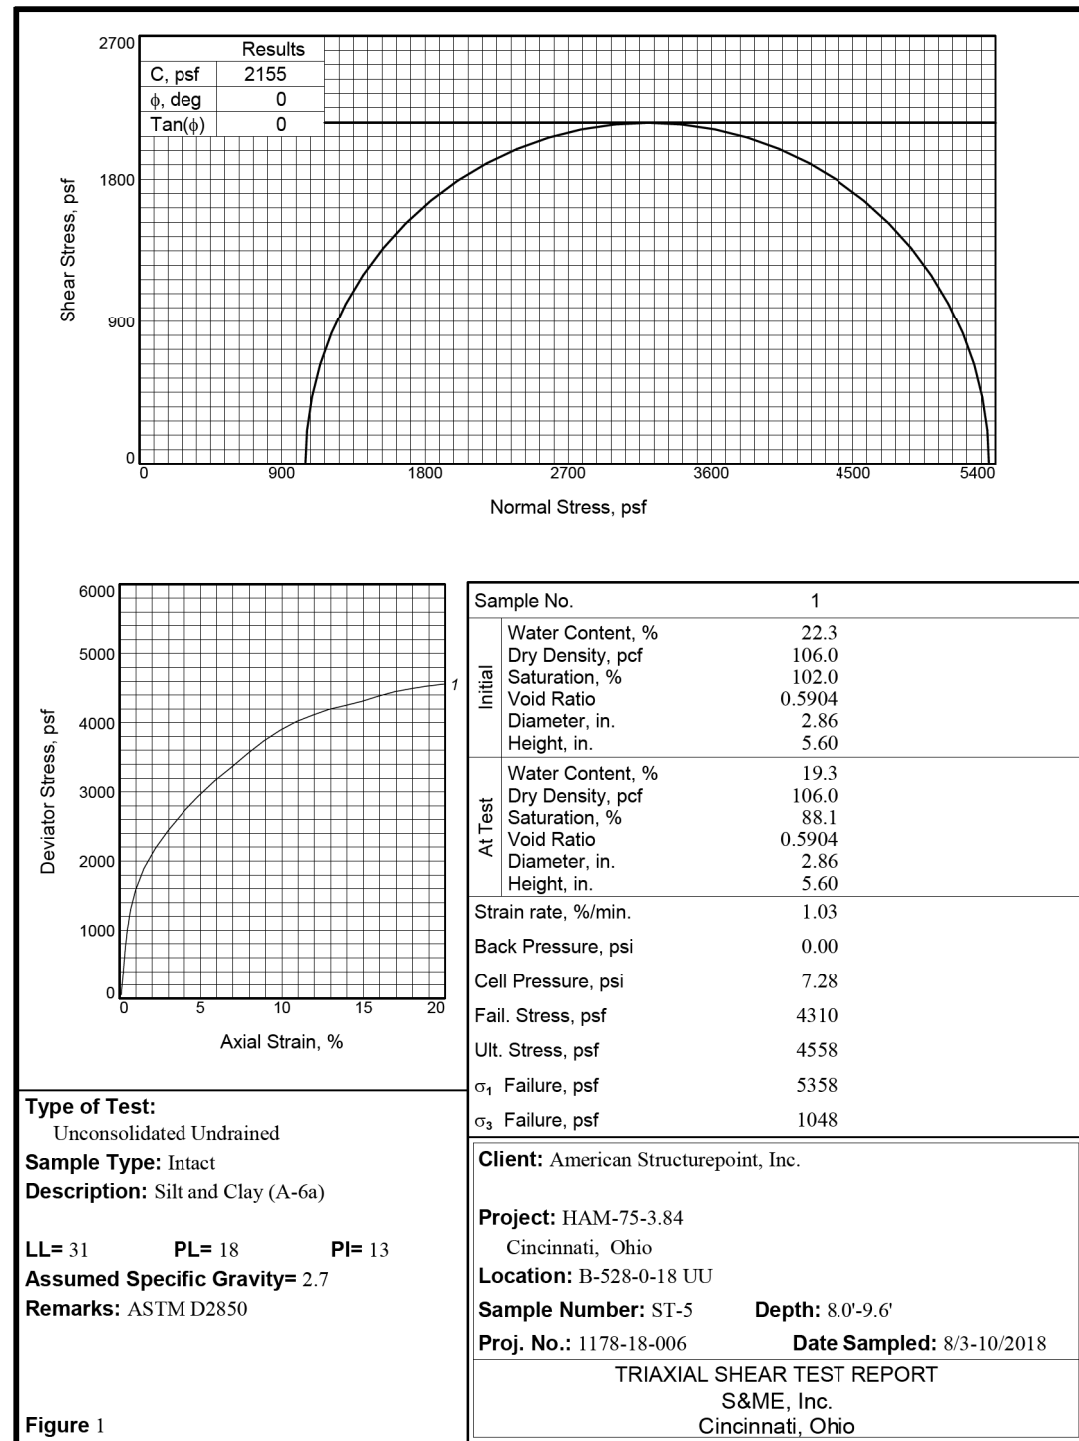

Tested By: PJM Checked By: NRR

C and phi are not test results but an interpretation of the test results. The designer is responsible for interpreting test data as provided by S&ME.

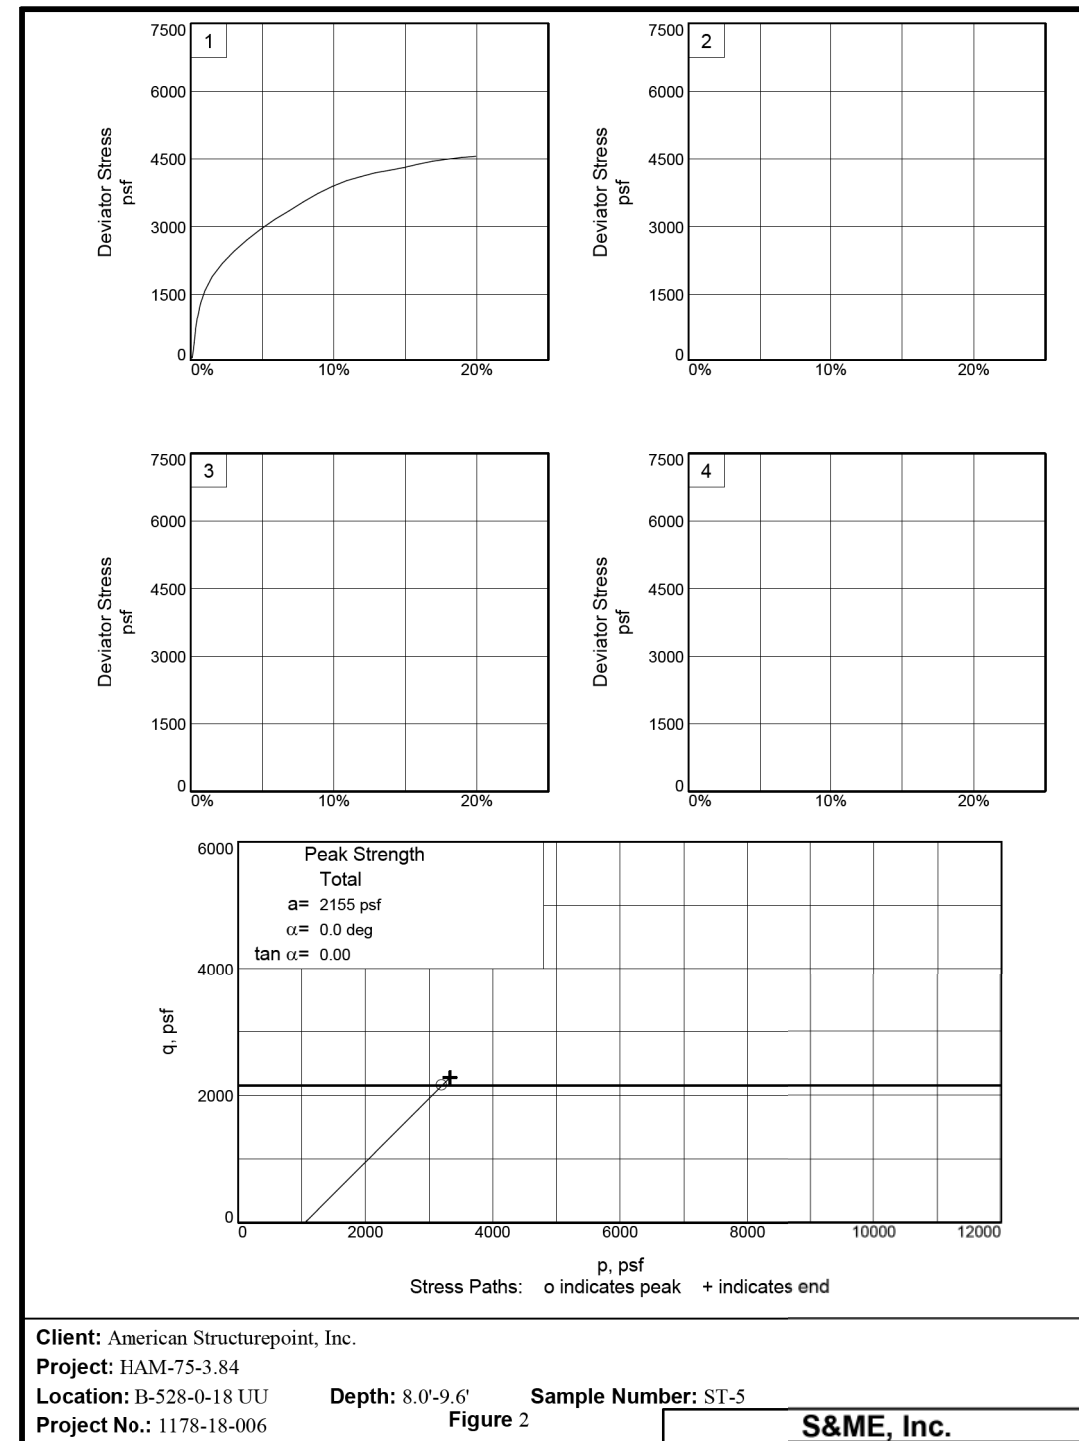

Tested By: PJM Checked By: NRR

