

STATE OF OHIO  
DEPARTMENT OF TRANSPORTATION

**HAM-75-3.84**  
**HAM-74-1908R**  
**BU-11 BEARINGS,**  
**SUBSTRUCTURE AND DECK**  
HAMILTON COUNTY  
CITY OF CINCINNATI

**PROJECT DESCRIPTION**

THIS IS PHASE 5A OF THE HAMILTON 75 CORRIDOR PROJECTS (MCE). THE PROJECT ADDS A LANE TO IR 75 SB, PROVIDES 4-LANE CONTINUITY NB, AND RECONFIGURES IR 74 EB RAMP TO IR 75. THE PROJECT ALSO INCLUDES SURFACE COURSE AND ADDITIONAL PAVEMENT WORK TO THE SOUTH AND IMPROVEMENTS TO RAMP A AT THE HOPPLE ST INTERCHANGE.

**BUILDABLE UNIT 11 DESCRIPTION**

THIS BUILDABLE UNIT 11 COVERS THE STAGE 2 REQUIREMENTS FOR BU-11 BEARINGS, SUBSTRUCTURE AND DECK FOR THE EXISTING HAM-74-1908R BRIDGE, UNITS NOS. 1, 2 AND 6.

**LIMITED ACCESS**

THIS IMPROVEMENT IS ESPECIALLY DESIGNED FOR THROUGH TRAFFIC AND HAS BEEN DECLARED A LIMITED ACCESS HIGHWAY OR FREEWAY BY ACTION OF THE DIRECTOR IN ACCORDANCE WITH THE PROVISIONS OF SECTION 5511.02 OF THE OHIO REVISED CODE.

**2016 SPECIFICATIONS**

THE STANDARD SPECIFICATIONS OF THE STATE OF OHIO, DEPARTMENT OF TRANSPORTATION, INCLUDING SUPPLEMENTAL SPECIFICATIONS LISTED IN THE PLANS AND CHANGES LISTED IN THE PROPOSAL SHALL GOVERN THIS IMPROVEMENT.

I HEREBY APPROVE THESE PLANS AND DECLARE THAT THE MAKING OF THIS IMPROVEMENT WILL NOT REQUIRE THE CLOSING TO TRAFFIC OF THE HIGHWAY AND THAT PROVISIONS FOR THE MAINTENANCE AND SAFETY OF TRAFFIC WILL BE AS SET FORTH ON THE PLANS AND ESTIMATES.

**AS-BUILT PLANS**

REV. BY	DATE	DESCRIPTION	SHEETS
1	6/19/19	MISCELLANEOUS UPDATES	3,6,8,10,34,36-39,41,45,46,49,61,90,100
2	8/3/20	MISCELLANEOUS UPDATES, UPDATED SIGN TRUSS LOCATION AND SHOULDER GRADE BREAK	2, 3, 5, 6, 20, 22, 23, 34, 35, 38, 50-52, 54, 55, 56A, 58, 63-66, 72-79, 84, 95, 97, 99, 100
3	1/19/21	UPDATED CROSSFRAME CONNECTIONS	45


DATE COMPLETED

**UNDERGROUND UTILITIES**

CONTACT BOTH SERVICES TWO WORKING DAYS BEFORE YOU DIG.

**OHIO Utilities Protection SERVICE**  
Call Before You Dig  
1-800-362-2764  
(Non-members must be called directly)

**OIL & GAS PRODUCERS UNDERGROUND PROTECTION SERVICE**  
1-800-925-0988

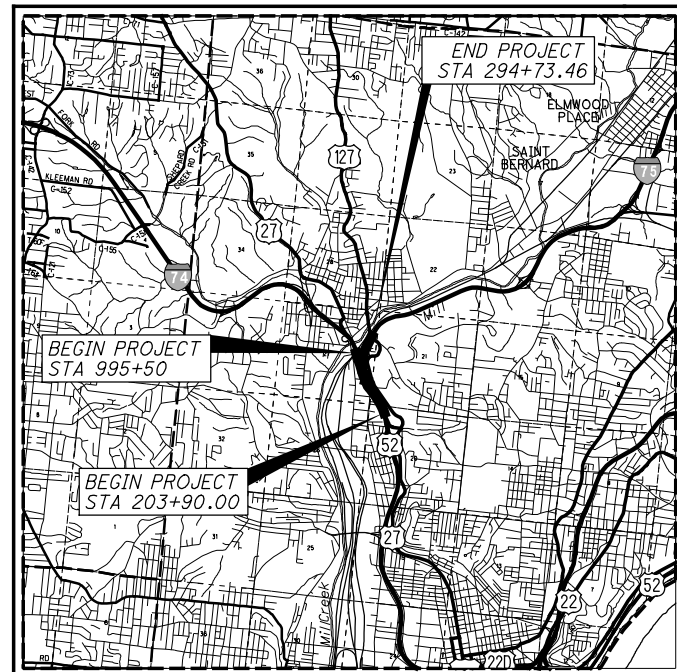

LOCATION MAP

LATITUDE: 39° 09' 03" LONGITUDE: 84° 32' 24"



PORTION TO BE IMPROVED	-----
INTERSTATE HIGHWAY	=====
FEDERAL ROUTES	====
STATE ROUTES	====
COUNTY & TOWNSHIP ROADS	====
OTHER ROADS	-----

**INDEX OF SHEETS:**

TITLE SHEET	1	DECK AND PARAPET DETAILS - UNIT 1	50-57
SITE PLANS	2-4	DECK AND PARAPET DETAILS - UNIT 2	58-66
GENERAL PLANS	5-7	DECK AND PARAPET DETAILS - UNIT 6	67-70
GENERAL NOTES	8-10	DECK POURING SEQUENCE	71
REFERENCE CHORD LAYOUT	11	FINAL DECK ELEVATION TABLES	72-81
STAGED CONSTRUCTION DETAILS	12-24	EXAMPLE DECK SCREED ELEVATION TABLE	82
REMOVALS	25-33	EXPANSION JOINT DETAILS	83
ABUTMENT DETAILS	34-36	APPROACH SLABS AND PARAPETS	84-88
BEARING DETAILS	37-41	DRAINAGE AND SCUPPER DETAILS	89-93
FRAMING PLAN AND STEEL DETAILS - UNIT 1	42-45	REINFORCING STEEL LIST	94-101
FRAMING PLAN AND STEEL DETAILS - UNIT 2	46-48	Shop Drawings - Bearings	102-120
FRAMING PLAN AND STEEL DETAILS - UNIT 6	49	Shop Drawings - Strip Seal Joints	121-134
		Stay-In-Place Metal Decking Forms	135-146

**DESIGN DESIGNATION**

	IR 75		IR 74		DIRECTIONAL ROADWAY	
	SOUTH OF MITCHELL	SOUTH OF IR 74	WEST OF BEEKMAN	EAST OF BEEKMAN	IR 75 NB TO IR 74 WB	IR 74 EB TO IR 75 SB
CURRENT ADT (2010)	149,400	152,100	75,000	88,300	25,300	25,300
DESIGN YEAR ADT (2030)	174,300	179,200	89,300	102,000	29,800	29,800
DESIGN HOURLY VOLUME (2030)	14,640	15,050	8,040	9,180	4,100	4,380
DIRECTIONAL DISTRIBUTION	0.54	0.70	0.72	0.73	1.00	1.00
TRUCKS (24 HOUR B&C)	0.16	0.13	0.15	0.13	0.03	0.08
DESIGN SPEED	60 MPH	60 MPH	60 MPH	60 MPH	50 MPH	50 MPH
LEGAL SPEED	55 MPH	55 MPH	55 MPH	55 MPH	50 MPH	50 MPH
DESIGN FUNCTIONAL CLASSIFICATION:	URBAN INTERSTATE	URBAN INTERSTATE	URBAN INTERSTATE	URBAN INTERSTATE	URBAN INTERSTATE	URBAN INTERSTATE

NHS PROJECT ----- YES

**DESIGN EXCEPTIONS**

DESIGN FEATURE	APPROVAL DATES	SHEET NUMBERS
STOP. SIGHT DIST. - SB IR 75 (CURVE 6)	4/6/18	SEE BU-14
SHOULDER WIDTH - IR 74-1892R BRIDGE	4/10/18	
SHOULDER WIDTH - RAMP P 1908S BRIDGE	4/11/18	
CURVE RADIUS - RAMP P 1908S BRIDGE	4/11/18	
STOP. SIGHT DIST. - RAMP P 1908S BRIDGE	4/11/18	
S.E. RATE - IR 74 EB CURVE 14, 1908R BRIDGE	4/26/18	

The DBT confirms that the record drawings have been updated to incorporate all red-lined changes and have been approved by the appropriate parties. These updated drawings represent the final and accurate record of the buildable unit's design and construction.



PLAN PREPARED BY:



540 WHITE POND DRIVE, STE E  
AKRON, OH 44320  
(614) 839-0250

**STANDARD CONSTRUCTION DRAWINGS**


STANDARD CONSTRUCTION DRAWINGS											SUPPLEMENTAL SPECIFICATIONS		
BP-1.1	7/28/00	I-2.4	1/15/16	MGS-5.3	7/15/16	VPF-1-90	1/19/18	MT-95.32	7/21/17	TC-21.50	7/15/16	800-2016	1/19/18
BP-2.1	7/17/15			MGS-6.1	1/19/18	HL-10.11	1/19/18	MT-95.50	7/21/17	TC-22.10	10/18/13	806	3/2/15
BP-2.2	7/18/08	MH-1.2	1/15/16			HL-10.12	1/20/17	MT-95.73	1/19/18	TC-22.20	1/17/14	808	10/16/15
BP-2.3	7/18/14			RM-1.1	7/18/14	HL-10.13	1/20/17	MT-98.30	7/21/17	TC-41.30	10/18/13	809	1/19/18
BP-2.4	7/19/13	DM-1.1	7/21/17	RM-4.1	7/21/17	HL-10.15	7/17/15	MT-99.30	1/19/18	TC-42.10	10/18/13	814	7/15/16
BP-3.1	7/18/14	DM-1.2	1/18/13	RM-4.3	7/18/14	HL-20.11	4/21/17	MT-101.70	1/17/14	TC-42.20	10/18/13	821	4/20/12
BP-6.1	7/19/13	DM-1.3	7/18/14	RM-4.4	7/21/17	HL-20.21	1/19/18	MT-101.75	7/15/16	TC-52.10	10/18/13	832	1/17/14
BP-8.1	7/18/08	DM-2.1	1/18/13	RM-4.5	7/21/17	HL-20.24	1/19/18	MT-101.80	1/16/18	TC-52.20	1/19/18	869	10/17/14
		DM-4.1	1/15/16	RM-4.6	7/19/13	HL-30.11	1/19/18	MT-101.90	7/21/17	TC-61.30	1/20/17	908	10/20/17
CB-1.1	1/15/16	DM-4.2	7/20/12	A-1-69	7/19/02	HL-30.21	1/17/14	MT-102.20	7/18/14	TC-65.10	1/17/14	914	7/15/16
CB-1.2	1/15/16	DM-4.3	1/15/16	AS-1-15	7/17/15	HL-30.22	1/17/14	MT-104.10	10/16/15	TC-65.11	7/21/17	921	4/20/12
CB-1.3	1/15/16	DM-4.4	1/15/16	AS-2-15	1/19/18	HL-30.31	1/17/14	MT-105.10	7/19/13	TC-71.10	1/19/18	939	7/17/15
CB-2.1	1/15/16			EXJ-4-87	1/19/18	HL-30.32	1/17/14			TC-72.20	7/15/16		
CB-2.2	1/15/16	MGS-1.1	1/19/18	GSD-1-96	7/19/02	HL-30.33	1/17/14	TC-7.65	1/15/16				
CB-2.3	1/15/16	MGS-2.1	1/19/18	PCB-91	1/18/13	HL-30.41	1/19/18	TC-9.10	1/19/18	ITS-13.10	7/17/15		
CB-3.1	1/15/16	MGS-3.1	1/19/18	PSID-1-13	7/15/16	HL-40.10	1/20/17	TC-9.30	1/19/18	ITS-14.10	7/17/15		
CB-3.3	1/15/16	MGS-3.2	1/18/13	RB-1-55	7/19/13	HL-40.20	1/20/17	TC-12.30	1/19/18	ITS-14.11	7/17/15		
		MGS-4.1	1/20/17	SBR-1-13	1/14/14	HL-50.11	1/16/15	TC-15.115	10/18/13	ITS-15.10	7/17/15		
I-2.1	1/15/16	MGS-4.2	7/19/13	SBR-2-13	1/14/14	HL-50.21	1/19/18	TC-16.21	1/19/18	ITS-15.11	7/17/15		
I-2.2	1/15/16	MGS-4.3	1/18/13	SICD-1-96	7/18/14	MT-95.30	7/21/17	TC-21.10	7/21/17	ITS-50.10	1/19/18		
I-2.3	1/15/16	MGS-5.2	7/15/16	SICD-2-14	7/18/14	MT-95.31	7/21/17	TC-21.20	1/19/18				

**SPECIAL PROVISIONS**

FEDERAL PROJECT NO. E170 (713)  
PID NO. 104667  
CONSTRUCTION PROJECT NO. 183000  
RAILROAD INVOLVEMENT CSXT (CSX OP# OH1179) NORFOLK SOUTHERN  
HAM-75-3.84

SUSER SPATES STIMESTAMPS 9/22/2023 4:49:05 PM erin.baumann  
P:\Projects\2018\04667\structures\HAM074\_1908R\sheet\074\_1908R.ctb

P:\Projects\2018\20H03DB-18232 HAM-75-03.84\104667\structures\HAM074\_1908R\sheets\074\_1908R\_SF001.dgn 9/20/2023 6:41:24 PM erin.baumann

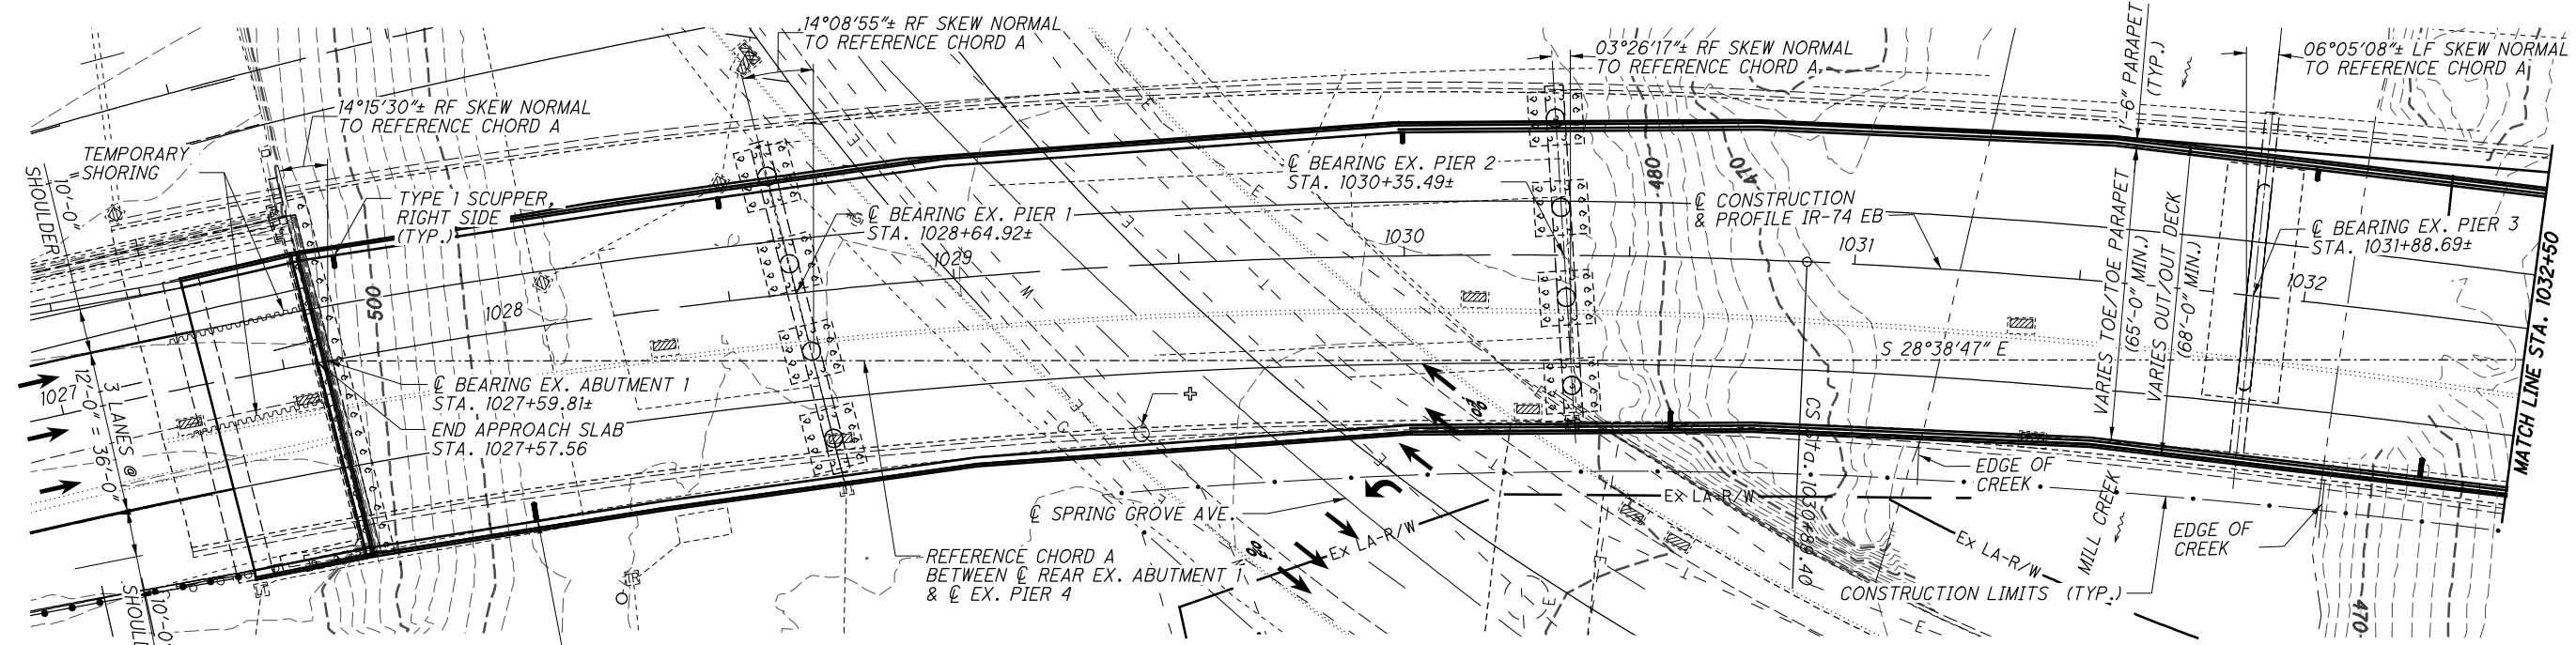

PLAN

**HORIZONTAL CURVE DATA**  
**IR-74 EB**

C13	PI STA 1028+73.19	p = 4.53'
	$\Delta = 33^\circ 33' 19''$ (RT)	$\Delta c = 17^\circ 57' 19''$ (RT)
	Dc = 3° 54' 00"	Lc = 460.39'
	R = 1,469.12'	Ts = 644.17'
	Ls = 400.00'	Es = 70.05'
	$\theta_s = 7^\circ 48' 00''$	C = 458.51'
	LT = 266.93'	C1 = C2 = 399.67'
	ST = 133.57'	C.B.1 = S 49° 10' 33" E
	x = 399.26'	C.B. = S 34° 59' 53" E
	y = 18.13'	C.B.2 = N 20° 49' 12" W
	k = 199.88'	$\theta_{max} = 0.075$

**LEGEND:**

- ⊕ - 16'-6" REQUIRED MINIMUM VERTICAL CLEARANCE
- ⊕ - 21'-7" PROPOSED MINIMUM VERTICAL CLEARANCE
- - TEMPORARY SHORING

**EXISTING STRUCTURE**

TYPE: CONTINUOUS WELDED PLATE GIRDER AND CONTINUOUS ROLLED STEEL BEAM WITH REINFORCED CONCRETE DECK AND SUBSTRUCTURE

SPANS: UNIT 1 - 105'-0"±, 174'-0"±, 157'-0"±, 110'-0"±  
 UNIT 2 - 113'-3"±, 143'-3"±, 127'-6"±  
 UNIT 6 - 52'-1/2"±, 65'-0"±, 52'-0"±


ROADWAY: VARIES  
 LOADING: CF 2000 (57) AND ALTERNATE MILITARY  
 SKEW: VARIES  
 APPROACH SLABS: AS-1-67 (25' LONG)  
 ALIGNMENT: VARIES  
 CROWN: VARIES  
 STRUCTURAL FILE NUMBER: 3115739  
 DATE BUILT: 1973  
 DISPOSITION: MAJOR REHABILITATION

**PROPOSED STRUCTURE**

TYPE: CONTINUOUS WELDED PLATE GIRDER AND CONTINUOUS ROLLED STEEL BEAM WITH NEW COMPOSITE REINFORCED CONCRETE DECK AND SUBSTRUCTURE

SPANS: UNIT 1 - 105'-1/8"±, 170'-7/2"±, 153'-2"±, 109'-8 3/8"±, 5'-11"± (HINGE)  
 UNIT 2 - 120'-2 7/8"±, 150'-7 1/4"±, 126'-4 1/4"±, 7'-3 5/8" (HINGE)  
 UNIT 6 - 51'-4 1/8"±, 64'-4 1/4"±, 51'-5 1/2"±

ROADWAY: VARIES (65'-0" MIN. TOE/TOE PARAPET)  
 LOADING: HS20 CASE I & ALTERNATE MILITARY LOADING  
 SKEW: VARIES  
 WEARING SURFACE: 1" MONOLITHIC CONCRETE  
 APPROACH SLABS: 25'-0" LONG (AS-1-15 & AS-2-15)  
 ALIGNMENT: VARIES  
 SUPERELEVATION: VARIES, 0.075 FT./FT. MAX  
 COORDINATES: LATITUDE 39°09'15.26"  
 LONGITUDE 84°32'32.60"

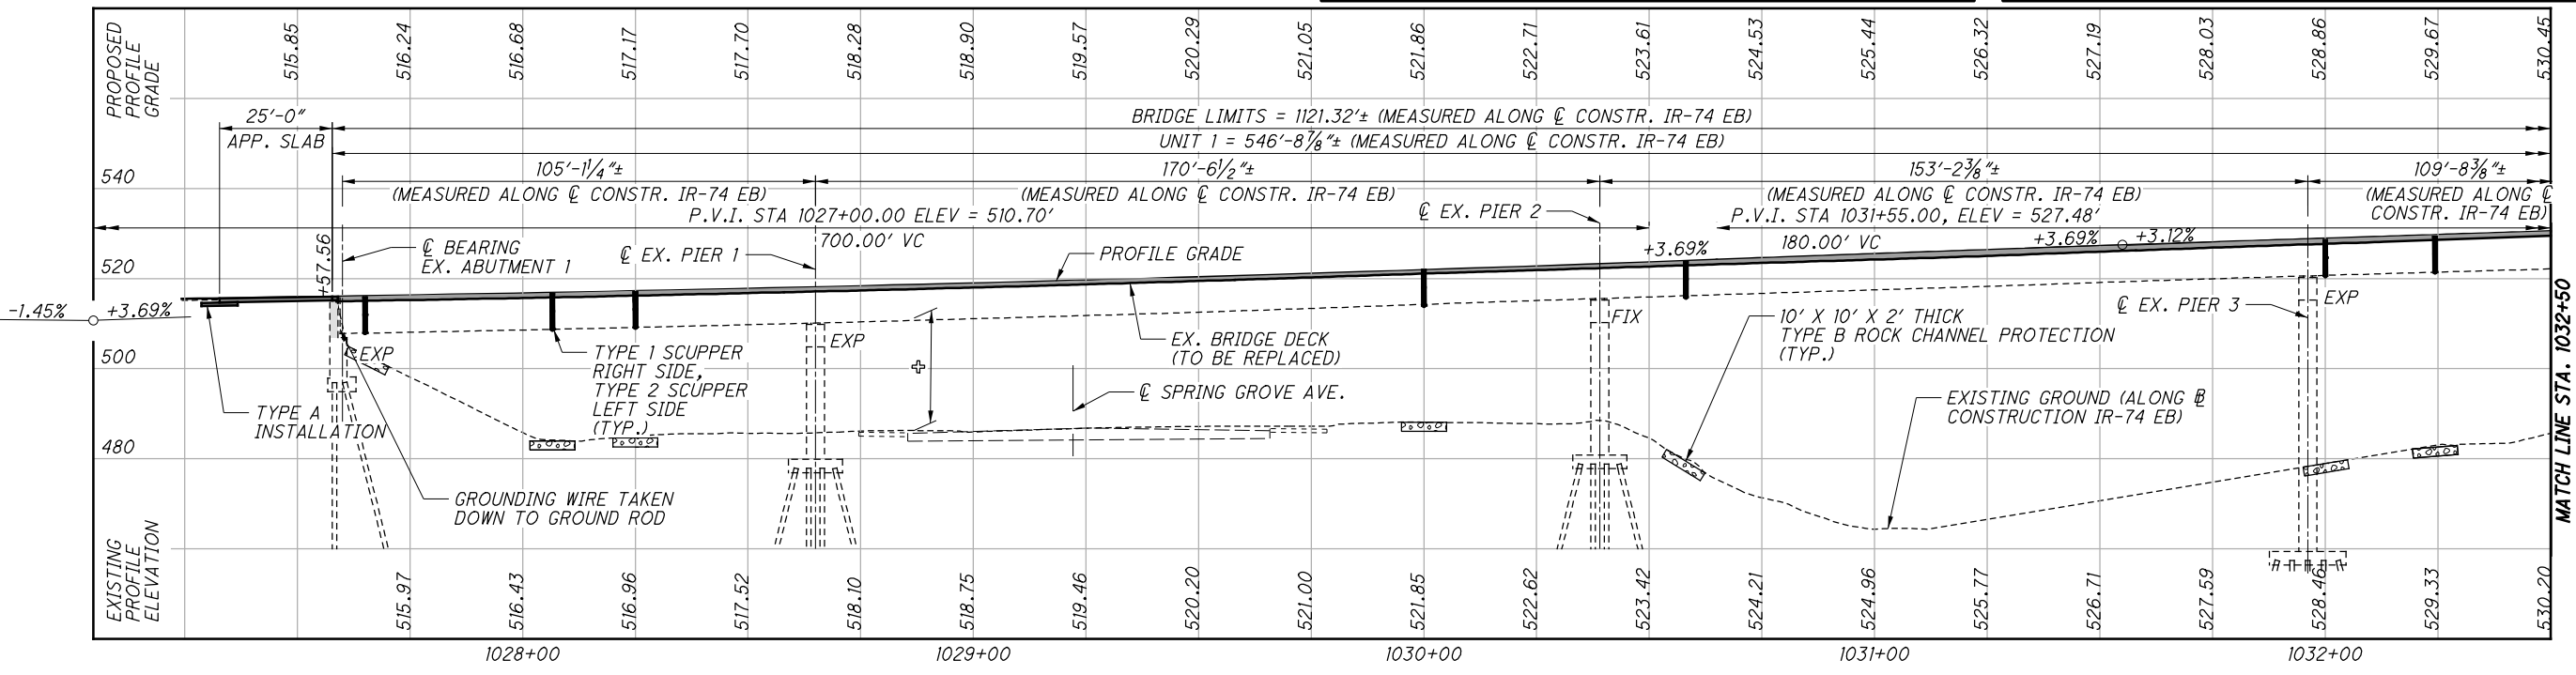

PROFILE ALONG  $\text{\textcircled{C}}$  CONSTRUCTION IR-74 EB



DESIGN AGENCY: **PRIMEW**  
 540 WHITE POND DR. SUITE E  
 AKRON, OH 44320

DATE: 3/27/2019  
 REVIEWED: TES  
 STRUCTURE FILE NUMBER: 3115739

DESIGNED: KDC  
 CHECKED: CRG

HAMILTON COUNTY  
 STA. 1027+57.56  
 STA. 1038+78.88


**SITE PLAN (1 OF 3)**  
 BRIDGE NO. HAM-74-1908R  
 IR-74 OVER MILL CREEK, RR & SPRING GROVE AVENUE

**HAM-75-3.84**  
 PID No. 104667

2/100  
 2/100



P:\Projects\2018\20H03DB-18232 HAM-75-03.84\104667\structures\HAM074\_1908R\sheets\074\_1908R\_SF002.dgn 9/21/2023 10:34:03 AM erin.baumann

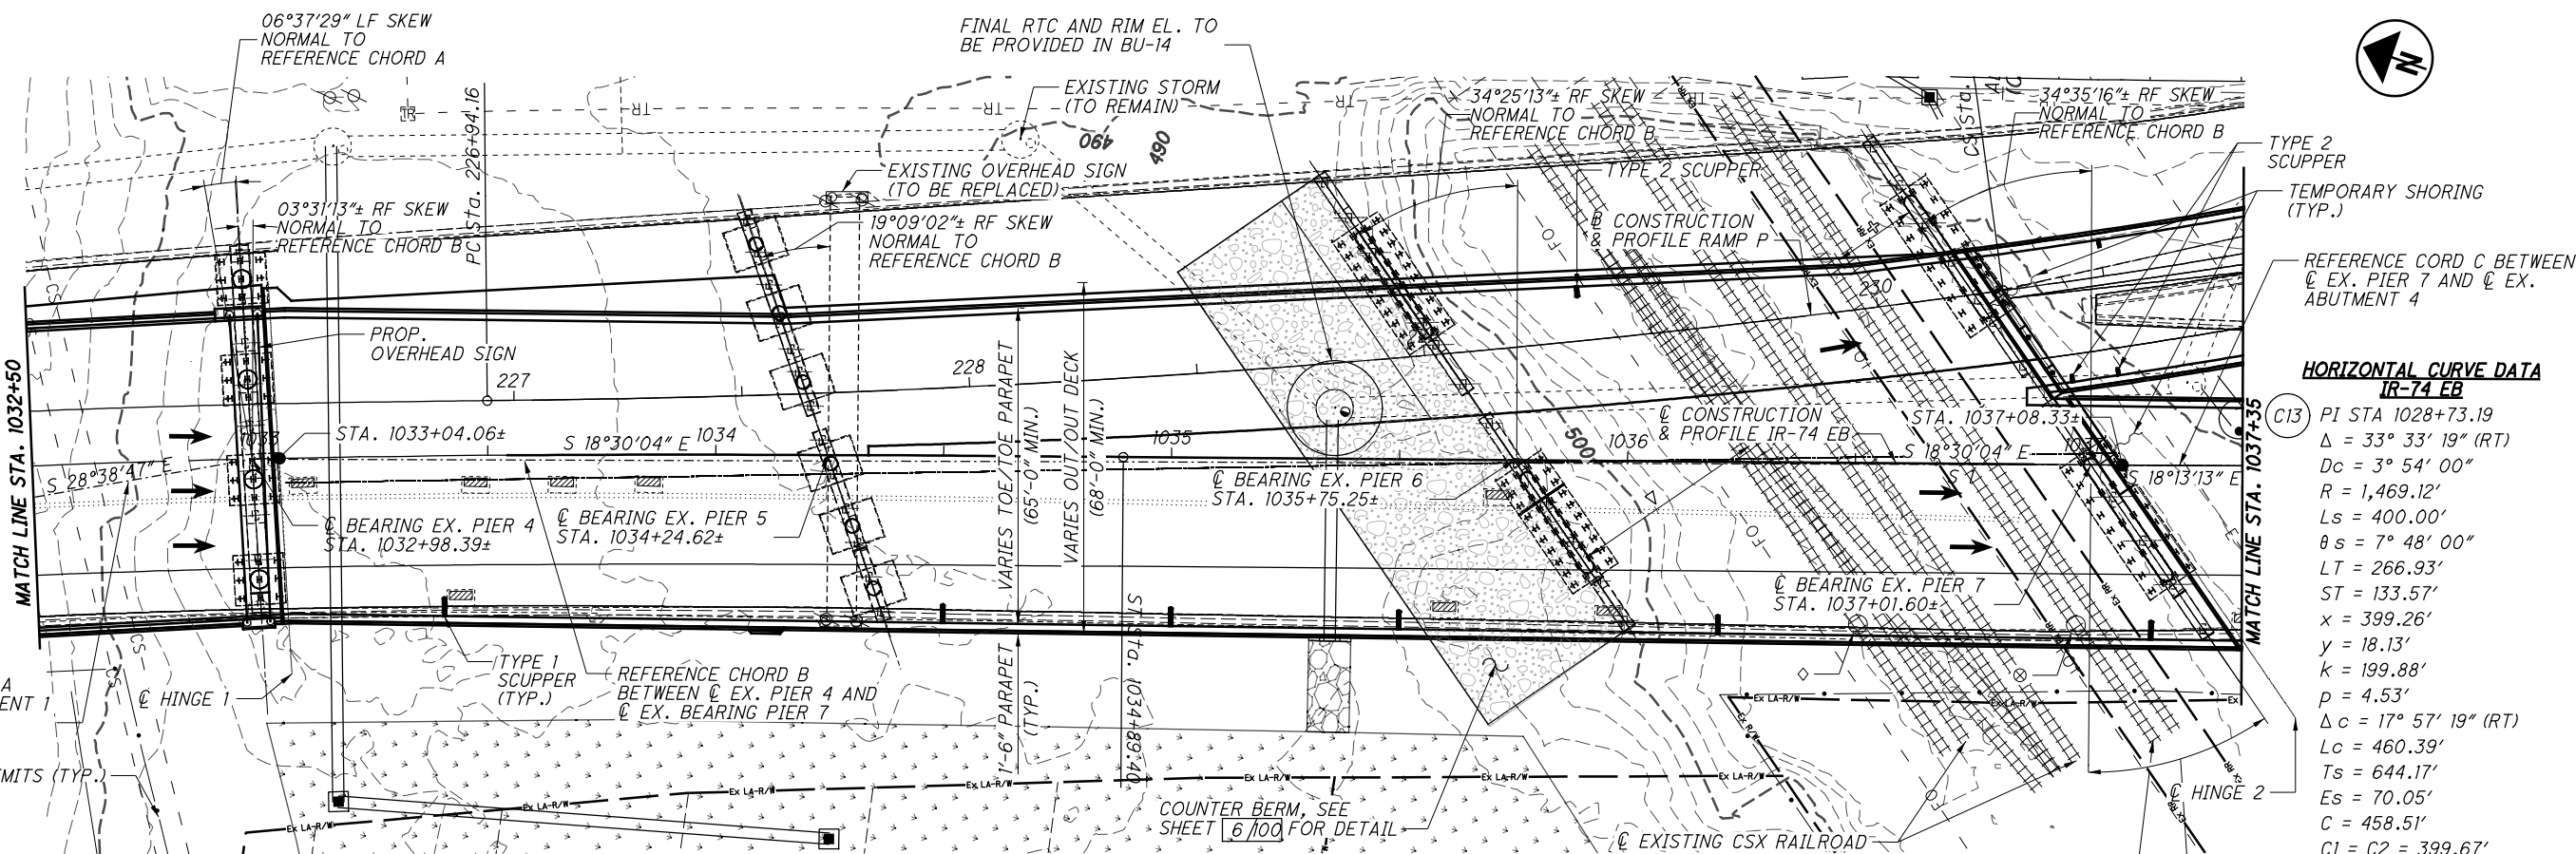



**HORIZONTAL CURVE DATA**  
**IR-74 EB**

C13

PI STA	1028+73.19
Δ	= 33° 33' 19" (RT)
Dc	= 3° 54' 00"
R	= 1,469.12'
Ls	= 400.00'
θs	= 7° 48' 00"
LT	= 266.93'
ST	= 133.57'
x	= 399.26'
y	= 18.13'
k	= 199.88'
p	= 4.53'
Δc	= 17° 57' 19" (RT)
Lc	= 460.39'
Ts	= 644.17'
Es	= 70.05'
C	= 458.51'
C1 = C2	= 399.67'
C.B.1	= S 49° 10' 33" E
C.B.2	= S 34° 59' 53" E
C.B.2	= N 20° 49' 12" W
emax	= 0.075

- LEGEND:**
- - MEASURED ALONG REFERENCE CHORD A
  - ◇ - EXISTING MINIMUM VERTICAL CLEARANCE = 22'-2"±  
 REQUIRED MINIMUM VERTICAL CLEARANCE = 22'-0"±  
 PROPOSED MINIMUM VERTICAL CLEARANCE = 22'-2"±
  - ⊗ - EXISTING MINIMUM VERTICAL CLEARANCE = 22'-7"±  
 REQUIRED MINIMUM VERTICAL CLEARANCE = 22'-0"±  
 PROPOSED MINIMUM VERTICAL CLEARANCE = 22'-7"±
  - ∇ - TEMPORARY SHORING
  - ▽ - EXISTING MINIMUM HORIZONTAL CLEARANCE = 42'-10"±  
 REQUIRED MINIMUM HORIZONTAL CLEARANCE = 14'-0"±  
 PROPOSED MINIMUM HORIZONTAL CLEARANCE = 42'-10"±
  - ⊕ - EXISTING MINIMUM HORIZONTAL CLEARANCE = 18'-6"±  
 REQUIRED MINIMUM HORIZONTAL CLEARANCE = 14'-0"±  
 PROPOSED MINIMUM HORIZONTAL CLEARANCE = 18'-6"±

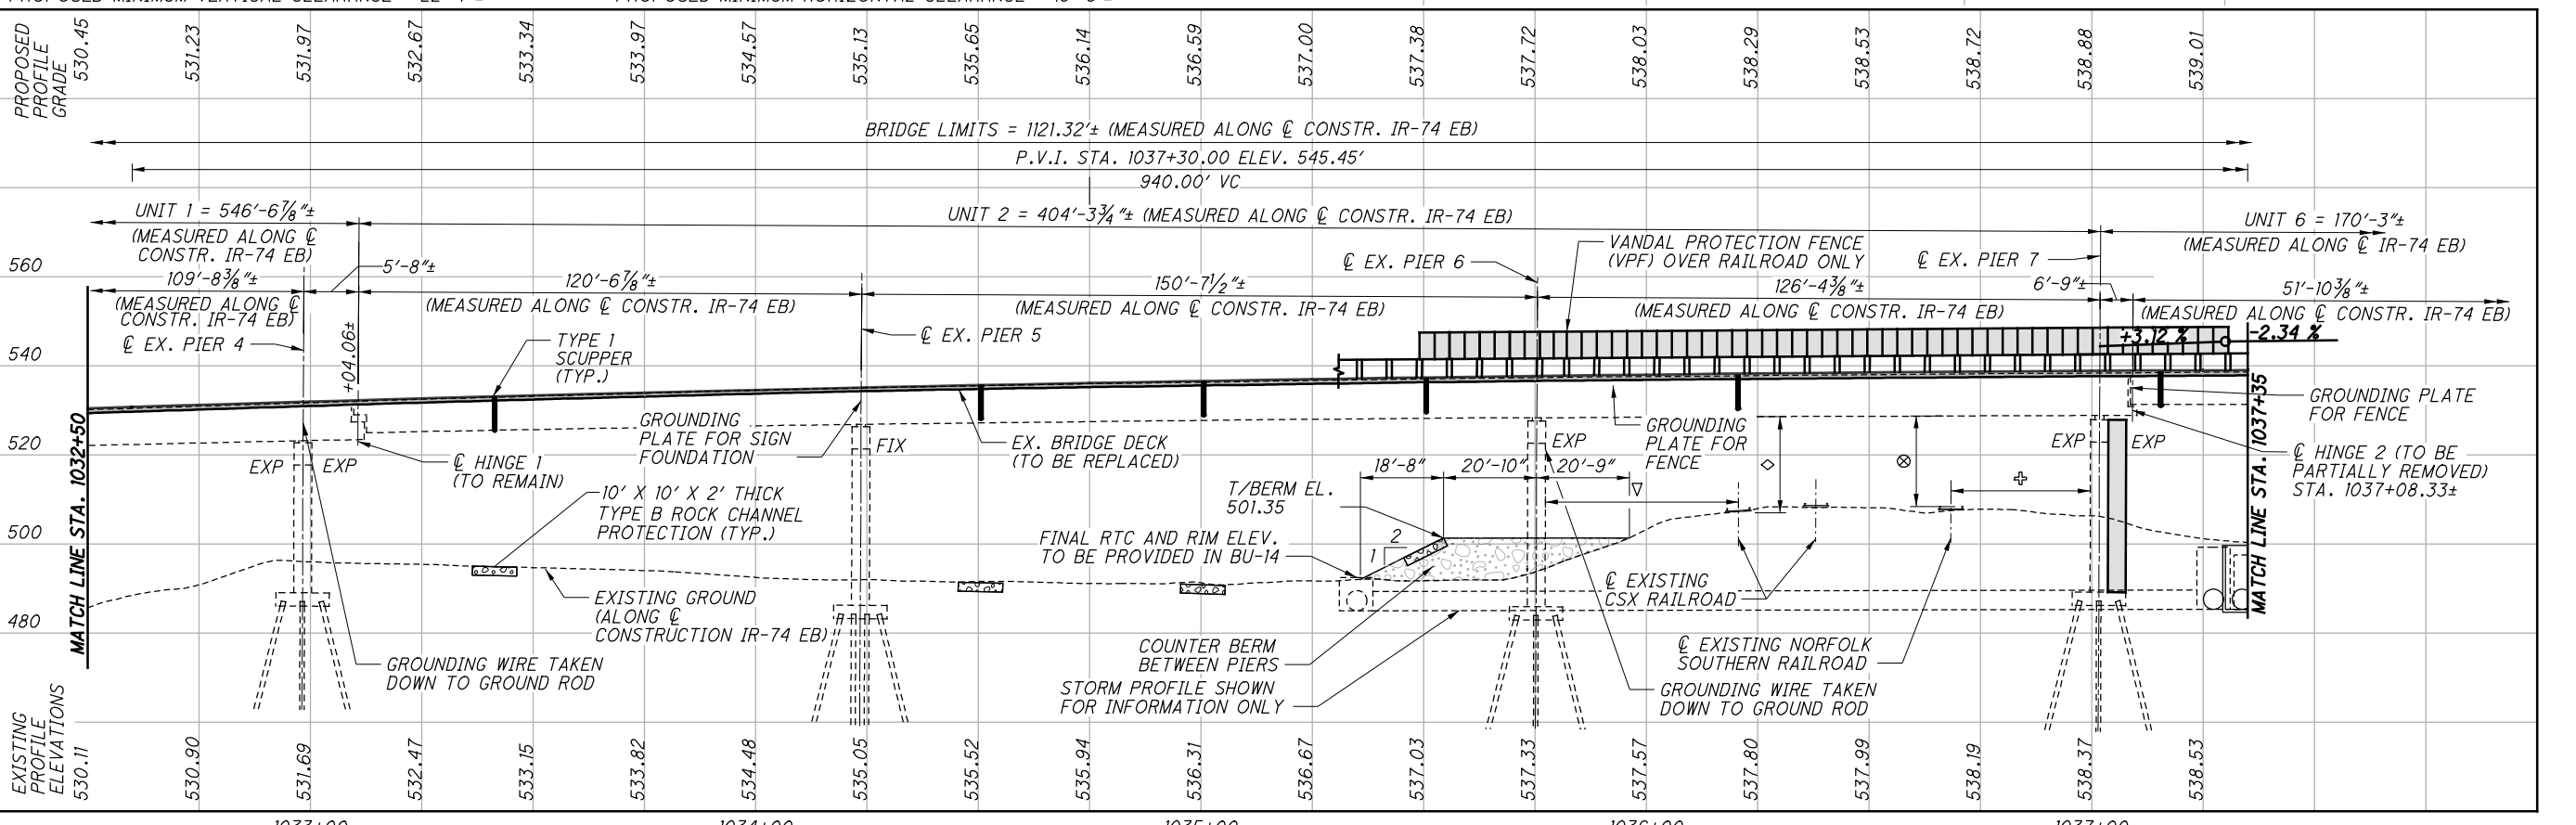


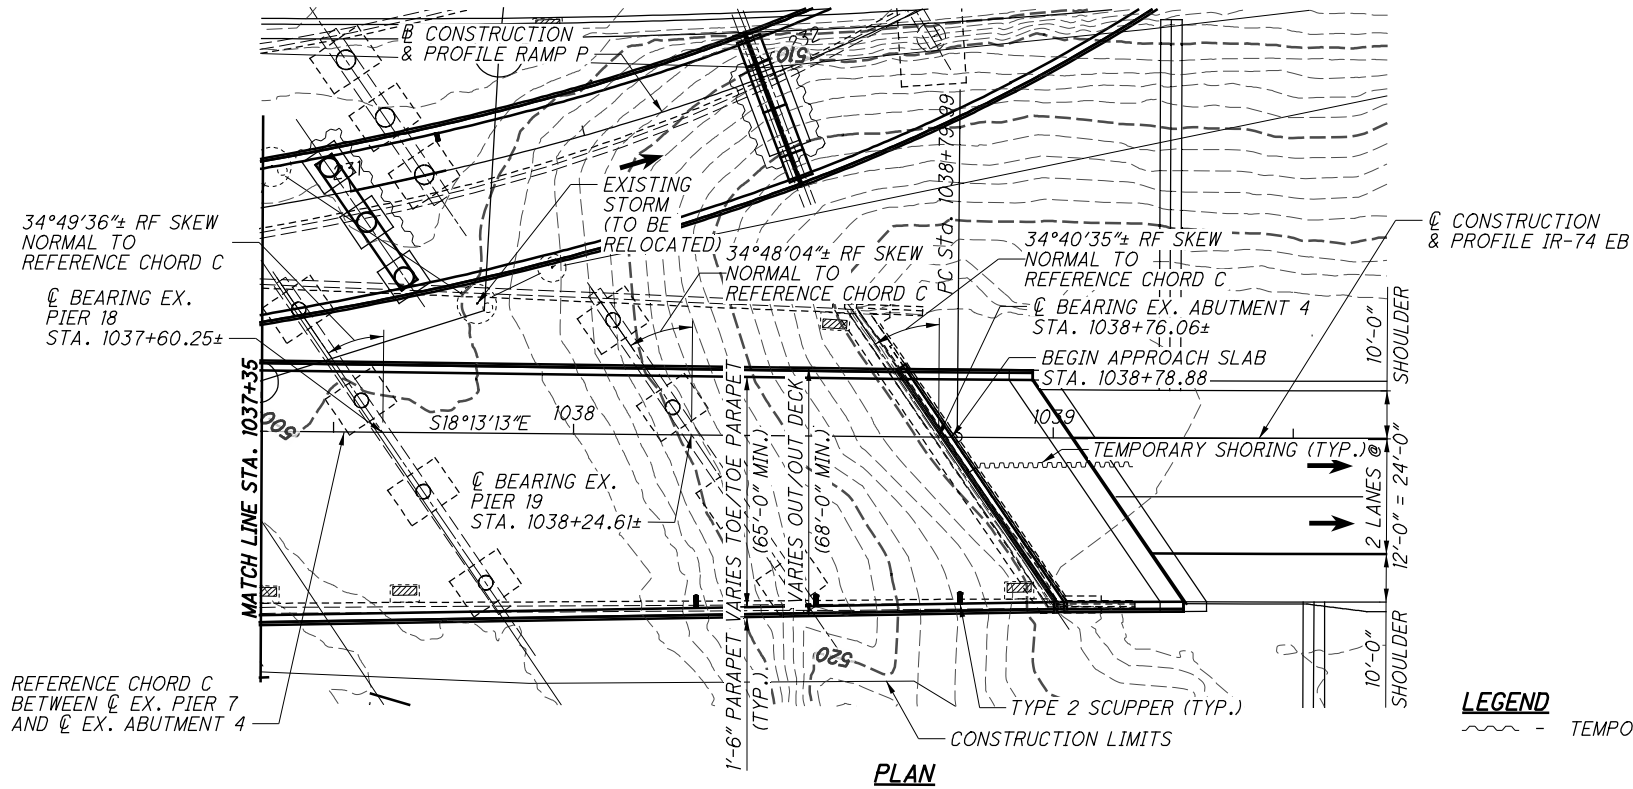

**HORIZONTAL CURVE DATA**  
**IR-74 EB**


C14 PI STA 1040+29.02  
 $\Delta = 1^\circ 29' 25''$  (LT)  
 50mph  $D_c = 0^\circ 30' 00''$   
 $R = 11,459.16'$   
 $T = 149.03'$   
 $L = 298.05'$   
 $E = 0.97'$   
 $C = 298.04'$   
 $C.B. = S 18^\circ 57' 56'' E$

**LEGEND**  
 TEMPORARY SHORING

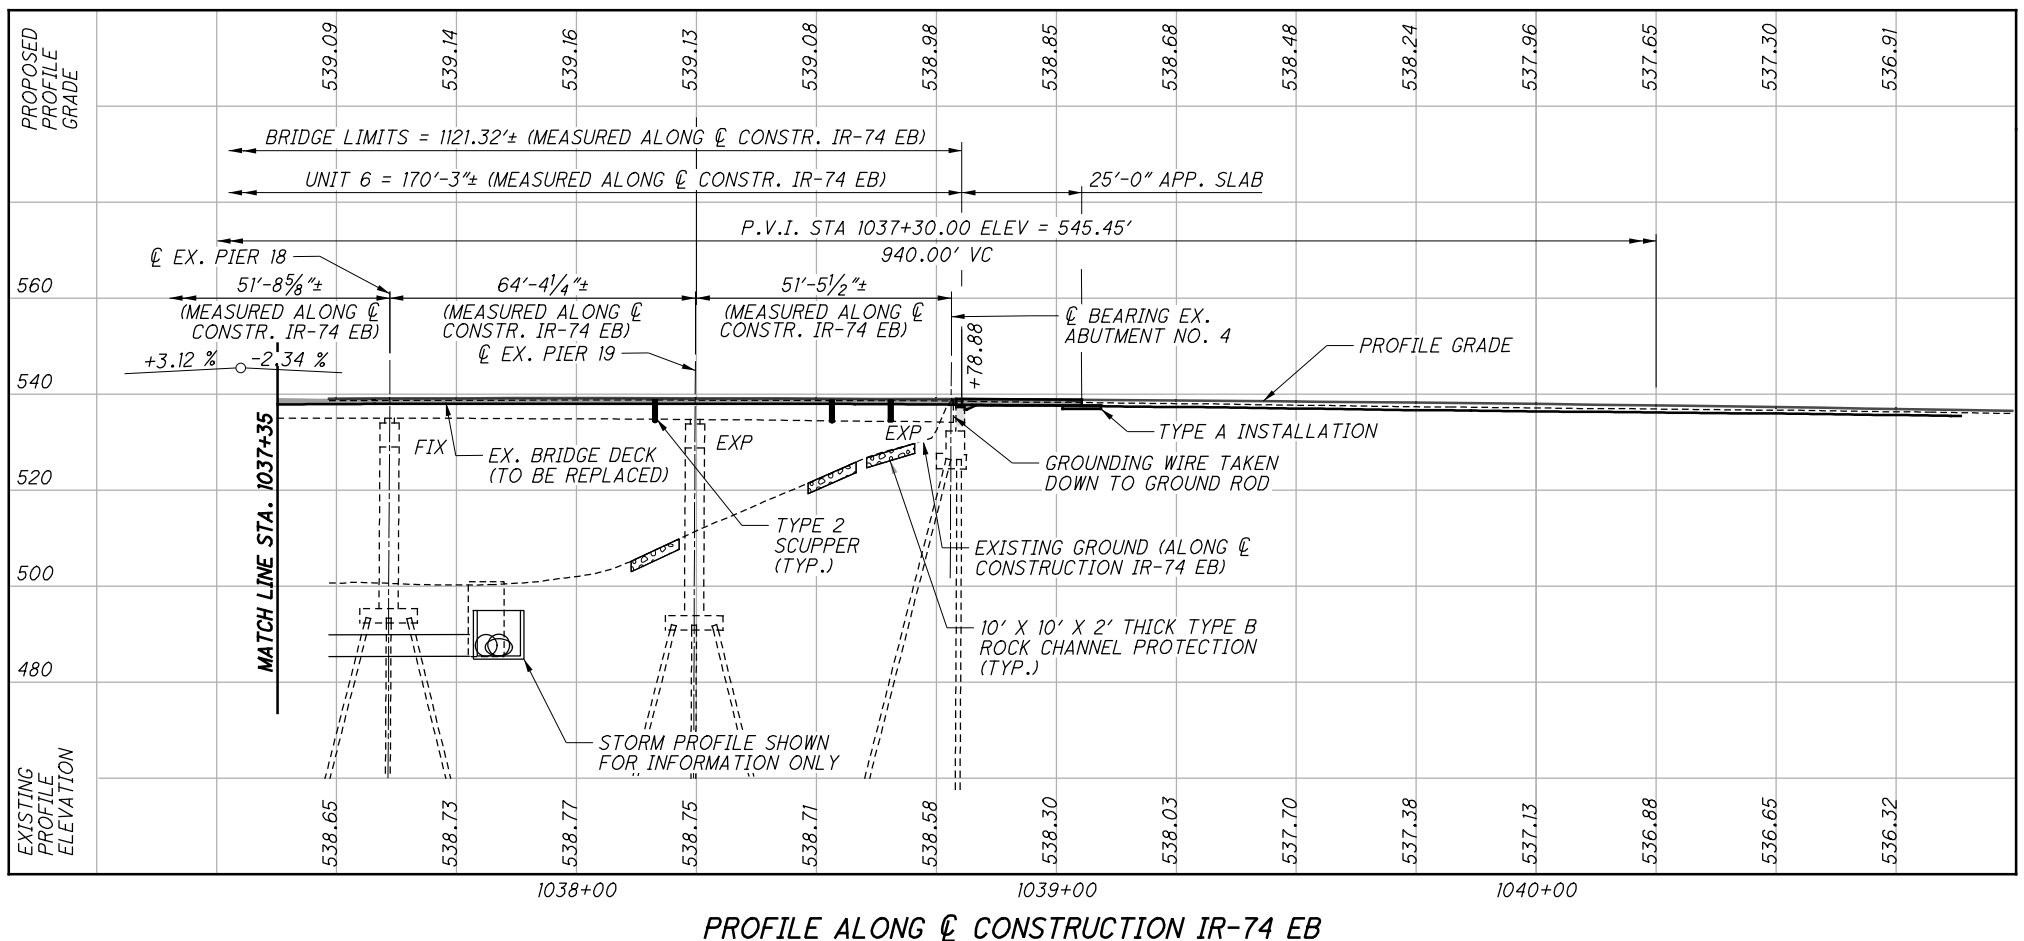

P:\Projects\2018\20H03DB-18232 HAM-75-03.84\104667\structures\HAM074\_1908R\sheets\074\_1908R\_SF003.dgn 9/8/2023 5:14:24 PM erin.baumann

P:\Projects\2018\20H03DB-18232 HAM-75-03.84\104667\structures\HAM074\_1908R\sheets\074\_1908R\_GPO01.dgn 9/21/2023 11:35:29 AM erin.baumann

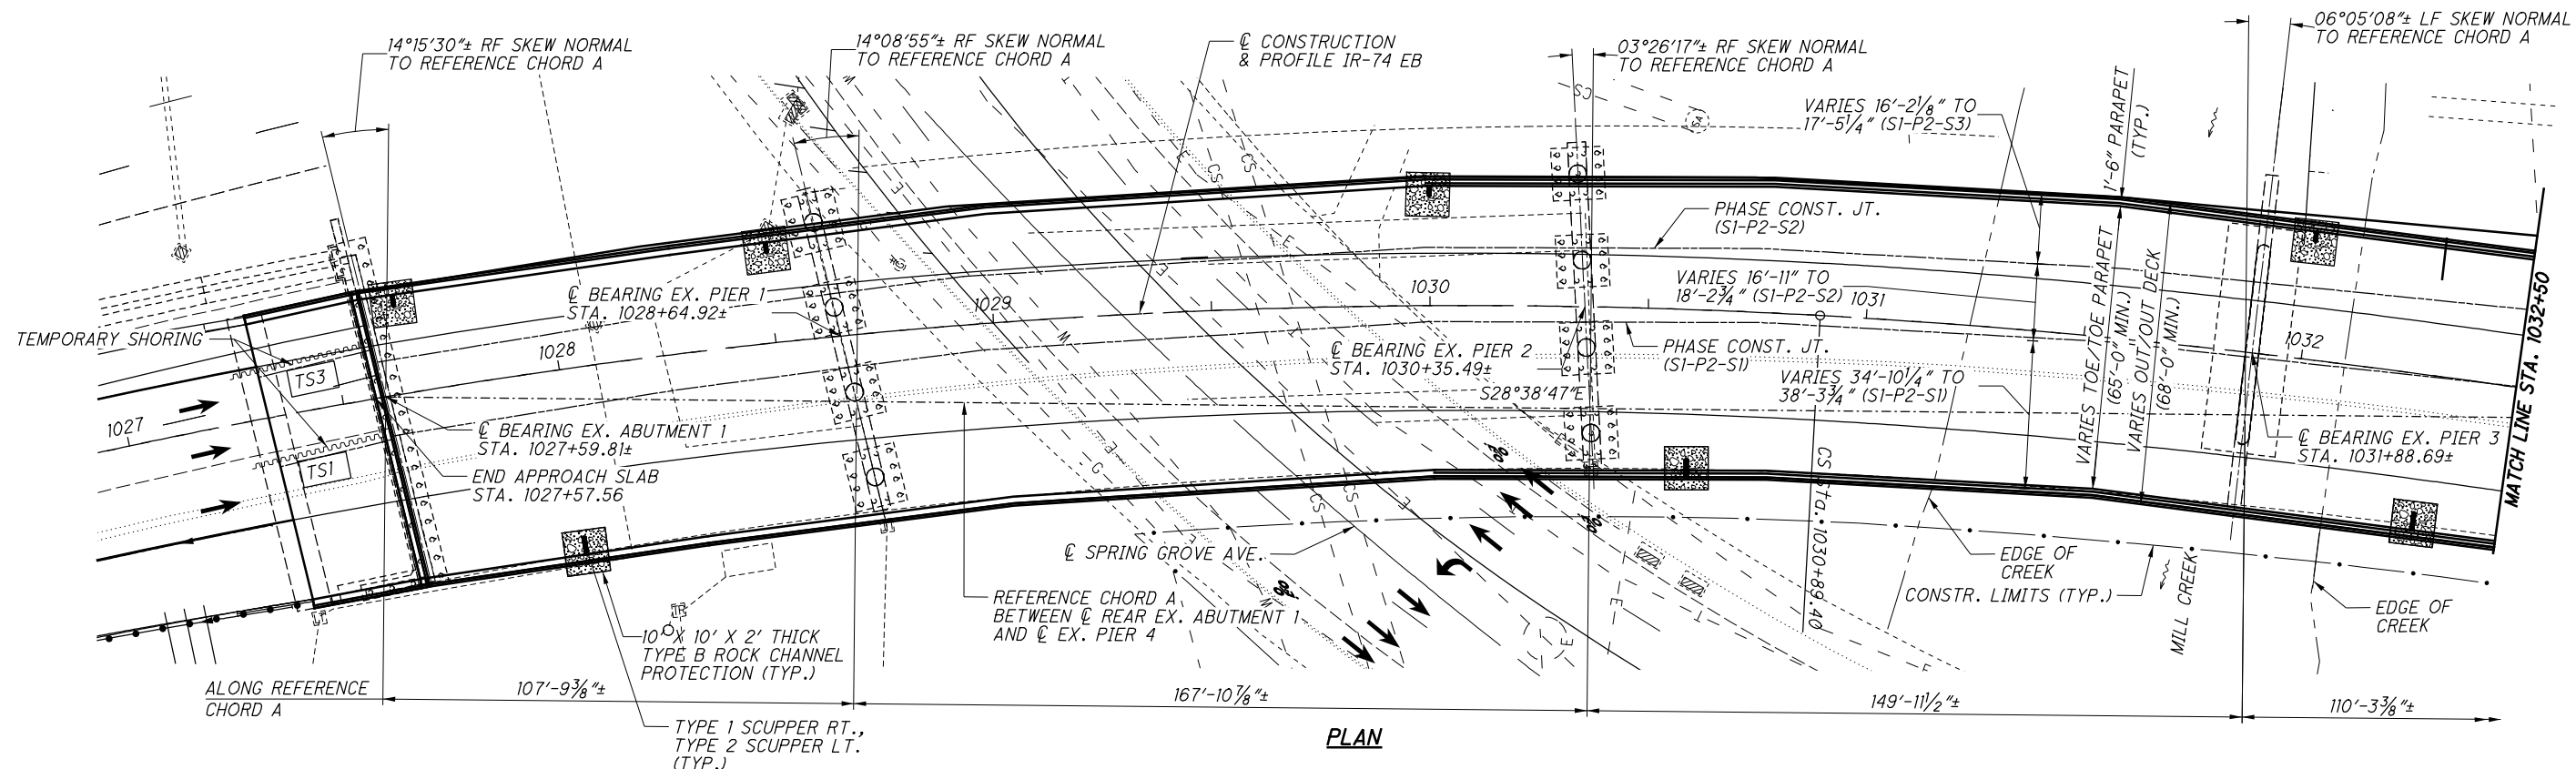

PLAN

**HORIZONTAL CURVE DATA**  
**IR-74 EB**

- C13 PI STA 1028+73.19
- $\Delta = 33^\circ 33' 19''$  (RT)
- $D_c = 3^\circ 54' 00''$
- $R = 1,469.12'$
- $L_s = 400.00'$
- $\theta_s = 7^\circ 48' 00''$
- $LT = 266.93'$
- $ST = 133.57'$
- $x = 399.26'$
- $y = 18.13'$
- $K = 199.88'$
- $p = 4.53'$
- $\Delta_c = 17^\circ 57' 19''$  (RT)
- $L_c = 460.39'$
- $T_s = 644.17'$
- $E_s = 70.05'$
- $C = 458.51'$
- $C1 = C2 = 399.67'$
- $C.B.1 = S 49^\circ 10' 33'' E$
- $C.B. = S 34^\circ 59' 53'' E$
- $C.B.2 = N 20^\circ 49' 12'' W$
- $e_{max} = 0.075$

**LEGEND**

- SX-PX-SX - STAGE X, PHASE X, STEP X (MOT PHASING)
- TS# - TEMPORARY SHORING LOCATION
- ~ - TEMPORARY SHORING

**NOTE:**

1. FOR DESCRIPTION OF PROPOSED WORK, SEE SHEET 8/100.



<p><b>HAM-75-3.84</b> PID No. 104667</p>	<p><b>GENERAL PLAN (1 OF 3)</b> BRIDGE NO. HAM-74-1908R IR-74 OVER MILL CREEK, RR &amp; SPRING GROVE AVENUE</p>	<p>HAMILTON COUNTY STA. 1027+56.76 STA. 1038+78.88</p>	<p>DESIGNED KDC CHECKED CRG</p>	<p>DRAWN KDC REVISED</p>	<p>REVIEWED TES</p>	<p>DATE 3/27/2019</p>	<p>STRUCTURE FILE NUMBER 3115739</p>	<p>DESIGN AGENCY <b>PRIMEW</b> 540 WHITE POND DR. SUITE E AKRON, OH 44320</p>
----------------------------------------------	-------------------------------------------------------------------------------------------------------------------------	----------------------------------------------------------------	---------------------------------------------	----------------------------------	-------------------------	---------------------------	------------------------------------------	-------------------------------------------------------------------------------------------



P:\Projects\2018\20H03DB-18232 HAM-75-03.84\104667\structures\HAM074\_1908R\sheets\074\_1908R\_GP002.dgn 9/21/2023 11:44:48 AM erin.baumann

REFERENCE CHORD A BETWEEN  $\text{C}$  ABUTMENT 1 AND  $\text{C}$  PIER 4

06°37'29" LF SKEW NORMAL TO REFERENCE CHORD A

19°09'02" RF SKEW NORMAL TO REFERENCE CHORD B

CONSTRUCTION & PROFILE RAMP P

FINAL RTC AND RIM ELEV. TO BE PROVIDED IN BU-14

34°25'13" RF SKEW NORMAL TO REFERENCE CHORD B


$\text{C}$  EXISTING NORFOLK SOUTHERN RAILROAD

34°35'16" RF SKEW NORMAL TO REFERENCE CHORD B


REFERENCE CHORD C BETWEEN  $\text{C}$  EX. PIER 7 AND  $\text{C}$  EX. ABUTMENT 4

**HORIZONTAL CURVE DATA IR-74 EB**

C13 PI STA 1028+73.19  
 $\Delta = 33^\circ 33' 19''$  (RT)  
 $D_c = 3^\circ 54' 00''$   
 $R = 1,469.12'$   
 $L_s = 400.00'$   
 $\theta_s = 7^\circ 48' 00''$   
 $LT = 266.93'$   
 $ST = 133.57'$   
 $x = 399.26'$   
 $y = 18.13'$   
 $k = 199.88'$   
 $p = 4.53'$   
 $\Delta_c = 17^\circ 57' 19''$  (RT)  
 $L_c = 460.39'$   
 $T_s = 644.17'$   
 $E_s = 70.05'$   
 $C = 458.51'$   
 $C1 = C2 = 399.67'$   
 $C.B.1 = S 49^\circ 10' 33'' E$   
 $C.B. = S 34^\circ 59' 53'' E$   
 $C.B.2 = N 20^\circ 49' 12'' W$   
 $e_{max} = 0.075$

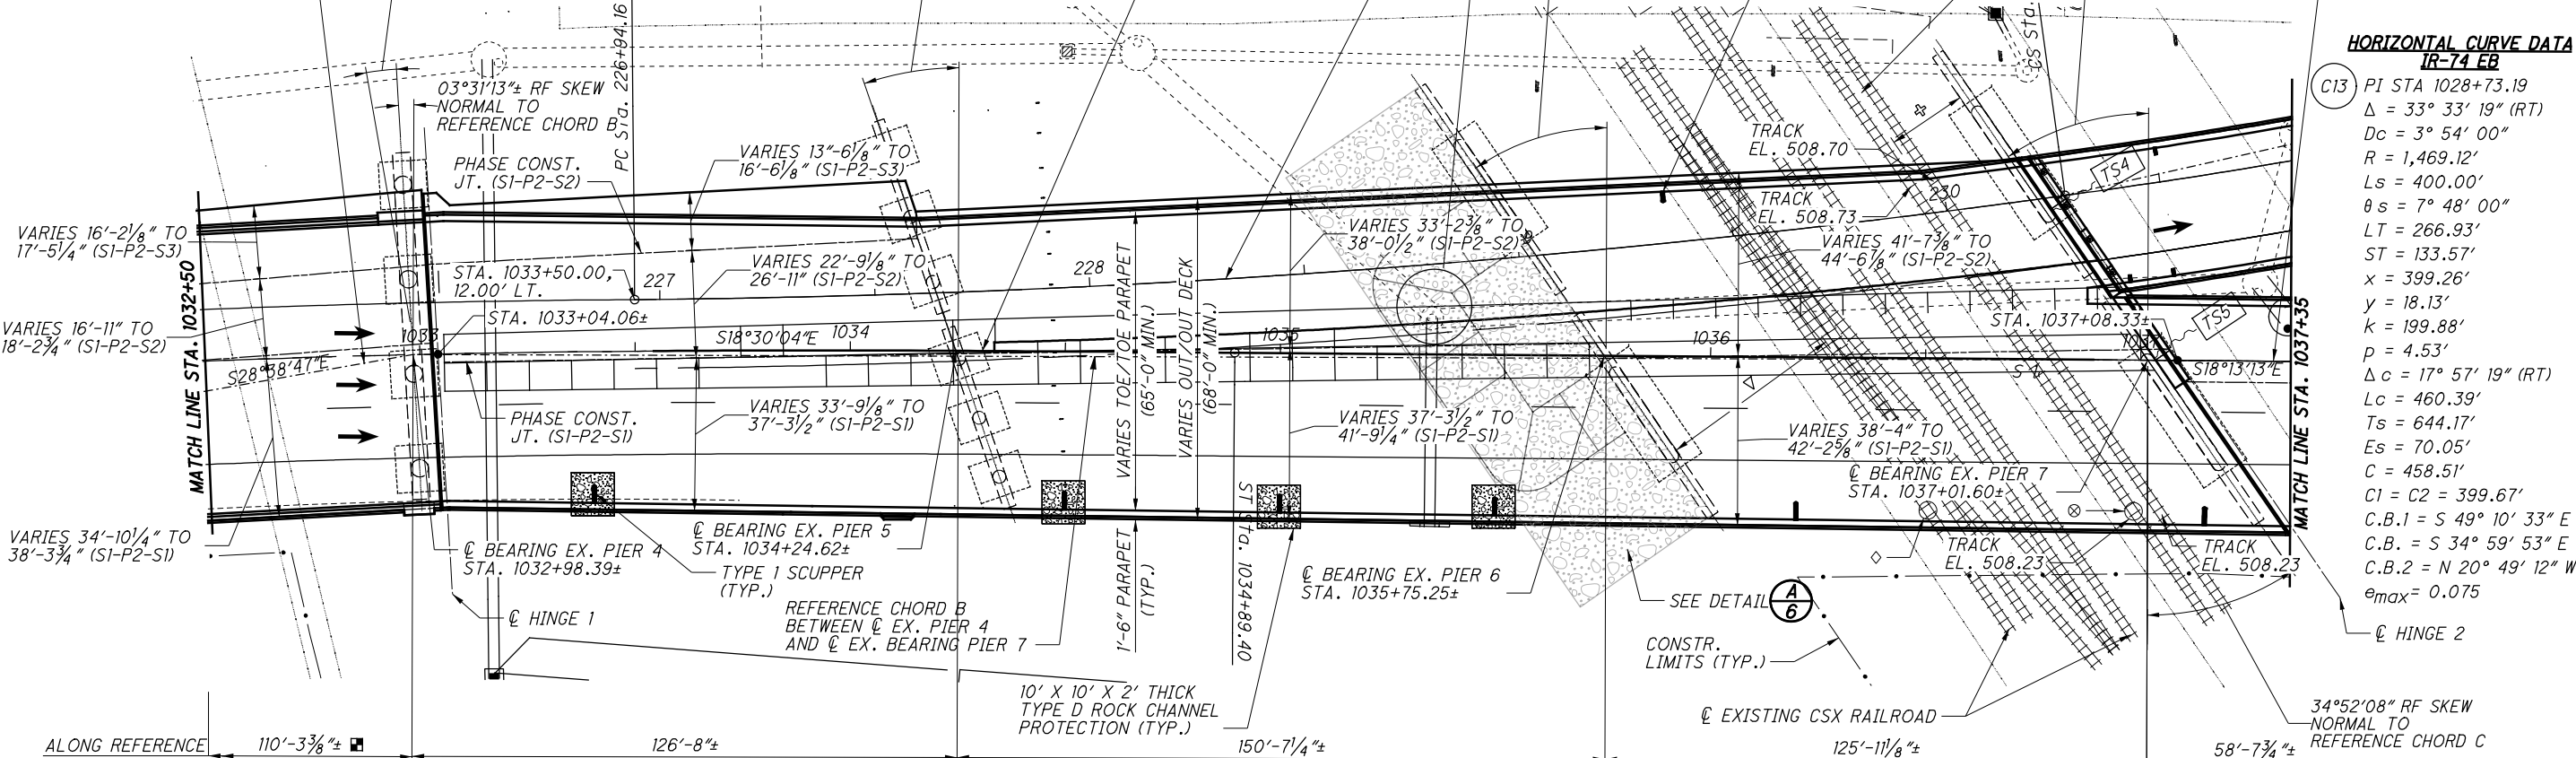

**PLAN**

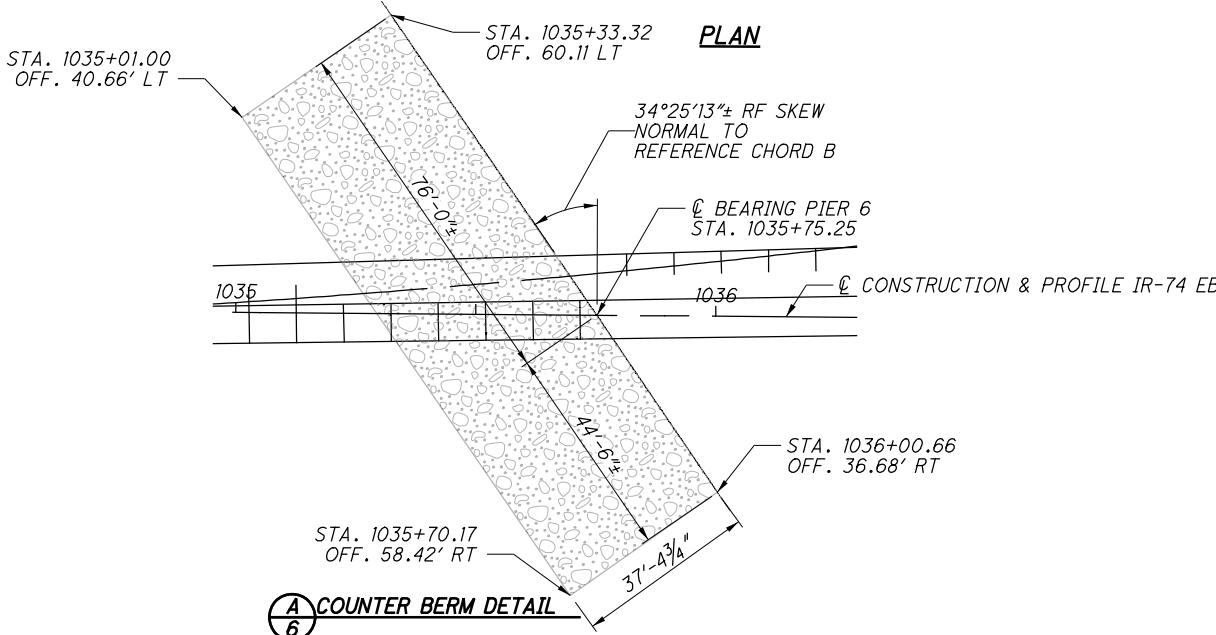

**LEGEND:**

- - MEASURED ALONG REFERENCE CHORD A
- ◇ - EXISTING MINIMUM VERTICAL CLEARANCE = 22'-2"±  
 REQUIRED MINIMUM VERTICAL CLEARANCE = 22'-0"  
 PROPOSED MINIMUM VERTICAL CLEARANCE = 22'-2"±
- ▽ - EXISTING MINIMUM HORIZONTAL CLEARANCE = 42'-10"±  
 REQUIRED MINIMUM HORIZONTAL CLEARANCE = 14'-0"  
 PROPOSED MINIMUM HORIZONTAL CLEARANCE = 42'-10"±
- ⊗ - EXISTING MINIMUM VERTICAL CLEARANCE = 22'-7"±  
 REQUIRED MINIMUM VERTICAL CLEARANCE = 22'-0"  
 PROPOSED MINIMUM VERTICAL CLEARANCE = 22'-7"±
- ⊕ - EXISTING MINIMUM HORIZONTAL CLEARANCE = 18'-6"±  
 REQUIRED MINIMUM HORIZONTAL CLEARANCE = 14'-0"  
 PROPOSED MINIMUM HORIZONTAL CLEARANCE = 18'-6"±


SX-PX-SX - STAGE X, PHASE X, STEP X (MOT PHASING)

- TS# - TEMPORARY SHORING LOCATION
- ~ - TEMPORARY SHORING
- ▨ - INDICATES ITEM 203 EMBANKMENT

**NOTE:**

1. FOR DESCRIPTION OF PROPOSED WORK, SEE SHEET 8/100.

P:\Projects\2018\20H03DB-18232 HAM-75-03.84\104667\structures\HAM074\_1908R\sheets\074\_1908R\_GP003.dgn 6/20/2019 9:02:48 AM asead

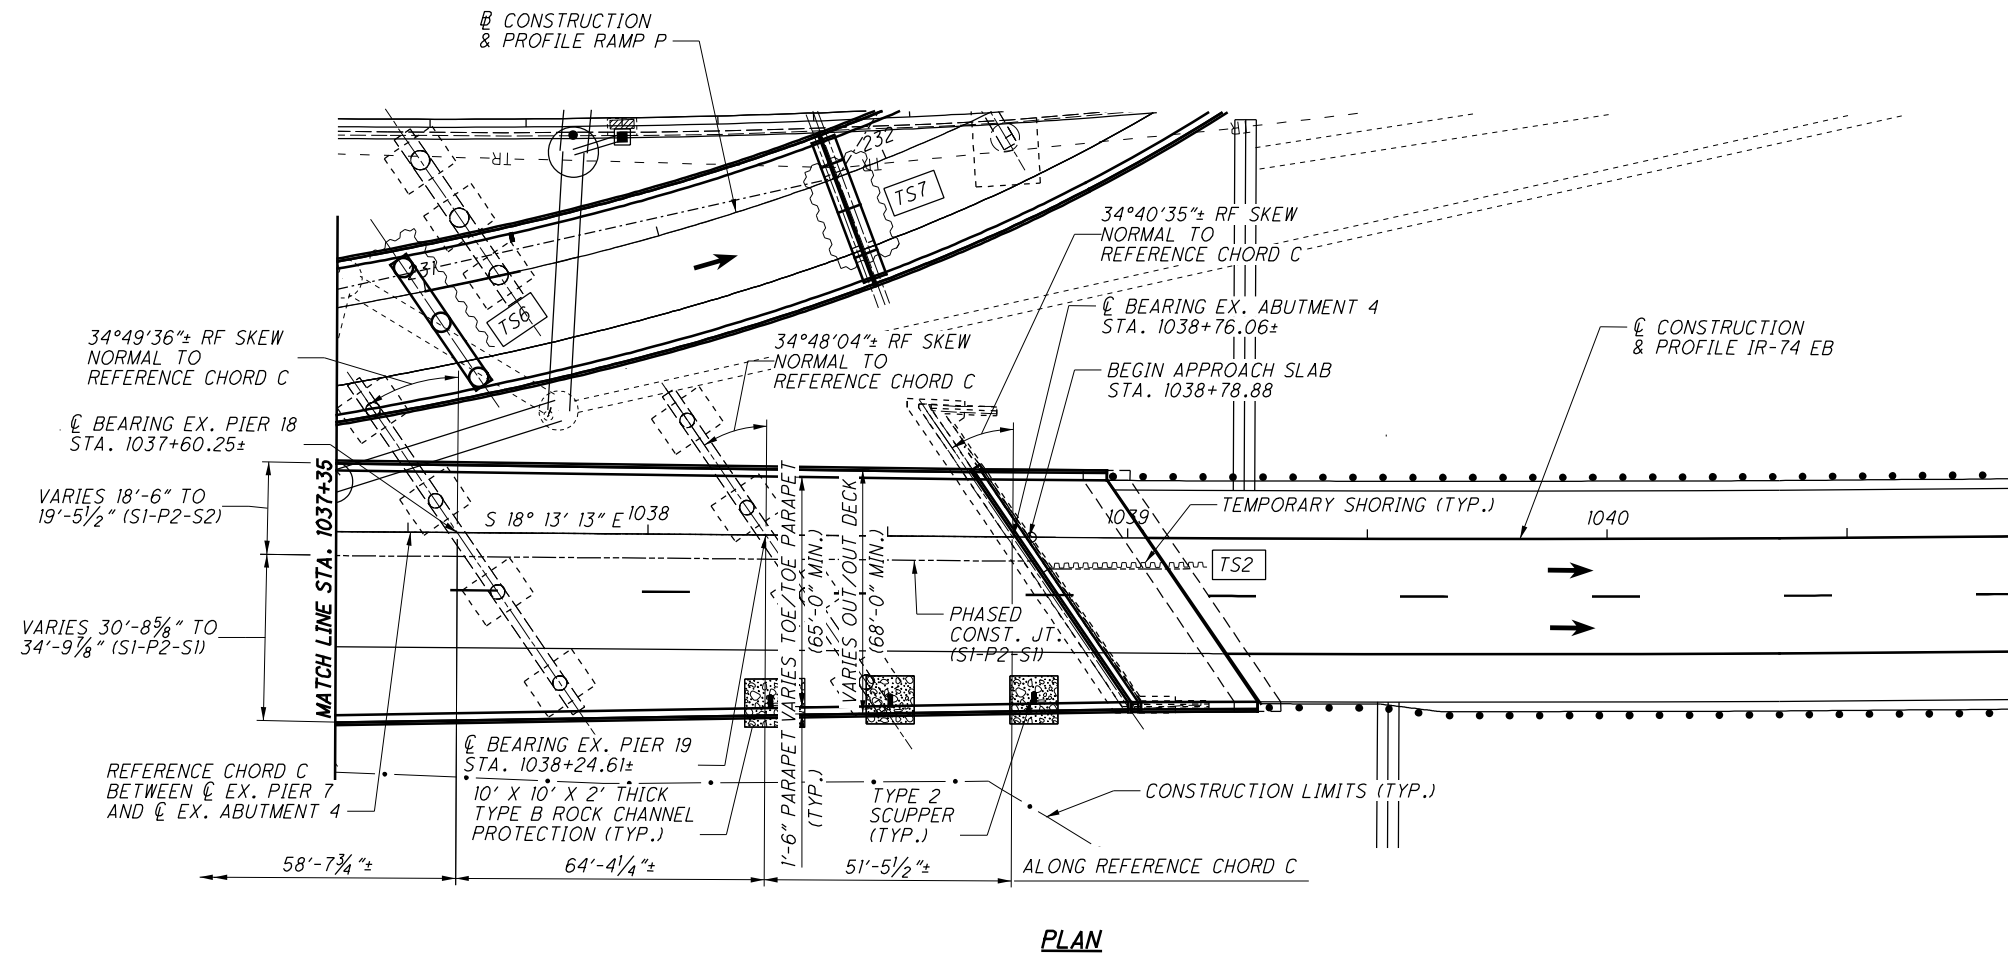

**HORIZONTAL CURVE DATA**  
**IR-74 EB**

Ⓢ C14 PI STA 1040+29.02  
 $\Delta = 1^\circ 29' 25''$  (LT)  
 50mph  $D_c = 0^\circ 30' 00''$   
 $R = 11,459.16'$   
 $T = 149.03'$   
 $L = 298.05'$   
 $E = 0.97'$   
 $C = 298.04'$   
 C.B. =  $S 18^\circ 57' 56'' E$

**LEGEND**

- SX-PX-SX - STAGE X, PHASE X, STEP X (MOT PHASING)
- TS# - TEMPORARY SHORING LOCATION
- ~~~~~ - TEMPORARY SHORING

**NOTE:**

1. FOR DESCRIPTION OF PROPOSED WORK, SEE SHEET 8/100.

<b>HAM-75-3.84</b> PID No. 104667	<b>GENERAL PLAN (3 OF 3)</b> BRIDGE NO. HAM-74-1908R IR-74 OVER MILL CREEK, RR & SPRING GROVE AVENUE	HAMILTON COUNTY STA. 1027+57.56 STA. 1038+78.88	DESIGNED KDC CHECKED CRG	REVIEWED TES STRUCTURE FILE NUMBER 3115739	DATE 3/27/2019	DESIGN AGENCY <b>PRIME</b> 540 WHITE POND DR. SUITE E AKRON, OH 44320
--------------------------------------	------------------------------------------------------------------------------------------------------------	-------------------------------------------------------	-----------------------------------	-----------------------------------------------------	-------------------	--------------------------------------------------------------------------------

# STRUCTURE GENERAL NOTES

## STANDARD DRAWINGS:

REFER TO THE FOLLOWING STANDARD BRIDGE DRAWINGS:

A-1-69 REVISED 07-19-02  
AS-1-15 REVISED 07-17-15  
AS-2-15 REVISED 01-19-18  
EXJ-4-87 REVISED 01-19-18  
GSD-1-96 REVISED 07-19-02  
PCB-91 REVISED 01-18-13  
RB-1-55 REVISED 07-19-13  
SBR-1-13 REVISED 01-14-14  
VPF-1-90 REVISED 01-19-18

## DESIGN SPECIFICATIONS:

DESIGN SPECIFICATIONS : THIS STRUCTURE CONFORMS TO "STANDARD SPECIFICATIONS FOR HIGHWAY BRIDGES" ADOPTED BY THE AMERICAN ASSOCIATION OF STATE HIGHWAY AND TRANSPORTATION OFFICIALS, 2002, INCLUDING THE 2005 INTERIM SPECIFICATIONS AND THE 2004 ODOT BRIDGE DESIGN MANUAL.

## DESIGN LOADING:

HS-20 AND ALTERNATE MILITARY LOADING  
FUTURE WEARING SURFACE (FWS) OF 0.060 KIPS/SF WAS NOT INCLUDED.

## DESIGN STRESSES:

CONCRETE CLASS QC3 - COMPRESSIVE STRENGTH 4.5 KSI (SUPERSTRUCTURE)  
CONCRETE CLASS QC3 - COMPRESSIVE STRENGTH 4.0 KSI (SUBSTRUCTURE)  
EXISTING CONCRETE CLASS C - COMPRESSIVE STRENGTH 4.0 KSI (SUBSTRUCTURE)  
EXISTING REINFORCING STEEL - ASTM A615, A616 OR A617, GRADE 40, MINIMUM YIELD STRENGTH 40 KSI, EPOXY COATED  
NEW REINFORCING STEEL - ASTM A615 OR A996, GRADE 60, MINIMUM YIELD STRENGTH 60 KSI, EPOXY COATED  
EXISTING STRUCTURAL STEEL - ASTM A36 - GRADE 36 - YIELD STRENGTH 36 KSI.  
NEW STRUCTURAL STEEL - ASTM A709 GRADE 50 - YIELD STRENGTH 50 KSI.

## DECK PROTECTION METHOD:

EPOXY COATED REINFORCING STEEL  
2 1/2" CONCRETE COVER

## MONOLITHIC WEARING SURFACE:

MONOLITHIC WEARING SURFACE IS ASSUMED, FOR DESIGN PURPOSES, TO BE 1 INCH THICK.

## EXISTING STRUCTURE VERIFICATION:

DETAILS AND DIMENSIONS SHOWN ON THESE PLANS PERTAINING TO THE EXISTING STRUCTURE HAVE BEEN OBTAINED FROM PLANS OF THE EXISTING STRUCTURE AND FROM FIELD OBSERVATIONS AND MEASUREMENTS. CONSEQUENTLY, THEY ARE INDICATIVE OF THE EXISTING STRUCTURE AND THE PROPOSED WORK BUT THEY SHALL BE CONSIDERED TENTATIVE AND APPROXIMATE. THE CONTRACTOR IS REFERRED TO CMS SECTIONS 102.05, 105.02 AND 513.04.

## EXISTING BRIDGE PLANS:

EXISTING AND REHABILITATION BRIDGE PLANS HAVE BEEN PROVIDED BY ODOT DISTRICT 8.

## ITEM 202. REMOVAL MISC.: EXISTING DRAINAGE CLEANOUT:

WORK UNDER THIS ITEM SHALL INCLUDE THE CLEANOUT OF EXISTING SCUPPERS AND DOWNSPOUTS PRIOR TO THE REDIRECTING OF TRAFFIC FOR PHASED CONSTRUCTION. THE EXISTING SCUPPERS AND DOWNSPOUTS SHALL BE CLEARED OF ANY EXISTING DEBRIS AND SHALL BE FULLY FUNCTIONAL DURING THE MAINTENANCE OF TRAFFIC PHASES.

## ITEM 202. PORTIONS OF STRUCTURE REMOVED, OVER 20 FOOT SPAN AS PER PLAN:

THE PROPOSED WORK CONSISTS OF REMOVING PORTIONS OF THE EXISTING STRUCTURES AS SHOWN IN THE PLANS AND CONSTRUCTING THE PROPOSED BRIDGE.

ALL REQUIREMENTS OF ODOT CMS 202.03 SHALL APPLY WITH THE FOLLOWING ADDITIONS. THIS WORK SHALL INCLUDE THE PHASED REMOVAL OF THE EXISTING STRUCTURES AS INDICATED IN THE PLANS AND GENERAL NOTES. THE STRUCTURE WILL BE CAREFULLY REMOVED BY PHASED CONSTRUCTION METHODS AS FURTHER DESCRIBED IN THE FOLLOWING SECTIONS. THE USE OF EXPLOSIVES AND HEADACHE BALLS WILL NOT BE PERMITTED FOR ANY DEMOLITION OF EXISTING STRUCTURES.

## PROTECTION OF STEEL SUPPORT SYSTEMS:

BEFORE DECK SLAB CUTTING IS PERMITTED LAYOUT AS BUILT BEAM CENTERLINE LOCATIONS ON THE SURFACE OF THE DECK. VERIFY CONCRETE DEPTH OF DECK BY DRILLING SMALL PILOT HOLES TO THE TOP OF BEAM PRIOR TO SAWCUTTING. DECK CUTS OVER OR WITHIN 2" OF FLANGE EDGE SHALL NOT EXTEND LOWER THAN THE BOTTOM LAYER OF DECK SLAB REINFORCING STEEL. CUTS MADE OUTSIDE 2 INCHES OF FLANGE EDGES MAY EXTEND THE FULL DEPTH OF THE DECK. PERFORM WORK CAREFULLY DURING THE CUTTING OF THE DECK SLAB TO AVOID DAMAGING STEEL MEMBERS THAT ARE TO BE INCORPORATED INTO THE PROPOSED STRUCTURE. REPLACE OR REPAIR STEEL MEMBERS DAMAGED BY THE DECK SLAB CUTTING OPERATIONS AT NO COST TO THE PROJECT. IF REQUIRED, AT LEAST 7 DAYS BEFORE PERFORMING REPAIR WORK, SUBMIT A PROPOSED REPAIR PLAN, DEVELOPED BY AN OHIO REGISTERED PROFESSIONAL ENGINEER TO THE ENGINEER. OBTAIN THE ENGINEERS APPROVAL BEFORE PERFORMING REPAIR.

## PHASED CONCRETE DECK REMOVAL:

WHEN NO LONGER REQUIRED TO MAINTAIN TRAFFIC, REMOVE THE CONCRETE DECK IN ACCORDANCE WITH THE SEQUENCE OF CONSTRUCTION SHOWN IN THE PLANS. PERFORM WORK CAREFULLY DURING THE CUTTING OF THE DECK SLAB AND DURING DECK PICKING OPERATIONS TO AVOID ANY DAMAGE TO THE EXISTING STEEL AND SUBSTRUCTURE TO REMAIN.

## EXISTING WELDED ATTACHMENTS:

REMOVE EXISTING WELDED ATTACHMENTS (E.G., FINISHING MACHINE AND FORM SUPPORTS; AND SUPPORTS FOR SCUPPERS AND BULB ANGLES WHICH ARE TO BE REMOVED) LOCATED IN THE DESIGNATED TENSION PORTIONS OF THE TOP FLANGES OF EXISTING STEEL MEMBERS AND GRIND THE FLANGE SURFACES SMOOTH. CAREFULLY GRIND IN THE DIRECTION OF THE MAIN STRESSES.

## CUT LINE CONSTRUCTION JOINT PREPARATION:

THOROUGHLY CLEAN THE JOINT SURFACE AND EXPOSED REINFORCEMENT OF ALL DIRT, DUST, RUST, OR OTHER FOREIGN MATERIAL BY THE USE OF WATER, AIR UNDER PRESSURE, OR OTHER METHODS THAT PRODUCE SATISFACTORY RESULTS. EXISTING REINFORCING STEEL DOES NOT HAVE TO HAVE A BRIGHT STEEL FINISH, BUT REMOVE ALL PACK AND LOOSE RUST. THOROUGHLY DRENCH EXISTING CONCRETE SURFACES WITH CLEAN WATER AND ALLOW TO DRY TO A DAMP CONDITION BEFORE PLACING CONCRETE.

## PHASED CONCRETE ABUTMENT REMOVAL:

WHEN NO LONGER REQUIRED TO MAINTAIN TRAFFIC, PORTIONS OF THE EXISTING ABUTMENT SHALL BE REMOVED BY MEANS OF APPROVED PNEUMATIC HAMMERS EMPLOYING POINTED AND BLUNT CHISEL TOOLS. HYDRAULIC HOE-RAM TYPE HAMMERS WILL NOT BE PERMITTED. THE WEIGHT OF THE HAMMER SHALL NOT BE MORE THAN 35 POUNDS FOR REMOVAL WITHIN 18 INCHES OF PORTIONS TO BE PRESERVED. OUTSIDE THE 18 INCH LIMIT, THE CONTRACTOR MAY USE HAMMERS NOT EXCEEDING 90 POUNDS. DO NOT PLACE PNEUMATIC HAMMERS IN DIRECT CONTACT WITH REINFORCING STEEL THAT IS TO BE RETAINED IN THE REBUILT STRUCTURE.

## ITEM 203. EMBANKMENT, AS PER PLAN:

PLACE AND COMPACT EMBANKMENT MATERIAL IN 6 INCH LIFTS FOR THE CONSTRUCTION OF THE APPROACH EMBANKMENT.

## ITEM 509. EPOXY COATED REINFORCING STEEL, AS PER PLAN:

IN ADDITION TO THE PROVISIONS OF ITEM 509, FIELD BEND AND/OR FIELD CUT THE REINFORCING STEEL DESIGNATED IN THE PLANS, AS NECESSARY, IN ORDER TO MAINTAIN THE REQUIRED CLEARANCES AND BAR SPACINGS. REPAIR ALL DAMAGE TO THE EPOXY COATING, AS A RESULT OF THIS WORK, ACCORDING TO 709.00.

## ITEM 512 SEALING OF CONCRETE SURFACES, AS PER PLAN, (PERMANENT GRAFFITI PROTECTION):

APPLY A PERMANENT GRAFFITI COATING QUALIFIED ACCORDING TO SUPPLEMENT 1083 THAT IS COMPATIBLE WITH THE CONCRETE SEALER OVER WHICH IT IS APPLIED. APPLY THE GRAFFITI COATING IN ACCORDANCE WITH THE MANUFACTURER'S PRINTED INSTRUCTIONS. THE EPOXY URETHANE SEALER SHALL BE FEDERAL COLOR NUMBER 17778.

IN ADDITION TO THE LIMITS DETAILED IN THE PLANS, WORK UNDER THIS ITEM SHALL INCLUDE ALL EXPOSED SURFACES OF EXISTING PIERS EXCEPT FOR THE TOP SURFACE OF THE PIER CAP.

EPOXY-URETHAN SEALER WAS APPLIED ON ABUTMENTS, EXISTING WINGWALLS, AND DECK SURFACES. NON-EPOXY URETHANE SEALER, CHEMMASTER TEXTURE DOT, WAS APPLIED AT PARAPETS AND EXISTING PIERS 3,5,6,18, AND 19.

## ITEM 512 SEALING CONCRETE BRIDGE DECKS WITH HMWM RESIN, AS PER PLAN

APPLY HIGH MOLECULAR WEIGHT METHACRYLATE (HMWM) TO FILL AND SEAL CRACKS IN THE CONCRETE APPROACH SLAB. HMWM CAN BE USED ON NEW DECKS THAT HAVE EXTENSIVE CRACKS AND COLD JOINTS.

## ITEM 512 TREATING CONCRETE BRIDGE DECKS WITH GRAVITY FED RESIN, AS PER PLAN

APPLY GRAVITY-FED RESIN (GFR) TO FILL AND SEAL CRACKS IN THE CONCRETE BRIDGE DECK. GFR IS COST EFFECTIVE WHEN USED TO FLOOD DECK SURFACES WITH WIDESPREAD DECK CRACKING.

## ITEM 513. STRUCTURAL STEEL MEMBERS, LEVEL UF, AS PER PLAN:

ALL REQUIREMENTS OF 513 APPLY TO SHOP FABRICATED MEMBERS. PERFORM WORK FOR FIELD-FABRICATED MEMBERS ACCORDING TO ITEM 513, EXCEPT AS MODIFIED HEREIN. THE DEPARTMENT WILL NOT REQUIRE THE CONTRACTOR PERFORMING FIELD FABRICATION TO BE PRE-QUALIFIED AS SPECIFIED IN SUPPLEMENT 1078. SUBMIT A WRITTEN LETTER OF MATERIAL ACCEPTANCE IN ACCORDANCE WITH 501.06, TO THE ENGINEER. PROVIDE THE ENGINEER "AS-BUILT" DRAWINGS ACCORDING TO 513.06, EXCEPT 501.04 DOES NOT APPLY. UPON RECEIPT OF THE ENGINEER'S ACCEPTANCE, SUPPLY A COPY OF THE DRAWINGS, ACCORDING TO SUPPLEMENT 1002, TO THE OFFICE OF MATERIAL MANAGEMENT FOR RECORD PURPOSES.

WORK UNDER THIS ITEM SHALL INCLUDE FURNISHING AND INSTALLING NEW CROSSFRAME MEMBERS AT EXISTING PIER NUMBERS 2, 5, 7, AND 18 AS DETAILED IN THE PLANS. CROSSFRAMES SHALL BE SHOP PRIMED AND INSTALLED PRIOR TO BEGINNING ITEM 514 FIELD PAINTING OPERATIONS. ALL REQUIREMENTS OF CMS 513 APPLY TO THE SHOP FABRICATION OF THE CROSSFRAME MEMBERS AND ASSOCIATED CONNECTION PLATES.

## PROPOSED WORK:

1. REPLACE DECK WITH COMPOSITE DECK AND PARAPETS.
2. WELD ALL EXISTING CROSSFRAME STIFFENERS TO TOP & BOTTOM FLANGES.
3. PREP AND PAINT NEW AND EXISTING STRUCTURAL STEEL TO REMAIN.
4. REPLACE BEARINGS AT PIERS 1, 3, 6 AND 19 AND AT THE HINGES.
5. REPLACE ALL ABUTMENT BEARINGS WITH ELASTOMERIC BEARINGS.
6. REPLACE APPROACH SLAB AND APPROACH PAVEMENT.
7. REPLACE REAR EXPANSION JOINT AND TOP OF BACKWALL DOWN TO APPROACH SLAB SEAT.
8. REPLACE ALL DOWNSPOUTS FROM DECK SURFACE TO GROUND.
9. PERFORM SEISMIC RETROFIT TO PIERS.
10. ADD STRIP SEAL EXPANSION JOINTS AT ALL INTERMEDIATE JOINTS OVER PIERS OR HINGES.
11. CONSTRUCT 10' WIDE COUNTER BERM ON WEST SIDE OF PIER 6.
12. SEAL SUPERSTRUCTURE AND SUBSTRUCTURE, AS SHOWN IN THE PLANS.

## ITEM 514. FIELD PAINTING STRUCTURAL STEEL, FINISH COAT:

IN ACCORDANCE WITH CMS 514, ALL NEW AND EXISTING STRUCTURAL STEEL SHALL BE PREPPED AND PAINTED WITH THE OZEU COATING SYSTEM. THE FINISH COAT SHALL BE FEDERAL COLOR 595B-34058 (DARK GREEN). SHERWIN WILLIAMS DOT HP ACRYLIC URETHANE USED FOR REPAIRS ON ABUTMENT NO. 1 CROSS FRAMES AND UNIT 6 GIRDER REPAIRS.

## CONSTRUCTION OF DECK:

THE REMOVAL OF THE DECK INCLUDES FIELD SURVEY OF THE BOTTOM OF EXISTING GIRDERS/BEAMS BEFORE AND AFTER DECK REMOVAL TO OBTAIN THE REBOUND. THE REBOUND WILL BE INPUT INTO A SPREADSHEET PROVIDED TO THE CONTRACTOR BY THE ENGINEER OF RECORD TO OBTAIN SCREED ELEVATIONS REQUIRED FOR DECK PLACEMENT OPERATIONS. A PDF OF THIS SPREADSHEET SHALL BE INCLUDED WITH THE AS-BUILT PLANS.

## TEMPORARY SHORING:

ALL TEMPORARY SHORING DESIGN WILL BE PERFORMED IN ACCORDANCE WITH CMS 501 AND SUBMITTED PRIOR TO CONSTRUCTION.

## DECK PLACEMENT DESIGN ASSUMPTIONS:

THE FOLLOWING ASSUMPTIONS OF CONSTRUCTION MEANS AND METHODS WERE MADE FOR THE ANALYSIS AND DESIGN OF THE SUPERSTRUCTURE. THE CONTRACTOR IS RESPONSIBLE FOR THE DESIGN OF THE FALSEWORK SUPPORT SYSTEM WITHIN THESE PARAMETERS AND WILL ASSUME RESPONSIBILITY FOR SUPERSTRUCTURE ANALYSIS FOR DEVIATION FROM THESE DESIGN ASSUMPTIONS.

AN EIGHT WHEEL FINISHING MACHINE WITH A MAXIMUM WHEEL LOAD OF 2.60 KIPS.

A MINIMUM OUT-TO-OUT WHEEL SPACING AT EACH END OF THE MACHINE OF 103".

A MAXIMUM SPACING OF OVERHANG FALSEWORK BRACKETS OF 48 INCHES.

A MAXIMUM DISTANCE FROM THE CENTERLINE OF THE FASCIA GIRDER TO THE FACE OF THE SAFETY HANDRAIL OF 77 INCHES.

## VANDAL PROTECTION FENCING:

VANDAL PROTECTION FENCING IS REQUIRED OVER RAILROAD RIGHT-OF-WAY.

INSTALL FENCING FOR EACH CONSTRUCTION PHASE PRIOR TO OPENING THAT PHASE TO VEHICULAR TRAFFIC.

## MAINTENANCE OF TRAFFIC:

SEE BU-04 AND BU-23 FOR MAINTENANCE OF TRAFFIC PLANS.



# STRUCTURE GENERAL NOTES

**RAILROAD REQUIREMENTS:**

ALL CONSTRUCTION WORK ON, OVER, UNDER OR ADJACENT TO THE NORFOLK-SOUTHERN (NS) OR CSX RIGHT-OF-WAY SHALL BE DONE IN ACCORDANCE WITH THE NORFOLK-SOUTHERN "SPECIAL PROVISIONS FOR THE PROTECTION OF RAILWAY INTERESTS" (NS SPECIAL PROVISIONS) OR CSX PUBLIC PROJECTS MANUAL.

CSXT MAY REQUIRE THE CONTRACTOR TO INSTALL FILTER FABRIC OVER THE TRACK(S) AND BALLAST TO PREVENT ANY CONSTRUCTION DEBRIS FROM FOULING THE BALLAST. THIS WILL BE DETERMINED DURING ACTUAL CONSTRUCTION ACTIVITIES BY CSXT OR ITS REPRESENTATIVE. FABRIC WILL REMAIN IN PLACE UNTIL ALL CONSTRUCTION ACTIVITIES ARE COMPLETE.

TEMPORARY CONSTRUCTION CLEARANCE - ENSURE ALL FALSEWORK, BRACING OR FORMS HAVE A MINIMUM HORIZONTAL CLEARANCE OF 12 FEET MEASURED PERPENDICULAR TO THE CENTERLINE OF THE NEAREST TRACK. ANY TEMPORARY VERTICAL CLEARANCE LESS THAN 23', OVER THE TRACKS, WILL REQUIRE SPECIAL PERMISSION, WITH NO GUARANTEE OF APPROVAL FROM CSX.

THE MINIMUM ALLOWABLE TEMPORARY CLEARANCES SHALL BE INDICATED ON THE GENERAL PLAN AND ELEVATION SHEET. A MINIMUM VERTICAL CLEARANCE OF 22'-0" ABOVE TOP OF HIGHEST RAIL AND A MINIMUM HORIZONTAL CLEARANCE OF 14'-0" SHALL BE MAINTAINED AT ALL TIMES

MEANS AND METHODS - THE CONTRACTOR SHALL DEVELOP A DETAILED SUBMISSION INDICATING THE PROGRESSION OF WORK WITH SPECIFIC TIMES WHEN TASKS WILL BE PERFORMED FOR WORK ACTIVITIES THAT ARE ON OR IN THE VICINITY OF THE CSXT PROPERTY. THIS SUBMISSION MAY REQUIRE A WALKTHROUGH AT WHICH TIME CSXT AND/OR THE REPRESENTATIVE WILL BE PRESENT. WORK WILL NOT BE PERMITTED TO COMMENCE UNTIL THE CONTRACTOR HAS PROVIDED CSXT WITH A SATISFACTORY PLAN THAT THE PROJECT WILL BE UNDERTAKEN WITHOUT SCHEDULING, PERFORMANCE OR SAFETY RELATED ISSUES. PROVIDE A LISTING OF THE ANTICIPATED EQUIPMENT TO BE USED, THE LOCATION OF ALL EQUIPMENT TO BE USED AND ENSURE A CONTINGENCY PLAN OF ACTION IS IN PLACE SHOULD A PRIMARY PIECE OF EQUIPMENT MALFUNCTION. ALL WORK IN THE VICINITY OF CSXT PROPERTY THAT HAS THE POTENTIAL OF AFFECTING CSXT TRAIN OPERATIONS MUST BE SUBMITTED AND APPROVED BY CSXT PRIOR TO WORK BEING PERFORMED. THIS SUBMISSION WILL ALSO INCLUDE A DETAILED NARRATIVE DISCUSSING THE COORDINATION OF PROJECT SAFETY ISSUES BETWEEN CONTRACTOR, CSXT AND THE REPRESENTATIVE. THE NARRATIVE SHALL ADDRESS PROJECT LEVEL COORDINATION AND DAY TO DAY, SPECIFIC WORK OPERATIONS INCLUDING CRANE AND EQUIPMENT OPERATIONS, ERECTION PLANS AND TEMPORARY WORKS.

DEMOLITION PROCEDURES, ERECTION PROCEDURES, AND PAINT CONTAINMENT PROCEDURES ARE REQUIRED TO BE SUBMITTED TO CSXT, OR THE REPRESENTATIVE, IN ACCORDANCE WITH THE CSXT CONSTRUCTION SUBMISSION CRITERIA, LAST REVISED APRIL 14, 2015. THE CSXT CONSTRUCTION SUBMISSION CRITERIA SHOULD BE REFERRED TO AND COMPLIED WITH PRIOR TO THE PREPARATION OF SUBMISSIONS, AS IT CONTAINS SPECIFIC REQUIREMENTS THAT COULD IMPACT THE CONTRACTOR'S MATERIAL SELECTION AND METHODS OR OPERATIONS FOR WORK NEAR THE RAILROAD. REVISIONS TO CONTRACTOR SUBMISSIONS MAY NOT BE FIELD APPROVED. ANY DEVIATION(S) FROM A PREVIOUSLY ACCEPTED PLAN INCLUDING EQUIPMENT SUBSTITUTIONS WILL REQUIRE A FORMAL RESUBMISSION OF THE PROCEDURE FOR REVIEW AND ACCEPTANCE PRIOR TO PERFORMING ANY WORK. A PROFESSIONAL ENGINEER REGISTERED IN THE STATE OF OHIO MUST SIGN AND SEAL THE PLANS. UP TO THIRTY (30) DAYS WILL BE REQUIRED TO REVIEW ALL CONSTRUCTION SUBMISSIONS. UP TO AN ADDITIONAL THIRTY (30) DAYS WILL BE REQUIRED TO REVIEW ANY SUBSEQUENT SUBMISSIONS RETURNED NOT APPROVED.

EMERGENCY ACTION PLAN - SUBMIT AN EMERGENCY ACTION PLAN INDICATING THE LOCATION OF THE SITE, CONTACT NUMBERS, ACCESS TO THE SITE, INSTRUCTIONS FOR EMERGENCY RESPONSE AND LOCATION OF THE NEAREST HOSPITALS. THIS PLAN SHOULD COVER ALL ITEMS REQUIRED IN THE EVENT OF AN EMERGENCY AT THE SITE INCLUDING FIRE SUPPRESSION. COORDINATE THE EMERGENCY ACTION PLAN WITH THE SAFETY RELATED DISCUSSION OF THE MEANS AND METHODS SUBMISSION DISCUSSED ABOVE. THE PLAN SHOULD ALSO INCLUDE A METHOD TO PROVIDE THIS INFORMATION TO EACH PROJECT WORKER FOR EACH DAY ON SITE.

**RAILROAD REQUIREMENTS CONTINUED:**

CONTRACTOR ACCESS WILL BE LIMITED TO THE IMMEDIATE PROJECT AREA ONLY. THE CSXT RIGHT-OF-WAY OUTSIDE THE PROJECT AREA MAY NOT BE USED FOR CONTRACTOR ACCESS TO THE PROJECT SITE AND NO TEMPORARY AT-GRADE CROSSINGS WILL BE ALLOWED.

"ONE CALL" SERVICES DO NOT LOCATE BURIED RAILROAD SIGNAL AND COMMUNICATIONS LINES. THE CONTRACTOR SHALL CONTACT THE RAILROAD'S REPRESENTATIVE TWO (2) DAYS IN ADVANCE OF THOSE PLACES WHERE EXCAVATION, PILE DRIVING, OR HEAVY LOADS MAY DAMAGE RAILROAD UNDERGROUND LINES ON RAILROAD PROPERTY. UPON REQUEST FROM THE CONTRACTOR OR AGENCY, RAILROAD SIGNAL FORCES WILL LOCATE AND PAINT MARK OR FLAG RAILROAD UNDERGROUND SIGNAL, COMMUNICATION, AND POWER LINES IN THE AREA TO BE DISTURBED FOR THE CONTRACTOR. THE CONTRACTOR SHALL AVOID EXCAVATION OR OTHER DISTURBANCE OF THESE LINES WHICH ARE CRITICAL TO THE SAFETY OF THE RAILROAD AND THE PUBLIC. IF DISTURBANCE OR EXCAVATION IS REQUIRED NEAR A BURIED RAILROAD SIGNAL, COMMUNICATION, OR POWER LINE, THE LINE SHALL BE POTHOLED MANUALLY WITH CAREFUL HAND EXCAVATION BY THE CONTRACTOR AND PROTECTED BY THE CONTRACTOR DURING THE COURSE OF THE DISTURBANCE UNDER THE SUPERVISION AND DIRECTION OF A RAILROAD SIGNAL REPRESENTATIVE.

ALL UTILITY INSTALLATIONS OR RELOCATIONS ON NORFOLK SOUTHERN RIGHT-OF-WAY THAT ARE REQUIRED IN CONJUNCTION WITH THIS PROJECT CAN BE INSTALLED OR RELOCATED AS PART OF THE PROJECT PROVIDED THE CONSTRUCTION IS PERFORMED BY THE PROJECT CONTRACTOR OR PROJECT CONTRACTOR'S SUB-CONTRACTOR. HOWEVER, THE UTILITY MUST SUBMIT AN APPLICATION FOR THE INSTALLATION OR RELOCATION TO AECOM FOR APPROPRIATE HANDLING FOR LICENSE AGREEMENT AND APPLICABLE FEES. FOR UTILITY APPLICATIONS GO TO: WWW.NSCORP.COM > REAL ESTATE > NS SERVICES > WIRE, PIPELINE, AND FIBER OPTICS PROJECTS. NOTE: LICENSE AGREEMENT MUST BE EXECUTED PRIOR TO UTILITY BEING INSTALLED OR RELOCATED.

FOR PROJECTS REQUIRING MORE THAN 30 CONSECUTIVE DAYS OF FLAGGING, CONTRACTOR SHALL PROVIDE THE FLAGMAN A SMALL WORK AREA WITH A DESK/COUNTER AND CHAIR WITHIN THE FIELD/SITE TRAILER, INCLUDING THE USE OF BATHROOM FACILITIES, WHERE THE FLAGMAN CAN CHECK IN/OUT WITH THE PROJECT, AS WELL AS TO THE FLAGMAN'S HOME TERMINAL. THE WORK AREA SHOULD PROVIDE ACCESS TO TWO (2) ELECTRICAL OUTLETS FOR RECHARGING RADIO(S), AND A LAPTOP COMPUTER; AND HAVE THE ABILITY TO PRINT OFF NEEDED DOCUMENTATION AND ORDERS AS NEEDED AT THE FIELD/SITE TRAILER. THIS SHOULD AID IN MAXIMIZING THE FLAGMAN'S TIME AND EFFICIENCY ON THE PROJECT.

THE ELEVATIONS OF THE EXISTING TOP-OF-RAIL PROFILE SHALL BE VERIFIED TO MATCH THE APPROVED FINAL PLANS BEFORE BEGINNING CONSTRUCTION. ANY DISCREPANCIES SHALL BE BROUGHT TO THE ATTENTION OF NORFOLK SOUTHERN PUBLIC PROJECTS ENGINEER.

**FINAL AS-BUILT DRAWINGS:**

THE CONTRACTOR SHALL PROVIDE AS-BUILT DRAWINGS SHOWING ACTUAL VERTICAL AND HORIZONTAL CLEARANCES AS WELL AS DEPTH, SIZE AND LOCATION OF ALL FOUNDATION COMPONENTS TO NORFOLK SOUTHERN RAILROAD AND CSX RAILROAD.

**UTILITIES:**

THE UTILITY(IES) SHALL BEAR ALL EXPENSE INVOLVED IN RELOCATING (INSTALLING) THE AFFECTED UTILITY LINES. THE CONTRACTOR AND UTILITY(IES) ARE TO COOPERATE BY ARRANGING THEIR WORK IN SUCH A MANNER THAT INCONVENIENCE TO EITHER WILL BE HELD TO A MINIMUM.

FOR A LISTING OF UTILITIES IN THE PROJECT AREA, SEE BU-14.

**LIGHTING:**

SEE BU-19 FOR REQUIRED LIGHTING WORK.

EXISTING UNDERPASS LIGHTING, IF REMOVED TO PERFORM REQUIRED WORK, SHALL BE STORED FOR REUSE.

IF ANY DAMAGE OCCURS DURING REMOVAL, OR RE-ERECTION OF THE LIGHTS, THE CONTRACTOR SHALL REPLACE THE AFFECTED LIGHTING FIXTURE WITH THE SAME MANUFACTURER AND MODEL.

THE SAME LEVEL OF LIGHTING, AS CURRENTLY EXISTS, SHALL BE MAINTAINED WITH TEMPORARY LIGHTING WHILE PERMANENT LIGHTING IS OFF-LINE.

**RAILROAD EXCAVATION REQUIREMENTS:**

THERE SHALL BE NO EXCAVATION ON OR AT THE TOE OF THE NORFOLK SOUTHERN OR CSX TRACK STRUCTURE SLOPES WITHOUT REVIEW AND COMPLIANCE WITH THE NORFOLK SOUTHERN AND CSX "SHORING REQUIREMENTS".

**REFURBISH BEARING DEVICE, AS PER PLAN:**

THIS ITEM SHALL INCLUDE ALL WORK NECESSARY TO PROPERLY CLEAN AND PAINT THE EXISTING BEARINGS AT PIER NUMBERS 2, 4, 5, 7, AND 18. INCLUDED SHALL BE THE HAND TOOL CLEANING (GRINDING IF NECESSARY), PAINTING ACCORDING TO ITEM 514, REPLACEMENT OF ANY DAMAGED SHEET LEAD WITH PREFORMED BEARING PADS (711.21), INSTALLATION OF ANY NECESSARY STEEL SHIMS OF THE SAME SIZE AS THE BEARINGS TO PROVIDE A SNUG FIT, AND LUBRICATING SLIDING SURFACES. ASSURE ALL BEARINGS ARE SHIMMED ADEQUATELY AND THAT NO BEAMS AND/OR BEARING DEVICES ARE "FLOATING".

**STAY-IN-PLACE FORMS:**

STAY-IN-PLACE FORMS SHALL ONLY BE USED OVER MILL CREEK (SPANS 3 AND 4 OF UNIT 1) AND THE RAILROAD (SPAN 7 OF UNIT 2). STAY-IN-PLACE FORMS SHALL BE GALVANIZED CONFORMING TO CMS 508.01 THRU 508.03.

FORMS SHALL NOT BE INSTALLED AT OVERHANGS, WITHIN EIGHT FEET OF EXPANSION JOINTS, AND WITHIN FOUR FEET OF ALL THROUGH DECK DRAINAGE SYSTEMS. FULL UNIT WIDTH FORMS ARE EXPECTED TO BE PROVIDED WITHIN THE APPROXIMATE LIMITS GIVEN.

THE FLUTES OF STAY-IN-PLACE FORMS SHALL BE FILLED WITH CONCRETE. THE DESIGN INCLUDES ALLOWANCE FOR 15 PSF OVER THE PROJECTED PLAN AREA OF THE METAL FORMS FOR THE UNIT WEIGHT OF METAL FORMS AND CONCRETE REQUIRED TO FILL THE FORM FLUTES.

MATERIALS- FURNISH FORM, SUPPORT MATERIALS AND HARDWARE CONFORMING TO THE FOLLOWING:

- I. FORM AND SUPPORT MATERIAL, ASTM A653 HAVING A COATING DESIGNATION OF G235, AND CONFORMING TO THE MECHANICAL PROPERTIES THE DESIGN REQUIRES.
- II. PROVIDE DECK FORMS WITH A 2 INCH MINIMUM FORM DEPTH.
- III. PROVIDE MINIMUM MATERIAL THICKNESS AS FOLLOWS: SIP FORMS (20 GAGE), SUPPORT ANGLES (12 GAGE) AND SUPPORT BARS (12 GAGE).
- IV. SUPPLY DECK, SELF DRILLING FASTENERS WITH CADMIUM PLATING PER ASTM B766 WITH MINIMUM THICKNESS OF 5, TEN THOUSANDS.(0.0005 INCH). THE HEADS OF THESE FASTENERS WILL BE HIGHLY VISIBLE COLOR, RED OR OTHER, TO AID INSPECTION.

HARDWARE SHALL BE DETAILED IN SHOP DRAWINGS.

WELDING- DO NOT WELD SIP FORMS OR THEIR SUPPORTS TO THE STEEL BRIDGE MEMBERS. SIP SUPPORTS MAY BE WELDED TO ANCHORS CAST INTO PRECAST CONCRETE BRIDGE MEMBERS. PERFORM WELDING PER 513.21.

THREADED STUDS SHALL BE WELDED FOR OVERHANG AND PHASE LINE FRAMEWORK ON SPANS 3, 4, AND 7 WHERE STAY-IN-PLACE FORMS ARE BEING INSTALLED.

**STRUCTURE GROUNDING:**

STRUCTURE TO BE GROUNDED IN ACCORDANCE WITH STD. DWG. HL-50.21 FOR EACH RUN OF VANDAL PROTECTION FENCE (VPF) AND THE OVERHEAD SIGN. THE VPF SHALL BE GROUNDED AT PIER 6 AND PIER 7 ON BOTH SIDES OF THE BRIDGE. THE OVERHEAD SIGN SHALL BE GROUNDED AT PIER 5 ON BOTH SIDES OF THE BRIDGE. THE GROUND WIRE SHALL BE EXOTHERMICALLY WELDED TO A GROUND ROD AND RUN UP THE OUTSIDE OF THE ADJACENT PIERS ON EACH SIDE, USING AN INSULATED COPPER CABLE, AND BONDED TO A SURFACE MOUNTED GROUND PLATE ON THE PIER CAP. THE GROUND PLATE SHALL BE EXOTHERMICALLY WELDED TO THE EXTERIOR GIRDER, WHICH CONNECTS THE TOP OF THE GIRDER WITH AN INSULATED COPPER WIRE CONCEALED IN THE DECK AND THE PARAPET TO A SURFACE MOUNTED GROUND PLATE ON THE TOP OF THE PARAPET, WHICH IS EXOTHERMICALLY WELDED TO THE VPF BASE PLATE OR THE OVERHEAD SIGN BASE PLATE.

EXTERIOR BEAMS AT HINGE 1 AND HINGE 2 SHALL ALSO BE BONDED WITH STRANDED INSULATED COPPER CABLES AND EXOTHERMIC WELDS ON BOTH SIDES. SEE STANDARD DRAWING HL-50.21 FOR MORE DETAILS.

P:\Projects\2018\20H03DB-18232 HAM-75-03.84\104667\structures\HAM074\_1908R\sheets\074\_1908R\_GN002.dgn 9/12/2023 11:37:08 AM erin.bojmann



DESIGNED	KDC	CHECKED	CRG
DRAWN	KDC	REVISED	
REVIEWED	TES	DATE	7/30/2019
STRUCTURE FILE NUMBER			3115739

GENERAL NOTES (2 OF 3)

BRIDGE NO. HAM-74-1908R  
IR-74 OVER MILL CREEK, RR & SPRING GROVE AVENUE

HAM-75-3.84  
PID No. 104667

## STRUCTURE GENERAL NOTES

### CLASS QC3 CONCRETE WITH QC/QA, SUBSTRUCTURE, AS PER PLAN

THIS ITEM MODIFIES THE STANDARD 511 CONCRETE FOR STRUCTURES SPECIFICATION TO INCLUDE MACRO-SYNTHETIC INTO THE SUBSTRUCTURE CONCRETE. THIS ITEM SHALL CONFORM TO CMS 511 WITH THE FOLLOWING CONDITIONS AND REVISIONS:

PROVIDE MATERIALS CONFORMING TO 511.02 EXCEPT AS MODIFIED BELOW:

PORTLAND CEMENT CONCRETE      499.03, CLASS QC 3, WITH MACRO-SYNTHETIC FIBERS WITH MODIFICATION PER 511.02

FIBERS FOR CONCRETE              ASTM C 1116, TYPE III

THE CLASS QC3 CONCRETE FOR THE SUBSTRUCTURE SHALL MEET THE FOLLOWING CRITERIA: WATER/CEMENT RATIO = 0.40 MAXIMUM; MINIMUM 4 LBS/CY MACRO-SYNTHETIC FIBERS (1.5 IN. MIN. TO 2.5 IN. MAX.) MEETING ASTM C1116 TYPE III SHALL BE ADDED TO THE MIX.

THE MACRO-SYNTHETIC FIBERS SHALL BE INCORPORATED INTO THE MIX IN SUCH A WAY THAT NO 'BALLING' OCCURS. UPON INSPECTION OF THE MIX AT THE TIME OF PLACEMENT, IF ANY 'BALLING' OCCURS, THE ENGINEER SHALL REJECT THE REMAINDER OF THE LOAD AT ANY TIME DURING THE POUR. IT IS IMPORTANT TO FOLLOW INDUSTRY STANDARDS AND ASTM SPECIFICATIONS ON THE PREMIXING OF THE CEMENT, AGGREGATE, AND MACRO-SYNTHETIC FIBERS PRIOR TO THE ADDITION OF WATER AND ADMIXTURES. PROVIDE MACRO-SYNTHETIC FIBERS THAT ARE MONOFILAMENT FIBERS MADE FROM VIRGIN POLYPROPYLENE, POLYETHYLENE, OR CO-POLYMERS THAT ARE INERT TO ALKALI ATTACK. ENSURE THE MACRO-SYNTHETIC FIBERS HAVE A MINIMUM TENSILE STRENGTH OF 70 KSI, A MINIMUM MODULUS OF ELASTICITY OF 800 KSI, A MINIMUM FILAMENT DIAMETER OF 0.012 INCHES, AND ASPECT RATIO BETWEEN 60 AND 100, AND ARE BETWEEN 1.5 AND 2.5 INCHES IN LENGTH. STORE THE MACRO-SYNTHETIC FIBERS ACCORDING TO THE MANUFACTURE'S RECOMMENDATION AND KEEP THE MATERIAL FREE FROM DUST, DIRT AND MOISTURE.

USE A MINIMUM DOSAGE RATE OF MACRO-SYNTHETIC FIBERS OF 4.0 LBS/CY OF CONCRETE. DETERMINE THE FINAL PROPOSED DOSAGE RATE THROUGH MIX TESTING. ENSURE THE FIBER REINFORCED CONCRETE MEETS OR EXCEEDS A MINIMUM EQUIVALENT FLEXURAL STRENGTH RATIO OF 25% ACCORDING TO ASTM C 1609. MACRO-SYNTHETIC FIBERS IS TO BE USED AS AN ADMIXTURE TO CONTROL CRACKING AND IS NOT TO BE USED TO SUPPLEMENT OR REPLACE REINFORCING STEEL IN THE DESIGN. ENSURE THE FINAL PROPOSED MIX IS WORKABLE AND ABLE TO BE PRODUCED SUCH THAT BALLING OR CLUMPING OF THE FIBERS IS NOT A PROBLEM AS DETERMINED BY THE ENGINEER. UTILIZE A LABORATORY REGULARLY INSPECTED BY THE CEMENT AND CONCRETE REFERENCE LABORATORY (CCRL) OF THE NATIONAL INSTITUTE OF STANDARDS AND TECHNOLOGY, OR OTHER APPROVED REFERENCE LABORATORY, TO PERFORM THE TESTING. BEFORE USE, SUBMIT DOCUMENTATION TO THE PROJECT ENGINEER CERTIFYING BOTH THE MACRO-SYNTHETIC FIBERS AND THE MIX MEET OR EXCEED THE REQUIRED PROPERTIES. SAMPLING WILL BE ALLOWED FOR TESTING PURPOSES. A DEMONSTRATION OF THE MIX PRODUCTION OR TRIAL MIX, WILL BE REQUIRED BY THE ENGINEER PRIOR TO PLACING ANY OF THE MIX ON THE PROJECT.

THE BATCH WEIGHTS SHALL BE CORRECTED TO COMPENSATE FOR THE MOISTURE CONTAINED IN THE AGGREGATE AT THE TIME OF USE. A CHEMICAL ADMIXTURE (705.12, TYPE A OR D) SHALL BE USED.

CONCRETE SUPPLIERS SHOULD RECOGNIZE THAT ADMIXTURES MAY HAVE AN EFFECT ON STRENGTH, ENTRAINED AIR CONTENT, WORKABILITY, ETC. OF THEIR CONCRETE MIXES. THE CONCRETE SUPPLIER'S CHOICE OF ADMIXTURES DOES NOT ALLEVIATE MEETING DESIGN REQUIREMENTS.

### CLASS QC3 CONCRETE WITH QC/QA, SUPERSTRUCTURE, AS PER PLAN

THIS ITEM MODIFIES THE STANDARD 511 CONCRETE FOR STRUCTURES SPECIFICATION TO INCLUDE MACRO-SYNTHETIC INTO THE SUPERSTRUCTURE CONCRETE. THIS ITEM SHALL CONFORM TO CMS 511 WITH THE FOLLOWING CONDITIONS AND REVISIONS:

PROVIDE MATERIALS CONFORMING TO 511.02 EXCEPT AS MODIFIED BELOW:

PORTLAND CEMENT CONCRETE      499.03, CLASS QC3, WITH MACRO-SYNTHETIC FIBERS WITH MODIFICATION PER 511.02

FIBERS FOR CONCRETE              ASTM C 1116, TYPE III

THE CLASS QC3 CONCRETE FOR THE SUPERSTRUCTURE SHALL MEET THE FOLLOWING CRITERIA: WATER/CEMENT RATIO = 0.40 MAXIMUM; MINIMUM 4 LBS/CY MACRO-SYNTHETIC FIBERS (1.5 IN. MIN. TO 2.5 IN. MAX.) MEETING ASTM C1116 TYPE III SHALL BE ADDED TO THE MIX.

THE MACRO-SYNTHETIC FIBERS SHALL BE INCORPORATED INTO THE MIX IN SUCH A WAY THAT NO 'BALLING' OCCURS. UPON INSPECTION OF THE MIX AT THE TIME OF PLACEMENT, IF ANY 'BALLING' OCCURS, THE ENGINEER SHALL REJECT THE REMAINDER OF THE LOAD AT ANY TIME DURING THE POUR. IT IS IMPORTANT TO FOLLOW INDUSTRY STANDARDS AND ASTM SPECIFICATIONS ON THE PREMIXING OF THE CEMENT, AGGREGATE, AND MACRO-SYNTHETIC FIBERS PRIOR TO THE ADDITION OF WATER AND ADMIXTURES. PROVIDE MACRO-SYNTHETIC FIBERS THAT ARE MONOFILAMENT FIBERS MADE FROM VIRGIN POLYPROPYLENE, POLYETHYLENE, OR CO-POLYMERS THAT ARE INERT TO ALKALI ATTACK. ENSURE THE MACRO-SYNTHETIC FIBERS HAVE A MINIMUM TENSILE STRENGTH OF 70 KSI, A MINIMUM MODULUS OF ELASTICITY OF 800 KSI, A MINIMUM FILAMENT DIAMETER OF 0.012 INCHES, AND ASPECT RATIO BETWEEN 60 AND 100, AND ARE BETWEEN 1.5 AND 2.5 INCHES IN LENGTH. STORE THE MACRO-SYNTHETIC FIBERS ACCORDING TO THE MANUFACTURE'S RECOMMENDATION AND KEEP THE MATERIAL FREE FROM DUST, DIRT AND MOISTURE.

USE A MINIMUM DOSAGE RATE OF MACRO-SYNTHETIC FIBERS OF 4.0 LBS/CY OF CONCRETE. DETERMINE THE FINAL PROPOSED DOSAGE RATE THROUGH MIX TESTING. ENSURE THE FIBER REINFORCED CONCRETE MEETS OR EXCEEDS A MINIMUM EQUIVALENT FLEXURAL STRENGTH RATIO OF 25% ACCORDING TO ASTM C 1609. MACRO-SYNTHETIC FIBERS IS TO BE USED AS AN ADMIXTURE TO CONTROL CRACKING AND IS NOT TO BE USED TO SUPPLEMENT OR REPLACE REINFORCING STEEL IN THE DESIGN. ENSURE THE FINAL PROPOSED MIX IS WORKABLE AND ABLE TO BE PRODUCED SUCH THAT BALLING OR CLUMPING OF THE FIBERS IS NOT A PROBLEM AS DETERMINED BY THE ENGINEER. UTILIZE A LABORATORY REGULARLY INSPECTED BY THE CEMENT AND CONCRETE REFERENCE LABORATORY (CCRL) OF THE NATIONAL INSTITUTE OF STANDARDS AND TECHNOLOGY, OR OTHER APPROVED REFERENCE LABORATORY, TO PERFORM THE TESTING. BEFORE USE, SUBMIT DOCUMENTATION TO THE PROJECT ENGINEER CERTIFYING BOTH THE MACRO-SYNTHETIC FIBERS AND THE MIX MEET OR EXCEED THE REQUIRED PROPERTIES. SAMPLING WILL BE ALLOWED FOR TESTING PURPOSES. A DEMONSTRATION OF THE MIX PRODUCTION OR TRIAL MIX, WILL BE REQUIRED BY THE ENGINEER PRIOR TO PLACING ANY OF THE MIX ON THE PROJECT.

THE BATCH WEIGHTS SHALL BE CORRECTED TO COMPENSATE FOR THE MOISTURE CONTAINED IN THE AGGREGATE AT THE TIME OF USE. A CHEMICAL ADMIXTURE (705.12, TYPE A OR D) SHALL BE USED.

CONCRETE SUPPLIERS SHOULD RECOGNIZE THAT ADMIXTURES MAY HAVE AN EFFECT ON STRENGTH, ENTRAINED AIR CONTENT, WORKABILITY, ETC. OF THEIR CONCRETE MIXES. THE CONCRETE SUPPLIER'S CHOICE OF ADMIXTURES DOES NOT ALLEVIATE MEETING DESIGN REQUIREMENTS.

APPROACH SLABS, DIAPHRAGMS, AND BRIDGE RAILING CONCRETE ARE TO USE THE SAME MIX DESIGN AS THE BRIDGE DECK (WHEN APPLICABLE). USE SELF-COMPACTING CONCRETE ON DECORATIVE RAILING SIMILAR TO TEXAS RAILING AND MACRO-SYNTHETIC CONCRETE PER THIS SPECIFICATION ON TRADITIONAL CONCRETE RAILING.

THE PLACING OF THE DECK AND THE APPROACH SLABS IN THE SAME CONCRETE POUR IS NOT PERMITTED.

DUE TO TRANSVERSE DECK CRACKS ACROSS VARIOUS SECTIONS OF THE BRIDGE DECK E-CHEM EP100HM GRAVITY FED RESIN WAS APPLIED TO THE ENTIRE BRIDGE DECK PER ODOT SPEC 512.06.

### ABBREVIATIONS

ABUT. - ABUTMENT  
 APPROX. - APPROXIMATELY  
 BOTT. - BOTTOM  
 BRG. - BEARING  
 BTW. - BETWEEN  
 C/C - CENTER TO CENTER  
 C.I.P. - CAST-IN-PLACE  
 C.J. - CONSTRUCTION JOINT  
 CLR. - CLEARANCE  
 CONST. - CONSTRUCTION  
 DIA. - DIAMETER  
 DWG. - DRAWING  
 EA. - EACH  
 E.F. - EACH FACE  
 EL. OR ELEV. - ELEVATION  
 EMB. - EMBEDMENT  
 EQ. - EQUAL  
 EX. - EXISTING  
 EXIST. - EXISTING  
 EXP. - EXPANSION  
 F.A. - FORWARD ABUTMENT  
 F.F. - FAR FACE  
 JT. - JOINT  
 MIN. - MINIMUM  
 MAX. - MAXIMUM  
 MOT - MAINTENANCE OF TRAFFIC  
 N.F. - NEAR FACE  
 NO. - NUMBER  
 N.P.C.P.P. - NON-PERFORATED CORRUGATED PLASTIC PIPE  
 P.C.P.P. - PERFORATED CORRUGATED PLASTIC PIPE  
 P.E.J.F. - PREFORMED EXPANSION JOINT FILLER  
 R.A. - REAR ABUTMENT  
 REQ'D. - REQUIRED  
 SPA. - SPACE(D) OR SPACING  
 STA. - STATION  
 STD. DWG. OR SCD - STANDARD CONSTRUCTION DRAWING  
 STR. - STRAIGHT  
 SQ. - SQUARE  
 T - TOP  
 T.B.D. - TO BE DETERMINED  
 T&B - TOP AND BOTTOM  
 TYP. - TYPICAL  
 U.N.O. - UNLESS NOTED OTHERWISE  
 W/ - WITH

P:\Projects\2018\20H03DB-18232 HAM-75-03.84\104667\structures\HAM074\_1908R\sheets\074\_1908R\_GN003.dgn 11/13/2023 3:40:45 PM adesimone



DESIGN AGENCY  
 DATE 7/30/2019  
 REVIEWED TES  
 STRUCTURE FILE NUMBER 3115739


DRAWN KDC  
 KDC REVISIONS  
 CHECKED CRG

GENERAL NOTES (3 OF 3)  
 BRIDGE NO. HAM-74-1908R  
 IR-74 OVER MILL CREEK, RR & SPRING GROVE AVENUE

HAM-75-3.84  
 PID No. 104667

10/100  
 10/100

P:\Projects\2018\20H03DB-18232 HAM-75-03.84\104667\structures\HAM074\_1908R\DP001.dgn 6/20/2019 9:03:03 AM asead

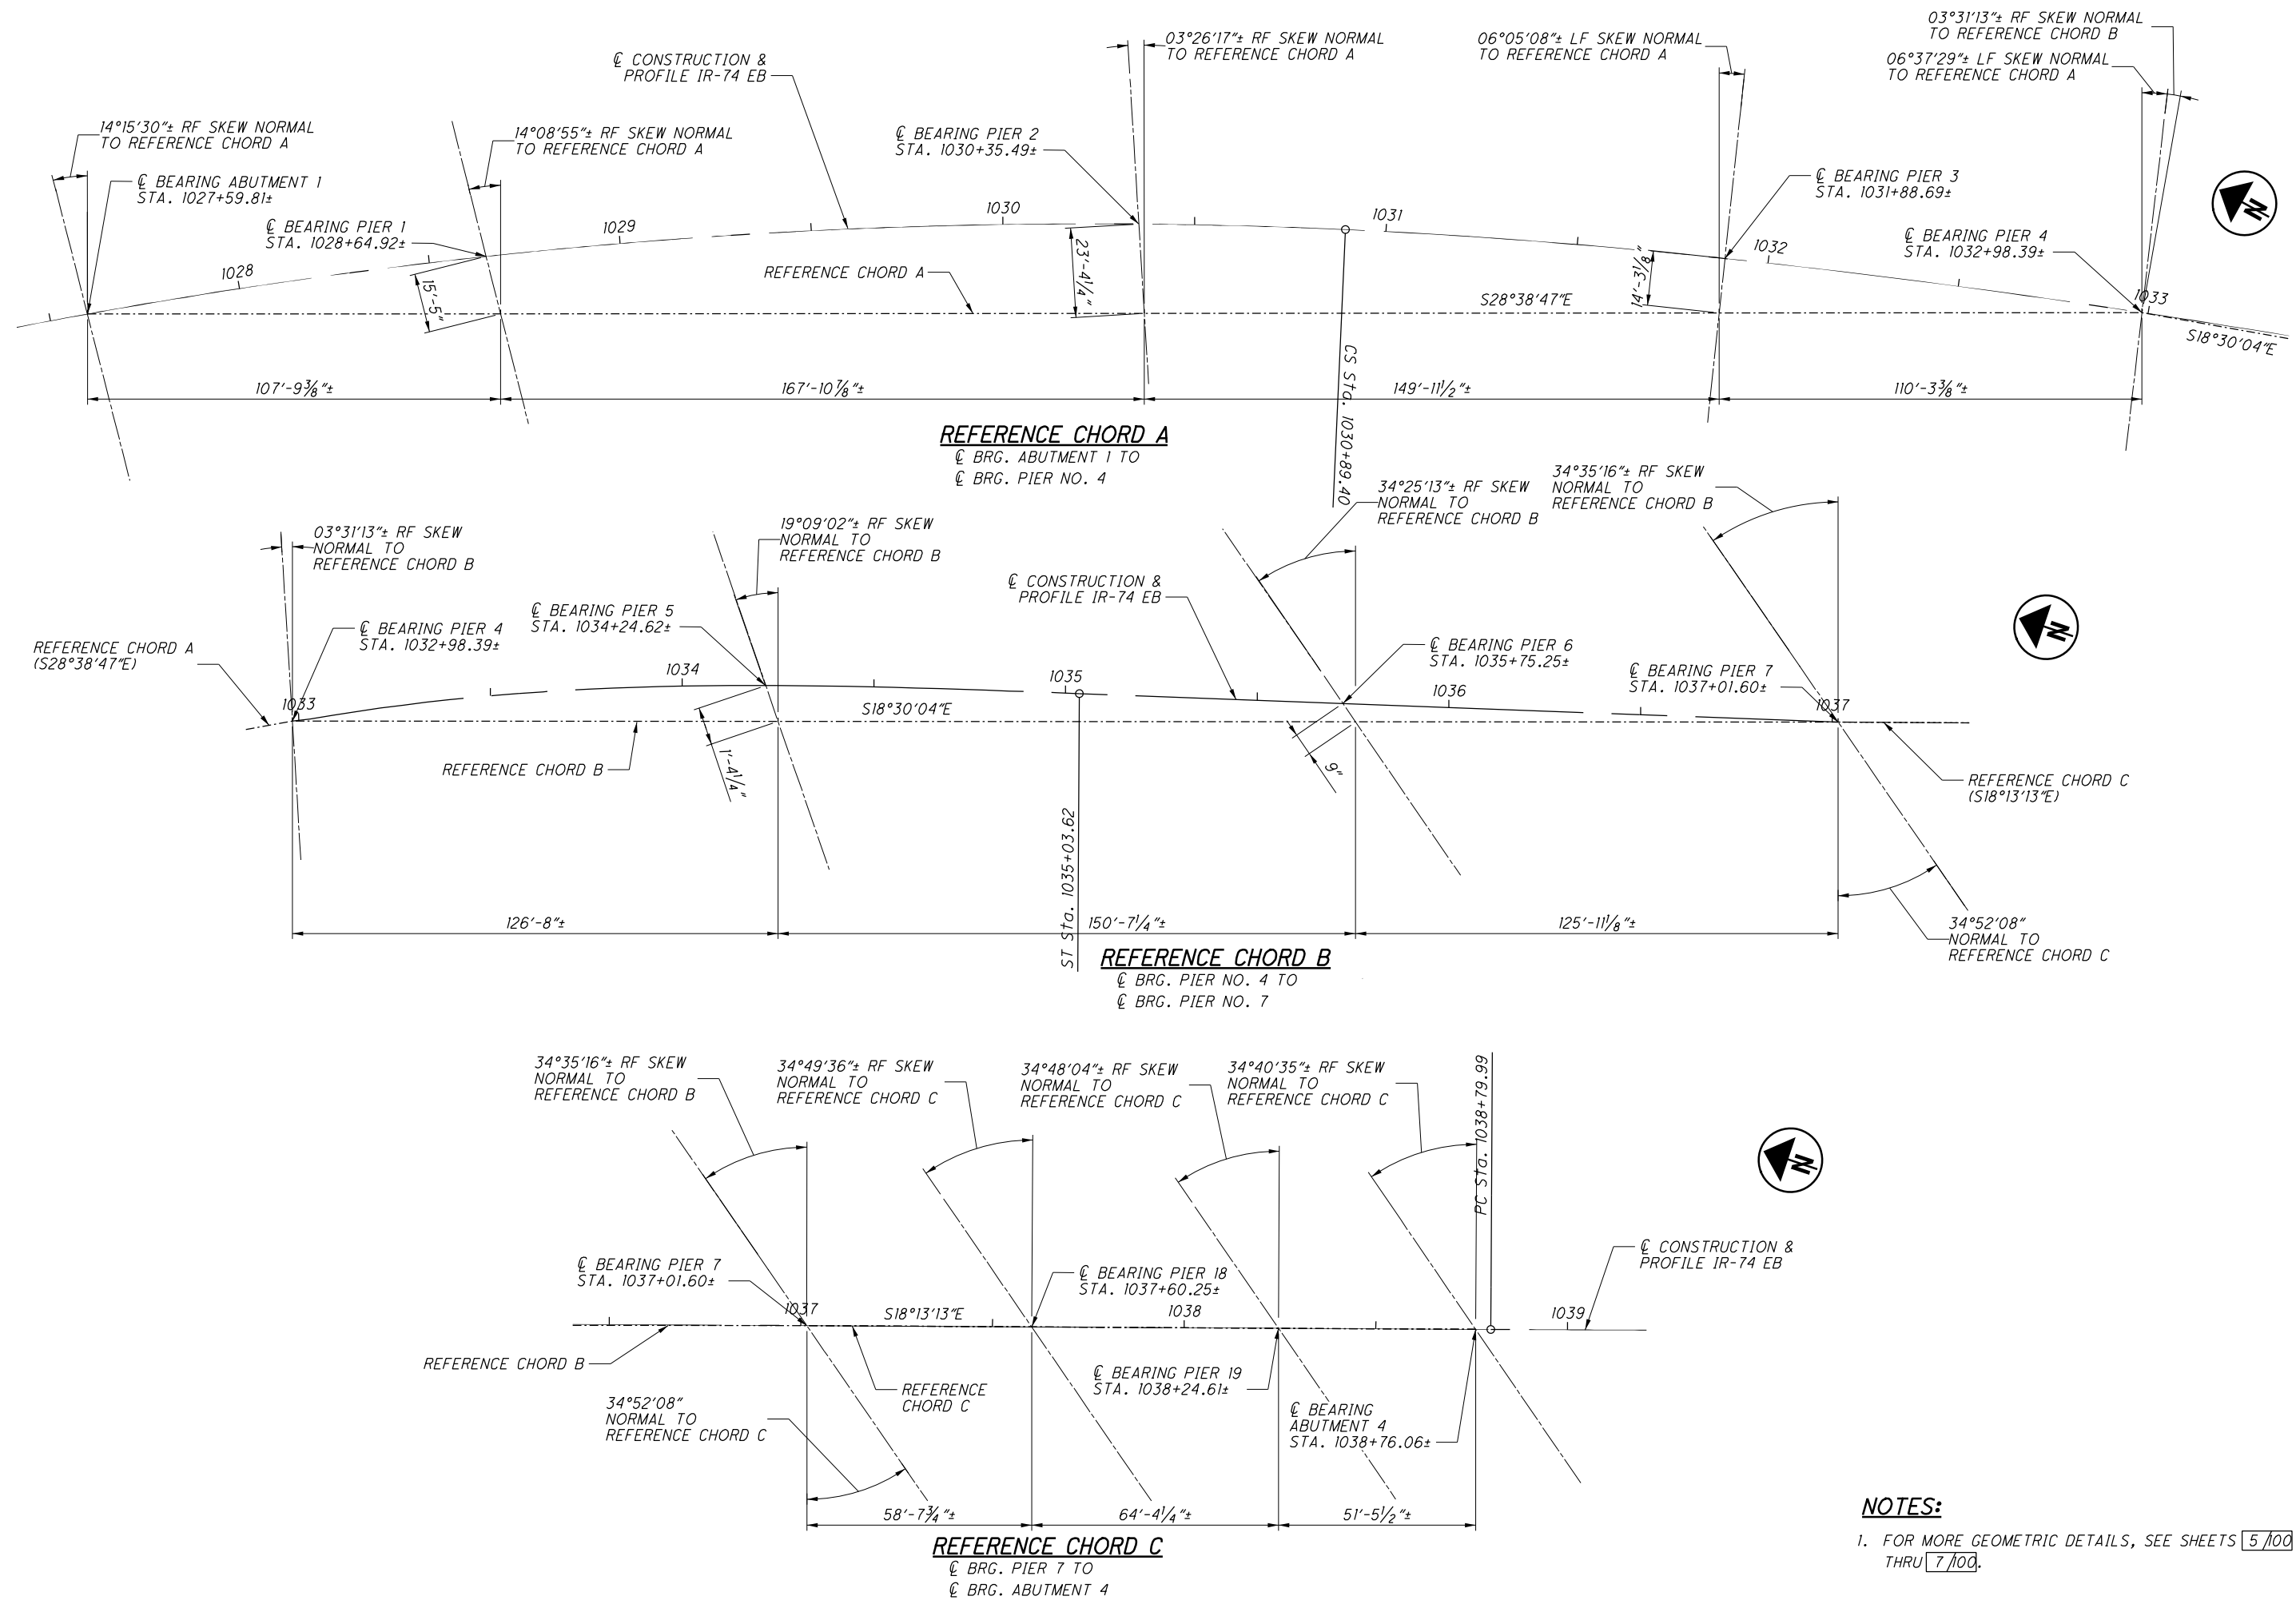


**NOTES:**  
 1. FOR MORE GEOMETRIC DETAILS, SEE SHEETS 5/100  
 THRU 7/100.


DESIGN AGENCY <b>PRIME</b> 540 WHITE POND DR. SUITE E AKRON, OH 44320	
DESIGNED KDC	CHECKED CRG
DRAWN ADS	REVISED
REVIEWED TES	DATE 3/27/2019
STRUCTURE FILE NUMBER 3115739	
<b>REFERENCE CHORD LAYOUT</b> BRIDGE NO. HAM-74-1908R IR-74 OVER MILL CREEK, RR & SPRING GROVE AVENUE	
HAM-75-3.84 PID No. 104667	
11 / 100 11 / 100	



P:\Projects\2018\20H03DB-18232 HAM-75-03.84\104667\structures\HAM074\_1908R\PC001.dgn 6/20/2019 9:03:53 AM oseed

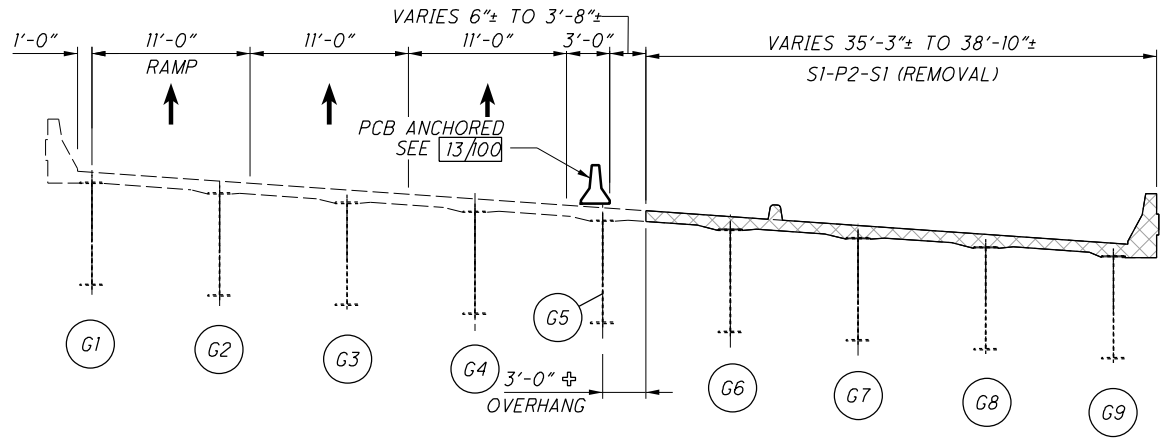

**A**  
**12** EXISTING UNIT 1 DECK REMOVAL  
TYP. SPAN 1-4

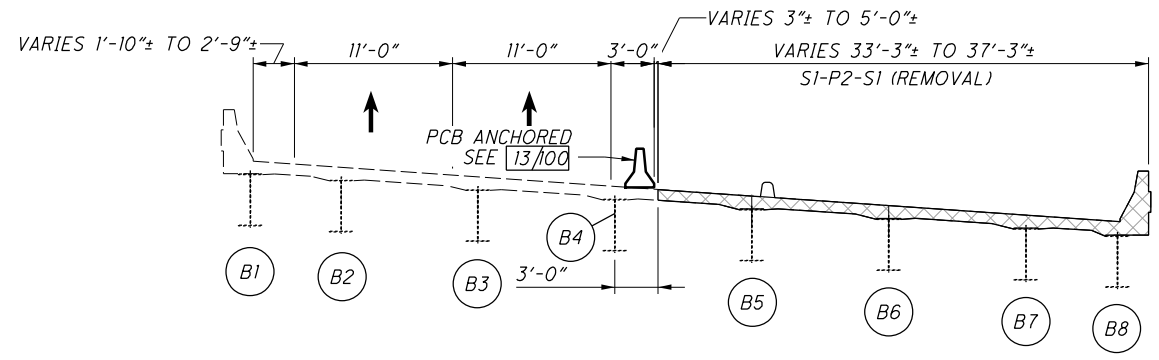

**E**  
**12** EXISTING UNIT 6 DECK REMOVAL  
TYP. SPAN 8-10

**DECK REMOVAL SEQUENCE:**


- 1 REMOVE PORTION OF EXISTING UNIT 2 FROM EXISTING PIER 6 TO EXISTING HINGE 2. REMOVE PORTION OF EXISTING UNIT 6 FROM EXISTING HINGE 2 TO EXISTING ABUTMENT 4.
- 2 REMOVE PORTION OF EXISTING UNITS 1 & 2 FROM EXISTING PIER 6 TO EXISTING ABUTMENT 1. SEQUENCE 2 MAY HAPPEN CONCURRENTLY WITH SEQUENCE 1.

**NOTES:**

1. REMOVAL DETAILS ARE FOR I-74 EB (HAM-74-1908R) ONLY. FOR CORRESPONDING REMOVAL DETAILS FOR RAMP P (HAM-74-1908S), SEE BU-05.
2. PRIOR TO ANY REMOVALS OF UNIT 3 OR UNIT 6, THE CONTRACTOR SHALL WELD PLATES NEAR THE LINKS AS SHOWN IN THE BU-10 REMOVAL SET.
3. PRIOR TO ANY REMOVALS OVER THE RAILROAD CONTRACTOR SHALL INSTALL TIMBER LAGGING DEBRIS SHIELD OVER RAILROAD IN SPAN 7. SEE SHEET 13/100 FOR MORE DETAILS.
4. FOR SUBSTRUCTURE REMOVAL DETAILS, SEE SHEETS 31/100 THRU 33/100.
5. FOR GENERAL NOTES AND MOT REFERENCE, SEE SHEET 8/100 AND 9/100.


**LEGEND:**

- INDICATES LIMITS OF DECK REMOVAL (SI-P2-S1)
- SX-PX-SX - STAGE X, PHASE X, STEP X (MOT PHASING)
- ⊕ - 4'-0" OVERHANG THE LAST 30'-0" OF UNIT 1
- # - SPAN NUMBER

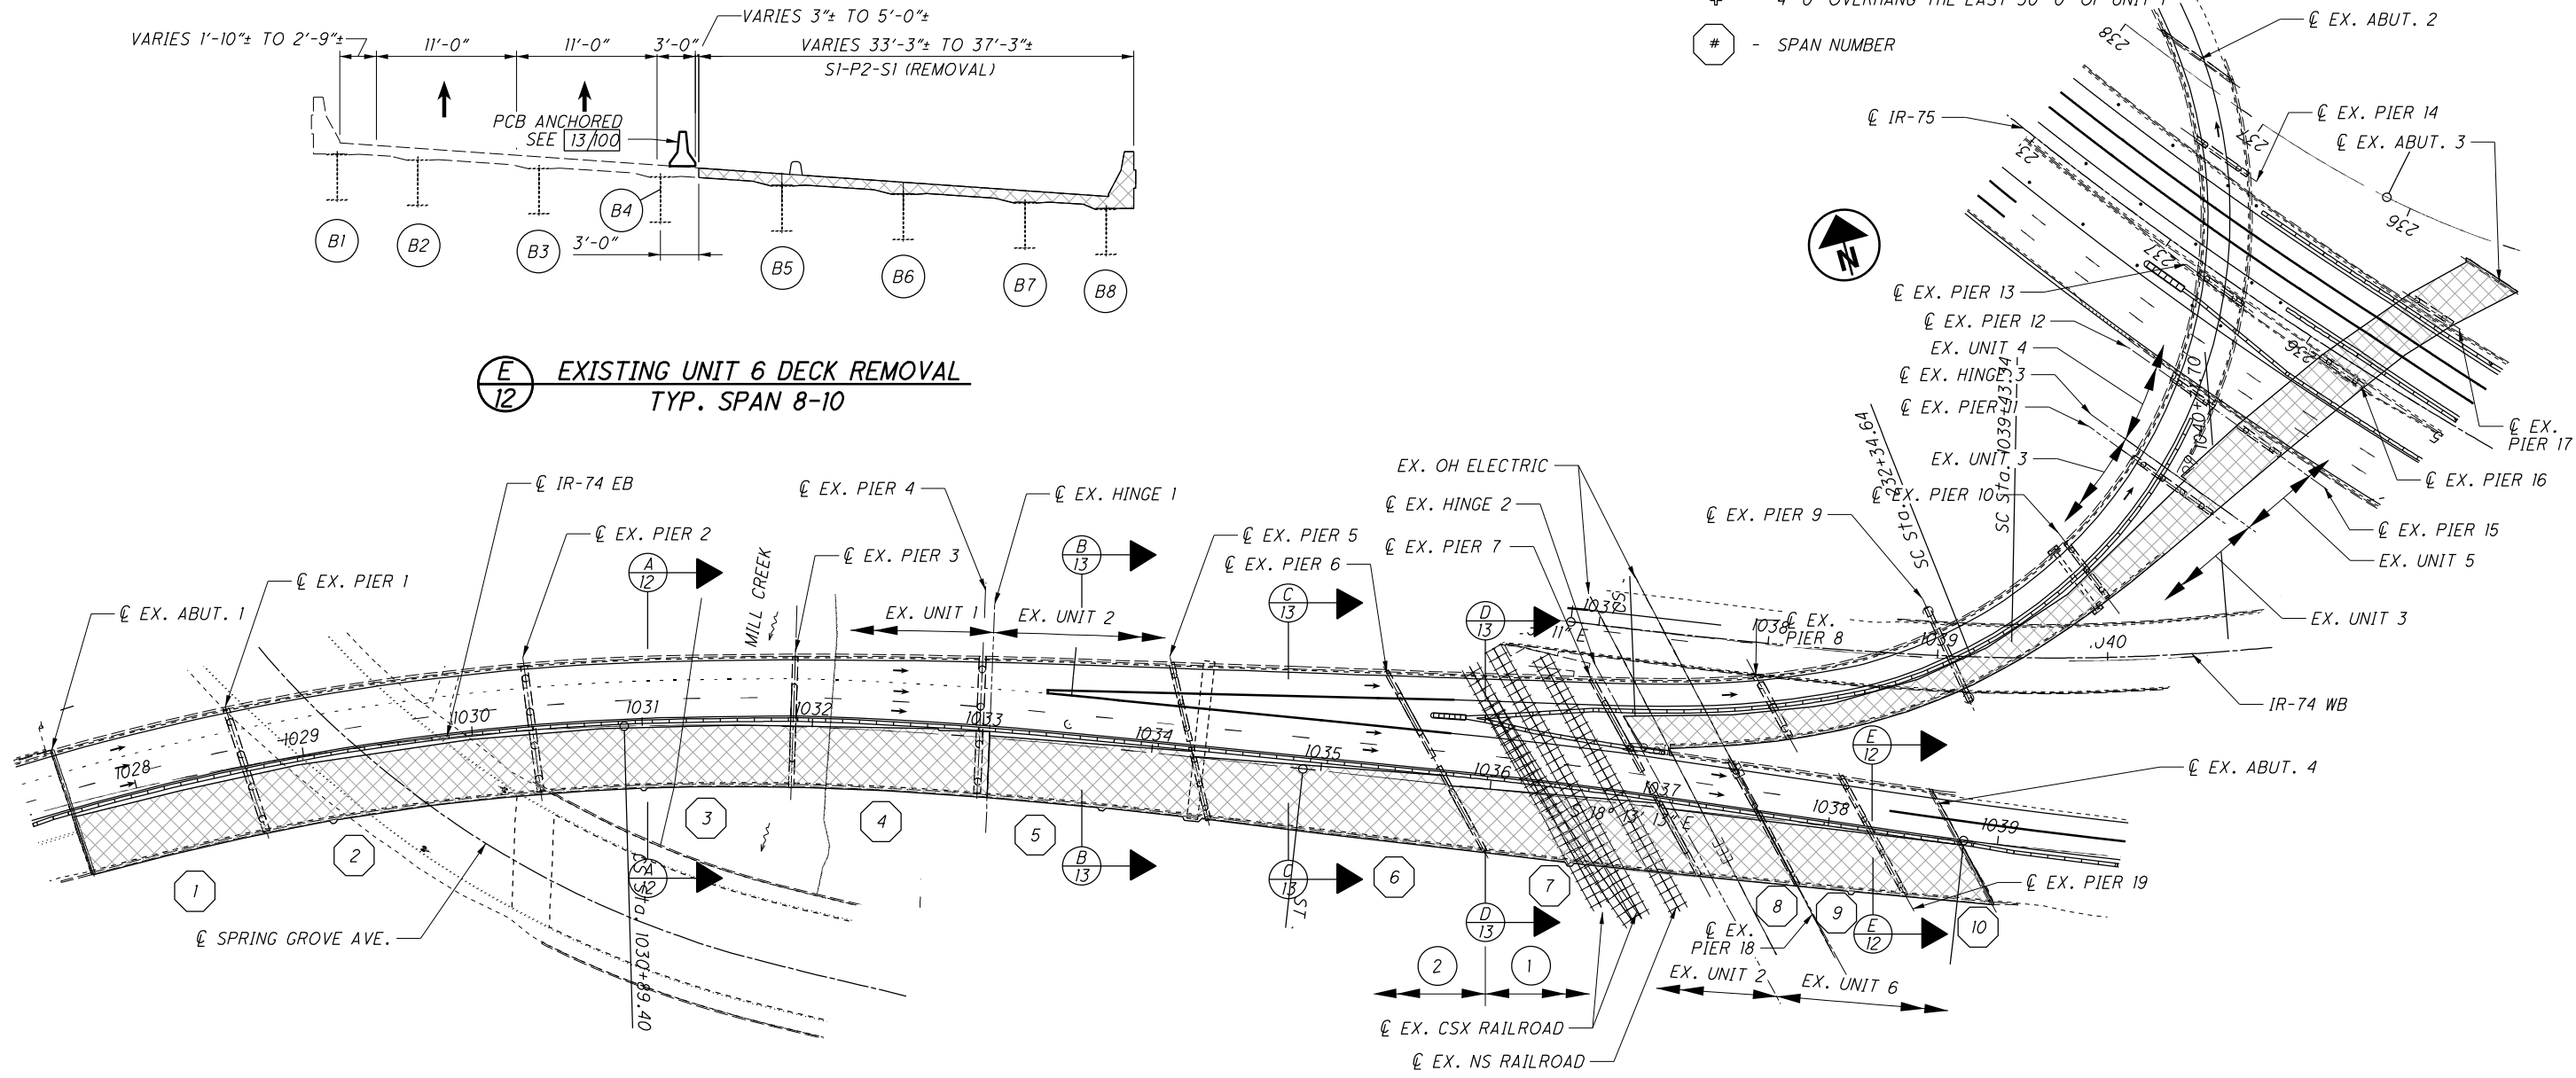


**DECK REMOVAL - STAGE 1, PHASE 2, STEP 1**


P:\Projects\2018\20H03DB-18232 HAM-75-03.84\104667\structures\HAM074\_1908R\sheets\074\_1908R\_PC008.dgn 6/20/2019 9:03:58 AM asead

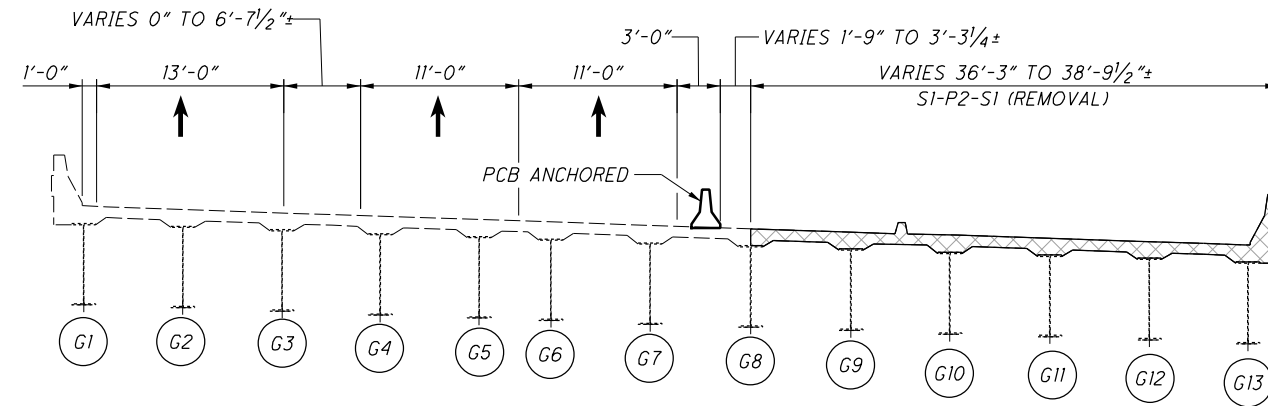

**B** EXISTING UNIT 2 - SPAN 5 DECK REMOVAL  
SI-P2-S1 (REMOVAL)

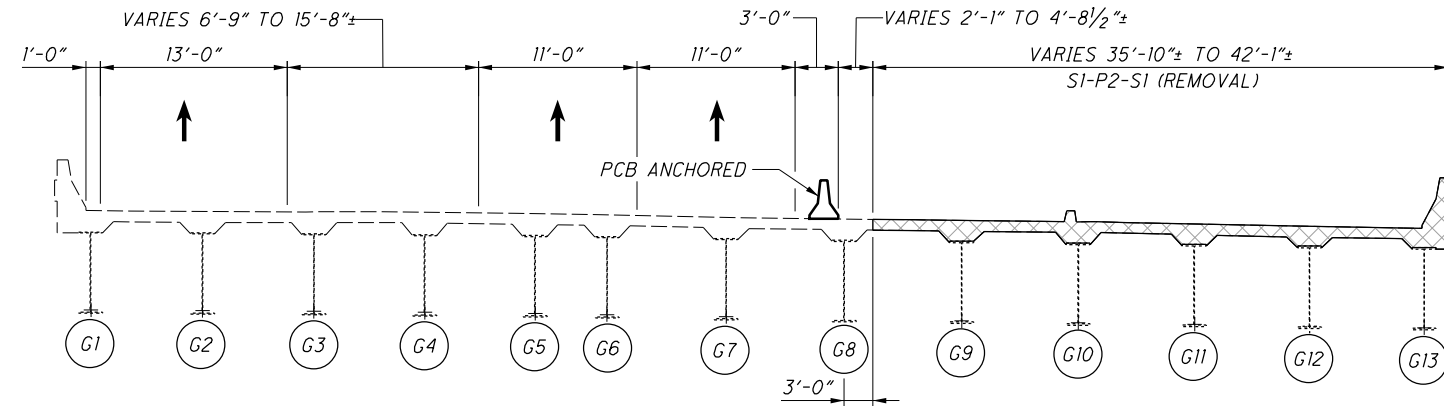

**C** EXISTING UNIT 2 - SPAN 6 DECK REMOVAL  
SI-P2-S1 (REMOVAL)

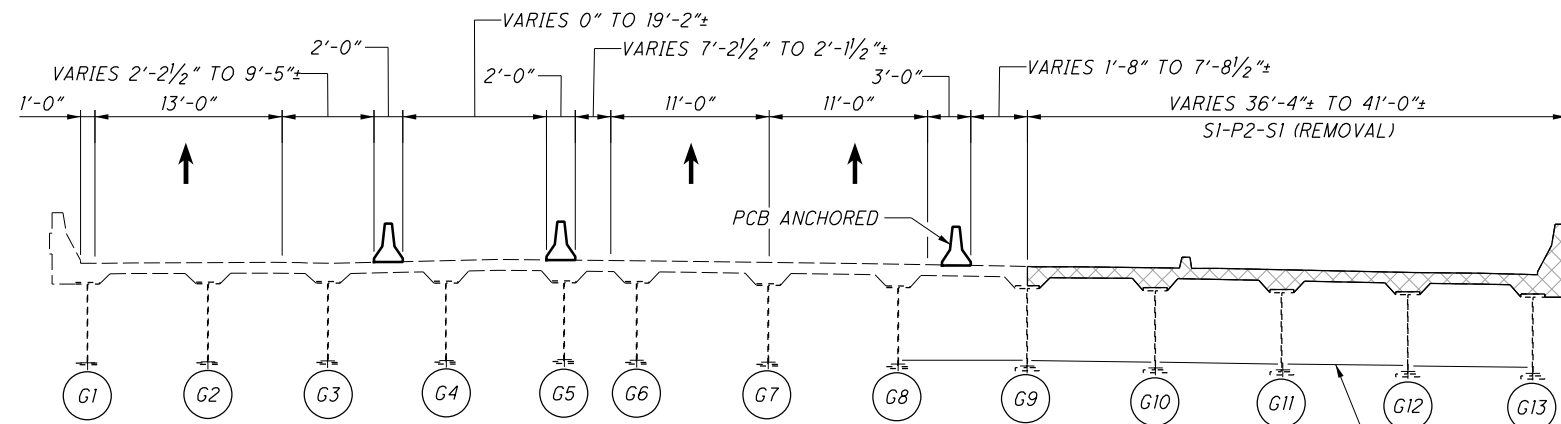

**D** EXISTING UNIT 2 - SPAN 7 DECK REMOVAL  
SI-P2-S1 (REMOVAL)

TIMBER SHIELDING PLACED PRIOR TO DEMOLITION. SEE DETAIL **F** 13, 17, 21


**NOTES:**

- CONSTRUCTION DETAILS ARE FOR I-74 EB (HAM-74-1908R) ONLY. FOR CORRESPONDING CONSTRUCTION DETAILS FOR RAMP P (HAM-74-1908S), SEE BU-05.
- FOR GENERAL NOTES AND MOT REFERENCE, SEE SHEETS **8/100** AND **9/100**.
- FOR LONGITUDINAL DECK REMOVAL CUT LINES OVER CENTERLINES OF EXISTING GIRDERS OR BEAMS, THE CONTRACTOR SHALL TAKE CARE NOT TO DAMAGE REMAINING GIRDERS OR BEAMS DURING THE REMOVAL PROCESS. SEE ITEM 202 ON SHEET **8/100**.
- TIMBER SHIELDING WAS DESIGNED FOR 4X8 TIMBERS SPACED ADJACENTLY; THE CONTRACTORS MAY SELECT LARGER TIMBER SIZES.
- THE TIMBER SHIELDING MATERIAL WAS DESIGNED PER LRFD 8.4.6 AND 8.6.2 FOR THE SPRUCE-PINE-FIR (SOUTH) VISUALLY GRADED NO. OTHER TIMBER MATERIALS MAY BE SELECTED FROM THE VISUALLY GRADED SAWN LUMBER TABLE, PROVIDED THAT THE MINIMUM DESIGN VALUES ARE:
  - $E_o = 1100 \text{ KSI}$
  - $F_o = 0.755 \text{ KSI}$
  - $F_o = 0.135 \text{ KSI}$
- THE CONTRACTOR SHALL HAVE THE OPTION TO UTILIZE A COMPARABLE SHIELDING SYSTEM THAT MEETS THE LOADING REQUIREMENTS, PROVIDED THE MANUFACTURER CAN PROVIDE SPECIFICATIONS AND TESTING RESULTS.
- FOR ADDITIONAL DETAILS AND NOTES ON THE PORTABLE CONCRETE BARRIER (PCB), SEE STANDARD DRAWING PCB-91.

**LEGEND:**

- INDICATES LIMITS OF DECK REMOVAL (SI-P2-S1)
- SX-PX-SX - STAGE X, PHASE X, STEP X (MOT PHASING)


PCB ANCHOR TABLE	
UNIT	# ANCHORS PER SEGMENT
UNIT 1	3
LAST 30' UNIT 1	6
UNIT 2	4
LAST 40' UNIT 2 (SPAN 5 AND 6)	8
UNIT 6 SPAN 8 AND 9	3
UNIT 6 SPAN 10	6

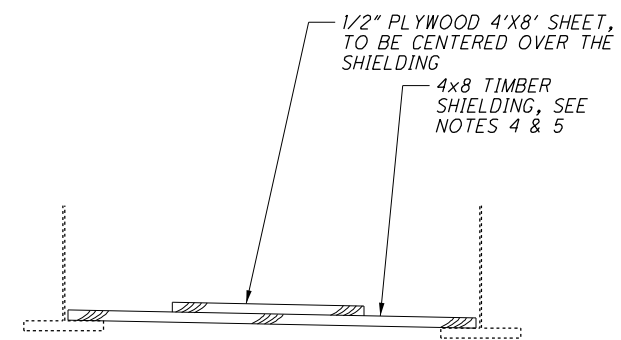


**DEBRIS SHIELDING**  
(ONLY OVER RAILROAD - SPAN 7)

**DECK REMOVAL - STAGE 1, PHASE 2, STEP 1**

P:\Projects\2018\20H03DB-18232 HAM-75-03.84\104667\structures\HAM074\_1908R\sheets\074\_1908R\_PC002.dgn 6/20/2019 9:04:55 AM aseed

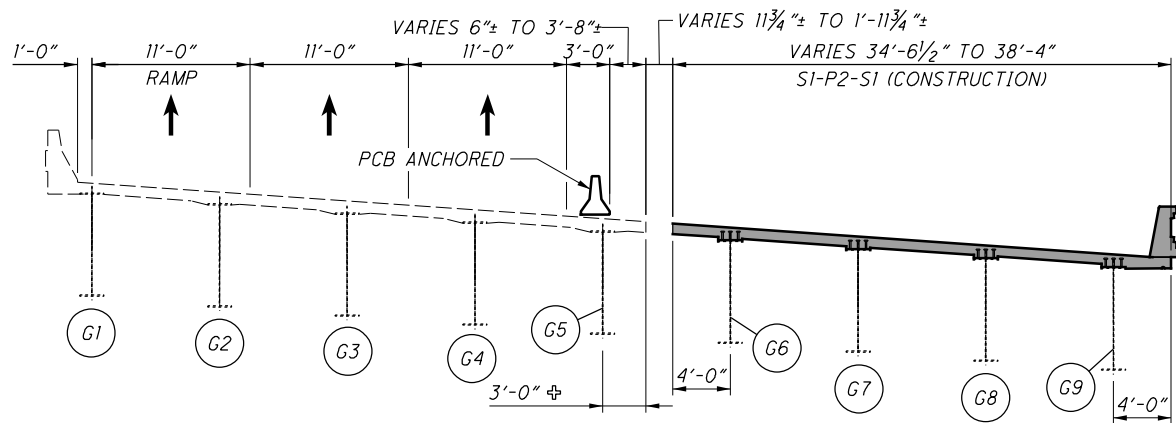

**A**  
14 EXISTING UNIT 1 DECK CONSTRUCTION

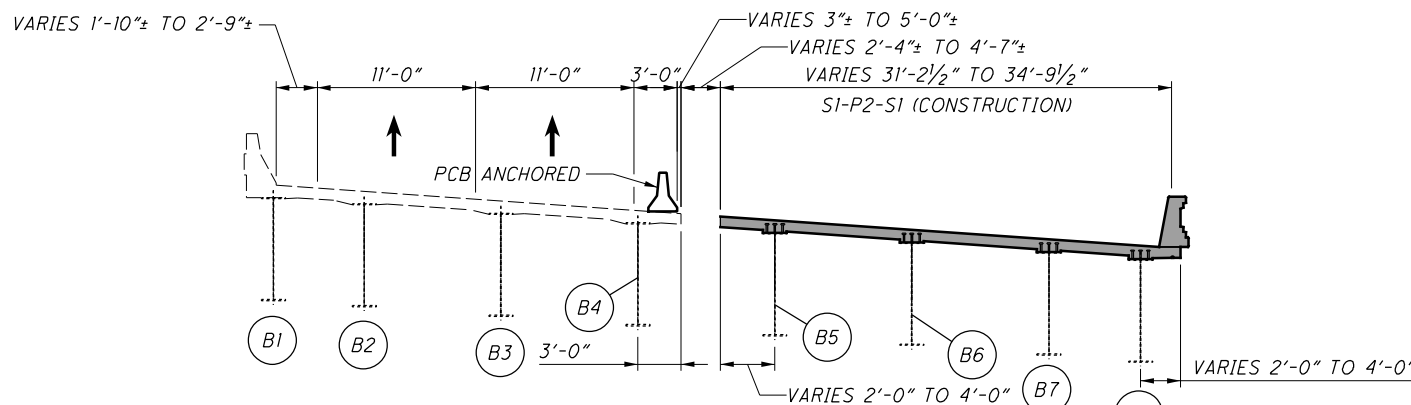


**E**  
14 EXISTING UNIT 6 DECK CONSTRUCTION

**NOTES:**

1. CONSTRUCTION DETAILS ARE FOR I-74 EB (HAM-74-1908R) ONLY. FOR CORRESPONDING CONSTRUCTION DETAILS FOR RAMP P (HAM-74-1908S), SEE BU-05.
2. FOR GENERAL NOTES AND MOT REFERENCE, SEE SHEET 8/100 AND 9/100.
3. FOR PCB ANCHOR DETAILS, SEE SHEET 13/100.

**LEGEND:**

- - INDICATES LIMITS OF DECK CONSTRUCTION (SI-P2-SI)
- SX-PX-SX - STAGE X, PHASE X, STEP X (MOT PHASING)
- + - 4'-0" OVERHANG THE LAST 30'-0" OF UNIT 1

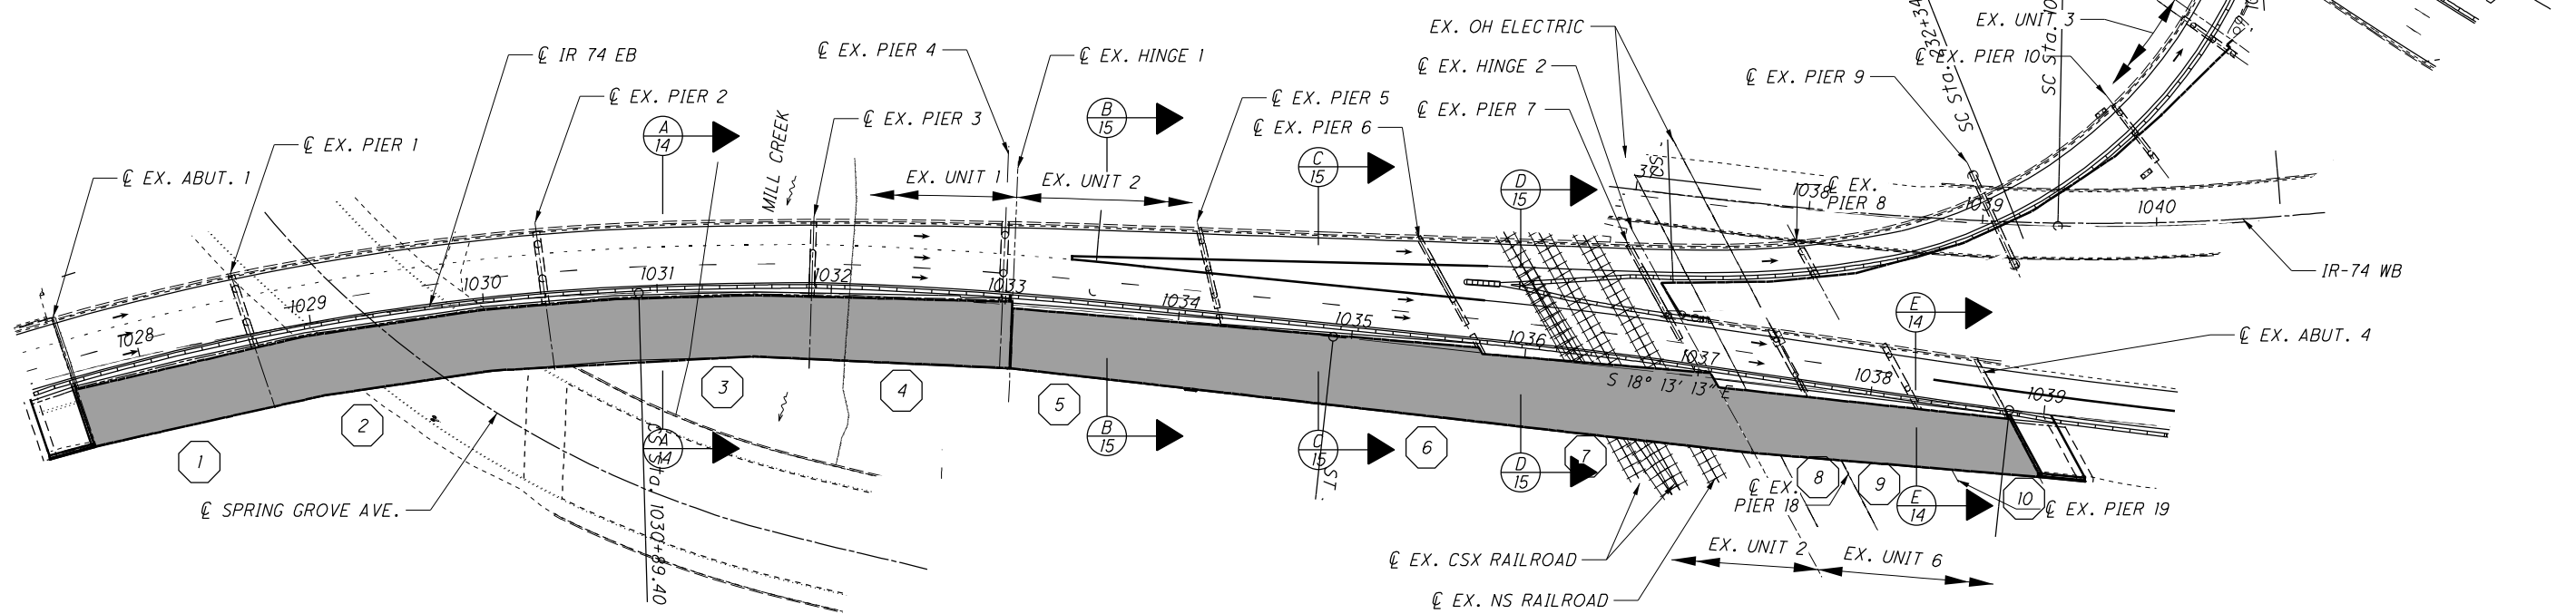


**DECK CONSTRUCTION - STAGE 1, PHASE 2, STEP 1**


DESIGN AGENCY <b>PRIMEW</b> 540 WHITE POND DR. SUITE E AKRON, OH 44320	
DESIGNED CRG	CHECKED CCU
DRAWN CRG	REVISED
REVIEWED TES	STRUCTURE FILE NUMBER 3115739
DATE 3/27/2019	
<b>DECK CONSTRUCTION - STAGE 1, PHASE 2, STEP 1</b> BRIDGE NO. HAM-74-1908R IR-74 OVER MILL CREEK, RR & SPRING GROVE AVENUE	
HAM-75-3.84 PID No. 104667	
14 / 100	
14 / 100	




P:\Projects\2018\20H03DB-18232 HAM-75-03.84\104667\structures\HAM074\_1908R\sheets\074\_1908R\_PC009.dgn 6/20/2019 9:04:59 AM aseed

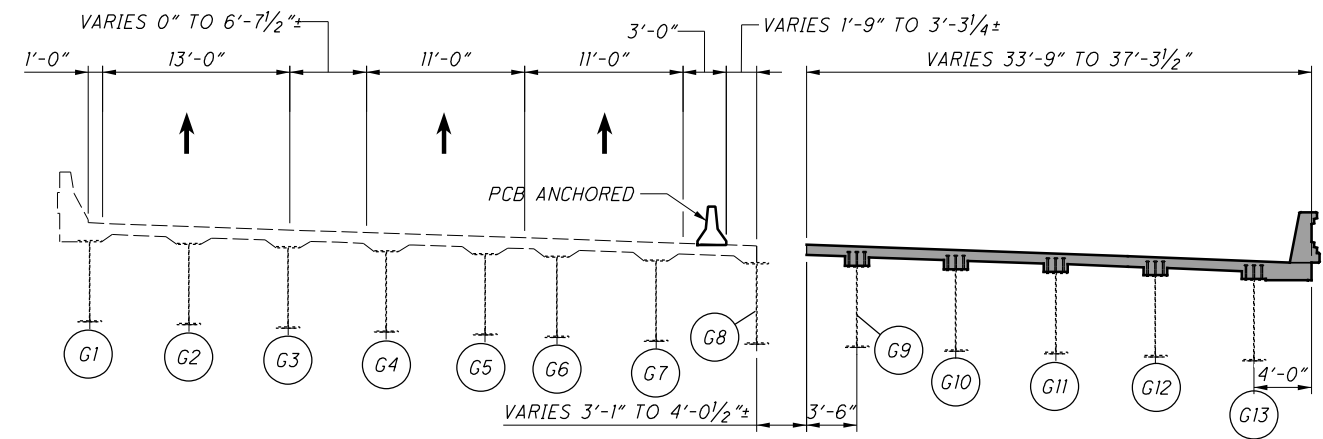

**B**  
**14** EXISTING UNIT 2 - SPAN 5 DECK CONSTRUCTION

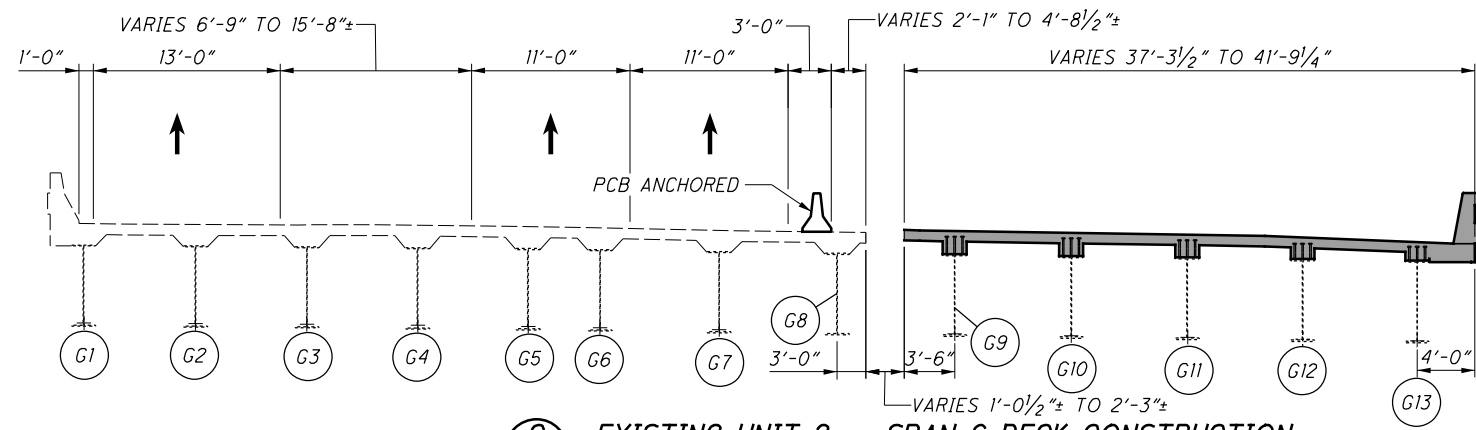

**C**  
**14** EXISTING UNIT 2 - SPAN 6 DECK CONSTRUCTION

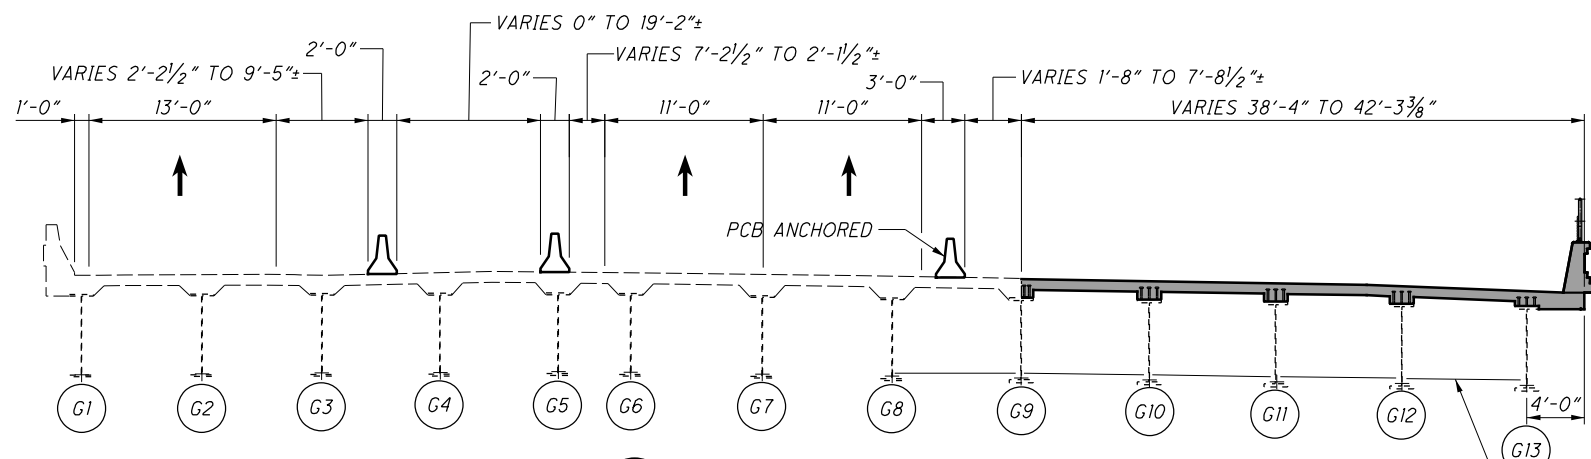

**D**  
**14** EXISTING UNIT 2 - SPAN 7 DECK CONSTRUCTION

TIMBER SHIELDING REMAINS UNTIL DECK POURING IS COMPLETE

**NOTES:**


- CONSTRUCTION DETAILS ARE FOR I-74 EB (HAM-74-1908R) ONLY. FOR CORRESPONDING CONSTRUCTION DETAILS FOR RAMP P (HAM-74-1908S), SEE BU-05.
- FOR GENERAL NOTES AND MOT REFERENCE, SEE SHEETS 8/100 AND 9/100.
- FOR PCB ANCHOR DETAILS, SEE SHEET 13/100.

**LEGEND:**


■ - INDICATES LIMITS OF DECK CONSTRUCTION (SI-P2-SI)

SX-PX-SX - STAGE X, PHASE X, STEP X (MOT PHASING)

P:\Projects\2018\20H03DB-18232 HAM-75-03.84\104667\structures\HAM074\_1908R\sheets\074\_1908R\_PC003.dgn 6/20/2019 9:05:53 AM aseed

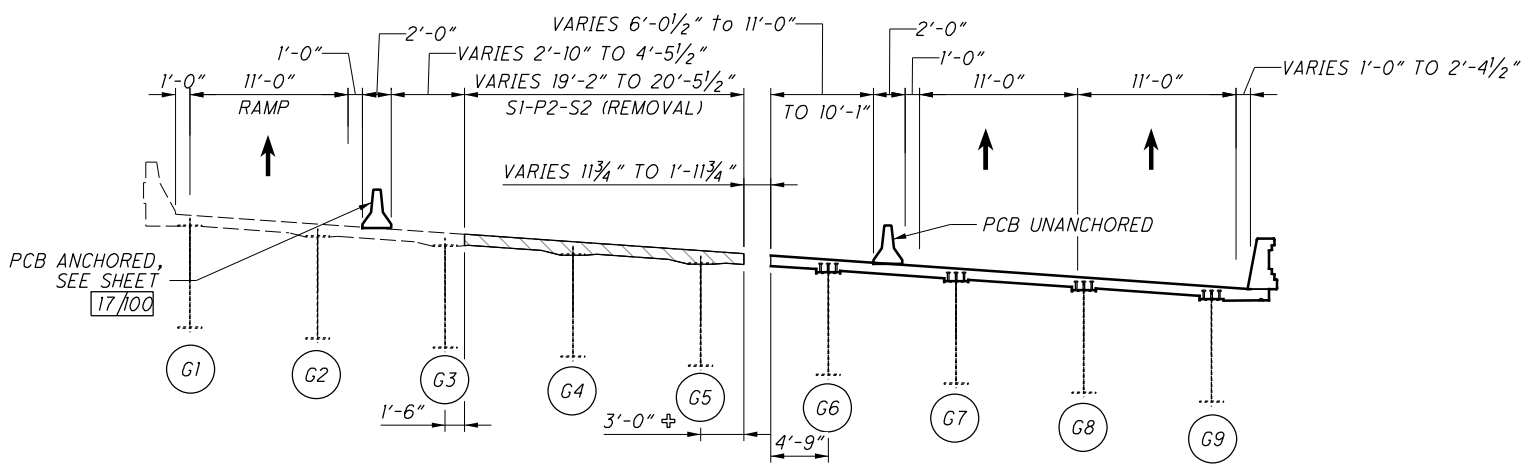

**A** EXISTING UNIT 1 DECK REMOVAL  
TYP. SPAN 1-4

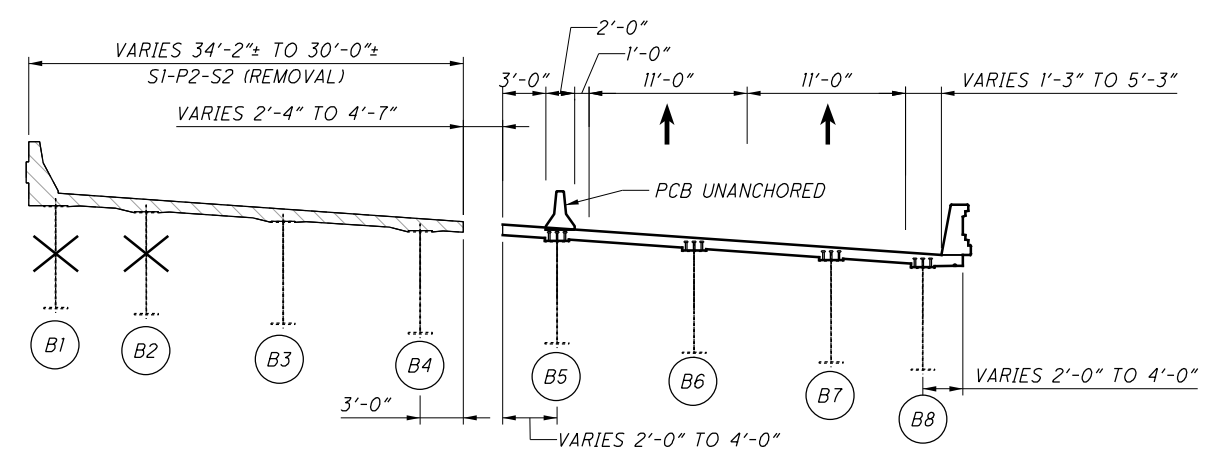

**E** EXISTING UNIT 6 DECK REMOVAL  
TYP. SPAN 8-10

**DECK REMOVAL SEQUENCE:**


- 1 REMOVE PORTION OF EXISTING UNIT 2 FROM EXISTING PIER 6 TO EXISTING HINGE 2. REMOVE PORTION OF EXISTING UNIT 6 FROM EXISTING HINGE 2 TO EXISTING ABUTMENT 4.
- 2 REMOVE PORTION OF EXISTING UNITS 1 & 2 FROM EXISTING PIER 6 TO EXISTING ABUTMENT 1. SEQUENCE 2 MAY HAPPEN CONCURRENTLY WITH SEQUENCE 1.

**NOTES:**


1. REMOVAL DETAILS ARE FOR I-74 EB (HAM-74-1908R) ONLY. FOR CORRESPONDING REMOVAL DETAILS FOR RAMP P (HAM-74-1908S), SEE BU-05.
2. PRIOR TO ANY REMOVALS OF UNIT 3 OR UNIT 6, CONTRACTOR SHALL WELD PLATES TO THE LINKS AS SHOWN IN THE BU-10 REMOVAL SET.
3. PRIOR TO ANY REMOVALS OVER THE RAILROAD CONTRACTOR SHALL INSTALL TIMBER LAGGING DEBRIS SHIELD OVER RAILROAD IN SPAN 7. SEE SHEET 13/100 FOR MORE DETAILS.
4. FOR SUBSTRUCTURE REMOVAL DETAILS, SEE SHEETS 31/100 THRU 33/100.
5. FOR GENERAL NOTES AND MOT REFERENCE, SEE SHEET 8/100 AND 9/100.

**LEGEND:**


- INDICATES LIMITS OF DECK REMOVAL (SI-P2-S2)
- SX-PX-SX - STAGE X, PHASE X, STEP X (MOT PHASING)
- 4'-0\"/>
- SPAN NUMBER

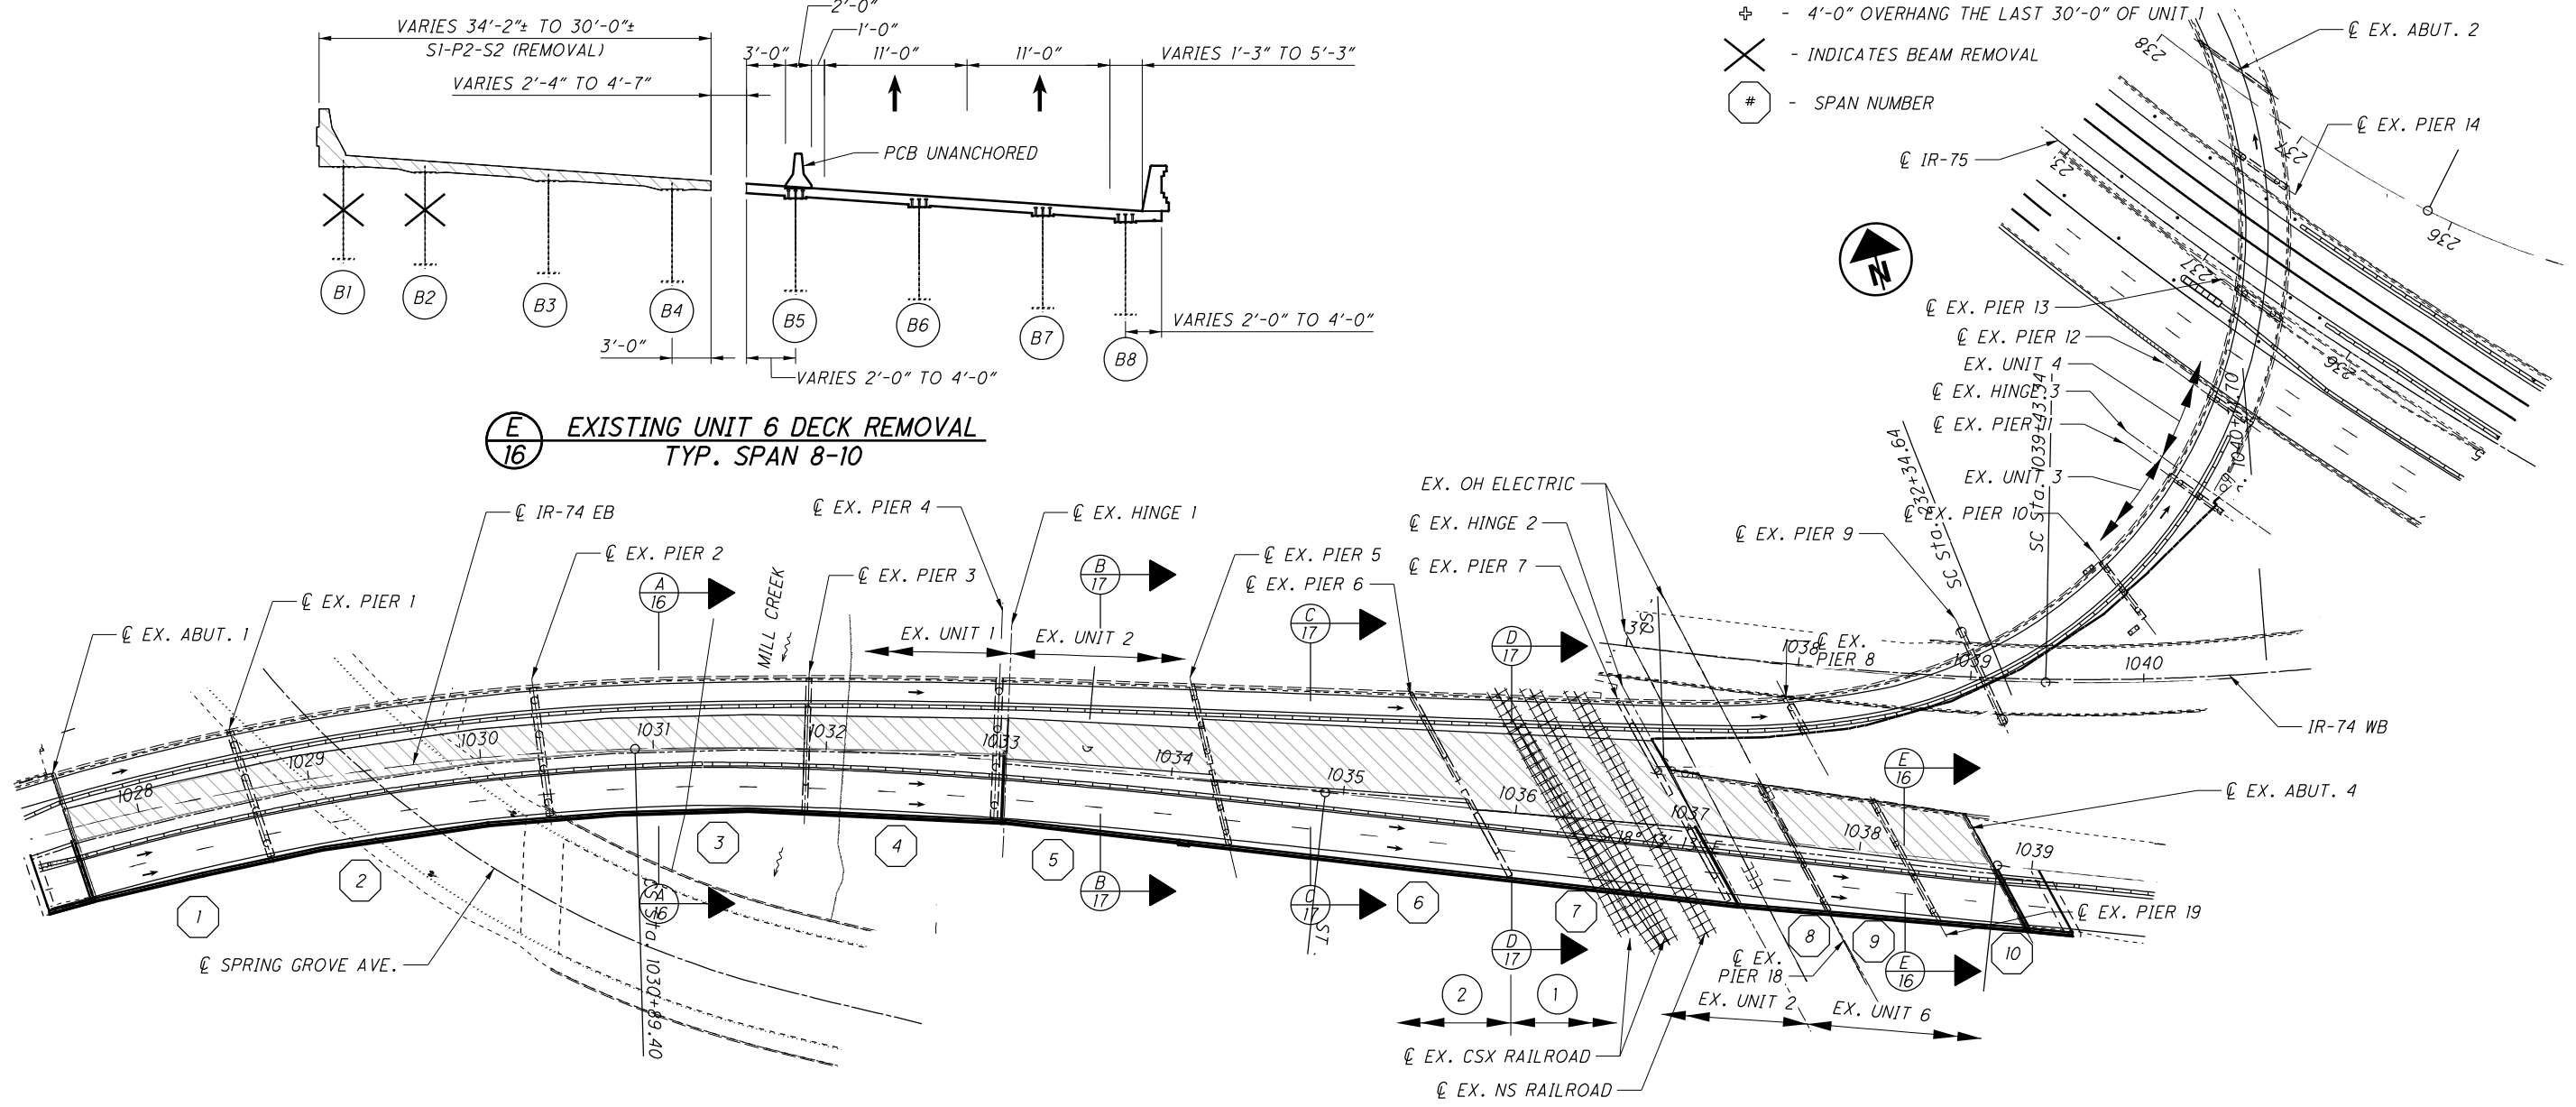


DECK REMOVAL - STAGE 1, PHASE 2, STEP 2

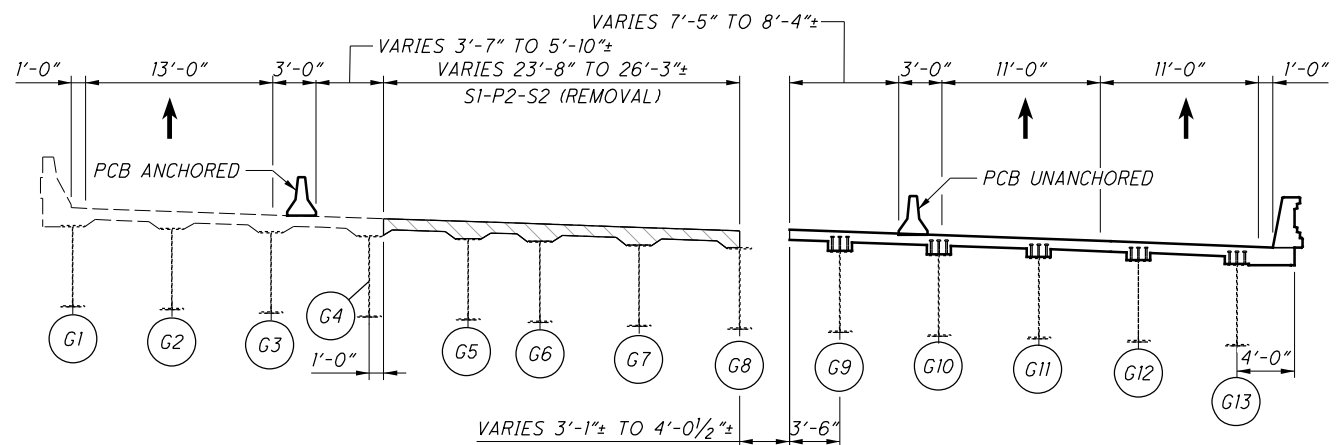

**B** EXISTING UNIT 2 - SPAN 5 DECK REMOVAL

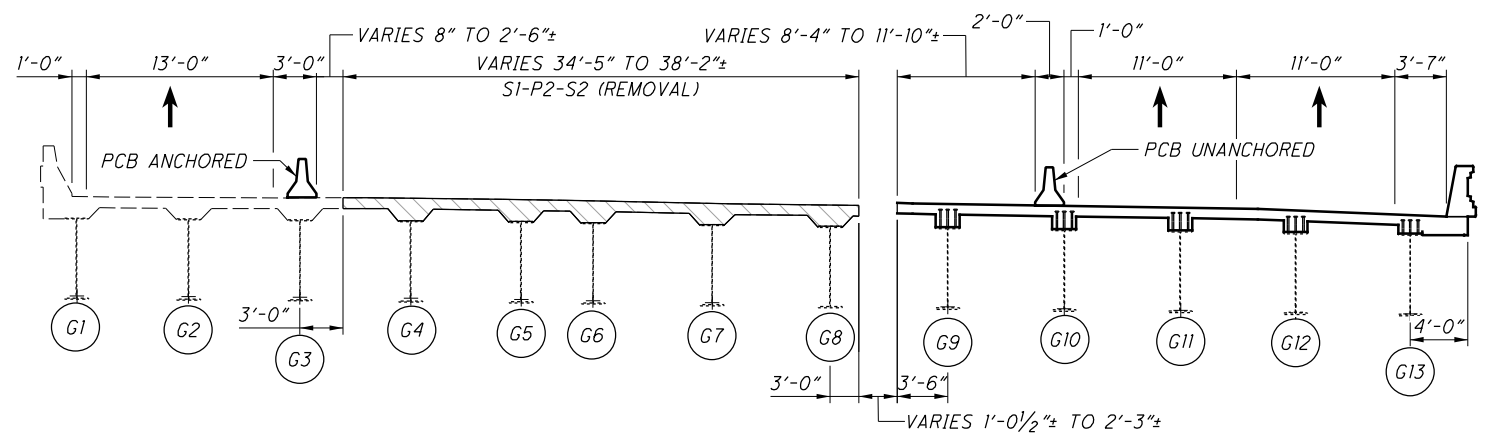

**C** EXISTING UNIT 2 - SPAN 6 DECK REMOVAL

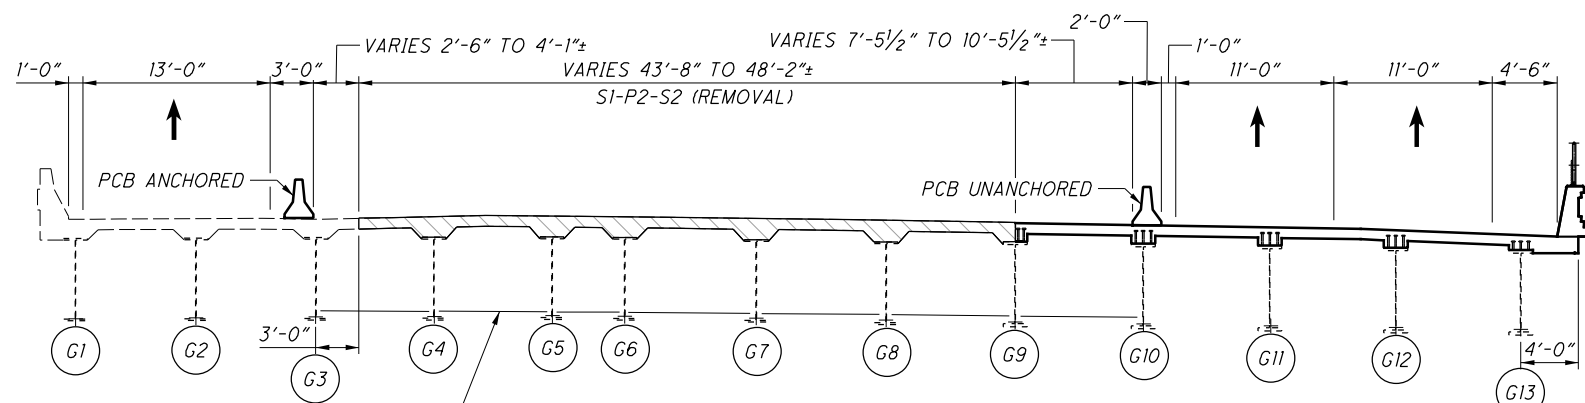

**D** EXISTING UNIT 2 - SPAN 7 DECK REMOVAL

TIMBER LAGGING DEBRIS SHIELD TO BE PLACED PRIOR TO DEMOLITION SEE DETAIL **F**

**NOTES:**


1. CONSTRUCTION DETAILS ARE FOR I-74 EB (HAM-74-1908R) ONLY. FOR CORRESPONDING CONSTRUCTION DETAILS FOR RAMP P (HAM-74-1908S), SEE BU-05.
2. FOR GENERAL NOTES AND MOT REFERENCE, SEE SHEETS **8/100** AND **9/100**.
3. FOR LONGITUDINAL DECK REMOVAL CUT LINES OVER CENTERLINES OF EXISTING GIRDERS OR BEAMS, THE CONTRACTOR SHALL TAKE CARE NOT TO DAMAGE REMAINING GIRDERS OR BEAMS DURING THE REMOVAL PROCESS. REFER TO ITEM 202 NOTE ON SHEET **8/100**.
4. FOR DEBRIS SHIELD DETAILS, SEE SHEET **13/100**.
5. FOR ADDITIONAL DETAILS AND NOTES ON THE PORTABLE CONCRETE BARRIER (PCB), SEE STANDARD DRAWING PCB-91.

**LEGEND:**


- INDICATES LIMITS OF DECK REMOVAL (SI-P2-S2)
- SX-PX-SX - STAGE X, PHASE X, STEP X (MOT PHASING)

PCB ANCHOR TABLE	
UNIT	# ANCHORS PER SEGMENT
UNIT 1	2
UNIT 2 SPAN 6 (FIRST 65')	4
REMAINDER UNIT 2	2

P:\Projects\2018\20H03DB-18232 HAM-75-03.84\104667\structures\HAM074\_1908R\sheets\074\_1908R\_PC004.dgn 6/20/2019 9:06:53 AM aseed

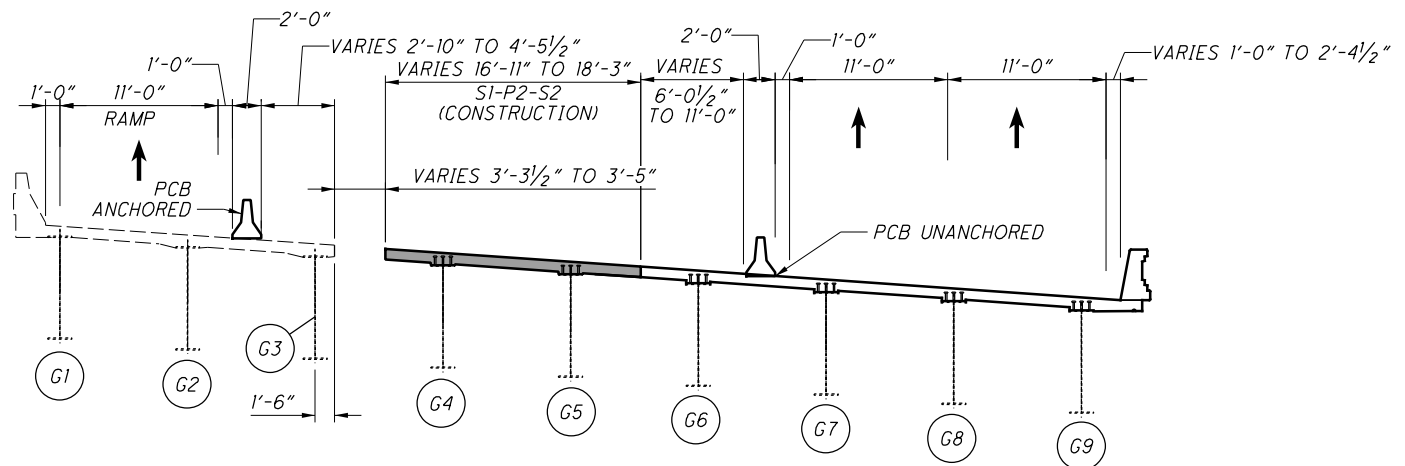

**A**  
**18** EXISTING UNIT 1 DECK CONSTRUCTION

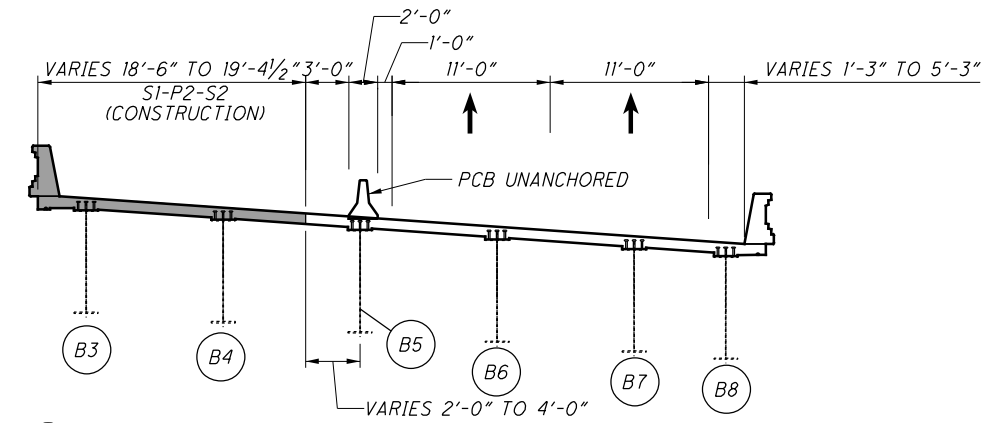


**E**  
**18** EXISTING UNIT 6 DECK CONSTRUCTION

**NOTES:**

1. CONSTRUCTION DETAILS ARE FOR I-74 EB (HAM-74-1908R) ONLY. FOR CORRESPONDING CONSTRUCTION DETAILS FOR RAMP P (HAM-74-1908S), SEE BU-05.
2. FOR GENERAL NOTES AND MOT REFERENCE, SEE SHEETS 8/100 AND 9/100.
3. FOR PCB ANCHOR DETAIL, SEE SHEET 17/100.


**LEGEND:**

- - INDICATES LIMITS OF DECK CONSTRUCTION (SI-P2-S2)
- SX-PX-SX - STAGE X, PHASE X, STEP X (MOT PHASING)

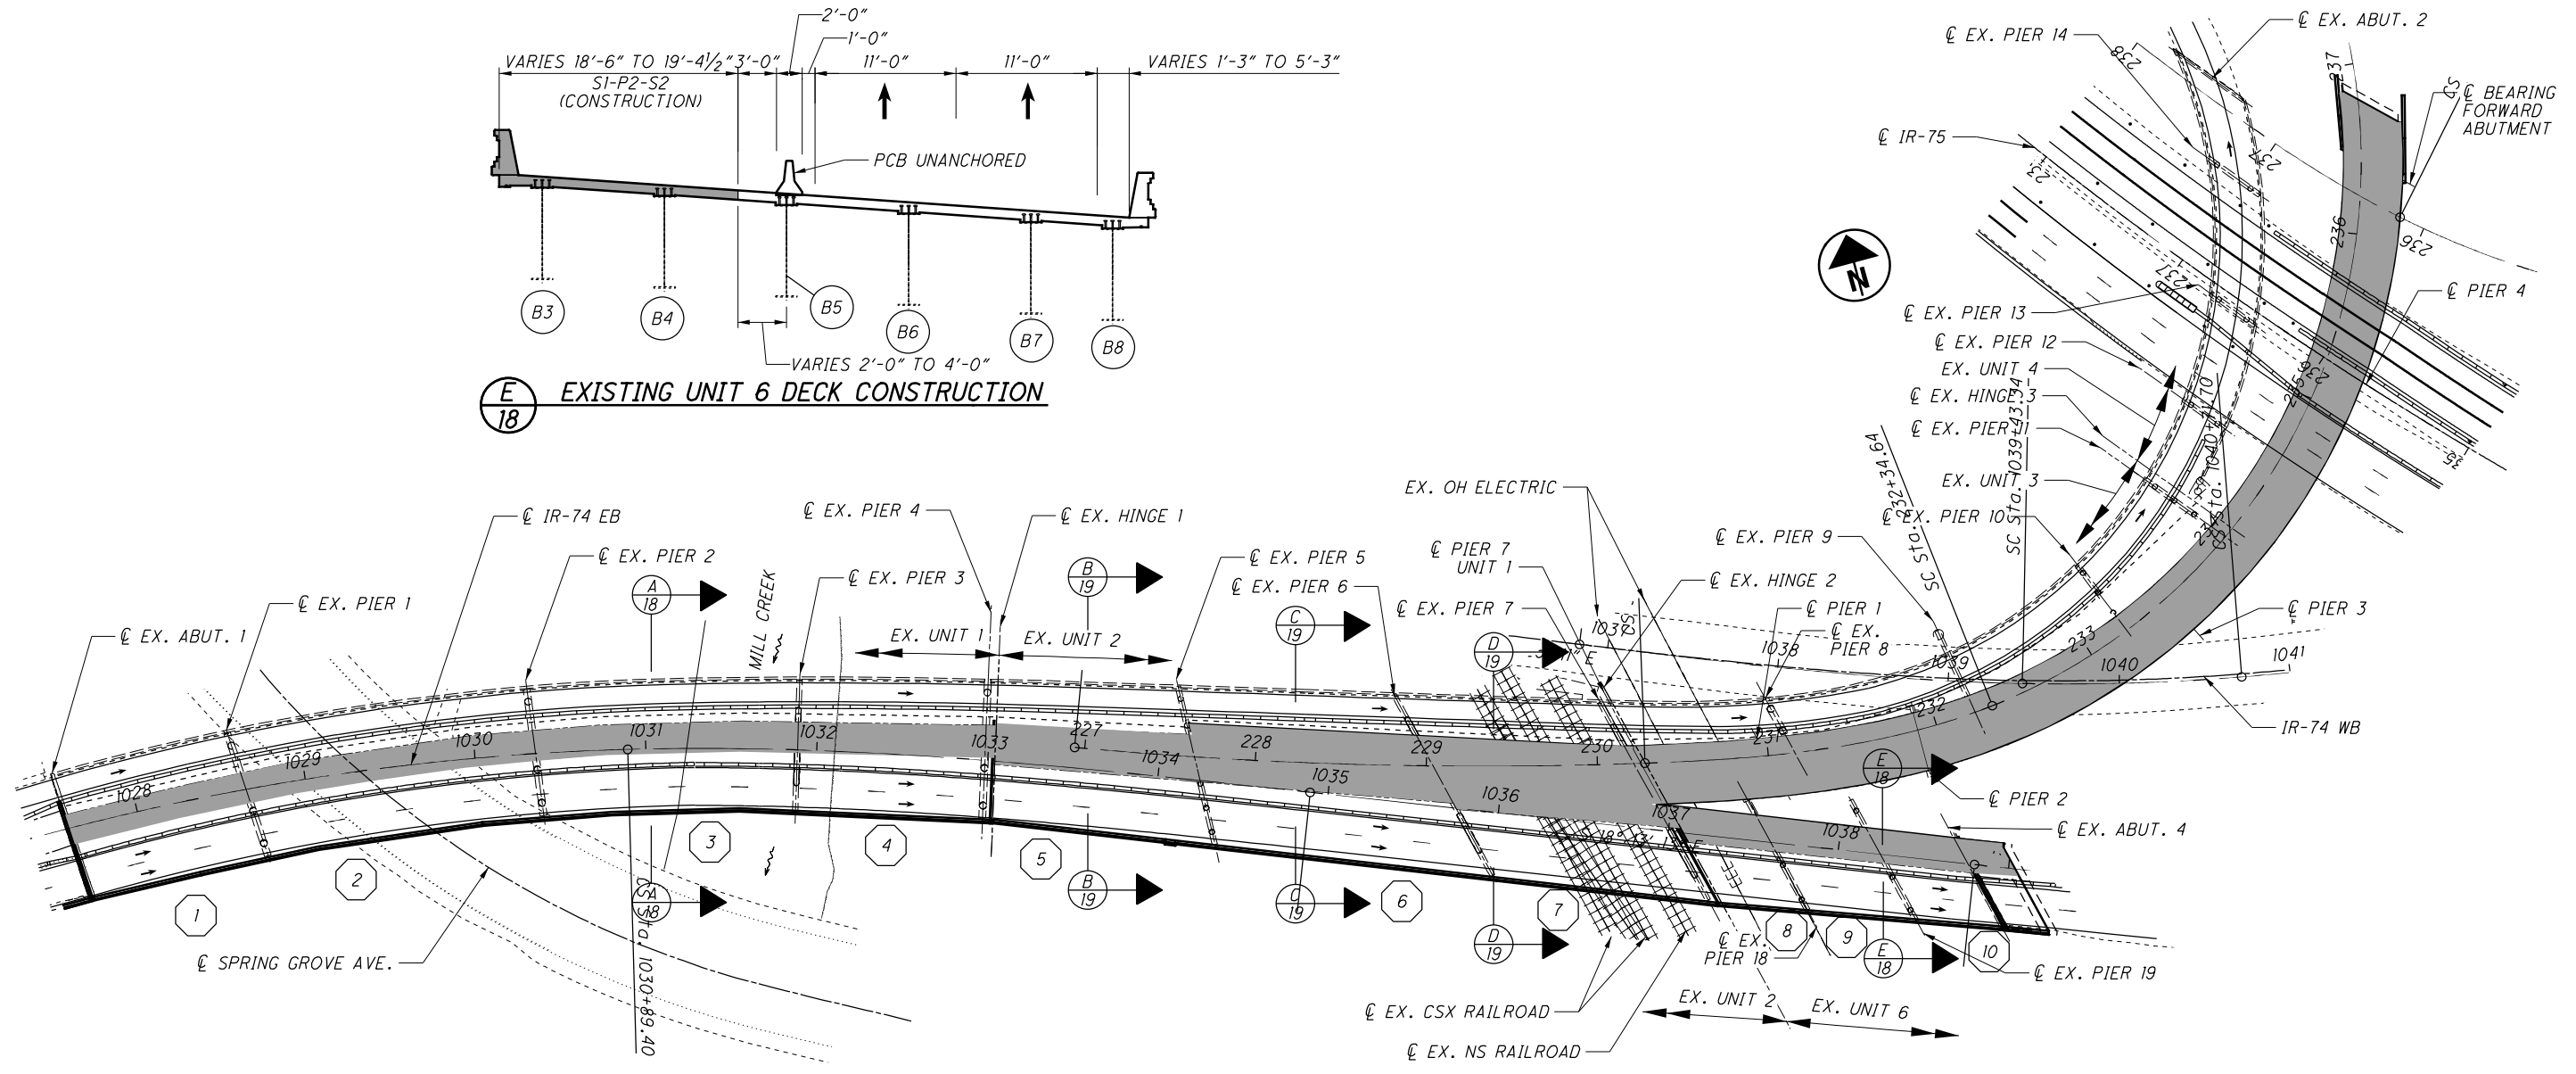


**DECK CONSTRUCTION-STAGE 1, PHASE 2, STEP 2**


P:\Projects\2018\20H03DB-18232 HAM-75-03.84\104667\structures\HAM074\_1908R\sheets\074\_1908R\_PC011.dgn 6/20/2019 9:06:58 AM asead

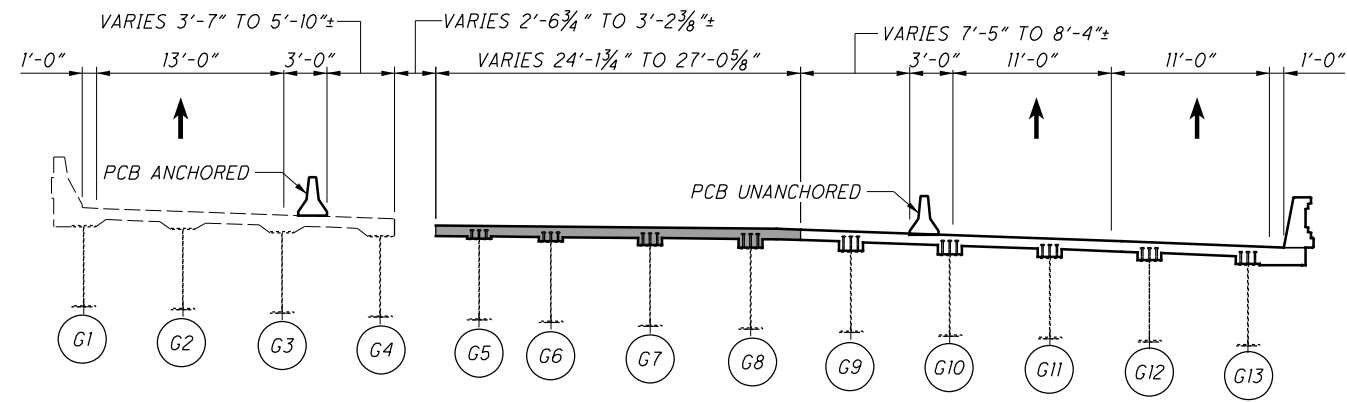

**B**  
18 EXISTING UNIT 2 - SPAN 5 DECK CONSTRUCTION

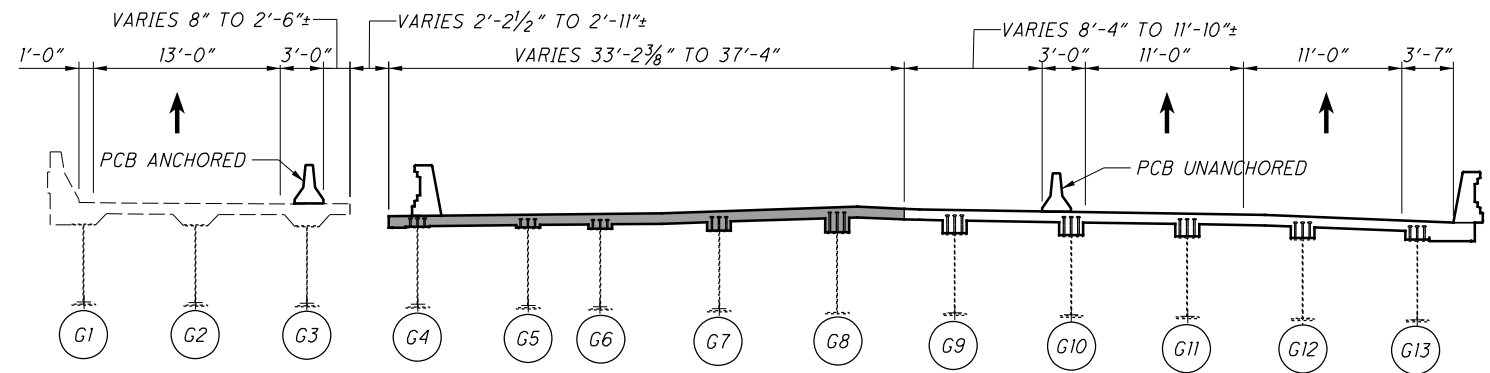

**C**  
18 EXISTING UNIT 2 - SPAN 6 DECK CONSTRUCTION

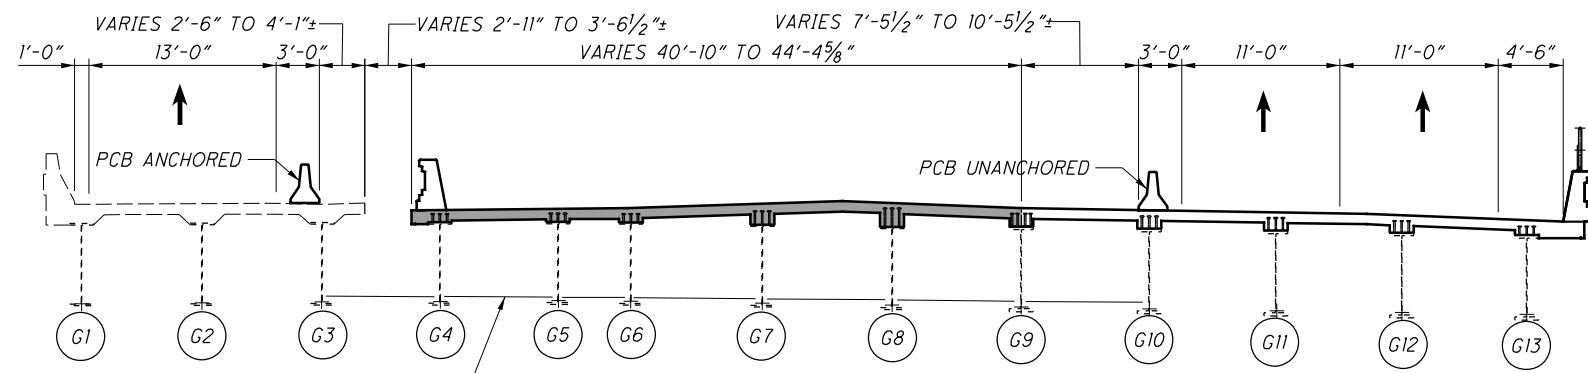

**D**  
18 EXISTING UNIT 2 - SPAN 7 DECK CONSTRUCTION

TIMBER SHIELDING REMAINS UNTIL DECK POURING IS COMPLETE


**NOTES:**

1. CONSTRUCTION DETAILS ARE FOR I-74 EB (HAM-74-1908R) ONLY. FOR CORRESPONDING CONSTRUCTION DETAILS FOR RAMP P (HAM-74-1908S), SEE BU-05.
2. FOR GENERAL NOTES AND MOT REFERENCE, SEE SHEETS 8/100 AND 9/100.
3. FOR PCB ANCHOR DETAILS, SEE SHEET 17/100.


**LEGEND:**

- - INDICATES LIMITS OF DECK CONSTRUCTION (S1-P2-S2)
- SX-PX-SX - STAGE X, PHASE X, STEP X (MOT PHASING)



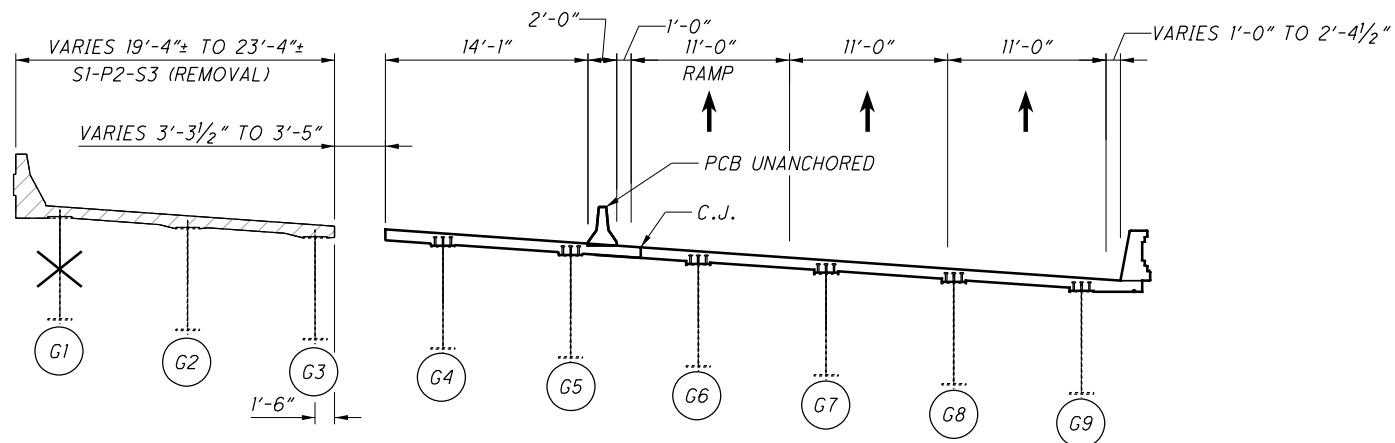

**A** 20 EXISTING UNIT 1 DECK REMOVAL  
TYP. SPAN 1-4

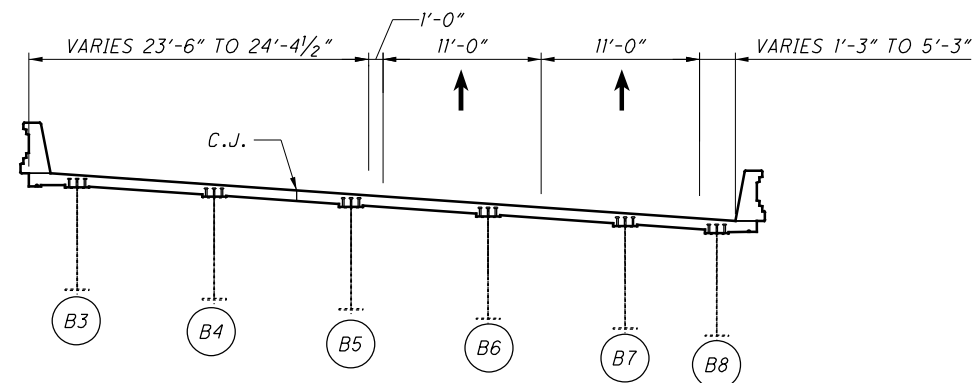

**E** 20 EXISTING UNIT 6 MOT  
TYP. SPAN 8-10

**DECK REMOVAL SEQUENCE:**


- 1 REMOVE PORTION OF EXISTING UNIT 2 FROM EXISTING PIER 6 TO EXISTING HINGE 2.
- 2 REMOVE PORTION OF EXISTING UNITS 1 & 2 FROM EXISTING PIER 6 TO EXISTING ABUTMENT 1. SEQUENCE 2 MAY HAPPEN CONCURRENTLY WITH SEQUENCE 1.

**NOTES:**

1. REMOVAL DETAILS ARE FOR I-74 EB (HAM-74-1908R) ONLY. FOR CORRESPONDING REMOVAL DETAILS FOR RAMP P (HAM-74-1908S), SEE BU-05.
2. PRIOR TO ANY REMOVALS OF UNIT 3 OR UNIT 6, CONTRACTOR SHALL WELD PLATES TO THE LINKS AS SHOWN IN THE BU-10 REMOVAL SET.
3. PRIOR TO ANY REMOVALS OVER THE RAILROAD CONTRACTOR SHALL INSTALL TIMBER LAGGING DEBRIS SHIELD OVER RAILROAD IN SPAN 7. SEE SHEET 13/100 FOR MORE DETAILS.
4. FOR SUBSTRUCTURE REMOVAL DETAILS, SEE SHEETS 31/100 THRU 33/100.
5. FOR GENERAL NOTES AND MOT REFERENCE, SEE SHEETS 8/100 AND 9/100.

**LEGEND:**

- INDICATES LIMITS OF DECK REMOVAL (SI-P2-S3)
- SX-PX-SX - STAGE X, PHASE X, STEP X (MOT PHASING)
- INDICATES BEAM REMOVAL
- SPAN NUMBER

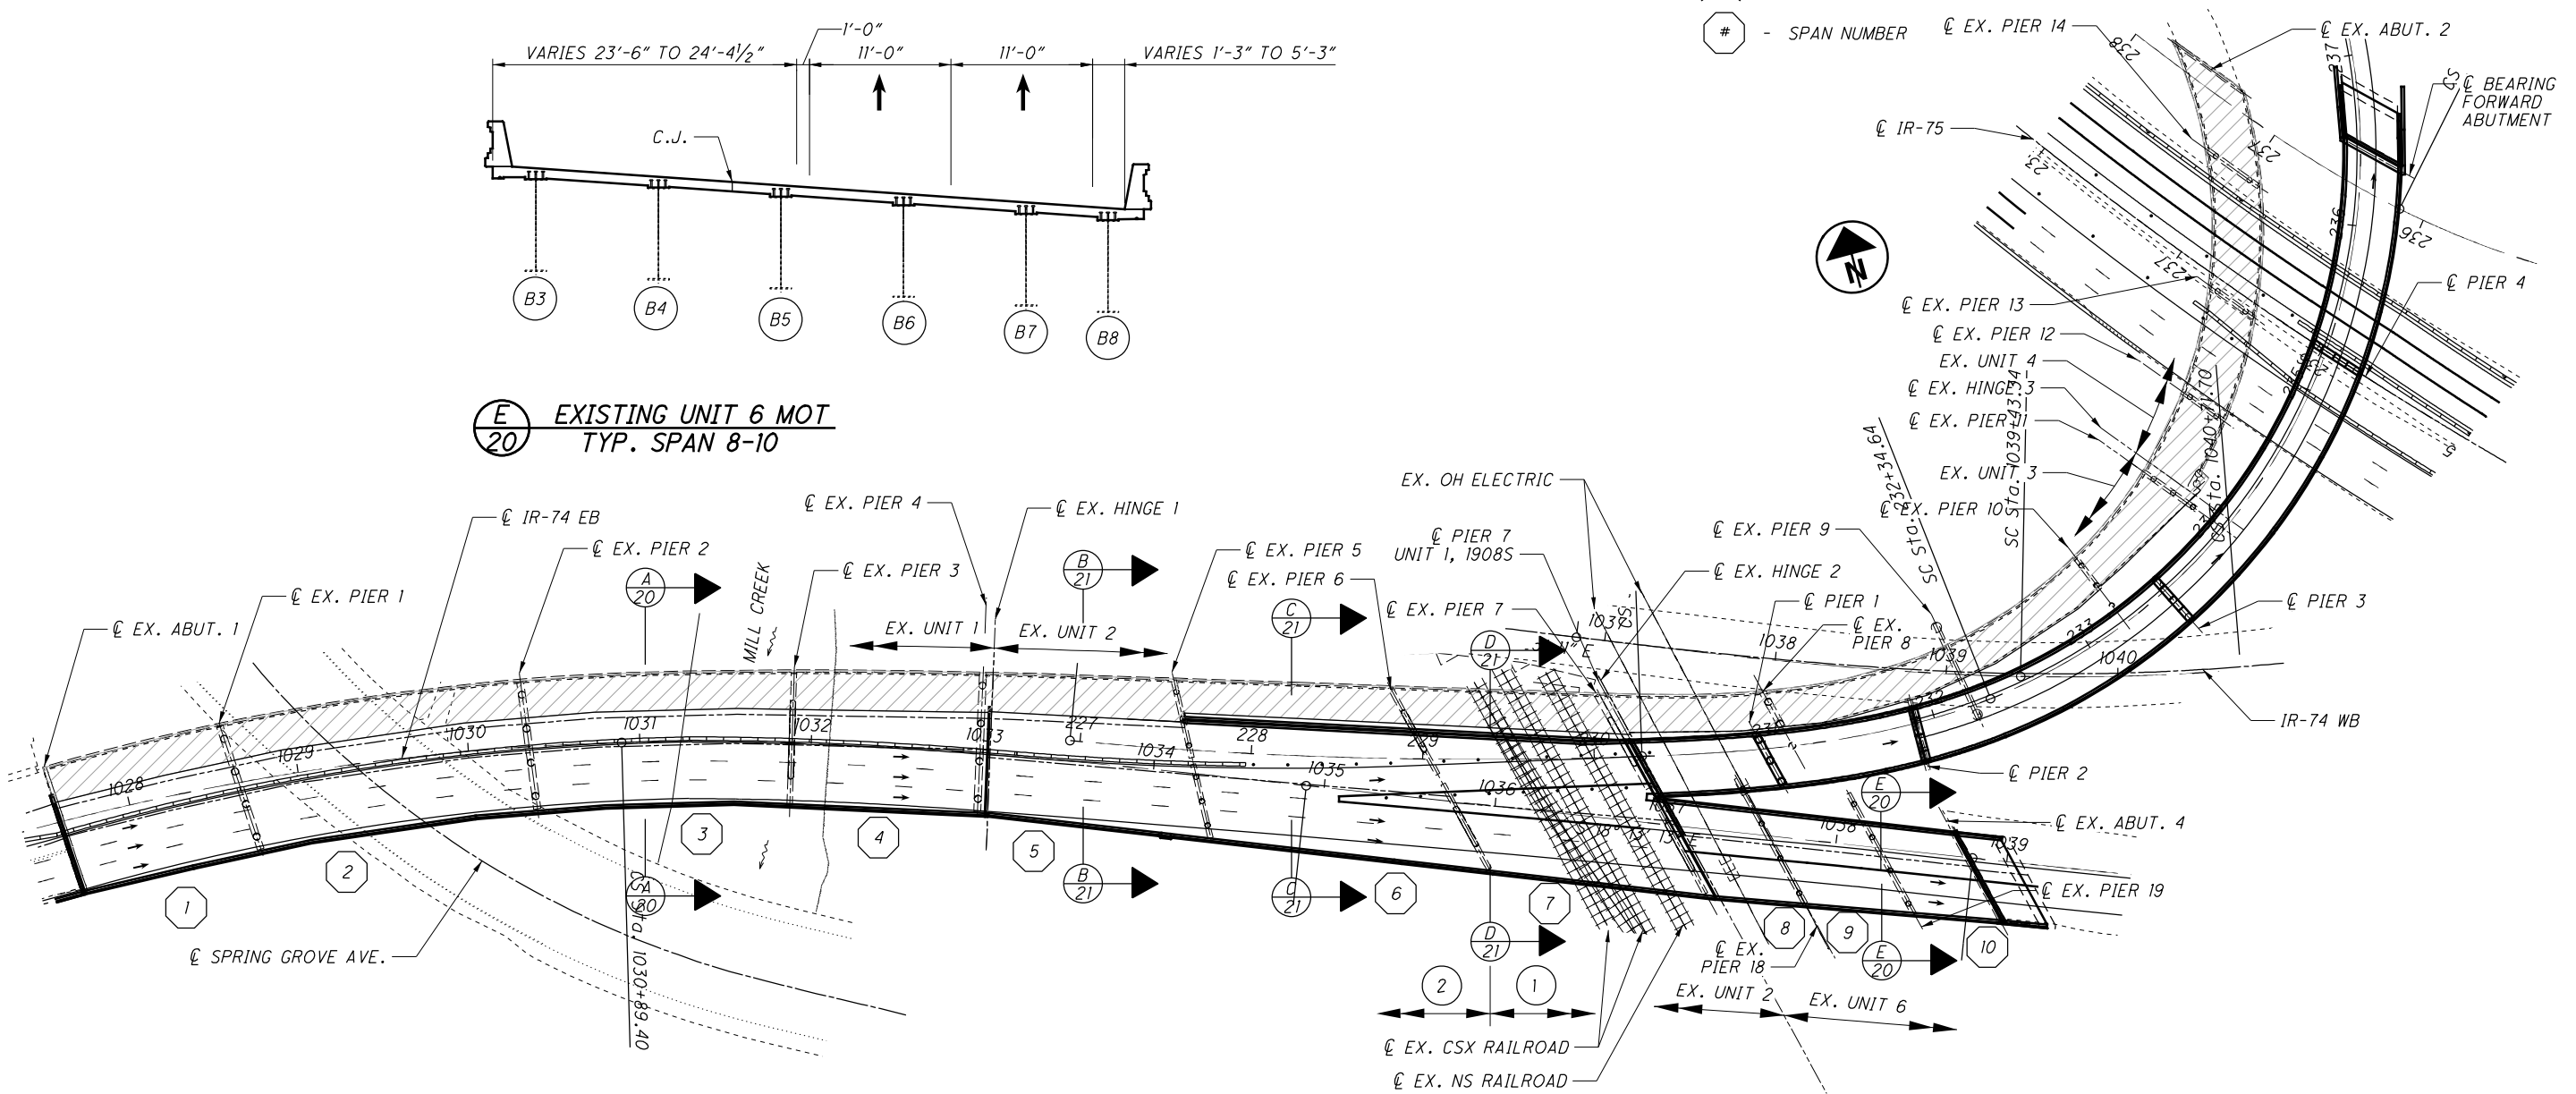

**DECK REMOVAL - STAGE 1, PHASE 2, STEP 3**

DESIGNED	CRG	CHECKED	KDC
DRAWN	CRG	REVISED	
REVIEWED	TES	DATE	3/27/2019
STRUCTURE FILE NUMBER			3115739


**DECK REMOVAL - STAGE 1, PHASE 2, STEP 3**  
BRIDGE NO. HAM-74-1908R  
IR-74 OVER MILL CREEK, RR & SPRING GROVE AVENUE

HAM-75-3.84  
PID No. 104667


20/100

20/100


P:\Projects\2018\20H03DB-18232 HAM-75-03-84\104667\structures\HAM074\_1908R\PC012.dgn 6/20/2019 9:07:59 AM asecd

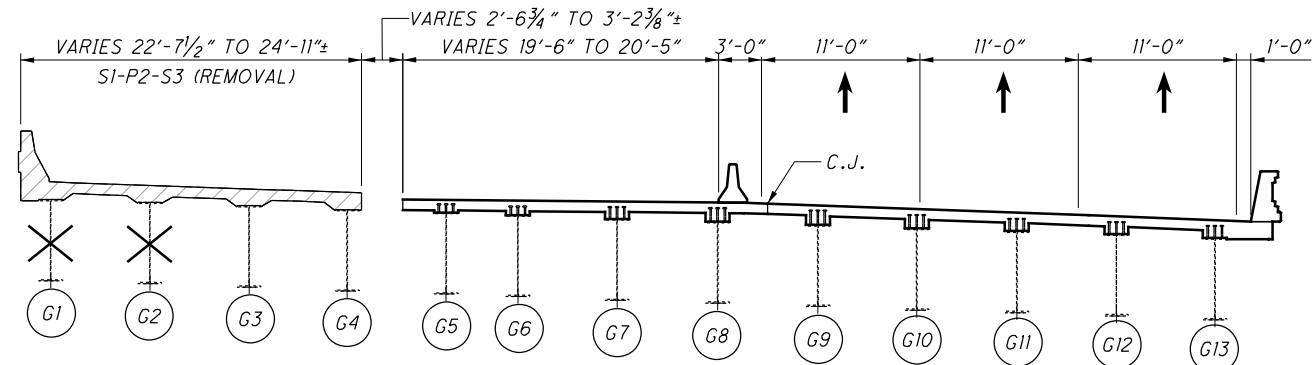

**B**  
20 EXISTING UNIT 2 - SPAN 5 DECK REMOVAL

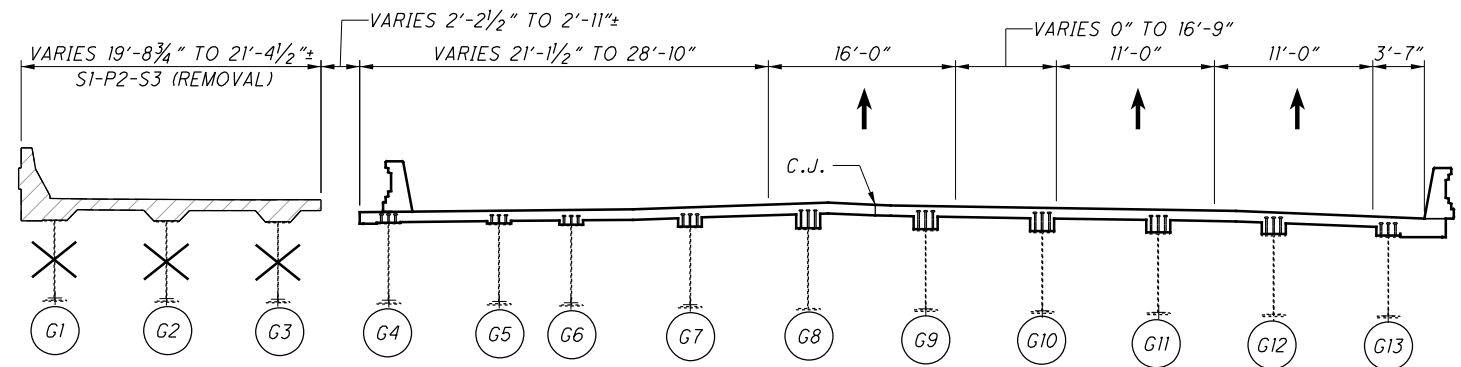

**C**  
20 EXISTING UNIT 2 - SPAN 6 DECK REMOVAL

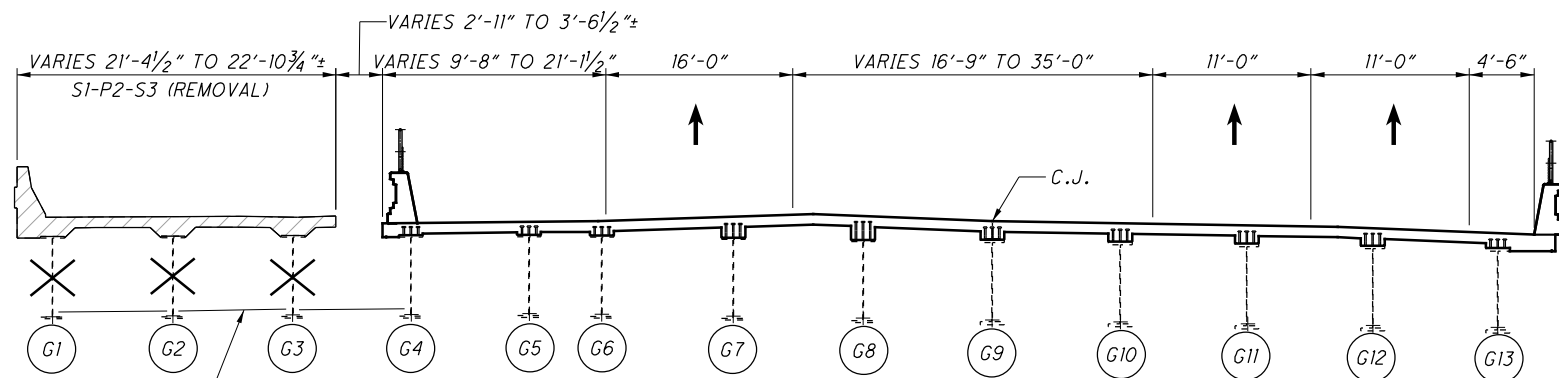

**D**  
20 EXISTING UNIT 2 - SPAN 7 DECK REMOVAL

TIMBER LAGGING DEBRIS SHIELD TO BE PLACED PRIOR TO DEMOLITION SEE DETAIL **F** 13

**NOTES:**

1. CONSTRUCTION DETAILS ARE FOR I-74 EB (HAM-74-1908R) ONLY. FOR CORRESPONDING CONSTRUCTION DETAILS FOR RAMP P (HAM-74-1908S), SEE BU-05.
2. FOR GENERAL NOTES AND MOT REFERENCE, SEE SHEETS **8/100** AND **9/100**.
3. FOR BEBRIS SHIELD DETAILS, SEE SHEET **13/100**.


**LEGEND:**

- INDICATES LIMITS OF DECK REMOVAL (SI-P2-S3)


SX-PX-SX - STAGE X, PHASE X, STEP X (MOT PHASING)

- INDICATES BEAM REMOVAL

P:\Projects\2018\20H03DB-18232 HAM-75-03.84\104667\structures\HAM074\_1908R\sheets\074\_1908R\_PC006.dgn 6/20/2019 9:08:45 AM asead

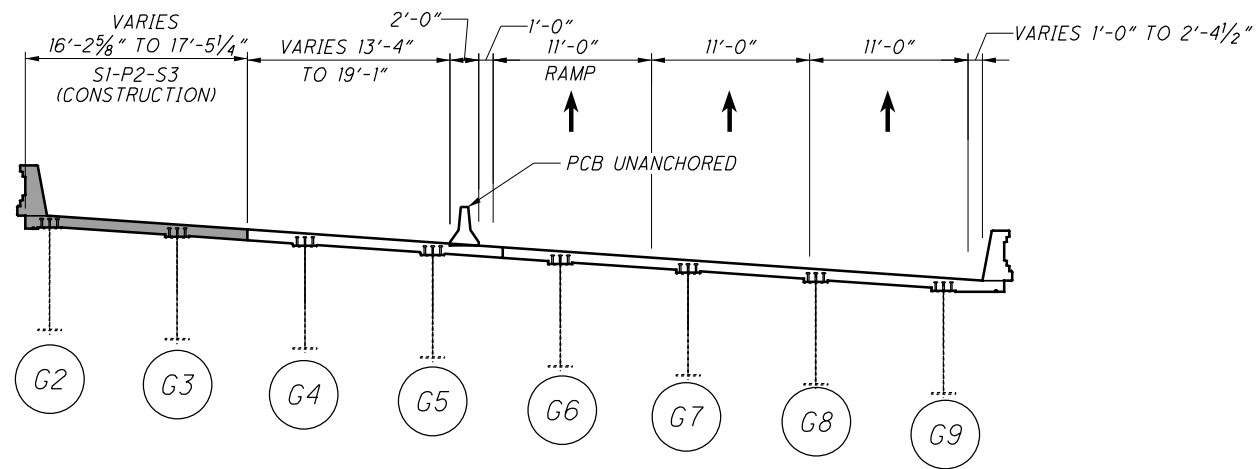

**A** EXISTING UNIT 1 DECK CONSTRUCTION

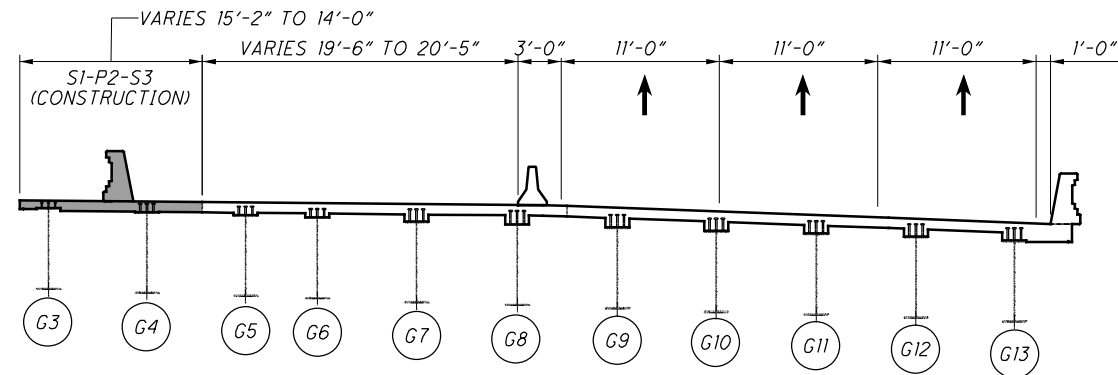


**B** EXISTING UNIT 2 - SPAN 5 DECK CONSTRUCTION

**NOTES:**

- CONSTRUCTION DETAILS ARE FOR I-74 EB (HAM-74-1908R) ONLY. FOR CORRESPONDING CONSTRUCTION DETAILS FOR RAMP P (HAM-74-1908S), SEE BU-05.
- FOR GENERAL NOTES AND MOT REFERENCE, SEE SHEETS 8/100 AND 9/100.


**LEGEND:**

- INDICATES LIMITS OF DECK CONSTRUCTION (SI-P2-S3)
- SX-PX-SX - STAGE X, PHASE X, STEP X (MOT PHASING)

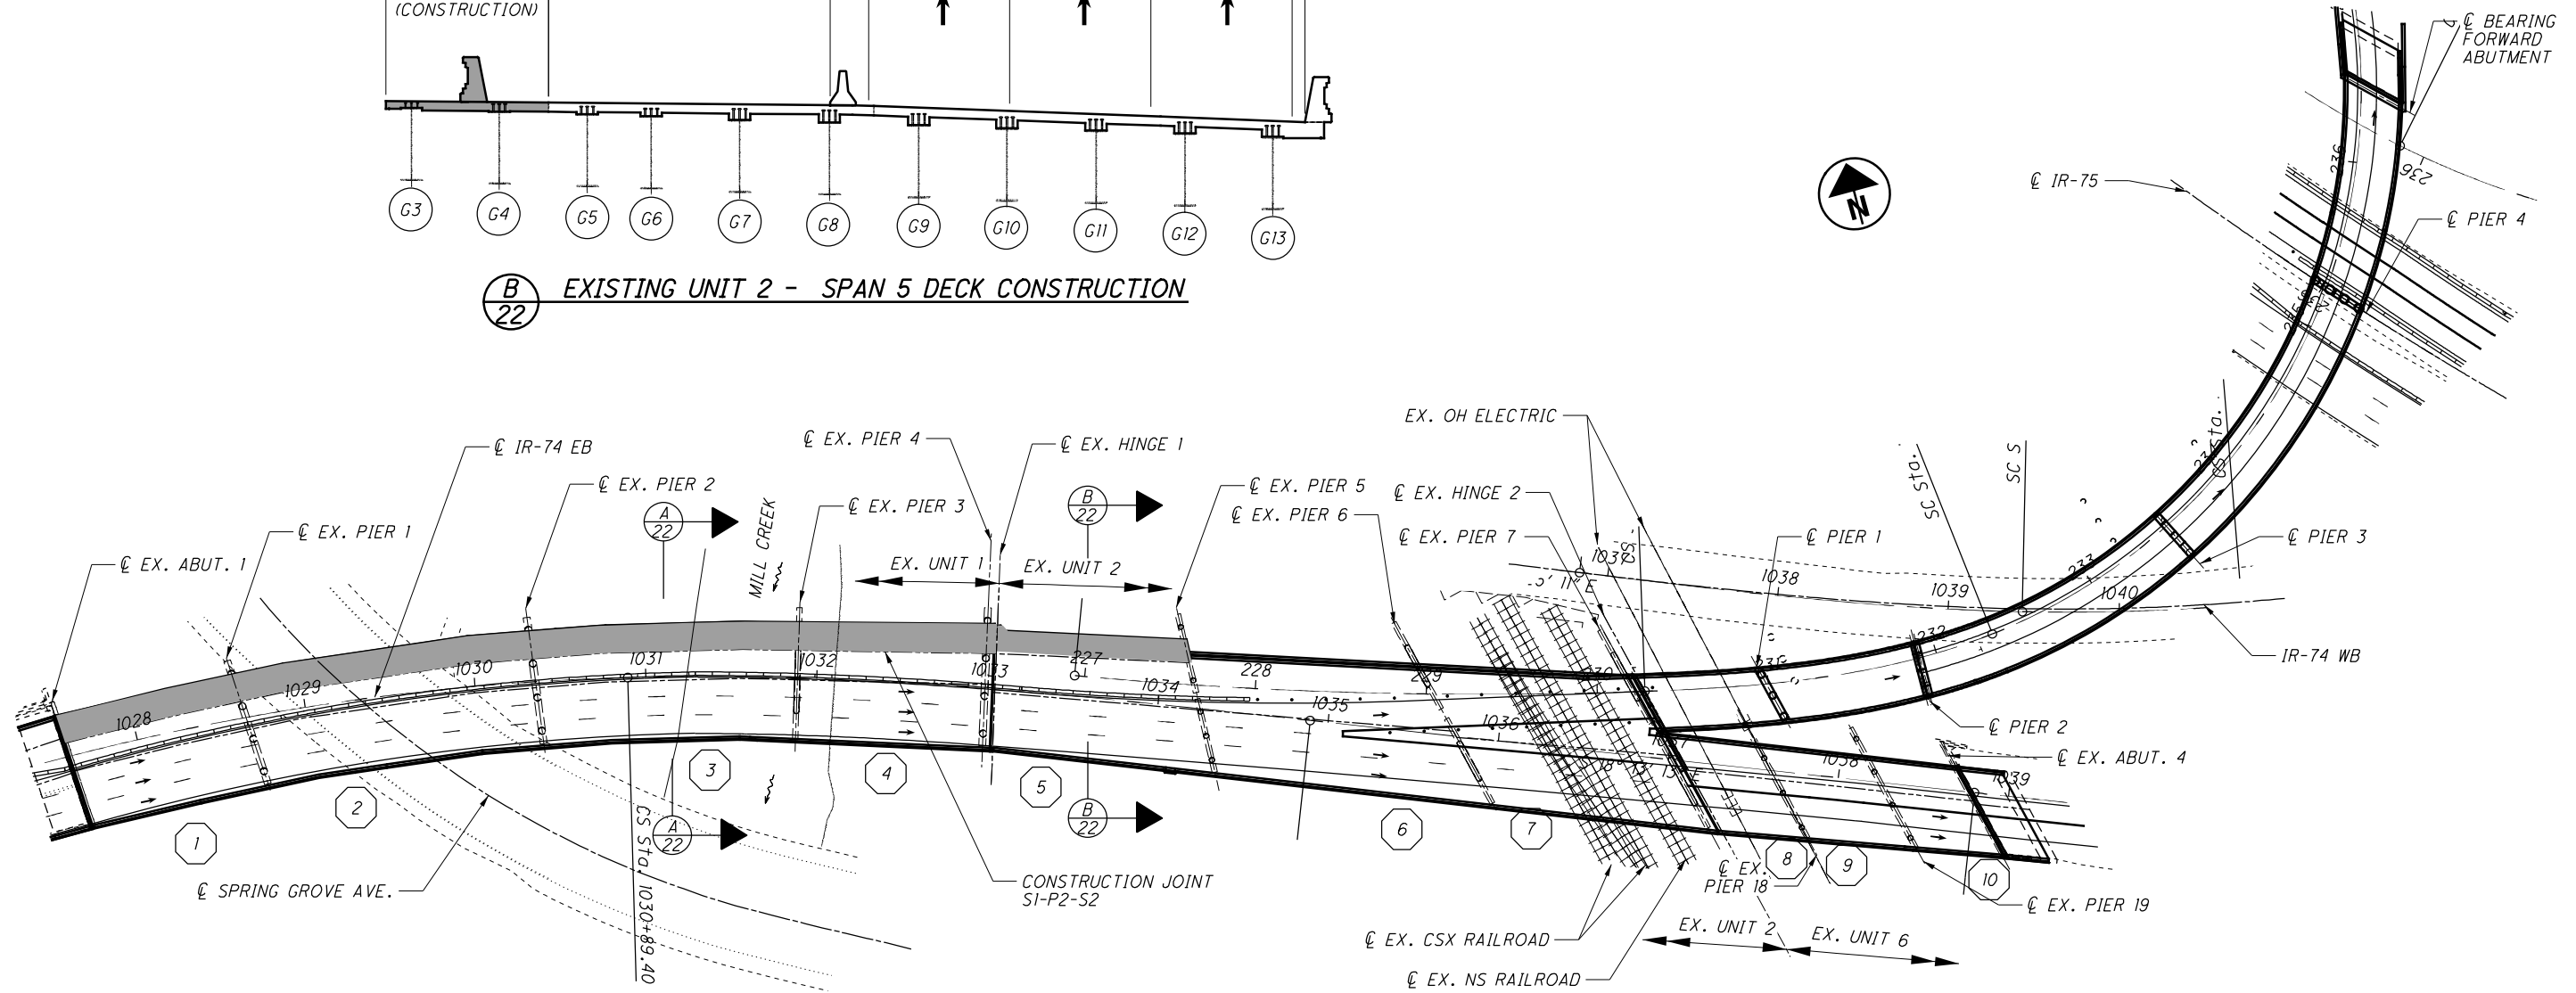


DECK CONSTRUCTION- STAGE 1, PHASE 2, STEP 3

P:\Projects\2018\20H03DB-18232 HAM-75-03.84\104667\structures\HAM074\_1908R\sheets\074\_1908R\_PC007.dgn 6/20/2019 9:09:07 AM asead

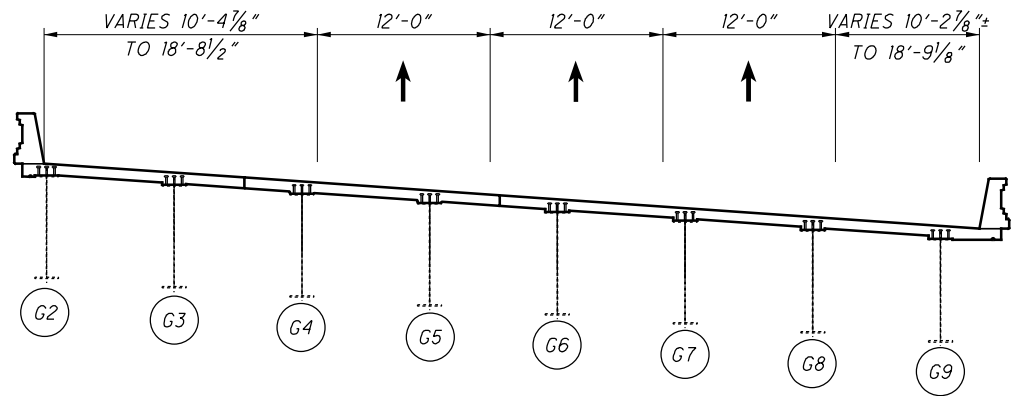


**A**  
23 FINAL EXISTING UNIT 1

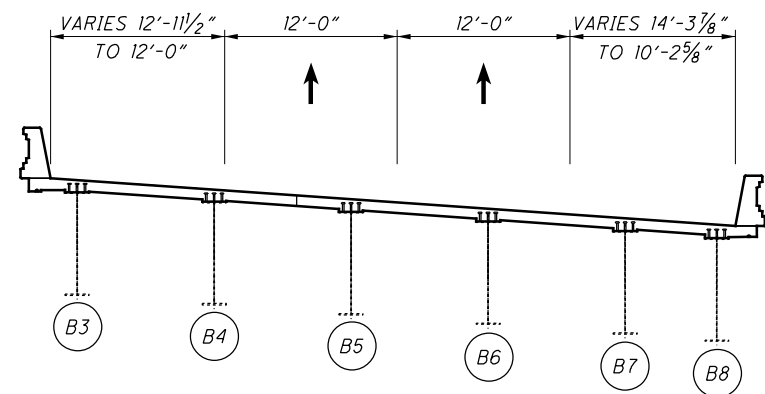

**E**  
23 FINAL EXISTING UNIT 6

**NOTES:**


1. CONSTRUCTION DETAILS ARE FOR I-74 EB (HAM-74-1908R) ONLY. FOR CORRESPONDING CONSTRUCTION DETAILS FOR RAMP P (HAM-74-1908S), SEE BU-05.
2. FOR GENERAL NOTES AND MOT REFERENCE, SEE SHEETS 8/100 AND 9/100.

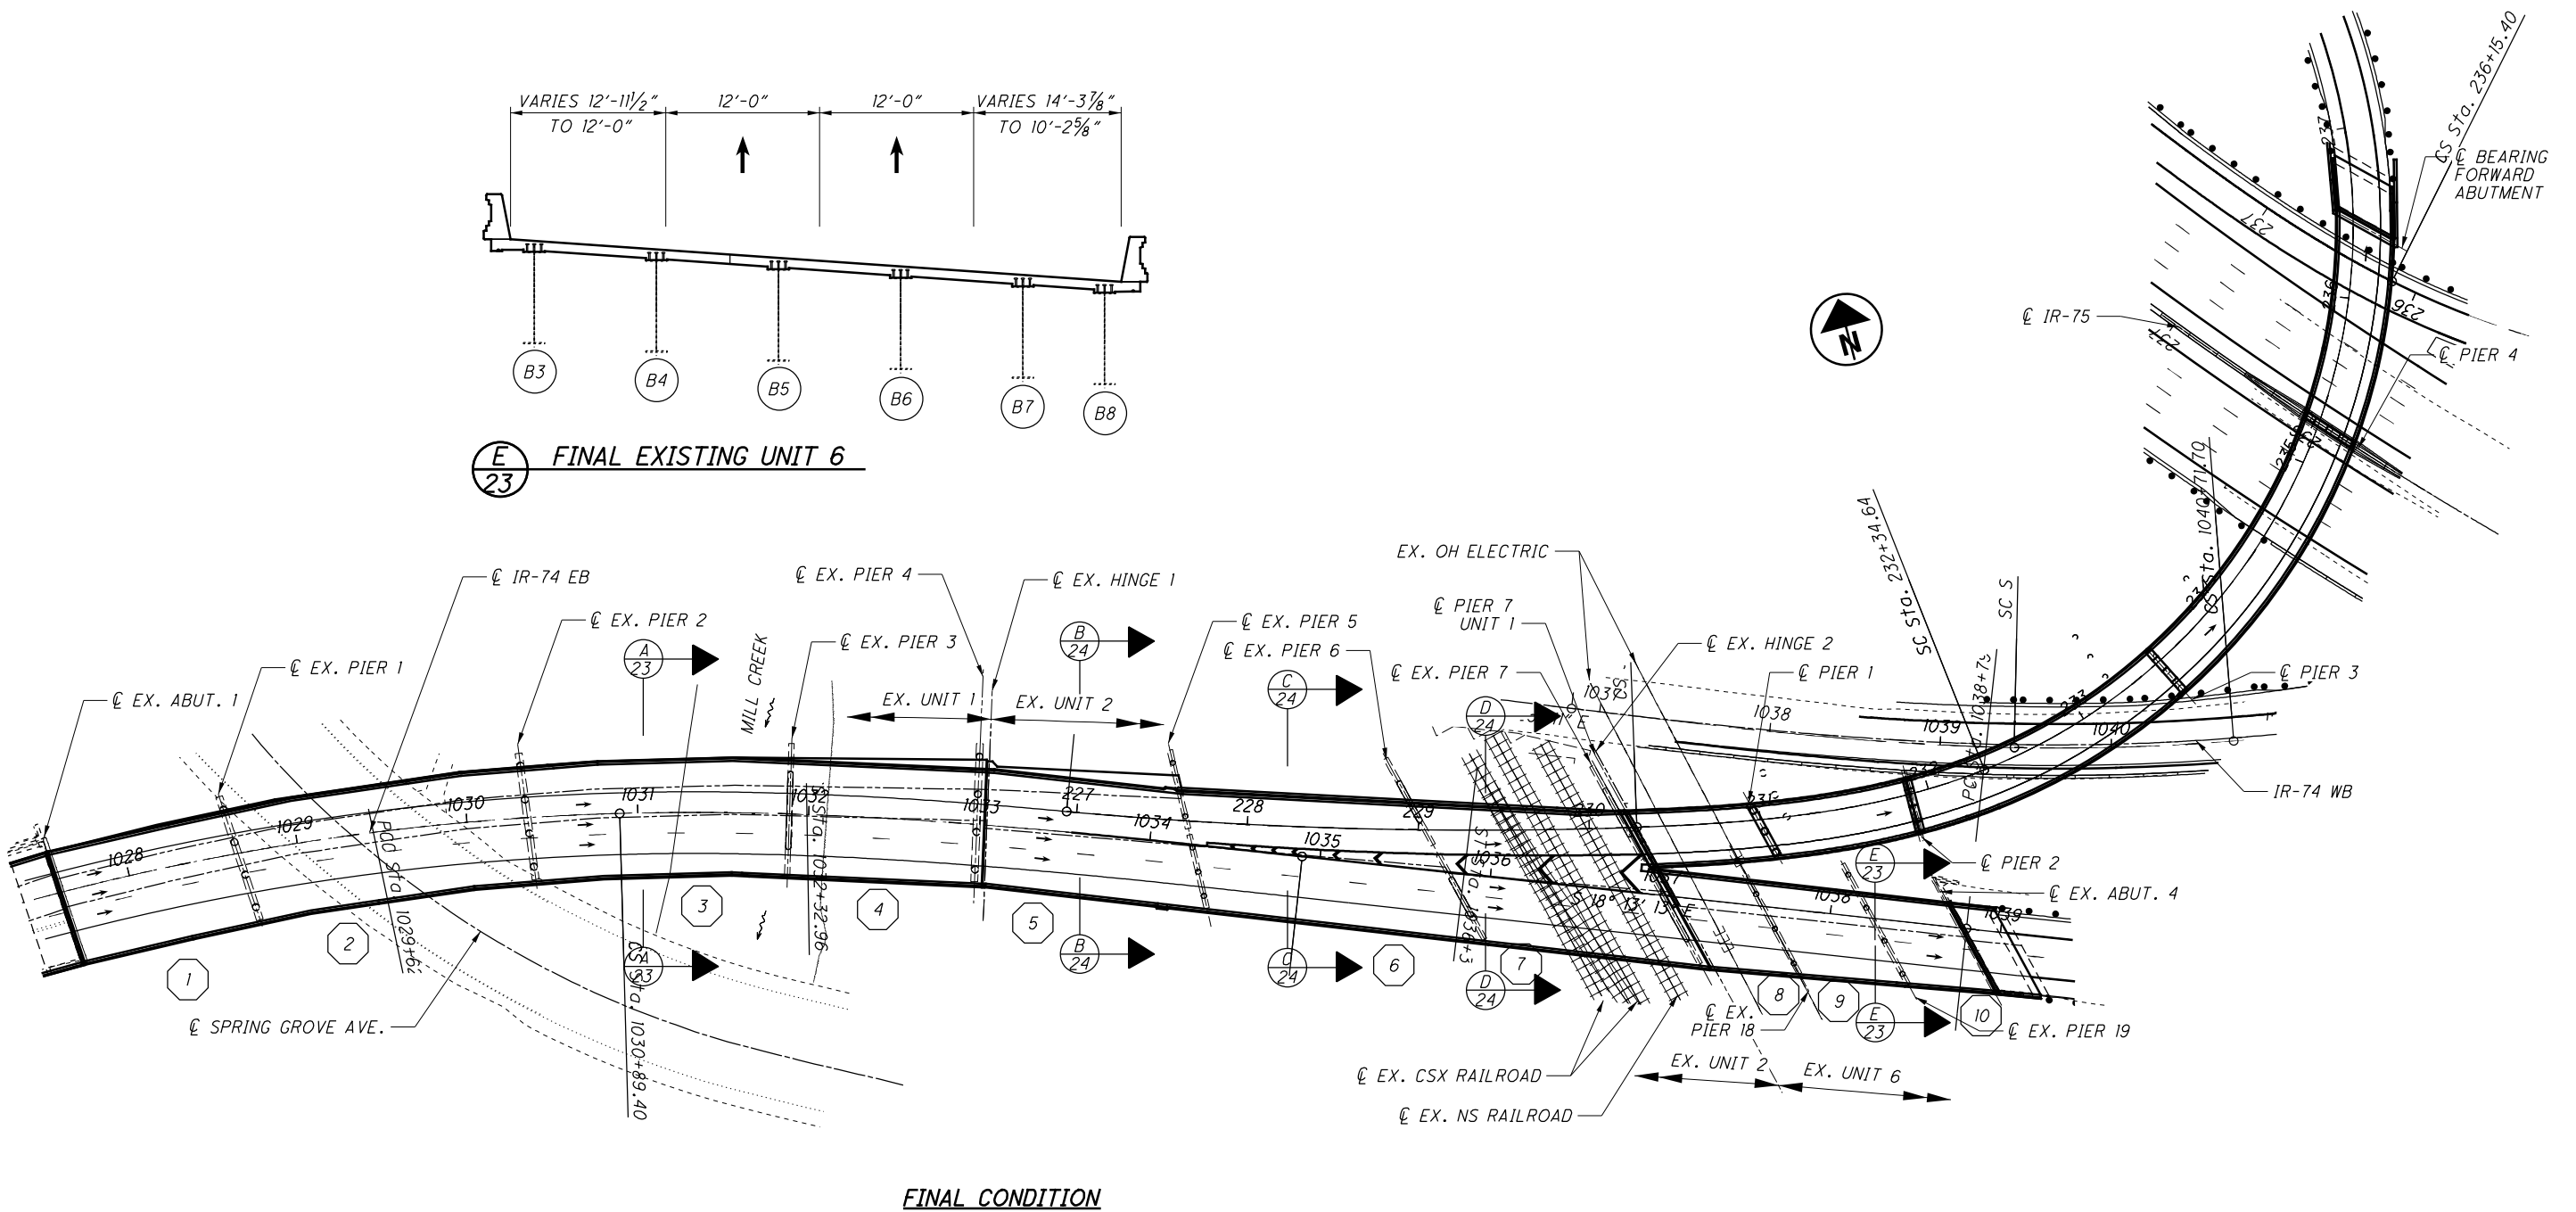

**FINAL CONDITION**

DESIGN AGENCY <b>PRIME</b> 540 WHITE POND DR. SUITE E AKRON, OH 44320	DATE 3/27/2019
	REVIEWED TES
STRUCTURE FILE NUMBER 3115739	DRAWN CRG
	CHECKED KDC
<b>DECK CONSTRUCTION - FINAL</b>	
BRIDGE NO. HAM-74-1908R	
IR-74 OVER MILL CREEK, RR & SPRING GROVE AVENUE	
<b>HAM-75-3.84</b>	<b>PID No. 104667</b>
23/100	
23/100	


P:\Projects\2018\20H03DB-18232 HAM-75-03.84\104667\structures\HAM074\_1908R\sheets\074\_1908R\_PC014.dgn 6/20/2019 9:09:12 AM oseed

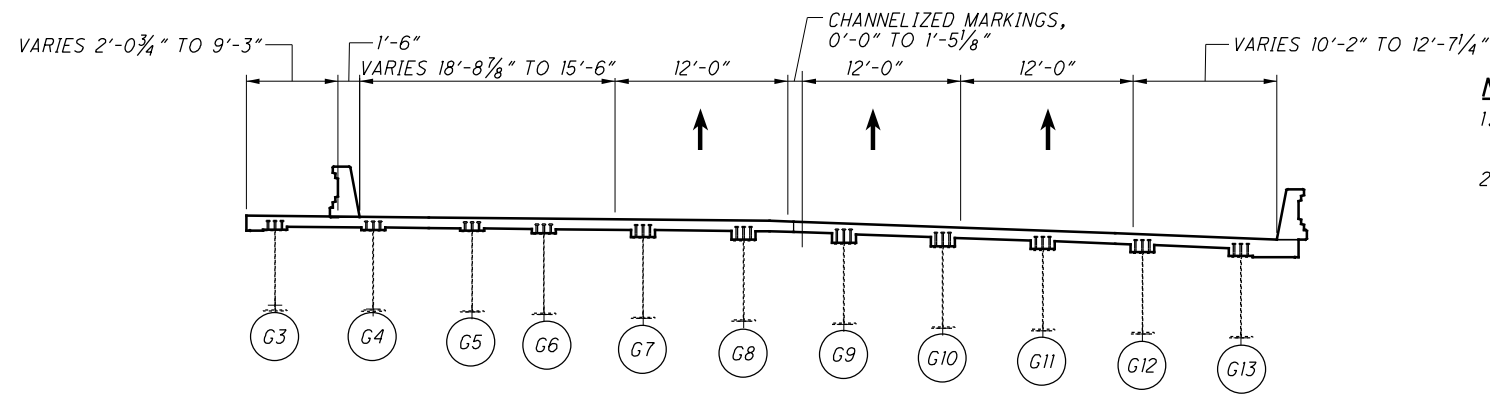


**NOTES:**

1. CONSTRUCTION DETAILS ARE FOR I-74 EB (HAM-74-1908R) ONLY. FOR CORRESPONDING CONSTRUCTION DETAILS FOR RAMP P (HAM-74-1908S), SEE BU-05.
2. FOR GENERAL NOTES AND MOT REFERENCE, SEE SHEETS 8/100 AND 9/100.

**B**  
23 EXISTING UNIT 2 - SPAN 5 DECK FINAL

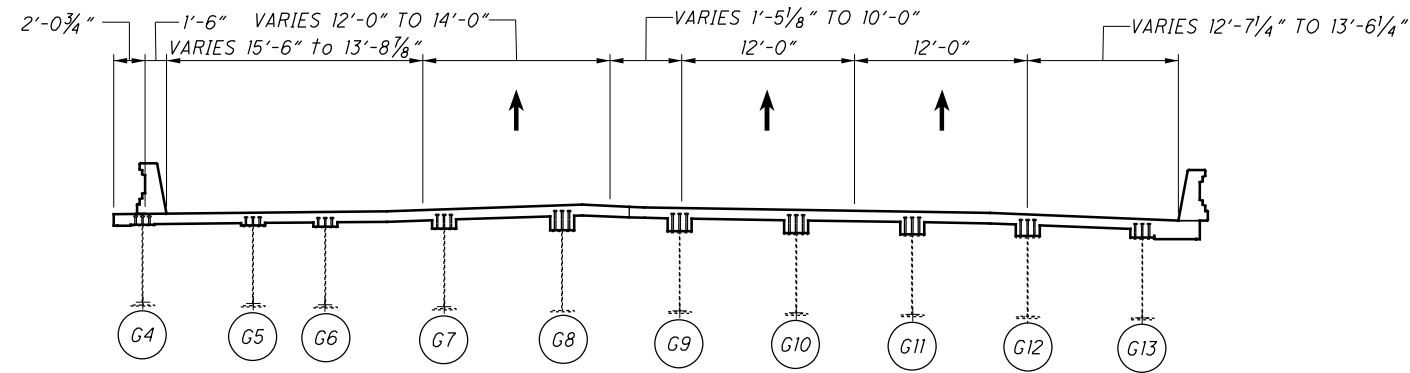

**C**  
23 EXISTING UNIT 2 - SPAN 6 DECK FINAL

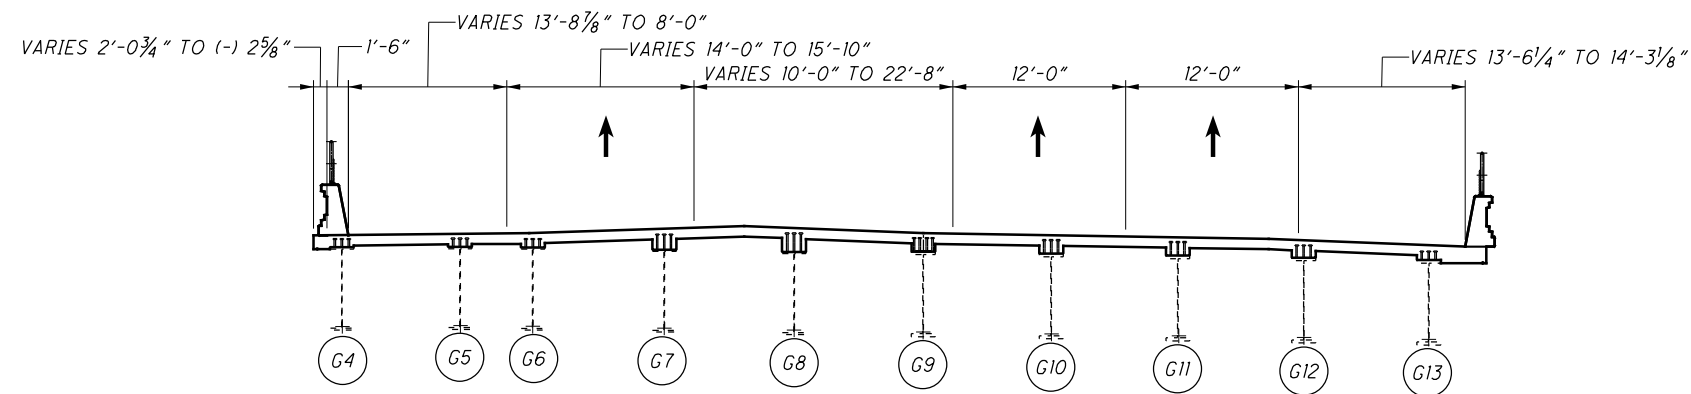

**D**  
23 EXISTING UNIT 2 - SPAN 7 DECK FINAL

**DECK CONSTRUCTION - FINAL**


DESIGNED	CRG	CHECKED	KDC
DRAWN	CRG	REVISED	
REVIEWED	TES	DATE	3/27/2019
STRUCTURE FILE NUMBER			3115739

**DECK CONSTRUCTION - FINAL**  
BRIDGE NO. HAM-74-1908R  
IR-74 OVER MILL CREEK, RR & SPRING GROVE AVENUE


HAM-75-3.84  
PID No. 104667




P:\Projects\2018\20H03DB-18232 HAM-75-03.84\104667\structures\HAM074\_1908R\sheets\074\_1908R\_R009.dgn 9/8/2023 6:17:16 PM erin.baumann

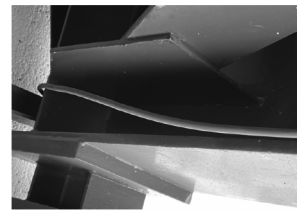


**GIRDER 2 MODIFICATION**  
PLATE ON LEFT SIDE

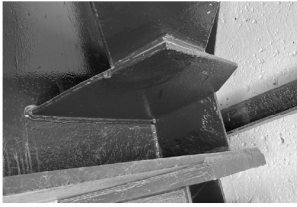


**GIRDER 4 MODIFICATION**  
PLATE ON RIGHT SIDE

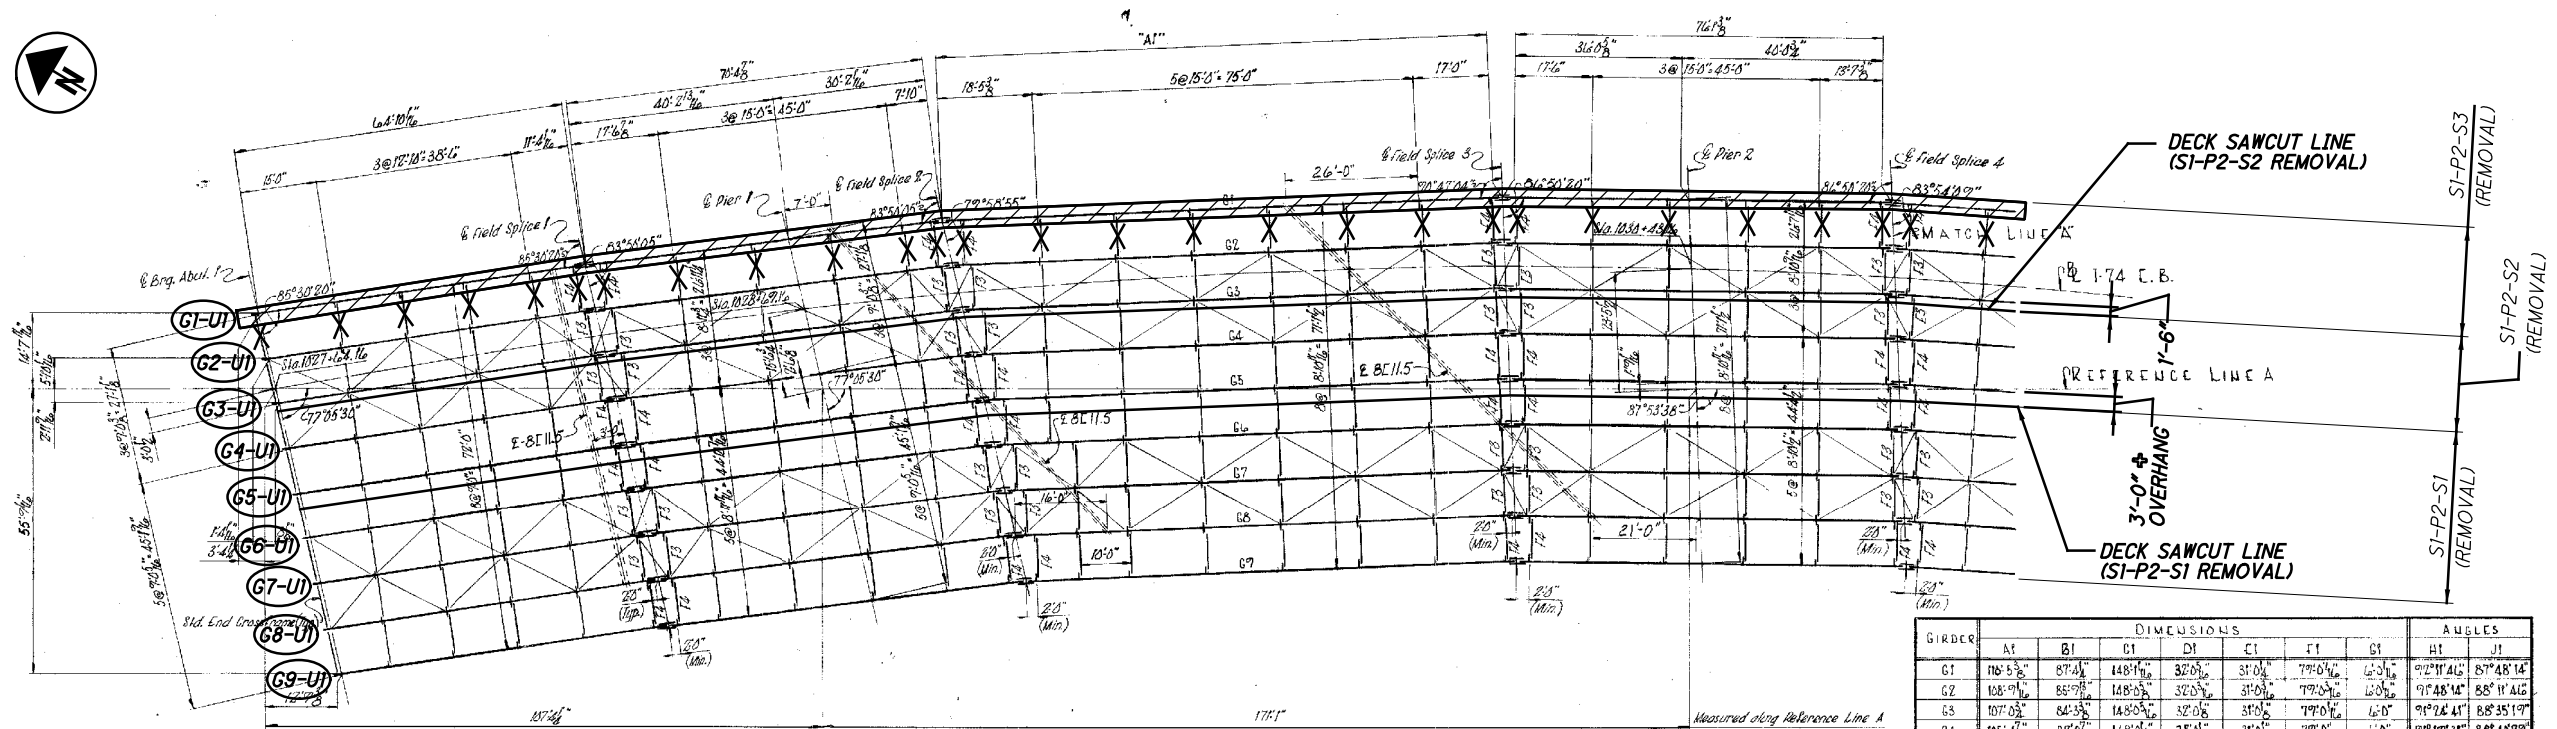

GIRDER	DIMENSIONS							ANGLES	
	A1	B1	C1	D1	E1	F1	G1	H1	J1
G1	116'-5 3/8"	87'-4"	148'-1 1/2"	32'-0"	31'-0"	77'-0 1/2"	12'-0"	9'-2 1/2"	87'-4 1/8"
G2	108'-0 1/2"	88'-7 1/8"	148'-5 1/2"	32'-0"	31'-0"	77'-0 1/2"	12'-0"	9'-4 1/8"	88'-11 1/8"
G3	107'-0 1/2"	84'-5 1/2"	148'-5 1/2"	32'-0"	31'-0"	77'-0 1/2"	12'-0"	9'-2 1/2"	88'-35 1/8"
G4	105'-4 1/2"	82'-8 1/2"	148'-5 1/2"	32'-0"	31'-0"	77'-0 1/2"	12'-0"	9'-4 1/8"	88'-48 1/8"
G5	103'-5 1/2"	81'-2 1/2"	148'-5 1/2"	32'-0"	31'-0"	77'-0 1/2"	12'-0"	9'-1 1/2"	88'-48 3/8"
G6	101'-11 1/2"	79'-8 1/2"	147'-1 1/2"	32'-0"	31'-0"	78'-1 1/2"	12'-0"	9'-5 1/8"	89'-0 1/8"
G7	100'-3 1/2"	78'-1 1/2"	147'-1 1/2"	32'-0"	31'-0"	78'-1 1/2"	12'-0"	9'-5 1/8"	89'-32 1/8"
G8	98'-7 1/2"	76'-7 1/2"	147'-1 1/2"	32'-0"	31'-0"	78'-1 1/2"	12'-0"	9'-5 1/8"	89'-52 1/8"
G9	96'-10 1/2"	75'-0 1/2"	147'-1 1/2"	32'-0"	31'-0"	78'-1 1/2"	12'-0"	9'-5 1/8"	89'-17 1/8"

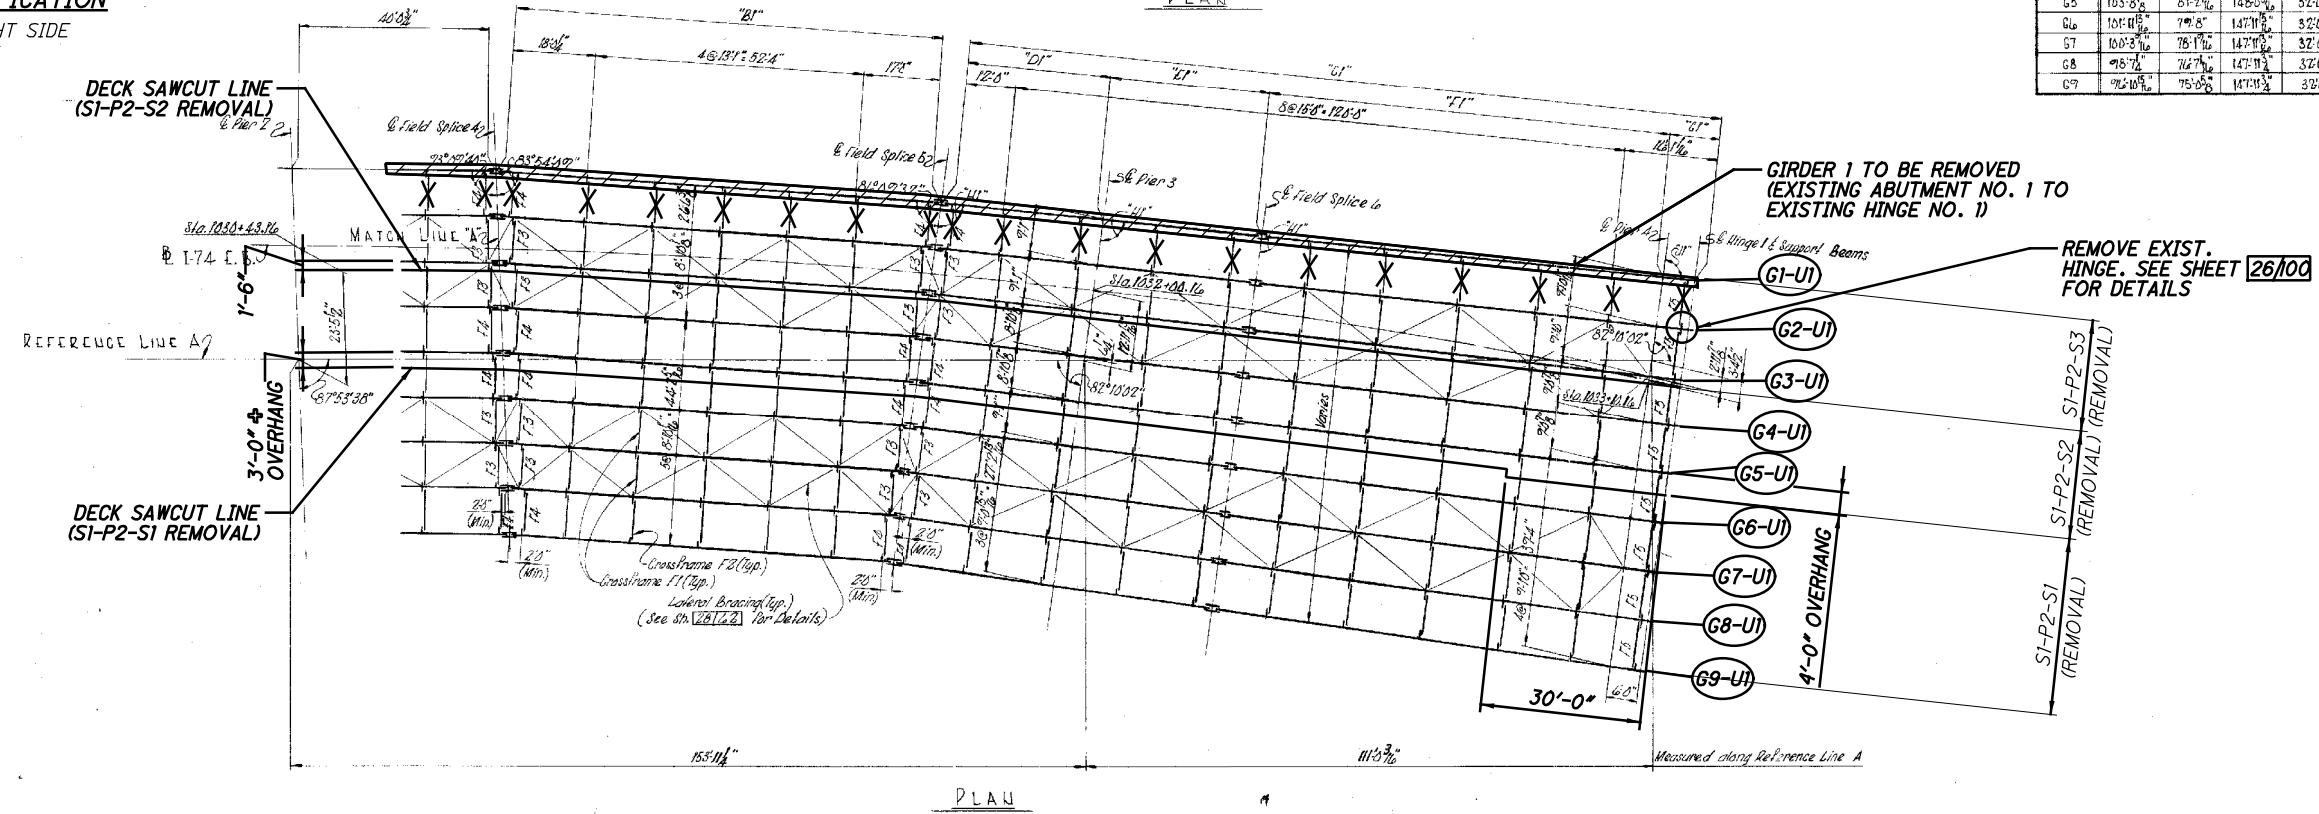

**GIRDER 6 MODIFICATION**  
PLATE ON LEFT SIDE

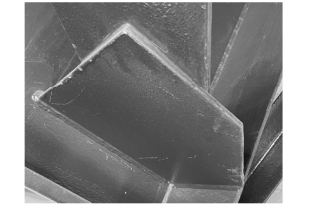


**GIRDER 8 MODIFICATION**  
PLATE ON LEFT SIDE

- LEGEND:**
- INDICATES LIMITS OF REMOVAL (SI-P2-S3)
  - INDICATES EXISTING CROSSFRAME TO BE REMOVED IN SI-P2-S3
  - GX-UX - GIRDER X UNIT X
  - SX-PX-SX - STAGE X PHASE X STEP X (NOT PHASING)
  - ⊕ - 4'-0" OVERHANG THE LAST 30'-0" OF UNIT 1


**EXISTING FRAMING PLAN - UNIT NO. 1**

- NOTES:**
- CONTRACTOR SHALL TAKE CARE WHEN REMOVING EXISTING G1 AND CROSSFRAMES NOT TO DAMAGE G2.
  - PAINT ALL REMAINING STRUCTURAL STEEL WITH SYSTEM OZEU PER CMS 514. THE TOP COAT PAINT SHALL BE FEDERAL COLOR 595B-34058 (DARK GREEN)
  - SEE SHEETS 12/100 THRU 21/100 FOR CONSTRUCTION SEQUENCE INFORMATION.
  - FOR ADDITIONAL DETAILS, SEE SHEET 26/100.

P:\Projects\2018\20H03DB-18232 HAM-75-03.84\104667\structures\HAM074\_1908R\sheets\074\_1908R\_REC011.dgn 6/20/2019 9:09:20 AM asecd

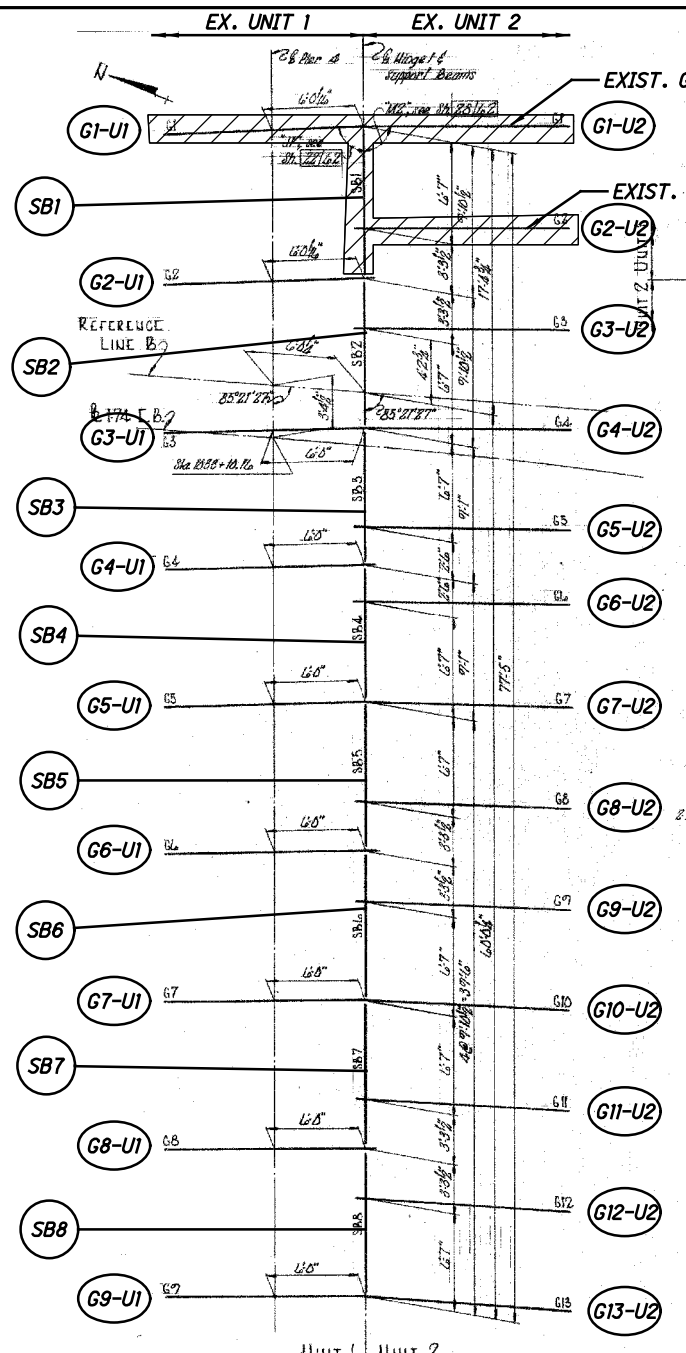

**LEGEND:**  
 - INDICATES LIMITS OF REMOVAL (S1-P2-S3)  
 GX-UX - GIRDER X UNIT X  
 SBX - SUPPORT BEAM X

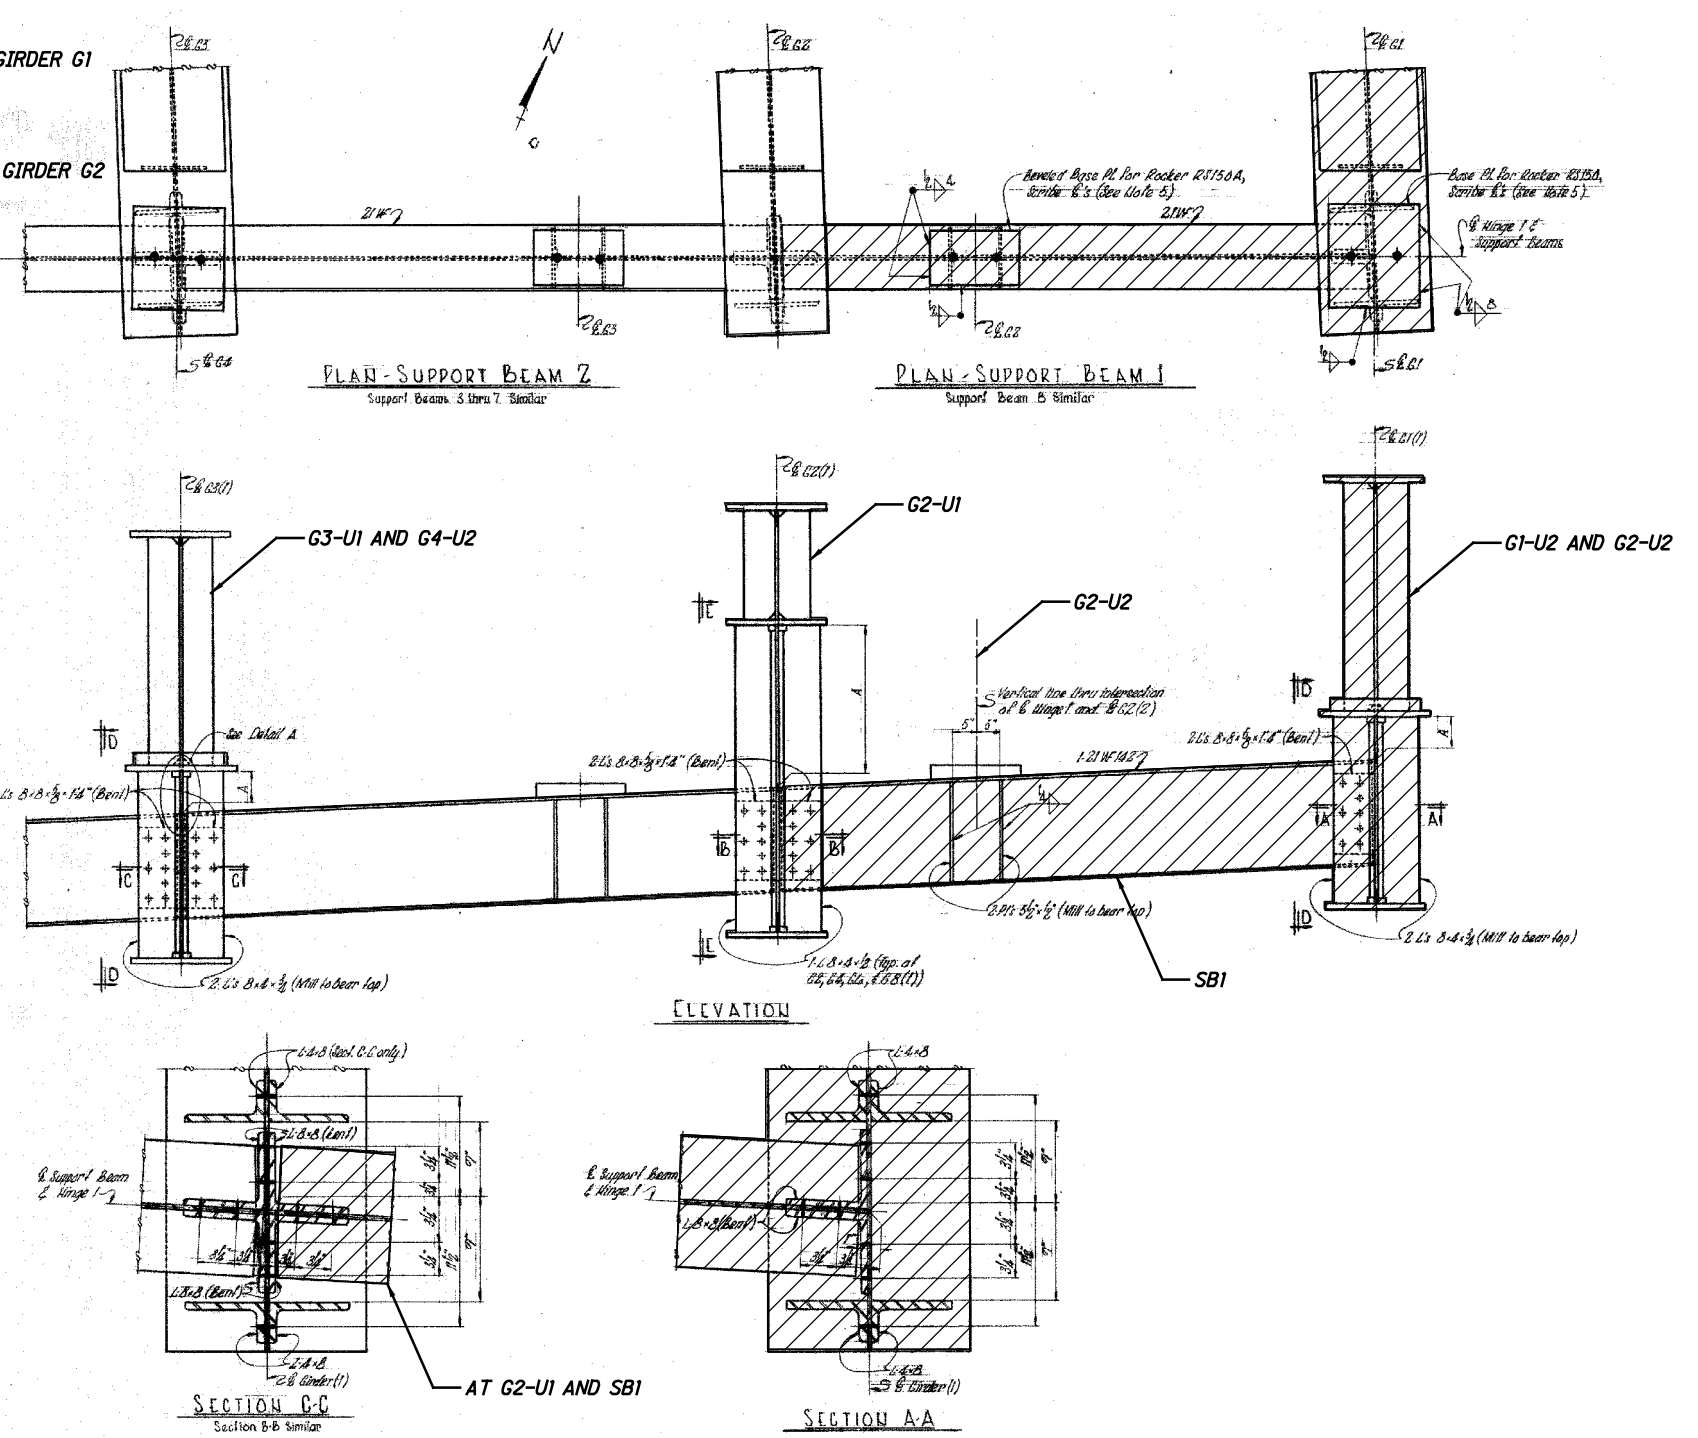

**EXISTING HINGE NO. 1 - REMOVAL DETAILS**

- NOTES:**
- FOR ADDITIONAL DETAILS, SEE SHEETS 25/100 AND 27/100.
  - REMOVE G1-U1, G1-U2, G2-U2, AND SBI DURING S1-P2-S3. CONTRACTOR SHALL TAKE CARE TO NOT DAMAGE G2-U1 AND SB2 DURING REMOVAL.
  - SEE SHEETS 12/100 THRU 21/100 FOR CONSTRUCTION SEQUENCE INFORMATION.

 DESIGN AGENCY 540 WHITE POND DR. SUITE E AKRON, OH 44320
<b>EXIST. SUPPORT BEAM REMOVAL DETAILS AT HINGE 1</b> BRIDGE NO. HAM-74-1908R IR-74 OVER MILL CREEK, RR & SPRING GROVE AVENUE
HAM-75-3.84 PID No. 104667
DESIGNED: CRG CHECKED: KDC DRAWN: CRG REVISED:
REVIEWED: TES DATE: 3/27/2019 STRUCTURE FILE NUMBER: 3115739
26/100 26/100

P:\Projects\2018\20H03DB-18232 HAM-75-03.84\104667\structures\HAM074\_1908R\012.dgn 9/8/2023 6:18:56 PM erin.baumann

REMOVE G1-U2 AND G2-U2 FROM EX. PIER 4 TO EX. HINGE NO. 2




REMOVE G3-U2 FROM EX. PIER 5 TO EX. HINGE NO. 2


DECK SAWCUT LINE (S1-P2-S2 REMOVAL)

CROSSFRAME RELOCATED 2' EAST OF EXISTING LOCATION

DECK SAWCUT LINE (S1-P2-S1 REMOVAL)

**LEGEND:**

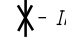-  - INDICATES LIMITS OF REMOVAL (S1-P2-S2)
-  - INDICATES LIMITS OF REMOVAL (S1-P2-S3)
-  - INDICATES EXISTING CROSSFRAME AND LATERAL BRACING TO BE REMOVED
- SX-PX-SX - STAGE X PHASE X STEP X (MOT PHASING)

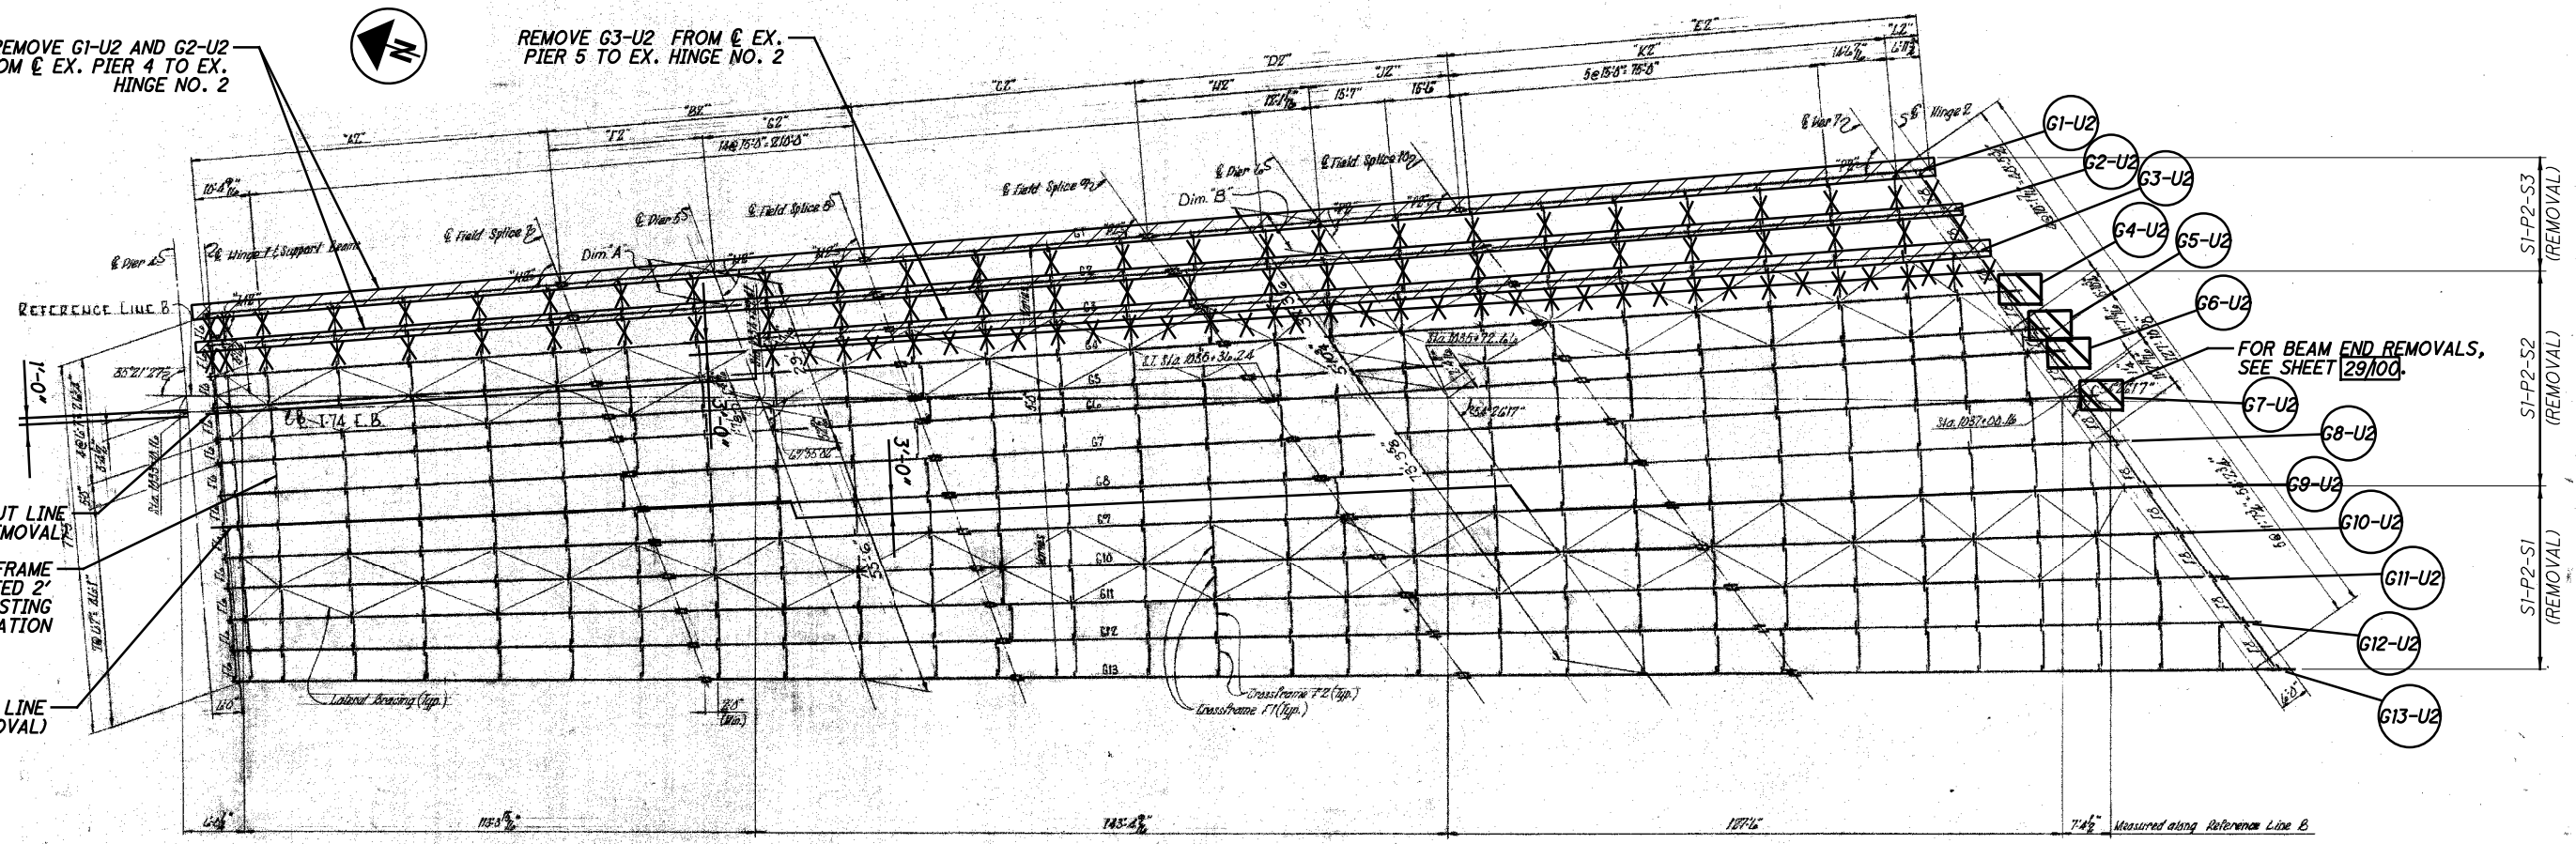

EXISTING FRAMING PLAN - UNIT NO. 2

RIBBER	DIMENSIONS											ANGLES		
	A2	B2	C2	D2	E2	F2	G2	H2	J2	K2	L2	M2	N2	P2
B1	73'4 7/8"	65'0 1/2"	59'9 1/2"	65'1 1/2"	76'0 1/2"	55'1 1/2"	31' 1/2"	31' 1/2"	27'0 1/2"	7'11 1/2"	6'11 1/2"	70° 15' 18"	74° 26' 54"	159° 18' 09"
B2	75'3 3/8"	65'0 1/2"	62'5"	65'4 1/2"	76'0 1/2"	32'2 1/2"	31' 1/2"	31' 1/2"	27'0 1/2"	7'10"	7'0"	89° 53' 00"	74° 26' 35"	158° 57' 50"
B3	77'3 3/8"	65'0 1/2"	65'0 1/2"	65' 7"	77'2 1/2"	32'2 1/2"	31' 1/2"	31' 1/2"	27'0 1/2"	7'10"	7'0"	7° 0'	89° 53' 15"	148° 06' 50"
B4	79'2 3/8"	65'0 1/2"	67' 7/8"	65'9 1/2"	79'1 1/2"	32'3 1/2"	31' 1/2"	31' 1/2"	27'0 1/2"	7'10"	7'0"	87° 14' 03"	73° 47' 39"	158° 18' 54"
B5	81' 2"	65'0 1/2"	70' 3/4"	66'0 1/2"	79'10 1/2"	32' 4"	31' 1/2"	31' 1/2"	27'0 1/2"	7'10"	7'0"	88° 55' 24"	73° 28' 59"	158° 00' 44"
B6	82' 1/2"	65'0 1/2"	71' 11 1/2"	66'0 1/2"	79'10 1/2"	32' 4"	31' 1/2"	31' 1/2"	27'0 1/2"	7'10"	7'0"	88° 55' 24"	73° 28' 59"	158° 00' 44"
B7	84' 7/2"	65'0 1/2"	74' 11 1/2"	66'0 1/2"	100' 5 1/2"	32' 5"	31' 1/2"	31' 1/2"	27'0 1/2"	7'10"	7'0"	88° 55' 24"	73° 28' 59"	158° 00' 44"
B8	86' 7 1/2"	65'0 1/2"	77' 11 1/2"	66'0 1/2"	100' 11 1/2"	32' 6"	31' 1/2"	31' 1/2"	27'0 1/2"	7'10"	7'0"	87° 57' 15"	73° 30' 50"	157° 02' 05"
B9	88' 8 1/2"	65'0 1/2"	80' 11 1/2"	67' 1 1/2"	101' 6 1/2"	32' 7"	31' 1/2"	31' 1/2"	27'0 1/2"	7'10"	7'0"	87° 29' 30"	72° 03' 06"	153° 34' 21"
B10	90' 9 1/2"	65'0 1/2"	84' 0 1/2"	67' 5 1/2"	102' 0 1/2"	32' 8 1/2"	31' 1/2"	31' 1/2"	27'0 1/2"	7'10"	7'0"	87° 02' 36"	71° 36' 11"	152° 07' 26"
B11	92' 10 1/2"	65'0 1/2"	87' 1 1/2"	67' 9 1/2"	102' 14 1/2"	32' 9"	31' 1/2"	31' 1/2"	27'0 1/2"	7'10"	7'0"	86° 36' 30"	71° 10' 05"	150° 41' 20"
B12	94' 11 1/2"	65'0 1/2"	90' 2 1/2"	68' 1 1/2"	103' 1 1/2"	32' 10 1/2"	31' 1/2"	31' 1/2"	27'0 1/2"	7'10"	7'0"	86° 11' 40"	70° 44' 45"	149° 16' 00"
B13	97' 0 1/2"	65'0 1/2"	93' 3 1/2"	68' 5 1/2"	103' 7 1/2"	32' 11"	31' 1/2"	31' 1/2"	27'0 1/2"	7'10"	7'0"	85° 46' 34"	70° 2' 01"	147° 51' 25"

**NOTES:**

1. SEE SHEETS [12/100] THRU [21/100] FOR CONSTRUCTION SEQUENCE INFORMATION.
2. FOR HINGE REMOVAL DETAILS, SEE SHEET [29/100].
3. FOR SUPPORT BEAM REMOVAL DETAILS, SEE SHEET [26/100].
4. FOR EXISTING G3 REMOVAL LIMITS, SEE SHEET [28/100].

DESIGN AGENCY  
**PRIMEWAY**  
540 WHITE POND DR. SUITE E  
AKRON, OH 44320

DATE  
7/30/2019

REVIEWED  
TES

DRAWN  
CRG

DESIGNED  
CRG

CHECKED  
KDC

STRUCTURE FILE NUMBER  
3115739

REVISIONS

EXISTING FRAMING PLAN - UNIT 2 - REMOVAL DETAILS

BRIDGE NO. HAM-74-1908R

IR-74 OVER MILL CREEK, RR & SPRING GROVE AVENUE


HAM-75-3.84

PID No. 104667

27/100

27/100

P:\Projects\2018\20H03DB-18232 HAM-75-03.84\104667\structures\HAM074\_1908R\sheets\074\_1908R\_RE013.dgn 6/20/2019 9:09:33 AM asead

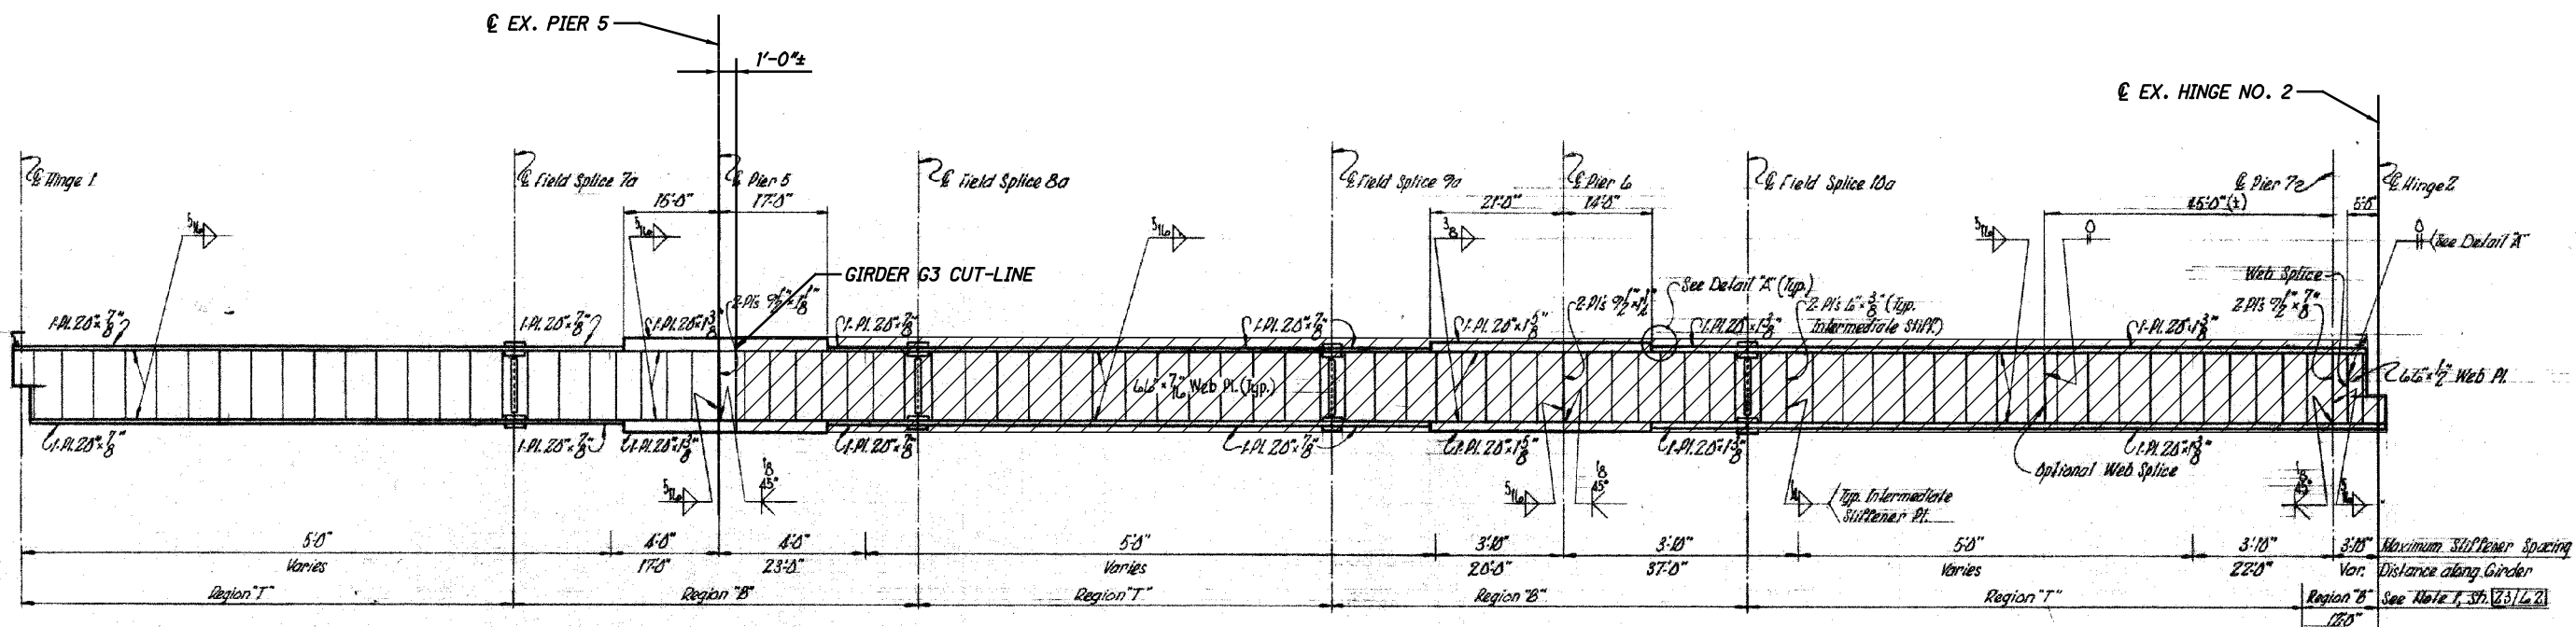

**LEGEND:**


- INDICATES LIMITS OF REMOVAL (S1-P2-S3)

**EXISTING GIRDER G3 REMOVAL LIMITS**


**NOTES:**

1. SEE SHEETS 12/100 THRU 21/100 FOR CONSTRUCTION SEQUENCE INFORMATION.


 540 WHITE POND DR. SUITE E AKRON, OH 44320
DESIGNED: CRG CHECKED: KDC DRAWN: CRG REVISED:
REVIEWED: TES DATE: 3/27/2019 STRUCTURE FILE NUMBER: 3115739
<b>EXISTING GIRDER 3 UNIT 2 BEAM REMOVAL DETAILS</b> BRIDGE NO. HAM-74-1908R IR-74 OVER MILL CREEK, RR & SPRING GROVE AVENUE
<b>HAM-75-3.84</b> PID No. 104667
28 / 100 <div style="border: 1px solid black; border-radius: 50%; width: 30px; height: 30px; display: flex; align-items: center; justify-content: center; margin: 0 auto;"> <span style="font-size: 12px;">28</span>  <span style="font-size: 12px;">100</span> </div>

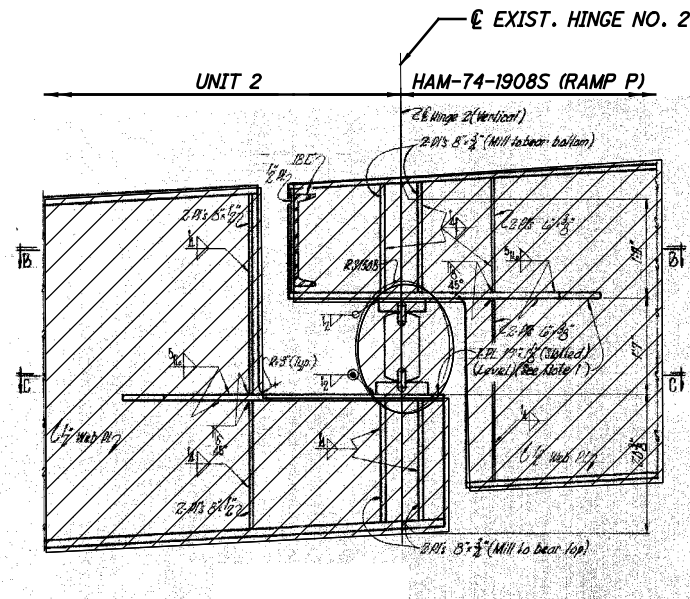

BEAM END REMOVALS - G1-U2 THRU G3-U2

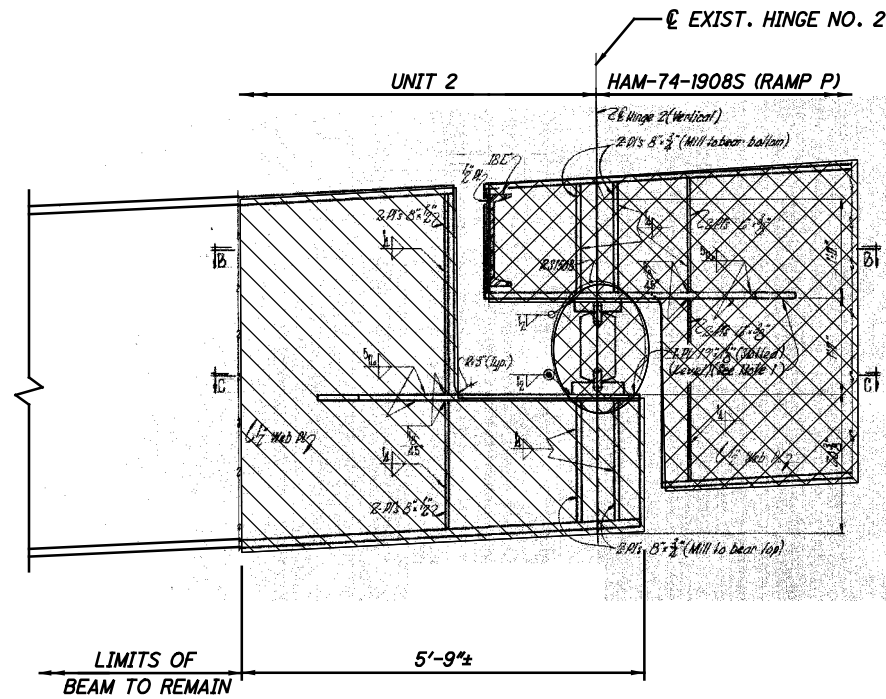

BEAM END REMOVALS - G4-U2 AND G5-U2

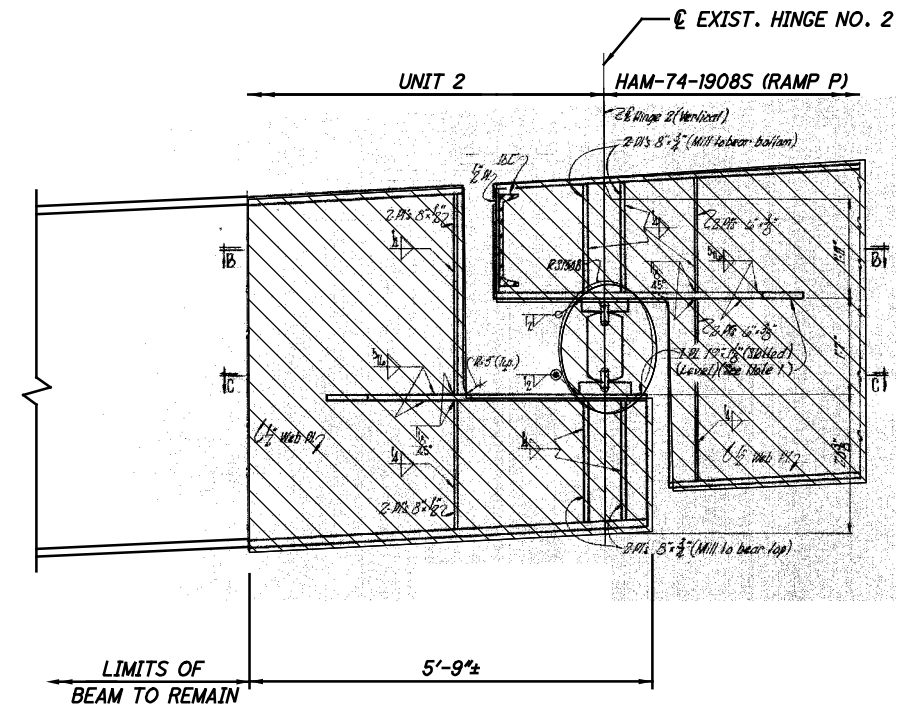

BEAM END REMOVALS - G6-U2 AND G7-U2

**LEGEND:**


- INDICATES LIMITS OF REMOVAL (S1-P2-S1)
- INDICATES LIMITS OF REMOVAL (S1-P2-S2)
- INDICATES LIMITS OF REMOVAL (S1-P2-S3)

**EXISTING HINGE 2 REMOVAL DETAILS**

**NOTES:**



1. FOR LOCATION OF HINGE REMOVAL, SEE SHEET 27/100.
2. SEE SHEETS 12/100 THRU 21/100 FOR CONSTRUCTION SEQUENCE INFORMATION.

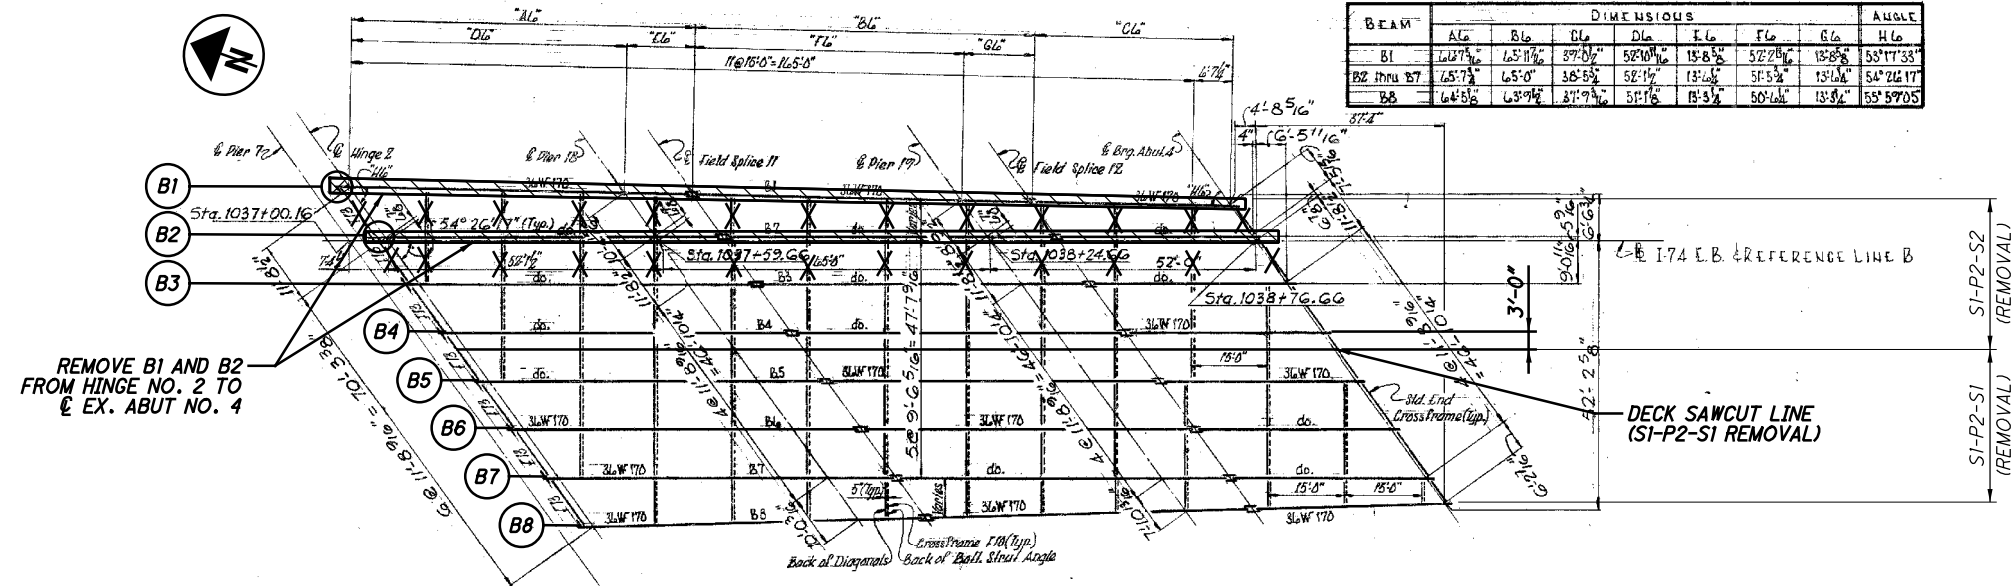






EXISTING FRAMING PLAN - UNIT NO. 6

**LEGEND:**

-  - INDICATES LIMITS OF REMOVAL (S1-P2-S2)
-  - INDICATES EXISTING CROSSFRAME TO BE REMOVED
- SX-PX-SX - STAGE X PHASE X STEP X (MOT PHASING)

**NOTES:**






1. SEE SHEETS 12/100 THRU 21/100 FOR CONSTRUCTION SEQUENCE INFORMATION.

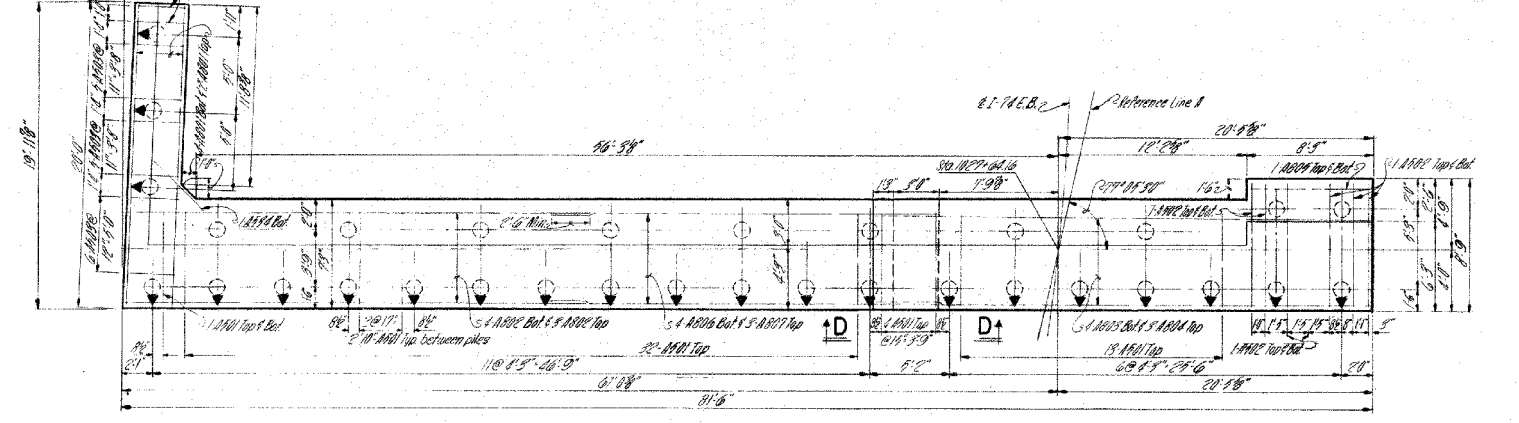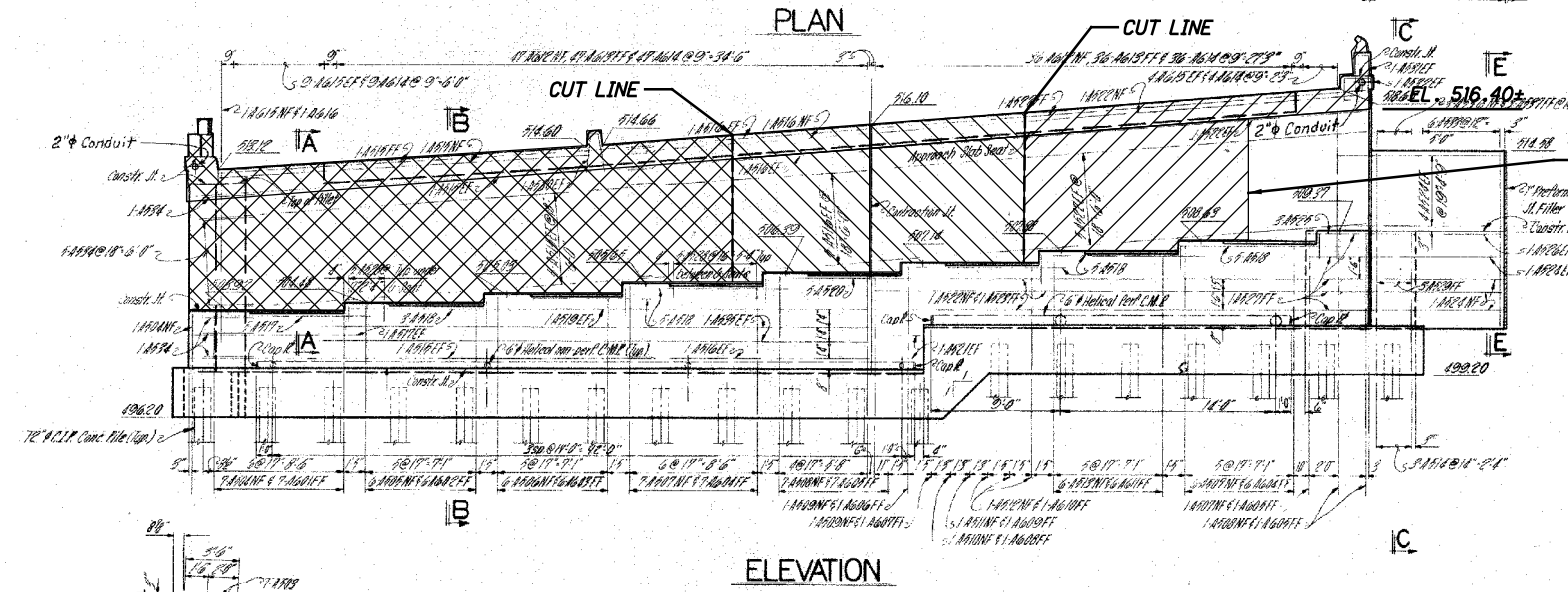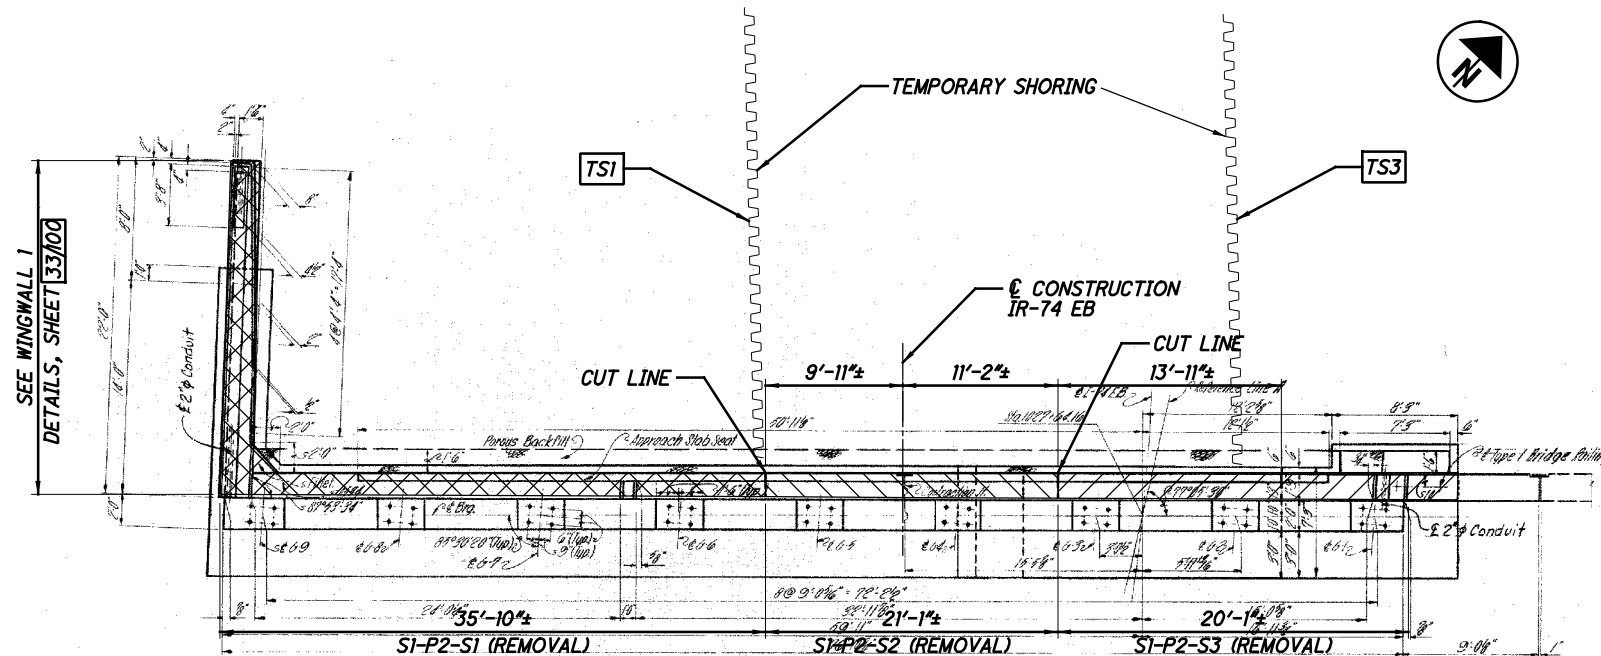

**LEGEND:**

- INDICATES LIMITS OF REMOVAL (S1-P2-S1)
- INDICATES LIMITS OF REMOVAL (S1-P2-S2)
- INDICATES LIMITS OF REMOVAL (S1-P2-S3)
- SX-PX-SX - STAGE X PHASE X STEP X (NOT PHASING)

**EXISTING ABUTMENT NO. 1 REMOVAL DETAILS**

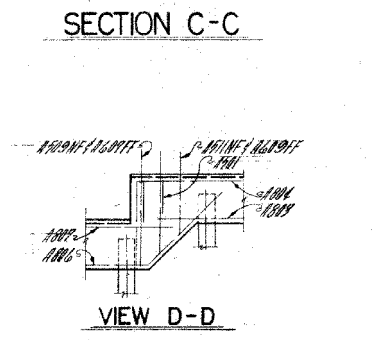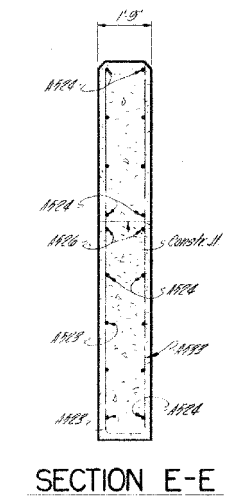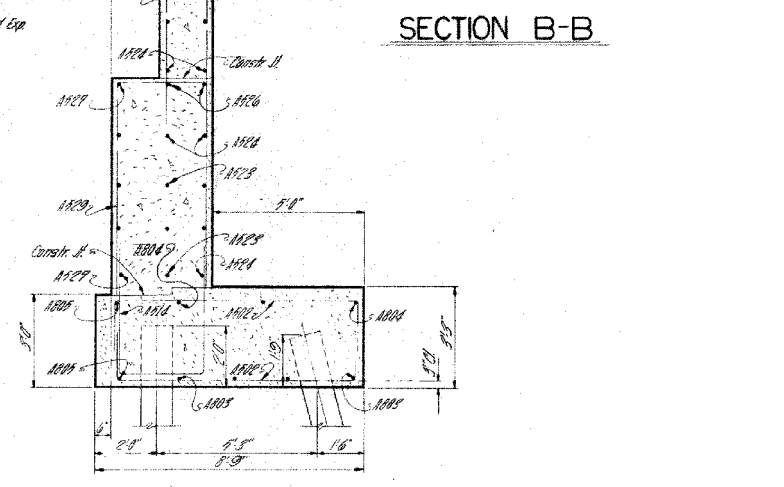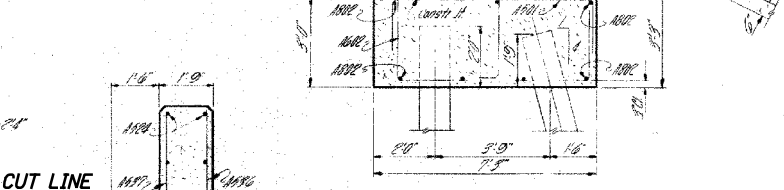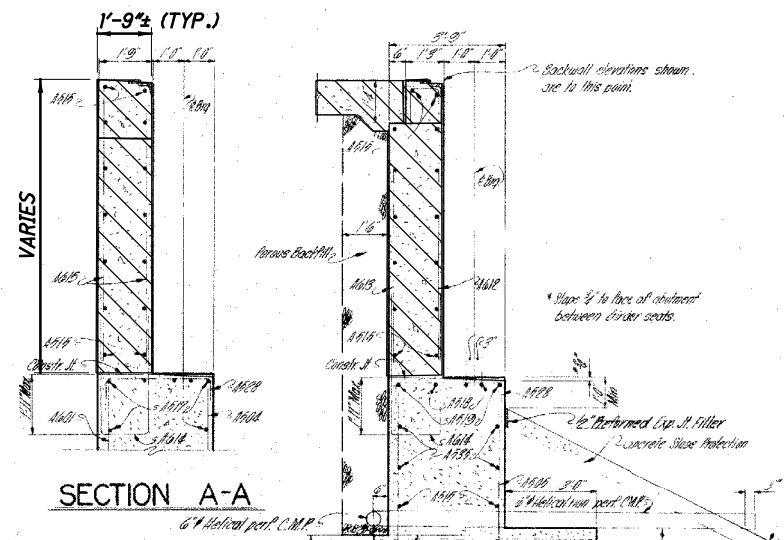


**LEGEND**

- EF - East Face
- NF - Near Face
- FF - Far Face
- Symbol indicates pile to be battered 1:4 in the direction of the arrow.
- Symbol indicates vertical pile.

- NOTES:**
- FOR ADDITIONAL DETAILS, SEE SHEET 33/100.
  - THE EXISTING REINFORCING STEEL, PROTRUDING INTO THE PORTIONS OF THE CONCRETE TO BE REMOVED, SHALL NOT BE SALVAGED.
  - SEE SHEETS 12/100 THRU 21/100 FOR CONSTRUCTION SEQUENCE INFORMATION.
  - ALL REMAINING EXPOSED SURFACES, EXCLUDING THE BEAM SEATS, WILL BE SEALED TO THE EXISTING GROUND ELEVATION.

P:\Projects\2018\20H03DB-18232 HAM-75-03-84\104667\structures\HAM074\_1908R\RE002.dgn 6/20/2019 9:10:03 AM asecd

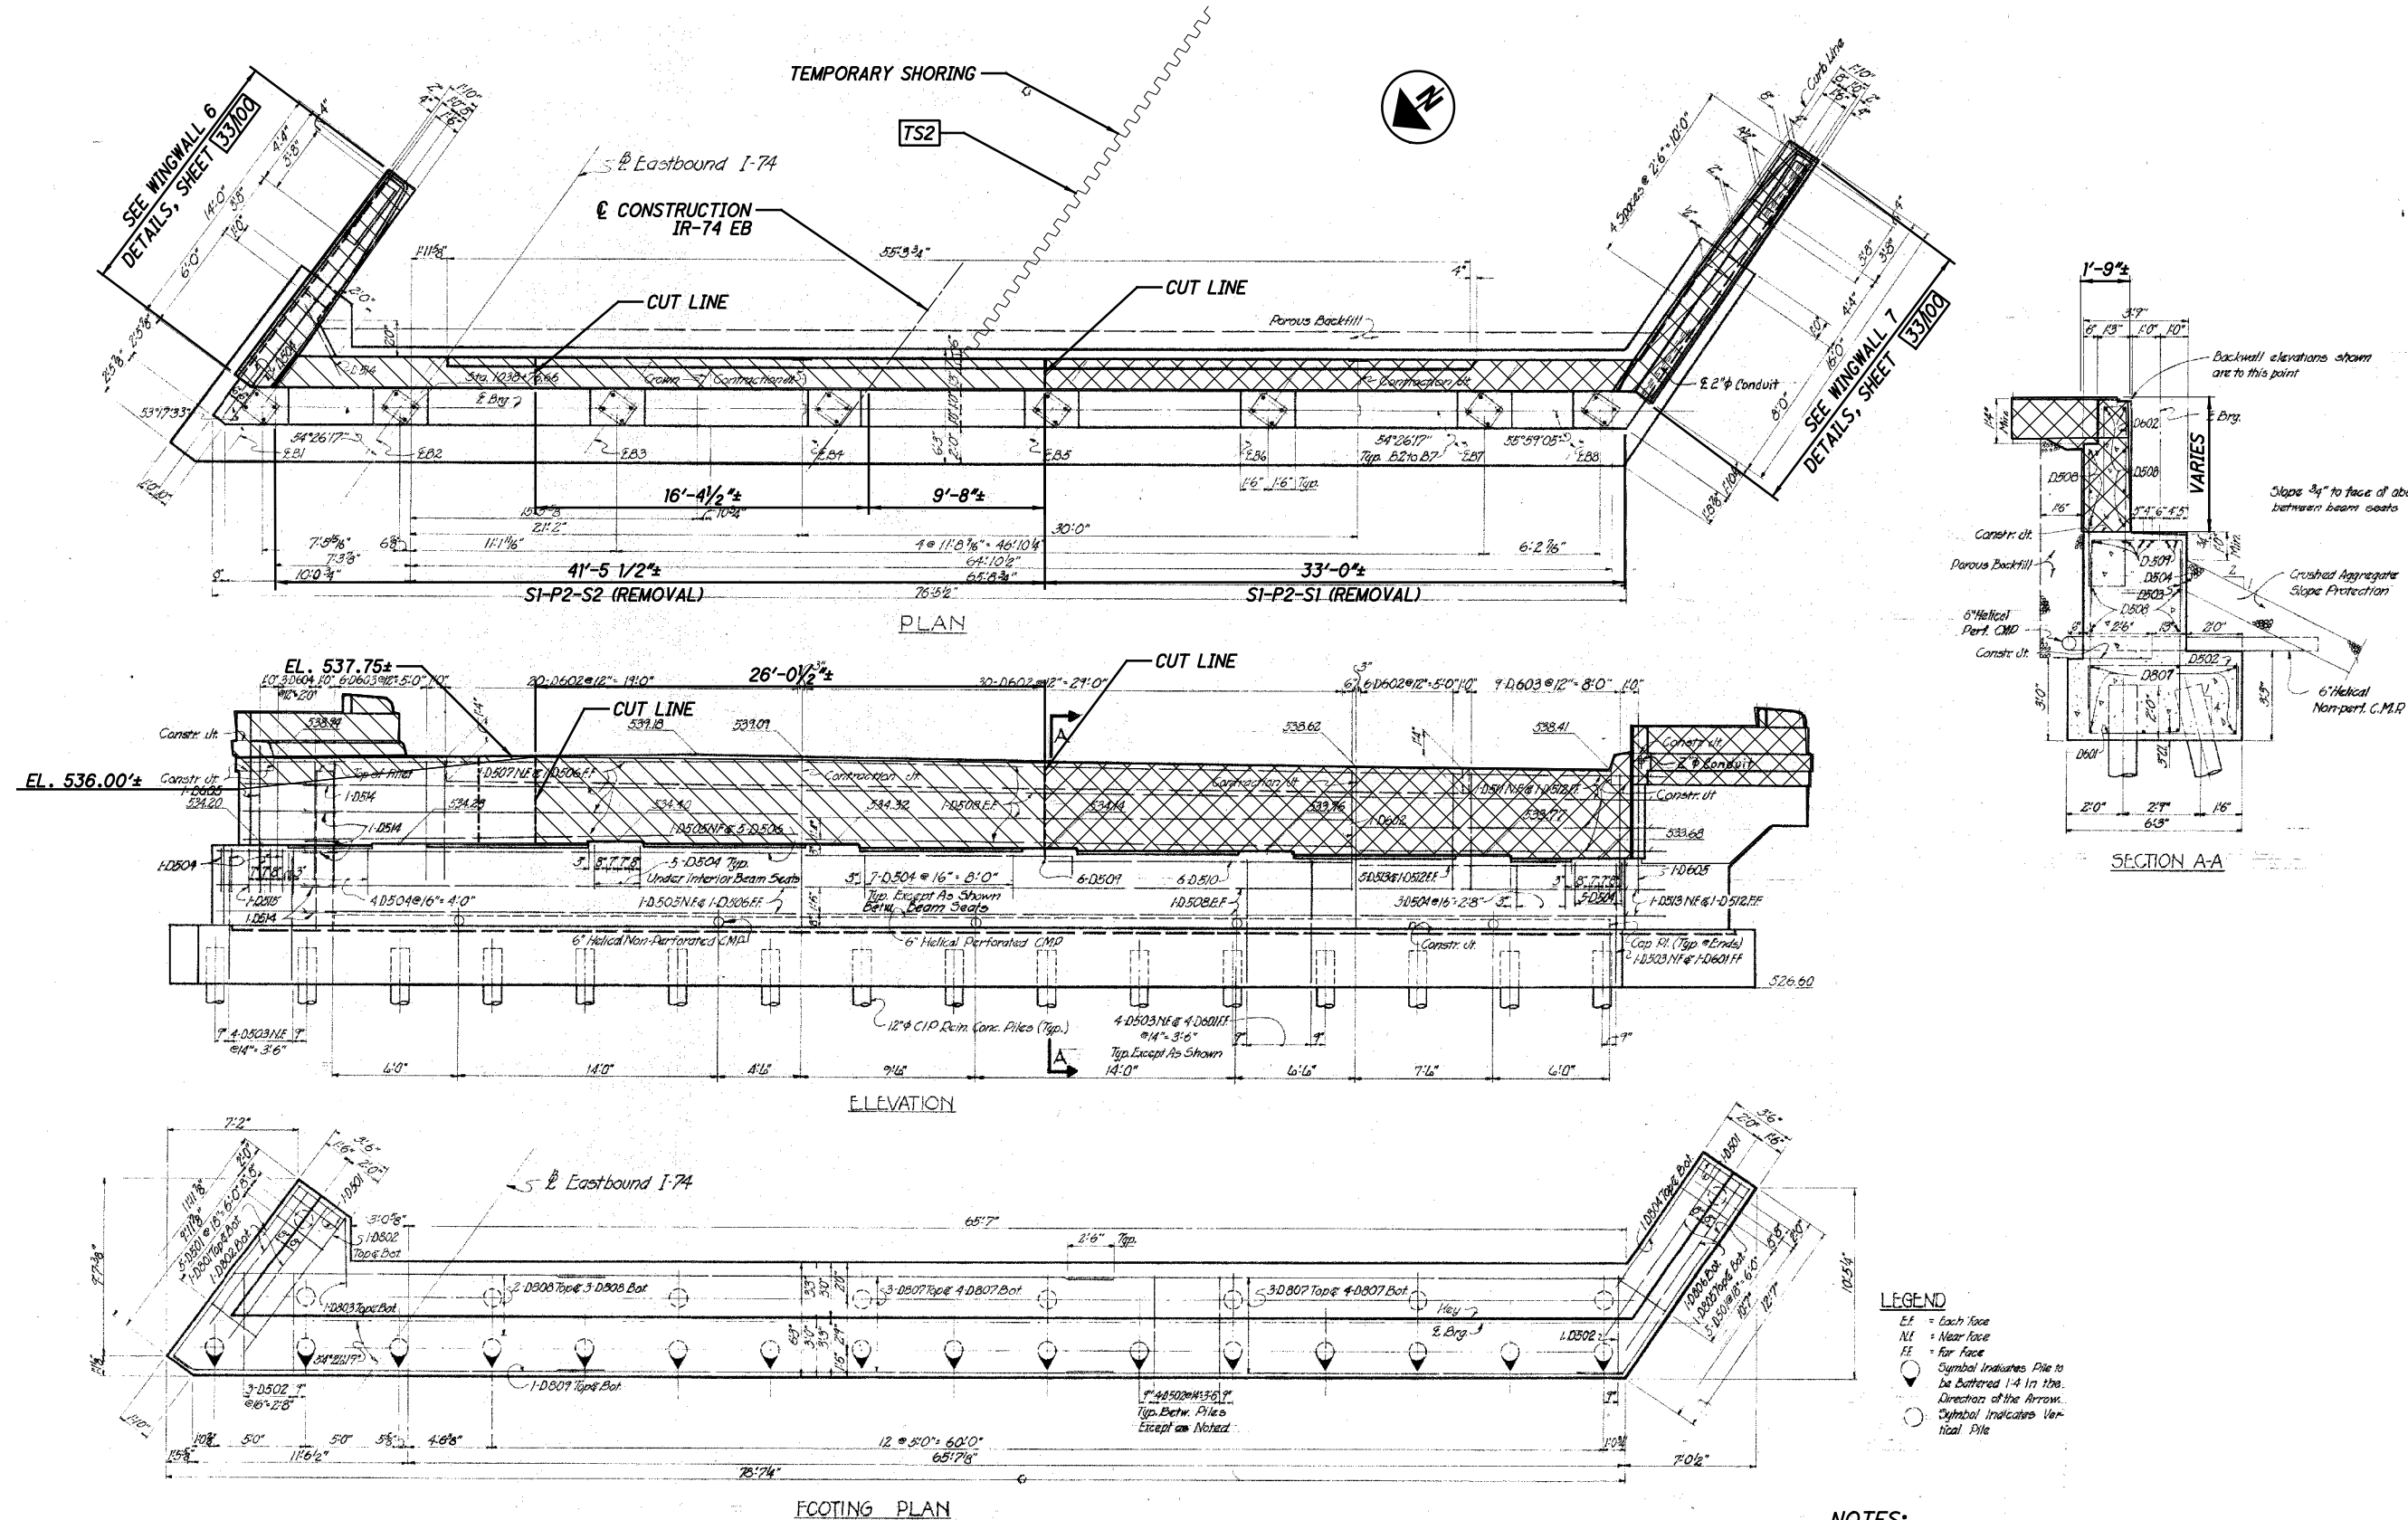


**LEGEND:**  
 - INDICATES LIMITS OF REMOVAL (SI-P2-SI)  
 - INDICATES LIMITS OF REMOVAL (SI-P2-S2)  
 SX-PX-SX - STAGE X PHASE X STEP X (MOT PHASING)

**EXISTING ABUTMENT NO. 4 REMOVAL DETAILS**



- NOTES:**
- FOR ADDITIONAL DETAILS, SEE SHEET 33/100.
  - THE EXISTING REINFORCING STEEL, PROTRUDING INTO THE PORTIONS OF THE CONCRETE TO BE REMOVED, SHALL NOT BE SALVAGED.
  - SEE SHEETS 12/100 THRU 21/100 FOR CONSTRUCTION SEQUENCE INFORMATION.
  - ALL REMAINING EXPOSED SURFACES, EXCLUDING THE BEAM SEATS, WILL BE SEALED TO THE EXISTING GROUND ELEVATION.

DESIGN AGENCY <b>PRIMEW</b> 540 WHITE POND DR. SUITE E AKRON, OH 44320	DATE 3/27/2019
	REVIEWED TES
DRAWN CRG	STRUCTURE FILE NUMBER 3115739
DESIGNED CRG	CHECKED KDC
<b>EXISTING ABUTMENT 4 REMOVAL DETAILS</b> BRIDGE NO. - HAM-74-1908R IR-74 OVER MILL CREEK, RR & SPRING GROVE AVENUE	
HAM-75-3.84	PID No. 104667

P:\Projects\2018\20H03DB-18232 HAM-75-03.84\104667\structures\HAM074\_1908R\sheets\074\_1908R\_RE003.dgn 6/20/2019 9:10:10 AM aseed

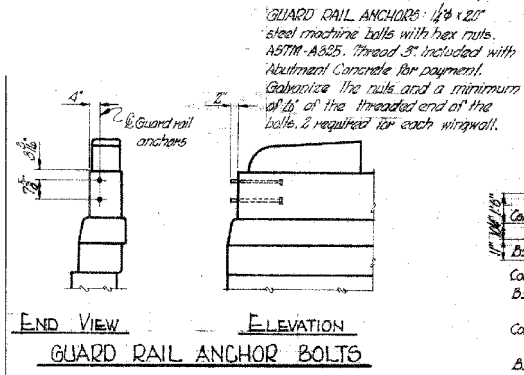


Note: Anchor bolts to be used for all 7 wingwalls.

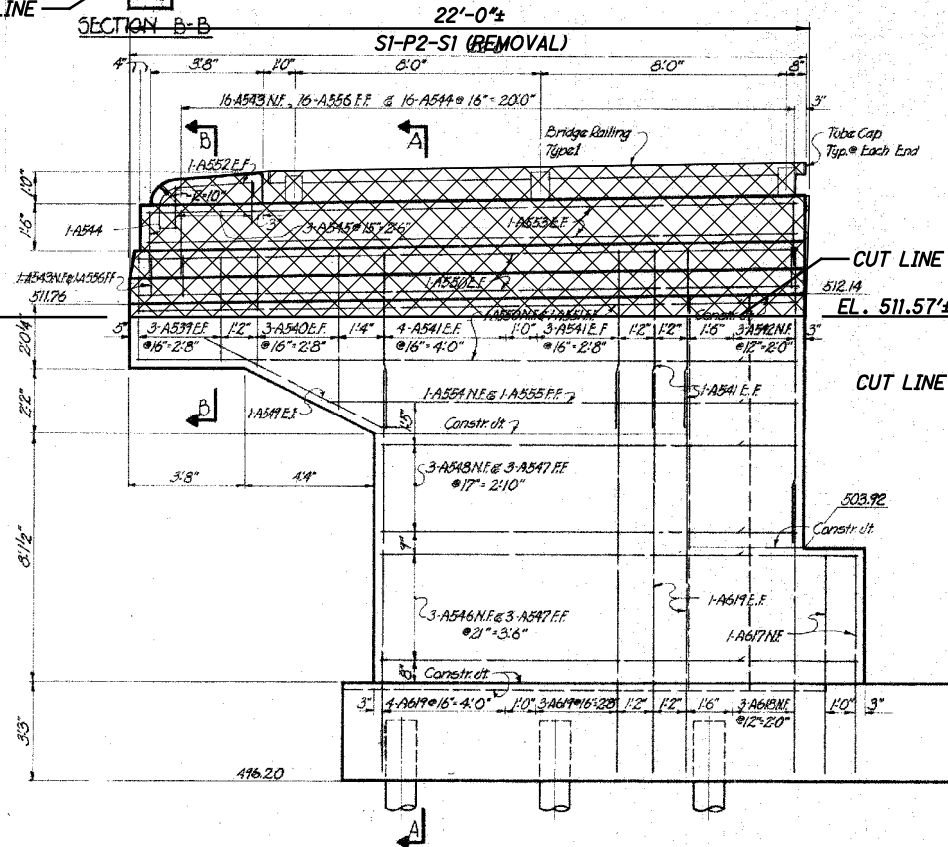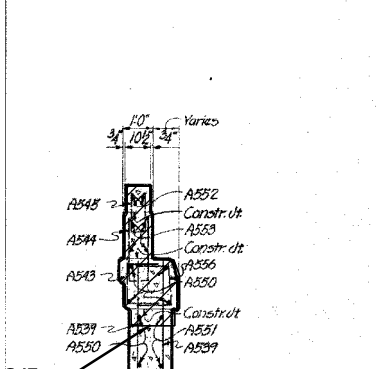


**LEGEND:**

- INDICATES LIMITS OF REMOVAL (SI-P2-S1)
- INDICATES LIMITS OF REMOVAL (SI-P2-S2)
- INDICATES LIMITS OF REMOVAL (SI-P2-S3)
- SX-PX-SX - STAGE X PHASE X STEP X (MOT PHASING)

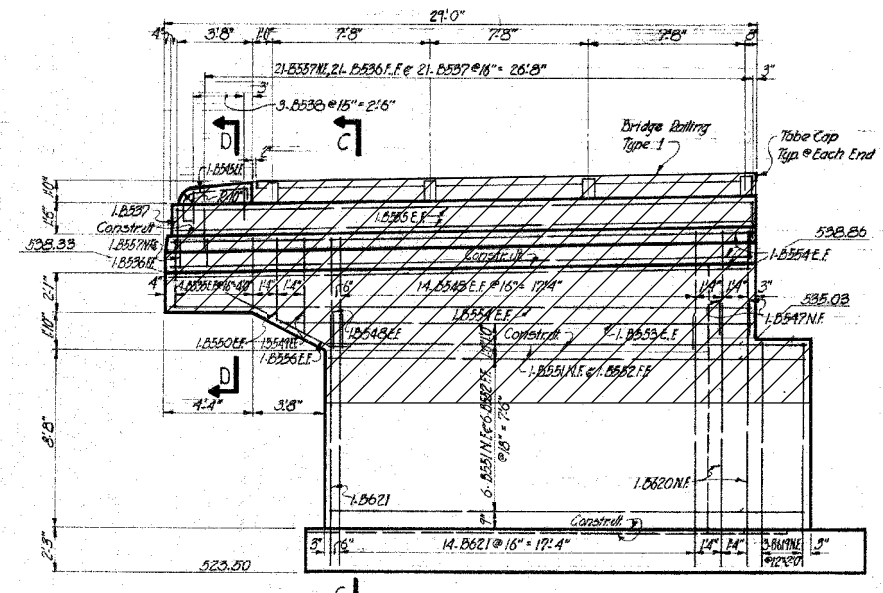


ELEVATION WINGWALL 2  
(REMOVED WITH RAMP P CONSTRUCTION)

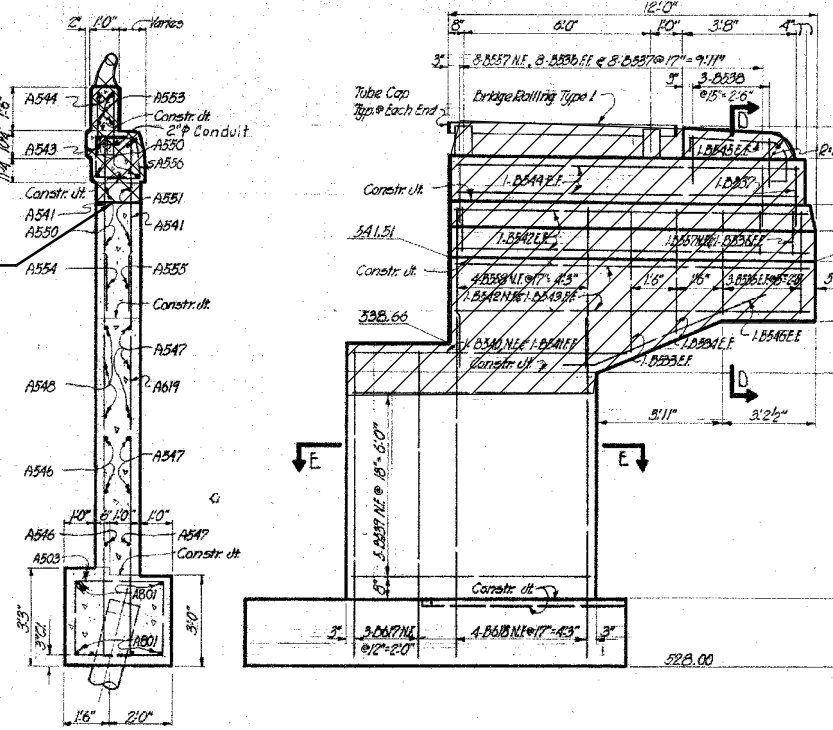


ELEVATION WINGWALL 3  
(REMOVED WITH RAMP P CONSTRUCTION)


**EXISTING WINGWALL REMOVAL DETAILS**

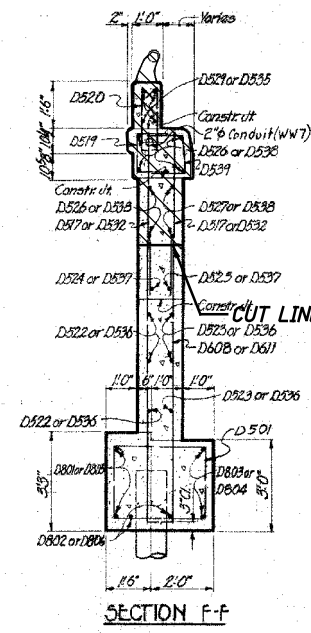


SECTION F-F

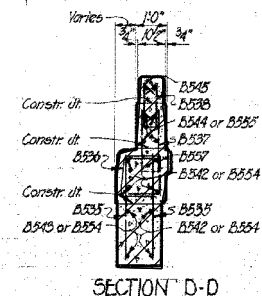


SECTION D-D

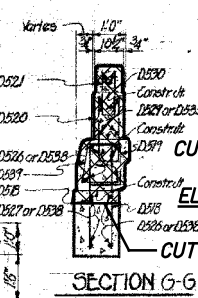


SECTION G-G

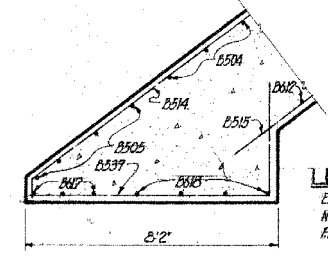

SECTION E-E

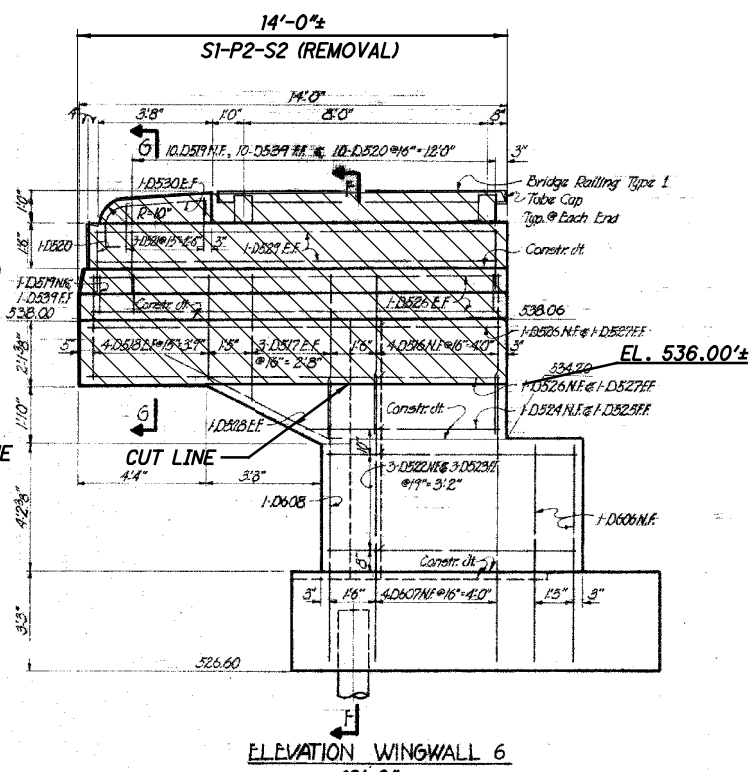

ELEVATION WINGWALL 6

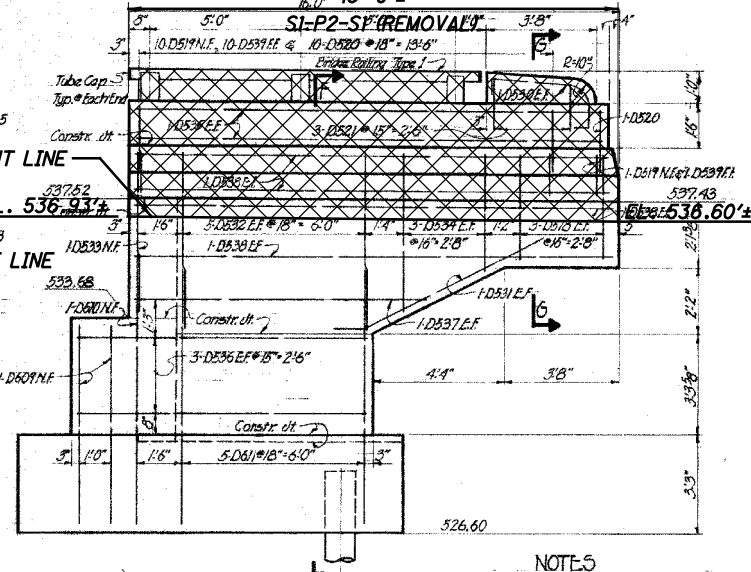


ELEVATION WINGWALL 7

**LEGEND**  
 E.F. = End Face  
 M.F. = Mean Face  
 F.F. = Fair Face


- NOTES:**
1. FOR ADDITIONAL DETAILS, SEE SHEETS 31/100 AND 32/100.
  2. THE EXISTING REINFORCING STEEL, PROTRUDING INTO THE PORTIONS OF THE CONCRETE TO BE REMOVED, SHALL NOT BE SALVAGED.
  3. SEE SHEETS 12/100 THRU 21/100 FOR CONSTRUCTION SEQUENCE INFORMATION.
  4. ALL REMAINING EXPOSED SURFACES, EXCLUDING THE BEAM SEATS, WILL BE SEALED TO THE EXISTING GROUND ELEVATION.

DESIGN AGENCY <b>PRIMEW</b> 540 WHITE POND DR. SUITE E AKRON, OH 44320	DATE	3/27/2019
	REVIEWED	TES
DRAWN	CRG	STRUCTURE FILE NUMBER
DESIGNED	CRG	3115739
CHECKED	REVISED	
KDC		
<b>EXISTING WINGWALL REMOVAL DETAILS</b>		
BRIDGE NO. HAM-74-1908R		
IR-74 OVER MILL CREEK, RR & SPRING GROVE AVENUE		
HAM-75-3.84	33/100	
PID No. 104667	33/100	


P:\Projects\2018\20H03DB-18232 HAM-75-03.84\104667\structures\HAM074\_1908R\_ARCH\01.dgn 9/21/2023 3:01:59 PM erin.baumann

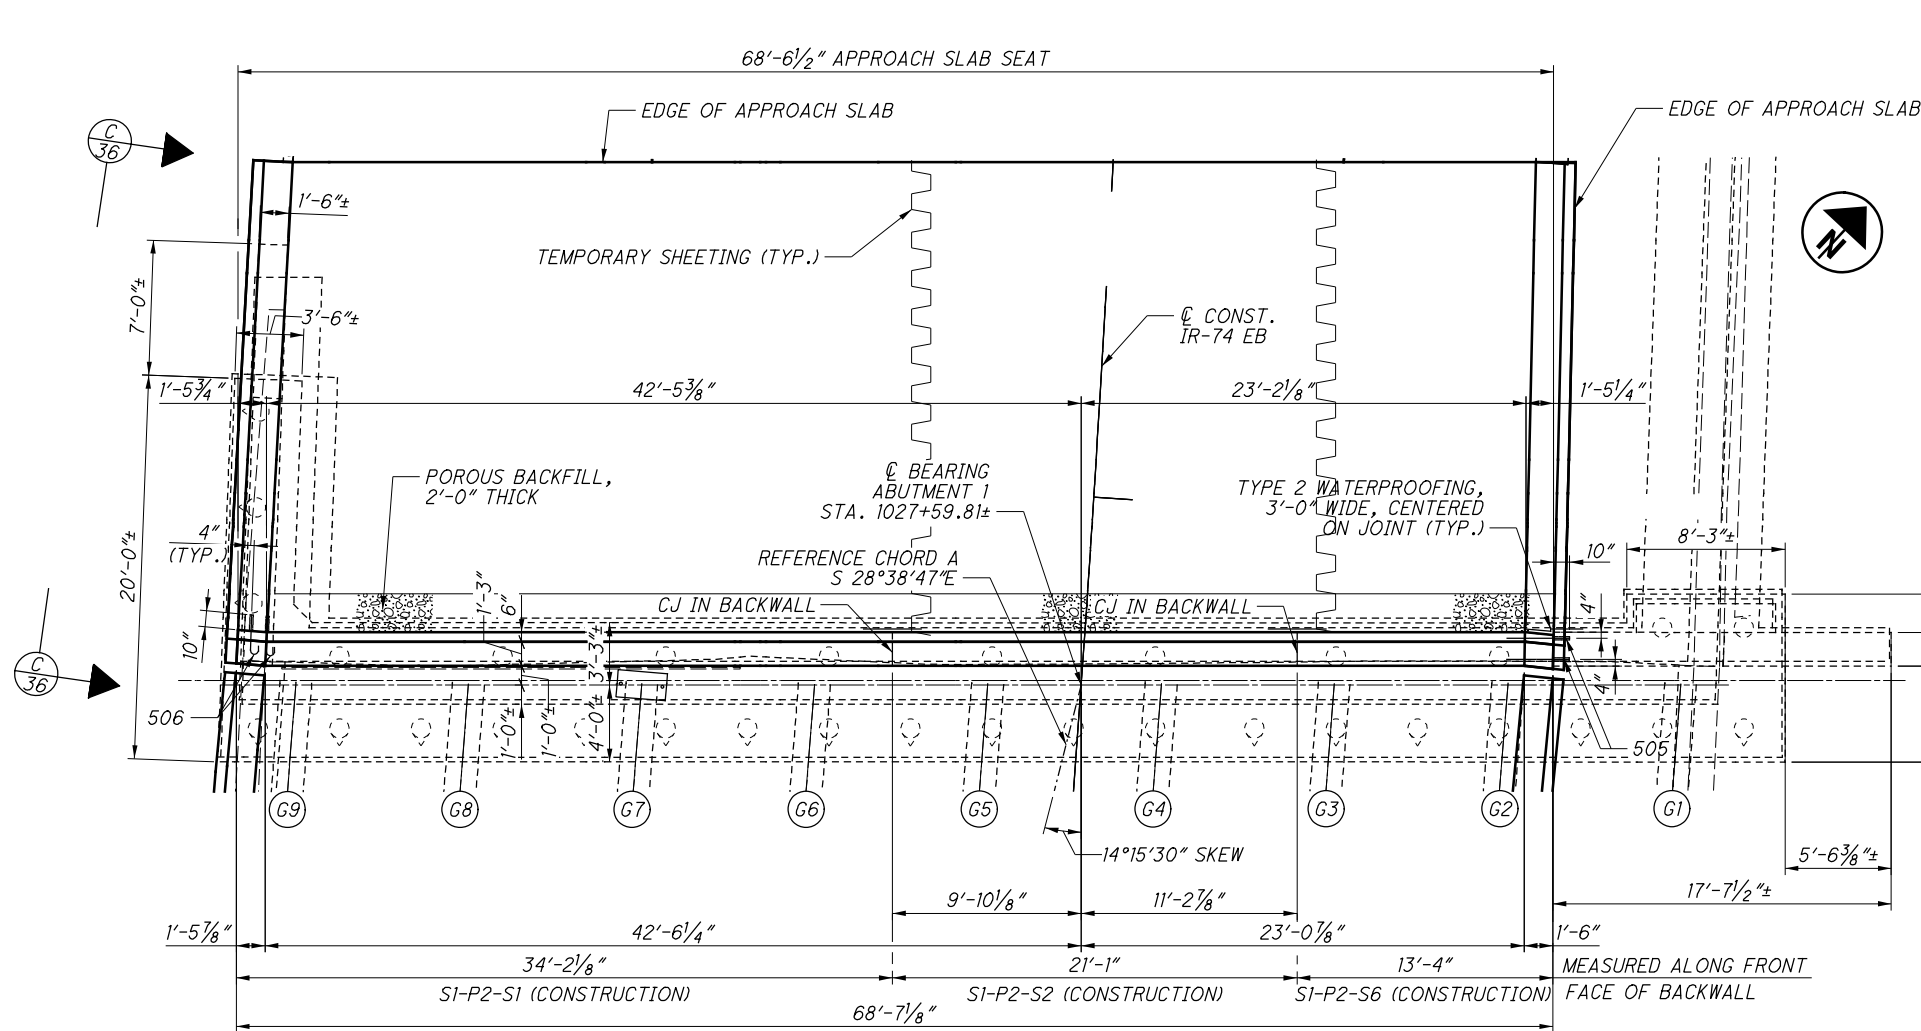

**PLAN**

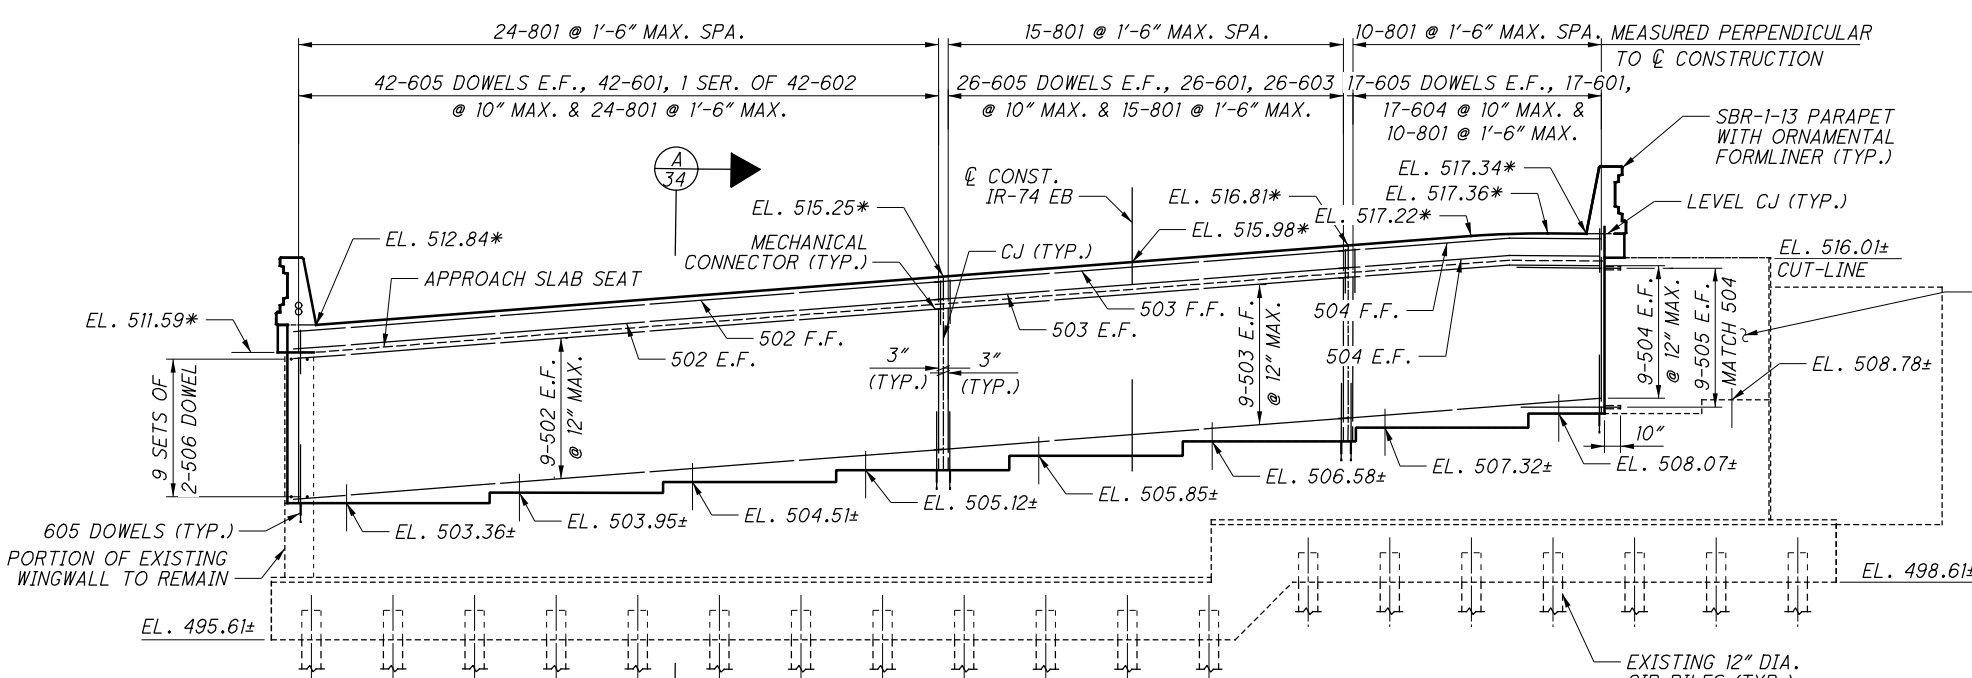

**ELEVATION**

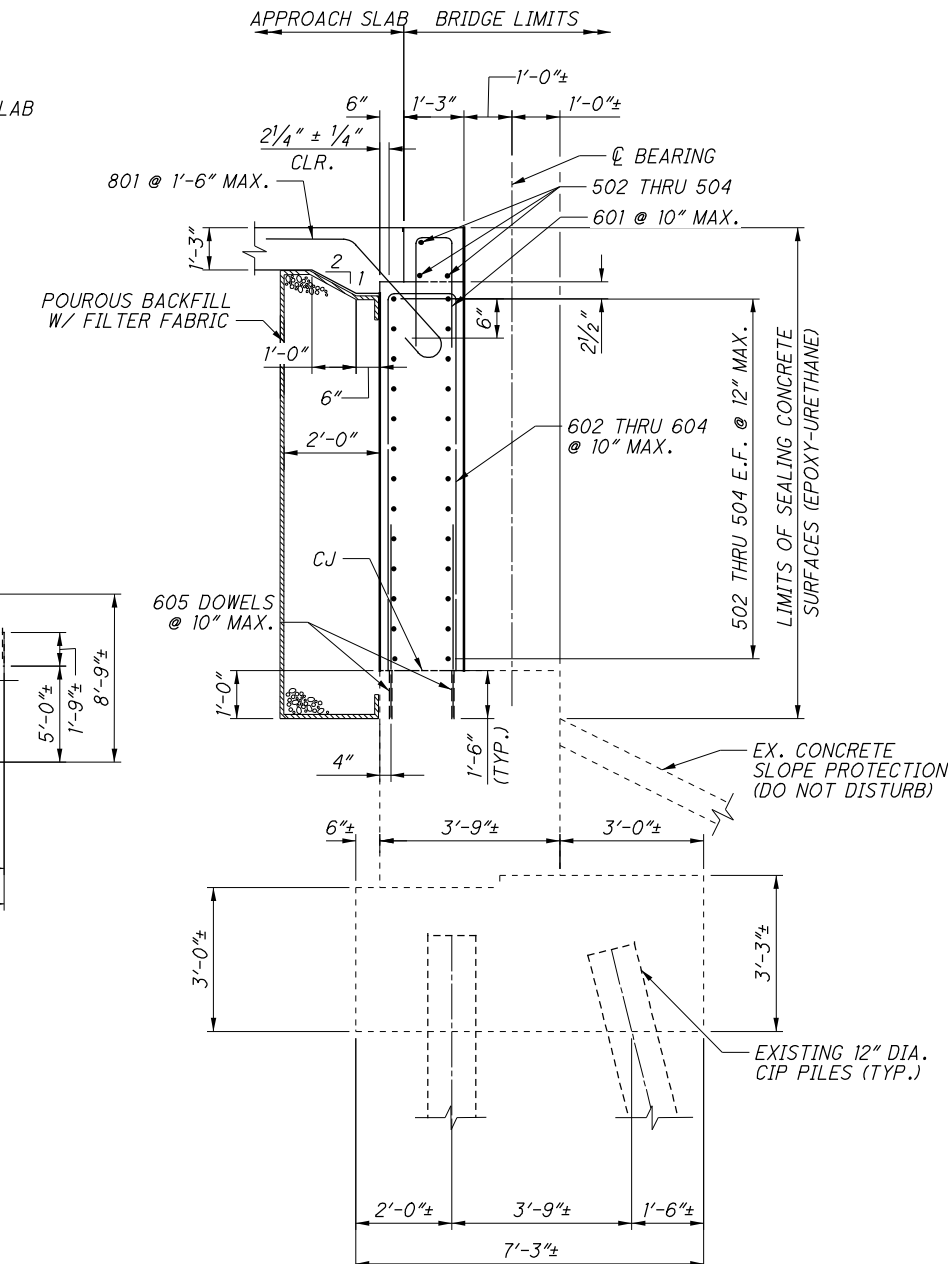

**SECTION**




**LEGEND:**  
\* - MEASURED AT FRONT FACE OF BACKWALL

MIN. REQUIRED LAP LENGTH	
#6 VERTICAL	2'-10"

- NOTES:**
- FOR ABUTMENT 1 REMOVAL DETAILS, SEE SHEET 31/100.
  - FOR ABUTMENT 1 WINGWALL REMOVAL DETAILS, SEE SHEET 33/100.
  - THE PREFIX "1A" SHALL BE ADDED TO ALL BAR MARKS FOR ABUTMENT 1.
  - FOR REINFORCING STEEL LIST, SEE SHEET 100/100.



P:\Projects\2018\20H03DB-18232 HAM-75-03.84\104667\structures\HAM074\_1908R\_AF001.dgn 9/21/2023 4:10:16 PM erin.baumann

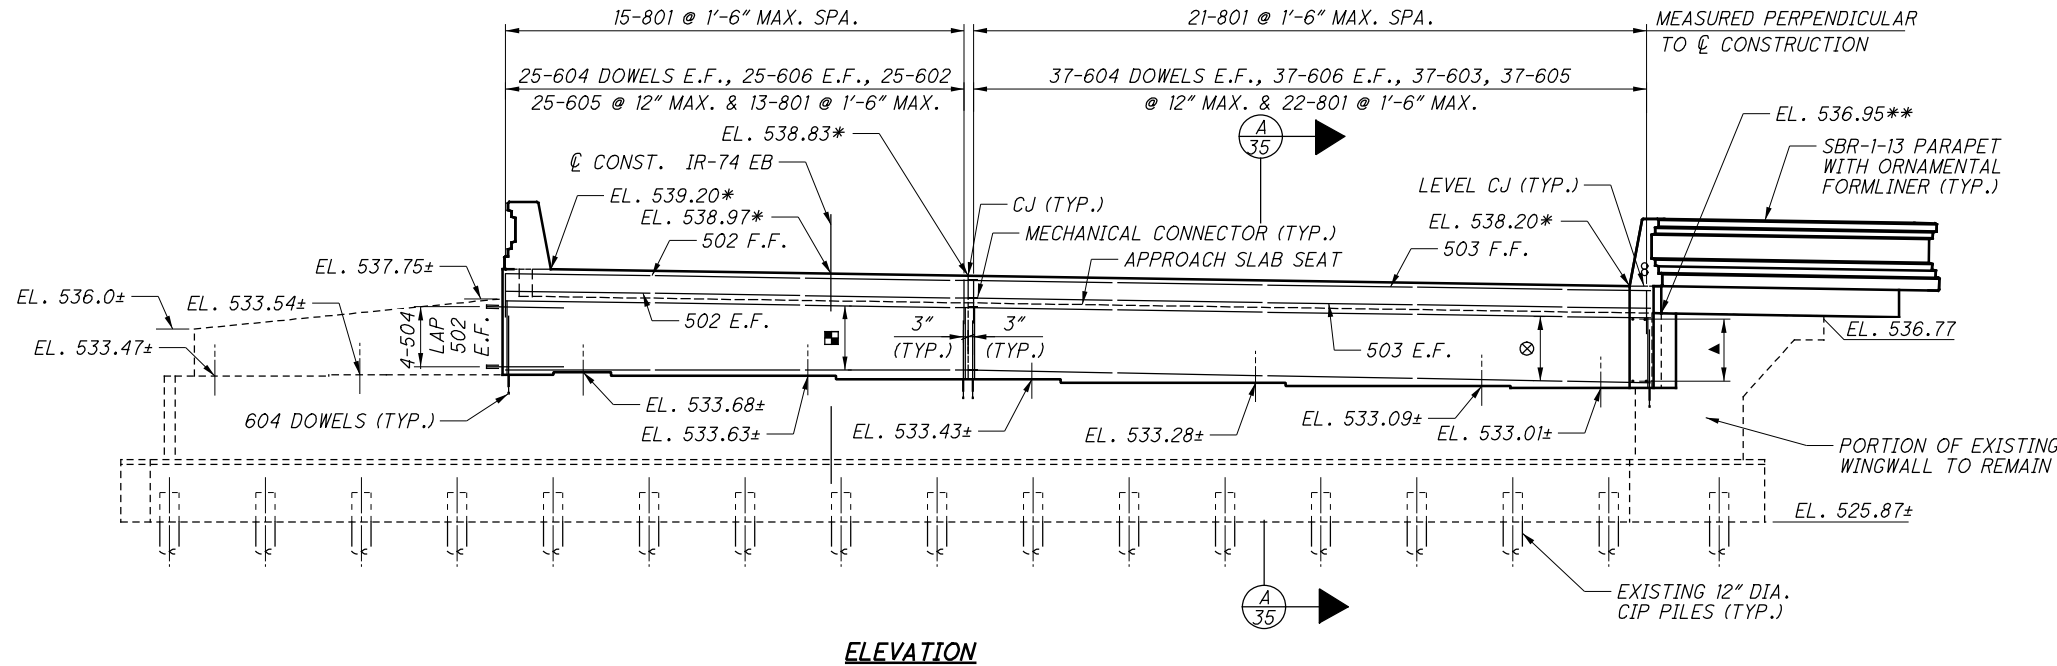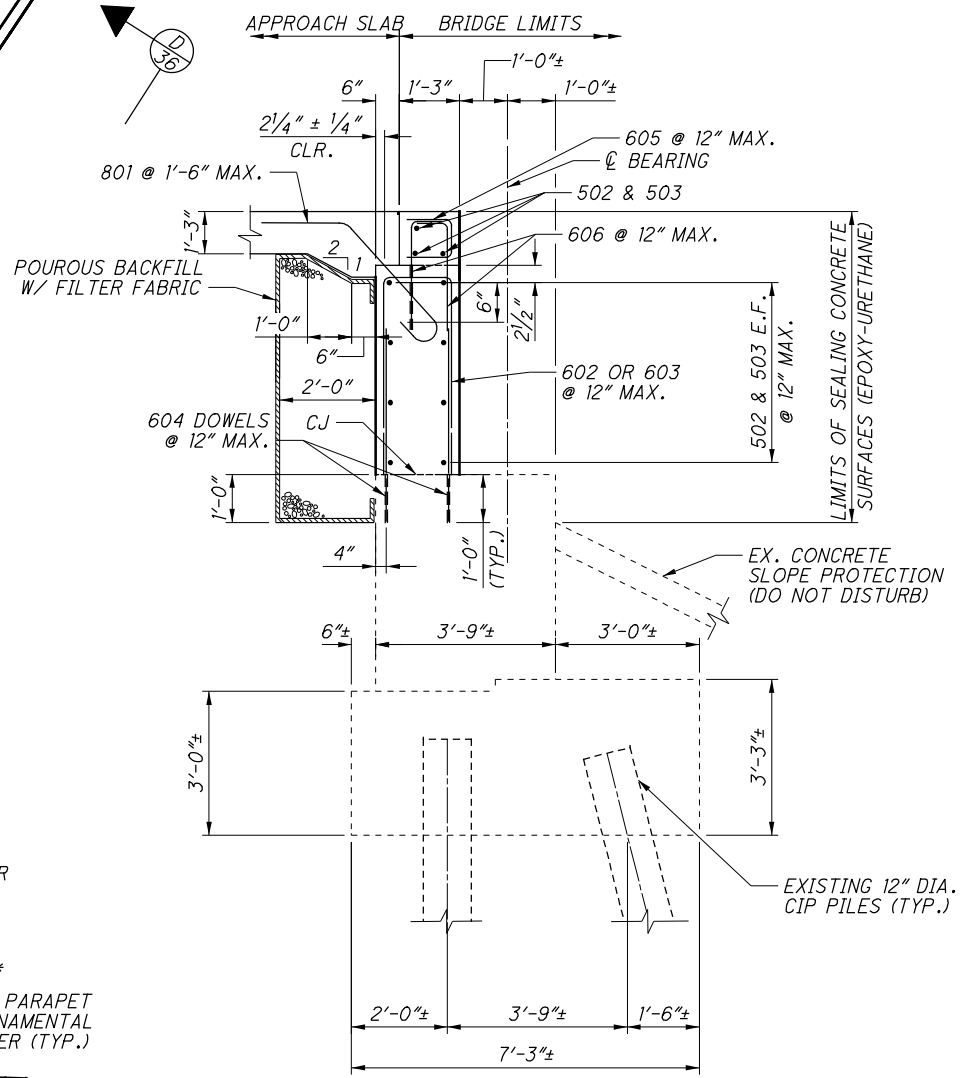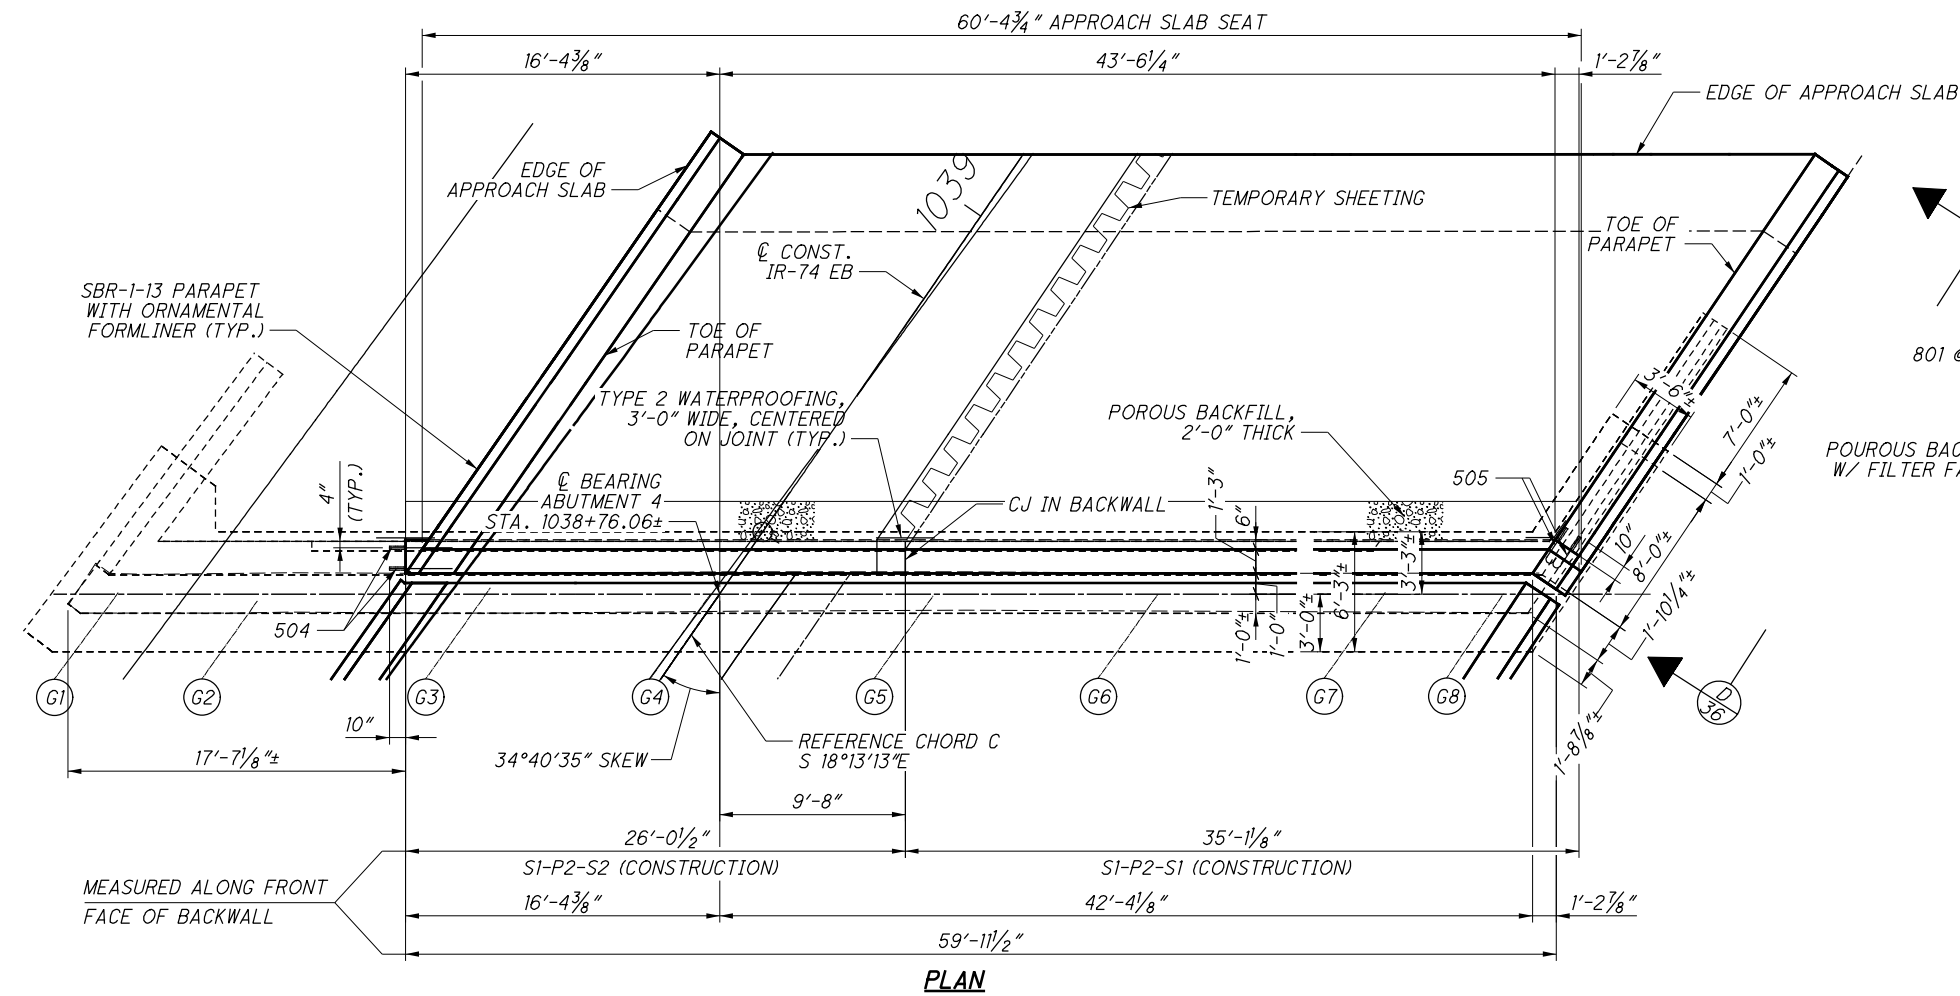

**LEGEND:**


- \* - MEASURED AT FRONT FACE OF BACKWALL
- \*\* - MEASURED AT BACK FACE OF BACKWALL
- - 4-502 E.F. @ 12" MAX.
- ⊗ - 4-503 E.F. @ 12" MAX.
- ▲ - 4 SETS OF 2-505 DOWELS LAP W/ 503 BARS

MIN. REQUIRED LAP LENGTH	
#6 VERTICAL	2'-10"


**NOTES:**

1. FOR ABUTMENT 4 REMOVAL DETAILS, SEE SHEET 32/100.
2. FOR ABUTMENT 4 WINGWALL REMOVAL DETAILS, SEE SHEET 33/100.
3. THE PREFIX "4A" SHALL BE ADDED TO ALL BAR MARKS FOR ABUTMENT 4.
4. FOR REINFORCING STEEL LIST, SEE SHEET 100/100.


P:\Projects\2018\20H03DB-18232 HAM-75-03-84\104667\structures\HAM074\_1908R\AR002.dgn 9/21/2023 4:29:35 PM erim.baumann

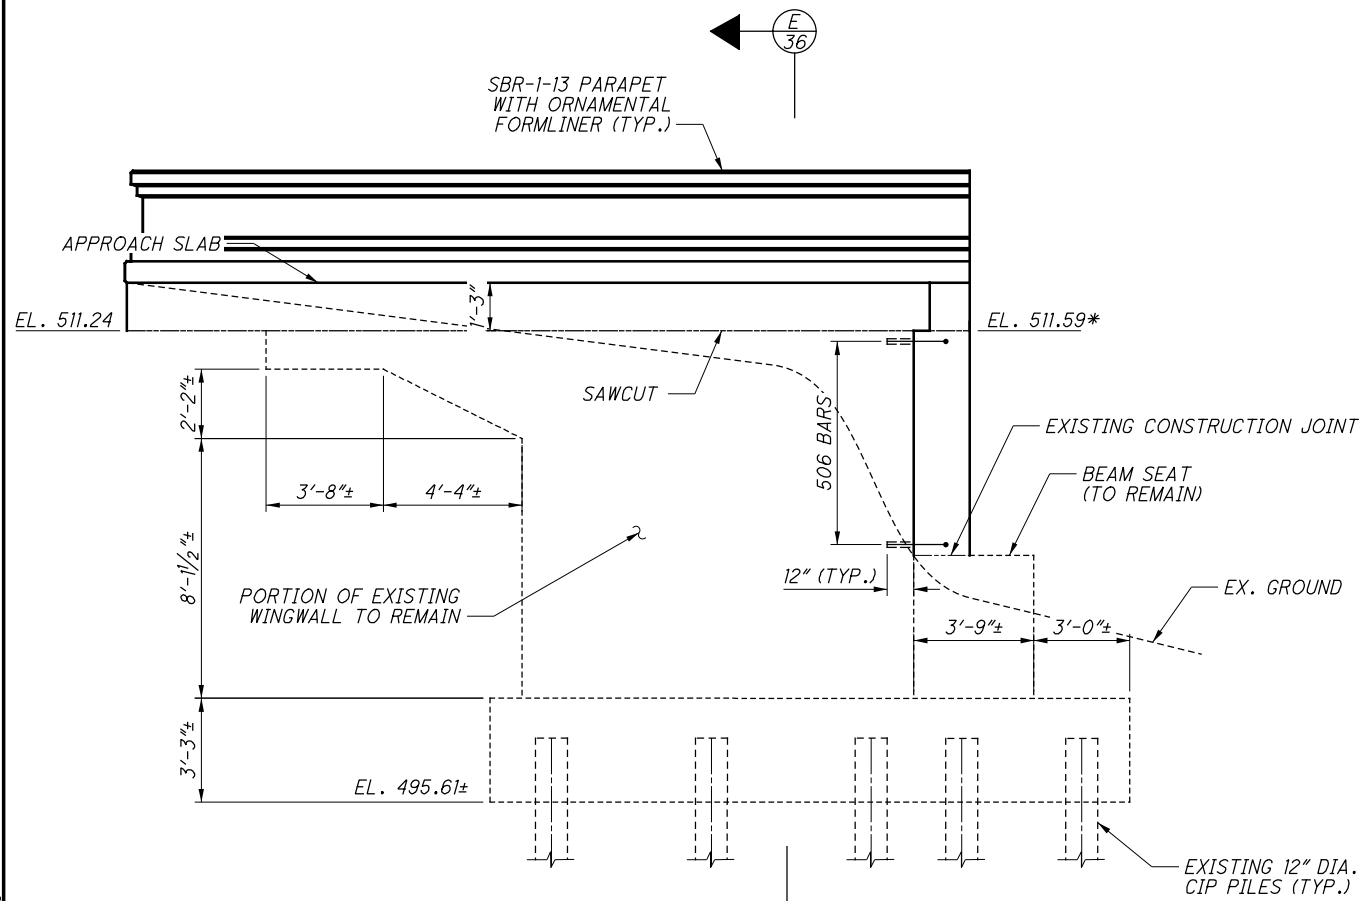


**C WINGWALL ELEVATION**  
BACKWALL REINFORCING NOT SHOWN

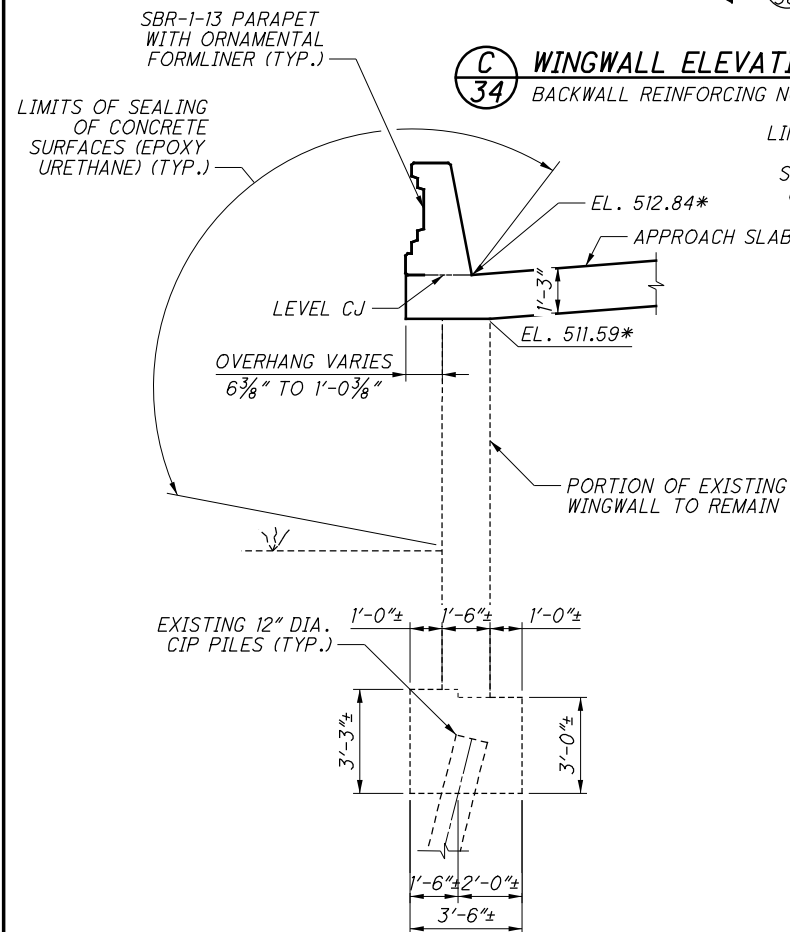

**E WINGWALL SECTION**

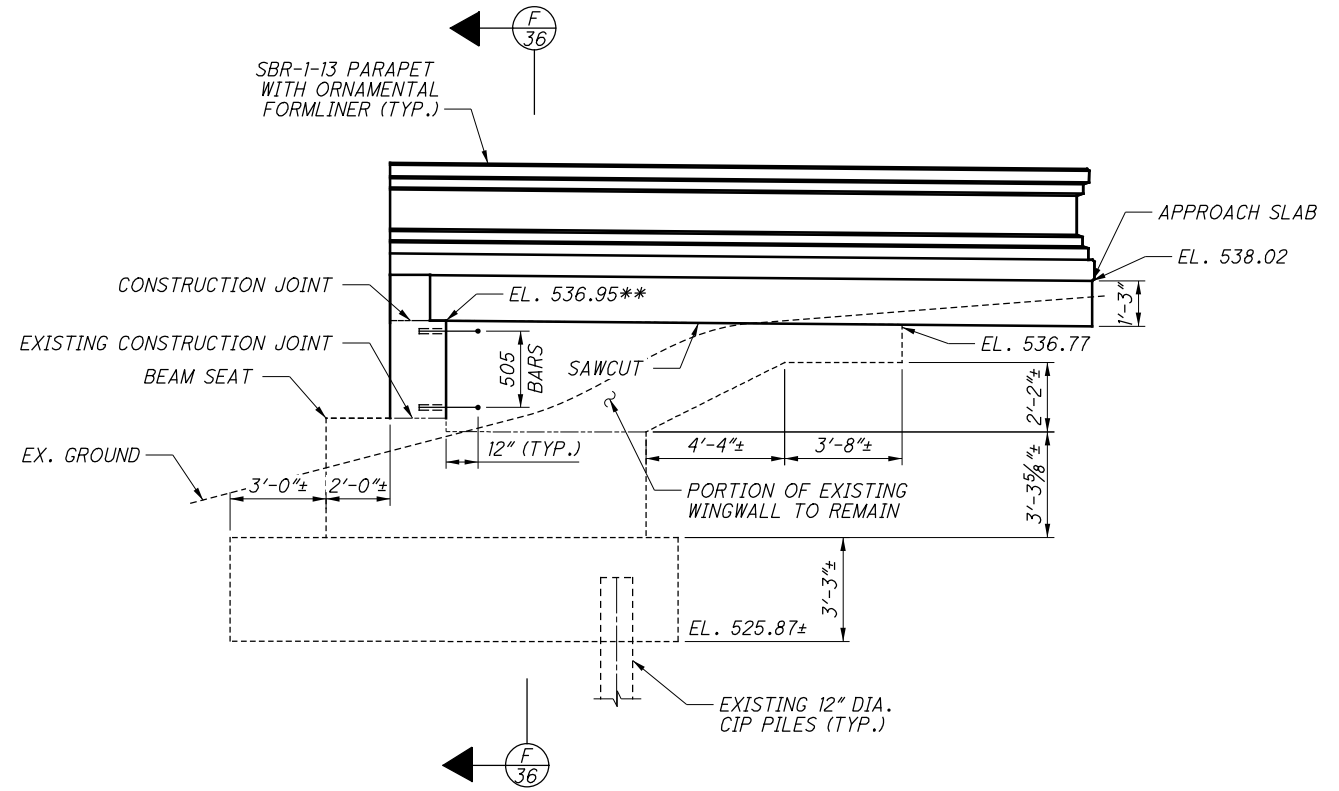

**D WINGWALL ELEVATION**  
BACKWALL REINFORCING NOT SHOWN

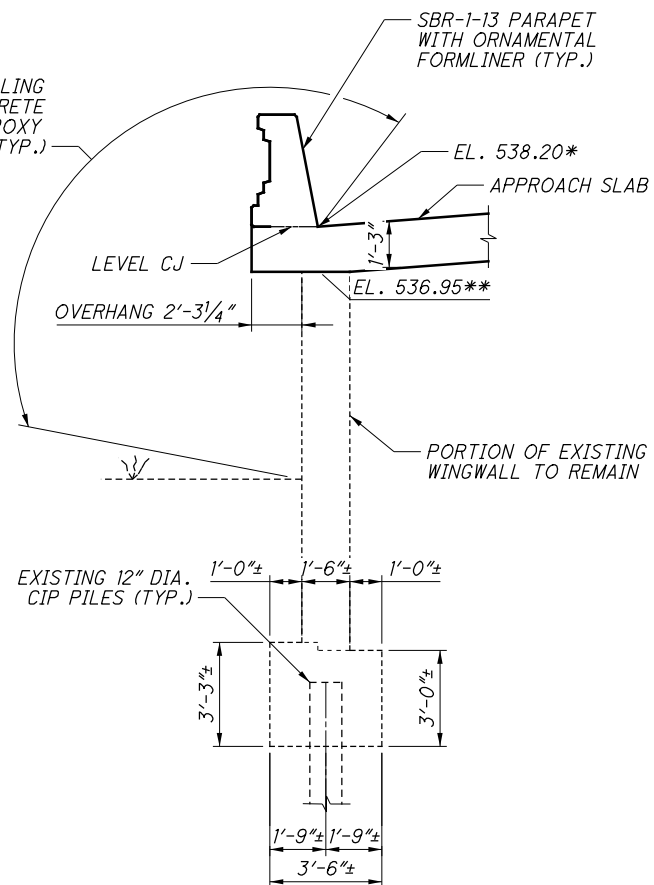

**F WINGWALL SECTION**


**LEGEND:**

- \* - MEASURED AT FRONT FACE OF BACKWALL
- \*\* - MEASURED AT BACK FACE OF BACKWALL

**NOTES:**


1. FOR PARAPET DETAILS AND REINFORCEMENT, SEE SHEETS 85,100 AND 88,100.
2. SEAL ALL EXPOSED SURFACES OF EXISTING WINGWALLS.

P:\Projects\2018\20HO3DB-18232 HAM-75-03.84\104667\structures\HAM074\_1908R\sheets\074\_1908R\_BR001.dgn 9/21/2023 4:47:31 PM erin.boumann

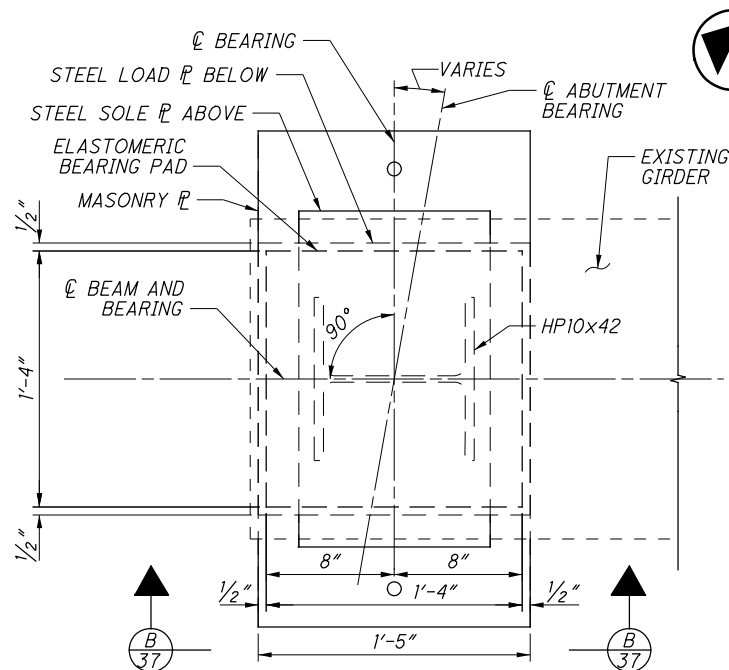


**ABUTMENT 1 BEARING PLAN**

\* SEE TABLE 1 FOR SOLE PLATE THICKNESS

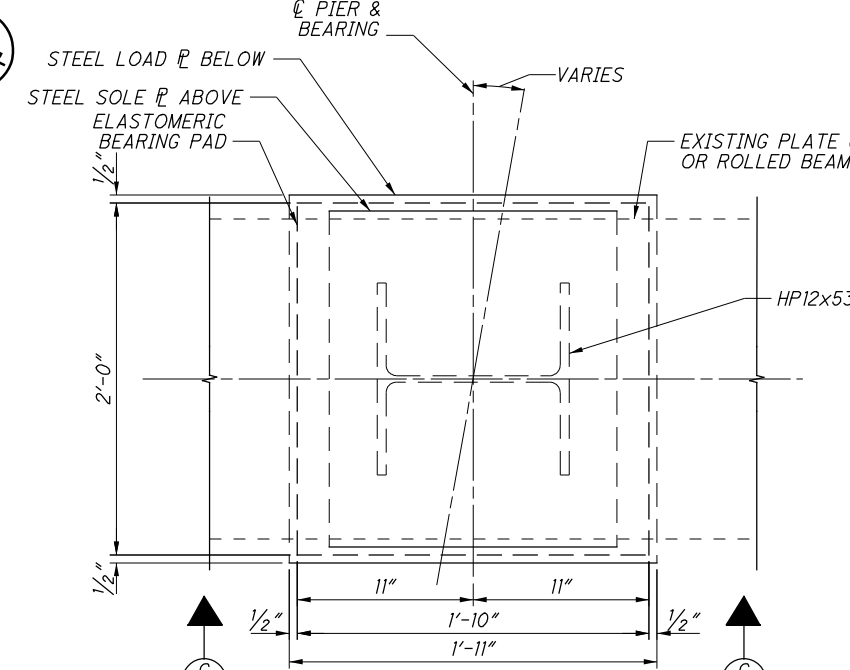


**PIER BEARING PLAN**

EX. PIER 1 SHOWN, OTHERS SIMILAR  
EX. PIERS 1, 3, 6 & 19  
\* SEE TABLE 1 FOR SOLE PLATE THICKNESS

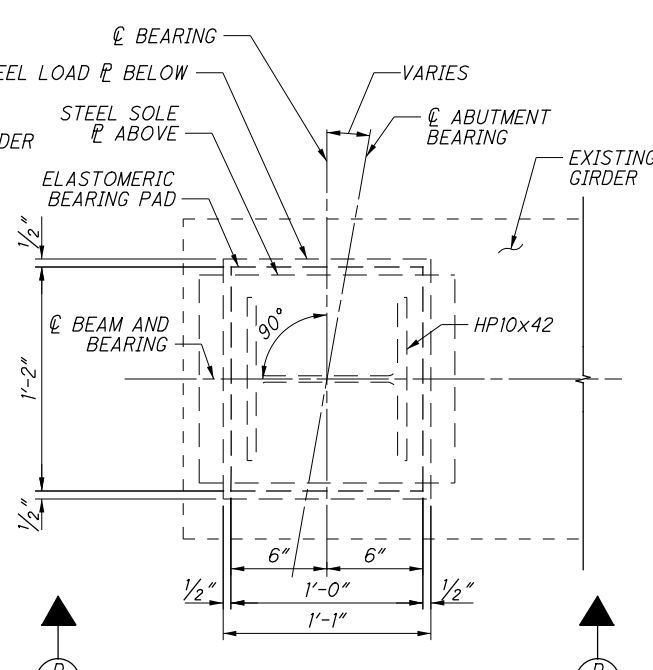


**ABUTMENT 4 BEARING PLAN**

\* SEE TABLE 1 FOR SOLE PLATE THICKNESS

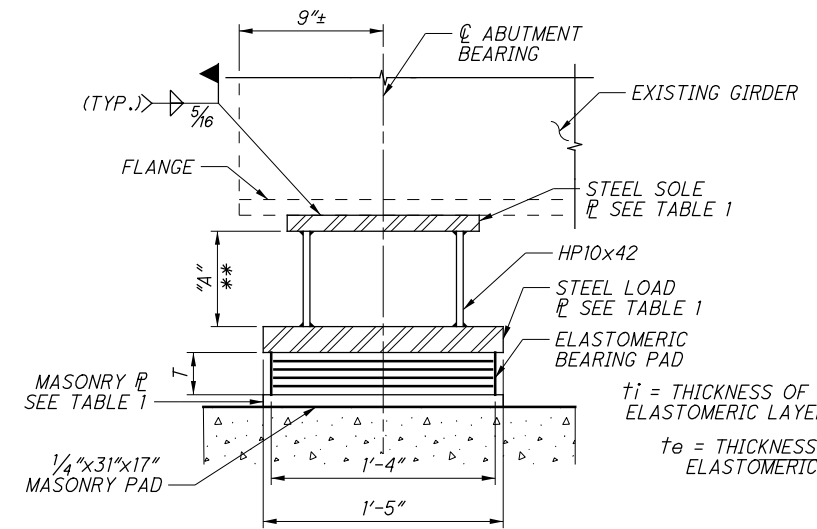


**SECTION B**

\* SEE TABLE 1 FOR SOLE PLATE THICKNESS  
\*\*SEE TABLE 2 FOR DIMENSION "A"

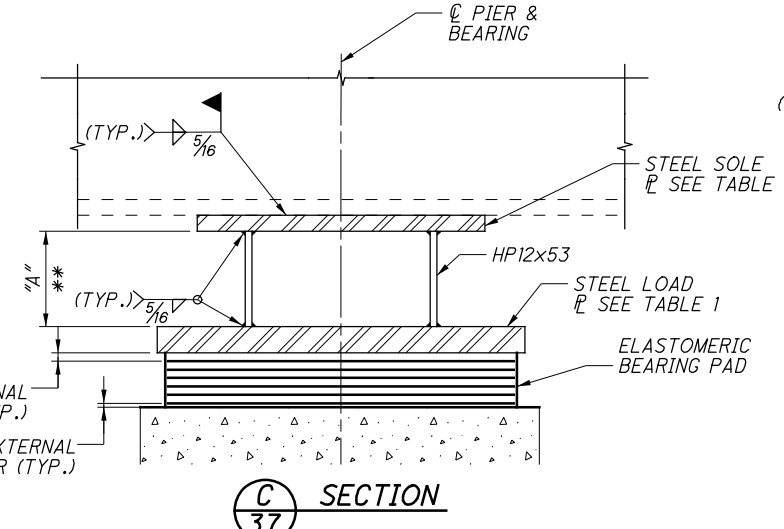


**SECTION C**

EX. PIER 1 SHOWN, OTHER SIMILAR  
EX. PIERS 1, 3, 6 & 19  
\* SEE TABLE 1 FOR SOLE PLATE THICKNESS  
\*\*SEE TABLE 2 FOR DIMENSION "A"

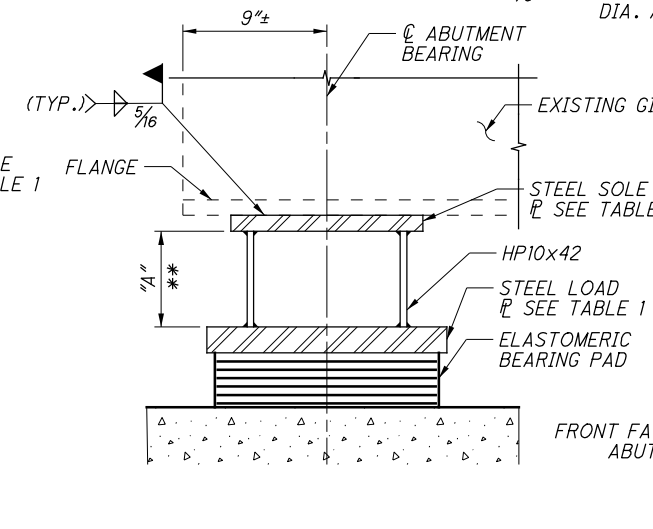


**SECTION D**

\* SEE TABLE 1 FOR SOLE PLATE THICKNESS  
\*\*SEE TABLE 2 FOR DIMENSION "A"

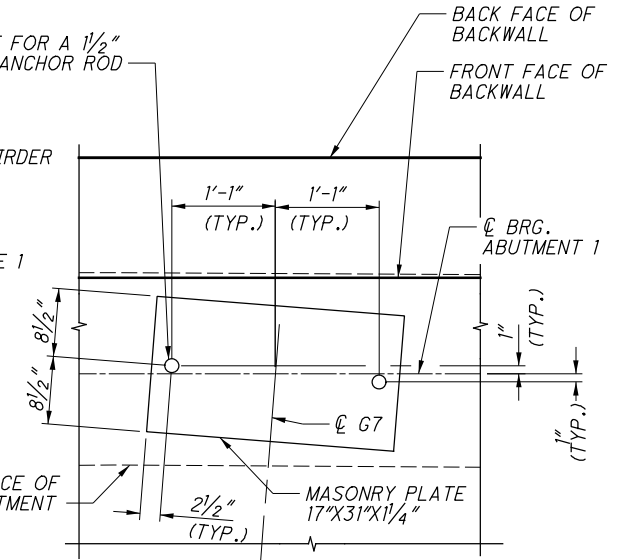

**TYPICAL MASONRY PLATE**

(ABUTMENT 1 ONLY. GIRDER 7 SHOWN, OTHERS SIMILAR)  
FOR ANCHOR BOLT DETAIL, SEE SHEET 39/100.

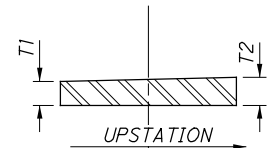

**SOLE PLATE**

\* SEE TABLE 1 FOR SOLE PLATE THICKNESS

BEARING TYPE	NO. OF BEARINGS	ELASTOMERIC BEARING PAD SIZE LxWxT	NO. OF STEEL LAMINATES 0.0747" THICK (14 GAGE)	INTERNAL LAYERS		EXTERNAL LAYERS		STEEL LOAD PLATE SIZE LxWxT	STEEL SOLE PLATE SIZE LxW	STEEL SOLE PLATE THICKNESS		UNFACTORED DESIGN LOADS			MASONRY PLATE SIZE LxWxT	MASONRY PLATE BOLTS	
				ti	NO.	te	NO.			T1	T2	DEAD LOAD IN KIPS	LIVE LOAD IN KIPS #	TOTAL LOAD IN KIPS		DIA.	NO.
EX. ABUT. 1	EXP.	8	16"x16"x4.52"	7	0.500"	8	-	17"x17"x1 1/2"	16"x21"	1.37"	1.63"	74	74	148	17"x31"x1 1/4"	1 1/2"	2
EX. PIER 1	EXP.	8	22"x24"x3.12"	5	0.500"	5	0.25"	1	23"x25"x2 1/4"	1.98"	2.52"	345	144	489	NA	NA	NA
EX. PIER 3	EXP.	8	22"x22"x2.55"	4	0.500"	4	0.25"	1	23"x23"x2 1/4"	1.87"	2.63"	325	145	470	NA	NA	NA
EX. PIER 6	EXP.	10	22"x24"x2.55"	4	0.500"	4	0.25"	1	23"x25"x2 1/2"	2.35"	2.65"	389	137	526	NA	NA	NA
EX. PIER 19	EXP.	6	16"x18"x3.12"	5	0.500"	5	0.25"	1	17"x19"x1 1/2"	1.50"	1.50"	140	61	201	NA	NA	NA
EX. ABUT. 4	EXP.	6	12"x14"x3.12"	5	0.500"	5	0.25"	1	13"x15"x1 1/2"	1.50"	1.50"	43	50	93	NA	NA	NA

TABLE 2 - DIM.	"A"
ABUTMENT 1	5"
PIER 1	13 1/8"
PIER 3	13.7"
PIER 6	13"
PIER 9	10 5/8"
ABUTMENT 4	5 1/8"

**NOTES:**  
1. FOR NOTES, SEE SHEET 39/100.  
2. GALVANIZED SHIM PLATES INSTALLED AT PIER 3, PIER 6, AND ABUTMENT NO. 4

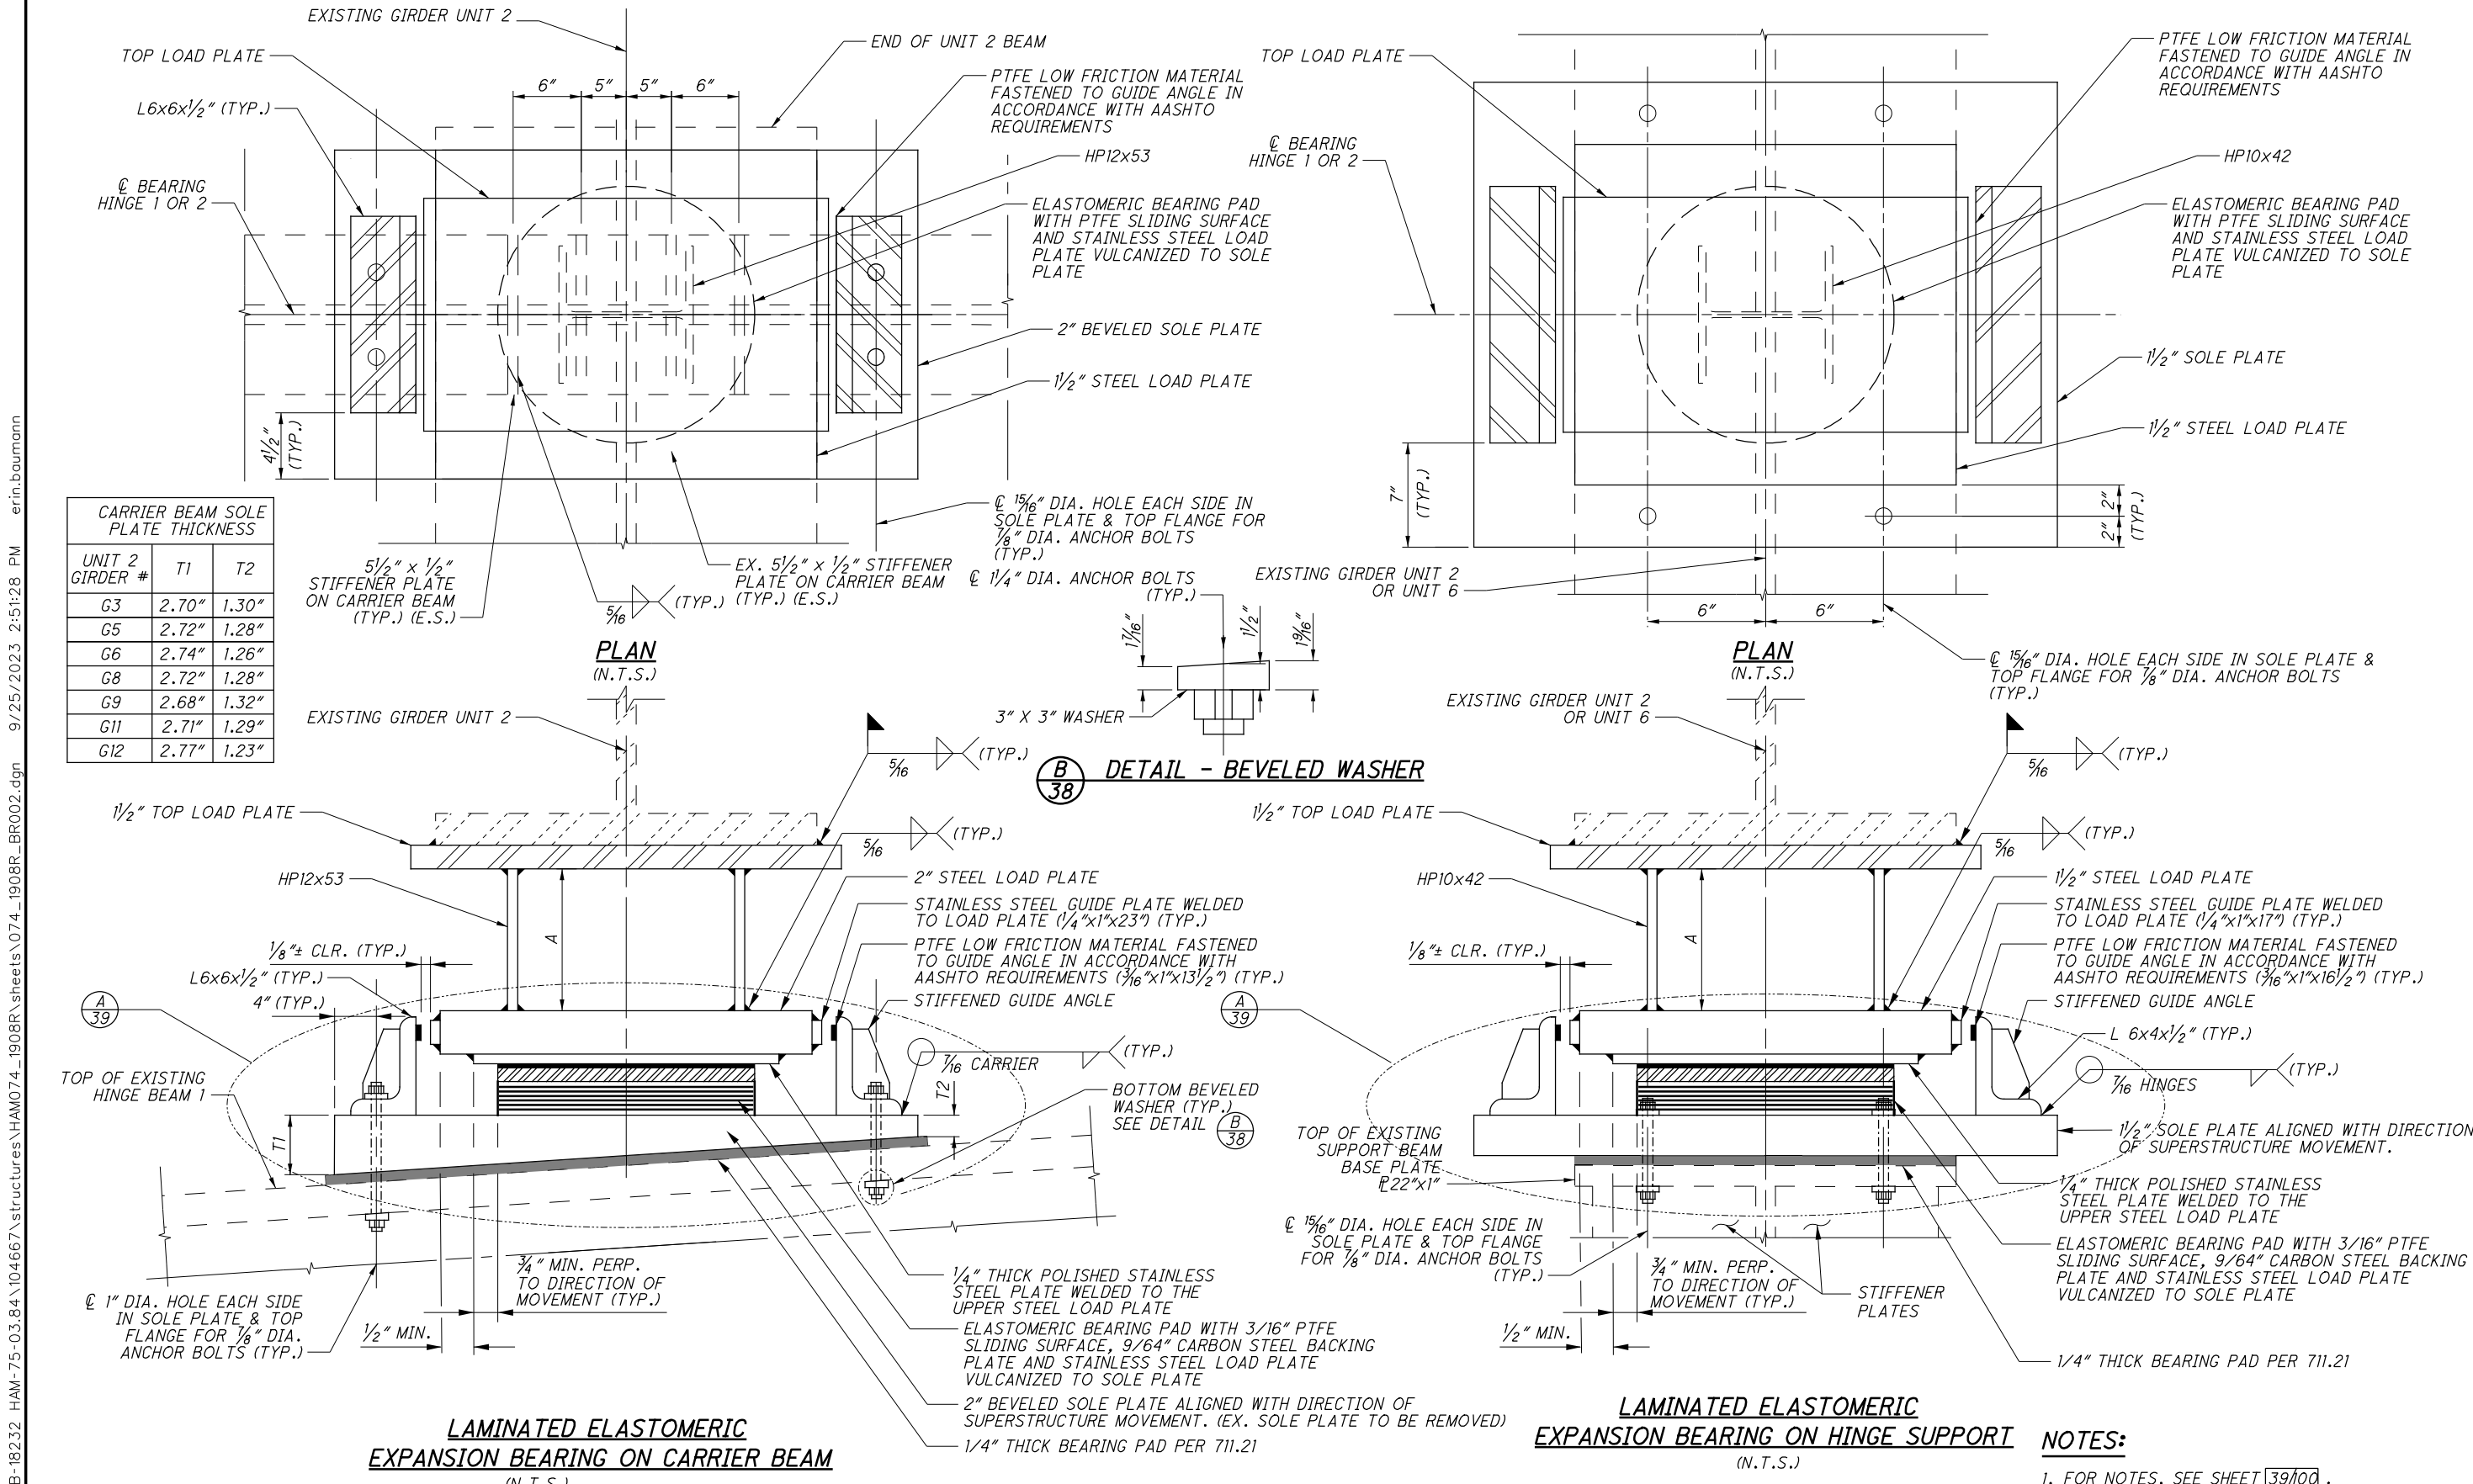


TABLE 1 - BEARING SCHEDULE


# = LIVE LOAD WITHOUT IMPACT

	BEARING TYPE	NO. OF BEARINGS	ELASTOMERIC BEARING PAD SIZE	NO. OF STEEL LAMINATES 0.0747" THICK (14 GAGE)	INTERNAL LAYERS (#, THICK.)	SOLE PLATE SIZE (LxWxT)	STEEL LOAD PLATE SIZE (LxWxT)	TOP LOAD PLATE (LxWxT)	HP HEIGHT A	SERVICE LIMIT STATE			ROTATION (RADIAN) MAX. ONE WAY MVT. (IN)		
										DEAD LOAD (K)	LIVE LOAD (K)#	TOTAL LOAD (K)	TOTAL LOAD (K)	STR LIMIT STATE	
														TOTAL	LONG.
CARRIER BEAM - UNIT 2	GUIDED EXP.	7	17" φx3.70"	6	6 @ 0.500"	23"x35"x1 1/2"	27"x20"x2"	16"x21"x1 1/2"	9 3/8"	80	99	179	330	0.004	2.70
HINGE SUPPORT - UNIT 2	GUIDED EXP.	4	17" φx3.70"	6	6 @ 0.500"	31"x30 1/4"x1 1/2"	27"x20"x1 1/2"	16"x21"x1 1/2"	9 3/8"	80	99	179	330	0.004	2.70
HINGE SUPPORT - UNIT 6	GUIDED EXP.	6	17" φx3.70"	6	6 @ 0.500"	31"x30 1/4"x1 1/2"	25"x20"x1 1/2"	16"x21"x1 1/2"	4 7/8"	37	49	86	160	0.003	1.90


- NOTES:**
- FOR NOTES, SEE SHEET 39/100.
  - FOR GUIDE ANGLE DETAILS, SEE SHEET 39/100.
  - FOR BEARING BUILD-UP DETAIL, SEE SHEET 39/100.

P:\Projects\2018\20H03DB-18232 HAM-75-03.84\104667\structures\HAM074\_1908R\sheets\074\_1908R\_BR002.dgn 9/25/2023 2:51:28 PM erin.baumann


P:\Projects\2018\20H03DB-18232 HAM-75-03.84\104667\structures\HAM074\_1908R\sheets\074\_1908R\_BR003.dgn 9/21/2023 5:16:07 PM erin.baumann

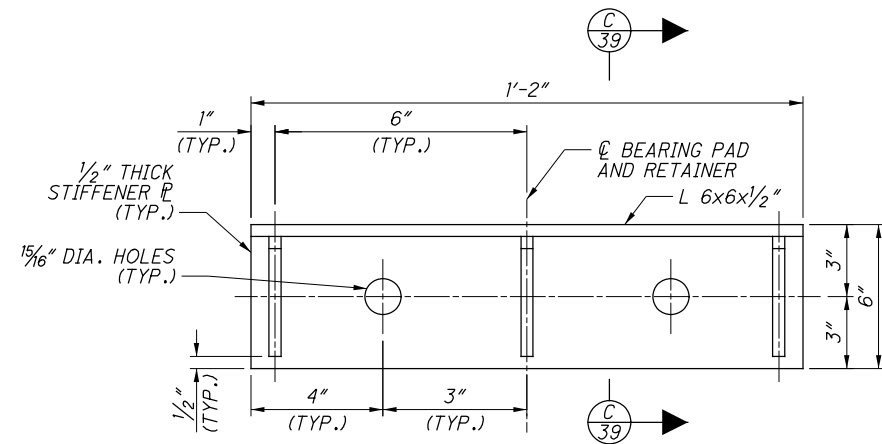


**BEARING GUIDE ANGLE PLAN - CARRIER BEAM**

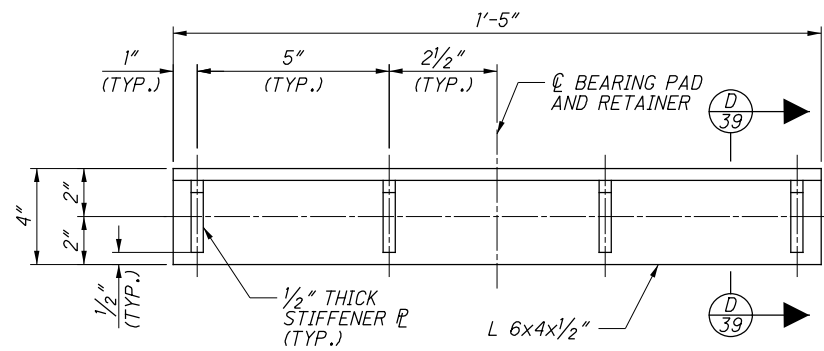


**BEARING GUIDE ANGLE PLAN - HINGE SUPPORT**

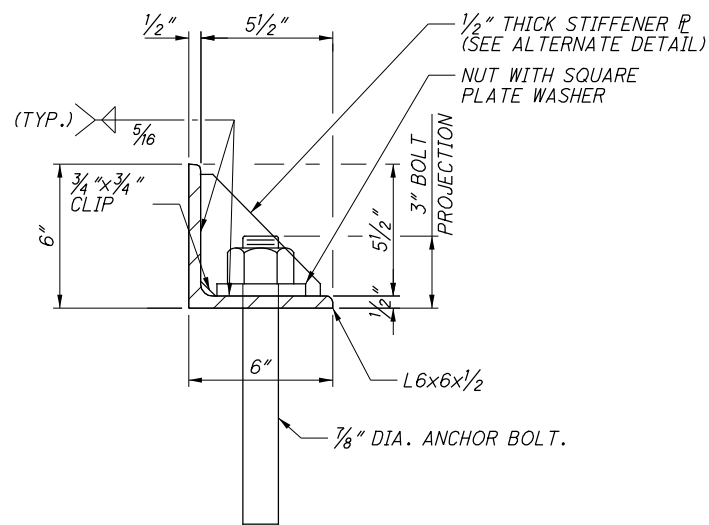


**C SECTION - BEARING GUIDE ANGLE - CARRIER BEAMS**

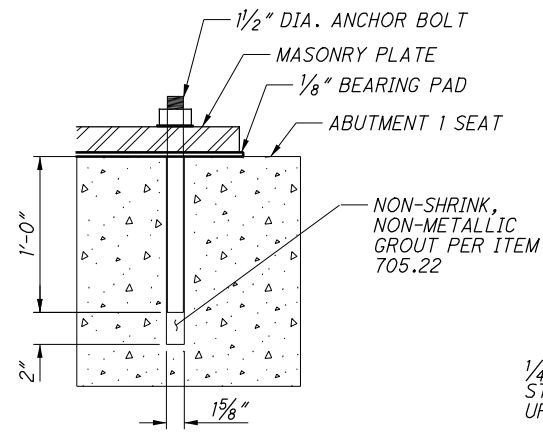


**ANCHOR BOLT DETAIL**

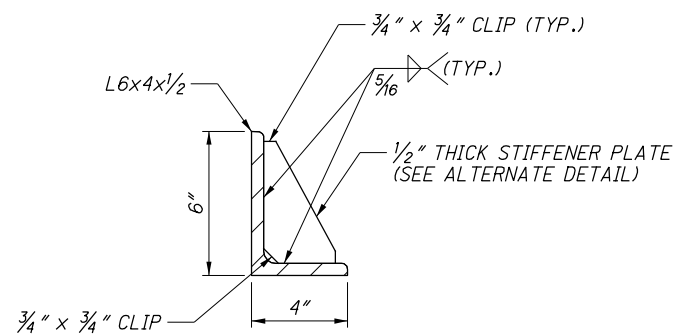


**D SECTION - BEARING GUIDE ANGLE - HINGE SUPPORT**

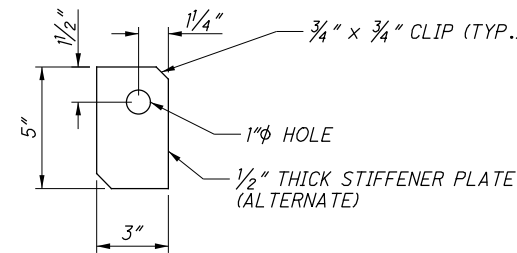

**ALTERNATE STIFFENER PLATE - HINGE SUPPORT**  
(TO FACILITATE SHIPPING & PLACEMENT)

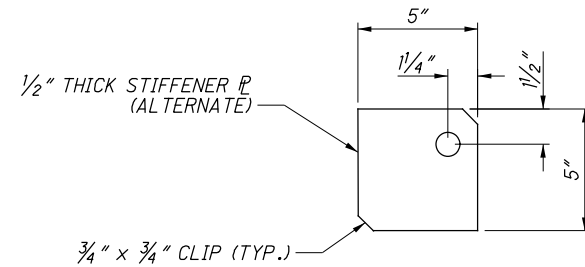

**ALTERNATE STIFFENER PLATE - CARRIER BEAMS**  
(TO FACILITATE SHIPPING & PLACEMENT)

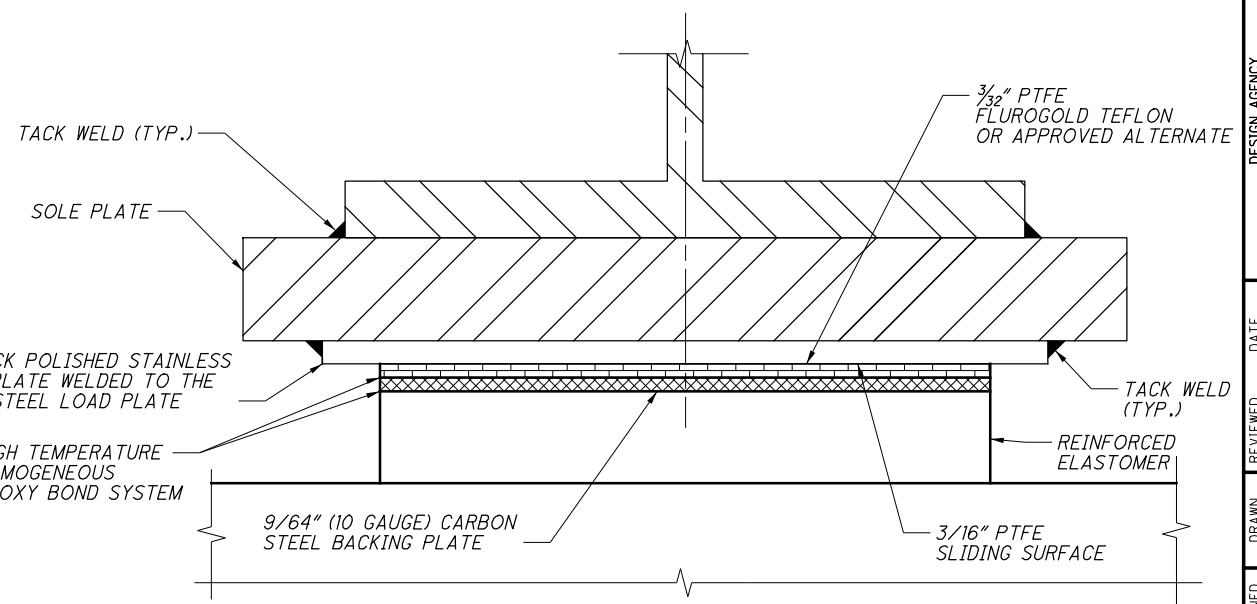


**A BEARING DETAIL**


**NOTES:**

- ELASTOMERIC BEARINGS:**  
THE ELASTOMER SHALL HAVE A HARDNESS OF 50 DUROMETER. ALL BEARINGS WERE DESIGNED IN ACCORDANCE WITH SECTION 14.7.6 (METHOD A) OF THE AASHTO LRFD BRIDGE DESIGN SPECIFICATIONS. THE LONG TERM COMPRESSION PROOF LOAD TEST (AASHTO STANDARD SPECIFICATIONS FOR HIGHWAY BRIDGES, DIVISION II, SECTION 18.7.2.6) IS NOT REQUIRED.
- LOAD PLATES:**  
THE TOP STEEL LOAD PLATE, STEEL LOAD PLATE AND SOLE PLATES SHALL CONFORM TO THE REQUIREMENTS OF ASTM A709 GRADE 50. THE SOLE PLATE SHALL BE BONDED TO THE ELASTOMER BY VULCANIZATION DURING THE MOLDING PROCESS IN ACCORDANCE WITH ITEM 516. CONTROL WELDING SO THAT THE PLATE TEMPERATURE DOES NOT EXCEED 300°F AS DETERMINED BY THE USE OF PYROMETRIC SENSORS OR OTHER TEMPERATURE MONITORING DEVICES.
- COMPONENTS OF THE BEARING DEVICES SHALL MEET THE REQUIREMENTS OF ODOT SUPPLEMENTAL SPECIFICATION 869.**
- MARKINGS:**  
ALL BEARINGS SHALL BE MARKED PRIOR TO SHIPPING. THE MARKS SHALL INCLUDE THE BEARING LOCATION ON THE BRIDGE, AND A DIRECTION ARROW THAT POINTS UP-STATION. ALL MARKS SHALL BE PERMANENT AND BE VISIBLE AFTER THE BEARING IS INSTALLED.
- CORROSION PROTECTION:**  
ALL STEEL SURFACES AND COMPONENTS, EXCEPT THE TOP OF THE STEEL LOAD PLATE, STAINLESS STEEL AND PTFE SURFACES SHALL BE METALLIZED IN ACCORDANCE WITH ODOT SUPPLEMENTAL SPECIFICATION 869. ONLY APPLICABLE FOR BEARINGS AT HINGE 1 & 2.
- PAINTING:**  
THE LOAD PLATES, SOLE PLATES AND HP SECTIONS SHALL BE PAINTED IN ACCORDANCE WITH ITEM 514 AND C&MS 708. THE FINISH COAT SHALL BE FEDERAL STANDARD COLOR 595B-16515 (GRAY). ONLY APPLICABLE TO BEARINGS AT ABUTMENTS 1 & 4 AND PIERS 1, 3, 6 AND 19.
- DESIGN LOAD:**  
TOTAL DESIGN LOAD FOR BEARINGS EQUALS THE SUM OF THE DEAD LOADS AND LIVE LOADS TABULATED IN THE BEARING TABLE. LOADS SHOWN ARE WITHOUT IMPACT FACTORS INCLUDED.
- BEARING ORIENTATION:**  
FOR BEARING ORIENTATION AT SUBSTRUCTURE UNITS, SEE INDIVIDUAL PLAN SHEETS.
- BRIDGE SEAT ELEVATIONS:**  
BRIDGE SEAT ELEVATIONS HAVE BEEN ADJUSTED UPWARD 0.139 INCHES AT PIER 2, UNIT 2, 0.125 INCHES AT PIER 3, 0.123 INCHES AT PIER 4 AND 0.105 INCHES AT THE FORWARD ABUTMENT TO COMPENSATE FOR THE VERTICAL DEFORMATION OF THE BEARINGS.
- BEARING SEAT ADJUSTMENT FOR SPECIAL BEARINGS:**  
THE PIER AND ABUTMENT BEAM SEAT ELEVATIONS ARE BASED ON BEARING HEIGHTS PROVIDED IN THE PLANS. IF THE CONTRACTOR'S SELECTED BEARING MANUFACTURER HAS A DESIGN THAT DOES NOT CONFORM TO THE HEIGHTS PROVIDED IN THESE PLANS, ADJUST THE BEARING SEAT ELEVATIONS AT NO ADDITIONAL COST TO THE STATE. ADJUST THE LOCATION OF REINFORCING STEEL HORIZONTALLY AS NECESSARY TO AVOID INTERFERENCE WITH THE BEARING ANCHOR BOLTS. MAINTAIN THE MINIMUM CONCRETE COVER AND MINIMUM SPACING REQUIRED BY THE PROJECT PLANS. IF THE REINFORCING STEEL CANNOT BE MOVED TO PROVIDE THE REQUIRED POSITION FOR THE ANCHOR BOLTS, THE CONTRACTOR'S BEARING MANUFACTURER SHALL REDESIGN THE BEARINGS TO ACCOMMODATE AN ACCEPTABLE ANCHOR BOLT CONFIGURATION.


\\primeclm01.primeclm.com\DFSRoot\Projects\2018\20H030B-18232-HAM-75-03.84\104667\_structures\HAM074\_1908R\_sheets\074\_1908R\_BR004.dgn 6/20/2019 9:13:11 AM oseed

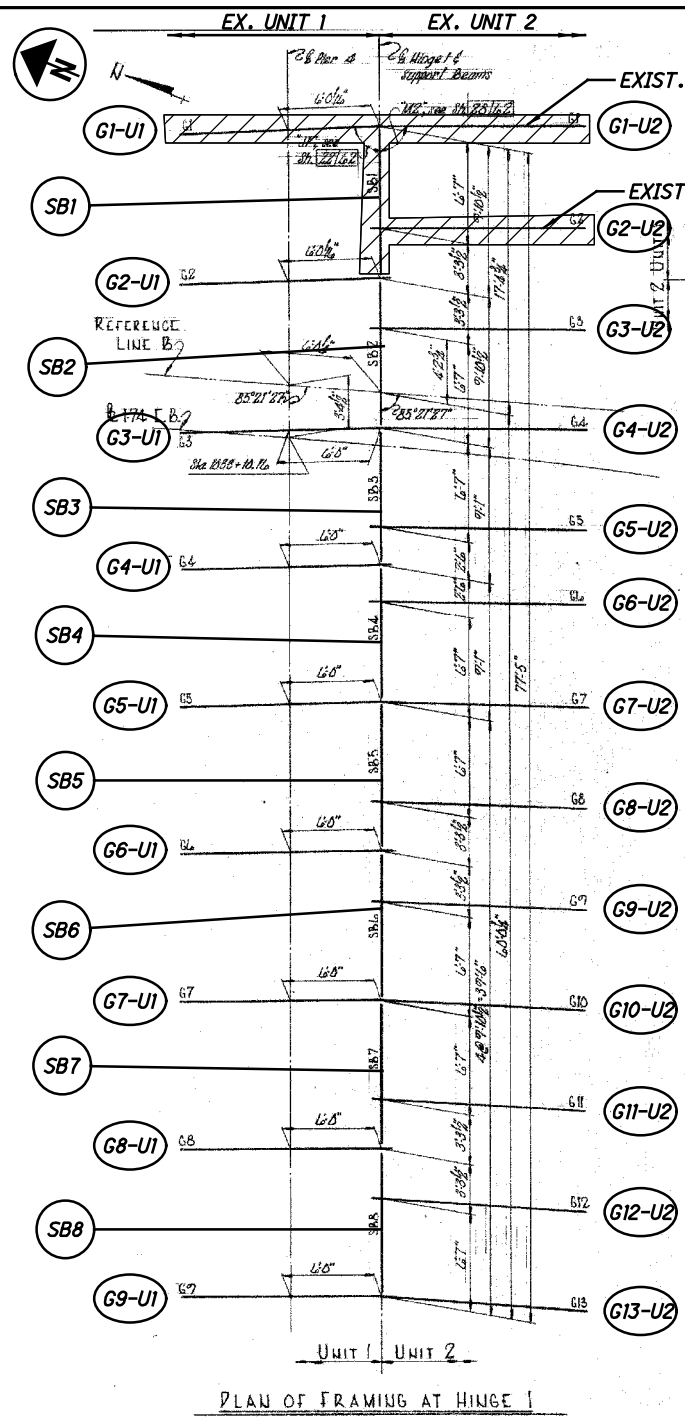


PLAN OF FRAMING AT HINGE 1

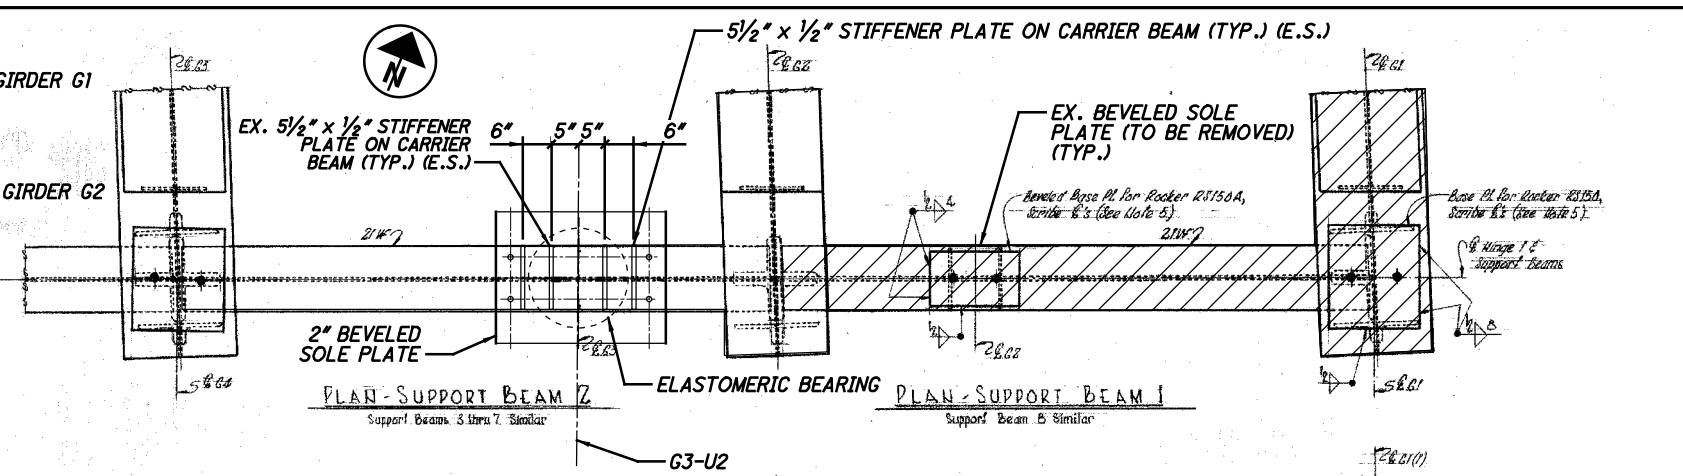

EXISTING HINGE NO. 1 - BEARING DETAILS

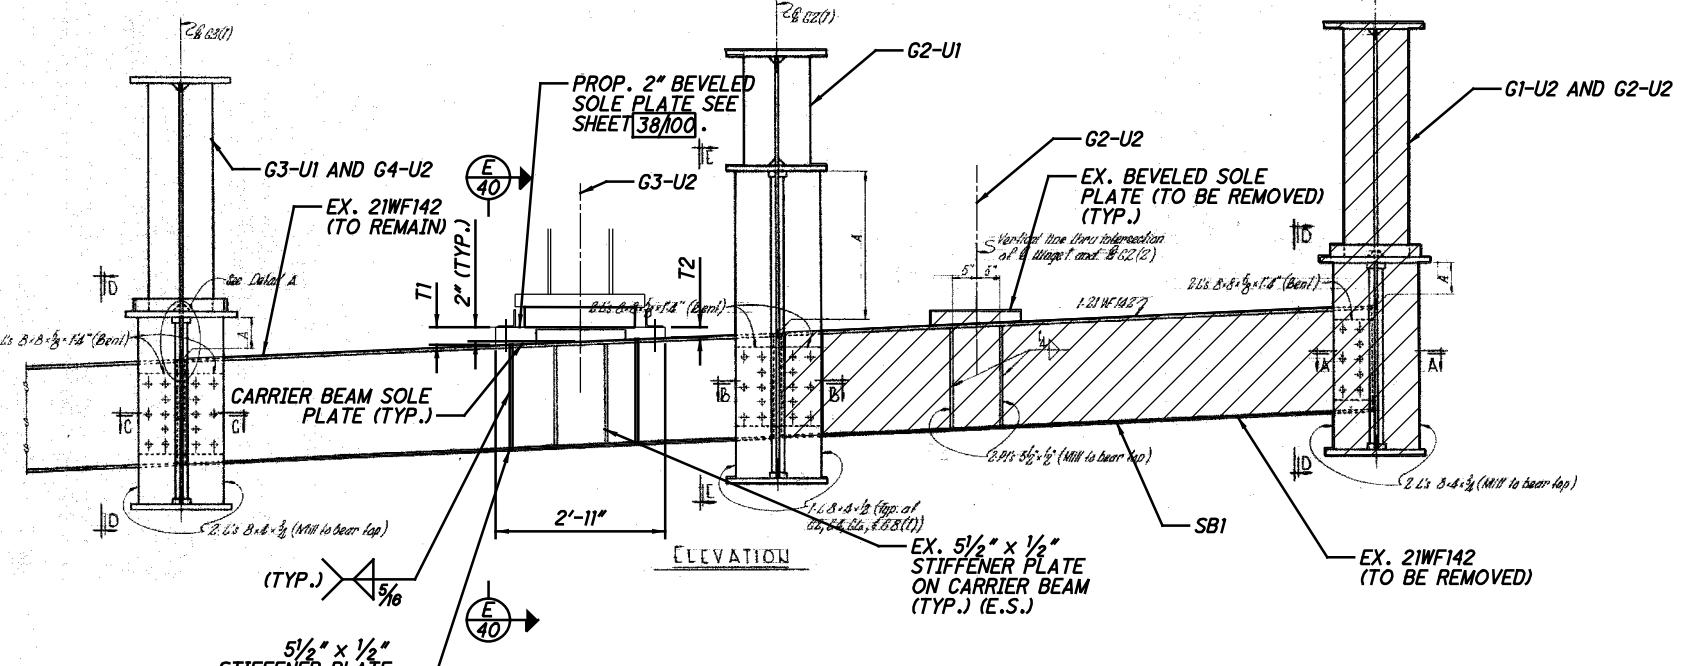

SECTION - CARRIER BEAM DETAIL

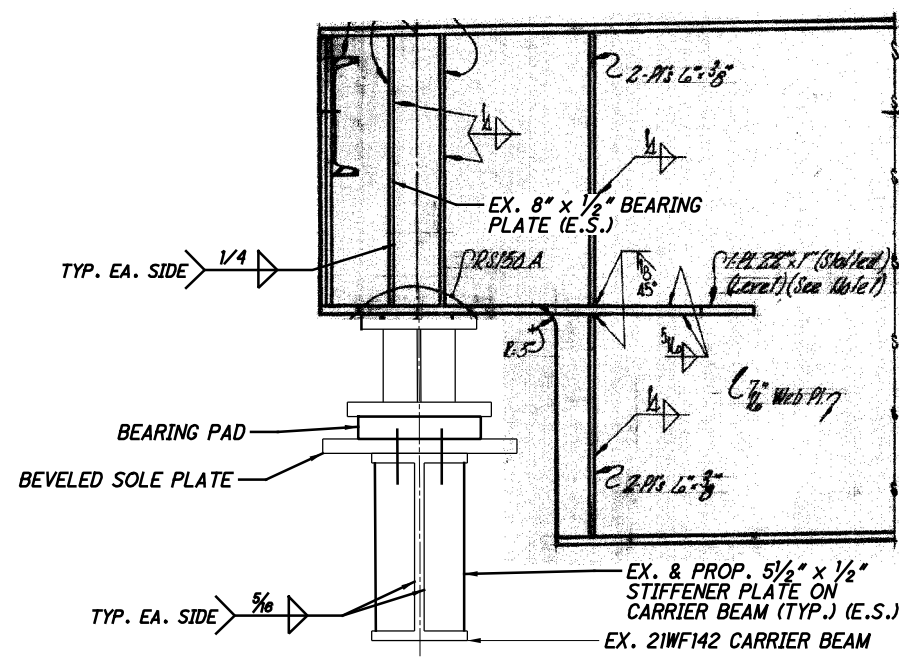

LEGEND:

- INDICATES LIMITS OF REMOVAL (S1-P2-S3)
- GX-UX - GIRDER X UNIT X
- SBX - SUPPORT BEAM X

NOTES:

1. FOR ADDITIONAL DETAILS AND BEARING DIMENSION TABLES, SEE SHEETS 38/00 AND 39/00.

DESIGN AGENCY: **PRIMECLM**  
 540 WHITE POND DR. SUITE E  
 AKRON, OH 44320

DESIGNED: **CRG** / CHECKED: **KDC** / DRAWN: **CRG** / REVISED: **CRG** / DATE: **3/27/2019** / REVIEWED: **TES** / STRUCTURE FILE NUMBER: **3115739**


**EXIST. SUPPORT BEAM BEARING DETAILS AT HINGE 1**  
 BRIDGE NO. HAM-74-1908R  
 IR-74 OVER MILL CREEK, RR & SPRING GROVE AVENUE

HAM-75-3.84 / PID No. 104667


40/100

40/100




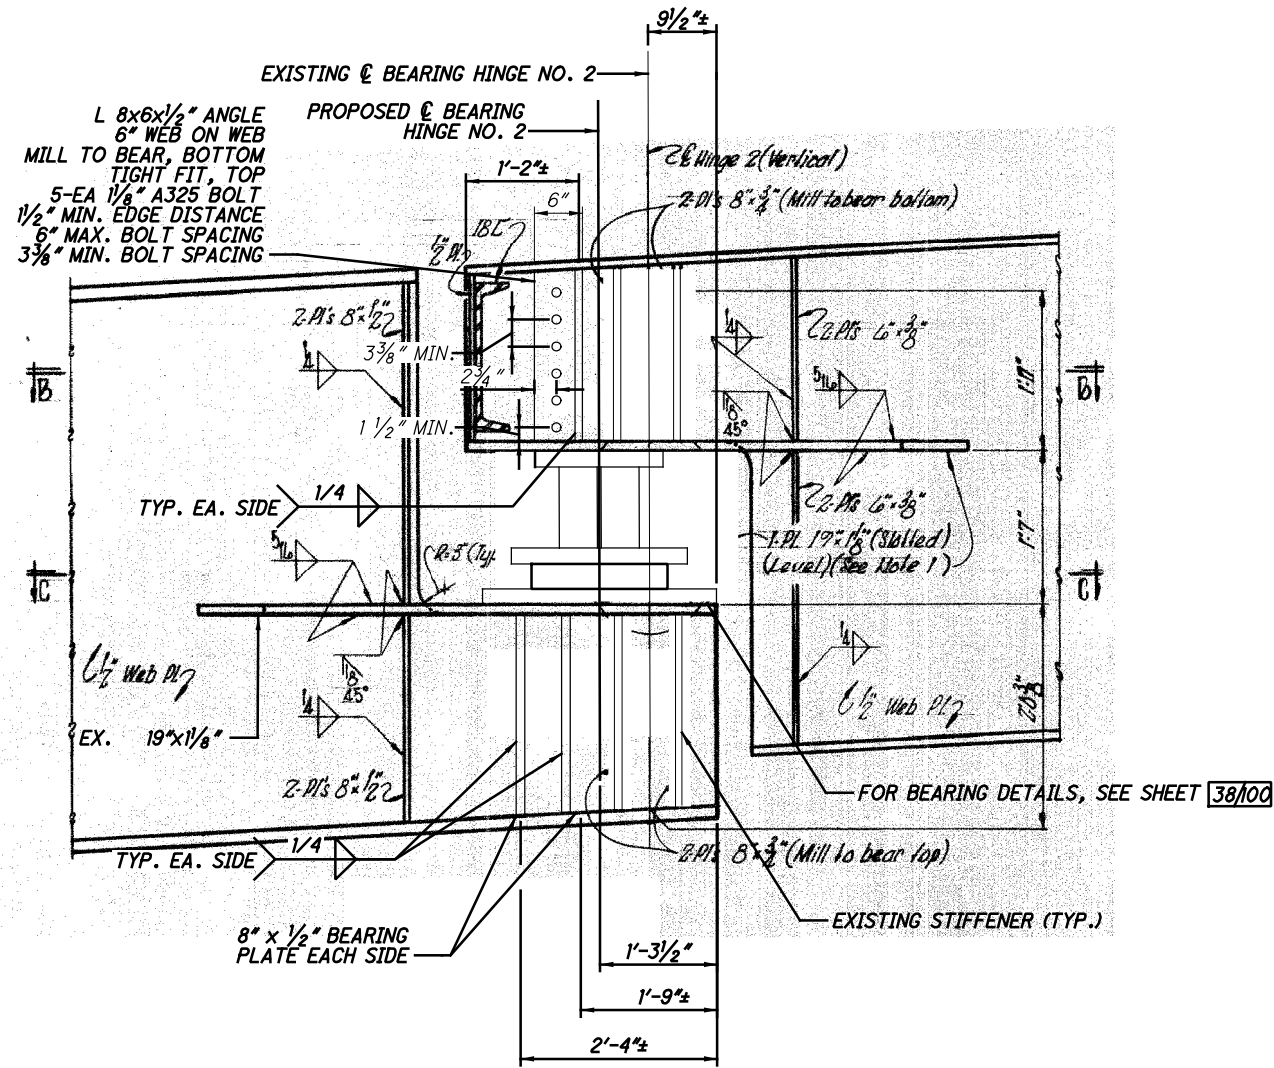


HINGE NO. 2 BEARING DETAIL

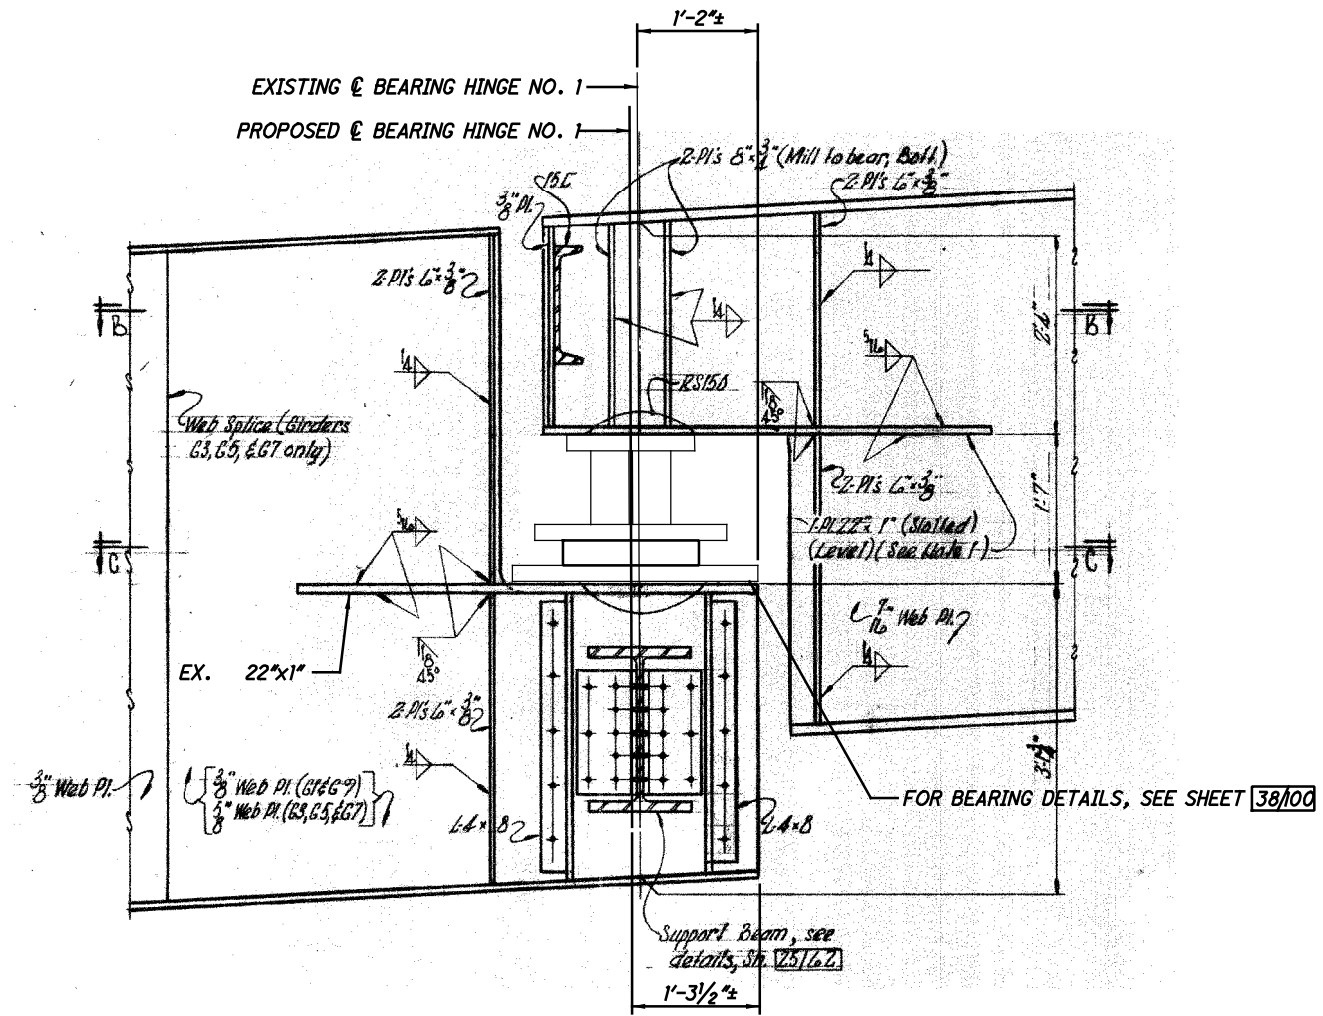

HINGE NO. 1 BEARING DETAIL

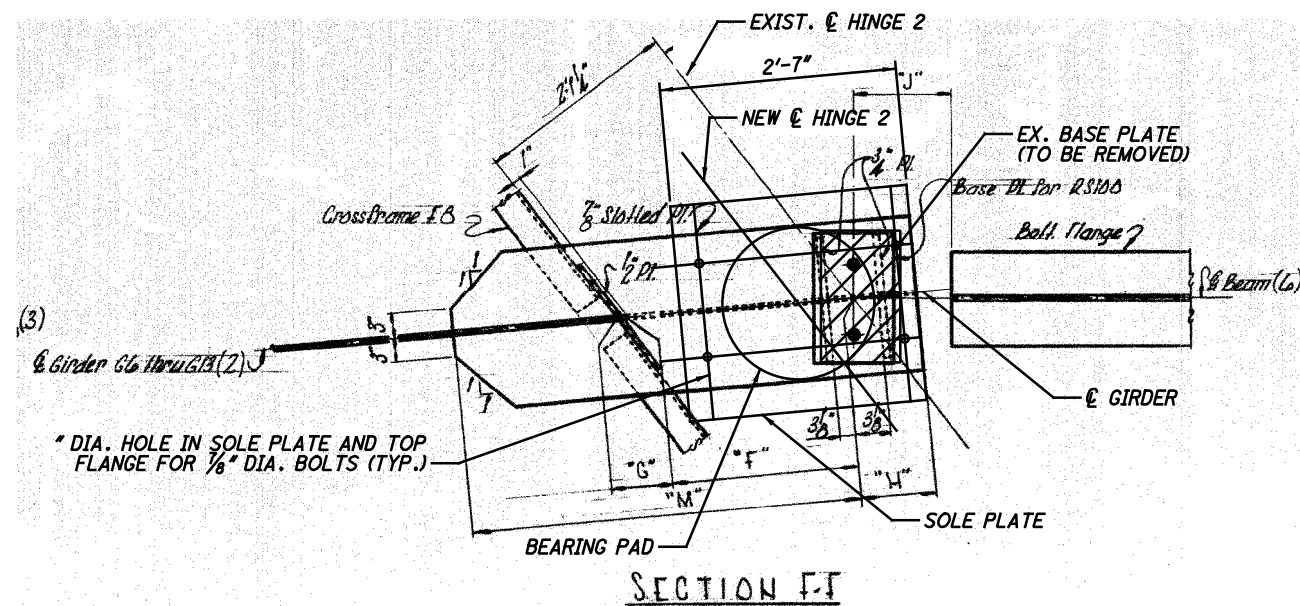


HINGE NO. 2 BEARING PLAN

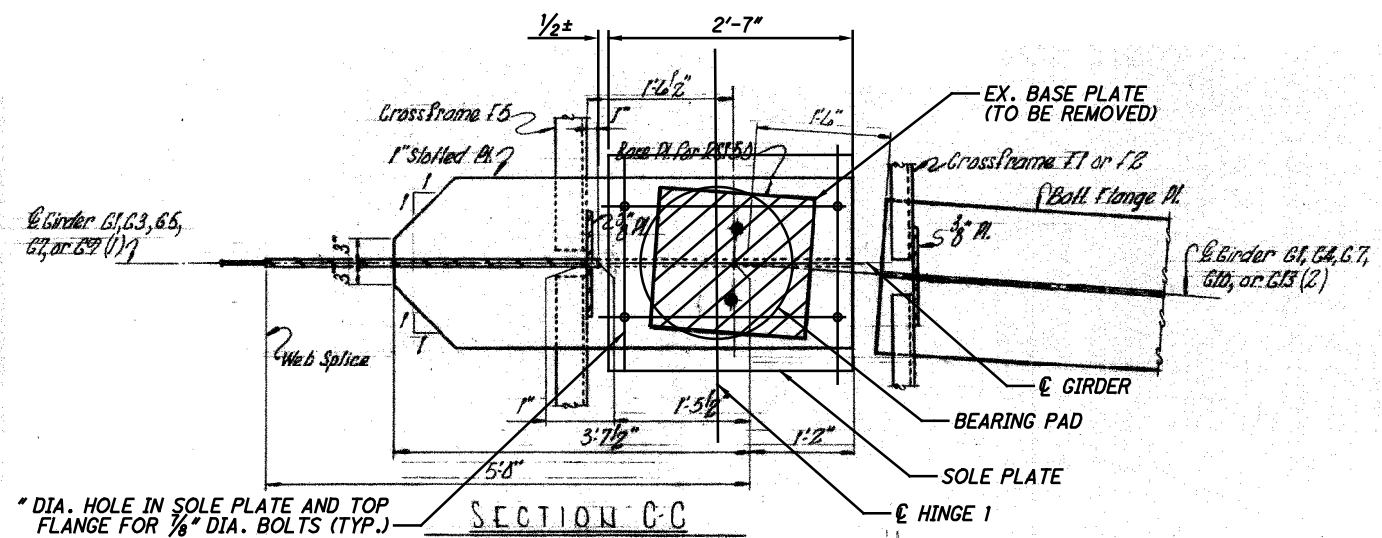

HINGE NO. 1 BEARING PLAN

NOTES:

1. FOR LOCATION OF HINGES, SEE SHEETS 3/100.
2. EXISTING " FILLET WELD. TRIM ANGLE TO CLEAR WEB TO FLANGE WELD (TYP. TOP AND BOTTOM).

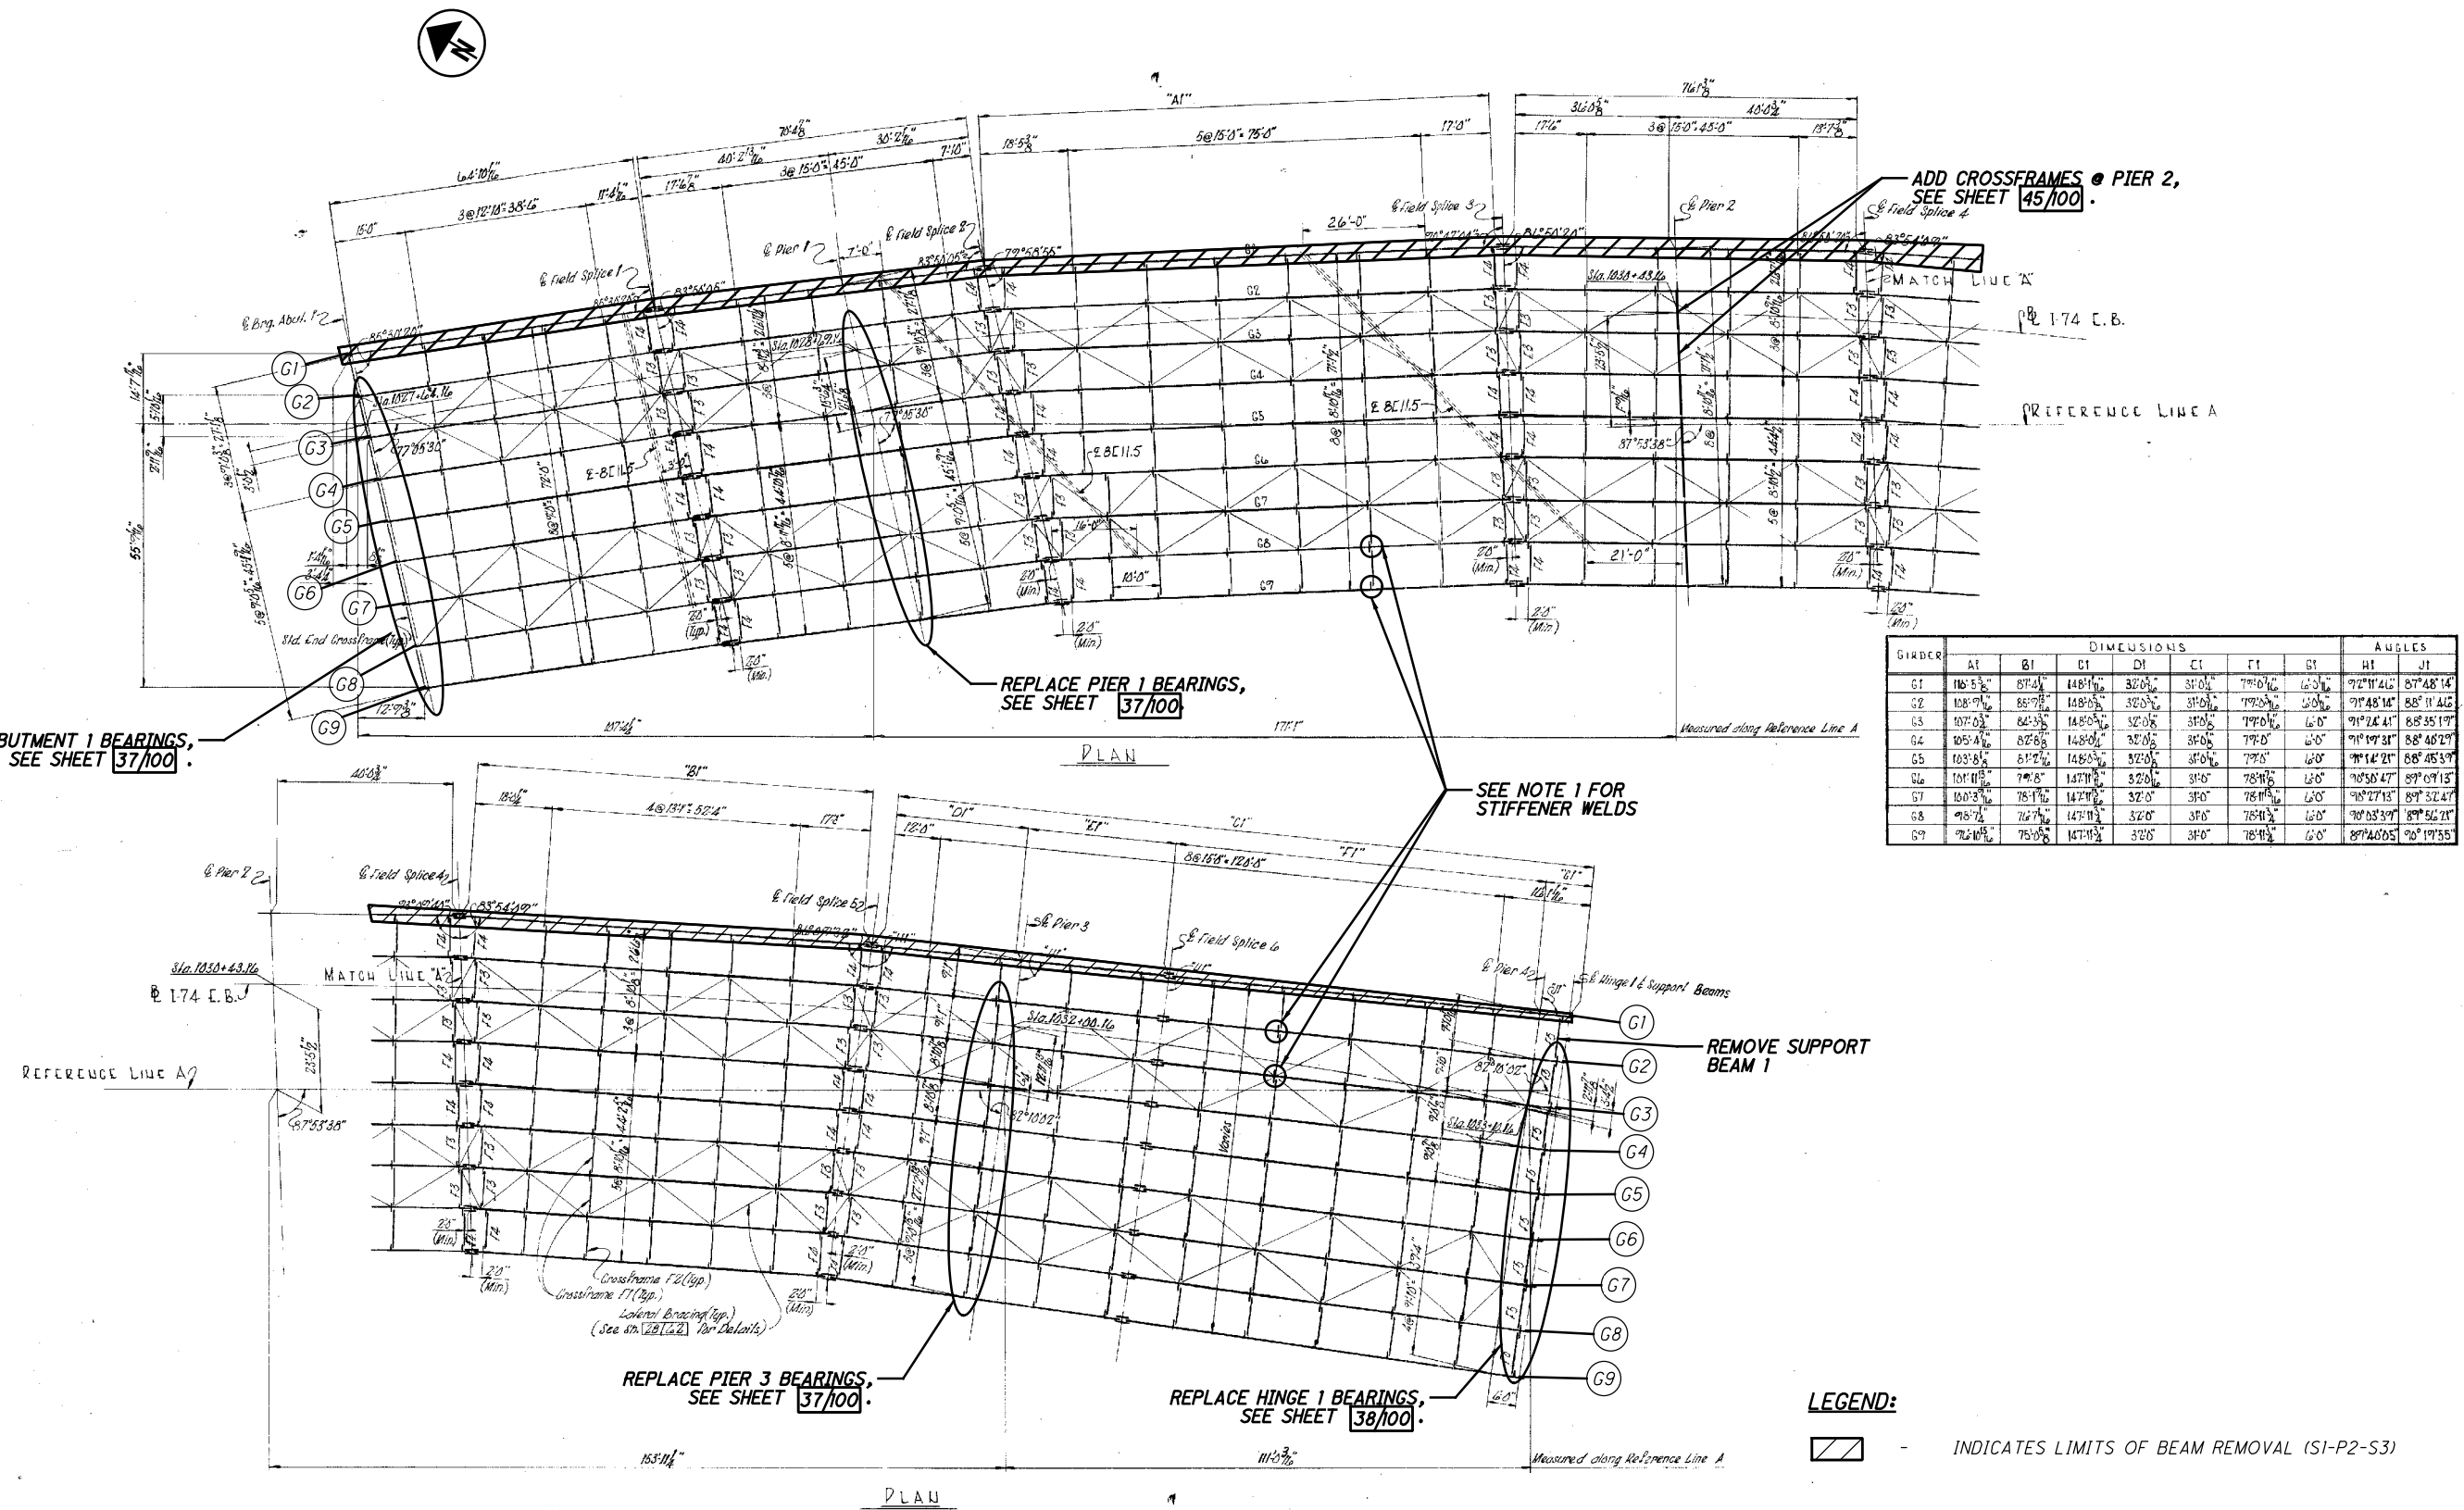

EXISTING FRAMING PLAN - UNIT NO. 1


LEGEND:

INDICATES LIMITS OF BEAM REMOVAL (S1-P2-S3)

NOTES:


- WELD INTERMEDIATE CROSSFRAME STIFFENERS TO TOP AND BOTTOM FLANGES AS SHOWN ON SHEET 45/100. BOTTOM STIFFENER LOCATIONS THAT HAVE LATERAL BRACING CONNECTIONS WITHIN 7" OF THE FLANGE MAY BE OMITTED FROM THE WELDING REQUIREMENT.
- FOR STEEL DETAILS, SEE SHEET 45/100.
- PAINT ALL EXISTING BEAMS TO REMAIN WITH SYSTEM OZEU IN ACCORDANCE WITH CMSS14. THE TOPCOAT SHALL BE FEDERAL COLOR 595B-3Y053 (DARK GREEN)

MICROFILMED  
JAN 4 1963

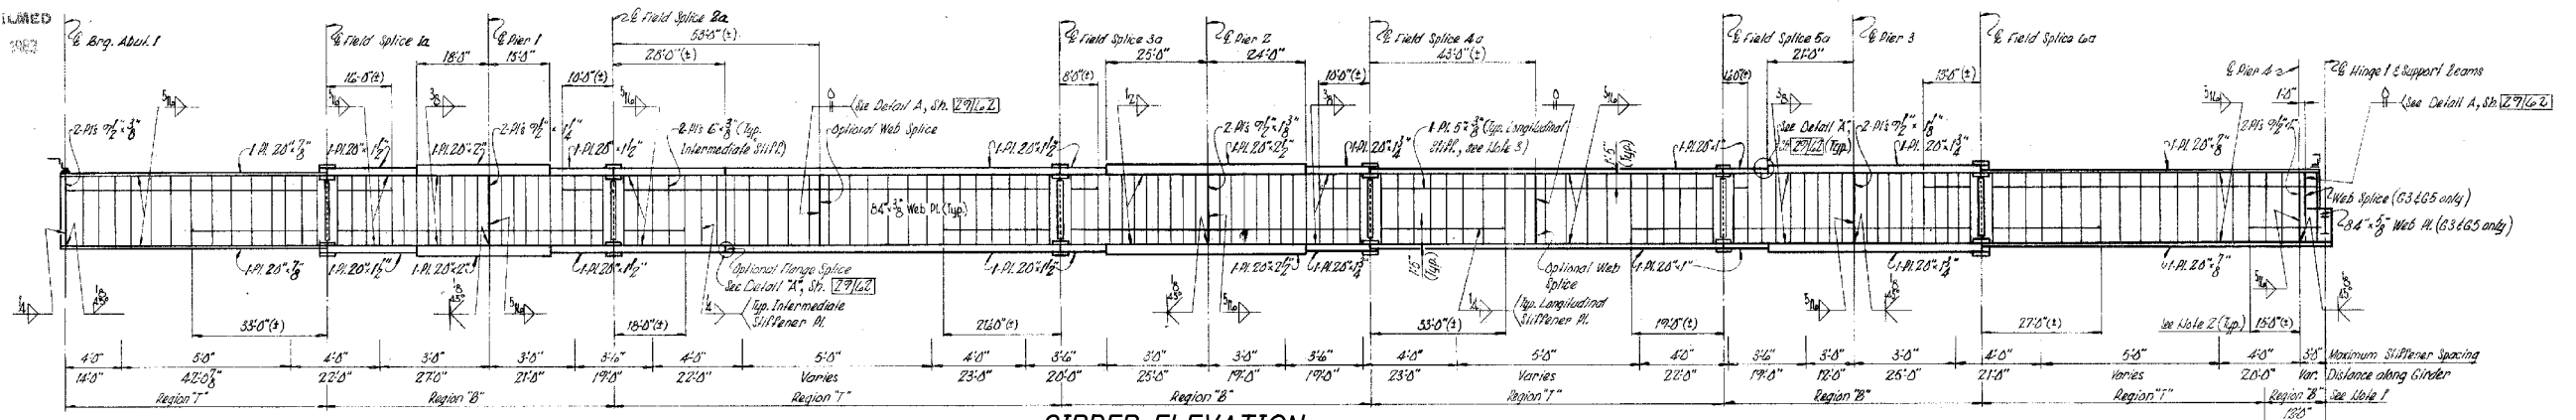


**GIRDER ELEVATION**

GIRDERS 2 THROUGH 5 (FOR DIMENSION REFERENCE ONLY)

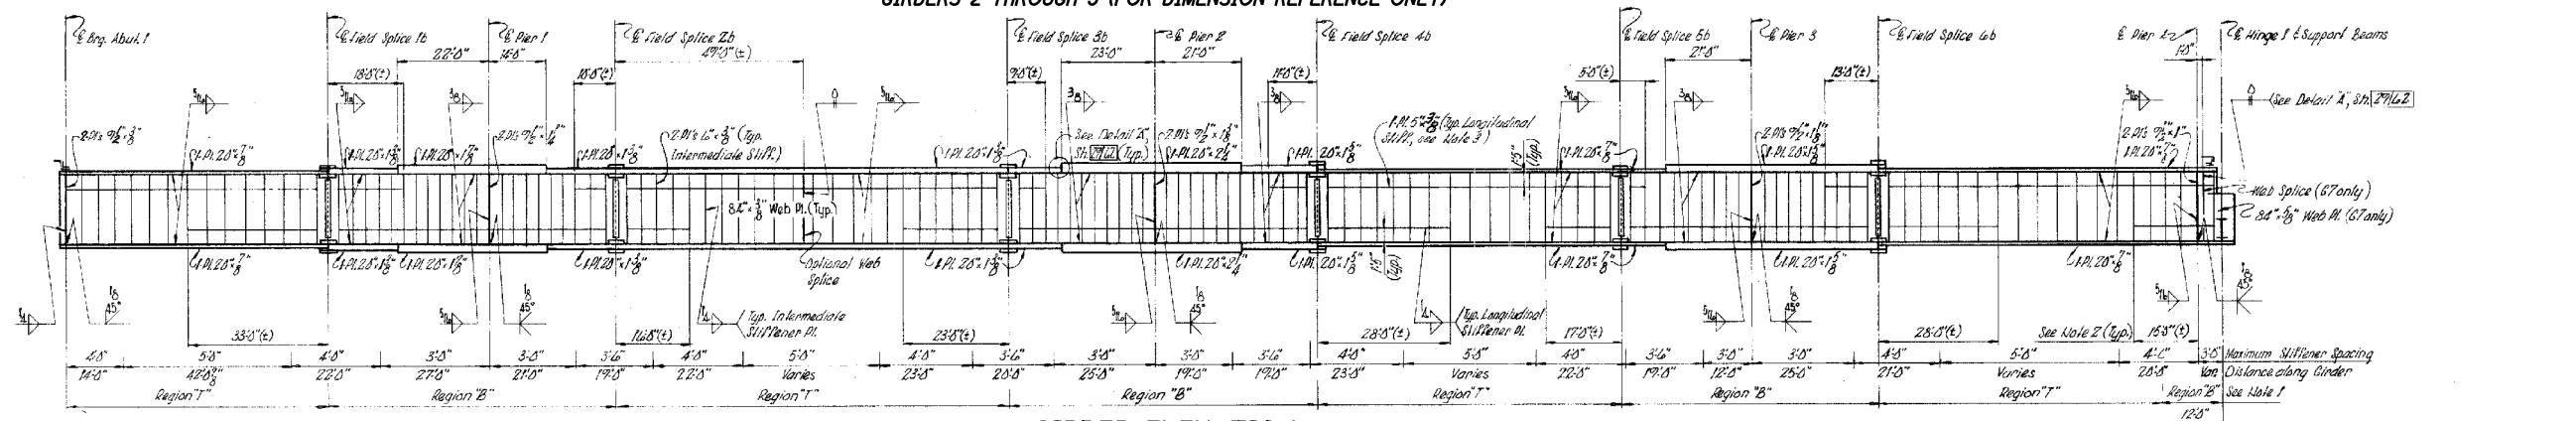


**GIRDER ELEVATION**

GIRDERS 6 THROUGH 9 (FOR DIMENSION REFERENCE ONLY)

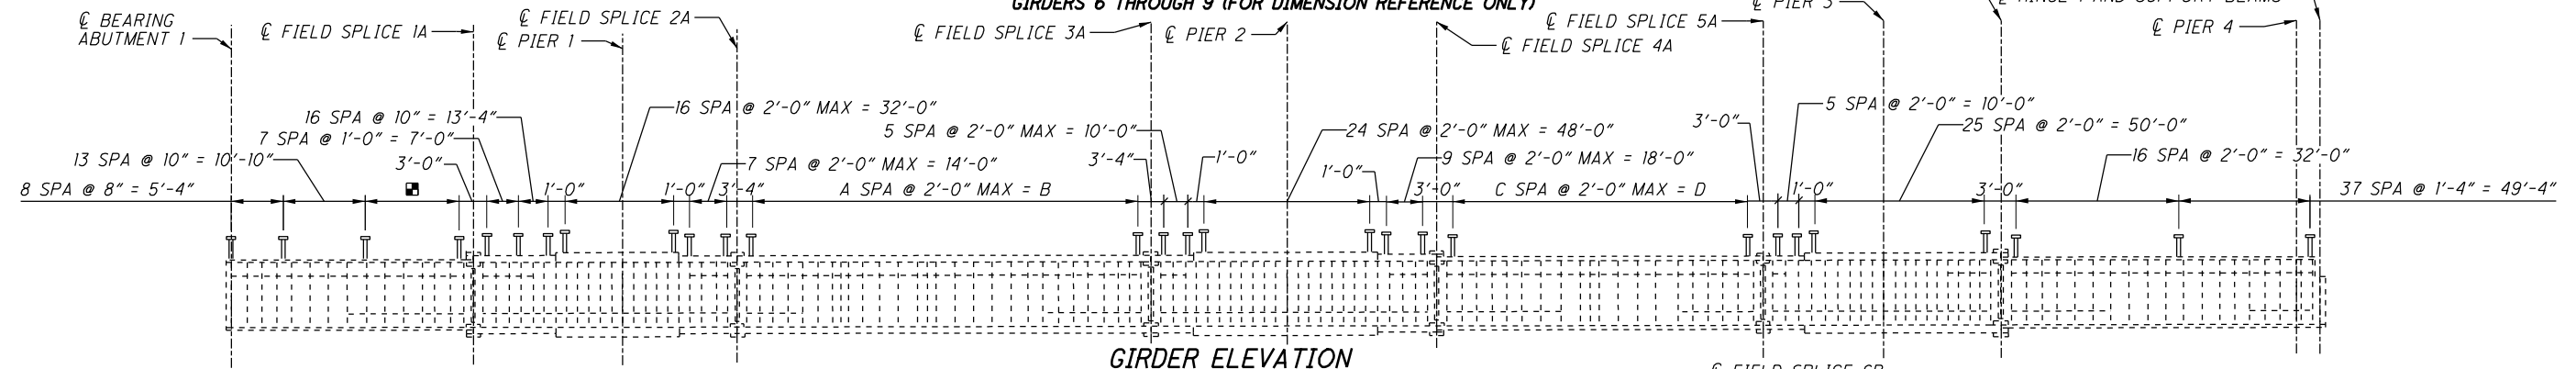

**GIRDER ELEVATION**

GIRDERS 2 THROUGH 5 - SHEAR STUD LAYOUT

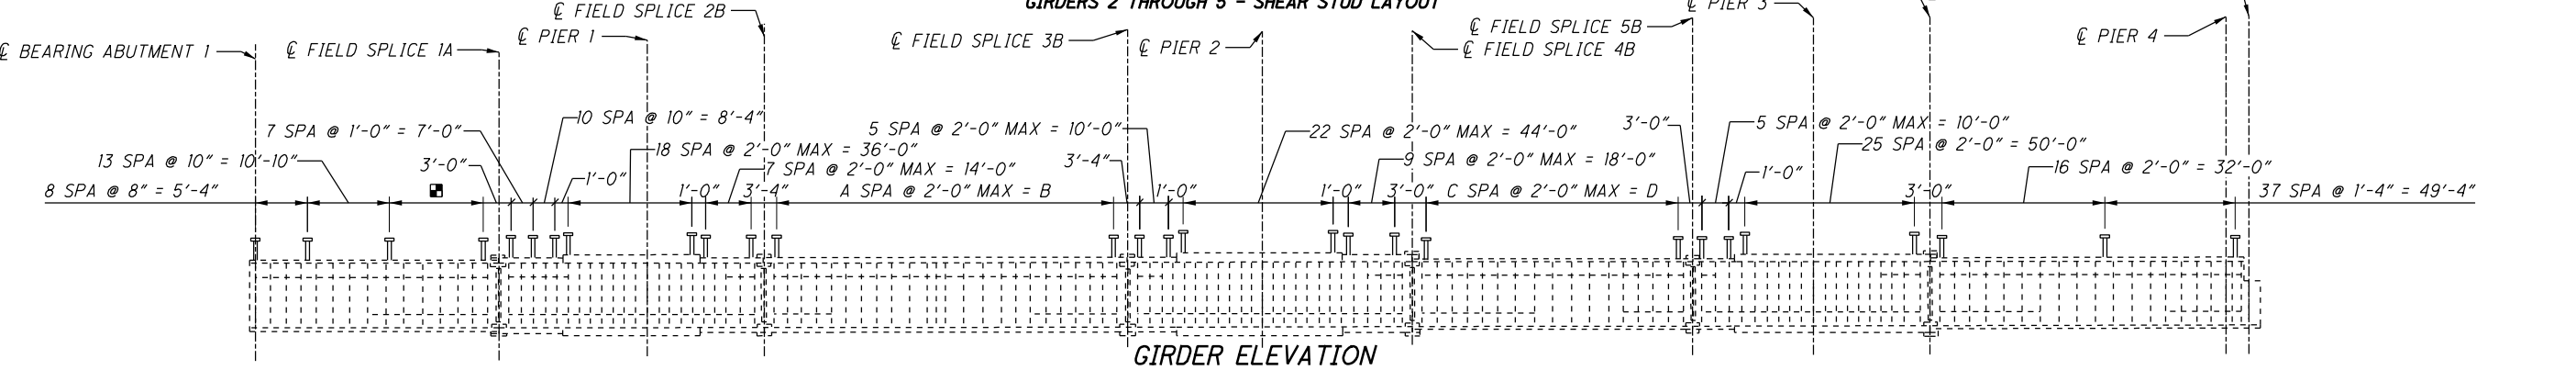

**GIRDER ELEVATION**

GIRDERS 6 THROUGH 9 - SHEAR STUD LAYOUT

SHEAR STUD SPACING				
	A	B	C	D
G2	53	106.00'	41	82.00'
G3	52	104.00'	41	82.00'
G4	51	102.00'	40	80.00'
G5	51	102.00'	40	80.00'

SHEAR STUD SPACING				
	A	B	C	D
G6	50	100.00'	39	78.00'
G7	49	98.00'	38	76.00'
G8	48	96.00'	37	74.00'
G9	47	94.00'	36	72.00'

**LEGEND:**


■ - 48 SPA. @ 1'-0" = 48'-0"

**NOTES:**

1. FOR NOTES, SEE SHEET 42/100.


P:\Projects\2018\20H03DB-18232 HAM-75-03.84\104667\structures\HAM074\_1908R\SD010.dgn 6/20/2019 9:13:18 AM asead

MICROFILMED  
JAN 4 1963

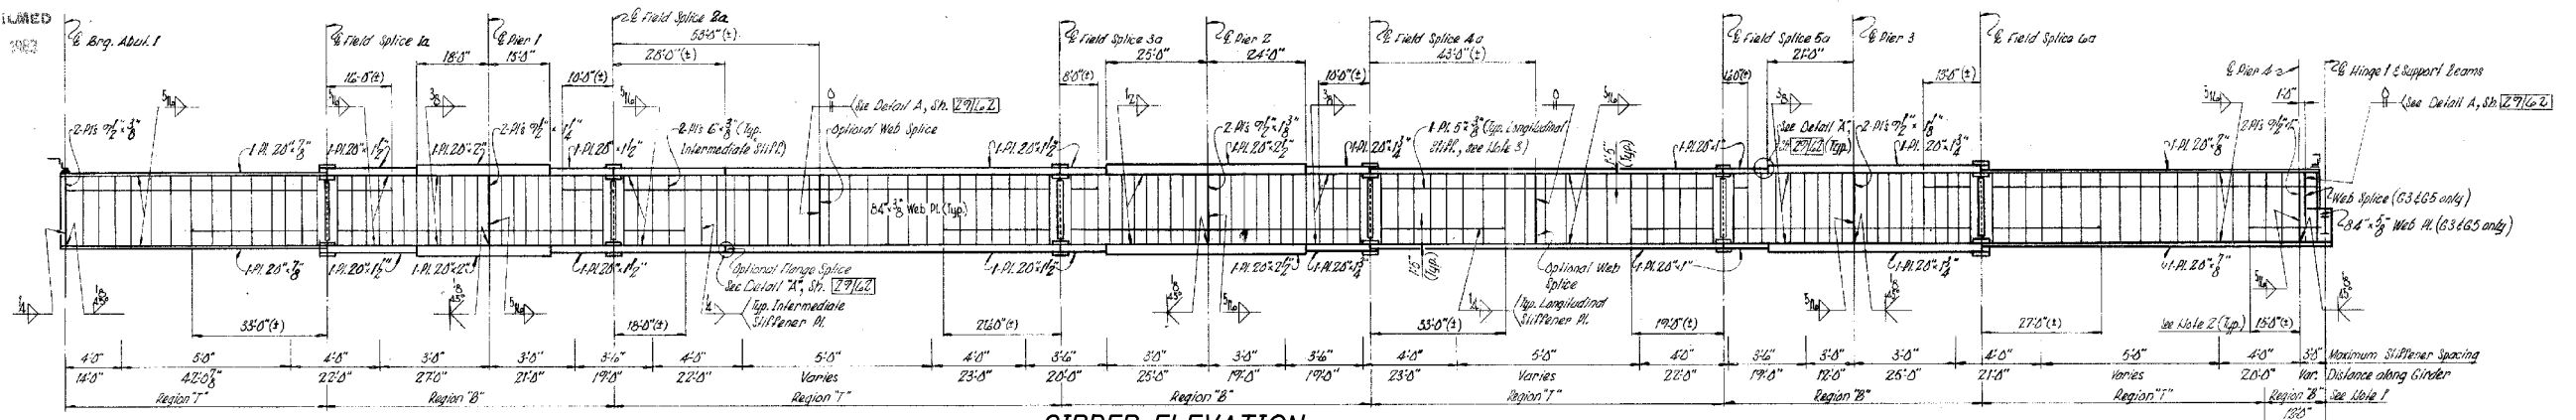


**GIRDER ELEVATION**

GIRDERS 2 THROUGH 5 (FOR DIMENSION REFERENCE ONLY)

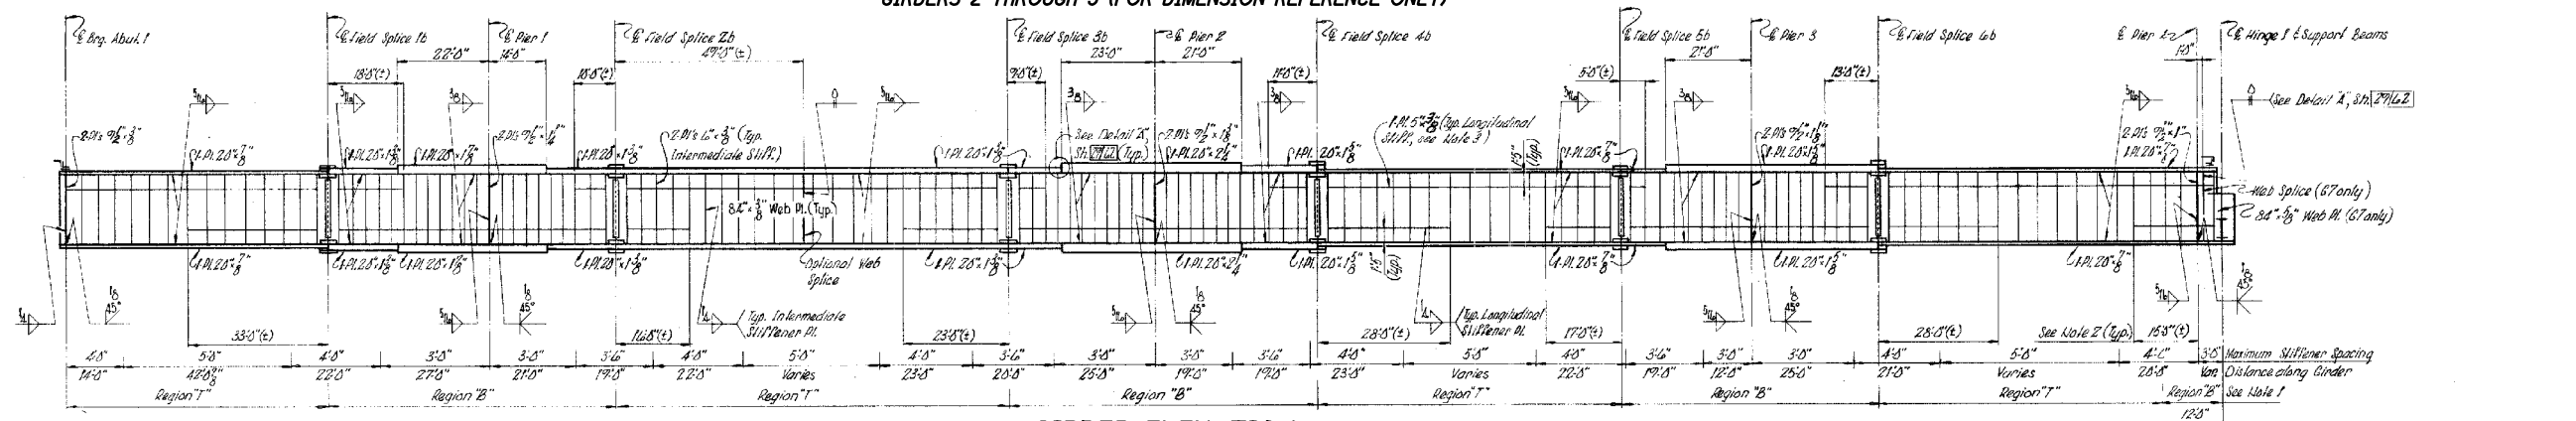


**GIRDER ELEVATION**

GIRDERS 6 THROUGH 9 (FOR DIMENSION REFERENCE ONLY)

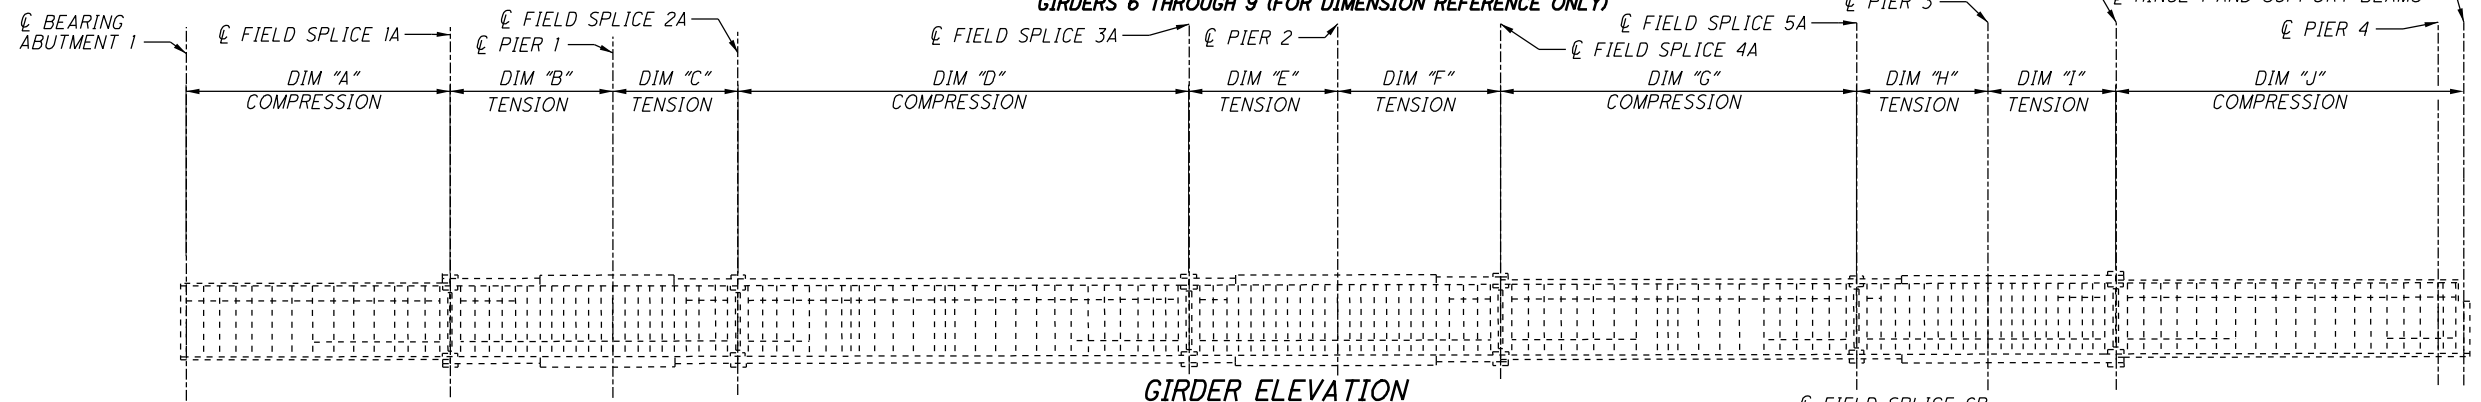

**GIRDER ELEVATION**

GIRDERS 2 THROUGH 5 - TENSION AND COMPRESSION ZONE LAYOUT

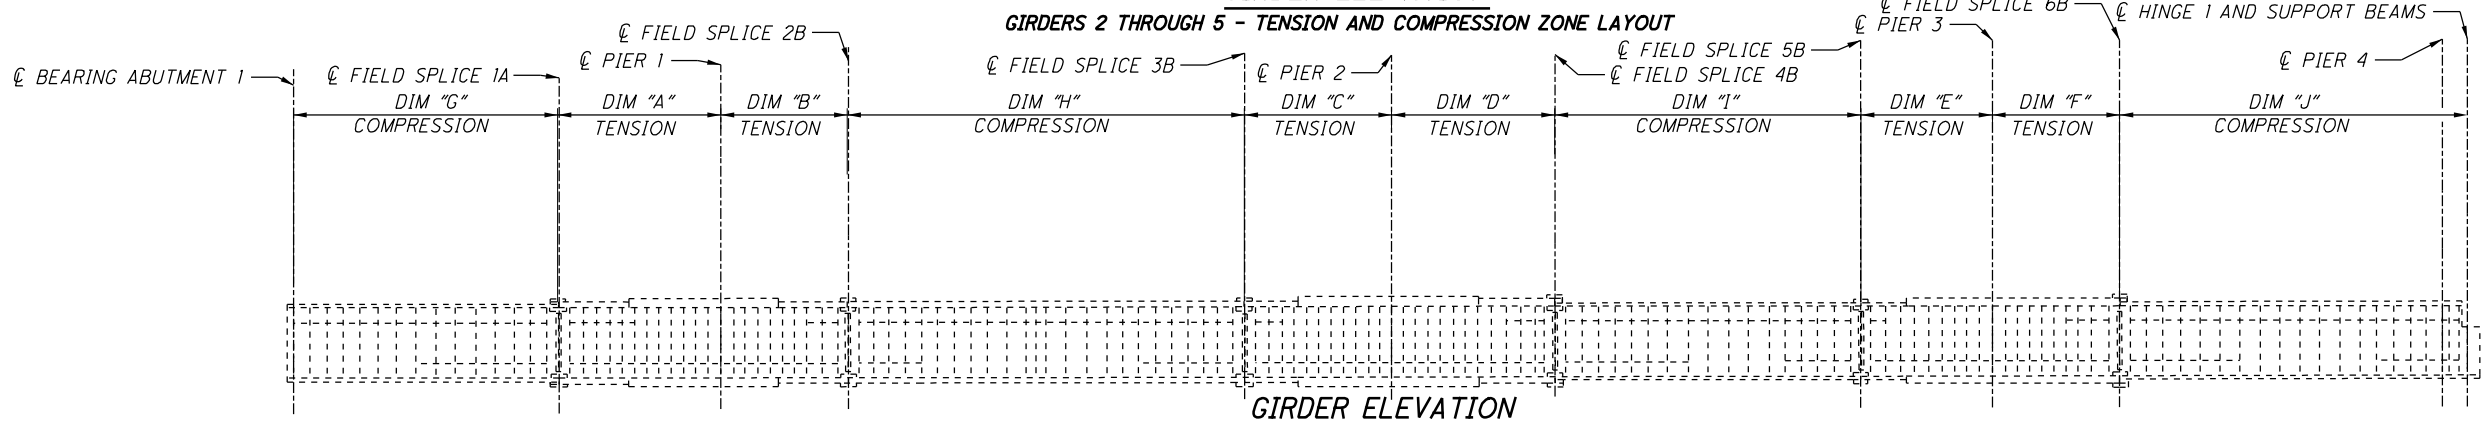

**GIRDER ELEVATION**

GIRDERS 6 THROUGH 9 - TENSION AND COMPRESSION ZONE LAYOUT

TOP FLANGE TENSION AND COMPRESSION AREAS										
GIRDER	DIM "A"	DIM "B"	DIM "C"	DIM "D"	DIM "E"	DIM "F"	DIM "G"	DIM "H"	DIM "I"	DIM "J"
G2	63'-10 <sup>3</sup> / <sub>8</sub> "	41'-4"	30'-8 <sup>3</sup> / <sub>4</sub> "	104'-10 <sup>1</sup> / <sub>2</sub> "	38'-5 <sup>1</sup> / <sub>4</sub> "	44'-6 <sup>7</sup> / <sub>8</sub> "	81'-5 <sup>3</sup> / <sub>4</sub> "	31'-8 <sup>7</sup> / <sub>8</sub> "	34'-0 <sup>3</sup> / <sub>4</sub> "	81'-11 <sup>5</sup> / <sub>8</sub> "
G3	65'-6 <sup>7</sup> / <sub>8</sub> "	39'-7 <sup>1</sup> / <sub>8</sub> "	30'-9 <sup>3</sup> / <sub>8</sub> "	103'-4 <sup>3</sup> / <sub>8</sub> "	39'-1 <sup>5</sup> / <sub>8</sub> "	43'-4 <sup>3</sup> / <sub>8</sub> "	81'-8 <sup>3</sup> / <sub>4</sub> "	31'-3 <sup>1</sup> / <sub>2</sub> "	33'-3 <sup>7</sup> / <sub>8</sub> "	82'-8 <sup>1</sup> / <sub>4</sub> "
G4	66'-0"	39'-2 <sup>1</sup> / <sub>8</sub> "	30'-9 <sup>3</sup> / <sub>4</sub> "	101'-11 <sup>3</sup> / <sub>4</sub> "	38'-10 <sup>3</sup> / <sub>4</sub> "	43'-3 <sup>7</sup> / <sub>8</sub> "	80'-1 <sup>5</sup> / <sub>8</sub> "	31'-5 <sup>1</sup> / <sub>2</sub> "	33'-4 <sup>1</sup> / <sub>2</sub> "	82'-7 <sup>5</sup> / <sub>8</sub> "
G5	66'-10 <sup>3</sup> / <sub>8</sub> "	38'-3 <sup>5</sup> / <sub>8</sub> "	30'-9 <sup>3</sup> / <sub>4</sub> "	100'-6 <sup>3</sup> / <sub>8</sub> "	38'-8"	42'-9 <sup>1</sup> / <sub>2</sub> "	79'-1"	31'-7"	33'-5 <sup>1</sup> / <sub>4</sub> "	82'-6 <sup>7</sup> / <sub>8</sub> "

TOP FLANGE TENSION AND COMPRESSION AREAS										
GIRDER	DIM "A"	DIM "B"	DIM "C"	DIM "D"	DIM "E"	DIM "F"	DIM "G"	DIM "H"	DIM "I"	DIM "J"
G6	66'-11 <sup>1</sup> / <sub>4</sub> "	38'-2 <sup>3</sup> / <sub>8</sub> "	30'-7 <sup>3</sup> / <sub>4</sub> "	99'-11 <sup>1</sup> / <sub>8</sub> "	37'-9"	42'-1 <sup>1</sup> / <sub>2</sub> "	78'-0 <sup>3</sup> / <sub>4</sub> "	31'-9 <sup>1</sup> / <sub>2</sub> "	32'-7"	83'-4 <sup>7</sup> / <sub>8</sub> "
G7	67'-3 <sup>3</sup> / <sub>8</sub> "	37'-10 <sup>1</sup> / <sub>4</sub> "	31'-1 <sup>1</sup> / <sub>4</sub> "	98'-0 <sup>3</sup> / <sub>4</sub> "	37'-5 <sup>7</sup> / <sub>8</sub> "	41'-10 <sup>7</sup> / <sub>8</sub> "	76'-6 <sup>3</sup> / <sub>4</sub> "	32'-0 <sup>1</sup> / <sub>4</sub> "	31'-10 <sup>1</sup> / <sub>4</sub> "	84'-1 <sup>5</sup> / <sub>8</sub> "
G8	67'-5 <sup>1</sup> / <sub>8</sub> "	37'-8 <sup>1</sup> / <sub>8</sub> "	31'-0"	97'-2 <sup>1</sup> / <sub>8</sub> "	36'-9 <sup>1</sup> / <sub>2</sub> "	41'-4 <sup>1</sup> / <sub>2</sub> "	75'-6 <sup>1</sup> / <sub>2</sub> "	32'-1 <sup>1</sup> / <sub>4</sub> "	31'-0 <sup>1</sup> / <sub>8</sub> "	84'-11 <sup>5</sup> / <sub>8</sub> "
G8	67'-2 <sup>3</sup> / <sub>4</sub> "	37'-10 <sup>3</sup> / <sub>8</sub> "	31'-0 <sup>3</sup> / <sub>4</sub> "	96'-1"	35'-11 <sup>3</sup> / <sub>4</sub> "	41'-8 <sup>1</sup> / <sub>2</sub> "	73'-8 <sup>3</sup> / <sub>4</sub> "	32'-1 <sup>1</sup> / <sub>2</sub> "	30'-3 <sup>7</sup> / <sub>8</sub> "	85'-7 <sup>7</sup> / <sub>8</sub> "

**NOTES:**  
1. FOR NOTES, SEE SHEET 42/100.

P:\Projects\2018\20H03DB-18232 HAM-75-03.84\104667\structures\HAM074\_1908R\sheets\074\_1908R\_S0024.dgn 6/20/2019 9:13:21 AM oseed

**PRIME**  
 540 WHITE POND DR. SUITE E  
 AKRON, OH 44320  
 DESIGN AGENCY


DATE: 3/27/2019  
 REVIEWED: TES  
 DRAWN: ADS  
 DESIGNED: CRG  
 CHECKED: KDC

STRUCTURE FILE NUMBER: 3115739  
 UNIT 1 (2 OF 2)  
 BRIDGE NO. - HAM-74-1908R  
 IR-74 OVER MILL CREEK, RR & SPRING GROVE AVENUE

HAM-75-3.84  
 PID No. 104667


44/100  
 44  
 100

P:\Projects\2018\20H03DB-18232 HAM-75-03.84\104667\structures\HAM074\_1908R\sheets\074\_1908R\_S0017.dgn 9/21/2023 5:27:46 PM erin.baumann

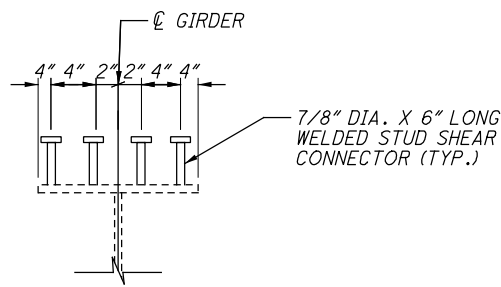


**SHEAR CONNECTOR DETAIL**

(UNIT 2, GIRDER 9, SPAN 7 ONLY)  
(STUD PLACEMENT ON SPLICE PLATES IS NOT PERMITTED)

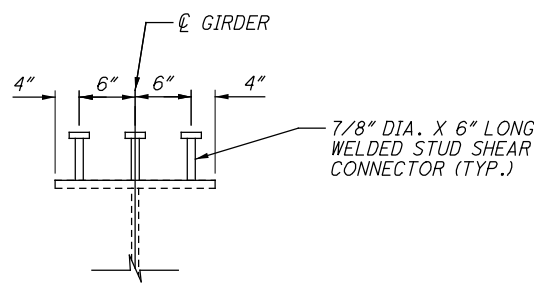


**TYPICAL SHEAR CONNECTOR DETAIL - UNIT 1 & UNIT 2**

(STUD PLACEMENT ON SPLICE PLATES IS NOT PERMITTED)

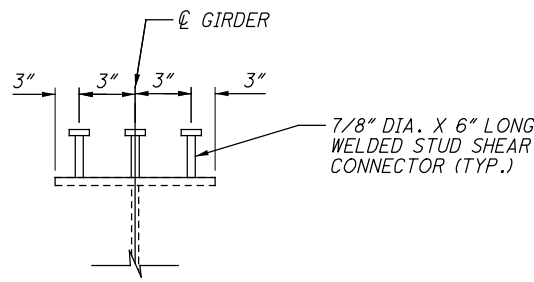


**TYPICAL SHEAR CONNECTOR DETAIL - UNIT 6**

(STUD PLACEMENT ON SPLICE PLATES IS NOT PERMITTED)

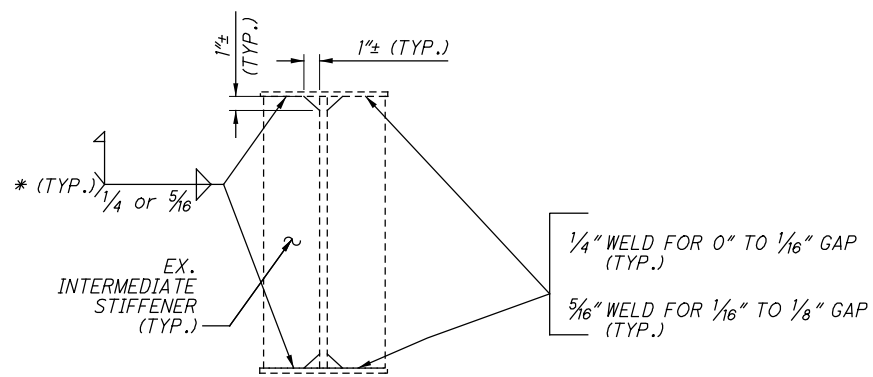


**INTERMEDIATE CROSSFRAME EXISTING STIFFENER WELDS**

\* WELD TERMINATION SHALL BE PER CMS 513.13.

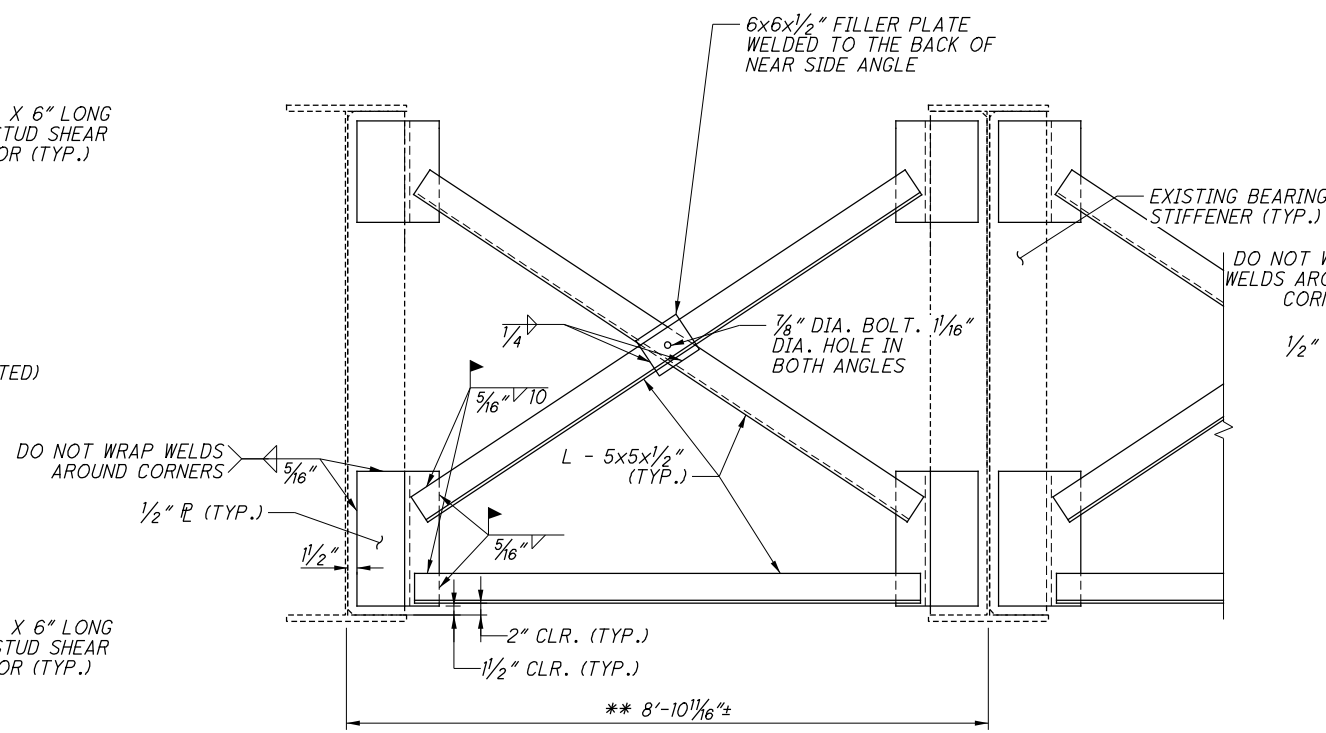


**UNIT 1, PIER 2 DIAPHRAGM**

\*\* SEE SHEET 42/100

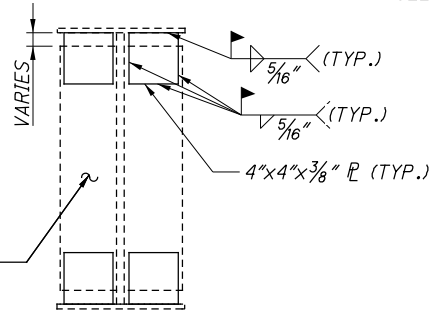


**OPTIONAL INTERMEDIATE CROSSFRAME EXISTING STIFFENER WELDS**

\* WELD TERMINATION SHALL BE PER CMS 513.13.

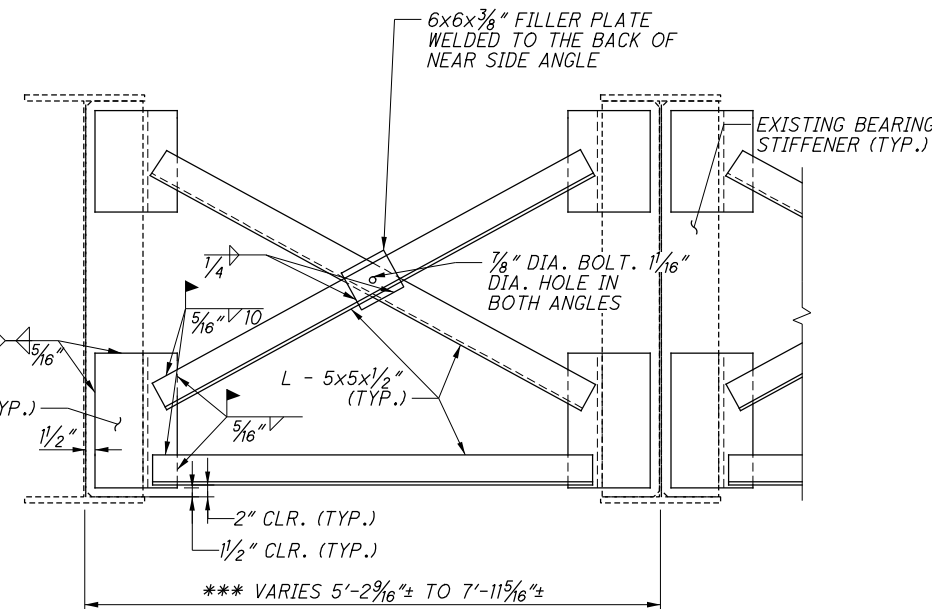


**UNIT 2, PIER 5 DIAPHRAGM**

\*\*\* SEE DIM. "A" IN TABLE A ON SHEET 46/100

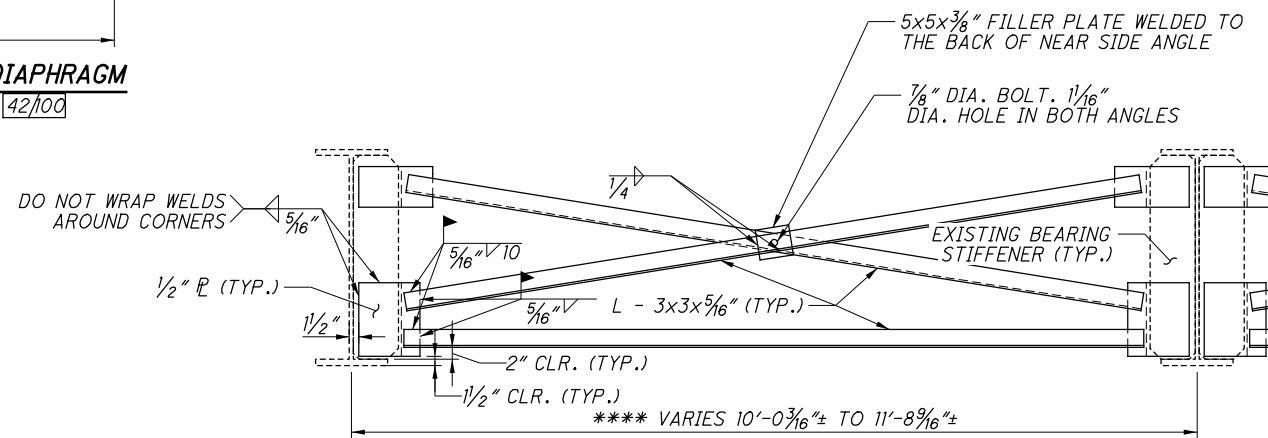

**UNIT 6, PIER 18 DIAPHRAGM**

\*\*\*\* SEE SHEET 49/100

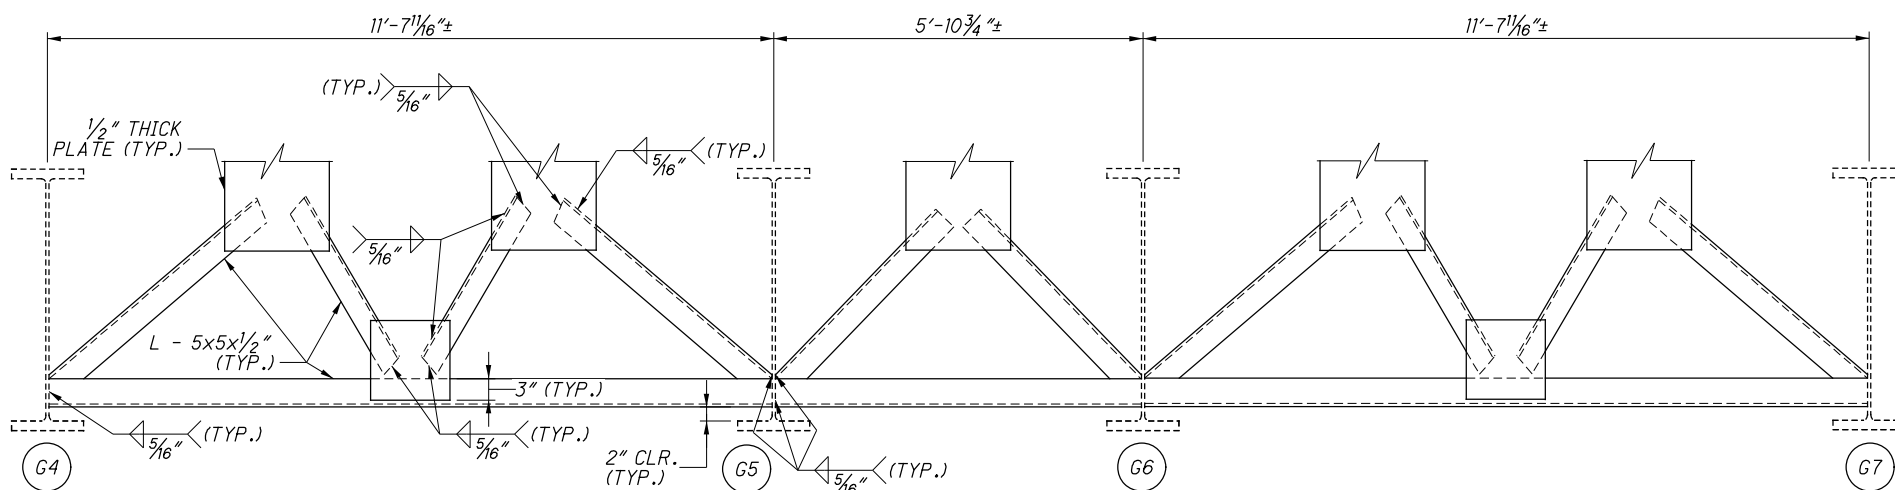

**UNIT 2, PIER 7 END CROSSFRAMES**


SEE SHEET 46/100

**NOTES:**


1. SEE STANDARD DRAWING GSD-1-96 FOR ADDITIONAL CROSSFRAME DETAILS AND NOTES.
2. FOR EXPANSION JOINT DETAILS, SEE SHEET 83/100.



P:\Projects\2018\20H03DB-18232 HAM-75-03.84\104667\structures\HAM074\_1908R\sheets\074\_1908R\_SD012.dgn 9/22/2023 11:33:49 AM erin.baumann

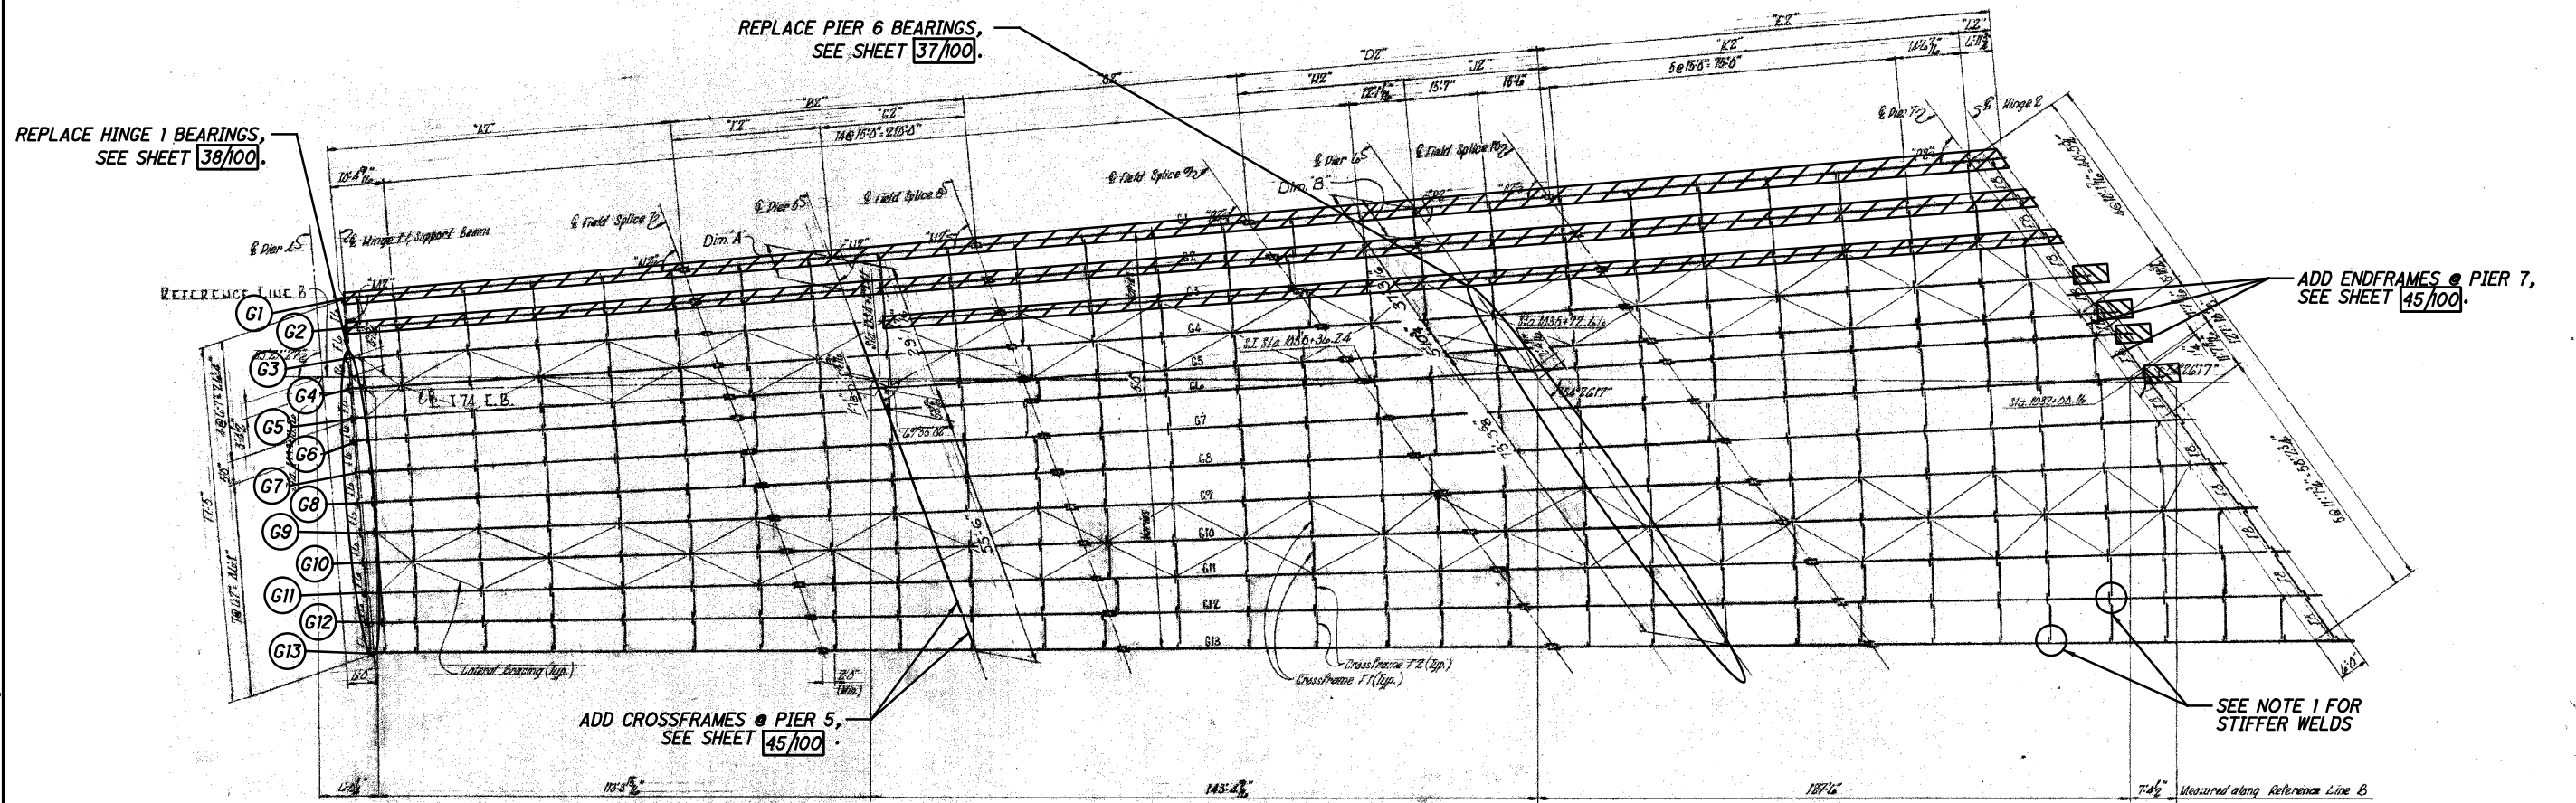

EXISTING FRAMING PLAN - UNIT NO. 2

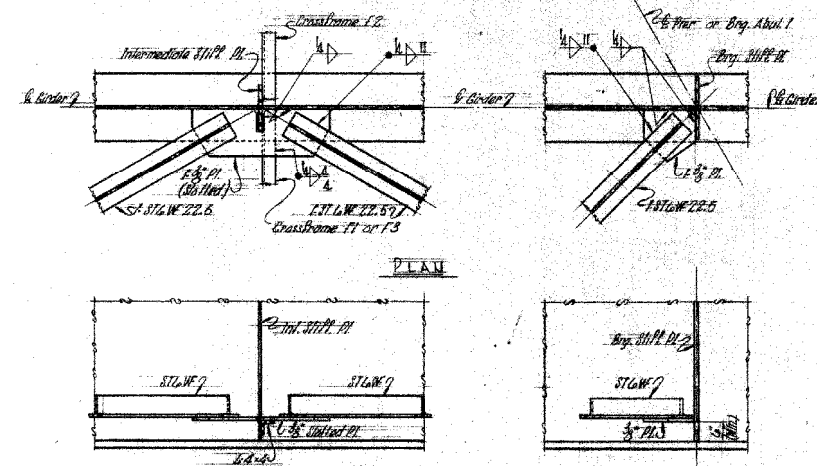

ELEVATION  
LATERAL BRACING DETAILS

**TABLE A:**  
Girder Spacing along Piers S&G

	Dim. A	Dim. B
G1 to G2	7'-5 1/2"	9'-3 3/8"
G2 to G3	7'-5 1/2"	9'-3 3/8"
G3 to G4	7'-5 1/2"	9'-3 3/8"
G4 to G5	7'-5 1/2"	9'-4 1/8"
G5 to G6	5'-2 3/8"	5'-10 3/8"
G6 to G7	7'-10 3/8"	10'-4 3/8"
G7 to G8	7'-11 1/8"	10'-5 1/8"
G8 to G9	7'-11 1/8"	10'-5 3/8"
G9 to G10	7'-11 1/8"	10'-5 1/8"
G10 to G11	7'-11 3/8"	10'-5 3/8"
G11 to G12	7'-11 1/2"	10'-6 1/8"
G12 to G13	7'-11 5/8"	10'-6 3/8"

GIRDER	DIMENSIONS											ANGLES		
	A2	B2	C2	D2	E2	F2	G2	H2	J2	K2	L2	M2	N2	P2
G1	75'-4 1/2"	63'-2 1/2"	59'-9 1/2"	65'-1 1/2"	78'-6 1/2"	32'-1 1/2"	31'-1 1/2"	31'-2 1/2"	27'-0 1/2"	78'-2 1/2"	63'-0 1/2"	90° 15' 18"	74° 26' 54"	59° 18' 09"
G2	75'-3 3/8"	63'-3 1/2"	62'-5 1/2"	65'-4 1/2"	78'-5 1/2"	32'-2 1/2"	31'-1 1/2"	31'-2 1/2"	27'-0 1/2"	78'-1 1/2"	63'-0 1/2"	89° 53' 00"	74° 26' 35"	58° 57' 50"
G3	77'-3 3/8"	63'-5 1/2"	63'-6 1/2"	65'-7 1/2"	79'-2 1/2"	32'-2 1/2"	31'-2 1/2"	31'-2 1/2"	27'-0 1/2"	78'-1 1/2"	63'-0 1/2"	89° 33' 45"	74° 26' 50"	58° 38' 05"
G4	79'-2 3/8"	63'-6 1/2"	63'-7 1/2"	65'-7 1/2"	79'-1 1/2"	32'-3 3/8"	31'-2 1/2"	31'-5 1/2"	27'-4 1/2"	78'-1 1/2"	63'-0 1/2"	89° 14' 03"	74° 27' 39"	58° 18' 54"
G5	81'-2"	63'-7 1/2"	70'-3 1/2"	66'-0 1/2"	79'-10 1/2"	32'-4"	31'-3 1/2"	31'-6 1/2"	27'-5 1/2"	78'-1 1/2"	63'-0 1/2"	88° 55' 24"	74° 28' 59"	58° 00' 44"
G6	82'-6 1/2"	63'-7 1/2"	71'-11 1/2"	66'-0 1/2"	79'-10 1/2"	32'-4"	31'-3 1/2"	31'-6 1/2"	27'-5 1/2"	78'-1 1/2"	63'-0 1/2"	88° 55' 24"	74° 28' 59"	58° 00' 44"
G7	84'-7 1/2"	63'-7 1/2"	74'-11 1/2"	66'-0 1/2"	100'-5 1/2"	32'-5"	31'-4 1/2"	31'-9"	27'-7 1/2"	78'-1 1/2"	63'-0 1/2"	88° 25' 52"	74° 29' 27"	57° 30' 42"
G8	86'-7 1/2"	63'-11 1/2"	77'-11 1/2"	66'-0 1/2"	100'-5 1/2"	32'-6"	31'-5 1/2"	31'-11 1/2"	27'-9 1/2"	78'-1 1/2"	63'-0 1/2"	87° 57' 45"	74° 30' 50"	57° 02' 05"
G9	88'-0 1/2"	64'-1 1/2"	80'-11 1/2"	67'-1 1/2"	101'-6 1/2"	32'-7"	31'-6 1/2"	31'-1 1/2"	27'-11 1/2"	78'-1 1/2"	63'-0 1/2"	87° 29' 30"	74° 03' 36"	56° 34' 21"
G10	90'-9 1/2"	64'-5 1/2"	84'-0 1/2"	67'-5 1/2"	102'-0 1/2"	32'-8 1/2"	31'-7 1/2"	31'-4 1/2"	28'-1 1/2"	78'-1 1/2"	63'-0 1/2"	87° 02' 36"	74° 06' 11"	56° 07' 26"
G11	92'-10 1/2"	64'-5 1/2"	87'-1 1/2"	67'-9 1/2"	102'-1 1/2"	32'-9"	31'-8 1/2"	31'-3 1/2"	28'-3 1/2"	78'-1 1/2"	63'-0 1/2"	86° 36' 30"	74° 10' 05"	55° 41' 20"
G12	94'-11 3/4"	64'-7 1/2"	90'-2 1/2"	68'-1 1/2"	103'-1 1/2"	32'-10 1/2"	31'-9 1/2"	31'-5 1/2"	28'-5 1/2"	78'-1 1/2"	63'-0 1/2"	86° 11' 40"	74° 14' 45"	55° 14' 00"
G13	97'-0 1/2"	64'-7 1/2"	93'-3 1/2"	68'-5 1/2"	103'-7 1/2"	32'-11"	31'-10 1/2"	31'-5 1/2"	28'-5 1/2"	78'-1 1/2"	63'-0 1/2"	85° 46' 34"	74° 20' 10"	54° 51' 25"

**LEGEND:**  
 - INDICATES LIMITS OF BEAM REMOVAL (S1-P2-S3)  
 - INDICATES LIMITS OF BEAM REMOVAL (S1-P2-S2)

**NOTES:**  
 1. FOR NOTES, SEE SHEET 42/100.

DESIGN AGENCY  
**PRIME**  
 540 WHITE POND DR. SUITE E  
 AKRON, OH 44320

DATE: 7/30/2019  
 FILE NUMBER: 3115739

DESIGNED: CRG  
 CHECKED: CCJ


FRAMING PLAN - UNIT 2  
 BRIDGE NO. HAM-74-1908R  
 IR-74 OVER MILL CREEK, RR & SPRING GROVE AVENUE

HAM-75-3.84  
 PID No. 104667


46/100  
 46  
 100




P:\Projects\2018\20HO3DB-18232 HAM-75-03.84\104667\structures\HAM074\_1908R\sheets\074\_1908R\_S0013.dgn 9/8/2023 7:09:12 PM erim.baumann

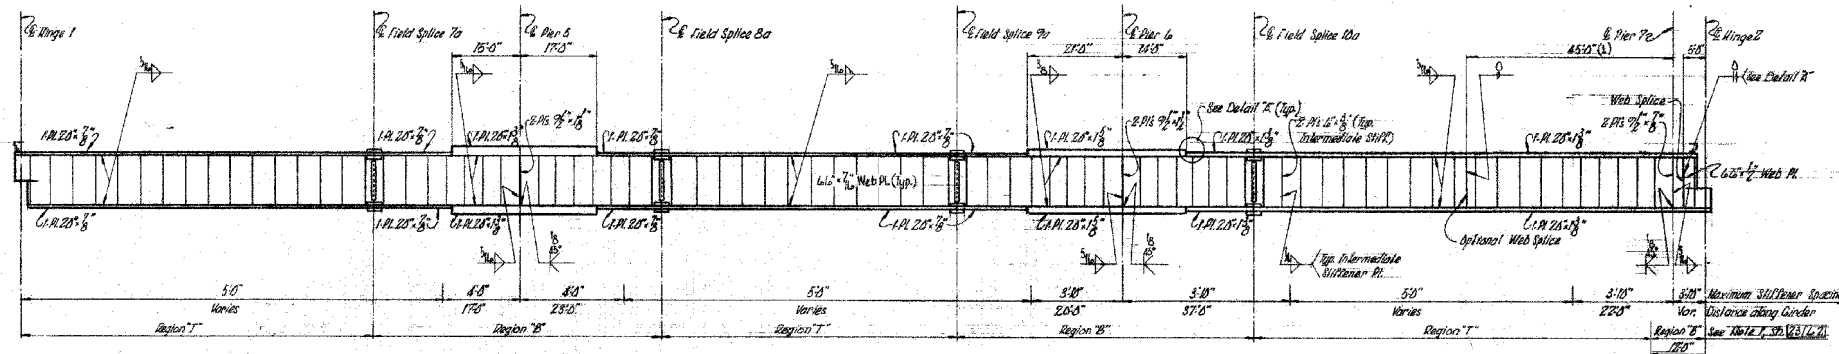


GIRDER ELEVATION (FOR DIMENSION REFERENCE ONLY)  
FOR GIRDERS 1, 2 AND 3

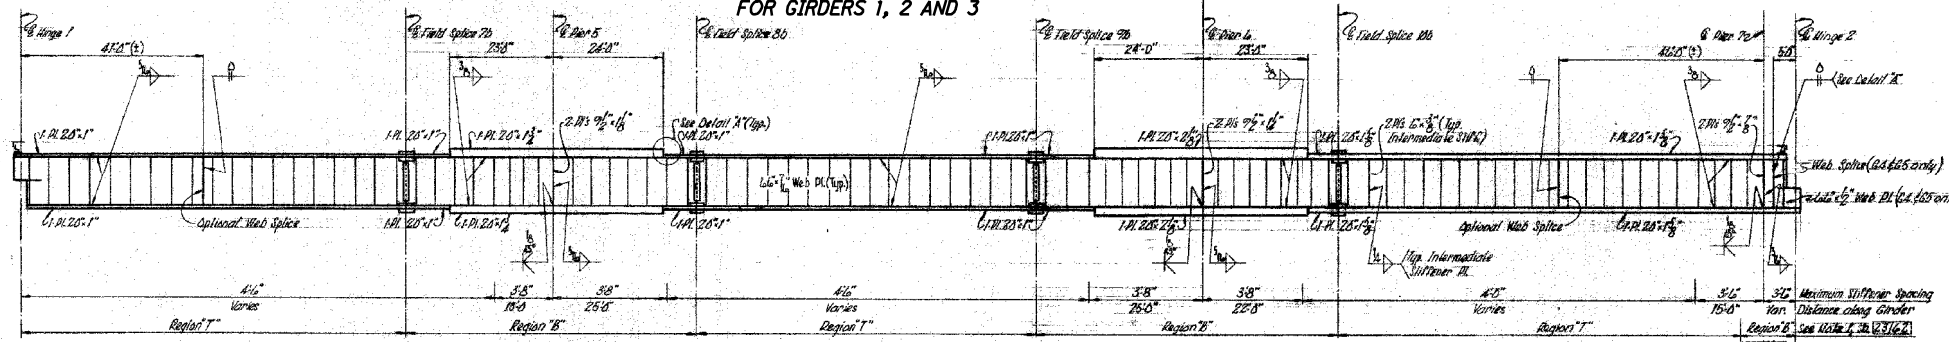

GIRDER ELEVATION (FOR DIMENSION REFERENCE ONLY)  
FOR GIRDERS 4 THROUGH 8

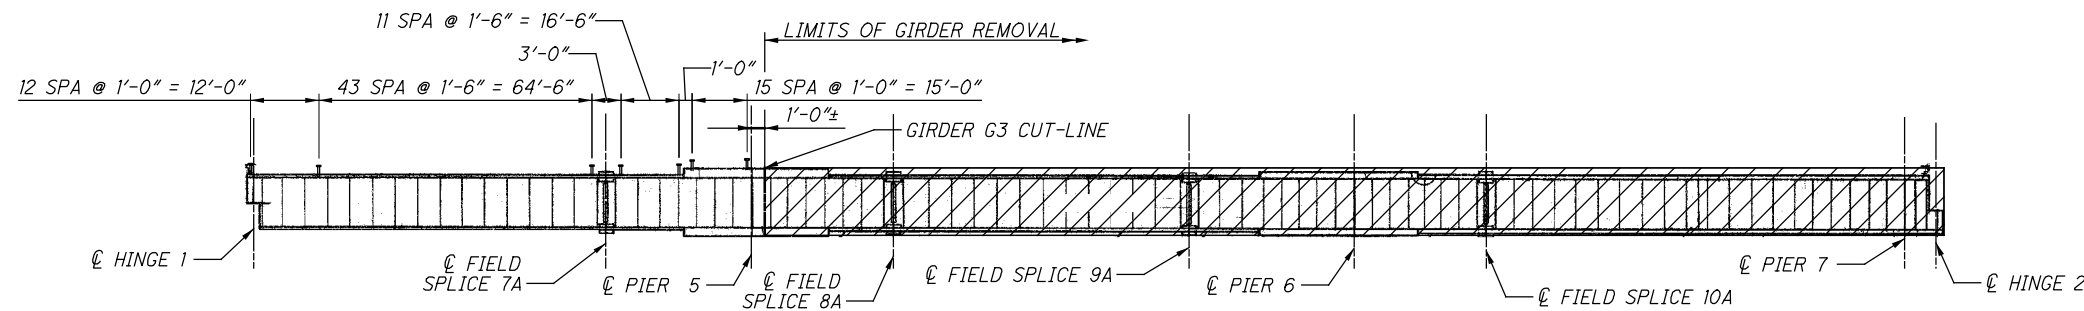

GIRDER ELEVATION  
FOR GIRDER 3 SHEAR STUD LAYOUT

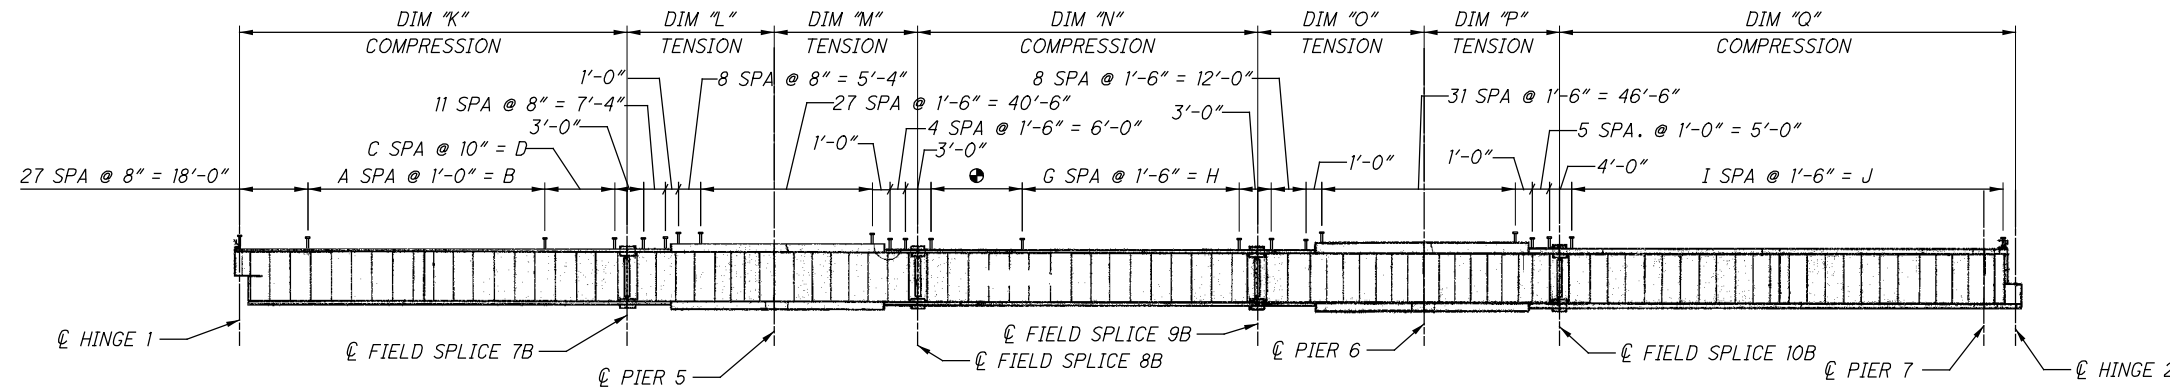

GIRDER ELEVATION  
FOR GIRDERS 4 THROUGH 8 SHEAR STUD LAYOUT


SHEAR STUD SPACING										
	A	B	C	D	E	F	G	H	I	J
G4	29	43.50'	20	16.67'	43	21.50'	30	45.00'	65	97.50'
G5	30	45.00'	20	16.67'	45	22.50'	31	46.50'	65	97.50'
G6	31	46.50'	20	16.67'	47	23.50'	32	48.00'	65	97.50'
G7	31	46.50'	23	19.17'	49	24.50'	33	49.50'	65	97.50'
G8	32	48.00'	23	19.17'	52	26.00'	34	51.00'	66	99.00'

TOP FLANGE TENSION AND COMPRESSION ZONES							
GIRDER	DIM "K"	DIM "L"	DIM "M"	DIM "N"	DIM "O"	DIM "P"	DIM "Q"
G4	86'-7 <sup>3</sup> / <sub>8</sub> "	25'-1 <sup>1</sup> / <sub>4</sub> "	36'-7 <sup>1</sup> / <sub>2</sub> "	60'-0 <sup>1</sup> / <sub>8</sub> "	36'-6 <sup>1</sup> / <sub>4</sub> "	26'-10 <sup>1</sup> / <sub>2</sub> "	102'-0 <sup>1</sup> / <sub>2</sub> "
G5	83'-4 <sup>1</sup> / <sub>2</sub> "	30'-4"	33'-3 <sup>1</sup> / <sub>4</sub> "	68'-5 <sup>3</sup> / <sub>8</sub> "	36'-3 <sup>5</sup> / <sub>8</sub> "	28'-1 <sup>1</sup> / <sub>2</sub> "	101'-3"
G6	83'-2"	31'-11"	31'-7 <sup>7</sup> / <sub>8</sub> "	70'-11 <sup>1</sup> / <sub>4</sub> "	37'-1"	29'-3 <sup>3</sup> / <sub>8</sub> "	100'-1 <sup>1</sup> / <sub>8</sub> "
G7	84'-11 <sup>3</sup> / <sub>8</sub> "	32'-3 <sup>1</sup> / <sub>8</sub> "	32'-3 <sup>1</sup> / <sub>2</sub> "	72'-1 <sup>1</sup> / <sub>4</sub> "	38'-7"	29'-2 <sup>1</sup> / <sub>2</sub> "	100'-10 <sup>1</sup> / <sub>2</sub> "
G8	86'-1 <sup>1</sup> / <sub>8</sub> "	33'-2 <sup>3</sup> / <sub>8</sub> "	33'-2 <sup>5</sup> / <sub>8</sub> "	75'-11 <sup>3</sup> / <sub>4</sub> "	37'-1 <sup>1</sup> / <sub>4</sub> "	29'-3 <sup>3</sup> / <sub>8</sub> "	101'-5 <sup>1</sup> / <sub>8</sub> "


LEGEND:  
● - E SPA @ 6" = F

- NOTES:
- FOR NOTES, SEE SHEET 42/100.
  - 1" STEEL PIPE AND SHEAR STUDS LEFT IN PLACE ON GIRDER 4 FROM PIER 5 TO HINGE 2. STEEL PIPE WAS USED FOR BIDWELL RAIL DURING DECK POUR. PIPES ARE UNDER PARAPET AND WERE FILLED WITH SCC DURING PARAPET POURS.
  - 1" STEEL PIPE AND SHEAR STUDS LEFT IN PLACE ON GIRDER 4 FROM PIER 5 TO HINGE 2.
  - STEEL PIPE WAS USED FOR BIDWELL RAIL DURING DECK POUR.
  - PIPES ARE UNDER PARAPET AND WERE FILLED WITH SCC DURING PARAPET POURS.

P:\Projects\2018\20HO3DB-18232 HAM-75-03.84\104667\structures\HAM074\_1908R\sheets\074\_1908R\_S0014.dgn 6/20/2019 9:13:32 AM oseed

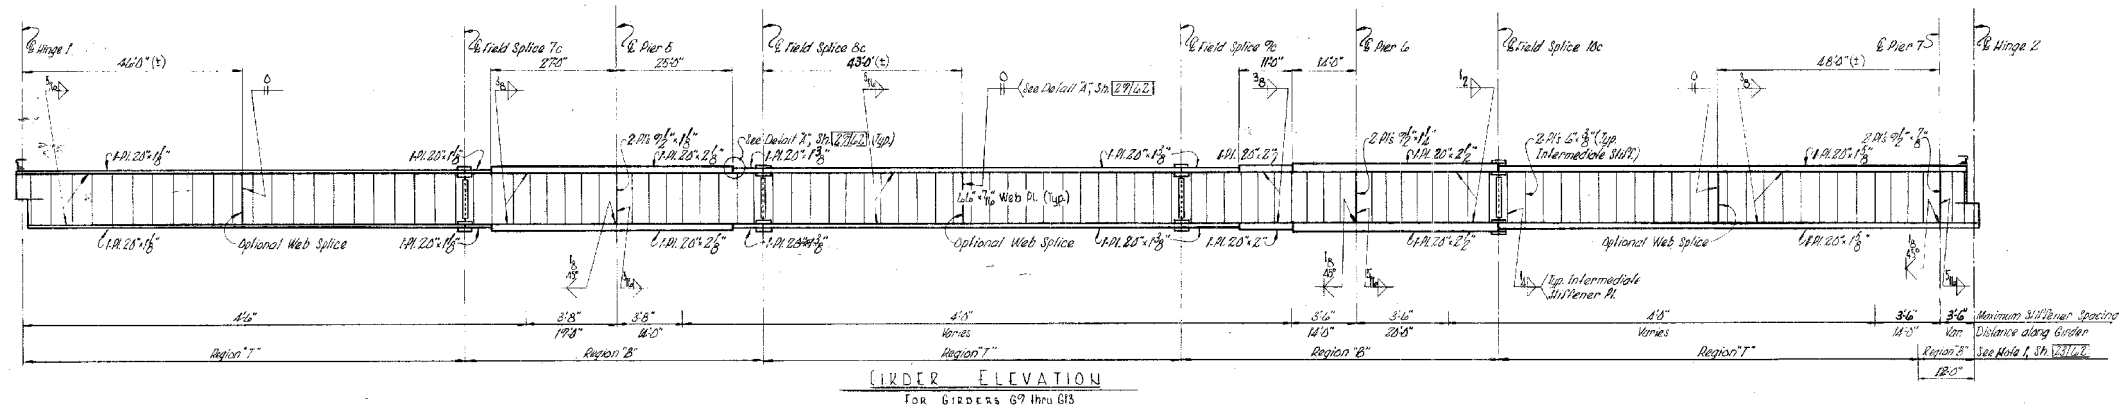

**GIRDER ELEVATION (FOR DIMENSION REFERENCE ONLY)  
FOR GIRDERS 9 THROUGH 13**

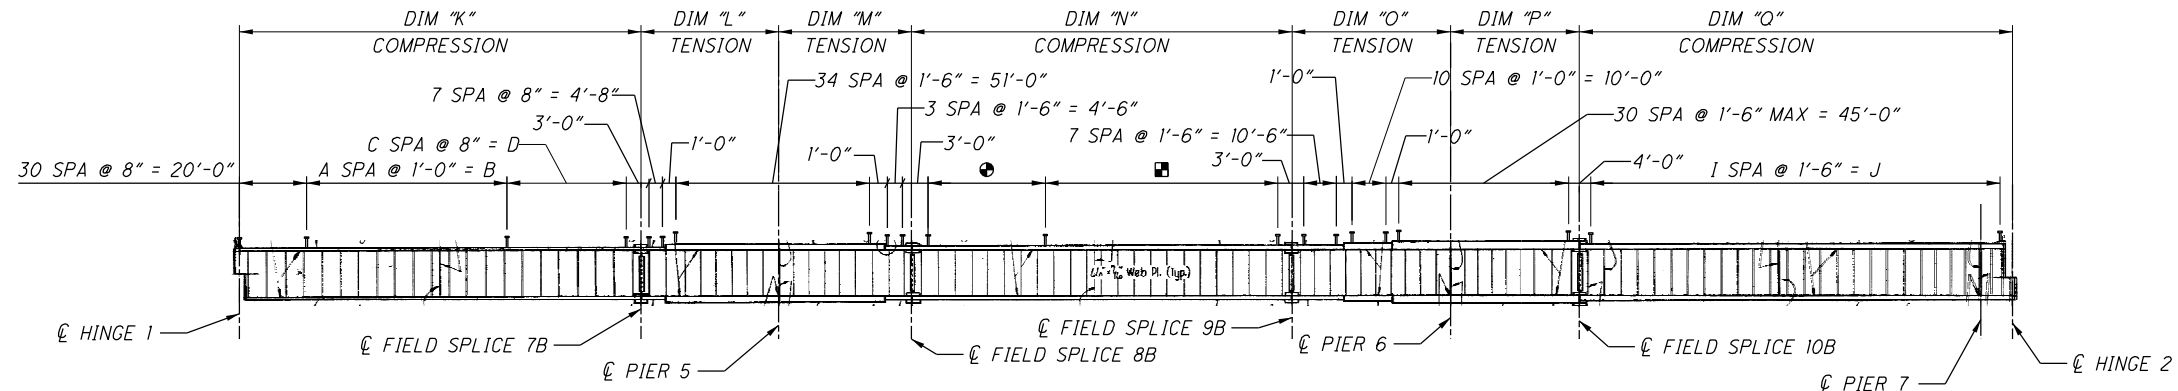

**GIRDER ELEVATION  
FOR GIRDERS 9 THROUGH 13 SHEAR STUD LAYOUT**

SHEAR STUD SPACING										
	A	B	C	D	E	F	G	H	I	J
G9	40	40.00'	41	27.33'	54	27.00'	34	51.00'	61	91.50'
G10	41	41.00'	43	28.67'	56	28.00'	36	54.00'	61	91.50'
G11	42	42.00'	45	30.00'	59	29.50'	37	55.50'	62	93.00'
G12	43	43.00'	46	30.67'	62	31.00'	38	57.00'	62	93.00'
G13	44	44.00'	48	32.00'	64	32.00'	39	58.50'	62	93.00'

TOP FLANGE TENSION AND COMPRESSION ZONES							
GIRDER	DIM "K"	DIM "L"	DIM "M"	DIM "N"	DIM "O"	DIM "P"	DIM "Q"
G9	85'-6 <sup>3</sup> / <sub>8</sub> "	35'-10 <sup>7</sup> / <sub>8</sub> "	33'-2 <sup>1</sup> / <sub>4</sub> "	79'-3 <sup>1</sup> / <sub>2</sub> "	37'-1 <sup>1</sup> / <sub>8</sub> "	31'-8 <sup>3</sup> / <sub>4</sub> "	99'-7 <sup>7</sup> / <sub>8</sub> "
G10	87'-0 <sup>3</sup> / <sub>8</sub> "	36'-7"	33'-6 <sup>3</sup> / <sub>4</sub> "	81'-5 <sup>1</sup> / <sub>8</sub> "	37'-10 <sup>1</sup> / <sub>2</sub> "	32'-5"	99'-7 <sup>7</sup> / <sub>8</sub> "
G11	88'-6 <sup>3</sup> / <sub>4</sub> "	37'-2 <sup>5</sup> / <sub>8</sub> "	34'-10 <sup>1</sup> / <sub>8</sub> "	85'-3 <sup>3</sup> / <sub>4</sub> "	36'-0 <sup>1</sup> / <sub>8</sub> "	32'-9 <sup>3</sup> / <sub>4</sub> "	99'-11 <sup>1</sup> / <sub>2</sub> "
G12	89'-10 <sup>1</sup> / <sub>2</sub> "	38'-1 <sup>3</sup> / <sub>8</sub> "	35'-9 <sup>7</sup> / <sub>8</sub> "	86'-6 <sup>1</sup> / <sub>2</sub> "	37'-1 <sup>1</sup> / <sub>2</sub> "	33'-7 <sup>7</sup> / <sub>8</sub> "	99'-9 <sup>3</sup> / <sub>4</sub> "
G13	90'-7 <sup>3</sup> / <sub>8</sub> "	39'-6 <sup>3</sup> / <sub>4</sub> "	36'-0 <sup>3</sup> / <sub>4</sub> "	89'-3 <sup>7</sup> / <sub>8</sub> "	37'-5 <sup>1</sup> / <sub>2</sub> "	33'-4 <sup>1</sup> / <sub>2</sub> "	100'-9 <sup>5</sup> / <sub>8</sub> "



**LEGEND:**

- ⊕ - E SPA. @ 6" = F
- ⊞ - G SPA. @ 1'-6" = H

**NOTES:**

1. FOR INTERMEDIATE CROSSFRAME STIFFNER WELD DETAILS AND SHEAR STUD DETAILS, SEE SHEET 45/100.

P:\Projects\2018\20H03DB-18232 HAM-75-03.84\104667\structures\HAM074\_1908R\sheets\074\_1908R\_S016.dgn 9/22/2023 12:23:06 PM erin.baumann

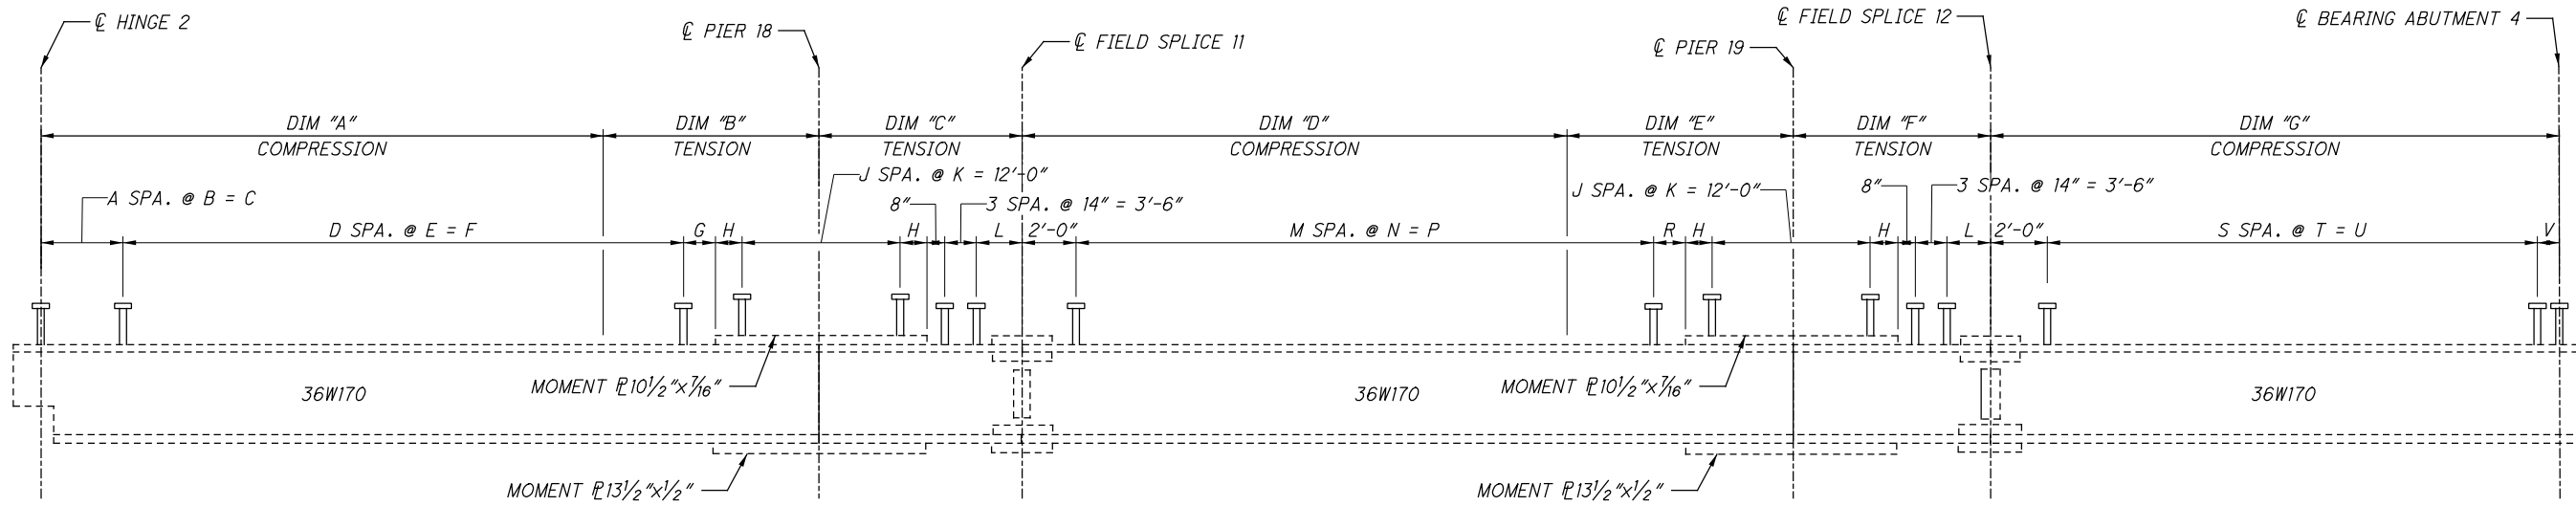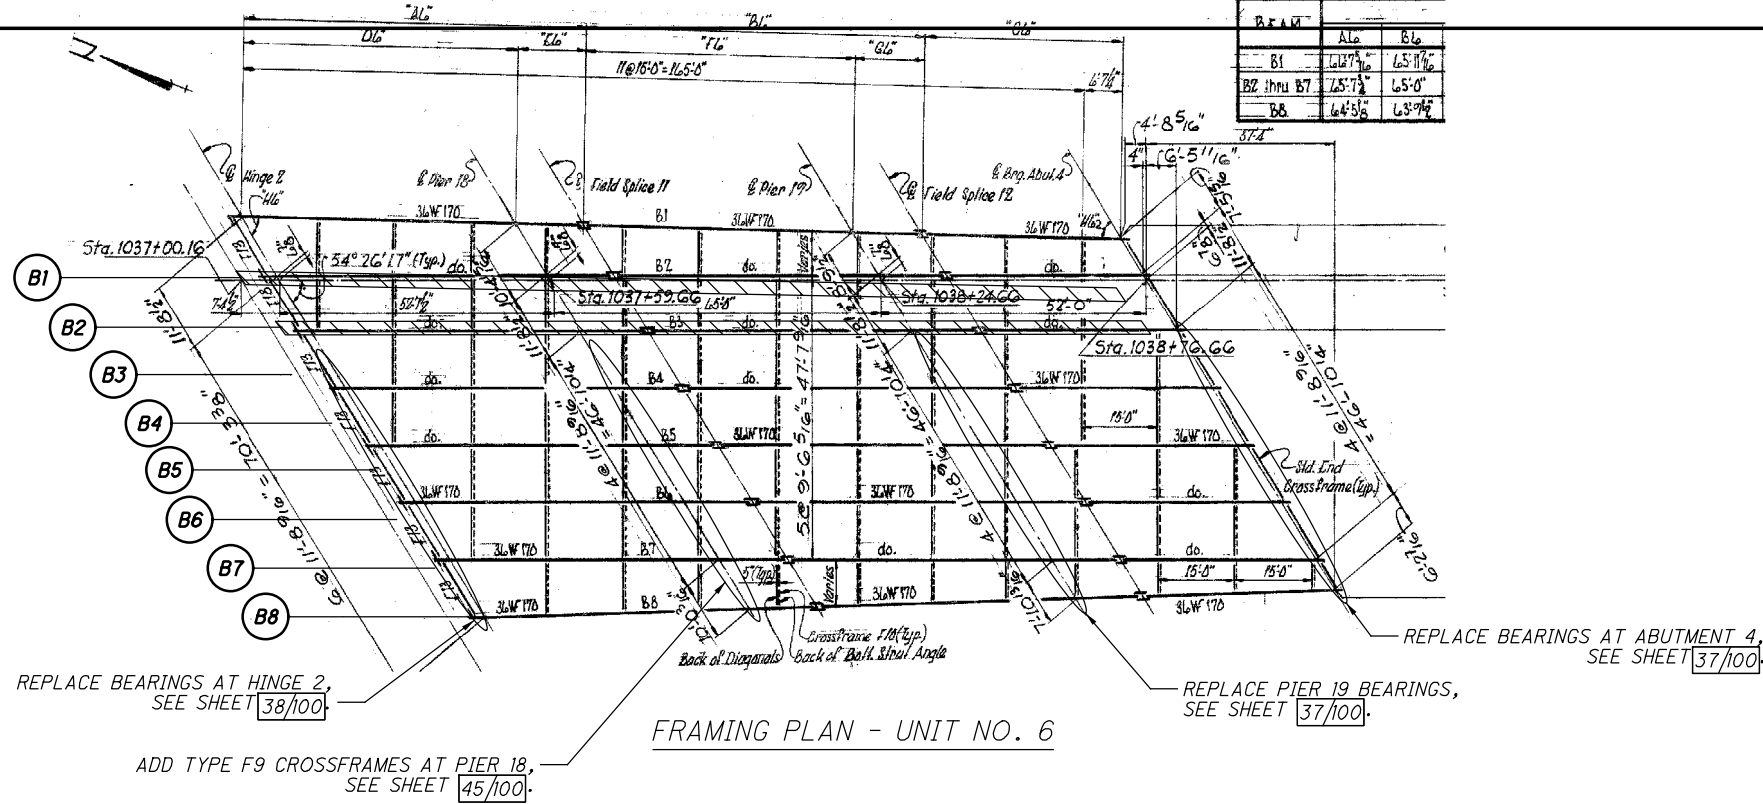

**BEAM ELEVATION**  
(FOR DIMENSION REFERENCE ONLY)

SHEAR STUD SPACING																			
BEAM	A	B	C	D	E	F	G	H	J	K	L	M	N	P	R	S	T	U	V
B3	6	11"	5'-6"	42	11"	38'-6"	1'-0 1/2"	1'-1"	6	2'-0"	2'-3 1/4"	50	10"	41'-8"	1'-4"	48	9"	36'-0"	0'-5 3/4"
B4-B7	8	8"	5'-4"	52	9"	39'-0"	0'-8 1/2"	0'-9 1/2"	9	1'-4"	2'-3 1/4"	56	9"	42'-0"	1'-0"	48	9"	36'-0"	0'-5 3/4"
B8	8	8"	5'-4"	51	9"	38'-3"	0'-5 7/8"	1'-1"	6	2'-0"	2'-0 1/4"	50	10"	41'-8"	1'-4"	26	1'-4"	34'-8"	1'-1 1/8"

TOP FLANGE TENSION AND COMPRESSION AREAS							
GIRDER	DIM "A"	DIM "B"	DIM "C"	DIM "D"	DIM "E"	DIM "F"	DIM "G"
B3	37'-9 3/4"	14'-3 3/4"	13'-10 3/8"	36'-5 7/8"	14'-8 3/4"	13'-7 3/8"	39'-1 3/4"
B4-B7	38'-1 1/2"	14'-0"	14'-3"	36'-3 7/8"	14'-6"	13'-8 7/8"	38'-3 1/8"
B8	38'-6 1/2"	12'-7 3/8"	15'-10 1/4"	36'-6 1/8"	11'-6 1/8"	16'-7 7/8"	34'-4 5/8"

**LEGEND:**

- INDICATES LIMITS OF BEAM REMOVAL (S1-P2-S2)


**FRAMING PLAN - UNIT 6 (PAGE 1 OF 2)**  
BRIDGE NO. HAM-74-1908R  
IR-74 OVER MILL CREEK, RR & SPRING GROVE AVENUE

**HAM-75-3.84**  
PID No. 104667


DESIGNED: JAT  
CHECKED: CCJ  
DRAWN: ADS  
REVISED:  
REVIEWED: TES  
DATE: 7/30/2019  
STRUCTURE FILE NUMBER: 3115739

DESIGN AGENCY  
**PRIMEW**  
540 WHITE POND DR. SUITE E  
AKRON, OH 44320

P:\Projects\2018\20H03DB-18232 HAM-75-03.84\104667\structures\HAM074\_1908R\sheets\074\_1908R\_TSO01.dgn 9/22/2023 12:34:23 PM erin.bourmann

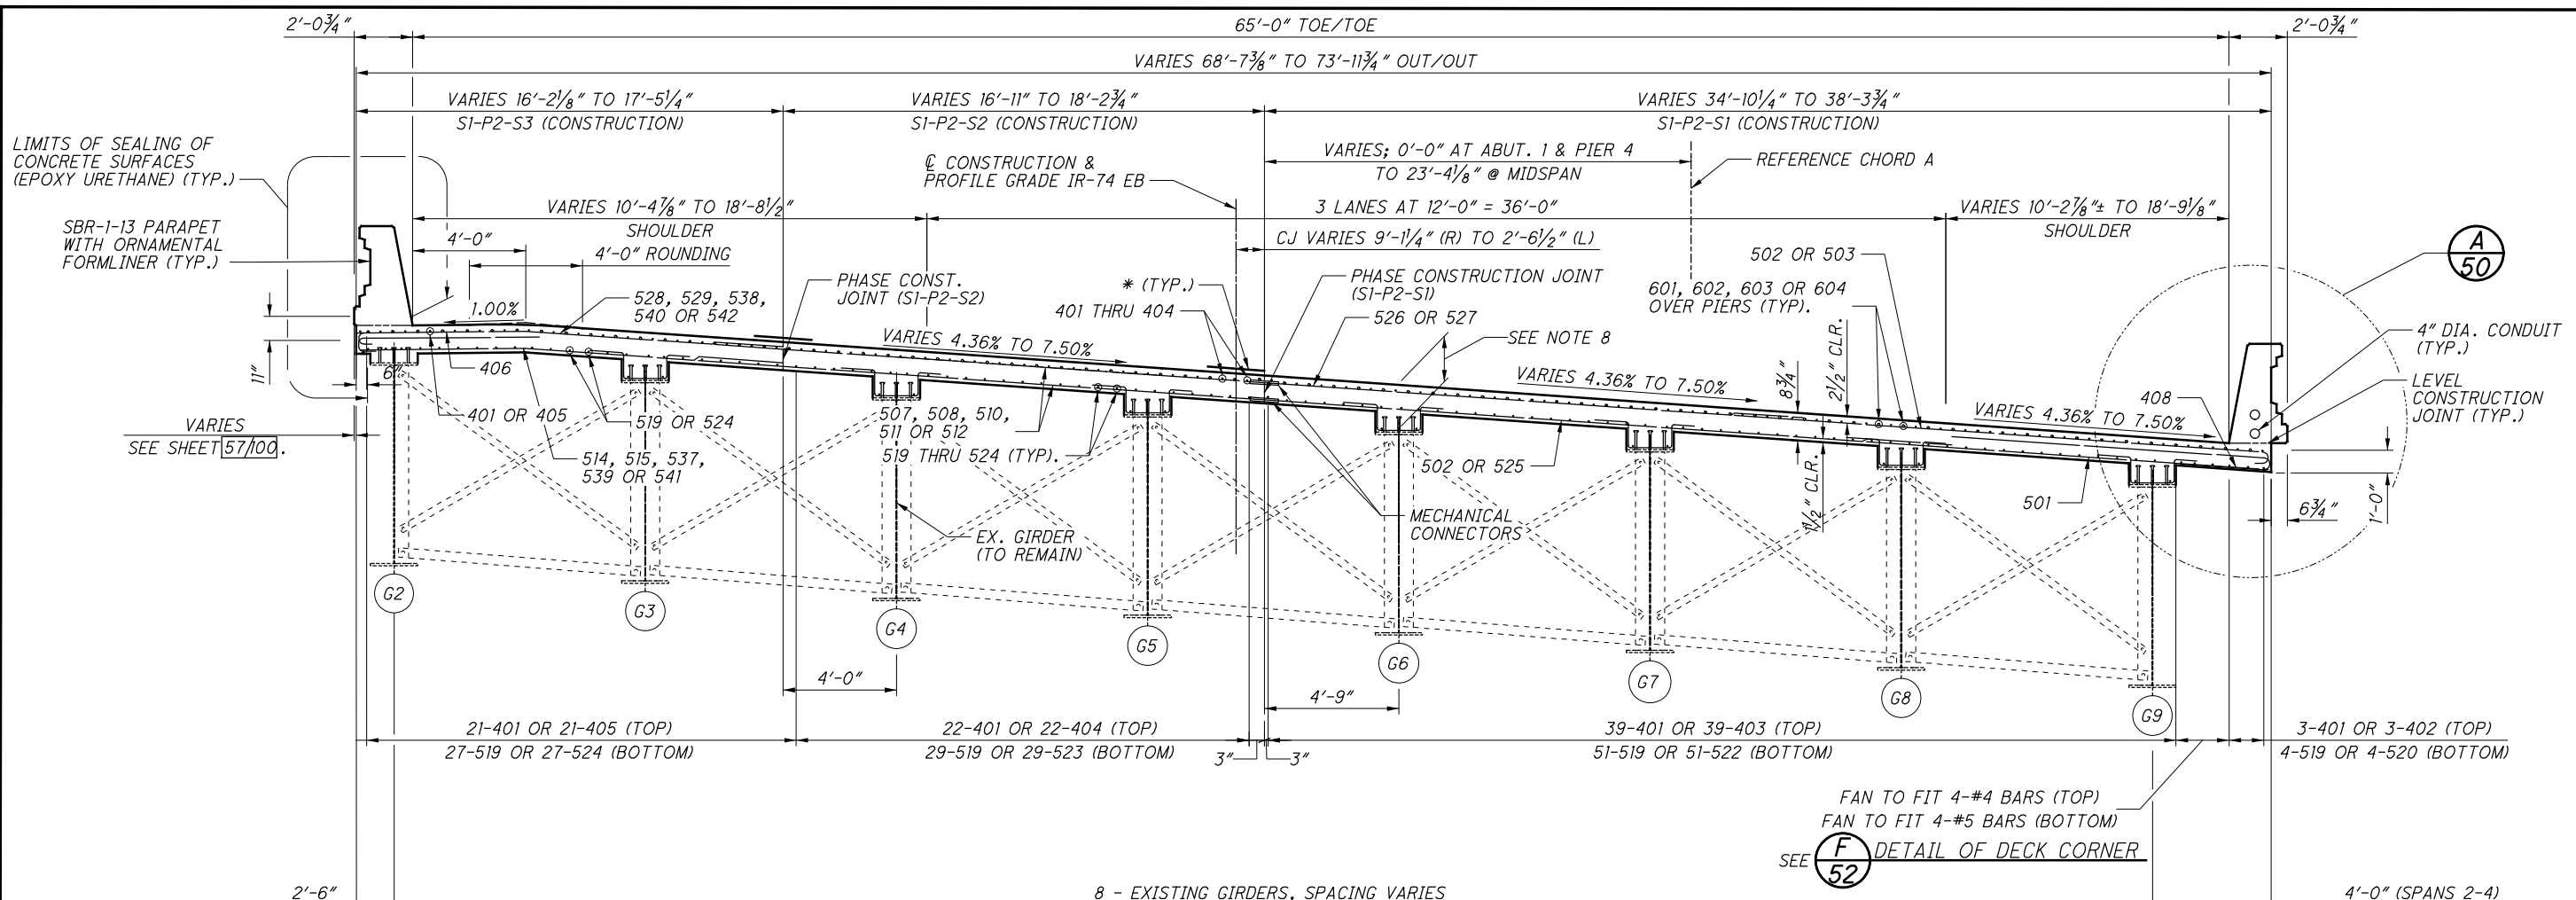

**TRANSVERSE SECTION - UNIT 1**  
(ABUTMENT NO. 1 TO HINGE NO. 1)

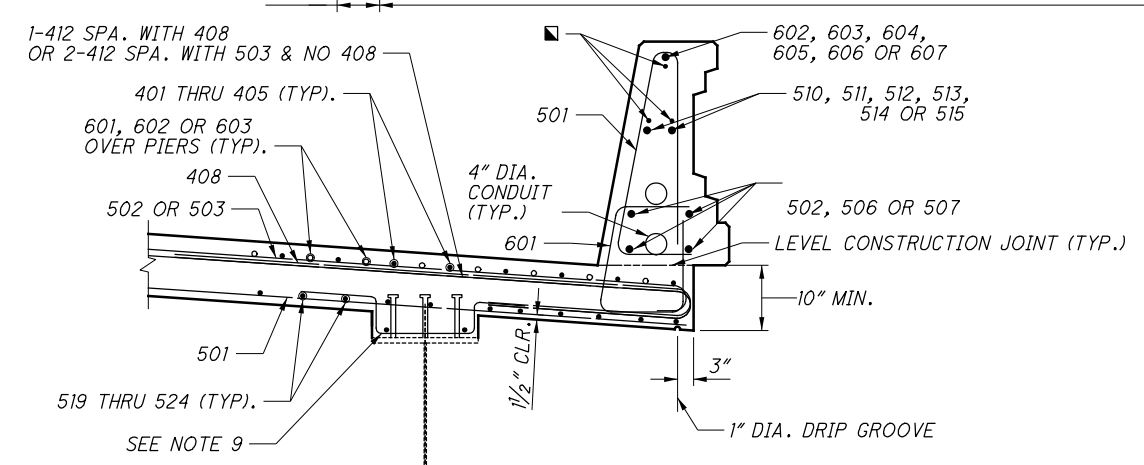

FAN TO FIT 4-#4 BARS (TOP)  
FAN TO FIT 4-#5 BARS (BOTTOM)  
SEE **F 52** DETAIL OF DECK CORNER

MIN. REQUIRED LAP LENGTH	
#4 LONGITUDINAL	1'-11"
#5 TRANSVERSE (TOP)	2'-5"
#5 TRANSVERSE (BOT.)	3'-0"
#5 LONGITUDINAL	2'-5"
#6 LONGITUDINAL	3'-7"

**LEGEND:**


- - 1/2" DIA. GLASS FIBER REINFORCED POLYMER (GFRP) STIFFENING REINFORCEMENT
- SX-PX-SX - STAGE X, PHASE X, STEP X
- \* HMWM RESIN, 2'-0" WIDE, CENTERED ON JOINT, FULL LENGTH OF JOINT.

**NOTES:**

- TRANSVERSE SECTIONS DRAWN LOOKING UPSTATION.
- SIP FORMS CAN BE USED OVER MILL CREEK AND THE RAILROAD.
- FOR FRAMING PLAN SEE SHEET **42/100**.
- FOR CROSSFRAME DETAILS SEE SHEET **45/100**.
- THE PREFIX "IS" SHALL BE ADDED TO ALL BAR MARKS FOR UNIT 1 AND "IR" FOR UNIT 1 RAILING.
- FOR FINAL DECK ELEVATIONS, SEE SHEET **73/100** & **74/100**.
- FOR DECK PLAN, SEE SHEETS **51/100** AND **52/100**.
- FOR ESTIMATED HAUNCH THICKNESSES, SEE SHEET **75/100**.
- FOR AS-BUILT HAUNCH MODIFICATION DETAILS SEE SHEET **54/100**.

**A 50** SLAB OVERHANG DETAIL

P:\Projects\2018\20H03DB-18232 HAM-75-03.84\104667\structures\HAM074\_1908R\sheets\074\_1908R\_DP002.dgn 11/13/2023 3:46:37 PM adesimone

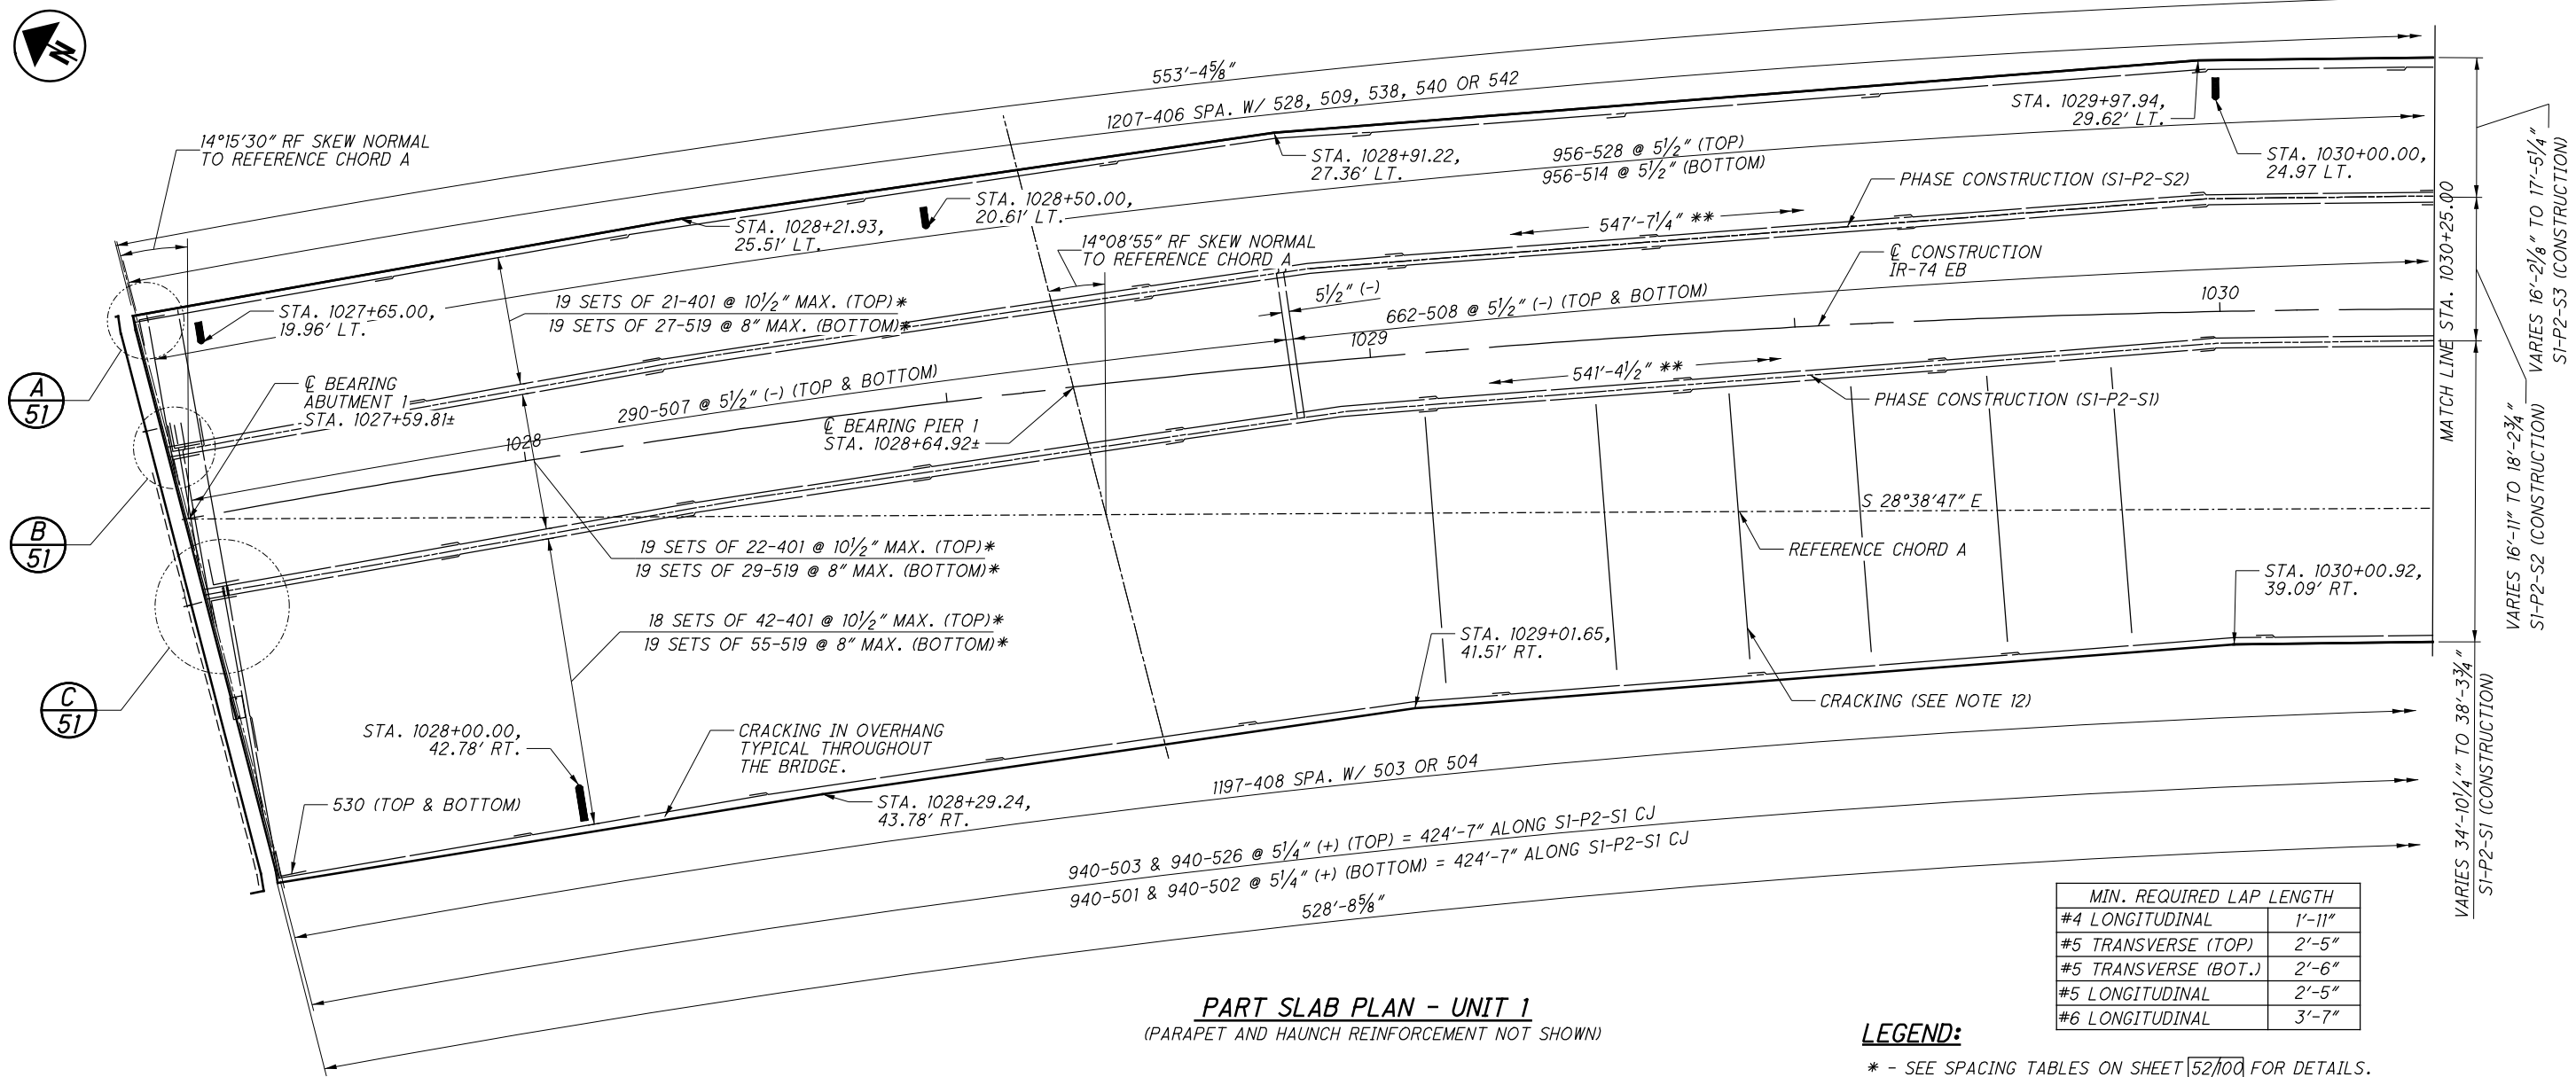


MIN. REQUIRED LAP LENGTH	
#4 LONGITUDINAL	1'-11"
#5 TRANSVERSE (TOP)	2'-5"
#5 TRANSVERSE (BOT.)	2'-6"
#5 LONGITUDINAL	2'-5"
#6 LONGITUDINAL	3'-7"

**LEGEND:**


- \* - SEE SPACING TABLES ON SHEET 52/100 FOR DETAILS.
- \*\* - MEASURED ALONG PHASE CONSTRUCTION LINE
- TYPE 1 SCUPPER
- TYPE 2 SCUPPER

**NOTES:**


1. FOR TRANSVERSE SECTION, SEE SHEET 50/100.
2. FOR LONGITUDINAL BAR SPACING OVER PIERS, SEE SHEET 53/100.
3. FOR EXPANSION JOINT DETAIL, SEE SHEET 83/100.
4. FOR PARAPET DETAILS, SEE SHEET 55/100 THRU 57/100.
5. FOR FINAL DECK ELEVATIONS, SEE SHEET 72/100 THRU 74/100.
6. FOR REINFORCING STEEL LIST, SEE SHEET 95/100.
7. REBAR CLEARANCE MEASURED TO THE FACE OF CONCRETE SHALL BE 2" UNLESS OTHERWISE NOTED.
8. FIELD BEND LONGITUDINAL BARS TO FIT CURVATURE OF ROADWAY AND TRANSVERSE BARS TO FIT CROWN. EPOXY COATED BARS DAMAGED BY FIELD BENDING SHALL BE REPAIRED IN ACCORDANCE WITH CMS 509.
9. THE PREFIX "IS" SHALL BE ADDED TO ALL BAR MARKS IN UNIT 1 SUPERSTRUCTURE.
10. FOR TYPE 1 SCUPPER DETAILS, SEE SHEET 92/100.
11. MOVE SCUPPER LOCATIONS AS NECESSARY TO AVOID CROSS FRAMES.
12. CRACK WIDTH 0.01 TO 0.016 INCHES (TYPICAL).

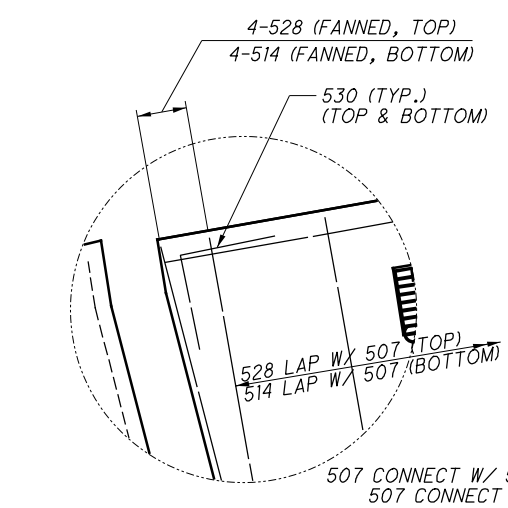

**A** DETAIL OF DECK CORNER  
51

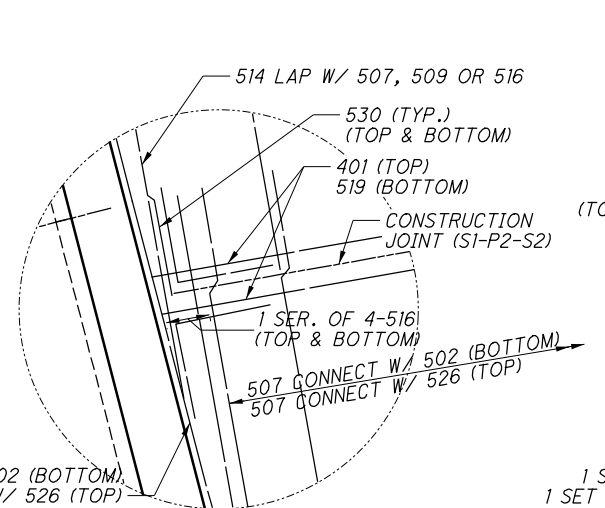

**B** DETAIL OF DECK CORNER  
51

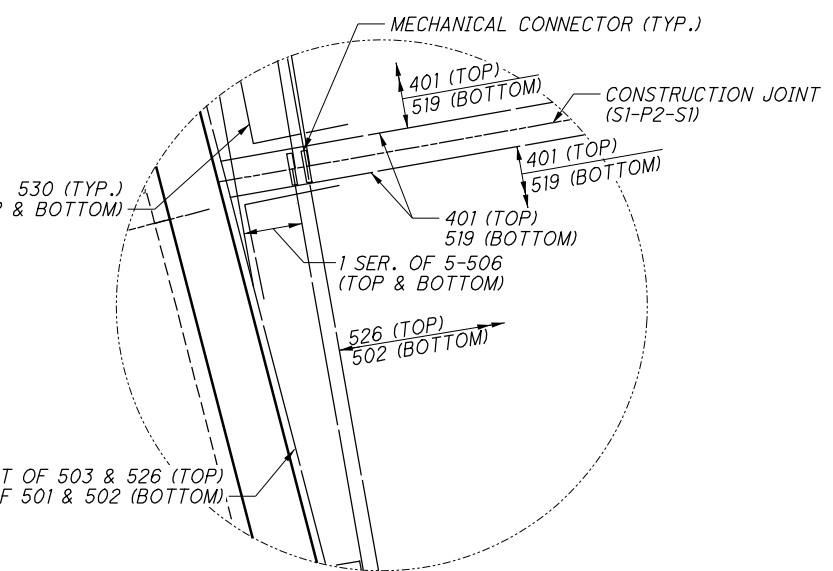

**C** DETAIL OF DECK CORNER  
51

DESIGN AGENCY  
**PRIMEW**  
540 WHITE POND DR. SUITE E  
AKRON, OH 44320


DESIGNED	CRG	CHECKED	KDC
DRAWN	JAT	REVISED	
REVIEWED	TES	DATE	7/30/2019
STRUCTURE FILE NUMBER	3115739		

**SLAB PLAN - UNIT 1 (1 OF 2)**  
BRIDGE NO. HAM-74-1908R  
IR-74 OVER MILL CREEK, RR & SPRING GROVE AVENUE


HAM-75-3.84  
PID No. 104667

51/100  
51  
100

P:\Projects\2018\20H03DB-18232 HAM-75-03.84\104667\structures\HAM074\_1908R\sheets\074\_1908R\_DP003.dgn 11/13/2023 3:57:34 PM adesimone

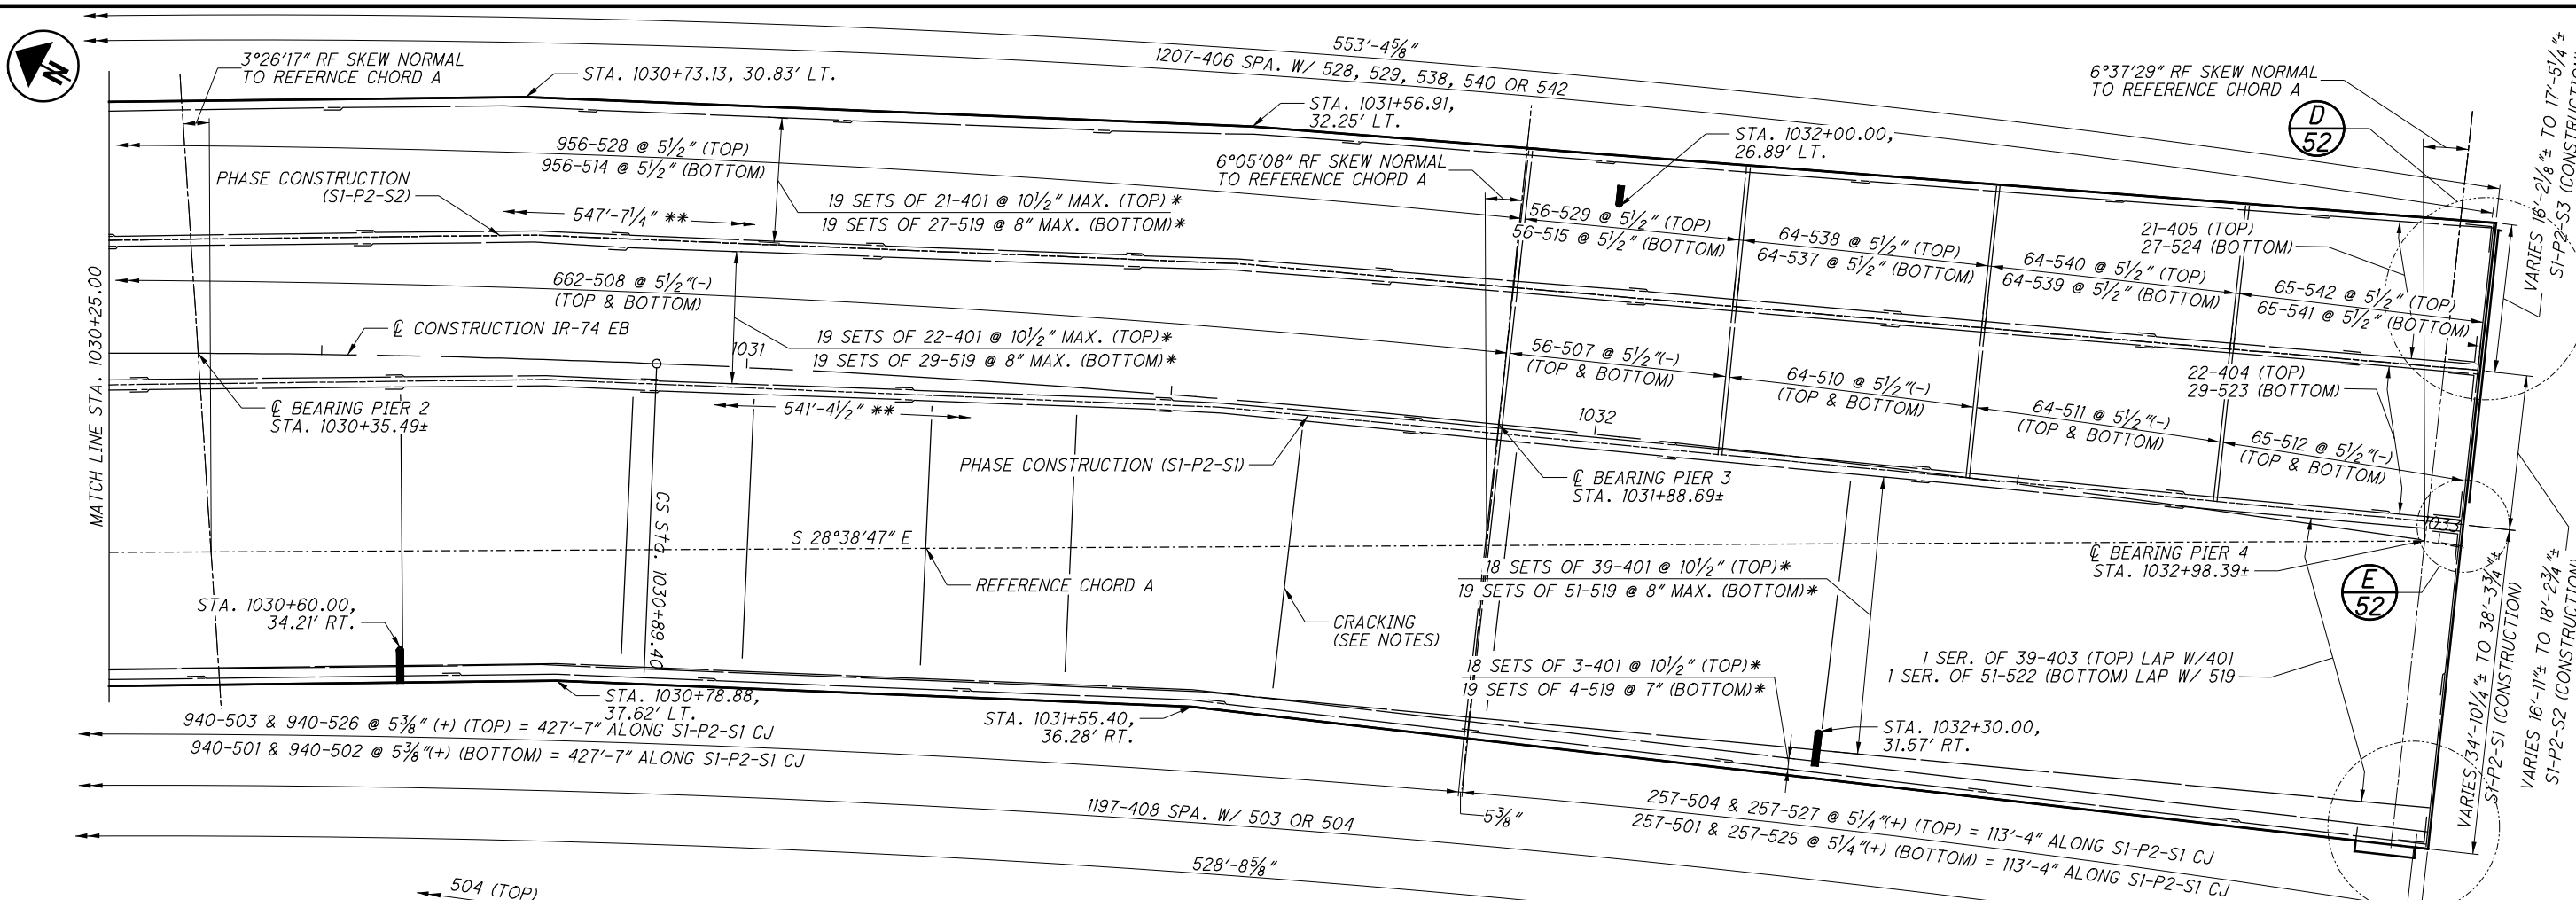

**PART SLAB PLAN - UNIT 1**  
(PARAPET AND HAUNCH REINFORCEMENT NOT SHOWN)

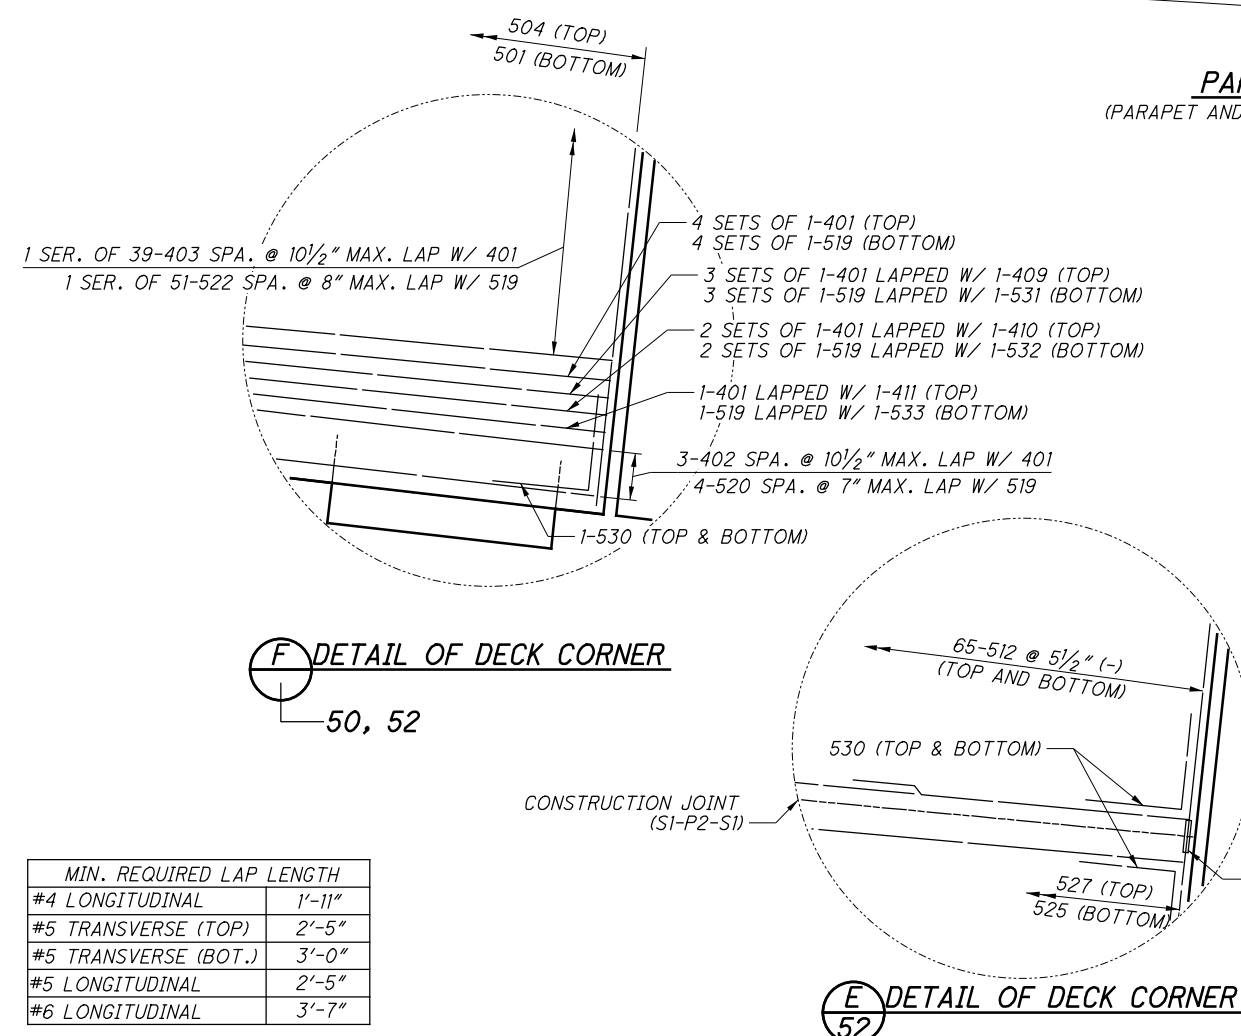

MIN. REQUIRED LAP LENGTH	
#4 LONGITUDINAL	1'-11"
#5 TRANSVERSE (TOP)	2'-5"
#5 TRANSVERSE (BOT.)	3'-0"
#5 LONGITUDINAL	2'-5"
#6 LONGITUDINAL	3'-7"

**LEGEND:**

- \* - SEE LONGITUDINAL SPACING TABLES
- \*\* - MEASURED ALONG PHASED CONSTRUCTION LINE

SI-P2-S1 (CONSTRUCTION) LONGITUDINAL BAR SPACING					
LOCATION	WIDTH	TOP BARS		BOTTOM BARS	
		NO. BARS	SPACING	NO. BARS	SPACING
REAR ABUTMENT	34'-10 1/4"	42	10" (+)	54	7 5/8" (+)
PIER 1	35'-8 5/8"	42	10 1/4" (+)	54	8" (-)
PIER 2	35'-4 1/8"	42	10 1/4" (-)	54	7 7/8" (-)
PIER 3	36'-0 1/8"	42	10 3/8" (+)	58	VARIES
PIER 4	38'-3 3/4"	45	10 3/8" (-)	58	8" (-)

SI-P2-S2 (CONSTRUCTION) LONGITUDINAL BAR SPACING					
LOCATION	WIDTH	TOP BARS		BOTTOM BARS	
		NO. BARS	SPACING	NO. BARS	SPACING
REAR ABUTMENT	17'-3 1/4"	22	9 5/8" (-)	28	7 1/2" (-)
PIER 1	17'-2 3/8"	22	9 1/2" (+)	28	7 3/8" (-)
PIER 2	16'-11 1/8"	22	9 3/8" (+)	28	7 3/8" (-)
PIER 3	17'-3 1/4"	22	9 5/8" (-)	28	7 1/2" (-)
PIER 4	18'-2 3/4"	22	10 1/8" (+)	28	7 7/8" (+)

SI-P2-S3 (CONSTRUCTION) LONGITUDINAL BAR SPACING					
LOCATION	WIDTH	TOP BARS		BOTTOM BARS	
		NO. BARS	SPACING	NO. BARS	SPACING
REAR ABUTMENT	16'-2 1/8"	21	9 5/8" (-)	27	7 3/8" (+)
PIER 1	16'-4 1/8"	21	9 1/2" (+)	27	7 3/8" (-)
PIER 2	16'-3 1/4"	21	9 1/2" (-)	27	7 1/4" (+)
PIER 3	16'-5 1/4"	21	9 1/2" (+)	27	7 3/8" (-)
PIER 4	17'-5 1/4"	21	10 1/8" (+)	27	7 3/4" (+)

**NOTES:**

- FOR NOTES, SEE SHEET 51/100.

DESIGN AGENCY  
**PRIMEV**  
540 WHITE POND DR. SUITE E  
AKRON, OH 44320

DATE  
7/30/2019

DESIGNED  
CRG

DRAWN  
JAT

REVIEWED  
TES

SLAB PLAN - UNIT 1 (2 OF 2)

BRIDGE NO. HAM-74-1908R

FILE NUMBER  
3115739

HAM-75-3.84


PID No. 104667

IR-74 OVER MILL CREEK, RR & SPRING GROVE AVENUE

52/100



P:\Projects\2018\20H03DB-18232 HAM-75-03.84\104667\structures\HAM074\_1908R\sheets\074\_1908R\_DP007.dgn 6/20/2019 9:14:15 AM oseed

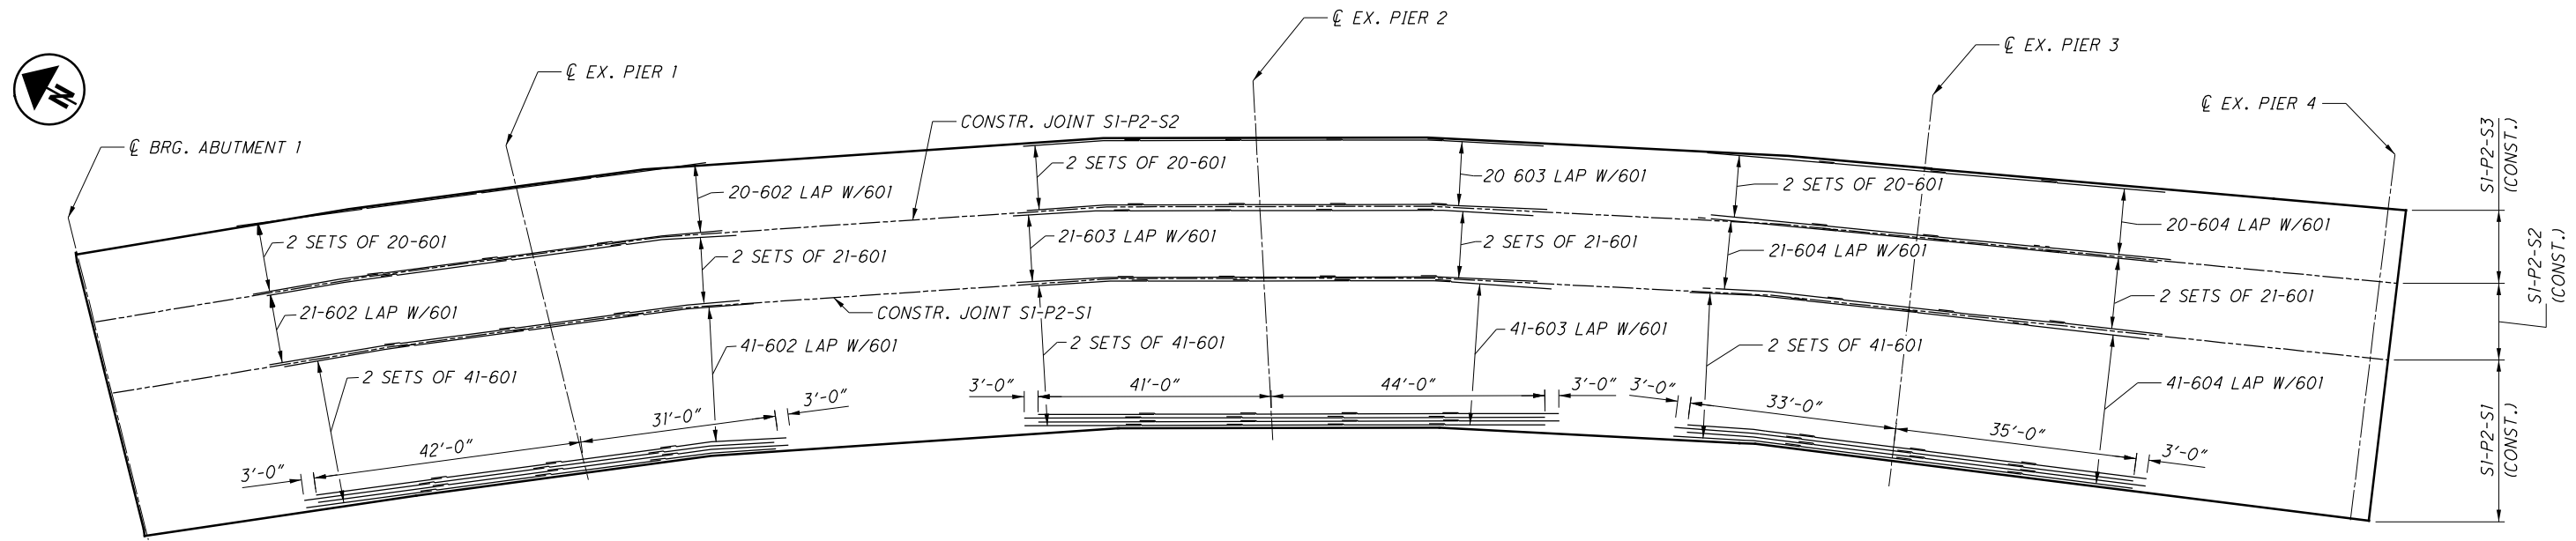


**STAGGER DIAGRAM, UNIT 1**

MIN. REQUIRED LAP LENGTH	
#6 LONGITUDINAL	3'-7"


**NOTES:**

1. BEND BARS AS NEEDED TO FIT.
2. FOR DECK REINFORCEMENT LAYOUT, SEE SHEET 50/100 THRU 69/100.
3. FOR ADDITIONAL SCUPPER DETAILS SEE SHEET 92/100, AND STD. DWG GSD-1-96.

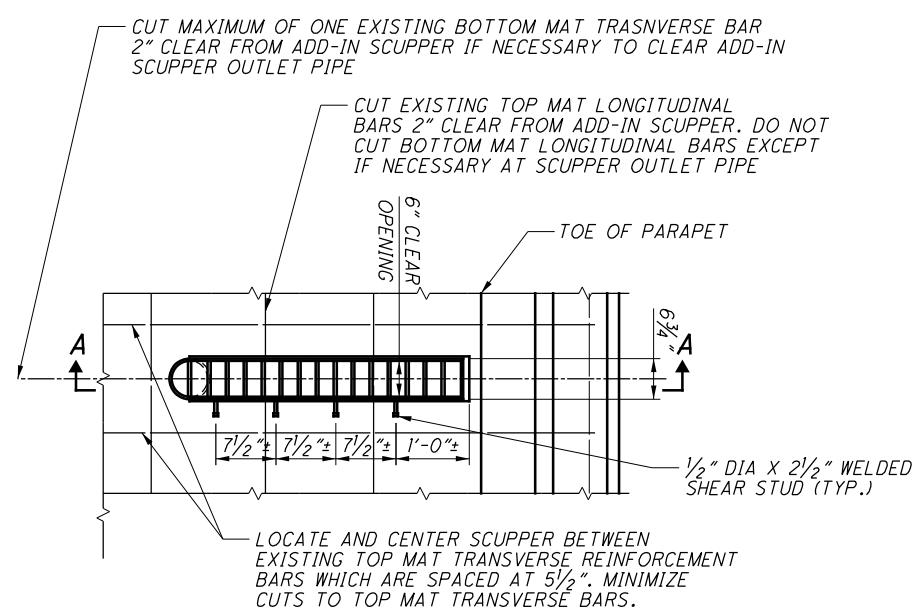


**TYPE 1 SCUPPER-PLAN**



P:\Projects\2018\20H03DB-18232 HAM-75-03.84\104667\structures\HAM074\_1908R\sheets\074\_1908R\_DP008.dgn 9/22/2023 1:23:40 PM erin.baumann

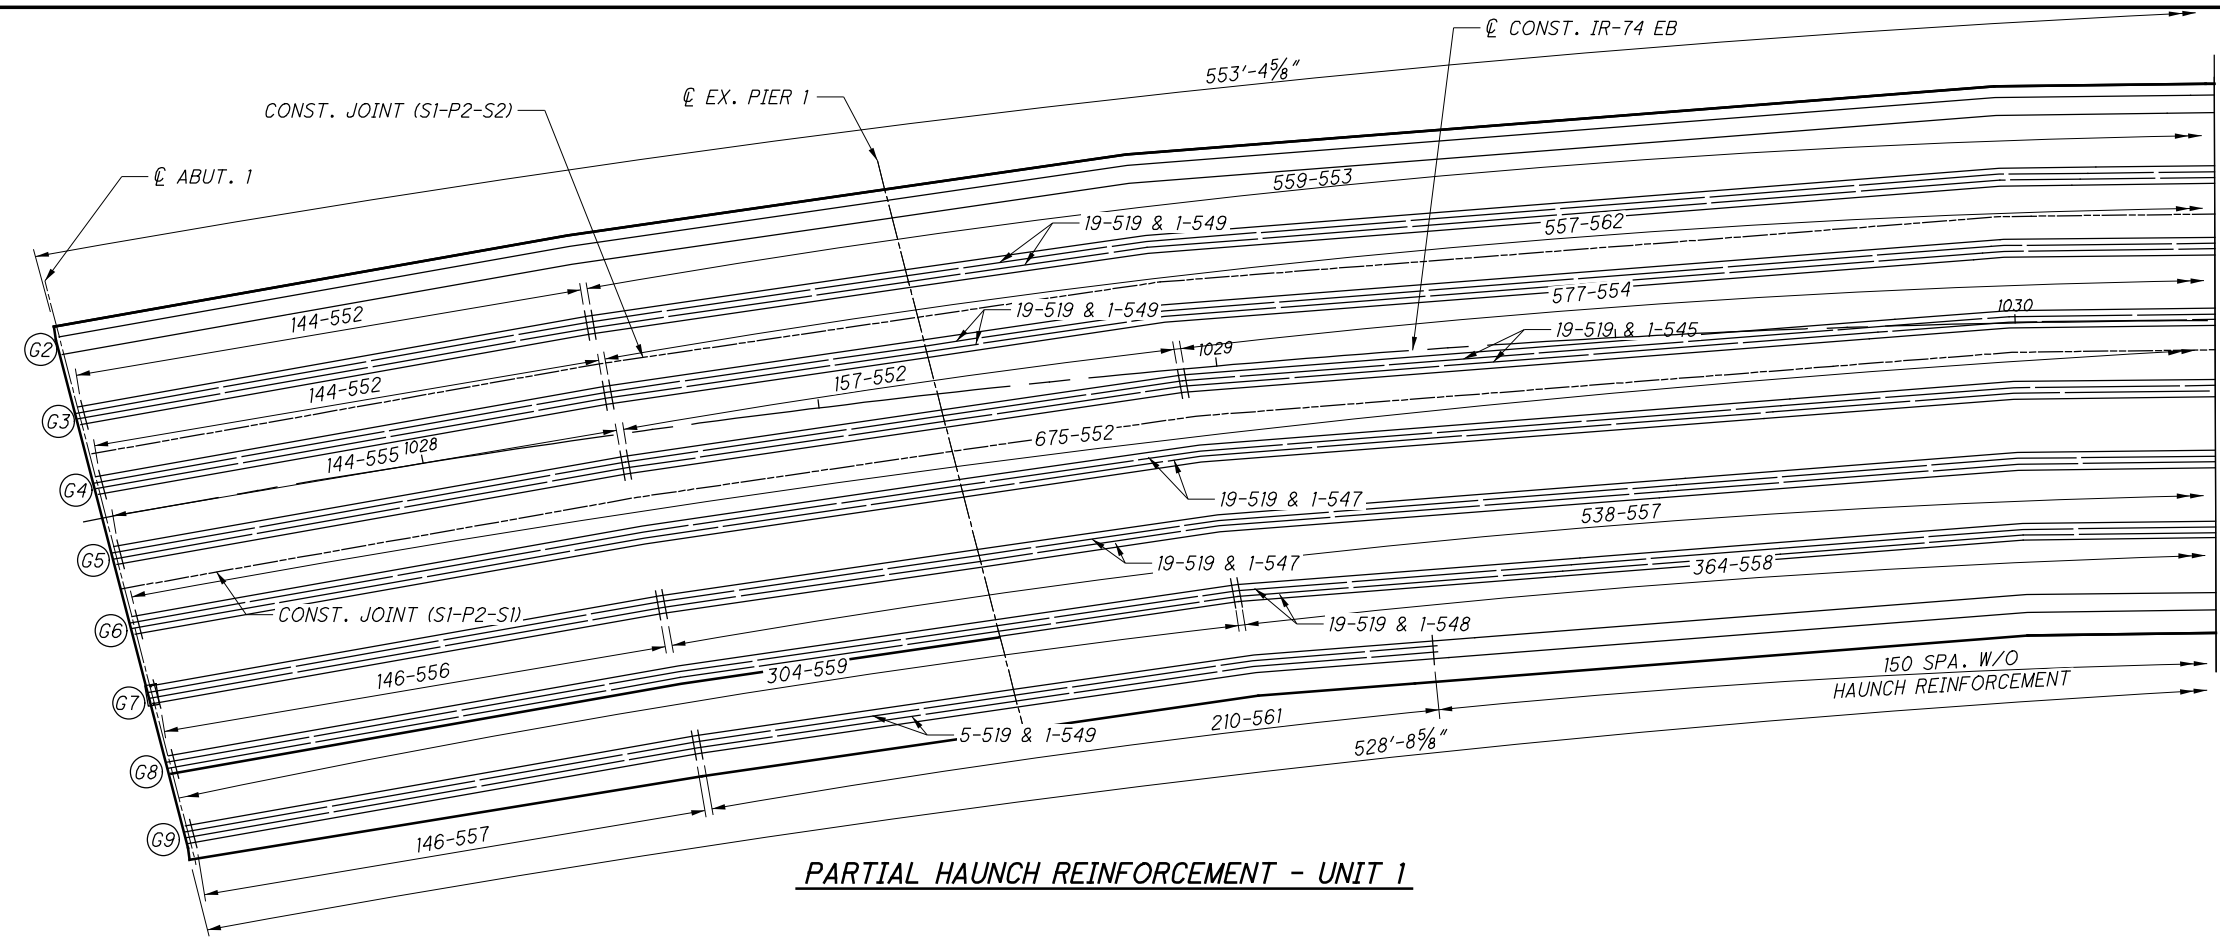

**PARTIAL HAUNCH REINFORCEMENT - UNIT 1**

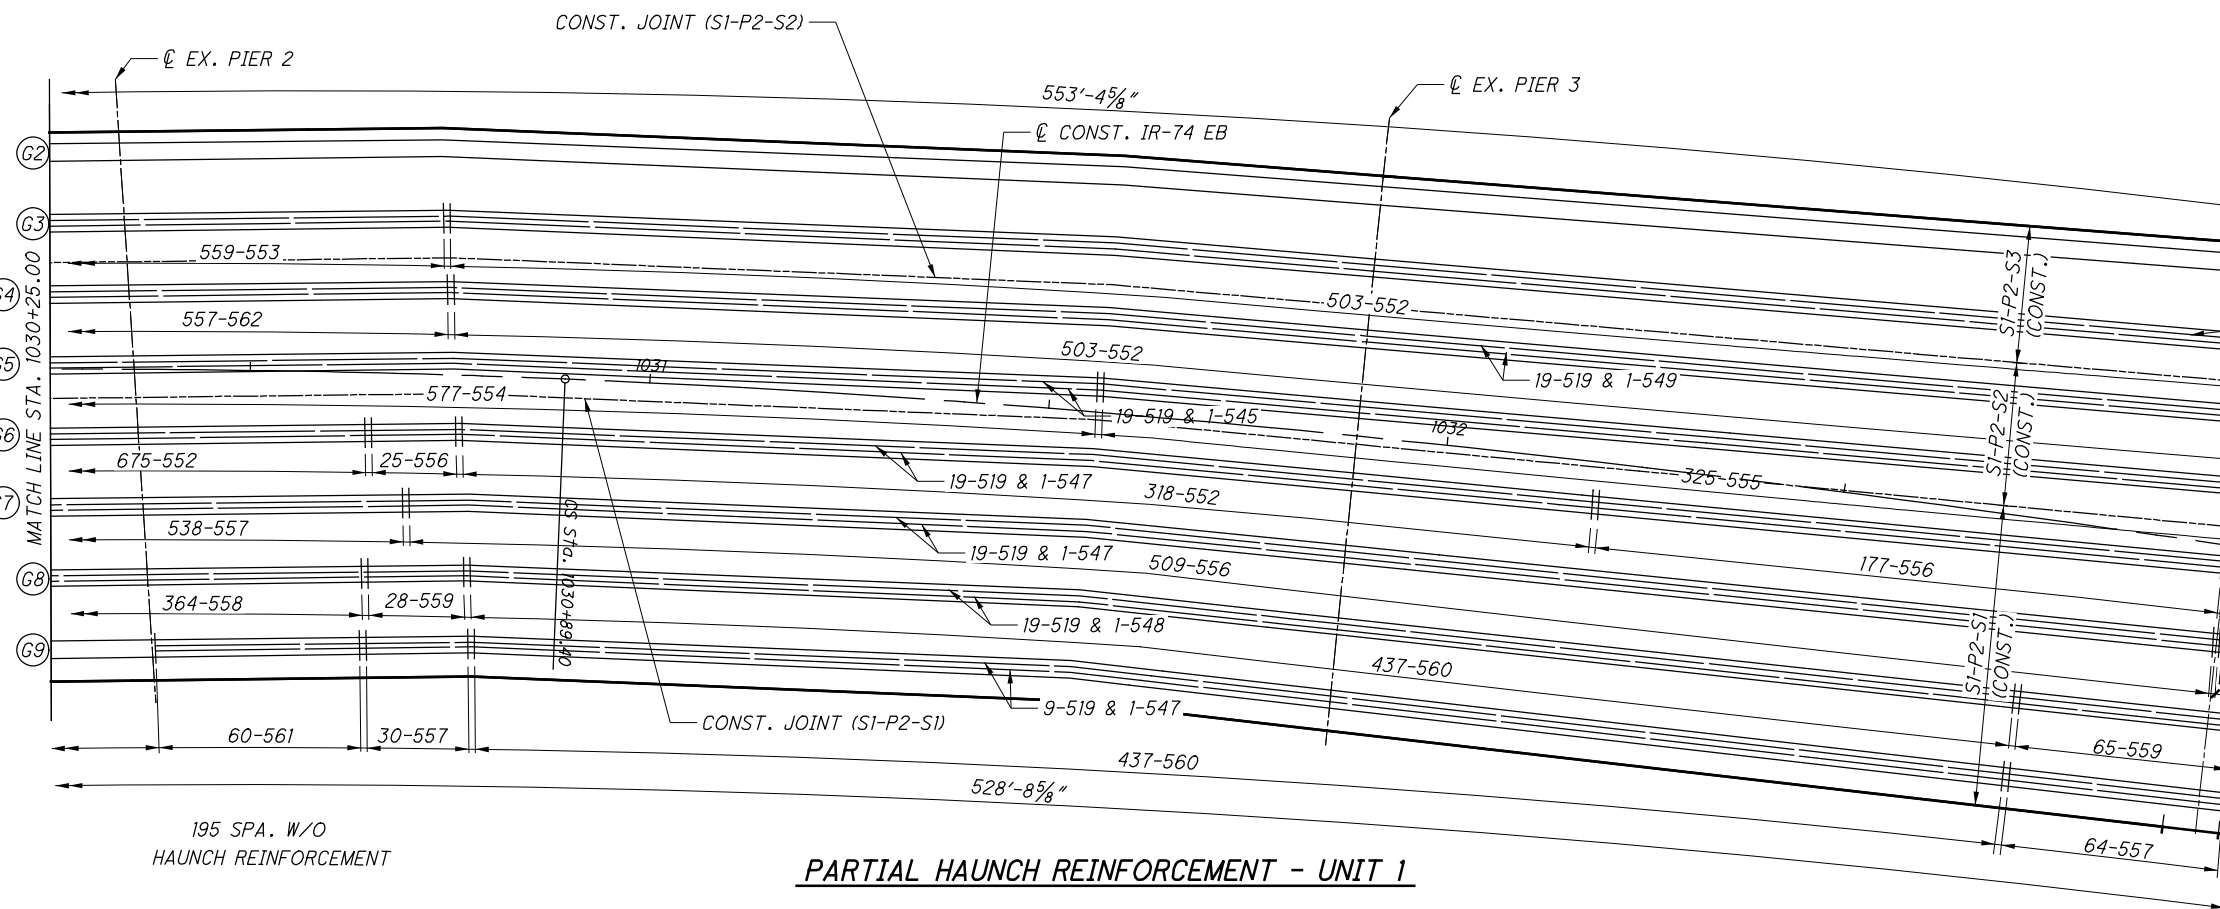

**PARTIAL HAUNCH REINFORCEMENT - UNIT 1**

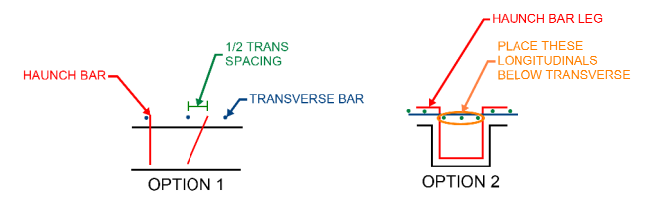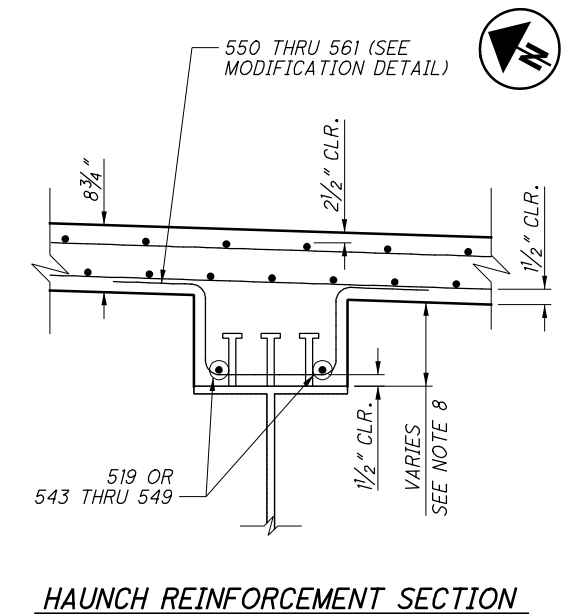

**HAUNCH REINFORCEMENT MODIFICATION**  
 HAUNCH BARS INSTALLED WITH 2 OPTIONS FOR CONSTRUCTABILITY:  
 OPTION 1: INSTALL HAUNCH BARS WITH AN ALLOWABLE LEAN OF UP TO 1/2 THE TRANSVERSE BAR SPACING.  
 OPTION 2: PLACE HAUNCH BAR LEGS ABOVE THE LONGITUDINAL BARS AND DROP THE REMAINING LONGITUDINAL BARS BELOW THE TRANSVERSE BAR WITHIN THE LIMITS OF THE HAUNCH.

MIN. REQUIRED LAP LENGTH	
#5 LONGITUDINAL	2'-5"

- NOTES:**
- FOR TRANSVERSE SECTION, SEE SHEET 50/100.
  - FOR FINAL DECK ELEVATIONS, SEE SHEET 88/100.
  - FOR REINFORCING STEEL LIST, SEE SHEETS 95/100 THRU 97/100.
  - REBAR CLEARANCE MEASURED TO THE FACE OF CONCRETE SHALL BE 2" UNLESS OTHERWISE NOTED.
  - FIELD BEND LONGITUDINAL BARS TO FIT CURVATURE OF ROADWAY AND TRANSVERSE BARS TO FIT CROWN. EPOXY COATED BARS DAMAGED BY FIELD BENDING SHALL BE REPAIRED IN ACCORDANCE WITH CMS 509.
  - THE PREFIX "IS" SHALL BE ADDED TO ALL BAR MARKS IN UNIT 1 SUPERSTRUCTURE.
  - TYPE 6 HAUNCH REINFORCEMENT BARS ARE TO BE SPACED WITH MAIN DECK REINFORCEMENT BARS.
  - FOR ESTIMATED HAUNCH THICKNESS, SEE SHEET 75/100.

**LEGEND:**  
 SX-PX-SX = STAGE X - PHASE X - STEP X  
 ■ - 7-552

DESIGN AGENCY: **PRIME**  
 540 WHITE POND DR. SUITE E  
 AKRON, OH 44320

DESIGNED: CRG  
 CHECKED: KDC

DRAWN: JAT  
 REVISED:


REVIEWED: TES  
 DATE: 7/30/2019  
 STRUCTURE FILE NUMBER: 3115739

**HAUNCH REINFORCEMENT PLAN - UNIT 1**  
 BRIDGE NO. HAM-74-1908R  
 IR-74 OVER MILL CREEK, RR & SPRING GROVE AVENUE


HAM-75-3.84  
 PID No. 104667

54/100  
 54  
 100

P:\Projects\2018\20H03DB-18232 HAM-75-03.84\104667\structures\HAM074\_1908R\RA001.dgn 6/20/2019 9:14:20 AM aseed

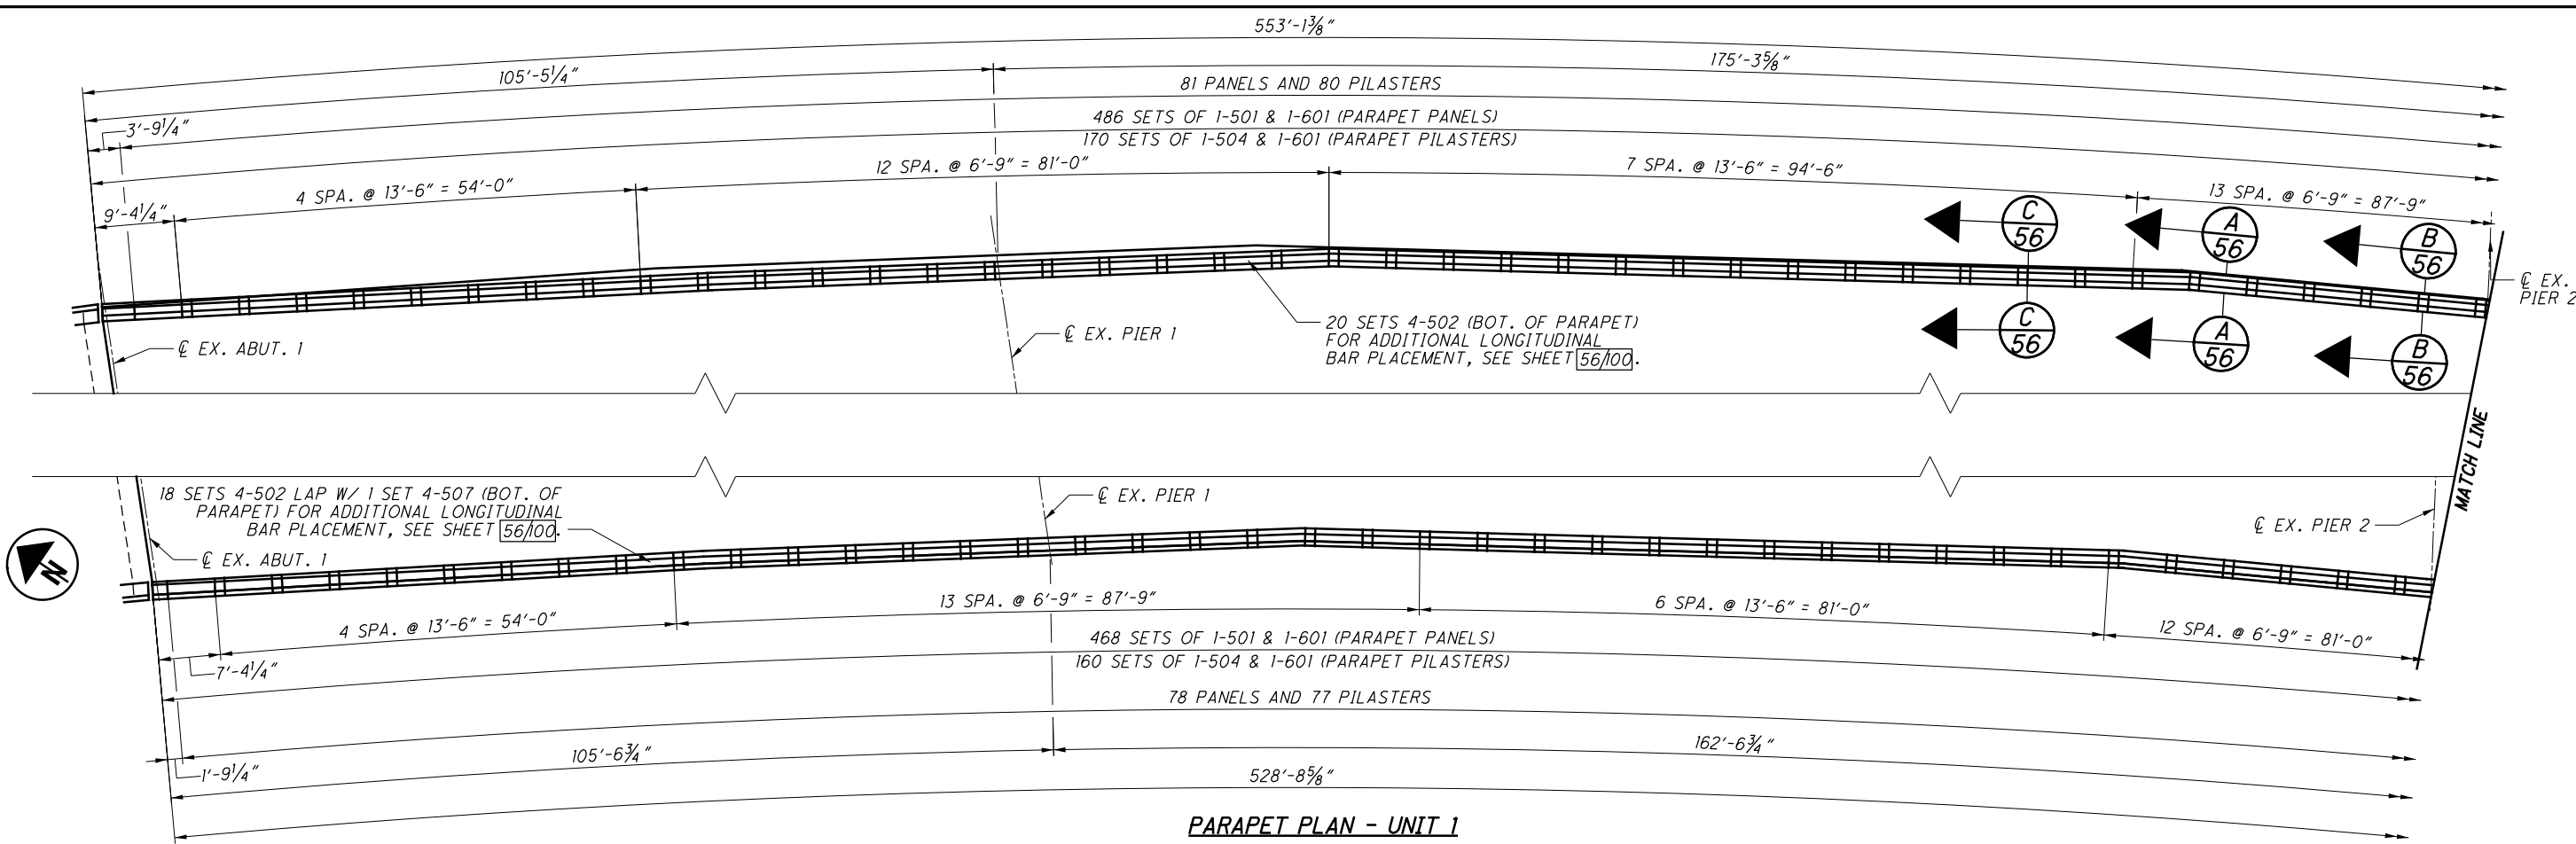

REQUIRED MINIMUM LAP LENGTHS	
NO. 5 BAR	2'-5"

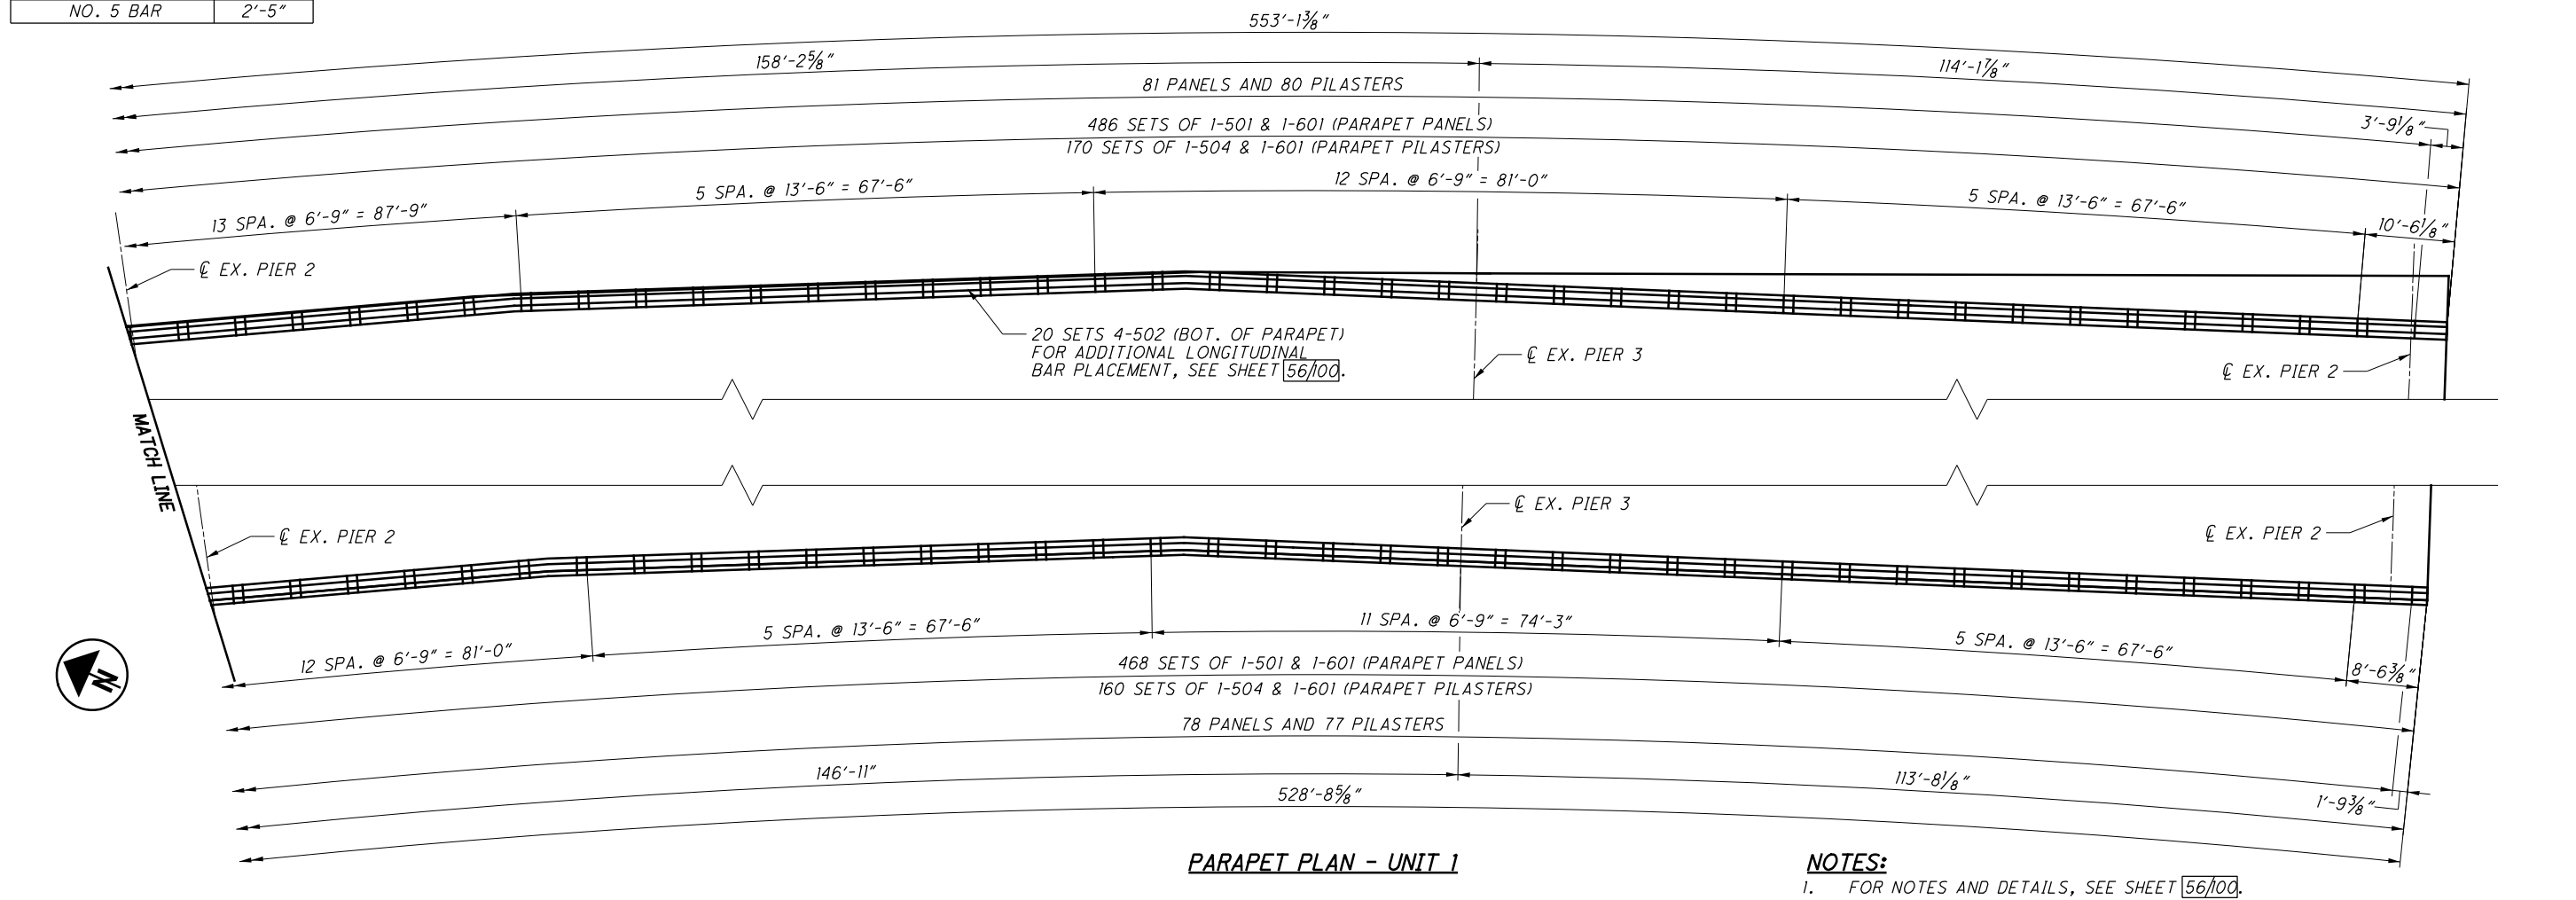

NOTES:  
1. FOR NOTES AND DETAILS, SEE SHEET 56/100.

DESIGN AGENCY  
**PRIMEW**  
540 WHITE POND DR. SUITE E  
AKRON, OH 44320

DESIGNED  
CRG

CHECKED  
KDC

DRAWN  
ADS

REVISED

REVIEWED  
TES

DATE  
3/27/2019

STRUCTURE FILE NUMBER  
3115739

BRIDGE NO. HAM-74-1908R  
IR-74 OVER MILL CREEK, RR & SPRING GROVE AVENUE


PARAPET AND MEDIAN BARRIER PLAN - UNIT 1

HAM-75-3.84  
PID No. 104667


55/100

55/100

P:\Projects\2018\20H03DB-18232 HAM-75-03.84\104667\structures\HAM074\_1908R\sheets\074\_1908R\RA006.dgn 9/8/2023 7:17:58 PM erin.baumann

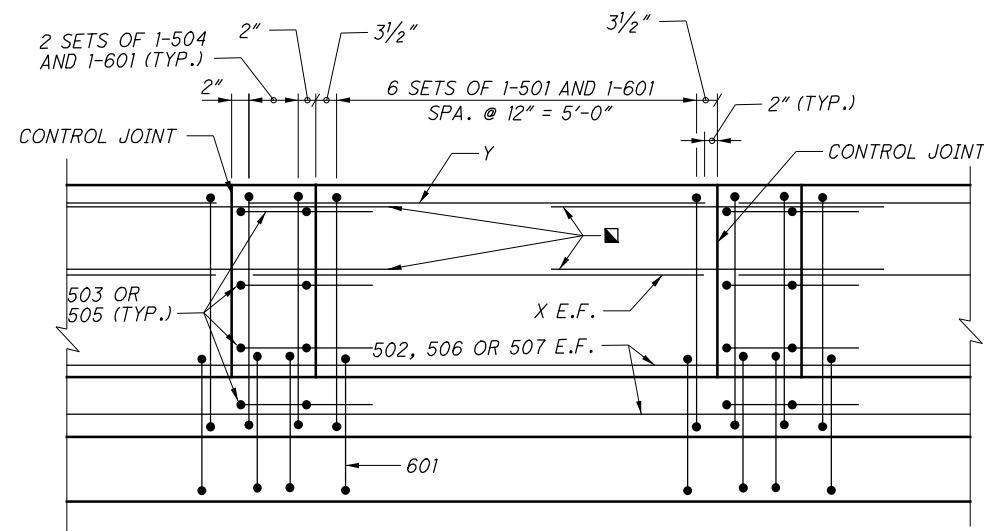


**TYPICAL ORNAMENTAL PARAPET PANEL REINFORCING**  
(SINGLE PANEL SHOWN, DOUBLE PANEL SIMILAR)

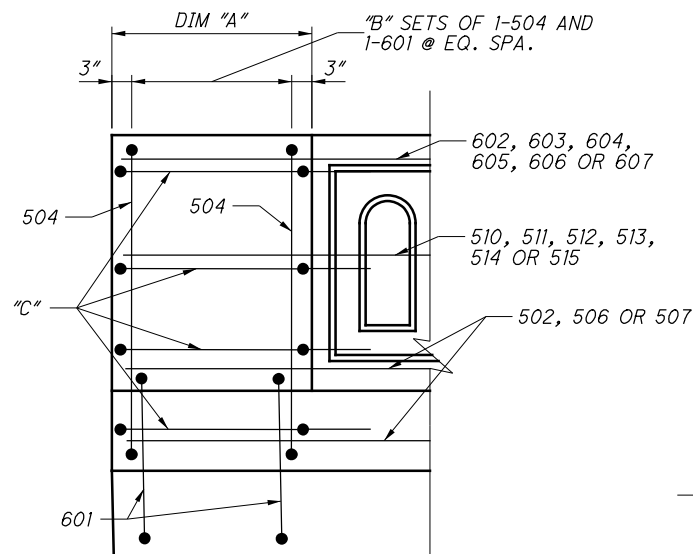

**END PILASTER DETAIL**



**C SECTION THRU CONTROL JOINT DETAIL**

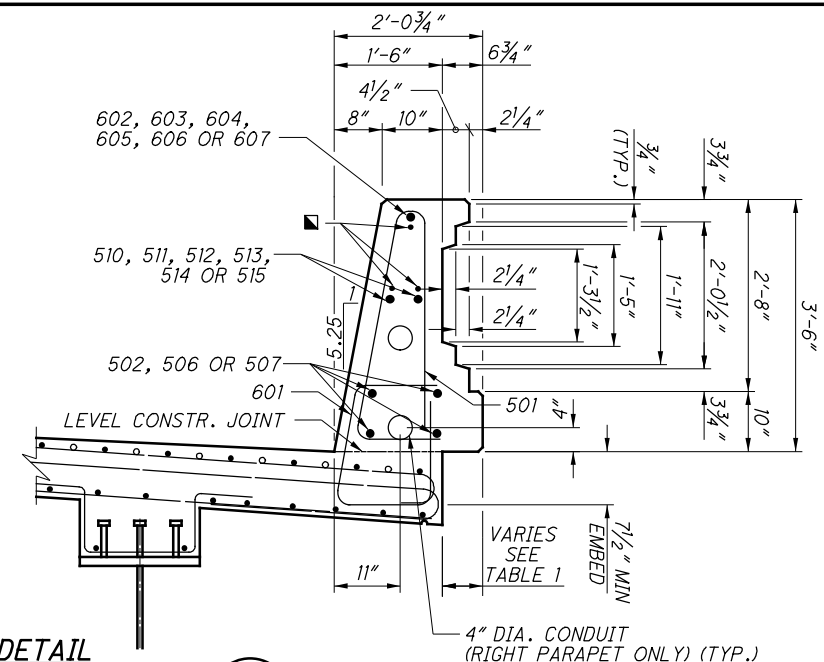

**A SECTION THRU PANEL**

UNIT	CONTROL JT. SPA.	# PANELS	BAR X	BAR Y
1	6'-9"	73	510	602
1	13'-6"	41	511	603
1	9'-4 1/4"	1	512	604
1	10'-6 3/8"	1	513	605
1	7'-4 1/4"	1	514	606
1	8'-6 5/8"	1	515	607


END PILASTERS				
UNIT	SIDE OF SLAB	DIM "A"	"B"	"C"
1	LEFT	3'-9 1/8"	5	508
1	RIGHT	1'-9 1/4"	3	509
2	LEFT	3'-8 3/8"	5	508
2	RIGHT	1'-9"	3	509
6	LEFT	1'-7"	3	508
6	RIGHT	3'-0 1/8"	4	509

TABLE 1 - PARAPET OVERHANGS		
UNIT	LEFT	RIGHT
1	VARIES, SEE SHEET 57/100	6 3/4"
2	VARIES, SEE SHEET 67/100	6 3/4"
6	6 3/4"	6 3/4"


UNIT	CONTROL JT. SPA.	# PANELS	BAR X	BAR Y
2	6'-9"	46	510	602
2	13'-6"	33	511	603
2	9'-3 3/8"	1	512	604
2	10'-5 3/8"	1	513	605
2	7'-4"	1	514	606
2	8'-6"	1	515	607

UNIT	CONTROL JT. SPA.	# PANELS	BAR X	BAR Y
6	6'-9"	33	510	602
6	13'-6"	6	511	603
6	7'-2"	1	512	604
6	8'-3 1/8"	1	513	605
6	8'-7 1/8"	1	514	606
6	9'-9 1/8"	1	515	607

- NOTES:**
1. THE PREFIX "1R" SHALL BE ADDED TO ALL BAR MARKS FOR PARAPET DETAILS IN UNIT 1, "2R" SHALL BE ADDED TO ALL BAR MARKS FOR PARAPET DETAILS IN UNIT 2 AND "3R" SHALL BE ADDED TO ALL BAR MARKS FOR PARAPET DETAILS IN UNIT 3.
  2. FOR REINFORCING STEEL LIST, SEE SHEET 98/100.
  3. FOR ADDITIONAL DETAILS, SEE STANDARD DRAWING SBR-1-13.

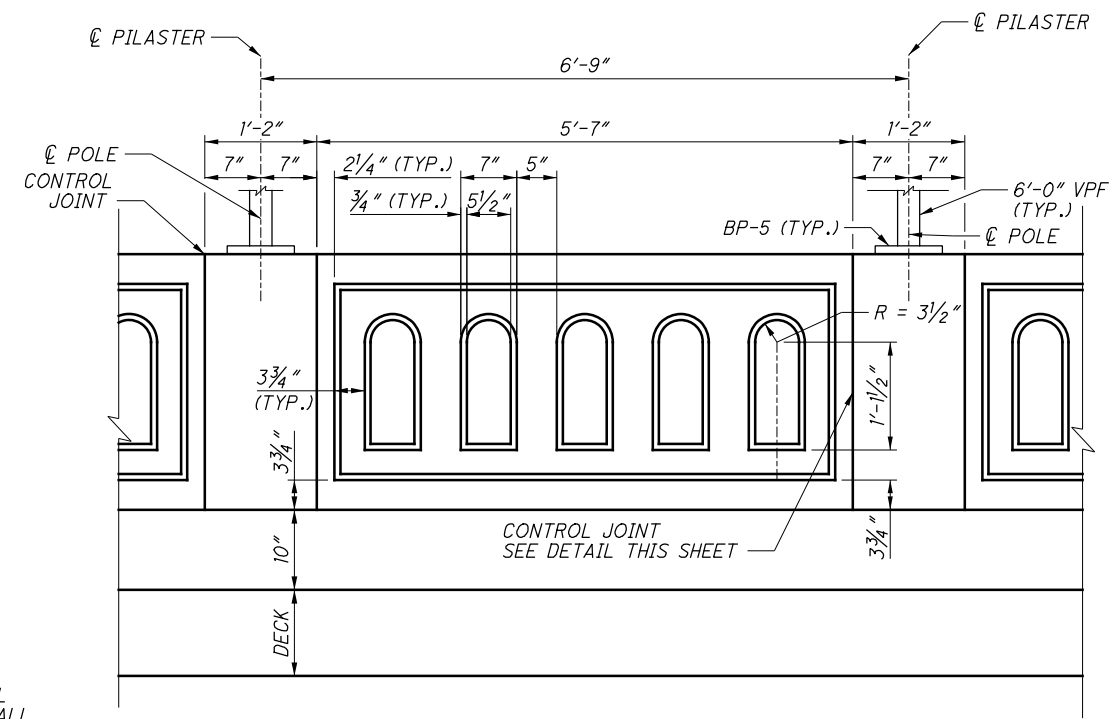

**TYPICAL ORNAMENTAL PARAPET PANEL**  
(VPF ON SPAN 7 OVER THE RAILROAD ONLY)

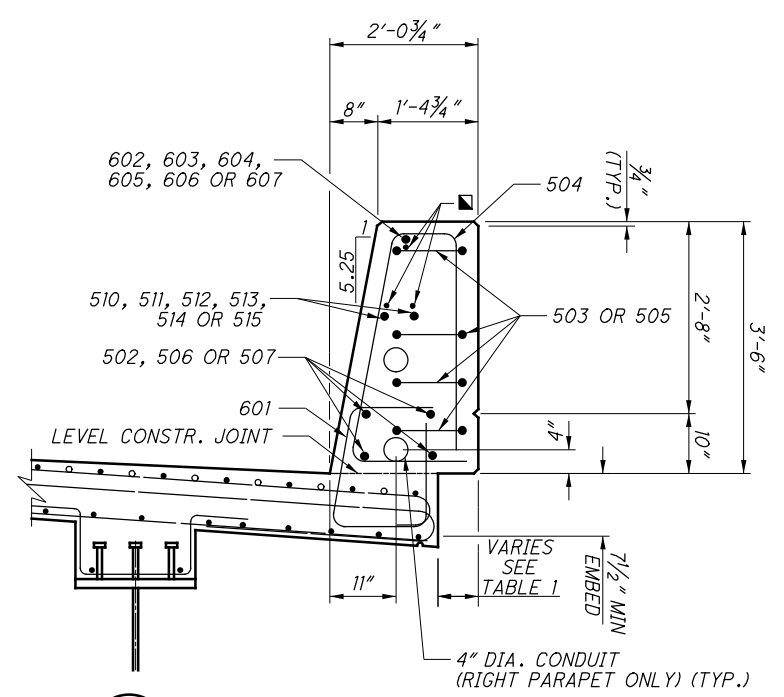

**B SECTION THRU PILASTER**

- LEGEND:**
- - 1/2" DIA. GLASS FIBER REINFORCED POLYMER (GFRP) STIFFENING REINFORCEMENT

DESIGN AGENCY: **PRIME**  
540 WHITE POND DR. SUITE E AKRON, OH 44320

DATE: 7/30/2019  
REVIEWED: TES  
STRUCTURE FILE NUMBER: 3115739


DESIGNED: KDC  
CHECKED: CRG

PARAPET DETAILS  
BRIDGE NO. HAM-74-1908R  
IR-74 OVER MILL CREEK, RR & SPRING GROVE AVENUE

HAM-75-3.84  
PID No. 104667


56/100  
56/100

P:\Projects\2018\20H03DB-18232 HAM-75-03.84\104667\structures\HAM074\_1908R\sheets\074\_1908R\_RA004.dgn 6/20/2019 9:15:09 AM cseee

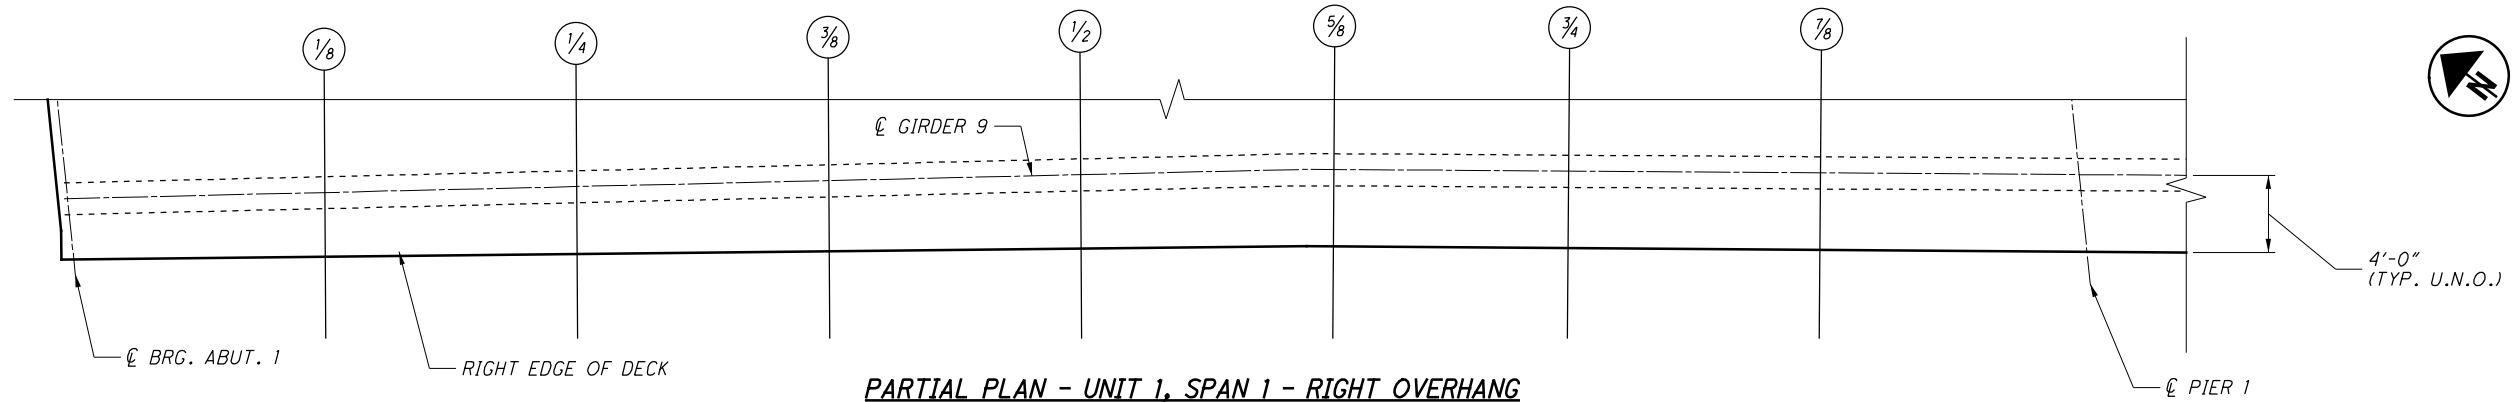


PARTIAL PLAN - UNIT 1, SPAN 1 - RIGHT OVERHANG

SPAN 1 RIGHT OVERHANG								
CL EX. ABUT 1	1/8	1/4	3/8	1/2	5/8	3/4	7/8 POINT	CL EX. PIER 1
3'-2 1/8"	3'-4 1/8"	3'-6 1/8"	3'-8 1/8"	3'-10 1/8"	4'-0"	4'-0"	4'-0"	4'-0"

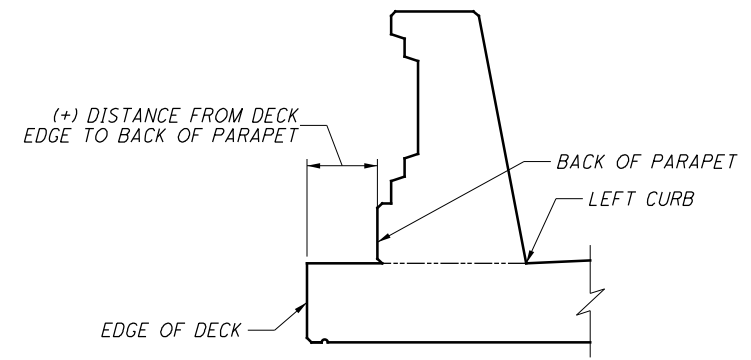

**A** PARAPET OVERHANG SECTION  
57

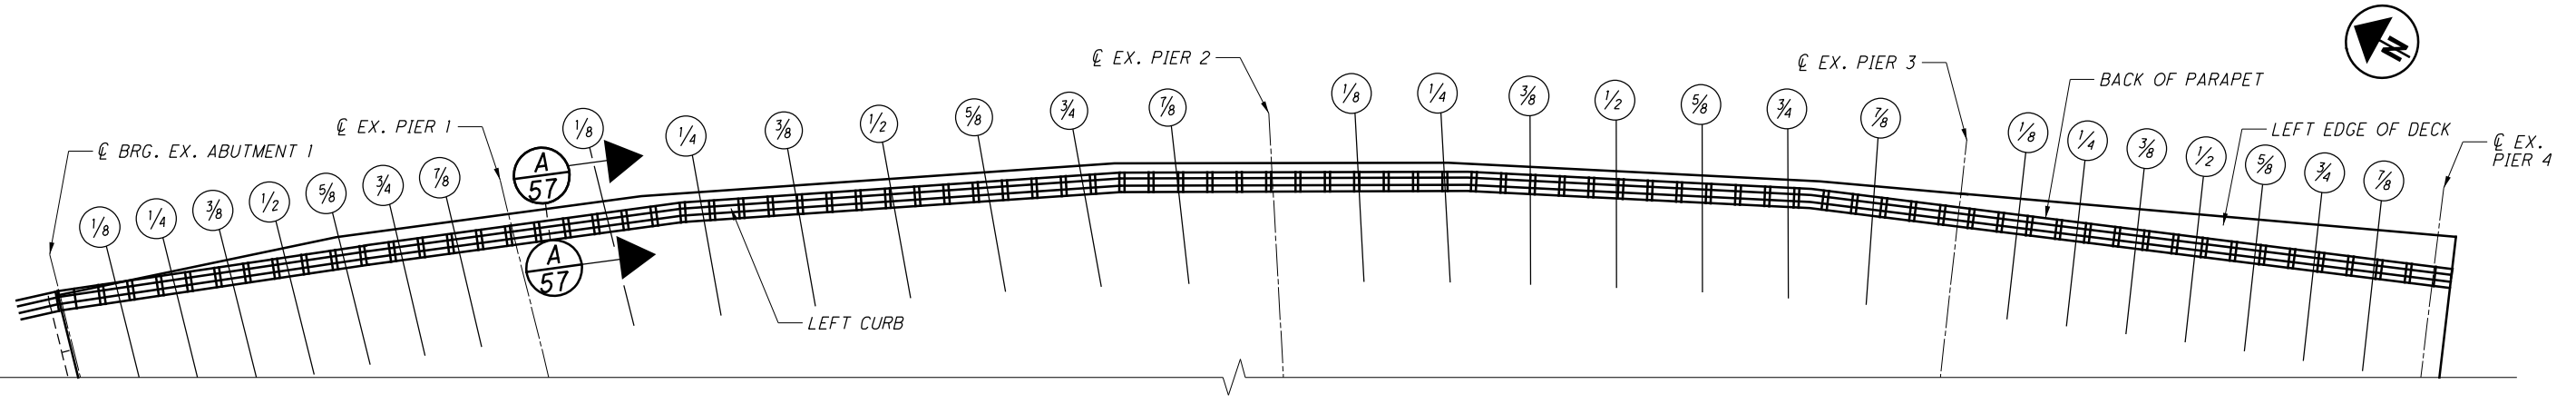



PARTIAL PLAN - LEFT PARAPET LOCATION OFFSET

DISTANCE FROM BACK OF PARAPET TO EDGE OF DECK															
CL EX. ABUT 1	1/8	1/4	3/8	1/2	5/8	3/4	7/8	CL EX. PIER 1	1/8	1/4	3/8	1/2	5/8	3/4	7/8
-4 3/8"	-1 3/8"	1/2"	4 1/2"	7 1/2"	10 1/8"	9 1/4"	9 1/4"	9 1/4"	9 1/8"	2 1/8"	2 1/8"	2 1/4"	2 1/8"	2 3/8"	1 3/8"

DISTANCE FROM BACK OF PARAPET TO EDGE OF DECK																
CL EX. PIER 2	1/8	1/4	3/8	1/2	5/8	3/4	7/8	CL EX. PIER 3	1/8	1/4	3/8	1/2	5/8	3/4	7/8	CL EX. PIER 4
1 1/4"	1"	1/8"	-2"	-2"	-1 1/8"	-1 1/8"	5 1/8"	1'-1 1/8"	1' 7 3/4"	2' 2"	2' 8 1/8"	3' 2 3/8"	3' 8 1/2"	4' 2 3/4"	4' 8 1/8"	5' 3 1/8"

NOTE: NEGATIVE NUMBER IMPLIES PARAPET OVERHANGS EDGE OF DECK

P:\Projects\2018\20H03DB-18232 HAM-75-03.84\104667\structures\HAM074\_1908R\sheets\074\_1908R\ISO02.dgn 9/22/2023 2:49:42 PM erin.bourmann

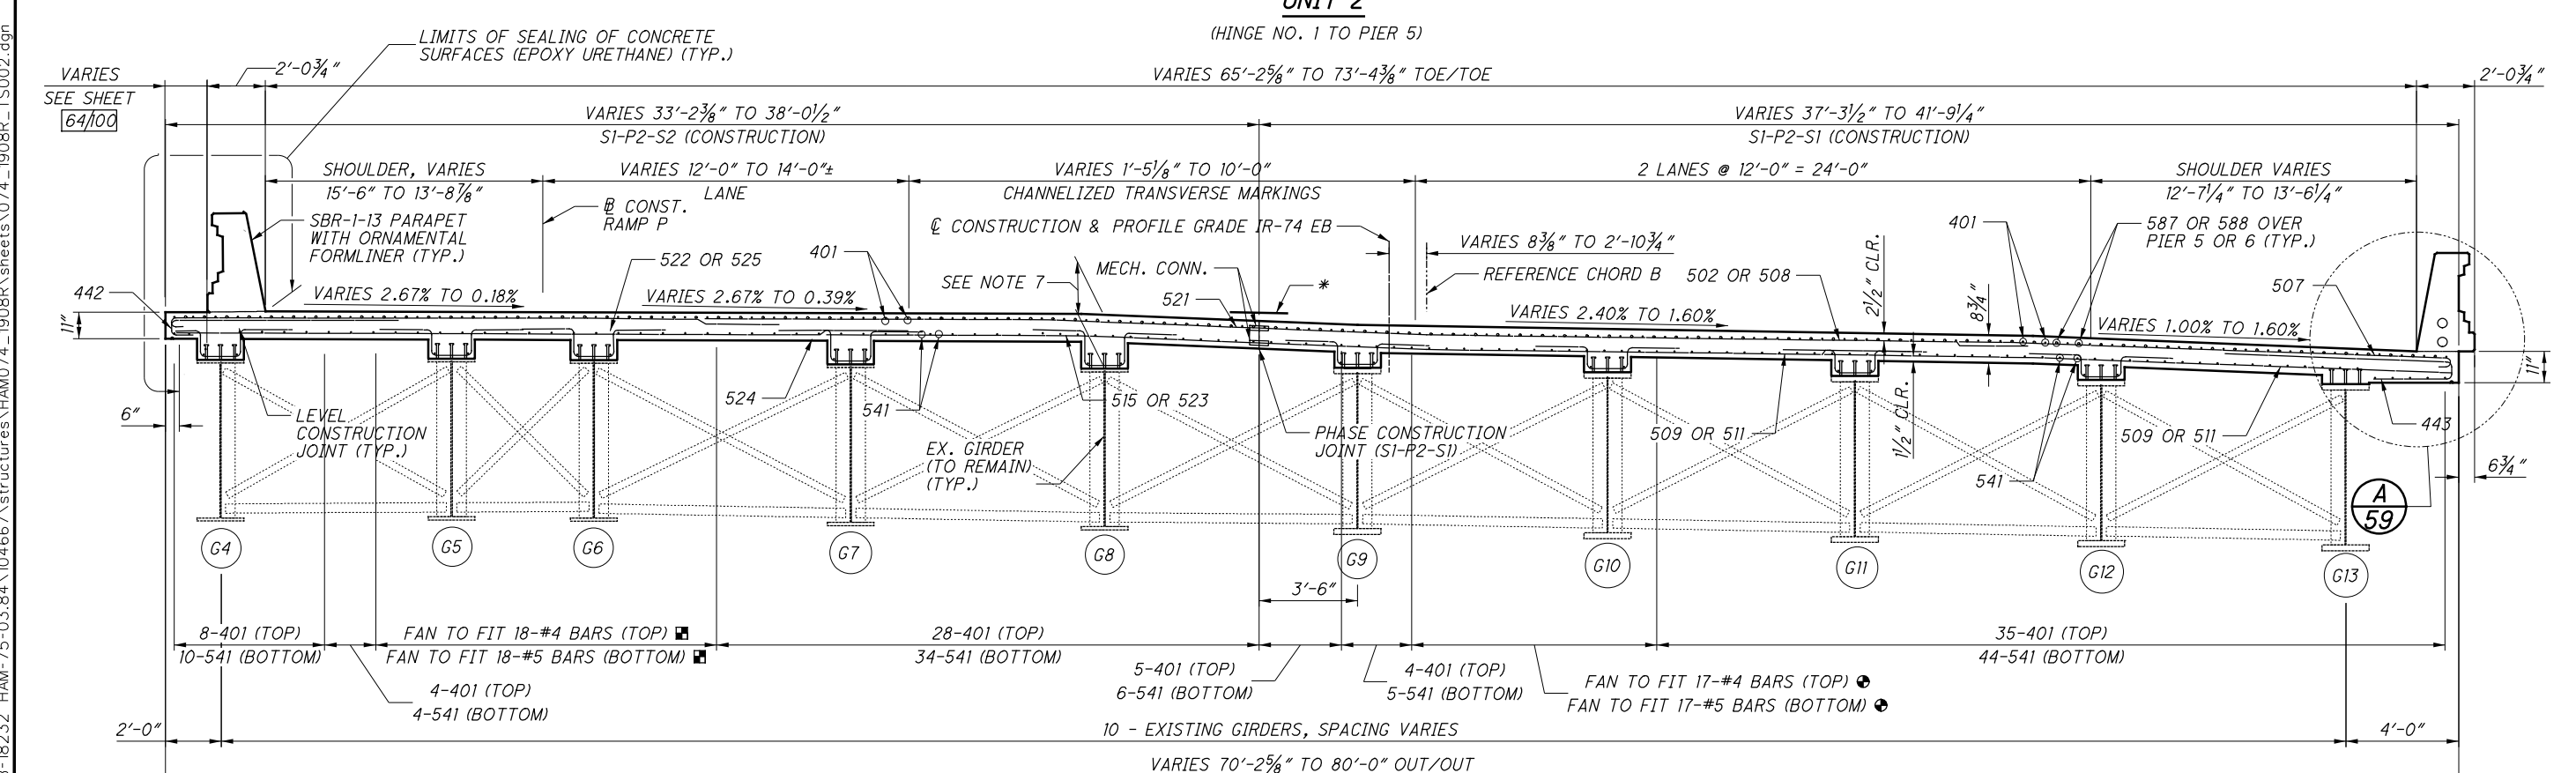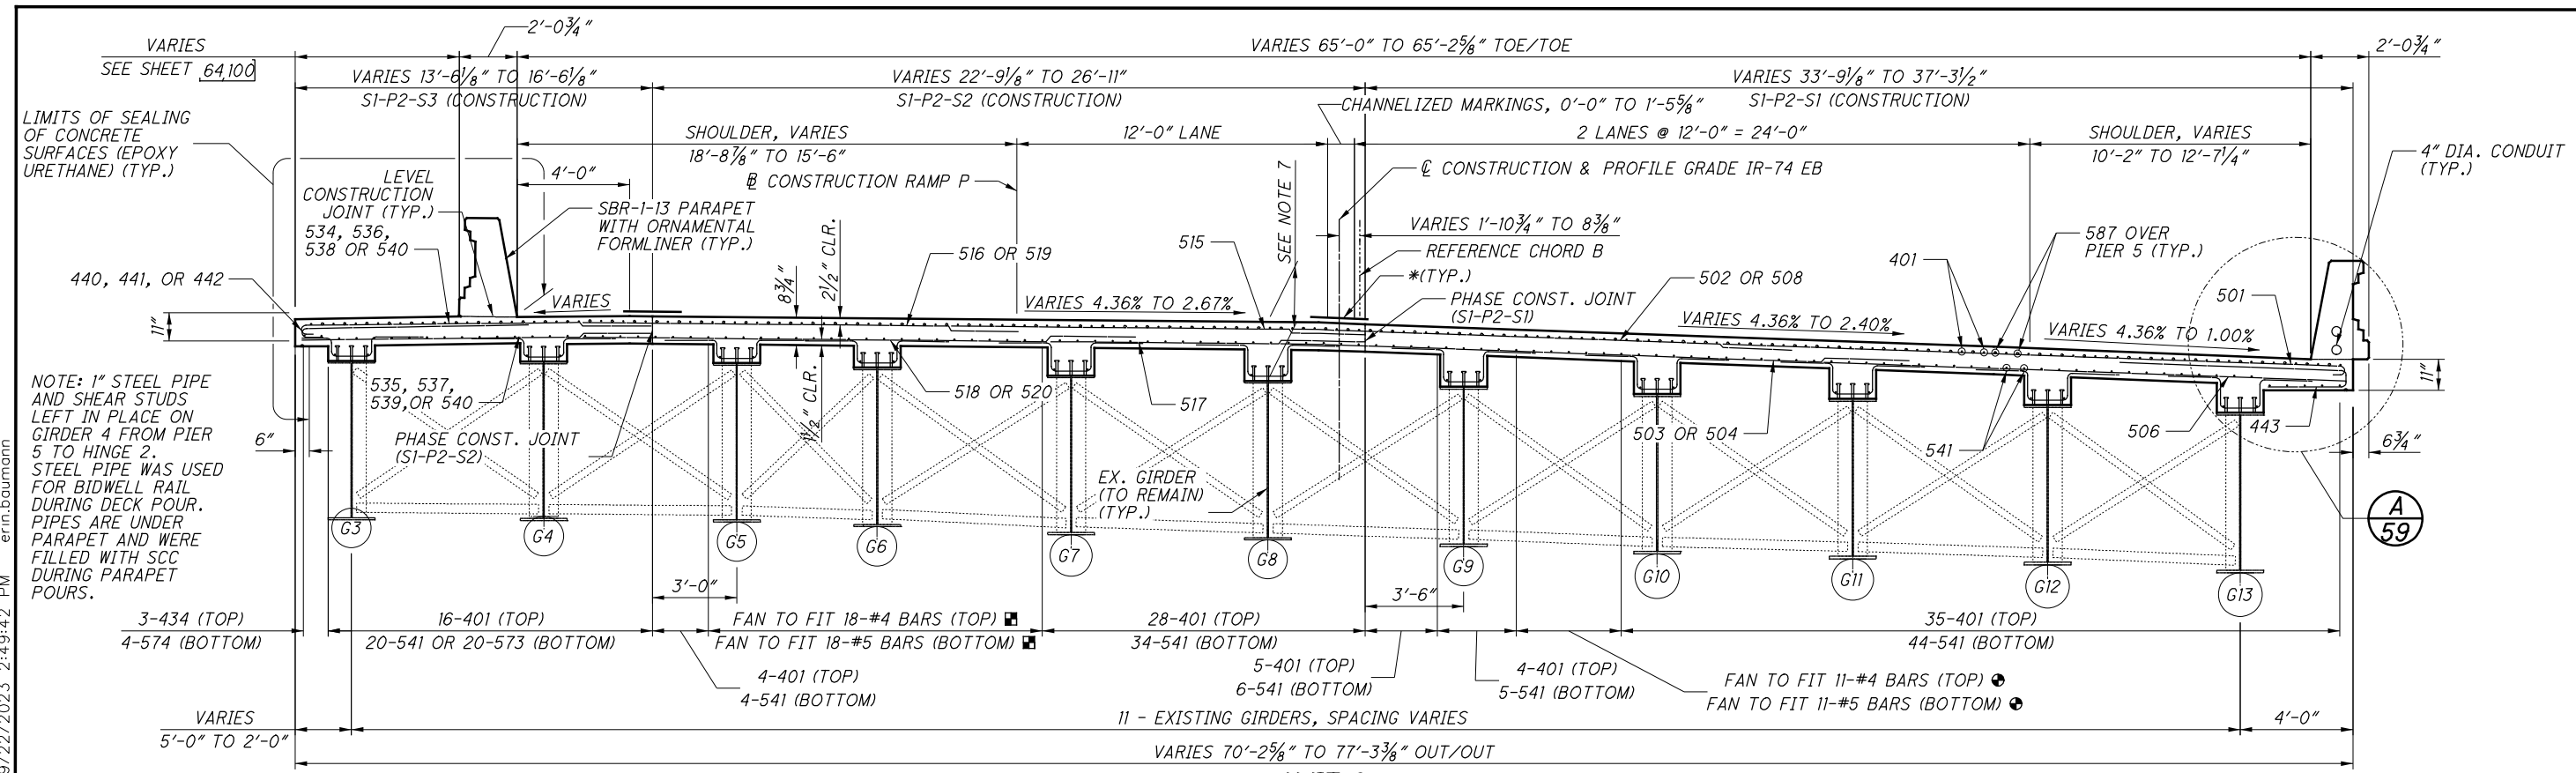

MIN. REQUIRED LAP LENGTH	
#4 LONGITUDINAL	1'-11"
#5 TRANSVERSE (TOP)	2'-5"
#5 TRANSVERSE (BOT.)	3'-0"
#5 LONGITUDINAL	2'-5"
#6 LONGITUDINAL	3'-7"

- LEGEND:**
- ⊕ SEE **(G)** 62 DETAIL OF DECK CORNER
  - ⊠ SEE **(F)** 62 DETAIL OF DECK CORNER
  - \* HMWM RESIN, 2'-0" WIDE, CENTERED ON JOINT, FULL LENGTH OF JOINT.

- UNIT 2 NOTES:**
- (PIER 5 TO PIER 6)
1. TRANSVERSE SECTIONS DRAWN LOOKING UPSTATION.
  2. SIP FORMS CAN BE USED OVER MILL CREEK AND THE RAILROAD.
  3. THE PREFIX "2S" SHALL BE ADDED TO ALL BAR MARKS FOR UNIT 2 SLAB AND "2R" FOR UNIT 2 RAILING.

- NOTES CONT.:**
4. FOR FINAL DECK ELEVATIONS, SEE SHEETS 76/100 THRU 78/100.
  5. FOR DECK PLAN, SEE SHEETS 60/100 AND 61/100.
  6. FOR FRAMING PLAN, SEE SHEET 46/100.
  7. FOR ESTIMATED HAUNCH THICKNESSES, SEE SHEET 79/100.

DESIGN AGENCY  
**PRIMEW**  
540 WHITE POND DR. SUITE E  
AKRON, OH 44320

DESIGNED  
CRG

DRAWN  
JAT

REVIEWED  
TES

DATE  
7/30/2019

BRIDGE NO. HAM-74-1908R

IR-74 OVER MILL CREEK, RR & SPRING GROVE AVENUE

TRANSVERSE SECTIONS - UNIT 2 (PAGE 1 OF 2)

PID No. 104667


HAM-75-3.84

58/100


58  
100



P:\Projects\2018\20H03DB-18232 HAM-75-03.84\104667\structures\HAM074\_1908R\sheets\074\_1908R\1908R-TS004.dgn 9/8/2023 7:19:34 PM erin.bourmann

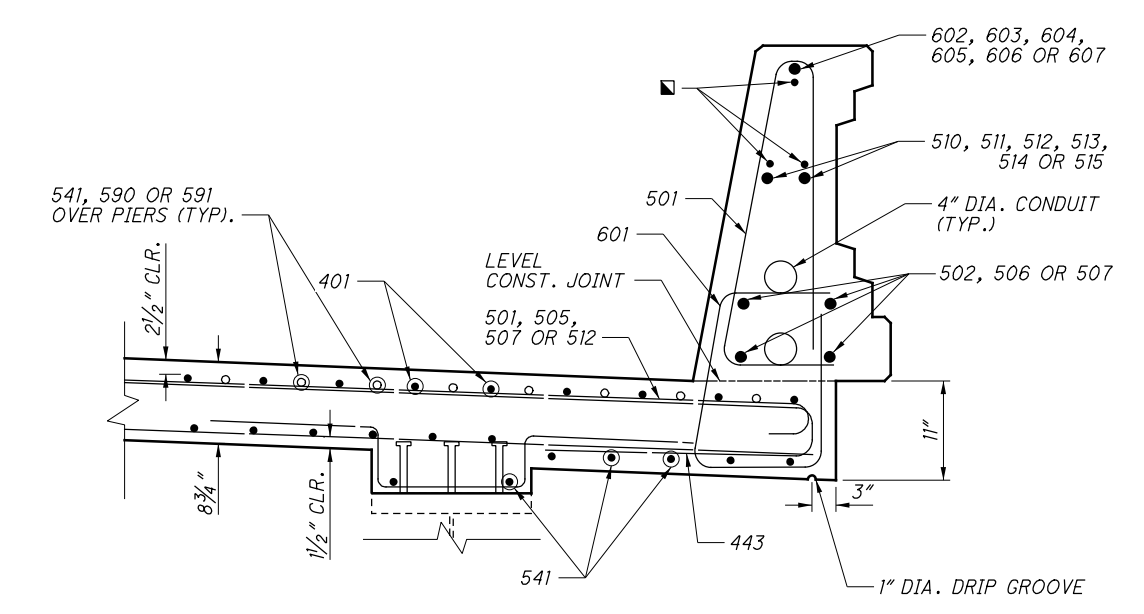

**A**  
58, 59  
DETAIL OF DECK CORNER

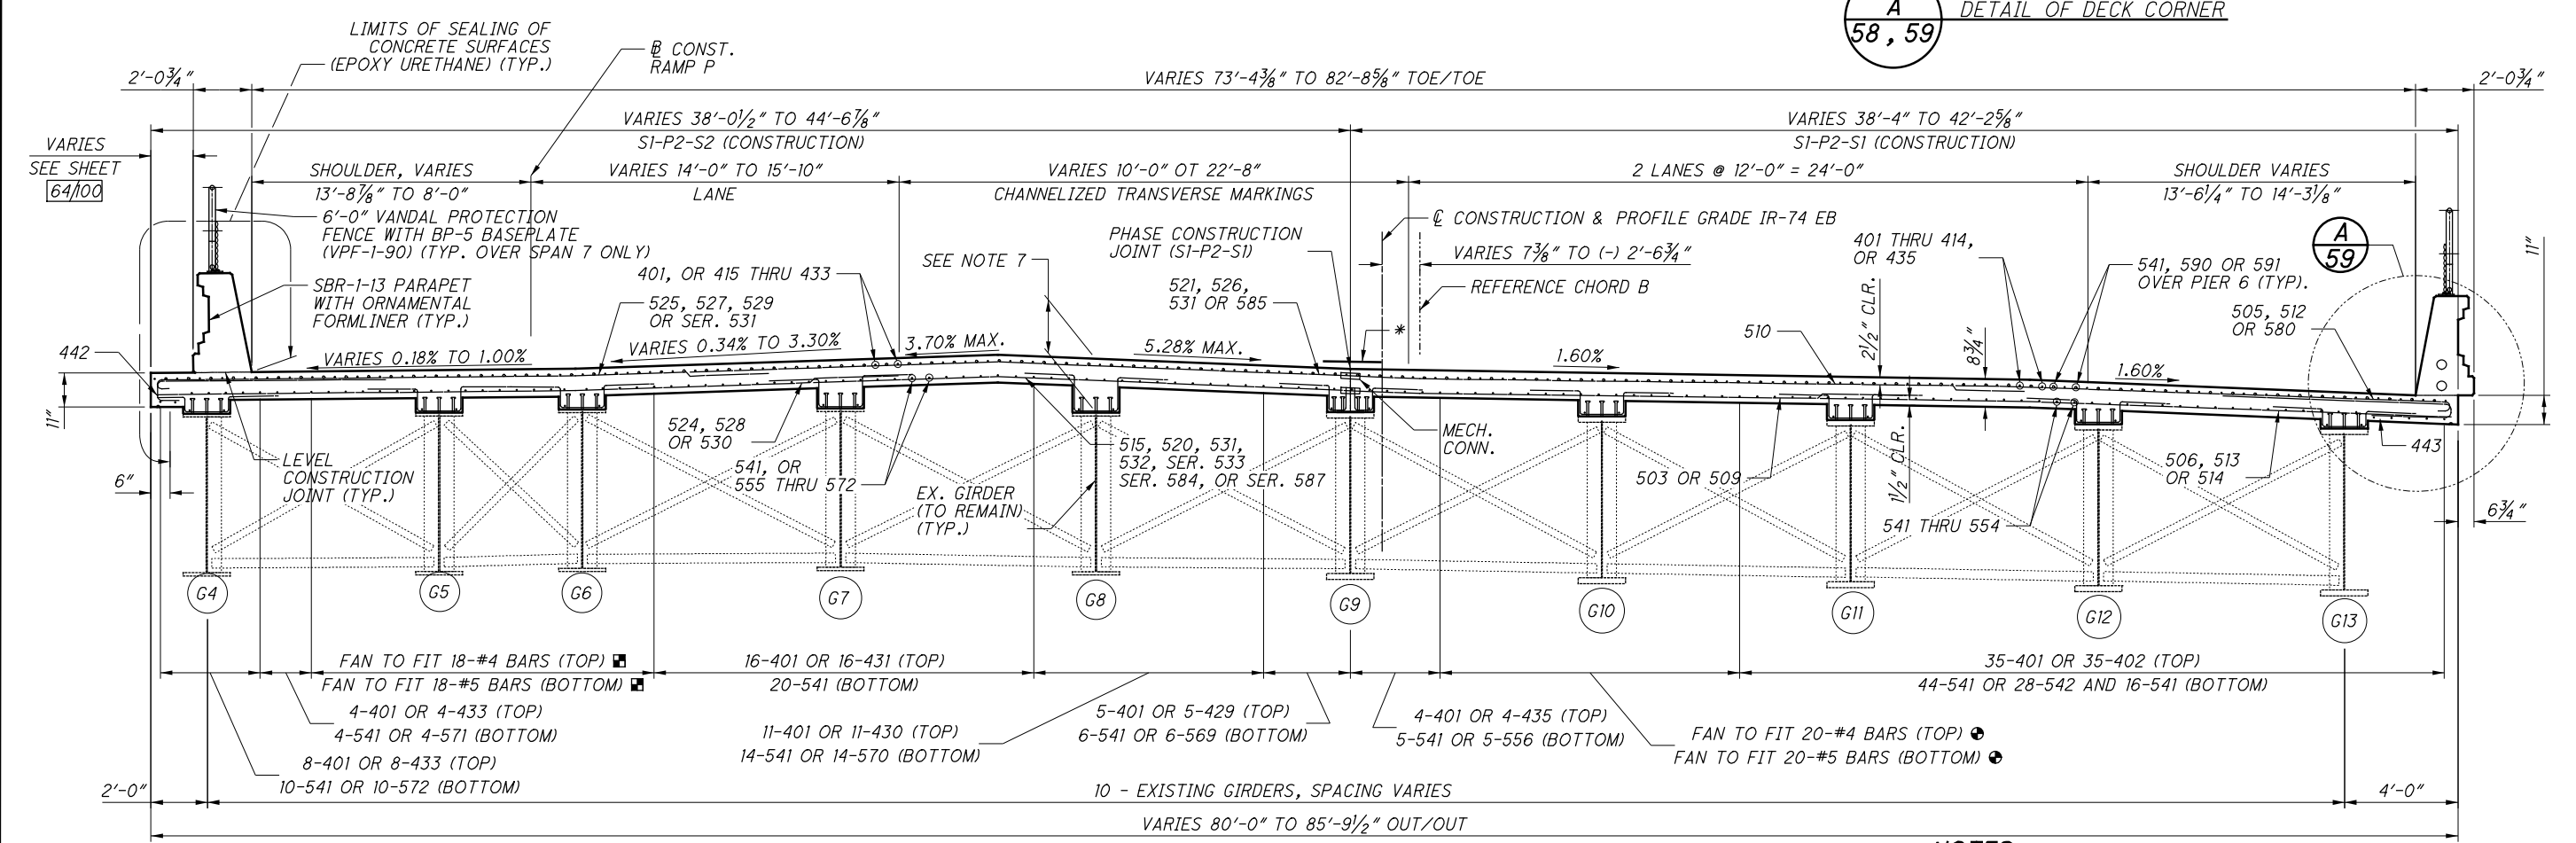

**LEGEND:**

- - 1/2" DIA. GLASS FIBER REINFORCED POLYMER (GFRP) STIFFENING REINFORCEMENT.
- - SEE **G** 62 DETAIL OF DECK CORNER
- - SEE **F** 62 DETAIL OF DECK CORNER
- \* - HMWM RESIN, 2'-0" WIDE, CENTERED ON JOINT, FULL LENGTH OF JOINT.

MIN. REQUIRED LAP LENGTH	
#4 LONGITUDINAL	1'-11"
#5 TRANSVERSE (TOP)	2'-5"
#5 TRANSVERSE (BOT.)	3'-0"
#5 LONGITUDINAL	2'-5"

**UNIT 2**  
(PIER 6 TO HINGE 2)

**NOTES:**

1. TRANSVERSE SECTIONS DRAWN LOOKING UPSTATION.
2. SIP FORMS CAN BE USED OVER MILL CREEK AND THE RAILROAD.
3. THE PREFIX "2S" SHALL BE ADDED TO ALL BAR MARKS FOR UNIT 2 SLAB AND "2R" FOR UNIT 2 RAILING.
4. FOR FINAL DECK ELEVATIONS, SEE SHEETS [76/100] THRU [78/100].
5. FOR DECK PLAN, SEE SHEETS [60/100] AND [61/100].
6. FOR FRAMING PLAN, SEE SHEET [46/100].
7. FOR ESTIMATED HAUNCH THICKNESSES, SEE SHEET [79/100].
8. FOR ADDITIONAL VANDAL PROTECTION FENCE DETAILS, SEE STD. DWG. VPF-1-90

DESIGN AGENCY  
**PRIMEW**  
540 WHITE POND DR., SUITE E  
AKRON, OH 44320

REVIEWED DATE  
TES 7/30/2019

STRUCTURE FILE NUMBER  
3115739

DRAWN JAT  
REVISED

DESIGNED CRG  
CHECKED KDC

**TRANSVERSE SECTIONS - UNIT 2 (PAGE 2 OF 2)**  
BRIDGE NO. HAM-74-1908R  
IR-74 OVER MILL CREEK, RR & SPRING GROVE AVENUE

HAM-75-3.84  
PID No. 104667

59/100  
**59**  
100

P:\Projects\2018\20H03DB-18232 HAM-75-03.84\104667\structures\HAM074\_1908R\DP004.dgn 11/13/2023 4:01:00 PM adesimone

MIN. REQUIRED LAP LENGTH	
#4 LONGITUDINAL	1'-11"
#5 TRANSVERSE (TOP)	2'-5"
#5 TRANSVERSE (BOT.)	3'-0"
#5 LONGITUDINAL	2'-5"

DESIGN AGENCY  
**PRIME**  
540 WHITE POND DR. SUITE E  
AKRON, OH 44320

DESIGNED  
JAT  
CHECKED  
CRG


DRAWN  
JAT  
REVISED

REVIEWED  
TES  
DATE  
7/30/2019  
STRUCTURE FILE NUMBER  
3115739

SLAB PLAN - UNIT 2 (1 OF 3)  
BRIDGE NO. HAM-74-1908R  
IR-74 OVER MILL CREEK, RR & SPRING GROVE AVENUE




HAM-75-3.84  
PID No. 104667

60/100  
60  
100

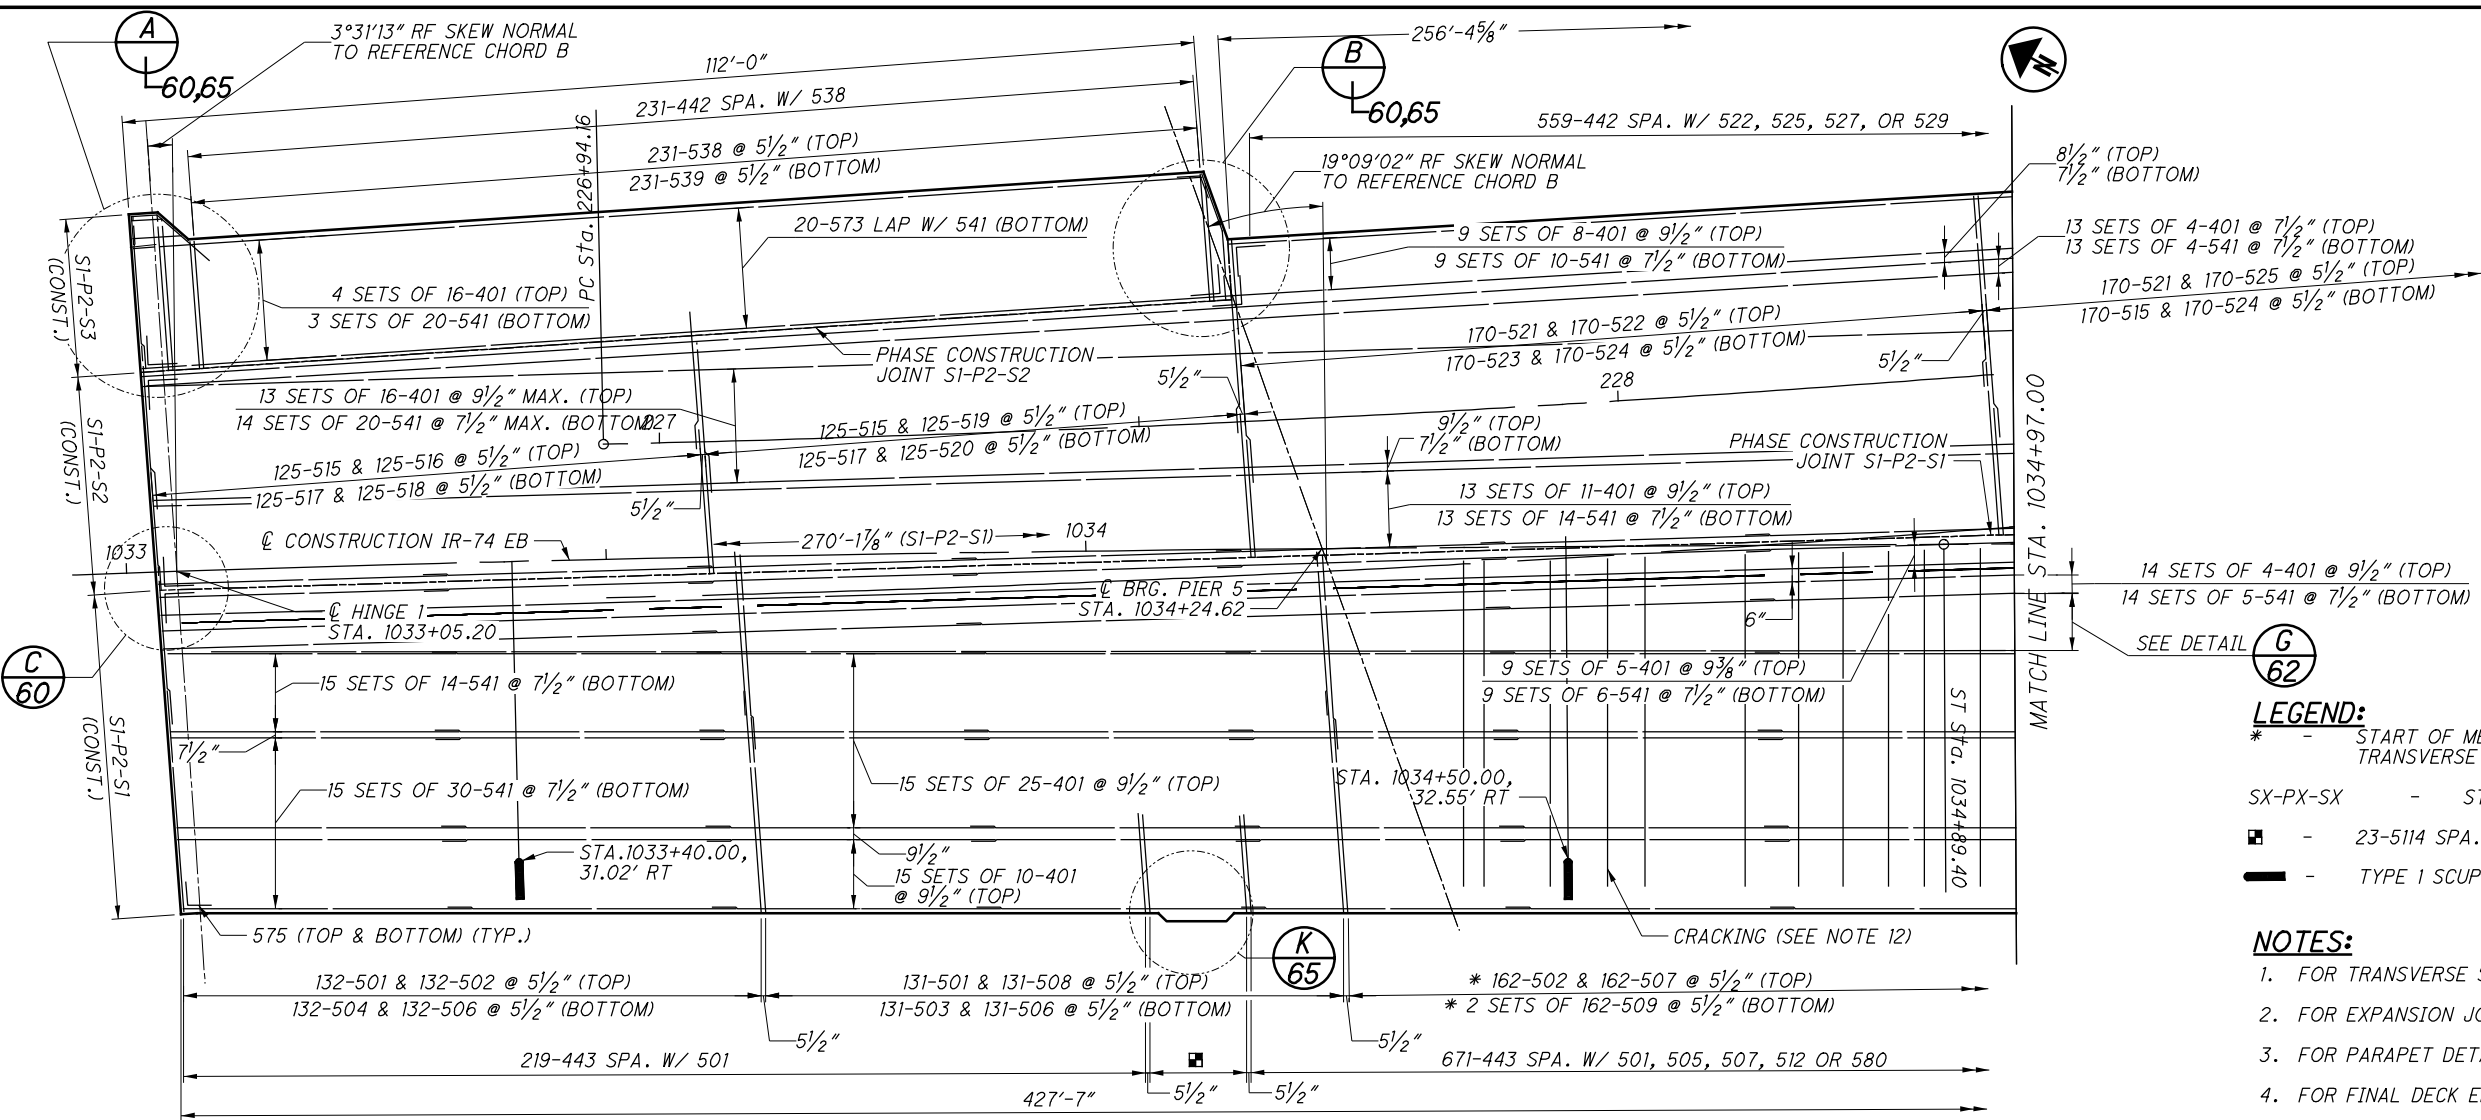

- LEGEND:**
- \* - START OF MECHANICAL CONNECTORS OF TRANSVERSE BARS AT S1-P2-S1
  - SX-PX-SX - STAGE X, PHASE X, STEP X
  - - 23-5114 SPA. W/ 501 (TOP)
  - ▬ - TYPE 1 SCUPPER
- NOTES:**
- FOR TRANSVERSE SECTION, SEE SHEETS 58/100 AND 59/100.
  - FOR EXPANSION JOINT DETAIL, SEE SHEET 83/100.
  - FOR PARAPET DETAILS, SEE SHEET 64/100 THRU 70/100.
  - FOR FINAL DECK ELEVATIONS, SEE SHEETS 76/100 THRU 78/100.
  - FOR REINFORCING STEEL LIST, SEE SHEETS 95/100 THRU 97/100.
  - REBAR CLEARANCE MEASURED TO THE FACE OF CONCRETE SHALL BE 2" UNLESS OTHERWISE NOTED.
  - FIELD BEND LONGITUDINAL BARS TO FIT CURVATURE OF ROADWAY AND TRANSVERSE BARS TO FIT CROWN. EPOXY COATED BARS DAMAGED BY FIELD BENDING SHALL BE REPAIRED IN ACCORDANCE WITH CMS 509.
  - THE PREFIX "2S" SHALL BE ADDED TO ALL BAR MARKS IN UNIT 2 SUPERSTRUCTURE.
  - FOR TYPE 2 SCUPPER DETAILS, SEE SHEET 93/100.
  - FOR TYPE 1 SCUPPER DETAILS, SEE SHEET 92/100.
  - MOVE SCUPPERS AS NECESSARY TO AVOID CROSS FRAMES.
  - CRACK WIDTH 0.01 TO 0.016 INCHES (TYPICAL).

**PART SLAB PLAN - UNIT 2**  
(PARAPET AND REFERENCE CHORD NOT SHOWN)

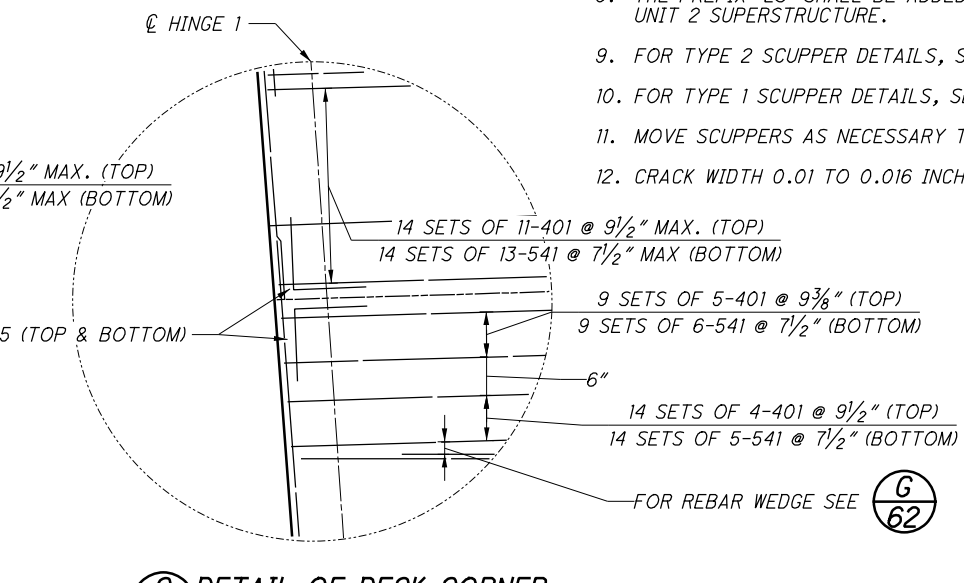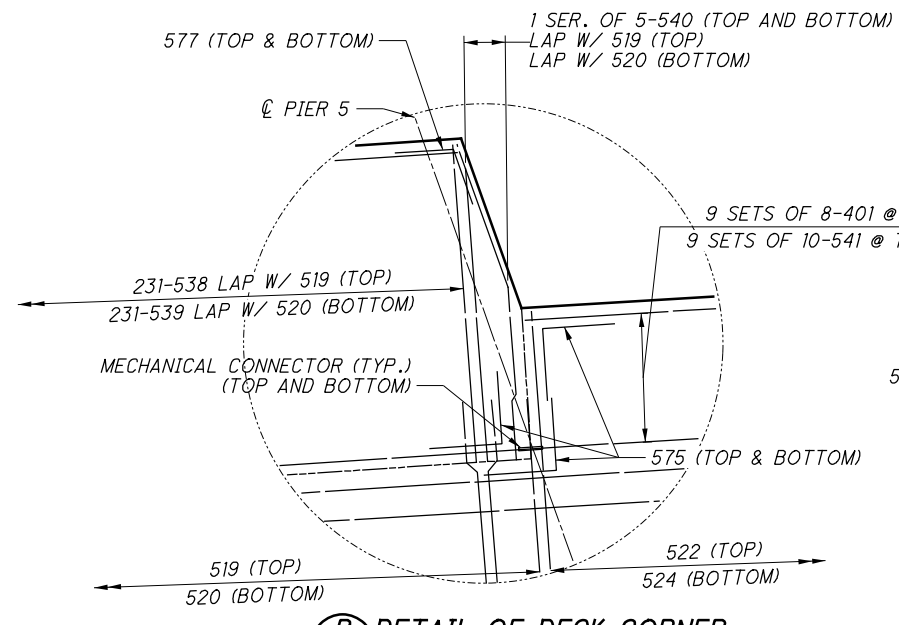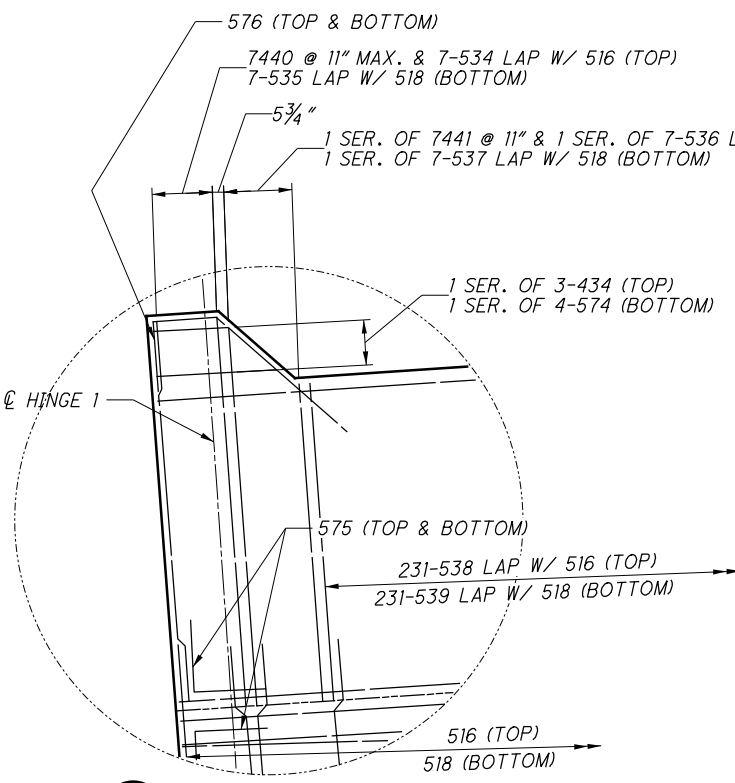


**A** DETAIL OF DECK CORNER


**B** DETAIL OF DECK CORNER

**C** DETAIL OF DECK CORNER


P:\Projects\2018\20H03DB-18232 HAM-75-03.84\104667\structures\HAM074\_1908R\DP005.dgn 11/13/2023 4:06:10 PM odesimone

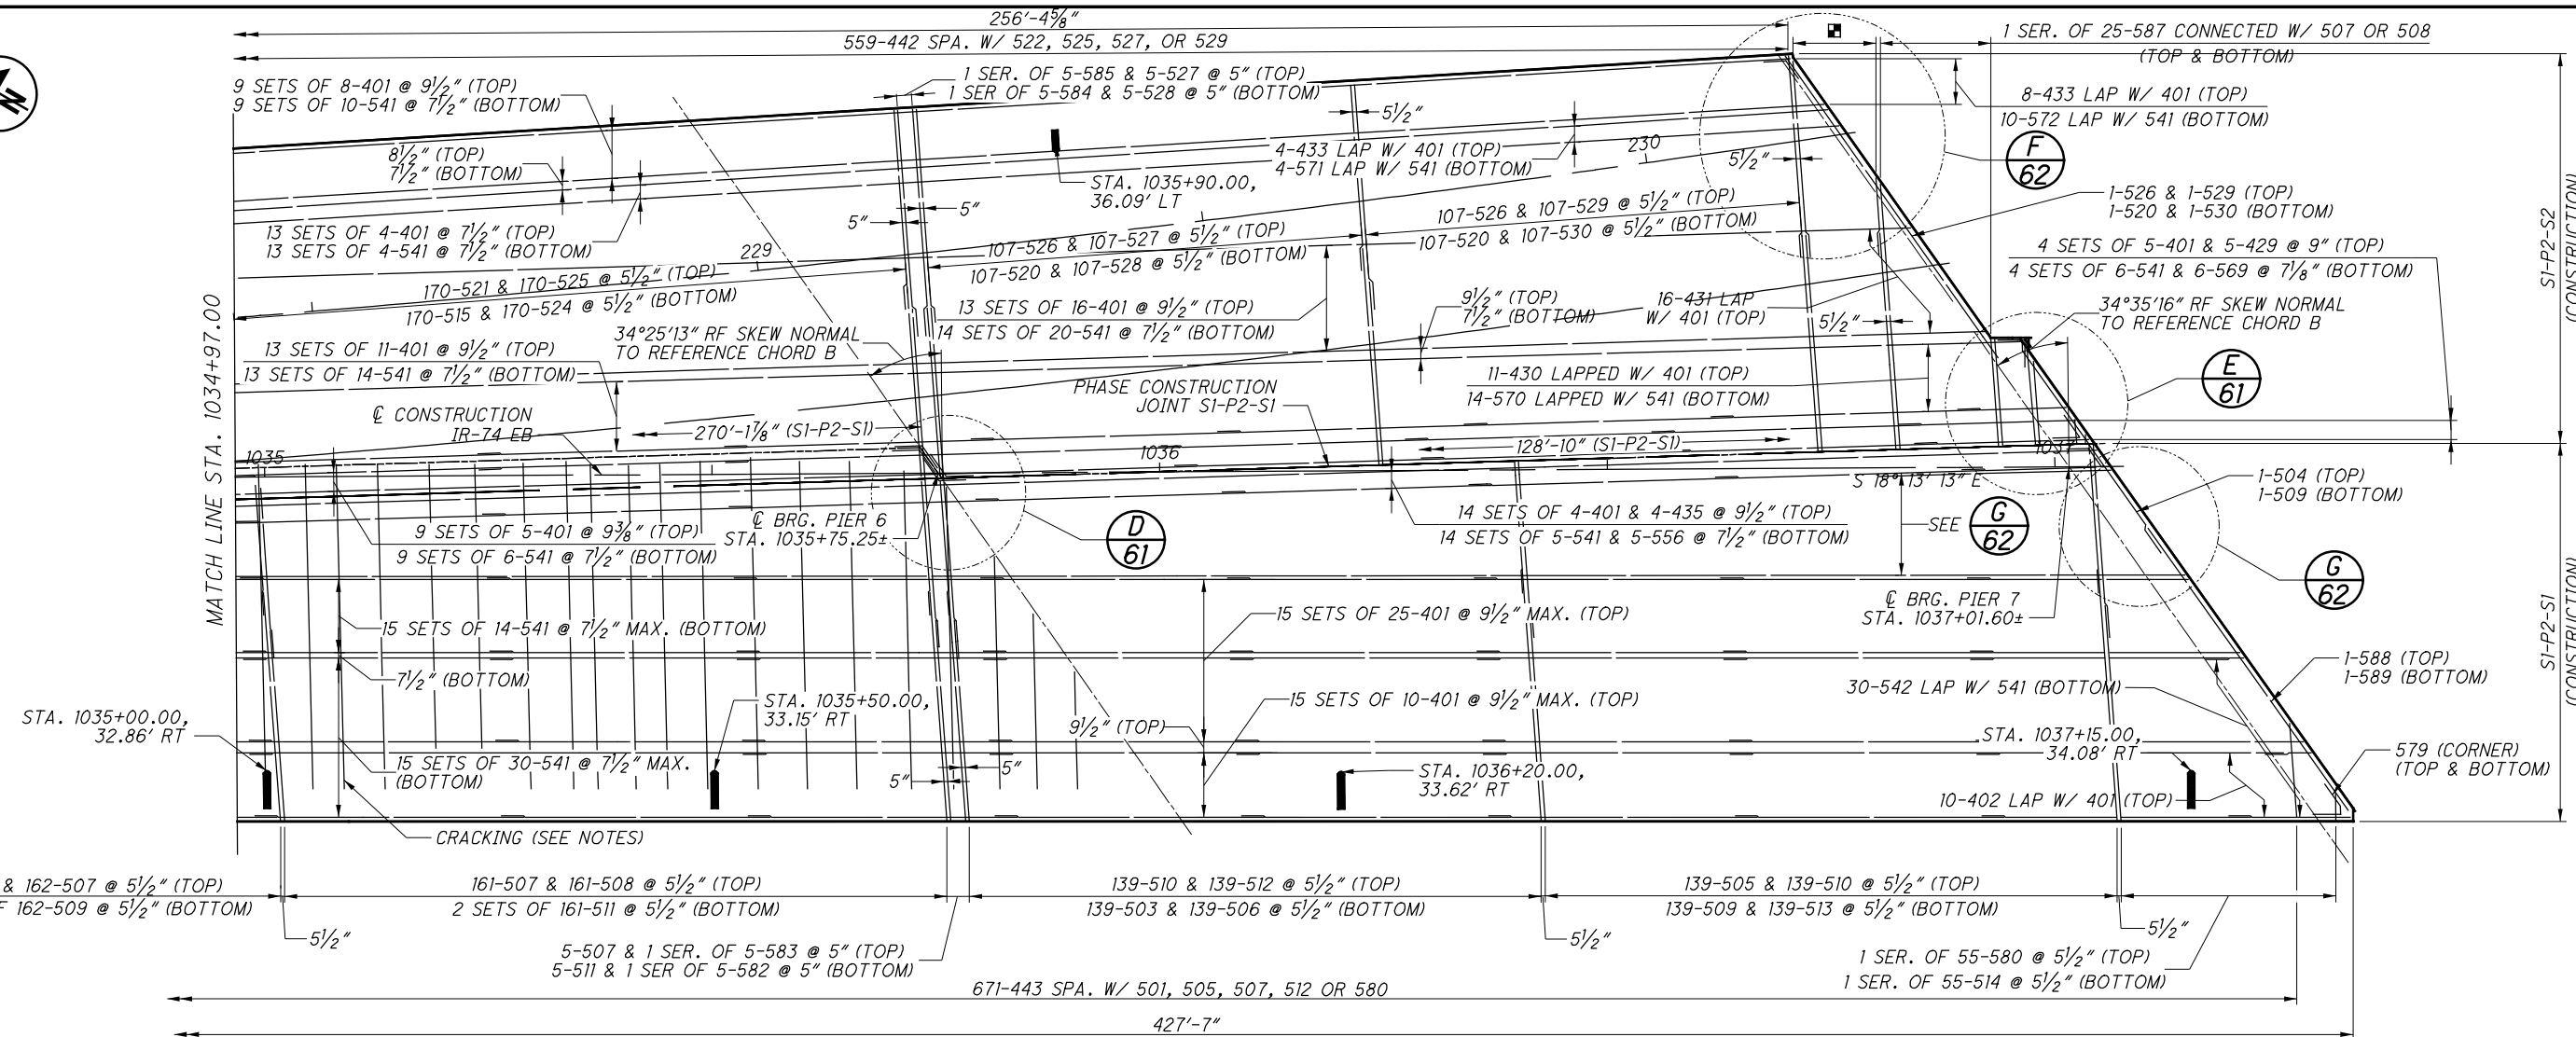

**PART SLAB PLAN - UNIT 2**  
(PARAPET AND REFERENCE CHORD NOT SHOWN)

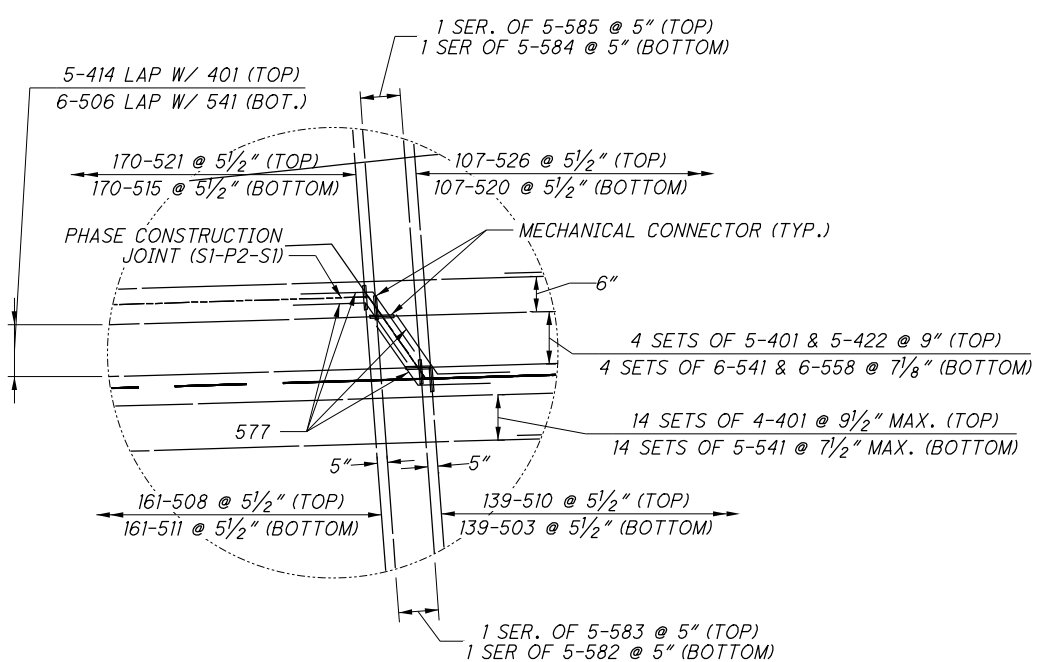

**(D) DETAIL OF DECK CORNER**

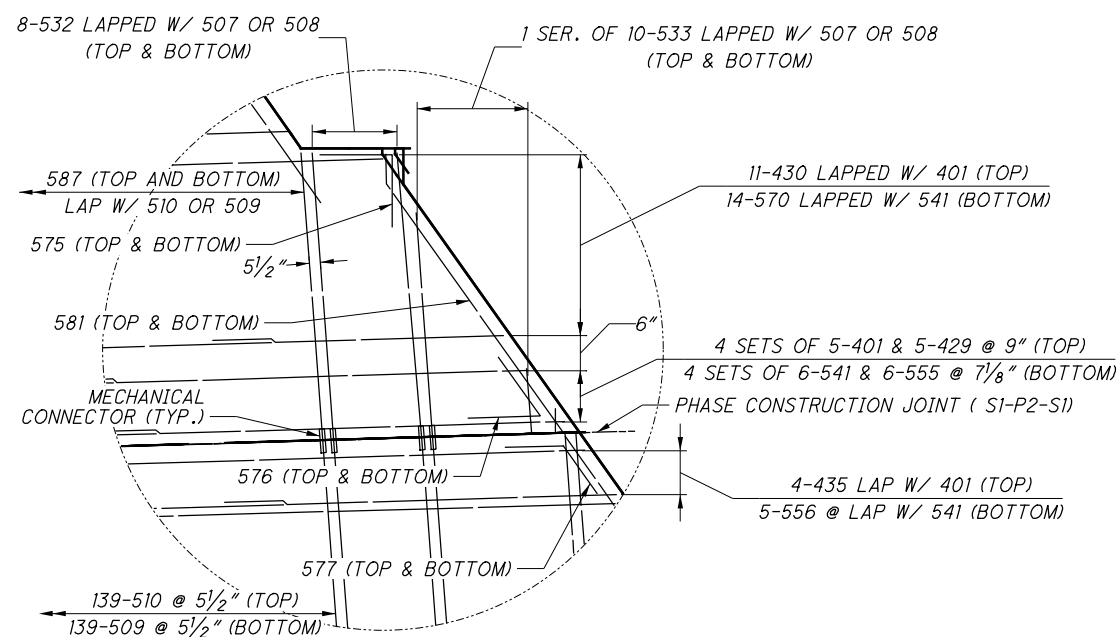

**(E) DETAIL OF DECK CORNER**

MIN. REQUIRED LAP LENGTH	
#4 LONGITUDINAL	1'-11"
#5 TRANSVERSE (TOP)	2'-5"
#5 TRANSVERSE (BOT.)	3'-0"
#5 LONGITUDINAL	2'-5"

**LEGEND:**

- SX-PX-SX - STAGE X, PHASE X, STEP X
- - 1 SER. OF 19-531 & 19-526 (TOP)  
1 SER. OF 19-586 & 19-520 (BOTTOM)
- ▬ - TYPE 2 SCUPPER
- ▬ - TYPE 1 SCUPPER

**NOTES:**

1. FOR NOTES SEE SHEET **60/100**.

**SLAB PLAN - UNIT 2 (2 OF 3)**  
BRIDGE NO. HAM-74-1908R  
IR-74 OVER MILL CREEK, RR & SPRING GROVE AVENUE

**HAM-75-3.84**  
PID No. 104667

61/100

61/100


DESIGN AGENCY  
**PRIME**  
540 WHITE POND DR. SUITE E  
AKRON, OH 44320

REVIEWED DATE  
TES 7/30/2019  
STRUCTURE FILE NUMBER  
3115739


DRAWN DATE  
JAT  
REVISED  
KDC

DESIGNED  
CRG  
CHECKED  
KDC


P:\Projects\2018\20H03DB-18232 HAM-75-03.84\104667\structures\HAM074\_1908R\sheets\074\_1908R\_DP011.dgn 6/20/2019 9:16:19 AM asecd

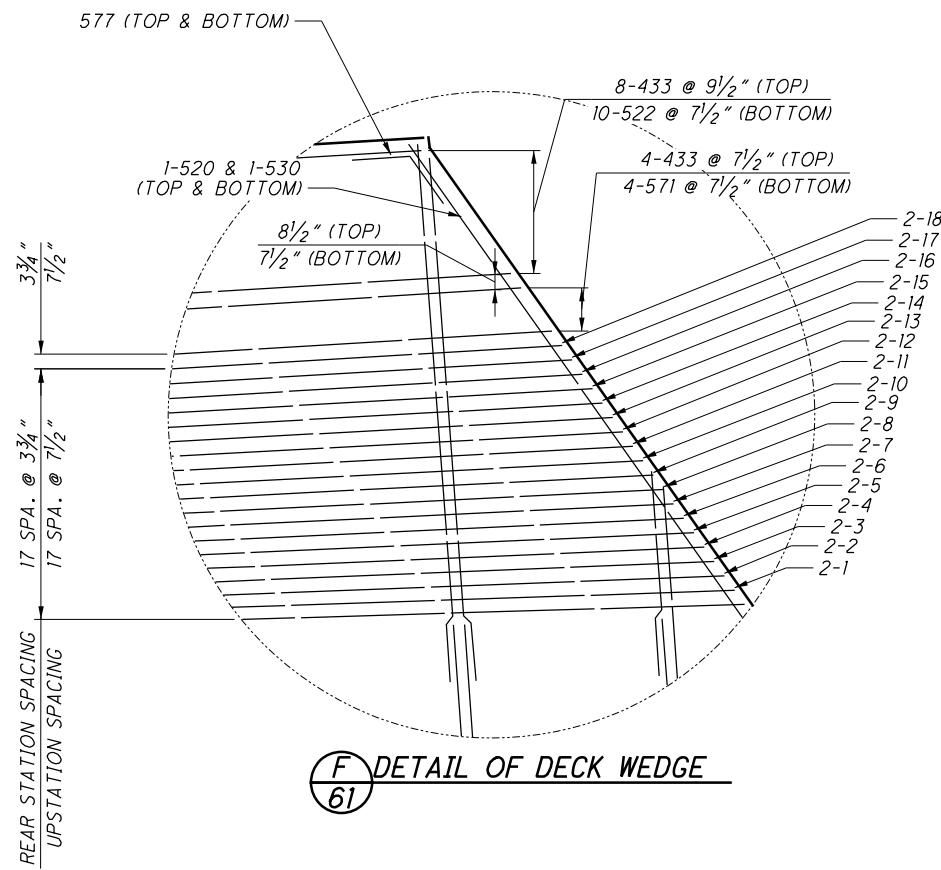

**F** DETAIL OF DECK WEDGE  
61

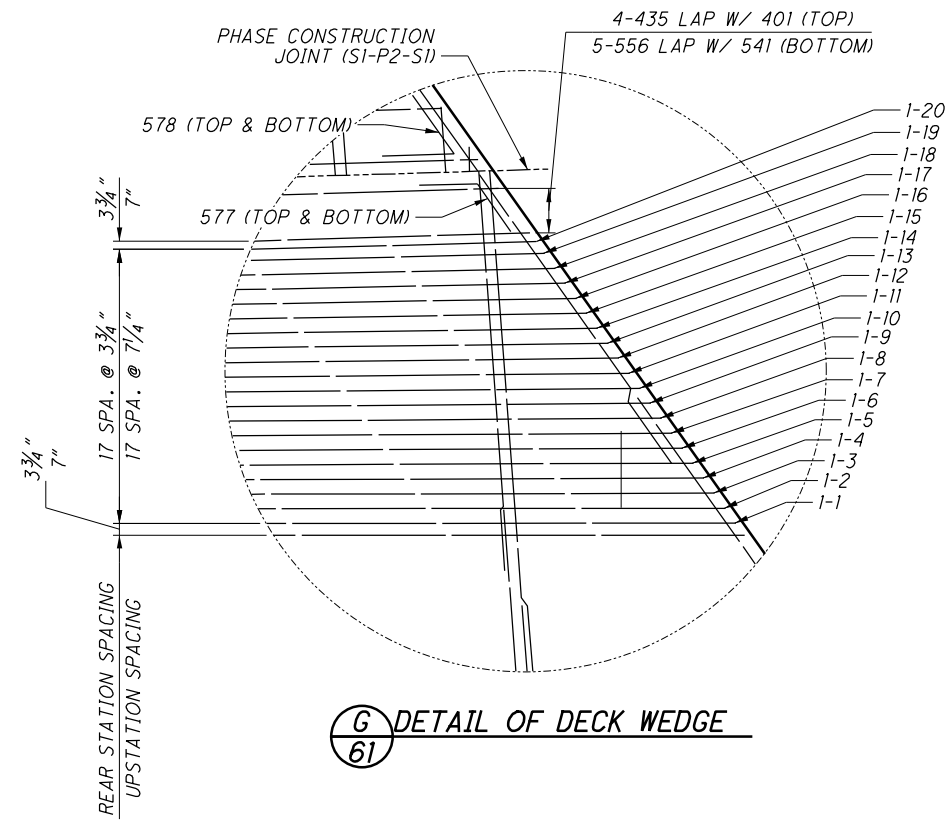

**G** DETAIL OF DECK WEDGE  
61

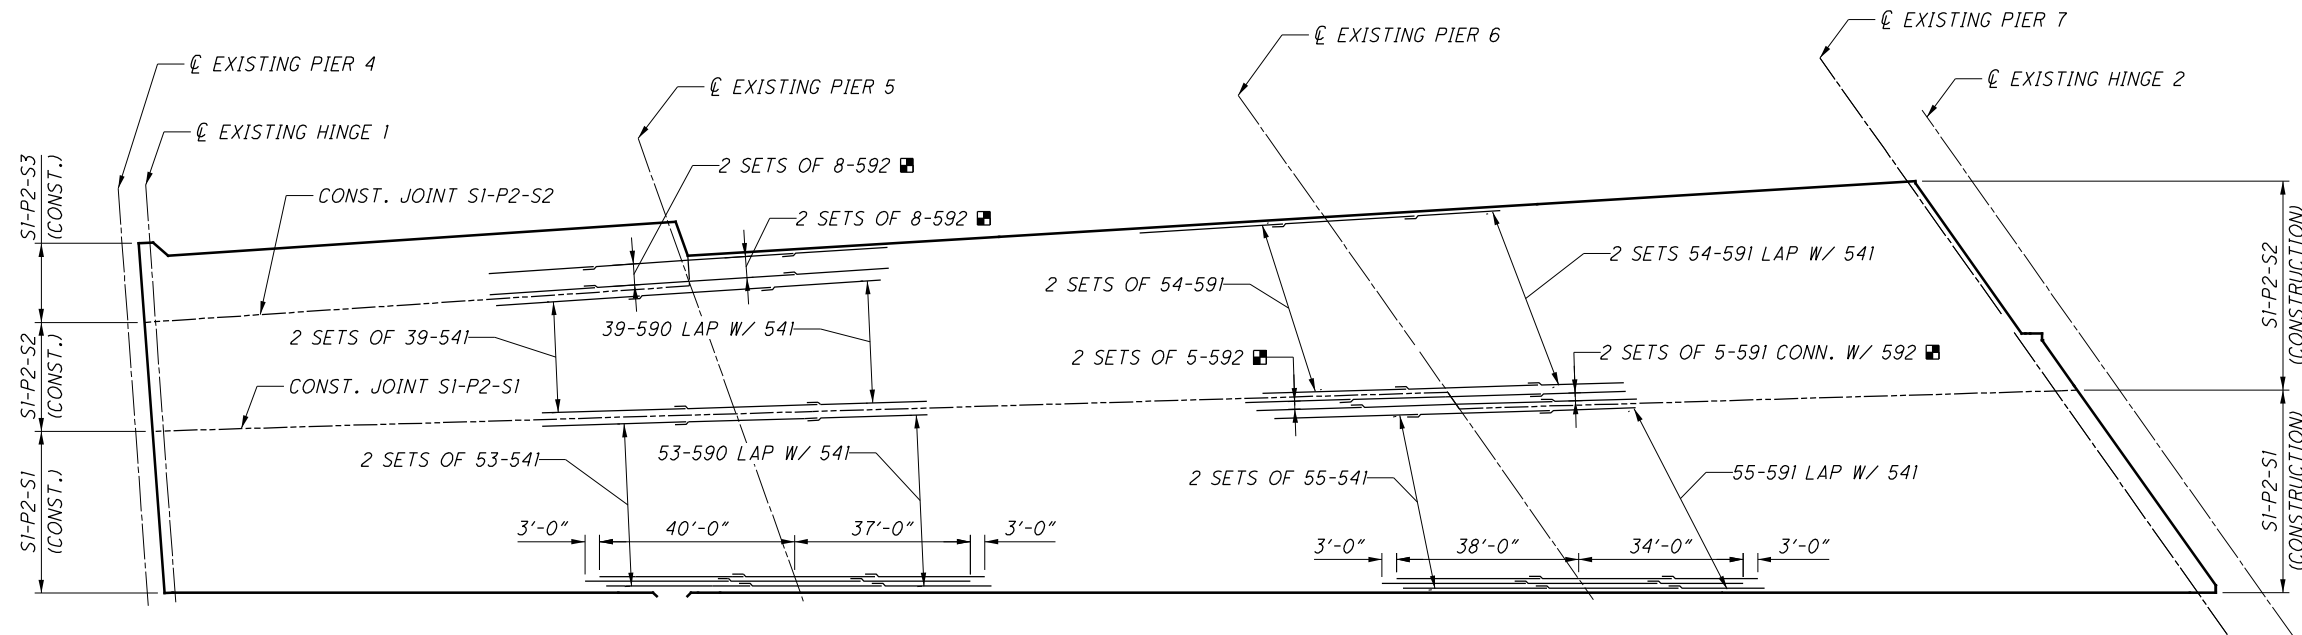

**STAGGER DIAGRAM**

MIN. REQUIRED LAP LENGTH	
#4 LONGITUDINAL	1'-11"
#5 TRANSVERSE (TOP)	2'-5"
#5 TRANSVERSE (BOT.)	3'-0"
#5 LONGITUDINAL	2'-5"

	LOCATION	1-1	1-2	1-3	1-4	1-5	1-6	1-7	1-8	1-9	1-10	1-11	1-12	1-13	1-14	1-15	1-16	1-17	1-18	1-19	1-20
TOP	NO. 401	14	14	13	13	13	12	12	11	11	10	10	9	9	7	7	6	6	4	4	2
	LAST TOP BAR	403	-	404	405	-	406	-	407	-	408	-	409	-	410	411	412	-	413	-	414
BOTTOM	NO. 541	14	14	14	13	13	12	11	11	10	10	10	9	9	8	7	7	6	5	4	2
	LAST BTM. BAR	543	544	-	545	-	546	547	548	549	550	-	551	-	552	553	-	-	-	-	554

	LOCATION	2-1	2-2	2-3	2-4	2-5	2-6	2-7	2-8	2-9	2-10	2-11	2-12	2-13	2-14	2-15	2-16	2-17	2-18
TOP	NO. 401	2	4	5	5	6	7	7	8	9	9	9	10	10	10	11	12	12	12
	LAST TOP BAR	415	-	-	416	417	418	419	420	-	421	422	423	424	425	426	-	427	428
BOTTOM	NO. 541	2	4	5	6	6	7	8	8	8	9	10	10	11	11	11	11	12	13
	LAST BTM. BAR	555	-	-	-	558	559	-	560	561	562	-	564	-	565	566	567	568	-


**NOTES:**

- BEND BARS AS NEEDED TO FIT.
- FOR DECK REINFORCEMENT LAYOUT, SEE SHEETS 51/100 THRU 69/100.
- FOR RIGHT OVERHANG SCUPPER, SEE SHEET 53/100.
- FOR SCUPPER DETAILS, SEE SHEETS 92/100, AND 93/100.


**LEGEND:**

■ - MECHANICALLY CONNECTED BETWEEN PHASES


P:\Projects\2018\20H03DB-18232 HAM-75-03.84\104667\structures\HAM074\_1908R\DP009.dgn 6/20/2019 9:16:42 AM cseed

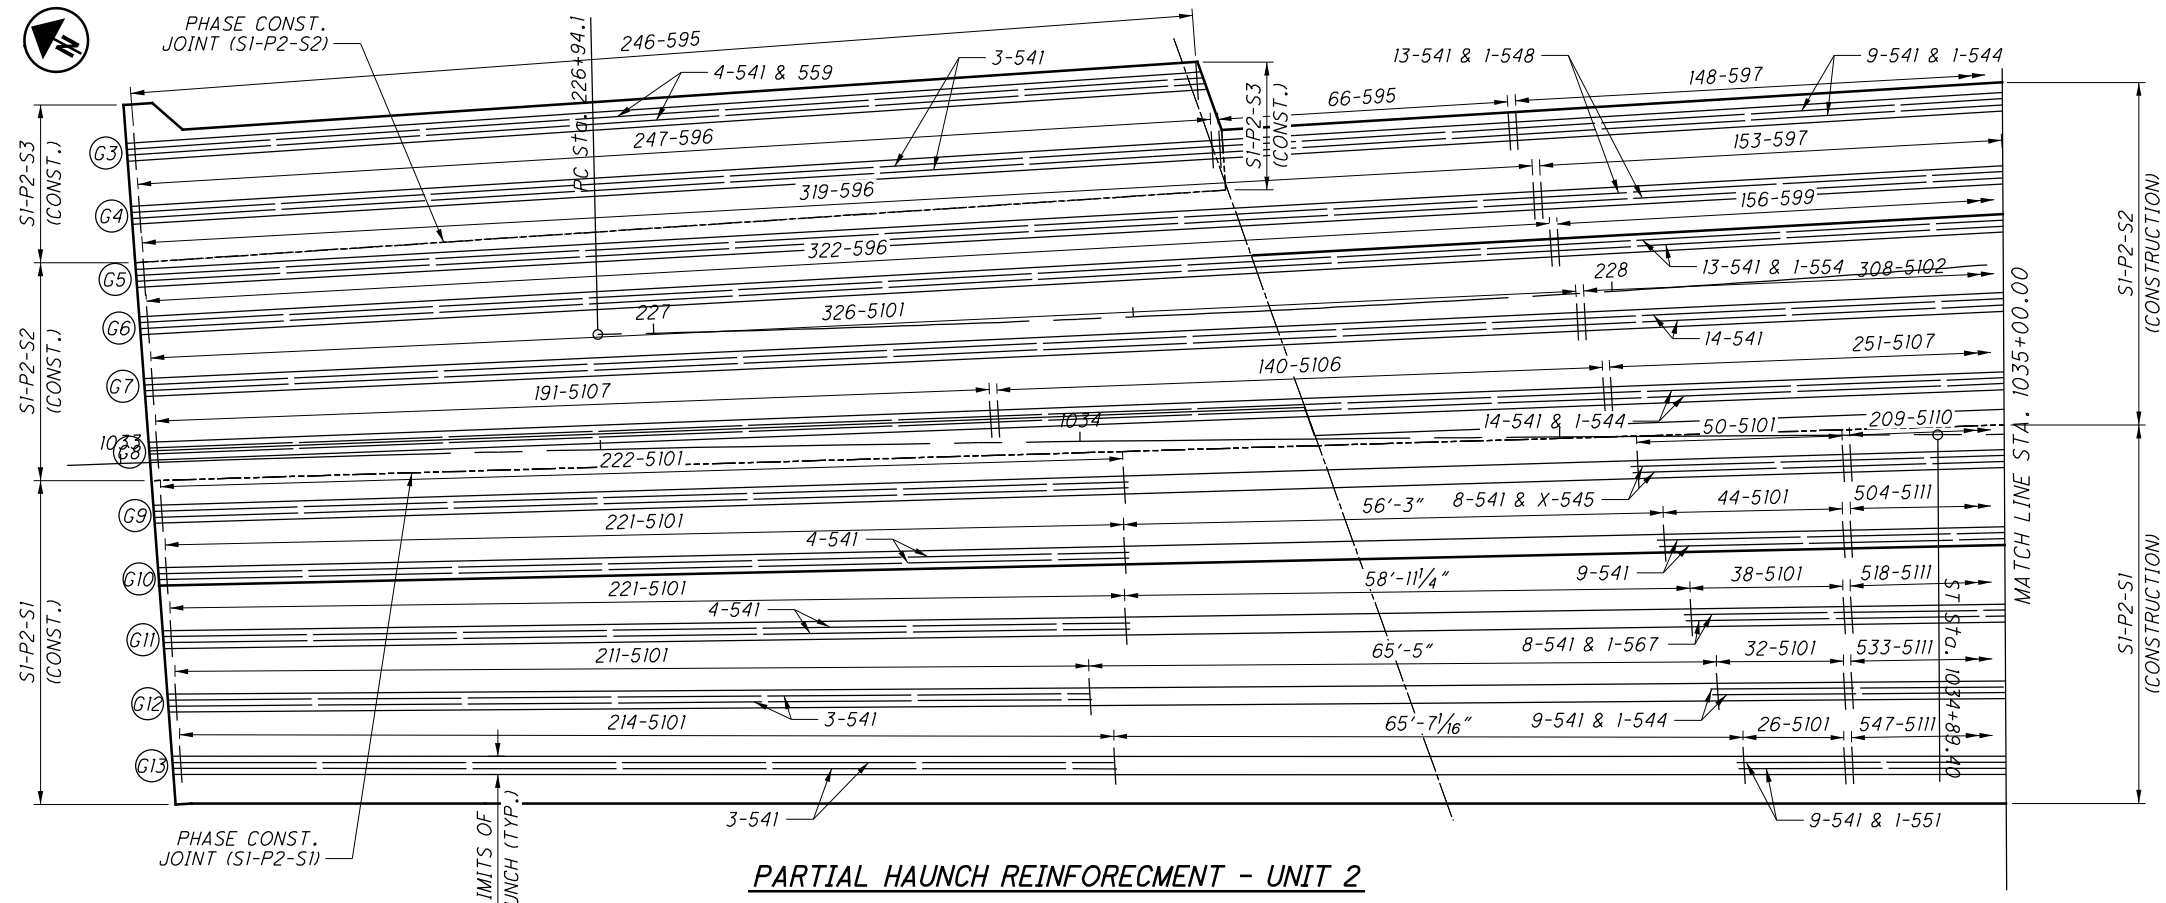


PARTIAL HAUNCH REINFORCEMENT - UNIT 2

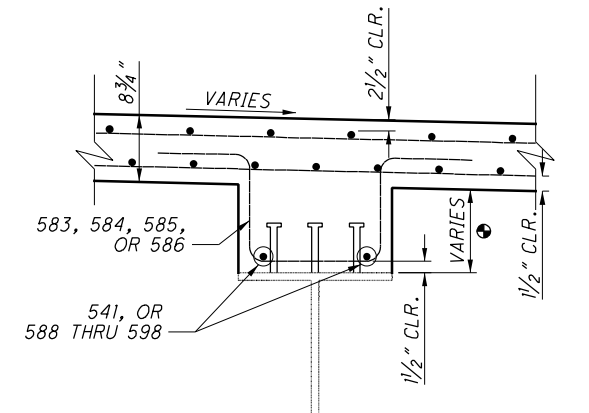

HAUNCH REINFORCEMENT SECTION

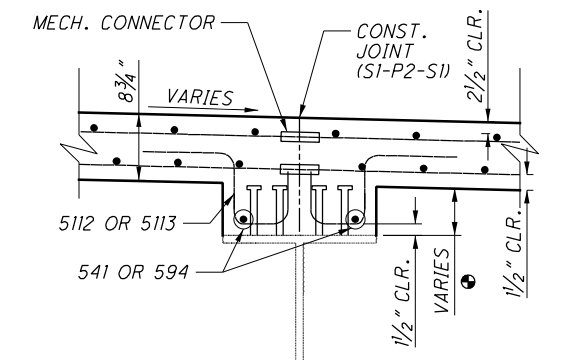

HAUNCH REINFORCEMENT SECTION (GIRDER 9, SPAN 7)

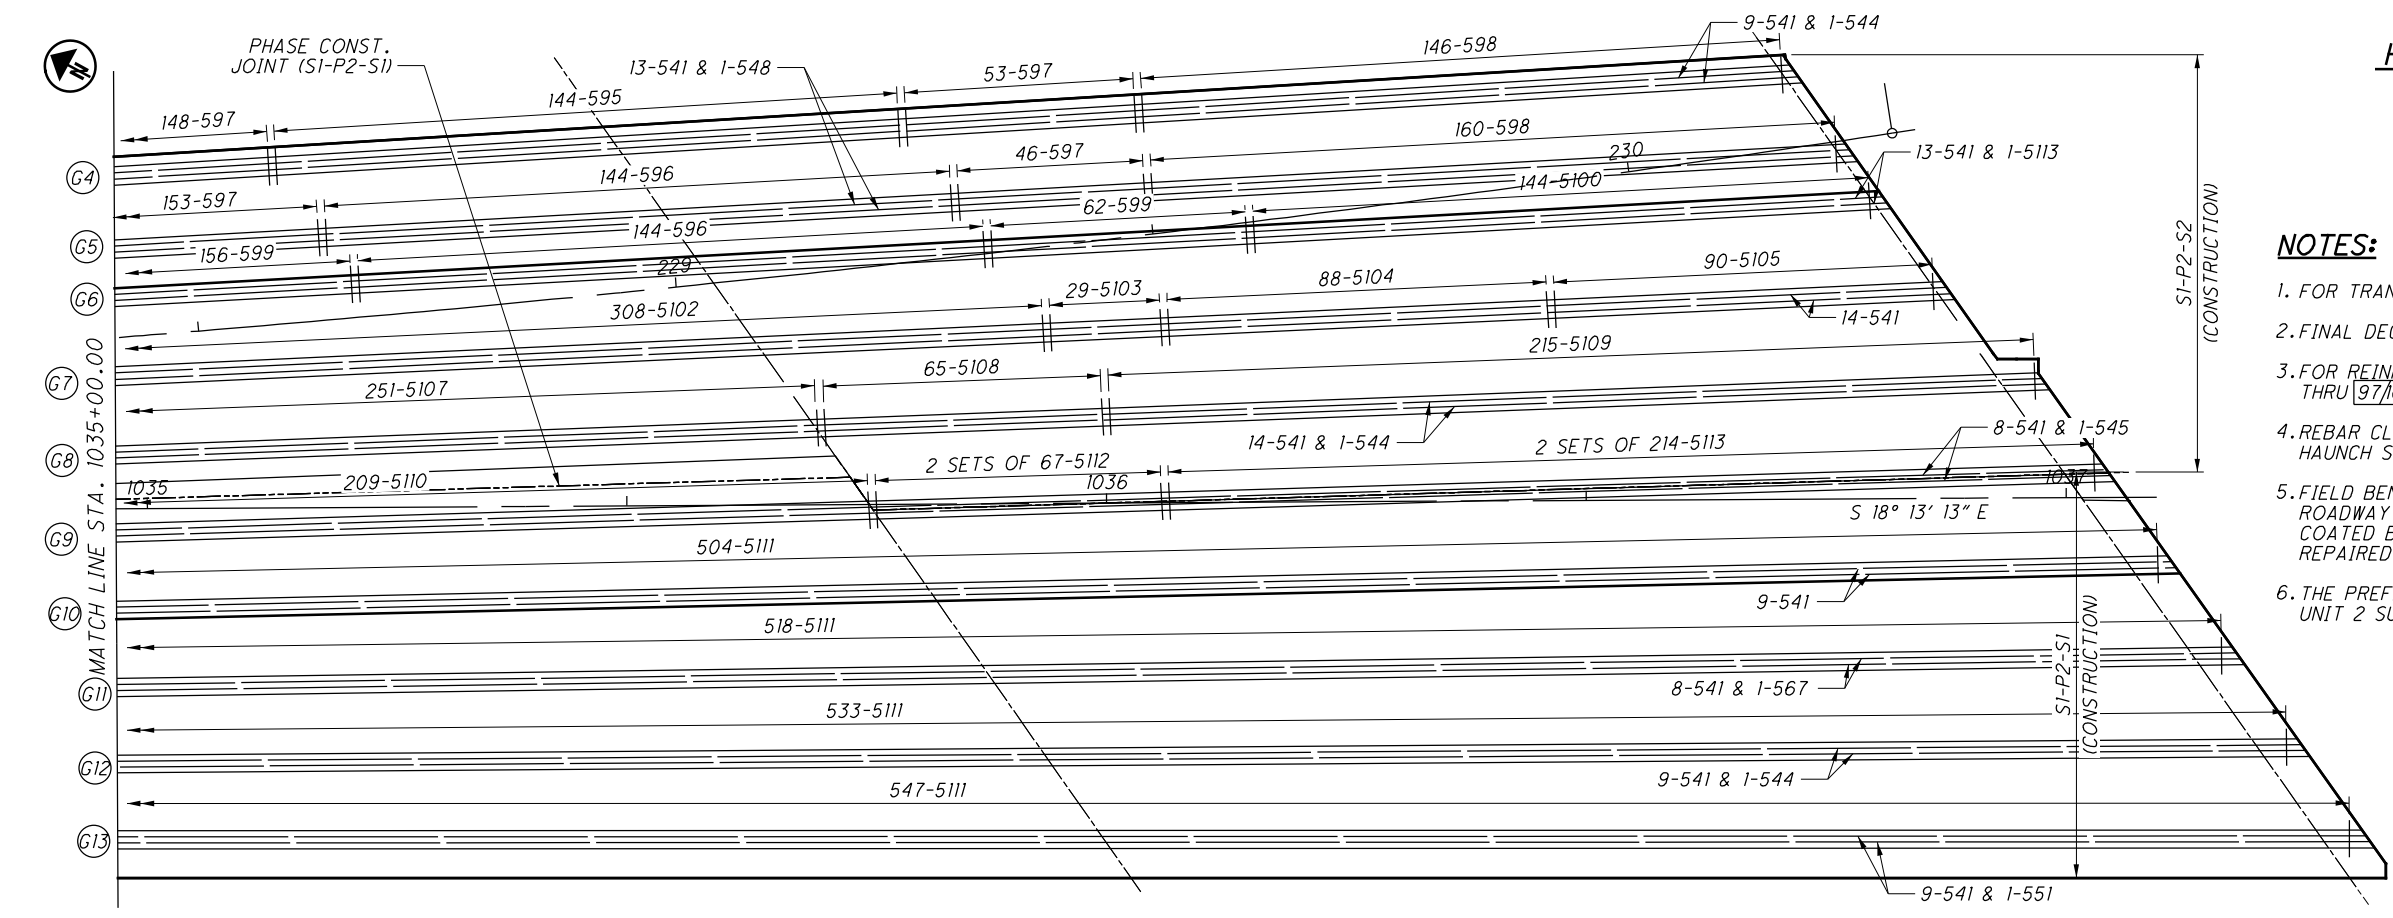

PARTIAL HAUNCH REINFORCEMENT - UNIT 2

NOTES:



- 1. FOR TRANSVERSE SECTION, SEE SHEETS 58/100 AND 59/100.
2. FINAL DECK ELEVATIONS, SEE SHEETS 76/100 THRU 78/100.
3. FOR REINFORCING STEEL LIST, SEE SHEETS 95/100 THRU 97/100.
4. REBAR CLEARANCE MEASURED TO THE FACE OF CONCRETE HAUNCH SHALL BE 2" UNLESS OTHERWISE NOTED.
5. FIELD BEND LONGITUDINAL BARS TO FIT CURVATURE OF ROADWAY AND TRANSVERSE BARS TO FIT CROWN. EPOXY COATED BARS DAMAGED BY FIELD BENDING SHALL BE REPAIRED IN ACCORDANCE WITH CMS 509.
6. THE PREFIX "2S" SHALL BE ADDED TO ALL BAR MARKS IN UNIT 2 SUPERSTRUCTURE.

LEGEND:

- SX - PX - SX - STAGE X - PHASE X - STEP X
- SEE ESTIMATED HAUNCH DEPTH TABLE, SHEET 79/100.

Table with 2 columns: MIN. REQUIRED LAP LENGTH, #5 LONGITUDINAL, and values 2'-5"


P:\Projects\2018\20H03DB-18232 HAM-75-03.84\104667\structures\HAM074\_1908R\sheets\074\_1908R\_RA002.dgn 6/20/2019 9:16:45 AM cseed

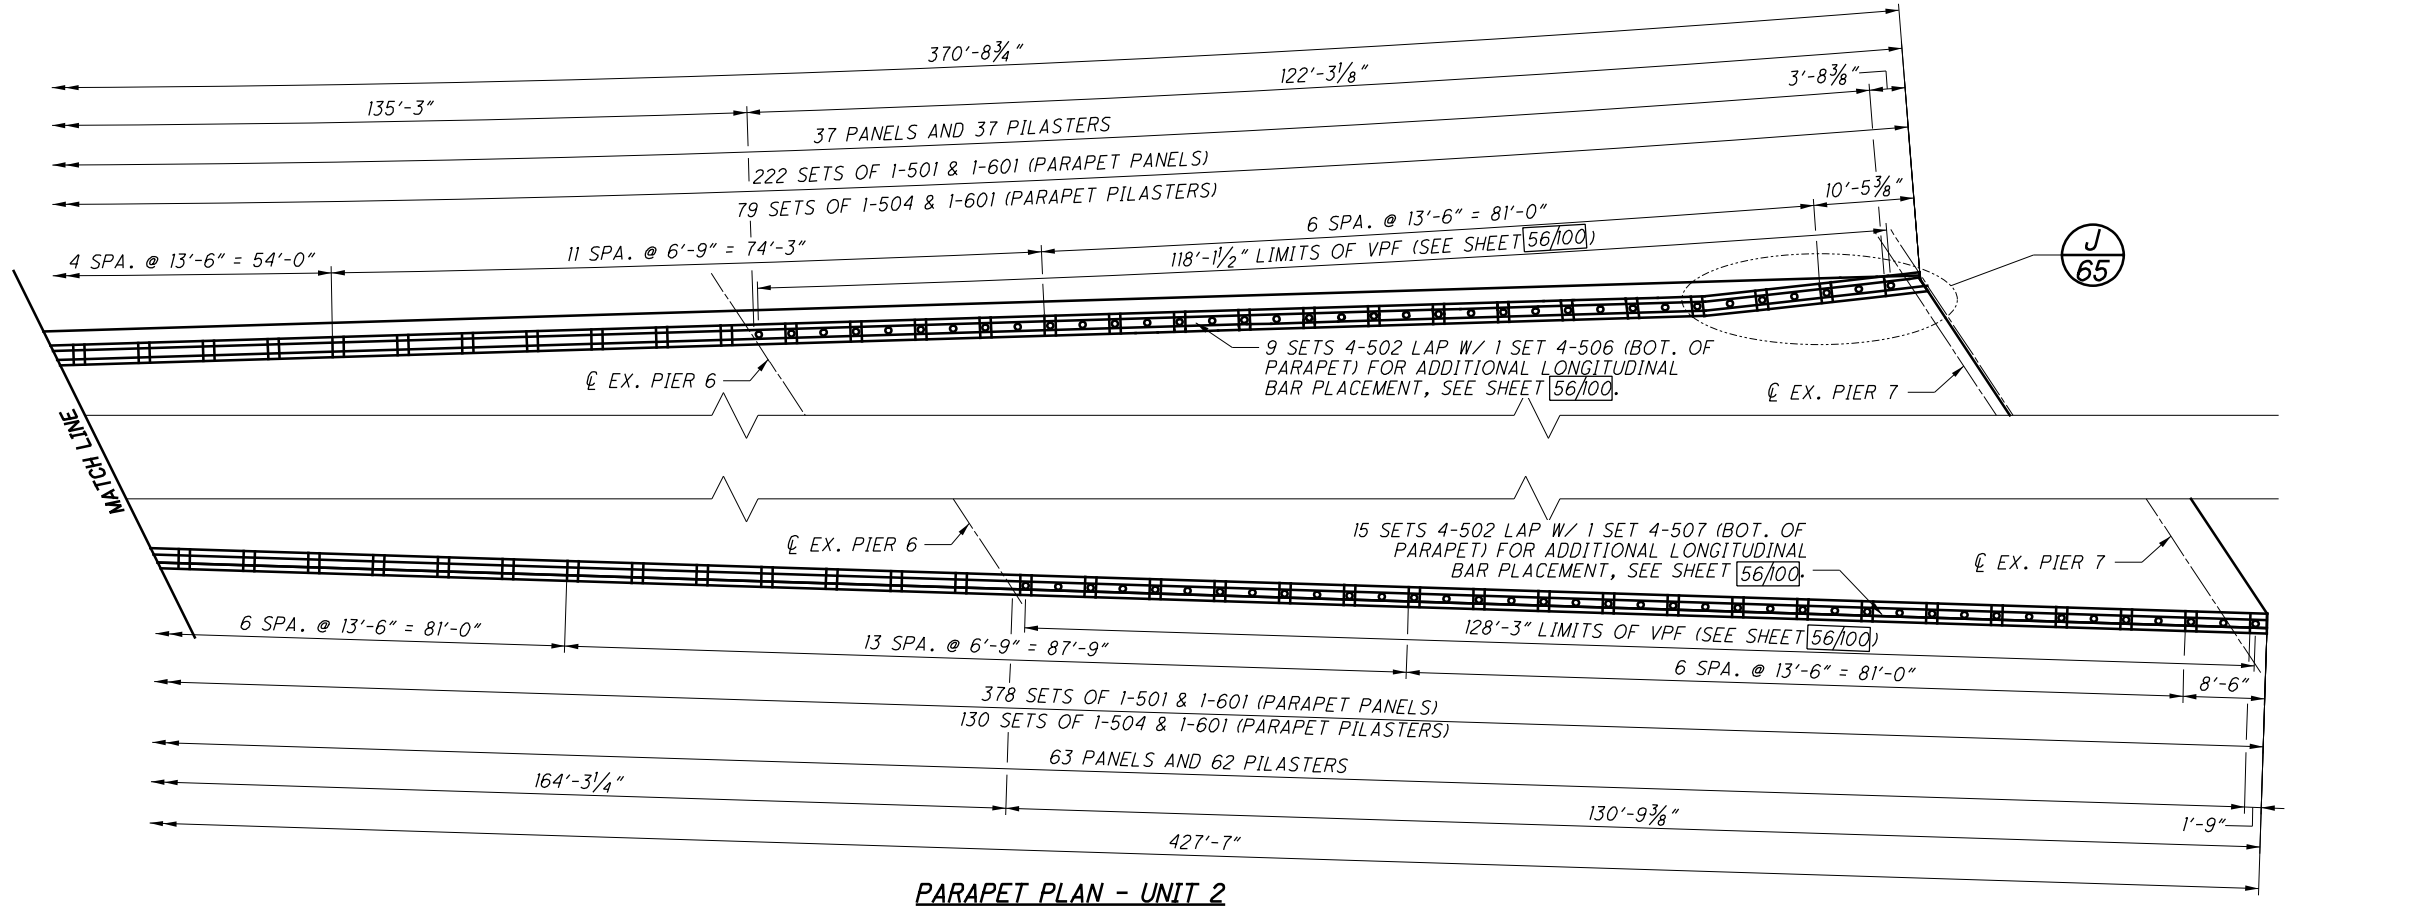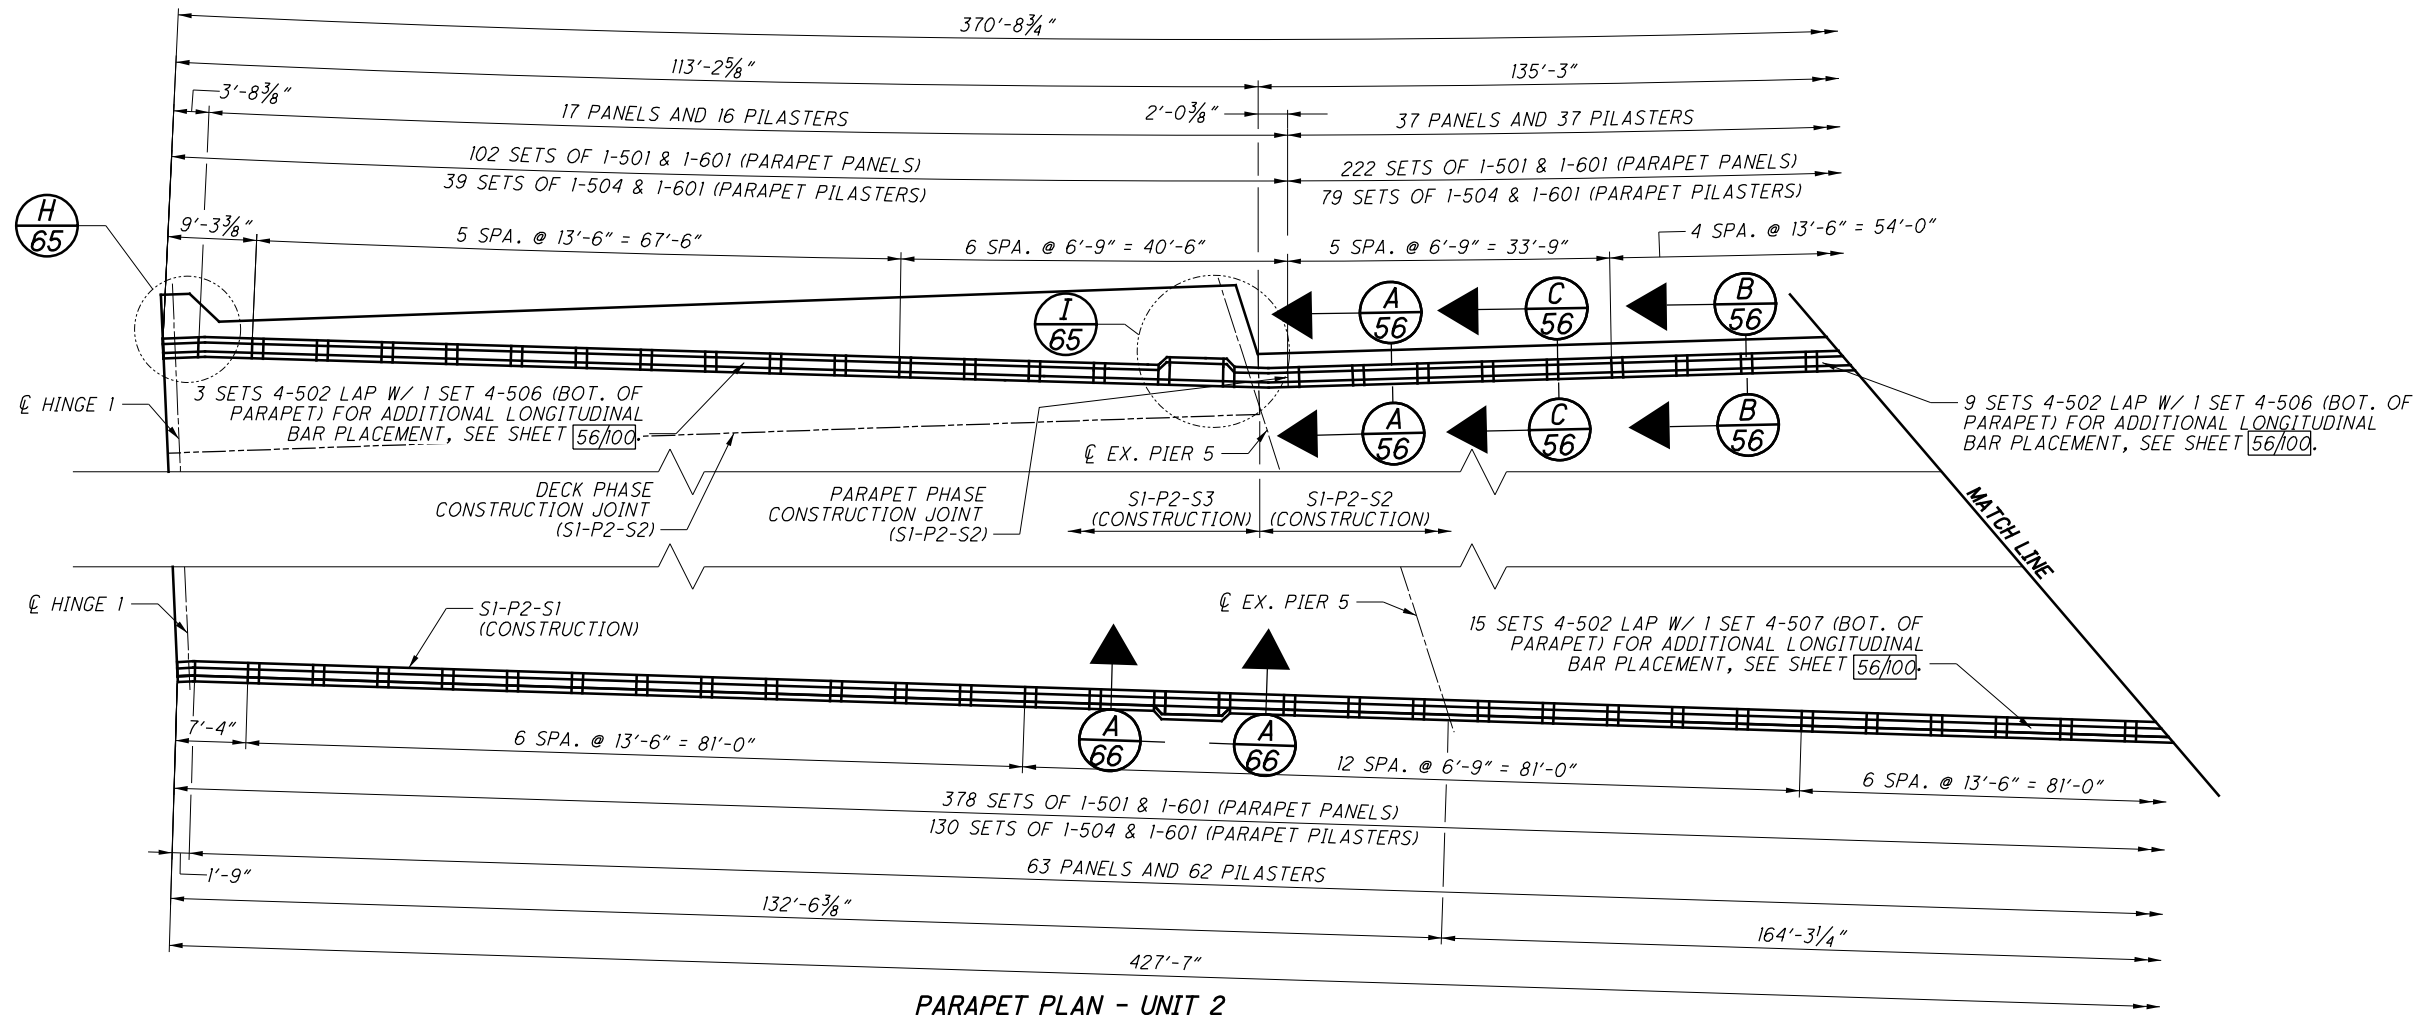


REQUIRED MINIMUM LAP LENGTHS	
NO. 5 BAR	2'-5"




P:\Projects\2018\20H03DB-18232 HAM-75-03.84\104667\structures\HAM074\_1908R\sheets\074\_1908R\_RA005.dgn 6/20/2019 9:18:07 AM cseed

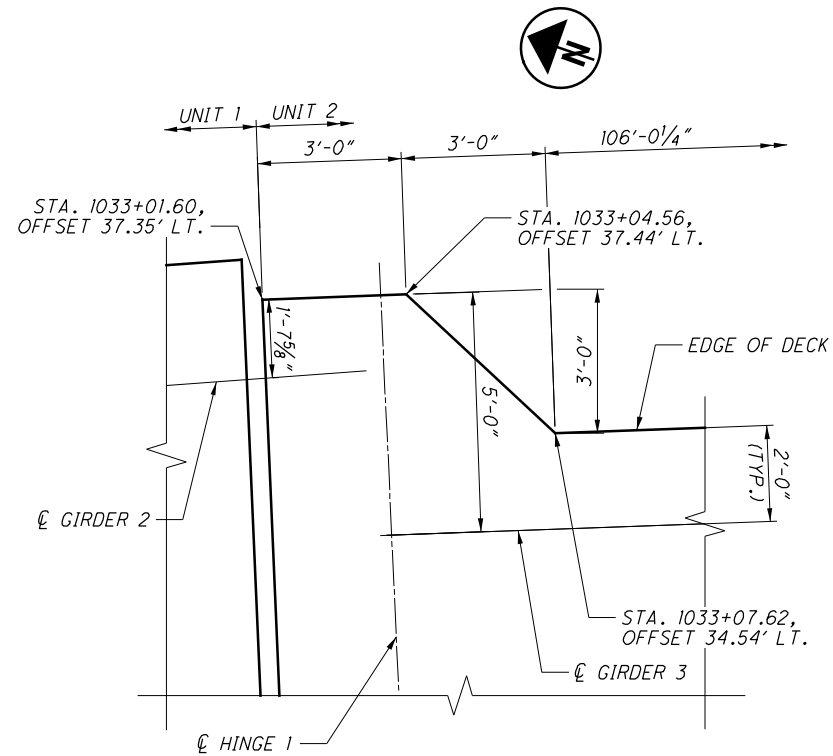


**A** PARTIAL PLAN - LEFT DECK EDGE  
60

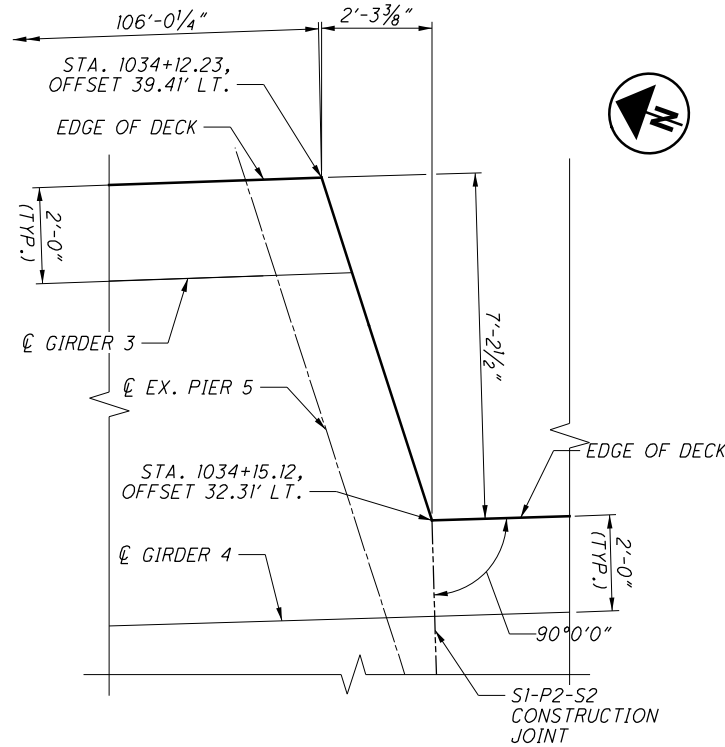


**B** PARTIAL PLAN - LEFT DECK EDGE  
60

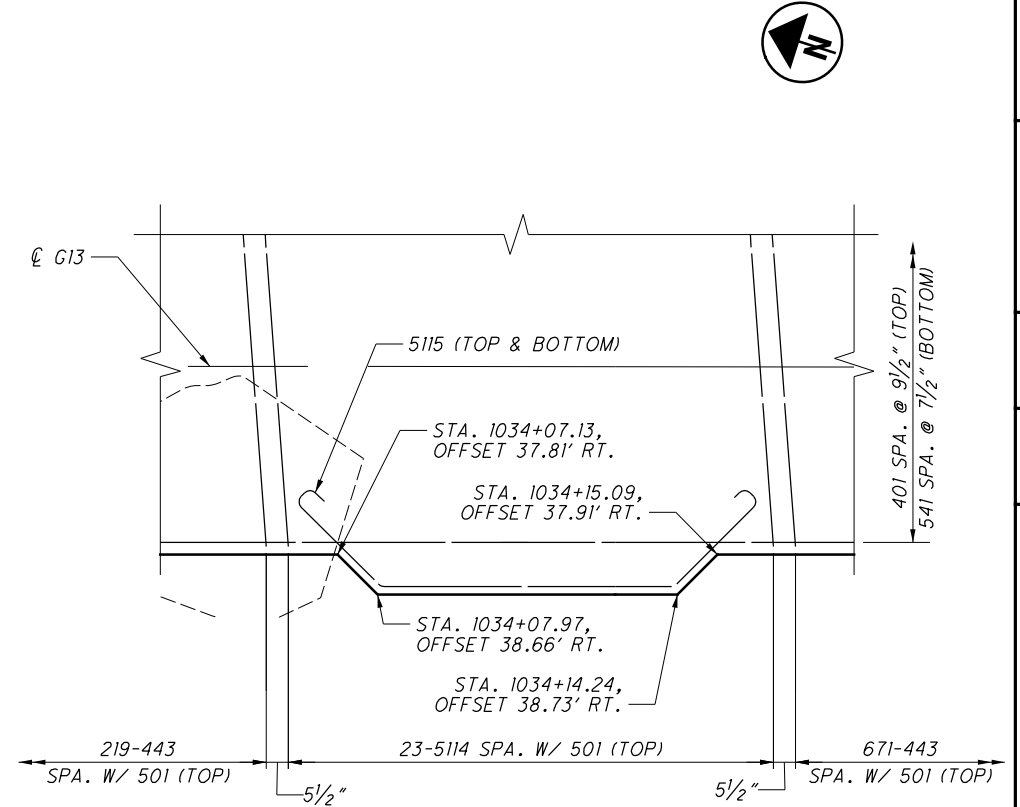


**K** OVERHEAD SIGN DETAIL  
60

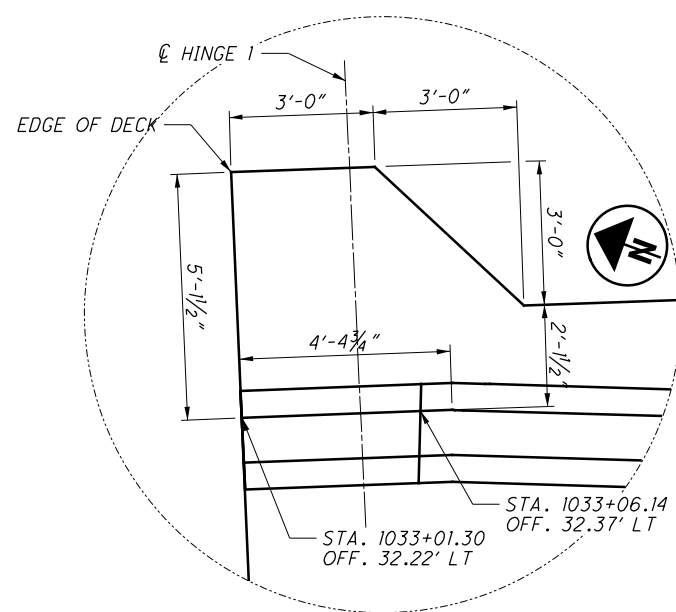

**H** PARAPET TRANSITION DETAIL  
64

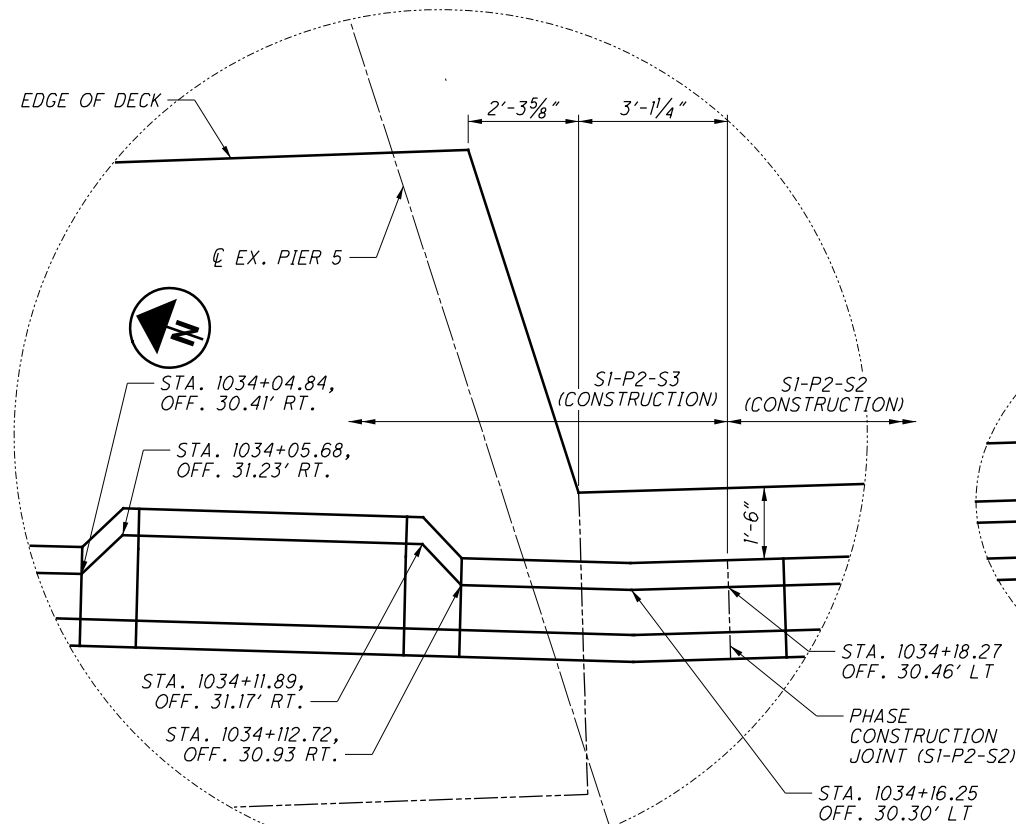


**I** PARAPET TRANSITION DETAIL  
64

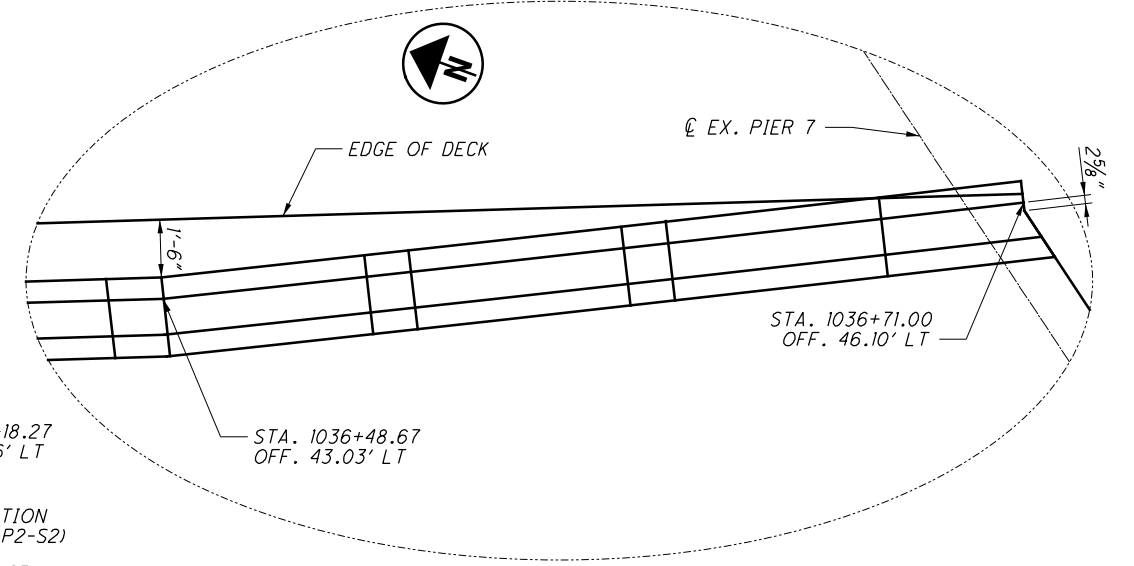


**J** PARAPET TRANSITION DETAIL  
64

DESIGN AGENCY <b>PRIME</b> 540 WHITE POND DR. SUITE E AKRON, OH 44320	DATE	3/27/2019
	REVIEWED	TES
DESIGNED	CRG	KDC
DRAWN	ADS	REVISED
STRUCTURE FILE NUMBER	3115739	
<b>DECK OVERHANG, SLAB AND PARAPET DETAILS - UNIT 2</b>		
BRIDGE NO. HAM-74-1908R		
IR-74 OVER MILL CREEK, RR & SPRING GROVE AVENUE		
HAM-75-3.84	65/100	
PID No. 104667	65/100	


P:\Projects\2018\20H03DB-18232 HAM-75-03.84\104667\structures\HAM074\_1908R\RA007.dgn 6/20/2019 9:18:19 AM asead

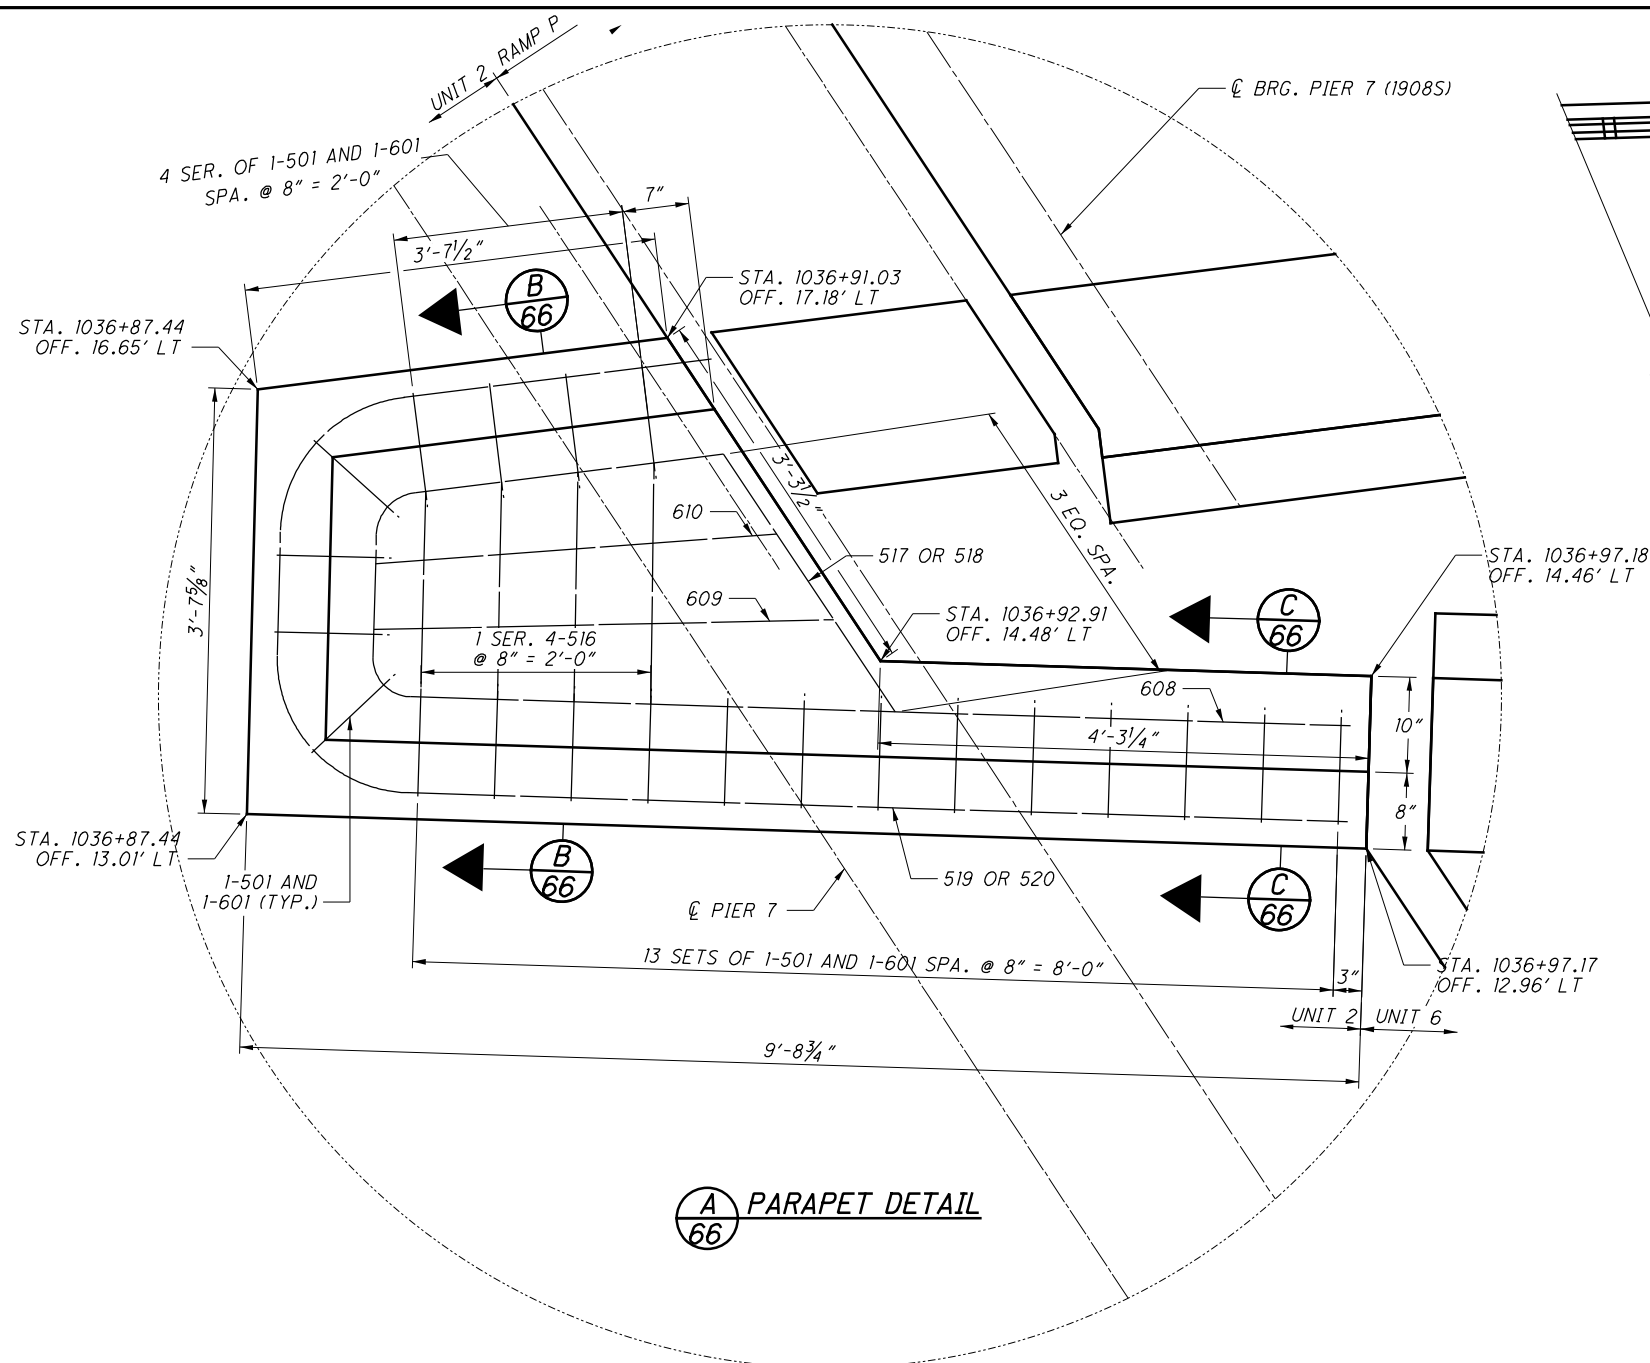


**A** PARAPET DETAIL

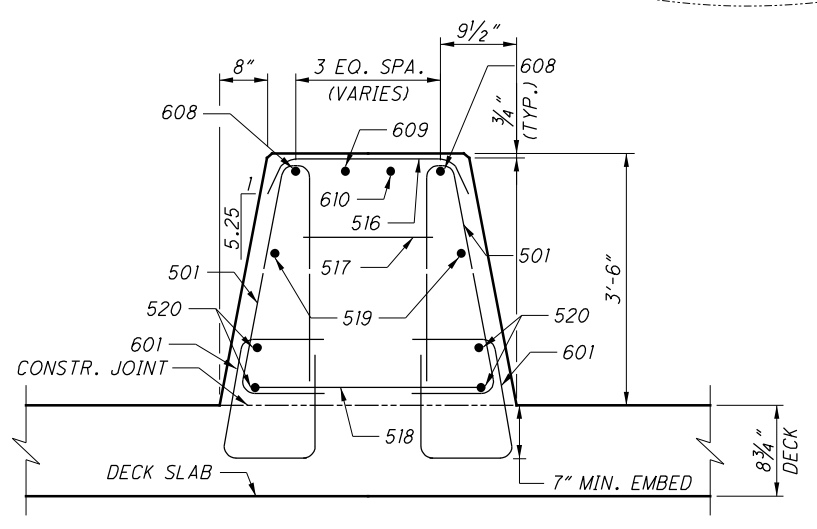


**B** SECTION THRU PARAPET

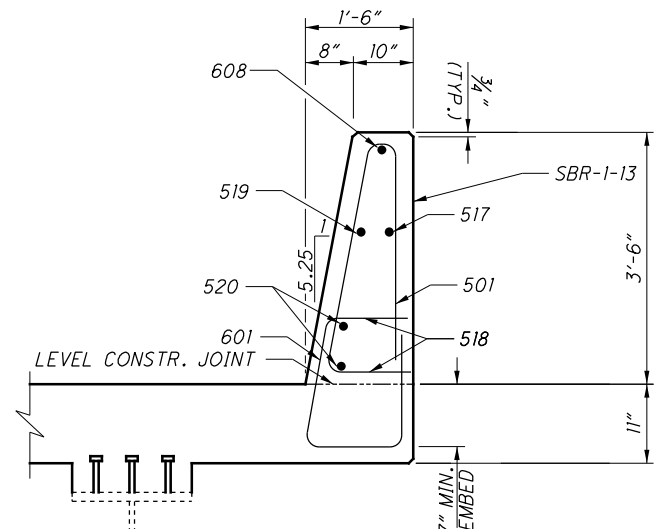


**C** SECTION THRU PANEL

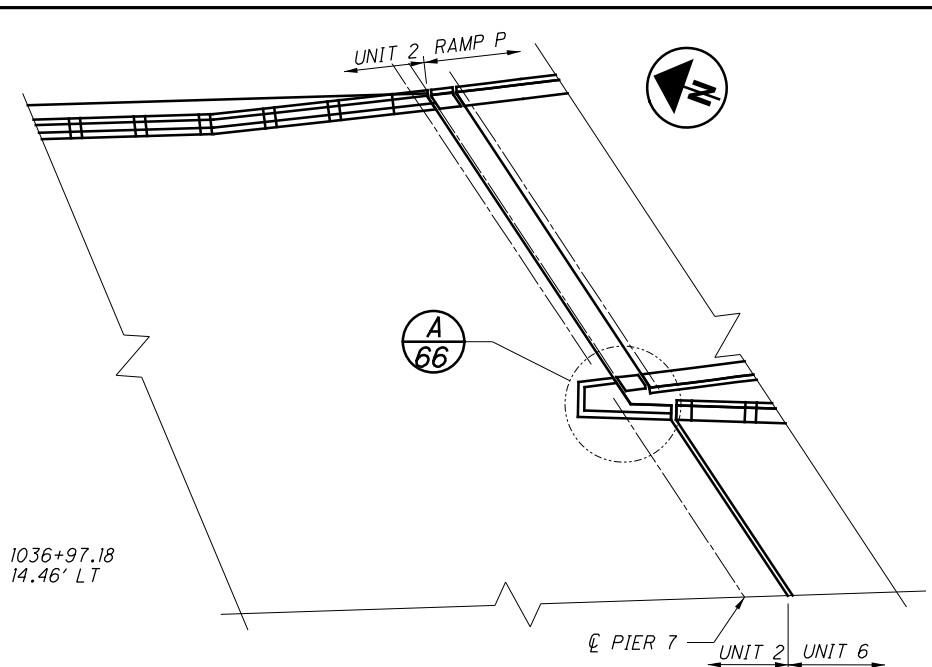

PARAPET PLAN - UNIT 2

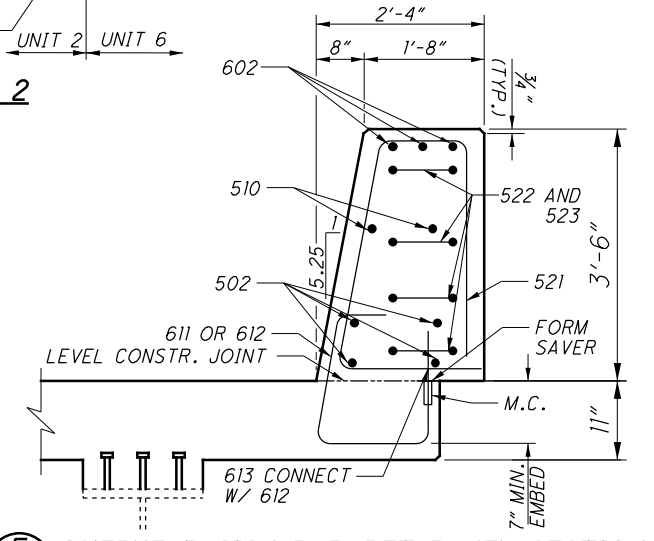

**E** OVERHEAD SIGN PARAPET PANEL SECTION  
(RIGHT OVERHEAD SIGN BASE SHOWN, LEFT OVERHEAD SIGN BASE SIMILAR)

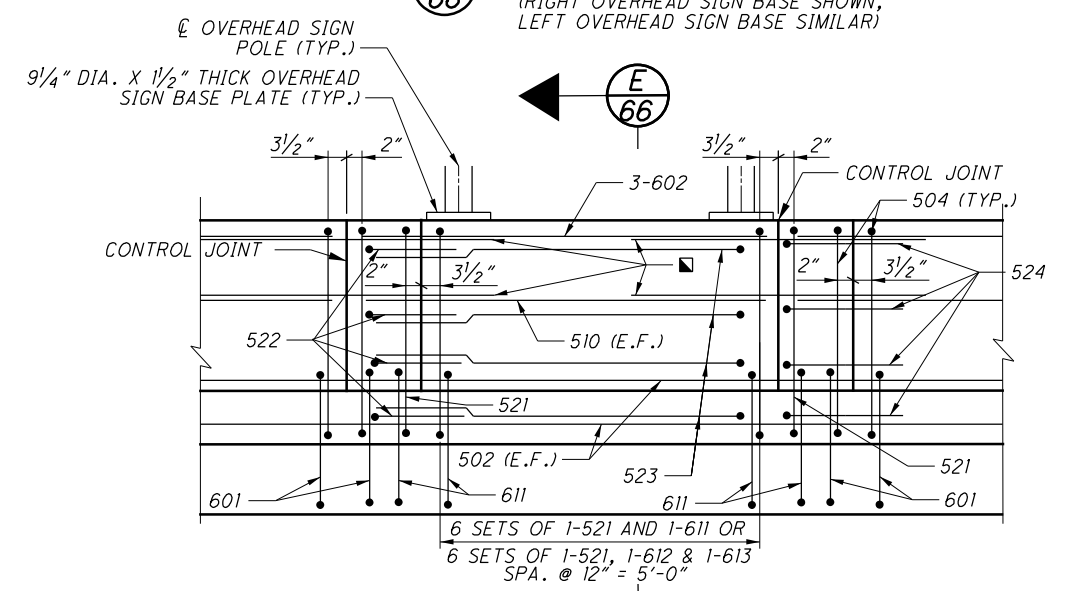


**D** OVERHEAD SIGN PARAPET PANEL

**NOTES:**


- FOR ADDITIONAL DETAILS, SEE STANDARD DRAWING SBR-1-13.
- THE PREFIX "2R" SHALL BE ADDED TO ALL BAR MARKS FOR PARAPET DETAILS.
- FOR ADDITIONAL OVERHEAD SIGN DETAILS, SEE BU-20.

DESIGN AGENCY <b>PRIME</b> 540 WHITE POND DR. SUITE E AKRON, OH 44320	
DESIGNED CRG	DATE 3/27/2019
DRAWN ADS	REVIEWED TES
CHECKED KDC	STRUCTURE FILE NUMBER 3115739
<b>PARAPET AND MEDIAN BARRIER DETAIL - UNIT 2</b> BRIDGE NO. HAM-74-1908R IR-74 OVER MILL CREEK, RR & SPRING GROVE AVENUE	
HAM-75-3.84 PID No. 104667	
66/100 66/100	

P:\Projects\2018\20H03DB-18232 HAM-75-03.84\104667\structures\HAM074\_1908R\sheets\074\_1908R\_IS003.dgn 9/8/2023 7:20:23 PM erin.baumann

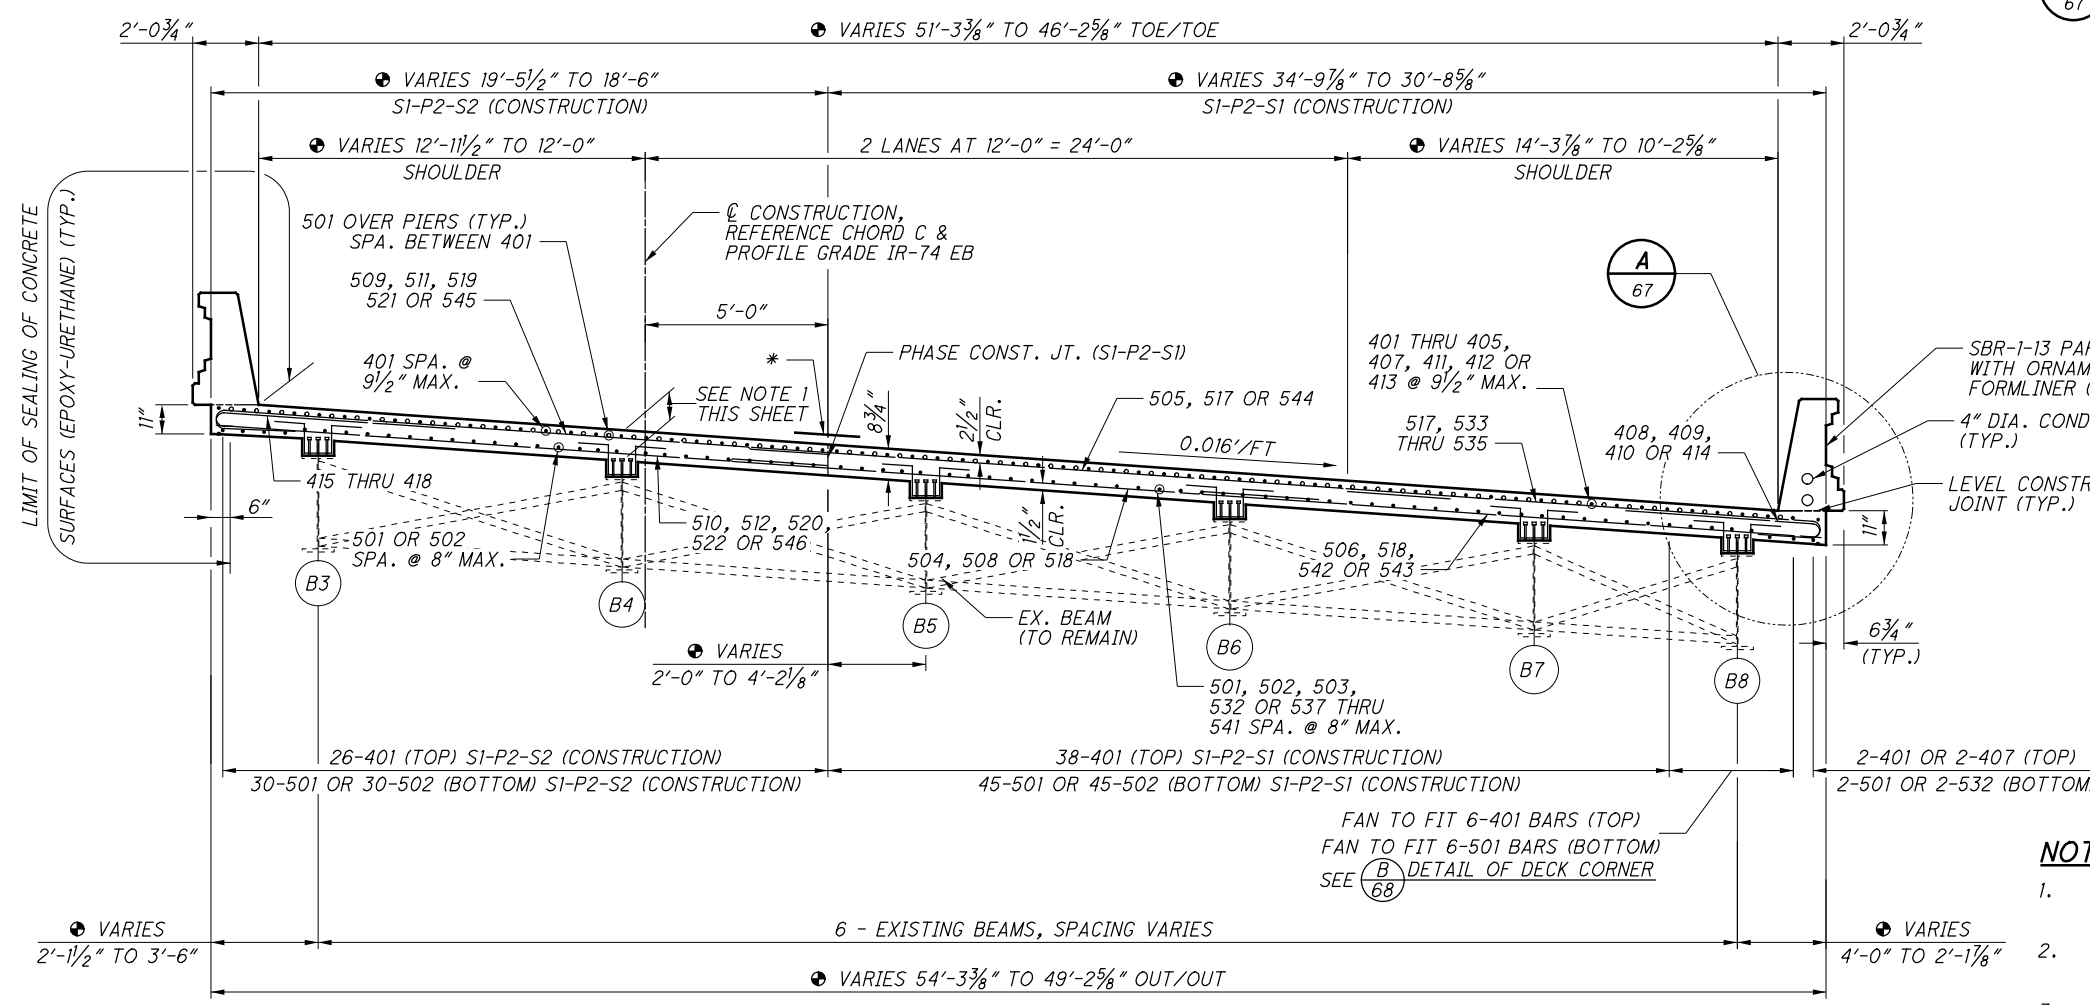

**A** **DETAIL OF DECK OVERHANG**  
67 (RIGHT SHOWN, LEFT SIMILAR)

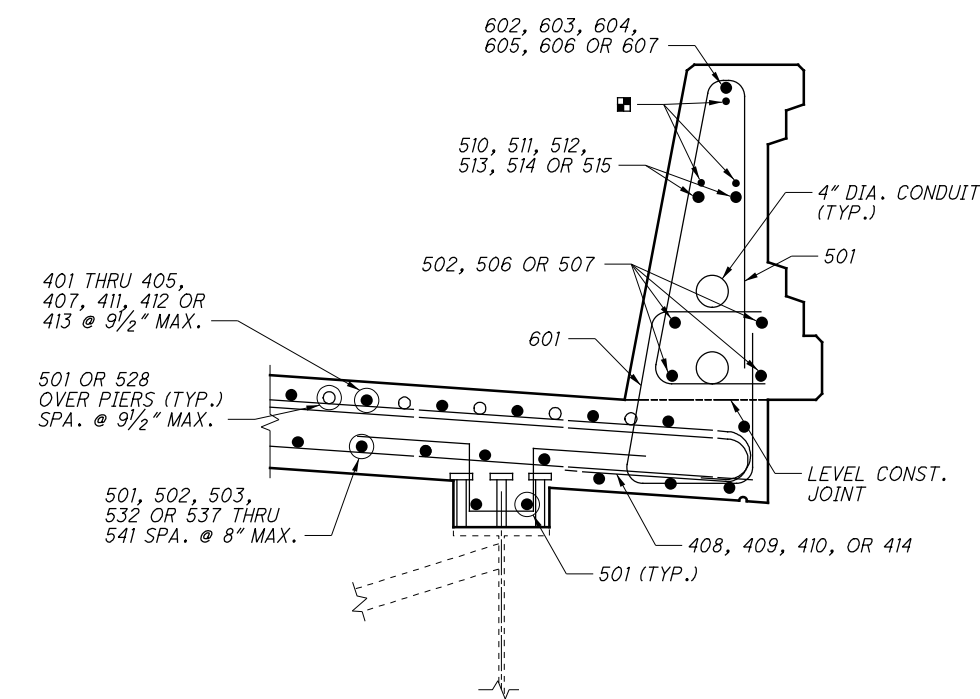

**LEGEND:**

- - 1/2" DIA. GLASS FIBER REINFORCED POLYMER (GFRP) STIFFENING REINFORCEMENT.
- SX-PX-SX - STAGE X, PHASE X, STEP X.
- - VARIES FROM BEGINNING JOINT NEAR HINGE 2 TO END JOINT NEAR ABUTMENT 4.
- \* HMWM RESIN, 2'-0" WIDE, CENTERED ON JOINT, FULL LENGTH OF JOINT.

MIN. REQUIRED LAP LENGTH	
#4 LONGITUDINAL	1'-11"
#5 TRANSVERSE (TOP)	2'-5"
#5 TRANSVERSE (BOT.)	3'-0"
#5 LONGITUDINAL	2'-5"


**NOTES:**

1. FOR HAUNCH DEPTH DETAILS AND ESTIMATED DEPTHS, SEE SHEET 81/100.
2. THE PREFIX "6S" SHALL BE ADDED TO ALL BAR MARKS IN UNIT 6 SUPERSTRUCTURE.
3. FOR FRAMING PLAN, SEE SHEET 49/100.
4. FOR FINAL DECK ELEVATIONS, SEE SHEET 81/100.
5. FOR DECK PLAN, SEE SHEET 68/100.

**TRANSVERSE SECTION - UNIT 6**


(HINGE NO. 2 TO ABUTMENT 4)  
(PARAPET REINFORCING STEEL NOT SHOWN)

P:\Projects\2018\20H03DB-18232 HAM-75-03-84\104667\structures\HAM074\_1908R\_DP006.dgn 6/20/2019 9:19:12 AM asecd

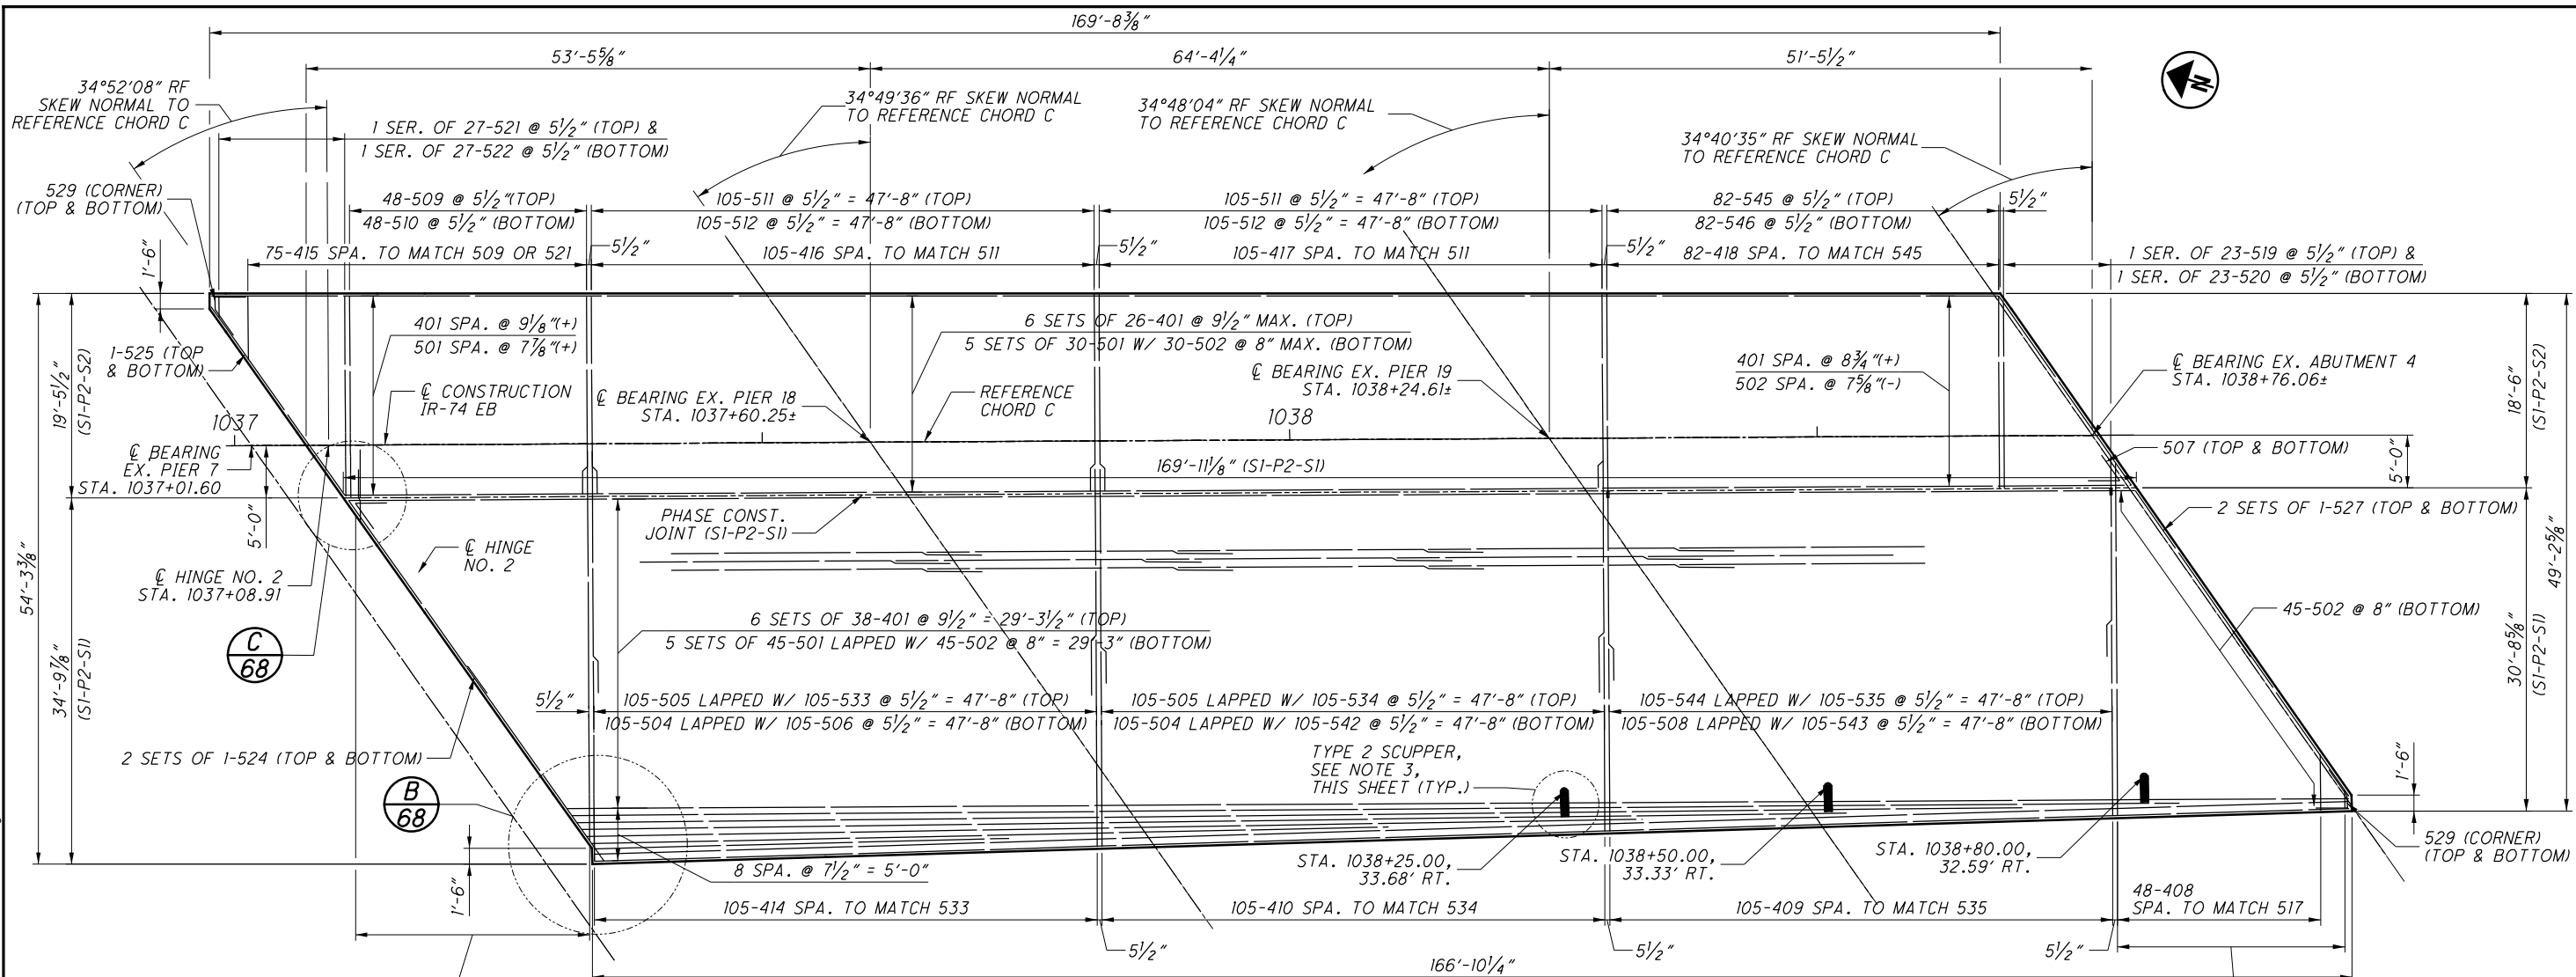


**SLAB PLAN - UNIT 6**  
(PARAPET NOT SHOWN)


MIN. REQUIRED LAP LENGTH	
#4 LONGITUDINAL	1'-11"
#5 TRANSVERSE (TOP)	2'-5"
#5 TRANSVERSE (BOT.)	3'-0"
#5 LONGITUDINAL	2'-5"

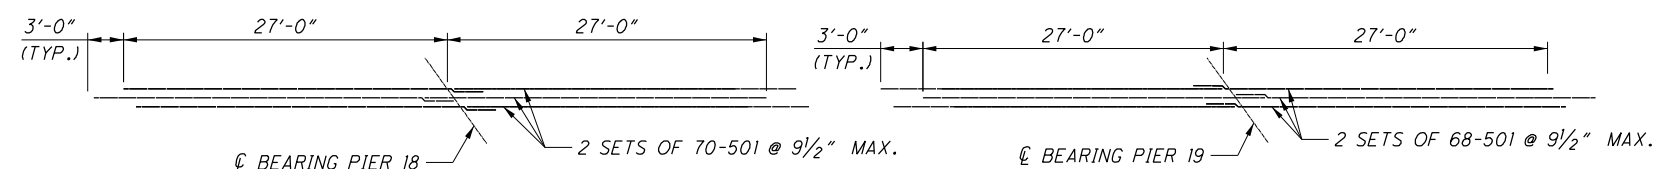

**STAGGER DIAGRAM**  
PIERS 18 & 19

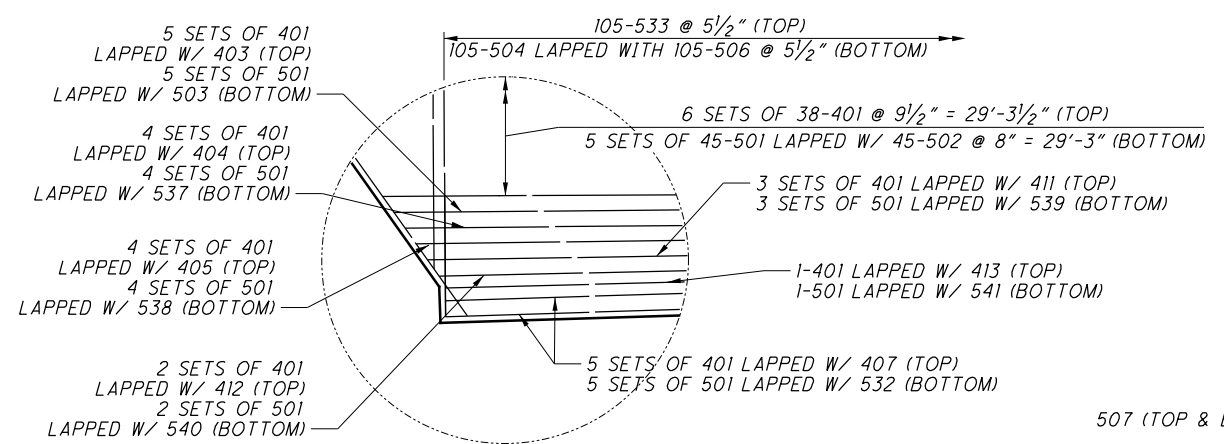

**B** DETAIL OF DECK CORNER

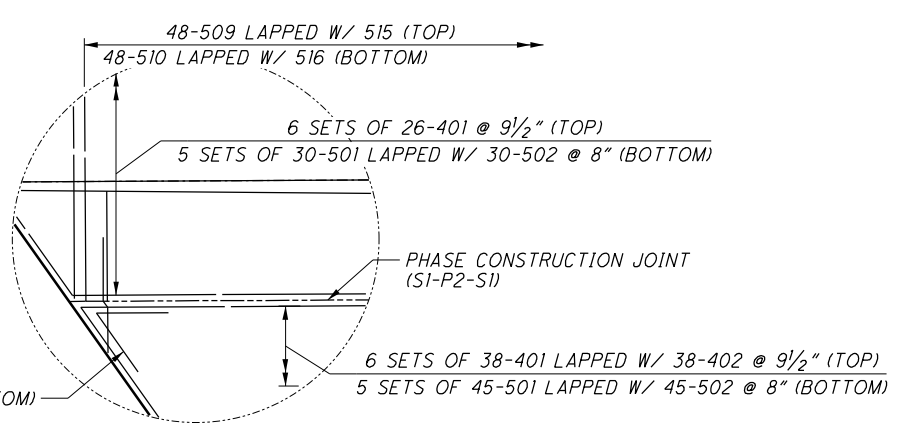

**C** DETAIL OF DECK CORNER

- NOTES:**
1. FOR TRANSVERSE SECTION, SEE SHEET 67100.
  2. THE PREFIX "6S" SHALL BE ADDED TO ALL BAR MARKS IN UNIT 6 SUPERSTRUCTURE.
  3. FOR TYPE 2 SCUPPER DETAILS, SEE SHEET 93100.

DESIGN AGENCY  
**PRIMEW**  
 540 WHITE POND DR. SUITE E  
 AKRON, OH 44320


DESIGNED	JAT	CHECKED	CRG
DRAWN	JAT	REVISED	
REVIEWED	TES	DATE	3/27/2019
STRUCTURE FILE NUMBER	3115739		

**SLAB PLAN - UNIT 6**  
 BRIDGE NO. HAM-74-1908R  
 IR-74 OVER MILL CREEK, RR & SPRING GROVE AVENUE

HAM-75-3.84  
 PID No. 104667

68/100  
 68  
 100

P:\Projects\2018\20H03DB-18232 HAM-75-03.84\104667\structures\HAM074\_1908R\Drawings\1908R\_DP010.dgn 6/20/2019 9:19:20 AM asead

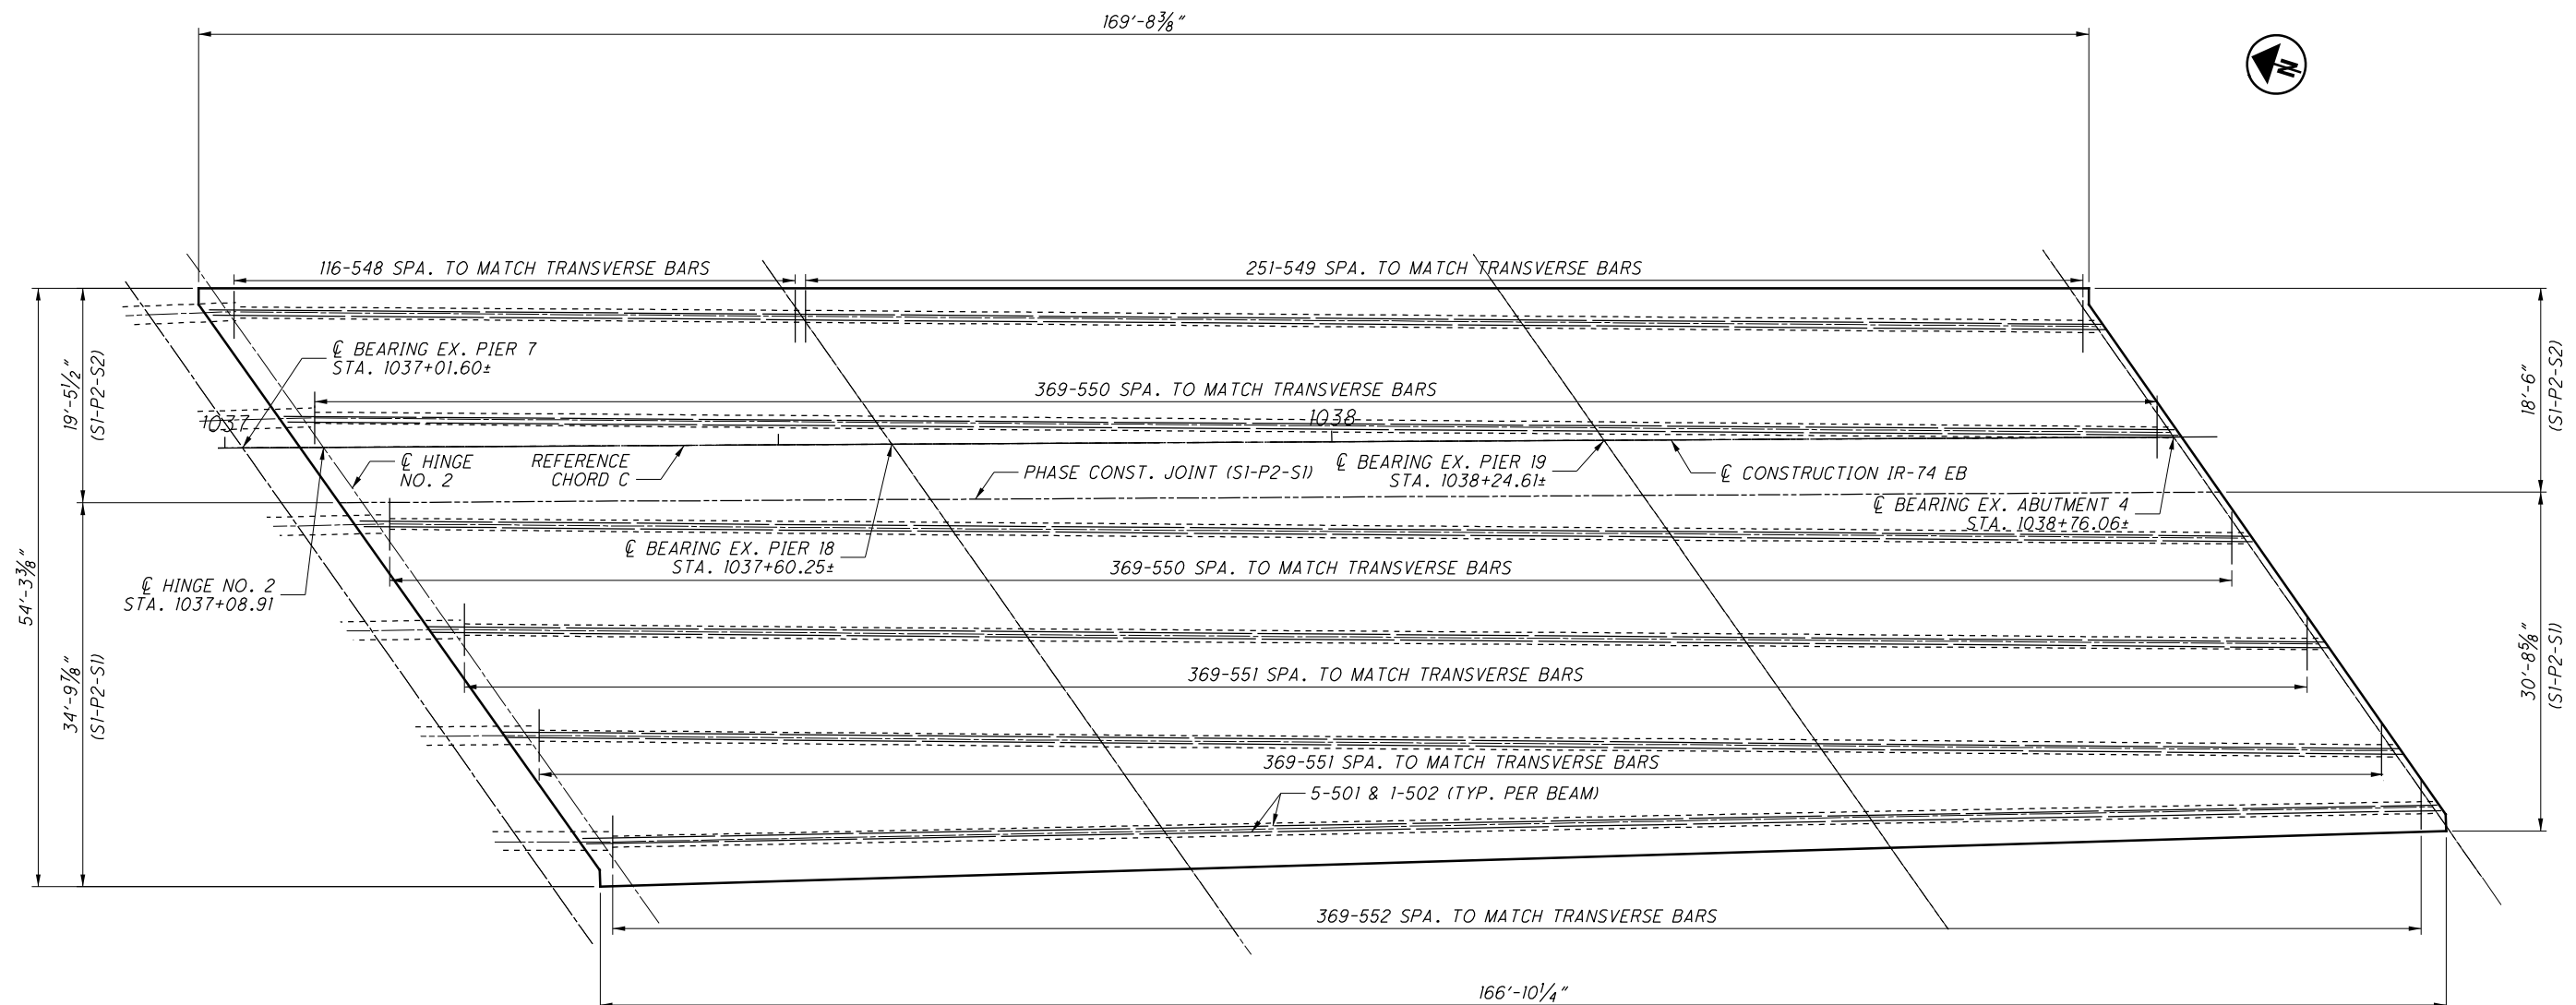


**PART SLAB PLAN - UNIT 6**  
(PARAPET NOT SHOWN)

MIN. REQUIRED LAP LENGTH	
#5 LONGITUDINAL	2'-5"

- NOTES:**
- FOR SLAB PLAN, SEE SHEET 68/100.
  - FOR REINFORCING LIST, SEE SHEET 98/100.

<b>HAM-75-3.84</b> PID No. 104667	<b>HAUNCH REINFORCEMENT PLAN - UNIT 6</b> BRIDGE NO. HAM-74-1908R IR-74 OVER MILL CREEK, RR & SPRING GROVE AVENUE	DESIGNED: JAT CHECKED: CRG	DRAWN: JAT REVISED:	REVIEWED: TES DATE: 3/27/2019 STRUCTURE FILE NUMBER: 3115739	DESIGN AGENCY: <b>PRIME</b> 540 WHITE POND DR. SUITE E AKRON, OH 44320
--------------------------------------	-------------------------------------------------------------------------------------------------------------------------	-------------------------------	------------------------	--------------------------------------------------------------------	---------------------------------------------------------------------------------

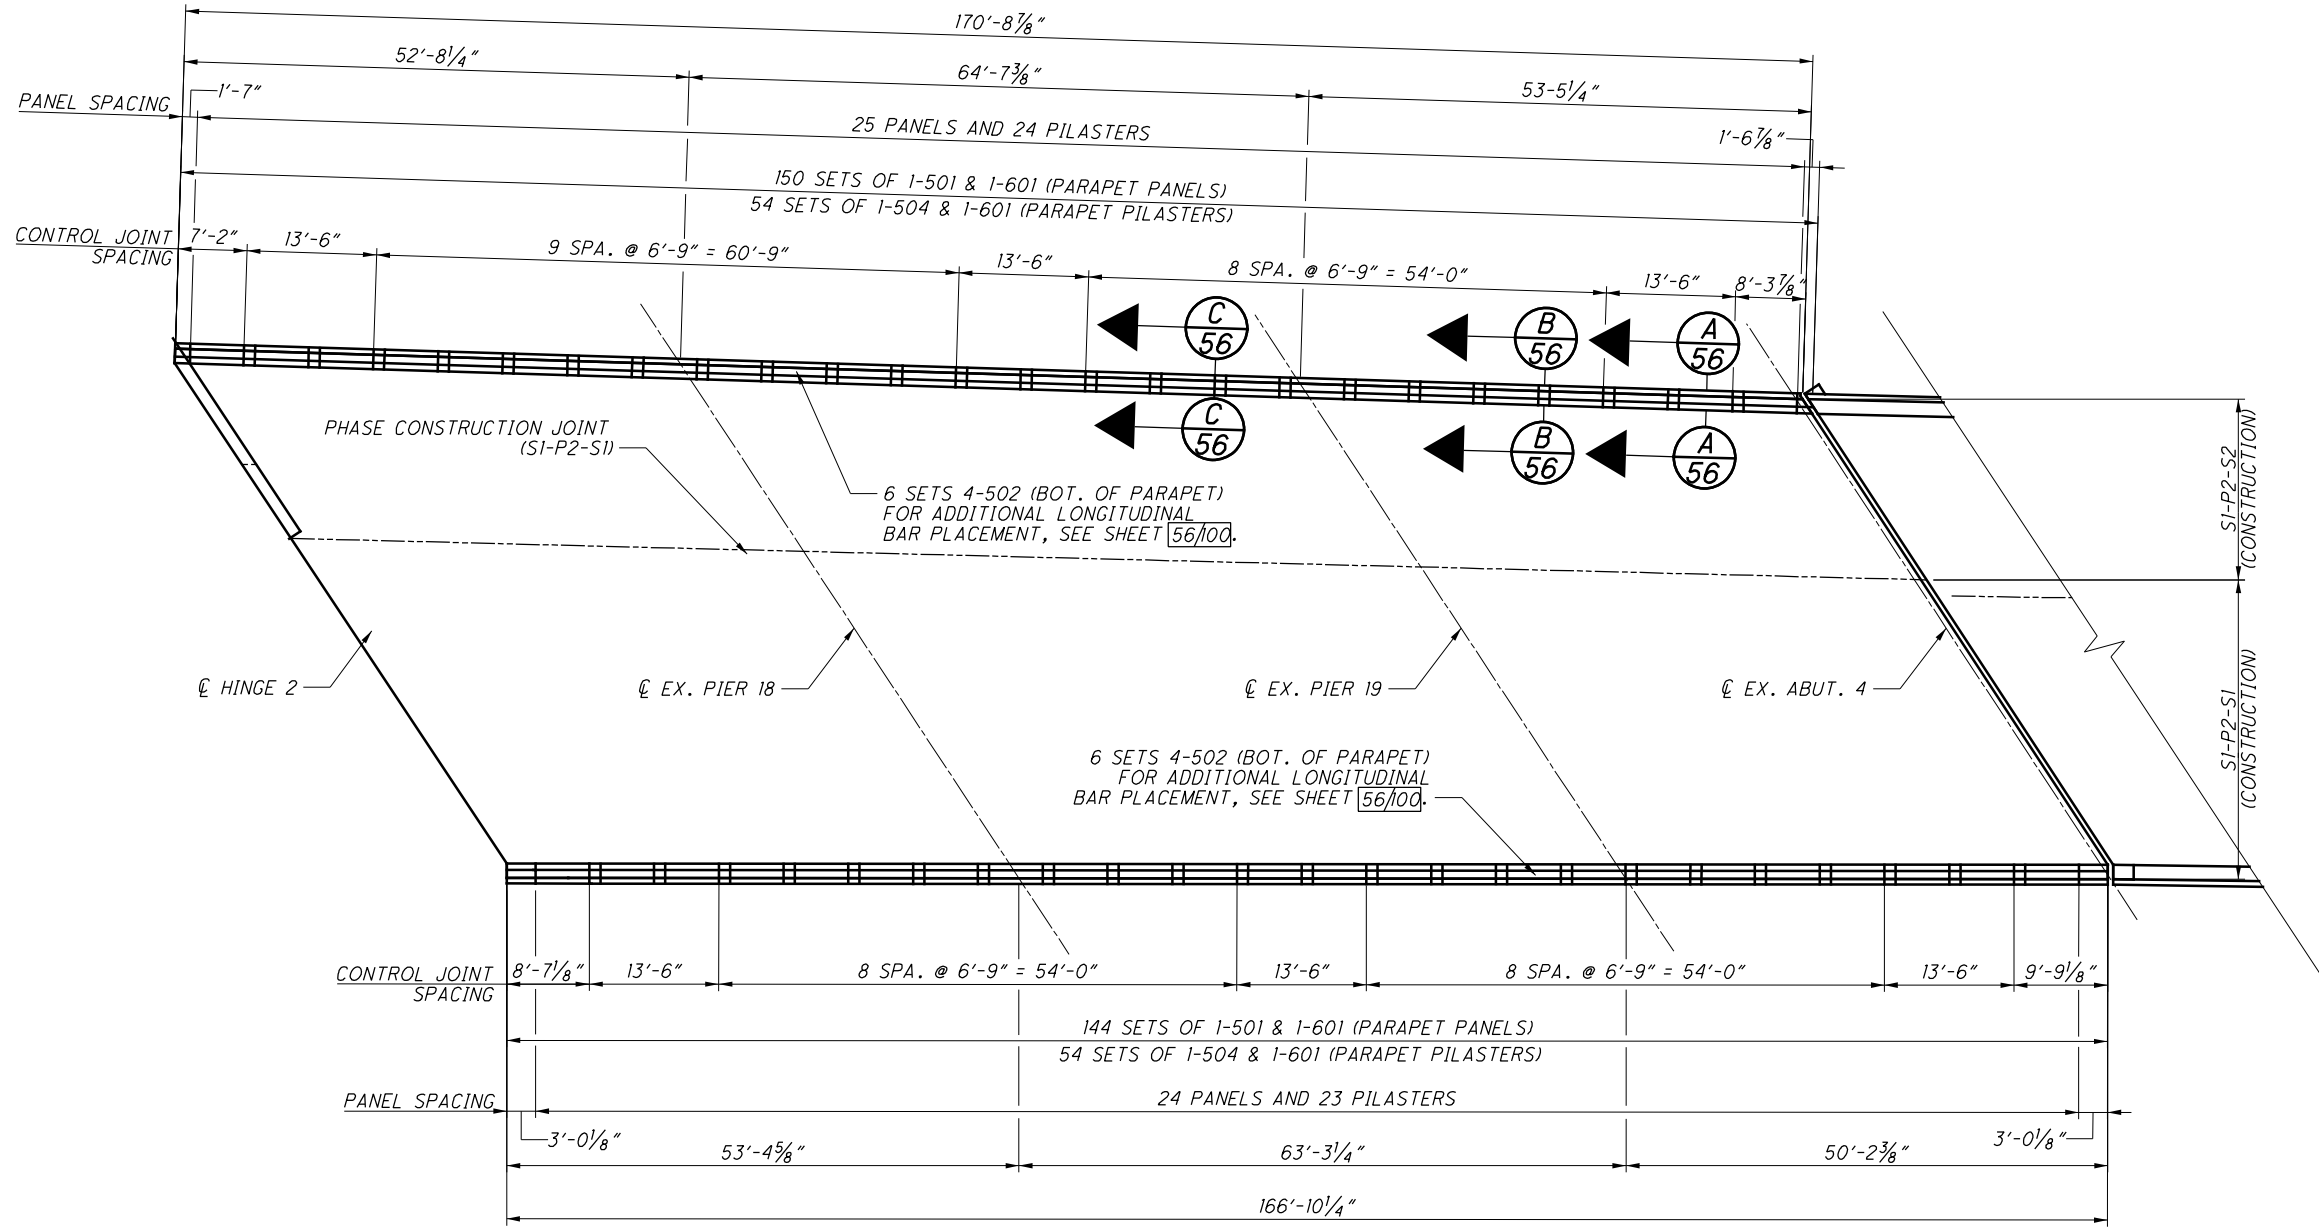

**PARAPET PLAN - UNIT 6**

REQUIRED MINIMUM LAP LENGTHS	
NO. 5 BAR	2'-5"

**NOTES:**

- SEE SHEET 56/100 FOR PARAPET DETAILS.
- ALL DIMENSIONS ALONG EDGE OF SLAB UNLESS NOTED OTHERWISE.
- THE PREFIX "6R" SHALL BE ADDED TO ALL BAR MARKS FOR PARAPET DETAILS.
- FOR REINFORCING STEEL LIST, SEE SHEET 99/100.

P:\Projects\2018\20H03DB-18232 HAM-75-03.84\104667\structures\HAM074\_1908R\sheets\074\_1908R\_RA003.dgn 6/20/2019 9:19:23 AM oseed



**SLAB POURING SEQUENCE**

**SI-P2-S1:**

- 1 POUR PHASED CONSTRUCTION FROM ABUTMENT 1 TO PIER 18. SEE NOTE 3 FOR MORE DETAILS.
- 2 POUR PHASED CONSTRUCTION FROM ABUTMENT 4 TO PIER 18. THIS POUR MUST HAPPEN AFTER SPAN 8 IS POURED, BUT DOES NOT REQUIRE SPAN 8 TO CURE BEFORE POURING THE REMAINDER OF UNIT 6.

**SI-P2-S2:**

- 1 POUR PHASED CONSTRUCTION FROM ABUTMENT 1 TO PIER 18. SEE NOTE 3 FOR MORE DETAILS.
- 2 POUR PHASED CONSTRUCTION FROM ABUTMENT 4 TO PIER 18. THIS POUR MUST HAPPEN AFTER SPAN 8 IS POURED, BUT DOES NOT REQUIRE SPAN 8 TO CURE BEFORE POURING THE REMAINDER OF UNIT 6. THE CONTRACTOR HAS THE OPTION OF POURING FROM ABUTMENT 1 TO ABUTMENT 4 IF HOLD DOWN ANCHORS OR COUNTER WEIGHTS CAPABLE OF RESISTING 5 KIPS PER BEAM ARE IMPLEMENTED. IF HOLD DOWN ANCHORS ARE USED, THE ANCHORS SHALL BE CENTERED ON THE BEARING AND WHEN OPERATIONS ARE COMPLETE, THE ANCHORS SHALL BE REMOVED TO 2 INCHES BELOW THE FINISHED CONCRETE SURFACE AND PATCHED WITH A NON-SHRINK, NON-METALLIC GROUT.

**SI-P2-S3:**

- 1 POUR PHASED CONSTRUCTION FROM ABUTMENT 1 TO PIER 5. SEE NOTE 3 FOR MORE DETAILS.


**LEGEND:**

➔ - DIRECTION OF POUR

**NOTES:**

1. CONSTRUCTION DETAILS ARE FOR I-74 EB (HAM-74-1908R) ONLY. FOR CORRESPONDING CONSTRUCTION DETAILS FOR RAMP P (HAM-74-1908S), SEE BU-05.
2. FOR GENERAL NOTES AND MOT REFERENCE, SEE SHEETS 8/100 AND 9/100.
3. THE CONTRACTOR SHALL CONDUCT SLAB POURS IN THE DIRECTION SHOWN ON THE PLANS. THE CONTRACTOR SHALL HAVE TO OPTION OF POURING ENTIRE UNITS IN ONE POUR; ALTERNATELY, THE CONTRACTOR SHALL HAVE THE OPTION TO STOP POURS WITHIN A UNIT AT PIERS OR AT SPLICE LOCATIONS.

P:\Projects\2018\20H03DB-18232 HAM-75-03.84\104667\structures\HAM074\_1908R\sheets\074\_1908R\_S0023.dgn 9/12/2023 11:35:07 AM erin.baumann

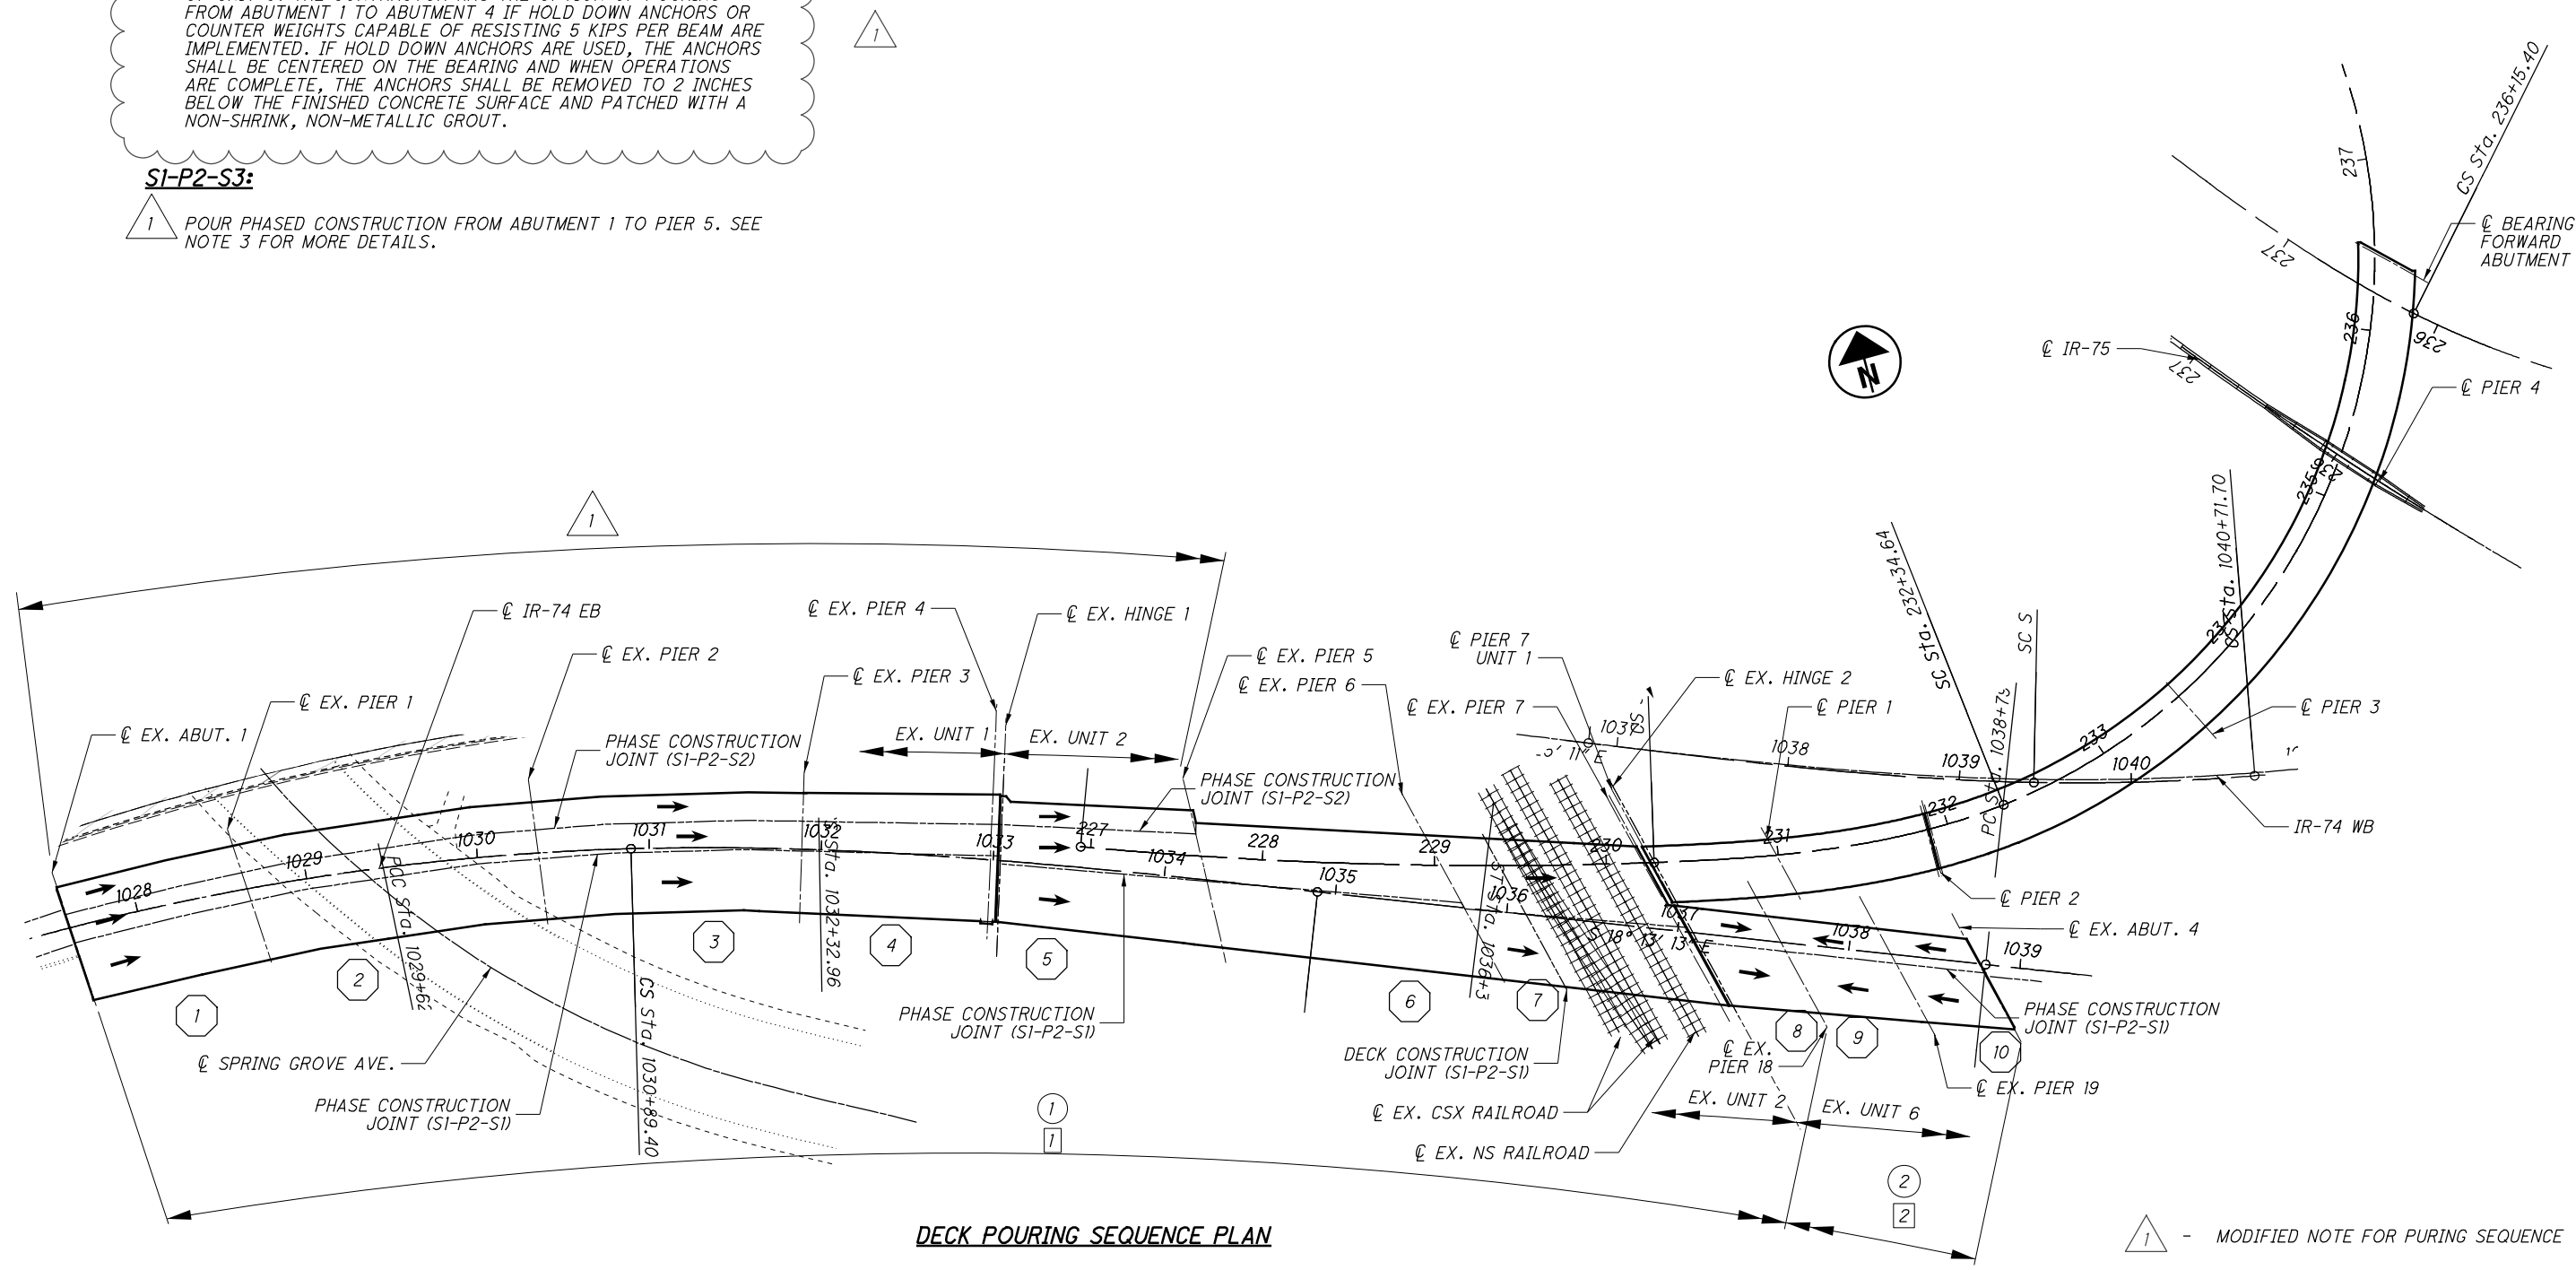


**DECK POURING SEQUENCE PLAN**

1 - MODIFIED NOTE FOR PURING SEQUENCE

<p>DESIGN AGENCY PRIME 540 WHITE POND DR. SUITE E AKRON, OH 44320</p>
<p>DESIGNED CRG</p> <p>DRAWN CRG</p> <p>REVIEWED TES</p> <p>DATE 7/30/2019</p> <p>STRUCTURE FILE NUMBER 3115739</p>
<p>DECK POURING SEQUENCE BRIDGE NO. HAM-74-1908R IR-74 OVER MILL CREEK, RR &amp; SPRING GROVE AVENUE</p>
<p>HAM-75-3.84 PID No. 104667</p>
<p>71/100</p> <p>71/100</p>


P:\Projects\2018\20H03DB-18232 HAM-75-03.84\104667\structures\HAM074\_1908R\MD009.dgn 6/20/2019 9:19:46 AM asecd

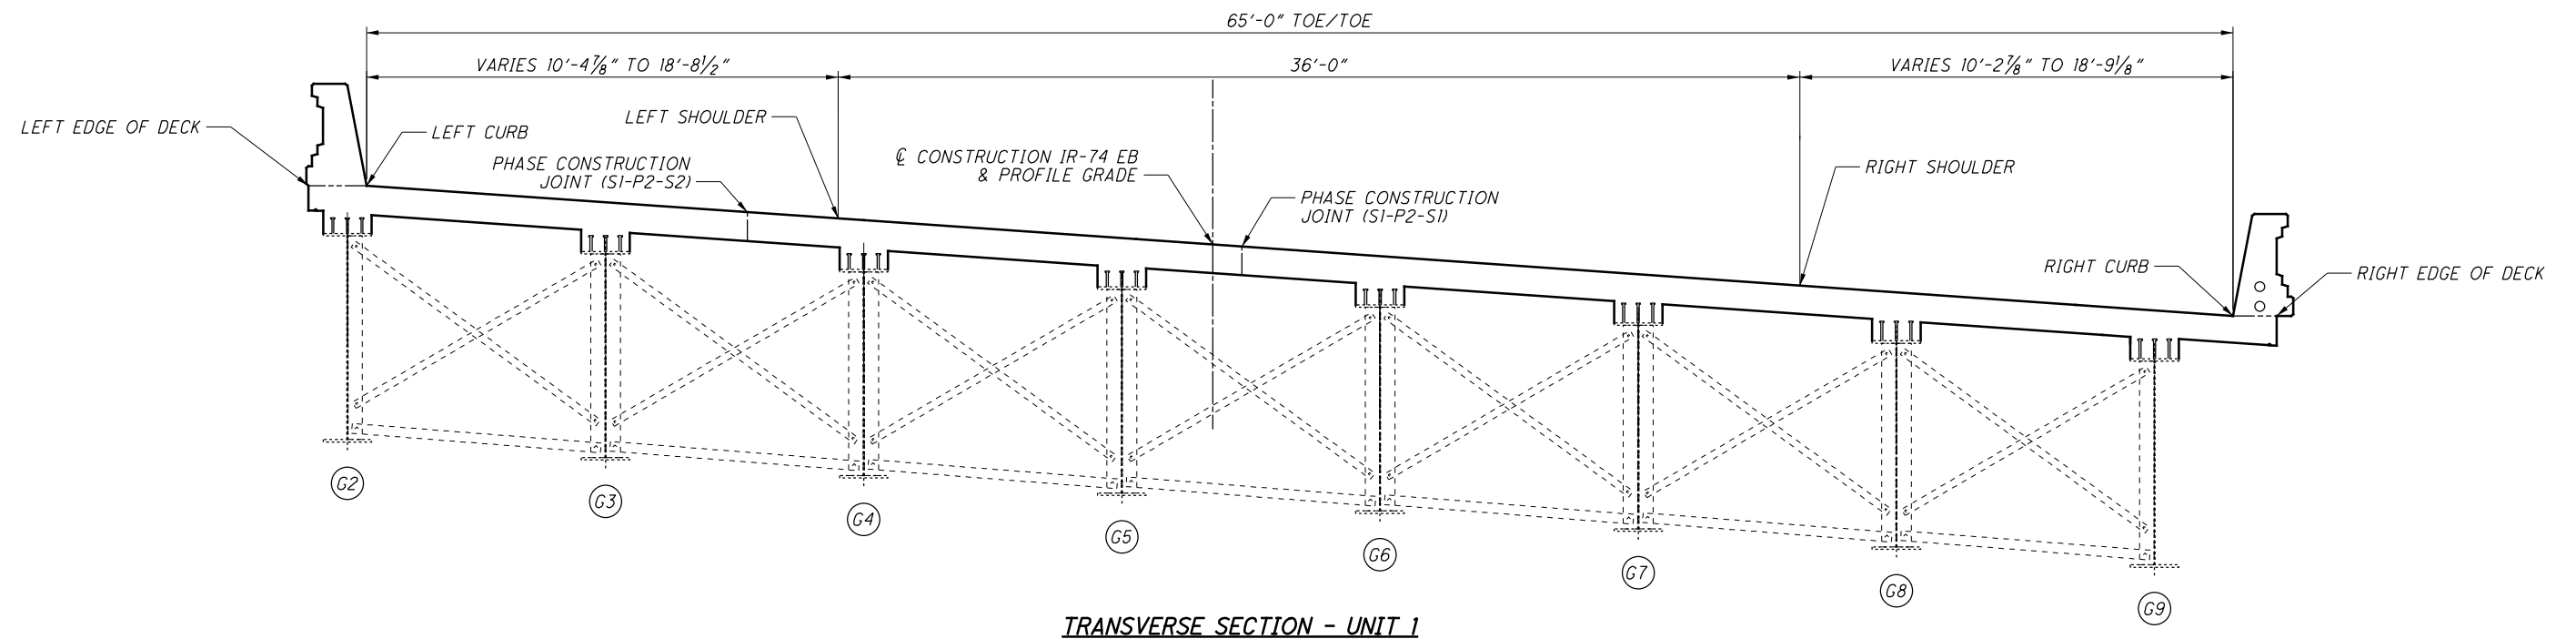

**TRANSVERSE SECTION - UNIT 1**

**NOTES:**

1. FOR FINAL DECK ELEVATIONS, SEE SHEET 73/100 & 74/100.
2. FOR DECK PLAN, SEE SHEETS 51/100 AND 52/100.
3. FOR TRANSVERSE SECTION, SEE SHEET 50/100.
4. FOR FRAMING PLAN, SEE SHEET 42/100.
5. FOR ESTIMATED HAUNCH THICKNESSES, SEE SHEET 75/100.

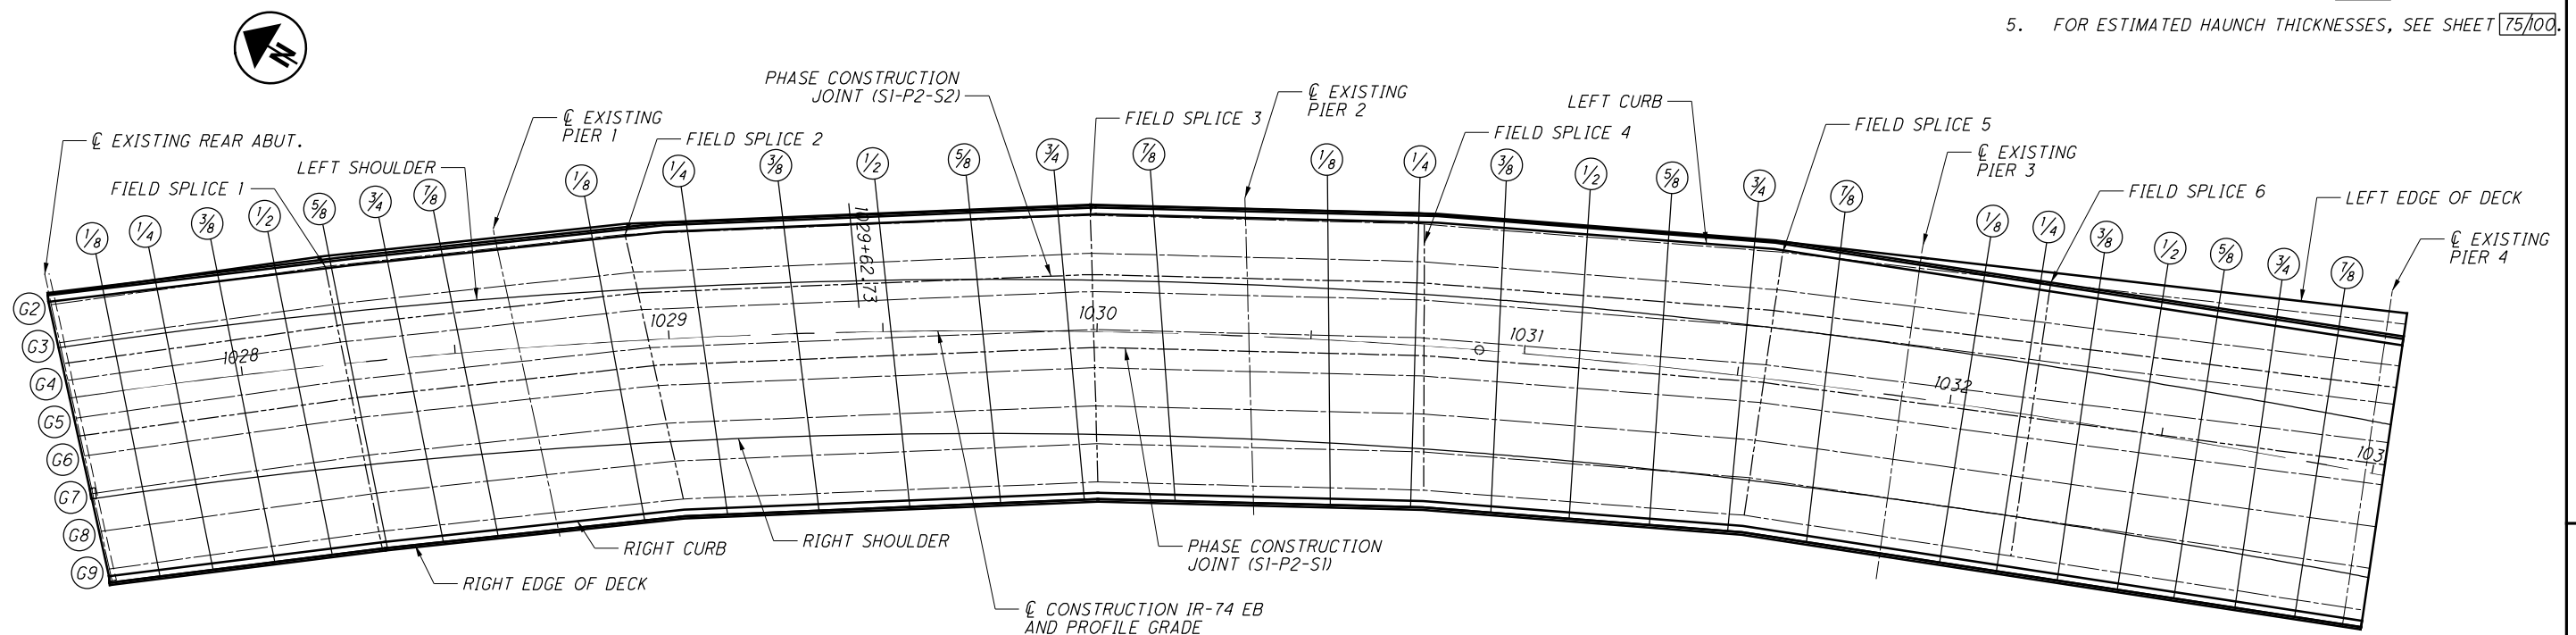

**ELEVATION LOCATION PLAN - UNIT 1**





\\prime01.prime01.com\DFSRoot\Data\Projects\2018\20H030B-18232-HAM-75-03.84\104667\_structures\HAM74\_1908R\sheets\074\_1908R\_MD023.dgn 6/20/2019 9:19:57 AM cseed

ESTIMATED HAUNCH DEPTH TABLE (IN)


	REAR ABUT, UNIT 1	1/8 POINT	1/4 POINT	3/8 POINT	1/2 POINT	FS1	5/8 POINT	3/4 POINT	7/8 POINT	BRG. PIER 1	1/8 POINT	FS2	1/4 POINT	3/8 POINT	1/2 POINT	5/8 POINT	3/4 POINT	FS3	7/8 POINT	BRG. PIER 2
GIRDER 2	6.84	6.42	6.25	6.33	6.49	4.56	5.55	5.29	4.21	4.38	5.59	4.34	5.12	4.06	3.69	4.02	5.03	4.04	3.22	3.30
GIRDER 3	7.79	7.44	7.33	7.48	7.89	6.24	7.21	6.92	5.88	6.10	7.01	5.67	6.17	5.11	4.72	5.01	6.00	4.97	4.14	4.23
GIRDER 4	8.86	8.46	8.31	8.43	8.79	7.11	8.07	7.73	6.63	6.78	7.59	6.20	6.73	5.66	5.26	5.55	6.52	5.44	4.70	4.91
GIRDER 5	9.62	9.28	9.19	9.36	9.80	8.18	9.15	8.77	7.77	7.90	8.82	7.53	8.02	6.81	6.28	6.41	7.21	6.08	5.53	6.04
GIRDER 6	10.48	10.02	9.82	9.88	10.21	8.74	9.72	9.49	8.53	8.83	9.85	8.56	9.10	7.92	7.42	7.59	8.39	6.99	6.99	7.56
GIRDER 7	9.85	9.53	9.47	9.67	10.14	8.81	9.77	9.27	8.05	8.08	8.67	7.19	7.81	6.73	6.31	6.55	7.43	6.02	5.98	6.51
GIRDER 8	8.51	8.14	8.04	8.22	8.64	7.28	8.24	7.74	6.49	6.52	7.36	6.01	6.66	5.57	5.12	5.32	6.17	4.73	4.71	5.25
GIRDER 9	7.35	6.99	6.89	7.06	7.50	6.14	7.10	6.66	5.49	5.59	6.31	4.91	5.56	4.41	3.91	4.05	4.83	3.34	3.49	4.25

ESTIMATED HAUNCH DEPTH TABLE (IN)


	BRG. PIER 2	1/8 POINT	1/4 POINT	FS4	3/8 POINT	1/2 POINT	5/8 POINT	3/4 POINT	FS5	7/8 POINT	BRG. PIER 3	1/8 POINT	1/4 POINT	FS6	3/8 POINT	1/2 POINT	5/8 POINT	3/4 POINT	7/8 POINT	BRG. PIER 4
GIRDER 2	3.30	3.96	5.46	6.00	8.53	8.32	8.16	8.01	6.96	6.33	5.63	5.51	5.39	4.36	7.01	6.86	6.71	6.56	6.31	5.96
GIRDER 3	4.23	4.89	6.38	6.45	9.31	9.17	9.08	9.01	7.96	7.45	7.41	7.47	7.50	6.49	9.26	9.24	9.17	9.08	8.88	8.55
GIRDER 4	4.91	5.68	7.26	7.35	10.07	10.10	10.18	10.26	9.29	8.51	8.12	8.12	8.10	7.10	9.82	9.73	9.62	9.48	9.24	8.86
GIRDER 5	6.04	7.07	8.90	9.01	11.49	11.49	11.52	11.59	10.59	9.72	9.16	9.06	8.92	7.90	10.53	10.32	10.10	9.85	9.49	8.97
GIRDER 6	7.56	8.63	11.23	11.40	12.68	12.75	12.86	12.98	11.99	10.76	9.72	9.57	9.41	8.35	10.71	10.44	10.20	9.93	9.53	8.99
GIRDER 7	6.51	7.54	10.08	10.32	11.79	12.22	12.68	13.20	12.32	11.27	10.48	10.27	10.01	8.97	11.28	10.96	10.67	10.31	9.89	9.29
GIRDER 8	5.25	6.27	8.81	9.00	10.53	11.21	11.92	12.63	11.80	10.91	10.40	10.10	9.79	8.72	10.96	10.60	10.24	9.84	9.33	8.71
GIRDER 9	4.25	5.46	8.18	8.43	9.96	10.80	11.65	12.49	11.67	10.87	10.50	10.13	9.74	8.67	10.86	10.44	10.01	9.56	9.00	8.32

NOTES:


- FOR ELEVATION DIAGRAM DEPICTING DECK SURFACE LOCATIONS IN TRANSVERSE SECTION AND PLAN VIEW, SEE SHEET 72/100.
- FOR ADDITIONAL NOTES, SEE SHEET 72/100.

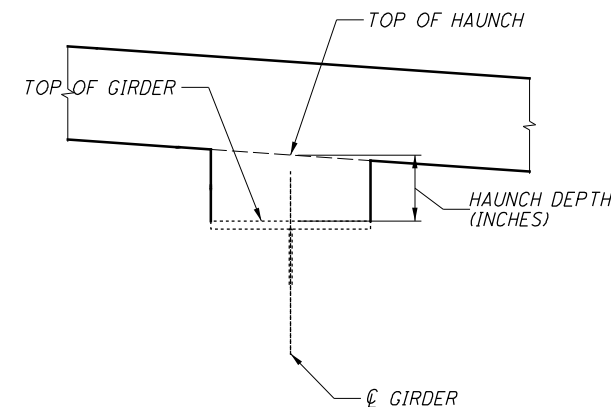

P:\Projects\2018\20H03DB-18232 HAM-75-03.84\104667\structures\HAM074\_1908R\sheets\074\_1908R\_MD012.dgn 6/20/2019 9:20:45 AM asecd

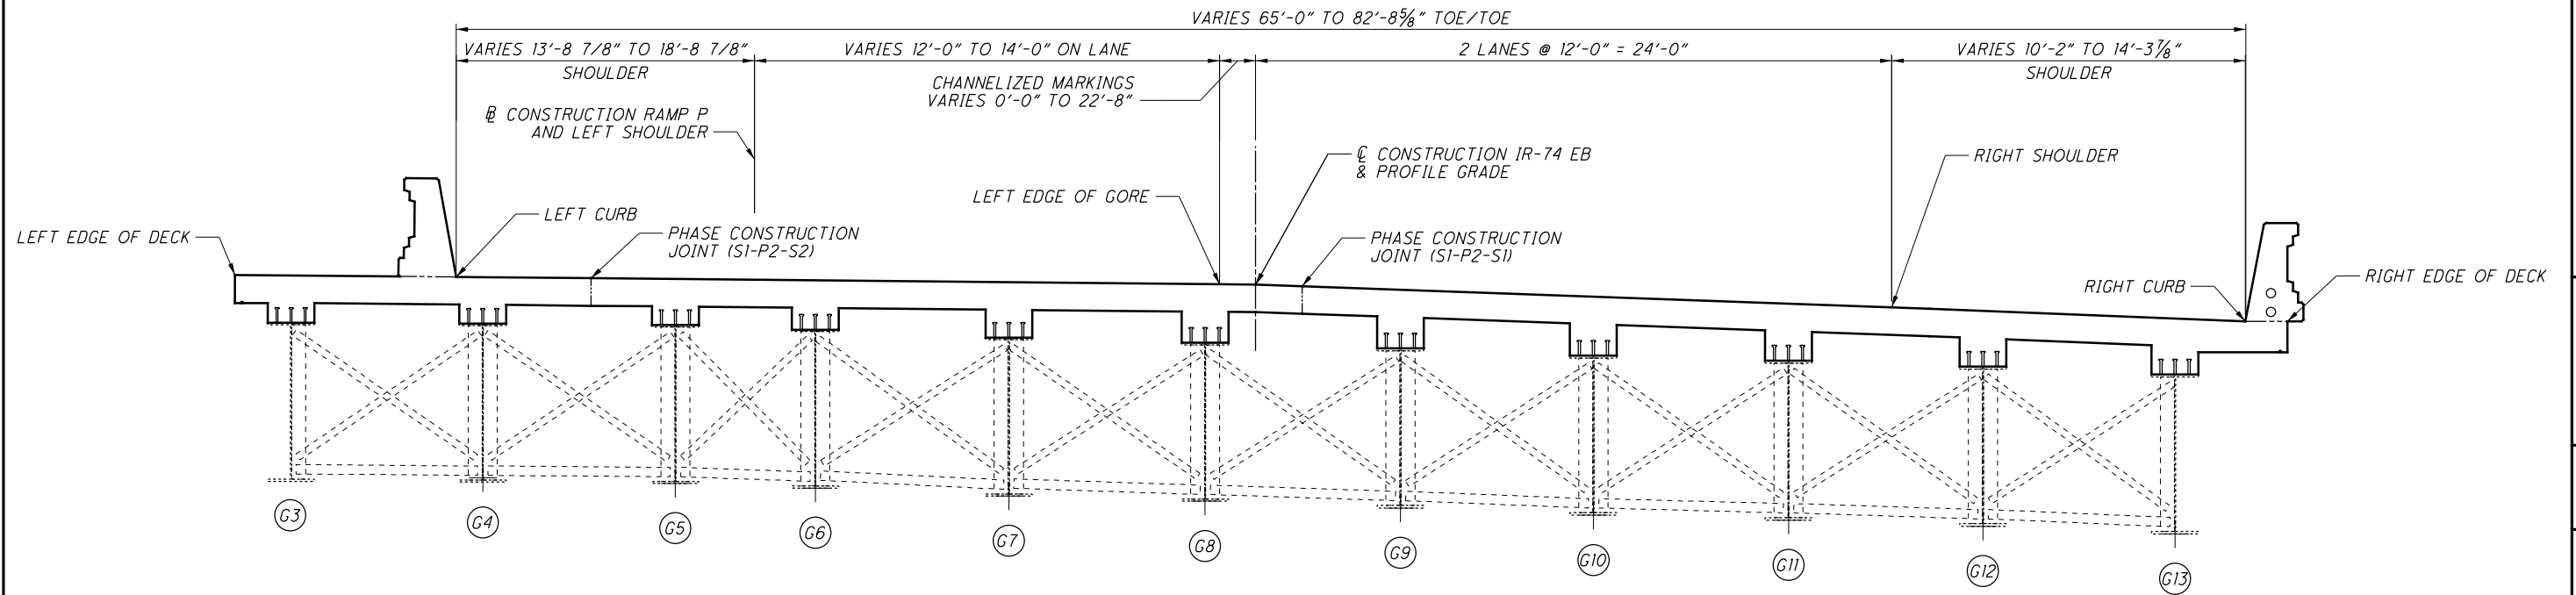

TRANSVERSE SECTION - UNIT 2

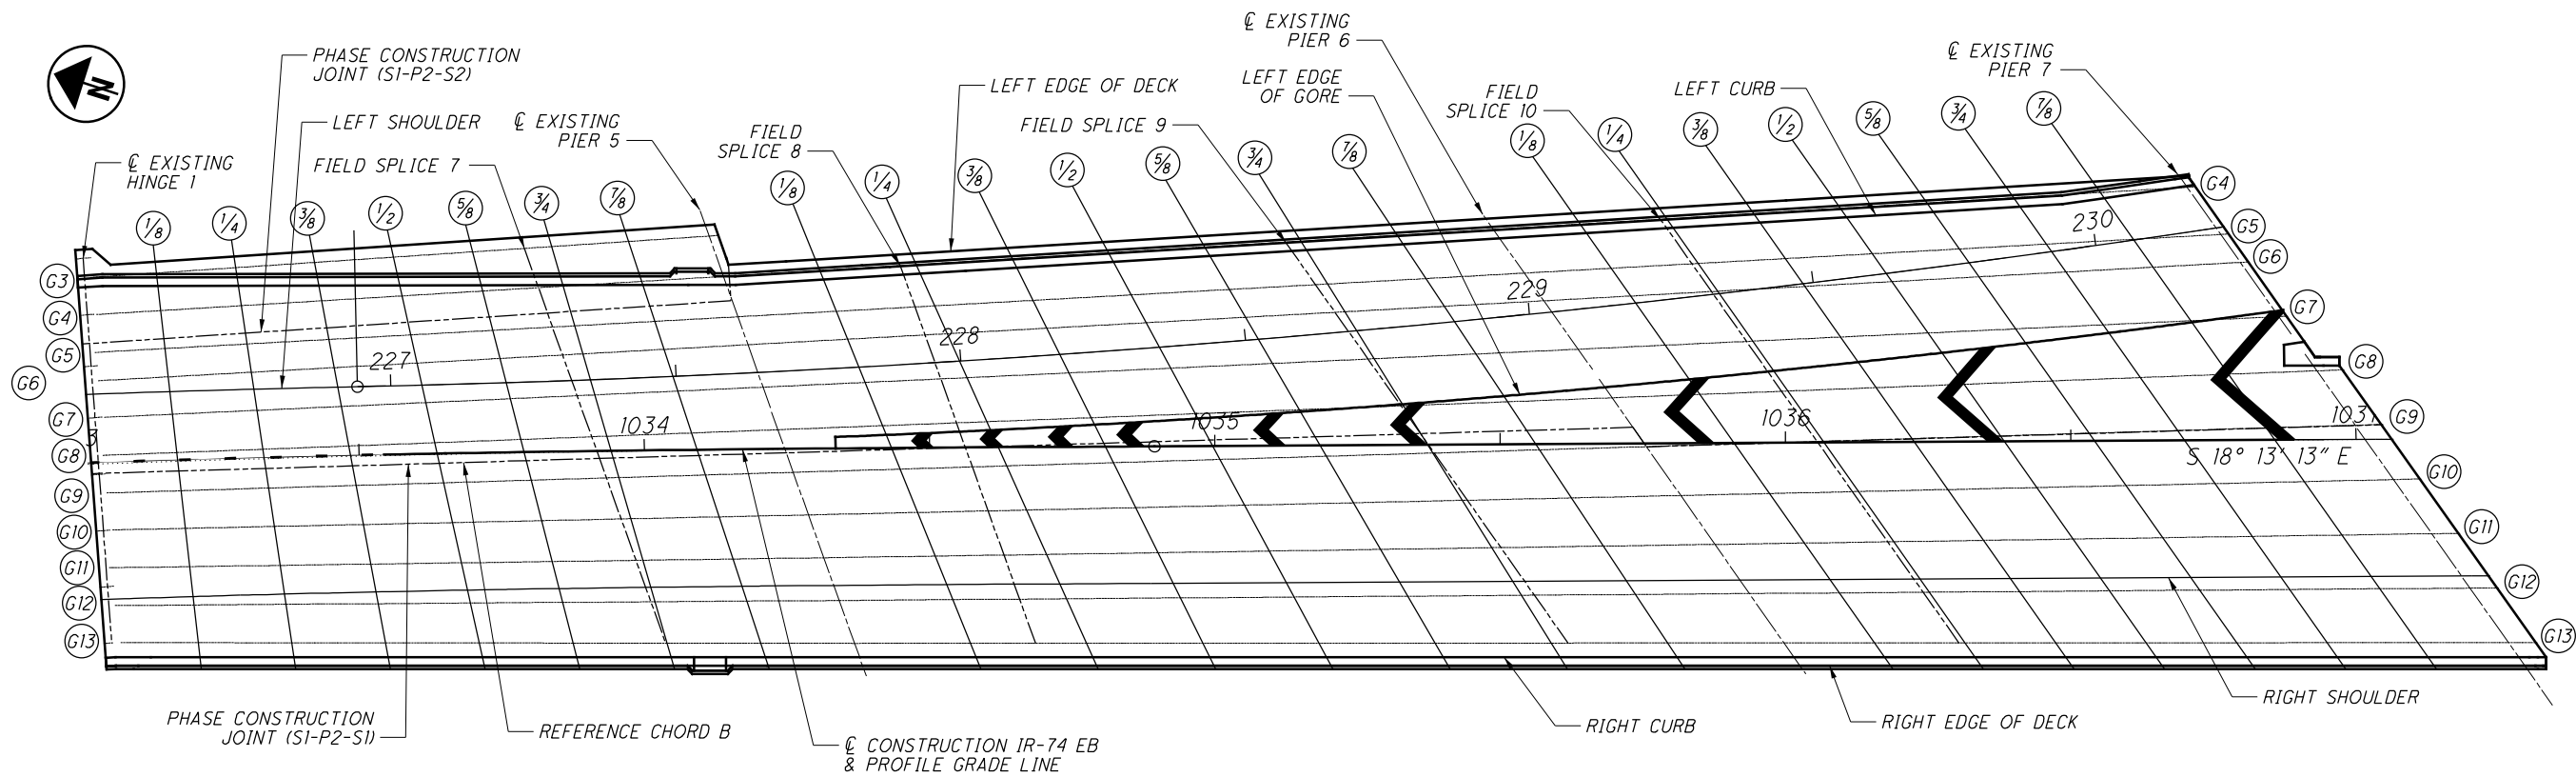

ELEVATION LOCATION PLAN - UNIT 2

**NOTES:**

1. FOR FINAL DECK ELEVATIONS, SEE SHEETS 577/100 AND 78/100.
2. FOR DECK PLAN, SEE SHEETS 60/100 AND 61/100.
3. FOR TRANSVERSE SECTION, SEE SHEET 58/100.
4. FOR FRAMING PLAN, SEE SHEET 46/100.
5. FOR ESTIMATED HAUNCH THICKNESSES, SEE SHEET 79/100.





P:\Projects\2018\20H03DB-18232 HAM-75-03.84\104667\structures\HAM074\_1908R\sheets\074\_1908R\_MD020.dgn 6/20/2019 9:20:57 AM oseed

		FINAL DECK SURFACE ELEVATIONS - UNIT 2													
		5/8 POINT	3/4 POINT	FS9	7/8 POINT	¢ BRG. PIER 6	1/8 POINT	FS10	1/4 POINT	3/8 POINT	1/2 POINT	5/8 POINT	3/4 POINT	7/8 POINT	¢ PIER 7
LEFT EDGE	STATION	228+43.24	228+60.18	228+57.33	228+77.11	228+94.03	229+09.34	229+23.54	229+24.65	229+39.94	229+55.23	229+70.50	229+85.76	230+01.01	230+16.25
	ELEV.	537.04	537.22	537.19	537.40	537.65	537.88	538.08	538.09	538.29	538.51	538.70	538.87	539.03	539.20
GIRDER 3	STATION	-	-	-	-	-	-	-	-	-	-	-	-	-	-
	ELEV.	-	-	-	-	-	-	-	-	-	-	-	-	-	-
GIRDER 4	STATION	228+44.21	228+61.21	228+58.51	228+78.21	228+95.20	229+10.50	229+24.66	229+25.79	229+41.07	229+56.34	229+71.60	229+86.85	230+02.08	230+17.30
	ELEV.	537.05	537.23	537.20	537.42	537.67	537.90	538.09	538.11	538.31	538.53	538.72	538.88	539.04	539.22
LEFT CURB	STATION	228+52.27	228+69.59	228+68.15	228+86.80	229+03.89	229+18.72	229+32.41	229+33.50	229+48.23	229+62.92	229+77.57	229+92.17	230+06.73	230+21.25
	ELEV.	536.97	537.21	537.19	537.51	537.83	538.08	538.30	538.32	538.53	538.71	538.88	539.02	539.17	539.34
SI-P2-S2 CONSTRUCTION JOINT	STATION	-	-	-	-	-	-	-	-	-	-	-	-	-	-
	ELEV.	-	-	-	-	-	-	-	-	-	-	-	-	-	-
GIRDER 5	STATION	228+47.94	228+63.12	228+65.25	228+82.54	228+99.83	229+15.13	229+29.27	229+30.41	229+45.69	229+60.96	229+76.21	229+91.45	230+06.68	230+21.89
	ELEV.	537.02	537.20	537.22	537.46	537.74	537.99	538.20	538.22	538.44	538.65	538.84	539.00	539.17	539.39
GIRDER 6	STATION	228+50.33	228+67.81	228+66.08	228+85.28	229+02.74	229+18.00	229+32.10	229+33.26	229+48.51	229+63.74	229+78.96	229+94.17	230+09.37	230+24.55
	ELEV.	536.99	537.21	537.19	537.49	537.80	538.06	538.29	538.31	538.54	538.75	538.95	539.13	539.34	539.60
RAMP P BASELINE & LEFT SHOULDER	STATION	228+52.27	228+69.59	228+68.15	228+86.80	229+03.89	229+18.72	229+32.41	229+33.50	229+48.23	229+62.92	229+77.57	229+92.17	230+06.73	230+21.25
	ELEV.	536.97	537.21	537.19	537.51	537.83	538.08	538.30	538.32	538.53	538.71	538.88	539.02	539.17	539.34
GIRDER 7	STATION	228+54.40	228+72.22	228+71.10	228+90.04	229+07.84	229+23.12	229+37.21	229+38.40	229+53.66	229+68.92	229+84.15	229+99.37	230+14.58	1036+86.52
	ELEV.	536.95	537.22	537.20	537.56	537.92	538.21	538.46	538.48	538.74	538.99	539.22	539.45	539.72	539.93
GIRDER 8	STATION	228+58.40	1035+33.13	1035+32.67	1035+51.40	1035+69.68	1035+85.11	1035+99.37	1036+00.55	1036+15.98	1036+31.42	1036+46.85	1036+62.28	1036+77.72	1036+93.15
	ELEV.	536.93	537.25	537.24	537.62	537.97	538.23	538.45	538.46	538.67	538.85	539.02	539.17	539.33	539.45
LEFT EDGE OF GORE	STATION	228+58.55	228+76.41	228+75.94	228+94.16	229+11.77	229+26.62	229+40.31	229+41.43	229+56.18	229+70.89	229+85.55	230+00.16	230+14.73	230+29.25
	ELEV.	536.93	537.25	537.24	537.64	538.02	538.32	538.58	538.60	538.85	539.09	539.30	539.61	539.73	539.98
¢ CONSTRUCTION IR-74 EB & PROFILE GRADE	STATION	1035+18.44	1035+36.94	1035+37.42	1035+56.28	1035+75.25	1035+91.04	1036+05.66	1036+06.84	1036+22.63	1036+38.42	1036+54.22	1036+70.01	1036+85.81	1037+01.60
	ELEV.	536.90	537.19	537.19	537.47	537.72	537.92	538.09	538.10	538.27	538.42	538.56	538.69	538.80	538.89
SI-P2-S1 CONSTRUCTION JOINT	STATION	1035+17.58	1035+37.42	1035+36.06	1035+54.70	1035+73.28	1035+91.19	1036+05.56	1036+06.72	1036+22.25	1036+37.78	1036+53.31	1036+68.84	1036+84.37	1036+99.89
	ELEV.	536.91	537.19	537.21	537.52	537.81	537.92	538.10	538.11	538.29	538.46	538.62	538.76	538.89	539.00
GIRDER 9	STATION	1035+19.55	1035+38.24	1035+38.43	1035+56.93	1035+75.62	1035+91.14	1036+05.51	1036+06.67	1036+22.19	1036+37.72	1036+53.24	1036+68.76	1036+84.29	1036+99.81
	ELEV.	536.88	537.18	537.19	537.46	537.72	537.92	538.10	538.11	538.30	538.47	538.62	538.77	538.90	539.00
GIRDER 10	STATION	1035+24.26	1035+43.36	1035+44.22	1035+62.47	1035+81.57	1035+97.18	1036+11.66	1036+12.80	1036+28.41	1036+44.02	1036+59.63	1036+75.25	1036+90.86	1037+06.47
	ELEV.	536.83	537.13	537.14	537.40	537.66	537.85	538.02	538.03	538.20	538.35	538.48	538.60	538.71	538.81
GIRDER 11	STATION	1035+28.98	1035+48.50	1035+50.02	1035+68.02	1035+87.54	1036+03.24	1036+17.82	1036+18.93	1036+34.63	1036+50.33	1036+66.03	1036+81.73	1036+97.43	1037+13.13
	ELEV.	536.77	537.07	537.09	537.34	537.59	537.78	537.94	537.95	538.11	538.26	538.38	538.50	538.60	538.69
RIGHT SHOULDER	STATION	1035+32.26	1035+54.25	1035+52.00	1035+71.99	1035+91.87	1036+07.68	1036+22.38	1036+23.48	1036+39.29	1036+55.10	1036+70.90	1036+86.71	1037+02.52	1037+18.32
	ELEV.	536.73	537.06	537.02	537.30	537.55	537.73	537.88	537.90	538.05	538.19	538.31	538.42	538.51	538.59
GIRDER 12	STATION	1035+33.71	1035+53.64	1035+55.84	1035+73.58	1035+93.51	1036+09.30	1036+23.99	1036+25.08	1036+40.87	1036+56.65	1036+72.44	1036+88.22	1037+04.00	1037+19.79
	ELEV.	536.71	537.01	537.04	537.28	537.53	537.71	537.86	537.87	538.03	538.16	538.28	538.39	538.49	538.56
GIRDER 13	STATION	1035+38.44	1035+58.79	1035+61.68	1035+79.15	1035+99.50	1036+15.37	1036+30.16	1036+31.24	1036+47.11	1036+62.98	1036+78.84	1036+94.71	1037+10.58	1037+26.45
	ELEV.	536.65	536.95	536.99	537.22	537.46	537.63	537.78	537.79	537.94	538.07	538.18	538.28	538.37	538.44
RIGHT CURB	STATION	1035+39.88	1035+60.37	1035+63.41	1035+80.81	1036+01.27	1036+17.15	1036+31.95	1036+33.02	1036+48.90	1036+64.78	1036+80.65	1036+89.39	1037+12.41	1037+28.28
	ELEV.	536.64	536.93	536.97	537.20	537.44	537.61	537.76	537.77	537.91	538.04	538.15	538.21	538.34	538.41
RIGHT EDGE	STATION	1035+40.75	1035+61.32	1035+64.44	1035+81.79	1036+02.31	1036+18.19	1036+33.00	1036+34.07	1036+49.95	1036+65.82	1036+81.70	1036+97.58	1037+13.46	1037+29.33
	ELEV.	536.65	536.94	536.98	537.21	537.45	537.62	537.77	537.78	537.92	538.05	538.16	538.26	538.34	538.41

**NOTES:**

1. FINAL DECK ELEVATIONS SHOWN REPRESENT THE DECK SURFACE LOCATION AFTER ALL ANTICIPATED DEAD LOAD DEFLECTIONS HAVE OCCURED.
2. FOR ELEVATION DIAGRAM DEPICTING DECK SURFACE LOCATIONS IN TRANSVERSE SECTION AND PLAN VIEW, SEE SHEET [76/100].
3. FOR DECK POURING SEQUENCE, SEE SHEET [71/100].
4. FOR ADDITIONAL NOTES, SEE SHEET [76/100].



DESIGN AGENCY  
**PRIME**  
540 WHITE POND DR SUITE E  
AKRON, OH 44320

DESIGNED: CRG  
CHECKED: CRG  
DRAWN: JAT  
REVISED: [ ]  
REVIEWED: TES  
DATE: 3/27/2019  
STRUCTURE FILE NUMBER: 3115739

**FINAL DECK SURFACE ELEVATIONS - UNIT 2 ( 2 OF 2 )**  
BRIDGE NO. HAM-74-1908R  
IR-74 OVER MILL CREEK, RR & SPRING GROVE AVENUE

**HAM-75-3.84**  
**PID No. 104667**

78/100  
78  
100

\\prime01.prime01.com\DFSRoot\Data\Projects\2018\20H030B-18232 HAM-75-03.84\104667\structures\HAM074\_1908R\MD024.dgn 6/20/2019 9:20:58 AM oseed

ESTIMATED HAUNCH DEPTH TABLE (IN)


	☉ BRG HINGE 1, UNIT 2	1/8 POINT	1/4 POINT	3/8 POINT	1/2 POINT	5/8 POINT	FS7	3/4 POINT	7/8 POINT	☉ BRG. PIER 5	1/8 POINT	FS8	1/4 POINT	3/8 POINT	1/2 POINT
GIRDER 3	5.76	5.97	6.25	6.43	6.56	6.60	5.62	6.59	5.45	5.15	-	-	-	-	-
GIRDER 4	4.69	7.63	8.13	8.50	8.75	8.88	7.93	8.90	7.04	6.43	7.31	8.35	9.46	9.78	9.97
GIRDER 5	6.49	7.09	7.60	7.98	8.22	8.35	7.39	8.36	6.74	6.41	7.28	8.27	9.37	9.62	9.73
GIRDER 6	6.40	6.79	7.31	7.70	7.94	8.07	7.08	8.05	6.37	5.97	6.92	7.99	9.11	9.45	9.65
GIRDER 7	7.19	7.69	7.98	8.14	8.17	8.04	6.87	7.78	5.86	5.21	6.36	7.57	8.77	9.34	9.69
GIRDER 8	7.02	7.57	7.78	7.85	7.76	7.54	6.26	7.18	5.13	4.23	5.61	6.95	8.21	9.05	9.67
GIRDER 9	6.57	6.64	6.87	6.95	6.88	6.66	4.96	6.29	3.75	3.04	4.70	5.79	7.57	8.70	9.50
GIRDER 10	6.79	7.06	7.11	7.02	6.76	6.38	4.55	5.82	3.12	2.26	4.18	5.46	7.35	8.76	9.60
GIRDER 11	6.66	6.89	6.82	6.62	6.26	5.76	3.79	5.11	2.26	1.33	3.59	5.00	7.12	8.85	9.66
GIRDER 12	5.50	5.67	5.71	5.62	5.37	4.98	3.22	4.55	1.96	1.24	3.73	5.12	7.35	9.00	9.80
GIRDER 13	5.28	7.08	5.53	5.75	5.79	3.85	2.58	4.15	2.19	1.60	3.95	5.21	7.44	8.90	9.74

ESTIMATED HAUNCH DEPTH TABLE (IN)


	1/2 POINT	5/8 POINT	3/4 POINT	FS9	7/8 POINT	☉ BRG. PIER 6	1/8 POINT	FS10	1/4 POINT	3/8 POINT	1/2 POINT	5/8 POINT	3/4 POINT	7/8 POINT	☉ BRG. PIER 7
GIRDER 3	-	-	-	-	-	-	-	-	-	-	-	-	-	-	-
GIRDER 4	9.97	9.53	7.85	8.70	5.75	5.84	6.99	7.12	8.93	9.80	10.80	11.51	11.94	12.23	12.77
GIRDER 5	9.73	9.24	7.57	8.47	5.87	6.12	7.32	7.48	9.29	10.21	10.93	11.38	11.55	11.80	12.70
GIRDER 6	9.65	9.30	7.79	8.73	6.50	6.98	8.31	8.60	10.42	11.34	12.06	12.61	13.02	13.74	14.93
GIRDER 7	9.69	9.74	8.64	9.63	8.15	9.13	10.83	11.48	13.34	14.67	15.82	16.81	17.78	19.19	19.95
GIRDER 8	9.67	10.12	9.52	10.55	9.43	10.31	11.74	12.01	13.83	14.62	15.13	15.37	15.51	15.79	15.51
GIRDER 9	9.50	10.01	8.90	10.28	9.06	7.84	8.50	7.29	10.83	11.31	11.62	11.75	11.73	11.61	11.12
GIRDER 10	9.60	10.10	8.97	10.36	9.09	7.83	8.48	7.18	10.71	11.02	11.16	11.13	10.93	10.56	10.01
GIRDER 11	9.66	10.20	9.11	10.50	9.25	8.00	8.60	7.26	10.79	11.05	11.14	11.05	10.80	10.37	9.77
GIRDER 12	9.80	10.31	9.18	10.56	9.26	7.94	8.52	7.15	10.67	10.90	10.95	10.83	10.54	10.08	9.44
GIRDER 13	9.74	10.30	9.20	10.59	9.30	7.99	8.58	7.24	10.76	11.01	11.08	10.98	10.71	10.25	9.62

**NOTES:**


- FOR ELEVATION DIAGRAM DEPICTING DECK SURFACE LOCATIONS IN TRANSVERSE SECTION AND PLAN VIEW, SEE SHEET 76/100.
- FOR ADDITIONAL NOTES, SEE SHEET 76/100.

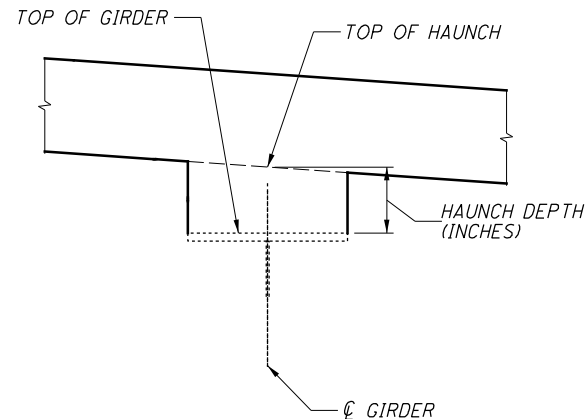

P:\Projects\2018\20H03DB-18232 HAM-75-03.84\104667\structures\HAM074\_1908R\sheets\074\_1908R\_MD015.dgn 6/20/2019 9:21:50 AM aseed

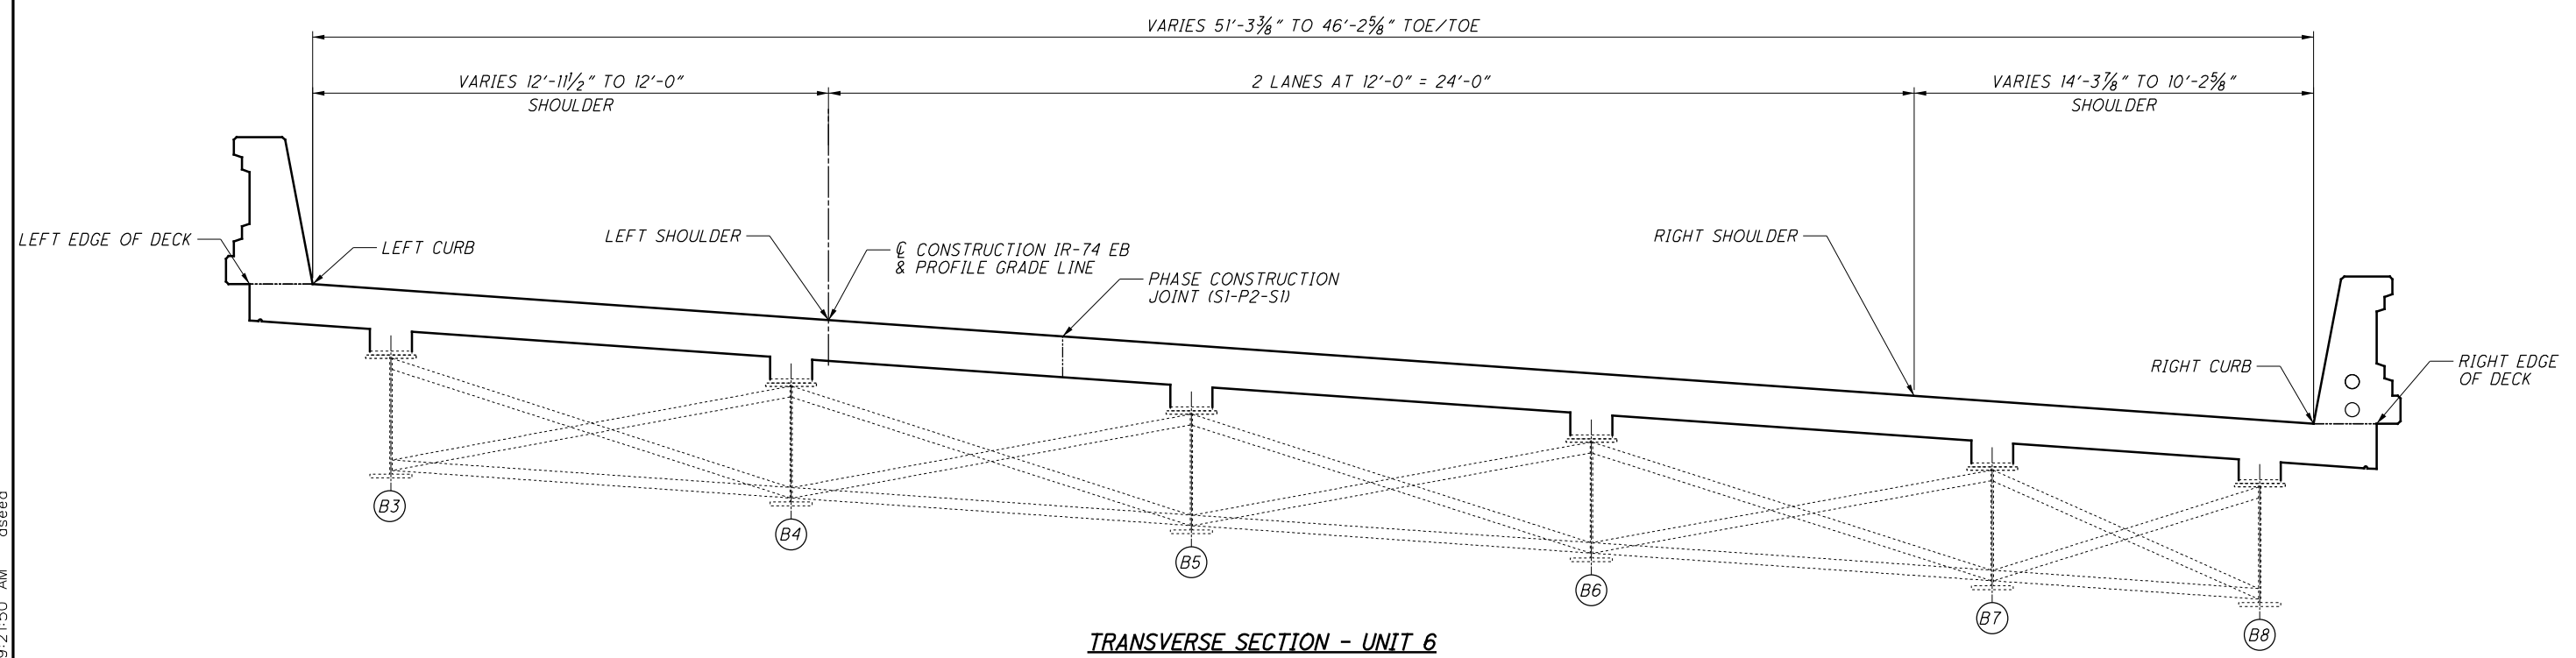

**TRANSVERSE SECTION - UNIT 6**

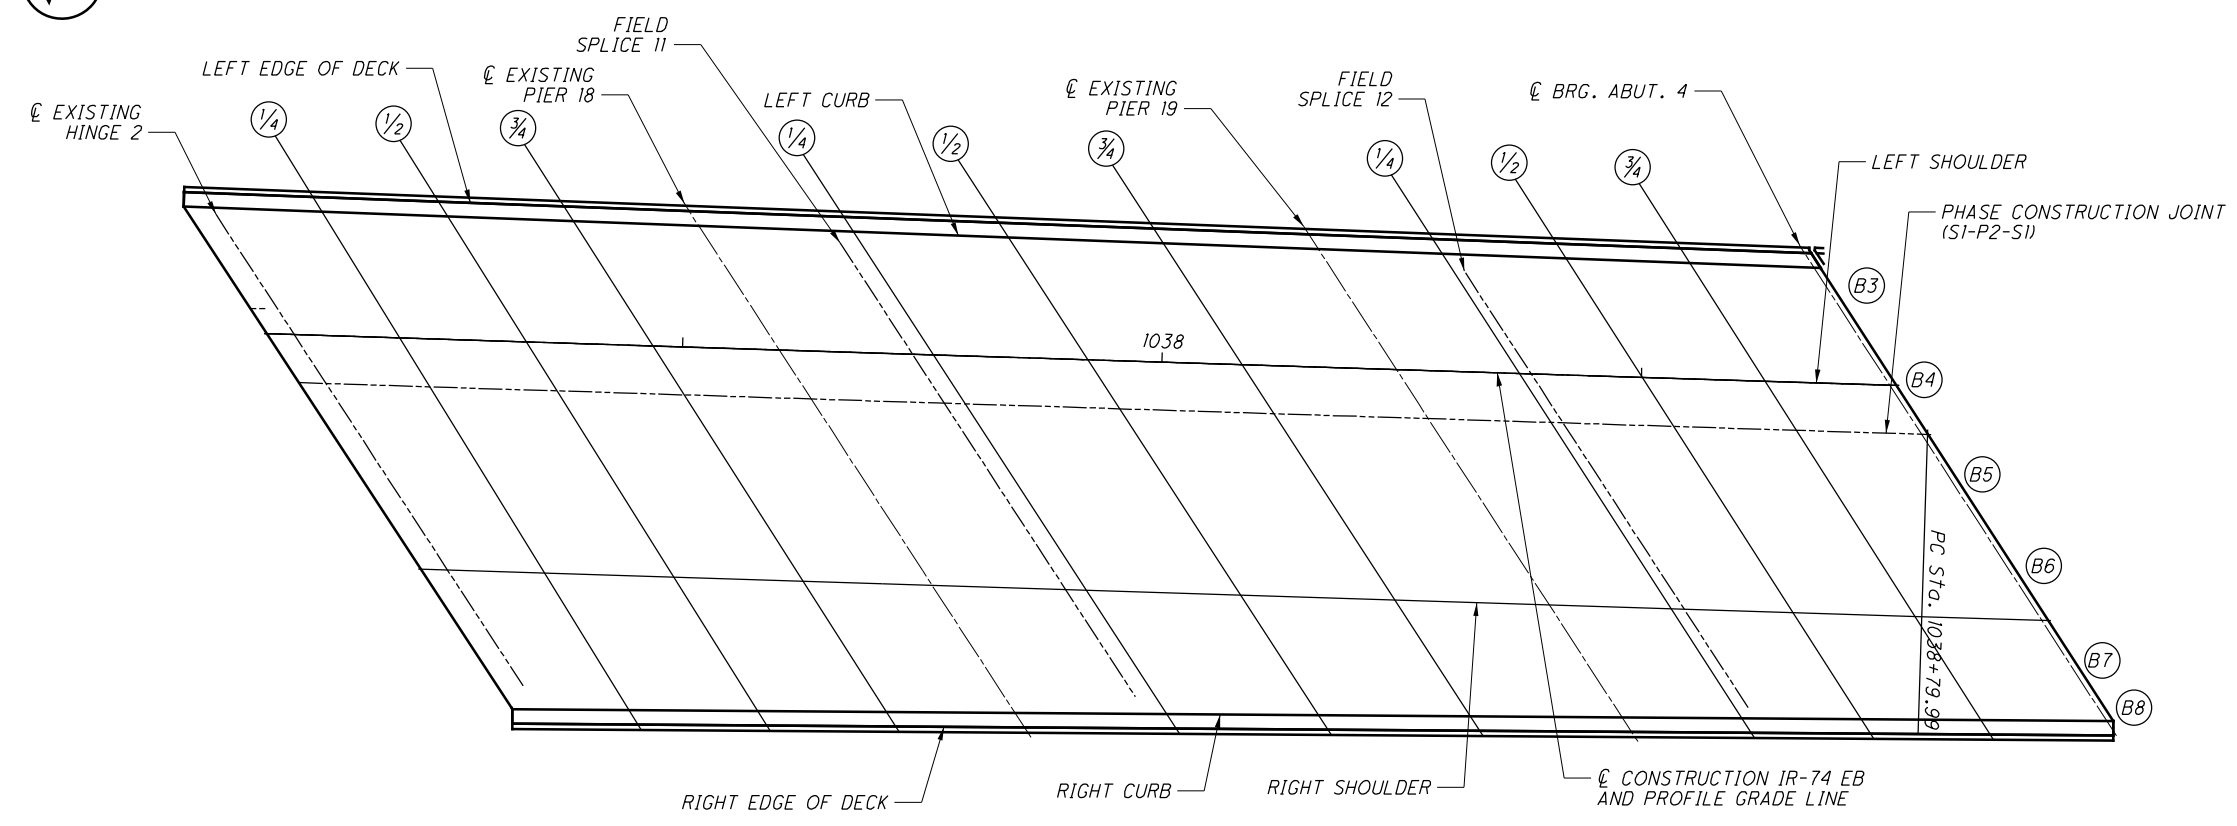

**ELEVATION LOCATION PLAN - UNIT 6**

**NOTES:**

1. FOR FINAL DECK ELEVATIONS, SEE SHEET 81/100.
2. FOR DECK PLAN, SEE SHEETS 68/100, 61/100.
3. FOR TRANSVERSE SECTION, SEE SHEET 67/100.
4. FOR FRAMING PLAN, SEE SHEET 49/100.
5. FOR ESTIMATED HAUNCH THICKNESSES, SEE SHEET 81/100.

 <small>DESIGN AGENCY 540 WHITE POND DR. SUITE E AKRON, OH 44320</small>																
<b>HAM-75-3.84</b> PID No. 104667																
<b>FINAL DECK SURFACE ELEVATION LOCATION - UNIT 6</b> <small>BRIDGE NO. HAM-74-1908R IR-74 OVER MILL CREEK, RR &amp; SPRING GROVE AVENUE</small>																
<table border="1" style="width: 100%; border-collapse: collapse;"> <tr> <td style="width: 25%;">DESIGNED</td> <td style="width: 25%;">DRAWN</td> <td style="width: 25%;">REVIEWED</td> <td style="width: 25%;">DATE</td> </tr> <tr> <td style="text-align: center;">CRG</td> <td style="text-align: center;">JAT</td> <td style="text-align: center;">TES</td> <td style="text-align: center;">3/27/2019</td> </tr> <tr> <td style="text-align: center;">CHECKED</td> <td style="text-align: center;">REVISED</td> <td style="text-align: center;">STRUCTURE FILE NUMBER</td> <td style="text-align: center;">3115739</td> </tr> <tr> <td style="text-align: center;">CRG</td> <td style="text-align: center;">CRG</td> <td></td> <td></td> </tr> </table>	DESIGNED	DRAWN	REVIEWED	DATE	CRG	JAT	TES	3/27/2019	CHECKED	REVISED	STRUCTURE FILE NUMBER	3115739	CRG	CRG		
DESIGNED	DRAWN	REVIEWED	DATE													
CRG	JAT	TES	3/27/2019													
CHECKED	REVISED	STRUCTURE FILE NUMBER	3115739													
CRG	CRG															
<table border="1" style="width: 100%; border-collapse: collapse;"> <tr> <td style="width: 50%; text-align: center;">80 / 100</td> <td style="width: 50%; text-align: center;">80 / 100</td> </tr> </table>	80 / 100	80 / 100														
80 / 100	80 / 100															

P:\Projects\2018\20H03DB-18232 HAM-75-03.84\104667\structures\HAM074\_1908R\MD016.dgn 6/20/2019 9:21:57 AM oseed

FINAL DECK SURFACE ELEVATIONS - UNIT 6


		☉ HINGE 2	1/4 POINT	1/2 POINT	3/4 POINT	☉ PIER 18	FS11	1/4 POINT	1/2 POINT	3/4 POINT	☉ PIER 19	1/4 POINT	FS12	1/2 POINT	3/4 POINT	☉ BRG. ABUTMENT 4
LEFT EDGE	STATION	1036+98.84	1037+12.54	1037+25.16	1037+37.78	1037+50.40	1037+64.17	1037+66.57	1037+82.71	1037+99.09	1038+15.02	1038+27.95	1038+28.94	1038+40.87	1038+53.79	1038+66.71
	ELEV.	539.50	539.49	539.48	539.46	539.43	539.39	539.38	539.35	539.35	539.34	539.32	539.32	539.30	539.26	539.21
LEFT CURB	STATION	1036+99.89	1037+13.59	1037+26.21	1037+38.83	1037+51.45	1037.65.22	1037+67.62	1037+83.76	1038+00.13	1038+16.06	1038+28.99	1038+29.99	1038+41.92	1038+54.84	1038+67.76
	ELEV.	539.50	539.49	539.48	539.46	539.43	539.39	539.38	539.35	539.35	539.34	539.32	539.32	539.29	539.25	539.20
BEAM 3	STATION	1037+00.30	1037+14.15	1037+26.84	1037+39.52	1037+52.20	1037+66.06	1037+68.46	1037+84.70	1038+01.15	1038+17.18	1038+30.19	1038+31.19	1038+43.17	1038+56.16	1038+69.15
	ELEV.	539.47	539.46	539.45	539.42	539.40	539.36	539.35	539.33	539.33	539.32	539.29	539.29	539.26	539.22	539.17
BEAM 4	STATION	1037+07.08	1037+20.85	1037+33.53	1037+46.21	1037+58.90	1037+72.76	1037+75.15	1037+91.38	1038+07.78	1038+23.85	1038+36.85	1038+37.88	1038+49.83	1038+62.82	1038+75.80
	ELEV.	539.03	539.08	539.11	539.14	539.16	539.17	539.17	539.18	539.17	539.15	539.13	539.12	539.09	539.04	538.98
☉ CONSTRUCTION IR-74 EB, PROFILE GRADE & LEFT SHOULDER	STATION	1037+08.91	1037+22.56	1037+35.12	1037+47.69	1037+60.25	1037+73.98	1037+76.35	1037+92.43	1038+08.68	1038+24.61	1038+37.48	1038+38.50	1038+50.34	1038+63.20	1038+76.06
	ELEV.	538.93	538.99	539.04	539.09	539.12	539.14	539.14	539.16	539.15	539.13	539.11	539.11	539.07	539.03	538.98
SI-P2-SI CONSTRUCTION JOINT	STATION	1037+12.39	1037+26.04	1037+38.60	1037+51.17	1037+63.73	1037+77.47	1037+79.83	1037+95.91	1038+12.13	1038+28.08	1038+40.95	1038+41.98	1038+53.81	1038+66.66	1038+79.52
	ELEV.	538.87	538.93	538.98	539.01	539.04	539.07	539.07	539.08	539.07	539.05	539.02	539.02	538.98	538.94	538.88
BEAM 5	STATION	1037+13.69	1037+27.55	1037+40.24	1037+52.92	1037+65.61	1037+79.47	1037+81.85	1037+98.08	1038+14.43	1038+30.54	1038+43.52	1038+41.98	1038+56.49	1038+69.47	1038+82.44
	ELEV.	538.84	538.90	538.94	538.98	539.00	539.02	539.02	539.03	539.01	538.99	538.95	538.95	538.91	538.86	538.80
BEAM 6	STATION	1037+20.38	1037+34.23	1037+46.92	1037+59.61	1037+72.30	1037+86.17	1037+88.53	1038+04.76	1038+21.07	1038+37.22	1038+50.19	1038+51.26	1038+63.15	1038+76.11	1038+89.06
	ELEV.	538.72	538.77	538.81	538.84	538.86	538.87	538.87	538.87	538.85	538.82	538.78	538.78	538.73	538.68	538.61
RIGHT SHOULDER	STATION	1037+25.62	1037+39.27	1037+51.83	1037+64.39	1037+76.95	1037+90.70	1037+93.04	1038+09.12	1038+25.26	1038+41.29	1038+54.14	1038+55.22	1038+66.98	1038+79.82	1038+92.66
	ELEV.	538.62	538.68	538.71	538.74	538.76	538.77	538.77	538.77	538.75	538.72	538.68	538.67	538.63	538.57	538.51
BEAM 7	STATION	1037+27.07	1037+40.92	1037+53.61	1037+66.30	1037+78.98	1037+92.86	1037+95.21	1038+11.44	1038+27.71	1038+43.90	1038+56.87	1038+57.97	1038+69.84	1038+82.80	1038+95.74
	ELEV.	538.60	538.64	538.68	538.70	538.72	538.72	538.72	538.71	538.69	538.65	538.61	538.60	538.55	538.48	538.38
BEAM 8	STATION	1037+33.77	1037+47.39	1037+59.83	1037+72.26	1037+84.70	1037+98.32	1038+00.62	1038+16.54	1038+32.48	1038+48.39	1038+61.12	1038+62.22	1038+73.85	1038+86.55	1038+99.24
	ELEV.	538.47	538.51	538.55	538.57	538.59	538.60	538.60	538.59	538.57	538.53	538.49	538.49	538.44	538.35	538.23
RIGHT CURB	STATION	1037+35.58	1037+49.00	1037+61.34	1037+73.68	1037+86.02	1037+99.55	1038+01.84	1038+17.65	1038+33.46	1038+49.27	1038+61.89	1038+62.98	1038+74.51	1038+87.11	1038+99.69
	ELEV.	538.43	538.48	538.52	538.54	538.56	538.57	538.57	538.56	538.54	538.51	538.47	538.47	538.42	538.33	538.21
RIGHT EDGE	STATION	1037+36.59	1037+50.02	1037+62.36	1037+76.31	1037+87.04	1038+00.58	1038+02.86	1038+18.67	1038+34.48	1038+50.29	1038+62.91	1038+64.01	1038+75.53	1038+88.13	1039+00.41
	ELEV.	538.44	538.49	538.52	538.55	538.56	538.57	538.57	538.56	538.54	538.51	538.47	538.46	538.42	538.32	538.19

ESTIMATED HAUNCH DEPTH TABLE (IN)

	☉ BRG HINGE 2, UNIT 6	1/4 POINT	1/2 POINT	3/4 POINT	☉ BRG. PIER 18	FS11	1/4 POINT	1/2 POINT	3/4 POINT	☉ BRG. PIER 19	1/4 POINT	FS12	1/2 POINT	3/4 POINT	☉ BRG. ABUTMENT 4
BEAM 3	14.02	13.43	12.77	11.99	11.15	10.15	10.46	10.11	10.00	9.72	9.67	9.20	9.51	9.23	8.83
BEAM 4	10.02	9.95	9.83	9.57	9.28	8.94	9.38	9.45	9.35	9.06	8.91	8.41	8.64	8.25	7.76
BEAM 5	9.02	9.14	9.16	9.06	8.85	8.56	9.03	9.03	8.84	8.48	8.37	7.87	8.14	7.79	7.22
BEAM 6	8.53	8.74	8.84	8.83	8.71	8.33	8.81	8.74	8.47	8.03	8.01	7.55	7.86	7.60	7.09
BEAM 7	8.08	8.39	8.59	8.67	8.65	8.34	8.81	8.78	8.58	8.19	8.06	7.55	7.82	7.34	6.57
BEAM 8	8.21	8.37	8.42	8.37	8.20	7.95	8.36	8.33	8.13	7.76	7.85	7.38	7.82	7.34	6.42

NOTES:


1. FINAL DECK ELEVATIONS SHOWN REPRESENT THE DECK SURFACE LOCATION AFTER ALL ANTICIPATED DEAD LOAD DEFLECTIONS HAVE OCCURED.
2. FOR ELEVATION DIAGRAM DEPICTING DECK SURFACE LOCATIONS IN TRANSVERSE SECTION AND PLAN VIEW, SEE SHEET 80/100.
3. FOR DECK POURING SEQUENCE, SEE SHEET 71/100.
4. FOR ADDITIONAL NOTES, SEE SHEET 80/100.

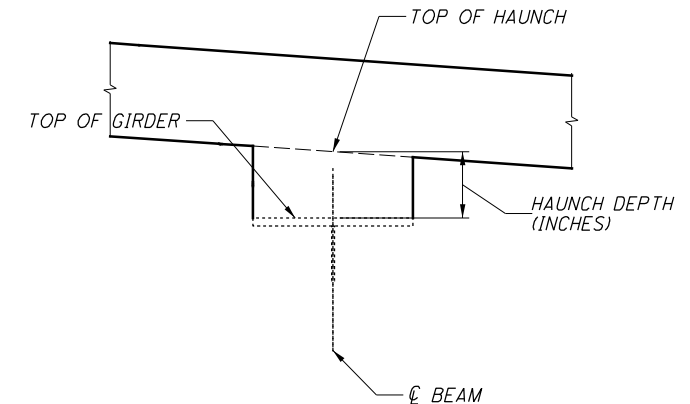







P:\Projects\2018\20H03DB-18232 HAM-75-03-84\104667\structures\HAM074\_1908R\sheets\074\_1908R\_EXA001.dgn 9/13/2023 4:16:08 PM erin.baumann

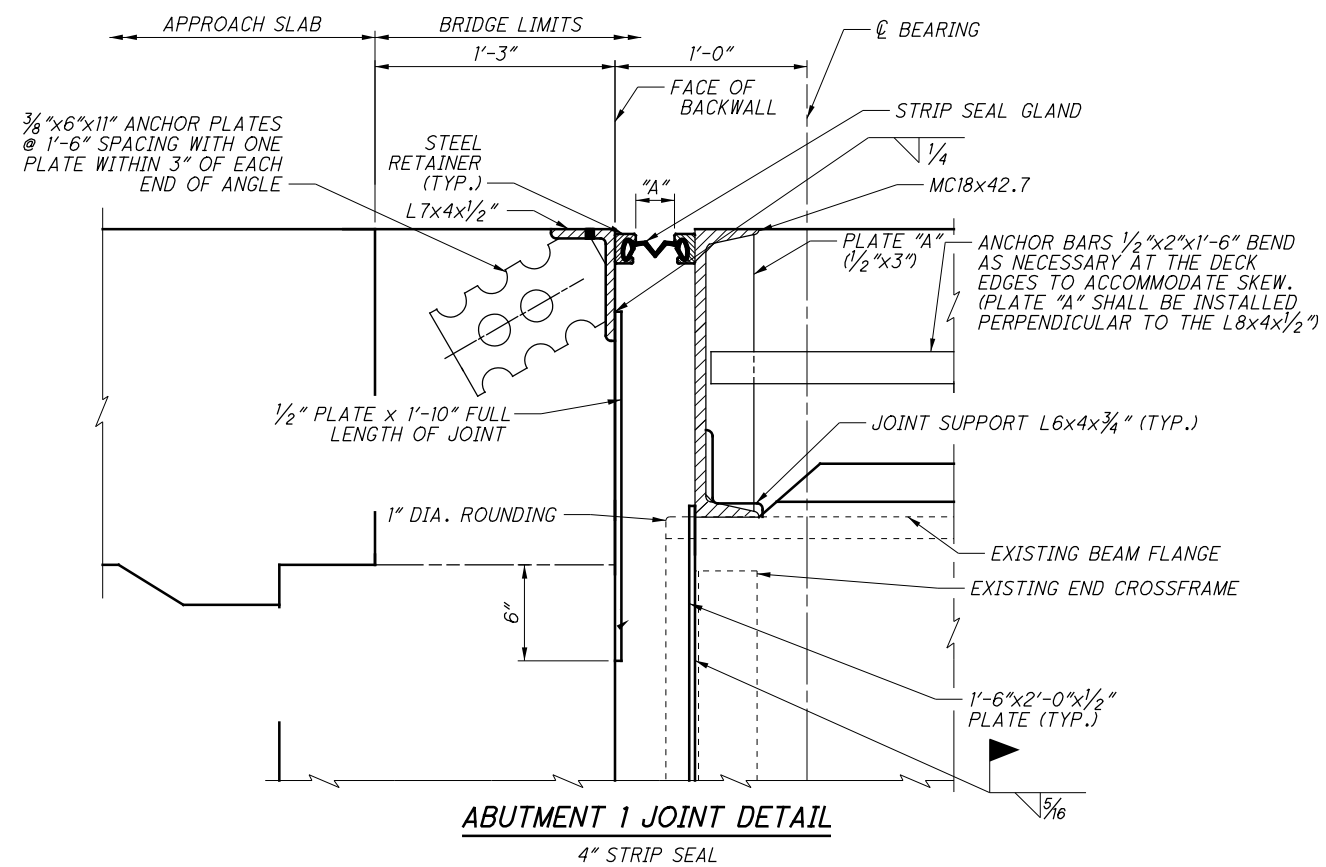


**ABUTMENT 1 JOINT DETAIL**  
4" STRIP SEAL

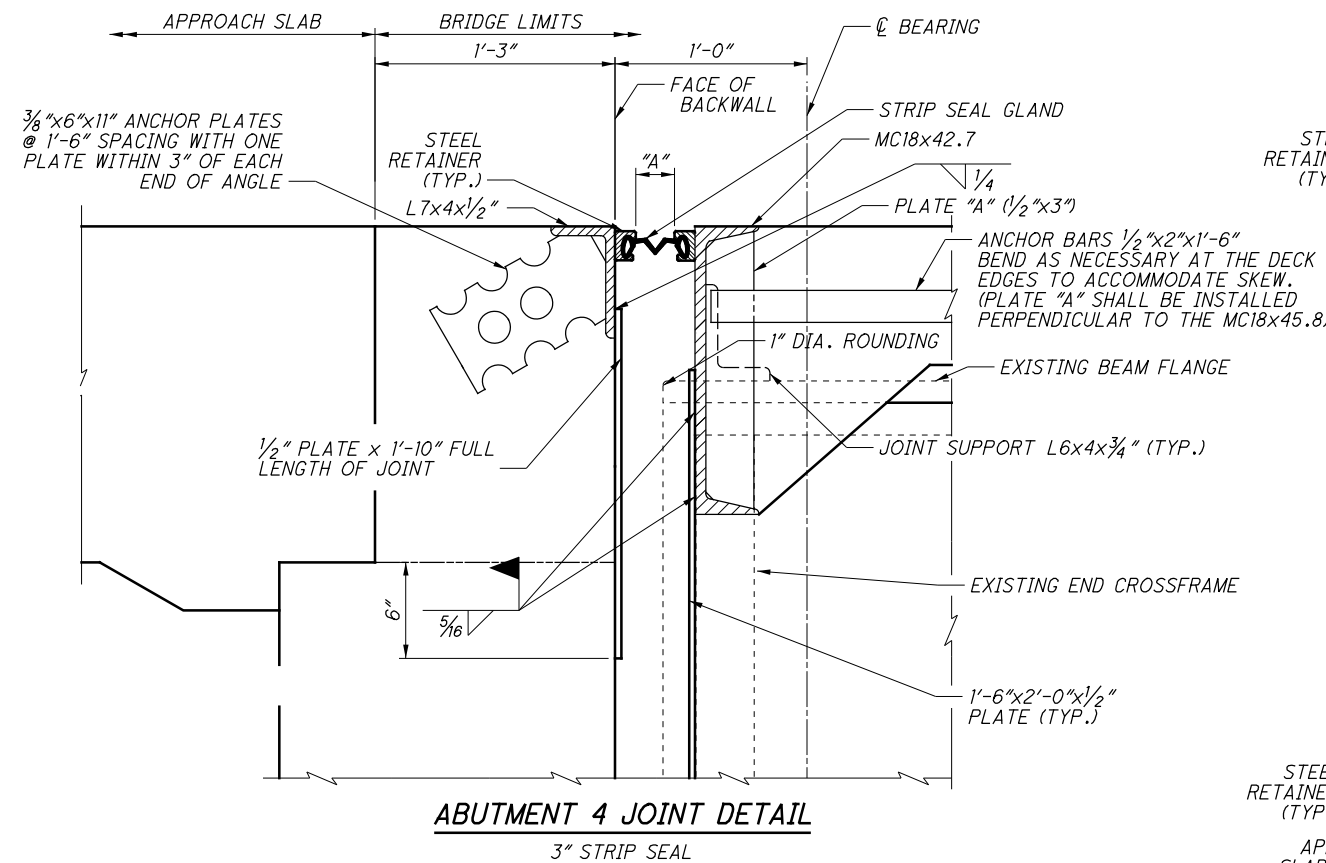


**ABUTMENT 4 JOINT DETAIL**  
3" STRIP SEAL

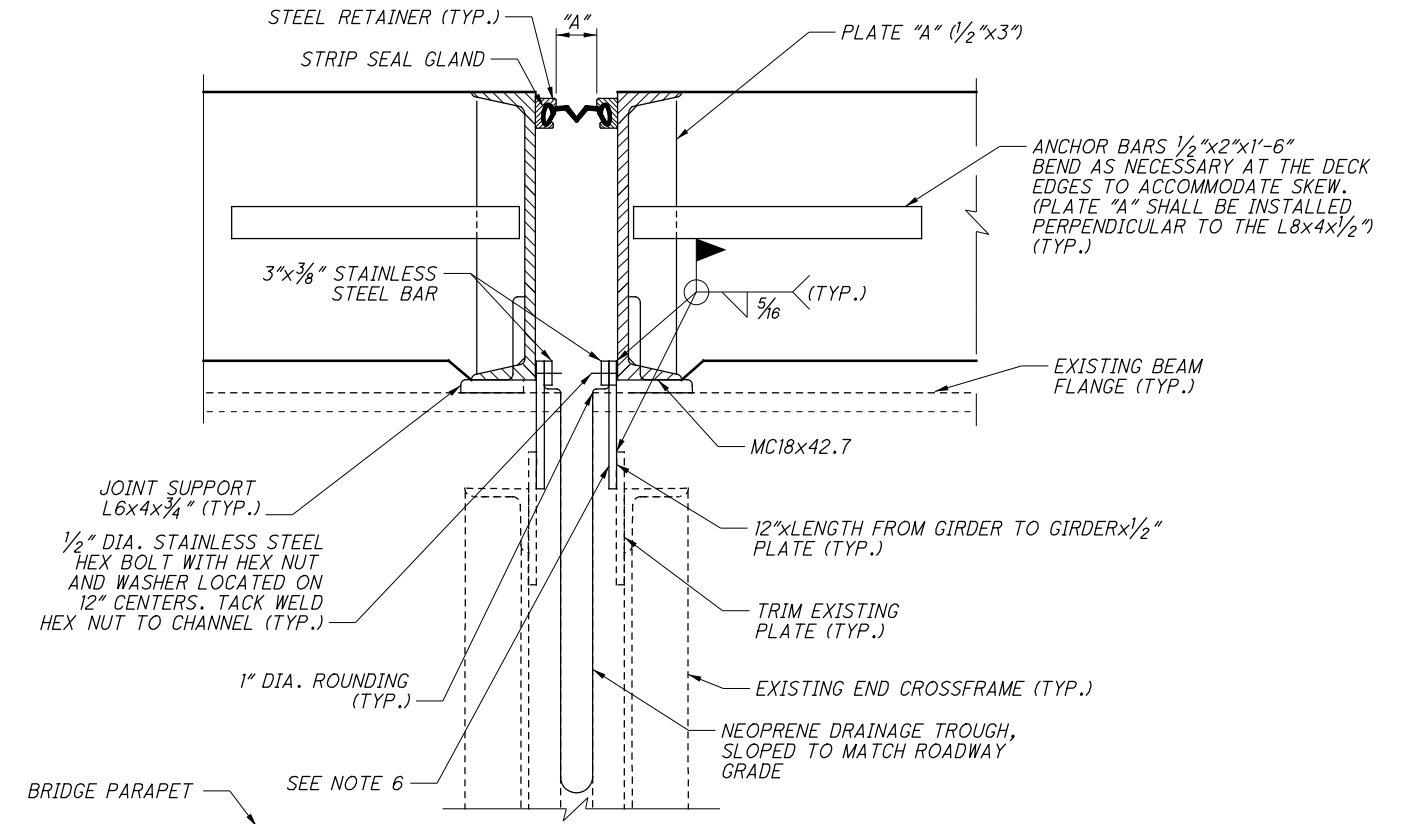


**HINGE 1 JOINT DETAIL**  
5" STRIP SEAL

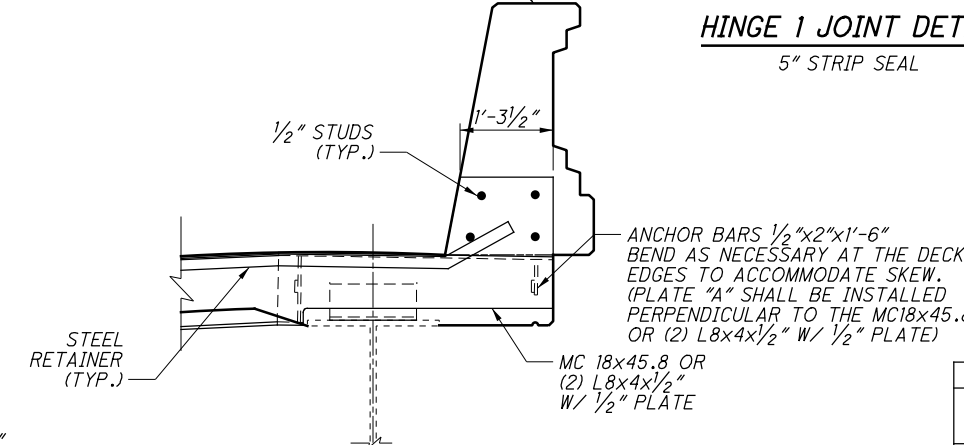

**TYPICAL JOINT SECTION BRIDGE DECK**  
REAR & FORWARD ABUTMENT  
HINGES 1 & 2

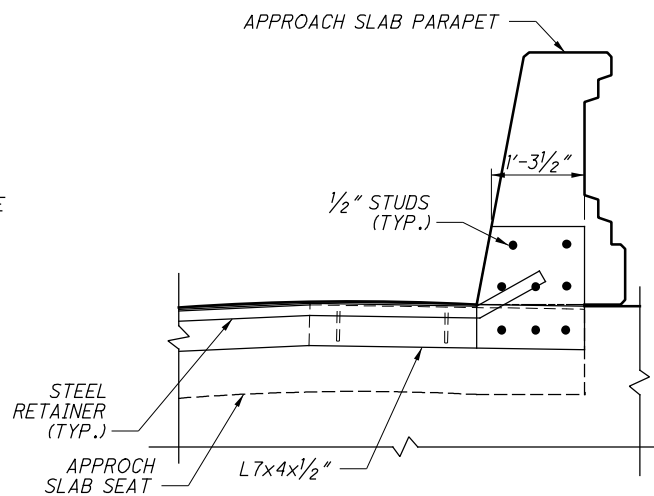

**TYPICAL JOINT SECTION APPROACH SLAB**

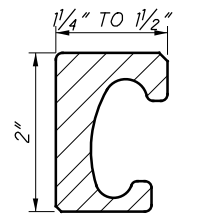

**RETAINER DETAIL**

TEMP (°F)	STRIP SEAL JOINT "A" DIMENSION			
	REAR ABUTMENT	HINGE 1	HINGE 2	FORWARD ABUTMENT
30°	3 3/16"	4"	3 3/8"	2 1/8"
40°	2 15/16"	3 11/16"	3 5/8"	2"
50°	2 3/4"	3 3/8"	3 3/8"	1 15/16"
60°	2 1/2"	3 1/16"	3 1/8"	1 7/8"
70°	2 5/16"	2 13/16"	2 13/16"	1 3/4"
80°	2 1/16"	2 1/2"	2 9/16"	1 11/16"
90°	1 7/8"	2 3/16"	2 3/16"	1 7/16"

**NOTES:**

- FOR ADDITIONAL EXPANSION JOINT DETAILS, SEE STANDARD DRAWING EXJ-4-87.
- THE TROUGH MATERIAL SHALL BE 3/32" THICK, HEAVY DUTY ELASTOMERIC SHEET OF NYLON FABRIC ENCASED IN A NEOPRENE POLYMER. THE MATERIAL SHALL BE "FAIRPRENE" WFP-N2N4 AS MANUFACTURED BY ALPHA ENGINEERING COMPOSITES LLC OR APPROVED EQUAL. THE MATERIAL SHALL CONFORM TO ASTM D751 AND THE FOLLOWING:  
THICKNESS: 0.093 INCH ± 0.01 INCH  
MIN. BREAKING STRENGTH: 650 LBS x 650 LBS  
LOW TEMPERATURE: ASTM D2136
- THE SUPPORT ANGLES SHALL BE ASTM A709, GRADE 50 AND SHALL BE GALVANIZED IN ACCORDANCE WITH CMS 711.02.
- THE STAINLESS STEEL BARS SHALL BE ASTM A480, TYPE 304.
- THE CONTRACTOR SHALL GRIND BEAM ENDS THAT CONTACT THE NEOPRENE SHEETING TO 1" DIAMETER ROUND AND SMOOTH ANY TEARS OR FINS SO AS TO NOT TEAR THE NEOPRENE SHEETING.
- SEE SHEET 40/100 FOR HINGE 1 CONFLICT DETAILS.

**PRIMEWAY**  
 DESIGN AGENCY  
 540 WHITE POND DR. SUITE E  
 AKRON, OH 44320

DATE: 7/30/2019  
 REVIEWED: TES  
 DRAWN: KDC  
 DESIGNED: KDC  
 CHECKED: CRG


STRUCTURE FILE NUMBER: 3115739  
 REVISED:

**EXPANSION JOINT DETAILS**  
 BRIDGE NO. HAM-74-1908R  
 IR-74 OVER MILL CREEK, RR & SPRING GROVE AVENUE


HAM-75-3.84  
 PID No. 104667

83/100  
 83  
 100

P:\Projects\2018\20H030B-18232 HAM-75-03.84\104667\structures\HAM074\_1908R\074\_1908R\_EXA001.dgn 9/13/2023 4:16:57 PM erin.baumann

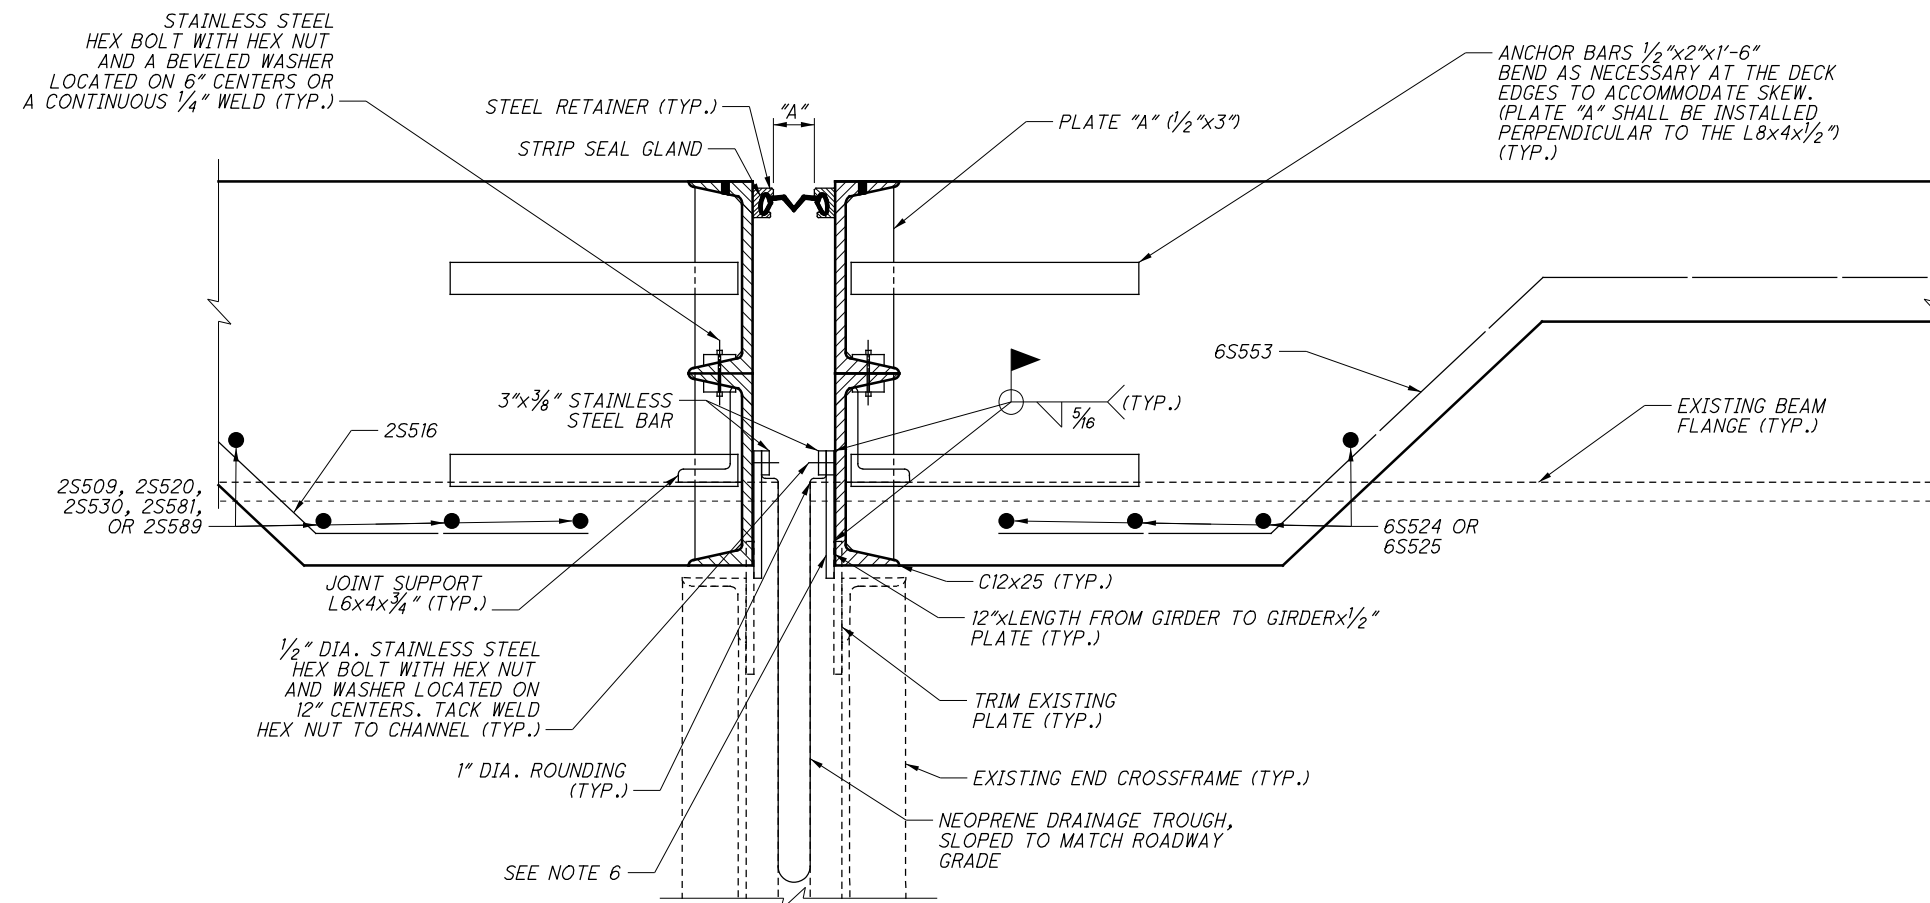

**HINGE 2 JOINT DETAIL**  
4" STRIP SEAL

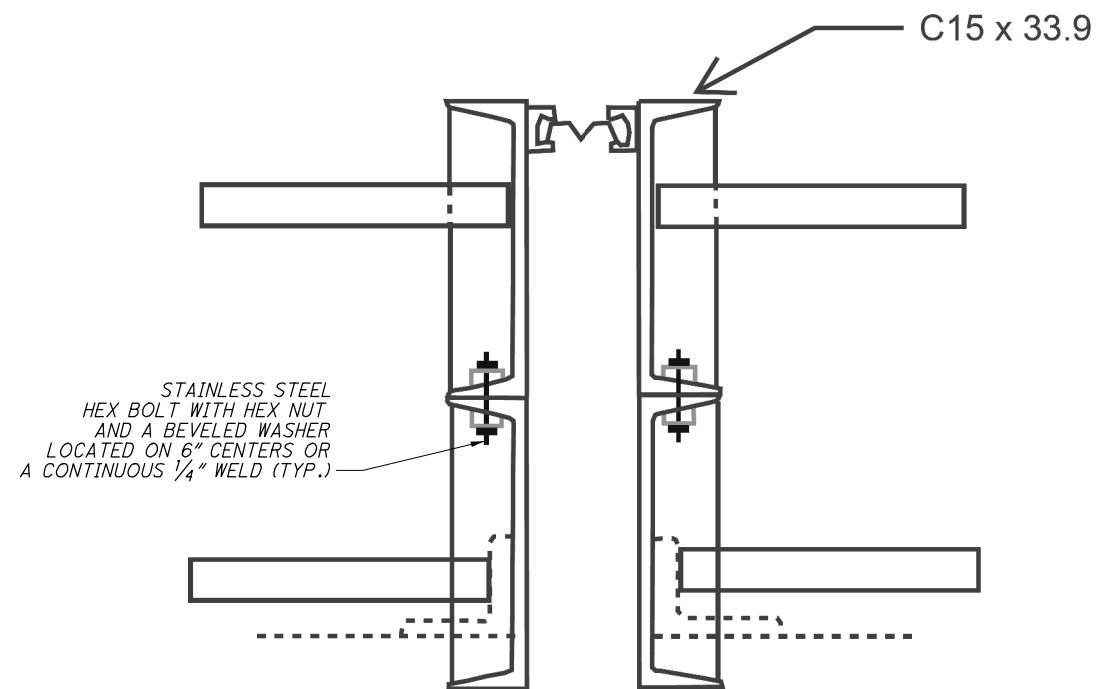


**PIER 7 JOINT DETAIL**

**NOTES:**


- FOR ADDITIONAL EXPANSION JOINT DETAILS, SEE STANDARD DRAWING EXJ-4-87.
- THE TROUGH MATERIAL SHALL BE 3/32" THICK, HEAVY DUTY ELASTOMERIC SHEET OF NYLON FABRIC ENCASED IN A NEOPRENE POLYMER. THE MATERIAL SHALL BE "FAIRPRENE" WFP-N2N4 AS MANUFACTURED BY ALPHA ENGINEERING COMPOSITES LLC OR APPROVED EQUAL. THE MATERIAL SHALL CONFORM TO ASTM D751 AND THE FOLLOWING:  
  

THICKNESS:	0.093 INCH ± 0.01 INCH
MIN. BREAKING STRENGTH:	650 LBS x 650 LBS
LOW TEMPERATURE:	ASTM D2136
- THE SUPPORT ANGLES SHALL BE ASTM A709, GRADE 50 AND SHALL BE GALVANIZED IN ACCORDANCE WITH CMS 711.02.
- THE STAINLESS STEEL BARS SHALL BE ASTM A480, TYPE 304.
- THE CONTRACTOR SHALL GRIND BEAM ENDS THAT CONTACT THE NEOPRENE SHEETING TO 1" DIAMETER ROUND AND SMOOTH ANY TEARS OR FINS SO AS TO NOT TEAR THE NEOPRENE SHEETING.
- EACH CANNEL IS TO BE METALIZED SEPERATELY THEN BOLTED TOGETHER.
- EXCESS CONCRETE REMOVED AT HINGE 2 TO AVOID CONFLICT WITH STEEL MEMBERS.

P:\Projects\2018\20H03DB-18232 HAM-75-03.84\104667\structures\HAM074\_1908R\MD019.dgn 9/22/2023 2:58:16 PM erin.baumann

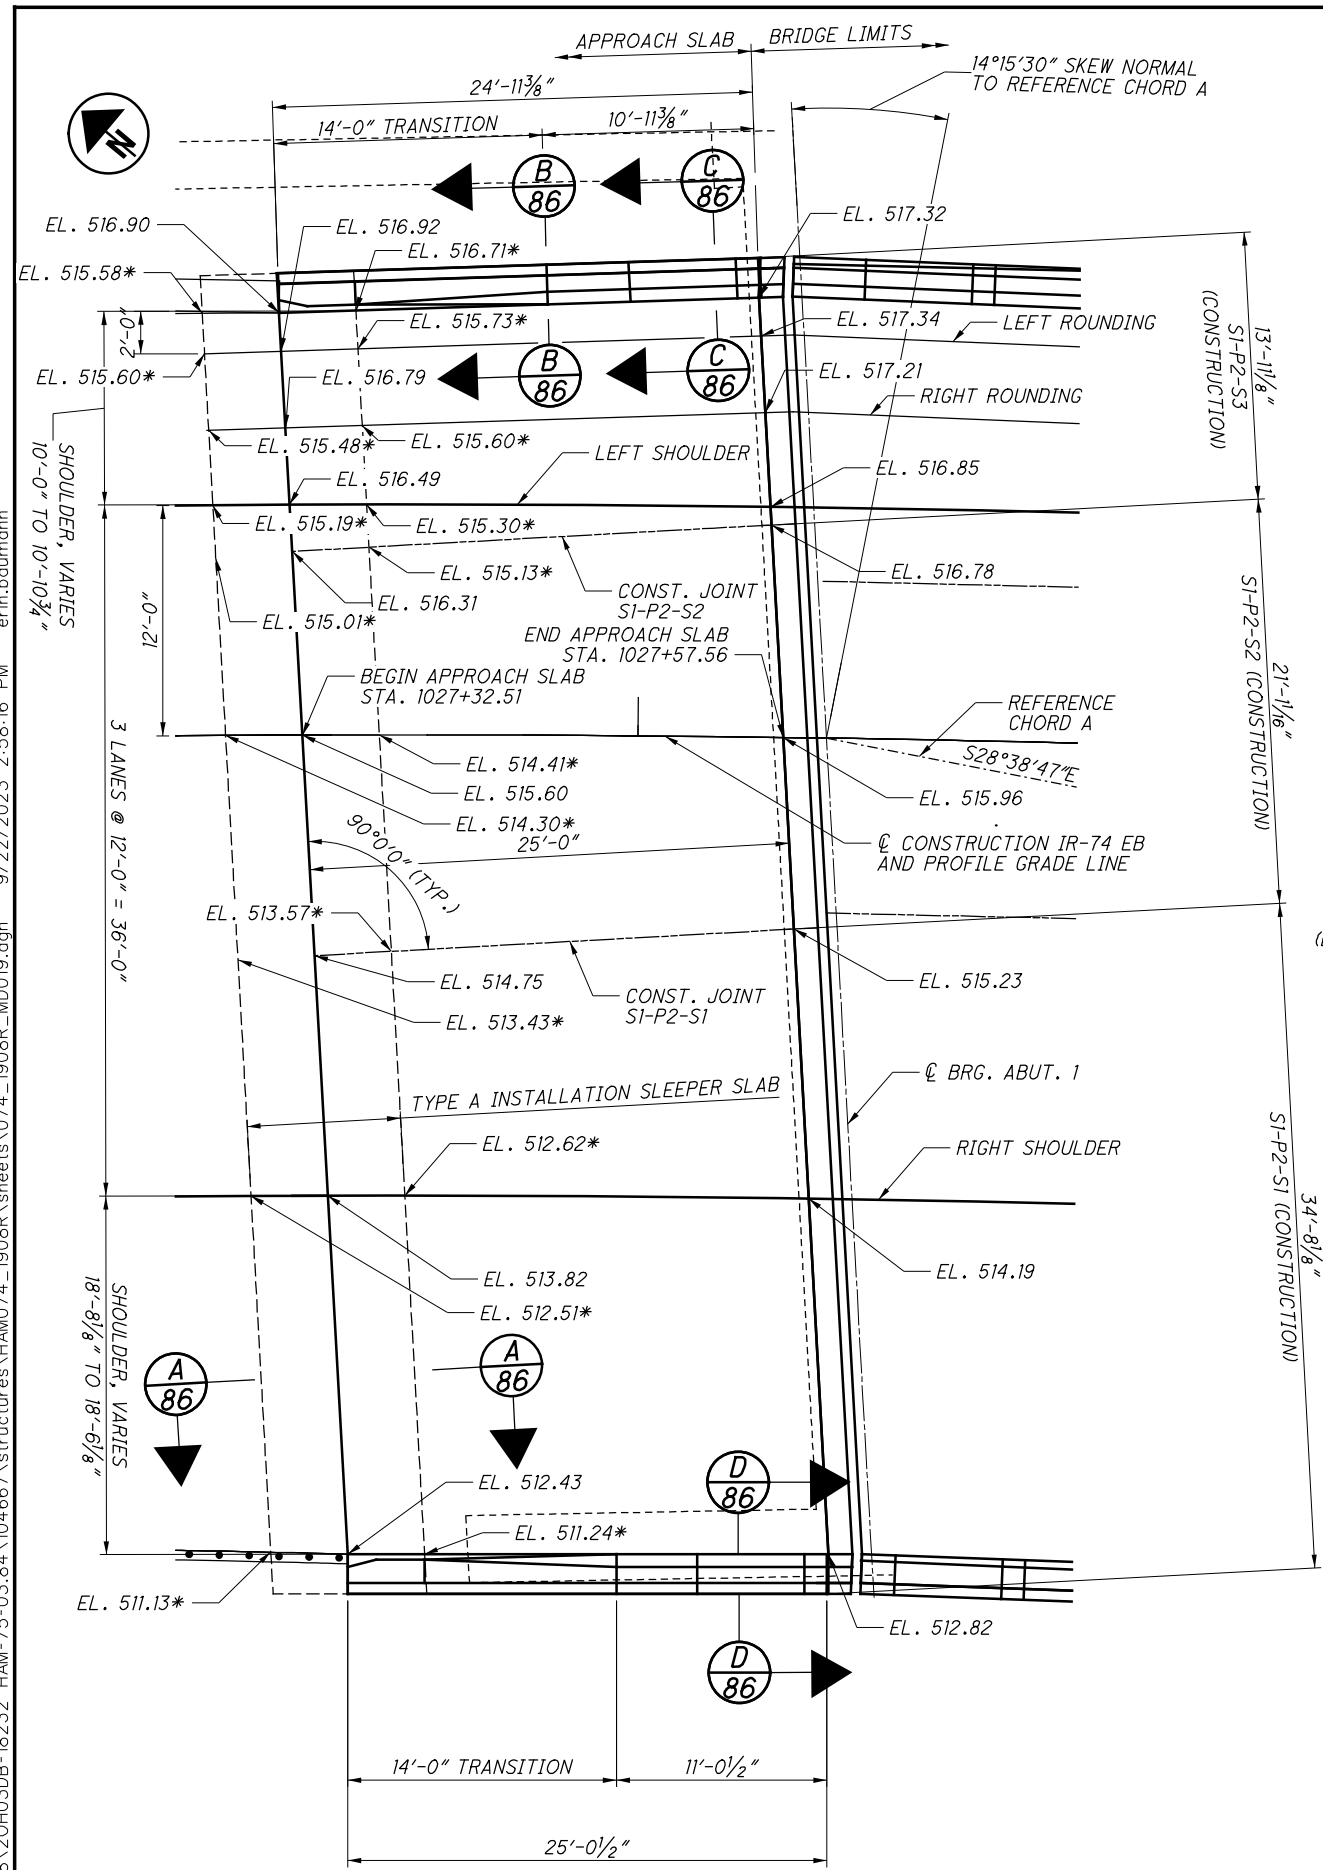

**REAR APPROACH SLAB PLAN**

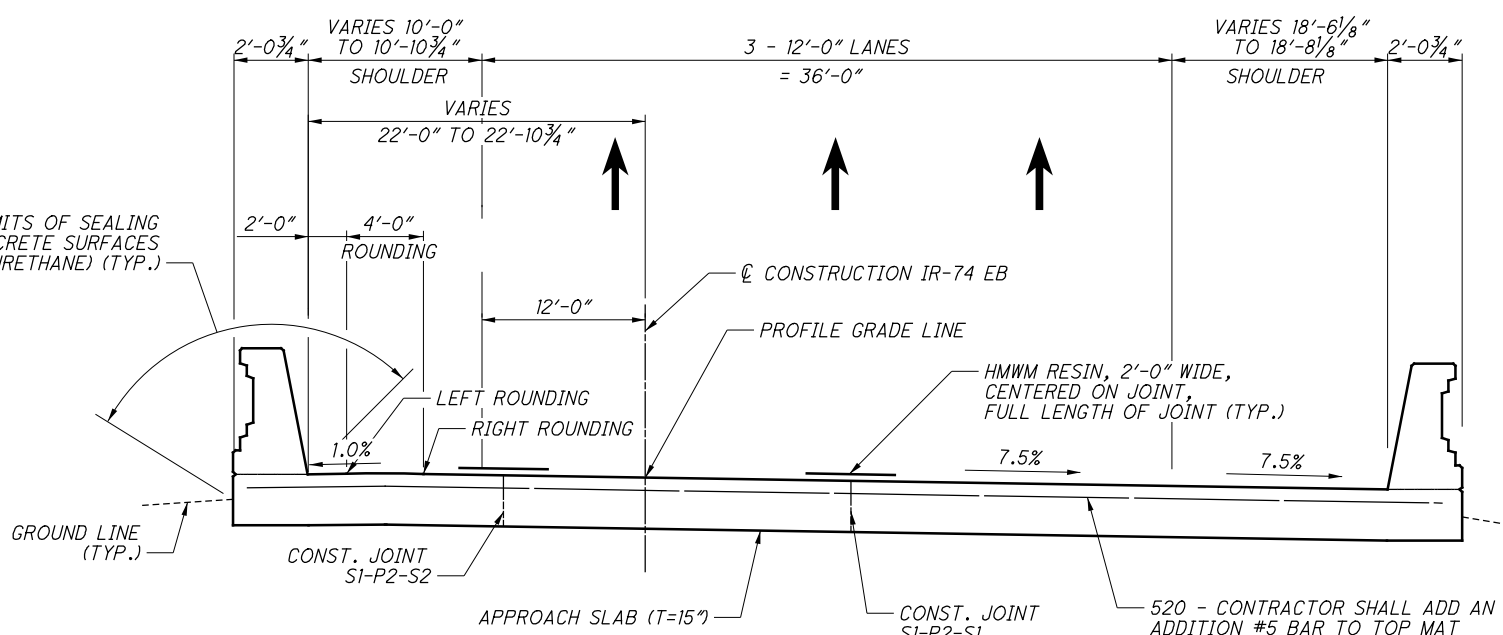

**REAR APPROACH SLAB SECTION**

**LEGEND**


\* - TOP OF SLEEPER SLAB ELEVATION

**NOTES:**

1. ALL CONCRETE SURFACES OF THE ORNAMENTAL PARAPET SHALL RECEIVE A RUBBER FINISH. SAW CUTTING AND TEXTURED FINISH ARE INCLUDED WITH ITEM 511 - CONCRETE CLASS QC3 WITH QC/QA-COMPRESSIVE STRENGTH 4.5 KSI, BRIDGE DECK (PARAPET, AS PER PLAN, FOR PAYMENT.
2. FOR MORE DETAILS, SEE STANDARD DRAWINGS AS-1-15 AND AS-2-15.
3. PARAPET DIMENSIONS ALONG OUTSIDE EDGE OF APPROACH SLAB.
4. ALL TRANSVERSE BARS IN THE APPROACH SLAB REQUIRE MECHANICAL CONNECTORS.
5. FOR REAR APPROACH SLAB AND ABUTMENT DETAILS, SEE SHEET 36100.
6. FOR LIMITS OF SEALING, SEE SHEET 36100.
7. CRACKS IN THE APPROACH SLAB CONCRETE WERE TREATED ACCORDING TO ODOT SPECIFICATIONS FOR ITEM 512 SEALING CONCRETE BRIDGE DECKS WITH HMWM RESIN.


<b>PRIMEW</b> 540 WHITE POND DR. SUITE E AKRON, OH 44320	DESIGNED	JAT	CHECKED	CRG
	DRAWN	ADS	REVISED	
REVIEWED	TES	DATE	7/30/2019	STRUCTURE FILE NUMBER
				3115739
<b>REAR APPROACH SLAB PLAN AND SECTION</b>				
BRIDGE NO. HAM-74-1908R				
IR-74 OVER MILL CREEK, RR & SPRING GROVE AVENUE				
HAM-75-3.84	PID No. 104667			84/100
				84 100

FACE OF CURB AND GUARDRAIL  
(SEE STD. CONSTR. DWGS. MGS-3.1  
AND MGS-3.2 FOR BRIDGE  
TERMINAL ASSEMBLY)

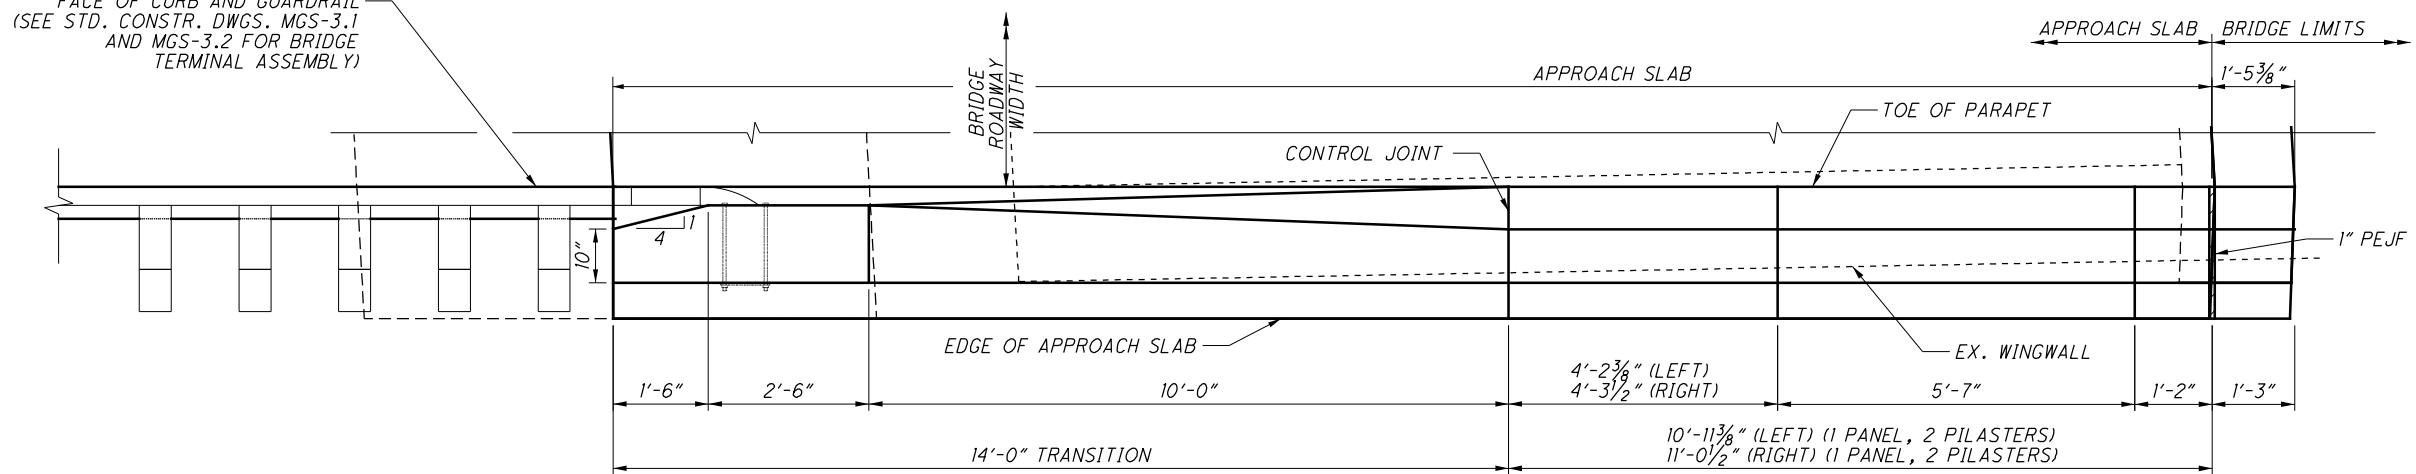


**APPROACH SLAB PARAPET PLAN**

(RIGHT REAR ABUTMENT SHOWN, LEFT SIMILAR)

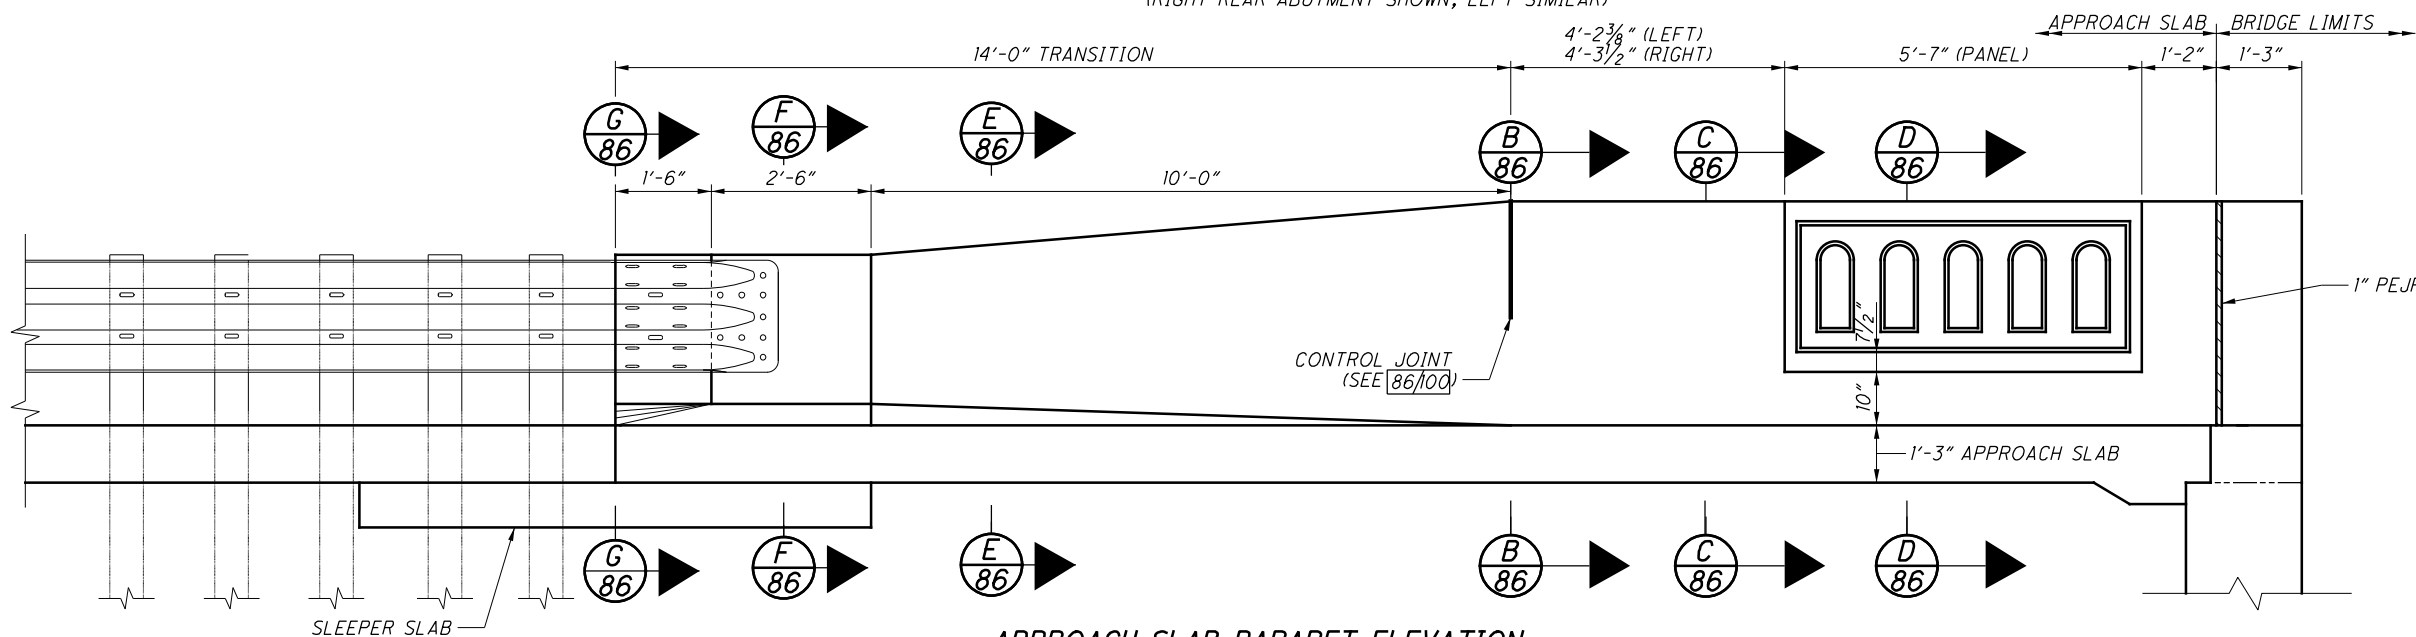

**APPROACH SLAB PARAPET ELEVATION**

(RIGHT REAR ABUTMENT SHOWN, LEFT SIMILAR)

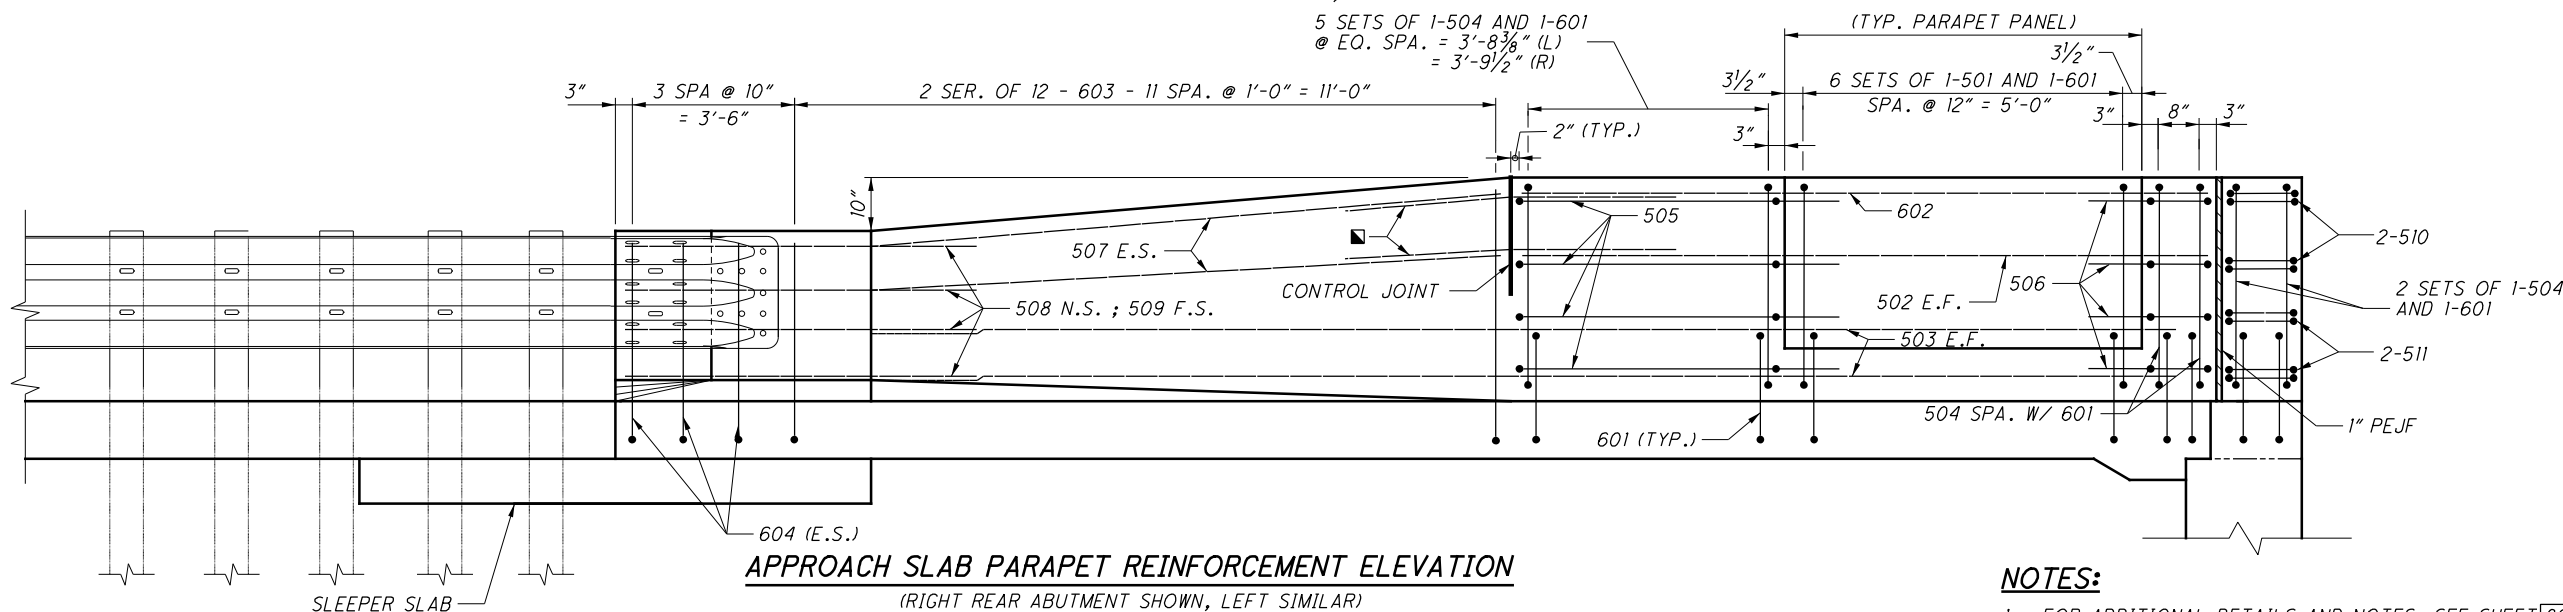

**APPROACH SLAB PARAPET REINFORCEMENT ELEVATION**

(RIGHT REAR ABUTMENT SHOWN, LEFT SIMILAR)

**LEGEND:**


■ - 1/2" DIA. GLASS FIBER REINFORCED POLYMER (GFRP) STIFFENING REINFORCEMENT

**NOTES:**


- FOR ADDITIONAL DETAILS AND NOTES, SEE SHEET 86/100.
- FOR PANEL DETAILS, SEE SHEET 56/100.
- THE PREFIX "RASR" SHALL BE ADDED TO ALL BAR MARKS FOR REAR APPROACH SLAB PARAPET DETAILS.

P:\Projects\2018\20H03DB-18232 HAM-75-03.84\104667\structures\HAM074\_1908R\sheets\074\_1908R\_MD018.dgn 6/20/2019 9:22:19 AM oseed


P:\Projects\2018\20H03DB-18232 HAM-75-03.84\104667\structures\HAM074\_1908R\sheets\074\_1908R\_MD003.dgn 6/20/2019 9:22:21 AM asead

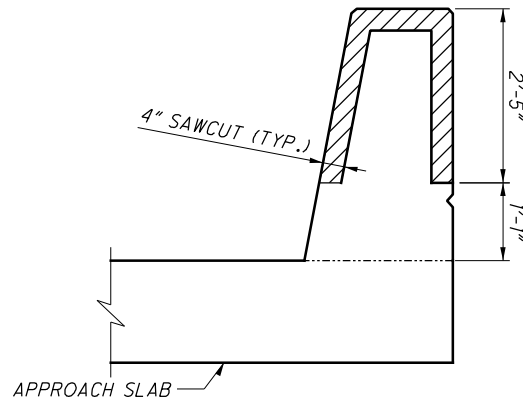


**B** CONTROL JOINT DETAIL  
85,88 (SECTION THROUGH SAWCUT)  
(SEE SBR-1-99)

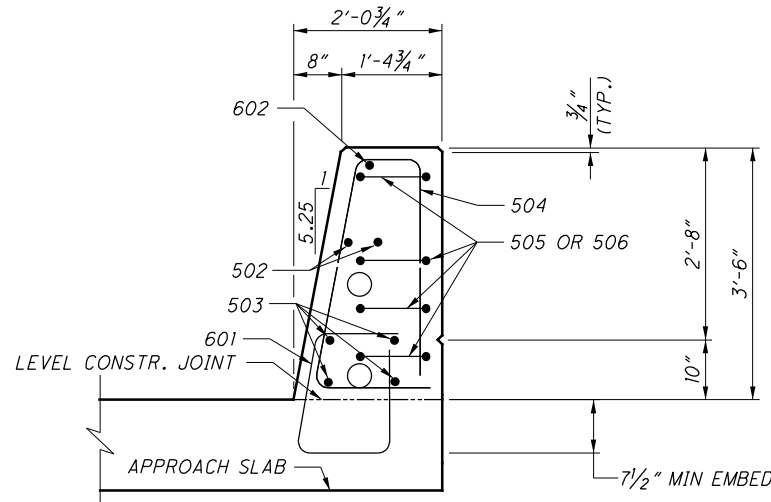


**C** SECTION THRU PILASTER  
85,88

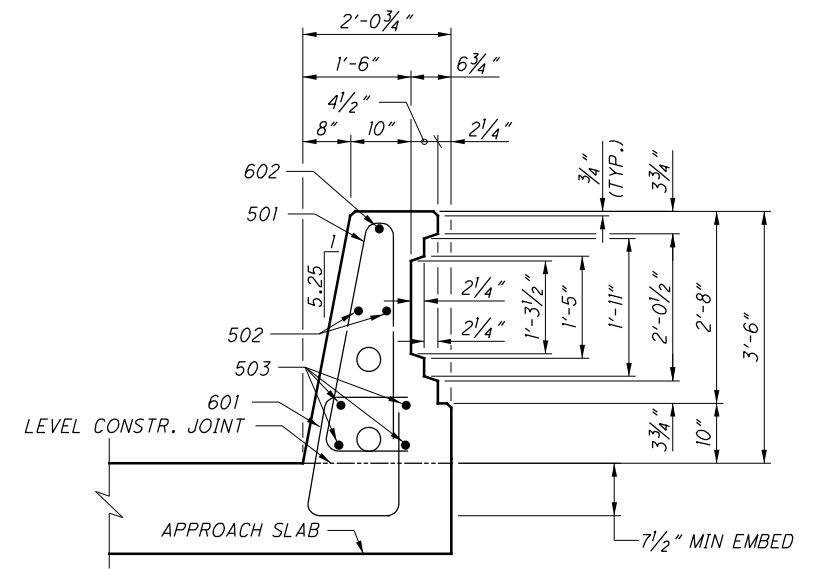


**D** SECTION THRU PANEL  
85,88

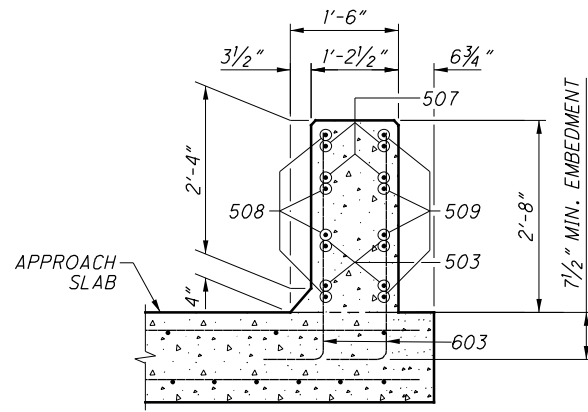


**E** SECTION  
85,88

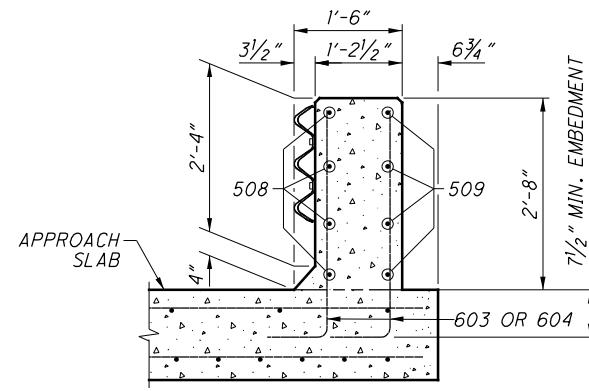

**F** SECTION  
85,88

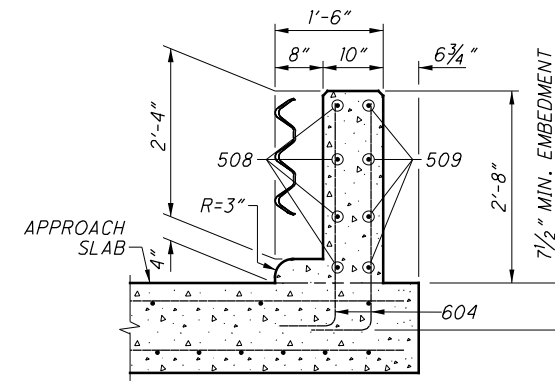

**G** SECTION  
85,88

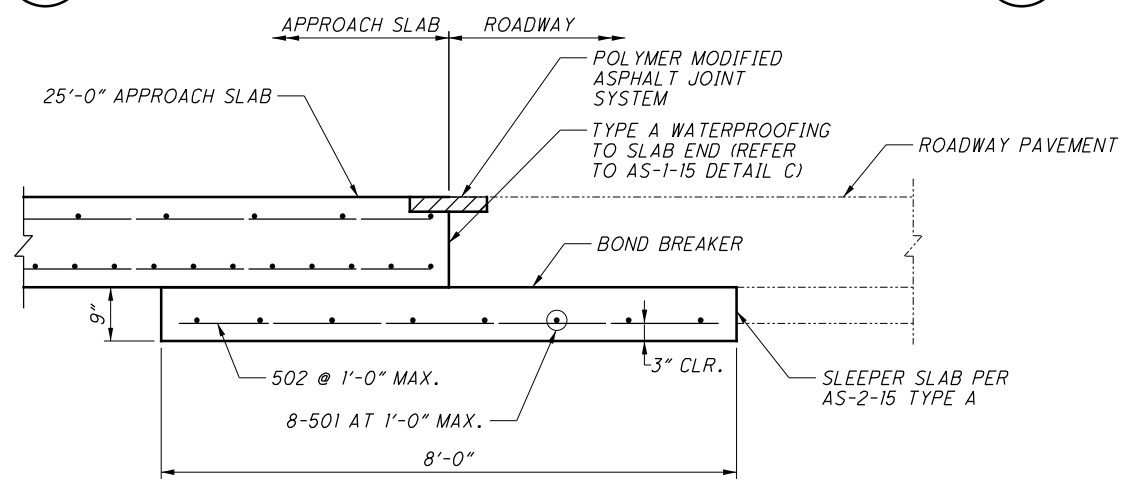


**A** SECTION  
87

**NOTES:**  
1. FOR NOTES, SEE SHEET 84/00.

**LEGEND:**  
■ - 1/2" DIA. GLASS FIBER REINFORCED POLYMER (GFRP) STIFFENING REINFORCEMENT

DESIGNED	JAT	CRC
CHECKED	JAT	CRC
DRAWN	ADS	REVISED
REVIEWED	TES	STRUCTURE FILE NUMBER
DATE	3/27/2019	3115739


P:\Projects\2018\20H03DB-18232 HAM-75-03.84\104667\structures\HAM074\_1908R\sheets\074\_1908R\_MD001.dgn 11/13/2023 4:08:37 PM adesimone

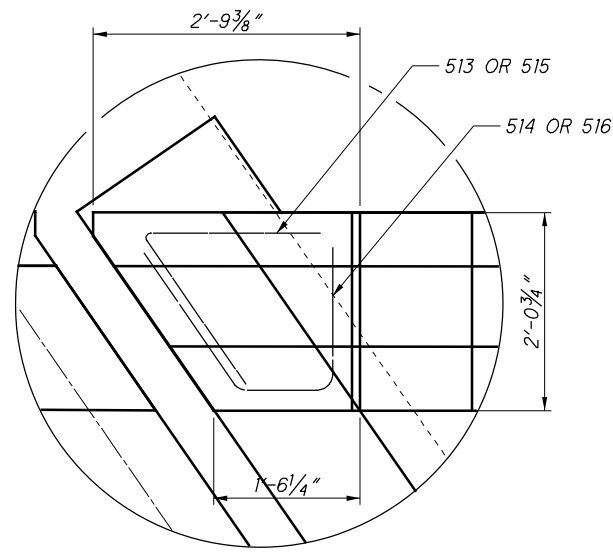

**H**  
**87** ABUTMENT PARAPET  
DETAIL


**LEGEND**

\* - TOP OF SLEEPER SLAB ELEVATION

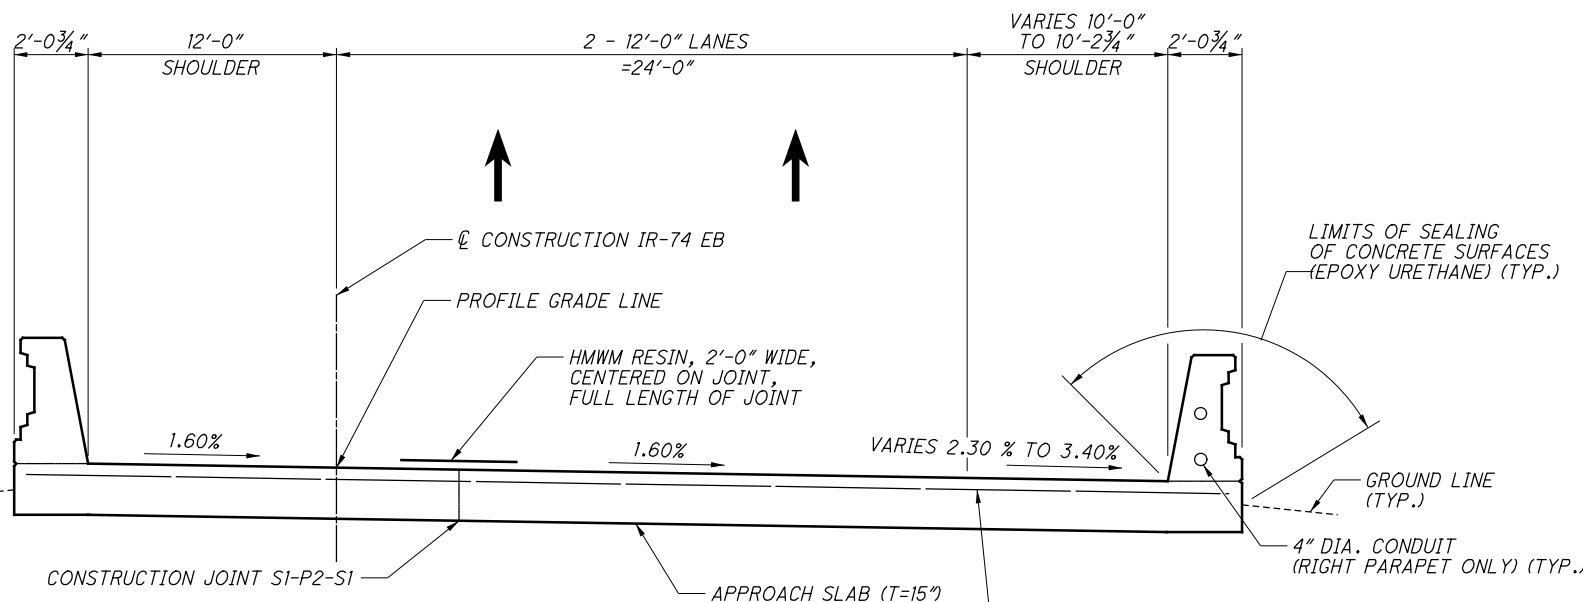

**FORWARD APPROACH SLAB SECTION**

520 - CONTRACTOR SHALL ADD AN ADDITION #5 BAR TO TOP MAT LOCATED BETWEEN THE STANDARD BARS ON AS-1-15. THE TOTAL ADDITIONAL WEIGHT SHALL BE INCLUDED IN THE APPROACH SLAB PARAPET REINFORCING LIST.

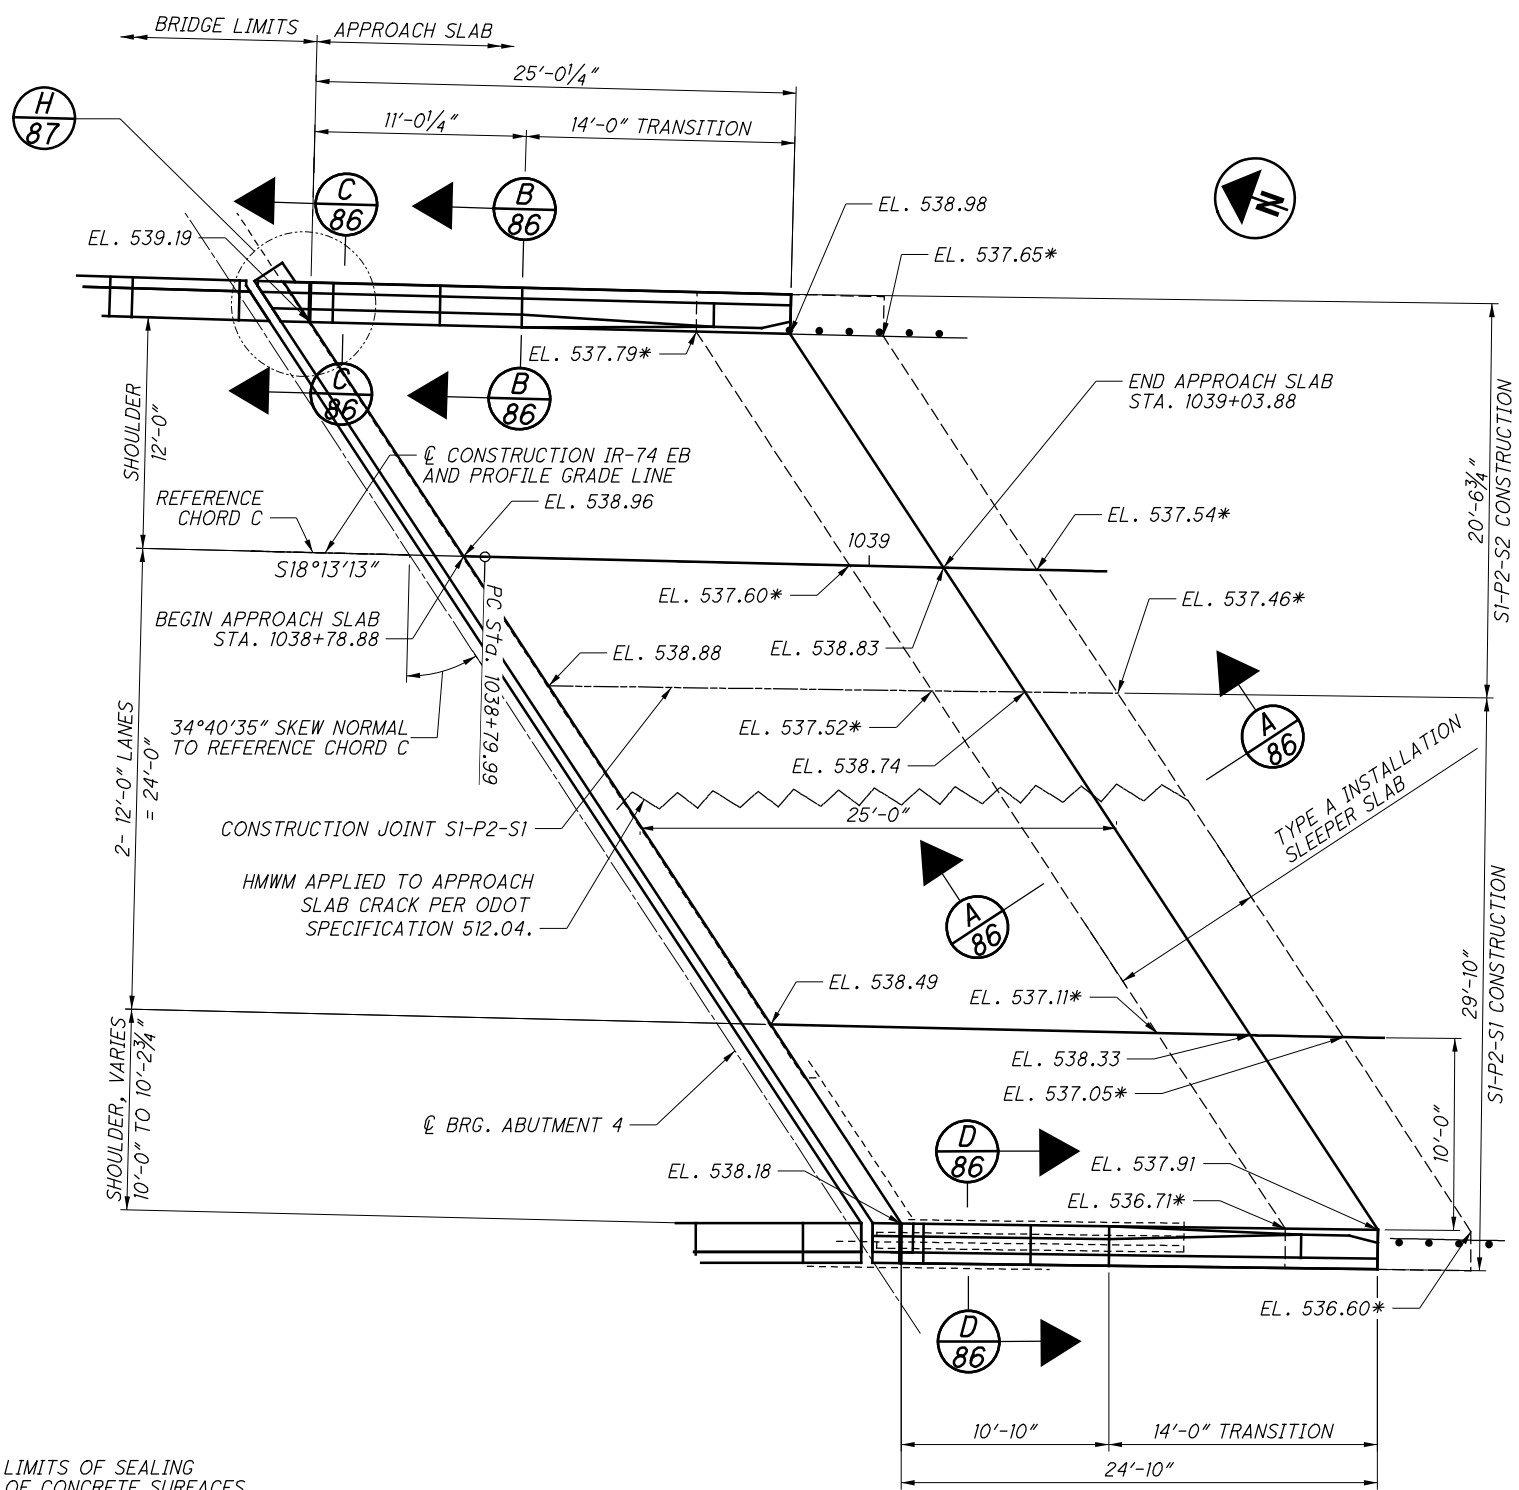

**FORWARD APPROACH SLAB PLAN**


**NOTES:**

1. ALL CONCRETE SURFACES OF THE ORNAMENTAL PARAPET SHALL RECEIVE A RUBBER FINISH. SAW CUTTING AND TEXTURED FINISH ARE INCLUDED WITH ITEM 511 - CONCRETE CLASS QC3 WITH QC/QA-COMPRESSIVE STRENGTH 4.5 KSI, BRIDGE DECK (PARAPET, AS PER PLAN, FOR PAYMENT.
2. FOR MORE DETAILS, SEE STANDARD DRAWINGS AS-1-15 AND AS-2-15.
3. PARAPET DIMENSIONS ALONG OUTSIDE EDGE OF APPROACH SLAB.
4. ALL TRANSVERSE BARS IN THE APPROACHSLAB REQUIRE MECHANICAL CONNECTORS.
5. FOR FORWARD APPROACH SLAB AND ABUTMENT DETAILS, SEE SHEET **36/100**.
6. FOR LIMITS OF SEALING, SEE SHEET **36/100**.


DESIGNED	JAT	CHECKED	CRG
DRAWN	ADS	REVISED	
REVIEWED	TES	DATE	7/30/2019
FILE NUMBER	3115739	STRUCTURE	




P:\Projects\2018\20H03DB-18232 HAM-75-03.84\104667\structures\HAM074\_1908R\MD002.dgn 6/20/2019 9:22:26 AM aseed

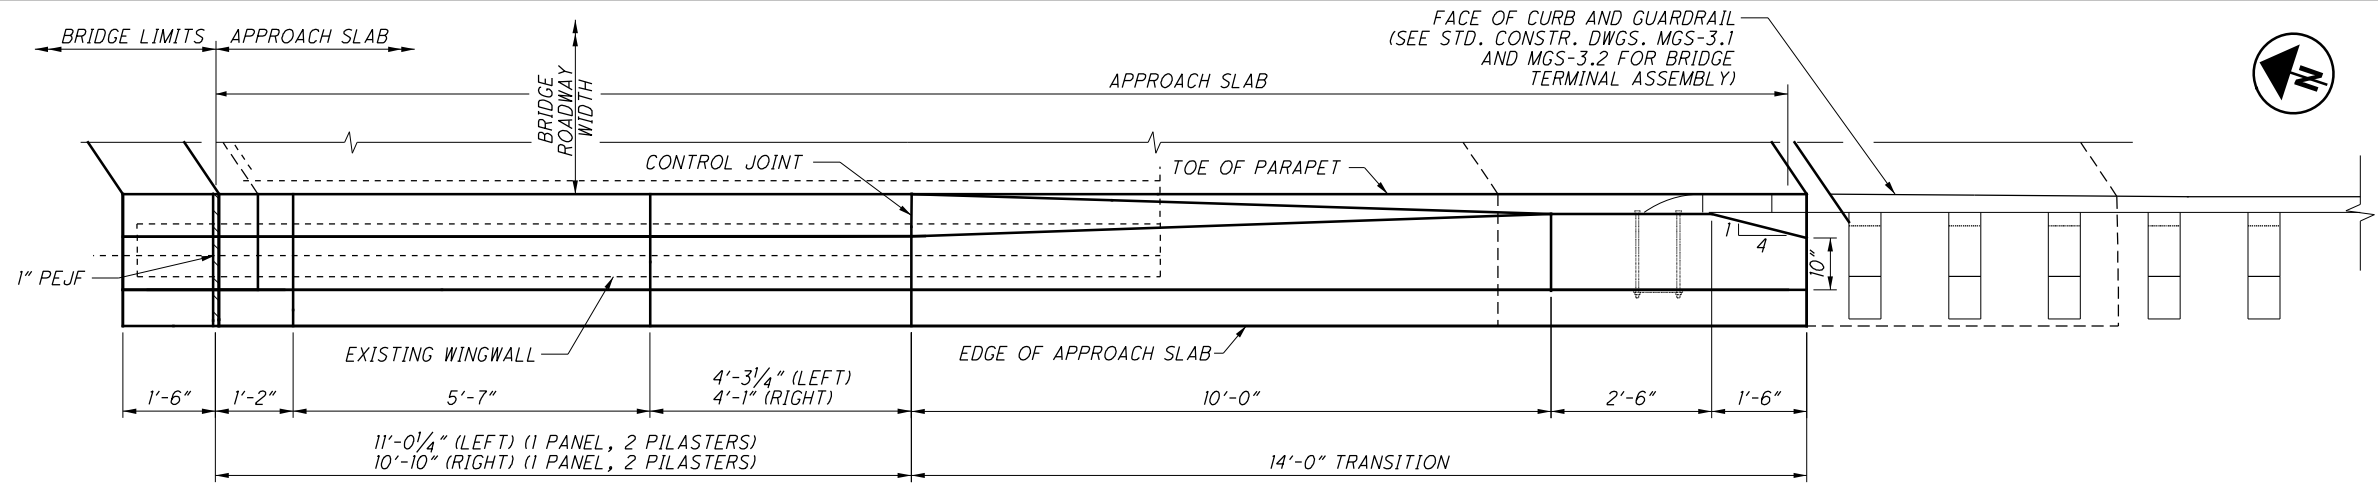

**APPROACH SLAB PARAPET PLAN**  
(RIGHT FORWARD ABUTMENT SHOWN, LEFT SIMILAR)

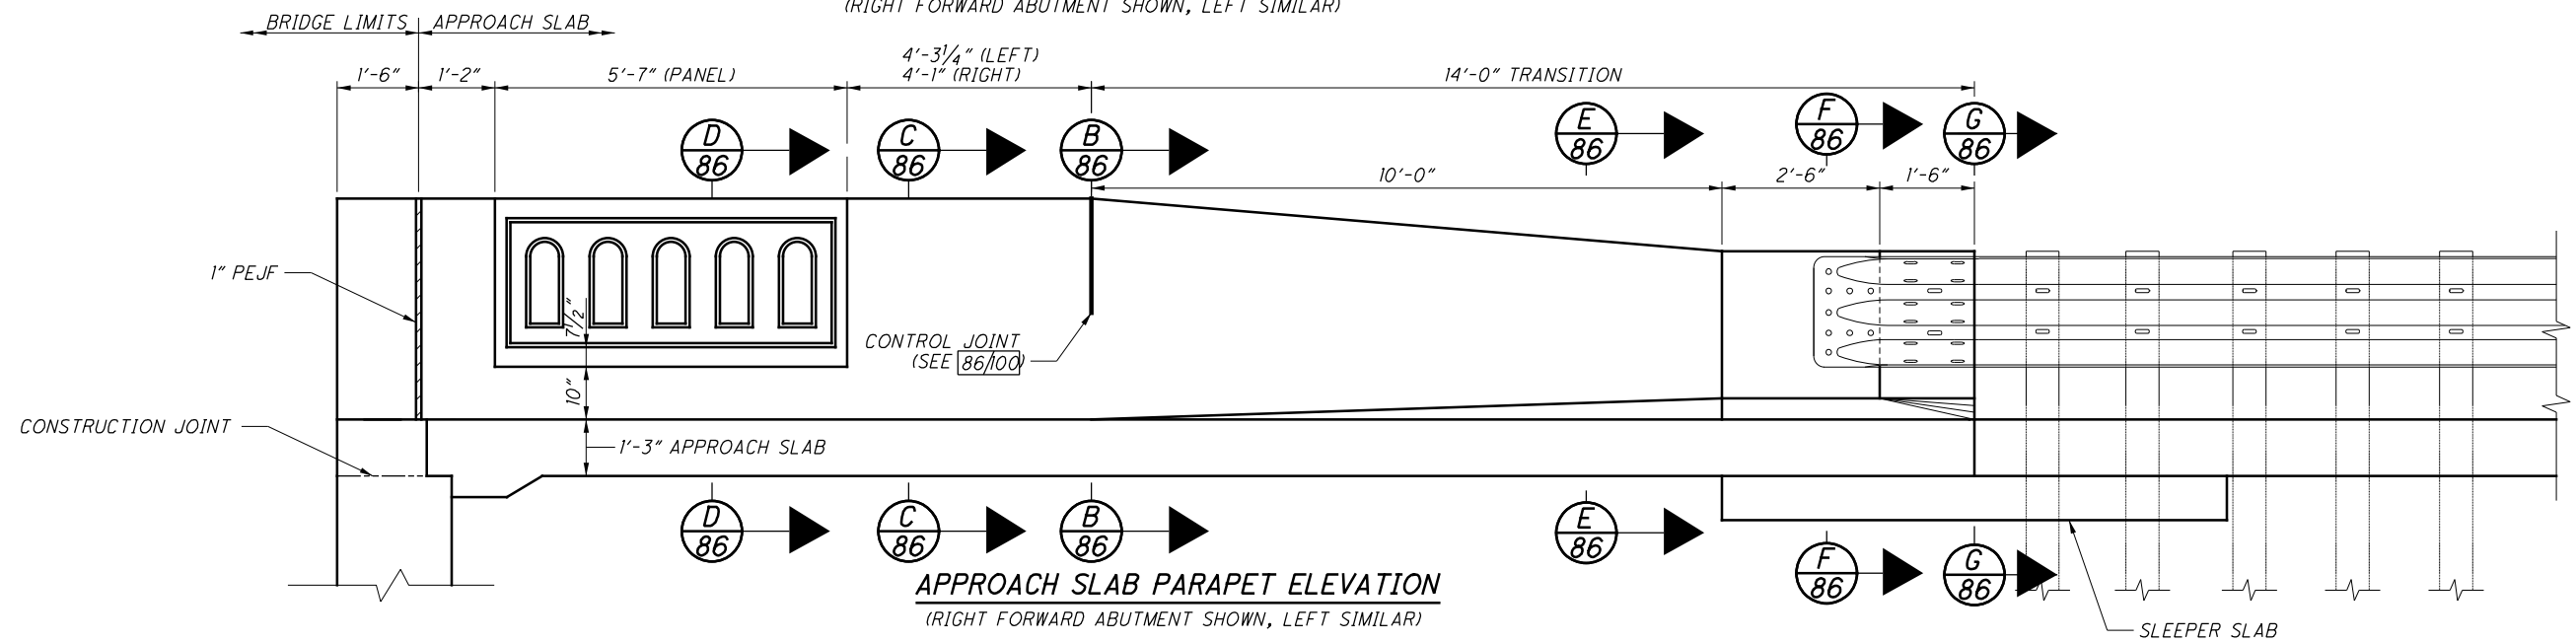

**APPROACH SLAB PARAPET ELEVATION**  
(RIGHT FORWARD ABUTMENT SHOWN, LEFT SIMILAR)

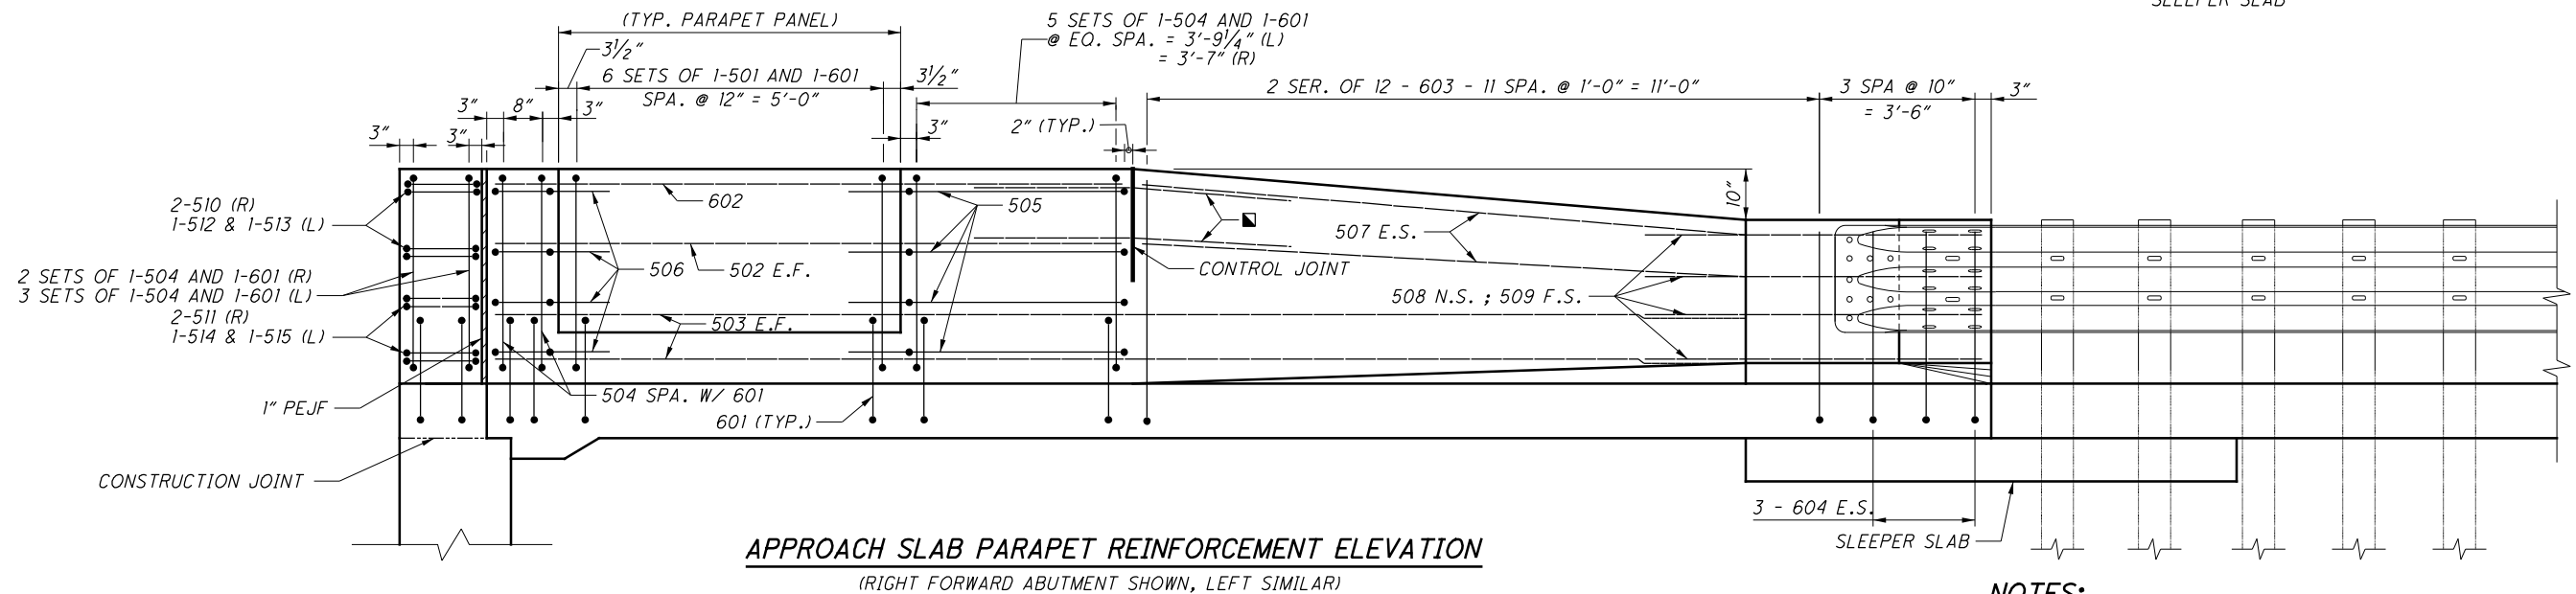


**APPROACH SLAB PARAPET REINFORCEMENT ELEVATION**  
(RIGHT FORWARD ABUTMENT SHOWN, LEFT SIMILAR)

**LEGEND:**  
 ■ - 1/2" DIA. GLASS FIBER REINFORCED POLYMER (GFRP) STIFFENING REINFORCEMENT


- NOTES:**
- FOR ADDITIONAL DETAILS AND NOTES, SEE SHEET 87100.
  - FOR PANEL DETAILS, SEE SHEET 56100.
  - THE PREFIX "FASR" SHALL BE ADDED TO ALL BAR MARKS FOR FORWARD APPROACH SLAB PARAPET DETAILS.

<b>DESIGN AGENCY</b> <b>PRIMEW</b> 540 WHITE POND DR. SUITE E AKRON, OH 44320	<b>DATE</b> 3/27/2019
	<b>REVIEWED</b> TES
<b>DESIGNED</b> JAT	<b>STRUCTURE FILE NUMBER</b> 3115739
<b>DRAWN</b> ADS	<b>REVISION</b> CRG
<b>FORWARD APPROACH PARAPET DETAILS</b> BRIDGE NO. HAM-74-1908R IR-74 OVER MILL CREEK, RR & SPRING GROVE AVENUE	
<b>HAM-75-3.84</b>	<b>PID No. 104667</b>
88 / 100	
88 / 100	


P:\Projects\2018\20H03DB-18232 HAM-75-03.84\104667\structures\HAM074\_1908R\sheets\074\_1908R\_MD004.dgn 6/20/2019 9:22:38 AM asead

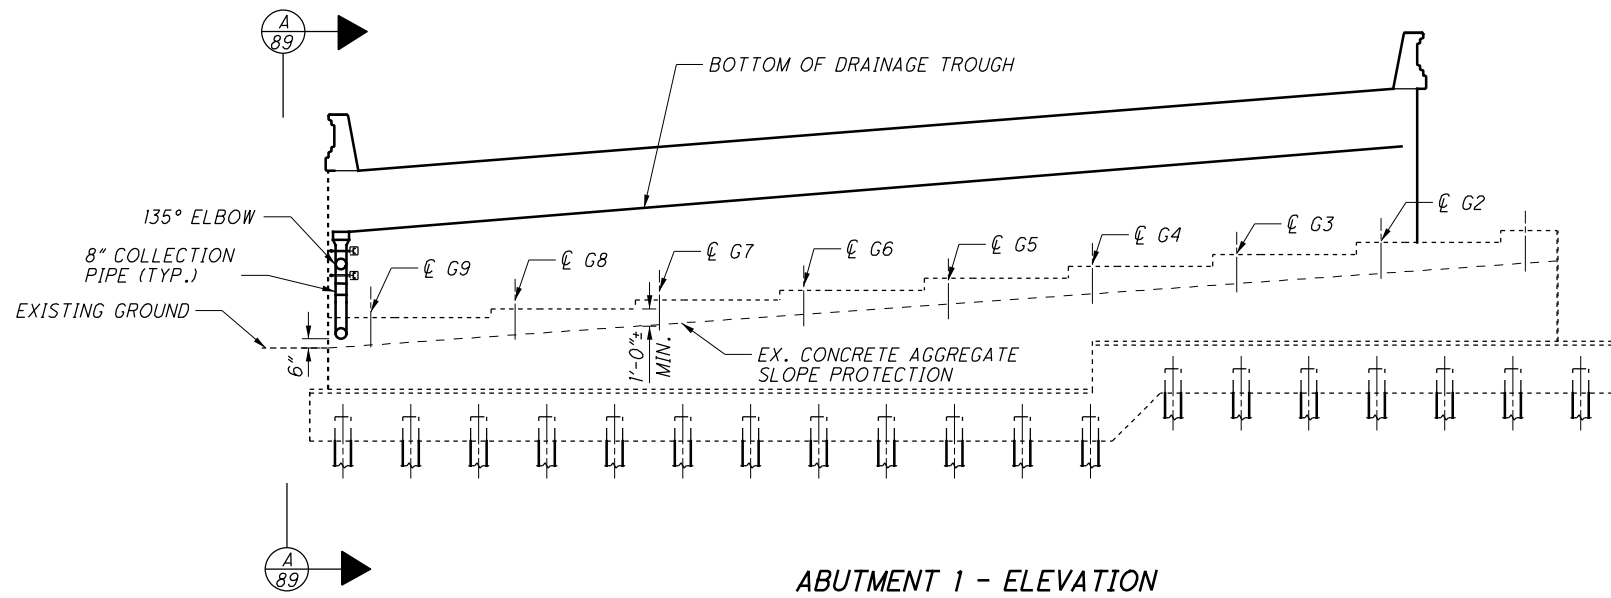


**ABUTMENT 1 - ELEVATION**

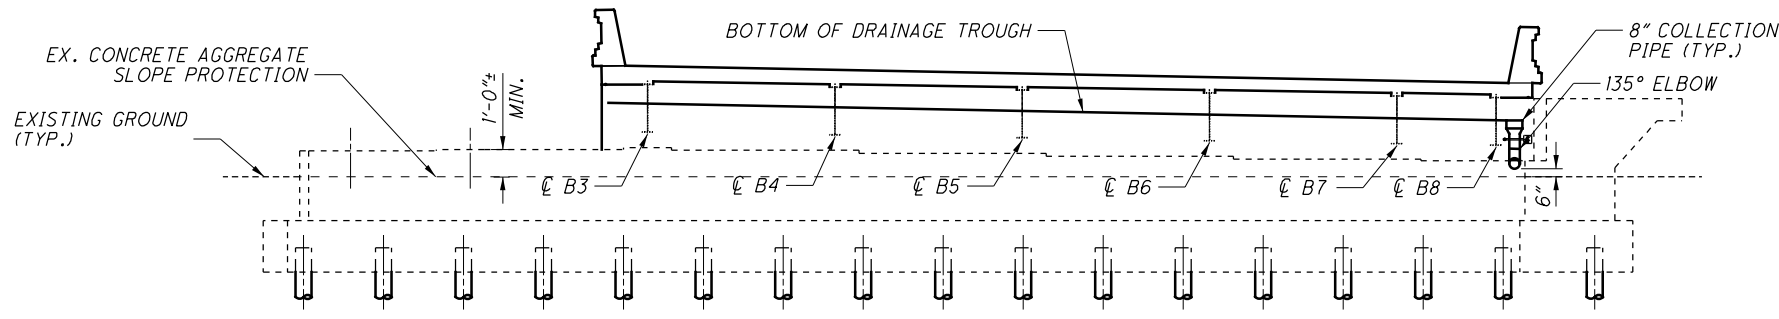


**ABUTMENT 4 - ELEVATION**

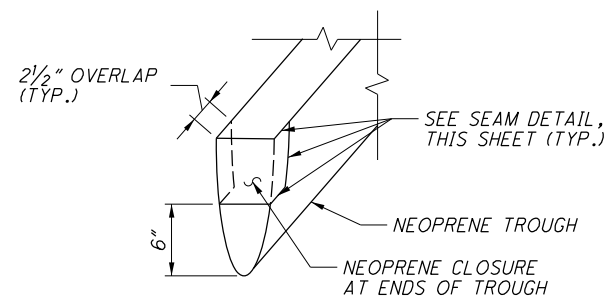

**END OF TROUGH CLOSURE DETAIL**

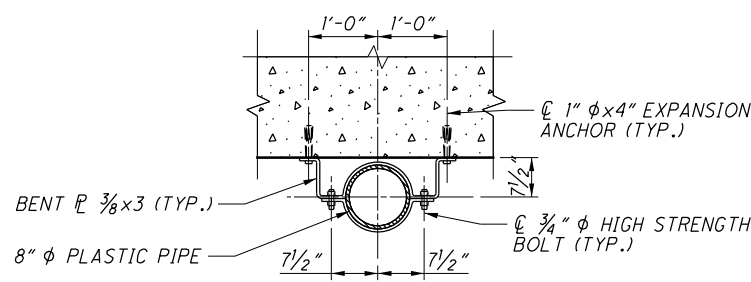


**DOWNSPOUT SUPPORT BRACKET**

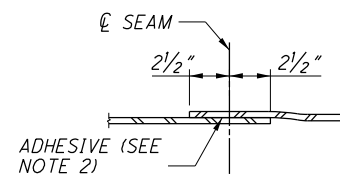


**SEAM DETAIL**

**NOTES:**


- FOR EXPANSION JOINT DETAILS, SEE SHEET 83/100.
- AT THE ENDS OF THE NEOPRENE DRAINAGE TROUGHS, OVERLAP THE ENDS OF THE NEOPRENE AND SEAL WITH 3M SCOTCH-WELD HP 1357 NEOPRENE CONTACT ADHESIVE OR APPROVED EQUAL.
- ALL BRACKETS SHALL BE ASTM A709, GRADE 50 AND SHALL BE GALVANIZED PER CMS 711.02.
- ALL MATERIALS FOR THE DOWNSPOUTS AND ELBOWS SHALL BE PLASTIC PIPE IN ACCORDANCE WITH CMS 707.45.

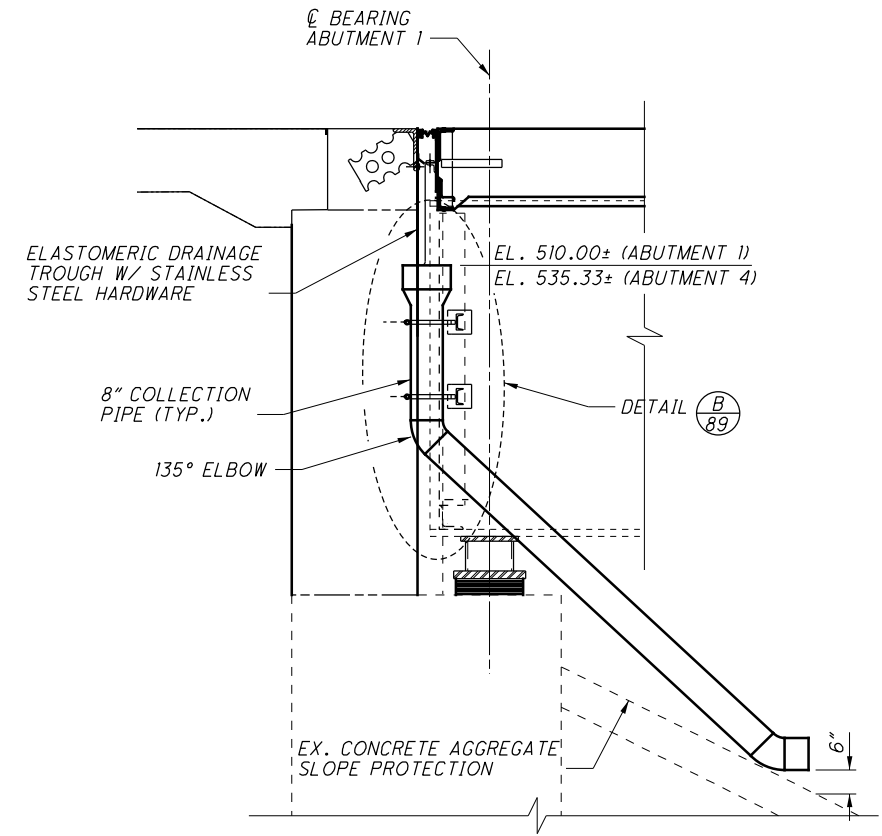

**SECTION - ABUTMENT 1 DRAINAGE DETAIL**  
ABUTMENT 4 SIMILAR

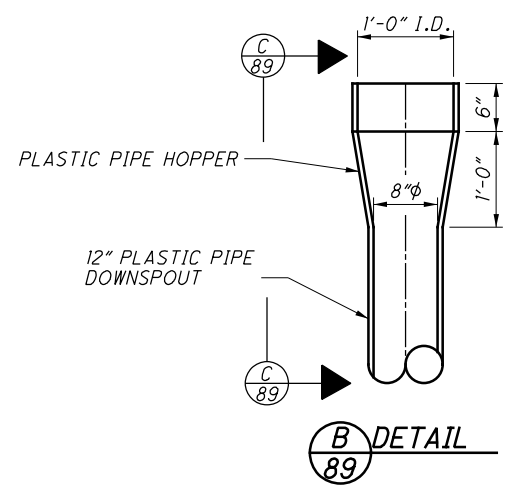


**DETAIL B**

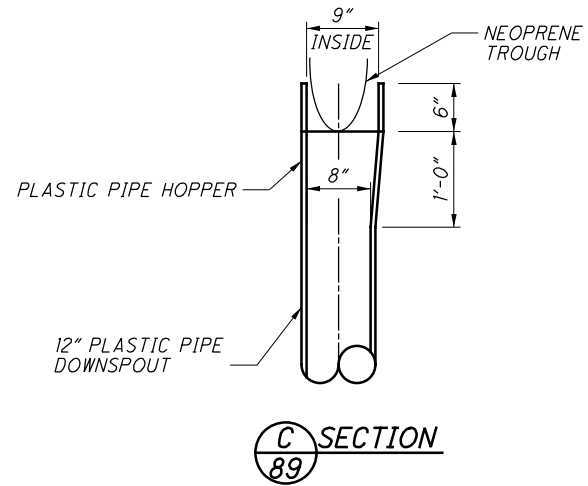


**SECTION C**


P:\Projects\2018\20H03DB-18232 HAM-75-03.84\104667\structures\HAM074\_1908R\sheets\074\_1908R\_MD005.dgn 9/25/2023 3:05:55 PM erin.boumann

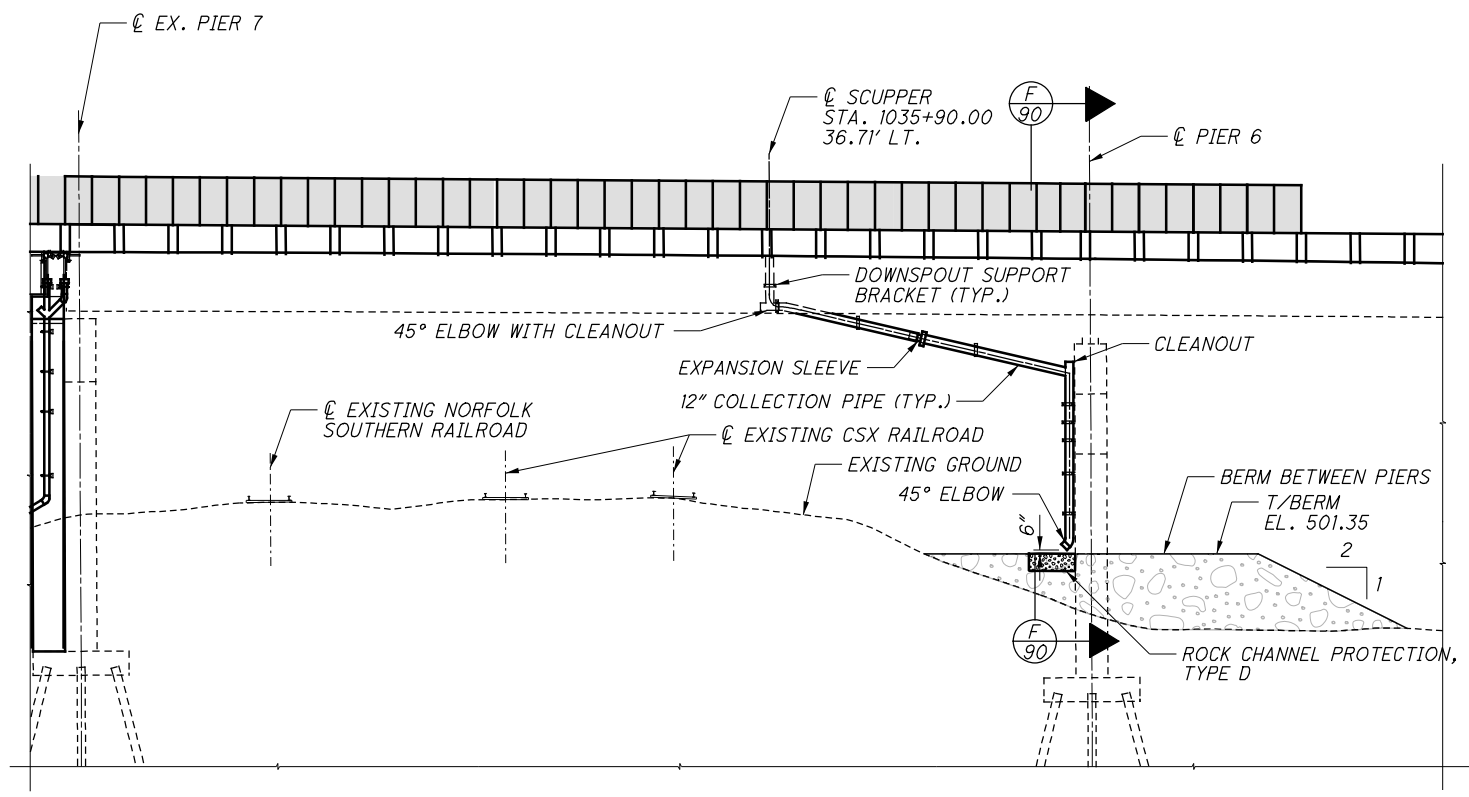


**UNIT 2 LEFT - ELEVATION**

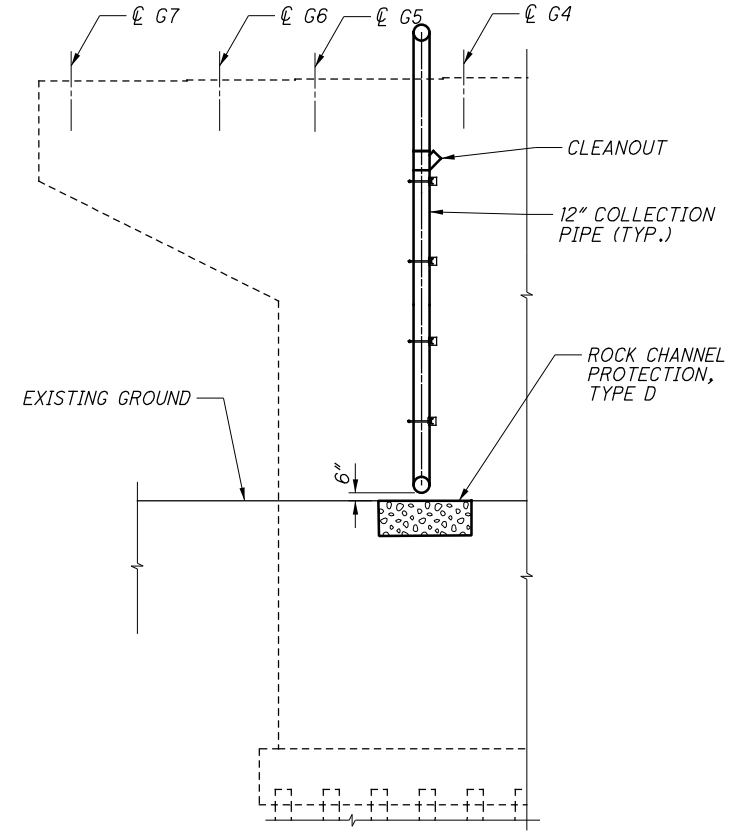

**SECTION - PIER 6 LEFT**

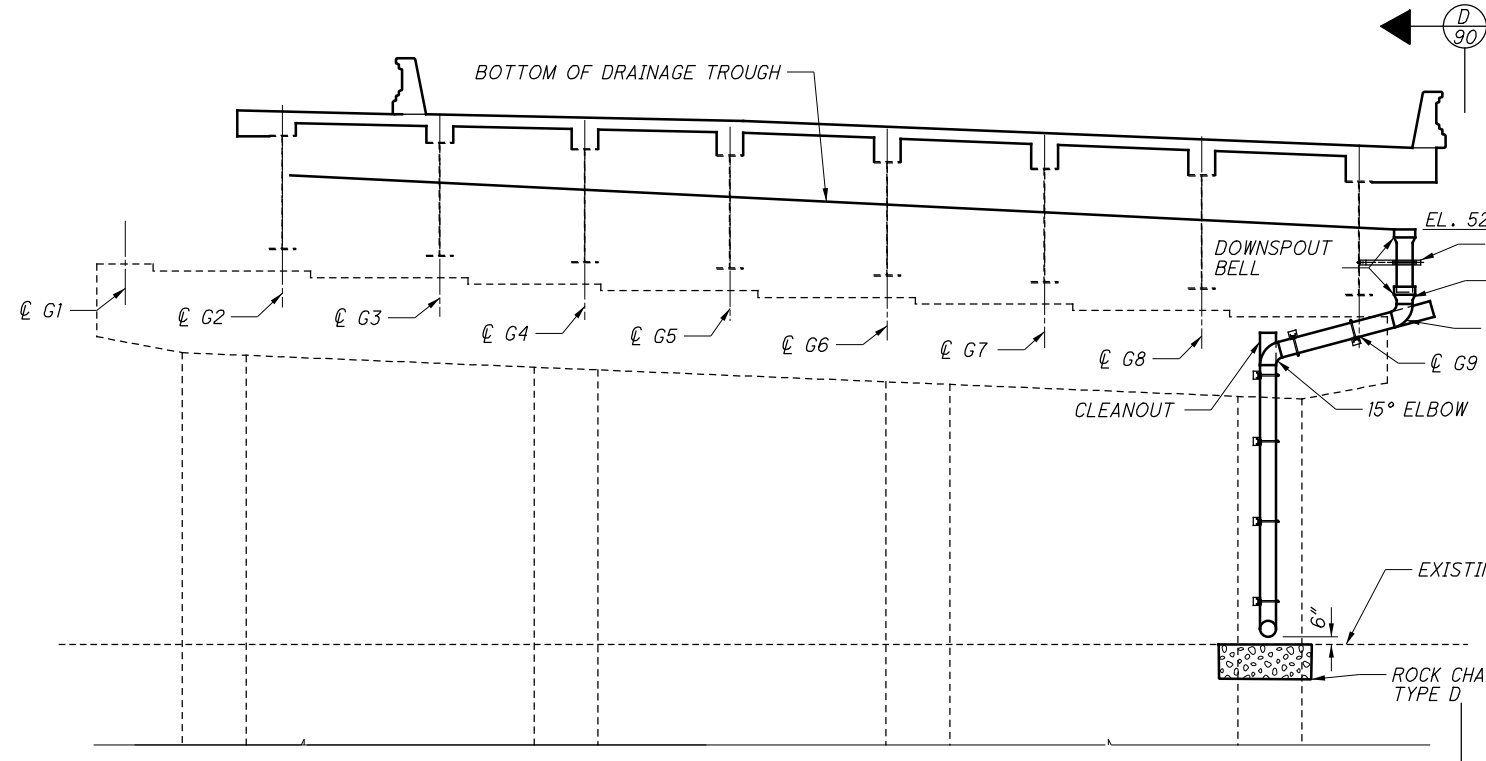


**HINGE 1 NEAR PIER 4**

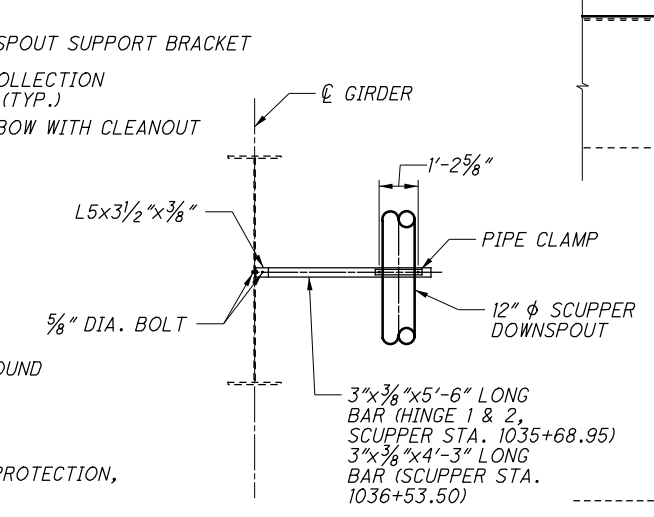

**DOWNSPOUT SUPPORT BRACKET**

PIPE CLAMPS SHALL BE EATON B-LINE SERIES B2400-12 OR APPROVED EQUAL.

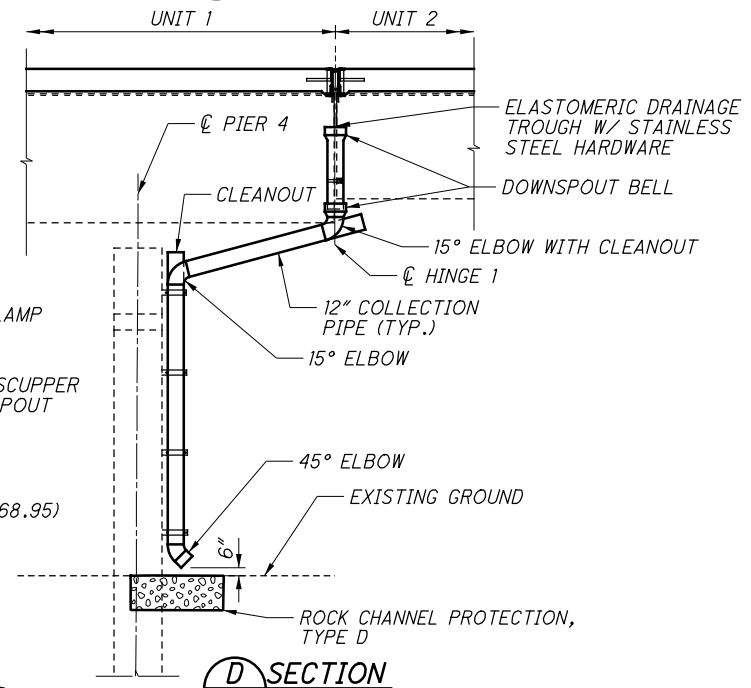


**SECTION**

**NOTES:**


- FOR EXPANSION JOINT DETAILS, SEE SHEET 83/100.
- NO BRIDGE SCUPPERS OR OTHER DECK DRAINS, ROADWAY DRAINAGE, CATCH BASINS, INLETS OR OUTLETS ARE PERMITTED TO DRAIN ONTO RAILWAY PROPERTY FROM OVERHEAD BRIDGE STRUCTURES. DRAINAGE FROM BRIDGE SCUPPERS AND DECK DRAINS MUST BE CONVEYED THROUGH PIPES, PREFERABLY TO A POINT OFF RAILROAD PROPERTY. ALL HANDLING SHALL BE IN KEEPING WITH REQUIREMENTS OF NS "OVERHEAD GRADE SEPARATION DESIGN CRITERIS".
- FOR ADDITIONAL NOTES AND DETAILS, SEE SHEET 89/100.

DESIGNED	KDC	CHECKED	CRG
DRAWN	KDC	REVISED	
REVIEWED	TES	DATE	7/30/2019
STRUCTURE FILE NUMBER			3115739


P:\Projects\2018\20H03DB-18232 HAM-75-03.84\104667\structures\HAM074\_1908R\sheets\074\_1908R\_MD026.dgn 9/22/2023 3:08:42 PM erin.boumann

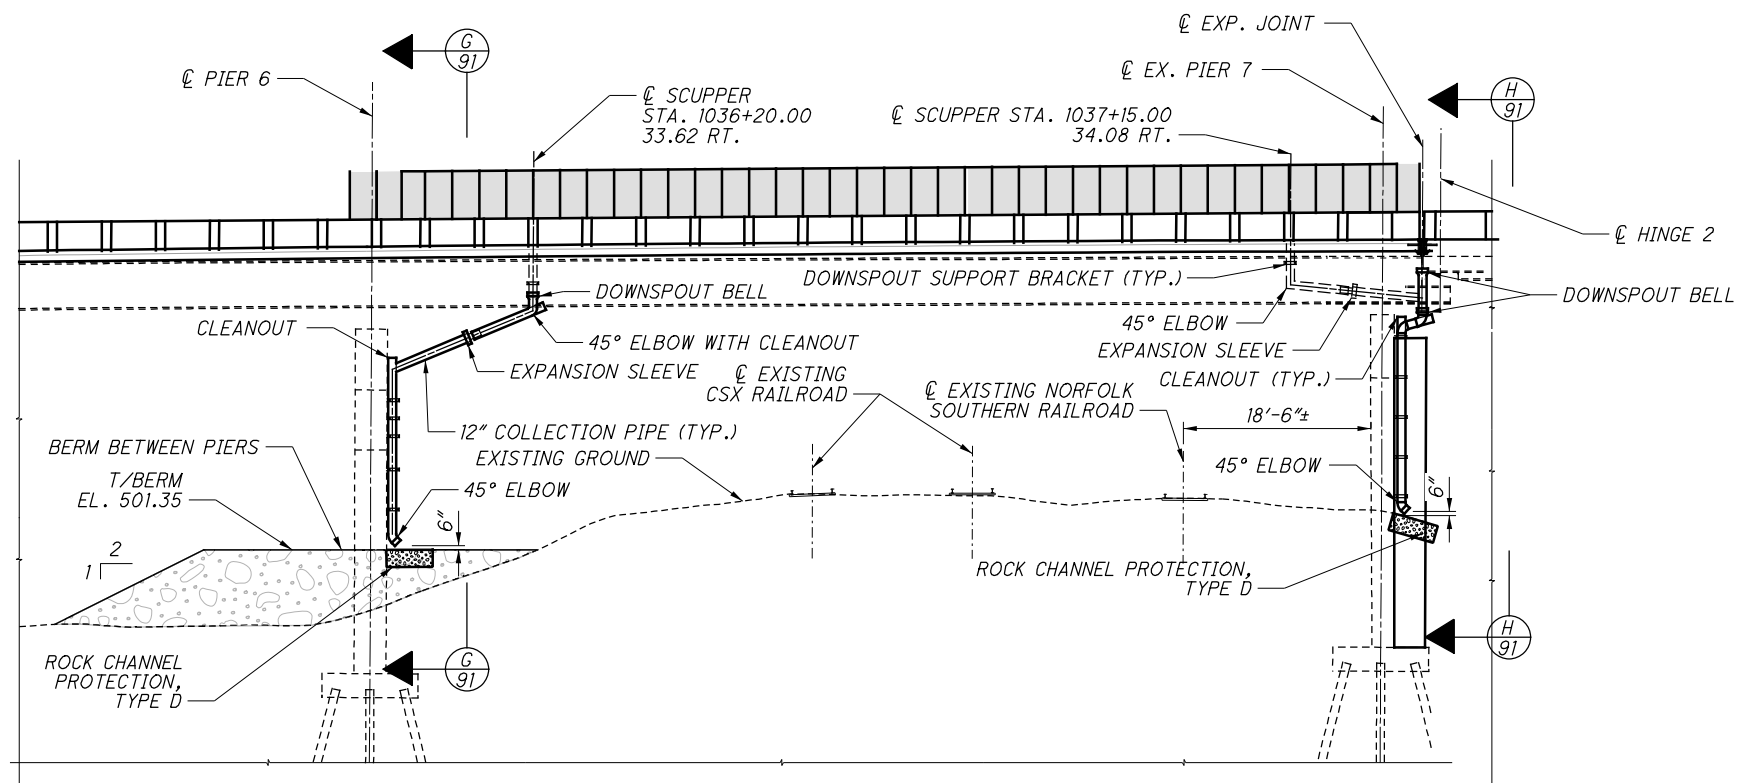


**UNIT 2 RIGHT - ELEVATION**

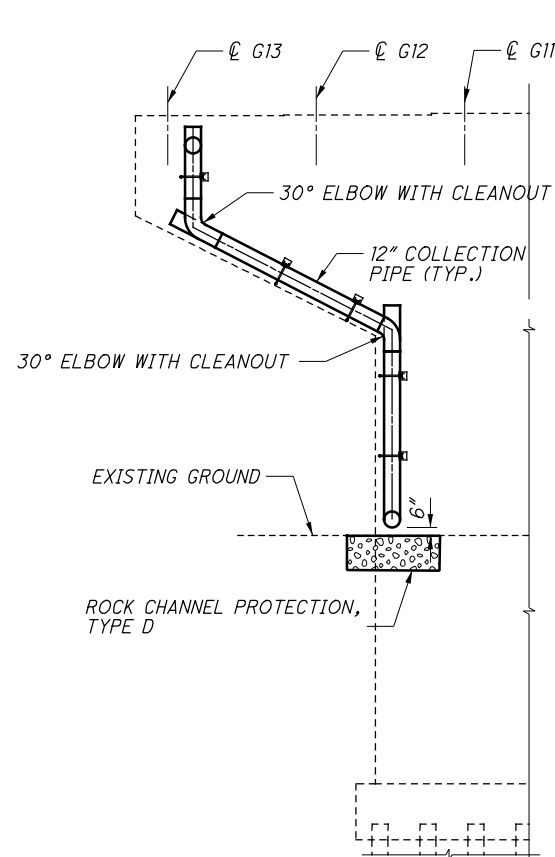

**G SECTION - PIER 6 RIGHT**

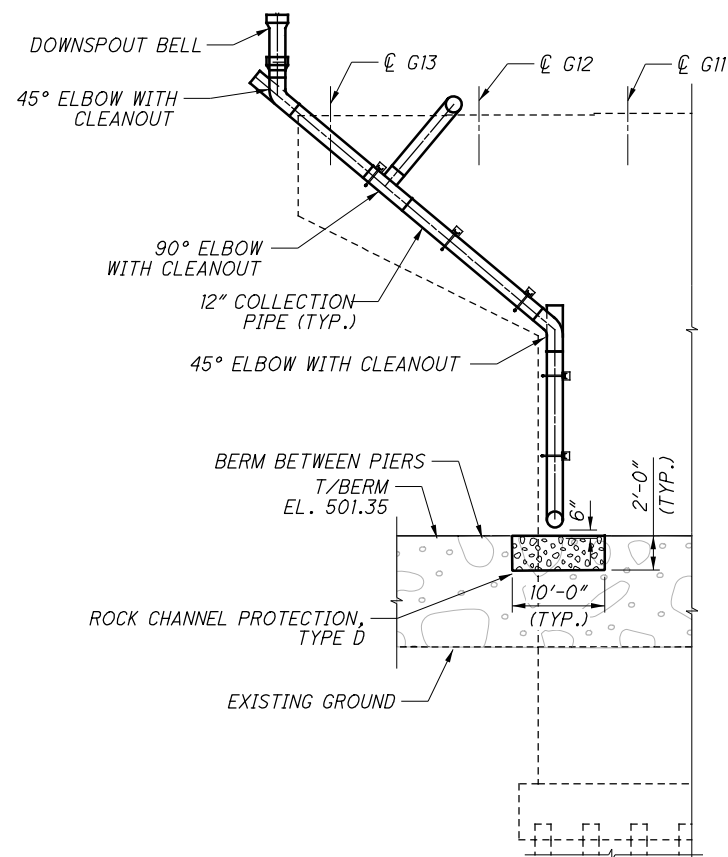

**H SECTION - PIER 7 RIGHT**

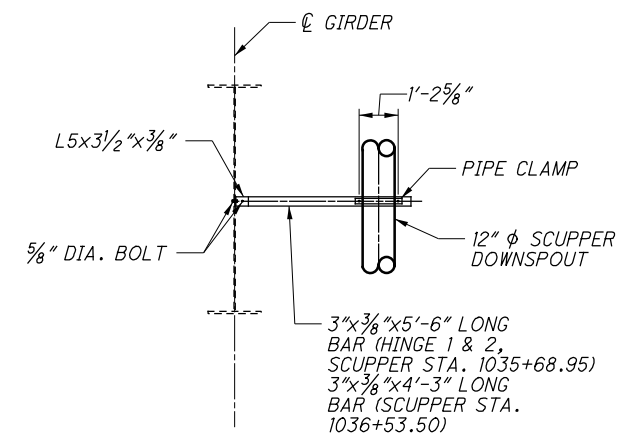

**DOWNSPOUT SUPPORT BRACKET**


PIPE CLAMPS SHALL BE EATON B-LINE SERIES B2400-12 OR APPROVED EQUAL.

**NOTES:**


- FOR EXPANSION JOINT DETAILS, SEE SHEET 83100.
- NO BRIDGE SCUPPERS OR OTHER DECK DRAINS, ROADWAY DRAINAGE, CATCH BASINS, INLETS OR OUTLETS ARE PERMITTED TO DRAIN ONTO RAILWAY PROPERTY FROM OVERHEAD BRIDGE STRUCTURES. DRAINAGE FROM BRIDGE SCUPPERS AND DECK DRAINS MUST BE CONVEYED THROUGH PIPES, PREFERABLY TO A POINT OFF RAILROAD PROPERTY. ALL HANDLING SHALL BE IN KEEPING WITH REQUIREMENTS OF NS "OVERHEAD GRADE SEPARATION DESIGN CRITERIS".
- FOR ADDITIONAL NOTES AND DETAILS, SEE SHEET 89100.

DESIGNED	KDC	CHECKED	CRG
DRAWN	KDC	REVISED	
REVIEWED	TES	DATE	7/30/2019
STRUCTURE FILE NUMBER			3115739


P:\Projects\2018\20H03DB-18232 HAM-75-03.84\104667\structures\HAM074\_1908R\sheets\074\_1908R\_DR001.dgn 11/13/2023 3:43:13 PM adesimone

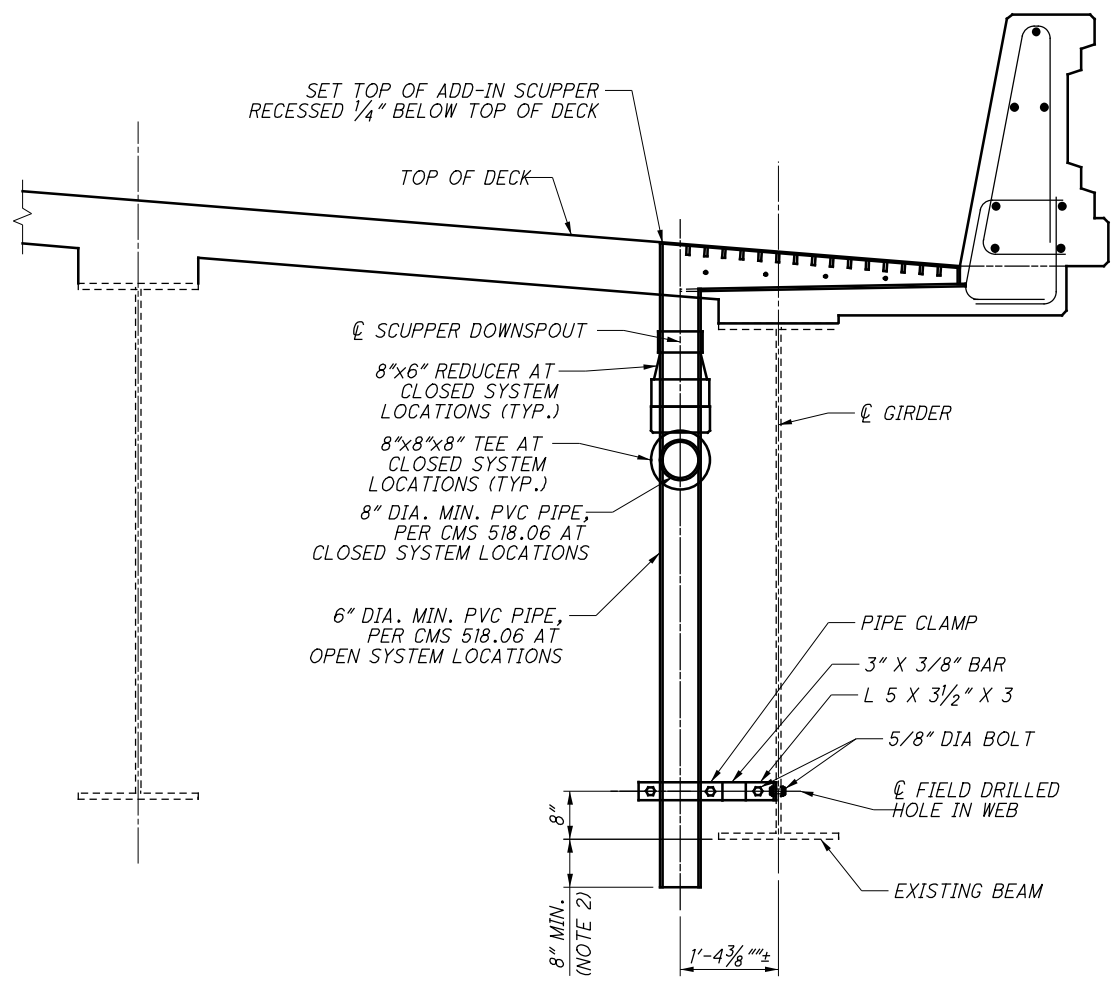


**TYPE 1 SCUPPER - UNIT 1**

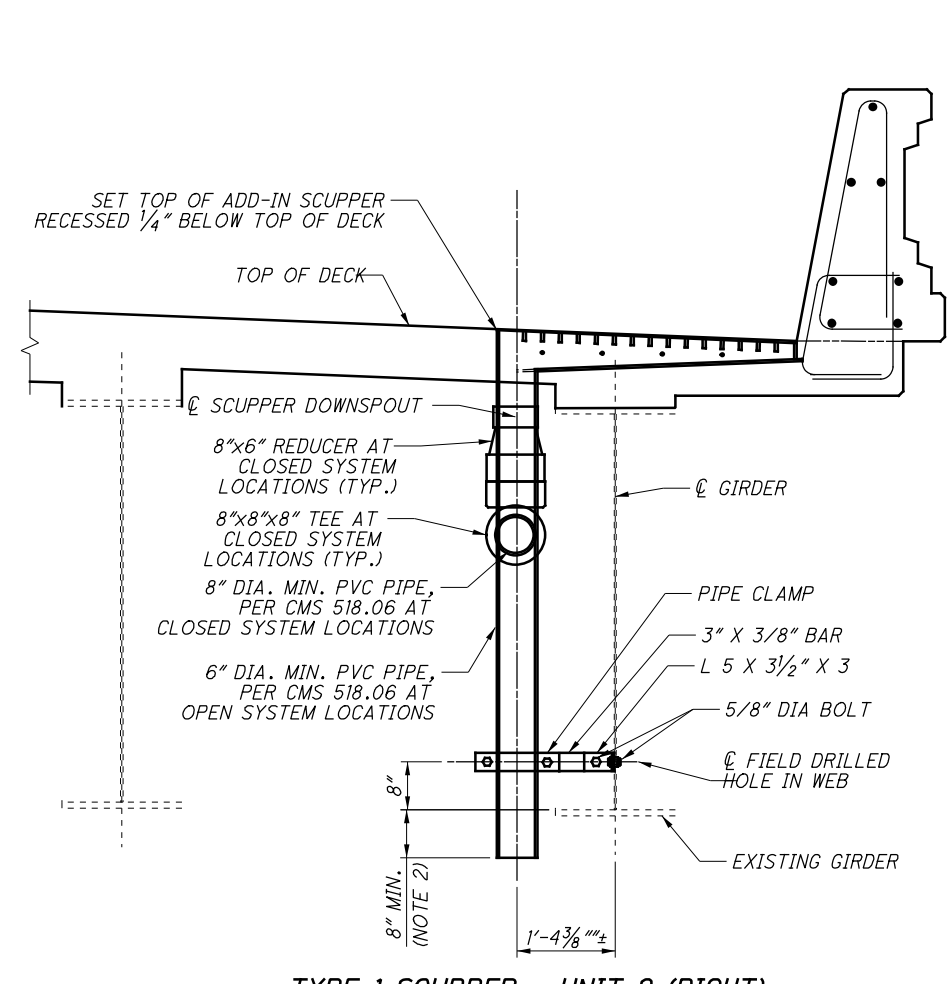

**TYPE 1 SCUPPER - UNIT 2 (RIGHT)**  
(SCUPPERS ON UNIT 2-LEFT ARE STANDARD SCUPPERS)

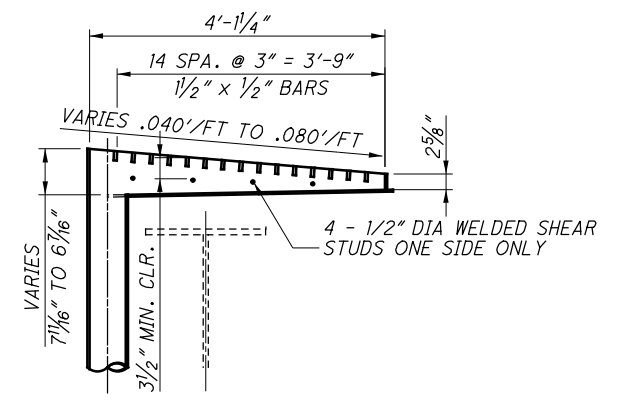

**SECTION A-A**

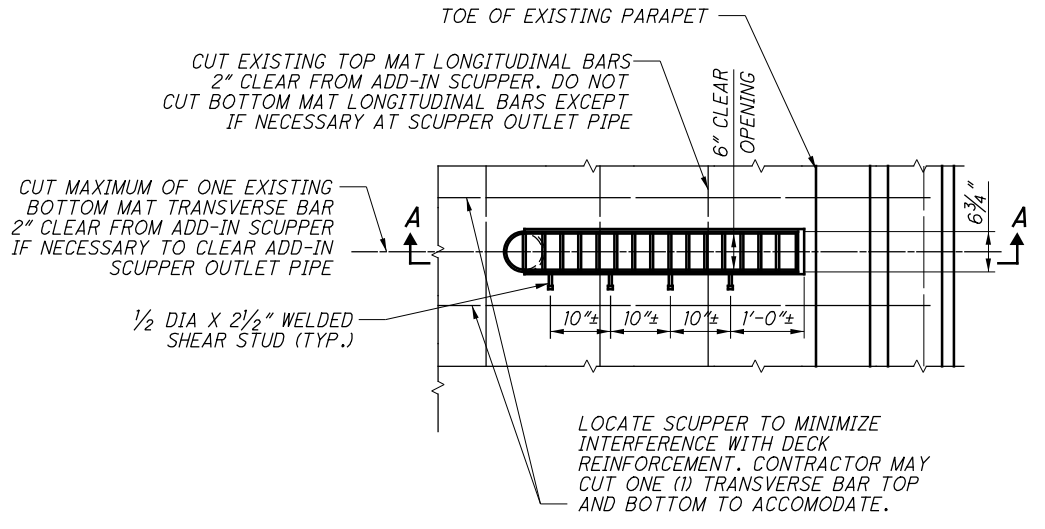


**TYPE 1 SCUPPER-PLAN**

**NOTES**


1. FABRICATE TEMPORARY ADD-IN SCUPPERS FROM MIN. 3/8" THICK STEEL PLATE; ASTM A36 OR EQUAL.
2. PRIOR TO REMOVING PORTION OF DECK TO INSTALL ADD-IN SCUPPER, VERIFY THE SCUPPER WILL NOT CONFLICT WITH EXISTING X-FRAMES.
3. EXTEND DOWNDRAIN 8" MIN. BEYOND BOTTOM OF EXISTING GIRDER.
4. PROVIDE SPLASH PAD WHEN ERODIBLE MATERIAL IS LOCATED BELOW ADD-IN SCUPPER.
5. PIPE HANGERS SHALL BE EATON B-LINE SERIES B3100-8 OR APPROVED EQUAL.
6. PIPE CLAMPS SHALL BE EATON B-LINE SERIES B3140-8 OR APPROVED EQUAL.
7. ALL COMPONENTS (ANGLES, BARS, CLAMPS, ANCHORS, BOLT COUPLERS, PIPE HANGERS, ETC.) SHALL BE GALVANIZED.
8. ALL BOLTS SHALL BE A325, TYPE 1 GALVANIZED. EACH ASSEMBLY SHALL INCLUDE BOLT, NUT, AND TWO WASHERS. TIGHTEN ACCORDING TO CMS 513.
9. FOR TYPE 1 SCUPPER LOCATIONS ON UNIT 1, SEE SHEETS 51/100 AND 52/100.
10. FOR TYPE 1 SCUPPER LOCATIONS ON UNIT 2, SEE SHEETS 60/100 AND 61/100.

DESIGN AGENCY		PRIME	
540 WHITE POND DR. SUITE E		AKRON, OH 44320	
DESIGNED	JAT	CHECKED	CRG
DRAWN	JAT	REVIEWED	TES
DATE	7/30/2019	STRUCTURE FILE NUMBER	3115739
<b>SCUPPER DETAILS - TYPE 1</b>			
BRIDGE NO. HAM-74-1908R			
IR-74 OVER MILL CREEK, RR & SPRING GROVE AVENUE			
HAM-75-3.84		PID No. 104667	
92/100		92/100	


\\primeidom01.primeidom.com\DFSRoot\Data\Projects\2018\20H030B-18232 HAM-75-03.84\104667\_structures\HAM074\_1908R\sheets\074\_1908R\_DR002.dgn 6/20/2019 9:22:56 AM cseed

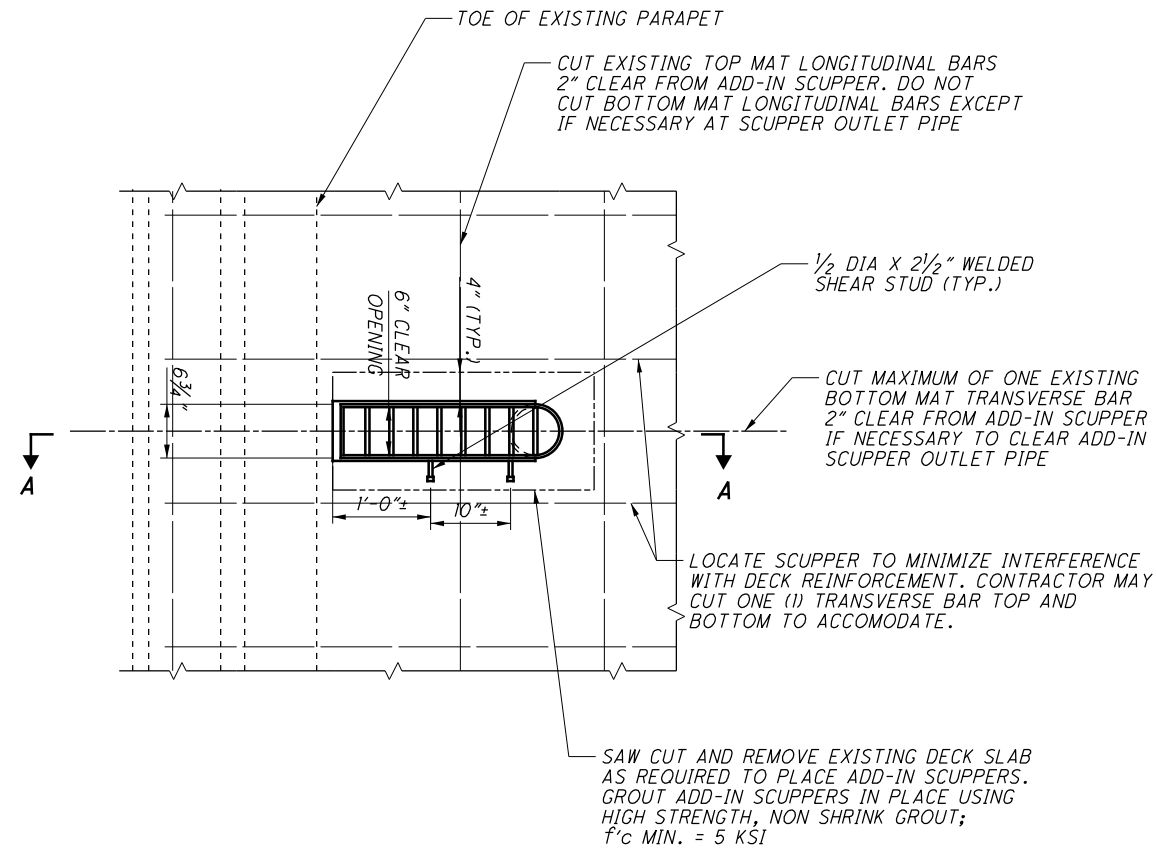


**TYPE 2 SCUPPER-PLAN**

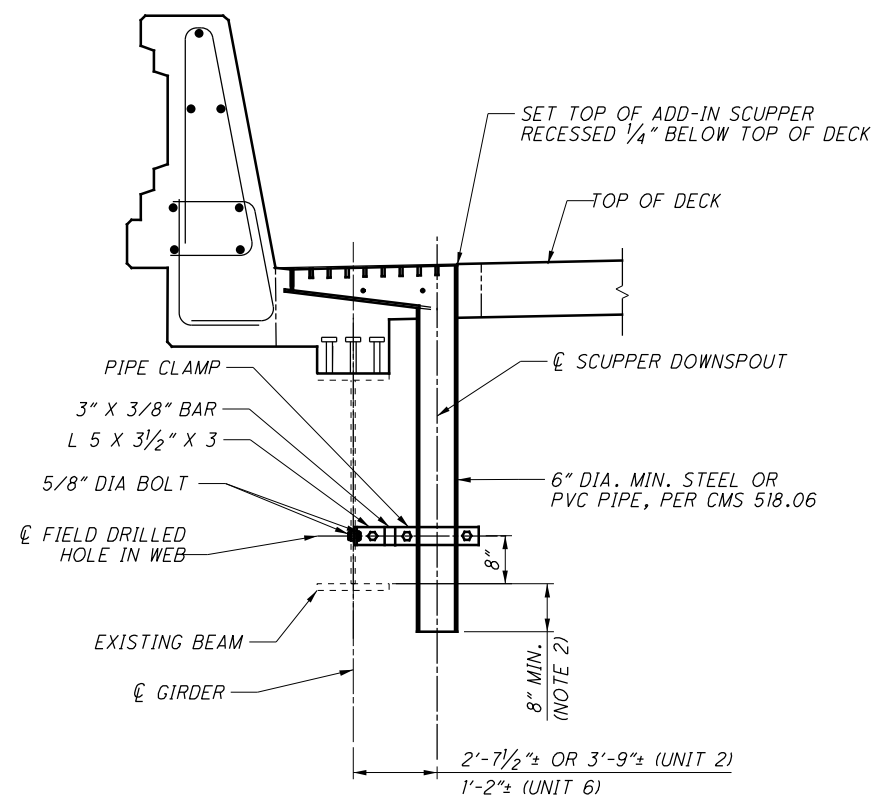

**TYPE 2 SCUPPER - UNIT 6 AND UNIT 2**

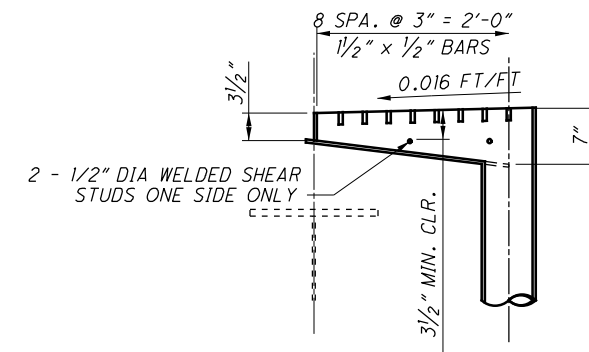

**SECTION A-A  
UNIT 6**

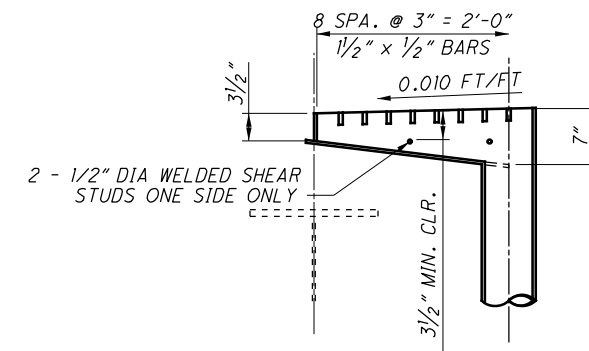


**SECTION A-A  
UNIT 2**

**NOTES**


1. FABRICATE TEMPORARY ADD-IN SCUPPERS FROM MIN. 3/8" THICK STEEL PLATE; ASTM A36 OR EQUAL.
2. PRIOR TO REMOVING PORTION OF DECK TO INSTALL ADD-IN SCUPPER, VERIFY THE SCUPPER WILL NOT CONFLICT WITH EXISTING X-FRAMES.
3. EXTEND DOWNDRAIN 8" MIN. BEYOND BOTTOM OF EXISTING GIRDER.
4. PROVIDE SPLASH PAD WHEN ERODIBLE MATERIAL IS LOCATED BELOW ADD-IN SCUPPER.
5. PIPE HANGERS SHALL BE EATON B-LINE SERIES B3100-8 OR APPROVED EQUAL.
6. PIPE CLAMPS SHALL BE EATON B-LINE SERIES B3140-8 OR APPROVED EQUAL.
7. ALL COMPONENTS (ANGLES, BARS, CLAMPS, ANCHORS, BOLT COUPLERS, PIPE HANGERS, ETC.) SHALL BE GALVANIZED.
8. ALL BOLTS SHALL BE A325, TYPE 1 GALVANIZED. EACH ASSEMBLY SHALL INCLUDE BOLT, NUT, AND TWO WASHERS. TIGHTEN ACCORDING TO CMS 513.
9. FOR TYPE 2 SCUPPER LOCATIONS ON UNIT 2 SEE SHEET 61/100, FOR UNIT 6 SEE SHEET 68/100.

<p><b>DESIGN AGENCY</b> <b>PRIMEID</b> 540 WHITE POND DR. SUITE E AKRON, OH 44320</p>	<p><b>REVIEWED</b> DATE TES 3/27/2019</p> <p><b>DRAWN</b> JAT JAT REVISED</p> <p><b>DESIGNED</b> JAT JAT CHECKED CRG</p>	<p><b>SCUPPER DETAILS - TYPE 2</b> BRIDGE NO. HAM-74-1908R IR-74 OVER MILL CREEK, RR &amp; SPRING GROVE AVENUE</p>	<p><b>HAM-75-3.84</b> <b>PID No. 104667</b></p>
<p>STRUCTURE FILE NUMBER 3115739</p>		<p>93/100</p> <p style="border: 1px solid black; border-radius: 50%; width: 30px; height: 30px; margin: 0 auto; display: flex; align-items: center; justify-content: center;"> <span style="margin-right: 5px;">93</span> <span>100</span> </p>	




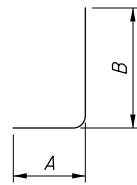


TYPE-1

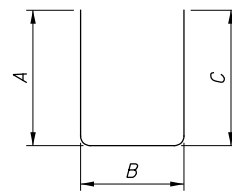


TYPE-2

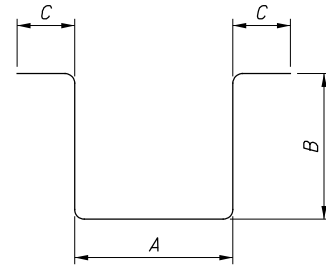


TYPE-6

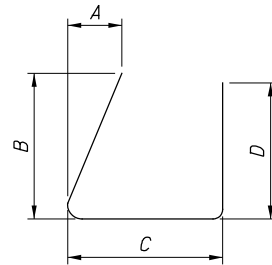


TYPE-9

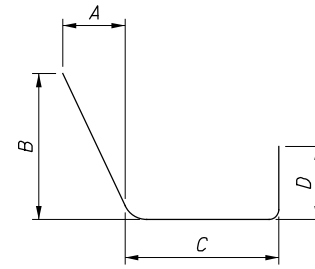


TYPE-10

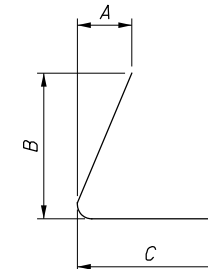


TYPE-11

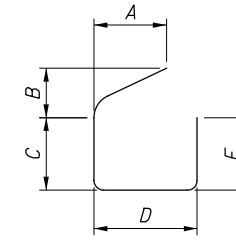


TYPE-12

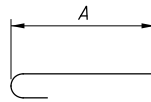


TYPE-16

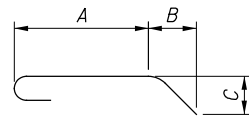


TYPE-18

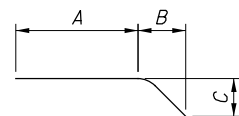


TYPE-19

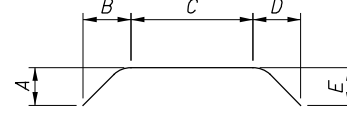


TYPE-20

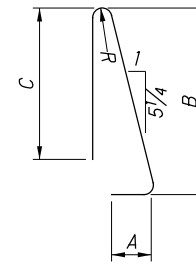


TYPE-23

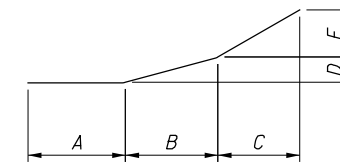


TYPE-25

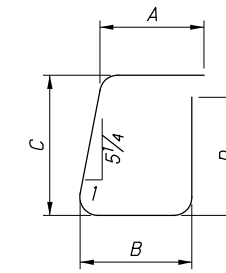


TYPE-29

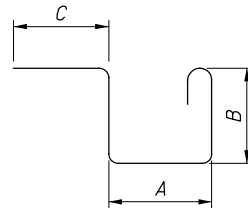


TYPE-44

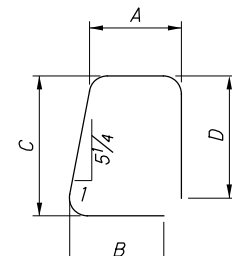


TYPE-45

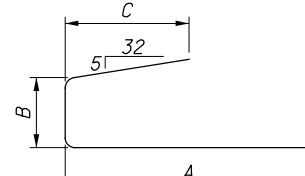


TYPE-46

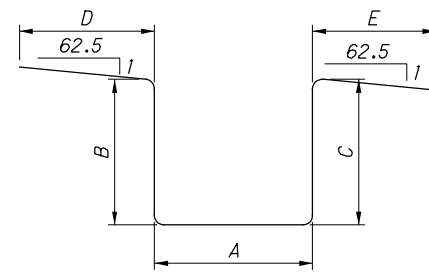


TYPE-47

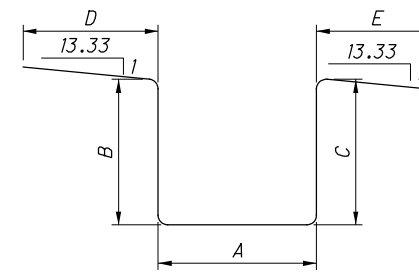


TYPE-48

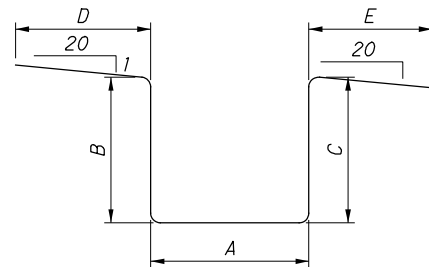


TYPE-49

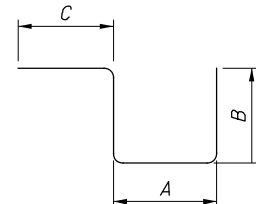

TYPE-50

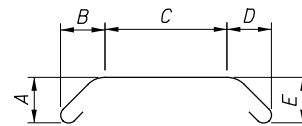

TYPE-51

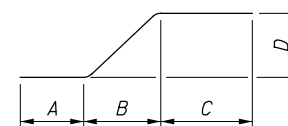

TYPE-52

**NOTES:**

- ALL REINFORCING SHALL BE EPOXY COATED.
- BAR SIZE: THE BAR SIZE IS INDICATED IN THE BAR MARK. THE MARK BEGINS WITH ONE OR TWO LETTER THAT IDENTIFY THE BAR LOCATION. THE NEXT ONE OR TWO DIGITS INDICATE THE BAR SIZE, AND THE REMAINING TWO DIGITS ARE THE SEQUENCE NUMBER.  
EXAMPLE: 2S501  
2S = UNIT 2 SLAB  
5 = #5 BAR  
01 = BAR SEQUENCE NUMBER 1
- BAR DIMENSIONS SHOWN ARE OUT TO OUT UNLESS NOTED OTHERWISE.
- INC. INDICATED THE LENGTH INCREMENT FOR SERIES BARS.

MARK	NUMBER				LENGTH	WEIGHT	TYPE	DIMENSIONS					
	1	2	3	TOTAL				A	B	C	D	E	R
<b>UNIT 1 SLAB</b>													
IS401	766	418	399	1583	30'-0"	31723	STR						
IS402	3			3	24'-0"	48	STR						
	1 SR			1 SR	24'-2"								
IS403	OF			OF	TO	782	STR					3 3/4"	
	39			39	35'-10"								
IS404		22		22	13'-9"	202	STR						
IS405			21	21	19'-6"	274	STR						
IS406			1207	1207	9'-6"	7660	2	8'-0"	0'-7"	1'-2"			
IS407	NOT USED											A = 1/4" C = 1/4"	
IS408	1197			1197	13'-6"	10795	2	10'-0"	0'-7"	3'-2"			
IS409	1			1	11'-0"	7	STR						
IS410	1			1	16'-3"	11	STR						
IS411	1			1	15'-7"	10	STR						
IS412	1197			1197	10'-5"	4688	16	10'-0"					
IS501	1198			1198	14'-6"	18118	STR						
IS502	941			941	24'-3"	23800	STR						
IS503	941			941	19'-8"	19302	16	19'-1"					
IS504	257			257	20'-11"	5607	16	20'-6"					
IS505	NOT USED												
	2 SR			2 SR	3'-3"								
IS506	OF			OF	TO	158	STR					6'-1 1/4"	
	5			5	27'-0"								
IS507		694		694	20'-7"	14899	STR						
IS508		1324		1324	20'-2"	27849	STR						
IS509													
IS510		128		128	20'-10"	2781	STR						
IS511		128		128	21'-1"	2815	STR						
IS512		130		130	21'-5"	2904	STR						
IS513	NOT USED												
IS514			960	960	16'-0"	16020	STR						
IS515			56	56	16'-3"	949	STR						
			2 SR	2 SR	6'-9"								
IS516	OF			OF	TO	114	STR					5'-3 3/4"	
	4			4	20'-7"								
IS517	NOT USED												
IS518	NOT USED												
IS519	1197	627	549	2373	30'-0"	74251	STR						
IS520	4			4	5'-6"	23	STR						
IS521	NOT USED												
	1 SR			1 SR	5'-6"								
IS522	OF			OF	TO	598	STR					0'-2 3/4"	
	51			51	17'-0"								
IS523		29		29	22'-9"	688	STR						
IS524			27	27	29'-0"	817	STR						
IS525	257			257	26'-8"	7150	STR						
IS526	941			941	19'-1"	18730	STR						
IS527	257			257	20'-2"	5406	STR						
IS528			960	960	16'-0"	16020	16	15'-5"					
IS529			56	56	16'-3"	949	16	15'-8"					
IS530	8	8	8	24	5'-10"	146	1	3'-0"	3'-0"				
IS531	1			1	12'-6"	13	STR						
IS532	1			1	17'-3"	18	STR						
IS533	1			1	16'-1"	17	STR						
IS534	NOT USED												
IS535	NOT USED												
IS536	NOT USED												
<b>SUB-TOTAL</b>						316,342							

MARK	NUMBER				LENGTH	WEIGHT	TYPE	DIMENSIONS					
	1	2	3	TOTAL				A	B	C	D	E	R
<b>UNIT 1 SLAB</b>													
IS537			64	64	16'-6"	1101	STR						
IS538			64	64	16'-6"	1101	16	15'-11"					
IS539			64	64	16'-9"	1118	STR						
IS540			64	64	16'-9"	1118	16	16'-2"					
IS541			65	65	17'-0"	1153	STR						
IS542			65	65	17'-0"	1153	16	16'-5"					
IS543	NOT USED												
IS544	NOT USED												
IS545		2		2	19'-0"	40	STR						
IS546	NOT USED												
IS547	6			6	15'-9"	99	STR						
IS548	4			4	10'-6"	44	STR						
IS549	2	2	2	6	25'-0"	156	STR						
IS550	NOT USED												
IS551	NOT USED												
IS552	1007	804	647	2458	6'-3"	16023	48	1'-4"	0'-11 1/4"	0'-10"	1'-10"	1'-10"	
IS553		559		559	5'-9"	3352	48	1'-4"	0'-8 1/4"	0'-7"	1'-10"	1'-10"	
IS554		577		577	5'-11"	3561	48	1'-4"	0'-9 1/2"	0'-8 1/4"	1'-10"	1'-10"	
IS555		469		469	6'-5"	3139	48	1'-4"	1'-0 1/4"	0'-11"	1'-10"	1'-10"	
IS556	857			857	6'-7"	5885	48	1'-4"	1'-1 1/2"	1'-0 1/4"	1'-10"	1'-10"	
IS557	778			778	6'-0"	4869	48	1'-4"	0'-10"	0'-8 3/4"	1'-10"	1'-10"	
IS558	364			364	5'-9"	2183	48	1'-4"	0'-8 1/2"	0'-7 1/4"	1'-10"	1'-10"	
IS559	397			397	6'-1"	2519	48	1'-4"	0'-10 1/2"	0'-9 1/4"	1'-10"	1'-10"	
IS560	874			874	6'-7"	6001	48	1'-4"	1'-1 1/4"	1'-0"	1'-10"	1'-10"	
IS561	270			270	5'-7"	1572	48	1'-4"	0'-7 1/2"	0'-6 1/4"	1'-10"	1'-10"	
IS562		557		557	5'-10"	3389	48	1'-4"	0'-8 3/4"	0'-7 1/2"	1'-10"	1'-10"	
IS601	246	126	120	492	30'-0"	22170	STR						
IS602	41	21	20	82	23'-3"	2863	STR						
IS603	41	21	20	82	35'-3"	4342	STR						
IS604	41	21	20	82	18'-3"	2248	STR						
<b>SUB-TOTAL</b>						91,199							

**NOTES:**  
1. FOR REINFORCING NOTES SEE SHEET 94/100.

P:\Projects\2018\20H03DB-18232 HAM-75-03.84\104667\structures\HAM074\_1908R\sheets\074\_1908R\_RL006.dgn 9/13/2023 2:50:33 PM erin.baumann

MARK	NUMBER				LENGTH	WEIGHT	TYPE	DIMENSIONS						
	1	2	3	TOTAL				A	B	C	D	E	R	INC
<b>UNIT 2 SLAB</b>														
2S401	813	635	64	1512	30'-0"	30300	STR							
2S402	10			10	6'-6"	43	STR							
2S403	1			1	13'-9"	9	STR							
2S404	1			1	18'-9"	13	STR							
2S405	1			1	7'-0"	5	STR							
2S406	1			1	10'-9"	7	STR							
2S407	1			1	12'-8"	8	STR							
2S408	1			1	12'-3"	8	STR							
2S409	1			1	10'-0"	7	STR							
2S410	1			1	32'-0"	21	STR							
2S411	1			1	12'-6"	8	STR							
2S412	1			1	19'-3"	13	STR							
2S413	1			1	24'-6"	16	STR							
2S414	1			1	18'-0"	12	STR							
2S415		1		1	17'-7"	12	STR							
2S416		1		1	14'-5"	10	STR							
2S417		1		1	17'-1"	11	STR							
2S418		1		1	7'-8"	5	STR							
2S419		1		1	24'-8"	16	STR							
2S420		1		1	12'-5"	8	STR							
2S421		1		1	13'-0"	9	STR							
2S422		1		1	26'-2"	17	STR							
2S423		1		1	10'-8"	7	STR							
2S424		1		1	22'-8"	15	STR							
2S425		1		1	34'-3"	23	STR							
2S426		1		1	17'-3"	12	STR							
2S427		1		1	10'-3"	7	STR							
2S428		1		1	20'-3"	14	STR							
2S429		5		5	16'-5"	55	STR							
2S430		11		11	33'-0"	242	STR							
2S431		16		16	24'-9"	265	STR							
2S432		NOT USED												
2S433		12		12	8'-5"	67	STR							
			1 SR	1 SR	3'-4"									
2S434			OF	OF	TO	8	STR						0'-9 1/2"	
			3	3	4'-11"									
2S435	4			4	9'-1"	24	STR							
2S436	NOT USED													
2S437	NOT USED													
2S438	NOT USED													
2S439	NOT USED													
2S440			7	7	11'-8"	55	2	7'-6"	0'-7"	3'-10"				
			1 SR	1 SR	5'-8"			4'-6"		10"			Incr A = 0'-6"	
2S441			OF	OF	TO	42	2	TO	0'-7"	TO			Incr C = 0'-6"	
			7	7	11'-8"			7'-6"		3'-10"				
2S442		231	559	790	5'-8"	2990	2	4'-6"	0'-7"	0'-10"				
2S443	890			890	9'-8"	5747	46	6'-6"	0'-7"	2'-10"				
<b>SUB-TOTAL</b>						<b>40,131</b>								

MARK	NUMBER				LENGTH	WEIGHT	TYPE	DIMENSIONS						
	1	2	3	TOTAL				A	B	C	D	E	R	INC
<b>UNIT 2 SLAB</b>														
2S501	263			263	23'-7"	6469	16	23'-0"						
2S502	294			294	17'-3"	5290	STR							
2S503	270			270	20'-6"	5773	STR							
2S504	132			132	18'-6"	2547	STR							
2S505	139			139	30'-7"	4434	16	30'-0"						
2S506	402			402	23'-0"	9644	STR							
2S507	328			328	26'-1"	8923	16	25'-6"						
2S508	292			292	19'-1"	5812	STR							
2S509	467			467	21'-6"	10472	STR							
2S510	278			278	14'-6"	4204	STR							
2S511	327			327	22'-6"	7674	STR							
2S512	139			139	28'-7"	4144	16	28'-0"						
2S513	139			139	24'-3"	3516	STR							
	1 SR			1 SR	3'-0"									
2S514	OF			OF	TO	1288	STR						0'-8 3/4"	
	55			55	41'-11"									
2S515	6	420		426	15'-6"	6887	STR							
2S516		125		125	14'-3"	1858	STR							
2S517		250		250	12'-3"	3194	STR							
2S518		125		125	18'-8"	2434	STR							
2S519		125		125	16'-4"	2129	STR							
2S520		363		363	20'-9"	7856	STR							
2S521		340		340	18'-0"	6383	STR							
2S522		170		170	20'-6"	3635	16	19'-11"						
2S523		170		170	13'-3"	2349	STR							
2S524		340		340	25'-4"	8984	STR							
2S525		170		170	22'-10"	4049	16	22'-3"						
2S526		234		234	24'-3"	5919	STR							
2S527		112		112	21'-10"	2550	16	21'-3"						
2S528		112		112	25'-6"	2979	STR							
2S529		108		108	23'-4"	2628	16	22'-9"						
2S530		112		112	27'-0"	3154	STR							
				1 SR	1 SR	8'-2"								
2S531	OF			OF	TO	696	STR						0'-4"	
	44			44	22'-2"									
2S532		16		16	11'-10"	197	STR							
		2 SR		2 SR	2'-9"									
2S533	OF			OF	TO	126	STR						0'-8 3/4"	
	10			10	9'-4"									
2S534		7		7	16'-10"	123	16	16'-3"						
2S535		7		7	16'-3"	119	STR							
				1 SR	1 SR	13'-10"				13'-3"				
2S536	OF			OF	TO	110	16	TO					0'-5"	
	7			7	16'-4"					15'-9"				
				1 SR	1 SR	13'-3"								
2S537	OF			OF	TO	106	STR						0'-5"	
	7			7	15'-9"									
2S538		231		231	13'-10"	3333	16	13'-3"						
2S539		231		231	13'-3"	3192	STR							
		2 SR		2 SR	6'-0"									
2S540	OF			OF	TO	95	STR						1'-6 3/4"	
		5		5	12'-3"									
<b>SUB-TOTAL</b>						<b>155,275</b>								



DESIGN AGENCY  
DATE 7/30/2019  
REVIEWED TES  
STRUCTURE FILE NUMBER 3115739

DRAWN JAT  
CHECKED CRG  
DESIGNED EDW

**REINFORCING STEEL LIST (3 OF 7)**  
BRIDGE NO. HAM-74-1908R  
IR-74 OVER MILL CREEK, RR & SPRING GROVE AVENUE

**HAM-75-3.84**  
PID No. 104667

96/100

96/100

**NOTES:**  
1. FOR REINFORCING NOTES SEE SHEET 94/100.

MARK	NUMBER				LENGTH	WEIGHT	TYPE	DIMENSIONS						
	1	2	3	TOTAL				A	B	C	D	E	R	INC
UNIT 2 SLAB														
2S541	1103	952	52	2107	30'-0"	65928	STR							
2S542	32			32	13'-8"	456	STR							
2S543	1			1	20'-9"	22	STR							
2S544	5	2		7	9'-2"	67	STR							
2S545	2			2	25'-0"	52	STR							
2S546	1			1	16'-7"	17	STR							
2S547	1			1	32'-3"	34	STR							
2S548	1	2		3	18'-2"	57	STR							
2S549	1			1	31'-9"	33	STR							
2S550	1			1	17'-1"	18	STR							
2S551	3			3	14'-7"	46	STR							
2S552	1			1	8'-0"	8	STR							
2S553	1			1	16'-1"	17	STR							
2S554	1			1	19'-0"	20	STR							
2S555		7		7	18'-7"	136	STR							
2S556	5			5	23'-0"	120	STR							
2S557	NOT USED													
2S558		1		1	20'-1"	21	STR							
2S559		1		1	11'-2"	12	STR							
2S560		1		1	16'-5"	17	STR							
2S561		1		1	31'-2"	33	STR							
2S562		1		1	17'-6"	18	STR							
2S563	NOT USED													
2S564		1		1	15'-8"	16	STR							
2S565		1		1	11'-8"	12	STR							
2S566		1		1	22'-9"	24	STR							
2S567	2	1		3	33'-5"	105	STR							
2S568		1		1	16'-3"	17	STR							
2S569		6		6	18'-5"	115	STR							
2S570		14		14	40'-0"	584	STR							
2S571	4	4		8	15'-0"	125	STR							
2S572		10		10	13'-0"	136	STR							
2S573			20	20	33'-0"	688	STR							
			1 SR	1 SR	3'-1"									
2S574			OF	OF	TO	17	STR					0'-7 3/4"		
			4	4	5'-0"									
2S575	4	10	4	18	5'-10"	110	1	3'-0"	3'-0"					
2S576			2	2	12'-8"	26	10	5'-1 1/4"	5'-1 1/4"	2'-7 3/4"	3'-0"			
2S577	6	6	2	14	5'-11"	86	19	3'-0"	0'-10"	2'-11"				
2S578		2		2	5'-10"	12	11	0'-10"	2'-11"	3'-0"				
2S579	2			2	6'-9"	14	10	2'-5"	1'-9"	0'-11 1/2"	3'-0"			
	1 SR			1 SR	3'-7"			3'-0"						
2S580	OF			OF	TO	1324	16	TO				0'-8 3/4"		
	55			55	42'-6"			41'-11"						
2S581		6		6	14'-0"	88	19	12'-9"	1'-0"	0'-9"				
	1 SR			1 SR	19'-2"									
2S582	OF			OF	TO	107	STR					0'-8"		
	5			5	21'-10"									
	1 SR			1 SR	15'-7"									
2S583	OF			OF	TO	88	STR					0'-8"		
	5			5	18'-3"									
	1 SR			1 SR	15'-9"									
2S584	OF			OF	TO	90	STR					0'-8 1/2"		
	5			5	18'-7"									
	1 SR			1 SR	18'-3"									
2S585	OF			OF	TO	103	STR					0'-8 1/2"		
	5			5	21'-3"									
SUB-TOTAL						71,019								

MARK	NUMBER				LENGTH	WEIGHT	TYPE	DIMENSIONS						
	1	2	3	TOTAL				A	B	C	D	E	R	INC
UNIT 2 SLAB														
2S586		1 SR		1 SR	12'-3"									
		OF		OF	TO	381	STR					0'-9 1/4"		
		19		19	26'-3"									
		2 SR		2 SR	12'-0"									
2S587		OF		OF	TO	1084	STR					0'-8 3/4"		
		25		25	29'-7"									
2S588	1			1	30'-3"	32	STR							
2S589	5			5	28'-0"	146	STR							
2S590	53	39		92	25'-0"	2399	STR							
2S591	55	64		119	20'-0"	2482	STR							
2S592	10	16	16	42	22'-0"	964	STR							
2S593	NOT USED													
2S594	NOT USED													
2S595		210		210	5'-3"	1150	49	1'-5"	0'-8 3/4"	0'-8 1/4"	1'-10"	1'-1 1/2"		
2S596		928	247	1175	6'-1"	7455	49	1'-5"	0'-9 1/2"	0'-9"	1'-10"	1'-10"		
2S597		400		400	6'-5"	2677	49	1'-5"	0'-11 1/4"	0'-10 3/4"	1'-10"	1'-10"		
2S598		306		306	6'-9"	2154	49	1'-5"	1'-1 3/4"	1'-1 1/4"	1'-10"	1'-10"		
2S599		218		218	6'-7"	1497	49	1'-5"	1'-0 3/4"	1'-0 1/4"	1'-10"	1'-10"		
2S5100		144		144	7'-2"	1076	49	1'-5"	1'-4"	1'-3 1/2"	1'-10"	1'-10"		
2S5101	1235	326		1561	5'-11"	9633	49	1'-5"	0'-8 3/4"	0'-8 1/4"	1'-10"	1'-10"		
2S5102		308		308	6'-5"	2061	49	1'-5"	0'-11 3/4"	0'-11 1/4"	1'-10"	1'-10"		
2S5103		29		29	7'-0"	212	49	1'-5"	1'-3 1/4"	1'-2 3/4"	1'-10"	1'-10"		
2S5104		88		88	7'-5"	681	49	1'-5"	1'-5 3/4"	1'-5 1/4"	1'-10"	1'-10"		
2S5105		90		90	7'-11"	743	49	1'-5"	1'-8 3/4"	1'-8 1/4"	1'-10"	1'-10"		
2S5106		140		140	5'-9"	840	49	1'-5"	0'-7 3/4"	0'-7 1/4"	1'-10"	1'-10"		
2S5107		442		442	6'-3"	2881	49	1'-5"	0'-10 3/4"	0'-10 1/4"	1'-10"	1'-10"		
2S5108		65		65	6'-9"	458	49	1'-5"	1'-1 3/4"	1'-1 1/4"	1'-10"	1'-10"		
2S5109		215		215	7'-2"	1607	49	1'-5"	1'-7 3/4"	1'-3 3/4"	1'-10"	1'-10"		
2S5110	209			209	6'-6"	1417	49	1'-5"	1'-0"	0'-11 1/2"	1'-10"	1'-10"		
2S5111	2102			2102	6'-5"	14068	49	1'-5"	0'-11 1/2"	0'-11"	1'-10"	1'-10"		
2S5112	67	67		134	3'-5"	472	50	0'-6"	0'-8 1/2"	1'-10"				
2S5113	214	214		428	3'-11"	1748	50	0'-6"	0'-11 3/4"	1'-10"				
2S5114	23			23	9'-8"	232	46	6'-6"	0'-7"	2'-10"				
2S5115	2			2	12'-5"	26	51	2'-0"	1'-9"	6'-0"	1'-9"	2'-0"		
2S5116	69			69	6'-2"	444	52	1'-5"	1'-5"	2'-0"	1'-4"			
SUB-TOTAL						61,020								

**NOTES:**

1. FOR REINFORCING NOTES SEE SHEET 94/100.



P:\Projects\2018\20H03DB-18232 HAM-75-03.84\104667\structures\HAM074\_1908R\1908R\_RL004.dgn 6/20/2019 9:23:15 AM cased

MARK	NUMBER			LENGTH	WEIGHT	TYPE	DIMENSIONS					
	S1	S3	TOTAL				A	B	C	D	E	R
<b>PARAPET - UNIT 1</b>												
IR501	486	468	954	7'-4"	7296	23	11"	3'-3"	3'-0"			2 3/4"
IR502	80	72	152	30'-0"	4756	STR						
IR503	236	228	464	4'-2"	2016	44	11"	1'-0"	1'-0"			
IR504	170	160	330	8'-7"	2954	45	1'-0"	1'-8"	3'-3"	3'-0"		
IR505	84	80	164	4'-5"	755	6	11"	1'-0"	1'-0"			
IR506												
IR507	0	4	4	32'-0"	134	STR						
IR508	0	8	8	6'-7"	55	44	3'-4"	1'-0"	1'-0"			
IR509	8	0	8	4'-7"	38	44	1'-4"	1'-0"	1'-0"			
IR510	74	72	146	6'-5"	977	STR						
IR511	42	40	82	13'-2"	1126	STR						
IR512	0	2	2	9'-0"	19	STR						
IR513	0	2	2	10'-2"	21	STR						
IR514	2	0	2	7'-0"	15	STR						
IR515	2	0	2	8'-2"	17	STR						
IR601	656	628	1284	4'-9"	9161	29	11"	1'-2 1/2"	1'-7"	1'-6"		
IR602	37	36	73	6'-5"	704	STR						
IR603	21	20	41	13'-2"	811	STR						
IR604	0	1	1	9'-0"	14	STR						
IR605	0	1	1	10'-2"	15	STR						
IR606	1	0	1	7'-0"	11	STR						
IR607	1	0	1	8'-2"	12	STR						
<b>SUB-TOTAL</b>					<b>30,907</b>							

MARK	NUMBER			LENGTH	WEIGHT	TYPE	DIMENSIONS					
	S1	S2	TOTAL				A	B	C	D	E	R
<b>PARAPET - UNIT 6</b>												
6R501	144	150	294	7'-4"	2249	23	11"	3'-3"	3'-0"			2 3/4"
6R502	24	20	44	30'-0"	1377	STR						
6R503	80	84	164	4'-2"	713	44	11"	1'-0"	1'-0"			
6R504	54	54	108	8'-7"	967	45	1'-0"	1'-8"	3'-3"	3'-0"		
6R505	12	12	24	4'-5"	111	6	11"	1'-0"	1'-0"			
6R506	0	4	4	32'-6"	136	STR						
6R507												
6R508	0	8	8	4'-6"	38	44	1'-3"	1'-0"	1'-0"			
6R509	8	0	8	5'-11"	50	44	2'-8"	1'-0"	1'-0"			
6R510	32	34	66	6'-5"	442	STR						
6R511	6	6	12	13'-2"	165	STR						
6R512	0	2	2	6'-10"	14	STR						
6R513	0	2	2	8'-0"	17	STR						
6R514	2	0	2	8'-3"	17	STR						
6R515	2	0	2	9'-5"	20	STR						
6R601	198	204	402	4'-9"	2868	29	11"	1'-2 1/2"	1'-7"	1'-6"		
6R602	16	17	33	6'-5"	318	STR						
6R603	3	3	6	13'-2"	119	STR						
6R604	0	1	1	6'-10"	10	STR						
6R605	0	1	1	8'-0"	12	STR						
6R606	1	0	1	8'-3"	12	STR						
6R607	1	0	1	9'-5"	14	STR						
<b>SUB-TOTAL</b>					<b>9,669</b>							

MARK	NUMBER				LENGTH	WEIGHT	TYPE	DIMENSIONS					
	S1	S2	S3	TOTAL				A	B	C	D	E	R
<b>PARAPET - UNIT 2</b>													
2R501	246	243	96	585	7'-4"	4474	23	11"	3'-3"	3'-0"		2 3/4"	
2R502	60	36	12	108	30'-0"	3380	STR						
2R503	176	108	44	328	4'-2"	1425	44	11"	1'-0"	1'-0"			
2R504	130	79	39	248	8'-7"	2220	45	1'-0"	1'-8"	3'-3"	3'-0"		
2R505	72	40	20	132	4'-5"	608	6	11"	1'-0"	1'-0"			
2R506	0	0	4	4	32'-3"	135	STR						
2R507	4	4	0	8	13'-8"	114	STR						
2R508	0	4	4	8	6'-6"	54	44	3'-4"	1'-0"	1'-0"			
2R509	8	0	0	8	4'-7"	38	44	1'-4"	1'-0"	1'-0"			
2R510	50	32	12	94	6'-5"	629	STR						
2R511	36	20	10	66	13'-2"	906	STR						
2R512	0	0	2	2	8'-11"	19	STR						
2R513	0	2	0	2	10'-1"	21	STR						
2R514	2	0	0	2	7'-0"	15	STR						
2R515	2	0	0	2	8'-2"	17	STR						
2R516	0	OF	0	OF	TO	18	20	1'-0"	2 1/4"	TO	2 1/4"	1'-0"	
		4		4	4'-4"					2'-3"			
2R517	0	1	0	1	7'-0"	7	19	4'-3"	1'-7"	2'-3"			
2R518	0	2	0	2	7'-5"	16	19	4'-3"	1'-10"	2'-8"			
2R519	0	1	0	1	13'-9"	14	46	8'-9 5/8"	2'-4 1/4"	3'-2 3/4"			
2R520	0	2	0	2	14'-4"	30	46	9'-0 5/8"	2'-10 1/4"	3'-4 1/8"			
2R521	8	0	8	16	9'-3"	154	45	1'-4"	2'-0"	3'-2"	3'-0"		
2R522	4	0	4	8	4'-1"	34	10	2'-5"	0'-10"	0'-10"	0'-10"		
2R523	4	0	4	8	15'-1"	126	12	0'-10"	0'-10"	5'-9"	2'-0"	6'-5"	
2R524	4	0	4	8	3'-9"	31	9	0'-10"	0'-10"	0'-10"	2'-5"		
2R601	506	322	139	967	4'-9"	6899	29	11"	1'-2 1/2"	1'-7"	1'-6"		
2R602	27	16	10	51	6'-5"	492	STR						
2R603	18	10	5	33	13'-2"	653	STR						
2R604	0	0	1	1	8'-11"	13	STR						
2R605	0	1	0	1	10'-1"	15	STR						
2R606	1	0	0	1	7'-0"	11	STR						
2R607	1	0	0	1	8'-2"	12	STR						
2R608	0	1	0	1	13'-10"	20	46	8'-6"	1'-9 1/4"	3'-0"			
2R609	0	1	0	1	8'-1"	12	1	4'-3"	4'-0"				
2R610	0	1	0	1	7'-7"	11	1	3'-9"	4'-0"				
2R611	0	0	8	8	5'-4"	64	29	11"	1'-9 1/2"	1'-7"	1'-6"		
2R612*	8	0	0	8	4'-5"	53	29	11"	1'-9 1/2"	1'-7"	7"		
2R613	8	0	0	8	2'-6"	30	STR						
<b>SUB-TOTAL</b>						<b>22,770</b>							

**LEGEND:**

\* - MECHANICAL CONNECTOR

**NOTES:**

1. SEE SHEET 94/100 FOR NOTES.

HAM-75-3.84  
PID No. 104667

REINFORCING STEEL LIST (6 OF 7)  
BRIDGE NO. HAM-74-1908R  
IR-74 OVER MILL CREEK, RR & SPRING GROVE AVENUE

DESIGNED  
KDC  
CHECKED  
CRG

DRAWN  
ADS  
REVISED

REVIEWED  
TES  
STRUCTURE FILE NUMBER  
3115739

DATE  
3/27/2019

DESIGN AGENCY  
PRIME  
540 WHITE POND DRIVE SUITE E  
AKRON, OH 44320

99/100

99  
100



P:\Projects\2018\20H03DB-18232 HAM-75-03.84\104667\structures\HAM074\_1908R\sheets\074\_1908R\_RL005.dgn 9/22/2023 3:23:34 PM erin.baumann

MARK	NUMBER				LENGTH	WEIGHT	TYPE	DIMENSIONS						
	1	2	3	TOTAL				A	B	C	D	E	R	INC
<b>ABUTMENT 1</b>														
IA501	NOT USED													
*IA502	21			21	33'-6"	734	STR							
*IA503		21		21	21'-1"	462	STR							
IA504			21	21	13'-10"	303	STR							
IA505			18	18	4'-0"	75	STR							
IA506	18			18	2'-5"	45	16	2'-0"						
IA601	42	26	17	85	6'-5"	819	2	3'-0"	9"	3'-0"				
	1 SR			1 SER	15'-11"			7'-6"		7'-6"				
IA602	OF			OF	TO	1057	2	TO	1'-3"	TO		1/2"		
	42			42	17'-7"			8'-4"		8'-4"				
IA603		26		26	17'-7"	687	2	8'-4"	1'-3"	8'-4"				
IA604			17	17	17'-11"	457	2	8'-6"	1'-3"	8'-6"				
IA605	84	52	34	170	4'-4"	1107	STR							
IA801	24	15	10	49	5'-5 1/2"	714	18	3'-3 1/2"	1'-0"	1'-0"				
<b>SUB-TOTAL</b>						6,460								

MARK	NUMBER				LENGTH	WEIGHT	TYPE	DIMENSIONS						
	1	2	3	TOTAL				A	B	C	D	E	R	INC
<b>ABUTMENT 4</b>														
4A501	NOT USED													
4A502	11			11	23'-11"	274	STR							
*4A503		11		11	36'-4"	417	STR							
4A504	8			8	4'-0"	33	STR							
4A505		8		8	2'-7"	22	16	2'-0"						
4A601	25			25	6'-5"	167	2	3'-0"	9"	3'-0"				
4A602	25			25	7'-11"	297	2	3'-6"	1'-3"	3'-6"				
4A603		37		37	7'-7"	421	2	3'-4"	1'-3"	3'-4"				
4A604	50	74		124	4'-0"	745	STR							
4S605		37		37	2'-7"	36	2	0'-11"	0'-11"	0'-11"				
AS606		74		74	3'-4"	370	1	0'-6"	3'-0"					
4A801	21	15		41	6'-2"	675	18	4'-0"	1'-0"	1'-0"				
<b>SUB-TOTAL</b>						3,435								

MARK	NUMBER				LENGTH	WEIGHT	TYPE	DIMENSIONS						
	1	2	3	TOTAL				A	B	C	D	E	R	INC
<b>REAR APPROACH SLAB PARAPET</b>														
RASR501	6		6	12	7'-4"	92	23	11"	3'-3"	3'-0"		2 3/4"		
RASR502	2		2	4	10'-7"	44	STR							
RASR503	4		4	8	20'-7"	172	STR							
RASR504	9		9	18	8'-7"	161	45	1'-0"	1'-8"	3'-3"	3'-0"			
RASR505	4		4	8	7'-1"	59	44	3'-10"	1'-0"	1'-0"				
RASR506	4		4	8	4'-2"	35	44	11"	1'-0"	1'-0"				
RASR507	4		4	8	9'-10"	82	STR							
RASR508	4		4	8	5'-9"	48	25	1'-10"	2'-5"	1'-5"	1 1/2"	5"		
RASR509	4		4	8	5'-8"	47	STR							
RASR510	8		8	16	3'-1"	51	2	1'-2"	1'-0"	1'-2"				
RASR511	8		8	16	3'-9"	63	2	1'-6"	1'-0"	1'-6"				
RASR520						1225	STR							
RASR601	15		15	30	4'-9"	214	29	11"	1'-2 1/2"	1'-7"	1'-6"			
RASR602	1		1	2	10'-7"	32	STR							
		2 SR		2 SR	3'-11"				3'-0 1/2"					
RASR603	OF			OF	TO	312	1	1'-0"	TO			1"		
	12			12	4'-10"				3'-11 1/2"					
RASR604	6		6	12	4'-0"	72	1	1'-0"	3'-1 1/2"					
<b>SUB-TOTAL</b>						2,709								

MARK	NUMBER				LENGTH	WEIGHT	TYPE	DIMENSIONS						
	1	2	3	TOTAL				A	B	C	D	E	R	INC
<b>FORWARD APPROACH SLAB PARAPET</b>														
FASR501	6	6		12	7'-4"	92	23	11"	3'-3"	3'-0"		2 3/4"		
FASR502	2			4	10'-6"	44	STR							
FASR503	4			8	20'-6"	171	STR							
FASR504	9		9	18	8'-7"	161	45	1'-0"	1'-8"	3'-3"	3'-0"			
FASR505	4		4	8	7'-0"	58	44	3'-9"	1'-0"	1'-0"				
FASR506	4		4	8	4'-2"	35	44	11"	1'-0"	1'-0"				
FASR507	4		4	8	9'-10"	82	STR							
FASR508	4		4	8	5'-9"	48	25	1'-10"	2'-5"	1'-5"	1 1/2"	5"		
FASR509	4		4	8	5'-8"	47	STR							
FASR510	8		8	16	3'-1"	51	2	1'-2"	1'-0"	1'-2"				
FASR511	8		8	16	3'-9"	63	2	1'-6"	1'-0"	1'-6"				
FASR512		2		2	3'-5"	7	10	10"	1'-2"	1'-0"	1'-2"			
FASR513		2		2	2'-10"	6	11	10"	1'-2"	1'-10"				
FASR514		2		2	4'-2"	9	10	1'-0"	1'-6"	1'-0"	1'-6"			
FASR515		2		2	3'-5"	7	11	1'-0"	1'-6"	2'-0"				
FASR520						1050	STR							
FASR601	15		15	30	4'-9"	214	29	11"	1'-2 1/2"	1'-7"	1'-6"			
FASR602	1		1	2	10'-6"	32	STR							
		2 SR		2 SR	3'-11"				3'-0 1/2"					
FASR603	OF			OF	TO	312	1	1'-0"	TO			1"		
	12			12	4'-10"				3'-11 1/2"					
FASR604	6		6	12	4'-0"	72	1	1'-0"	3'-1 1/2"					
<b>SUB-TOTAL</b>						2,561								

**NOTES:**  
 1. SEE SHEET 94100 FOR NOTES.  
 2. BAR MARKS DENOTED WITH AN "\*" REQUIRE MECHANICAL CONNECTORS.

# COSMEC INC. / DYNAMIC RUBBER

P.O. Box 2159  
1501 Rocky Ridge Road  
Athens, TX 75751  
TEL: 903.677.2871 FAX: 903.675.4776

<b>PRIME AE, Group, Inc</b>		<b>RELEASED FOR FABRICATION</b>
DATE REC'D: <b>8/1/2019</b>	BUILDABLE UNIT NO.: <b>11</b>	
Review conforms that the shop drawings meet the intent of the contract.		
<input checked="" type="checkbox"/> CONFORMS AS-IS	<input type="checkbox"/> CONFORMS AS NOTED	
	<input type="checkbox"/> REVISE AND RESEND	
<b>1908R - BEARINGS</b>		
By: <b>Conrad Gagnon</b>	By: _____	
Date: <b>8/2/2019</b>	Date: _____	

## TRANSMITTAL SHEET

TO: WALSH CONSTRUCTION CO. II  
RACE SHARRETT RSHARRETT@WALSHGROUP.ONMICROSOFT.COM  
CC KATHI MILLS

DATE: 8/1/19  
JOB: 183000 BRIDGE HAM-74-1908R  
RE: FINAL DRAWING DISTRIBUTION  
DRP JOB NO: 15353B2 LOCATION: HAMILTON COUNTY

WE TRANSMIT TO YOU UNDER SEPARATE COVER HERE WITH THE FOLLOWING DRAWINGS:

DWG NO	REV NO	NO EACH	DESCRIPTION	REMARKS
15353B2-GN1	1	1	<b>GENERAL NOTES</b>	
15353B2-D1	1	1	<b>SHOP DRAWING</b>	
15353B2-D2	1	1	<b>SHOP DRAWING</b>	
15353B2-D3	1	1	<b>SHOP DRAWING</b>	
15353B2-D4	0	1	<b>SHOP DRAWING</b>	
15353B2-D5	1	1	<b>SHOP DRAWING</b>	
15353B2-D6	1	1	<b>SHOP DRAWING</b>	
15353B2-D7	1	1	<b>SHOP DRAWING</b>	
15353B2-D8	1	1	<b>SHOP DRAWING</b>	

DWG NO	REV NO	NO EACH	DESCRIPTION	REMARKS
15353B2-D9	0	1	<b>SHOP DRAWING</b>	
15353B2-D10	1	1	<b>SHOP DRAWING</b>	
15353B2-D11	1	1	<b>SHOP DRAWING</b>	
15353B2-D12	1	1	<b>SHOP DRAWING</b>	
15353B2-D13	1	1	<b>SHOP DRAWING</b>	
15353B2-D14	1	1	<b>SHOP DRAWING</b>	
15353B2-D15	1	1	<b>SHOP DRAWING</b>	
15353B2-D16	1	1	<b>SHOP DRAWING</b>	
15353B2-D17	0	1	<b>SHOP DRAWING</b>	

COMMENTS: **THE ATTACHED SHOP DRAWINGS ARE PROVIDED FOR FINAL DISTRIBUTION, NO ACTION REQUIRED ON YOUR PART.**

THE ABOVE PRINTS ARE SUBMITTED TO YOU FOR:

( ) Approval	( ) Final Approval	(XXX) Distribution
( ) Field Use	( ) Fabrication	(XXX) E-MAIL
( ) Next Day Air	( ) Second Day Air	( ) Messenger
( ) UPS	( ) First Class Mail	( ) Fax

Thank you


STEPHANIE RITZ

COSMEC INC. / DYNAMIC RUBBER PRODUCTS

[WWW.COSMECINC.COM](http://WWW.COSMECINC.COM)

# GENERAL NOTES

**GENERAL NOTES:**

1. ALL BEARINGS IN ACCORDANCE WITH THE 2016 OHIO DEPARTMENT OF TRANSPORTATION STANDARD SPECIFICATION FOR CONSTRUCTION AND MAINTENANCE OF HIGHWAYS, STREETS AND BRIDGES AND SUPPLEMENTAL SPECIFICATIONS 800 DATED 10/19/18, AND 869 DATED 10/17/14.
2. SHOP TO MARK LOCATION, BEAM/GIRDER NUMBER, BEARING NUMBER, HIGH-SIDE  AND AHEAD STATION AS SHOWN. MARKS SHALL BE PERMANENT AND BE VISIBLE AFTER BEARING IS INSTALLED.
3. ALL DIMENSIONS ARE IN INCHES.
4. ALL PLATES SHALL BE SMOOTH AND STRAIGHT.
5. SHIP THE SAMPLE BEARING TO AN INDEPENDENT TESTING LABORATORY FOR TESTING PER OH DOT STANDARD SPECIFICATIONS SECTION 711.23.
6. NOTIFY THE OH DOT OFFICE OF STRUCTURAL ENGINEERING AT LEAST TWO WEEKS BEFORE STARTING SHOP FABRICATION.
7. DYNAMIC RUBBER REPRESENTATIVE:  
KATHI MILLS  
903-677-2871  
1501 ROCKY RIDGE RD.  
ATHENS, TX 75751

**FINISH NOTES:**



**ABUTMENT 1, PIER 1, PIER 3, PIER 6, PIER 19 & ABUTMENT 4:**

1. BLAST EXPOSED STEEL SURFACES OF THE STEEL PLATES AND HP PEDESTALS TO SSPC-SP10 (NEAR WHITE BLAST CLEANING) PRIOR TO PAINTING.
2. UNLESS NOTED OTHERWISE, THE STEEL PLATES AND HP PEDESTALS SHALL BE PRIME PAINTED WITH SHERWIN WILLIAMS ZINC CLAD II PLUS PRIME PAINT (3-5 MILS DFT) PER SPECIFICATION SECTION 514.

**CARRIER BEAM – UNIT 2, HINGE SUPPORTS – UNIT 2 & UNIT 6:**

1. BLAST EXPOSED STEEL SURFACES OF THE STEEL PLATES, ANGLES AND HP PEDESTALS TO SSPC-SP5 (WHITE METAL BLAST CLEANING) PRIOR TO METALIZING.
2. UNLESS NOTED OTHERWISE, THE STEEL PLATES, ANGLES AND HP PEDESTALS SHALL BE METALIZED (12 MILS MIN. DFT) & SEAL COATED PER SUPPLEMENTAL SPECIFICATION 869.

**MATERIAL NOTES:**

**ABUTMENT 1, PIER 1, PIER 3, PIER 6, PIER 19 & ABUTMENT 4:**

1. STEEL LOAD & SOLE PLATES: ASTM A709 GRADE 50 (PAINTED)
2. STEEL HP10x42 PEDESTALS: ASTM A709 GRADE 50 (PAINTED)
3. STEEL HP12x53 PEDESTALS: ASTM A709 GRADE 50 (PAINTED)

**CARRIER BEAM – UNIT 2, HINGE SUPPORTS – UNIT 2 & UNIT 6:**

1. STEEL LOAD & SOLE PLATES: ASTM A709 GRADE 50 (METALIZED)
2. STEEL HP10x42 PEDESTALS: ASTM A709 GRADE 50 (METALIZED)
3. STEEL HP12x53 PEDESTALS: ASTM A709 GRADE 50 (METALIZED)
4. STEEL GUIDE ANGLES & STIFFENERS: ASTM A709 GRADE 50 (METALIZED)
5. GUIDE PTFE: ASTM D4894 OR D4895 UNFILLED
6. PRIMARY PTFE: ASTM D4894 OR D4895 DIMPLED AND LUBRICATED
7. STAINLESS STEEL: ASTM A240, TYPE 304 W/ #8 MIRROR FINISH ON THE SLIDING SURFACE.

8. PLATE WASHER: ASTM A709 GRADE 50 (HOT-DIPPED GALVANIZED)
9. PREFORMED BEARING PAD: PER C&MS 711.21


**ALL BEARINGS**


1. ELASTOMER: 50 DUROMETER GRADE 3 NEOPRENE
2. STEEL LAMINATES: ASTM A709 GRADE 36, A1011 GRADE 36, GRADE 40 OR EQUIVALENT.
3. ALL-THREAD ANCHOR ROD: ASTM F1554 GRADE 55 (HOT-DIPPED GALVANIZED)
4. HVY. HEX NUT: ASTM A563-DH (HOT-DIPPED GALVANIZED)
5. HD WASHER: ASTM F436 (HOT-DIPPED GALVANIZED)




**CONTRACTOR NOTES:**


1. WHEN WELDING BEAM FLANGE TO SOLE PLATES, USE TEMPERATURE INDICATING WAX PEN OR OTHER SUITABLE MEANS TO INSURE THAT THE TEMPERATURE OF THE ELASTOMER DOES NOT EXCEED 250°F. TEMPERATURES ABOVE THIS MAY DAMAGE THE ELASTOMER.

<b>PRIME AE, Group, Inc</b>		<b>RELEASED FOR FABRICATION</b>
DATE REC'D: 8/1/2019	BUILDABLE UNIT NO.: 11	
Review conforms that the shop drawings meet the intent of the contract.		
<input checked="" type="checkbox"/> CONFORMS AS-IS	<input type="checkbox"/> CONFORMS AS NOTED	
<b>1908R - BEARINGS</b>		
By: Conrad Gagnon	By:	
Date: 8/2/2019	Date:	

STATE OF OHIO DEPARTMENT OF TRANSPORTATION		
BRIDGE NO.: HAM-74-1908R OVER MILL CREEK, RR & SPRING GROVE AVENUE		
HAM-75-3.84 CITY OF CINCINNATI		
STATE	COUNTY	PID NO.
OH	HAMILTON	104667
FED. PROJ. NO.: E170 (713)		
<b>DYNAMIC RUBBER LAM. ELASTOMERIC BEARING ASSY.'S</b>		
		1501 ROCKY RIDGE ROAD P.O. BOX 2159 ATHENS, TEXAS 75751
SCALE: NONE	DRAWN BY: MH	CHECKED BY: ELS
	DATE: 06/11/19	DATE: 07/16/19
SHEET GN1 OF 1		<b>JOB NO.: 15353B2</b>
REV.	DESCRIPTION	BY DATE CK'D DATE
	REMOVED CONTRACTOR NOTE AND CLOUD. CHANGED HP10x57 TO HP10x42 PER DESIGN CHANGE.	MH 07/26/19 ELS 07/29/19
CUSTOMER WALSH CONSTRUCTION CO. II		DRAWING NUMBER 15353B2-GN1 REV. 1

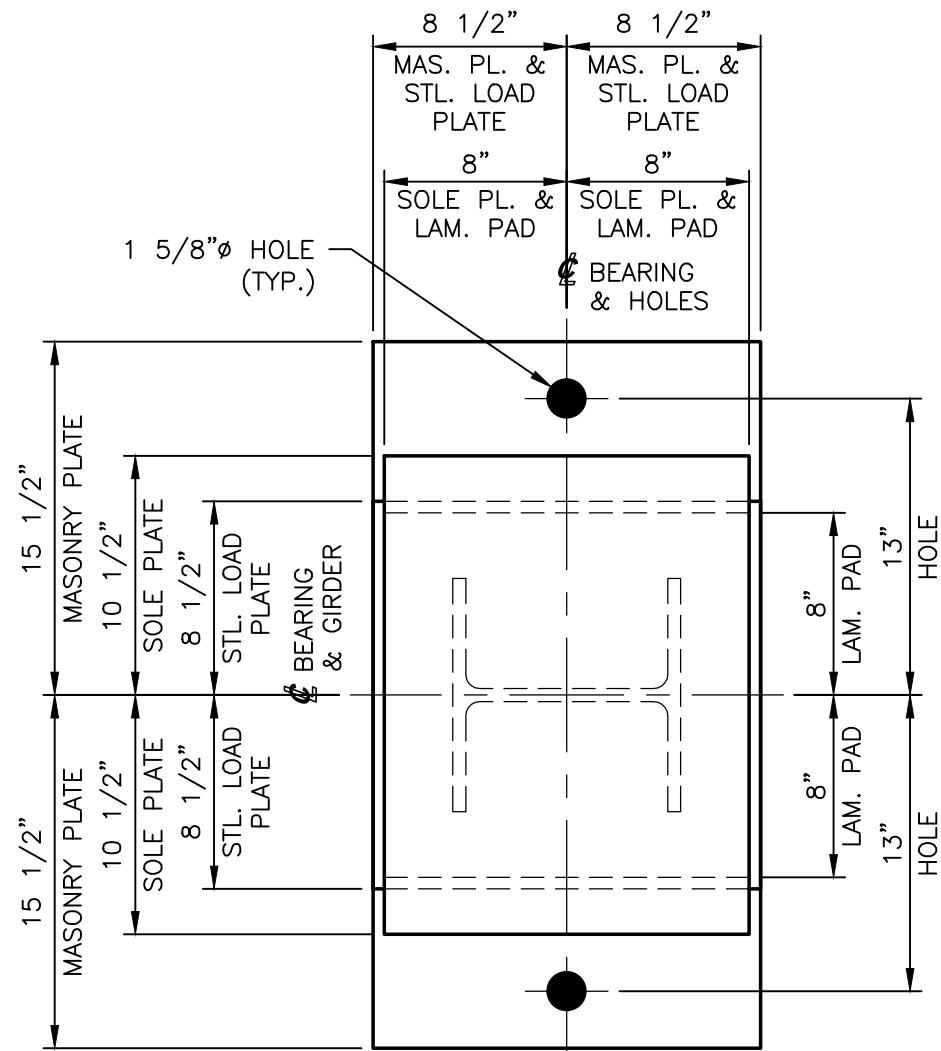


**PLAN VIEW**

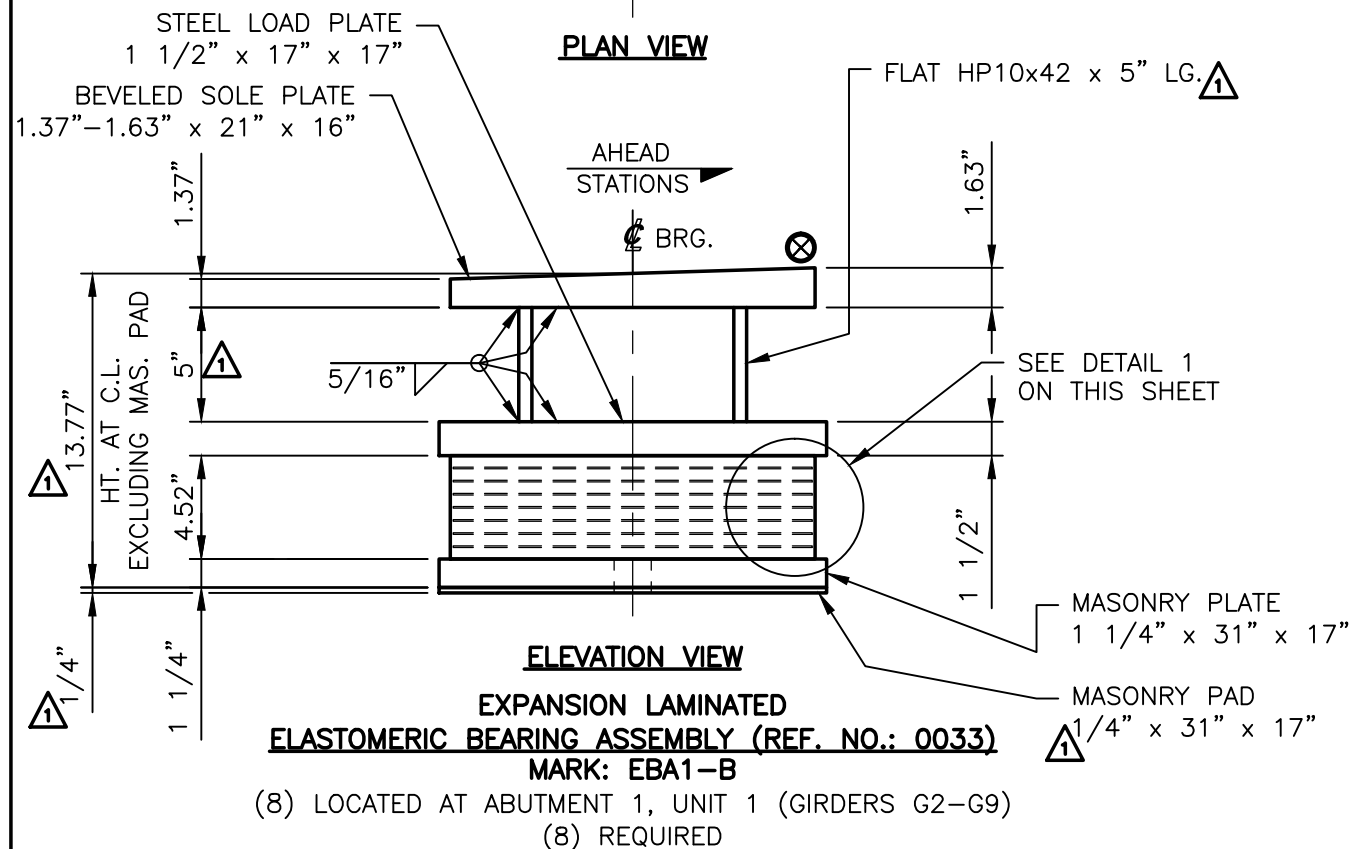

**ELEVATION VIEW**


**EXPANSION LAMINATED ELASTOMERIC BEARING ASSEMBLY (REF. NO.: 0033)**  
**MARK: EBA1-B**

(8) LOCATED AT ABUTMENT 1, UNIT 1 (GIRDERS G2-G9)  
(8) REQUIRED

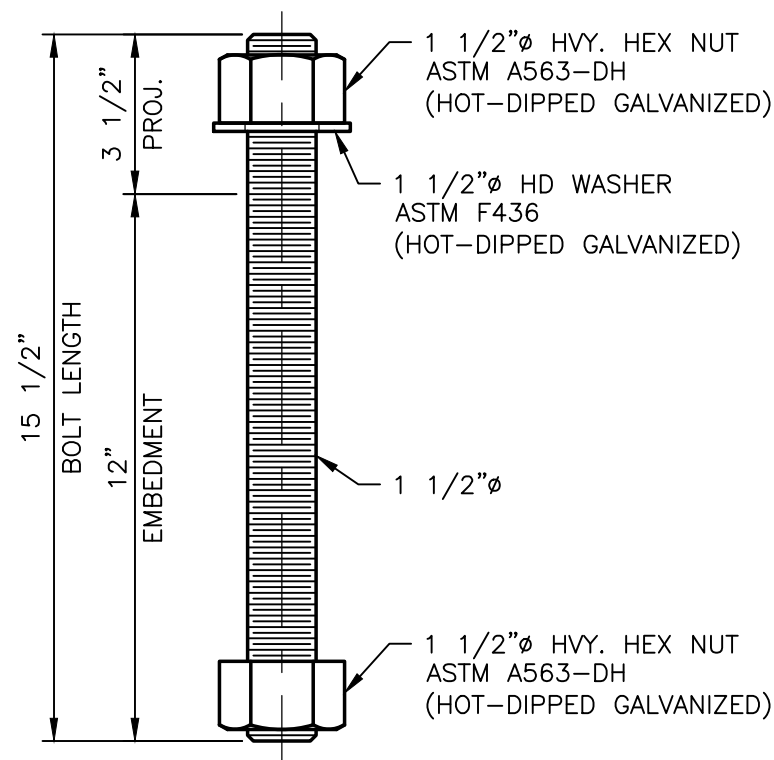


**ALL-THREAD ANCHOR ROD ASSEMBLY**

**MARK NO.: AB1-B**  
1 1/2"Ø x 15 1/2" LG.  
ASTM F1554 GRADE 55 (HOT-DIPPED GALV.)  
(16) LOCATED AT ABUTMENT 1, UNIT 1 (GIRDERS G2-G9) (EBA1-B)  
(16) REQUIRED

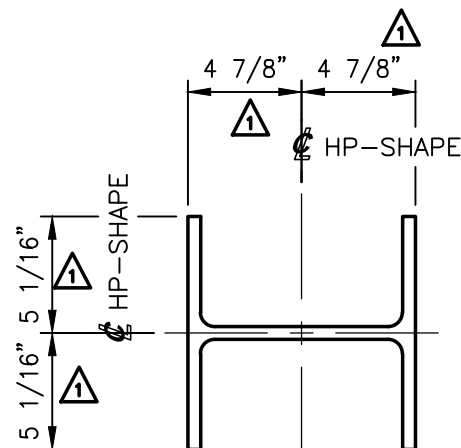


**PLAN VIEW**

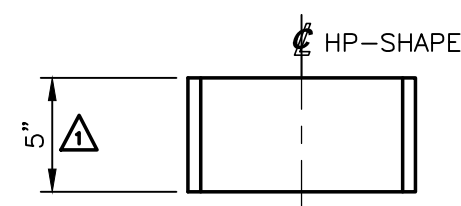

**ELEVATION VIEW**

**FLAT HP10x42**  
(8) REQUIRED

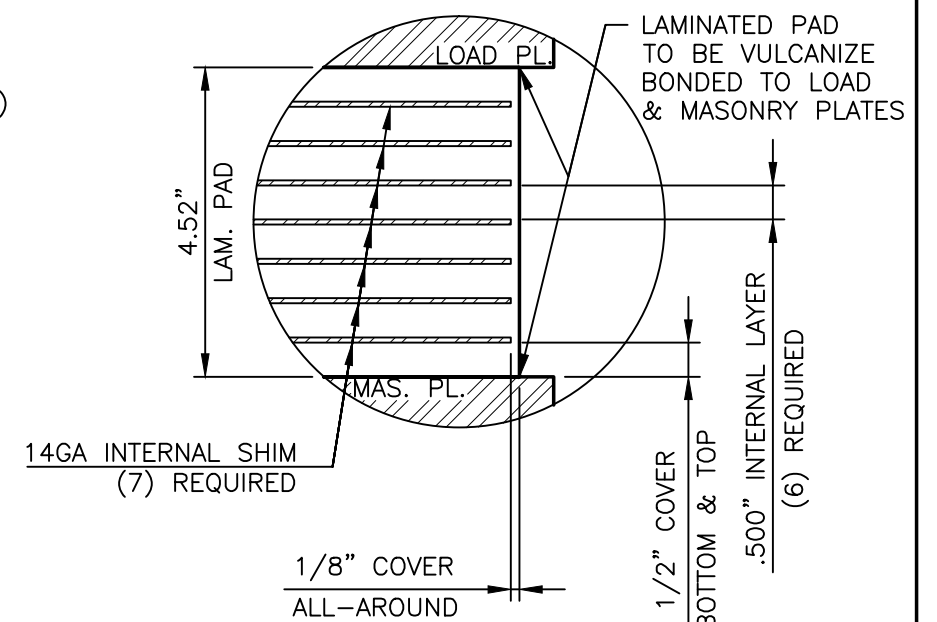

**DETAIL 1**

4.52" x 16" x 16" LAMINATED PAD  
50 DUROMETER GRADE 3 NEOPRENE  
VULCANIZE BONDED TO LOAD & MASONRY PLATES  
(8) REQUIRED

**TEST1-B**

4.52" x 16" x 16" LAMINATED PAD  
50 DUROMETER GRADE 3 NEOPRENE  
PAD ONLY FOR TESTING  
(1) REQUIRED

UNFACTORED ELASTOMERIC BEARING LOADS	
DEAD LOAD	74 KIPS
LIVE LOAD	74 KIPS
TOTAL LOAD (DL+LL)	148 KIPS

SEE NOTES ON SHEET GN1 OF 1

STATE OF OHIO  
DEPARTMENT OF TRANSPORTATION

BRIDGE NO.: HAM-74-1908R  
OVER MILL CREEK, RR & SPRING GROVE AVENUE

HAM-75-3.84  
CITY OF CINCINNATI

STATE	COUNTY	PID NO.
OH	HAMILTON	104667

FED. PROJ. NO.: E170 (713)

**DYNAMIC RUBBER LAM. ELASTOMERIC BEARING ASSY.'S**

**Cosmee** 1501 ROCKY RIDGE ROAD  
P.O. BOX 2159  
ATHENS, TEXAS 75751

SCALE	DRAWN BY	CHECKED BY
NONE	MH	ELS


DATE: 06/11/19 DATE: 07/16/19

SHEET 1 OF 17 **JOB NO.: 15353B2**

**PRIME AE, Group, Inc**  
DATE REC'D: 8/1/2019 BUILDABLE UNIT NO.: 11  
Review conforms that the shop drawings meet the intent of the contract.  
 CONFORMS AS-IS  CONFORMS AS NOTED  
 REVISE AND RESEND  
1908R - BEARINGS  
By: Conrad Gagnon Date: 8/2/2019  
**RELEASED FOR FABRICATION**  
**WALSH**  
By: Date:


REV.	DESCRIPTION	BY	DATE	CK'D	DATE
1	CHANGED HP10x57 TO HP10x42 AND CHANGED MAS. PAD THICKNESS PER DESIGN CHANGE.	MH	07/26/19	ELS	07/29/19

CUSTOMER: WALSH CONSTRUCTION CO. II DRAWING NUMBER: 15353B2-01 REV. 1

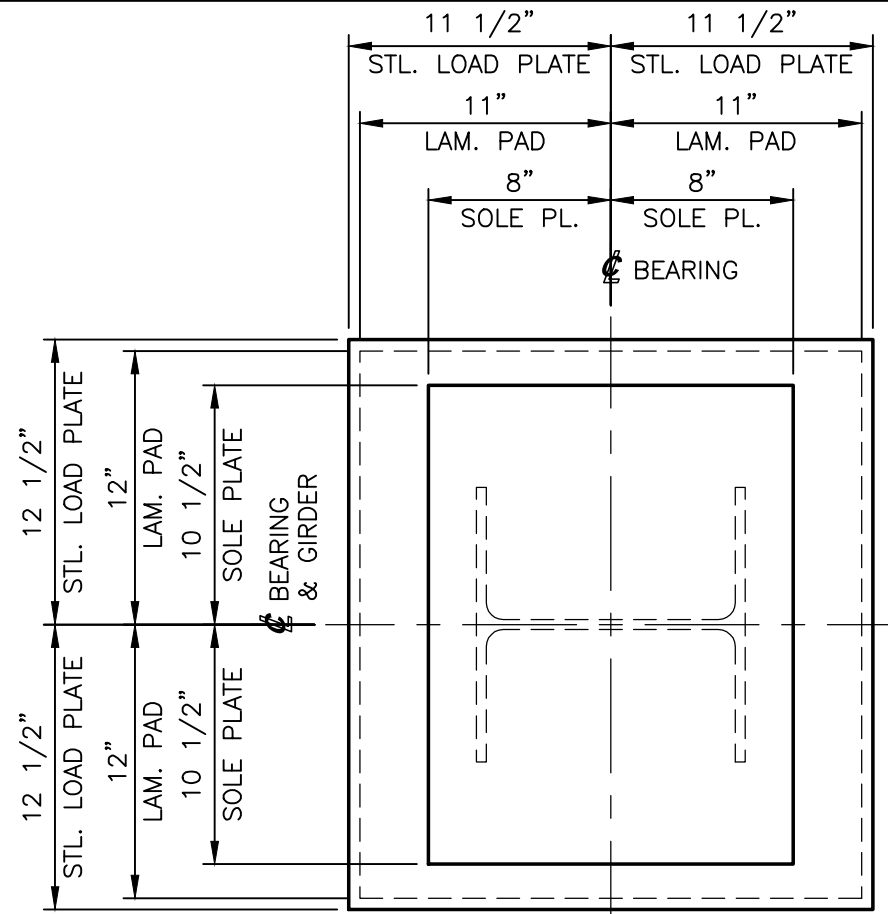

**PLAN VIEW**

BEVELED SOLE PLATE  
1.98"-2.52" x 21" x 16"

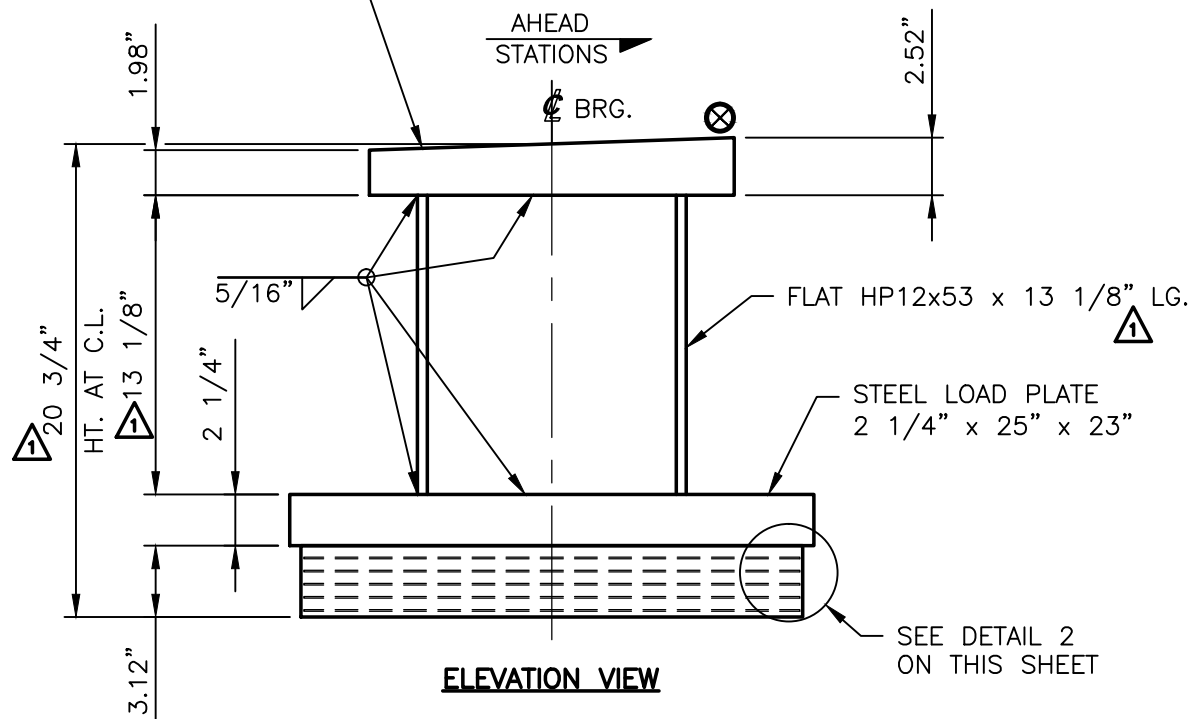


**ELEVATION VIEW**


**EXPANSION LAMINATED  
ELASTOMERIC BEARING ASSEMBLY (REF. NO.: 0033)**

**MARK: EBA2-B**

(8) LOCATED AT PIER 1, UNIT 1 (GIRDERS G2-G9)  
(8) REQUIRED

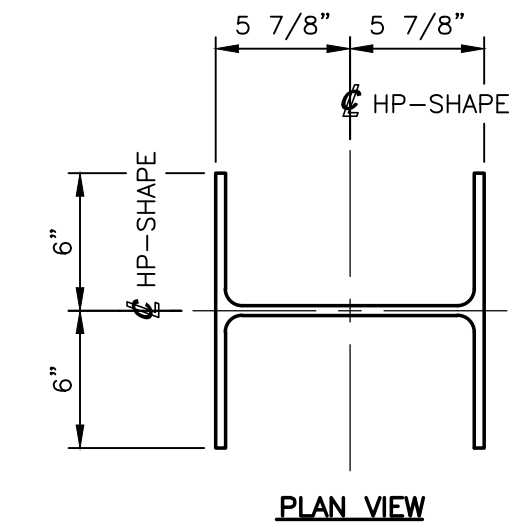


**PLAN VIEW**

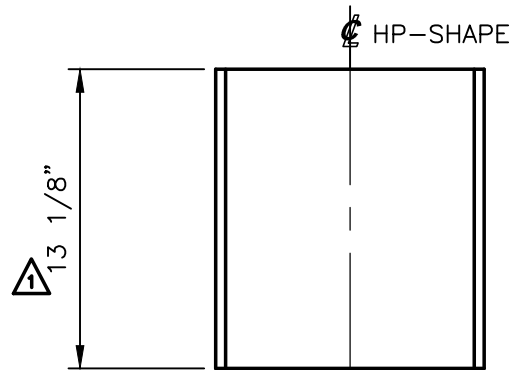

**ELEVATION VIEW**

**FLAT HP12x53**  
(8) REQUIRED

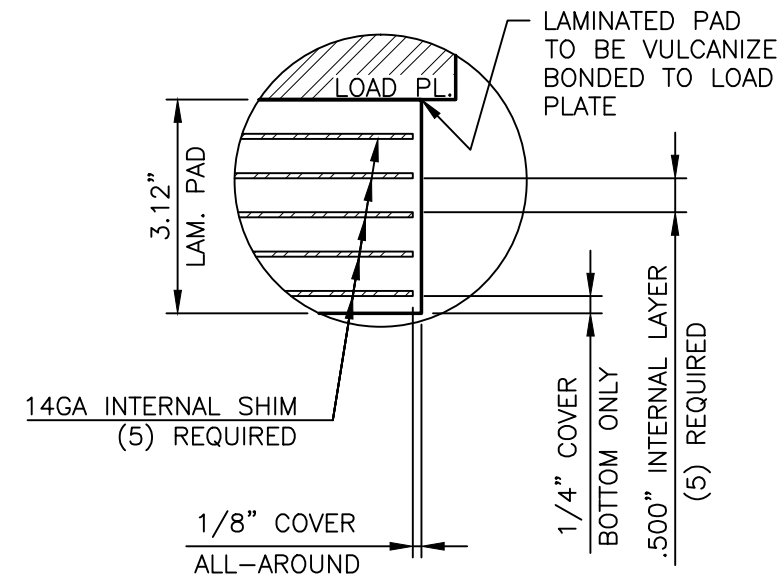

**DETAIL 2**

3.12" x 24" x 22" LAMINATED PAD  
50 DUROMETER GRADE 3 NEOPRENE  
VULCANIZE BONDED TO LOAD PLATE  
(8) REQUIRED


UNFACTORED ELASTOMERIC BEARING LOADS	
DEAD LOAD	345 KIPS
LIVE LOAD	144 KIPS
TOTAL LOAD (DL+LL)	489 KIPS

<b>PRIME AE, Group, Inc</b>		<b>RELEASED FOR FABRICATION</b>
DATE REC'D: 8/1/2019	BUILDABLE UNIT NO.: 11	
Review conforms that the shop drawings meet the intent of the contract.		<b>WALSH</b>
<input checked="" type="checkbox"/> CONFORMS AS-IS	<input type="checkbox"/> CONFORMS AS NOTED	
<input type="checkbox"/> REVISE AND RESEND		
1908R - BEARINGS		
By: Conrad Gagnon	By:	
Date: 8/2/2019	Date:	

SEE NOTES ON SHEET GN1 OF 1  
**STATE OF OHIO**  
DEPARTMENT OF TRANSPORTATION  
**BRIDGE NO.: HAM-74-1908R**  
OVER MILL CREEK, RR &  
SPRING GROVE AVENUE  
**HAM-75-3.84**  
CITY OF CINCINNATI


STATE	COUNTY	PID NO.
OH	HAMILTON	104667
FED. PROJ. NO.: E170 (713)		
<b>DYNAMIC RUBBER LAM. ELASTOMERIC BEARING ASSY.'S</b>		
<b>Cosmee</b> 1501 ROCKY RIDGE ROAD P.O. BOX 2159 ATHENS, TEXAS 75751		
SCALE: NONE	DRAWN BY: MH	CHECKED BY: ELS
	DATE: 06/11/19	DATE: 07/16/19

CHANGE HP12x53 HEIGHT PER DESIGN CHANGE.	MH	07/26/19	ELS	07/29/19	SHEET 2 OF 17	<b>JOB NO.: 15353B2</b>
REV.	DESCRIPTION	BY	DATE	CK'D	DATE	CUSTOMER WALSH CONSTRUCTION CO. II
						DRAWING NUMBER 15353B2-D2
						REV. 1

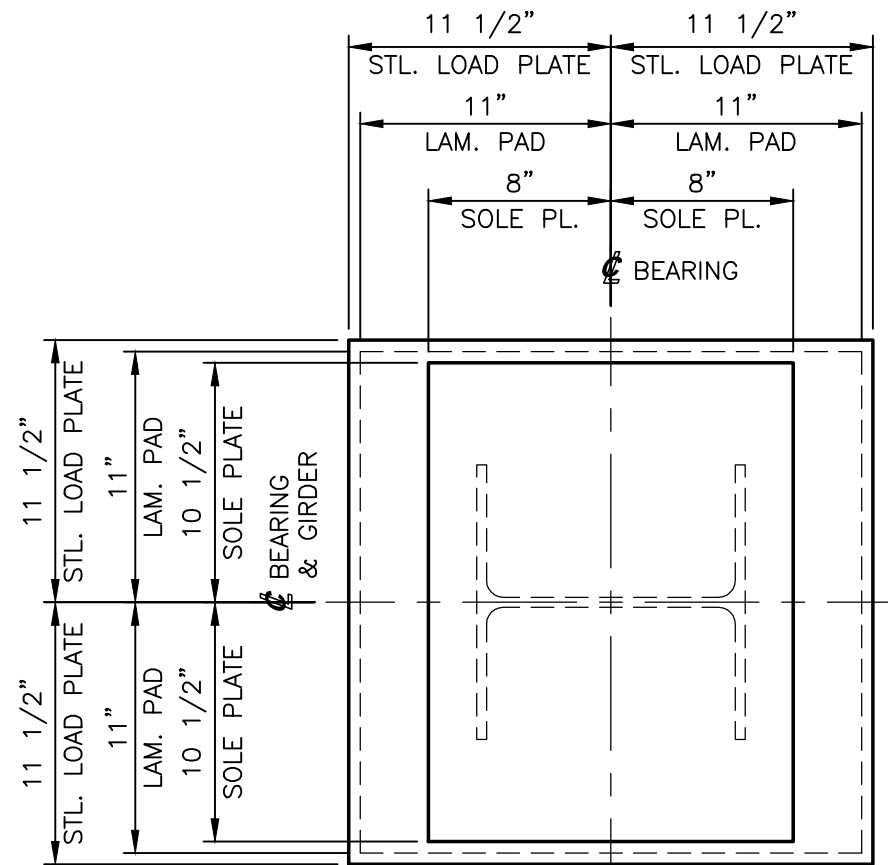

**PLAN VIEW**


BEVELED SOLE PLATE  
1.87"–2.63" x 21" x 16"

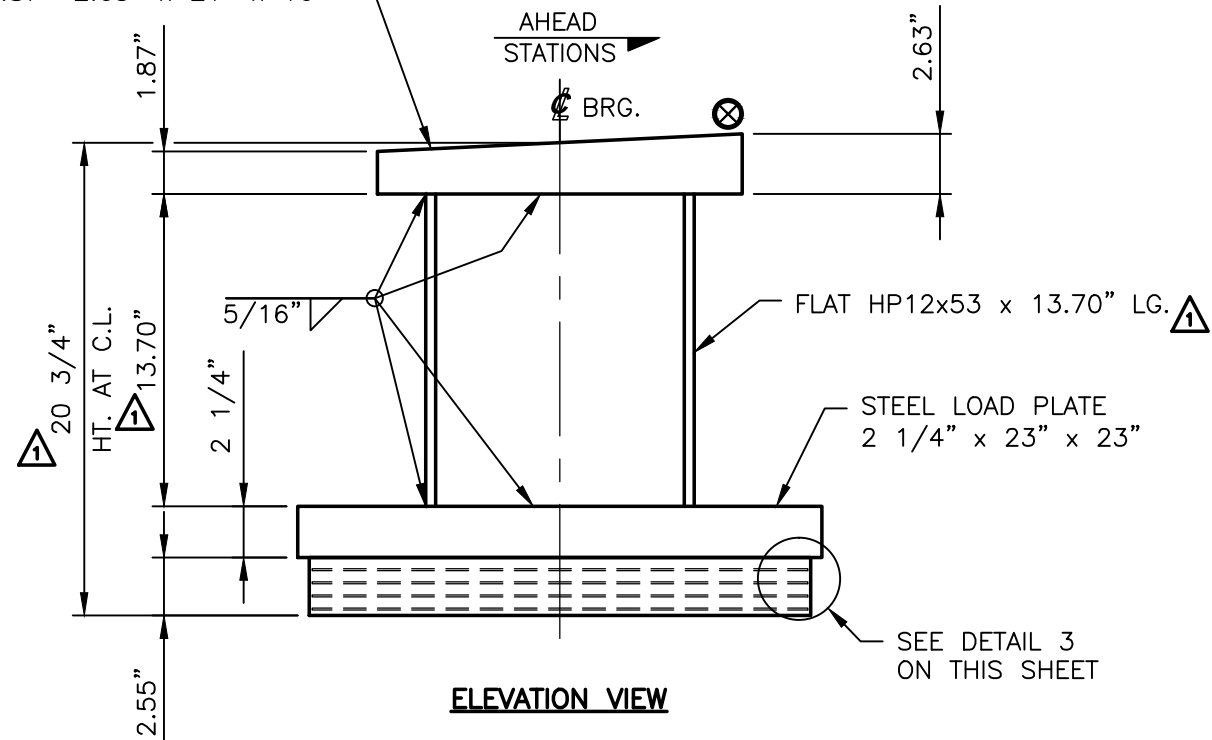


**ELEVATION VIEW**

**EXPANSION LAMINATED ELASTOMERIC BEARING ASSEMBLY (REF. NO.: 0033)**  
**MARK: EBA3-B**

(8) LOCATED AT PIER 3, UNIT 1 (GIRDERS G2–G9)  
(8) REQUIRED

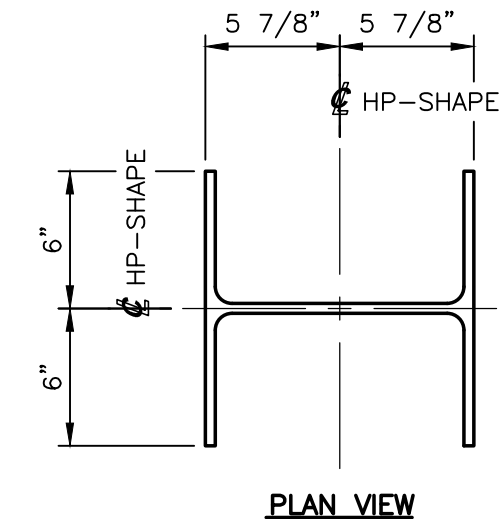


**PLAN VIEW**

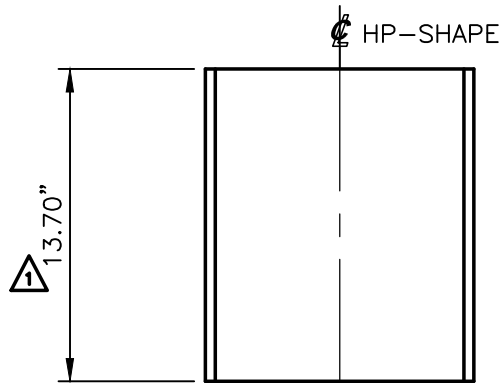

**ELEVATION VIEW**

**FLAT HP12x53**  
(8) REQUIRED

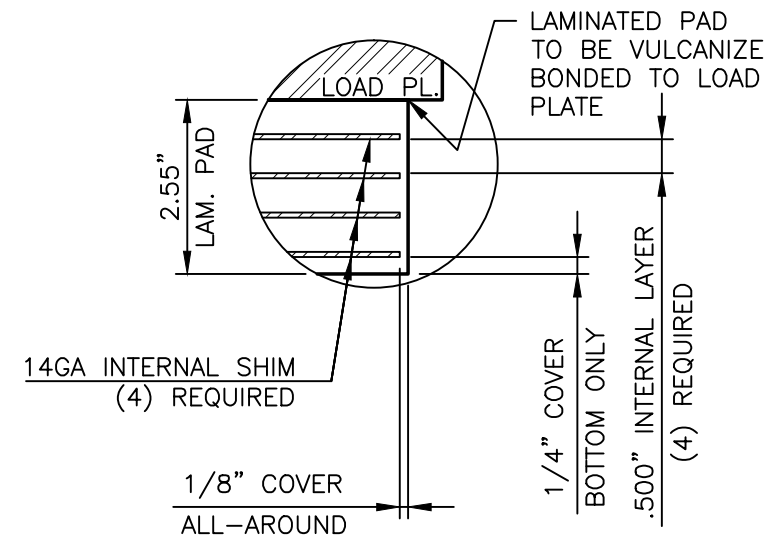

**DETAIL 3**

2.55" x 22" x 22" LAMINATED PAD  
50 DUROMETER GRADE 3 NEOPRENE  
VULCANIZE BONDED TO LOAD PLATE  
(8) REQUIRED

UNFACTORED ELASTOMERIC BEARING LOADS	
DEAD LOAD	325 KIPS
LIVE LOAD	145 KIPS
TOTAL LOAD (DL+LL)	470 KIPS

SEE NOTES ON SHEET GN1 OF 1

STATE OF OHIO  
DEPARTMENT OF TRANSPORTATION

BRIDGE NO.: HAM-74-1908R  
OVER MILL CREEK, RR &  
SPRING GROVE AVENUE

HAM-75-3.84  
CITY OF CINCINNATI

STATE	COUNTY	PID NO.
OH	HAMILTON	104667

FED. PROJ. NO.: E170 (713)

**DYNAMIC RUBBER LAM. ELASTOMERIC BEARING ASSY.'S**

**Cosmee** 1501 ROCKY RIDGE ROAD  
P.O. BOX 2159  
ATHENS, TEXAS 75751

SCALE:	DRAWN BY:	CHECKED BY:
NONE	MH	ELS


DATE: 06/11/19 DATE: 07/16/19

SHEET 3 OF 17 **JOB NO.: 15353B2**

<b>PRIME AE, Group, Inc</b>		<b>RELEASED FOR FABRICATION</b>	
DATE REC'D: 8/1/2019	BUILDABLE UNIT NO.: 11	<b>WALSH</b>	
Review conforms that the shop drawings meet the intent of the contract.			
<input checked="" type="checkbox"/> CONFORMS AS-IS	<input type="checkbox"/> CONFORMS AS NOTED		
<input type="checkbox"/> REVISE AND RESEND			
<b>1908R - BEARINGS</b>			
By: Conrad Gagnon	By:		
Date: 8/2/2019	Date:		


REV.	DESCRIPTION	BY	DATE	CK'D	DATE	CUSTOMER	DRAWING NUMBER	REV.
△	REVISED HP12x53 HEIGHT PER DESIGN CHANGE.	MH	07/26/19	ELS	07/29/19	WALSH CONSTRUCTION CO. II	15353B2-D3	1



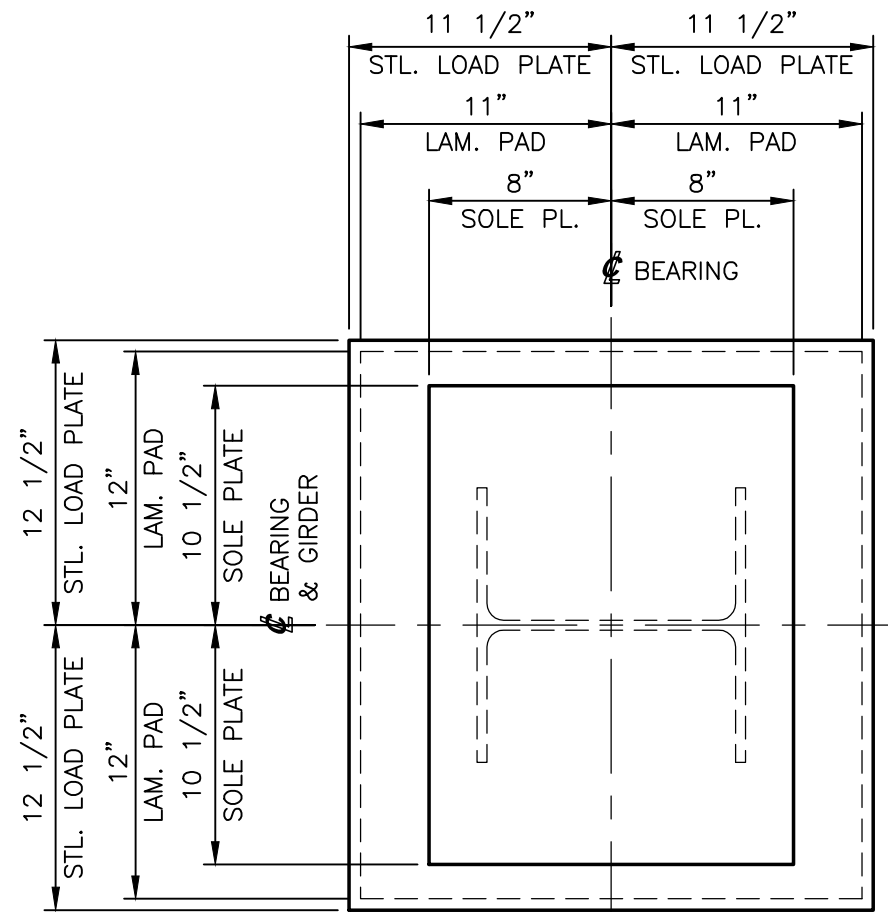


**PLAN VIEW**

BEVELED SOLE PLATE  
 2.35"-2.65" x 21" x 16"

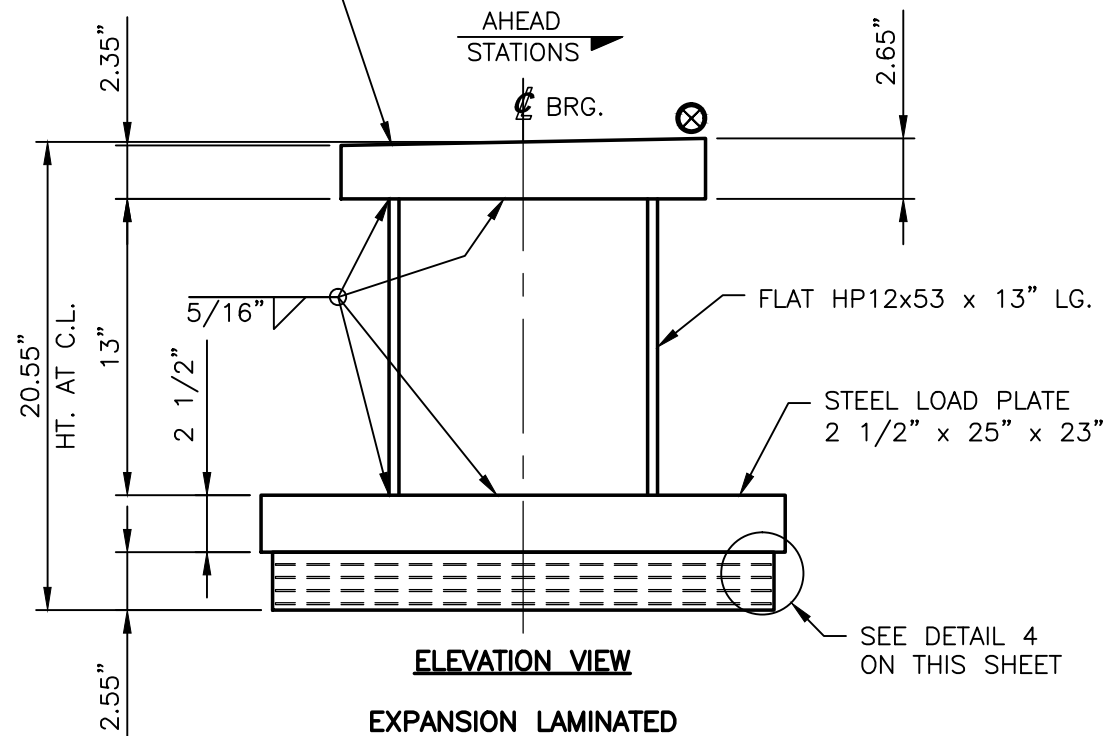


**ELEVATION VIEW**

**EXPANSION LAMINATED ELASTOMERIC BEARING ASSEMBLY (REF. NO.: 0033)**  
**MARK: EBA4-B**  
 (10) LOCATED AT PIER 6, UNIT 2 (GIRDERS G4-G13)  
 (10) REQUIRED

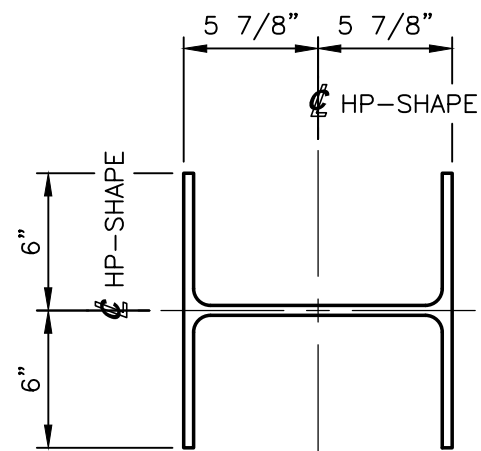


**PLAN VIEW**

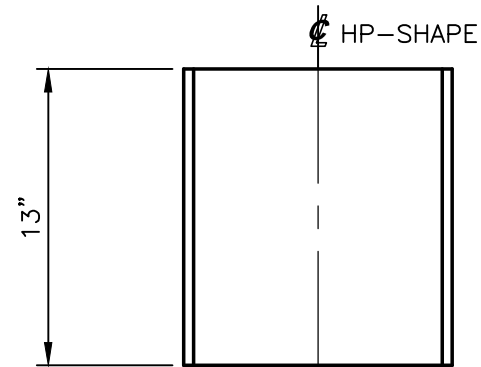

**ELEVATION VIEW**

**FLAT HP12x53**  
 (10) REQUIRED

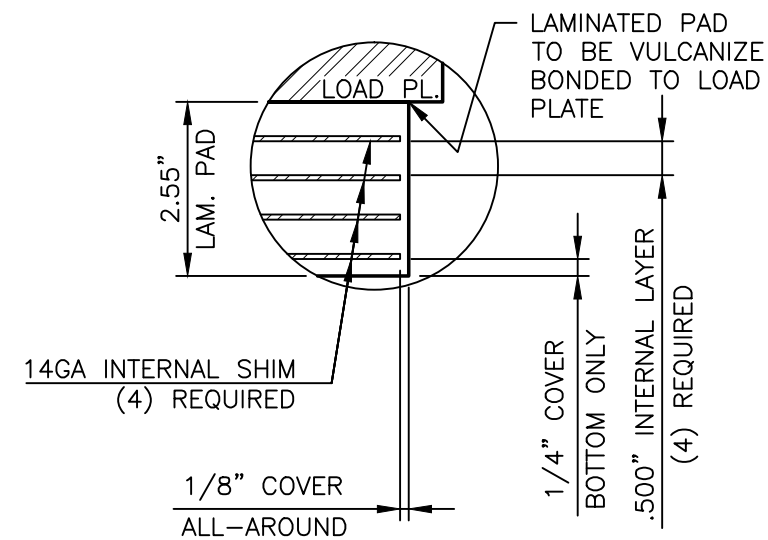

**DETAIL 4**

2.55" x 24" x 22" LAMINATED PAD  
 50 DUROMETER GRADE 3 NEOPRENE  
 VULCANIZE BONDED TO LOAD PLATE  
 (10) REQUIRED

UNFACTORED ELASTOMERIC BEARING LOADS	
DEAD LOAD	389 KIPS
LIVE LOAD	137 KIPS
TOTAL LOAD (DL+LL)	526 KIPS

<b>PRIME AE, Group, Inc</b>		<b>RELEASED FOR FABRICATION</b>
DATE REC'D: 8/1/2019	BUILDABLE UNIT NO.: 11	
Review conforms that the shop drawings meet the intent of the contract.		
<input checked="" type="checkbox"/> CONFORMS AS-IS	<input type="checkbox"/> CONFORMS AS NOTED	<b>WALSH</b>
<input type="checkbox"/> REVISE AND RESEND		
<b>1908R - BEARINGS</b>		
By: Conrad Gagnon	By:	
Date: 8/2/2019	Date:	

SEE NOTES ON SHEET GN1 OF 1  
**STATE OF OHIO**  
 DEPARTMENT OF TRANSPORTATION  
**BRIDGE NO.: HAM-74-1908R**  
 OVER MILL CREEK, RR &  
 SPRING GROVE AVENUE  
**HAM-75-3.84**  
 CITY OF CINCINNATI

STATE	COUNTY	PID NO.
OH	HAMILTON	104667
FED. PROJ. NO.: E170 (713)		


**DYNAMIC RUBBER LAM. ELASTOMERIC BEARING ASSY.'S**

**Cosmee** 1501 ROCKY RIDGE ROAD  
 P.O. BOX 2159  
 ATHENS, TEXAS 75751


SCALE: NONE	DRAWN BY: MH	CHECKED BY: ELS
	DATE: 06/11/19	DATE: 07/16/19

REV.	DESCRIPTION	BY	DATE	CK'D	DATE	SHEET 4 OF 17	JOB NO.: 15353B
						CUSTOMER WALSH CONSTRUCTION CO. II	DRAWING NUMBER 15353B-D4 REV. 0




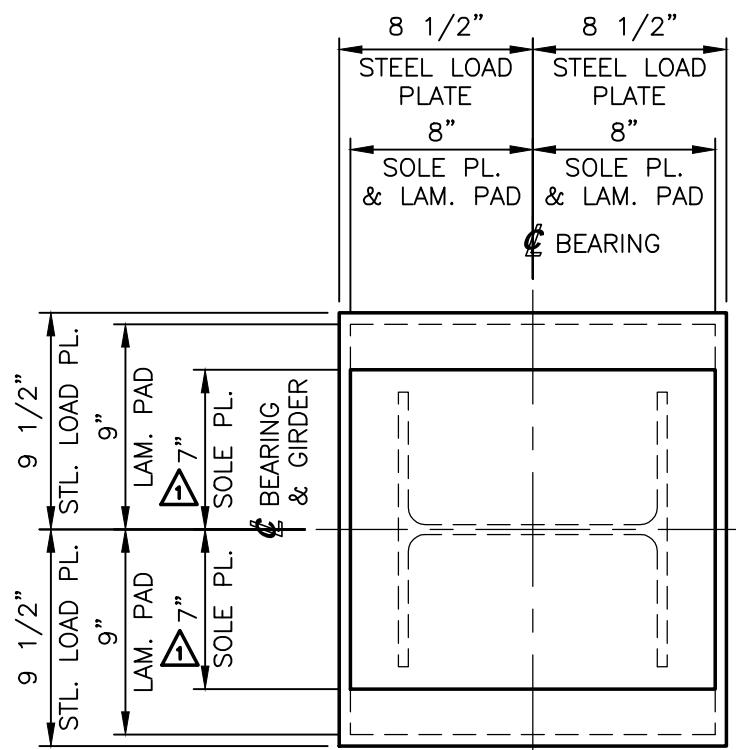

**PLAN VIEW**

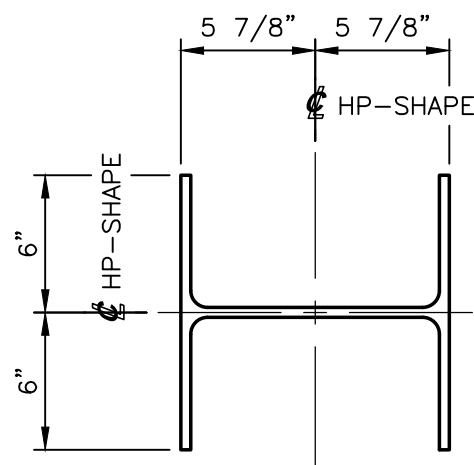


**PLAN VIEW**

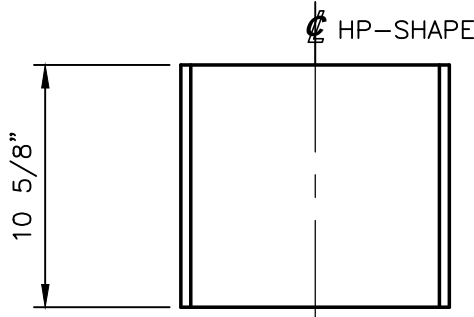

**ELEVATION VIEW**


**FLAT HP12x53**  
(6) REQUIRED

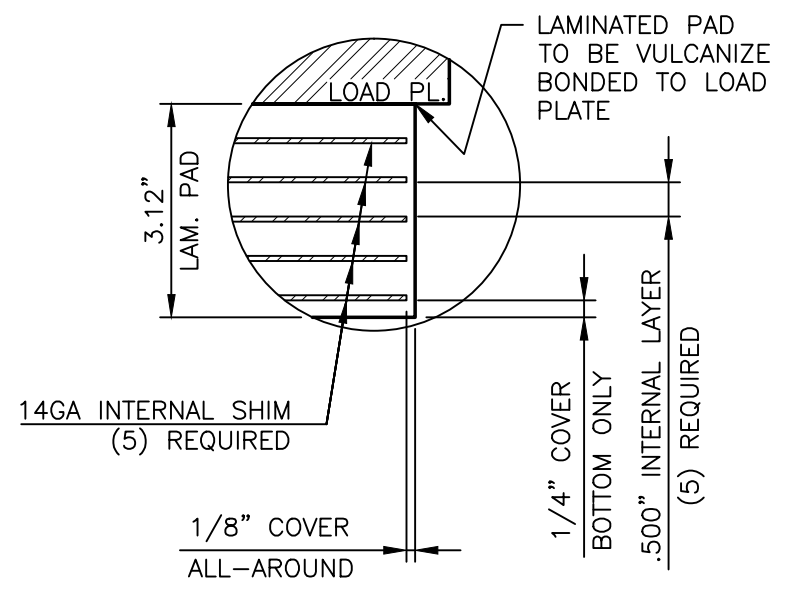

**DETAIL 5**

3.12" x 18" x 16" LAMINATED PAD  
50 DUROMETER GRADE 3 NEOPRENE  
VULCANIZE BONDED TO LOAD PLATE  
(6) REQUIRED

UNFACTORED ELASTOMERIC BEARING LOADS	
DEAD LOAD	140 KIPS
LIVE LOAD	61 KIPS
TOTAL LOAD (DL+LL)	201 KIPS

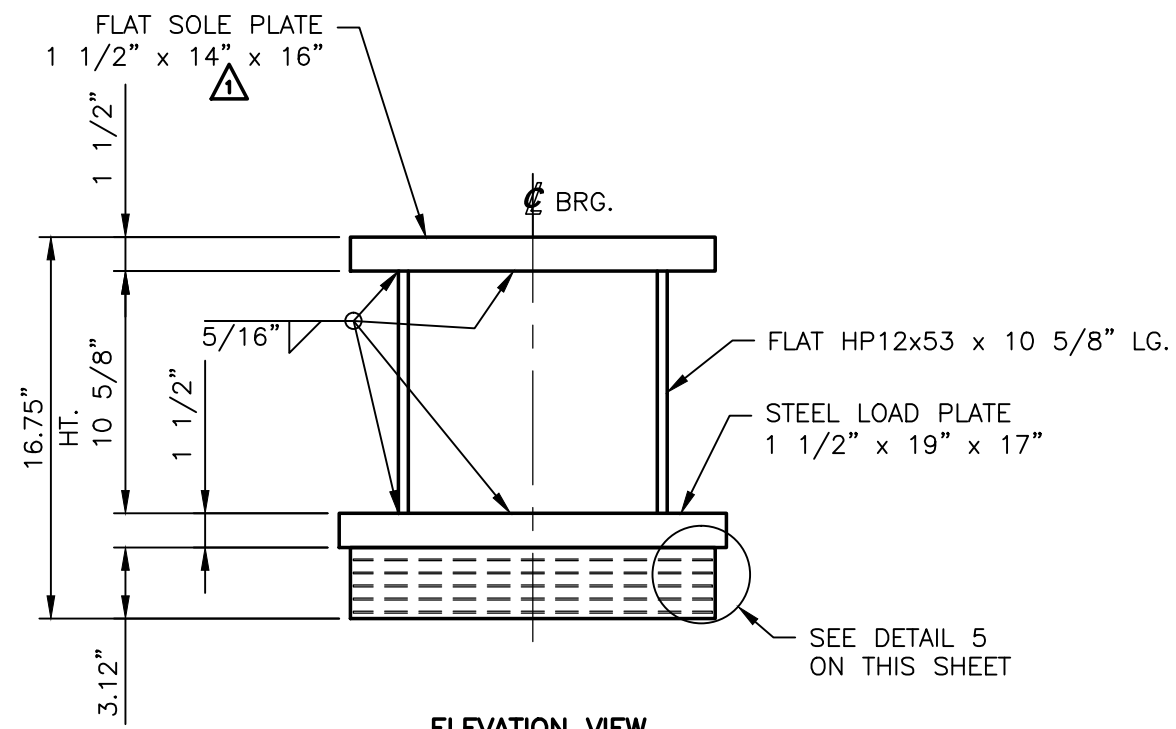

**ELEVATION VIEW**

**EXPANSION LAMINATED ELASTOMERIC BEARING ASSEMBLY (REF. NO.: 0033)**  
**MARK: EBA5-B**

(6) LOCATED AT PIER 19, UNIT 6 (GIRDERS G3-G8)  
(6) REQUIRED

<b>PRIME AE, Group, Inc</b>		<b>RELEASED FOR FABRICATION</b>  <b>WALSH</b>
DATE REC'D: 8/1/2019	BUILDABLE UNIT NO.: 11	
Review conforms that the shop drawings meet the intent of the contract.		
<input checked="" type="checkbox"/> CONFORMS AS-IS	<input type="checkbox"/> CONFORMS AS NOTED	
<b>1908R - BEARINGS</b>		
By: Conrad Gagnon	By:	
Date: 8/2/2019	Date:	

SEE NOTES ON SHEET GN1 OF 1  
**STATE OF OHIO**  
DEPARTMENT OF TRANSPORTATION  
**BRIDGE NO.: HAM-74-1908R**  
OVER MILL CREEK, RR &  
SPRING GROVE AVENUE  
**HAM-75-3.84**  
CITY OF CINCINNATI


STATE	COUNTY	PID NO.
OH	HAMILTON	104667
FED. PROJ. NO.: E170 (713)		

**DYNAMIC RUBBER LAM. ELASTOMERIC BEARING ASSY.'S**


**Cosmee** 1501 ROCKY RIDGE ROAD  
P.O. BOX 2159  
ATHENS, TEXAS 75751

SCALE: NONE	DRAWN BY: MH	CHECKED BY: ELS
	DATE: 06/11/19	DATE: 07/16/19


REVISION	DESCRIPTION	BY	DATE	CK'D	DATE	SHEET 5 OF 17	JOB NO.: 15353B2
1	REVISED SOLE PLATE WIDTH PER DESIGN CHANGE.	MH	07/26/19	ELS	07/29/19		
CUSTOMER: WALSH CONSTRUCTION CO. II						DRAWING NUMBER: 15353B2-D5	REV. 1

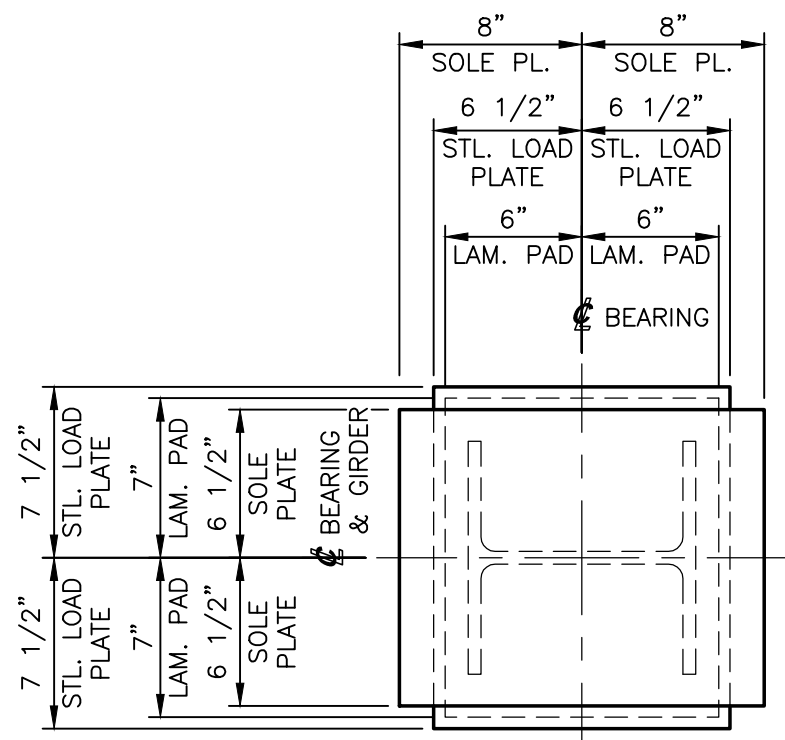

PLAN VIEW

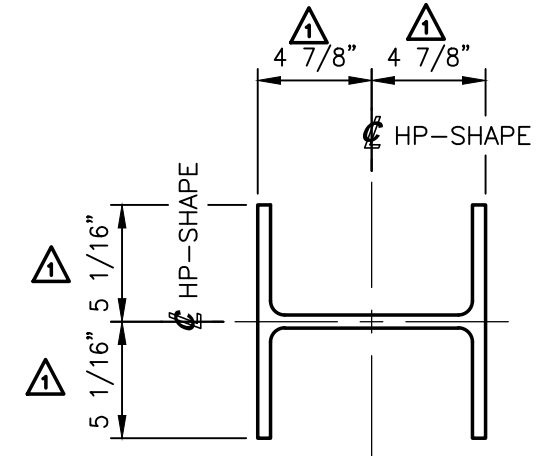


PLAN VIEW

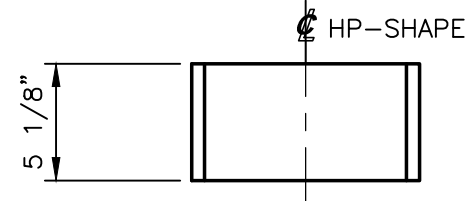

ELEVATION VIEW


FLAT HP10x42 (6) REQUIRED

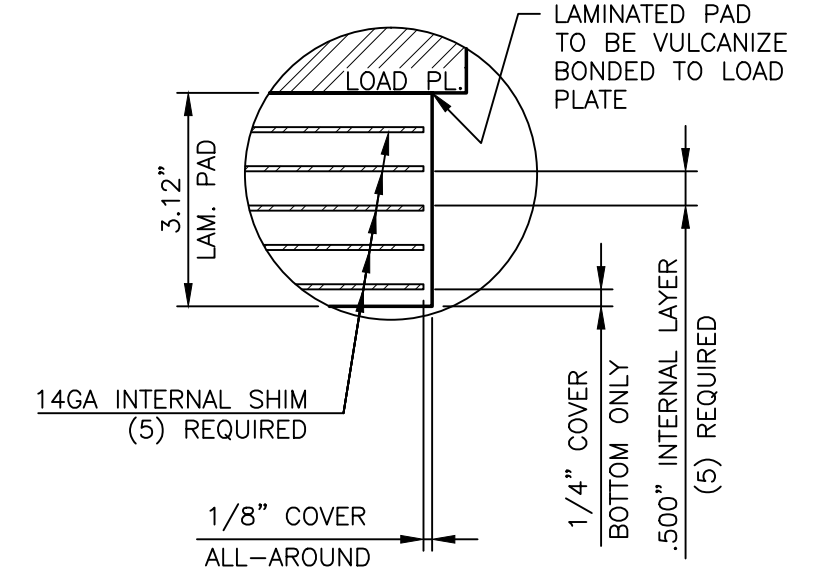

DETAIL 6

3.12" x 14" x 12" LAMINATED PAD  
50 DUROMETER GRADE 3 NEOPRENE  
VULCANIZE BONDED TO LOAD PLATE  
(6) REQUIRED

UNFACTORED ELASTOMERIC BEARING LOADS	
DEAD LOAD	43 KIPS
LIVE LOAD	50 KIPS
TOTAL LOAD (DL+LL)	93 KIPS

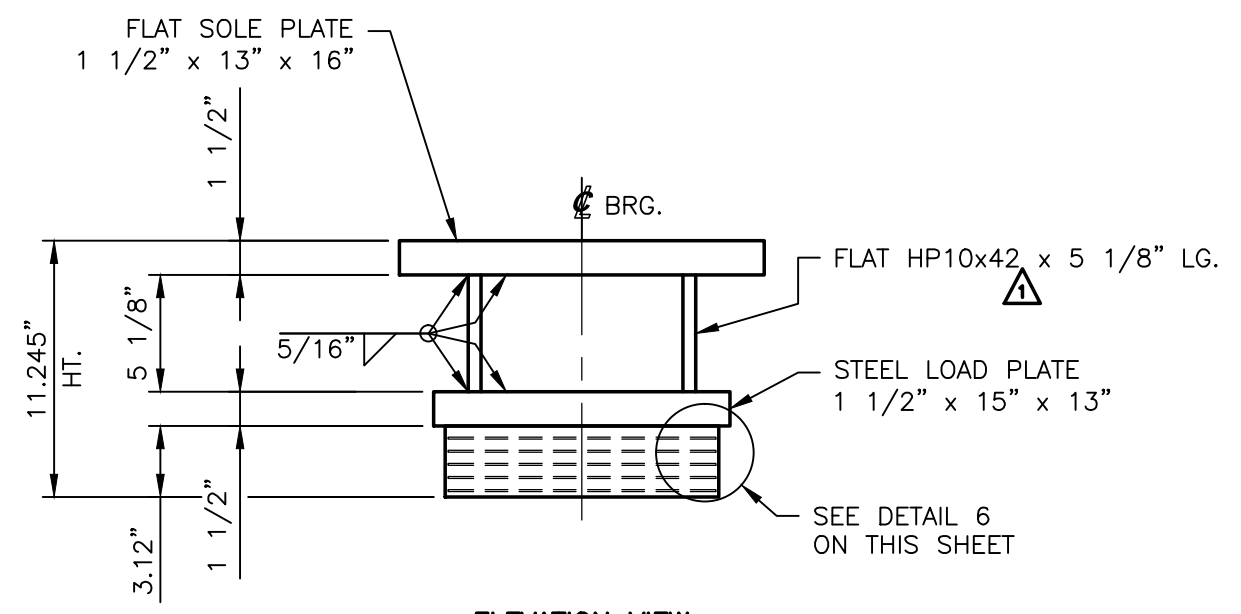

ELEVATION VIEW

EXPANSION LAMINATED ELASTOMERIC BEARING ASSEMBLY (REF. NO.: 0033)  
MARK: EBA6-B  
(6) LOCATED AT ABUTMENT 4, UNIT 6 (GIRDERS G3-G8)  
(6) REQUIRED

SEE NOTES ON SHEET GN1 OF 1

STATE OF OHIO  
DEPARTMENT OF TRANSPORTATION  
BRIDGE NO.: HAM-74-1908R  
OVER MILL CREEK, RR &  
SPRING GROVE AVENUE  
HAM-75-3.84  
CITY OF CINCINNATI

STATE	COUNTY	PID NO.
OH	HAMILTON	104667
FED. PROJ. NO.: E170 (713)		

DYNAMIC RUBBER  
LAM. ELASTOMERIC BEARING ASSY.'S

**Cosmee** 1501 ROCKY RIDGE ROAD  
P.O. BOX 2159  
ATHENS, TEXAS 75751

SCALE: NONE	DRAWN BY: MH	CHECKED BY: ELS
	DATE: 06/11/19	DATE: 07/16/19

**PRIME AE, Group, Inc**  
DATE REC'D: 8/1/2019 BUILDABLE UNIT NO.: 11  
Review conforms that the shop drawings meet the intent of the contract.

CONFORMS AS-IS  CONFORMS AS NOTED  
 REVISE AND RESEND


1908R - BEARINGS

By: Conrad Gagnon Date: 8/2/2019

**RELEASED FOR FABRICATION**  
**WALSH**

By: \_\_\_\_\_ Date: \_\_\_\_\_

CHANGED HP10x57 TO HP10x42 PER DESIGN CHANGE.	MH	07/26/19	ELS	07/29/19	SHEET 6 OF 17	JOB NO.: 15353B2
REV.	DESCRIPTION	BY	DATE	CK'D	DATE	CUSTOMER WALSH CONSTRUCTION CO. II
						DRAWING NUMBER 15353B2-D6 REV. 1

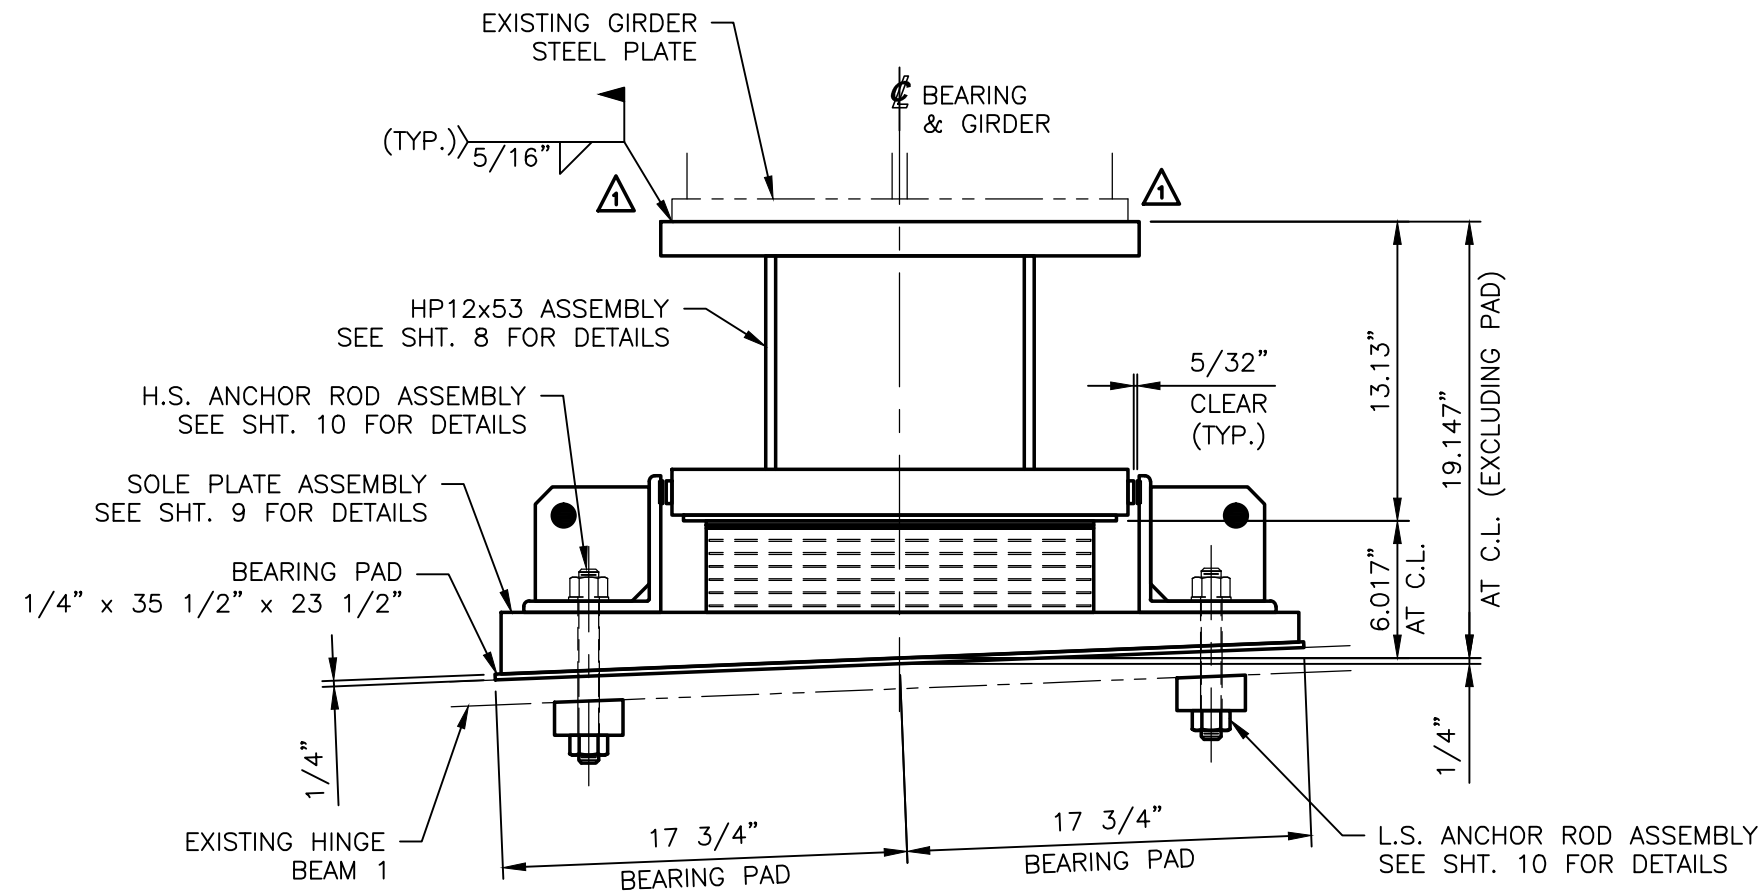

**EXPANSION LAMINATED  
ELASTOMERIC BEARING ASSEMBLY (REF.: 0033)  
AT CARRIER BEAM**

REFER TO EXP. BEARING TABLE #1  
FOR MARK NO.'s, QTY.'S AND LOCATIONS  
(7) REQUIRED

EXP. BEARING TABLE #1			
MARK NO.	QTY.	LOCATION	
		UNIT	GIRDER NO.
EBA7-B	1	2	G3-U2
EBA8-B	2	2	G5-U2 & G8-U2
EBA9-B	1	2	G6-U2
EBA10-B	1	2	G9-U2
EBA11-B	1	2	G11-U2
EBA12-B	1	2	G12-U2

<b>PRIME AE, Group, Inc</b>	<b>RELEASED FOR FABRICATION</b>
DATE REC'D: 8/1/2019 BUILDABLE UNIT NO.: 11	<b>WALSH</b>
Review conforms that the shop drawings meet the intent of the contract.	
<input checked="" type="checkbox"/> CONFORMS AS-IS <input type="checkbox"/> CONFORMS AS NOTED <input type="checkbox"/> REVISE AND RESEND	
1908R - BEARINGS	
By: Conrad Gagnon	By:
Date: 8/2/2019	Date:

SEE NOTES ON SHEET GN1 OF 1  
STATE OF OHIO  
DEPARTMENT OF TRANSPORTATION  
BRIDGE NO.: HAM-74-1908R  
OVER MILL CREEK, RR &  
SPRING GROVE AVENUE  
HAM-75-3.84  
CITY OF CINCINNATI


STATE	COUNTY	PID NO.
OH	HAMILTON	104667
FED. PROJ. NO.: E170 (713)		

**DYNAMIC RUBBER  
LAM. ELASTOMERIC BEARING ASSY.'S**


**Cosmee** 1501 ROCKY RIDGE ROAD  
P.O. BOX 2159  
ATHENS, TEXAS 75751

SCALE: NONE	DRAWN BY: MH	CHECKED BY: ELS
	DATE: 07/15/19	DATE: 07/16/19


REVISOR	DESCRIPTION	BY	DATE	CK'D	DATE	SHEET 7 OF 17	JOB NO.: 15353B2	
△	REVISED EXISTING GIRDER PLATE PER APPROVER NOTATIONS.	MH	07/26/19	ELS	07/29/19			
CUSTOMER: WALSH CONSTRUCTION CO. II							DRAWING NUMBER: 15353B2-D7	REV. 1

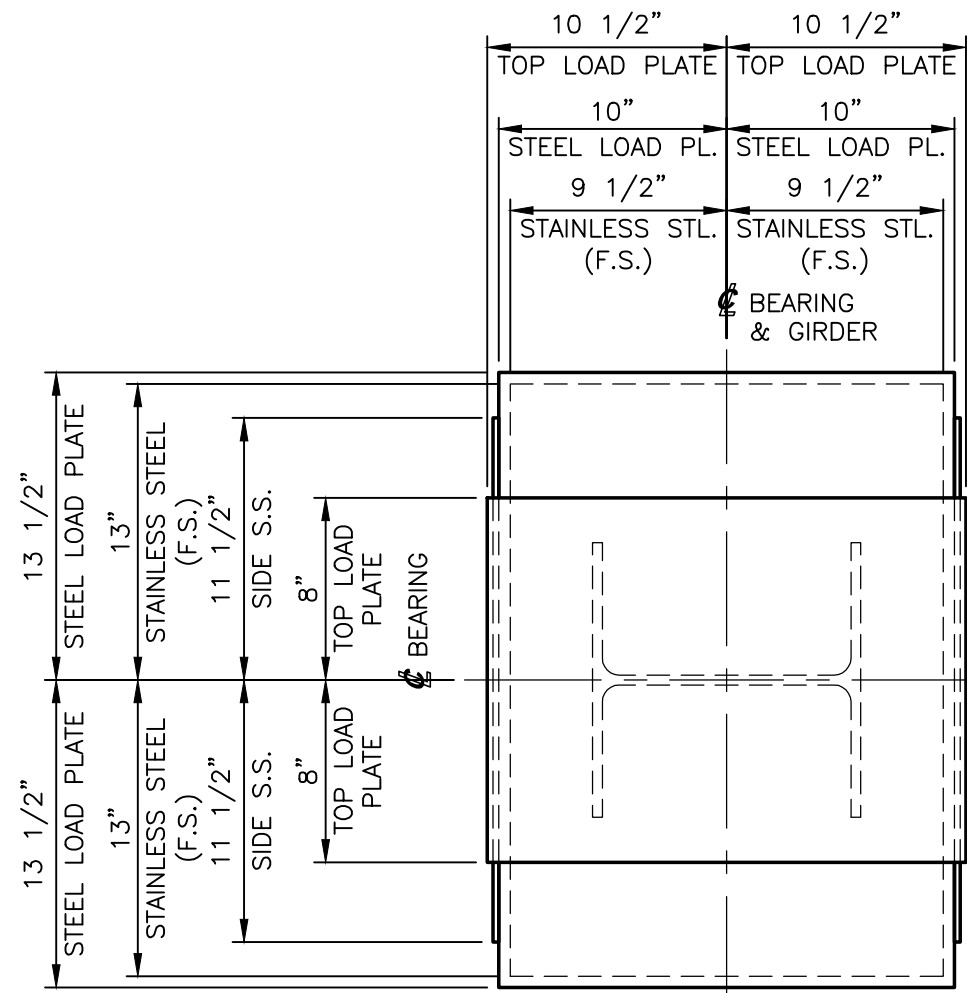


PLAN VIEW

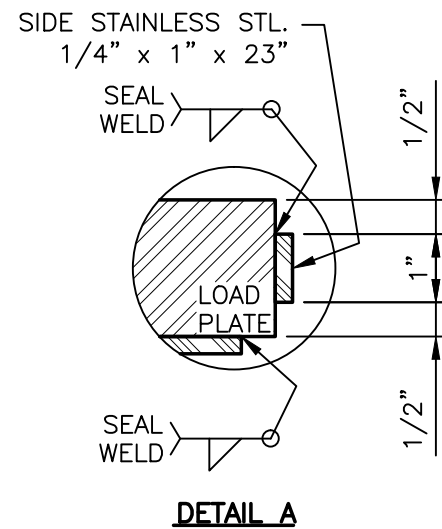

DETAIL A

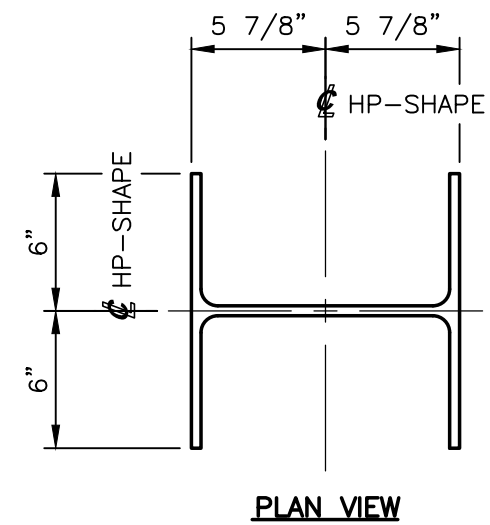


PLAN VIEW

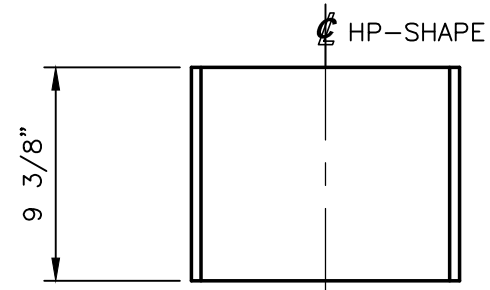

ELEVATION VIEW

FLAT HP12x53  
 (7) REQUIRED

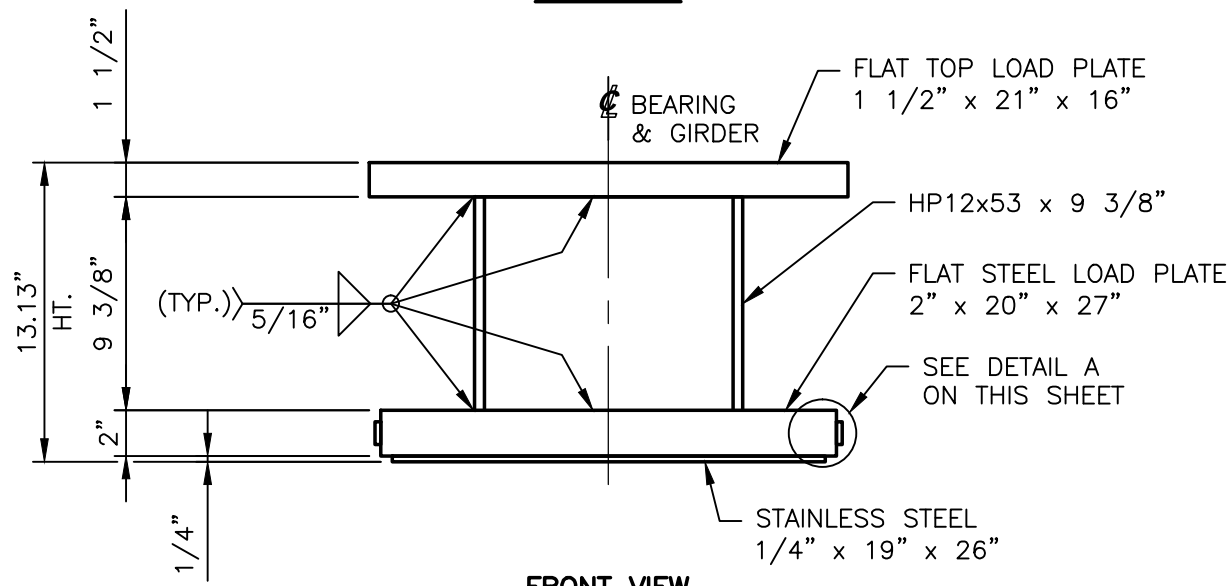

FRONT VIEW

HP12x53 ASSEMBLY DETAIL  
 REFER TO HP12x53 ASSEMBLY TABLE  
 FOR MARK NO.'S, QTY.'S AND LOCATIONS  
 (7) REQUIRED

**PRIME AE, Group, Inc**  
 DATE REC'D: 8/1/2019 BUILDABLE UNIT NO.: 11  
 Review conforms that the shop drawings meet the intent of the contract.

CONFORMS AS-IS  CONFORMS AS NOTED  
 REVISE AND RESEND

**1908R - BEARINGS**  
 By: Conrad Gagnon Date: 8/2/2019

**RELEASED FOR FABRICATION**  
**WALSH**  
 By: Date:

HP12x53 ASSEMBLY TABLE		
MARK NO.	QTY.	GIRDER NO.
EBA7-B	1	G3-U2
EBA8-B	2	G5-U2 & G8-U2
EBA9-B	1	G6-U2
EBA10-B	1	G9-U2
EBA11-B	1	G11-U2
EBA12-B	1	G12-U2

SEE NOTES ON SHEET GN1 OF 1  
 STATE OF OHIO  
 DEPARTMENT OF TRANSPORTATION  
 BRIDGE NO.: HAM-74-1908R  
 OVER MILL CREEK, RR &  
 SPRING GROVE AVENUE  
 HAM-75-3.84  
 CITY OF CINCINNATI

STATE	COUNTY	PID NO.
OH	HAMILTON	104667
FED. PROJ. NO.: E170 (713)		
DYNAMIC RUBBER LAM. ELASTOMERIC BEARING ASSY.'S		
Cosmee 1501 ROCKY RIDGE ROAD P.O. BOX 2159 ATHENS, TEXAS 75751		
SCALE: NONE	DRAWN BY: MH	CHECKED BY: ELS
	DATE: 07/15/19	DATE: 07/16/19

ADDED AHEAD STATIONING PER APPROVER.	MH	07/26/19	ELS	07/29/19	SHEET 8 OF 17	JOB NO.: 15353B2
REV.	DESCRIPTION	BY	DATE	CK'D	DATE	CUSTOMER: WALSH CONSTRUCTION CO. II DRAWING NUMBER: 15353B2-D8 REV. 1

**PRIME AE, Group, Inc**  
 DATE REC'D: 8/1/2019 BUILDABLE UNIT NO.: 11  
 Review conforms that the shop drawings meet the intent of the contract.

CONFORMS AS-IS     CONFORMS AS NOTED  
 REVISIONS     REVISE AND RESEND



1908R - BEARINGS  
 By: Conrad Gagnon  
 Date: 8/2/2019

**RELEASED FOR FABRICATION**

**WALSH**


10G BACK PLATE  
 3/16" PTFE

By: \_\_\_\_\_  
 Date: \_\_\_\_\_

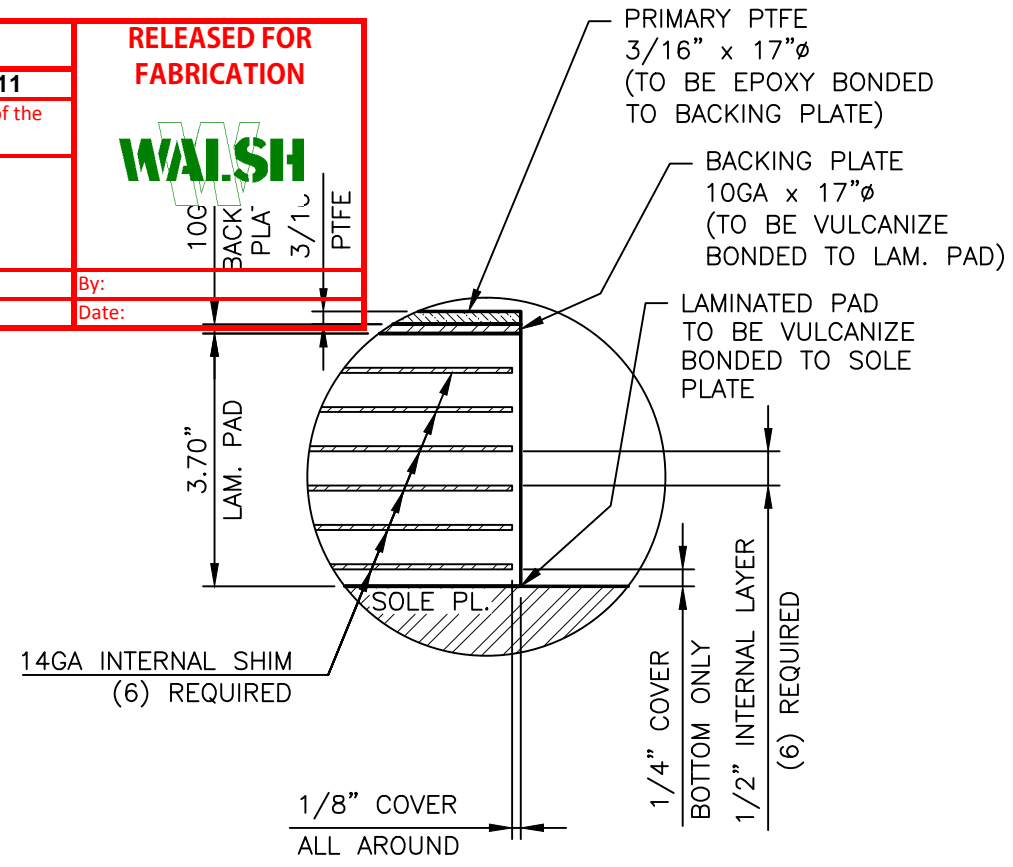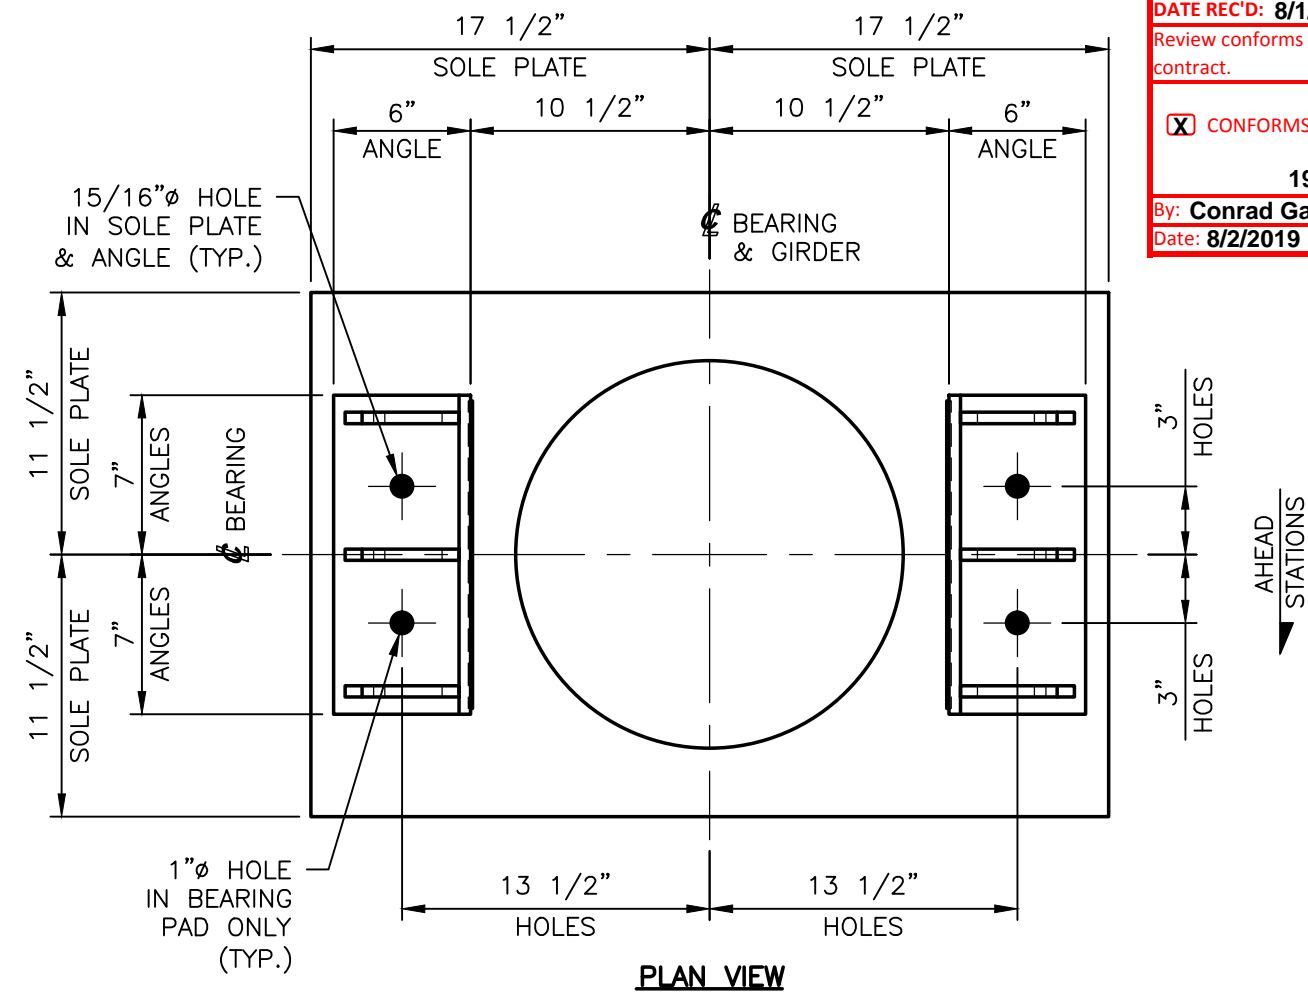

**DETAIL 7**  
 3.70" x 17"ø LAMINATED PAD  
 50 DUROMETER GRADE 3 NEOPRENE  
 VULCANIZE BONDED TO SOLE & BACKING PLATES  
 (7) REQUIRED

UNFACTORED ELASTOMERIC BEARING LOADS	
DEAD LOAD	80 KIPS
LIVE LOAD	99 KIPS
TOTAL LOAD (DL+LL)	179 KIPS

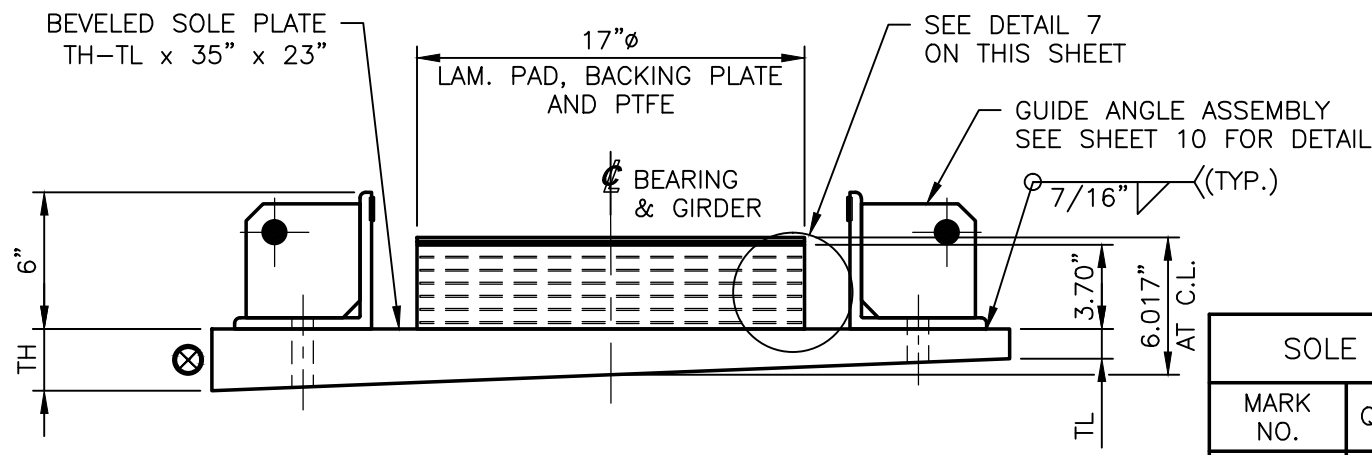

**FRONT VIEW**  
**SOLE PLATE ASSEMBLY DETAIL**  
 REFER TO SOLE PLATE ASSEMBLY TABLE FOR MARK NO.'S, QTY.'S, LOCATIONS AND DIMENSIONS  
 (7) REQUIRED


SOLE PLATE ASSEMBLY TABLE				
MARK NO.	QTY.	GIRDER NO.	TH	TL
EBA7-B	1	G3-U2	2.70"	1.30"
EBA8-B	2	G5-U2 & G8-U2	2.72"	1.28"
EBA9-B	1	G6-U2	2.74"	1.26"
EBA10-B	1	G9-U2	2.68"	1.32"
EBA11-B	1	G11-U2	2.71"	1.29"
EBA12-B	1	G12-U2	2.77"	1.23"

SEE NOTES ON SHEET GN1 OF 1  
**STATE OF OHIO**  
 DEPARTMENT OF TRANSPORTATION  
**BRIDGE NO.: HAM-74-1908R**  
 OVER MILL CREEK, RR & SPRING GROVE AVENUE  
**HAM-75-3.84**  
 CITY OF CINCINNATI


STATE	COUNTY	PID NO.
OH	HAMILTON	104667
FED. PROJ. NO.: E170 (713)		
<b>DYNAMIC RUBBER LAM. ELASTOMERIC BEARING ASSY.'S</b>		
<b>Cosmee</b> 1501 ROCKY RIDGE ROAD P.O. BOX 2159 ATHENS, TEXAS 75751		
SCALE: NONE	DRAWN BY: MH	CHECKED BY: ELS
	DATE: 07/15/19	DATE: 07/16/19

REV.	DESCRIPTION	BY	DATE	CK'D	DATE

SHEET 9 OF 17    JOB NO.: 15353B2  
 CUSTOMER: WALSH CONSTRUCTION CO. II    DRAWING NUMBER: 15353B2-D9    REV. 0

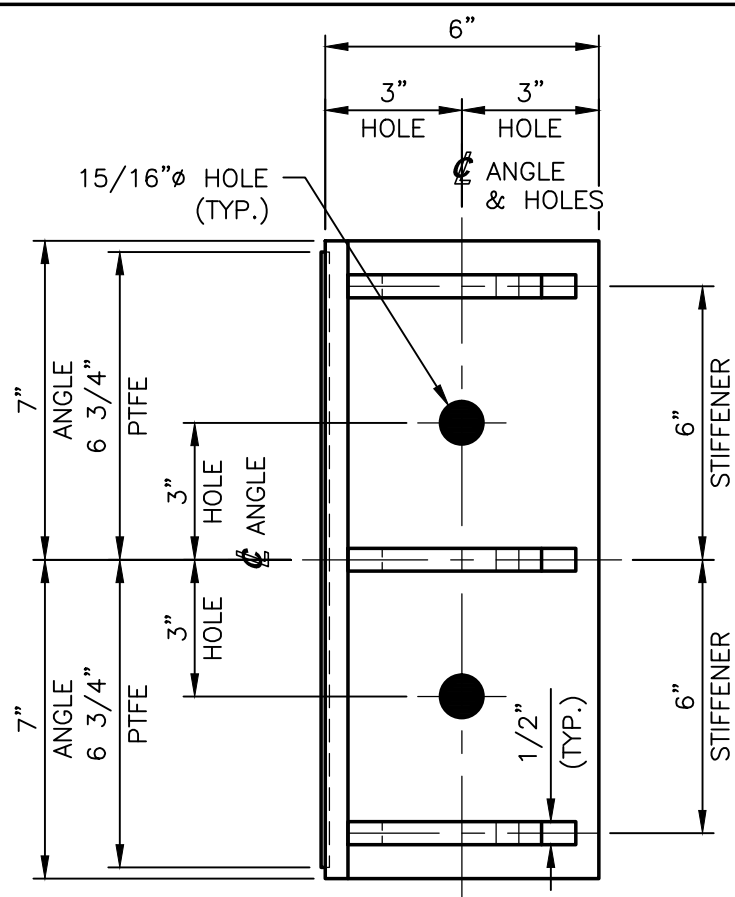


**PLAN VIEW**

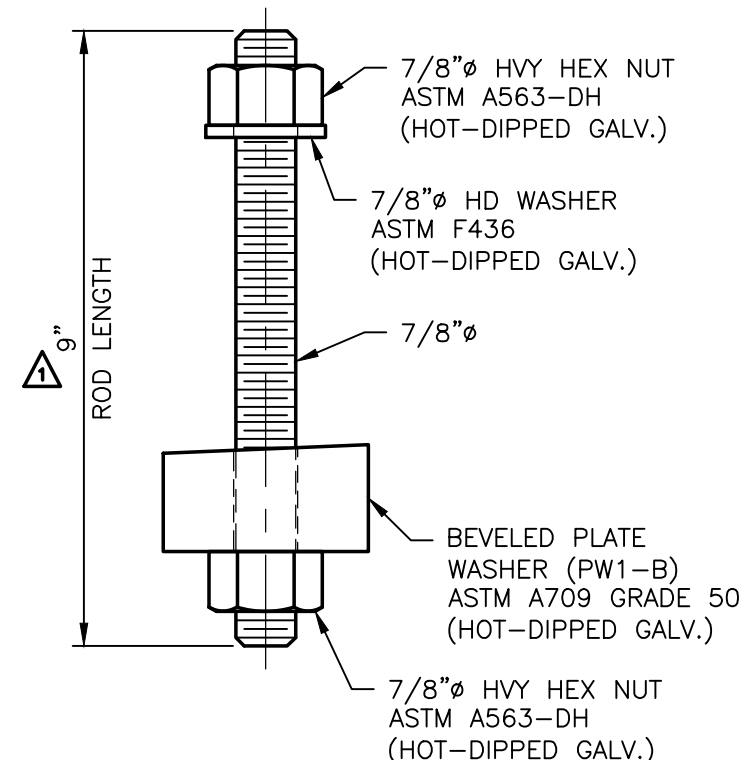


**H.S. ALL-THREAD ANCHOR ROD ASSEMBLY  
MARK: AB2-B**

ROD: 7/8"Ø x 9" LONG  $\Delta$   
ASTM F1554 GRADE 55 (HOT-DIPPED GALV.)  
(14) LOCATED AT CARRIER BEAM UNIT 2  
(GIRDERS G3-U2, G5-U2, G6-U2, G8-U2,  
G9-U2, G11-U2 & G12-U2)  
(14) REQUIRED

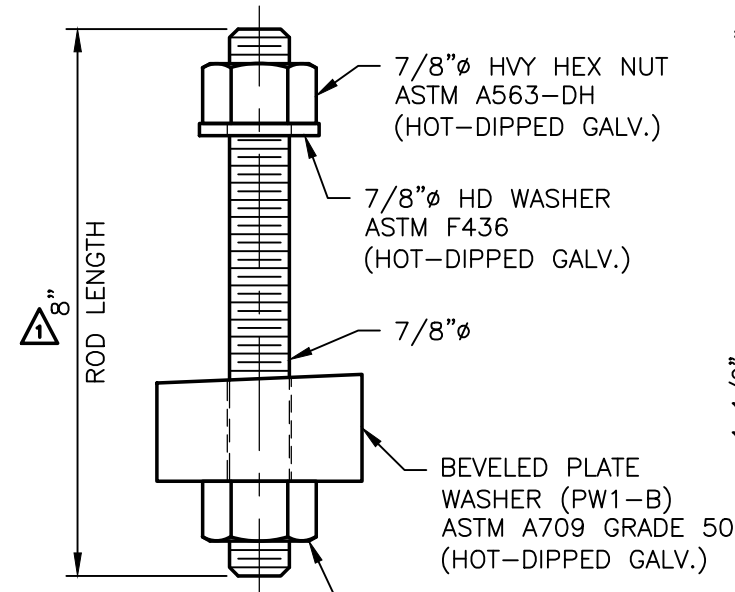


**L.S. ALL-THREAD ANCHOR ROD ASSEMBLY  
MARK: AB3-B**

ROD: 7/8"Ø x 8" LONG  $\Delta$   
ASTM F1554 GRADE 55 (HOT-DIPPED GALV.)  
(14) LOCATED AT CARRIER BEAM UNIT 2  
(GIRDERS G3-U2, G5-U2, G6-U2, G8-U2,  
G9-U2, G11-U2 & G12-U2)  
(14) REQUIRED

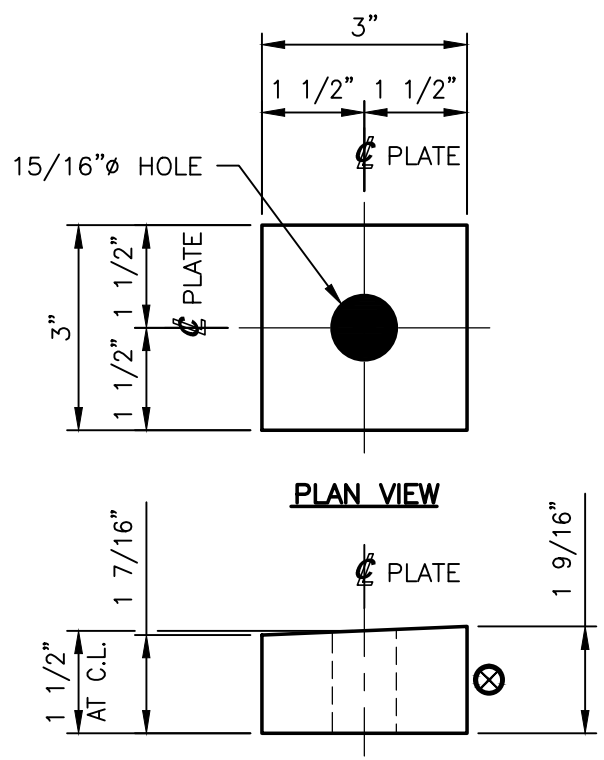


**BEVELED PLATE WASHER  
MARK: PW1-B**

PL 1 7/16"-1 9/16" x 3" x 3"  
ASTM A709 GRADE 50  
(HOT-DIPPED GALV.)  
(28) REQUIRED

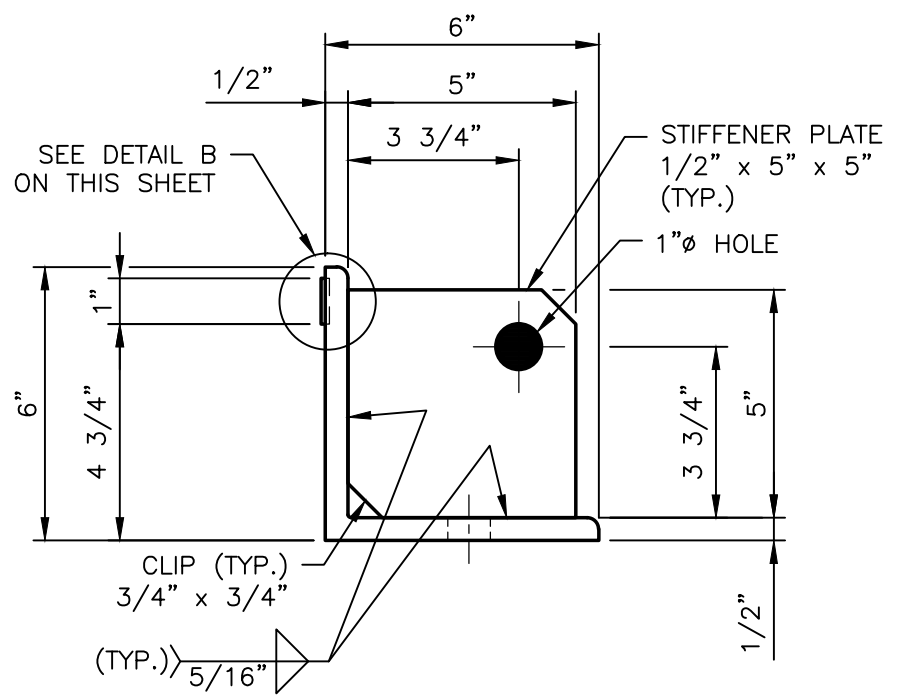

**ELEVATION VIEW**

**GUIDE ANGLE DETAIL**  
L6" x 6" x 1/2" x 14" LONG  
ASTM A709 GRADE 50 (METALIZED)  
(14) REQUIRED

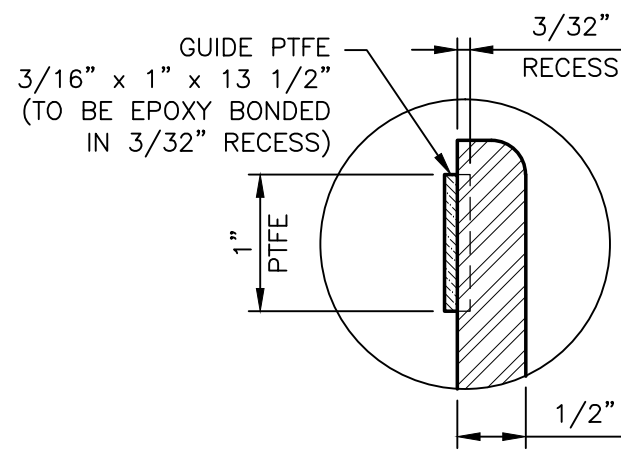

**DETAIL B**

<b>PRIME AE, Group, Inc</b>		<b>RELEASED FOR FABRICATION</b> <b>WALSH</b>
DATE REC'D: 8/1/2019	BUILDABLE UNIT NO.: 11	
Review conforms that the shop drawings meet the intent of the contract.		
<input checked="" type="checkbox"/> CONFORMS AS-IS	<input type="checkbox"/> CONFORMS AS NOTED	
	<input type="checkbox"/> REVISE AND RESEND	
<b>1908R - BEARINGS</b>		
By: Conrad Gagnon	By:	
Date: 8/2/2019	Date:	

SEE NOTES ON SHEET GN1 OF 1  
**STATE OF OHIO**  
DEPARTMENT OF TRANSPORTATION  
**BRIDGE NO.: HAM-74-1908R**  
OVER MILL CREEK, RR &  
SPRING GROVE AVENUE  
**HAM-75-3.84**  
CITY OF CINCINNATI


STATE	COUNTY	PID NO.
OH	HAMILTON	104667
FED. PROJ. NO.: E170 (713)		
<b>DYNAMIC RUBBER</b>		
<b>LAM. ELASTOMERIC BEARING ASSY.'S</b>		
<b>Cosmee</b>		
1501 ROCKY RIDGE ROAD P.O. BOX 2159 ATHENS, TEXAS 75751		
SCALE: NONE	DRAWN BY: MH	CHECKED BY: ELS
	DATE: 07/15/19	DATE: 07/16/19

$\Delta$ REVISED ANCHOR BOLT LENGTHS PER DESIGN CHANGE.	MH	07/26/19	ELS	07/29/19	SHEET 10 OF 17	<b>JOB NO.: 15353B2</b>
REV.	DESCRIPTION	BY	DATE	CK'D	DATE	CUSTOMER WALSH CONSTRUCTION CO. II
						DRAWING NUMBER 15353B2-D10
						REV. 1









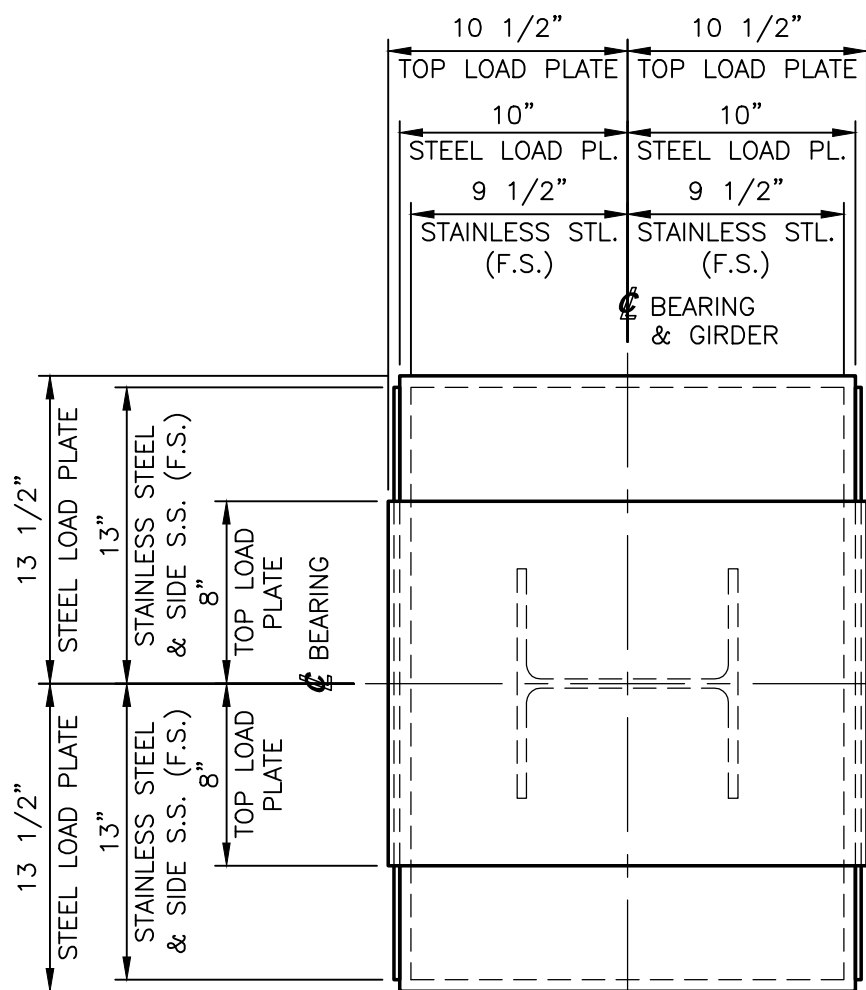


**PLAN VIEW**

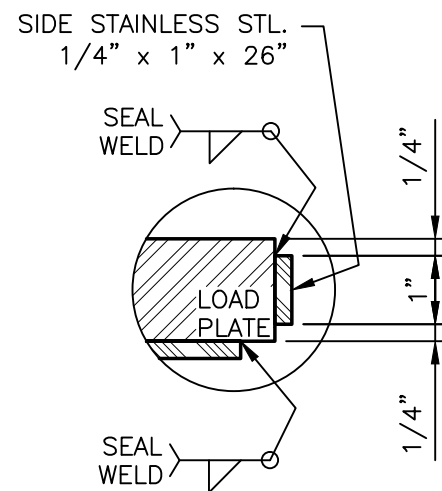

**DETAIL C**

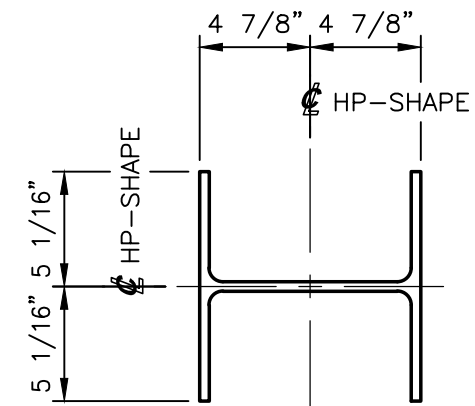


**PLAN VIEW**

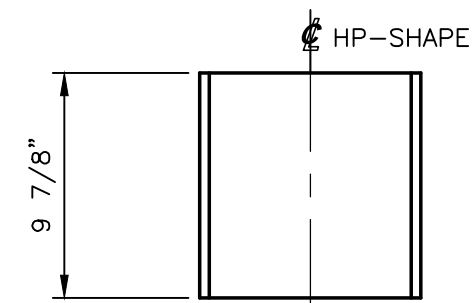

**ELEVATION VIEW**

**FLAT HP10x42**  
(4) REQUIRED

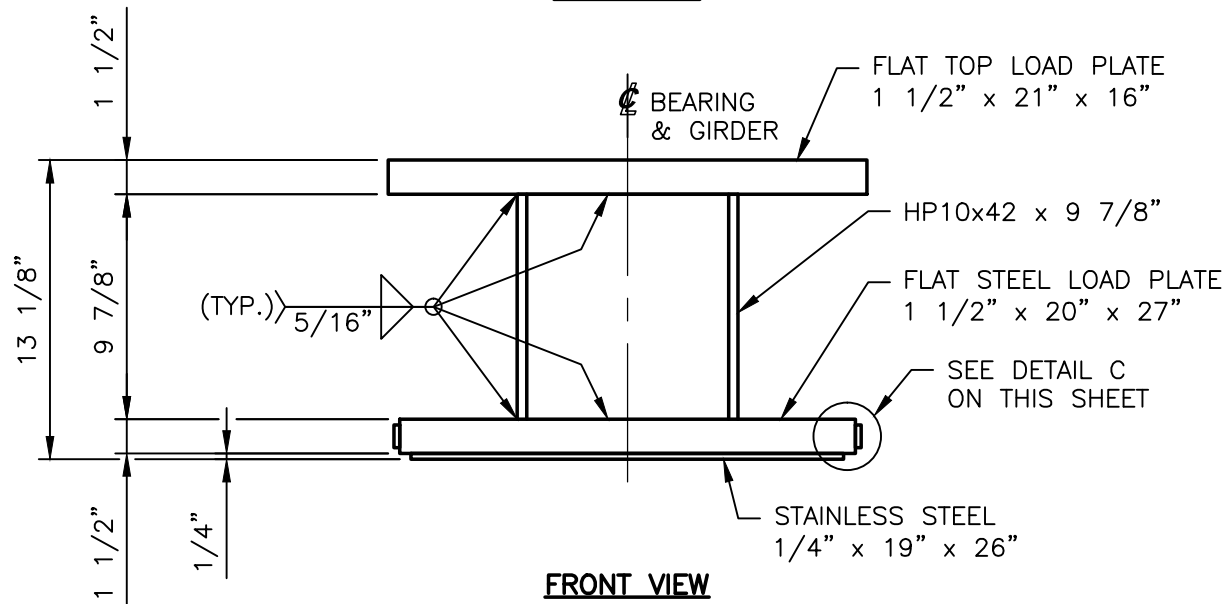

**FRONT VIEW**

**HP10x42 ASSEMBLY DETAIL**  
**MARK: EBA13-B**

(4) LOCATED AT HINGE 1, UNIT 2  
(GIRDERS G4-U2, G7-U2, G10-U2 & G13-U2)  
(4) REQUIRED

SEE NOTES ON SHEET GN1 OF 1

**STATE OF OHIO**  
DEPARTMENT OF TRANSPORTATION  
**BRIDGE NO.: HAM-74-1908R**  
OVER MILL CREEK, RR &  
SPRING GROVE AVENUE  
**HAM-75-3.84**  
CITY OF CINCINNATI

STATE	COUNTY	PID NO.
OH	HAMILTON	104667
FED. PROJ. NO.: E170 (713)		

**DYNAMIC RUBBER**  
**LAM. ELASTOMERIC BEARING ASSY.'S**


**Cosmee** 1501 ROCKY RIDGE ROAD  
P.O. BOX 2159  
ATHENS, TEXAS 75751

SCALE: NONE	DRAWN BY: MH	CHECKED BY: ELS
	DATE: 07/15/19	DATE: 07/16/19

<b>PRIME AE, Group, Inc</b>		<b>RELEASED FOR FABRICATION</b>
DATE REC'D: 8/1/2019	BUILDABLE UNIT NO.: 11	
Review conforms that the shop drawings meet the intent of the contract.		<b>WALSH</b>
<input checked="" type="checkbox"/> CONFORMS AS-IS	<input type="checkbox"/> CONFORMS AS NOTED	
<input type="checkbox"/> REVISE AND RESEND		
<b>1908R - BEARINGS</b>		
By: Conrad Gagnon	By:	
Date: 8/2/2019	Date:	

ADDED AHEAD STATIONING PER APPROVER.	MH	07/26/19	ELS	07/29/19	SHEET 12 OF 17	<b>JOB NO.: 15353B2</b>
REV.	DESCRIPTION	BY	DATE	CK'D	DATE	CUSTOMER: WALSH CONSTRUCTION CO. II
						DRAWING NUMBER: 15353B2-D12
						REV. 1



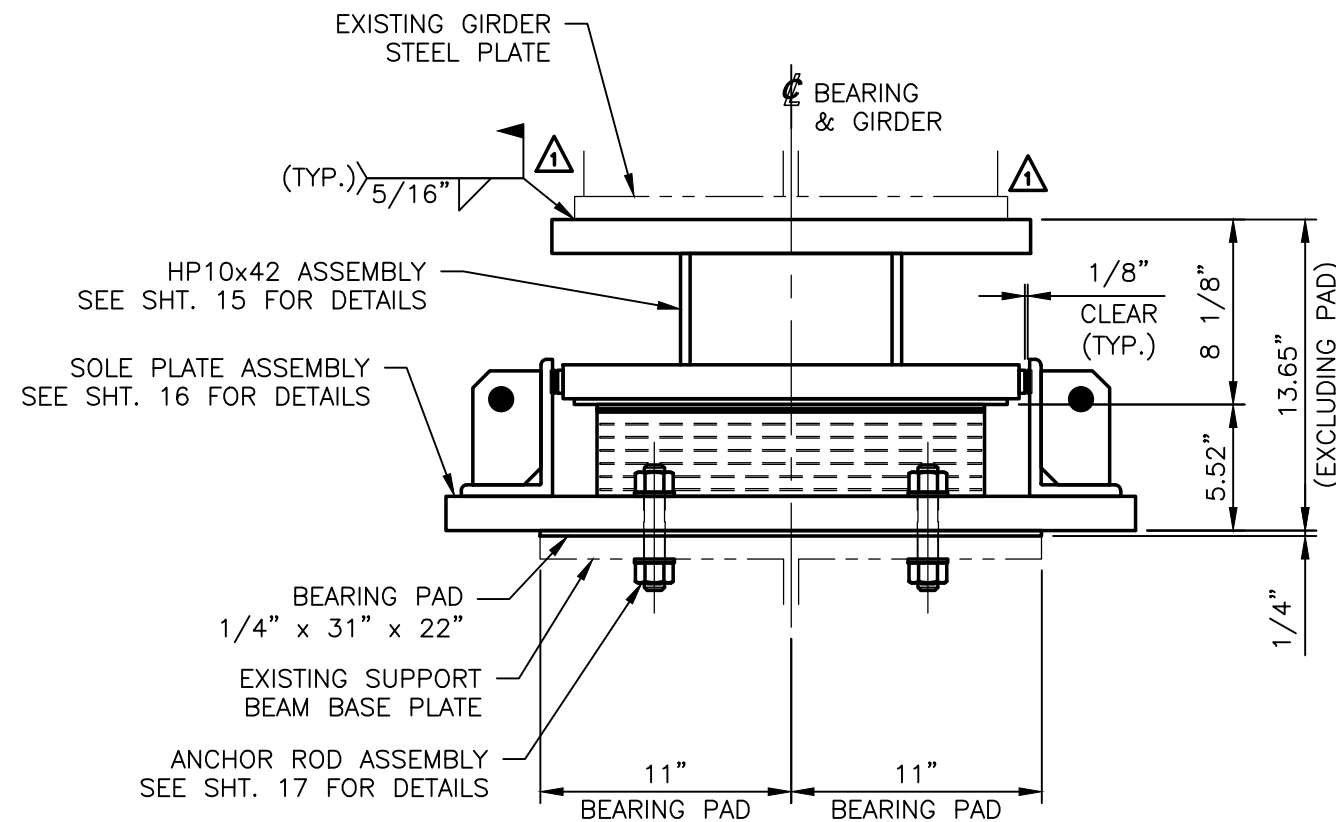

**EXPANSION LAMINATED  
ELASTOMERIC BEARING ASSEMBLY (REF.: 0033)**

**AT HINGE SUPPORT - UNIT 6  
MARK: EBA14-B**

(6) LOCATED AT HINGE 2, UNIT 6  
(GIRDERS B3 THRU B8)  
(6) REQUIRED

SEE NOTES ON SHEET GN1 OF 1

STATE OF OHIO  
DEPARTMENT OF TRANSPORTATION  
**BRIDGE NO.: HAM-74-1908R  
OVER MILL CREEK, RR &  
SPRING GROVE AVENUE**  
**HAM-75-3.84  
CITY OF CINCINNATI**

STATE	COUNTY	PID NO.
OH	HAMILTON	104667

FED. PROJ. NO.: E170 (713)


**DYNAMIC RUBBER  
LAM. ELASTOMERIC BEARING ASSY.'S**

**Cosmee** 1501 ROCKY RIDGE ROAD  
P.O. BOX 2159  
ATHENS, TEXAS 75751


SCALE: NONE	DRAWN BY: MH	CHECKED BY: ELS
	DATE: 07/15/19	DATE: 07/16/19

<b>PRIME AE, Group, Inc</b>		<b>RELEASED FOR FABRICATION</b>
DATE REC'D: 8/1/2019	BUILDABLE UNIT NO.: 11	
Review conforms that the shop drawings meet the intent of the contract.		<b>WALSH</b>
<input checked="" type="checkbox"/> CONFORMS AS-IS	<input type="checkbox"/> CONFORMS AS NOTED	
	<input type="checkbox"/> REVISE AND RESEND	
<b>1908R - BEARINGS</b>		
By: Conrad Gagnon	By:	
Date: 8/2/2019	Date:	


REVISOR	DESCRIPTION	BY	DATE	CK'D	DATE	SHEET 14 OF 17	JOB NO.: 15353B2	CUSTOMER WALSH CONSTRUCTION CO. II	DRAWING NUMBER 15353B2-D14	REV. 1
		MH	07/26/19	ELS	07/29/19					

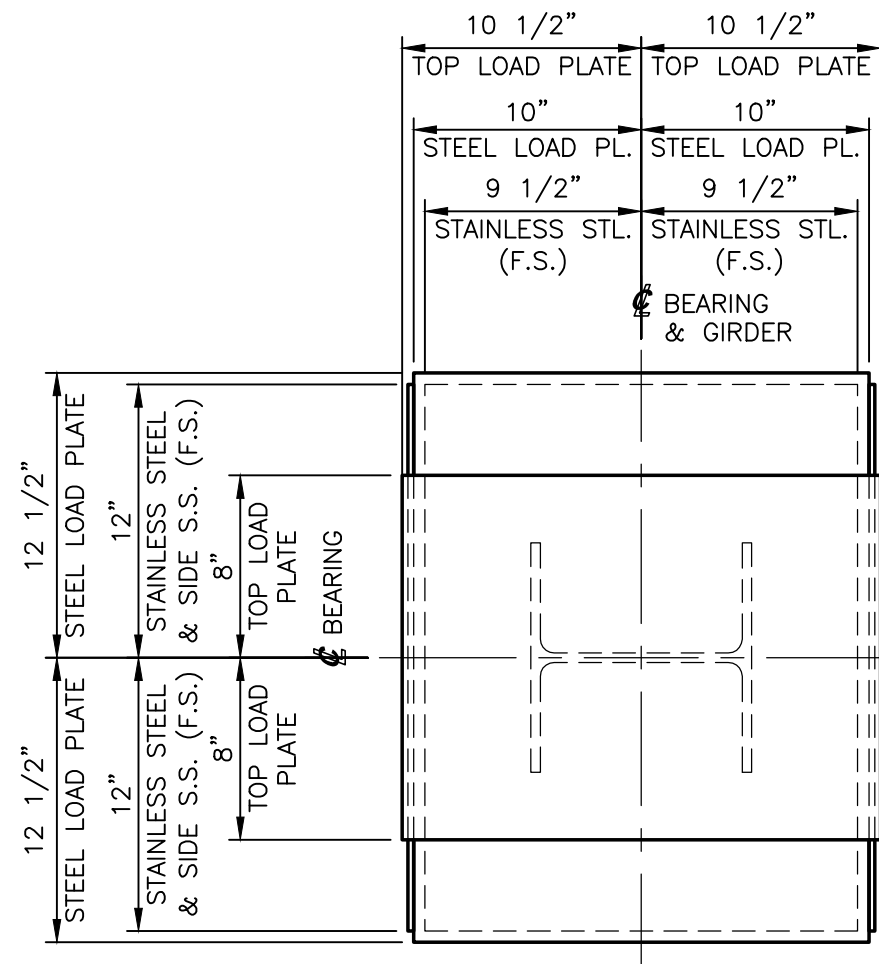


**PLAN VIEW**

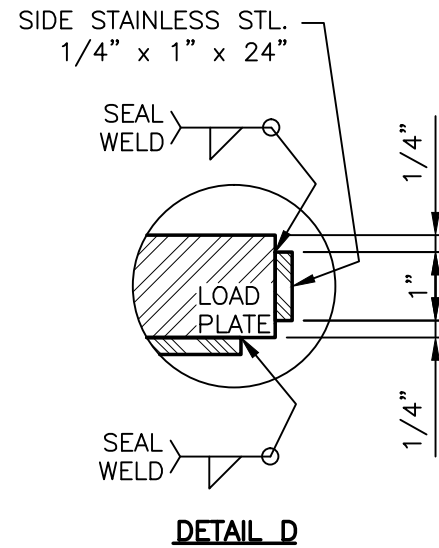

**DETAIL D**

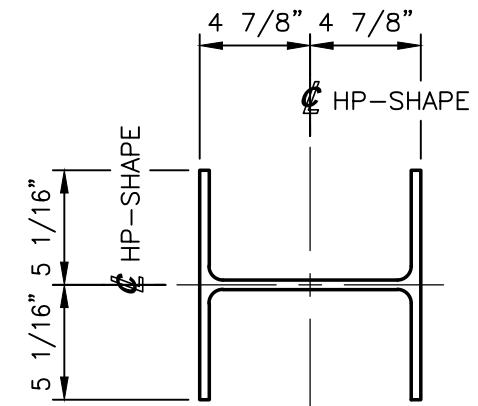


**PLAN VIEW**

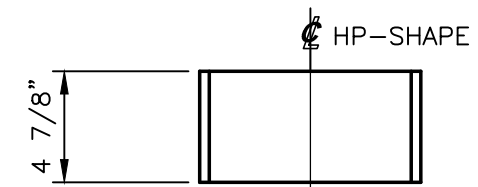

**ELEVATION VIEW**

**FLAT HP10x42**  
(6) REQUIRED

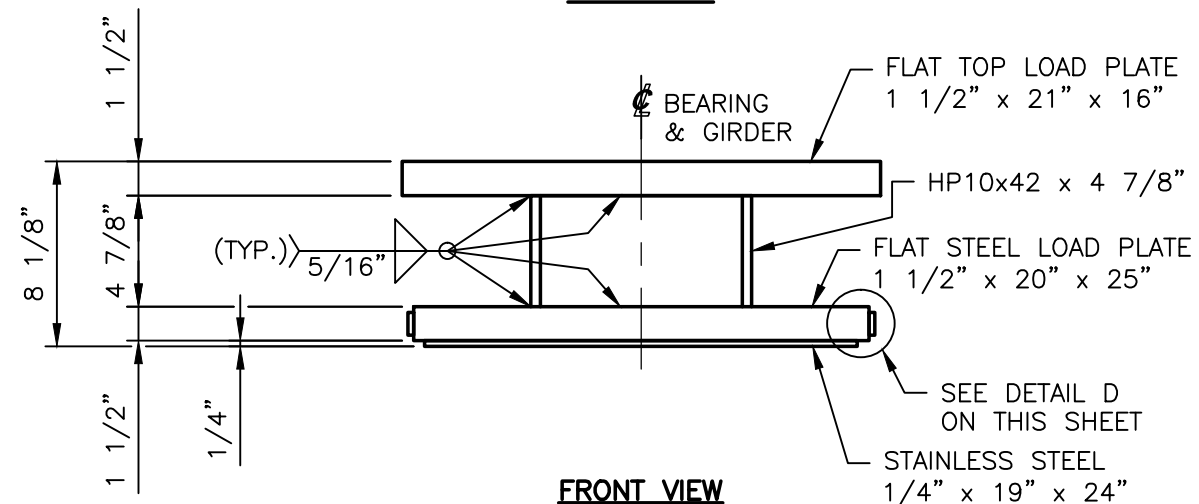

**FRONT VIEW**

**HP10x42 ASSEMBLY DETAIL**  
**MARK: EBA14-B**

(6) LOCATED AT HINGE 2, UNIT 6  
(GIRDERS B3 THRU B8)  
(6) REQUIRED

<b>PRIME AE, Group, Inc</b>		<b>RELEASED FOR FABRICATION</b>  <b>WALSH</b>
DATE REC'D: <b>8/1/2019</b>	BUILDABLE UNIT NO.: <b>11</b>	
Review conforms that the shop drawings meet the intent of the contract.		
<input checked="" type="checkbox"/> CONFORMS AS-IS	<input type="checkbox"/> CONFORMS AS NOTED	
	<input type="checkbox"/> REVISE AND RESEND	
<b>1908R - BEARINGS</b>		
By: <b>Conrad Gagnon</b>	By:	
Date: <b>8/2/2019</b>	Date:	

SEE NOTES ON SHEET GN1 OF 1

STATE OF OHIO  
DEPARTMENT OF TRANSPORTATION  
**BRIDGE NO.: HAM-74-1908R**  
**OVER MILL CREEK, RR & SPRING GROVE AVENUE**  
  
**HAM-75-3.84**  
CITY OF CINCINNATI


STATE	COUNTY	PID NO.
OH	HAMILTON	104667
FED. PROJ. NO.: E170 (713)		

**DYNAMIC RUBBER**  
**LAM. ELASTOMERIC BEARING ASSY.'S**


**Cosmee** 1501 ROCKY RIDGE ROAD  
P.O. BOX 2159  
ATHENS, TEXAS 75751

SCALE: NONE	DRAWN BY: <b>MH</b>	CHECKED BY: <b>ELS</b>
	DATE: 07/15/19	DATE: 07/16/19

ADDED AHEAD STATIONING PER APPROVER.	<b>MH</b>	07/26/19	ELS	07/29/19	SHEET 15 OF 17	<b>JOB NO.: 15353B2</b>
REV.	DESCRIPTION	BY	DATE	CK'D	DATE	CUSTOMER WALSH CONSTRUCTION CO. II
						DRAWING NUMBER 15353B2-D15
						REV. 1

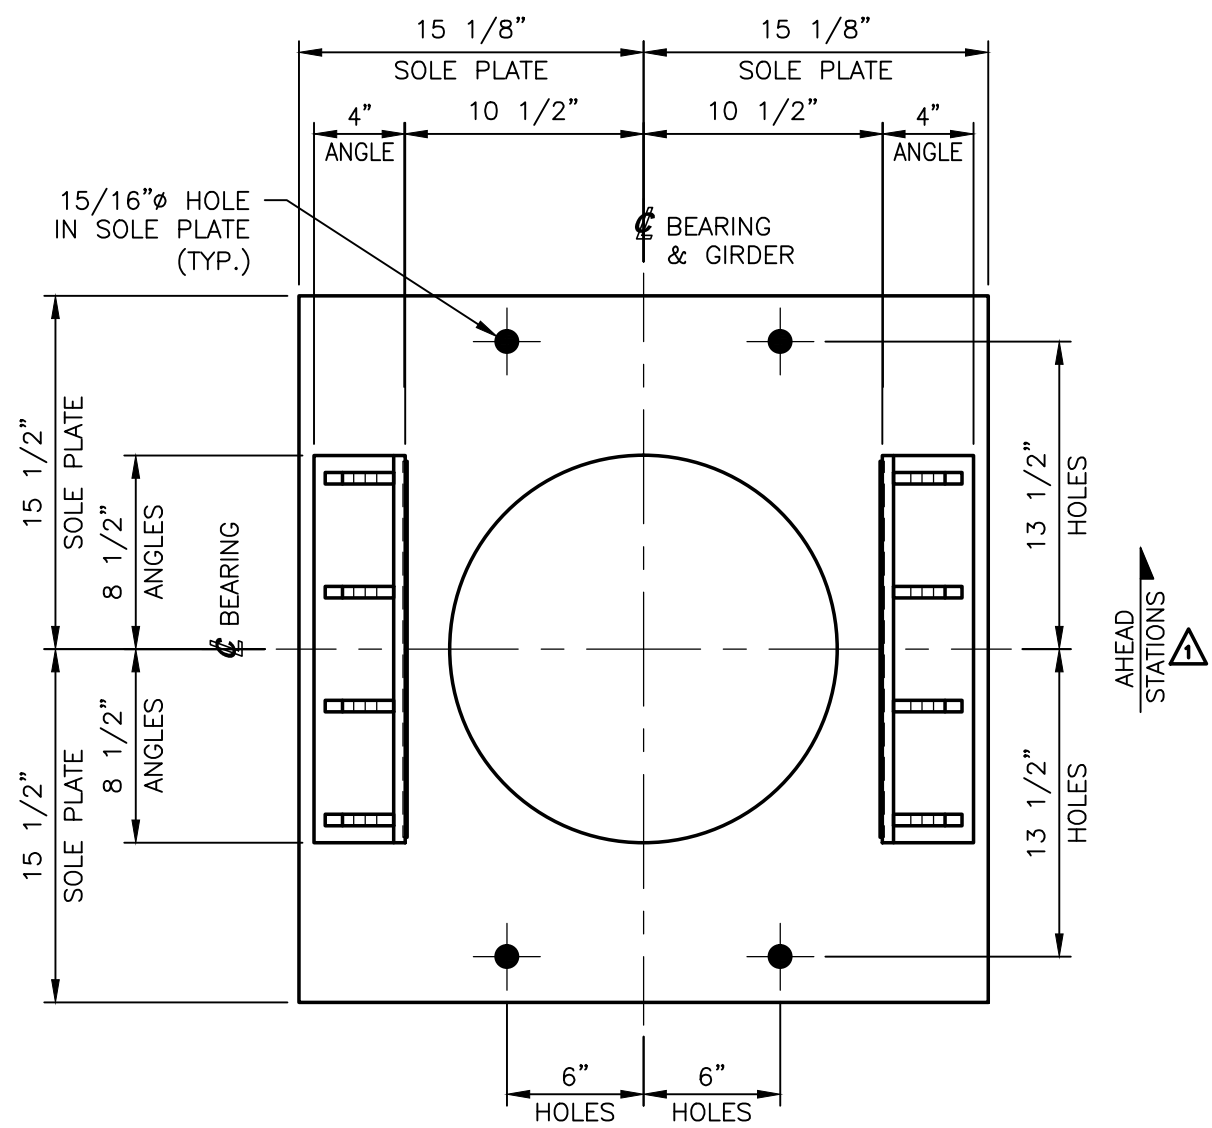


**PLAN VIEW**

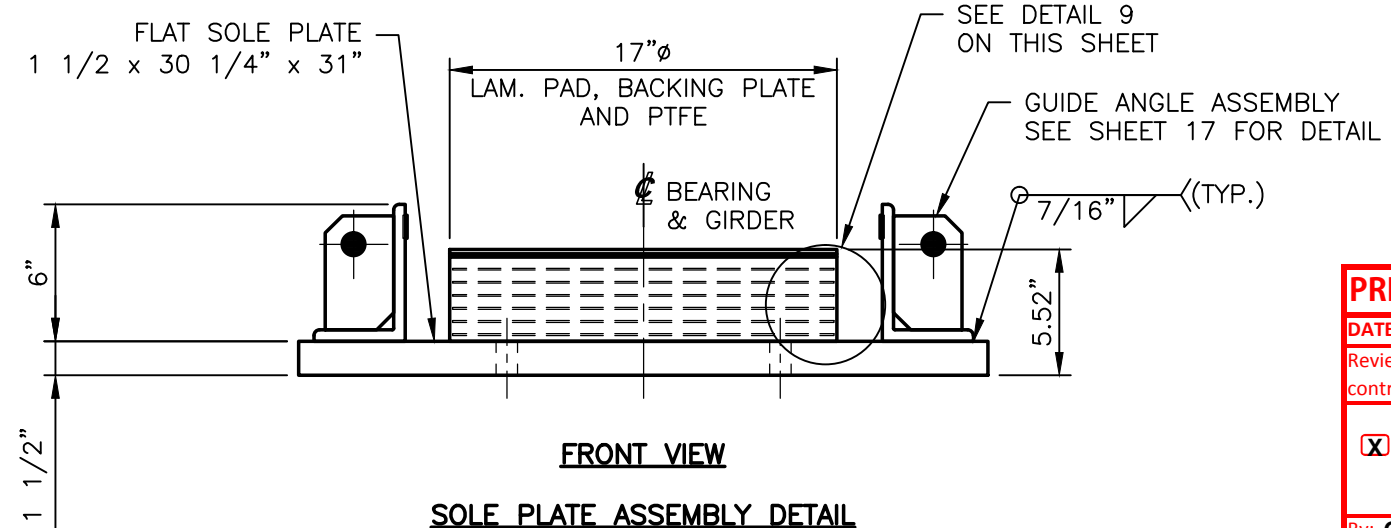

**SOLE PLATE ASSEMBLY DETAIL**  
MARK: EBA14-B

(6) LOCATED AT HINGE 2, UNIT 6  
(GIRDERS B3 THRU B8)  
(6) REQUIRED

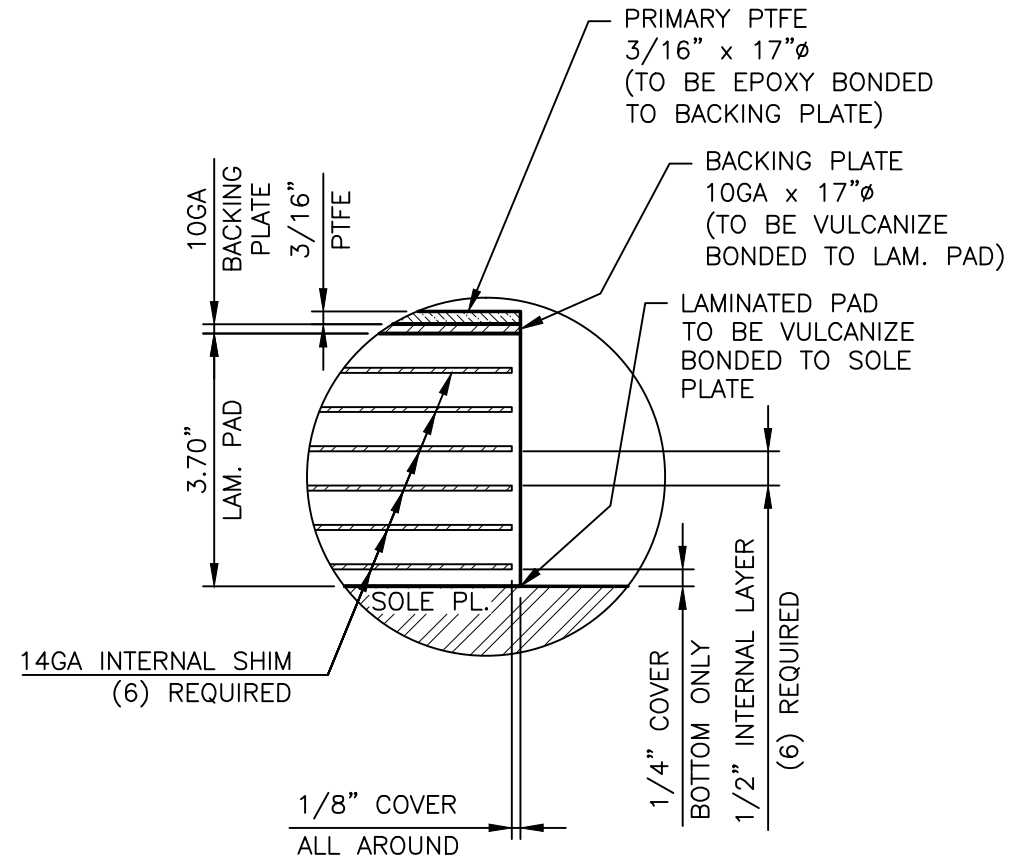

**DETAIL 9**  
3.70" x 17"Ø LAMINATED PAD  
50 DUROMETER GRADE 3 NEOPRENE  
VULCANIZE BONDED TO SOLE & BACKING PLATES  
(6) REQUIRED

UNFACTORED ELASTOMERIC BEARING LOADS	
DEAD LOAD	37 KIPS
LIVE LOAD	49 KIPS
TOTAL LOAD (DL+LL)	86 KIPS

SEE NOTES ON SHEET GN1 OF 1  
**STATE OF OHIO**  
DEPARTMENT OF TRANSPORTATION  
**BRIDGE NO.: HAM-74-1908R**  
OVER MILL CREEK, RR &  
SPRING GROVE AVENUE  
**HAM-75-3.84**  
CITY OF CINCINNATI

STATE	COUNTY	PID NO.
OH	HAMILTON	104667
FED. PROJ. NO.: E170 (713)		


**DYNAMIC RUBBER**  
**LAM. ELASTOMERIC BEARING ASSY.'S**

**Cosmee** 1501 ROCKY RIDGE ROAD  
P.O. BOX 2159  
ATHENS, TEXAS 75751


SCALE: NONE	DRAWN BY: MH	CHECKED BY: ELS
	DATE: 07/15/19	DATE: 07/16/19

<b>PRIME AE, Group, Inc</b>		<b>RELEASED FOR FABRICATION</b>
DATE REC'D: 8/1/2019	BUILDABLE UNIT NO.: 11	
Review conforms that the shop drawings meet the intent of the contract.		<b>WALSH</b>
<input checked="" type="checkbox"/> CONFORMS AS-IS	<input type="checkbox"/> CONFORMS AS NOTED	
<input type="checkbox"/> REVISE AND RESEND		
<b>1908R - BEARINGS</b>		
By: Conrad Gagnon	By:	
Date: 8/2/2019	Date:	

ADDED AHEAD STATIONING PER APPROVER.	MH	07/26/19	ELS	07/19/19	SHEET 16 OF 17	<b>JOB NO.: 15353B2</b>
REV.	DESCRIPTION	BY	DATE	CK'D	DATE	CUSTOMER: WALSH CONSTRUCTION CO. II
						DRAWING NUMBER: 15353B2-D16
						REV. 1

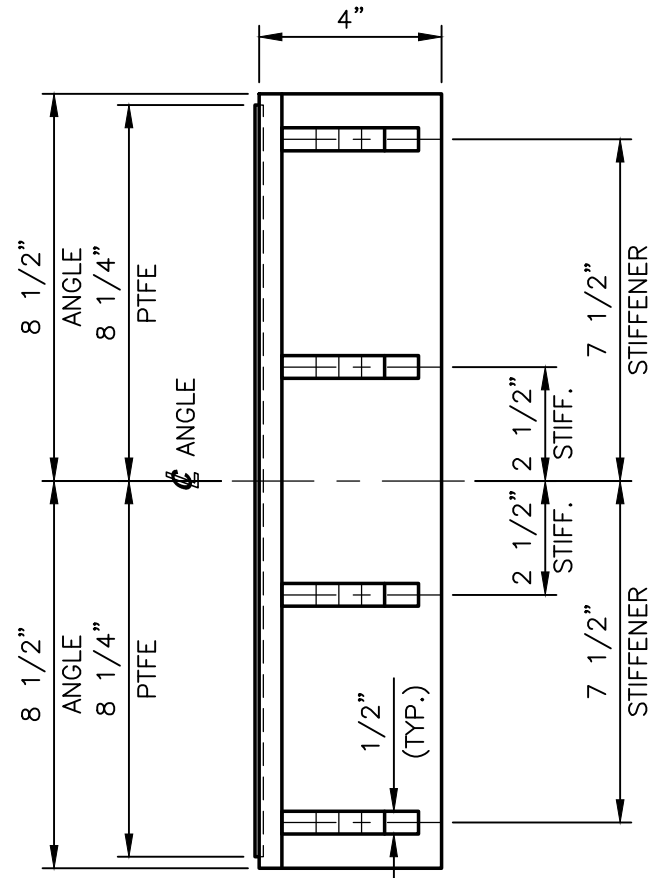


**PLAN VIEW**

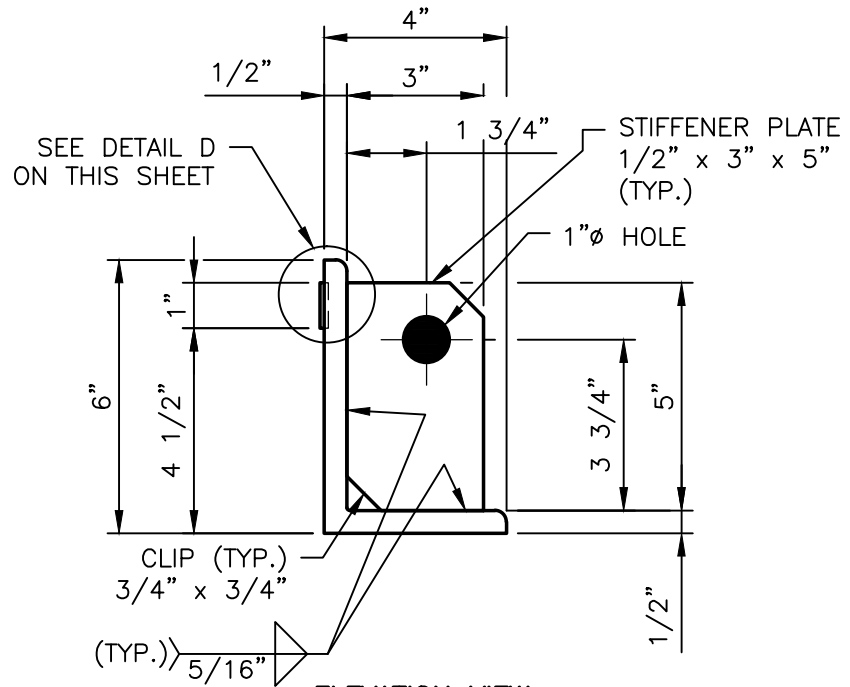


**ELEVATION VIEW**

**GUIDE ANGLE DETAIL**  
 L6" x 4" x 1/2" x 17" LONG  
 ASTM A709 GRADE 50 (METALIZED)  
 (8) LOCATED AT EBA13-B  
 (12) LOCATED AT EBA14-B  
 (20) REQUIRED

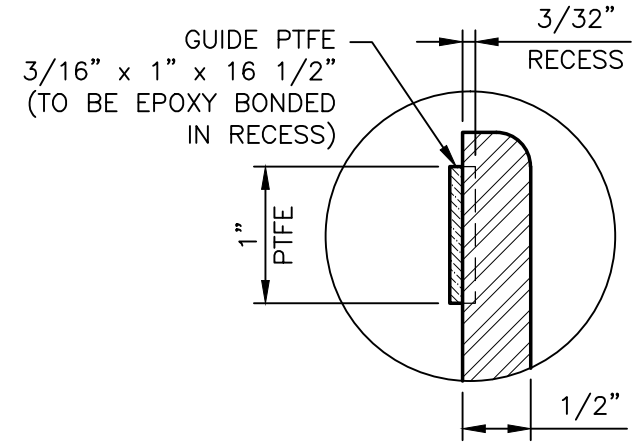

**DETAIL D**

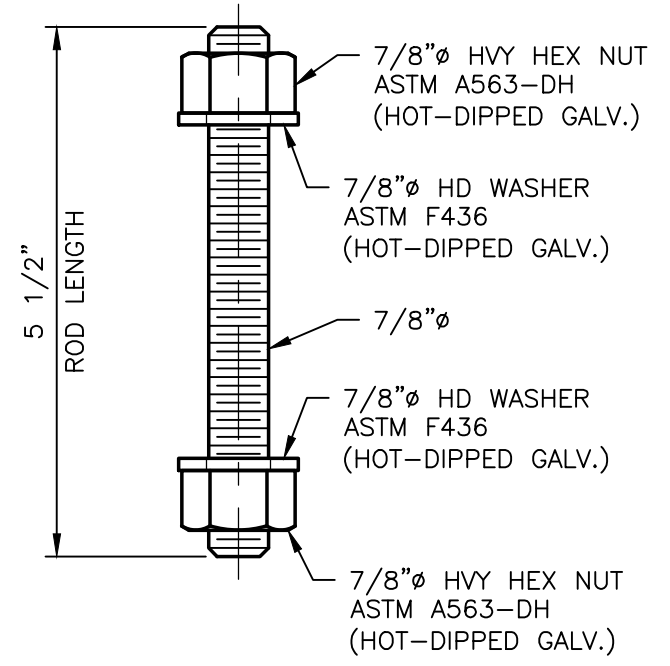

**ALL-THREAD ANCHOR ROD ASSEMBLY**  
**MARK: AB4-B**

ROD: 7/8"Ø x 5 1/2" LONG  
 ASTM F1554 GRADE 55 (HOT-DIPPED GALV.)  
 (16) LOCATED AT HINGE 1, UNIT 2  
 (GIRDERS G4-U2, G7-U2, G10-U2 & G13-U2)  
 (24) LOCATED AT HINGE 2, UNIT 6  
 (GIRDERS B3 THRU B8)  
 (40) REQUIRED

<b>PRIME AE, Group, Inc</b>		<b>RELEASED FOR FABRICATION</b>
DATE REC'D: 8/1/2019	BUILDABLE UNIT NO.: 11	
Review conforms that the shop drawings meet the intent of the contract.		<b>WALSH</b>
<input checked="" type="checkbox"/> CONFORMS AS-IS	<input type="checkbox"/> CONFORMS AS NOTED	
<input type="checkbox"/> REVISE AND RESEND		
1908R - BEARINGS		
By: Conrad Gagnon	By:	
Date: 8/2/2019	Date:	

SEE NOTES ON SHEET GN1 OF 1

**STATE OF OHIO**  
 DEPARTMENT OF TRANSPORTATION

**BRIDGE NO.: HAM-74-1908R**  
 OVER MILL CREEK, RR &  
 SPRING GROVE AVENUE

**HAM-75-3.84**  
 CITY OF CINCINNATI

STATE	COUNTY	PID NO.
OH	HAMILTON	104667

FED. PROJ. NO.: E170 (713)

**DYNAMIC RUBBER**  
**LAM. ELASTOMERIC BEARING ASSY.'S**


**Cosmee** 1501 ROCKY RIDGE ROAD  
 P.O. BOX 2159  
 ATHENS, TEXAS 75751

SCALE: NONE	DRAWN BY: MH	CHECKED BY: ELS
	DATE: 07/15/19	DATE: 07/16/19

REV.	DESCRIPTION	BY	DATE	CK'D	DATE	SHEET 17 OF 17	<b>JOB NO.: 15353B2</b>	CUSTOMER WALSH CONSTRUCTION CO. II	DRAWING NUMBER 15353B2-D17	REV. 0
------	-------------	----	------	------	------	----------------	-------------------------	---------------------------------------	-------------------------------	-----------



based on 33'-11 1/2" from phase 1  
 31'-7 3/4" based on 33'-11 1/2" from phase 1 comments (Toe curb/toe curb is 65'-7 1/4")

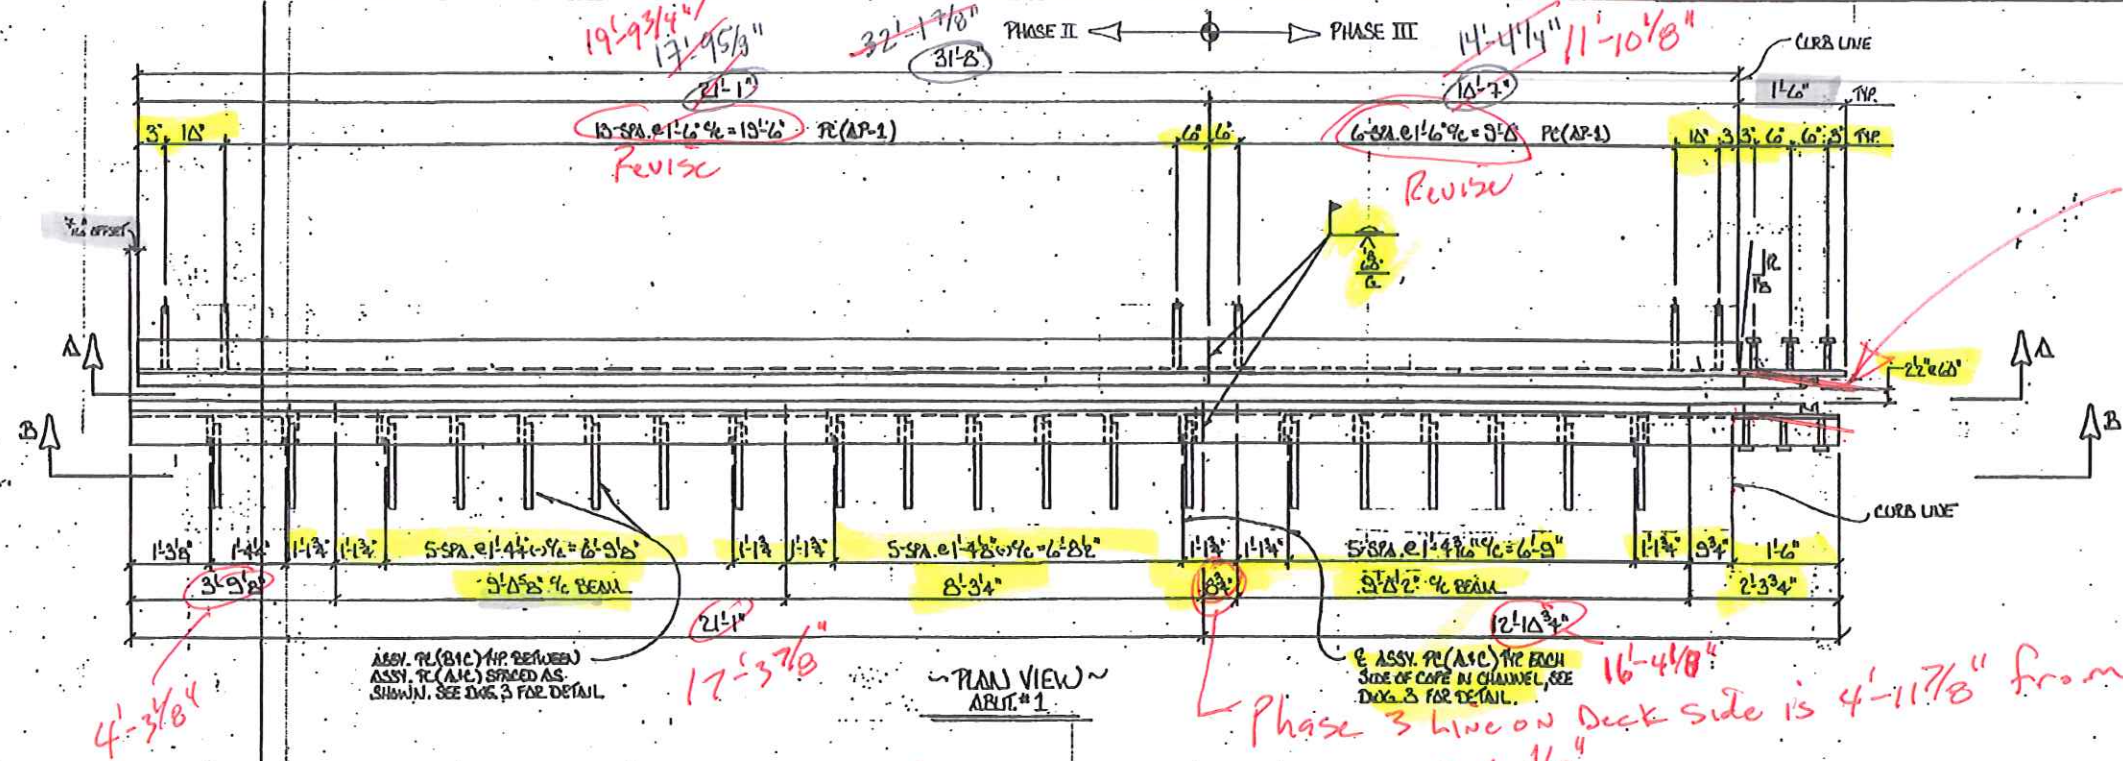

5' 3/2" 31" Bend

- Deck + Haunch:
- 15.59" (G2)
  - 16.54" (G3)
  - 17.61" (G4)
  - 18.37" (G5)
  - 19.23" (G6)

Phase 3 line on Deck side is 4'-11 7/8" from G3.

4'-3 1/8"

17'-5 7/8"

16'-4 1/8"

17'-9 7/8" 19'-9 3/4"

14'-4 1/4" 11'-10 1/8"

1/2" VENT HLS. @ 9% MAX. (1 1/2" GA)  
 ADJUST HLS. AS NEEDED TO CLEAR ABUT. ANCHORS

VIEW A-A  
 1-REQ'D. AS SHOWN (14EJ113)

17'-3 7/8" 17'-9 5/8" 21'-1" (14EJ12)

14'-7 1/4" 14'-10 1/8" 10'-7" (14EJ14)

1/2" VENT HLS. @ 9% MAX. (1 1/2" GA)  
 ADJUST HLS. AS NEEDED TO CLEAR DECK ANCHORS

4'-0 1/2" 4'-6"

VIEW B-B  
 1-REQ'D. AS SHOWN (14EJ2+4)

4'-9 1/8" from prev. comments

shouldn't this be 4'-3" to make 9'-14" b/w 65 & 66

4'-3 1/8"

4'-11 7/8"

- assumed
- Dim = 15.59 - 1 3/4" = 13.84" (G2)
- 16.54 - 1 3/4" = 14.79" (G3)
- 17.61 - 1 3/4" = 15.86" (G4)
- 18.37 - 1 3/4" = 16.62" (G5)

**PRIME AE, Group, Inc**

DATE REC'D: 3/10/2020 BUILDABLE UNIT NO.: 11

Review conforms that the shop drawings meet the intent of the contract.

CONFORMS AS-IS  CONFORMS AS NOTED  INCOMPLETE  DOES NOT CONFORM

By: Kelly Chrisman Date: 3/10/2020

RELEASED FOR FABRICATION

**WALSH**


STATE OF OHIO  
 Kelly D. Chrisman  
 E-58020  
 PROFESSIONAL ENGINEER

D.D.O.T. PROJ. 3000-18  
 COUNTY: HAMILTON  
 BRIDGE No. HAM-74-1908R  
 REF. No.


		100 Highland Drive, Suite 9 Medina, Ohio 44029-3160 Office: (330) 721-0181 Fax: (330) 721-0181 E-mail: contact@marbri.net	
NO.	REV.	DATE	DESCRIPTION
1	APP	3-9-20	
PROJECT		D.D.O.T. PROJ. 3000-18	
CONTRACTOR		WALSH CONSTRUCTION	
LOCATION		HAMILTON COUNTY	
DESCRIPTION		EXP. JOINT DETAILS - ABUT #1	
DESIGNED BY		PHASE II & III	
CHECKED BY		DATE: 3-4-20	
DRAWN BY		DATE: 3-7-20	
MATERIALS		JOB NUMBER: 3000	
		DRAWING NO.: 14	

PREPARER: MARK STUCKY (RMS - MARBRI)  
 CHECKER: KELLY D CHRISMAN (KDC - PRIME AE)




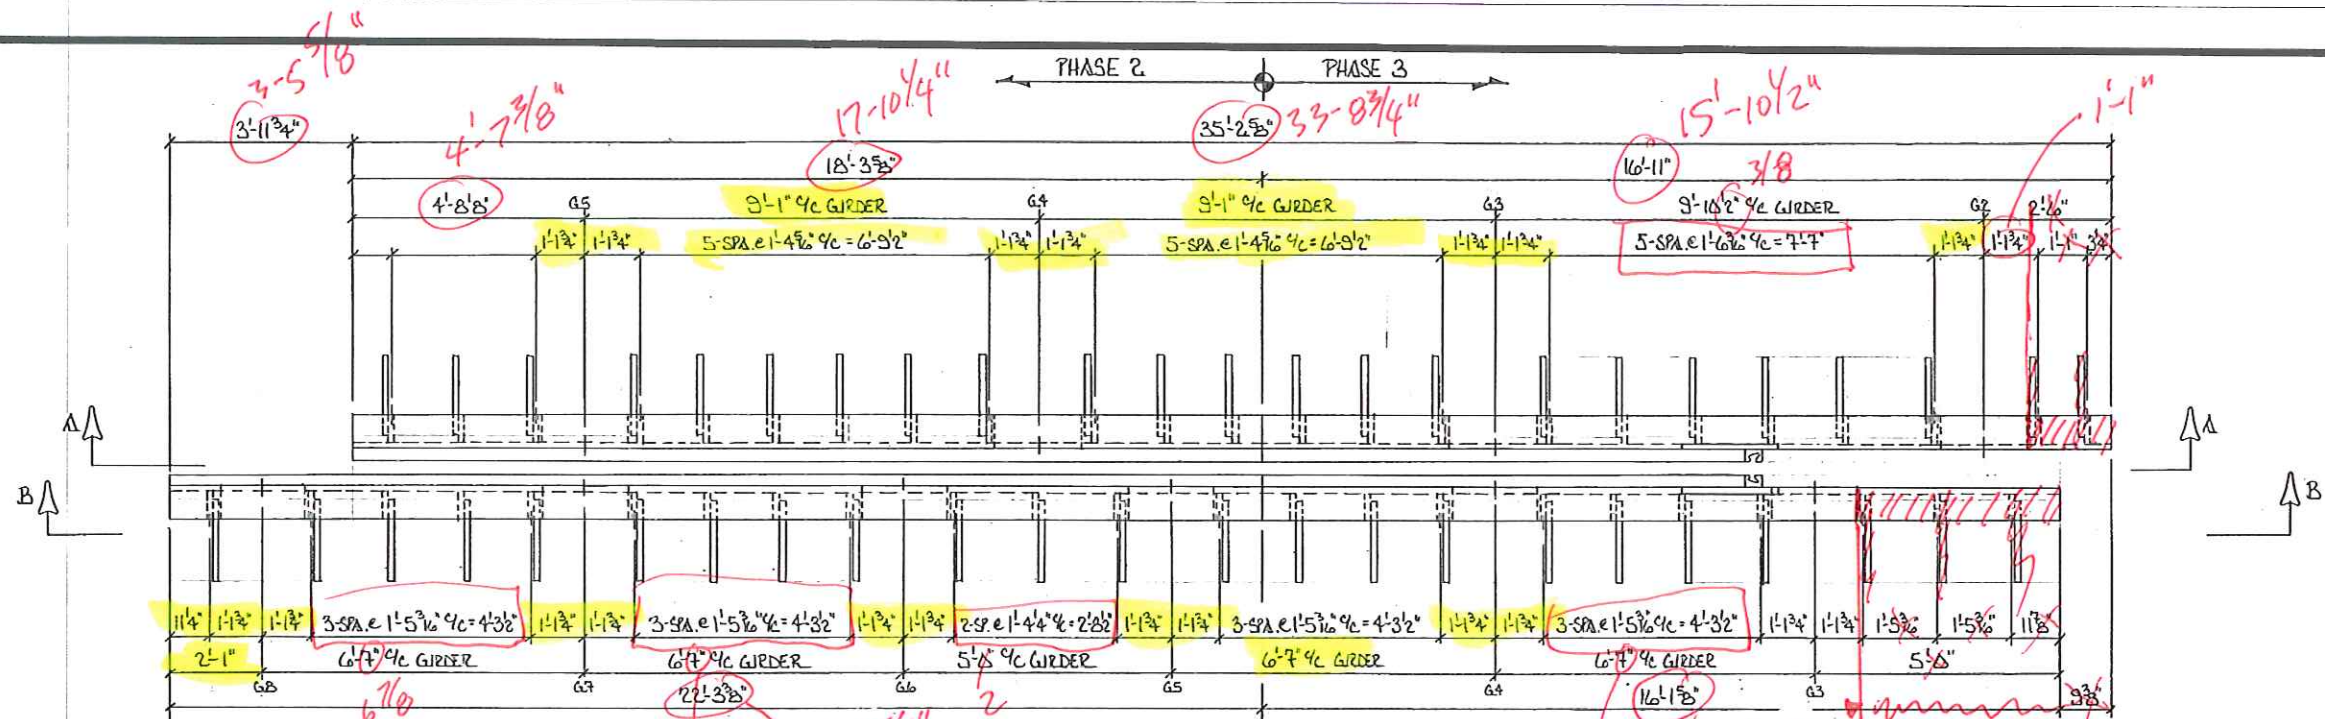

~PLAN VIEW~  
(HINGE #1)

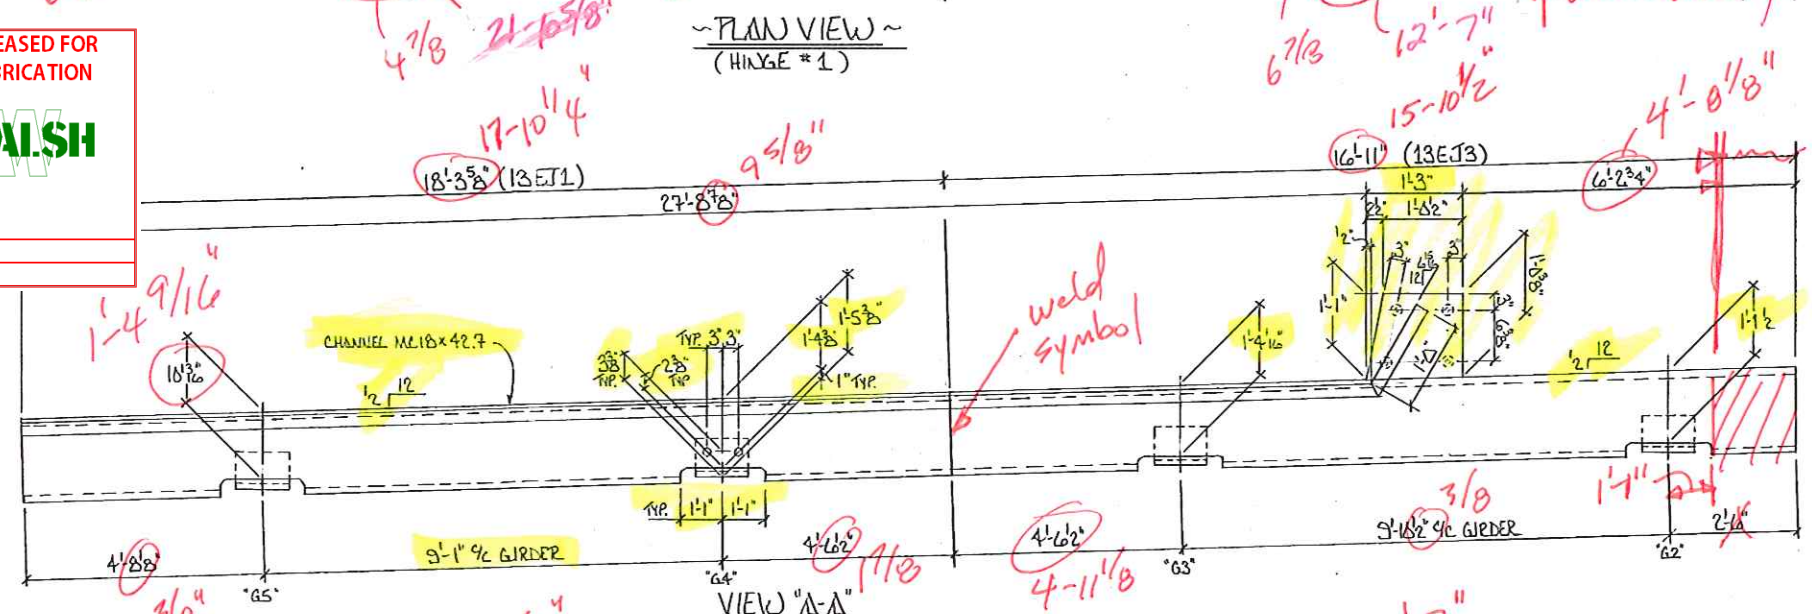

VIEW "A-A"  
1-REQ'D. EA. (13EJ1+3)

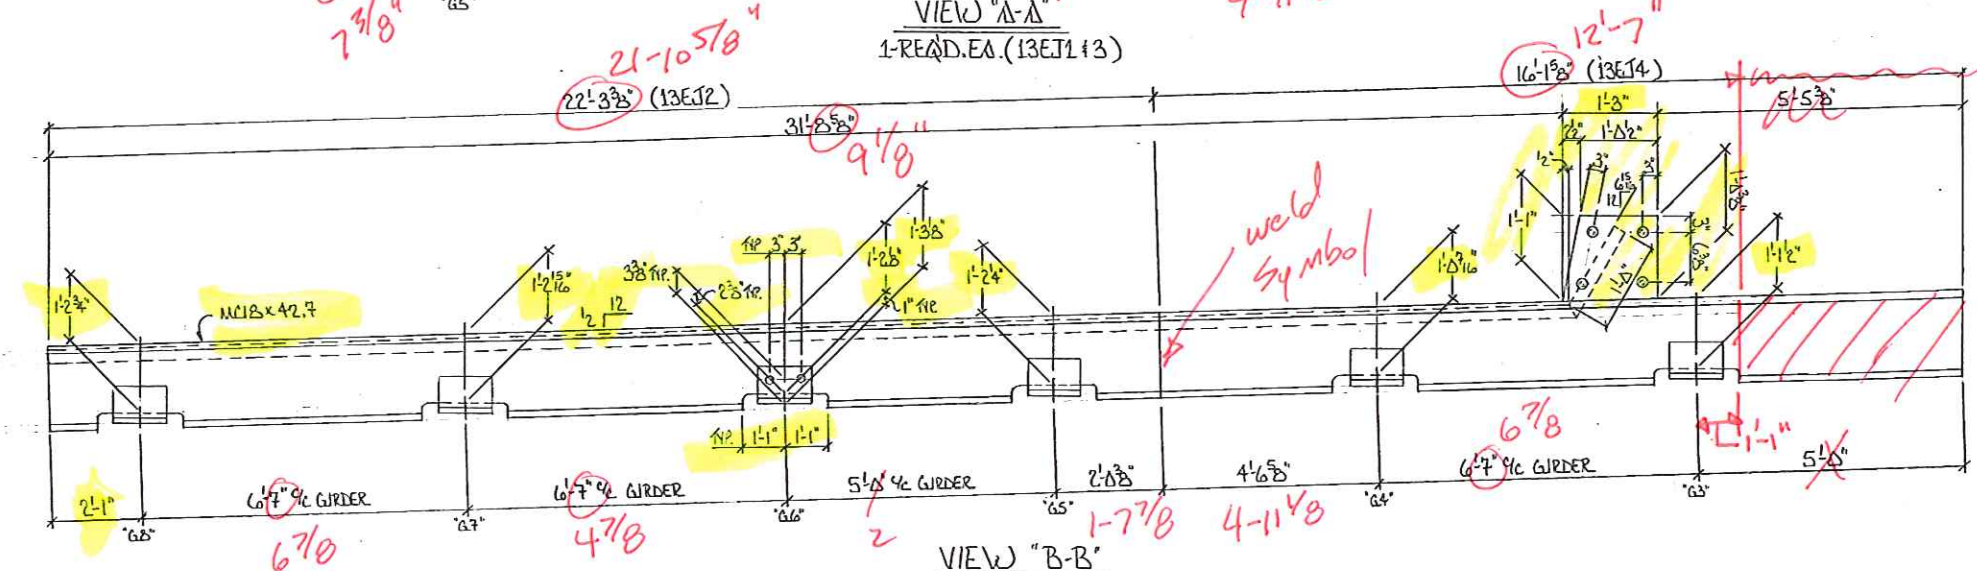

VIEW "B-B"  
1-REQ'D. EA. (13EJ2+4)

- not needed

O.D.A.T. PROJ. 3000-18  
COUNTY: HAMILTON  
BRIDGE No. HAM-75-1908R  
REF. No.



NO.	USE	DATE	FABRICATOR
1	APP	2.26.20	
PROJECT: O.D.A.T. PROJ. 3000-18			
CONTRACTOR: WALSH CONSTRUCTION			
LOCATION: HAMILTON COUNTY			
DESCRIPTION: PHASE 2 & 3 / HINGE #1			
DETAILED A.D.S. DATE 2.26.20			JOB NUMBER 3000
CHECKED R.M.S. DATE 2.26.20			DRAWING NO. 13
FINISH: REALIZED			

**PRIME AE, Group, Inc**

DATE REC'D: 2/26/2020 BUILDABLE UNIT NO.: 11

Review conforms that the shop drawings meet the intent of the contract.

CONFORMS AS-IS  CONFORMS AS NOTED  INCOMPLETE  DOES NOT CONFORM

By: Kelly Chrisman Date: 2/28/2020


RELEASED FOR FABRICATION

**WALSH**

STATE OF OHIO  
Kelly D. Chrisman  
E-68020  
REGISTERED PROFESSIONAL ENGINEER


PREPARER: MARK STUCKY (RMS - MARBRI)  
CHECKER: KELLY D CHRISMAN (KDC - PRIME AE)



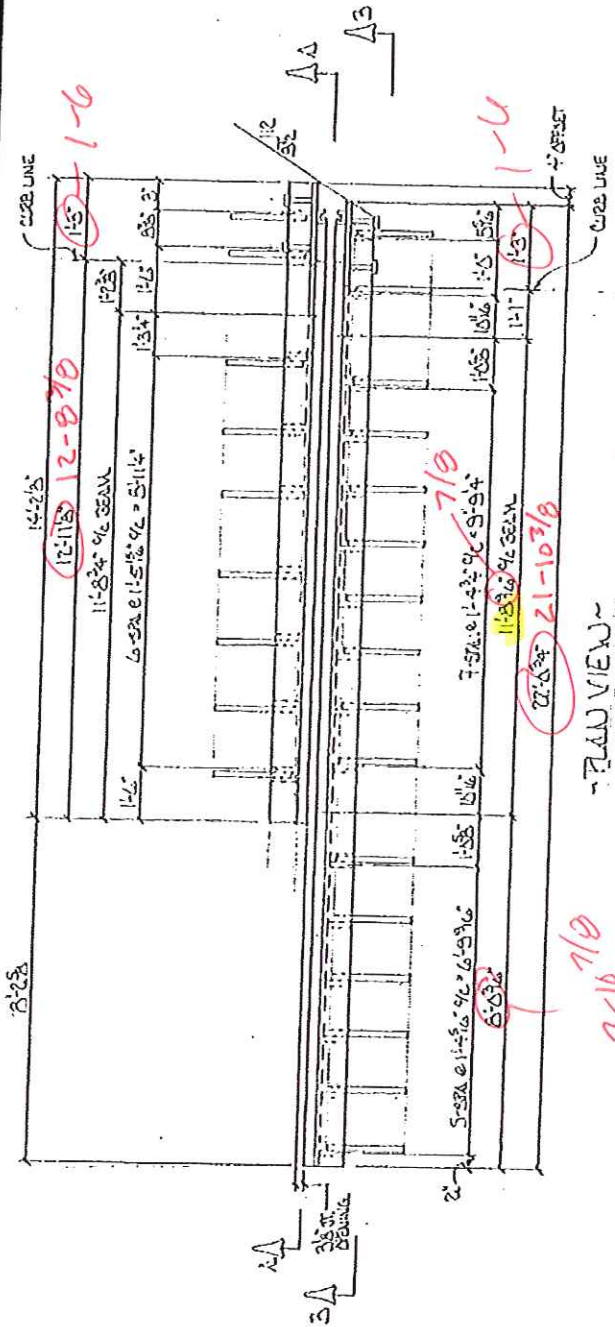


PLAN VIEW - HINGE #2


Curb to curb = 62'-7 3/8"  
 Phase 1 U2 = 49'-11"  
 " " O6 = 42'-0"  
 U2 P2 = 62'-7 3/8" - 49'-11" = 12'-8 7/8"  
 U6 P2 = 62'-7 3/8" - 42'-0" = 20'-7 3/8"

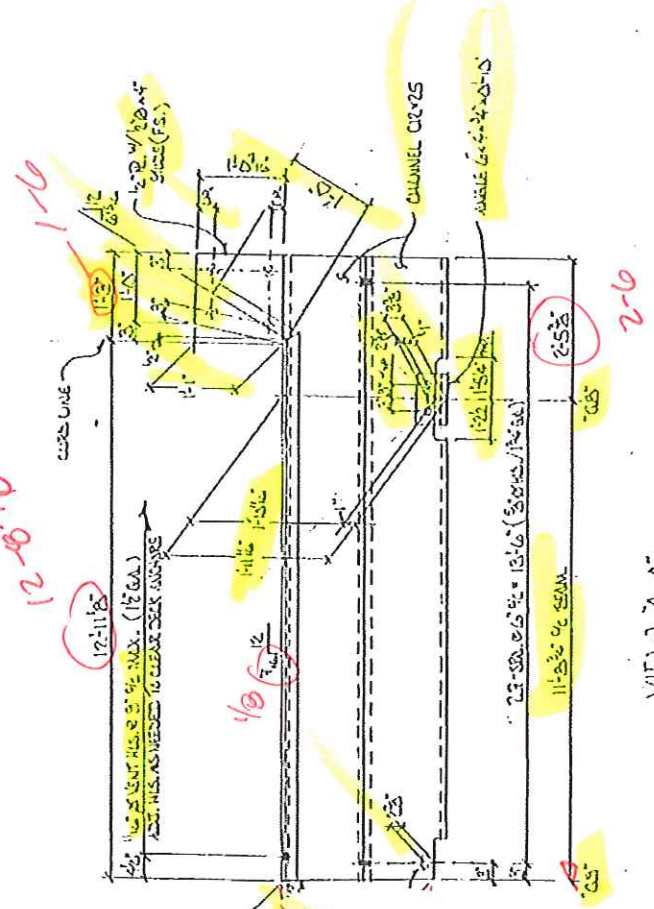

VIEW A-A (UNIT = 2)

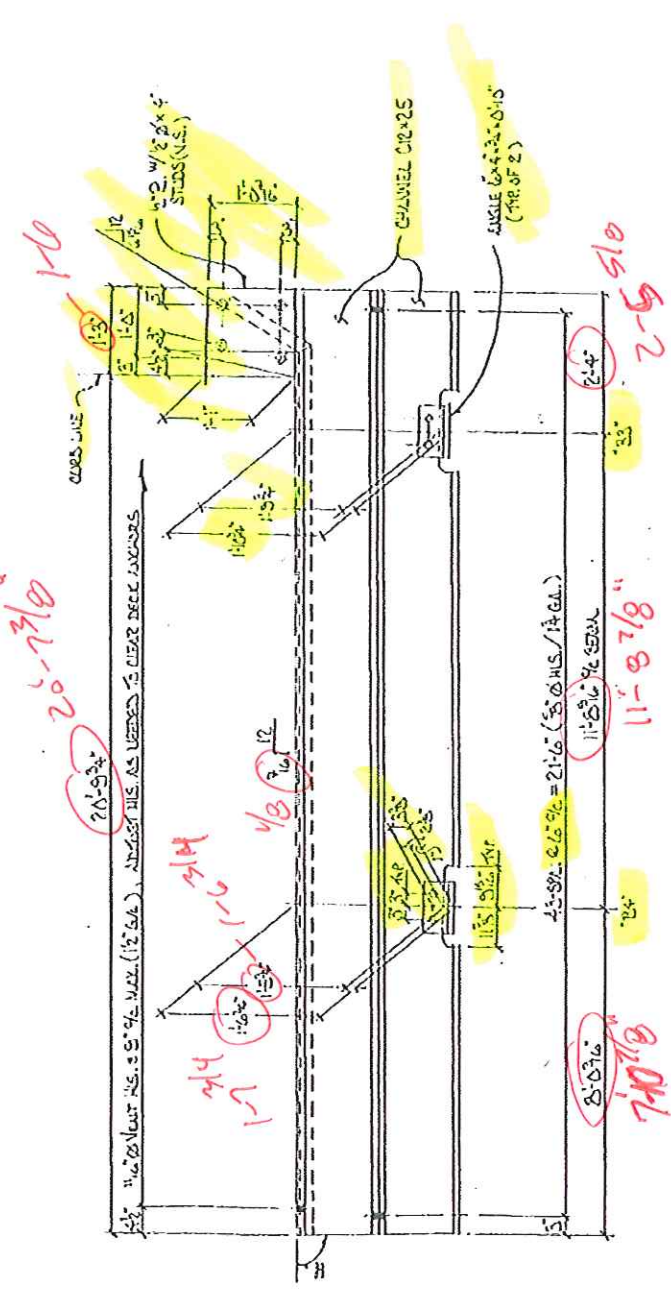

VIEW B-B (UNIT = 2)

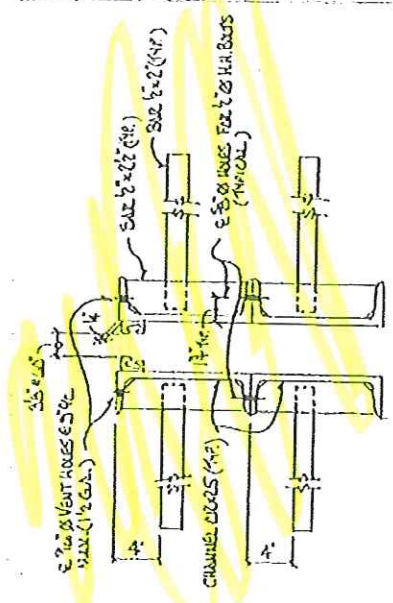


TYP. SECTION THRU EXP. JT.

O.D.A.T. PROJ.: 3000-18  
 COUNTY: HAMILTON  
 BRIDGE NO. HAM-75-1908R  
 REF. NO.

PREPARER: MARK STUCKY (RMS - MARBRI)  
 CHECKER: KELLY D CHRISMAN (KDC - PRIME AE)

<b>PRIME AE, Group, Inc</b>		<b>RELEASED FOR FABRICATION</b>	
DATE REC'D: 4/7/2020	BUILDABLE UNIT NO.: 11		
Review conforms that the shop drawings meet the intent of the contract.			
<input type="checkbox"/> CONFORMS AS-IS	<input checked="" type="checkbox"/> CONFORMS AS NOTED	Date: 4/10/2020	Date:
<input type="checkbox"/> INCOMPLETE	<input type="checkbox"/> DOES NOT CONFORM		

NO.	REV.	DATE	DESCRIPTION
1	001	4-6-20	ISSUED
PROJECT: O.D.A.T. PROJ. 3000-18 CONTRACTOR: WALSH CONSTRUCTION LOCATION: HAMILTON COUNTY DESCRIPTION: EXP. JT. DETAILS AS HINGE #2 PHASE 2			
ISSUED BY:	RMS	DATE:	3-30-20
CHECKED BY:	RMS	DATE:	4-6-20
SCALE:	METALLIZED		
			15

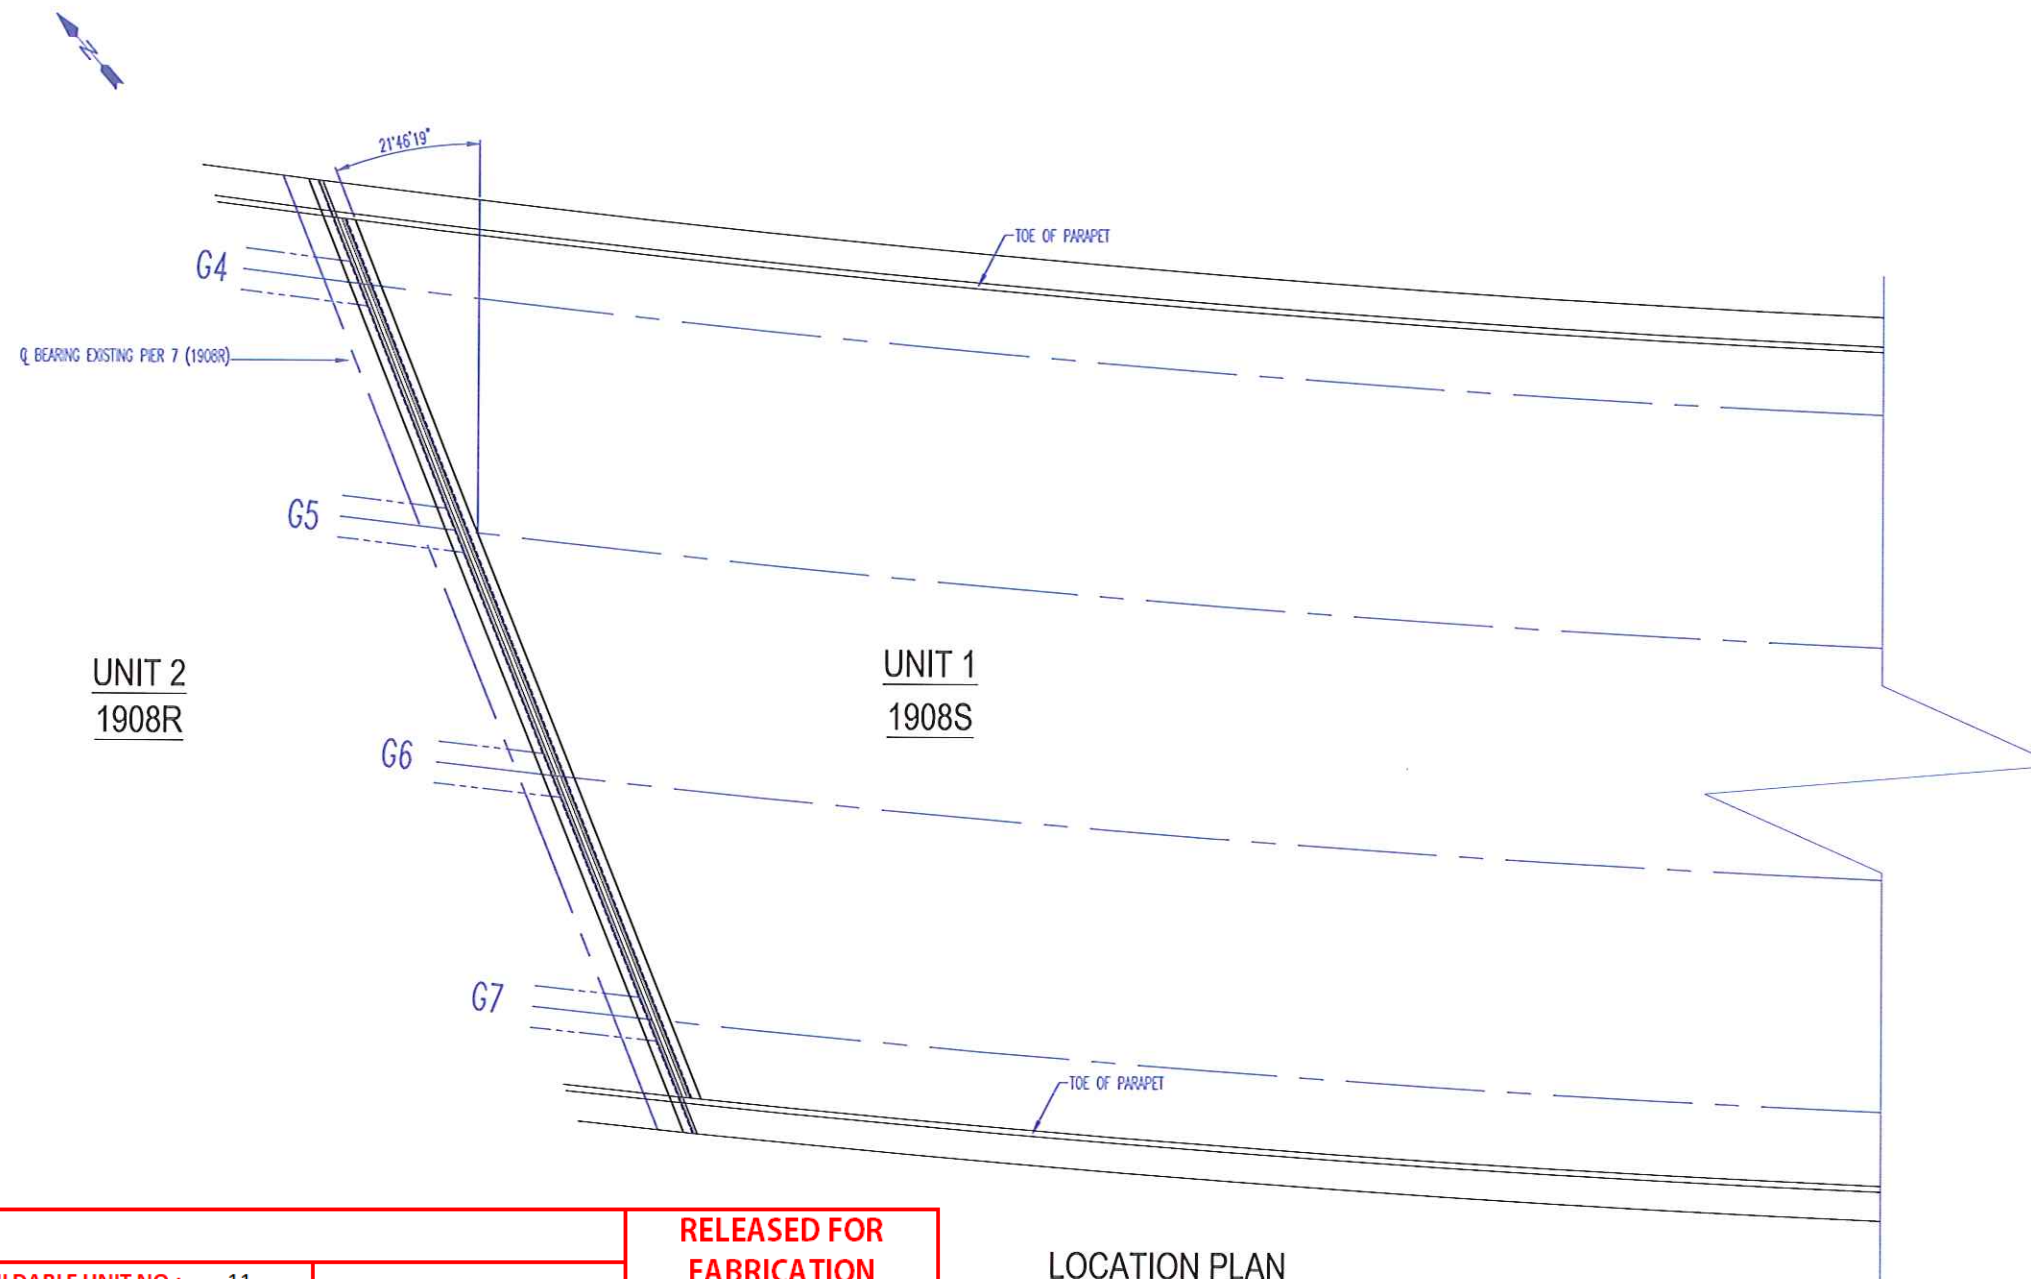

LOCATION PLAN

<b>PRIME AE, Group, Inc</b>		<b>RELEASED FOR FABRICATION</b>	
DATE REC'D: 4/15/2020	BUILDABLE UNIT NO.: 11		
Review conforms that the shop drawings meet the intent of the contract.			
<input checked="" type="checkbox"/> CONFORMS AS-IS	<input type="checkbox"/> CONFORMS AS NOTED	By: Kelly Chrisman	By:
<input type="checkbox"/> INCOMPLETE	<input type="checkbox"/> DOES NOT CONFORM	Date: 4/20/2020	Date:



APPROVAL

**OHIO STRUCTURES INC.**  
 4030 BOARDMAN - CANFIELD RD. SUITE 200D  
 CANFIELD, OHIO 44406  
 (330) 533-0084 FAX: (330) 533-0191

**OHIO DEPARTMENT OF TRANSPORTATION**  
 BRIDGE: HAM-74-1908R  
 IR-74 OVER MILLCREEK, RR & SPRING GROVE AVE


SCALE: N.T.S.	WALSH CONSTRUCTION	DRAWN: LF
DATE: 4/20	LOCATION PLAN 1908R PIER 7 UNIT 2	CHECK: MI
REF NO.: 0033		ITEM NO.: 516
ODOT PROJ. NO.: 183000	HAMILTON COUNTY	DWG. NO.: E1
OSI PROJ. NO.: 00-18	PID NO.: 104667	SFN: 3115739   1 OF 5

PREPARER: MAT IANNARELLI (MI - OHIO STRUCTURES)  
 CHECKER: KELLY D CHRISMAN (KDC - PRIME AE)


NOTES:  
 SEE SHEET 2 FOR EXPANSION JOINT DETAILS  
 SEE SHEET 5 FOR GENERAL NOTES & BILL OF MATERIAL

REV. No.	REVISION
SHOP INSPECTED BY:	




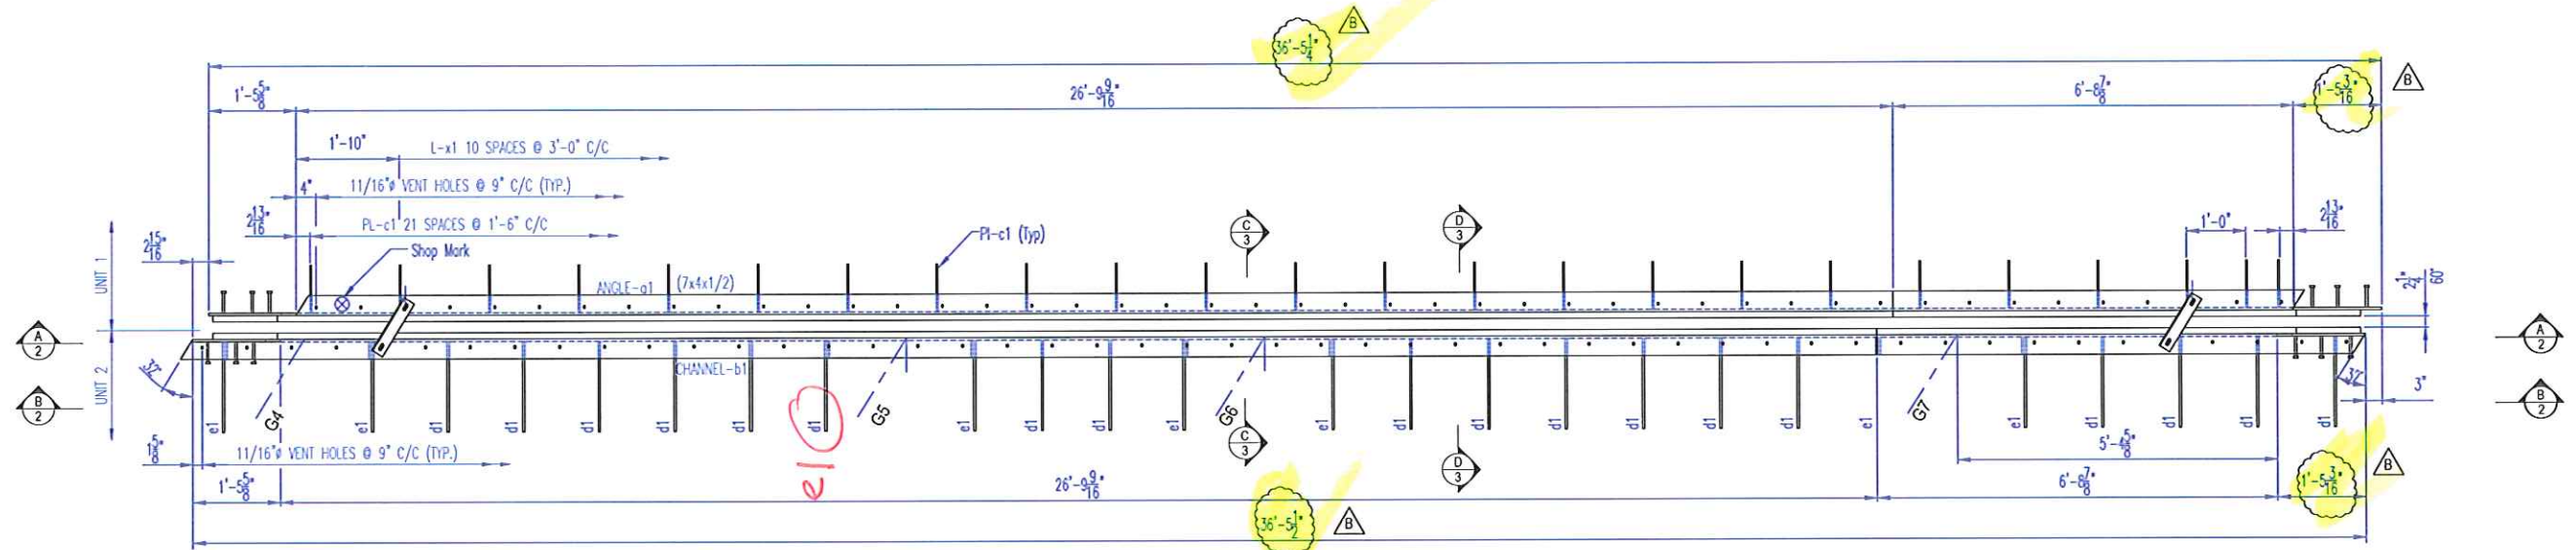

PIER 7 - EXPANSION JOINT - 1908R

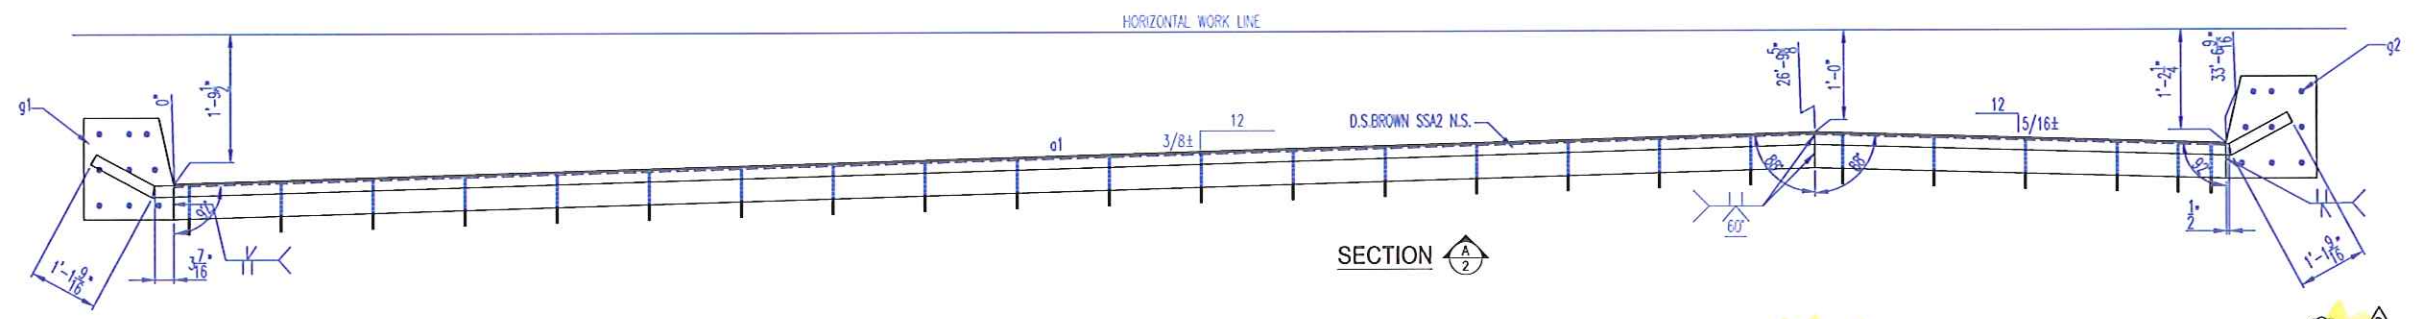

SECTION A2

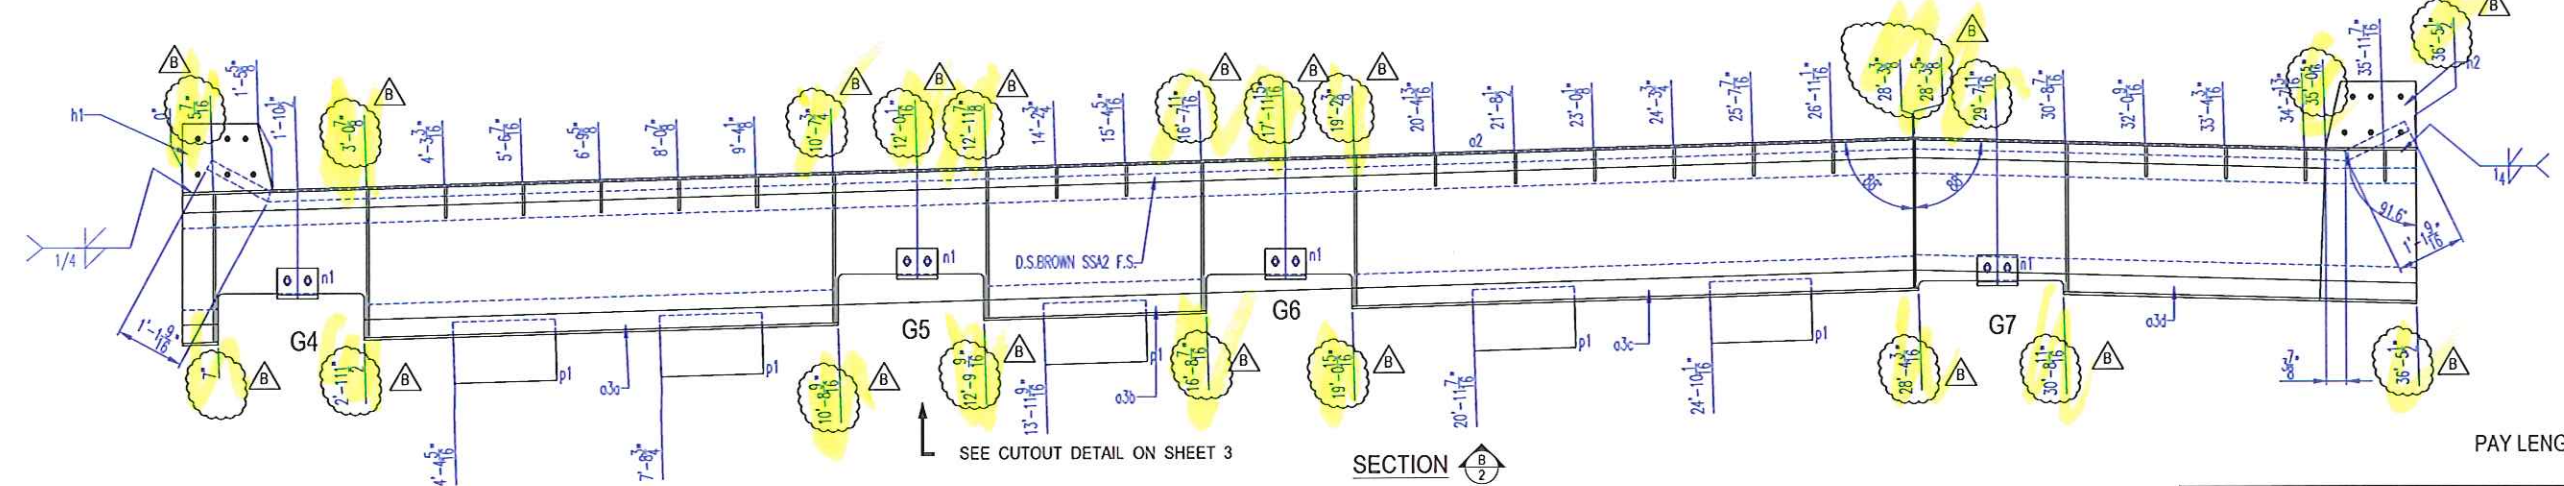

SECTION B2

PAY LENGTH: 36.5 FT.

PREPARER: MI  
CHECKER: KDC

NOTES:  
SEE SHEET 1 FOR EXPANSION JOINT LOCATION PLAN  
SEE SHEET 3 FOR SECTION VIEWS, DETAILS  
SEE SHEET 4 FOR CHANNEL b1 DETAILS  
SEE SHEET 5 FOR DETAILS, GENERAL NOTES & BILL OF MATERIAL

**AISC**  
CERTIFIED  
FABRICATOR

BRIDGE - INTERMEDIATE (MAJOR)  
FRACTURE CRITICAL ENDORSEMENT  
SOPHISTICATED PAINT ENDORSEMENT

REV. No.	REVISION
A	REVISED PER CONTRACTORS REVIEW 4/20/20

SHOP INSPECTED BY:

APPROVAL



**OHIO STRUCTURES INC.**  
4030 BOARDMAN - CANFIELD RD. SUITE 200D  
CANFIELD, OHIO 44406  
(330) 533-0084 FAX: (330) 533-0191

**OHIO DEPARTMENT OF TRANSPORTATION**  
BRIDGE: HAM-74-1908R  
IR-74 OVER MILLCREEK, RR & SPRING GROVE AVE




SCALE: N.T.S. DRAWN: LF  
DATE: 4/20 CHECK: MI

PIER 7 UNIT 2 EXPANSION JOINT 1908R

REF NO: 0033	ITEM NO: 516
ODOT PROJ NO: 183000	HAMILTON COUNTY DWG. NO: D1
OSI PROJ NO: 00-18	PID NO: 104667 SFN: 3115739 2 OF 5

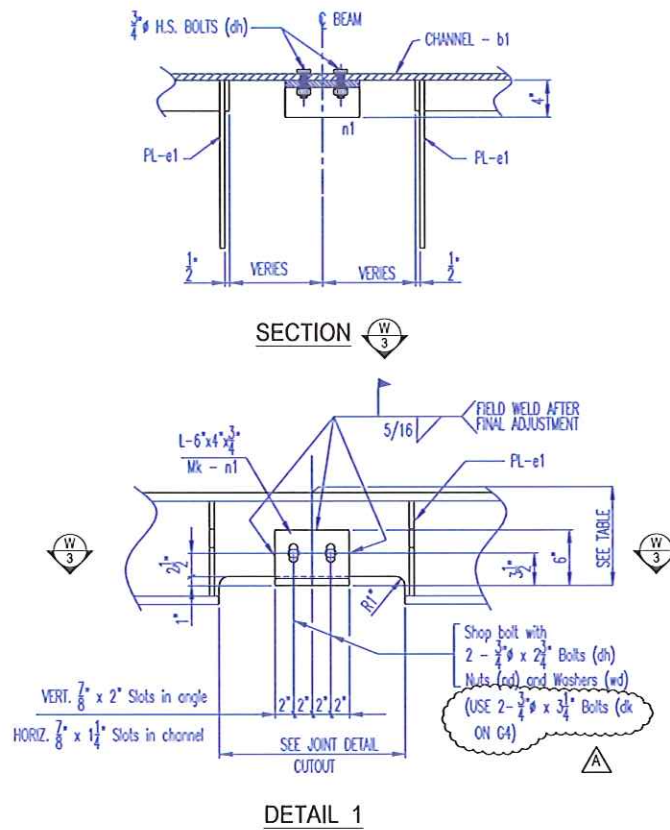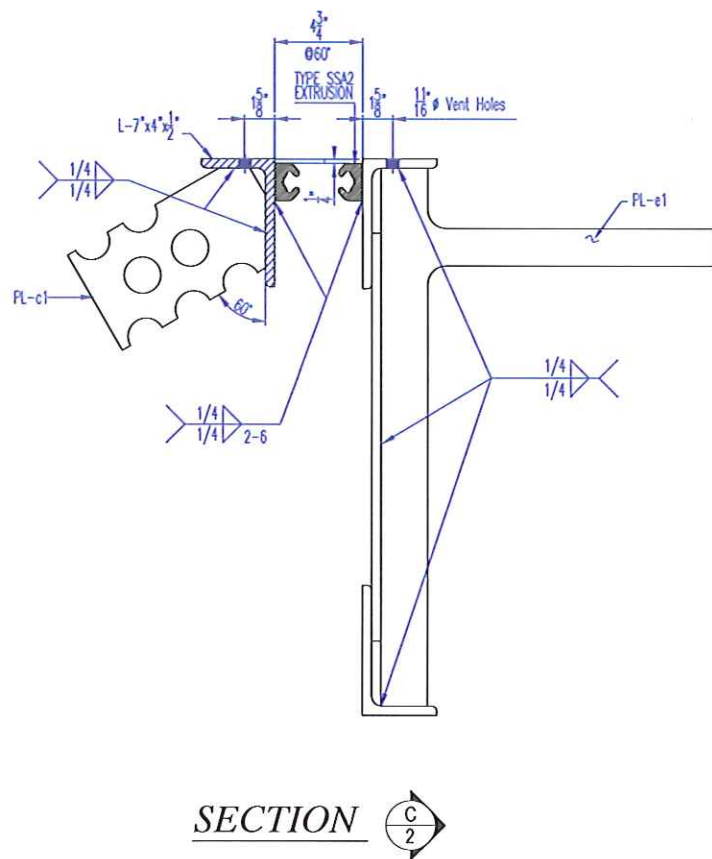

HAUNCH TABLE	
G4	1'-9 1/2"
G5	1'-9 7/16"
G6	1'-11 11/16"
G7	2'-4 11/16"

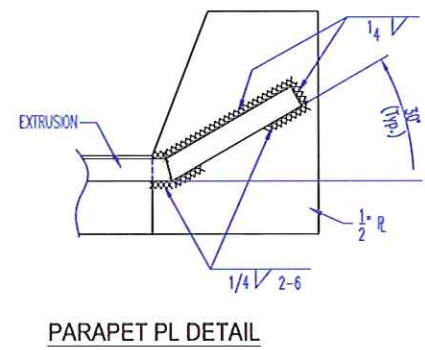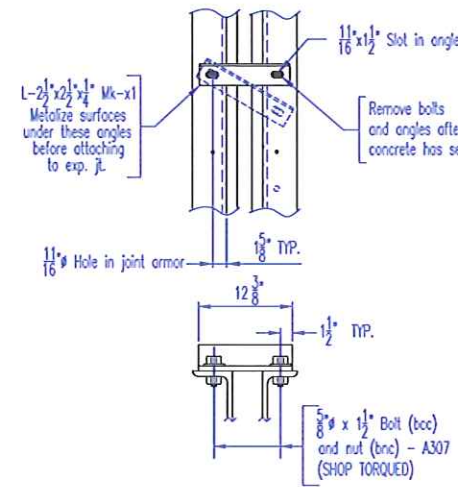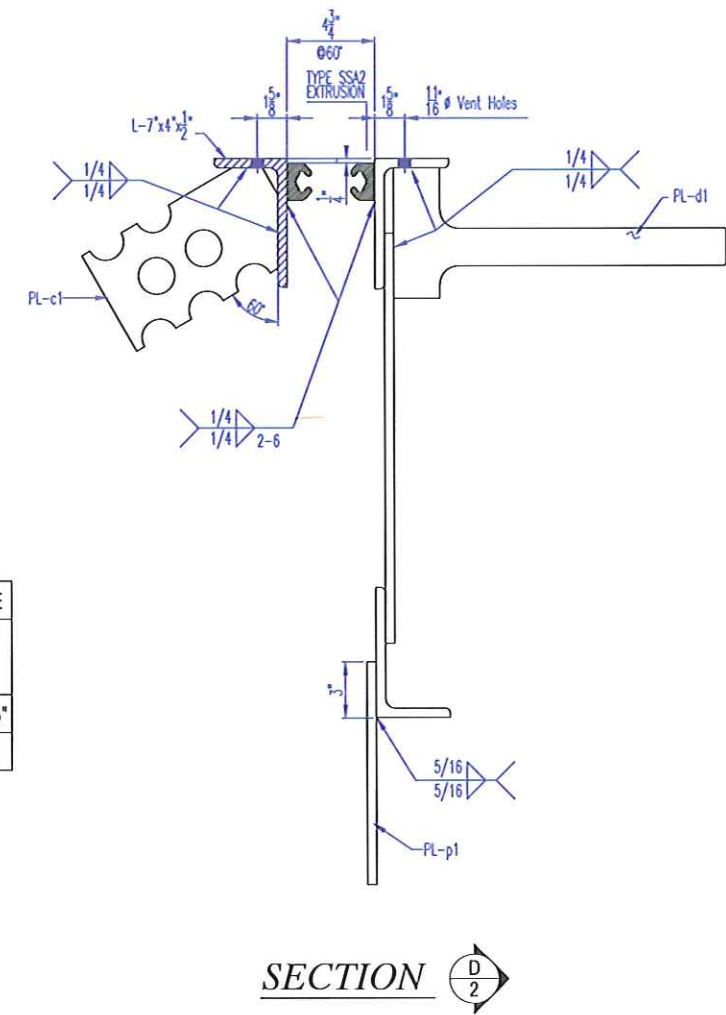

PREPARER: MI  
CHECKER: KDC

NOTES:  
SEE SHEET 1 FOR EXPANSION JOINT LOCATION PLAN  
SEE SHEET 2 FOR EXPANSION JOINT DETAILS  
SEE SHEET 5 FOR GENERAL NOTES & BILL OF MATERIAL

**AISC**  
CERTIFIED  
FABRICATOR  
BRIDGE - INTERMEDIATE (MAJOR)  
FRACTURE CRITICAL ENDORSEMENT  
SOPHISTICATED PAINT ENDORSEMENT

REV. No.	REVISION
△	ADJUST BOLT LENGTH 4/15/20

SHOP INSPECTED BY:

APPROVAL

**OHIO STRUCTURES INC.**  
4030 BOARDMAN - CANFIELD RD. SUITE 200D  
CANFIELD, OHIO 44406  
(330) 533-0084 FAX: (330) 533-0191


**OHIO DEPARTMENT OF TRANSPORTATION**  
BRIDGE: HAM-74-1908R  
IR-74 OVER MILLCREEK, RR & SPRING GROVE AVE

SCALE: N.T.S.	<b>WALSH CONSTRUCTION</b>	DRAWN: LF
DATE: 4/20		CHECK: MI


SECTION VIEWS, DETAILS

REF NO.: 0033	ITEM NO.: 516
ODOT PROJ. NO.: 183000	HAMILTON COUNTY DWG. NO.: D2
OSI PROJ. NO.: 00-18	PID NO.: 104667 SFN: 3115739 3 OF 5




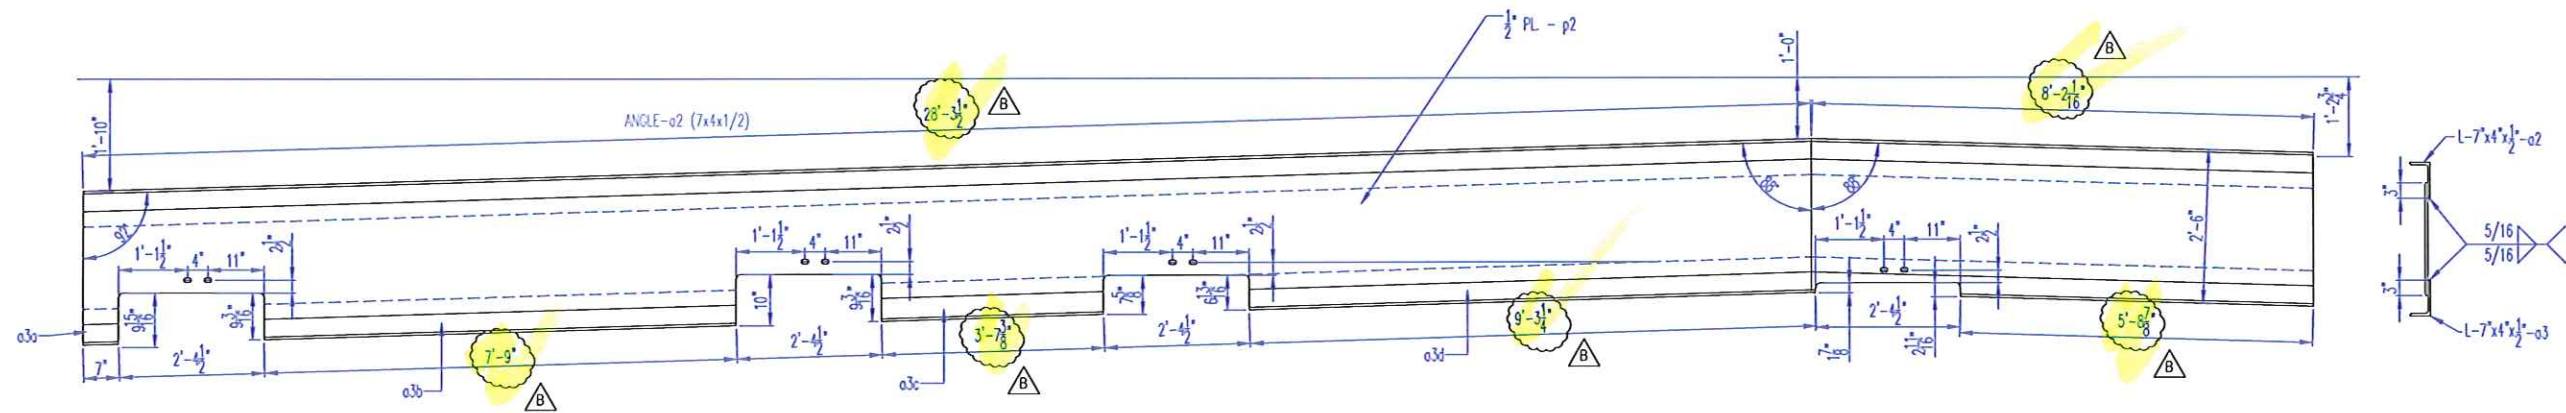


DETAILS CHANNEL - b1

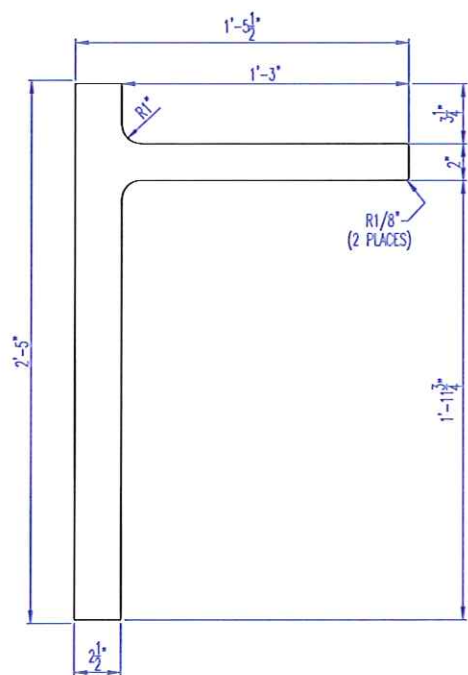

DETAIL e1  
MATERIAL: 1/2" PL  
QUANTITY: 8

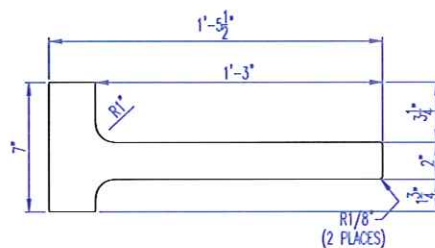

DETAIL d1  
MATERIAL: 1/2" PL  
QUANTITY: 17

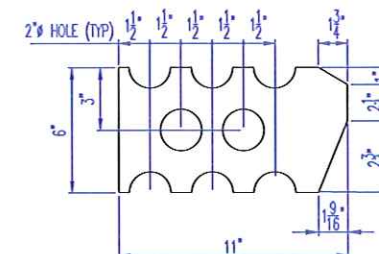

DETAIL PL-c1  
MATERIAL: 3/8" PL  
QUANTITY: 24

PREPARER: MI  
CHECKER: KDC

NOTES:  
SEE SHEET 5 FOR DETAILS, GENERAL NOTES & BILL OF MATERIAL



APPROVAL

REV. No.	REVISION
A	REVISED PER CONTRACTORS REVIEW 4/20/20
SHOP INSPECTED BY:	





**OHIO STRUCTURES INC.**  
4030 BOARDMAN - CANFIELD RD. SUITE 200D  
CANFIELD, OHIO 44406  
(330) 533-0084 FAX: (330) 533-0191

**OHIO DEPARTMENT OF TRANSPORTATION**  
BRIDGE: HAM-74-1908R  
IR-74 OVER MILLCREEK, RR & SPRING GROVE AVE

SCALE: N.T.S.	WALSH CONSTRUCTION	DRAWN: LF
DATE: 4/20		CHECK: MI
DETAILS CHANNEL b1		
REF NO.: 0033		ITEM NO.: 516
ODOT PROJ. NO.: 183000	HAMILTON COUNTY	DWG. NO.: D3
OSI PROJ. NO.: 00-18	PID NO.: 104667	SFN: 3115739 4 OF 5



ODOT DOT PROJECT : 183000		PID NO.: 104667		OSI PROJ. #: 00-18		REF #:1		ITEM #: 516			
1908R PIER 7 UNIT 2 EXPANSION JOINT											
MATERIALS ONLY:											
LINE	PO#	QTY	MARK	SECTION	LENGTH (FEET)	LENGTH (INCHES)	STL SPEC	PC WT (N LBS)	NET WT (N LBS)	HEAT #	REMARKS
1		1	a1	ANGLE 7x4x1/2	33	9	A709-50	604.13	604.13		
2		1	a2	ANGLE 7x4x1/2	36	5 1/2	A709-50	652.60	652.60		
3		1	a3a	ANGLE 7x4x1/2	0	7	A709-50	10.44	10.44		
4		1	a3b	ANGLE 7x4x1/2	7	9 1/8	A709-50	138.26	138.26		
5		1	a3c	ANGLE 7x4x1/2	3	10 7/8	A709-50	69.92	69.92		
6		1	a3d	ANGLE 7x4x1/2	17	4 11/16	A709-50	311.29	311.29		
7		1	--	ANGLE 2-1/2x2-1/2x1/4	1	3-8	A709-36	4.23	46.51		SHIPPING
8		4	n1	ANGLE 6x4x3/4	0	8	A709-50	15.73	62.93		
9		24	c1	PLATE 3/8 x 6	0	11	A709-36	5.02	120.48		
10		8	e1	PLATE 1/2 x 29	1	5 1/2	A709-36	14.74	117.92		
11		17	d1	PLATE 1/2 x 7	1	5 1/2	A709-36	6.94	117.98		
12		4	p1	PLATE 1/2 x 20	1	0	A709-50	34.03	136.12		
13		1	p2	PLATE 1/2 x 22	36	6 3/8	A709-50	1,355.81	1,355.81		
14		1	g1	PLATE 1/2 x 20	1	5 5/8	A709-36	47.28	47.28		
15		1	g2	PLATE 1/2 x 20	1	5 3/16	A709-36	48.64	48.64		
16		1	h1	PLATE 1/2 x 13 1/2	1	5 5/8	A709-36	30.35	30.35		
17		1	h2	PLATE 1/2 x 13 1/2	1	5 3/16	A709-36	31.67	31.67		
								SUB TOTAL	3,902.34		
HARDWARE ONLY:											
LINE	QTY	MARK	DESCRIPTION	STL SPEC	WT PER (N LBS)	NET WT (N LBS)	HEAT #	REMARKS			
18	30	--	1/2" x 4" STUD	A108	0.29	8.70					
19	6	dh	3/4x2-3/4 HEX HEAD BOLT	A325 Galv	0.48	2.89					
19	2	dk	3/4x3-1/4 HEX HEAD BOLT	A325 Galv	0.54	1.08					
20	8	nd	3/4 HEAVY HEX NUT	A563 Galv	0.20	1.60					
21	8	wd	3/4 FLAT WASHER	F436 Galv	0.04	0.33					
22	22	loc	5/8x1-1/2 HEX HEAD BOLT	A307	0.22	4.77					
23	22	tnr	5/8 HEAVY HEX NUT	A307	0.12	2.64					
								SUB TOTAL	22.01		
MISC:											
LINE	QTY	MARK	DESCRIPTION	STL SPEC	WT PER (N LBS)	NET WT (N LBS)	HEAT #	REMARKS			
24	3.16	--	SSA2 EXTRUSION (D.S. BROWN) x 23'-0"	A709-36	121.90	385.20					
25	1	--	3" A2R STRIP SEAL x 37'-0" (D.S. BROWN)		0.00	0.00					
26	1	--	GALLON OF GLUE		0.00	0.00					
								SUB TOTAL	385.20		
								TOTAL WT	4,309.55		

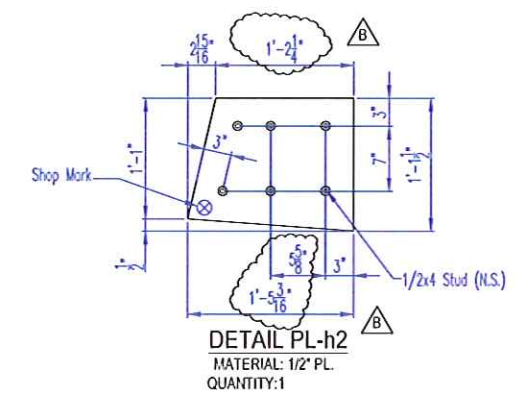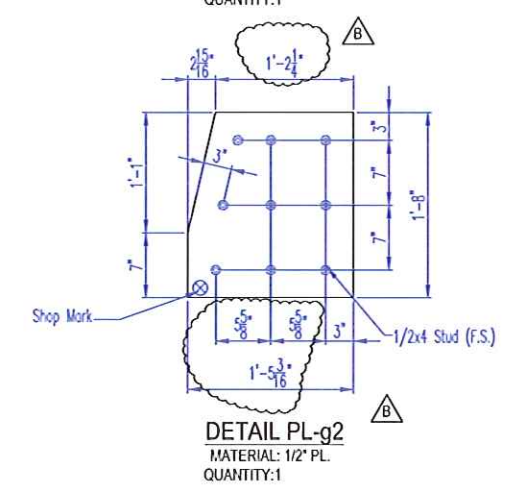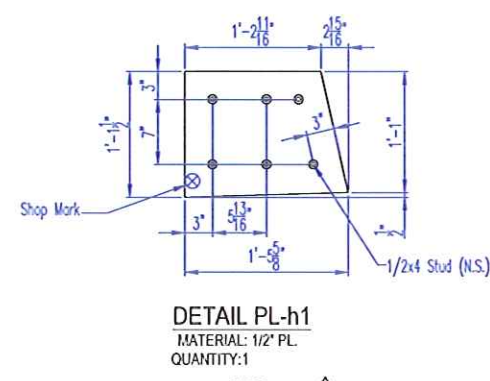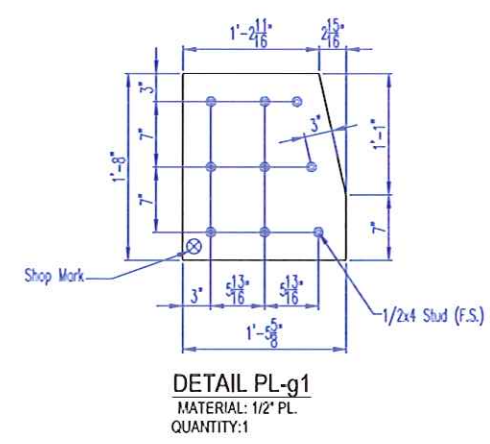

- GENERAL NOTES:**
- \* ALL MATERIAL SHALL BE ASTM A709 GR50/36.
  - \* MATERIAL AND WORKMANSHIP SHALL BE IN ACCORDANCE WITH ODOT-CMS-2019.
  - \* WELDING SHALL BE IN ACCORDANCE WITH AWS/AASHTO D1.5-15 AND ODOT 1011.
  - \* ALL MATERIAL TO BE METALIZED IN CONFORMANCE WITH O.D.O.T. STANDARD DRAWING EXJ-4-87 DATED 7/19/02.
  - \* ALL INFORMATION & DIMENSIONS ARE TO BE APPROVED BY THE CONTRACTOR PRIOR TO COMMENCING FABRICATION.
  - \* GENERAL TOLERANCE ±1/8" UNLESS NOTED.

PREPARER: MI  
CHECKER: KDC

NOTES:  
SEE SHEET 1 FOR EXPANSION JOINT LOCATION PLAN  
SEE SHEET 2 FOR EXPANSION JOINT DETAILS



APPROVAL

**OHIO STRUCTURES INC.**  
4030 BOARDMAN - CANFIELD RD. SUITE 2000  
CANFIELD, OHIO 44406  
(330) 533-0084 FAX: (330) 533-0191

**OHIO DEPARTMENT OF TRANSPORTATION**  
BRIDGE: HAM-74-1908R  
IR-74 OVER MILLCREEK, RR & SPRING GROVE AVE


SCALE: N.T.S. DATE: 4/20  
DRAWN: LF CHECK: MI

DETAILS, GENERAL NOTES, MATERIAL LIST


REF NO: 1 ODOT PROJ. NO.: 183000 OSI PROJ. NO.: 00-18  
ITEM NO: 516 HAMILTON COUNTY DWG. NO.: D4  
PID NO.: 104667 SFN: 3115739 5 OF 5

REV. No.	REVISION
1	REVISED PER CONTRACTORS REVIEW 4/20/20


SHOP INSPECTED BY:

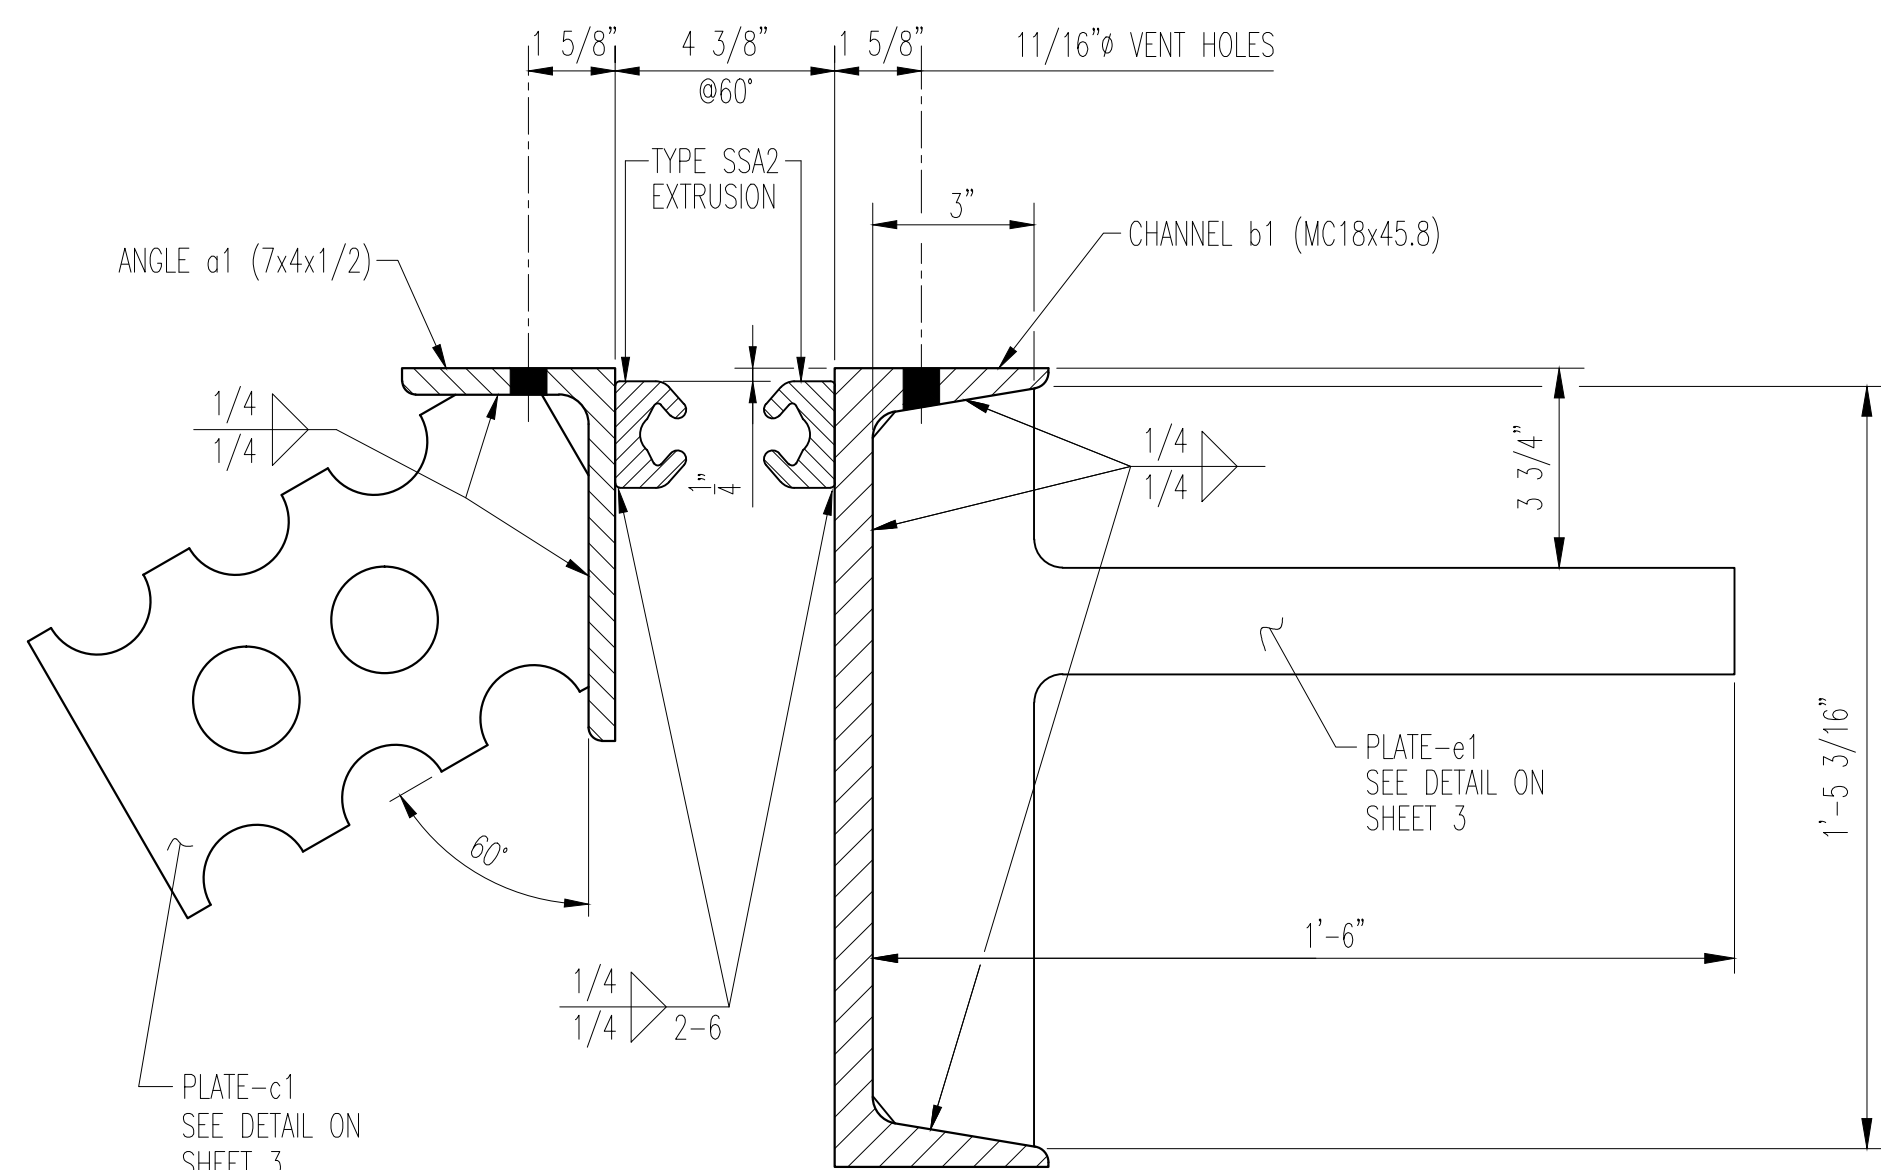

SECTION C-1 & 2

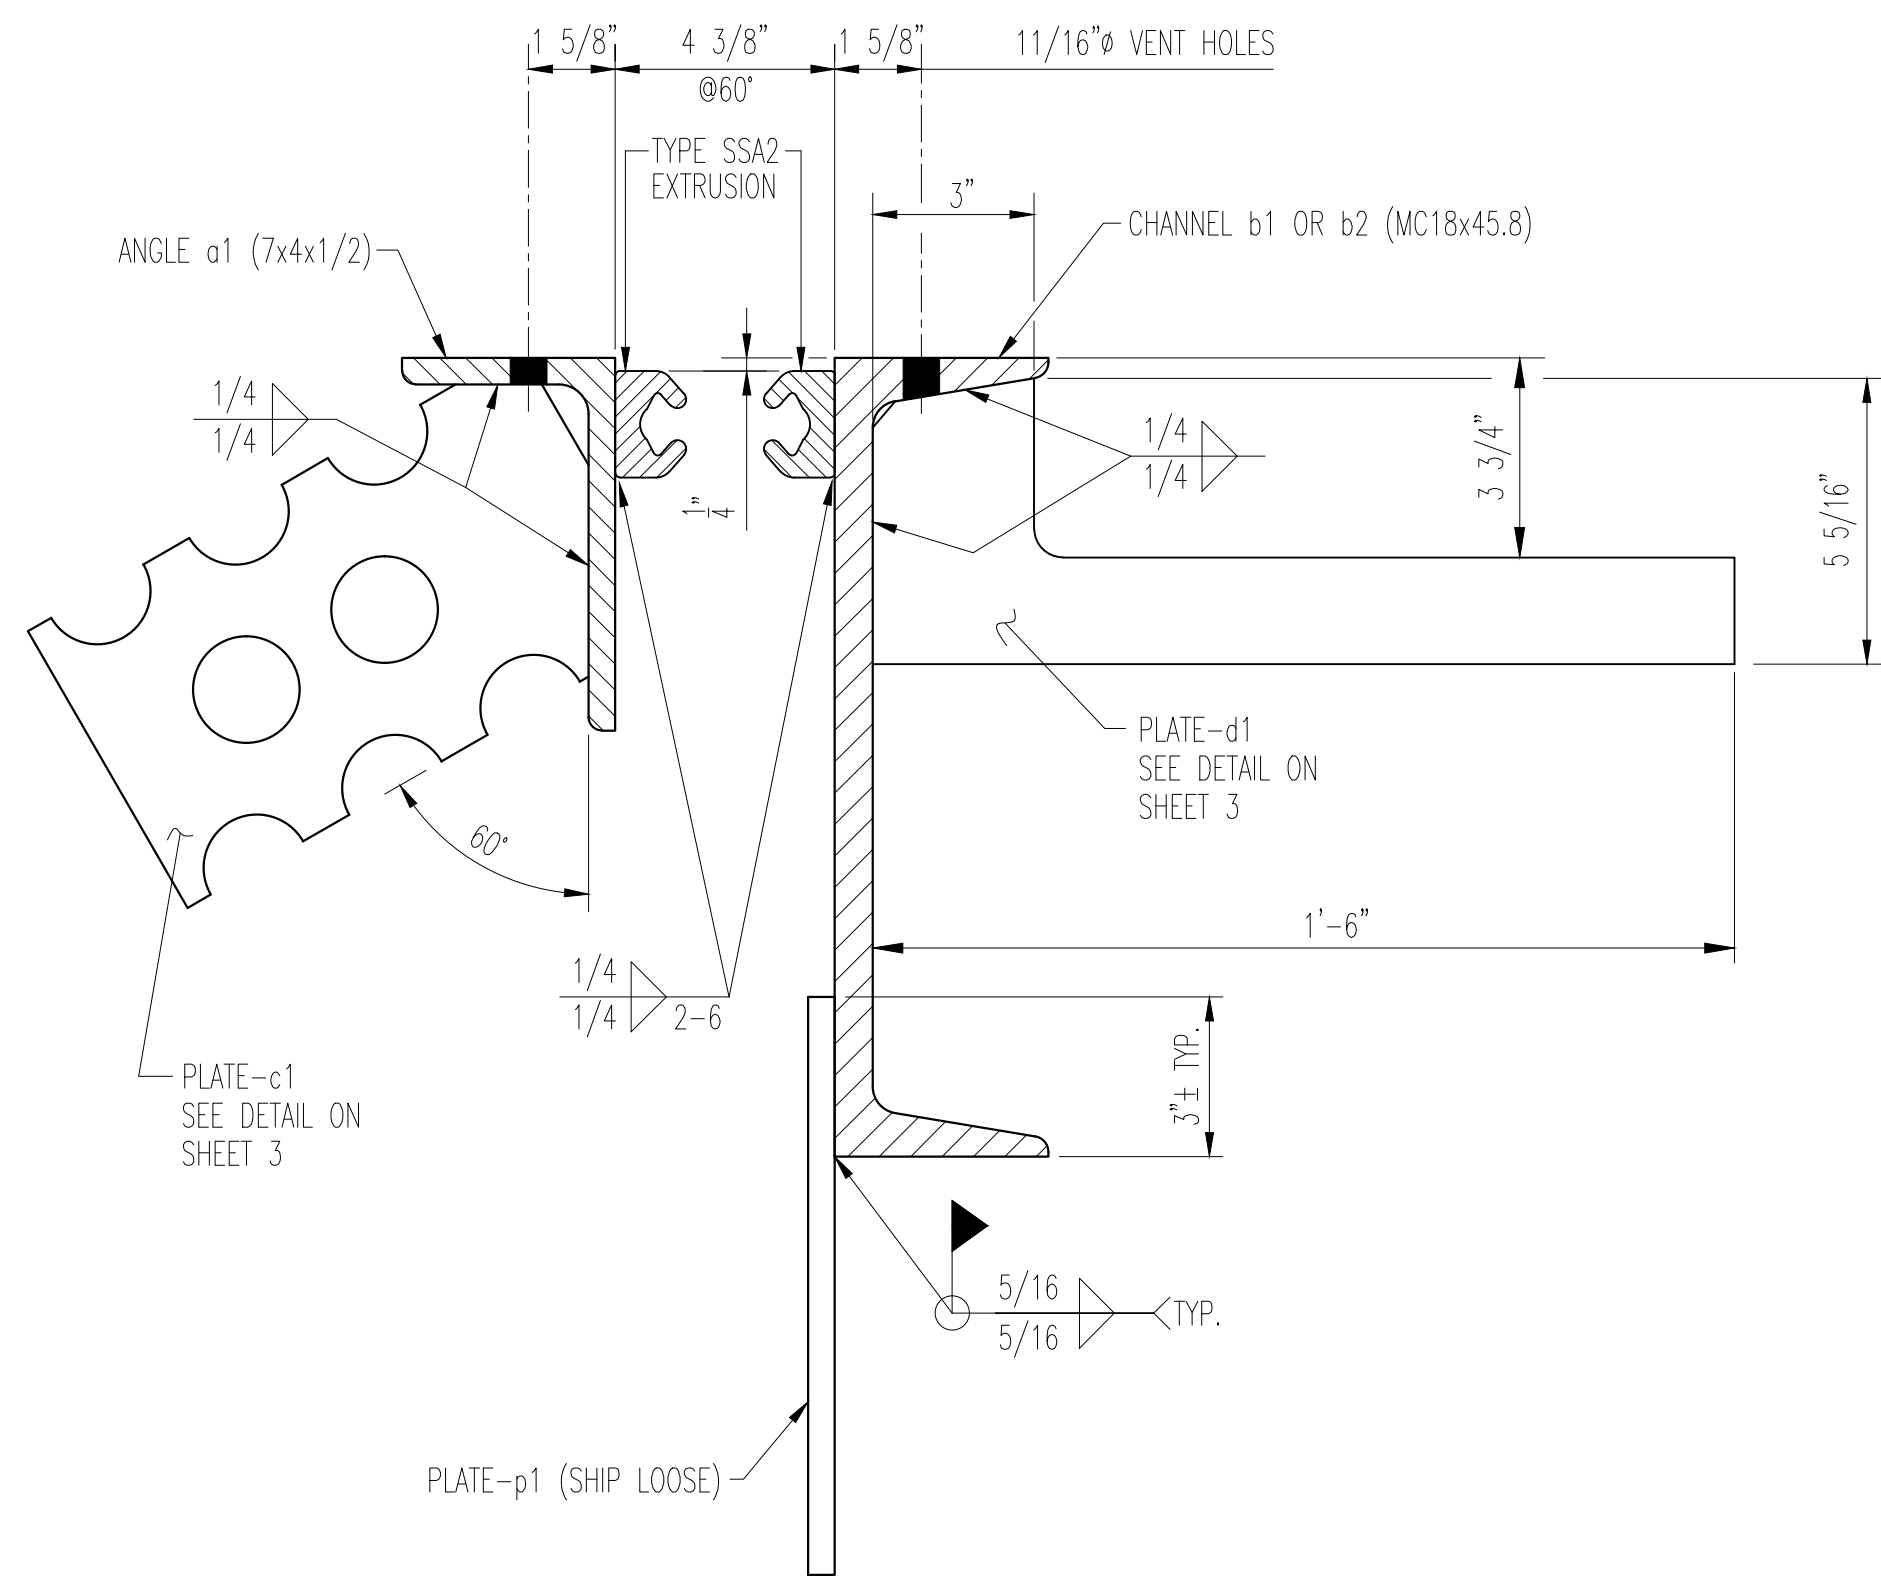

SECTION D-1 & 2

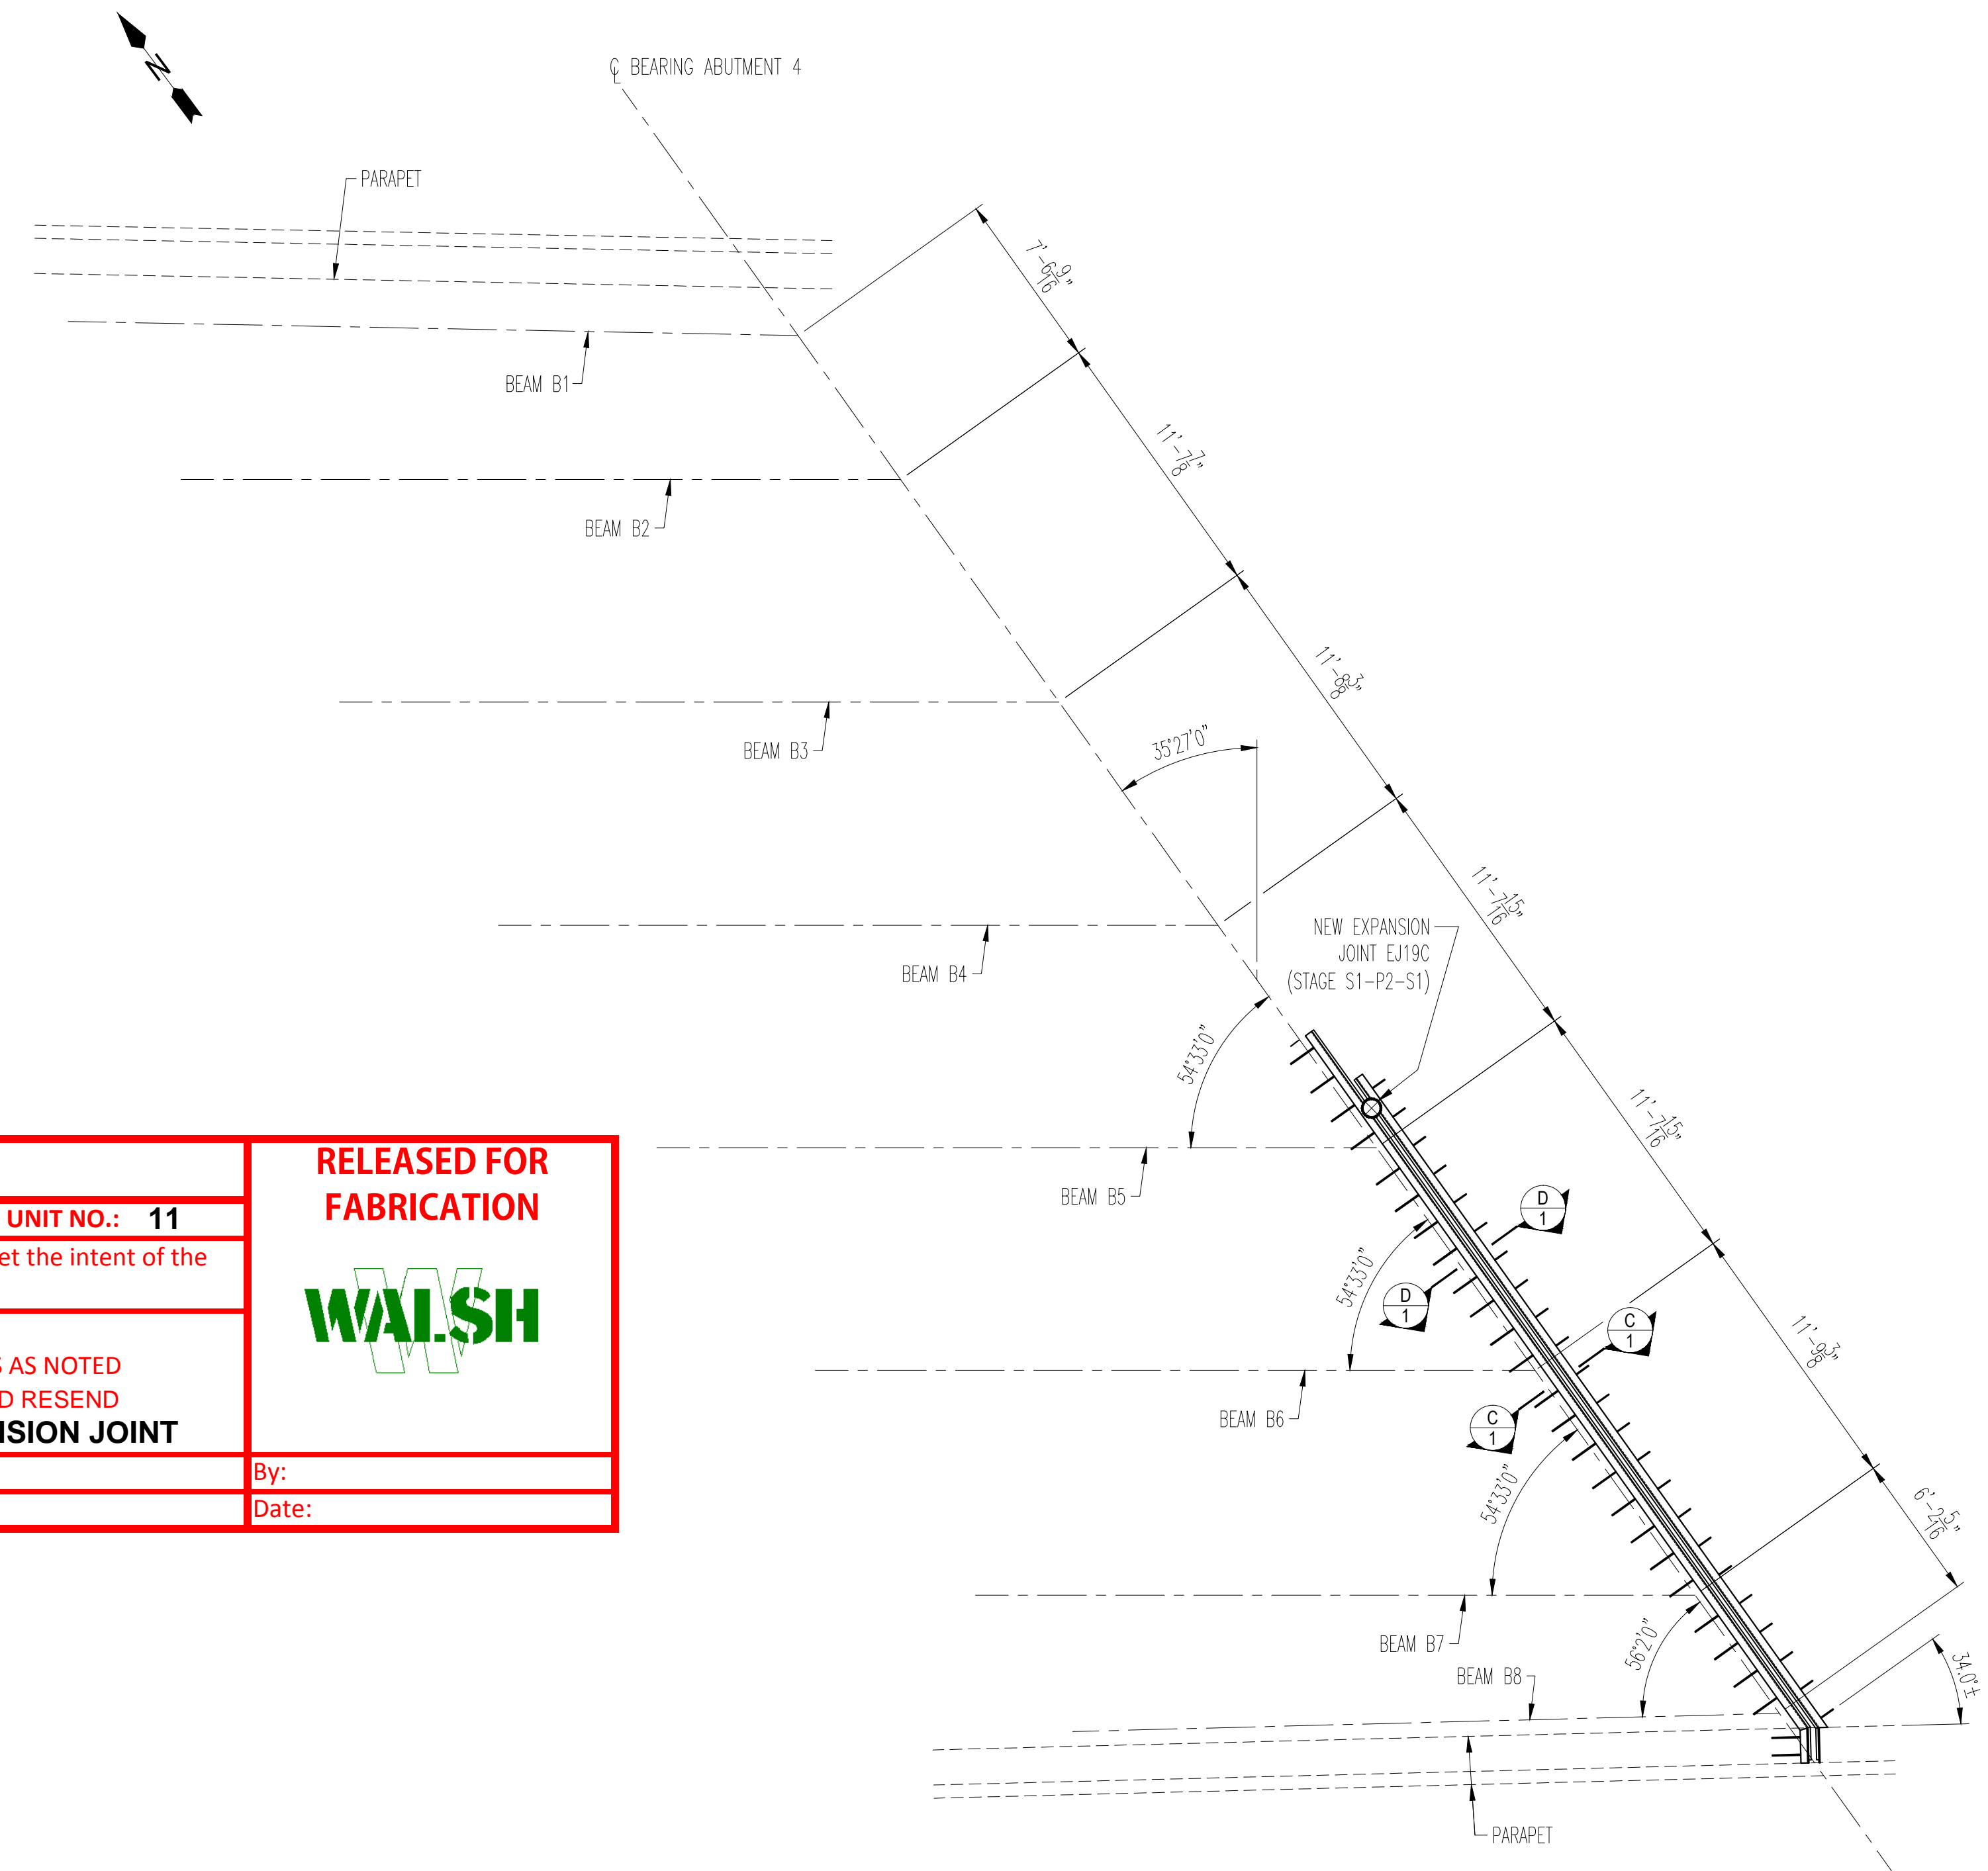

EXPANSION JOINT LOCATION PLAN

<b>PRIME AE, Group, Inc</b>		<b>RELEASED FOR FABRICATION</b>
DATE REC'D: <b>9/20/2019</b>	BUILDABLE UNIT NO.: <b>11</b>	
Review conforms that the shop drawings meet the intent of the contract.		<b>WALSH</b>
<input type="checkbox"/> CONFORMS AS-IS	<input checked="" type="checkbox"/> CONFORMS AS NOTED	
<input type="checkbox"/> REVISIONS	<input type="checkbox"/> REVISE AND RESEND	
<b>1908R - ABUTMENT #4 EXPANSION JOINT</b>		
By: <b>Tom Stora</b>	By:	
Date: <b>9/24/2019</b>	Date:	

NOTES:  
 SEE SHEET 2 FOR DETAIL OF EXPANSION JOINT EJ19C  
 SEE SHEET 3 FOR EXPANSION JOINT DETAILS, GENERAL NOTES & BILL OF MATERIAL




APPROVAL

<b>OHIO STRUCTURES INC.</b> 535 NORTH BROAD STREET SUITE 5 CANFIELD, OHIO 44406 (330) 533-0084 FAX: (330) 533-0191	
<b>OHIO DEPARTMENT OF TRANSPORTATION</b> BRIDGE: HAM-74-1908R IR 74 OVER MILL CREEK, RR & SPRING GROVE AVENUE	
SCALE: N.T.S. DATE: 9/19	Walsh Construction Company EXPANSION JOINT LOCATION PLAN
REF NO.: 2	ITEM NO.: 516
ODOT PROJ. NO.: 183000	HAMILTON COUNTY DWG. NO.: E1
OSI PROJ. NO.: 19-19	PID NO.: 104667 SFN: 3115739 1 OF 3



REV. No.	REVISION

SHOP INSPECTED BY:



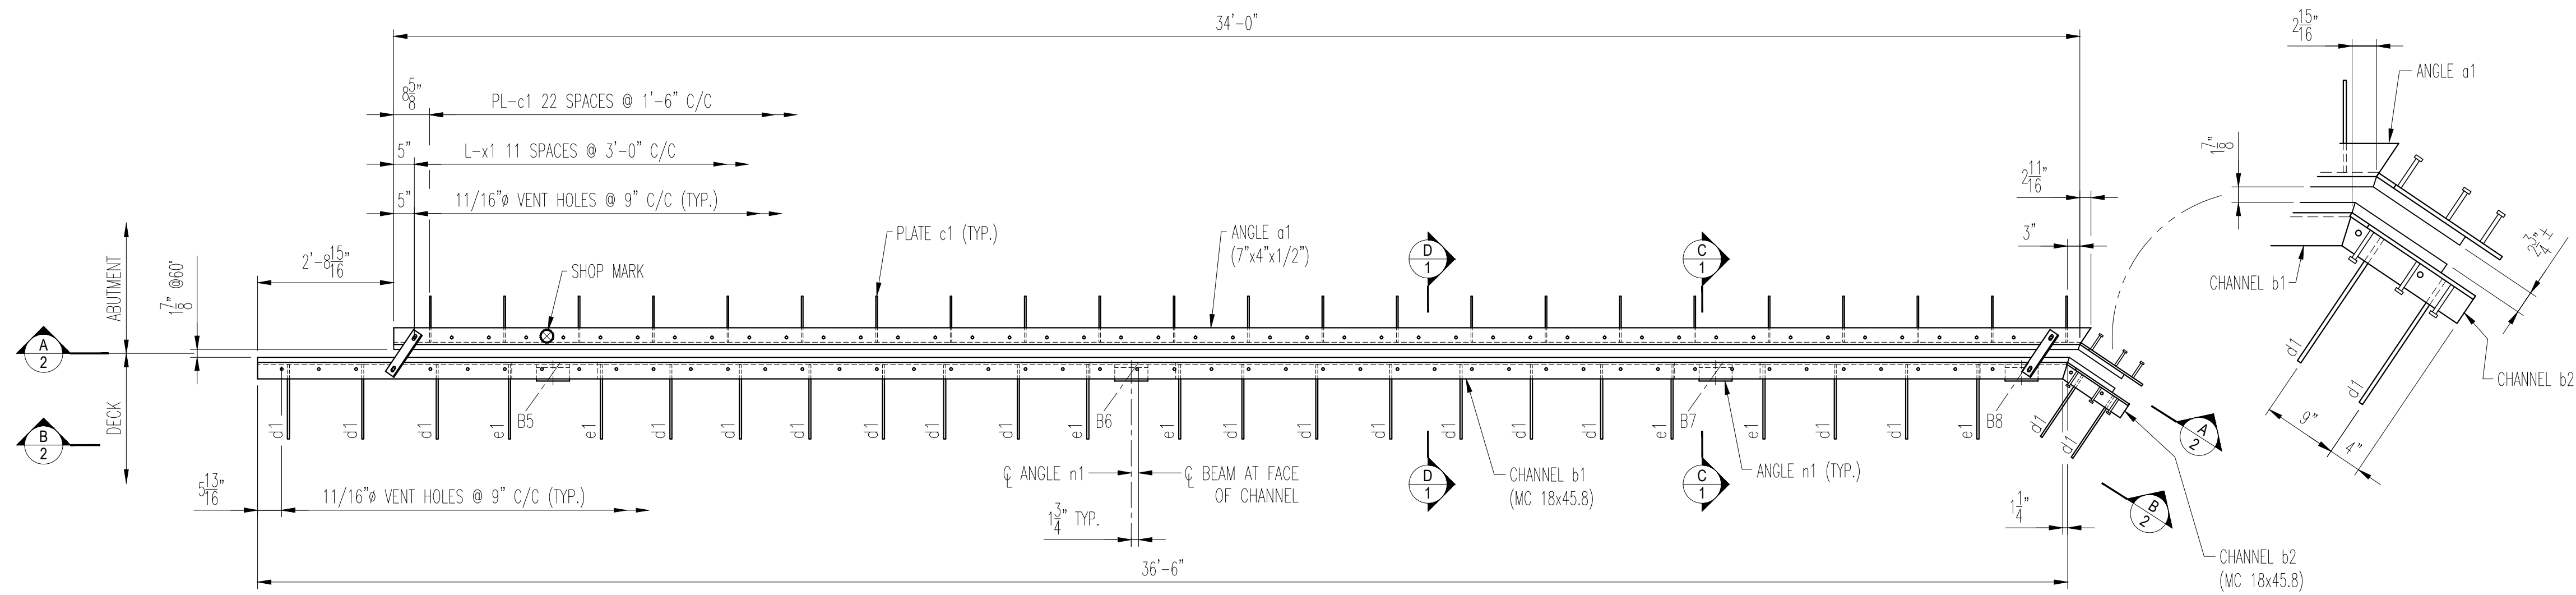


1 - EXPANSION JOINT EJ19C (PHASE S1-P2-S1 CONST.)

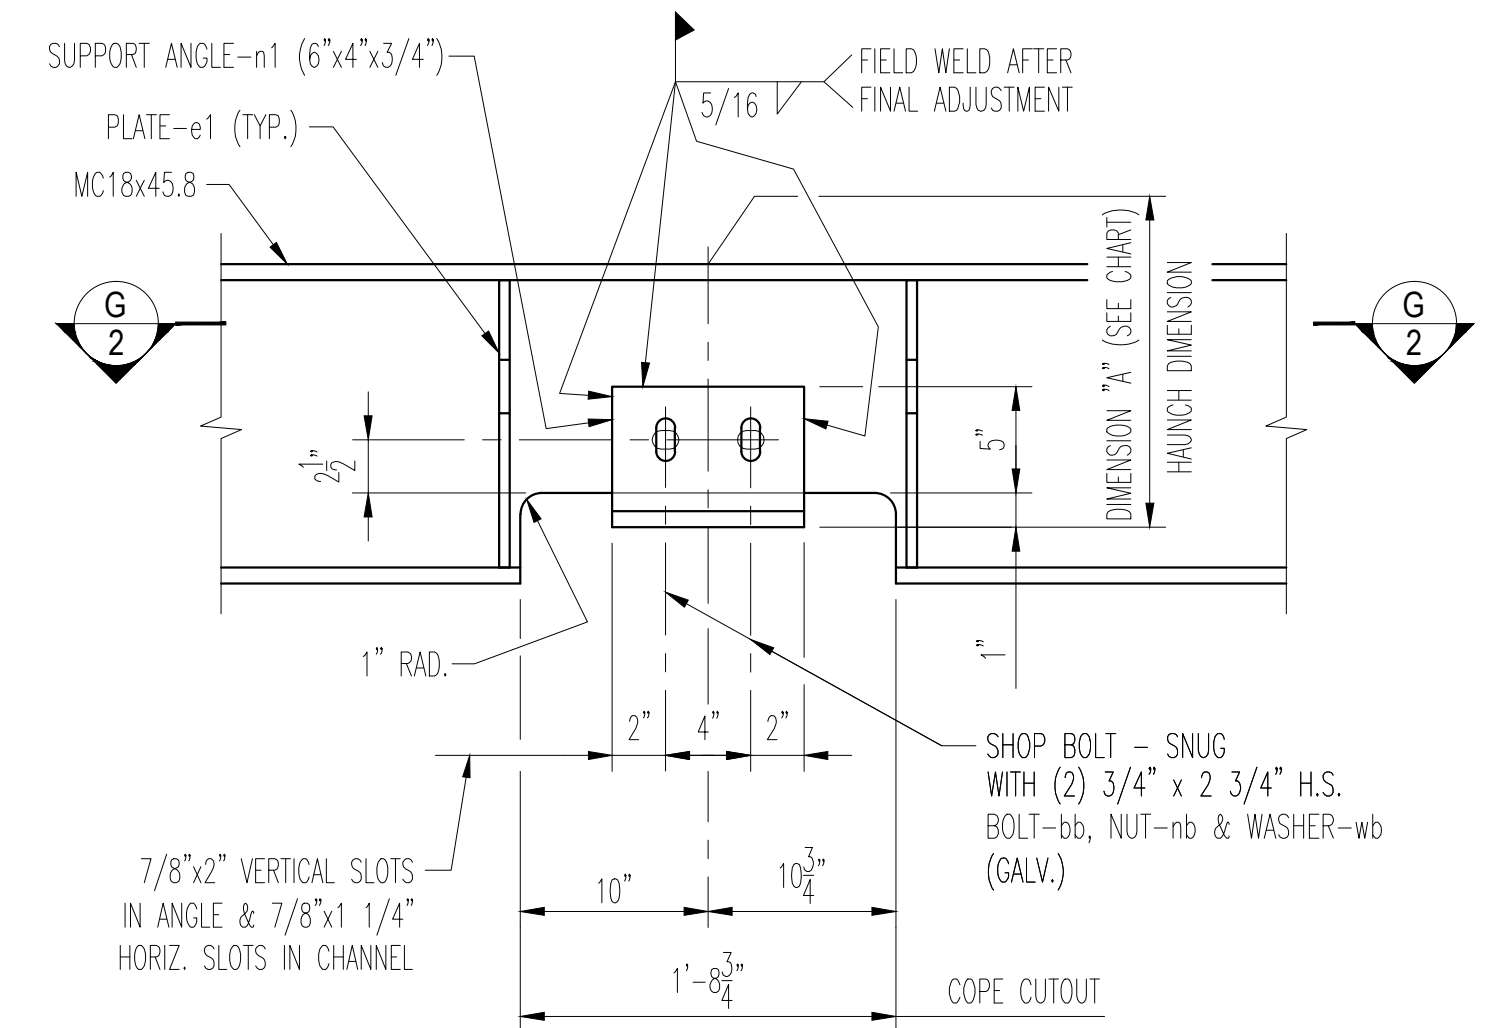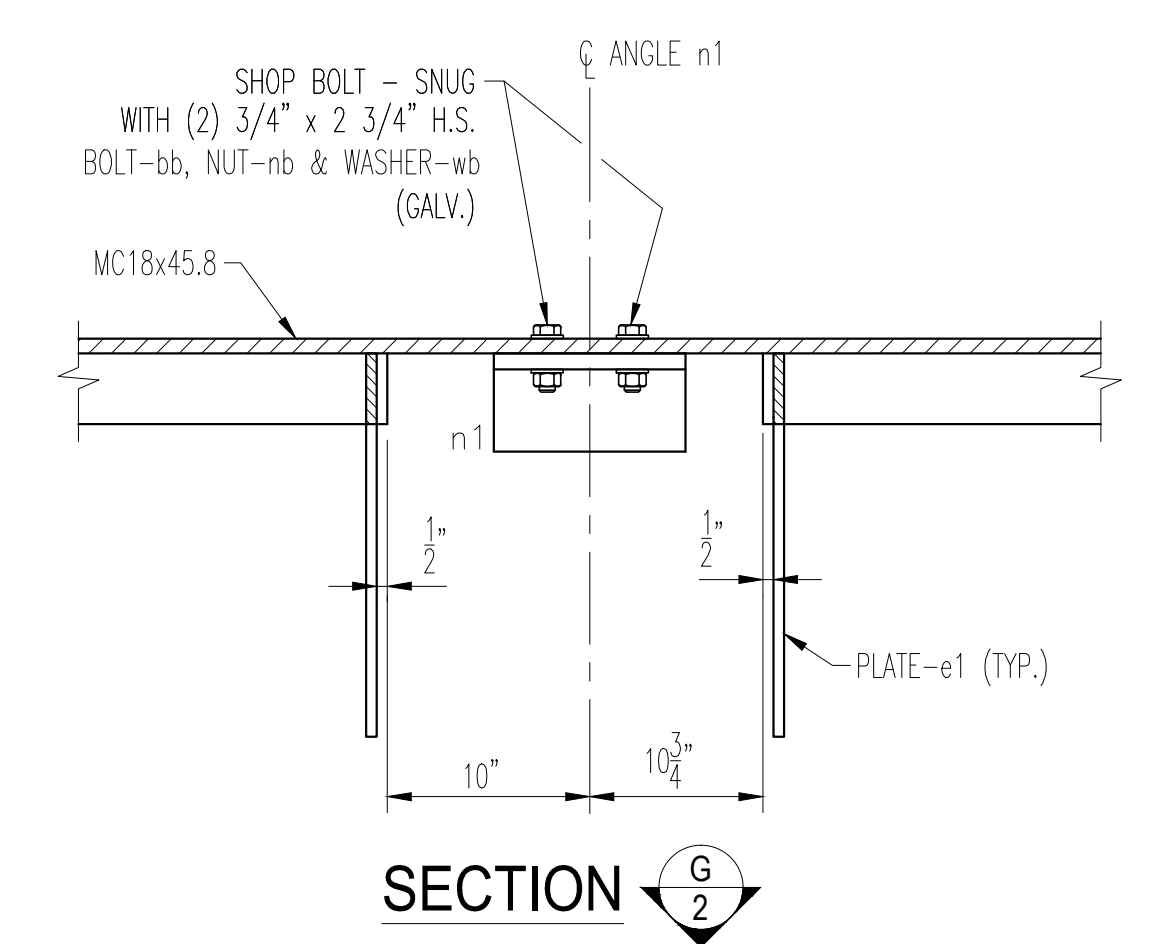


CHANNEL CUTOUT DETAIL @ SUPPORT ANGLE - n1

HAUNCH CHART (DIM "A")		
BEAM	SUPPORT	HAUNCH
B5	USE n1	16 5/8"
B6	USE n1	16 1/4"
B7	USE n1	16"
B8	USE n1	15 1/2"

THE HAUNCH DIMENSION IS THE MEASUREMENT FROM THE TOP OF THE CHANNEL TO THE TOP OF THE CHANNEL TO SUPPORT ANGLE n1

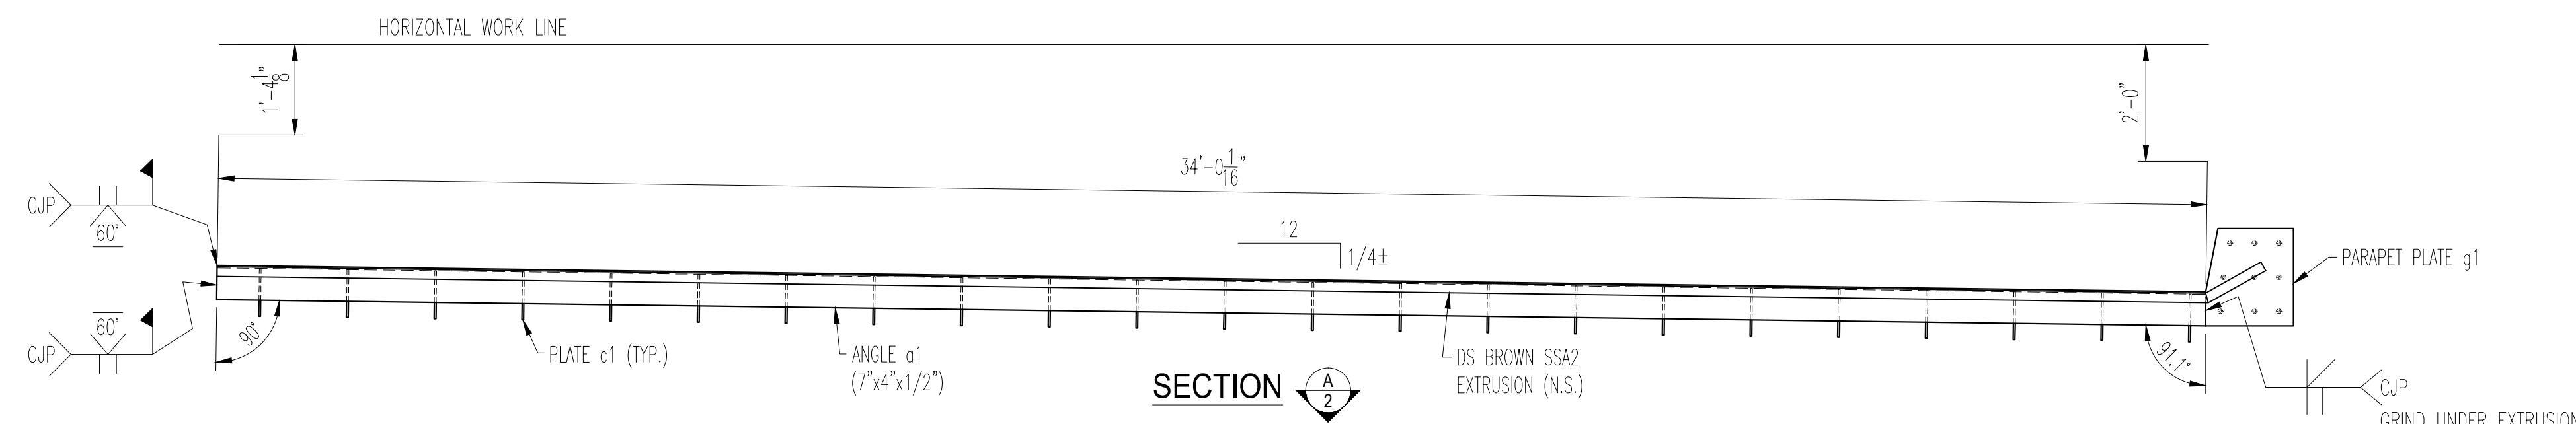



SECTION A-2

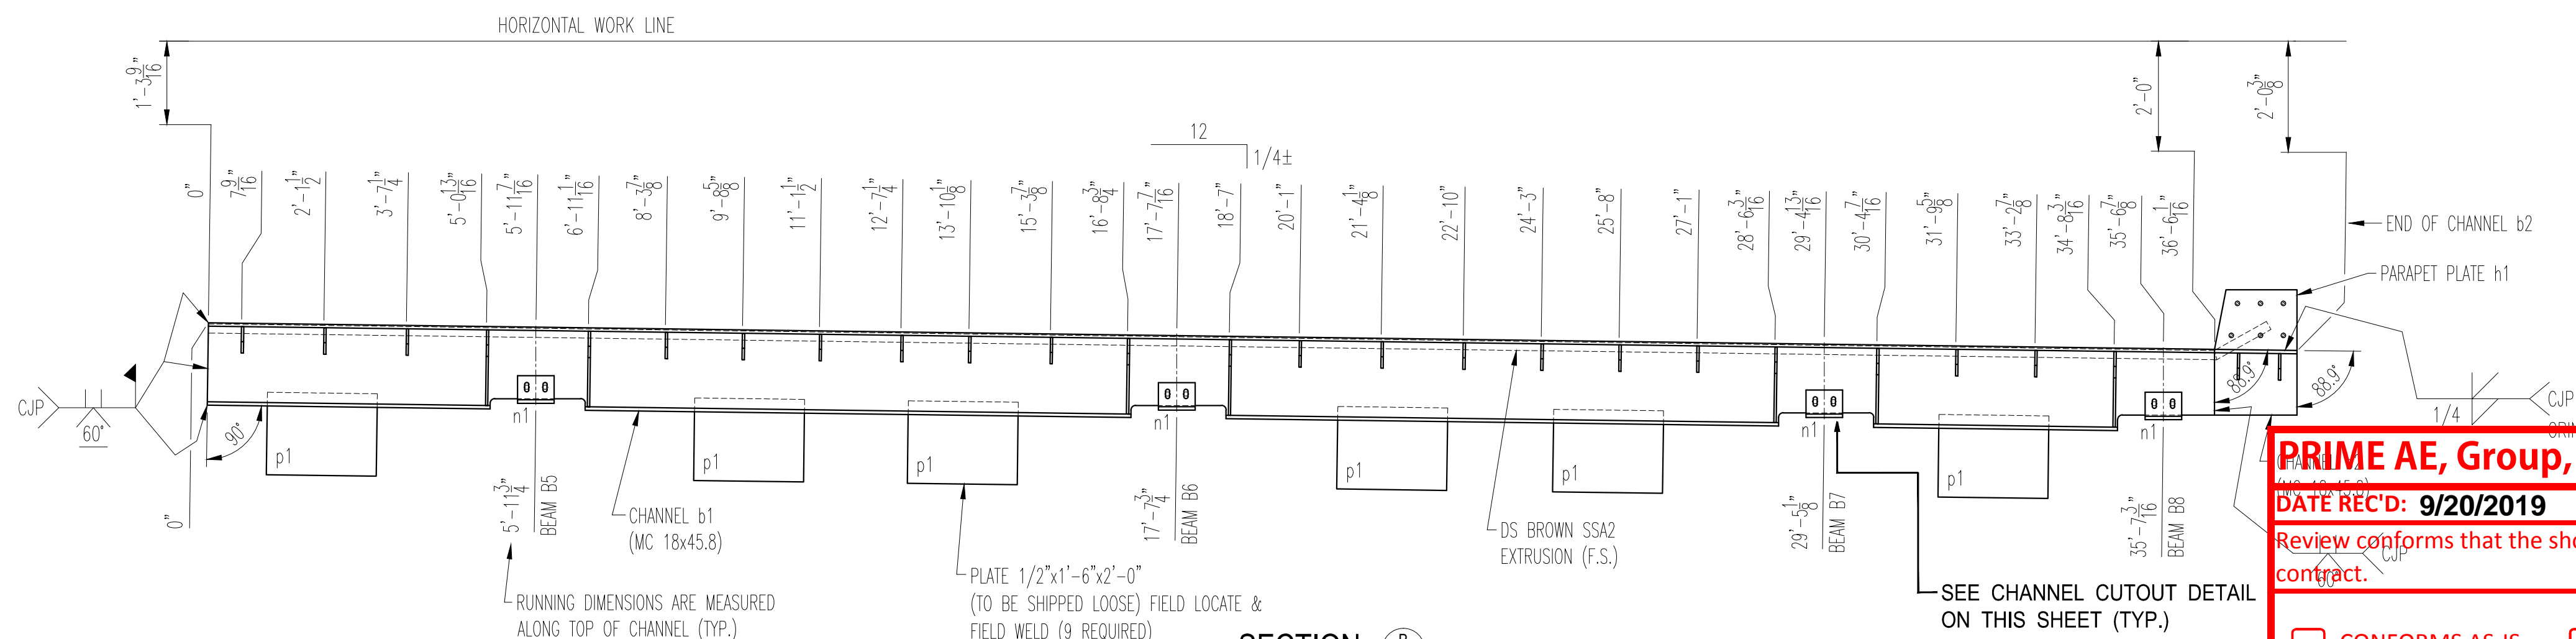

SECTION B-2

**PRIME AE, Group, Inc**  
 DATE REC'D: 9/20/2019 BUILDABLE UNIT NO.: 11  
 Review conforms that the shop drawings meet the intent of the contract.  
 CONFORMS AS-IS  CONFORMS AS NOTED  
 REVISE AND RESEND  
**1908R - ABUTMENT #4 EXPANSION JOINT**  
 By: Tom Stora Date: 9/24/2019

**RELEASED FOR FABRICATION**  
**WALSH**  
 NOTES:  
 SEE SHEET 1 FOR EXPANSION JOINT LOCATION PLAN  
 SEE SHEET 3 FOR EXPANSION JOINT DETAILS, GENERAL NOTES & BILL OF MATERIAL  
 DATE: 9/19/2019 DAY LENGTH: 38.25 ET

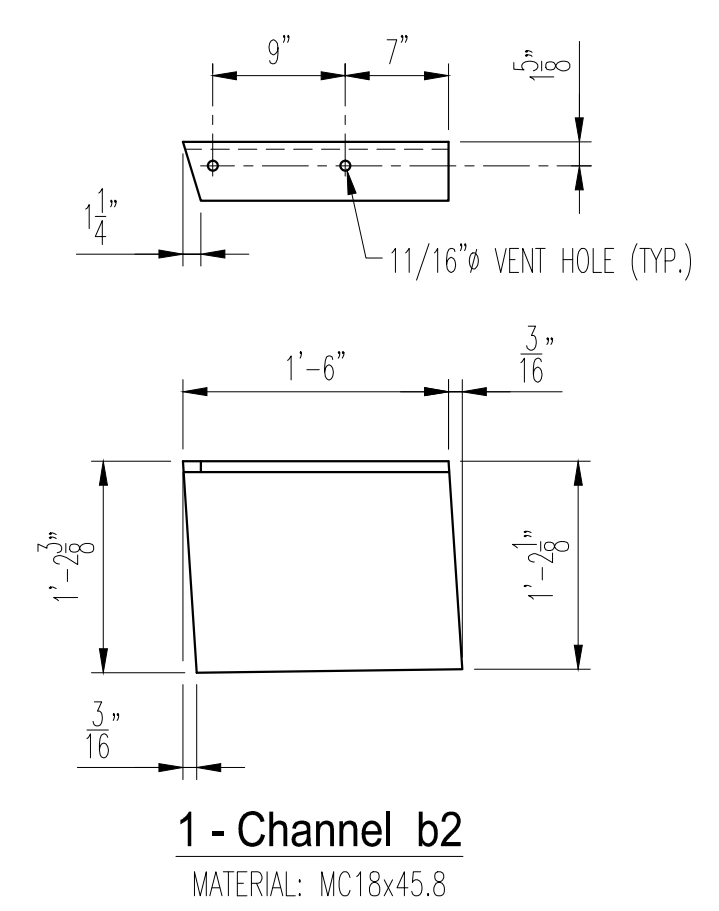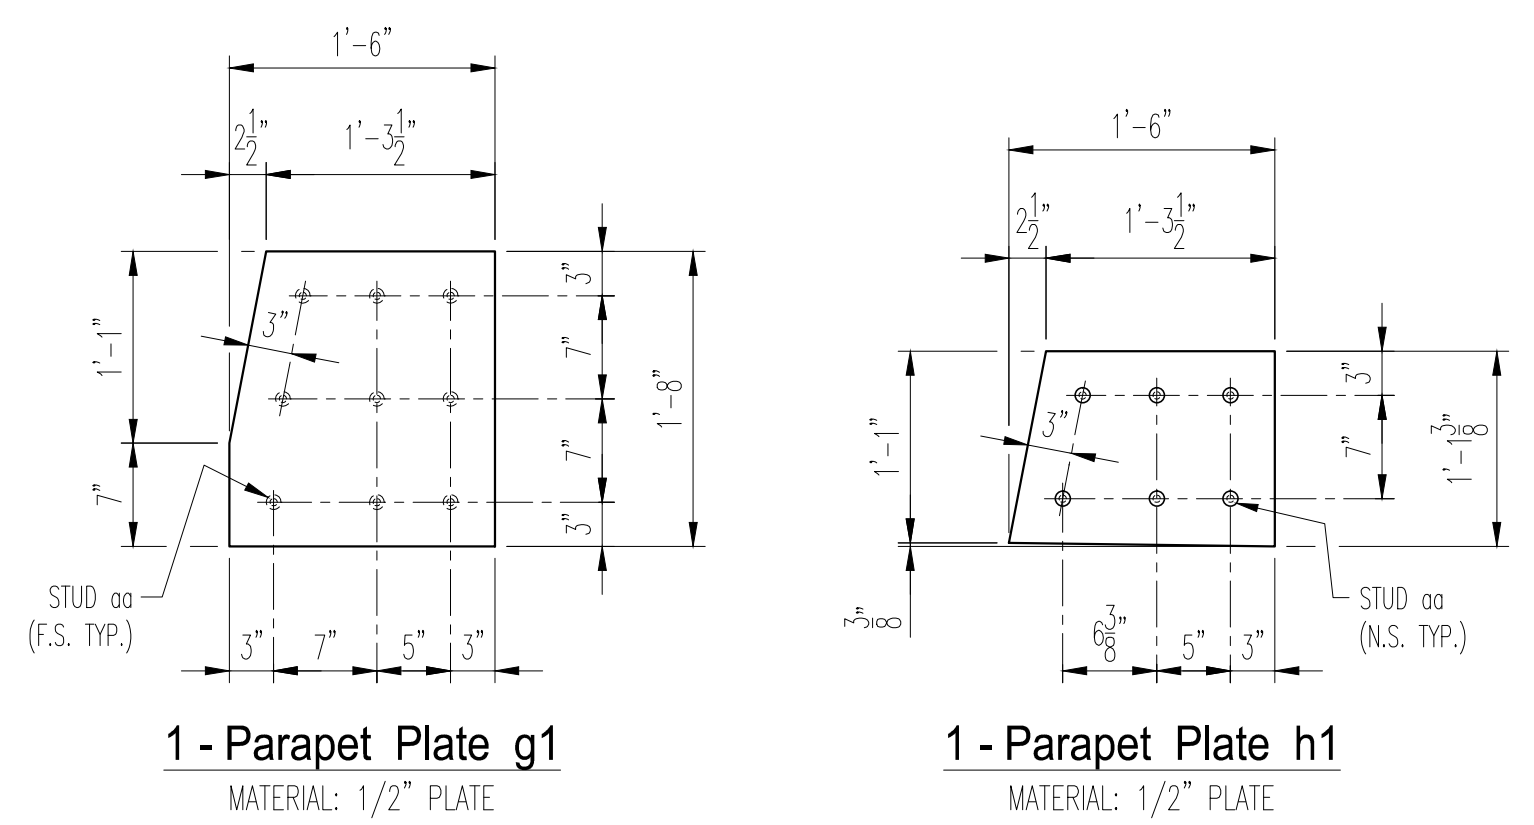

REV. No.	REVISION

SHOP INSPECTED BY:

APPROVAL




**OHIO STRUCTURES INC.**  
 535 NORTH BROAD STREET SUITE 5  
 CANFIELD, OHIO 44406  
 (330) 533-0084 FAX: (330) 533-0191

**OHIO DEPARTMENT OF TRANSPORTATION**  
 BRIDGE: HAM-74-1908R  
 IR 74 OVER MILL CREEK, RR & SPRING GROVE AVENUE


SCALE: N.T.S. DRAWN: JDC  
 DATE: 9/19/2019 CHECK: TJK  
 WALSH Construction Company

REF NO.: 2 ITEM NO.: 516  
 ODOT PROJ. NO.: 183000 HAMILTON COUNTY DWG. NO.: D1  
 OSI PROJ. NO.: 19-19 PID NO.: 104667 SFN: 3115739 2 OF 3


ODOT PROJECT : 183000		PID #: 104667		OSI PROJECT #: 19-19		REF #: 2					
1 - EXPANSION JOINT EJ19C											
MATERIALS ONLY:											
LINE	PO#	QTY	MARK	SECTION	LENGTH (FEET)	LENGTH (INCHES)	STL SPEC	PC WT (IN LBS)	NET WT (IN LBS)	HEAT #	REMARK
1		1	a1	ANGLE 7x4x1/2	34	2 3/4	A709-50	612.70	612.70		
2		1	b1	MC18x45.8	36	6 3/8	A709-50	1,673.13	1,673.13		
3		1	b1	MC18x45.8	1	6 1/4	A709-50	69.65	69.65		
4		4	n1	ANGLE 6x4x3/4	0	8	A709-50	15.73	62.93		
5		12	x1	ANGLE 2-1/2x2-1/2x1/4	1	1/4	A709-36	4.19	50.23		SHIPPING
6		23	c1	PLATE 3/8 x 6	0	11	A709-36	4.92	113.16		
7		19	d1	PLATE 1/2 x 5 5/16	1	6	A709-36	6.38	121.22		
8		7	e1	PLATE 1/2 x 17 3/16	1	6	A709-36	11.29	79.03		
9		1	g1	PLATE 1/2 x 18	1	8	A709-36	48.75	48.75		
10		1	h1	PLATE 1/2 x 13 1/4	1	6	A709-36	31.20	31.20		
11		*9	p1	PLATE 1/2 x 18	2	0	A709-50	60.60	545.40		
SUB TOTAL									3,407.41		
HARDWARE ONLY:											
LINE	QTY	MARK	DESCRIPTION	STL SPEC	WT PER (IN LBS)	NET WT (IN LBS)	HEAT #	REMARKS			
12	15	aa	1/2"x4" STUD	A108	0.29	4.35					
13	8	bb	3/4x2-3/4 HEX HEAD BOLT	A325 Galv	0.48	3.85					
14	8	nb	3/4 HEAVY HEX NUT	A563 Galv	0.20	1.60					
15	8	wb	3/4 FLAT WASHER	F436 Galv	0.04	0.33					
16	24	cc	5/8x2 HEX HEAD BOLT	A307	0.26	6.14		SHIPPING			
17	24	nc	5/8 HEAVY HEX NUT	A307	0.12	2.88		SHIPPING			
SUB TOTAL									19.15		
MISC:											
LINE	QTY	MARK	DESCRIPTION	WT PER (IN LBS)	NET WT (IN LBS)	HEAT #	REMARKS				
18	3.20	---	SSA2 EXTRUSION x 23'-0"	A709-36	121.90	390.08		D.S. BROWN			
19	* 1	---	A2R-400 STRIP SEAL x 42'-0"		0.00	0.00		D.S. BROWN			
20	* 1	---	GALLON OF SEAL GLUE		0.00	0.00		D.S. BROWN			
SUB TOTAL									390.08		
* INDICATES AN ITEM THAT WILL BE SHIPPED LOOSE											
TOTAL WT									3,816.64		

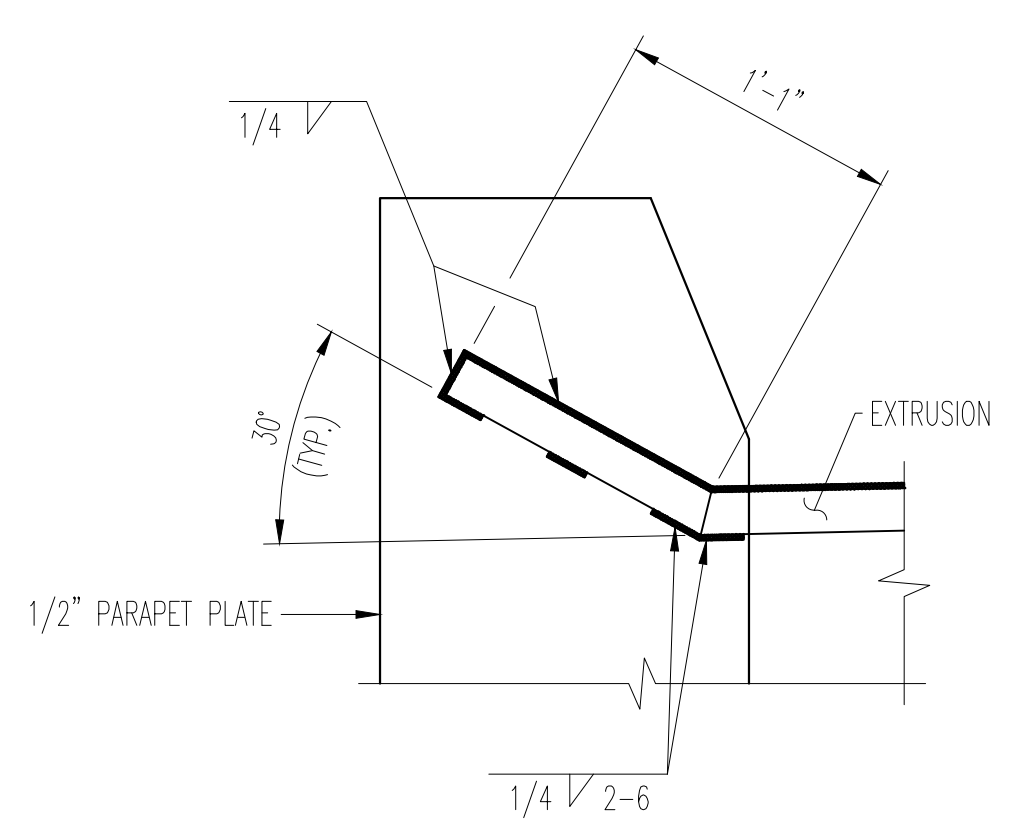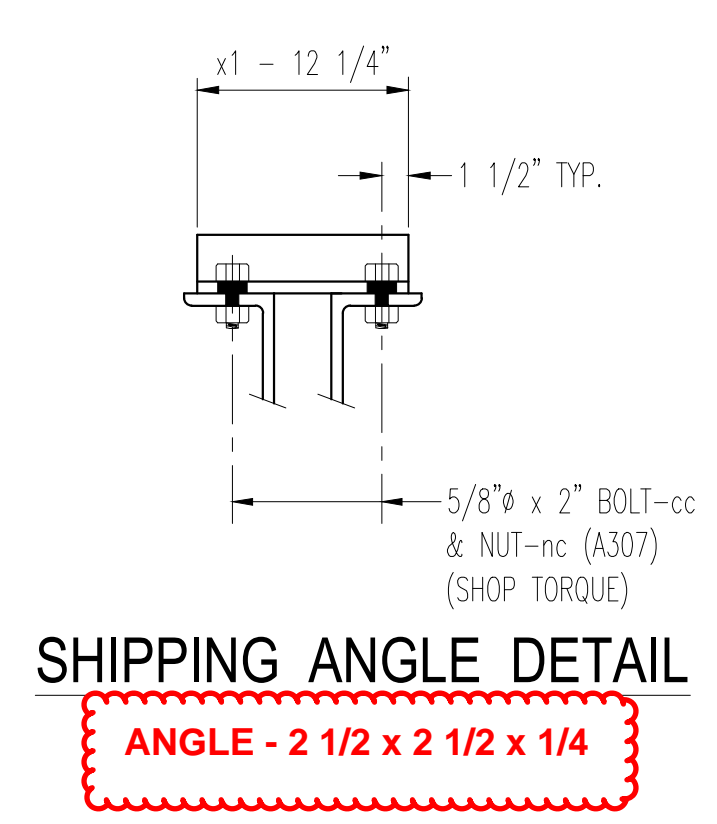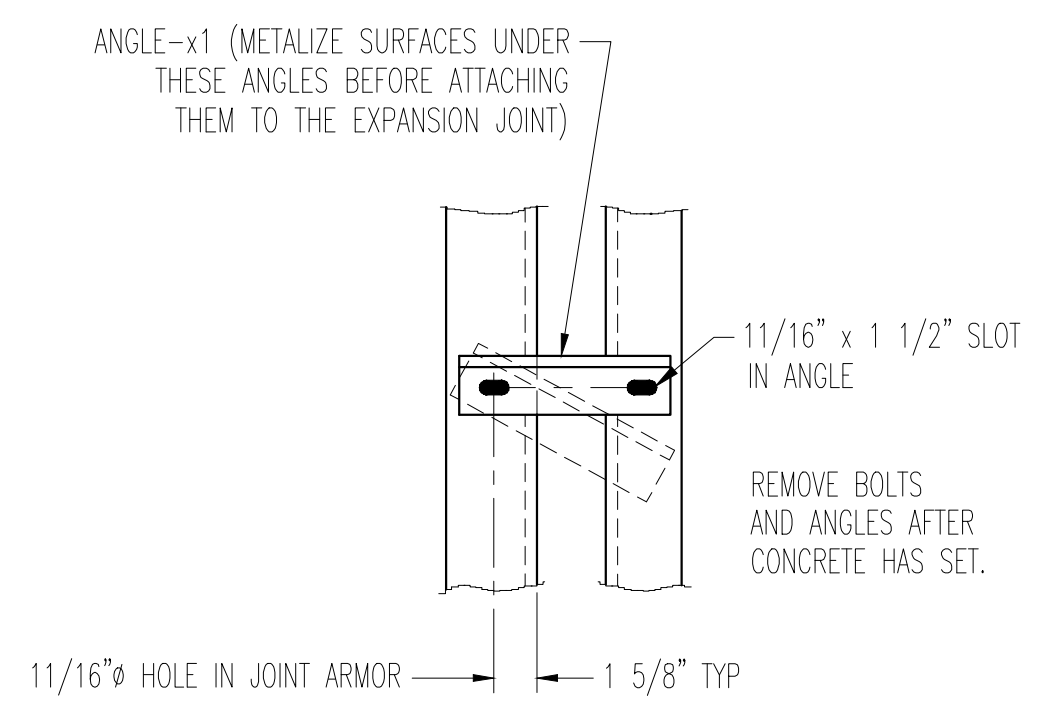


TYPICAL PARAPET WELD DETAIL

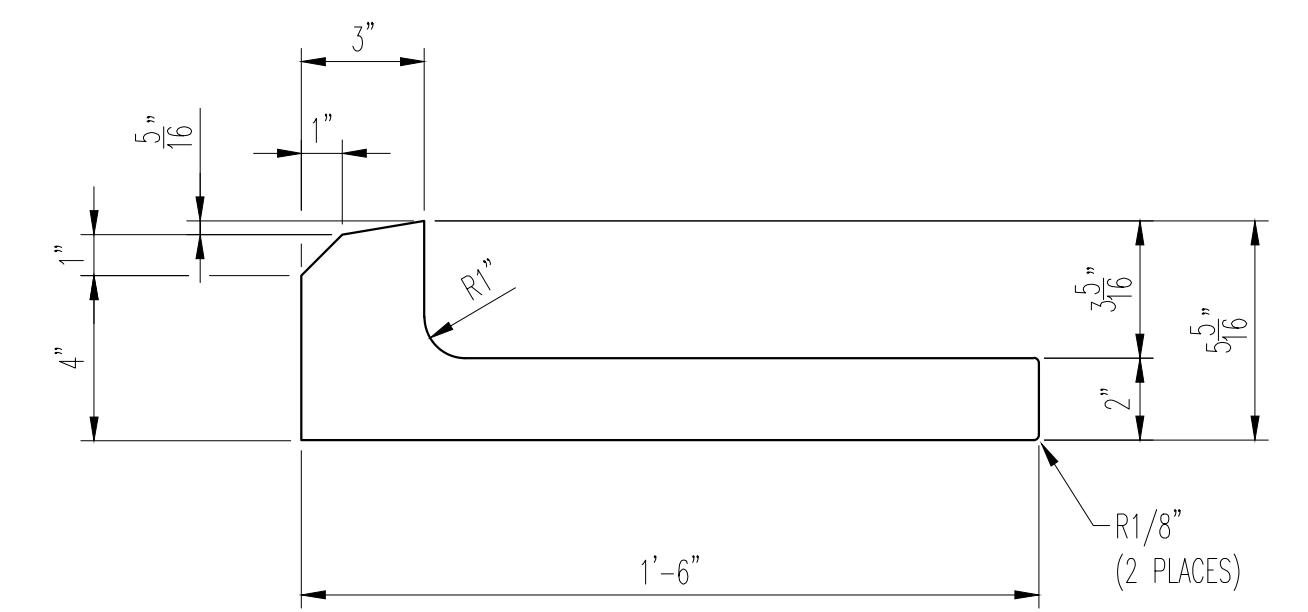


19 - Plates d1  
MATERIAL: 1/2" PLATE  
ADJUST SIZE TO FIT INSIDE THE MC18x45.8 CHANNEL

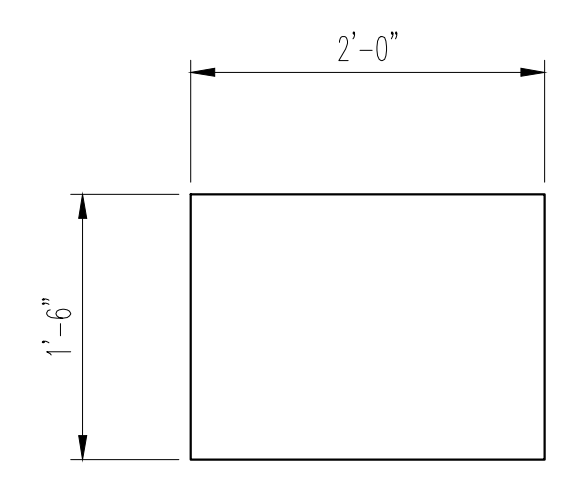

9 - Plates p1  
MATERIAL: 1/2" PLATE (SHIP LOOSE)  
5 REQUIRED FOR STAGE S1-P2-S1  
4 REQUIRED FOR STAGE S1-P2-S2

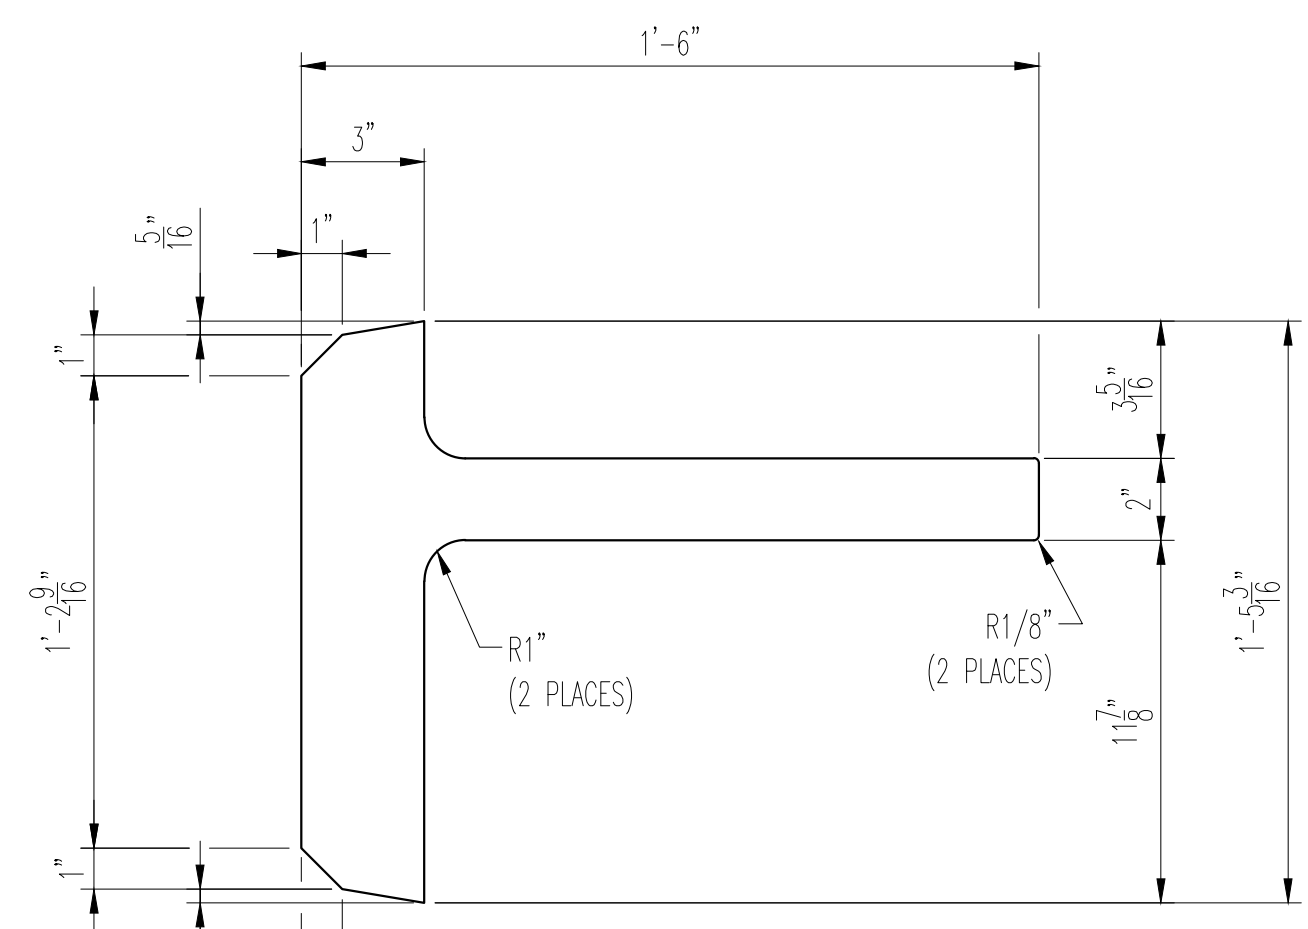

7 - Plates e1  
MATERIAL: 1/2" PLATE  
ADJUST SIZE TO FIT INSIDE THE MC18x45.8 CHANNEL

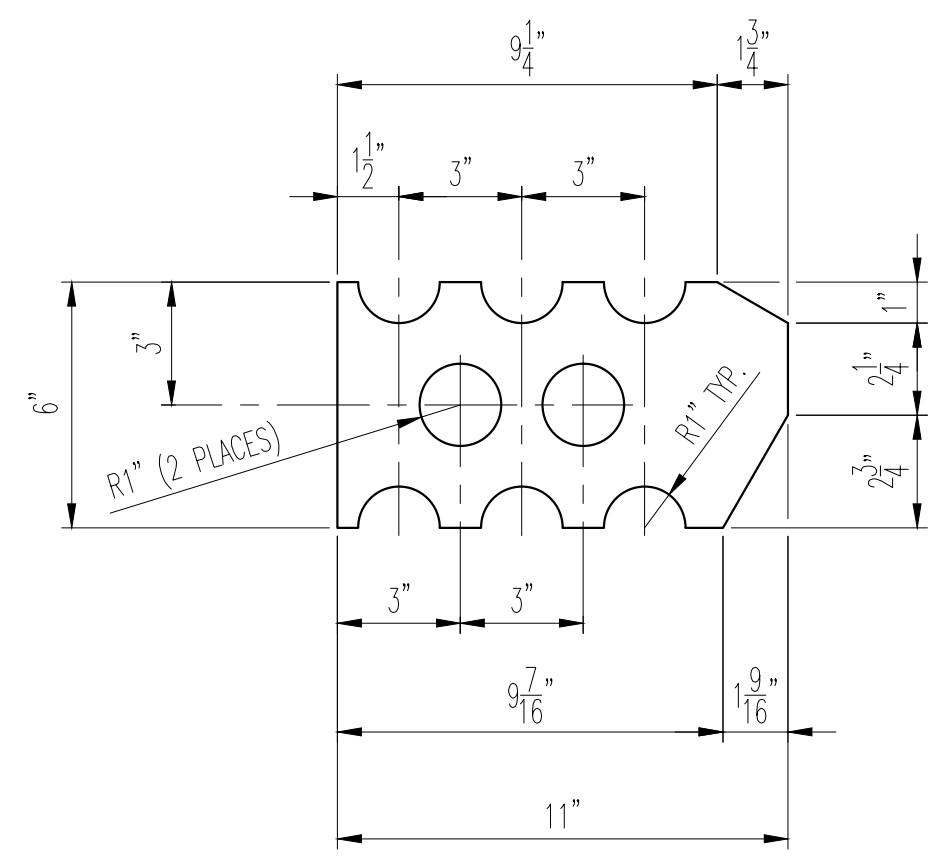

23 - Plates c1  
MATERIAL: 3/8" PLATE

**PRIME AE, Group, Inc**

DATE REC'D: 9/20/2019 BUILDABLE UNIT NO.: 11

Review conforms that the shop drawings meet the intent of the contract.

CONFORMS AS-IS  CONFORMS AS NOTED  
 REVISE AND RESEND

**1908R - ABUTMENT #4 EXPANSION JOINT**

By: Tom Stora Date: 9/24/2019

**RELEASED FOR FABRICATION**

**WALSH**

By: \_\_\_\_\_ Date: \_\_\_\_\_



REV. No.	REVISION
SHOP INSPECTED BY:	

APPROVAL

- GENERAL NOTES:
- \* MATERIAL AND WORKMANSHIP SHALL BE IN ACCORDANCE WITH ODOT-CMS-2016.
  - \* WELDING SHALL BE IN ACCORDANCE WITH AWS/AASHTO D1.5-10 AND ODOT 1011.
  - \* ALL MATERIAL TO BE METALIZED IN CONFORMANCE WITH O.D.O.T. STANDARD DRAWING EXJ-4-87 DATED 7/19/02.
  - \* ALL INFORMATION & DIMENSIONS ARE TO BE APPROVED BY THE CONTRACTOR PRIOR TO COMMENCING FABRICATION.

**OHIO STRUCTURES INC.**  
535 NORTH BROAD STREET SUITE 5  
CANFIELD, OHIO 44406  
(330) 533-0084 FAX: (330) 533-0191

**OHIO DEPARTMENT OF TRANSPORTATION**  
BRIDGE: HAM-74-1908R  
IR 74 OVER MILL CREEK, RR & SPRING GROVE AVENUE

SCALE: N.T.S. DATE: 9/19/19 DRAWN: JDC CHECK: TJK


Walsh Construction Company

EXPANSION JOINT DETAILS, GENERAL NOTES & BILL OF MATERIAL

REF NO.: 2 ITEM NO.: 516


ODOT PROJ. NO.: 183000 HAMILTON COUNTY DWG. NO.: D2  
OSI PROJ. NO.: 19-19 PID NO.: 104667 SFN: 3115739 3 OF 3



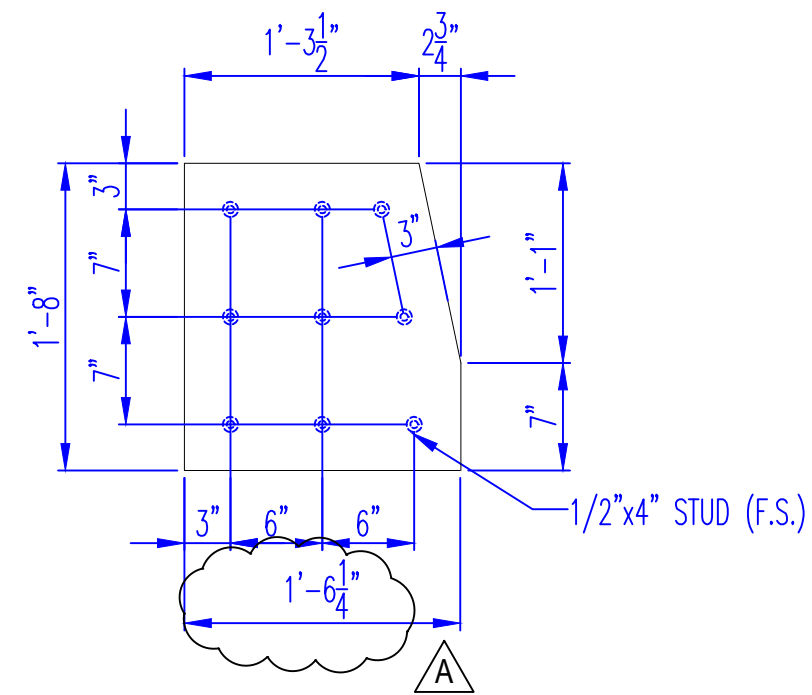


**DETAIL - g1**

MATERIAL: 1/2" PL.  
QUANTITY: 1

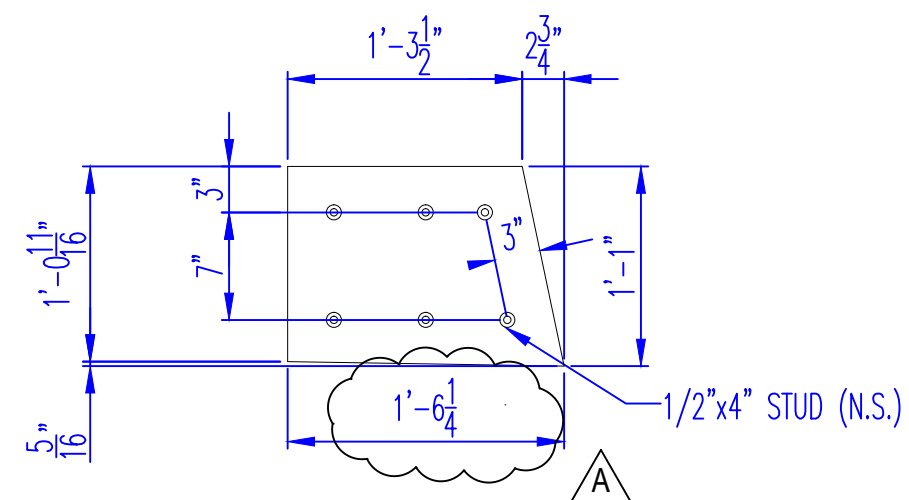


**DETAIL - h1**


MATERIAL: 1/2" PL.  
QUANTITY: 1

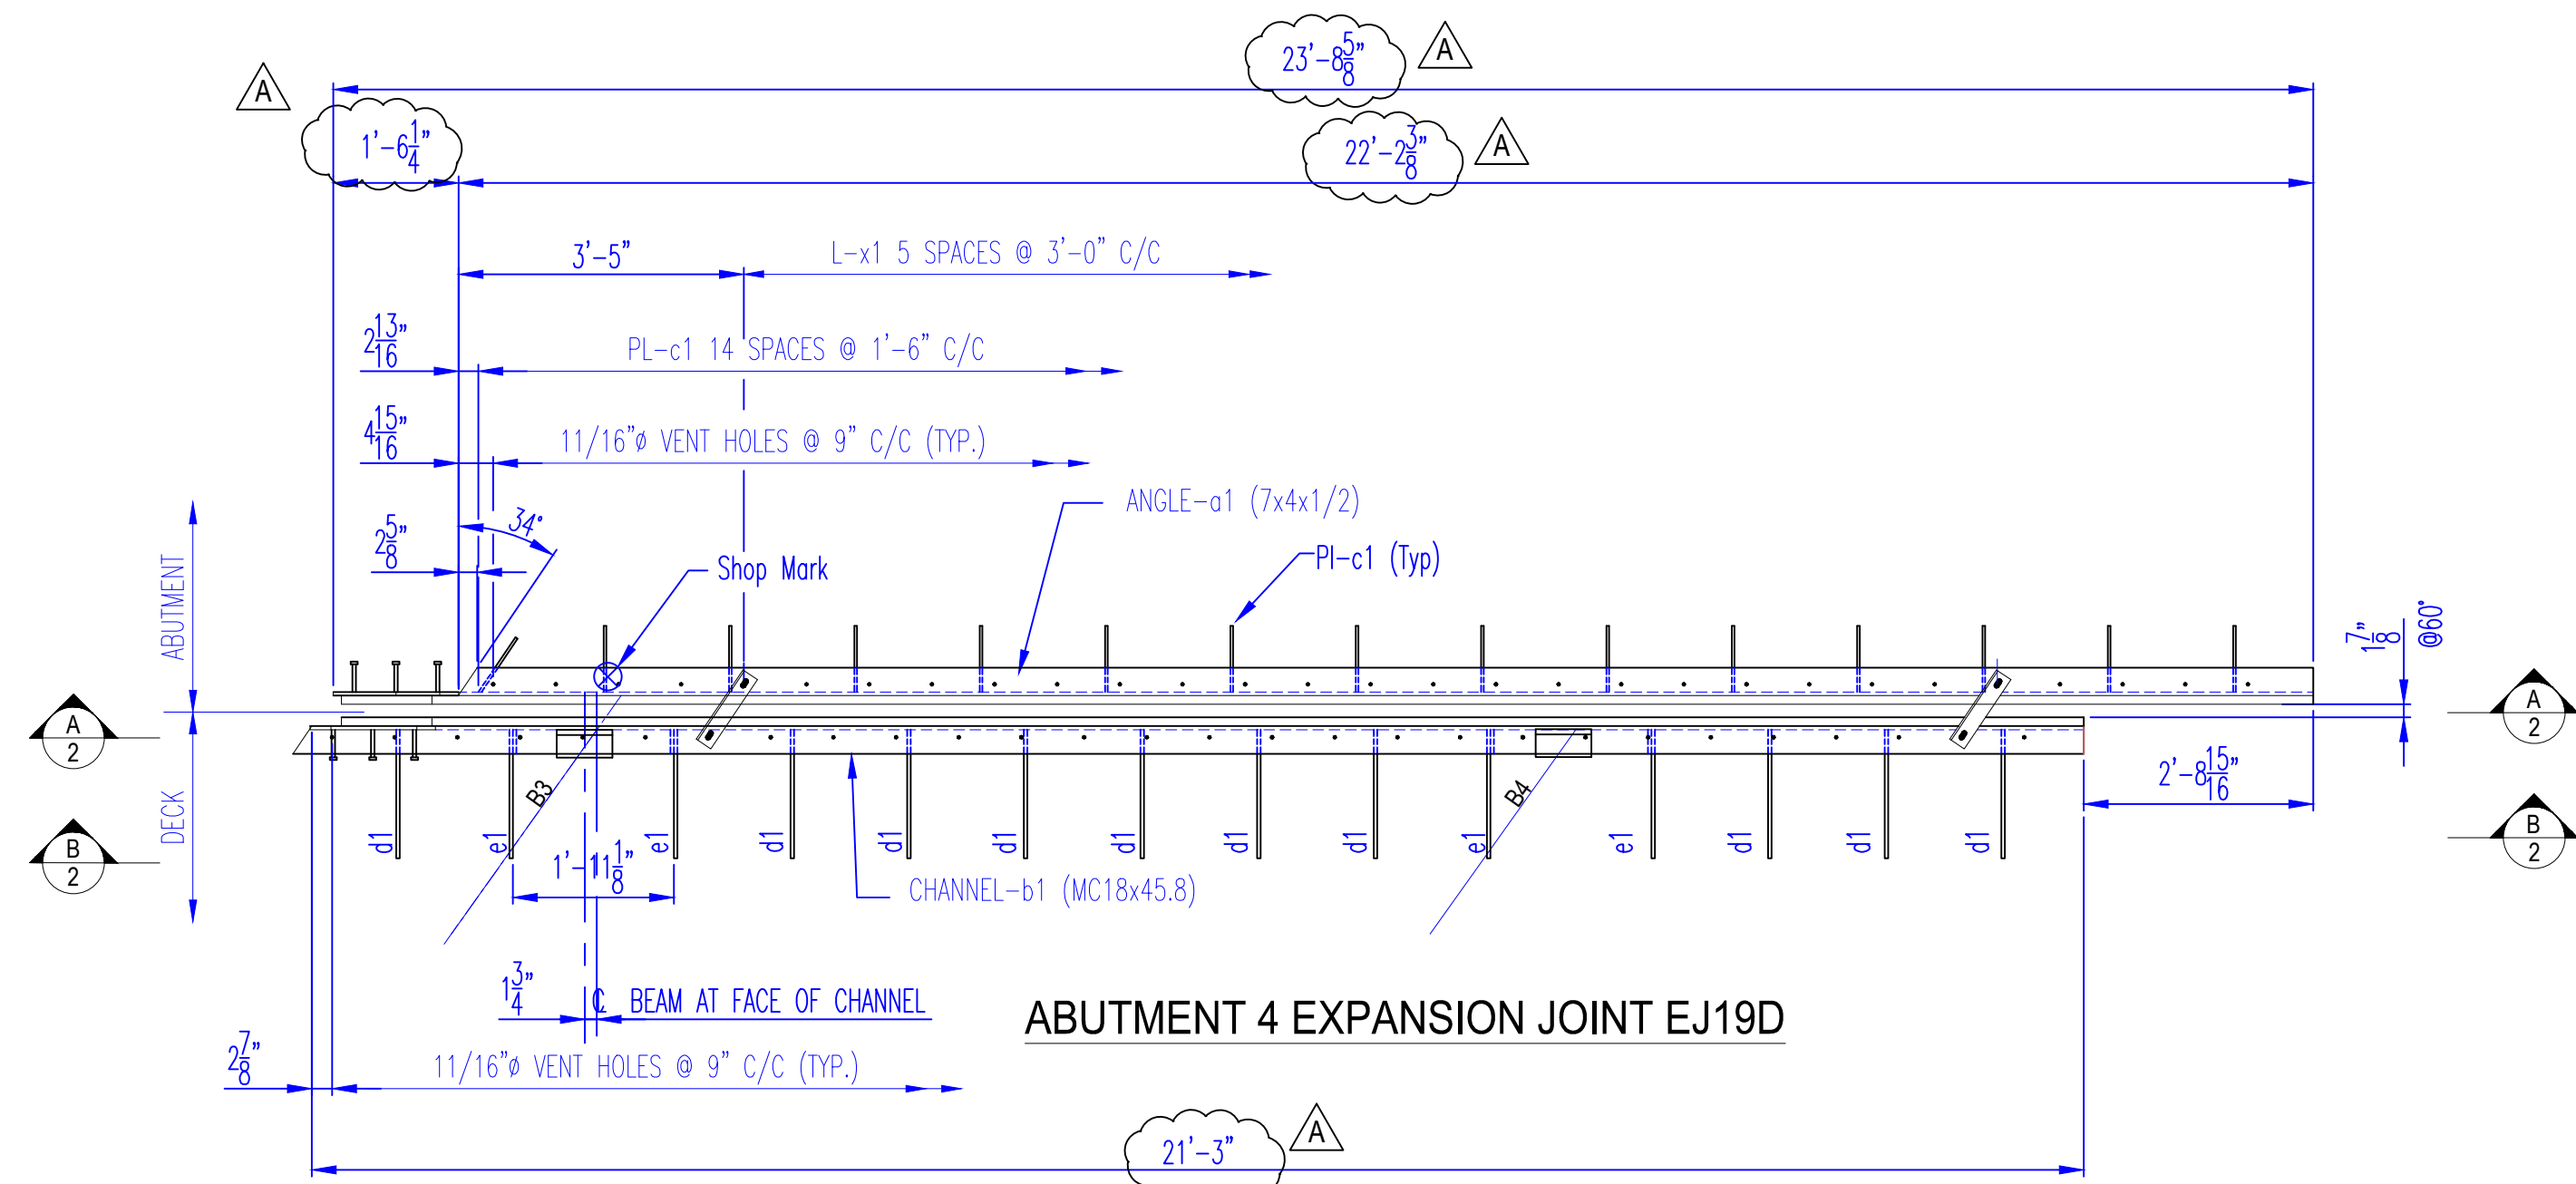


**ABUTMENT 4 EXPANSION JOINT EJ19D**

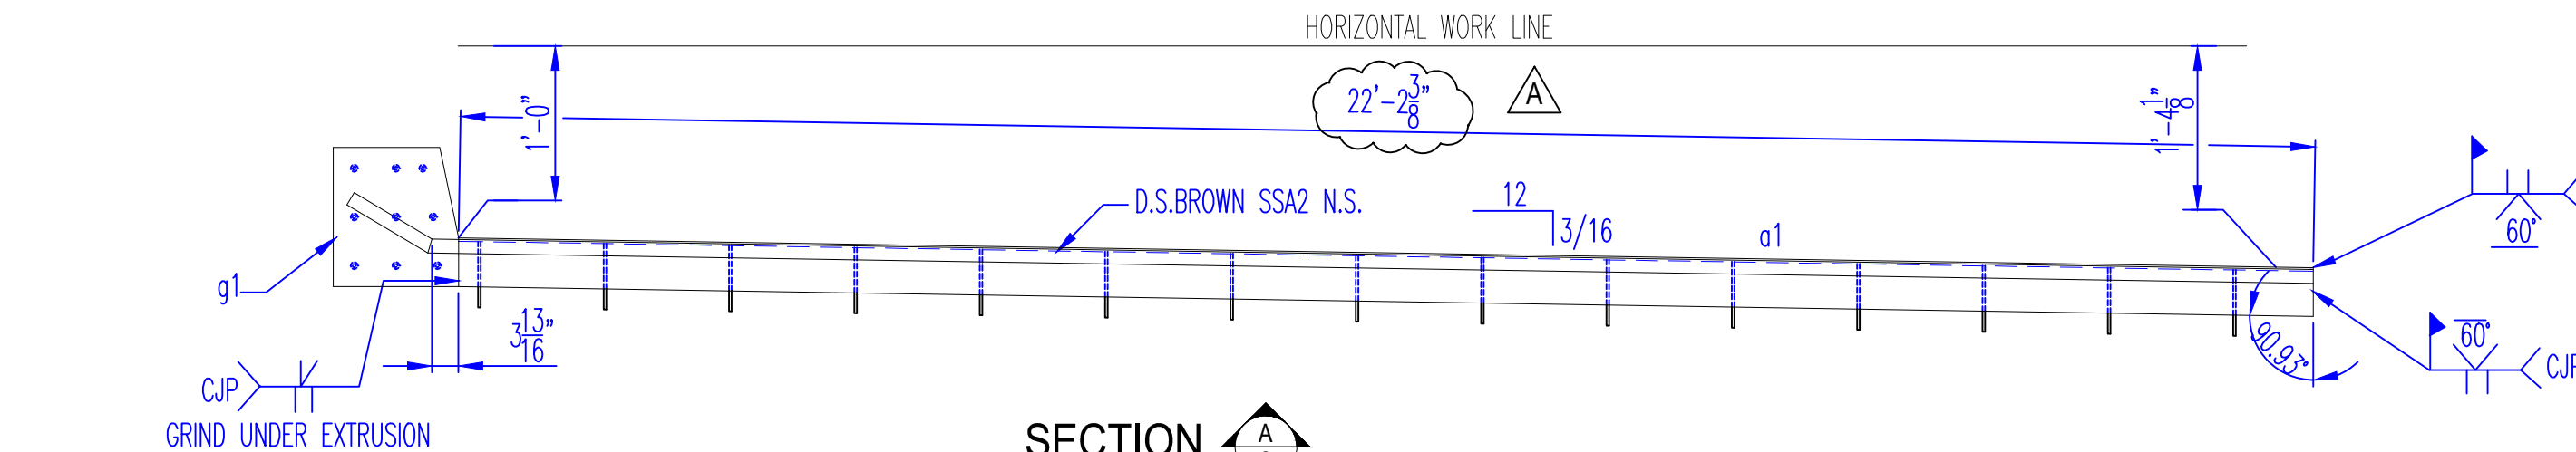


**SECTION A-A**

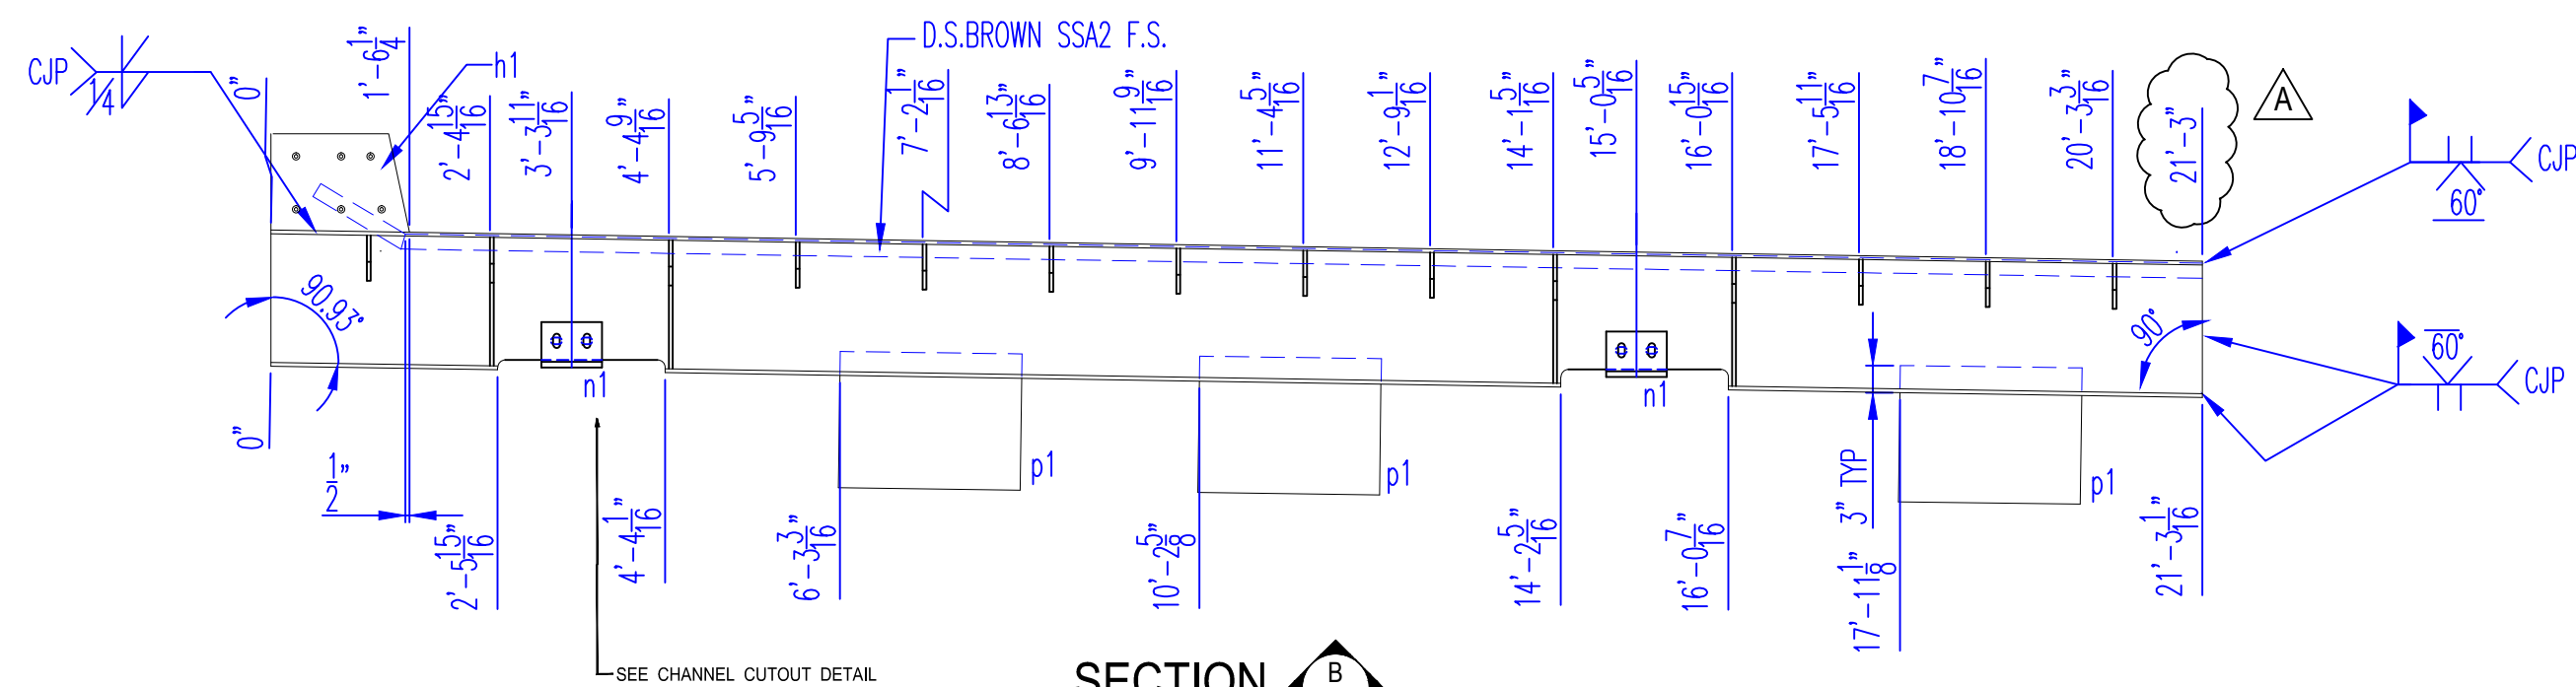


**SECTION B-B**

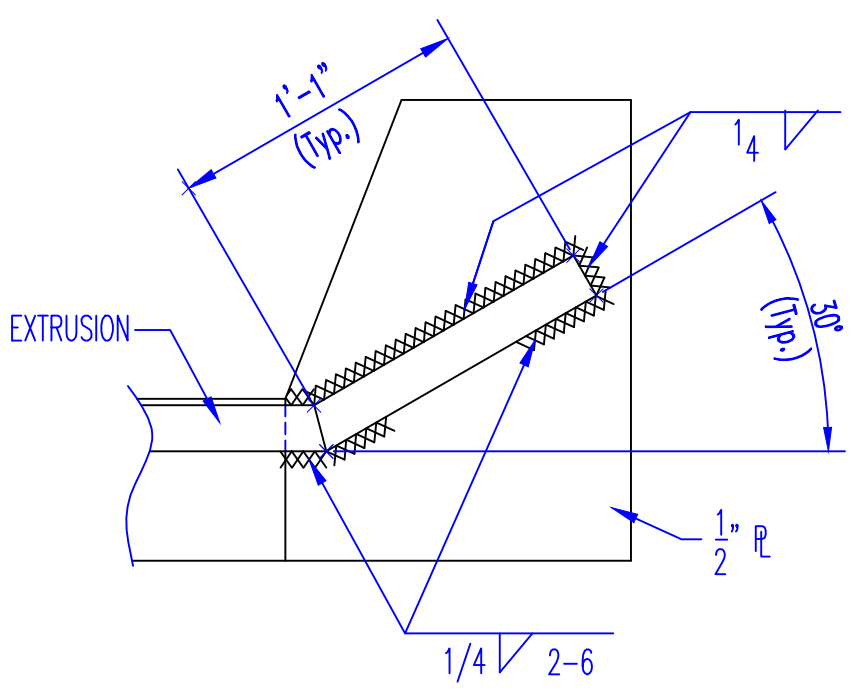

**PARAPET PL DETAIL**

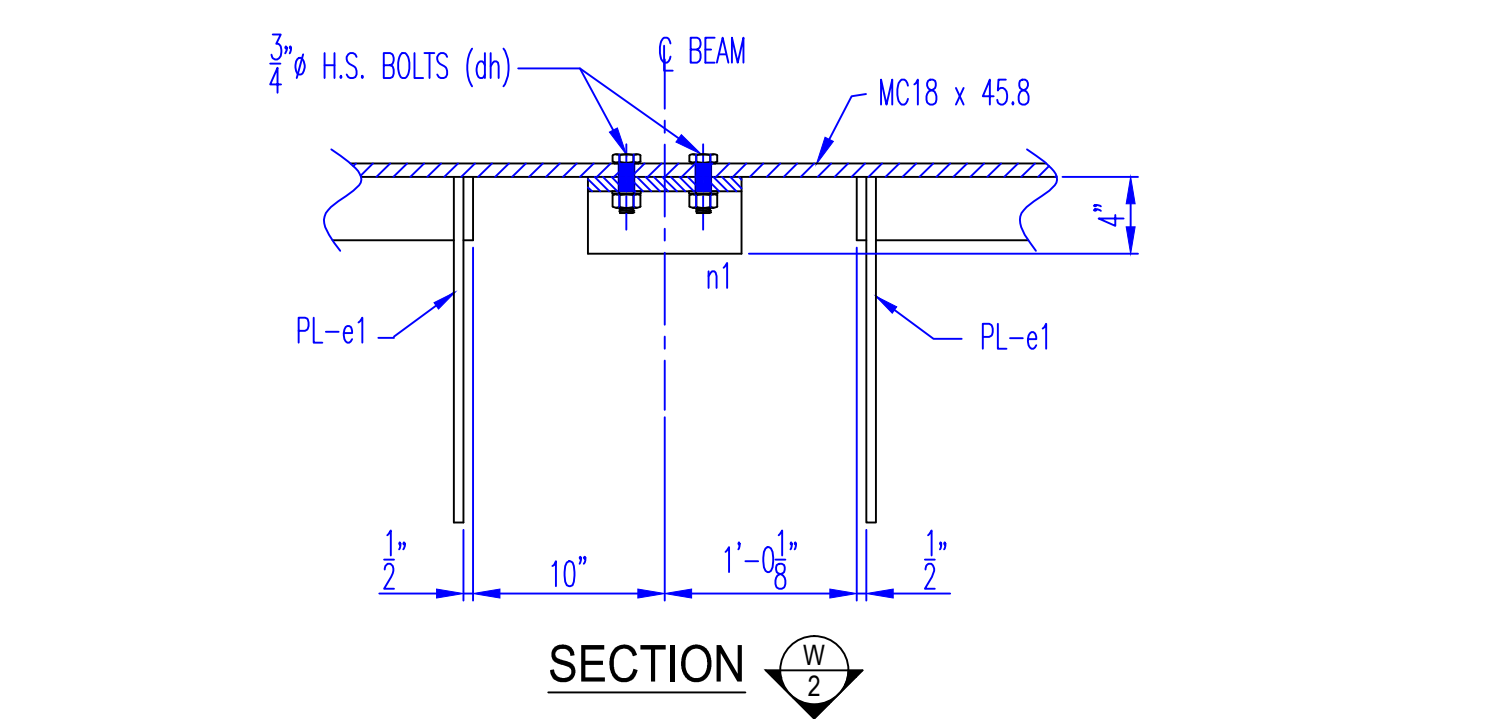

**SECTION W-W**

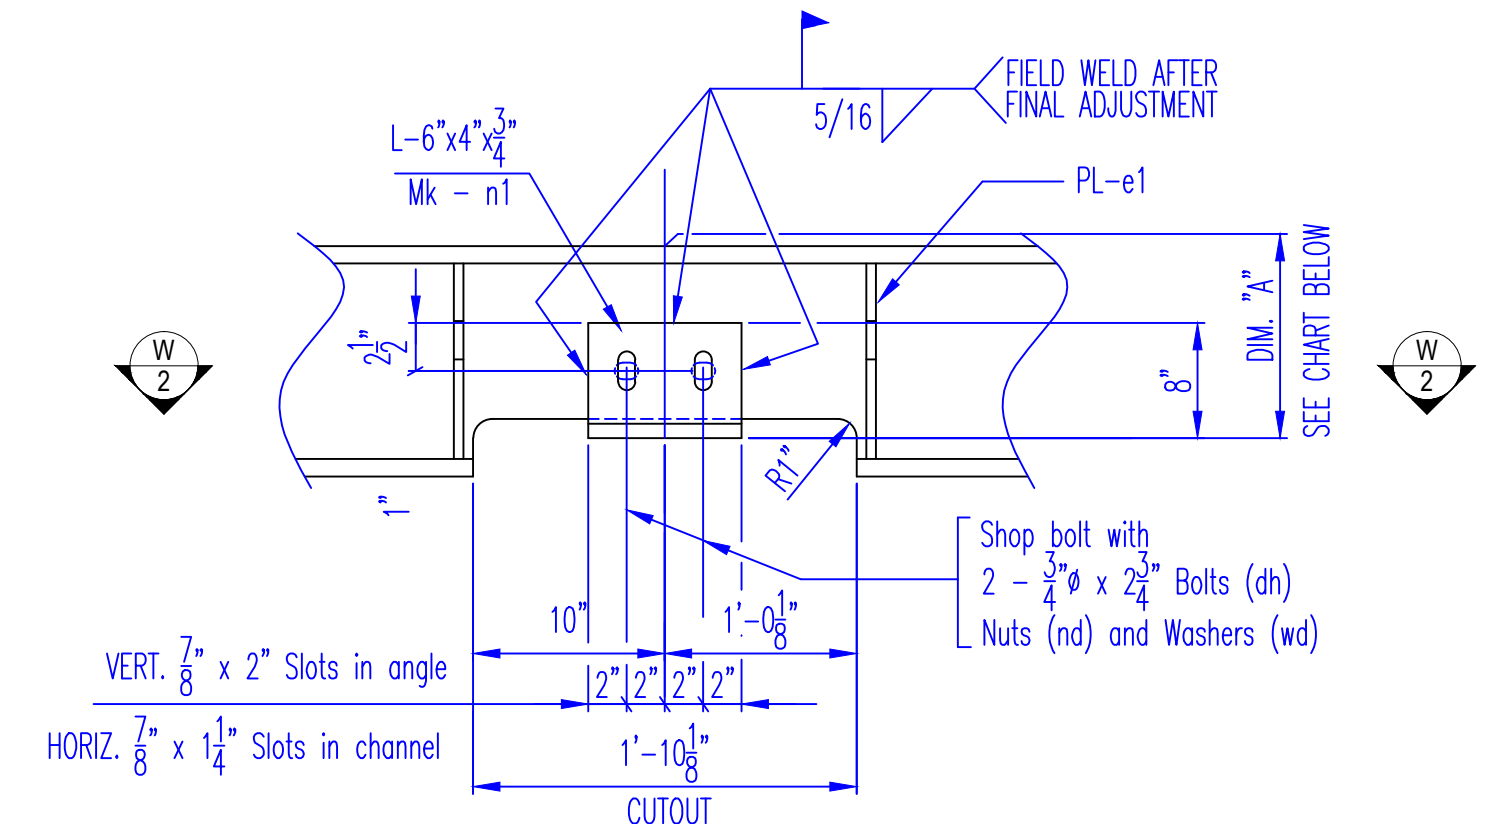

**CHANNEL CUTOUT DETAIL @ SUPPORT ANGLE - n1**

HAUNCH CHART (DIM A)		
BEAM	SUPPORT	HAUNCH
B3	USE n1	1'-5 9/16"
B4	USE n1	1'-4 1/2"

THE HAUNCH DIMENSION IS THE MEASUREMENT FROM THE TOP OF THE CHANNEL TO THE BOTTOM OF THE SUPPORT ANGLE (n1)

<b>PRIME AE, Group, Inc</b>		<b>RELEASED FOR FABRICATION</b>	
DATE REC'D: 1/22/2020	BUILDABLE UNIT NO.: 11		
Review conforms that the shop drawings meet the intent of the contract.			
<b>Unit No. 6 - Abutment #4 Bearings</b>		By: <b>Thomas E. Stora</b>	By:
<input checked="" type="checkbox"/> CONFORMS AS-IS <input type="checkbox"/> INCOMPLETE		Date: 1/22/2020	Date:
<input type="checkbox"/> CONFORMS AS NOTED <input type="checkbox"/> DOES NOT CONFORM			



REV. No.	REVISION
A	ADJUST DIMENSION PER CONTRACTOR 1/15/20
SHOP INSPECTED BY:	

SEE SHEET E1 FOR EXPANSION JOINT LOCATION PLAN  
SEE SHEET 3 FOR EXPANSION JOINT DETAILS, GENERAL NOTES & BILL OF MATERIAL

PAY LENGTH 23.71 FT.

4030 BOARDMAN - CANFIELD RD. SUITE 200D CANFIELD, OHIO 44406 (330) 533-0084 FAX: (330) 533-0191	
<b>OHIO DEPARTMENT OF TRANSPORTATION</b> BRIDGE: HAM-74-1908R IR 74 OVER MILL CREEK, RR & SPRING GROVE AVENUE	
SCALE: N.T.S.	DRAWN: LF
DATE: 1/20	CHECK: MI
<b>WALSH CONSTRUCTION</b> EXPANSION JOINT EJ19D DETAILS	
REF NO.: 0033A	ITEM NO.: 516
ODOT PROJ. NO.: 183000	HAMILTON COUNTY DWG. NO.: D1
OSI PROJ. NO.: 19-19	PID NO.: 104667 3115739 2 OF 3

**1 - EXPANSION JOINT EJ19D**

**MATERIALS ONLY:**

LINE	PO#	QTY	MARK	SECTION	LENGTH (FEET)	LENGTH (INCHES)	STL SPEC	PC WT (IN LBS)	NET WT (IN LBS)	HEAT #	REMARK
1		1	a1	ANGLE 7x4x1/2	22	2 3/8	A709-50	397.34	397.34		
2		1	b1	MC18x45.8	21	3	A709-50	973.25	973.25		
3		2	n1	ANGLE 8x4x3/4	0	8	A709-50	19.13	38.27		
5		6	x1	ANGLE 2-1/2x2-1/2x1/4	1	0	A709-36	4.10	24.60		SHIPPING
6		15	c1	PLATE 3/8 x 6	0	11	A709-36	4.92	73.80		
7		10	d1	PLATE 1/2 x 5 5/16	1	6	A709-36	6.38	63.80		
8		1	g1	PLATE 1/2 x 20	1	6 1/4	A709-36	11.29	11.29		
9		1	h1	PLATE 1/2 x 13	1	6 1/4	A709-36	48.75	48.75		
10		3	p1	PLATE 1/2 x 18	2	0	A709-36	22.90	68.70		
								<b>SUB TOTAL</b>	<b>1,699.80</b>		

**HARDWARE ONLY:**



LINE	QTY	MARK	DESCRIPTION	STL SPEC	WT PER (IN LBS)	NET WT (IN LBS)	HEAT #	REMARKS
11	15	--	1/2"x4" STUD	A108	0.29	4.35		
12	4	dh	3/4x2-3/4 HEX HEAD BOLT	A325 Galv	0.48	1.92		
13	4	nd	3/4 HEAVY HEX NUT	A563 Galv	0.20	0.80		
14	4	wd	3/4 FLAT WASHER	F436 Galv	0.04	0.16		
15	12	nc	5/8x2 HEX HEAD BOLT	A307	0.26	3.07		SHIPPING
16	12	wc	5/8 HEAVY HEX NUT	A307	0.12	1.44		SHIPPING
						<b>SUB TOTAL</b>	<b>11.75</b>	

**MISC:**

LINE	QTY	MARK	DESCRIPTION	WT PER (IN LBS)	NET WT (IN LBS)	HEAT #	REMARKS
17	1.90	--	SSA2 EXTRUSION x 23'-0"	A709-36	121.90	231.61	D.S. BROWN
18	* 1	--	A2R-400 STRIP SEAL x59'-0"		0.00	0.00	D.S. BROWN
19	* 1	--	GALLON OF SEAL GLUE		0.00	0.00	D.S. BROWN
					<b>SUB TOTAL</b>	<b>231.61</b>	



\* INDICATES AN ITEM THAT WILL BE SHIPPED LOOSE

**TOTAL WT 1,943.16**

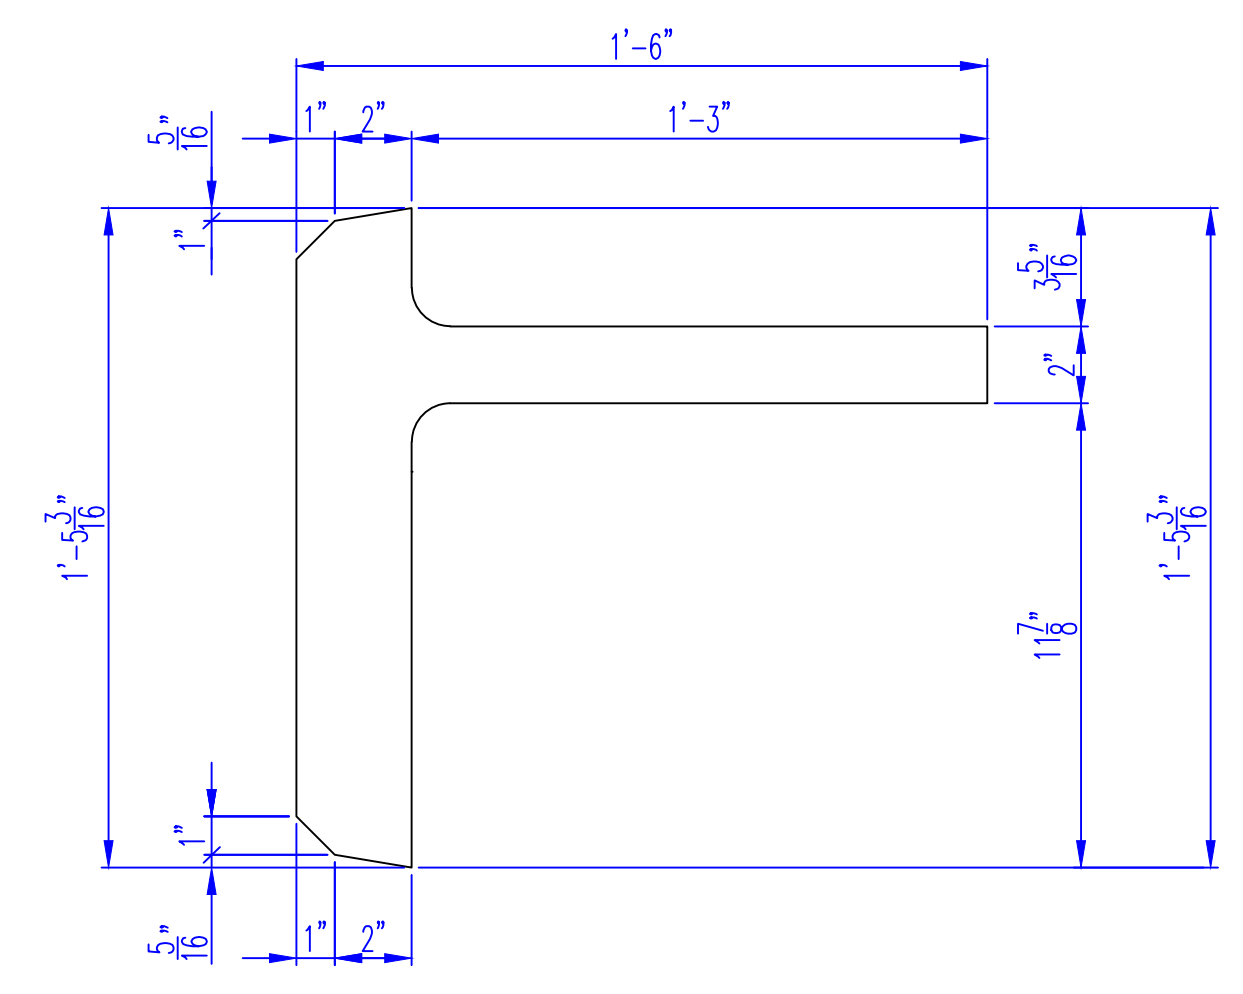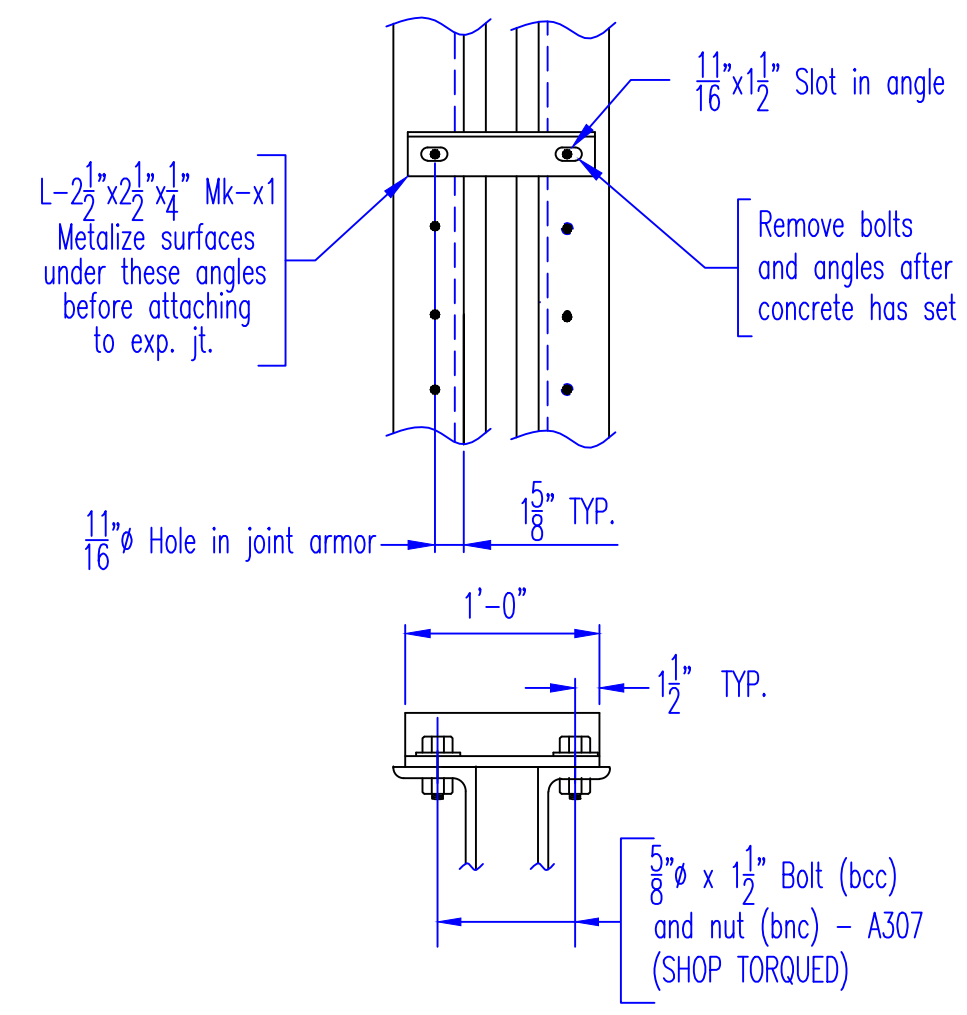


**SHIPPING ANGLE DETAIL**

**DETAIL e1**  
MATERIAL: 1/2" PL.  
QUANTITY: 4

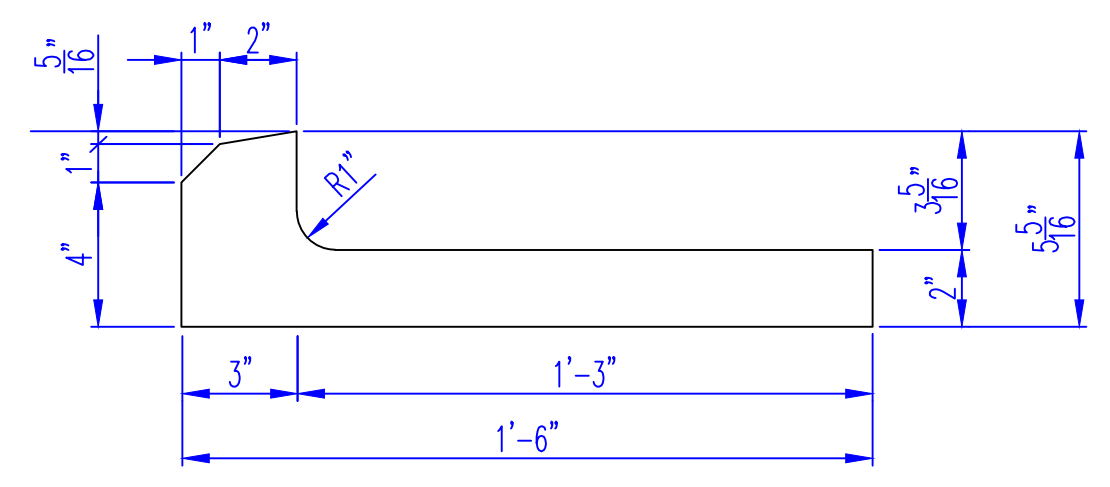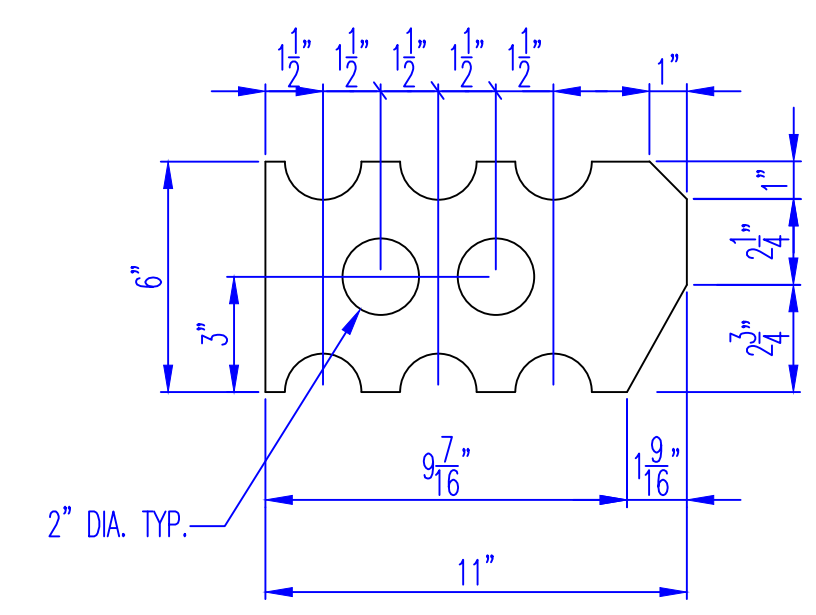

**DETAIL PL-c1**  
MATERIAL: 3/8" PL.  
QUANTITY: 15

**DETAIL d1**  
MATERIAL: 1/2" PL.  
QUANTITY: 10

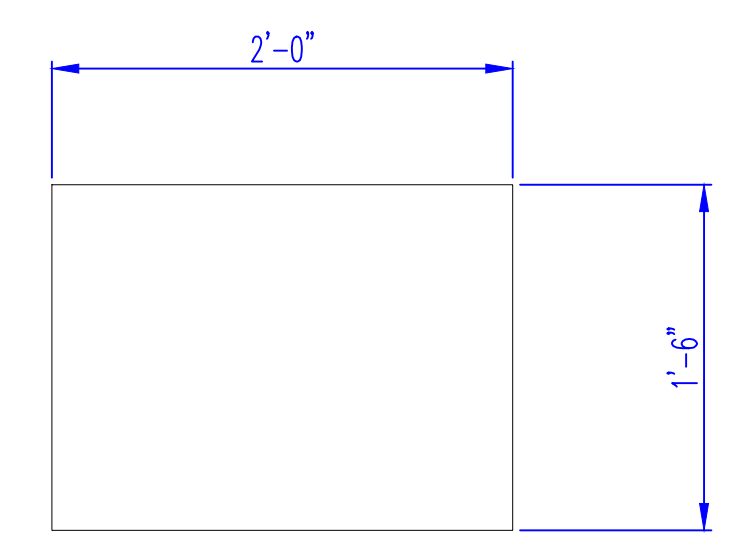

**DETAIL p1**  
MATERIAL: 1/2" PL.  
QUANTITY: 3

**PRIME AE, Group, Inc**

DATE REC'D: 1/22/2020 BUILDABLE UNIT NO.: 11

Review conforms that the shop drawings meet the intent of the contract.

**Unit No. 6 - Abutment #4 Bearings**

CONFORMS AS-IS  CONFORMS AS NOTED  INCOMPLETE  DOES NOT CONFORM

By: **Thomas E. Stora** Date: 1/22/2020

RELEASED FOR FABRICATION

**WALSH**

STATE OF OHIO REGISTERED PROFESSIONAL ENGINEER THOMAS E. STORA E-66634

- GENERAL NOTES:**
- \* ALL MATERIAL SHALL BE ASTM A709 GR50/36.
  - \* MATERIAL AND WORKMANSHIP SHALL BE IN ACCORDANCE WITH ODOT-CMS-2016.
  - \* WELDING SHALL BE IN ACCORDANCE WITH AWS/AASHTO D1.5-15 AND ODOT 1011.
  - \* ALL MATERIAL TO BE METALIZED IN CONFORMANCE WITH O.D.O.T. STANDARD DRAWING EXJ-4-87 DATED 1/18/19.
  - \* ALL INFORMATION & DIMENSIONS ARE TO BE APPROVED BY THE CONTRACTOR PRIOR TO COMMENCING FABRICATION.
  - \* GENERAL TOLERANCE ±1/8" UNLESS NOTED.



APPROVAL

REV. No.	REVISION
SHOP INSPECTED BY:	

**OHIO STRUCTURES INC.**  
4030 BOARDMAN - CANFIELD RD. SUITE 200D  
CANFIELD, OHIO 44406  
(330) 533-0084 FAX: (330) 533-0191

**OHIO DEPARTMENT OF TRANSPORTATION**  
BRIDGE: HAM-74-1908R  
IR 74 OVER MILL CREEK, RR & SPRING GROVE AVENUE


SCALE: N.T.S. DATE: 1/20 DRAWN: LF CHECK: MI

**WALSH CONSTRUCTION**

EXPANSION JOINT EJ19D DETAILS, GENERAL NOTES, BILL OF MATERIAL  
REF NO.: 0033 ITEM NO.: 516


ODOT PROJ. NO.: 183000 HAMILTON COUNTY DWG. NO.: D2  
OSI PROJ. NO.: 19-19 PID NO.: 104667 3115739 3 OF 3



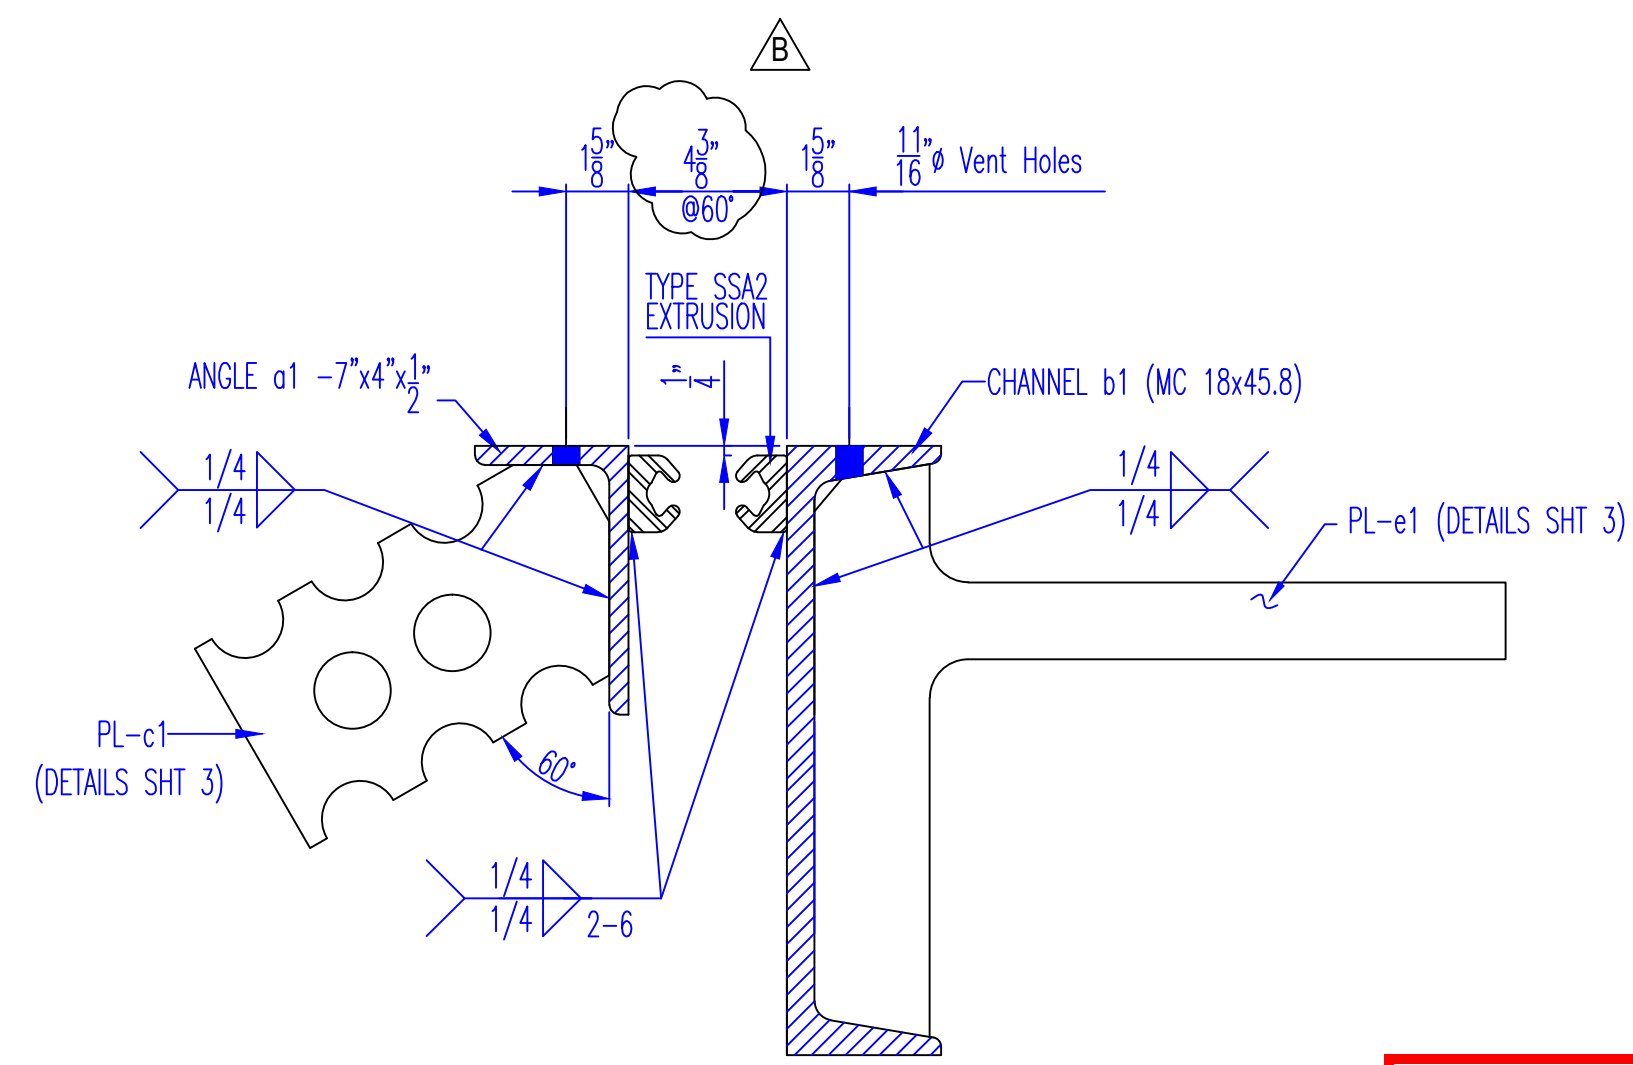


SECTION

<b>PRIME AE, Group, Inc</b>		<b>RELEASED FOR FABRICATION</b>	
DATE REC'D: 1/22/2020	BUILDABLE UNIT NO.: 11		
Review conforms that the shop drawings meet the intent of the contract.			
<b>Unit No. 6 - Abutment #4 Bearings</b>			
<input checked="" type="checkbox"/> CONFORMS AS-IS	<input type="checkbox"/> CONFORMS AS NOTED	By: <b>Thomas E. Stora</b>	By:
<input type="checkbox"/> INCOMPLETE	<input type="checkbox"/> DOES NOT CONFORM	Date: 1/22/2020	Date:

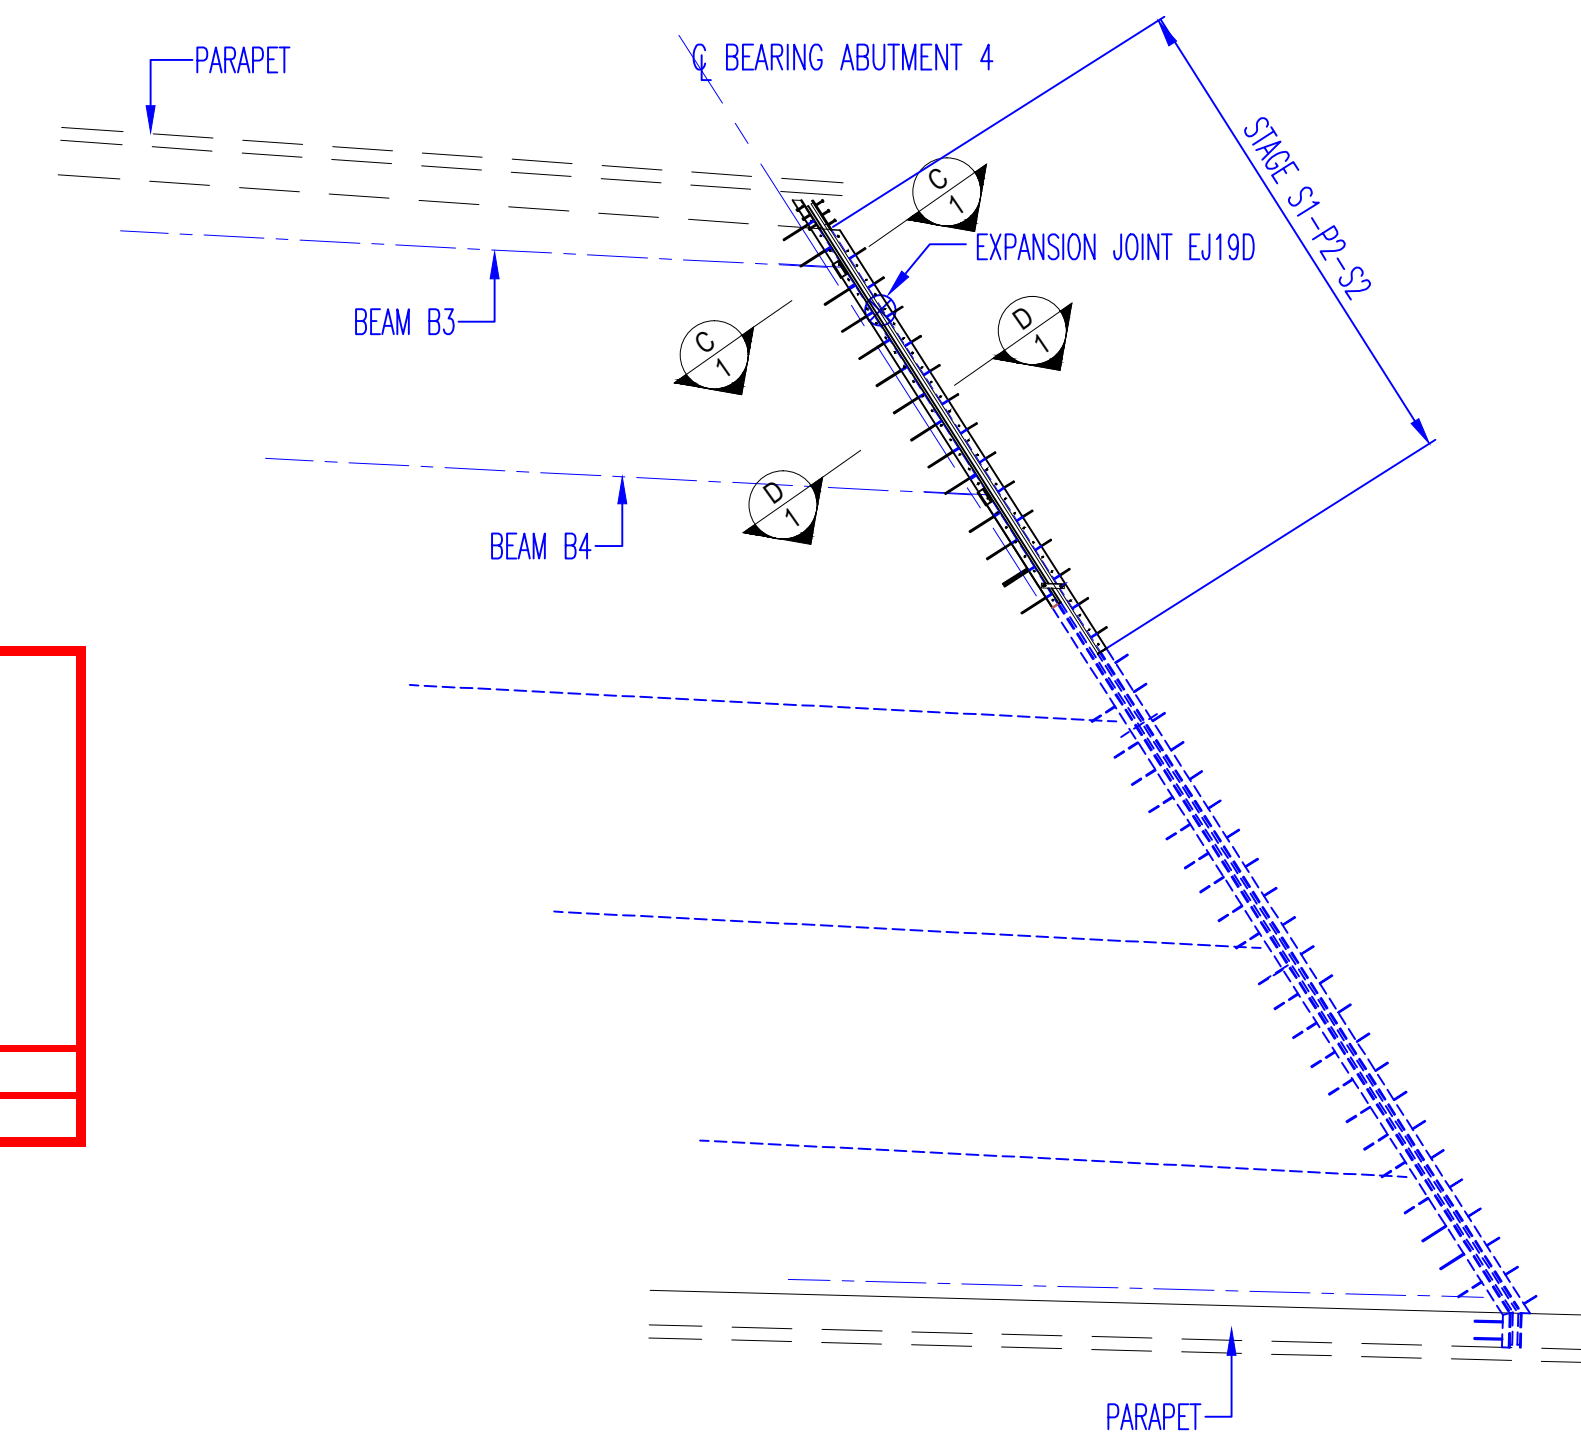

**ABUTMENT 4 - EXPANSION JOINT LOCATION PLAN**

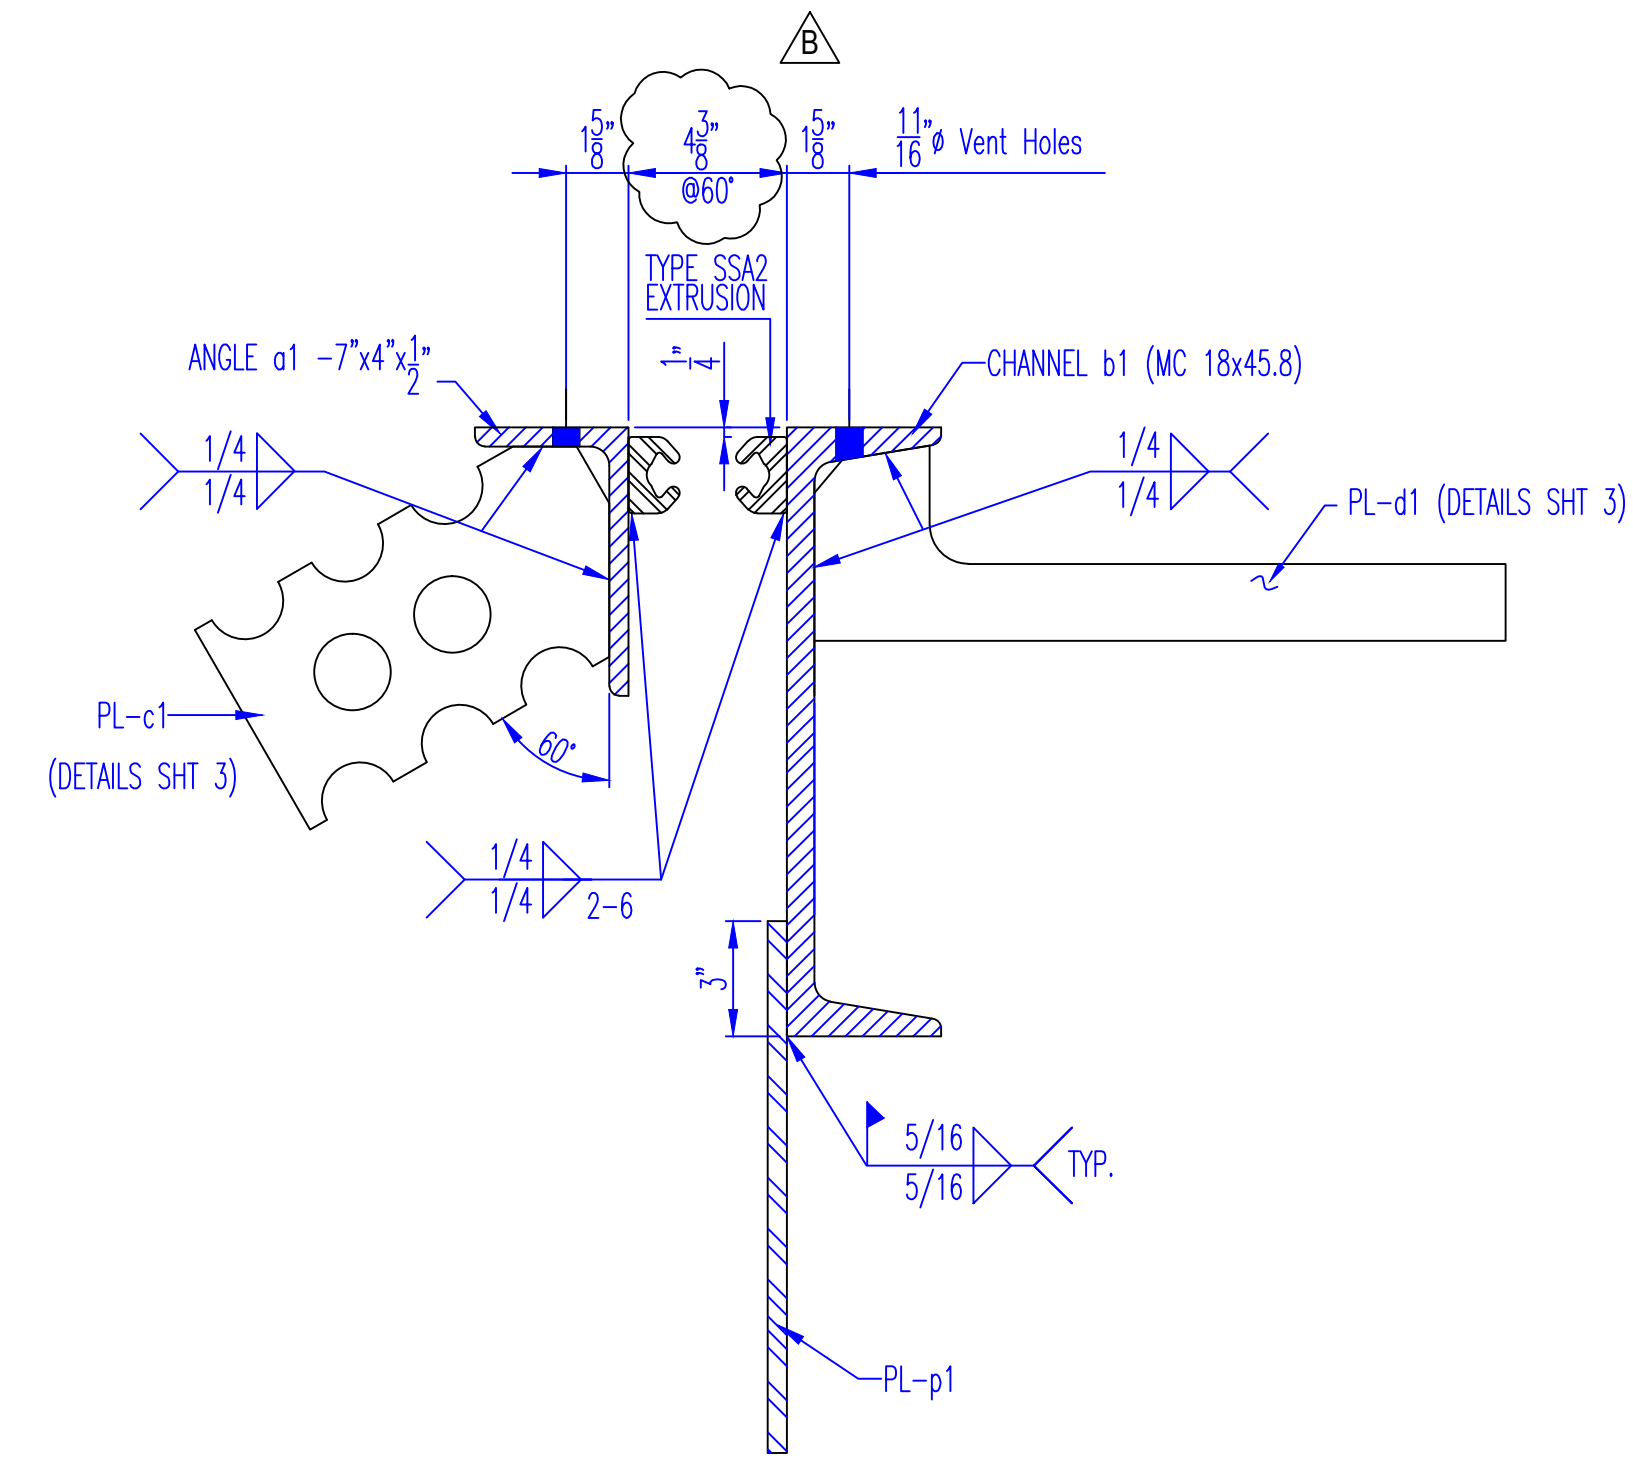

SECTION

**NOTES:**  
 SEE SHEET 2 FOR EXPANSION JOINT EJ19D DETAILS  
 SEE SHEET 3 FOR EXPANSION JOINT DETAILS, GENERAL NOTES & BILL OF MATERIAL




APPROVAL	

 <b>OHIO STRUCTURES INC.</b> 4030 BOARDMAN - CANFIELD RD. SUITE 200D CANFIELD, OHIO 44406 (330) 533-0084 FAX: (330) 533-0191			
<b>OHIO DEPARTMENT OF TRANSPORTATION</b> BRIDGE: HAM-74-1908R IR 74 OVER MILL CREEK, RR & SPRING GROVE AVENUE			
SCALE: N.T.S.	DATE: 1/20	WALSH CONSTRUCTION	DRAWN: LF
		EXPANSION JOINT LOCATION PLAN	CHECK: MI
REF NO.: 0033	ODOT PROJ. NO.: 183000	HAMILTON COUNTY	ITEM NO.: 516
OSI PROJ. NO.: 19-19	PID NO.: 104667	3115739	DWG. NO.: E1
			1 OF 3

REV. No.	REVISION
	ADJUST DIMENSION PER CONTRACTOR 1/21/20
SHOP INSPECTED BY:	

\* BEAM SPACING DIMENSIONS SHOWN ARE MEASURED FROM THE  $\zeta$  OF BEAMS AT THE INTERSECTION OF  $\zeta$  OF BEARING PERPENDICULAR TO ADJACENT BEAMS, AND INCLUDE A 5.3% CROSS-SLOPE (AVERAGED).

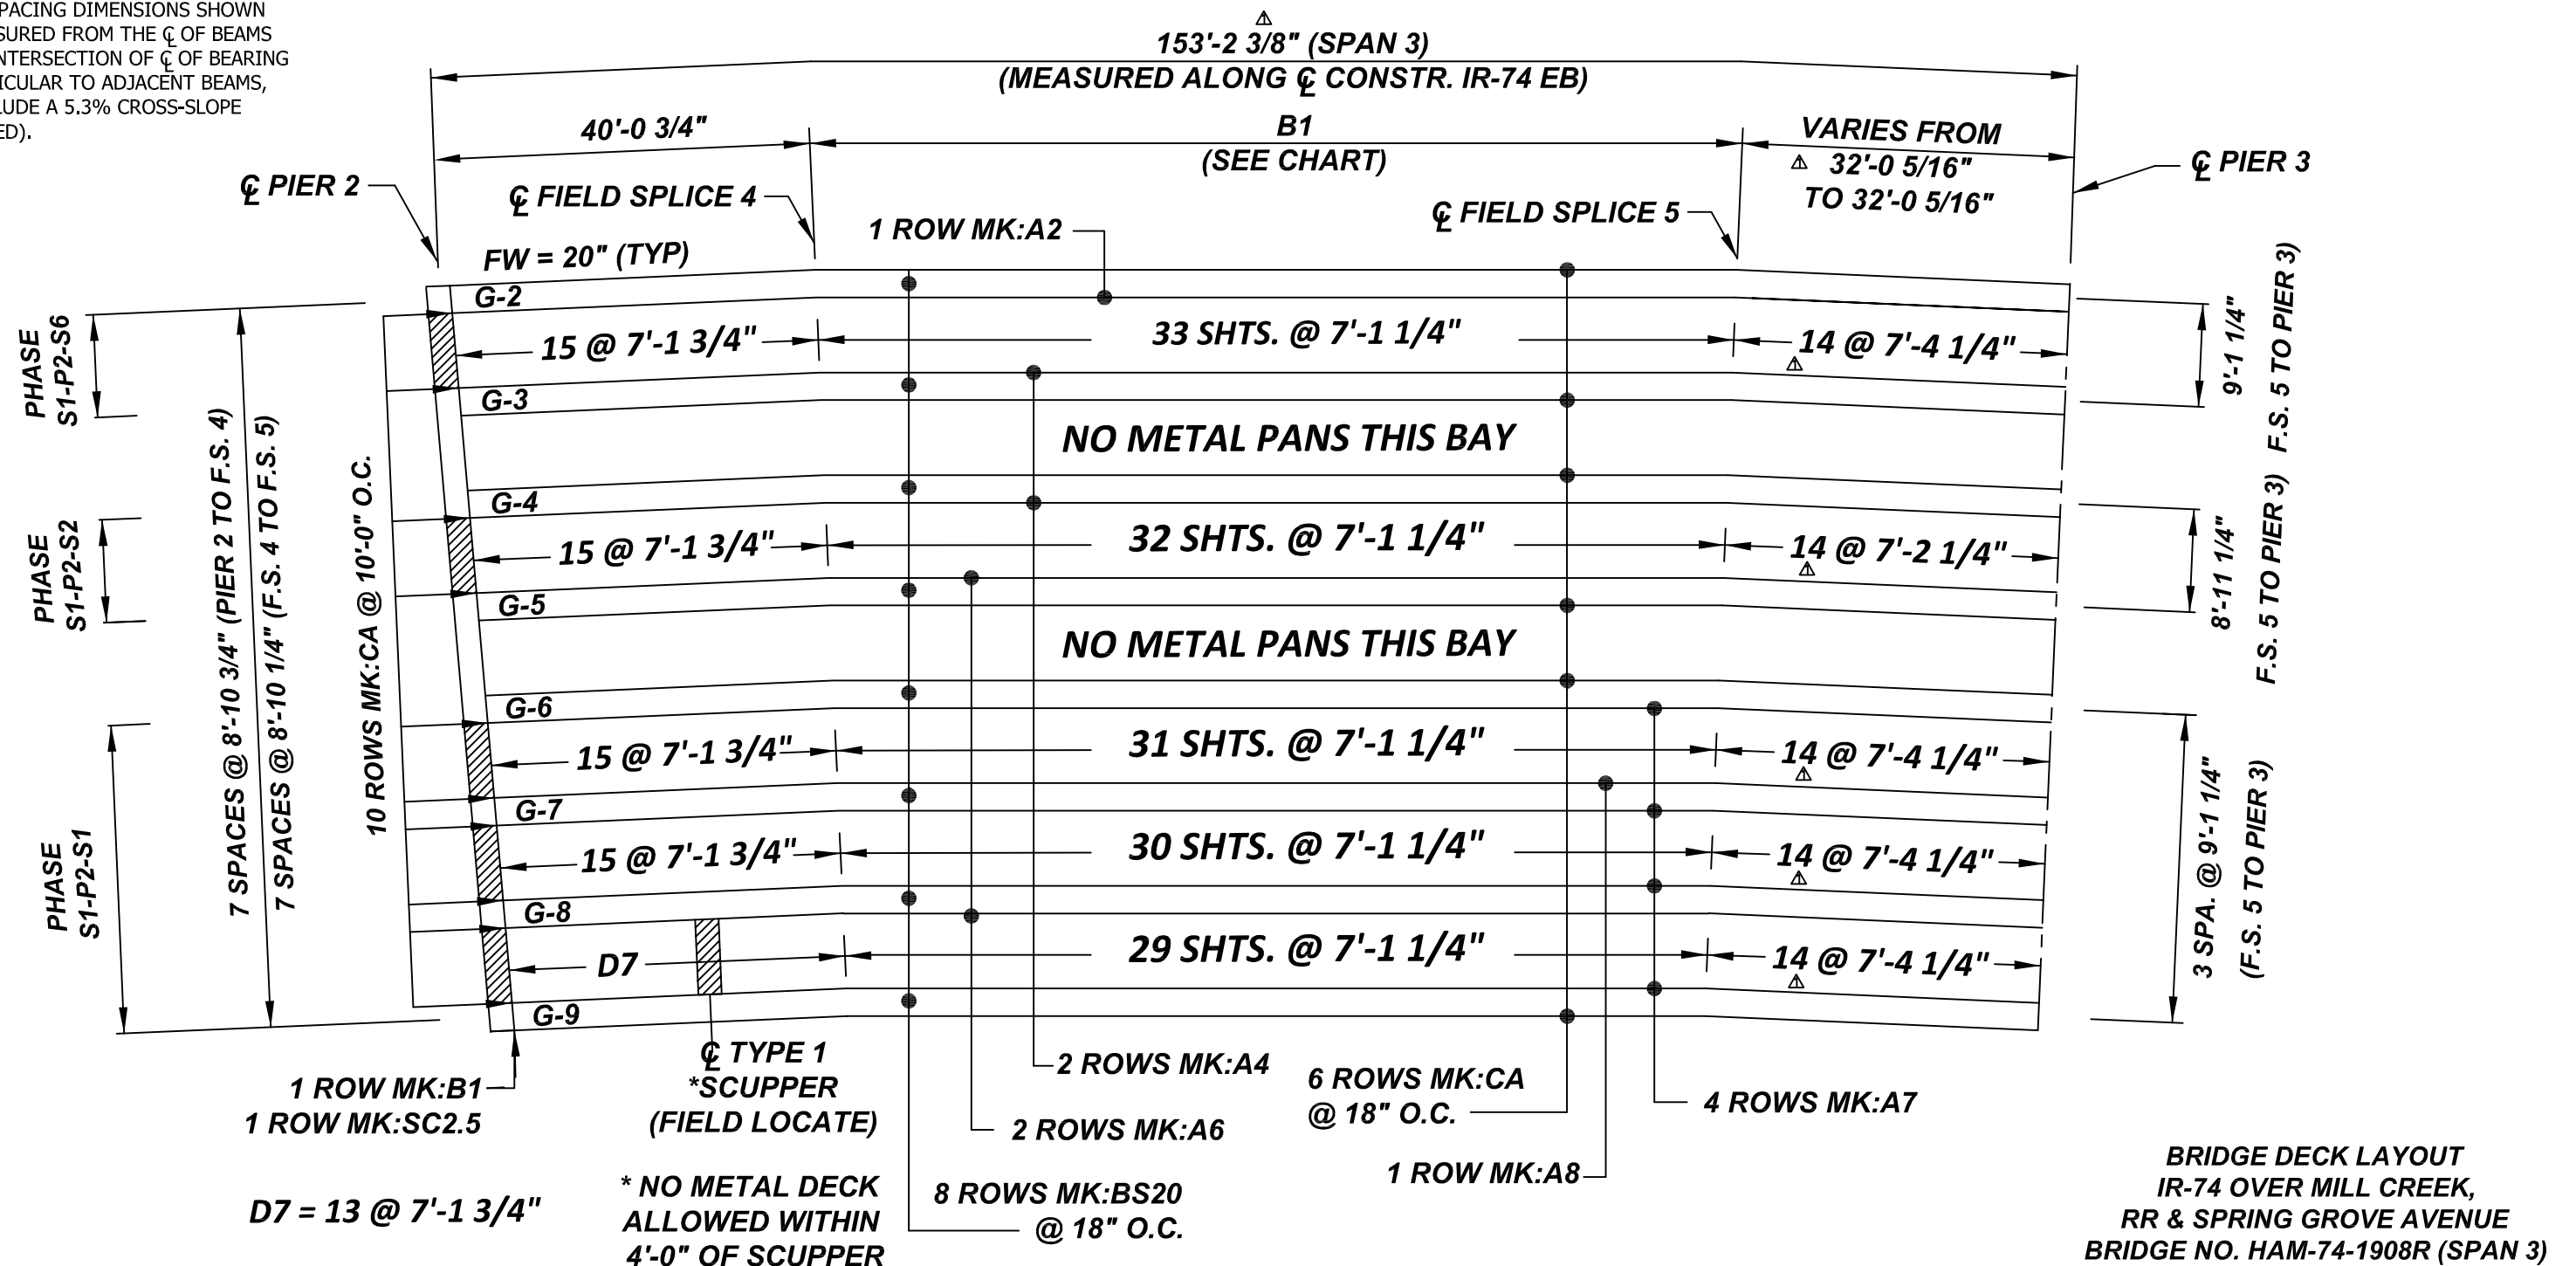

ERECTOR NOTE: BRIDGE RE-DECKING PROJECTS REQUIRE THAT BOTH EXISTING BRIDGE PLANS AND NEW BRIDGE PLANS BE FURNISHED TO NEW MILLENNIUM IN THE EVENT THAT A FULL SET OF EXISTING SUBSTRUCTURE PLANS ARE NOT AVAILABLE, IT IS THE ERECTOR'S RESPONSIBILITY TO VERIFY THE TOP FLANGE SIZES, GIRDER SPACING, COVER PLATE SIZES AND LOCATIONS, AND SLAB DEPTHS THAT ARE ILLUSTRATED ON SHOP DRAWINGS.

**NOTES**

- UTILIZE DROPS OF SUPPORT ANGLES, SHEET CLOSURES AND CLOSURE ANGLES.
- SEE HAUNCH TABLE ON SHEET 4 FOR ANGLE SUPPORT LIMITS.
- BEAM STRAPS & MODIFIED BEAM ANGLES WILL ACCOMMODATE THE TOP FLANGE WIDTHS PER CONTRACT DRAWINGS. IF TOP FLANGE WIDTHS DIFFER FROM CONTRACT DRAWINGS, PLEASE PROVIDE TO NMBS PRIOR TO FABRICATION.
- METAL DECK PANS MAY REQUIRE FIELD CUTTING AT FIELD SPICE 4 & 5 - SEE DETAIL SHEET 4


B1 CHART	
GIRDER	LENGTH
G1	87'-4 1/4"
G2	85'-9 13/16"
G3	84'-3 3/8"
G4	82'-8 7/8"
G5	81'-2 7/16"
G6	79'-8"
G7	78'-1 9/16"
G8	76'-7 1/16"
G9	75'-0 5/8"

AMERICAN STRUCTUREPOINT, INC.  
 ADDRESS: 7260 SHADELAND STATION,  
 INDIANAPOLIS, IN 46256  
 TELEPHONE #: 317.547.5580  
 CERTIFICATE OF AUTHORITY # 016489

STATE OF OHIO  
 DERREK W. DAY  
 83601  
 REGISTERED PROFESSIONAL ENGINEER  
 06/04/2019  
*Derrek W. Day*

REVISIONS	DATE	COMMENTS
RV-1	6/3/19	PER APPROVER

REMARKS			
BRIDGE DECK LAYOUT			
IR-74 OVER MILL CREEK, RR & SPRING GROVE AVENUE BRIDGE NO. HAM-74-1908R			
New Millennium Building Systems, LLC 4900 Hungerford Road Memphis, Tennessee 38118 Phone: (901) 365-0226   www.newmill.com			
CUSTOMER	WALSH CONSTRUCTION COMPANY II		
PROJECT	183000	FED. NO. E170 (713)	PID NO. 104667
LOCATION	HAMILTON COUNTY, OHIO		
ENGINEER	STATE OF OHIO DEPARTMENT OF TRANSPORTATION		
DRAWN	TLC	DATE	04/2019
CHECKED	TC	DATE	04/2019
		NEW MILLENNIUM JOB NO.	BR18-0527
		DRAWING NO.	1 of 5

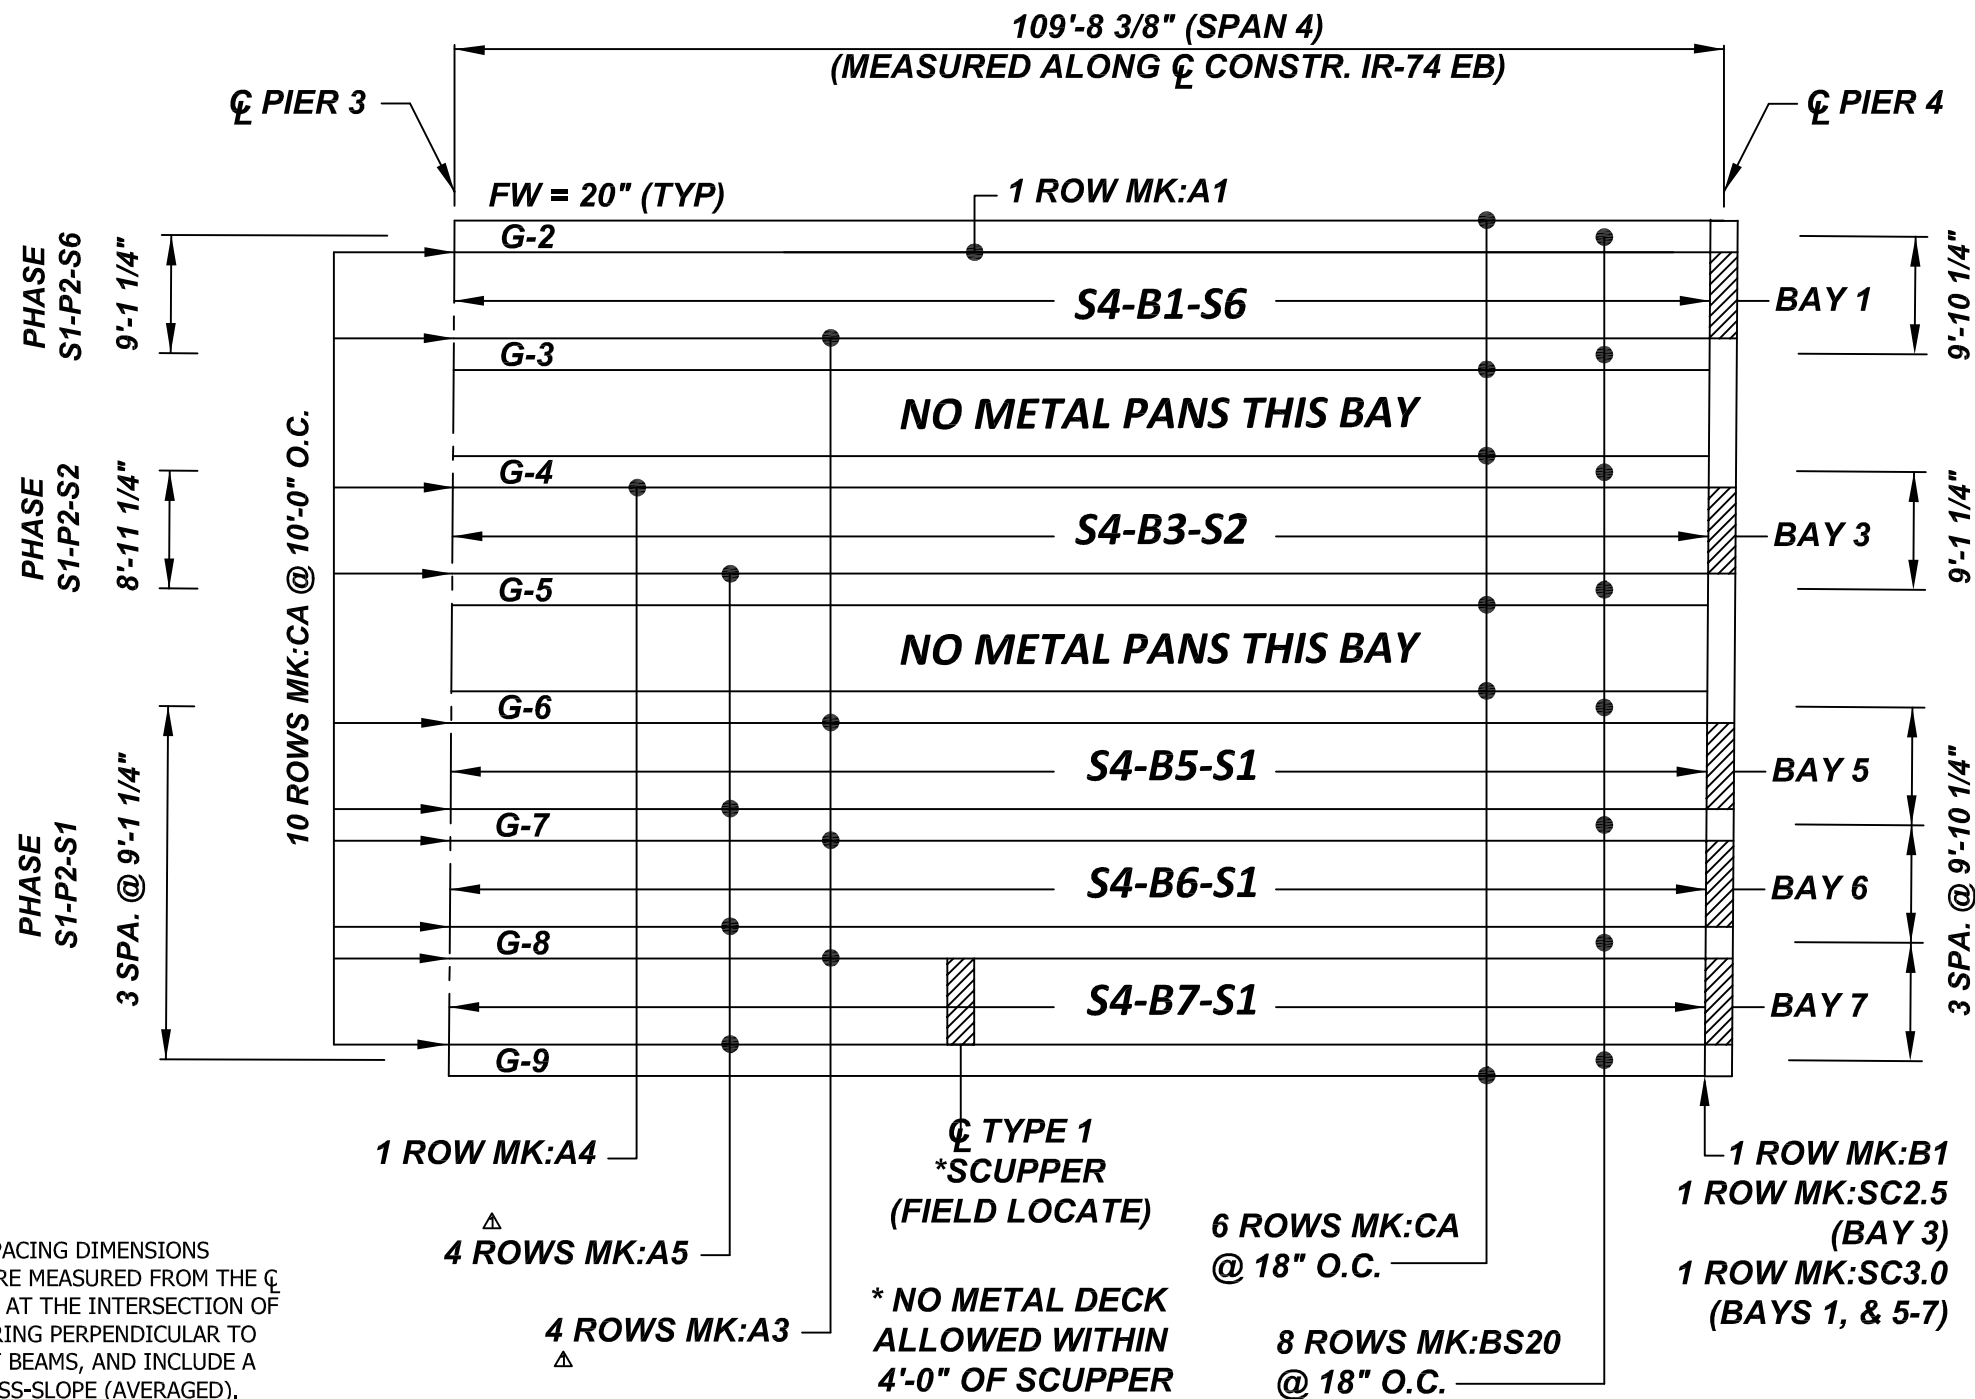

\* BEAM SPACING DIMENSIONS SHOWN ARE MEASURED FROM THE  $\phi$  OF BEAMS AT THE INTERSECTION OF  $\phi$  OF BEARING PERPENDICULAR TO ADJACENT BEAMS, AND INCLUDE A 5.3% CROSS-SLOPE (AVERAGED).


ERECTOR NOTE: BRIDGE RE-DECKING PROJECTS REQUIRE THAT BOTH EXISTING BRIDGE PLANS AND NEW BRIDGE PLANS BE FURNISHED TO NEW MILLENNIUM IN THE EVENT THAT A FULL SET OF EXISTING SUBSTRUCTURE PLANS ARE NOT AVAILABLE, IT IS THE ERECTOR'S RESPONSIBILITY TO VERIFY THE TOP FLANGE SIZES, GIRDER SPACING, COVER PLATE SIZES AND LOCATIONS, AND SLAB DEPTHS THAT ARE ILLUSTRATED ON SHOP DRAWINGS.

**NOTES**

- UTILIZE DROPS OF SUPPORT ANGLES, SHEET CLOSURES AND CLOSURE ANGLES.
- SEE HAUNCH TABLE ON SHEET 4 FOR ANGLE SUPPORT LIMITS.
- BEAM STRAPS & MODIFIED BEAM ANGLES WILL ACCOMMODATE THE TOP FLANGE WIDTHS PER CONTRACT DRAWINGS. IF TOP FLANGE WIDTHS DIFFER FROM CONTRACT DRAWINGS, PLEASE PROVIDE TO NMBS PRIOR TO FABRICATION.
- METAL DECK PANS MAY REQUIRE FIELD CUTTING AT FIELD SPICE 4 & 5 - SEE DETAIL SHEET 4

**BRIDGE DECK LAYOUT  
IR-74 OVER MILL CREEK,  
RR & SPRING GROVE AVENUE  
BRIDGE NO. HAM-74-1908R (SPAN 4)**


AMERICAN STRUCTUREPOINT, INC.  
ADDRESS: 7260 SHADELAND STATION,  
INDIANAPOLIS, IN 46256  
TELEPHONE #: 317.547.5580  
CERTIFICATE OF AUTHORITY # 016489

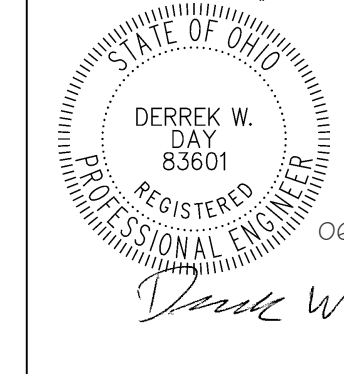

**BRIDGE DECK GENERAL NOTES**


- NMBS will furnish only that material listed in the Bill of Material.
- All material for bridge deck forms, support angles (Grade 50) and accessories (Grade 40) shall conform to ASTM specification A-653 having a coating designation of G-235.
- The contractor shall verify all dimensions.
- Extra concrete poured on deck slab as a result of these metal forms shall be provided by the General Contractor and will not be the responsibility of or to the account of NMBS.
- ALL DECK SHEETS SHALL HAVE A MINIMUM BEARING OF 1 1/2" AT EACH END OF THE DECK, CENTER FORMS ON SUPPORT ANGLES.
- FOR THE SAFETY OF THE WORKMEN, ALL DECK SHEETS SHALL BE SECURELY FASTENED TO THE SUPPORT ANGLE AS THEY ARE PLACED, BEFORE CONSTRUCTION TRAFFIC IS PERMITTED.
- Reinforcing steel and supports for reinforcing steel shall be placed in accordance with applicable drawings and in conformance with good reinforced concrete practice, and under the continuous supervision of a properly trained foreman.
- CALCIUM CHLORIDE (OR ANY ADMIXTURE CONTAINING CHLORIDE SALTS) SHALL NOT BE USED IN THE CONCRETE PLACED ON THE BRIDGE DECK.
- Concrete should be poured from a low level to avoid impacting the deck. It should be placed uniformly over the supporting structure (DECK SUPPORTS) and spread towards the center of the deck span. Workers should not congregate around the concrete placement zone.
- If situations arise that are not specifically covered by these notes or placing plans, or if there is any doubt as to the correct procedure to be followed in erection, please contact New Millennium Building Systems for additional instructions or clarification.
- Vertical adjustment of support angles shall be determined in the field to maintain the correct slab thickness and roadway slope.
- Closure angles shall not be used as support for deck form panels.

DATE	REVISIONS	COMMENTS	REMARKS																																
6/5/19	RV-1	PER APPROVER	BRIDGE DECK LAYOUT AND GENERAL NOTES																																
			IR-74 OVER MILL CREEK, RR & SPRING GROVE AVENUE BRIDGE NO. HAM-74-1908R																																
			 <b>NEW MILLENNIUM</b> BUILDING SYSTEMS New Millennium Building Systems, LLC 4900 Hungerford Road Memphis, Tennessee 38118 Phone: (901) 365-0226   www.newmill.com																																
			<table border="1"> <tr> <td>CUSTOMER</td> <td colspan="3">WALSH CONSTRUCTION COMPANY II</td> </tr> <tr> <td>PROJECT</td> <td>183000</td> <td>FED. NO. E170 (713)</td> <td>PID NO. 104667</td> </tr> <tr> <td>LOCATION</td> <td colspan="3">HAMILTON COUNTY, OHIO</td> </tr> <tr> <td>ENGINEER</td> <td colspan="3">STATE OF OHIO DEPARTMENT OF TRANSPORTATION</td> </tr> <tr> <td>DRAWN</td> <td>TLC</td> <td>DATE</td> <td>04/2019</td> </tr> <tr> <td>CHECKED</td> <td>TC</td> <td>DATE</td> <td>04/2019</td> </tr> <tr> <td></td> <td></td> <td></td> <td>BR18-0527</td> </tr> <tr> <td></td> <td></td> <td></td> <td>2 of 5</td> </tr> </table>	CUSTOMER	WALSH CONSTRUCTION COMPANY II			PROJECT	183000	FED. NO. E170 (713)	PID NO. 104667	LOCATION	HAMILTON COUNTY, OHIO			ENGINEER	STATE OF OHIO DEPARTMENT OF TRANSPORTATION			DRAWN	TLC	DATE	04/2019	CHECKED	TC	DATE	04/2019				BR18-0527				2 of 5
CUSTOMER	WALSH CONSTRUCTION COMPANY II																																		
PROJECT	183000	FED. NO. E170 (713)	PID NO. 104667																																
LOCATION	HAMILTON COUNTY, OHIO																																		
ENGINEER	STATE OF OHIO DEPARTMENT OF TRANSPORTATION																																		
DRAWN	TLC	DATE	04/2019																																
CHECKED	TC	DATE	04/2019																																
			BR18-0527																																
			2 of 5																																

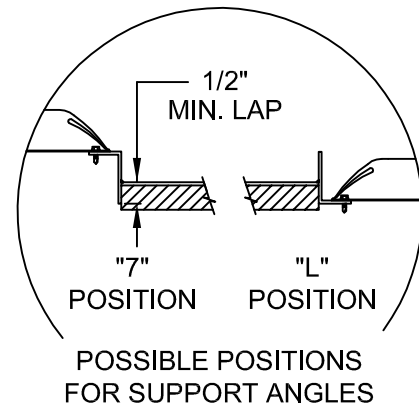


NOTE: THE VERTICAL LEGS OF THE SUPPORT ANGLES IN THE "L" POSITION MAY NEED TO BE CUT IN THE FIELD AS NEEDED PER BRIDGE PLANS.


**CONNECTION DETAIL**

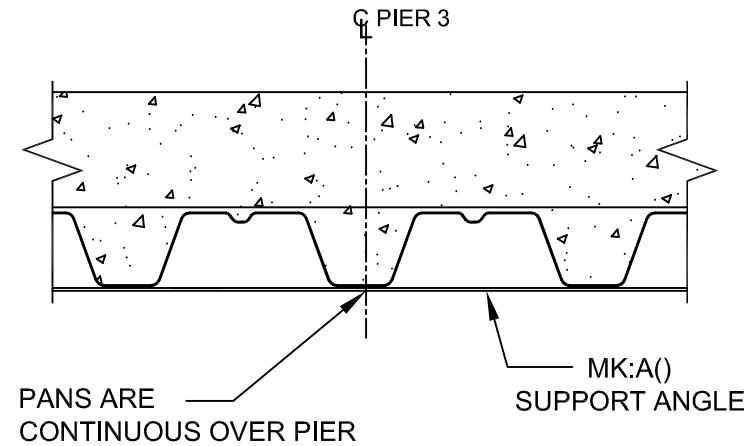

**SECTION @ PIER 3**

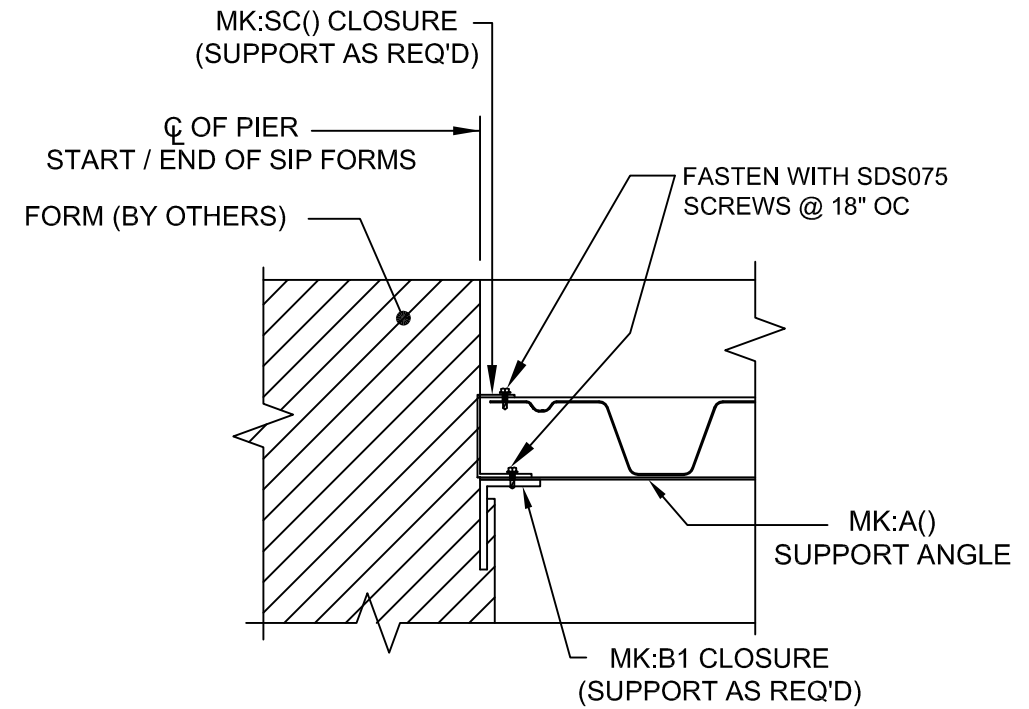


**SECTION @ PIERS 2 & 4**

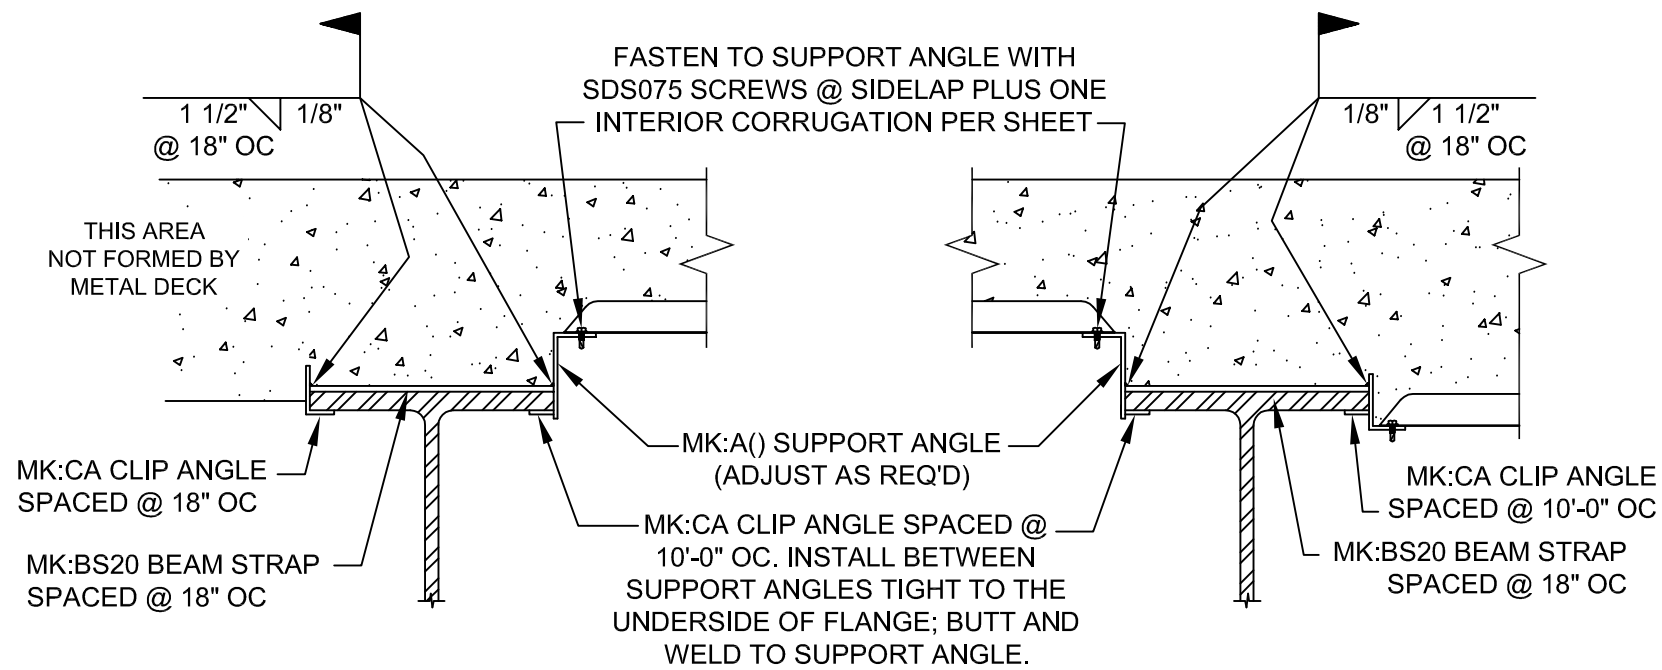

**SECTION @ EXTERIOR GIRDERS**

**SECTION @ INTERIOR GIRDERS**


AMERICAN STRUCTUREPOINT, INC.  
 ADDRESS: 7260 SHADELAND STATION,  
 INDIANAPOLIS, IN 46256  
 TELEPHONE #: 317.547.5580  
 CERTIFICATE OF AUTHORITY # 016489

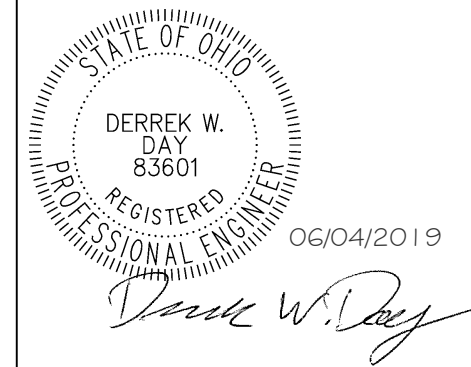


REVISIONS		COMMENTS		DATE	
RV-1		FIELD USE		6/3/19	

REMARKS			
BRIDGE DECK SECTIONS			
IR-74 OVER MILL CREEK, RR & SPRING GROVE AVENUE			
BRIDGE NO. HAM-74-1908R			
New Millennium Building Systems, LLC 4900 Hungerford Road Memphis, Tennessee 38118 Phone: (901) 365-0226   www.newmill.com			
CUSTOMER	WALSH CONSTRUCTION COMPANY II		
PROJECT	183000	FED. NO. E170 (713)	PID NO. 104667
LOCATION	HAMILTON COUNTY, OHIO		
ENGINEER	STATE OF OHIO DEPARTMENT OF TRANSPORTATION		
DRAWN	TLC	DATE	04/2019
CHECKED	TC	DATE	04/2019
		NEW MILLENNIUM JOB NO.	BR18-0527
		DRAWING NO.	3 OF 5

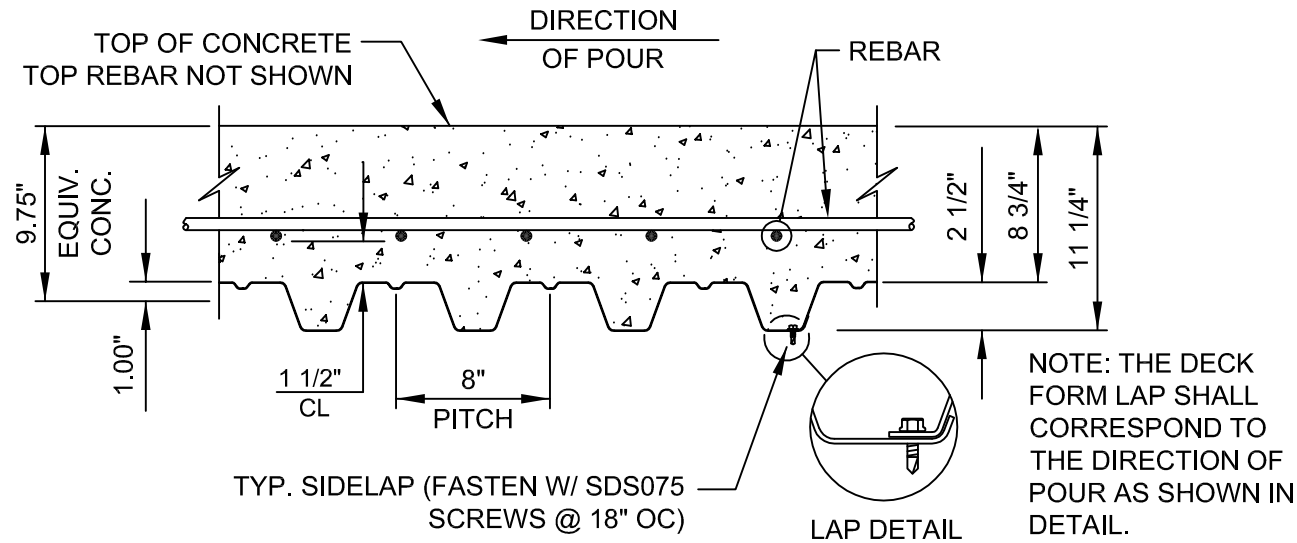


## 2 1/2" x 8" SLAB SECTION

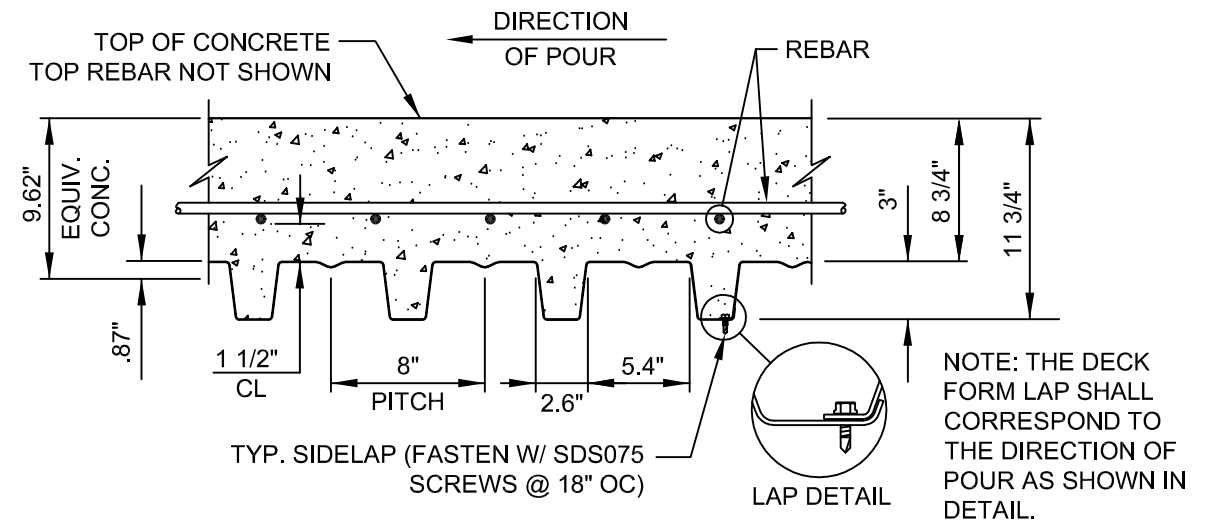

## 3" x 8" SLAB SECTION

*ANGLE SUPPORT LIMITS CHART			
MARK	MAX. HAUNCH	MIN. HAUNCH	SIP PROFILE
A1	7 1/2"	-1 1/2"	3"
A2	8 1/2"	-3 1/2"	2 1/2"
A3	11"	-5"	3"
A4	10 1/2"	-5 1/2"	2 1/2"
A5	11 1/2"	-6 1/2"	2 1/2"
A5	12"	-6"	3"
A6	12 1/2"	-7 1/2"	2 1/2"
A7	13 1/2"	-8 1/2"	2 1/2"
A8	14"	-9"	2 1/2"

\*BOTH MAX. & MIN. MEASURED AT THE EDGE OF BEAM. IF A LARGER HAUNCH EXISTS, i.e. DUE TO CAMBER & DEAD LOAD DEFLECTION, THIS VALUE MUST BE PROVIDED TO NMBS PRIOR TO DRAWING APPROVAL.

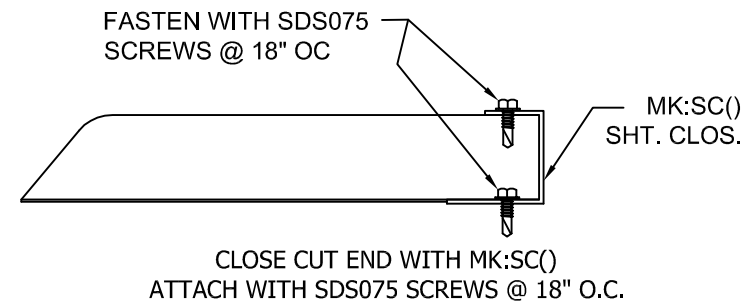

## CLOSURE FOR FIELD CUT DECK ENDS


### BRIDGE DECK GENERAL NOTES

- NMBS will furnish only that material listed in the Bill of Material.
- All material for bridge deck forms, support angles (Grade 50) and accessories (Grade 40) shall conform to ASTM specification A-653 having a coating designation of G-235.
- The contractor shall verify all dimensions.
- Extra concrete poured on deck slab as a result of these metal forms shall be provided by the General Contractor and will not be the responsibility of or to the account of NMBS.
- ALL DECK SHEETS SHALL HAVE A MINIMUM BEARING OF 1 1/2" AT EACH END OF THE DECK. CENTER FORMS ON SUPPORT ANGLES.
- FOR THE SAFETY OF THE WORKMEN, ALL DECK SHEETS SHALL BE SECURELY FASTENED TO THE SUPPORT ANGLE AS THEY ARE PLACED, BEFORE CONSTRUCTION TRAFFIC IS PERMITTED.
- Reinforcing steel and supports for reinforcing steel shall be placed in accordance with applicable drawings and in conformance with good reinforced concrete practice, and under the continuous supervision of a properly trained foreman.
- CALCIUM CHLORIDE (OR ANY ADMIXTURE CONTAINING CHLORIDE SALTS) SHALL NOT BE USED IN THE CONCRETE PLACED ON THE BRIDGE DECK.
- Concrete should be poured from a low level to avoid impacting the deck. It should be placed uniformly over the supporting structure (DECK SUPPORTS) and spread towards the center of the deck span. Workers should not congregate around the concrete placement zone.
- If situations arise that are not specifically covered by these notes or placing plans, or if there is any doubt as to the correct procedure to be followed in erection, please contact New Millennium Building Systems for additional instructions or clarification.
- Vertical adjustment of support angles shall be determined in the field to maintain the correct slab thickness and roadway slope.
- Closure angles shall not be used as support for deck form panels.











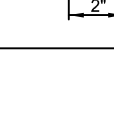
REVISIONS		COMMENTS		DATE	
RV-1		FIELD USE		6/3/19	













REMARKS			
BRIDGE DECK SECTIONS AND GENERAL NOTES			
IR-74 OVER MILL CREEK, RR & SPRING GROVE AVENUE BRIDGE NO. HAM-74-1908R			
New Millennium Building Systems, LLC 4900 Hungerford Road Memphis, Tennessee 38118 Phone: (901) 365-0226   www.newmill.com			
CUSTOMER	WALSH CONSTRUCTION COMPANY II		
PROJECT	183000	FED. NO. E170 (713)	PID NO. 104667
LOCATION	HAMILTON COUNTY, OHIO		
ENGINEER	STATE OF OHIO DEPARTMENT OF TRANSPORTATION		
DRAWN	TLC	DATE	04/2019
CHECKED	TC	DATE	04/2019
		NEW MILLENNIUM JOB NO.	BR18-0527
		DRAWING NO.	4 of 5

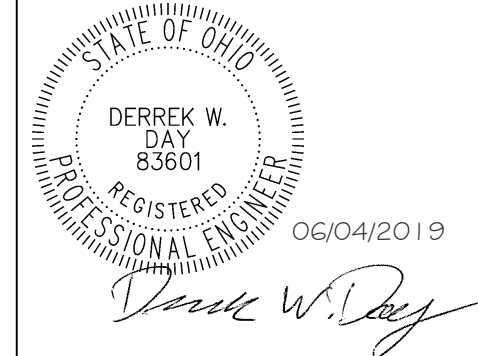AMERICAN STRUCTUREPOINT, INC.  
ADDRESS: 7260 SHADELAND STATION,  
INDIANAPOLIS, IN 46256  
TELEPHONE #: 317.547.5580  
CERTIFICATE OF AUTHORITY # 016489



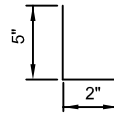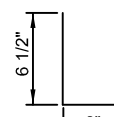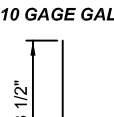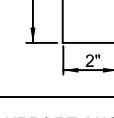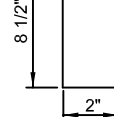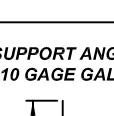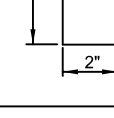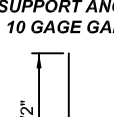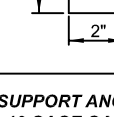

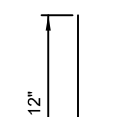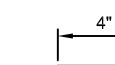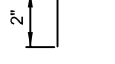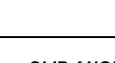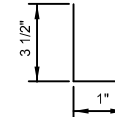BILL OF MATERIAL			
MARK	NO. PCS.	LENGTH	DESCRIPTION
S1-P2-S6 A1	11	10'-0"	SUPPORT ANGLE 10 GAGE GALV. 
S1-P2-S6 A2	17	10'-0"	SUPPORT ANGLE 12 GAGE GALV. 
S1-P2-S6 A3	11	10'-0"	SUPPORT ANGLE 10 GAGE GALV. 
S1-P2-S1 A3	34	10'-0"	SUPPORT ANGLE 10 GAGE GALV. 
S1-P2-S6 A4	17	10'-0"	SUPPORT ANGLE 12 GAGE GALV. 
S1-P2-S2 A4	28	10'-0"	SUPPORT ANGLE 12 GAGE GALV. 
S1-P2-S2 A5	11	10'-0"	SUPPORT ANGLE 10 GAGE GALV. 
S1-P2-S1 A5	32	10'-0"	SUPPORT ANGLE 10 GAGE GALV. 
S1-P2-S2 A6	17	10'-0"	SUPPORT ANGLE 10 GAGE GALV. 
S1-P2-S1 A6	16	10'-0"	SUPPORT ANGLE 10 GAGE GALV. 
S1-P2-S1 A7	64	10'-0"	SUPPORT ANGLE 10 GAGE GALV. 

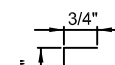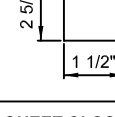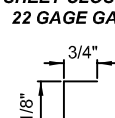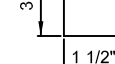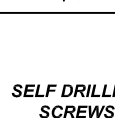BILL OF MATERIAL			
MARK	NO. PCS.	LENGTH	DESCRIPTION
S1-P2-S1 A8	16	10'-0"	SUPPORT ANGLE 8 GAGE GALV. 
S1-P2-S6 B	2	10'-0"	CLOSURE ANGLE 16 GAGE GALV. 
S1-P2-S2 B	2	10'-0"	CLOSURE ANGLE 16 GAGE GALV. 
S1-P2-S1 B	6	10'-0"	CLOSURE ANGLE 16 GAGE GALV. 
S1-P2-S6 CA	433	2"	CLIP ANGLE 12 GAGE GALV. 
S1-P2-S2 CA	433	2"	CLIP ANGLE 12 GAGE GALV. 
S1-P2-S1 CA	542	2"	CLIP ANGLE 12 GAGE GALV. 
S1-P2-S6 BS20	370	20 1/8"	BEAM STRAPS 12 GAGE 2" WIDE FLAT
S1-P2-S2 BS20	370	20 1/8"	BEAM STRAPS 12 GAGE 2" WIDE FLAT
S1-P2-S1 BS20	740	20 1/8"	BEAM STRAPS 12 GAGE 2" WIDE FLAT
S1-P2-S6 SC2.5	3	10'-0"	SHEET CLOSURE 22 GAGE GALV. 
S1-P2-S2 SC2.5	4	10'-0"	SHEET CLOSURE 22 GAGE GALV. 
S1-P2-S1 SC2.5	9	10'-0"	SHEET CLOSURE 22 GAGE GALV. 
S1-P2-S6 SC3.0	1	10'-0"	SHEET CLOSURE 22 GAGE GALV. 
S1-P2-S1 SC3.0	3	10'-0"	SHEET CLOSURE 22 GAGE GALV. 
S1-P2-S6 SDS075	1,300	----	SELF DRILLING SCREWS 1/4-14x3/4" CADMIUM PLTD.
S1-P2-S2 SDS075	1,300	----	SELF DRILLING SCREWS 1/4-14x3/4" CADMIUM PLTD.
S1-P2-S1 SDS075	3,900	----	SELF DRILLING SCREWS 1/4-14x3/4" CADMIUM PLTD.

BILL OF MATERIAL: SPAN 3			
MARK	NO. PCS.	LENGTH	DESCRIPTION
S1-P2-S6			BRIDGE DECK 2 1/2" DEEP 8" PITCH 32" COVER CLOSED ENDS ASTM A653 GRADE 50 GALV. G-235 20 GAGE I=0.645 in^4/ft S=0.462 in^3/ft
7'-1 1/4"	33	7'-1 1/4"	
7'-1 3/4"	15	7'-1 3/4"	
7'-4 1/4"	14	7'-4 1/4"	
S1-P2-S2			BRIDGE DECK 2 1/2" DEEP 8" PITCH 32" COVER CLOSED ENDS ASTM A653 GRADE 50 GALV. G-235 20 GAGE I=0.645 in^4/ft S=0.462 in^3/ft
7'-1 1/4"	32	7'-1 1/4"	
7'-1 3/4"	15	7'-1 3/4"	
7'-2 1/4"	14	7'-2 1/4"	
S1-P2-S1			BRIDGE DECK 2 1/2" DEEP 8" PITCH 32" COVER CLOSED ENDS ASTM A653 GRADE 50 GALV. G-235 20 GAGE I=0.645 in^4/ft S=0.462 in^3/ft
7'-1 1/4"	90	7'-1 1/4"	
7'-1 3/4"	43	7'-1 3/4"	
7'-4 1/4"	42	7'-4 1/4"	

BILL OF MATERIAL: SPAN 4 BAY 1, PHASE S1-P2-S6			
MARK	NO. PCS.	LENGTH	DESCRIPTION
S4-B1-S6	2	7'-4 1/2"	BRIDGE DECK 3" DEEP 8" PITCH 24" COVER CLOSED ENDS ASTM A653 GRADE 50 GALV. G-235 20 GAGE I=1.002 in^4/ft S=0.541 in^3/ft
	2	7'-4 3/4"	
	2	7'-5 1/4"	
	2	7'-5 1/2"	
	2	7'-5 3/4"	
	2	7'-6 1/4"	
	2	7'-6 1/2"	
	2	7'-6 3/4"	
	2	7'-7 1/4"	
	2	7'-7 1/2"	
	2	7'-7 3/4"	
	2	7'-8 1/4"	
	2	7'-8 1/2"	
	2	7'-8 3/4"	
	2	7'-9"	
	2	7'-9 1/2"	
	2	7'-9 3/4"	
	2	7'-10"	
	2	7'-10 1/2"	
	2	7'-10 3/4"	
	2	7'-11"	
	2	7'-11 1/2"	
	2	7'-11 3/4"	
	2	8'-0"	
	2	8'-0 1/2"	
	2	8'-0 3/4"	
	2	8'-1"	
	2	8'-1 1/4"	

BILL OF MATERIAL: SPAN 4 BAY 3, PHASE S1-P2-S2			
MARK	NO. PCS.	LENGTH	DESCRIPTION
S4-B3-S2	7	7'-2 1/2"	BRIDGE DECK 2 1/2" DEEP 8" PITCH 32" COVER CLOSED ENDS ASTM A653 GRADE 50 GALV. G-235 20 GAGE I=0.645 in^4/ft S=0.462 in^3/ft
	6	7'-2 3/4"	
	6	7'-3"	
	6	7'-3 1/4"	
	6	7'-3 1/2"	
	6	7'-4"	
	7	7'-4 1/4"	

BILL OF MATERIAL: SPAN 4 BAY 4, PHASE S1-P2-S1			
MARK	NO. PCS.	LENGTH	DESCRIPTION
S4-B5-S1	2	7'-4 1/2"	BRIDGE DECK 3" DEEP 8" PITCH 24" COVER CLOSED ENDS ASTM A653 GRADE 50 GALV. G-235 20 GAGE I=1.002 in^4/ft S=0.541 in^3/ft
	2	7'-4 3/4"	
	2	7'-5 1/4"	
	2	7'-5 1/2"	
	2	7'-5 3/4"	
	2	7'-6 1/4"	
	2	7'-6 1/2"	
	2	7'-6 3/4"	
	2	7'-7 1/4"	
	2	7'-7 1/2"	
	2	7'-7 3/4"	
	2	7'-8 1/4"	
	2	7'-8 1/2"	
	2	7'-8 3/4"	
	2	7'-9"	
	2	7'-9 1/2"	
	2	7'-9 3/4"	
	2	7'-10"	
	2	7'-10 1/2"	
	2	7'-10 3/4"	
	2	7'-11"	
	2	7'-11 1/2"	
	2	7'-11 3/4"	
	2	8'-0"	
	2	8'-0 1/2"	
	2	8'-0 3/4"	
	2	8'-1"	
	2	8'-1 1/4"	

BILL OF MATERIAL: SPAN 4 BAY 6, PHASE S1-P2-S1			
MARK	NO. PCS.	LENGTH	DESCRIPTION
S4-B6-S1	2	7'-4 1/2"	BRIDGE DECK 3" DEEP 8" PITCH 24" COVER CLOSED ENDS ASTM A653 GRADE 50 GALV. G-235 20 GAGE I=1.002 in^4/ft S=0.541 in^3/ft
	2	7'-4 3/4"	
	2	7'-5 1/4"	
	2	7'-5 1/2"	
	2	7'-5 3/4"	
	2	7'-6 1/4"	
	2	7'-6 1/2"	
	2	7'-6 3/4"	
	2	7'-7 1/4"	
	2	7'-7 1/2"	
	2	7'-7 3/4"	
	2	7'-8 1/4"	
	2	7'-8 1/2"	
	2	7'-8 3/4"	
	2	7'-9"	
	2	7'-9 1/2"	
	2	7'-9 3/4"	
	2	7'-10"	
	2	7'-10 1/2"	
	2	7'-10 3/4"	
	2	7'-11"	
	2	7'-11 1/2"	
	2	7'-11 3/4"	
	2	8'-0"	
	2	8'-0 1/2"	
	2	8'-0 3/4"	
	2	8'-1"	
	2	8'-1 1/4"	

### BRIDGE DECK GENERAL NOTES

- NMBS will furnish only that material listed in the Bill of Material.
- All material for bridge deck forms, support angles (Grade 50) and accessories (Grade 40) shall conform to ASTM specification A-653 having a coating designation of G-235.
- The contractor shall verify all dimensions.
- Extra concrete poured on deck slab as a result of these metal forms shall be provided by the General Contractor and will not be the responsibility of or to the account of NMBS.
- ALL DECK SHEETS SHALL HAVE A MINIMUM BEARING OF 1 1/2" AT EACH END OF THE DECK. CENTER FORMS ON SUPPORT ANGLES.
- FOR THE SAFETY OF THE WORKMEN, ALL DECK SHEETS SHALL BE SECURELY FASTENED TO THE SUPPORT ANGLE AS THEY ARE PLACED, BEFORE CONSTRUCTION TRAFFIC IS PERMITTED.
- Reinforcing steel and supports for reinforcing steel shall be placed in accordance with applicable drawings and in conformance with good reinforced concrete practice, and under the continuous supervision of a properly trained foreman.
- CALCIUM CHLORIDE (OR ANY ADMIXTURE CONTAINING CHLORIDE SALTS) SHALL NOT BE USED IN THE CONCRETE PLACED ON THE BRIDGE DECK.
- Concrete should be poured from a low level to avoid impacting the deck. It should be placed uniformly over the supporting structure (DECK SUPPORTS) and spread towards the center of the deck span. Workers should not congregate around the concrete placement zone.
- If situations arise that are not specifically covered by these notes or placing plans, or if there is any doubt as to the correct procedure to be followed in erection, please contact New Millennium Building Systems for additional instructions or clarification.
- Vertical adjustment of support angles shall be determined in the field to maintain the correct slab thickness and roadway slope.
- Closure angles shall not be used as support for deck form panels.


DATE	REVISIONS	COMMENTS
6/5/19	RV-1	PER APPROVER

AMERICAN STRUCTUREPOINT, INC.  
ADDRESS: 7260 SHADELAND STATION,  
INDIANAPOLIS, IN 46256  
TELEPHONE #: 317.547.5580  
CERTIFICATE OF AUTHORITY # 016489

STATE OF OHIO  
DERREK W. DAY  
83601  
REGISTERED PROFESSIONAL ENGINEER  
06/04/2019  
*Derrek W. Day*

REMARKS			
BRIDGE DECK BILL OF MATERIAL AND GENERAL NOTES			
IR-74 OVER MILL CREEK, RR & SPRING GROVE AVENUE BRIDGE NO. HAM-74-1908R			
 NEW MILLENNIUM BUILDING SYSTEMS New Millennium Building Systems, LLC 4900 Hungerford Road Memphis, Tennessee 38118 Phone: (901) 365-0226   www.newmill.com			
CUSTOMER	WALSH CONSTRUCTION COMPANY II		
PROJECT	183000	FED. NO. E170 (713)	PID NO. 104667
LOCATION	HAMILTON COUNTY, OHIO		
ENGINEER	STATE OF OHIO DEPARTMENT OF TRANSPORTATION		
DRAWN	TLC	DATE	04/2019
CHECKED	TC	DATE	04/2019
		NEW MILLENNIUM JOB NO.	BR18-0527
		DRAWING NO.	5 9 5

B2 CHART	
GIRDER	LENGTH
G4	121'-9 5/8"
G5	122'-2 5/8"
G6	122'-3"
G7	122'-11"
G8	123'-6 7/8"
G9	124'-3 1/4"
G10	124'-11 5/8"
G11	125'-7 1/2"
G12	126'-3 5/8"
G13	126'-11 3/4"

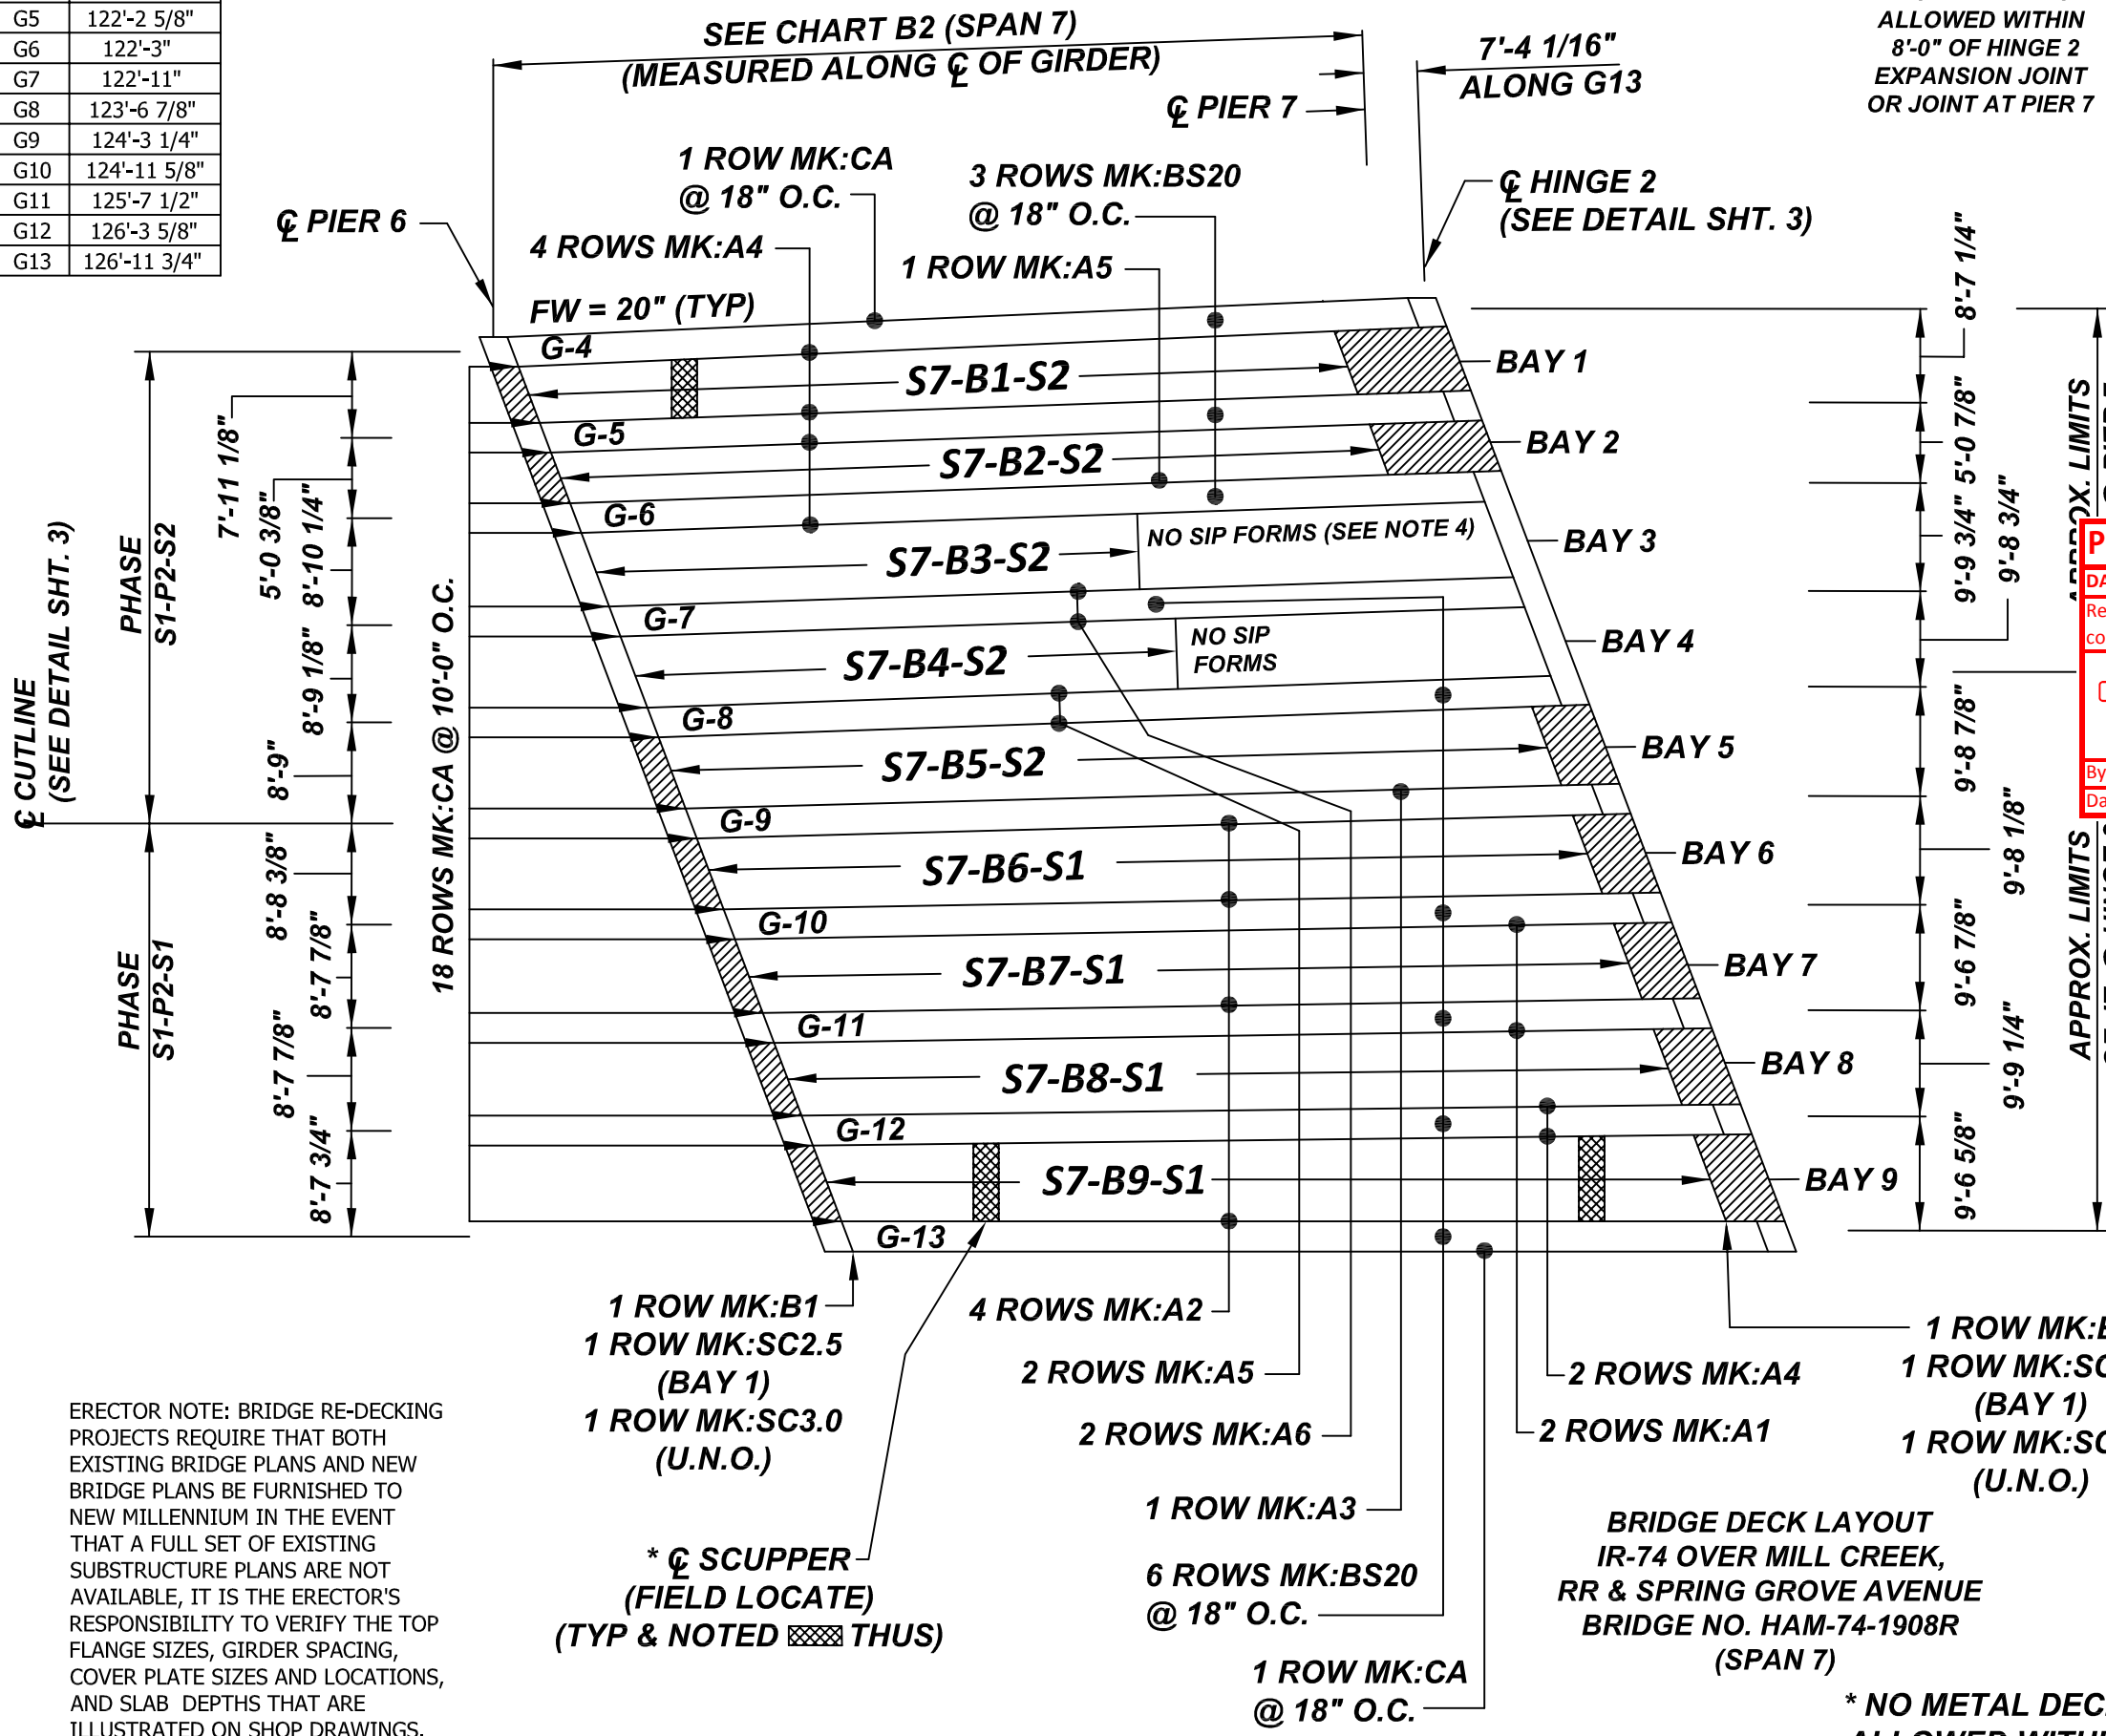

- NOTES**
- UTILIZE DROPS OF SUPPORT ANGLES, SHEET CLOSURES AND CLOSURE ANGLES.
  - SEE HAUNCH TABLE ON SHEET 7 FOR ANGLE SUPPORT LIMITS.
  - BEAM STRAPS & MODIFIED BEAM ANGLES WILL ACCOMMODATE THE TOP FLANGE WIDTHS PER CONTRACT DRAWINGS. IF TOP FLANGE WIDTHS DIFFER FROM CONTRACT DRAWINGS, PLEASE PROVIDE TO NMBS PRIOR TO FABRICATION.
  - AT BAYS 3 & 4 SIP FORMS ARE USED FROM PIER 6 TO THE MIDPOINT OF SPAN DUE TO THE EXTREMELY HIGH HAUNCHES PAST THIS POINT.

AMERICAN STRUCTUREPOINT, INC.  
ADDRESS: 7260 SHADELAND STATION,  
INDIANAPOLIS, IN 46256  
TELEPHONE #: 317.547.5580  
CERTIFICATE OF AUTHORITY # 016489

<b>PRIME AE, Group, Inc</b>		<b>RELEASED FOR FABRICATION</b>
DATE REC'D: 7/12/2019	BUILDABLE UNIT NO.: BU-11	
Review conforms that the shop drawings meet the intent of the contract.		
<input type="checkbox"/> CONFORMS AS-IS <input checked="" type="checkbox"/> CONFORMS AS NOTED		<b>WALSH</b>
SIP Forms over Railroad - Span 7		
By: Tom Stora, PE	By:	
Date: 7/16/2019	Date:	

ERECTOR NOTE: BRIDGE RE-DECKING PROJECTS REQUIRE THAT BOTH EXISTING BRIDGE PLANS AND NEW BRIDGE PLANS BE FURNISHED TO NEW MILLENNIUM IN THE EVENT THAT A FULL SET OF EXISTING SUBSTRUCTURE PLANS ARE NOT AVAILABLE, IT IS THE ERECTOR'S RESPONSIBILITY TO VERIFY THE TOP FLANGE SIZES, GIRDER SPACING, COVER PLATE SIZES AND LOCATIONS, AND SLAB DEPTHS THAT ARE ILLUSTRATED ON SHOP DRAWINGS.

1 ROW MK:B1  
1 ROW MK:SC2.5 (BAY 1)  
1 ROW MK:SC3.0 (U.N.O.)

\*  $\phi$  SCUPPER (FIELD LOCATE) (TYP & NOTED THUS)

4 ROWS MK:A2

2 ROWS MK:A5

2 ROWS MK:A6

1 ROW MK:A3

6 ROWS MK:BS20 @ 18" O.C.

1 ROW MK:CA @ 18" O.C.

2 ROWS MK:A4

2 ROWS MK:A1



1 ROW MK:B1  
1 ROW MK:SC2.5 (BAY 1)  
1 ROW MK:SC3.0 (U.N.O.)

**BRIDGE DECK LAYOUT  
IR-74 OVER MILL CREEK,  
RR & SPRING GROVE AVENUE  
BRIDGE NO. HAM-74-1908R  
(SPAN 7)**

**\* NO METAL DECK ALLOWED WITHIN 4'-0" OF SCUPPER**

- BRIDGE DECK GENERAL NOTES**
- NMBS will furnish only that material listed in the Bill of Material.
  - All material for bridge deck forms, support angles (Grade 50) and accessories (Grade 40) shall conform to ASTM specification A-653 having a coating designation of G-235.
  - The contractor shall verify all dimensions.
  - Extra concrete poured on deck slab as a result of these metal forms shall be provided by the General Contractor and will not be the responsibility of or to the account of NMBS.
  - ALL DECK SHEETS SHALL HAVE A MINIMUM BEARING OF 1 1/2" AT EACH END OF THE DECK. CENTER FORMS ON SUPPORT ANGLES.
  - FOR THE SAFETY OF THE WORKMEN, ALL DECK SHEETS SHALL BE SECURELY FASTENED TO THE SUPPORT ANGLE AS THEY ARE PLACED, BEFORE CONSTRUCTION TRAFFIC IS PERMITTED.
  - Reinforcing steel and supports for reinforcing steel shall be placed in accordance with applicable drawings and in conformance with good reinforced concrete practice, and under the continuous supervision of a properly trained foreman.
  - CALCIUM CHLORIDE (OR ANY ADMIXTURE CONTAINING CHLORIDE SALTS) SHALL NOT BE USED IN THE CONCRETE PLACED ON THE BRIDGE DECK.
  - Concrete should be poured from a low level to avoid impacting the deck. It should be placed uniformly over the supporting structure (DECK SUPPORTS) and spread towards the center of the span. Workers should not congregate around the concrete placement zone.
  - If situations arise that are not specifically covered by these notes or placing plans, or if there is any doubt as to the correct procedure to be followed in erection, please contact New Millennium Building Systems for additional instructions or clarification.
  - Vertical adjustment of support angles shall be determined in the field to maintain the correct slab thickness and roadway slope.
  - Closure angles shall not be used as support for deck form panels.


DATE	REVISIONS	COMMENTS	REMARKS												
			BRIDGE DECK LAYOUT AND GENERAL NOTES												
			IR-74 OVER MILL CREEK, RR & SPRING GROVE AVENUE BRIDGE NO. HAM-74-1908R (SPAN 7)												
			 NEW MILLENNIUM BUILDING SYSTEMS New Millennium Building Systems, LLC 4900 Hungerford Road Memphis, Tennessee 38118 Phone: (901) 365-0226   www.newmill.com												
			<table border="1"> <tr> <td>CUSTOMER</td> <td>WALSH CONSTRUCTION COMPANY II</td> </tr> <tr> <td>PROJECT</td> <td>183000 FED. NO. E170 (713) PID NO. 104667</td> </tr> <tr> <td>LOCATION</td> <td>HAMILTON COUNTY, OHIO</td> </tr> <tr> <td>ENGINEER</td> <td>STATE OF OHIO DEPARTMENT OF TRANSPORTATION</td> </tr> <tr> <td>DRAWN</td> <td>TLC DATE 06/2019 NEW MILLENNIUM JOB NO.</td> </tr> <tr> <td>CHECKED</td> <td>TC DATE 06/2019 BR18-0527 1 OF 7</td> </tr> </table>	CUSTOMER	WALSH CONSTRUCTION COMPANY II	PROJECT	183000 FED. NO. E170 (713) PID NO. 104667	LOCATION	HAMILTON COUNTY, OHIO	ENGINEER	STATE OF OHIO DEPARTMENT OF TRANSPORTATION	DRAWN	TLC DATE 06/2019 NEW MILLENNIUM JOB NO.	CHECKED	TC DATE 06/2019 BR18-0527 1 OF 7
CUSTOMER	WALSH CONSTRUCTION COMPANY II														
PROJECT	183000 FED. NO. E170 (713) PID NO. 104667														
LOCATION	HAMILTON COUNTY, OHIO														
ENGINEER	STATE OF OHIO DEPARTMENT OF TRANSPORTATION														
DRAWN	TLC DATE 06/2019 NEW MILLENNIUM JOB NO.														
CHECKED	TC DATE 06/2019 BR18-0527 1 OF 7														

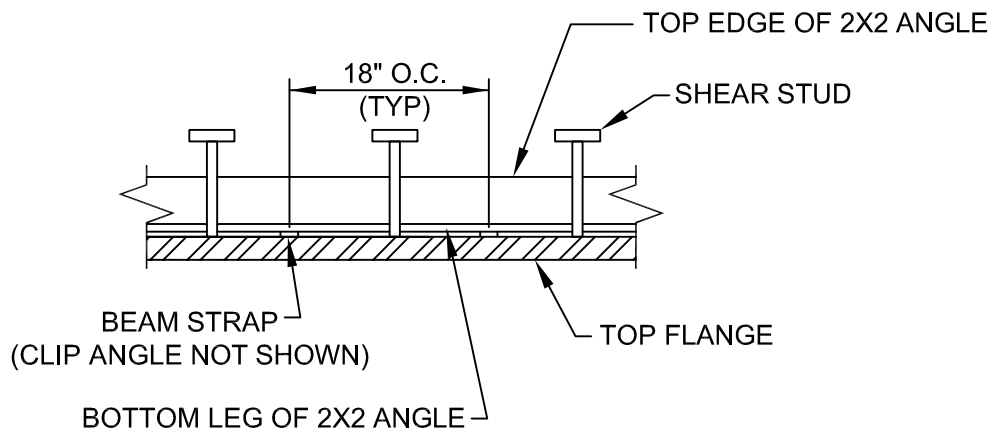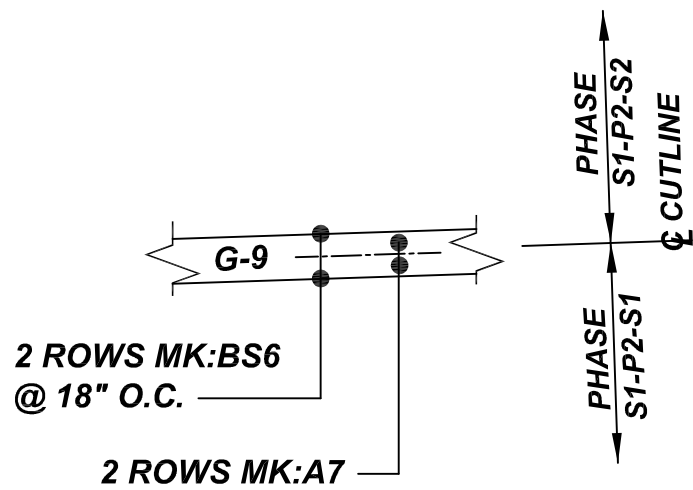

AMERICAN STRUCTUREPOINT, INC.  
 ADDRESS: 7260 SHADELAND STATION,  
 INDIANAPOLIS, IN 46256  
 TELEPHONE #: 317.547.5580  
 CERTIFICATE OF AUTHORITY # 016489

## SECTION @ BRIDGE DECK LAYOUT (GIRDER 9)

**(DETAIL A)**

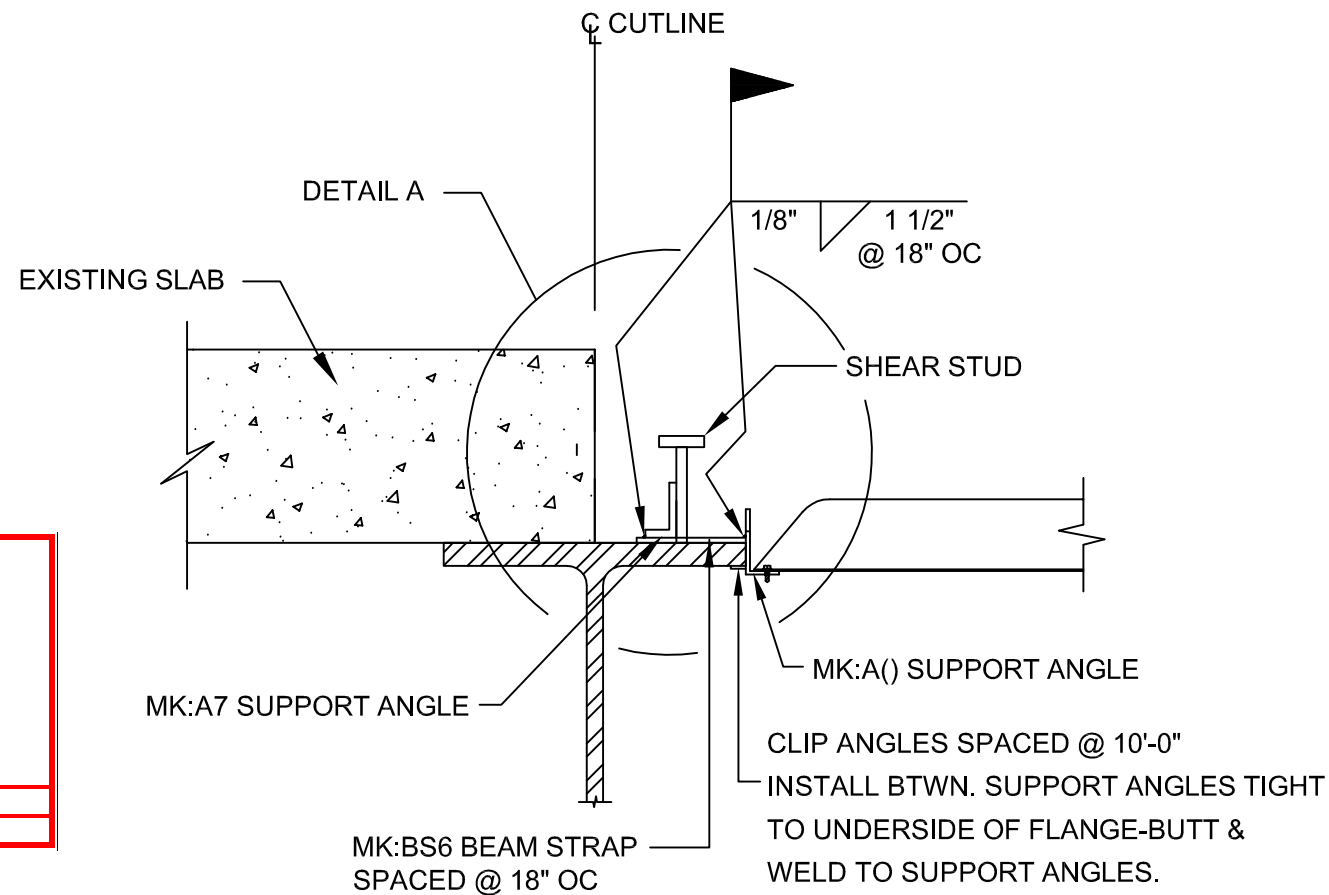


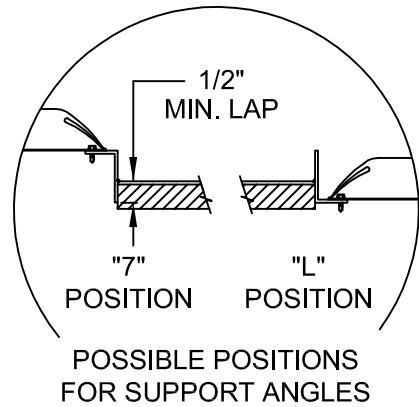
## SECTION @ EXISTING SLAB (GIRDER 9)

### BRIDGE DECK GENERAL NOTES

- NMBS will furnish only that material listed in the Bill of Material.
- All material for bridge deck forms, support angles (Grade 50) and accessories (Grade 40) shall conform to ASTM specification A-653 having a coating designation of G-235.
- The contractor shall verify all dimensions.
- Extra concrete poured on deck slab as a result of these metal forms shall be provided by the General Contractor and will not be the responsibility of or to the account of NMBS.
- ALL DECK SHEETS SHALL HAVE A MINIMUM BEARING OF 1 1/2" AT EACH END OF THE DECK. CENTER FORMS ON SUPPORT ANGLES.
- FOR THE SAFETY OF THE WORKMEN, ALL DECK SHEETS SHALL BE SECURELY FASTENED TO THE SUPPORT ANGLE AS THEY ARE PLACED, BEFORE CONSTRUCTION TRAFFIC IS PERMITTED.
- Reinforcing steel and supports for reinforcing steel shall be placed in accordance with applicable drawings and in conformance with good reinforced concrete practice, and under the continuous supervision of a properly trained foreman.
- CALCIUM CHLORIDE (OR ANY ADMIXTURE CONTAINING CHLORIDE SALTS) SHALL NOT BE USED IN THE CONCRETE PLACED ON THE BRIDGE DECK.
- Concrete should be poured from a low level to avoid impacting the deck. It should be placed uniformly over the supporting structure (DECK SUPPORTS) and spread towards the center of the deck span. Workers should not congregate around the concrete placement zone.
- If situations arise that are not specifically covered by these notes or placing plans, or if there is any doubt as to the correct procedure to be followed in erection, please contact New Millennium Building Systems for additional instructions or clarification.
- Vertical adjustment of support angles shall be determined in the field to maintain the correct slab thickness and roadway slope.
- Closure angles shall not be used as support for deck form panels.


<b>PRIME AE, Group, Inc</b>		<b>RELEASED FOR FABRICATION</b>  <b>WALSH</b>
DATE REC'D: 7/12/2019	BUILDABLE UNIT NO.: BU-11	
Review conforms that the shop drawings meet the intent of the contract.		
<input type="checkbox"/> CONFORMS AS-IS	<input checked="" type="checkbox"/> CONFORMS AS NOTED	
SIP Forms over <b>Railroad - Span 7</b>		
By: Tom Stora, PE	By:	
Date: 7/16/2019	Date:	

DATE	REVISIONS	COMMENTS	REMARKS
			BRIDGE DECK LAYOUT AND GENERAL NOTES
			IR-74 OVER MILL CREEK, RR & SPRING GROVE AVENUE BRIDGE NO. HAM-74-1908R (SPAN 7)
			 <b>NEW MILLENNIUM</b> BUILDING SYSTEMS New Millennium Building Systems, LLC 4900 Hungerford Road Memphis, Tennessee 38118 Phone: (901) 365-0226   www.newmill.com
			CUSTOMER: WALSH CONSTRUCTION COMPANY II
			PROJECT: 183000    FED. NO. E170 (713)    PID NO. 104667
			LOCATION: HAMILTON COUNTY, OHIO
			ENGINEER: STATE OF OHIO DEPARTMENT OF TRANSPORTATION
			DRAWN: TLC    DATE: 06/2019    NEW MILLENNIUM JOB NO.    DRAWING NO.
			CHECKED: TC    DATE: 06/2019    BR18-0527    2 OF 7




NOTE: THE VERTICAL LEGS OF THE SUPPORT ANGLES IN THE "L" POSITION MAY NEED TO BE CUT IN THE FIELD AS NEEDED PER BRIDGE PLANS.

**CONNECTION DETAIL**

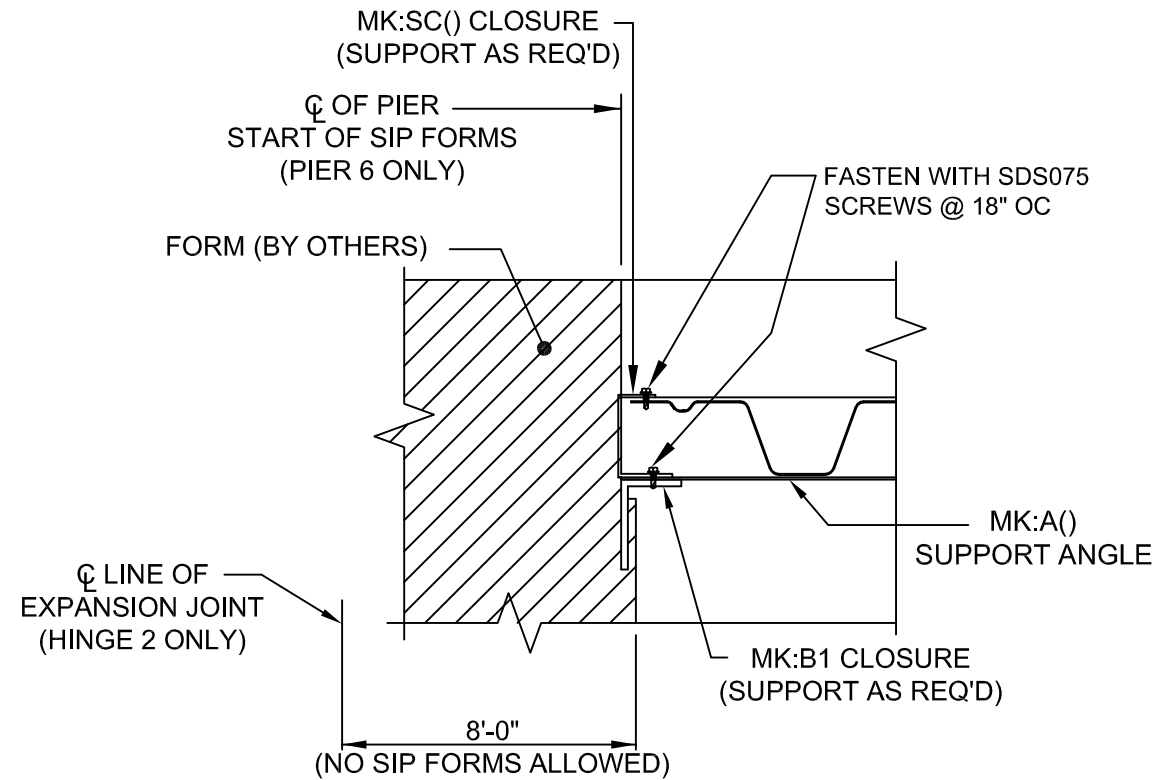

**SECTION @  
PIER 6, 7 & HINGE 2**

AMERICAN STRUCTUREPOINT, INC.  
ADDRESS: 7260 SHADELAND STATION,  
INDIANAPOLIS, IN 46256  
TELEPHONE #: 317.547.5580  
CERTIFICATE OF AUTHORITY # 016489

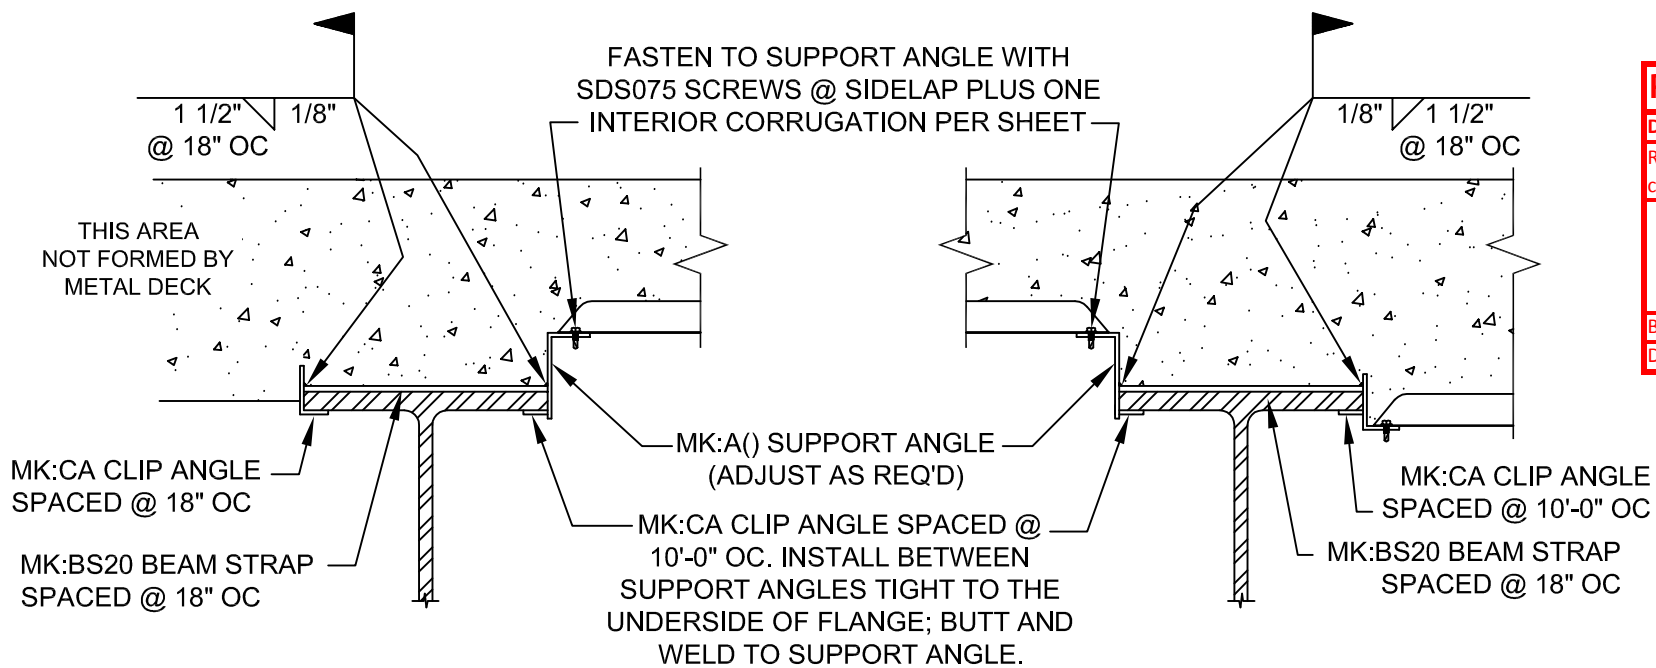

**SECTION @  
EXTERIOR GIRDERS**




**SECTION @  
INTERIOR GIRDERS**

FASTEN TO SUPPORT ANGLE WITH SDS075 SCREWS @ SIDELAP PLUS ONE INTERIOR CORRUGATION PER SHEET

<b>PRIME AE, Group, Inc</b>		<b>RELEASED FOR FABRICATION</b>  <b>WALSH</b>
DATE REC'D: 7/12/2019	BUILDABLE UNIT NO.: BU-11	
Review conforms that the shop drawings meet the intent of the contract.		
<input type="checkbox"/> CONFORMS AS-IS	<input checked="" type="checkbox"/> CONFORMS AS NOTED	
SIP Forms over <b>Railroad - Span 7</b>		
By: Tom Stora, PE	By:	
Date: 7/16/2019	Date:	

DATE	REVISIONS	COMMENTS	REMARKS
			BRIDGE DECK SECTIONS
			IR-74 OVER MILL CREEK, RR & SPRING GROVE AVENUE BRIDGE NO. HAM-74-1908R (SPAN 7)
			 <b>NEW MILLENNIUM</b> BUILDING SYSTEMS New Millennium Building Systems, LLC 4900 Hungerford Road Memphis, Tennessee 38118 Phone: (901) 365-0226   www.newmill.com
			CUSTOMER: WALSH CONSTRUCTION COMPANY II
			PROJECT: 183000 FED. NO. E170 (713) PID NO. 104667
			LOCATION: HAMILTON COUNTY, OHIO
			ENGINEER: STATE OF OHIO DEPARTMENT OF TRANSPORTATION
			DRAWN: TLC DATE: 06/2019 NEW MILLENNIUM JOB NO. DRAWING NO.
			CHECKED: TC DATE: 06/2019 BR18-0527 3 OF 7



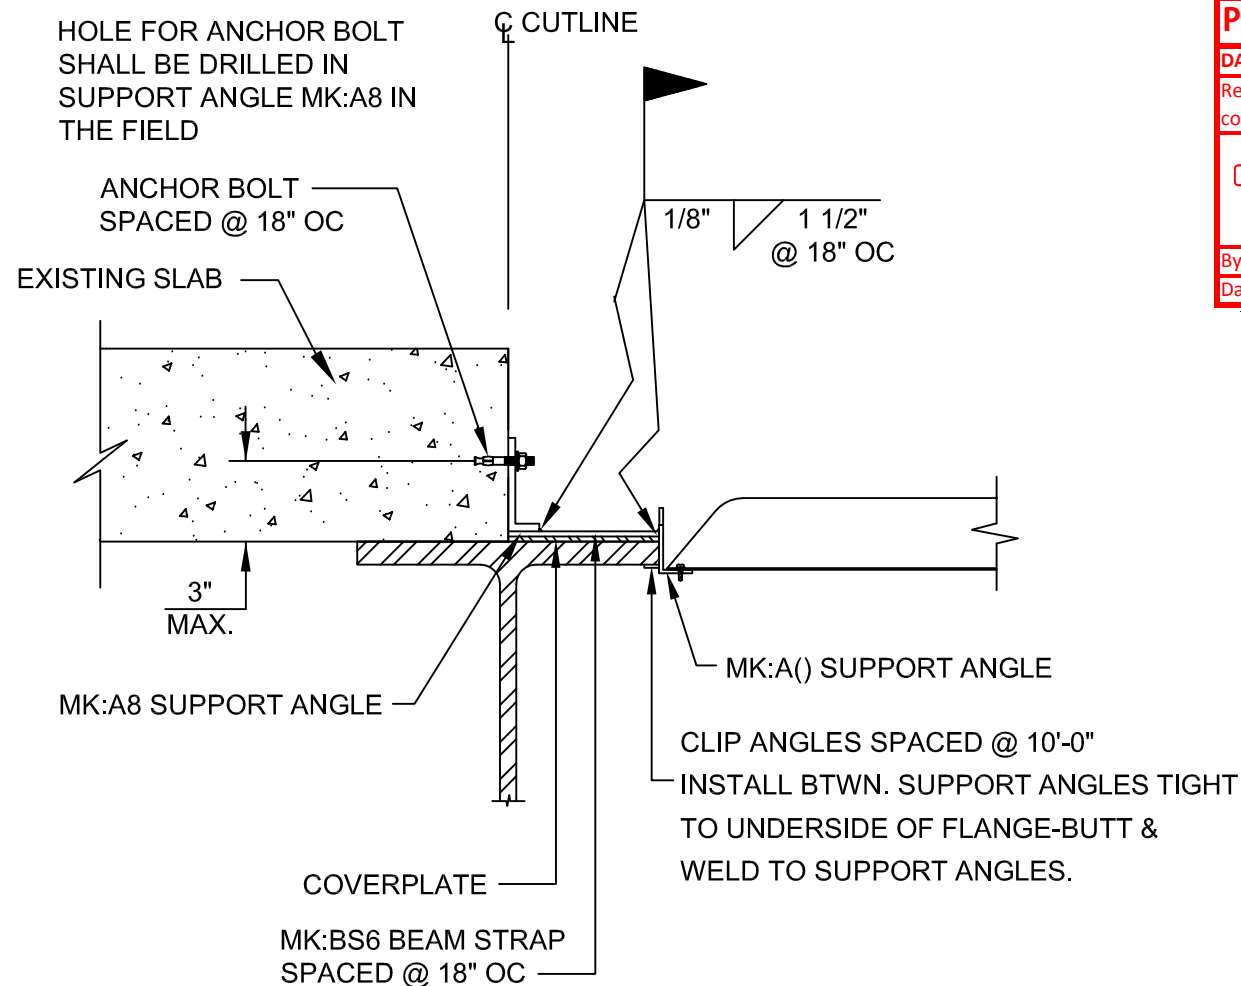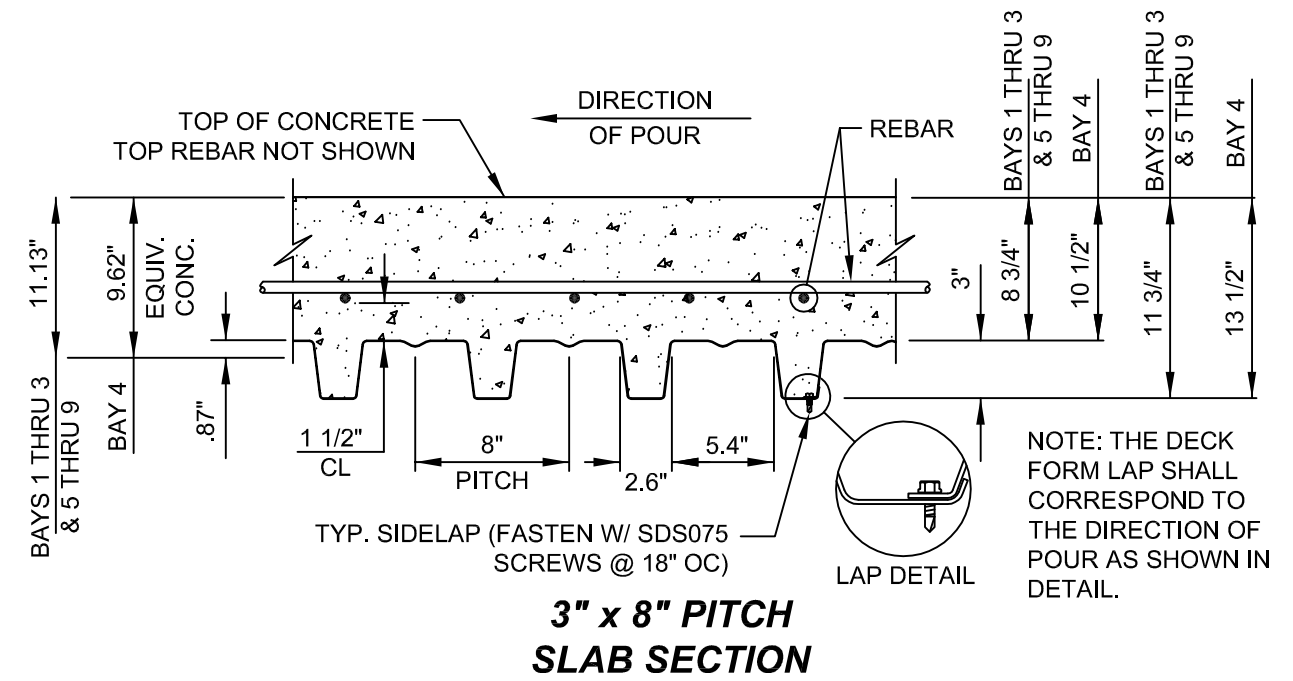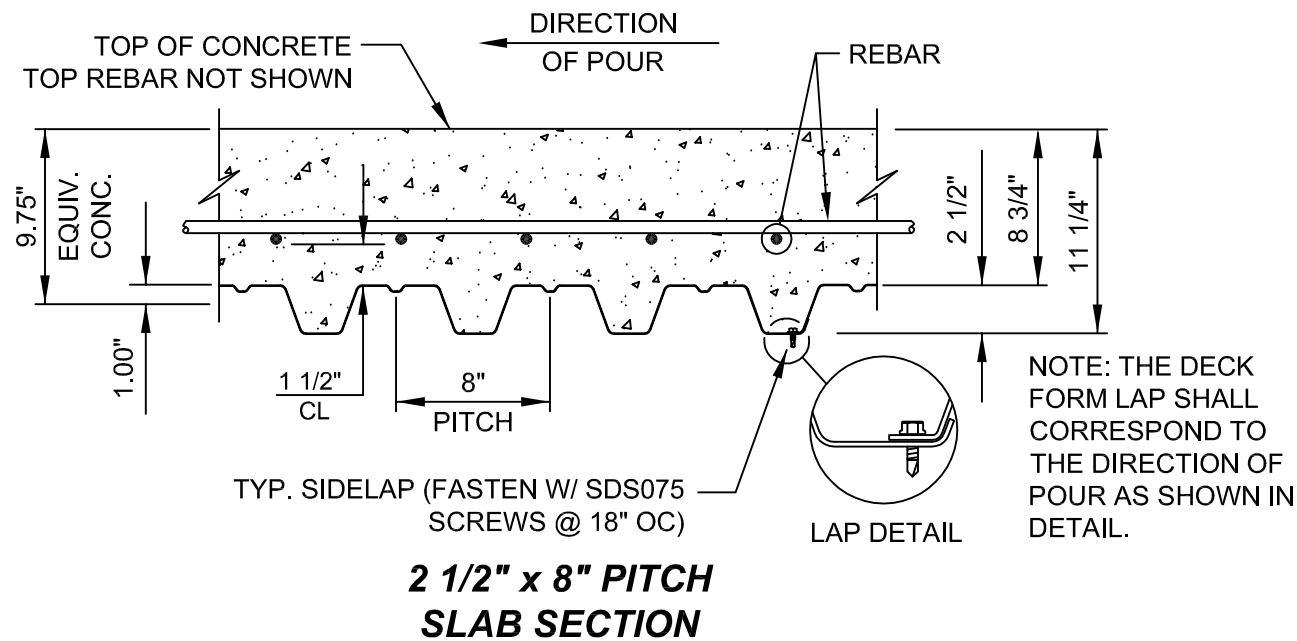

<b>PRIME AE, Group, Inc</b>		<b>RELEASED FOR FABRICATION</b>
DATE REC'D: 7/12/2019	BUILDABLE UNIT NO.: BU-11	
Review conforms that the shop drawings meet the intent of the contract.		<b>WALSH</b>
<input type="checkbox"/> CONFORMS AS-IS	<input checked="" type="checkbox"/> CONFORMS AS NOTED	
SIP Forms over Railroad - Span 7		
By: Tom Stora, PE	By:	
Date: 7/16/2019	Date:	

AMERICAN STRUCTUREPOINT, INC.  
ADDRESS: 7260 SHADELAND STATION,  
INDIANAPOLIS, IN 46256  
TELEPHONE #: 317.547.5580  
CERTIFICATE OF AUTHORITY # 016489

**BRIDGE DECK GENERAL NOTES**

- NMBS will furnish only that material listed in the Bill of Material.
- All material for bridge deck forms, support angles (Grade 50) and accessories (Grade 40) shall conform to ASTM specification A-653 having a coating designation of G-235.
- The contractor shall verify all dimensions.
- Extra concrete poured on deck slab as a result of these metal forms shall be provided by the General Contractor and will not be the responsibility of or to the account of NMBS.
- ALL DECK SHEETS SHALL HAVE A MINIMUM BEARING OF 1 1/2" AT EACH END OF THE DECK. CENTER FORMS ON SUPPORT ANGLES.
- FOR THE SAFETY OF THE WORKMEN, ALL DECK SHEETS SHALL BE SECURELY FASTENED TO THE SUPPORT ANGLE AS THEY ARE PLACED, BEFORE CONSTRUCTION TRAFFIC IS PERMITTED.
- Reinforcing steel and supports for reinforcing steel shall be placed in accordance with applicable drawings and in conformance with good reinforced concrete practice, and under the continuous supervision of a properly trained foreman.
- CALCIUM CHLORIDE (OR ANY ADMIXTURE CONTAINING CHLORIDE SALTS) SHALL NOT BE USED IN THE CONCRETE PLACED ON THE BRIDGE DECK.
- Concrete should be poured from a low level to avoid impacting the deck. It should be placed uniformly over the supporting structure (DECK SUPPORTS) and spread towards the center of the deck span. Workers should not congregate around the concrete placement zone.
- If situations arise that are not specifically covered by these notes or placing plans, or if there is any doubt as to the correct procedure to be followed in erection, please contact New Millennium Building Systems for additional instructions or clarification.
- Vertical adjustment of support angles shall be determined in the field to maintain the correct slab thickness and roadway slope.
- Closure angles shall not be used as support for deck form panels.

REVISIONS		DATE		COMMENTS	


REMARKS			
BRIDGE DECK SECTIONS AND GENERAL NOTES			
IR-74 OVER MILL CREEK, RR & SPRING GROVE AVENUE BRIDGE NO. HAM-74-1908R (SPAN 7)			
New Millennium Building Systems, LLC 4900 Hungerford Road Memphis, Tennessee 38118 Phone: (901) 365-0226   www.newmill.com			
CUSTOMER	WALSH CONSTRUCTION COMPANY II		
PROJECT	183000	FED. NO. E170 (713)	PID NO. 104667
LOCATION	HAMILTON COUNTY, OHIO		
ENGINEER	STATE OF OHIO DEPARTMENT OF TRANSPORTATION		
DRAWN	TLC	DATE	06/2019
CHECKED	TC	DATE	06/2019
NEW MILLENNIUM JOB NO.		DRAWING NO.	
BR18-0527		4 of 7	




BILL OF MATERIAL: SPAN 7 BAY 1, PHASE S1-P2-S2			
MARK	NO. PCS.	LENGTH	DESCRIPTION
<b>S7-B1-S2</b>	4	6' - 2 1/2"	<b>BRIDGE DECK</b> 2 1/2" DEEP 8" PITCH 32" COVER CLOSED ENDS ASTM A653 GRADE 50 GALV. G-235 20 GAGE I=0.645 in <sup>4</sup> /ft S=0.462 in <sup>3</sup> /ft
	2	6' - 2 3/4"	
	2	6' - 3 1/4"	
	2	6' - 3 1/2"	
	2	6' - 3 3/4"	
	2	6' - 4 1/4"	
	2	6' - 4 1/2"	
	2	6' - 4 3/4"	
	2	6' - 5 1/4"	
	2	6' - 5 1/2"	
	2	6' - 5 3/4"	
	2	6' - 6 1/4"	
	2	6' - 6 1/2"	
	2	6' - 6 3/4"	
	2	6' - 7 1/4"	
	2	6' - 7 1/2"	
	2	6' - 7 3/4"	
	2	6' - 8"	
	2	6' - 8 1/2"	
	2	6' - 8 3/4"	
2	6' - 9"		
2	6' - 9 1/2"		
2	6' - 9 3/4"		
2	6' - 10"		
4	6' - 10 1/2"		

BILL OF MATERIAL: SPAN 7 BAY 2, PHASE S1-P2-S2			
MARK	NO. PCS.	LENGTH	DESCRIPTION
<b>S7-B2-S2</b>	67	3' - 3 3/4"	<b>BRIDGE DECK</b> 3" DEEP 8" PITCH 24" COVER CLOSED ENDS ASTM A653 GRADE 50 GALV. G-235 20 GAGE I=1.002 in <sup>4</sup> /ft S=0.541 in <sup>3</sup> /ft

BILL OF MATERIAL: SPAN 7 BAY 5, PHASE S1-P2-S2			
MARK	NO. PCS.	LENGTH	DESCRIPTION
<b>S7-B5-S2</b>	3	7' - 0 1/4"	<b>BRIDGE DECK</b> 3" DEEP 8" PITCH 24" COVER CLOSED ENDS ASTM A653 GRADE 50 GALV. G-235 20 GAGE I=1.002 in <sup>4</sup> /ft S=0.541 in <sup>3</sup> /ft
	2	7' - 0 3/4"	
	2	7' - 1"	
	2	7' - 1 1/2"	
	2	7' - 1 3/4"	
	2	7' - 2"	
	2	7' - 2 1/2"	
	2	7' - 2 3/4"	
	2	7' - 3 1/4"	
	2	7' - 3 1/2"	
	2	7' - 4"	
	2	7' - 4 1/4"	
	2	7' - 4 1/2"	
	2	7' - 5"	
	2	7' - 5 1/4"	
	2	7' - 5 3/4"	
	2	7' - 6"	
	2	7' - 6 1/2"	
	2	7' - 6 3/4"	
	2	7' - 7 1/4"	
	2	7' - 7 1/2"	
	2	7' - 7 3/4"	
	2	7' - 8 1/4"	
	2	7' - 8 1/2"	
	2	7' - 9"	
	2	7' - 9 1/4"	
	2	7' - 9 3/4"	
	2	7' - 10"	
2	7' - 10 1/2"		
2	7' - 10 3/4"		
2	7' - 11"		
2	7' - 11 1/2"		
4	7' - 11 3/4"		

<b>PRIME AE, Group, Inc</b>		<b>RELEASED FOR FABRICATION</b>  
DATE REC'D: 7/12/2019	BUILDABLE UNIT NO.: BU-11	
Review conforms that the shop drawings meet the intent of the contract.		
<input type="checkbox"/> CONFORMS AS-IS <input checked="" type="checkbox"/> CONFORMS AS NOTED		
SIP Forms over <b>Railroad - Span 7</b>		
By: Tom Stora, PE	By:	
Date: 7/16/2019	Date:	

AMERICAN STRUCTUREPOINT, INC.  
ADDRESS: 7260 SHADELAND STATION,  
INDIANAPOLIS, IN 46256  
TELEPHONE #: 317.547.5580  
CERTIFICATE OF AUTHORITY # 016489

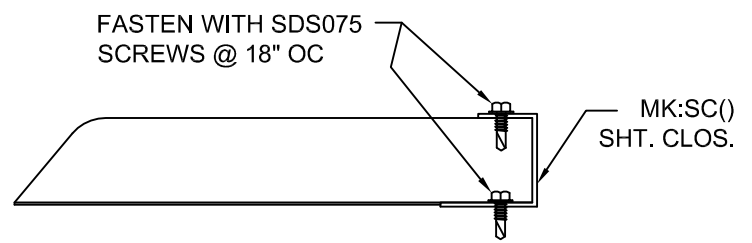


CLOSE CUT END WITH MK:SC()  
ATTACH WITH SDS075 SCREWS @ 18" O.C.

**CLOSURE FOR FIELD CUT DECK ENDS**

**BRIDGE DECK GENERAL NOTES**

- NMBS will furnish only that material listed in the Bill of Material.
- All material for bridge deck forms, support angles (Grade 50) and accessories (Grade 40) shall conform to ASTM specification A-653 having a coating designation of G-235.
- The contractor shall verify all dimensions.
- Extra concrete poured on deck slab as a result of these metal forms shall be provided by the General Contractor and will not be the responsibility of or to the account of NMBS.
- ALL DECK SHEETS SHALL HAVE A MINIMUM BEARING OF 1 1/2" AT EACH END OF THE DECK. CENTER FORMS ON SUPPORT ANGLES.
- FOR THE SAFETY OF THE WORKMEN, ALL DECK SHEETS SHALL BE SECURELY FASTENED TO THE SUPPORT ANGLE AS THEY ARE PLACED, BEFORE CONSTRUCTION TRAFFIC IS PERMITTED.
- Reinforcing steel and supports for reinforcing steel shall be placed in accordance with applicable drawings and in conformance with good reinforced concrete practice, and under the continuous supervision of a properly trained foreman.
- CALCIUM CHLORIDE (OR ANY ADMIXTURE CONTAINING CHLORIDE SALTS) SHALL NOT BE USED IN THE CONCRETE PLACED ON THE BRIDGE DECK.
- Concrete should be poured from a low level to avoid impacting the deck. It should be placed uniformly over the supporting structure (DECK SUPPORTS) and spread towards the center of the deck span. Workers should not congregate around the concrete placement zone.
- If situations arise that are not specifically covered by these notes or placing plans, or if there is any doubt as to the correct procedure to be followed in erection, please contact New Millennium Building Systems for additional instructions or clarification.
- Vertical adjustment of support angles shall be determined in the field to maintain the correct slab thickness and roadway slope.
- Closure angles shall not be used as support for deck form panels.

REVISIONS		DATE		COMMENTS	

REMARKS					
BRIDGE DECK BILL OF MATERIAL AND GENERAL NOTES					
IR-74 OVER MILL CREEK, RR & SPRING GROVE AVENUE					
BRIDGE NO. HAM-74-1908R (SPAN 7)					
					
New Millennium Building Systems, LLC 4900 Hungerford Road Memphis, Tennessee 38118 Phone: (901) 365-0226   www.newmill.com					
CUSTOMER	WALSH CONSTRUCTION COMPANY II				
PROJECT	183000	FED. NO. E170 (713)	PID NO. 104667		
LOCATION	HAMILTON COUNTY, OHIO				
ENGINEER	STATE OF OHIO DEPARTMENT OF TRANSPORTATION				
DRAWN	TLC	DATE	06/2019	NEW MILLENNIUM JOB NO.	DRAWING NO.
CHECKED	TC	DATE	06/2019	BR18-0527	5 of 7

BILL OF MATERIAL: SPAN 7 BAY 6, PHASE S1-P2-S1			
MARK	NO. PCS.	LENGTH	DESCRIPTION
S7-B6-S1	4	6' - 11 3/4"	BRIDGE DECK 3" DEEP 8" PITCH 24" COVER
	2	7' - 0"	
	2	7' - 0 1/2"	
	2	7' - 0 3/4"	
	2	7' - 1"	CLOSED ENDS ASTM A653 GRADE 50 GALV. G-235 20 GAGE I=1.002 in^4/ft S=0.541 in^3/ft
	2	7' - 1 1/2"	
	2	7' - 1 3/4"	
	2	7' - 2 1/4"	
	2	7' - 2 1/2"	
	2	7' - 2 3/4"	
	2	7' - 3 1/4"	
	2	7' - 3 1/2"	
	2	7' - 4"	
	2	7' - 4 1/4"	
	2	7' - 4 1/2"	
	2	7' - 5"	
	2	7' - 5 1/4"	
	2	7' - 5 3/4"	
	2	7' - 6"	
	2	7' - 6 1/2"	
2	7' - 6 3/4"		
2	7' - 7"		
2	7' - 7 1/2"		
2	7' - 7 3/4"		
2	7' - 8 1/4"		
2	7' - 8 1/2"		
2	7' - 8 3/4"		
2	7' - 9 1/4"		
2	7' - 9 1/2"		
2	7' - 10"		
2	7' - 10 1/4"		
2	7' - 10 3/4"		
2	7' - 11"		
4	7' - 11 1/4"		

BILL OF MATERIAL: SPAN 7 BAY 7, PHASE S1-P2-S1			
MARK	NO. PCS.	LENGTH	DESCRIPTION
S7-B7-S1	4	6' - 11 3/4"	BRIDGE DECK 3" DEEP 8" PITCH 24" COVER
	2	7' - 0 1/4"	
	2	7' - 0 1/2"	
	2	7' - 0 3/4"	
	2	7' - 1"	CLOSED ENDS ASTM A653 GRADE 50 GALV. G-235 20 GAGE I=1.002 in^4/ft S=0.541 in^3/ft
	2	7' - 1 1/2"	
	2	7' - 1 3/4"	
	2	7' - 2"	
	2	7' - 2 1/4"	
	2	7' - 2 1/2"	
	2	7' - 3"	
	2	7' - 3 1/4"	
	2	7' - 3 1/2"	
	2	7' - 3 3/4"	
	2	7' - 4 1/4"	
	2	7' - 4 1/2"	
	2	7' - 4 3/4"	
	2	7' - 5"	
	2	7' - 5 1/2"	
	2	7' - 5 3/4"	
2	7' - 6"		
2	7' - 6 1/4"		
2	7' - 6 3/4"		
2	7' - 7"		
2	7' - 7 1/4"		
2	7' - 7 1/2"		
2	7' - 8"		
2	7' - 8 1/4"		
2	7' - 8 1/2"		
2	7' - 8 3/4"		
2	7' - 9"		
2	7' - 9 1/2"		
2	7' - 9 3/4"		
3	7' - 10"		

BILL OF MATERIAL: SPAN 7 BAY 8, PHASE S1-P2-S1			
MARK	NO. PCS.	LENGTH	DESCRIPTION
S7-B8-S1	4	6' - 11 1/4"	BRIDGE DECK 3" DEEP 8" PITCH 24" COVER
	2	6' - 11 1/2"	
	2	7' - 0"	
	2	7' - 0 1/2"	
	2	7' - 0 3/4"	CLOSED ENDS ASTM A653 GRADE 50 GALV. G-235 20 GAGE I=1.002 in^4/ft S=0.541 in^3/ft
	2	7' - 1 1/4"	
	2	7' - 1 1/2"	
	2	7' - 2"	
	2	7' - 2 1/2"	
	2	7' - 2 3/4"	
	2	7' - 3 1/4"	
	2	7' - 3 1/2"	
	2	7' - 4"	
	2	7' - 4 1/2"	
	2	7' - 4 3/4"	
	2	7' - 5 1/4"	
	2	7' - 5 1/2"	
	2	7' - 6"	
	2	7' - 6 1/2"	
	2	7' - 6 3/4"	
2	7' - 7 1/4"		
2	7' - 7 1/2"		
2	7' - 8"		
2	7' - 8 1/2"		
2	7' - 8 3/4"		
2	7' - 9 1/4"		
2	7' - 9 1/2"		
2	7' - 10"		
2	7' - 10 1/2"		
2	7' - 10 3/4"		
2	7' - 11 1/4"		
2	7' - 11 1/2"		
2	8' - 0"		
3	8' - 0 1/4"		

BILL OF MATERIAL: SPAN 7 BAY 9, PHASE S1-P2-S1			
MARK	NO. PCS.	LENGTH	DESCRIPTION
S7-B9-S1	4	6' - 11 1/4"	BRIDGE DECK 3" DEEP 8" PITCH 24" COVER
	2	6' - 11 3/4"	
	2	7' - 0"	
	2	7' - 0 1/4"	
	2	7' - 0 1/2"	CLOSED ENDS ASTM A653 GRADE 50 GALV. G-235 20 GAGE I=1.002 in^4/ft S=0.541 in^3/ft
	2	7' - 1"	
	2	7' - 1 1/4"	
	2	7' - 1 1/2"	
	2	7' - 2"	
	2	7' - 2 1/2"	
	2	7' - 2 3/4"	
	2	7' - 3 1/4"	
	2	7' - 3 1/2"	
	2	7' - 3 3/4"	
	2	7' - 4 1/4"	
	2	7' - 4 1/2"	
	2	7' - 4 3/4"	
	2	7' - 5"	
	2	7' - 5 1/2"	
	2	7' - 5 3/4"	
2	7' - 6"		
2	7' - 6 1/2"		
2	7' - 6 3/4"		
2	7' - 7"		
2	7' - 7 1/2"		
2	7' - 7 3/4"		
2	7' - 8"		
2	7' - 8 1/4"		
2	7' - 8 3/4"		
2	7' - 9"		
2	7' - 9 1/4"		
2	7' - 9 3/4"		
3	7' - 10"		

BILL OF MATERIAL: SPAN 7 BAY 3, PHASE S1-P2-S2			
MARK	NO. PCS.	LENGTH	DESCRIPTION
S7-B3-S2	3	7' - 1 1/2"	BRIDGE DECK 3" DEEP 8" PITCH 24" COVER
	2	7' - 2"	
	2	7' - 2 1/4"	
	2	7' - 2 1/2"	
	2	7' - 3"	CLOSED ENDS ASTM A653 GRADE 50 GALV. G-235 20 GAGE I=1.002 in^4/ft S=0.541 in^3/ft
	2	7' - 3 1/4"	
	2	7' - 3 3/4"	
	2	7' - 4"	
	2	7' - 4 1/2"	
	2	7' - 4 3/4"	
	2	7' - 5"	
	2	7' - 5 1/2"	
	2	7' - 5 3/4"	
	2	7' - 6 1/4"	
	2	7' - 6 1/2"	
	2	7' - 6 3/4"	
4	7' - 7 1/4"		

BILL OF MATERIAL: SPAN 7 BAY 4, PHASE S1-P2-S2			
MARK	NO. PCS.	LENGTH	DESCRIPTION
S7-B4-S2	3	7' - 0 1/4"	BRIDGE DECK 3" DEEP 8" PITCH 24" COVER
	2	7' - 0 3/4"	
	2	7' - 1"	
	2	7' - 1 1/2"	
	2	7' - 1 3/4"	CLOSED ENDS ASTM A653 GRADE 50 GALV. G-235 20 GAGE I=1.002 in^4/ft S=0.541 in^3/ft
	2	7' - 2 1/4"	
	2	7' - 2 1/2"	
	2	7' - 3"	
	2	7' - 3 1/4"	
	2	7' - 3 1/2"	
	2	7' - 4"	
	2	7' - 4 1/4"	
	2	7' - 4 3/4"	
	2	7' - 5"	
	2	7' - 5 1/2"	
	2	7' - 5 3/4"	
2	7' - 6"		
4	7' - 6 1/2"		







<b>PRIME AE, Group, Inc</b>	<b>RELEASED FOR FABRICATION</b>
DATE REC'D: 7/12/2019 BUILDABLE UNIT NO.: BU-11	
Review conforms that the shop drawings meet the intent of the contract.	
<input type="checkbox"/> CONFORMS AS-IS <input checked="" type="checkbox"/> CONFORMS AS NOTED	
SIP Forms over Railroad - Span 7	
By: Tom Stora, PE	By:
Date: 7/16/2019	Date:







AMERICAN STRUCTUREPOINT, INC.  
ADDRESS: 7260 SHADELAND STATION,  
INDIANAPOLIS, IN 46256  
TELEPHONE #: 317.547.5580  
CERTIFICATE OF AUTHORITY # 016489






### BRIDGE DECK GENERAL NOTES

- NMBS will furnish only that material listed in the Bill of Material.
- All material for bridge deck forms, support angles (Grade 50) and accessories (Grade 40) shall conform to ASTM specification A-653 having a coating designation of G-235.
- The contractor shall verify all dimensions.
- Extra concrete poured on deck slab as a result of these metal forms shall be provided by the General Contractor and will not be the responsibility of or to the account of NMBS.
- ALL DECK SHEETS SHALL HAVE A MINIMUM BEARING OF 1 1/2" AT EACH END OF THE DECK. CENTER FORMS ON SUPPORT ANGLES.
- FOR THE SAFETY OF THE WORKMEN, ALL DECK SHEETS SHALL BE SECURELY FASTENED TO THE SUPPORT ANGLE AS THEY ARE PLACED, BEFORE CONSTRUCTION TRAFFIC IS PERMITTED.
- Reinforcing steel and supports for reinforcing steel shall be placed in accordance with applicable drawings and in conformance with good reinforced concrete practice, and under the continuous supervision of a properly trained foreman.
- CALCIUM CHLORIDE (OR ANY ADMIXTURE CONTAINING CHLORIDE SALTS) SHALL NOT BE USED IN THE CONCRETE PLACED ON THE BRIDGE DECK.
- Concrete should be poured from a low level to avoid impacting the deck. It should be placed uniformly over the supporting structure (DECK SUPPORTS) and spread towards the center of the deck span. Workers should not congregate around the concrete placement zone.
- If situations arise that are not specifically covered by these notes or placing plans, or if there is any doubt as to the correct procedure to be followed in erection, please contact New Millennium Building Systems for additional instructions or clarification.
- Vertical adjustment of support angles shall be determined in the field to maintain the correct slab thickness and roadway slope.
- Closure angles shall not be used as support for deck form panels.

		REMARKS	
		BRIDGE DECK BILL OF MATERIAL AND GENERAL NOTES	
		IR-74 OVER MILL CREEK, RR & SPRING GROVE AVENUE BRIDGE NO. HAM-74-1908R (SPAN 7)	
		 <b>NEW MILLENNIUM BUILDING SYSTEMS</b> New Millennium Building Systems, LLC 4900 Hungerford Road Memphis, Tennessee 38118 Phone: (901) 365-0226   www.newmill.com	
CUSTOMER	WALSH CONSTRUCTION COMPANY II		
PROJECT	183000 FED. NO. E170 (713) PID NO. 104667		
LOCATION	HAMILTON COUNTY, OHIO		
ENGINEER	STATE OF OHIO DEPARTMENT OF TRANSPORTATION		
DRAWN	TLC	DATE	06/2019
CHECKED	TC	DATE	06/2019
		NEW MILLENNIUM JOB NO.	BR18-0527
		DRAWING NO.	6 of 7

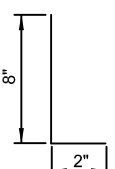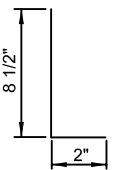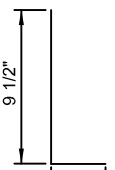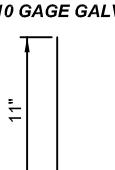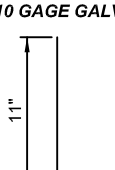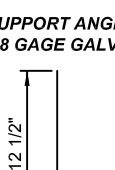
BILL OF MATERIAL			
MARK	NO. PCS.	LENGTH	DESCRIPTION
S1-P2-S1 A1	26	10'-0"	SUPPORT ANGLE 10 GAGE GALV. 
S1-P2-S1 A2	52	10'-0"	SUPPORT ANGLE 10 GAGE GALV. 
S1-P2-S2 A3	13	10'-0"	SUPPORT ANGLE 10 GAGE GALV. 
S1-P2-S1 A4	26	10'-0"	SUPPORT ANGLE 10 GAGE GALV. 
S1-P2-S2 A4	46	10'-0"	SUPPORT ANGLE 10 GAGE GALV. 
S1-P2-S2 A5	37	10'-0"	SUPPORT ANGLE 8 GAGE GALV. 

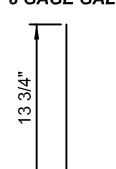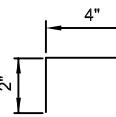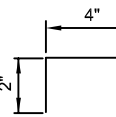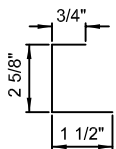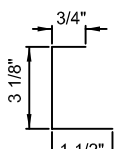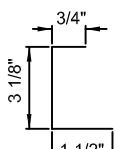BILL OF MATERIAL			
MARK	NO. PCS.	LENGTH	DESCRIPTION
S1-P2-S2 A6	14	10'-0"	SUPPORT ANGLE 8 GAGE GALV. 
S1-P2-S1 B	8	10'-0"	CLOSURE ANGLE 16 GAGE GALV. 
S1-P2-S2 B	10	10'-0"	CLOSURE ANGLE 16 GAGE GALV. 
S1-P2-S2 SC2.5	2	10'-0"	SHEET CLOSURE 20 GAGE GALV. 
S1-P2-S1 SC3.0	21	10'-0"	SHEET CLOSURE 20 GAGE GALV. 
S1-P2-S2 SC3.0	8	10'-0"	SHEET CLOSURE 20 GAGE GALV. 

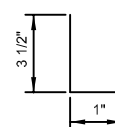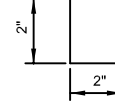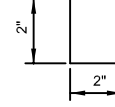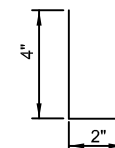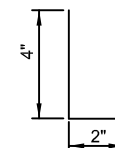BILL OF MATERIAL			
MARK	NO. PCS.	LENGTH	DESCRIPTION
CA	420	2"	CLIP ANGLE 12 GAGE GALV. 
S1-P2-S1 BS20	360	20 1/8"	BEAM STRAPS 12 GAGE 2" WIDE FLAT
BS6	90	6 1/16"	
S1-P2-S2 BS20	442	20 1/8"	BEAM STRAPS 12 GAGE 2" WIDE FLAT
BS6	90	6 1/16"	
SDS075	3,900	---	SELF DRILLING SCREWS 1/4-14x3/4" CADMIUM PLTD.
S1-P2-S1 A7	13	2"	SUPPORT ANGLE 10 GAGE GALV. 
S1-P2-S2 A7	13	2"	SUPPORT ANGLE 10 GAGE GALV. 
S1-P2-S1 A8	1	10'-0"	SUPPORT ANGLE 10 GAGE GALV. 
S1-P2-S1 A8	1	10'-0"	SUPPORT ANGLE 10 GAGE GALV. 

*ANGLE SUPPORT LIMITS CHART		
MARK	MAX. HAUNCH	SIP PROFILE
A1	10 1/2"	3"
A2	10 1/2"	2 1/2"
A3	12"	3"
A4	13"	2 1/2"
A5	14 1/2"	2 1/2"
A5	15"	3"
A6	16 1/4"	3"



\* MAX. MEASURED AT THE EDGE OF BEAM. IF A LARGER HAUNCH EXISTS, i.e. DUE TO CAMBER & DEAD LOAD DEFLECTION, THIS VALUE MUST BE PROVIDED TO NMBS PRIOR TO DRAWING APPROVAL.

<b>PRIME AE, Group, Inc</b>		<b>RELEASED FOR FABRICATION</b>
DATE REC'D: 7/12/2019	BUILDABLE UNIT NO.: BU-11	
Review conforms that the shop drawings meet the intent of the contract.		
<input type="checkbox"/> CONFORMS AS-IS <input checked="" type="checkbox"/> CONFORMS AS NOTED		
SIP Forms over Railroad - Span 7		
By: Tom Stora, PE	By:	
Date: 7/16/2019	Date:	

### BRIDGE DECK GENERAL NOTES

- NMBS will furnish only that material listed in the Bill of Material.
- All material for bridge deck forms, support angles (Grade 50) and accessories (Grade 40) shall conform to ASTM specification A-653 having a coating designation of G-235.
- The contractor shall verify all dimensions.
- Extra concrete poured on deck slab as a result of these metal forms shall be provided by the General Contractor and will not be the responsibility of or to the account of NMBS.
- ALL DECK SHEETS SHALL HAVE A MINIMUM BEARING OF 1 1/2" AT EACH END OF THE DECK. CENTER FORMS ON SUPPORT ANGLES.
- FOR THE SAFETY OF THE WORKMEN, ALL DECK SHEETS SHALL BE SECURELY FASTENED TO THE SUPPORT ANGLE AS THEY ARE PLACED, BEFORE CONSTRUCTION TRAFFIC IS PERMITTED.
- Reinforcing steel and supports for reinforcing steel shall be placed in accordance with applicable drawings and in conformance with good reinforced concrete practice, and under the continuous supervision of a properly trained foreman.
- CALCIUM CHLORIDE (OR ANY ADMIXTURE CONTAINING CHLORIDE SALTS) SHALL NOT BE USED IN THE CONCRETE PLACED ON THE BRIDGE DECK.
- Concrete should be poured from a low level to avoid impacting the deck. It should be placed uniformly over the supporting structure (DECK SUPPORTS) and spread towards the center of the deck span. Workers should not congregate around the concrete placement zone.
- If situations arise that are not specifically covered by these notes or placing plans, or if there is any doubt as to the correct procedure to be followed in erection, please contact New Millennium Building Systems for additional instructions or clarification.
- Vertical adjustment of support angles shall be determined in the field to maintain the correct slab thickness and roadway slope.
- Closure angles shall not be used as support for deck form panels.

AMERICAN STRUCTUREPOINT, INC.  
ADDRESS: 7260 SHADELAND STATION,  
INDIANAPOLIS, IN 46256  
TELEPHONE #: 317.547.5580  
CERTIFICATE OF AUTHORITY # 016489

REVISIONS	COMMENTS	DATE	REMARKS
			BRIDGE DECK BILL OF MATERIAL AND GENERAL NOTES IR-74 OVER MILL CREEK, RR & SPRING GROVE AVENUE BRIDGE NO. HAM-74-1908R (SPAN 7)
			  New Millennium Building Systems, LLC 4900 Hungerford Road Memphis, Tennessee 38118 Phone: (901) 365-0226   www.newmill.com
			CUSTOMER: WALSH CONSTRUCTION COMPANY II PROJECT: 183000    FED. NO. E170 (713)    PID NO. 104667 LOCATION: HAMILTON COUNTY, OHIO ENGINEER: STATE OF OHIO DEPARTMENT OF TRANSPORTATION DRAWN: TLC    DATE: 06/2019    NEW MILLENNIUM JOB NO. CHECKED: TC    DATE: 06/2019    BR18-0527    7 OF 7