



S:\Plans\2023_4-26-11 PM 10/26/2023 4:26:11 PM
 O:\2017\01113\C.Design\104667.HAM-75-3.84\Design\Structures\HAM0075_0440C_Sheets\HAM0075_0440C_SP001.dgn

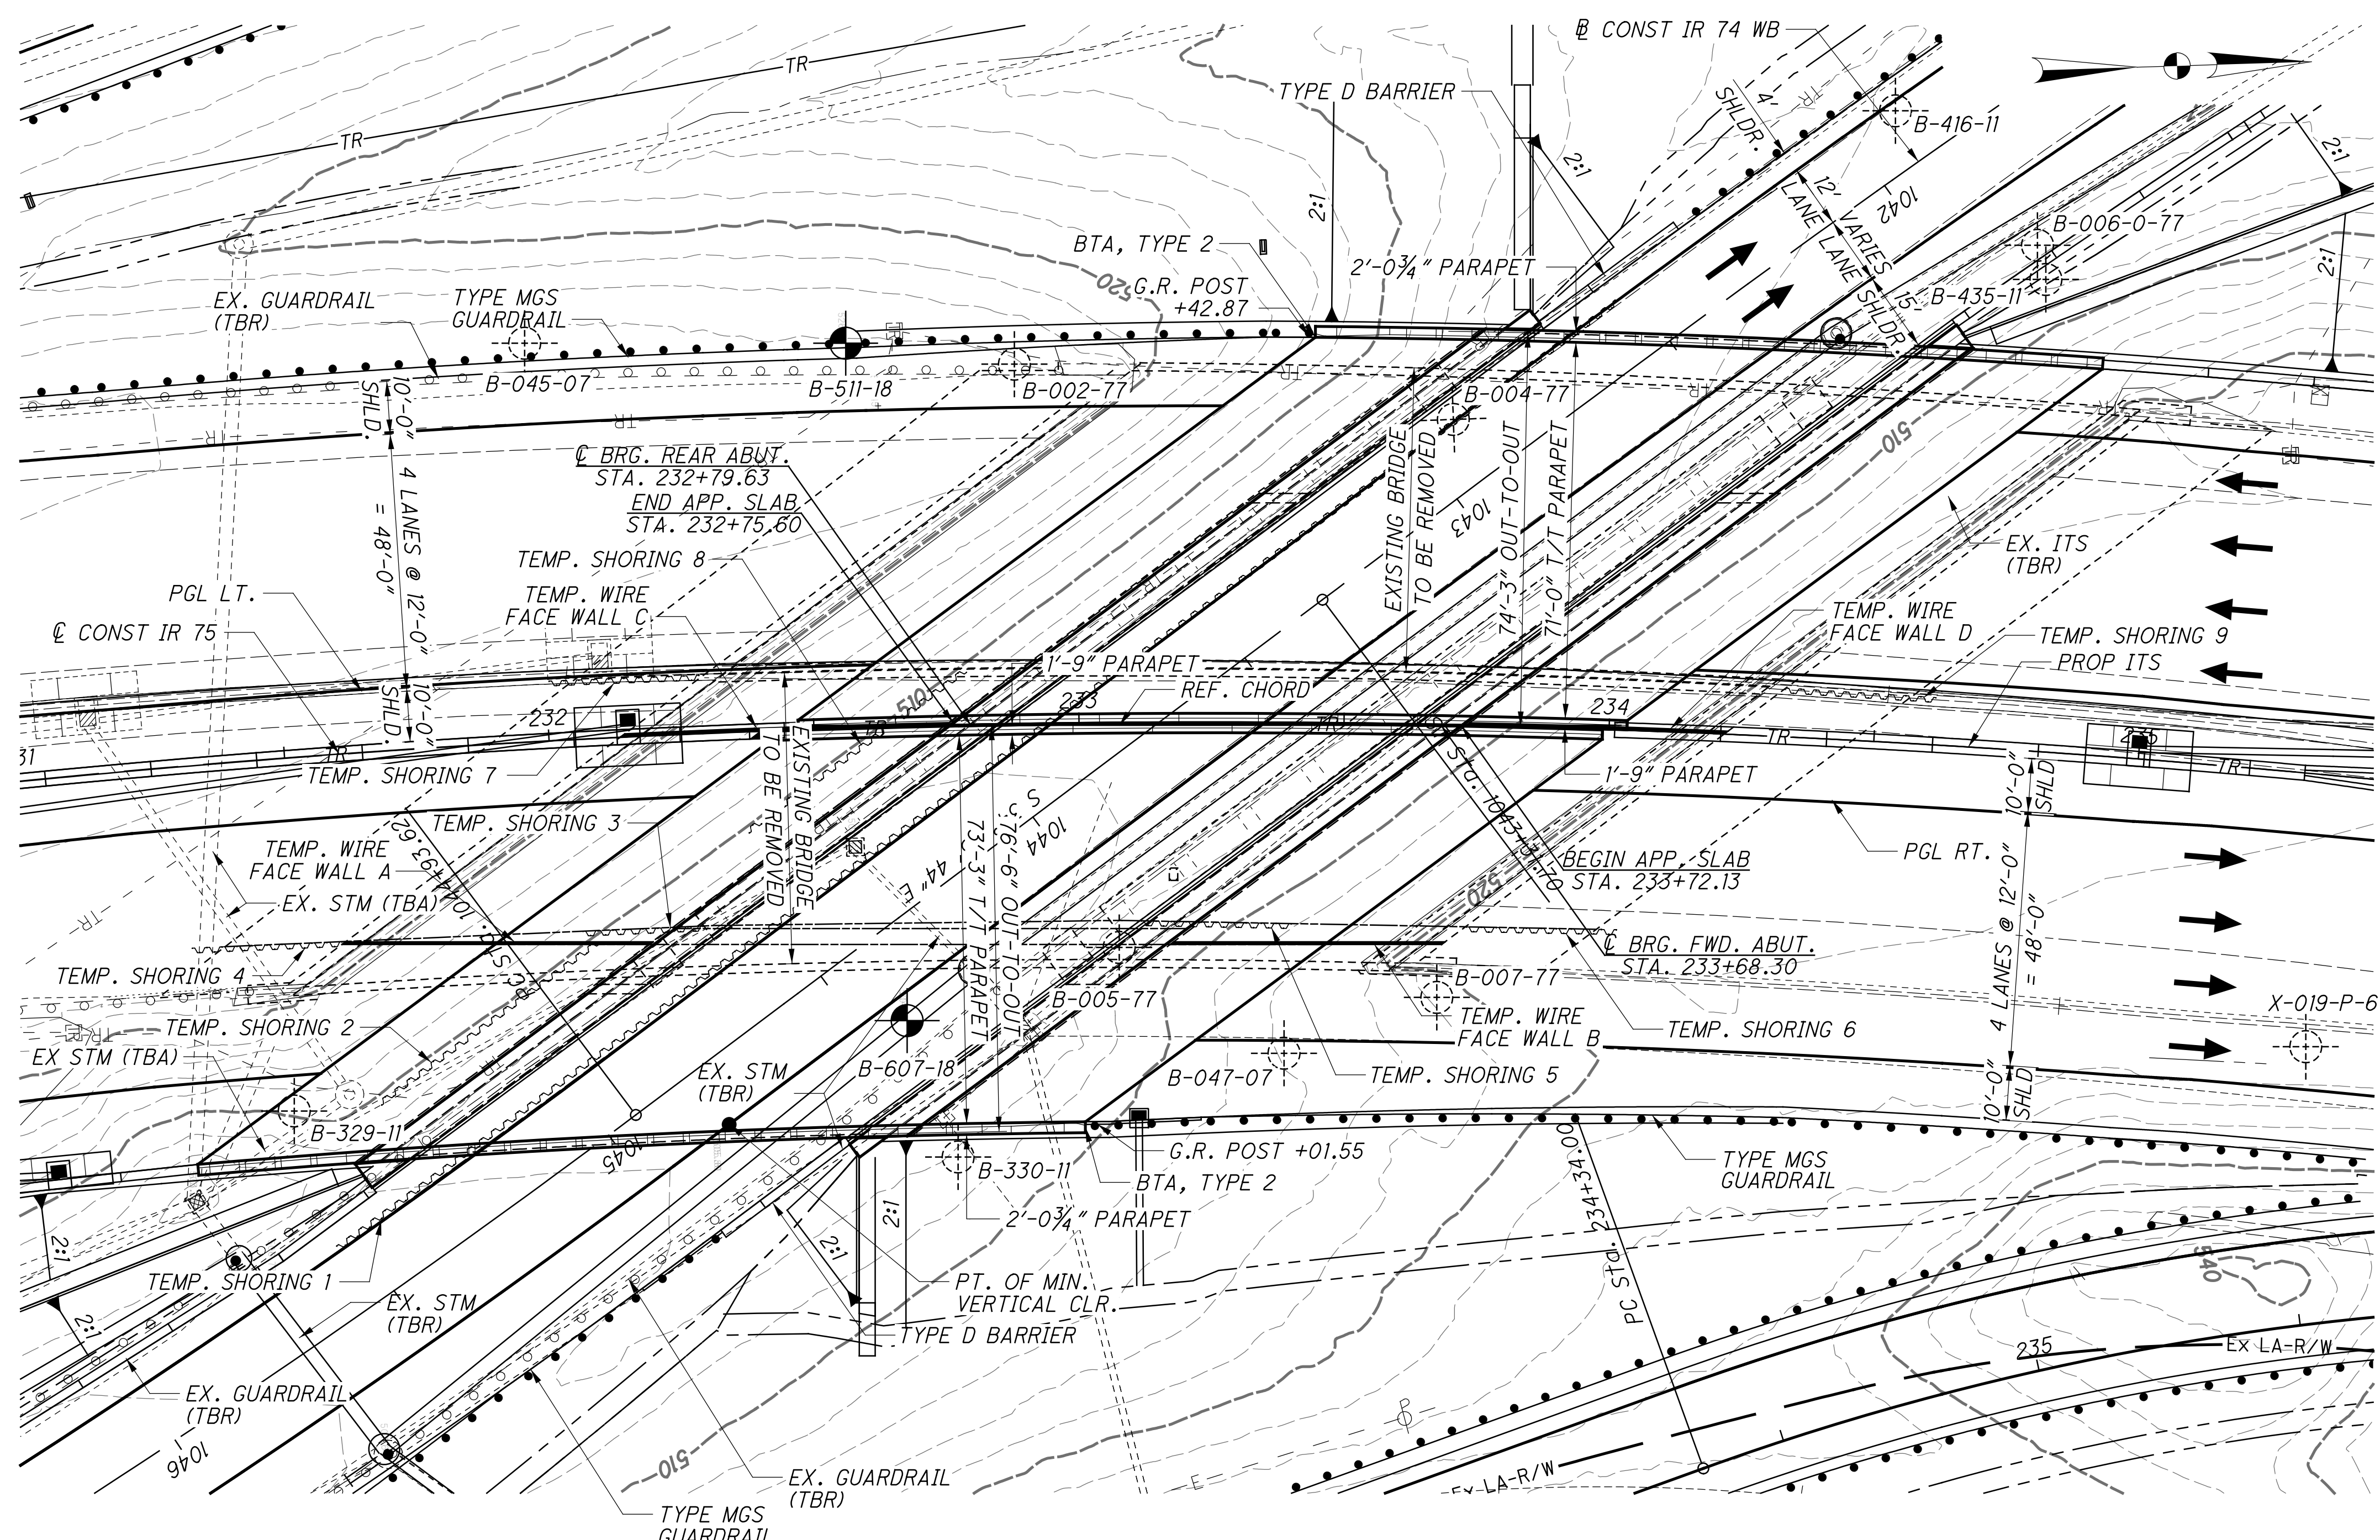

PLAN

I-74WB CURVE DATA	I-75 CURVE DATA
P.I. Sta. 1048+15.00	P.I. Sta. 232+75.63
Δ = 19° 46' 26" (RT)	Δ = 61° 02' 03" (RT)
Dc = 3° 06' 12"	Dc = 2° 30' 00"
R = 1,846.24'	R = 2,291.83'
T = 321.79'	T = 1,350.91'
L = 637.17'	L = 2,441.37'
E = 27.83'	E = 368.52'
C = 634.01'	C = 2,327.56'
C.B. = S 25° 00' 32" E	C.B. = N 2° 28' 45" W

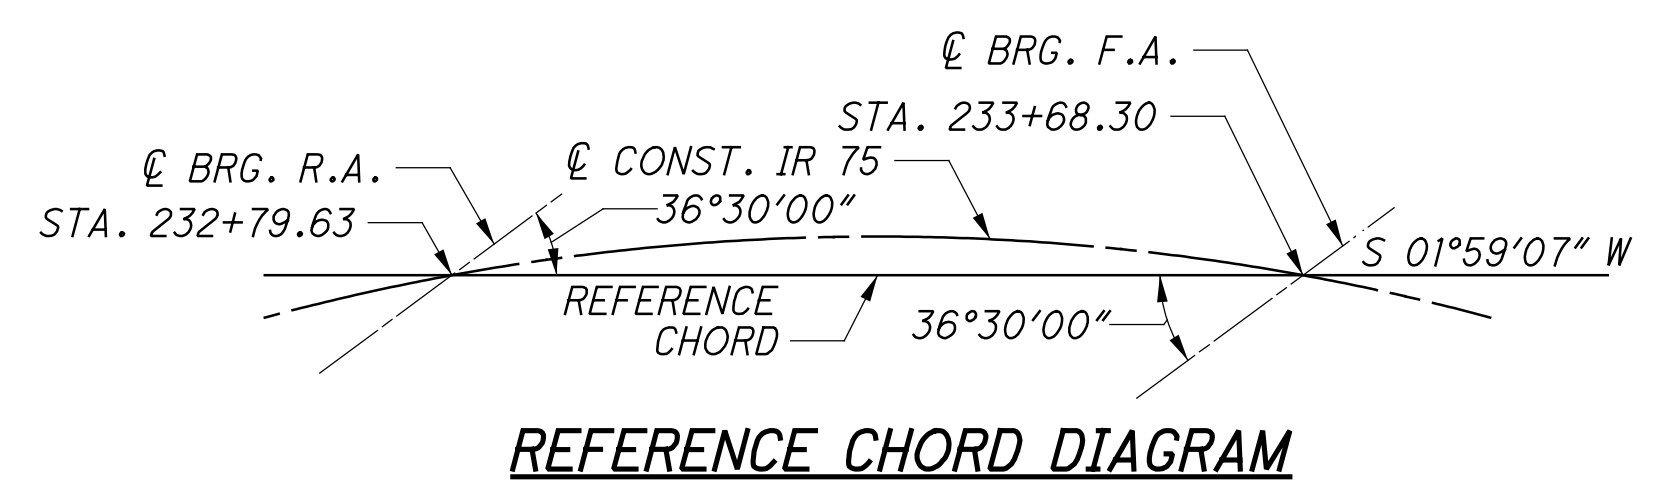

REFERENCE CHORD DIAGRAM

BENCHMARK DATA

SEE BU-14 FOR BENCHMARK INFORMATION.

NOTES

EARTHWORK LIMITS SHOWN ARE APPROXIMATE. ACTUAL SLOPES SHALL CONFORM TO PLAN CROSS SECTIONS.

DESIGN TRAFFIC:
 2010 ADT = 149,400 2010 ADTT = 23,904
 2030 ADT = 174,300 2030 ADTT = 27,888
 DIRECTIONAL DISTRIBUTION = 0.54

LEGEND

- PROJECT BORING LOCATION
- HISTORIC BORING LOCATION

- 16'-0" REQUIRED MINIMUM VERTICAL CLEARANCE
- 16'-3 1/2" (+) ACTUAL MINIMUM VERTICAL CLEARANCE
- BTA = BRIDGE TERMINAL ASSEMBLY
- TBR = TO BE REMOVED
- TBRL = TO BE RELOCATED BY OTHERS
- DND = DO NOT DISTURB
- TBA = TO BE ABANDONED

EXISTING STRUCTURE


TYPE: CONTINUOUS STEEL BEAMS WITH CONCRETE DECK AND CONCRETE SUBSTRUCTURES
 SPANS: 60'-4", 73'-10 1/2", 60'-4" C/C BRGS.
 ROADWAY: 2 @ 53'-6" ± T/T PARAPET
 LOADING: CF 1200
 SKEW: 52°29'57" ± LF
 APPROACH SLABS: AS-1-54 (25'-0" LONG)
 WEARING SURFACE: 1 1/4" MICROSILICA MODIFIED CONCRETE OVERLAY
 ALIGNMENT: 2°30'00" CURVE RIGHT
 SUPERELEVATION: 0.041 FT/FT
 STRUCTURAL FILE NUMBER: 3109755
 DATE BUILT: 1965±
 DISPOSITION: TO BE REMOVED

PROPOSED STRUCTURE


TYPE: SINGLE SPAN PRESTRESSED CONCRETE I-BEAM WITH COMPOSITE REINFORCED DECK SUPPORTED ON REINFORCED CONCRETE SEMI-INTEGRAL WALL TYPE ABUTMENTS
 SPANS: 88'-8" C/C BRG. (MEASURED ALONG REF. CHORD)
 ROADWAY: 71'-0" LEFT / 73'-3" RIGHT T/T PARAPET
 LOADING: HL-93 AND FWS = 0.060 KSF
 WEARING SURFACE: 1" MONOLITHIC CONCRETE
 SKEW: 53°30'00" LF. (NORMAL TO REFERENCE CHORD)
 APPROACH SLABS: 30' LONG (AS-1-15 & AS-2-15)
 ALIGNMENT: 2°30'00" CURVE RIGHT
 SUPERELEVATION 0.051 FT/FT
 COORDINATES: LATITUDE 39°09'00.96" N
 LONGITUDE 84°32'23.93" W

DESIGN AGENCY: STRUCTUREPOINT
 DATE: 1/3/19
 REVIEWED: MDS
 DRAWN: TMT
 DESIGNED: SUJ
 CHECKED: CLB
 HAMILTON COUNTY
 STA. 232+75.60
 STA. 233+72.13
SITE PLAN - 1
 BRIDGE NO. HAM-75-0440 L/R
 OVER IR-74 WB
HAM-75-3.84
 PID No. 104667
 2 / 68
 2 / 68

S:\Plans.dgn 10/26/2023 4:26:13 PM
 O:\2017\01113\C.Design\104667_HAM-75-3.84\Design\Structures\HAM0075_0440C_Sheets\HAM0075_0440C_SP002.dgn

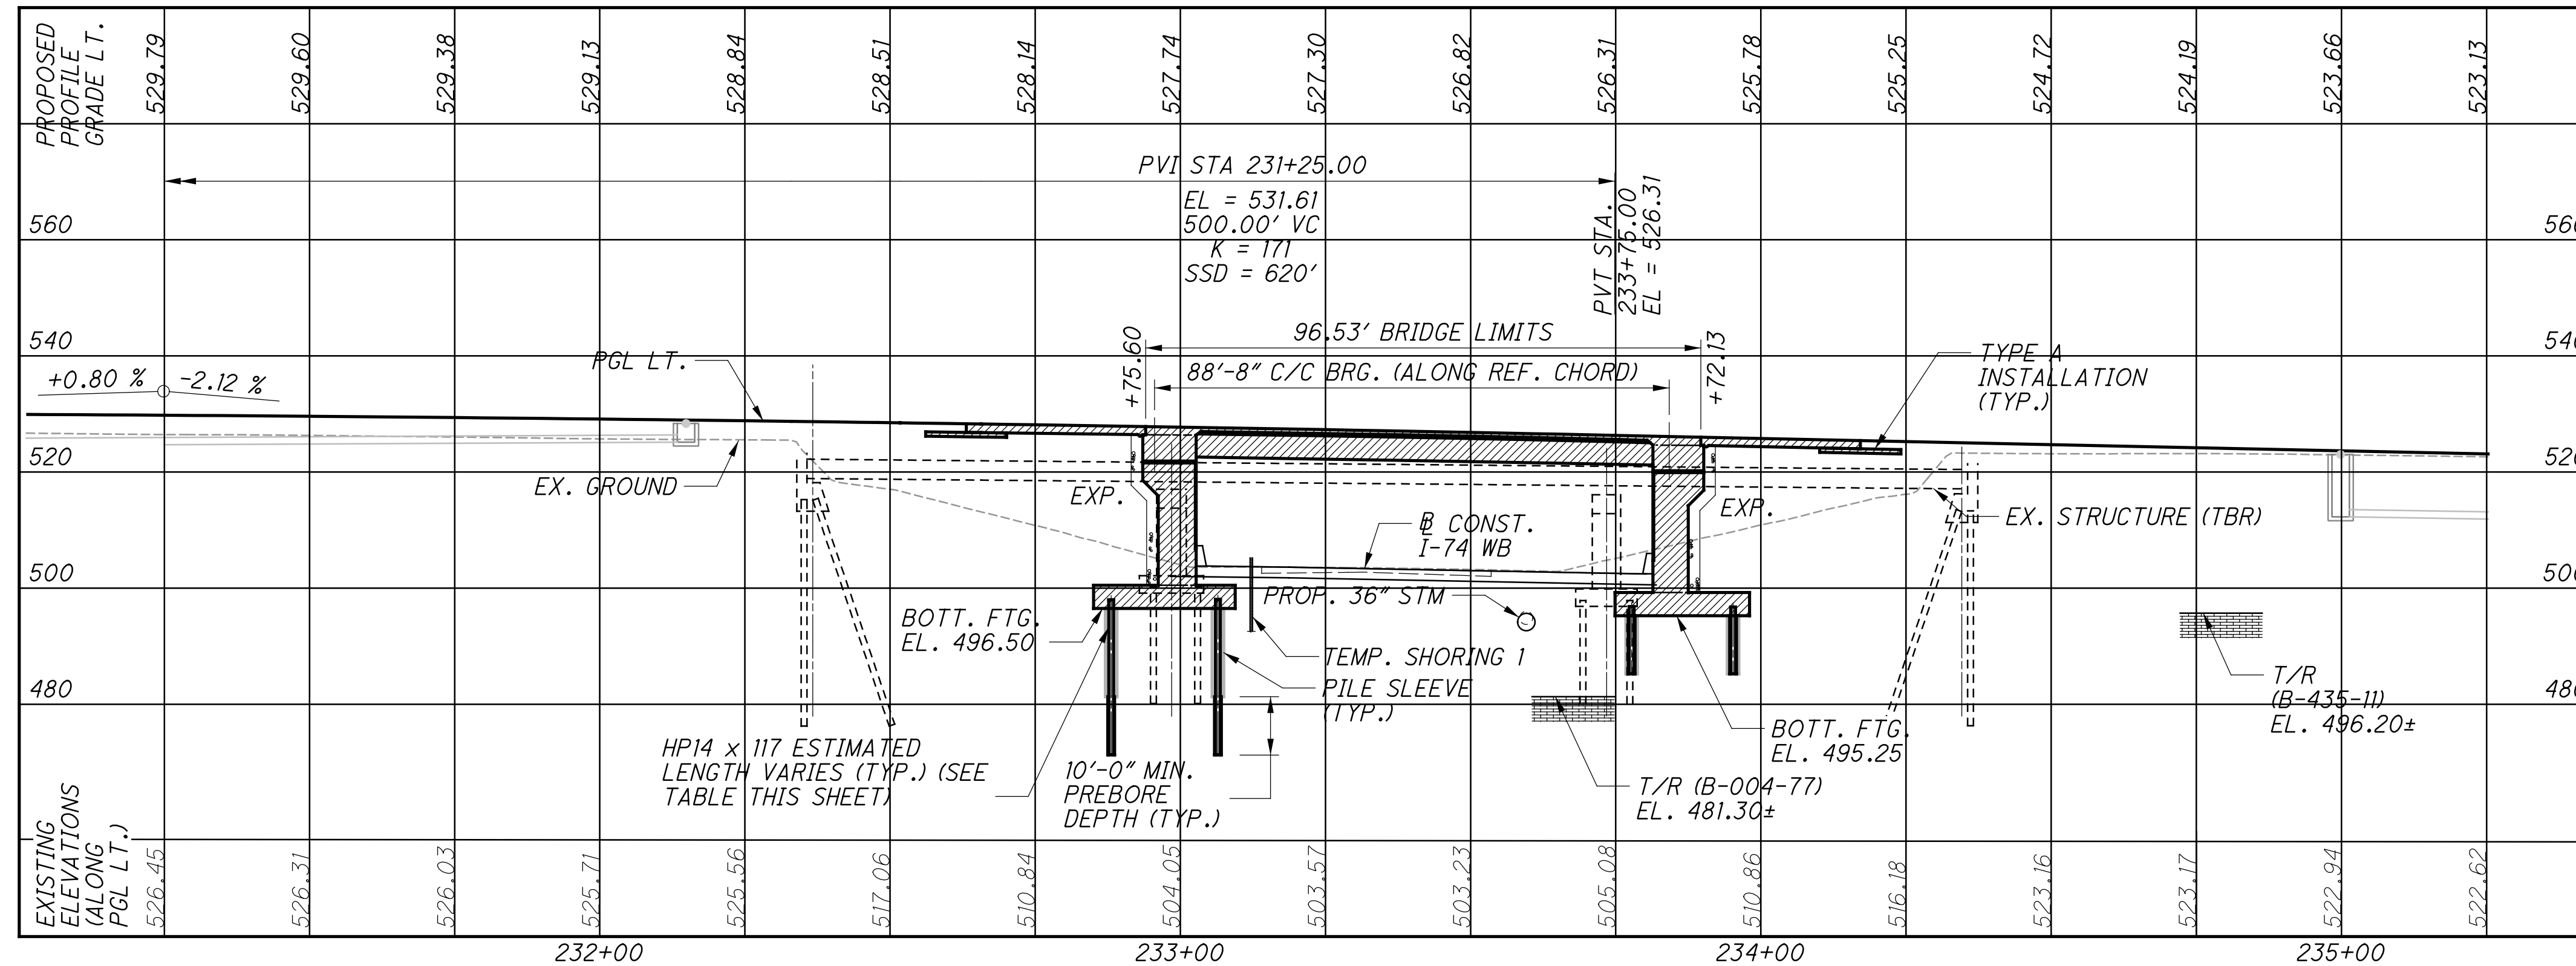

**PROFILE
ALONG PGL LT.**

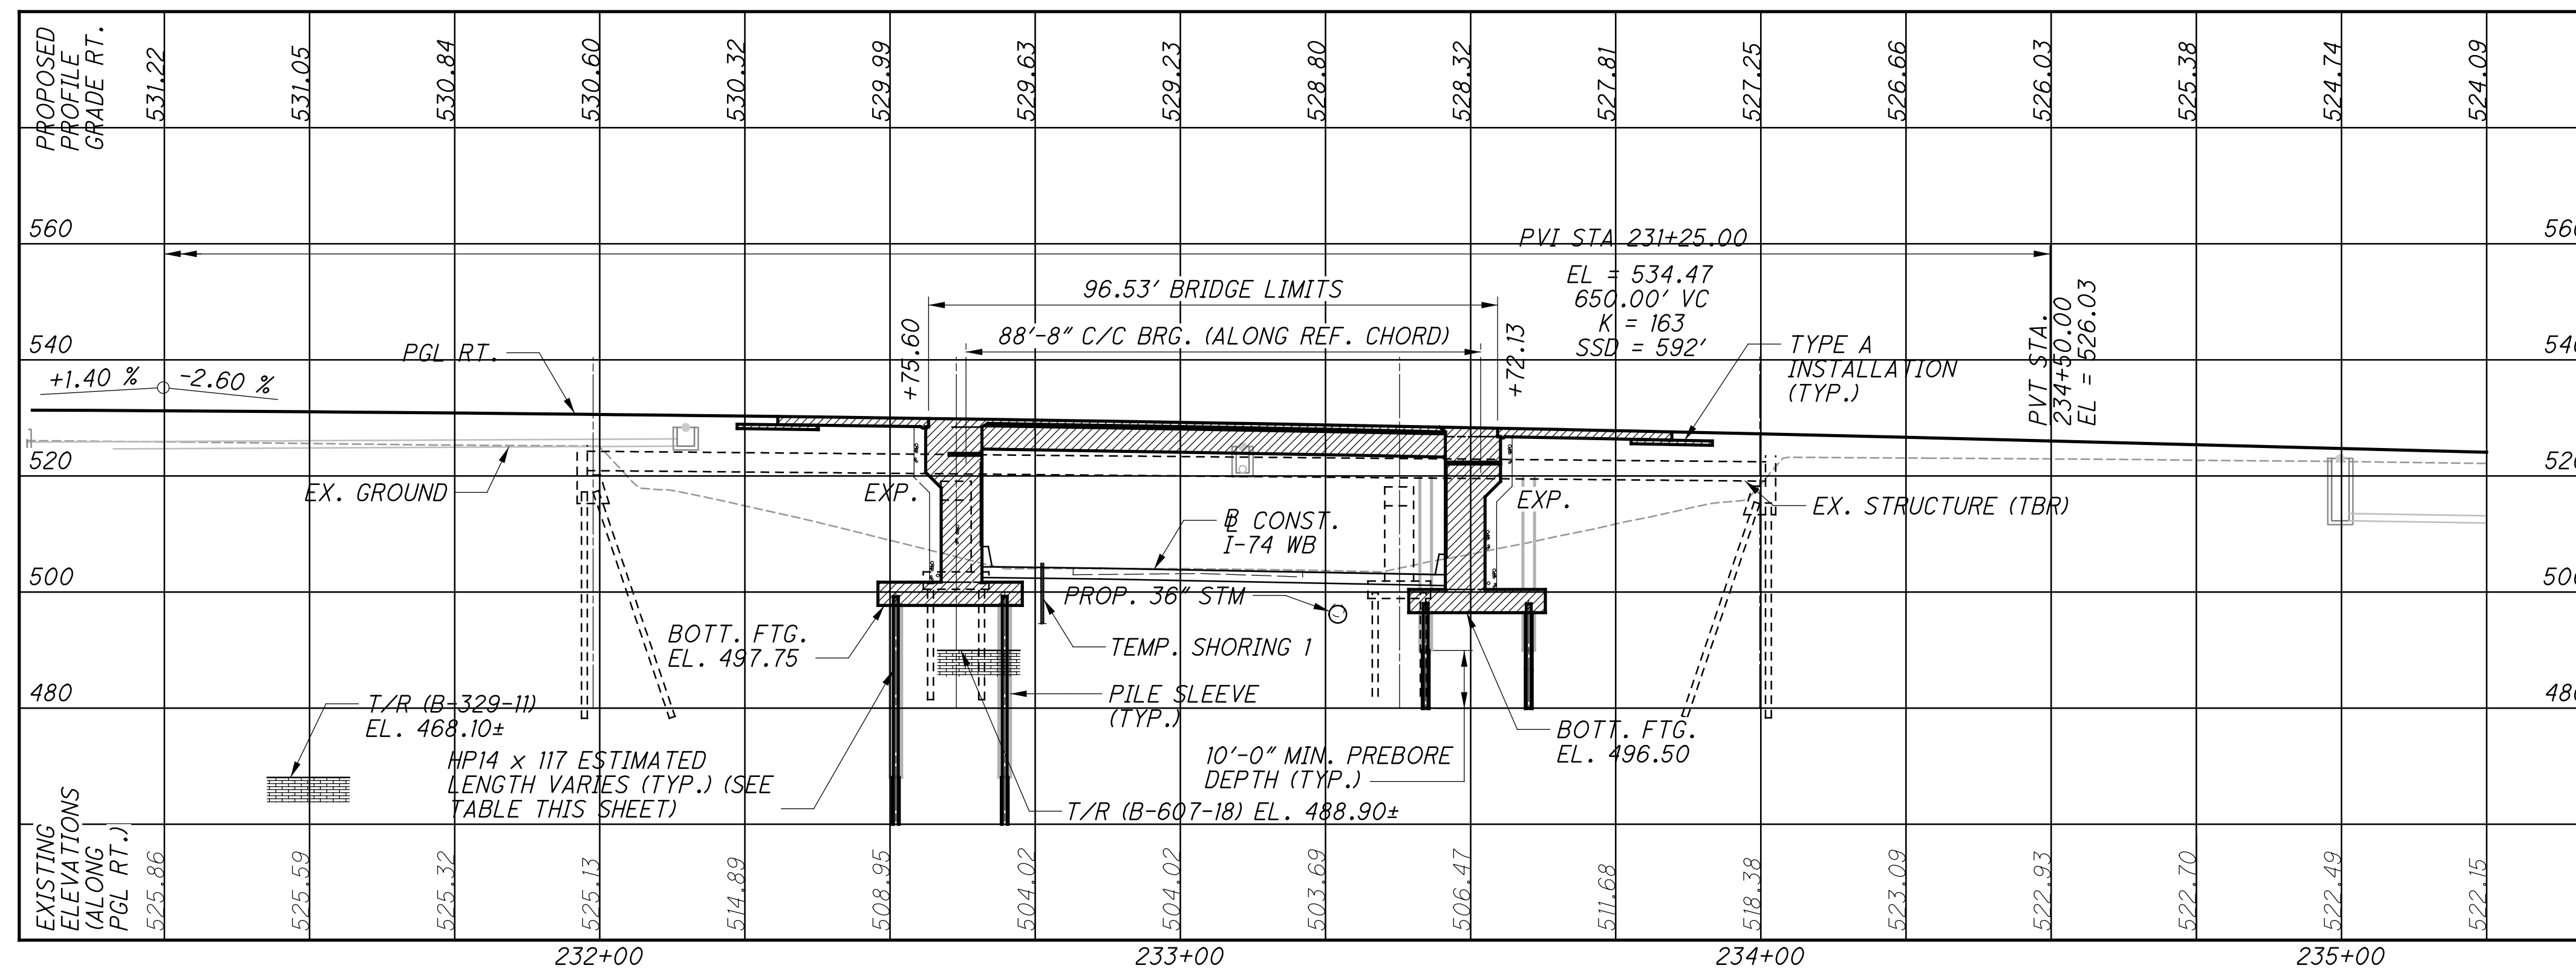

**PROFILE
ALONG PGL RT.**

PILE LENGTHS	
REAR ABUTMENT PILES:	
PILES 1-9/19-27	15 FEET LONG
PILES 10-18/28-38	20 FEET LONG
PILES 39-49/61-68,	35 FEET LONG
PILES 50-60/69-78	10 FEET LONG
FORWARD ABUTMENT PILES:	
PILES 79-88/99-107	15 FEET LONG
PILES 89-97/108-114	15 FEET LONG
PILES 115-124/134-145	35 FEET LONG
PILES 125-133/146-154	35 FEET LONG

FOR PILE LOCATIONS SEE SHEETS 10, 11, 18, 19/68

DESIGN AGENCY: **STRUCTUREPOINT**

DATE: 1/03/19

REVIEWED: MDS

DRAWN: TMT

DESIGNED: SUJ

HAMILTON COUNTY

STA. 232+75.60

STA. 233+72.13

SITE PLAN - 2

BRIDGE NO. HAM-75-0440 L/R


OVER IR-74 WB

HAM-75-3.84

PID No. 104667

3/68

S:\Flansburg\10/26/2023 4:26:13 PM\2017\01113\C.Design\104667_HAM-75-3.84\Design\Structures\HAM0075-0440C_Sheets\HAM0075-0440C_GP001.dgn

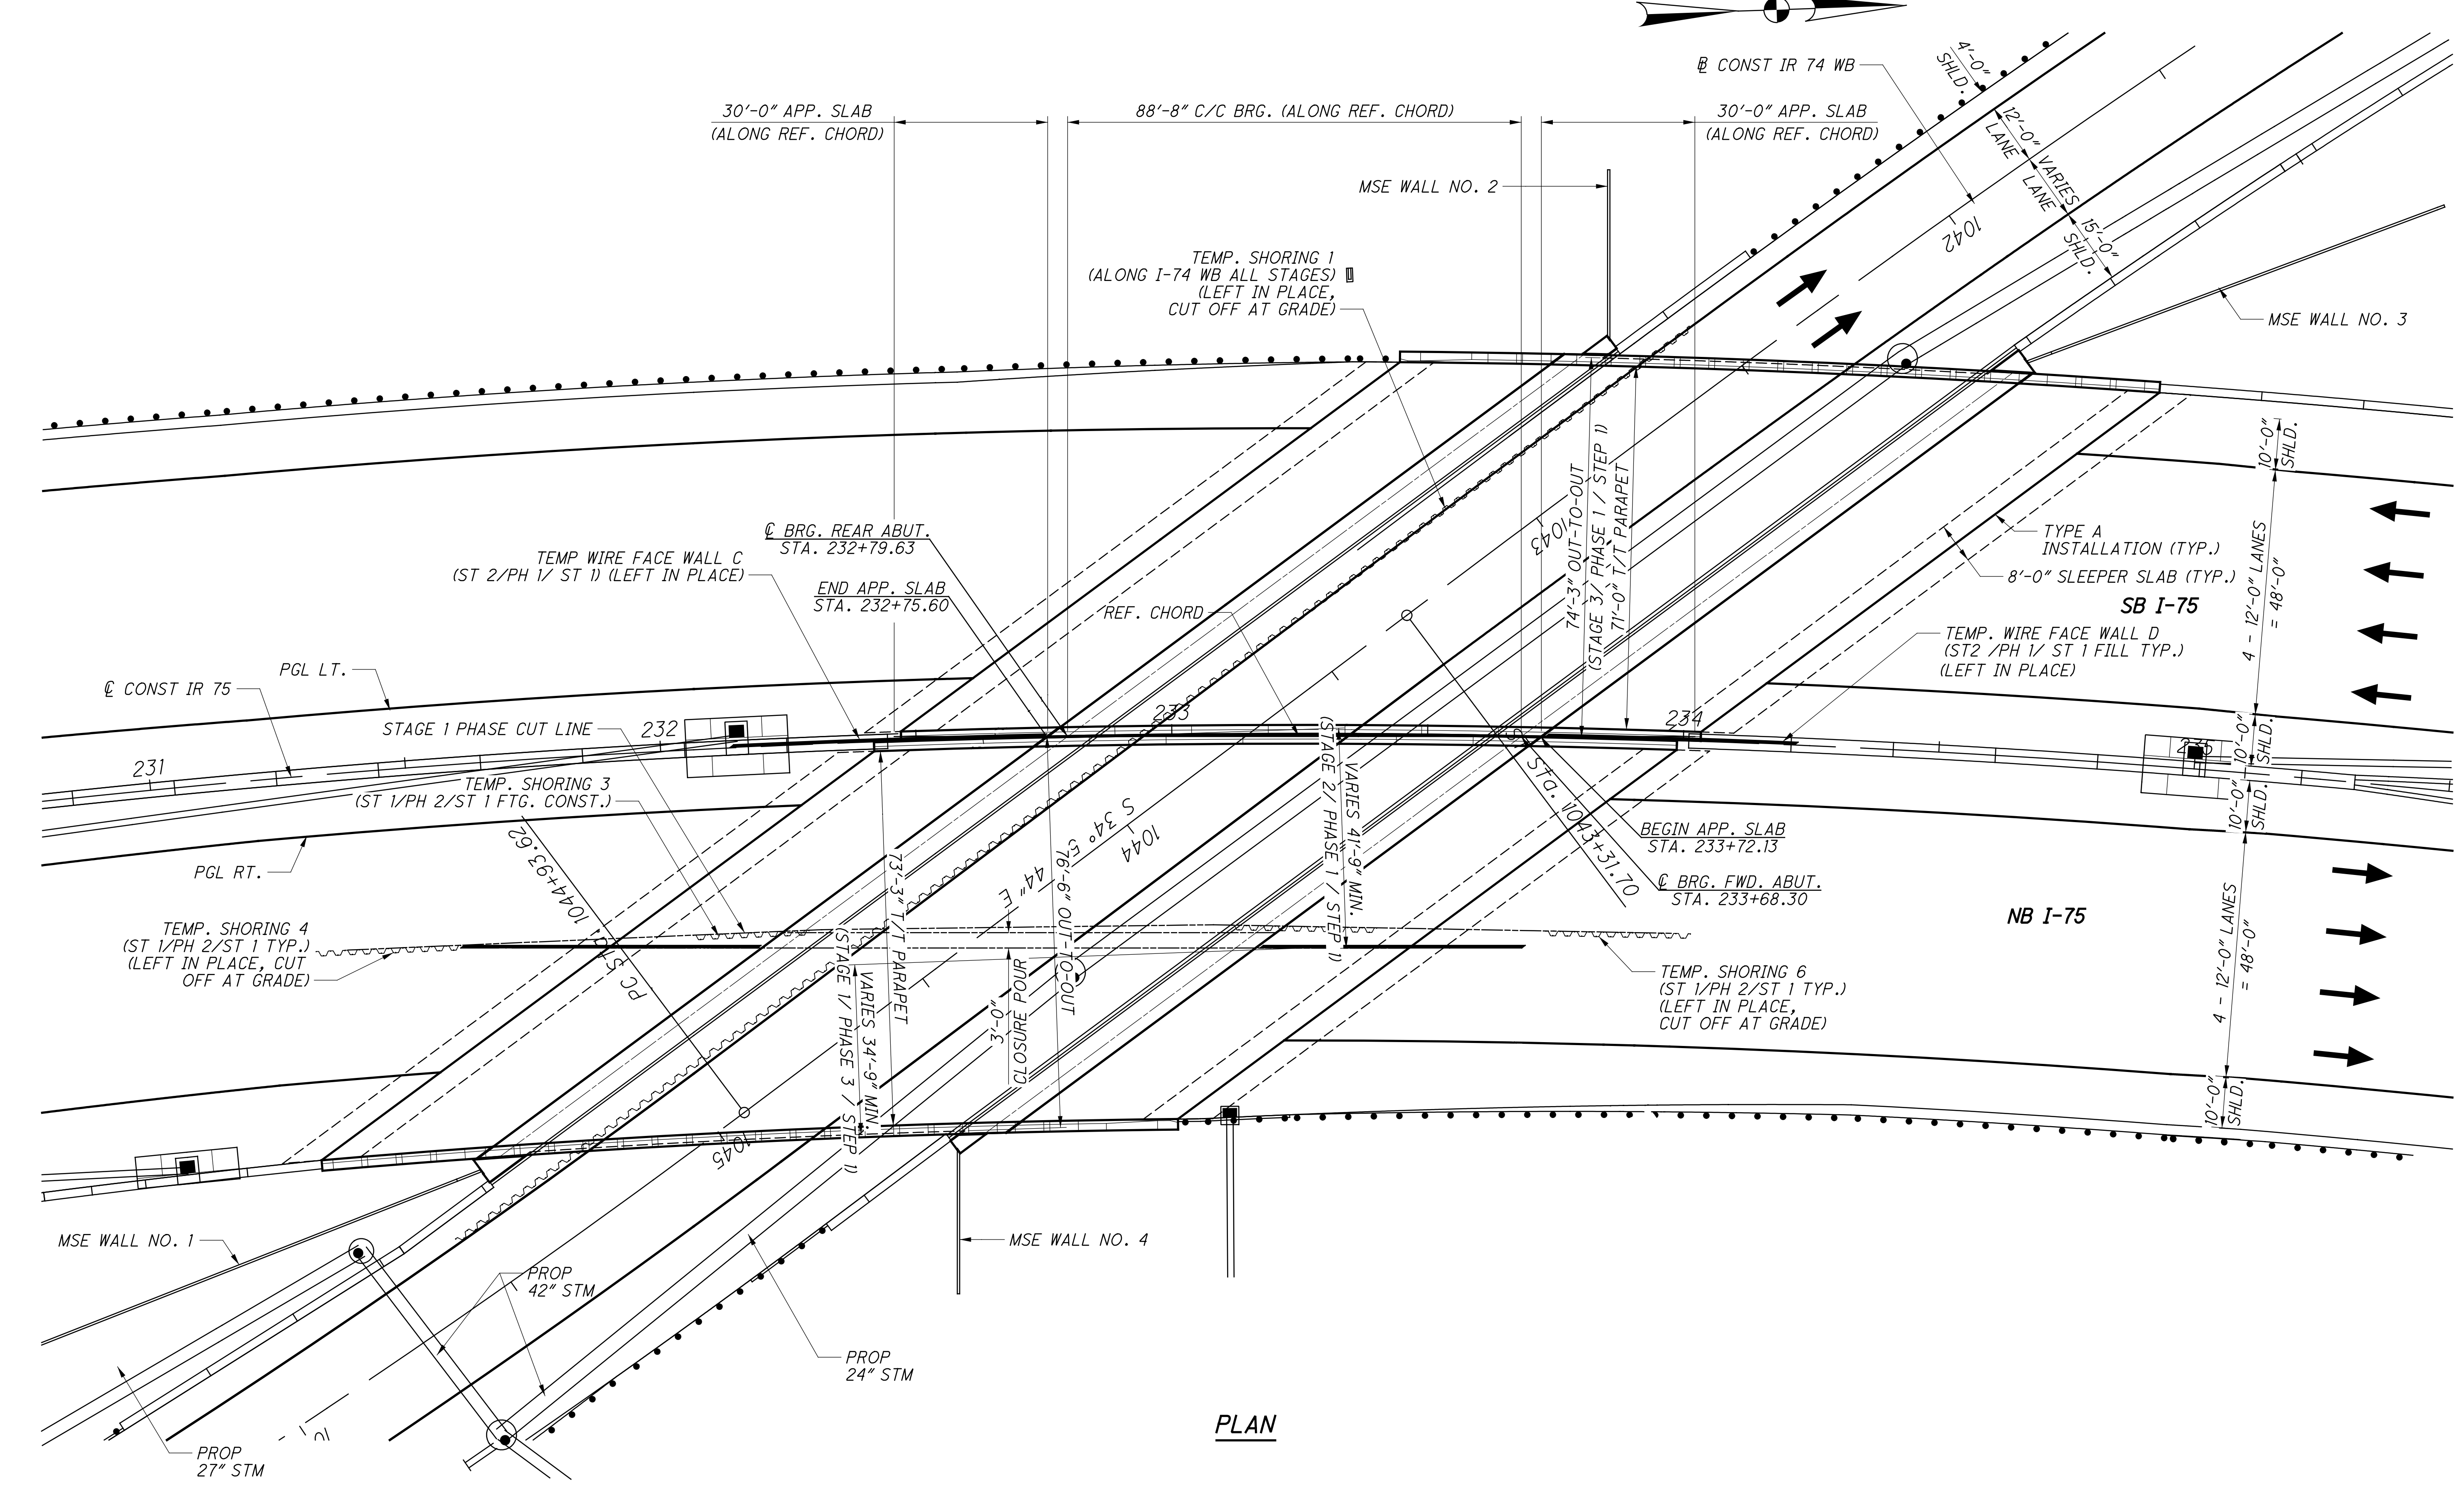

PLAN

SFlanagan 10/26/2023 4:26:14 PM \\01\2017\01113\C.Design\104667-HAM-75-3.84.Design\Structures\HAM0075_0440C_Sheets\HAM0075_0440C_GN001.dgn

STANDARD DRAWINGS AND SUPPLEMENTAL SPECIFICATIONS:

REFER TO THE FOLLOWING STANDARD BRIDGE DRAWINGS:

- AS-1-15 REVISED 07-17-15
- AS-2-15 REVISED 01-19-18
- PCB-91 REVISED 01-18-13
- PSID-1-13 REVISED 07-20-18
- SBR-1-13 REVISED 07-20-18
- SBR-2-13 REVISED 07-20-18
- SICD-1-96 REVISED 07-18-14
- SICD-2-14 REVISED 07-18-14

AND TO THE FOLLOWING SUPPLEMENTAL SPECIFICATIONS:

- 800 REVISED 01-19-18
- 840 REVISED 07-20-18
- 867 REVISED 04-15-16

DESIGN SPECIFICATIONS:

THE STRUCTURE CONFORMS TO THE "LRFD BRIDGE DESIGN SPECIFICATIONS" ADOPTED BY THE AMERICAN ASSOCIATION OF STATE HIGHWAY AND TRANSPORTATION OFFICIALS, 8TH EDITION, AND THE ODOT BRIDGE DESIGN MANUAL, 2007.

OPERATIONAL IMPORTANCE:

A LOAD MODIFIER OF 1.05 HAS BEEN ASSUMED FOR THE DESIGN OF THIS STRUCTURE IN ACCORDANCE WITH THE AASHTO LRFD BRIDGE DESIGN SPECIFICATIONS, ARTICLE 1.3.5 AND THE ODOT BRIDGE DESIGN MANUAL, 2007.

DESIGN LOADING:

HL-93

FUTURE WEARING SURFACE (FWS) OF 0.06 KSF

DESIGN DATA:

QC/QA CONCRETE, CLASS QC3 - COMPRESSIVE STRENGTH 4500 PSI (SUPERSTRUCTURE)

CONCRETE, CLASS QC3 - COMPRESSIVE STRENGTH 4000 PSI (SUBSTRUCTURE)

REINFORCING STEEL - MINIMUM YIELD STRENGTH 75,000 PSI (ABUTMENTS & DECK)

REINFORCING STEEL - MINIMUM YIELD STRENGTH 60,000 PSI (PARAPETS & APPROACH SLABS)

STRUCTURAL STEEL - ASTM A709 GRADE 50 - YIELD STRENGTH 50 KSI (BEARINGS)

STEEL H-PILES - ASTM A572 - YIELD STRENGTH 50 KSI

CONCRETE FOR PRESTRESSED BEAMS:
 COMPRESSIVE STRENGTH (FINAL) - 8.5 KSI
 COMPRESSIVE STRENGTH (RELEASE) - 6.5 KSI

WELDED WIRE FABRIC:
 YIELD STRENGTH - 70 KSI

PRESTRESSING STRAND:
 AREA = 0.217 SQ. IN.
 ULTIMATE STRENGTH = 270 KSI
 INITIAL STRESS = 202.5 KSI (LOW RELAXATION STRANDS)

DECK PROTECTION METHOD:

EPOXY COATED REINFORCING STEEL

2 1/2" CONCRETE COVER

MONOLITHIC WEARING SURFACE:

MONOLITHIC WEARING SURFACE IS ASSUMED, FOR DESIGN PURPOSES, TO BE 1 INCH THICK.

EXISTING STRUCTURE VERIFICATION:

DETAILS AND DIMENSIONS SHOWN ON THESE PLANS PERTAINING TO THE EXISTING STRUCTURE HAVE BEEN OBTAINED FROM PLANS OF THE EXISTING STRUCTURE AND FROM FIELD OBSERVATIONS AND MEASUREMENTS. CONSEQUENTLY, THEY ARE INDICATIVE OF THE EXISTING STRUCTURE AND THE PROPOSED WORK BUT THEY SHALL BE CONSIDERED TENTATIVE AND APPROXIMATE. THE CONTRACTOR IS REFERRED TO CMS SECTIONS 102.05 AND 105.02.

BASE CONTRACT BID PRICES UPON A RECOGNITION OF THE UNCERTAINTIES DESCRIBED ABOVE AND UPON A PREBID EXAMINATION OF THE EXISTING STRUCTURE. HOWEVER, THE DEPARTMENT WILL PAY FOR ALL PROJECT WORK BASED UPON ACTUAL DETAILS AND DIMENSIONS THAT HAVE BEEN VERIFIED IN THE FIELD.

EMBANKMENT:

PLACE AND COMPACT EMBANKMENT MATERIAL IN 6 INCH LIFTS FOR THE CONSTRUCTION OF THE APPROACH EMBANKMENT.

SEALING OF CONCRETE SURFACES (PERMANENT GRAFFITI PROTECTION):

APPLY A PERMANENT GRAFFITI COATING QUALIFIED ACCORDING TO SUPPLEMENT 1083 THAT IS COMPATIBLE WITH THE CONCRETE SEALER OVER WHICH IT IS APPLIED. APPLY THE GRAFFITI COATING IN ACCORDANCE WITH THE MANUFACTURER'S PRINTED INSTRUCTIONS.

PILES TO BEDROCK:

PILES SHALL BE INSTALLED THROUGH 24" PILE SLEEVES IN 30" DIAMETER PREBORED HOLES. PILE SLEEVES PER SS840.03 SHALL BE INSTALLED FROM TOP OF ROCK TO BOTTOM OF FOOTING. PILE TIP ELEVATIONS SHALL EXTEND TO A MINIMUM OF 10 FEET INTO COMPETENT BEDROCK. THE PILE SLEEVES SHALL BE BACKFILLED WITH CONCRETE, CLASS QC MISC. PER CMS 499 TO THE TOP OF BEDROCK. ABOVE THE TOP OF BEDROCK ELEVATION PILE SLEEVES SHALL BE FILLED WITH LOW STRENGTH MORTAR (LSM) BACKFILL PER CMS 613. LSM SHALL NOT BE PLACED UNTIL AT LEAST 24 HOURS AFTER PLACING CONCRETE, CLASS QC MISC. THE ANNULAR SPACE BETWEEN PREBORED HOLES AND PILE SLEEVES SHALL BE FILLED WITH LOW STRENGTH MORTAR (LSM) BACKFILL PER CMS 613.

THE TOTAL FACTORED LOAD IS 520 KIPS PER PILE FOR THE ABUTMENT PILES.

REAR ABUTMENT PILES:

PILES 1-9/19-27, 35 FEET LONG, ORDER LENGTH
 PILES 10-18/28-38, 40 FEET LONG, ORDER LENGTH
 PILES 39-49/61-68, 45 FEET LONG, ORDER LENGTH
 PILES 50-60/69-78, 50 FEET LONG, ORDER LENGTH

FORWARD ABUTMENT PILES:

PILES 79-88/99-107, 20 FEET LONG, ORDER LENGTH
 PILES 89-97/108-114, 20 FEET LONG, ORDER LENGTH
 PILES 115-124/134-145, 25 FEET LONG, ORDER LENGTH
 PILES 125-133/146-154, 25 FEET LONG, ORDER LENGTH

MSE WALL FOUNDATION BEARING RESISTANCE:

THE FOUNDATION BEARING RESISTANCE IS LISTED IN THE TABLE BELOW.

FOUNDATION BEARING RESISTANCE			
MSE WALL NUMBER	WALL LIMITS		FACTORED BEARING RESISTANCE
	FROM STA.	TO STA.	
1	1046+39.67	1045+42.27	11.2 KSF
2	1042+67.61	1042+48.17	12.1 KSF
3	1041+17.64	1042+04.06	11.0 KSF
4	1044+64.78	1044+81.59	15.5 KSF

SEALING OF CONCRETE SURFACES (EPOXY-URETHANE):

THE FINISH COAT COLOR SHALL BE FEDERAL COLOR NO. 595B-17778, LIGHT NEUTRAL.

AESTHETIC SURFACE TREATMENT:

ALL MSE PANELS SHALL HAVE A "FRACTURED FIN" FINISH WITH A 1/2" RELIEF. THE MANUFACTURER SHALL FABRICATE AND THE CONTRACTOR INSTALL THE PANELS SUCH THAT THE VERTICAL FINNS AND VALLEYS IN THE FRACTURED FIN AESTHETIC TREATMENT ALIGN VERTICALLY ACROSS ADJACENT PANELS FROM THE BOTTOM OF THE WALL TO THE TOP.

THE FRONT FACE OF ABUTMENTS SHALL HAVE A "FRACTURED FIN" FINISH WITH A 1/2" RELIEF APPLIED TO THE LIMITS SHOWN IN THE PLANS. THE VERTICAL FINNS AND VALLEYS IN THE FRACTURED FIN AESTHETIC TREATMENT SHALL ALIGN VERTICALLY FROM THE BOTTOM OF THE WALL TO THE TOP.

THE "FRACTURED FIN" FINISH ON THE MSE PANELS SHALL MATCH THE ABUTMENT WALL FINISH AND SHALL BE SUPPLIED BY THE SAME FORMLINER MANUFACTURER.

DECK PLACEMENT DESIGN ASSUMPTIONS:

DECK PLACEMENT DESIGN ASSUMPTIONS: THE FOLLOWING ASSUMPTIONS OF CONSTRUCTION MEANS AND METHODS WERE MADE FOR THE ANALYSIS AND DESIGN OF THE SUPERSTRUCTURE. THE CONTRACTOR IS RESPONSIBLE FOR THE DESIGN OF THE FALSEWORK SUPPORT SYSTEM WITHIN THESE PARAMETERS AND WILL ASSUME RESPONSIBILITY FOR SUPERSTRUCTURE ANALYSIS FOR DEVIATION FROM THESE DESIGN ASSUMPTIONS.

AN EIGHT WHEEL FINISHING MACHINE WITH A MAXIMUM WHEEL LOAD OF 3.32 KIPS.

A MINIMUM OUT-TO-OUT WHEEL SPACING AT EACH END OF THE MACHINE OF 103".

A MAXIMUM SPACING OF OVERHANG FALSEWORK BRACKETS OF 48 IN.



A MAXIMUM DISTANCE FROM THE CENTERLINE OF THE FASCIA GIRDER TO THE FACE OF THE SAFETY HANDRAIL OF 65".

BUILDABLE UNIT REFERENCES:

REFERENCE THE FOLLOWING BUILDABLE UNITS FOR ADDITIONAL INFORMATION, DETAILS, AND SPECIFICATIONS:
 ROADWAY AND DRAINAGE - BU-14
 MAINTENANCE OF TRAFFIC - BU-04 AND BU-23
 LIGHTING, STRIPING, PAVEMENT MARKINGS, ITS - BU-19

MECHANICAL CONNECTORS:

MECHANICAL CONNECTORS SHALL BE CAPABLE OF DEVELOPING 125 PERCENT OF THE YIELD STRENGTH OF THE CONNECTED BARS. FOR CONNECTORS WITH THREADED BAR ENDS, IN ORDER TO OFFSET THE EFFECT OF AREA REDUCTION ON THE STRENGTH OF THE BAR AND STILL MEET THE REQUIREMENTS OF ASTM A615, USE THE NEXT LARGER DIAMETER BAR OR A HIGHER GRADE OF STEEL BAR.

 STRUCTUREPOINT <small>AN IRVING-CLOUD COMPANY</small>	DESIGN AGENCY PROJECT NO. HAM-75-0440 L/R BRIDGE NO. HAM-75-0440 L/R OVER 1-74 WB	REVIEWED MDS DATE 01/03/19	DRAWN SUJ CHECKED SUJ	FILE NUMBER 3109763 CHECKED CLB
GENERAL NOTES - 1 BRIDGE NO. - HAM-75-0440 L/R OVER 1-74 WB				
HAM-75-3.84 PID No. 104667				
5 / 68				
				

CLASS QC3 CONCRETE WITH QC/QA, SUBSTRUCTURE

THIS ITEM MODIFIES THE STANDARD 511 CONCRETE FOR STRUCTURES SPECIFICATION TO INCLUDE MACRO-SYNTHETIC FIBERS INTO THE SUBSTRUCTURE CONCRETE. THIS ITEM SHALL CONFORM TO CMS 511 WITH THE FOLLOWING CONDITIONS AND REVISIONS:

PROVIDE MATERIALS CONFORMING TO 511.02 EXCEPT AS MODIFIED BELOW:

PORTLAND CEMENT CONCRETE - 499.03, CLASS QC 3 MEETING A DESIGN STRENGTH OF 4,000 PSI, WITH MACRO-SYNTHETIC FIBERS WITH MODIFICATION PER 511.02. FIBERS FOR CONCRETE - ASTM C 1116, TYPE III

THE CLASS QC3 CONCRETE FOR THE SUBSTRUCTURE SHALL MEET THE FOLLOWING CRITERIA: WATER/CEMENT RATIO = 0.40 MAXIMUM; MINIMUM 4 LBS/CY MACRO-SYNTHETIC FIBERS (1.5 IN. MIN. TO 2.5 IN. MAX.) MEETING ASTM C1116 TYPE III SHALL BE ADDED TO THE MIX.

THE MACRO-SYNTHETIC FIBERS SHALL BE INCORPORATED INTO THE MIX IN SUCH A WAY THAT NO 'BALLING' OCCURS. UPON INSPECTION OF THE MIX AT THE TIME OF PLACEMENT, IF ANY 'BALLING' OCCURS, THE ENGINEER SHALL REJECT THE REMAINDER OF THE LOAD AT ANY TIME DURING THE POUR. IT IS IMPORTANT TO FOLLOW INDUSTRY STANDARDS AND ASTM SPECIFICATIONS ON THE PREMIXING OF THE CEMENT, AGGREGATE, AND MACRO-SYNTHETIC FIBERS PRIOR TO THE ADDITION OF WATER AND ADMIXTURES. PROVIDE MACRO-SYNTHETIC FIBERS THAT ARE MONOFILAMENT FIBERS MADE FROM VIRGIN POLYPROPYLENE, POLYETHYLENE, OR CO-POLYMERS THAT ARE INERT TO ALKALI ATTACK. ENSURE THE MACRO-SYNTHETIC FIBERS HAVE A MINIMUM TENSILE STRENGTH OF 70 KSI, A MINIMUM MODULUS OF ELASTICITY OF 800 KSI, A MINIMUM FILAMENT DIAMETER OF 0.012 INCHES, AND ASPECT RATIO BETWEEN 60 AND 100, AND ARE BETWEEN 1.5 AND 2.5 INCHES IN LENGTH. STORE THE MACRO-SYNTHETIC FIBERS ACCORDING TO THE MANUFACTURE'S RECOMMENDATION AND KEEP THE MATERIAL FREE FROM DUST, DIRT AND MOISTURE.

USE A MINIMUM DOSAGE RATE OF MACRO-SYNTHETIC FIBERS OF 4.0 LBS/CY OF CONCRETE. DETERMINE THE FINAL PROPOSED DOSAGE RATE THROUGH MIX TESTING. ENSURE THE FIBER REINFORCED CONCRETE MEETS OR EXCEEDS A MINIMUM EQUIVALENT FLEXURAL STRENGTH RATIO OF 25% ACCORDING TO ASTM C 1609. MACRO-SYNTHETIC FIBERS IS TO BE USED AS AN ADMIXTURE TO CONTROL CRACKING AND IS NOT TO BE USED TO SUPPLEMENT OR REPLACE REINFORCING STEEL IN THE DESIGN. ENSURE THE FINAL PROPOSED MIX IS WORKABLE AND ABLE TO BE PRODUCED SUCH THAT BALLING OR CLUMPING OF THE FIBERS IS NOT A PROBLEM AS DETERMINED BY THE ENGINEER. UTILIZE A LABORATORY REGULARLY INSPECTED BY THE CEMENT AND CONCRETE REFERENCE LABORATORY (CCRL) OF THE NATIONAL INSTITUTE OF STANDARDS AND TECHNOLOGY, OR OTHER APPROVED REFERENCE LABORATORY, TO PERFORM THE TESTING. BEFORE USE, SUBMIT DOCUMENTATION TO THE PROJECT ENGINEER CERTIFYING BOTH THE MACRO-SYNTHETIC FIBERS AND THE MIX MEET OR EXCEED THE REQUIRED PROPERTIES. SAMPLING WILL BE ALLOWED FOR TESTING PURPOSES. A DEMONSTRATION OF THE MIX PRODUCTION OR TRIAL MIX, MAY BE REQUIRED BY THE ENGINEER PRIOR TO PLACING ANY OF THE MIX ON THE PROJECT.

THE BATCH WEIGHTS SHALL BE CORRECTED TO COMPENSATE FOR THE MOISTURE CONTAINED IN THE AGGREGATE AT THE TIME OF USE. A CHEMICAL ADMIXTURE (705.12, TYPE A OR D) SHALL BE USED.

CONCRETE SUPPLIERS SHOULD RECOGNIZE THAT ADMIXTURES MAY HAVE AN EFFECT ON STRENGTH, ENTRAINED AIR CONTENT, WORKABILITY, ETC. OF THEIR CONCRETE MIXES. THE CONCRETE SUPPLIER'S CHOICE OF ADMIXTURES DOES NOT ALLEVIATE MEETING DESIGN REQUIREMENTS.

CLASS QC3 CONCRETE WITH QC/QA, SUPERSTRUCTURE

THIS ITEM MODIFIES THE STANDARD 511 CONCRETE FOR STRUCTURES SPECIFICATION TO INCLUDE MACRO-SYNTHETIC FIBERS INTO THE SUPERSTRUCTURE CONCRETE. THIS ITEM SHALL CONFORM TO CMS 511 WITH THE FOLLOWING CONDITIONS AND REVISIONS:

PROVIDE MATERIALS CONFORMING TO 511.02 EXCEPT AS MODIFIED BELOW:

PORTLAND CEMENT CONCRETE - 499.03, CLASS QC 3 MEETING A DESIGN STRENGTH OF 4,500 PSI, WITH MACRO-SYNTHETIC FIBERS WITH MODIFICATION PER 511.02 FIBERS FOR CONCRETE - ASTM C 1116, TYPE III

THE CLASS QC3 CONCRETE FOR THE SUPERSTRUCTURE SHALL MEET THE FOLLOWING CRITERIA: WATER/CEMENT RATIO = 0.40 MAXIMUM; MINIMUM 4 LBS/CY MACRO-SYNTHETIC FIBERS (1.5 IN. MIN. TO 2.5 IN. MAX.) MEETING ASTM C1116 TYPE III SHALL BE ADDED TO THE MIX.

THE MACRO-SYNTHETIC FIBERS SHALL BE INCORPORATED INTO THE MIX IN SUCH A WAY THAT NO 'BALLING' OCCURS. UPON INSPECTION OF THE MIX AT THE TIME OF PLACEMENT, IF ANY 'BALLING' OCCURS, THE ENGINEER SHALL REJECT THE REMAINDER OF THE LOAD AT ANY TIME DURING THE POUR. IT IS IMPORTANT TO FOLLOW INDUSTRY STANDARDS AND ASTM SPECIFICATIONS ON THE PREMIXING OF THE CEMENT, AGGREGATE, AND MACRO-SYNTHETIC FIBERS PRIOR TO THE ADDITION OF WATER AND ADMIXTURES. PROVIDE MACRO-SYNTHETIC FIBERS THAT ARE MONOFILAMENT FIBERS MADE FROM VIRGIN POLYPROPYLENE, POLYETHYLENE, OR CO-POLYMERS THAT ARE INERT TO ALKALI ATTACK. ENSURE THE MACRO-SYNTHETIC FIBERS HAVE A MINIMUM TENSILE STRENGTH OF 70 KSI, A MINIMUM MODULUS OF ELASTICITY OF 800 KSI, A MINIMUM FILAMENT DIAMETER OF 0.012 INCHES, AND ASPECT RATIO BETWEEN 60 AND 100, AND ARE BETWEEN 1.5 AND 2.5 INCHES IN LENGTH. STORE THE MACRO-SYNTHETIC FIBERS ACCORDING TO THE MANUFACTURE'S RECOMMENDATION AND KEEP THE MATERIAL FREE FROM DUST, DIRT AND MOISTURE.

USE A MINIMUM DOSAGE RATE OF MACRO-SYNTHETIC FIBERS OF 4.0 LBS/CY OF CONCRETE. DETERMINE THE FINAL PROPOSED DOSAGE RATE THROUGH MIX TESTING. ENSURE THE FIBER REINFORCED CONCRETE MEETS OR EXCEEDS A MINIMUM EQUIVALENT FLEXURAL STRENGTH RATIO OF 25% ACCORDING TO ASTM C 1609. MACRO-SYNTHETIC FIBERS IS TO BE USED AS AN ADMIXTURE TO CONTROL CRACKING AND IS NOT TO BE USED TO SUPPLEMENT OR REPLACE REINFORCING STEEL IN THE DESIGN. ENSURE THE FINAL PROPOSED MIX IS WORKABLE AND ABLE TO BE PRODUCED SUCH THAT BALLING OR CLUMPING OF THE FIBERS IS NOT A PROBLEM AS DETERMINED BY THE ENGINEER. UTILIZE A LABORATORY REGULARLY INSPECTED BY THE CEMENT AND CONCRETE REFERENCE LABORATORY (CCRL) OF THE NATIONAL INSTITUTE OF STANDARDS AND TECHNOLOGY, OR OTHER APPROVED REFERENCE LABORATORY, TO PERFORM THE TESTING. BEFORE USE, SUBMIT DOCUMENTATION TO THE PROJECT ENGINEER CERTIFYING BOTH THE MACRO-SYNTHETIC FIBERS AND THE MIX MEET OR EXCEED THE REQUIRED PROPERTIES. SAMPLING WILL BE ALLOWED FOR TESTING PURPOSES. A DEMONSTRATION OF THE MIX PRODUCTION OR TRIAL MIX, MAY BE REQUIRED BY THE ENGINEER PRIOR TO PLACING ANY OF THE MIX ON THE PROJECT.

THE BATCH WEIGHTS SHALL BE CORRECTED TO COMPENSATE FOR THE MOISTURE CONTAINED IN THE AGGREGATE AT THE TIME OF USE. A CHEMICAL ADMIXTURE (705.12, TYPE A OR D) SHALL BE USED.

CONCRETE SUPPLIERS SHOULD RECOGNIZE THAT ADMIXTURES MAY HAVE AN EFFECT ON STRENGTH, ENTRAINED AIR CONTENT, WORKABILITY, ETC. OF THEIR CONCRETE MIXES. THE CONCRETE SUPPLIER'S CHOICE OF ADMIXTURES DOES NOT ALLEVIATE MEETING DESIGN REQUIREMENTS.


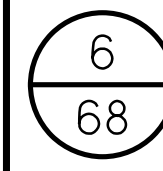
APPROACH SLABS, DIAPHRAGMS, AND BRIDGE RAILING CONCRETE ARE TO USE THE SAME MIX DESIGN AS THE BRIDGE DECK (WHEN APPLICABLE). USE SELF-COMPACTING CONCRETE ON DECORATIVE RAILING SIMILAR TO TEXAS RAILING AND MACRO-SYNTHETIC CONCRETE PER THIS SPECIFICATION ON TRADITIONAL CONCRETE RAILING WHEN APPLICABLE.

THE PLACING OF THE DECK AND THE APPROACH SLABS IN THE SAME CONCRETE POUR IS NOT PERMITTED.

ABBREVIATION LIST:

THE FOLLOWING STANDARD ABBREVIATIONS ARE USED THROUGHOUT THE BRIDGE PLANS.

- ABUT. = ABUTMENT
- ACT. = ACTUAL
- APP. = APPROACH
- BRG. = BEARING
- BOT. = BOTTOM
- BTW. = BETWEEN
- CB = CATCH BASIN
- C.I.P. = CAST-IN-PLACE
- C.J. = CONSTRUCTION JOINT
- CLR. = CLEARANCE
- CONST = CONSTRUCTION
- CONT. = CONTINUOUS
- DIA. = DIAMETER
- DIM. = DIMENSION
- DWG. = DRAWING
- E.S. = EACH SIDE
- EL. = ELEVATION
- EQ. = EQUAL
- EST. = ESTIMATED
- EX. = EXISTING
- EXP. = EXPANSION
- F.A. = FORWARD ABUTMENT
- F.D.S. = FINAL DECK SURFACE
- F.S. = FAR SIDE
- FTG. = FOOTING
- FWD. = FORWARD
- GR. = GUARDRAIL
- HMWM = HIGH MOLECULAR WEIGHT METHACRYLATE
- INT. = INTERIOR
- INV. = INVERT
- NPCCP = NON-PERFORATED CORRUGATED PLASTIC PIPE
- N.S. = NEAR SIDE
- O.C.J. = OPTIONAL CONSTRUCTION JOINT
- PCCP = PERFORATED CORRUGATED PLASTIC PIPE
- PEJF = PERFORMED EXPANSION JOINT FILLER
- PERP. = PERPENDICULAR
- PG = PROFILE GRADE
- PGL = PROFILE GRADE LINE
- PH. = PHASE
- PROP. = PROPOSED
- PT. = POINT
- R.A. = REAR ABUTMENT
- REQD. = REQUIRED
- SER. = SERIES
- SHLD. = SHOULDER
- SPA. = SPACES
- ST. = STAGE OR STEP
- STA. = STATION
- STD. = STANDARD
- STM = STORM SEWER LINE
- T&B = TOP AND BOTTOM
- T.O.H. = TOP OF HAUNCH
- T/R = TOP OF ROCK
- T/S = TOP OF SLOPE
- TYP. = TYPICAL
- U.N.O = UNLESS NOTED OTHERWISE

	DESIGN AGENCY STRUCTUREPOINT	DATE 01/03/19	REVIEWED MDS	DRAWN SUJ
		FILE NUMBER 3109T63	STRUCTURE FILE NUMBER 3109T63	CHECKED CLB
GENERAL NOTES - 2 BRIDGE NO. - HAM-75-0440 L/R OVER I-74 WB				
HAM-75-3.84 PID No. 104667				
6/68				

ITEM SPECIAL - SETTLEMENT PLATFORM:

SETTLEMENT PLATFORMS SHALL BE PLACED AT THE BOTTOM OF THE MSE WALL AT THE LOCATIONS INDICATED IN THE PLANS, UNLESS OTHERWISE DIRECTED BY THE ENGINEER.

CONTRACTOR HAS THE OPTION OF USING EITHER STEEL OR PLYWOOD PLATFORM BASE.

CONTRACTOR SHALL FURNISH MATERIALS AND LABOR TO EXTEND PIPE THROUGH ENTIRE FILL.

SETTLEMENT PLATFORMS SHALL BE ANCHORED BY STAKES DRIVEN AT EACH CORNER TO PREVENT OVERTURNING.

SPECIFICATIONS:

DESCRIPTION: THIS ITEM CONSISTS OF FURNISHING, CONSTRUCTING, AND MAINTAINING SETTLEMENT PLATFORMS AND OBTAINING SETTLEMENT READINGS AS REQUIRED BY THE PLANS OR AS DIRECTED BY THE ENGINEER. AT THE OPTION AND EXPENSE OF THE CONTRACTOR, ADDITIONAL SETTLEMENT PLATFORMS MAY BE INSTALLED AT LOCATIONS APPROVED BY THE ENGINEER.

SETTLEMENT READINGS SHALL BE TAKEN THREE TIMES PER WEEK DURING CONSTRUCTION AND DURING ANY SPECIFIED WAITING PERIOD. THE READINGS SHALL BE PLOTTED ON GRAPH PAPER PRESENTING DEFORMATION (ON THE NEGATIVE Y-AXIS) AND FILL HEIGHT (ON THE POSITIVE Y-AXIS) VERSUS TIME (ON THE X-AXIS). A COPY OF EACH CUMULATIVE PLOT SHALL BE SENT TO THE DISTRICT GEOTECHNICAL ENGINEER AND THE OFFICE OF GEOTECHNICAL ENGINEERING, ATTENTION: GEOTECHNICAL DESIGN COORDINATOR, AFTER EACH SETTLEMENT READING IS RECORDED.

THE CONTRACTOR SHALL IDENTIFY, SET, AND MAINTAIN AN APPROPRIATE NUMBER OF FIXED BENCHMARKS, REFERENCE POINTS, ETC. TO FACILITATE THE SURVEYING OF THE SETTLEMENT PLATFORMS. ALL FIXED POINTS SHALL BE LOCATED NOT LESS THAN 150 FEET FROM TOE OF THE PROPOSED EMBANKMENT FILL AT ANY LOCATION.

MATERIALS:

SOUND LUMBER SUCH AS 3/4" EXTERIOR GRADE PLYWOOD SHALL BE USED FOR THE BASE. THE PIPE SHALL BE 2 1/2" STANDARD BLACK PIPE WITH THREADED FITTINGS AS SHOWN ON THE PLANS. A STEEL PLATE 3'-0" x 3'-0" x 1/8" MAY BE SUBSTITUTED FOR THE LUMBER FOR THE PLATFORMS, AT THE CONTRACTOR'S OPTION.

CONSTRUCTION METHODS:

THE PLATFORM SHALL CONFORM TO THE DETAILS SHOWN ON THE PLANS. IF EXISTING PAVEMENT IS ENCOUNTERED AT THE SPECIFIED LOCATIONS, THE PAVEMENT (INCLUDING ANY BASE MATERIAL) SHALL BE REMOVED AND THE SETTLEMENT PLATFORM SHALL BE SET ON THE EXPOSED SUBGRADE. THE PLATFORM SHALL BE SET ON A LEVEL SURFACE. THE PIPE SHALL BE FIRMLY SECURED TO THE PLATFORM AND SHALL BE MAINTAINED IN A PLUMB POSITION DURING THE PLACEMENT OF THE EMBANKMENT. THE PIPE SHALL BE MARKED AT INTERVALS TO FACILITATE MEASUREMENT OF THE DEPTH OF FILL.

THE CONTRACTOR SHALL PROTECT SETTLEMENT PLATFORMS FROM CONSTRUCTION TRAFFIC/ACTIVITIES USING APPROPRIATE METHODS SUCH AS BARRICADES, CONES, ETC. THE CONTRACTOR SHALL STOP WORK IN ANY LOCATION WHERE THE SETTLEMENT PLATFORM HAS BEEN DISTURBED OR DAMAGED. PLATFORMS OR PIPES DAMAGED OR DISPLACED DURING CONSTRUCTION SHALL BE RESTORED TO THEIR PROPER CONDITION AT THE CONTRACTOR'S EXPENSE.

PRIOR TO PAVING:

THE TOP OF THE SETTLEMENT PLATFORM PIPE SHALL BE CUT OFF TWO FEET BELOW THE FINISHED SURFACE OF THE SUBGRADE OR FINISHED GROUND SURFACE, WHICHEVER IS APPLICABLE.

ITEM SPECIAL - SETTLEMENT PLATFORM (CONT.):

WAITING PERIOD:

THE WAITING PERIOD SHALL NOT BE CONSIDERED TO BEGIN UNTIL ALL PROPOSED FILL FOR THE LOADING HAS BEEN PLACED TO THE SUBGRADE LEVEL. AT ANY LOCATION ON THE PROJECT THE LOADING FILL SHALL CONSIST OF THE PROPOSED EMBANKMENT CONSTRUCTED TO THE ENTIRE PROPOSED LATERAL EXTENTS AND TO WITHIN ONE FOOT OF THE PROPOSED VERTICAL EXTENTS.

CONSTRUCTION OF THE MSE WALL COPING OR PAVING OF ROADWAYS SHALL NOT BEGIN UNTIL CONFIRMATION HAS BEEN RECEIVED FROM THE ENGINEER THAT THE CRITERIA TO END THE WAITING PERIOD HAVE BEEN MET.


WAITING PERIOD CRITERIA:

THE ENGINEER WILL CONSIDER THE WAITING PERIOD COMPLETE WHEN CONSECUTIVE SETTLEMENT READINGS, AT LEAST ONE WEEK (168 HOURS) APART, RECORDED AFTER EMBANKMENT CONSTRUCTION IS COMPLETE RESULT IN ELEVATION DIFFERENCES EQUAL TO OR LESS THAN 1/8 INCH PER WEEK FOR TWO CONSECUTIVE WEEKS.

THE ANTICIPATED WAITING PERIOD IN CALANDAR DAYS FOR THE SETTLEMENT TO OCCUR IS LISTED IN THE FOLLOWING TABLE.

WAITING PERIODS	
WALL NUMBER	TOTAL WAITING PERIOD
1	78 DAYS
2	54 DAYS
3	56 DAYS
4	76 DAYS

IF SETTLEMENT RATES EXCEED 3/4 INCH PER MONTH AFTER EMBANKMENT CONSTRUCTION HAS BEEN COMPLETE FOR 45 CALENDAR DAYS, REMAINING MSE WALL CONSTRUCTION, INCLUDING ANY NECESSARY CORRECTIVE MEASURES, MAY PROCEED ONLY AT THE DIRECTION OF THE ENGINEER.

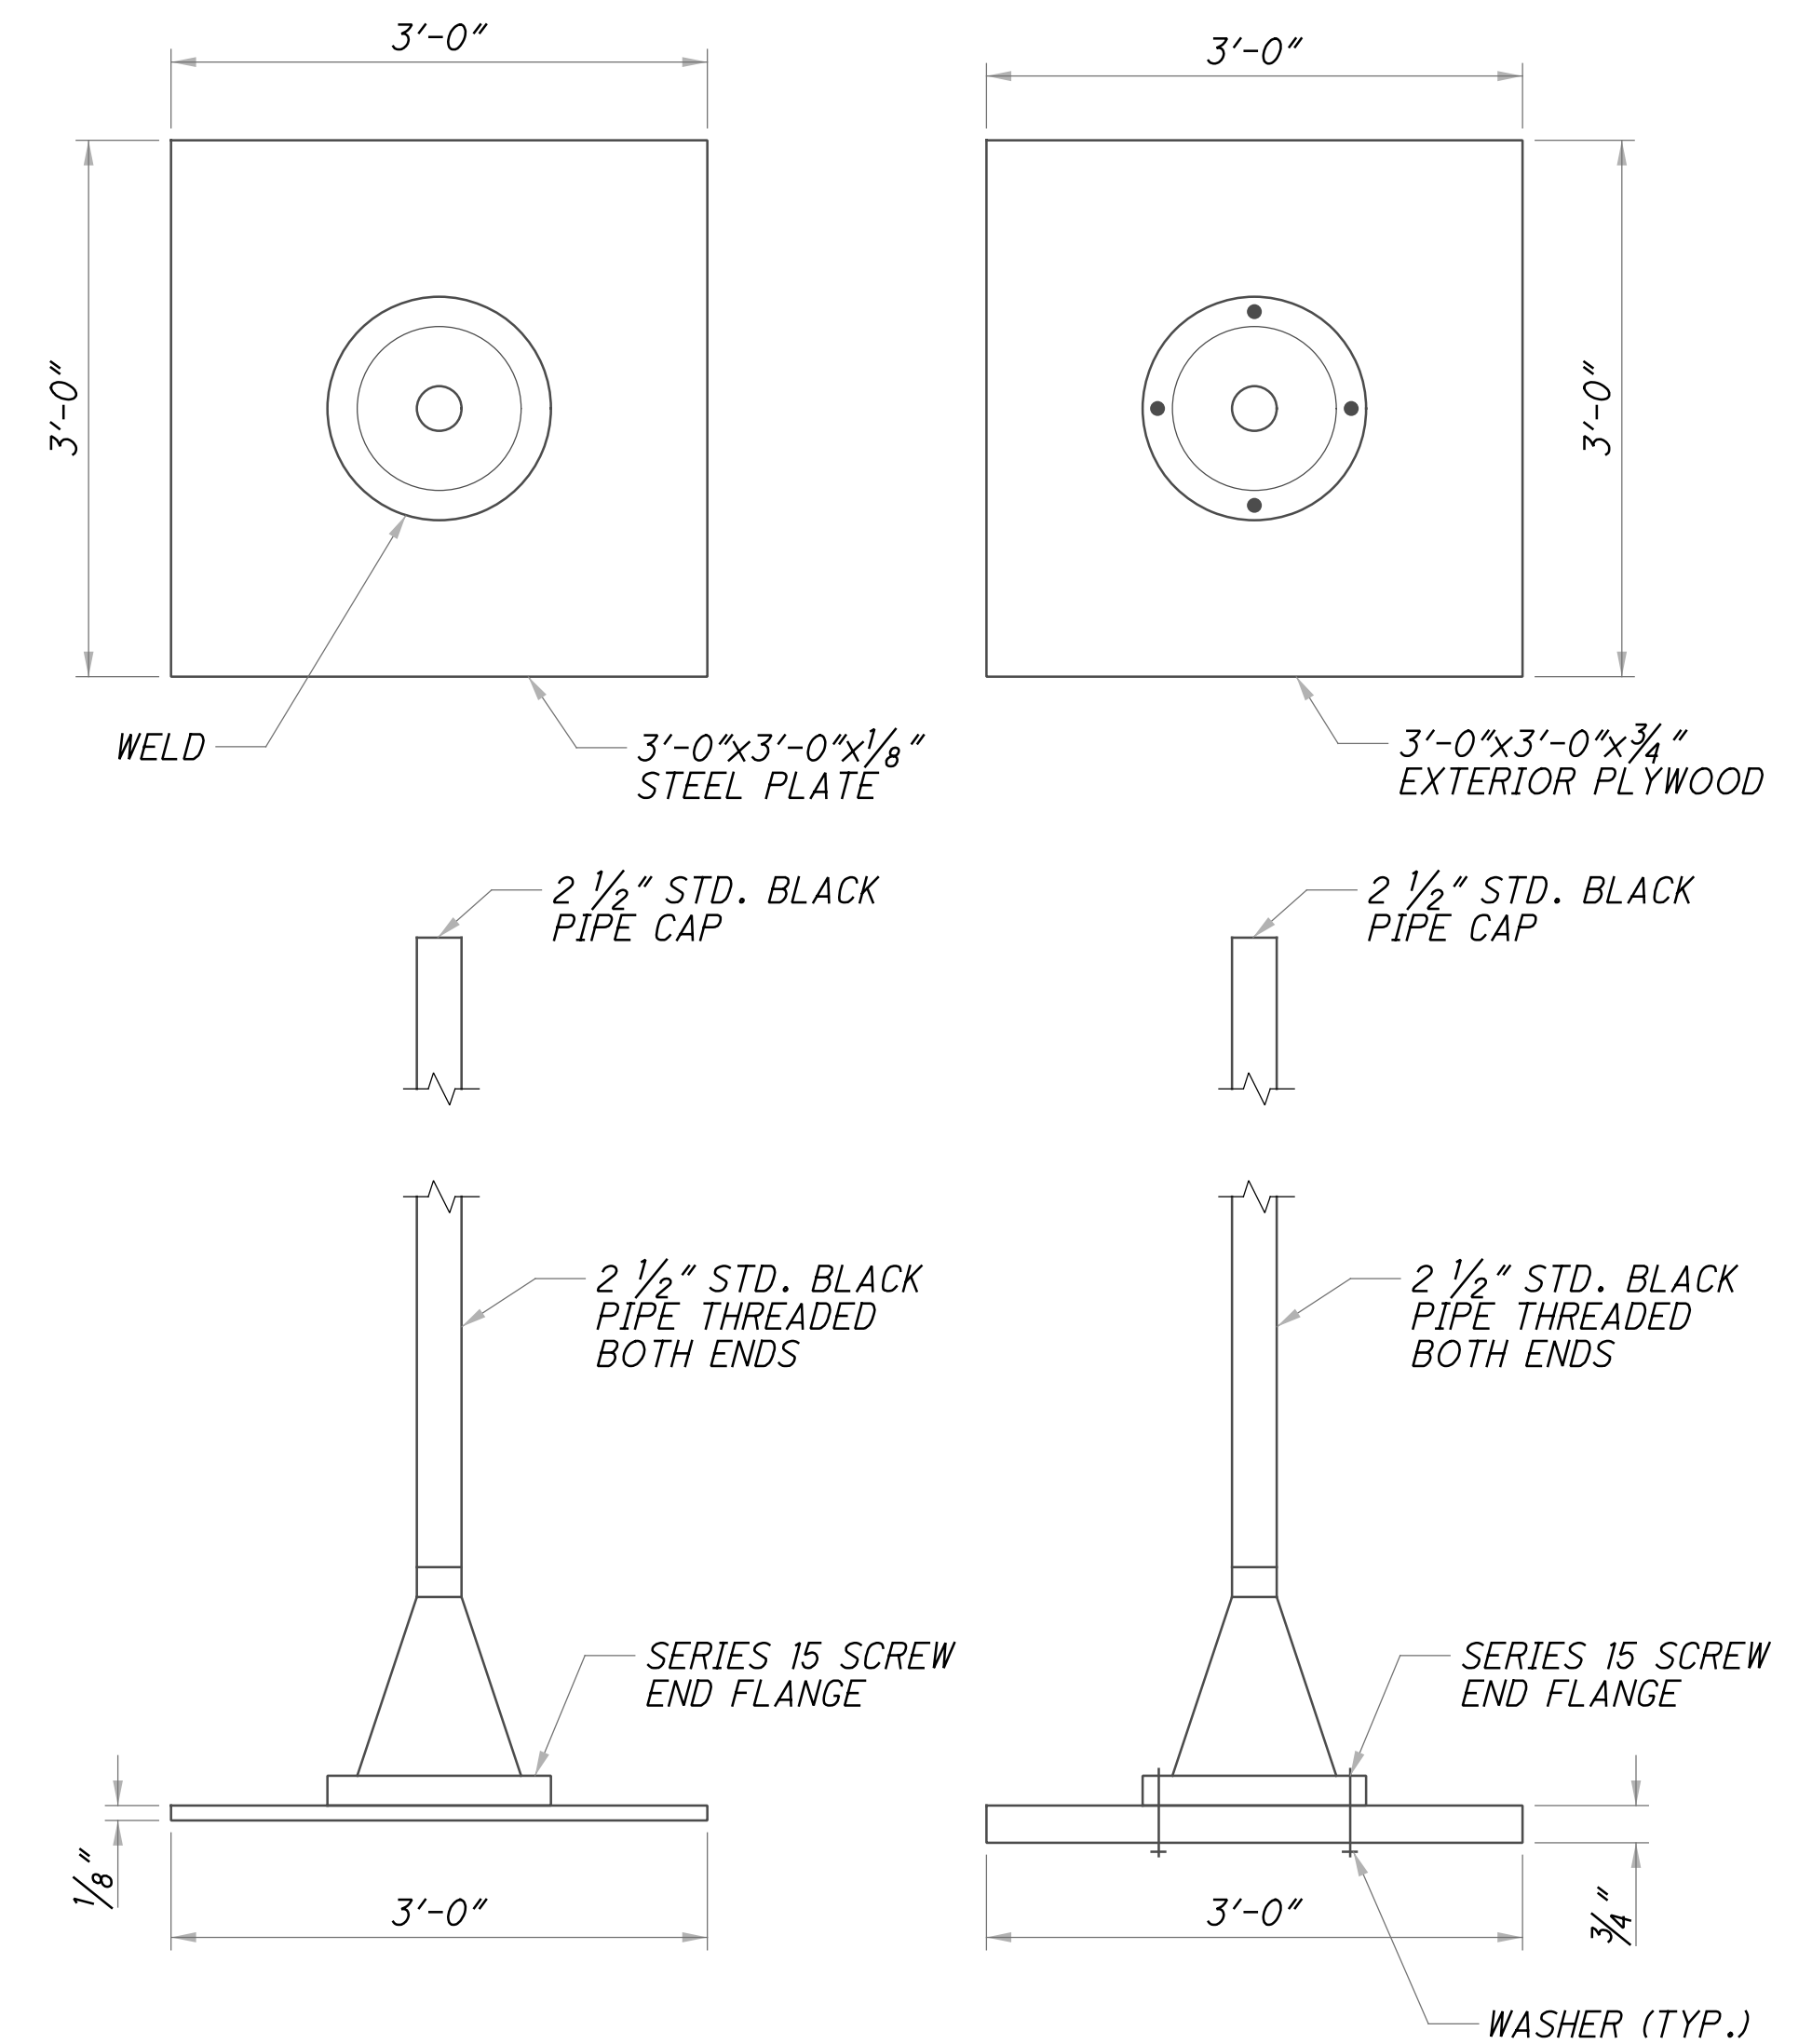


SETTLEMENT PLATFORM DETAILS


S:\Flannagan\10/26/2023 4:26:15 PM\01\2017\01113\C.Design\104667-HAM-75-3.84.Design\Structures\HAM0075_0440C_Sheets\HAM0075_0440C_GN003.dgn

 DESIGN AGENCY 200 CORPORATE PARKWAY, SUITE 100 FARMINGTON, CT 06030 TEL: 860.633.8000 FAX: 860.633.8001 WWW.STRUCTUREPOINT.COM	DATE: 01/03/19 REVIEWED: MDS DRAWN: SJF DESIGNED: SJF CHECKED: CLB	STRUCTURE FILE NUMBER: 3109T63 REVISED:
GENERAL NOTES - 3 BRIDGE NO. HAM-75-0440 L/R OVER I-74 WB		
HAM-75-3.84 PID No. 104667		
7/68		
7 68		


SFlennagan
 10/26/2023 4:26:16 PM
 O:\2017\01113\C.Design\104667_HAM-75-3.84.Design\Structures\HAM0075_0440C_Sheets\HAM0075_0440C_PC001.dgn

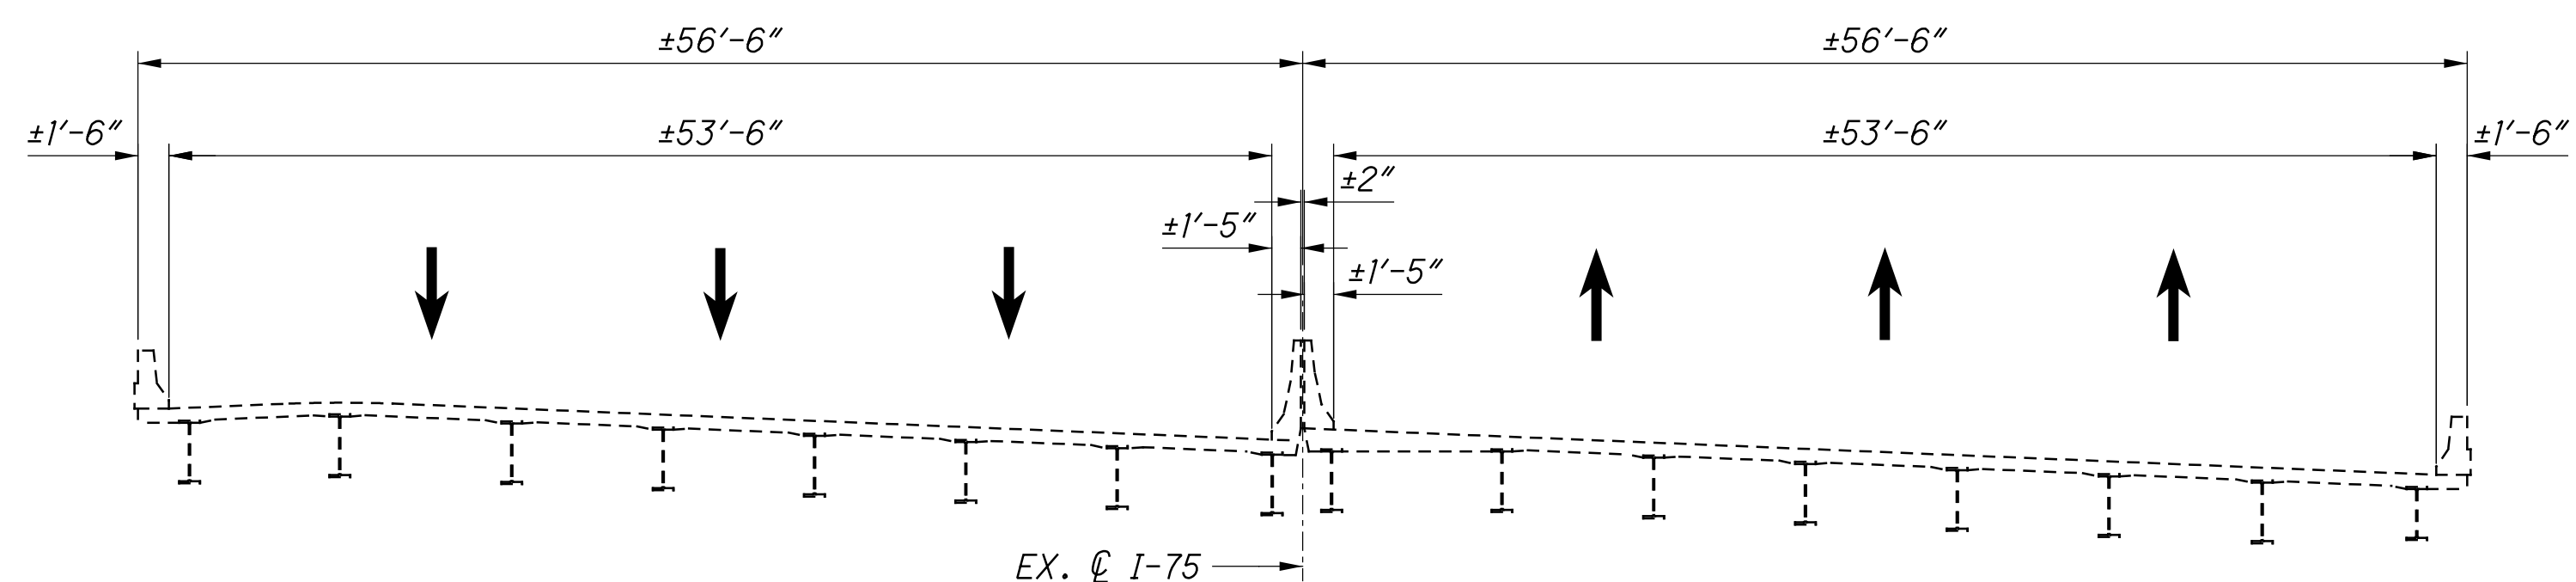


EX. TRANSVERSE SECTION

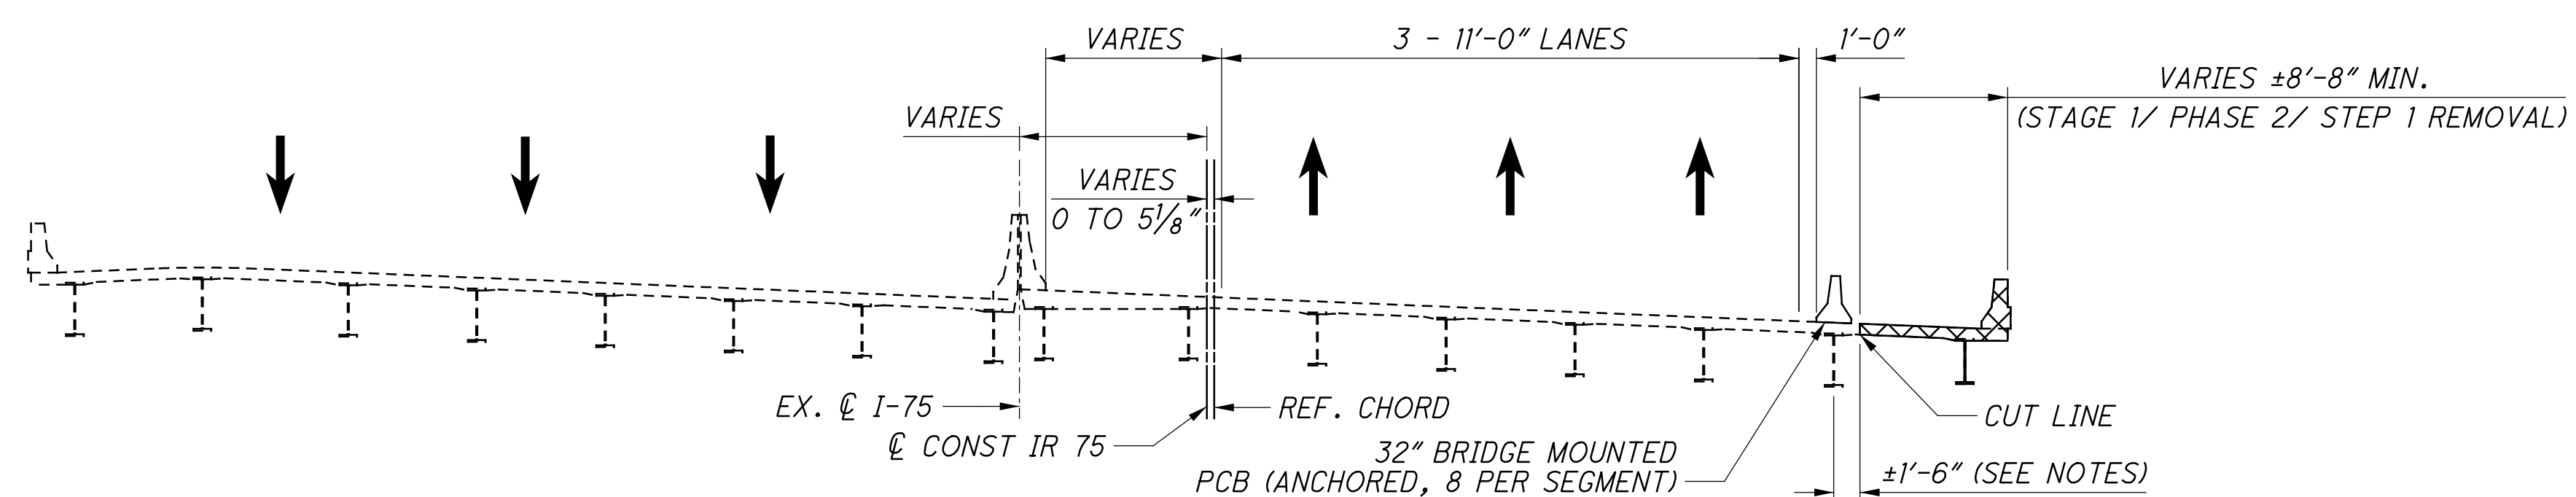

STAGE 1/ PHASE 2/ STEP 1 REMOVAL

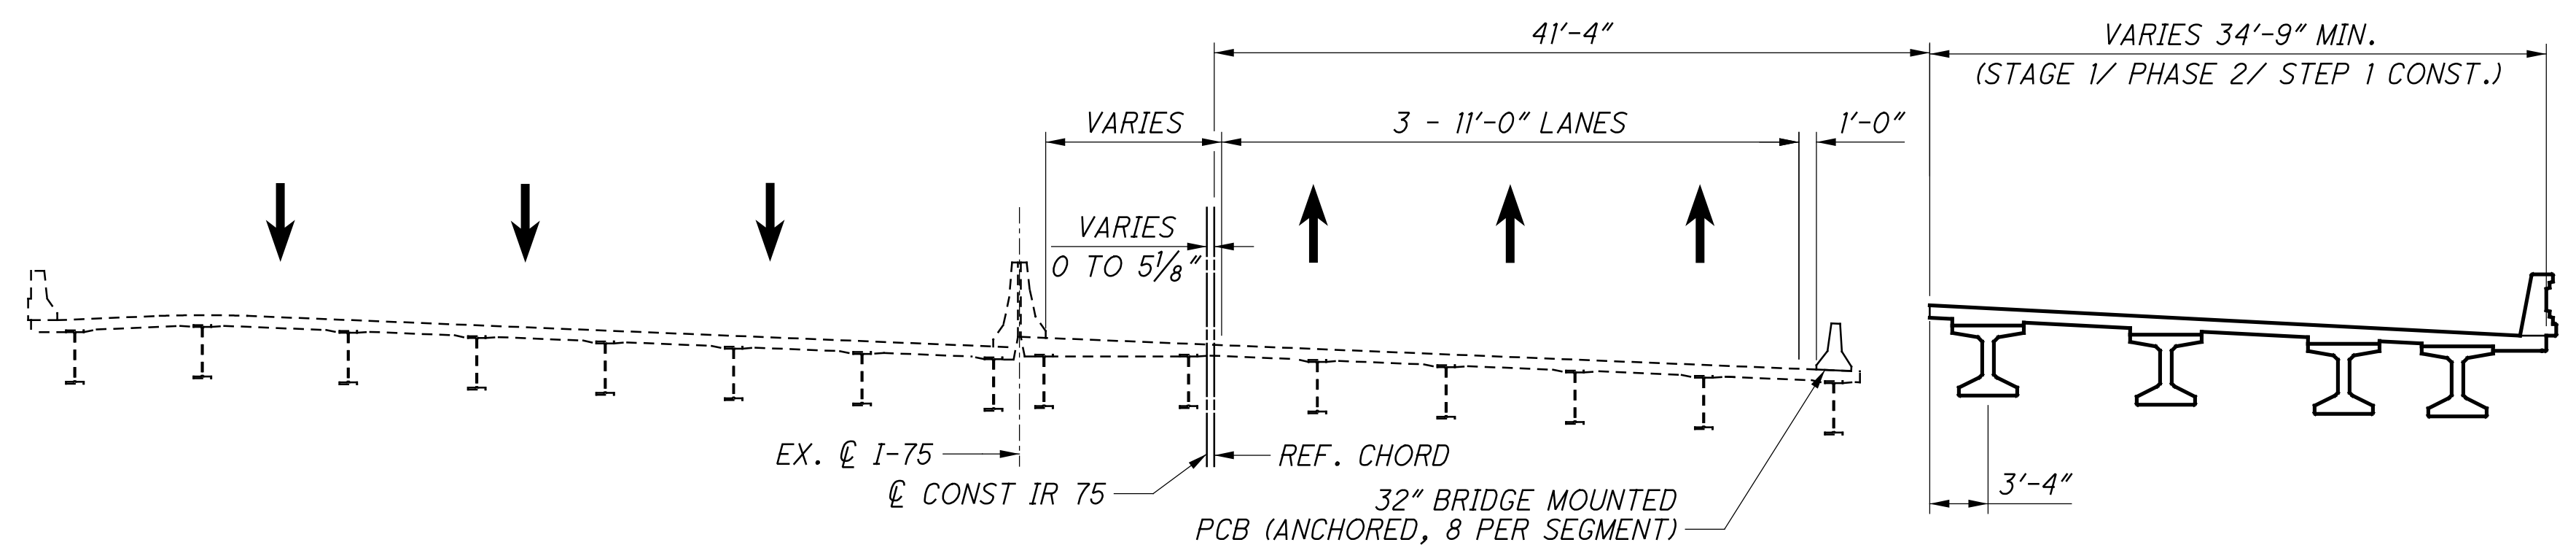

STAGE 1/ PHASE 2/ STEP 1 CONSTRUCTION

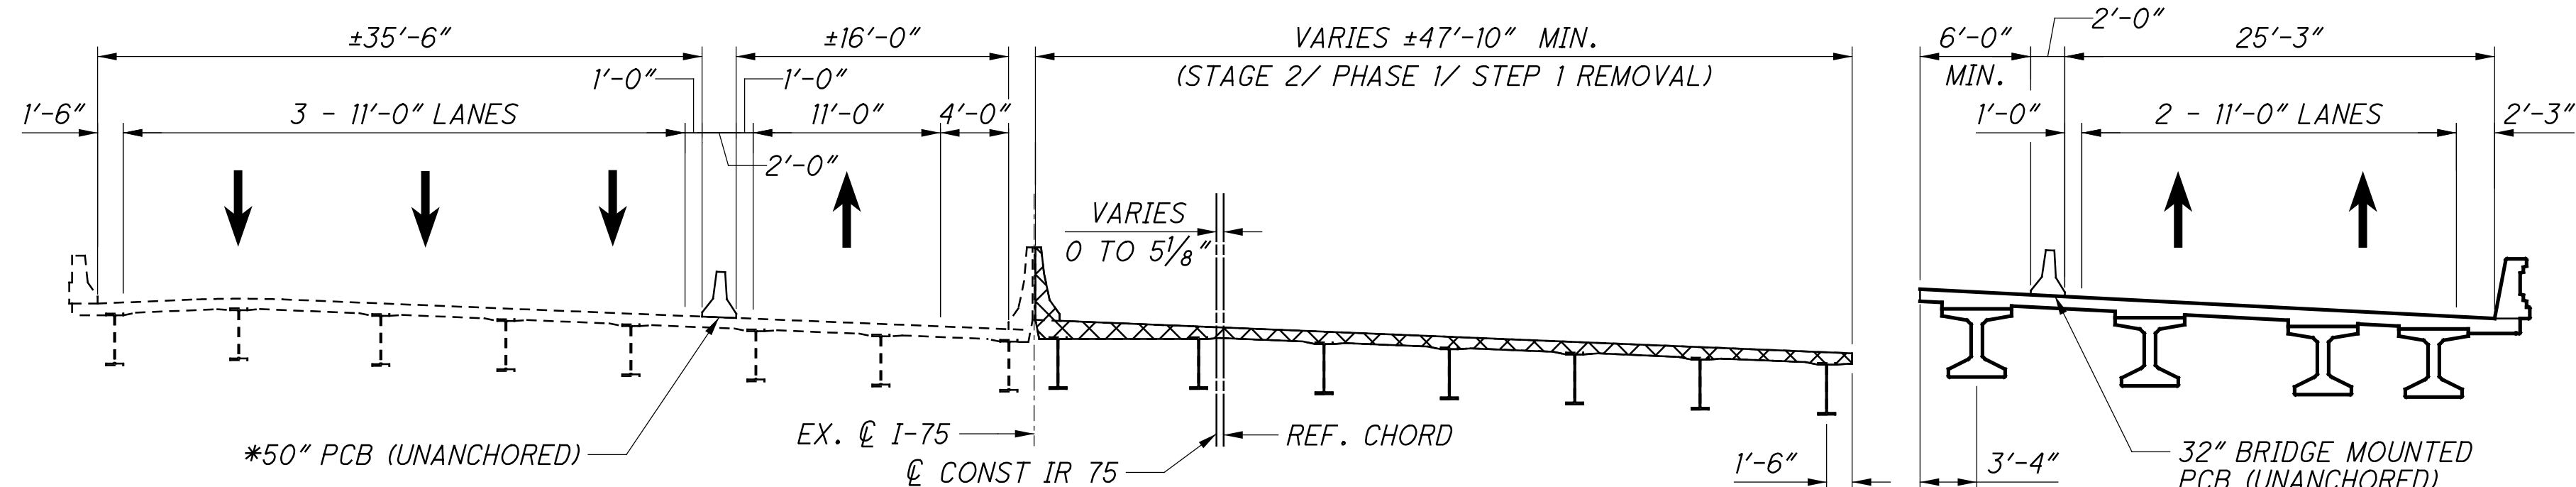

STAGE 2/ PHASE 1/ STEP 1 REMOVAL

SEQUENCE OF CONSTRUCTION

STAGE 1/ PHASE 2/ STEP 1

1. INSTALL PCB AS SHOWN IN BU-02 & BU-23 PLANS.
2. MAINTAIN TRAFFIC AS SHOWN.
3. INSTALL TEMP. SHORING.
4. REMOVE STAGE 1/ PHASE 2/ STEP 1 PORTIONS OF RIGHT BRIDGE.
5. CONSTRUCT STAGE 1/ PHASE 2/ STEP 1 PORTIONS OF RIGHT BRIDGE.
6. CONSTRUCT TEMP. WIRE FACE WALLS.

STAGE 2/ PHASE 1/ STEP 1

1. RELOCATE PCB AS SHOWN IN BU-02 & BU-23 PLANS.
2. MAINTAIN TRAFFIC AS SHOWN.
3. INSTALL TEMP. SHORING.
4. REMOVE STAGE 2/ PHASE 1/ STEP 1 PORTIONS OF RIGHT BRIDGE.
5. CONSTRUCT STAGE 2/ PHASE 1/ STEP 1 PORTIONS OF RIGHT BRIDGE.
6. CONSTRUCT TEMP. WIRE FACE WALLS.

* 32" PCB WITH GLARE SCREEN MAY BE USED AS AN ALTERNATE

LEGEND


LIMITS OF REMOVAL PER ITEM 202 - STRUCTURE REMOVED, OVER 20 FOOT SPAN

NOTES:


CUT LINE IS A CONSTANT 1'-6" FROM C EXISTING GIRDER ALONG ENTIRE LENGTH OF BRIDGE.

DESIGN AGENCY STRUCTUREPOINT <small>AMERICAN SOCIETY OF CIVIL ENGINEERS</small>	DATE 1/3/19	REVIEWED MDS	STRUCTURE FILE NUMBER 3109763	DRAWN SUJ	REVISIONS REVISED
STAGE CONSTRUCTION DETAILS - 1 BRIDGE NO. HAM-75-0440 L/R OVER IR-74 WB					
HAM-75-3.84 PID No. 104667					
8 / 68					
8 68					


SFlansagan
 10/26/2023 4:26:16 PM
 O:\2017\01113\C.Design\104667_HAM-75-3.84.Design\Structures\HAM0075_0440C_Sheets\HAM0075_0440C_PC002.dgn

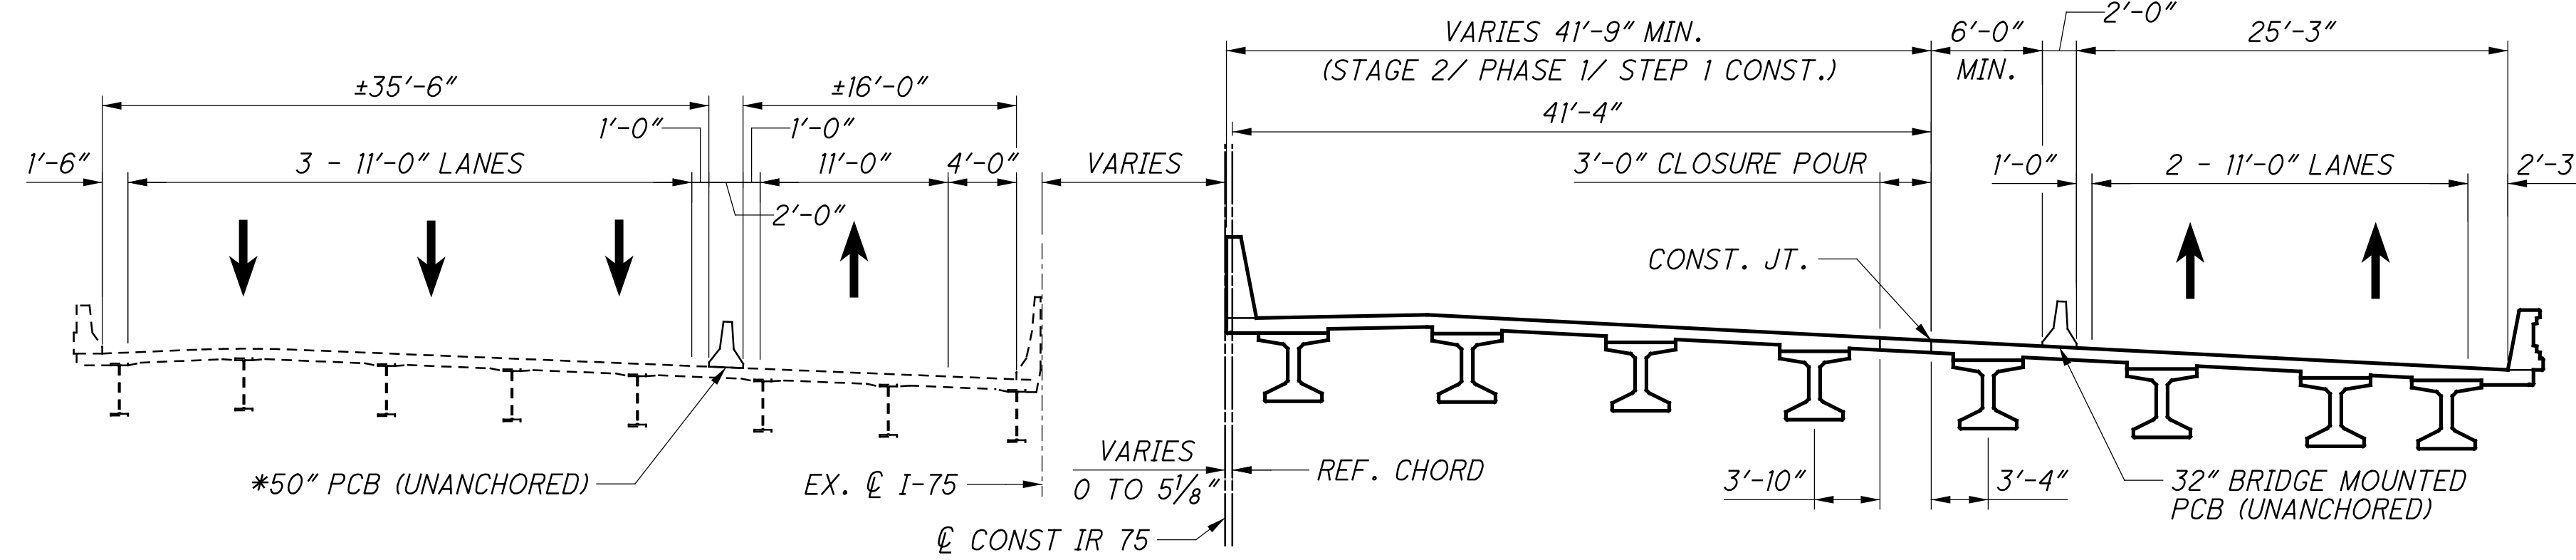


STAGE 2/ PHASE 1/ STEP 1 CONSTRUCTION

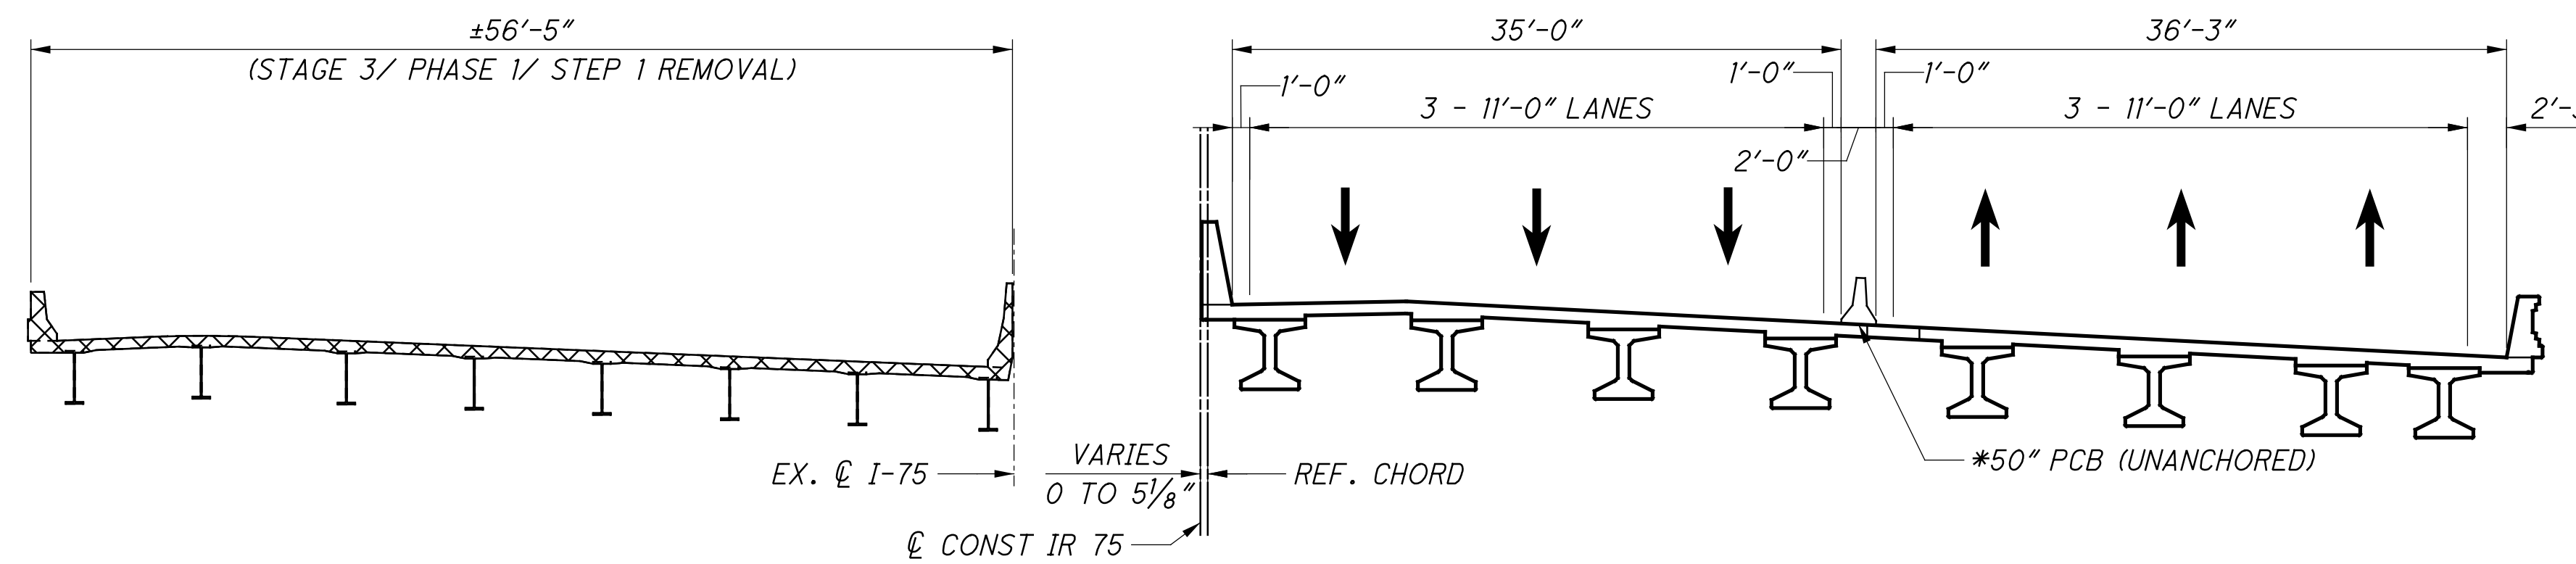

STAGE 3/ PHASE 1/ STEP 1 REMOVAL

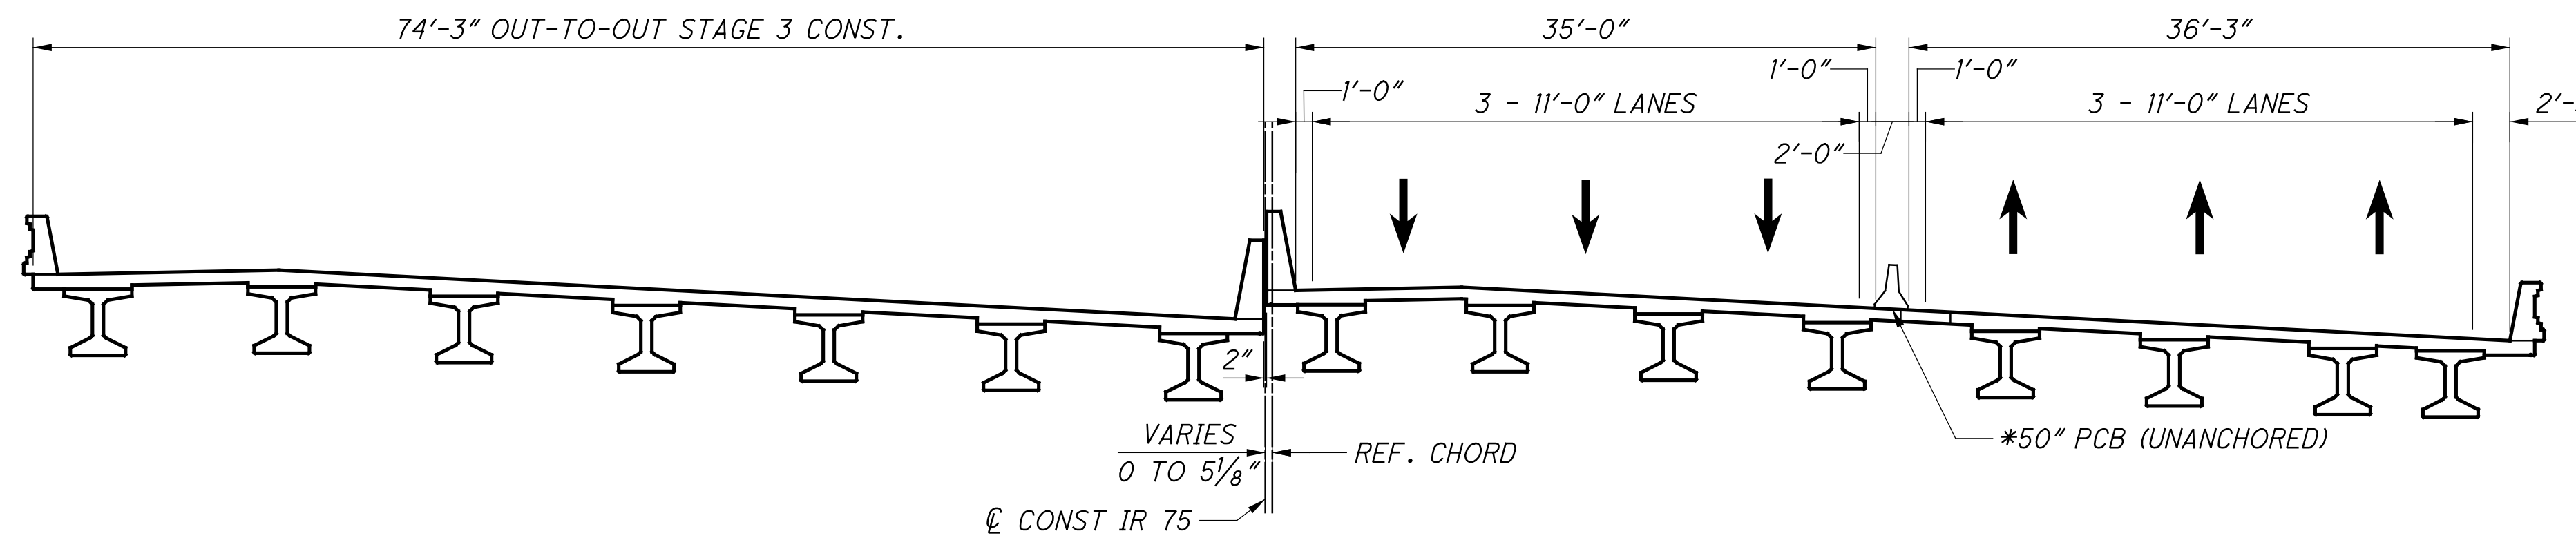

STAGE 3/ PHASE 1/ STEP 1 CONSTRUCTION

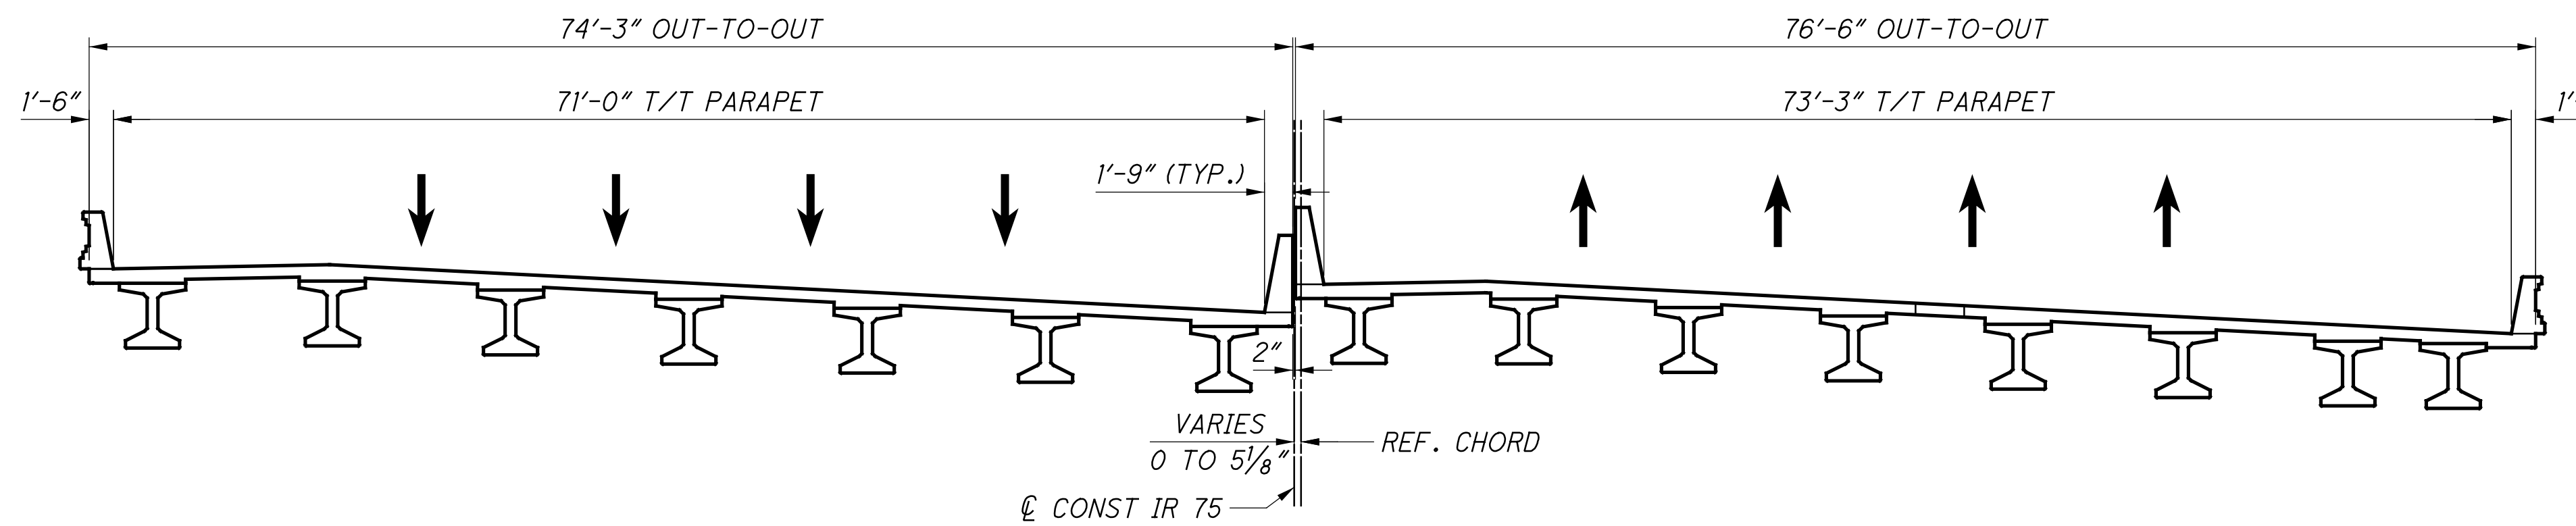

TRANSVERSE SECTION

SEQUENCE OF CONSTRUCTION

STAGE 2/ PHASE 1/ STEP 1

1. RELOCATE PCB AS SHOWN IN BU-02 & BU-23 PLANS.
2. MAINTAIN TRAFFIC AS SHOWN.
3. INSTALL TEMP. SHORING.
4. REMOVE STAGE 2/ PHASE 1/ STEP 1 PORTIONS OF RIGHT BRIDGE.
5. CONSTRUCT STAGE 2/ PHASE 1/ STEP 1 PORTIONS OF RIGHT BRIDGE.
6. CONSTRUCT TEMP. WIRE FACE WALLS.

STAGE 3/ PHASE 1/ STEP 1

1. RELOCATE PCB AS SHOWN IN BU-02 & BU-23 PLANS.
2. MAINTAIN TRAFFIC AS SHOWN.
3. REMOVE STAGE 3/ PHASE 1/ STEP 1 PORTIONS OF LEFT BRIDGE.
4. CONSTRUCT STAGE 3/ PHASE 1/ STEP 1 PORTIONS OF LEFT BRIDGE.


* 32" PCB WITH GLARE SCREEN MAY BE USED AS AN ALTERNATE

LEGEND

LIMITS OF REMOVAL PER ITEM 202 - STRUCTURE REMOVED, OVER 20 FOOT SPAN

DESIGN AGENCY STRUCTUREPOINT	DATE 1/3/19	REVIEWED MDS	DRAWN SUJ	DESIGNED SUJ	CHECKED CLB	STRUCTURE FILE NUMBER 3109763
STAGE CONSTRUCTION DETAILS - 2						
BRIDGE NO. HAM-75-0440 L/R OVER IR-74 WB						
HAM-75-3.84 PID No. 104667						
9/68						
9 68						

SFlanagan
 10/26/2023 4:26:17 PM
 \\01\2017\01113\C.Design\104667-HAM-75-3.84\Design\Structures\HAM0075_0440C\Sheets\HAM0075_0440C_AR008.dgn

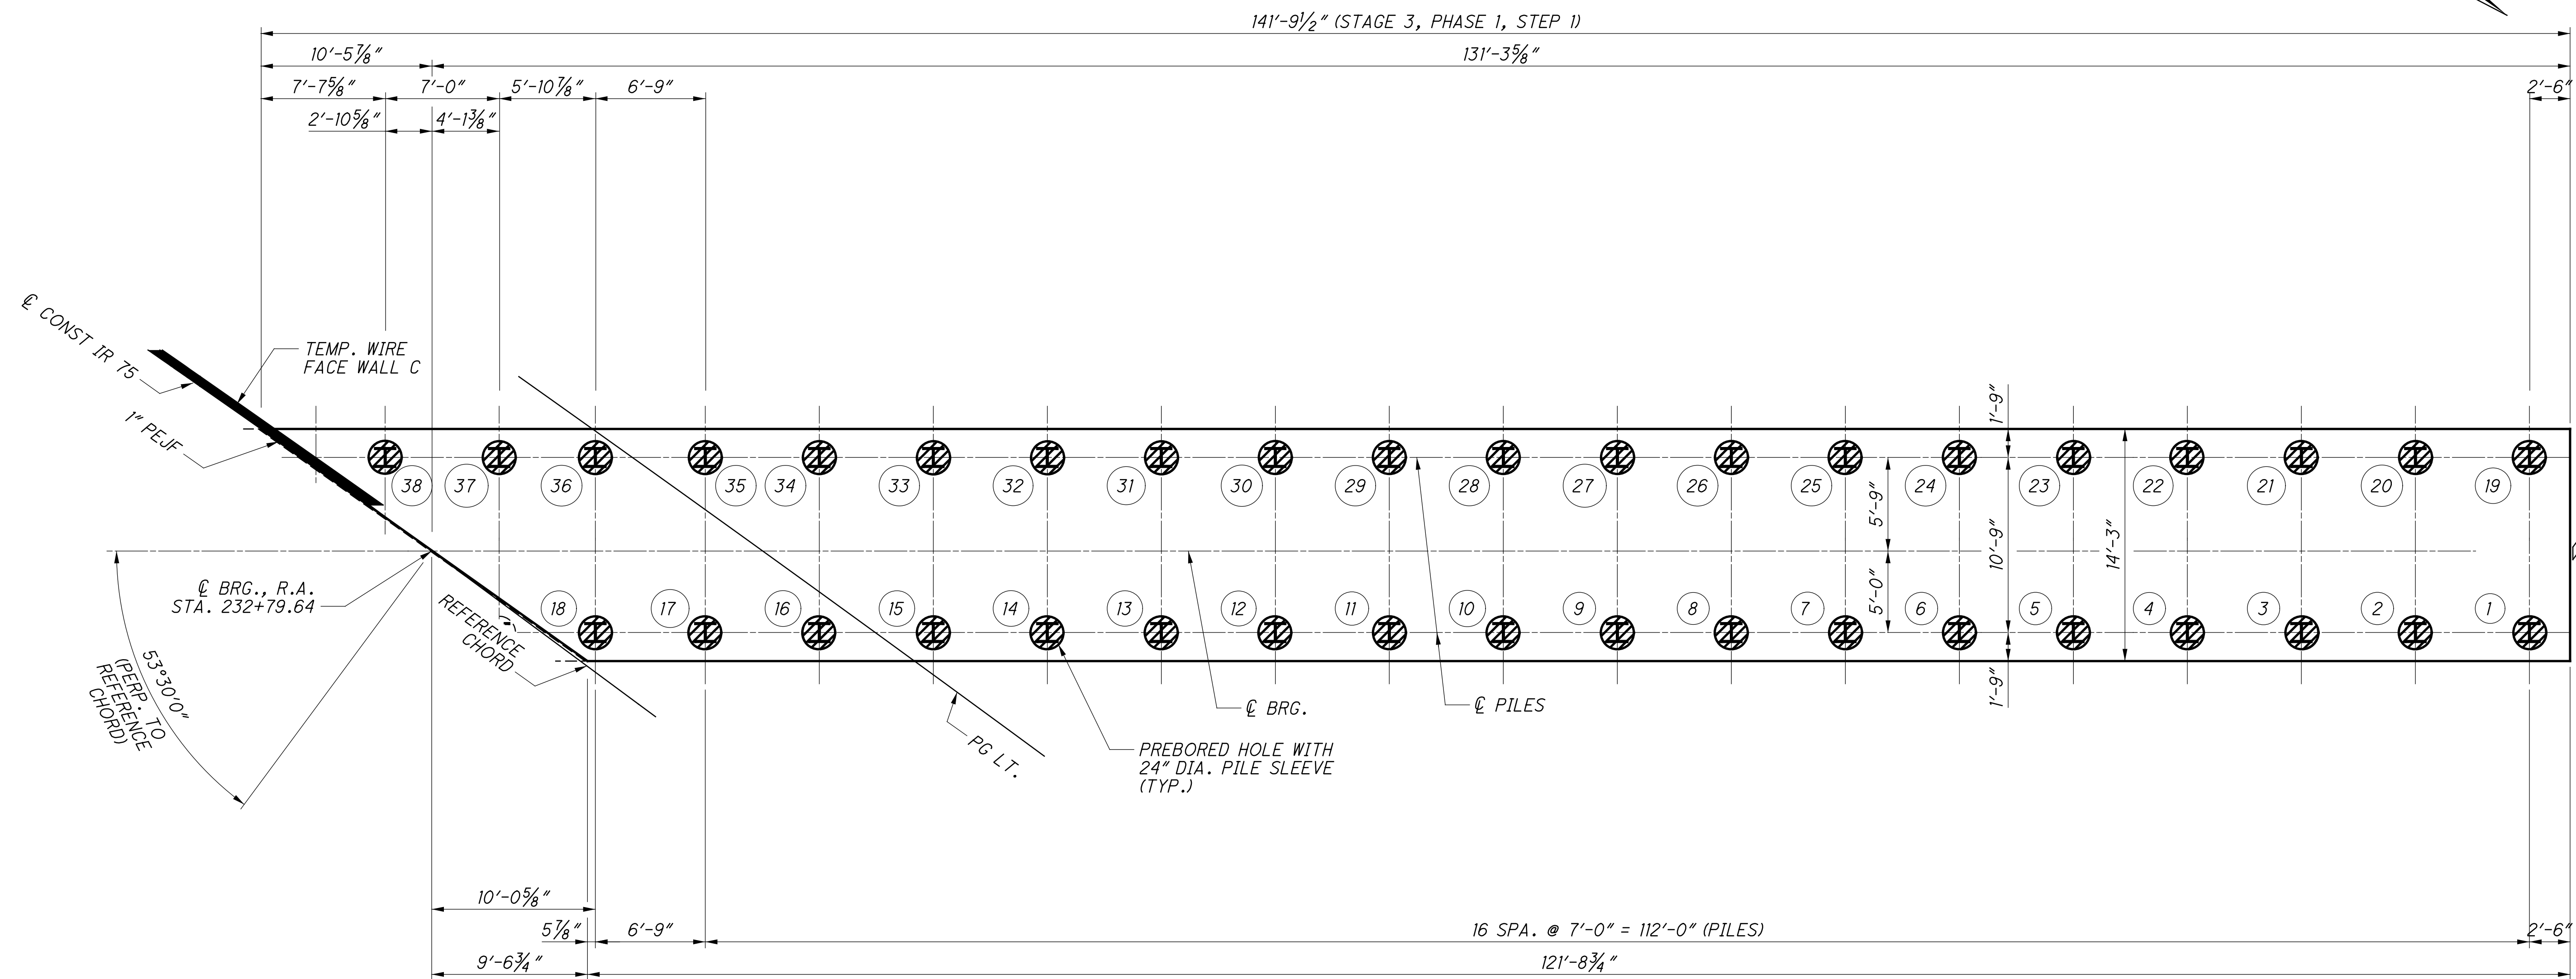


LEFT REAR ABUTMENT PILE LAYOUT PLAN

LEGEND

- ⊗ INDICATES PILE NUMBER
- ⊔ INDICATES HP14x117 STEEL "H" PILE WITH 30" PREBORED HOLE
- ⊘ PILE SLEEVE AND LSM NOT INSTALLED. PREBORED HOLE ANNULAR SPACE FILLED WITH CONC. CLASS QC, MISC. FROM BOTTOM OF HOLE TO BOTTOM OF FOOTING

 DESIGN AGENCY STRUCTUREPOINT 2000 CORPORATE PARKWAY SUITE 400 WASHINGTON, DC 20008 TEL: (800) 333-3333 FAX: (202) 333-3333 WWW.STRUCTUREPOINT.COM	DATE 1/03/19
REVIEWED MDS	STRUCTURE FILE NUMBER 3109763
DRAWN DSH	REVISED
DESIGNED SUJ	CHECKED CLB
REAR ABUTMENT DETAILS (LEFT BRIDGE) BRIDGE NO. - HAM-75-0440 L/R OVER WB I-74	
HAM-75-3.84 PID No. 104667	
10 / 68	
<div style="border: 1px solid black; border-radius: 50%; width: 30px; height: 30px; display: flex; align-items: center; justify-content: center; margin: 0 auto;"> <div style="border: 1px solid black; border-radius: 50%; width: 15px; height: 15px; display: flex; align-items: center; justify-content: center; margin: 0 auto;"> 10 </div> <div style="border: 1px solid black; border-radius: 50%; width: 15px; height: 15px; display: flex; align-items: center; justify-content: center; margin: 0 auto;"> 68 </div> </div>	


SFlanagan
 10/26/2023 4:26:17 PM
 \\0\2017\01113\C.Design\104667-HAM-75-3.84\Design\Structures\HAM0075_0440C\Sheets\HAM0075_0440C_AR007.dgn

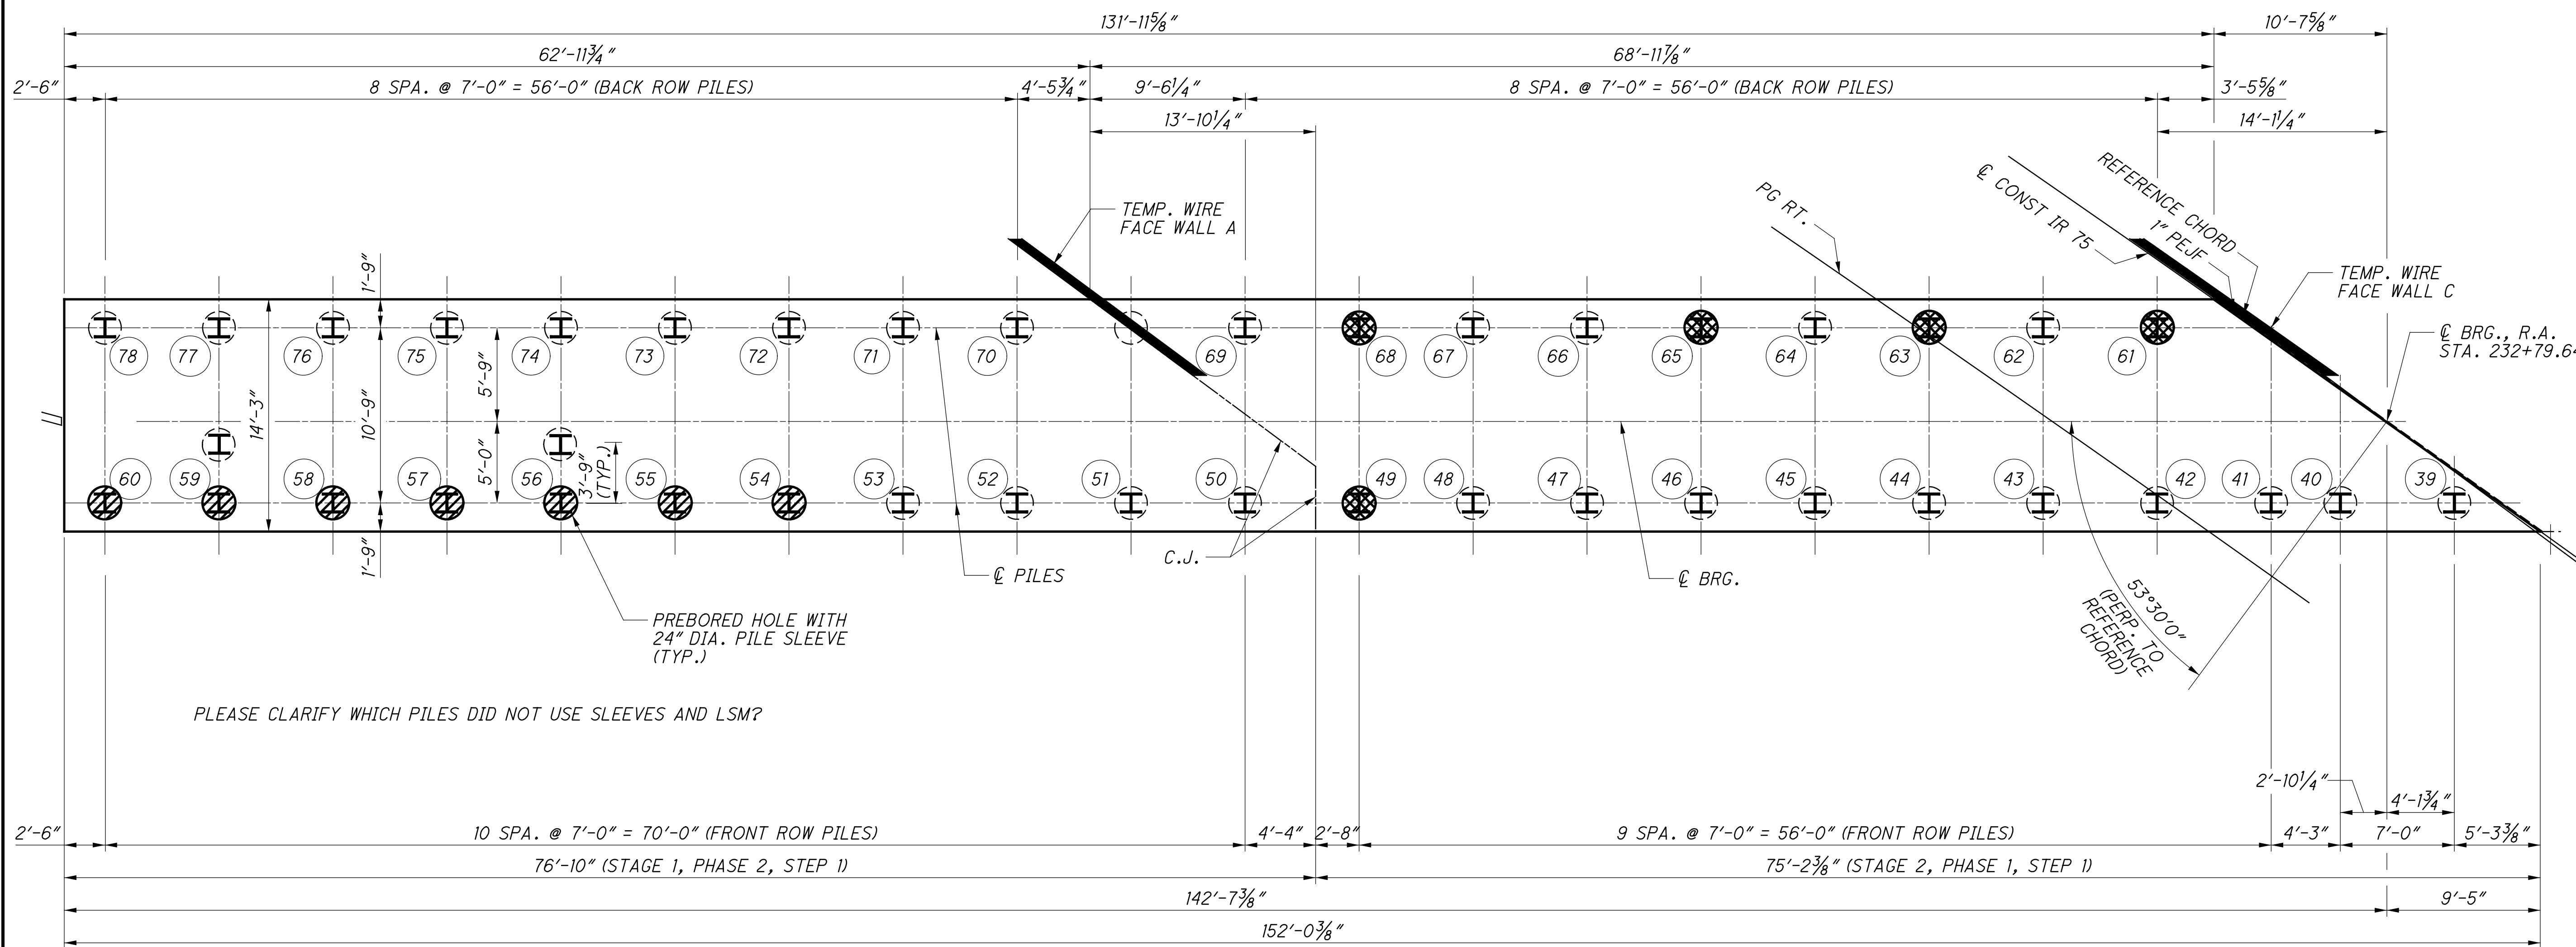

RIGHT REAR ABUTMENT PILE LAYOUT PLAN


LEGEND

- XX INDICATES PILE NUMBER
- ⊥ INDICATES HP14x117 STEEL "H" PILE WITH 30" PREBORED HOLE
- ⊘ PILE SLEEVE AND LSM NOT INSTALLED. PREBORED HOLE ANNULAR SPACE FILLED WITH CONC. CLASS QC, MISC. FROM BOTTOM OF HOLE TO BOTTOM OF FOOTING
- ⊗ TEMP. CASING LEFT IN PLACE

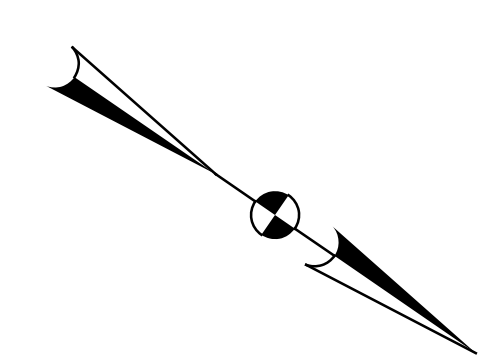


 DESIGN AGENCY 2000 CORPORATE PARKWAY SUITE 400 WILSONVILLE, OR 97150 TEL: 503.261.1333 FAX: 503.261.1335 WWW.STRUCTUREPOINT.COM
DATE: 1/03/19 REVIEWED: MDS DRAWN: DSH DESIGNED: SUJ CHECKED: CLB
STRUCTURE FILE NUMBER: 3109763 REVISIONS: 1 FILE NUMBER: 3109763
REAR ABUTMENT DETAILS (RIGHT BRIDGE) BRIDGE NO. - HAM-75-0440 L/R OVER WB I-74
HAM-75-3.84 PID No. 104667
11 / 68 11 / 68

SFlanagan
 10/26/2023 4:26:18 PM
 \\0\2017\01113\C.Design\104667-HAM-75-3.84\Design\Structures\HAM0075_0440C\Sheets\HAM0075_0440C_AR002.dgn

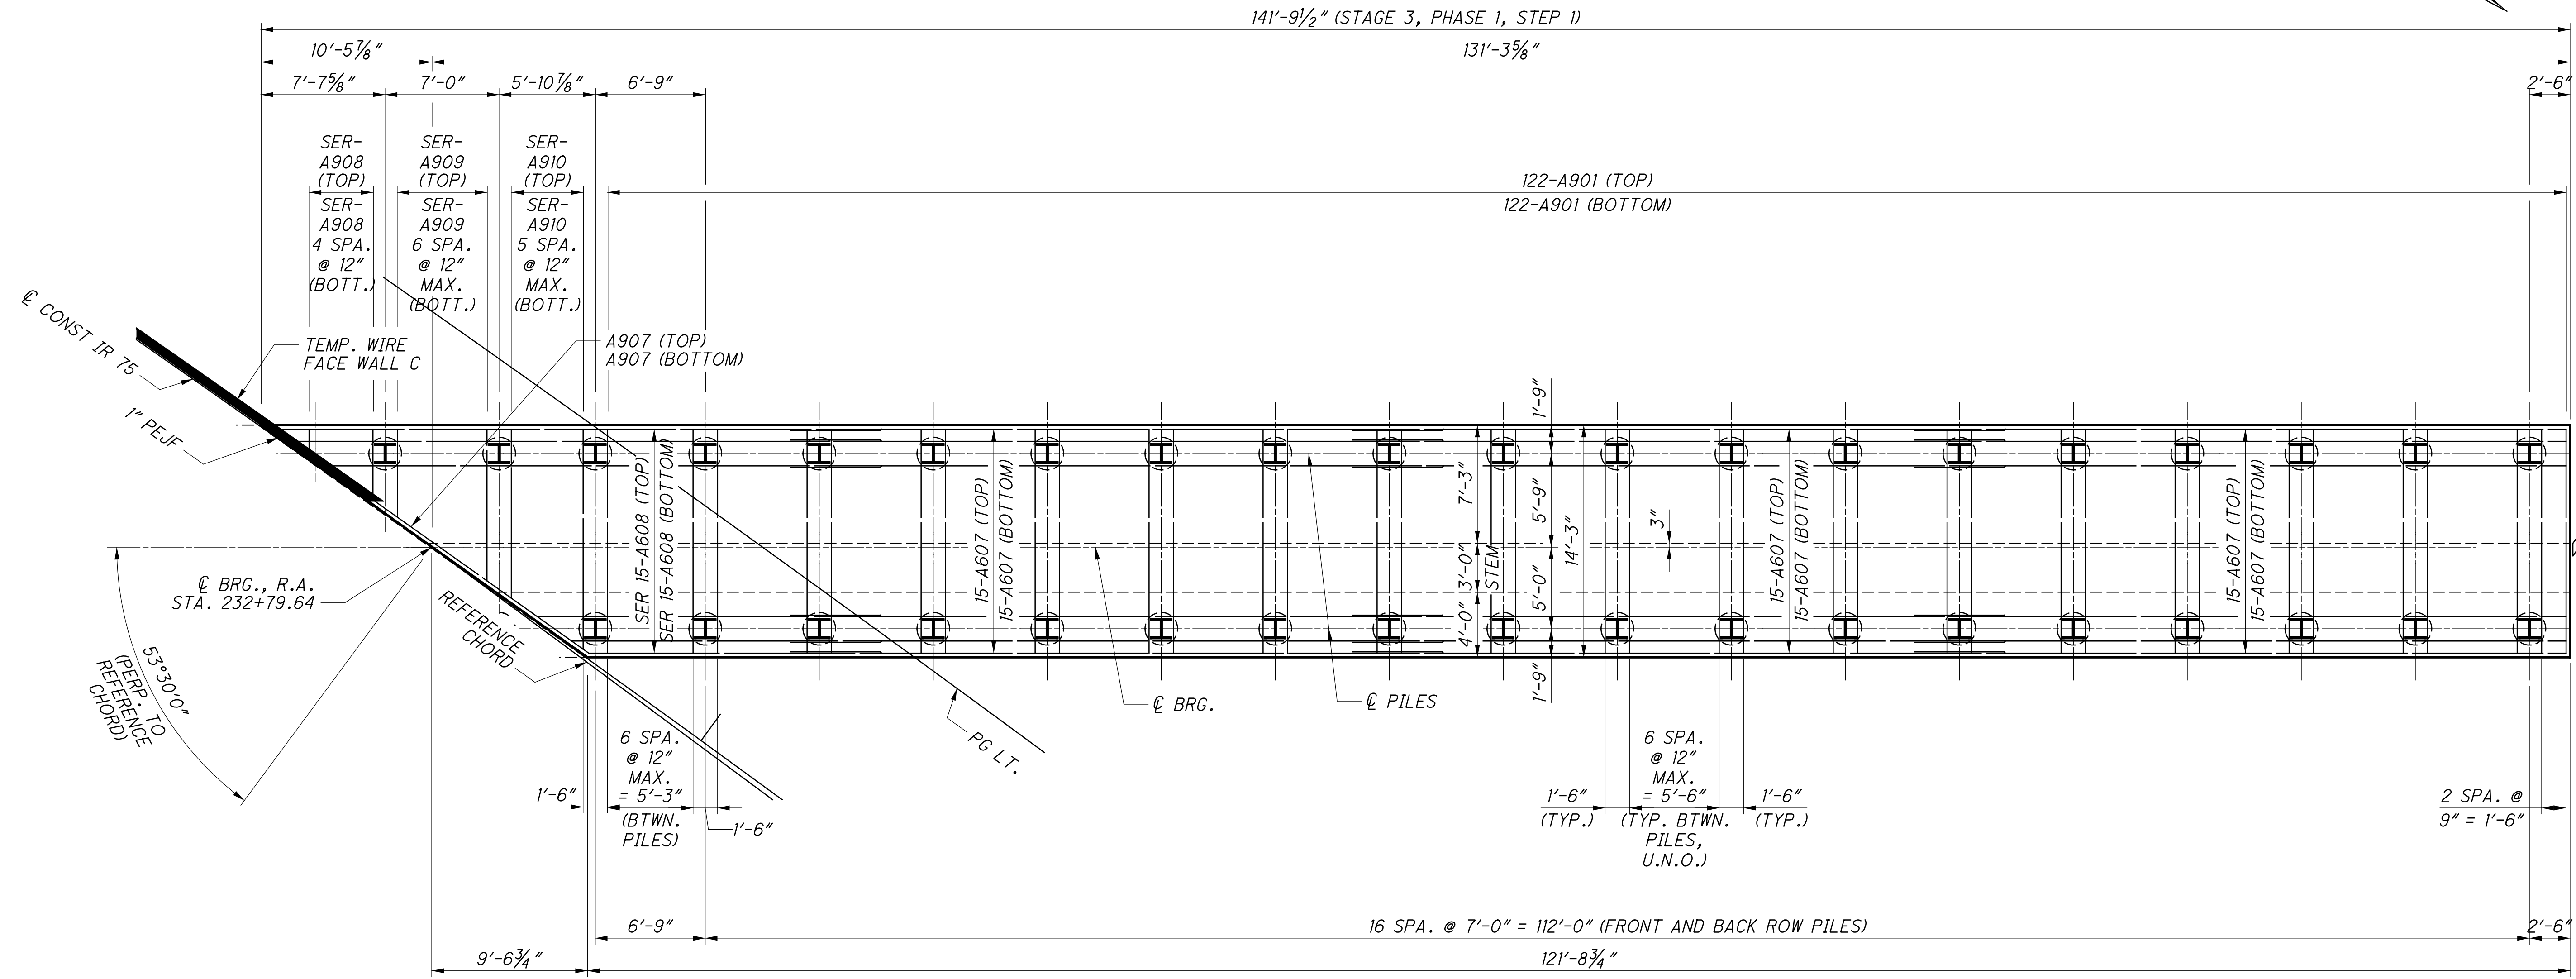


LEFT REAR ABUTMENT FOOTING PLAN

MINIMUM BAR LAP	
#6	5'-6"

LEGEND
 INDICATES HP14x17 STEEL "H" PILE WITH 30" PREBORED HOLE

NOTES:
 FOR ABUTMENT PILE LAYOUT PLAN, SEE SHEETS 10/68 TO 14/68.
 FOR ABUTMENT PLAN AND ELEVATION, SEE SHEETS 14/68 TO 15/68.

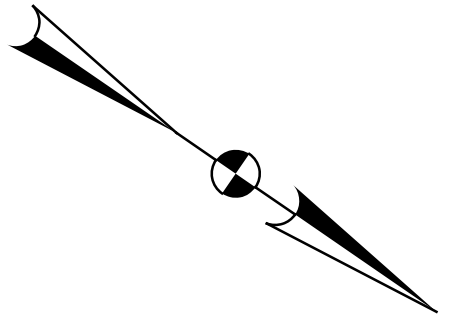

DESIGN AGENCY
STRUCTUREPOINT
 2000 CORPORATE CENTER DR., 4TH FL.
 ST. LOUIS, MO 63103
 TEL: 314.433.3300 FAX: 314.433.3300


DESIGNED	SJF	CHECKED	CLB
DRAWN	DSH	REVISED	
REVIEWED	MDS	DATE	1/03/19
STRUCTURE FILE NUMBER	3109763		

REAR ABUTMENT DETAILS (LEFT BRIDGE)
 BRIDGE NO. - HAM-75-0440 L/R
 OVER WB I-74

HAM-75-3.84
PID No. 104667

12/68
 12/68

SFlanagan
 10/26/2023 4:26:19 PM
 \\0\2017\01113\C.Design\104667-HAM-75-3.84\Design\Structures\HAM0075_0440C_Sheets\HAM0075_0440C_AR001.dgn

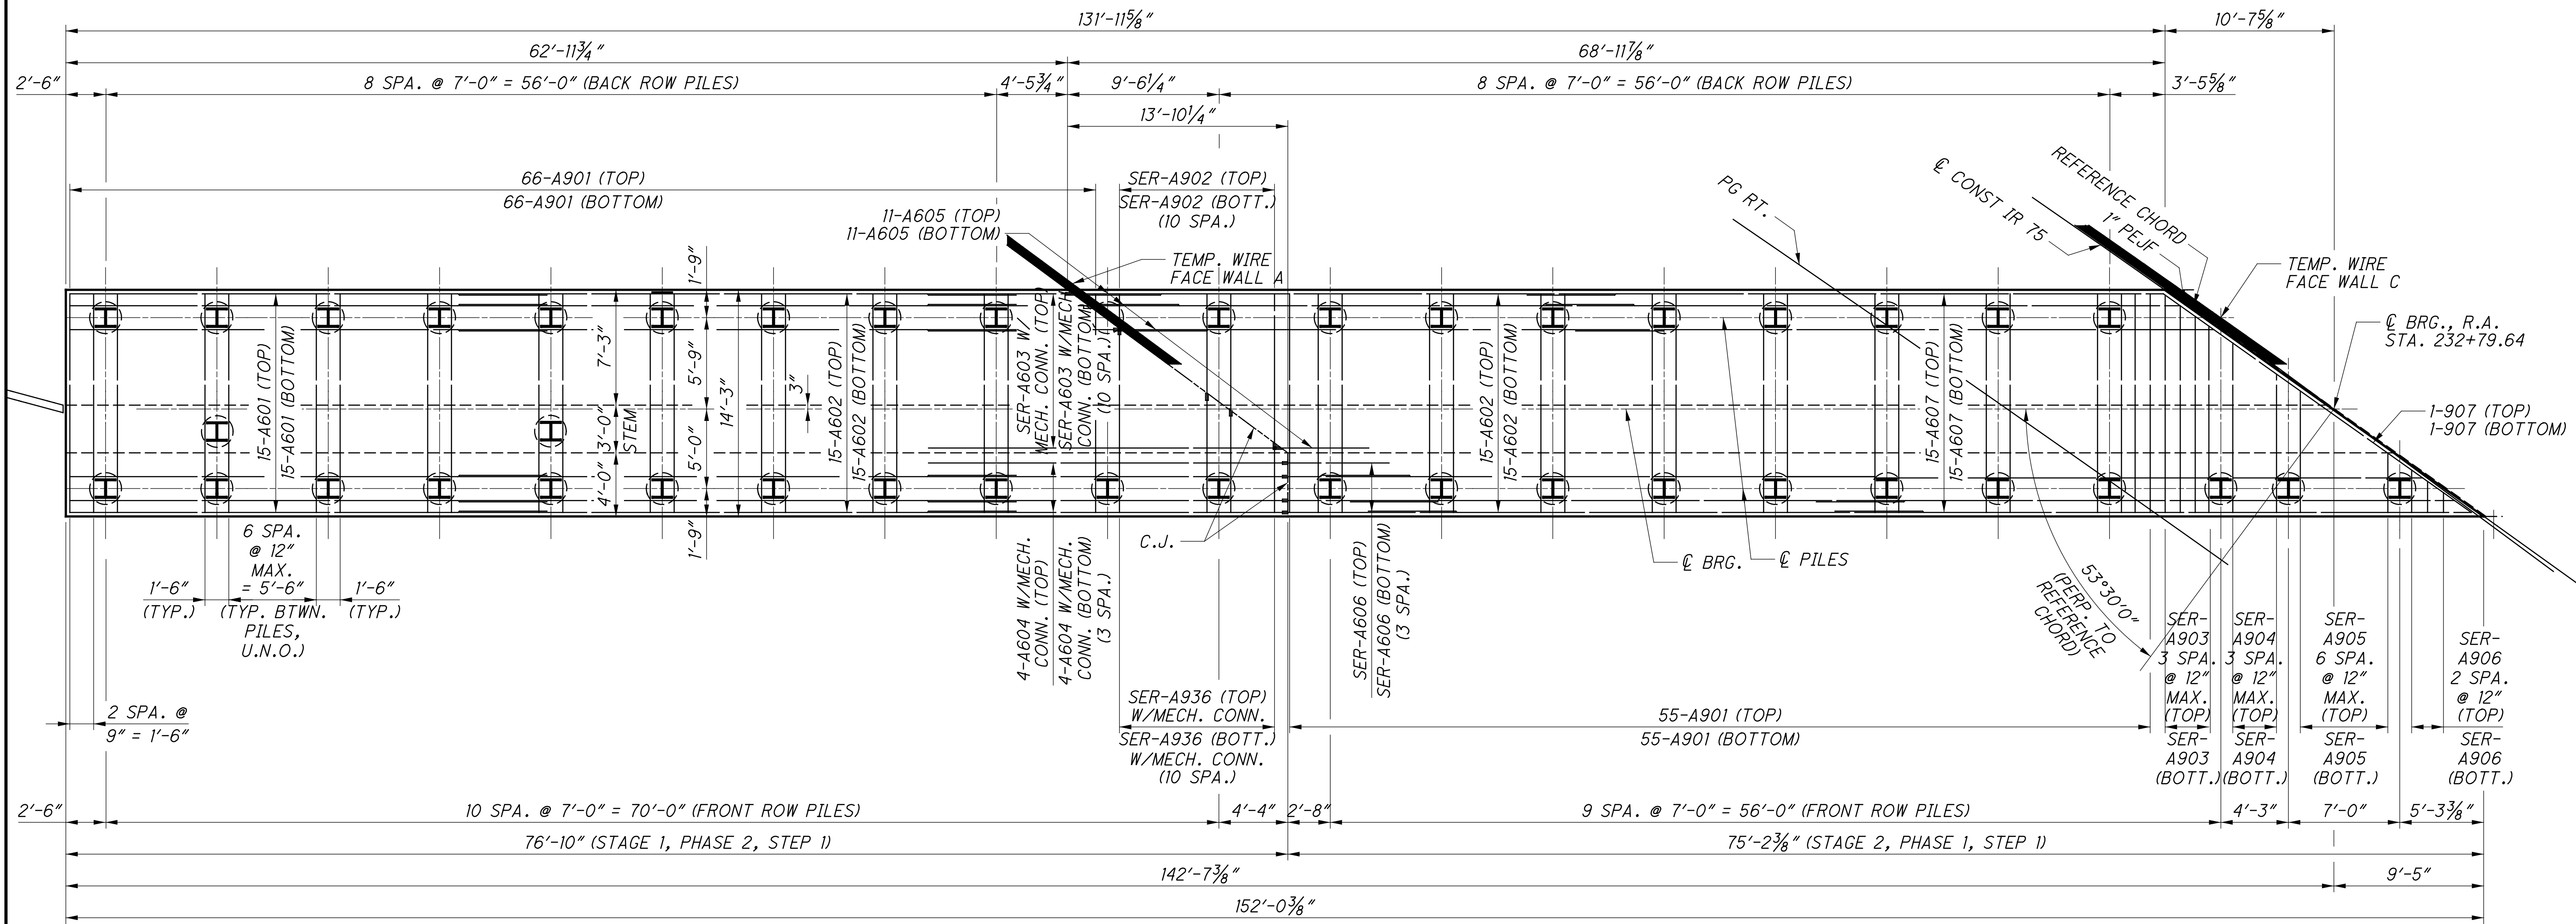

RIGHT REAR ABUTMENT FOOTING PLAN

MINIMUM BAR LAP	
#6	5'-6"


LEGEND

 INDICATES HP14x117 STEEL "H" PILE WITH 30" PREBORED HOLE


NOTES:

FOR ABUTMENT PILE LAYOUT PLAN, SEE SHEETS 10/68 TO 11/68.
 FOR ABUTMENT PLAN AND ELEVATION, SEE SHEETS 14/68 TO 15/68.

DESIGN AGENCY: STRUCTUREPOINT
 DATE: 1/03/19
 REVIEWED: MDS
 DRAWN: DSH
 DESIGNED: SUJ
 CHECKED: CLB
 STRUCTURE FILE NUMBER: 3109763
 BRIDGE NO. HAM-75-0440 L/R
 OVER WB I-74
 HAM-75-3.84
 PID No. 104667
 13/68
 13/68

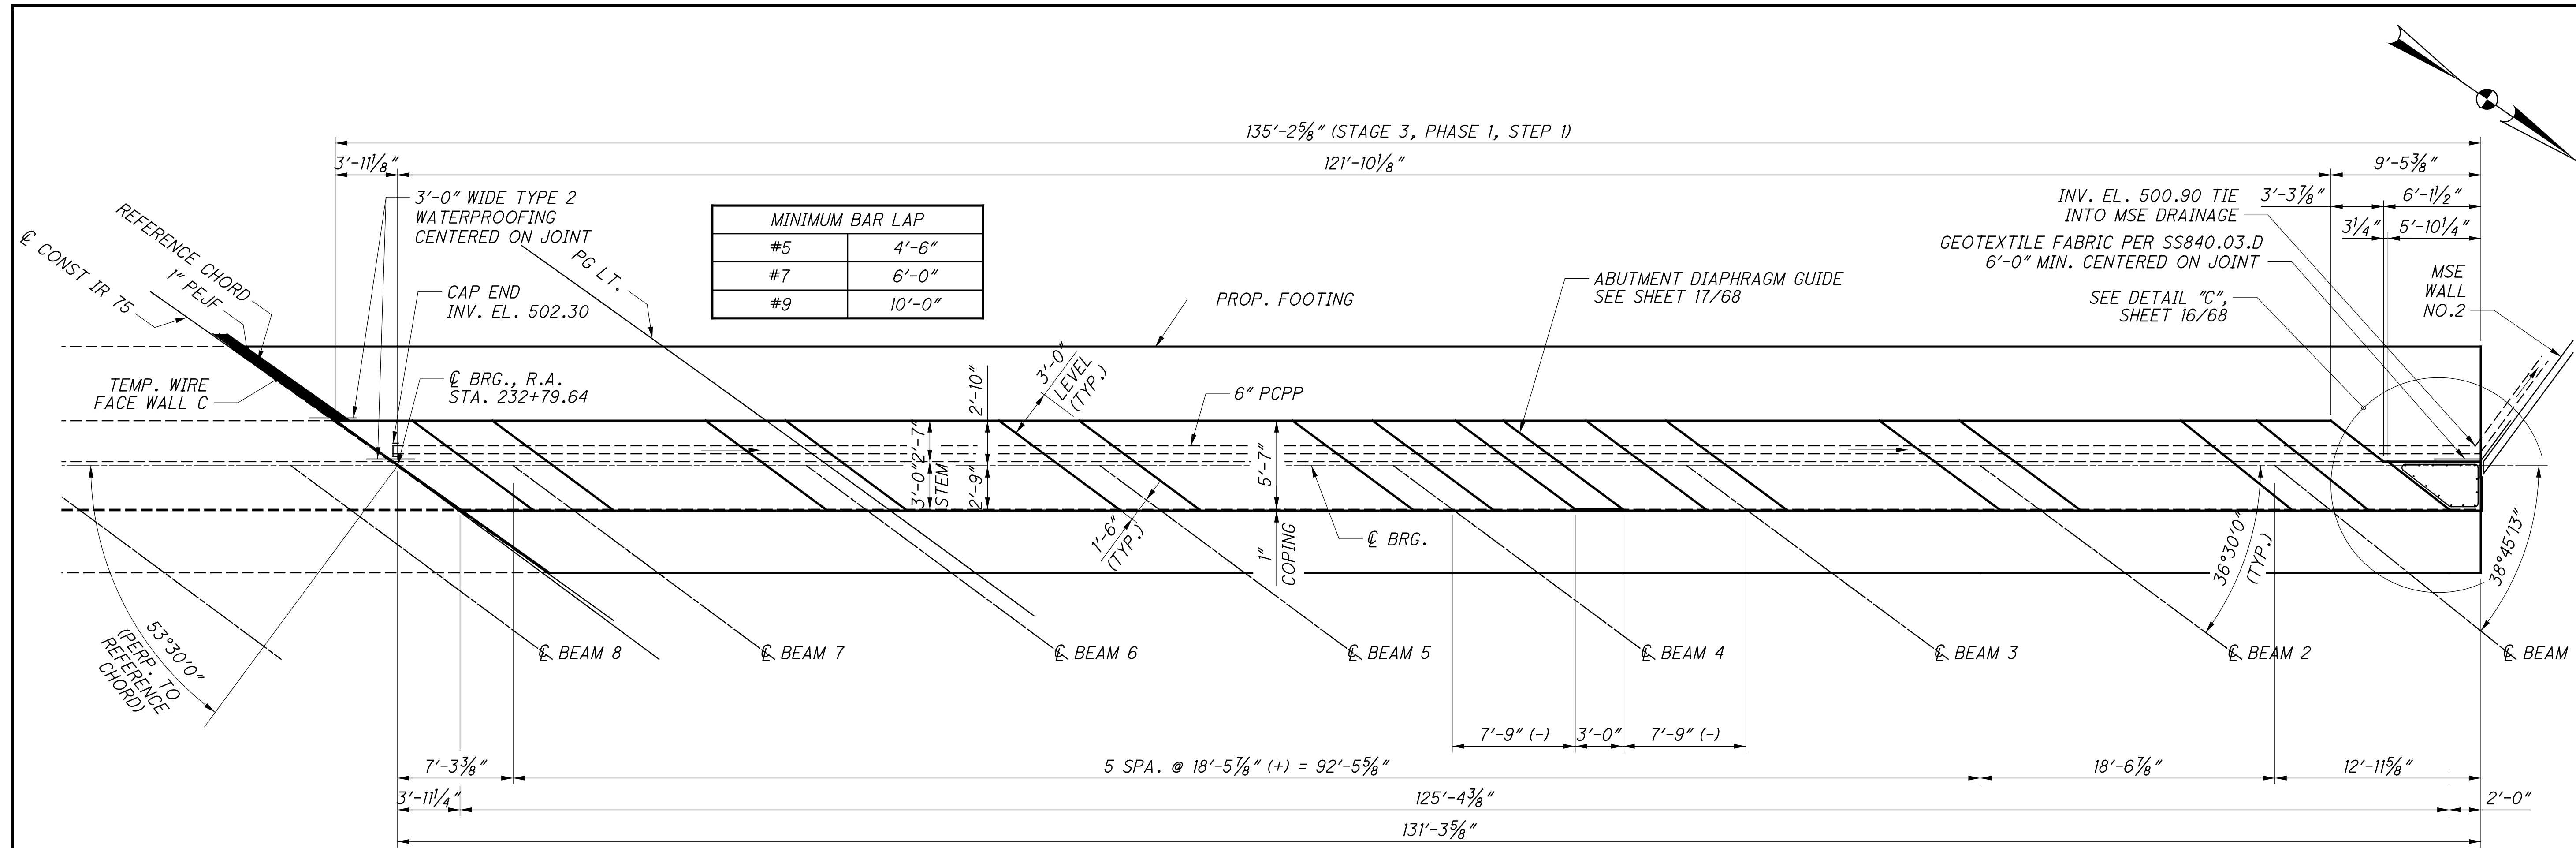



**PLAN - REAR ABUTMENT
LEFT BRIDGE**

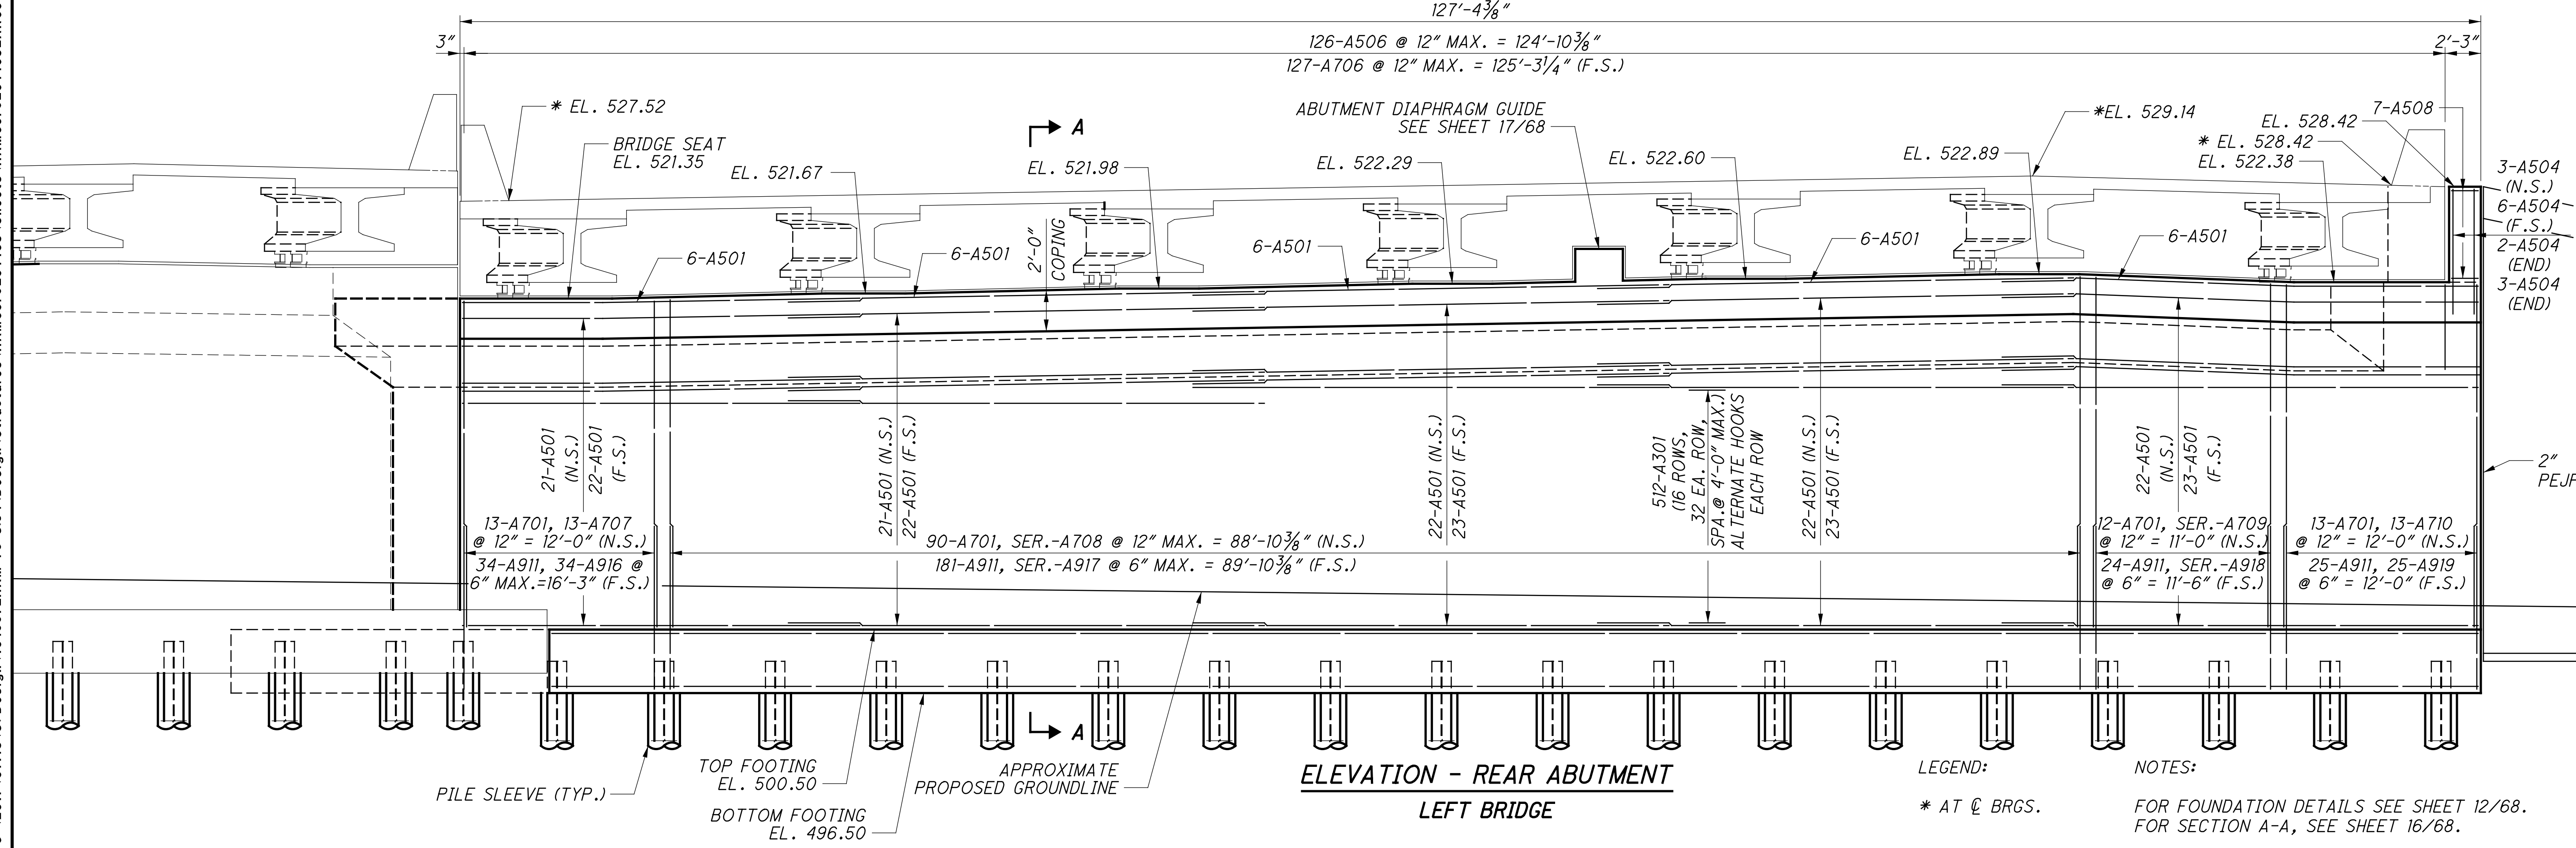

**ELEVATION - REAR ABUTMENT
LEFT BRIDGE**


LEGEND: * AT @ BRGS.
 NOTES: FOR FOUNDATION DETAILS SEE SHEET 12/68.
 FOR SECTION A-A, SEE SHEET 16/68.

S:\Flanagan\10_26_2023 4:26:19 PM\01\2017\01113\C.Design\104667-HAM-75-3.84.Design\Structures\HAM0075_0440C_Sheets\HAM0075_0440C_AR004.dgn

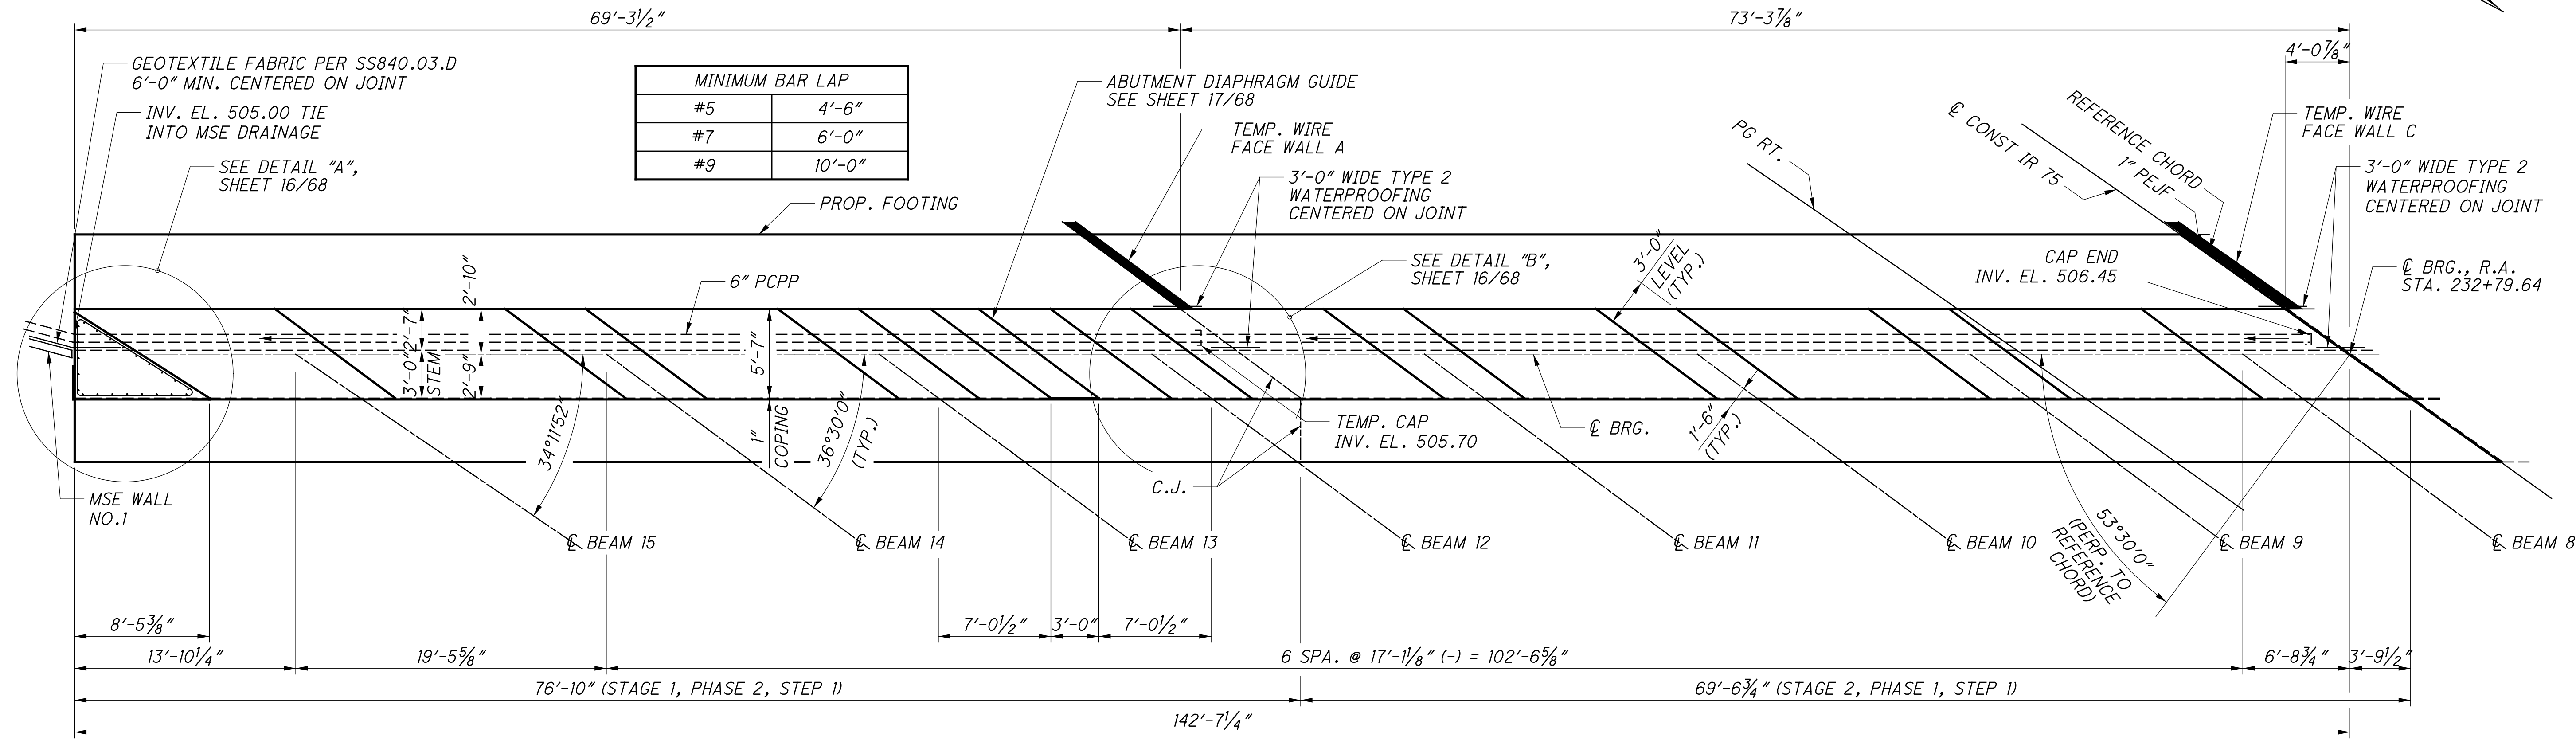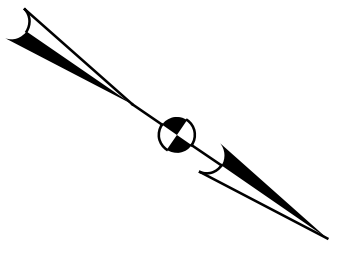

MINIMUM BAR LAP	
#5	4'-6"
#7	6'-0"
#9	10'-0"

**PLAN - REAR ABUTMENT
RIGHT BRIDGE**

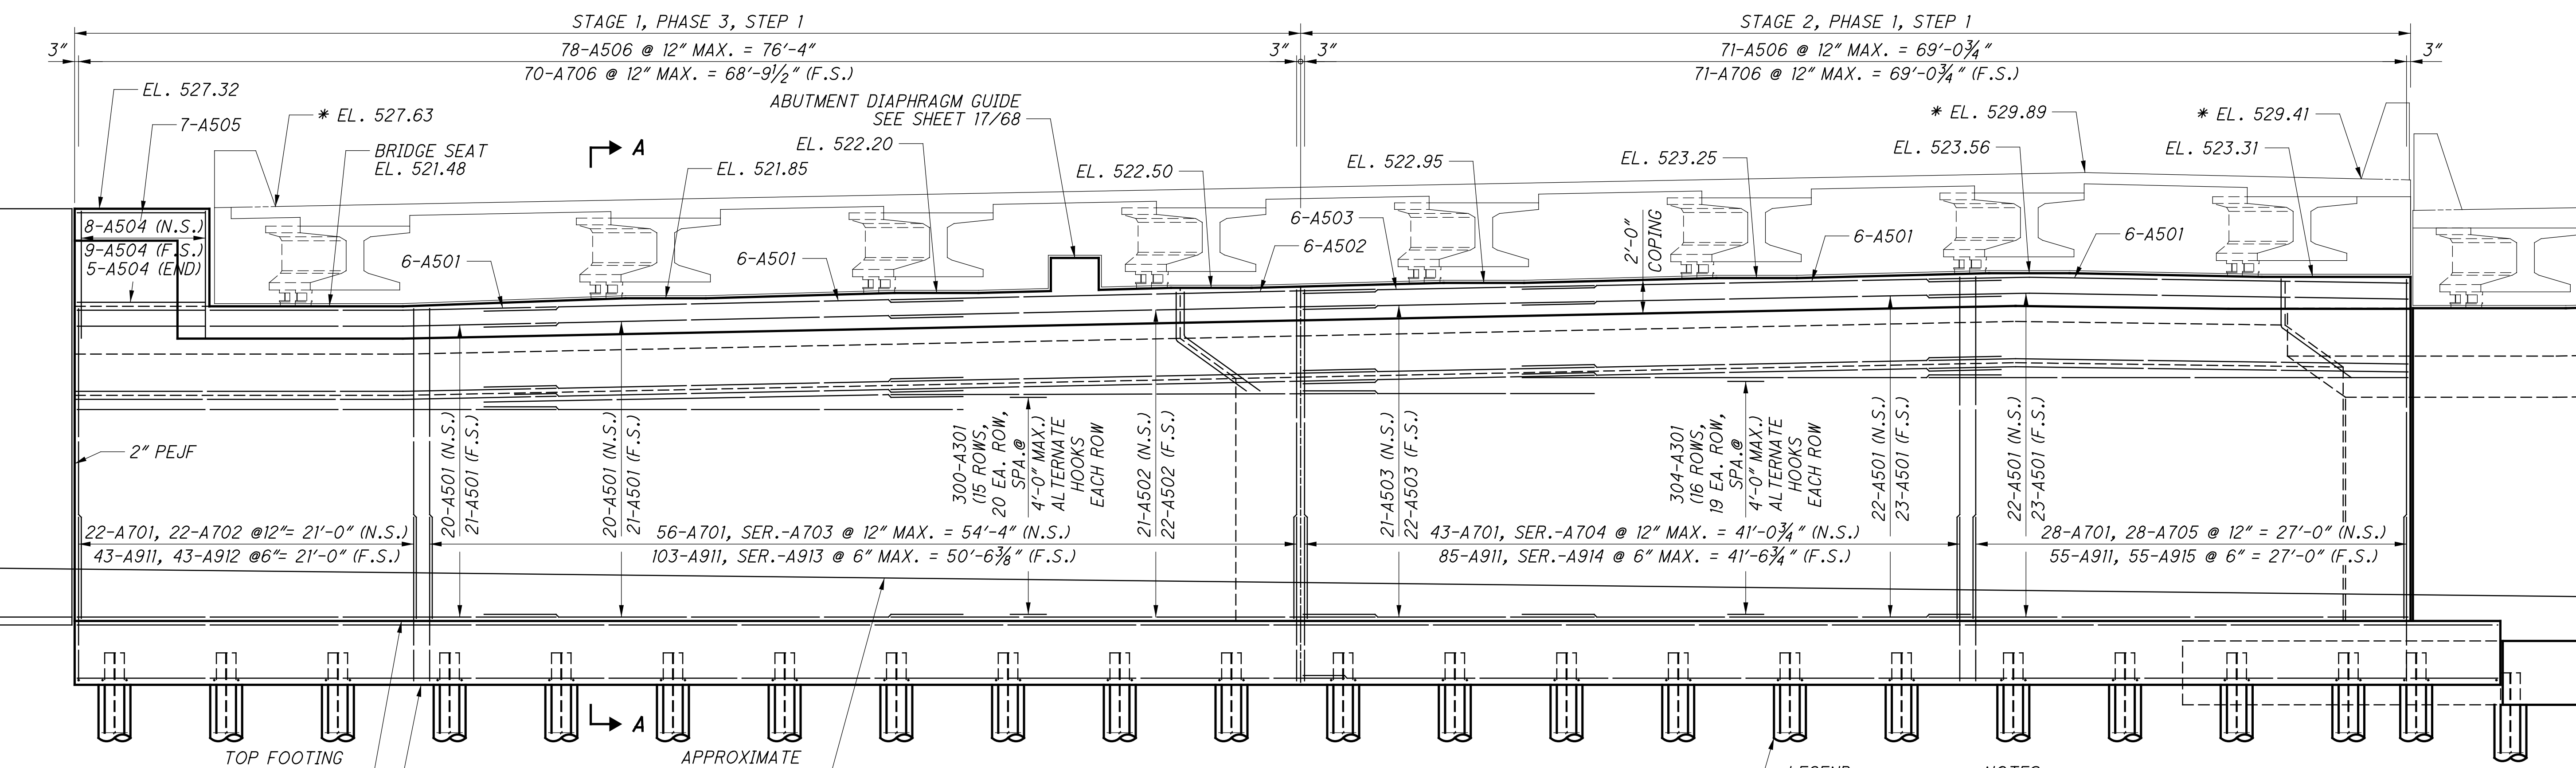

**ELEVATION - REAR ABUTMENT
RIGHT BRIDGE**


LEGEND:
* AT C BRGS.

NOTES:
FOR FOUNDATION DETAILS SEE SHEET 13/68.
FOR SECTION A-A, SEE SHEET 16/68.


S:\Flanagan\10_26_2023 4:26:20 PM\01\2017\01113\C.Design\104667-HAM-75-3.84\Design\Structures\HAM0075_0440C\Sheets\HAM0075_0440C_AR003.dgn

DESIGN AGENCY: STRUCTUREPOINT
 DATE: 1/03/19
 REVIEWED: MDS
 DRAWN: DSH
 DESIGNED: SJF
 CHECKED: CLB
 STRUCTURE FILE NUMBER: 3109763
 BRIDGE NO.: HAM-75-0440 L/R
 OVER WB 1-74
 HAM-75-3.84
 PID No. 104667
 15/68
 15/68


SFlansagan
 10/26/2023 4:26:21 PM
 O:\2017\01113\C.Design\104667_HAM-75-3.84\Design\Structures\HAM0075_0440C_Sheets\HAM0075_0440C_AR005.dgn

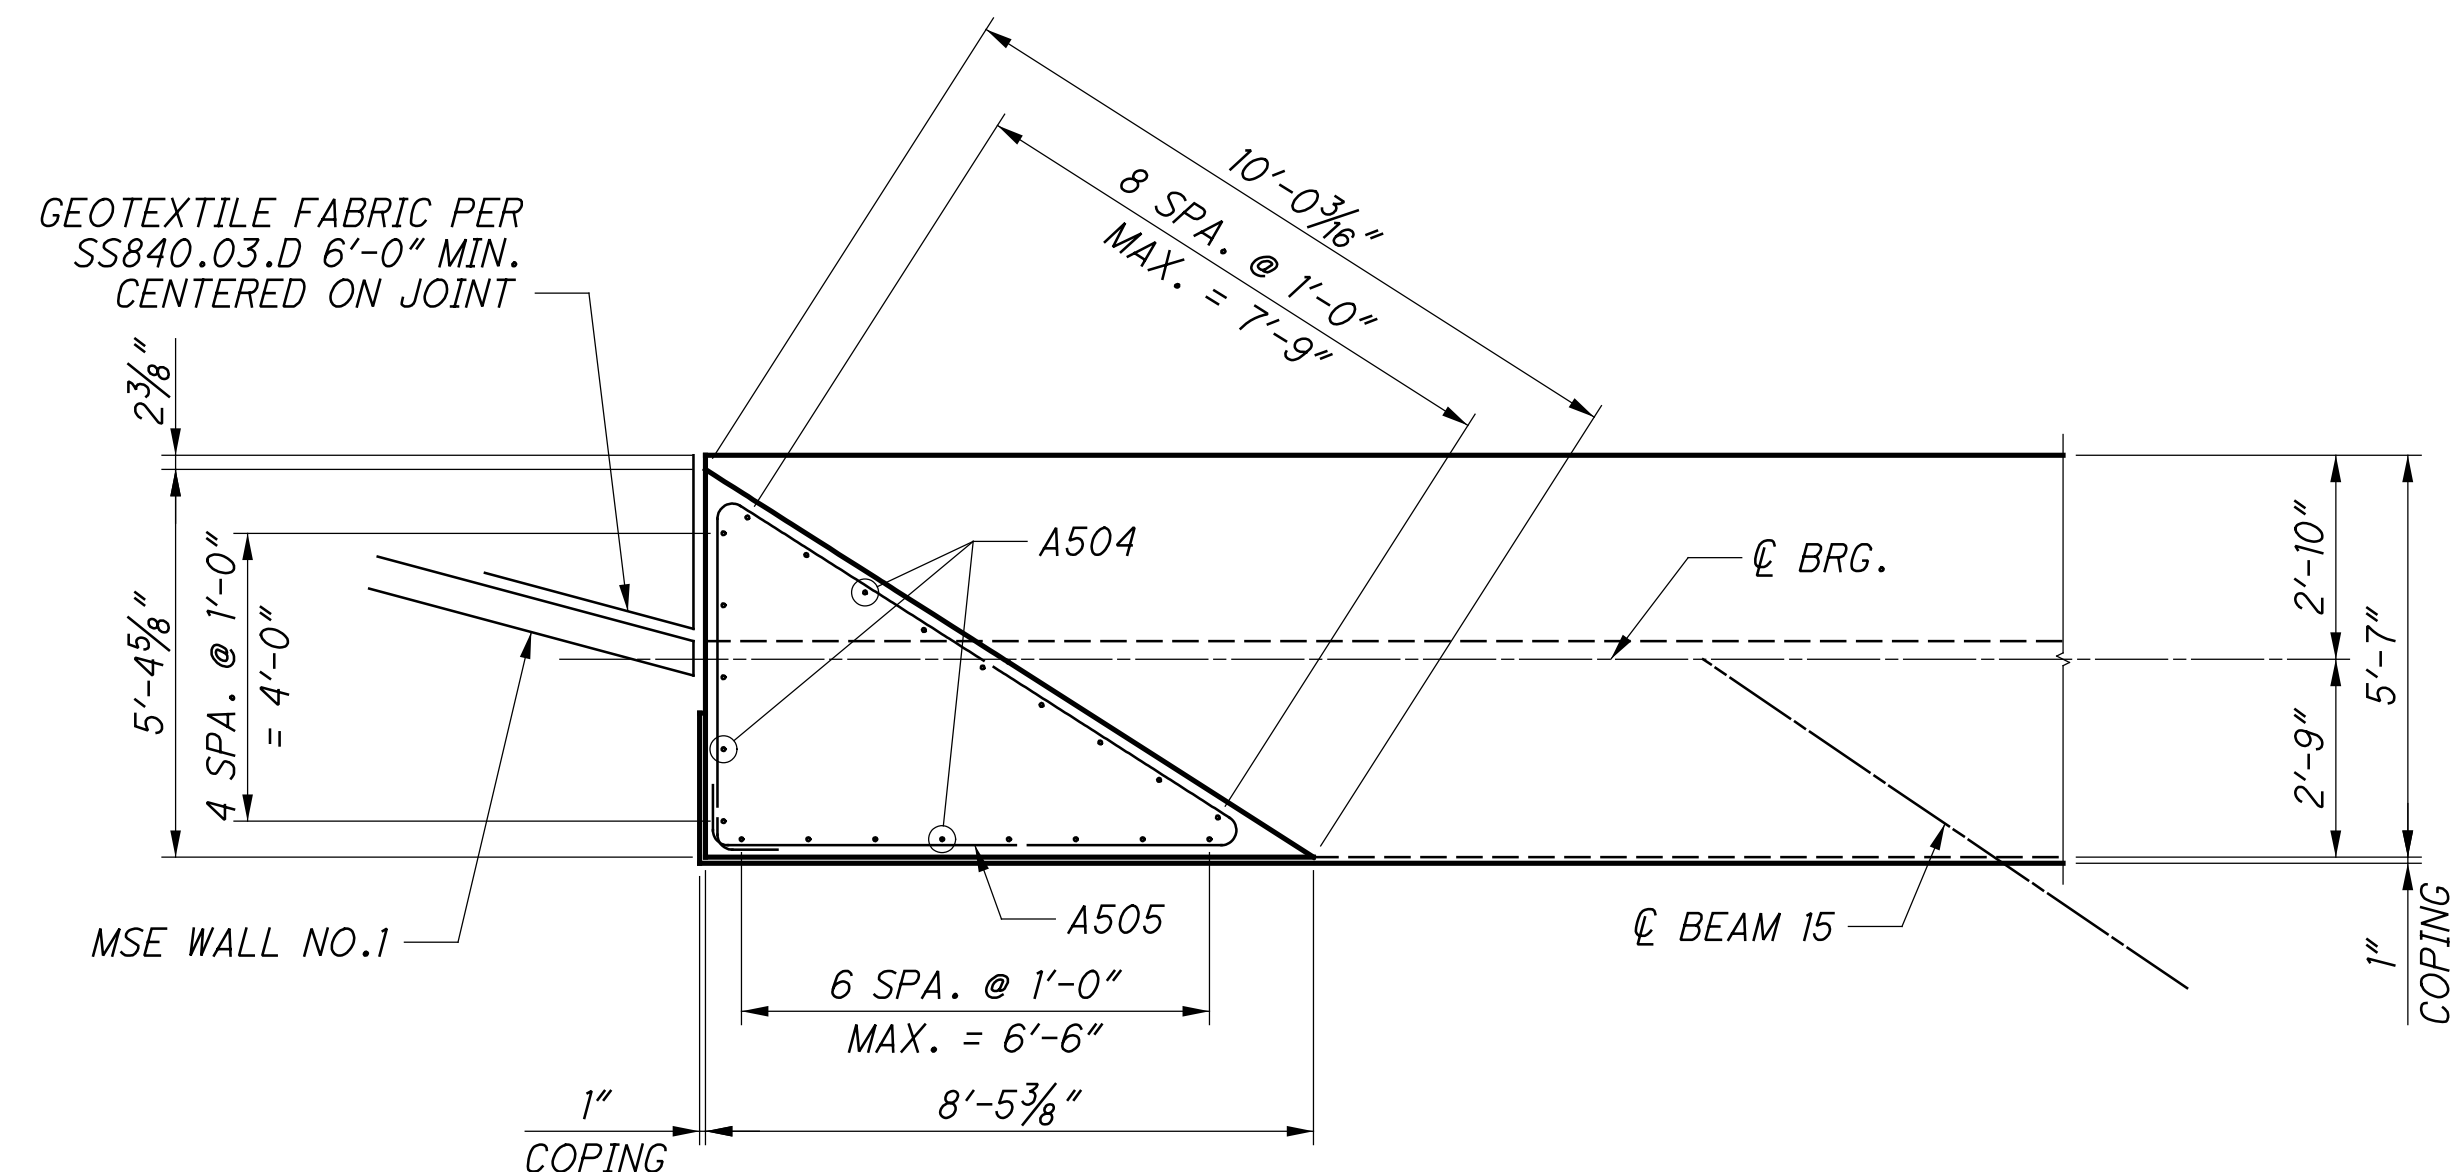


DETAIL "A"

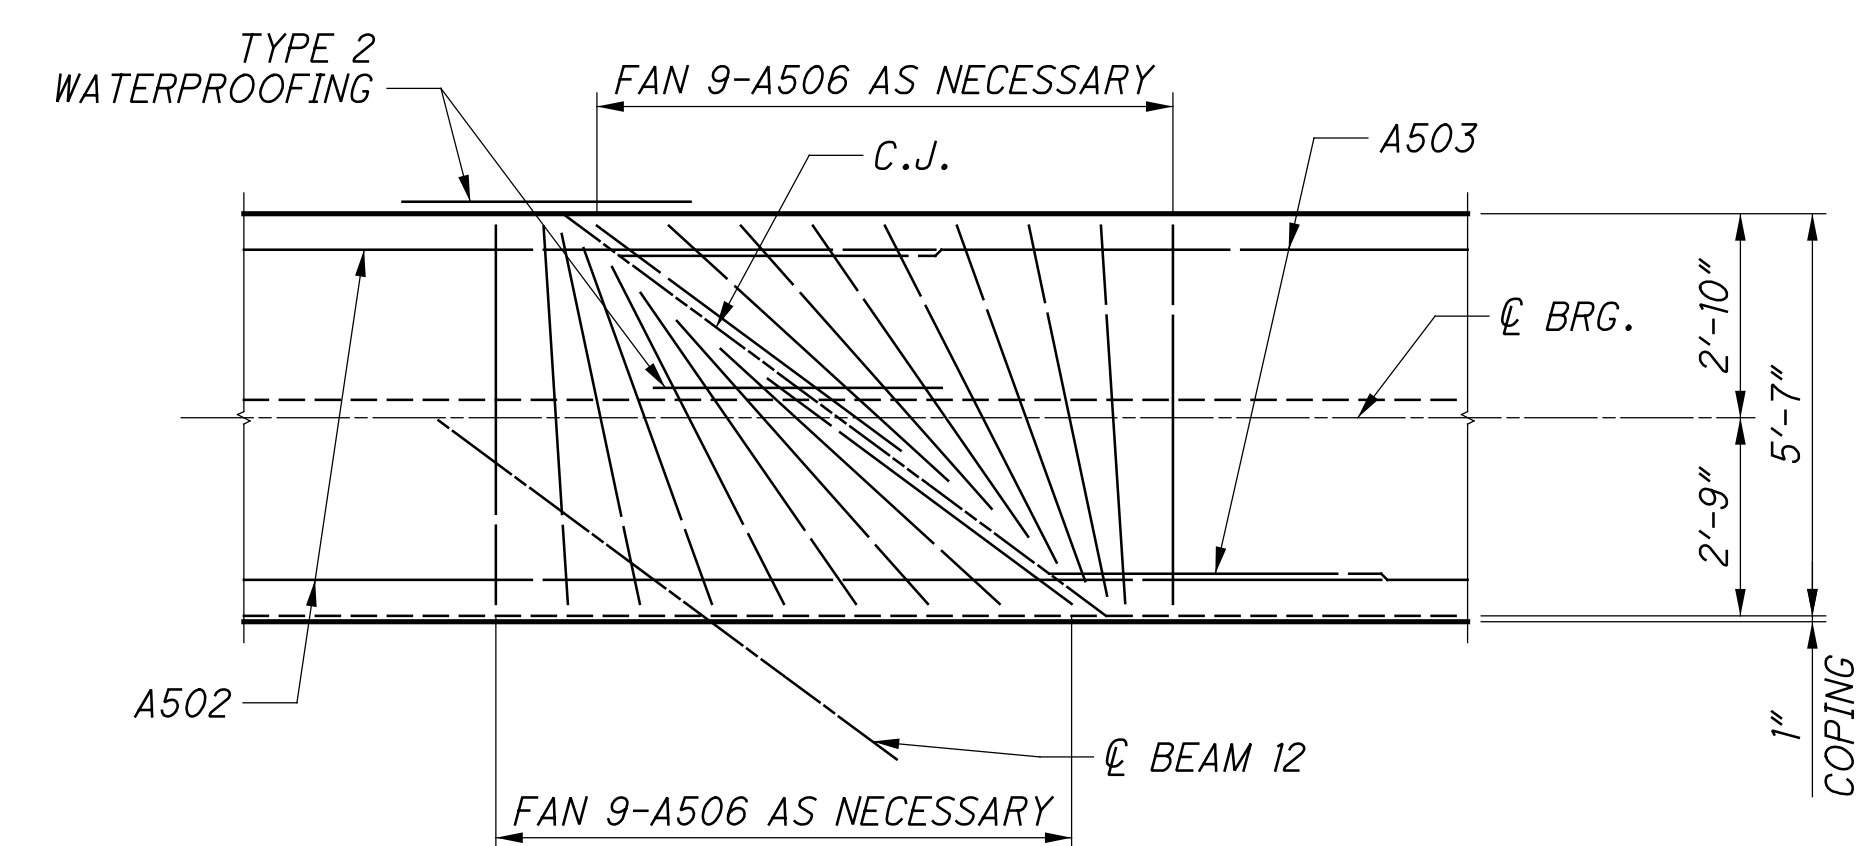

DETAIL "B"

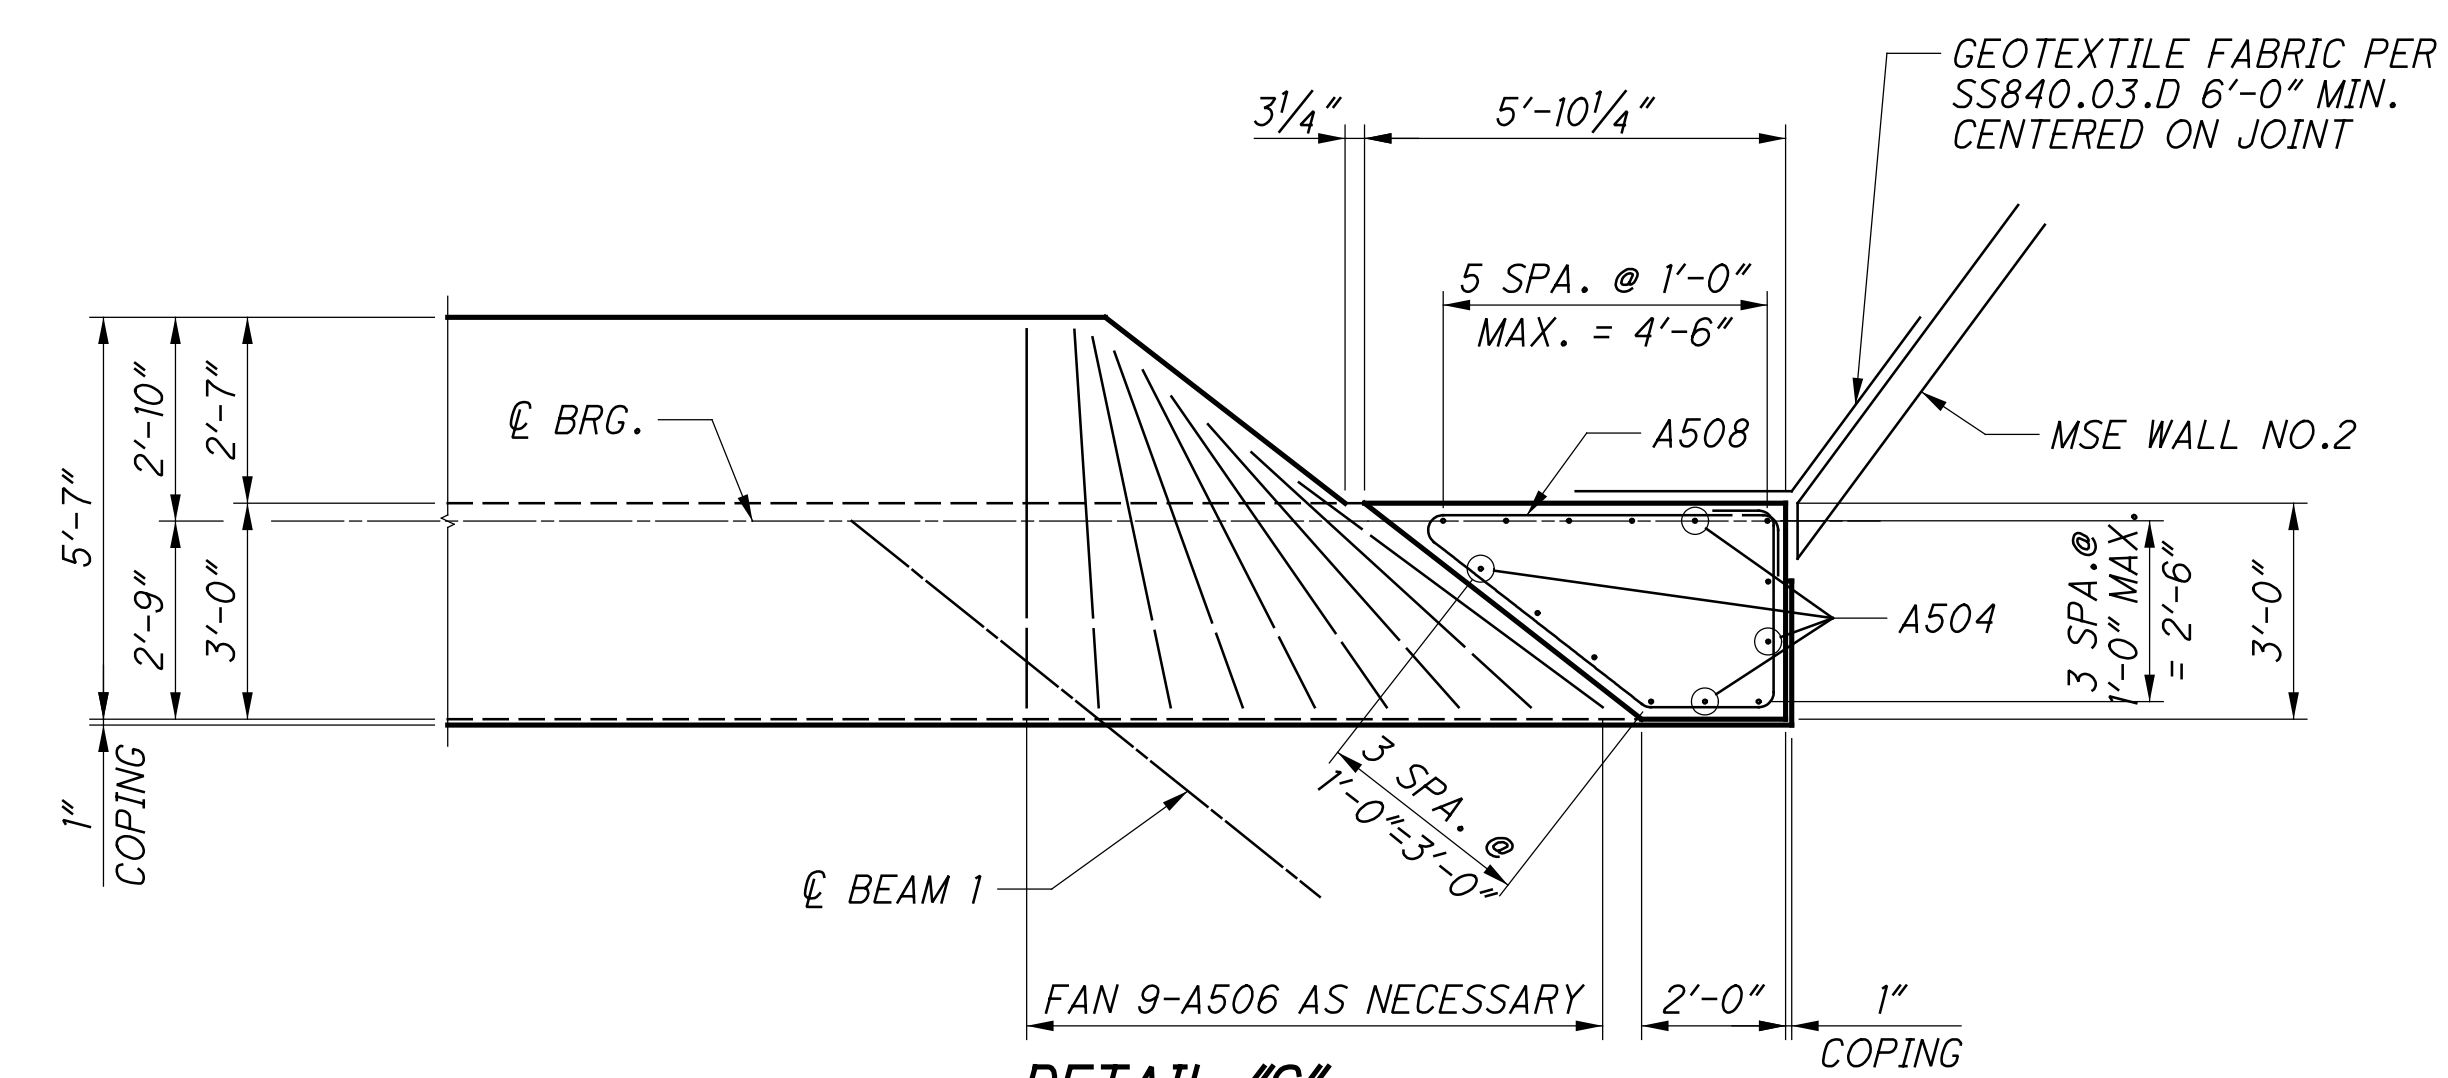

DETAIL "C"

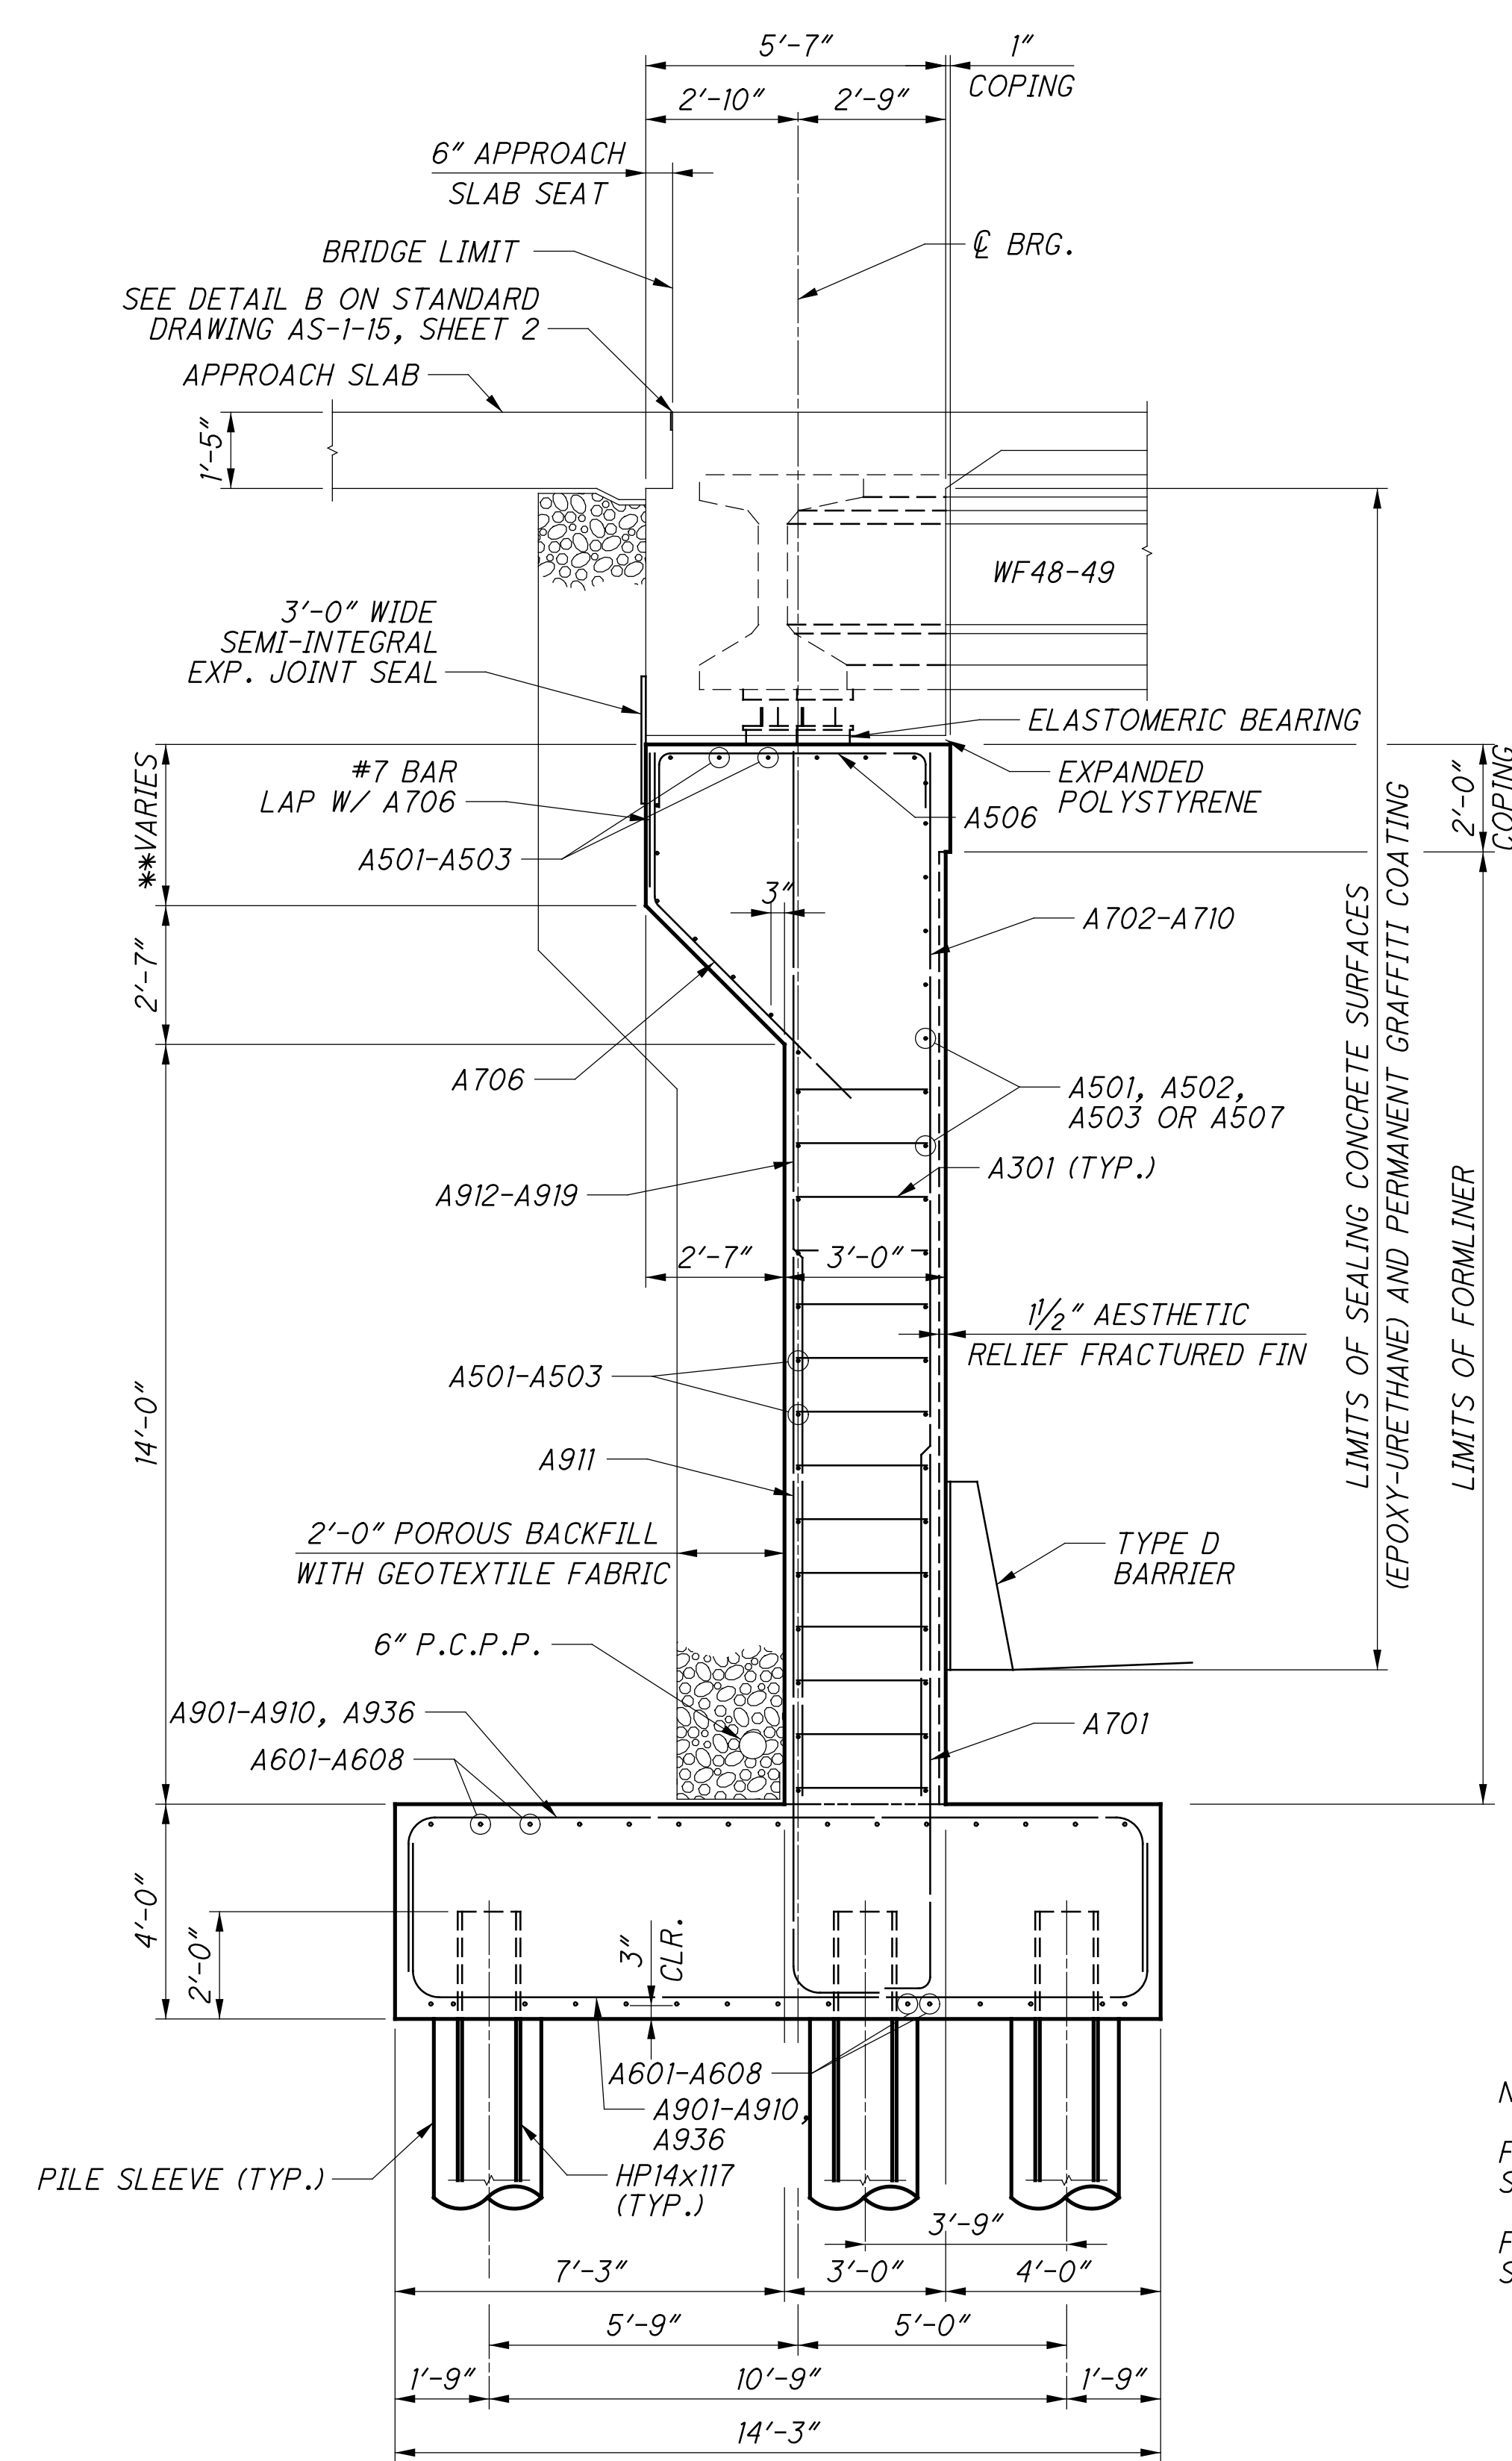


SECTION A-A

** RIGHT BRIDGE VARIES 3'-1 3/4" MIN. TO 5'-2 3/4" MAX.
 LEFT BRIDGE VARIES 4'-3 1/4" MIN. TO 5'-9 3/4" MAX.


MINIMUM BAR LAP	
#5	4'-6"
#7	6'-0"
#9	10'-0"

NOTES:
 FOR LOCATION OF DETAILS "A" AND "B",
 SEE SHEET 15/68.
 FOR LOCATION OF DETAIL "C",
 SEE SHEET 14/68.



SFlanagan
 10/26/2023 4:26:21 PM
 \\0\2017\01113\C.Design\104667-HAM-75-3.84\Design\Structures\HAM0075_0440C_Sheets\HAM0075_0440C_AR006.dgn

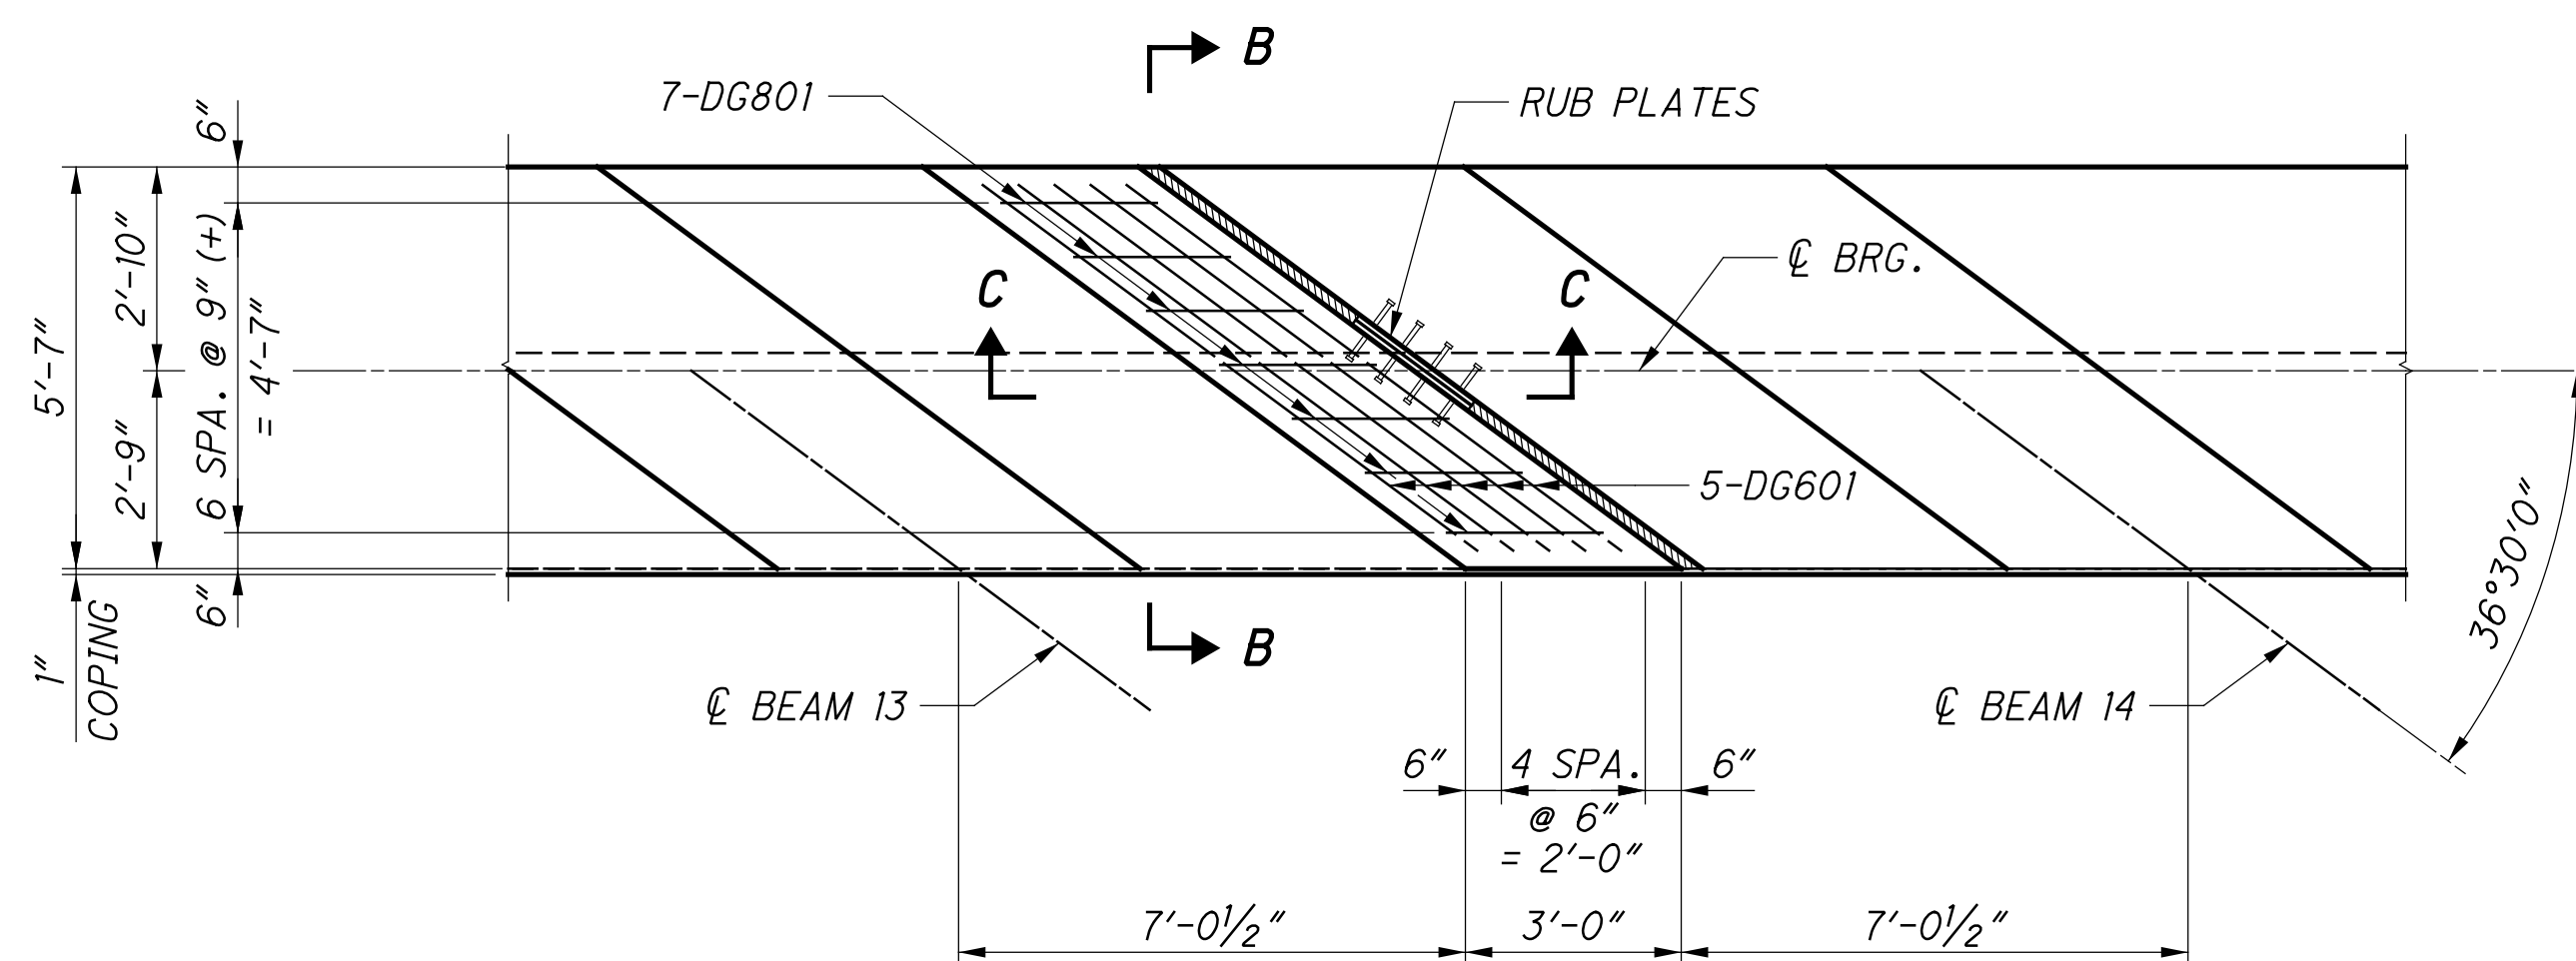

**ABUTMENT DIAPHRAGM GUIDE PLAN AT
 REAR ABUTMENT - RIGHT BRIDGE**

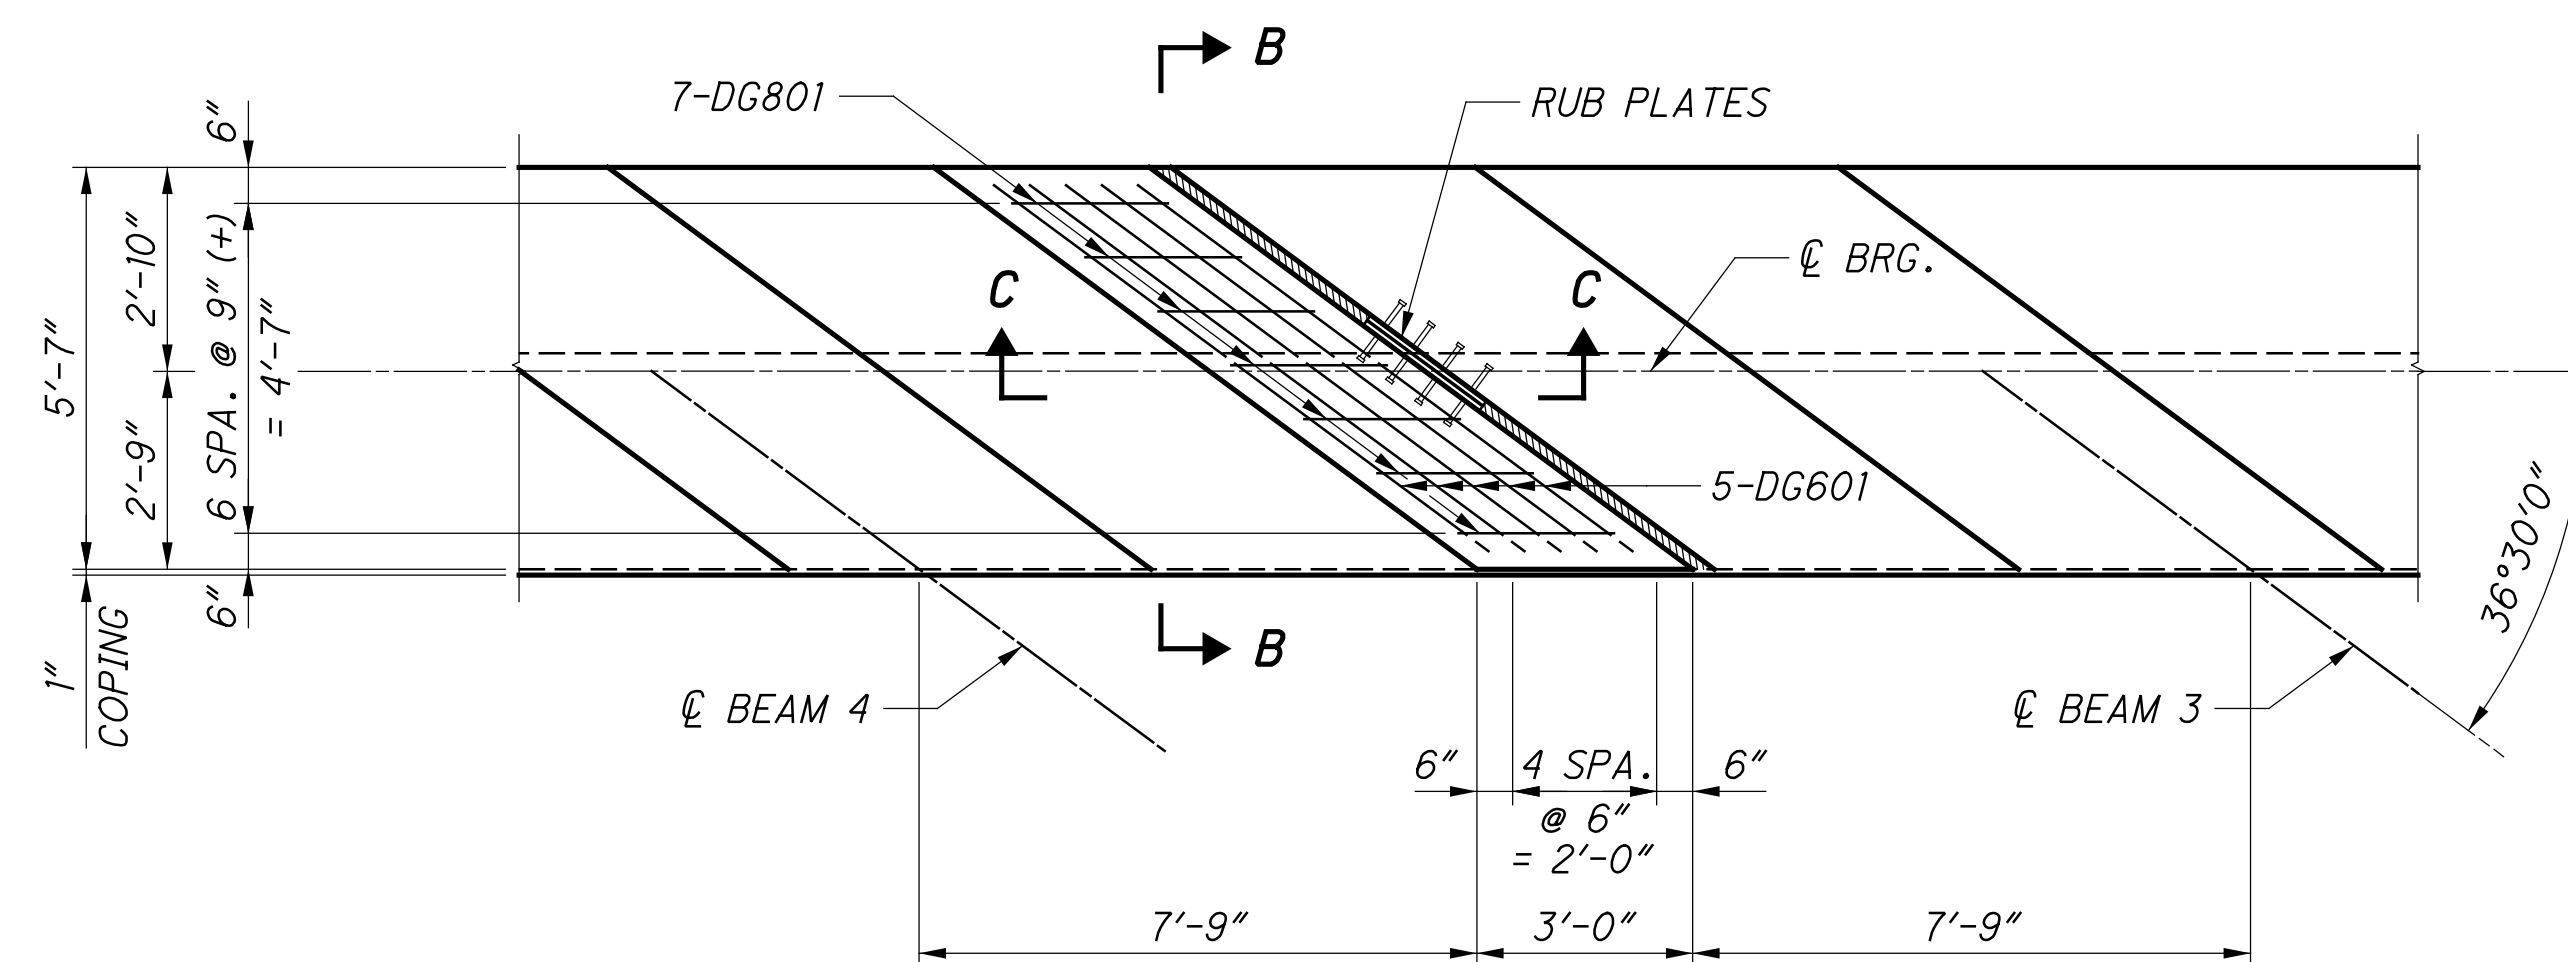

**ABUTMENT DIAPHRAGM GUIDE PLAN AT
 REAR ABUTMENT - LEFT BRIDGE**

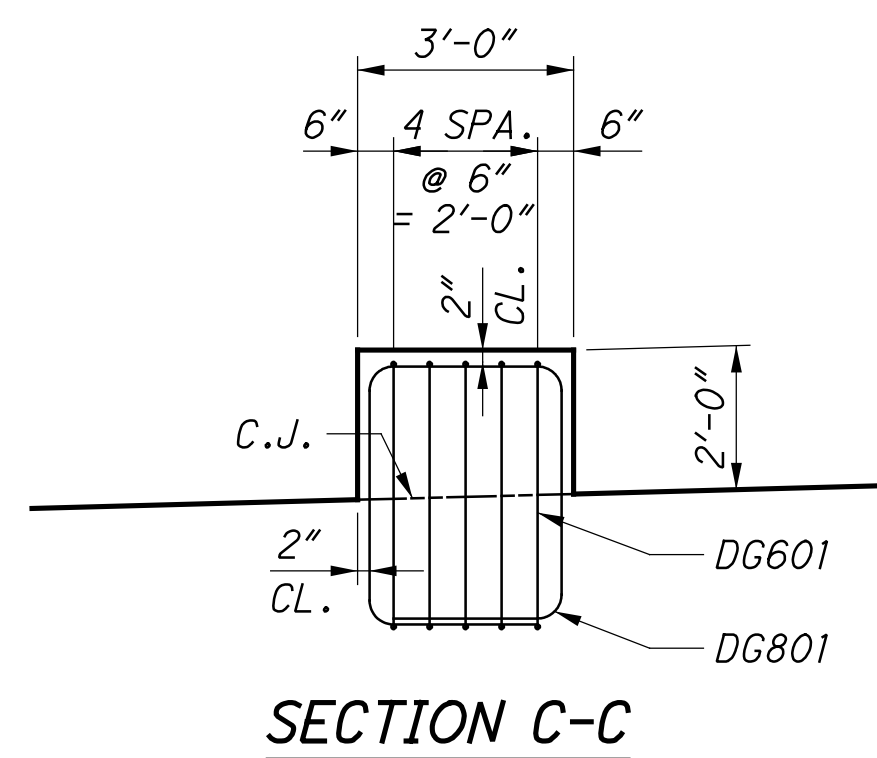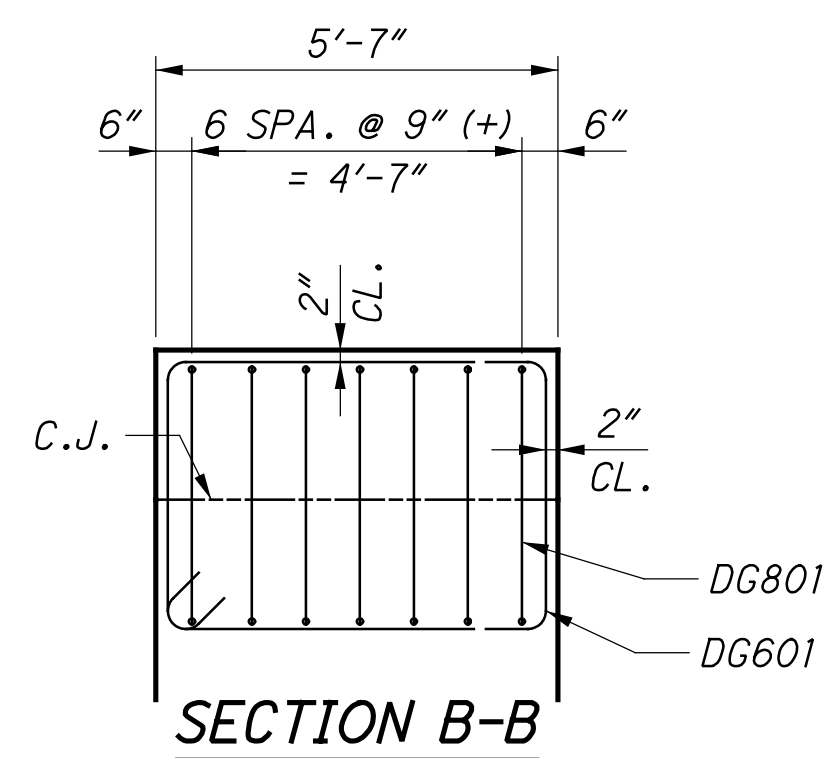


ABUTMENT DIAPHRAGM GUIDE DETAILS

NOTES:

FOR ADDITIONAL ABUTMENT DIAPHRAGM GUIDE DETAILS,
 SEE STANDARD DRAWING SICD-2-14.

DESIGN AGENCY <small>STRUCTUREPOINT A DIVISION OF PARSONS BRINCKERHOFF</small>	DESIGNED SJF CHECKED CLB	DRAWN DSH REVISED	REVIEWED MDS	DATE 1/03/19
	BRIDGE NO. - HAM-75-0440 L/R OVER WB 1-74	REAR ABUTMENT DETAILS BRIDGE NO. - HAM-75-0440 L/R OVER WB 1-74	STRUCTURE FILE NUMBER 3109163	FILE NUMBER 3109163
HAM-75-3.84 PID No. 104667	17 / 68	17 / 68	17 / 68	17 / 68

SFlanagan
 10/26/2023 4:26:22 PM
 \\0\2017\01113\C.Design\104667-HAM-75-3.84\Design\Structures\HAM0075_0440C\Sheets\HAM0075_0440C_AF008.dgn

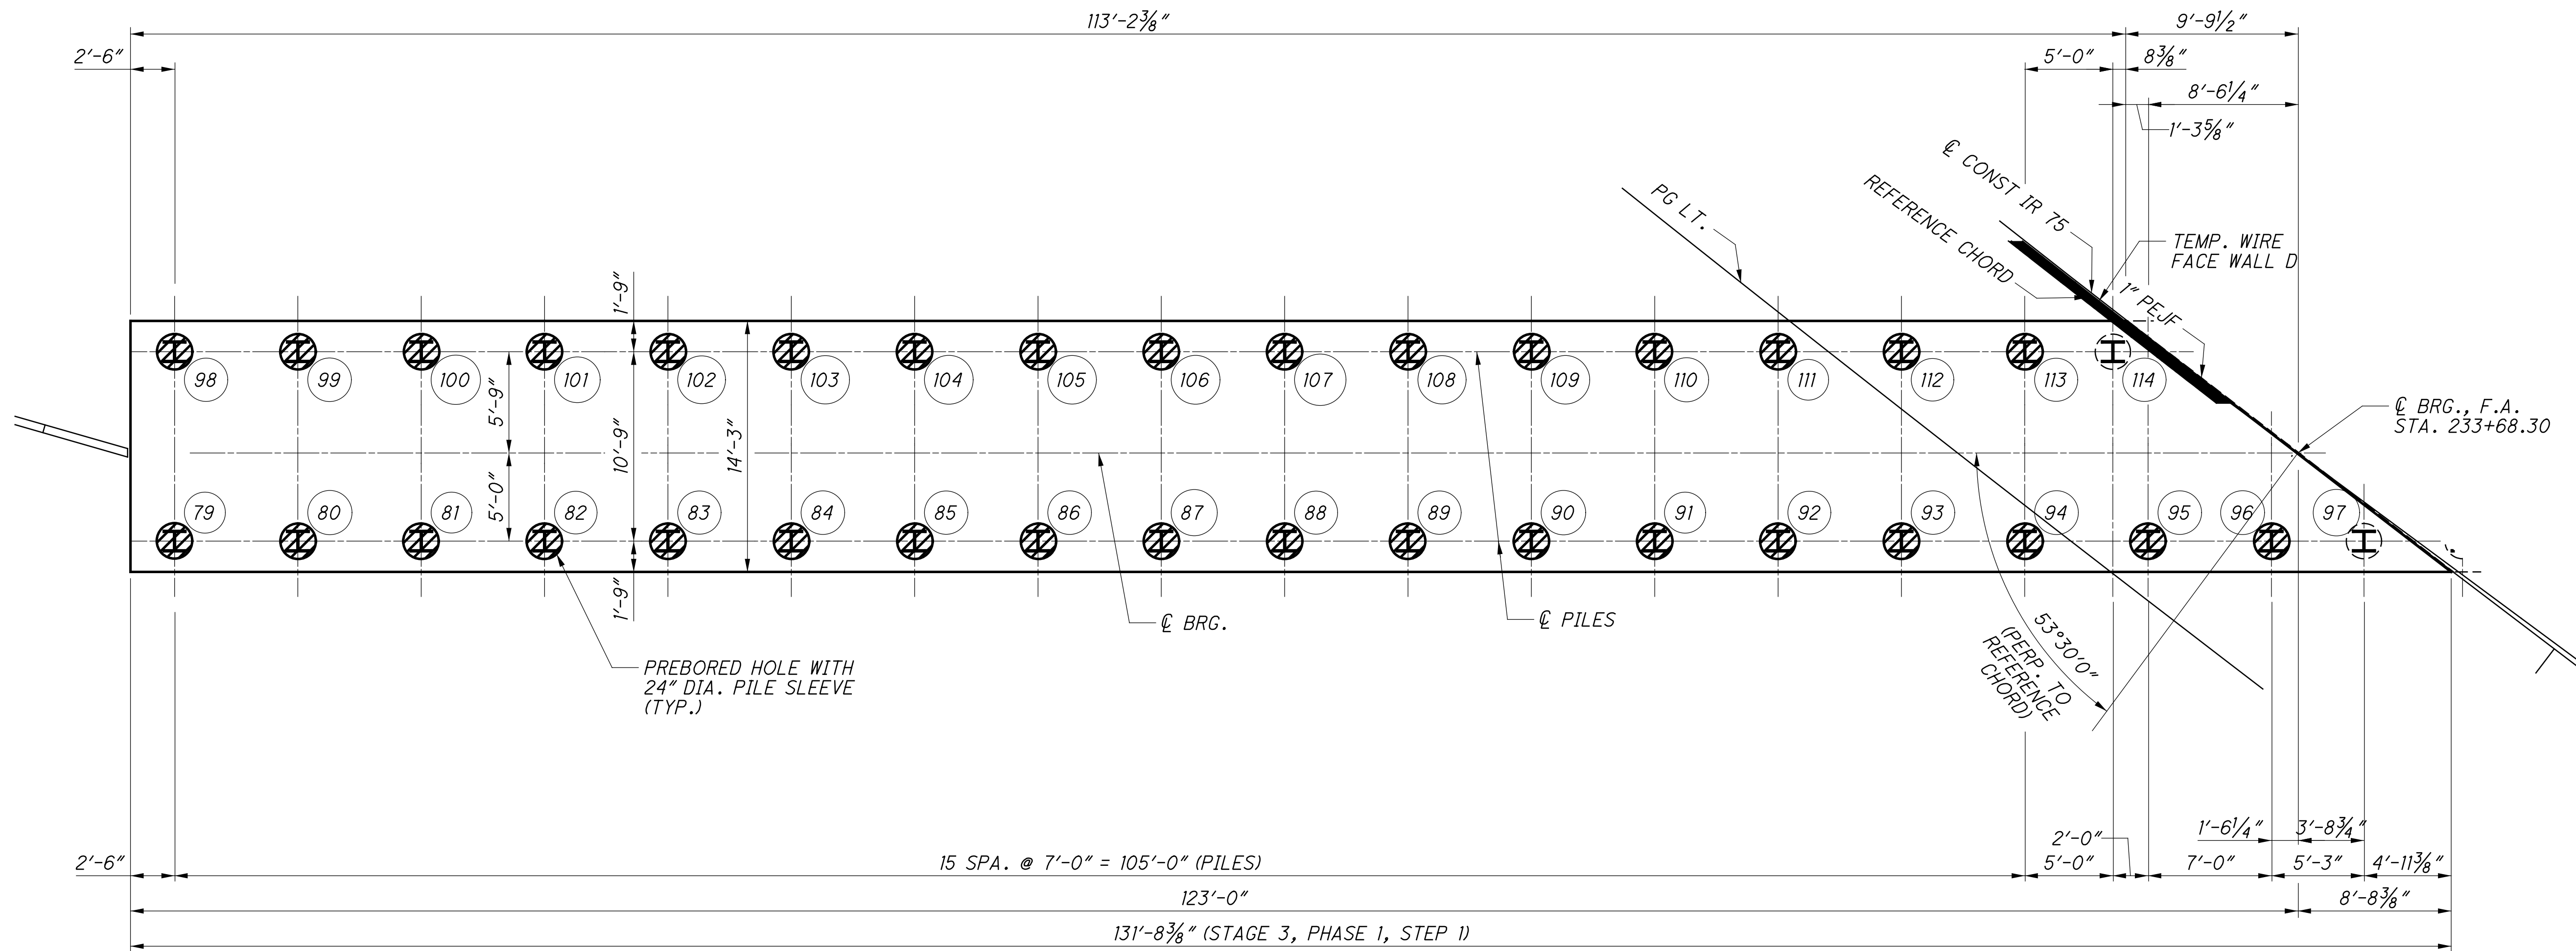


LEFT FORWARD ABUTMENT PILE LAYOUT PLAN

LEGEND

- (XX) INDICATES PILE NUMBER
- (I) INDICATES HP14x117 STEEL "H" PILE WITH 30" PREBORED HOLE
- (/ /) PILES 98-113 TOP OF ROCK ENCOUNTERED AT BOTTOM OF FOOTING ELEVATION. PILE SLEEVES AND LSM WERE ELIMINATED. PILE POURED IN 14' ROCK SOCKET WITH CONCRETE.
- (/ /) PILES 79-96 TOP OF ROCK ENCOUNTERED AT BOTTOM OF FOOTING ELEVATION. PILE SLEEVES AND LSM WERE ELIMINATED. PILE POURED IN 17' ROCK SOCKET WITH CONCRETE.

	DESIGN AGENCY STRUCTUREPOINT <small>2000 CORPORATE CENTER DRIVE, SUITE 200 WASHINGTON, DC 20004 TEL: (800) 421-2222 FAX: (202) 462-1000 WWW.STRUCTUREPOINT.COM</small>
DESIGNED SUJ CHECKED CLB	DRAWN DSH REVISED
REVIEWED MDS	DATE 1/03/19
STRUCTURE FILE NUMBER 3109763	OVER WB I-74
FORWARD ABUTMENT DETAILS (LEFT BRIDGE) BRIDGE NO. HAM-75-0440 L/R	
HAM-75-3.84 PID No. 104667	
18 / 68	
<div style="border: 1px solid black; border-radius: 50%; width: 30px; height: 30px; display: flex; align-items: center; justify-content: center; margin: 0 auto;"> 18 68 </div>	


SFlanagan
 10/26/2023 4:26:22 PM
 \\0\2017\01113\C.Design\104667-HAM-75-3.84\Design\Structures\HAM0075-0440C\Sheets\HAM0075-0440C_AF007.dgn

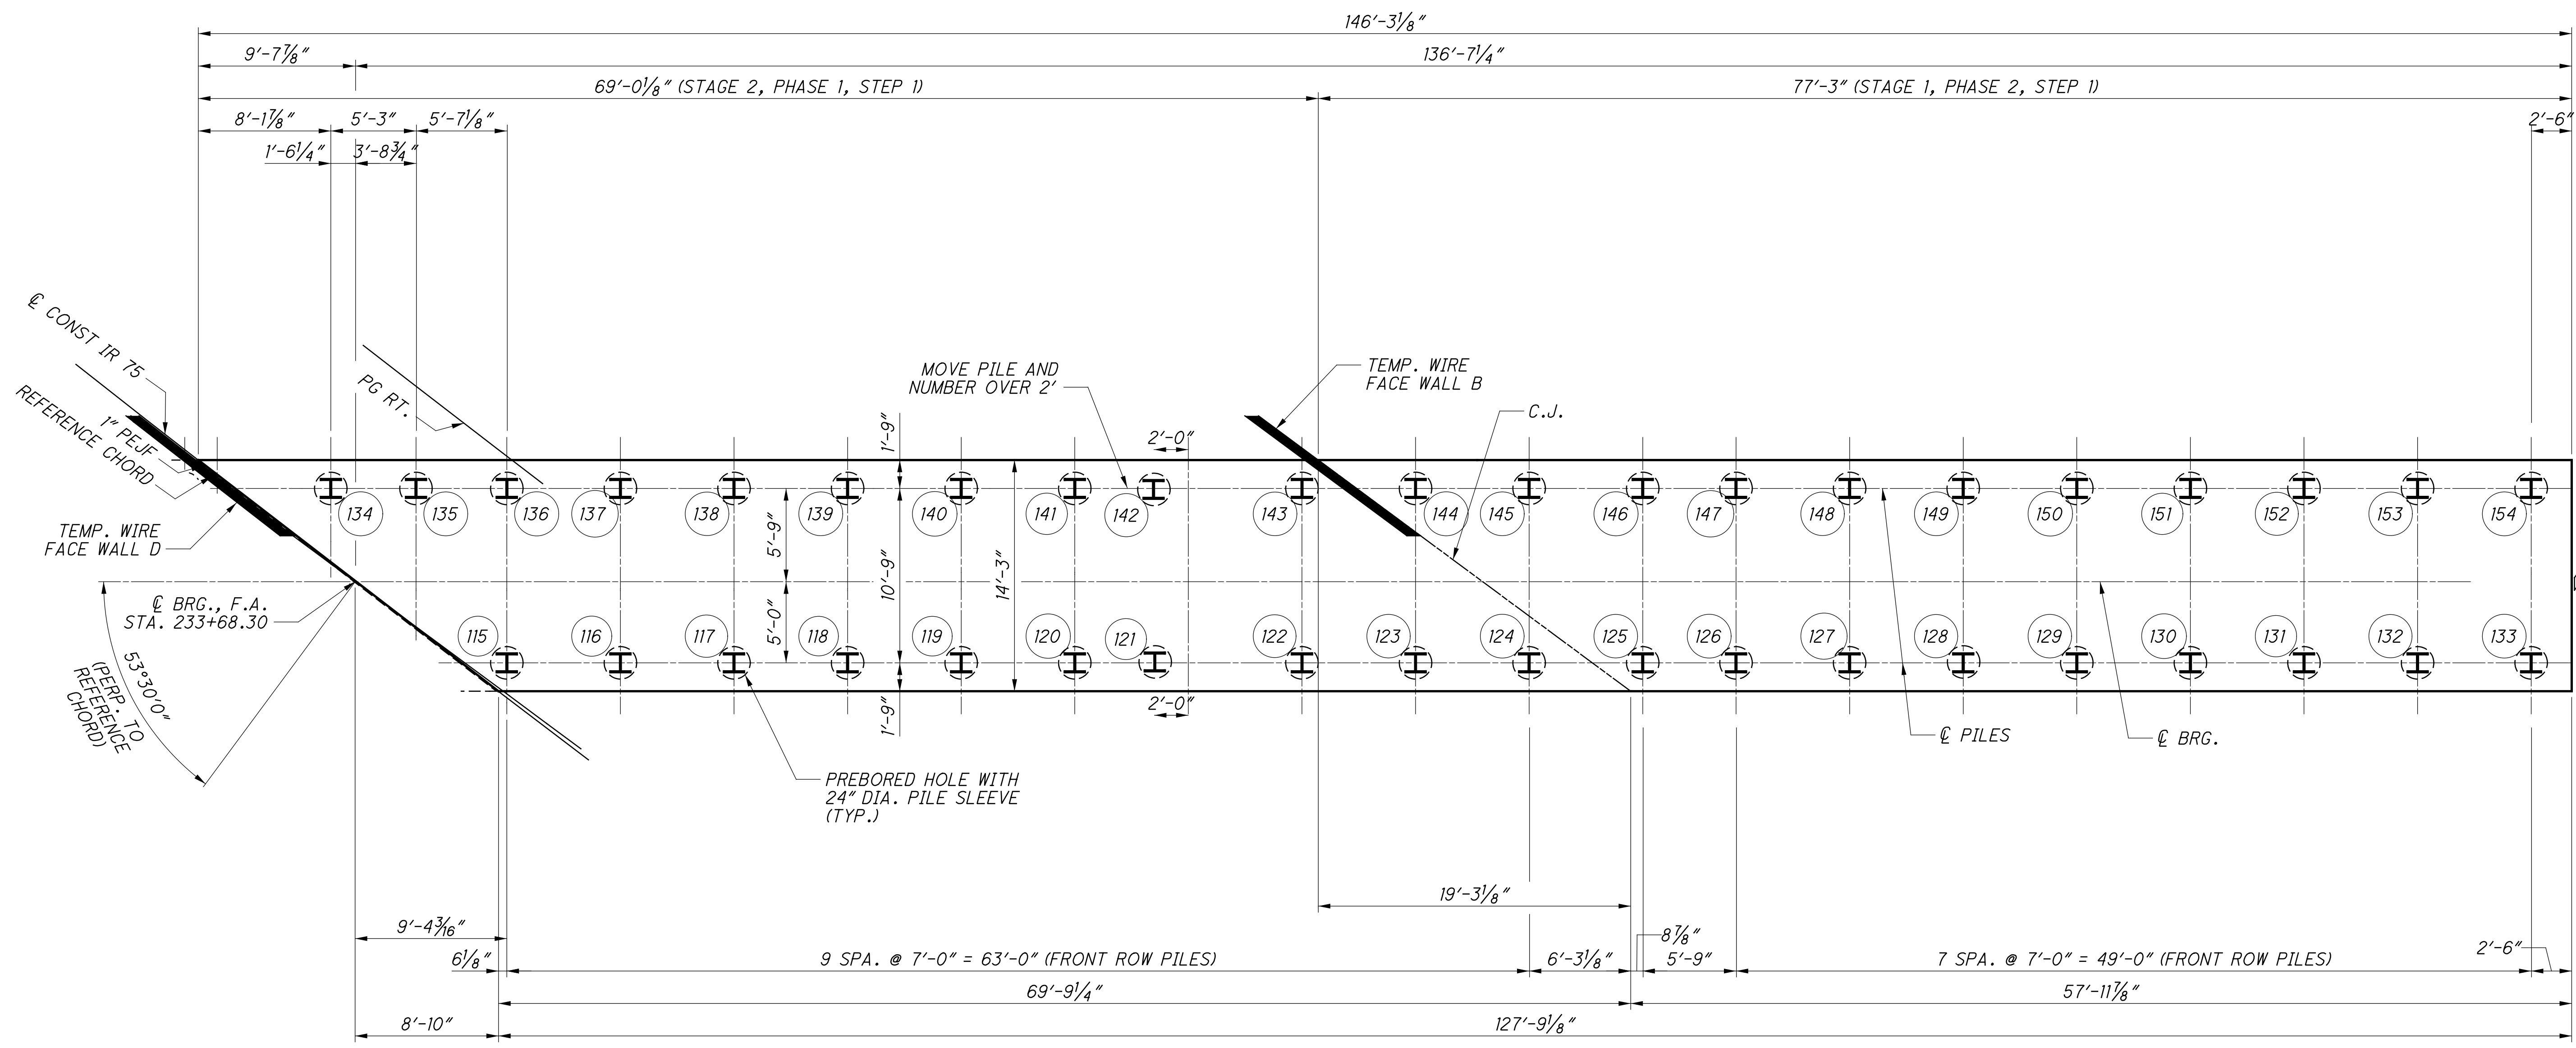

RIGHT FORWARD ABUTMENT PILE LAYOUT PLAN


LEGEND

- (XX) INDICATES PILE NUMBER
- (H) INDICATES HP14x117 STEEL "H" PILE WITH 30" PREBORED HOLE

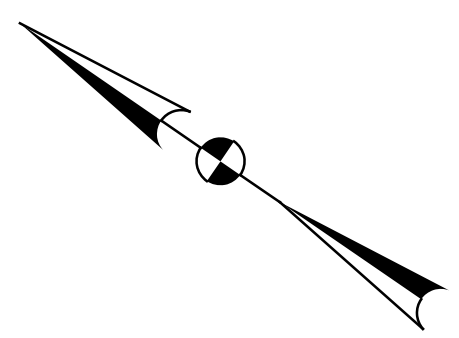

	DESIGN AGENCY STRUCTUREPOINT <small>2000 CORPORATE CENTER DRIVE, SUITE 200 WESTMINSTER, CO 80057 TEL: 303.440.2300 FAX: 303.440.2302 WWW.STRUCTUREPOINT.COM</small>
DESIGNED SUJ CHECKED CLB	DRAWN DSH REVISED
REVIEWED MDS STRUCTURE FILE NUMBER 3109163	DATE 1/03/19
FORWARD ABUTMENT DETAILS (RIGHT BRIDGE) BRIDGE NO. - HAM-75-0440 L/R OVER WB I-74	
HAM-75-3.84 PID No. 104667	
19 / 68	
<div style="border: 1px solid black; border-radius: 50%; width: 30px; height: 30px; display: flex; align-items: center; justify-content: center; margin: 0 auto;"> 19 68 </div>	

S:\Flanagan\10/26/2023 4:26:23 PM\0\2017\01113\C.Design\104667-HAM-75-3.84\Design\Structures\HAM0075_0440C_Sheets\HAM0075_0440C_AF002.dgn

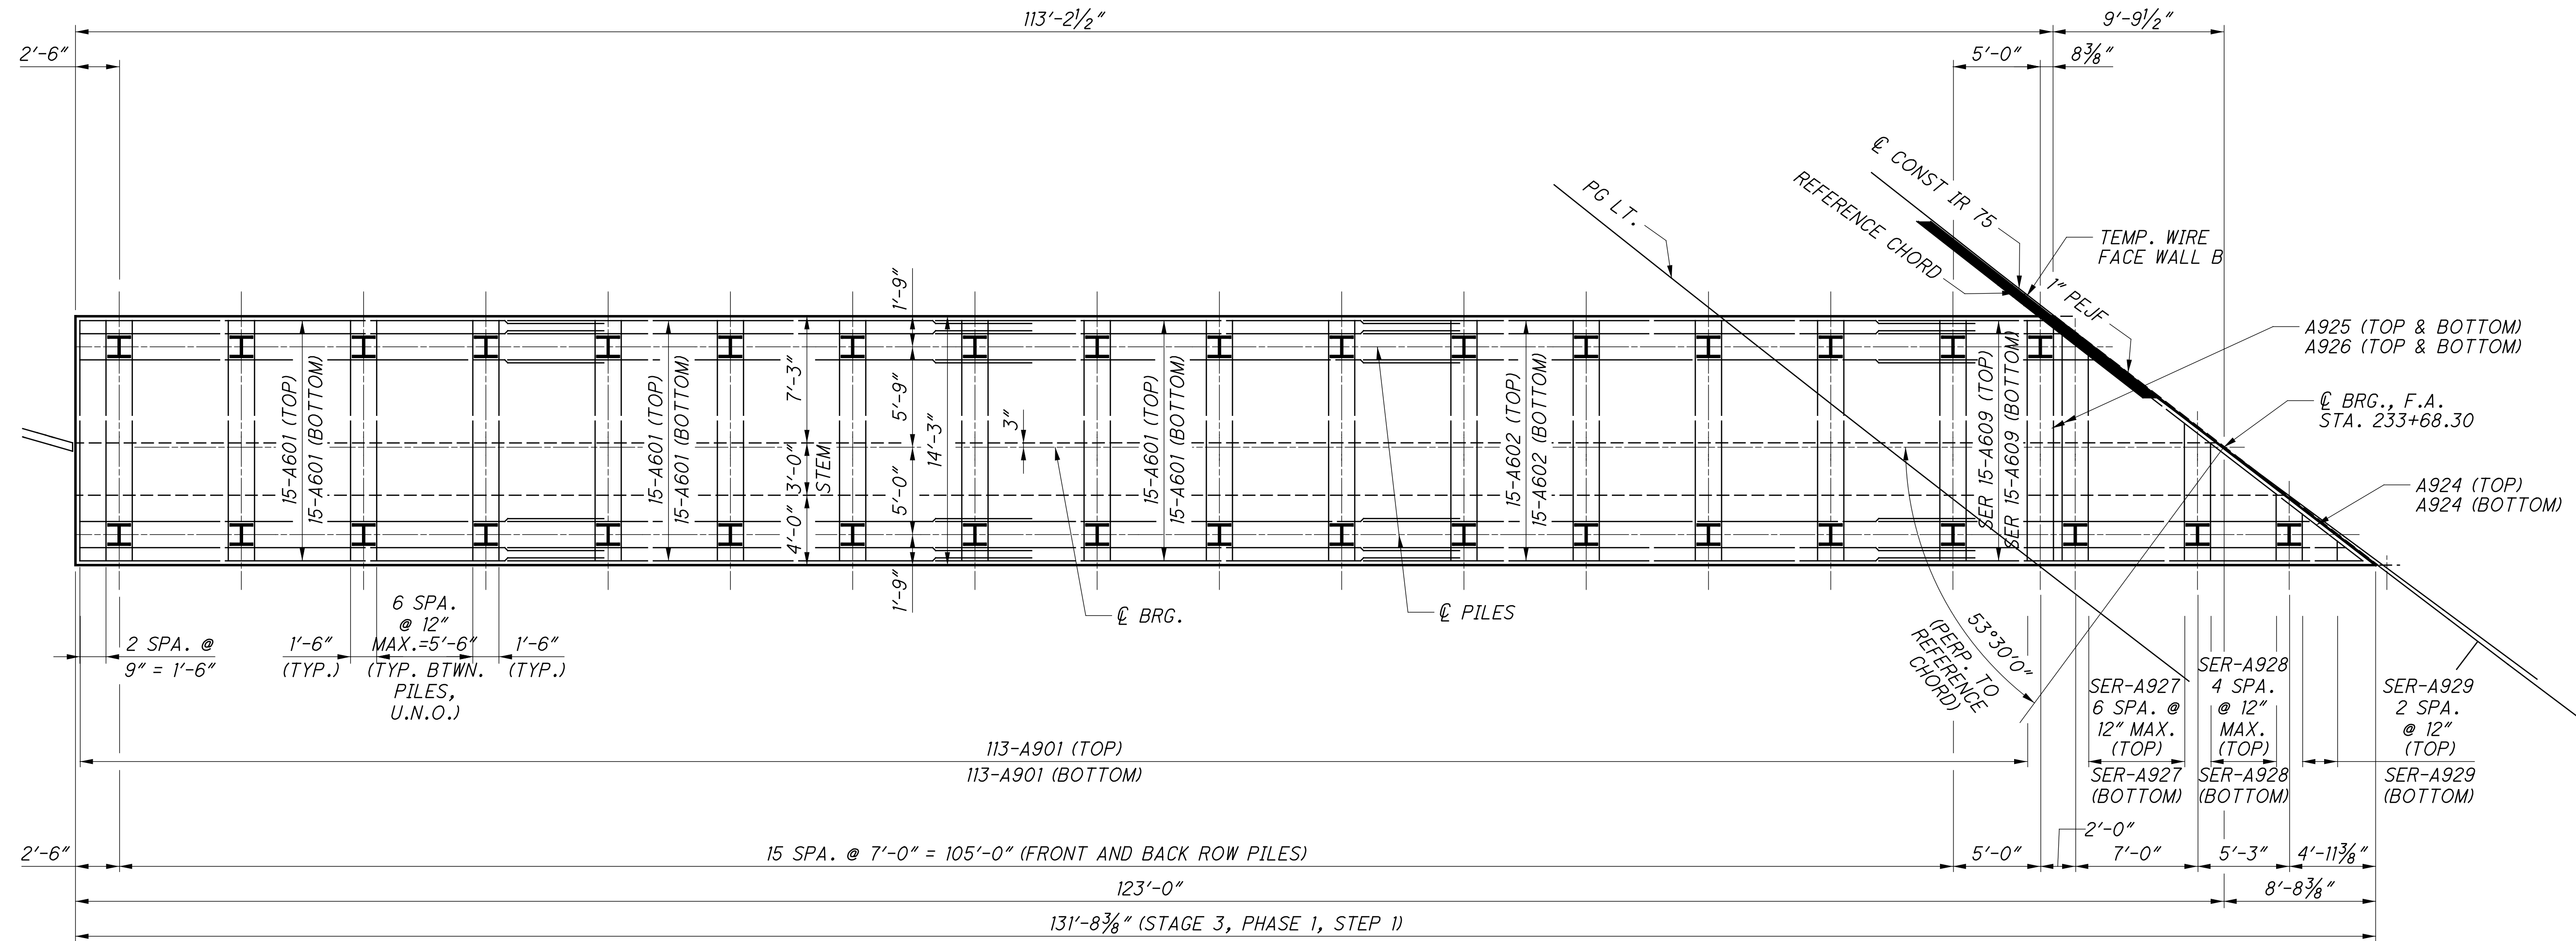

LEFT FORWARD ABUTMENT FOOTING PLAN


MINIMUM BAR LAP	
#6	5'-6"

LEGEND

 INDICATES HP14x117 STEEL "H" PILE WITH 30" PREBORED HOLE

NOTES:

FOR ABUTMENT PILE LAYOUT PLAN, SEE SHEETS 18/68 TO 19/68.
FOR ABUTMENT PLAN AND ELEVATION, SEE SHEETS 22/68 TO 23/68.

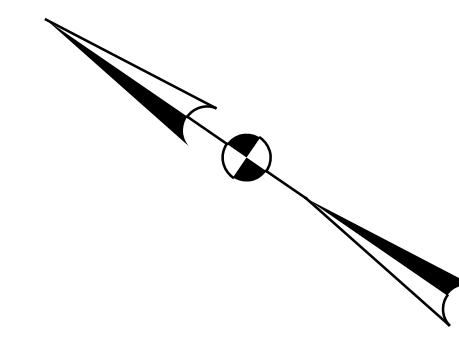

DESIGN AGENCY
STRUCTUREPOINT
INCORPORATED
2000 CORPORATE CENTER DRIVE, SUITE 200
DALLAS, TEXAS 75201
TEL: 972.968.3333 FAX: 972.968.3335
WWW.STRUCTUREPOINT.COM

REVIEWED: MDS DATE: 1/03/19
STRUCTURE FILE NUMBER: 3109163


DRAWN: DSH
DESIGNED: SUJ
CHECKED: CLB

FORWARD ABUTMENT DETAILS (LEFT BRIDGE)
BRIDGE NO. HAM-75-0440 L/R
OVER WB I-74

HAM-75-3.84
PID No. 104667

20/68
20/68

SFlanagan
10/26/2023 4:26:23 PM
0\2017\01113\C.Design\104667-HAM-75-3.84\Design\Structures\HAM0075_0440C\Sheets\HAM0075_0440C_AF001.dgn

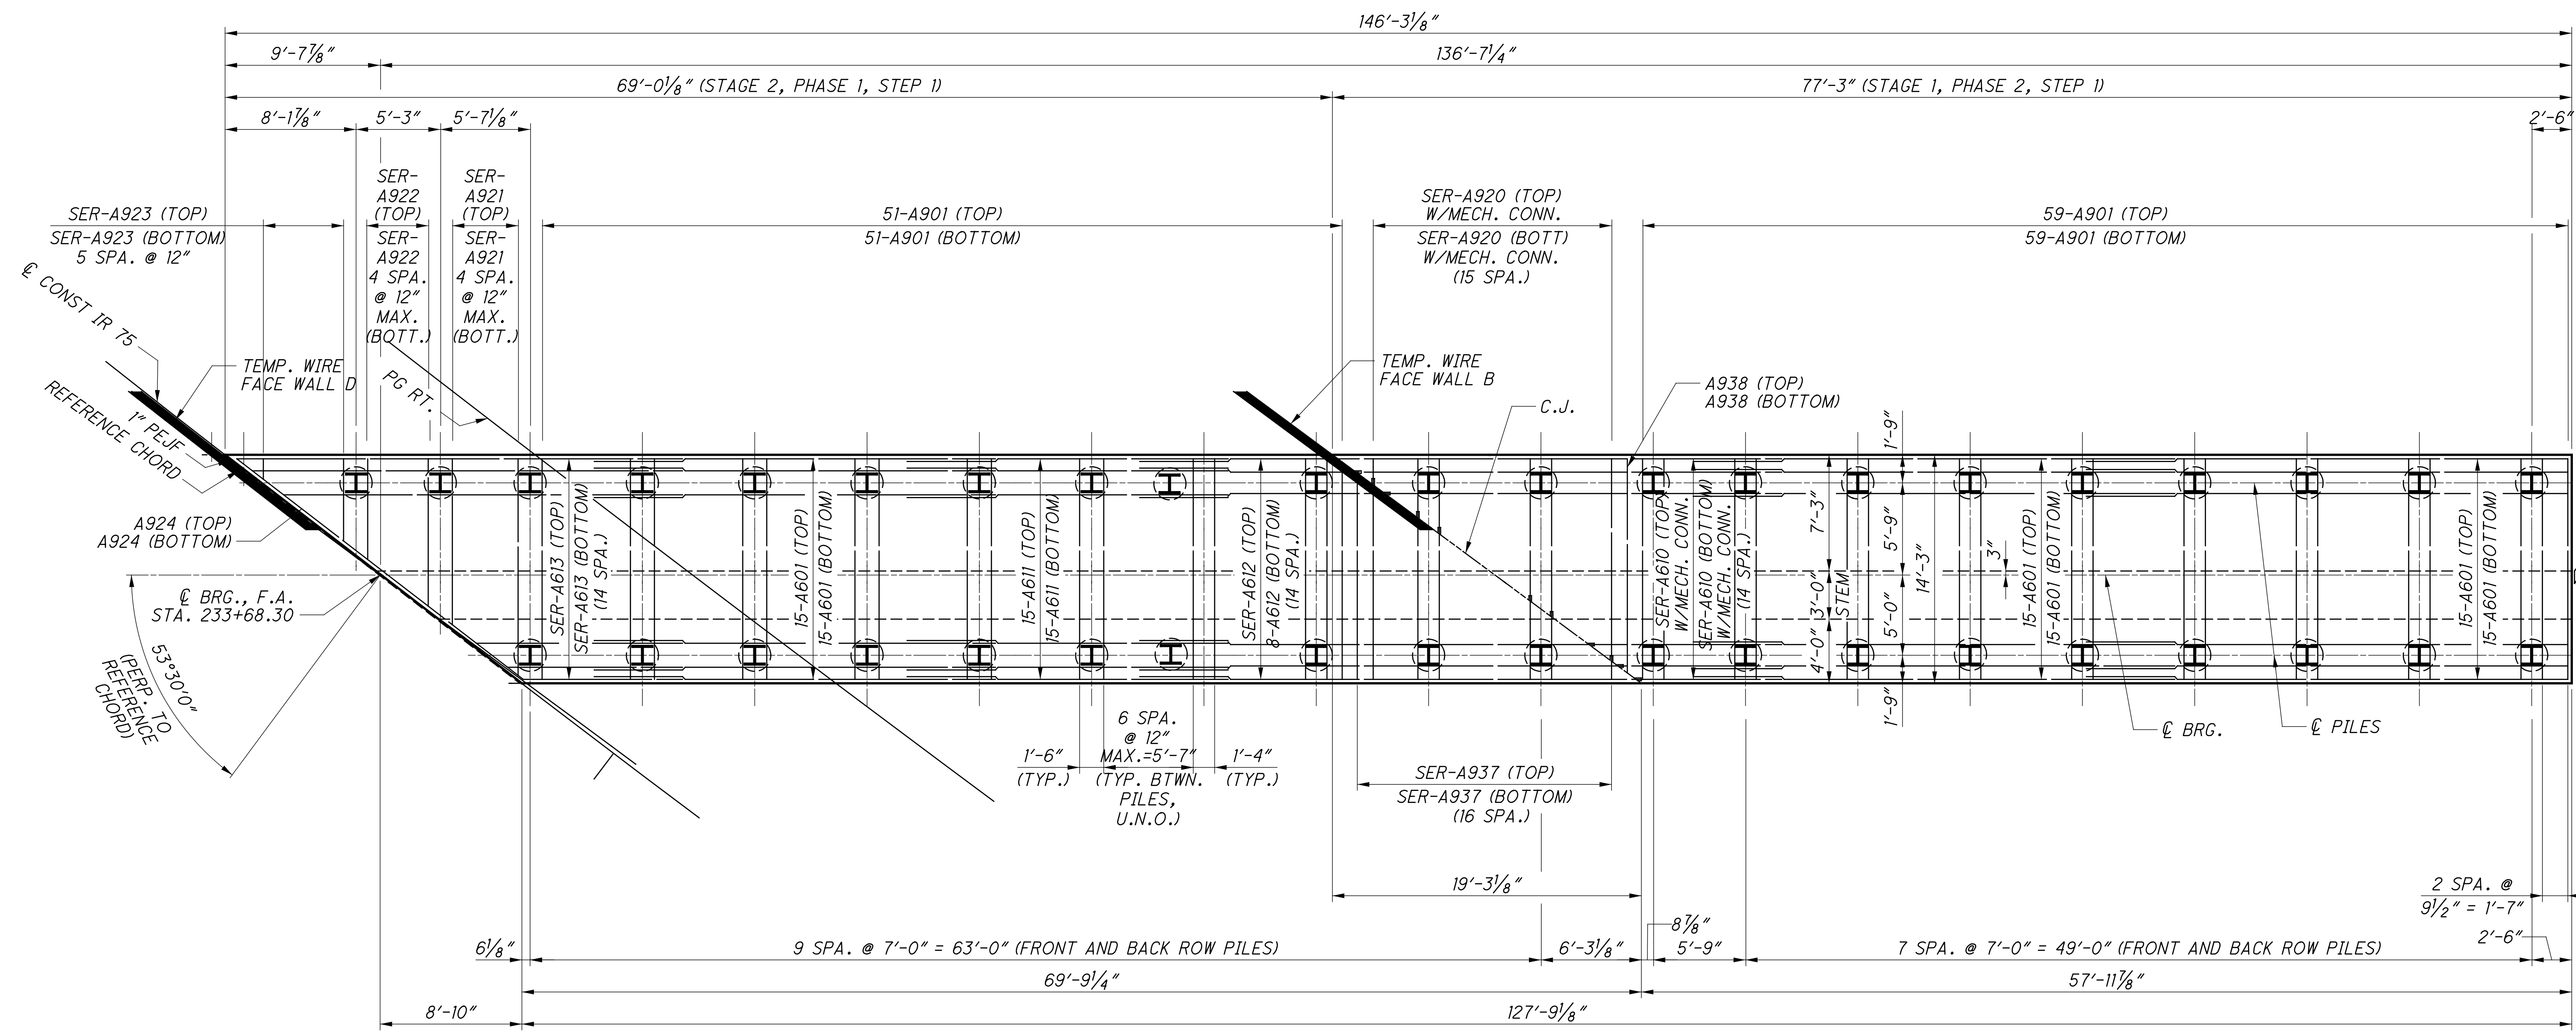


RIGHT FORWARD ABUTMENT FOOTING PLAN

MINIMUM BAR LAP	
#6	5'-6"

LEGEND
 INDICATES HP14x117 STEEL "H" PILE WITH 30" PREBORED HOLE

NOTES:
 FOR ABUTMENT PILE LAYOUT PLAN, SEE SHEETS 18/68 TO 19/68.
 FOR ABUTMENT PLAN AND ELEVATION, SEE SHEETS 22/68 TO 23/68.

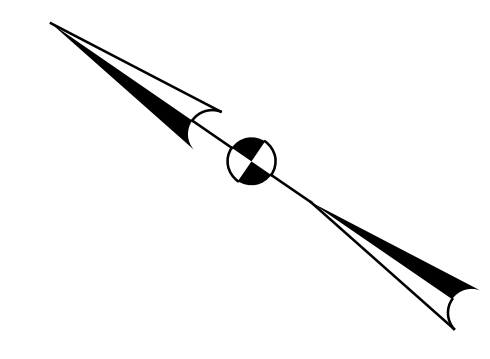

FORWARD ABUTMENT DETAILS (RIGHT BRIDGE)
 BRIDGE NO. - HAM-75-0440 L/R
 OVER WB I-74


DESIGNED	SJF	CHECKED	CLB
DRAWN	DSH	REVISED	
REVIEWED	MDS	STRUCTURE FILE NUMBER	3109763
DATE	1/03/19		

DESIGN AGENCY
STRUCTUREPOINT
 2000 CORPORATE CENTER DR., 4TH FL.
 ST. LOUIS, MO 63103
 TEL: 314.433.7000 FAX: 314.433.7001
 WWW.STRUCTUREPOINT.COM


HAM-75-3.84
 PID No. 104667

21 / 68
 21
 68

S:\Flanagan\10/26/2023 4:26:24 PM\01\2017\01113\C.Design\104667-HAM-75-3.84\Design\Structures\HAM0075_0440C_Sheets\HAM0075_0440C_AF004.dgn

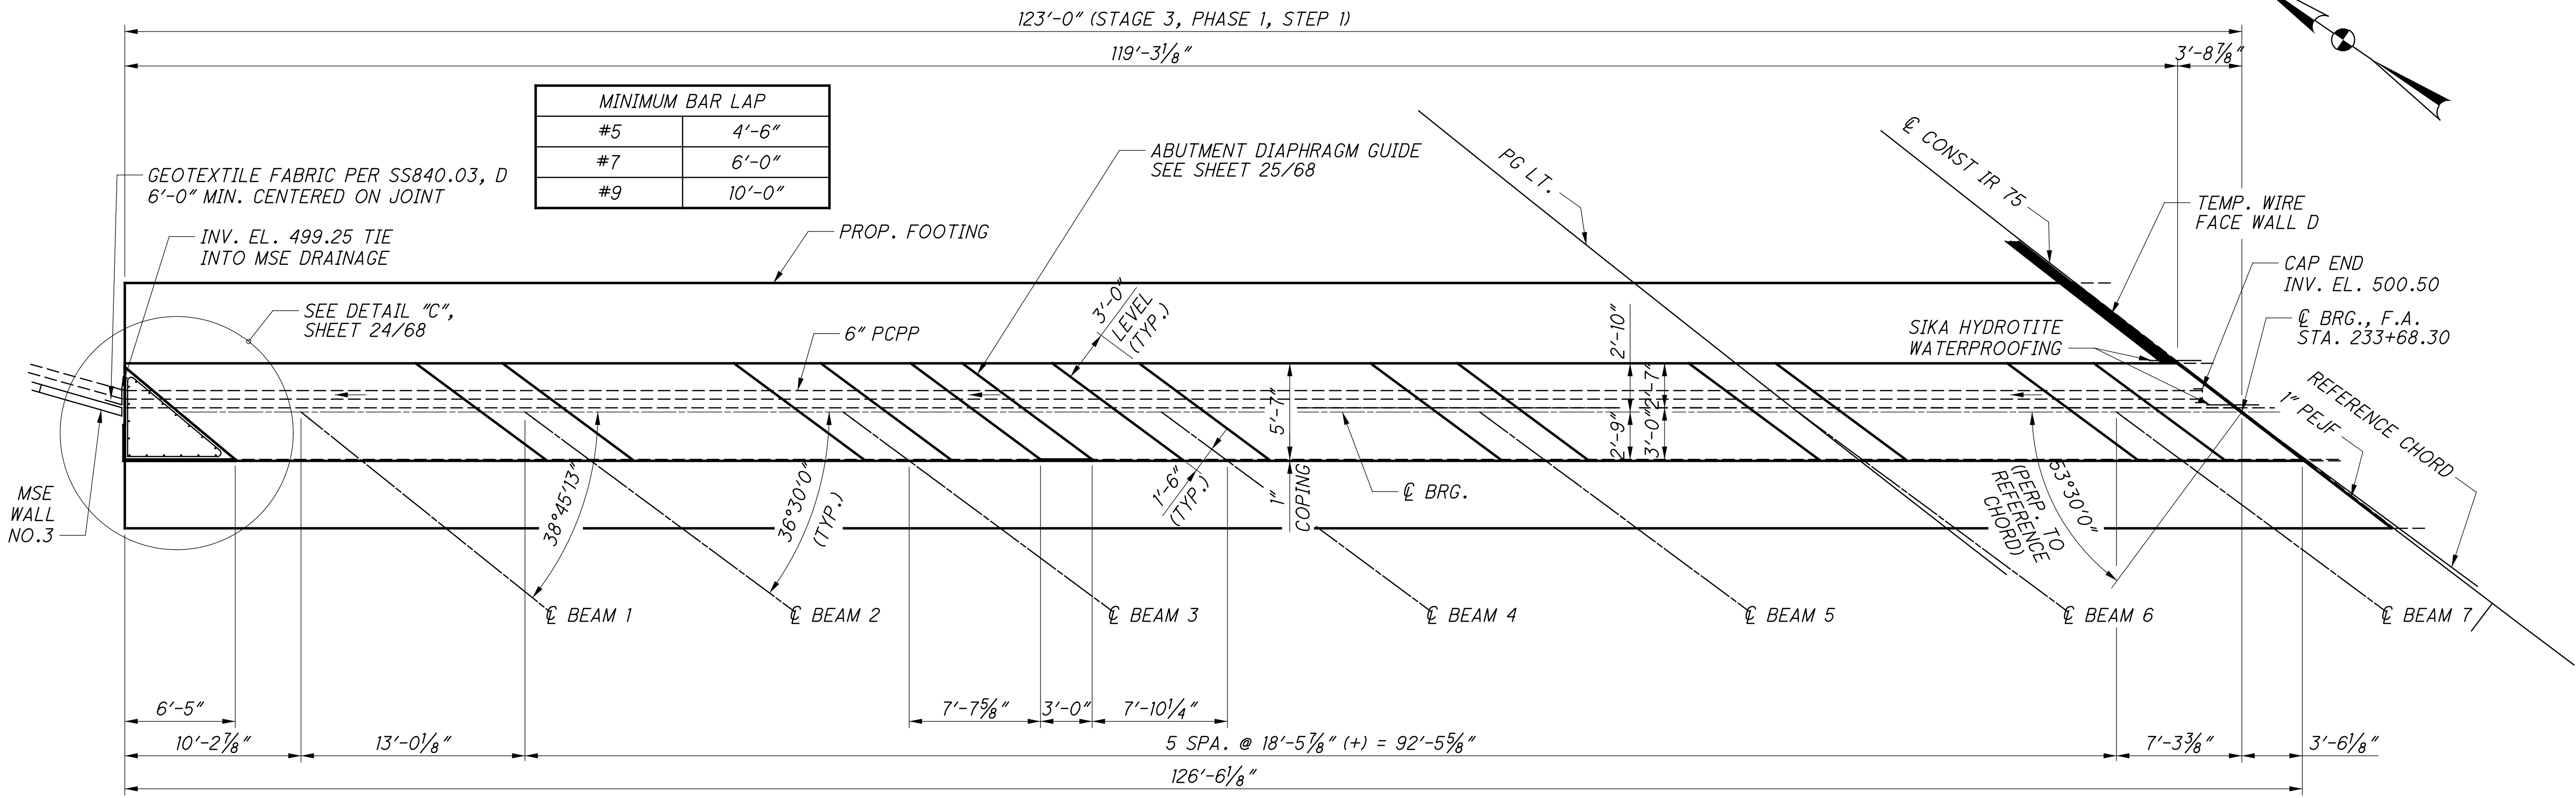

**PLAN - FORWARD ABUTMENT
LEFT BRIDGE**

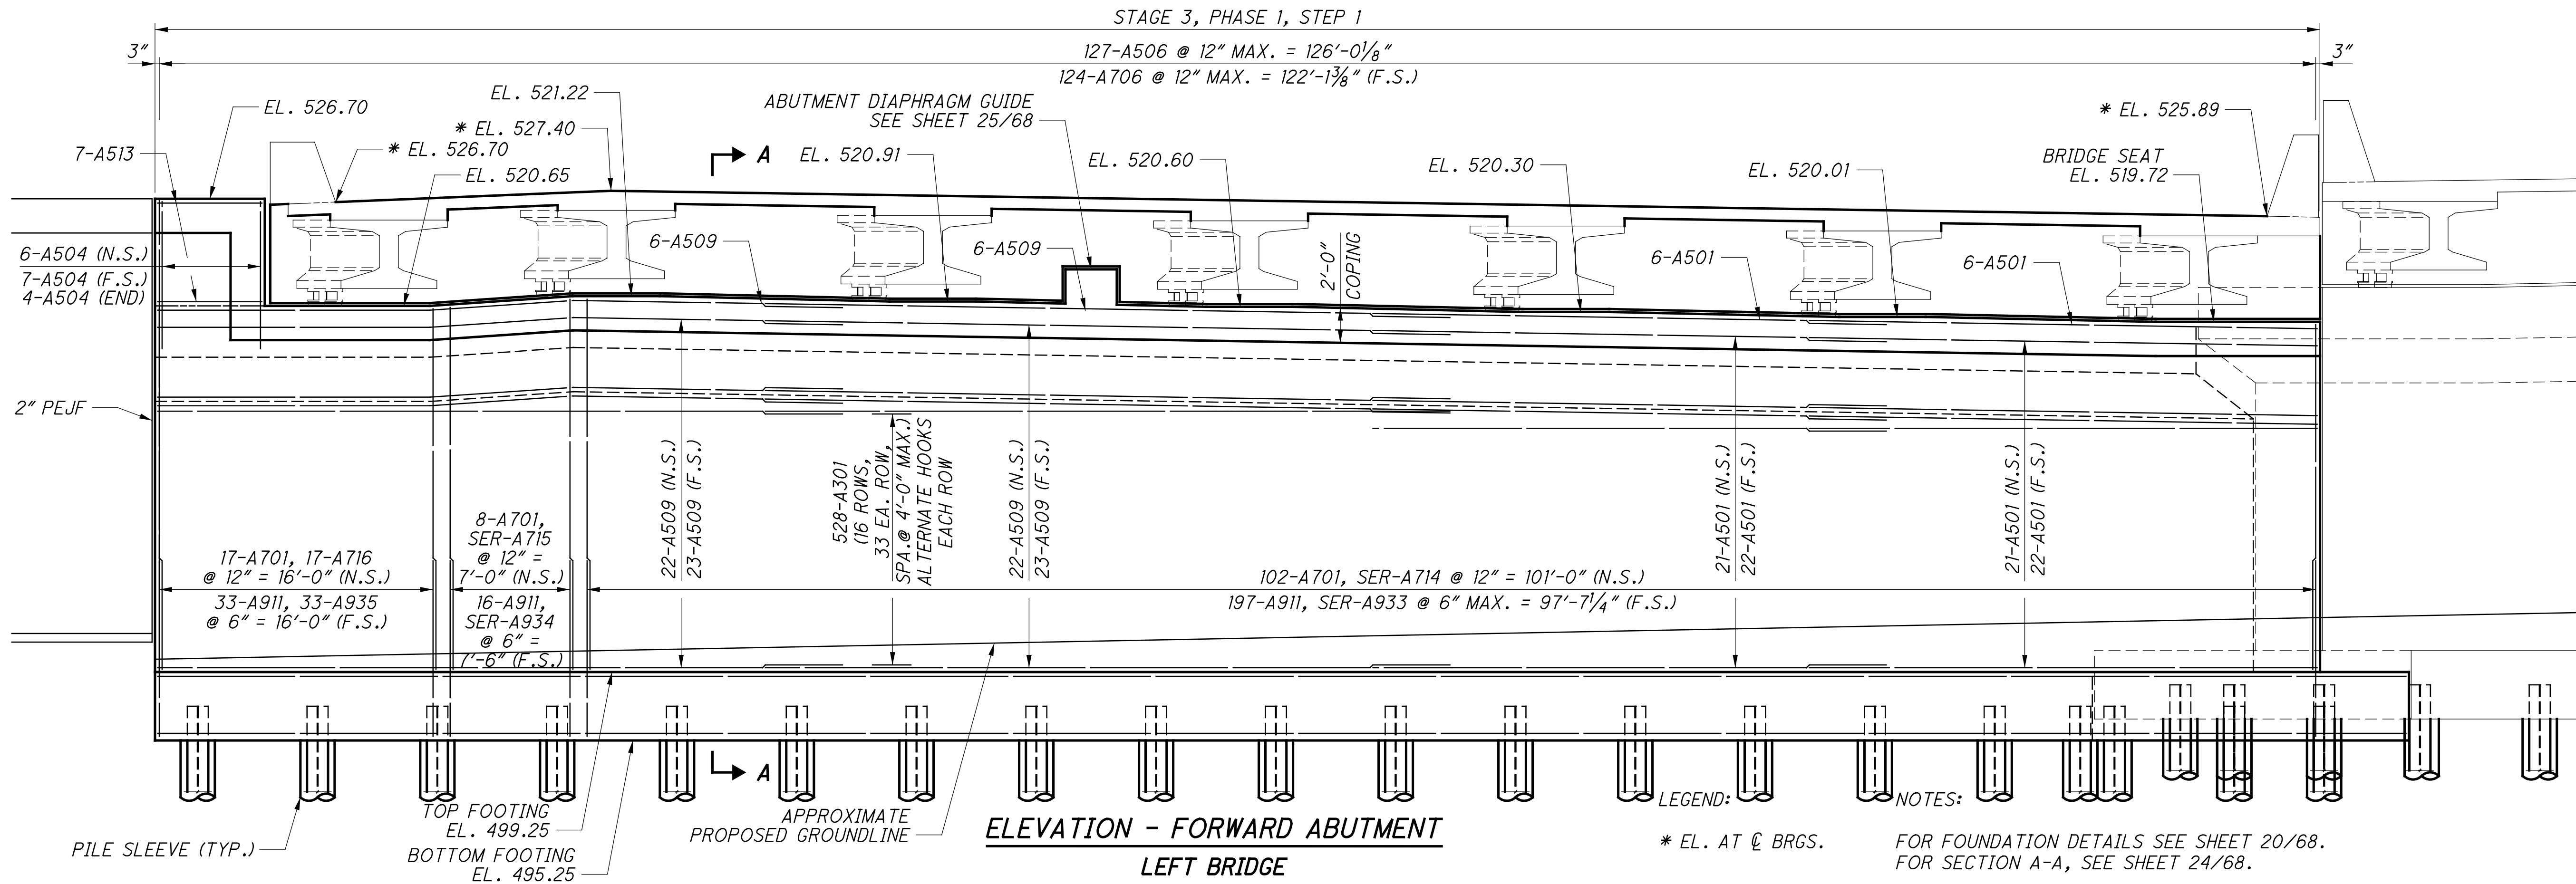


**ELEVATION - FORWARD ABUTMENT
LEFT BRIDGE**


LEGEND: * EL. AT @ BRGS.

NOTES: FOR FOUNDATION DETAILS SEE SHEET 20/68. FOR SECTION A-A, SEE SHEET 24/68.

DESIGN AGENCY: STRUCTUREPOINT
 DATE: 1/03/19
 REVIEWED: MDS
 DRAWN: DSH
 DESIGNED: SJF
 CHECKED: CLB
 STRUCTURE FILE NUMBER: 3109163
 BRIDGE NO.: HAM-75-0440 L/R
 OVER WB I-74
HAM-75-3.84
 PID No. 104667
 22/68
 22/68

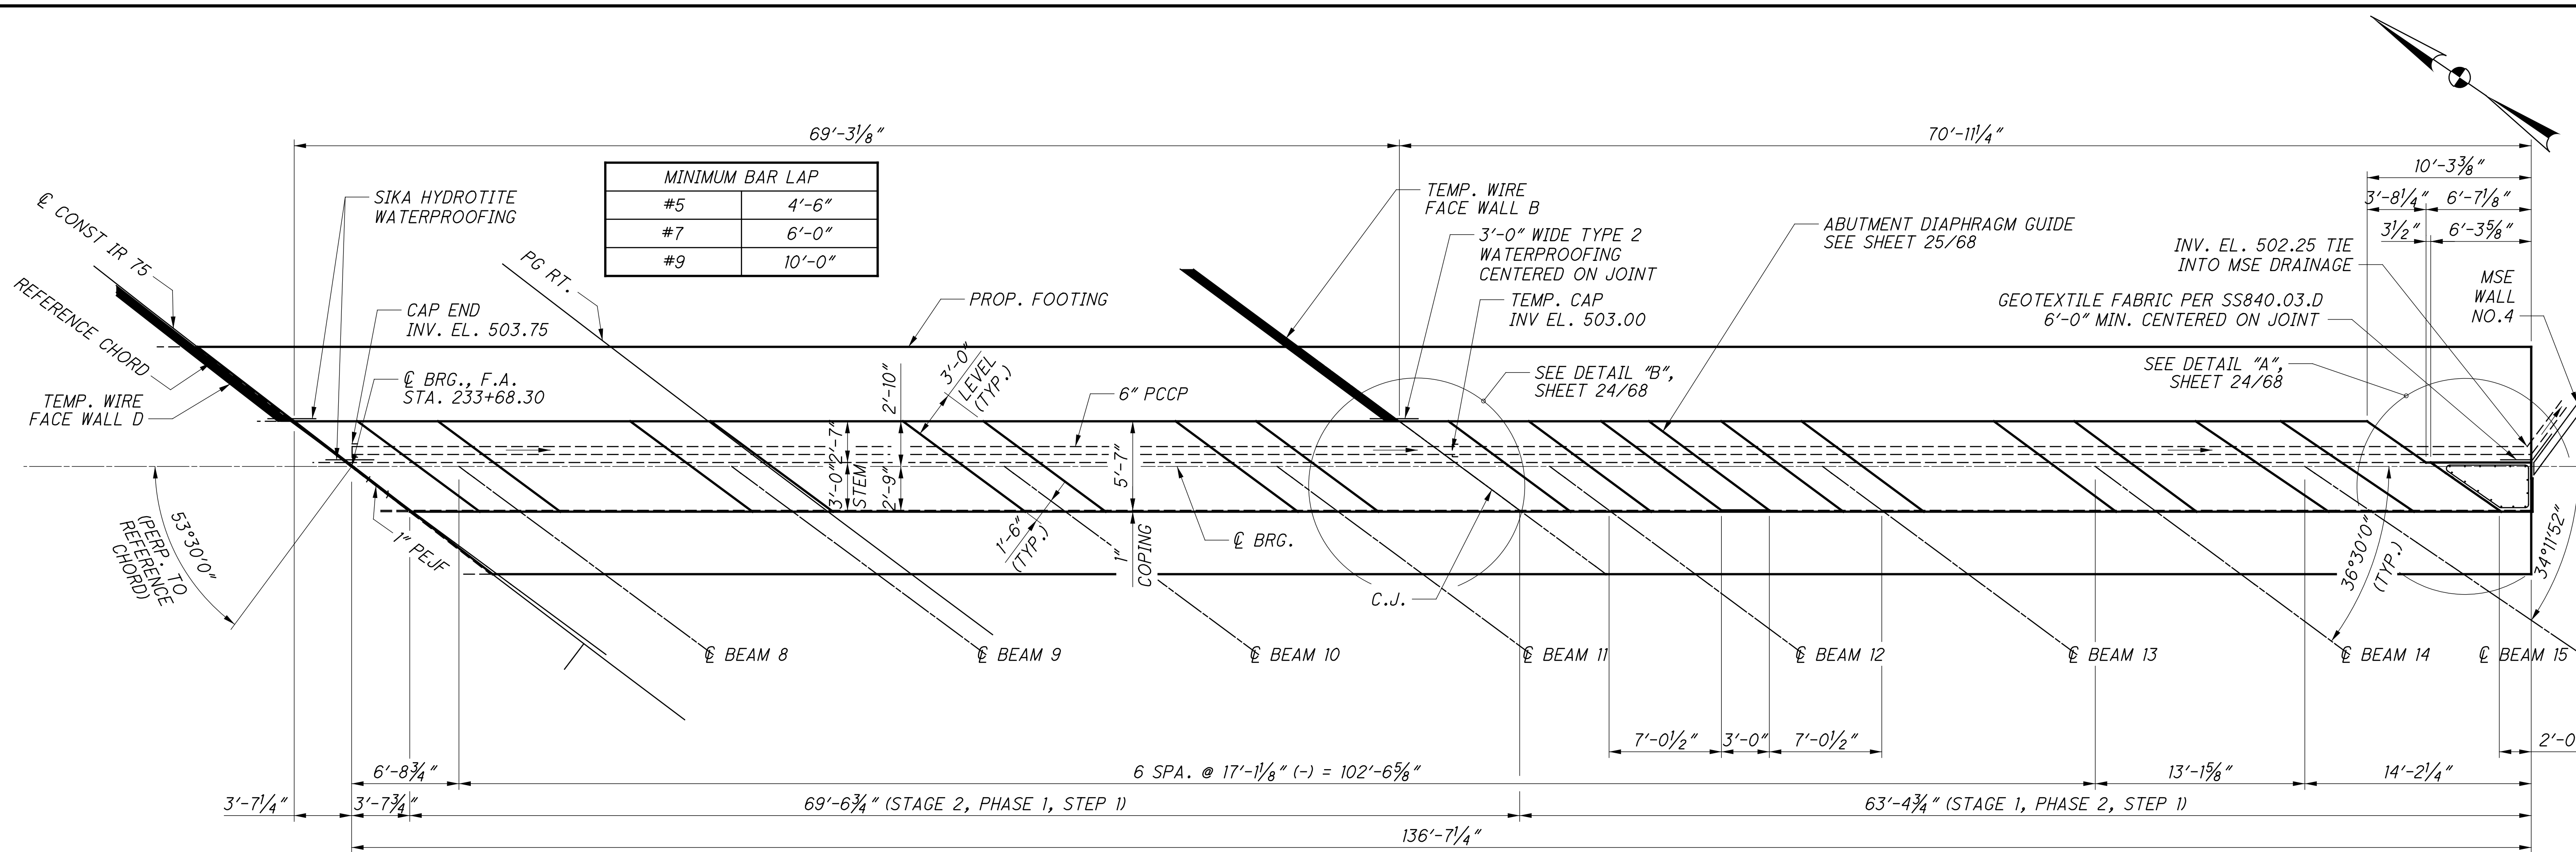





**PLAN - FORWARD ABUTMENT
RIGHT BRIDGE**

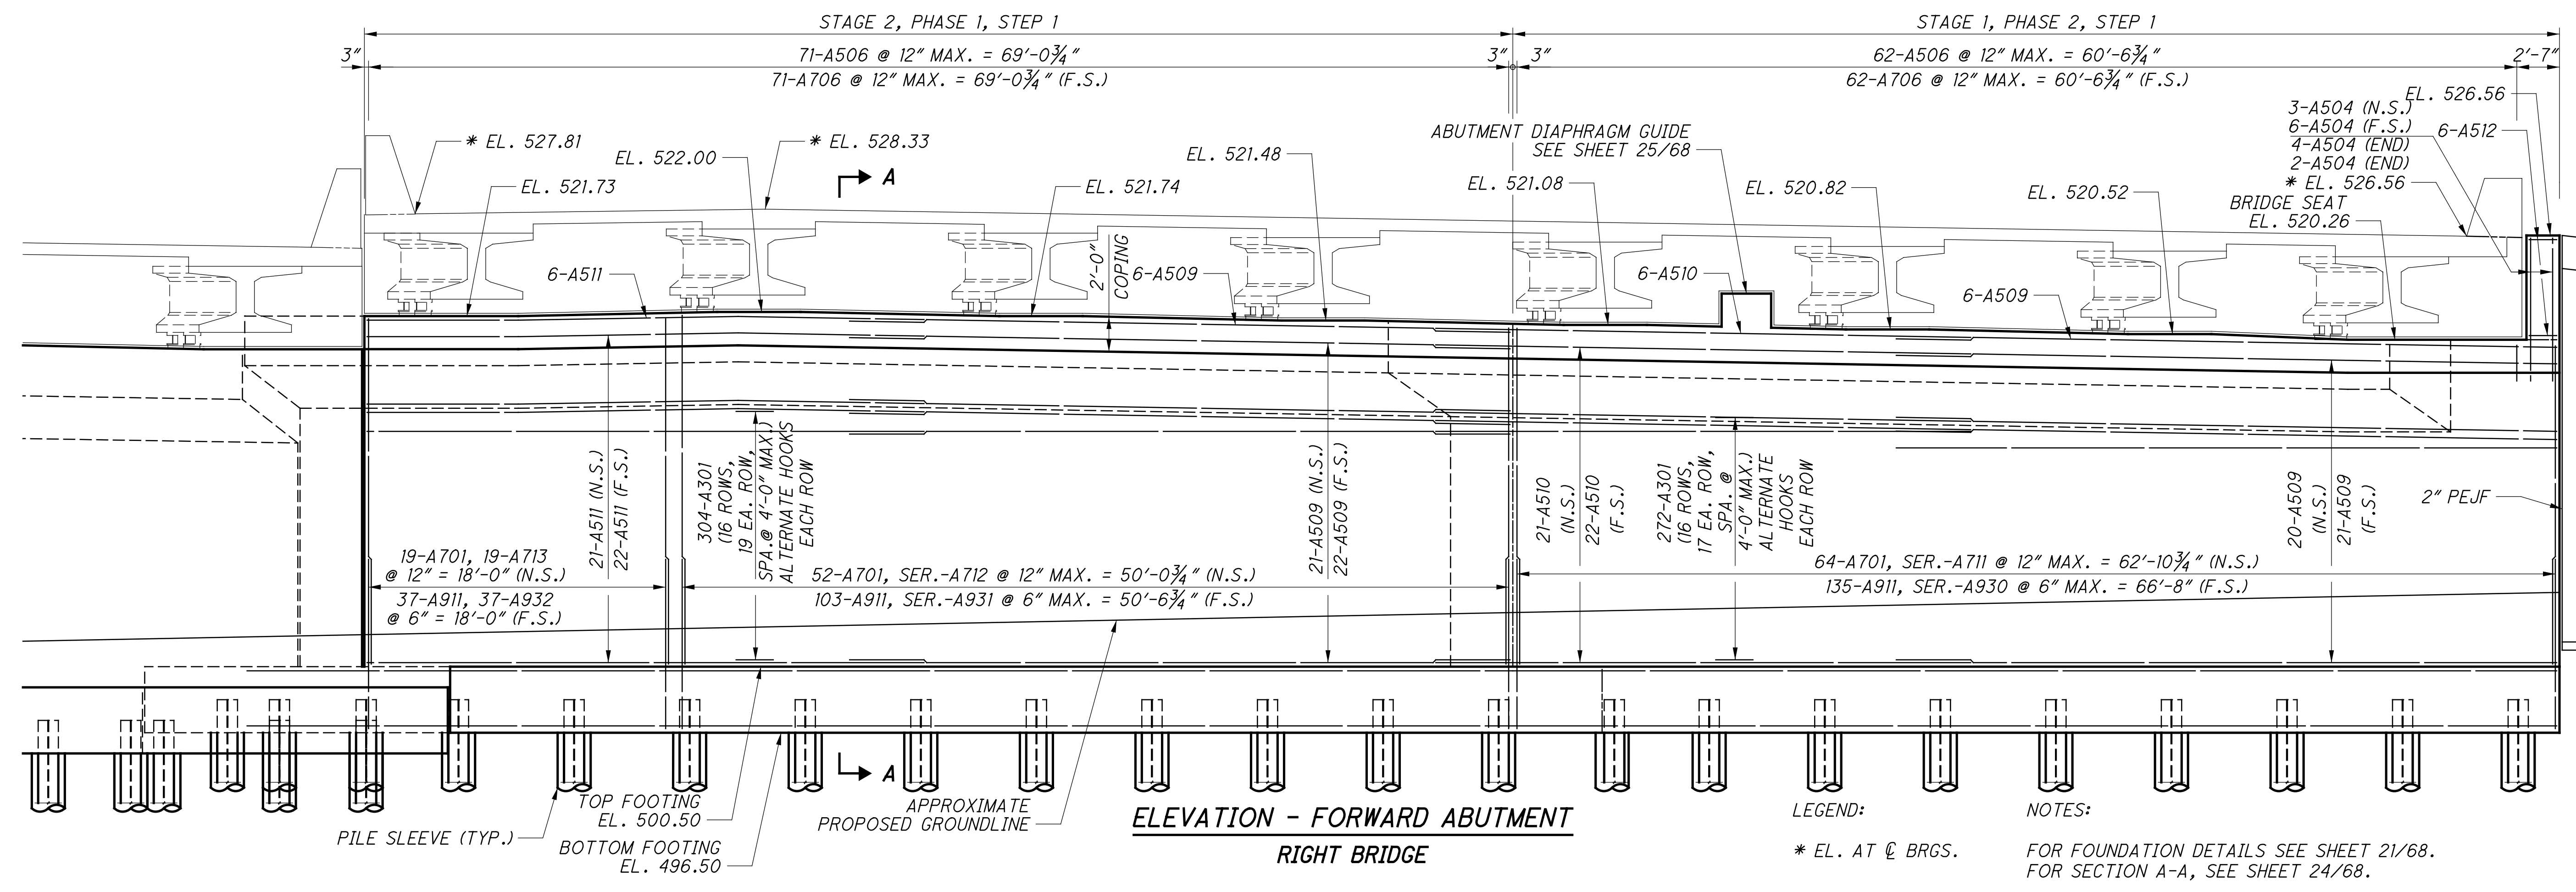

**ELEVATION - FORWARD ABUTMENT
RIGHT BRIDGE**

S:\Flanagan\10_26_2023 4:26:24 PM\01_2017\01113\C.Design\104667-HAM-75-3.84\Design\Structures\HAM0075_0440C_Sheets\HAM0075_0440C_AF003.dgn

SFlansgan
10/26/2023 4:26:25 PM
C:\2017\01113\C.Design\104667.HAM-75-3.84.Design\Structures.HAM0075_0440C.Sheets.HAM0075_0440C.AF005.dgn

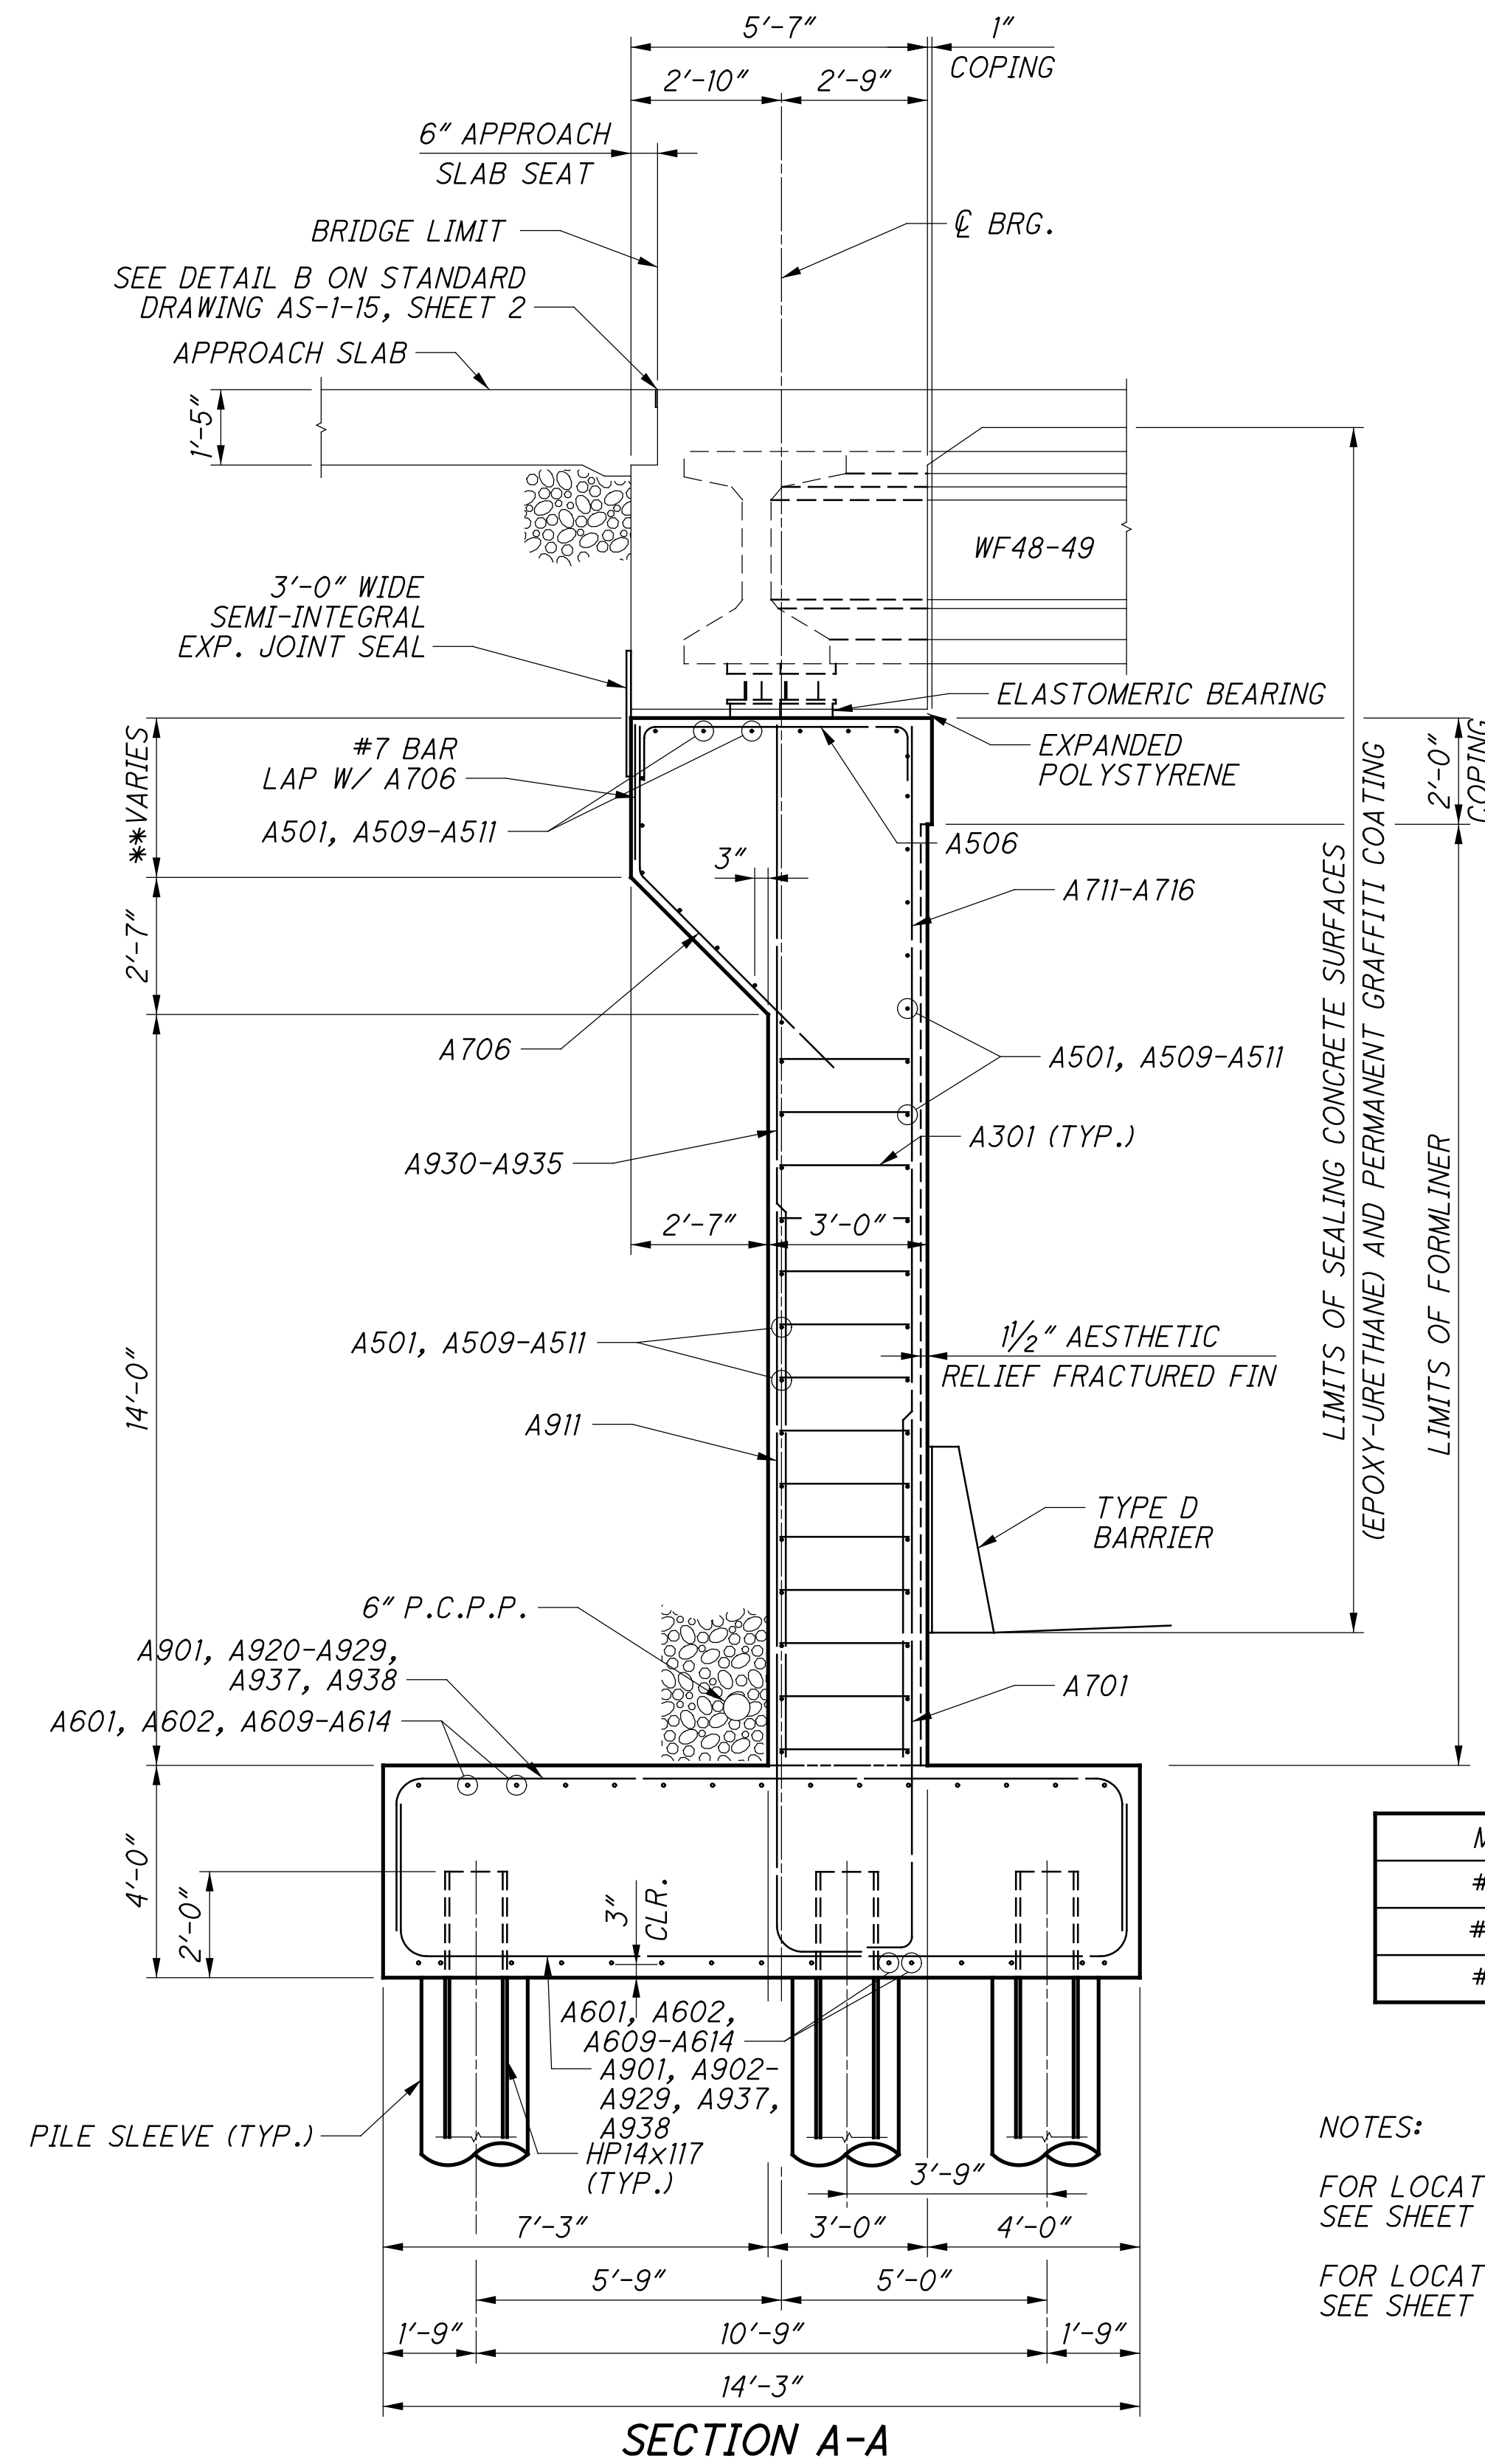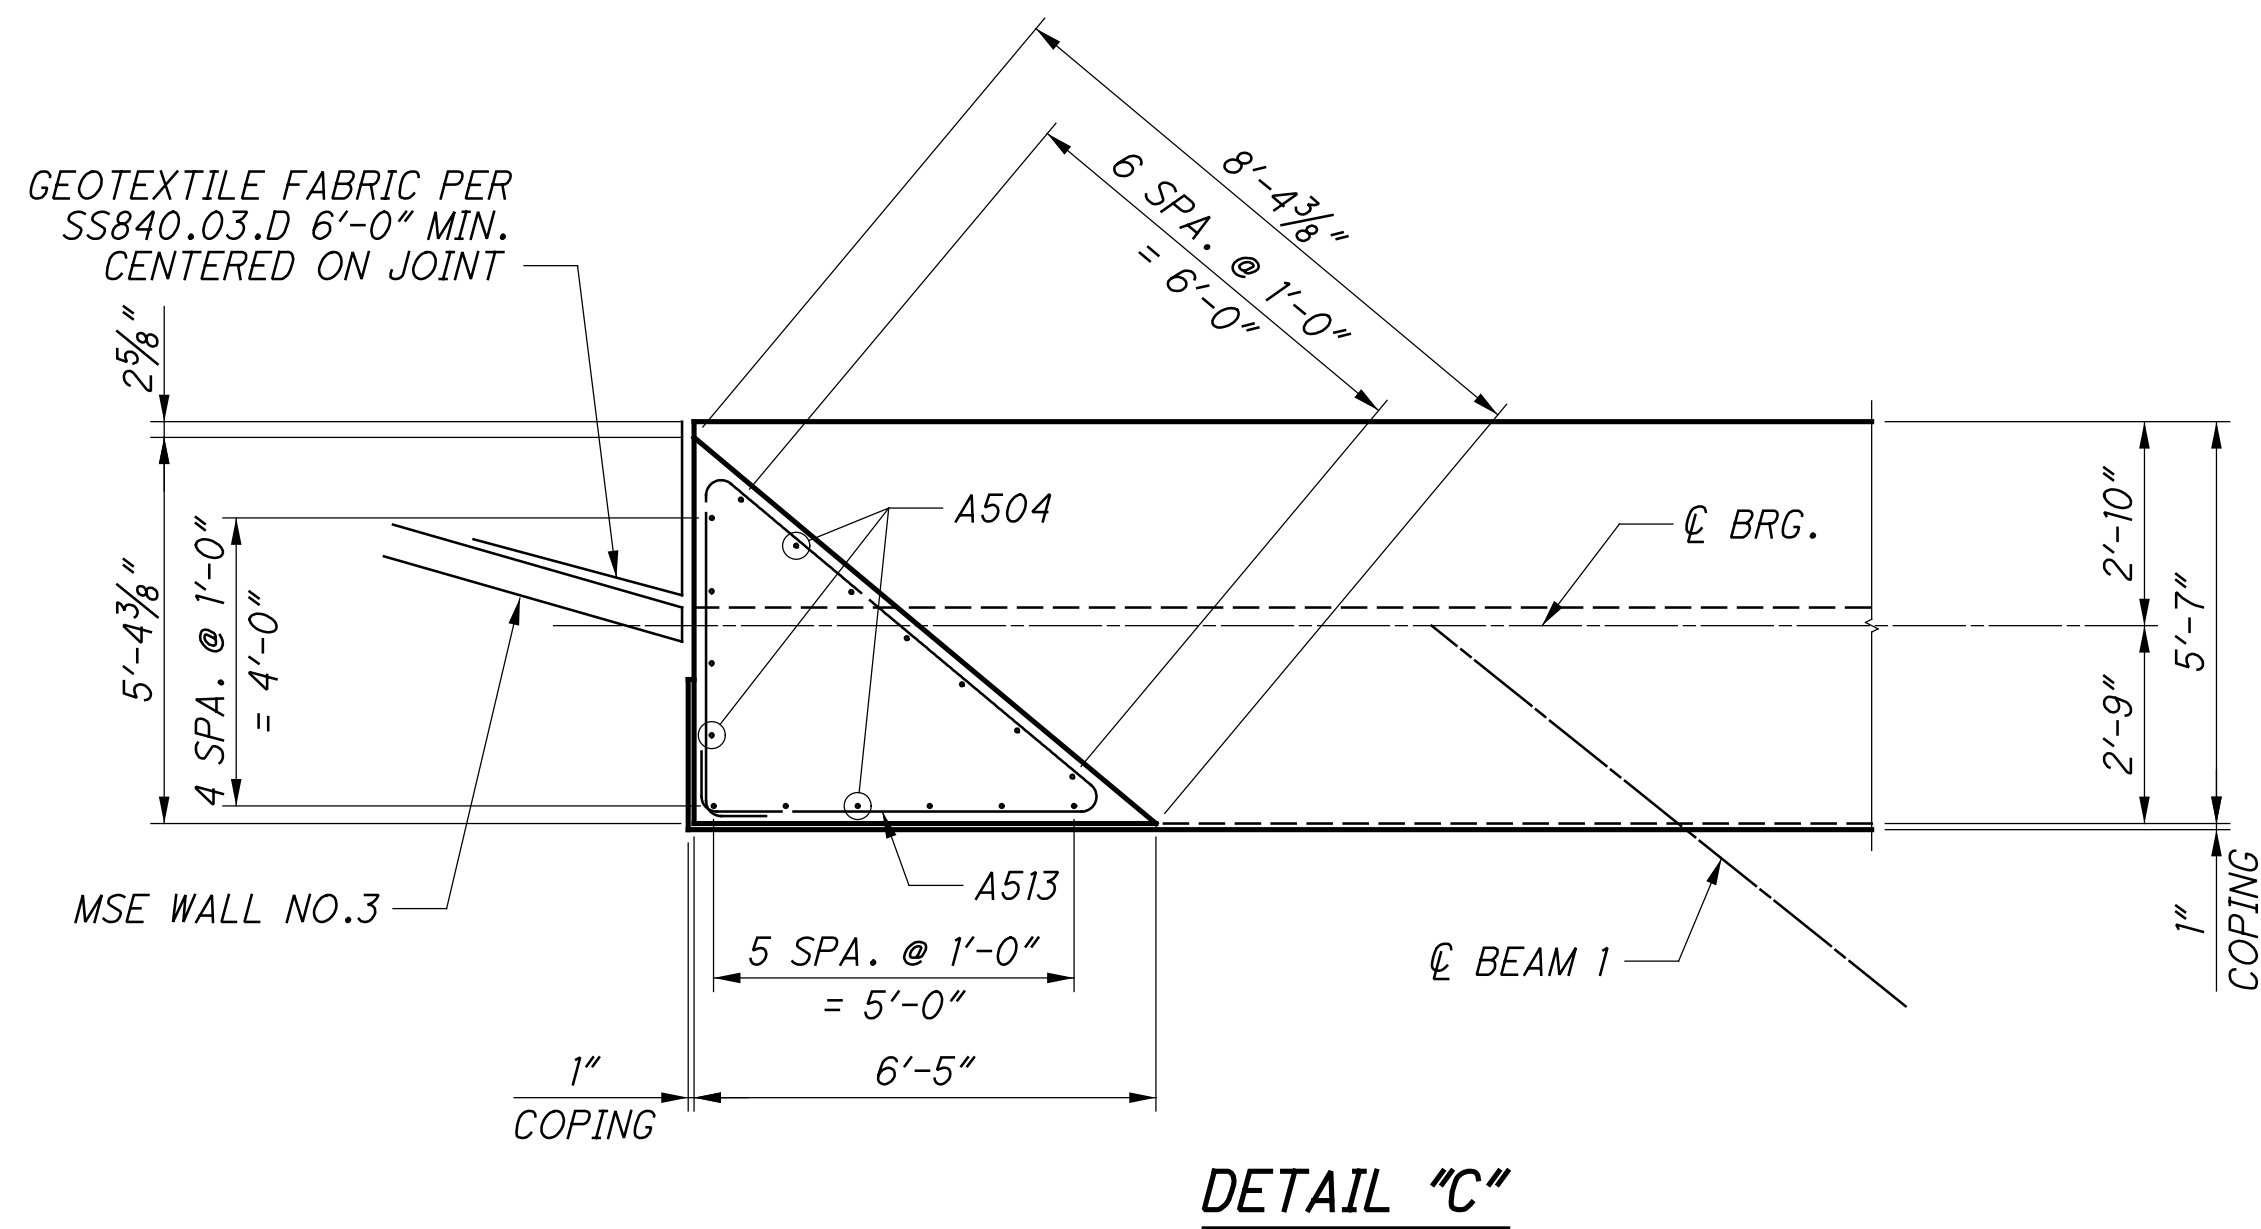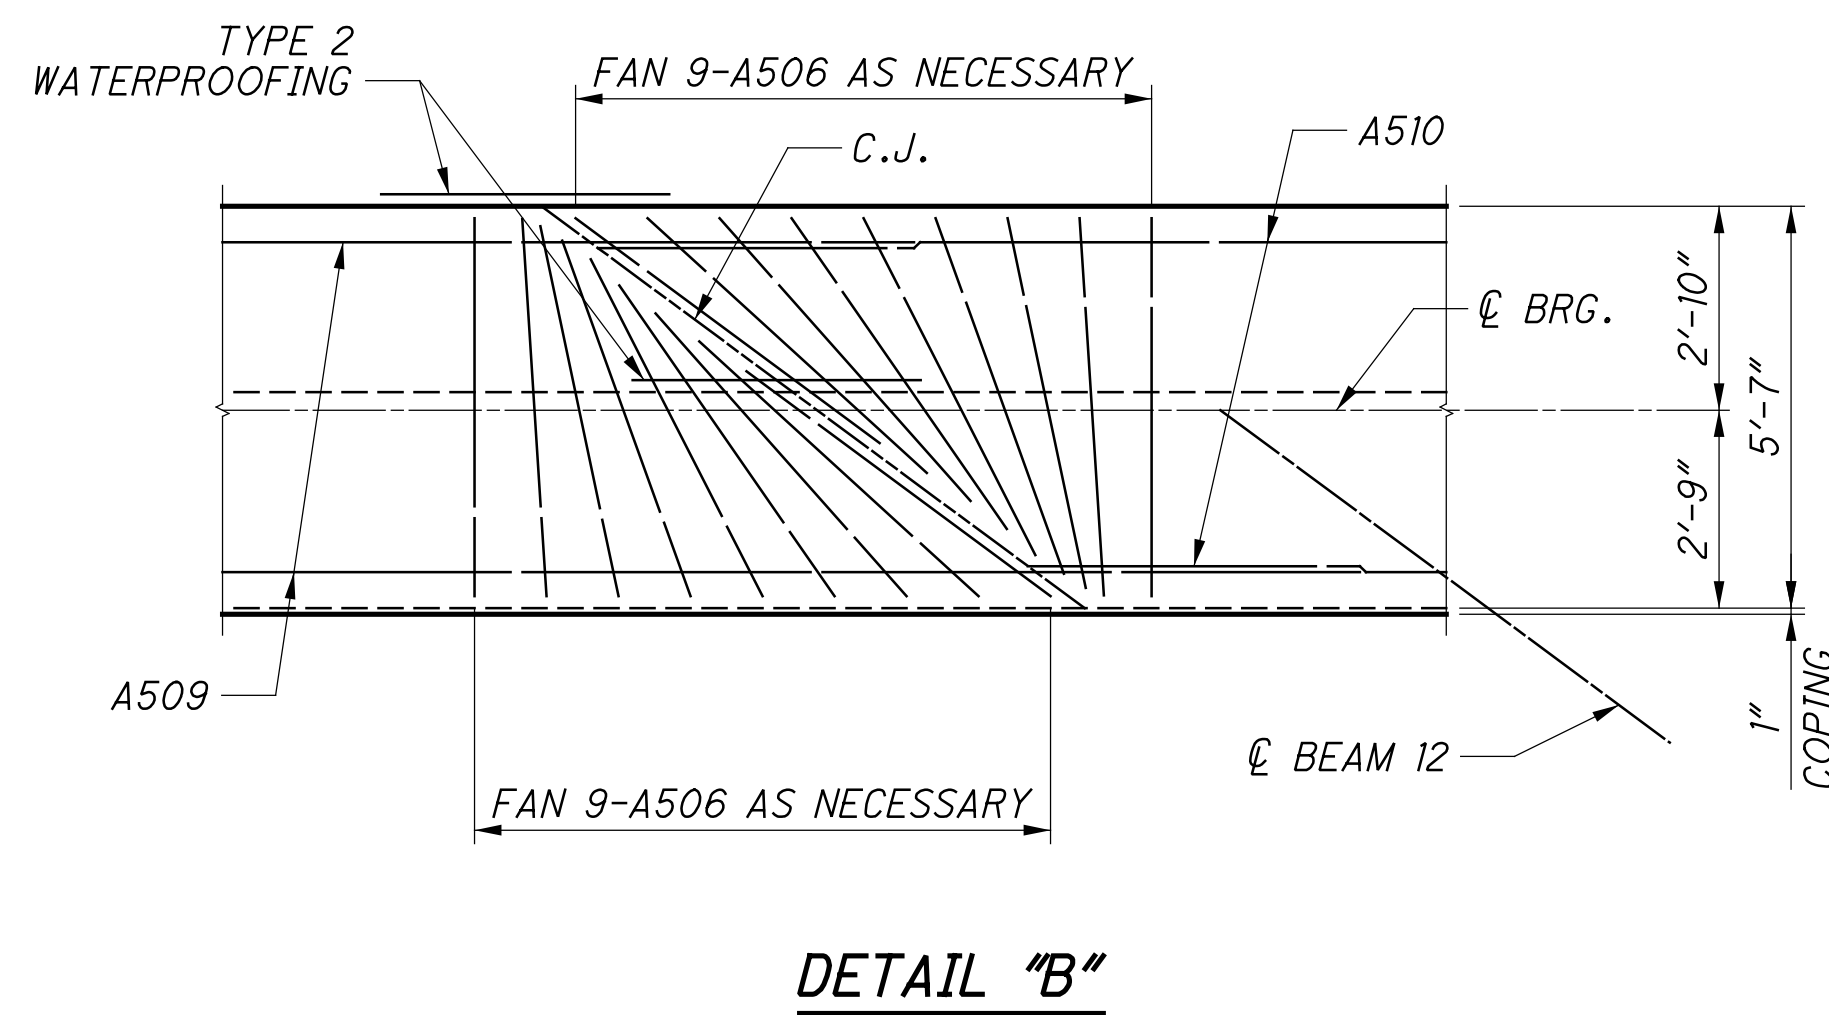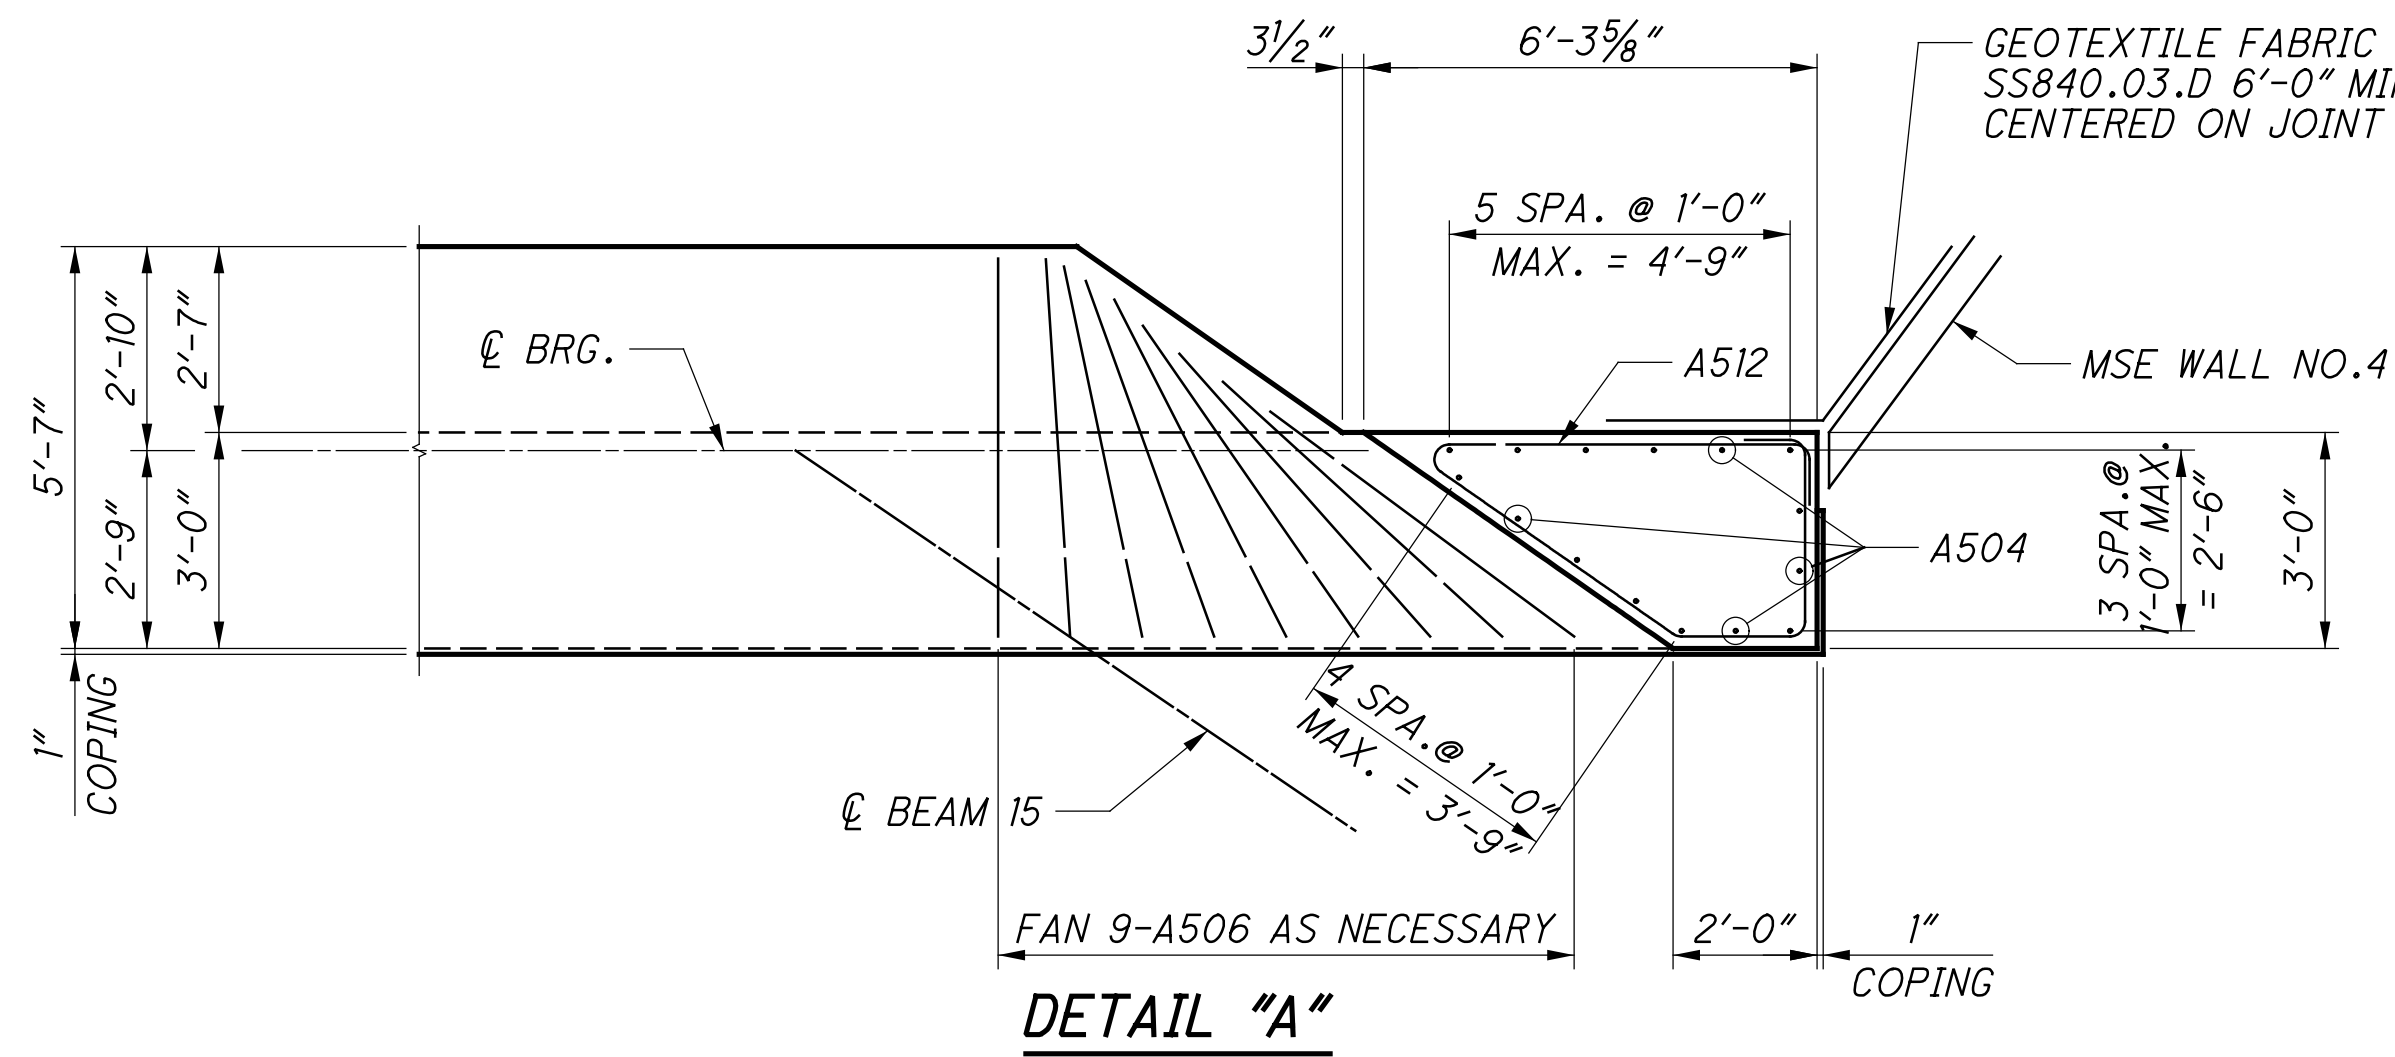


MINIMUM BAR LAP	
#5	4'-6"
#7	6'-0"
#9	10'-0"

NOTES:
FOR LOCATION OF DETAILS "A" AND "B",
SEE SHEET 23/68.
FOR LOCATION OF DETAIL "C",
SEE SHEET 22/68.


** RIGHT BRIDGE VARIES 3'-1 3/4" MIN. TO 5'-2 3/4" MAX.
LEFT BRIDGE VARIES 4'-3 1/4" MIN. TO 5'-9 3/4" MAX.

DESIGN AGENCY: STRUCTUREPOINT
 DATE: 1/03/19
 REVIEWED: MDS
 DRAWN: DSH
 DESIGNED: SUJ
 CHECKED: CLB
 STRUCTURE FILE NUMBER: 3109T63
 OVER WB I-74
 FORWARD ABUTMENT DETAILS
 BRIDGE NO. HAM-75-0440 L/R
 PID No. 104667
 24/68
 24
 68



SFlanagan
 10/26/2023 4:26:26 PM
 \\01\2017\01113\C.Design\104667-HAM-75-3.84\Design\Structures\HAM0075_0440C_Sheets\HAM0075_0440C_AF006.dgn

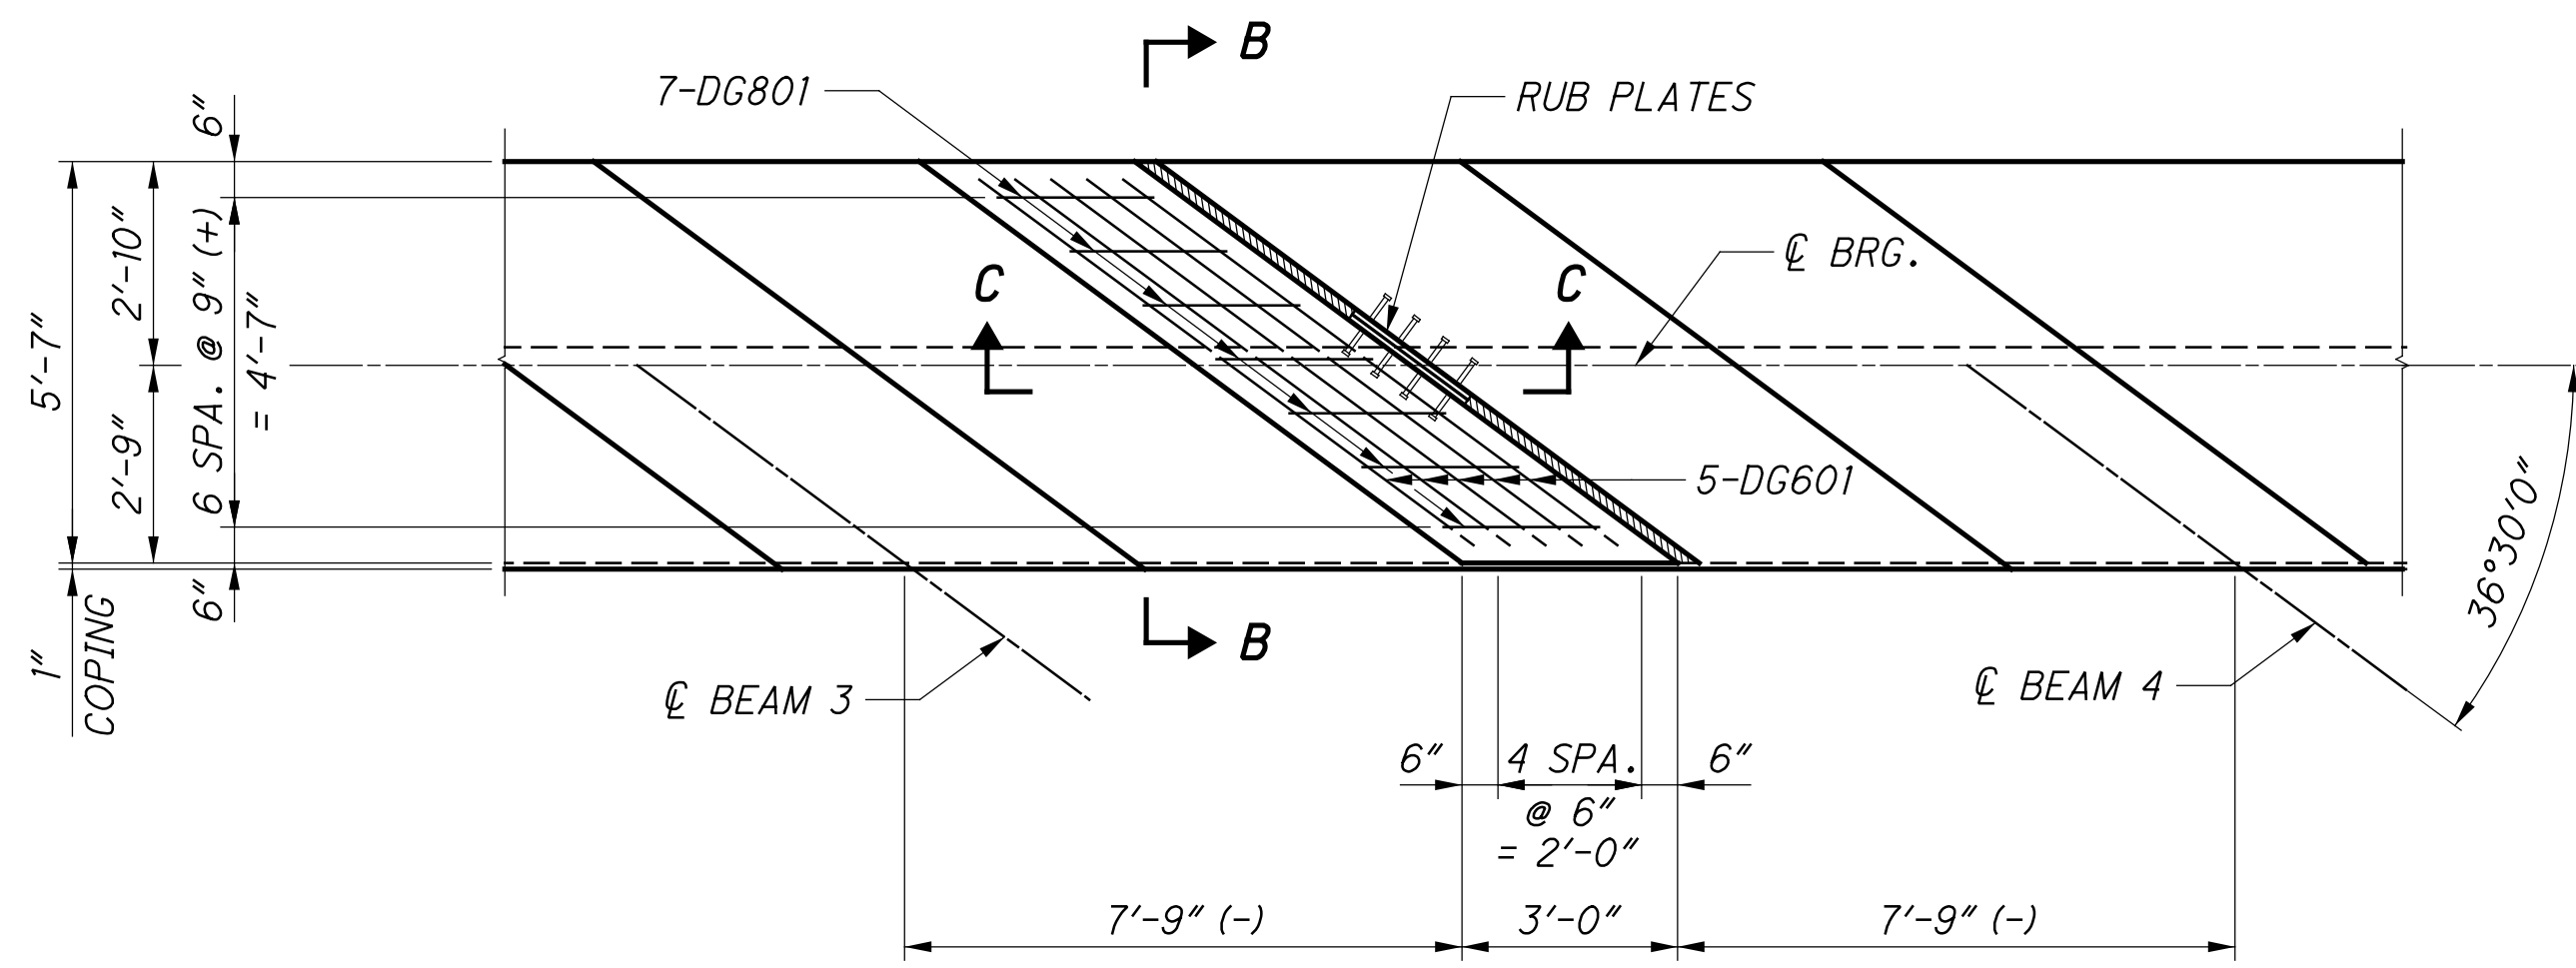

ABUTMENT DIAPHRAGM GUIDE PLAN AT FORWARD ABUTMENT - LEFT BRIDGE

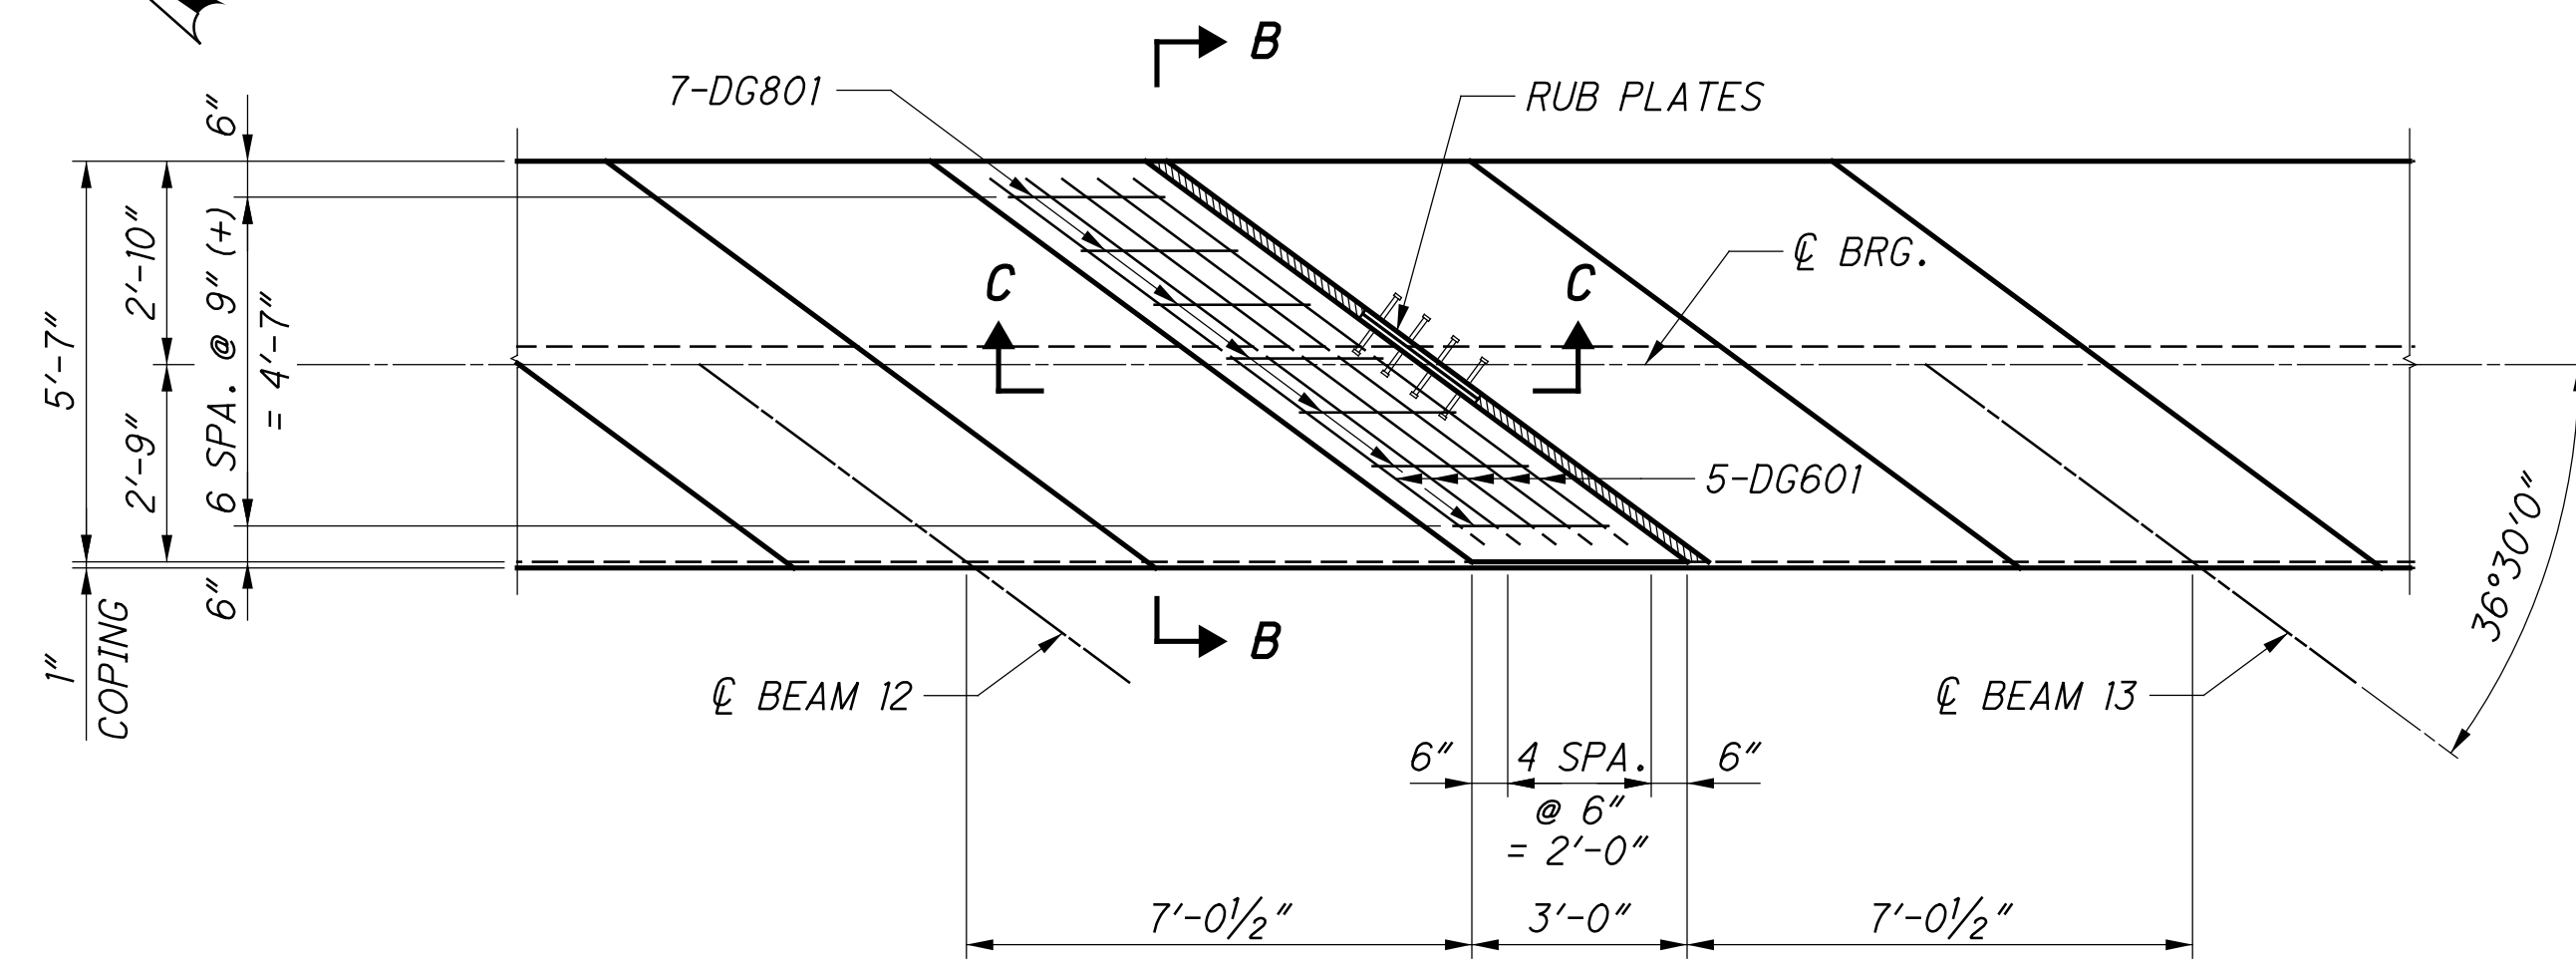

ABUTMENT DIAPHRAGM GUIDE PLAN AT FORWARD ABUTMENT - RIGHT BRIDGE

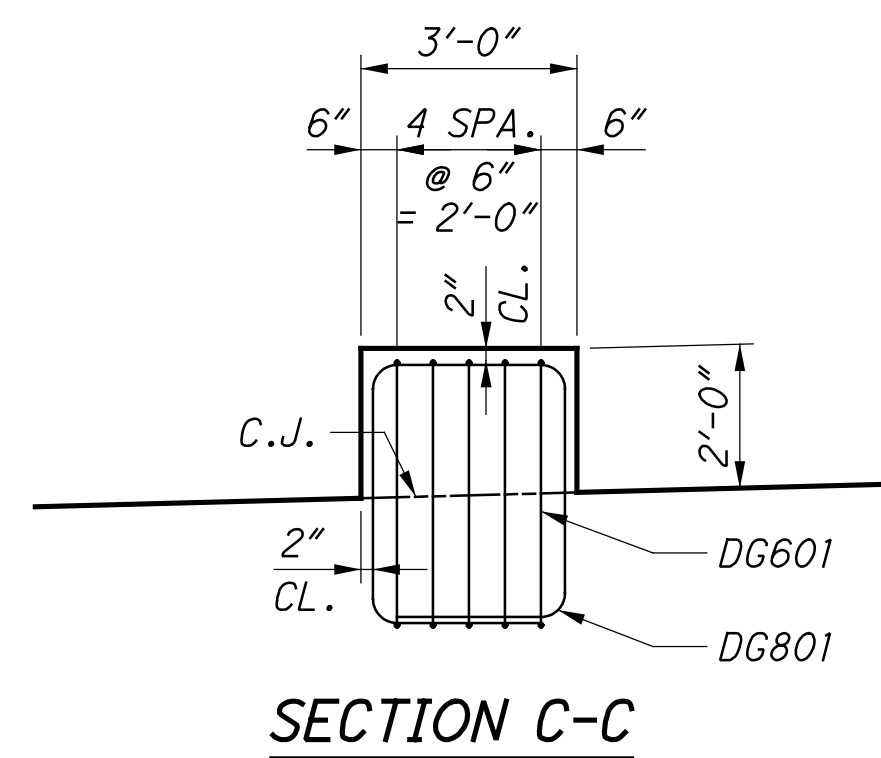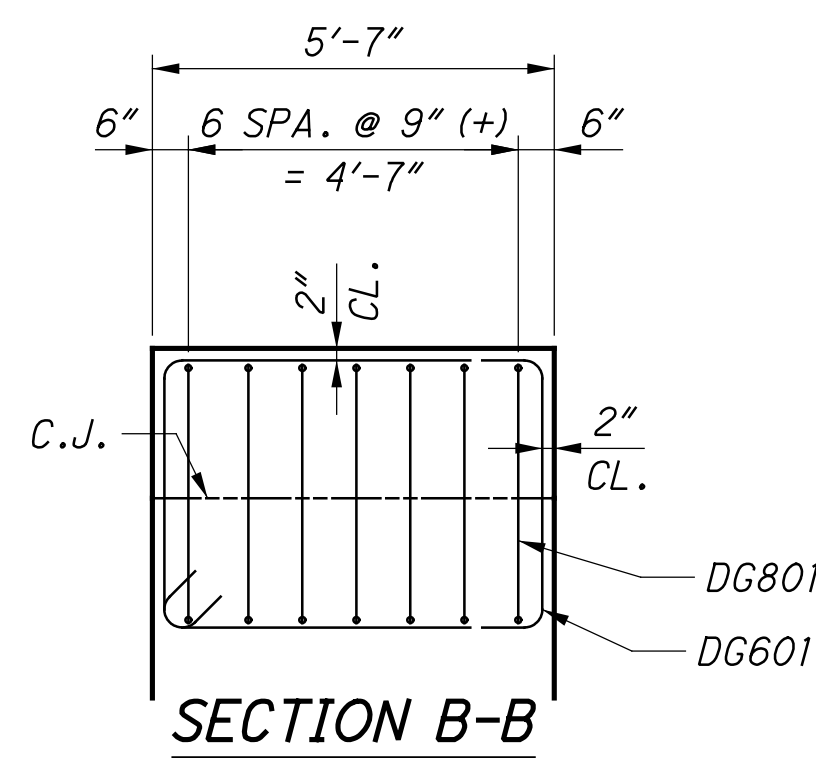


ABUTMENT DIAPHRAGM GUIDE DETAILS

NOTES:
 FOR ADDITIONAL ABUTMENT DIAPHRAGM GUIDE DETAILS,
 SEE STANDARD DRAWING SICD-2-14.

DESIGN AGENCY STRUCTUREPOINT <small>AN AMERICAN CORPORATION</small> <small>2000 CORPORATION CENTER DRIVE, SUITE 200</small> <small>TEL: 610.426.1200 FAX: 610.426.1202</small> <small>WWW.STRUCTUREPOINT.COM</small>	DESIGNED SUJ CHECKED CLB	DRAWN DSH REVISED	REVIEWED MDS STRUCTURE FILE NUMBER 3109163	DATE 1/03/19
	FORWARD ABUTMENT DETAILS BRIDGE NO. - HAM-75-0440 L/R OVER WB I-74			
	HAM-75-3.84 PID No. 104667			
	25 / 68 <div style="border: 1px solid black; border-radius: 50%; width: 30px; height: 30px; display: flex; align-items: center; justify-content: center; margin: 0 auto;"> 25 68 </div>			


S:\Plans\10/26/2023 4:26:27 PM
 10/26/2023 4:26:27 PM
 O:\2017\01113\C.Design\104667_HAM-75-3.84\Design\Structures\HAM0075_0440C_Sheets\HAM0075_0440C_WE001.dgn

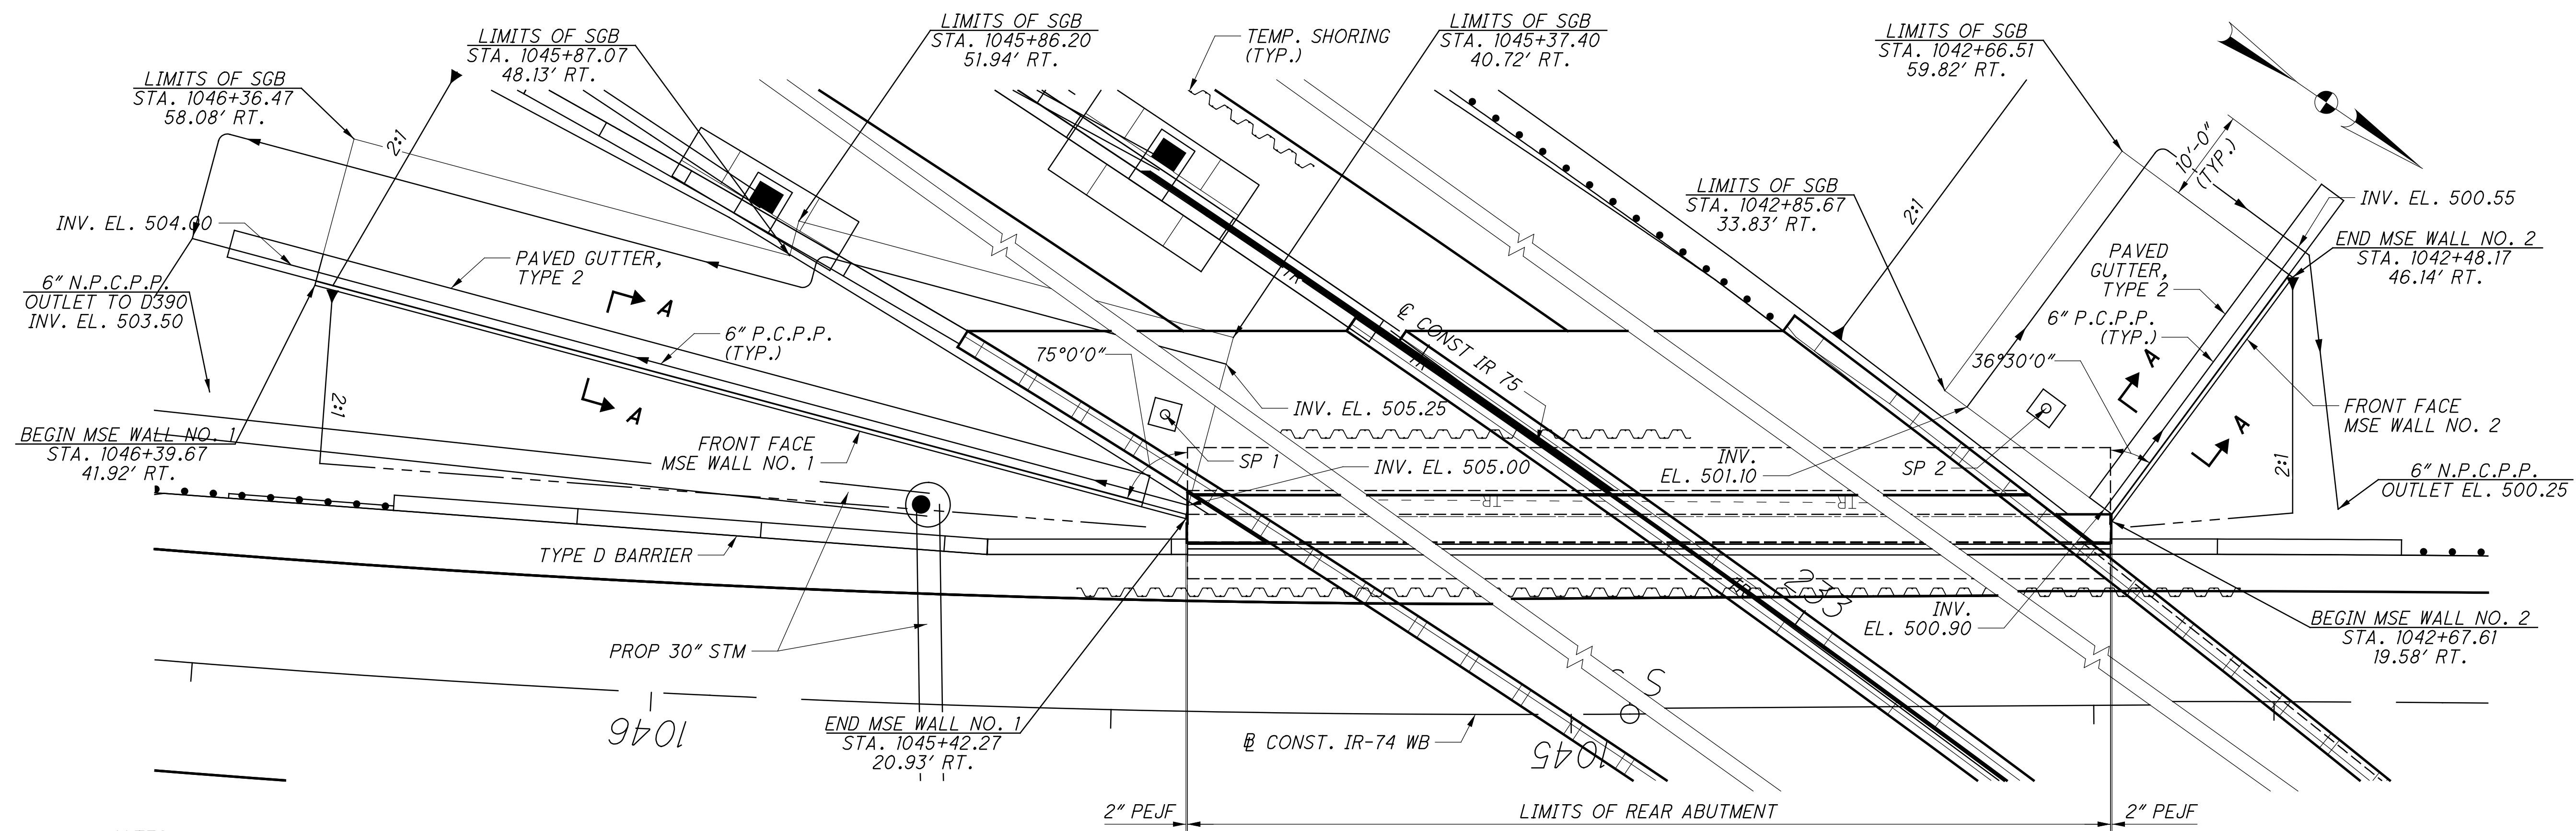


NOTES
 * 6'-0" GEOTEXTILE FABRIC PER SS840.03.D ON BACK FACE CENTERED ON JOINT FROM TOP OF LEVELING PAD TO TOP OF WALL.
 ALL STATIONS AND OFFSETS GIVEN ALONG FRONT FACE OF MSE WALL FROM @ CONST IR 74 WB.
 PROFILE SHOWN ALONG FRONT FACE OF MSE WALL.
 FOR SECTIONS A-A, SEE SHEET 28/68.

LEGEND
 □ - SETTLEMENT PLATFORM (SP)
 SP 1, MSE WALL NO. 1 - STA. 1045+44.81, 32.21' RT.
 SP 2, MSE WALL NO. 2 - STA. 1042+74.72, 31.87' RT.

PLAN

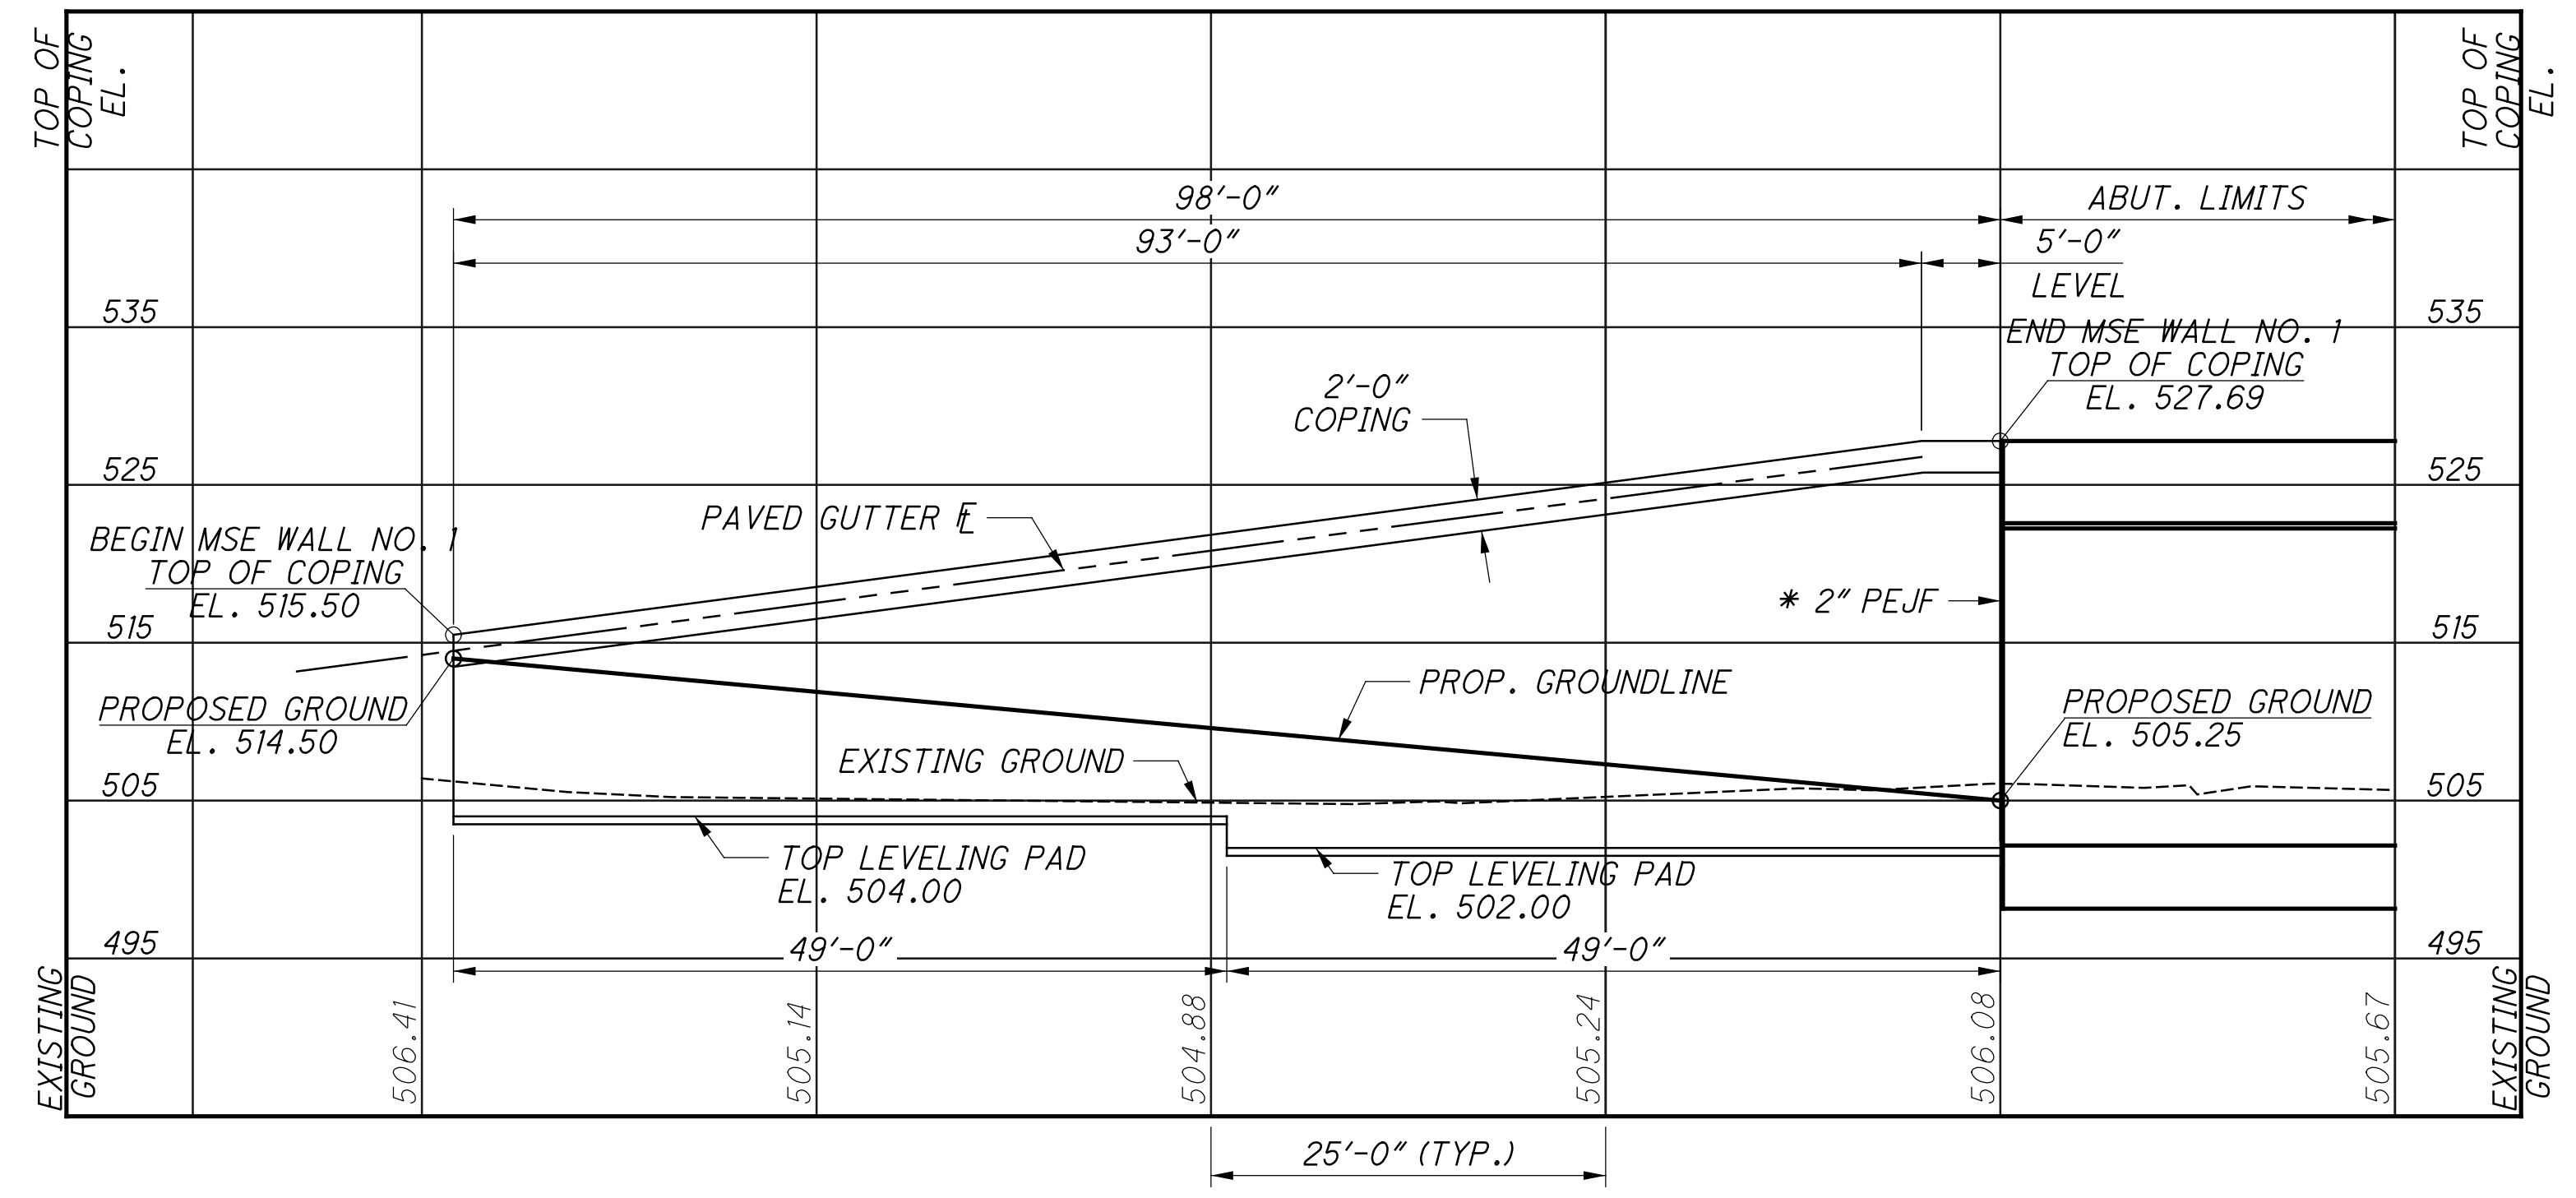


PROFILE
 ALONG FRONT FACE MSE WALL NO. 1

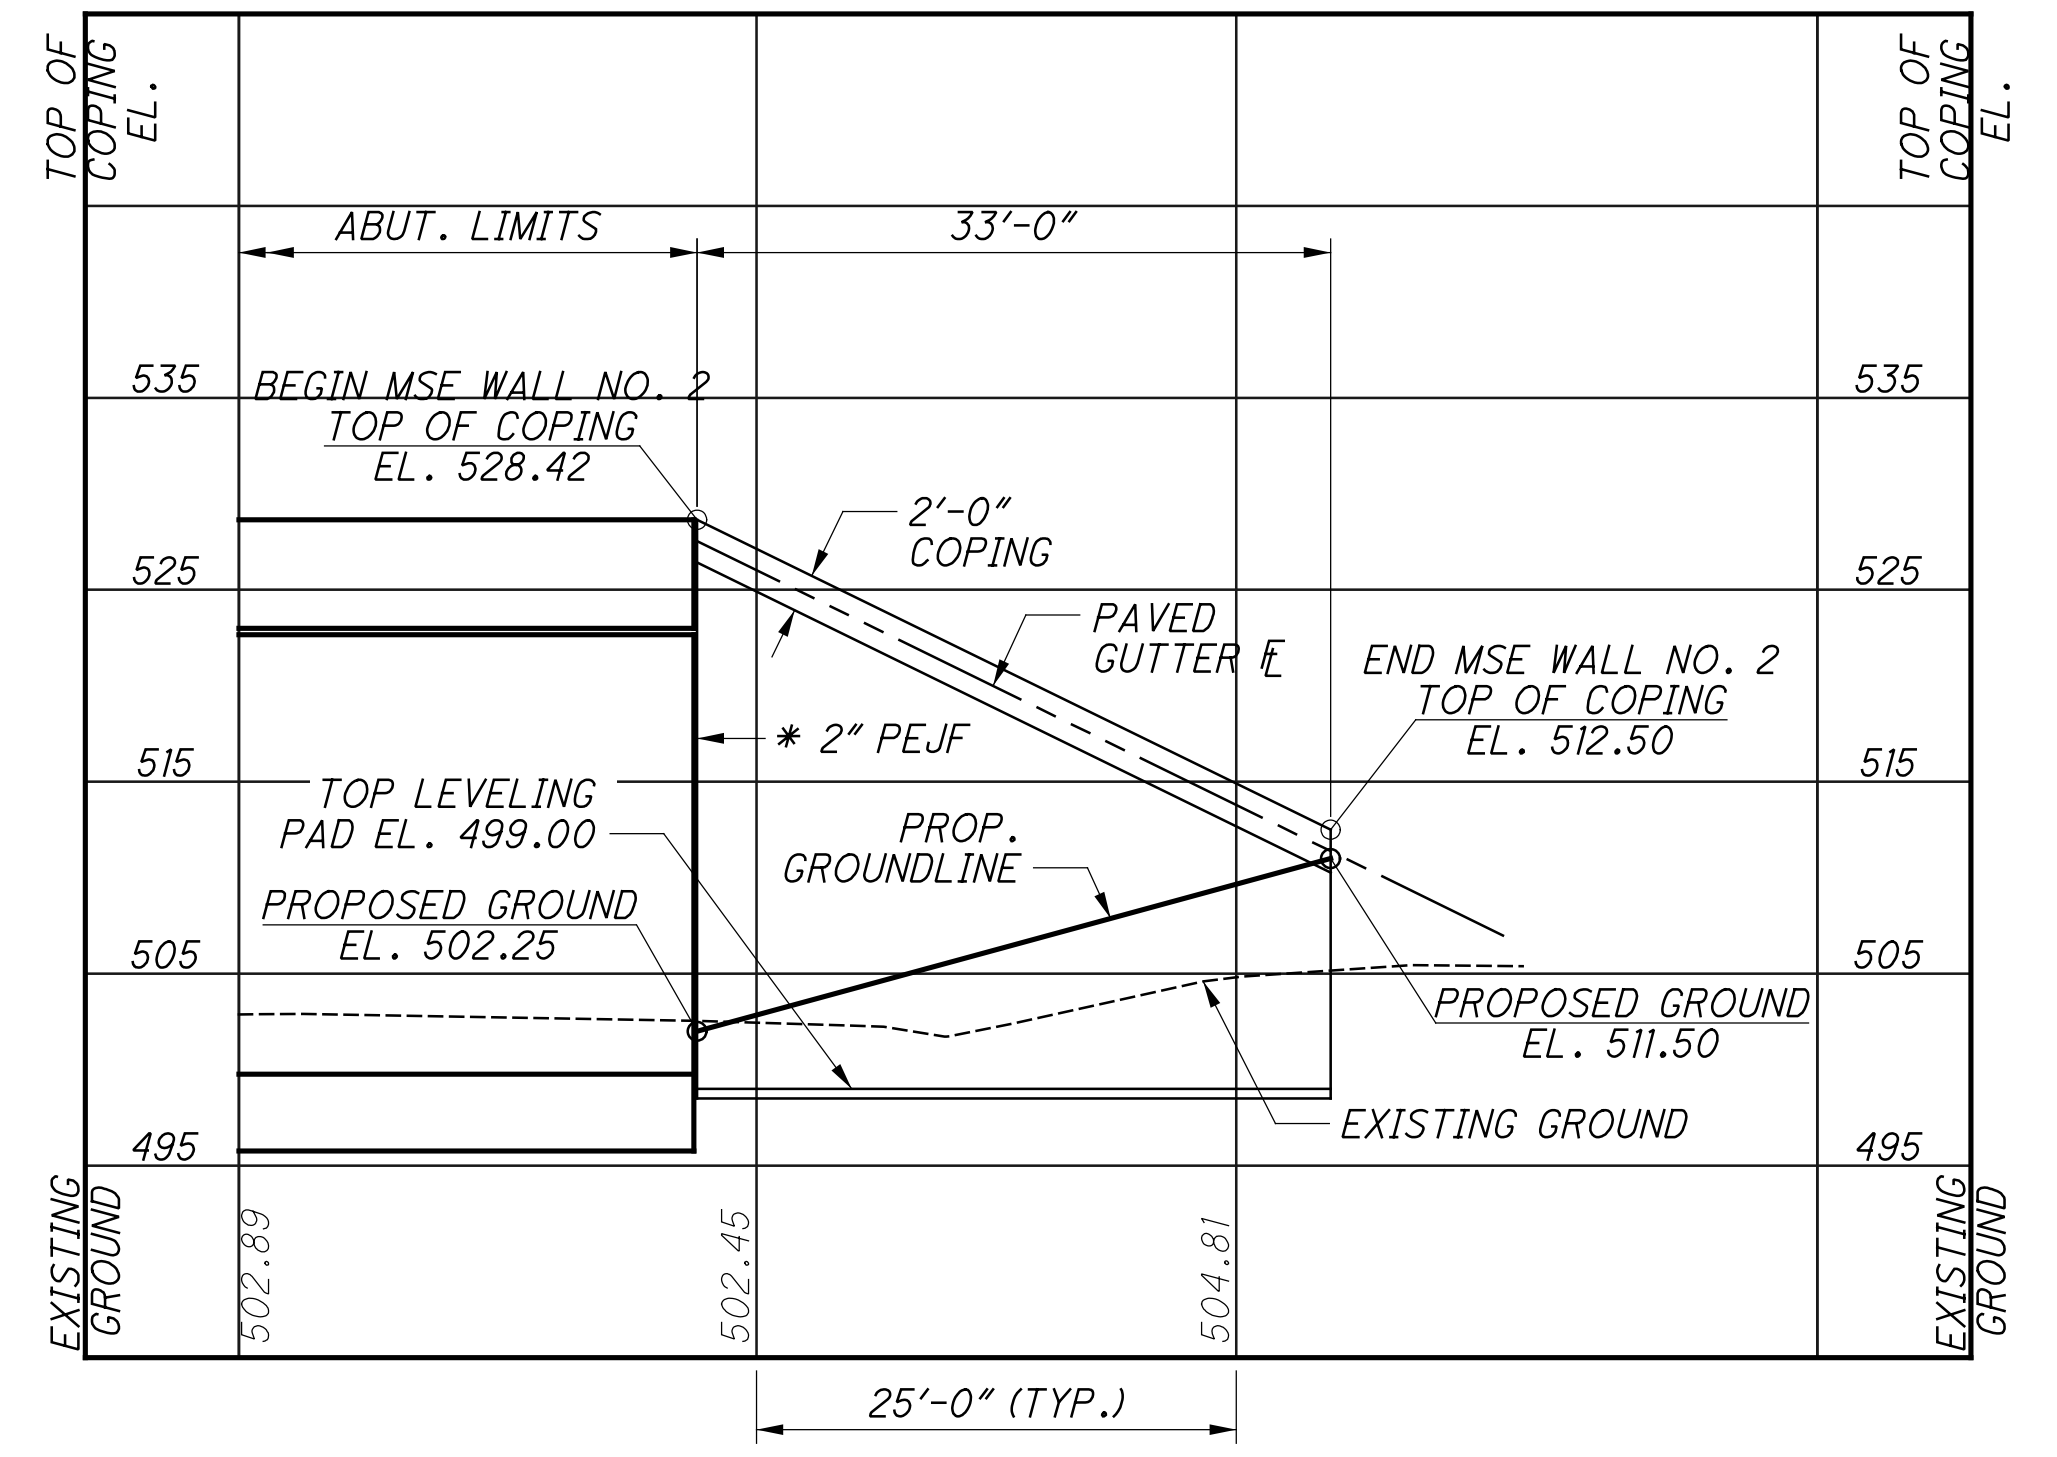

PROFILE
 ALONG FRONT FACE MSE WALL NO. 2

DESIGN AGENCY: STRUCTUREPOINT
 DATE: 01/03/19
 REVIEWED: MDS
 DRAWN: TMT
 DESIGNED: SUJ
 CHECKED: CLB
 STRUCTURE FILE NUMBER: 3109763
PLAN & PROFILE - MSE WALL NO. 1 & 2
 BRIDGE NO. HAM-75-0440 L/R
 OVER IR 74 WB
HAM-75-3.84
 PID No. 104667
 26/68
 26
 68


S:\Projects\104667 - HAM-75-3.84\Design\Structures\HAM0075_0440C\Sheets\HAM0075_0440C_WE002.dgn
 10/26/2023 4:26:28 PM
 01/2017\01113\C.Design\104667 - HAM-75-3.84\Design\Structures\HAM0075_0440C\Sheets\HAM0075_0440C_WE002.dgn

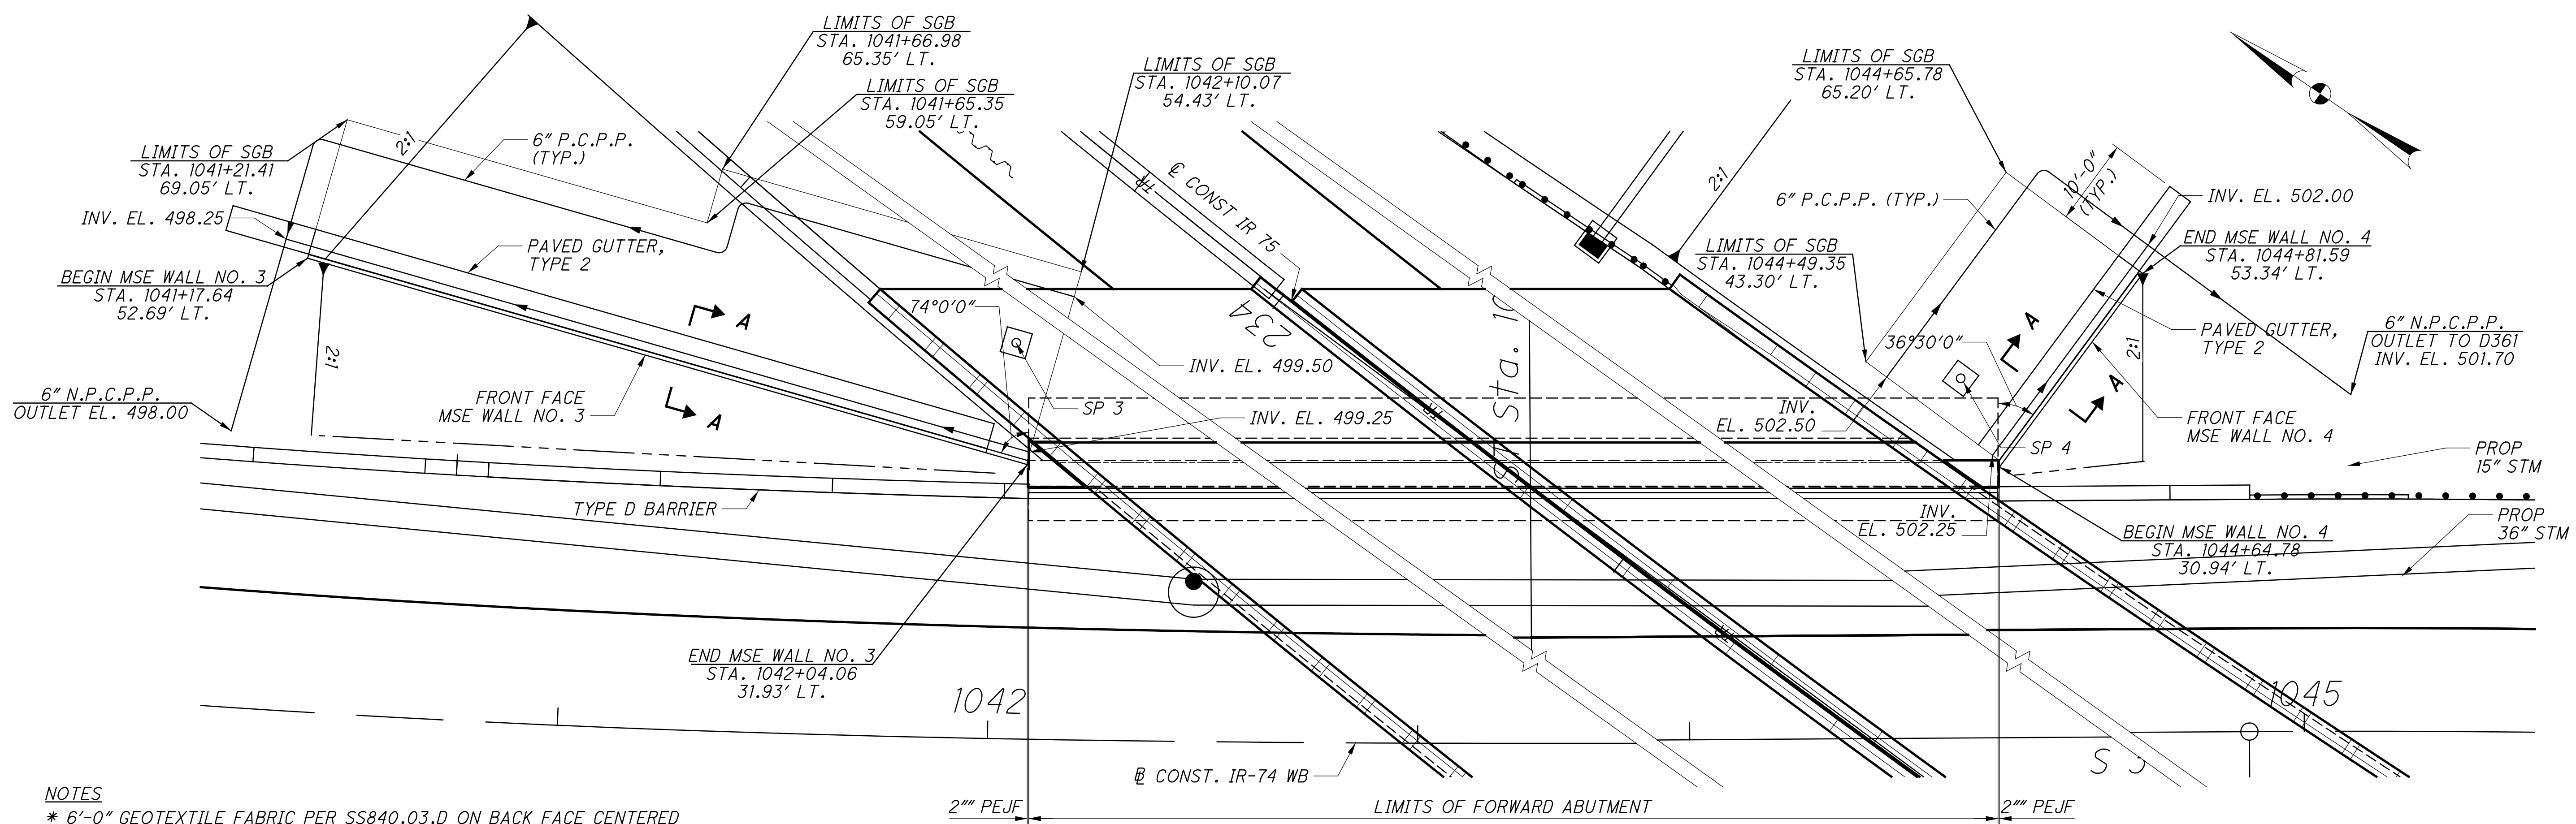


NOTES
 * 6'-0" GEOTEXTILE FABRIC PER SS840.03.D ON BACK FACE CENTERED ON JOINT FROM TOP OF LEVELING PAD TO TOP OF WALL.
 ALL STATIONS AND OFFSETS GIVEN ALONG FRONT FACE OF MSE WALL FROM @ CONST IR 74 WB.
 PROFILE SHOWN ALONG FRONT FACE OF MSE WALL.
 FOR SECTIONS A-A, SEE SHEET 28/68.

LEGEND
 [Square with circle] - SETTLEMENT PLATFORM (SP)
 SP 3, MSE WALL NO. 3 - STA. 1042+02.50, 46.06' LT.
 SP 4, MSE WALL NO. 4 - STA. 1044+60.35, 41.30' LT.

PLAN

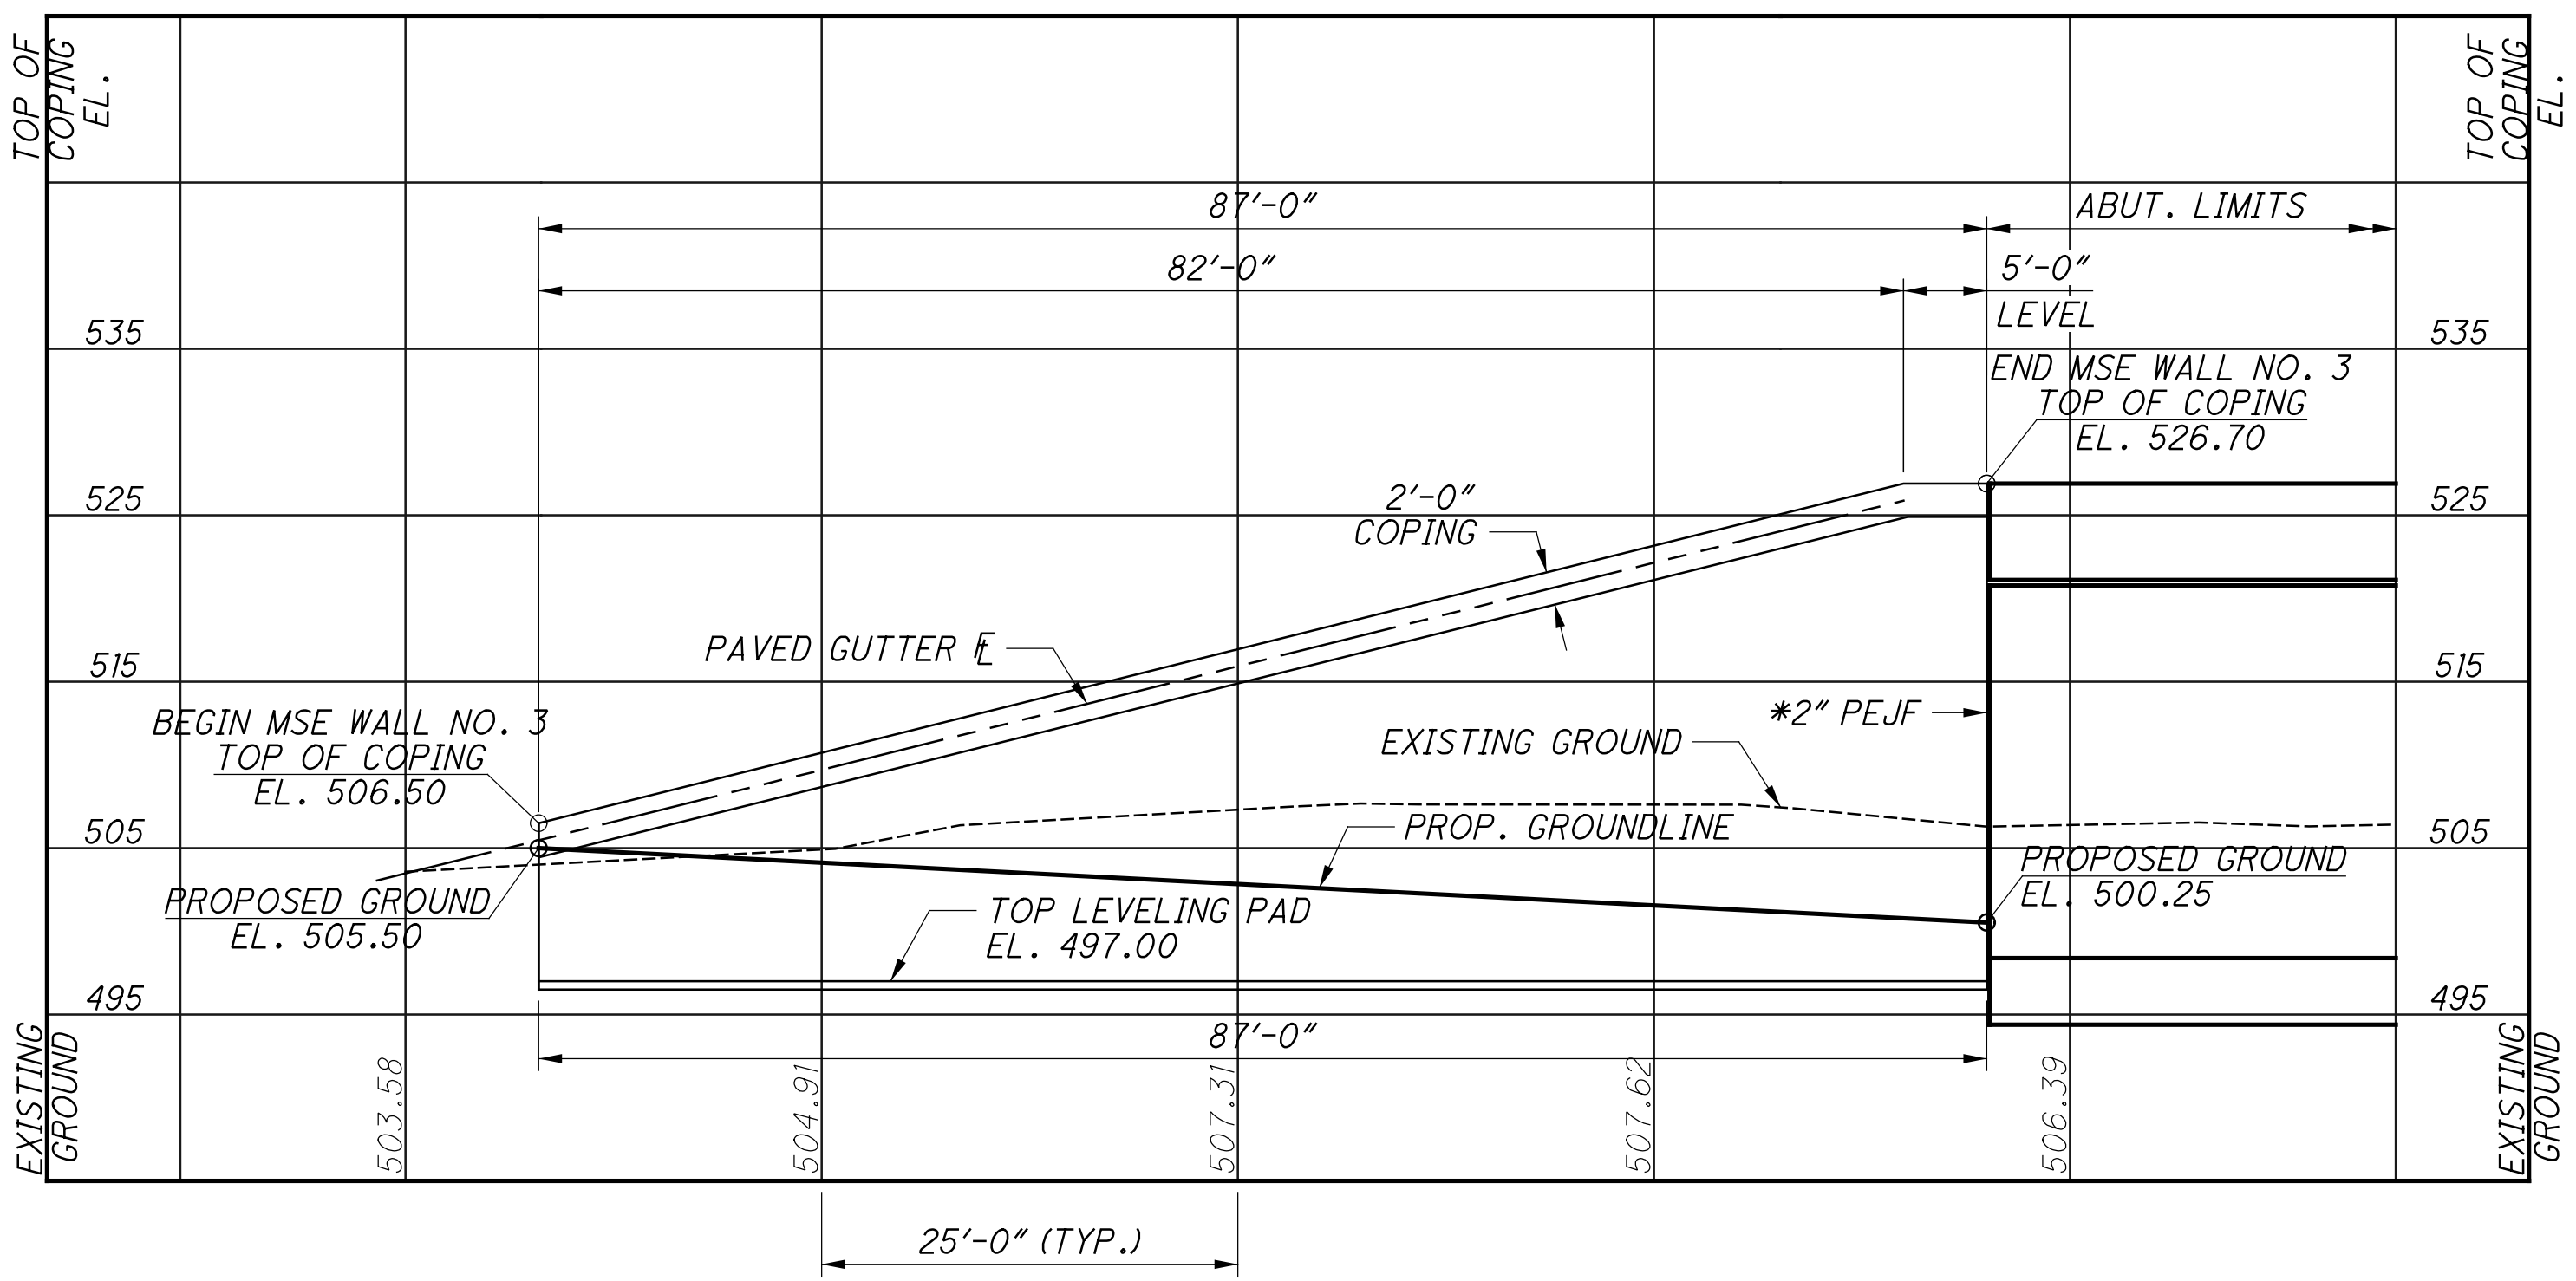


PROFILE
 ALONG FRONT FACE MSE WALL NO. 3

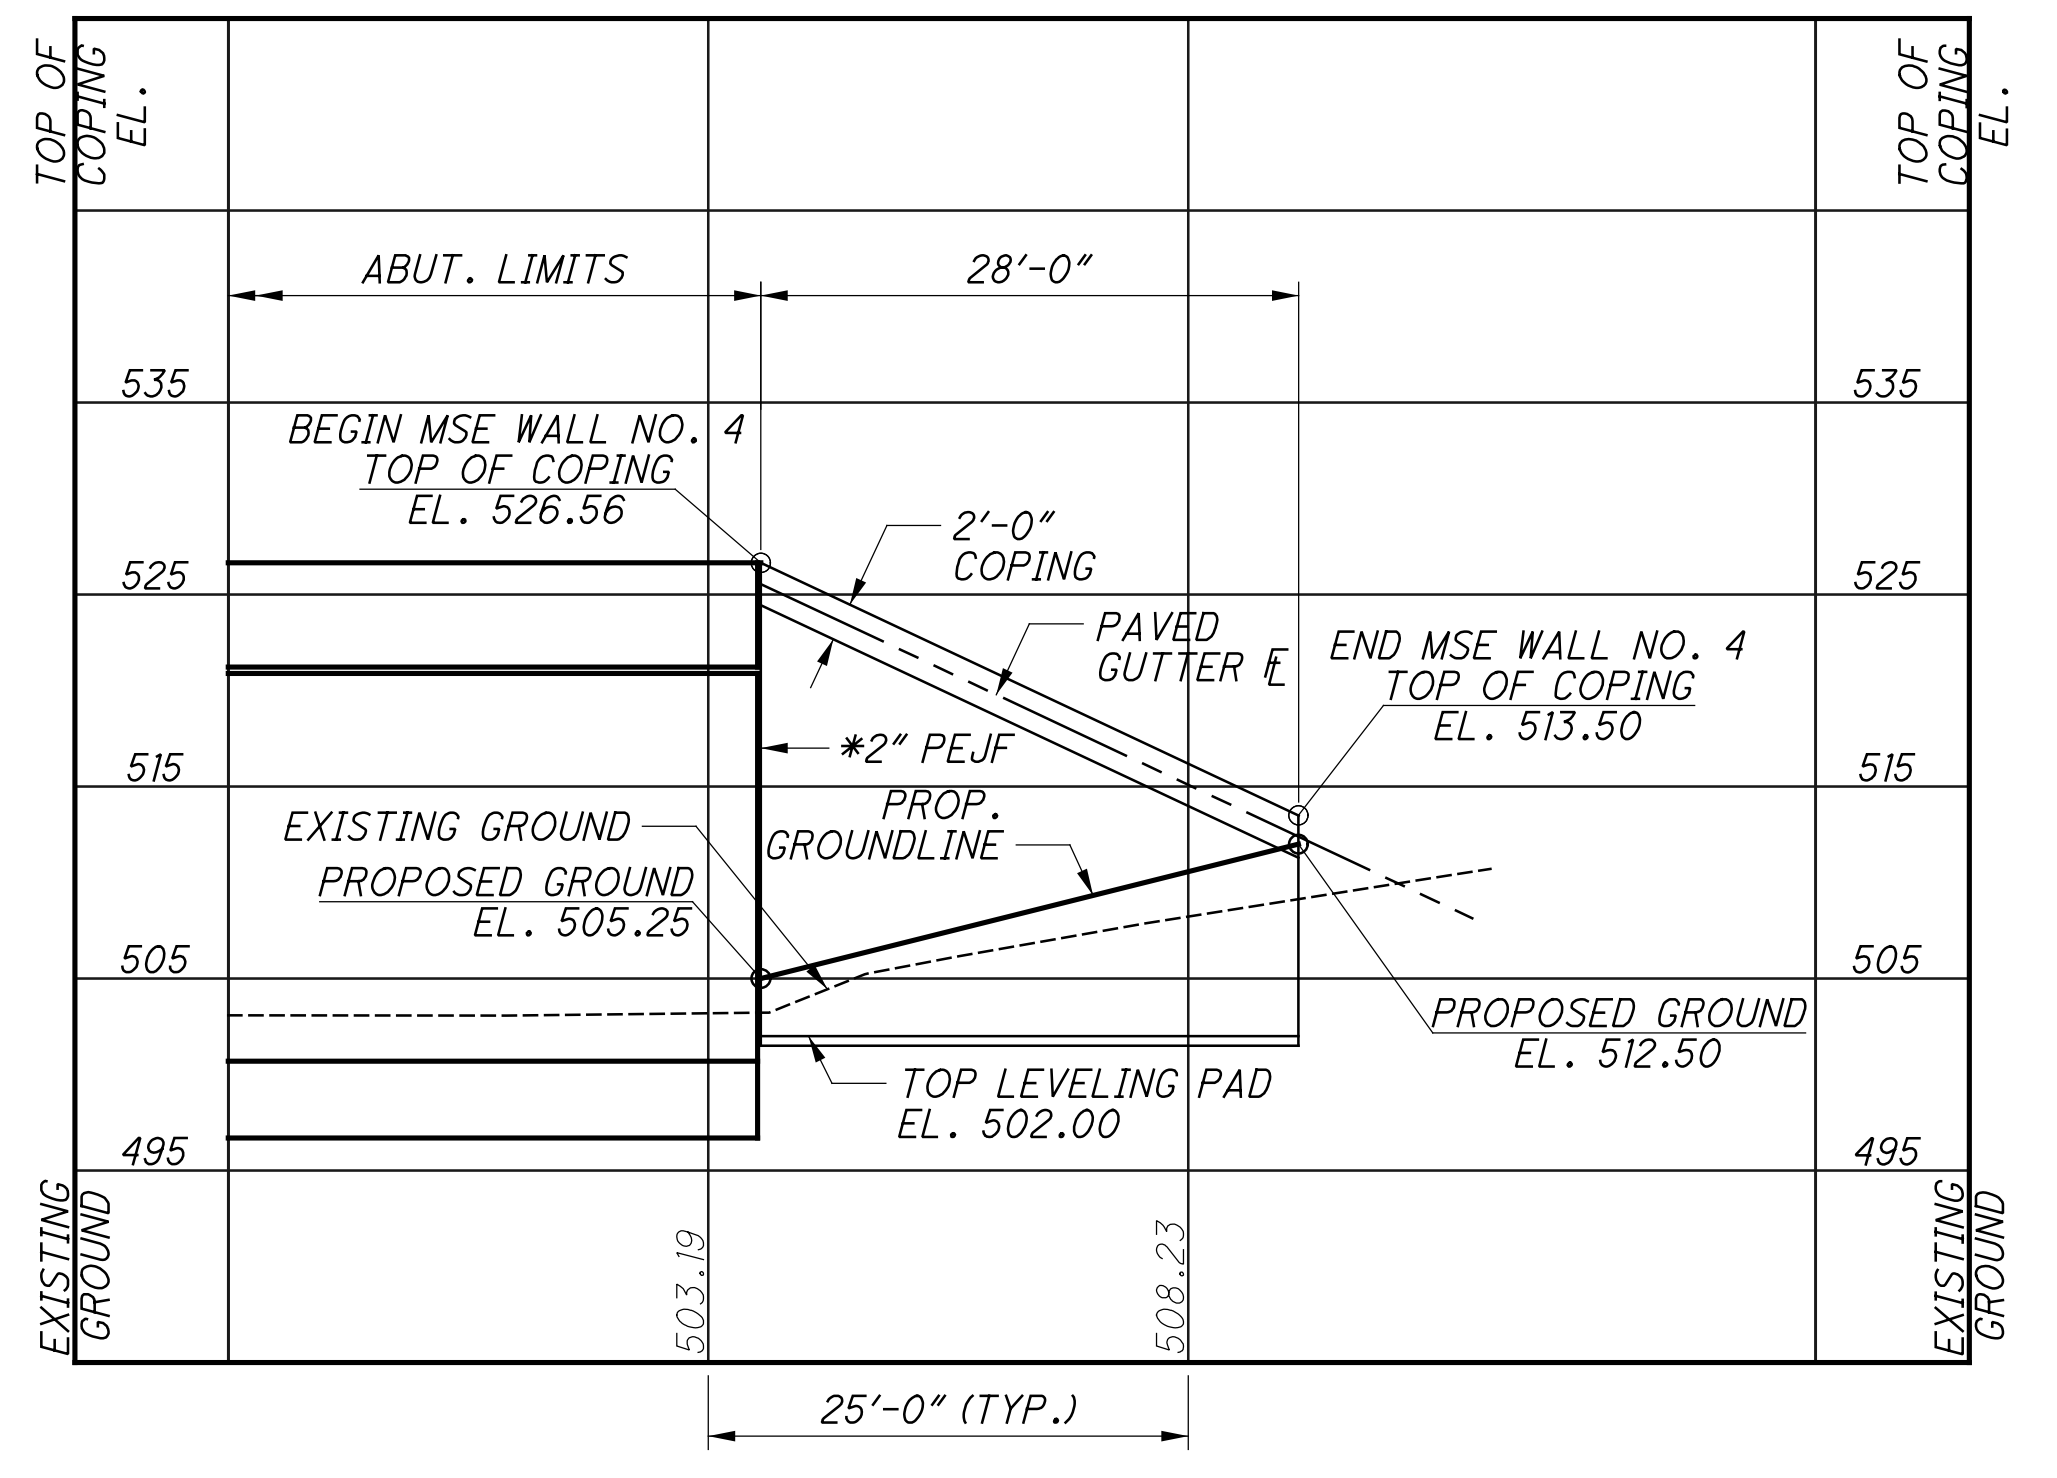


PROFILE
 ALONG FRONT FACE MSE WALL NO. 4

DESIGN AGENCY: STRUCTUREPOINT
 DATE: 01/03/19
 REVIEWED: MDS
 DRAWN: TMT
 DESIGNED: SUJ
 CHECKED: CLB
 STRUCTURE FILE NUMBER: 3109763
 REVISIONS: 1
 PLAN & PROFILE - MSE WALL NO. 3 & 4
 BRIDGE NO. HAM-75-0440 L/R
 OVER IR 74 WB
 HAM-75-3.84
 PID No. 104667
 27/68
 27
 68


S:\Plans\10/26/2023 4:26:29 PM
 01\2017\01113\C.Design\104667.HAM-75-3.84.Design\Structures\HAM0075_0440C_Sheets\HAM0075_0440C_WY001.dgn

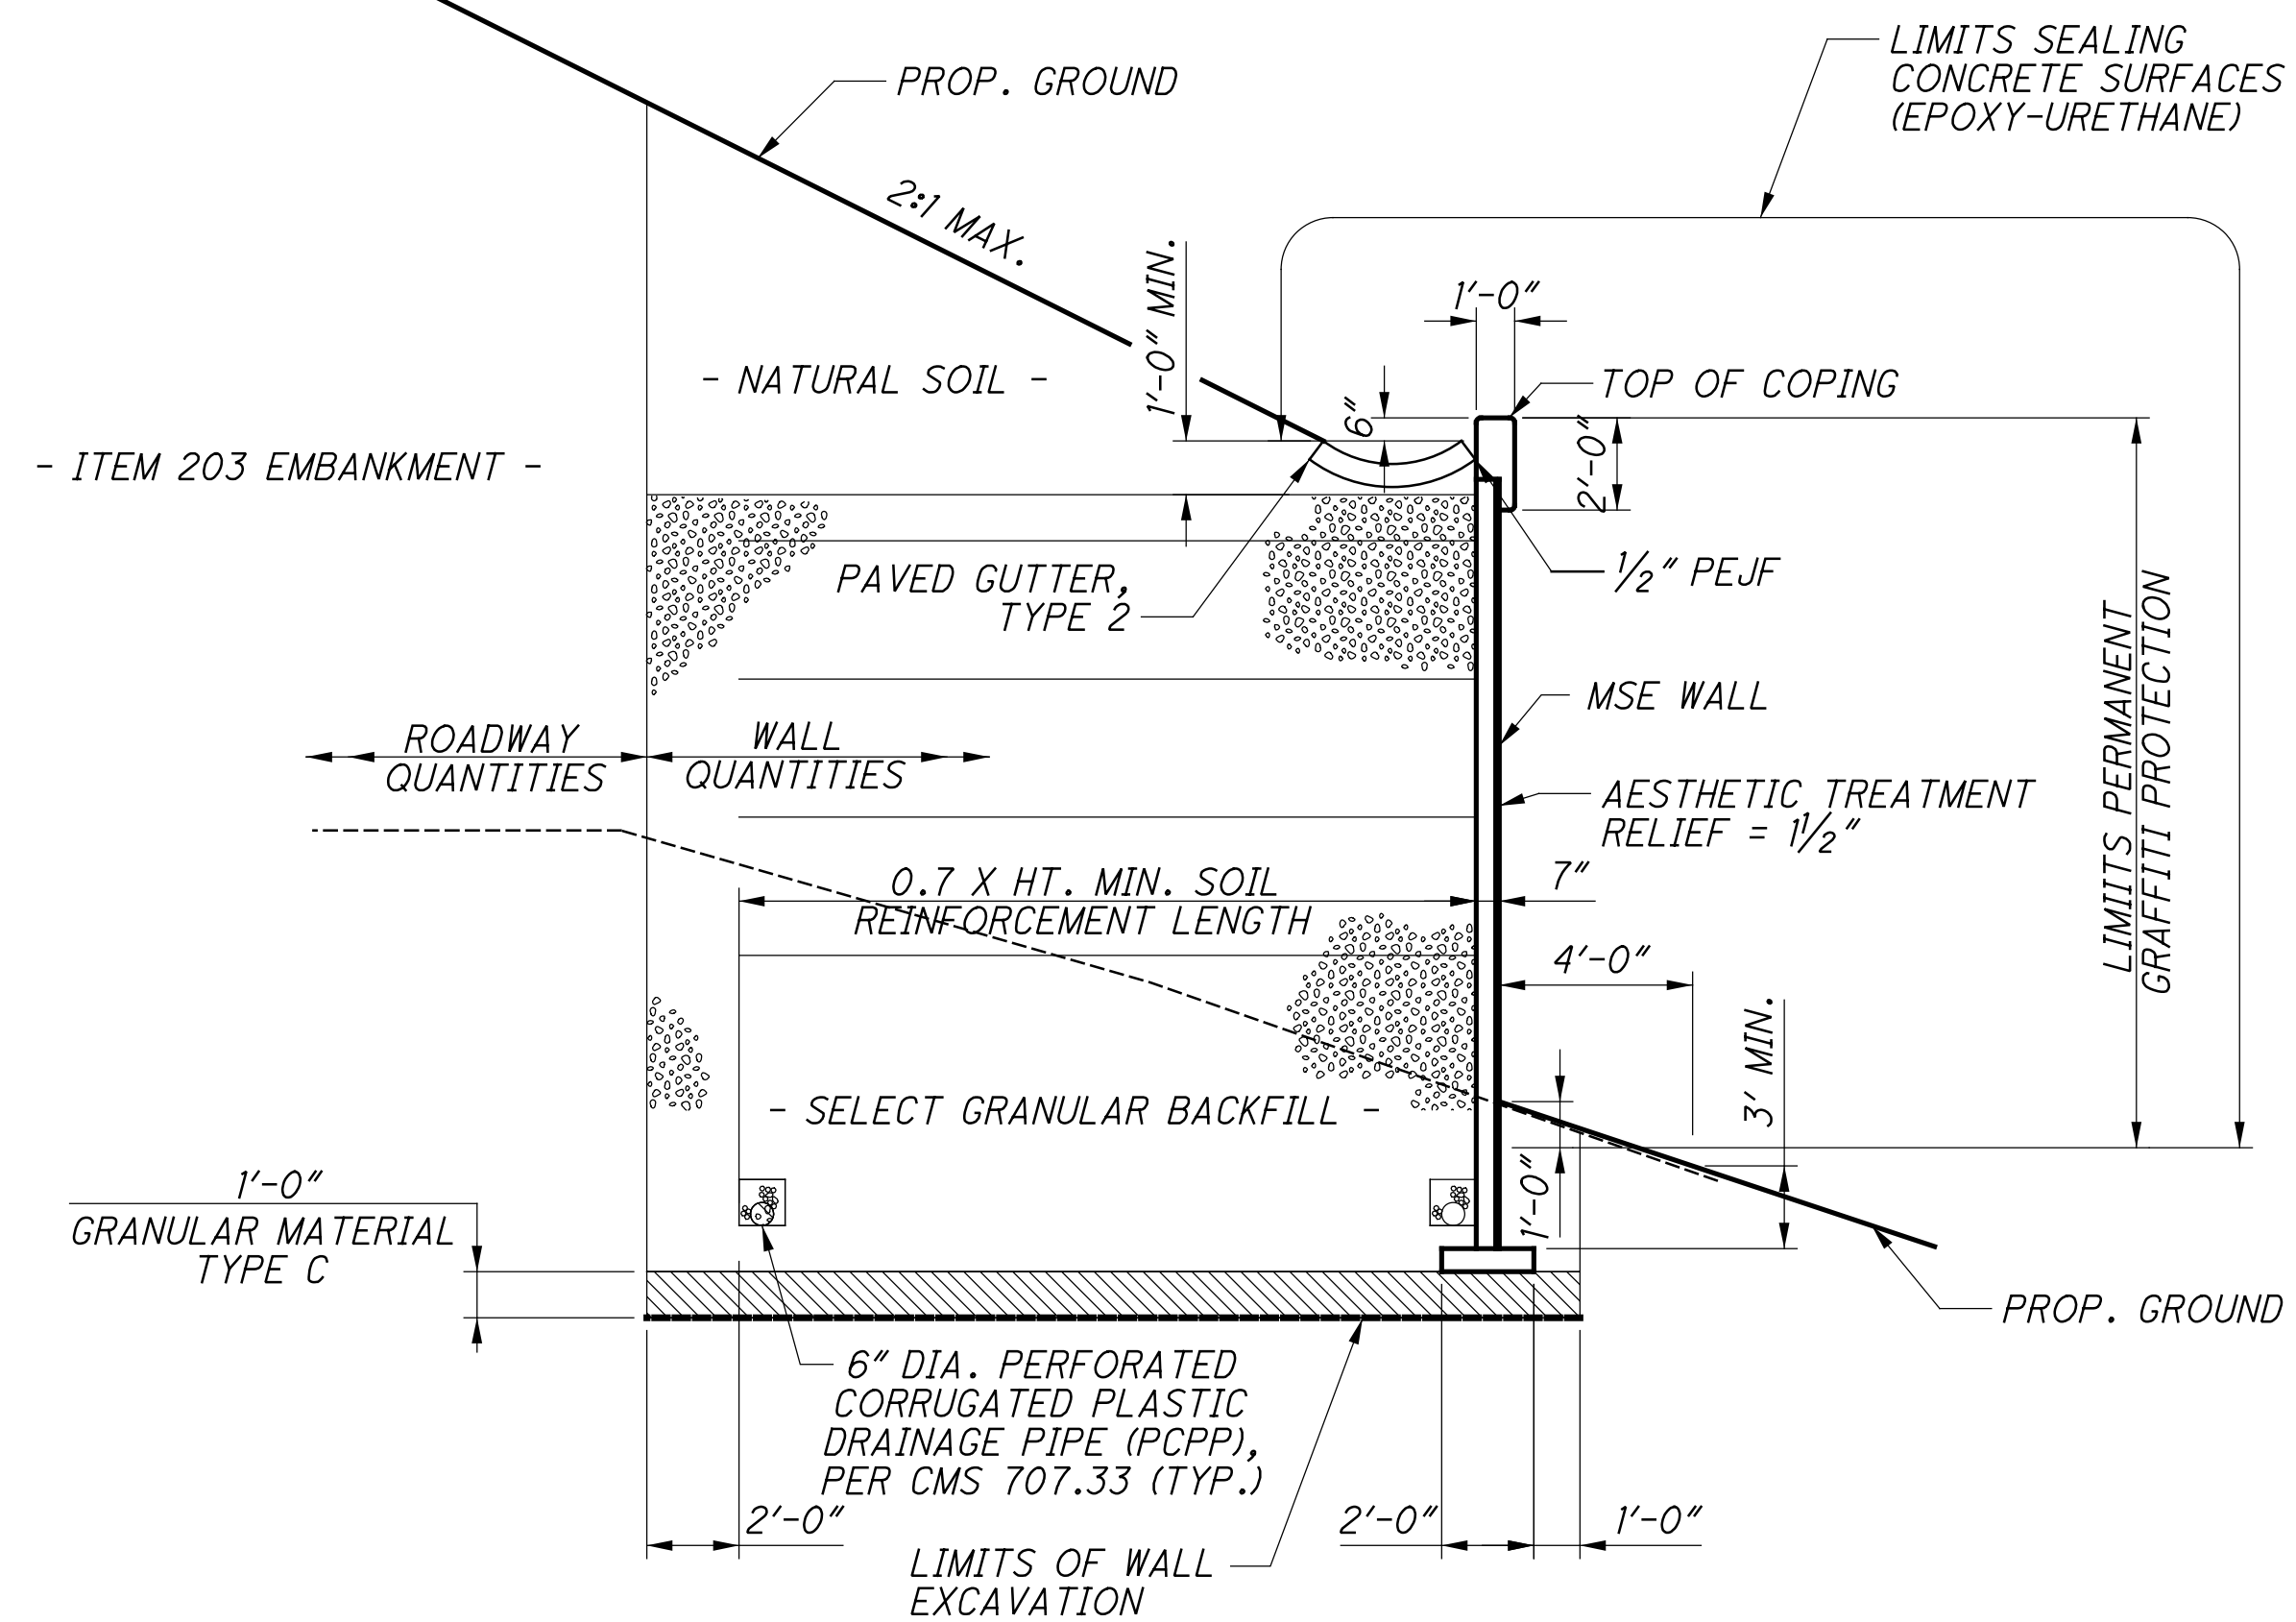


TYPICAL MSE WINGWALL SECTION

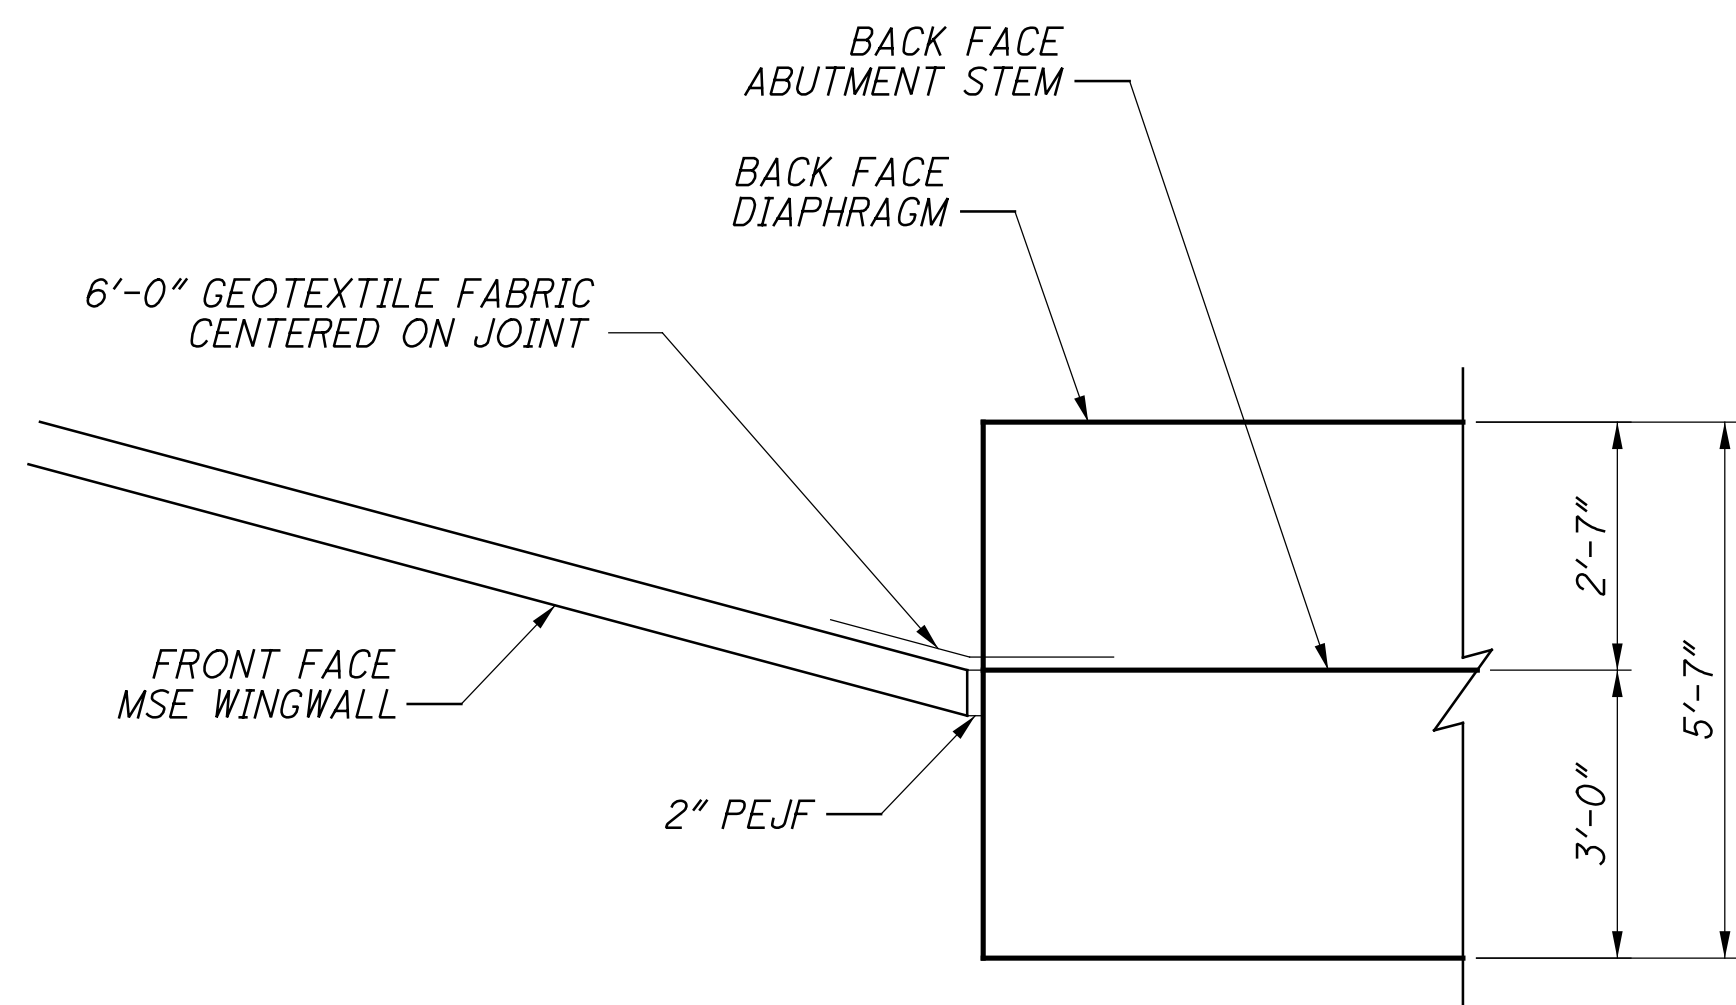


ABUTMENT INTERFACE DETAIL

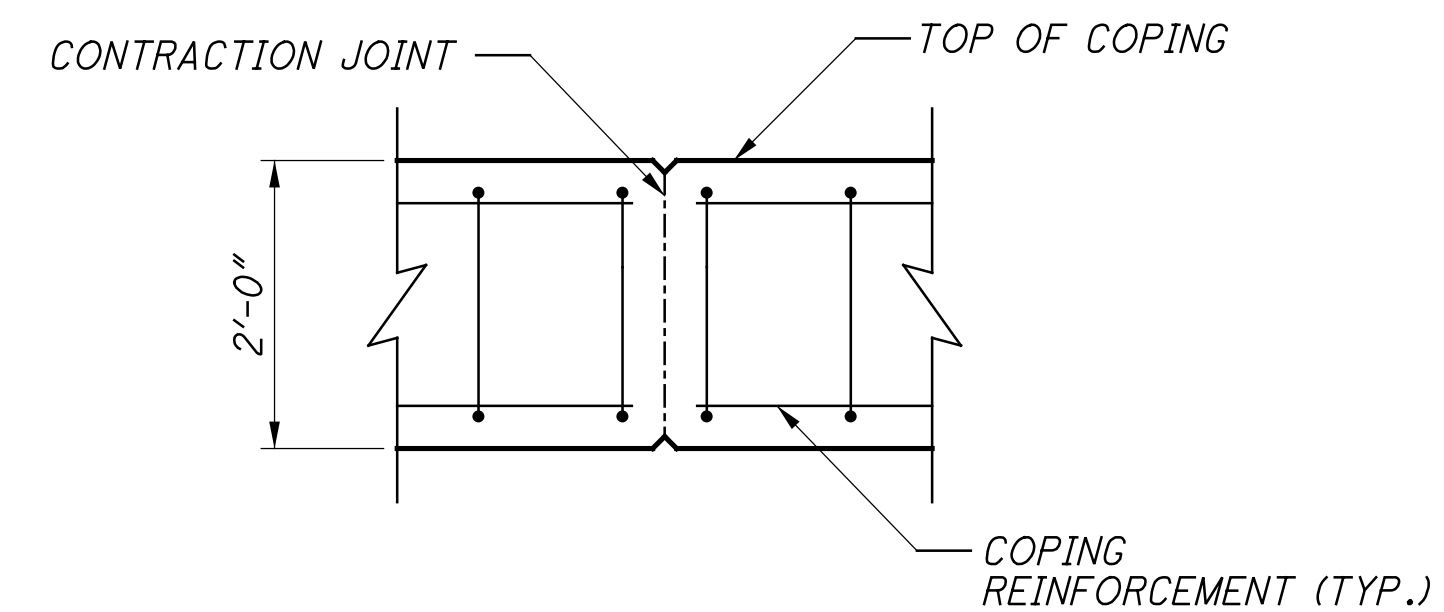

COPING CONTRACTION JOINT

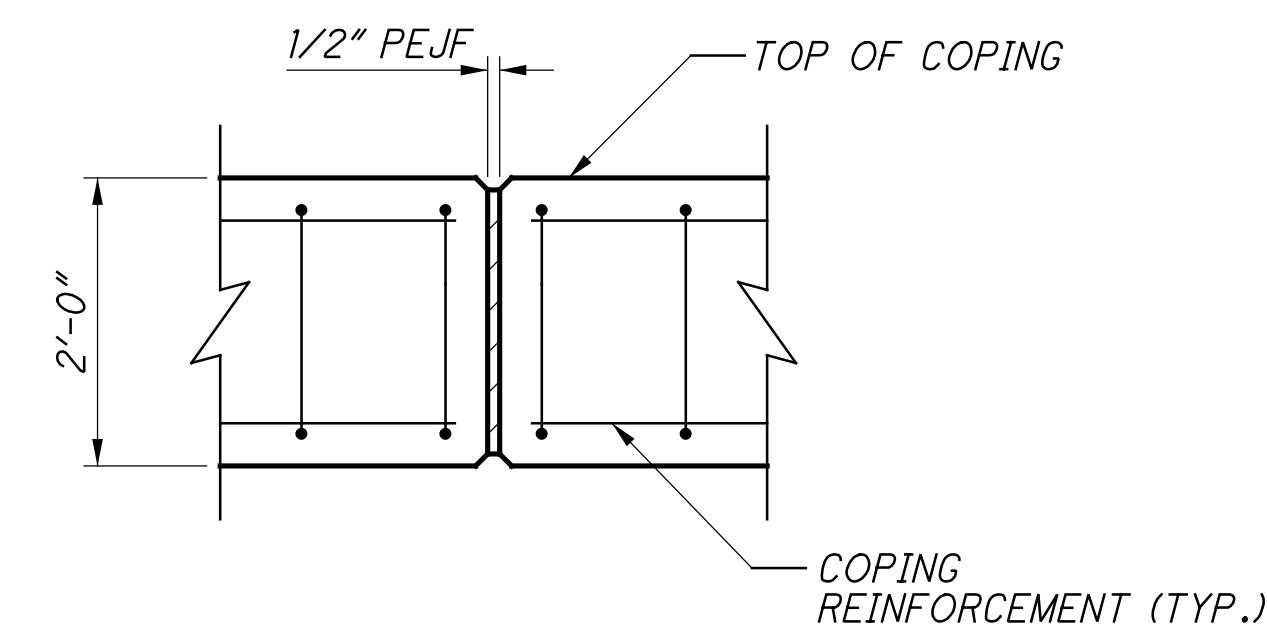


COPING EXPANSION JOINT

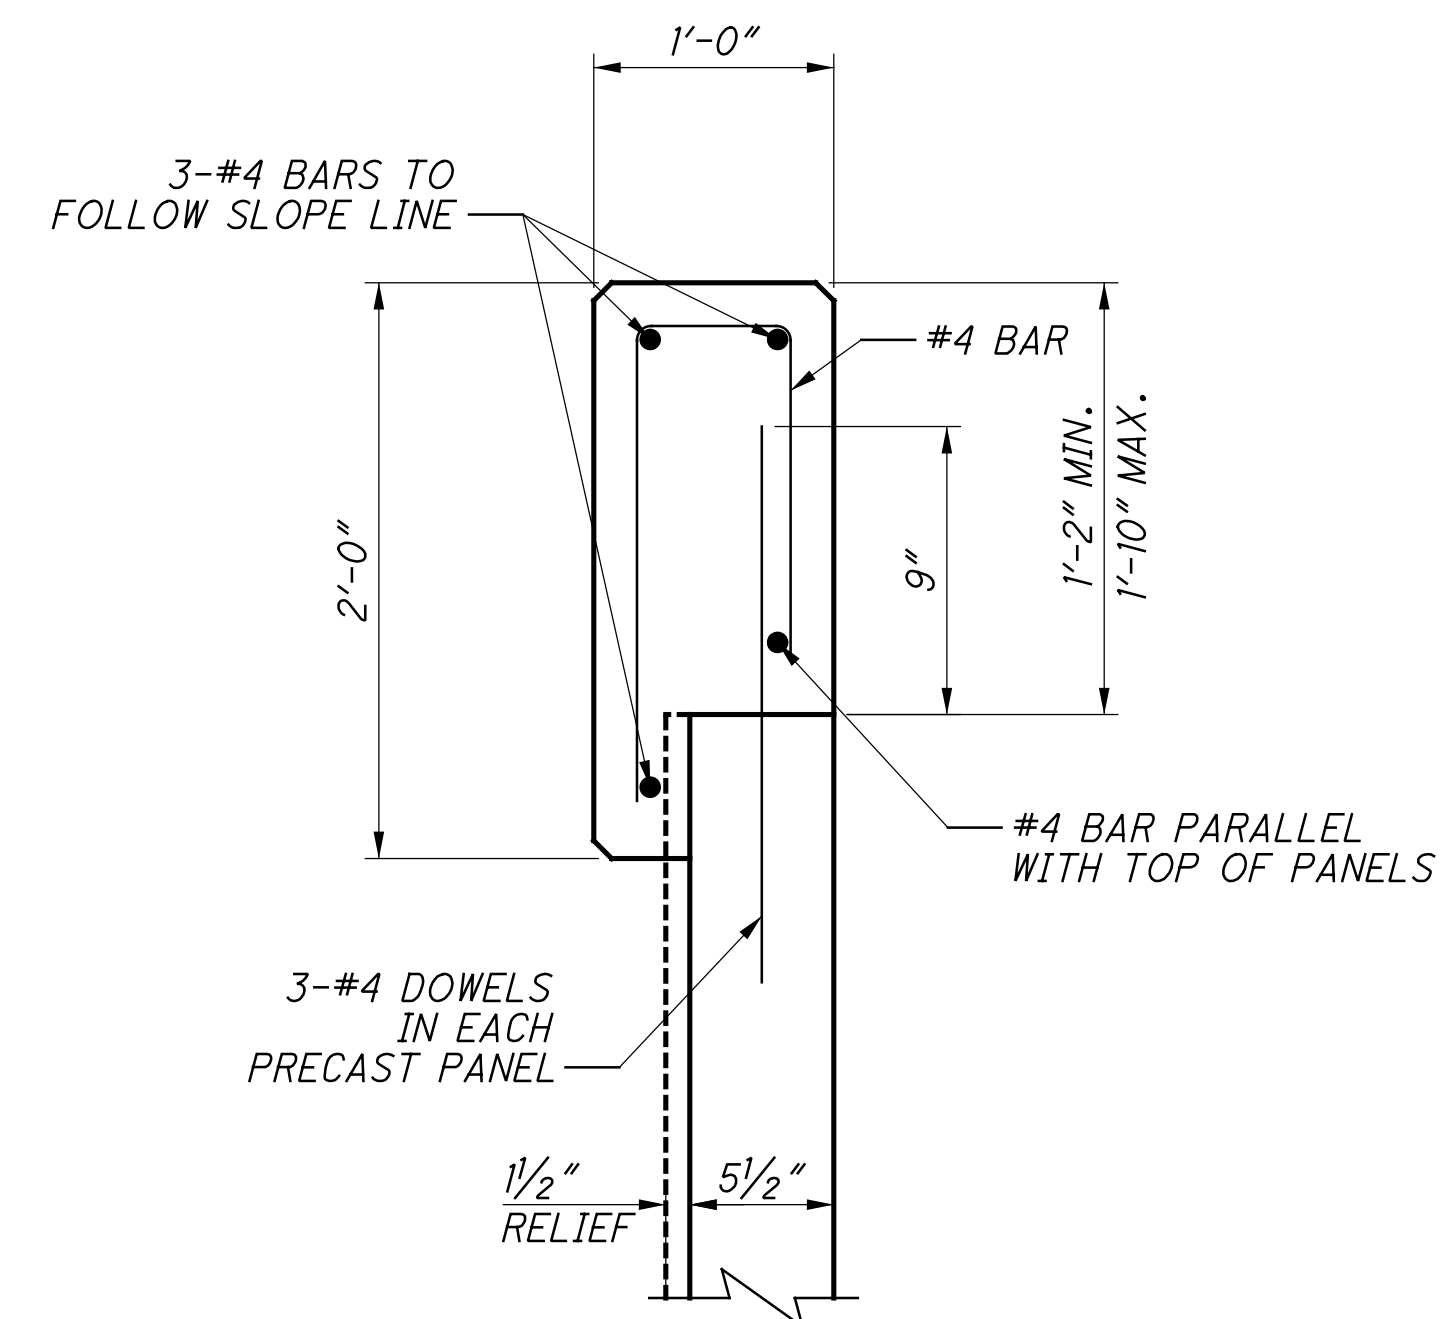

COPING DETAIL

DESIGN AGENCY STRUCTUREPOINT	
DESIGNED SUJ	DATE 01/03/19
DRAWN SUJ	REVIEWED MDS
CHECKED CLB	STRUCTURE FILE NUMBER 3109763
MSE WINGWALL SECTION AND DETAILS BRIDGE NO. HAM-75-0440 L/R OVER IR-74 WB	
HAM-75-3.84 PID No. 104667	
28/68	
<div style="border: 1px solid black; border-radius: 50%; width: 30px; height: 30px; display: flex; align-items: center; justify-content: center; margin: 0 auto;"> 28 68 </div>	

S:\Plans\2023\10/26/2023\4:26:29 PM\01\2017\01113\C.Design\104667_HAM-75-3.84.Design\Structures\HAM0075_0440C_Sheets\HAM0075_0440C_SD002.dgn

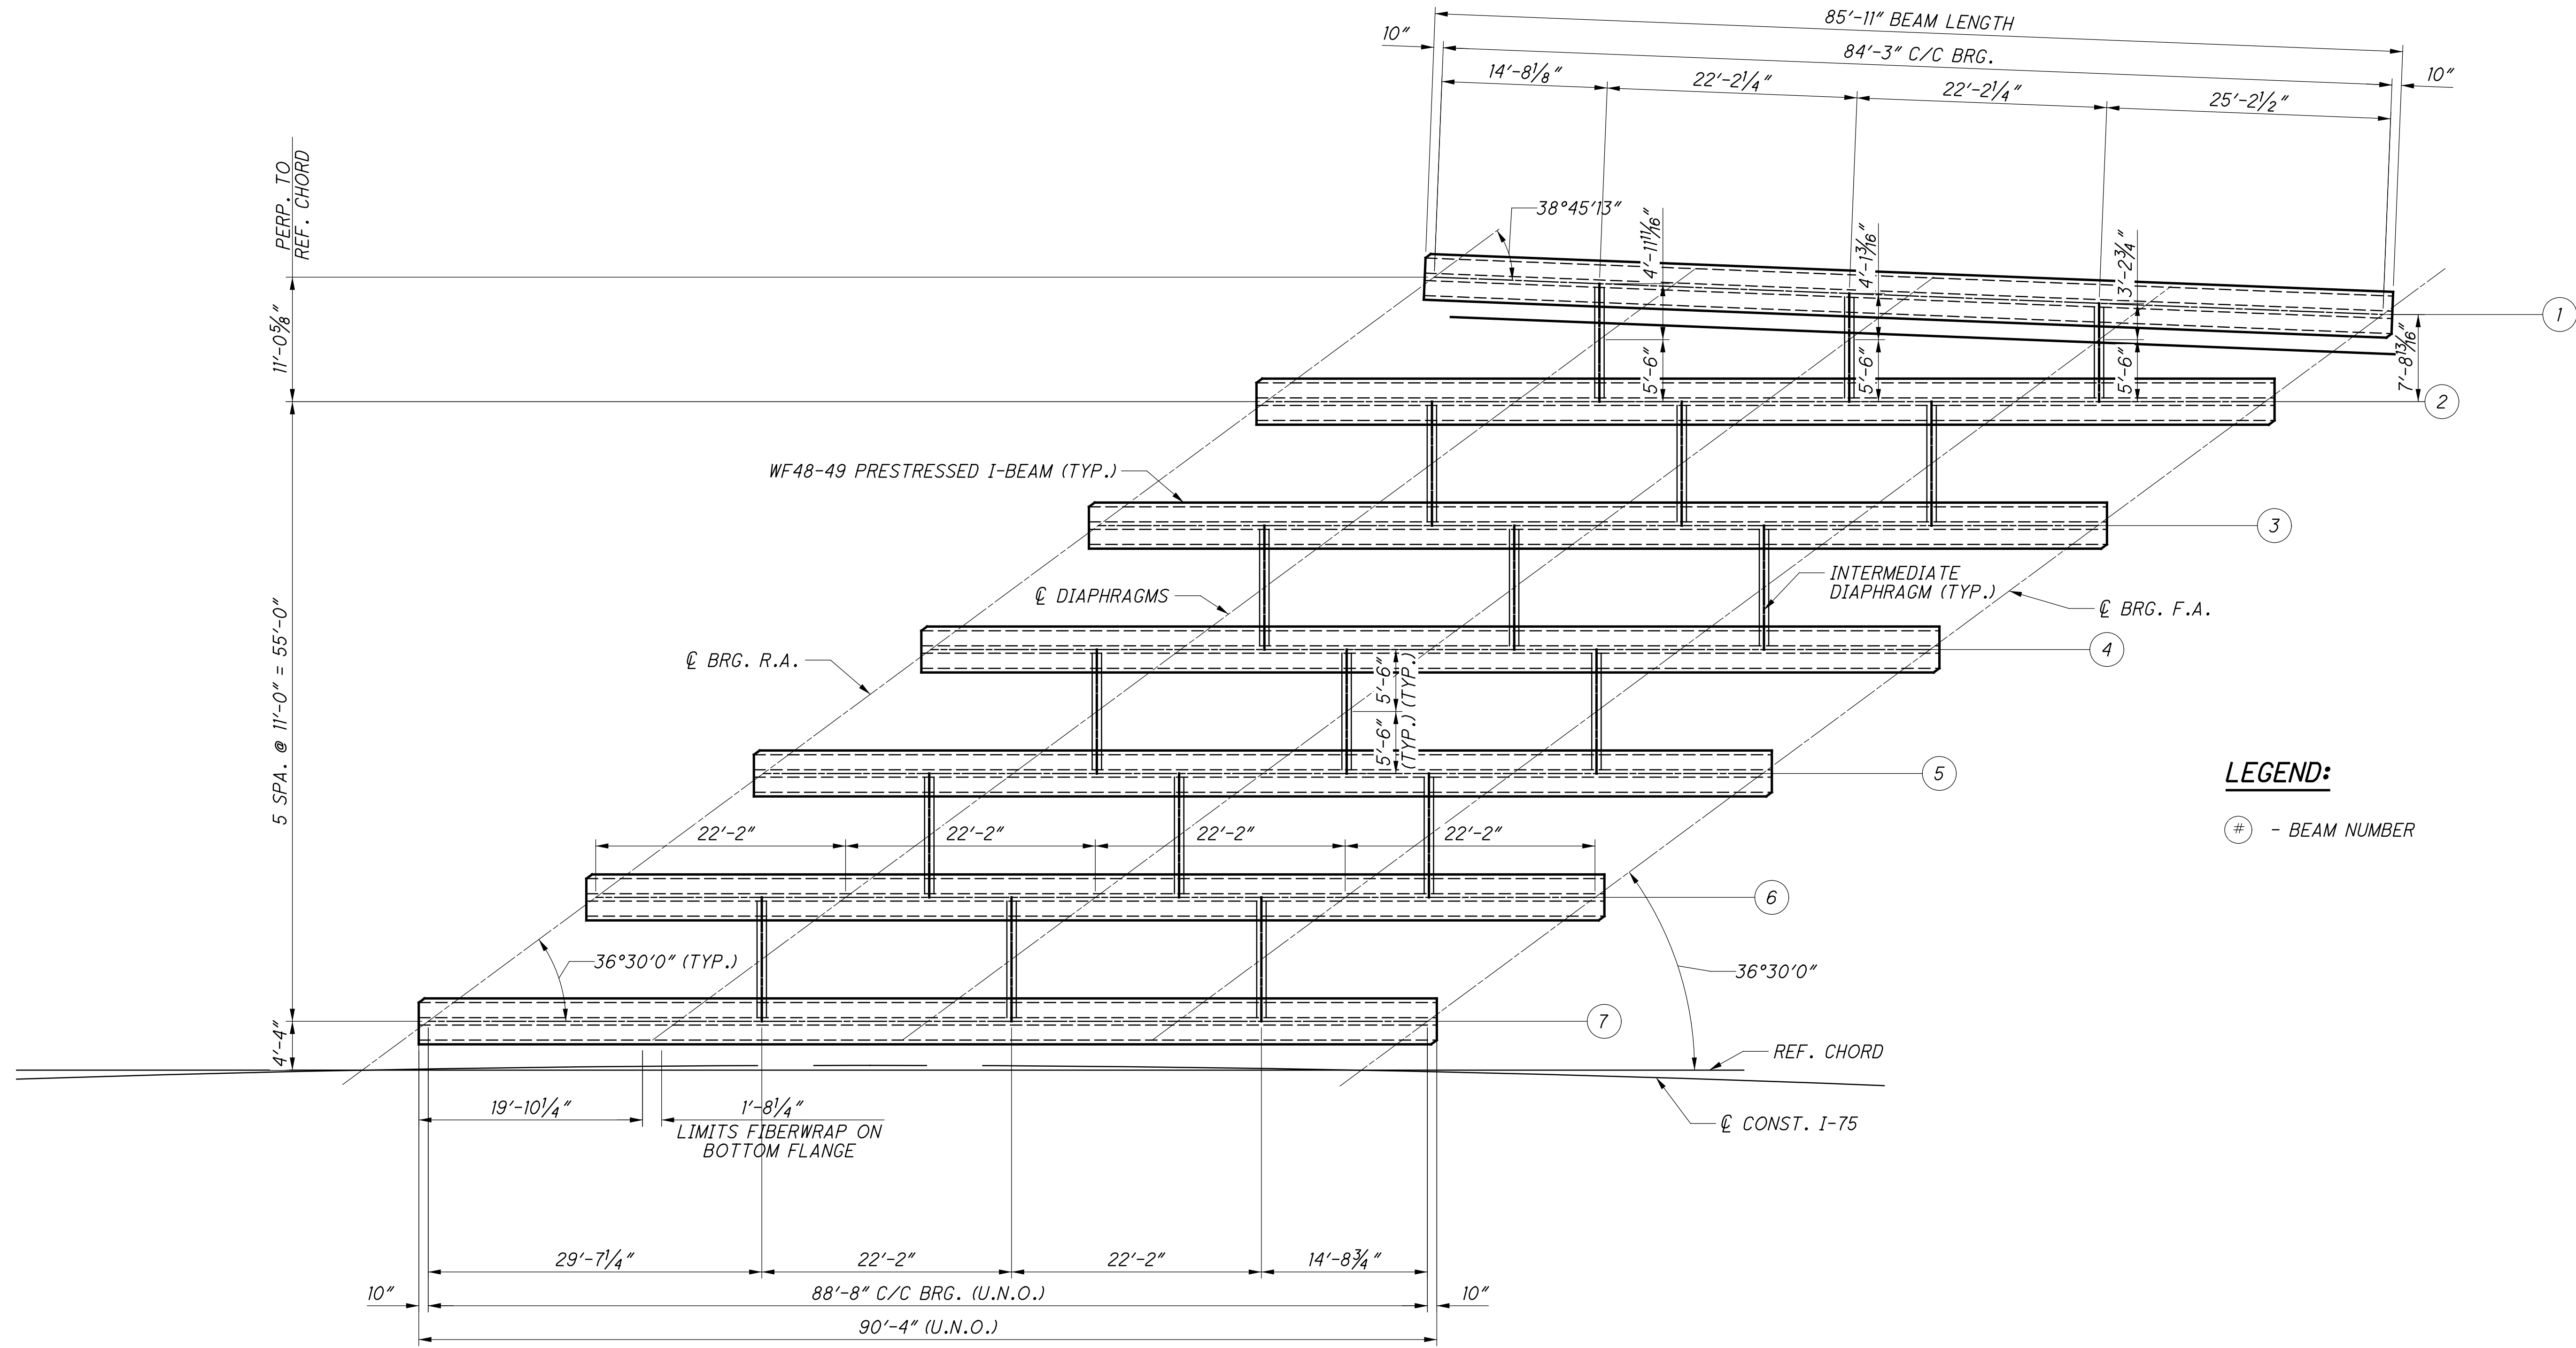



FRAMING PLAN

LEGEND:
 # - BEAM NUMBER

NOTES:
 1. SEE STD. DWG. PSID-I-13 FOR INTERMEDIATE DIAPHRAGM DETAILS.
 2. SEE SHEETS 31/68 TO 32/68 FOR BEAM DETAILS.

		DESIGN AGENCY STRUCTUREPOINT
DESIGNED SUJ	CHECKED CLB	DRAWN BNM
REVIEWED MDS	DATE 1/2/19	STRUCTURE FILE NUMBER 3109763
FRAMING PLAN (LEFT BRIDGE) BRIDGE NO. HAM-75-0440 L/R IR-75 OVER IR-74 WB		
HAM-75-3.85 PID No. 104667		
29/68		29 68

S:\Flansburg\10/26/2023 4:26:30 PM\O:\2017\01113\C.Design\104667_HAM-75-3.84\Design\Structures\HAM0075_0440C\Sheets\HAM0075_0440C_SD001.dgn

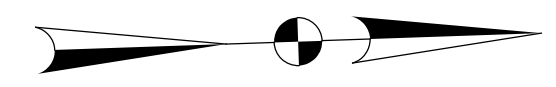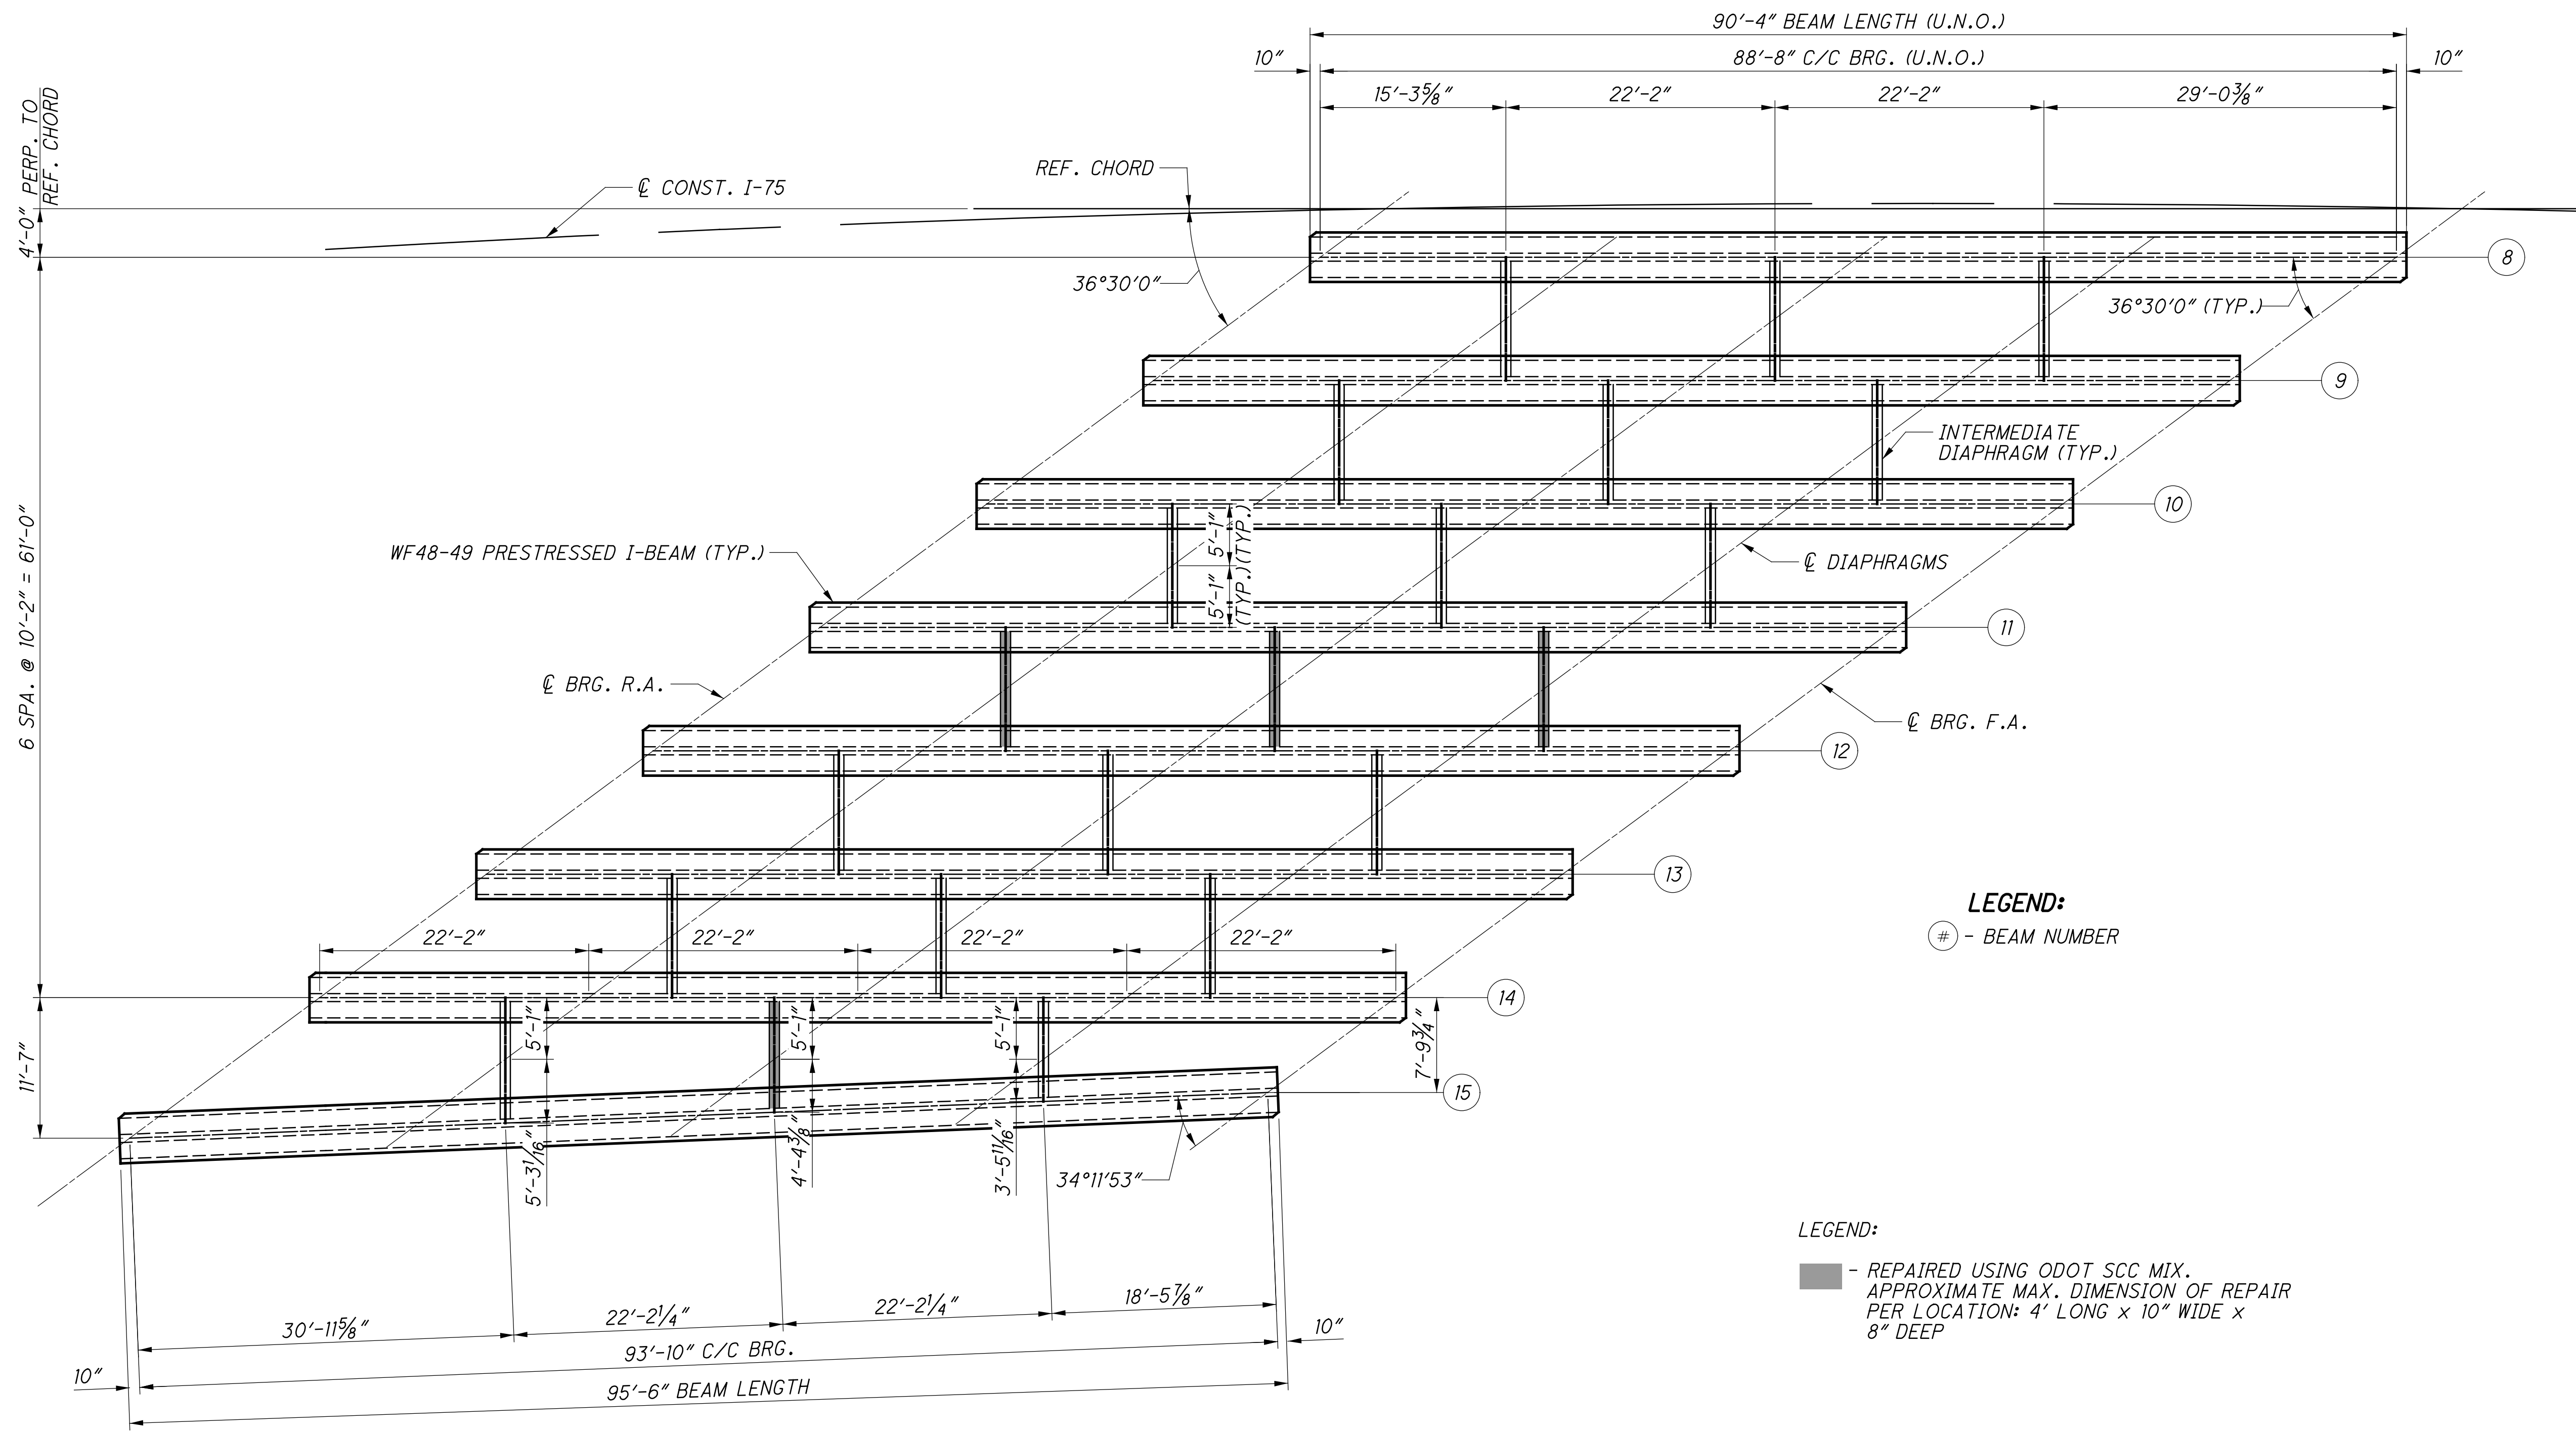


FRAMING PLAN

LEGEND:
 ■ - REPAIRED USING ODOT SCC MIX.
 APPROXIMATE MAX. DIMENSION OF REPAIR
 PER LOCATION: 4' LONG x 10" WIDE x
 8" DEEP

NOTES:
 1. SEE STD. DWG. PSID-1-13 FOR INTERMEDIATE DIAPHRAGM DETAILS.
 2. SEE SHEETS 31/68 TO 32/68 FOR BEAM DETAILS.

DESIGN AGENCY	DATE
STRUCTUREPOINT	1/2/19
DESIGNED	REVIEWED
SJF	MDS
CHECKED	STRUCTURE FILE NUMBER
CLB	3109763
FRAMING PLAN (RIGHT BRIDGE) BRIDGE NO. HAM-75-0440 L/R IR-75 OVER IR-74 WB	
HAM-75-3.85 PID No. 104667	
30/68 <div style="border: 1px solid black; border-radius: 50%; width: 30px; height: 30px; display: flex; align-items: center; justify-content: center; margin: 0 auto;"> 30 68 </div>	

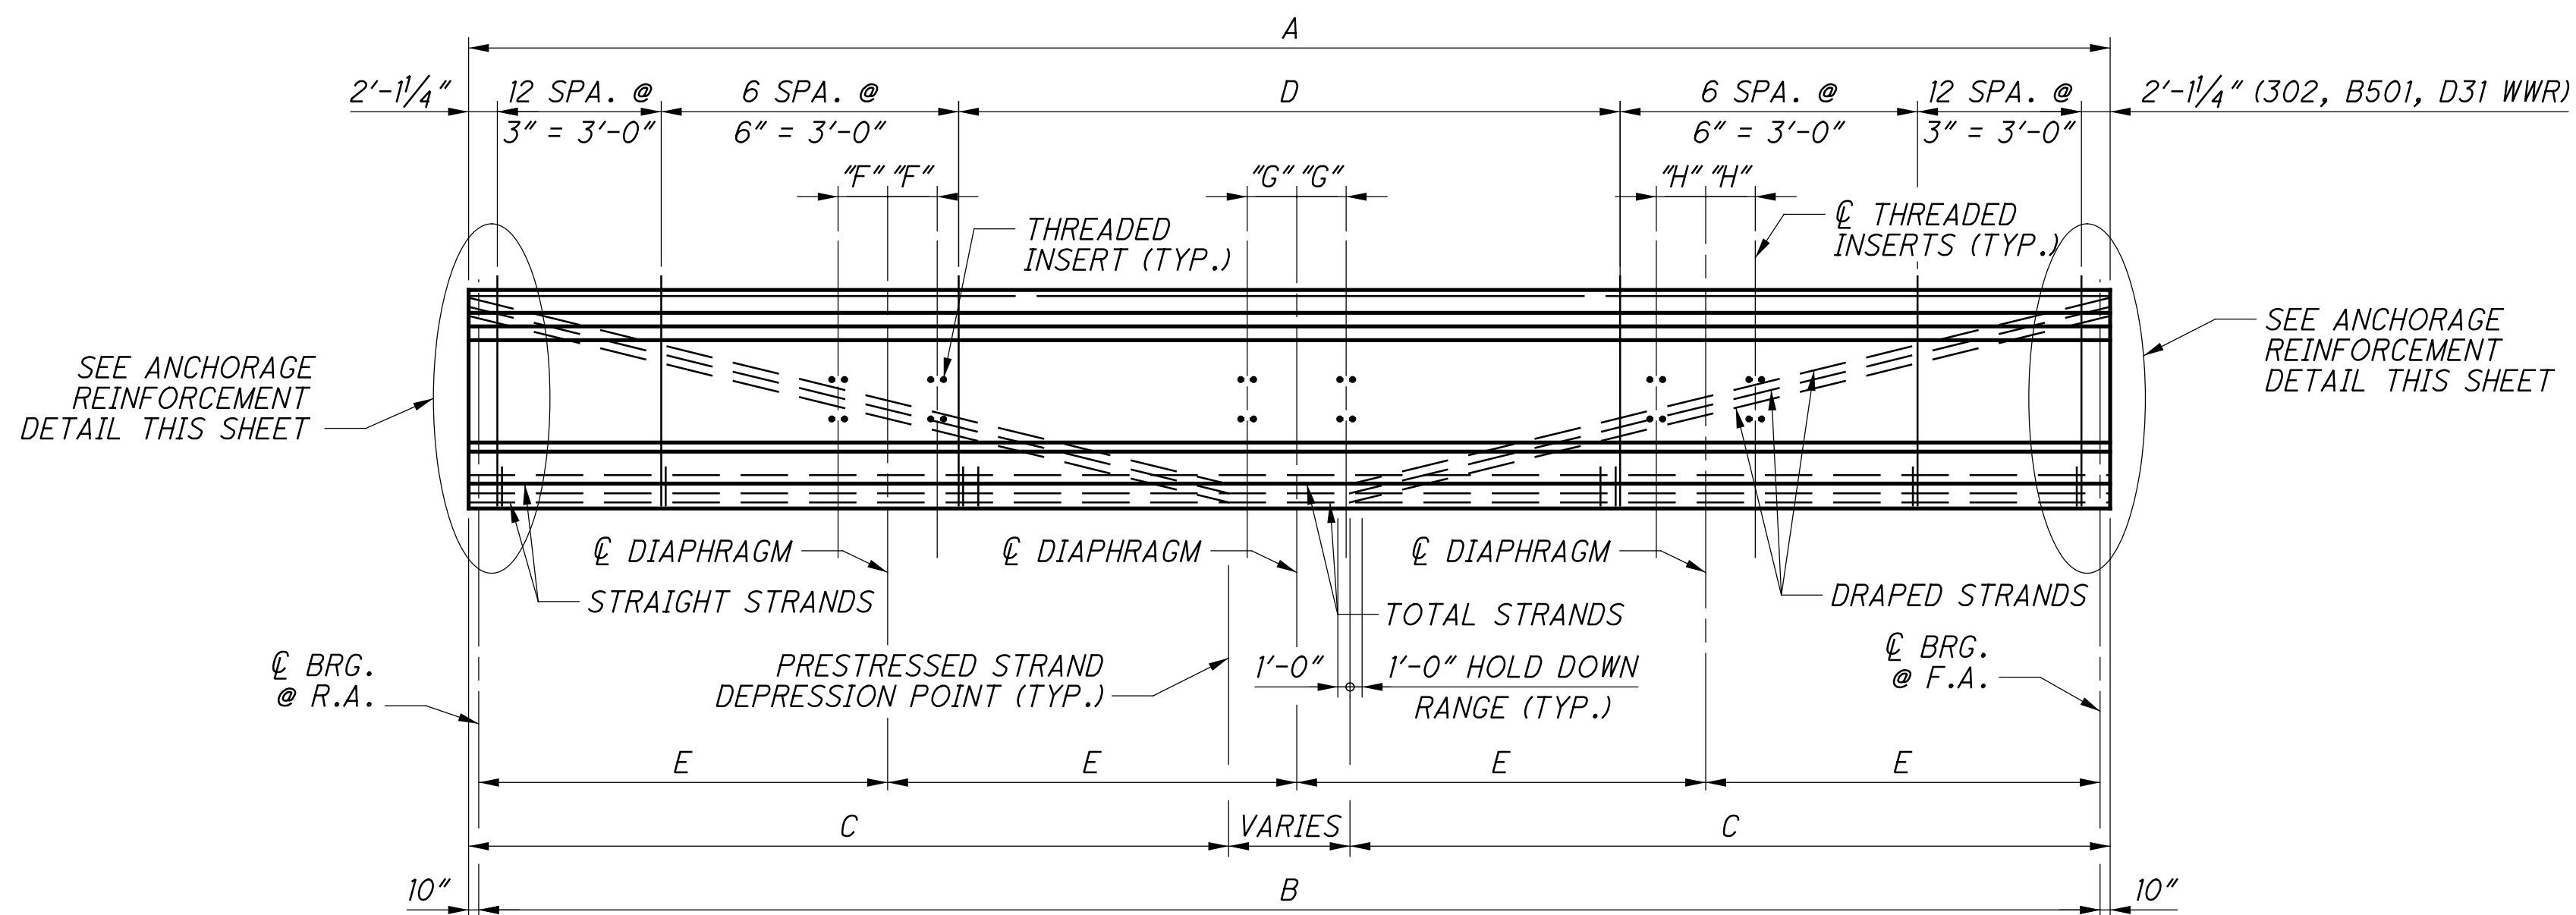


TYPICAL BEAM ELEVATION
 (SHEAR REINFORCEMENT AND PRESTRESSED STRAND DEPRESSION POINTS)
 WF48-49 PRESTRESSED I-BEAM (TYP.)

BEAM NO.	TOTAL STRANDS	NO. DRAPED	NO. STRAIGHT	DIMENSIONS							
				A	B	C	D	E	F	G	H
LEFT BRIDGE											
1	43	3	40	Δ 85'-11"	Δ 84'-3"	34'-4 1/2"	77 SPA. @ 11" (-)	21'-0 3/4"	6'-4 5/8"	5'-3 1/8"	4'-1 3/4"
2-7	43	3	40	Δ 90'-4"	Δ 88'-8"	36'-1 1/8"	81 SPA. @ 11" (-)	22'-2"	7'-5 1/4"	7'-5 1/4"	7'-5 1/4"
RIGHT BRIDGE											
8-14	43	3	40	Δ 90'-4"	Δ 88'-8"	36'-1 1/8"	81 SPA. @ 11" (-)	22'-2"	6'-10 1/2"	6'-10 1/2"	6'-10 1/2"
15	43	3	40	Δ 95'-6"	Δ 93'-10"	38'-2 1/2"	87 SPA. @ 11" (-)	23'-5 1/2"	7'-6 1/8"	6'-2 7/8"	4'-11 5/8"

ESTIMATED CAMBER AND REMAINING DL DEFLECTION			
	D ₀	D ₃₀	REMAINING DL DEFLECTION
BEAM 1	2.01	3.26	1.04
BEAM 2	2.14	3.46	1.43
BEAM 3-6	2.14	3.46	1.45
BEAM 7	2.14	3.46	1.26
BEAM 8	2.03	3.28	1.16
BEAM 9-13	2.03	3.28	1.33
BEAM 14	2.03	3.28	1.14
BEAM 15	2.27	3.68	1.37

NOTE TO FABRICATOR
 THE DIMENSIONS MEASURED ALONG THE LENGTH OF THE BEAM, MARKED WITH A Δ, DO NOT CONTAIN AN ALLOWANCE FOR THE EFFECT OF THE LONGITUDINAL GRADE. INCLUDE THE PROPER ALLOWANCE FOR THESE DIMENSIONS IN THE SHOP DRAWINGS.

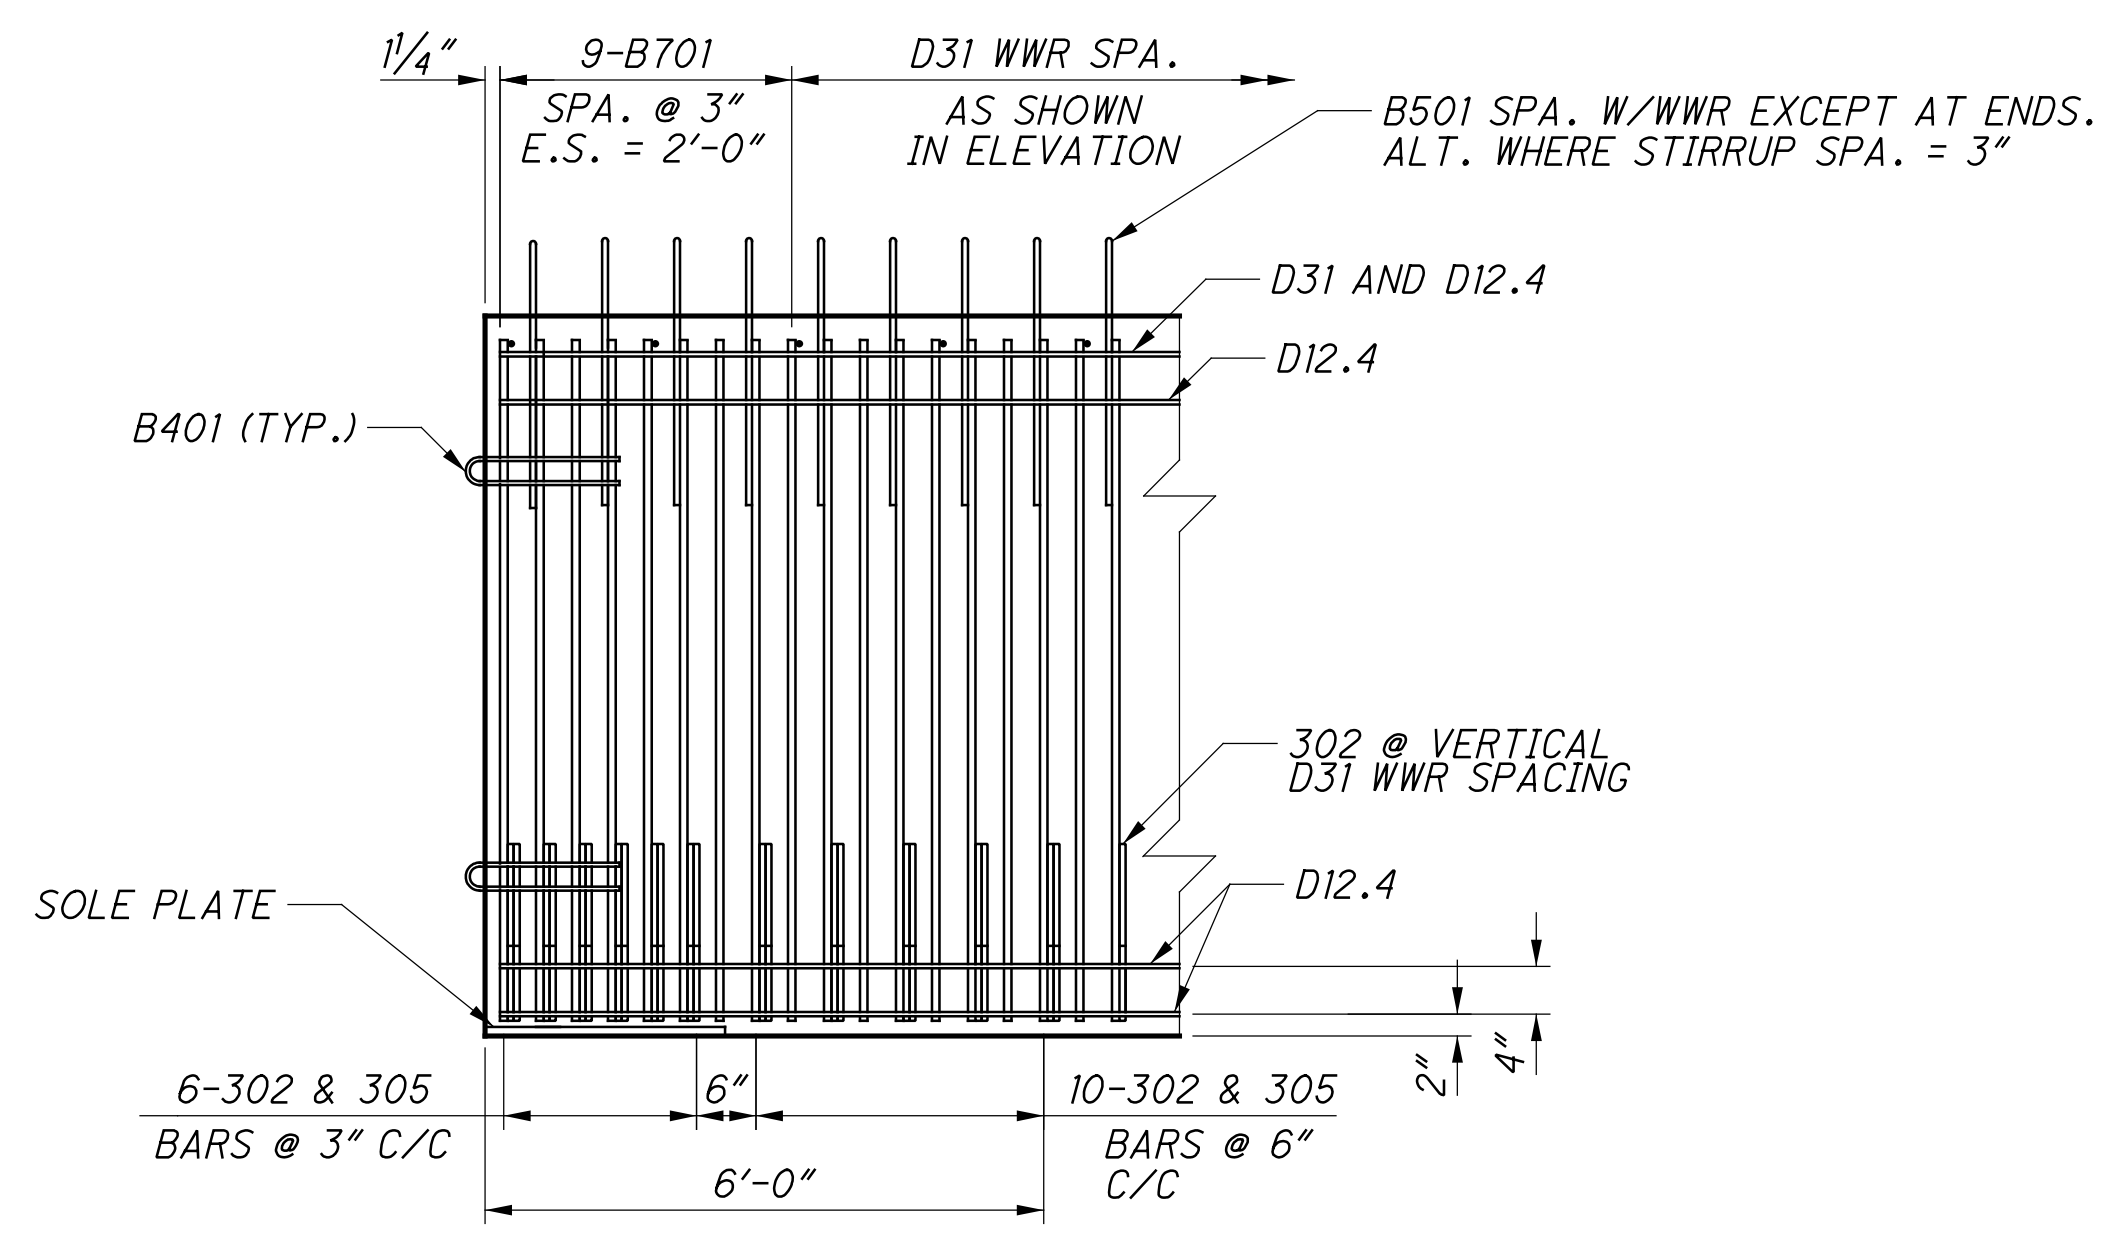



ANCHORAGE ZONE REINFORCING STEEL
 STRANDS NOT SHOWN FOR CLARITY

- NOTES:**
- PRESTRESSED CONCRETE I-BEAMS: STANDARD TYPE WF48-49 TYPICAL. REFER TO STD. DWG. PSD-1-13 FOR OTHER NOTES AND PERTINENT DETAILS.
 - CAMBER: SEE TABLE FOR ESTIMATED CAMBER AT DAY 0. (D0) SEE TABLE FOR ESTIMATED CAMBER AT DAY 30. (D30) DEFLECTION DUE TO REMAINING DEAD LOAD (E.G. CONCRETE DECK, CROSS FRAMES, DIAPHRAGMS, BARRIERS, UTILITIES, ETC.) ARE NOT INCLUDED IN THE ESTIMATED CAMBER VALUES ABOVE.
 - THE BEAM SEAT ELEVATIONS ASSUME ESTIMATED CAMBER D30 WITH SACRIFICIAL HAUNCH THICKNESS PROVIDE IN THE HAUNCH THICKNESS TABLE ON SHEETS 38/68 AND 40/68.
 - DESIGN STRESSES: PRESTRESSED CONCRETE - F'_C = 8.5 KSI (28 DAY) F'_{CI} = 6.5 KSI (RELEASE)

SFlansgan 10/26/2023 4:26:31 PM O:\2017\01113\C.Design\104667.HAM-75-3.84.Design\Structures\HAM0075_0440C.Sheets\HAM0075_0440C_SD003.dgn

DESIGN AGENCY: STRUCTUREPOINT
 DATE: 1/2/19
 REVIEWED: MDS
 DRAWN: BNM
 DESIGNED: SUJ
 CHECKED: CLB
 STRUCTURE FILE NUMBER: 3109763
 BEAM DETAILS
 BRIDGE NO. HAM-75-0440 L/R
 IR-75 OVER IR-74 WB
 HAM-75-3.85
 PID No. 104667
 31/68
 31/68

SFlansagan 10/26/2023 4:26:31 PM C:\2017\01113\C.Design\104667_HAM-75-3.84\Design\Structures\HAM0075_0440C_Sheets\HAM0075_0440C_SD012.dgn

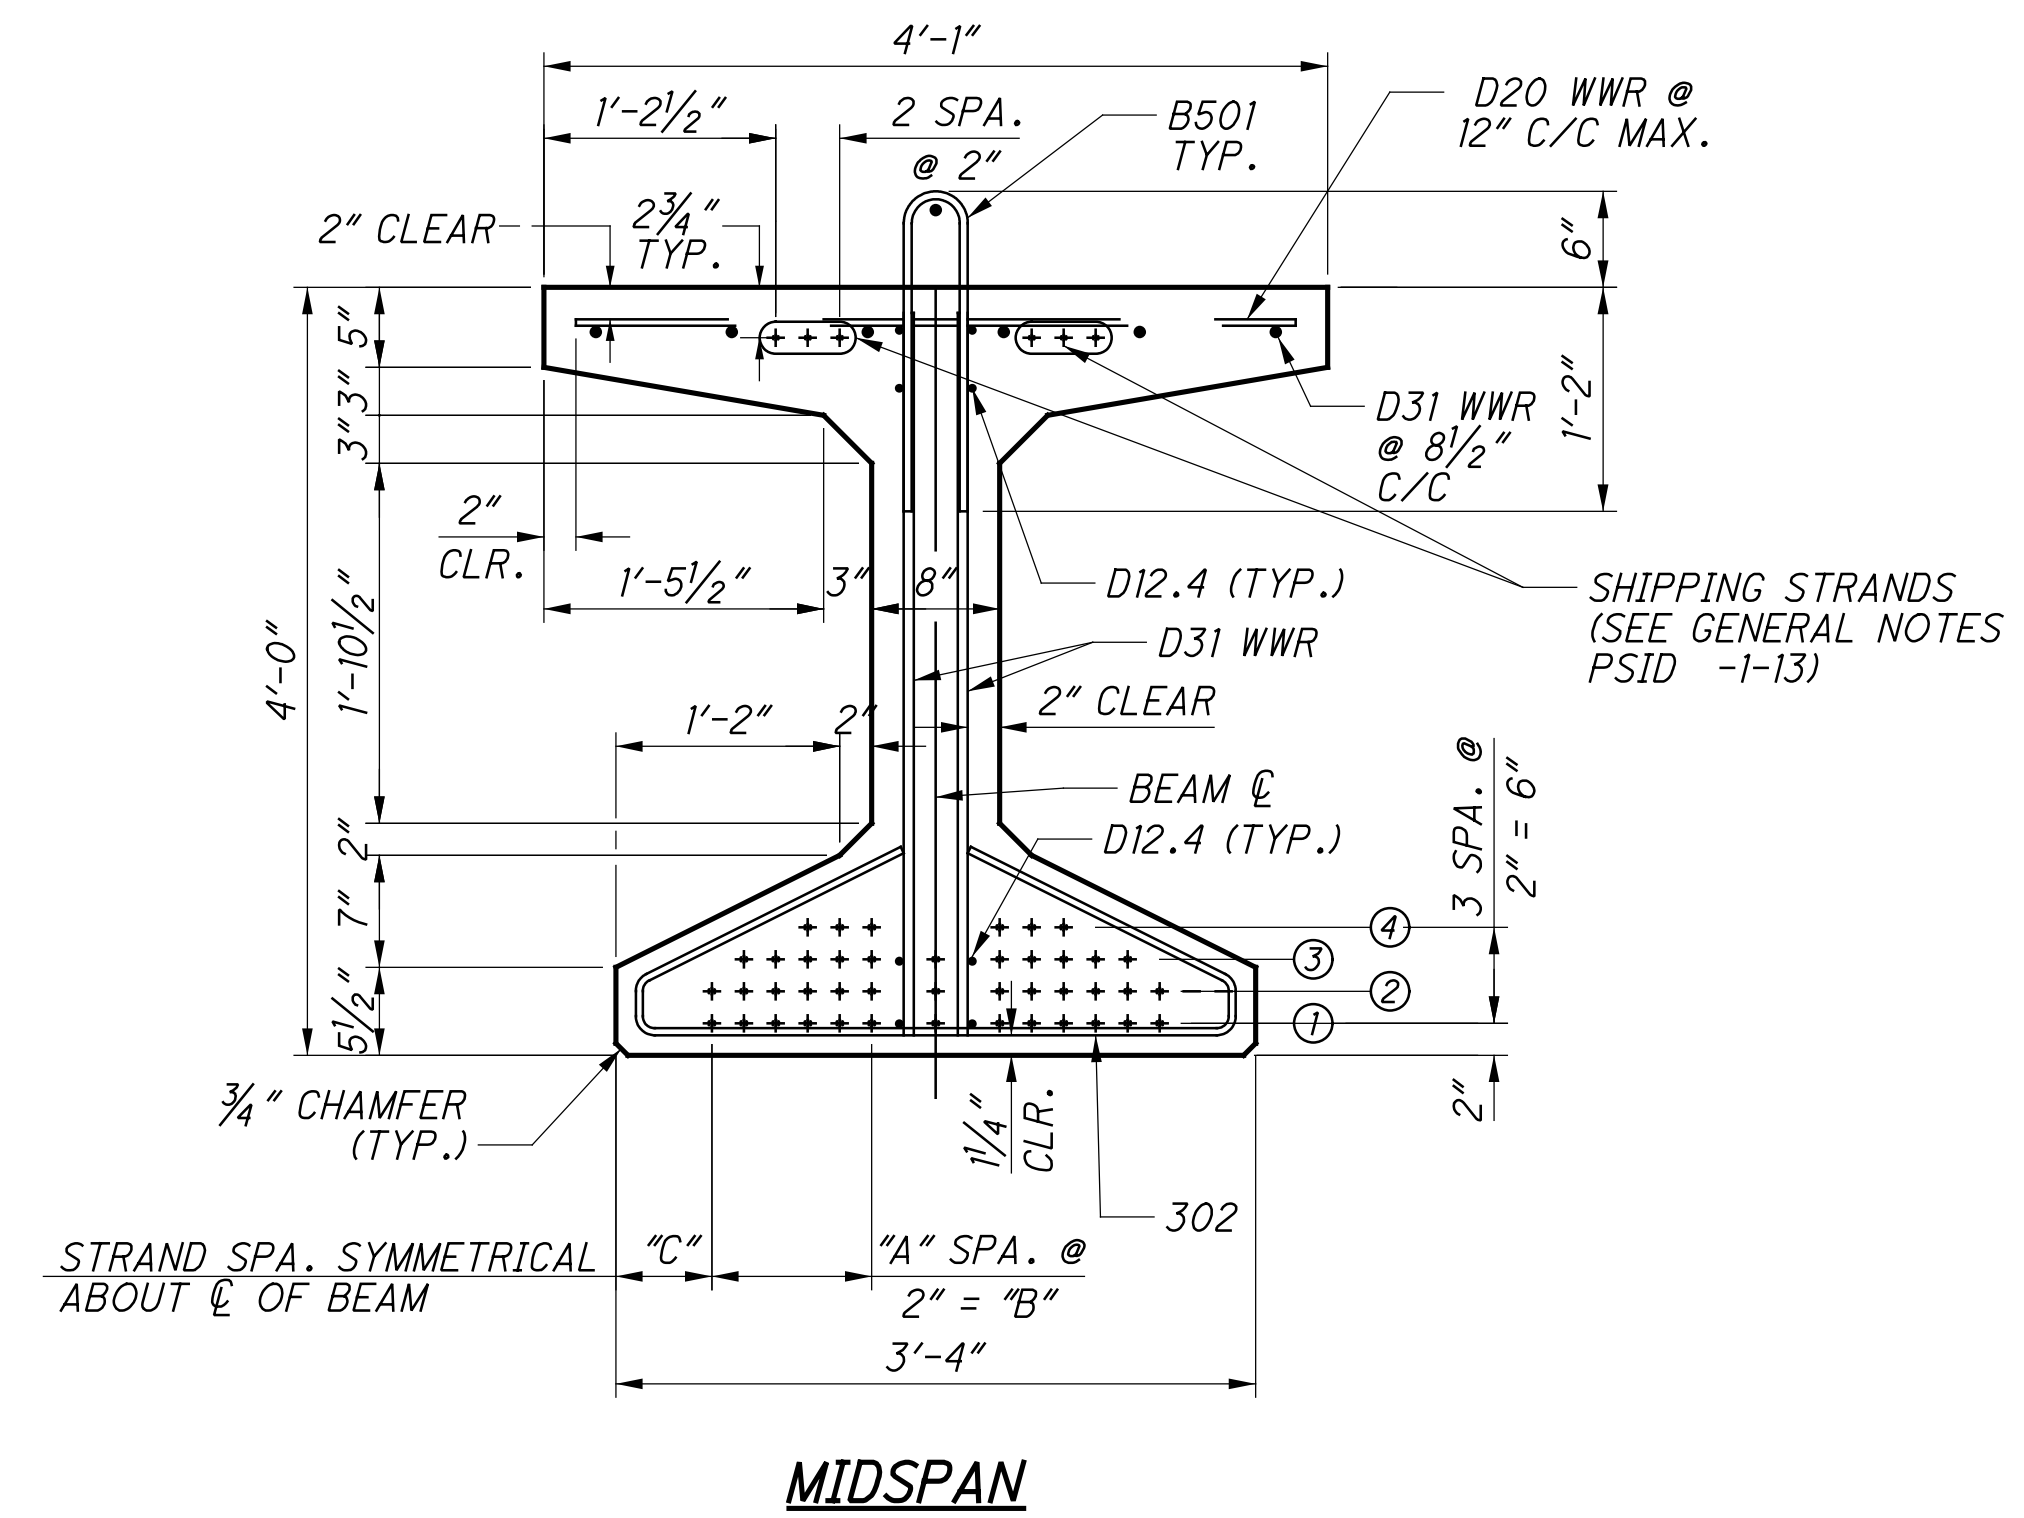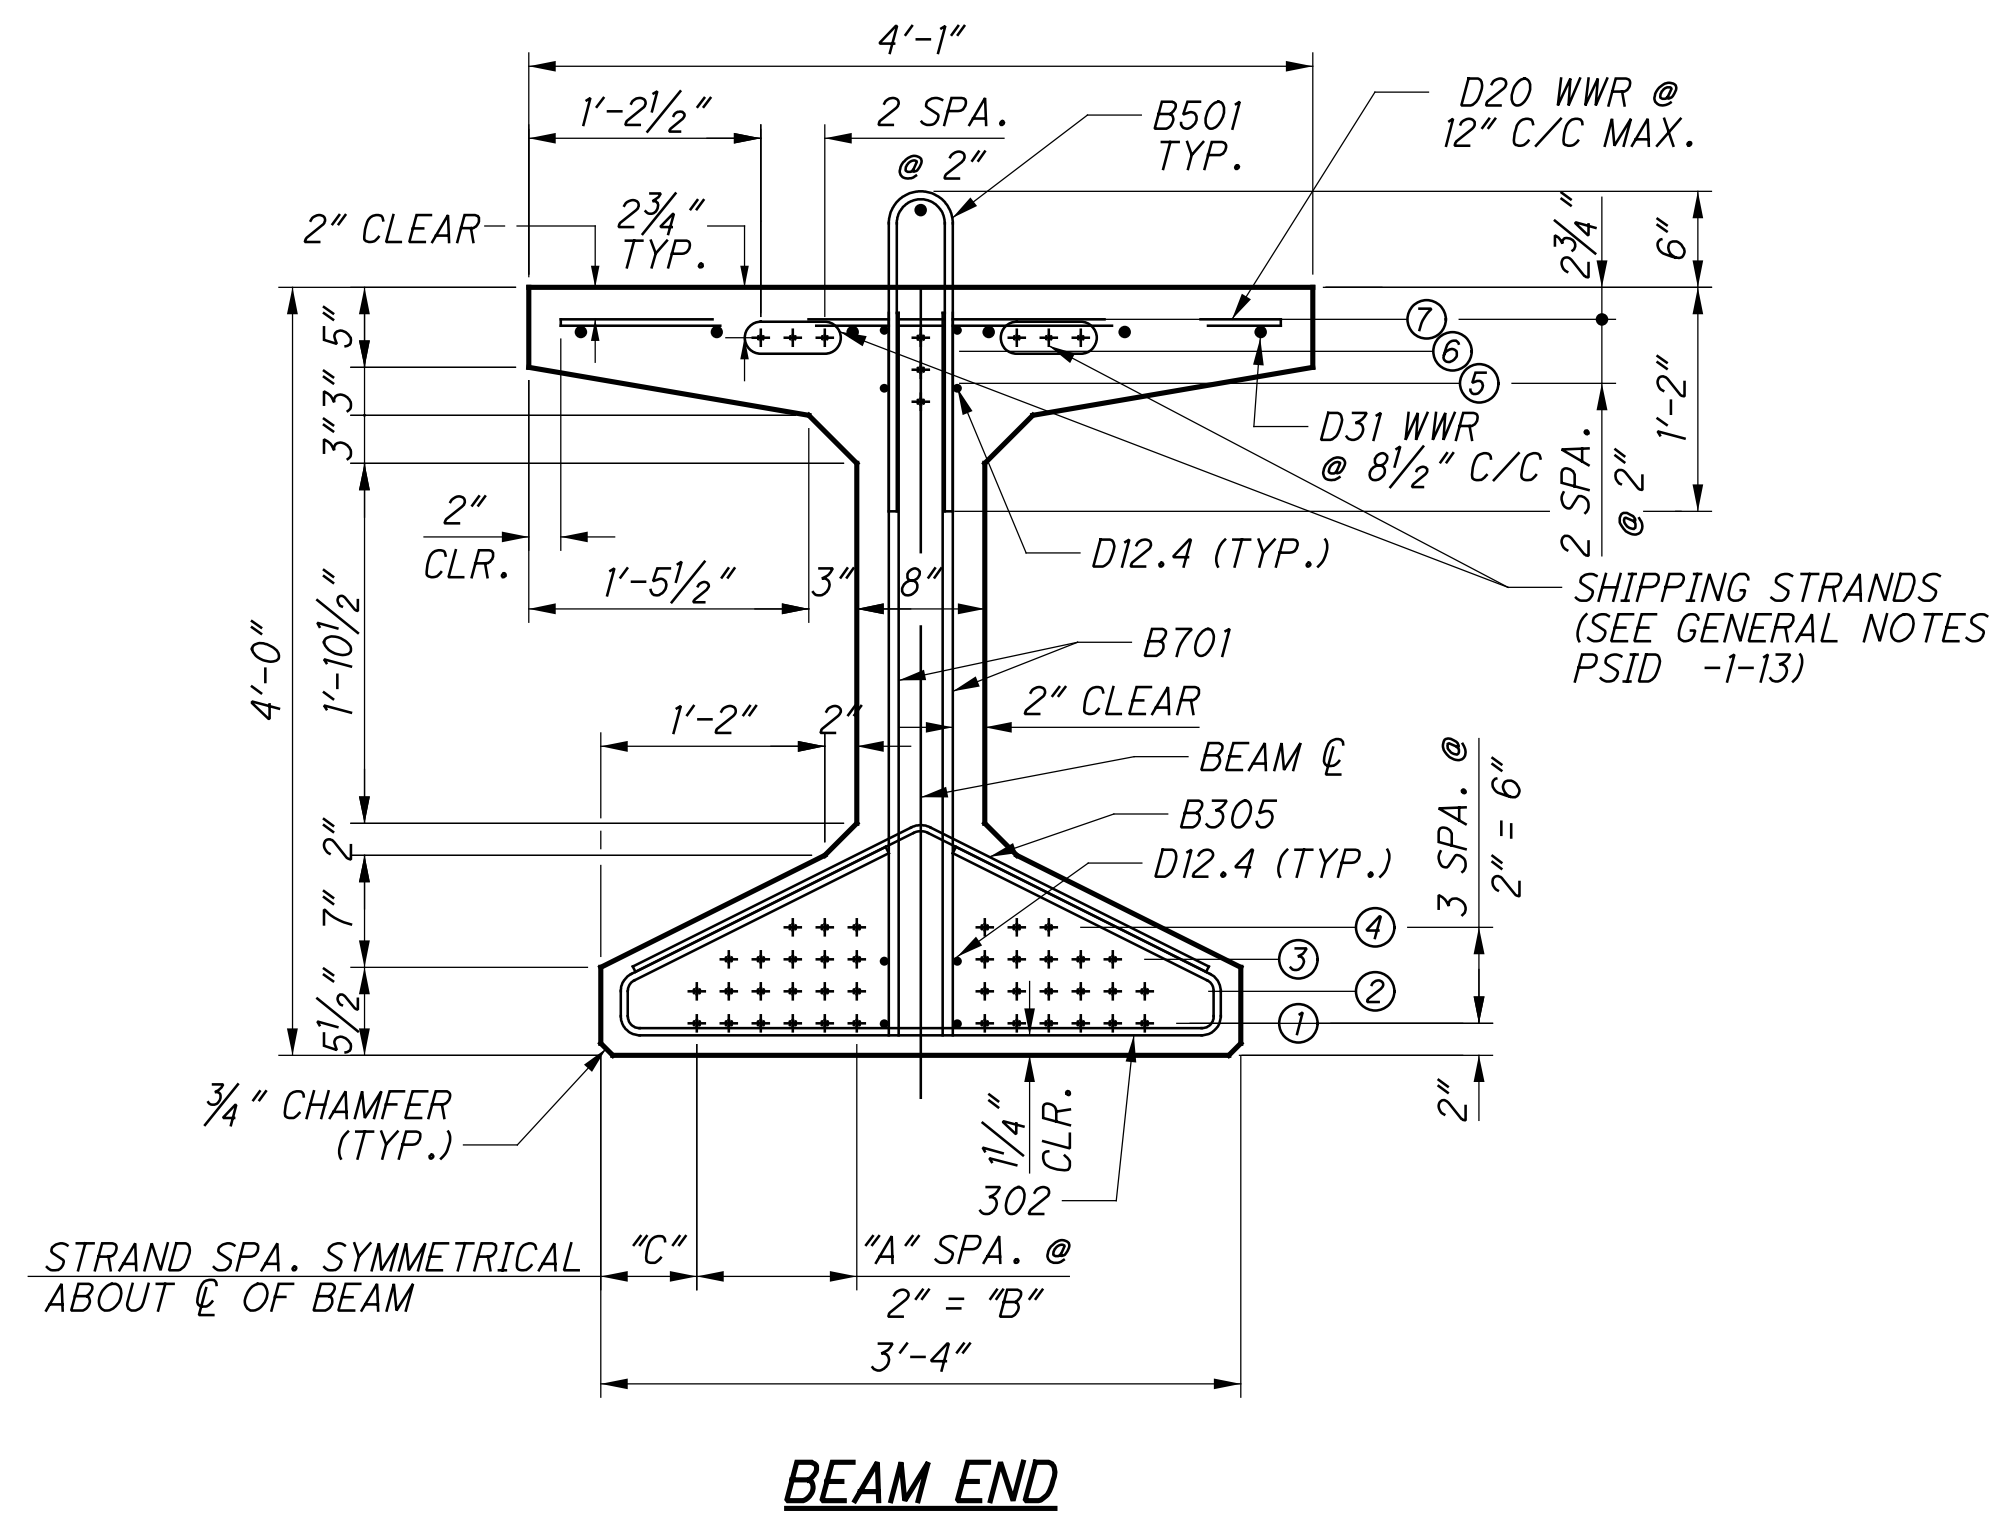

		BEAM STRAND INFORMATION												
BRIDGE	BEAM NO.	BEAM END							MIDSPAN				TOTAL	
		ROW NUMBER	1	2	3	4	5	6	7	1	2	3		4
LEFT BRIDGE	1 - 7	STRANDS	12	12	10	6	1	1	1	13	13	11	6	43
		"A" (SPA.)	5	5	4	2				5	5	4	2	
		"B"	10"	10"	8"	4"				10"	10"	8"	4"	
		"C"	6"	6"	8"	12"				6"	6"	8"	12"	
RIGHT BRIDGE	8 - 14	ROW NUMBER	1	2	3	4	5	6	7	1	2	3	4	TOTAL
		STRANDS	12	12	10	6	1	1	1	13	13	11	6	43
		"A" (SPA.)	5	5	4	2				5	5	4	2	
		"B"	10"	10"	8"	4"				10"	10"	8"	4"	
RIGHT BRIDGE	15	ROW NUMBER	1	2	3	4	5	6	7	1	2	3	4	TOTAL
		STRANDS	12	12	10	6	1	1	1	13	13	11	6	43
		"A" (SPA.)	5	5	4	2				5	5	4	2	
		"B"	10"	10"	8"	4"				10"	10"	8"	4"	
RIGHT BRIDGE	15	"C"	6"	6"	8"	12"				6"	6"	8"	12"	


LEGEND:

Ⓝ - STRAND ROW

BENDING DIAGRAMS
(ALL DIMENSIONS ARE OUT-TO-OUT)

MARK	TYPE	DIMENSIONS				
		A	B	C	D	R
BARS IN BEAMS						
*B501	1	5"	1'-8"			1 1/8"
B701	3	3'-8 3/4"				


* INDICATES STEEL TO BE EPOXY-COATED.

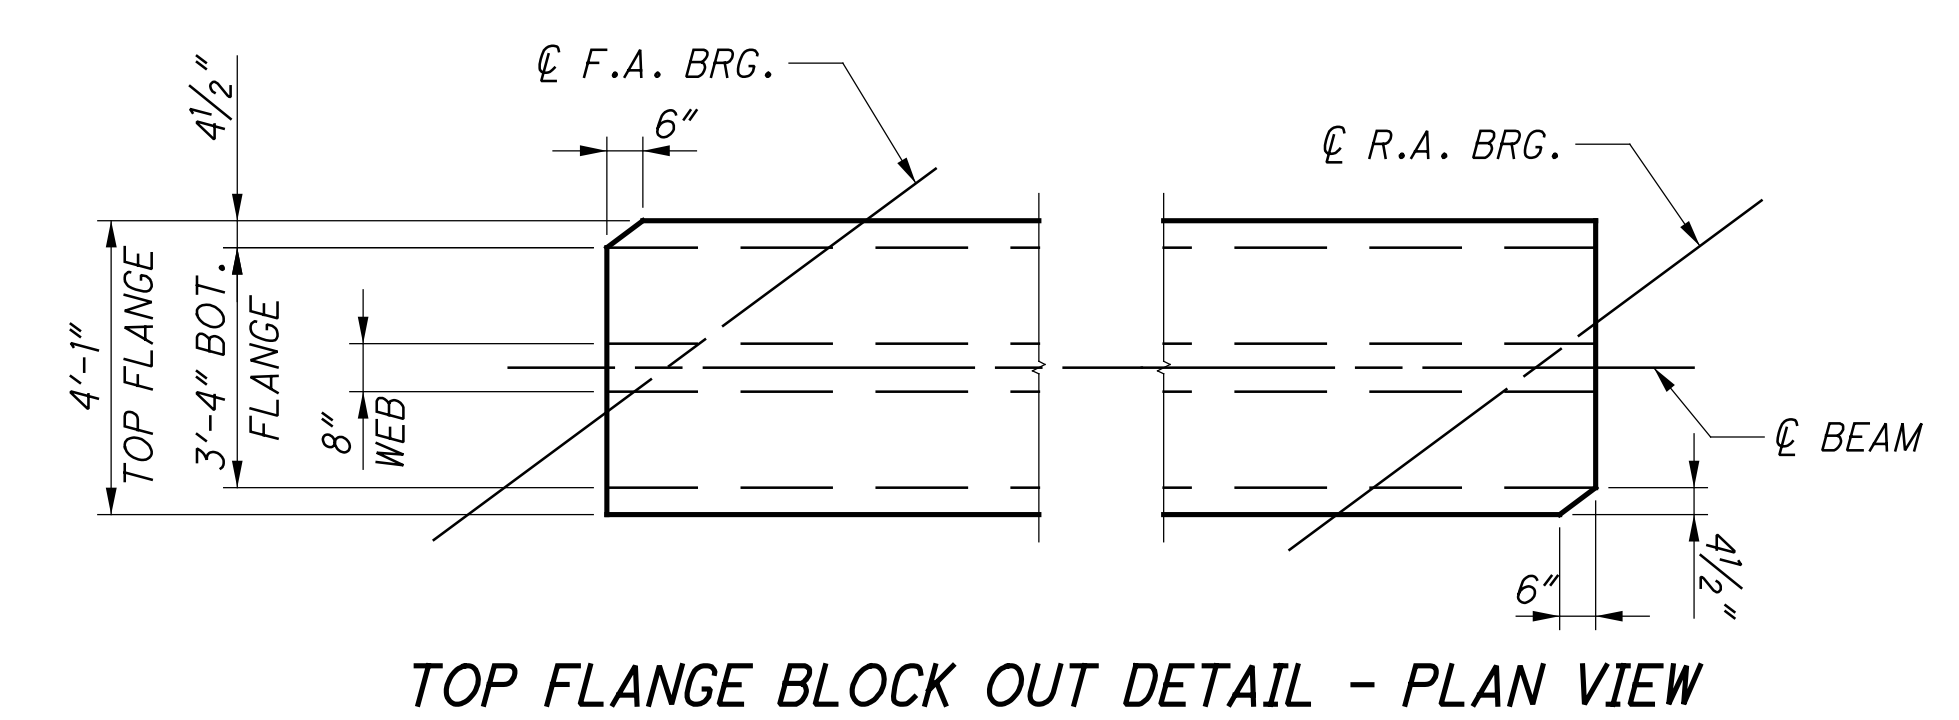

NOTES:
1. FOR ADDITIONAL BEAM DETAILS AND NOTES, SEE SHEET 31/68.

DESIGN AGENCY: STRUCTUREPOINT
 DATE: 1/2/19
 REVIEWED: MDS
 DRAWN: BNM
 DESIGNED: SJF
 CHECKED: CLB
 STRUCTURE FILE NUMBER: 3109763
 BEAM DETAILS
 BRIDGE NO.: HAM-75-0440 L/R
 IR-75 OVER IR-74 WB
 HAM-75-3.85
 PID No. 104667
 32/68
 32/68


S:\Flansagan\10/26/2023 4:26:32 PM\01\2017\01113\C.Design\104667_HAM-75-3.84\Design\Structures\HAM0075_0440C\Sheets\HAM0075_0440C_TS002.dgn

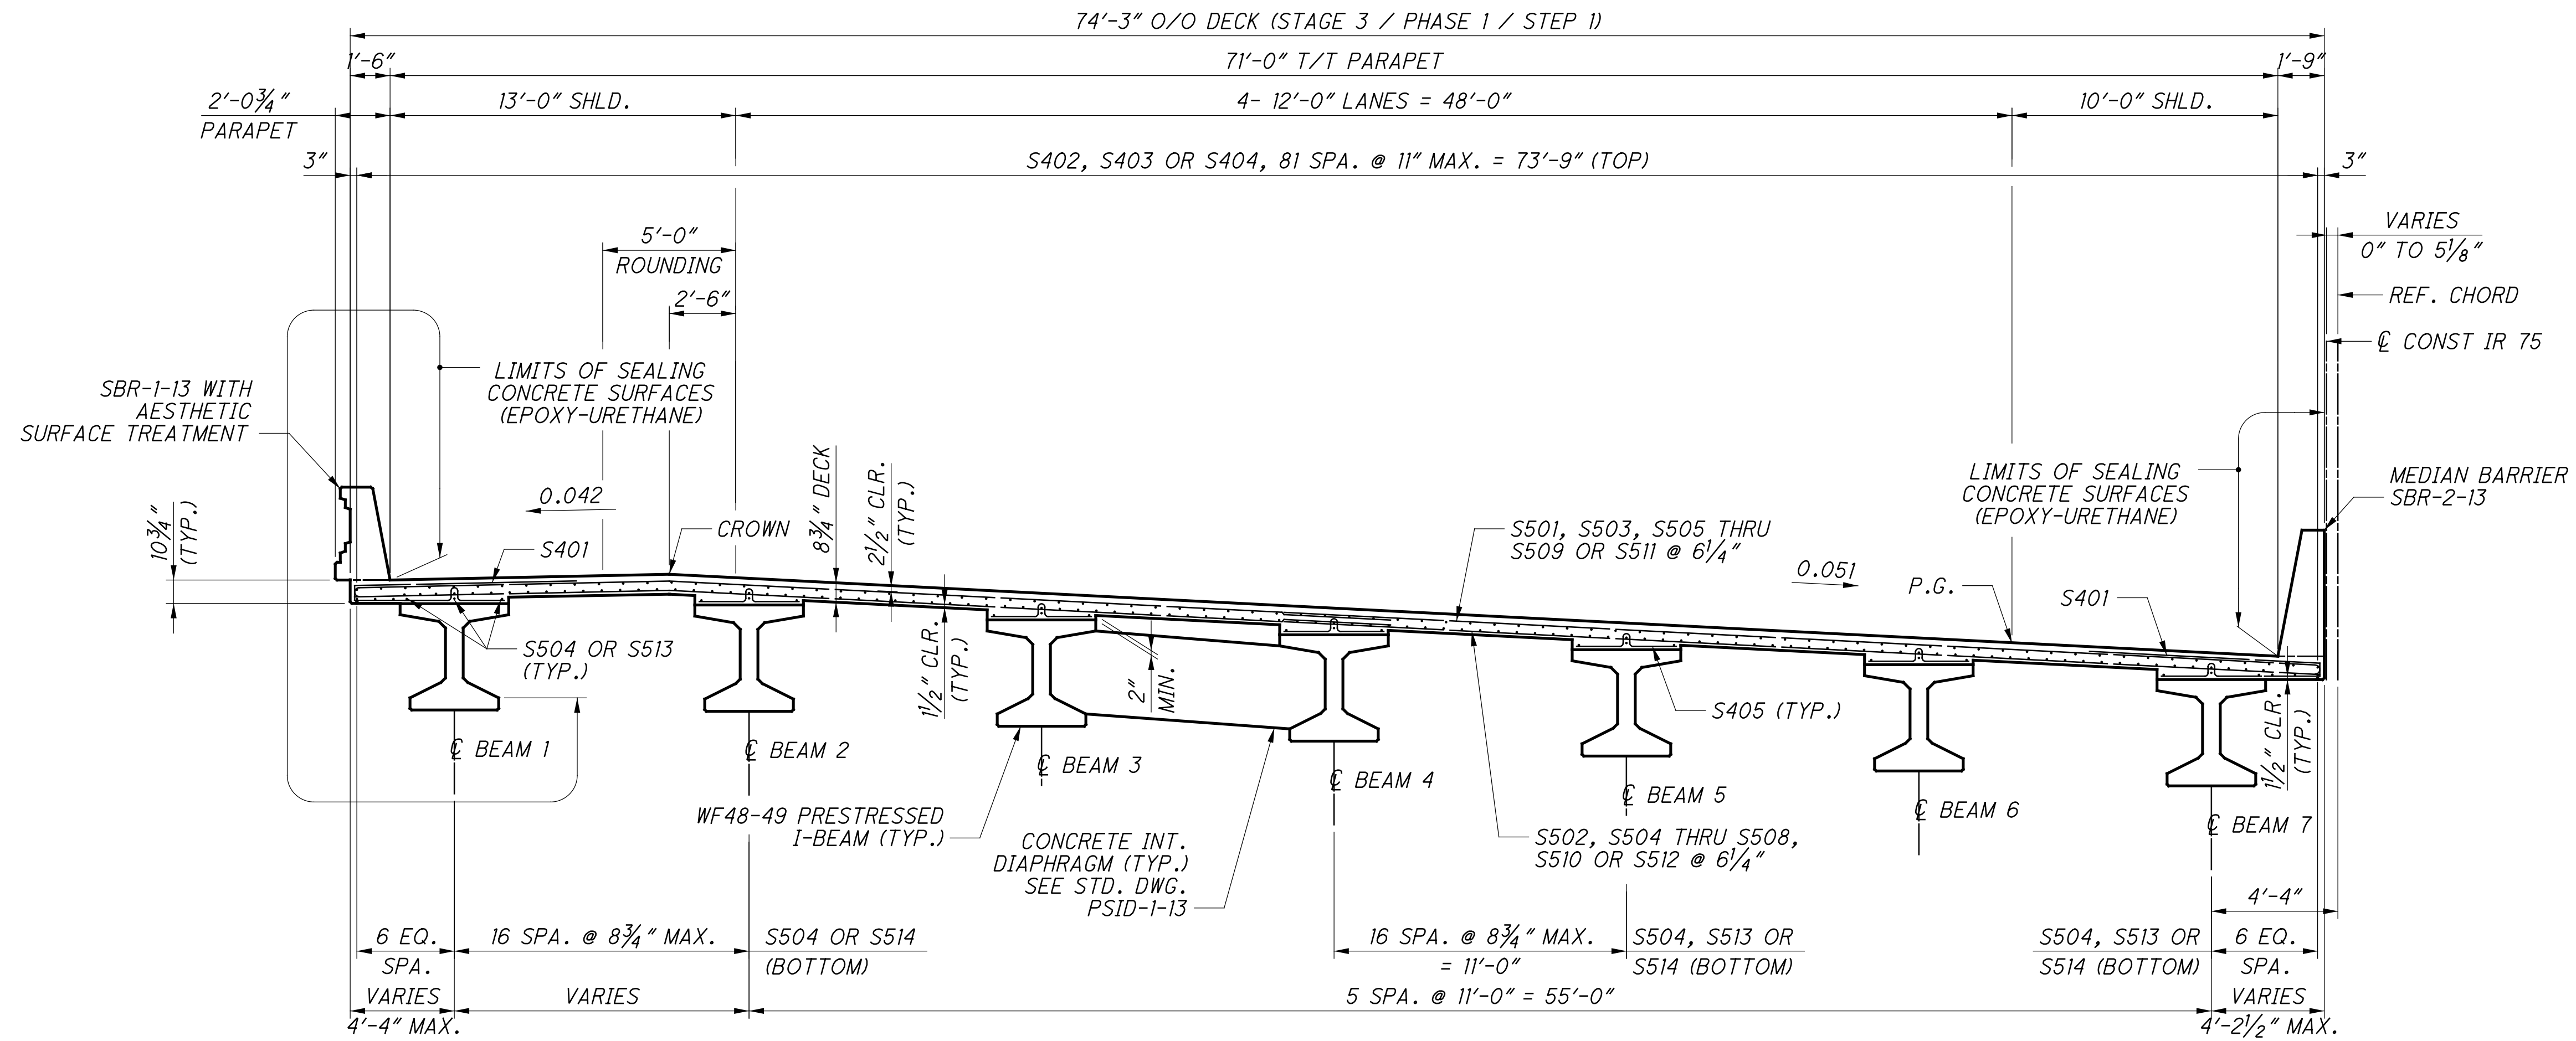


TRANSVERSE SECTION
(LEFT BRIDGE)

DESIGN AGENCY STRUCTUREPOINT	
DESIGNED SUF CLB	DATE 1/2/19
DRAWN SUF REVISED	STRUCTURE FILE NUMBER 3109763
REVIEWED MDS	
BRIDGE NO. HAM-75-0440 L/R OVER IR-74 WB	
TRANSVERSE SECTION (LEFT BRIDGE)	
HAM-75-3.84 PID No. 104667	
33/68	
33 68	

S:\Flansagan\10/26/2023 4:26:32 PM\O:\2017\01113\C.Design\104667_HAM-75-3.84\Design\Structures\HAM0075_0440C_Sheets\HAM0075_0440C_TS001.dgn

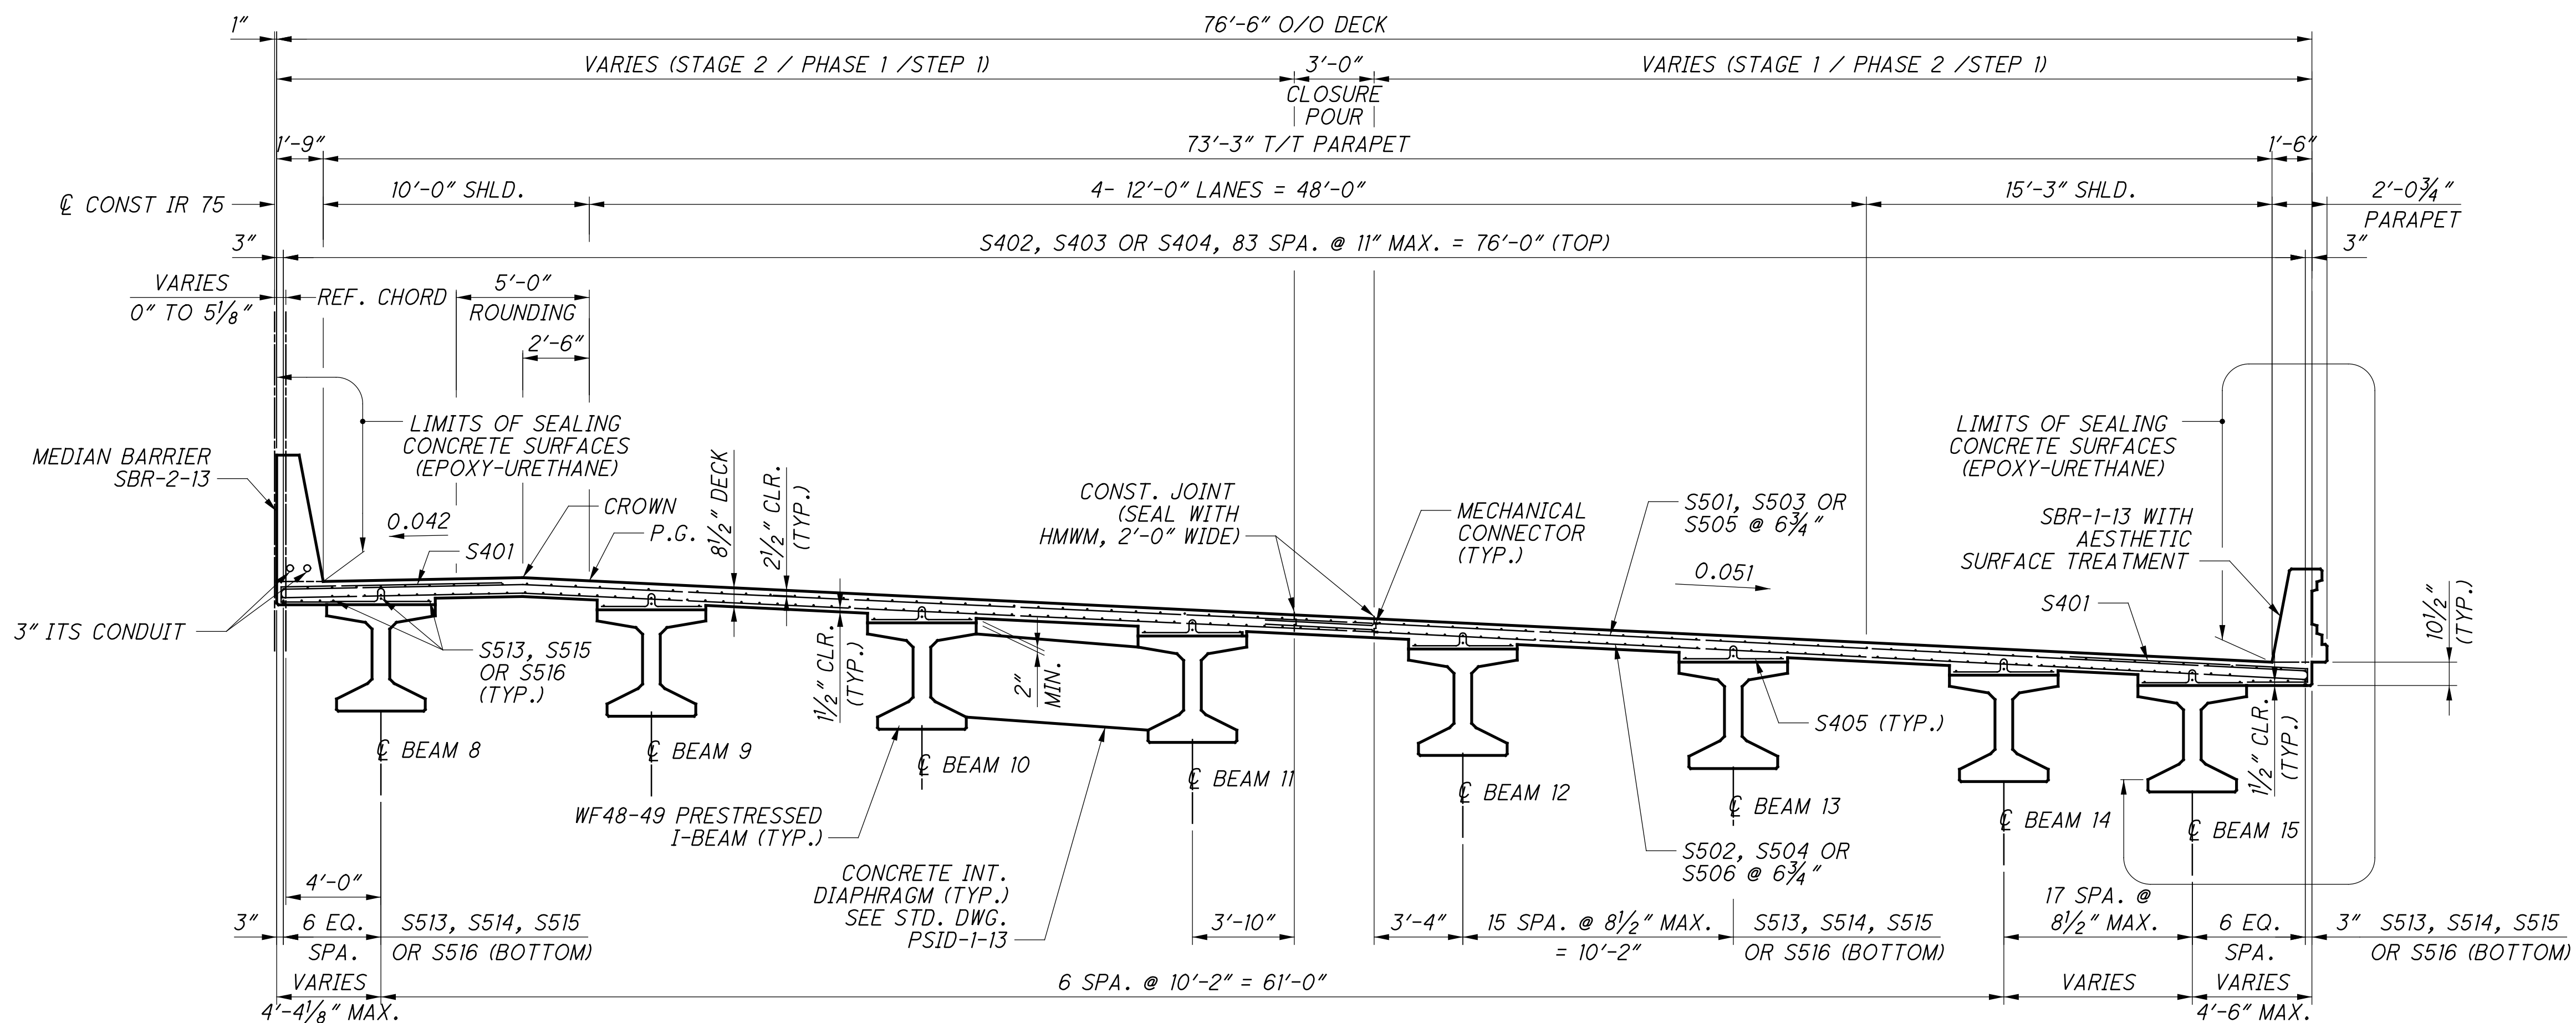



TRANSVERSE SECTION
(RIGHT BRIDGE)

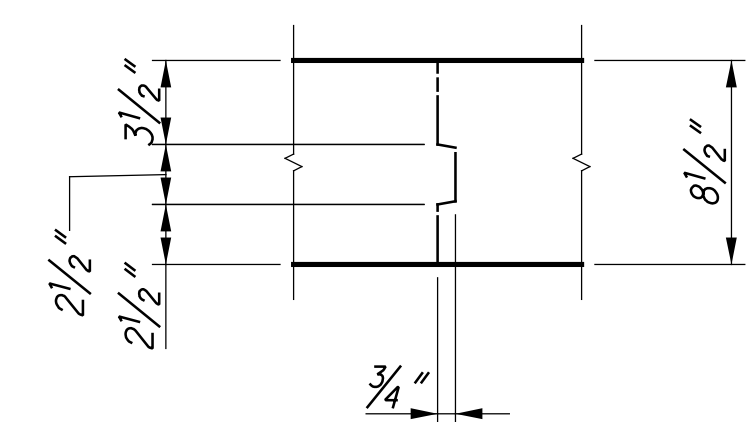

CONSTRUCTION JOINT KEYWAY DETAIL
 REFER TO CMS 511.12 FOR ADDITIONAL INFORMATION

DESIGN AGENCY STRUCTUREPOINT	DATE 1/2/19
REVIEWED MDS	STRUCTURE FILE NUMBER 3109763
DRAWN SUF	REVISED
DESIGNED SUF	CHECKED CLB
TRANSVERSE SECTION (RIGHT BRIDGE)	
BRIDGE NO. HAM-75-0440 L/R OVER IR-74 WB	
HAM-75-3.84	
PID No. 104667	
34/68	
34 68	

S:\Plans\2023 4-26-23 PM 10-26-2023 C. Design 104667 HAM-75-3.84 Design Structures HAM0075_0440C.Sheets HAM0075_0440C_DP002.dgn

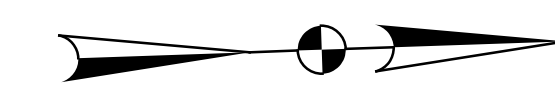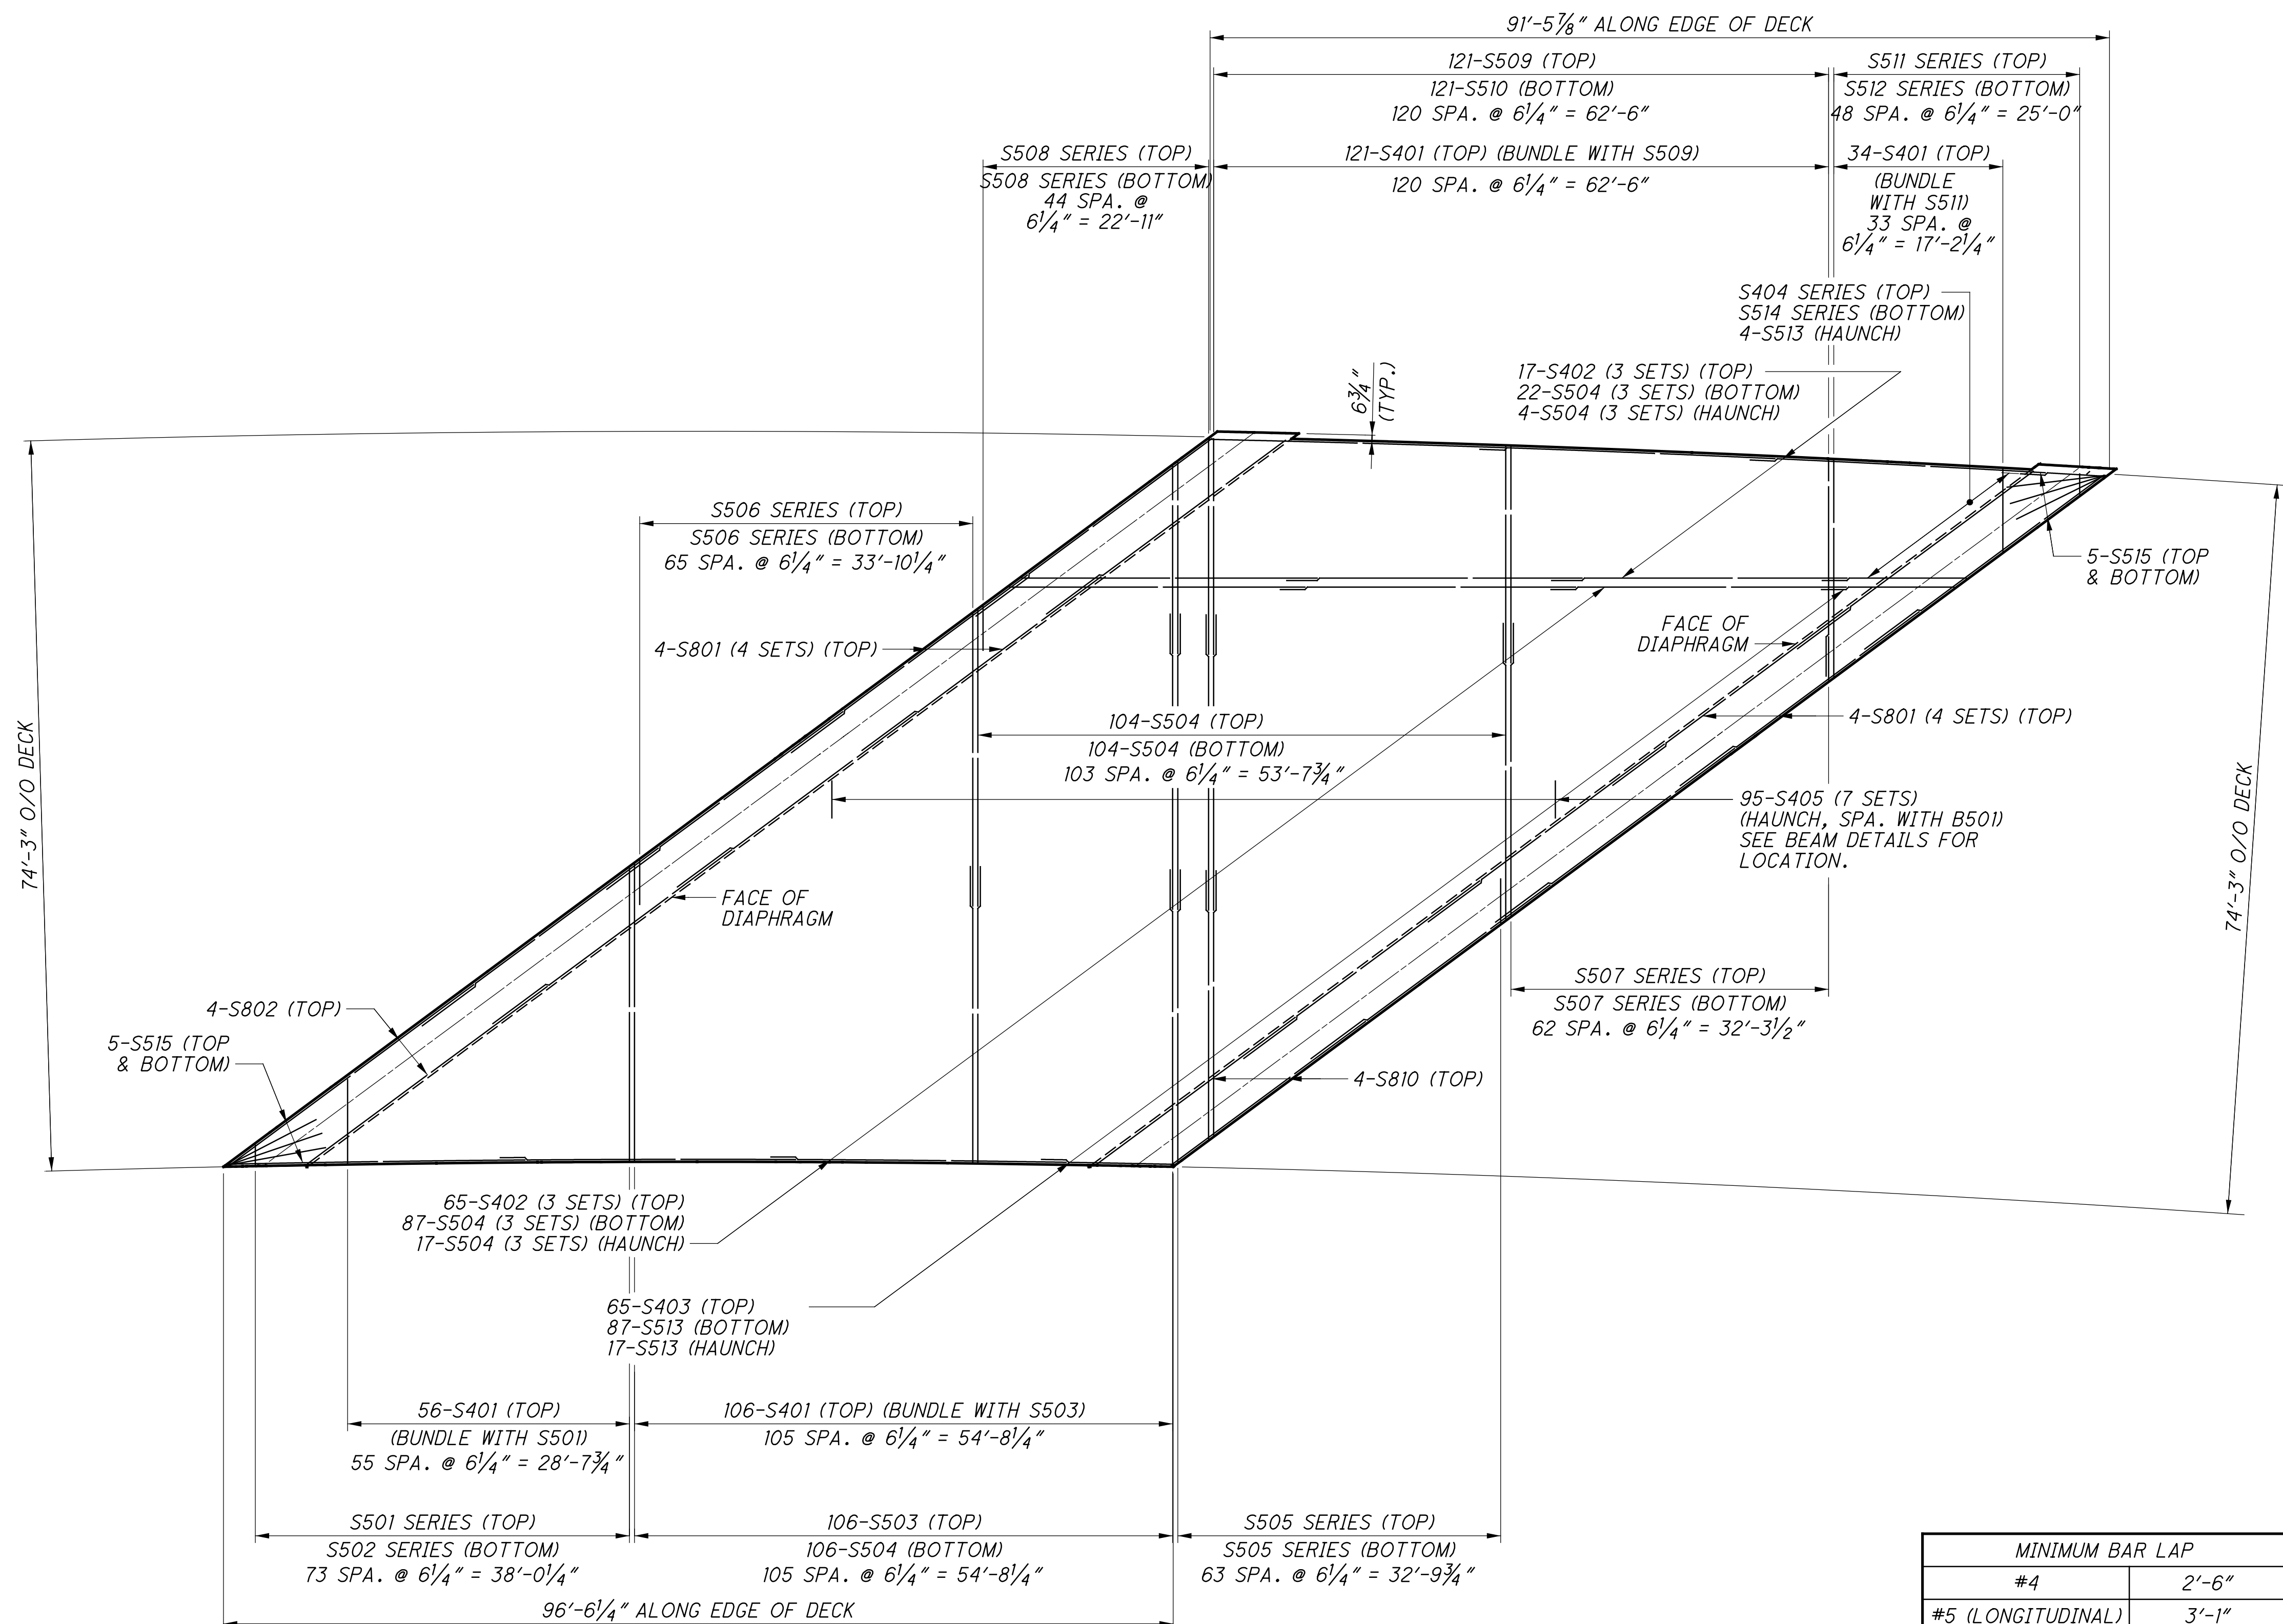

MINIMUM BAR LAP	
#4	2'-6"
#5 (LONGITUDINAL)	3'-1"
#5 (TRANSVERSE)	4'-0"
#8 (TRANSVERSE)	6'-8"

NOTES:

1. FOR PARAPET DETAILS, SEE SHEETS 46/68 THRU 51/68.
2. FOR END DIAPHRAGM DETAILS, SEE SHEETS 41/68 TO 42/68.
3. FOR TRANSVERSE SECTION, SEE SHEET 33/68.

DESIGN AGENCY: STRUCTUREPOINT

DATE: 1/2/19

DESIGNED: SUJ

DRAWN: TLH

REVIEWED: MDS

FILE NUMBER: 3109T63

BRIDGE NO. - HAM-75-0440 L/R

OVER IR-74 WB


HAM-75-3.84

PID No. 104667

35 / 68

35 / 68

S:\Flansagan\10/26/2023 4:26:33 PM\01/2017\01113\C.Design\104667_HAM-75-3.84\Design\Structures\HAM0075_0440C_Sheets\HAM0075_0440C_DP001.dgn

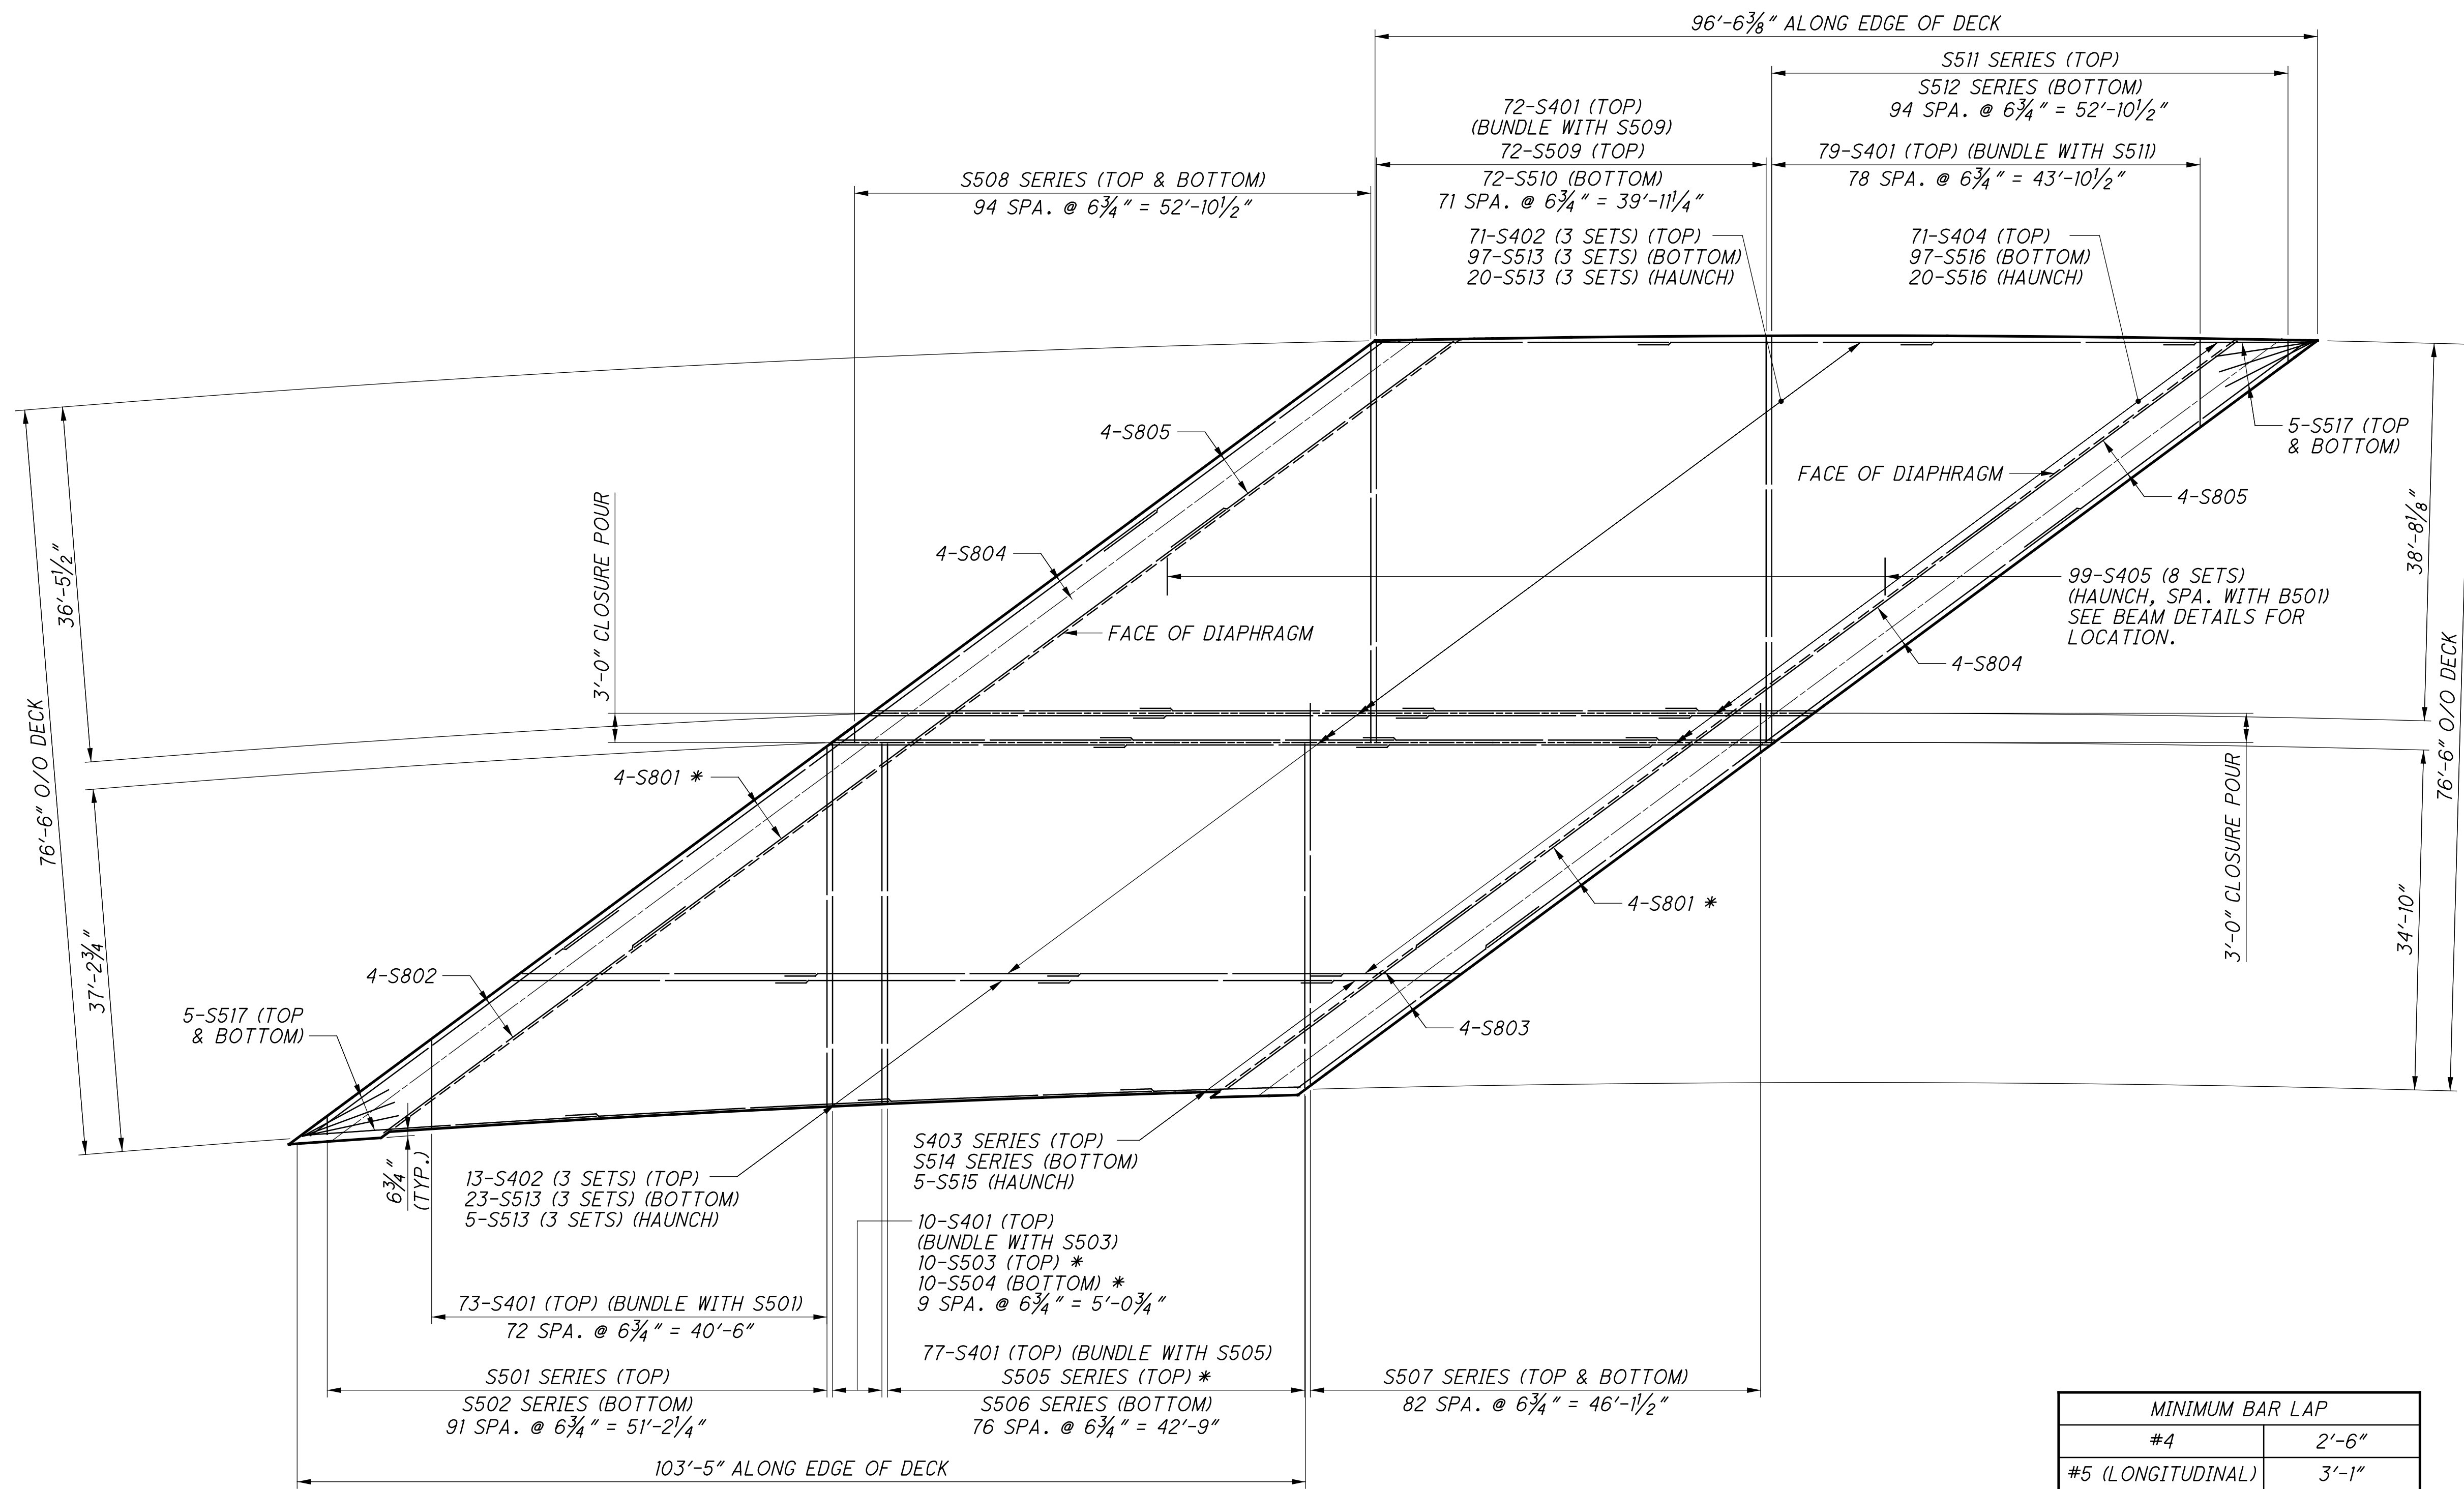


DECK REINFORCING PLAN

MINIMUM BAR LAP	
#4	2'-6"
#5 (LONGITUDINAL)	3'-1"
#5 (TRANSVERSE)	4'-0"
#8 (TRANSVERSE)	6'-8"

NOTES:

- * INDICATES MECHANICAL CONNECTORS REQUIRED.
- MECHANICAL CONNECTORS FOR REINFORCING BARS SHALL BE USED AT LONGITUDINAL CONSTRUCTION JOINT.
- FOR PARAPET DETAILS, SEE SHEETS 52/68 THRU 57/68.
- FOR END DIAPHRAGM DETAILS, SEE SHEETS 43/68 TO 44/68.
- FOR TRANSVERSE SECTION, SEE SHEET 34/68.

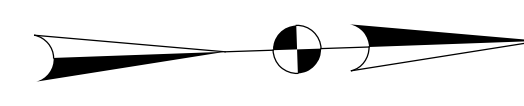

DESIGN AGENCY
STRUCTUREPOINT
INCORPORATED ENGINEERS ARCHITECTS PLANNERS
 1000 EAST 10TH AVENUE, SUITE 1000
 DENVER, COLORADO 80202
 TEL: 303.733.8800 FAX: 303.733.8801
 WWW.STRUCTUREPOINT.COM

DESIGNED	SJF	CHECKED	CLB
DRAWN	TLH	REVISED	
REVIEWED	MDS	DATE	1/2/19
STRUCTURE FILE NUMBER	3109763		


DECK PLAN (RIGHT BRIDGE)
 BRIDGE NO. - HAM-75-0440 L/R
 OVER IR-74 WB

HAM-75-3.84
 PID No. 104667


36/68

36
 68

SFlansgan
 10/26/2023 4:26:34 PM
 \\O:\2017\01113\C.Design\104667.HAM-75-3.84.Design\Structures\HAM0075_0440C.Sheets\HAM0075_0440C_SD010.dgn

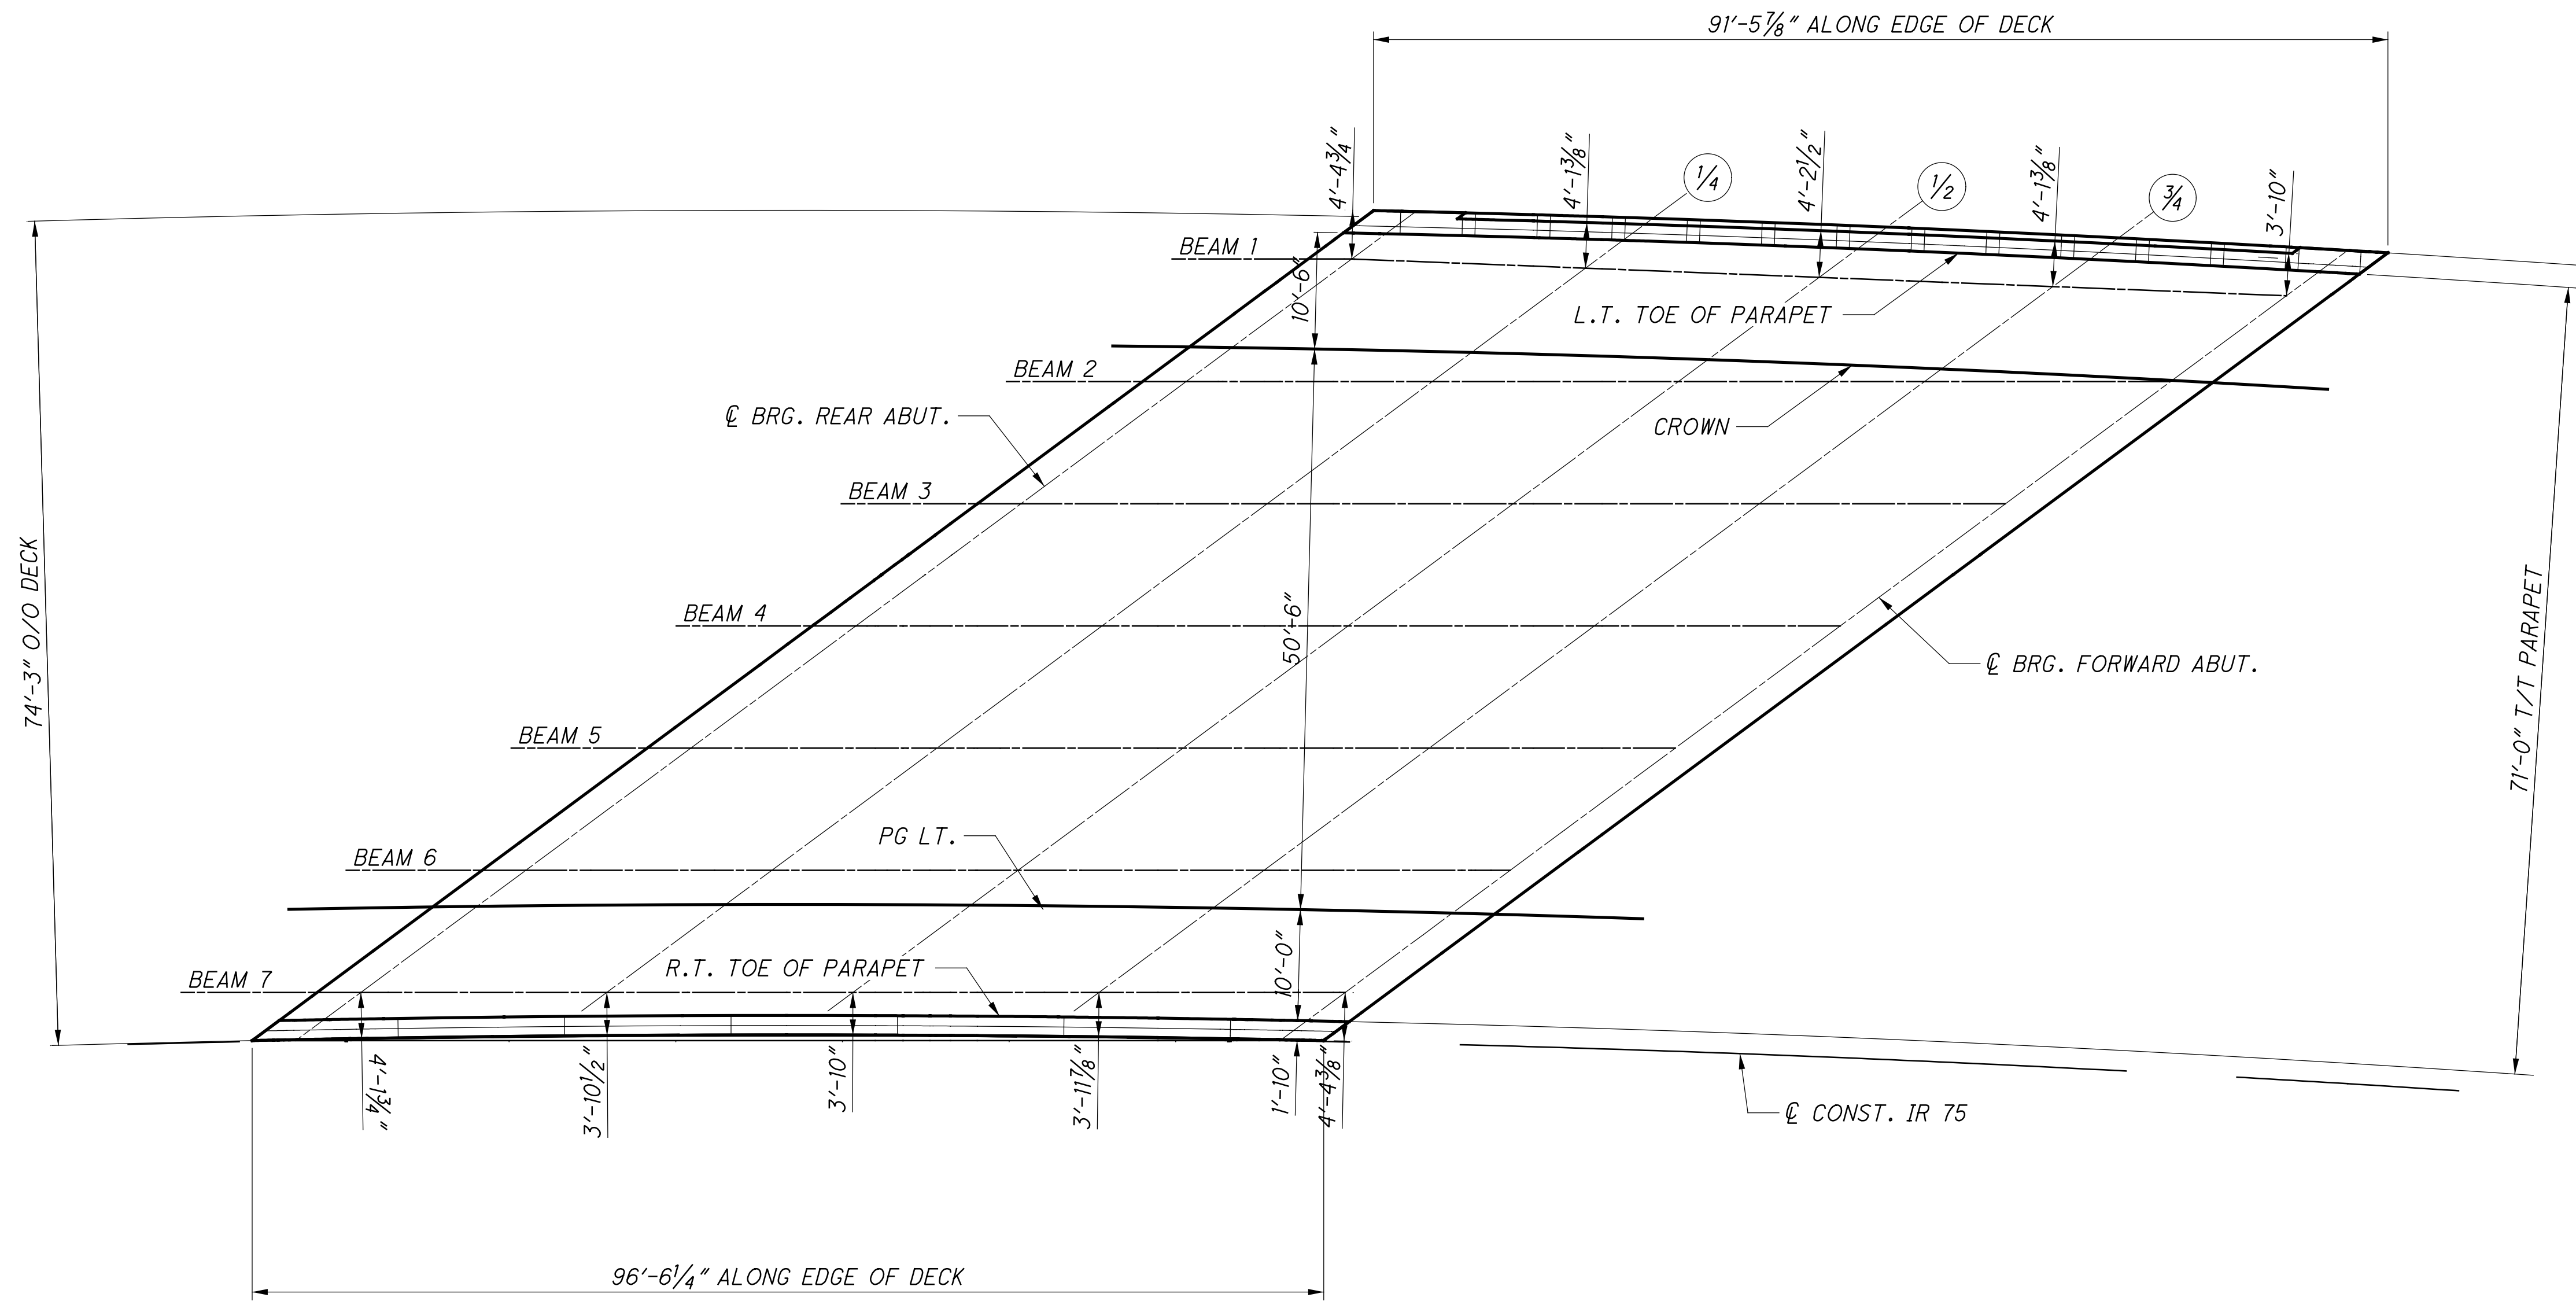

SCREED PLAN

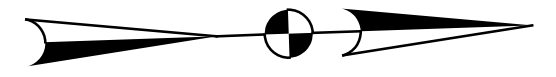


NOTES:

1. FOR TOP OF HAUNCH (T.O.H.) AND FINAL DECK SURFACE (F.D.S.) ELEVATIONS TABLE, SEE SHEET 38/68.

DESIGN AGENCY STRUCTUREPOINT <small>INCORPORATED</small>	
REVIEWED MDS	DATE 1/3/19
DRAWN BNM	STRUCTURE FILE NUMBER 3109763
DESIGNED SUJ	CHECKED CLB
SCREED DETAILS (LEFT BRIDGE) BRIDGE NO. - HAM-75-0440 L/R OVER IR-74 WB	
HAM-75-3.84 PID No. 104667	37/68 <div style="border: 1px solid black; border-radius: 50%; width: 30px; height: 30px; display: flex; align-items: center; justify-content: center; margin: 0 auto;"> 37 68 </div>

S:\Plans\10/26/2023 4:26:34 PM 2017\01113.C Design\104667.HAM-75-3.84 Design\Structures\HAM0075_0440C_Sheets\HAM0075_0440C_SDO11.dgn

SCREED ELEVATIONS TABLE							HAUNCH ELEVATIONS TABLE						
SCREED LINE	DESCRIPTION	℄ BRG. REAR ABUT.	¼ POINT	½ POINT	¾ POINT	℄ BRG. FWD. ABUT.	SCREED LINE	DESCRIPTION	℄ BRG. REAR ABUT.	¼ POINT	½ POINT	¾ POINT	℄ BRG. FWD. ABUT.
HAM-75-0440L SCREED ELEVATIONS							HAM-75-0440L TOP OF HAUNCH ELEVATIONS						
LT. TOE OF PARAPET	STATION	233+76.17	233+96.89	234+17.39	234+37.65	234+57.70	BEAM 1	STATION	233+73.25	233+93.68	234+14.12	234+34.56	234+54.99
	OFFSET	-72.83	-72.83	-72.83	-72.83	-72.83		OFFSET	-70.50	-70.22	-70.12	-70.22	-70.50
	F.D.S. ELEV.	528.42	527.98	527.55	527.12	526.70		F.D.S. ELEV.	528.58	528.16	527.73	527.30	526.85
	DEFLECTION	0.00	0.06	0.08	0.06	0.00		DEFLECTION	0.00	0.06	0.08	0.06	0.00
	SCREED ELEV.	528.42	528.04	527.63	527.18	526.70		T.O.H. ELEV.	527.85	527.49	527.08	526.62	526.12
CROWN	STATION	233+62.94	233+83.91	234+04.64	234+25.14	234+45.41	BEAM 2	STATION	233+58.92	233+80.53	234+02.12	234+23.70	234+45.26
	OFFSET	-62.33	-62.33	-62.33	-62.33	-62.33		OFFSET	-59.18	-59.62	-60.27	-61.13	-62.20
	F.D.S. ELEV.	529.14	528.70	528.26	527.83	527.40		F.D.S. ELEV.	529.06	528.63	528.21	527.80	527.39
	DEFLECTION	0.00	0.07	0.11	0.07	0.00		DEFLECTION	0.00	0.07	0.11	0.07	0.00
	SCREED ELEV.	529.14	528.77	528.37	527.90	527.40		T.O.H. ELEV.	528.33	527.98	527.59	527.14	526.66
PGL	STATION	232+96.12	233+18.40	233+40.38	233+62.09	233+83.53	BEAM 3	STATION	233+44.53	233+66.24	233+87.94	234+09.63	234+31.30
	OFFSET	-11.83	-11.83	-11.83	-11.83	-11.83		OFFSET	-48.00	-48.30	-48.82	-49.54	-50.47
	F.D.S. ELEV.	527.80	527.42	527.01	526.58	526.13		F.D.S. ELEV.	528.78	528.36	527.93	527.50	527.09
	DEFLECTION	0.00	0.08	0.11	0.08	0.00		DEFLECTION	0.00	0.08	0.11	0.08	0.00
	SCREED ELEV.	527.80	527.49	527.12	526.66	526.13		T.O.H. ELEV.	528.05	527.70	527.30	526.85	526.36
RT. TOE OF PARAPET	STATION	232+82.21	233+04.77	233+27.02	233+48.99	233+70.69	BEAM 4	STATION	233+30.00	233+51.81	233+73.62	233+95.42	234+17.21
	OFFSET	-1.83	-1.83	-1.83	-1.83	-1.83		OFFSET	-36.91	-37.08	-37.45	-38.04	-38.83
	F.D.S. ELEV.	527.52	527.15	526.75	526.33	525.89		F.D.S. ELEV.	528.49	528.08	527.65	527.22	526.80
	DEFLECTION	0.00	0.07	0.10	0.07	0.00		DEFLECTION	0.00	0.08	0.11	0.08	0.00
	SCREED ELEV.	527.52	527.22	526.85	526.40	525.89		T.O.H. ELEV.	527.76	527.42	527.03	526.56	526.07
	STATION						BEAM 5	STATION	233+15.32	233+37.24	233+59.16	233+81.07	234+02.97
	OFFSET							OFFSET	-25.92	-25.94	-26.18	-26.62	-27.28
	F.D.S. ELEV.							F.D.S. ELEV.	528.19	527.79	527.37	526.94	526.51
	DEFLECTION							DEFLECTION	0.00	0.08	0.11	0.08	0.00
	SCREED ELEV.							T.O.H. ELEV.	527.46	527.14	526.75	526.29	525.78
	STATION						BEAM 6	STATION	233+00.51	233+22.54	233+44.56	233+66.58	233+88.59
	OFFSET							OFFSET	-15.03	-14.90	-15.00	-15.30	-15.82
	F.D.S. ELEV.							F.D.S. ELEV.	527.89	527.50	527.09	526.67	526.23
	DEFLECTION							DEFLECTION	0.00	0.08	0.11	0.08	0.00
	SCREED ELEV.							T.O.H. ELEV.	527.16	526.85	526.47	526.01	525.50
	STATION						BEAM 7	STATION	232+85.56	233+07.69	233+29.82	233+51.95	233+74.07
	OFFSET							OFFSET	-4.23	-3.96	-3.91	-4.08	-4.45
	F.D.S. ELEV.							F.D.S. ELEV.	527.59	527.21	526.81	526.39	525.96
	DEFLECTION							DEFLECTION	0.00	0.07	0.10	0.07	0.00
	SCREED ELEV.							T.O.H. ELEV.	526.86	526.55	526.18	525.73	525.23

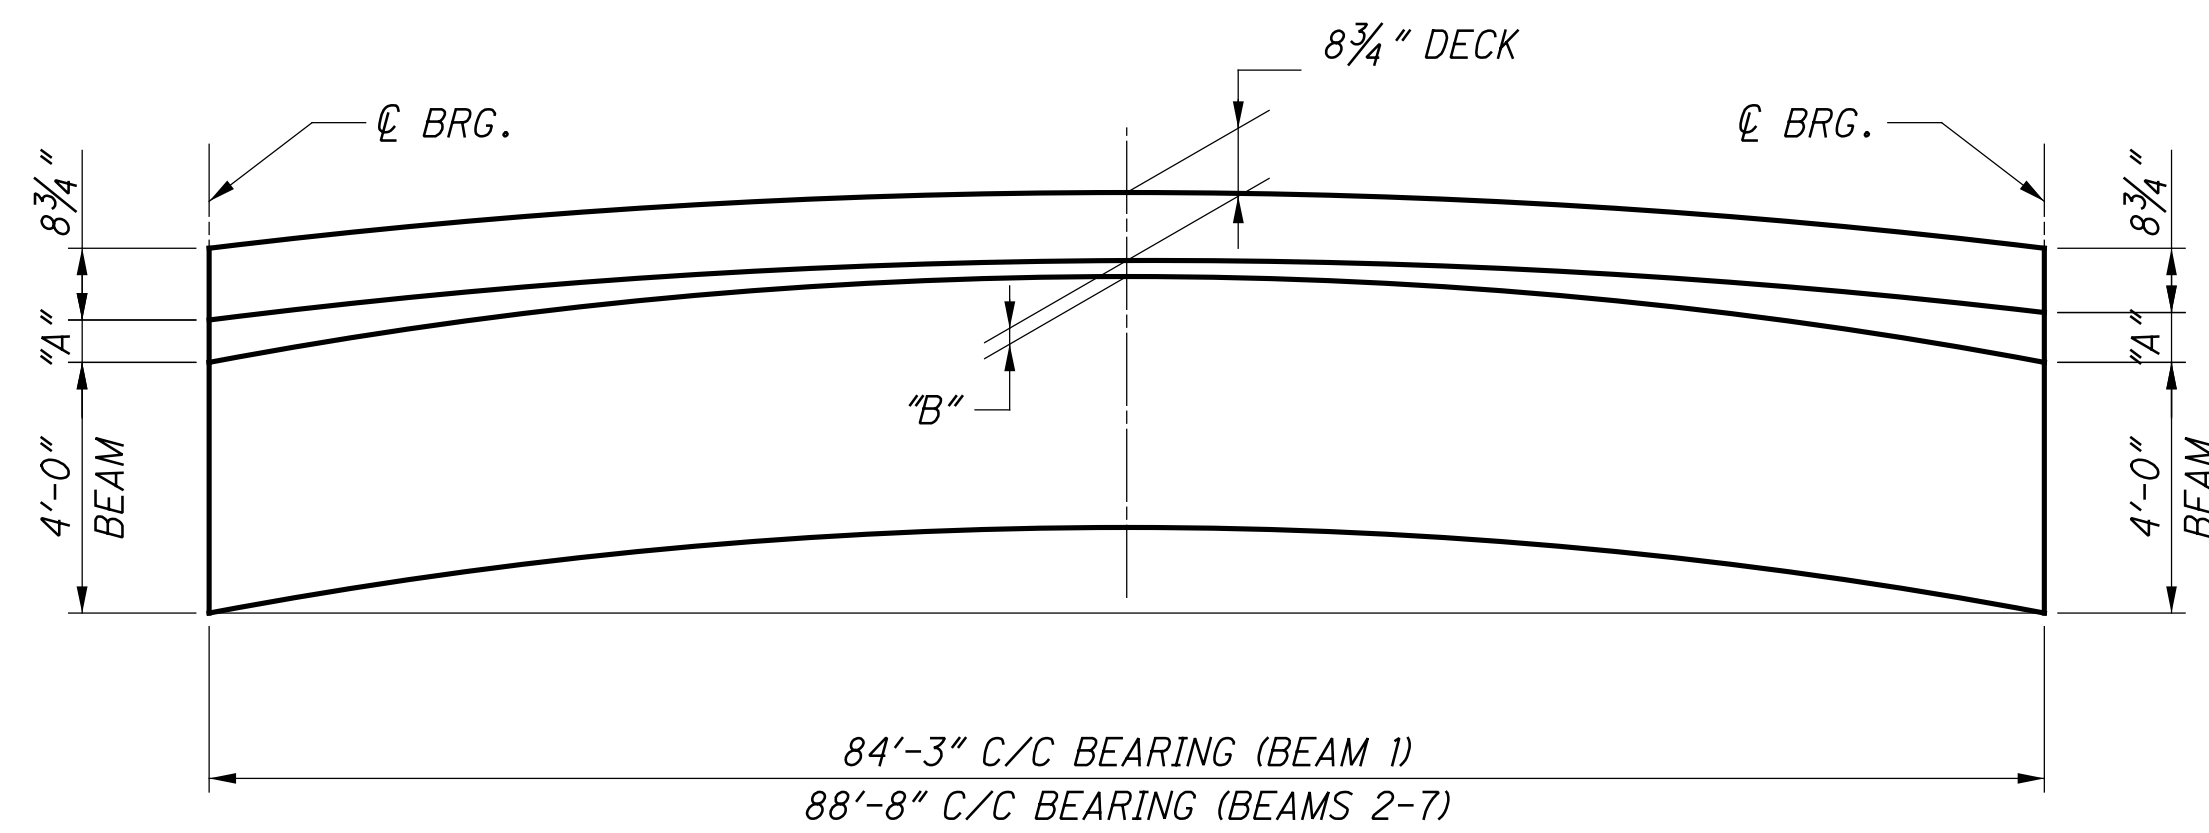

SCHEMATIC LONGITUDINAL SUPERSTRUCTURE CROSS-SECTION
(ONE SPAN)

LEFT HAUNCH THICKNESS TABLE							
LOCATION	BEAM 1	BEAM 2	BEAM 3	BEAM 4	BEAM 5	BEAM 6	BEAM 7
DIM "A"	5 7/16"	5 1/16"	5 1/8"	5 3/8"	5 1/2"	5 5/8"	5 7/8"
DIM "B"	3"	3 1/4"	3 1/4"	3 1/4"	3 1/4"	3 1/4"	3 1/4"

NOTES:

FOR SCREED PLAN, SEE SHEET 37/68.

SCREED ELEVATIONS SHOWN REPRESENT THE THEORETICAL DECK SURFACE LOCATION PRIOR TO DEFLECTIONS CAUSED BY DECK PLACEMENT AND OTHER ANTICIPATED DEAD LOADS.

TOP OF HAUNCH (T.O.H.) ELEVATIONS SHOWN REPRESENT THE THEORETICAL LOCATION OF THE BOTTOM OF THE DECK ABOVE THE BEAM HAUNCH PRIOR TO DEFLECTIONS CAUSED BY DECK PLACEMENT AND OTHER ANTICIPATED DEAD LOADS.

FINAL DECK SURFACE (F.D.S.) ELEVATIONS SHOWN REPRESENT THE DECK SURFACE LOCATION AFTER ALL ANTICIPATED DEAD LOAD DEFLECTIONS HAVE OCCURRED.

DESIGN AGENCY
STRUCTUREPOINT

DATE
10/25/18

DESIGNED
SUF

REVIEWED
RMC

DRAWN
TMT

STRUCTURE FILE NUMBER
3109163

DESIGNED
SUF

CHECKED
CLB

HAM-75-3.84

BRIDGE NO. - HAM-75-0440 L/R


PID No. 104667

OVER IR-74 WB

38/68

38
68


S:\Plans.dgn 10/26/2023 4:26:35 PM
 \O:\2017\01113\C.Design\104667_HAM-75-3.84.Design\104667_HAM0075_0440C.Sheets\HAM0075_0440C_SD008.dgn

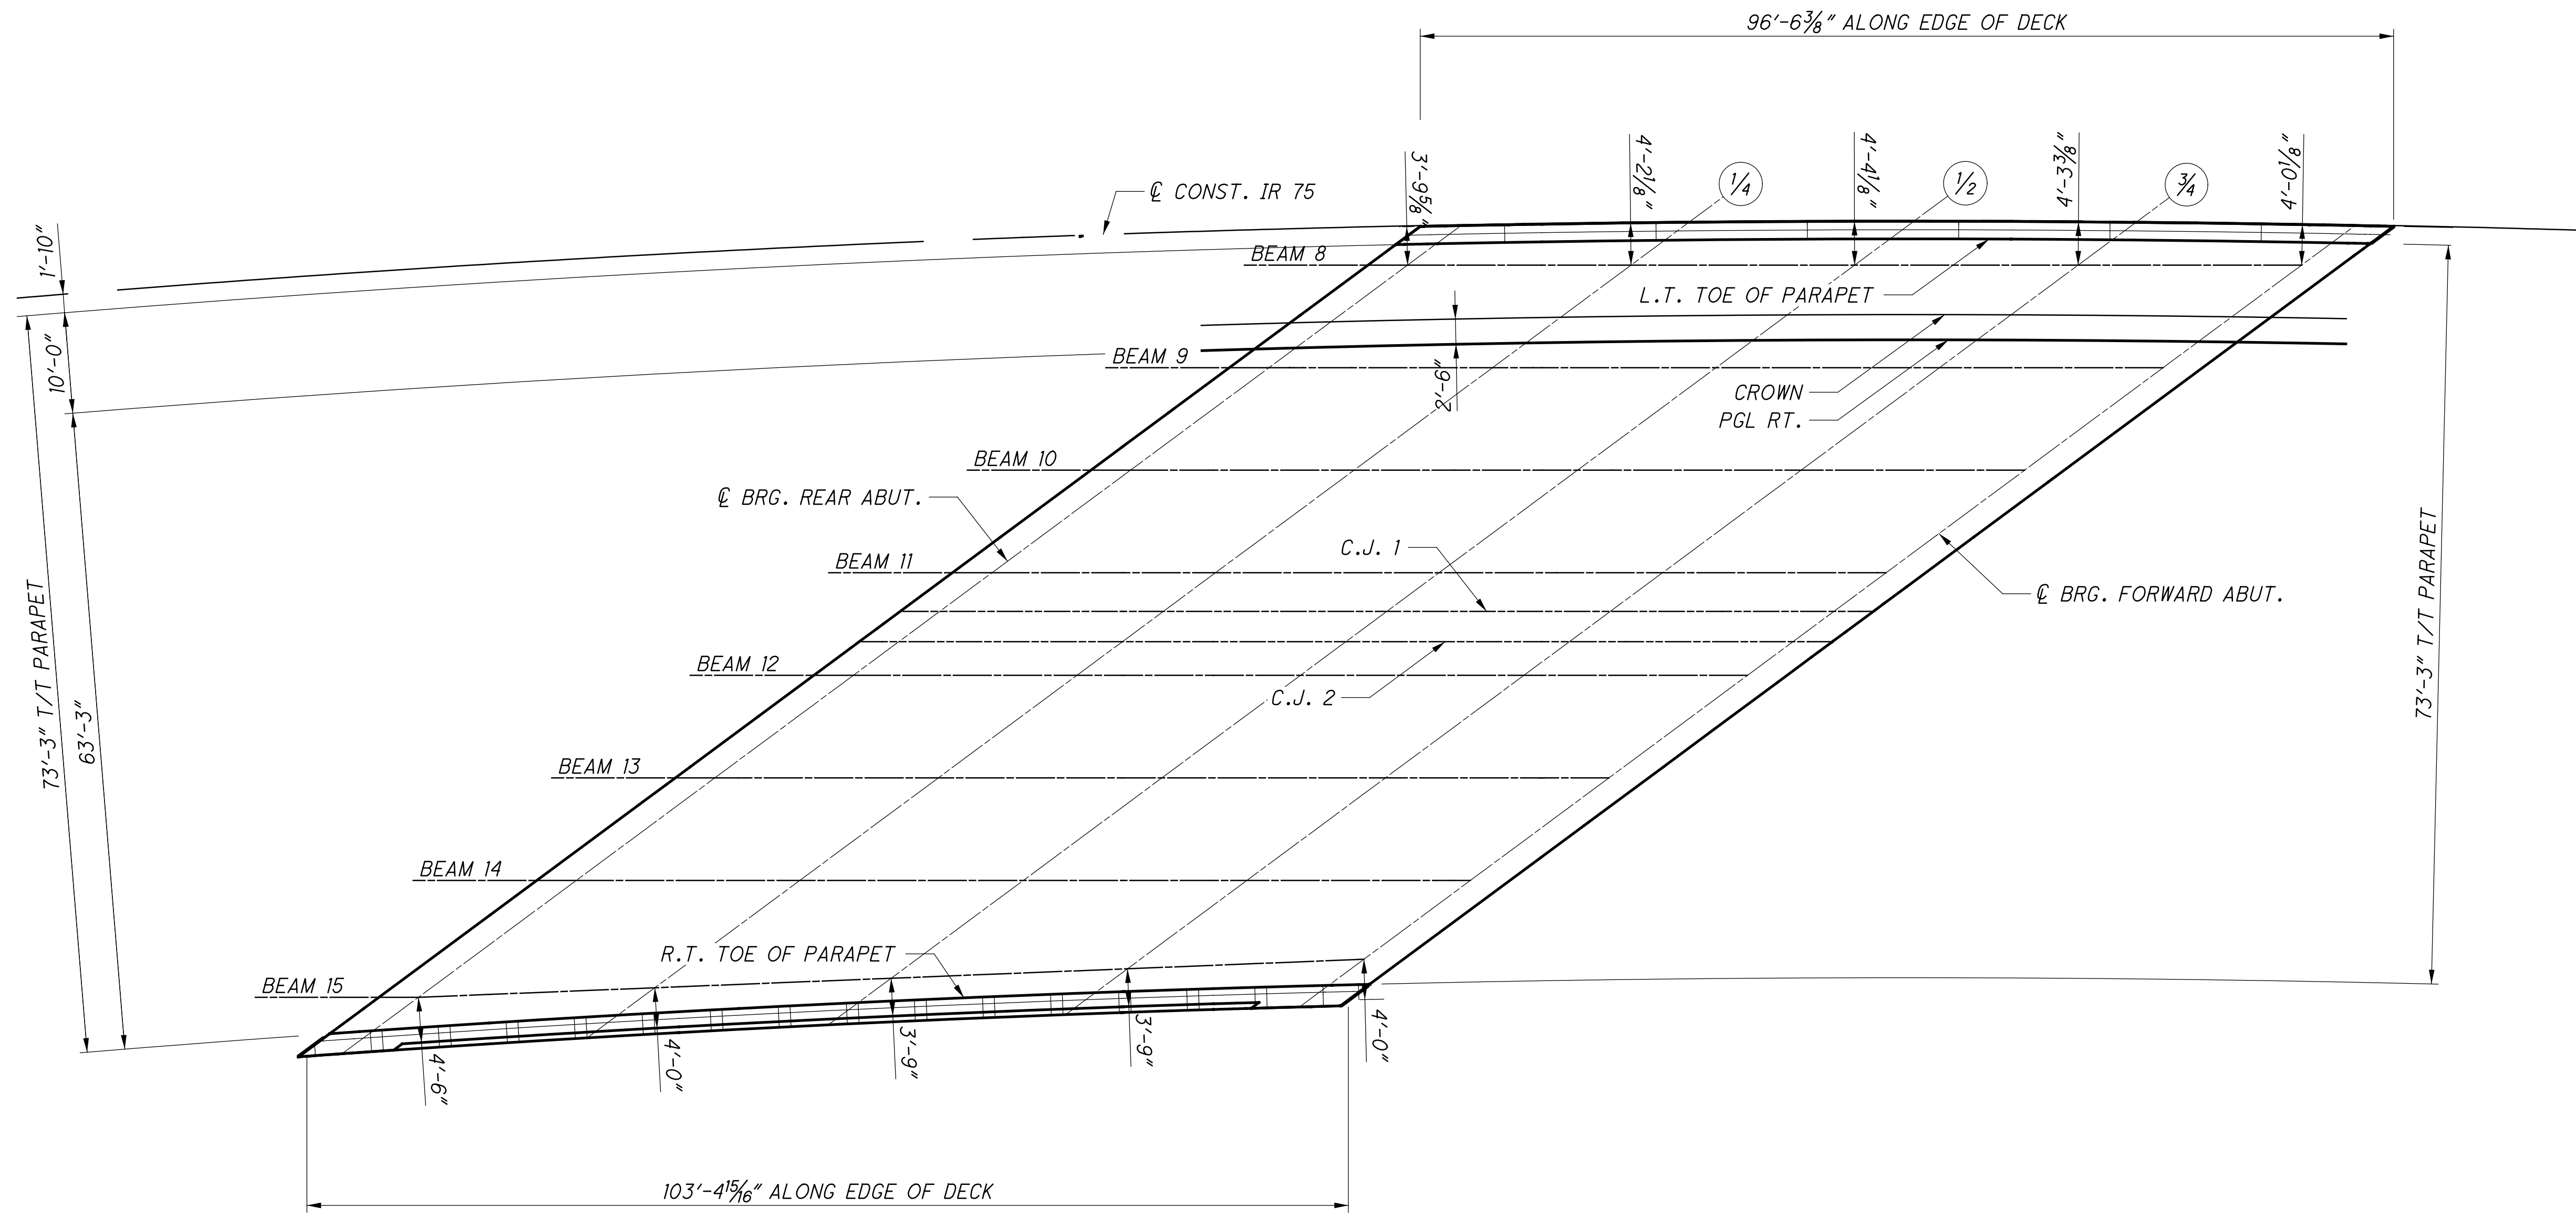

SCREED PLAN

NOTES:


1. FOR TOP OF HAUNCH (T.O.H.) AND FINAL DECK SURFACE (F.D.S.) ELEVATIONS TABLE, SEE SHEET 40/68.

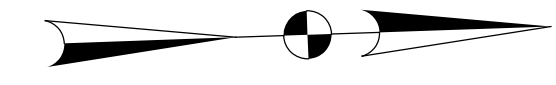

		DESIGN AGENCY STRUCTUREPOINT <small>2000 CORPORATE CENTER DR. STE. 200 WILSONVILLE, OR 97158 TEL: 503.261.1333 FAX: 503.261.1335 WWW.STRUCTUREPOINT.COM</small>
DESIGNED SUJ	DRAWN BNM	REVIEWED MDS
CHECKED CLB	REVISED	DATE 1/2/19
BRIDGE NO. HAM-75-0440 L/R OVER IR-74 WB		STRUCTURE FILE NUMBER 309763
HAM-75-3.84 PID No. 104667		39/68
39 68		

S:\Plans\dgn 10/26/2023 4:26:35 PM 2017\01113.C Design 104667 HAM-75-3.84 Design Structures HAM0075_0440C_Sheets HAM0075_0440C_SD009.dgn

SCREED ELEVATIONS TABLE							HAUNCH ELEVATIONS TABLE						
SCREED LINE	DESCRIPTION	℄ BRG. REAR ABUT.	¼ POINT	½ POINT	¾ POINT	℄ BRG. FWD. ABUT.	SCREED LINE	DESCRIPTION	℄ BRG. REAR ABUT.	¼ POINT	½ POINT	¾ POINT	℄ BRG. FWD. ABUT.
HAM-75-0440R SCREED ELEVATIONS							HAM-75-0440R TOP OF HAUNCH ELEVATIONS						
LT. TOE OF PARAPET	STATION	232+77.05	232+99.71	233+22.07	233+44.14	233+65.93	BEAM 8	STATION	232+74.15	232+96.35	233+18.56	233+40.77	233+62.97
	OFFSET	1.83	1.83	1.83	1.83	1.83		OFFSET	3.89	4.26	4.42	4.37	4.10
	F.D.S. ELEV.	529.41	529.05	528.66	528.25	527.81		F.D.S. ELEV.	529.54	529.21	528.83	528.42	527.97
	DEFLECTION	0.00	0.06	0.09	0.06	0.00		DEFLECTION	0.00	0.06	0.09	0.06	0.00
	SCREED ELEV.	529.41	529.11	528.75	528.31	527.81		T.O.H. ELEV.	528.84	528.56	528.22	527.77	527.26
CROWN	STATION	232+66.39	232+89.28	233+11.85	233+34.12	233+56.10	BEAM 9	STATION	232+60.10	232+82.40	233+04.71	233+27.01	233+49.32
	OFFSET	9.33	9.33	9.33	9.33	9.33		OFFSET	13.71	14.22	14.52	14.59	14.46
	F.D.S. ELEV.	529.89	529.54	529.16	528.75	528.33		F.D.S. ELEV.	529.76	529.40	529.02	528.62	528.20
	DEFLECTION	0.00	0.07	0.10	0.07	0.00		DEFLECTION	0.00	0.07	0.10	0.07	0.00
	SCREED ELEV.	529.89	529.60	529.25	528.82	528.33		T.O.H. ELEV.	529.05	528.76	528.41	527.98	527.49
PGL	STATION	232+62.81	232+85.77	233+08.41	233+30.75	233+52.80	BEAM 10	STATION	232+45.94	232+68.33	232+90.73	233+13.14	233+35.55
	OFFSET	11.83	11.83	11.83	11.83	11.83		OFFSET	23.45	24.09	24.52	24.74	24.73
	F.D.S. ELEV.	529.81	529.47	529.09	528.69	528.26		F.D.S. ELEV.	529.46	529.11	528.74	528.35	527.94
	DEFLECTION	0.00	0.07	0.10	0.07	0.00		DEFLECTION	0.00	0.07	0.10	0.07	0.00
	SCREED ELEV.	529.81	529.53	529.19	528.76	528.26		T.O.H. ELEV.	528.75	528.47	528.13	527.71	527.23
C.J. #1	STATION	232+26.24	232+48.76	232+71.29	232+93.83	233+16.37	BEAM 11	STATION	232+31.66	232+54.14	232+76.63	232+99.14	233+21.65
	OFFSET	36.71	37.55	38.17	38.57	38.75		OFFSET	33.10	33.86	34.45	37.80	34.93
	F.D.S. ELEV.	529.03	528.70	528.35	527.97	527.58		F.D.S. ELEV.	529.15	528.81	528.45	527.92	527.68
	DEFLECTION	0.00	0.07	0.10	0.07	0.00		DEFLECTION	0.00	0.07	0.10	0.07	0.00
	SCREED ELEV.	529.03	528.77	528.45	528.04	527.58		T.O.H. ELEV.	528.44	528.17	527.85	527.28	526.97
C.J. #2	STATION	232+21.99	232+44.53	232+67.09	232+89.66	233+12.23	BEAM 12	STATION	232+17.25	232+39.82	232+62.41	232+85.01	233+07.62
	OFFSET	39.53	40.41	41.07	41.51	41.73		OFFSET	42.66	43.58	44.28	44.77	45.04
	F.D.S. ELEV.	528.94	528.61	528.26	527.89	527.50		F.D.S. ELEV.	528.84	528.51	528.16	527.80	527.41
	DEFLECTION	0.00	0.07	0.10	0.07	0.00		DEFLECTION	0.00	0.07	0.10	0.07	0.00
	SCREED ELEV.	528.94	528.68	528.36	527.96	527.50		T.O.H. ELEV.	528.13	527.87	527.56	527.16	526.70
RT. TOE OF PARAPET	STATION	231+66.39	231+91.50	232+16.20	232+40.51	232+64.45	BEAM 13	STATION	232+02.72	232+25.38	232+48.07	232+70.76	232+93.47
	OFFSET	75.08	75.08	75.08	75.08	75.08		OFFSET	52.13	53.19	54.04	54.66	55.06
	F.D.S. ELEV.	527.69	527.46	527.19	526.89	526.56		F.D.S. ELEV.	528.52	528.20	527.87	527.51	527.14
	DEFLECTION	0.00	0.08	0.11	0.08	0.00		DEFLECTION	0.00	0.07	0.10	0.07	0.00
	SCREED ELEV.	527.69	527.54	527.31	526.97	526.56		T.O.H. ELEV.	527.81	527.56	527.26	526.87	526.43
	STATION						BEAM 14	STATION	231+88.07	232+10.82	232+33.60	232+56.39	232+79.19
	OFFSET							OFFSET	61.51	62.71	63.70	64.46	65.00
	F.D.S. ELEV.							F.D.S. ELEV.	528.19	527.89	527.56	527.22	526.86
	DEFLECTION							DEFLECTION	0.00	0.07	0.10	0.07	0.00
	SCREED ELEV.							T.O.H. ELEV.	527.48	527.25	526.96	526.58	526.15
	STATION						BEAM 15	STATION	231+71.23	231+95.45	232+19.67	232+43.90	232+68.13
	OFFSET							OFFSET	72.08	72.58	72.83	72.83	72.58
	F.D.S. ELEV.							F.D.S. ELEV.	527.81	527.55	527.27	526.96	526.64
	DEFLECTION							DEFLECTION	0.00	0.08	0.11	0.08	0.00
	SCREED ELEV.							T.O.H. ELEV.	527.10	526.92	526.67	526.33	525.93

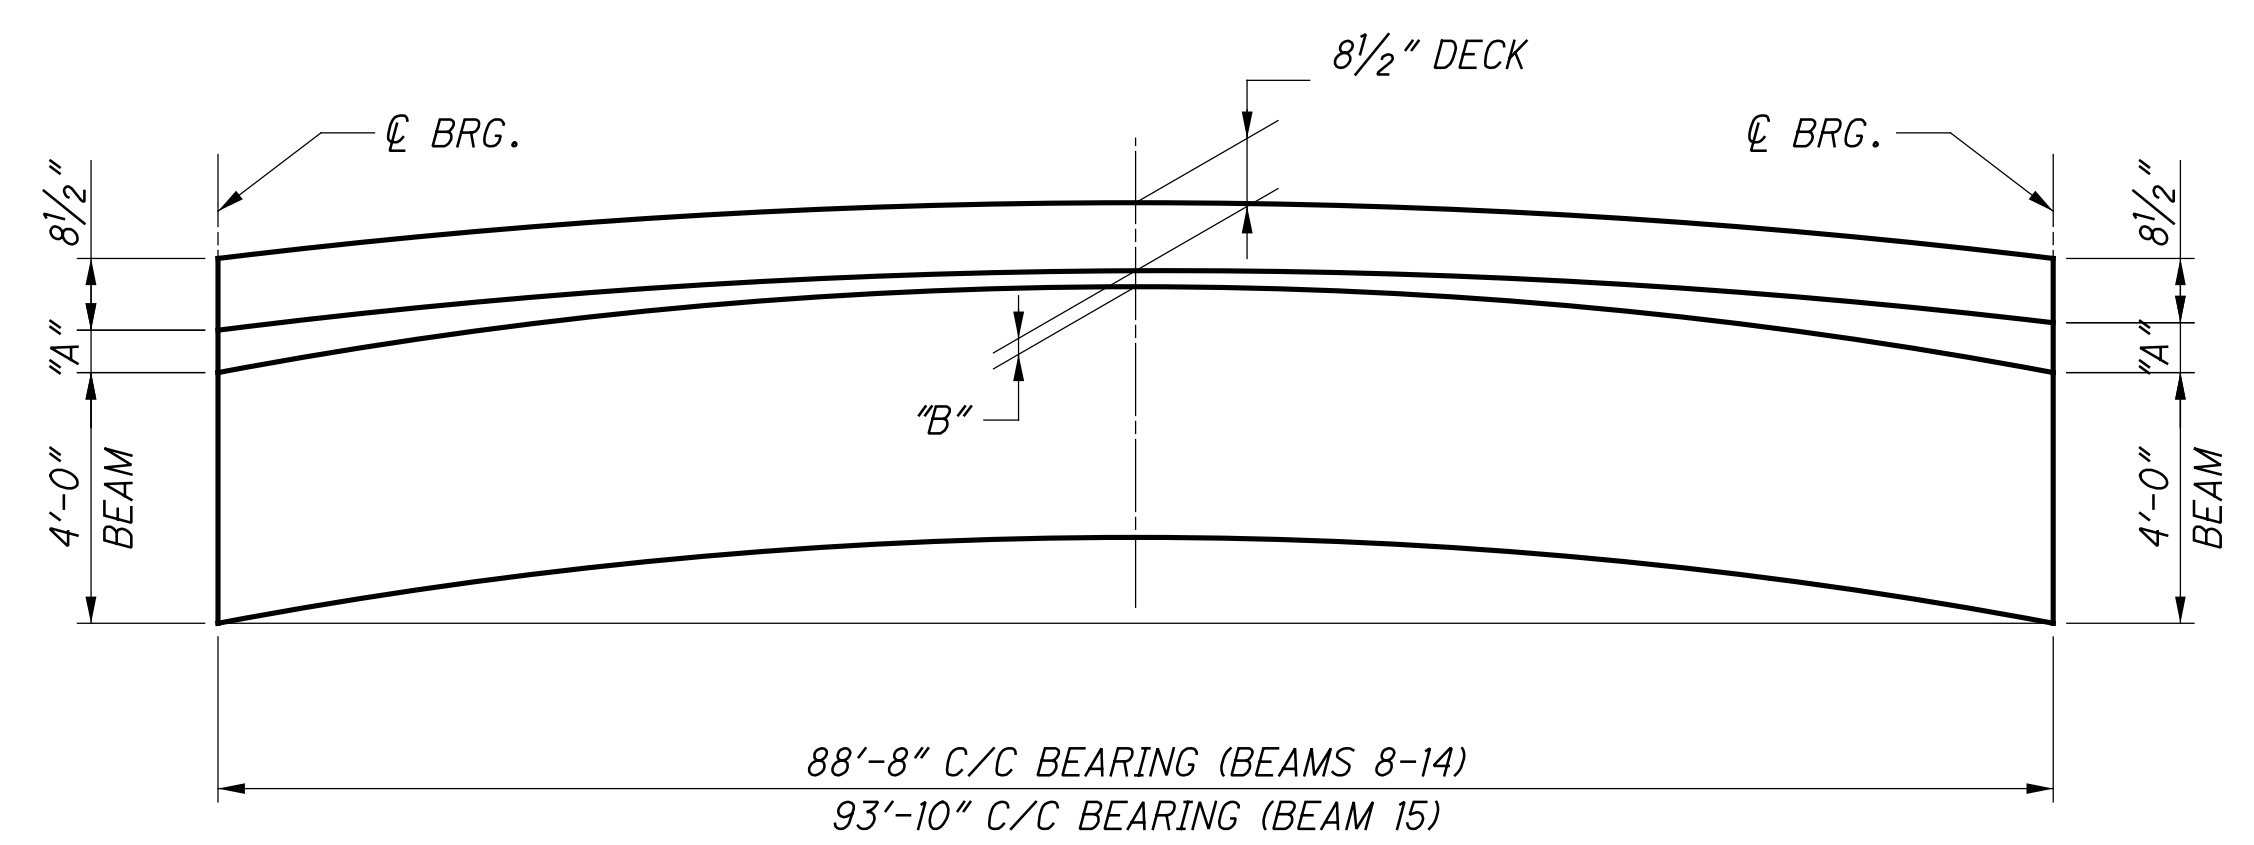


SCHEMATIC LONGITUDINAL SUPERSTRUCTURE CROSS-SECTION
(ONE SPAN)

LOCATION	BEAM 8	BEAM 9	BEAM 10	BEAM 11	BEAM 12	BEAM 13	BEAM 14	BEAM 15
DIM "A"	6 1/16"	5 11/16"	5 11/16"	5 11/16"	7 1/4"	7"	7 1/4"	6 1/8"
DIM "B"	3"	3 1/4"	3 1/4"	3 1/4"	3 1/4"	3 1/4"	3 1/4"	3 1/4"


NOTES:
 FOR SCREED PLAN, SEE SHEET 39/68.
 SCREED ELEVATIONS SHOWN REPRESENT THE THEORETICAL DECK SURFACE LOCATION PRIOR TO DEFLECTIONS CAUSED BY DECK PLACEMENT AND OTHER ANTICIPATED DEAD LOADS.
 TOP OF HAUNCH (T.O.H.) ELEVATIONS SHOWN REPRESENT THE THEORETICAL LOCATION OF THE BOTTOM OF THE DECK ABOVE THE BEAM HAUNCH PRIOR TO DEFLECTIONS CAUSED BY DECK PLACEMENT AND OTHER ANTICIPATED DEAD LOADS.
 FINAL DECK SURFACE (F.D.S.) ELEVATIONS SHOWN REPRESENT THE DECK SURFACE LOCATION AFTER ALL ANTICIPATED DEAD LOAD DEFLECTIONS HAVE OCCURRED.

DESIGN AGENCY: STRUCTUREPOINT
 DATE: 1/2/19
 REVIEWED: MDS
 DRAWN: TMT
 DESIGNED: SJF
 CHECKED: CLB
 STRUCTURE FILE NUMBER: 3109163
 BRIDGE NO.: HAM-75-0440 L/R
 OVER IR-74 WB
 HAM-75-3.84
 PID No. 104667
 40/68
 40/68

SFlanagan
 10/26/2023 4:26:36 PM
 \\01\2017\01113\C.Design\104667-HAM-75-3.84\Design\Structures\HAM0075_0440C\Sheets\HAM0075_0440C_SD006.dgn

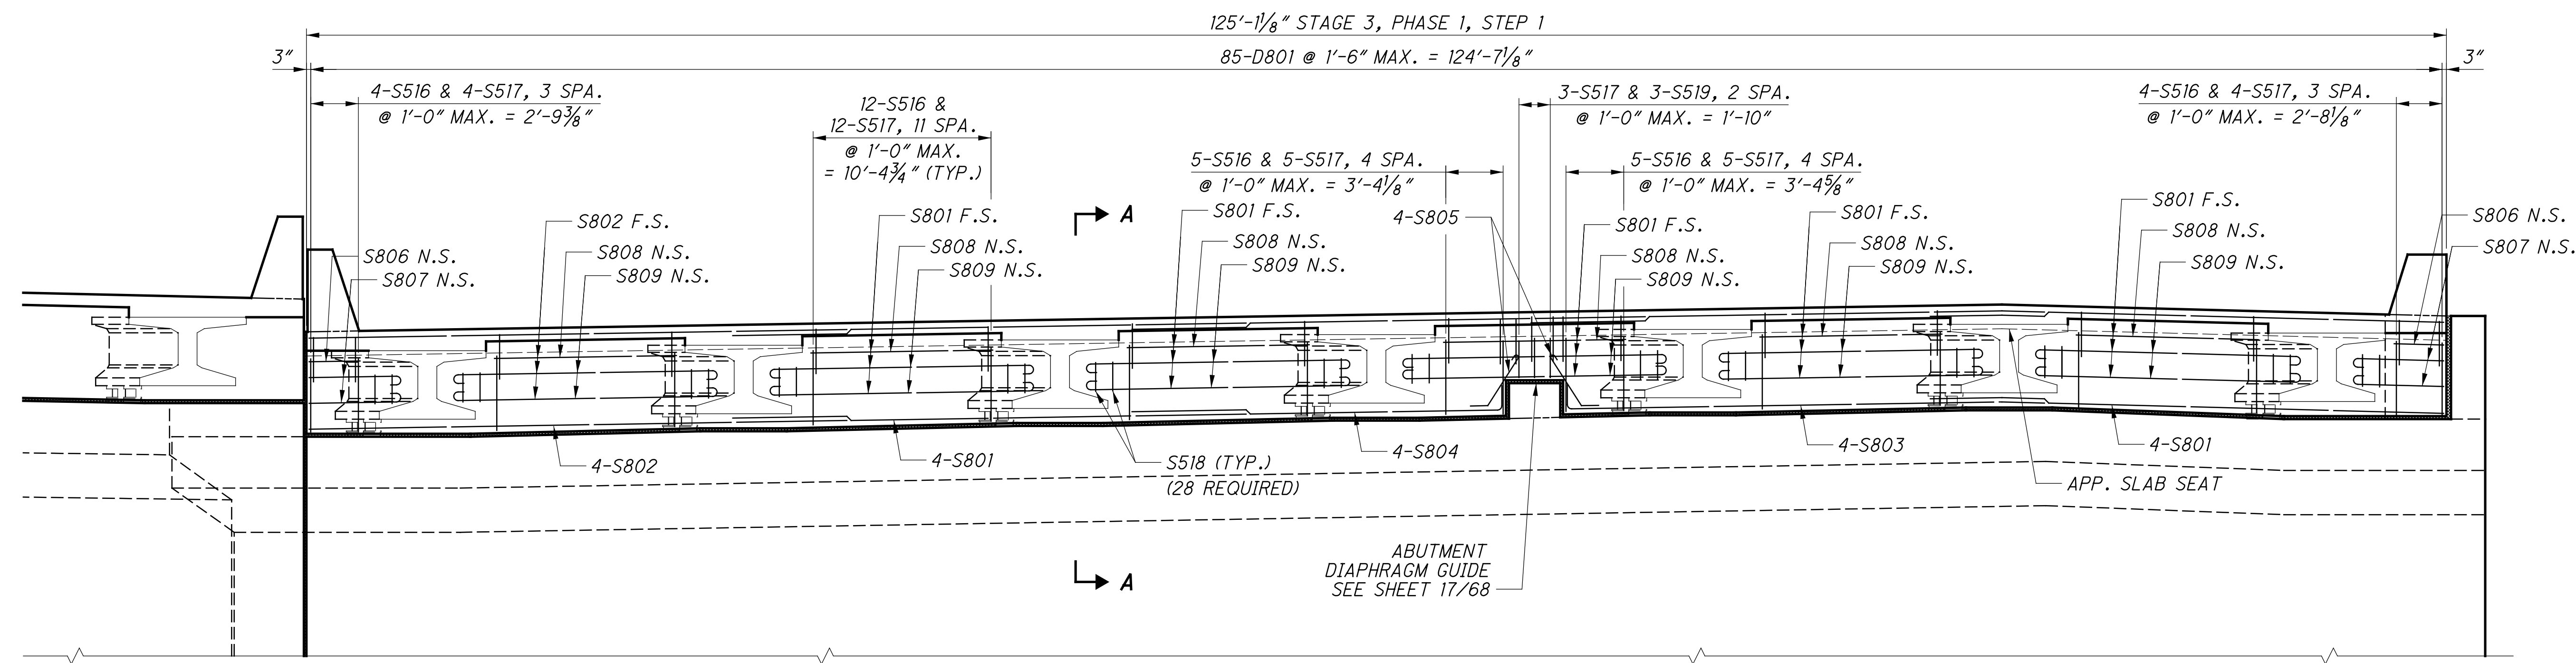

**END DIAPHRAGM ELEVATION
 REAR ABUTMENT**

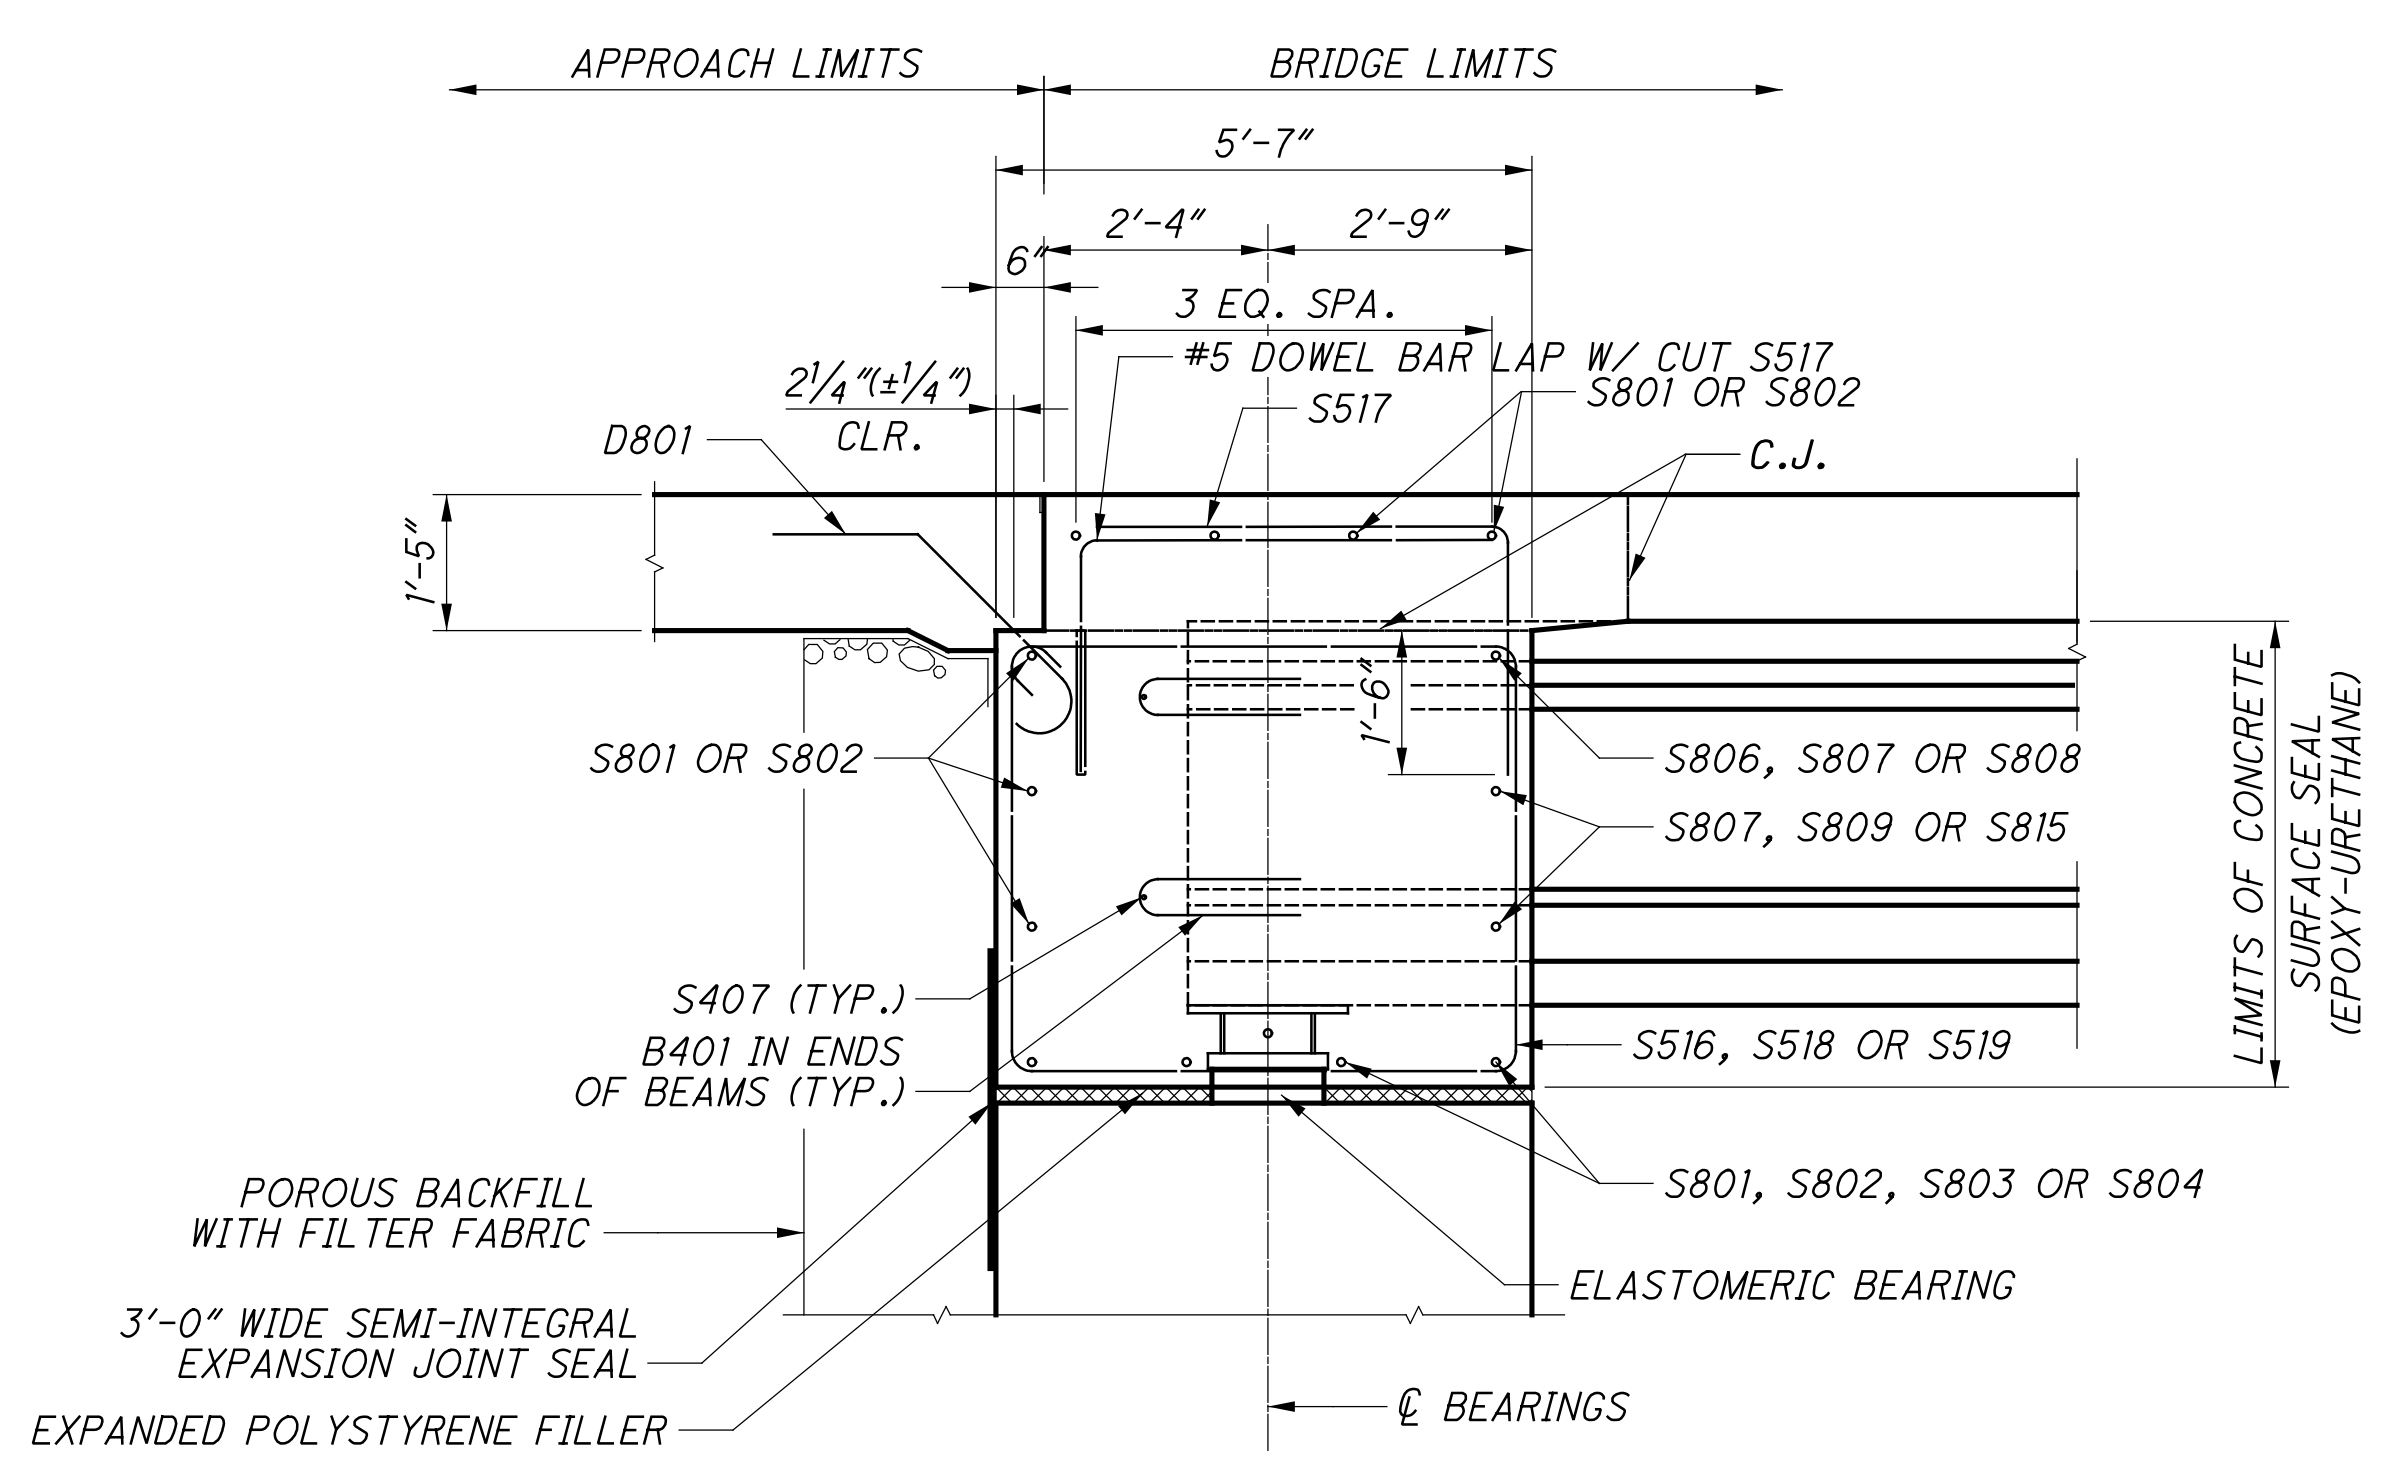


SECTION A-A


NOTES:

1. PLACE THE DIAPHRAGM CONCRETE ENCASING THE STRUCTURAL MEMBER ENDS AFTER THE DECK PLACEMENT IN THE ADJACENT SPAN IS COMPLETE. PROCEDURES THAT PLACE THE ABUTMENT DIAPHRAGM WITH THE DECK CONCRETE MAY BE APPROVED BY THE ENGINEER IF THE PLACEMENT SUBMITTAL CAN ASSURE THAT THE DECK CONCRETE IN THE ADJACENT SPAN WILL BE PLACED BEFORE CONCRETE IN THE DIAPHRAGM HAS REACHED ITS INITIAL SET.

	DESIGN AGENCY	DATE	1/2/19
	STRUCTUREPOINT	REVIEWED	MDS
	DRAWN	TLH	REVISED
	DESIGNED	SJF	CHECKED
		CLB	
SUPERSTRUCTURE DETAILS (LEFT BRIDGE) BRIDGE NO. - HAM-75-0440 L/R OVER WB I-74		FILE NUMBER 3109163	
HAM-75-3.84 PID No. 104667			
		41/68	
		41	68

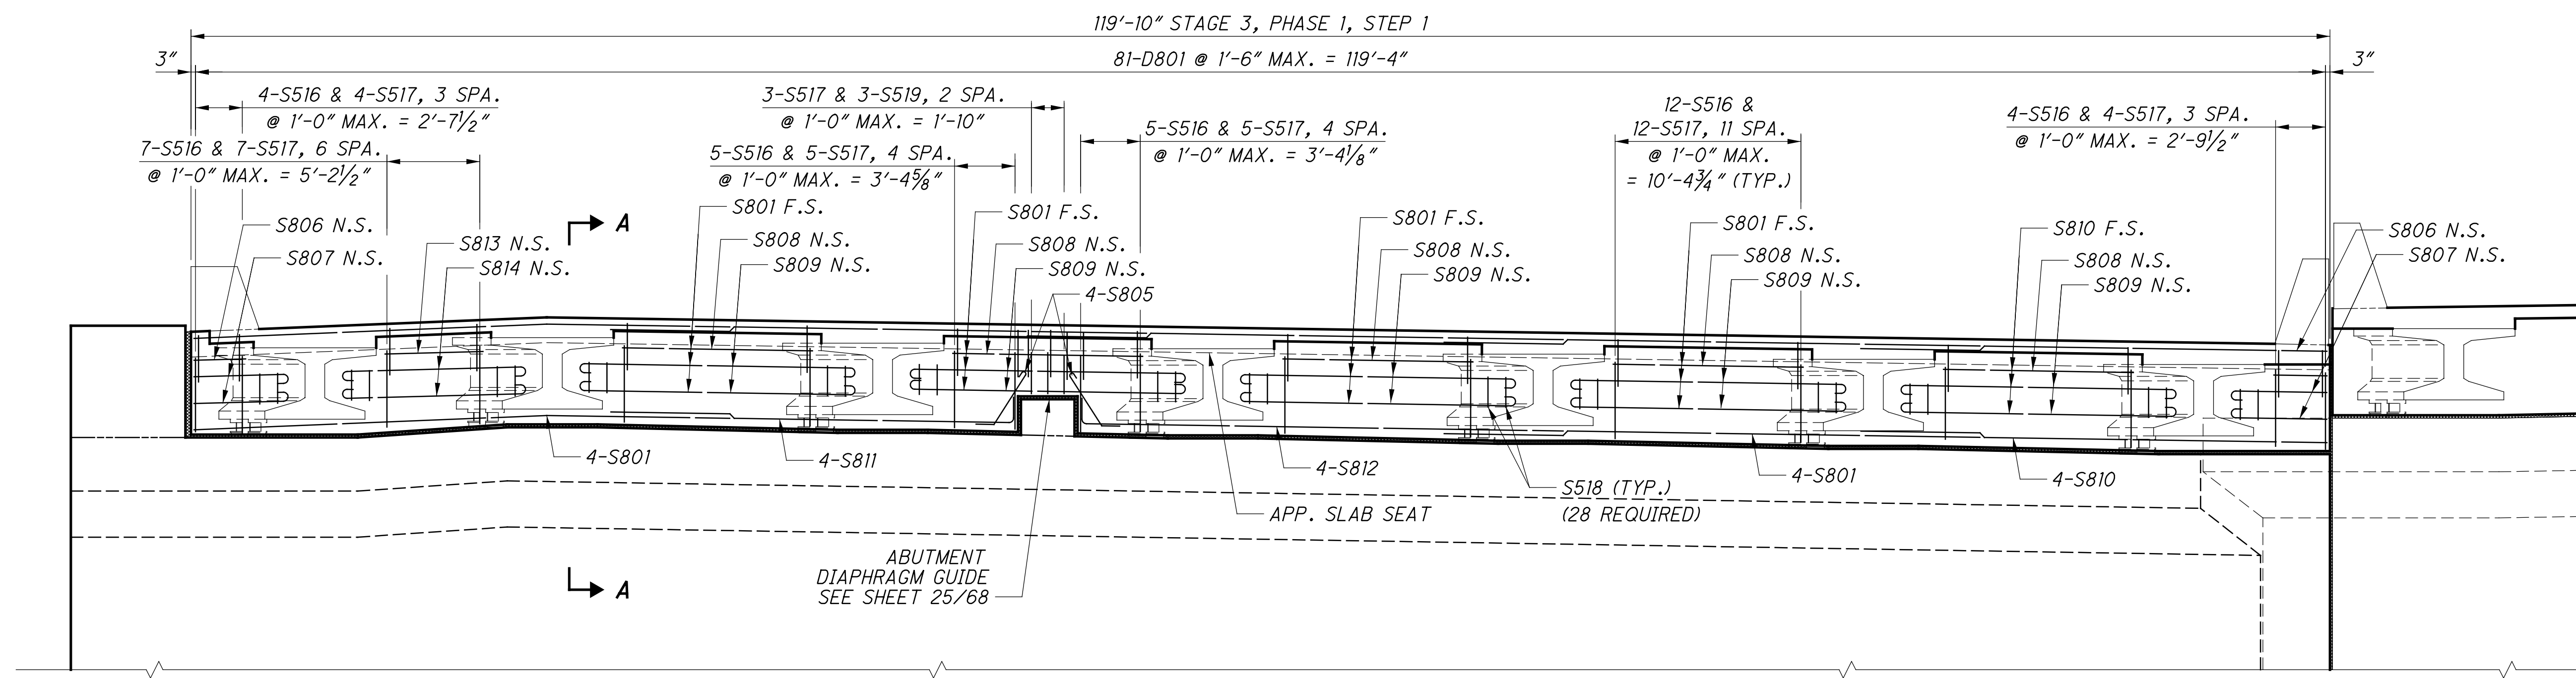

**END DIAPHRAGM ELEVATION
FORWARD ABUTMENT**

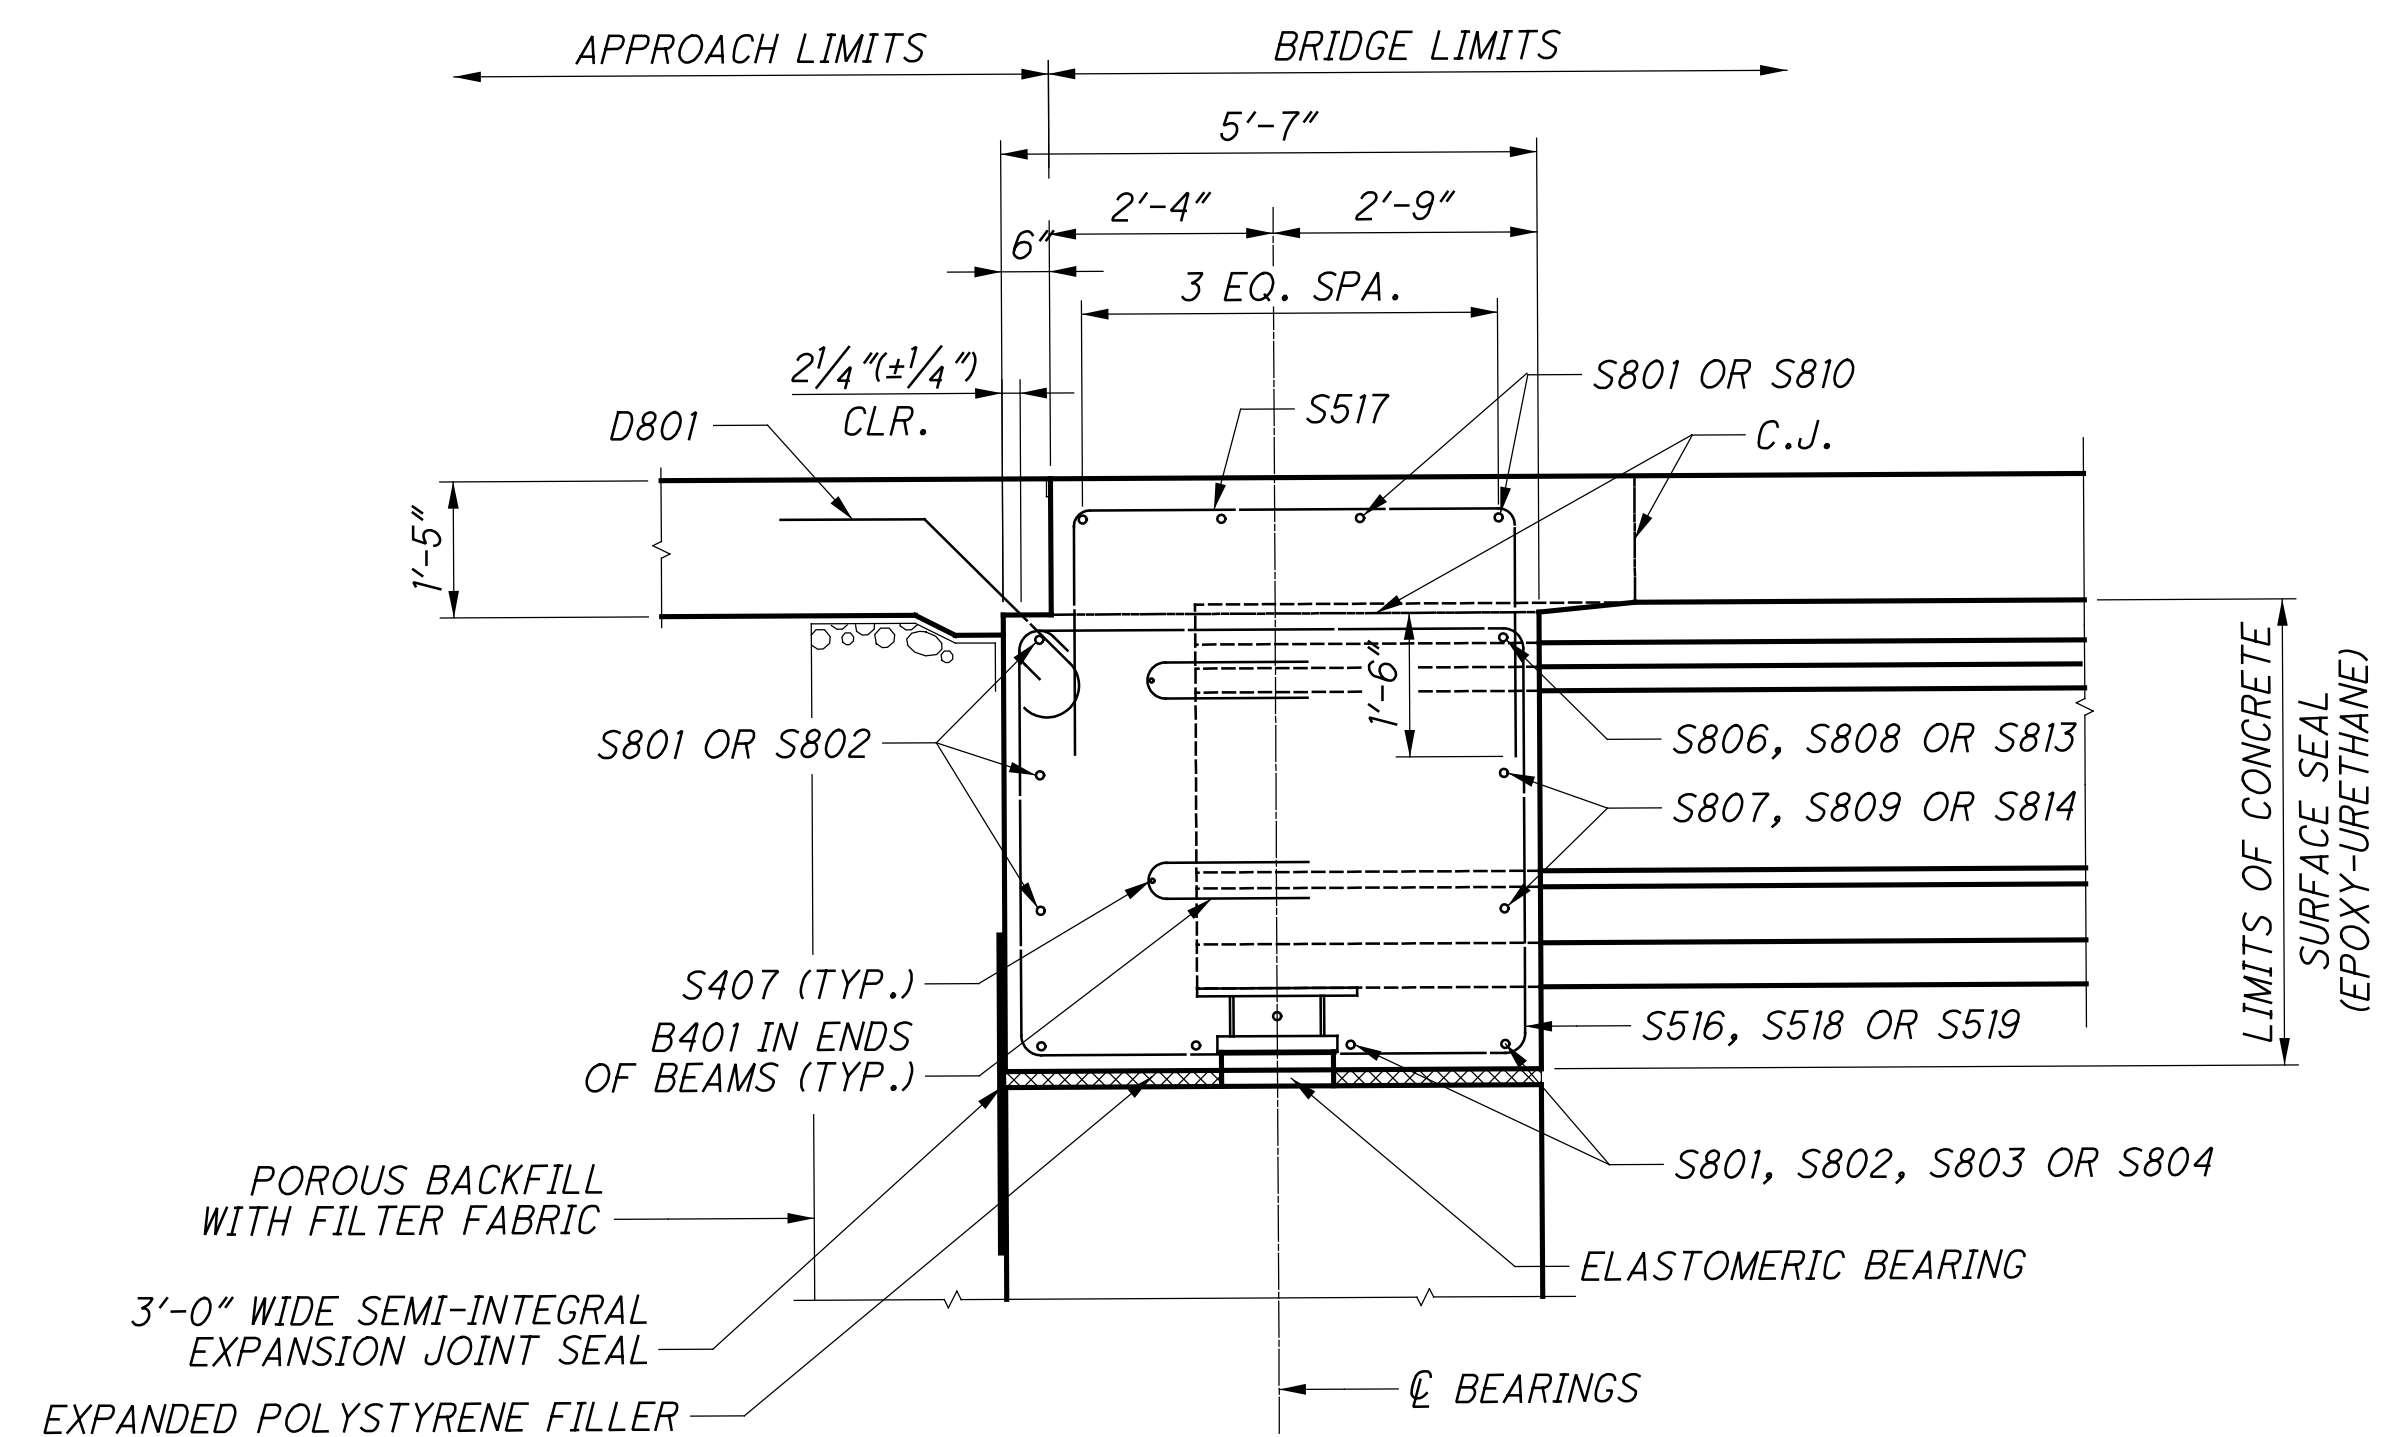


SECTION A-A

- NOTES:
1. PLACE THE DIAPHRAGM CONCRETE ENCASING THE STRUCTURAL MEMBER ENDS AFTER THE DECK PLACEMENT IN THE ADJACENT SPAN IS COMPLETE. PROCEDURES THAT PLACE THE ABUTMENT DIAPHRAGM WITH THE DECK CONCRETE MAY BE APPROVED BY THE ENGINEER IF THE PLACEMENT SUBMITTAL CAN ASSURE THAT THE DECK CONCRETE IN THE ADJACENT SPAN WILL BE PLACED BEFORE CONCRETE IN THE DIAPHRAGM HAS REACHED ITS INITIAL SET.


SFlanagan
10/26/2023 4:26:37 PM
\\01\2017\01113\C.Design\104667-HAM-75-3.84\Design\Structures\HAM0075_0440C\Sheets\HAM0075_0440C_SD007.dgn

DESIGN AGENCY STRUCTUREPOINT	
DATE 1/2/19	REVIEWED MDS
FILE NUMBER 3109763	STRUCTURE FILE NUMBER 3109763
DRAWN TLH	REVISED
DESIGNED SUF	CHECKED CLB
SUPERSTRUCTURE DETAILS (LEFT BRIDGE)	
BRIDGE NO. - HAM-75-0440 L/R	
OVER WB 1-74	
HAM-75-3.84	
PID No. 104667	
42/68	
42	
68	

SFlanagan 10/26/2023 4:26:38 PM
 C:\2017\01113\C.Design\104667-HAM-75-3.84\Design\Structures\HAM0075_0440C\Sheets\HAM0075_0440C_SD004.dgn

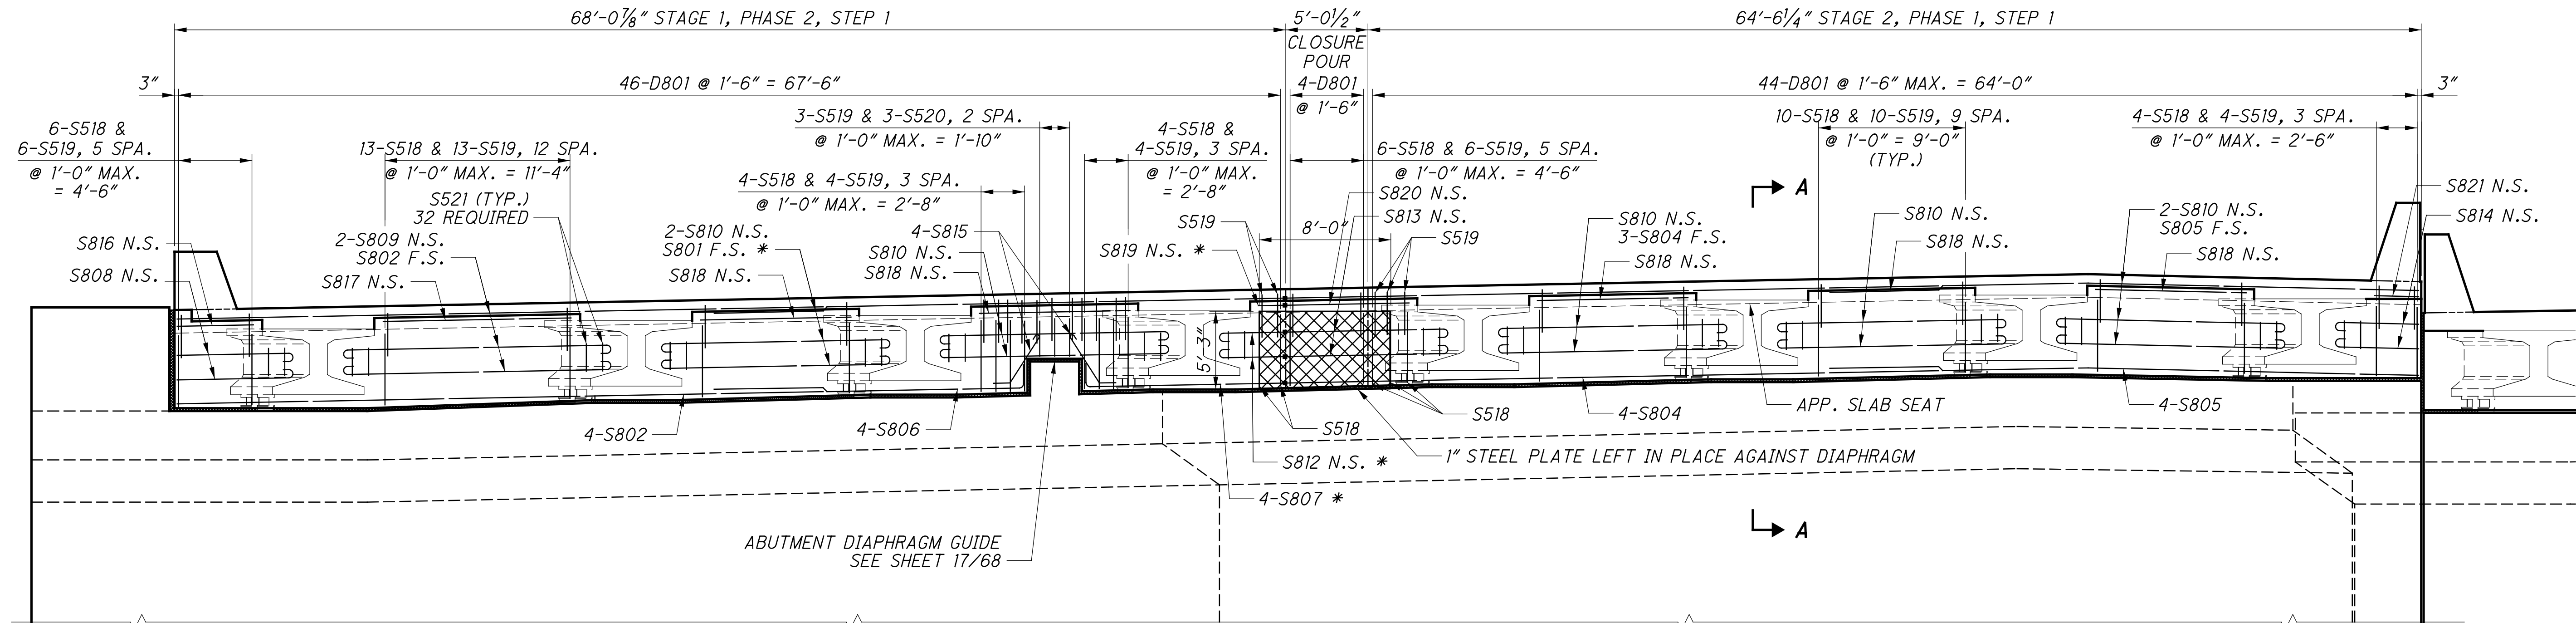


**END DIAPHRAGM ELEVATION
REAR ABUTMENT**

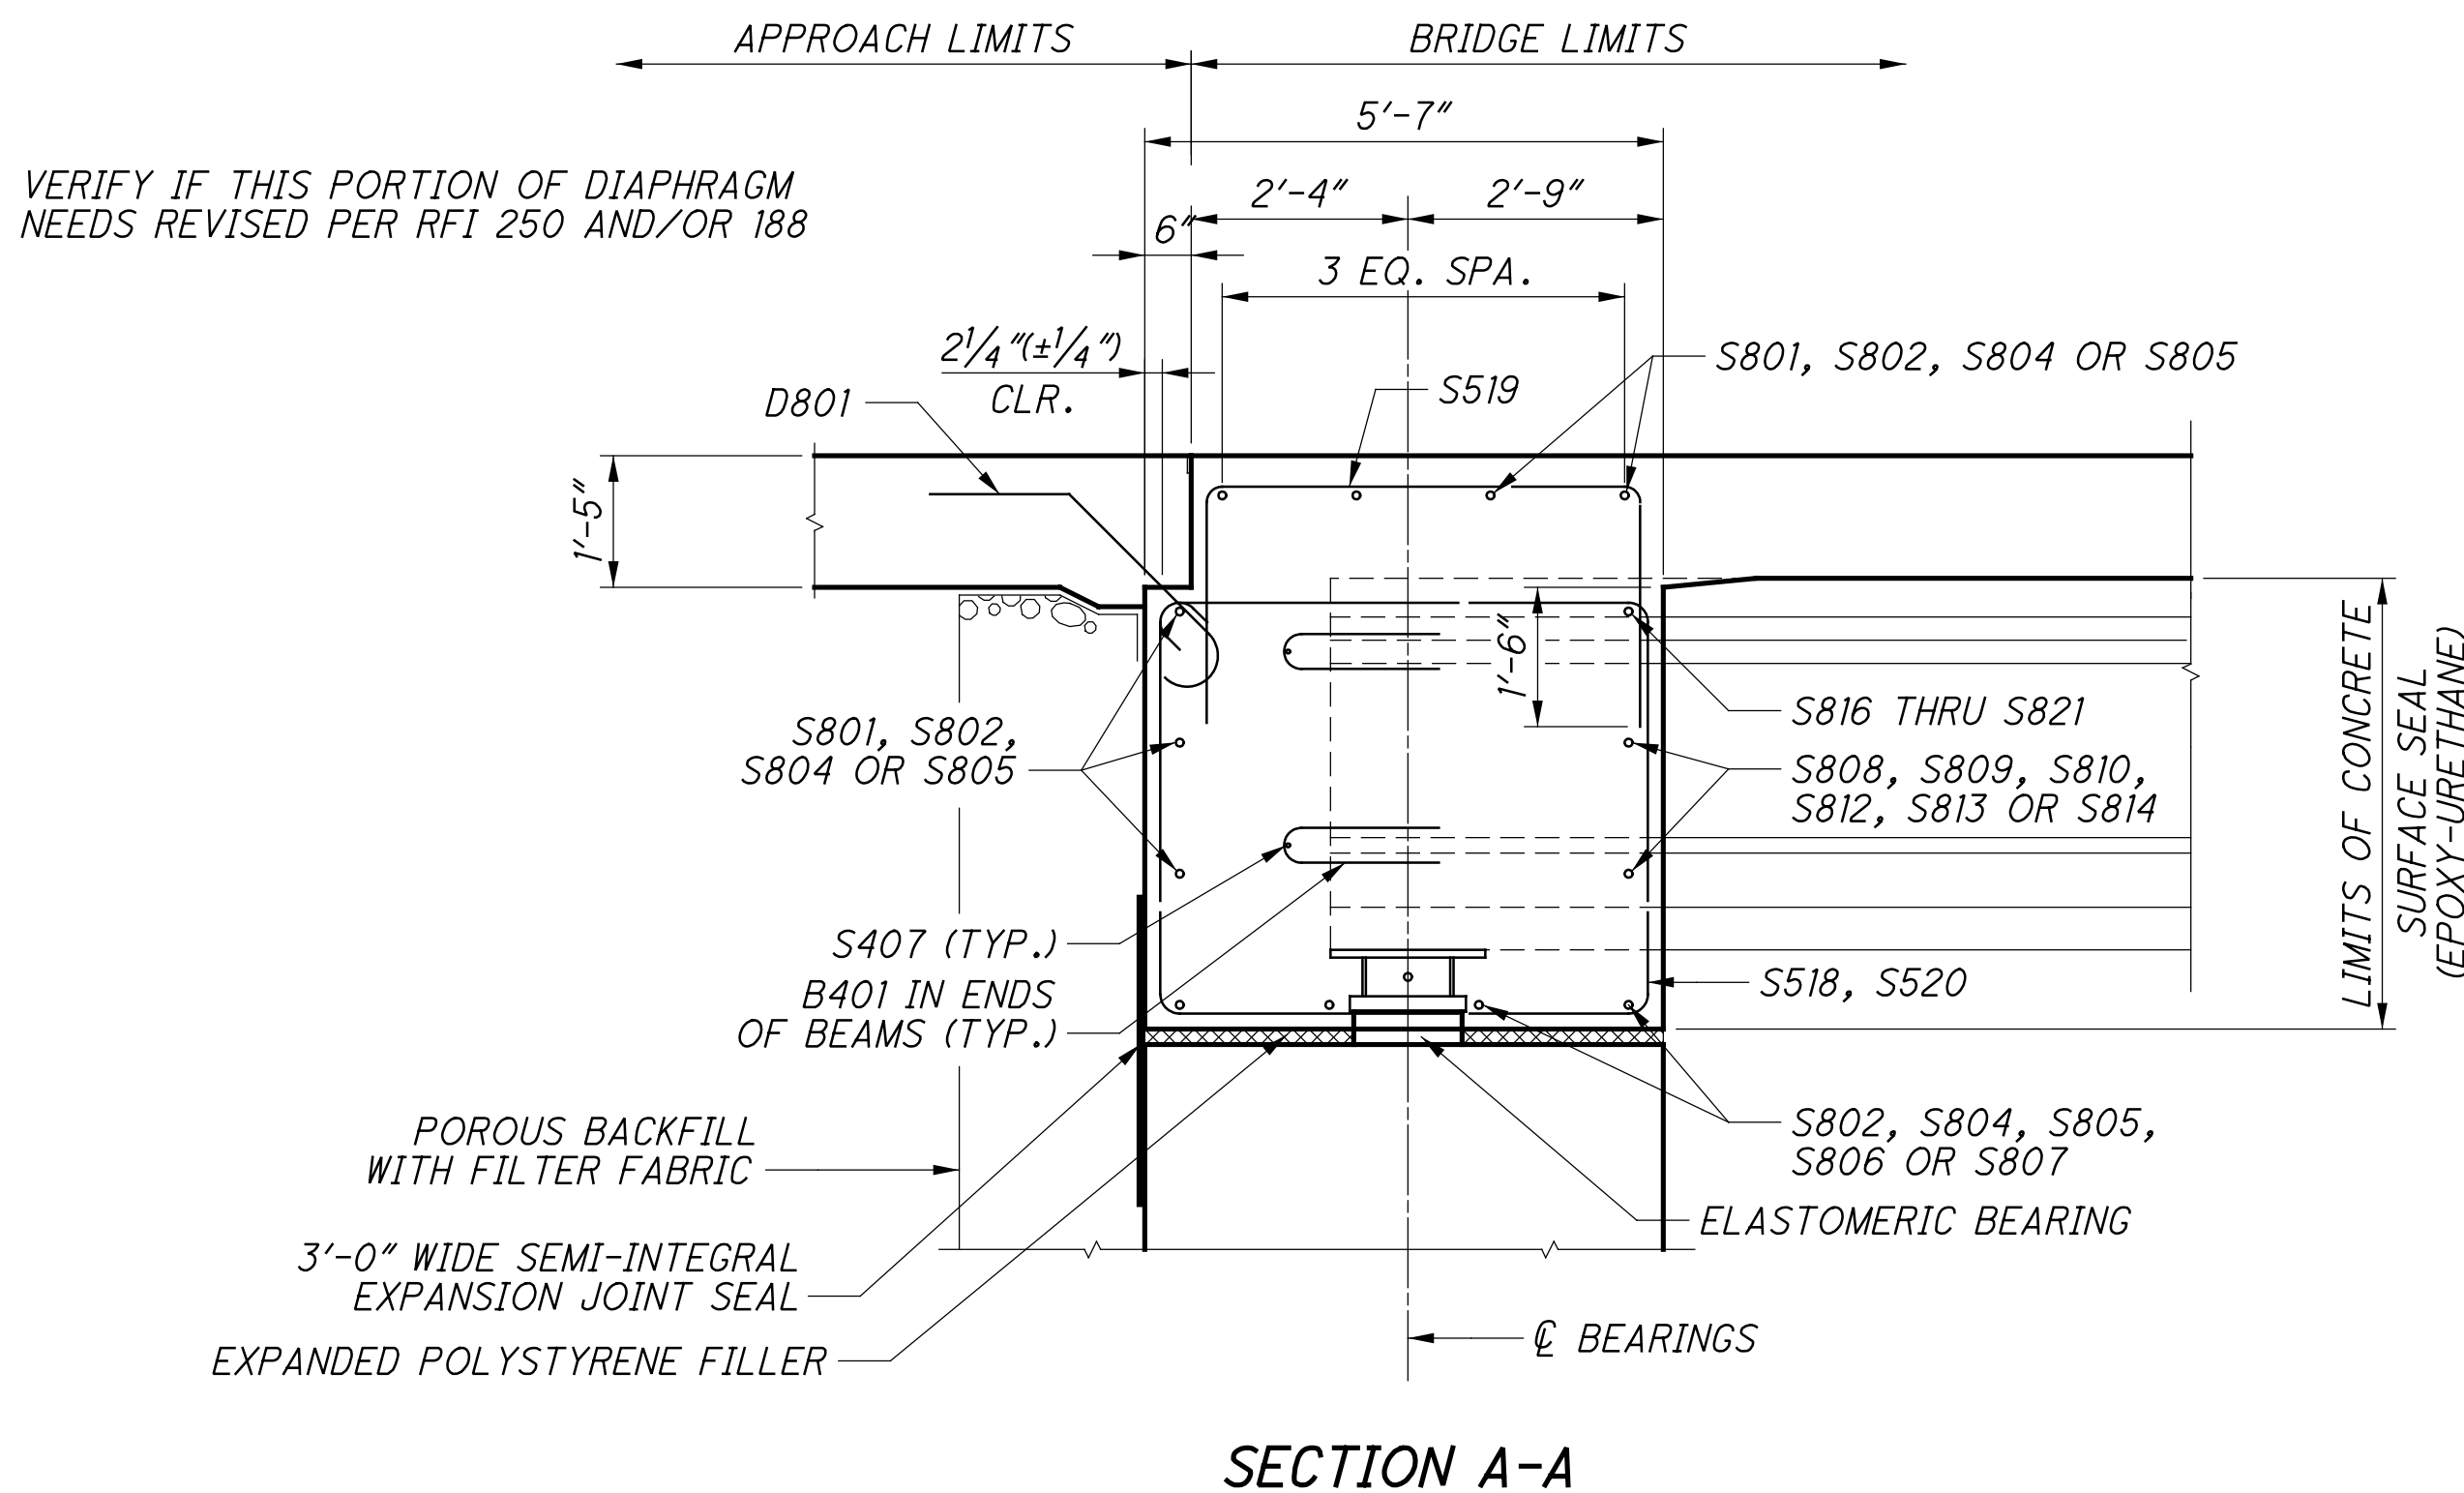


SECTION A-A

- NOTES:**
1. ABUTMENT DIAPHRAGM CONCRETE, PHASED CONSTRUCTION: PLACE THE DIAPHRAGM CONCRETE ENCASEING THE STRUCTURAL MEMBER ENDS OF AN INDIVIDUAL PHASE AFTER THE DECK PLACEMENT IN THE ADJACENT SPAN IS COMPLETE. PROCEDURES THAT PLACE THE ABUTMENT DIAPHRAGM WITH THE DECK CONCRETE MAY BE APPROVED BY THE ENGINEER IF THE PLACEMENT SUBMITTAL CAN ASSURE THAT THE DECK CONCRETE IN THE ADJACENT SPAN WILL BE PLACED BEFORE CONCRETE IN THE DIAPHRAGM HAS REACHED ITS INITIAL SET. PLACE CLOSURE POUR CONCRETE IN THE DIAPHRAGM AND DECK CONCURRENTLY.
 2. * INDICATES MECHANICAL CONNECTOR REQUIRED.

	DESIGN AGENCY STRUCTUREPOINT <small>2000 COMPASS CENTER DRIVE, SUITE 200 WILSONVILLE, OR 97150 TEL: 503.535.3000 FAX: 503.535.3002 WWW.STRUCTUREPOINT.COM</small>
DRAWN TLH CHECKED CLB	REVISIONS MDS FILE NUMBER 3109163
DESIGNED SUJ CHECKED CLB	DATE 1/2/19
SUPERSTRUCTURE DETAILS (RIGHT BRIDGE) BRIDGE NO. - HAM-75-0440 L/R OVER WB 1-74	
HAM-75-3.84 PID No. 104667	
43 / 68	
<div style="border: 1px solid black; border-radius: 50%; width: 30px; height: 30px; display: flex; align-items: center; justify-content: center; margin: 0 auto;"> 43 68 </div>	

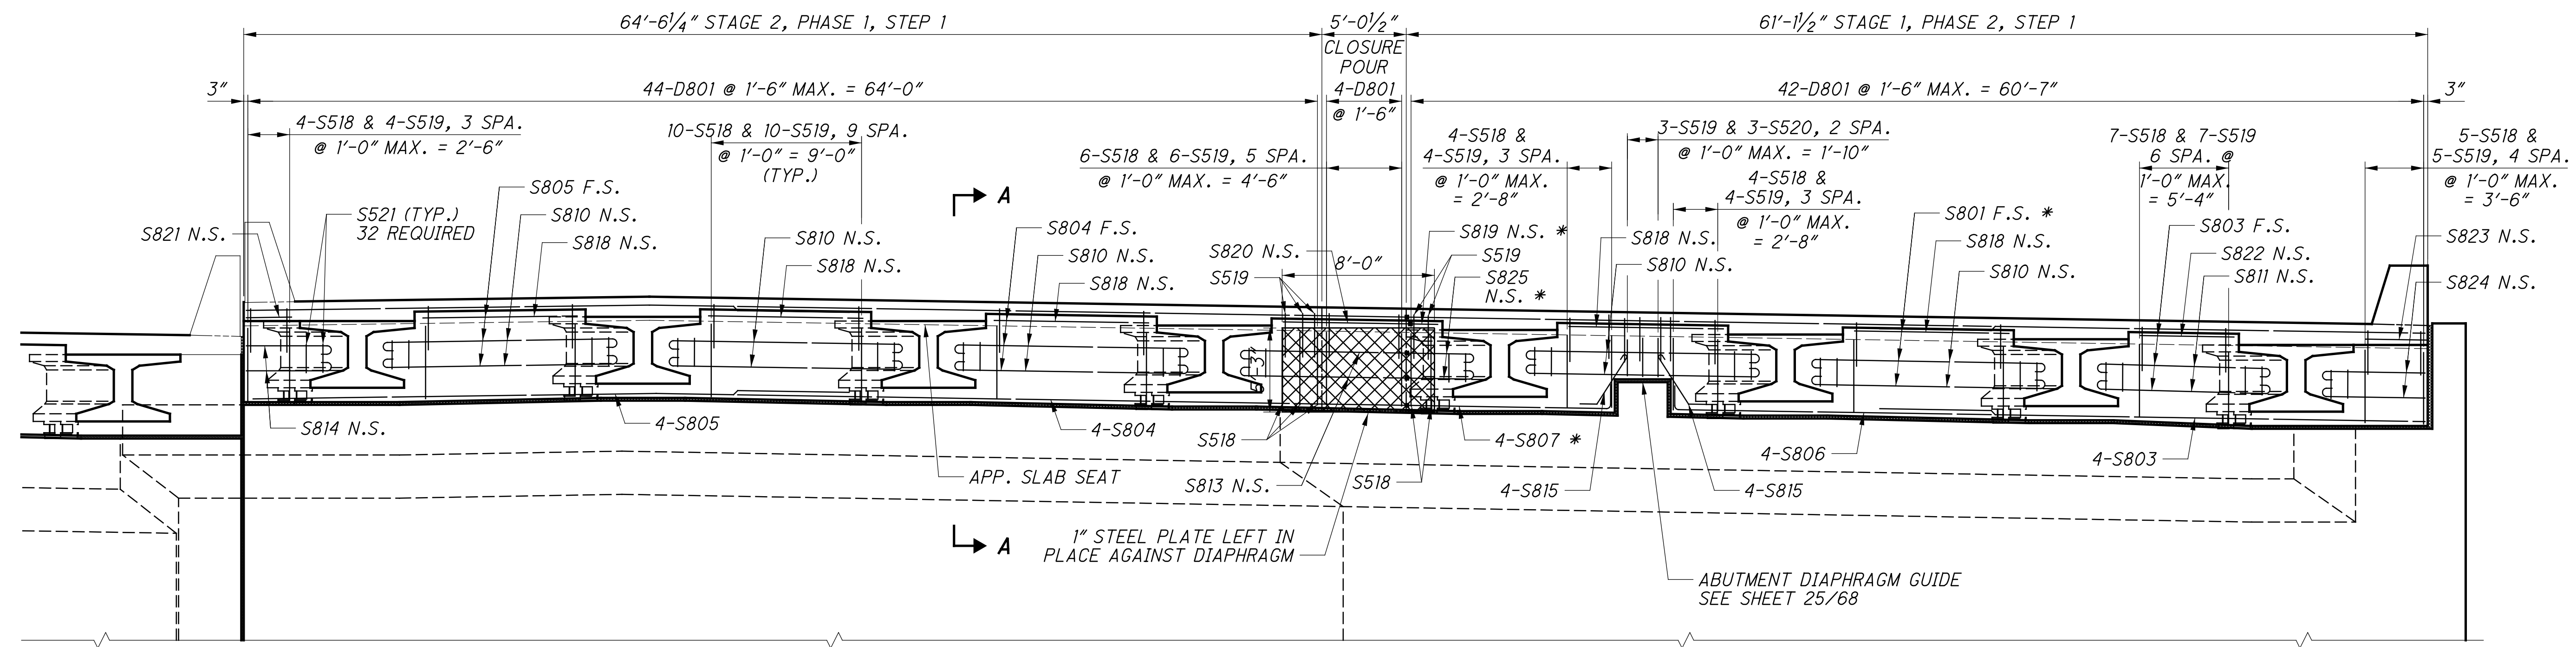

**END DIAPHRAGM ELEVATION
FORWARD ABUTMENT**

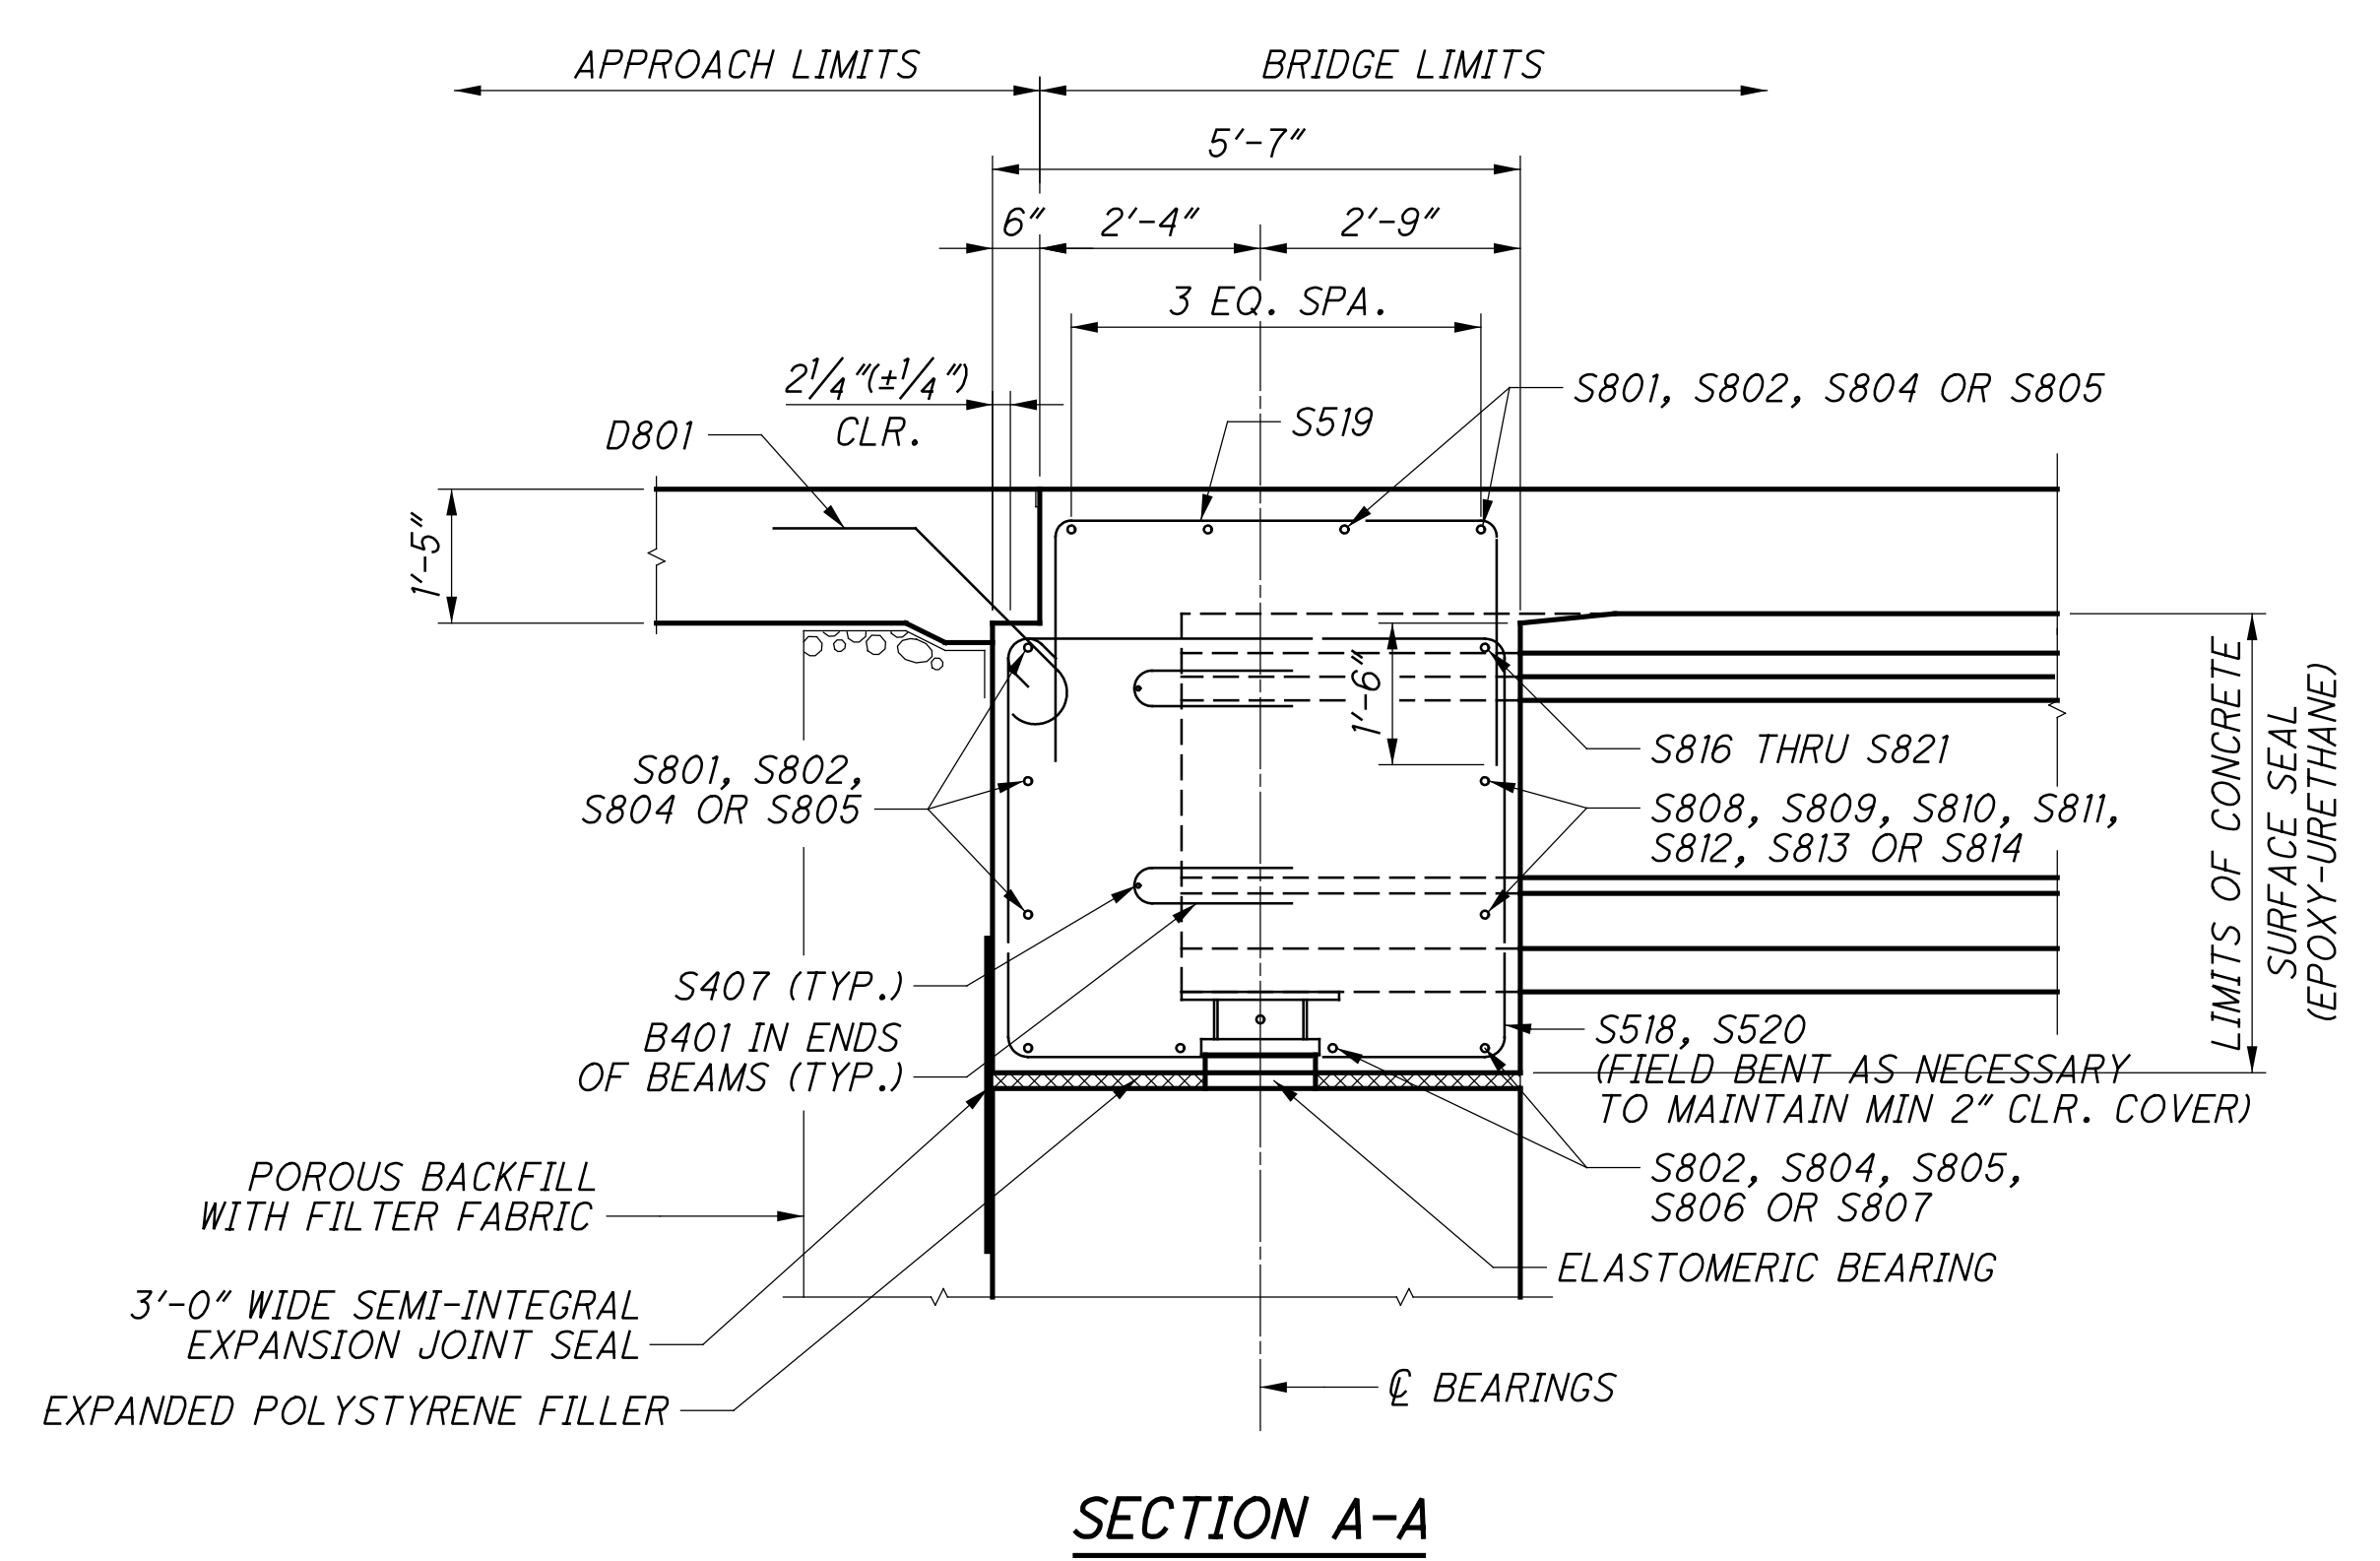

SECTION A-A




NOTES:

1. ABUTMENT DIAPHRAGM CONCRETE, PHASED CONSTRUCTION: PLACE THE DIAPHRAGM CONCRETE ENCASING THE STRUCTURAL MEMBER ENDS OF AN INDIVIDUAL PHASE AFTER THE DECK PLACEMENT IN THE ADJACENT SPAN IS COMPLETE. PROCEDURES THAT PLACE THE ABUTMENT DIAPHRAGM WITH THE DECK CONCRETE MAY BE APPROVED BY THE ENGINEER IF THE PLACEMENT SUBMITTAL CAN ASSURE THAT THE DECK CONCRETE IN THE ADJACENT SPAN WILL BE PLACED BEFORE CONCRETE IN THE DIAPHRAGM HAS REACHED ITS INITIAL SET. PLACE CLOSURE POUR CONCRETE IN THE DIAPHRAGM AND DECK CONCURRENTLY.
2. * INDICATES MECHANICAL CONNECTOR REQUIRED.

SFlanagan
 10/26/2023 4:26:38 PM
 C:\2017\01113\C.Design\104667-HAM-75-3.84\Design\Structures\HAM0075_0440C\Sheets\HAM0075_0440C_SD005.dgn

	DESIGN AGENCY STRUCTUREPOINT	DATE 1/2/19	REVIEWED MDS	STRUCTURE FILE NUMBER 3109763
DESIGNED SUJ	CHECKED CLB	DRAWN DSH	REVISED	3109763
SUPERSTRUCTURE DETAILS (RIGHT BRIDGE) BRIDGE NO. - HAM-75-0440 L/R OVER WB I-74				
HAM-75-3.84 PID No. 104667				
44/68 <div style="border: 1px solid black; border-radius: 50%; width: 30px; height: 30px; display: flex; align-items: center; justify-content: center; margin: 0 auto;"> 44 68 </div>				

SFlanagan
10/26/2023 4:26:39 PM
O:\2017\01113\C.Design\104667-HAM-75-3.84.Design\Structures\HAM0075_0440C_Sheets\HAM0075_0440C_BR001.dgn

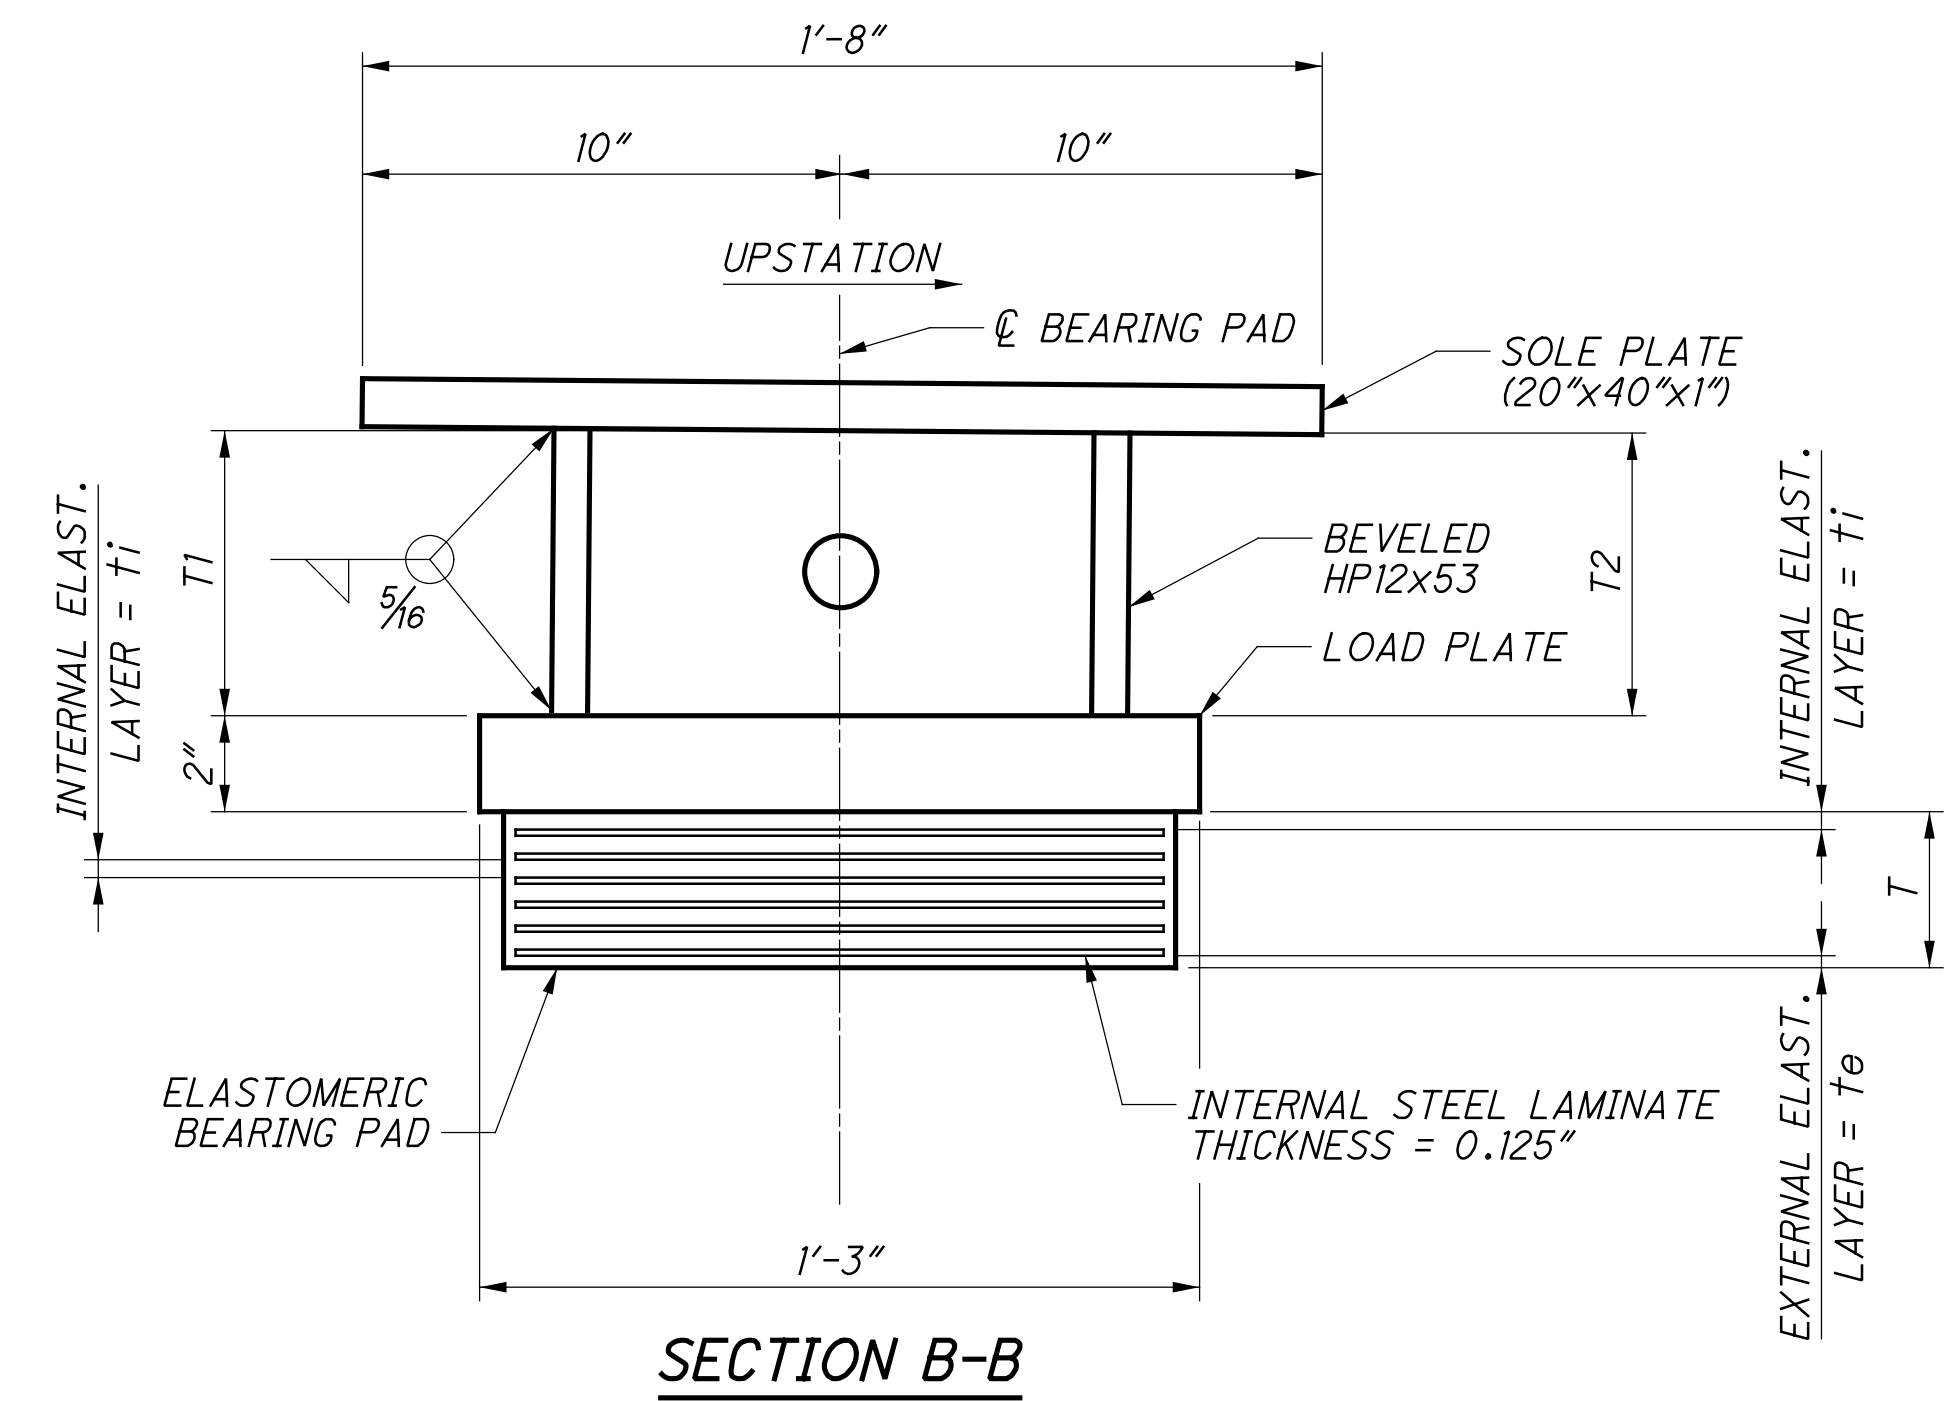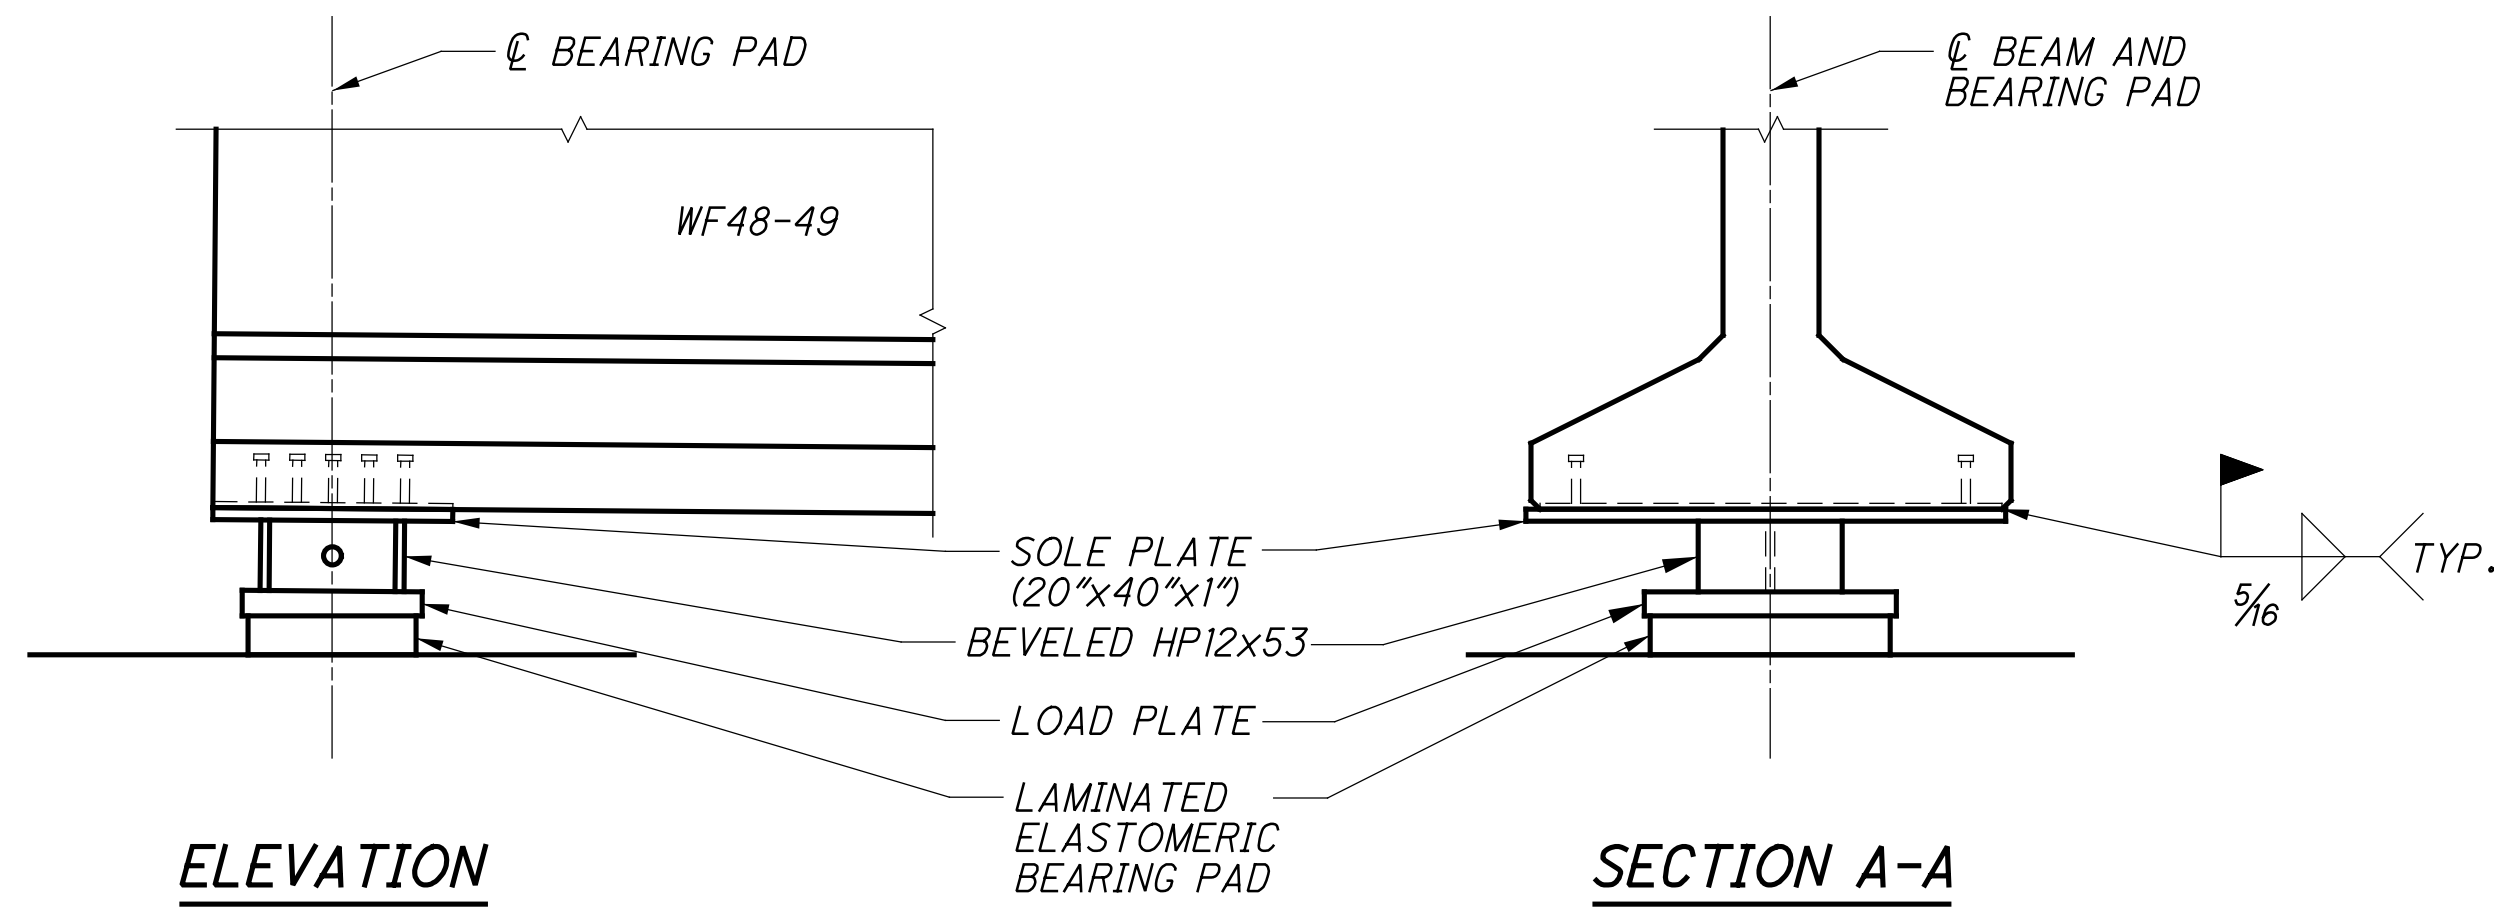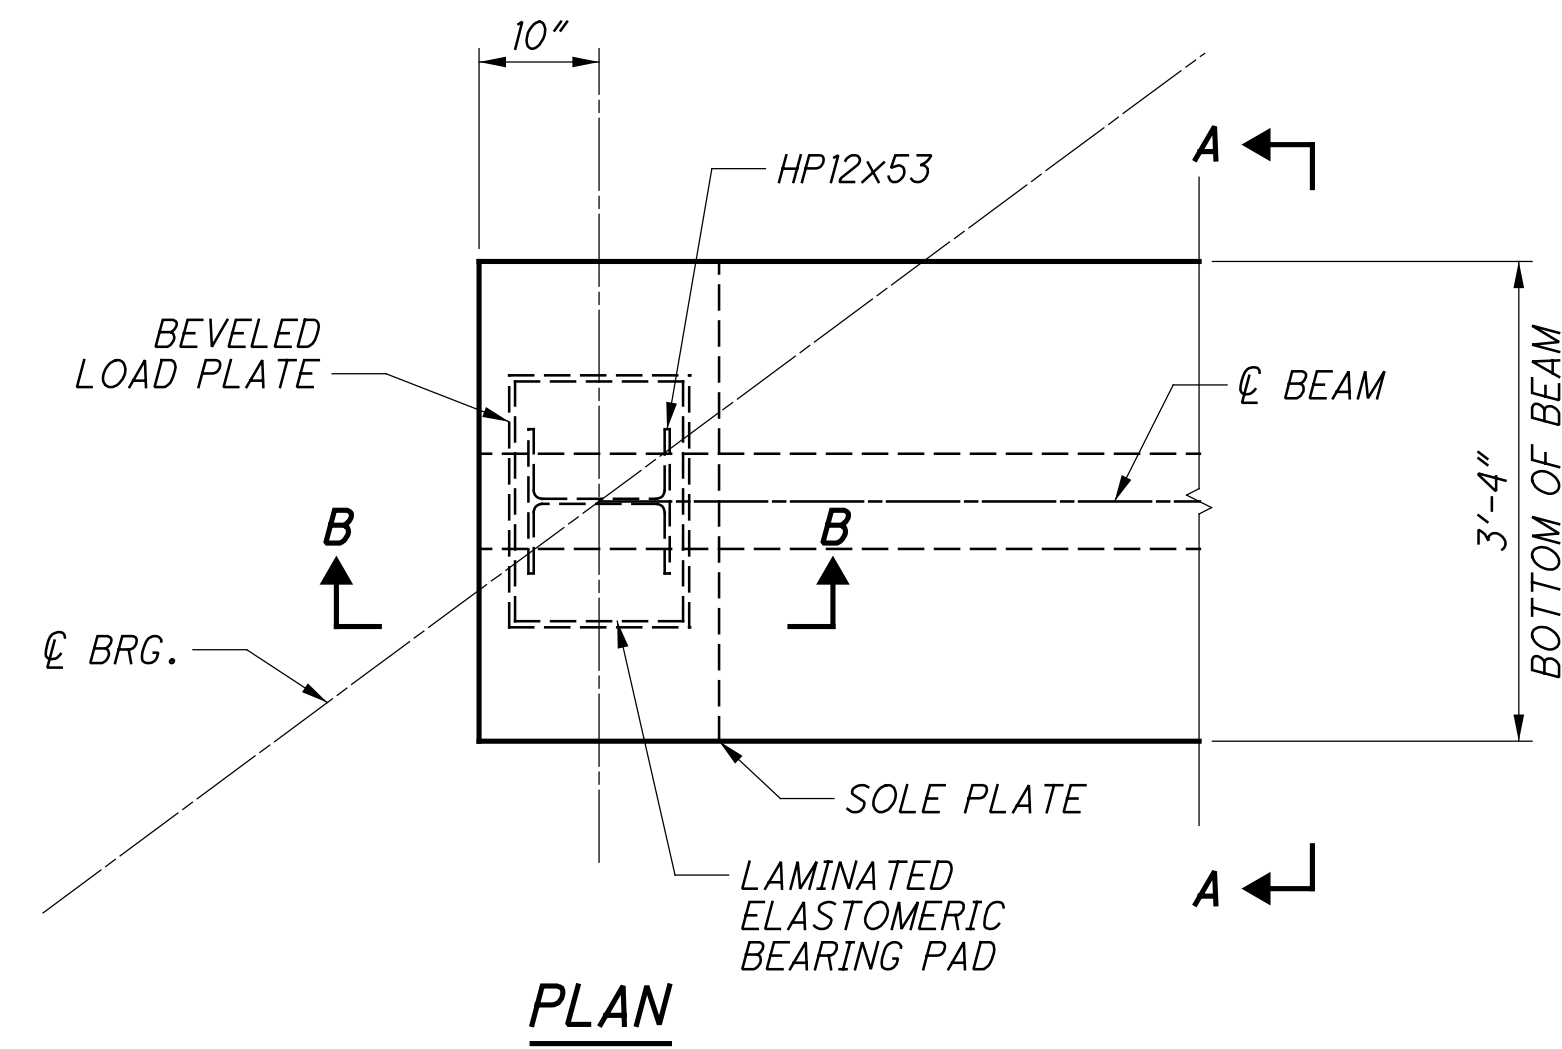

UNFACTORED ELASTOMERIC BEARING LOADS:

	LEFT	RIGHT
DEAD LOAD	= 223 K	207 K
LIVE LOAD	= 107 K	101 K
TOTAL LOAD	= 330 K	308 K


NOTES:

1. THE ELASTOMER SHALL HAVE A HARDNESS OF 50 DUROMETER. THE BEARINGS WERE DESIGNED UNDER DIVISION I, SECTION 14.6.6 (METHOD A) OF THE AASHTO STANDARD SPECIFICATION FOR HIGHWAY BRIDGES. THE LONG-TERM COMPRESSION PROOF LOAD TEST (AASHTO STANDARD SPECIFICATIONS FOR HIGHWAY BRIDGES, DIVISION II, SECTION 18.7.2.6) IS NOT REQUIRED.
2. GALVANIZE ALL STRUCTURAL STEEL STUDS, EMBEDDED SOLE PLATES AND LOAD PLATES ACCORDING TO CMS 711.02.
3. ALL BEARINGS SHALL BE MARKED PRIOR TO SHIPPING. THE MARKS SHALL INCLUDE THE BEARING LOCATION ON THE BRIDGE, AND A DIRECTION ARROW THAT POINTS UP-STATION. ALL MARKS SHALL BE PERMANENT AND BE VISIBLE AFTER THE BEARING IS INSTALLED.
4. SEE STANDARD DRAWING PSID-1-13 FOR EMBEDDED STEEL PLATE AND STUDS.

BRIDGE	ASSEMBLY TYPE	NO. OF BEARINGS	SIZE L x W x T	NO. OF STEEL LAMINATES	t_i	NO. OF t_i LAYERS	t_e	NO. OF t_e LAYERS	BEVELED STEEL LOAD P		
									L x W	T1	T2
LEFT	EXPANSION	14	1'-8" x 1'-2" x 3/4"	6	0.375"	6	0.25"	1	1'-9" x 1-3"	6 1/8"	5 7/8"
RIGHT	EXPANSION	16	1'-8" x 1'-2" x 3/4"	6	0.375"	6	0.25"	1	1'-9" x 1-3"	6 1/8"	5 7/8"

DESIGN AGENCY: STRUCTUREPOINT
 DATE: 1/2/19
 REVIEWED: MDS
 DRAWN: DSH
 DESIGNED: SUJ
 CHECKED: CLB
 STRUCTURE FILE NUMBER: 3109T63
 BEARING DETAILS
 BRIDGE NO. - HAM-75-0440 L/R
 OVER WB I-74
 HAM-75-3.84
 PID No. 104667
 45/68
 45
 68


S:\Plans\2023\10/26/2023\4:26:40 PM\01\2017\01113\C.Design\104667_HAM-75-3.84\Design\104667_HAM-75-3.84\Design\104667_HAM0075_0440C_Sheets\HAM0075_0440C_RA003.dgn

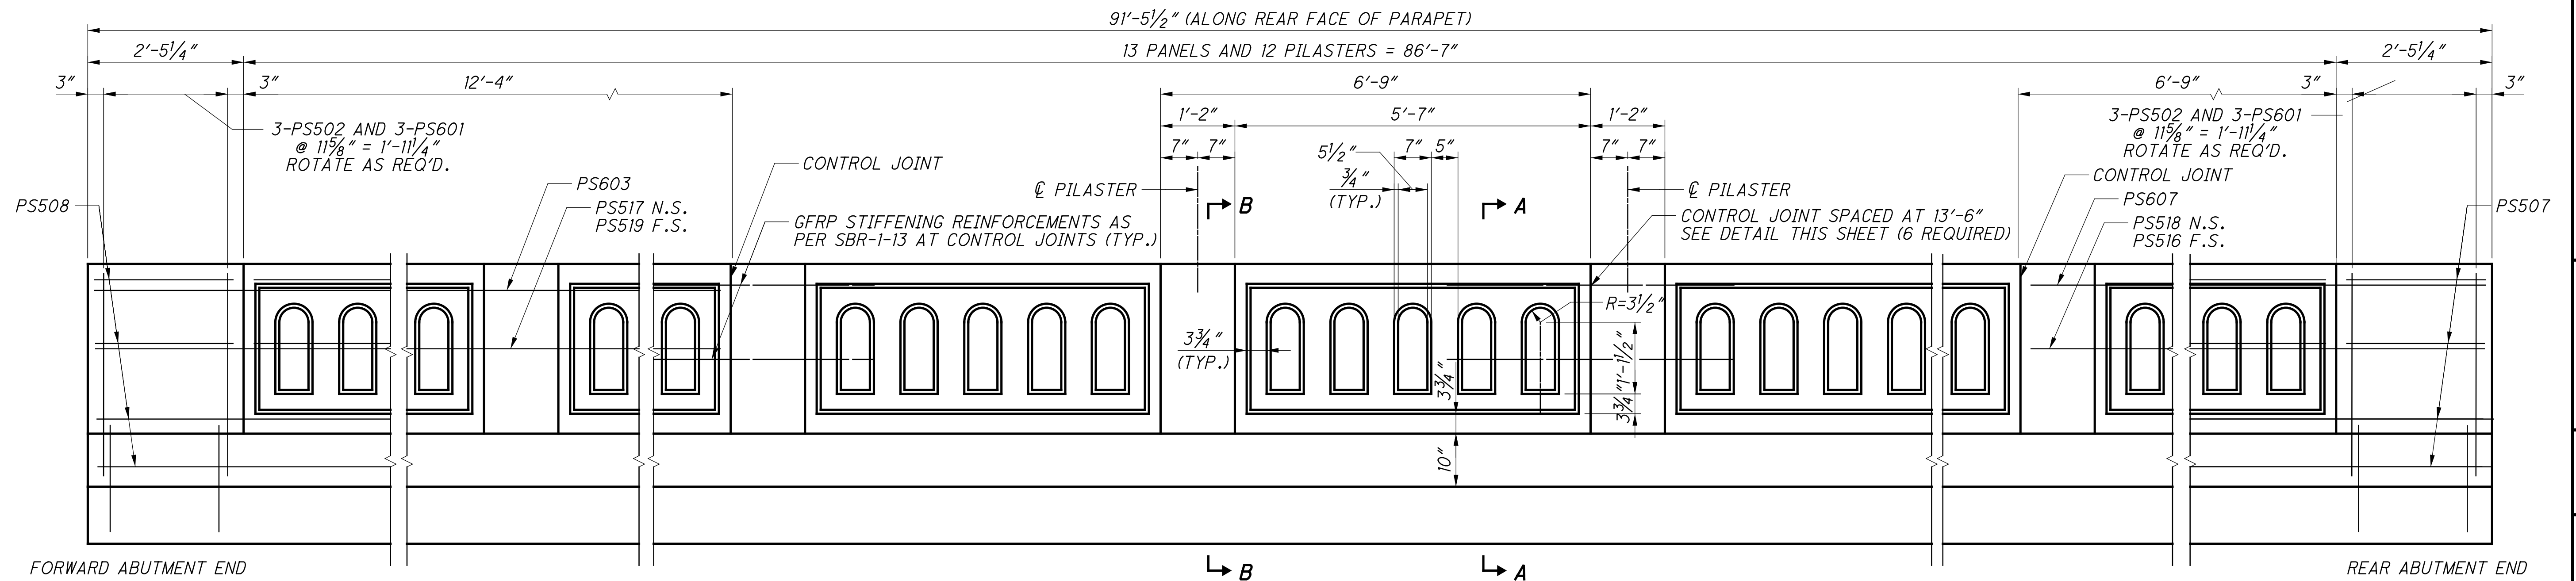


END ORNAMENTAL PARAPET PANEL

**TYPICAL ORNAMENTAL PARAPET PANEL
(ALONG REAR FACE OF PARAPET)**


END ORNAMENTAL PARAPET PANEL

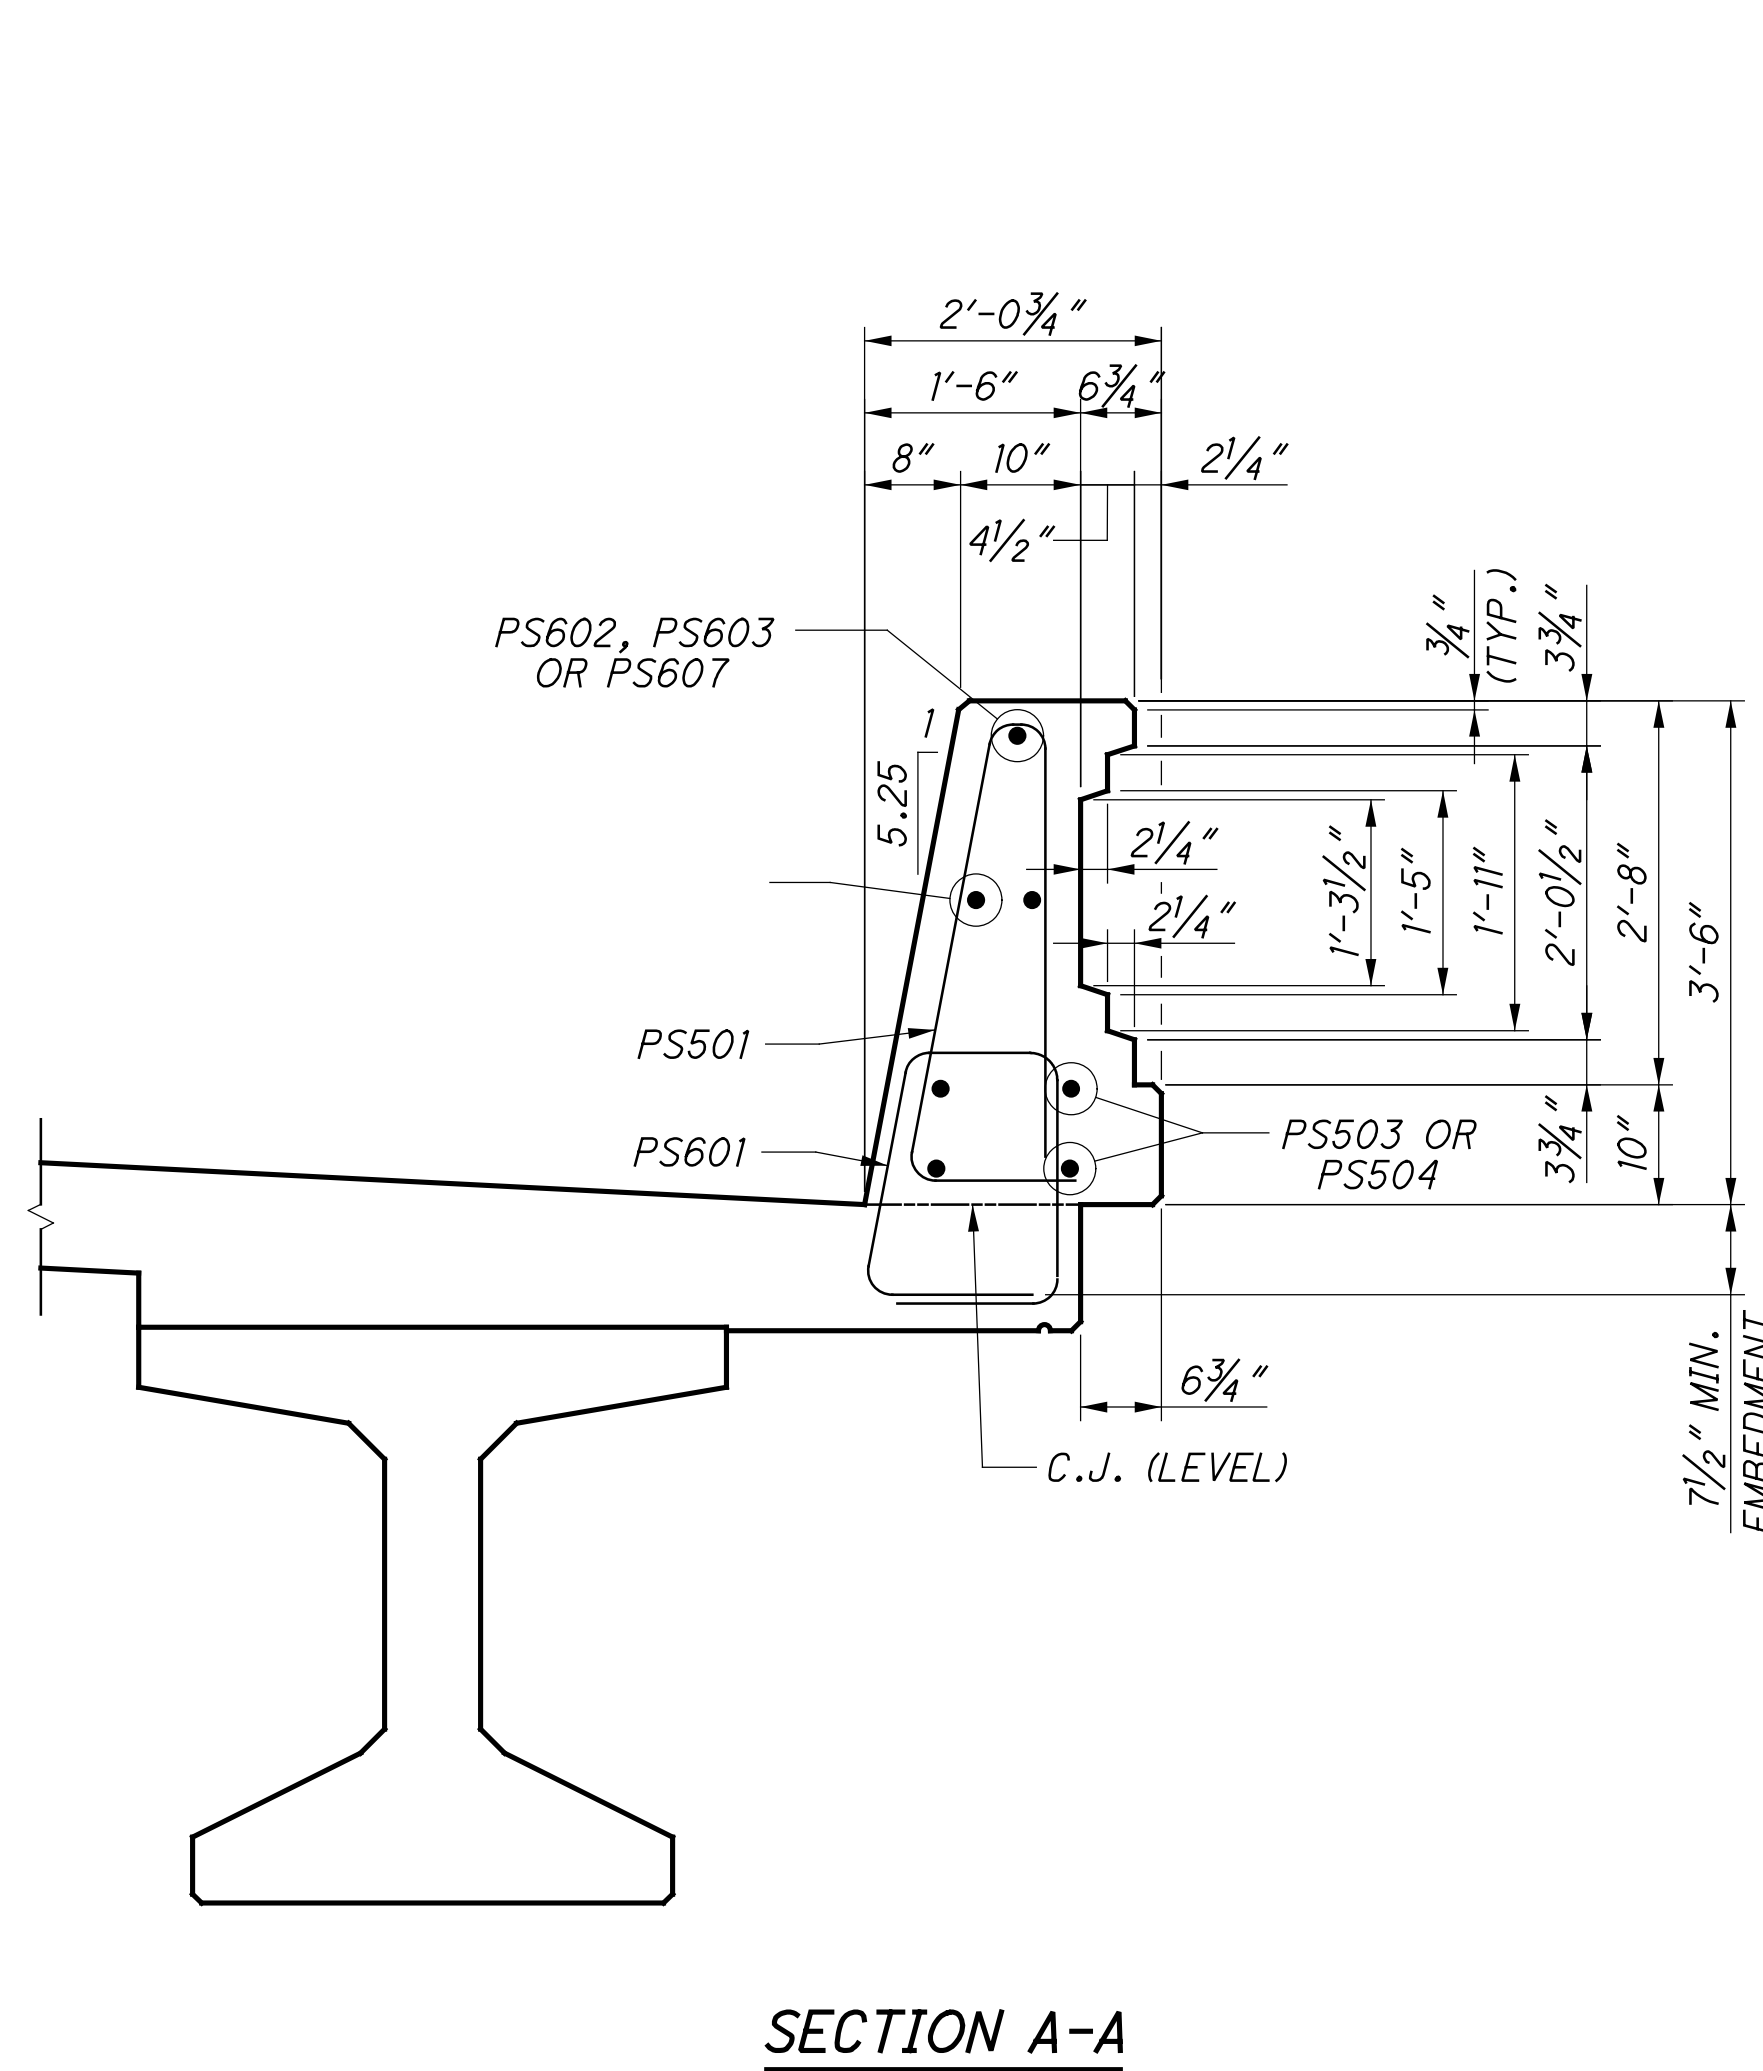

SECTION A-A

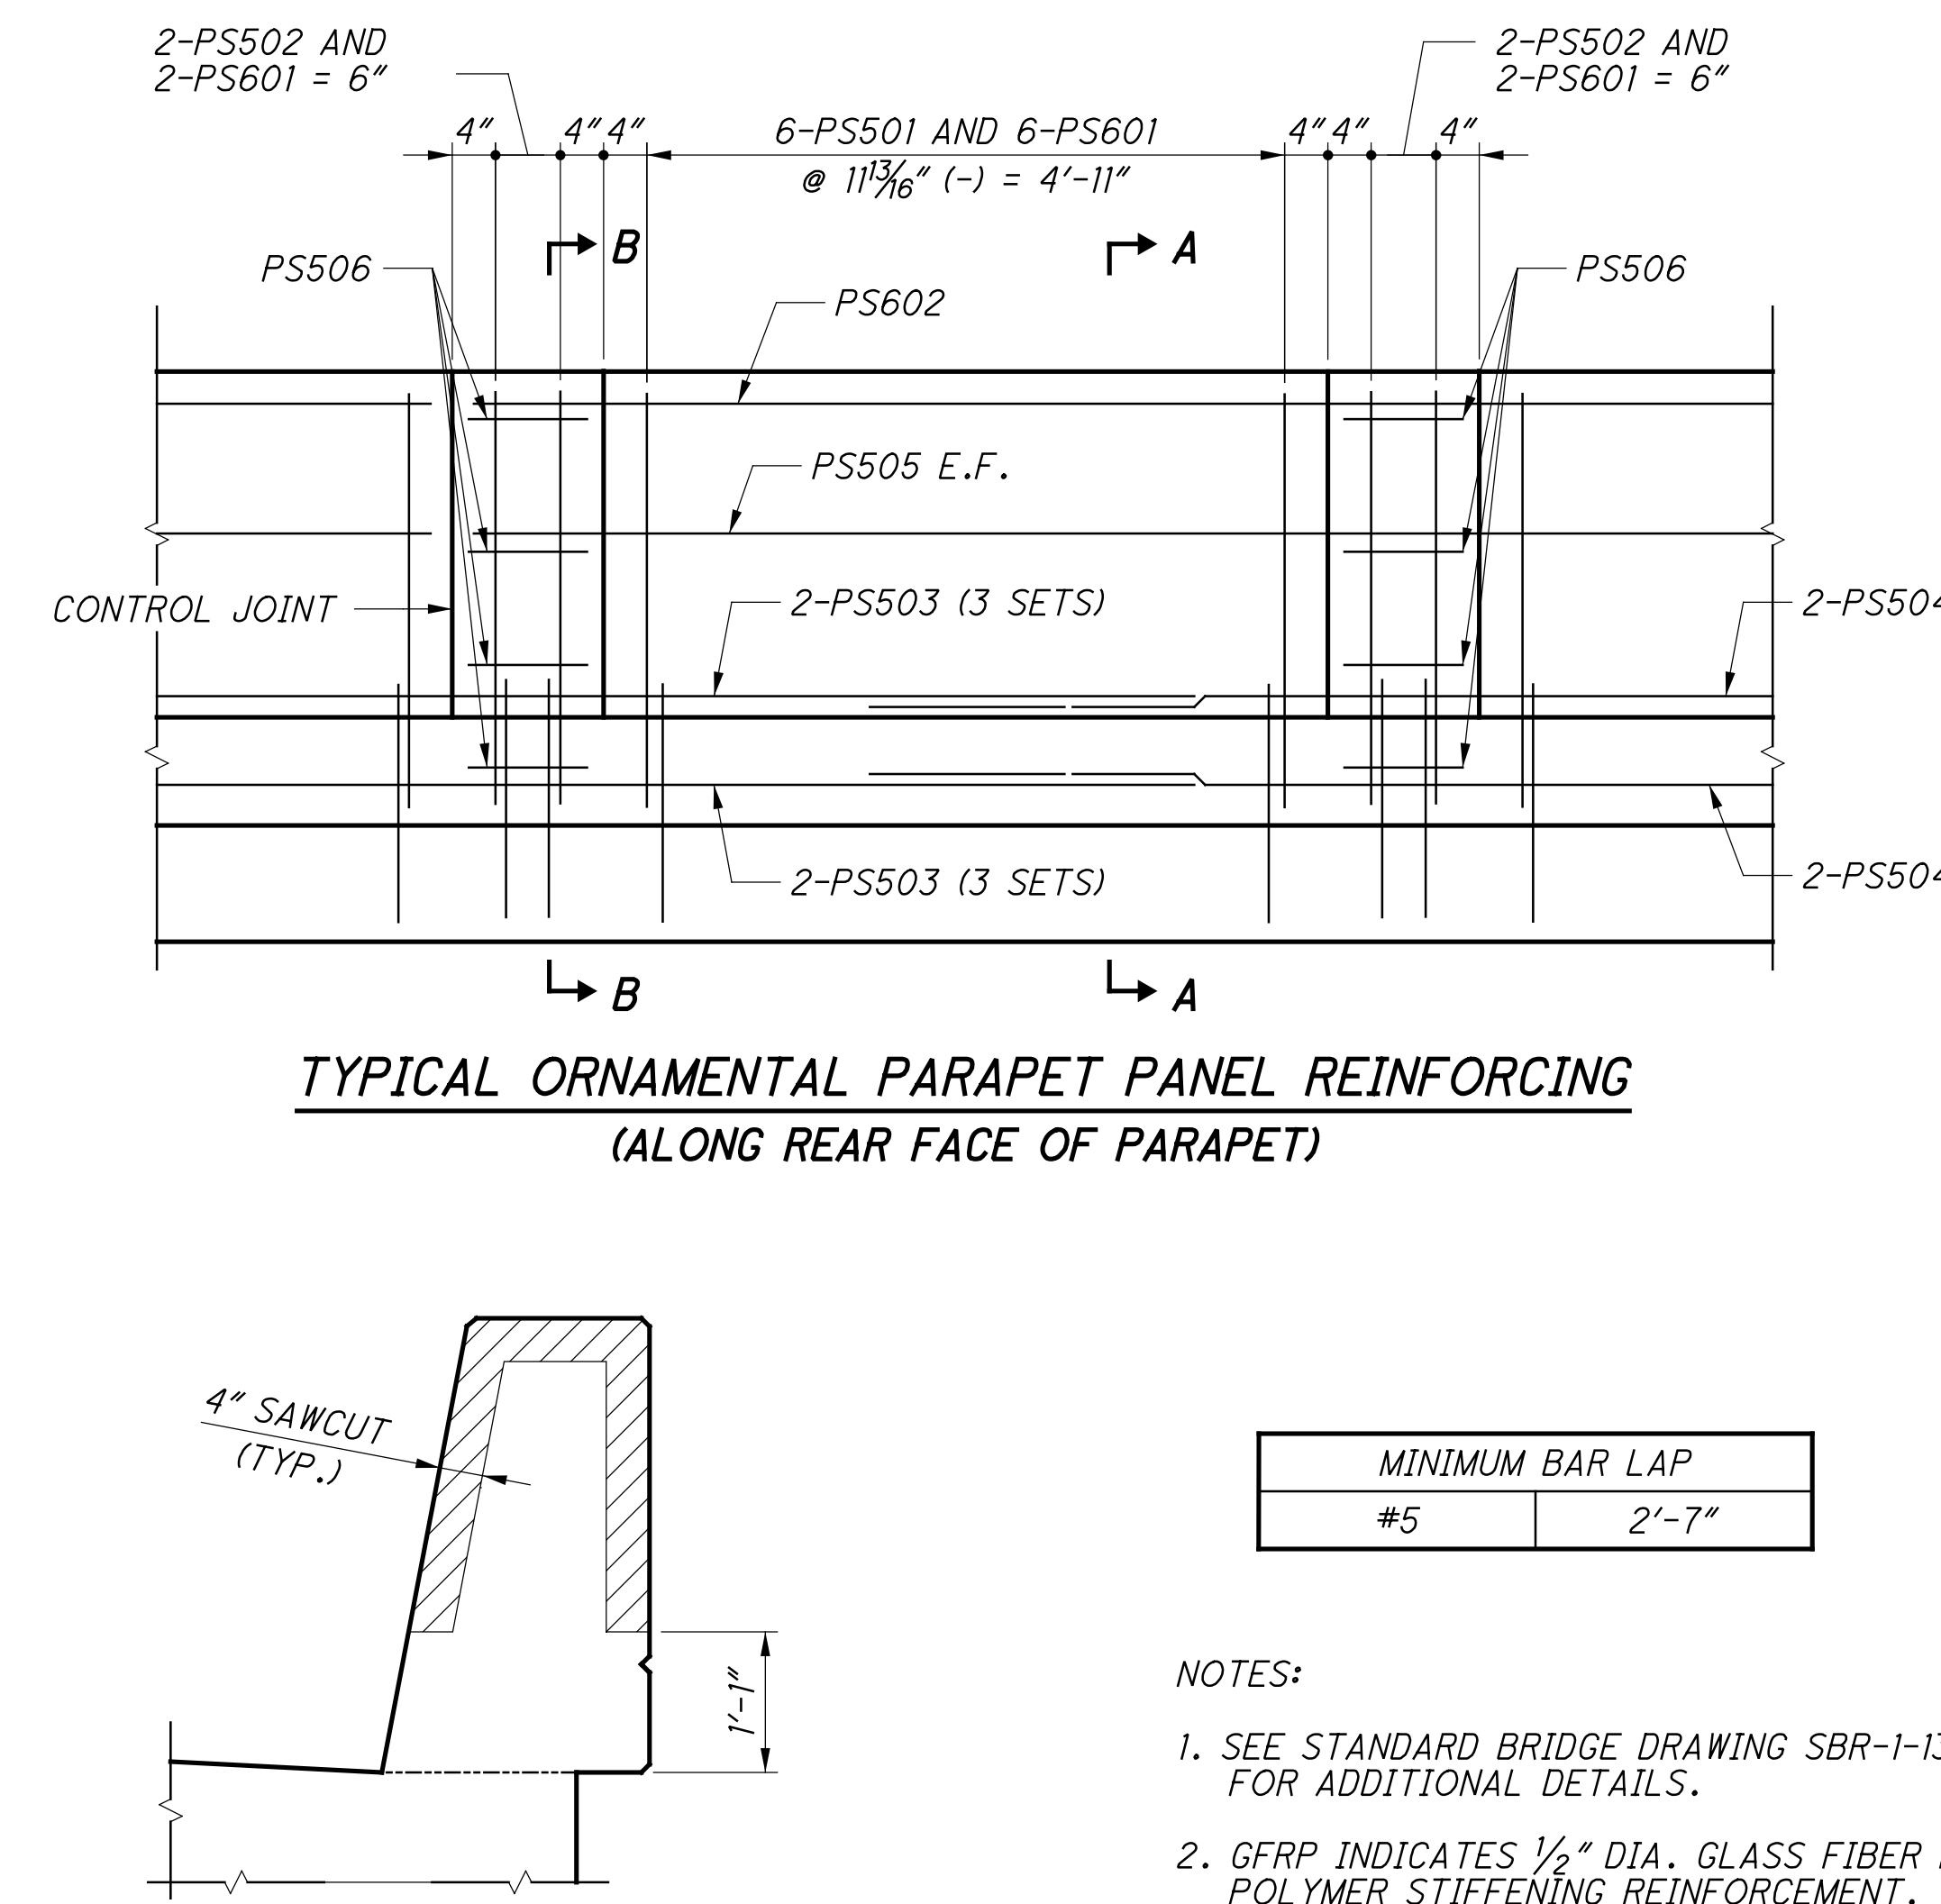


SECTION THRU CONTROL JOINT DETAIL

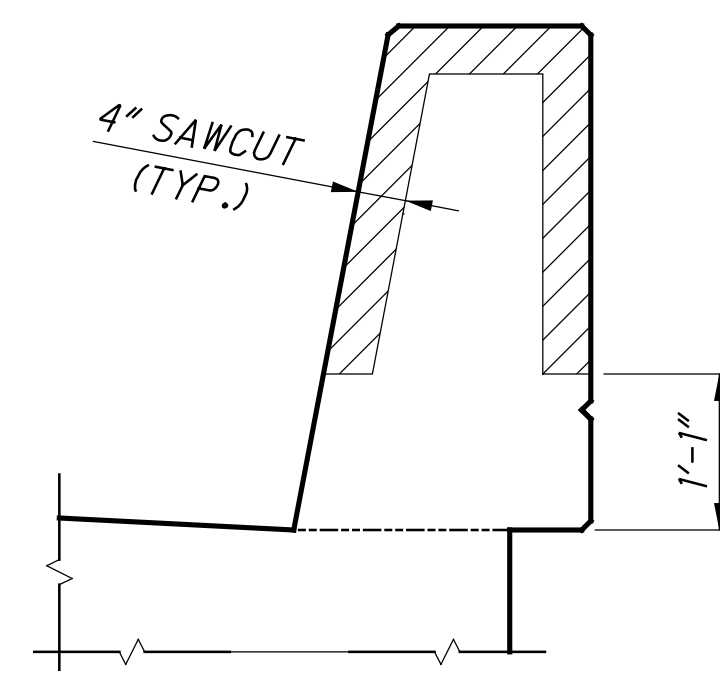

MINIMUM BAR LAP	
#5	2'-7"


- NOTES:
- SEE STANDARD BRIDGE DRAWING SBR-1-13 FOR ADDITIONAL DETAILS.
 - GFRP INDICATES 1/2" DIA. GLASS FIBER REINFORCED POLYMER STIFFENING REINFORCEMENT.

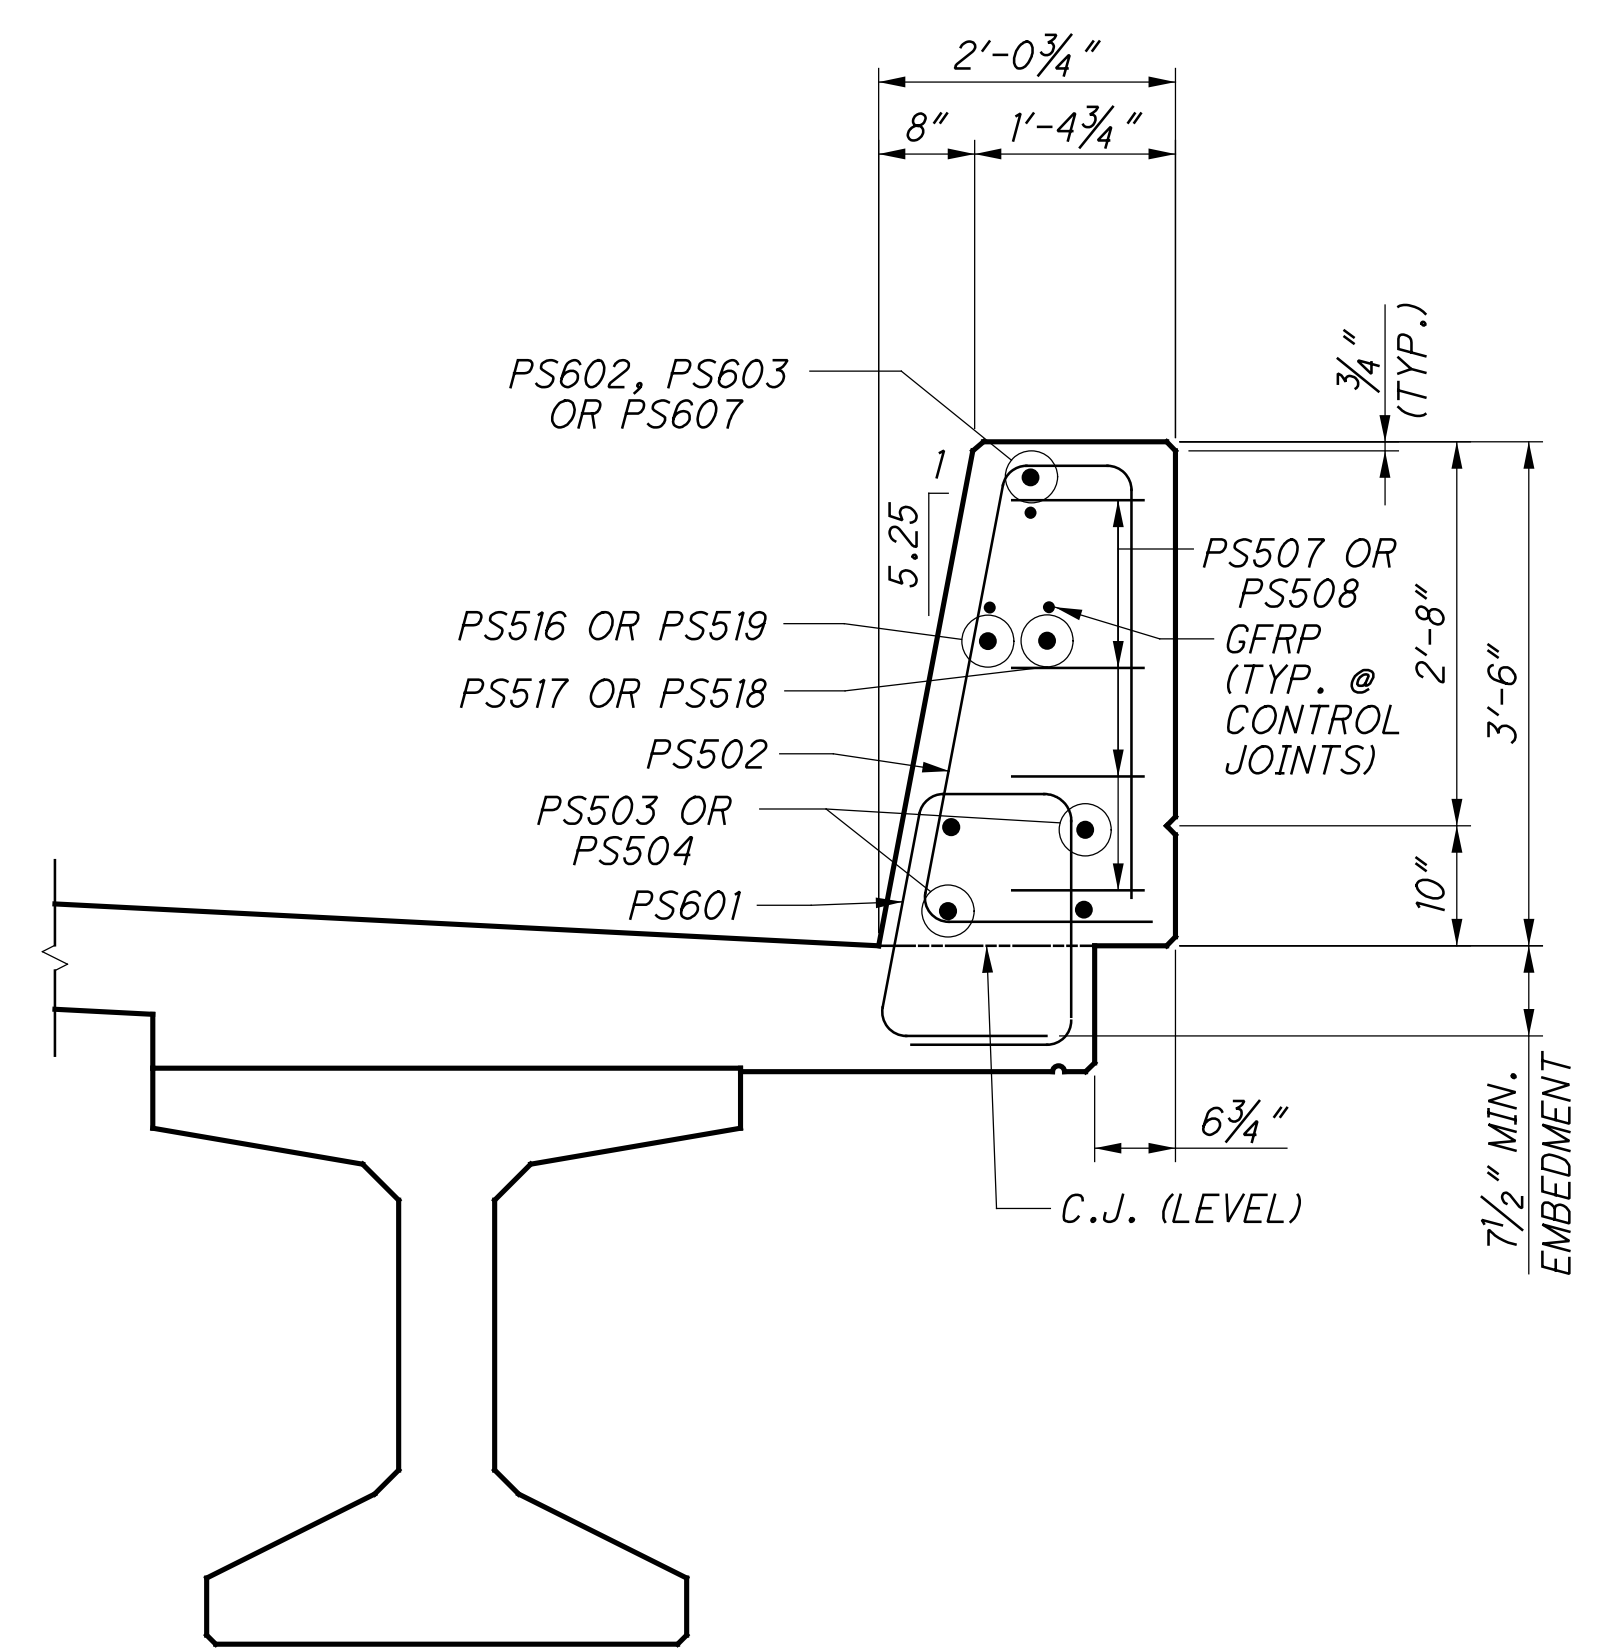


SECTION B-B

DESIGN AGENCY: STRUCTUREPOINT
 DATE: 1/2/19
 REVIEWED: MDS
 DRAWN: SUJ
 DESIGNED: SUJ
 CHECKED: CLB
 STRUCTURE FILE NUMBER: 3109763
 BRIDGE NO.: HAM-75-0440 L/R
 OVER IR-74 WB
HAM-75-3.84
 PID No. 104667
 46/68
 46
 68

S:\Plans\2023\10/26/2023\4:26:40 PM\01\2017\01113\C.Design\104667_HAM-75-3.84.Design\104667_HAM-75-3.84.Design\Structures\HAM0075_0440C_Sheets\HAM0075_0440C_RA004.dgn

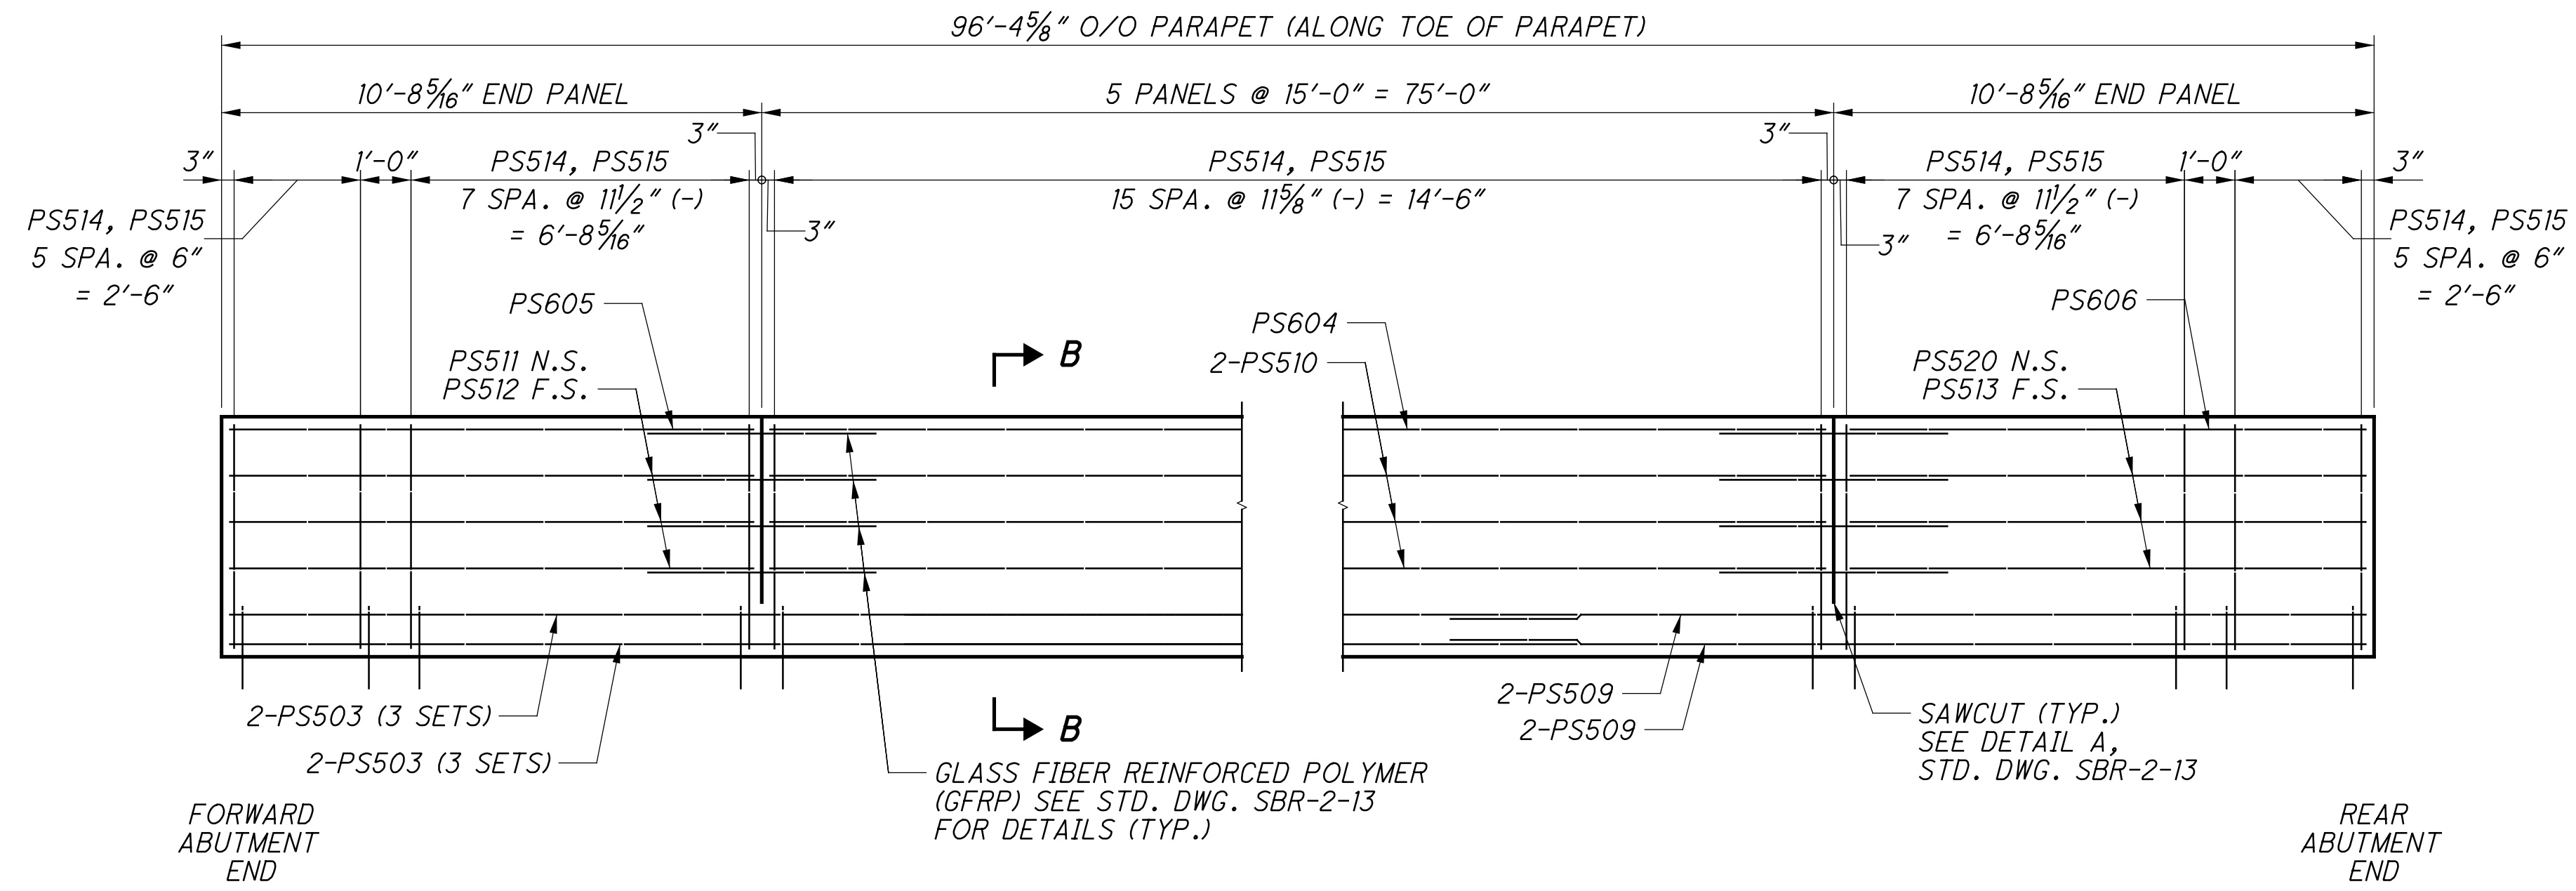

PARAPET ELEVATION
RIGHT PARAPET SHOWN (ALONG TOE PARAPET)

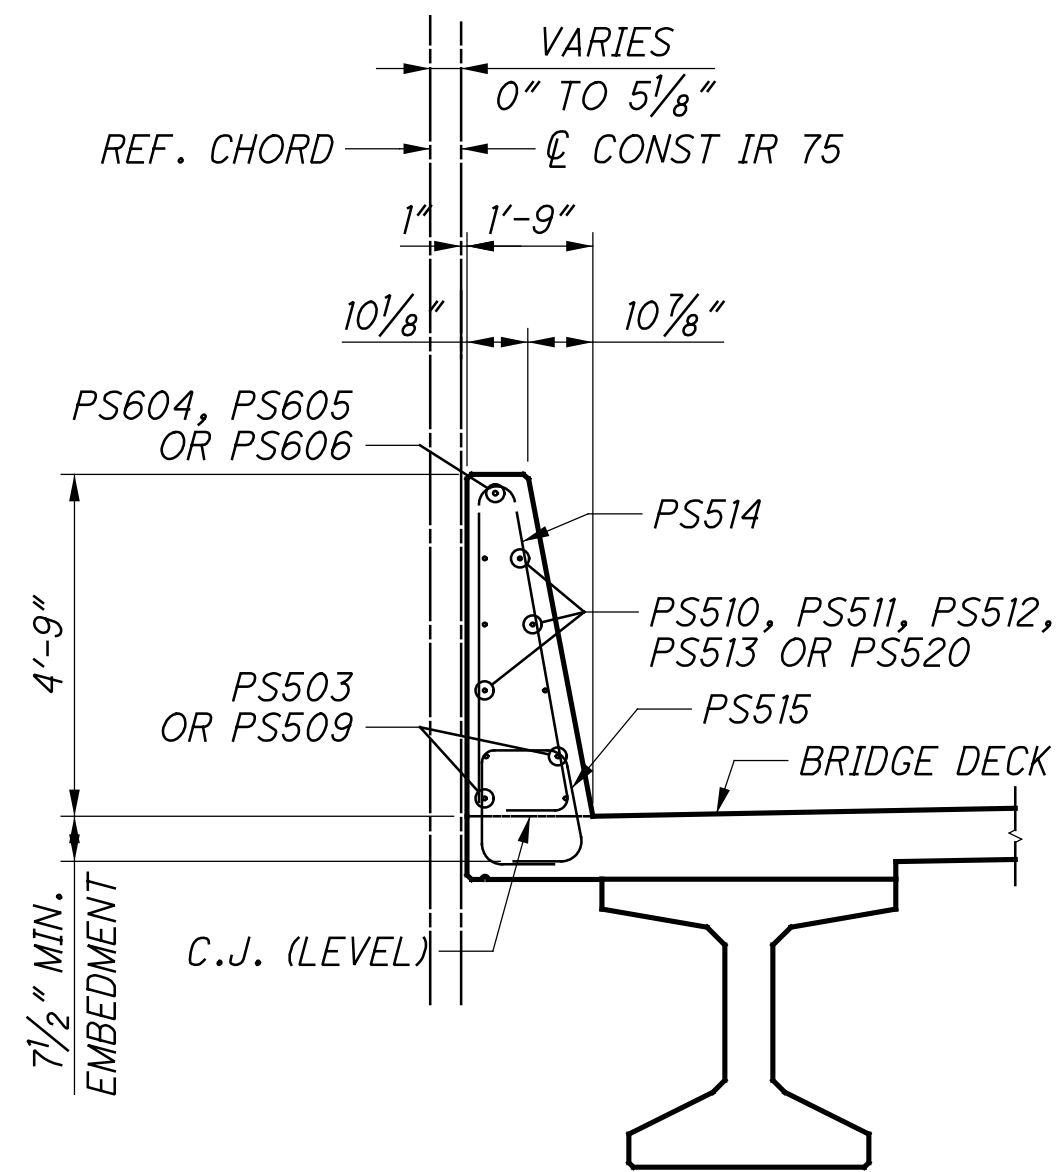


SECTION B-B

MINIMUM BAR LAP	
#5	2'-7"


NOTES:

- SEE STANDARD BRIDGE DRAWING SBR-2-13 FOR ADDITIONAL DETAILS.


	DESIGN AGENCY		
	DATE 1/2/19		
	REVIEWED MDS		
	STRUCTURE FILE NUMBER 3109763		
DRAWN SUJ	REVISOR		
DESIGNED SUJ	CHECKED CLB		
PARAPET DETAILS (LEFT BRIDGE) BRIDGE NO. HAM-75-0440 L/R OVER IR-74 WB			
HAM-75-3.84 PID No. 104667			
47/68			
<table border="1"> <tr> <td>47</td> </tr> <tr> <td>68</td> </tr> </table>		47	68
47			
68			

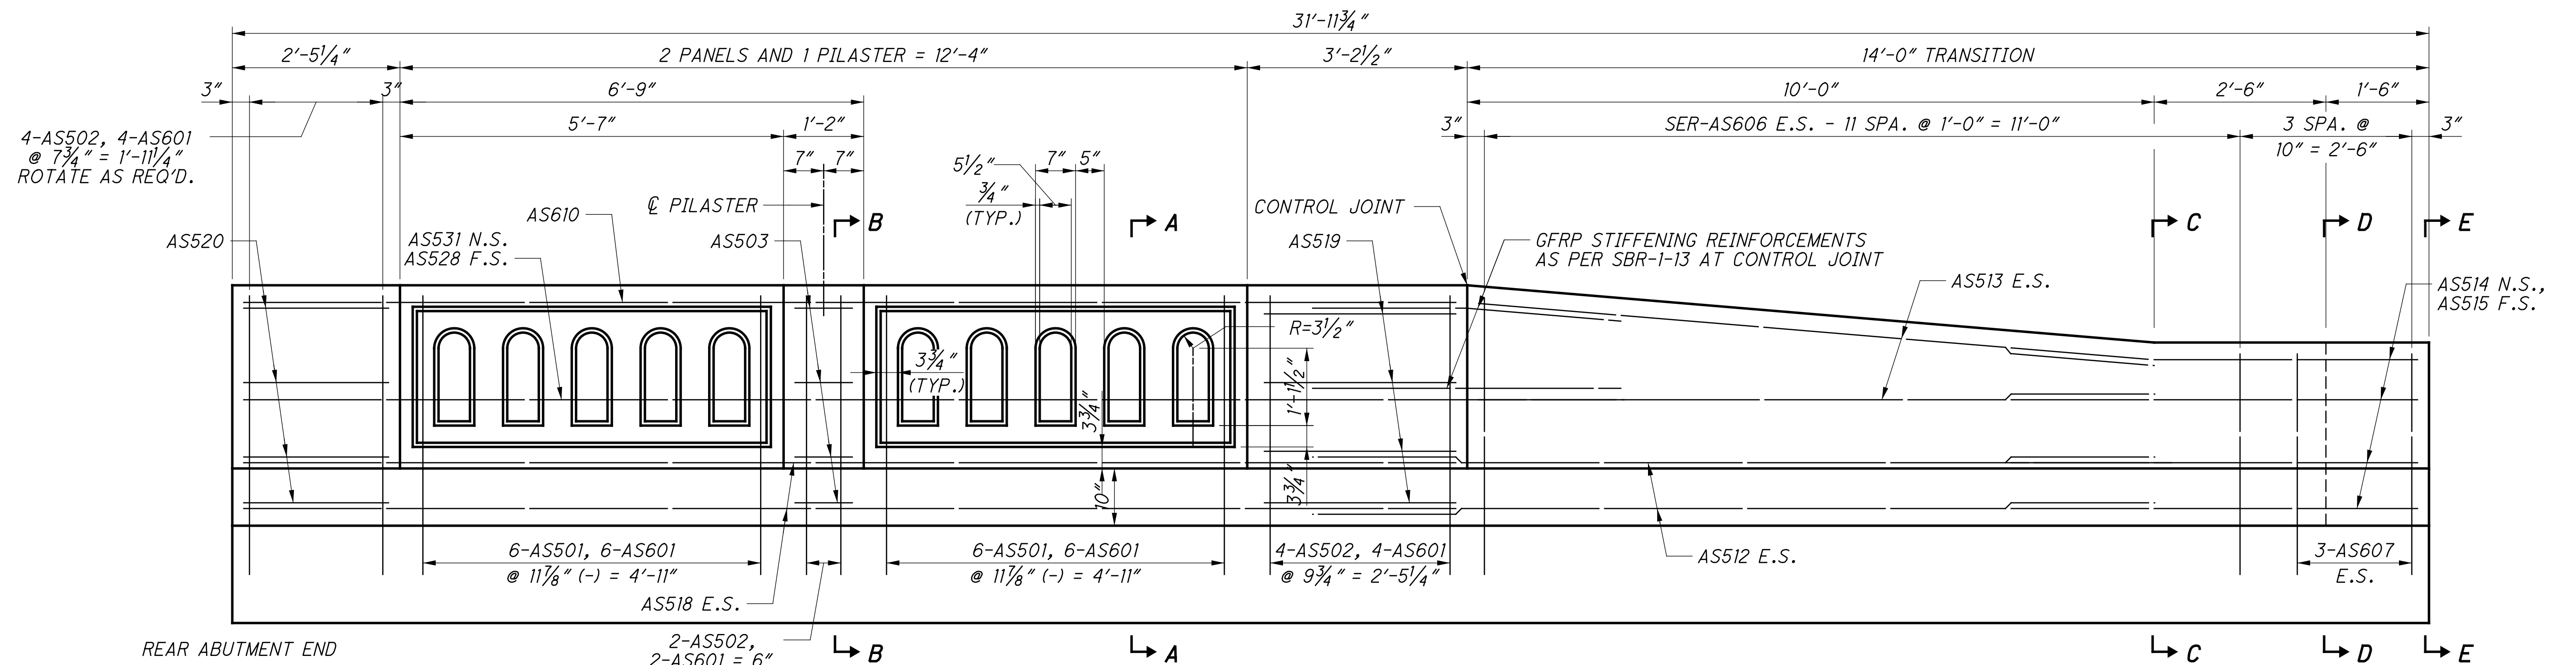


REAR ABUTMENT APPROACH SLAB ORNAMENTAL PARAPET PANEL
(ALONG REAR FACE OF PARAPET)

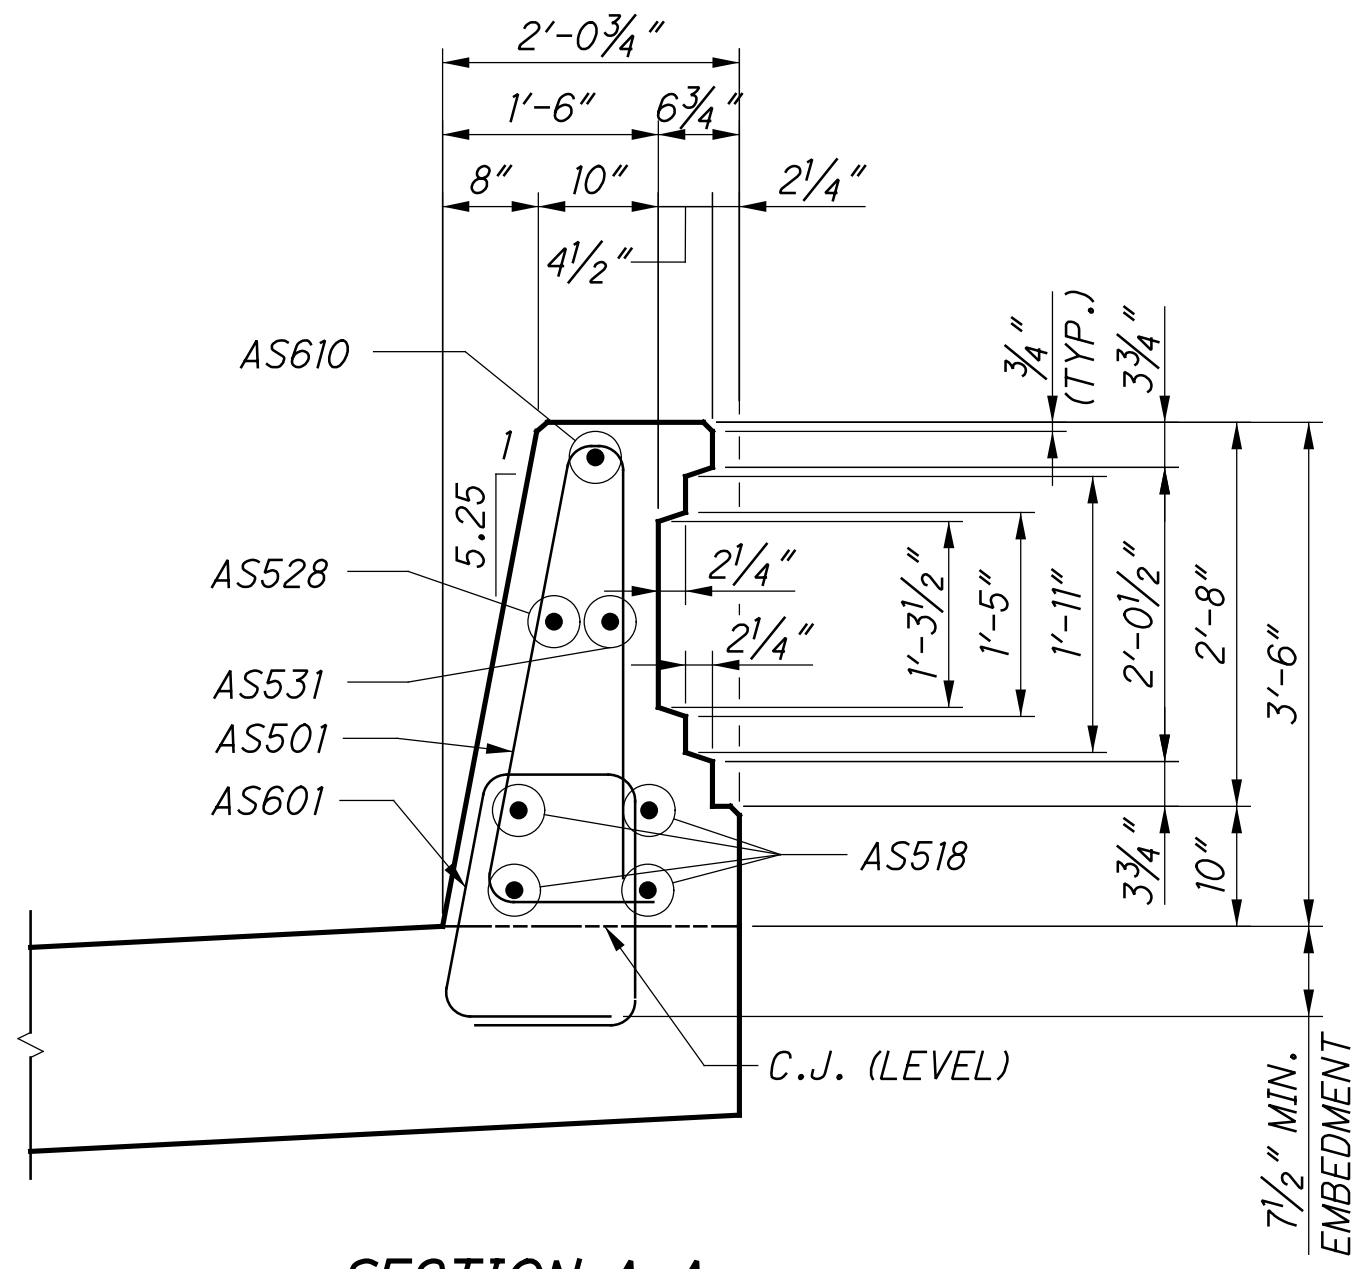


SECTION A-A

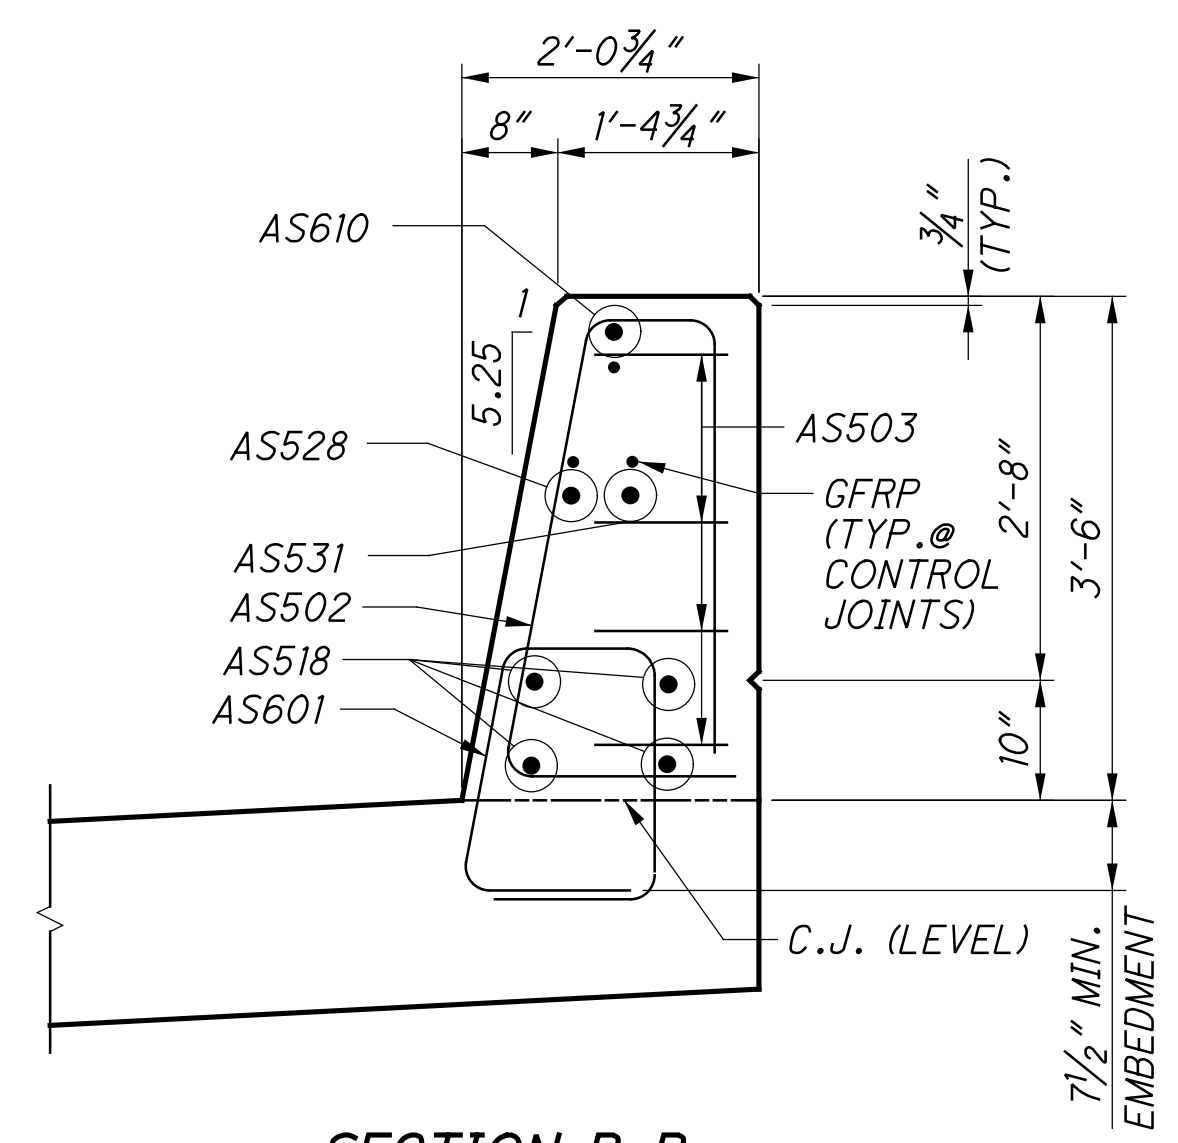


SECTION B-B

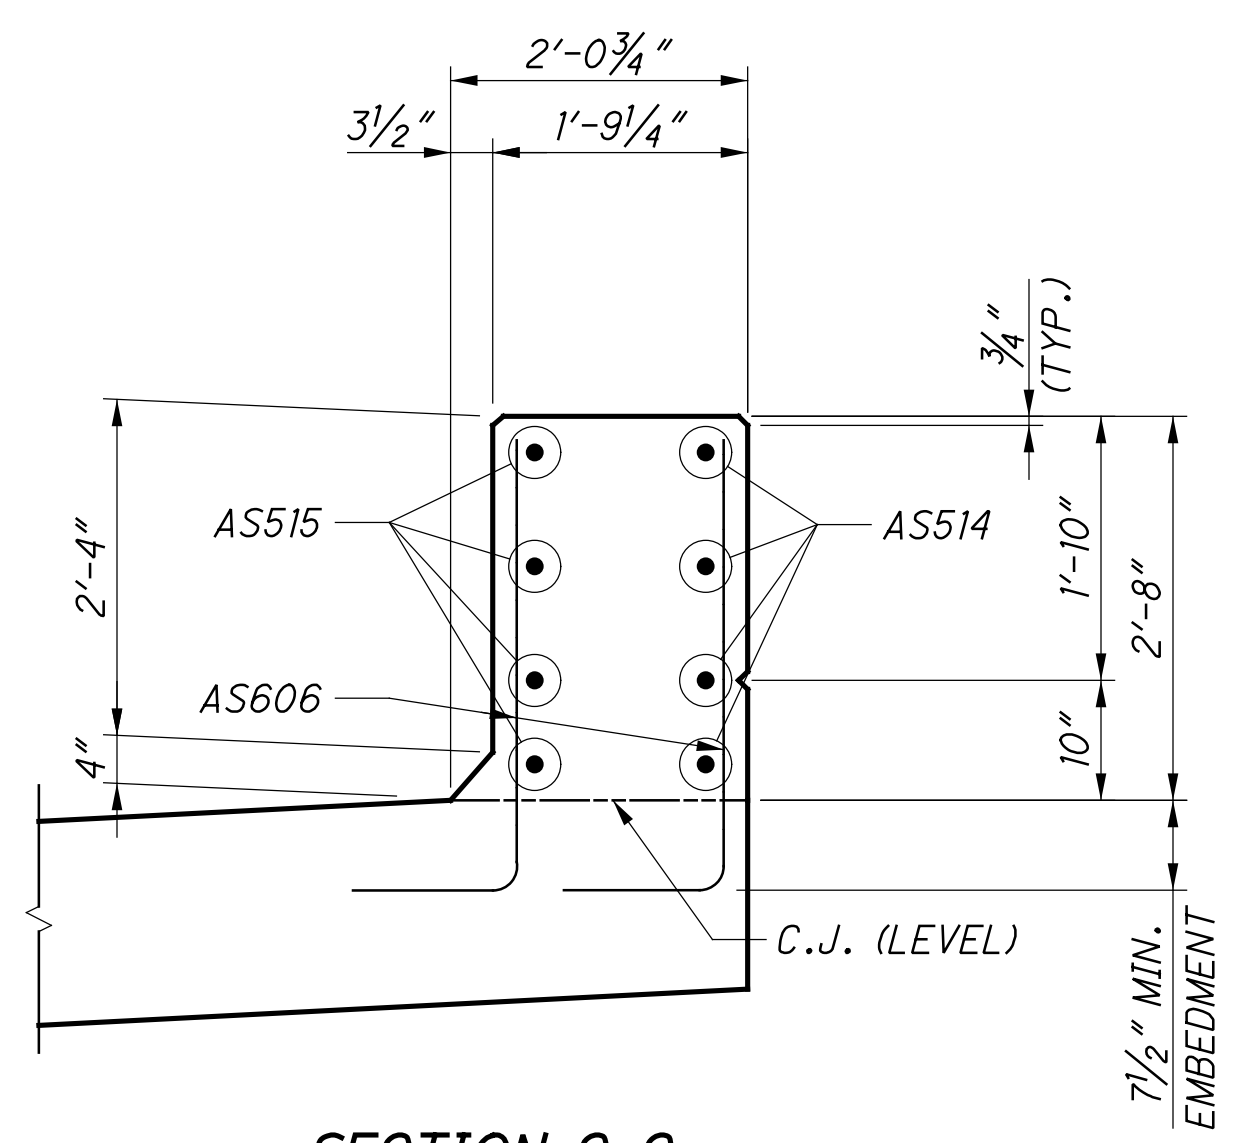


SECTION C-C

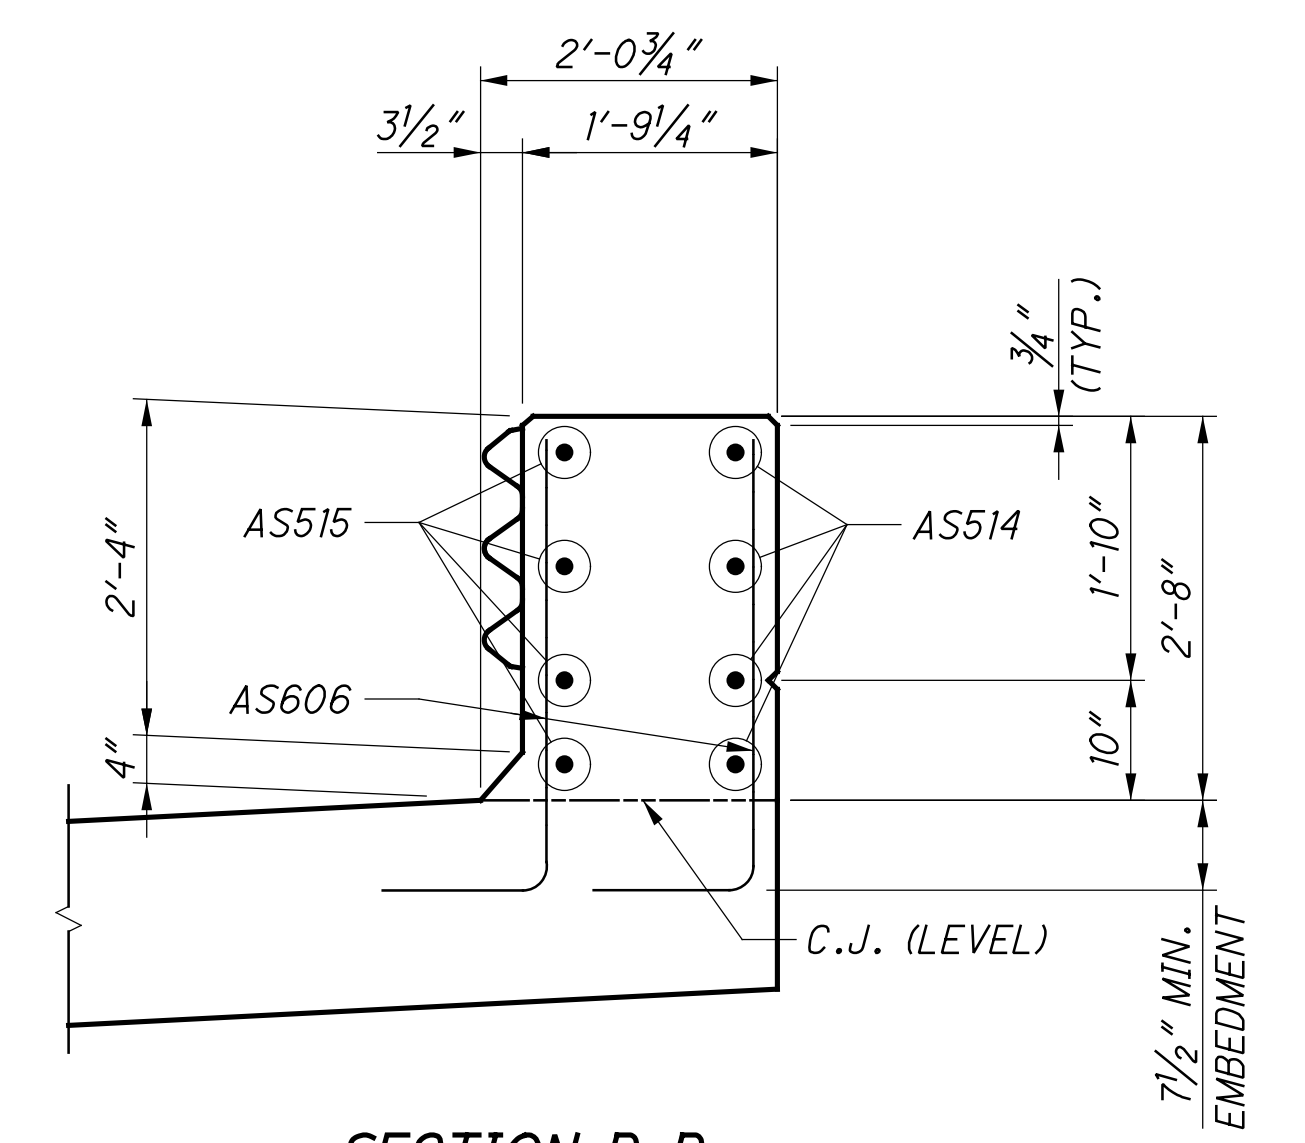

SECTION D-D

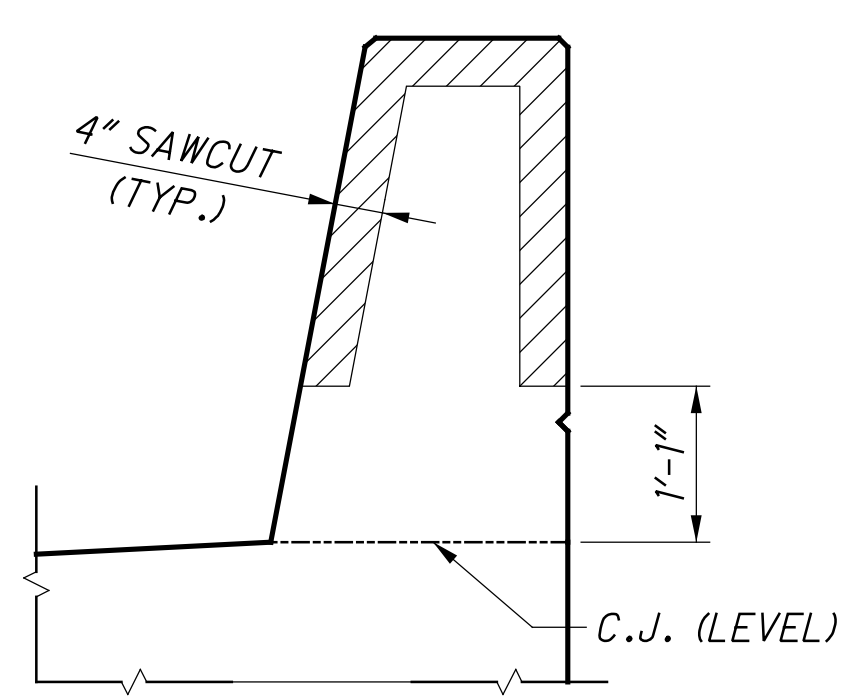

SECTION THRU CONTROL JOINT DETAIL

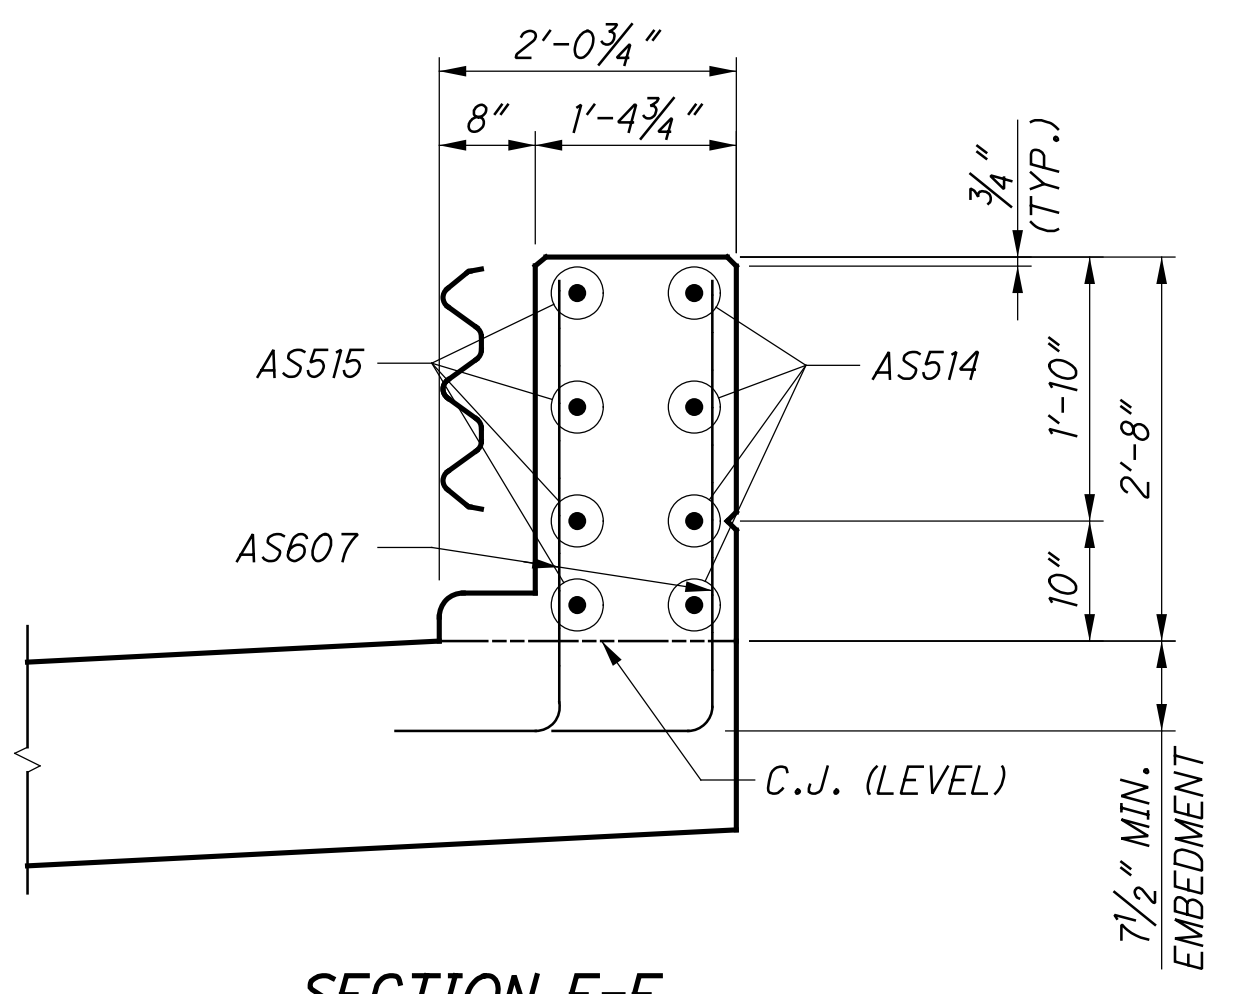

SECTION E-E


MINIMUM BAR LAP	
#5	2'-7"

- NOTES:
- SEE STANDARD BRIDGE DRAWING SBR-1-13 FOR ADDITIONAL DETAILS.
 - GFRP INDICATES 1/2" DIA. GLASS FIBER REINFORCED POLYMER STIFFENING REINFORCEMENT.


SFlansagan
 10/26/2023 4:26:41 PM
 C:\Users\101113\OneDrive\Documents\Design\104667_HAM-75-3.84\Design\Structures\HAM0075_0440C_Sheets\HAM0075_0440C_RA014.dgn

	DESIGN AGENCY STRUCTUREPOINT <small>2020 CORPORATION LICENSED BY THE STATE OF CALIFORNIA</small>
DESIGNED SUJ	CHECKED CLB
DRAWN DSH	REVISED
REVIEWED MDS	STRUCTURE FILE NUMBER 3109163
DATE 1/2/19	3109163
PARAPET DETAILS (LEFT BRIDGE) BRIDGE NO. HAM-75-0440 L/R OVER WB I-74	
HAM-75-3.84 PID No. 104667	
48 / 68	
48 68	


SFlansagan
10/26/2023 4:26:41 PM
C:\2017\01113\C.Design\104667_HAM-75-3.84\Design\Structures\HAM0075_0440C_Sheets\HAM0075_0440C_RAO15.dgn

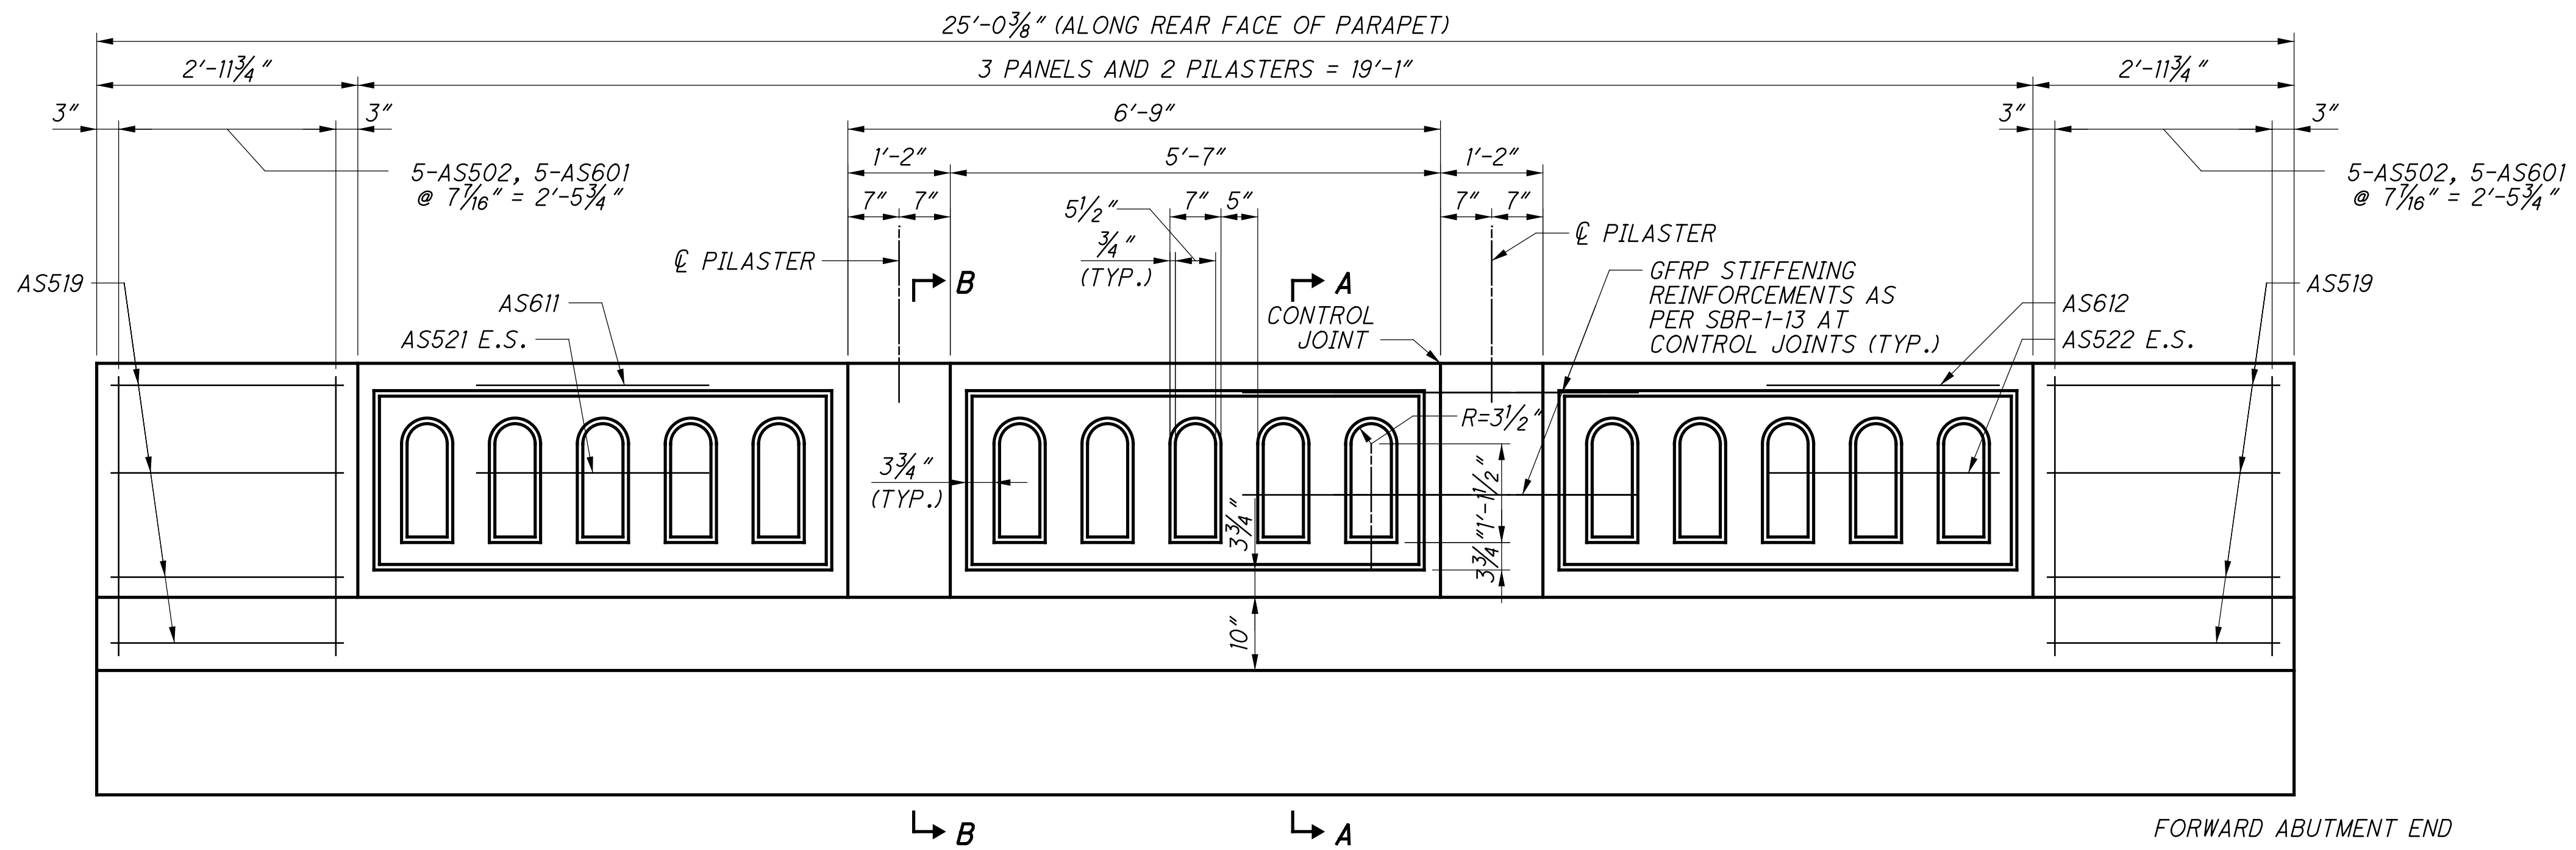


FORWARD ABUTMENT APPROACH SLAB ORNAMENTAL PARAPET PANEL
(ALONG REAR FACE OF PARAPET)

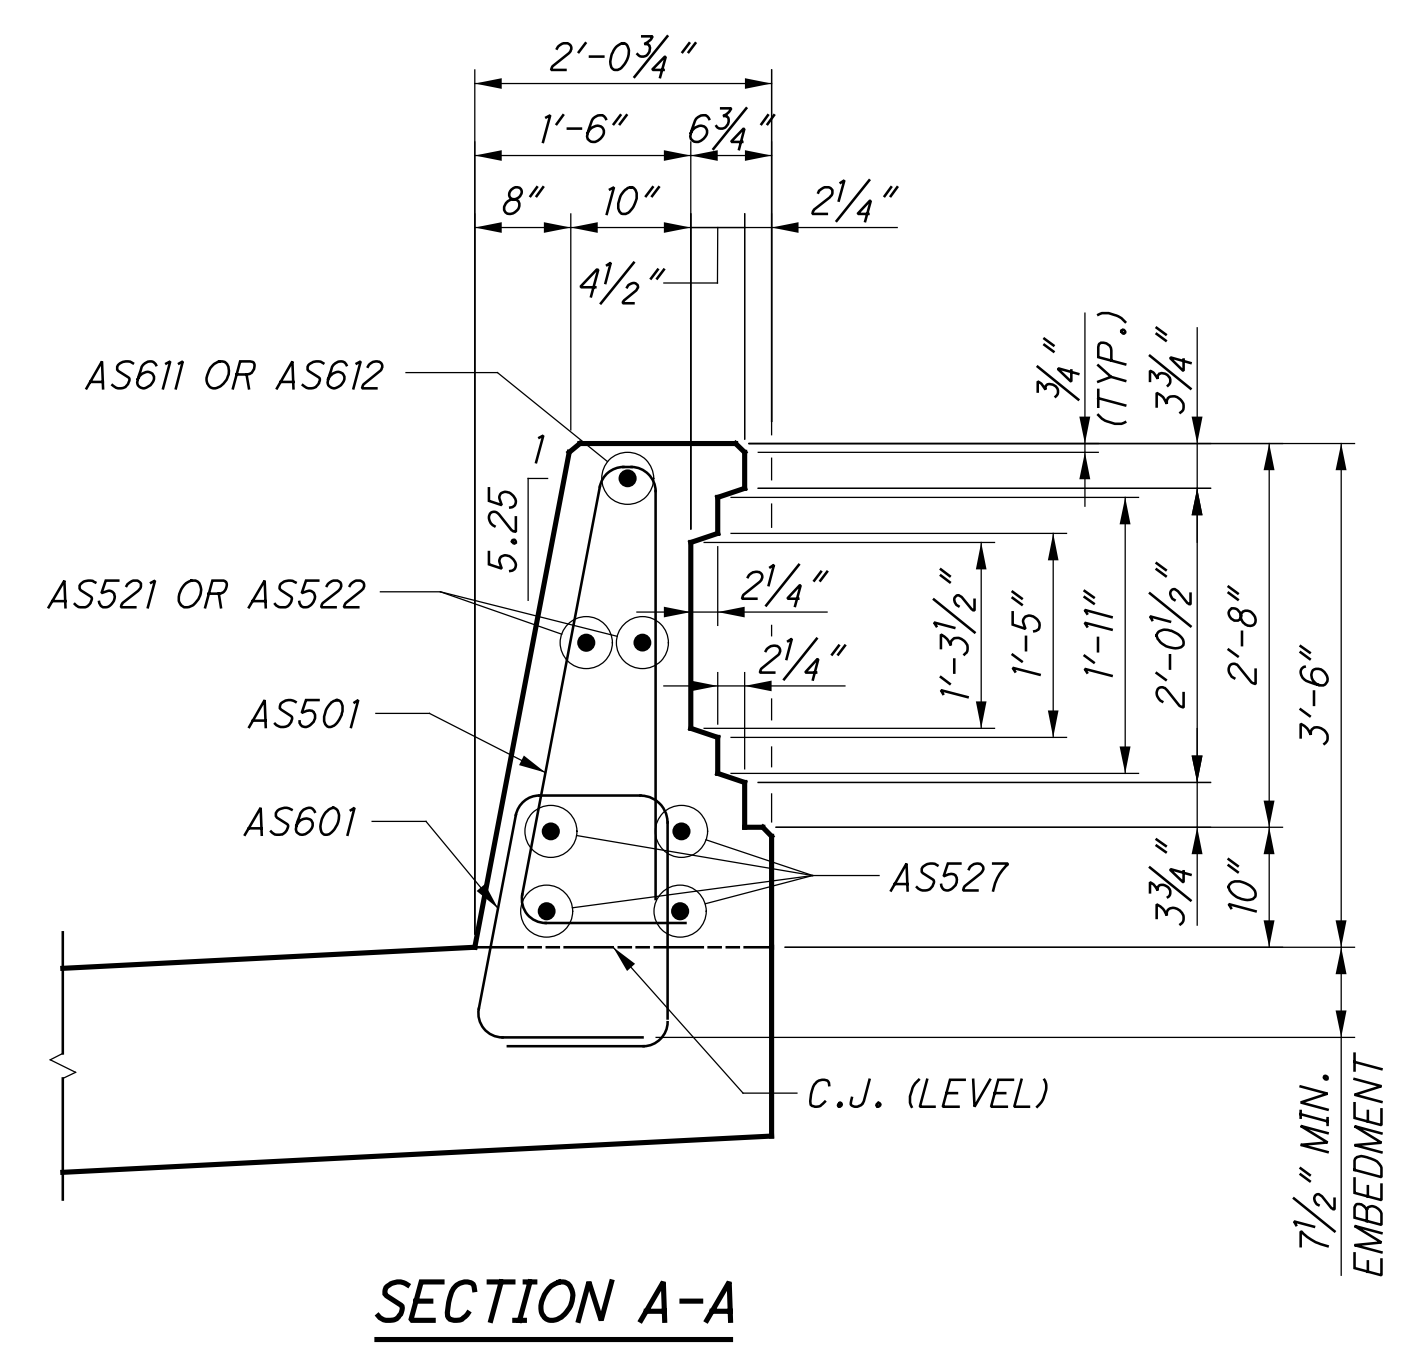


SECTION A-A

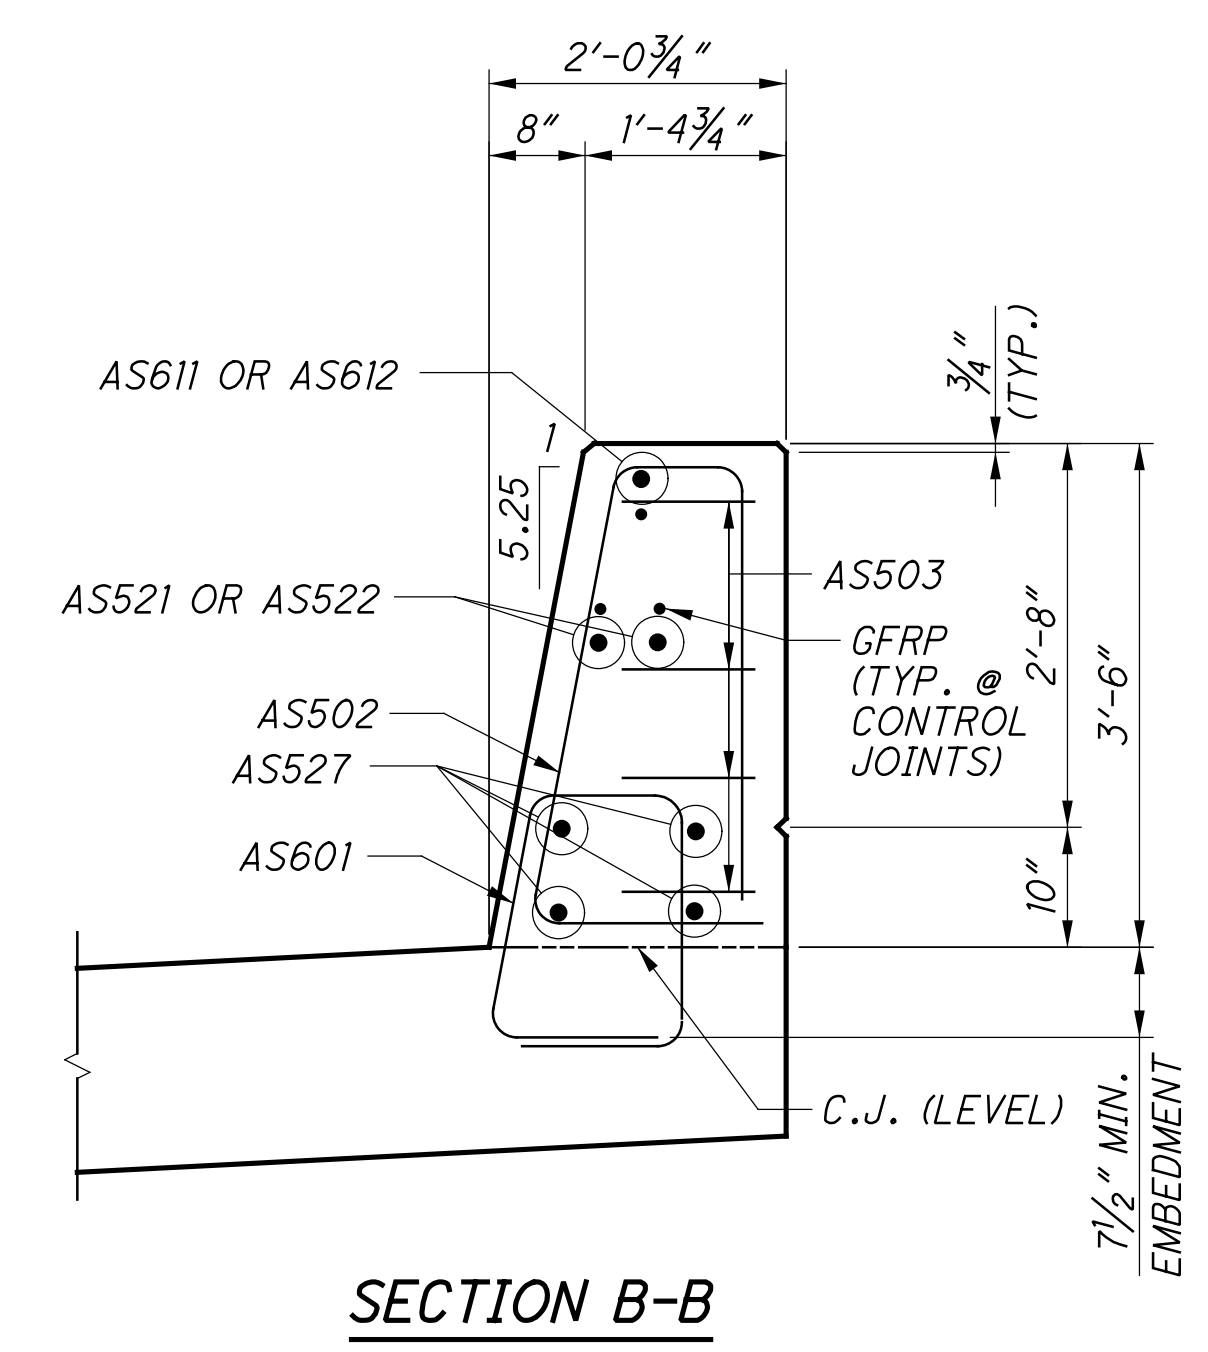

SECTION B-B

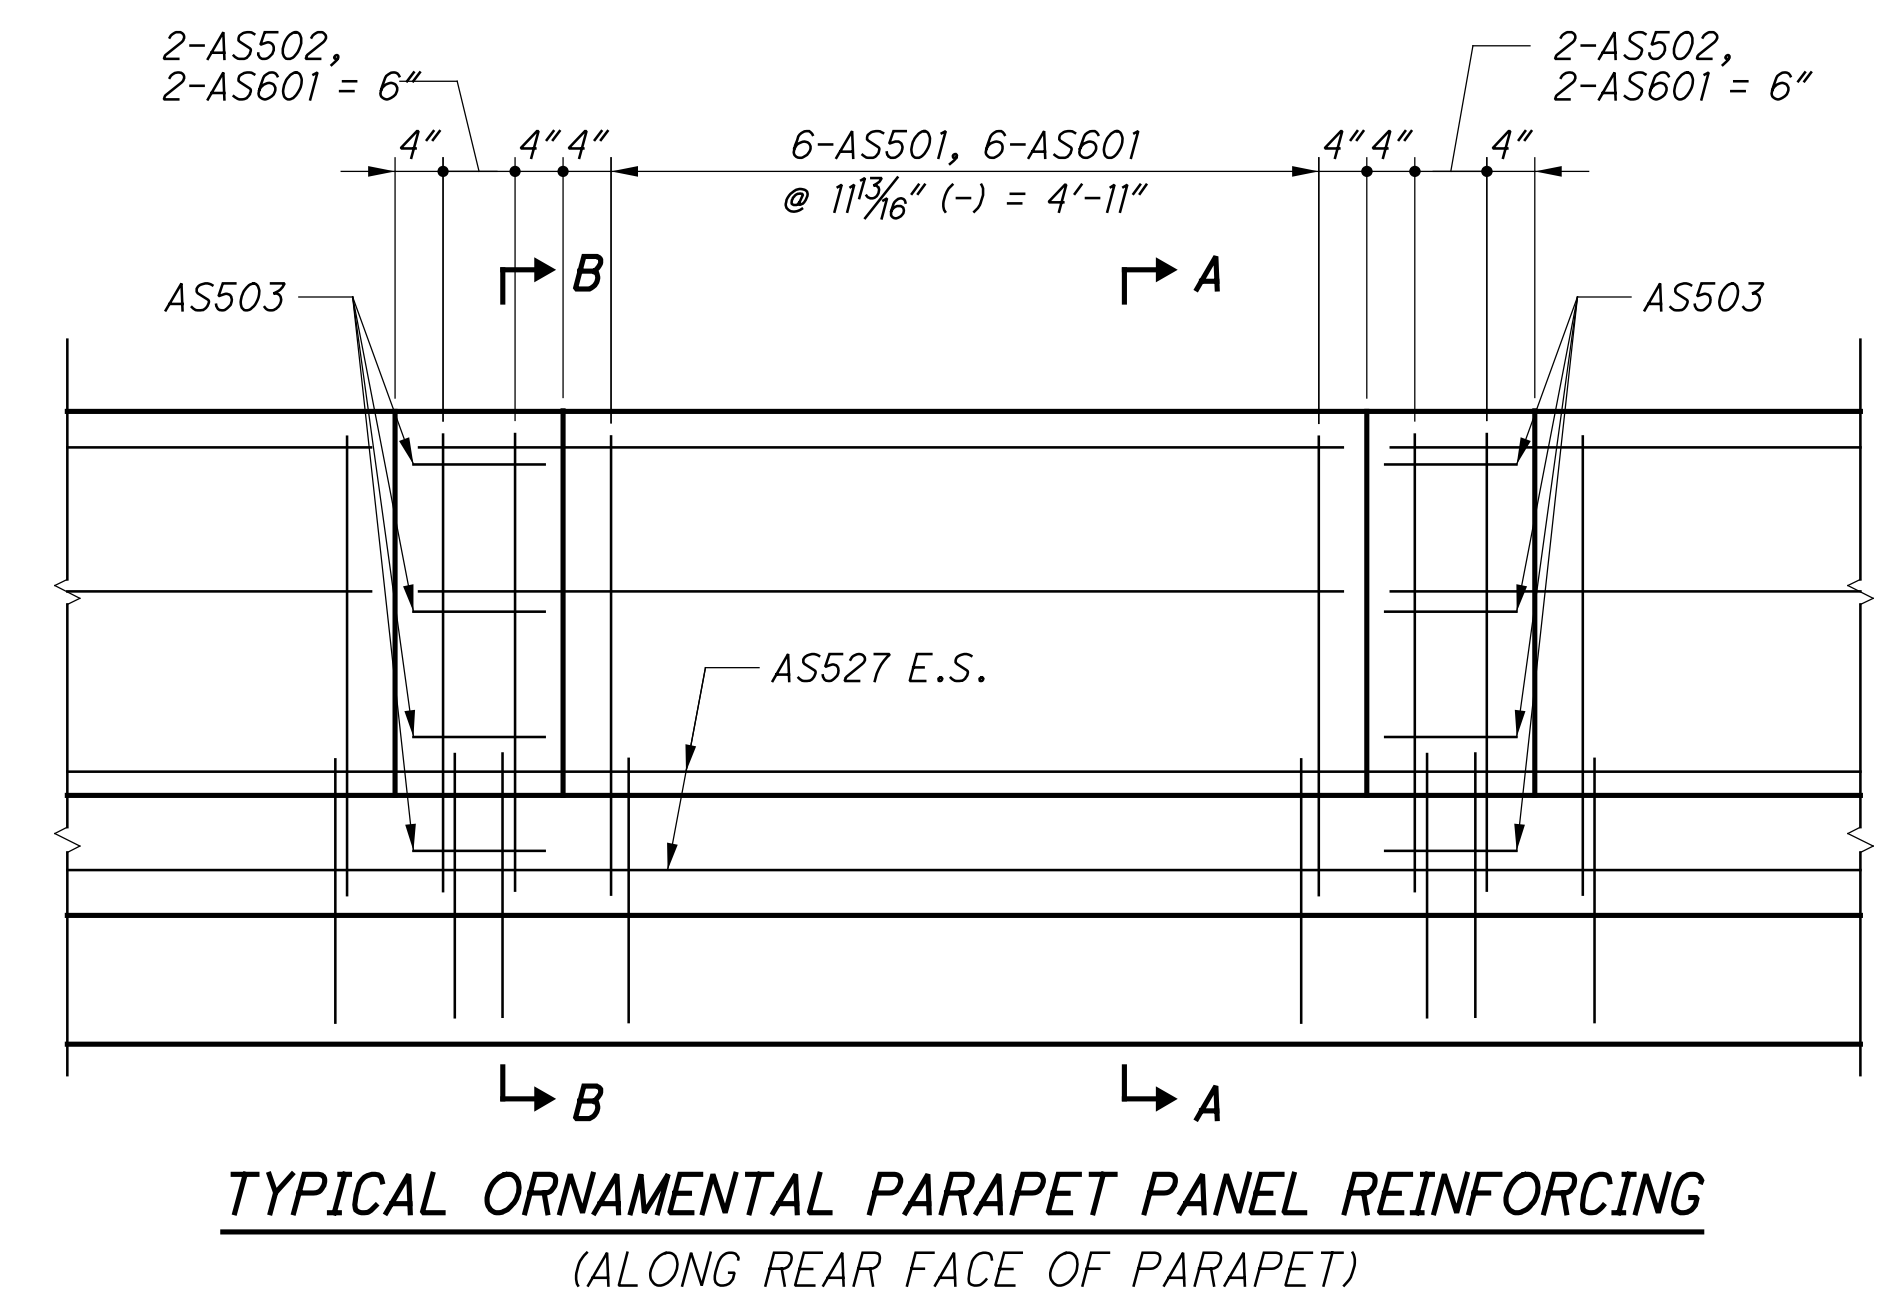

TYPICAL ORNAMENTAL PARAPET PANEL REINFORCING
(ALONG REAR FACE OF PARAPET)

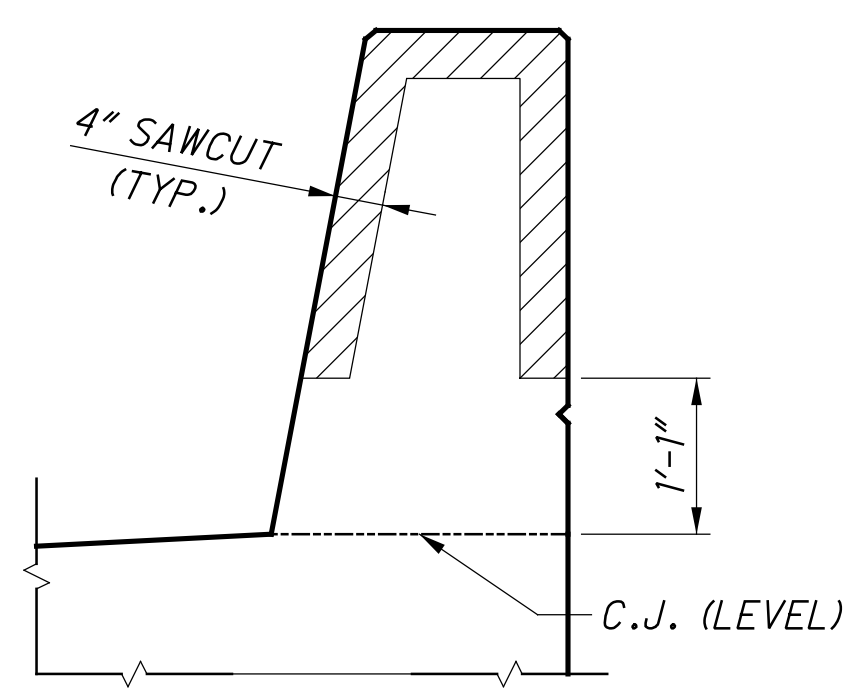


SECTION THRU CONTROL JOINT DETAIL

MINIMUM BAR LAP	
#5	2'-7"


- NOTES:
- SEE STANDARD BRIDGE DRAWING SBR-1-13 FOR ADDITIONAL DETAILS.
 - GFRP INDICATES 1/2" DIA. GLASS FIBER REINFORCED POLYMER STIFFENING REINFORCEMENT.

DESIGN AGENCY: STRUCTUREPOINT
 DATE: 1/2/19
 REVIEWED: MDS
 DRAWN: DSH
 DESIGNED: SUJ
 CHECKED: CLB
 STRUCTURE FILE NUMBER: 3109163
 REVISIONS: 3109163
 PARAPET DETAILS (LEFT BRIDGE)
 BRIDGE NO. - HAM-75-0440 L/R
 OVER WB I-74
 HAM-75-3.84
 PID No. 104667
 49/68
 49
 68

SFlansgan
 10/26/2023 4:26:42 PM
 \\O:\2017\01113\C.Design\104667.HAM-75-3.84.Design\Structures\HAM0075_0440C.Sheets\HAM0075_0440C.RA016.dgn

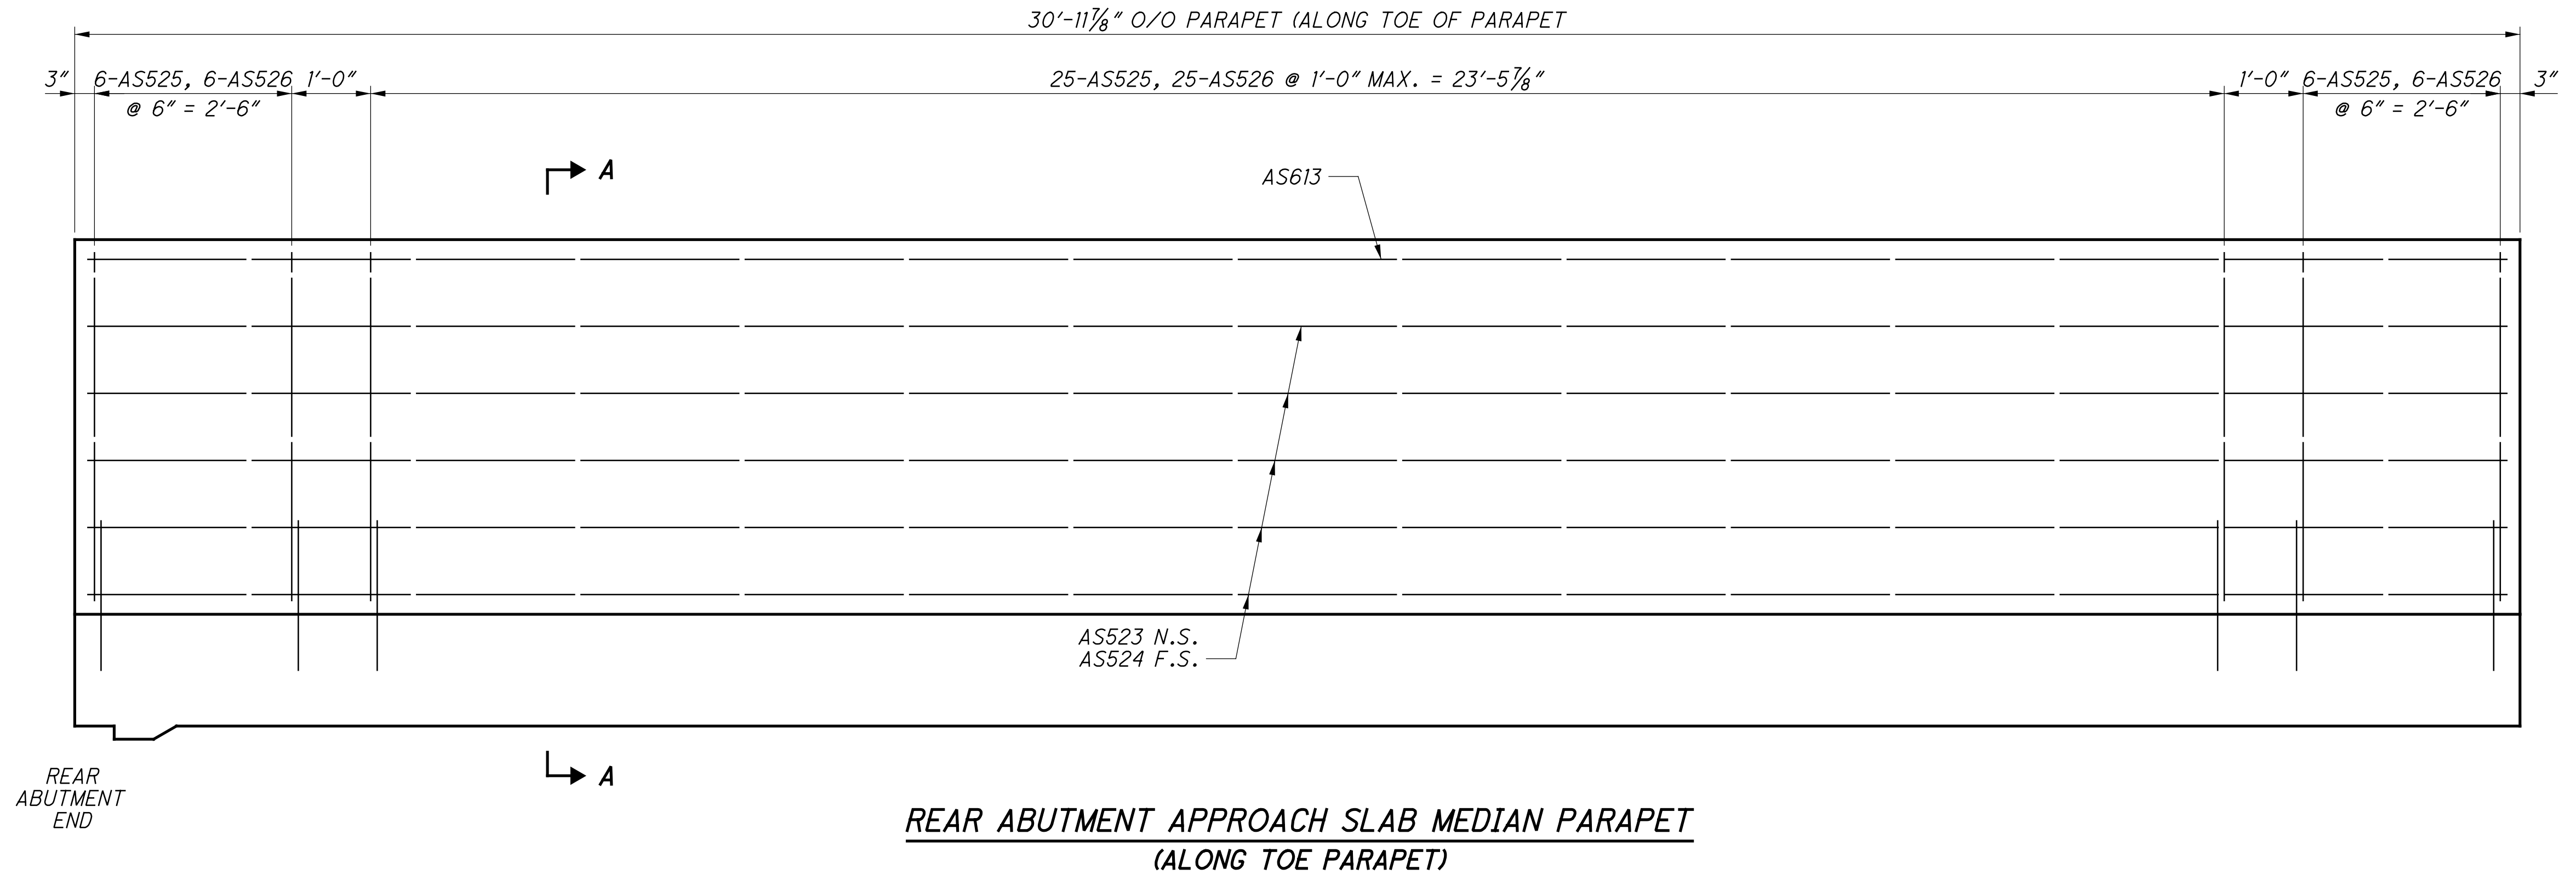

**REAR ABUTMENT APPROACH SLAB MEDIAN PARAPET
 (ALONG TOE PARAPET)**

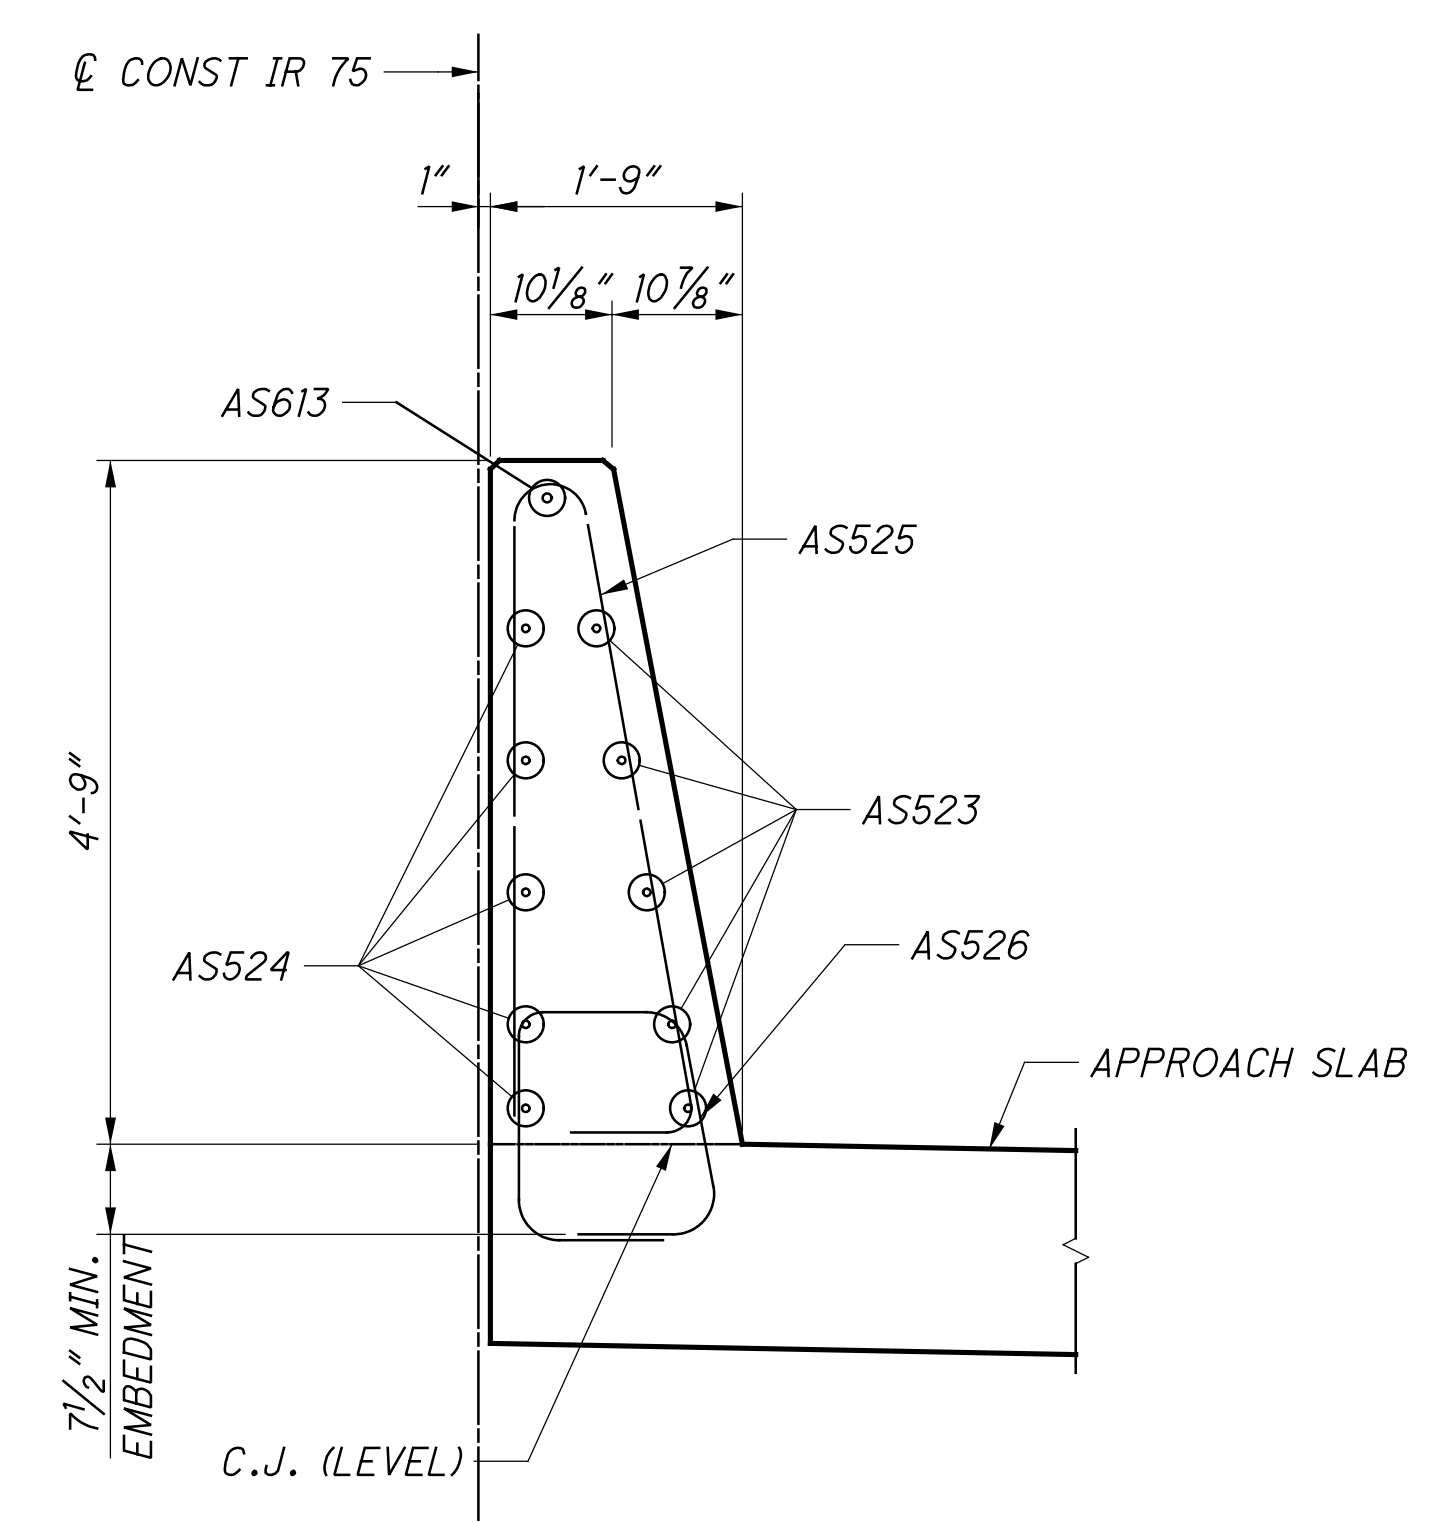

SECTION A-A

NOTES:
 1. SEE STANDARD BRIDGE DRAWING SBR-2-13 FOR ADDITIONAL DETAILS.

DESIGN AGENCY
STRUCTUREPOINT
 2020 CORPORATE HEADQUARTERS DR. STE. 200
 1000 W. 10TH ST. SUITE 200
 DENVER, CO 80202
 TEL: 303.440.3333 FAX: 303.440.3334
 WWW.STRUCTUREPOINT.COM

DESIGNED	DATE	REVIEWED	DATE
SJF	1/2/19	MDS	1/2/19
CHECKED	FILE NUMBER	STRUCTURE	FILE NUMBER
CLB		3109163	


PARAPET DETAILS (LEFT BRIDGE)
 BRIDGE NO. HAM-75-0440 L/R
 OVER WB I-74

HAM-75-3.84
PID No. 104667

50/68


50
68

SFlansgan
 10/26/2023 4:26:42 PM
 \\O:\2017\01113\C_Design\104667_HAM-75-3.84\Design\Structures\HAM0075_0440C_Sheets\HAM0075_0440C_RA017.dgn

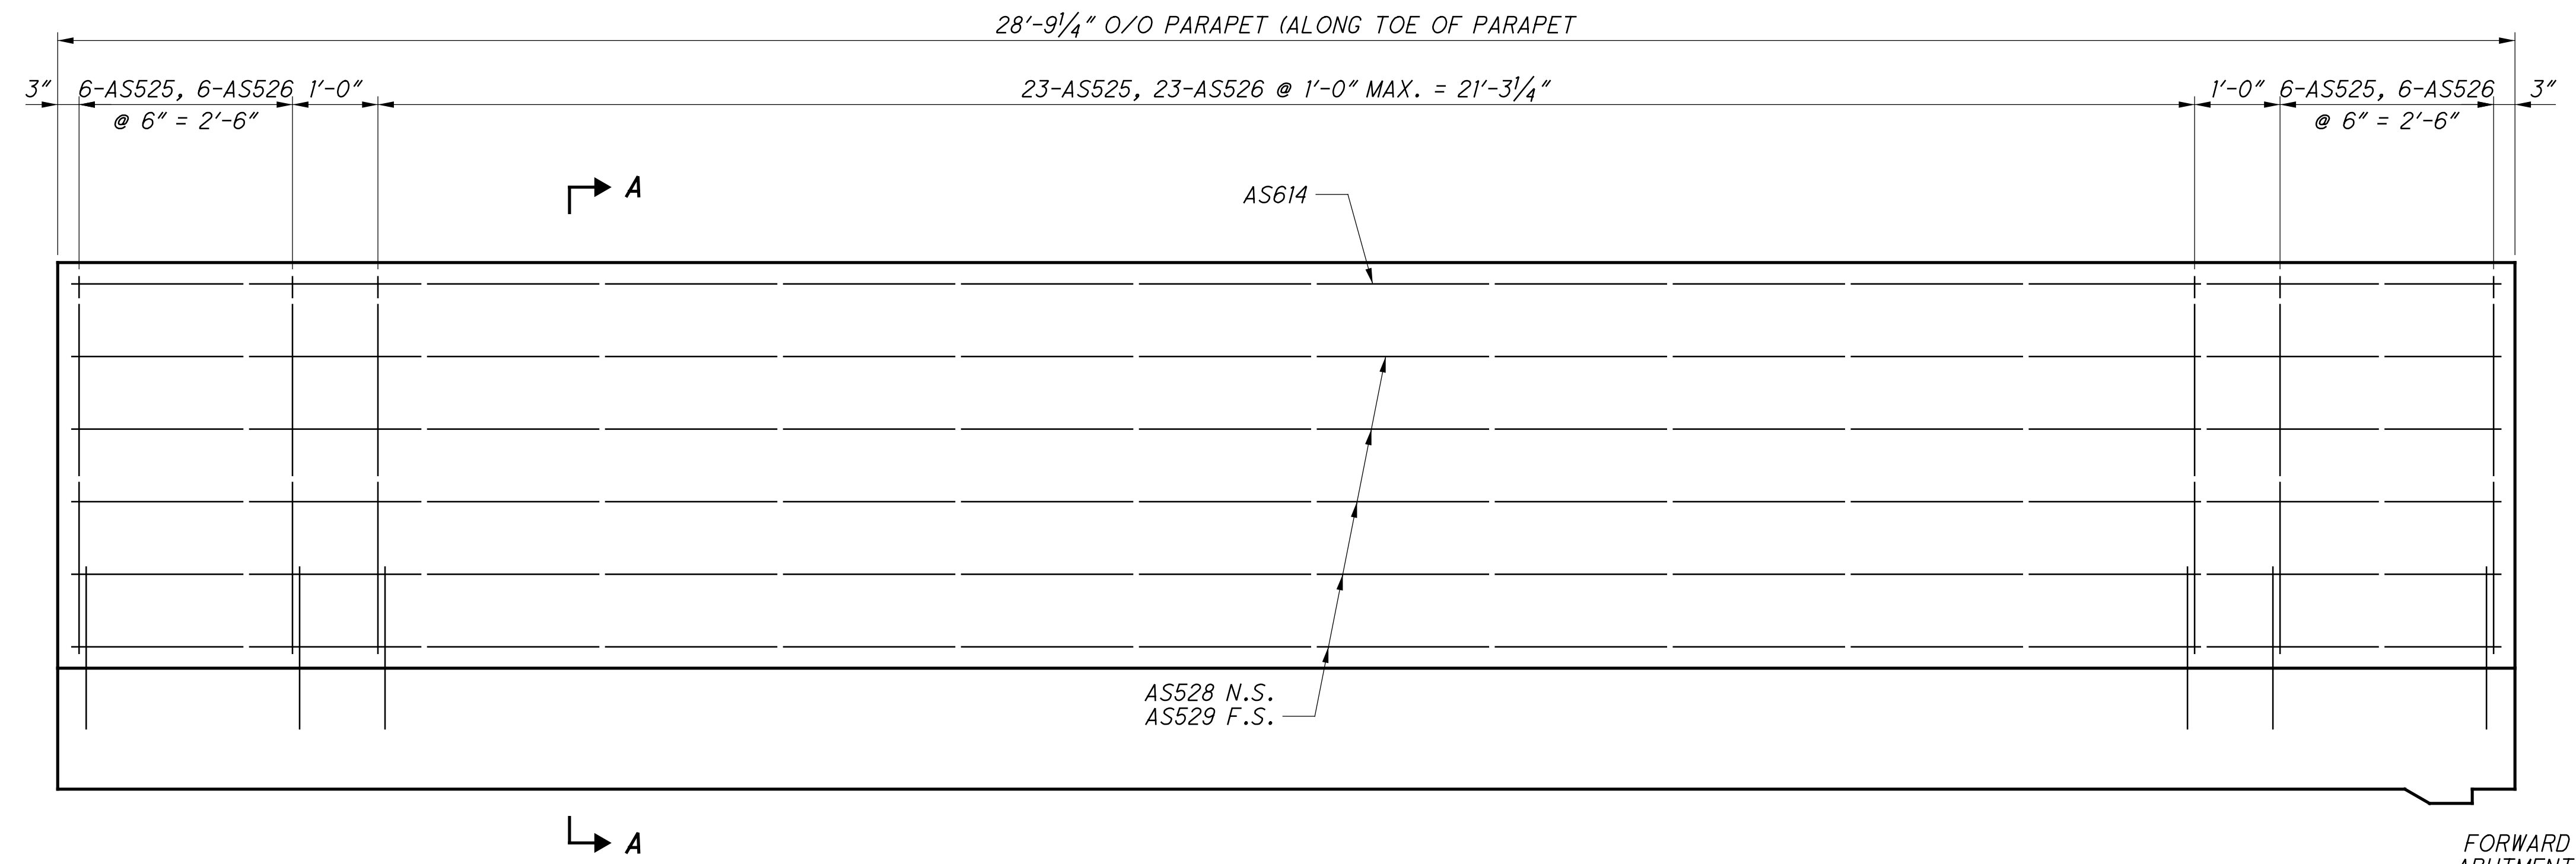

**FORWARD ABUTMENT APPROACH SLAB MEDIAN PARAPET
 (ALONG TOE PARAPET)**

FORWARD
 ABUTMENT
 END

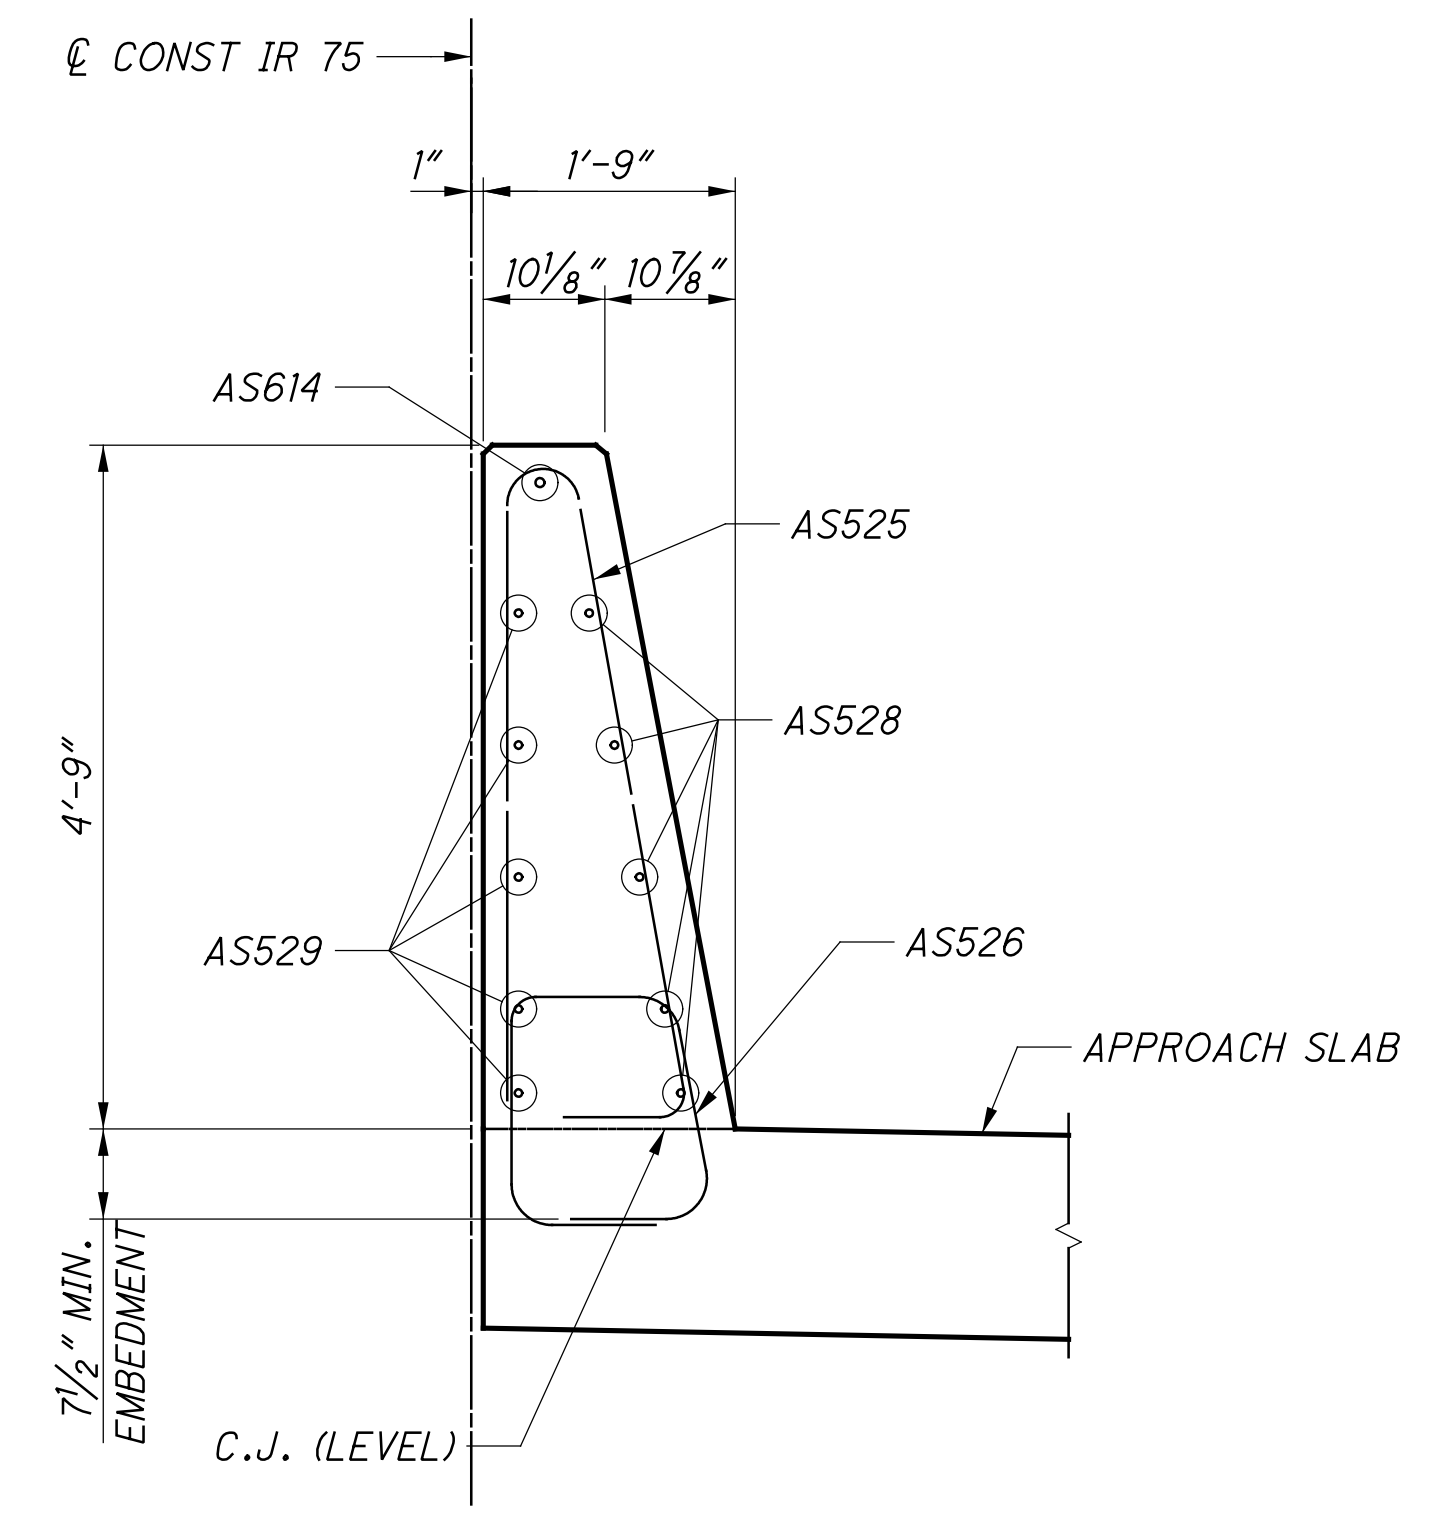

SECTION A-A






NOTES:
 1. SEE STANDARD BRIDGE DRAWING SBR-2-13
 FOR ADDITIONAL DETAILS.

DESIGNED	REVIEWED	DATE
SJF	MDS	1/2/19
CHECKED	STRUCTURE FILE NUMBER	
CLB	3109763	

PARAPET DETAILS (LEFT BRIDGE)
 BRIDGE NO. - HAM-75-0440 L/R
 OVER WB I-74

HAM-75-3.84
PID No. 104667

SFlanagan
10/26/2023 4:26:43 PM
\\01\2017\01113\C.Design\104667-HAM-75-3.84\Design\Structures\HAM0075_0440C\Sheets\HAM0075_0440C_RA001.dgn

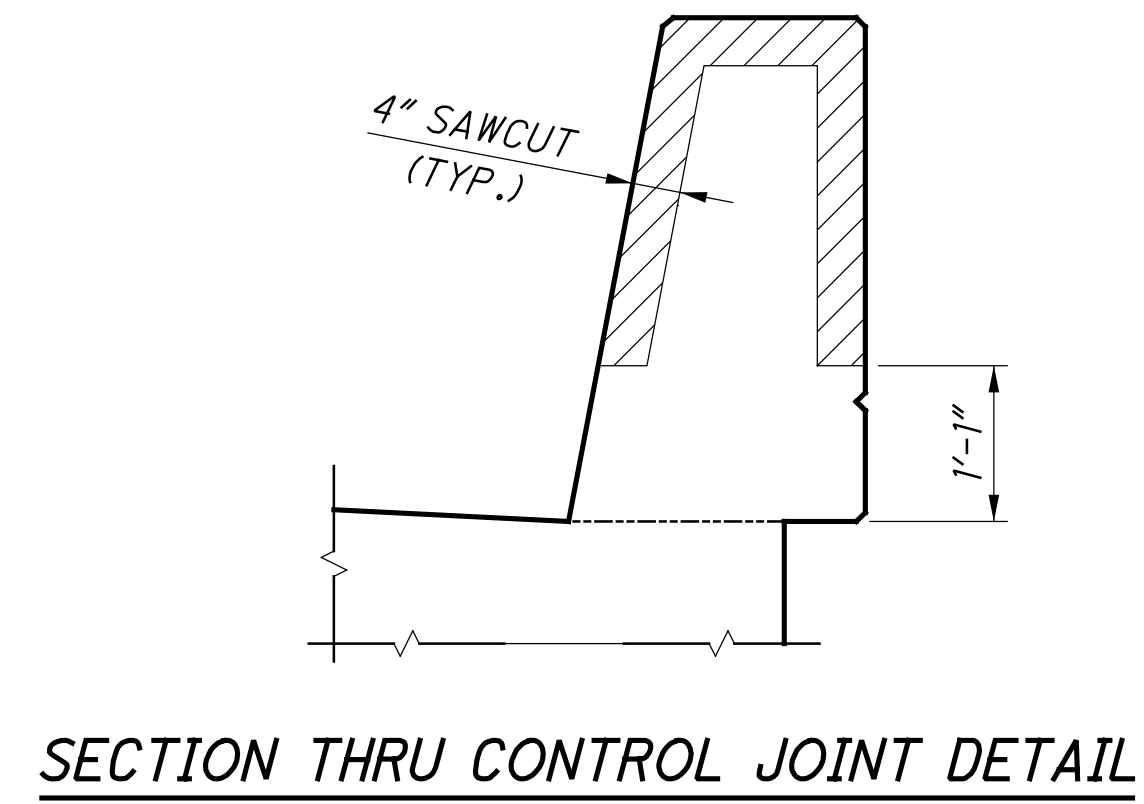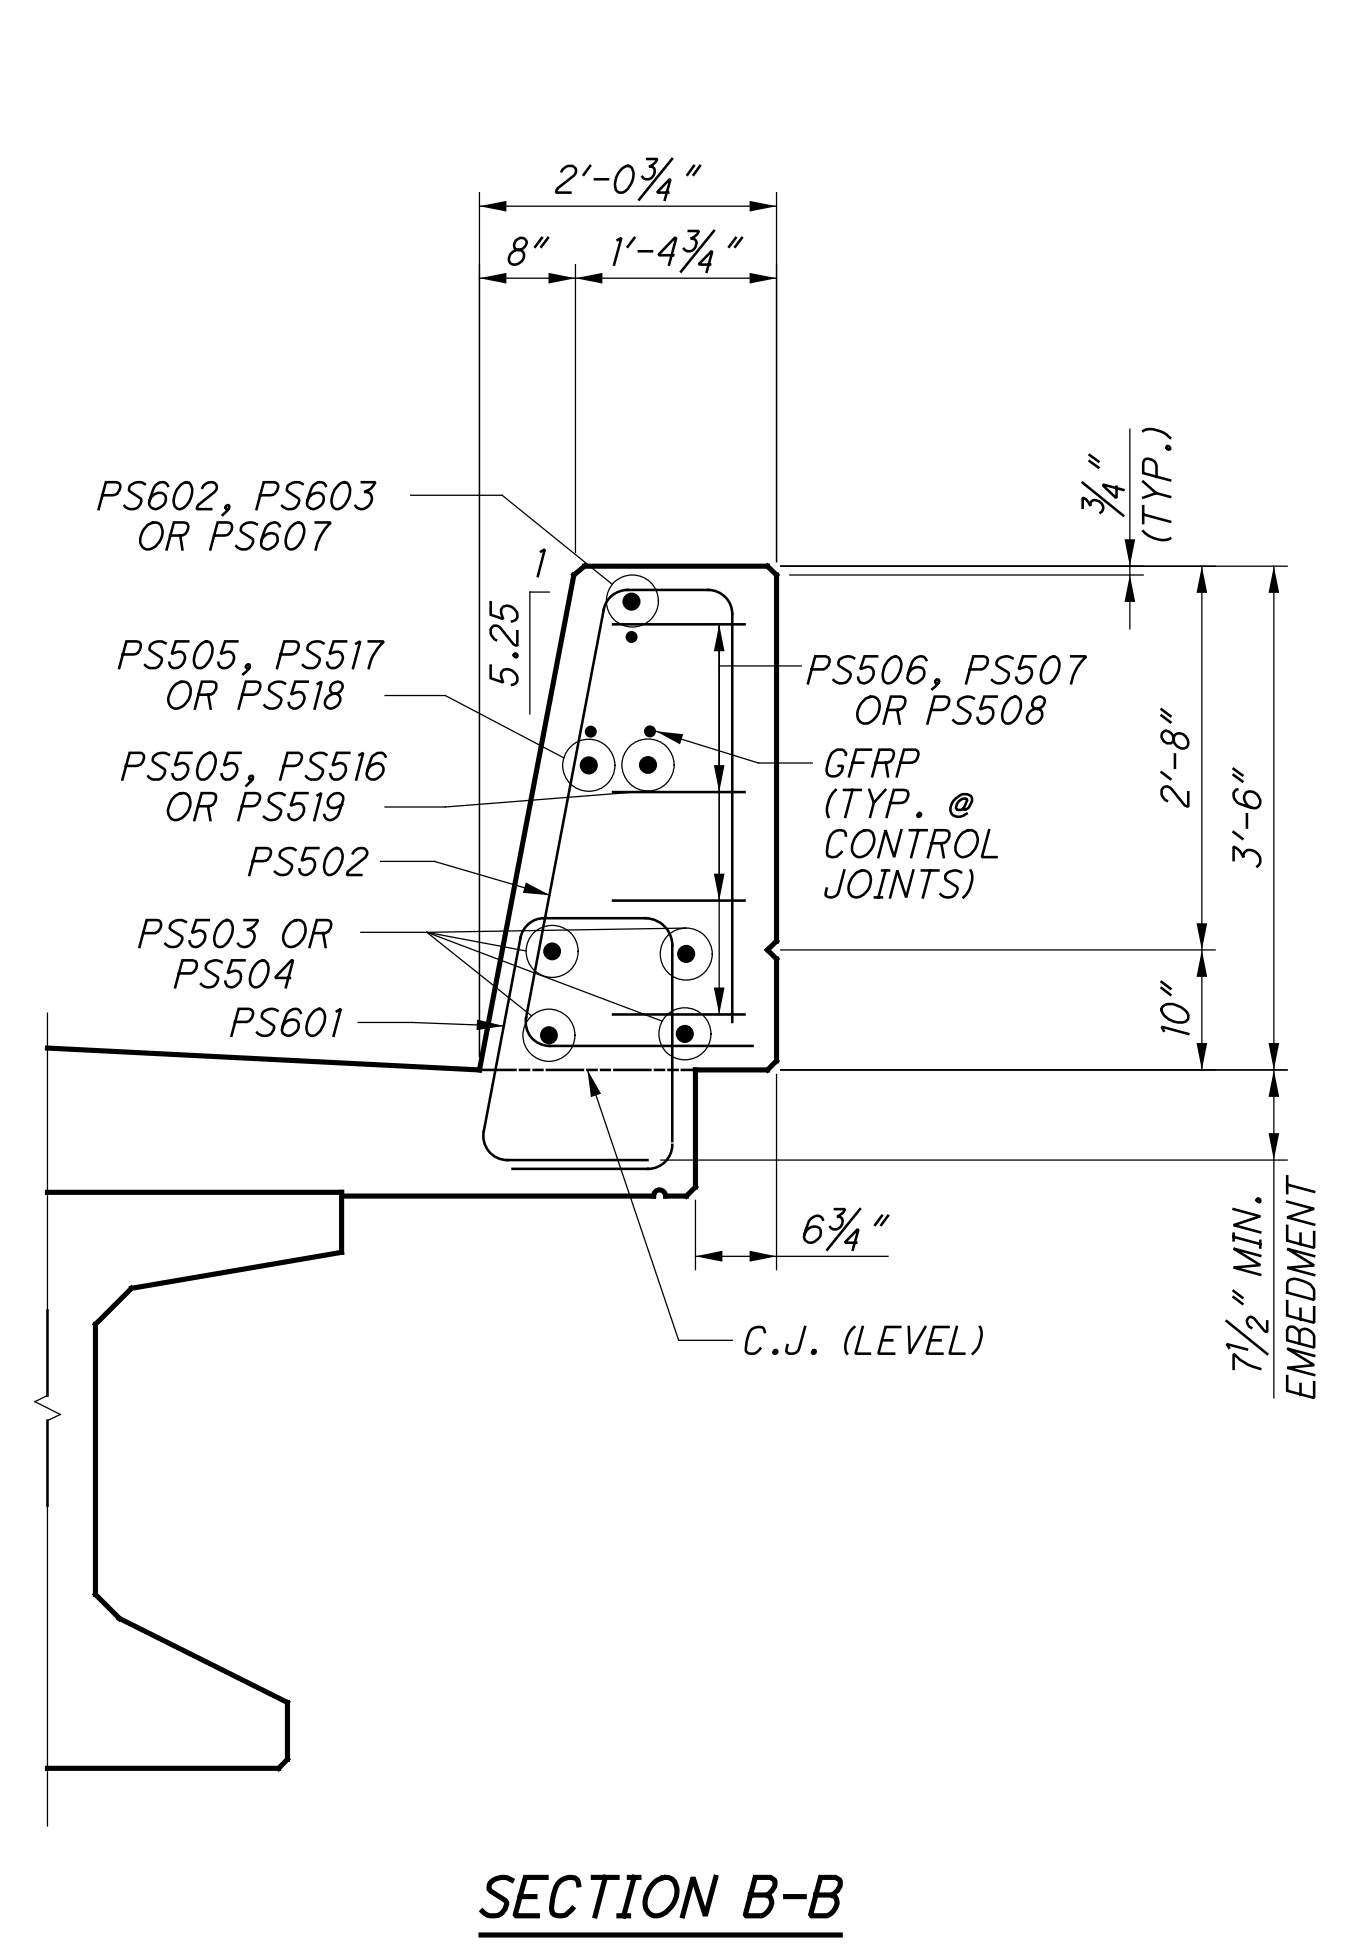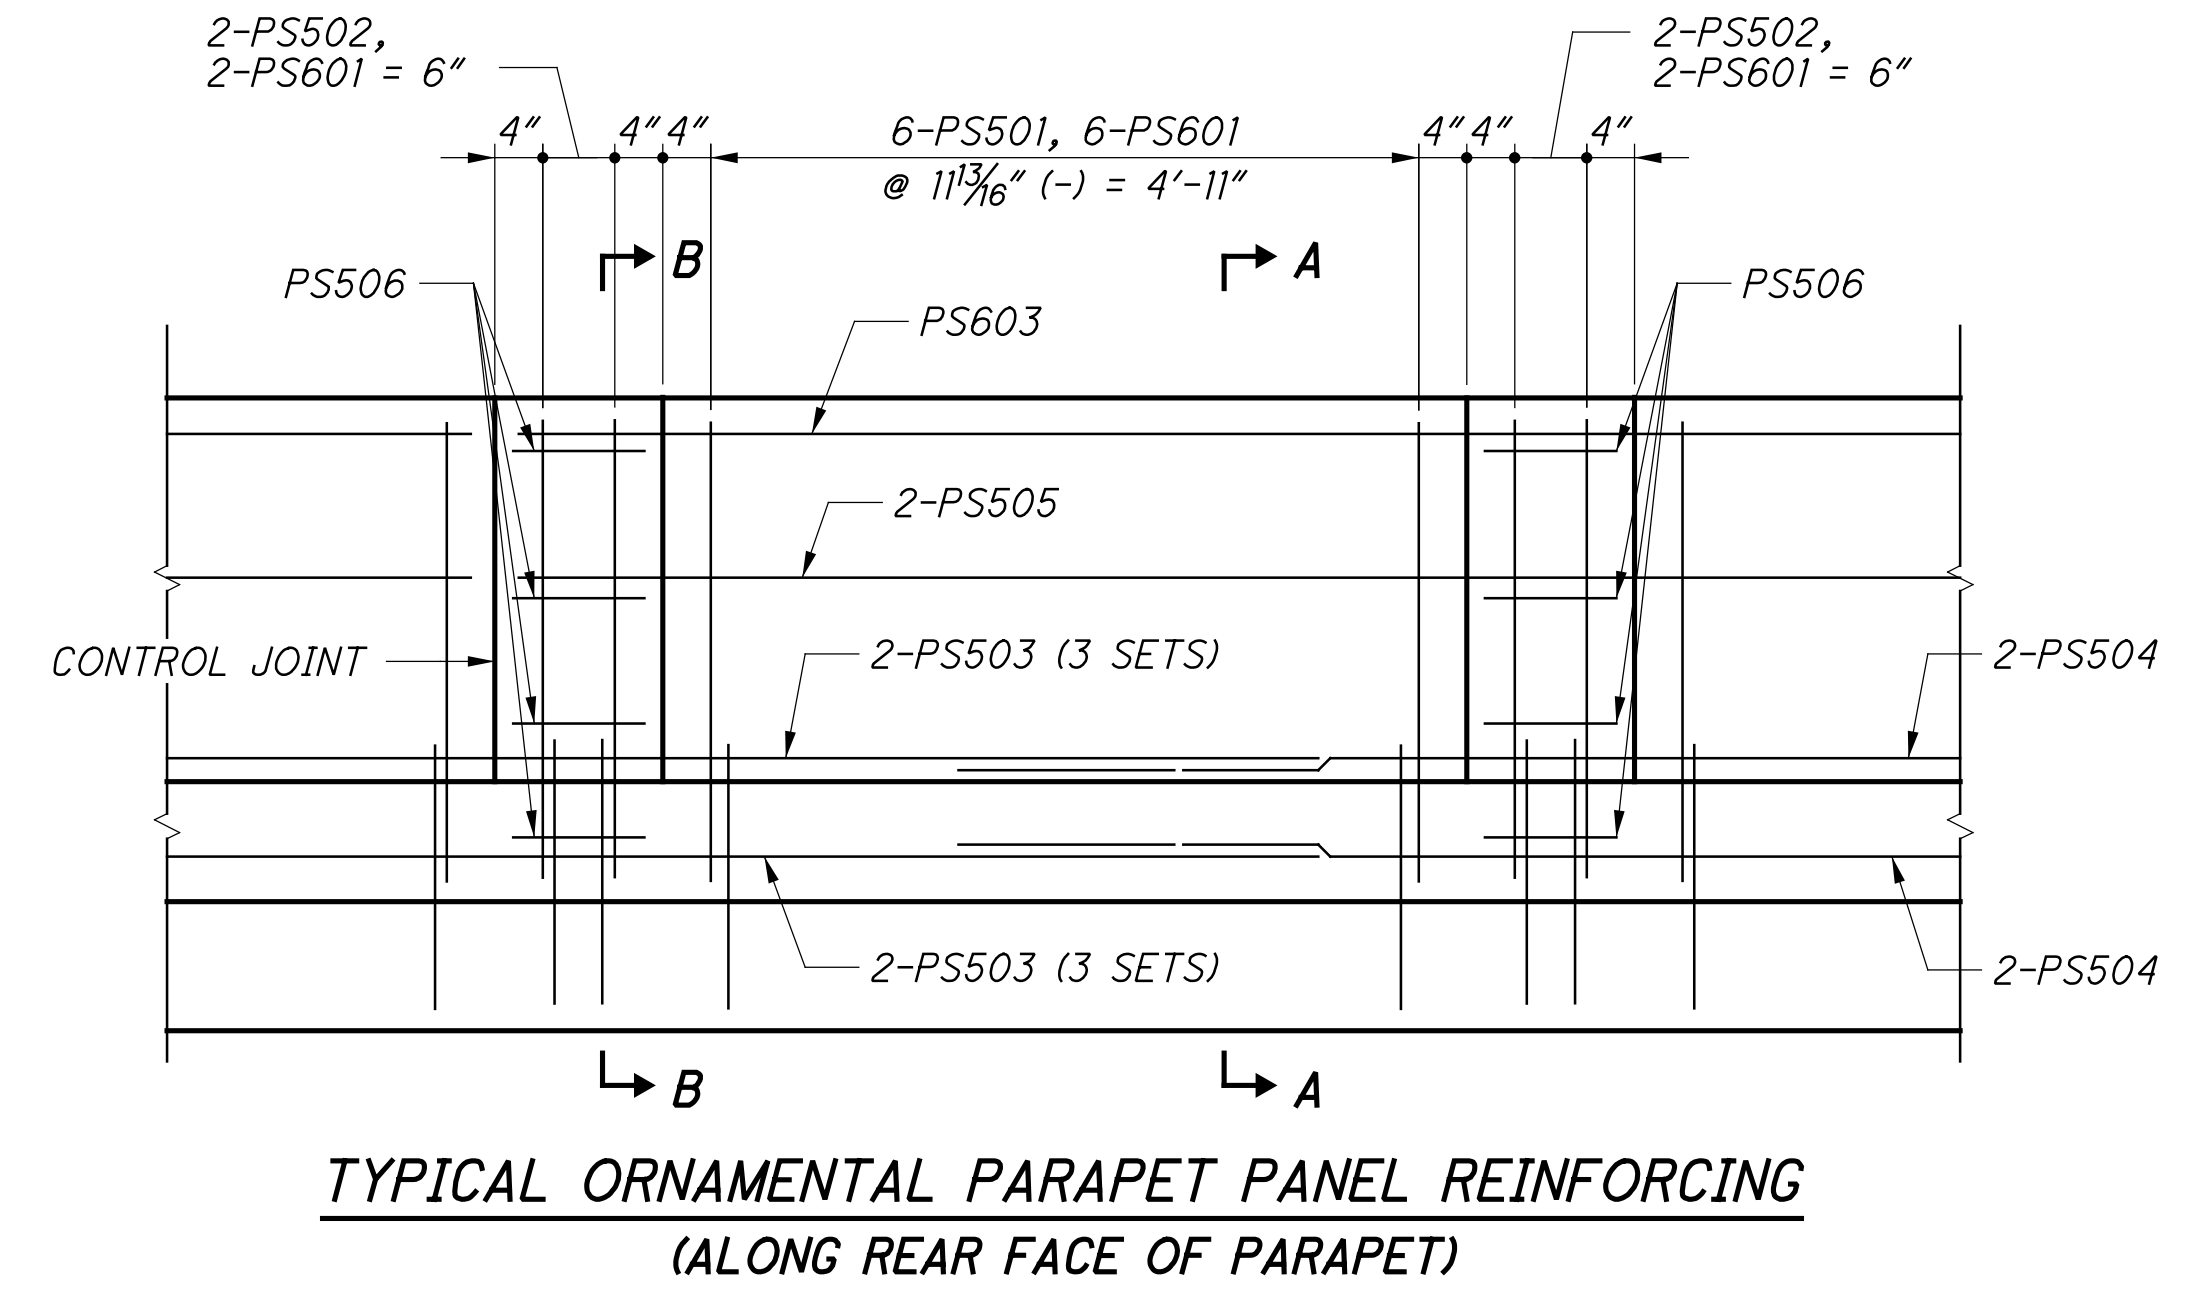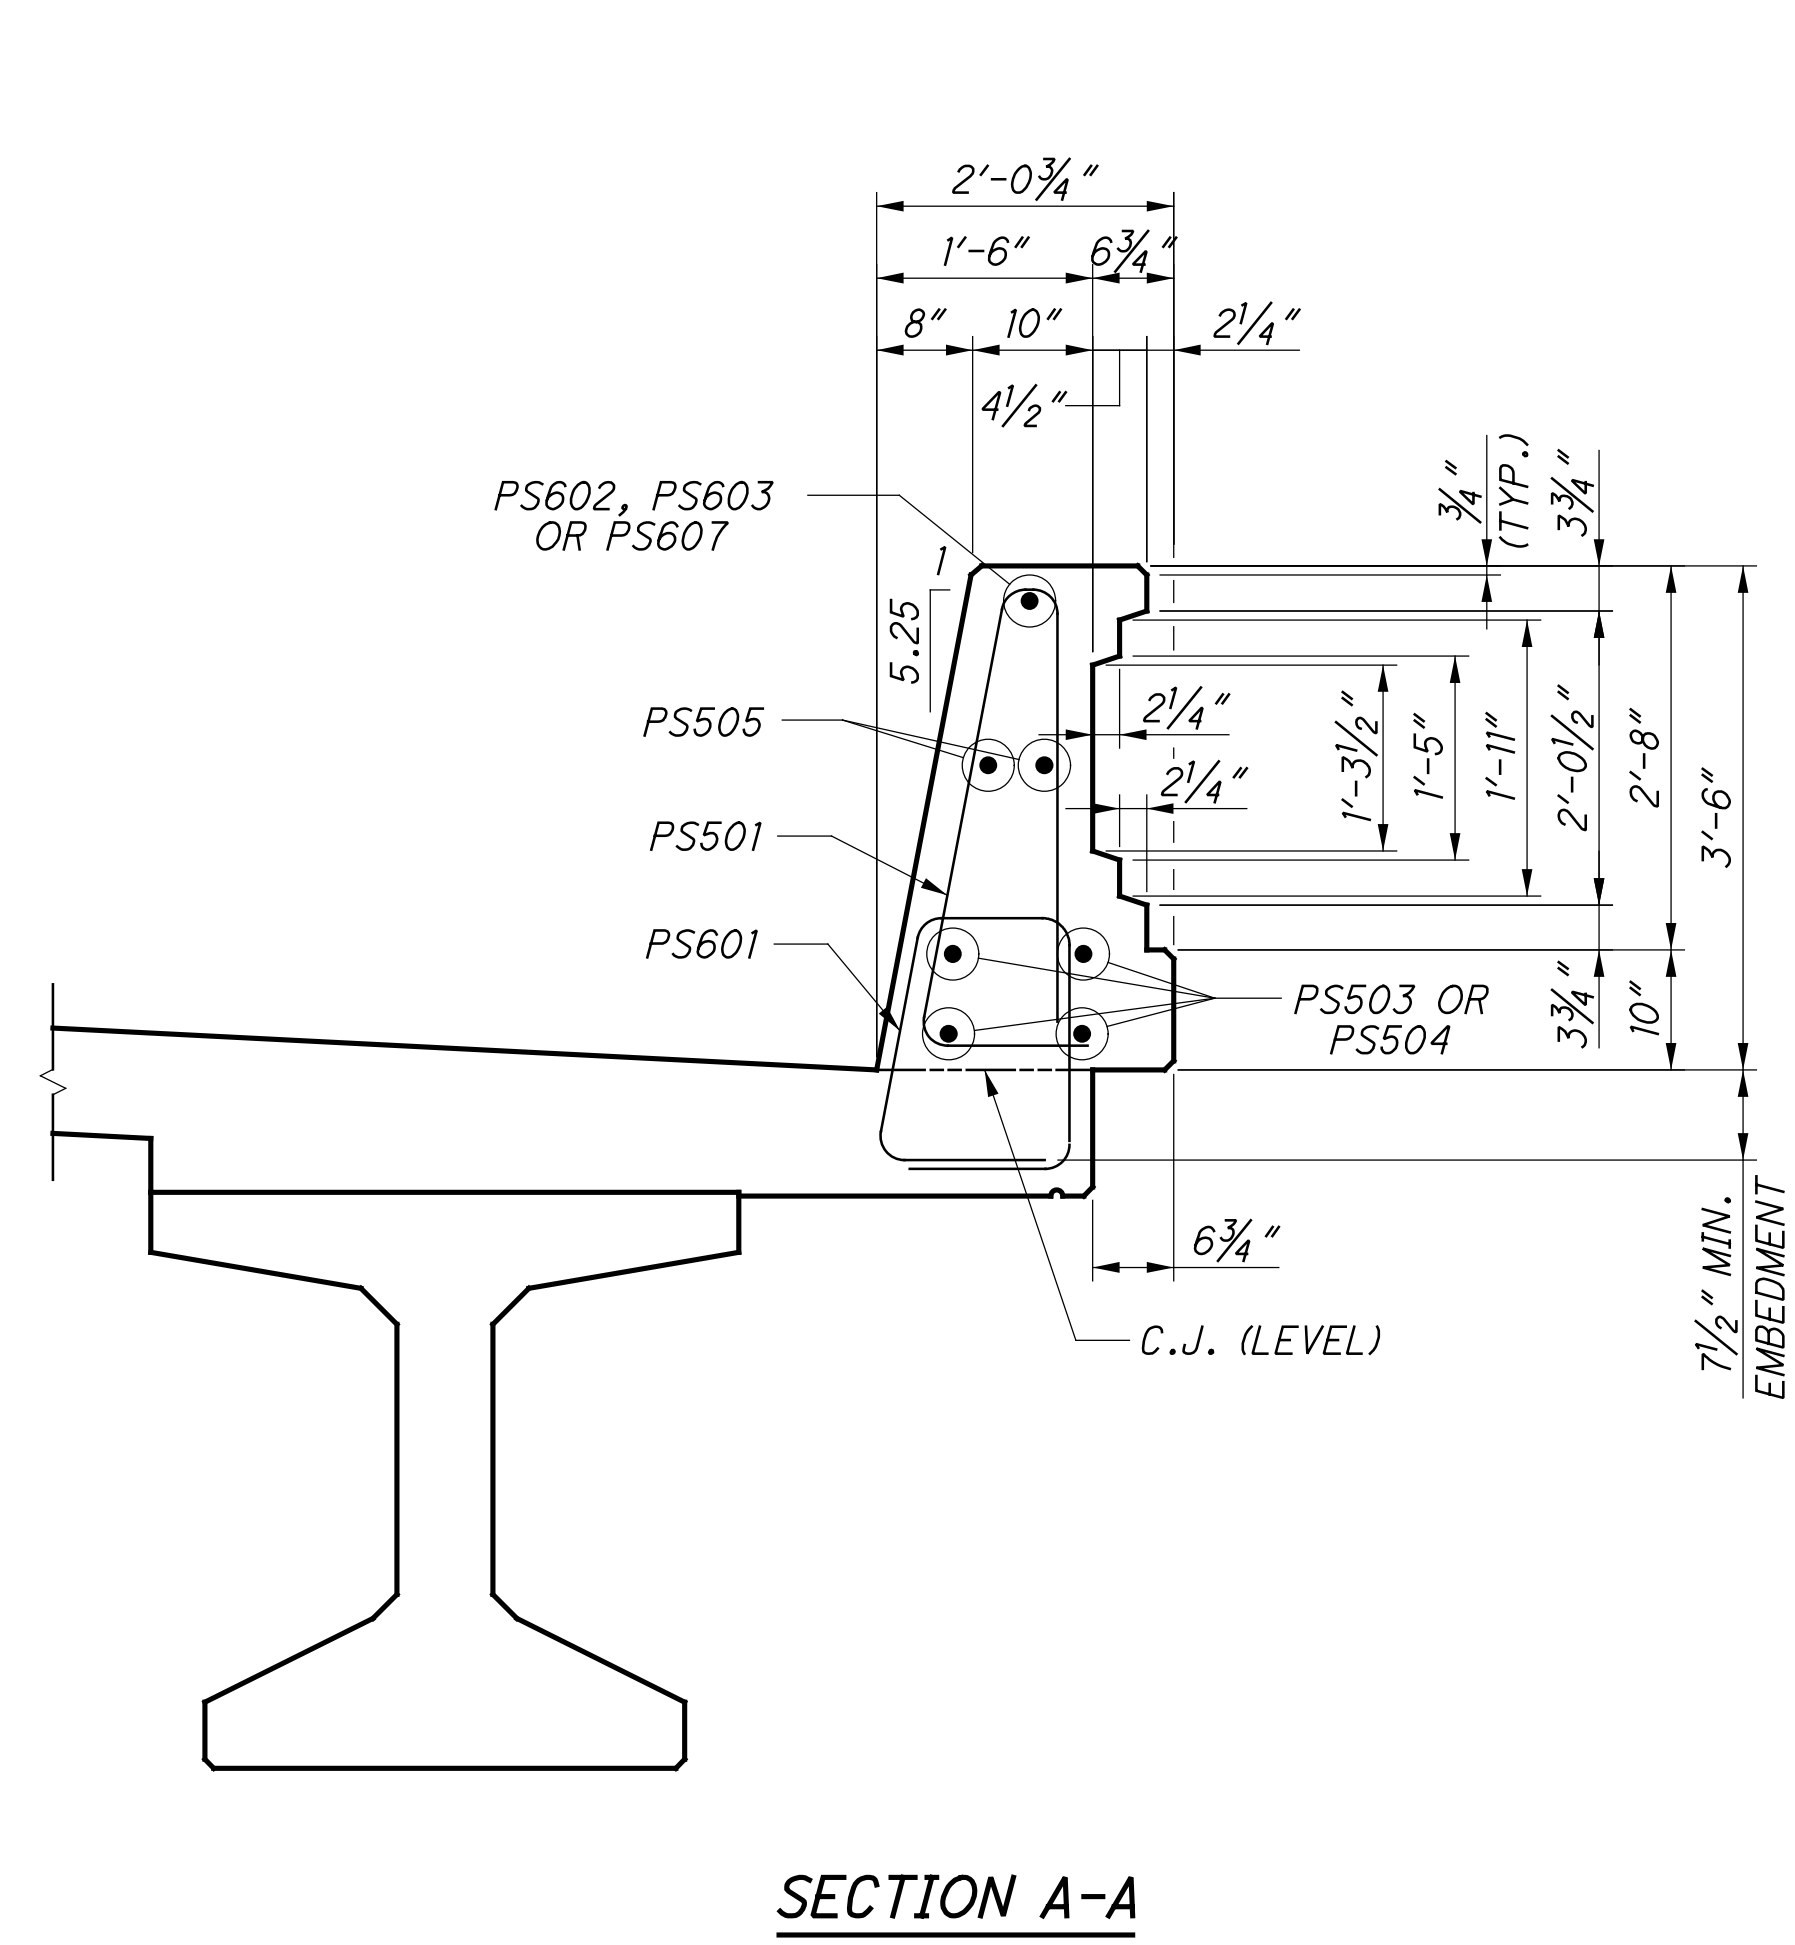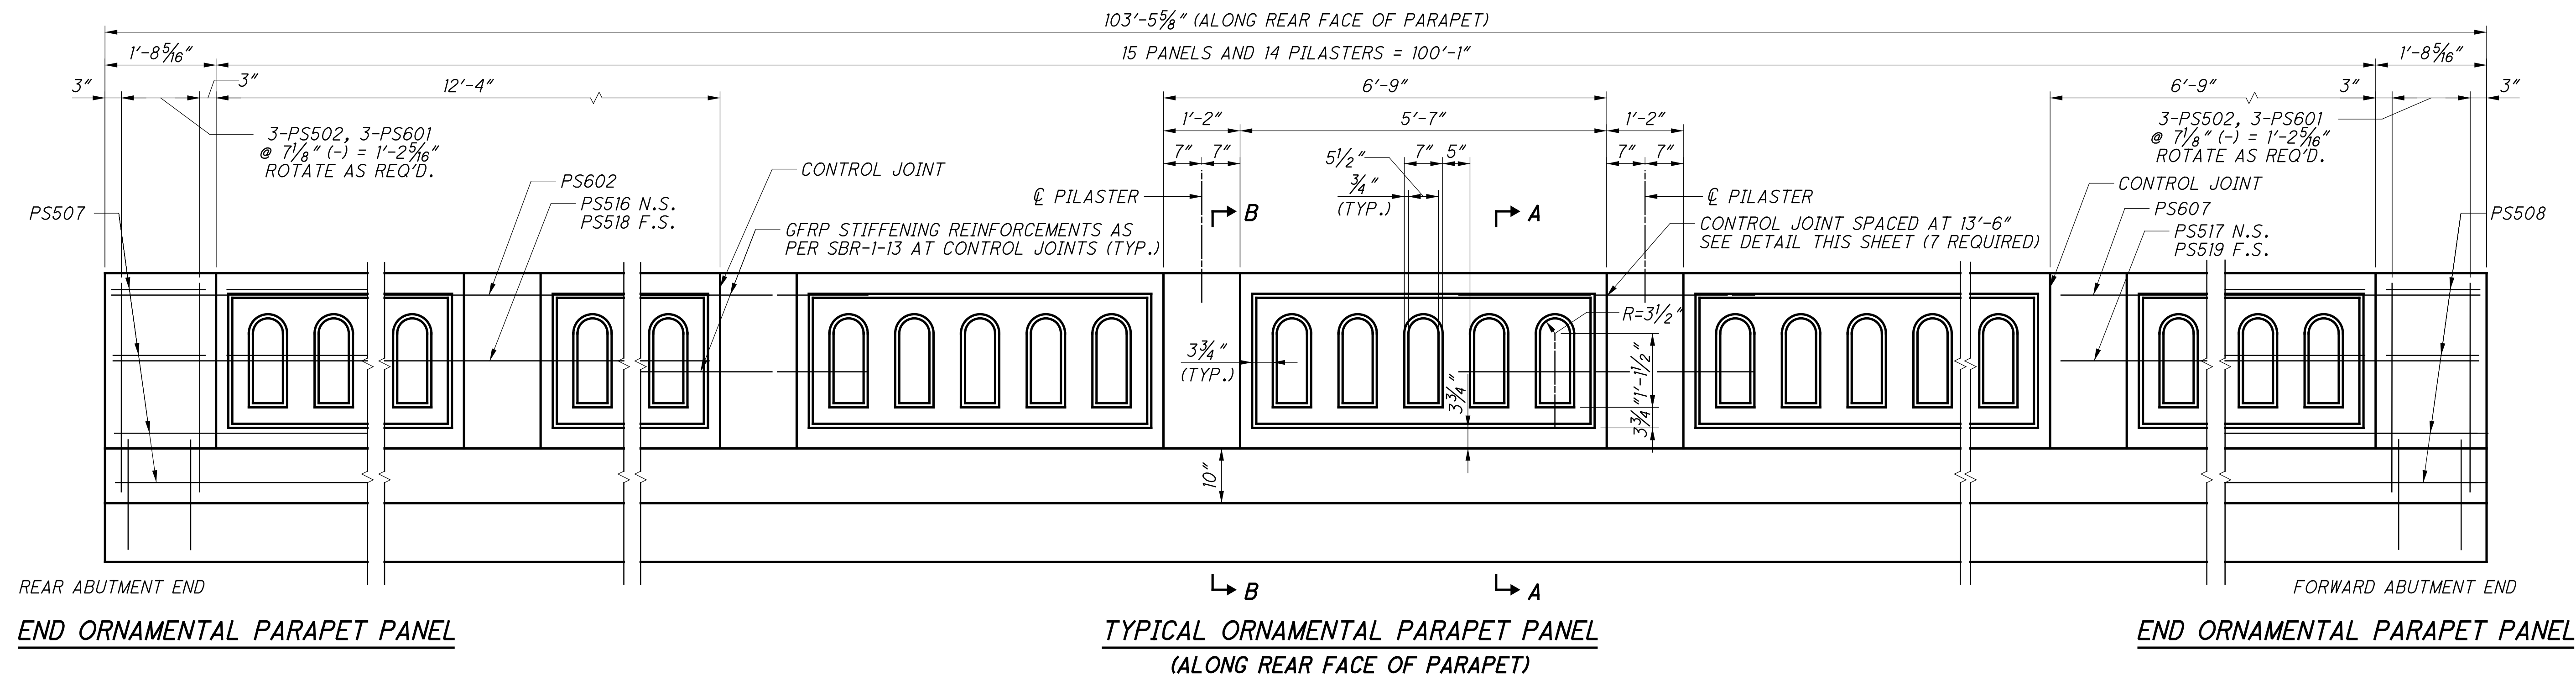

MINIMUM BAR LAP	
#5	2'-7"

- NOTES:
- SEE STANDARD BRIDGE DRAWING SBR-1-13 FOR ADDITIONAL DETAILS.
 - GFRP INDICATES 1/2" DIA. GLASS FIBER REINFORCED POLYMER STIFFENING REINFORCEMENT.

DESIGN AGENCY: STRUCTUREPOINT

DATE: 1/2/19

REVIEWED: MDS

STRUCTURE FILE NUMBER: 3109763

DESIGNED: SUJ

CHECKED: CLB

DRAWN: TLH

REVISED:

BRIDGE NO. HAM-75-0440 L/R

OVER IR-74 WB


HAM-75-3.84

PID No. 104667


52/68

52/68

SFlanagan
 10/26/2023 4:26:43 PM
 \\0\2017\01113\C.Design\104667-HAM-75-3.84\Design\Structures\HAM0075_0440C\Sheets\HAM0075_0440C_RA002.dgn

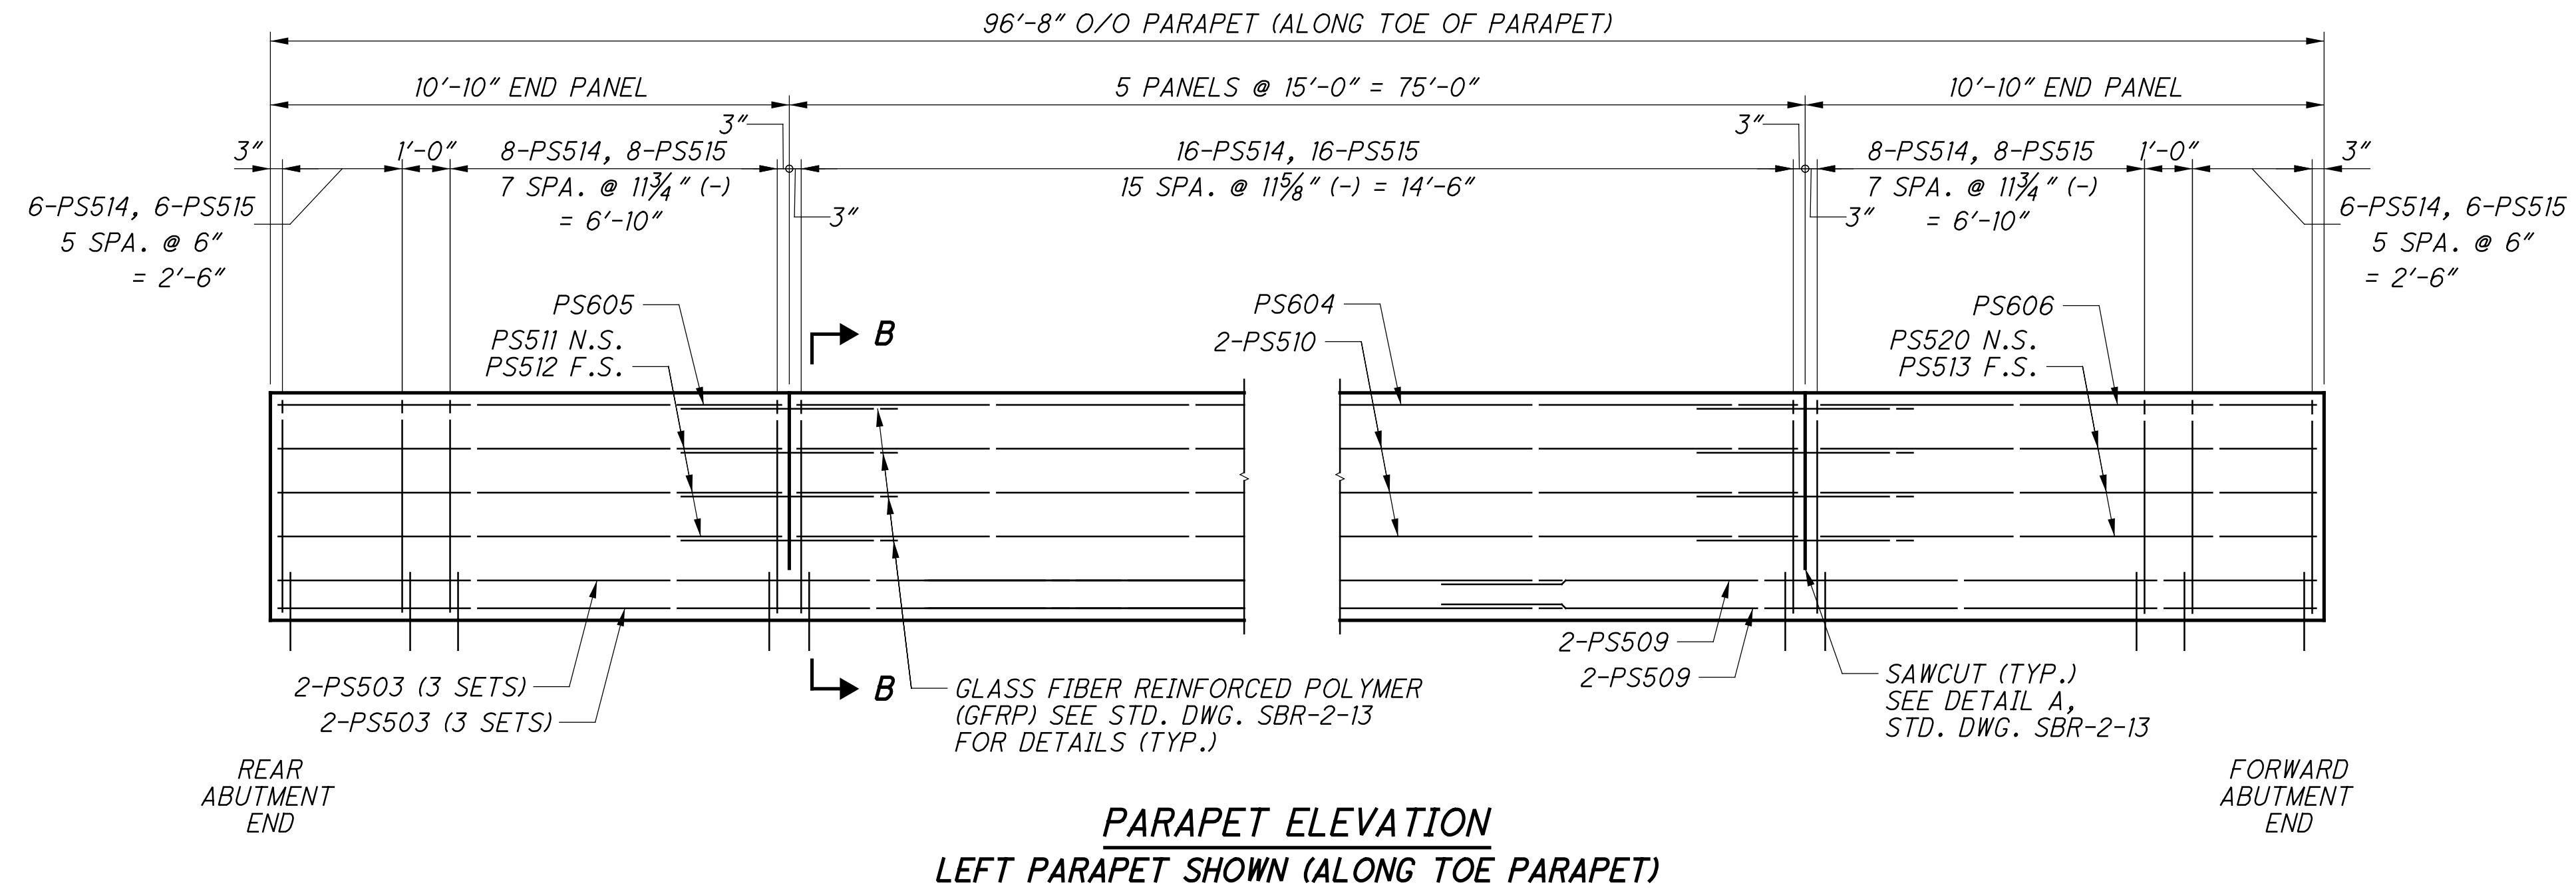

PARAPET ELEVATION
 LEFT PARAPET SHOWN (ALONG TOE PARAPET)

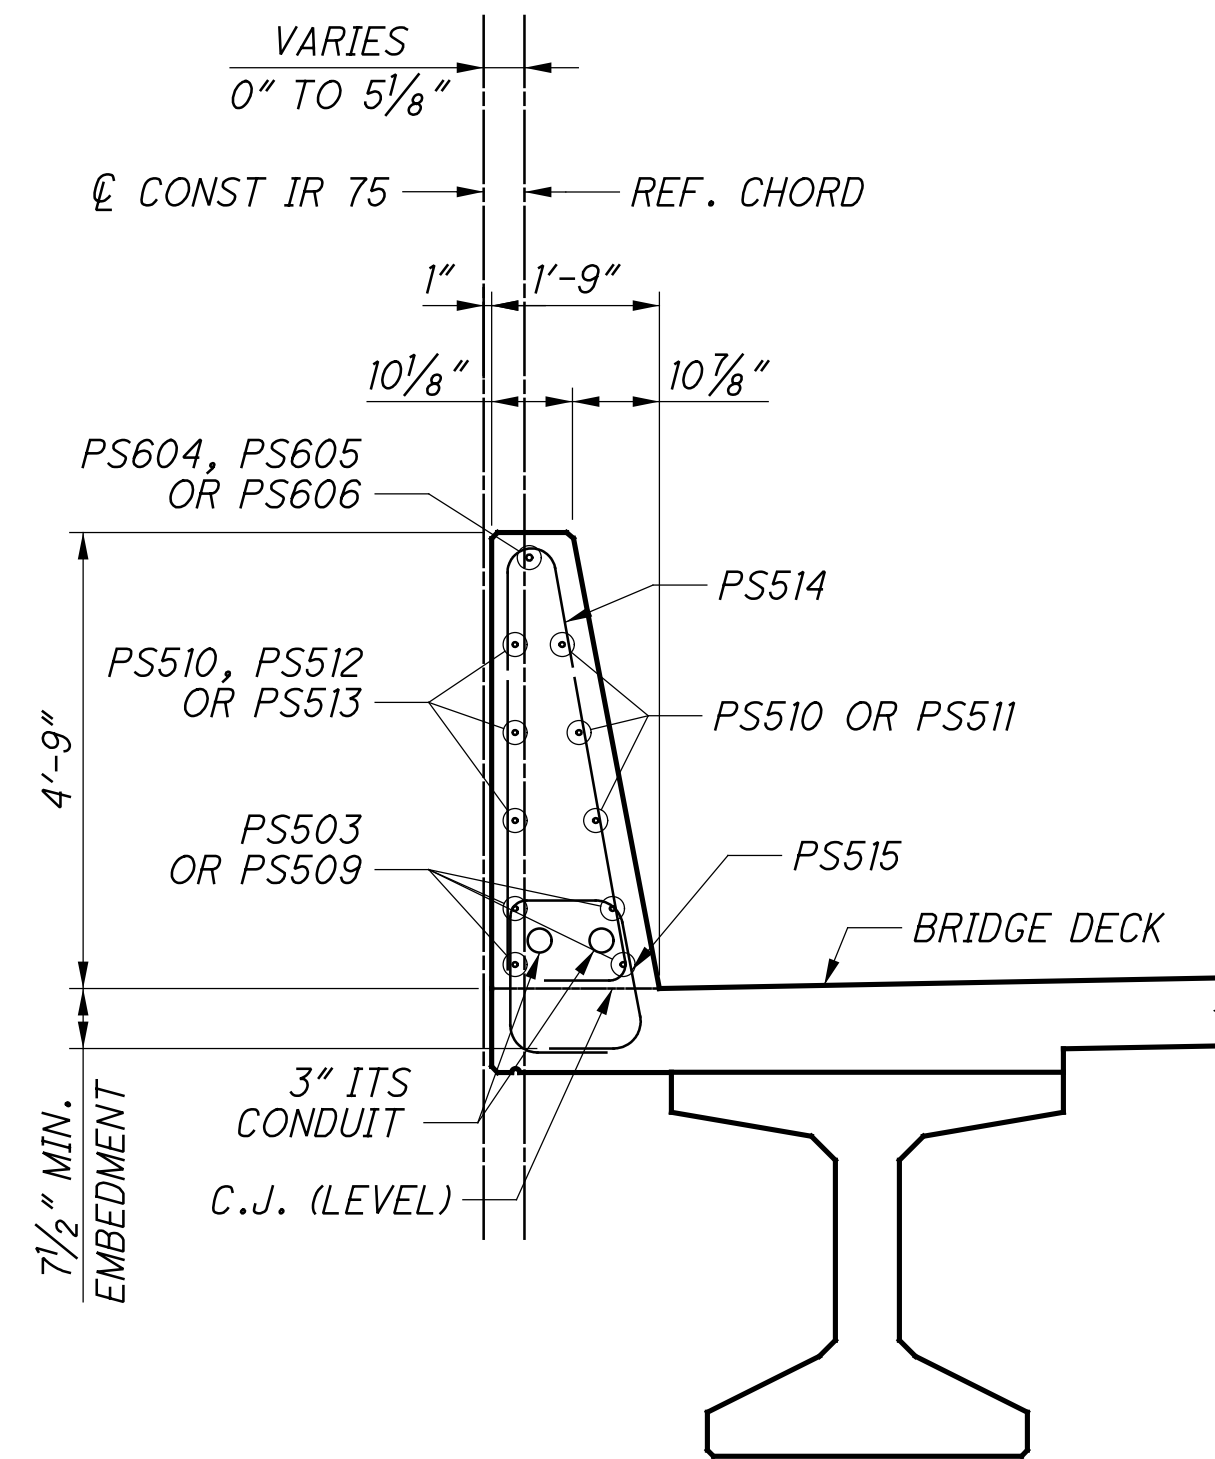

SECTION B-B

MINIMUM BAR LAP	
#5	2'-7"


NOTES:
 1. SEE STANDARD BRIDGE DRAWING SBR-2-13 FOR ADDITIONAL DETAILS.

DESIGNED	SJF	CHECKED	CLB
DRAWN	TLH	REVISED	
REVIEWED	MDS	DATE	1/2/19
STRUCTURE FILE NUMBER	3109163		


PARAPET DETAILS (RIGHT BRIDGE)
 BRIDGE NO. - HAM-75-0440 L/R
 OVER IR-74 WB

HAM-75-3.84
PID No. 104667


SFlansgan
 10/26/2023 4:26:44 PM
 \\01\2017\01113\C.Design\104667_HAM-75-3.84\Design\Structures\HAM0075_0440C_Sheets\HAM0075_0440C_RA010.dgn

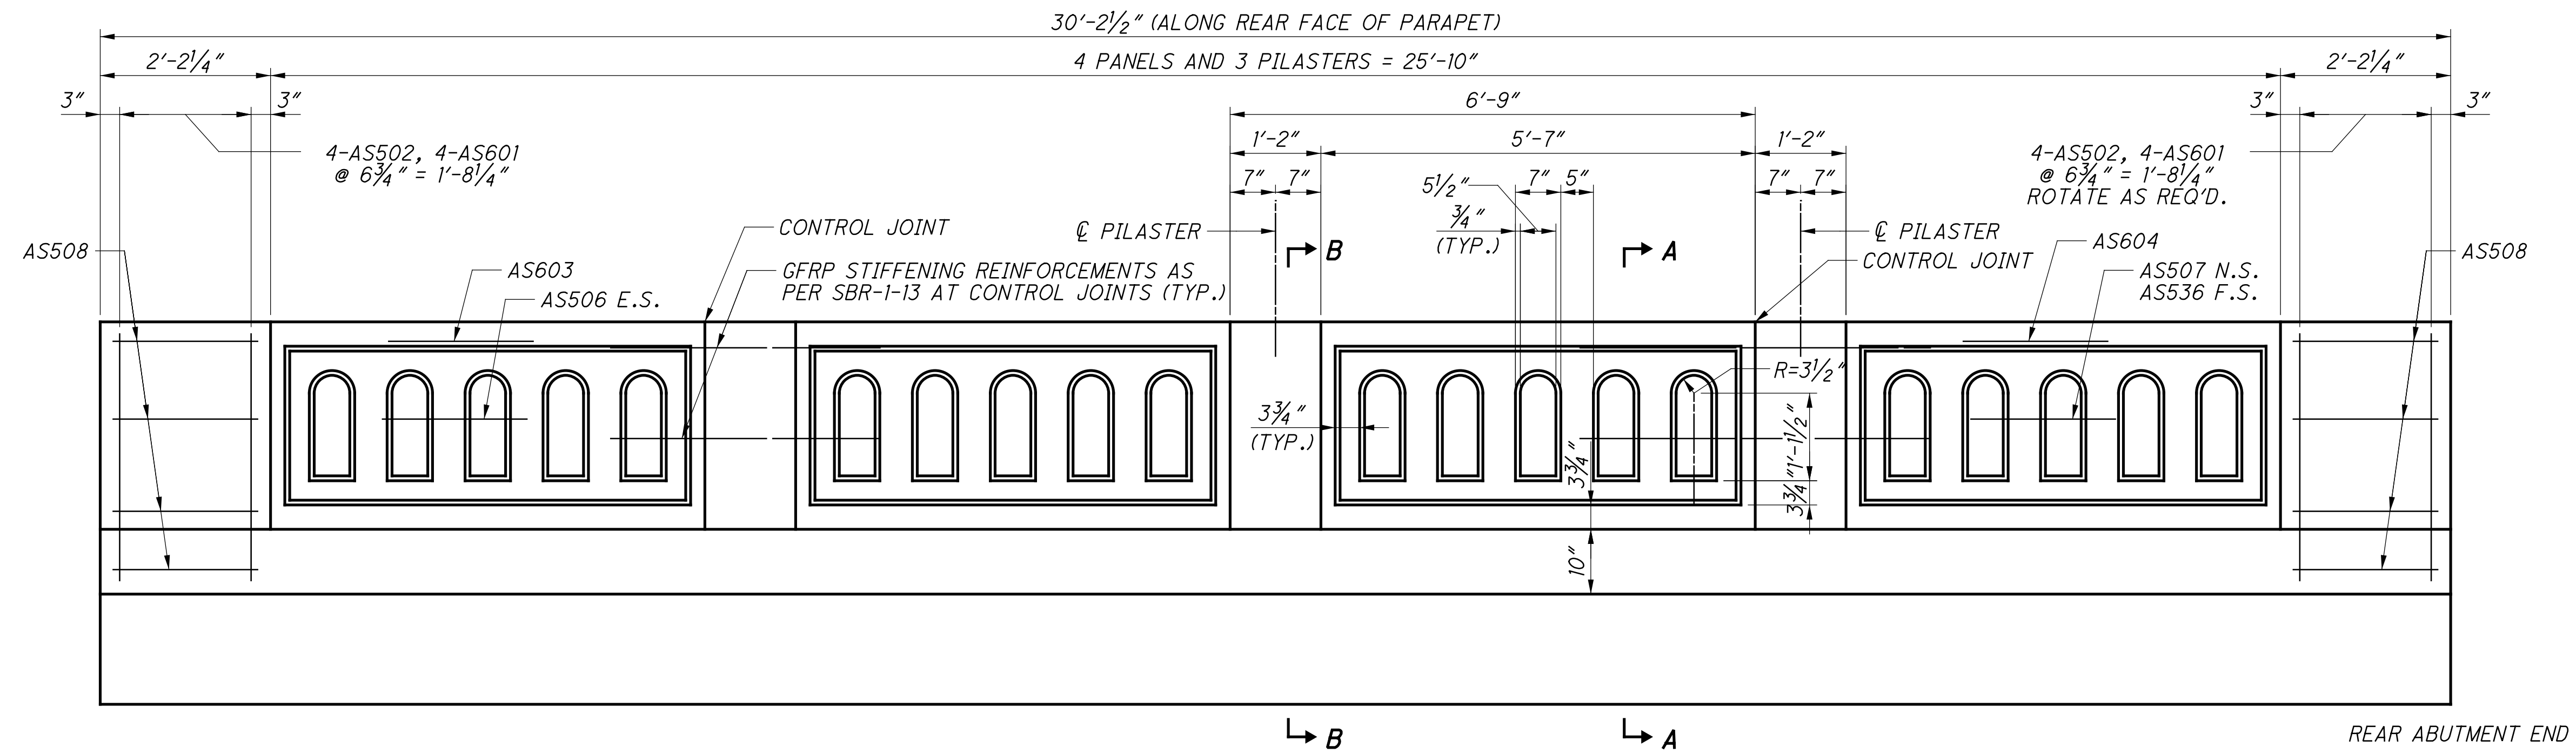


REAR ABUTMENT APPROACH SLAB ORNAMENTAL PARAPET PANEL
 (ALONG REAR FACE OF PARAPET)

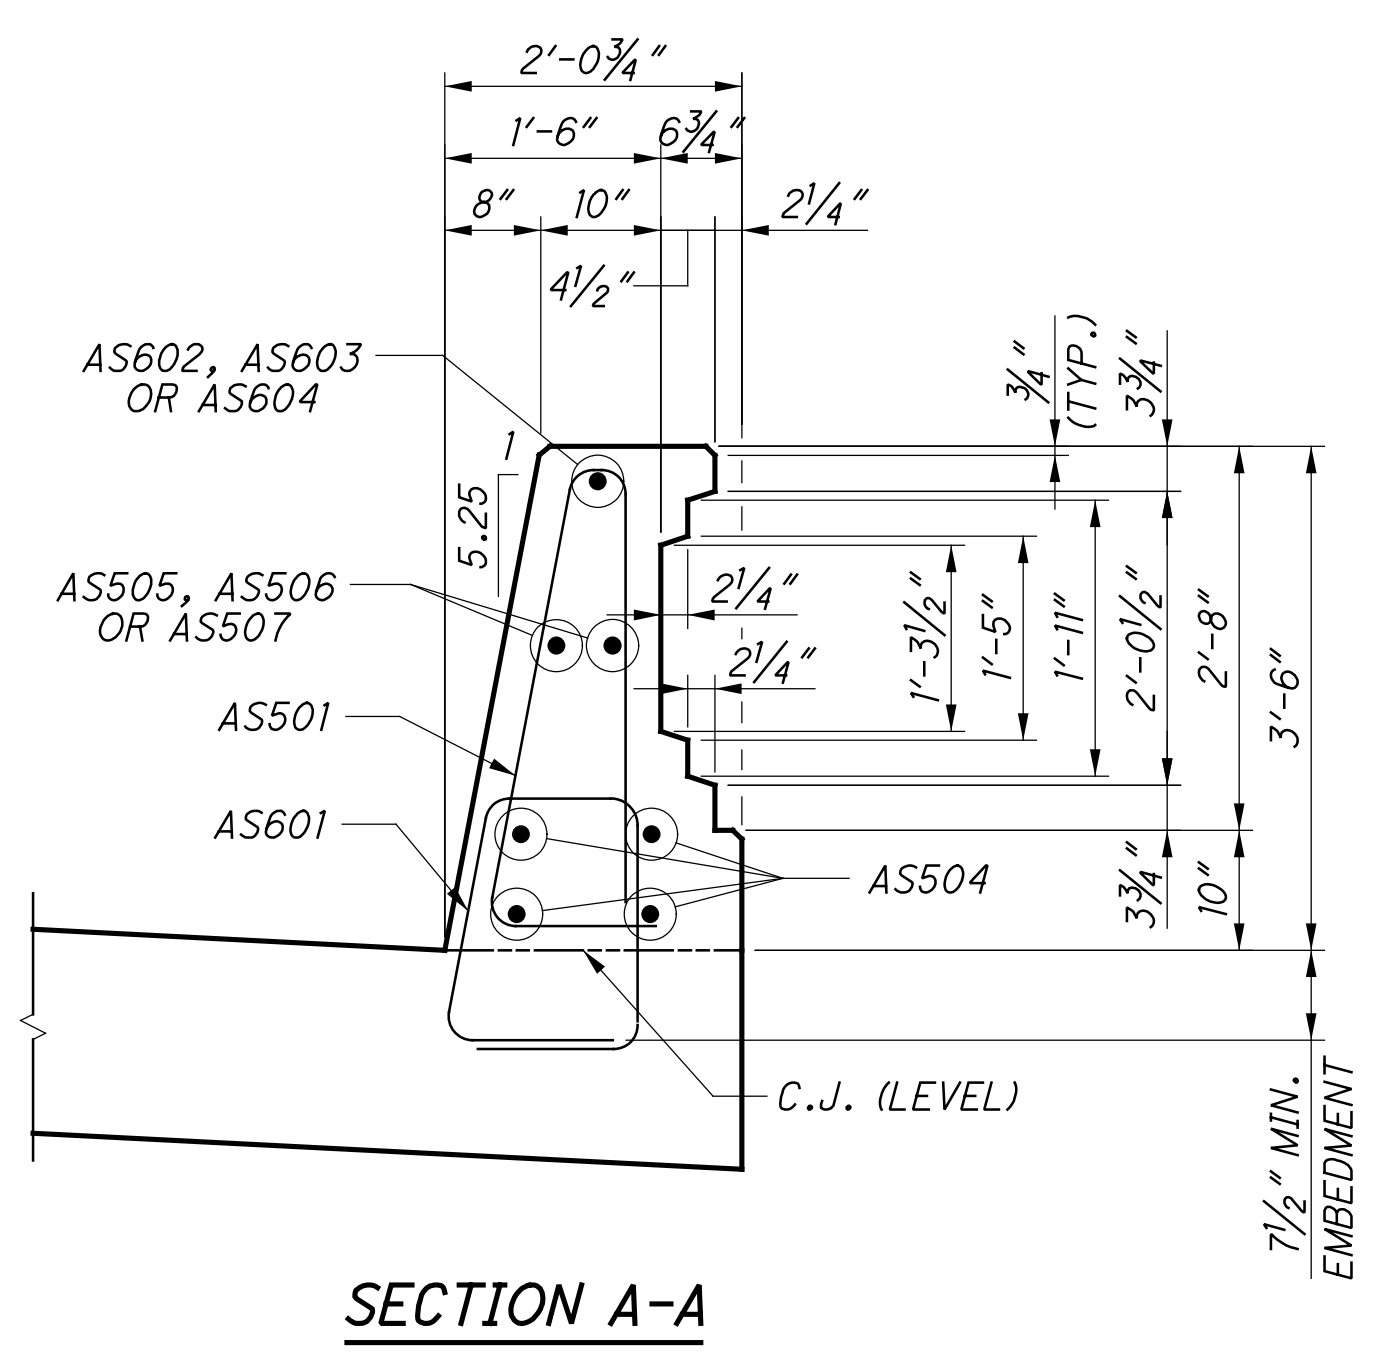


SECTION A-A

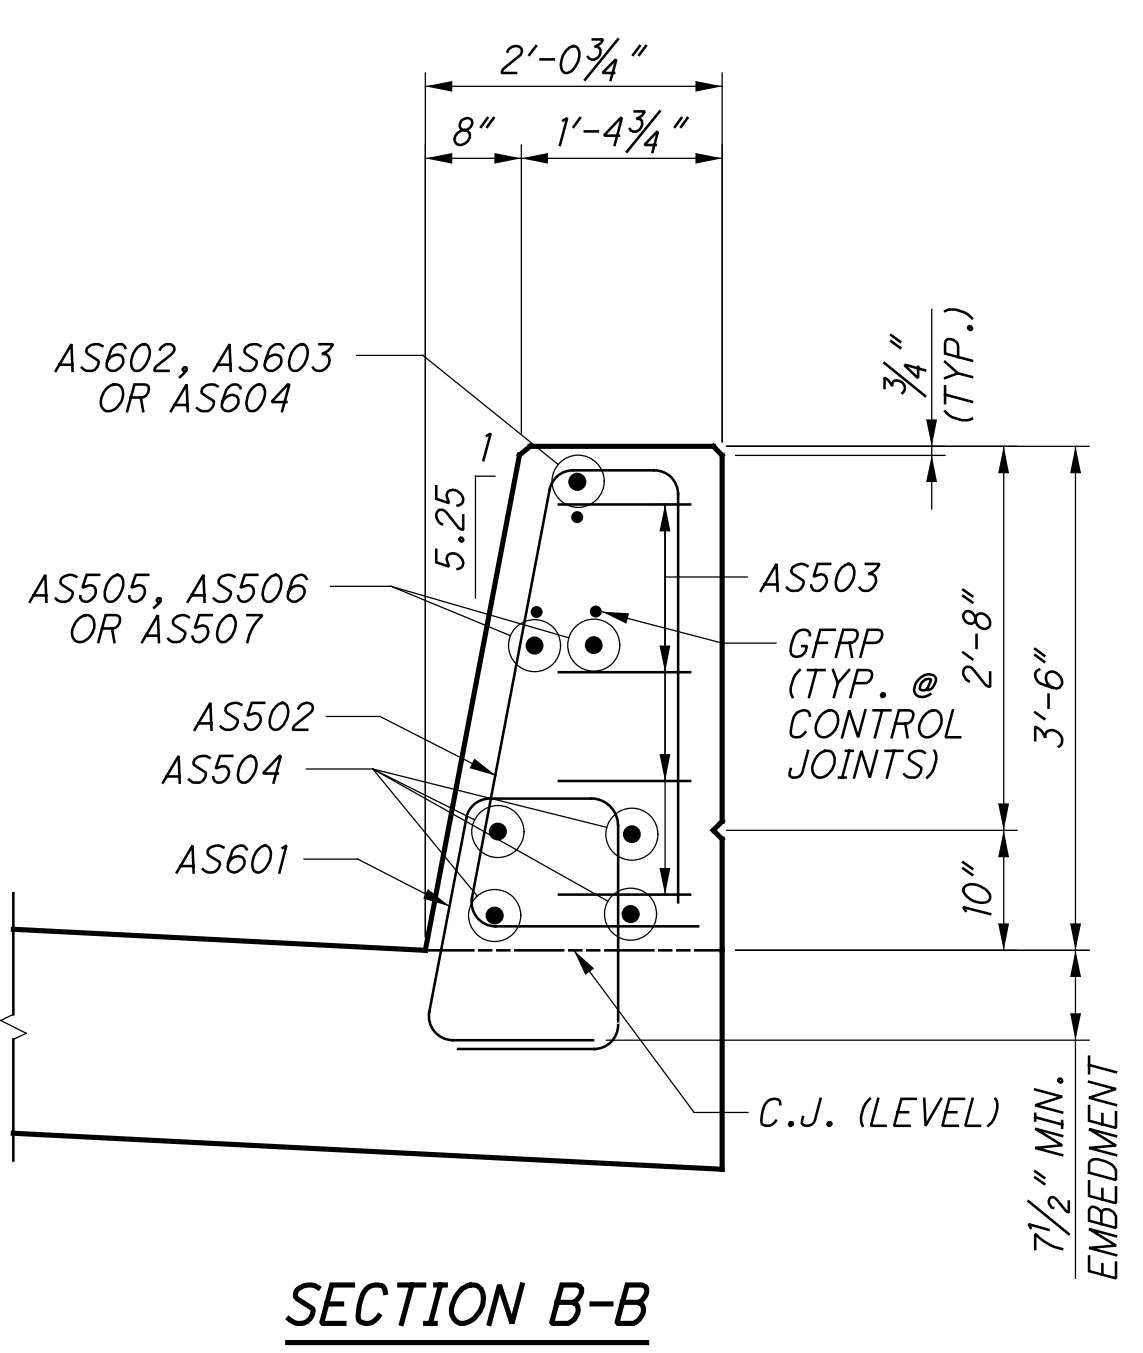

SECTION B-B

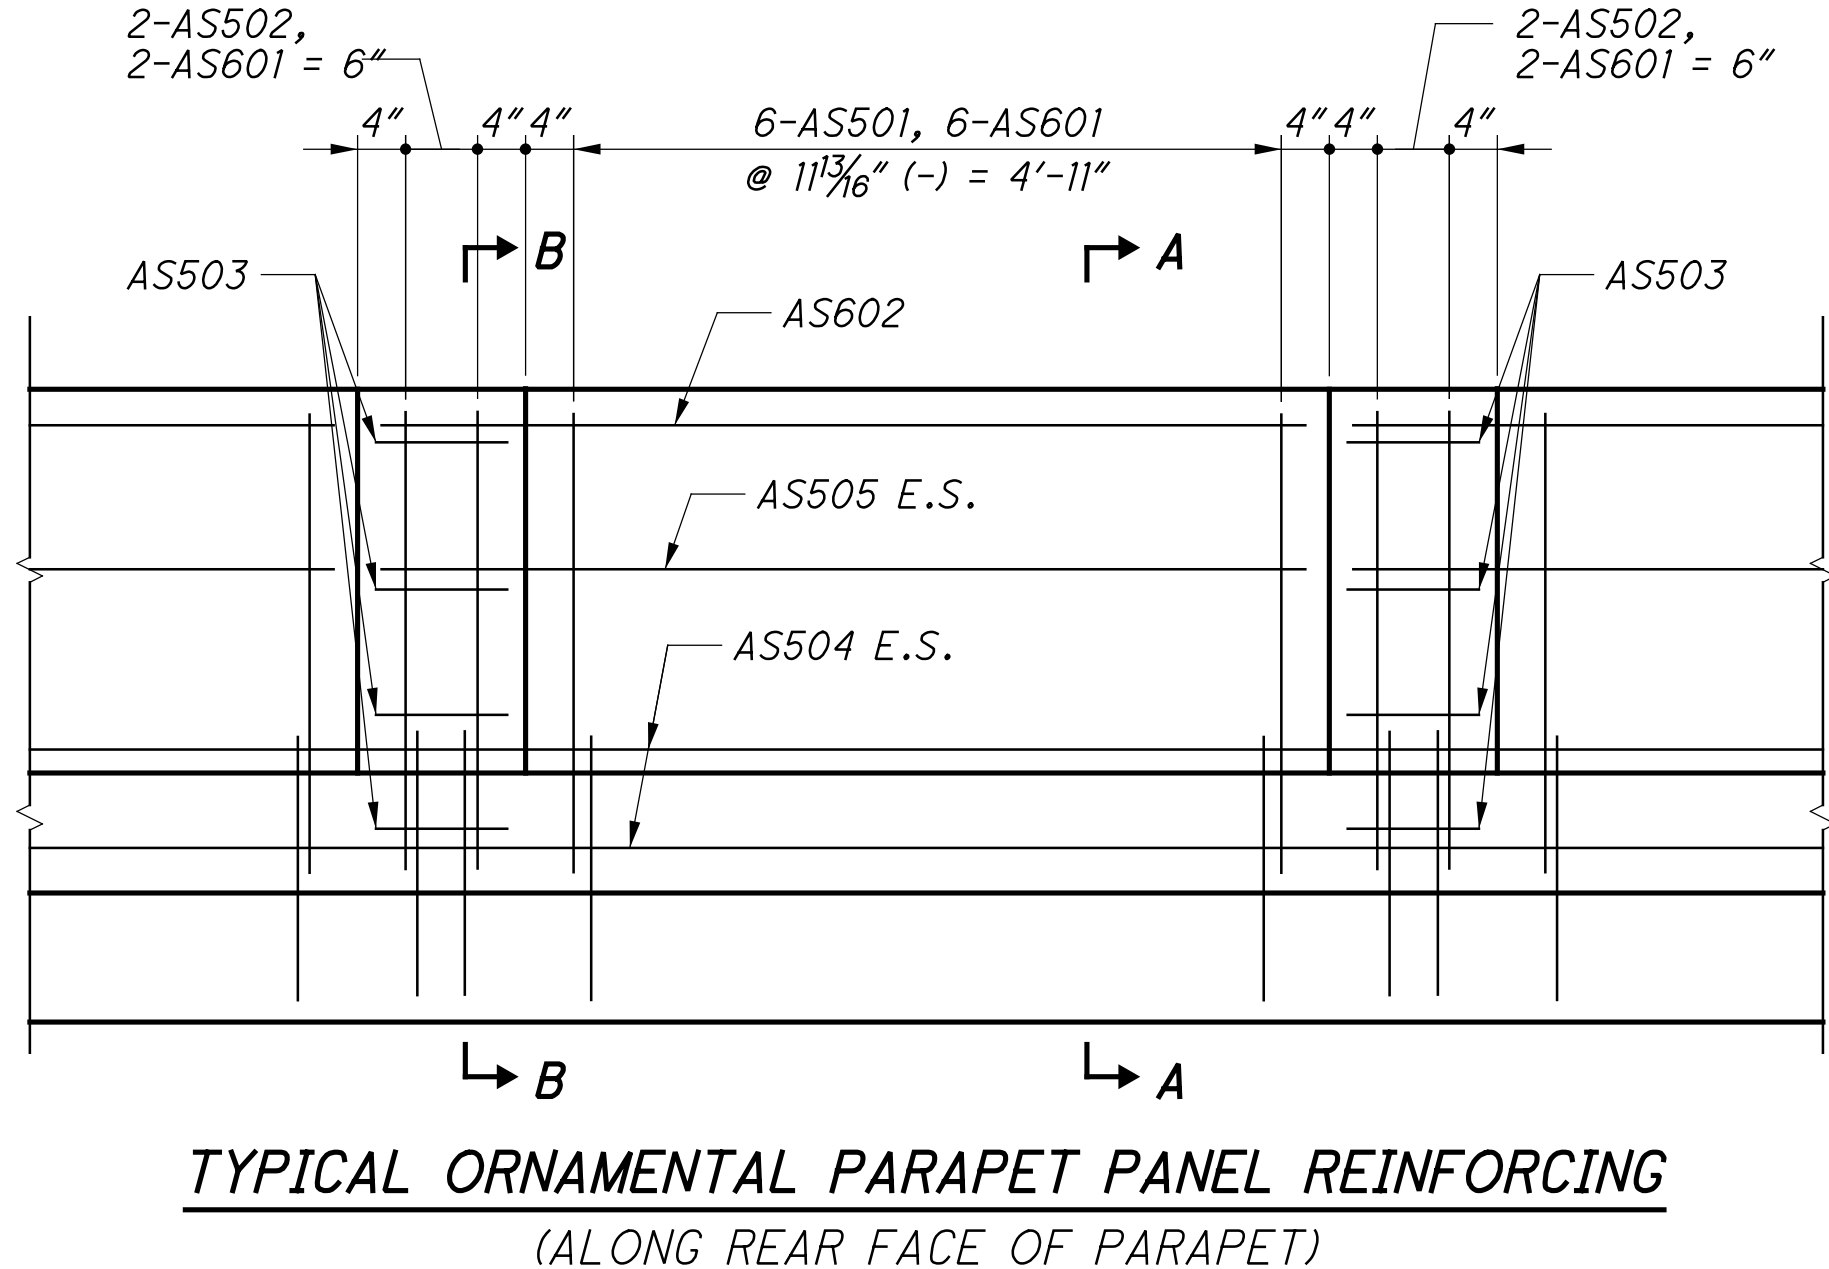

TYPICAL ORNAMENTAL PARAPET PANEL REINFORCING
 (ALONG REAR FACE OF PARAPET)

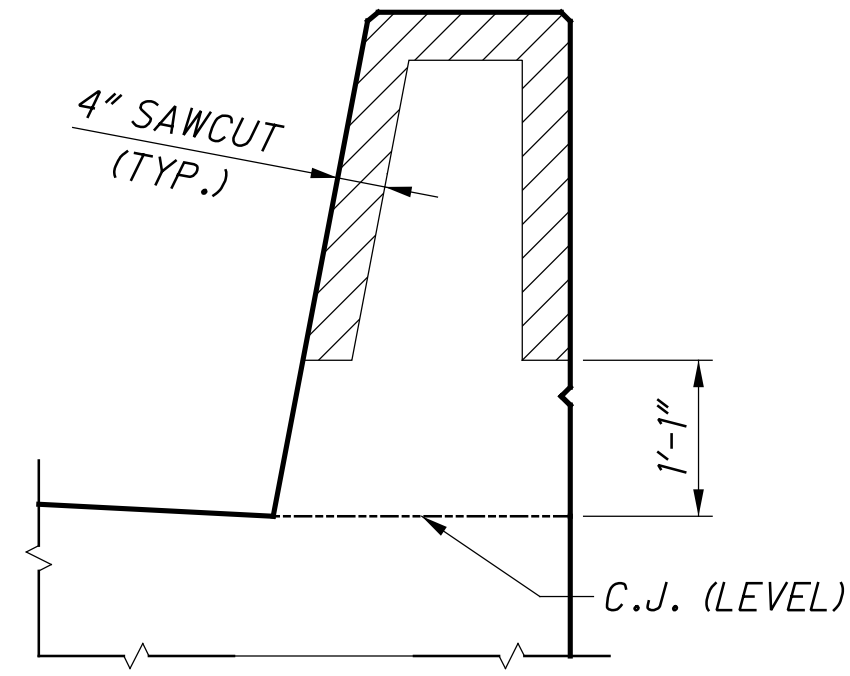


SECTION THRU CONTROL JOINT DETAIL


MINIMUM BAR LAP	
#5	2'-7"

- NOTES:
- SEE STANDARD BRIDGE DRAWING SBR-1-13 FOR ADDITIONAL DETAILS.
 - GFRP INDICATES 1/2" DIA. GLASS FIBER REINFORCED POLYMER STIFFENING REINFORCEMENT.


	DESIGN AGENCY STRUCTUREPOINT
DESIGNED SUJ	DRAWN DSH
CHECKED CLB	REVIEWED MDS
DATE 1/2/19	FILE NUMBER 3109163
PARAPET DETAILS (RIGHT BRIDGE) BRIDGE NO. - HAM-75-0440 L/R OVER WB I-74	
HAM-75-3.84	PID No. 104667
54 / 68	54 68

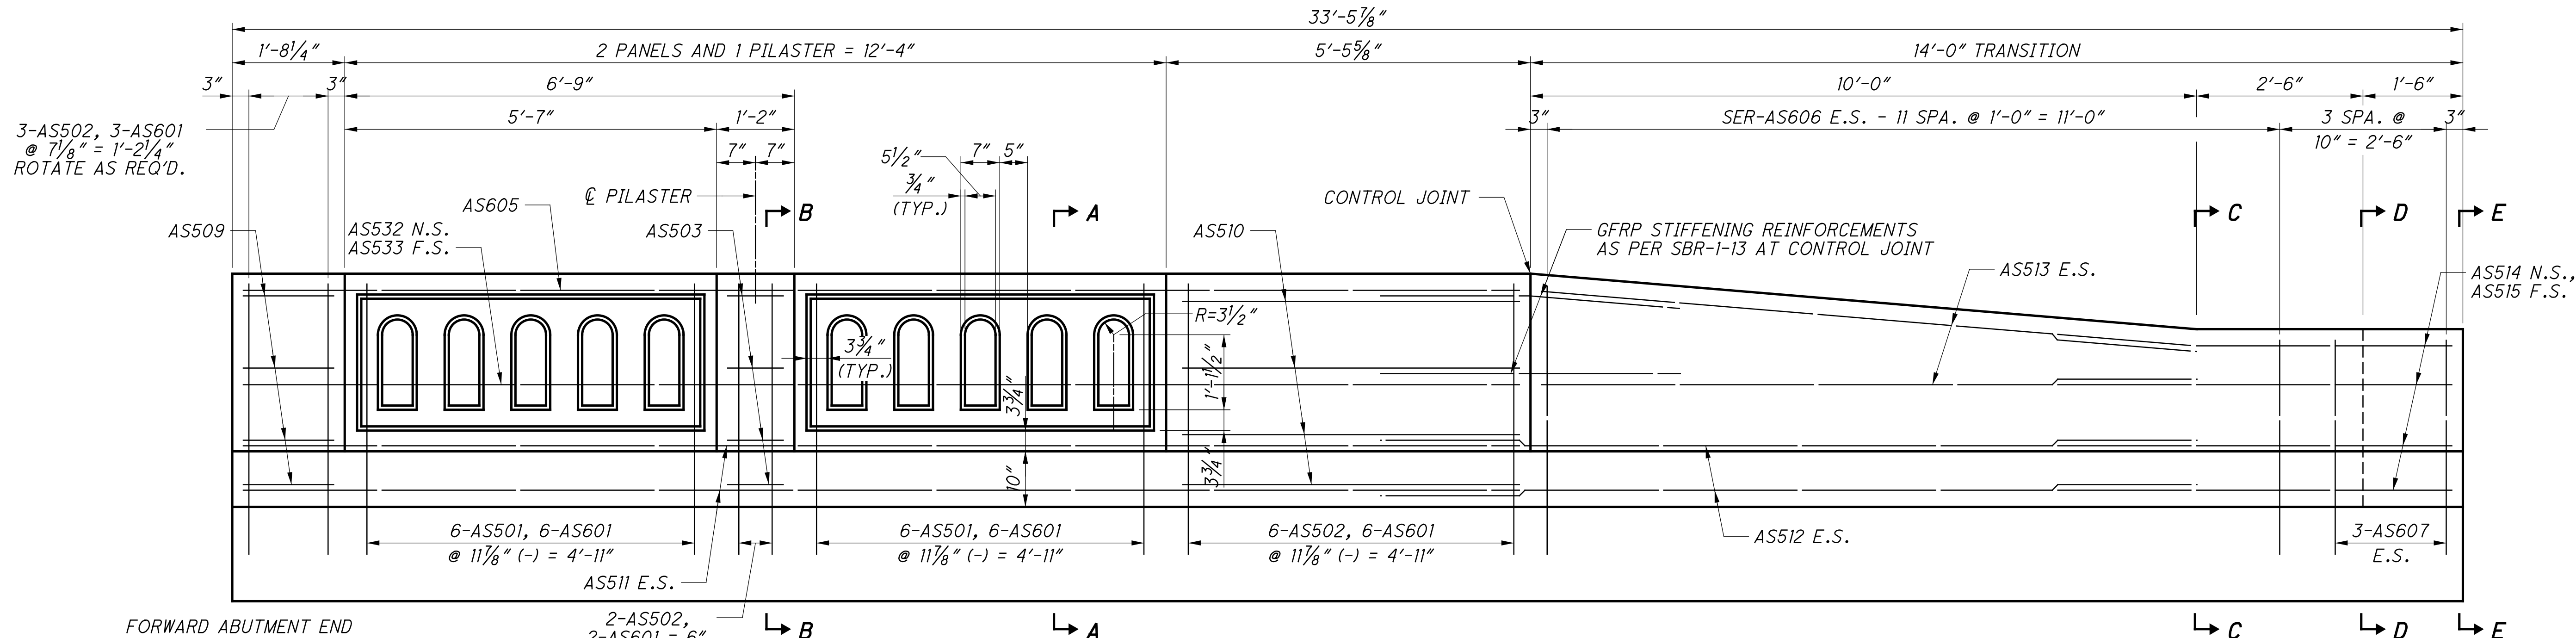


FORWARD ABUTMENT APPROACH SLAB ORNAMENTAL PARAPET PANEL
(ALONG REAR FACE OF PARAPET)

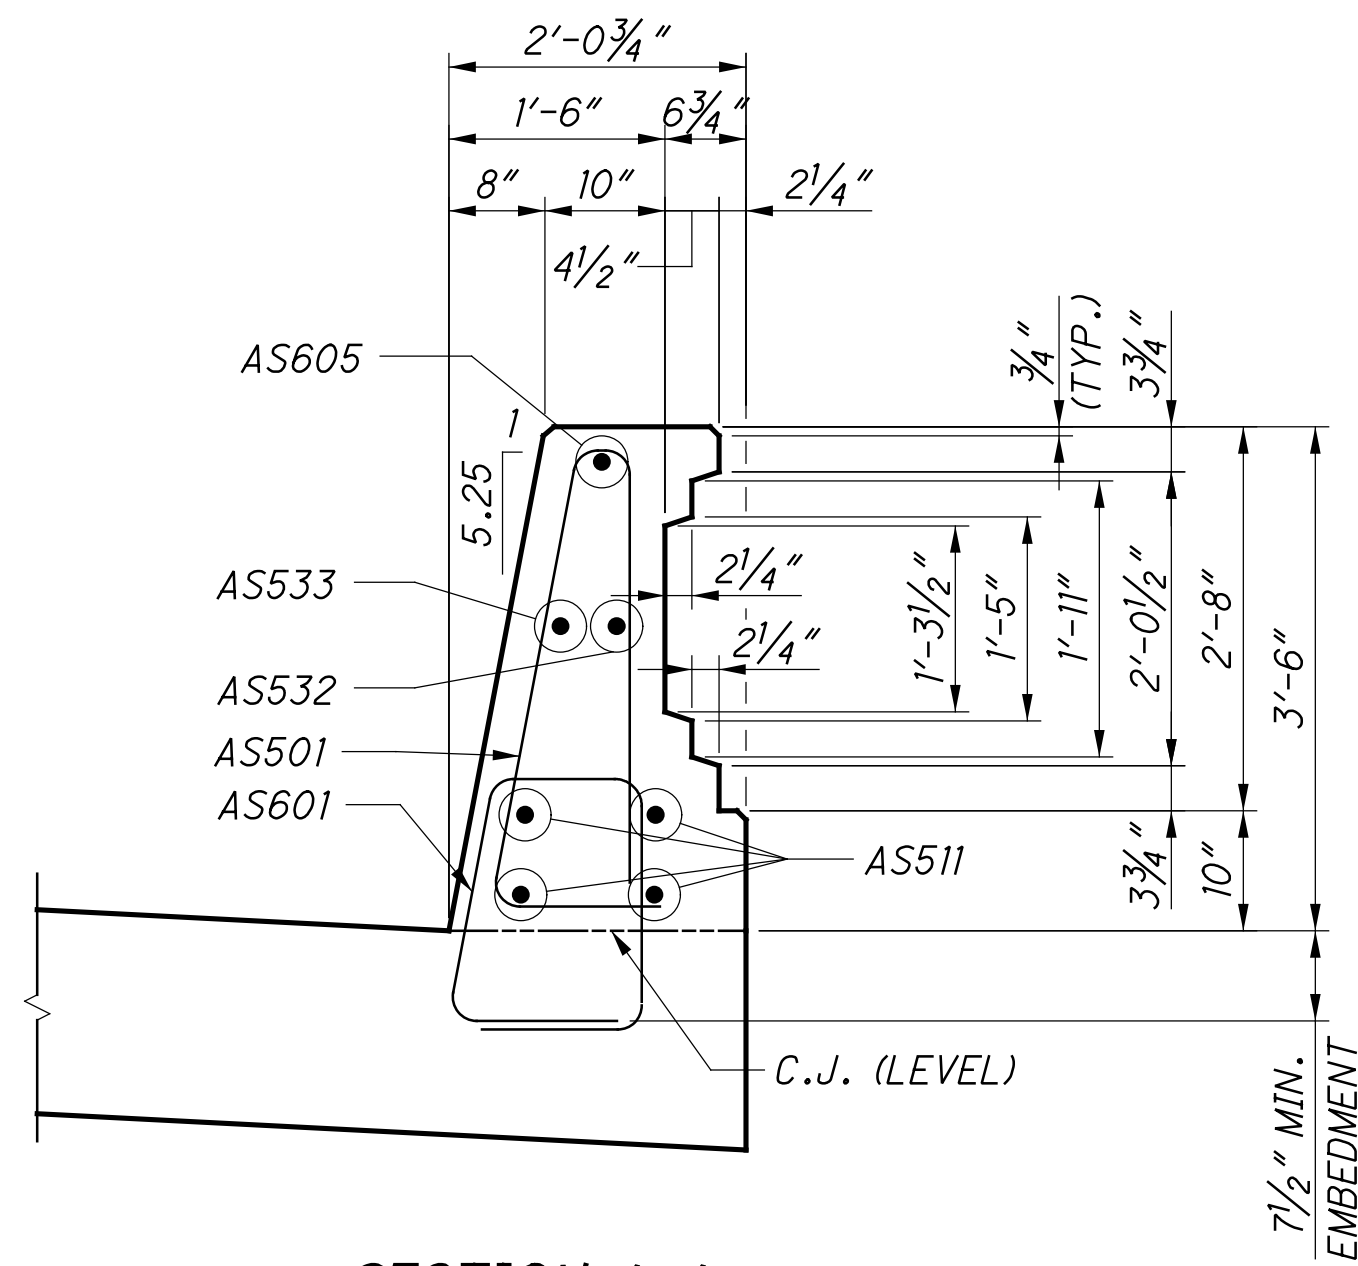


SECTION A-A

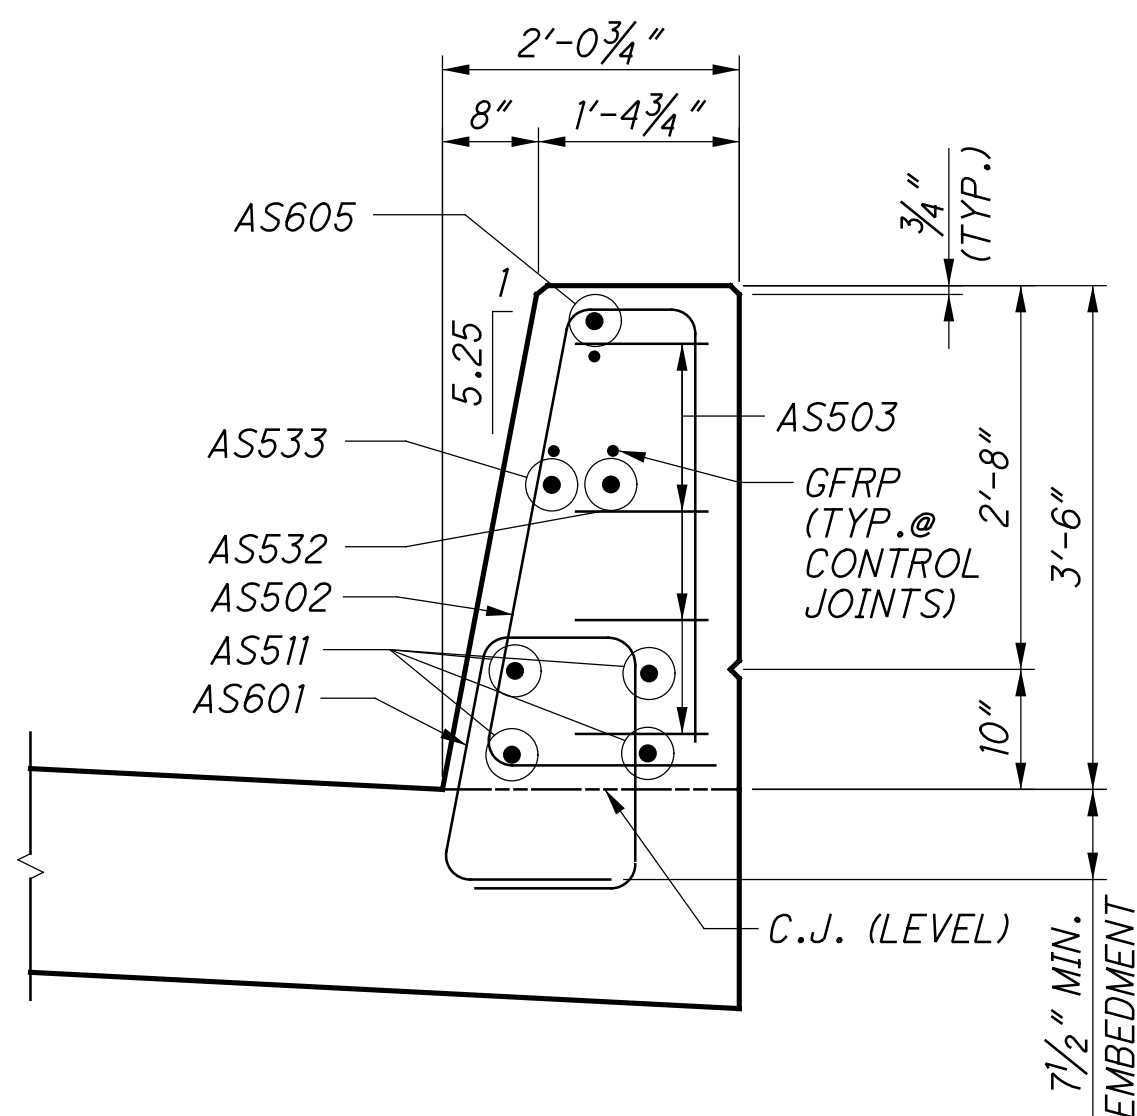


SECTION B-B

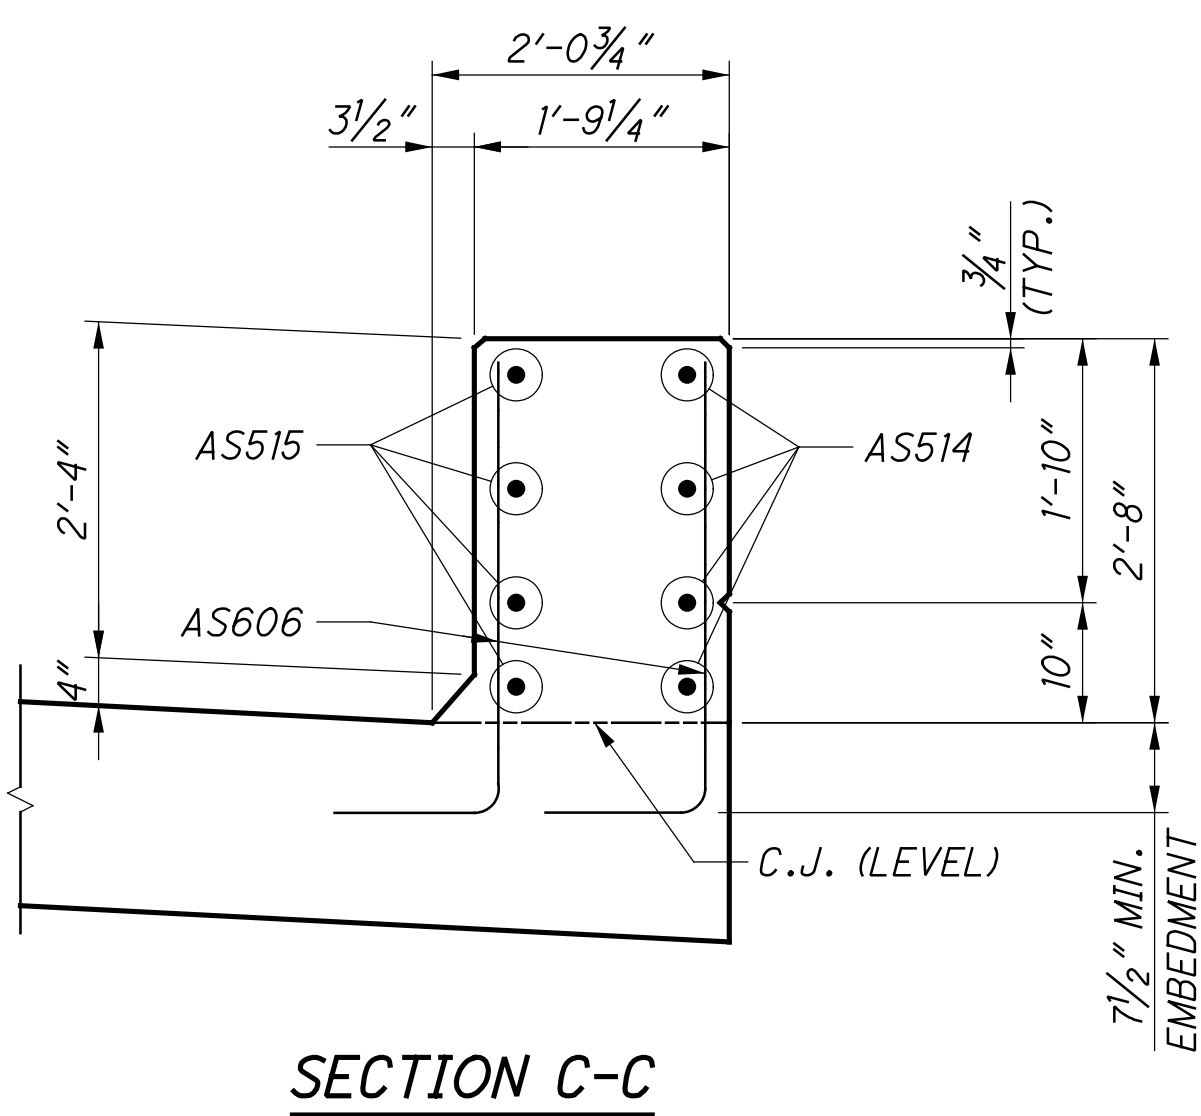


SECTION C-C

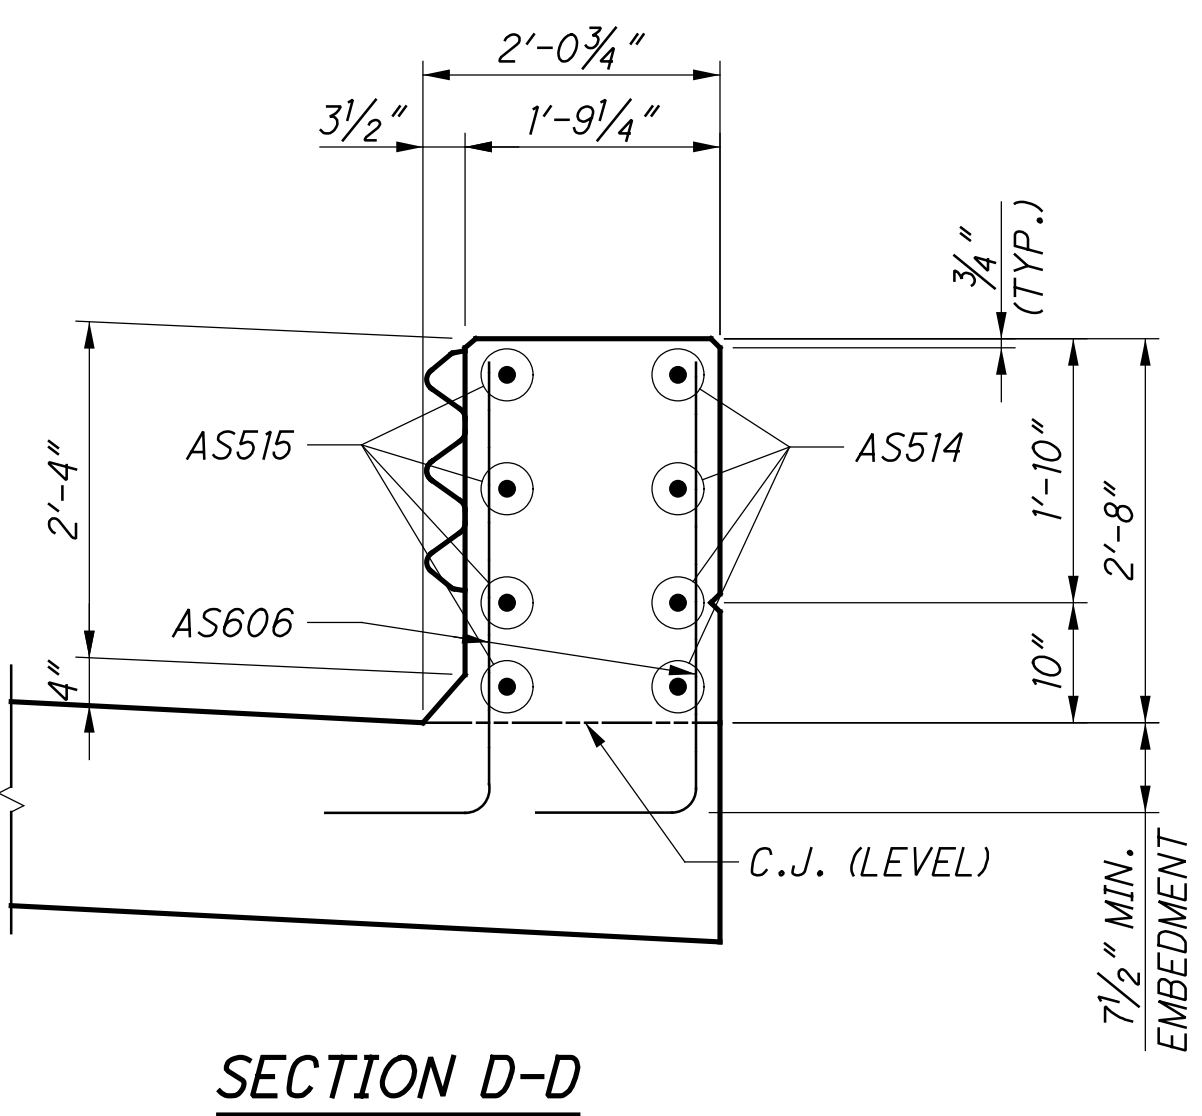

SECTION D-D

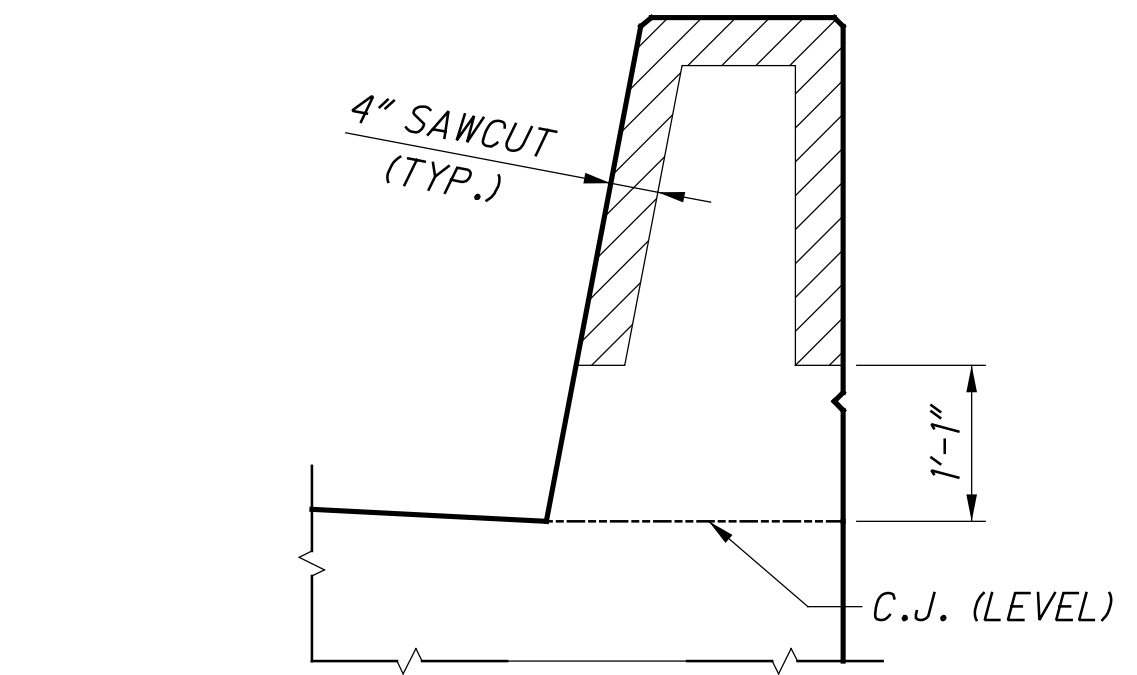

SECTION THRU CONTROL JOINT DETAIL

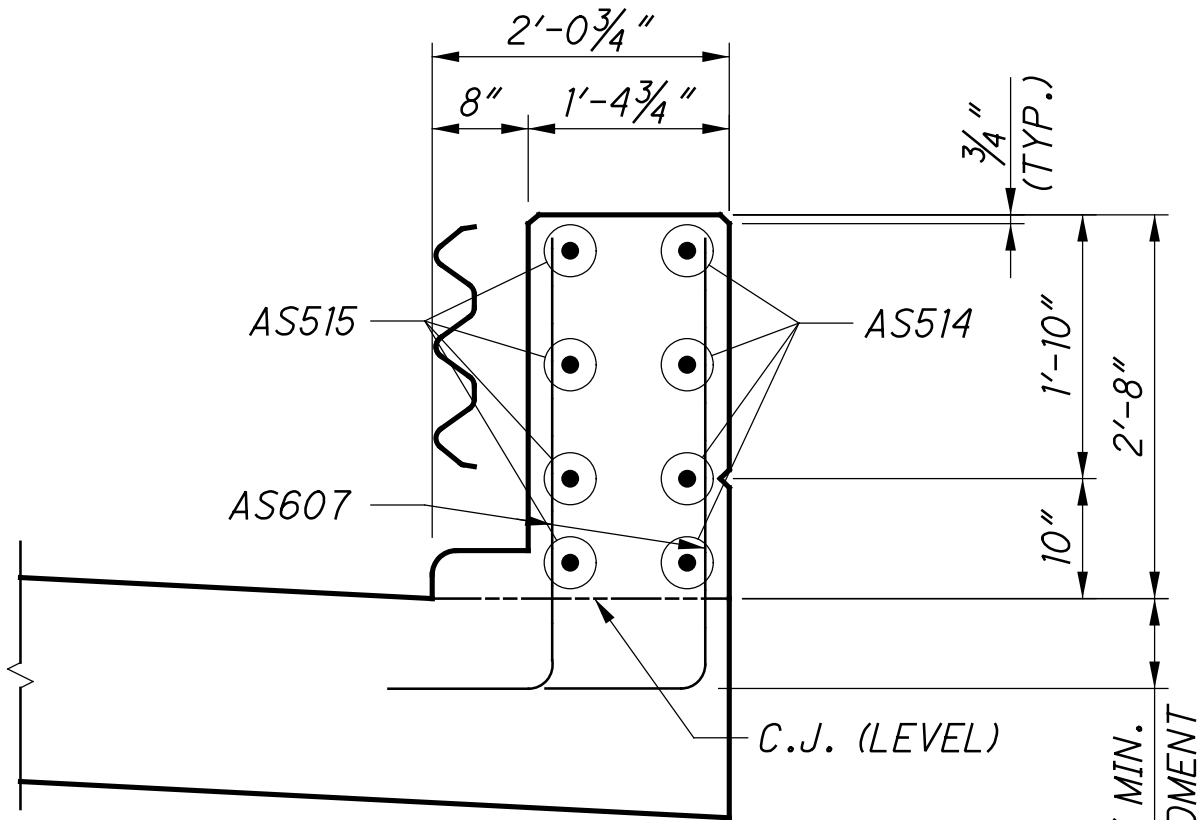



SECTION E-E

MINIMUM BAR LAP	
#5	2'-7"

- NOTES:
- SEE STANDARD BRIDGE DRAWING SBR-1-13 FOR ADDITIONAL DETAILS.
 - GFRP INDICATES 1/2" DIA. GLASS FIBER REINFORCED POLYMER STIFFENING REINFORCEMENT.

S:\Plans\10/26/2023 4:26:45 PM
 10/26/2023 4:26:45 PM
 2017 01113 C:\Design\104667_HAM-75-3.84\Design\Structures\HAM0075_0440C_Sheets\HAM0075_0440C_RA011.dgn

S:\Plans\10/26/2023 4:26:45 PM
 10/26/2023 4:26:45 PM
 \O:\2017\01113\C.Design\104667.HAM-75-3.84.Design\Structures\HAM0075_0440C.Sheets\HAM0075_0440C.RA012.dgn

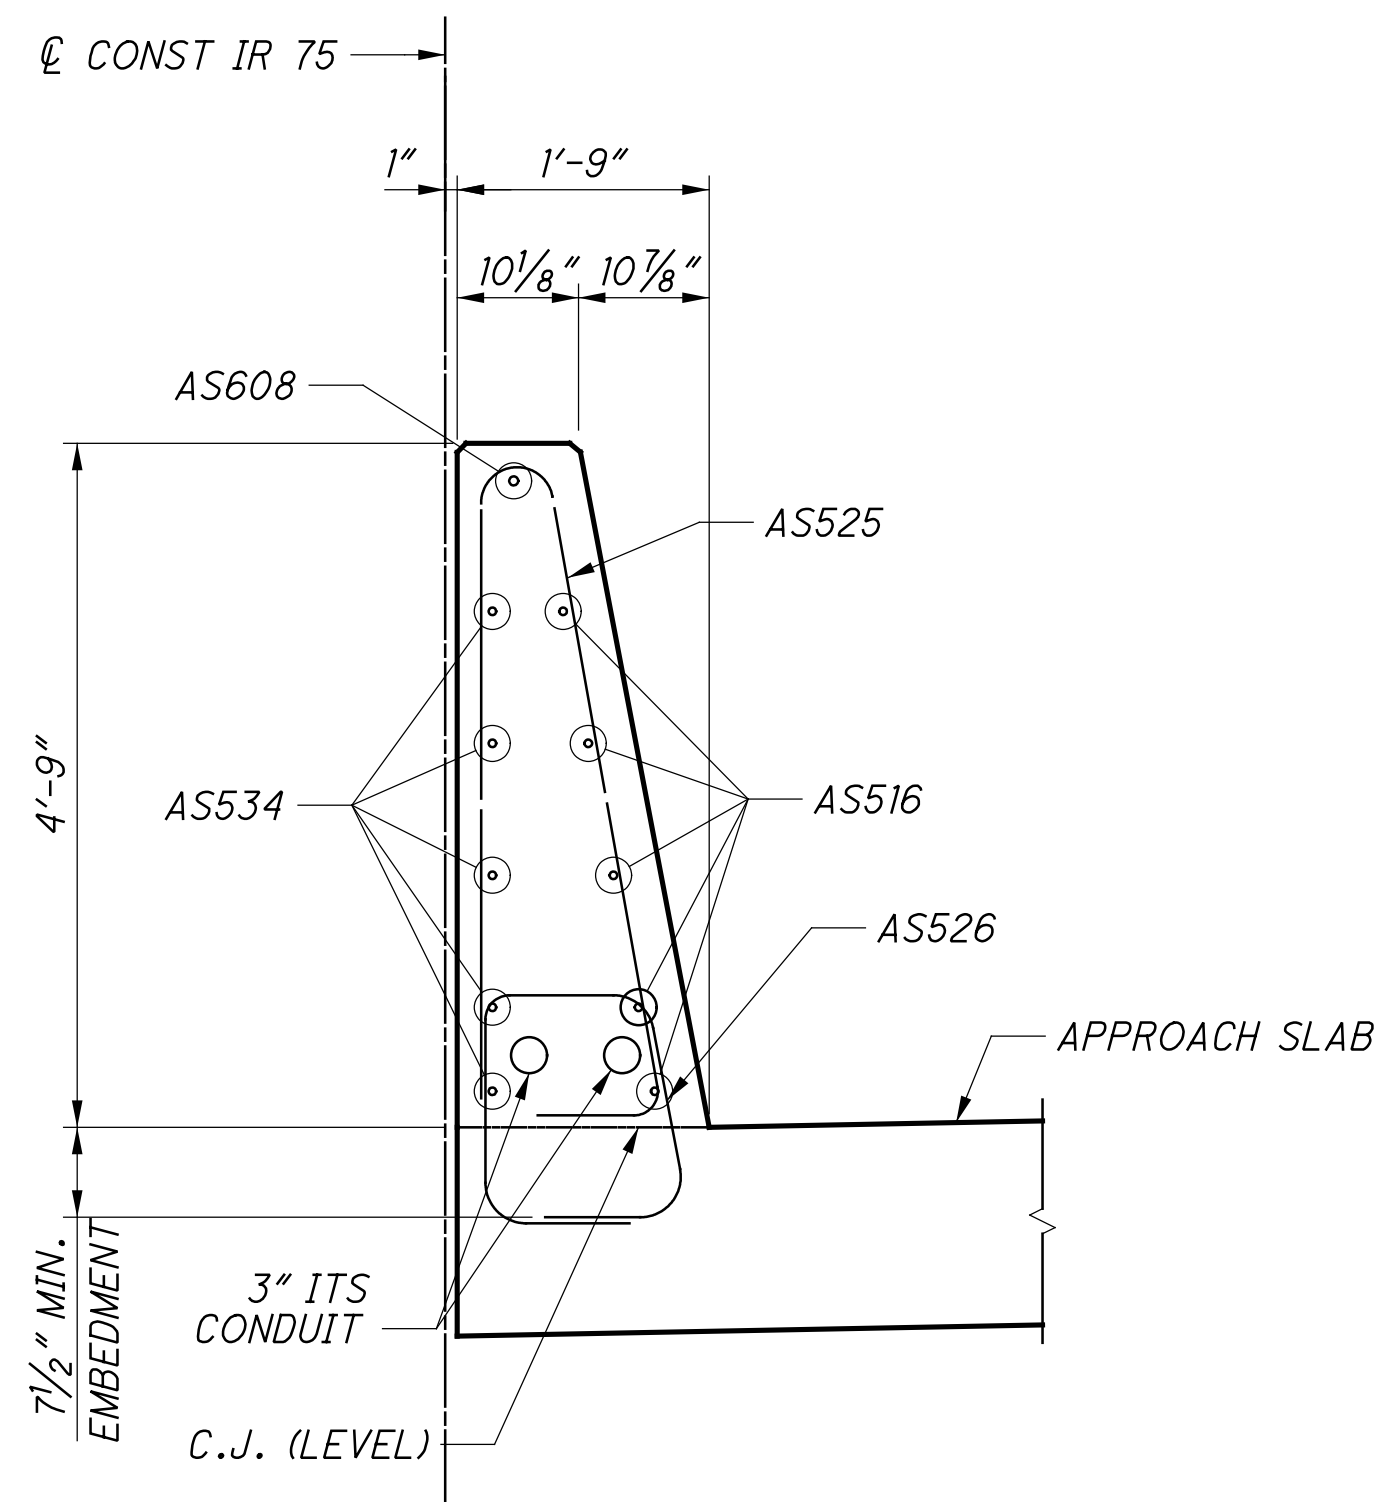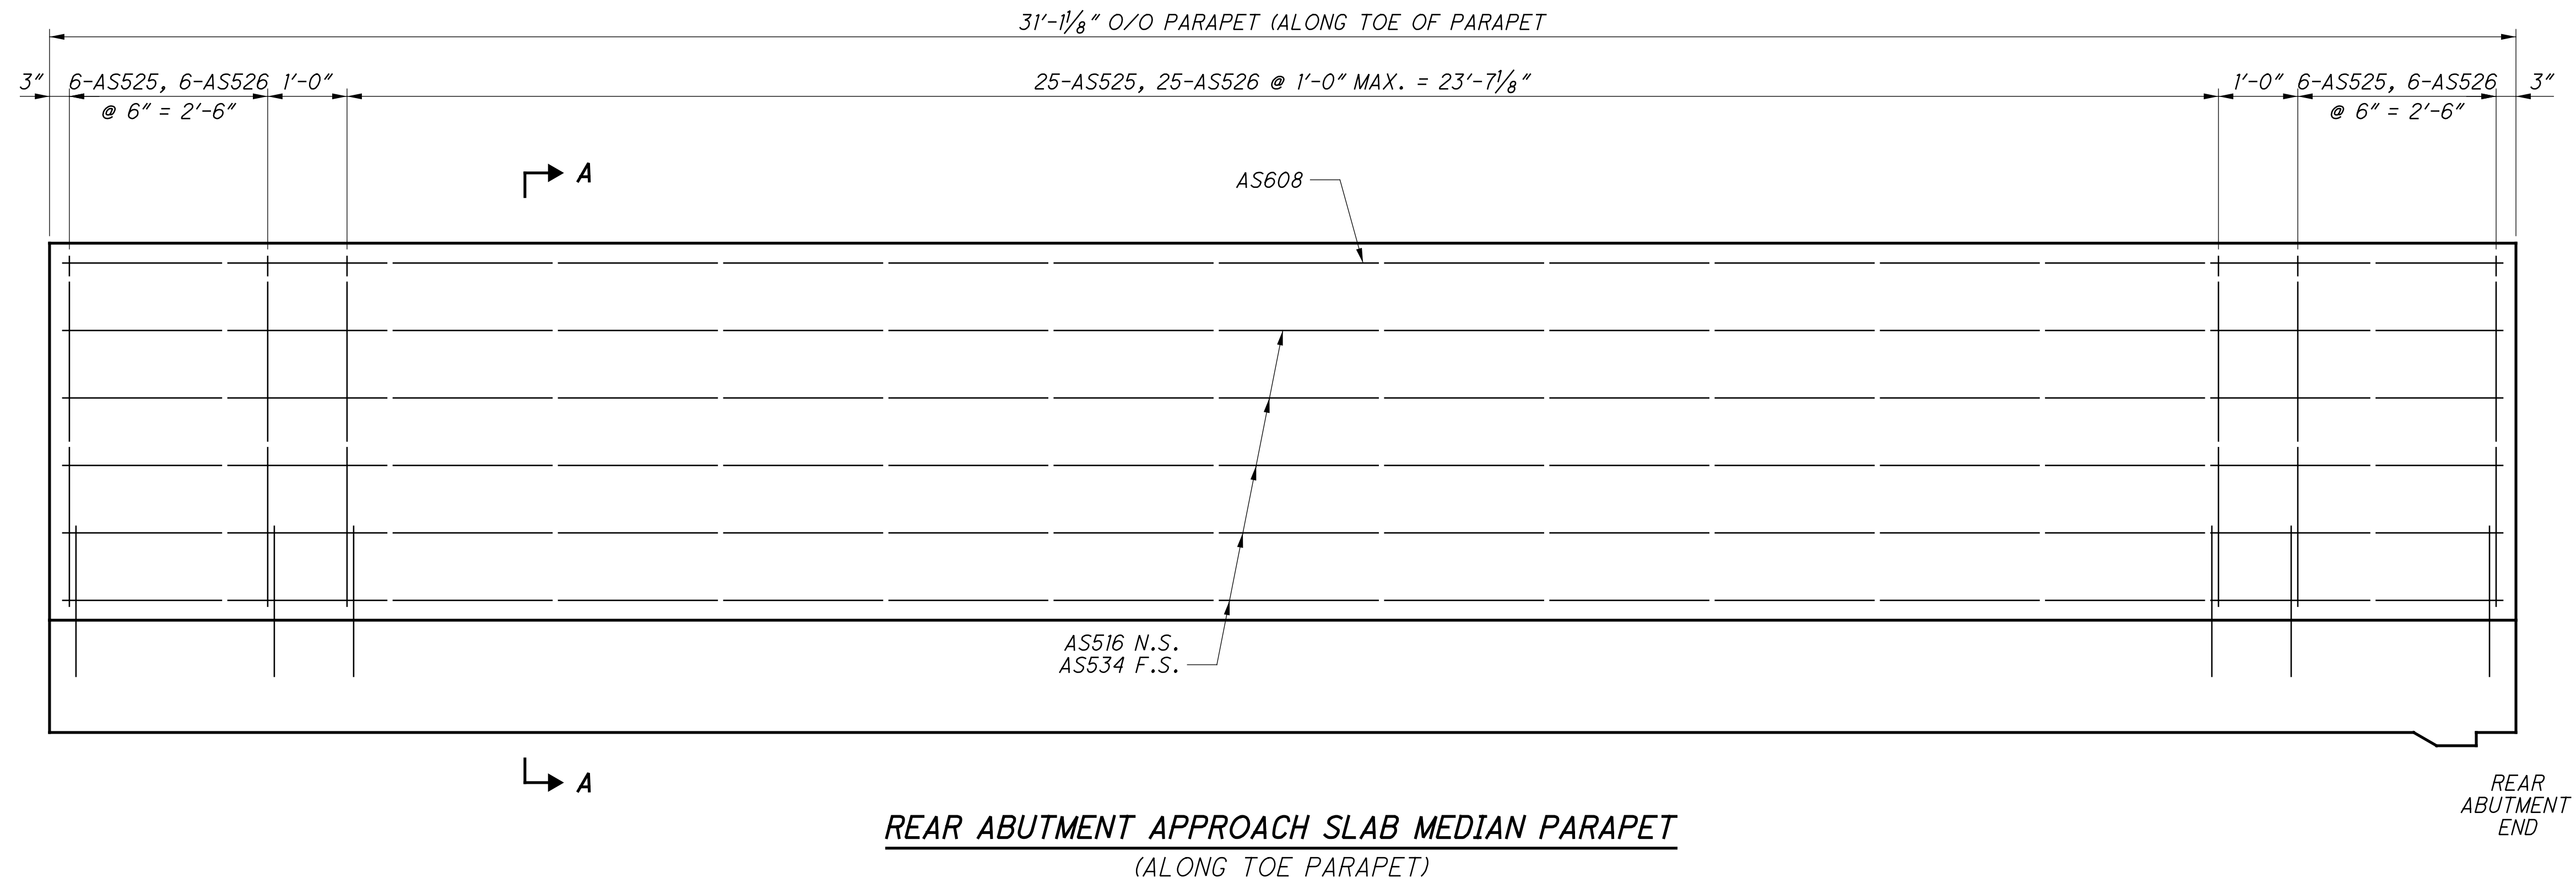



SECTION A-A

NOTES:

- SEE STANDARD BRIDGE DRAWING SBR-2-13 FOR ADDITIONAL DETAILS.

DESIGN AGENCY STRUCTUREPOINT	
DESIGNED SUF	CHECKED CLB
DRAWN DSH	REVISED
REVIEWED MDS	DATE 1/2/19
STRUCTURE FILE NUMBER 3109163	
PARAPET DETAILS (RIGHT BRIDGE) BRIDGE NO. - HAM-75-0440 L/R OVER WB I-74	
HAM-75-3.84 PID No. 104667	
56/68	
<div style="border: 1px solid black; border-radius: 50%; width: 30px; height: 30px; display: flex; align-items: center; justify-content: center;"> 56 68 </div>	

SFlansgan
 10/26/2023 4:26:46 PM
 \\01\2017\01113\C_Design\104667_HAM-75-3.84\Design\Structures_HAM0075_0440C_Sheets_HAM0075_0440C_RA013.dgn

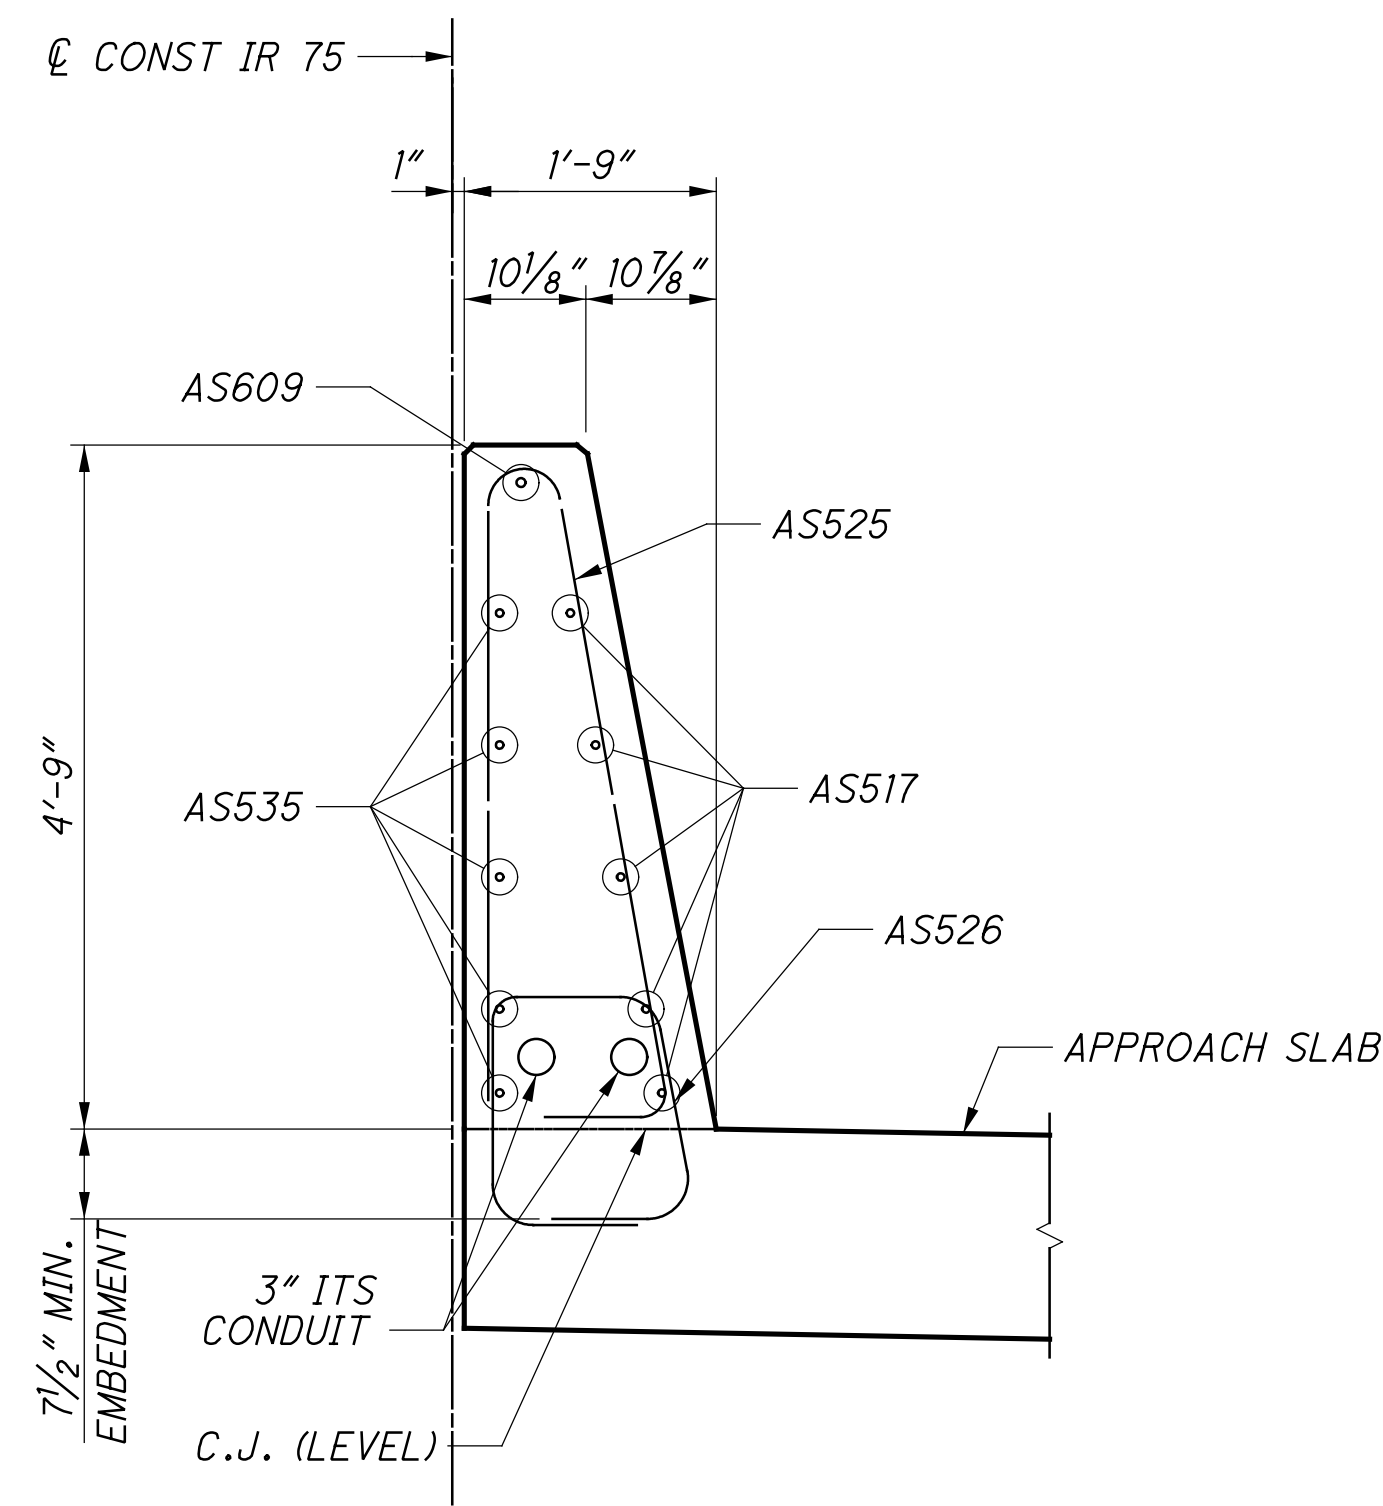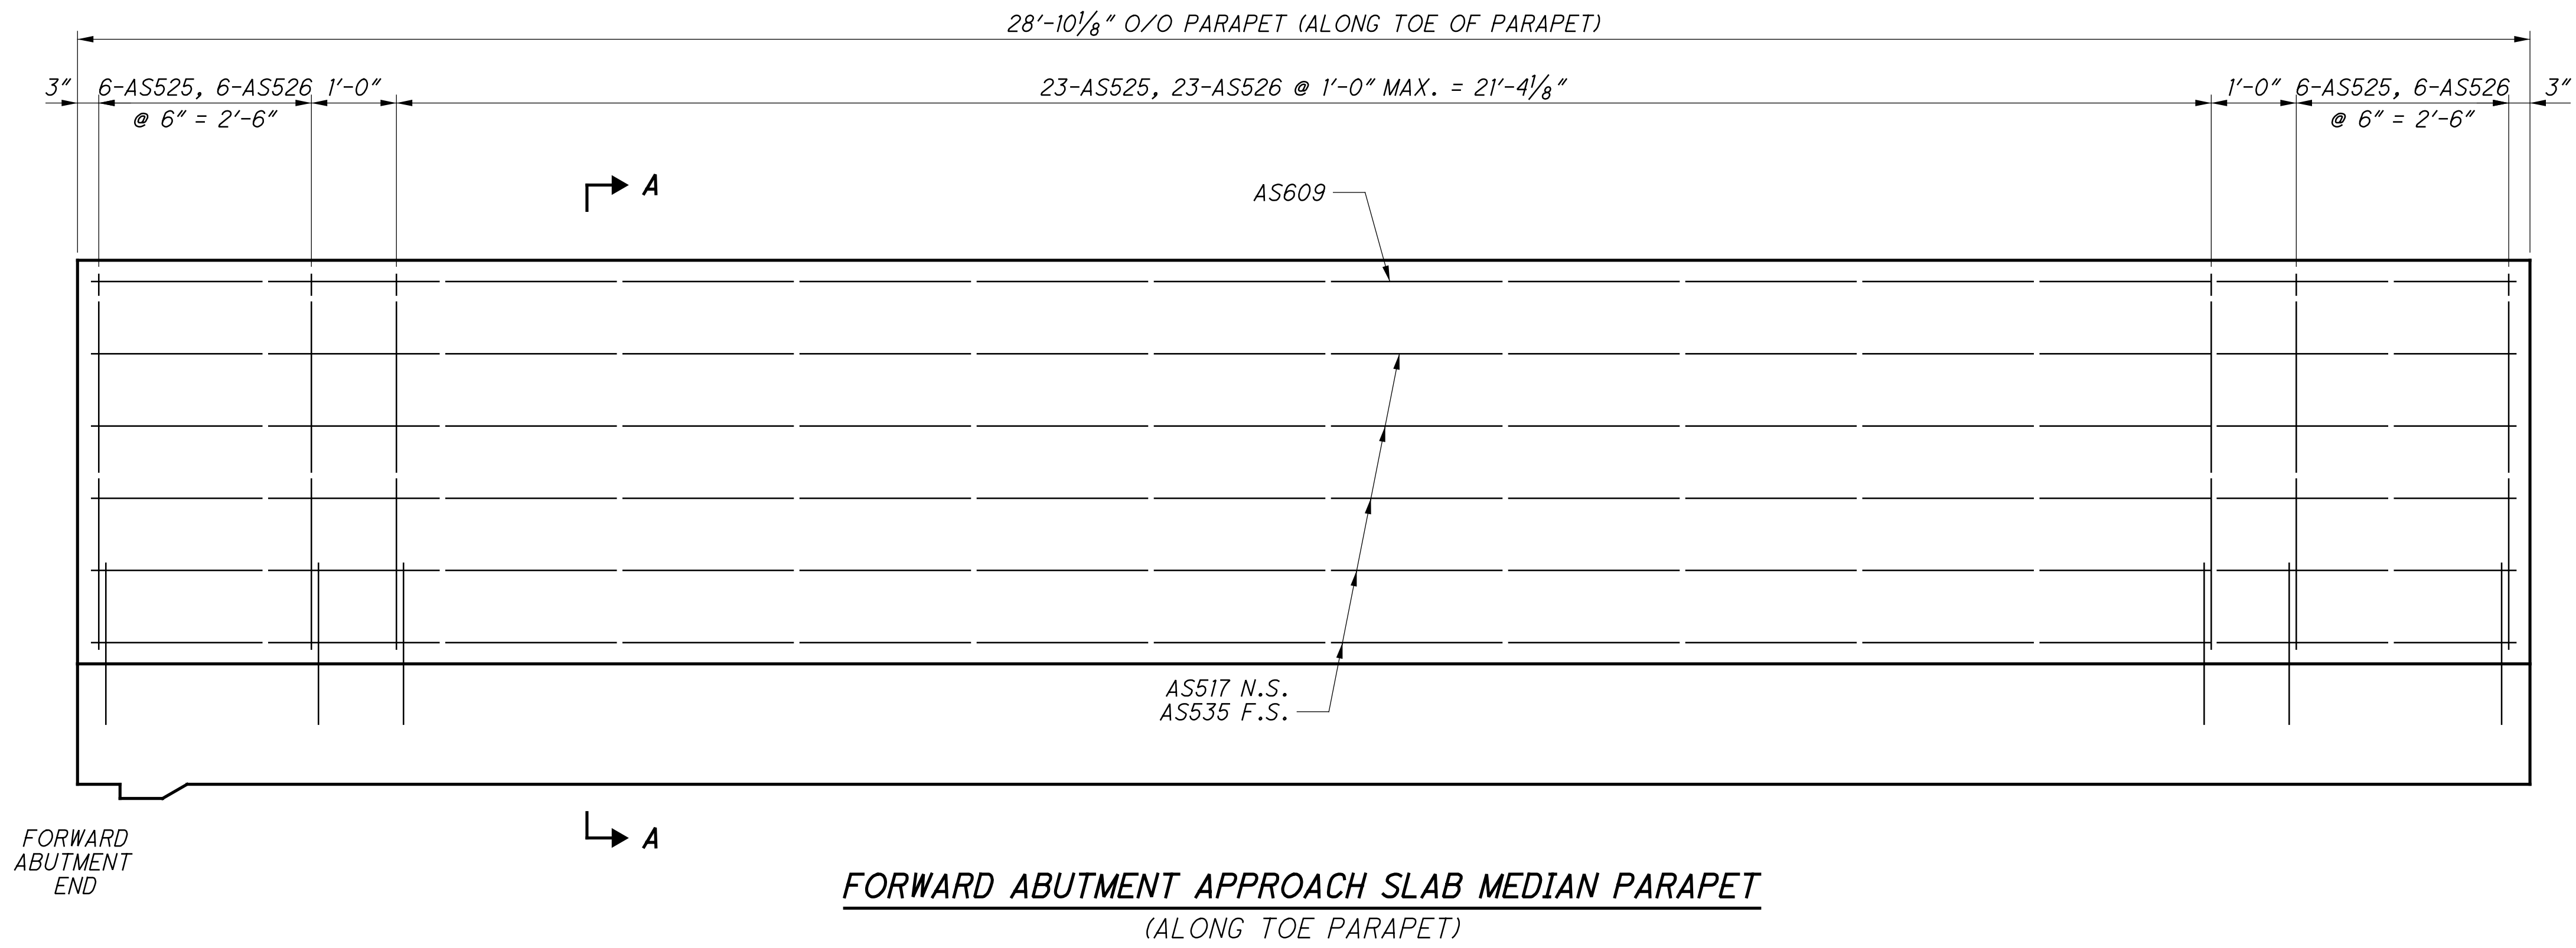


SECTION A-A

NOTES:

- SEE STANDARD BRIDGE DRAWING SBR-2-13 FOR ADDITIONAL DETAILS.

DESIGNED	DESIGNED BY
SUJ CHECKED CLB	MDS REVISED
DATE	FILE NUMBER
1/2/19	3109763
DESIGN AGENCY STRUCTUREPOINT 2000 CORPORATE CENTER DR., STE. 200 FORT WORTH, TEXAS 76102 TEL: 817.339.3333 FAX: 817.339.3335 WWW.STRUCTUREPOINT.COM	
PARAPET DETAILS (RIGHT BRIDGE) BRIDGE NO. - HAM-75-0440 L/R OVER WB I-74	
HAM-75-3.84 PID No. 104667	
57/68	
57 68	

SFlanagan
10/26/2023 4:26:46 PM
\\01\2017\01113\C.Design\104667-HAM-75-3.84\Design\Structures\HAM0075_0440C\Sheets\HAM0075_0440C_MDO003.dgn

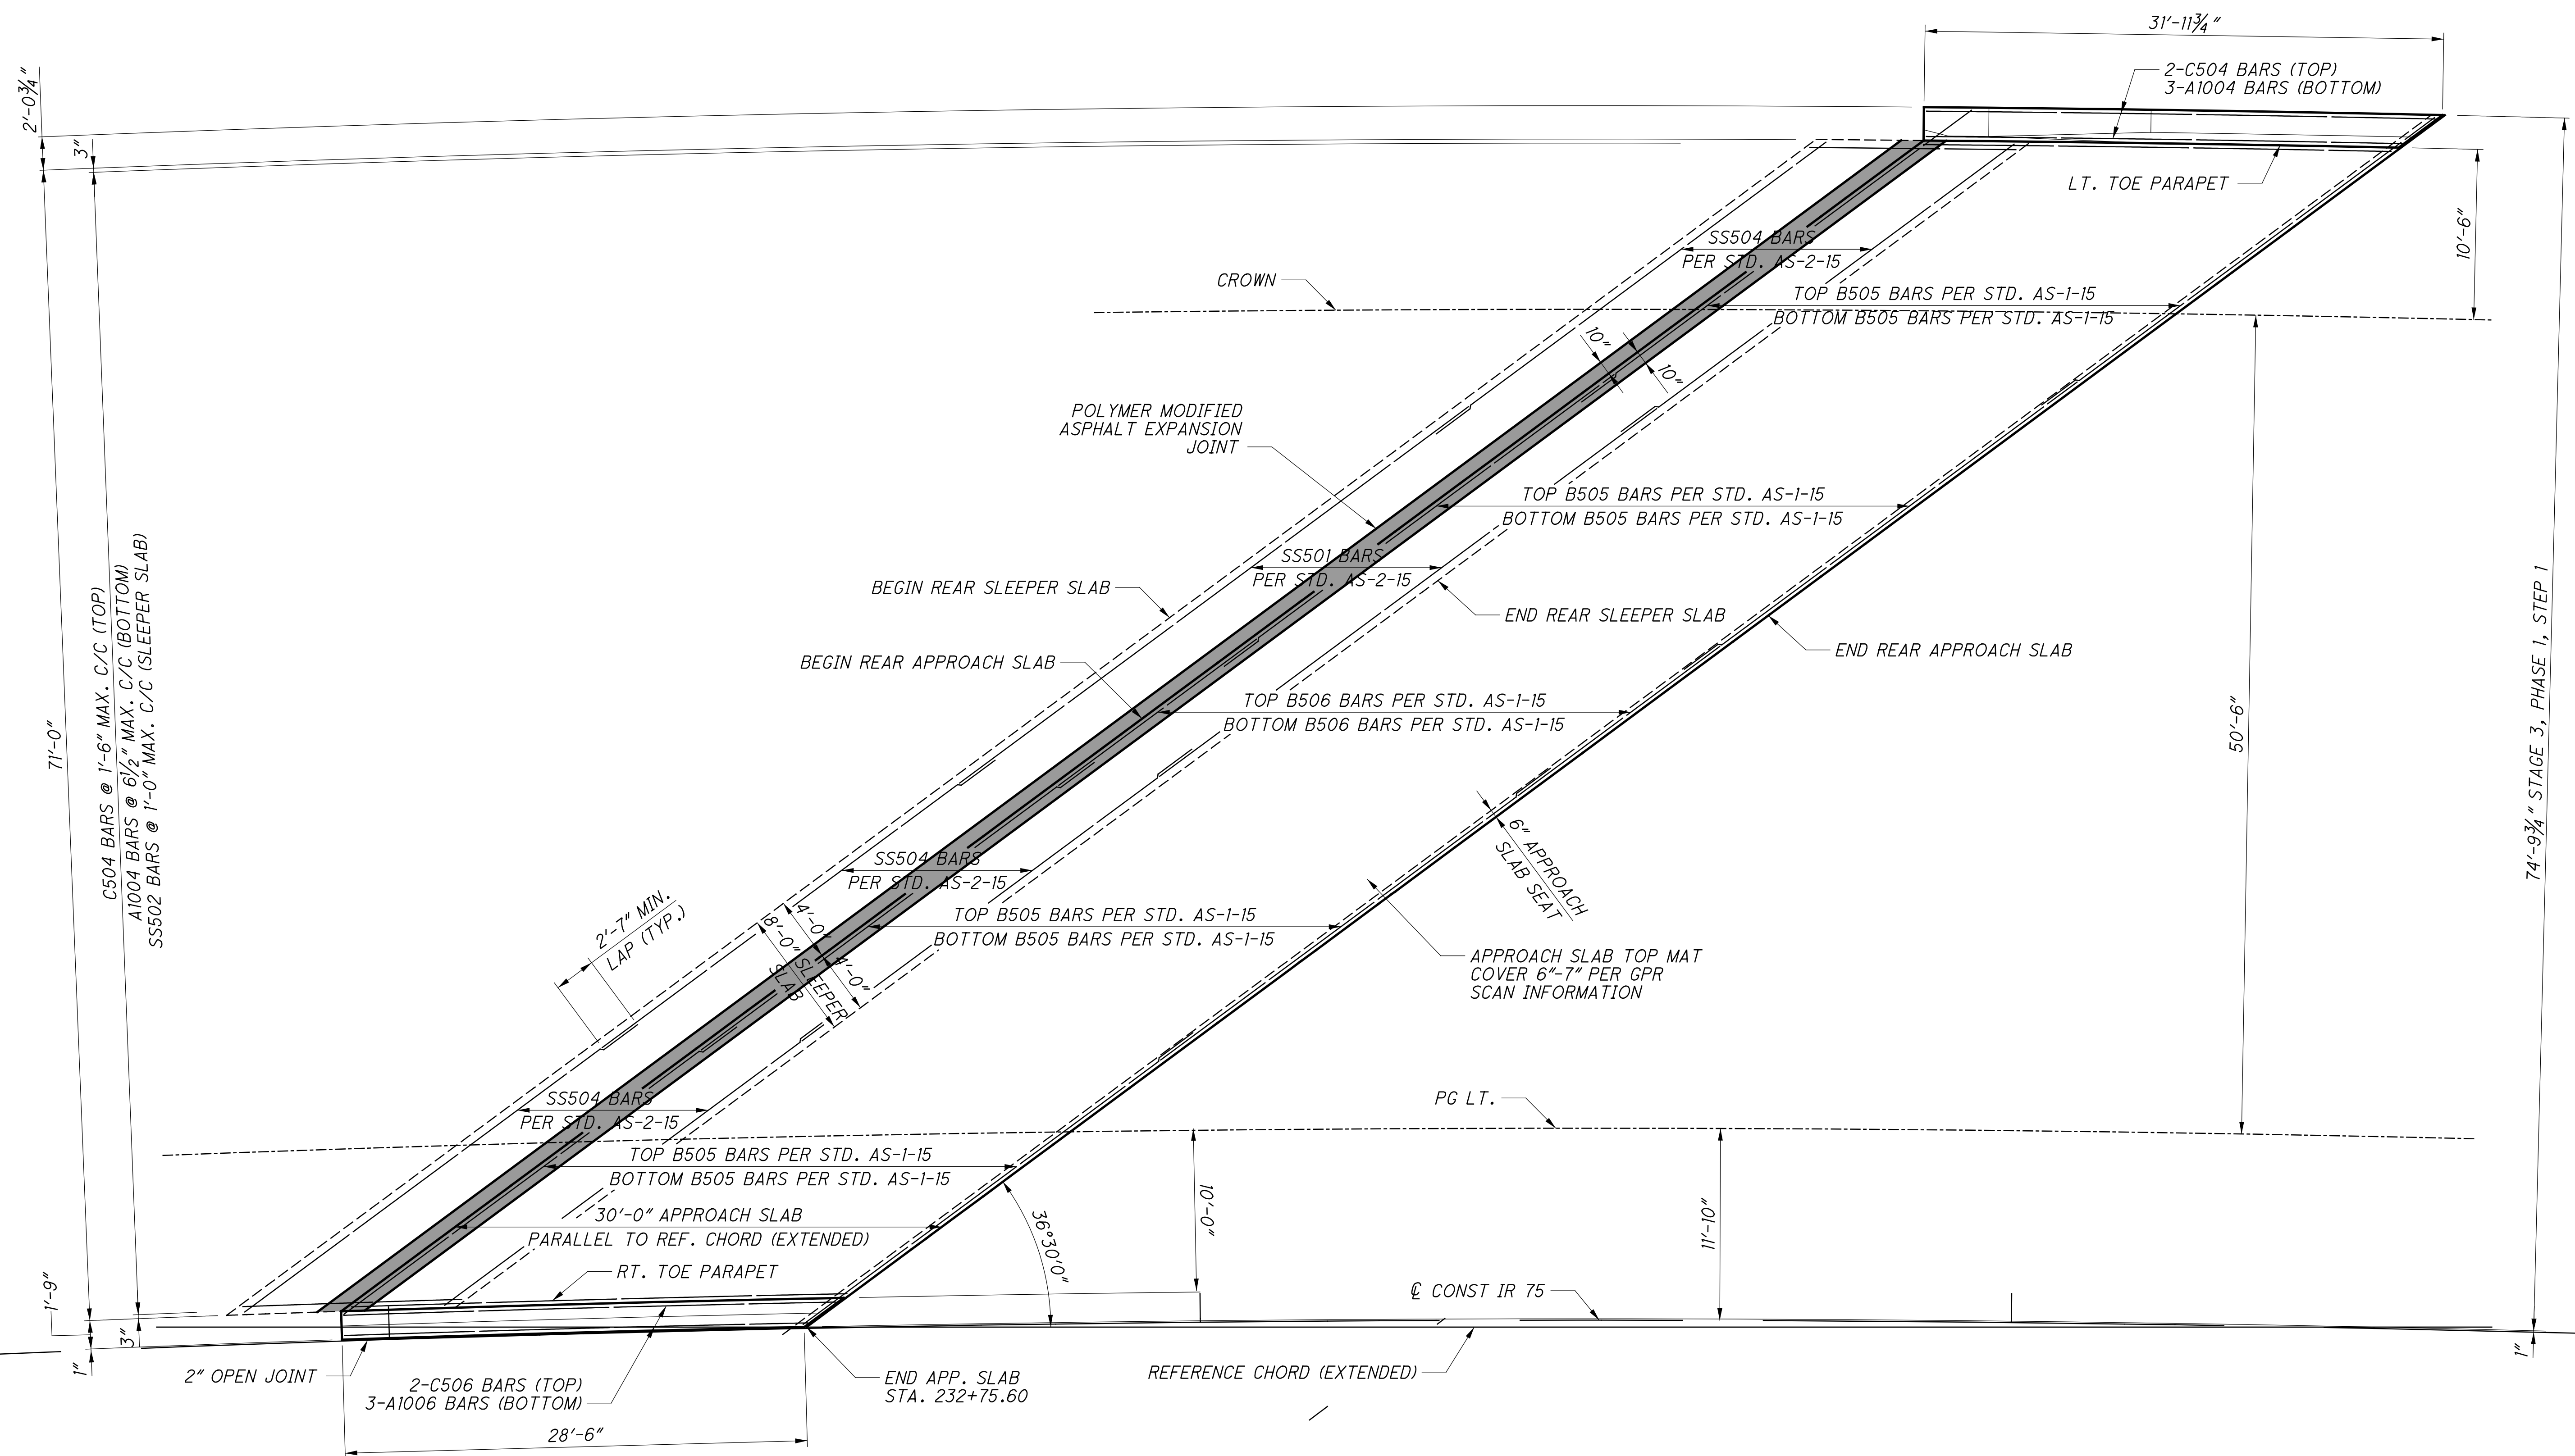


PLAN
LEFT REAR APPROACH SLAB

- NOTES:
1. FOR STANDARD APPROACH SLAB DETAILS, SEE STANDARD BRIDGE DWG. AS-1-15 AND STANDARD BRIDGE DWG. AS-2-15.
 2. FOR PARAPET DETAILS, SEE SHEETS 48/68 AND 50/68.
 3. FOR APPROACH SLAB ELEVATIONS, SEE SHEET 62/68.
 4. THE ENTIRE APPROACH SLAB RECEIVED A 1/4" EPOXY OVERLAY, CONSTRUCTED PER SS 858

DESIGN AGENCY STRUCTUREPOINT	
DATE 1/2/19	REVIEWED MDS
STRUCTURE FILE NUMBER 3109763	DRAWN DSH
DESIGNED SUJ	CHECKED CLB
APPROACH SLAB DETAILS (LEFT BRIDGE)	
BRIDGE NO. HAM-75-0440 L/R	
OVER WB 1-74	
HAM-75-3.84	
PID No. 104667	
58/68	
58 68	

SFlanagan
 10/26/2023 4:26:47 PM
 \\01\2017\01113\C.Design\104667-HAM-75-3.84\Design\Structures\HAM0075_0440C_Sheets\HAM0075_0440C_MDO004.dgn

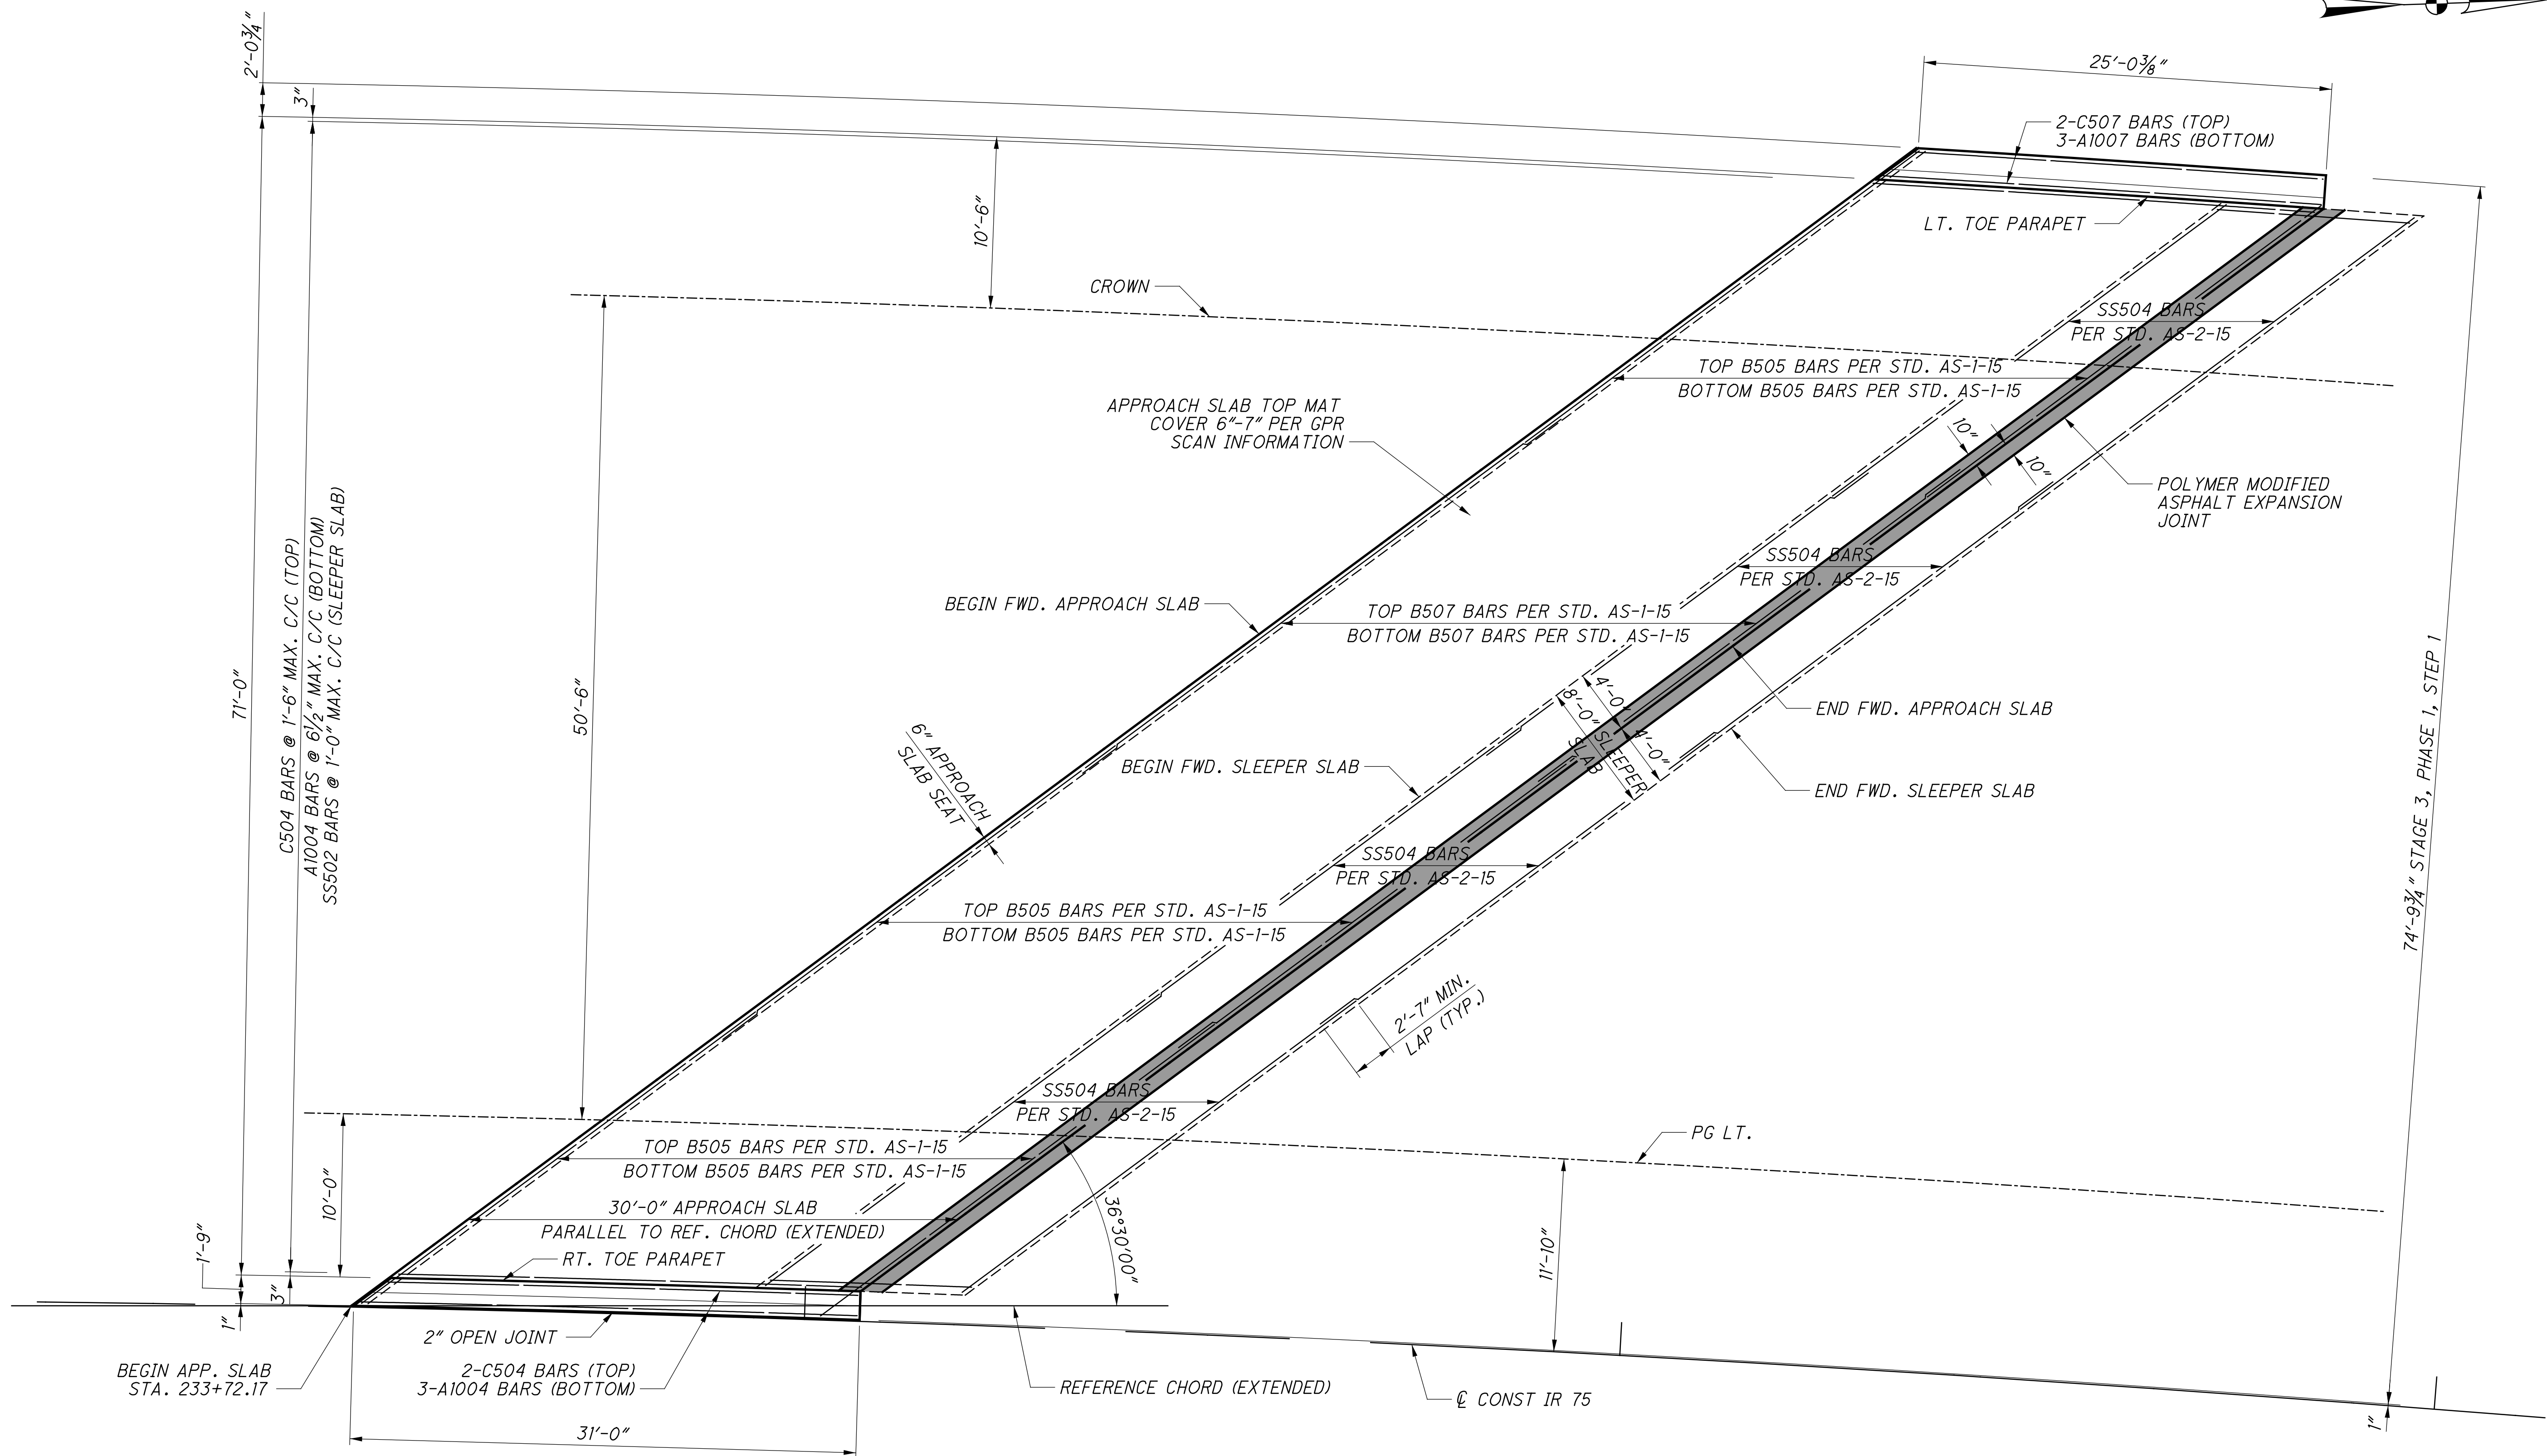


PLAN
LEFT FORWARD APPROACH SLAB

- NOTES:
1. FOR STANDARD APPROACH SLAB DETAILS, SEE STANDARD BRIDGE DWG. AS-1-15 AND STANDARD BRIDGE DWG. AS-2-15.
 2. FOR PARAPET DETAILS, SEE SHEETS 49/68 AND 51/68.
 3. FOR APPROACH SLAB ELEVATIONS, SEE SHEET 62/68.
 4. THE ENTIRE APPROACH SLAB RECEIVED A 1/4" EPOXY OVERLAY, CONSTRUCTED PER SS 858.

DESIGN AGENCY STRUCTUREPOINT	
DESIGNED SUF	CHECKED CLB
DRAWN DSH	REVISED
REVIEWED MDS	DATE 1/2/19
STRUCTURE FILE NUMBER 3109763	
BRIDGE NO. - HAM-75-0440 L/R OVER WB 1-74	
APPROACH SLAB DETAILS (LEFT BRIDGE)	
HAM-75-3.84 PID No. 104667	
59/68	
59 68	

SFlanagan
 10/26/2023 4:26:47 PM
 C:\2017\01113\C.Design\104667-HAM-75-3.84\Design\Structures\HAM0075_0440C\Sheets\HAM0075_0440C_MDO01.dgn

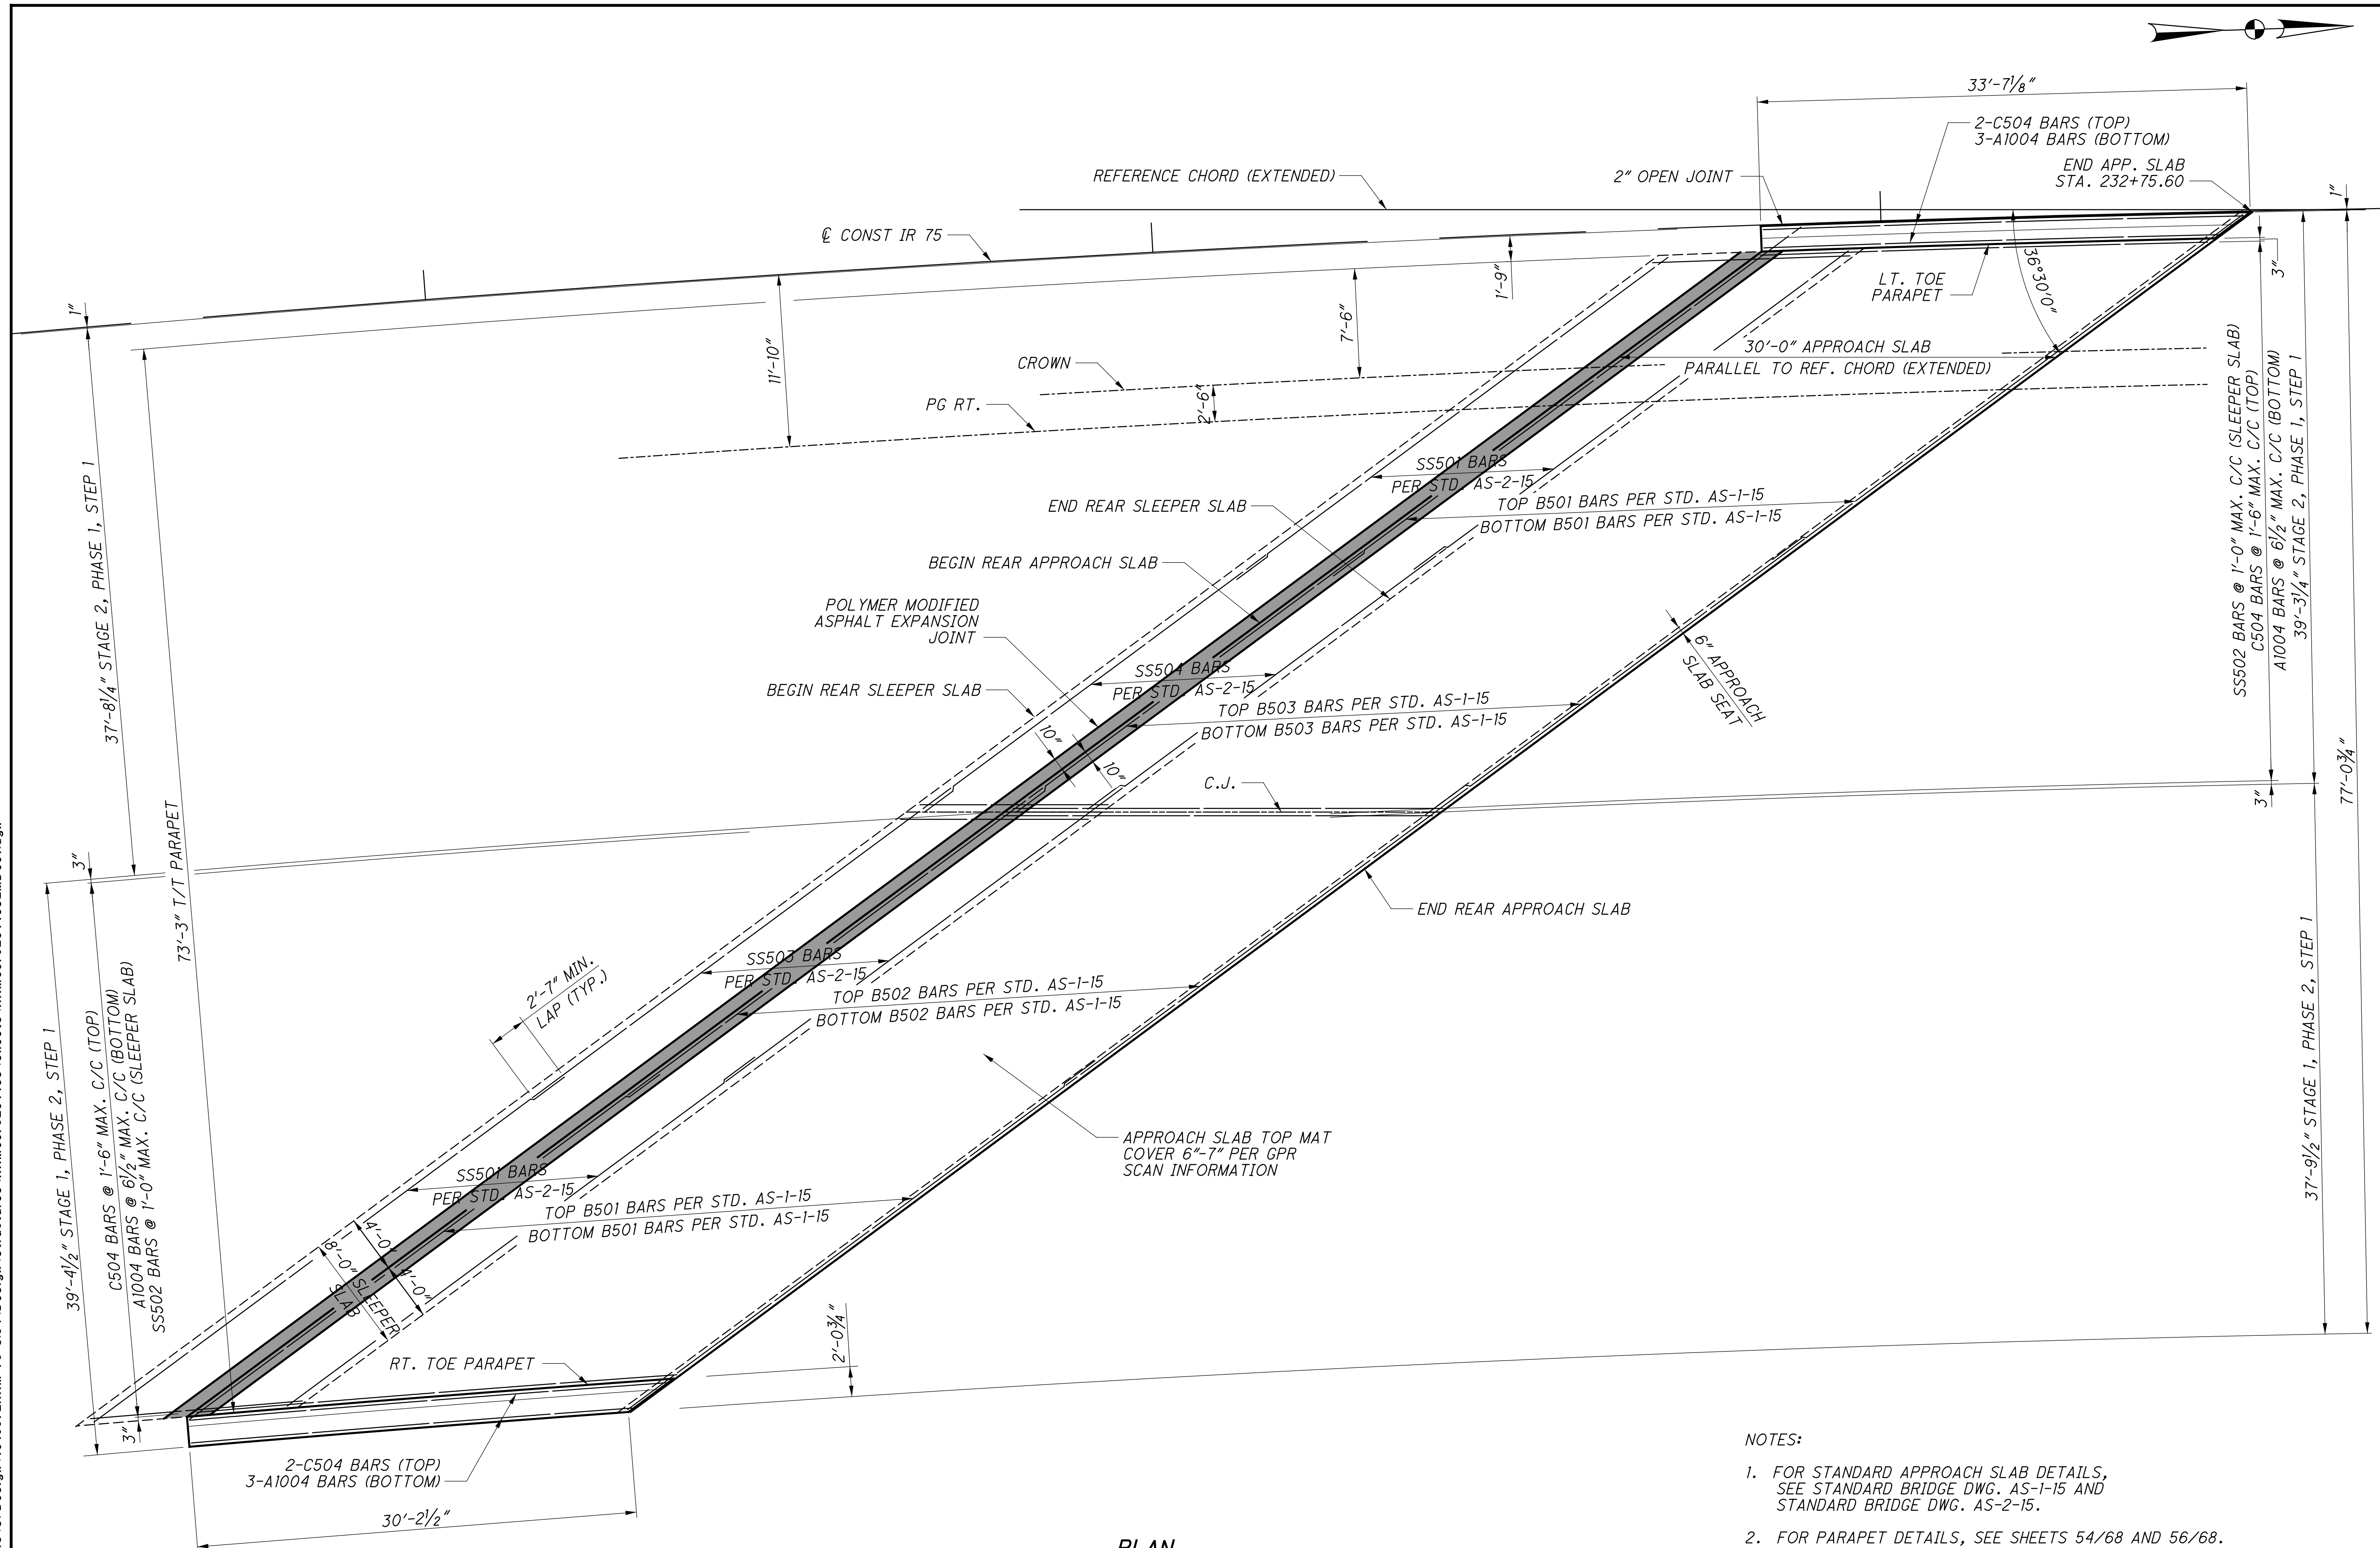


PLAN
RIGHT REAR APPROACH SLAB

- NOTES:
- FOR STANDARD APPROACH SLAB DETAILS, SEE STANDARD BRIDGE DWG. AS-1-15 AND STANDARD BRIDGE DWG. AS-2-15.
 - FOR PARAPET DETAILS, SEE SHEETS 54/68 AND 56/68.
 - FOR APPROACH SLAB ELEVATIONS, SEE SHEET 62/68.
 - THE ENTIRE APPROACH SLAB RECEIVED A 1/4" EPOXY OVERLAY, CONSTRUCTED PER SS 858.

DESIGN AGENCY STRUCTUREPOINT	
DESIGNED SUF	CHECKED CLB
DRAWN DSH	REVISED
REVIEWED MDS	DATE 1/2/19
STRUCTURE FILE NUMBER 3109163	
HAM-75-3.84 BRIDGE NO. - HAM-75-0440 L/R OVER WB 1-74	
PID No. 104667	
60/68	
60 68	

S:\Flannagan\10_26_2023 4:26:48 PM\01\2017\01113\C.Design\104667-HAM-75-3.84\Design\Structures\HAM0075_0440C\Sheets\HAM0075_0440C_MDO002.dgn

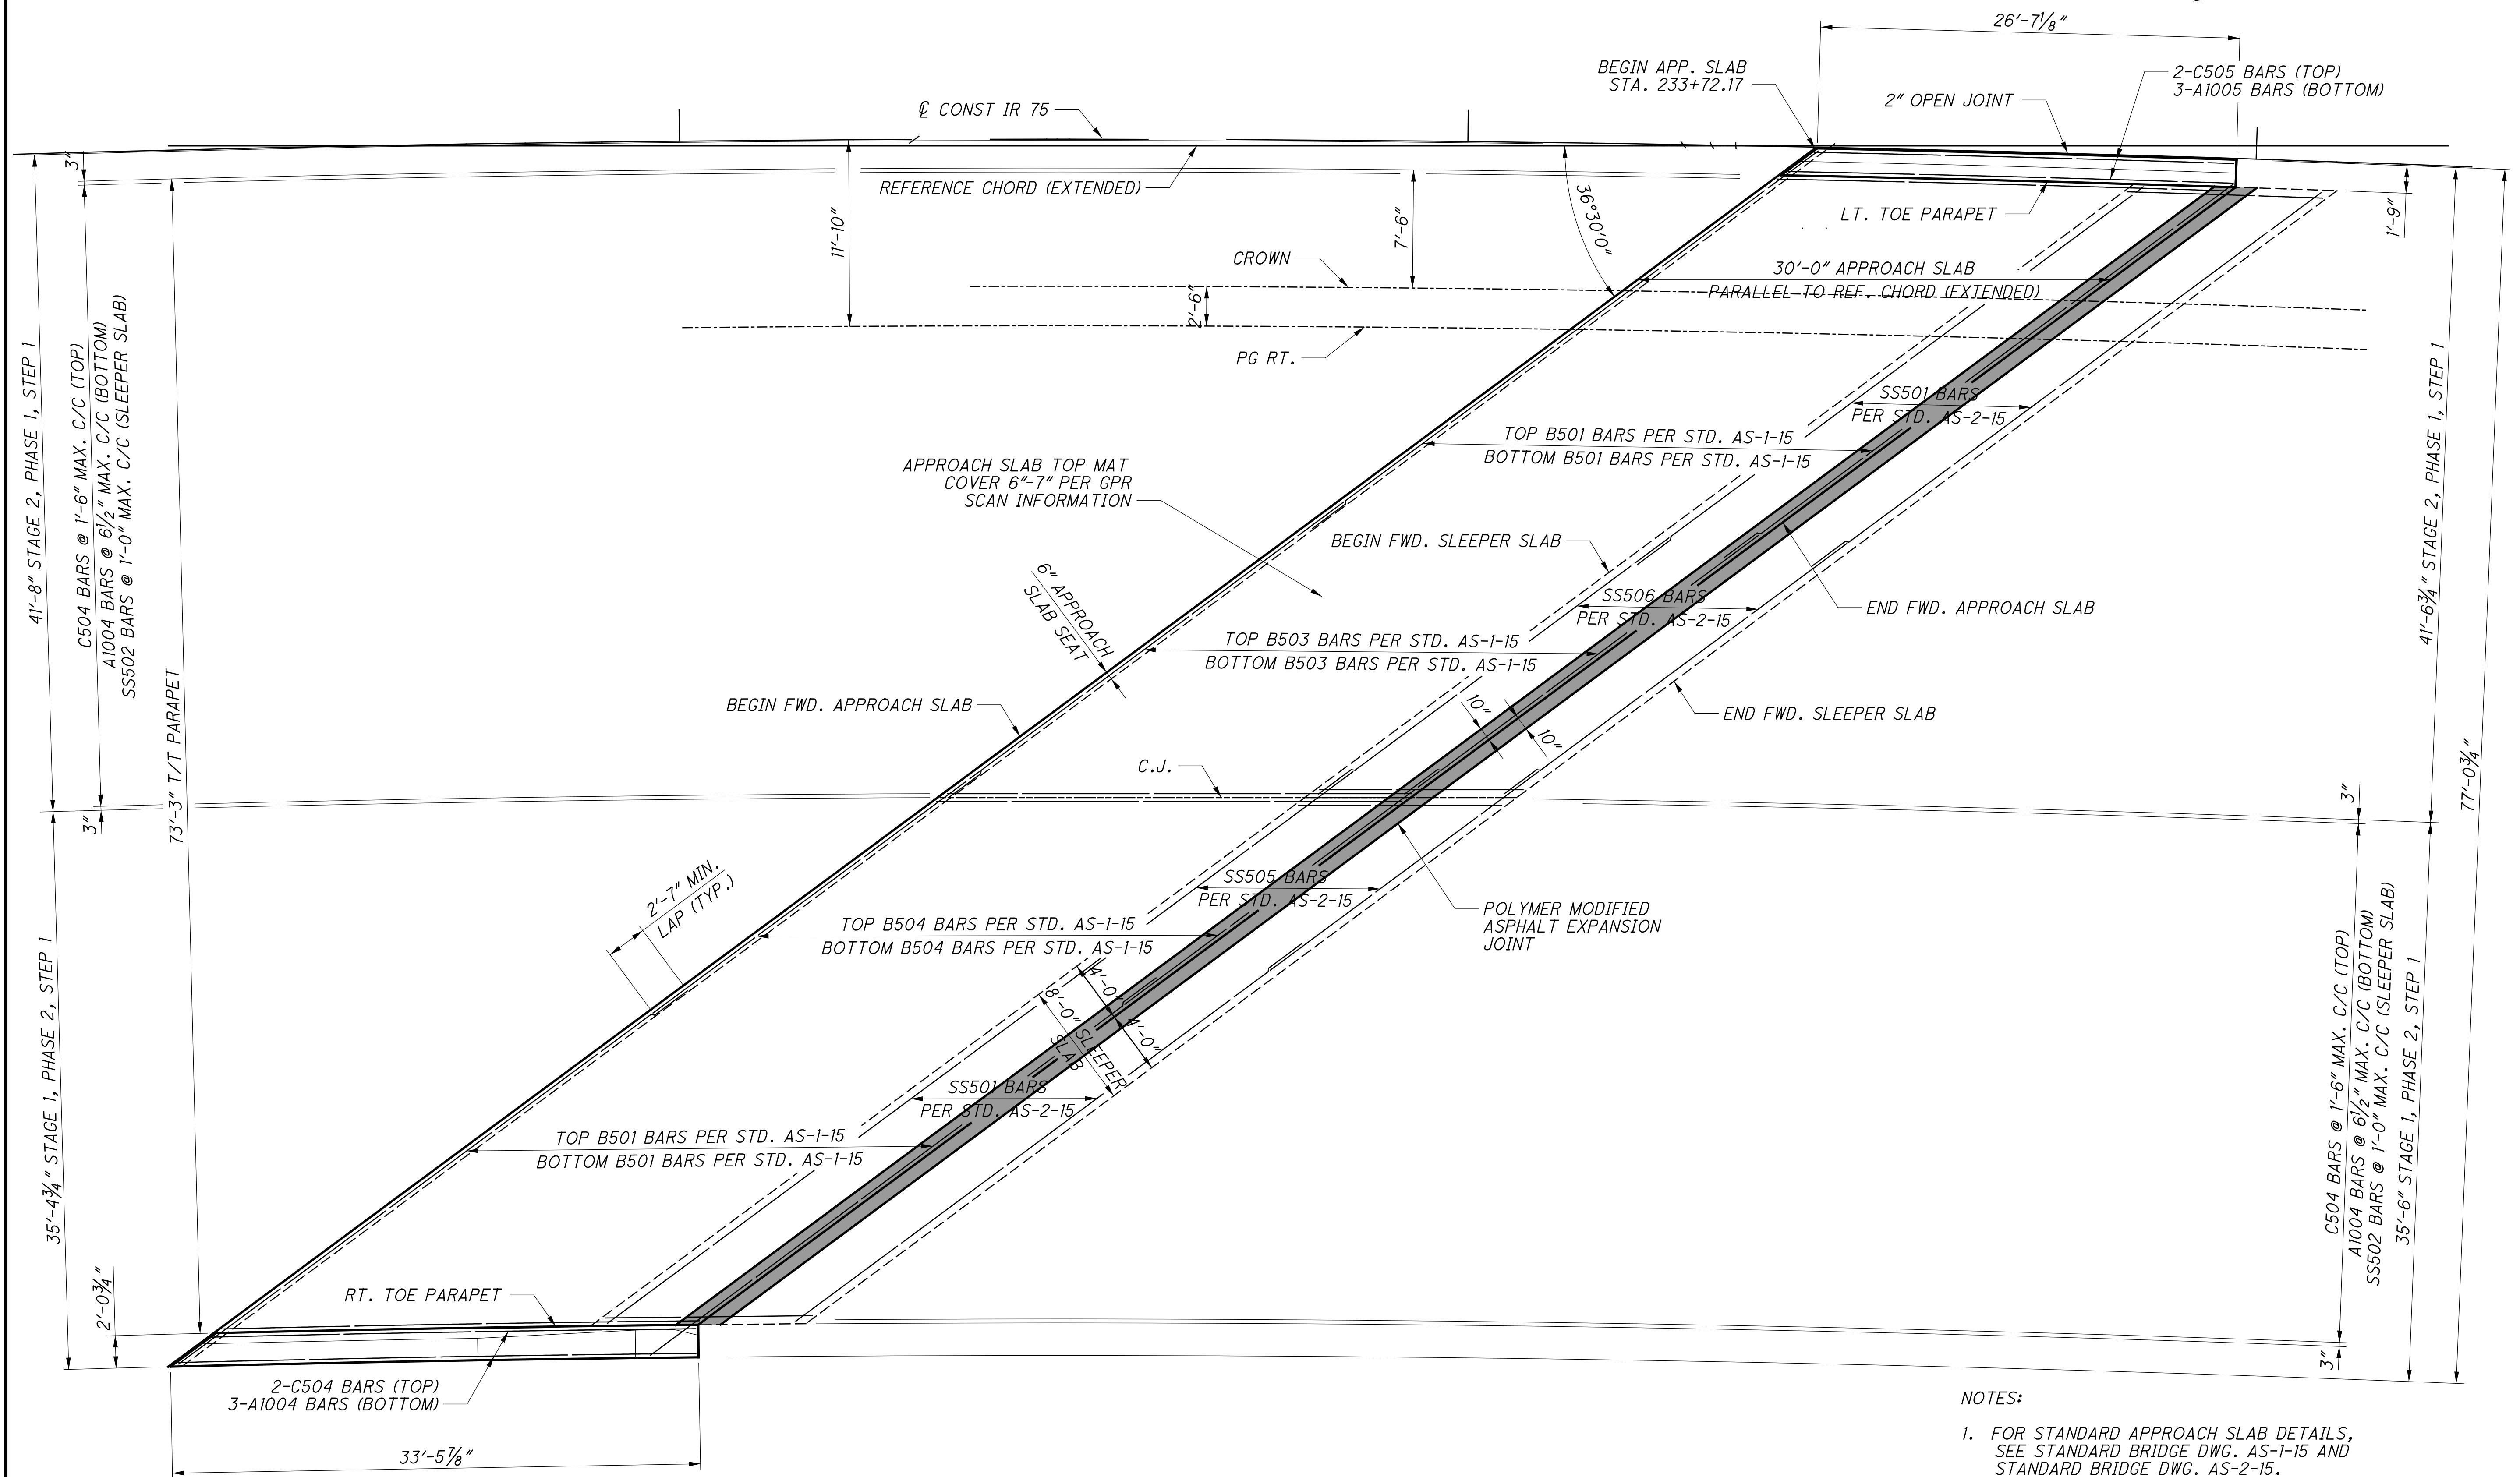

PLAN
RIGHT FORWARD APPROACH SLAB


NOTES:

1. FOR STANDARD APPROACH SLAB DETAILS, SEE STANDARD BRIDGE DWG. AS-1-15 AND STANDARD BRIDGE DWG. AS-2-15.
2. FOR PARAPET DETAILS, SEE SHEETS 55/68 AND 57/68.
3. FOR APPROACH SLAB ELEVATIONS, SEE SHEET 62/68.
4. THE ENTIRE APPROACH SLAB RECEIVED A 1/4" EPOXY OVERLAY, CONSTRUCTED PER SS 858.

DESIGN AGENCY STRUCTUREPOINT	DATE 1/2/19
	REVIEWED MDS
DRAWN DSH	STRUCTURE FILE NUMBER 3109763
DESIGNED SUJ	CHECKED CLB
APPROACH SLAB DETAILS (RIGHT BRIDGE) BRIDGE NO. HAM-75-0440 L/R OVER WB 1-74	
HAM-75-3.84	PID No. 104667
61 / 68	






APPROACH SLAB ELEVATIONS LEFT BRIDGE										
APPROACH LINE	DESCRIPTION	BEGIN REAR SLEEPER SLAB	BEGIN REAR APPROACH SLAB	END REAR SLEEPER SLAB	END REAR APPROACH SLAB	STRUCTURE LIMITS	BEGIN FWD. APPROACH SLAB	BEGIN FWD. SLEEPER SLAB	END FWD. APPROACH SLAB	END FWD. SLEEPER SLAB
LT. TOE OF PARAPET	STATION	233+37.50	233+43.96	233+50.39	233+72.47		234+61.23	234+82.01	234+87.98	234+93.94
	OFFSET	-72.83	-72.83	-72.83	-72.83		-72.83	-72.83	-72.83	-72.83
	ELEVATION	527.78	529.08	527.53	528.50		526.62	524.76	526.05	524.51
CROWN	STATION	233+23.80	233+30.34	233+36.85	233+59.20		234+48.98	234+69.99	234+76.02	234+82.03
	OFFSET	-62.33	-62.33	-62.33	-62.33		-62.33	-62.33	-62.33	-62.33
	ELEVATION	528.48	529.78	528.24	529.22		527.32	525.46	526.75	525.20
PGL	STATION	232+54.48	232+61.44	232+68.38	232+92.15		233+87.29	234+09.49	234+15.85	234+22.19
	OFFSET	-11.83	-11.83	-11.83	-11.83		-11.83	-11.83	-11.83	-11.83
	ELEVATION	527.03	528.34	526.82	527.87		526.05	524.17	525.45	523.90
RT. TOE OF PARAPET	STATION	232+40.02	232+47.08	232+54.10	232+78.19		233+74.50	233+96.95	234+03.38	234+09.79
	OFFSET	-1.83	-1.83	-1.83	-1.83		-1.83	-1.83	-1.83	-1.83
	ELEVATION	526.72	528.04	526.52	527.58		525.81	523.92	525.20	523.65

APPROACH SLAB ELEVATIONS RIGHT BRIDGE										
APPROACH LINE	DESCRIPTION	BEGIN REAR SLEEPER SLAB	BEGIN REAR APPROACH SLAB	END REAR SLEEPER SLAB	END REAR APPROACH SLAB	STRUCTURE LIMITS	BEGIN FWD. APPROACH SLAB	BEGIN FWD. SLEEPER SLAB	END FWD. APPROACH SLAB	END FWD. SLEEPER SLAB
LT. TOE OF PARAPET	STATION	232+34.65	232+41.74	232+48.81	232+73.01		233+69.75	233+92.30	233+98.76	234+05.19
	OFFSET	1.83	1.83	1.83	1.83		1.83	1.83	1.83	1.83
	ELEVATION	528.59	529.92	528.41	529.48		527.73	525.82	527.09	525.53
CROWN	STATION	232+23.56	232+30.73	232+37.86	232+62.31		233+59.96	233+82.71	233+89.22	233+95.71
	OFFSET	9.33	9.33	9.33	9.33		9.33	9.33	9.33	9.33
	ELEVATION	529.04	530.37	528.87	529.95		528.25	526.35	527.62	526.06
PGL	STATION	232+19.83	232+27.02	232+34.18	232+58.71		233+56.67	233+79.48	233+86.02	233+92.53
	OFFSET	11.83	11.83	11.83	11.83		11.83	11.83	11.83	11.83
	ELEVATION	528.96	530.29	528.79	529.87		528.19	526.29	527.57	526.01
C.J. #2	STATION	231+80.71	231+87.43	231+94.36	232+18.00		233+16.23	233+39.94	233+46.79	233+53.64
	OFFSET	37.36	37.76	38.16	39.35		41.75	41.71	41.65	41.57
	ELEVATION	528.07	529.41	527.90	529.00		527.43	525.58	526.86	525.31
RT. TOE OF PARAPET	STATION	231+19.19	231+27.11	231+34.99	231+61.90		232+68.65	232+93.36	233+00.42	233+07.46
	OFFSET	75.08	75.08	75.08	75.08		75.08	75.08	75.08	75.08
	ELEVATION	526.61	527.98	526.51	527.73		526.50	524.70	526.00	524.46


	DESIGN AGENCY	DATE	REVIEWED	DRAWN	DESIGNED		
	STRUCTUREPOINT	1/2/19	MDS	DSH	SJF		
	FILE NUMBER	STRUCTURE	REVISED	CHECKED	CHECKED		
	309763	CLB		CLB	CLB		
APPROACH SLAB DETAILS							
BRIDGE NO. - HAM-75-0440 L/R							
OVER WB I-74							
HAM-75-3.84							
PID No. 104667							
62/68							
<table border="1" style="margin: auto;"> <tr> <td>62</td> </tr> <tr> <td>68</td> </tr> </table>						62	68
62							
68							

MARK	NUMBER TOTAL	LENGTH	WEIGHT	TYPE	DIMENSIONS								
					A	B	C	D	E	R	INC		
SUPERSTRUCTURE													
S401	311	11'-5"	2372	2	8'-10"	0'-6 1/4"	2'-3"						
S402	252	30'-0"	5050	STR									
	1 SR	13'-6"											
S403	OF	TO	147	STR							0'-6 3/4"		
	13	20'-4"											
S404	71	13'-6"	640	STR									
S405	792	5'-4"	2820	42	1'-9"	3'-9"	0'-6"				0'-1 1/2"		
S406	NOT USED												
S407	32	4'-0"	86	STR									
	1 SR	2'-3"			1'-8"								
S501	OF	TO	1887	16	TO						0'-4 1/2"		
	92	37'-1"			36'-6"								
	1 SR	1'-8"											
S502	OF	TO	1831	STR							0'-4 1/2"		
	92	36'-6"											
① S503	10	37'-3"	389	16	36'-8"								
① S504	10	36'-8"	382	STR									
	1 SR	35'-9"			35'-2"								
① S505	OF	TO	2931	16	TO						0'-0 1/4"		
	77	37'-3"			36'-8"								
	1 SR	35'-2"											
① S506	OF	TO	2885	STR									
	77	36'-8"											
	2 SR	4'-9"											
S507	OF	TO	3419	STR							0'-4 1/2"		
	83	34'-9"											
	2 SR	1'-6"											
S508	OF	TO	4170	STR							0'-5"		
	95	40'-7"											
S509	72	41'-7"	3123	16	41'-0"								
S510	72	41'-0"	3079	STR									
	1 SR	2'-6"			1'-11"								
S511	OF	TO	2205	16	TO						0'-5"		
	95	42'-0"			41'-5"								
	1 SR	1'-11"											
S512	OF	TO	2147	STR							0'-5"		
	95	41'-5"											
S513	435	30'-0"	13611	STR									
	1 SR	15'-3"											
S514	OF	TO	414	STR							0'-2 1/4"		
	23	19'-3"											
S515	5	19'-3"	100	STR									
S516	117	15'-3"	1861	STR									
S517	20	10'-0"	209	STR									
S518	157	27'-4"	4476	3	9'-0"	4'-4"							
S519	163	12'-11"	2196	2	2'-6"	8'-2"	2'-6"						
S520	6	22'-10"	143	3	9'-0"	2'-1"							
S521	64	22'-0"	1469	3	9'-0"	1'-8"							
S801	14	35'-0"	1308	STR									
S802	11	39'-6"	1160	STR									
S803	11	32'-8"	959	STR									
S804	22	40'-0"	2350	STR									
S805	22	36'-1"	2120	STR									
S806	8	20'-3"	433	1	1'-5"	19'-0"							
① S807	8	13'-5"	287	1	1'-5"	12'-2"							
S808	2	7'-11"	42	16	7'-1"								
S809	2	18'-0"	96	17	16'-4"								
S810	20	15'-8"	837	17	14'-0"								
S811	2	12'-0"	64	17	10'-4"								
① S812	2	4'-11"	26	16	4'-1"								
S813	4	10'-9"	115	16	9'-11"								
S814	4	5'-10"	62	16	5'-0"								
		SUB-TOTAL											73,901

MARK	NUMBER TOTAL	LENGTH	WEIGHT	TYPE	DIMENSIONS							
					A	B	C	D	E	R	INC	
SUPERSTRUCTURE (CONT'D.)												
S815	16	5'-2"	221	18	3'-5"	0'-7"	0'-10"					
S816	1	4'-8"	12	STR								
S817	1	11'-6"	31	STR								
S818	10	9'-3"	247	STR								
① S819	2	1'-8"	9	STR								
S820	2	7'-6"	40	STR								
S821	2	2'-8"	14	STR								
S822	1	5'-7"	15	STR								
S823	1	3'-9"	10	STR								
S824	2	7'-0"	37	16	6'-2"							
S825	2	4'-10"	26	16	4'-0"							
D801	184	4'-9"	2334	18	2'-5 1/2"	1'-1"	1'-1"					
		SUB-TOTAL			2,996							
PARAPETS (DECK)												
PS501	90	7'-4"	688	23	0'-11"	3'-3"	3'-0"				0'-3"	
PS502	34	8'-6"	302	41	1'-0"	1'-7"	3'-3"	3'-0"				
PS503	24	30'-0"	751	STR								
PS504	4	20'-11"	87	STR								
PS505	12	13'-2"	165	STR								
PS506	56	2'-5"	141	2	0'-11"	0'-10"	0'-11"					
PS507	4	1'-6"	6	9	0'-11"	0'-7"	0'-11"	0'-7"				
PS508	4	4'-0"	17	10	1'-5"	1'-0"	1'-5"	1'-0"				
PS509	4	14'-1"	59	STR								
PS510	15	14'-8"	229	STR								
PS511	3	9'-6"	30	STR								
PS512	3	8'-3"	26	STR								
PS513	3	12'-5"	39	STR								
PS514	108	10'-0"	1127	23	0'-11"	4'-6"	4'-3"				0'-3"	
PS515	108	5'-10"	657	40	1'-1/2"	1'-0"	1'-7"	1'-7"				
PS516	1	12'-2"	13	STR								
PS517	1	9'-5"	10	STR								
PS518	1	11'-2"	12	STR								
PS519	1	9'-11"	10	STR								
PS520	3	10'-10"	34	STR								
PS601	34	6'-2"	315	40	1'-0"	1'-2"	1'-9"	1'-9"				
PS602	1	12'-0"	18	STR								
PS603	12	13'-2"	237	STR								
PS604	5	14'-8"	110	STR								
PS605	1	8'-7"	13	STR								
PS606	1	12'-3"	18	STR								
PS607	1	9'-6"	14	STR								
		SUB-TOTAL			5,128							

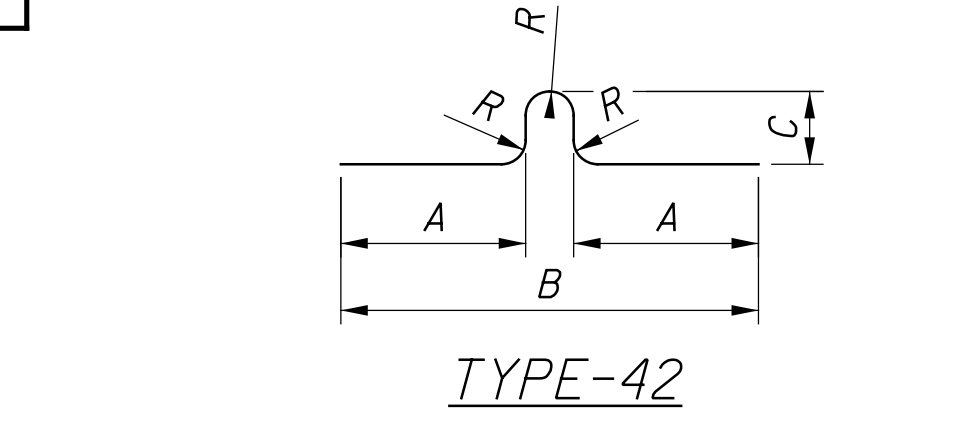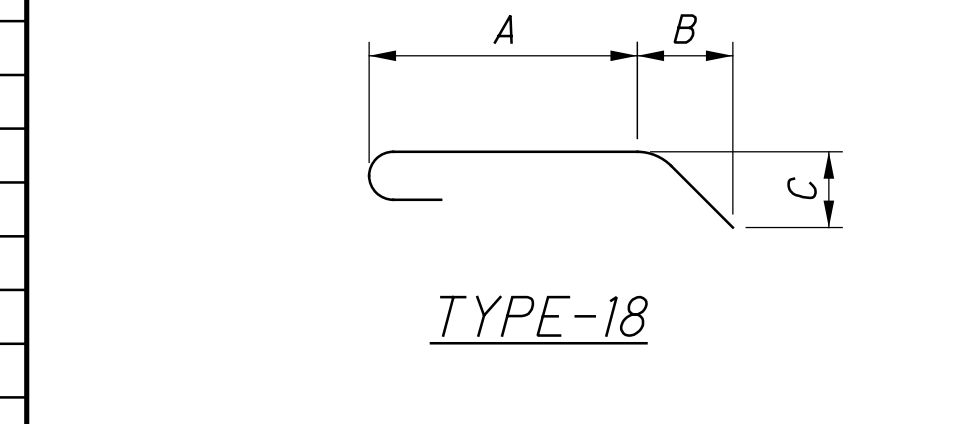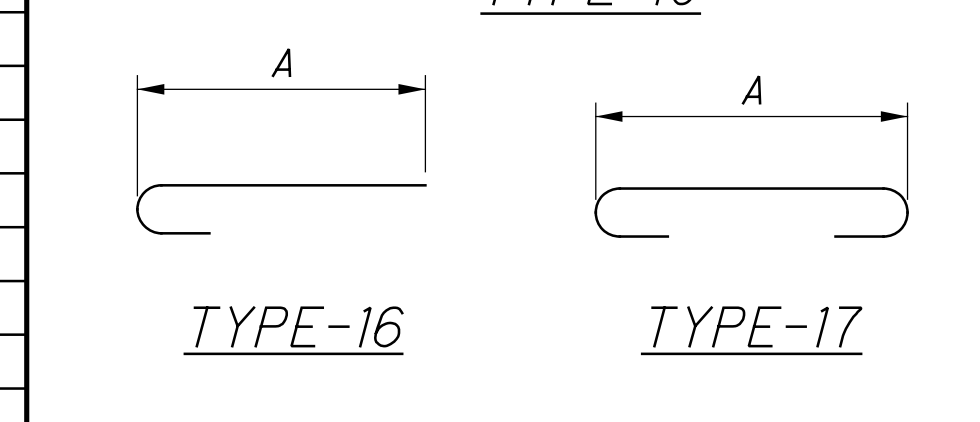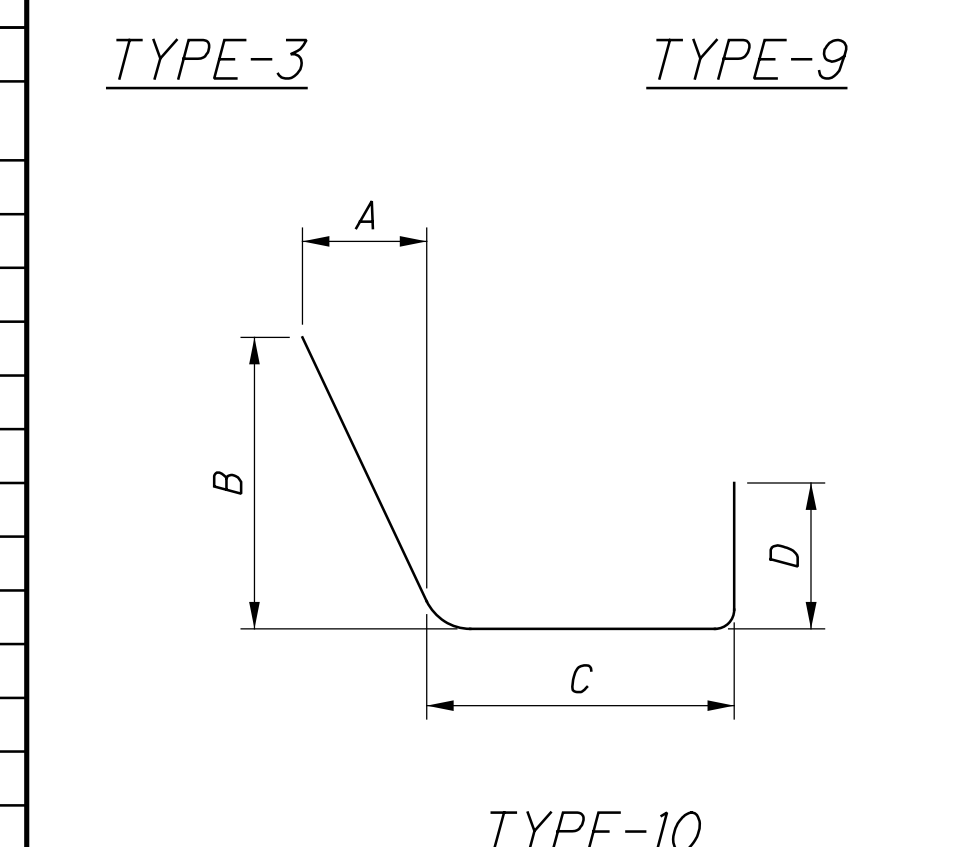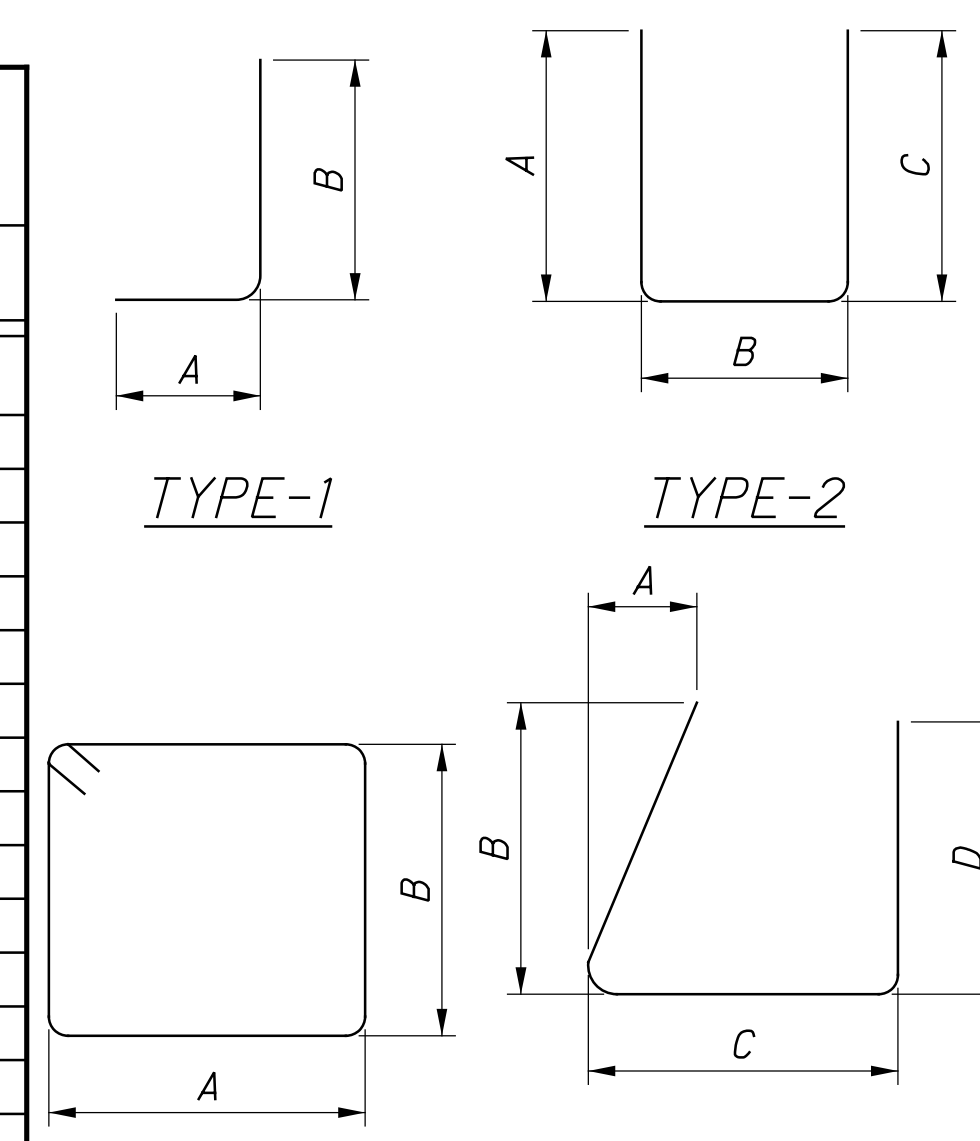


① REQUIRES MECHANICAL CONNECTORS. (109 REQUIRED)
 NOTE:
 BAR MARKS SHOWN ON THIS SHEET ARE FOR RIGHT BRIDGE ONLY.

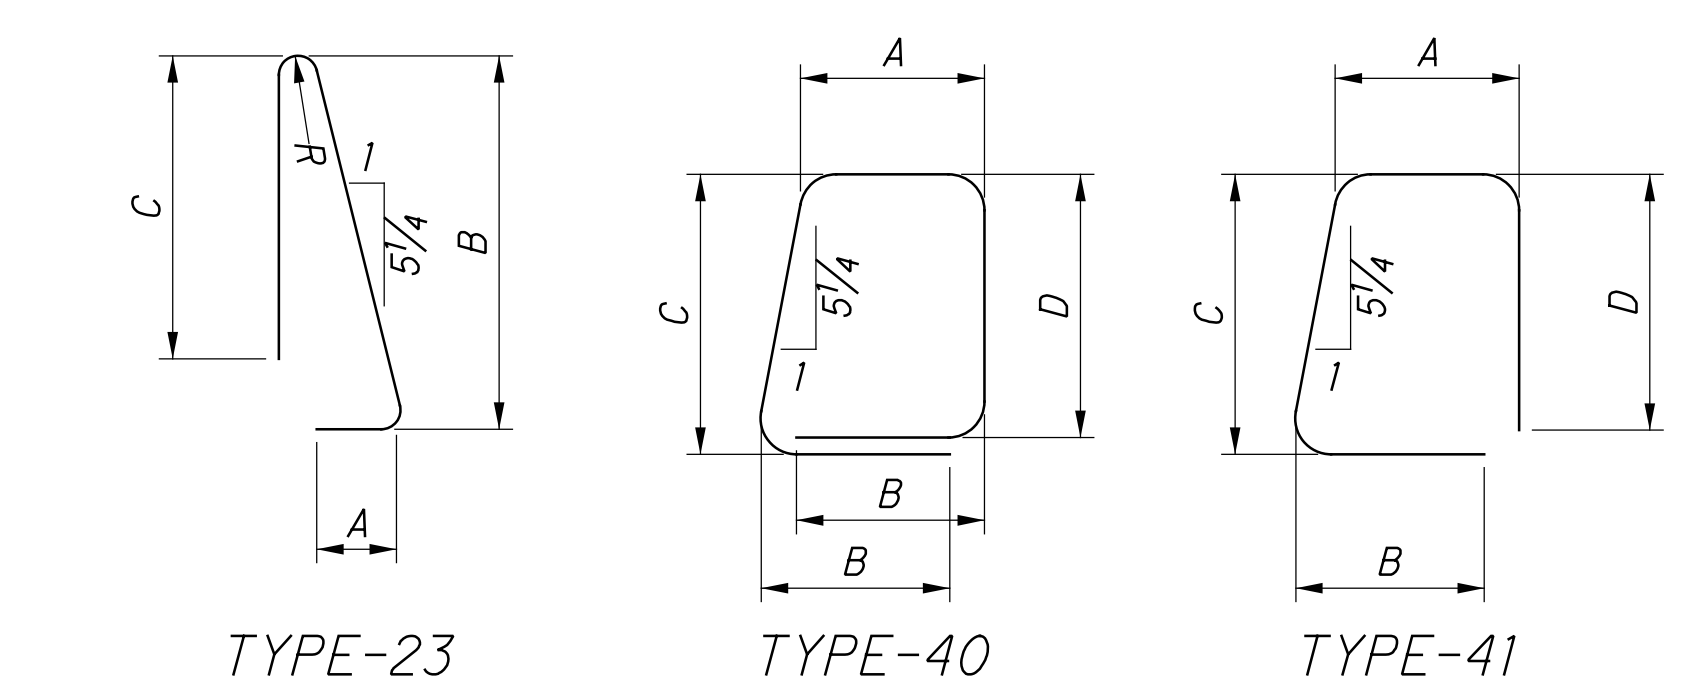


NOTES:
 ① REQUIRES MECHANICAL CONNECTORS (NON-PROTRUDING TYPE)
 AN APPROVED TYPE OF MECHANICAL CONNECTOR FOR REINFORCING SHALL BE PROVIDED. INSTALLATION OF THE CONNECTORS SHALL CONFORM WITH RECOMMENDED MANUFACTURER'S PROCEDURES. IF A DOWEL BAR SPLICE IS FURNISHED, THE MINIMUM DOWEL BAR LENGTH TO BE INCLUDED WITH THE CONNECTOR SHALL BE GIVEN BY THE DIMENSION "L" SHOWN BELOW:
 #5 REINFORCING BAR, L = 3'-6"
 WHERE MECHANICAL CONNECTORS ARE REQUIRED THE REINFORCING BAR LENGTH IS MEASURED TO THE CONSTRUCTION JOINT. EXTRA BAR LENGTH AND/OR BAR PREPARATION MAY BE NECESSARY DEPENDING ON THE TYPE OF MECHANICAL CONNECTOR FURNISHED.

S:\Flanagan\10/26/2023 4:26:51 PM\0\2017\01113\C.Design\104667-HAM-75-3.84.Design\Structures\HAM0075_0440C_Sheets\HAM0075_0440C_RL006.dgn


MARK	NUMBER			LENGTH	WEIGHT	TYPE	DIMENSIONS					
	REAR ABUT.	FWD. ABUT.	TOTAL				A	B	C	D	E	R
APPROACH SLAB PARAPETS (LEFT BRIDGE)												
AS501	12	18	30	7'-4"	229	23	0'-11"	3'-3"	3'-0"			0'-3"
AS502	10	14	24	8'-8"	217	46	1'-8"	3'-2"	1'-1"	2'-11"		
AS503	4	8	12	2'-7"	32	2	1'-0"	0'-10"	1'-0"			
AS512	4		4	12'-9"	53	STR						
AS513	4		4	10'-0"	42	STR						
AS514	4		4	6'-5"	27	STR						
AS515	4		4	5'-9"	24	25	1'-10"	2'-5"	1'-5"	0'-1 1/2"	0'-5"	
AS518	6		6	17'-5"	109	STR						
AS519	4	8	12	4'-5"	55	2	1'-0"	2'-8"	1'-0"			
AS520	4		4	3'-10"	16	2	1'-0"	2'-1"	1'-0"			
AS521		2	2	15'-0"	31	STR						
AS522		2	2	10'-6"	22	STR						
AS523	5		5	29'-2"	152	STR						
AS524	5		5	28'-5"	148	STR						
AS525	37	35	72	9'-11"	745	47	1'-0"	4'-5"	4'-2"		0'-3"	
AS526	37	35	72	6'-0"	451	40	1'-2 1/2"	1'-0"	1'-7"	1'-6"		
AS527	4		4	24'-8"	103	STR						
AS528	1		1	15'-3"	16	STR						
AS529		5	5	28'-11"	151	STR						
AS530		5	5	30'-4"	158	STR						
AS531	1		1	16'-9"	17	STR						
AS601	22	32	54	6'-3"	507	40	1'-2"	1'-0"	1'-9"	1'-8"		
	2 SR		2 SR	3'-11"				3'-1"				
AS606	OF		OF	TO	159	1	1'-0"	TO				0'-1"
	12		12	4'-10"				4'-0"				
AS607	6		6	4'-0"	36	1	1'-0"	3'-2"				
AS610	1		1	16'-9"	28	STR						
AS611		1										
AS612		1	1	10'-6"	16	STR						
AS613	1		1	28'-8"	43	STR						
AS614		1	1	30'-2"	45	STR						
SUB-TOTAL					3,649							
APPROACH SLABS (LEFT BRIDGE)												
B505	260	195	455	30'-0"	14237	STR						
B506	65		65	15'-4"	1040	STR						
B507		65	65	37'-0"	2508	STR						
C504	50	50	100	29'-6"	3077	STR						
C506	2		2	28'-0"	59	STR						
C507		2	2	24'-6"	51	STR						
SS501	8		8	40'-0"	334	STR						
SS502	72	72	144	12'-5"	1865	STR						
SS504	24	32	56	30'-0"	1752	STR						
A1004	135	135	270	30'-11"	35919	16	29'-6"					
A1006	3		3	29'-5"	380	16	28'-0"					
A1007		3	3	25'-11"	335	16	24'-6"					
SUB-TOTAL					61,557							

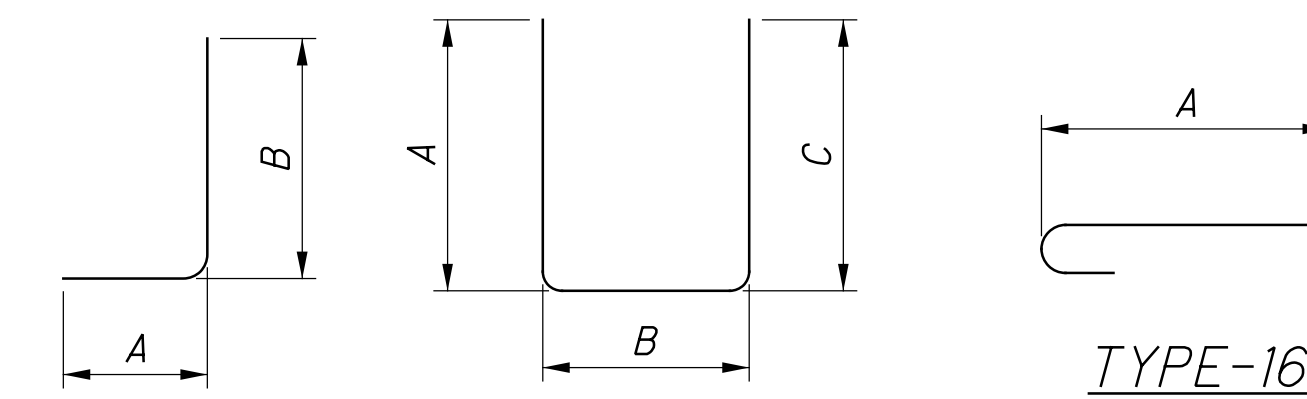

TYPE-1 TYPE-2 TYPE-16

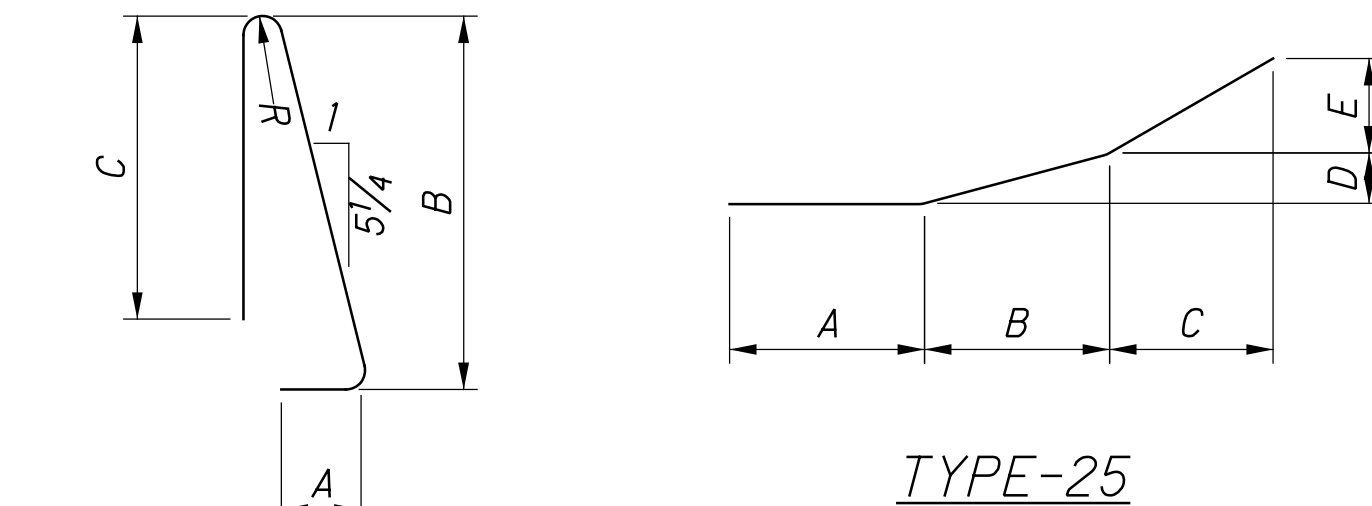

TYPE-23 TYPE-25

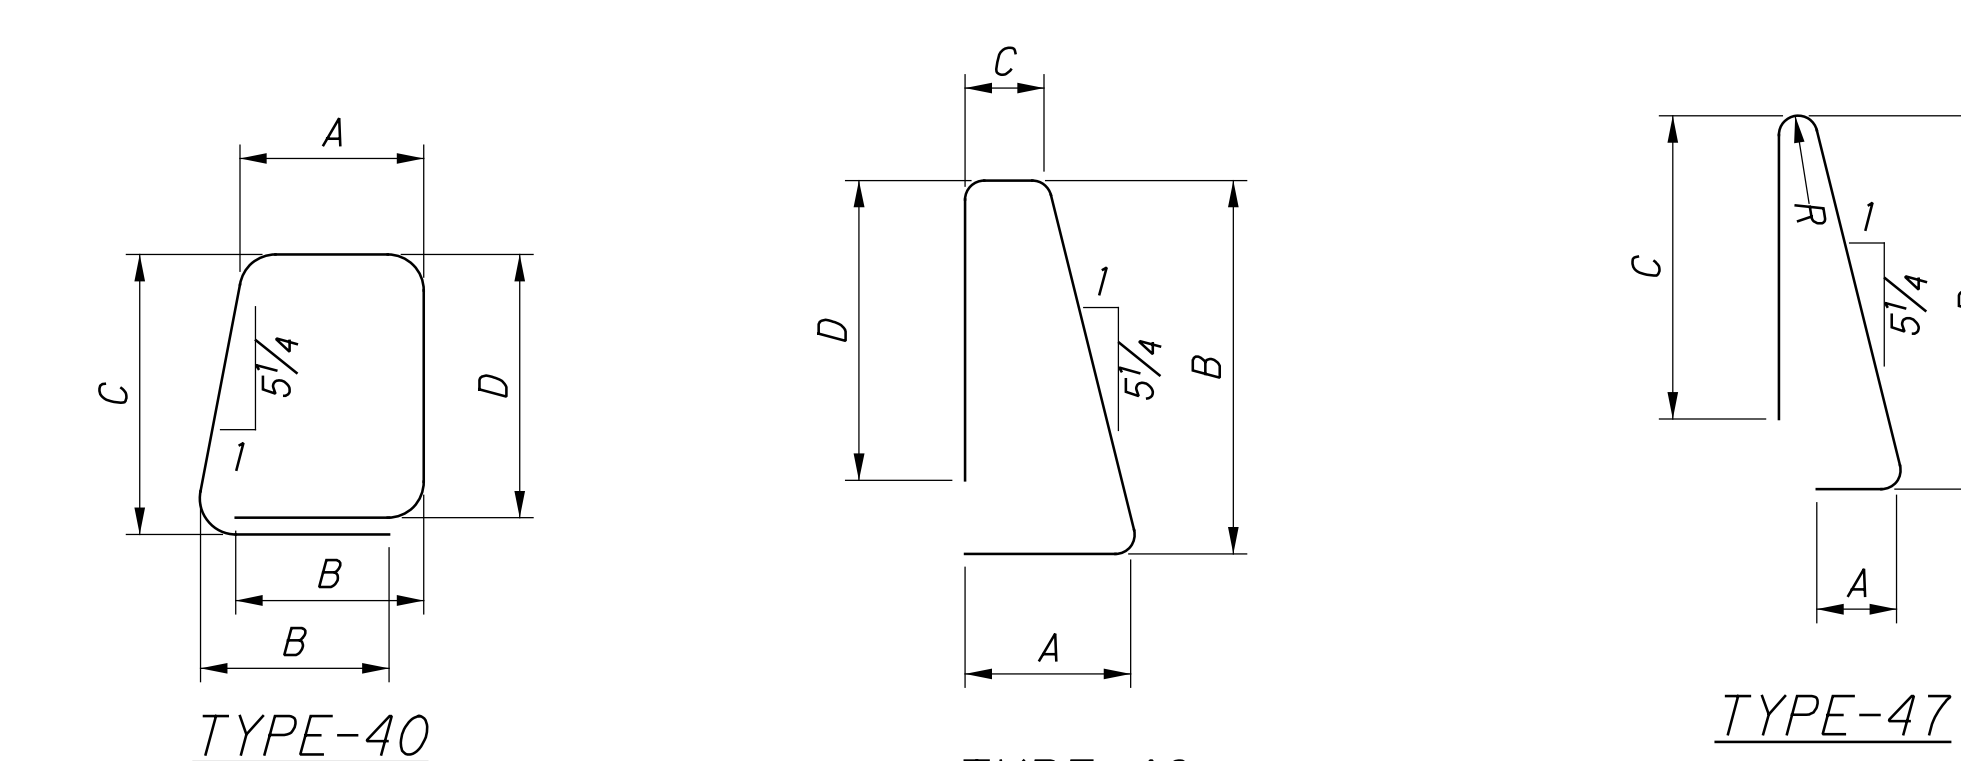

TYPE-40 TYPE-46 TYPE-47

NOTES:
 ALL REINFORCING STEEL SHALL BE EPOXY COATED, GRADE 60.
 LENGTHS ARE RECORDED IN FEET - INCHES.
 "STR" IN THE TYPE COLUMN INDICATES STRAIGHT BARS.
 ALL DIMENSIONS ARE MEASURED OUT-TO-OUT OF BAR.
 THE LENGTH OF BENT BARS IS MEASURED ALONG THE CENTERLINE.
 THE BAR SIZE NUMBER IS SPECIFIED ON THE PLANS IN THE BAR MARK COLUMN. THE FIRST DIGIT WHERE THREE DIGITS ARE USED, AND THE FIRST TWO DIGITS WHERE FOUR DIGITS ARE USED, INDICATES THE BAR SIZE NUMBER. FOR EXAMPLE, P601 IS A NO. 6 BAR.
 "R" INDICATES INSIDE RADIUS, UNLESS OTHERWISE NOTED.
 "STD" WRITTEN IN PLACE OF A DIMENSION INDICATES A STANDARD BEND AT THE END OF THE BAR.
 FOR STANDARD HOOK DIMENSIONS, SEE SECTION 509.05 OF THE SPECIFICATIONS.
 PAYMENT FOR REINFORCING STEEL SHALL BE INCLUDED IN THE CONTRACT PRICE BID FOR ITEM 509, EPOXY COATED REINFORCING STEEL.
 REINFORCING SAMPLES: REFER TO CMS SECTIONS 106.02, 700, 709.01 THROUGH 709.05 AND 709.08. SUFFICIENT ADDITIONAL REINFORCING STEEL SHALL BE PROVIDED FOR SAMPLING. RANDOM SAMPLES SHALL BE REPLACED IN THE STRUCTURE BY THE ADDITIONAL STEEL, SPLICED IN ACCORDANCE WITH 509.07.

DESIGN AGENCY
 STRUCTUREPOINT
 2000 CORPORATE PARKWAY SUITE 200
 FARMINGTON, CT 06030
 TEL: 860.633.7000 FAX: 860.633.7001
 WWW.STRUCTUREPOINT.COM

DATE
 1/18/19

REVIEWED
 MDS

DRAWN
 DSH

DESIGNED
 SJF

STRUCTURE FILE NUMBER
 3109763

REVISER
 REVISED

CHECKED
 CLB

REINFORCING STEEL LIST (LEFT BRIDGE)

BRIDGE NO. - HAM-75-0440 L/R
 OVER WB I-74




HAM-75-3.84
PID No. 104667

67/68

67
 68

S:\Flannagan\10_26_2023\01_2017\01113\C.Design\104667_HAM-75-3.84.Design\Structures\HAM0075_0440C\Sheets\HAM0075_0440C_RL005.dgn

MARK	NUMBER			LENGTH	WEIGHT	TYPE	DIMENSIONS							
	REAR ABUT.	FWD. ABUT.	TOTAL				A	B	C	D	E	R	INC	
APPROACH SLAB PARAPETS (RIGHT BRIDGE)														
AS501	24	12	36	7'-4"	275	23	0'-11"	3'-3"	3'-0"			0'-3"		
AS502	14	11	25	8'-8"	226	46	1'-8"	3'-2"	1'-1"	2'-11"				
AS503	12	4	16	2'-7"	43	2	1'-0"	0'-10"	1'-0"					
AS504	4		4	29'-10"	124	STR								
AS505	2		2	13'-2"	27	STR								
AS506	2		2	7'-5"	15	STR								
AS507	1		1	9'-10"	10	STR								
AS508	8		8	3'-7"	30	2	1'-0"	1'-10"	1'-0"					
AS509		4	4	3'-1"	13	2	1'-0"	3'-1"	1'-0"					
AS510		4	4	6'-10"	29	2	1'-0"	5'-1"	1'-0"					
AS511		4	4	19'-1"	80	STR								
AS512		4	4	12'-9"	53	STR								
AS513		4	4	10'-0"	42	STR								
AS514		4	4	6'-5"	27	STR								
AS515		4	4	5'-9"	24	25	1'-10"	2'-5"	1'-5"	0'-1 1/2"	0'-5"			
AS516	5		5	31'-1"	162	STR								
AS517		5	5	27'-2"	142	STR								
AS525	37	35	72	9'-11"	745	47	1'-0"	4'-5"	4'-2"			0'-3"		
AS526	37	35	72	6'-0"	451	40	1'-2 1/2"	1'-0"	1'-7"	1'-6"				
AS532		1	1	18'-0"	19	STR								
AS533		1	1	17'-0"	18	STR								
AS534	5		5	32'-10"	171	STR								
AS535		5	5	26'-7"	139	STR								
AS536	1		1	10'-10"	11	STR								
AS601	38	23	61	6'-3"	573	40	1'-2"	1'-0"	1'-9"	1'-8"				
AS602	1		1	13'-2"	20	STR								
AS603	1		1	7'-5"	11	STR								
AS604	1		1	9'-10"	15	STR								
AS605		1	1	18'-0"	27	STR								
		2 SR	2 SR	3'-11"				3'-1"						
AS606		OF	OF	TO	159	1	1'-0"	TO				0'-1"		
		12	12	4'-10"				4'-0"						
AS607		6	6	3'-11"	35	1	1'-0"	3'-1"						
AS608	1		1	32'-8"	49	STR								
AS609		1	1	26'-9"	40	STR								
			SUB-TOTAL		3,805									
APPROACH SLABS (RIGHT BRIDGE)														
B501	130	130	260	40'-0"	10847	STR								
B502	65		65	34'-6"	2339	STR								
B503	65	65	130	32'-0"	4339	STR								
B504		65	65	26'-0"	1763	STR								
C504	56	53	109	29'-6"	3354	STR								
C505		2	2	26'-1"	55	STR								
SS501	16	16	32	40'-0"	1335	STR								
SS502	76	75	151	12'-5"	1956	STR								
SS503	8		8	36'-0"	300	STR								
SS504	8		8	30'-0"	250	STR								
SS505		8	8	22'-0"	184	STR								
SS506		8	8	28'-0"	234	STR								
A1004	145	139	284	30'-11"	37782	16	29'-6"							
A1005		3	3	27'-6"	355	16	26'-1"							
			SUB-TOTAL		65,093									

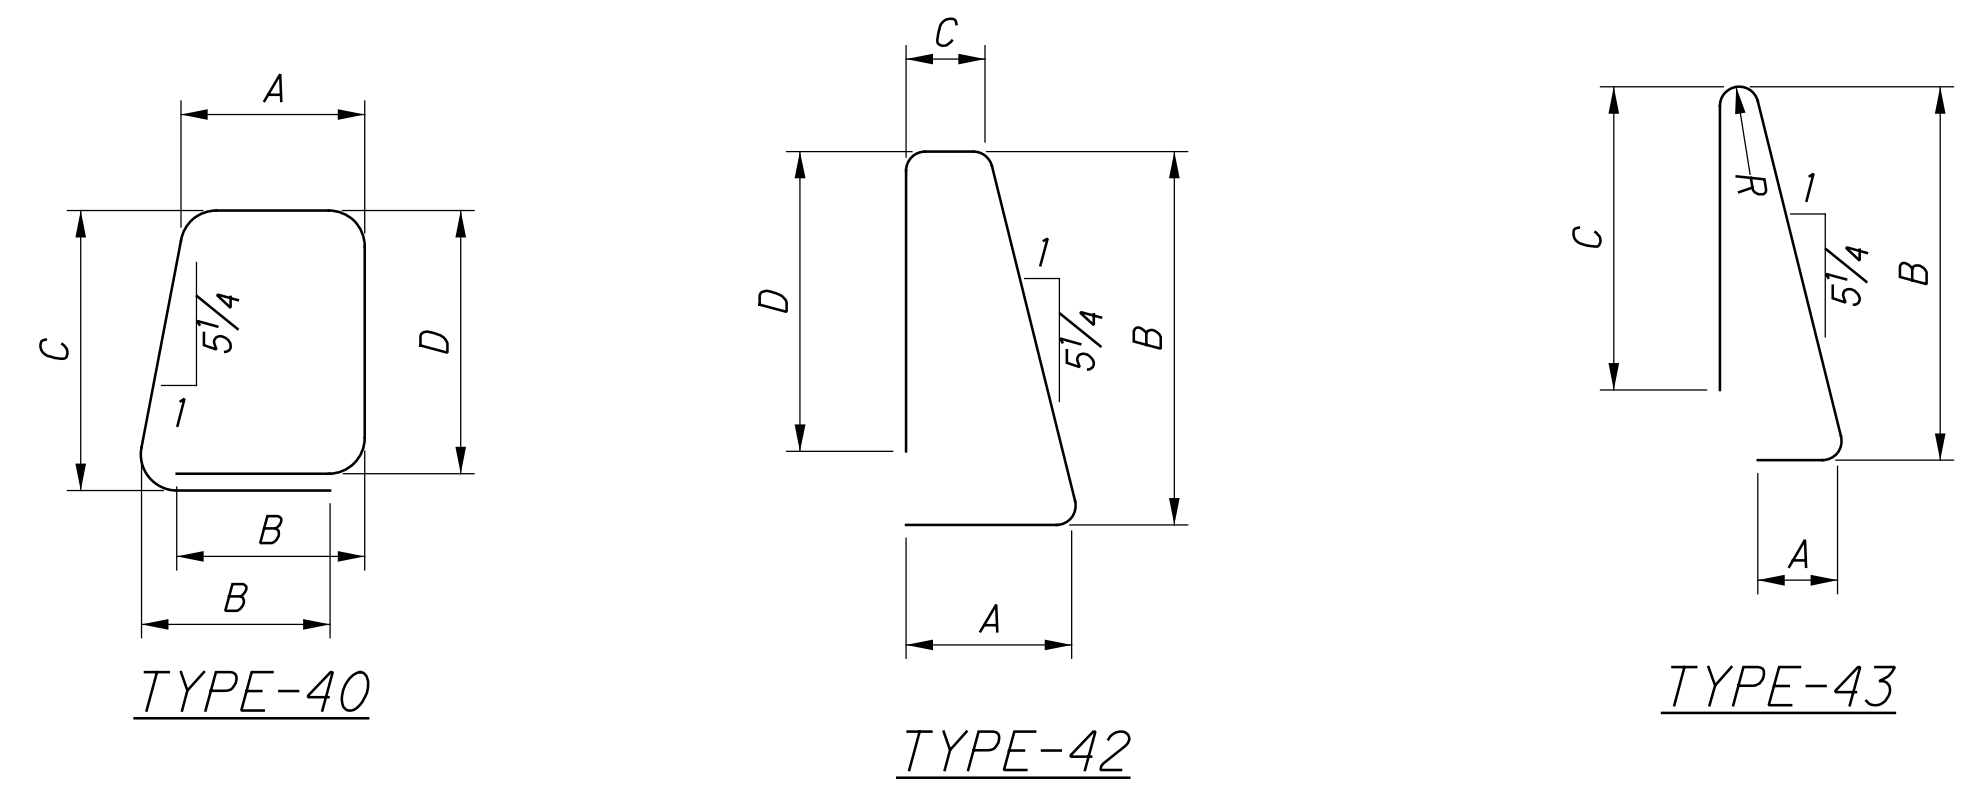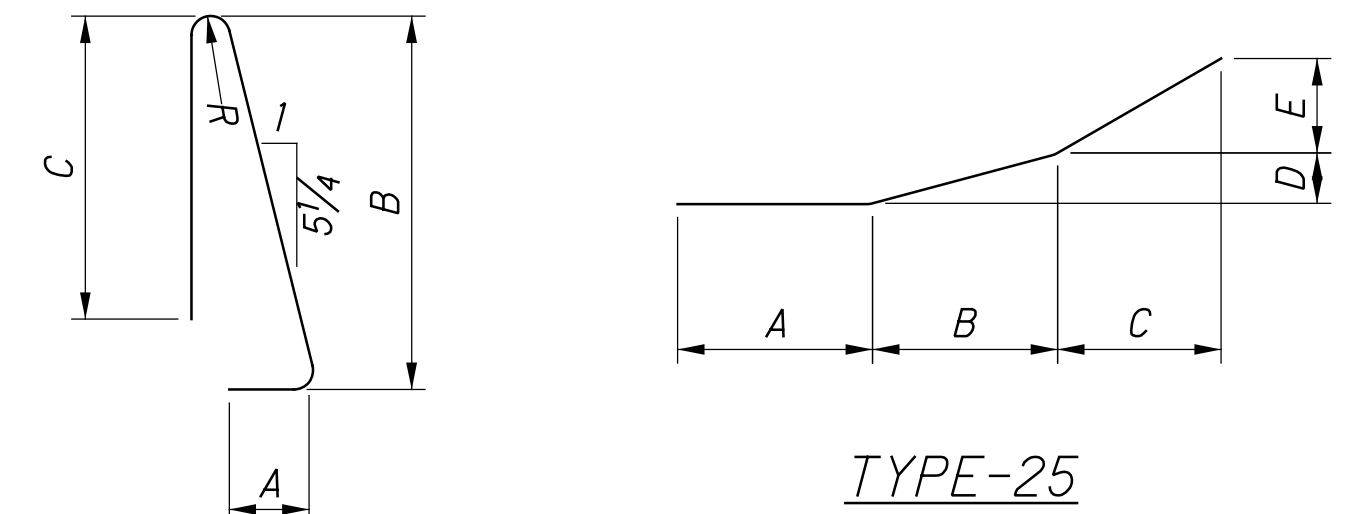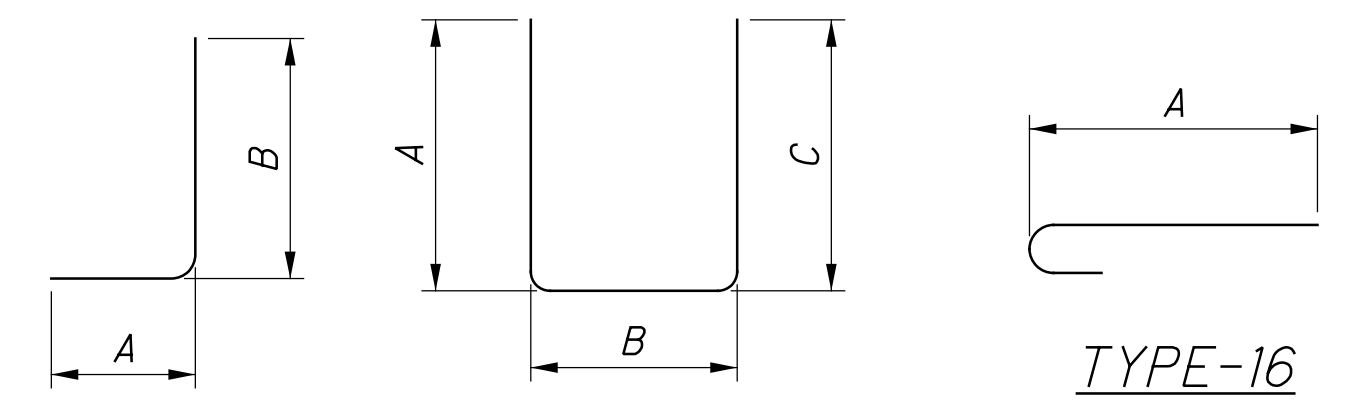

NOTES:

ALL REINFORCING STEEL SHALL BE EPOXY COATED, GRADE 60.

LENGTHS ARE RECORDED IN FEET - INCHES.

"STR" IN THE TYPE COLUMN INDICATES STRAIGHT BARS.

ALL DIMENSIONS ARE MEASURED OUT-TO-OUT OF BAR.

THE LENGTH OF BENT BARS IS MEASURED ALONG THE CENTERLINE.

THE BAR SIZE NUMBER IS SPECIFIED ON THE PLANS IN THE BAR MARK COLUMN. THE FIRST DIGIT WHERE THREE DIGITS ARE USED, AND THE FIRST TWO DIGITS WHERE FOUR DIGITS ARE USED, INDICATES THE BAR SIZE NUMBER. FOR EXAMPLE, P601 IS A NO. 6 BAR. "R" INDICATES INSIDE RADIUS, UNLESS OTHERWISE NOTED. "STD" WRITTEN IN PLACE OF A DIMENSION INDICATES A STANDARD BEND AT THE END OF THE BAR.

FOR STANDARD HOOK DIMENSIONS, SEE SECTION 509.05 OF THE SPECIFICATIONS.

PAYMENT FOR REINFORCING STEEL SHALL BE INCLUDED IN THE CONTRACT PRICE BID FOR ITEM 509, EPOXY COATED REINFORCING STEEL.

REINFORCING SAMPLES: REFER TO CMS SECTIONS 106.02, 700, 709.01 THROUGH 709.05 AND 709.08. SUFFICIENT ADDITIONAL REINFORCING STEEL SHALL BE PROVIDED FOR SAMPLING. RANDOM SAMPLES SHALL BE REPLACED IN THE STRUCTURE BY THE ADDITIONAL STEEL, SPLICED IN ACCORDANCE WITH 509.07.

DESIGN AGENCY
STRUCTUREPOINT
3000 CORPORATE PARKWAY SUITE 200
FARMINGTON, CT 06032
TEL: 860.633.8000 FAX: 860.633.8001
WWW.STRUCTUREPOINT.COM

DATE
1/18/19

REVIEWED
MDS

DRAWN
DSH

DESIGNED
SJF

BRIDGE NO. - HAM-75-0440 L/R
OVER WB I-74

REINFORCING STEEL LIST (RIGHT BRIDGE)

PID No. 104667

68 / 68



45610 Woodland Road, Suite 200, Sterling, VA 20166
Tel: 703-547-8797 Fax: 703-348-8485
www.reinforcedearth.com

November 4, 2020

Walsh Construction Company
3298 Spring Grove Ave.
Cincinnati OH 45225

Attn: Zach Wirrig

SUBJECT: **HAM-75-0440 Wire Walls**
Wire Wall C and D Geometry
RECo Project No. 20114 (PN2752)

The Reinforced Earth Company (RECo) has been informed that Walsh Construction Company intends to build temporary Walls C and D with modified geometry compared to that shown in the design drawings. This geometry is shown in the attached elevation views and photograph.

The additional area of the wire wall should be built with the same Miragrid weight (i.e. 7XT, 5XT, or 3XT) as the adjacent as-designed sections at the same elevation. The slight plan view bend shown in the photograph does not affect the design calculations or wall stability, so it is acceptable. The same design calculations and bearing pressures apply to the wall as shown in the attached elevation, so no additional calculations are necessary.

If you have any questions, please contact me at (703) 547-8797.

Sincerely,

THE REINFORCED EARTH COMPANY

A handwritten signature in black ink, appearing to read "K.C. Von Handorf".

Kevin Von Handorf, P.E., S.E.
Senior Engineer

Attachments




11-4-2020



NOTES:

1. BACK FACE OF WALL SHOWN
2. APPLIED BEARING PRESSURE SHOWN AS: FACTORED

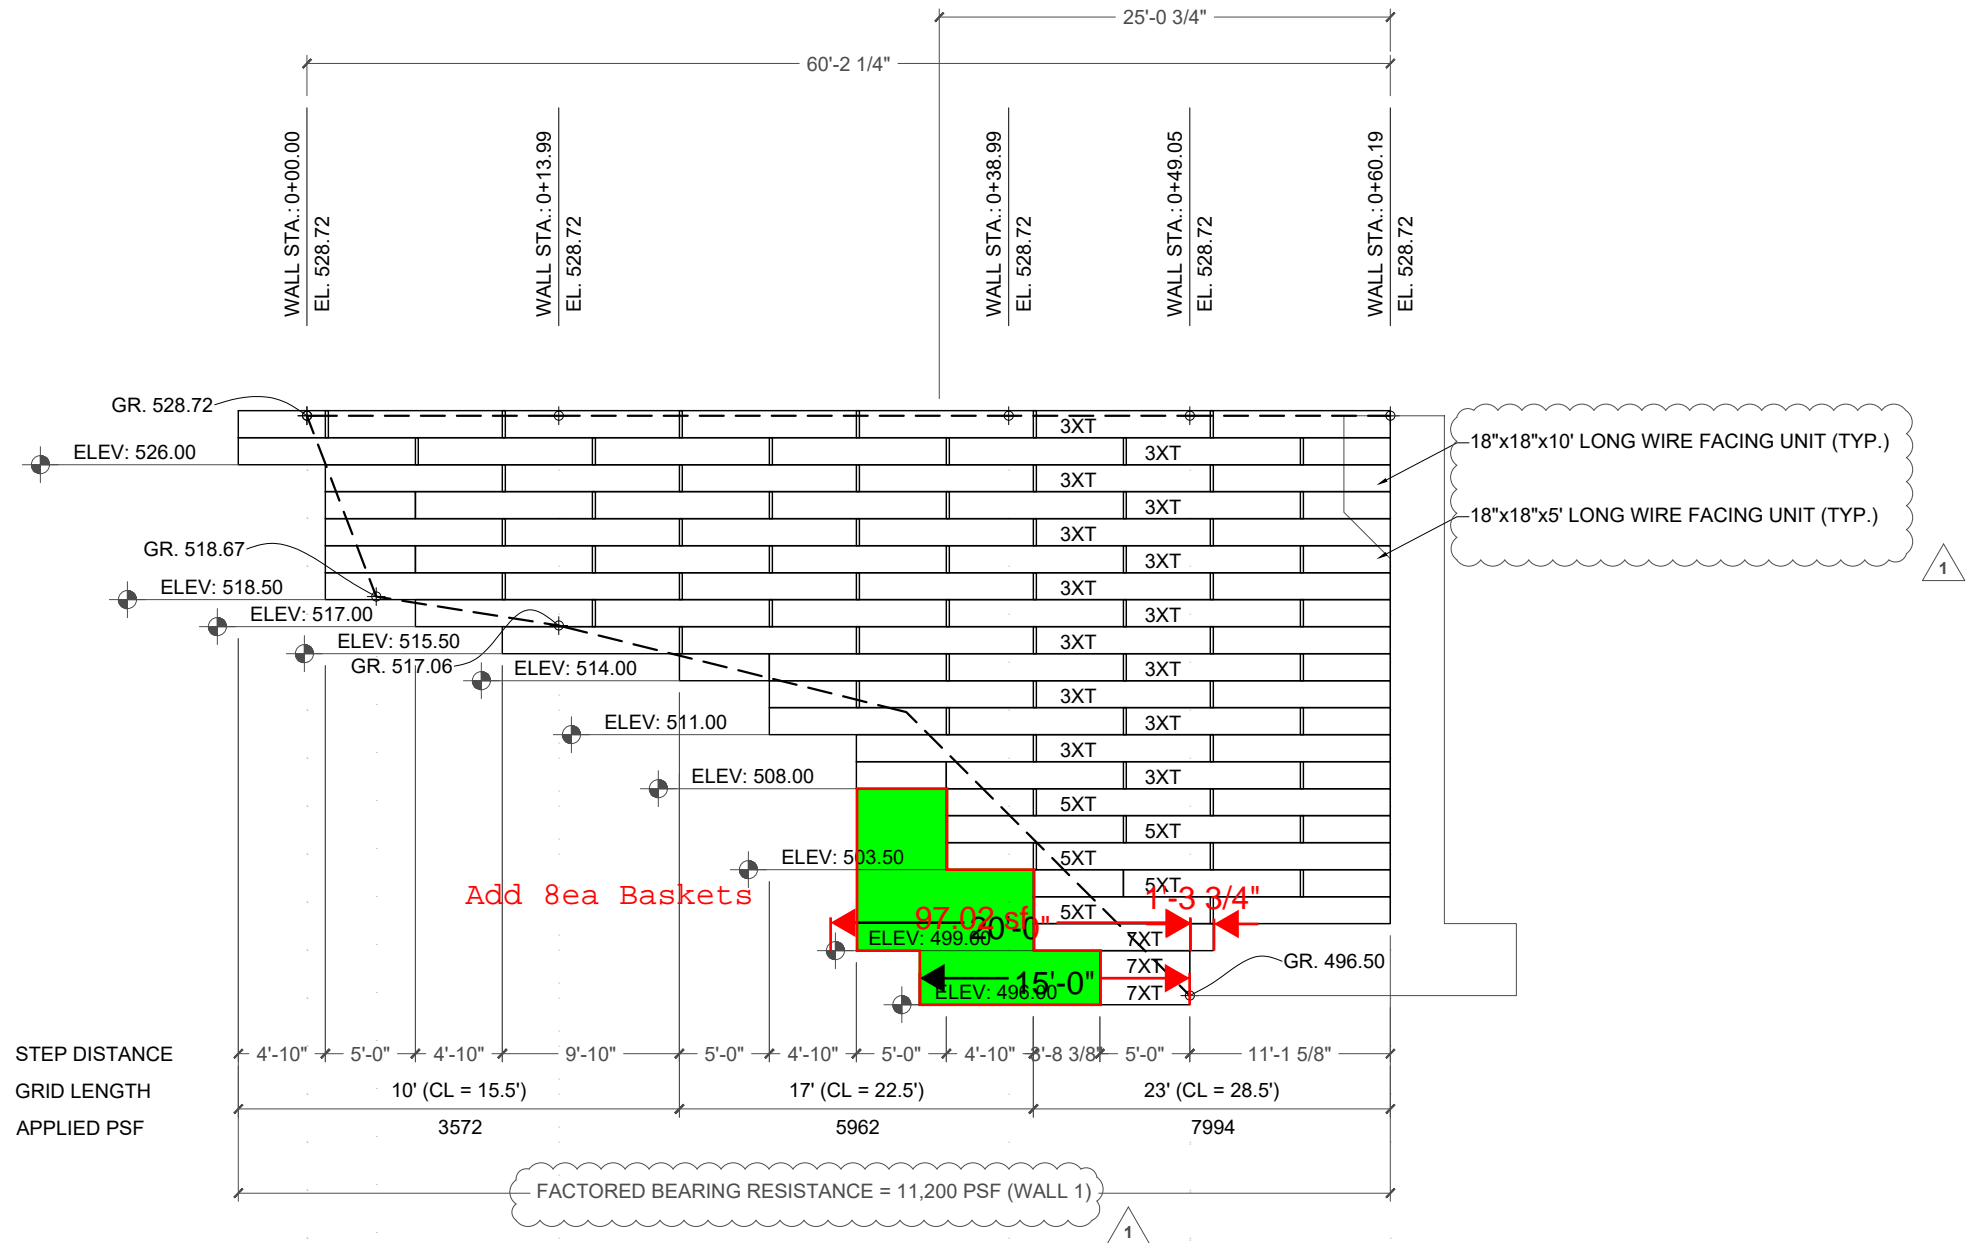

WIRE WALL C (BACK FACE)
NO SCALE

COPYRIGHT 2019 THE REINFORCED EARTH COMPANY®

THIS DRAWING CONTAINS INFORMATION PROPRIETARY TO THE REINFORCED EARTH COMPANY, AND IS BEING FURNISHED FOR THE USE OF _____ ONLY IN CONNECTION WITH THIS PROJECT, AND THE INFORMATION CONTAINED HEREIN IS NOT TO BE TRANSMITTED TO ANY OTHER ORGANIZATION UNLESS SPECIFICALLY AUTHORIZED IN WRITING BY THE REINFORCED EARTH COMPANY. THE REINFORCED EARTH COMPANY IS EXCLUSIVE LICENSEE IN THE UNITED STATES UNDER PATENTS HELD BY OUR AFFILIATED COMPANIES, AND THE FURNISHING OF THIS DRAWING DOES NOT CONSTITUTE AN EXPRESSED OR IMPLIED LICENSE UNDER ANY APPLICABLE PATENTS.

PREPARED BY:
REINFORCED EARTH
11640 North Park Drive - Suite 110
Wake Forest, NC 27587
Ph.: (919)453-2011 / Fax.: (513)297-7930

DESIGN BY: JL
DRAWN BY: JL
CHECKED BY: KV

PROJECT NAME: **STATE PROJECT #HAM-75-3.84**
PID 104667
MILL CREEK EXPRESSWAY PHASE 5A
WIRE WALLS

THE DESIGN CONTAINED ON THESE DRAWINGS IS BASED ON INFORMATION PROVIDED BY THE OWNER ON THE BASIS OF THIS INFORMATION, THE REINFORCED EARTH COMPANY HAS DESIGNED, AND IS RESPONSIBLE FOR THE INTERNAL STABILITY OF THE STRUCTURE ONLY. EXTERNAL STABILITY, INCLUDING FOUNDATION BEARING CAPACITY AND SETTLEMENT) AND GLOBAL STABILITY (INCLUDING SLIDING AND ROTATION), IS THE RESPONSIBILITY OF THE OWNER.

PAGE NAME:
WIRE WALL ELEVATION


SUBMITTAL DATE: 06/11/2019
11/13/2019 REV. 1

PROJECT NO.: **2752**
PLAN VIEW, NOTES & LOGO

SET: **S** PAGE #: **2.03**

NOTES:

1. BACK FACE OF WALL SHOWN
2. APPLIED BEARING PRESSURE SHOWN AS: FACTORED

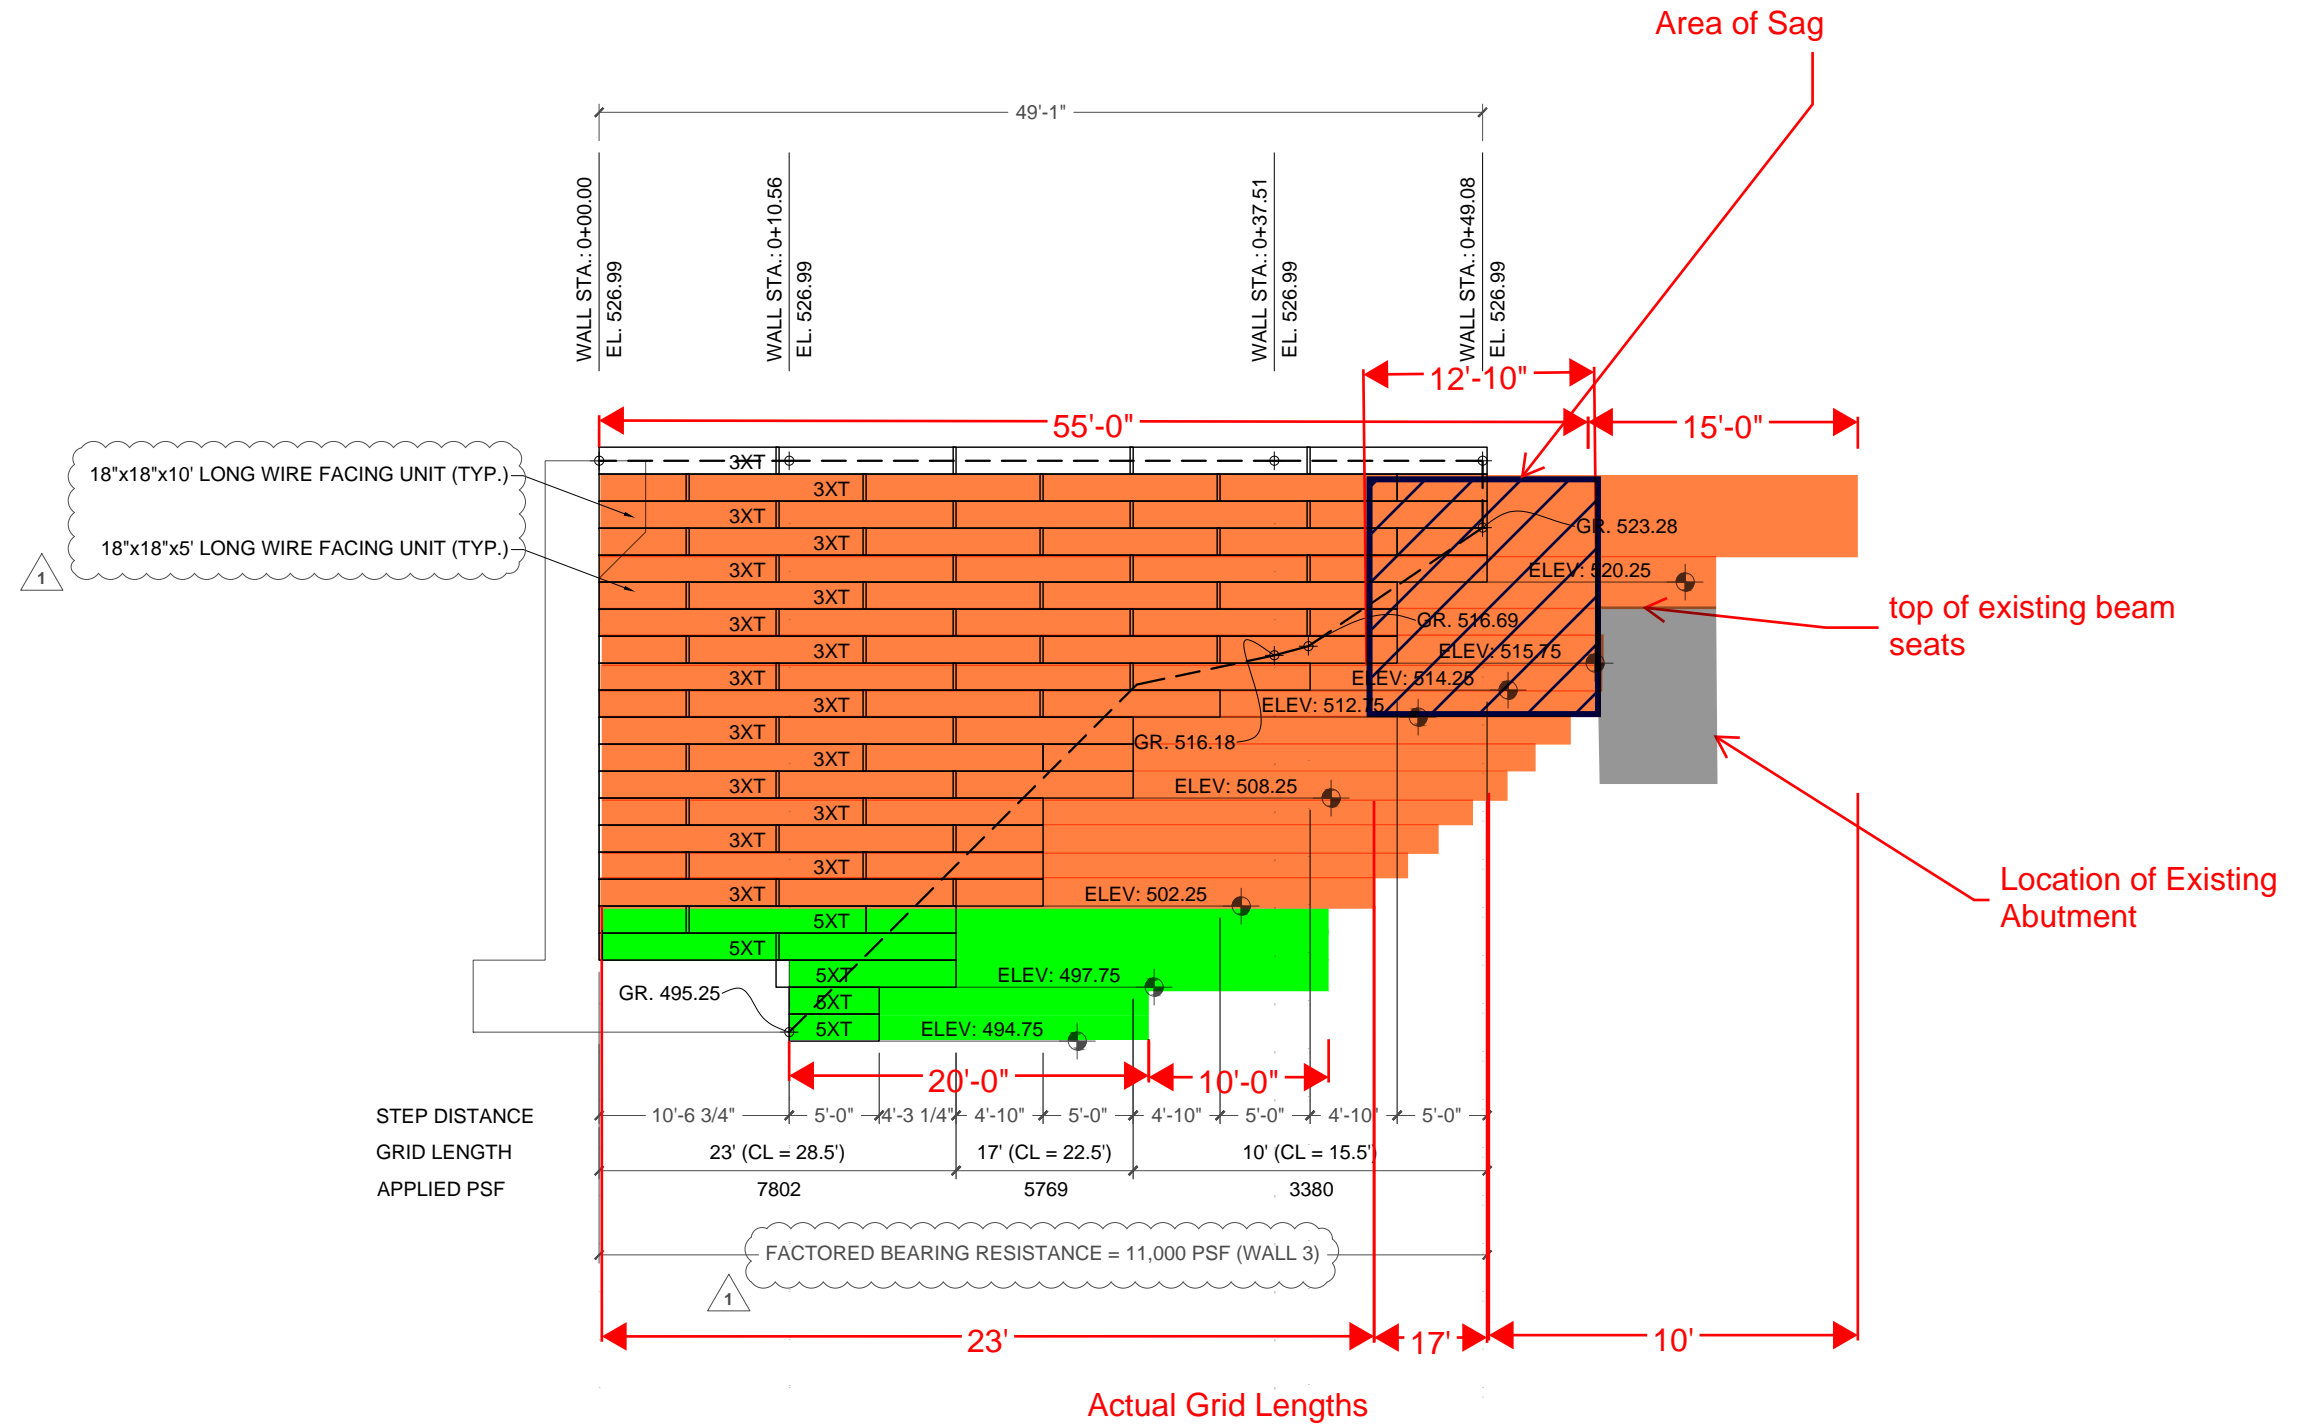

WIRE WALL D (BACK FACE)
NO SCALE

COPYRIGHT 2019 THE REINFORCED EARTH COMPANY®

THIS DRAWING CONTAINS INFORMATION PROPRIETARY TO THE REINFORCED EARTH COMPANY, AND IS BEING FURNISHED FOR THE USE OF ODOT ONLY IN CONNECTION WITH THIS PROJECT. AND THE INFORMATION CONTAINED HEREIN IS NOT TO BE TRANSMITTED TO ANY OTHER ORGANIZATION UNLESS SPECIFICALLY AUTHORIZED IN WRITING BY THE REINFORCED EARTH COMPANY. THE REINFORCED EARTH COMPANY IS EXCLUSIVE LICENSEE IN THE UNITED STATES UNDER PATENTS HELD BY OUR AFFILIATED COMPANIES, AND THE FURNISHING OF THIS DRAWING DOES NOT CONSTITUTE AN EXPRESSED OR IMPLIED LICENSE UNDER ANY APPLICABLE PATENTS.

PREPARED BY:
REINFORCED EARTH
11640 North Park Drive - Suite 110
Wake Forest, NC 27587
Ph.: (919)453-2011 / Fax.: (513)297-7930

DESIGN BY: JL
DRAWN BY: JL
CHECKED BY: KV

PROJECT NAME: **STATE PROJECT #HAM-75-3.84**
PID 104667
MILL CREEK EXPRESSWAY PHASE 5A
WIRE WALLS
HAMILTON COUNTY


THE DESIGN CONTAINED ON THESE DRAWINGS IS BASED ON INFORMATION PROVIDED BY THE OWNER. ON THE BASIS OF THIS INFORMATION, THE REINFORCED EARTH COMPANY HAS DESIGNED, AND IS RESPONSIBLE FOR THE INTERNAL STABILITY OF THE STRUCTURE ONLY. EXTERNAL STABILITY, INCLUDING FOUNDATION BEARING CAPACITY AND SETTLEMENT, AND GLOBAL STABILITY (INCLUDING SLIDING AND ROTATION), IS THE RESPONSIBILITY OF THE OWNER.

PAGE NAME:
WIRE WALL ELEVATION

SUBMITTAL DATE: 06/11/2019
PROJECT NO.: 2752
11/13/2019 REV. 1 PLAN VIEW, NOTES & LOGO

SET
PAGE #
S 2.04

WALL	ESTIMATED SELECT BACKFILL VOLUME
WALL 1	936
WALL 2	399
WALL 3	1038
WALL 4	250

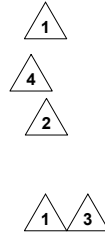

INSTALLED WALL AREA:
 WALL 1: 1,575 SF
 WALL 2: 616 SF
 WALL 3: 1,558 SF
 WALL 4: 442 SF
 (INSTALLED WALL AREA CALCULATED FROM TOP OF LEVELING PAD TO TOP OF PANEL)

DESIGN, MATERIALS AND CONSTRUCTION ARE BASED ON AASHTO LRFD BRIDGE DESIGN & CONSTRUCTION SPECIFICATIONS 2018, 8TH EDITION, AND THE ODOT BRIDGE DESIGN MANUAL 2007.

SINE WALL®

STATE PROJECT #HAM-75-3.84

PID 104677

MILL CREEK EXPRESSWAY PHASE 5A

WALLS 1-4

HAMILTON COUNTY, OHIO

THESE DRAWINGS AND INCLUDED DESIGN ARE BASED ON THE CONTRACT PLANS DATED 02/05/2019, PREPARED BY AMERICAN STRUCTUREPOINT, INC.

SHEET INDEX (MSE WALL)		
SHEET NO.	CONTENTS	REVISION
CVR	COVER SHEET-INDEX	1,3,4
NTS	GENERAL NOTES & SPECIFICATIONS	3
1.01 - 1.02	MSE WALL PLAN	1,3
2.01 - 2.04	MSE WALL ELEVATION	1,2,3,4
3.01	(REMOVED THIS PAGE)	
3.02	TYPICAL MSE DETAILS	3
3.03	TYPICAL WALL SECTIONS	1,3

CERTIFIED WITH RESPECT TO THE INTERNAL STABILITY OF SINE WALL STRUCTURES ONLY.



BY SIGNING AND SEALING THIS COVER SHEET, I CERTIFY THAT THE DRAWINGS HEREIN, REFERENCED IN THE SHEET INDEX, WERE PREPARED OR APPROVED BY ME, A PROFESSIONAL ENGINEER IN THE STATE OF OHIO.

DESIGNED BY: JIM LEE CHECKED BY: KEVIN VON HANDORF

COPYRIGHT 2019 THE REINFORCED EARTH COMPANY®

THIS DRAWING CONTAINS INFORMATION PROPRIETARY TO THE REINFORCED EARTH COMPANY, AND IS BEING FURNISHED FOR THE USE OF ODOT ONLY IN CONNECTION WITH THIS PROJECT. AND THE INFORMATION CONTAINED HEREIN IS NOT TO BE TRANSMITTED TO ANY OTHER ORGANIZATION UNLESS SPECIFICALLY AUTHORIZED IN WRITING BY THE REINFORCED EARTH COMPANY. THE REINFORCED EARTH COMPANY IS EXCLUSIVE LICENSEE IN THE UNITED STATES UNDER PATENTS HELD BY OUR AFFILIATED COMPANIES, AND THE FURNISHING OF THIS DRAWING DOES NOT CONSTITUTE AN EXPRESSED OR IMPLIED LICENSE UNDER ANY APPLICABLE PATENTS.

PREPARED BY:

 11640 North Park Drive - Suite 110
 Wake Forest, NC 27587
 Ph.: (919)453-2011 / Fax.: (513)297-7930

DESIGN BY: JL
 DRAWN BY: JL
 CHECKED BY: KV
 PROJECT NAME: **STATE PROJECT #HAM-75-3.84**
PID 104677
MILL CREEK EXPRESSWAY PHASE 5A
WALLS 1-4
 HAMILTON COUNTY OHIO

THE DESIGN CONTAINED ON THESE DRAWINGS IS BASED ON INFORMATION PROVIDED BY THE OWNER. ON THE BASIS OF THIS INFORMATION, THE REINFORCED EARTH COMPANY HAS DESIGNED, AND IS RESPONSIBLE FOR THE INTERNAL STABILITY OF THE STRUCTURE ONLY. EXTERNAL STABILITY, INCLUDING FOUNDATION (BEARING CAPACITY AND SETTLEMENT) AND GLOBAL STABILITY (INCLUDING SLIDING AND ROTATION), IS THE RESPONSIBILITY OF THE OWNER.

PAGE NAME: **COVER SHEET - INDEX**

SUBMITTAL DATE:	PROJECT NO.:
05/08/2019	2752
06/21/2019 REV. 2	STATIONS, OFFSETS & ELEVATIONS
08/02/2019 REV. 3	WALLS 1-4
08/12/2019 REV. 4	WALL 2 STEP

SET PAGE #
S CVR



GENERAL NOTES

DESIGN NOTES

1. THE FOLLOWING DRAWINGS ARE BASED ON THE ASSUMPTION THAT THE MATERIAL WITHIN THE REINFORCED VOLUME, METHODS OF CONSTRUCTION AND QUALITY OF PREFABRICATED COMPONENTS MEET THE SPECIFICATIONS FOR MSE WALLS.

2. SOIL PARAMETERS:
SEE WALL CONTROL DRAWINGS AND CONTRACT SPECIFICATIONS FOR THE SOIL CHARACTERISTICS OF FOUNDATION MATERIAL TO BE USED IN THE DESIGN OF THE WALL SYSTEM. THE CONTRACTOR SHALL PROVIDE THE SOIL DESIGN PARAMETERS FOR BACKFILL MATERIAL BASED ON THE ACTUAL SOIL CHARACTERISTICS TO BE USED AT THE SITE.

BACKFILL PROPERTIES:
SELECT BACKFILL, $\phi = 34^\circ$, $\gamma = 120$ pcf, $c=0$
RETAINED BACKFILL, $\phi = 30^\circ$, $\gamma = 120$ pcf, $c=0$
FOUNDATION SOIL, $\phi = 30^\circ$, $\gamma = 120$ pcf, $c=0$

3. THE MAXIMUM APPLIED BEARING PRESSURE AT THE FOUNDATION LEVEL IS SHOWN ON THE WALL ELEVATIONS ON THE PLANS. IT IS THE RESPONSIBILITY OF OTHERS TO DETERMINE THAT THIS APPLIED BEARING PRESSURE IS ALLOWABLE AT THAT LOCATION.

4. ANY UNSUITABLE FOUNDATION MATERIAL BELOW THE REINFORCED VOLUME, AS DETERMINED BY THE ENGINEER, SHALL BE EXCAVATED AND REPLACED WITH SUITABLE MATERIAL OR OTHERWISE STABILIZED AS DIRECTED BY THE ENGINEER.

5. DESIGN, MATERIALS AND CONSTRUCTION ARE BASED ON THE AASHTO LRFD BRIDGE DESIGN & CONSTRUCTION SPECIFICATIONS, 8TH EDITION, AND THE ODOT BRIDGE DESIGN MANUAL, 2007.

LIVE LOAD SURCHARGE = 250 PSF
BARRIER IMPACT = N/A
SEISMIC = N/A
HYDROSTATIC = N/A
DESIGN LIFE = 100 YEARS

6. THE DESIGN CONTAINED IN THESE DRAWINGS IS BASED ON INFORMATION PROVIDED BY OTHERS. ON THE BASIS OF THIS INFORMATION, THE REINFORCED EARTH COMPANY[®], IS RESPONSIBLE FOR INTERNAL STABILITY OF THE STRUCTURE ONLY. EXTERNAL STABILITY, INCLUDING THE FOUNDATION AND SLOPE STABILITY IS THE RESPONSIBILITY OF OTHERS.

7. DESIGN OF DRAINAGE SYSTEM TO BE PROVIDED BY OWNER AND SUPPLIED BY CONTRACTOR

WALL CONSTRUCTION

1. VERTICAL AND HORIZONTAL JOINTS SHALL BE 3/4" UNLESS SHOWN OTHERWISE ON THE PLANS.

2. WALLS ALONG CURVES WILL BE ACHIEVED BY A SERIES OF SHORT CHORDS OF THE PANEL LENGTH TO MATCH THE REQUIRED RADIUS.

3. FOR LOCATION AND ALIGNMENT OF THE MSE STRUCTURES, SEE RETAINING WALL CONTROL PLANS.

4. IF MANHOLES AND DROP INLETS ARE REQUIRED, THEY SHALL BE LOCATED AS SHOWN ON RETAINING WALL ELEVATIONS.

5. IF PILES ARE LOCATED WITHIN THE REINFORCED VOLUME, THEY SHALL BE DRIVEN PRIOR TO CONSTRUCTION OF THE WALL UNLESS AN ALTERNATIVE METHOD TO PROTECT THE STRUCTURE, WHICH IS ACCEPTABLE TO THE ENGINEER AND THE REINFORCED EARTH COMPANY[®] IS PROPOSED AND APPROVED IN WRITING. ALL PILING OR OTHER DEEP SEATED COLUMNS SHALL BE SLEEVED WITH BOND BREAKERS THROUGH THE REINFORCED MASS IF SHOWN IN THE CONTRACT PLANS.

6. INSTALLATION OF SINEstrips SHALL BE PERMITTED ONLY AFTER PLACEMENT AND COMPACTION OF THE BACKFILL HAS REACHED THE REQUIRED ELEVATION.

7. ALL BACKFILL SHALL BE PLACED AND COMPACTED PER ODOT SS840.

8. IF EXISTING OR FUTURE STRUCTURES WITHIN THE REINFORCED VOLUME INTERFERE WITH THE NORMAL PLACEMENT OF SINEstrip AND SPECIFIC DIRECTION HAS NOT BEEN PROVIDED IN THE PLANS, THE CONTRACTOR SHALL NOTIFY THE ENGINEER IMMEDIATELY.

9. THE CONTRACTOR IS RESPONSIBLE FOR DEFLECTING THE TOP ROWS OF SINEstrip DOWNWARD TO AVOID CONFLICTS WITH ROADWAY CONSTRUCTION OPERATIONS SUCH AS SUPER ELEVATIONS, ETC.

10. THE CONTRACTOR IS RESPONSIBLE FOR THE CONTROL OF STORM WATER AND RUN-OFF TO BE COLLECTED AND DISCHARGED AWAY FROM THE WALL AND REINFORCED BACKFILL.

11. FOR OTHER INFORMATION PERTAINING TO WALL CONSTRUCTION PLEASE REFER TO THE SINE WALL CONSTRUCTION MANUAL.

12. THE REINFORCED EARTH COMPANY[®] SUPPLIES MSE PANEL WALLS AND COMPONENTS FOR THE STRUCTURES DETAILED HEREIN. THE CONSTRUCTION AND QA/QC MANUAL FURNISHED BY THE REINFORCED EARTH COMPANY[®] IS INTENDED TO PROVIDE A GENERAL EXPLANATION OF THE SYSTEM. IT IS THE CONTRACTORS OBLIGATION TO PREPARE AND EXECUTE A PROJECT SPECIFIC ERECTION SEQUENCE, PANEL UNLOADING, HANDLING AND BRACING AND FALL PROTECTION SYSTEM. THE BRACING SYSTEM SHOWN IN THE CONSTRUCTION AND QA/QC MANUAL IS GENERAL IN NATURE AND DOES NOT ACCOUNT FOR PROJECT SPECIFIC CRITERIA. COMPLIANCE WITH THE GUIDELINES IN THIS MANUAL DOES NOT RELIEVE THE CONTRACTOR OF HIS RESPONSIBILITY TO CONSTRUCT THE WALL ACCORDING TO THE PROJECT PLANS, SPECIFICATIONS AND CONTRACT DOCUMENTS OR COMPLIANCE WITH ALL FALL PROTECTION, SAFETY, LAWS, STANDARDS AND PROCEDURES REQUIRED.


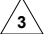
13. NO CHANGES SHALL BE MADE TO THESE PLANS WITHOUT THE WRITTEN APPROVAL OF THE REINFORCED EARTH COMPANY[®].

14. PANELS WITH IDENTICAL DIMENSIONS AND CONNECTOR LAYOUTS MAY BE USED INTERCHANGEABLY WHEN APPROVED IN WRITING BY THE REINFORCED EARTH COMPANY[®].

MATERIAL NOTES

1. ONLY THE MATERIALS SHOWN IN THE TABLE "MATERIALS PROVIDED FOR SINE WALL SYSTEM" WILL BE SUPPLIED BY THE REINFORCED EARTH COMPANY[®]. ANY OTHER MATERIALS REQUIRED TO CONSTRUCT THE MSE STRUCTURE ACCORDING TO THE CONTRACT DRAWINGS AND SPECIFICATIONS SHALL BE SUPPLIED BY THE CONTRACTOR, INCLUDING BUT NOT LIMITED TO: EXPANSION JOINT MATERIAL SANDBLASTING, PAINTING, GALVANIZING, SEALERS OR OTHER SPECIAL APPLIED COATINGS.

MATERIALS PROVIDED FOR SINE WALL SYSTEM

	SPECIFICATIONS	NOTES	MSE PANEL SYSTEM
PRECAST CONCRETE			
STANDARD PANEL SIZE	5'x10'		
CONCRETE STRENGTH	$f_c' = 4000$ PSI @ 28 DAYS		
CONCRETE SURFACE FINISH			
PANEL	FRACTURE FIN (CUSTOM ROCK 3012)	PLAIN GRAY	
STEEL REINFORCING			
PANEL	ASTM A615 OR A996 GRADE 60	 COATING: EPOXY	
SINEstrip CONNECTOR	ASTM A 1011, GRADE 50	**GALVANIZED	
SINEstrip-US PATENT 7,270,502	S2 (2.0" x .156") GRADE 65 - ASTM A1011	*GALVANIZED	
BOLTS - NUTS	1/2" DIA. x 1.25" LONG BOLTS: ASTM A325 NUTS: ASTM A563	**GALVANIZED	
WASHERS	WASHER: ASTM F 463	**GALVANIZED	
GEOTEXTILE JOINT FABRIC	 18" WIDE TO MEET AASHTO M 288 CLASS 2		
BEARING PADS	3"x6"x3/4" ASTM D-2000 M2AA 807 DUROMETER HARDNESS OF 80 +/-5		


*HOT-DIP GALVANIZED PER ASTM A123,AASHTO M111 WITH 2.0 OZ/SF OR 3.4 MILS THICKNESS.

**GALVANIZED PER ASTM A153.



COPYRIGHT 2019 THE REINFORCED EARTH COMPANY[®]

THIS DRAWING CONTAINS INFORMATION PROPRIETARY TO THE REINFORCED EARTH COMPANY, AND IS BEING FURNISHED FOR THE USE OF ODOT ONLY IN CONNECTION WITH THIS PROJECT, AND THE INFORMATION CONTAINED HEREIN IS NOT TO BE TRANSMITTED TO ANY OTHER ORGANIZATION UNLESS SPECIFICALLY AUTHORIZED IN WRITING BY THE REINFORCED EARTH COMPANY. THE REINFORCED EARTH COMPANY IS EXCLUSIVE LICENSEE IN THE UNITED STATES UNDER PATENTS HELD BY OUR AFFILIATED COMPANIES, AND THE FURNISHING OF THIS DRAWING DOES NOT CONSTITUTE AN EXPRESSED OR IMPLIED LICENSE UNDER ANY APPLICABLE PATENTS.

PREPARED BY:

11640 North Park Drive - Suite 110
Wake Forest, NC 27587
Ph.: (919)453-2011 / Fax.: (513)297-7930

DESIGN BY: JL
DRAWN BY: JL
CHECKED BY: KV

PROJECT NAME: **STATE PROJECT #HAM-75-3.84**
PID 104677
MILL CREEK EXPRESSWAY PHASE 5A
WALLS 1-4
HAMILTON COUNTY OHIO

THE DESIGN CONTAINED ON THESE DRAWINGS IS BASED ON INFORMATION PROVIDED BY THE OWNER. ON THE BASIS OF THIS INFORMATION, THE REINFORCED EARTH COMPANY HAS DESIGNED, AND IS RESPONSIBLE FOR THE INTERNAL STABILITY OF THE STRUCTURE ONLY. EXTERNAL STABILITY, INCLUDING FOUNDATION (BEARING CAPACITY AND SETTLEMENT) AND GLOBAL STABILITY (INCLUDING SLIDING AND ROTATION), IS THE RESPONSIBILITY OF THE OWNER.

PAGE NAME:
GENERAL NOTES & SPECIFICATIONS


SUBMITTAL DATE: 05/08/2019
08/02/2019 REV. 3 WALLS 1-4

PROJECT NO.: 2752

SET: S
PAGE #: NTS



COPYRIGHT 2019 THE REINFORCED EARTH COMPANY®

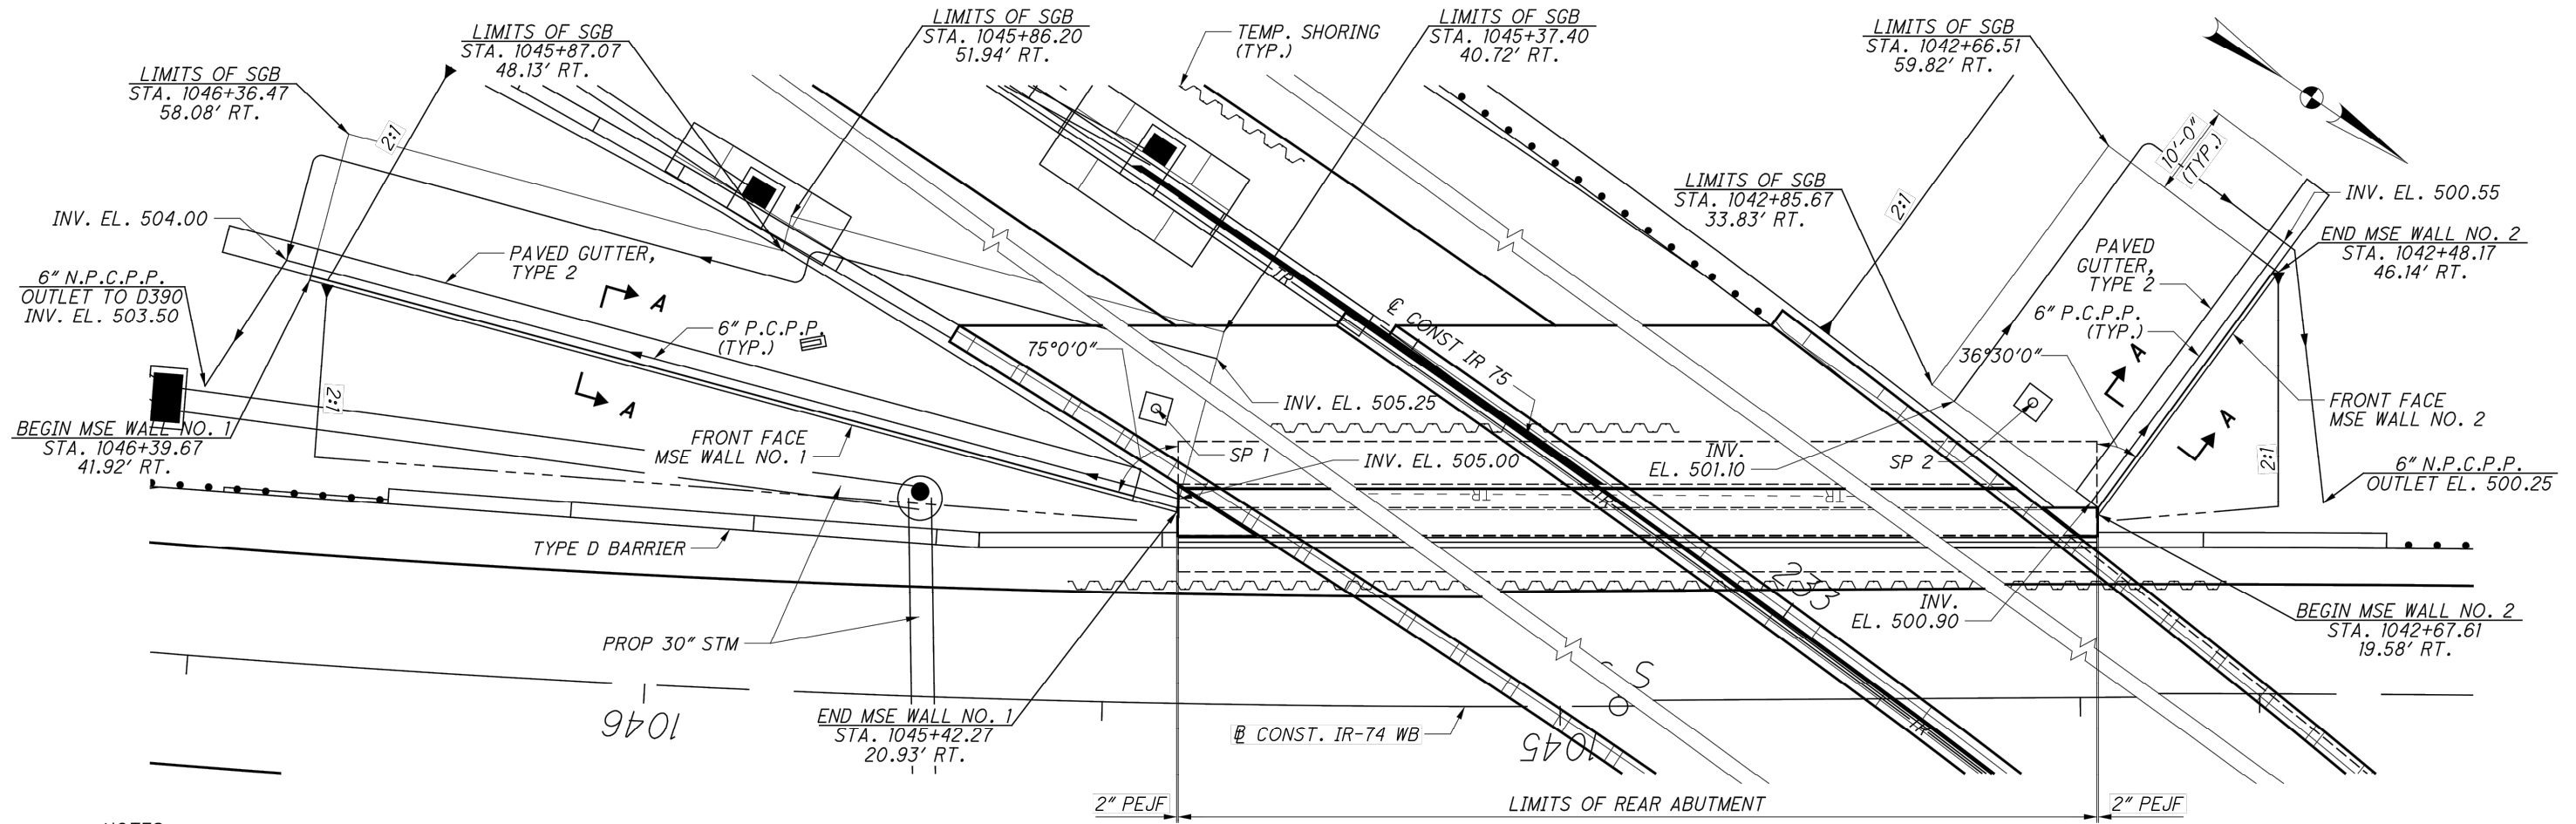

NOTES

1
 DETAILS ARE TAKEN FROM THE PROJECT CONTRACT PLANS SHEET 26 OF 68.
 DETAILS SHOWN IN THE PROJECT CONTRACT DRAWINGS ARE SHOWN HERE FOR INFORMATION ONLY AND INVENTURE CIVIL ACCEPTS NO LIABILITY ASSOCIATED WITH THEIR USE.

WALL 1 & 2 PLAN
 NO SCALE

THIS DRAWING CONTAINS INFORMATION PROPRIETARY TO THE REINFORCED EARTH COMPANY, AND IS BEING FURNISHED FOR THE USE OF ODOT ONLY IN CONNECTION WITH THIS PROJECT. AND THE INFORMATION CONTAINED HEREIN IS NOT TO BE TRANSMITTED TO ANY OTHER ORGANIZATION UNLESS SPECIFICALLY AUTHORIZED IN WRITING BY THE REINFORCED EARTH COMPANY. THE REINFORCED EARTH COMPANY IS EXCLUSIVE LICENSEE IN THE UNITED STATES UNDER PATENTS HELD BY OUR AFFILIATED COMPANIES, AND THE FURNISHING OF THIS DRAWING DOES NOT CONSTITUTE AN EXPRESSED OR IMPLIED LICENSE UNDER ANY APPLICABLE PATENTS.

PREPARED BY:

 11640 North Park Drive - Suite 110
 Wake Forest, NC 27587
 Ph.: (919)453-2011 / Fax.: (513)297-7930

PROJECT NAME: **STATE PROJECT #HAM-75-3.84**
PID 104677
MILL CREEK EXPRESSWAY PHASE 5A
WALLS 1-4
 HAMILTON COUNTY OHIO

THE DESIGN CONTAINED ON THESE DRAWINGS IS BASED ON INFORMATION PROVIDED BY THE OWNER. ON THE BASIS OF THIS INFORMATION, THE REINFORCED EARTH COMPANY HAS DESIGNED, AND IS RESPONSIBLE FOR THE INTERNAL STABILITY OF THE STRUCTURE ONLY. EXTERNAL STABILITY, INCLUDING FOUNDATION (BEARING CAPACITY AND SETTLEMENT) AND GLOBAL STABILITY (INCLUDING SLIDING AND ROTATION), IS THE RESPONSIBILITY OF THE OWNER.

PAGE NAME:
MSE WALL PLAN

SUBMITTAL DATE: **05/08/2019**
 PROJECT NO.: **2752**
05/28/2019 REV. 1 AFC PLANS & LEVEING PAD


SET
S 1.01

3

3

3

1

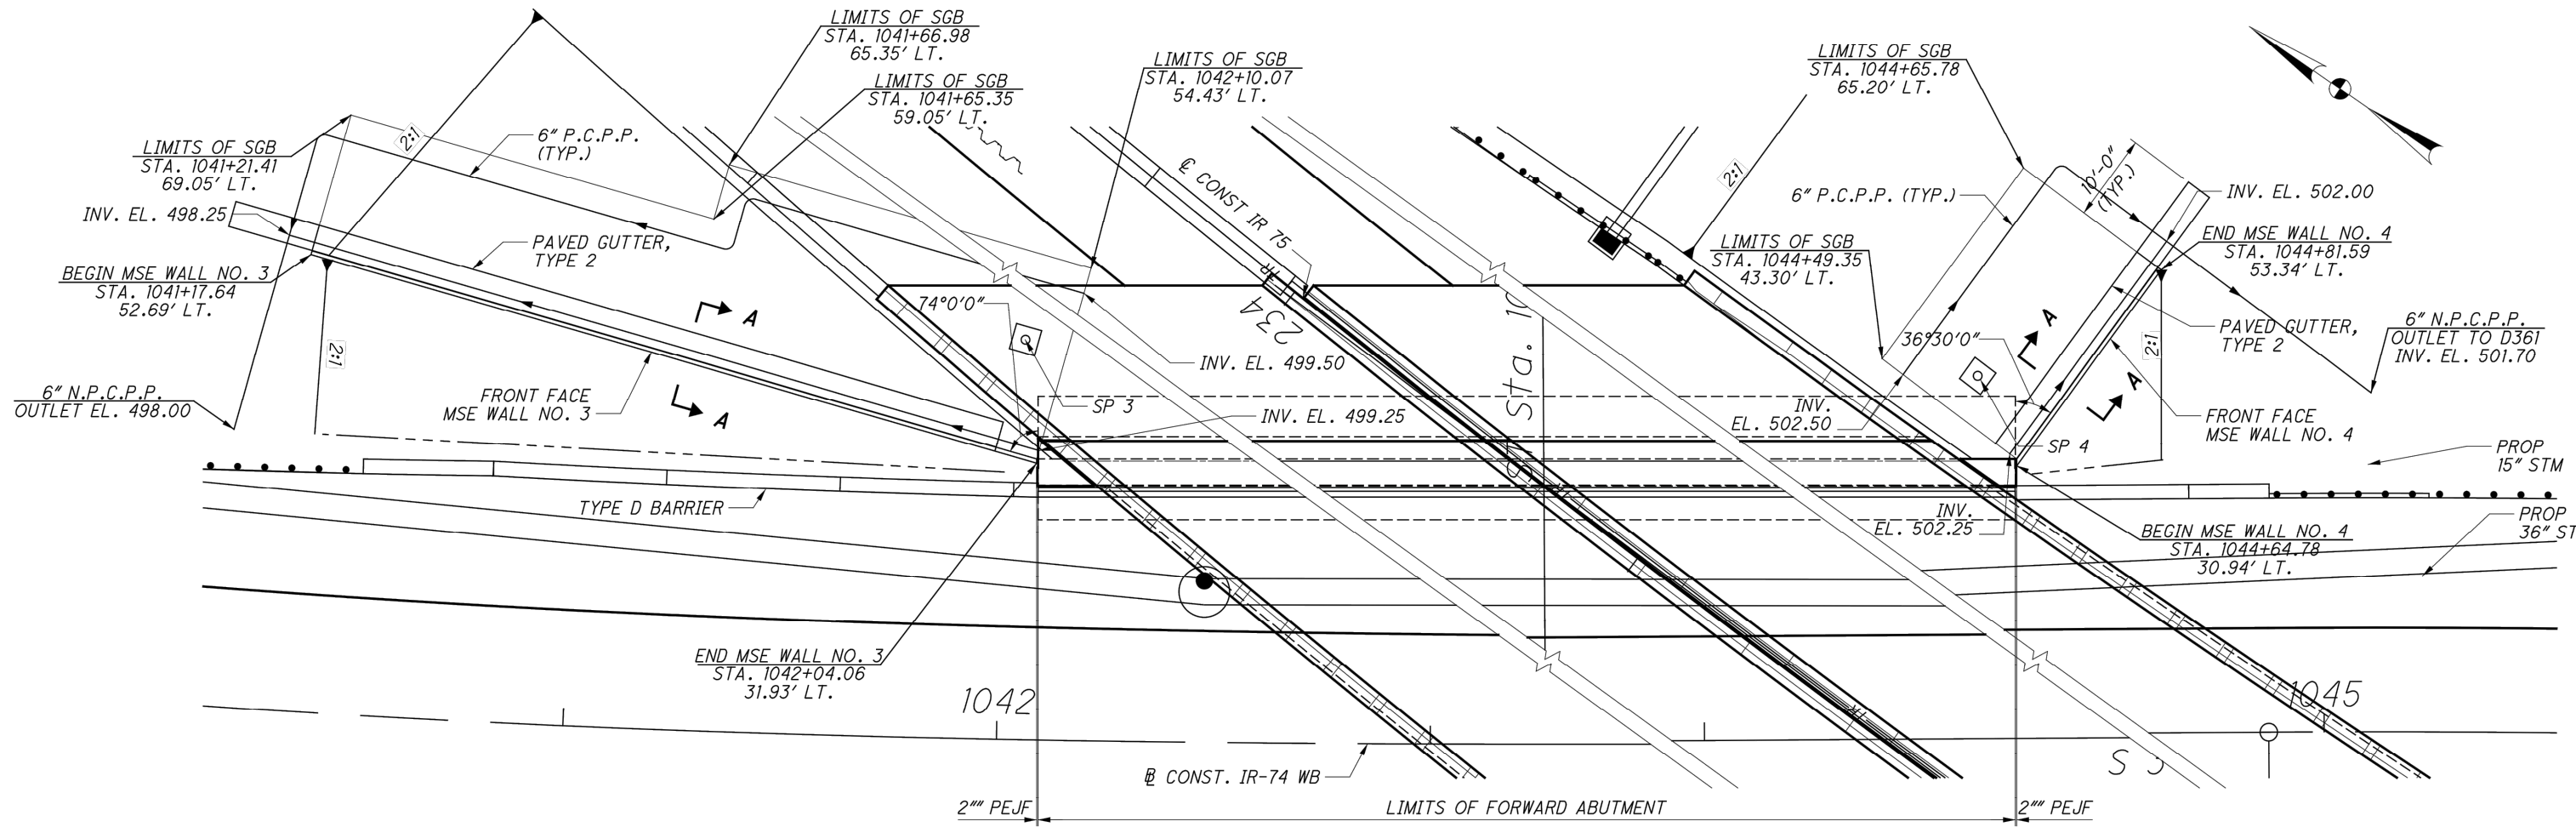

DETAILS ARE TAKEN FROM THE PROJECT CONTRACT PLANS SHEET 27 OF 68. DETAILS SHOWN IN THE PROJECT CONTRACT DRAWINGS ARE SHOWN HERE FOR INFORMATION ONLY AND INVENTURE CIVIL ACCEPTS NO LIABILITY ASSOCIATED WITH THEIR USE.

WALL 3 & 4 PLAN
NO SCALE

COPYRIGHT 2019 THE REINFORCED EARTH COMPANY®

THIS DRAWING CONTAINS INFORMATION PROPRIETARY TO THE REINFORCED EARTH COMPANY, AND IS BEING FURNISHED FOR THE USE OF ODOT ONLY IN CONNECTION WITH THIS PROJECT, AND THE INFORMATION CONTAINED HEREIN IS NOT TO BE TRANSMITTED TO ANY OTHER ORGANIZATION UNLESS SPECIFICALLY AUTHORIZED IN WRITING BY THE REINFORCED EARTH COMPANY. THE REINFORCED EARTH COMPANY IS EXCLUSIVE LICENSEE IN THE UNITED STATES UNDER PATENTS HELD BY OUR AFFILIATED COMPANIES, AND THE FURNISHING OF THIS DRAWING DOES NOT CONSTITUTE AN EXPRESSED OR IMPLIED LICENSE UNDER ANY APPLICABLE PATENTS.

PREPARED BY:
REINFORCED EARTH
11640 North Park Drive - Suite 110
Wake Forest, NC 27587
Ph.: (919)453-2011 / Fax.: (513)297-7930

DESIGN BY: JL
DRAWN BY: JL
CHECKED BY: KV

PROJECT NAME: **STATE PROJECT #HAM-75-3.84**
PID 104677
MILL CREEK EXPRESSWAY PHASE 5A
WALLS 1-4
HAMILTON COUNTY OHIO

THE DESIGN CONTAINED ON THESE DRAWINGS IS BASED ON INFORMATION PROVIDED BY THE OWNER. ON THE BASIS OF THIS INFORMATION, THE REINFORCED EARTH COMPANY HAS DESIGNED, AND IS RESPONSIBLE FOR THE INTERNAL STABILITY OF THE STRUCTURE ONLY. EXTERNAL STABILITY, INCLUDING FOUNDATION (BEARING CAPACITY AND SETTLEMENT) AND GLOBAL STABILITY (INCLUDING SLIDING AND ROTATION), IS THE RESPONSIBILITY OF THE OWNER.

PAGE NAME: **MSE WALL PLAN**

SUBMITAL DATE:	05/08/2019	PROJECT NO.:	2752
05/28/2019	REV. 1	AFC PLANS & LEVEING PAD	
08/02/2019	REV. 3	WALLS 1-4	


SET **S 1.02**

3

3

3

1

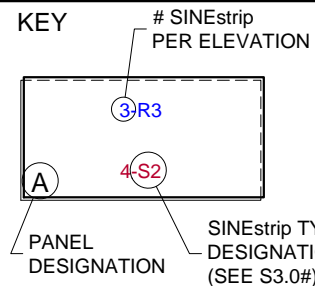

- NOTES:**
1. STATIONS AND OFFSETS ARE BASED ON FRONT FACE OF WALL.
 2. FRONT FACE OF WALL SHOWN.
 3. SEE CONTRACT PLANS FOR PERFORATED PIPE, COARSE AGGREGATE AND GEOTEXTILES REQUIRED.


4. T/PAD = TOP OF LEVELING PAD.
5. BEND IN WALL LOCATIONS TO BE AT NEAREST PANEL JOINT.
6. C.I.P. COPING REQUIRED AT BENDS AND VERTICAL STEPS. ESTIMATED CIP COPING LIMITS ARE SHOWN & CAN BE ADJUSTED IN THE FIELD AS NEEDED.

7. FRONT FACE OF WALL EMBEDMENT = 3'-0" MIN.
8. BEARING PRESSURES PROVIDED AS FACTORED.
9. TOP PANELS AT C.I.P. COPING TO HAVE DOWELS EXTENDING FROM TOP OF PANEL, DESIGNATED WITH 'D.'

10. IF ANTICIPATED SHORT TERM SETTLEMENT EXCEEDS 1", CONTACT THE REINFORCED EARTH COMPANY.

CAST IN PLACE COPING

LEVELING PAD

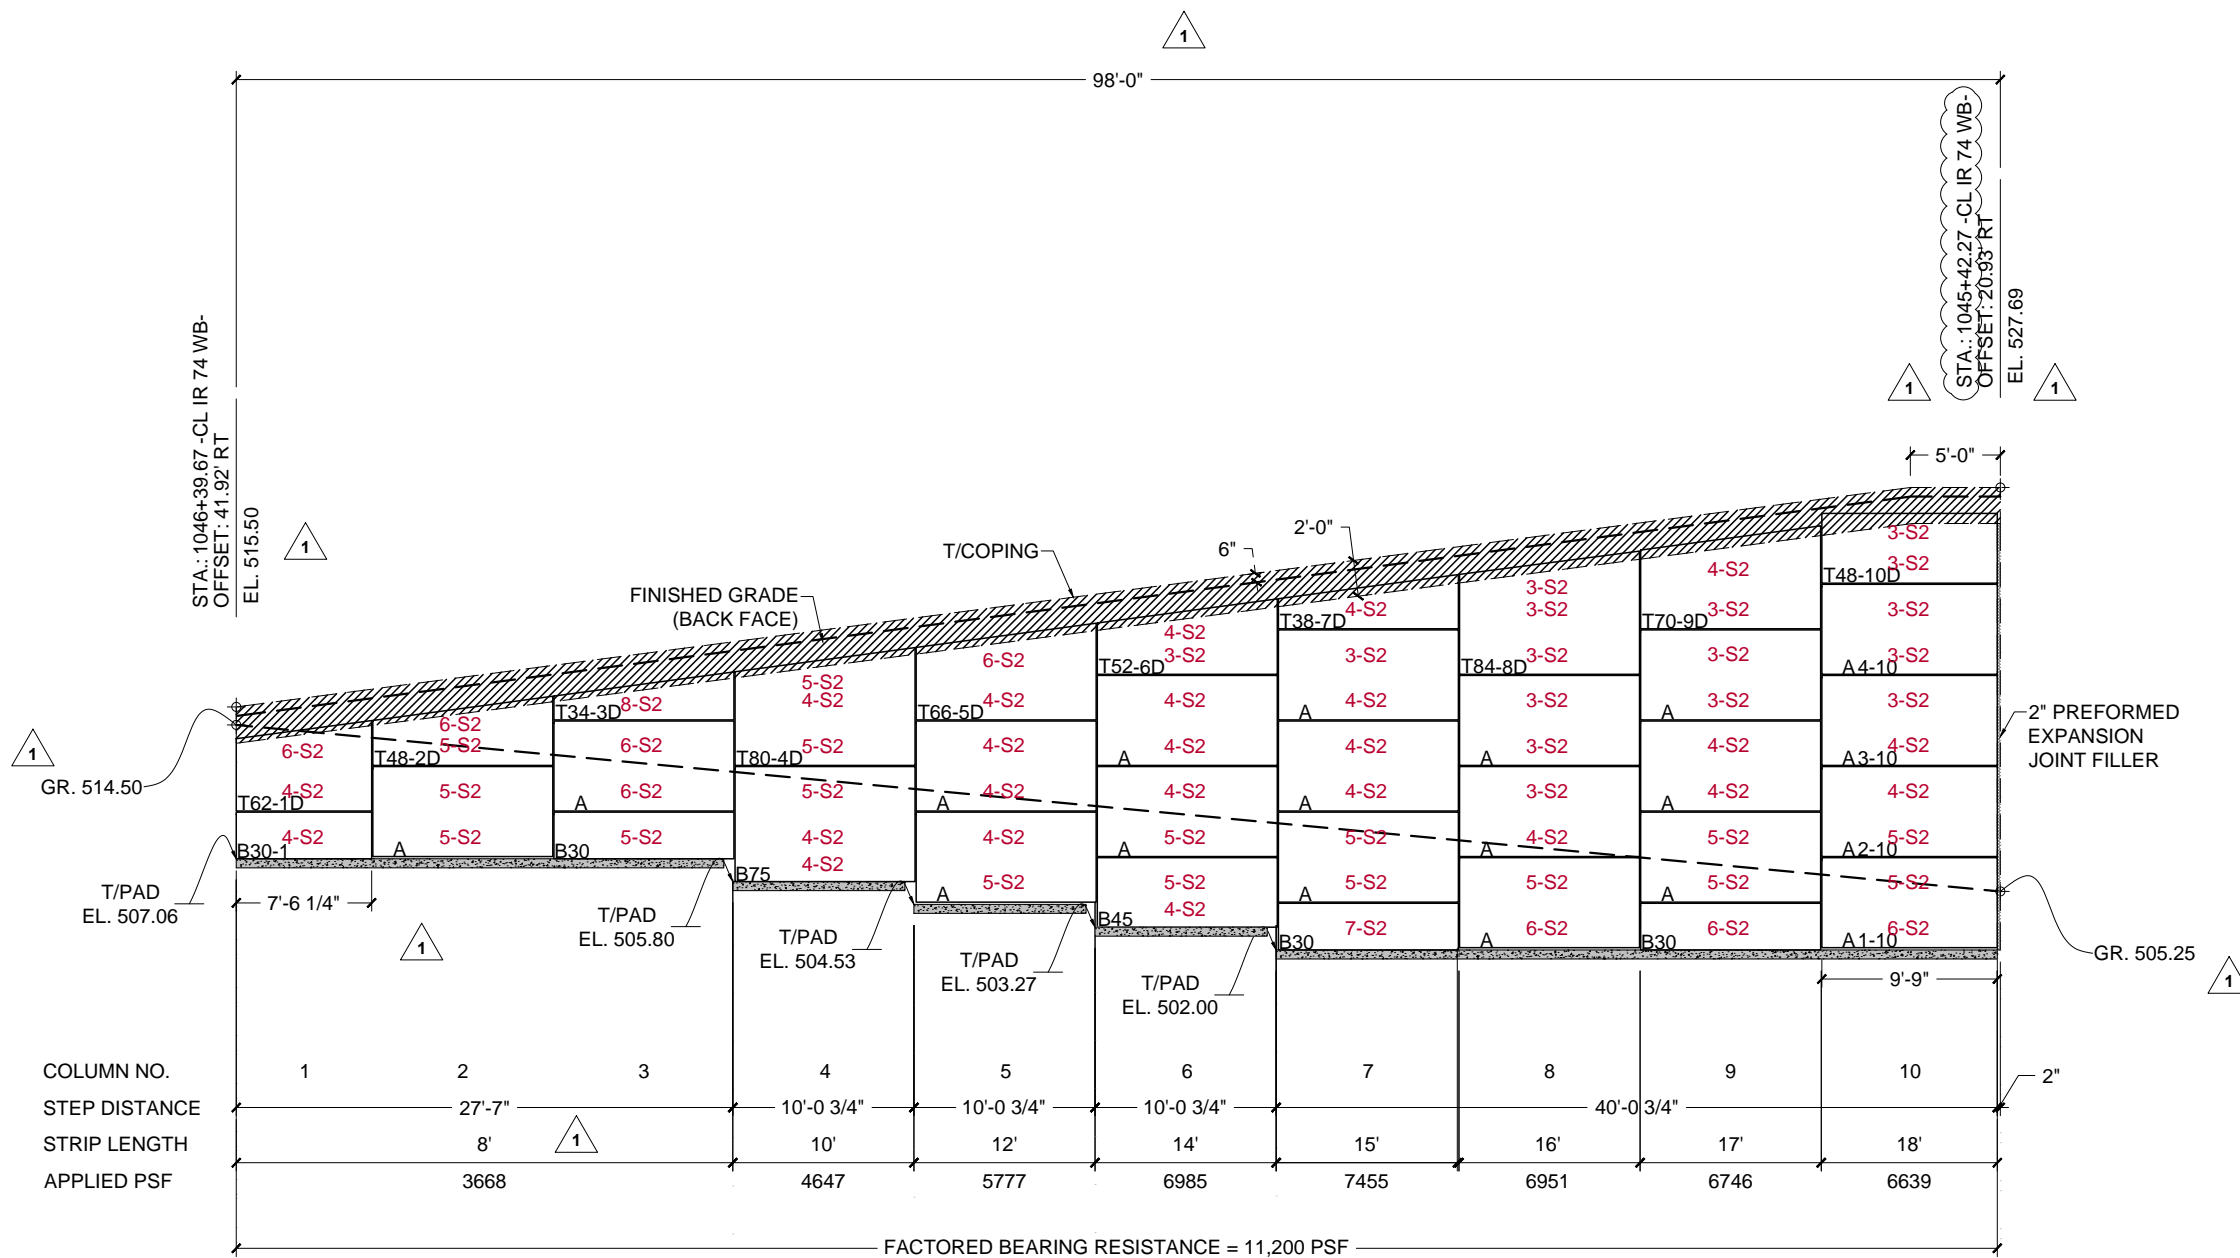

WALL 1
NO SCALE

COPYRIGHT 2019 THE REINFORCED EARTH COMPANY®

THIS DRAWING CONTAINS INFORMATION PROPRIETARY TO THE REINFORCED EARTH COMPANY, AND IS BEING FURNISHED FOR THE USE OF _____ ONLY IN CONNECTION WITH THIS PROJECT, AND THE INFORMATION CONTAINED HEREIN IS NOT TO BE TRANSMITTED TO ANY OTHER ORGANIZATION UNLESS SPECIFICALLY AUTHORIZED IN WRITING BY THE REINFORCED EARTH COMPANY. THE REINFORCED EARTH COMPANY IS EXCLUSIVE LICENSEE IN THE UNITED STATES UNDER PATENTS HELD BY OUR AFFILIATED COMPANIES, AND THE FURNISHING OF THIS DRAWING DOES NOT CONSTITUTE AN EXPRESSED OR IMPLIED LICENSE UNDER ANY APPLICABLE PATENTS.

PREPARED BY:
 REINFORCED EARTH
11640 North Park Drive - Suite 110
Wake Forest, NC 27587
Ph.: (919)453-2011 / Fax.: (513)297-7930

DESIGN BY: JL
DRAWN BY: JL
CHECKED BY: KV

PROJECT NAME: **STATE PROJECT #HAM-75-3.84**
PID 104677
MILL CREEK EXPRESSWAY PHASE 5A
WALLS 1-4


HAMILTON COUNTY OHIO

THE DESIGN CONTAINED ON THESE DRAWINGS IS BASED ON INFORMATION PROVIDED BY THE OWNER. ON THE BASIS OF THIS INFORMATION, THE REINFORCED EARTH COMPANY HAS DESIGNED, AND IS RESPONSIBLE FOR THE INTERNAL STABILITY OF THE STRUCTURE ONLY. EXTERNAL STABILITY, INCLUDING FOUNDATION (BEARING CAPACITY AND SETTLEMENT) AND GLOBAL STABILITY (INCLUDING SLIDING AND ROTATION), IS THE RESPONSIBILITY OF THE OWNER.

PAGE NAME: **MSE WALL ELEVATION**

SUBMITTAL DATE:	05/08/2019	PROJECT NO.:	2752
05/28/2019	REV. 1	AFC PLANS & LEVEING PAD	
08/02/2019	REV. 3	WALLS 1-4	

SET **S 2.01**

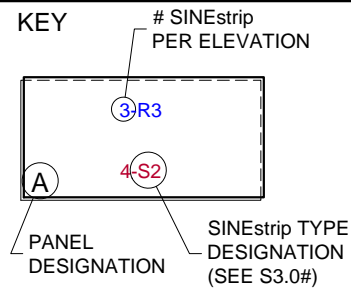

- NOTES:**
1. STATIONS AND OFFSETS ARE BASED ON FRONT FACE OF WALL.
 2. FRONT FACE OF WALL SHOWN.
 3. SEE CONTRACT PLANS FOR PERFORATED PIPE, COARSE AGGREGATE AND GEOTEXTILES REQUIRED.


4. T/PAD = TOP OF LEVELING PAD.
5. BEND IN WALL LOCATIONS TO BE AT NEAREST PANEL JOINT.
6. C.I.P. COPING REQUIRED AT BENDS AND VERTICAL STEPS. ESTIMATED CIP COPING LIMITS ARE SHOWN & CAN BE ADJUSTED IN THE FIELD AS NEEDED.

7. FRONT FACE OF WALL EMBEDMENT = 3'-0" MIN.
8. BEARING PRESSURES PROVIDED AS FACTORED.
9. TOP PANELS AT C.I.P. COPING TO HAVE DOWELS EXTENDING FROM TOP OF PANEL, DESIGNATED WITH 'D.'

10. IF ANTICIPATED SHORT TERM SETTLEMENT EXCEEDS 1", CONTACT THE REINFORCED EARTH COMPANY.

CAST IN PLACE COPING

LEVELING PAD

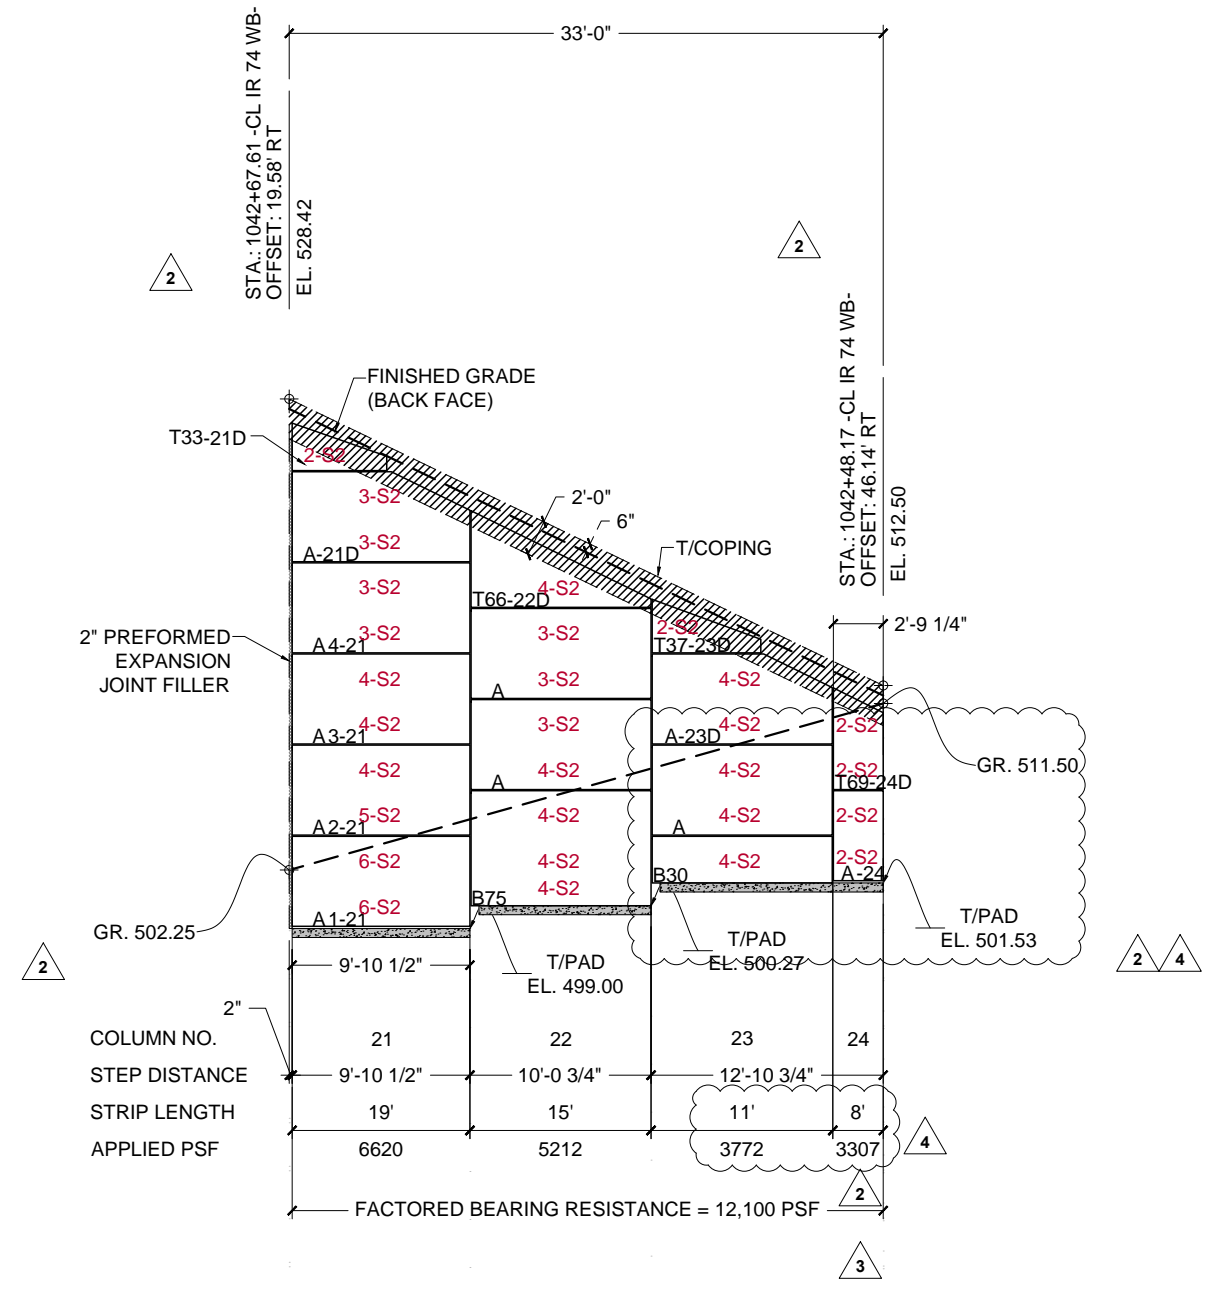

WALL 2
NO SCALE

COPYRIGHT 2019 THE REINFORCED EARTH COMPANY®

THIS DRAWING CONTAINS INFORMATION PROPRIETARY TO THE REINFORCED EARTH COMPANY, AND IS BEING FURNISHED FOR THE USE OF ODOT ONLY IN CONNECTION WITH THIS PROJECT. AND THE INFORMATION CONTAINED HEREIN IS NOT TO BE TRANSMITTED TO ANY OTHER ORGANIZATION UNLESS SPECIFICALLY AUTHORIZED IN WRITING BY THE REINFORCED EARTH COMPANY. THE REINFORCED EARTH COMPANY IS EXCLUSIVE LICENSEE IN THE UNITED STATES UNDER PATENTS HELD BY OUR AFFILIATED COMPANIES, AND THE FURNISHING OF THIS DRAWING DOES NOT CONSTITUTE AN EXPRESSED OR IMPLIED LICENSE UNDER ANY APPLICABLE PATENTS.

PREPARED BY:
 REINFORCED EARTH
11640 North Park Drive - Suite 110
Wake Forest, NC 27587
Ph.: (919)453-2011 / Fax.: (513)297-7930

DESIGN BY: JL
DRAWN BY: JL
CHECKED BY: KV

PROJECT NAME: **STATE PROJECT #HAM-75-3.84**
PID 104677
MILL CREEK EXPRESSWAY PHASE 5A
WALLS 1-4


HAMILTON COUNTY OHIO

THE DESIGN CONTAINED ON THESE DRAWINGS IS BASED ON INFORMATION PROVIDED BY THE OWNER. ON THE BASIS OF THIS INFORMATION, THE REINFORCED EARTH COMPANY HAS DESIGNED, AND IS RESPONSIBLE FOR THE INTERNAL STABILITY OF THE STRUCTURE ONLY. EXTERNAL STABILITY, INCLUDING FOUNDATION (BEARING CAPACITY AND SETTLEMENT) AND GLOBAL STABILITY (INCLUDING SLIDING AND ROTATION), IS THE RESPONSIBILITY OF THE OWNER.

PAGE NAME:
MSE WALL ELEVATION

SUBMITAL DATE:	05/08/2019	PROJECT NO.:	2752
06/21/2019	REV. 2	STATIONS, OFFSETS & ELEVATIONS	
08/02/2019	REV. 3	WALLS 1-4	
08/12/2019	REV. 4	WALL 2 STEP	

SET
S 2.02

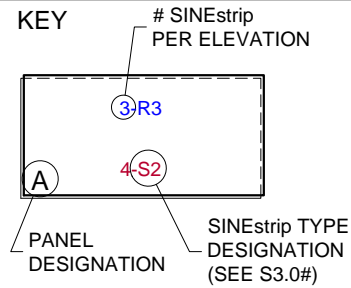

- NOTES:**
1. STATIONS AND OFFSETS ARE BASED ON FRONT FACE OF WALL.
 2. FRONT FACE OF WALL SHOWN.
 3. SEE CONTRACT PLANS FOR PERFORATED PIPE, COARSE AGGREGATE AND GEOTEXTILES REQUIRED.


4. T/PAD = TOP OF LEVELING PAD.
5. BEND IN WALL LOCATIONS TO BE AT NEAREST PANEL JOINT.
6. C.I.P. COPING REQUIRED AT BENDS AND VERTICAL STEPS. ESTIMATED CIP COPING LIMITS ARE SHOWN & CAN BE ADJUSTED IN THE FIELD AS NEEDED.

7. FRONT FACE OF WALL EMBEDMENT = 3'-0" MIN.
8. BEARING PRESSURES PROVIDED AS FACTORED.
9. TOP PANELS AT C.I.P. COPING TO HAVE DOWELS EXTENDING FROM TOP OF PANEL, DESIGNATED WITH 'D'.

10. IF ANTICIPATED SHORT TERM SETTLEMENT EXCEEDS 1", CONTACT THE REINFORCED EARTH COMPANY.

CAST IN PLACE COPING

LEVELING PAD

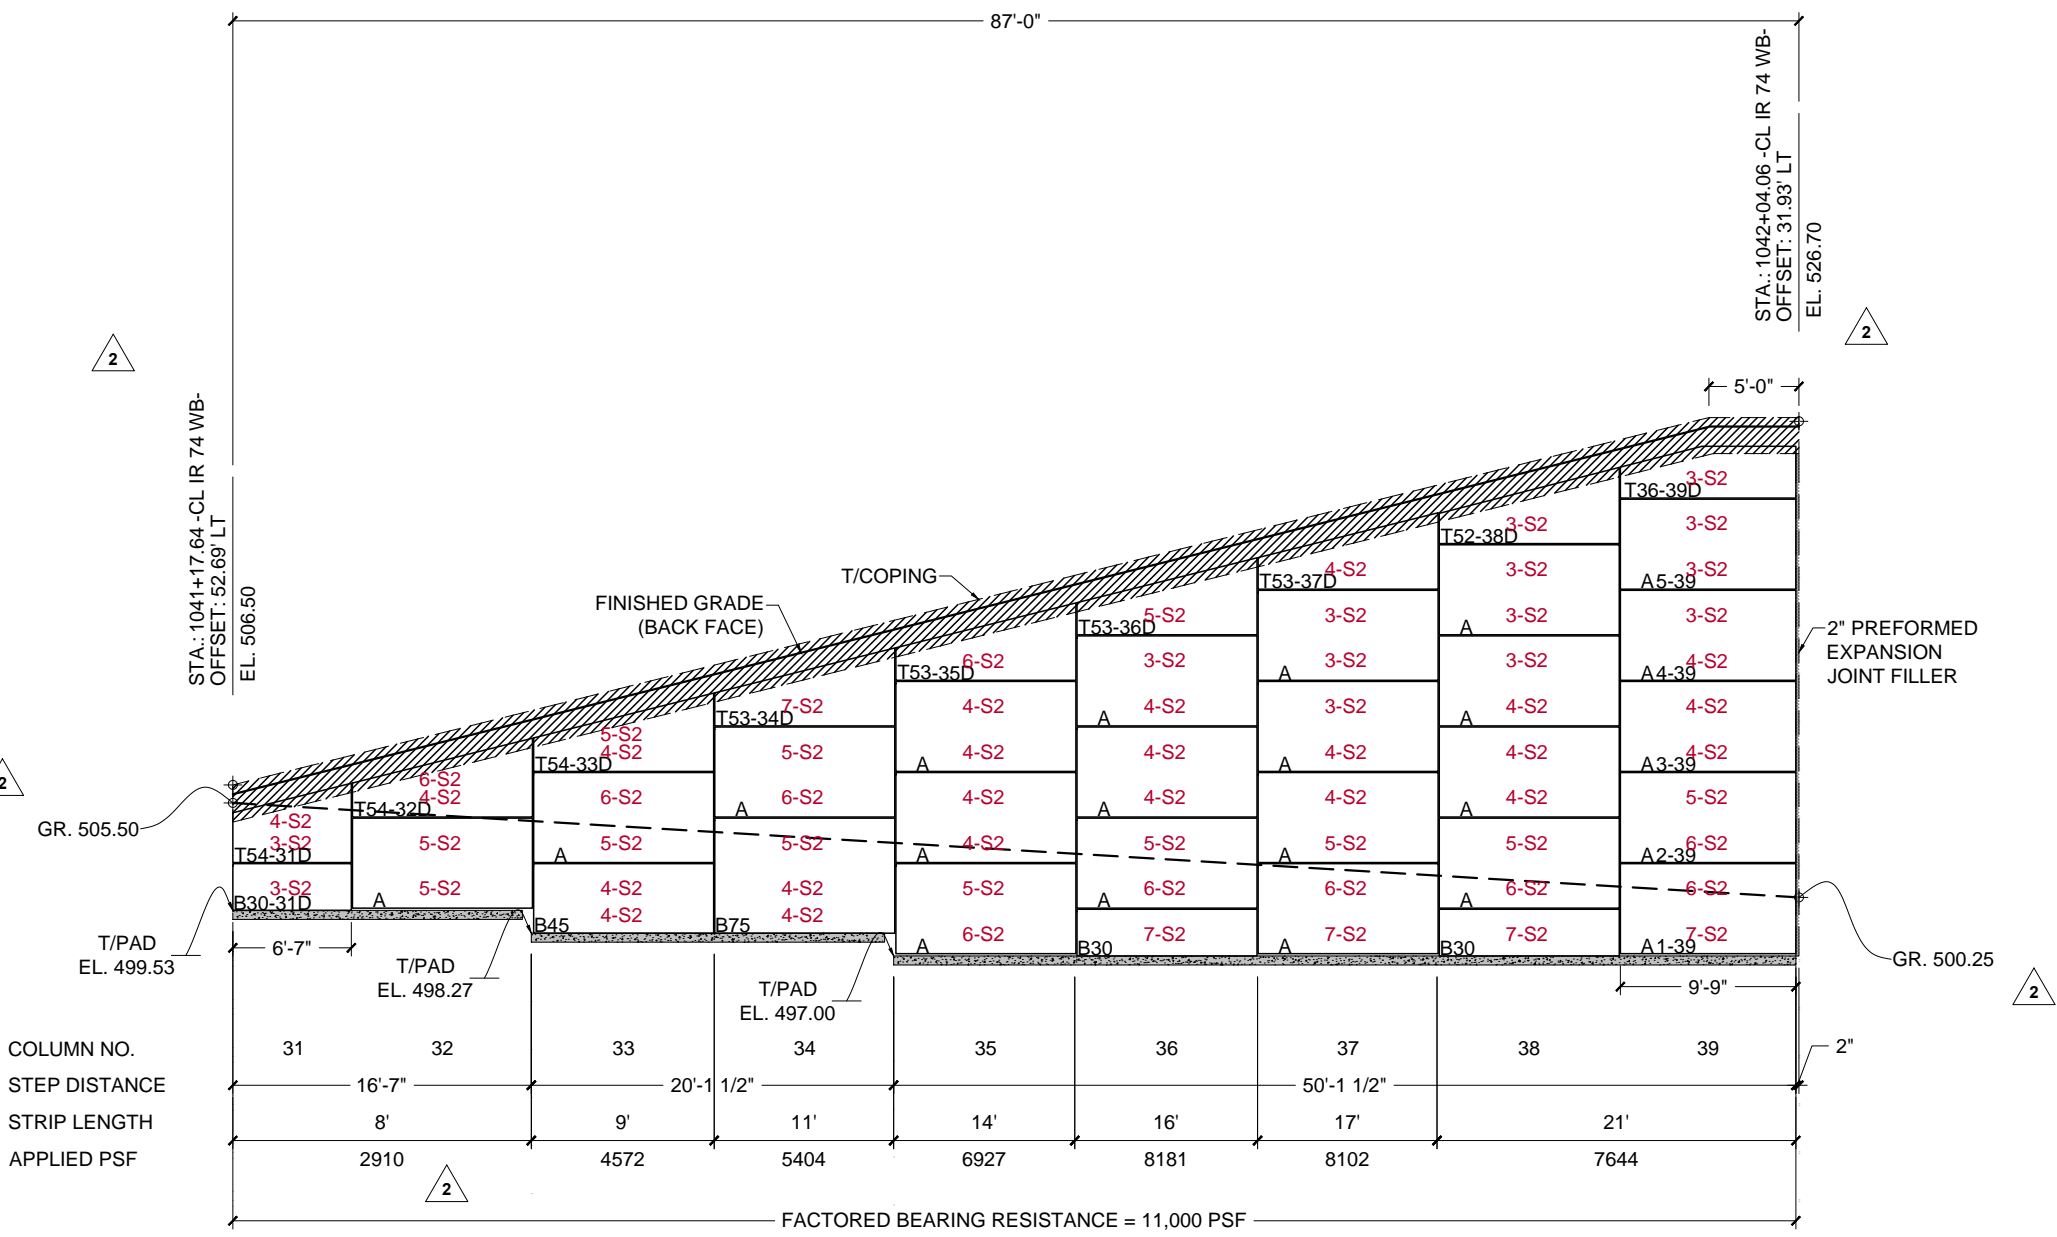

WALL 3
NO SCALE

COPYRIGHT 2019 THE REINFORCED EARTH COMPANY®

THIS DRAWING CONTAINS INFORMATION PROPRIETARY TO THE REINFORCED EARTH COMPANY, AND IS BEING FURNISHED FOR THE USE OF _____ ONLY IN CONNECTION WITH THIS PROJECT. AND THE INFORMATION CONTAINED HEREIN IS NOT TO BE TRANSMITTED TO ANY OTHER ORGANIZATION UNLESS SPECIFICALLY AUTHORIZED IN WRITING BY THE REINFORCED EARTH COMPANY. THE REINFORCED EARTH COMPANY IS EXCLUSIVE LICENSEE IN THE UNITED STATES UNDER PATENTS HELD BY OUR AFFILIATED COMPANIES, AND THE FURNISHING OF THIS DRAWING DOES NOT CONSTITUTE AN EXPRESSED OR IMPLIED LICENSE UNDER ANY APPLICABLE PATENTS.

PREPARED BY:
 REINFORCED EARTH
11640 North Park Drive - Suite 110
Wake Forest, NC 27587
Ph.: (919)453-2011 / Fax.: (513)297-7930

DESIGN BY: JL
DRAWN BY: JL
CHECKED BY: KV

PROJECT NAME: **STATE PROJECT #HAM-75-3.84**
PID 104677
MILL CREEK EXPRESSWAY PHASE 5A
WALLS 1-4


HAMILTON COUNTY OHIO

THE DESIGN CONTAINED ON THESE DRAWINGS IS BASED ON INFORMATION PROVIDED BY THE OWNER. ON THE BASIS OF THIS INFORMATION, THE REINFORCED EARTH COMPANY HAS DESIGNED, AND IS RESPONSIBLE FOR THE INTERNAL STABILITY OF THE STRUCTURE ONLY. EXTERNAL STABILITY, INCLUDING FOUNDATION (BEARING CAPACITY AND SETTLEMENT) AND GLOBAL STABILITY (INCLUDING SLIDING AND ROTATION), IS THE RESPONSIBILITY OF THE OWNER.

PAGE NAME: **MSE WALL ELEVATION**

SUBMITTAL DATE:	05/08/2019	PROJECT NO.:	2752
06/21/2019	REV. 2	STATIONS, OFFSETS & ELEVATIONS	
08/02/2019	REV. 3	WALLS 1-4	

SET **S 2.03**

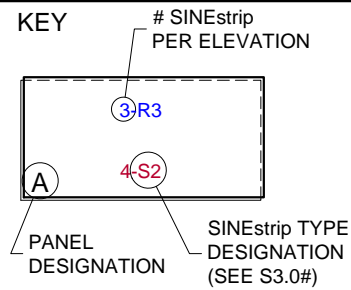

- NOTES:**
1. STATIONS AND OFFSETS ARE BASED ON FRONT FACE OF WALL.
 2. FRONT FACE OF WALL SHOWN.
 3. SEE CONTRACT PLANS FOR PERFORATED PIPE, COARSE AGGREGATE AND GEOTEXTILES REQUIRED.


4. T/PAD = TOP OF LEVELING PAD.
5. BEND IN WALL LOCATIONS TO BE AT NEAREST PANEL JOINT.
6. C.I.P. COPING REQUIRED AT BENDS AND VERTICAL STEPS. ESTIMATED CIP COPING LIMITS ARE SHOWN & CAN BE ADJUSTED IN THE FIELD AS NEEDED.

7. FRONT FACE OF WALL EMBEDMENT = 3'-0" MIN.
8. BEARING PRESSURES PROVIDED AS FACTORED.
9. TOP PANELS AT C.I.P. COPING TO HAVE DOWELS EXTENDING FROM TOP OF PANEL, DESIGNATED WITH 'D.'

10. IF ANTICIPATED SHORT TERM SETTLEMENT EXCEEDS 1", CONTACT THE REINFORCED EARTH COMPANY.

CAST IN PLACE COPING

LEVELING PAD

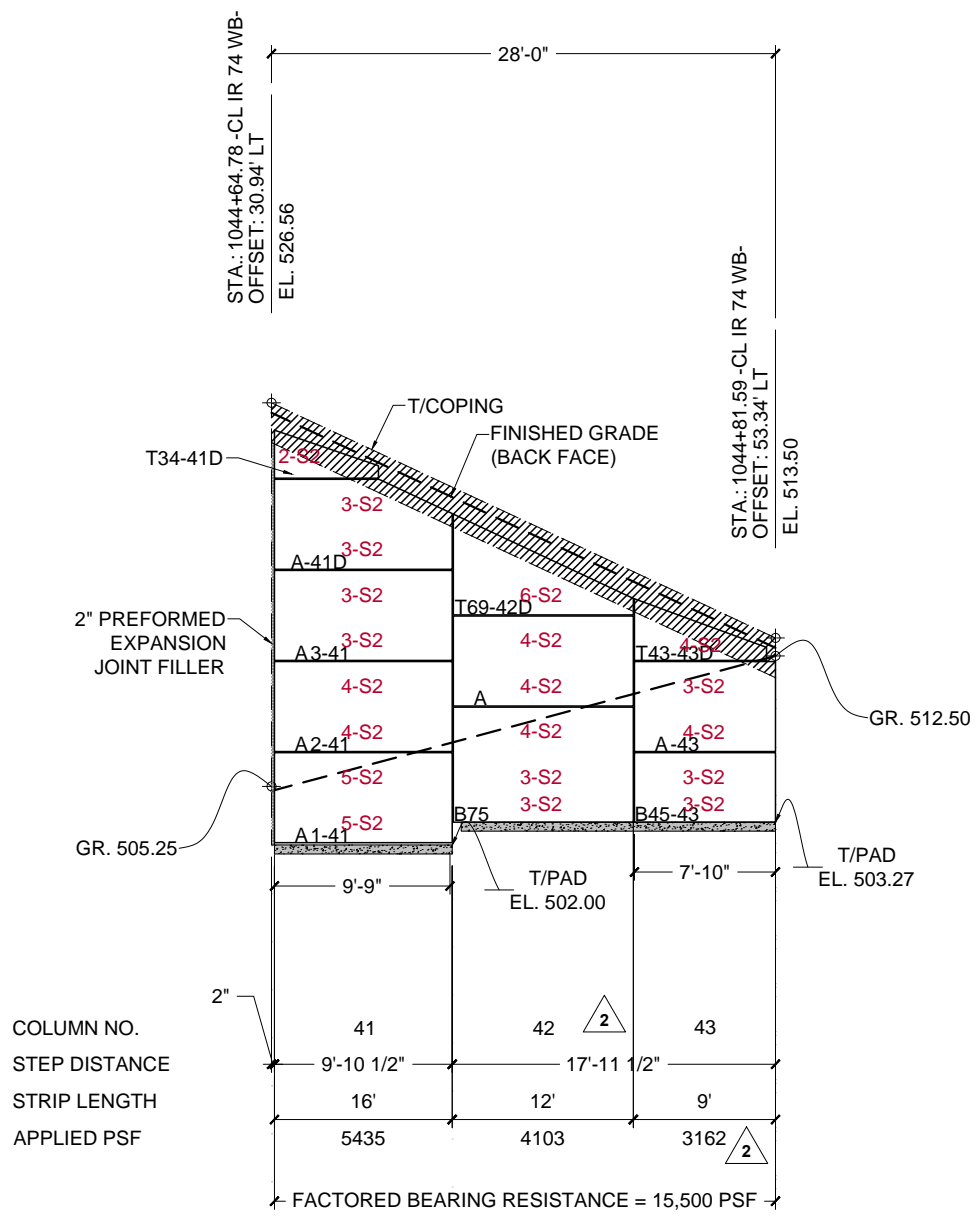

COLUMN NO.	41	42	43
STEP DISTANCE	9'-10 1/2"	17'-11 1/2"	
STRIP LENGTH	16'	12'	9'
APPLIED PSF	5435	4103	3162
FACTORED BEARING RESISTANCE = 15,500 PSF			

WALL 4
NO SCALE

COPYRIGHT © 2019 THE REINFORCED EARTH COMPANY®

THIS DRAWING CONTAINS INFORMATION PROPRIETARY TO THE REINFORCED EARTH COMPANY, AND IS BEING FURNISHED FOR THE USE OF ODOT ONLY IN CONNECTION WITH THIS PROJECT. AND THE INFORMATION CONTAINED HEREIN IS NOT TO BE TRANSMITTED TO ANY OTHER ORGANIZATION UNLESS SPECIFICALLY AUTHORIZED IN WRITING BY THE REINFORCED EARTH COMPANY. THE REINFORCED EARTH COMPANY IS EXCLUSIVE LICENSEE IN THE UNITED STATES UNDER PATENTS HELD BY OUR AFFILIATED COMPANIES, AND THE FURNISHING OF THIS DRAWING DOES NOT CONSTITUTE AN EXPRESSED OR IMPLIED LICENSE UNDER ANY APPLICABLE PATENTS.

PREPARED BY:
 REINFORCED EARTH
11640 North Park Drive - Suite 110
Wake Forest, NC 27587
Ph.: (919)453-2011 / Fax.: (513)297-7930

DESIGN BY: JL
DRAWN BY: JL
CHECKED BY: KV

PROJECT NAME: **STATE PROJECT #HAM-75-3.84**
PID 104677
MILL CREEK EXPRESSWAY PHASE 5A
WALLS 1-4


HAMILTON COUNTY OHIO

THE DESIGN CONTAINED ON THESE DRAWINGS IS BASED ON INFORMATION PROVIDED BY THE OWNER. ON THE BASIS OF THIS INFORMATION, THE REINFORCED EARTH COMPANY HAS DESIGNED, AND IS RESPONSIBLE FOR THE INTERNAL STABILITY OF THE STRUCTURE ONLY. EXTERNAL STABILITY, INCLUDING FOUNDATION BEARING CAPACITY AND SETTLEMENT, AND GLOBAL STABILITY (INCLUDING SLIDING AND ROTATION), IS THE RESPONSIBILITY OF THE OWNER.


PAGE NAME: **MSE WALL ELEVATION**

SUBMITAL DATE:	05/08/2019	PROJECT NO.:	2752
06/21/2019	REV. 2	STATIONS, OFFSETS & ELEVATIONS	
08/02/2019	REV. 3	WALLS 1-4	


S 2.04

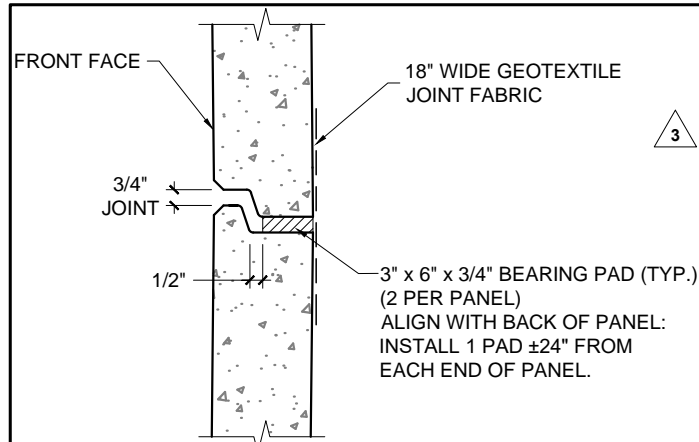


TYPICAL BEARING PAD DETAIL
NO SCALE

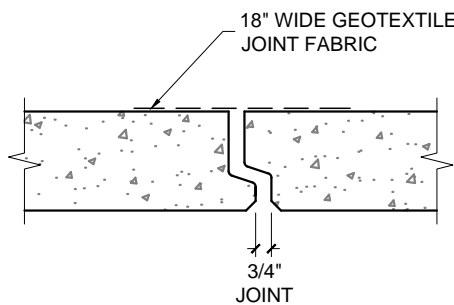

VERTICAL JOINT DETAIL
NO SCALE

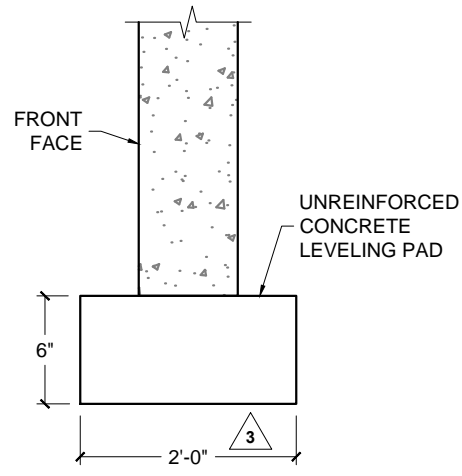


TYPICAL LEVELING PAD DETAIL
NO SCALE

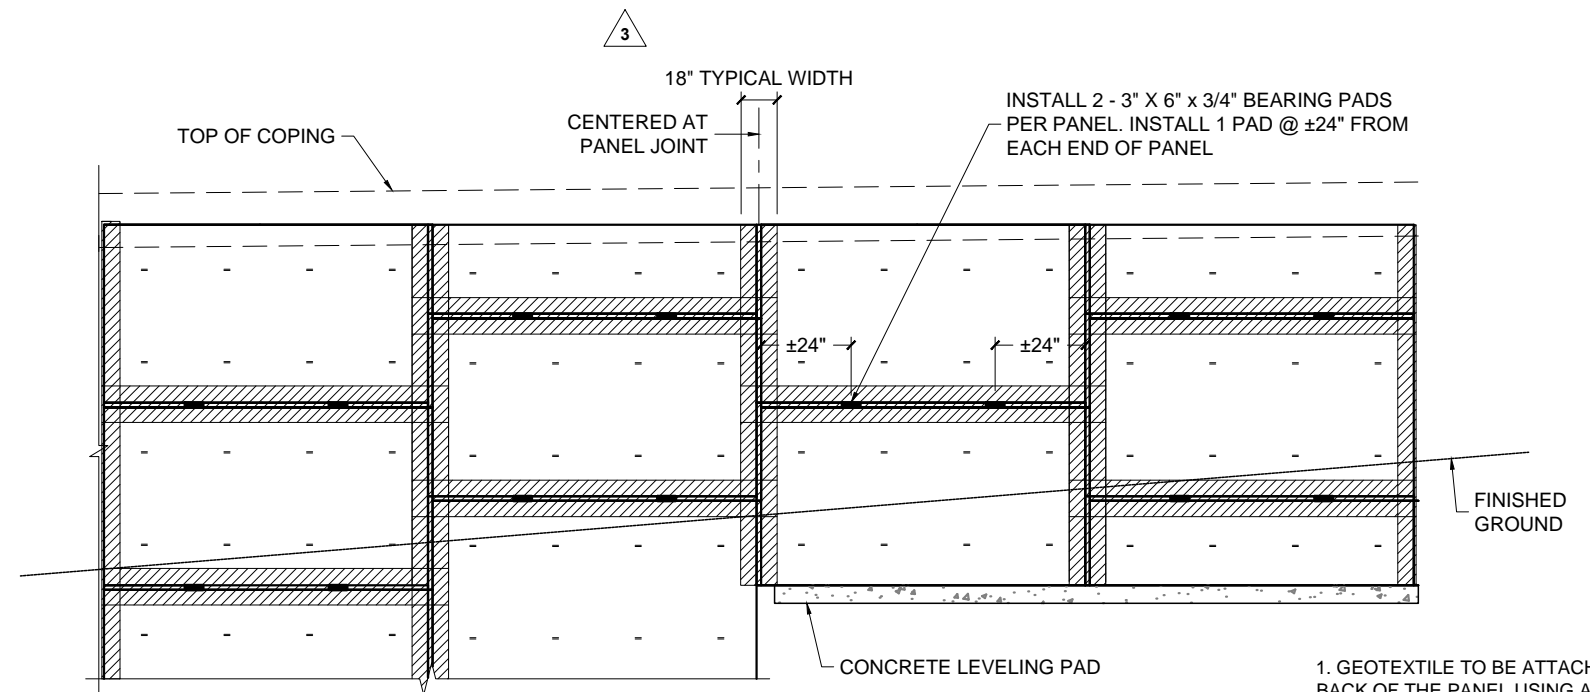


TYPICAL GEOTEXTILE JOINT FABRIC AND BEARING PAD DETAIL
NO SCALE


1. GEOTEXTILE TO BE ATTACHED TO THE BACK OF THE PANEL USING ADHESIVE.
2. ADHESIVE TO BE APPLIED TO THE PANELS ONLY AND SHALL NOT BE APPLIED WITHIN 2" OF A JOINT.
3. FABRIC SHALL OVERLAP A MINIMUM OF 12". QUANTITIES SUPPLIED ARE BASED ON A 12" OVERLAP.

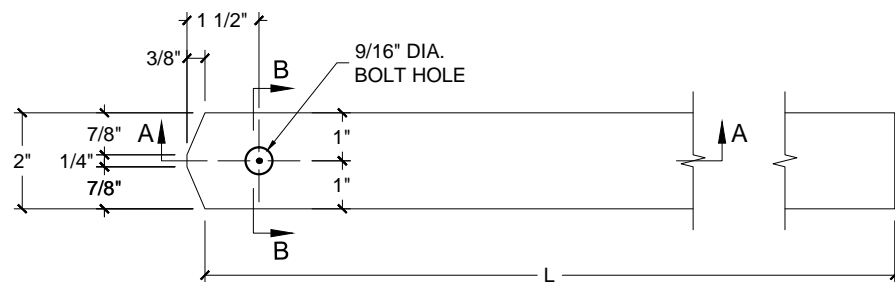

PLAN VIEW

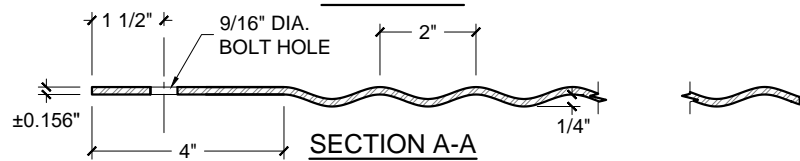


SECTION A-A

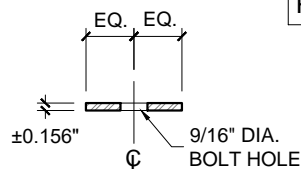

SECTION B-B

S2 - SINestrip DETAIL
NO SCALE

PATENT # 7,270,502

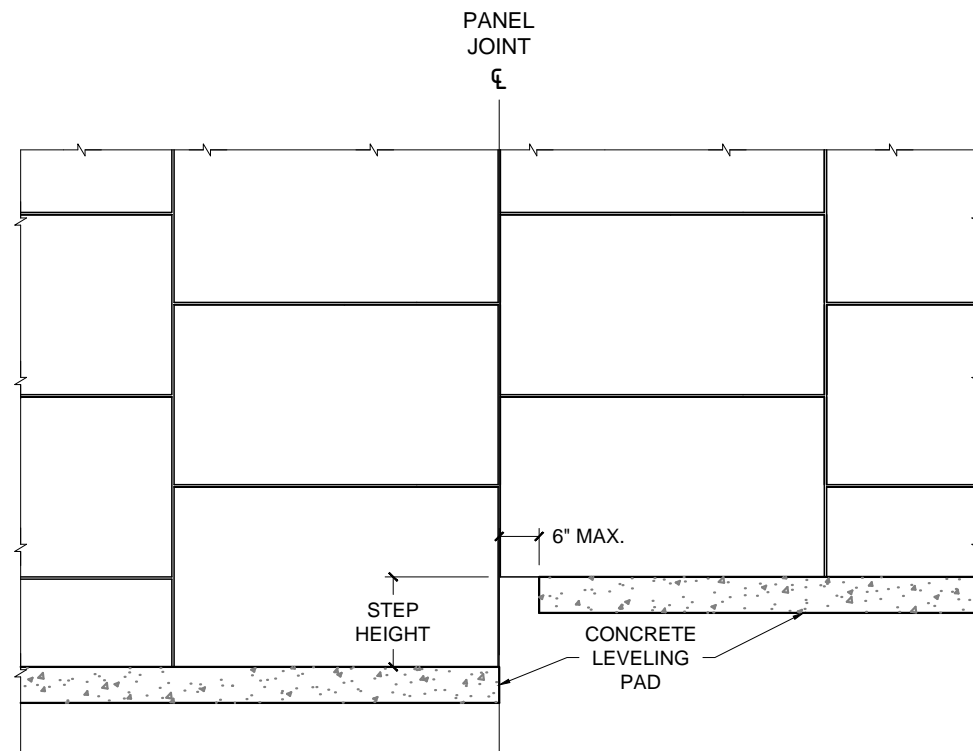

TYPICAL LEVELING PAD STEP
NO SCALE

COPYRIGHT 2019 THE REINFORCED EARTH COMPANY®

THIS DRAWING CONTAINS INFORMATION PROPRIETARY TO THE REINFORCED EARTH COMPANY, AND IS BEING FURNISHED FOR THE USE OF ODOT ONLY IN CONNECTION WITH THIS PROJECT, AND THE INFORMATION CONTAINED HEREIN IS NOT TO BE TRANSMITTED TO ANY OTHER ORGANIZATION UNLESS SPECIFICALLY AUTHORIZED IN WRITING BY THE REINFORCED EARTH COMPANY. THE REINFORCED EARTH COMPANY IS EXCLUSIVE LICENSEE IN THE UNITED STATES UNDER PATENTS HELD BY OUR AFFILIATED COMPANIES, AND THE FURNISHING OF THIS DRAWING DOES NOT CONSTITUTE AN EXPRESSED OR IMPLIED LICENSE UNDER ANY APPLICABLE PATENTS.

PREPARED BY:
REINFORCED EARTH
11640 North Park Drive - Suite 110
Wake Forest, NC 27587
Ph.: (919)453-2011 / Fax.: (513)297-7930

DESIGN BY: JL
DRAWN BY: JL
CHECKED BY: KV

PROJECT NAME: **STATE PROJECT #HAM-75-3.84**
PID 104677
MILL CREEK EXPRESSWAY PHASE 5A
WALLS 1-4
HAMILTON COUNTY OHIO


THE DESIGN CONTAINED ON THESE DRAWINGS IS BASED ON INFORMATION PROVIDED BY THE OWNER. ON THE BASIS OF THIS INFORMATION, THE REINFORCED EARTH COMPANY HAS DESIGNED, AND IS RESPONSIBLE FOR THE INTERNAL STABILITY OF THE STRUCTURE ONLY. EXTERNAL STABILITY, INCLUDING FOUNDATION (BEARING CAPACITY AND SETTLEMENT) AND GLOBAL STABILITY (INCLUDING SLIDING AND ROTATION), IS THE RESPONSIBILITY OF THE OWNER.

PAGE NAME:
TYPICAL DETAILS

SUBMITAL DATE: **05/08/2019**
08/02/2019 REV. 3 WALLS 1-4

PROJECT NO.: **2752**

SET
PAGE #
S 3.02

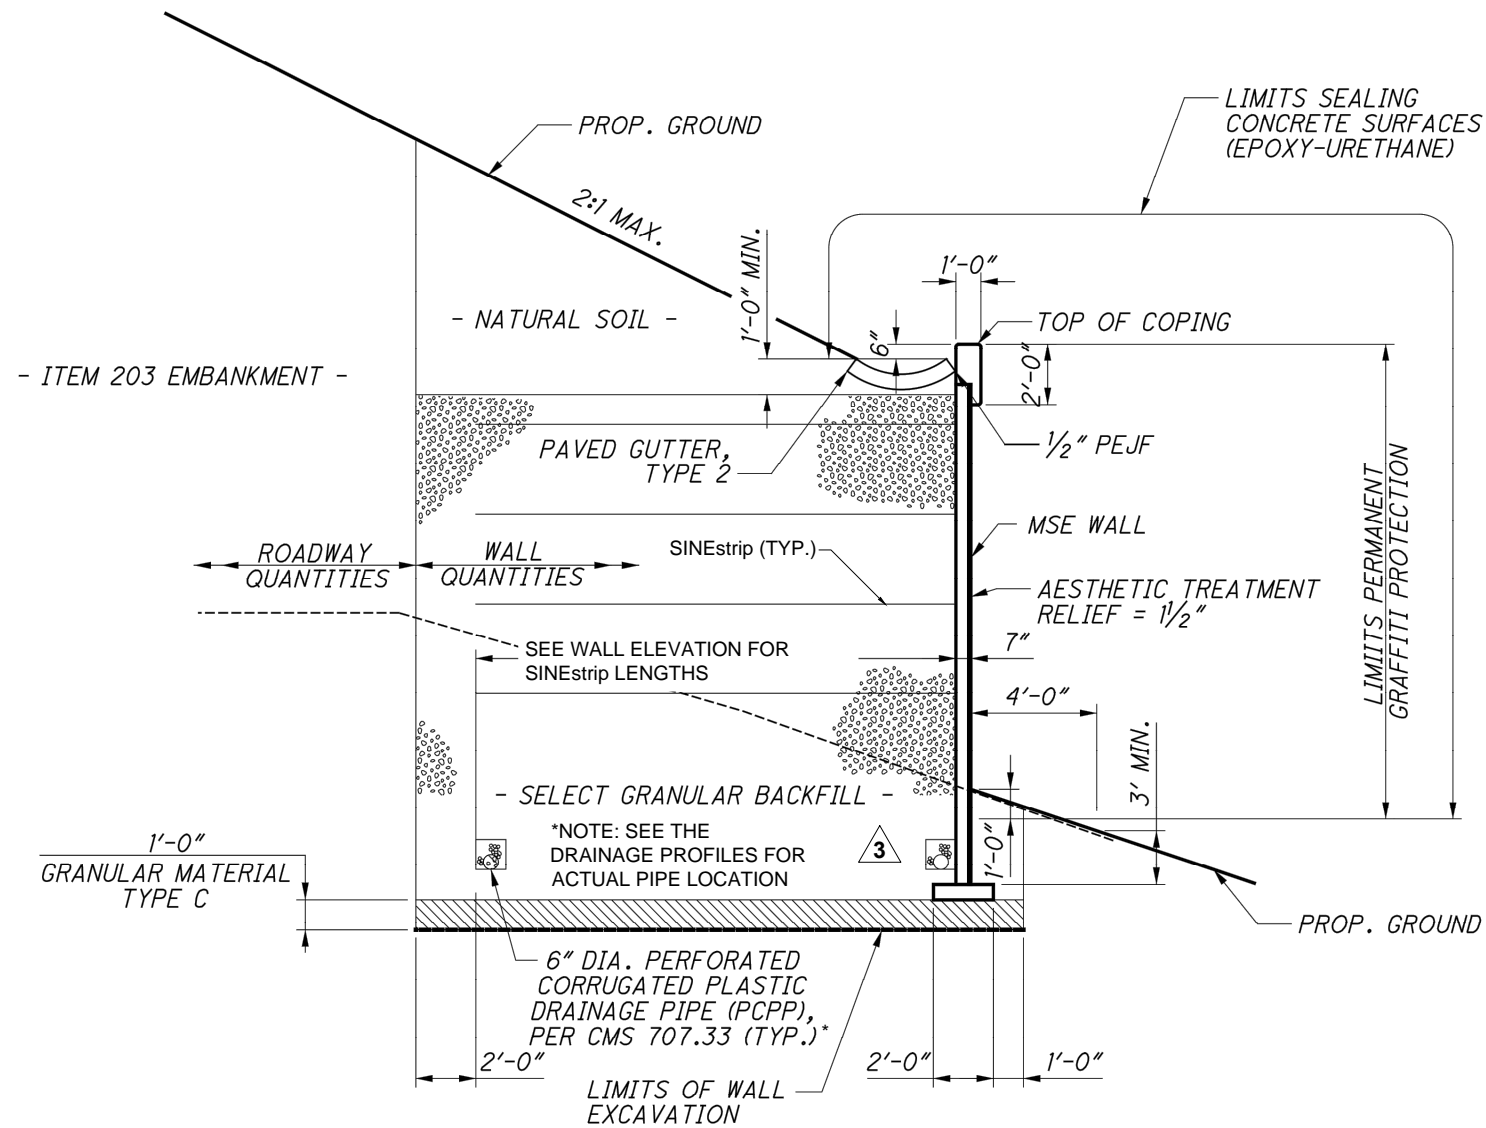

TYPICAL WALL SECTION FOR WALLS 1 - 4
NO SCALE

DETAILS ARE TAKEN FROM THE PROJECT CONTRACT PLANS SHEET (28 OF 68). DETAILS SHOWN IN THE PROJECT CONTRACT DRAWINGS ARE SHOWN HERE FOR INFORMATION ONLY AND INVENTURE CIVIL ACCEPTS NO LIABILITY ASSOCIATED WITH THEIR USE.

COPYRIGHT 2019 THE REINFORCED EARTH COMPANY®

THIS DRAWING CONTAINS INFORMATION PROPRIETARY TO THE REINFORCED EARTH COMPANY, AND IS BEING FURNISHED FOR THE USE OF ODOT ONLY IN CONNECTION WITH THIS PROJECT, AND THE INFORMATION CONTAINED HEREIN IS NOT TO BE TRANSMITTED TO ANY OTHER ORGANIZATION UNLESS SPECIFICALLY AUTHORIZED IN WRITING BY THE REINFORCED EARTH COMPANY. THE REINFORCED EARTH COMPANY IS EXCLUSIVE LICENSEE IN THE UNITED STATES UNDER PATENTS HELD BY OUR AFFILIATED COMPANIES, AND THE FURNISHING OF THIS DRAWING DOES NOT CONSTITUTE AN EXPRESSED OR IMPLIED LICENSE UNDER ANY APPLICABLE PATENTS.

PREPARED BY:
REINFORCED EARTH
11640 North Park Drive - Suite 110
Wake Forest, NC 27587
Ph.: (919)453-2011 / Fax.: (513)297-7930

DESIGN BY: JL
DRAWN BY: JL
CHECKED BY: KV

PROJECT NAME: **STATE PROJECT #HAM-75-3.84**
PID 104677
MILL CREEK EXPRESSWAY PHASE 5A
WALLS 1-4
HAMILTON COUNTY OHIO

THE DESIGN CONTAINED ON THESE DRAWINGS IS BASED ON INFORMATION PROVIDED BY THE OWNER. ON THE BASIS OF THIS INFORMATION, THE REINFORCED EARTH COMPANY HAS DESIGNED, AND IS RESPONSIBLE FOR THE INTERNAL STABILITY OF THE STRUCTURE ONLY. EXTERNAL STABILITY, INCLUDING FOUNDATION (BEARING CAPACITY AND SETTLEMENT) AND GLOBAL STABILITY (INCLUDING SLIDING AND ROTATION), IS THE RESPONSIBILITY OF THE OWNER.

PAGE NAME: **TYPICAL WALL SECTIONS**

SUBMITAL DATE:	05/08/2019	PROJECT NO.:	2752
05/28/2019	REV. 1	AFC PLANS & LEVEING PAD	
08/02/2019	REV. 3	WALLS 1-4	

SET: **S** PAGE #: **3.03**

COSMEC INC. / DYNAMIC RUBBER

P.O. Box 2159
 1501 Rocky Ridge Road
 Athens, TX 75751
 TEL: 903.677.2871 FAX: 903.675.4776

TRANSMITTAL SHEET

TO: WALSH CONSTRUCTION CO. II
RACE SHARRETT RSHARRETT@WALSHGROUP.ONMICROSOFT.COM
CC KATHI MILLS

DATE: 4/8/19
E170 (713) BRIDGES HAM-75-0440 L/R, HAM-74-1840 L/R,
 JOB: HAM-74-1852 L/R, HAM-75-3.84
 RE: SHOP DRAWING SUBMITTAL
 DRP JOB NO: 15353A LOCATION: HAMILTON CO.

WE TRANSMIT TO YOU UNDER SEPARATE COVER HERE WITH THE FOLLOWING DRAWINGS:

DWG NO	REV NO	NO EACH	DESCRIPTION	REMARKS
15353A-GN1	0	1	GENERAL NOTES	
15353A-D1	0	1	SHOP DRAWING	APPROVER NOTS REQUIRE REPLY
15353A-D2	0	1	SHOP DRAWING	APPROVER NOTS REQUIRE REPLY
15353A-D3	0	1	SHOP DRAWING	
15353A-D4	0	1	SHOP DRAWING	
15353A-D5	0	1	SHOP DRAWING	
15353A-D6	0	1	SHOP DRAWING	
15353A-D7	0	1	SHOP DRAWING	

DWG NO	REV NO	NO EACH	DESCRIPTION	REMARKS
15353A-D8	0	1	SHOP DRAWING	APPROVER NOTS REQUIRE REPLY

COMMENTS: **THE ATTACHED SHOP DRAWINGS ARE**
SUBMITTED FOR APPROVAL. PLEASE FORWARD THIS
PACKAGE TO THE ENGINEER FOR REVIEW AND ADVISE
THE APPROVAL STATUS AS SOON AS POSSIBLE.

***** APPROVER NOTES REQUIRE REPLY *****

THE ABOVE PRINTS ARE SUBMITTED TO YOU FOR:

(XXX) Approval	() Final Approval	() Distribution
() Field Use	() Fabrication	(XXX) E-MAIL
() Next Day Air	() Second Day Air	() Messenger
() UPS	() First Class Mail	() Fax

BY:

Thank you

STEPHANIE RITZ

COSMEC INC. / DYNAMIC RUBBER PRODUCTS

WWW.COSMECINC.COM

GENERAL NOTES

GENERAL NOTES:

1. ALL BEARINGS IN ACCORDANCE WITH THE 2016 OHIO DEPARTMENT OF TRANSPORTATION STANDARD SPECIFICATION FOR CONSTRUCTION AND MAINTENANCE OF HIGHWAYS, STREETS AND BRIDGES AND SUPPLEMENTAL SPECIFICATIONS 800 DATED 10/19/18, AND 869 DATED 10/17/14.
2. SHOP TO MARK LOCATION, BEAM/GIRDER NUMBER, BEARING NUMBER, HIGH-SIDE ⊗ AND AHEAD STATION AS SHOWN. MARKS SHALL BE PERMANENT AND BE VISIBLE AFTER BEARING IS INSTALLED.
3. ALL DIMENSIONS ARE IN INCHES.
4. ALL PLATES SHALL BE SMOOTH AND STRAIGHT.
5. SHIP THE SAMPLE BEARING TO AN INDEPENDENT TESTING LABORATORY FOR TESTING PER OH DOT STANDARD SPECIFICATIONS SECTION 711.23.
6. NOTIFY THE OH DOT OFFICE OF STRUCTURAL ENGINEERING AT LEAST TWO WEEKS BEFORE STARTING SHOP FABRICATION.
7. DYNAMIC RUBBER REPRESENTATIVE:
KATHI MILLS
903-677-2871
1501 ROCKY RIDGE RD.
ATHENS, TX 75751

MATERIAL NOTES:

- BRIDGE NO.: HAM-75-0440 L/R**
1. ELASTOMER: 50 DUROMETER GRADE 3 NEOPRENE
 2. STEEL LAMINATES: ASTM A709 GRADE 36, A1011 GRADE 36, GRADE 40 OR EQUIVALENT.
 3. STEEL PLATES: ASTM A709 GRADE 50 (GALVANIZED)
 4. STEEL HP12x53 PEDESTALS: ASTM A709 GRADE 50 (GALVANIZED)
 5. RUB PLATES: ASTM A709 GRADE 50 (METALIZED)
 6. STAINLESS STEEL (RUB PLATE): ASTM A240 TYPE 304 W/#8 MIRROR FINISH ON SLIDING SURFACE
 7. PTFE (RUB PLATE): ASTM D4894 (UNFILLED) – UNDIMPLED (PER AASHTO 18.8)
 8. SHEAR STUDS: ASTM A108 GRADE 1018 (METALIZED)
- BRIDGE NO.: HAM-74-1840 L/R & HAM-74-1852 L/R**
1. ELASTOMER: 50 DUROMETER GRADE 3 NEOPRENE
 2. STEEL LAMINATES: ASTM A709 GRADE 36, A1011 GRADE 36, GRADE 40 OR EQUIVALENT.
 3. STEEL PLATES: ASTM A709 GRADE 50 (PRIME PAINTED)
 4. STEEL HP12x53 PEDESTALS: ASTM A709 GRADE 50 (PRIME PAINTED)



CONTRACTOR NOTES:

1. WHEN WELDING BEAM FLANGE TO SOLE PLATES, USE TEMPERATURE INDICATING WAX PEN OR OTHER SUITABLE MEANS TO INSURE THAT THE TEMPERATURE OF THE ELASTOMER DOES NOT EXCEED 250°F. TEMPERATURES ABOVE THIS MAY DAMAGE THE ELASTOMER.
2. HAM-74-1840 & HAM-74-1852 ARE REHABILITATION PROJECTS. THE CONTRACTOR MUST VERIFY ALL SIZES AND DIMENSIONS ON THESE SHOP DRAWINGS PRIOR TO ANY FABRICATION BY COSMEC, INC.. THE CONTRACTOR IS SOLELY RESPONSIBLE FOR THE CORRECT SIZES AND CORRECT FIT, IN THE FIELD, OF ALL COMPONENTS.

FINISH NOTES:

- BRIDGE NO.: HAM-75-0440 L/R**
1. BLAST EXPOSED STEEL SURFACES OF THE SOLE PLATES, LOAD PLATES AND HP12x53 PEDESTALS TO SSPC-SP6 (COMMERCIAL BLAST CLEANING) PRIOR TO GALVANIZING.
 2. BLAST EXPOSED STEEL SURFACES OF THE RUB PLATES & STUDS TO SSPC-SP5 (WHITE METAL BLAST CLEANING) PRIOR TO METALIZING.
 3. GALVANIZED THE SOLE PLATES, LOAD PLATES AND HP12x53 PEDESTALS ACCORDING TO SECTION 711.02.
 4. RUB PLATES & STUDS SHALL BE ZINC METALIZED AND SEAL COATED PER SUPPLEMENTAL SPECIFICATION SECTION 869.13.
- BRIDGE NO.: HAM-74-1840 L/R & HAM-74-1852 L/R**
1. BLAST EXPOSED STEEL SURFACES OF THE SOLE PLATES, LOAD PLATES AND HP12x53 PEDESTALS TO SSPC-SP10 (NEAR WHITE BLAST CLEANING) PRIOR TO PAINTING.
 2. THE SOLE PLATES, LOAD PLATES AND HP12x53 PEDESTALS SHALL BE PRIME PAINTED WITH A CONTRACTOR DESIGNATED PRIME PAINT PER SPECIFICATION SECTION 514.


STATE OF OHIO		
DEPARTMENT OF TRANSPORTATION		
BRIDGE NO.: HAM-75-0440 L/R OVER IR-74 WB		
BRIDGE NO.: HAM-74-1840 L/R OVER SB BEEKMAN ST. (U.S. 27) AND RAMP F		
BRIDGE NO. HAM-74-1852 L/R OVER NB BEEKMAN ST. (U.S. 27)		
HAM-75-3.84 CITY OF CINCINNATI		
STATE	COUNTY	PID NO.
OH	HAMILTON	104667
FED. PROJ. NO.: E170 (713)		
DYNAMIC RUBBER LAM. ELASTOMERIC BEARING ASSY.'S		
1501 ROCKY RIDGE ROAD P.O. BOX 2159 ATHENS, TEXAS 75751		
SCALE: NONE	DRAWN BY: MH	CHECKED BY: ELS
	DATE: 03/18/19	DATE: 03/29/19
SHEET GN1 OF 1		JOB NO.: 15353A
REV.	DESCRIPTION	BY DATE CK'D DATE
	CUSTOMER	DRAWING NUMBER REV.
	WALSH CONSTRUCTION CO. II	15353A-GN1 0

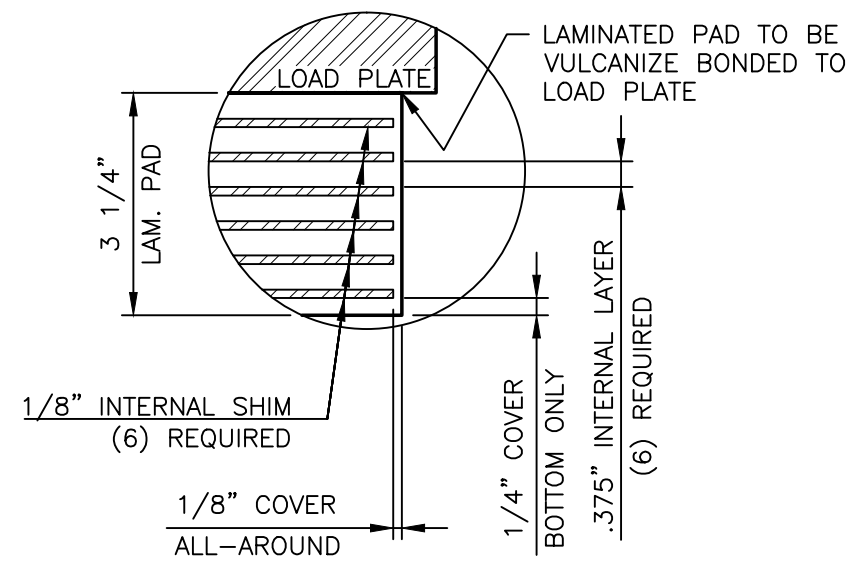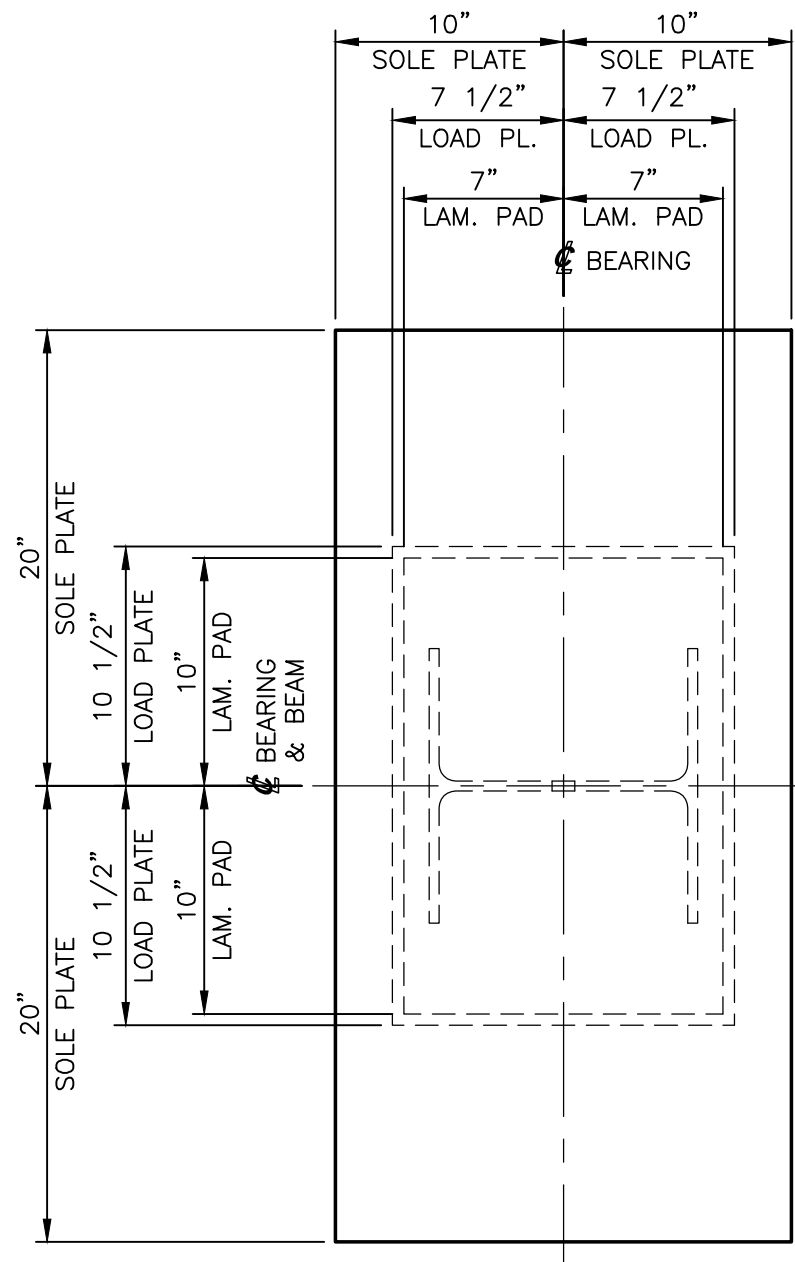


DETAIL 1
 3 1/4" x 20" x 14" LAMINATED PAD
 50 DUROMETER GRADE 3 NEOPRENE
 VULCANIZE BONDED TO LOAD PLATE
 (30) REQUIRED

TEST1-A
 3 1/4" x 20" x 14" LAMINATED PAD
 50 DUROMETER GRADE 3 NEOPRENE
 PAD ONLY FOR TESTING
 (2) REQUIRED

UNFACTORED ELASTOMERIC BEARING LOADS		
	EBA1-A (LEFT)	EBA2-A (RIGHT)
DEAD LOAD	223 KIPS	207 KIPS
LIVE LOAD	107 KIPS	101 KIPS
TOTAL LOAD (DL+LL)	330 KIPS	308 KIPS

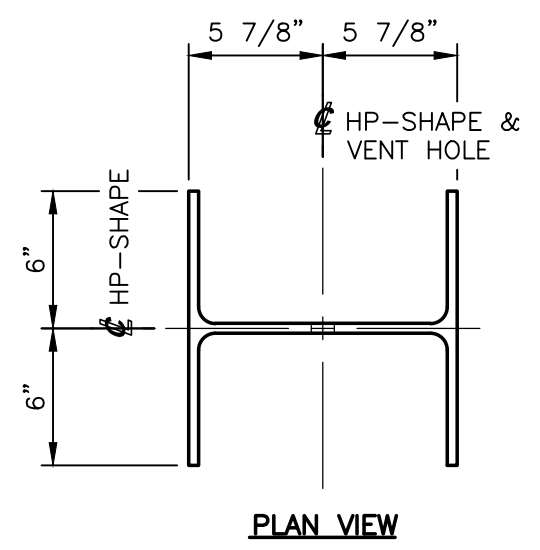


PLAN VIEW

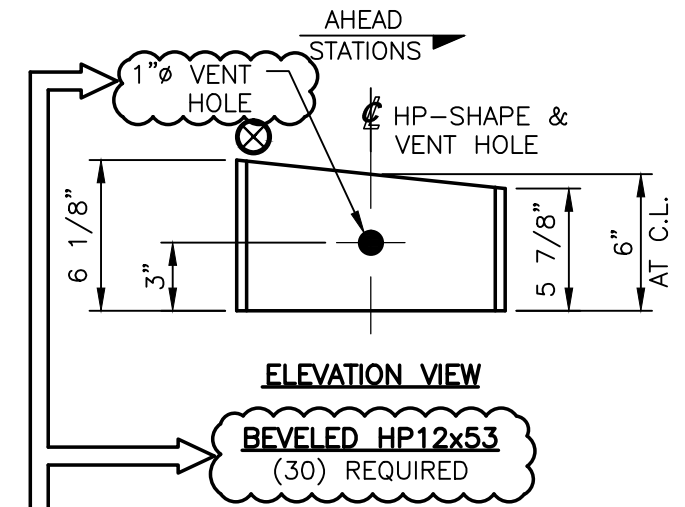

ELEVATION VIEW

BEVELED HP12x53
 (30) REQUIRED

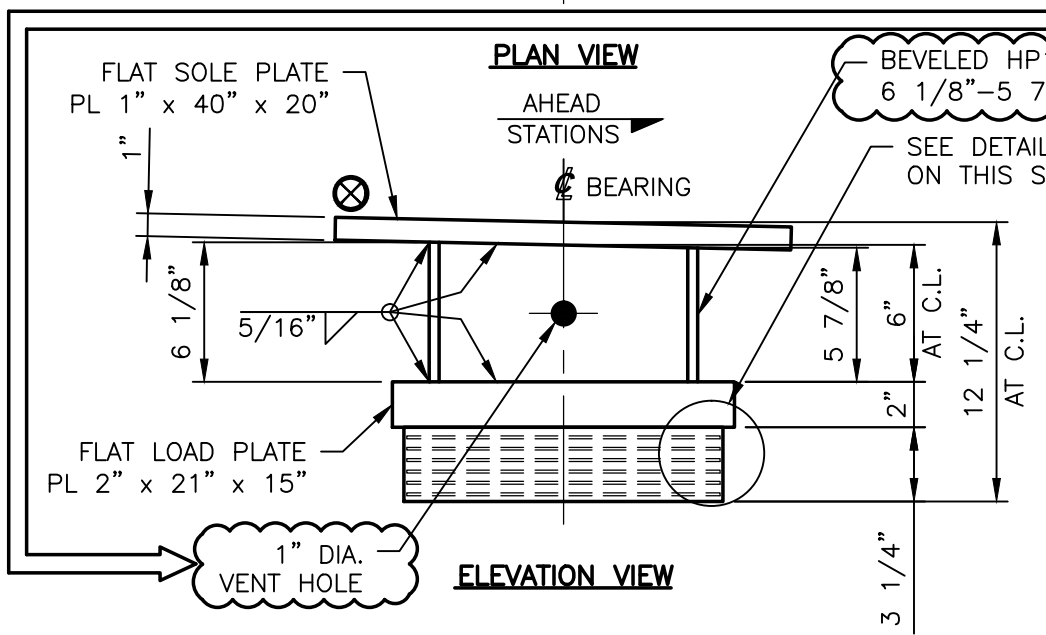

PLAN VIEW

ELEVATION VIEW

BEVELED HP12x53
 6 1/8" - 5 7/8" LG.

SEE DETAIL 1
 ON THIS SHEET

EXPANSION LAMINATED ELASTOMERIC BEARING ASSEMBLY (REF. NO.: 0039)
MARK: EBA1-A & EBA2-A

- LEFT BRIDGE (EBA1-A)
 - (7) LOCATED AT REAR ABUT. (BEAMS 1-7)
 - (7) LOCATED AT FORWARD ABUT. (BEAMS 1-7)
 - RIGHT BRIDGE (EBA2-A)
 - (8) LOCATED AT REAR ABUT. (BEAMS 8-15)
 - (8) LOCATED AT FORWARD ABUT. (BEAMS 8-15)
- (30) REQUIRED

APPROVER NOTE:
 1. PER SECTIONS A-A, B-B AND ELEVATION VIEWS SHOWN ON CONTRACT SHEET 45 OF 68, THE HP12x53 IS TO BE BEVELED. IN THE PLAN AND BEARING SCHEDULE TABLE ON SHEET 45 OF 68 THE LOAD PLATE IS TO BE BEVELED. PLEASE VERIFY IF THE HP12x53 IS BEVELED AS SHOWN.
 2. A VENT HOLE IS SHOWN IN THE DETAILS ON CONTRACT SHEET 45 OF 68 BUT THE SIZE IS NOT CALLED OUT. PLEASE VERIFY IF THE 1" DIAMETER, AS SHOWN, IS ACCEPTABLE.

BRIDGE NO.: HAM-75-0440 L/R
 SEE NOTES ON SHEET GN1 OF 1

STATE OF OHIO
 DEPARTMENT OF TRANSPORTATION
 BRIDGE NO.: HAM-75-0440 L/R
 OVER IR-74 WB
 BRIDGE NO.: HAM-74-1840 L/R
 OVER SB BEEKMAN ST. (U.S. 27)
 AND RAMP F
 BRIDGE NO. HAM-74-1852 L/R
 OVER NB BEEKMAN ST. (U.S. 27)
 HAM-75-3.84
 CITY OF CINCINNATI

STATE	COUNTY	PID NO.
OH	HAMILTON	104667

FED. PROJ. NO.: E170 (713)


DYNAMIC RUBBER LAM. ELASTOMERIC BEARING ASSY.'S

Cosmee 1501 ROCKY RIDGE ROAD
 P.O. BOX 2159
 ATHENS, TEXAS 75751

SCALE: NONE	DRAWN BY: MH	CHECKED BY: ELS
	DATE: 03/18/19	DATE: 03/29/19

SHEET 1 OF 8	JOB NO.: 15353A
CUSTOMER WALSH CONSTRUCTION CO. II	DRAWING NUMBER 15353A-D1
	REV. 0

REV.	DESCRIPTION	BY	DATE	CK'D	DATE

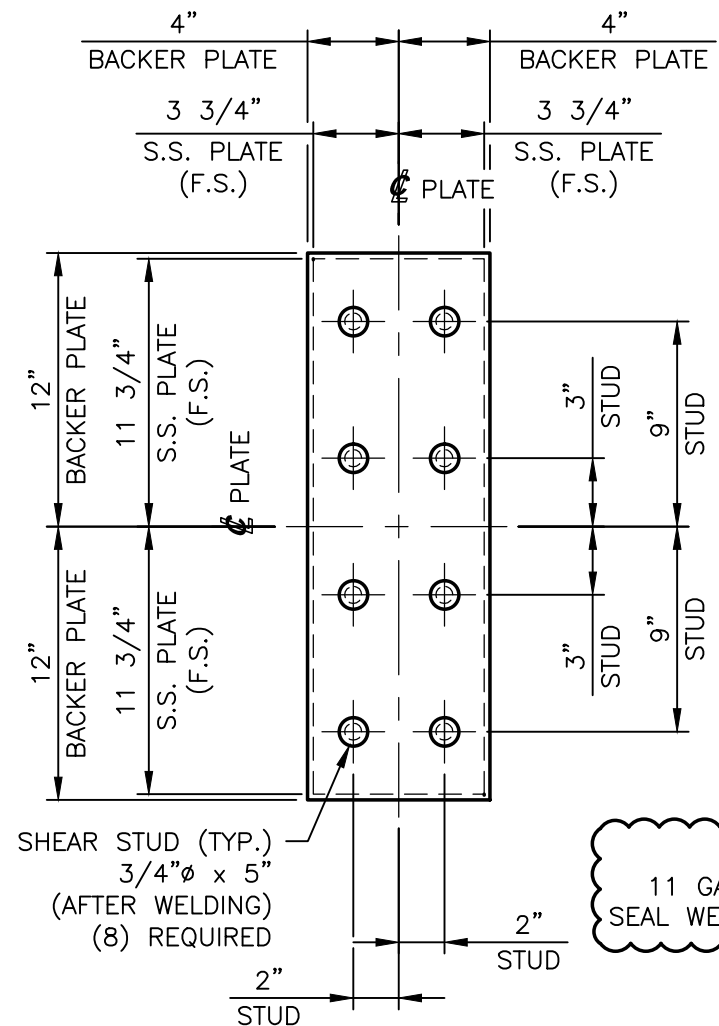


PLAN VIEW

FRONT VIEW

STAINLESS STEEL SHEET
11 GA. x 7 1/2" x 23 1/2"
SEAL WELDED TO BACKER PLATE

APPROVER NOTE:
13GA STAINLESS STEEL IS NOT
AVAILABLE WITH A MIRROR FINISH.
PLEASE VERIFY IF 11GA IS
ACCEPTABLE.

RUB PLATE ASSEMBLY (REF. NO.: 0039)
MARK NO.: RP1-A
PL 1" x 8" x 24"
ASTM A709 GRADE 50 (METALIZED)
LEFT BRIDGE
(1) LOCATED AT REAR ABUTMENT
(1) LOCATED AT FRONT ABUTMENT
RIGHT BRIDGE
(1) LOCATED AT REAR ABUTMENT
(1) LOCATED AT FRONT ABUTMENT
(4) REQUIRED

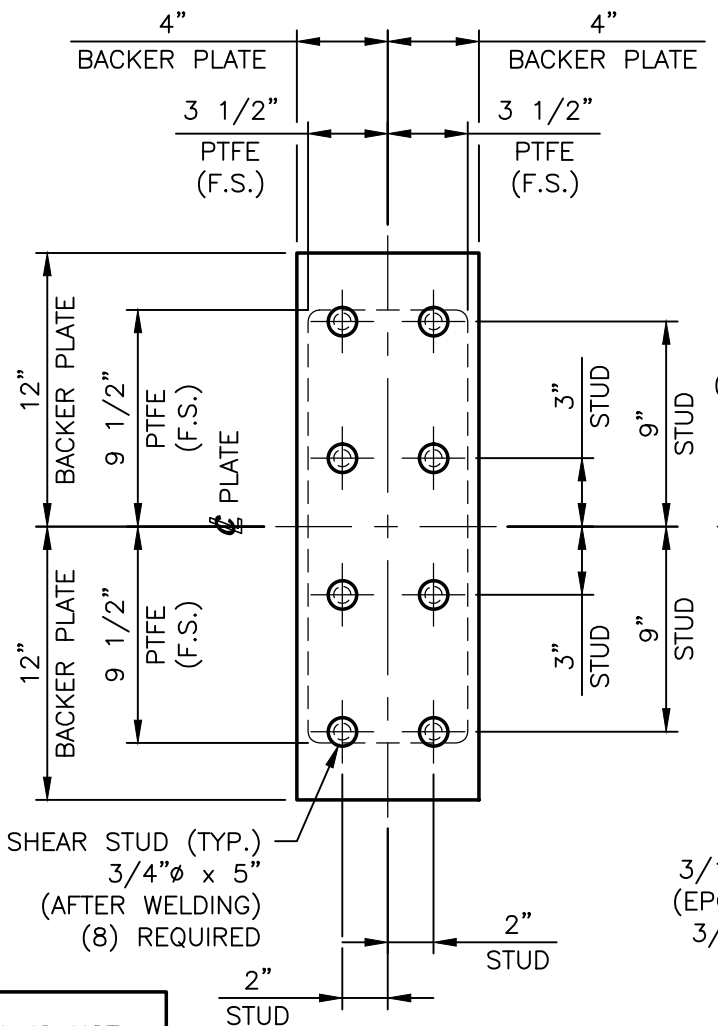

PLAN VIEW

FRONT VIEW

PTFE
3/16" x 7" x 19"
(EPOXY BONDED IN
3/32" RECESS IN
BACKER PLATE)


RUB PLATE ASSEMBLY (REF. NO.: 0039)
MARK NO.: RP2-A
PL 1" x 8" x 24"
ASTM A709 GRADE 50 (METALIZED)
LEFT BRIDGE
(1) LOCATED AT REAR ABUTMENT
(1) LOCATED AT FRONT ABUTMENT
RIGHT BRIDGE
(1) LOCATED AT REAR ABUTMENT
(1) LOCATED AT FRONT ABUTMENT
(4) REQUIRED

BRIDGE NO.: HAM-75-0440 L/R
SEE NOTES ON SHEET GN1 OF 1


STATE OF OHIO
DEPARTMENT OF TRANSPORTATION
BRIDGE NO.: HAM-75-0440 L/R
OVER IR-74 WB
BRIDGE NO.: HAM-74-1840 L/R
OVER SB BEEKMAN ST. (U.S. 27)
AND RAMP F
BRIDGE NO. HAM-74-1852 L/R
OVER NB BEEKMAN ST. (U.S. 27)
HAM-75-3.84
CITY OF CINCINNATI

STATE	COUNTY	PID NO.
OH	HAMILTON	104667
FED. PROJ. NO.: E170 (713)		
DYNAMIC RUBBER LAM. ELASTOMERIC BEARING ASSY.'S		
Cosmee 1501 ROCKY RIDGE ROAD P.O. BOX 2159 ATHENS, TEXAS 75751		
SCALE: NONE	DRAWN BY: MH	CHECKED BY: ELS
	DATE: 03/18/19	DATE: 03/29/19

REV.	DESCRIPTION	BY	DATE	CK'D	DATE	SHEET 2 OF 8	JOB NO.: 15353A	CUSTOMER WALSH CONSTRUCTION CO. II	DRAWING NUMBER 15353A-D2	REV. 0
------	-------------	----	------	------	------	--------------	-----------------	---------------------------------------	-----------------------------	-----------

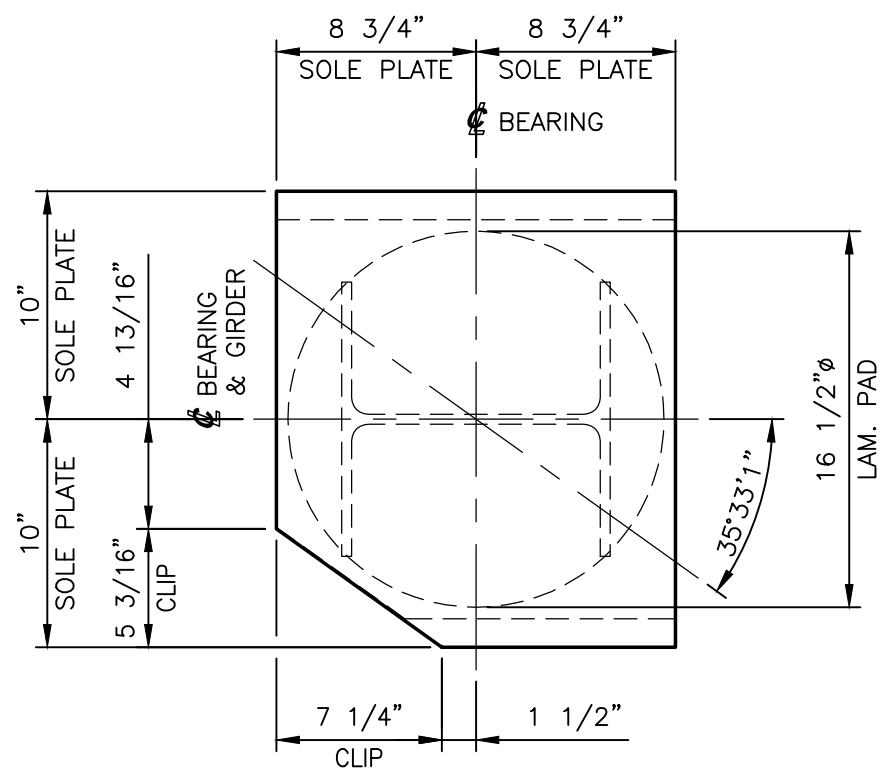


PLAN VIEW

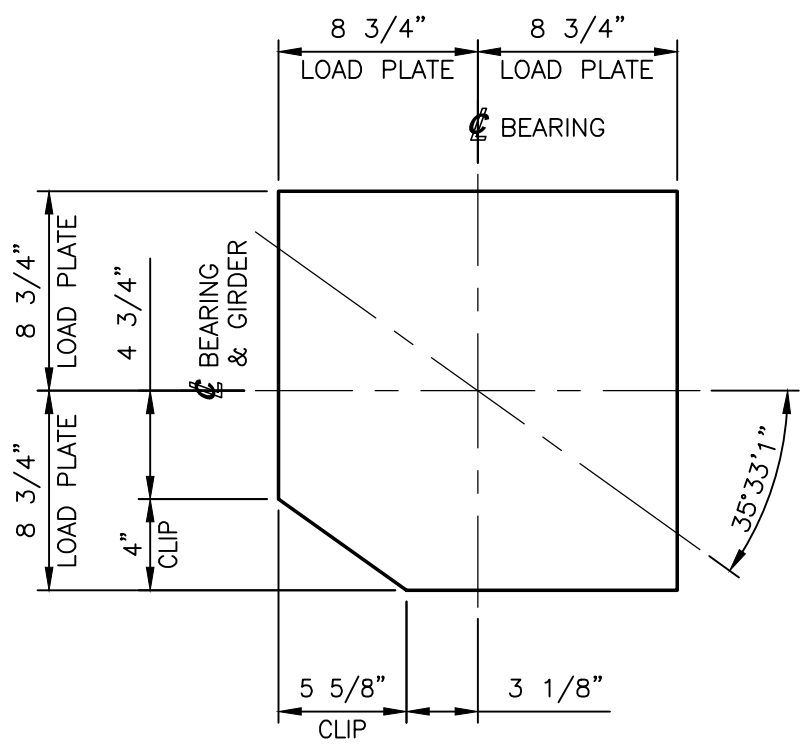

LOAD PLATE DETAIL

PL 1 1/2" x 17 1/2" x 17 1/2"
 ASTM A709 GRADE 50 (PRIME PAINTED)
 (10) REQUIRED

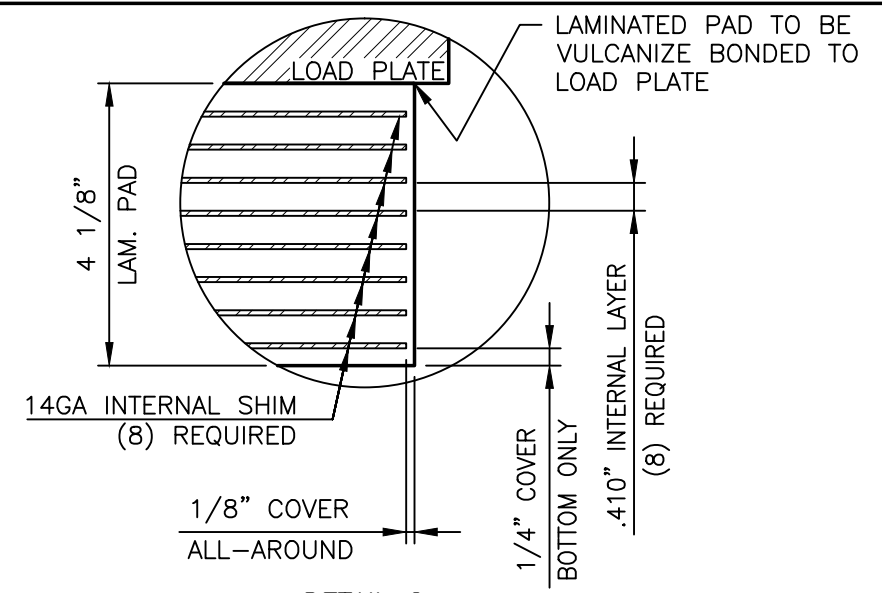


DETAIL 2

4 1/8" x 16 1/2" LAMINATED PAD
 50 DUROMETER GRADE 3 NEOPRENE
 VULCANIZE BONDED TO LOAD PLATE
 (10) REQUIRED

TEST2-A

4 1/8" x 16 1/2" LAMINATED PAD
 50 DUROMETER GRADE 3 NEOPRENE
 PAD ONLY FOR TESTING
 (2) REQUIRED


BRIDGE NO.: HAM-74-1840 L/R

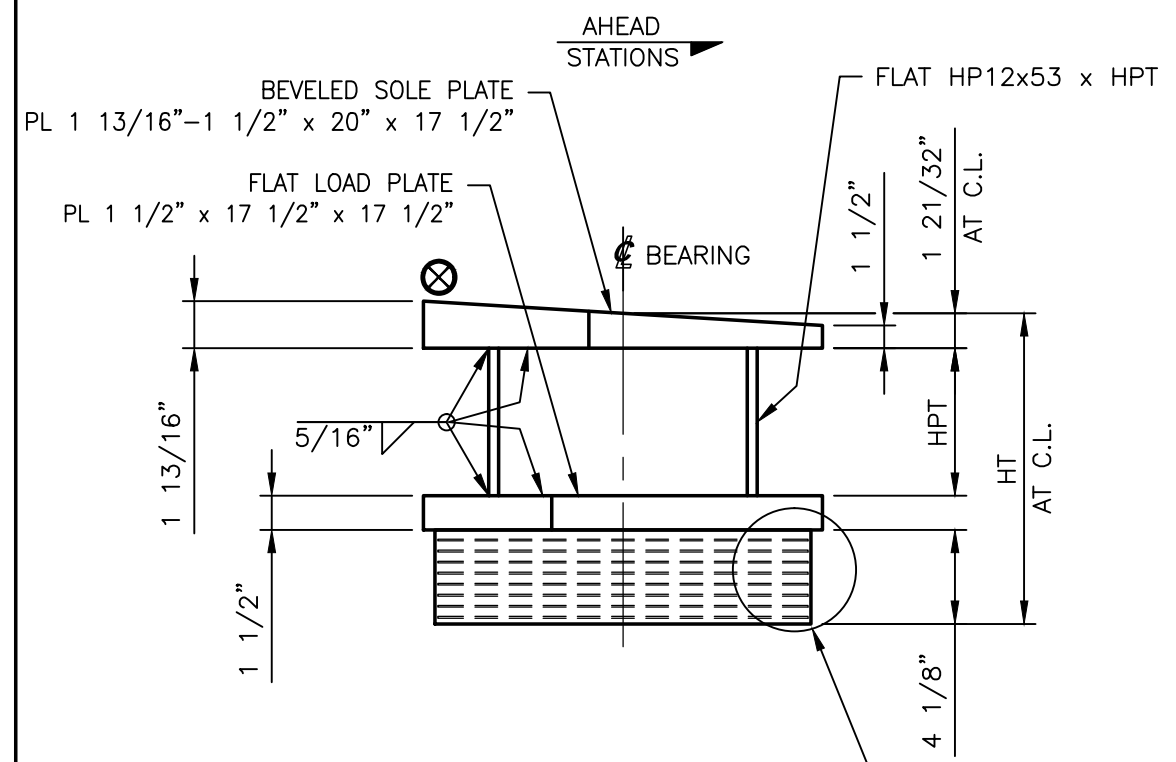


ELEVATION VIEW

EXPANSION LAMINATED ELASTOMERIC BEARING ASSEMBLY (REF. NO.: 0036) AT REAR ABUT.
 SEE BEARING TABLE 1 ON SHEET 5 FOR MARK NUMBERS, QTY.'S, LOADS, LOCATIONS AND DIMENSIONS NOT SHOWN

SEE DETAIL 2 ON THIS SHEET

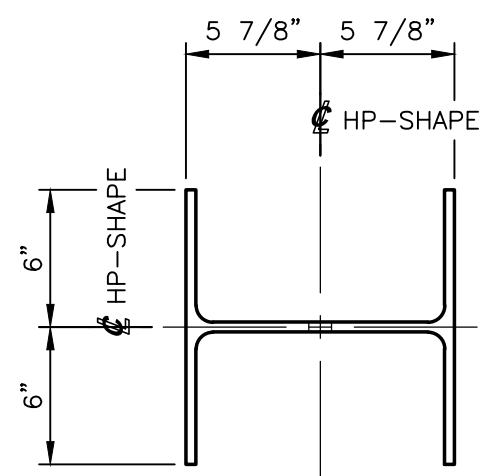

PLAN VIEW

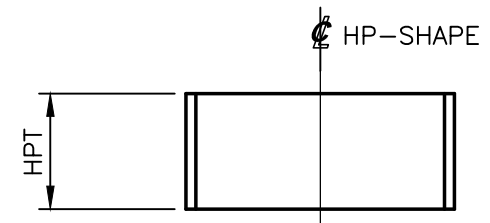

ELEVATION VIEW

FLAT HP12x53
 (10) REQUIRED

SEE NOTES ON SHEET GN1 OF 1

STATE OF OHIO
 DEPARTMENT OF TRANSPORTATION
 BRIDGE NO.: HAM-75-0440 L/R
 OVER IR-74 WB
 BRIDGE NO.: HAM-74-1840 L/R
 OVER SB BEEKMAN ST. (U.S. 27)
 AND RAMP F
 BRIDGE NO. HAM-74-1852 L/R
 OVER NB BEEKMAN ST. (U.S. 27)
 HAM-75-3.84
 CITY OF CINCINNATI

STATE	COUNTY	PID NO.
OH	HAMILTON	104667
FED. PROJ. NO.: E170 (713)		


DYNAMIC RUBBER LAM. ELASTOMERIC BEARING ASSY.'S

Cosmee 1501 ROCKY RIDGE ROAD
 P.O. BOX 2159
 ATHENS, TEXAS 75751


SCALE: NONE	DRAWN BY: MH	CHECKED BY: ELS
	DATE: 03/18/19	DATE: 03/29/19

SHEET 3 OF 8 **JOB NO.: 15353A**

REV.	DESCRIPTION	BY	DATE	CK'D	DATE	CUSTOMER WALSH CONSTRUCTION CO. II	DRAWING NUMBER 15353A-D3	REV. 0
------	-------------	----	------	------	------	---------------------------------------	-----------------------------	-----------

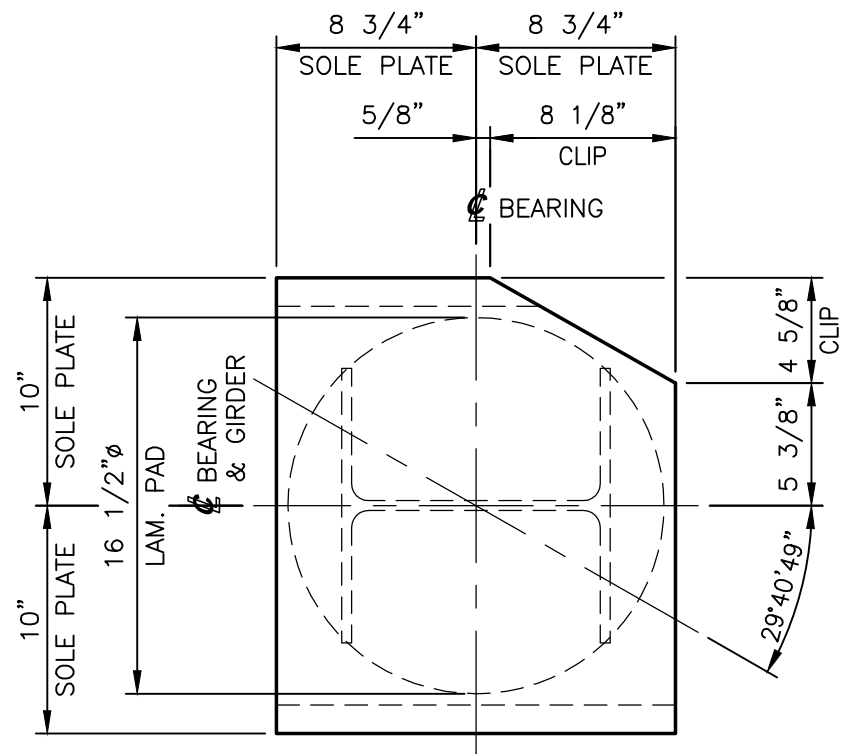


PLAN VIEW

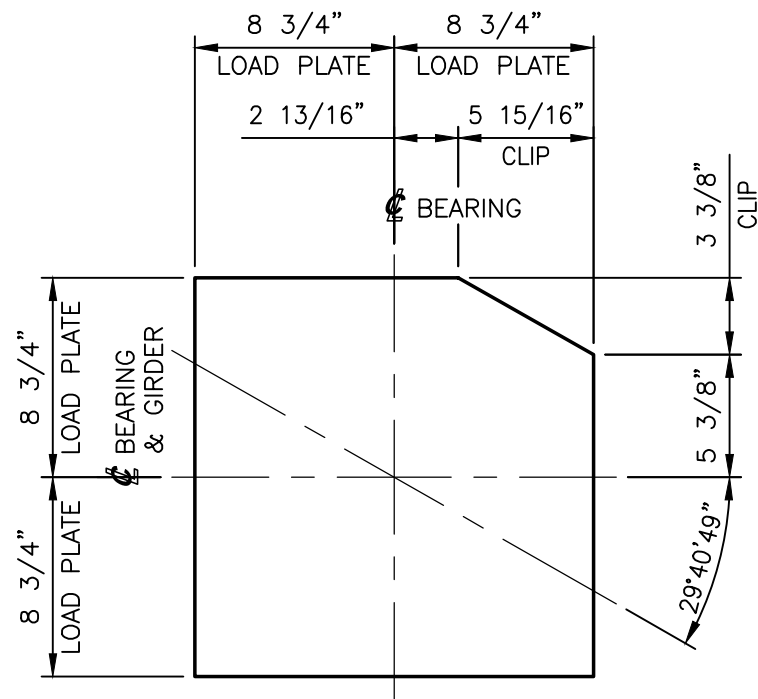


LOAD PLATE DETAIL

PL 1 1/2" x 17 1/2" x 17 1/2"
ASTM A709 GRADE 50 (PRIME PAINTED)
(10) REQUIRED

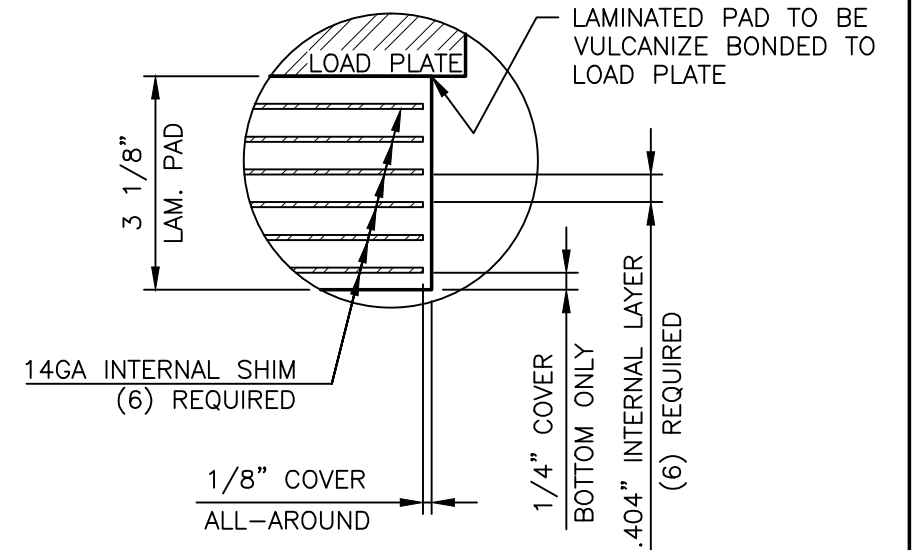


DETAIL 3

3 1/8" x 16 1/2" φ LAMINATED PAD
50 DUROMETER GRADE 3 NEOPRENE
VULCANIZE BONDED TO LOAD PLATE
(10) REQUIRED

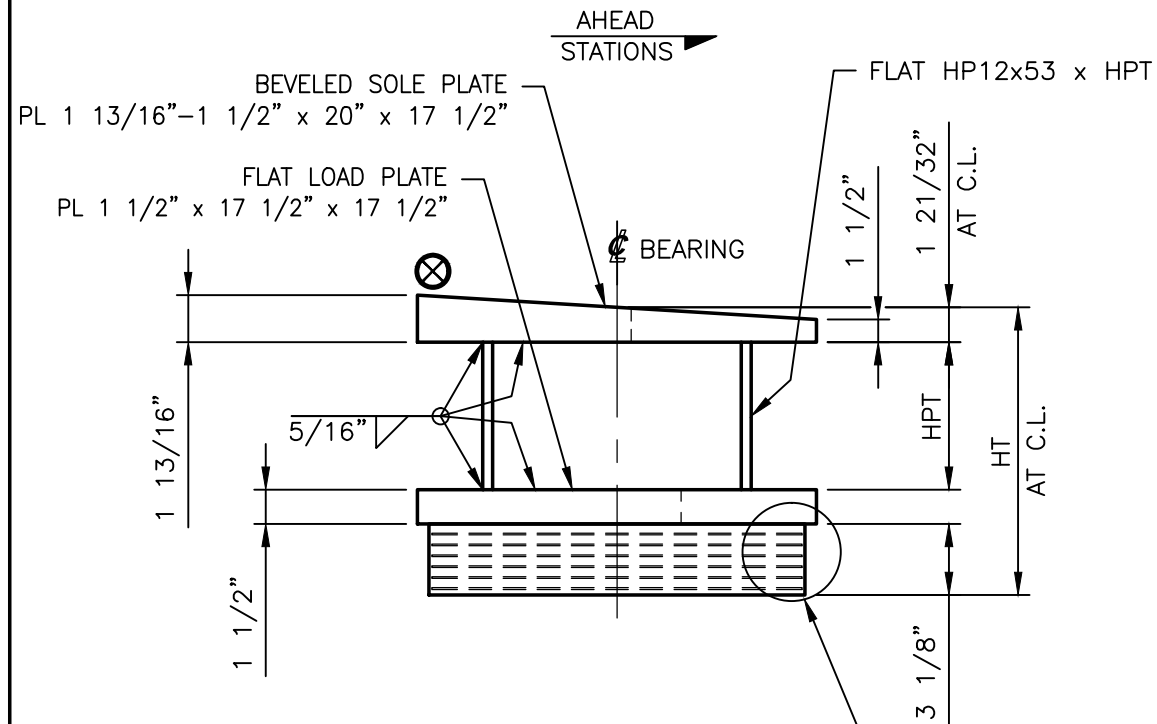


ELEVATION VIEW

EXPANSION LAMINATED ELASTOMERIC BEARING ASSEMBLY (REF. NO.: 0036) AT FORWARD ABUT.
SEE BEARING TABLE 2 ON SHEET 5 FOR MARK NUMBERS, QTY.'S, LOADS, LOCATIONS AND DIMENSIONS NOT SHOWN

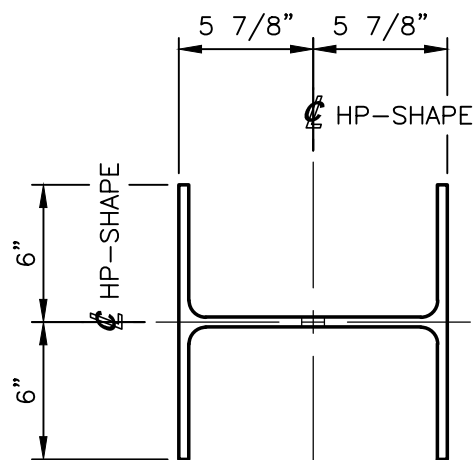

PLAN VIEW

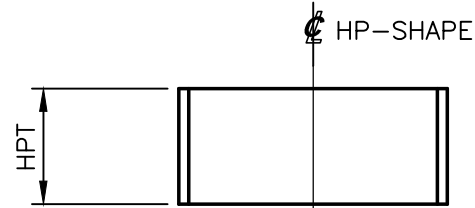

ELEVATION VIEW

FLAT HP12x53
(10) REQUIRED

BRIDGE NO.: HAM-74-1840 L/R

SEE NOTES ON SHEET GN1 OF 1

STATE OF OHIO
DEPARTMENT OF TRANSPORTATION

BRIDGE NO.: HAM-75-0440 L/R
OVER IR-74 WB

BRIDGE NO.: HAM-74-1840 L/R
OVER SB BEEKMAN ST. (U.S. 27)
AND RAMP F

BRIDGE NO. HAM-74-1852 L/R
OVER NB BEEKMAN ST. (U.S. 27)

HAM-75-3.84
CITY OF CINCINNATI

STATE	COUNTY	PID NO.
OH	HAMILTON	104667

FED. PROJ. NO.: E170 (713)

**DYNAMIC RUBBER
LAM. ELASTOMERIC BEARING ASSY.'S**

Cosmee 1501 ROCKY RIDGE ROAD
P.O. BOX 2159
ATHENS, TEXAS 75751

SCALE: NONE	DRAWN BY: MH	CHECKED BY: ELS
	DATE: 03/18/19	DATE: 03/29/19

SHEET 4 OF 8 **JOB NO.: 15353A**

REV.	DESCRIPTION	BY	DATE	CK'D	DATE	CUSTOMER WALSH CONSTRUCTION CO. II	DRAWING NUMBER 15353A-D4	REV. 0
------	-------------	----	------	------	------	---------------------------------------	-----------------------------	-----------

TABLE 1 - EXPANSION LAMINATED ELASTOMERIC BEARING ASSEMBLIES											
REF. NO.	BEARING MARK	QTY.	LOCATION			BEARING TYPE	DESIGN LOADS (KIPS)			HP12x53	HT AT C.L. (in.)
			BRIDGE	ABUTMENT	GIRDER(s)		D.L. (KIPS)	L.L. (KIPS)	TOTAL LOAD (DL+LL) (KIPS)	HPT THK. (in.)	
0036	EBA3-A	1	LEFT	REAR	G1	EXP	69	60	129	6 9/32	13 9/16
0036	EBA4-A	1	LEFT	REAR	G2	EXP	69	60	129	6.406	13 11/16
0036	EBA5-A	2	LEFT	REAR	G3 & G4	EXP	69	60	129	6 19/32	13 7/8
0036	EBA6-A	1	LEFT	REAR	G5	EXP	69	60	129	6 21/32	13 15/16
0036	EBA7-A	4	RIGHT	REAR	G6, G7, G9 & G10	EXP	69	60	129	6.639	13.92
0036	EBA8-A	1	RIGHT	REAR	G8	EXP	69	60	129	6.519	13.80

TABLE 2 - EXPANSION LAMINATED ELASTOMERIC BEARING ASSEMBLIES											
REF. NO.	BEARING MARK	QTY.	LOCATION			BEARING TYPE	DESIGN LOADS (KIPS)			HP12x53	HT AT C.L. (in.)
			BRIDGE	ABUTMENT	GIRDER(s)		D.L. (KIPS)	L.L. (KIPS)	TOTAL LOAD (DL+LL) (KIPS)	HPT THK. (in.)	
0036	EBA9-A	1	LEFT	FORWARD	G1	EXP	85	85	170	7 5/32	13 7/16
0036	EBA10-A	1	LEFT	FORWARD	G2	EXP	85	85	170	7 27/32	14 1/8
0036	EBA11-A	1	LEFT	FORWARD	G3	EXP	85	85	170	7 23/32	14
0036	EBA12-A	1	LEFT	FORWARD	G4	EXP	85	85	170	7 29/32	14 3/16
0036	EBA13-A	1	LEFT	FORWARD	G5	EXP	85	85	170	7 19/32	13 7/8
0036	EBA14-A	2	RIGHT	FORWARD	G6 & G8	EXP	85	85	170	7.519	13.80
0036	EBA15-A	3	RIGHT	FORWARD	G7, G9 & G10	EXP	85	85	170	7.639	13.92

NOTE:
REFER TO SHEETS 3 & 4 FOR BEARINGS ASSEMBLIES.

BRIDGE NO.: HAM-74-1840 L/R

SEE NOTES ON SHEET GN1 OF 1

STATE OF OHIO
DEPARTMENT OF TRANSPORTATION
BRIDGE NO.: HAM-75-0440 L/R
OVER IR-74 WB
BRIDGE NO.: HAM-74-1840 L/R
OVER SB BEEKMAN ST. (U.S. 27)
AND RAMP F
BRIDGE NO. HAM-74-1852 L/R
OVER NB BEEKMAN ST. (U.S. 27)
HAM-75-3.84
CITY OF CINCINNATI


STATE	COUNTY	PID NO.
OH	HAMILTON	104667
FED. PROJ. NO.: E170 (713)		

**DYNAMIC RUBBER
LAM. ELASTOMERIC BEARING ASSY.'S**

Cosmee 1501 ROCKY RIDGE ROAD
P.O. BOX 2159
ATHENS, TEXAS 75751


SCALE: NONE	DRAWN BY: MH	CHECKED BY: ELS
	DATE: 03/18/19	DATE: 03/29/19

△						SHEET 5 OF 8	JOB NO.: 15353A	
REV.	DESCRIPTION	BY	DATE	CK'D	DATE	CUSTOMER WALSH CONSTRUCTION CO. II	DRAWING NUMBER 15353A-D5	REV. 0

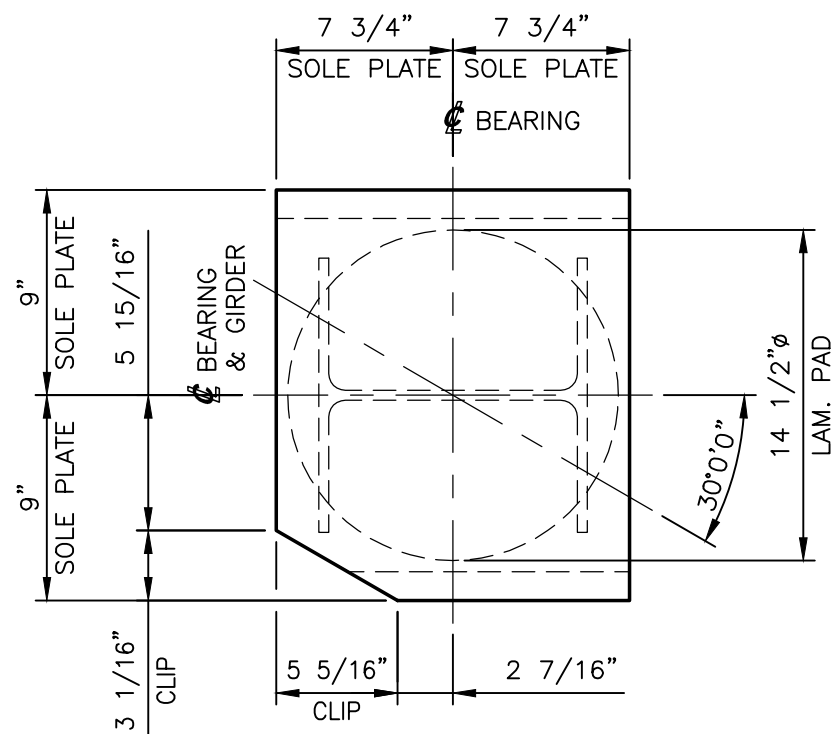


PLAN VIEW

AHEAD STATIONS

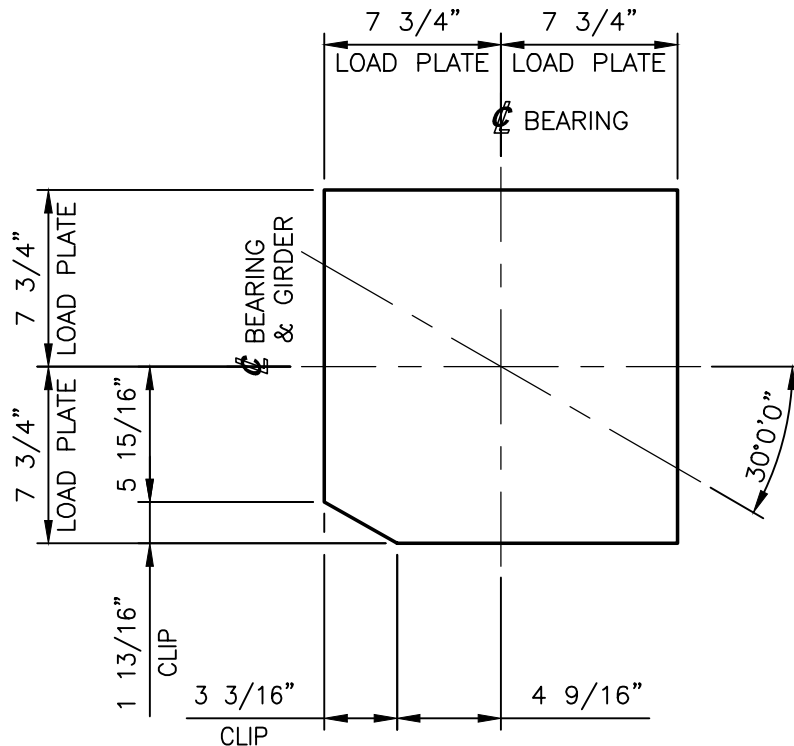

LOAD PLATE DETAIL

PL 1 1/2" x 15 1/2" x 15 1/2"
ASTM A709 GRADE 50 (PRIME PAINTED)
(10) REQUIRED

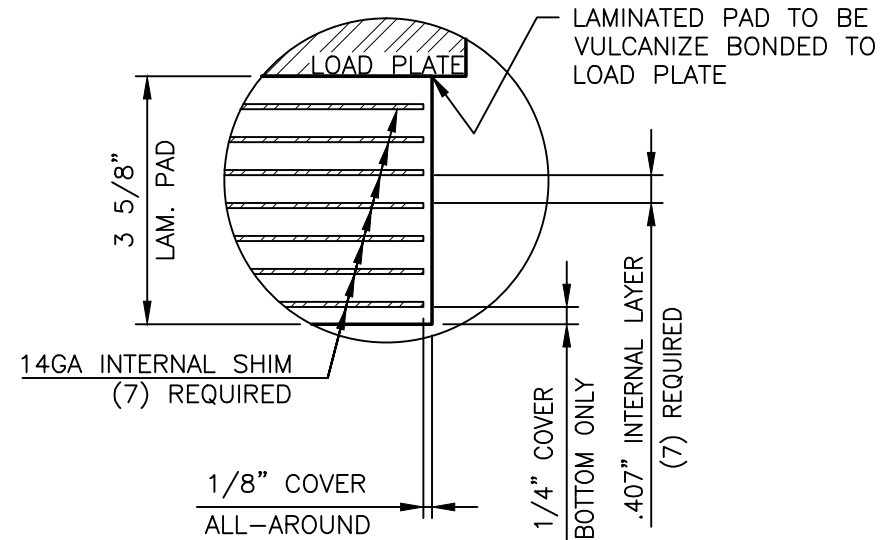


DETAIL 4

3 5/8" x 14 1/2"φ LAMINATED PAD
50 DUROMETER GRADE 3 NEOPRENE
VULCANIZE BONDED TO LOAD PLATE
(10) REQUIRED

TEST3-A

3 5/8" x 14 1/2"φ LAMINATED PAD
50 DUROMETER GRADE 3 NEOPRENE
PAD ONLY FOR TESTING
(2) REQUIRED


BRIDGE NO.: HAM-74-1852 L/R

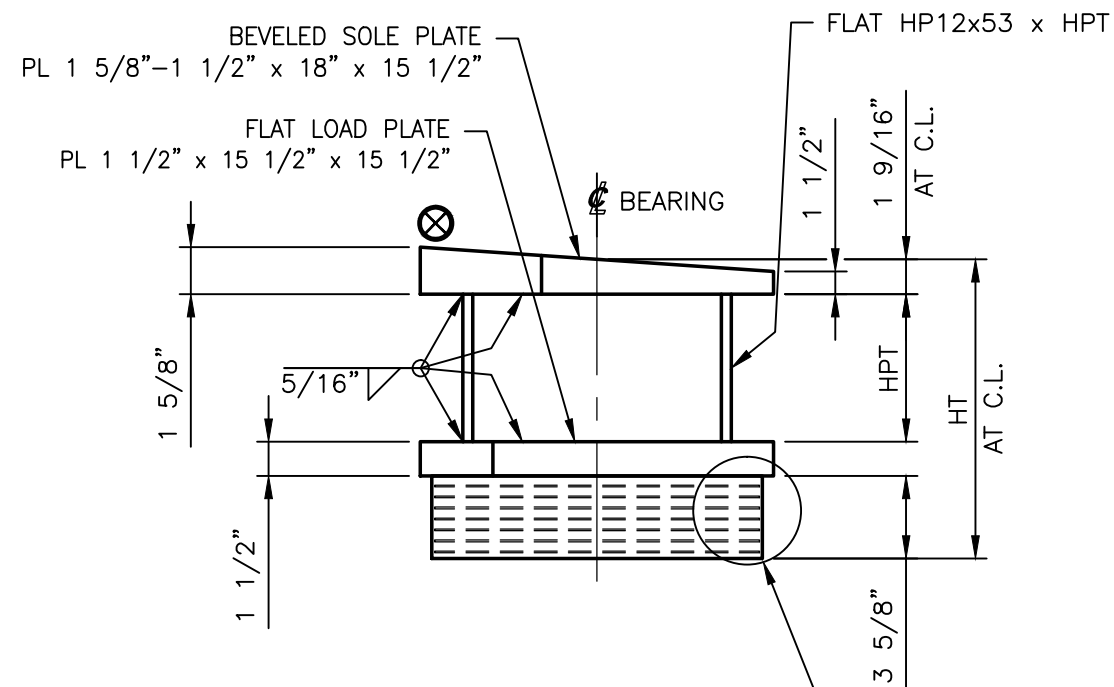


ELEVATION VIEW

EXPANSION LAMINATED ELASTOMERIC BEARING ASSEMBLY (REF. NO.: Q037) AT REAR ABUT.
SEE BEARING TABLE 3 ON SHEET 8 FOR MARK NUMBERS, QTY.'S, LOADS, LOCATIONS AND DIMENSIONS NOT SHOWN

SEE DETAIL 4 ON THIS SHEET

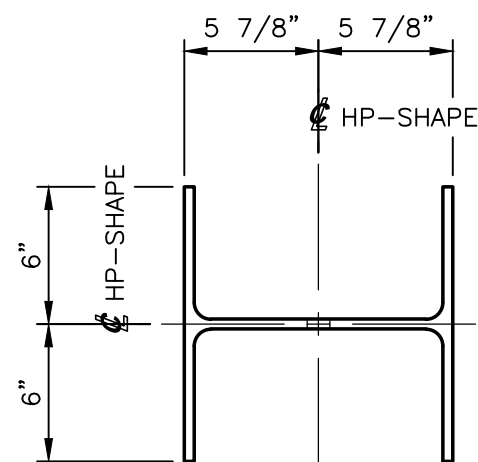

PLAN VIEW

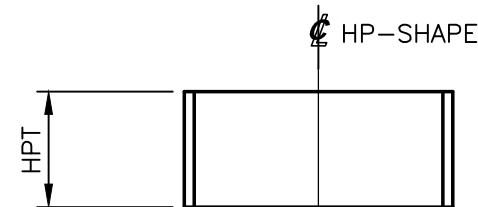

ELEVATION VIEW

FLAT HP12x53
(10) REQUIRED

SEE NOTES ON SHEET GN1 OF 1

STATE OF OHIO
DEPARTMENT OF TRANSPORTATION
BRIDGE NO.: HAM-75-0440 L/R
OVER IR-74 WB
BRIDGE NO.: HAM-74-1840 L/R
OVER SB BEEKMAN ST. (U.S. 27)
AND RAMP F
BRIDGE NO. HAM-74-1852 L/R
OVER NB BEEKMAN ST. (U.S. 27)

HAM-75-3.84
CITY OF CINCINNATI

STATE	COUNTY	PID NO.
OH	HAMILTON	104667
FED. PROJ. NO.: E170 (713)		


DYNAMIC RUBBER LAM. ELASTOMERIC BEARING ASSY.'S

Cosmee 1501 ROCKY RIDGE ROAD
P.O. BOX 2159
ATHENS, TEXAS 75751


SCALE: NONE	DRAWN BY: MH	CHECKED BY: ELS
	DATE: 03/18/19	DATE: 03/29/19

SHEET 6 OF 8 **JOB NO.: 15353A**

REV.	DESCRIPTION	BY	DATE	CK'D	DATE	CUSTOMER WALSH CONSTRUCTION CO. II	DRAWING NUMBER 15353A-D6	REV. 0
------	-------------	----	------	------	------	---------------------------------------	-----------------------------	-----------

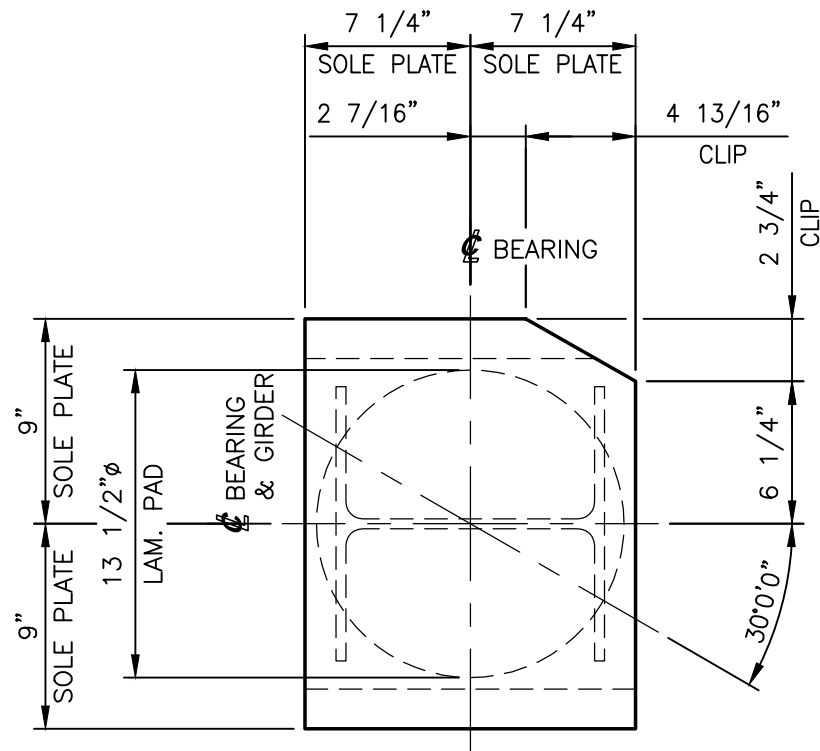


PLAN VIEW

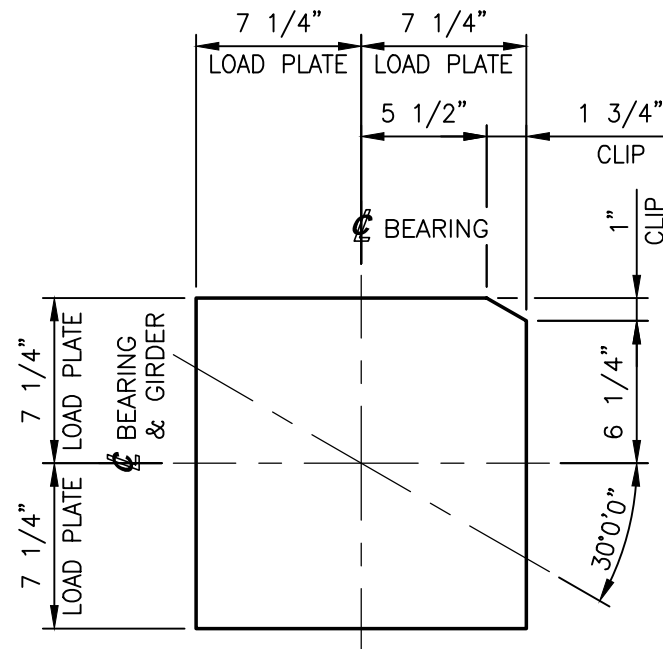


LOAD PLATE DETAIL

PL 1 1/2" x 14 1/2" x 14 1/2"
ASTM A709 GRADE 50 (PRIME PAINTED)
(10) REQUIRED

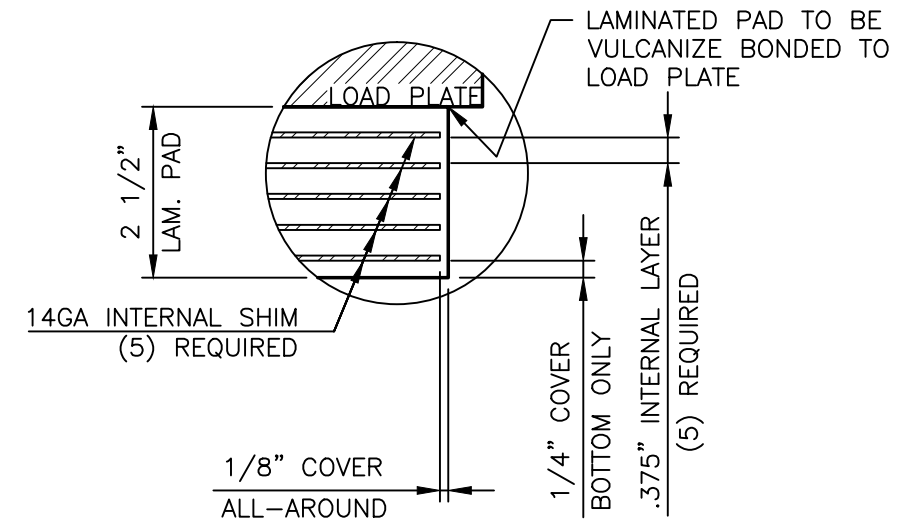

DETAIL 5


2 1/2" x 13 1/2" LAMINATED PAD
50 DUROMETER GRADE 3 NEOPRENE
VULCANIZE BONDED TO LOAD PLATE
(10) REQUIRED

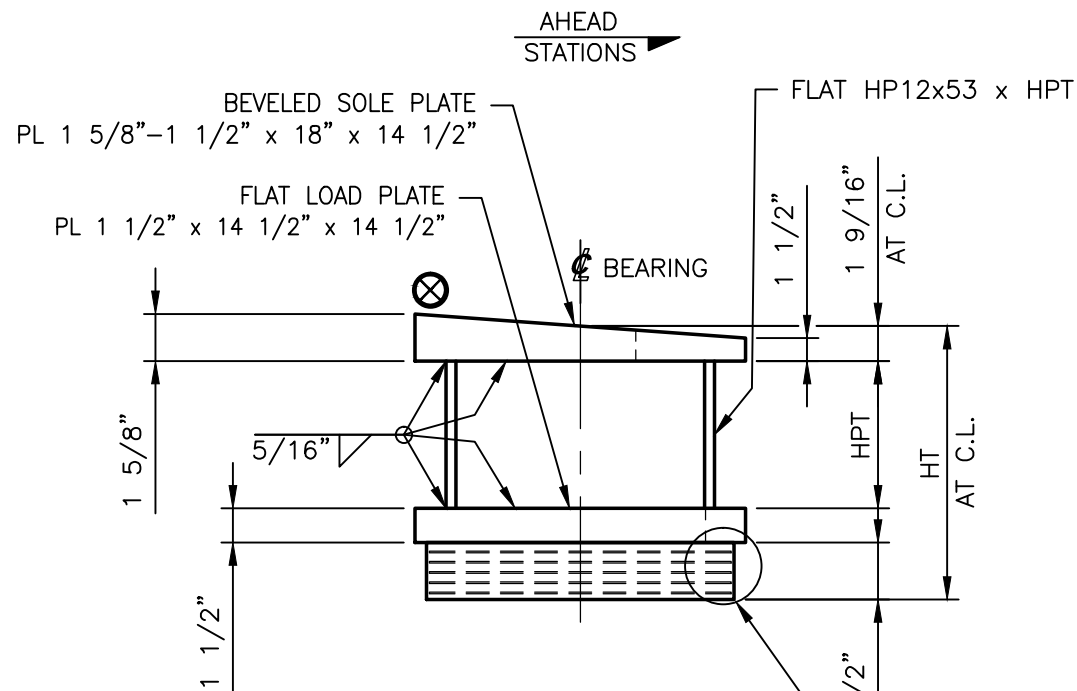


ELEVATION VIEW

EXPANSION LAMINATED ELASTOMERIC BEARING ASSEMBLY (REF. NO.: 0037) AT FORWARD ABUT.
SEE BEARING TABLE 4 ON SHEET 8 FOR MARK NUMBERS, QTY.'S, LOADS, LOCATIONS AND DIMENSIONS NOT SHOWN

SEE DETAIL 5 ON THIS SHEET

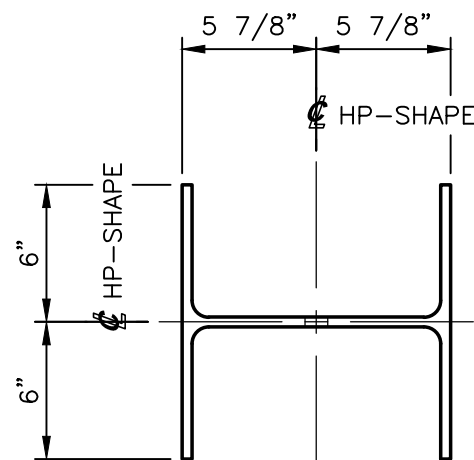

PLAN VIEW

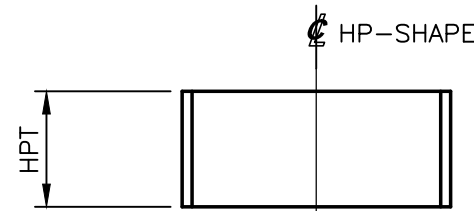

ELEVATION VIEW

FLAT HP12x53
(10) REQUIRED

BRIDGE NO.: HAM-74-1852 L/R

SEE NOTES ON SHEET GN1 OF 1

STATE OF OHIO
DEPARTMENT OF TRANSPORTATION

BRIDGE NO.: HAM-75-0440 L/R
OVER IR-74 WB

BRIDGE NO.: HAM-74-1840 L/R
OVER SB BEEKMAN ST. (U.S. 27)
AND RAMP F

BRIDGE NO. HAM-74-1852 L/R
OVER NB BEEKMAN ST. (U.S. 27)

HAM-75-3.84
CITY OF CINCINNATI

STATE	COUNTY	PID NO.
OH	HAMILTON	104667

FED. PROJ. NO.: E170 (713)

DYNAMIC RUBBER LAM. ELASTOMERIC BEARING ASSY.'S

Cosmee 1501 ROCKY RIDGE ROAD
P.O. BOX 2159
ATHENS, TEXAS 75751

SCALE: NONE	DRAWN BY: MH	CHECKED BY: ELS
	DATE: 03/18/19	DATE: 03/29/19

SHEET 7 OF 8 **JOB NO.: 15353A**

REV.	DESCRIPTION	BY	DATE	CK'D	DATE	CUSTOMER WALSH CONSTRUCTION CO. II	DRAWING NUMBER 15353A-D7	REV. 0
------	-------------	----	------	------	------	---------------------------------------	-----------------------------	-----------

TABLE 3 - EXPANSION LAMINATED ELASTOMERIC BEARING ASSEMBLIES											
REF. NO.	BEARING MARK	QTY.	LOCATION			BEARING TYPE	DESIGN LOADS (KIPS)			HP12x53	HT AT C.L. (in.)
			BRIDGE	ABUTMENT	GIRDER(s)		D.L. (KIPS)	L.L. (KIPS)	TOTAL LOAD (DL+LL) (KIPS)	HPT THK. (in.)	
0037	EBA16-A	2	LEFT	REAR	G1 & G4	EXP	56	56	112	7 13/16	14 1/2
0037	EBA17-A	2	LEFT	REAR	G2 & G3	EXP	56	56	112	8	14 11/16
0037	EBA18-A	1	LEFT	REAR	G5	EXP	56	56	112	7 11/16	14 3/8
0037	EBA19-A	1	RIGHT	REAR	G6	EXP	56	56	112	8 5/16	15
0037	EBA20-A	2	RIGHT	REAR	G7 & G9	EXP	56	56	112	8 3/16	14.88
0037	EBA21-A	1	RIGHT	REAR	G8	EXP	56	56	112	7.95	14.64
0037	EBA22-A	1	RIGHT	REAR	G9	EXP	56	56	112	8.07	14.76

APPROVER NOTE:
PLEASE VERIFY 14 3/8" IS CORRECT.
FIELD DIMENSIONS WERE SHOWN AS 14 6/16"

TABLE 4 - EXPANSION LAMINATED ELASTOMERIC BEARING ASSEMBLIES											
REF. NO.	BEARING MARK	QTY.	LOCATION			BEARING TYPE	DESIGN LOADS (KIPS)			HP12x53	HT AT C.L. (in.)
			BRIDGE	ABUTMENT	GIRDER(s)		D.L. (KIPS)	L.L. (KIPS)	TOTAL LOAD (DL+LL) (KIPS)	HPT THK. (in.)	
0037	EBA23-A	1	LEFT	FORWARD	G1	EXP	62	54	116	7 3/8	12 15/16
0037	EBA24-A	1	LEFT	FORWARD	G2	EXP	62	54	116	7	12 9/16
0037	EBA25-A	2	LEFT	FORWARD	G3 & G4	EXP	62	54	116	7 3/16	12 3/4
0037	EBA26-A	1	LEFT	FORWARD	G5	EXP	62	54	116	6 3/4	12 5/16
0037	EBA27-A	3	RIGHT	FORWARD	G6, G8 & G10	EXP	62	54	116	6.80	12.36
0037	EBA28-A	1	RIGHT	FORWARD	G7	EXP	62	54	116	7.04	12.60
0037	EBA29-A	1	RIGHT	FORWARD	G9	EXP	62	54	116	6.92	12.48

NOTE:
REFER TO SHEETS 6 & 7 FOR BEARINGS ASSEMBLIES.

BRIDGE NO.: HAM-74-1852 L/R

SEE NOTES ON SHEET GN1 OF 1

STATE OF OHIO
DEPARTMENT OF TRANSPORTATION

BRIDGE NO.: HAM-75-0440 L/R
OVER IR-74 WB

BRIDGE NO.: HAM-74-1840 L/R
OVER SB BEEKMAN ST. (U.S. 27)
AND RAMP F

BRIDGE NO. HAM-74-1852 L/R
OVER NB BEEKMAN ST. (U.S. 27)

HAM-75-3.84
CITY OF CINCINNATI

STATE	COUNTY	PID NO.
OH	HAMILTON	104667

FED. PROJ. NO.: E170 (713)

**DYNAMIC RUBBER
LAM. ELASTOMERIC BEARING ASSY.'S**

Cosmee 1501 ROCKY RIDGE ROAD
P.O. BOX 2159
ATHENS, TEXAS 75751

SCALE: NONE	DRAWN BY: MH	CHECKED BY: ELS
	DATE: 03/18/19	DATE: 03/29/19

SHEET 8 OF 8 **JOB NO.: 15353A**

REV.	DESCRIPTION	BY	DATE	CK'D	DATE	CUSTOMER WALSH CONSTRUCTION CO. II	DRAWING NUMBER 15353A-D8	REV. 0
------	-------------	----	------	------	------	---------------------------------------	-----------------------------	-----------

Prestress Services Industries, LLC
 5501 Briar Hill Road
 Lexington, Ky. 40516
 (859) 299-0461



Date
 6/7/2019
 ODOT
 (18)3000

Shop Drawings

<u>Drawing Number</u>	<u>Revision</u>	<u>Description</u>	<u>Detailer</u> (Shannon Travis)	<u>Checker</u> (Monica Kennedy)	<u>Date Detailed/Revised</u>
1	0	Cover Sheet	ST	MK	5/6/2019
2	0	Erection Layout	ST	MK	5/6/2019
3	0	Casting Bed Layout - Sheet 1	ST	MK	5/6/2019
4	0	Casting Bed Layout - Sheet 2	ST	MK	5/6/2019
5	0	Bar Bending Details	ST	MK	5/6/2019
6	0	Step 1 Forming (MK 501)	ST	MK	5/6/2019
7	0	Step 1 Forming (MK 502)	ST	MK	5/6/2019
8	0	Step 1 Forming (MK 503)	ST	MK	5/6/2019
9	0	Step 1 Forming (MK 504)	ST	MK	5/6/2019
10	0	Step 1 Forming (MKs 505-507)	ST	MK	5/6/2019
11	0	Step 1 Forming (MK 508)	ST	MK	5/6/2019
12	0	Step 1 Section Details	ST	MK	5/6/2019
13	0	Step 2 Details (MK 501)	ST	MK	5/6/2019
14	0	Step 2 Details (MKs 502-507)	ST	MK	5/6/2019
15	0	Step 2 Details (MK 508)	ST	MK	5/6/2019
16	0	Step 3 Details (MKs 501-503 & 505)	ST	MK	5/6/2019
17	0	Step 3 Details (MKs 504 & 506)	ST	MK	5/6/2019
18	0	Step 3 Details (MKs 507 & 508)	ST	MK	5/6/2019
19	0	Step 4 Details (MKs 501-508)	ST	MK	5/6/2019

	2550 Corporate Exchange Drive, Suite 300 Columbus, Ohio 43231 TEL 614.901.2235 FAX 614.901.2236	
	<input checked="" type="checkbox"/> Reviewed <input type="checkbox"/> Reviewed as Noted	<input type="checkbox"/> Not Accepted <input type="checkbox"/> Revise and Resubmit
By: <u>SJF</u>	Date: <u>06/10/19</u>	
Project No.: _____		
<p>This submittal has been reviewed for conformance with the design concept and for compliance with the contract documents only. The notes made do not relieve the CONTRACTOR from compliance with the contract documents. Design and certification of manufactured items that are not specifically designed and detailed in the contract documents are the responsibility of the registered professional engineer working for the CONTRACTOR. The CONTRACTOR is responsible for all dimensions, quantities, fabrication, fit, and the coordination with other trades. Dimensions shall be confirmed and correlated by the CONTRACTOR at the job site. Any changes made to the submittal, other than those indicated by our review, shall be clouded or otherwise highlighted on subsequent submittals.</p>		

GENERAL NOTES

- ALL 48" HYBRID I-BEAMS ARE MADE IN ACCORDANCE WITH 2016 ODOT STANDARD DRAWINGS, PSID-1-13 REV 07-20-18 AND THE AASHTO LRFD BRIDGE DESIGN SPECIFICATIONS, 8th EDITION, AND THE ODOT BRIDGE DESIGN MANUAL, 2007. **LOADING IS PER HL-93 WITH 60 PSF FWS.**
- CONCRETE: 150 LBS/CF (INCLUDES REINFORCEMENT).
- CORROSION INHIBITING ADMIXTURE SHALL BE USED IN ACCORDANCE TO SPECIAL PROVISION AT A RATE OF 4 GAL. PER CY (OR EQUIVALENT).
- CONCRETE STRENGTHS: 6,500 PSI AT RELEASE, 8,500 PSI AT 28 DAYS.**
- FINISHES: TOP - 9" ALONG BOTH EDGES TROWELED SMOOTH, REMAINING INTENTIONALLY ROUGHENED @ 1 1/2" %C, 1/4" DEEP. BOTTOM & SIDES - AS CAST AGAINST FORMS. PRESSURE WASH - EXT. SIDE OF EXT. BEAMS AND BOTTOM FLANGE OF EXT. BEAMS PRIOR TO APPLYING SEALER. SEALER - EPOXY/URETHANE TO BE FURNISHED BY CONTRACTOR AND APPLIED BY PS. (SEE DETAIL THIS SHEET) COVERAGE - EPOXY & URETHANE = 120 SF/GAL. ENDS - SEAL ALL STRANDS WITH TYPE E WATERPROOFING PER CM SURROUNDING EACH STRAND.
- HANDLING DEVICES SHALL BE IN ACCORDANCE TO THE CURRENT EDITION PCI
- ESTIMATED CAMBER:

	AT DAY 0	AT DAY 30	DEFLECTION
BEAM 1:	2.01"	3.26"	1.04"
BEAM 2:	2.14"	3.46"	1.43"
BEAMS 3-6:	2.14"	3.46"	1.45"
BEAM 7:	2.14"	3.46"	1.26"
BEAM 8:	2.03"	3.28"	1.16"
BEAMS 9-13:	2.03"	3.28"	1.33"
BEAM 14:	2.03"	3.28"	1.14"
BEAM 15:	2.27"	3.68"	1.37"

DEFLECTION DUE TO REMAINING DEAD LOAD IS INCLUDED IN THE ESTIMATED C
- LIFTLOOPS ARE TO BE REMOVED AFTER ERECTION (NOT BY PS).
- BEAM SHIPPING LENGTHS & WEIGHTS (FOR INTERNAL USE ONLY): MK 501: 86'-11" 46 TONS.
MK 502-507: 91'-4" 48 TONS.
MK 508: 96'-6" 51 TONS.

AMERICAN **STRUCTUREPOINT** INC. 2550 Corporate Exchange Drive, Suite 300 Columbus, Ohio 43231 TEL 614.901.2235 FAX 614.901.2236

By: **SJF** Date: **06/10/19**

Project No.:

Reviewed Not Accepted
 Reviewed as Noted Revise and Resubmit

This submittal has been reviewed for conformance with the design concept and for compliance with the contract documents only. The notes made do not relieve the CONTRACTOR from compliance with the contract documents. Design and certification of manufactured items that are not specifically designed and detailed in the contract documents are the responsibility of the registered professional engineer working for the CONTRACTOR. The CONTRACTOR is responsible for all dimensions, quantities, fabrication, fit, and the coordination with other trades. Dimensions shall be confirmed and correlated by the CONTRACTOR at the job site. Any changes made to the submittal, other than those indicated by our review, shall be clouded or otherwise highlighted on subsequent submittals.

LIFTING LOOP GUIDELINES:

ALL LIFTING DEVICES SHOWN MUST BE USED SIMULTANEOUSLY AND EQUALLY, 90° TO THE BEAM. ANY DEVIATION FROM THIS STANDARD FOR ERECTING PURPOSES IS THE RESPONSIBILITY OF THE CONTRACTOR. THE CONTRACTOR IS ADVISED TO HAVE AN ENGINEER REVIEW ANY DEVIATION FROM THIS STANDARD WITH CONSIDERATION GIVEN TO BEAM STRESSES, STRENGTH AND STABILITY. PRESTRESS SERVICES WILL NOT BE LIABLE FOR ANY VARIATIONS TO THE STANDARD PROCEDURE.


SHEET #	SHEET TITLE	BY	ISSUED FOR					
			DATE	SUBMITTAL	APPROVAL	REVISION	REVISION	REVISION
1	COVER SHEET		5/23/19	X				
2	ERECTION LAYOUT		X/X/XX	X				
3	CASTING BED LAYOUT- SHEET 1		X/X/XX	X				
4	CASTING BED LAYOUT - SHEET 2		X/X/XX	X				
5	BAR BENDING DETAILS		X/X/XX	X				
6	STEP 1 FORMING (MK 501)		X/X/XX	X				
7	STEP 1 FORMING (MK 502)		X/X/XX	X				
8	STEP 1 FORMING (MK 503)		X/X/XX	X				
9	STEP 1 FORMING (MK 504)		X/X/XX	X				
10	STEP 1 FORMING (MKs 505-507)		X/X/XX	X				
11	STEP 1 FORMING (MK 508)		X/X/XX	X				
12	STEP 1 SECTION DETAILS		X/X/XX	X				
13	STEP 2 DETAILS (MK 501)		X/X/XX	X				
14	STEP 2 DETAILS (MKs 502-507)		X/X/XX	X				
15	STEP 2 DETAILS (MK 508)		X/X/XX	X				
16	STEP 3 DETAILS (MKs 501-503 & 505)		X/X/XX	X				
17	STEP 3 DETAILS (MKs 504 & 506)		X/X/XX	X				
18	STEP 3 DETAILS (MKs 507 & 508)		X/X/XX	X				
19	STEP 4 DETAILS (MKs 501-508)		X/X/XX	X				

FABRICATION TOLERANCES FOR BEAMS

BEAM DIMENSIONS	
DESCRIPTION	TOLERANCE
LENGTH OF BEAM	±1/8" PER 10 FT, MAX ±1"
DEPTH OF BEAM	+1/2", -1/4"
DEPTH OF FLANGE INCLUDING FILLETS	±1/4"
FLANGE WIDTH	+3/8", -1/4"
FLANGE THICKNESS EXCLUDING FILLETS	±1/4"
WIDTH WEB	+3/8", -1/4"
DEVIATION FROM TRUE VERTICAL	1/8" PER FT.
DEVIATION FROM SKEW ANGLE	±1/2"
BEAM ACCESSORY	
POSITION OF LIFTING DEVICES	±6"
POSITIONS OF ANCHOR DOWELS AND TIE RODS, INSERTS	±1/2"
BEAM STRAND	
STRAND TENDON POSITION	±1/4"
STRAND CG POSITION	±1/4"
BEAMS SWEEP AND CAMBER	
HORIZONTAL SWEEP	±1/8" PER 10 FT, MAX. ±1"
DEVIATION FROM DESIGN CAMBER	+ SACRIFICIAL HAUNCH
REINFORCING STEEL	
CLEAR COVER	-0", +1/4"
SPLICE LENGTHS	-1 1/2"
STIRRUP SPACING IN ANCHORAGE ZONE	±1/4"
STIRRUP SPACING OUTSIDE ANCHORAGE ZONE	±1"
STIRRUP EXTENSION ABOVE TOP FLANGE	-0", +1"

SHIPLOOSE HARDWARE
 312 - 3/4" x 2'-2" THREADED RODS (G) (FIT FOR 3/8" Ø INSERTS)

INSTALLED HARDWARE
 15 - TOTAL GALLONS OF SEALER CALCULATED AT A RATE OF 120 SF/GAL.

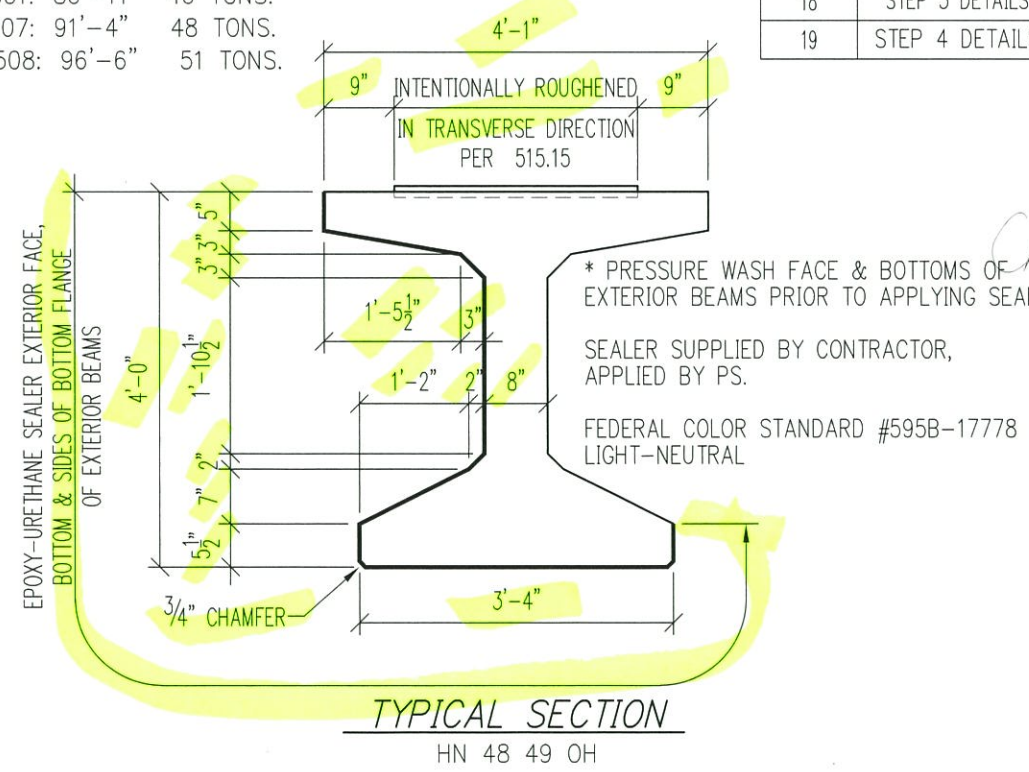

STATE PROJECT

COVER SHEET
 HAMILTON COUNTY, OHIO. HAM-75-3.85
 IR-75 OVER IR-74 WB
 BRIDGE No. HAM-75-0440 L/R STR. FILE: 3109763
 48" HYBRID I-BEAM. ODOT: (18)3000 PID: 104667
 CONTRACTOR: WALSH



PRESTRESS SERVICES INDUSTRIES LLC

Production: Lexington, KY (859) 299-0461 | Drafting: Lexington, KY (859) 299-0461
 DATE: 05/06/19 | DRAWN BY: Shannon Travis | CHECKED: Monica Kennedy


REVISIONS	△		
	△		
	△		

CODE: HN 48 49 OH | SHEET: 1 OF 19 | JOB NO: L19165

L19165 < 01 Cover Sheet > STRAVIS 4:24 PM 5/23/2019

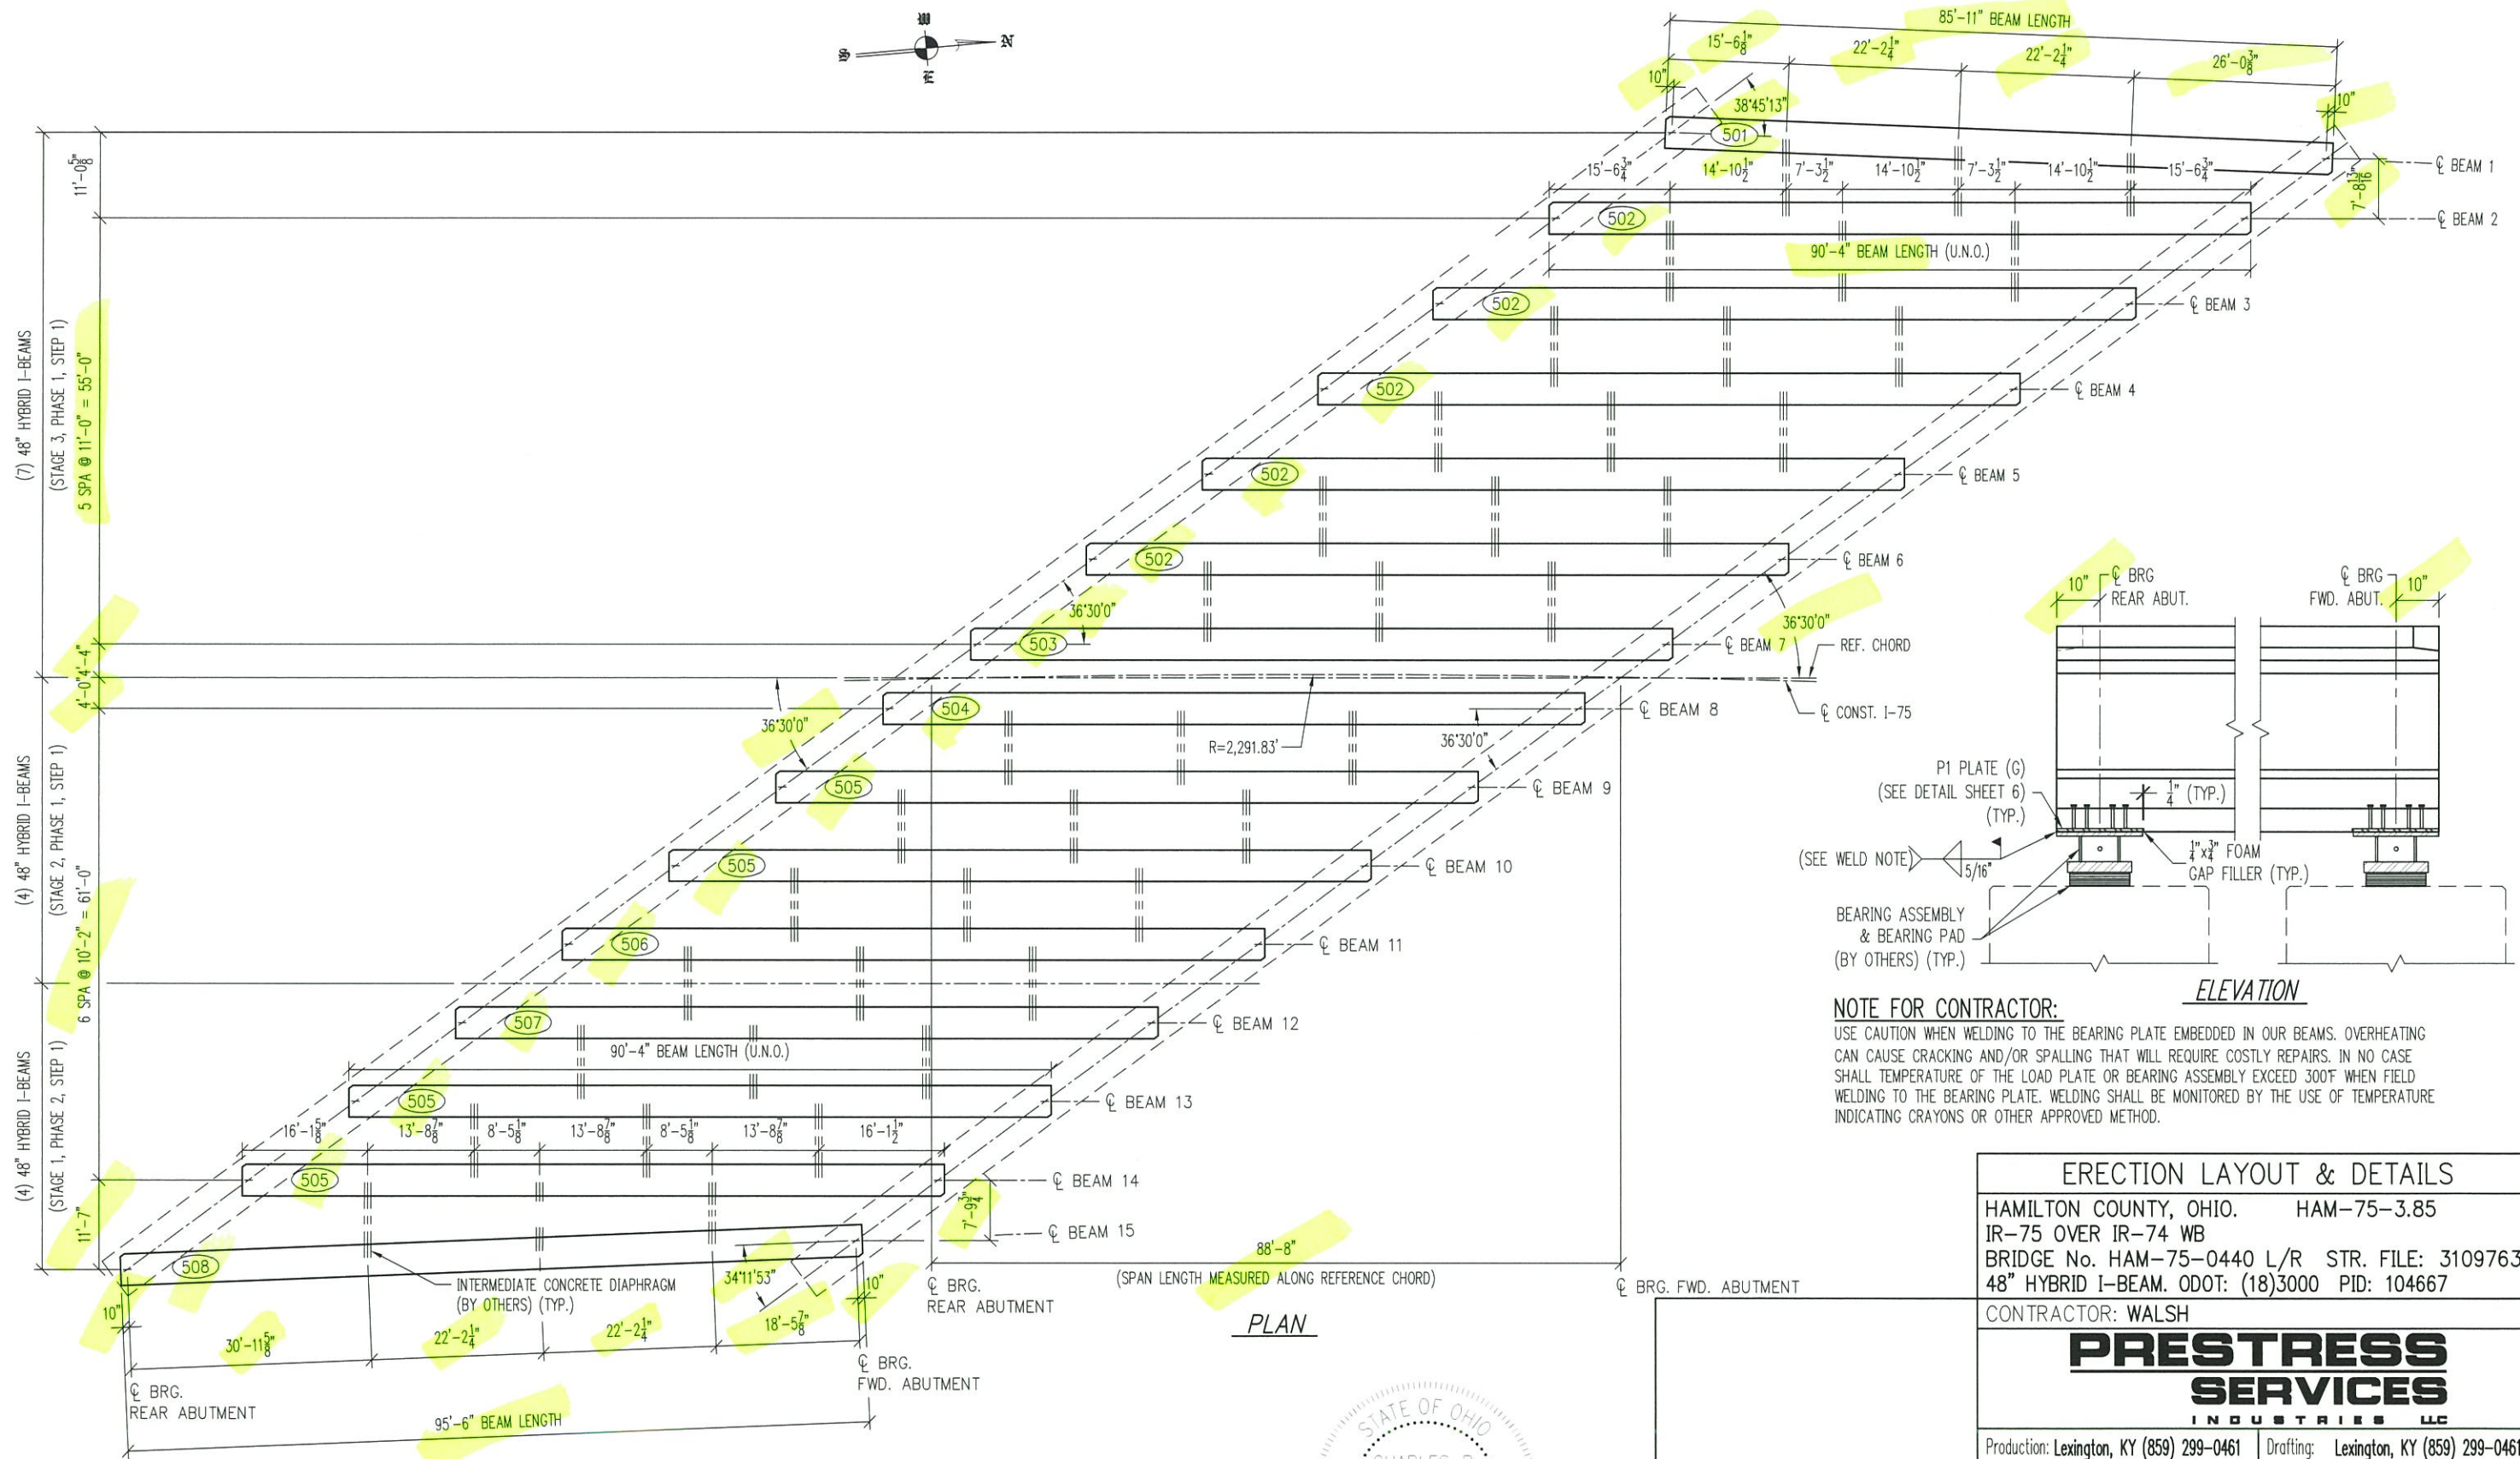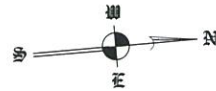


PLAN


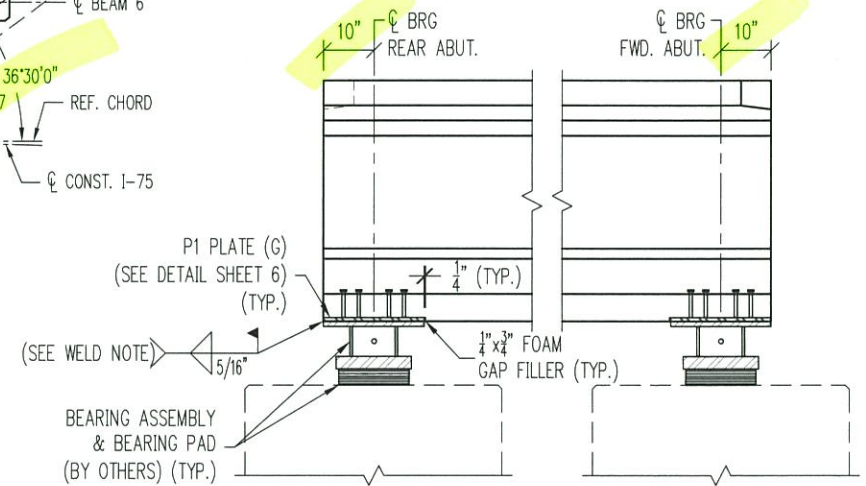


ELEVATION

NOTE FOR CONTRACTOR:
 USE CAUTION WHEN WELDING TO THE BEARING PLATE EMBEDDED IN OUR BEAMS. OVERHEATING CAN CAUSE CRACKING AND/OR SPALLING THAT WILL REQUIRE COSTLY REPAIRS. IN NO CASE SHALL TEMPERATURE OF THE LOAD PLATE OR BEARING ASSEMBLY EXCEED 300°F WHEN FIELD WELDING TO THE BEARING PLATE. WELDING SHALL BE MONITORED BY THE USE OF TEMPERATURE INDICATING CRAYONS OR OTHER APPROVED METHOD.

ERECTION LAYOUT & DETAILS	
HAMILTON COUNTY, OHIO	HAM-75-3.85
IR-75 OVER IR-74 WB	
BRIDGE No. HAM-75-0440 L/R	STR. FILE: 3109763
48" HYBRID I-BEAM. ODOT: (18)3000	PID: 104667
CONTRACTOR: WALSH	
PRESTRESS SERVICES INDUSTRIES LLC	
Production: Lexington, KY (859) 299-0461	Drafting: Lexington, KY (859) 299-0461
DATE: 05/06/19	DRAWN BY: Shannon Travis CHECKED: Monica Kennedy
REVISIONS	
CODE: HN 48 49 OH	SHEET: 2 OF 19
	JOB NO: L19165

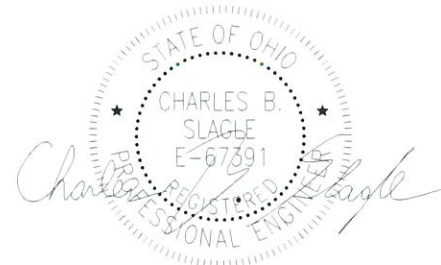


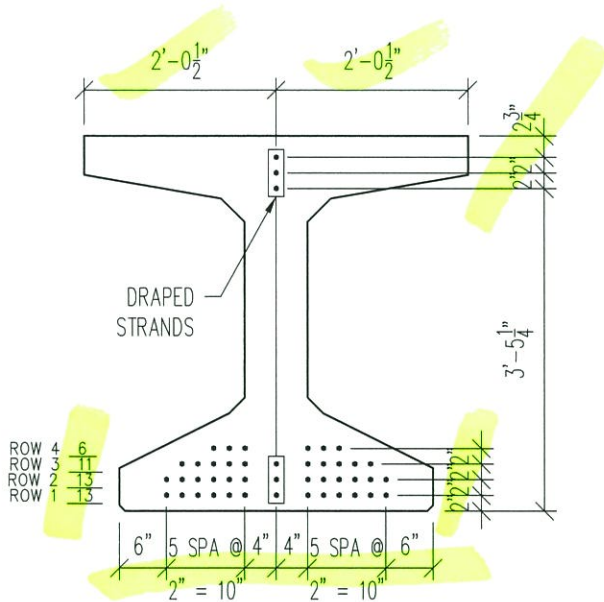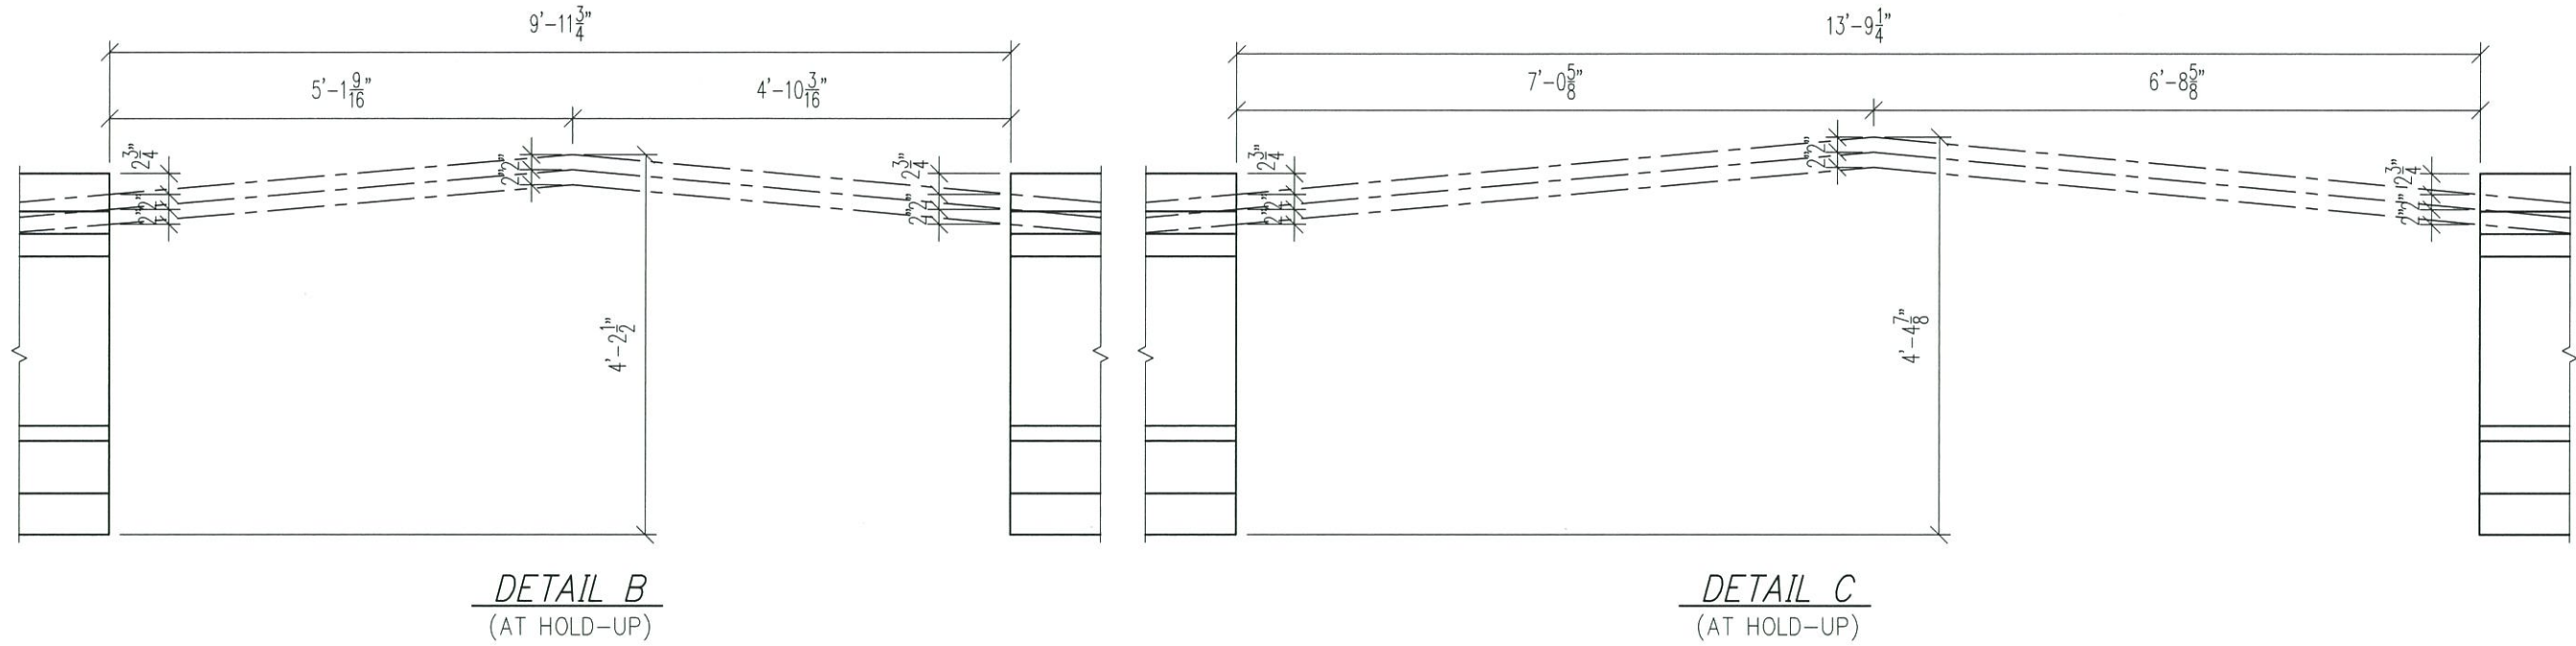

43 - 0.6" ϕ 270K LOW RELAX ($A_s=0.217"$)
 PREPULL AT 5,000 LBS., FINAL PULL AT 43,943 LBS.


POUR 1
 (SINGLE SPAN)

STRAND PATTERN

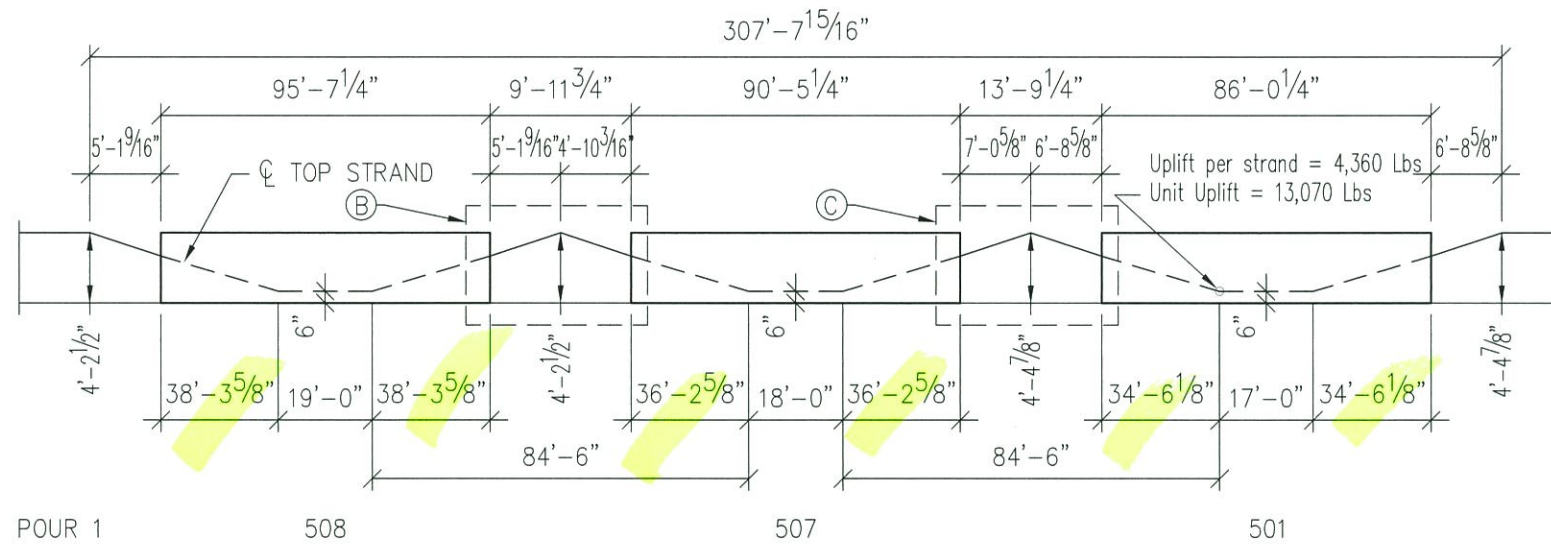


BED LAYOUT NOTES


1. ALL DIMENSIONS ARE CASTING DIMENSIONS AND ARE MEASURED ALONG THE SOFFIT AT THE CENTERLINE OF THE BEAM.
2. DRAPED STRANDS ARE STRESSED IN THE DRAPED POSITION.
3. ALL HOLDDOWNS ARE DAYTON/RICHMOND H-40.
 MAXIMUM SAFE WORKING LOADS: 8,000 Lbs. PER STRAND AND 40,000 LBS. PER UNIT.

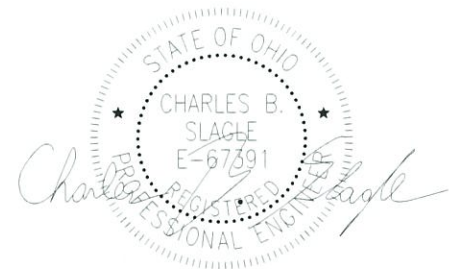

CASTING BED LAYOUT - SHEET 1	
HAMILTON COUNTY, OHIO. HAM-75-3.85	
IR-75 OVER IR-74 WB	
BRIDGE No. HAM-75-0440 L/R STR. FILE: 3109763	
48" HYBRID I-BEAM. ODOT: (18)3000 PID: 104667	
CONTRACTOR: WALSH	
PRESTRESS SERVICES INDUSTRIES LLC	
Production: Lexington, KY (859) 299-0461	Drafting: Lexington, KY (859) 299-0461
DATE: 05/06/19	DRAWN BY: Shannon Travis CHECKED: Monica Kennedy
REVISIONS	
△	
△	
△	
CODE: HN 48 49 OH	SHEET: 3 OF 19 JOB NO: L19165

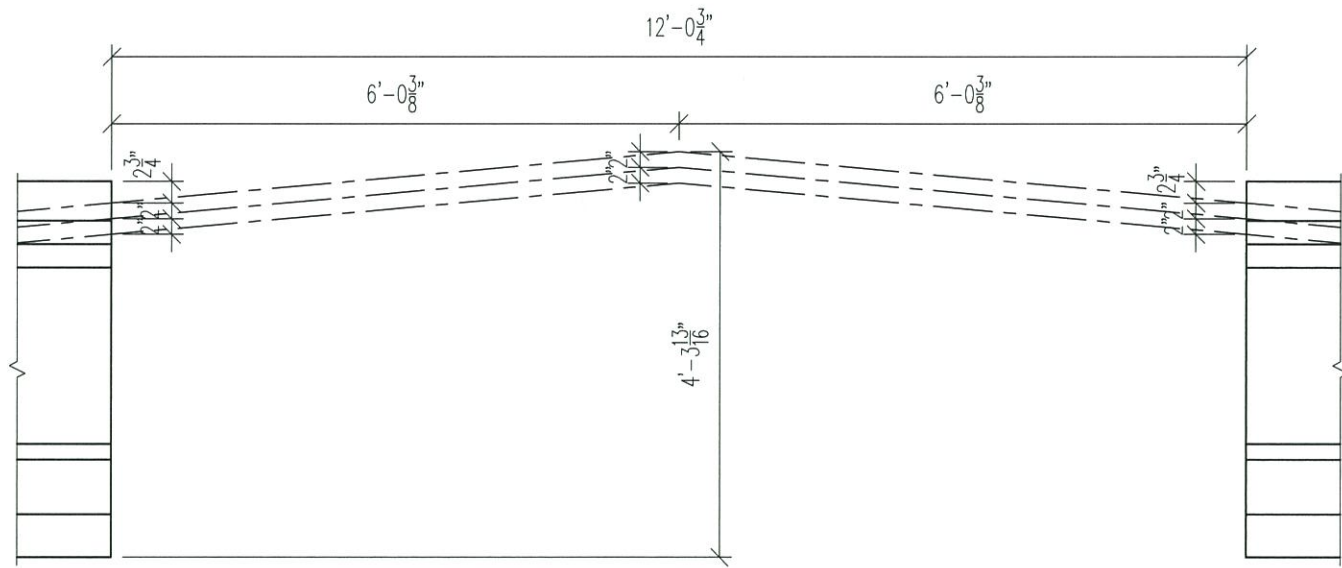


DETAIL C
(AT HOLD-UP)

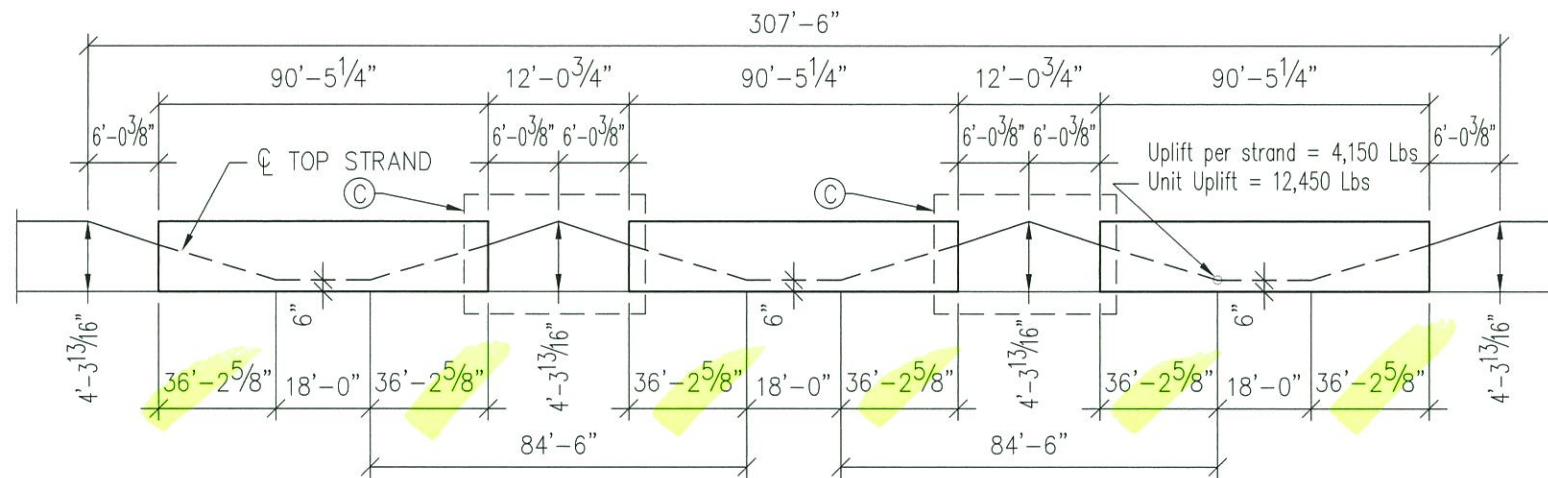

POUR 2	503	505	505
POUR 3	504	505	505
POUR 4	502	502	502
POUR 5	502	502	506

350' BED LAYOUT
* FOR INTERNAL USE ONLY

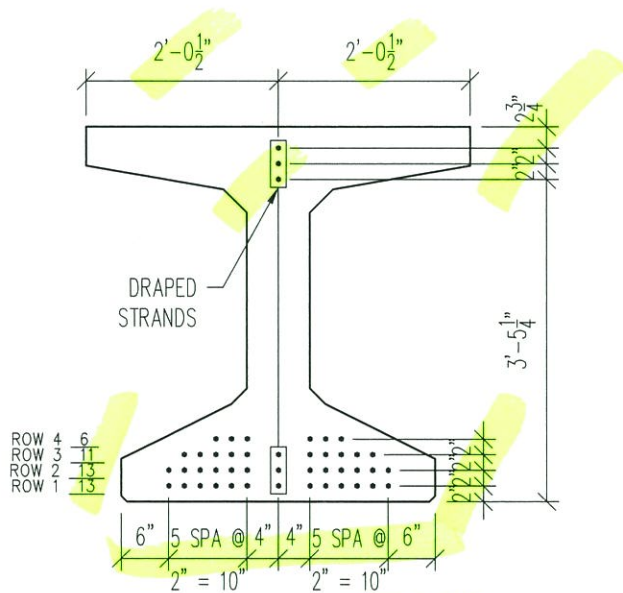

43 - 0.6" ϕ 270K LOW RELAX ($A_s=0.217''^2$)
PREPULL AT 5,000 LBS., FINAL PULL AT 43,943 LBS.

POURS 2 THRU 5
(SINGLE SPAN)


STRAND PATTERN

BED LAYOUT NOTES


- ALL DIMENSIONS ARE CASTING DIMENSIONS AND ARE MEASURED ALONG THE SOFFIT AT THE CENTERLINE OF THE BEAM.
- DRAPED STRANDS ARE STRESSED IN THE DRAPED POSITION.
- ALL HOLDDOWNS ARE DAYTON/RICHMOND H-40.
MAXIMUM SAFE WORKING LOADS: 8,000 Lbs. PER STRAND AND 40,000 Lbs. PER UNIT.




CASTING BED LAYOUT - SHEET 2	
HAMILTON COUNTY, OHIO. HAM-75-3.85	
IR-75 OVER IR-74 WB	
BRIDGE No. HAM-75-0440 L/R STR. FILE: 3109763	
48" HYBRID I-BEAM. ODOT: (18)3000 PID: 104667	
CONTRACTOR: WALSH	
PRESTRESS SERVICES INDUSTRIES LLC	
Production: Lexington, KY (859) 299-0461	Drafting: Lexington, KY (859) 299-0461
DATE: 05/06/19	DRAWN BY: Shannon Travis CHECKED: Monica Kennedy
REVISIONS	
CODE: HN 48 49 OH	SHEET: 4 OF 19 JOB NO: L19165

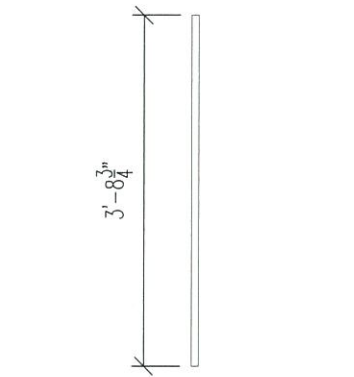

#505x3'-8 3/4"
(540 REQ'D)
(AT BEAM ENDS)

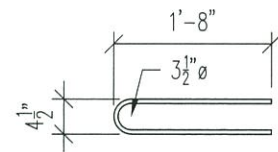


#S401(E)x3'-8"
(60 REQ'D)
(AT BEAM ENDS)

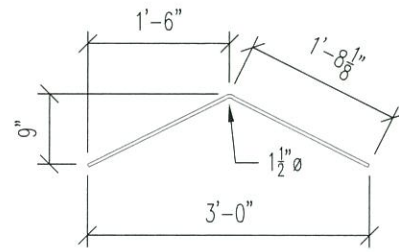


#305x3'-4"
(480 REQ'D)
(AT BEAM ENDS)




#4x5'-0"
(240 REQ'D)
(2'-0" MIN LAP)

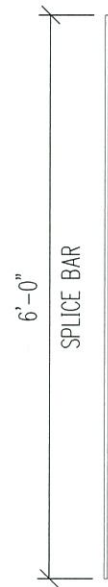

#5x6'-0"
(90 REQ'D)
(2'-6" MIN LAP)

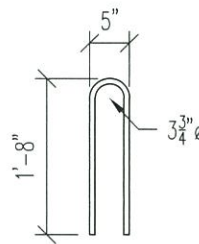

#501(E)x3'-7"
(1,710 REQ'D)

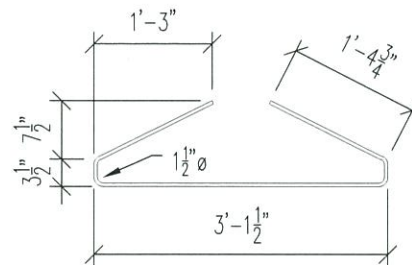



#302x6'-3"
(1,772 REQ'D)

#3xFULL LENGTH (FOR FABRICATION)

- 4 - #3x85'-8"
- 52 - #3x90'-1"
- 4 - #3x95'-3"

NOTE:

- 1) ALL REBAR IS ASTM A615 GRADE 60.
- 2) SEE PIECE DRAWINGS FOR INDIVIDUAL QUANTITIES PER BEAM.
- 3) WORK THIS SHEET WITH ALL BEAMS.
- 4) REBAR EXTENDING INTO DECK SHALL BE EPOXY COATED (E).
- 5) DIMENSIONS GIVEN ARE FROM OUT TO OUT OF BAR.
- 6) ALL WELDED WIRE REINFORCEMENT (WWR) MIN. YIELD TO BE 70 KSI.

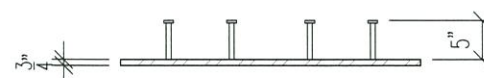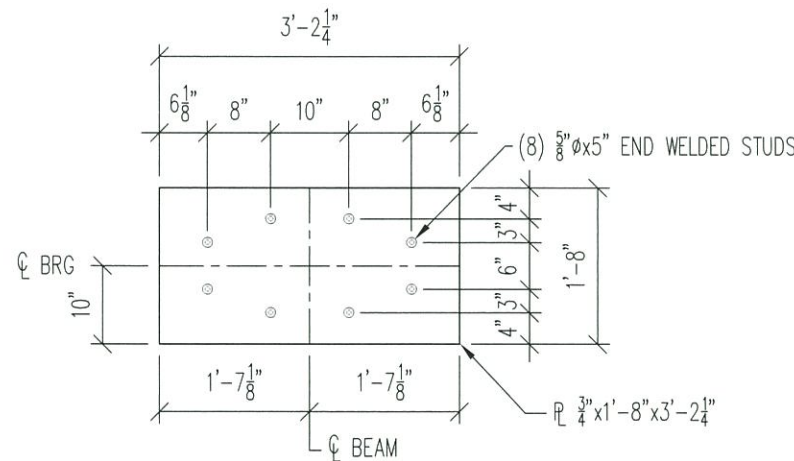

P1 PLATE (GALV)
(ASTM A709 GRADE 50)
(30 REQ'D)

MARK 501		
BILL OF MATERIALS		
QTY	ITEM	FINISH
REBAR		
108	#501(E)x3'-7"	(E)
4	#401(E)x3'-8"	(E)
114	#302x6'-3"	(B)
32	#305x3'-4"	(B)
36	#505x3'-8 3/4"	(B)
4	#3x85'-8"	(B)
	#3 (FABRICATION)	
16	#4x5'-0"	(B)
12	#5x6'-0"	(B)
WELDED WIRE FABRIC		
4	VERT. SHEAR END	
2	VERT. SHEAR MID	
2	TOP FLANGE END	
1	TOP FLANGE MID	
HARDWARE		
8	0.5" Ø DOUBLE LIFTLIPS	(B)
2	P1 PLATES	(G)
2	H40 HOLDDOWNS B=2"/S3	
12	3/4" Øx4" F-64 INSERTS	(G)
24	4 APR 45° HANGERS	(G)
STRAND		
43	0.6" Ø 270K LR (As=0.217%)	(B)
MATERIAL FINISHES		
(B) BLACK, (E) EPOXY, (G) GALVANIZED & (P) PRIMED		
CONCRETE		
CUBIC TOTAL:		21.60 CY
WEIGHT:		87,400 LBS.

MKs 502/503/504/505/506/507		
BILL OF MATERIALS		
QTY	ITEM	FINISH
REBAR		
114	#501(E)x3'-7"	(E)
4	#401(E)x3'-8"	(E)
118	#302x6'-3"	(B)
32	#305x3'-4"	(B)
36	#505x3'-8 3/4"	(B)
4	#3x90'-1"	(B)
	#3 (FABRICATION)	
16	#4x5'-0"	(B)
12	#5x6'-0"	(B)
WELDED WIRE FABRIC		
4	VERT. SHEAR END	
2	VERT. SHEAR MID	
2	TOP FLANGE END	
1	TOP FLANGE MID	
HARDWARE		
8	0.5" Ø DOUBLE LIFTLIPS	(B)
2	P1 PLATES	(G)
2	H40 HOLDDOWNS B=2"/S3	
24/12/12/24/24/24	3/4" Øx4" F-64 INSERTS	(G)
* 0/25/25/0/0/25	4 APR 45° HANGERS	(G)
* 0/0/0/0/25/25	4 PR 90° HANGERS	(G)
* 0/36/0/0/0/0	1" Øx10" COIL RODS	(G)
STRAND		
43	0.6" Ø 270K LR (As=0.217%)	(B)
MATERIAL FINISHES		
(B) BLACK, (E) EPOXY, (G) GALVANIZED & (P) PRIMED		
CONCRETE		
CUBIC TOTAL:		22.70 CY
WEIGHT:		91,800 LBS.

MARK 508		
BILL OF MATERIALS		
QTY	ITEM	FINISH
REBAR		
120	#501(E)x3'-7"	(E)
4	#401(E)x3'-8"	(E)
124	#302x6'-3"	(B)
32	#305x3'-4"	(B)
36	#505x3'-8 3/4"	(B)
4	#3x95'-3"	(B)
	#3 (FABRICATION)	
16	#4x5'-0"	(B)
12	#5x6'-0"	(B)
WELDED WIRE FABRIC		
4	VERT. SHEAR END	
2	VERT. SHEAR MID	
2	TOP FLANGE END	
1	TOP FLANGE MID	
HARDWARE		
8	0.5" Ø DOUBLE LIFTLIPS	(B)
2	P1 PLATES	(G)
2	H40 HOLDDOWNS B=2"/S3	
12	3/4" Øx4" F-64 INSERTS	(G)
27	4 APR 45° HANGERS	(G)
STRAND		
43	0.6" Ø 270K LR (As=0.217%)	(B)
MATERIAL FINISHES		
(B) BLACK, (E) EPOXY, (G) GALVANIZED & (P) PRIMED		
CONCRETE		
CUBIC TOTAL:		24.00 CY
WEIGHT:		97,100 LBS.

* QUANTITIES SHOWN ARE PER BEAM/MARK UNLESS NOTED OTHERWISE

QTY:	1	MARK:	501
QTY:	5/1/1/4/1/1	MARK:	502/503/504/505/506/507
QTY:	1	MARK:	508

BAR BENDING DETAILS

HAMILTON COUNTY, OHIO. HAM-75-3.85
IR-75 OVER IR-74 WB
BRIDGE No. HAM-75-0440 L/R STR. FILE: 3109763
48" HYBRID I-BEAM. ODOT: (18)3000 PID: 104667

CONTRACTOR: WALSH





Production: Lexington, KY (859) 299-0461 | Drafting: Lexington, KY (859) 299-0461

DATE: 05/06/19 | DRAWN BY: Shannon Travis | CHECKED: Monica Kennedy

REVISIONS	△		
	△		
	△		

CODE: HN 48 49 OH | SHEET: 5 OF 19 | JOB NO: L19165



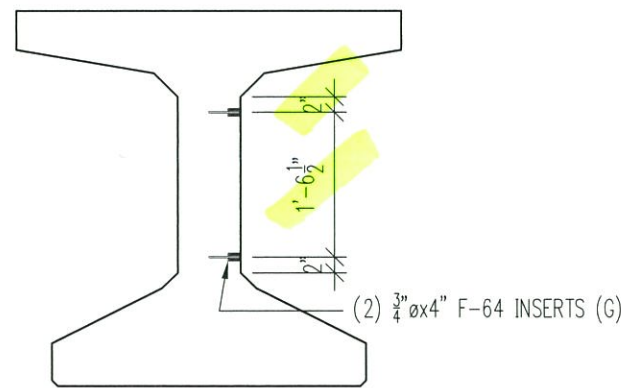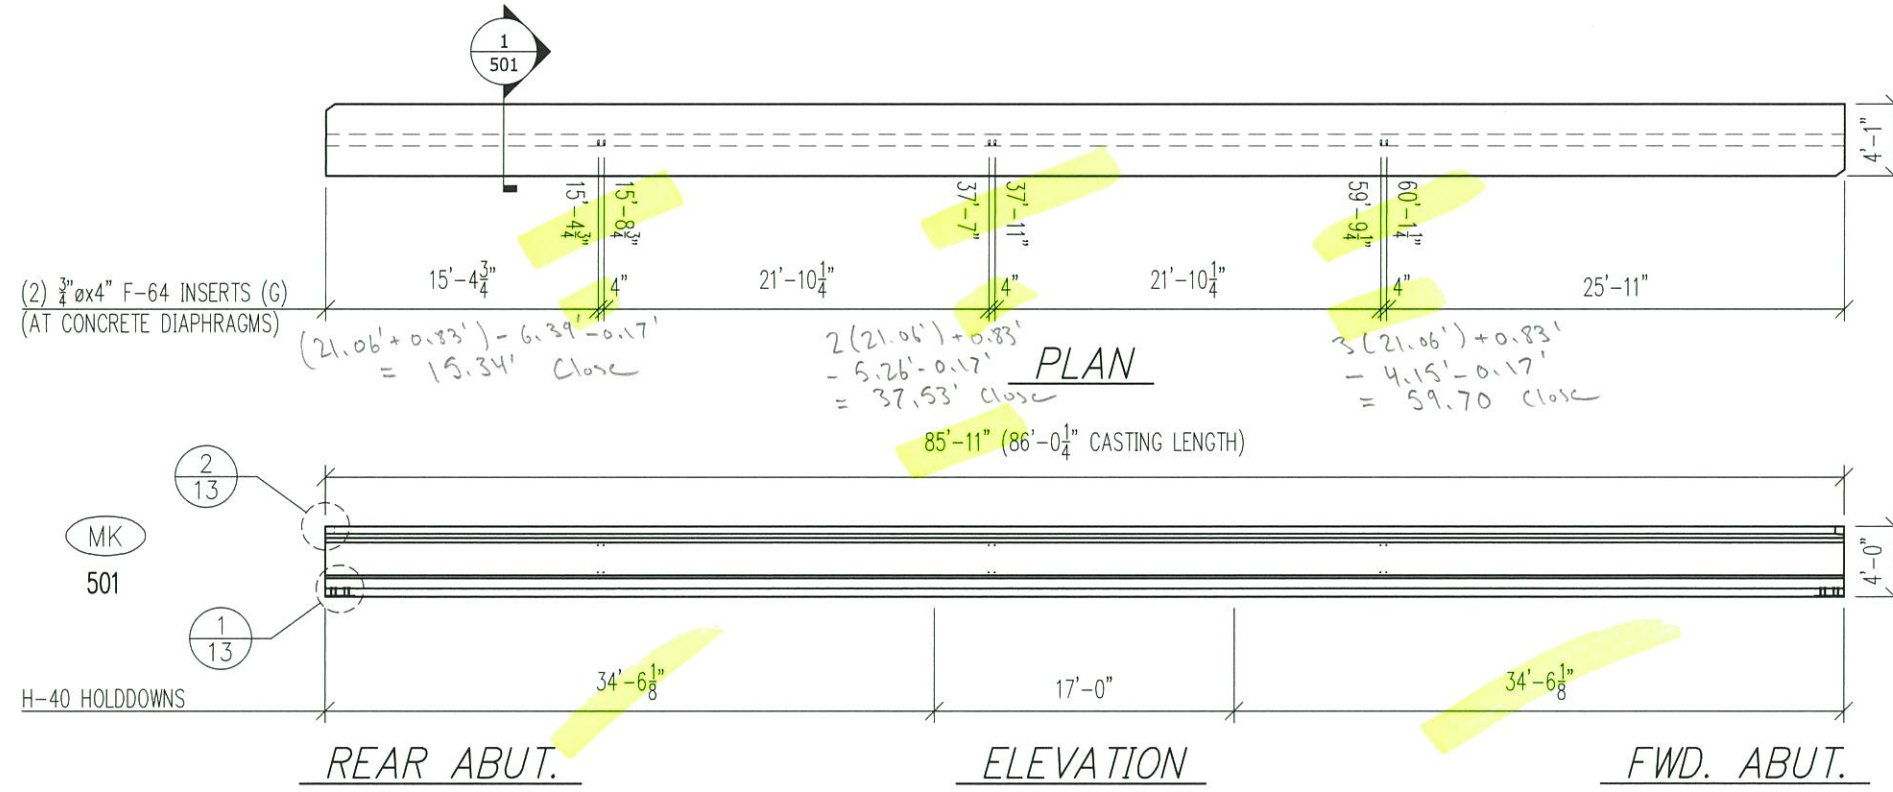


1 SECTION (501)
 Scale: 1/2" = 1'-0"

STEP 1 - FORMING PLAN



STEPS:

- 1) LOCATE HOLDDOWN LOCATIONS
- 2) LOCATE AND INSTALL HEADERS FROM HOLDDOWN POINTS
- 3) INSTALL BLOCKOUTS FOR CLIPPED TOP FLANGE
- 4) PLACE P1 PLATE AT BEAM ENDS
- 5) LOCATE INSERTS ON SIDE FORMS

NOTE: 3/4" x 2'-2" THREADED RODS (G) FOR 3/4" F-64 INSERTS (G) ARE SUPPLIED BY PRESTRESS & INSTALLED BY CONTRACTOR.

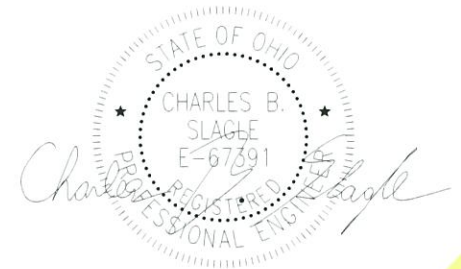

QTY:	1	MARK:	501
STEP 1 FORMING PLAN (SHEET 1)			
HAMILTON COUNTY, OHIO. HAM-75-3.85			
IR-75 OVER IR-74 WB			
BRIDGE No. HAM-75-0440 L/R STR. FILE: 3109763			
48" HYBRID I-BEAM. ODOT: (18)3000 PID: 104667			
CONTRACTOR: WALSH			
PRESTRESS SERVICES INDUSTRIES, LLC			
Production: Lexington, KY (859) 299-0461		Drafting: Lexington, KY (859) 299-0461	
DATE: 05/06/19		DRAWN BY: Shannon Travis	
		CHECKED: Monica Kennedy	
REVISIONS	▲		
	▲		
	▲		
CODE: HN 48 49 OH	SHEET: 6 OF 19	JOB NO: L19165	

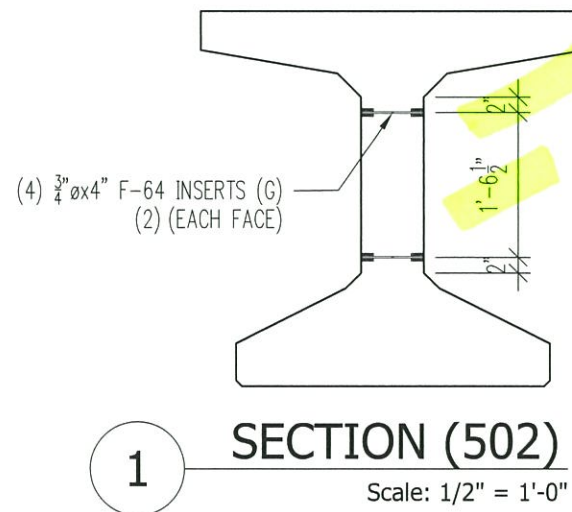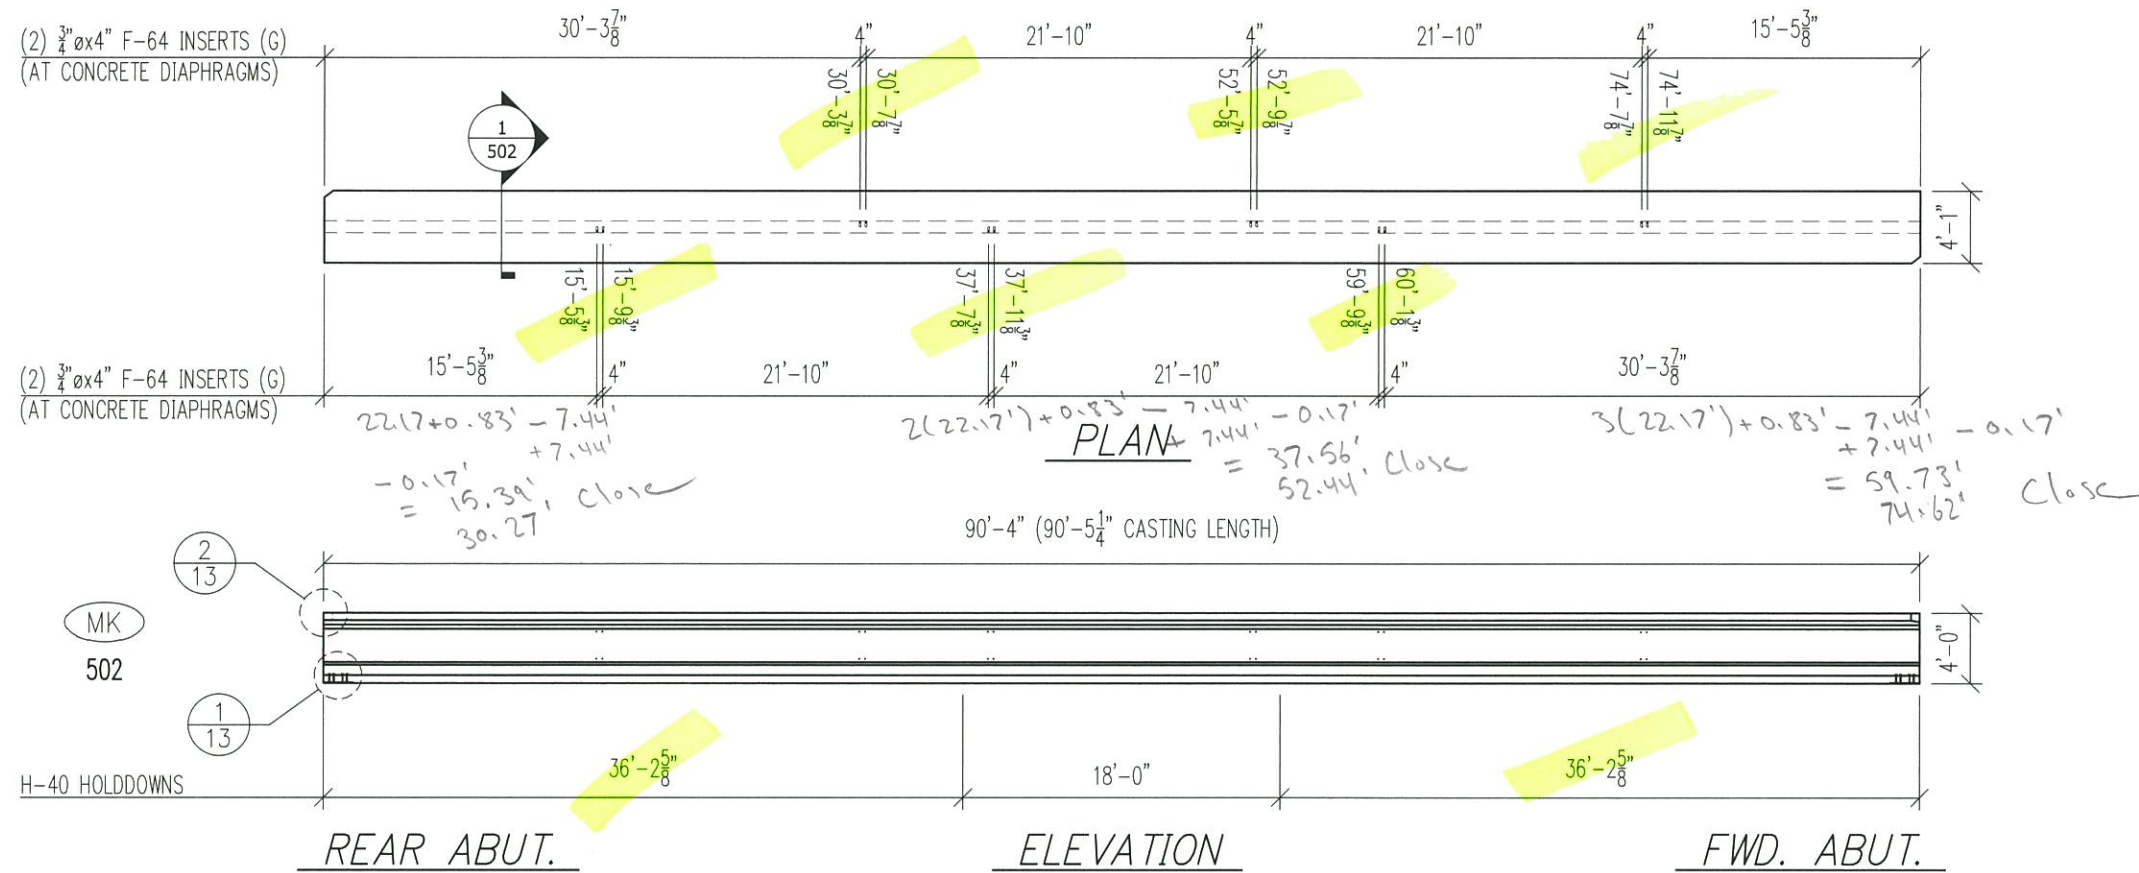


STEP 1 - FORMING PLAN

STEPS:


- 1) LOCATE HOLDDOWN LOCATIONS
- 2) LOCATE AND INSTALL HEADERS FROM HOLDDOWN POINTS
- 3) INSTALL BLOCKOUTS FOR CLIPPED TOP FLANGE
- 4) PLACE P1 PLATE AT BEAM ENDS
- 5) LOCATE INSERTS ON SIDE FORMS

NOTE: 3/4" x 2'-2" TREADED RODS (G) FOR 3/4" F-64 INSERTS (G) ARE SUPPLIED BY PRESTRESS & INSTALLED BY CONTRACTOR.

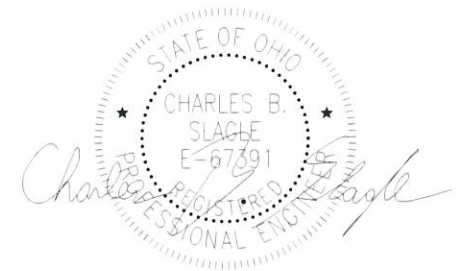


QTY:	5	MARK:	502
STEP 1 FORMING PLAN (SHEET 2)			
HAMILTON COUNTY, OHIO.		HAM-75-3.85	
IR-75 OVER IR-74 WB			
BRIDGE No. HAM-75-0440 L/R STR. FILE: 3109763			
48" HYBRID I-BEAM. ODOT: (18)3000 PID: 104667			
CONTRACTOR: WALSH			
PRESTRESS SERVICES INDUSTRIES LLC			
Production: Lexington, KY (859) 299-0461		Drafting: Lexington, KY (859) 299-0461	
DATE: 05/06/19		DRAWN BY: Shannon Travis CHECKED: Monica Kennedy	
REVISIONS			
CODE: HN 48 49 OH	SHEET: 7 OF 19	JOB NO: L19165	

(2) $\frac{3}{4}$ " \times 4" F-64 INSERTS (G)
(AT CONCRETE DIAPHRAGMS)

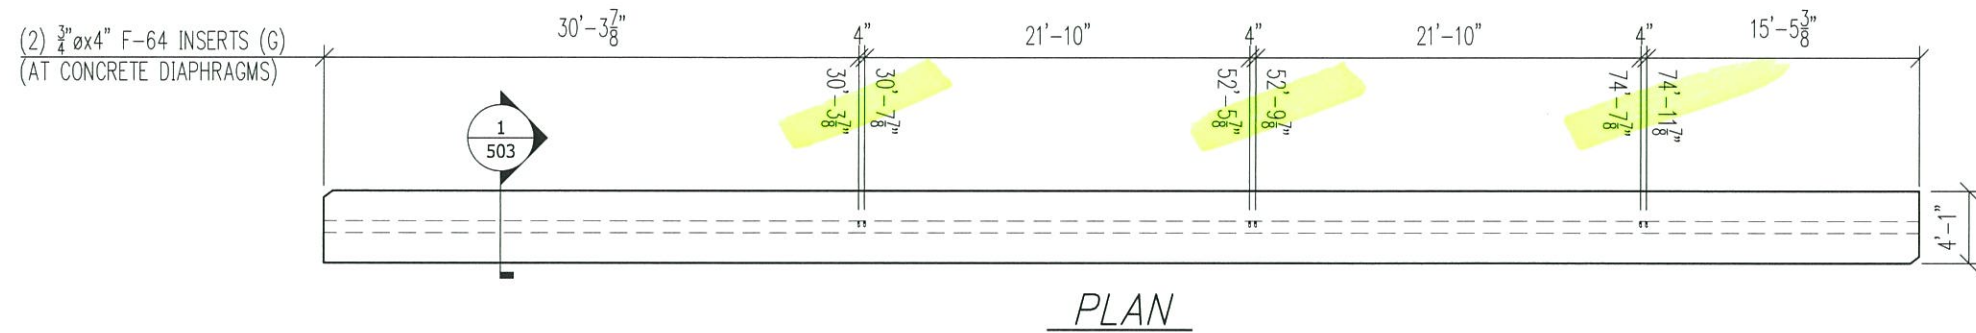


PLAN

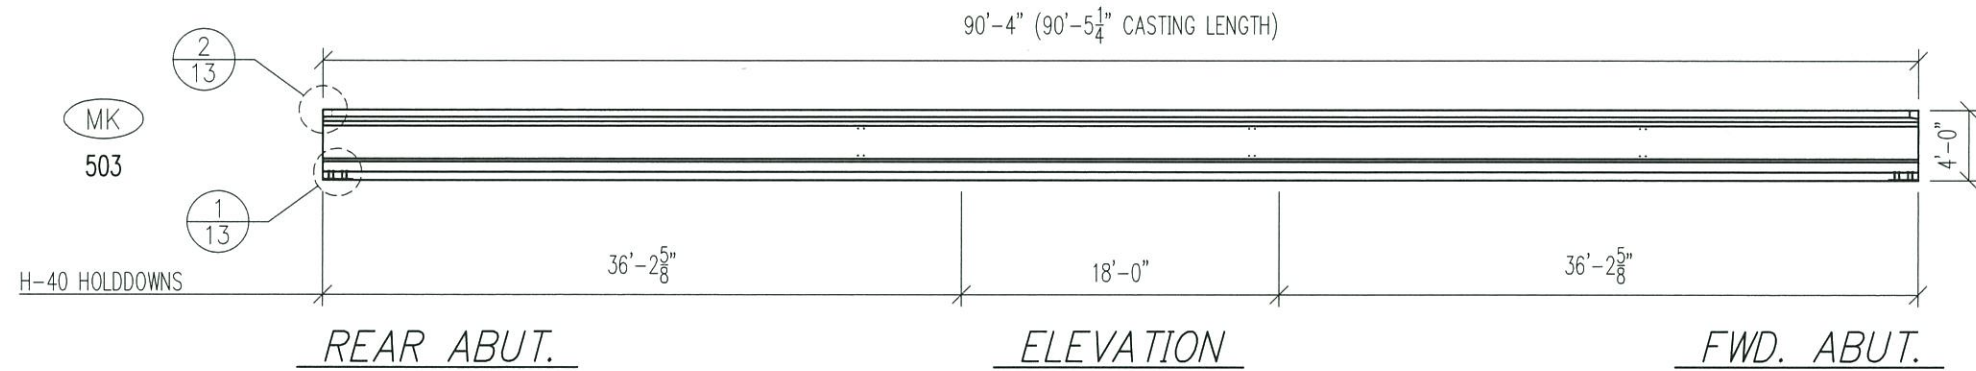

ELEVATION

H-40 HOLDDOWNS

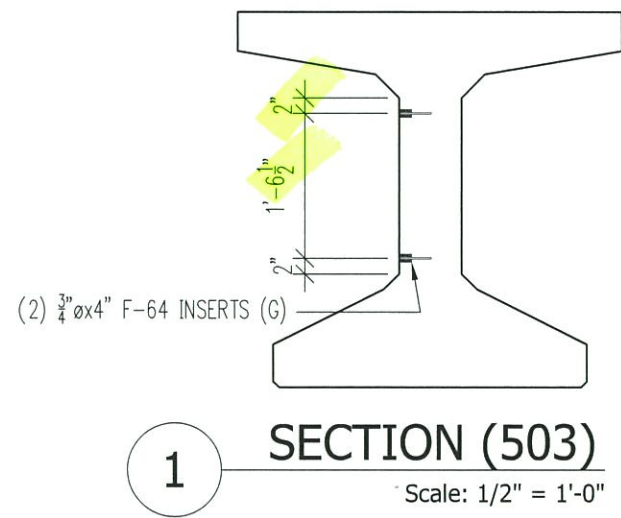

1 SECTION (503)
Scale: 1/2" = 1'-0"



STEP 1 - FORMING PLAN

- STEPS:
- 1) LOCATE HOLDDOWN LOCATIONS
 - 2) LOCATE AND INSTALL HEADERS FROM HOLDDOWN POINTS
 - 3) INSTALL BLOCKOUTS FOR CLIPPED TOP FLANGE
 - 4) PLACE P1 PLATE AT BEAM ENDS
 - 5) LOCATE INSERTS ON SIDE FORMS

NOTE: $\frac{3}{4}$ " \times 2'-2" THREADED RODS (G) FOR $\frac{3}{4}$ " \times F-64 INSERTS (G) ARE SUPPLIED BY PRESTRESS & INSTALLED BY CONTRACTOR.



QTY:	1	MARK:	503
STEP 1 FORMING PLAN (SHEET 3)			
HAMILTON COUNTY, OHIO. HAM-75-3.85		IR-75 OVER IR-74 WB	
BRIDGE No. HAM-75-0440 L/R STR. FILE: 3109763			
48" HYBRID I-BEAM. ODOT: (18)3000 PID: 104667			
CONTRACTOR: WALSH			
PRESTRESS SERVICES INDUSTRIES LLC			
Production: Lexington, KY (859) 299-0461		Drafting: Lexington, KY (859) 299-0461	
DATE: 05/06/19		DRAWN BY: Shannon Travis CHECKED: Monica Kennedy	
REVISIONS	△		
	△		
	△		
CODE: HN 48 49 OH		SHEET: 8 OF 19	JOB NO: L19165

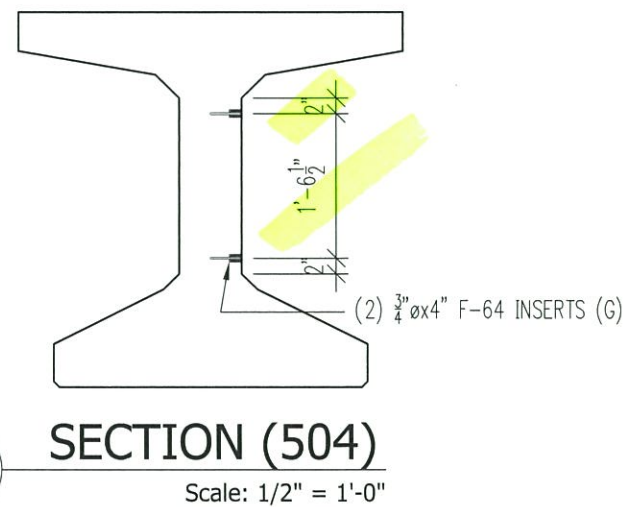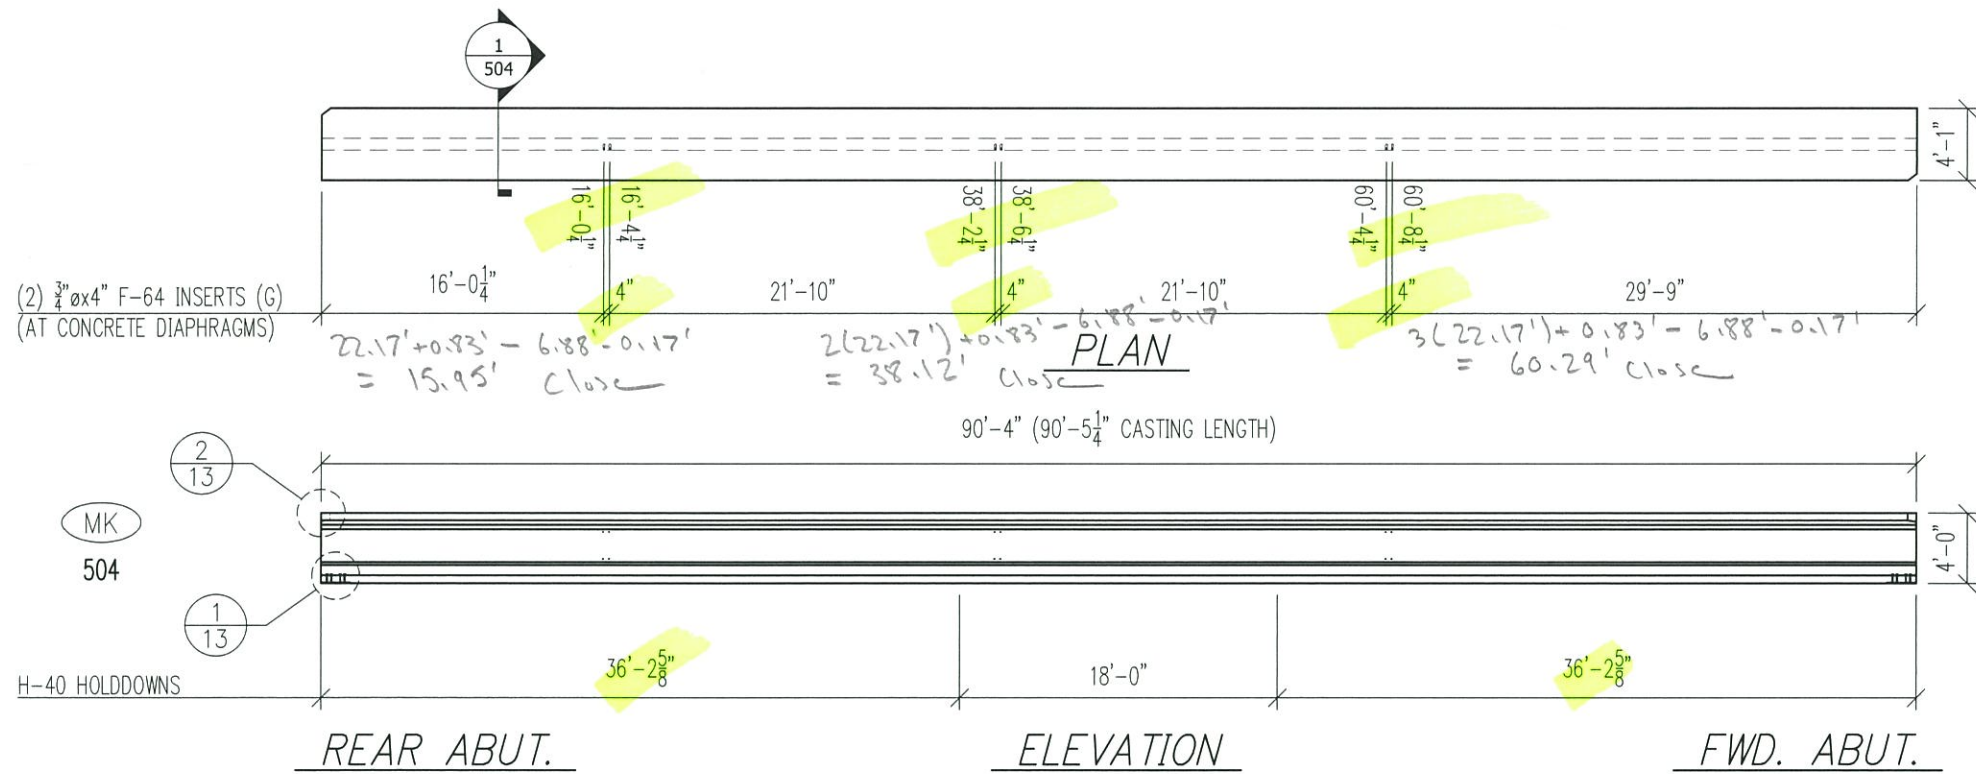

STEP 1 - FORMING PLAN




STEPS:

- 1) LOCATE HOLDDOWN LOCATIONS
- 2) LOCATE AND INSTALL HEADERS FROM HOLDDOWN POINTS
- 3) INSTALL BLOCKOUTS FOR CLIPPED TOP FLANGE
- 4) PLACE P1 PLATE AT BEAM ENDS
- 5) LOCATE INSERTS ON SIDE FORMS

NOTE: 3/4" x 2'-2" THREADED RODS (G) for 3/4" x F-64 INSERTS (G) ARE SUPPLIED BY PRESTRESS & INSTALLED BY CONTRACTOR.



QTY:	1	MARK:	504
STEP 1 FORMING PLAN (SHEET 4)			
HAMILTON COUNTY, OHIO.		HAM-75-3.85	
IR-75 OVER IR-74 WB			
BRIDGE No. HAM-75-0440 L/R STR. FILE: 3109763			
48" HYBRID I-BEAM. ODOT: (18)3000 PID: 104667			
CONTRACTOR: WALSH			
PRESTRESS SERVICES INDUSTRIES LLC			
Production: Lexington, KY (859) 299-0461		Drafting: Lexington, KY (859) 299-0461	
DATE: 05/06/19		DRAWN BY: Shannon Travis (CHECKED) Monica Kennedy	
REVISIONS	△		
	△		
	△		
CODE: HN 48 49 OH		SHEET: 9 OF 19	JOB NO: L19165

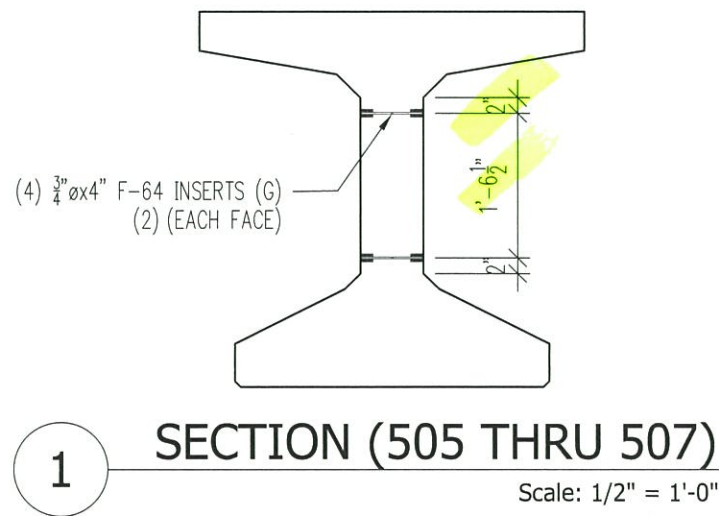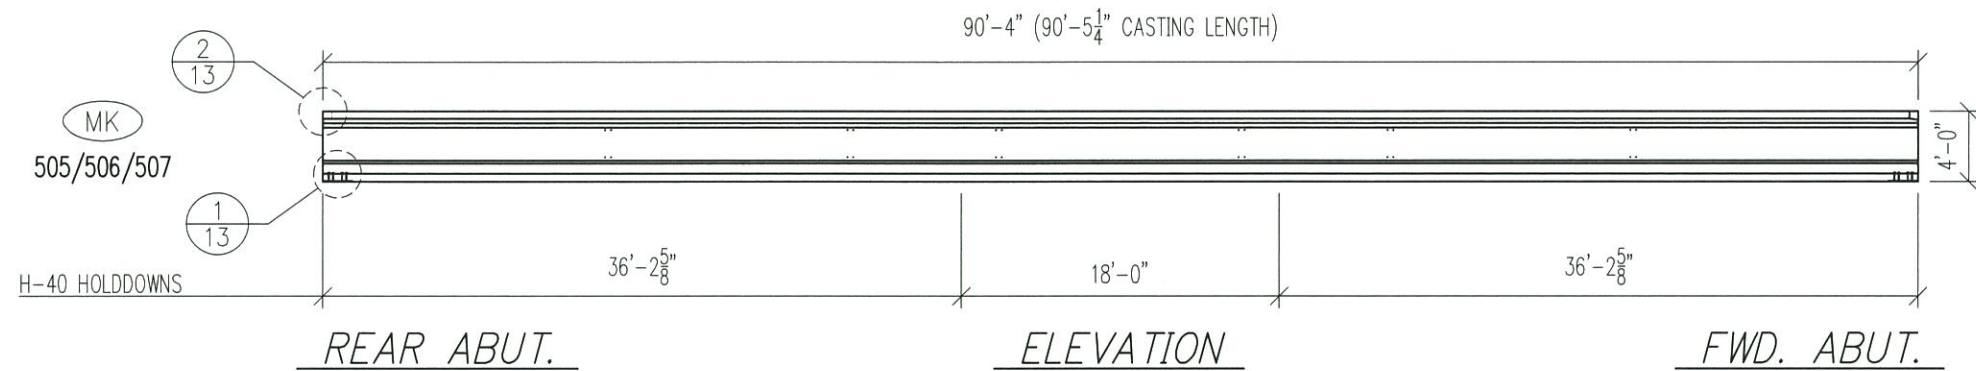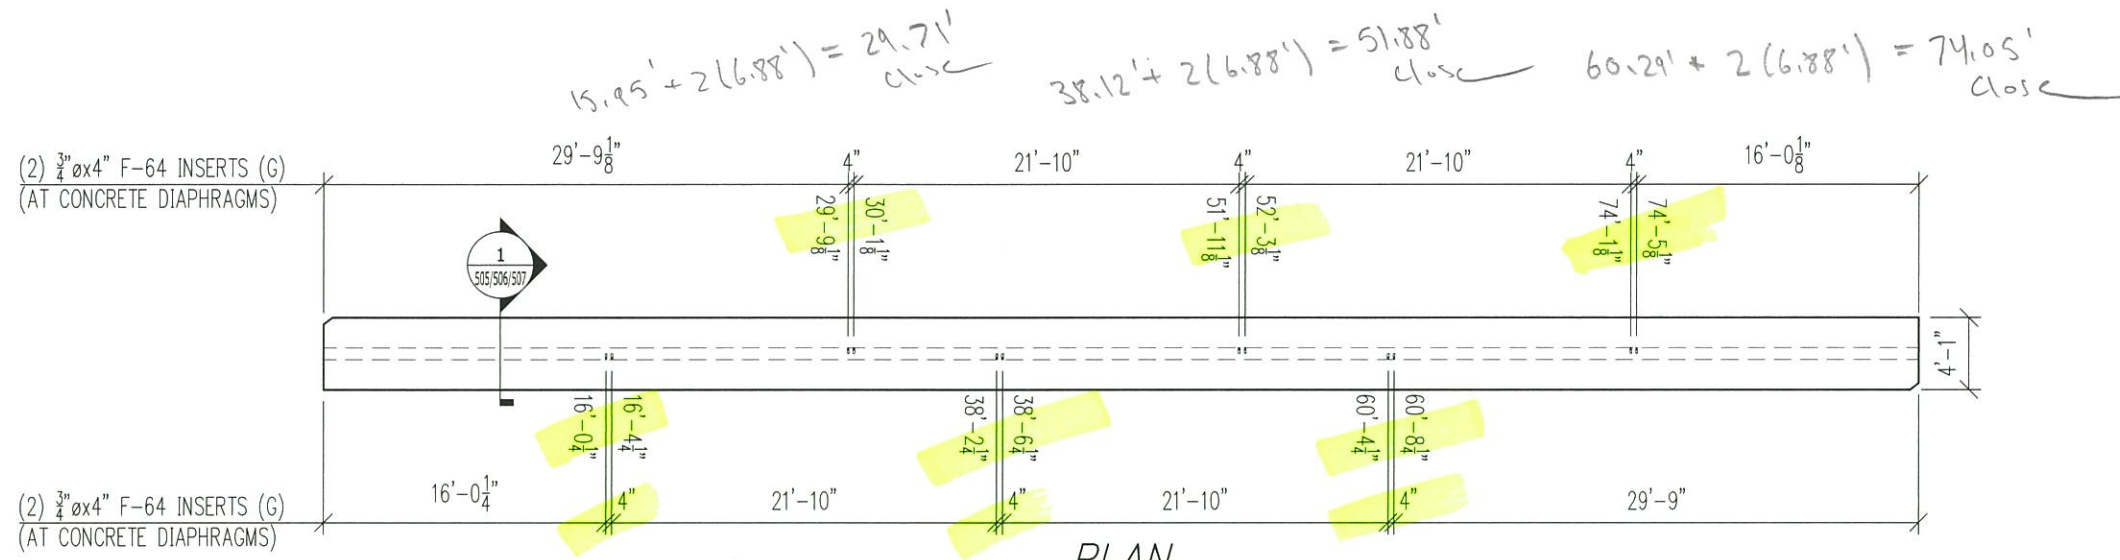

STEP 1 - FORMING PLAN


- STEPS:
- 1) LOCATE HOLDDOWN LOCATIONS
 - 2) LOCATE AND INSTALL HEADERS FROM HOLDDOWN POINTS
 - 3) INSTALL BLOCKOUTS FOR CLIPPED TOP FLANGE
 - 4) PLACE P1 PLATE AT BEAM ENDS
 - 5) LOCATE INSERTS ON SIDE FORMS

NOTE: 3/4" x 2'-2" THREADED RODS (G) FOR 3/4" F-64 INSERTS (G) ARE SUPPLIED BY PRESTRESS & INSTALLED BY CONTRACTOR.




QTY:	4/1/1	MARK:	505/506/507
STEP 1 FORMING PLAN (SHEET 5)			
HAMILTON COUNTY, OHIO.		HAM-75-3.85	
IR-75 OVER IR-74 WB			
BRIDGE No. HAM-75-0440 L/R STR. FILE: 3109763			
48" HYBRID I-BEAM. ODOT: (18)3000 PID: 104667			
CONTRACTOR: WALSH			
PRESTRESS SERVICES INDUSTRIES LLC			
Production: Lexington, KY (859) 299-0461		Drafting: Lexington, KY (859) 299-0461	
DATE:	05/06/19	DRAWN BY:	Shannon Travis
		CHECKED BY:	Monica Kennedy
REVISIONS	△		
	△		
	△		
CODE:	HN 48 49 OH	SHEET:	10 OF 19
		JOB NO:	L19165


$23.46' + 0.83' + 7.51' - 0.17' = 31.63' \text{ Close}$
 $2(23.46') + 0.83' + 6.24' - 0.17' = 53.82' \text{ Close}$
 $3(23.46') + 0.83' + 4.17' - 0.17' = 76.01' \text{ Close}$

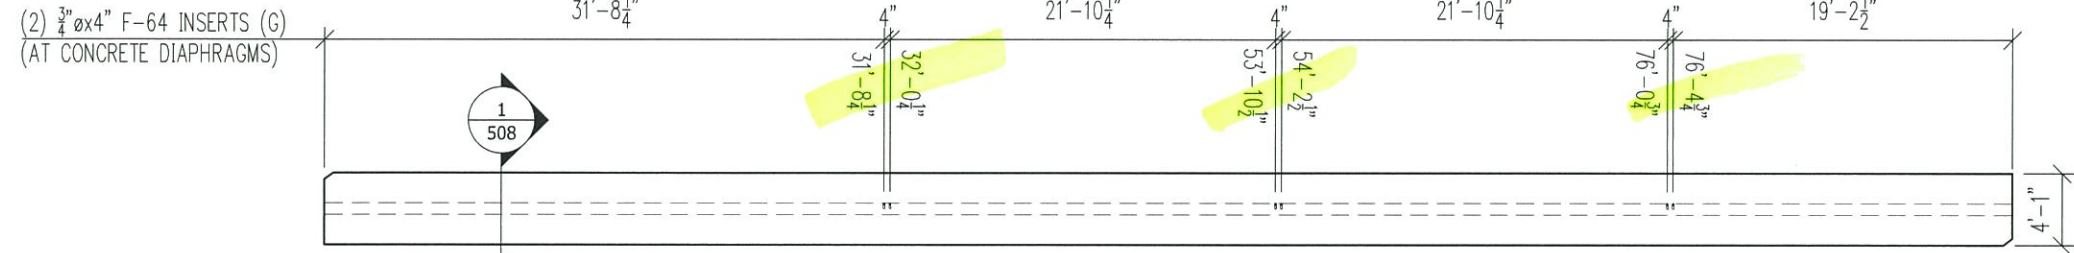

PLAN

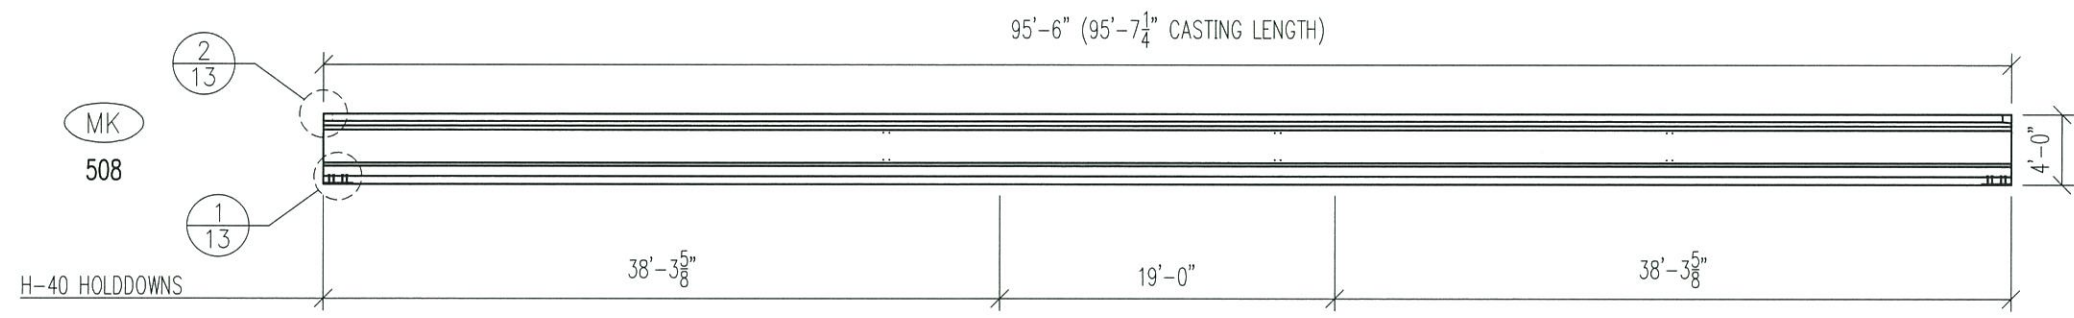

ELEVATION

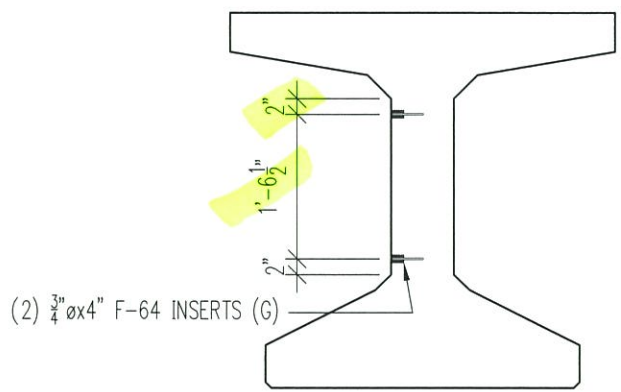


SECTION (508)
Scale: 1/2" = 1'-0"


STEP 1 - FORMING PLAN

- STEPS:
- 1) LOCATE HOLDDOWN LOCATIONS
 - 2) LOCATE AND INSTALL HEADERS FROM HOLDDOWN POINTS
 - 3) INSTALL BLOCKOUTS FOR CLIPPED TOP FLANGE
 - 4) PLACE P1 PLATE AT BEAM ENDS
 - 5) LOCATE INSERTS ON SIDE FORMS


NOTE: 3/4" x 2'-2" THREADED RODS (G) FOR 3/4" F-64 INSERTS (G) ARE SUPPLIED BY PRESTRESS & INSTALLED BY CONTRACTOR.

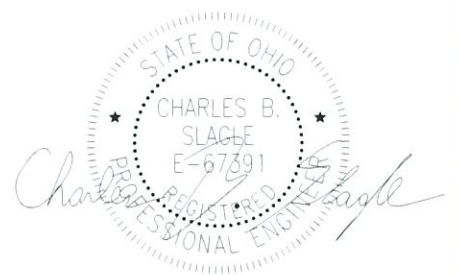


QTY:	1	MARK:	508
STEP 1 FORMING PLAN (SHEET 6)			
HAMILTON COUNTY, OHIO. HAM-75-3.85		IR-75 OVER IR-74 WB	
BRIDGE No. HAM-75-0440 L/R STR. FILE: 3109763			
48" HYBRID I-BEAM. ODOT: (18)3000 PID: 104667			
CONTRACTOR: WALSH			
PRESTRESS SERVICES INDUSTRIES LLC			
Production: Lexington, KY (859) 299-0461		Drafting: Lexington, KY (859) 299-0461	
DATE: 05/06/19		DRAWN BY: Shannon Travis CHECKED: Monica Kennedy	
REVISIONS	△		
	△		
	△		
CODE: HN 48 49 OH	SHEET: 11 OF 19	JOB NO: L19165	

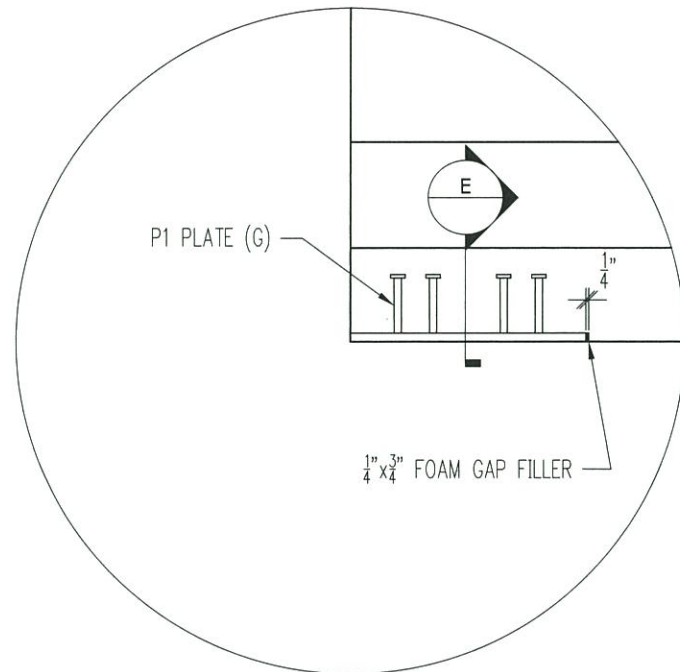

DETAIL 1

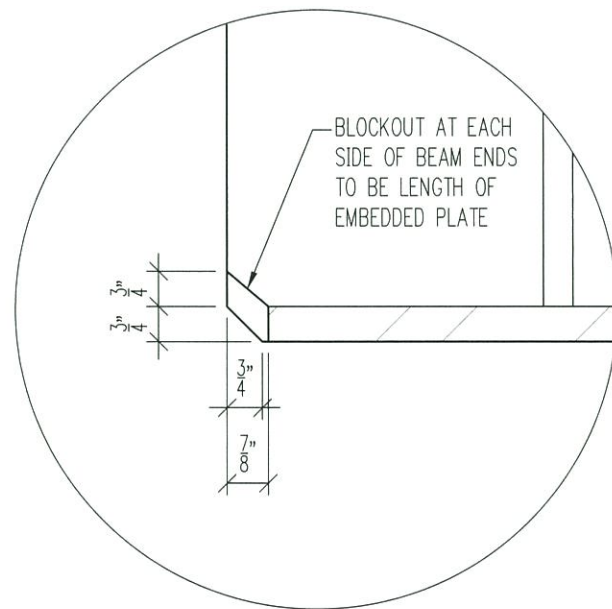


SECTION E

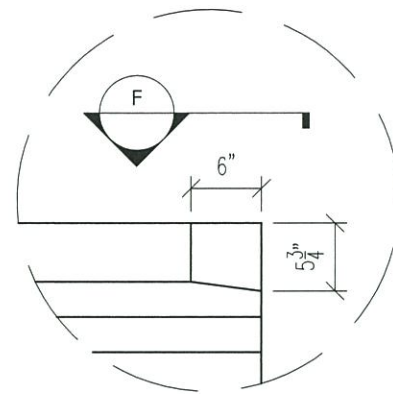



DETAIL 2
CLIPPED TOP FLANGE

BENT 2 SHOWN, BENT 1 SIMILAR BY OPPOSITE HAND

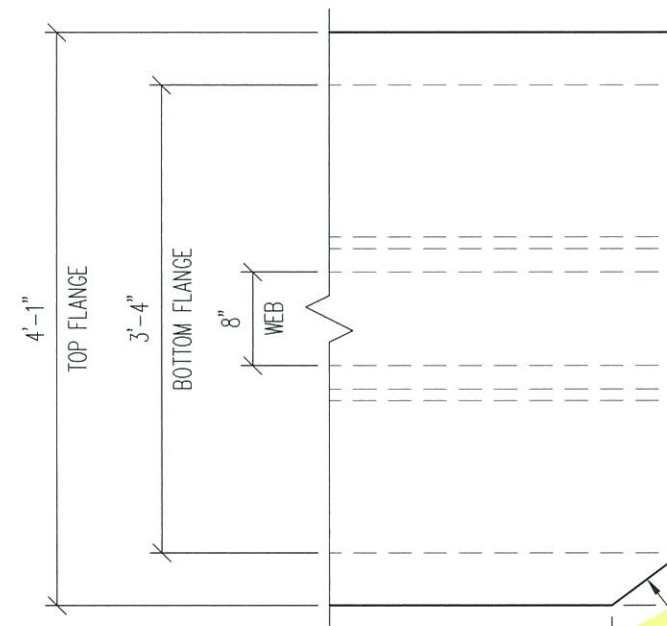

SECTION F
CLIPPED TOP FLANGE

FWD. ABUT. SHOWN, REAR ABUT. SIMILAR BY OPPOSITE HAND

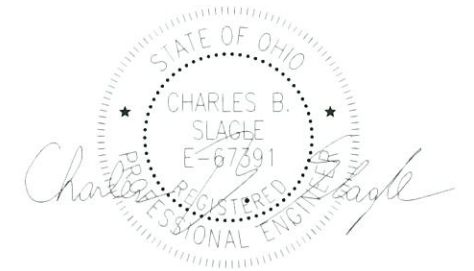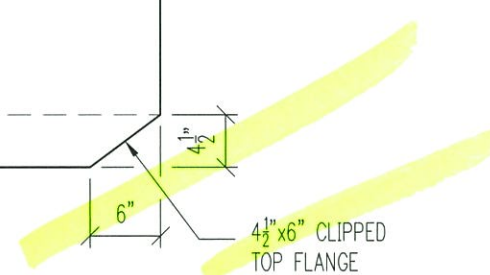

QTY:	1/5/1	MARK:	501/502/503
QTY:	1/4/1/1/1	MARK:	504/505/506/507/508

STEP 1 DETAILS

HAMILTON COUNTY, OHIO. HAM-75-3.85
IR-75 OVER IR-74 WB
BRIDGE No. HAM-75-0440 L/R STR. FILE: 3109763
48" HYBRID I-BEAM. ODOT: (18)3000 PID: 104667





CONTRACTOR: WALSH



Production: Lexington, KY (859) 299-0461 | Drafting: Lexington, KY (859) 299-0461
DATE: 05/06/19 | DRAWN BY: Shannon Travis | CHECKED: Monica Kennedy

REVISIONS	△		
	△		
	△		

CODE: HN 48 49 OH | SHEET: 12 OF 19 | JOB NO: L19165

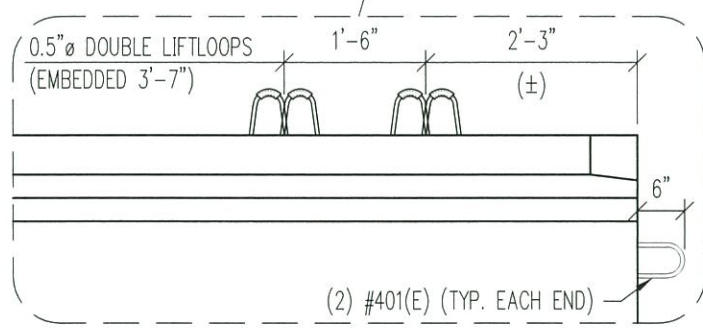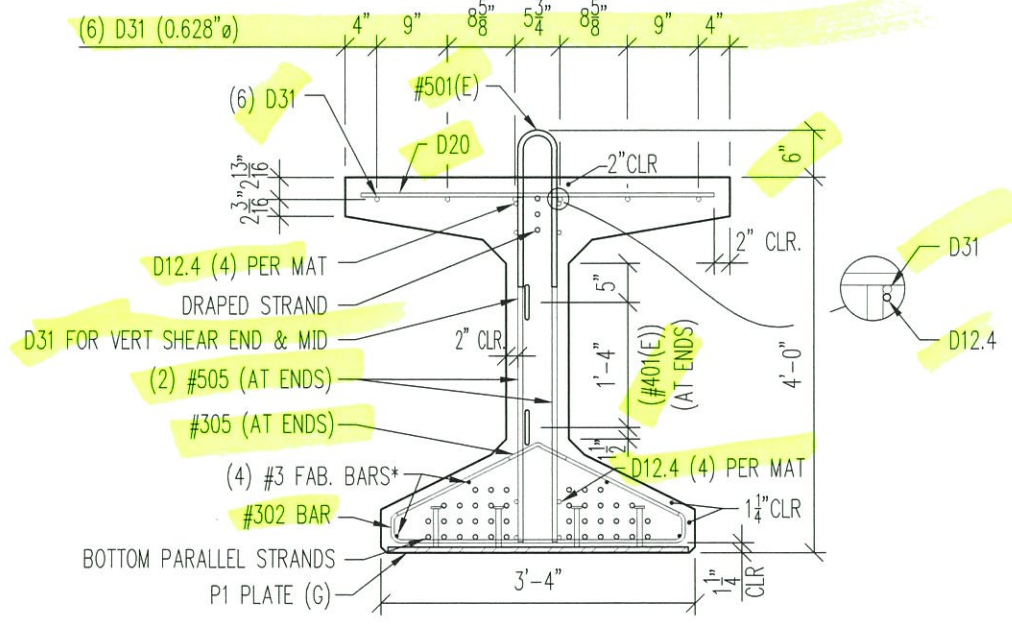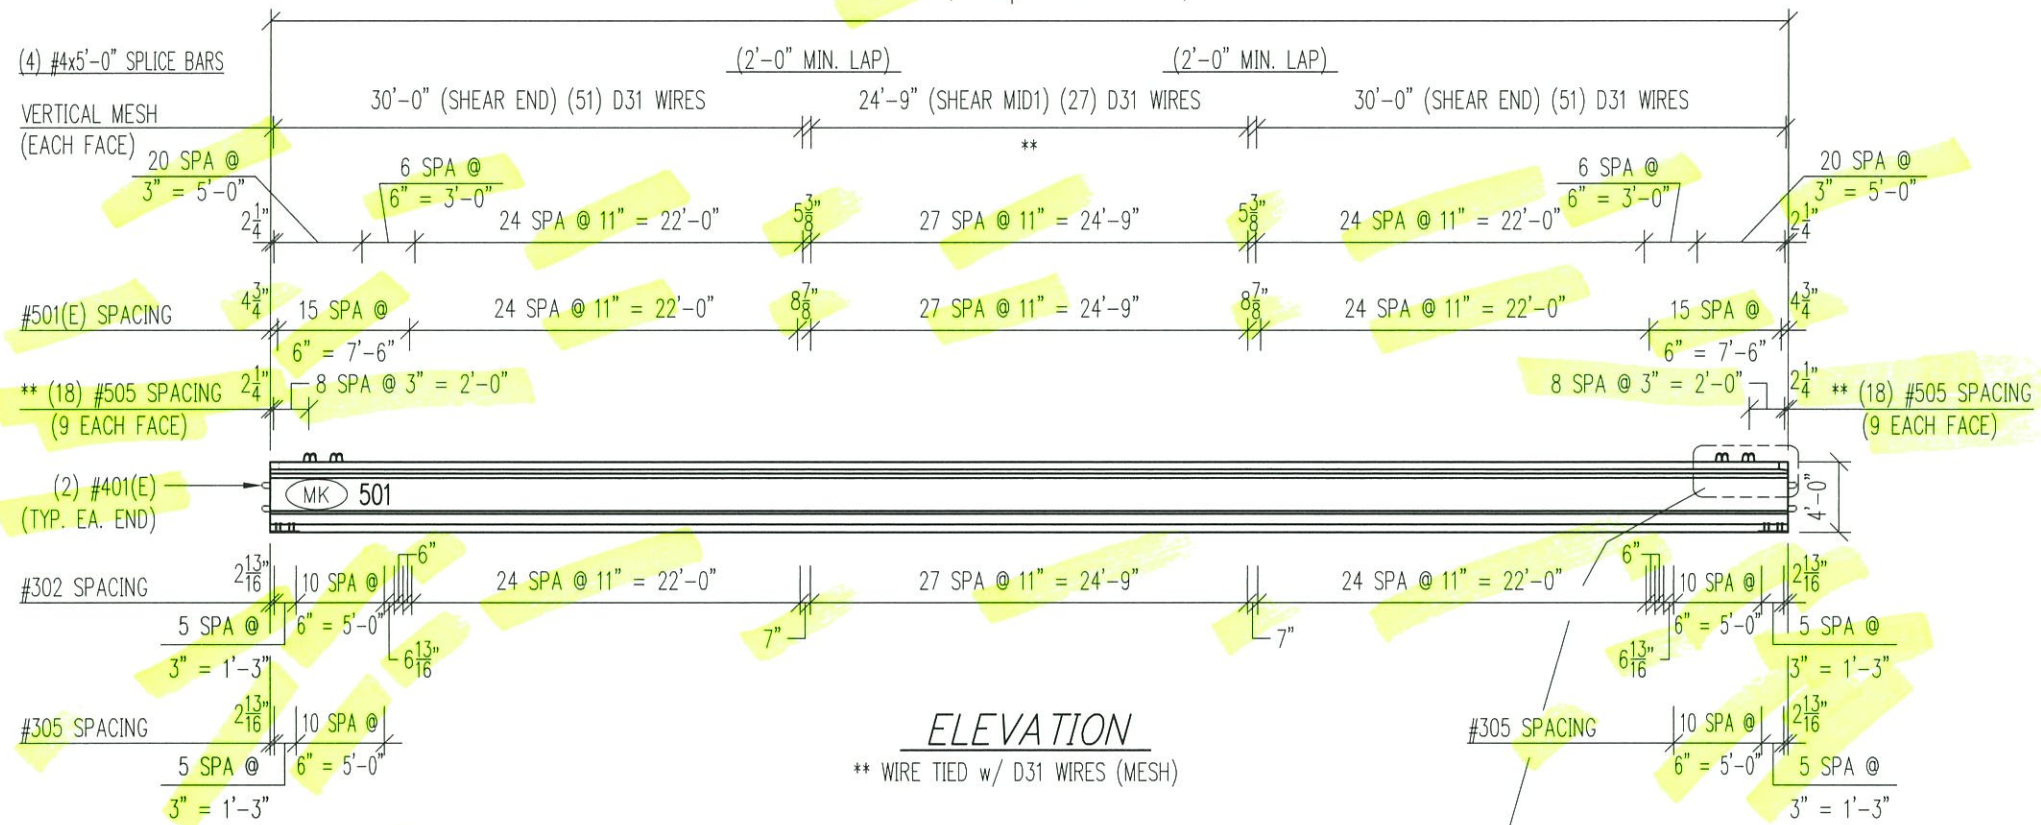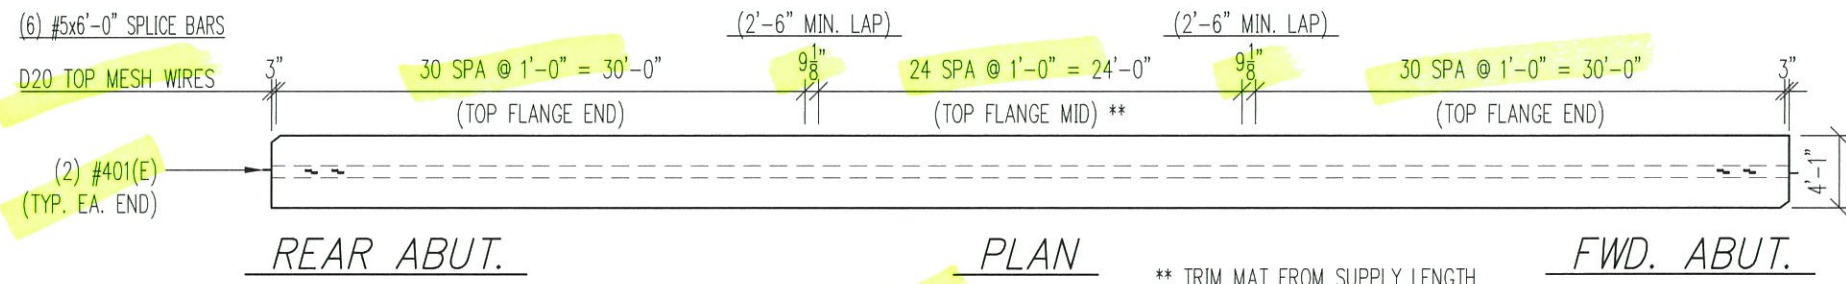

STEP 2 - INSTALL CAGE & RUN STRANDS




- STEPS:
- 1) INSTALL BOTTOM CAGE (#302 & #3 FAB BARS)
 - 2) INSTALL HOLDDOWNS
 - 3) RUN AND PREPULL BOTTOM STRAND
 - 4) RUN AND PREPULL DRAPED STRAND
 - 5) FINAL TENSION ALL STRAND
 - 6) INSTALL TOP CAGE CONSISTING OF #501(E), TOP & VERTICAL MESH, AND SPLICE BARS
 - 7) INSTALL #401(E), #505 & #305 BARS AT ENDS
 - 8) INSTALL LIFTLIPS
 - 9) CLOSE FORMS

* REINFORCEMENT CAGES ARE TO BE MANUFACTURED IN SECTIONS TO OPTIMIZE PRODUCTION EFFICIENCY. ALL REINFORCEMENT DESIGNATED FULL LENGTH WILL BE MANUFACTURED PER THE SECTION LENGTHS AND SPLICED TOGETHER IN THE FORM AFTER SECTIONS HAVE BEEN SET, PER PCI GUIDELINES.




QTY:	1	MARK:	501
STEP 2 DETAILS (SHEET 1)			
HAMILTON COUNTY, OHIO.		HAM-75-3.85	
IR-75 OVER IR-74 WB			
BRIDGE No. HAM-75-0440 L/R STR. FILE: 3109763			
48" HYBRID I-BEAM. ODOT: (18)3000 PID: 104667			
CONTRACTOR: WALSH			
PRESTRESS SERVICES INDUSTRIES LLC			
Production: Lexington, KY (859) 299-0461		Drafting: Lexington, KY (859) 299-0461	
DATE: 05/06/19		DRAWN BY: Shannon Travis	
		CHECKED: Monica Kennedy	
REVISIONS	△		
	△		
	△		
CODE: HN 48 49 OH		SHEET: 13 OF 19	
JOB NO: L19165			

L19165 < 13 501 S1 > STRAVIS 5/23/2019 4:24 PM

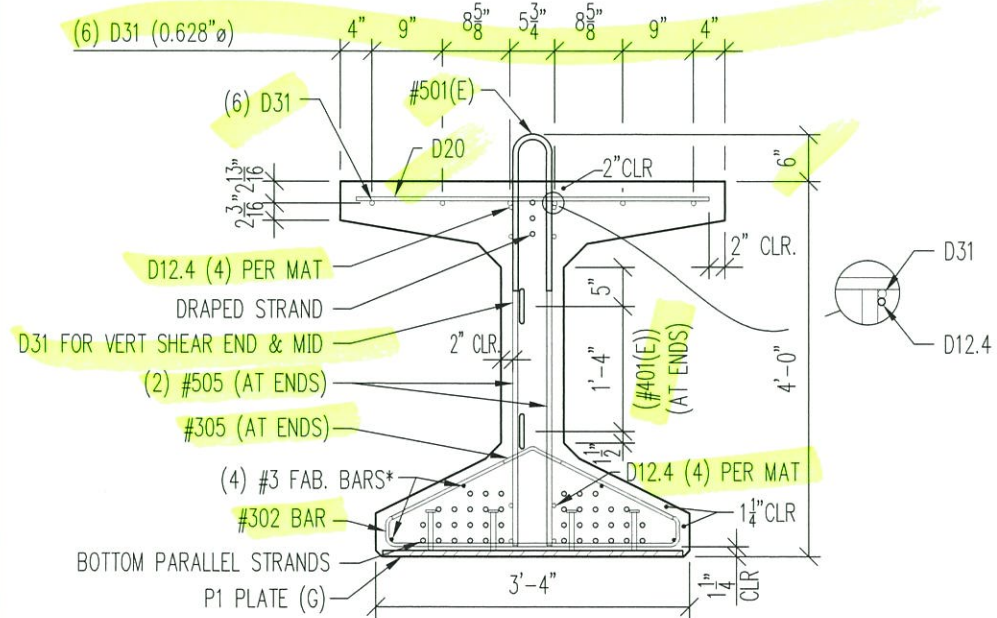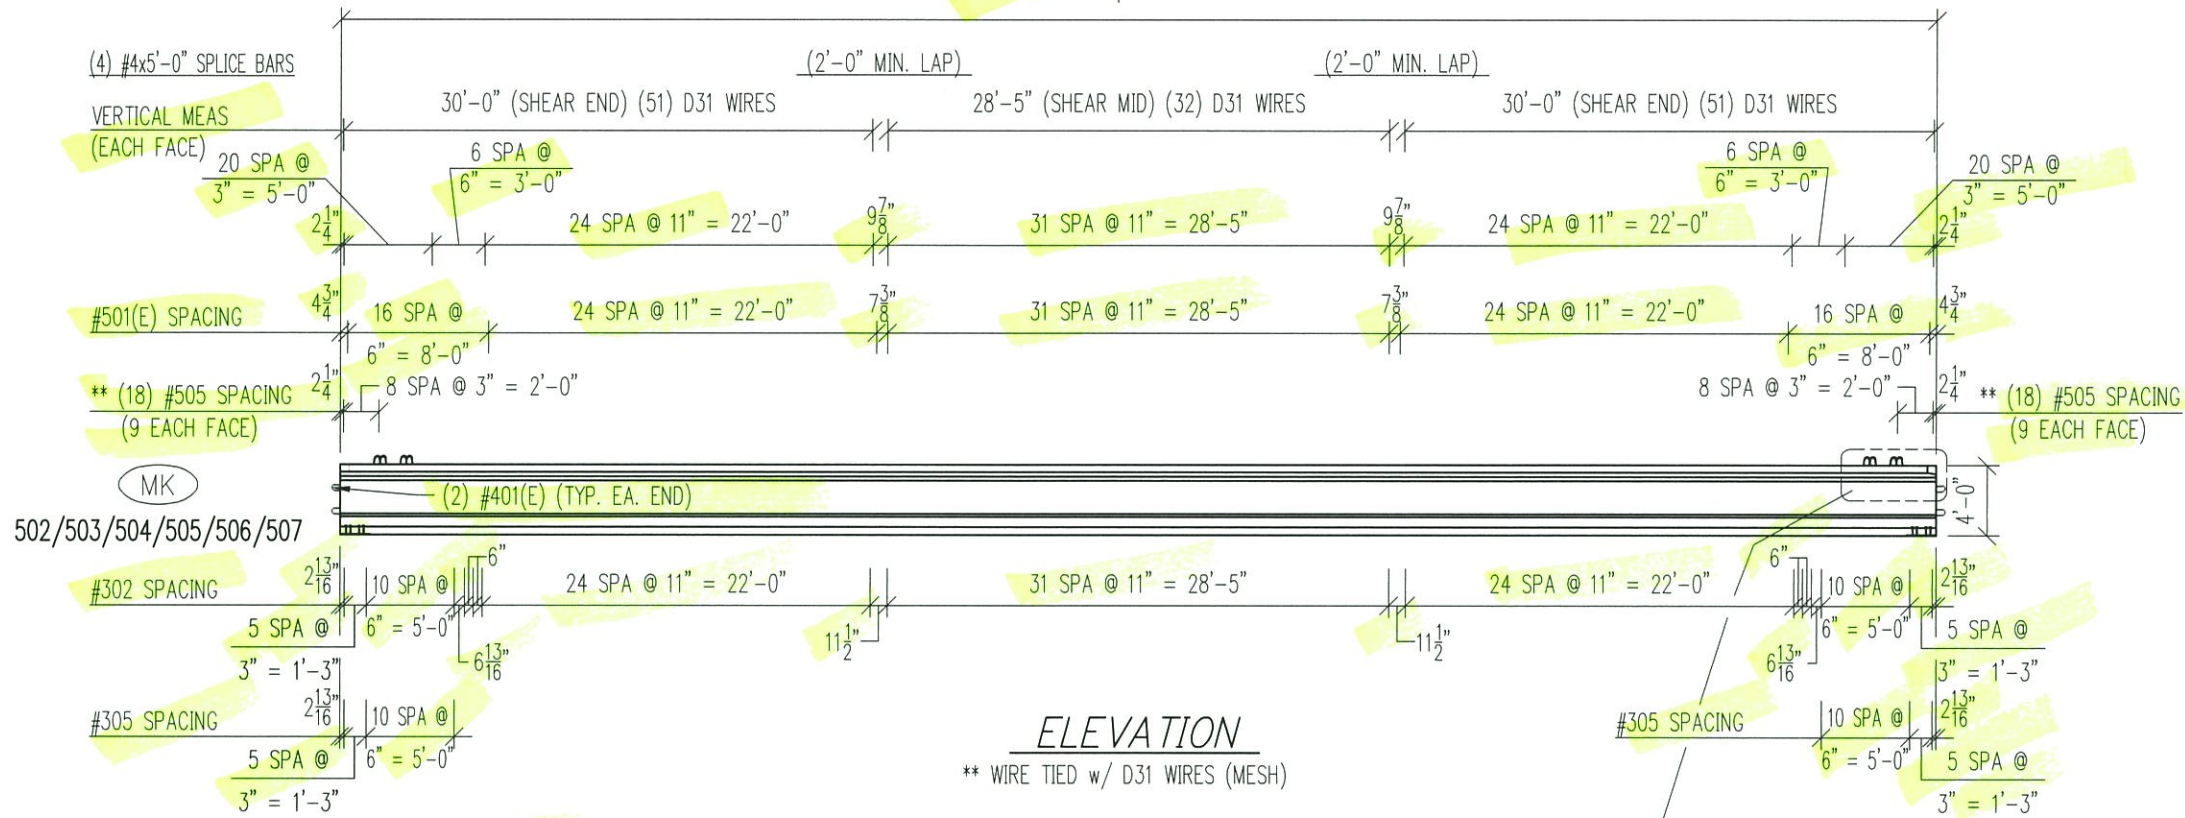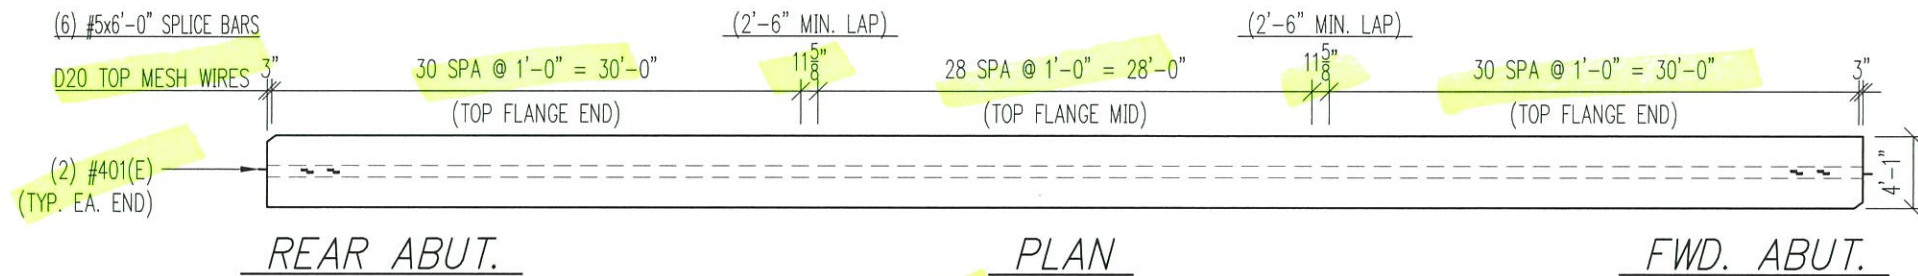

STEP 2 - INSTALL CAGE & RUN STRANDS

- STEPS:
- 1) INSTALL BOTTOM CAGE (#302 & #3 FAB BARS)
 - 2) INSTALL HOLDDOWNS
 - 3) RUN AND PREPULL BOTTOM STRAND
 - 4) RUN AND PREPULL DRAPED STRAND
 - 5) FINAL TENSION ALL STRAND
 - 6) INSTALL TOP CAGE CONSISTING OF #501(E), TOP & VERTICAL MESH, AND SPLICE BARS
 - 7) INSTALL #401(E), #505 & #305 BARS AT ENDS
 - 8) INSTALL LIFTLOOPS
 - 9) CLOSE FORMS

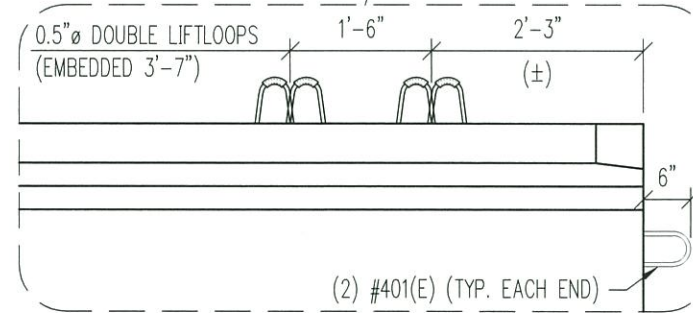

QTY:	5/1	MARK:	502/503
QTY:	1/4/1/1	MARK:	504/505/506/507
STEP 2 DETAILS (SHEET 2)			

HAMILTON COUNTY, OHIO. HAM-75-3.85
IR-75 OVER IR-74 WB
BRIDGE No. HAM-75-0440 L/R STR. FILE: 3109763
48" HYBRID I-BEAM. ODOT: (18)3000 PID: 104667

CONTRACTOR: WALSH


PRESTRESS SERVICES
INDUSTRIES LLC

Production: Lexington, KY (859) 299-0461 | Drafting: Lexington, KY (859) 299-0461
DATE: 05/06/19 | DRAWN BY: Shannon Travis (CHECK) Monica Kennedy


REVISIONS	△		
	△		
	△		

CODE: HN 48 49 OH | SHEET: 14 OF 19 | JOB NO: L19165

* REINFORCEMENT CAGES ARE TO BE MANUFACTURED IN SECTIONS TO OPTIMIZE PRODUCTION EFFICIENCY. ALL REINFORCEMENT DESIGNATED FULL LENGTH WILL BE MANUFACTURED PER THE SECTION LENGTHS AND SPLICED TOGETHER IN THE FORM AFTER SECTIONS HAVE BEEN SET, PER PCI GUIDELINES.

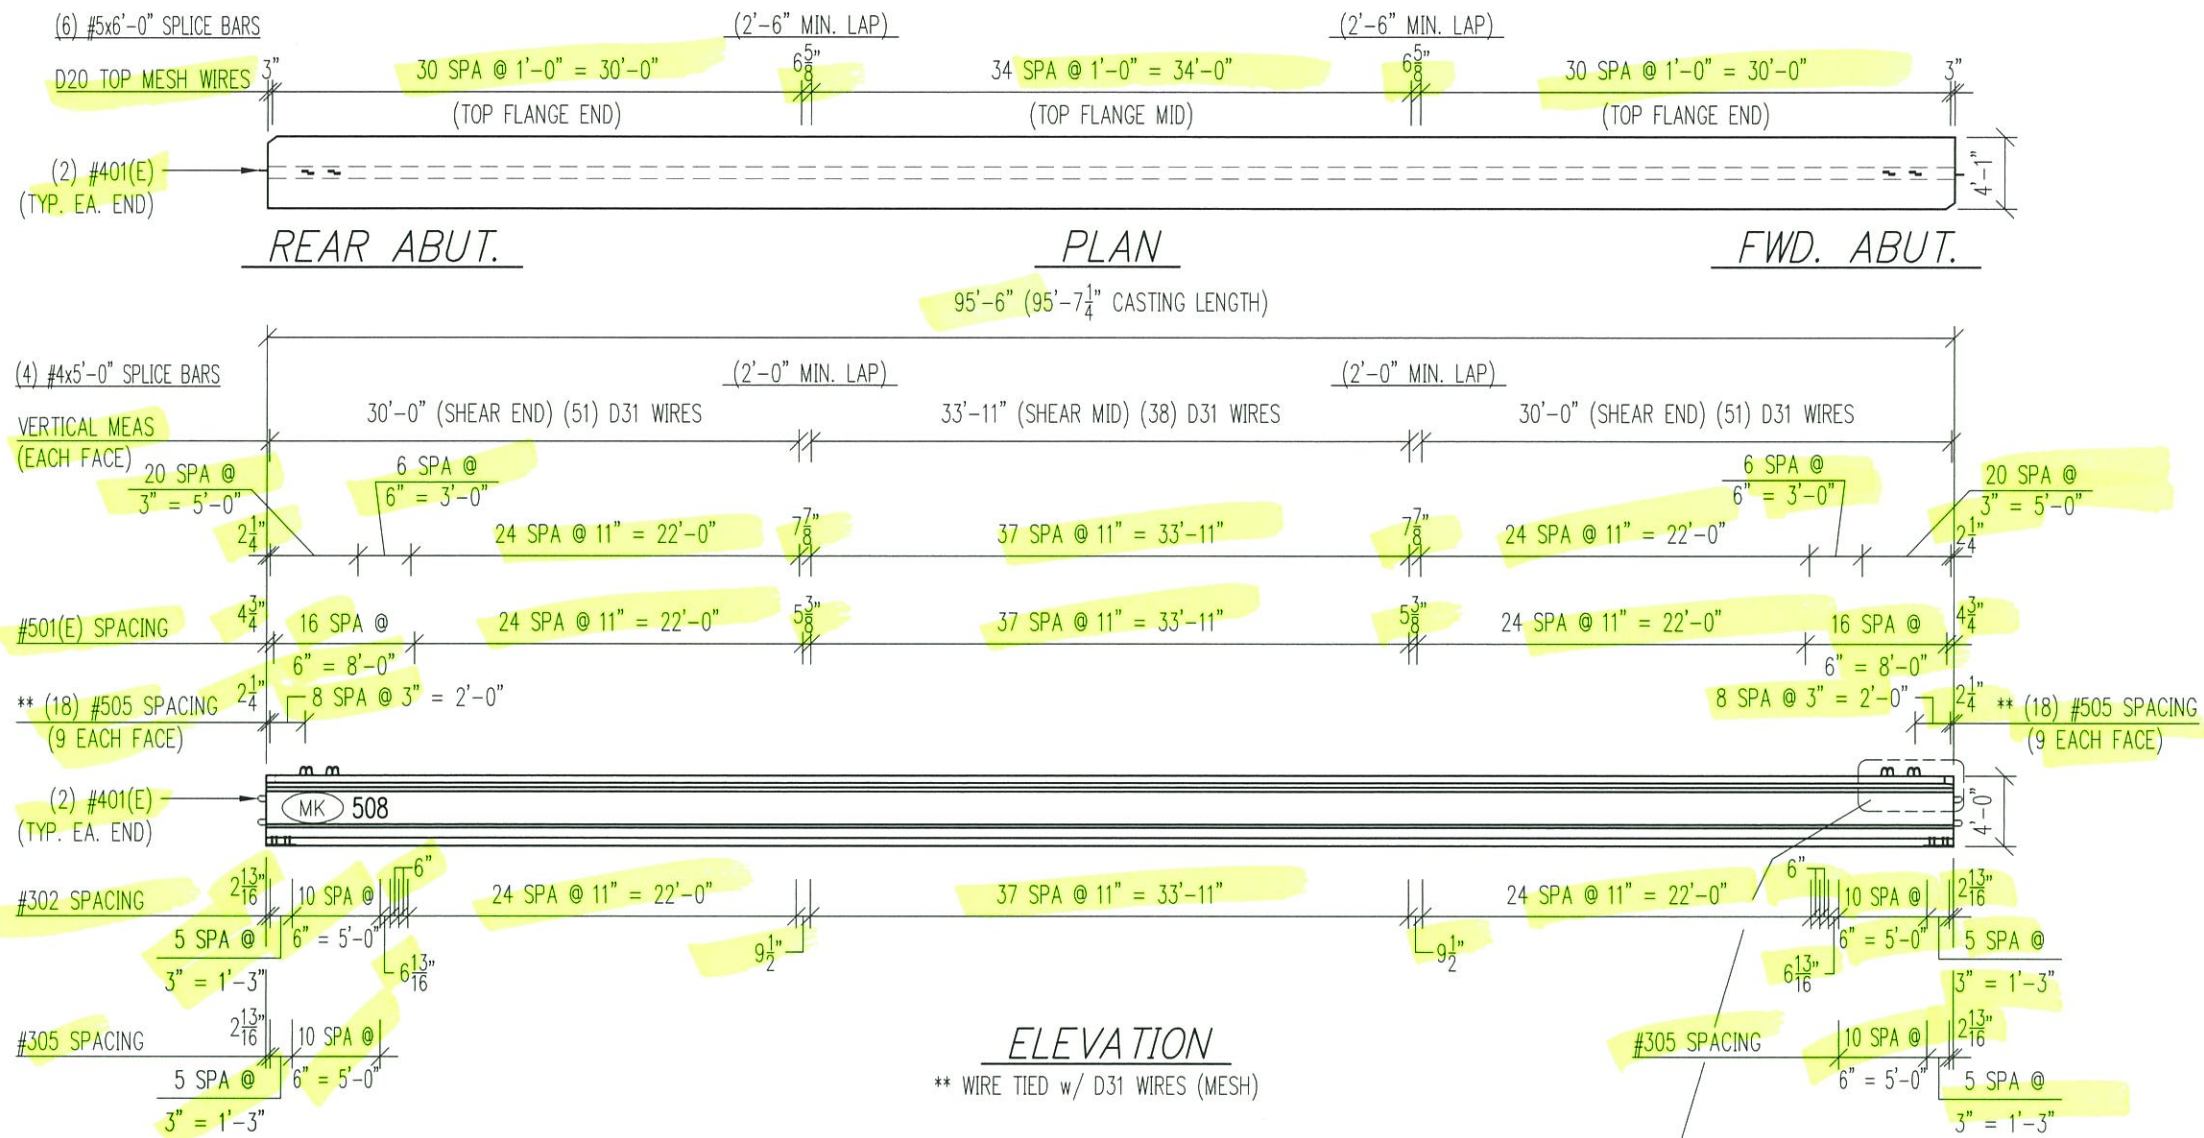

** WIRE TIED w/ D31 WIRES (MESH)

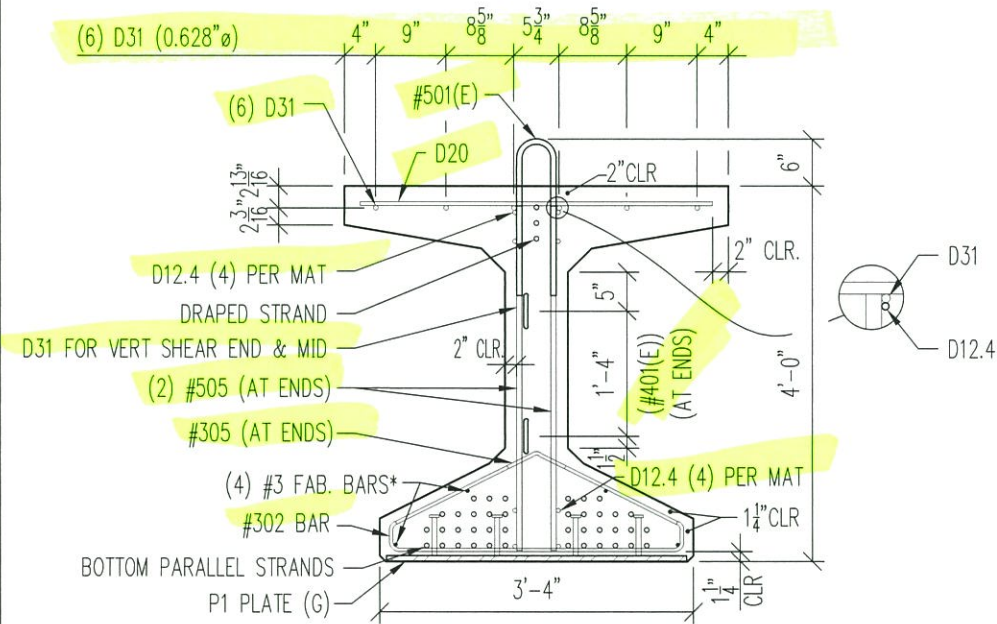


REINFORCEMENT DETAIL


* REINFORCEMENT CAGES ARE TO BE MANUFACTURED IN SECTIONS TO OPTIMIZE PRODUCTION EFFICIENCY. ALL REINFORCEMENT DESIGNATED FULL LENGTH WILL BE MANUFACTURED PER THE SECTION LENGTHS AND SPLICED TOGETHER IN THE FORM AFTER SECTIONS HAVE BEEN SET, PER PCI GUIDELINES.

STEP 2 - INSTALL CAGE & RUN STRANDS

- STEPS:
- 1) INSTALL BOTTOM CAGE (#302 & #3 FAB BARS)
 - 2) INSTALL HOLDDOWNS
 - 3) RUN AND PREPULL BOTTOM STRAND
 - 4) RUN AND PREPULL DRAPED STRAND
 - 5) FINAL TENSION ALL STRAND
 - 6) INSTALL TOP CAGE CONSISTING OF #501(E), TOP & VERTICAL MESH, AND SPLICE BARS
 - 7) INSTALL #401(E), #505 & #305 BARS AT ENDS
 - 8) INSTALL LIFTLOOPS
 - 9) CLOSE FORMS

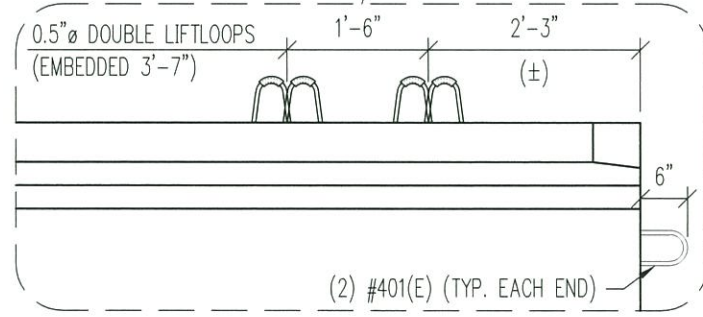

QTY:	1	MARK:	508
STEP 2 DETAILS (SHEET 3)			
HAMILTON COUNTY, OHIO. HAM-75-3.85			
IR-75 OVER IR-74 WB			
BRIDGE No. HAM-75-0440 L/R STR. FILE: 3109763			
48" HYBRID I-BEAM. ODOT: (18)3000 PID: 104667			
CONTRACTOR: WALSH			
PRESTRESS SERVICES INDUSTRIES LLC			
Production: Lexington, KY (859) 299-0461		Drafting: Lexington, KY (859) 299-0461	
DATE: 05/06/19	DRAWN BY: Shannon Travis	CHECKED: Monica Kennedy	
REVISIONS	△		
	△		
	△		
CODE: HN 48 49 OH	SHEET: 15 OF 19	JOB NO: L19165	

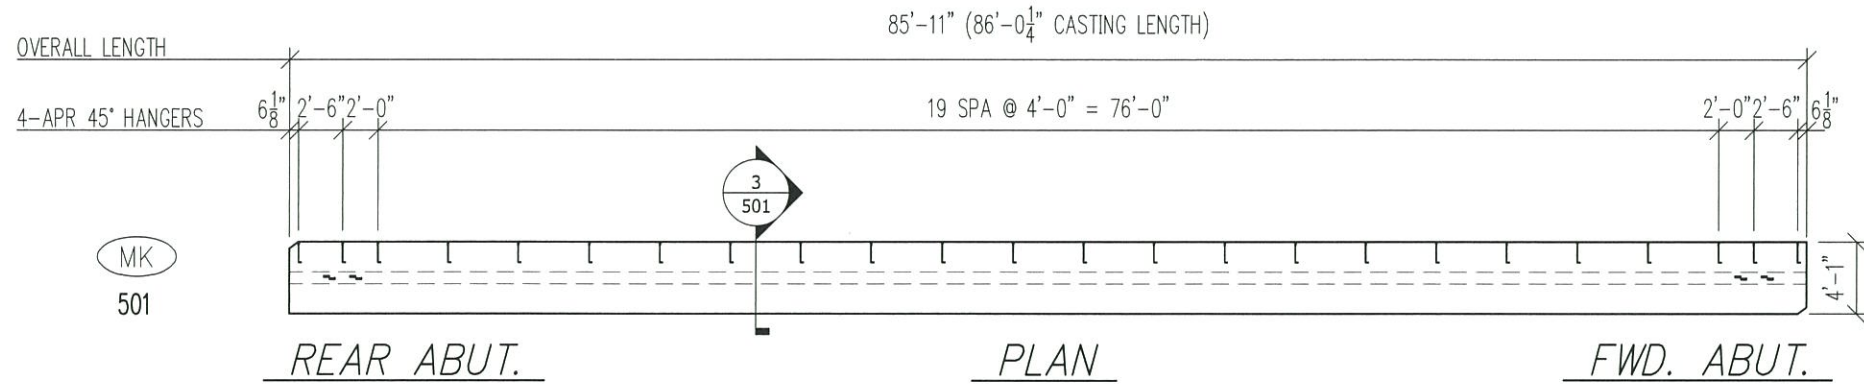


MK
501

REAR ABUT.

PLAN

FWD. ABUT.

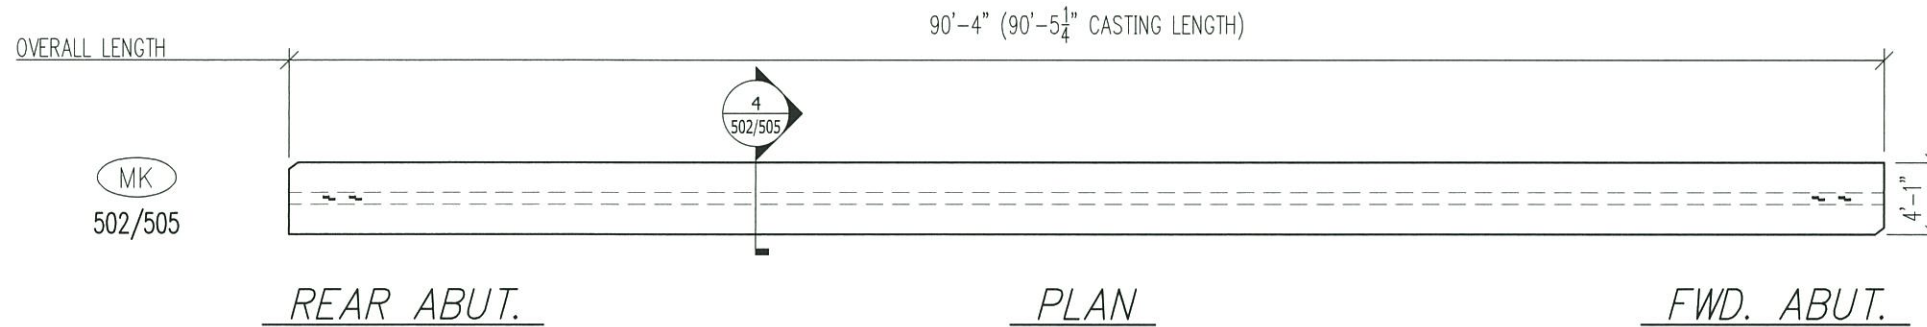


MK
502/505

REAR ABUT.

PLAN

FWD. ABUT.

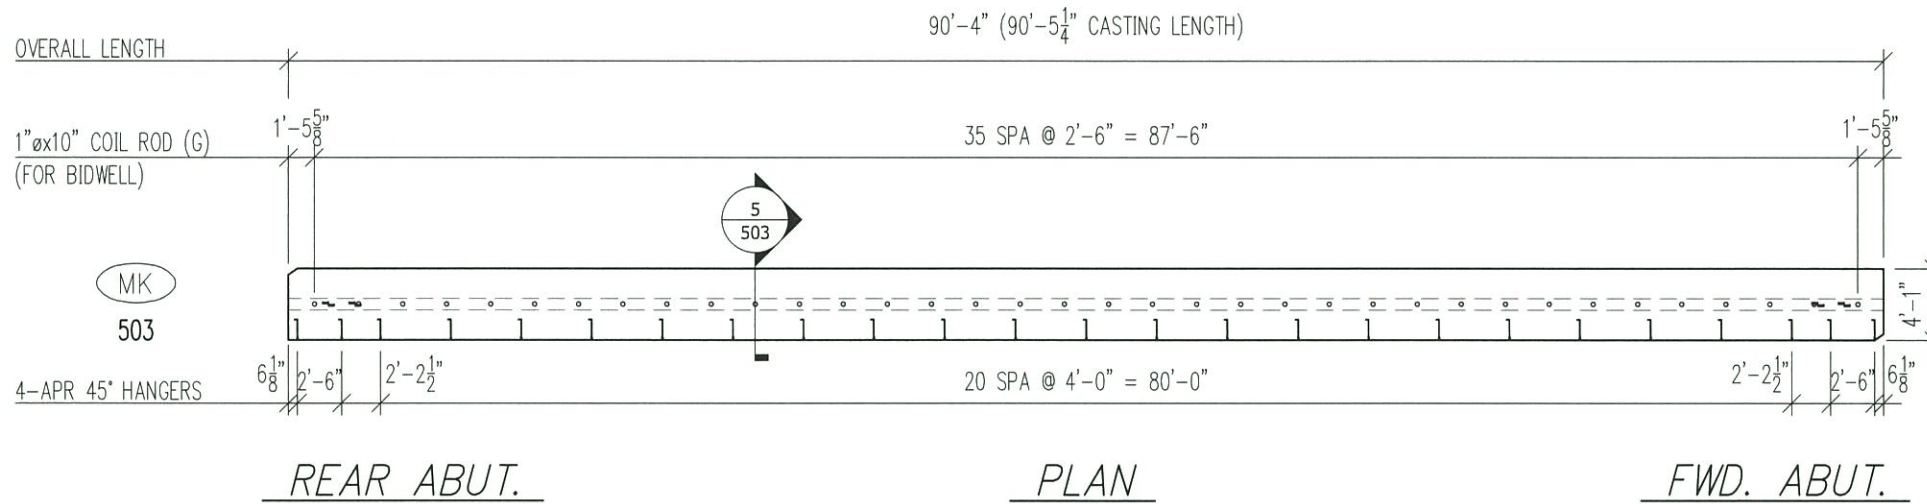


MK
503

REAR ABUT.

PLAN

FWD. ABUT.

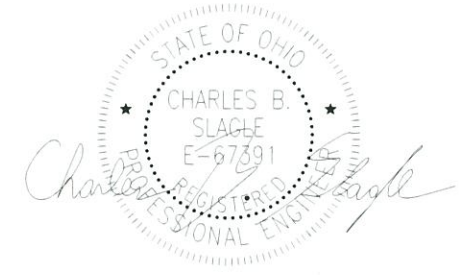

STEP 3 - POUR CONCRETE & INSTALL CONTRACTOR HARDWARE

- STEPS:
- 1) POUR CONCRETE
 - 2) SCORE TOPS OF BEAMS
 - 3) INSTALL CONTRACTOR HARDWARE
 - 4) COVER FORMS

QTY: 1/5/1/4 MARK: 501/502/503/505

STEP 3 DETAILS (SHEET 1)

HAMILTON COUNTY, OHIO. HAM-75-3.85
IR-75 OVER IR-74 WB
BRIDGE No. HAM-75-0440 L/R STR. FILE: 3109763
48" HYBRID I-BEAM. ODOT: (18)3000 PID: 104667

CONTRACTOR: WALSH




Production: Lexington, KY (859) 299-0461 Drafting: Lexington, KY (859) 299-0461


DATE: 05/06/19 DRAWN BY: Shannon Travis CHECKED: Monica Kennedy

REVISIONS	▲		
	▲		
	▲		


CODE: HN 48 49 OH SHEET: 16 OF 19 JOB NO: L19165

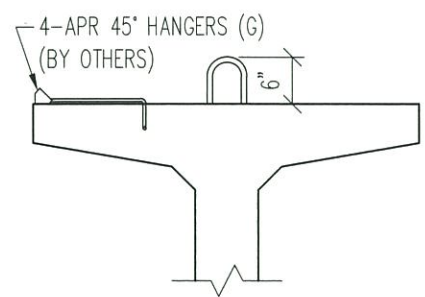




3 SECTION (501)
Scale: 1/2" = 1'-0"

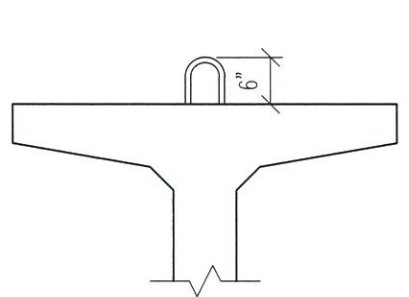


4 SECTION (502 & 505)
Scale: 1/2" = 1'-0"

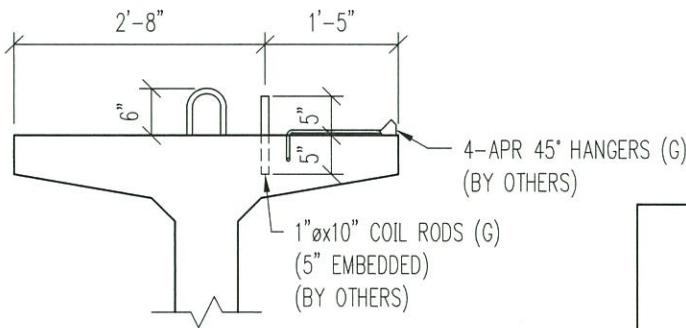

5 SECTION (503)
Scale: 1/2" = 1'-0"

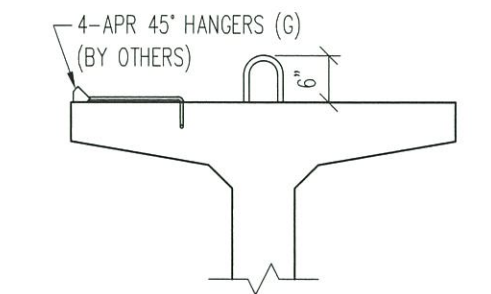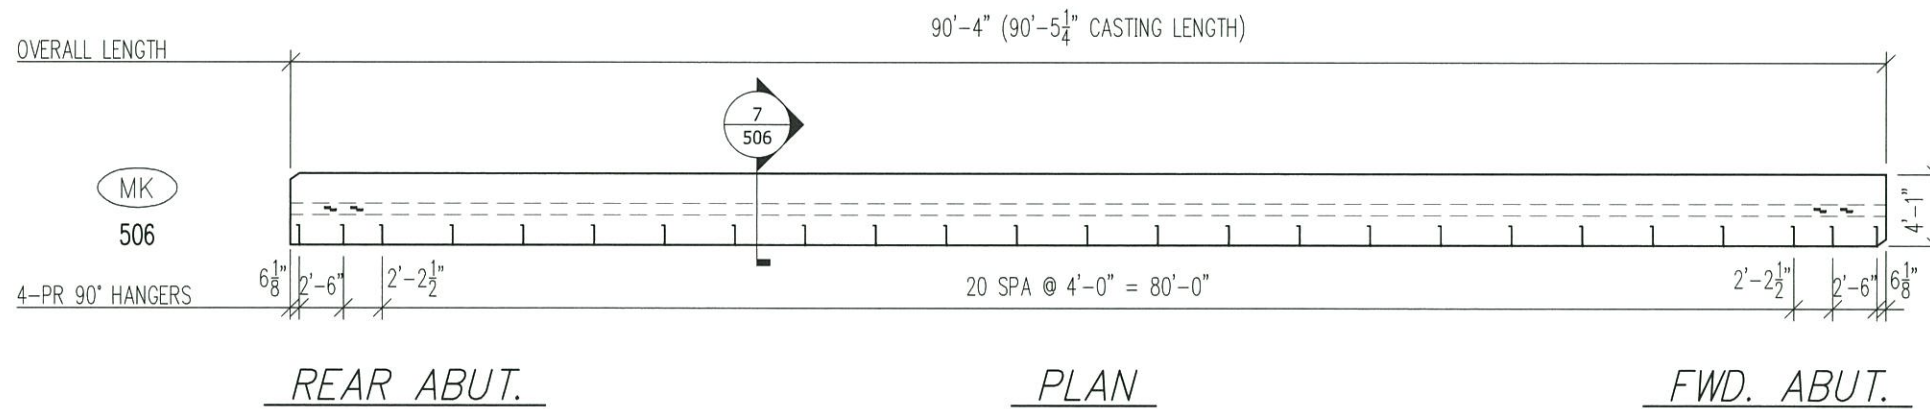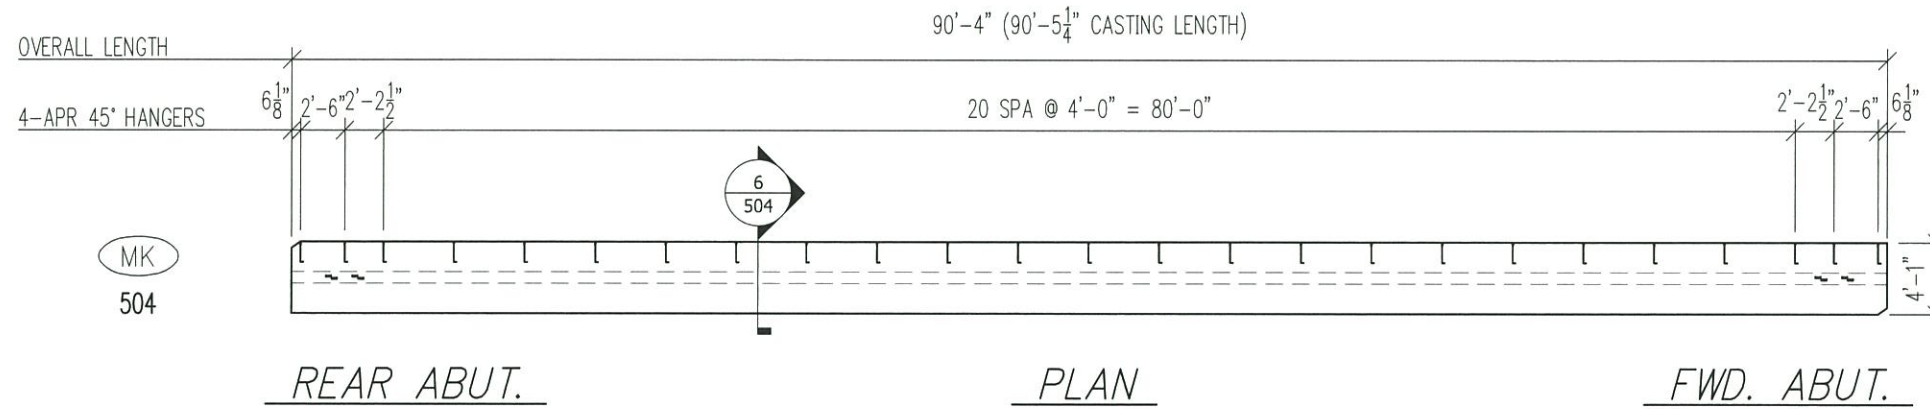

6 SECTION (504)
Scale: 1/2" = 1'-0"

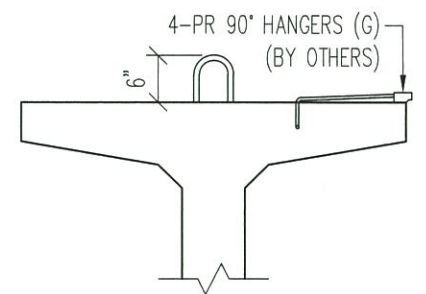

7 SECTION (506)
Scale: 1/2" = 1'-0"



STEP 3 - POUR CONCRETE & INSTALL CONTRACTOR HARDWARE

- STEPS:
- 1) POUR CONCRETE
 - 2) SCORE TOPS OF BEAMS
 - 3) INSTALL CONTRACTOR HARDWARE
 - 4) COVER FORMS

QTY: 1/1 | MARK: 504/506

STEP 3 DETAILS (SHEET 2)

HAMILTON COUNTY, OHIO. HAM-75-3.85
 IR-75 OVER IR-74 WB
 BRIDGE No. HAM-75-0440 L/R STR. FILE: 3109763
 48" HYBRID I-BEAM. ODOT: (18)3000 PID: 104667

CONTRACTOR: WALSH






Production: Lexington, KY (859) 299-0461 | Drafting: Lexington, KY (859) 299-0461


DATE: 05/06/19 | DRAWN BY: Shannon Travis | CHECKED: Monica Kennedy

REVISIONS	DATE	DESCRIPTION
△		
△		
△		

CODE: HN 48 49 OH | SHEET: 17 OF 19 | JOB NO: L19165

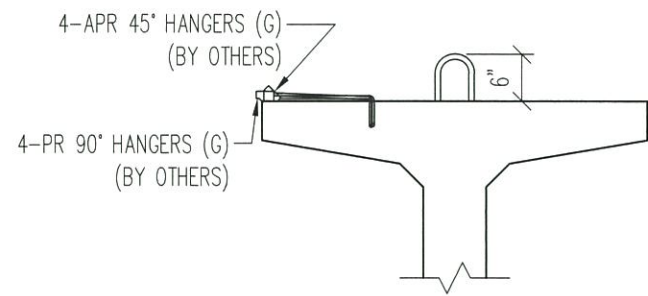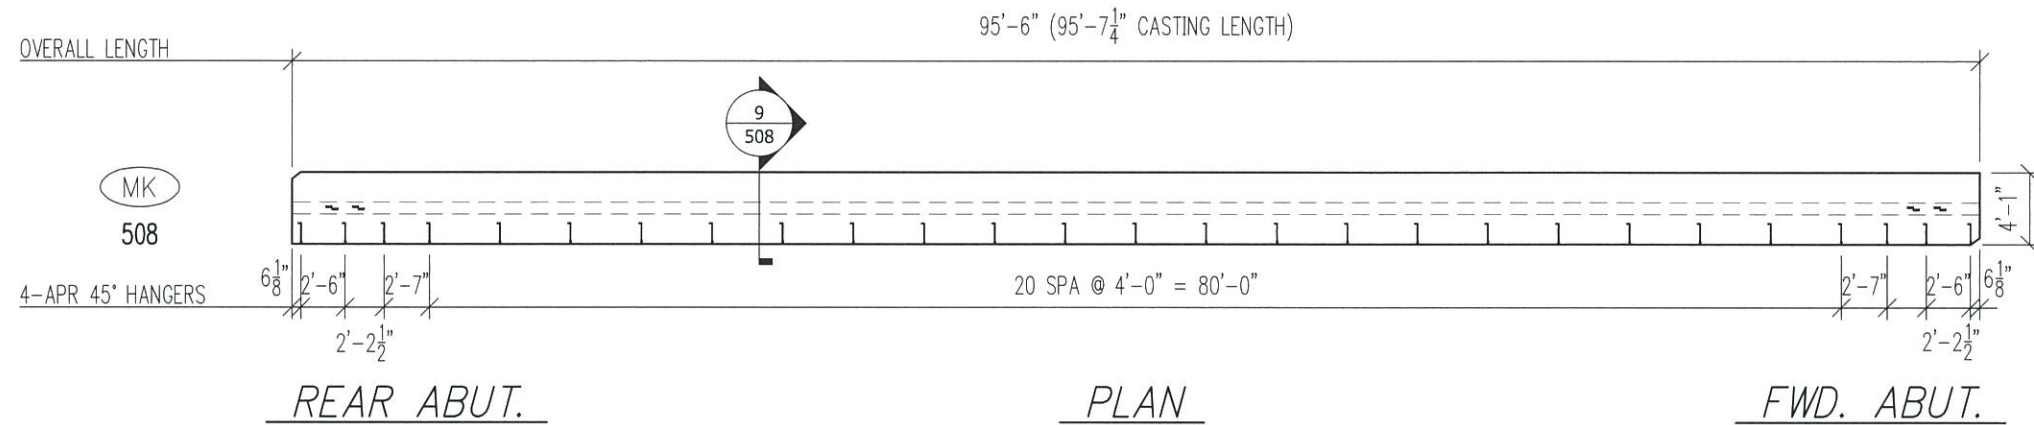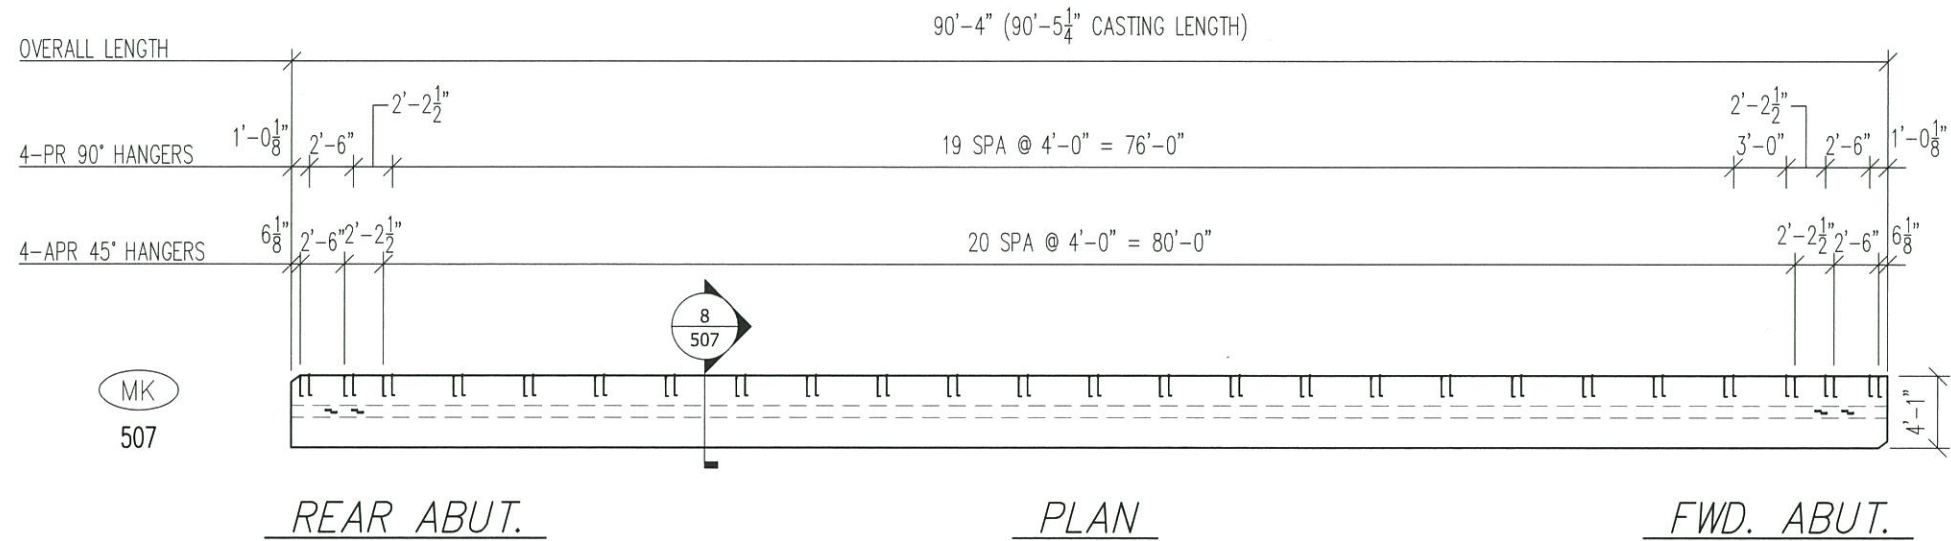

8 SECTION (507)
Scale: 1/2" = 1'-0"

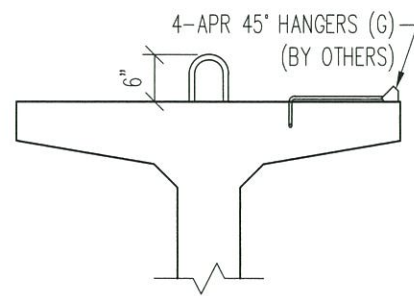

9 SECTION (508)
Scale: 1/2" = 1'-0"



STEP 3 - POUR CONCRETE & INSTALL CONTRACTOR HARDWARE

- STEPS:
- 1) POUR CONCRETE
 - 2) SCORE TOPS OF BEAMS
 - 3) INSTALL CONTRACTOR HARDWARE
 - 4) COVER FORMS

QTY: 1/1 MARK: 507/508

STEP 3 DETAILS (SHEET 3)

HAMILTON COUNTY, OHIO. HAM-75-3.85
IR-75 OVER IR-74 WB
BRIDGE No. HAM-75-0440 L/R STR. FILE: 3109763
48" HYBRID I-BEAM. ODOT: (18)3000 PID: 104667

CONTRACTOR: WALSH







Production: Lexington, KY (859) 299-0461 Drafting: Lexington, KY (859) 299-0461


DATE: 05/06/19 DRAWN BY: Shannon Travis CHECKED: Monica Kennedy

REVISIONS	△		
	△		
	△		

CODE: HN 48 49 OH SHEET: 18 OF 19 JOB NO: L19165

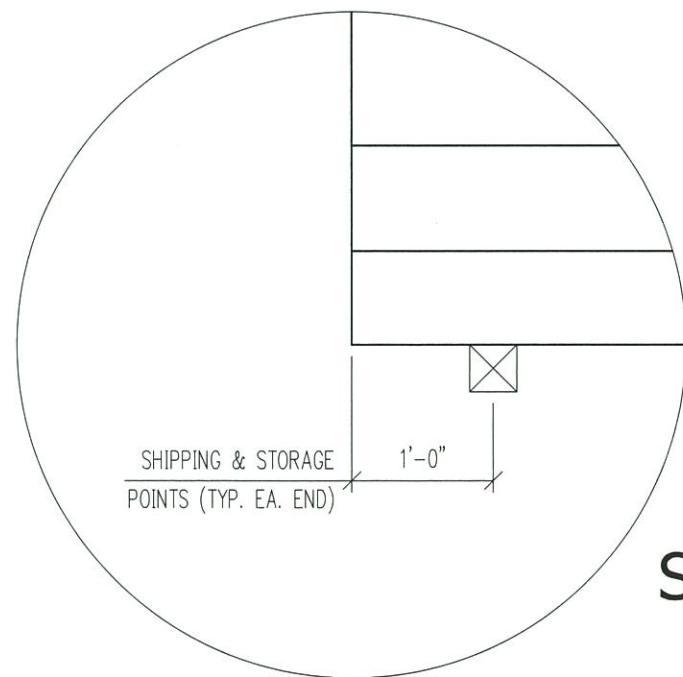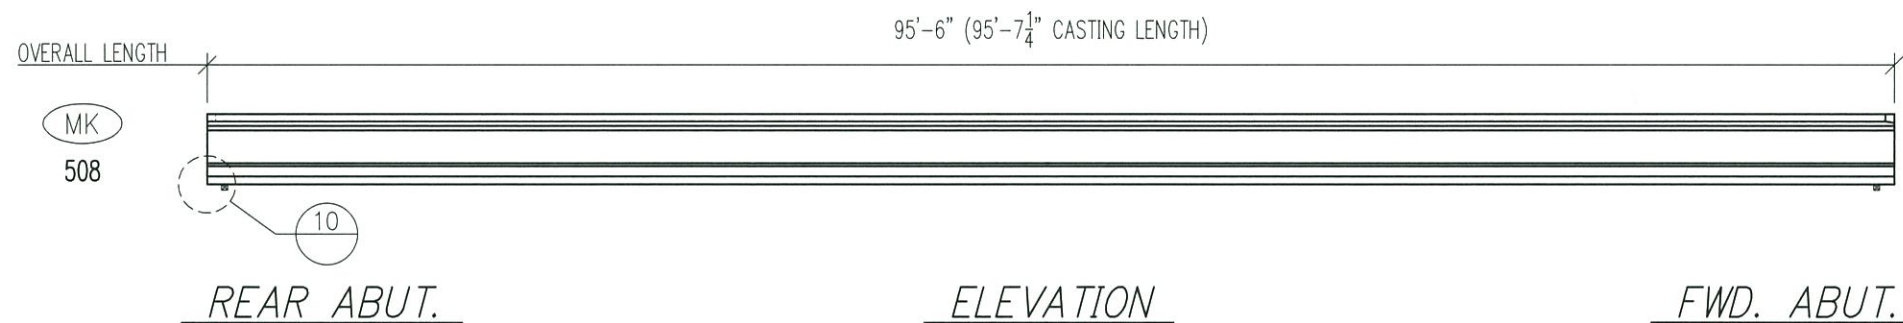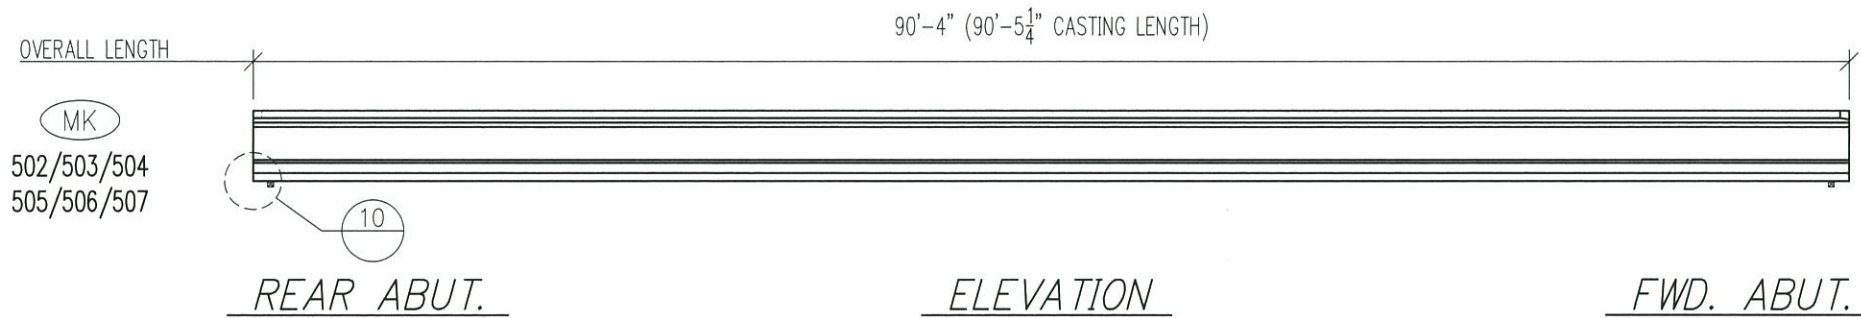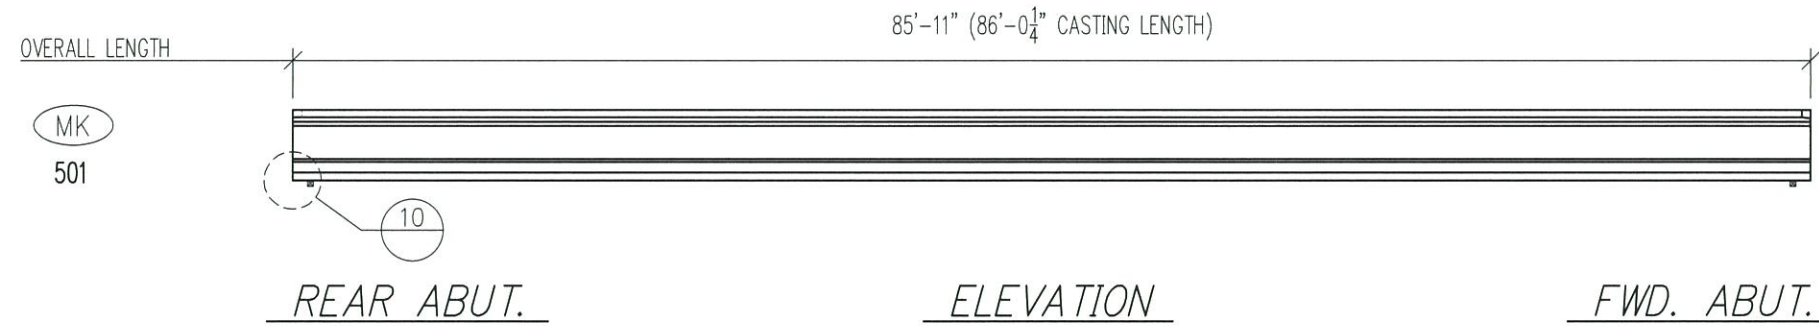


DETAIL 10

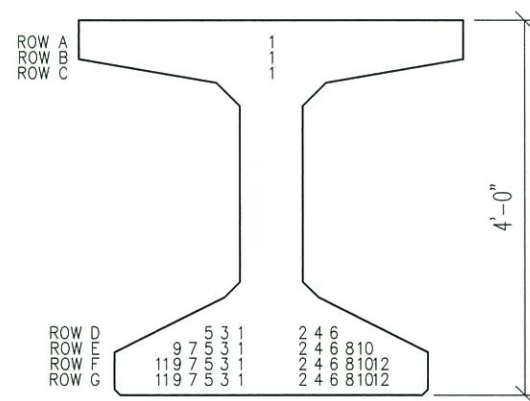

DETENSIONING DETAIL
(SINGLE SPAN)

DETENSIONING NOTES

- SEE DETENSIONING DETAIL(S) FOR DETENSIONING PROCEDURE SEQUENCE.
- STRAND DETENSIONING STARTS WITH ROW A THEN B AND SO ON. DETENSION TOTAL ROW IN SEQUENCE BEFORE MOVING TO NEXT ROW. AFTER DETENSIONING DRAPED STRANDS, RELEASE HOLDDOWNS THEN DETENSION PARALLEL STRANDS.
- THERE ARE NO EXTENDED STRANDS.

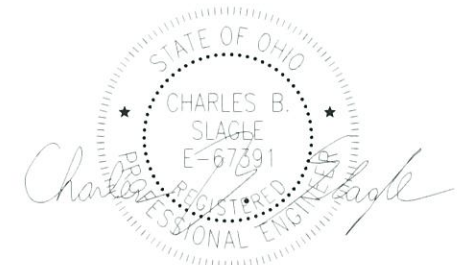

QTY:	1/5/1	MARK:	501/502/503
QTY:	1/4/1/1/1	MARK:	504/505/506/507/508

STEP 4 DETAILS

HAMILTON COUNTY, OHIO. HAM-75-3.85
IR-75 OVER IR-74 WB
BRIDGE No. HAM-75-0440 L/R STR. FILE: 3109763
48" HYBRID I-BEAM. ODOT: (18)3000 PID: 104667

CONTRACTOR: WALSH



Production: Lexington, KY (859) 299-0461 | Drafting: Lexington, KY (859) 299-0461
DATE: 05/06/19 | DRAWN BY: Shannon Travis | CHECKED: Monica Kennedy

REVISIONS	△		
	△		
	△		

CODE: HN 48 49 OH | SHEET: 19 OF 19 | JOB NO: L19165

STEP 4 - DETENSION STRAND & STORAGE

- STEPS:
- DETENSION STRAND PER DETAIL
 - CUT ALL STRAND FLUSH
 - PUT BEAM INTO STORAGE AS SHOWN