















**ITEM 511 - CLASS QC3 CONCRETE, MISC.: CLASS QC3 CONCRETE WITH QC/QA, SUPERSTRUCTURE (CONTINUED):**  
**ITEM 526 - REINFORCED CONCRETE APPROACH SLABS WITH QC/QA (T=15"), AS PER PLAN (CONTINUED):**

FABRICATE THE SIP FORMING SYSTEM ACCORDING TO ITEM 513 EXCEPT THAT FABRICATOR PRE-QUALIFICATION IS NOT REQUIRED. SUBMIT MILL TEST REPORTS FOR THE SIP FORMS ACCORDING TO 501.06. SUBMIT SHOP DRAWINGS AND DESIGN CALCULATIONS FOR THE SIP FORMS ACCORDING TO 513.06. FURNISH FORM MATERIALS CONFORMING TO ASTM A653 WITH G235 COATING WEIGHT WITH A MINIMUM THICKNESS OF 20 GAGE. HOT DIP GALVANIZE ALL HARDWARE, HANGERS, AND INCIDENTALS.

DO NOT WELD SIP FORMS OR THEIR SUPPORTS TO THE STEEL BRIDGE MEMBERS.

ACHIEVE A ONE-INCH MINIMUM BEARING LENGTH ON ALL SUPPORTS OF A FLUTE.

PLACE CONCRETE ACCORDING TO THE CONTRACT SPECIFICATIONS:  
 -FILL THE ENTIRE FORM WITH DECK CONCRETE.  
 -UTILIZE PROPER CONSTRUCTION TECHNIQUES TO PREVENT VOIDS AND HONEYCOMBS ESPECIALLY AT ENDS OF SIP FORM SHEETS.

INSTALL SIP FORMS ACCORDING TO THESE NOTES:

1. PROVIDE THE ENGINEER WITH A WRITTEN INSTALLATION AND INSPECTION PROCEDURE. INCLUDE METHODS FOR ADJUSTING SUPPORT HEIGHTS, SIP ATTACHMENT SEQUENCE, PLACEMENT METHODS USED TO MINIMIZE COATING DAMAGE, COATING REPAIR METHODS, ACCEPTABLE TOLERANCES, AND INSPECTION CRITERIA.
2. FIELD CUT SIP FORMS USING MECHANICAL CUTTING METHODS. THERMAL CUTTING IS NOT PERMITTED.
3. PLACE FORM SUPPORTS IN DIRECT CONTACT WITH THE TOP OF THE BRIDGE'S STRUCTURAL MEMBERS.
4. SET THE HEIGHT OF THE FORM SUPPORTS SO SIP FORMS DO NOT REST DIRECTLY ON THE BRIDGE'S STRUCTURAL MEMBERS AND TO DEVELOP THE SPECIFIED DECK THICKNESS.
5. PLACE THE SIP FORMS DIRECTLY ON THE SUPPORTS.
6. CONNECT SIP FORMS TO SUPPORTS BEFORE USING THE SIP AS A WORKING SURFACE AND BEFORE THE END OF EACH WORK SHIFT.
7. PROVIDE SAFETY STOPS TO ELIMINATE HAZARDS FROM SUDDEN UPLIFT AND LATERAL MOVEMENT.

IN ADDITION TO THE REQUIREMENTS OF 105.10, FURNISH, ERECT, AND MOVE APPROPRIATE EQUIPMENT OR SCAFFOLDING TO ALLOW THE FOLLOWING INSPECTION ACCESS. PROVIDE COMPLETED INSPECTION CHECK LISTS TO DOCUMENT THE FOLLOWING INSPECTIONS:

1. PRIOR TO PLACING CONCRETE, VISUALLY INSPECT SIP FORMS FOR DAMAGE.
2. TWO DAYS AFTER CONCRETE PLACEMENT, TEST DECK FOR SOUNDNESS OR BONDING OF THE FORMS BY SOUNDING ON THE FORMS WITH A HAMMER. SOUND ALL SURFACES OR AT LEAST 10% OF THE PANELS WITH THE ENGINEER.
3. REMOVE SIP FORMS IN AREAS WITH DOUBTFUL SOUNDNESS OR BONDING FOR THE ENGINEER'S VISUAL INSPECTION. DO NOT REPLACE SIP FORMS REMOVED FOR INSPECTION. REMOVE FORMS SO THAT ADJACENT FORMS OR WORK IS NOT DEBONDED OR OTHERWISE DAMAGED.
4. IF DEFECTS ARE DISCOVERED DURING THE SPECIFIED INSPECTIONS, TEST THE COMPLETE DECK AND PROPOSE REPAIR OR REMOVAL METHODS ACCEPTABLE TO THE DEPARTMENT. THE DEPARTMENT MAY REQUIRE ADVANCED NON-DESTRUCTIVE TESTING METHODS SUCH AS GROUND PENETRATING RADAR TO VERIFY THE DECK CONDITION ACCORDING TO 105.11.

FURNISH GALVANIZED STEEL REINFORCEMENT 709.16 IN LIEU OF EPOXY COATED STEEL REINFORCEMENT FOR REINFORCED CONCRETE APPROACH SLABS.

ALL LABOR, MATERIALS AND INCIDENTALS FOR THE FABRICATION, DESIGN, AND INSTALLATION OF THE SIP FORMS SHALL BE INCLUDED WITH ITEM 511 - CLASS QC3 CONCRETE, MISC.: CLASS QC3 CONCRETE WITH QC/QA, SUPERSTRUCTURE FOR PAYMENT.

**ITEM 511 - CLASS QC3 CONCRETE, MISC.: CLASS QC3 CONCRETE WITH QC/QA, SUPERSTRUCTURE BRIDGE RAILING:**

THIS ITEM MODIFIES THE STANDARD 511 CONCRETE FOR STRUCTURES SPECIFICATION TO INCLUDE LIGHTWEIGHT AGGREGATE, MACRO-SYNTHETIC FIBERS, AND CORROSION INHIBITORS INTO THE SUPERSTRUCTURE RAILING CONCRETE. THIS ITEM SHALL CONFORM TO 511 WITH THE FOLLOWING CONDITIONS AND REVISIONS:

PROVIDE MATERIALS CONFORMING TO 511.02 EXCEPT AS MODIFIED BELOW:

PORTLAND CEMENT 499.03, CLASS QC3 MEETING A DESIGN STRENGTH OF 4,500 PSI WITH MACRO-SYNTHETIC FIBERS AND WITH MODIFICATION PER 511.02

FIBERS FOR CONCRETE ASTM C1116, TYPE III

CORROSION INHIBITOR 515.15

LIGHTWEIGHT AGGREGATE ASTM C3300

THE CLASS QC3 CONCRETE FOR THE SUPERSTRUCTURE RAILING SHALL MEET THE FOLLOWING CRITERIA:  
 WATER/CEMENT RATIO = 0.40 MAXIMUM; MINIMUM 4 LBS/CY MACRO-SYNTHETIC FIBERS (1.5 INCHES MIN. TO 2.5 INCHES MAX.) MEETING ASTM C1116 TYPE III SHALL BE ADDED TO THE MIX. THE FINAL CONCRETE MIX SHALL HAVE A MAXIMUM DRY WEIGHT OF 120 LBS/CF WITH THE LIGHTWEIGHT AGGREGATE MEETING THE REQUIREMENTS OF ASTM C330.

MIX SHALL INCLUDE A MIGRATING CORROSION INHIBITOR AS MANUFACTURED BY AN APPROVED SUPPLIER LISTED ON ODOT'S QUALIFIED APPROVED SUPPLIERS, ITEM 515.15. THE DOSAGE RATE LISTED ON THE ODOT QUALIFIED APPROVED SUPPLIERS LIST WILL APPLY.

THE MACRO-SYNTHETIC FIBERS SHALL BE INCORPORATED INTO THE MIX IN SUCH A WAY THAT NO 'BALLING' OCCURS. UPON INSPECTION OF THE MIX AT THE TIME OF PLACEMENT, IF ANY 'BALLING' OCCURS, THE ENGINEER SHALL REJECT THE REMAINDER OF THE LOAD AT ANY TIME DURING THE POUR. IT IS IMPORTANT TO FOLLOW INDUSTRY STANDARDS AND ASTM SPECIFICATIONS ON THE PREMIXING OF THE CEMENT, AGGREGATE, AND MACRO-SYNTHETIC FIBERS PRIOR TO THE ADDITION OF WATER AND ADMIXTURES. PROVIDE MACRO-SYNTHETIC FIBERS THAT ARE MONOFILAMENT FIBERS MADE FROM VIRGIN POLYPROPYLENE, POLYETHYLENE, OR CO-POLYMERS THAT ARE INERT TO ALKALI ATTACK. ENSURE THE MACRO-SYNTHETIC FIBERS HAVE A MINIMUM TENSILE STRENGTH OF 70 KSI, A MINIMUM MODULUS OF ELASTICITY OF 800 KSI, A MINIMUM FILAMENT DIAMETER OF 0.012 INCHES, AN ASPECT RATIO BETWEEN 60 AND 100, AND ARE BETWEEN 1.5 AND 2.5 INCHES IN LENGTH. STORE THE MACRO-SYNTHETIC FIBERS ACCORDING TO THE MANUFACTURER'S RECOMMENDATION AND KEEP THE MATERIAL FREE FROM DUST, DIRT, AND MOISTURE. PLACING THE BAG THAT THE FIBERS COME IN INTO THE CONCRETE MIX IS NOT PERMITTED.

USE A MINIMUM DOSAGE RATE OF MACRO-SYNTHETIC FIBERS OF 4.0 LBS/CY OF CONCRETE. DETERMINE THE FINAL PROPOSED DOSAGE RATE THROUGH MIX TESTING. ENSURE THE FIBER REINFORCED CONCRETE MEETS OR EXCEEDS A MINIMUM EQUIVALENT FLEXURAL STRENGTH RATIO OF 25% ACCORDING TO ASTM C 1609. ENSURE THE FINAL PROPOSED MIX IS WORKABLE AND ABLE TO BE PRODUCED SUCH THAT BALLING OR CLUMPING OF THE FIBERS IS NOT A PROBLEM AS DETERMINED BY THE ENGINEER. UTILIZE A LABORATORY REGULARLY INSPECTED BY THE CEMENT AND CONCRETE REFERENCE LABORATORY (CCRL) OF THE NATIONAL INSTITUTE OF STANDARDS AND TECHNOLOGY, OR OTHER APPROVED REFERENCE LABORATORY, TO PERFORM THE TESTING. BEFORE USE, SUBMIT DOCUMENTATION TO THE PROJECT ENGINEER CERTIFYING BOTH THE MACRO-SYNTHETIC FIBERS AND THE MIX MEET OR EXCEED THE REQUIRED PROPERTIES. SAMPLING WILL BE ALLOWED FOR TESTING PURPOSES. A DEMONSTRATION OF THE MIX PRODUCTION OR TRIAL MIX MAY BE REQUIRED BY THE ENGINEER PRIOR TO PLACING ANY OF THE MIX ON THE PROJECT.

THE BATCH WEIGHTS SHALL BE CORRECTED TO COMPENSATE FOR THE MOISTURE CONTAINED IN THE AGGREGATE AT THE TIME OF USE. A CHEMICAL ADMIXTURE (705.12, TYPE A OR D) SHALL BE USED. THE TRANSIT MIXER CHARGE SHALL BE LIMITED TO 3/4 OF ITS RATED CAPACITY OR 6 CUBIC YARDS, WHICHEVER IS SMALLER. THE FIRST THREE TRANSIT MIXER LOADS ARE REQUIRED TO BE AT THE MINIMUM YARDAGE LISTED ABOVE TO SHOW PROOF OF THE SUCCESSFUL BATCHING OPERATION. AFTER CONSISTENCY IN THE DELIVERED MATERIAL HAS BEEN ESTABLISHED, THE CONCRETE SUPPLIER MAY INCREASE THE BATCH DELIVERED QUANTITIES AS LONG AS THE QUALITY REMAINS ACCEPTABLE TO THE ENGINEER. THE ENGINEER CAN REDUCE THE BATCH LOAD SIZE AT ANY TIME AS NEEDED TO CORRECT/IMPROVE CONCRETE QUALITY.

**ITEM 511 - CLASS QC3 CONCRETE, MISC.: CLASS QC3 CONCRETE WITH QC/QA, SUPERSTRUCTURE BRIDGE RAILING (CONTINUED):**

CONCRETE SUPPLIERS SHOULD RECOGNIZE THAT THE CORROSION INHIBITOR AND ADMIXTURES MAY HAVE AN EFFECT ON STRENGTH, ENTRAINED AIR CONTENT, WORKABILITY, ETC. OF THEIR CONCRETE MIXES. THE CORROSION INHIBITOR IS SUGGESTED TO BE AN MCI PRODUCT BY CORTEC OR AN APPROVED EQUAL FROM THE QUALIFIED PRODUCTS LIST. THE CONCRETE SUPPLIER'S CHOICE OF ONE OF THESE CORROSION INHIBITORS DOES NOT ALLEVIATE MEETING DESIGN REQUIREMENTS. PLEASE BE ADVISED THAT SOME PRODUCTS ON THE LIST AFFECT THE DELIVERED MIX PROPERTIES GREATLY WHILE OTHER PRODUCTS DO NOT.

THIS LIGHTWEIGHT CONCRETE WILL ONLY BE USED ON THE SUPERSTRUCTURE RAILING AND NOT ON THE RAILINGS ON ANY APPROACH SLAB OR ABUTMENT BACKWALL. THE CONTRACTOR SHOULD BE ADVISED THAT CONCRETE RETARDING AGENTS MAY NEED TO BE ADDED TO OFFSET THE EFFECTS OF THE MIGRATING CORROSION INHIBITOR SELECTED.

**ITEM 514 - SURFACE PREPARATION OF EXISTING STEEL:**  
**ITEM 514 - FIELD PAINTING OF EXISTING STRUCTURAL STEEL, PRIME COAT, AS PER PLAN:**  
**ITEM 514 - FIELD PAINTING STRUCTURAL STEEL, INTERMEDIATE COAT, AS PER PLAN:**  
**ITEM 514 - FIELD PAINTING STRUCTURAL STEEL, FINISH COAT, AS PER PLAN:**

NO SPECIFIC AREAS HAVE BEEN DESIGNATED IN THE PLANS THAT WILL REQUIRE PAINTING. HOWEVER, AN ESTIMATED QUANTITY OF 100 SF HAS BEEN PROVIDED IF THE ENGINEER DETERMINES AN AREA REQUIRES PAINTING. THE CONTRACTOR MUST RECEIVE APPROVAL FROM THE ENGINEER BEFORE PERFORMING THIS WORK.

THE CONTRACTOR SHALL PROVIDE THE ENGINEER WITH ALL NECESSARY EQUIPMENT TO INSPECT THIS WORK.

EXISTING STEEL AREAS SHALL RECEIVE A PRIME, INTERMEDIATE, AND FINISH COAT APPLIED IN THE FIELD. PROPOSED STEEL, IF APPLICABLE, SHALL BE SHOP PRIMED AND RECEIVE AN INTERMEDIATE AND FINISH COAT APPLIED IN THE FIELD.

THE FINISH COAT SHALL MATCH THE EXISTING BEAM'S COLOR. OBTAIN THE ENGINEER'S APPROVAL OF PAINT COLOR BEFORE APPLYING FINISH COAT.

PRIOR TO THE START OF WORK ON THE STRUCTURE, THE CONTRACTOR SHALL DOCUMENT THE EXISTING CONDITION OF THE PAINTED STRUCTURE TO IDENTIFY AREAS PREVIOUSLY DAMAGED THAT ARE OUTSIDE THE LIMITS OF THE CURRENT PAY ITEMS. PAINTED AREAS THAT WERE NOT PREVIOUSLY DAMAGED THAT RECEIVE DAMAGE BY THE CONTRACTOR'S ACTIVITIES ONCE WORK BEGINS WILL BE REPAIRED AT THE CONTRACTOR'S COST.

**ITEM 519 - PATCHING CONCRETE STRUCTURES, AS PER PLAN:**

PRIOR TO THE SURFACE CLEANING SPECIFIED IN CMS 519.04 AND WITHIN 24 HOURS OF PLACING PATCHING MATERIAL, BLAST CLEAN ALL SURFACES TO BE PATCHED INCLUDING THE EXPOSED STEEL REINFORCEMENT. ACCEPTABLE METHODS INCLUDE HIGH-PRESSURE WATER BLASTING WITH OR WITHOUT ABRASIVES IN THE WATER, ABRASIVE BLASTING WITH CONTAINMENT, OR VACUUM ABRASIVE BLASTING.

**ITEM SPECIAL - STRUCTURES: SITE ACCESS:**

THIS ITEM SHALL INCLUDE ALL LABOR, MATERIAL, AND EQUIPMENT NECESSARY TO ACCESS THE BRIDGE, INCLUDING BUT NOT LIMITED TO, COORDINATION WITH THE RAILROAD(S) ON THEIR REQUIREMENTS OF A TEMPORARY GRADE CROSSING AT THEIR TRACKS, ANY CLEARING AND GRUBBING REQUIRED TO GAIN ACCESS THAT IS NOT ACCOUNTED FOR IN OTHER WORK ITEMS, AND THE INSTALLATION, MAINTENANCE, AND REMOVAL OF RAILROAD TEMPORARY GRADE CROSSINGS. THIS ITEM ALSO INCLUDES REPAIR OF OLD RED BANK ROAD TO BE DONE AS DIRECTED BY THE ENGINEER, AND THE REPLACEMENT OF ANY EXISTING ROAD FEATURES, TO THE SATISFACTION OF THE ENGINEER, THAT ARE DAMAGED DUE TO THE CONTRACTOR'S CHOSEN SITE ACCESS.

**ITEM 601 - CRUSHED AGGREGATE SLOPE PROTECTION, AS PER PLAN:**

WITH PRIOR APPROVAL OF THE ENGINEER, THE CONTRACTOR MAY REDRESS THE SLOPES WITH THE EXISTING CRUSHED AGGREGATE. WHERE ADDITIONAL MATERIAL IS REQUIRED, FURNISH AND PLACE CRUSHED AGGREGATE IN ACCORDANCE WITH CMS 601. AN ESTIMATED QUANTITY OF 100 SQUARE YARDS HAS BEEN INCLUDED FOR THIS WORK. ACTUAL QUANTITIES OF SLOPE TO BE REDRESSED AND NEW MATERIAL TO BE PLACED SHALL BE AS DIRECTED BY THE ENGINEER.

**ITEM 607 - VANDAL PROTECTION FENCE, 6' STRAIGHT, COATED FABRIC, AS PER PLAN:**

THE STANDARD DRAWING VPF-1-90 SHALL BE FOLLOWED CONCERNING THE VANDAL PROTECTION FENCE EXCEPT FOR THE FOLLOWING:

THE FABRIC SHALL CONSIST OF A 1 INCH DIAMOND MESH USING 0.148 INCH DIAMETER (9 GAGE) WIRE CONFORMING TO ASTM F668 CLASS 2A OR 2B.

**ITEM SPECIAL - AS-BUILT CONSTRUCTION PLANS:**

ALL NECESSARY CHANGES TO THE RAILROAD TRACK CLEARANCES (VERTICAL AND HORIZONTAL) AND DEPTH, SIZE, AND LOCATION OF FOUNDATION COMPONENTS MADE IN THE FIELD TO THIS CONSTRUCTION PLAN SHALL BE CAREFULLY DOCUMENTED AND PRESENTED TO EACH RAILROAD COMPANY AT THE CONCLUSION OF THE PROJECT. THEREFORE, STRICT ADHERENCE TO THE PLANS IS IN THE BEST INTEREST OF ALL PARTIES. HOWEVER, IF CHANGES MUST BE MADE IN THE FIELD, THE CONTRACTOR SHALL CAREFULLY AND CLEARLY RECORD THEM. AT THE CONCLUSION OF THE PROJECT, THE CONTRACTOR SHALL SUBMIT THESE CHANGES (IF ANY) TO THE PROJECT ENGINEER IN A DOCUMENT SIGNED, DATED, AND SEALED BY A REGISTERED PROFESSIONAL ENGINEER OR SURVEYOR IN THE STATE OF OHIO. THE PROJECT ENGINEER SHALL SUBMIT THE COMPLETED DOCUMENT TO EACH RAILROAD COMPANY.



ALL LABOR, MATERIALS, EQUIPMENT, AND OTHER INCIDENTALS NECESSARY TO PERFORM THIS WORK SHALL BE INCLUDED IN ITEM SPECIAL - AS-BUILT CONSTRUCTION PLANS FOR PAYMENT.

**ABBREVIATIONS:**


CONST.	CONSTRUCTION
DIA.	DIAMETER
DIM.	DIMENSION
E.F.	EACH FACE
EL.	ELEVATION
EX.	EXISTING
EXP.	EXPANSION
F.F.	FAR FACE
FIX.	FIXED
FT.	FOOT/FEET
H.P.	HIGH PRESSURE
INV.	INVERT
L.F.	LEFT FORWARD
LT.	LEFT
MAX.	MAXIMUM
MIN.	MINIMUM
N.F.	NEAR FACE
P.E.J.F.	PREFORMED EXPANSION JOINT FILLER
PT.	POINT
R.F.	RIGHT FORWARD
RT.	RIGHT
SPA.	SPACING/SPACES
STA.	STATION
TYP.	TYPICAL

SFN	3103811
DESIGN AGENCY	TRANSYSTEMS 1100 SUPERIOR AVE. E. STE 1000 CLEVELAND, OHIO 44114
DESIGNER	CHECKER
ZTW	RSB
REVIEWER	
NFF	08/22/23
PROJECT ID	110570
SUBSET	TOTAL
10	50
SHEET	TOTAL
P.124	208



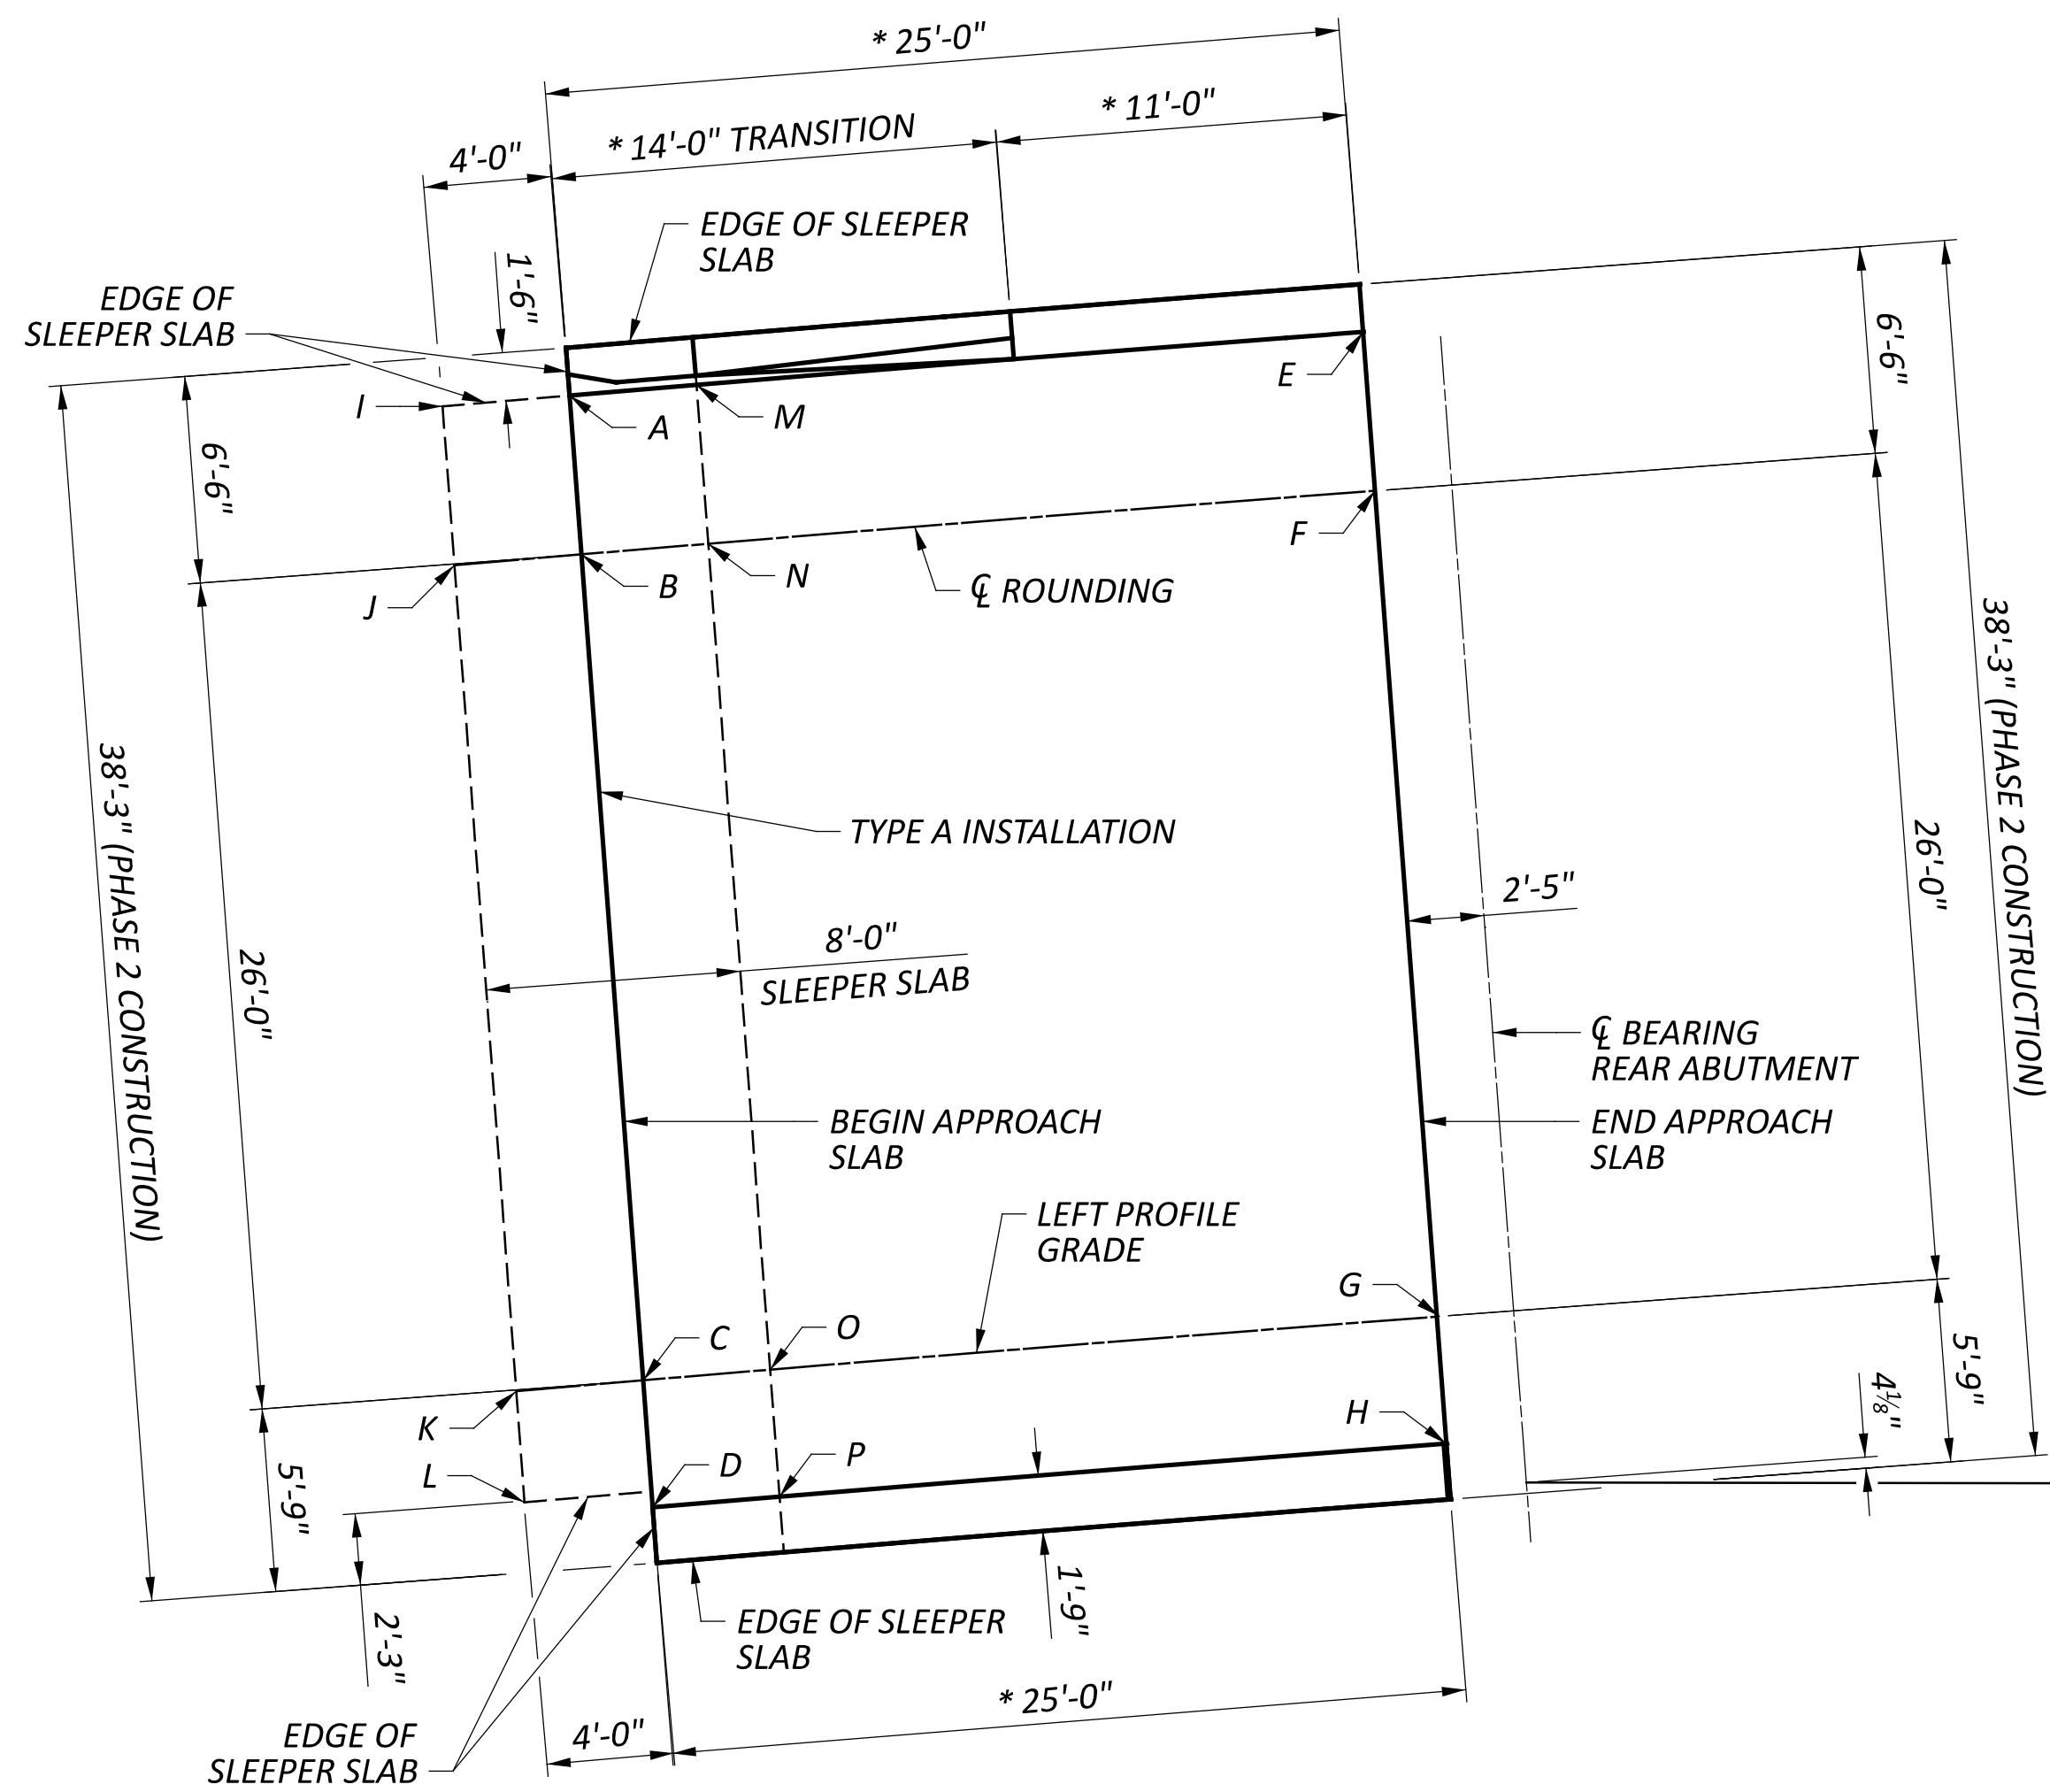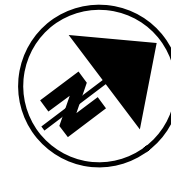

**LEFT BRIDGE REAR APPROACH SLAB PLAN**

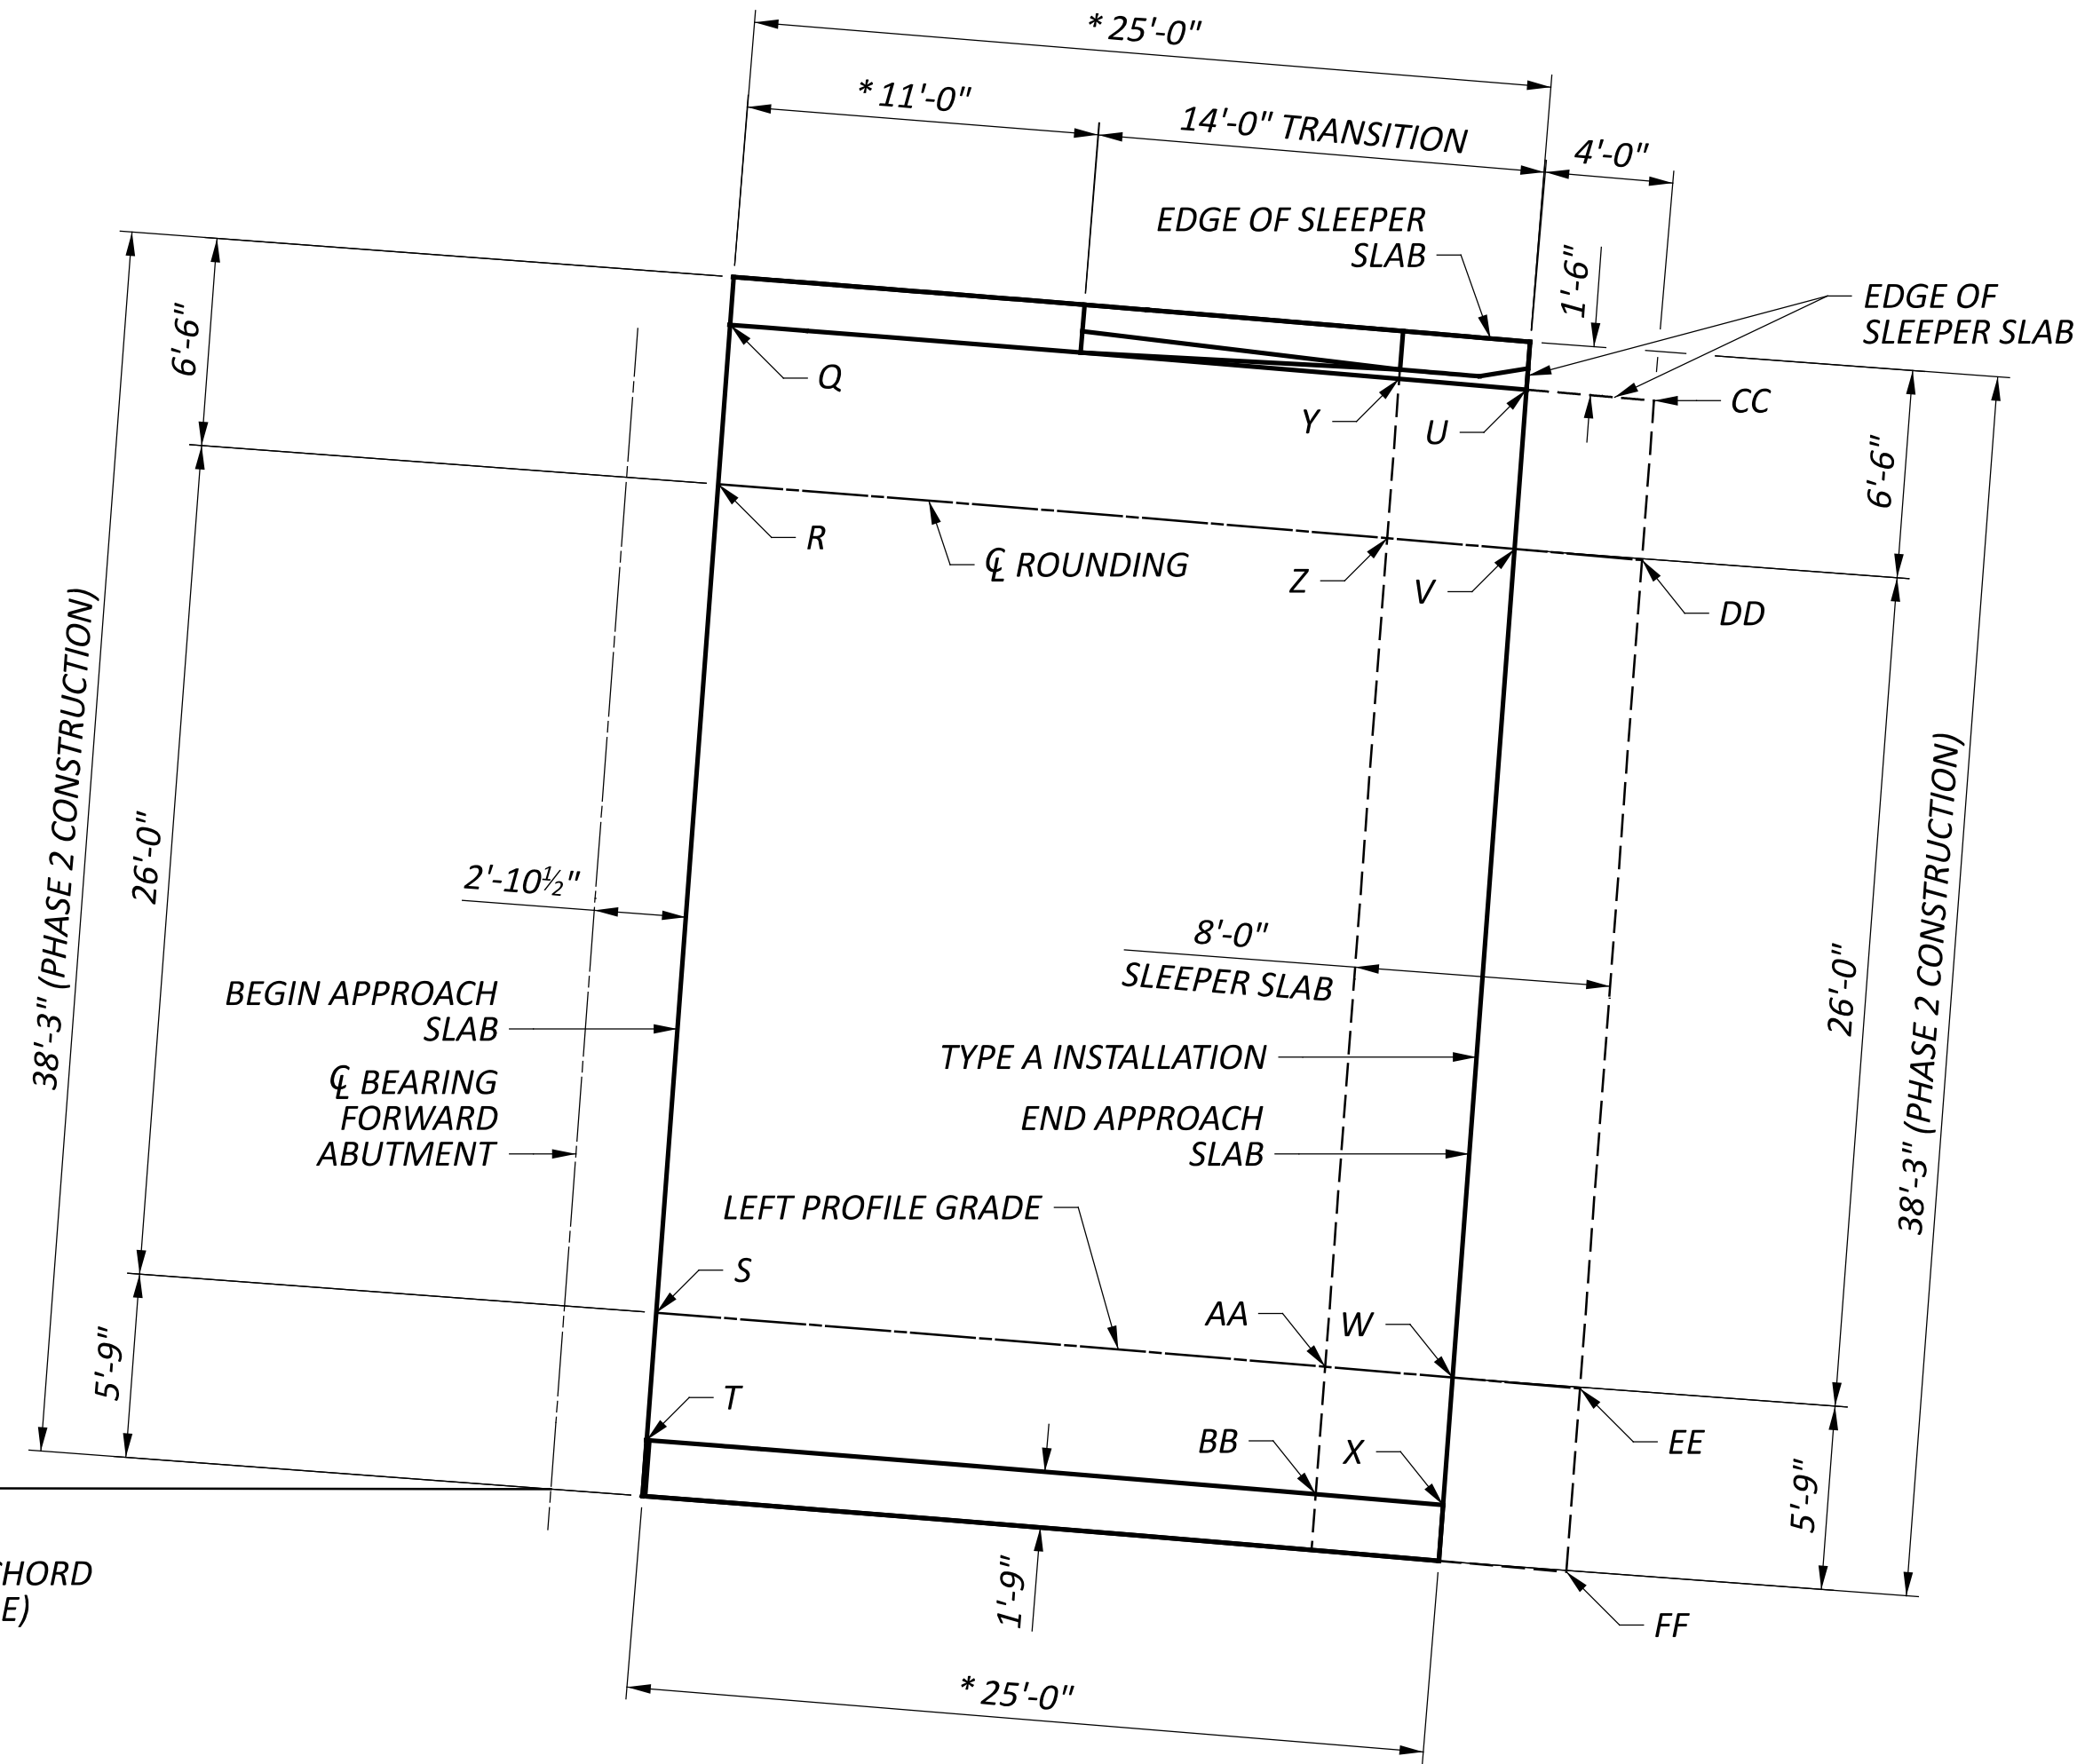

**LEFT BRIDGE FORWARD APPROACH SLAB PLAN**

REAR APPROACH SLAB LOCATIONS							
APPROACH SLAB SURFACE ELEVATIONS			SLEEPER SLAB ELEVATIONS				
STATION	OFFSET	ELEVATION	STATION	OFFSET	ELEVATION		
A	94+18.09	36.36' LT.	548.53	I	94+14.14	36.36' LT.	547.33
B	94+18.05	31.36' LT.	548.69	J	94+14.09	31.36' LT.	547.49
C	94+17.84	5.36' LT.	547.52	K	94+13.84	5.36' LT.	546.31
D	94+17.80	1.36' LT.	547.33	L	94+13.81	1.86' LT.	546.15
E	94+42.77	36.40' LT.	548.23	M	94+22.04	36.37' LT.	547.24
F	94+42.78	31.40' LT.	548.39	N	94+22.00	31.37' LT.	547.39
G	94+42.79	5.40' LT.	547.21	O	94+21.83	5.37' LT.	546.22
H	94+42.79	1.40' LT.	547.02	P	94+21.80	1.37' LT.	546.03

FORWARD APPROACH SLAB LOCATIONS							
APPROACH SLAB SURFACE ELEVATIONS			SLEEPER SLAB ELEVATIONS				
STATION	OFFSET	ELEVATION	STATION	OFFSET	ELEVATION		
Q	98+76.03	36.76' LT.	542.71	Y	98+96.77	36.76' LT.	541.18
R	98+76.05	31.76' LT.	542.86	Z	98+96.82	31.76' LT.	541.34
S	98+76.11	5.76' LT.	541.68	AA	98+97.07	5.76' LT.	540.16
T	98+76.12	1.76' LT.	541.50	BB	98+97.10	1.76' LT.	539.97
U	99+00.72	36.76' LT.	542.38	CC	99+04.67	36.76' LT.	541.08
V	99+00.77	31.76' LT.	542.53	DD	99+04.73	31.76' LT.	541.23
W	99+01.06	5.76' LT.	541.35	EE	99+05.05	5.76' LT.	540.05
X	99+01.10	1.76' LT.	541.16	FF	99+05.12	0.01' LT.	539.86

**LEGEND:**

\* MEASURED ALONG EDGE OF APPROACH SLAB


**NOTES:**

- FOR THE 25-FT. APPROACH SLAB REINFORCEMENT REQUIREMENTS AND ADDITIONAL STANDARD APPROACH SLAB DETAILS, SEE GENERAL NOTE ITEM 526 - REINFORCED CONCRETE APPROACH SLABS WITH QC/QA (T=15"), AS PER PLAN AND ODOT STANDARD DRAWING AS-1-15.
- FOR APPROACH SLAB TYPE A INSTALLATION REQUIREMENTS, SEE ODOT STANDARD DRAWING AS-2-15.
- FOR APPROACH SLAB RAILING DETAILS, SEE SHEETS 42 THROUGH 44 OF 50.
- FOR ROUNDING DETAIL, SEE SHEET 37 OF 50.


LEFT BRIDGE APPROACH SLAB  
 BRIDGE NO. HAM-00050-29.100  
 US-50 OVER NSRR, IORY, DUCK CREEK, & RED BANK ROAD

SFN	3103811
DESIGN AGENCY	TRANSYSTEMS
DESIGNER	GJZ
CHECKER	TOR
REVIEWER	NFF
PROJECT ID	110570
SUBSET	46
TOTAL	50
SHEET	P.160
TOTAL	208



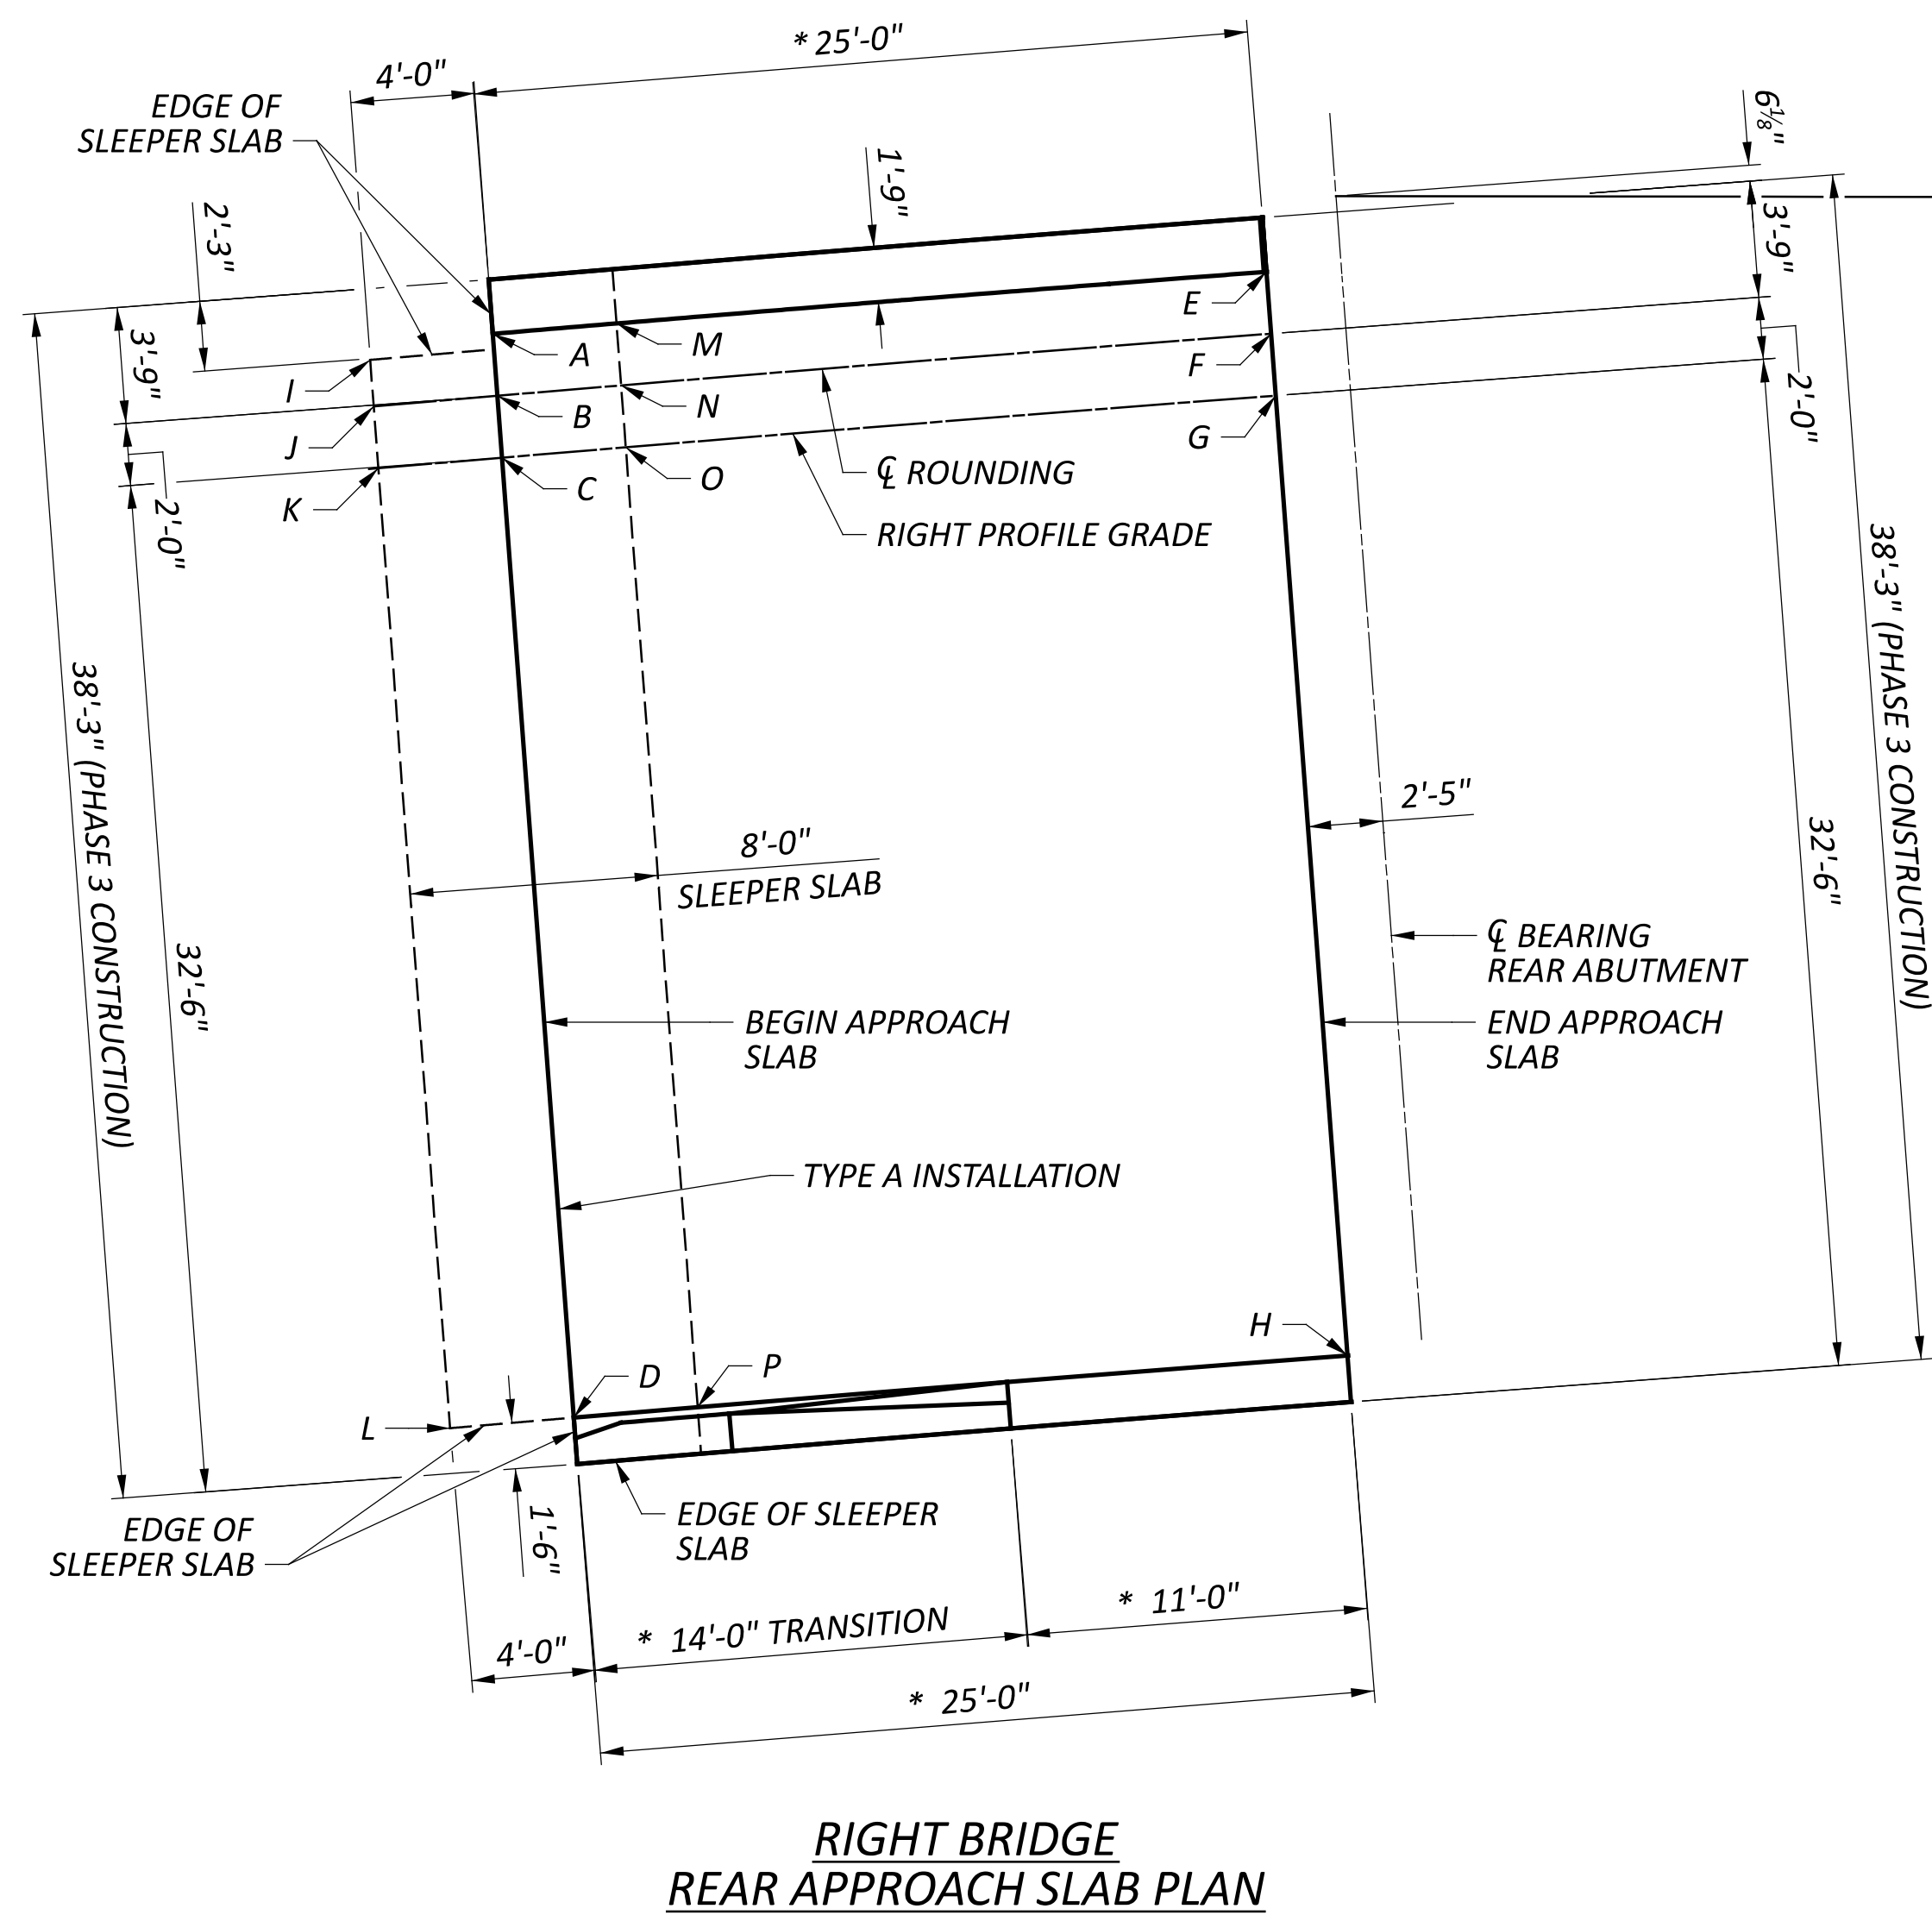

RIGHT BRIDGE  
REAR APPROACH SLAB PLAN

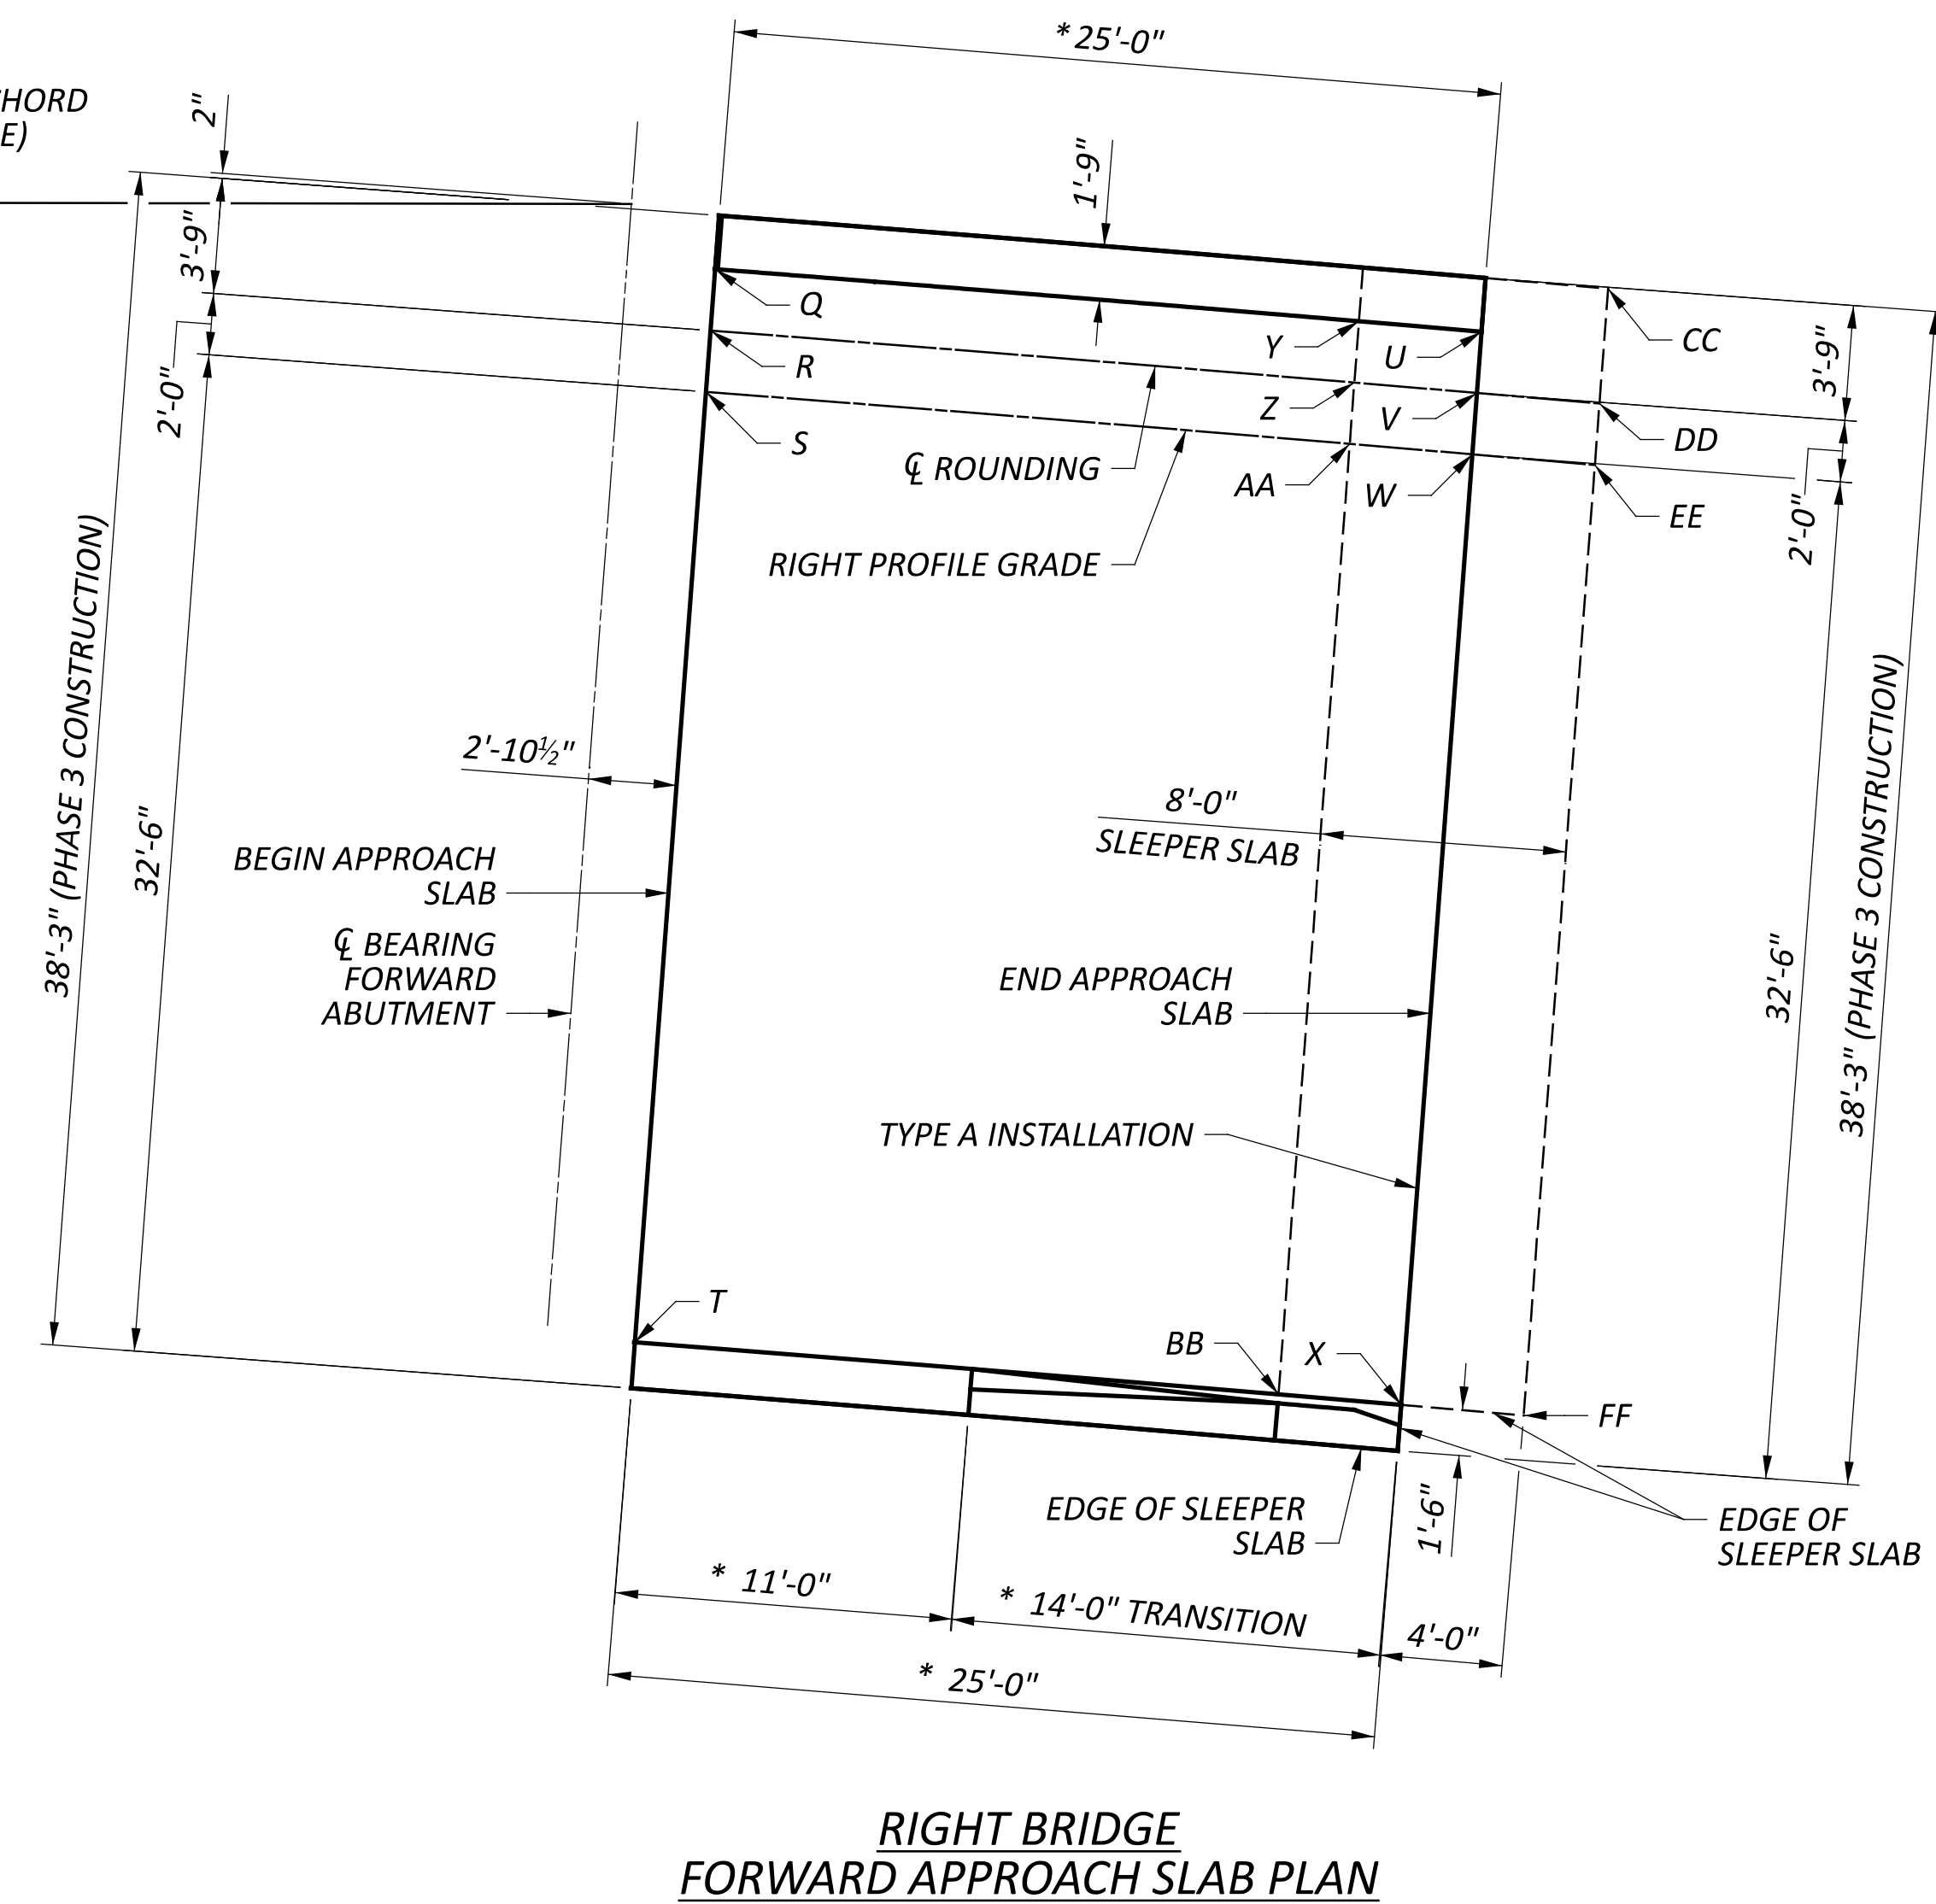

RIGHT BRIDGE  
FORWARD APPROACH SLAB PLAN

**LEGEND:**

\* MEASURED ALONG EDGE OF APPROACH SLAB

**NOTES:**

- FOR THE 25-FT. APPROACH SLAB REINFORCEMENT REQUIREMENTS AND ADDITIONAL STANDARD APPROACH SLAB DETAILS, SEE GENERAL NOTE ITEM 526 - REINFORCED CONCRETE APPROACH SLABS WITH QC/QA (T=15"), AS PER PLAN AND ODOT STANDARD DRAWING AS-1-15.
- FOR APPROACH SLAB TYPE A INSTALLATION REQUIREMENTS, SEE ODOT STANDARD DRAWING AS-2-15.
- FOR APPROACH SLAB RAILING DETAILS, SEE SHEETS 42 THROUGH 44 OF 50.
- FOR ROUNDING DETAIL, SEE SHEET 37 OF 50.

**REAR APPROACH SLAB LOCATIONS**

APPROACH SLAB SURFACE ELEVATIONS			SLEEPER SLAB ELEVATIONS				
STATION	OFFSET	ELEVATION	STATION	OFFSET	ELEVATION		
A	94+17.77	2.30' RT.	547.05	I	94+13.77	2.81' RT.	545.86
B	94+17.76	4.30' RT.	547.08	J	94+13.75	4.31' RT.	545.88
C	94+17.74	6.30' RT.	547.03	K	94+13.73	6.31' RT.	545.83
D	94+17.48	37.30' RT.	545.58	L	94+13.43	37.31' RT.	544.38
E	94+42.79	2.27' RT.	546.75	M	94+21.78	2.30' RT.	545.75
F	94+42.80	4.27' RT.	546.78	N	94+21.76	4.30' RT.	545.79
G	94+42.80	6.27' RT.	546.73	O	94+21.75	6.30' RT.	545.73
H	94+42.81	37.27' RT.	545.28	P	94+21.54	37.30' RT.	544.28

**FORWARD APPROACH SLAB LOCATIONS**

APPROACH SLAB SURFACE ELEVATIONS			SLEEPER SLAB ELEVATIONS				
STATION	OFFSET	ELEVATION	STATION	OFFSET	ELEVATION		
Q	98+76.13	1.91' RT.	541.16	Y	98+97.14	1.91' RT.	539.62
R	98+76.13	3.91' RT.	541.19	Z	98+97.16	3.91' RT.	539.65
S	98+76.14	5.91' RT.	541.14	AA	98+97.18	5.91' RT.	539.60
T	98+76.21	36.91' RT.	539.69	BB	98+97.48	36.91' RT.	538.14
U	99+01.14	1.91' RT.	540.81	CC	99+05.12	0.16' RT.	539.50
V	99+01.16	3.91' RT.	540.85	DD	99+05.17	3.91' RT.	539.54
W	99+01.19	5.91' RT.	540.80	EE	99+05.20	5.91' RT.	539.49
X	99+01.54	36.91' RT.	539.33	FF	99+05.59	36.91' RT.	538.03



**STRUCTURE GENERAL NOTES**

REFER TO THE FOLLOWING STANDARD BRIDGE DRAWINGS:

AS-1-15	REVISED	01-20-2023
AS-2-15	REVISED	07-21-2023
PCB-91	REVISED	07-17-2020
SBR-1-20	REVISED	07-21-2023
SBR-2-20	REVISED	07-21-2023
SICD-2-14	REVISED	01-15-2021

AND TO THE FOLLOWING SUPPLEMENTAL SPECIFICATION:  
 800 DATED 10-20-2023

**DESIGN SPECIFICATIONS:**

THIS STRUCTURE CONFORMS TO THE REQUIREMENTS OF THE 9TH EDITION OF THE "LRFD BRIDGE DESIGN SPECIFICATIONS" ADOPTED BY THE AMERICAN ASSOCIATION OF STATE HIGHWAY AND TRANSPORTATION OFFICIALS, 2020 AND THE ODOT BRIDGE DESIGN MANUAL, 2020.

**OPERATIONAL IMPORTANCE:**

A LOAD MODIFIER OF 1.00 HAS BEEN ASSUMED FOR THE DESIGN OF THIS STRUCTURE IN ACCORDANCE WITH THE AASHTO LRFD BRIDGE DESIGN SPECIFICATIONS, ARTICLE 1.3.5 AND THE ODOT BRIDGE DESIGN MANUAL.

**DESIGN LOADING:**

DECK:	VEHICULAR LIVE LOAD: HL-93 FUTURE WEARING SURFACE (FWS) OF 0.00KSF
SUPERSTRUCTURE:	EXISTING BEAMS - AS LOAD RATED, VEHICULAR LIVE LOAD: HL-93 FUTURE WEARING SURFACE (FWS) OF 0.00KSF
SUBSTRUCTURE:	EXISTING SUBSTRUCTURE VEHICULAR LIVE LOAD: CF 2000 (57) FUTURE WEARING SURFACE (FWS) OF 0.00KSF
FOUNDATIONS:	EXISTING FOUNDATIONS VEHICULAR LIVE LOAD: CF 2000 (57) FUTURE WEARING SURFACE (FWS) OF 0.00KSF

**DESIGN DATA:**

- CONCRETE CLASS QC3 - COMPRESSIVE STRENGTH 4.5 KSI (SUPERSTRUCTURE)
- CONCRETE CLASS QC1 - COMPRESSIVE STRENGTH 4.0 KSI (SUBSTRUCTURE)
- CONCRETE REINFORCEMENT: GALVANIZED STEEL REINFORCEMENT - MINIMUM YIELD STRENGTH 60 KSI (DECK, BRIDGE RAILING, DIAPHRAGM, WINGWALLS, APPROACH SLABS)
- GFRP REINFORCEMENT (BRIDGE RAILING)
- STRUCTURAL STEEL - ASTM A709 GRADE 50 - YIELD STRENGTH 50 KSI

**MONOLITHIC WEARING SURFACE:**

MONOLITHIC WEARING SURFACE IS ASSUMED, FOR DESIGN PURPOSES, TO BE 1-INCH THICK.

**PROTECTION OF TRAFFIC:**

PRIOR TO DEMOLITION OF ANY PORTIONS OF THE EXISTING SUPERSTRUCTURE AND SUBSTRUCTURE, SUBMIT PLANS FOR THE PROTECTION OF VEHICULAR TRAFFIC ADJACENT TO AND/OR UNDER THE STRUCTURE TO THE ENGINEER AT LEAST 30 DAYS BEFORE DEMOLITION BEGINS. THESE PLANS SHALL INCLUDE PROVISIONS FOR ANY DEVICES AND STRUCTURES THAT WILL BE NECESSARY TO ENSURE SUCH PROTECTION. ALL COSTS ASSOCIATED WITH THIS TRAFFIC PROTECTION WILL BE INCLUDED WITH ITEM 202 FOR PAYMENT.

**MAINTENANCE OF TRAFFIC:**

FOR MAINTENANCE OF TRAFFIC NOTES, PERMITTED LANE CLOSURES AND DETAILS, REFER TO MAINTENANCE OF TRAFFIC PLANS.

**EXISTING STRUCTURE PLANS:**

CONSTRUCTION PLANS FOR THE EXISTING BRIDGE ARE ON FILE AT THE OHIO DEPARTMENT OF TRANSPORTATION, DISTRICT 8 OFFICE, 505 S. STATE ROUTE 741, LEBANON, OH 45036 AND ARE AVAILABLE FOR REFERENCE. EXISTING PLANS HAVE BEEN INCLUDED IN THE REFERENCE FOLDER ON THE OFFICE OF CONTRACTS WEB PAGE FOR DOWNLOAD.

**EXISTING STRUCTURE VERIFICATION:**

DETAILS AND DIMENSIONS SHOWN ON THESE PLANS PERTAINING TO THE EXISTING STRUCTURE HAVE BEEN OBTAINED FROM PLANS OF THE EXISTING STRUCTURE AND FROM FIELD OBSERVATIONS AND MEASUREMENTS. CONSEQUENTLY, THEY ARE INDICATIVE OF THE EXISTING STRUCTURE AND THE PROPOSED WORK BUT THEY SHALL BE CONSIDERED TENTATIVE AND APPROXIMATE. THE CONTRACTOR IS REFERRED TO CMS SECTIONS 102.05, 105.02, AND 513.04. BASE CONTRACT BID PRICES UPON A RECOGNITION OF THE UNCERTAINTIES DESCRIBED ABOVE AND UPON A PREBID EXAMINATION OF THE EXISTING STRUCTURE. HOWEVER, THE DEPARTMENT WILL PAY FOR ALL PROJECT WORK BASED UPON ACTUAL DETAILS AND DIMENSIONS THAT HAVE BEEN VERIFIED IN THE FIELD.

**DECK PLACEMENT DESIGN ASSUMPTIONS:**

THE FOLLOWING ASSUMPTIONS OF CONSTRUCTION MEANS AND METHODS WERE MADE FOR THE ANALYSIS AND DESIGN OF THE SUPERSTRUCTURE. THE CONTRACTOR IS RESPONSIBLE FOR THE DESIGN OF THE FALSEWORK SUPPORT SYSTEM WITHIN THESE PARAMETERS AND WILL ASSUME RESPONSIBILITY FOR SUPERSTRUCTURE ANALYSIS FOR DEVIATION FROM THESE DESIGN ASSUMPTIONS.

AN EIGHT WHEEL FINISHING MACHINE WITH A MAXIMUM WHEEL LOAD OF 2.58 KIPS FOR THE LEFT AND RIGHT BRIDGES.


A MINIMUM OUT-TO-OUT WHEEL SPACING AT EACH END OF THE MACHINE OF 103 INCHES.

A MAXIMUM SPACING OF OVERHANG FALSEWORK BRACKETS OF 48 INCHES.

A MAXIMUM DISTANCE FROM THE CENTERLINE OF THE FASCIA BEAM TO THE FACE OF THE SAFETY HANDRAIL OF 65 INCHES.

THE EXISTING BEAMS REQUIRE LATERAL RESTRAINT DURING THE DECK POURING OPERATION AT THE CENTERLINE OF ABUTMENT BEARINGS IF THE DIAPHRAGM CONCRETE ENCASES THE BEAM ENDS IS PLACED CONCURRENTLY WITH THE DECK CONCRETE. THE CONTRACTOR SHALL PROVIDE A MEANS OF TEMPORARILY BRACING THE EXISTING BEAMS TO PREVENT ROTATION, SLIDING, TIPPING, OR OTHER MOVEMENT THAT MAY RESULT FROM THE DECK POURING OPERATION IN A MANNER SATISFACTORY TO THE ENGINEER. SUBMIT SEALED CONSTRUCTION PLANS AND CALCULATIONS FOR THE BEAM RESTRAINT PER CMS 501.05.

THE LEFT AND RIGHT BRIDGES REQUIRE TEMPORARY TIMBER BLOCKING OF THE EXISTING EXTERIOR BEAM BOTTOM FLANGE TO PREVENT ROTATION DURING DECK PLACEMENT. THE LOCATIONS OF THE TEMPORARY TIMBER BLOCKING ARE SHOWN ON THE LEFT AND RIGHT BRIDGE FRAMING PLAN, SHEETS 21 AND 22 OF 44, RESPECTIVELY. SEE TEMPORARY TIMBER BLOCKING DETAIL BELOW FOR ADDITIONAL DETAILS.

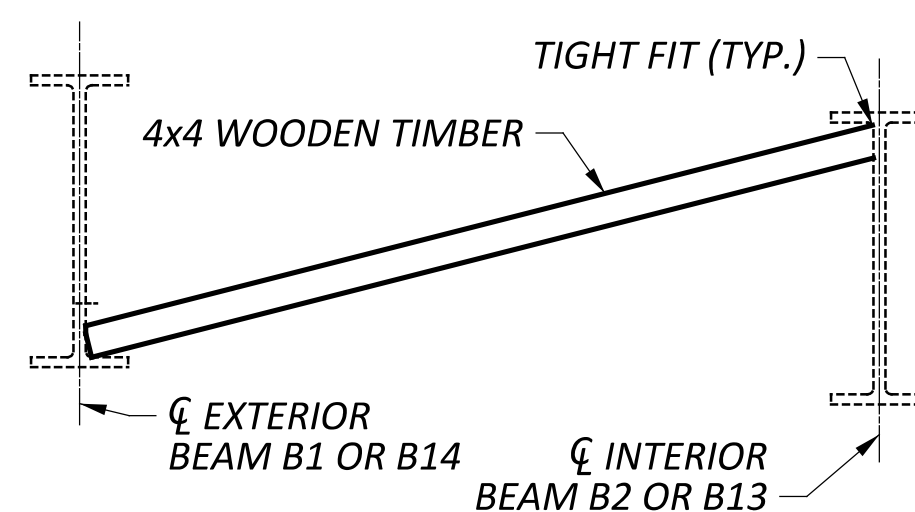

**TEMPORARY TIMBER BLOCKING DETAIL**  
 (LEFT BRIDGE SHOWN, RIGHT BRIDGE SIMILAR)

ALL MATERIAL, LABOR, AND EQUIPMENT NECESSARY TO PROVIDE RESTRAINT OF THE EXISTING BEAMS AT THE  $\phi$  OF ABUTMENT BEARING DURING DECK PLACEMENT, AS WELL AS TEMPORARY TIMBER BLOCKING AS SHOWN IN THE PLANS, SHALL BE INCLUDED WITH ITEM 511 - CLASS QC3 CONCRETE, MISC.: CLASS QC3 CONCRETE WITH QC/QA, BRIDGE DECK FOR PAYMENT.

**NON-USE OF ASBESTOS-CONTAINING MATERIALS:**

THE CONTRACTOR SHALL AT NO TIME INCORPORATE ANY MATERIALS WHICH ARE COMPOSED OF OR CONTAIN ANY AMOUNTS OF ASBESTOS. THE SUBSTITUTION OF MATERIALS WHICH CONTAIN ANY AMOUNTS OF ASBESTOS WILL IN NO CIRCUMSTANCES BE ACCEPTABLE. UPON COMPLETION OF THE PROJECT, THE CONTRACTOR SHALL SUBMIT A WRITTEN STATEMENT OF CERTIFICATION ASSERTING THAT NO ASBESTOS CONTAINING MATERIALS WERE USED IN ANY PORTION OF THE CONSTRUCTION.

**ITEM 202 - PORTIONS OF STRUCTURE REMOVED, OVER 20 FOOT SPAN, AS PER PLAN:**

DESCRIPTION:  
 THIS WORK CONSISTS OF THE REMOVAL OF CONCRETE DECKS INCLUDING CONCRETE BRIDGE RAILINGS, DECK JOINTS, BEARINGS, EXISTING UTILITY LINES, AND OTHER APPURTENANCES FROM STEEL SUPPORTING SYSTEMS (BEAMS, END CROSS-FRAMES, SCUPPERS, ETC.) THIS ITEM INCLUDES TAKING SURVEY SHOTS OF THE BEAM FLANGES BEFORE AND AFTER DECK REMOVAL AND CALCULATING THE REQUIRED ITEMS TO DETERMINE THE SCREED AND TOP OF HAUNCH ELEVATIONS. IT SHALL ALSO INCLUDE THE REMOVAL OF ABUTMENT BACKWALLS, PORTIONS OF THE WINGWALLS, POROUS BACKFILL, PLUGGING OF WEEPHOLES, AND OTHER APPURTENANCES AS SHOWN IN THE PLANS. THE PROVISIONS OF ITEM 202 APPLY EXCEPT AS SPECIFIED BY THE FOLLOWING NOTES. PERFORM WORK CAREFULLY DURING DECK REMOVALS TO PROTECT PORTIONS OF SUCH SYSTEMS THAT ARE TO BE SALVAGED AND INCORPORATED INTO THE PROPOSED STRUCTURE. THE DEPARTMENT WILL NOT PERMIT THE USE OF EXPLOSIVES, HEADACHE BALLS, AND/OR HOE RAM TYPE OF EQUIPMENT IS PROHIBITED. SUBMIT CONSTRUCTION PLANS ACCORDING TO CMS 501.05.

MAXIMUM REMOVAL LIMITS:  
 SOUND THE CONCRETE TO DETERMINE THE LIMITS OF THE CONCRETE TO BE REMOVED AND COMPARE THESE LIMITS TO THE AREAS SHOWN IN THE PLANS. IF NEW AREAS ARE DISCOVERED OR IF THE DIMENSIONS OF THE PLAN AREAS INCREASE BY MORE THAN 25% IN ANY DIRECTION, DOCUMENT THE AREAS AND NOTIFY THE ENGINEER FOR EVALUATION TWO WEEKS PRIOR TO REMOVAL. THE ENGINEER WILL DETERMINE IF PATCHING IN DISCRETE SECTIONS/STAGES IS NEEDED OR IF THE INSTALLATION OF TEMPORARY FALSEWORK IS REQUIRED.

PROTECTION OF STEEL SUPPORT SYSTEMS:  
 BEFORE DECK SLAB CUTTING BEGINS, DRAW THE OUTLINE OF PRIMARY STEEL MEMBERS IN CONTACT WITH THE BOTTOM OF THE DECK ON THE SURFACE OF THE DECK. DRILL SMALL DIAMETER PILOT HOLES 2 INCHES OUTSIDE THESE LINES TO CONFIRM THE LOCATION OF FLANGE EDGES. DECK CUTS OVER OR WITHIN 2 INCHES OF FLANGE EDGES SHALL NOT EXTEND LOWER THAN THE BOTTOM LAYER OF CONCRETE REINFORCEMENT IN THE DECK SLAB. CUTS MADE OUTSIDE 2 INCHES OF FLANGE EDGES MAY EXTEND THE FULL DEPTH OF THE DECK. PERFORM WORK CAREFULLY DURING CUTTING OF THE DECK SLAB TO AVOID DAMAGING STEEL MEMBERS THAT ARE TO THE PROPOSED STRUCTURE. REPLACE OR REPAIR STEEL MEMBERS DAMAGED BY THE DECK SLAB CUTTING OPERATIONS AT NO COST TO THE PROJECT. AT LEAST 7 DAYS BEFORE PERFORMING REPAIR WORK, SUBMIT A PROPOSED REPAIR PLAN, DEVELOPED BY AN OHIO REGISTERED PROFESSIONAL ENGINEER, TO THE ENGINEER. OBTAIN THE ENGINEER'S APPROVAL BEFORE PERFORMING REPAIR.

EXISTING WELDED ATTACHMENTS:  
 REMOVE EXISTING WELDED ATTACHMENTS (E.G., FINISHING MACHINE AND FORM SUPPORTS); AND SUPPORTS FOR SCUPPERS WHICH ARE TO BE REMOVED) LOCATED IN THE DESIGNATED TENSION PORTIONS OF THE TOP FLANGES OF EXISTING STEEL MEMBERS AND GRIND THE FLANGE SURFACES SMOOTH. CAREFULLY GRIND PARALLEL TO THE FLANGES.

REMOVAL METHODS:  
 THE CONTRACTOR MAY REMOVE CONCRETE BY CUTTING AND BY MEANS OF HAND OPERATED PNEUMATIC HAMMERS EMPLOYING POINTED OR BLUNTED CHISEL TYPE TOOLS. FOR REMOVALS OVER STRUCTURAL MEMBERS (STEEL BEAMS, STEEL GIRDER, ETC.), THE CONTRACTOR MAY USE A HAMMER HEAVIER THAN 35 POUNDS BUT NOT TO EXCEED 90 POUNDS UNLESS APPROVED BY THE ENGINEER. REMOVAL METHODS OVER STRUCTURAL MEMBERS SHALL ENSURE ADEQUATE DEPTH CONTROL AND PREVENT NICKING OR GOUGING THE PRIMARY STRUCTURAL MEMBERS. DUE TO THE POSSIBLE PRESENCE OF ATTACHMENTS (E.G., FINISHING MACHINE, SCUPPER AND FORM SUPPORTS, ETC.) TO EXISTING STRUCTURAL MEMBERS, PERFORM WORK CAREFULLY DURING DECK REMOVAL TO AVOID DAMAGING STRUCTURAL MEMBERS THAT ARE TO REMAIN. REPLACE OR REPAIR STRUCTURAL MEMBERS DAMAGED BY THE REMOVAL OPERATIONS AT NO COST TO THE PROJECT. AT LEAST 7 DAYS BEFORE PERFORMING REPAIR WORK, SUBMIT A PROPOSED REPAIR PLAN, DEVELOPED BY AN OHIO REGISTERED PROFESSIONAL ENGINEER TO THE ENGINEER. OBTAIN THE ENGINEER'S APPROVAL BEFORE PERFORMING REPAIR.

CUT LINE CONSTRUCTION JOINT PREPARATION:  
 SAW CUT BOUNDARIES OF PROPOSED CONCRETE REMOVALS 1 INCH DEEP. REMOVE CONCRETE TO A ROUGH SURFACE. LEAVE THE EXISTING CONCRETE REINFORCEMENT, IF REQUIRED IN THE PLANS, IN PLACE. INSTALL DOWEL BARS IF SPECIFIED. PRIOR TO CONCRETE PLACEMENT, ABRASIVELY CLEAN JOINT SURFACES AND EXISTING EXPOSED REINFORCEMENT TO REMOVE LOOSE AND DISINTEGRATED CONCRETE AND LOOSE RUST. THOROUGHLY CLEAN THE JOINT SURFACE AND EXPOSED REINFORCEMENT OF ALL DIRT, DUST, RUST OR OTHER FOREIGN MATERIAL BY THE USE OF WATER, AIR UNDER PRESSURE, OR OTHER METHODS THAT PRODUCE SATISFACTORY RESULTS. EXISTING STEEL REINFORCEMENT DOES NOT HAVE TO HAVE A BRIGHT STEEL FINISH BUT REMOVE ALL PACK AND LOOSE RUST. THOROUGHLY DRENCH EXISTING CONCRETE SURFACES WITH CLEAN WATER AND ALLOW TO DRY TO A DAMP CONDITION BEFORE PLACING CONCRETE.

**ITEM 202 - PORTIONS OF STRUCTURE REMOVED, OVER 20 FOOT SPAN, AS PER PLAN (CONTINUED):**

SUBSTRUCTURE CONCRETE REMOVAL:  
 REMOVE CONCRETE BY MEANS OF APPROVED PNEUMATIC HAMMERS EMPLOYING POINTED AND BLUNT CHISEL TOOLS. THE DEPARTMENT WILL NOT PERMIT HYDRAULIC HOE-RAM TYPE HAMMERS. THE WEIGHT OF THE HAMMER SHALL NOT BE MORE THAN 35 POUNDS FOR REMOVAL WITHIN 18 INCHES OF PORTIONS TO BE PRESERVED. OUTSIDE THE 18 INCH LIMIT, THE CONTRACTOR MAY USE HAMMERS NOT EXCEEDING 90 POUNDS UPON THE APPROVAL OF THE ENGINEER. DO NOT PLACE PNEUMATIC HAMMERS IN DIRECT CONTACT WITH CONCRETE REINFORCEMENT THAT IS TO BE RETAINED IN THE REBUILT STRUCTURE.

PLUGGING EXISTING WEEPHOLES:  
 THE EXISTING WEEPHOLES SHALL BE FLUSHED OUT TO REMOVE ANY LOOSE DEBRIS AND FILLED ENTIRELY WITH CLASS QC1 CONCRETE AS PER ITEM 499.

MEASUREMENT & PAYMENT:  
 THE DEPARTMENT WILL MEASURE THE QUANTITY OF REMOVALS ON A LUMP SUM BASIS. THE DEPARTMENT WILL PAY FOR THE ACCEPTED QUANTITIES OF REMOVAL AT THE CONTRACT PRICE FOR ITEM 202 - PORTIONS OF STRUCTURE REMOVED, OVER 20 FOOT SPAN, AS PER PLAN.

**ITEM 202 - REMOVAL MISC.: PORTION OF STRUCTURE REMOVED, BULB ANGLE, AS PER PLAN:**

THIS WORK CONSISTS OF REMOVING IN ITS ENTIRETY THE EXISTING BULB ANGLES THAT WERE CAST INTO THE DECK WHEN THE EXISTING DECK WAS CONSTRUCTED. THE USE OF EXPLOSIVES, HEADACHE BALLS, AND/OR HOE-RAMS WILL NOT BE PERMITTED. THE METHOD OF REMOVAL AND THE WEIGHT OF HAMMER SHALL BE APPROVED BY THE ENGINEER. PERFORM ALL WORK IN A MANNER THAT WILL NOT CUT, ELONGATE, OR DAMAGE THE STRUCTURAL STEEL TO BE PRESERVED. CHIPPING HAMMERS SHALL NOT BE HEAVIER THAN THE NOMINAL 90-POUND CLASS. SUBMIT CONSTRUCTION PLANS ACCORDING TO CMS 501.05.

EXISTING WELDED ATTACHMENTS:  
 GRIND THE FLANGE SURFACES SMOOTH WHERE THE EXISTING WELDED BULB ANGLE ATTACHES TO THE FLANGES LOCATED IN THE DESIGNATED TENSION PORTIONS OF THE TOP FLANGES OF EXISTING STEEL MEMBERS.

MEASUREMENT & PAYMENT:  
 THE DEPARTMENT WILL MEASURE THE QUANTITY OF REMOVALS ON A LINEAR FOOT BASIS. THE DEPARTMENT WILL PAY FOR THE ACCEPTED QUANTITIES OF REMOVAL AT THE CONTRACT PRICE FOR ITEM 202 - REMOVAL MISC.: PORTION OF STRUCTURE REMOVED, BULB ANGLE, AS PER PLAN.

**ITEM 503 - COFFERDAMS AND EXCAVATION BRACING, AS PER PLAN (TEMPORARY WALL 1):**  
**ITEM 503 - COFFERDAMS AND EXCAVATION BRACING, AS PER PLAN (TEMPORARY WALL 2):**

THIS ITEM SHALL INCLUDE THE INSTALLATION AND REMOVAL OF THE TEMPORARY WALLS AS SHOWN IN THE PLANS.

THE DESIGN SHOWN ON THE PLANS FOR TEMPORARY SUPPORT OF EXCAVATION IS ONE REPRESENTATIVE DESIGN THAT MAY BE USED TO CONSTRUCT THE PROJECT. THE CONTRACTOR MAY CONSTRUCT THE DESIGN SHOWN ON THE PLANS OR PREPARE AN ALTERNATE DESIGN TO SUPPORT THE SIDES OF EXCAVATIONS. IF CONSTRUCTING AN ALTERNATE DESIGN FOR TEMPORARY SUPPORT OF EXCAVATION, PREPARE AND PROVIDE PLANS IN ACCORDANCE WITH CMS 501.05. THE DEPARTMENT WILL PAY FOR THE TEMPORARY SUPPORT OF EXCAVATION AT THE CONTRACT LUMP SUM PRICE BID FOR COFFERDAMS AND EXCAVATION BRACING. THE DEPARTMENT WILL NOT MAKE ADDITIONAL PAYMENT FOR PROVIDING AN ALTERNATE DESIGN.

**ITEM 503 - UNCLASSIFIED EXCAVATION, AS PER PLAN:**

UNCLASSIFIED EXCAVATION SHALL BE IN ACCORDANCE WITH PERTINENT SECTIONS OF CMS SECTION 503 AND SHALL INCLUDE THE EXCAVATION AND BACKFILLING REQUIRED TO CONSTRUCT THE NEW PORTIONS OF THE ABUTMENT DIAPHRAGMS AND WINGWALLS. EXCAVATION AND BACKFILLING FOR SUBSTRUCTURE REMOVAL AND STRUCTURE DRAINAGE SHALL BE INCLUDED WITH RESPECTIVE ITEMS 202 AND 518.

SFN	3103870
DESIGN AGENCY	TRANSYSTEMS 1100 SUPERIOR AVE. E. STE 1000 CLEVELAND, OHIO 44114
DESIGNER	CHECKER
ZTW	RSB
REVIEWER	
NFF	08/22/23
PROJECT ID	110570
SUBSET	TOTAL
3	44
SHEET	TOTAL
P.167	208



**ITEM 509 - CONCRETE REINFORCEMENT, REPLACEMENT OF EXISTING CONCRETE REINFORCEMENT, AS PER PLAN:**

REPLACE ALL EXISTING REINFORCING BARS DEEMED BY THE ENGINEER TO BE UNUSABLE BECAUSE OF CORROSION. THE DEPARTMENT WILL MEASURE THE REPLACEMENT CONCRETE REINFORCEMENT BY THE NUMBER OF POUNDS ACCEPTED IN PLACE. REPLACE ALL EXISTING STEEL REINFORCEMENT BARS WHICH ARE TO BE INCORPORATED INTO THE NEW WORK AND ARE DEEMED BY THE ENGINEER TO BE MADE UNUSABLE BY CONCRETE REMOVAL OPERATIONS WITH NEW CONCRETE REINFORCEMENT OF THE SAME SIZE, COATING, AND MATERIAL AT NO COST TO THE DEPARTMENT. AN ESTIMATED QUANTITY OF 100 POUNDS HAS BEEN INCLUDED FOR THIS WORK.

**ITEM 509 - GALVANIZED STEEL REINFORCEMENT, AS PER PLAN:**

IN ADDITION TO THE PROVISIONS OF ITEM 509, FIELD BEND AND/OR FIELD CUT THE STEEL REINFORCEMENT DESIGNATED IN THE PLANS, AS NECESSARY, IN ORDER TO MAINTAIN THE REQUIRED CLEARANCES AND BAR SPACINGS. REPAIR ALL DAMAGE TO THE GALVANIZED COATING, AS A RESULT OF THIS WORK, ACCORDING TO CMS 711.02.

**ITEM 510 - DOWEL HOLES WITH NONSHRINK, NONMETALLIC GROUT, AS PER PLAN:**

DOWEL BARS SHALL BE INSTALLED USING NONSHRINK, NONMETALLIC GROUT PER CMS 510 AND ACI 355.4. ALL EXISTING CONCRETE REINFORCEMENT IN THE AREA OF THE DOWEL HOLE SHALL BE LOCATED WITH THE AID OF A CONCRETE REINFORCEMENT LOCATOR (PACHOMETER) PRIOR TO DRILLING THE HOLES. IF EXISTING CONCRETE REINFORCEMENT IS ENCOUNTERED AT THE SAME LOCATION AS A PROPOSED DOWEL HOLE, THE DOWEL HOLE SHALL BE MOVED TO EITHER SIDE OF THE EXISTING CONCRETE REINFORCEMENT.

**ITEM 511 - CLASS QC3 CONCRETE, MISC.: CLASS QC3 CONCRETE WITH QC/QA, BRIDGE DECK:  
ITEM 511 - CLASS QC3 CONCRETE, MISC.: CLASS QC3 CONCRETE WITH QC/QA, BRIDGE RAILING:  
ITEM 511 - CLASS QC3 CONCRETE, MISC.: CLASS QC3 CONCRETE WITH QC/QA, DIAPHRAGMS:  
ITEM 526 - REINFORCED CONCRETE APPROACH SLABS WITH QC/QA, (T=15"), AS PER PLAN:**

THIS ITEM MODIFIES THE STANDARD 511 CONCRETE FOR STRUCTURES SPECIFICATION TO INCLUDE MACRO-SYNTHETIC FIBERS AND CORROSION INHIBITORS INTO THE SUPERSTRUCTURE CONCRETE. THIS ITEM SHALL CONFORM TO 511 WITH THE FOLLOWING CONDITIONS AND REVISIONS:

PROVIDE MATERIALS CONFORMING TO 511.02 EXCEPT AS MODIFIED BELOW:

PORTLAND CEMENT CONCRETE	499.03, CLASS QC3 MEETING A DESIGN STRENGTH OF 4,500 PSI WITH MACRO-SYNTHETIC FIBERS AND WITH MODIFICATION PER 511.02
FIBERS FOR CONCRETE	ASTM C1116, TYPE III
CORROSION INHIBITOR	515.15

THE CLASS QC3 CONCRETE FOR THE SUPERSTRUCTURE SHALL MEET THE FOLLOWING CRITERIA:  
WATER/CEMENT RATIO = 0.40 MAXIMUM; MINIMUM 4 LBS/CY MACRO-SYNTHETIC FIBERS (1.5 INCHES MIN. TO 2.5 INCHES MAX.) MEETING ASTM C1116 TYPE III SHALL BE ADDED TO THE MIX.

MIX SHALL INCLUDE A MIGRATING CORROSION INHIBITOR AS MANUFACTURED BY AN APPROVED SUPPLIER LISTED ON ODOT'S QUALIFIED APPROVED SUPPLIERS, ITEM 515.15. THE DOSAGE RATE LISTED ON THE ODOT QUALIFIED APPROVED SUPPLIERS LIST WILL APPLY.

THE MACRO-SYNTHETIC FIBERS SHALL BE INCORPORATED INTO THE MIX IN SUCH A WAY THAT NO 'BALLING' OCCURS. UPON INSPECTION OF THE MIX AT THE TIME OF PLACEMENT, IF ANY 'BALLING' OCCURS, THE ENGINEER SHALL REJECT THE REMAINDER OF THE LOAD AT ANY TIME DURING THE POUR. IT IS IMPORTANT TO FOLLOW INDUSTRY STANDARDS AND ASTM SPECIFICATIONS ON THE PREMIXING OF THE CEMENT, AGGREGATE, AND MACRO-SYNTHETIC FIBERS PRIOR TO THE ADDITION OF WATER AND ADMIXTURES. PROVIDE MACRO-SYNTHETIC FIBERS THAT ARE MONOFILAMENT FIBERS MADE FROM VIRGIN POLYPROPYLENE, POLYETHYLENE, OR CO-POLYMERS THAT ARE INERT TO ALKALI ATTACK. ENSURE THE MACRO-SYNTHETIC FIBERS HAVE A MINIMUM TENSILE STRENGTH OF 70 KSI, A MINIMUM MODULUS OF ELASTICITY OF 800 KSI, A MINIMUM FILAMENT DIAMETER OF 0.012 INCHES, AN ASPECT RATIO BETWEEN 60 AND 100, AND ARE BETWEEN 1.5 AND 2.5 INCHES IN LENGTH. STORE THE MACRO-SYNTHETIC FIBERS ACCORDING TO THE MANUFACTURER'S RECOMMENDATION AND KEEP THE MATERIAL FREE FROM DUST, DIRT, AND MOISTURE. PLACING THE BAG THAT THE FIBERS COME IN INTO THE CONCRETE MIX IS NOT PERMITTED.

**ITEM 511 - CLASS QC3 CONCRETE, MISC.: CLASS QC3 CONCRETE WITH QC/QA, BRIDGE DECK (CONTINUED):  
ITEM 511 - CLASS QC3 CONCRETE, MISC.: CLASS QC3 CONCRETE WITH QC/QA, BRIDGE RAILING (CONTINUED):  
ITEM 511 - CLASS QC3 CONCRETE, MISC.: CLASS QC3 CONCRETE WITH QC/QA, DIAPHRAGMS (CONTINUED):  
ITEM 526 - REINFORCED CONCRETE APPROACH SLABS WITH QC/QA, (T=15"), AS PER PLAN (CONTINUED):**

USE A MINIMUM DOSAGE RATE OF MACRO-SYNTHETIC FIBERS OF 4.0 LBS/CY OF CONCRETE. DETERMINE THE FINAL PROPOSED DOSAGE RATE THROUGH MIX TESTING. ENSURE THE FIBER REINFORCED CONCRETE MEETS OR EXCEEDS A MINIMUM EQUIVALENT FLEXURAL STRENGTH RATIO OF 25% ACCORDING TO ASTM C 1609. ENSURE THE FINAL PROPOSED MIX IS WORKABLE AND ABLE TO BE PRODUCED SUCH THAT BALLING OR CLUMPING OF THE FIBERS IS NOT A PROBLEM AS DETERMINED BY THE ENGINEER. UTILIZE A LABORATORY REGULARLY INSPECTED BY THE CEMENT AND CONCRETE REFERENCE LABORATORY (CCRL) OF THE NATIONAL INSTITUTE OF STANDARDS AND TECHNOLOGY, OR OTHER APPROVED REFERENCE LABORATORY, TO PERFORM THE TESTING. BEFORE USE, SUBMIT DOCUMENTATION TO THE PROJECT ENGINEER CERTIFYING BOTH THE MACRO-SYNTHETIC FIBERS AND THE MIX MEET OR EXCEED THE REQUIRED PROPERTIES. SAMPLING WILL BE ALLOWED FOR TESTING PURPOSES. A DEMONSTRATION OF THE MIX PRODUCTION OR TRIAL MIX MAY BE REQUIRED BY THE ENGINEER PRIOR TO PLACING ANY OF THE MIX ON THE PROJECT.

THE BATCH WEIGHTS SHALL BE CORRECTED TO COMPENSATE FOR THE MOISTURE CONTAINED IN THE AGGREGATE AT THE TIME OF USE. A CHEMICAL ADMIXTURE (705.12, TYPE A OR D) SHALL BE USED. THE TRANSIT MIXER CHARGE SHALL BE LIMITED TO 3/4 OF ITS RATED CAPACITY OR 6 CUBIC YARDS, WHICHEVER IS SMALLER. THE FIRST THREE TRANSIT MIXER LOADS ARE REQUIRED TO BE AT THE MINIMUM YARDAGE LISTED ABOVE TO SHOW PROOF OF THE SUCCESSFUL BATCHING OPERATION. AFTER CONSISTENCY IN THE DELIVERED MATERIAL HAS BEEN ESTABLISHED, THE CONCRETE SUPPLIER MAY INCREASE THE BATCH DELIVERED QUANTITIES AS LONG AS THE QUALITY REMAINS ACCEPTABLE TO THE ENGINEER. THE ENGINEER CAN REDUCE THE BATCH LOAD SIZE AT ANY TIME AS NEEDED TO CORRECT/IMPROVE CONCRETE QUALITY.

CONCRETE SUPPLIERS SHOULD RECOGNIZE THAT THE CORROSION INHIBITOR AND ADMIXTURES MAY HAVE AN EFFECT ON STRENGTH, ENTRAINED AIR CONTENT, WORKABILITY, ETC. OF THEIR CONCRETE MIXES. THE CORROSION INHIBITOR IS SUGGESTED TO BE AN MCI PRODUCT BY CORTEC OR AN APPROVED EQUAL FROM THE QUALIFIED PRODUCTS LIST. THE CONCRETE SUPPLIER'S CHOICE OF ONE OF THESE CORROSION INHIBITORS DOES NOT ALLEVIATE MEETING DESIGN REQUIREMENTS. PLEASE BE ADVISED THAT SOME PRODUCTS ON THE LIST AFFECT THE DELIVERED MIX PROPERTIES GREATLY WHILE OTHER PRODUCTS DO NOT.

APPROACH SLABS, DIAPHRAGMS, AND BRIDGE RAILING CONCRETE ARE TO USE THE SAME MIX DESIGN AS THE BRIDGE DECK. THE CONTRACTOR SHOULD BE ADVISED THAT CONCRETE RETARDING AGENTS MAY NEED TO BE ADDED TO OFFSET THE EFFECTS OF THE MIGRATING CORROSION INHIBITOR SELECTED. USE SELF-COMPACTING CONCRETE ON DECORATIVE RAILING SIMILAR TO TEXAS RAILING AND MACRO-SYNTHETIC CONCRETE PER THIS SPECIFICATION ON TRADITIONAL CONCRETE RAILING WHEN APPLICABLE.

THE CONTRACTOR SHALL PROVIDE TRADITIONAL BRIDGE DECK FORMS CONFORMING TO CMS 508. PERMANENT STAY-IN-PLACE (SIP) FORMS ARE NOT ALLOWED. THE PLACING OF THE DECK AND THE APPROACH SLABS IN THE SAME CONCRETE POUR IS NOT PERMITTED.

FURNISH GALVANIZED STEEL REINFORCEMENT 709.16 IN LIEU OF EPOXY COATED STEEL REINFORCEMENT FOR REINFORCED CONCRETE APPROACH SLABS.

**ABBREVIATIONS:**

CONST.	CONSTRUCTION
DIA.	DIAMETER
DIM.	DIMENSION
E.F.	EACH FACE
EL.	ELEVATION
EX.	EXISTING
EXP.	EXPANSION
F.F.	FAR FACE
FIX.	FIXED
FT.	FOOT/FEET
H.P.	HIGH PRESSURE
INV.	INVERT
LT.	LEFT
MAX.	MAXIMUM
MIN.	MINIMUM
N.F.	NEAR FACE
P.E.J.F.	PERFORMED EXPANSION JOINT FILLER
PT.	POINT
RT.	RIGHT
SPA.	SPACING/SPACES
STA.	STATION
TYP.	TYPICAL

**ITEM 513 - STRUCTURAL STEEL, MISC.: MOMENT PLATE RETROFIT  
ITEM 513 - STRUCTURAL STEEL, MISC.: FIELD DRILLING HOLES**

THE EXISTING BEAMS SHALL HAVE RETROFIT SPLICE PLATES INSTALLED AS INDICATED IN THE PLANS. STEEL SHALL BE ASTM A709 GRADE 50 (YIELD STRENGTH 50 KSI) AND BOLTS SHALL BE ASTM F3125 GRADE A325, TYPE 1.

AFTER THE DECK HAS BEEN REMOVED, PERFORM SURFACE PREPARATION OF THE TOP FLANGE RETROFIT AREAS TO REMOVE THE EXISTING PAINT SYSTEM. THE SURFACE PREPARATION LIMITS SHALL EXTEND 1-FT. PAST EACH END OF THE TOP RETROFIT SPLICE PLATES.

THE ENGINEER SHALL CAREFULLY VISUALLY INSPECT THE CLEANED AREA AT EACH END OF ALL THE TOP FLANGE MOMENT PLATES.

IF THE ENGINEER DETERMINES THE TRANSVERSE MOMENT PLATE WELD IS STILL PERFORMING ADEQUATELY, LEAVE THE WELD IN PLACE. IF THE WELD APPEARS RUSTED OR HAS SEPARATED FROM THE EXISTING BEAM OR MOMENT PLATE, THE CONTRACTOR SHALL REMOVE THE EXISTING TRANSVERSE MOMENT PLATE WELD AND INSPECT FOR DAMAGE TO THE BASE METAL OF THE BEAM. GRINDING MAY BE DIRECTED BY THE ENGINEER TO ENHANCE THE INVESTIGATION FOR CRACK PRESENCE. ALL STEEL GRINDING MUST BE DONE CAUTIOUSLY ON A CASE-BY-CASE BASIS.

IF THE ENGINEER SUSPECTS THAT A CRACK HAS ADVANCED INTO THE BASE METAL OF THE BEAM, IMMEDIATELY ALERT THE OFFICE OF CONSTRUCTION ADMINISTRATION - BRIDGE CONSTRUCTION SPECIALIST. PROVIDE THE LOCATION OF THE CRACK, LENGTH, AND DEPTH SO AN EVALUATION AND REPAIR OR REPLACEMENT RECOMMENDATION CAN BE MADE.

AFTER APPROVAL FROM THE ENGINEER, EXISTING MOMENT PLATES WITH ADEQUATE TRANSVERSE WELDS OR TRANSVERSE WELD AREAS THAT HAVE BEEN REPAIRED TO THE SATISFACTION OF THE ENGINEER, SHALL BE RETROFITTED WITH BOLTED SPLICE PLATES AS SHOWN IN THE PLANS.

APPLY ORGANIC ZINC PRIME COAT TO THE EXISTING STRUCTURAL STEEL IN THE RETROFIT AREA TO THE SURFACE PREPARATION LIMITS. NEW STRUCTURAL STEEL FOR THE MOMENT PLATE RETROFIT SHALL HAVE SHOP DRILLED BOLT HOLES AND SHALL BE DELIVERED TO THE SITE WITH A SHOP APPLIED INORGANIC ZINC PRIME COAT.

FIELD DRILL BOLT HOLES THROUGH THE EXISTING STEEL MOMENT PLATES AND EXISTING BEAM FLANGES USING THE NEW RETROFIT SPLICE PLATES AS A TEMPLATE. INSTALL BOLTED RETROFIT SPLICE PLATES AT EACH END OF ALL TOP MOMENT PLATES OF BOTH LEFT AND RIGHT BRIDGES (56 LOCATIONS).

APPLY INTERMEDIATE AND FINISH PAINT COATS TO THE NEW AND EXISTING STEEL AT EACH MOMENT PLATE RETROFIT LOCATION. SEE SHEET 23 OF 44 FOR ADDITIONAL MOMENT PLATE RETROFIT/FLANGE PAINTING LIMITS. PAINT COLOR SHALL MATCH EXISTING.

STEEL MEMBERS TO BE FABRICATED UNDER THIS ITEM DO NOT REQUIRE SHOP DRAWINGS PRIOR TO FABRICATION. HOWEVER, THE CONTRACTOR SHALL MAKE NECESSARY MEASUREMENTS AND PREPARE SKETCHES, DRAWINGS, TABLES, ETC. TO ENSURE ADEQUATE INFORMATION IS PROVIDED TO THE FABRICATOR. THE ENGINEER SHALL HAVE THE AUTHORITY AND RESPONSIBILITY FOR ENSURING THE FABRICATED STEEL IS ACCEPTABLE. TECHNICAL ASSISTANCE WILL BE PROVIDED TO THE ENGINEER, IF REQUESTED, BY THE OFFICE OF STRUCTURAL ENGINEERING.

IN ACCORDANCE WITH CMS 501.06, MILL TEST REPORTS AND SHIPPING DOCUMENTS SHALL BE SUBMITTED TO THE ENGINEER FOR REVIEW AND APPROVAL PRIOR TO INCORPORATING NEW STEEL ITEMS INTO THE WORK. AFTER FABRICATION, THE CONTRACTOR SHALL SUBMIT AS-BUILT DRAWINGS TO THE ENGINEER FOR REVIEW AND APPROVAL TO ENSURE THE DRAWINGS DEPICT THE STEEL AS ACTUALLY INCORPORATED INTO THE WORK. THE ENGINEER WILL THEN SEND AN APPROVED SET OF DRAWINGS TO THE OFFICE OF STRUCTURAL ENGINEERING FOR INFORMATION. PAY WEIGHTS SHALL BE COMPUTED IN COMPLIANCE WITH CMS 513 AND SUBMITTED TO THE ENGINEER FOR REVIEW AND APPROVAL.

ALL NECESSARY LABOR, EQUIPMENT, AND MATERIAL TO PERFORM THE INITIAL INSPECTION, APPLY A SHOP PRIME COAT, AND INSTALL THE BOLTED RETROFIT SPLICE PLATES AS DESCRIBED ABOVE SHALL BE INCLUDED WITH ITEM 513 - STRUCTURAL STEEL, MISC.: MOMENT PLATE RETROFIT FOR PAYMENT.

ALL NECESSARY LABOR, EQUIPMENT, AND MATERIAL TO PERFORM THE FIELD DRILLING OF BOLT HOLES THROUGH THE EXISTING STRUCTURAL STEEL BEAM FLANGES AND EXISTING MOMENT PLATES SHALL BE INCLUDED WITH ITEM 513 - STRUCTURAL STEEL, MISC.: FIELD DRILLING HOLES FOR PAYMENT.

SURFACE PREPARATION AND PAINTING OF NEW AND EXISTING STRUCTURAL STEEL AS DESCRIBED SHALL BE INCLUDED WITH ITEM 514 FOR PAYMENT.

**ITEM 514 - FIELD PAINTING OF EXISTING STRUCTURAL STEEL, PRIME COAT:  
ITEM 514 - FIELD PAINTING STRUCTURAL STEEL, INTERMEDIATE COAT, AS PER PLAN:  
ITEM 514 - FIELD PAINTING STRUCTURAL STEEL, FINISH COAT, AS PER PLAN:**

PAINTED AREAS THAT ARE DAMAGED BY WELDING, DRILLING, CUTTING, OR OTHER MEANS TO REHABILITATE THIS BRIDGE ARE DESIGNATED IN THE PROJECT PLANS.

THE CONTRACTOR SHALL PROVIDE THE ENGINEER WITH ALL NECESSARY EQUIPMENT TO INSPECT THIS WORK. THE MAJORITY OF THE AREAS TO BE REPAIR PAINTED ARE:  
EXISTING BEAM MOMENT PLATE RETROFIT LOCATIONS

EXISTING STEEL AREAS SHALL RECEIVE A PRIME, INTERMEDIATE, AND FINISH COAT APPLIED IN THE FIELD. PROPOSED STEEL SHALL BE SHOP PRIMED AND RECEIVE AN INTERMEDIATE AND FINISH COAT APPLIED IN THE FIELD.

THE FINISH COAT SHALL MATCH THE EXISTING BEAM'S COLOR. OBTAIN THE ENGINEER'S APPROVAL OF PAINT COLOR BEFORE APPLYING FINISH COAT.

PRIOR TO THE START OF WORK ON THE STRUCTURE, THE CONTRACTOR SHALL DOCUMENT THE EXISTING CONDITION OF THE PAINTED STRUCTURE TO IDENTIFY AREAS PREVIOUSLY DAMAGED THAT ARE OUTSIDE THE LIMITS OF THE CURRENT PAY ITEMS. PAINTED AREAS THAT WERE NOT PREVIOUSLY DAMAGED THAT RECEIVE DAMAGE BY THE CONTRACTOR'S ACTIVITIES ONCE WORK BEGINS WILL BE REPAIRED AT THE CONTRACTOR'S COST.

**ITEM 514 - FIELD PAINTING, MISC.: COATING OF BEAM ENDS:**

PRIOR TO ENCASING THE BEAM ENDS, PREPARE THE ENDS PER SSPC SP10 OR SSPC SP11 TO BARE METAL ACHIEVING A 1.5 TO 3.5 MIL PROFILE. PAINT THE BEAM ENDS WITH ORGANIC ZINC PRIME COAT PER CMS 514. PROVIDE THE PRIME COAT THICKNESS AS PER CMS 514.20. EXTEND THE LIMITS OF THE BEAM PREPARATION AND PAINTING 1 FOOT BEYOND THE LIMITS OF THE END DIAPHRAGM CONCRETE.

AFTER THE DIAPHRAGM IS SET, SEAL THE INTERFACE BETWEEN THE BEAM AND CONCRETE WITH CAULK.

THE DEPARTMENT WILL PAY FOR ALL MATERIAL, LABOR, AND EQUIPMENT NECESSARY TO PERFORM WORK AS DESCRIBED ABOVE AT THE CONTRACT BID PRICE FOR ITEM 514 - FIELD PAINTING, MISC.: COATING OF BEAM ENDS.

**ITEM 516 - JACKING AND TEMPORARY SUPPORT OF SUPERSTRUCTURE, AS PER PLAN:**

THIS WORK CONSISTS OF RAISING OR RE-POSITIONING EXISTING STRUCTURES TO THE DIMENSIONS AND REQUIREMENTS DEFINED IN THE PROJECT PLANS. SUBMIT CONSTRUCTION PLANS IN ACCORDANCE WITH CMS 501.05. IF, DURING THE JACKING OPERATIONS, DAMAGE TO THE STRUCTURE IS VISUALLY OBSERVED, IMMEDIATELY CEASE THE JACKING OPERATION AND INSTALL SUPPORTS TO THE SATISFACTION OF THE ENGINEER. ANALYZE THE DAMAGE AND SUBMIT A METHOD OF CORRECTION TO THE ENGINEER FOR APPROVAL. THE BRIDGE BEARINGS SHALL BE FULLY SEATED AT ALL CONTACT AREAS. IF FULL SEATING IS NOT ATTAINED, SUBMIT A REPAIR PLAN TO THE ENGINEER. THE DEPARTMENT WILL NOT PAY FOR THE REPAIR COSTS TO ENSURE FULL SEATING ON BEARINGS. THE DEPARTMENT WILL MEASURE THIS WORK ON A LUMP SUM BASIS. THE DEPARTMENT WILL PAY FOR THE ACCEPTED QUANTITIES AT THE CONTRACT PRICE FOR ITEM 516 - JACKING AND TEMPORARY SUPPORT OF SUPERSTRUCTURE, AS PER PLAN.

**ITEM 519 - PATCHING CONCRETE STRUCTURES, AS PER PLAN:**


PRIOR TO THE SURFACE CLEANING SPECIFIED IN CMS 519.04 AND WITHIN 24 HOURS OF PLACING PATCHING MATERIAL, BLAST CLEAN ALL SURFACES TO BE PATCHED INCLUDING THE EXPOSED STEEL REINFORCEMENT. ACCEPTABLE METHODS INCLUDE HIGH-PRESSURE WATER BLASTING WITH OR WITHOUT ABRASIVES IN THE WATER, ABRASIVE BLASTING WITH CONTAINMENT, OR VACUUM ABRASIVE BLASTING.

**ITEM 601 - CRUSHED AGGREGATE SLOPE PROTECTION, AS PER PLAN:**

WITH PRIOR APPROVAL OF THE ENGINEER, THE CONTRACTOR MAY REDRESS THE SLOPES WITH THE EXISTING CRUSHED AGGREGATE. WHERE ADDITIONAL MATERIAL IS REQUIRED, FURNISH AND PLACE CRUSHED AGGREGATE IN ACCORDANCE WITH CMS 601. AN ESTIMATED QUANTITY OF 100 SQUARE YARDS HAS BEEN INCLUDED FOR THIS WORK. ACTUAL QUANTITIES OF SLOPE TO BE REDRESSED AND NEW MATERIAL TO BE PLACED SHALL BE AS DIRECTED BY THE ENGINEER.

SFN		3103870
DESIGN AGENCY		
TRANSYSTEMS 1100 SUPERIOR AVE. E. STE 1000 CLEVELAND, OHIO 44114		
DESIGNER	CHECKER	
ZTW	RSB	
REVIEWER		
NFF 08/22/23		
PROJECT ID		
110570		
SUBSET TOTAL		
4	44	
SHEET TOTAL		
P.168	208	



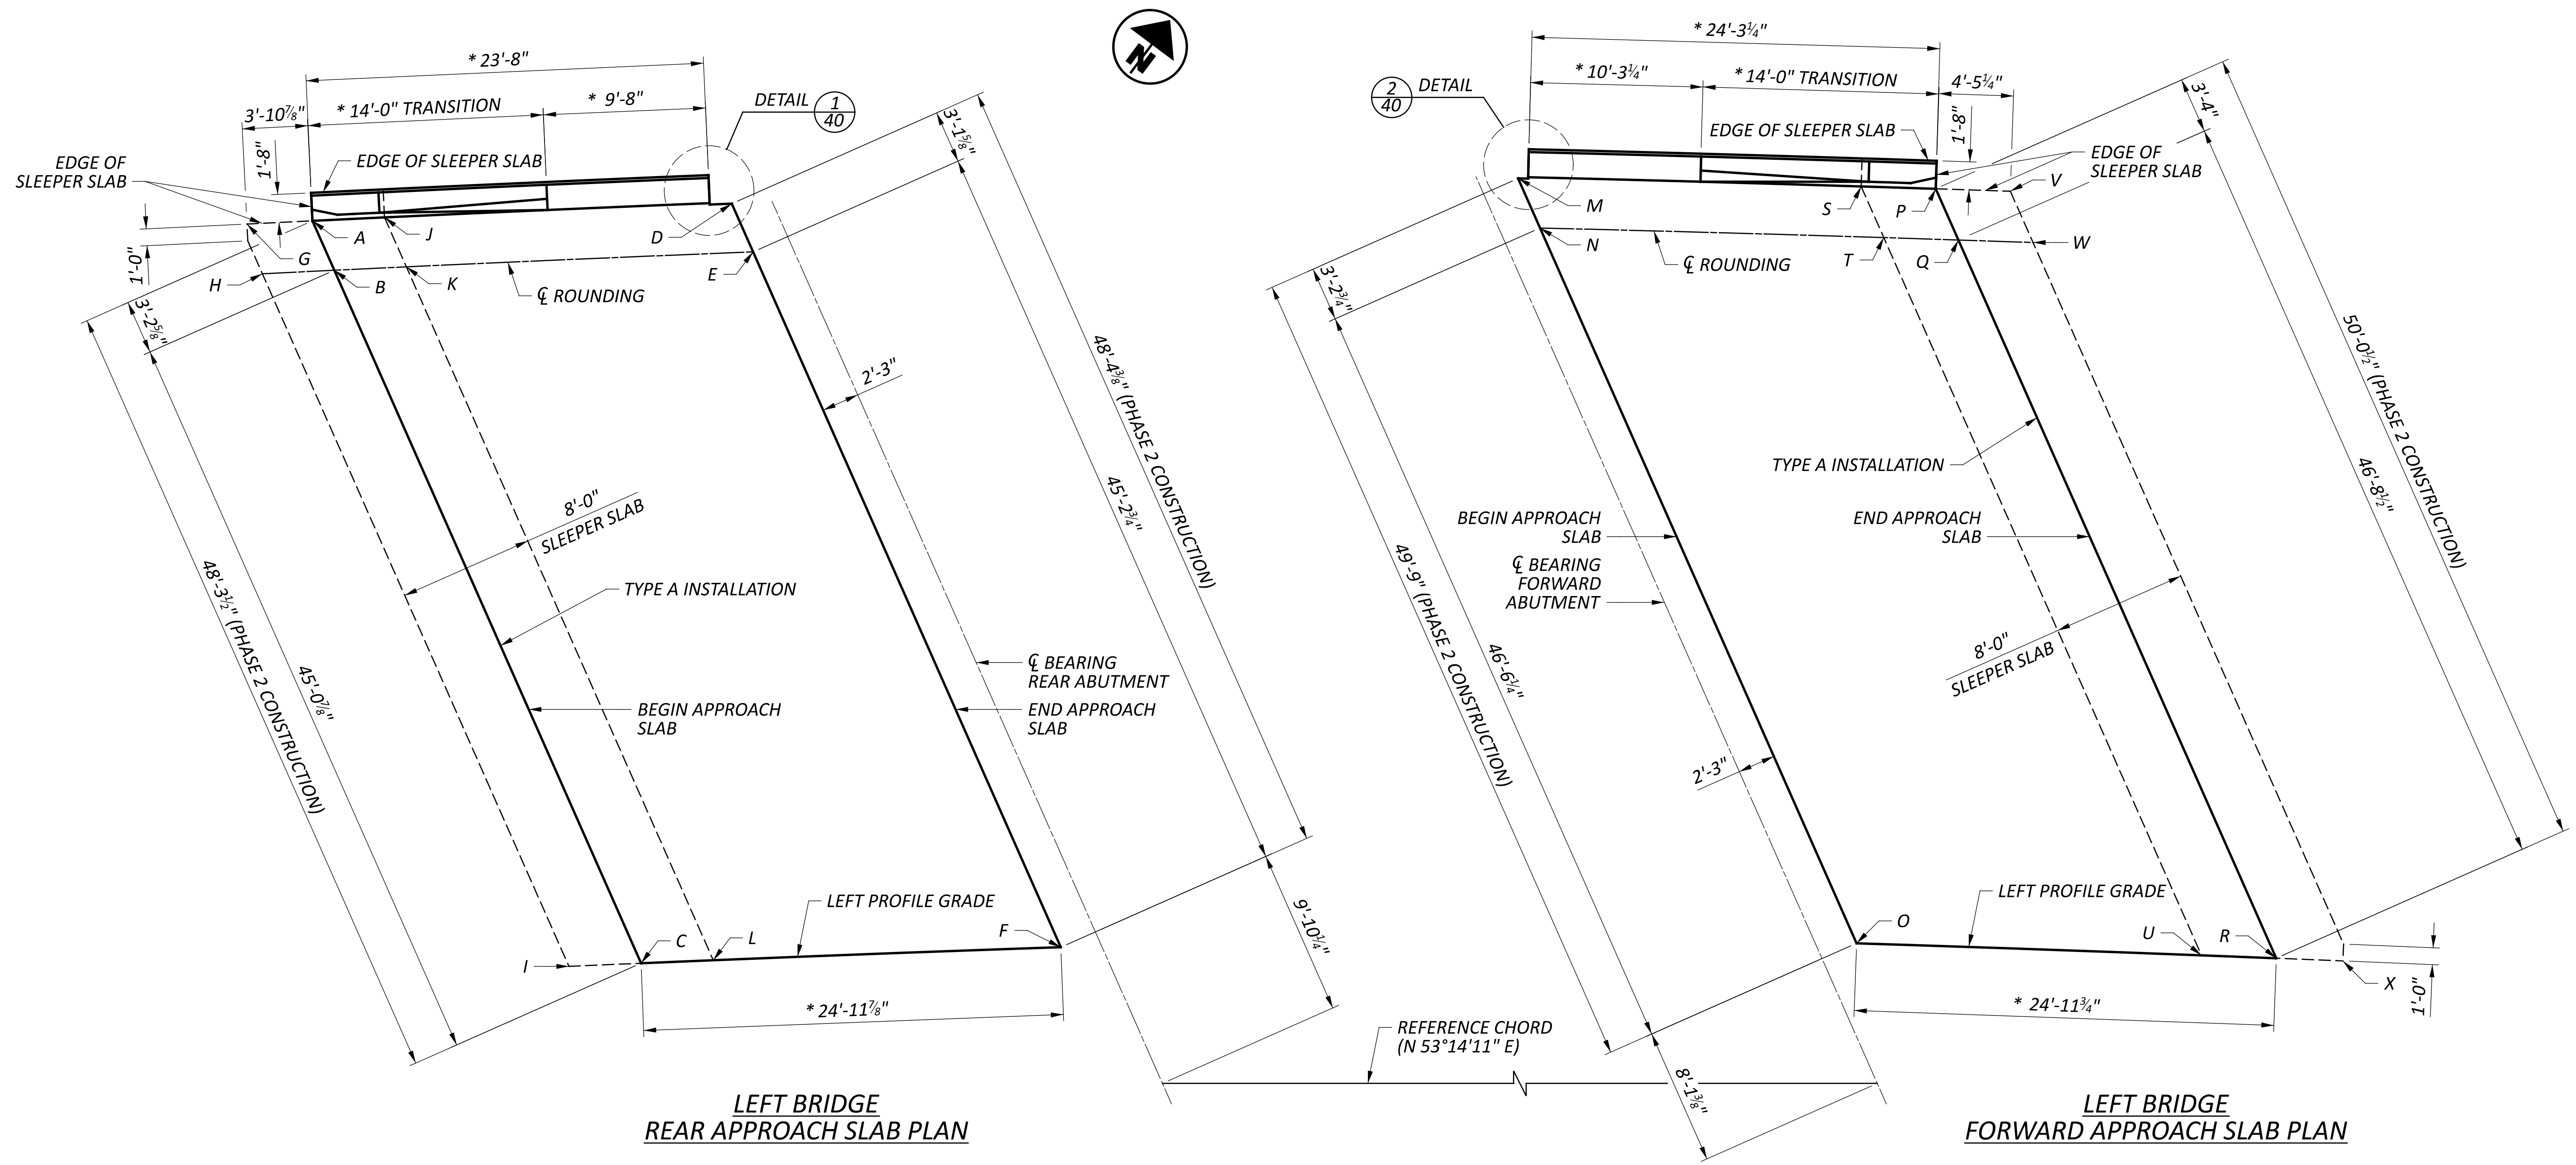

LEFT BRIDGE REAR APPROACH SLAB PLAN


LEFT BRIDGE FORWARD APPROACH SLAB PLAN

REAR APPROACH SLAB LOCATIONS

APPROACH SLAB SURFACE ELEVATIONS (SEE NOTE 4)			SLEEPER SLAB ELEVATIONS				
STATION	OFFSET	ELEVATION	STATION	OFFSET	ELEVATION		
A	103+31.21	53.29' LT.	538.48	G	103+27.38	53.29' LT.	537.25
B	103+32.35	50.29' LT.	538.55	H	103+28.13	50.29' LT.	537.32
C	103+48.54	8.29' LT.	536.54	I	103+44.26	8.29' LT.	535.31
D	103+55.71	53.21' LT.	538.36	J	103+35.42	53.29' LT.	537.21
E	103+56.85	50.29' LT.	538.43	K	103+36.56	50.29' LT.	537.28
F	103+73.46	8.29' LT.	536.43	L	103+52.83	8.29' LT.	535.27

FORWARD APPROACH SLAB LOCATIONS

APPROACH SLAB SURFACE ELEVATIONS (SEE NOTE 4)			SLEEPER SLAB ELEVATIONS				
STATION	OFFSET	ELEVATION	STATION	OFFSET	ELEVATION		
M	105+38.60	53.21' LT.	537.97	S	105+58.64	53.29' LT.	536.73
N	105+39.95	50.29' LT.	538.05	T	105+60.06	50.29' LT.	536.81
O	103+59.76	8.29' LT.	536.13	U	105+80.23	8.29' LT.	534.91
P	105+63.00	53.29' LT.	537.99	V	105+67.36	53.29' LT.	536.74
Q	105+64.42	50.29' LT.	538.07	W	105+68.79	50.29' LT.	536.82
R	105+84.67	8.29' LT.	536.16	X	105+88.62	8.29' LT.	534.92

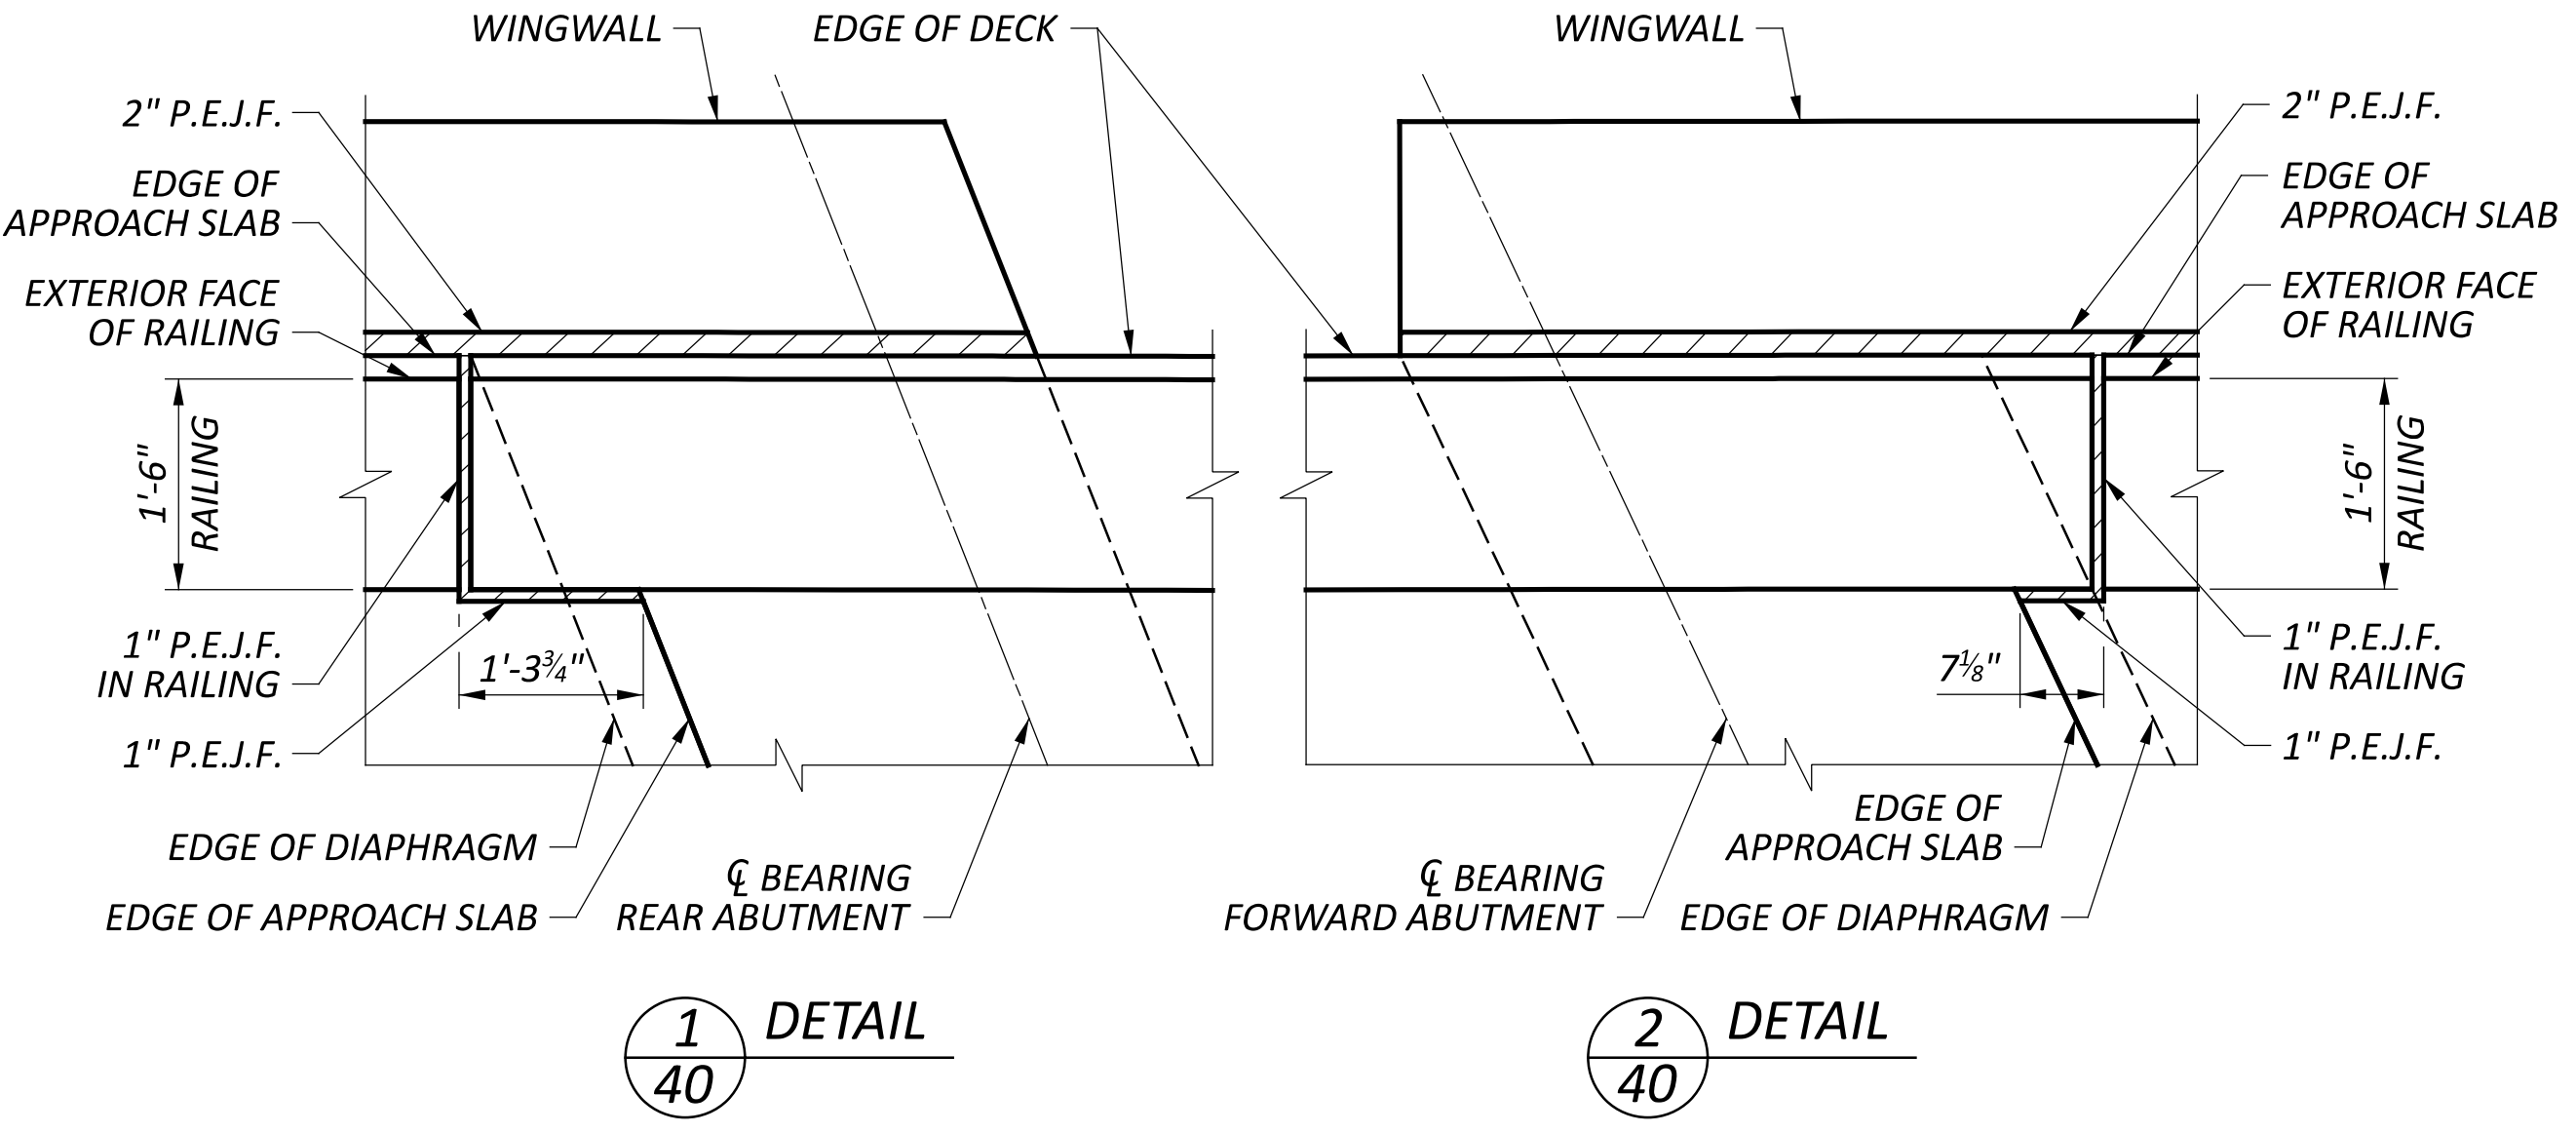

LEGEND:

\* MEASURED ALONG EDGE OF APPROACH SLAB


NOTES:

- FOR THE 25-FT. APPROACH SLAB REINFORCEMENT REQUIREMENTS AND ADDITIONAL STANDARD APPROACH SLAB DETAILS, SEE GENERAL NOTE ITEM 526 - REINFORCED CONCRETE APPROACH SLABS WITH QC/QA, (T=15"), AS PER PLAN AND ODOT STANDARD DRAWING AS-1-15.
- FOR APPROACH SLAB TYPE A INSTALLATION REQUIREMENTS, SEE ODOT STANDARD DRAWING AS-2-15.
- FOR APPROACH SLAB RAILING DETAILS, SEE SHEETS 38 AND 39 OF 44.
- APPROACH SLAB SURFACE ELEVATIONS ARE GIVEN AT TOP OF CONCRETE APPROACH SLAB, UNDERNEATH THE ASPHALT.
- FOR ROUNDING DETAIL, SEE SHEET 29 OF 44.


LEFT BRIDGE APPROACH SLAB DETAILS  
 BRIDGE NO. HAM-00050-29.280  
 US-50 OVER RAMPS TO RED BANK ROAD

SFN	3103870
DESIGN AGENCY	TRANSYSTEMS
DESIGNER	GJZ
CHECKER	TOR
REVIEWER	NFF
PROJECT ID	110570
SUBSET	40
TOTAL	44
SHEET	P.204
TOTAL	208



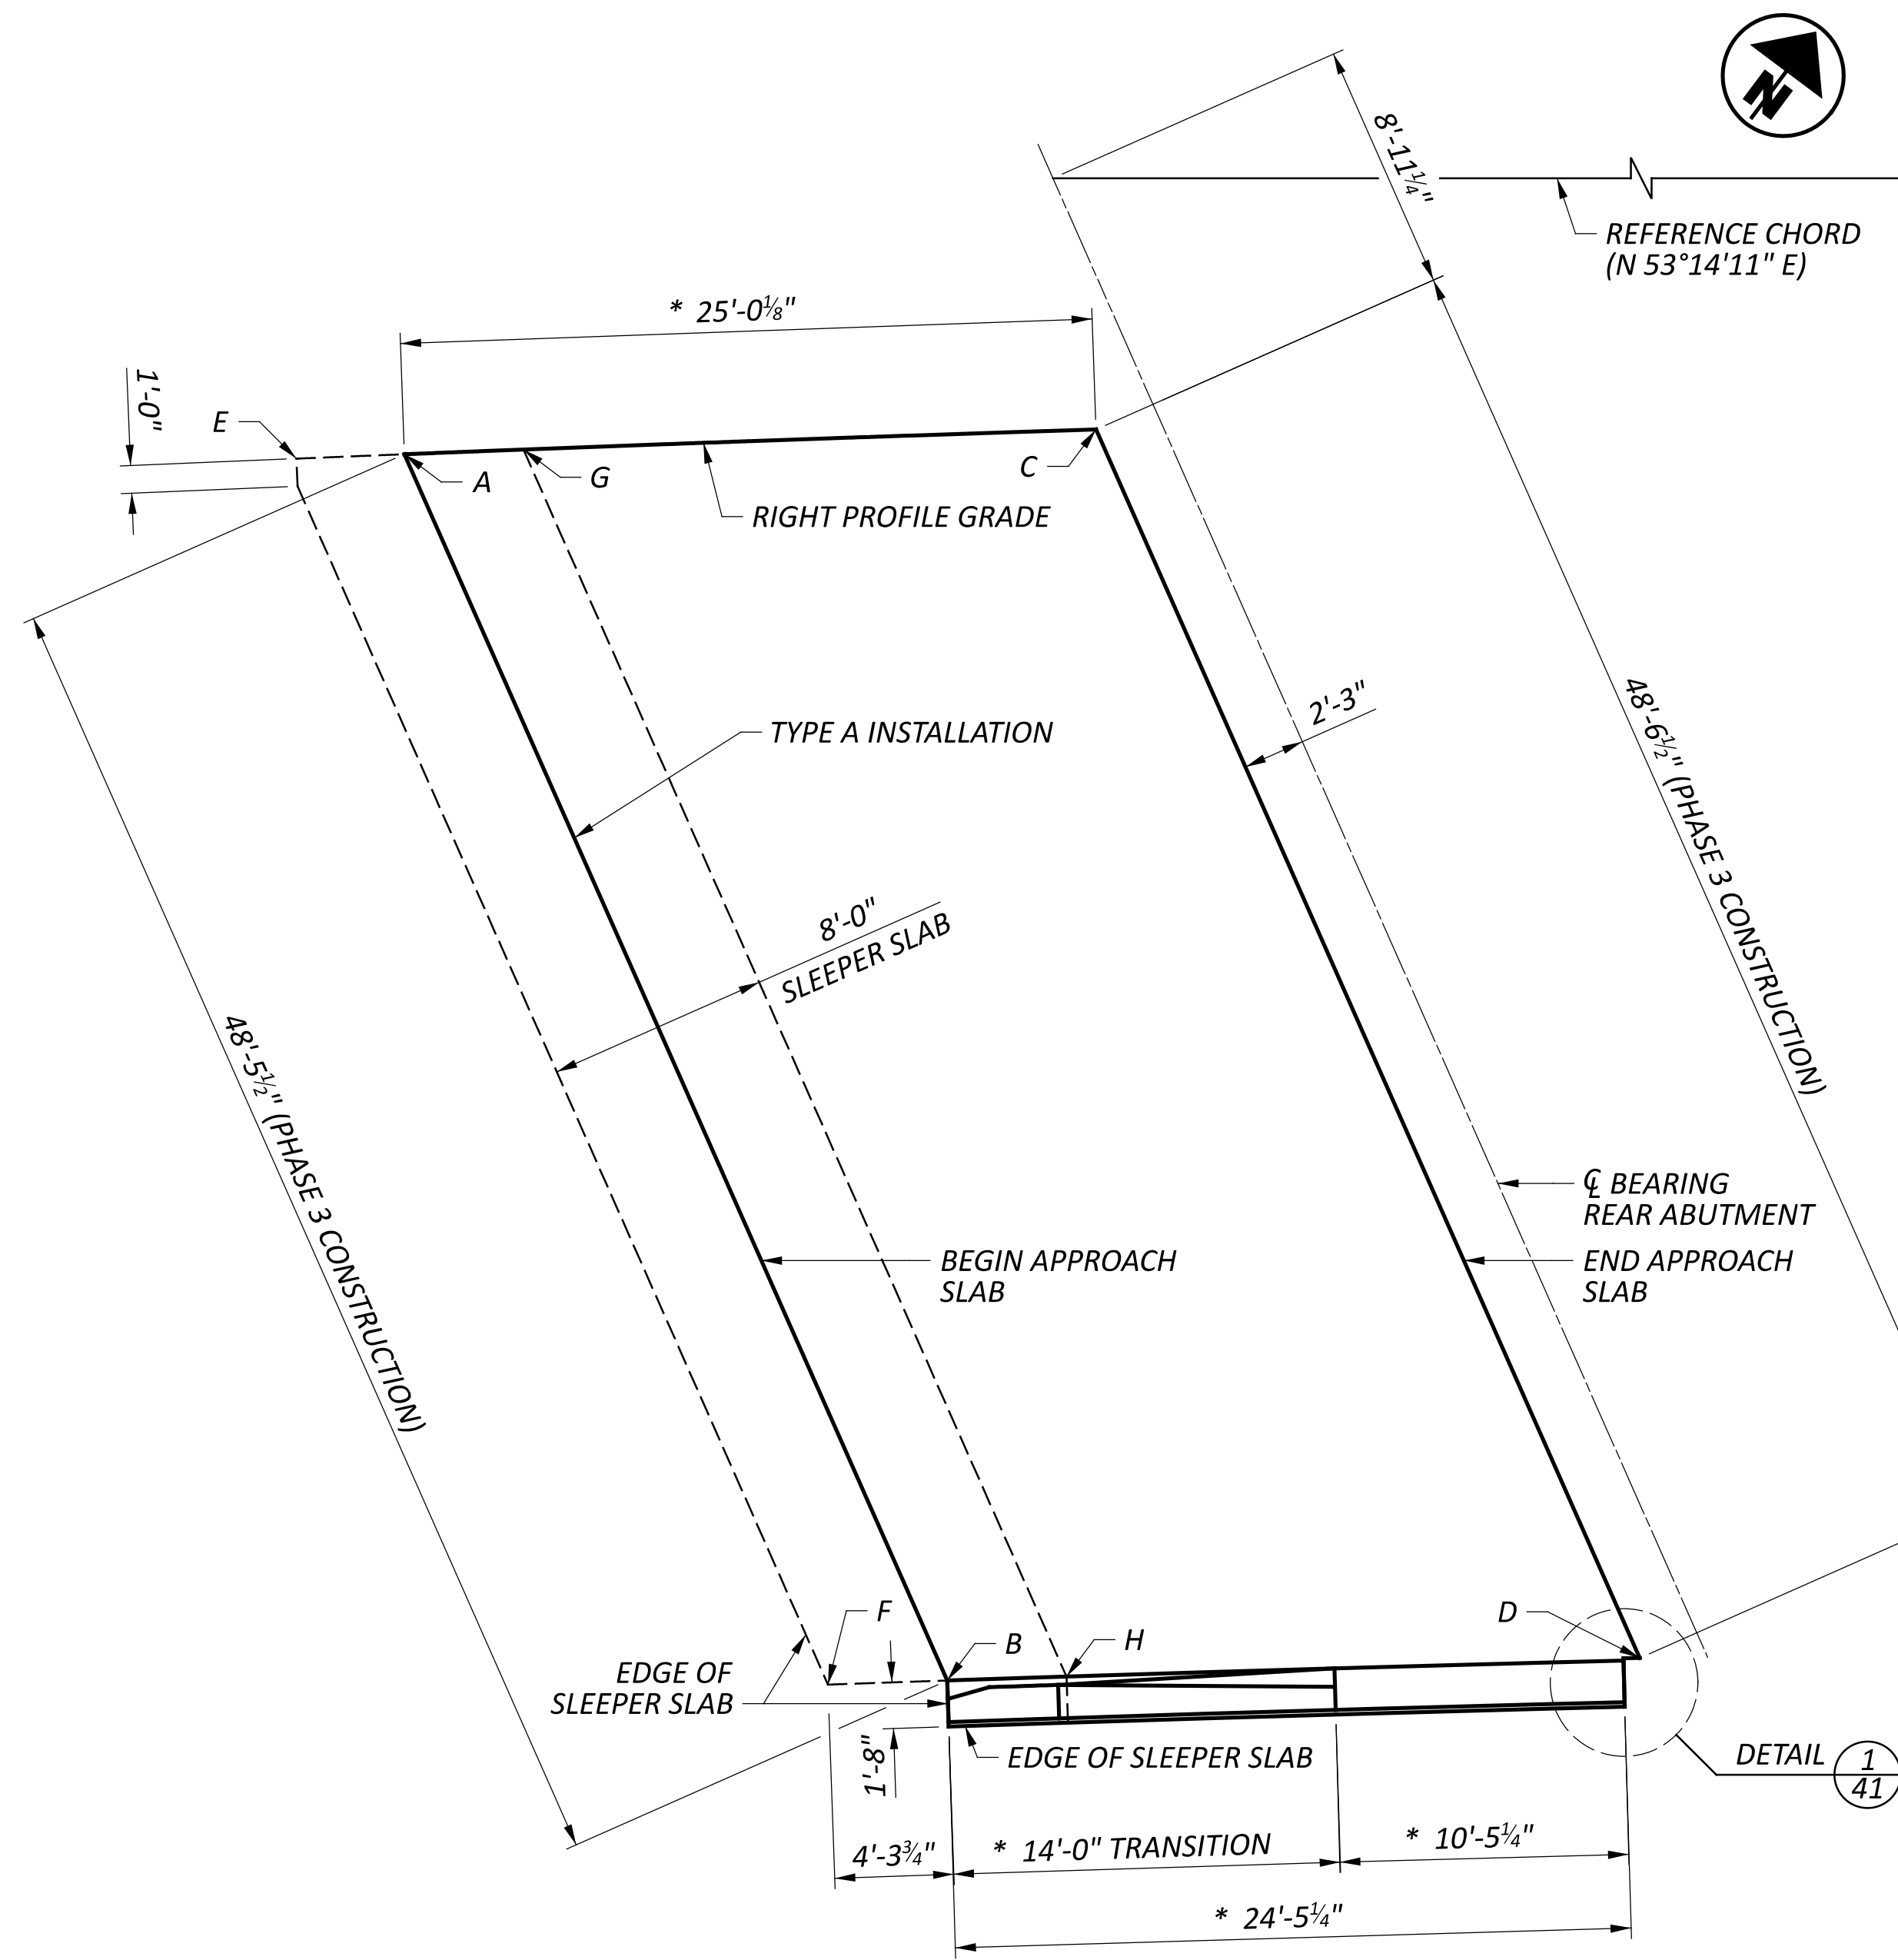


RIGHT BRIDGE  
REAR APPROACH SLAB PLAN

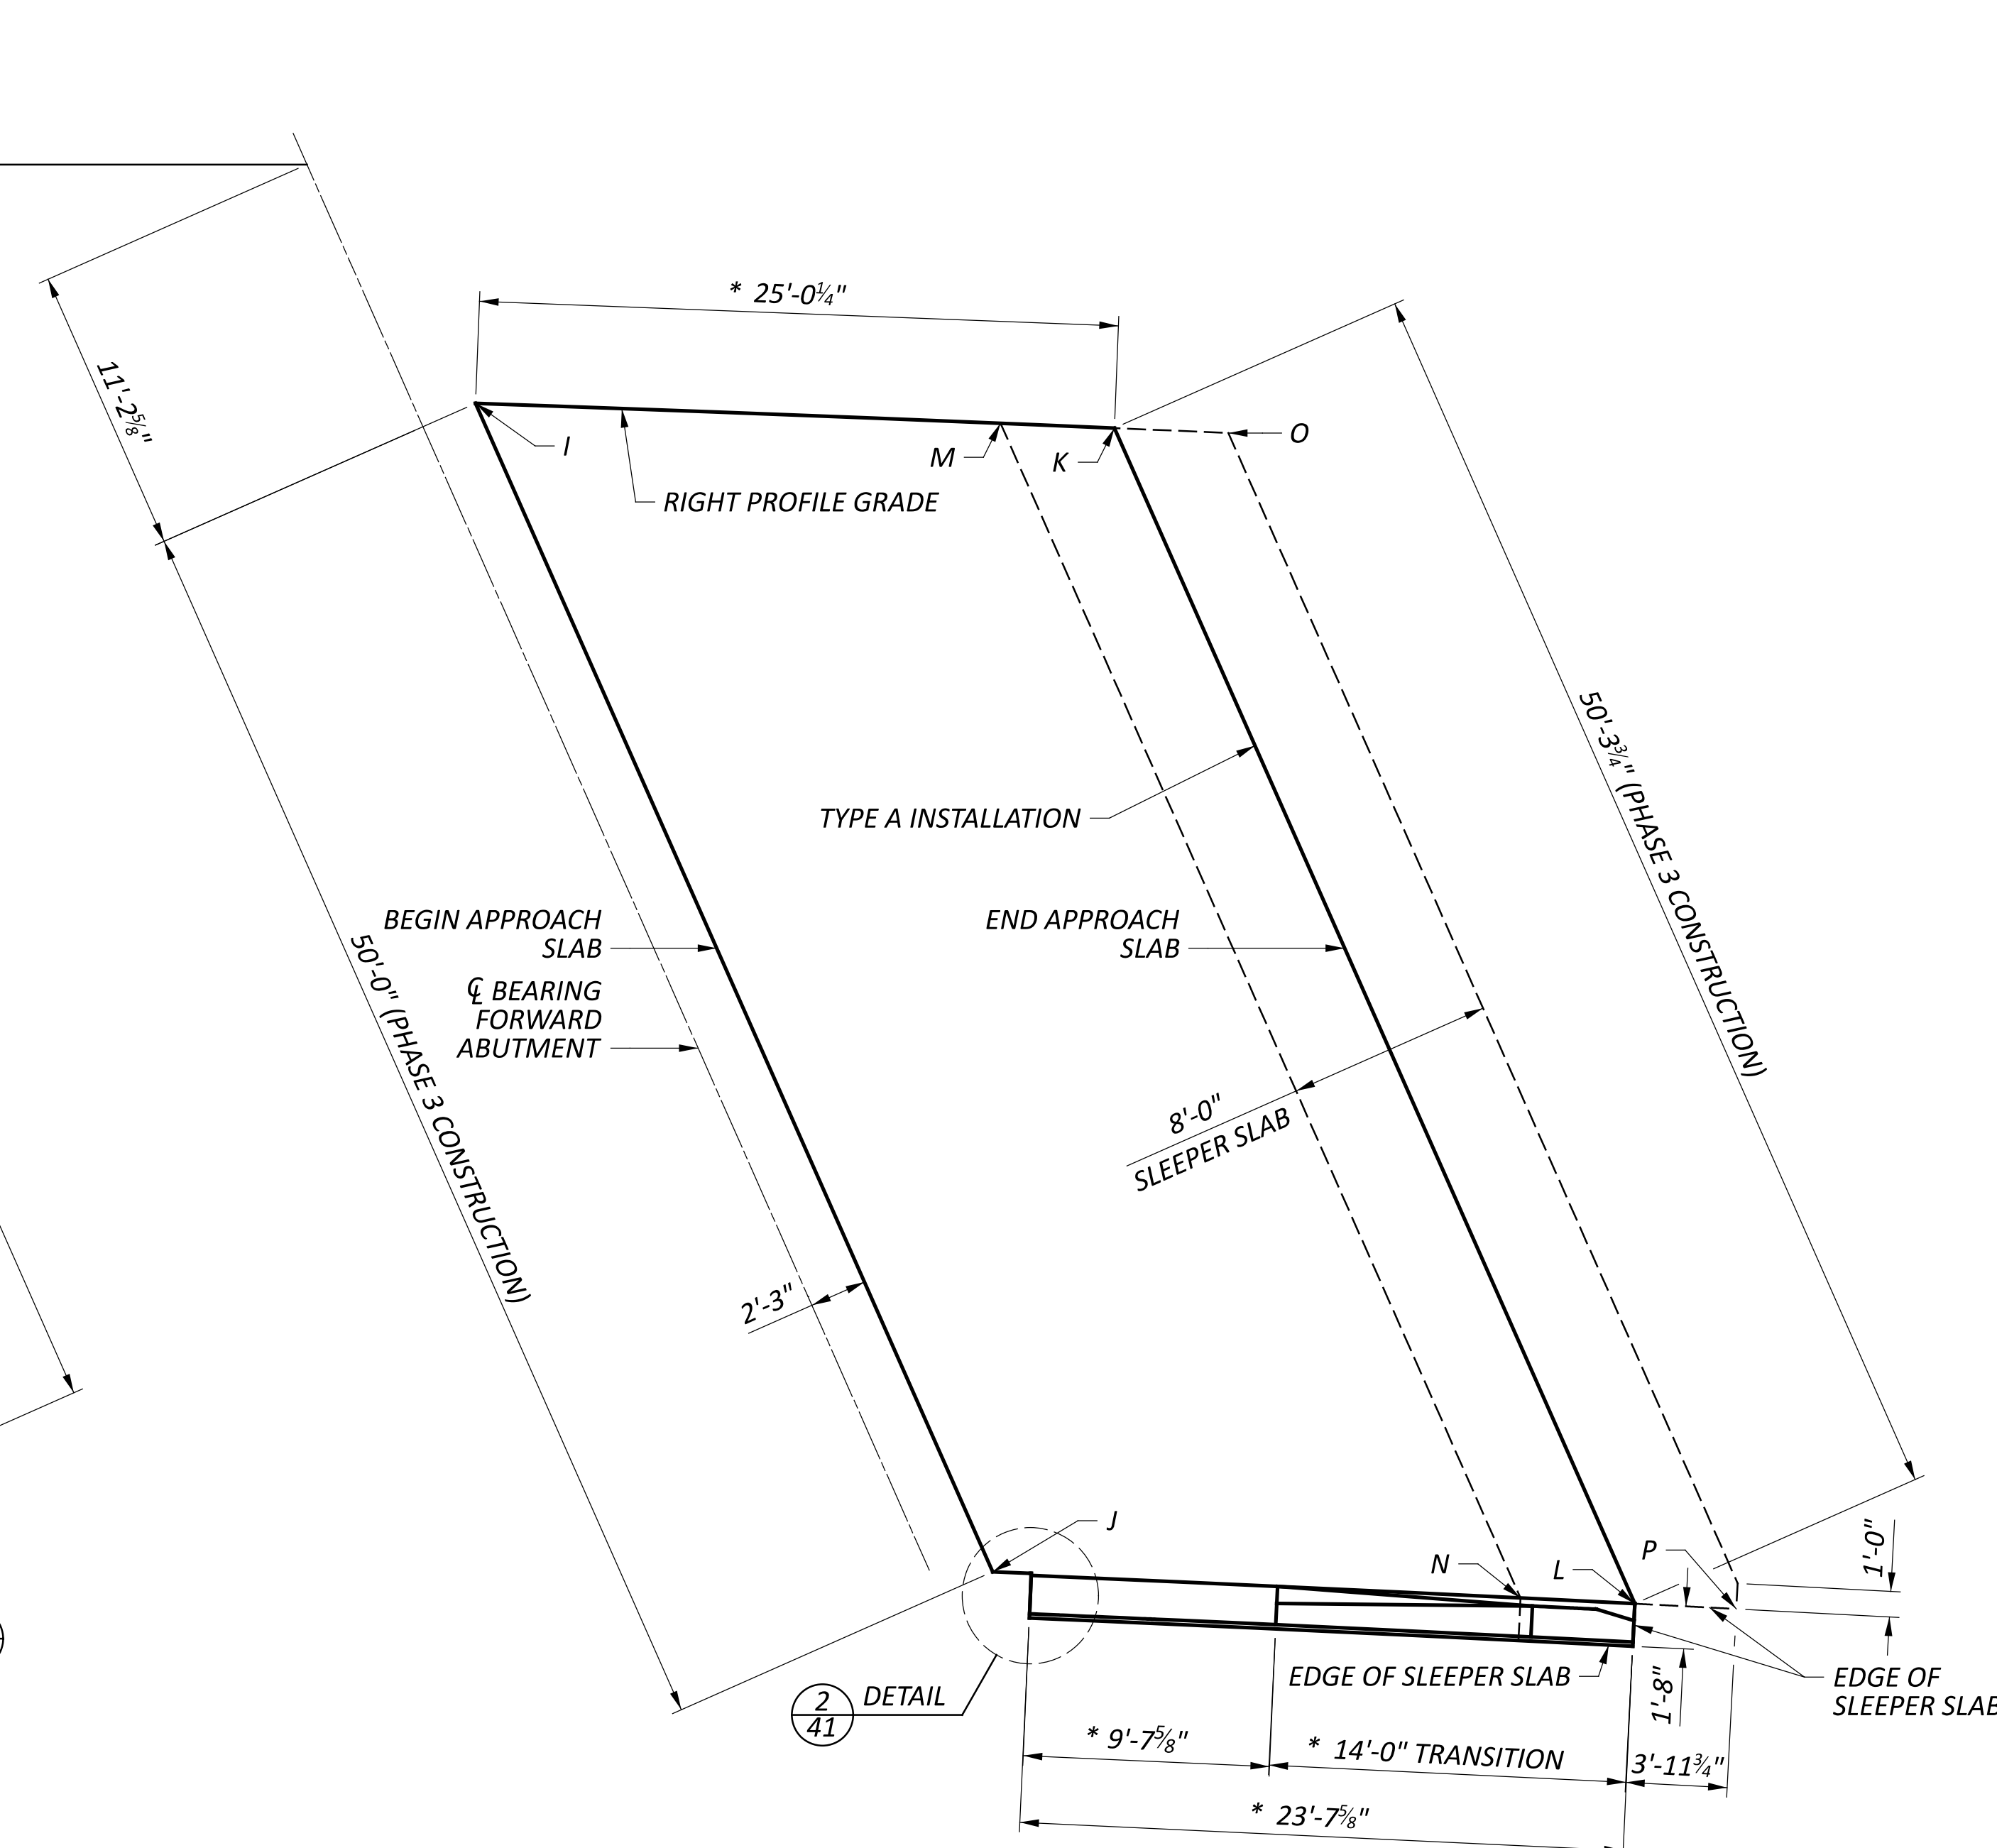


RIGHT BRIDGE  
FORWARD APPROACH SLAB PLAN

REAR APPROACH SLAB LOCATIONS							
APPROACH SLAB SURFACE ELEVATIONS (SEE NOTE 4)			SLEEPER SLAB ELEVATIONS				
	STATION	OFFSET	ELEVATION		STATION	OFFSET	ELEVATION
A	103+55.41	9.13' RT.	535.91	E	103+51.49	9.13' RT.	534.68
B	103+73.58	54.13' RT.	533.73	F	103+69.18	54.13' RT.	532.49
C	103+80.50	9.13' RT.	535.81	G	103+59.73	9.13' RT.	534.65
D	103+99.10	54.04' RT.	533.63	H	103+77.97	54.13' RT.	532.46

FORWARD APPROACH SLAB LOCATIONS							
APPROACH SLAB SURFACE ELEVATIONS (SEE NOTE 4)			SLEEPER SLAB ELEVATIONS				
	STATION	OFFSET	ELEVATION		STATION	OFFSET	ELEVATION
I	105+68.16	9.13' RT.	535.59	M	105+88.78	9.13' RT.	534.37
J	105+90.37	54.04' RT.	533.52	N	106+11.45	54.13' RT.	532.30
K	105+93.26	9.13' RT.	535.63	O	105+97.74	9.13' RT.	534.39
L	106+16.01	54.13' RT.	533.55	P	106+20.07	54.13' RT.	532.31

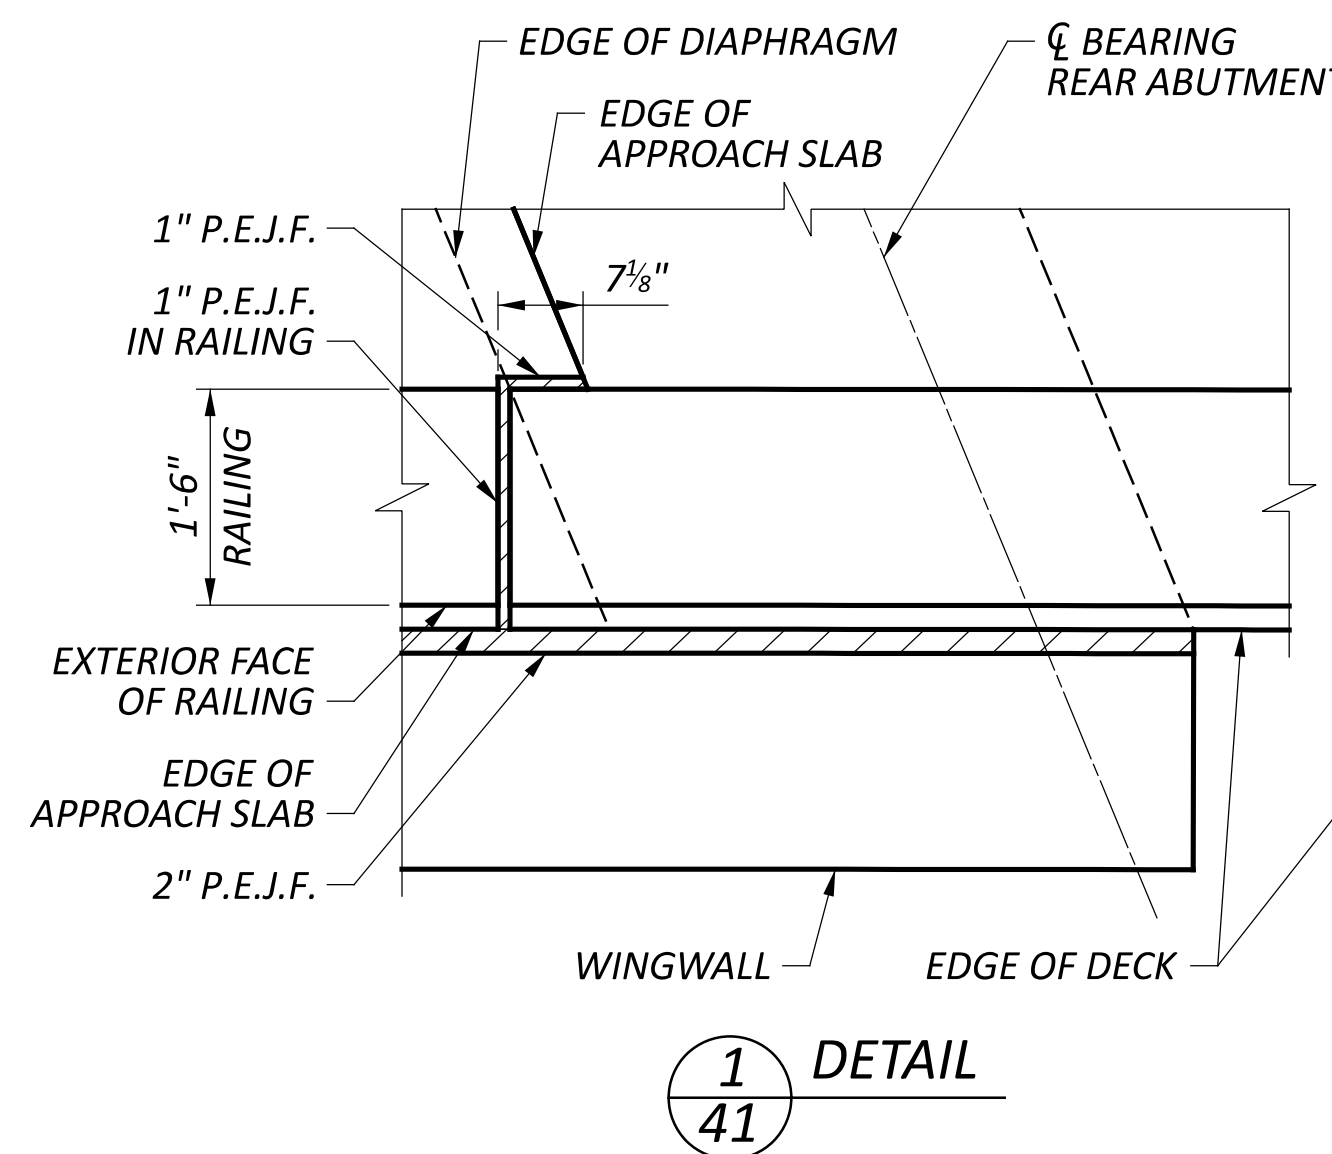

1  
41  
DETAIL

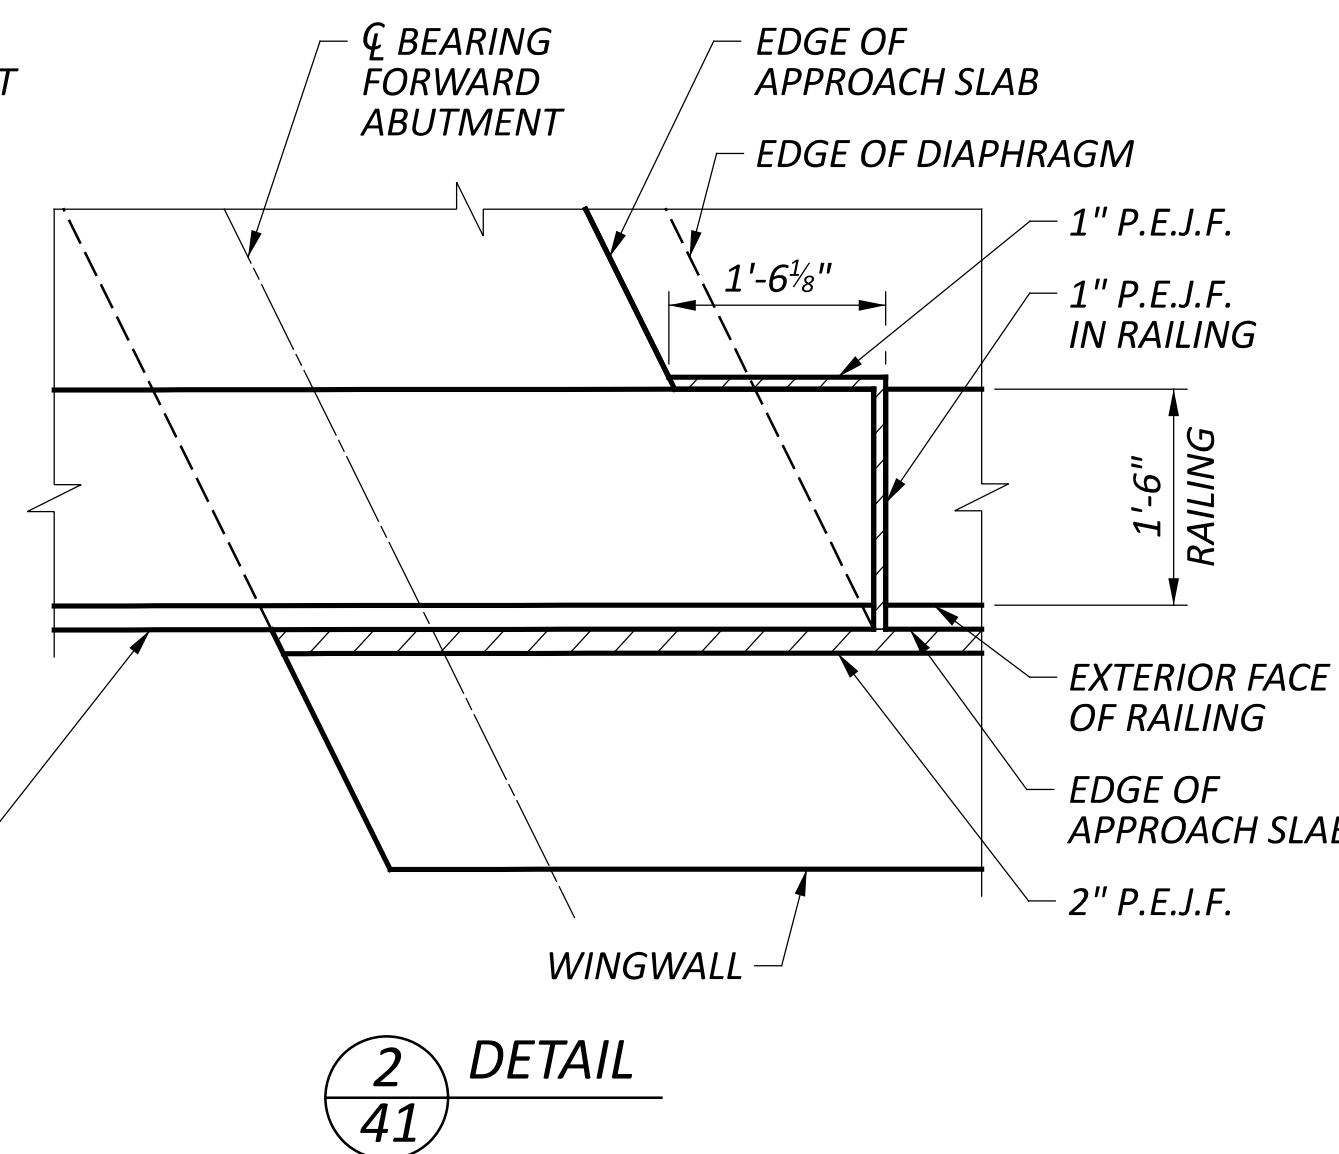

2  
41  
DETAIL

**LEGEND:**

\* MEASURED ALONG EDGE OF APPROACH SLAB

**NOTES:**

- FOR THE 25-FT. APPROACH SLAB REINFORCEMENT REQUIREMENTS AND ADDITIONAL STANDARD APPROACH SLAB DETAILS, SEE GENERAL NOTE ITEM 526 - REINFORCED CONCRETE APPROACH SLABS WITH QC/QA (T=15"), AS PER PLAN AND ODOT STANDARD DRAWING AS-1-15.
- FOR APPROACH SLAB TYPE A INSTALLATION REQUIREMENTS, SEE ODOT STANDARD DRAWING AS-2-15.
- FOR APPROACH SLAB RAILING DETAILS, SEE SHEETS 38 AND 39 OF 44.
- APPROACH SLAB SURFACE ELEVATIONS ARE GIVEN AT TOP OF CONCRETE APPROACH SLAB, UNDERNEATH THE ASPHALT.



**CONTINGENCY QUANTITIES**

THE CONTRACTOR SHALL NOT ORDER MATERIALS OR PERFORM WORK LISTED IN THE GENERAL SUMMARY FOR ITEMS DESIGNATED BY PLAN NOTE TO BE USED "AS DIRECTED BY THE ENGINEER" UNLESS AUTHORIZED BY THE ENGINEER. THE ACTUAL WORK LOCATIONS AND QUANTITIES USED AT THE ENGINEER'S DIRECTION SHALL BE MADE A MATTER OF RECORD BY INCORPORATION INTO THE FINAL CHANGE ORDER GOVERNING COMPLETION OF THE PROJECT.

**ITEM 254 - PAVEMENT PLANING, ASPHALT CONCRETE**

THE SEGMENT 1 PAVEMENT PLANING SHALL BE SCHEDULED TO BE COVERED BY THE SURFACE COURSE PRIOR TO REOPENING THE LANE TO TRAFFIC, EXCEPT THE CONTRACTOR IS PERMITTED TO MILL AHEAD 1000 FEET BEYOND THE PLACED SURFACE COURSE. THE MILLED AHEAD SURFACE SHALL BE COVERED BY THE SURFACE COURSE ASPHALT WITHIN 72 HOURS OF BEING OPEN TO TRAFFIC. ADDITIONALLY, THE MILLED AHEAD SURFACE SHALL NOT BE LOCATED WITHIN AN INTERSECTION OR RAMP. THE MILLED AHEAD SURFACE SHALL BE SMOOTH, FREE OF DEBRIS, AND FREE OF POTHOLES.

THE SEGMENT 2 PAVEMENT PLANING SHALL BE SCHEDULED SUCH THAT THE MILLED SURFACE SHALL BE COVERED BY THE SURFACE COURSE ASPHALT WITHIN 72 HOURS OF BEING OPEN TO TRAFFIC. THE MILLED SURFACE SHALL BE SMOOTH, FREE OF DEBRIS, AND FREE OF POTHOLES.


A DISINCENTIVE IN THE AMOUNT OF \$9,300 SHALL BE ASSESSED FOR EACH DAY THE CONTRACTOR FAILS TO MEET ANY OF THESE REQUIREMENTS.

**ITEM 251 - PARTIAL DEPTH PAVEMENT REPAIR (442)**

THIS OPERATION SHALL BE PERFORMED BEFORE RESURFACING OF ROADWAY.

THE FOLLOWING QUANTITY IS GENERATED ON SHEETS P.007 & P.009 AND CARRIED TO THE GENERAL SUMMARY TO ADDRESS LOCATIONS REQUIRING PARTIAL DEPTH PAVEMENT REPAIR:

ITEM 251 - PARTIAL DEPTH PAVEMENT REPAIR (442) 341 CY

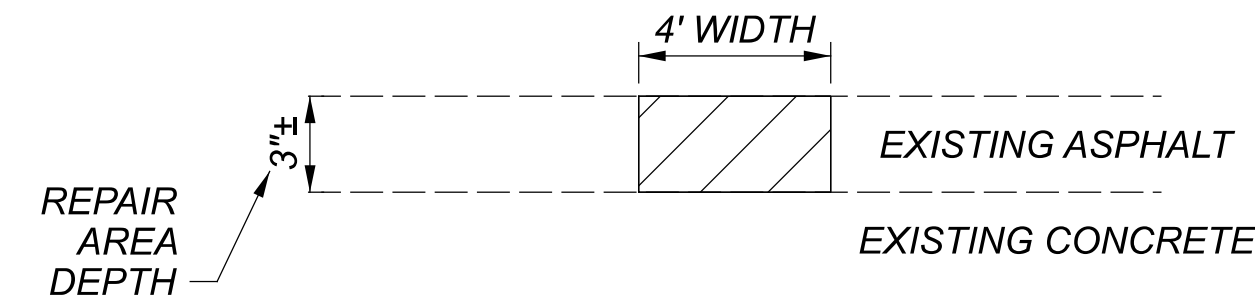


EXISTING DETERIORATED ASPHALT SHALL BE REMOVED TO A DEPTH OF 3"± AND MINIMUM WIDTH OF 4' OR AS DIRECTED BY THE ENGINEER. THIS WORK CONSISTS OF PARTIAL DEPTH REMOVAL OF EXISTING PAVEMENT IN AREAS EXHIBITING DETERIORATION AT THE SURFACE, APPLYING TACK COAT, AND PLACING AND COMPACTING ASPHALT CONCRETE. THE LOCATION AND SIZE OF THE REPAIR SHALL BE DETERMINED BY THE ENGINEER. THE EXISTING CONCRETE SURFACE SHALL NOT BE DISTURBED.

PLACE ITEM 442 - ASPHALT CONCRETE INTERMEDIATE COURSE, 12.5MM, TYPE A (449) INTO THE REPAIR.

**ITEM 252 - FULL DEPTH RIGID PAVEMENT REMOVAL AND FLEXIBLE REPLACEMENT, AS PER PLAN**

THIS ITEM SHALL CONSIST OF CUTTING AND REMOVING DETERIORATED PAVEMENT FULL DEPTH AND PLACING 10"-12"± ITEM 252 - FULL DEPTH RIGID PAVEMENT REMOVAL AND FLEXIBLE REPLACEMENT. IT IS NOT THE INTENT TO REPAIR EVERY DETERIORATED AREA WITHIN THE PROJECT. THE ENGINEER SHALL DETERMINE WHICH AREAS ARE TO BE REPAIRED. THIS ITEM SHALL COMMENCE WITHIN 7 DAYS OF THE BEGINNING OF MAINLINE PAVEMENT PLANING. PAYMENT SHALL BE BASED ON THE ACTUAL NUMBER OF SQUARE YARDS OF PAVEMENT REMOVED AND REPLACED TO THE LIMITS DESIGNATED BY THE ENGINEER.

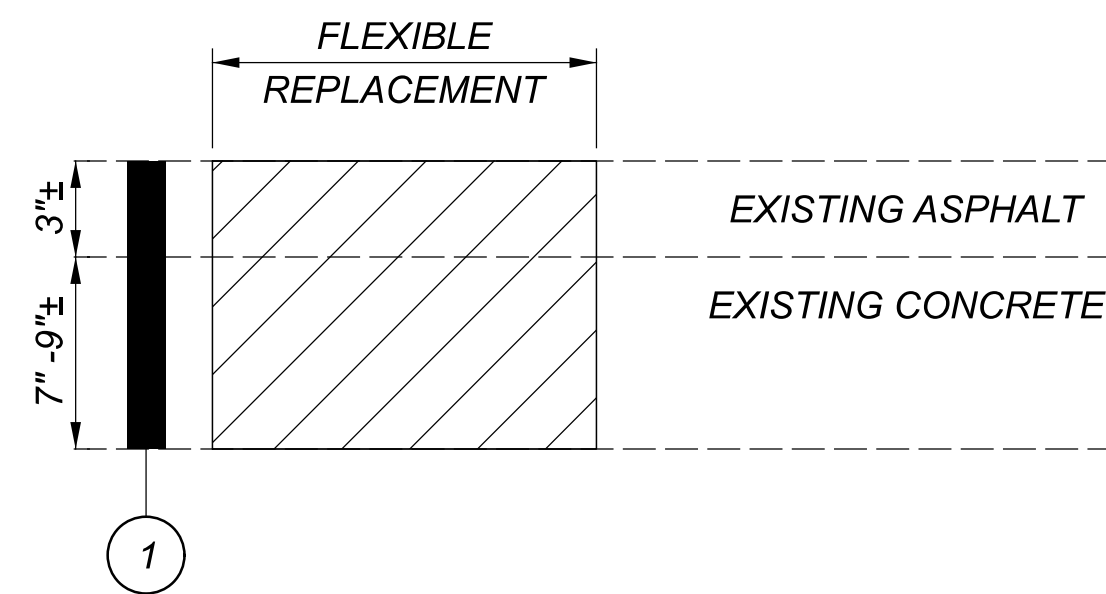

1 ITEM 252 - PAVEMENT REPAIR (10"-12"±)

PLACE ITEM 301 - ASPHALT CONCRETE BASE (449) INTO THE REPAIR.



**EXISTING LEGEND**






- ① 3"± EXISTING ASPHALT PAVEMENT
- ② 7-9"± EXISTING CONCRETE PAVEMENT

**LEGEND**

- ① ITEM 254 - PAVEMENT PLANING, ASPHALT CONCRETE (1.5" THICK)
- ② ITEM 442 - 1-1/2" ASPHALT CONCRETE SURFACE COURSE, 12.5 MM, TYPE A (446)
- ③ ITEM 872 - VOID REDUCING ASPHALT MEMBRANE (VRAM)
- ④ ITEM 407 - NON TRACKING TACK COAT (0.06 or 0.09 GAL/SY, PER CMS TABLE 407.06-1)
- ⑤ ITEM 442 - 1-3/4" ASPHALT CONCRETE INTERMEDIATE COURSE, 12.5 MM, TYPE A (446)
- ⑥ ITEM 301 - 9" ASPHALT CONCRETE BASE, PG64-22 (449) (PLACE IN 2 LIFTS)
- ⑦ ITEM 304 - 6" AGGREGATE BASE
- ⑧ ITEM 204 - EXCAVATION OF SUBGRADE, 12 INCHES DEEP
- ⑨ ITEM 422 - SINGLE SLOPE CONCRETE BRIDGE RAILING
- ⑩ ITEM 605 - 6" BASE PIPE UNDERDRAIN
- ⑪ ITEM 204 - PROOF ROLLING
- ⑫ ITEM 622 - CONCRETE BARRIER, SINGLE SLOPE, TYPE D
- ⑬ ITEM 622 - BARRIER, MISC.: MC-9.3, TYPE A
- ⑭ ITEM 606 - GUARDRAIL, TYPE MGS
- ⑮ APPROACH SLAB (T = 15")
- ⑯ ITEM 204 - GEOTEXTILE FABRIC
- ⑰ ITEM 204 - GRANULAR MATERIAL, TYPE C
- ⑱ ITEM 622 - CONCRETE BARRIER, SINGLE SLOPE, TYPE C1
- ⑲ ITEM 204 - SUBGRADE COMPACTION
- ⑳ ITEM 609 - CURB, TYPE 4C

Ψ - APPLY FULL WIDTH AND FULL RATE AS PER VRAM APPLICATION REQUIREMENTS IN ODOT SS 872, TABLE 872.04-1. (LOCATIONS ARE APPROXIMATELY AS SHOWN IN THE TYPICAL SECTION DETAILS. ACTUAL LOCATIONS IN THE FIELD WILL BE SLIGHTLY OFF THE LANE LINES.)


Σ - APPLY HALF WIDTH AND HALF RATE AS PER VRAM APPLICATION REQUIREMENTS IN ODOT SS 872, TABLE 872.04-1

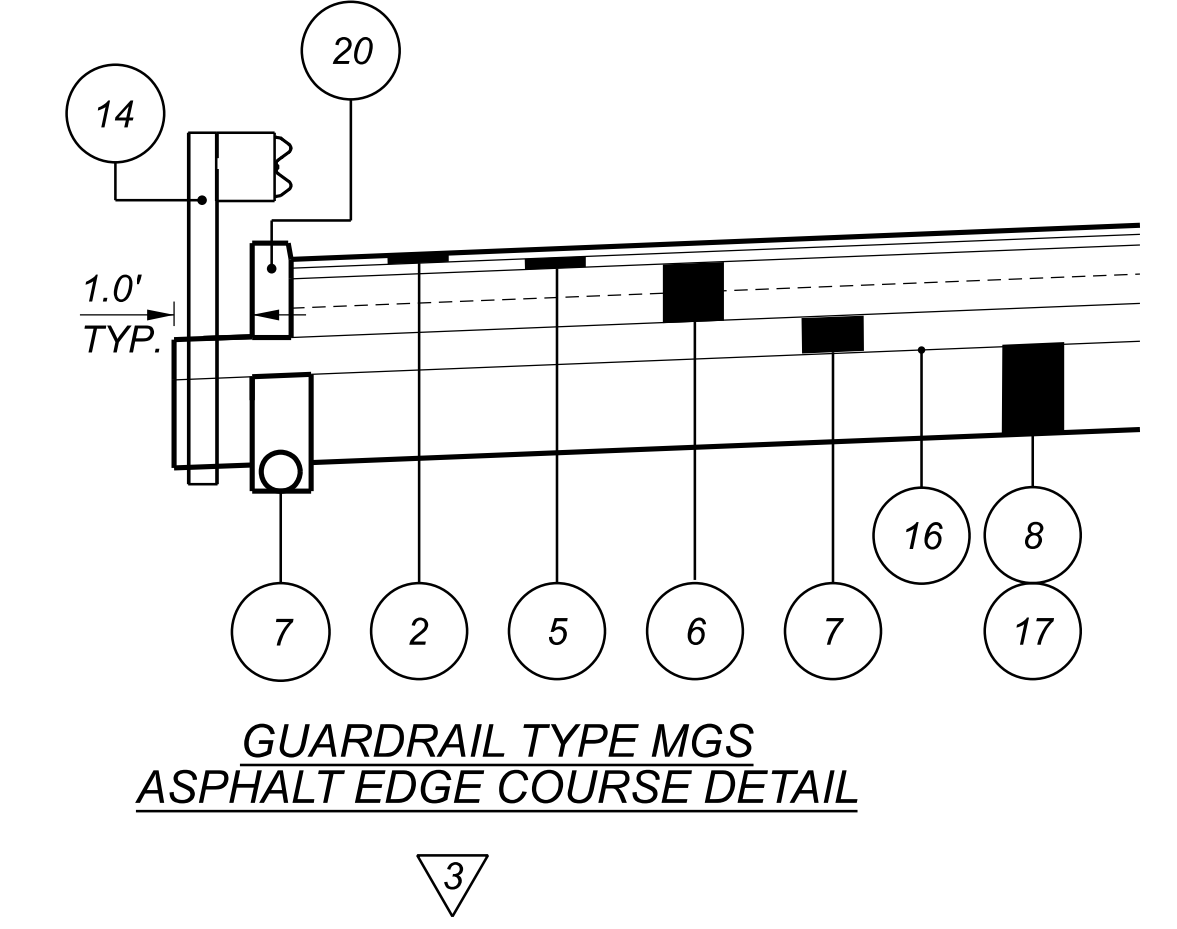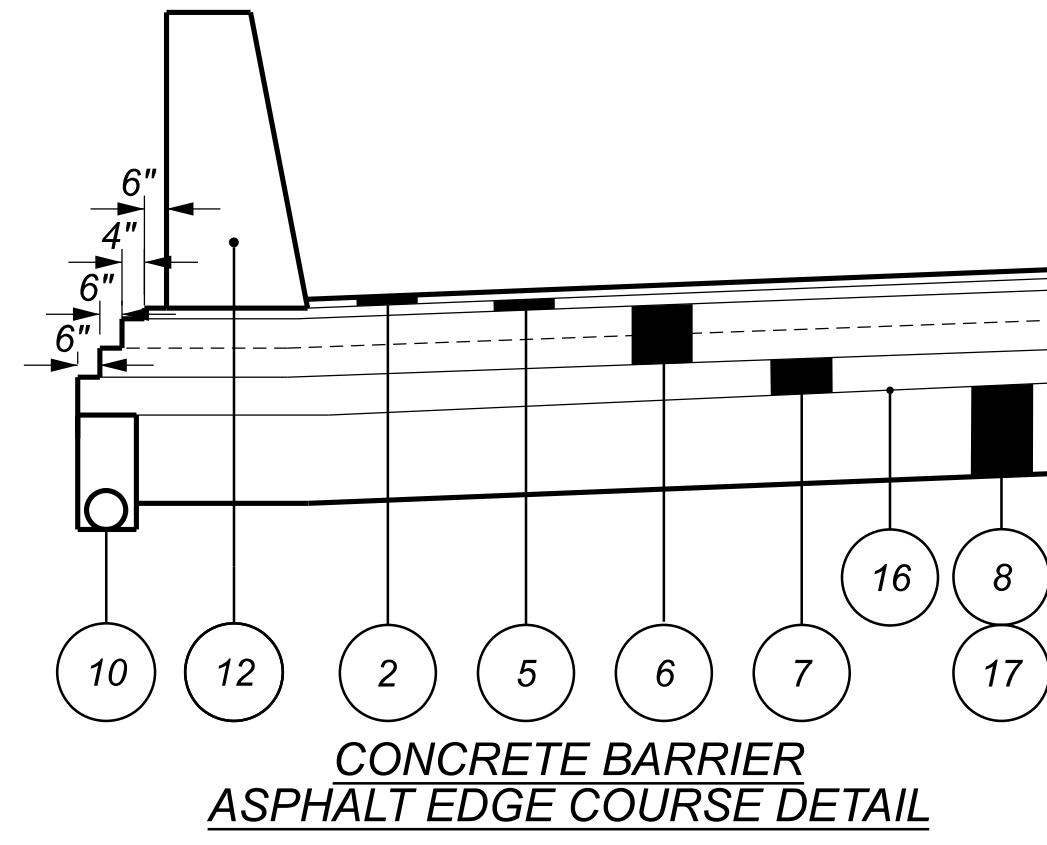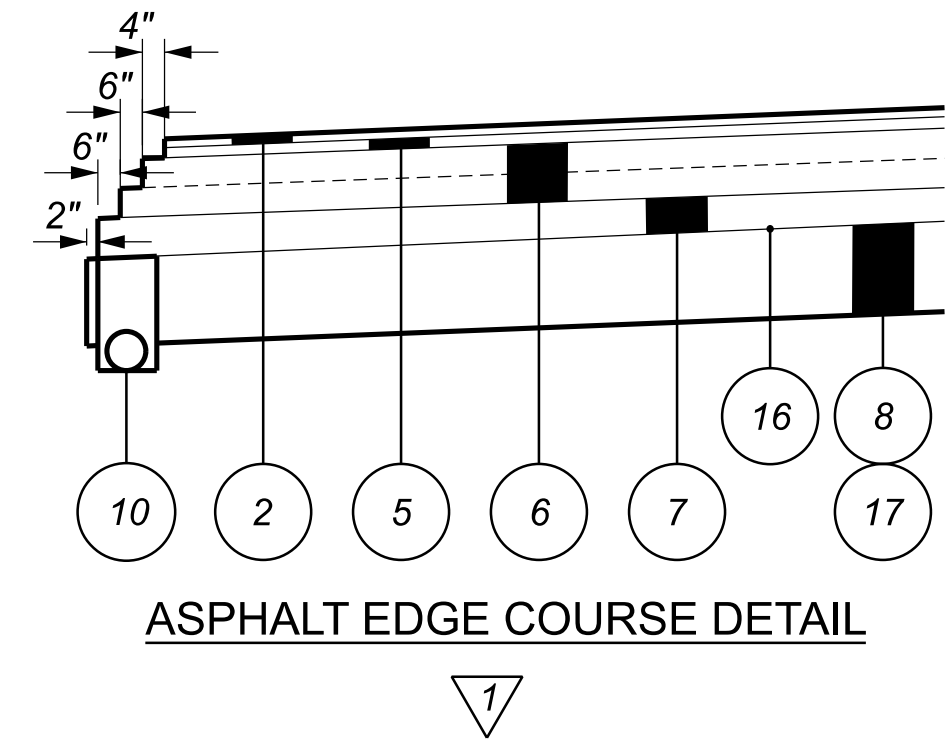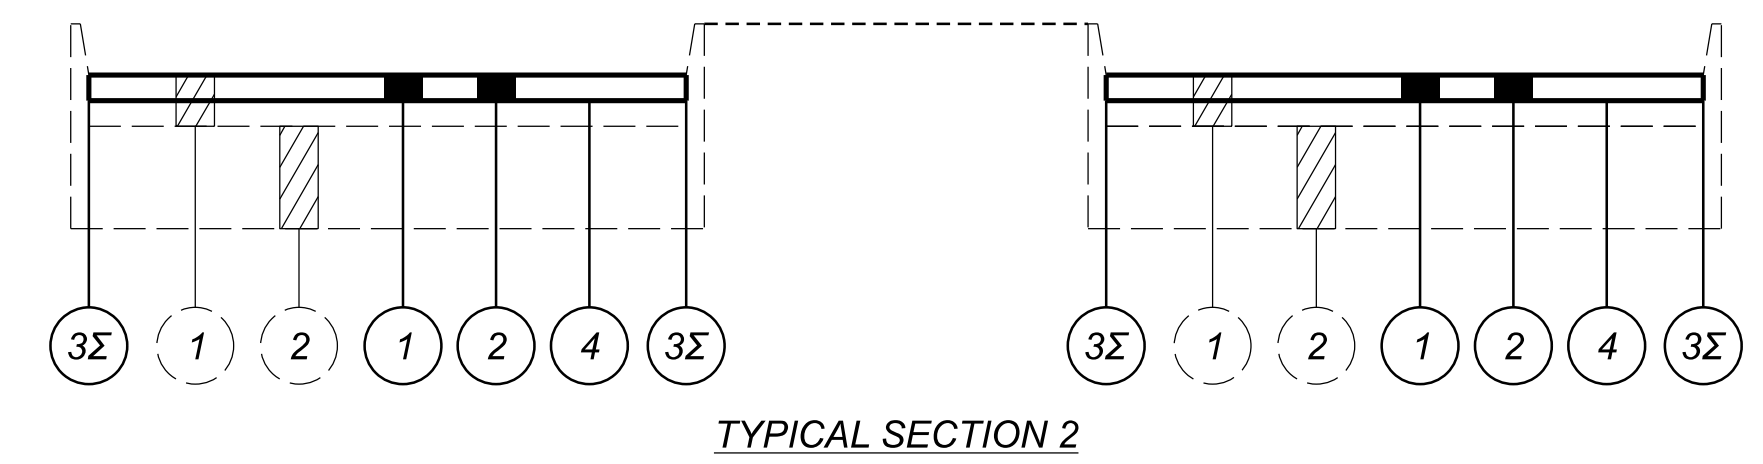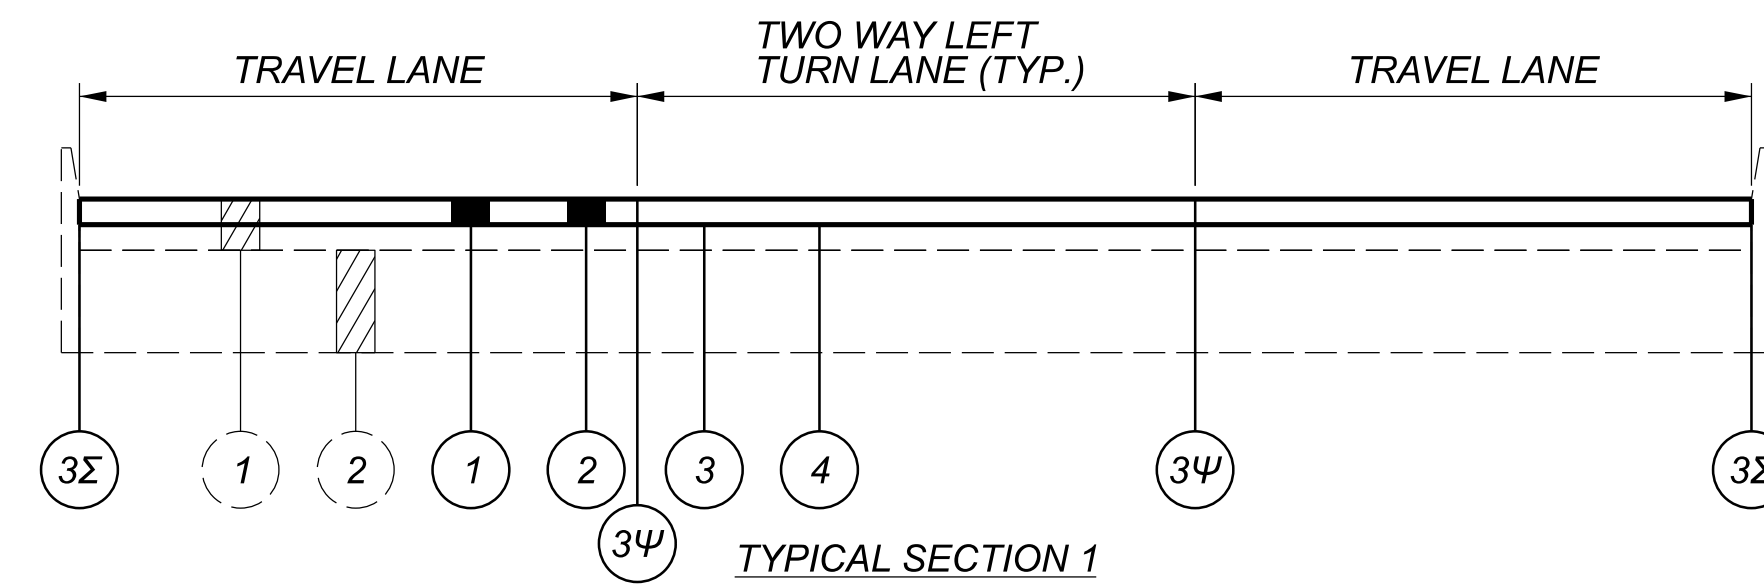


SEGMENT	LOG POINT TO LOG POINT	LENGTH		AVG WIDTH	TYPICAL	PAVEMENT AREA	251		252		254		407		442		872		632		644		644		644		644		644	
		MILES	MILES				FT	FT	CY	SY	FT	SY	SY	GAL	CY	FT	EACH	FT	MILE	MILE	FT	FT	FT	FT	FT	FT	FT	FT	FT	FT
US-50 SLM																														
1	29.31 TO 29.35	0.04	211	110.0	1	2581	11	129	774	2581	258	232.3	107.6	2112	SEE TRAFFIC CONTROL SUBSUMMARY OF SEGMENT 1 FOR THE QUANTITIES WITHIN THESE SLM POINTS.															
1	29.35 TO 29.45	0.10	528	84.0	1	4928	21	246	1478	4928	493	443.5	205.3	4224																
1	29.45 TO 29.46	0.01	53	100.0	1	587	2	29	176	587	59	52.8	24.4	475																
1	29.46 TO 29.53	0.07	370	110.0	1	4517	19	226	1355	4517	452	406.6	188.2	3696																
1	29.53 TO 29.59	0.06	317	100.0	1	3520	15	176	1056	3520	352	316.8	146.7	2851																
1	29.59 TO 29.75	0.16	845	84.0	1	7885	33	394	2365	7885	788	709.6	328.5	6758																
1	29.75 TO 29.79	0.04	211	56.0	1	1314	5	66	394	1314	131	118.3	54.8	1056																
1	29.79 TO 29.85	0.06	317	30.0	2	1056	4	53	317	1056	106	95.0	44.0	634	1	150	0.12	0.06	122	25	111	64	3	297	0	0	0	0	0	
1	29.85 TO 29.86	0.01	53	44.0	1	258	1	13	77	258	26	23.2	10.8	211	0	0	0.00	0.00	0	0	0	0	0	0	0	0	0	0	0	
1	29.86 TO 29.92	0.06	317	31.0	2	1091	5	55	327	1091	109	98.2	45.5	634	0	0	0.00	0.04	50	0	0	0	1	0	1	0	0	0		
1	29.92 TO 29.94	0.02	106	38.0	1	446	2	22	134	446	45	40.1	18.6	422	0	0	0.00	0.09	0	0	84	55	0	0	1	0	0	0		
1	29.94 TO 29.95	0.01	53	32.0	2	188	1	9	56	188	19	16.9	7.8	106	0	0	0.00	0.00	0	0	0	0	0	0	0	0	0	0		
1	29.95 TO 29.99	0.04	211	40.0	1	939	4	47	282	939	94	84.5	39.1	845	0	0	0.00	0.05	40	0	84	66	1	0	3	0	0	0		
1	29.99 TO 30.02	0.03	158	31.0	2	546	2	27	164	546	55	49.1	22.7	317	0	0	0.00	0.00	0	0	75	50	0	0	1	0	0	0		
1	30.02 TO 30.05	0.03	158	37.0	1	651	3	33	195	651	65	58.6	27.1	634	0	0	0.00	0.11	0	0	0	0	0	0	1	0	0	0		
1	30.05 TO 30.07	0.02	106	24.0	2	282	1	14	84	282	28	25.3	11.7	211	0	0	0.00	0.00	0	0	0	0	0	0	2	0	0	0		
1	30.07 TO 30.08	0.01	53	40.0	1	235	1	12	70	235	23	21.1	9.8	211	0	0	0.00	0.00	65	0	0	0	0	0	0	0	0	0		
1	30.08 TO 30.10	0.02	106	28.0	2	329	1	16	99	329	33	29.6	13.7	211	1	150	0.00	0.06	0	26	77	56	1	0	1	0	0	0		
1	30.10 TO 30.11	0.01	53	38.0	1	223	1	11	67	223	22	20.1	9.3	211	0	0	0.00	0.00	0	12	0	0	0	0	0	0	0	0		
1	30.11 TO 30.14	0.03	158	28.0	2	493	2	25	148	493	49	44.4	20.5	317	0	0	0.00	0.03	0	0	74	0	0	0	2	0	0	0		
1	30.14 TO 30.17	0.03	158	38.0	1	669	3	33	201	669	67	60.2	27.9	634	0	0	0.00	0.00	0	0	0	0	0	0	2	0	0	0		
1	30.17 TO 30.19	0.02	106	28.0	2	329	1	16	99	329	33	29.6	13.7	211	0	0	0.00	0.00	0	0	0	0	0	0	0	0	0	0		
1	30.19 TO 30.21	0.02	106	40.0	1	469	2	23	141	469	47	42.2	19.6	422	0	0	0.00	0.09	37	0	82	60	1	0	5	0	0	0		
1	30.21 TO 30.22	0.01	53	28.0	2	164	1	8	49	164	16	14.8	6.8	106	0	0	0.00	0.00	0	0	0	0	0	0	0	0	0			
1	30.22 TO 30.27	0.05	264	44.0	1	1,291	5	65	387	1,291	129	116.2	54	1056	0	0	0.02	0.04	30	0	60	60	3	0	2	24	0	0		
SUBTOTAL							145.8	1,749.4	10,496.6	34,988.8	3,498.9	3,149.0	1,457.9	28,564.8	2	300	0.14	0.57	344	63	647	411	10	297	21	24	24	24	24	
TOTAL CARRIED TO GENERAL SUMMARY							146	1,749	10,497	34,989	3,499	3,149	1,458	28,565	2	300	0.14	0.57	344	63	647	411	10	297	21	24	24	24	24	



- ① 3"± EXISTING ASPHALT PAVEMENT
- ② 7-9"± EXISTING CONCRETE PAVEMENT
- ① ITEM 254 - PAVEMENT PLANING, ASPHALT CONCRETE (1.5" THICK)
- ② ITEM 442 - 1-1/2" ASPHALT CONCRETE SURFACE COURSE, 12.5 MM, TYPE A (446)
- ③ ITEM 872 - VOID REDUCING ASPHALT MEMBRANE (VRAM)
- ④ ITEM 407 - NON-TRACKING TACK COAT (0.06 OR 0.09 GAL/SY, PER CMS TABLE 407.06-1)

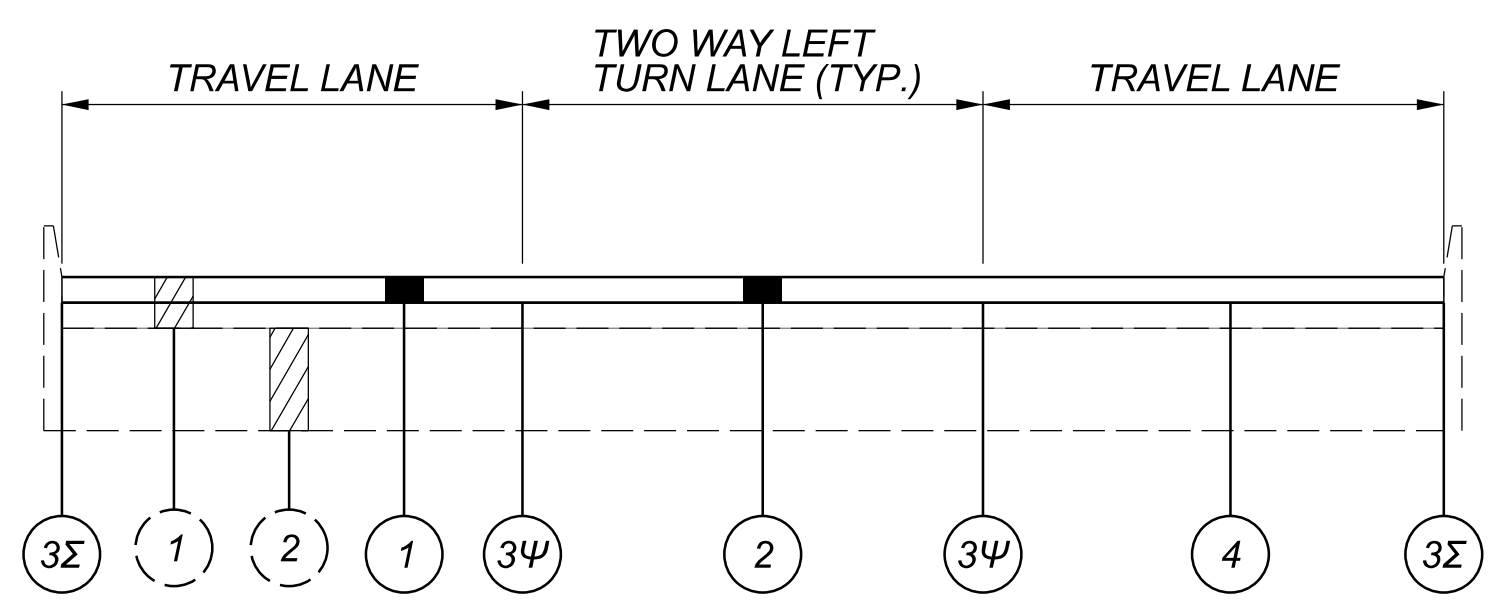

TYPICAL SECTION 1

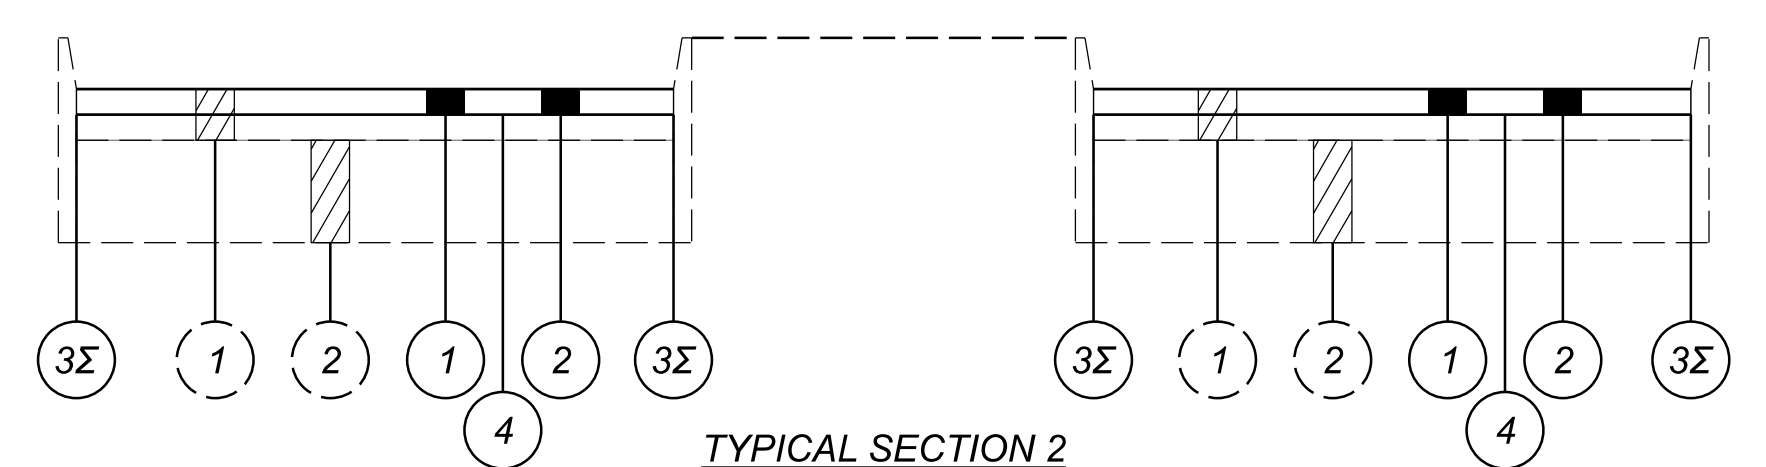

TYPICAL SECTION 2

Ψ - APPLY FULL WIDTH AND FULL RATE AS PER VRAM APPLICATION REQUIREMENTS IN ODOT SS 872, TABLE 872.04-1 (LOCATIONS ARE APPROXIMATELY AS SHOWN IN THE TYPICAL SECTION DETAILS. ACTUAL LOCATIONS IN THE FIELD WILL BE SLIGHTLY OFF THE LANE LINES.)

Σ - APPLY HALF WIDTH AND HALF RATE AS PER VRAM APPLICATION REQUIREMENTS IN ODOT SS 872, TABLE 872.04-1

SEGMENT	ROUTE	LOG POINT TO LOG POINT	LENGTH		TYPICAL	EXISTING PAVEMENT TYPE	PAVEMENT AREA	251	252	252	254	254	407	442	872	621	621	644	644	644	644	644	644		
			PARTIAL DEPTH PAVEMENT REPAIR (442)	FULL DEPTH RIGID PAVEMENT REMOVAL AND FLEXIBLE REPLACEMENT, AS PER PLAN				FULL DEPTH PAVEMENT SAWING	PAVEMENT PLANING, ASPHALT CONCRETE (1.5")	PATCHING PLANED SURFACE	NON-TRACKING TACK COAT	1.5" ASPHALT CONCRETE SURFACE COURSE, 12.5 MM, TYPE A (446)	VOID REDUCING ASPHALT MEMBRANE (VRAM)	RPM	RAISED PAVEMENT MARKER REMOVED	EDGE LINE, 6"	LANE LINE, 6"	CENTER LINE	CHANNELIZING LINE, 12"	STOP LINE	LANE ARROW				
		MILE	MILE	FT	FT		SY	CY	SY	FT	SY	SY	GAL	CY	FT	EACH	EACH	MILE	MILE	MILE	FT	EACH	EACH		
2	US-50	34.24 TO 34.40	0.16	845	39.50	1	ASPHALT	3709	21	186	1116	3709	371	334	155	3380	16	16	0.32	0	0.32	0	0	0	
		34.40 TO 34.44	0.04	212	30.25	2	ASPHALT	713	4	36	216	713	72	65	30	848	2	2	0.08	0	0.08	0	0	0	
		34.44 TO 34.53	0.09	476	39.00	1	ASPHALT	2063	12	104	624	2063	207	186	86	1904	16	16	0.16	0	0.16	110	0	2	
		34.53 TO 34.56	0.03	159	30.00	2	ASPHALT	530	3	27	162	530	53	48	23	636	2	2	0.06	0	0.06	0	0	0	
		34.56 TO 34.60	0.04	212	40.25	1	ASPHALT	949	6	48	288	949	95	86	40	848	8	8	0.08	0	0.06	0	0	2	
		34.60 TO 34.64	0.04	212	28.00	2	ASPHALT	660	4	33	198	660	66	60	28	848	2	2	0.08	0	0.08	0	0	0	
		34.64 TO 34.79	0.15	792	42.25	1	ASPHALT	3718	21	186	1116	3718	372	335	155	3168	26	26	0.28	0	0.28	0	0	2	
		34.79 TO 34.84	0.05	265	30.50	2	ASPHALT	899	5	45	270	899	90	81	38	1060	2	2	0.10	0	0.10	0	0	0	
		34.84 TO 34.91	0.07	370	40.75	1	ASPHALT	1676	10	84	504	1676	168	151	70	1480	10	10	0.14	0	0.12	0	0	2	
		34.91 TO 34.92	0.01	53	30.75	2	ASPHALT	182	2	10	60	182	19	17	8	212	2	2	0.02	0	0.02	0	0	0	
		34.92 TO 34.93	0.01	53	39.75	1	ASPHALT	235	2	12	72	235	24	22	10	212	2	2	0.02	0	0.02	0	0	0	
		34.93 TO 34.94	0.01	53	30.25	2	ASPHALT	179	1	9	54	179	18	17	8	212	2	2	0.02	0	0.02	0	0	0	
		34.94 TO 35.07	0.13	687	42.00	1	ASPHALT	3206	18	161	966	3206	321	289	134	2748	14	14	0.23	0	0.22	0	0	4	
		35.07 TO 35.08	0.01	53	29.00	2	ASPHALT	171	1	9	54	171	18	16	8	212	2	2	0.02	0	0.02	0	0	0	
		35.08 TO 35.14	0.06	317	40.25	1	ASPHALT	1418	8	81	486	1418	142	128	60	1268	10	10	0.12	0	0.12	0	0	0	
		35.14 TO 35.15	0.01	53	29.75	2	ASPHALT	176	1	9	54	176	18	16	8	212	2	2	0.02	0	0.02	0	0	0	
		35.15 TO 35.20	0.05	265	39.50	1	ASPHALT	1164	7	59	354	1164	117	105	49	1060	6	6	0.10	0	0.10	0	0	0	
		35.20 TO 35.21	0.01	53	31.50	2	ASPHALT	186	2	10	60	186	19	17	8	212	2	2	0.02	0	0.02	0	0	0	
		35.21 TO 35.43	0.22	1162	40.75	1	ASPHALT	5262	30	264	1584	5262	527	474	220	4648	40	40	0.38	0.05	0.30	480	50	9	
		35.43 TO 35.47	0.04	212	28.25	2	ASPHALT	666	4	34	204	666	67	60	28	848	4	4	0.08	0	0.08	0	0	0	
35.47 TO 35.52	0.05	265	40.00	1	ASPHALT	1178	7	59	354	1178	118	107	50	1060	10	10	0.09	0	0.08	0	0	2			
35.52 TO 35.55	0.03	159	30.00	2	ASPHALT	530	3	27	162	530	53	48	23	636	2	2	0.06	0	0.04	0	0	2			
35.55 TO 35.64	0.09	476	39.75	1	ASPHALT	2103	12	106	636	2103	211	190	88	1904	8	8	0.18	0	0.18	0	0	0			
35.64 TO 35.66	0.02	106	31.50	2	ASPHALT	371	3	19	114	371	38	34	16	424	2	2	0.04	0	0.04	0	0	0			
35.66 TO 35.72	0.06	317	39.75	1	ASPHALT	1401	8	71	426	1401	141	127	59	1268	2	2	0.10	0	0.12	185	0	2			
SUBTOTAL																									
TOTALS CARRIED TO GENERAL SUMMARY								195	1,689	10,134	33,345	3,345	3,013	1,402	31,308	194	194	2.80	0.05	2.66	775	50	27		

HAM-US 50-29.00

MODEL: Sheet PAPER/DATE: 3/4/22 (in.) DATE: 1/29/2024 TIME: 12:09:27 PM USER: mswright  
 p:\hpc\p\m\01-a-e-transyscorp.com\transyscorp-pw\1\Documents\Projects\_2020\CL402402200084\Agency\_Folders\400-Engineering\Roadway\Sheets\2LMN\_Sheets\110570\_C\001.dgn

TYPICAL SECTIONS (SEGMENT 2)

DESIGN AGENCY  
  
 DESIGNER  
 MAK  
 REVIEWER  
 ALL 08/22/23  
 PROJECT ID  
 110570  
 SHEET TOTAL  
 P.009 208



SHEET NUM.											PART.			ITEM	ITEM EXT	GRAND TOTAL	UNIT	DESCRIPTION	SEE SHEET NO.
P.007	P.009	P.011	P.012	P.016	P.059	P.060	P.061	P.063	P.064		01/NHS/13	02/S>2/13	03/S>2/05						
			4								2	2		601	21050	4	SY	<b>EROSION CONTROL</b> TIED CONCRETE BLOCK MAT WITH TYPE 1 UNDERLAYMENT	
						5					5			601	21060	5	SY	TIED CONCRETE BLOCK MAT WITH TYPE 2 UNDERLAYMENT	
		2									1	1		659	00100	2	EACH	SOIL ANALYSIS TEST	
		190									178	12		659	00300	190	CY	TOPSOIL	
		1,708									1,604	104		659	10000	1,708	SY	SEEDING AND MULCHING	
		86									81	5		659	14000	86	SY	REPAIR SEEDING AND MULCHING	
		86									81	5		659	15000	86	SY	INTER-SEEDING	
		0.24									0.22	0.02		659	20000	0.24	TON	COMMERCIAL FERTILIZER	
		0.35									0.33	0.02		659	31000	0.35	ACRE	LIME	
		10									9.5	0.5		659	35000	10	MGAL	WATER	
		4									3.8	0.2		659	40000	4	MSF	MOWING	
						188					188			670	00720	188	SY	DITCH EROSION PROTECTION MAT, TYPE B	
									LS		LS	LS		832	15000	LS		STORM WATER POLLUTION PREVENTION PLAN	
									LS		LS	LS		832	15002	LS		STORM WATER POLLUTION PREVENTION INSPECTIONS	
									LS		LS	LS		832	15010	LS		STORM WATER POLLUTION PREVENTION INSPECTION SOFTWARE	
									107,210		36,451	70,759		832	30000	107,210	EACH	EROSION CONTROL	
																		<b>DRAINAGE</b>	
			20								10	10		605	13300	20	FT	6" UNCLASSIFIED PIPE UNDERDRAINS	
								3,216			2,006	1,210		605	14000	3,216	FT	6" BASE PIPE UNDERDRAINS	
								476			345	131		611	00510	476	FT	6" CONDUIT, TYPE F FOR UNDERDRAIN OUTLETS	
			50								25	25		611	01500	50	FT	6" CONDUIT, TYPE F	
											371			611	04400	371	FT	12" CONDUIT, TYPE B	
											98			611	04400	98	FT	12" CONDUIT, TYPE B, 706.02	
											22			611	04400	22	FT	12" CONDUIT, TYPE B, 707.42	
											14			611	05900	14	FT	15" CONDUIT, TYPE B	
											141			611	10400	141	FT	24" CONDUIT, TYPE B	
											2			611	98370	2	EACH	CATCH BASIN, NO. 6	
											1			611	99111	1	EACH	INLET, NO. 3 FOR SINGLE SLOPE BARRIER, TYPE C1, AS PER PLAN A	
											1			611	99111	1	EACH	INLET, NO. 3 FOR SINGLE SLOPE BARRIER, TYPE C1, AS PER PLAN B	
												1		611	99151	1	EACH	INLET ADJUSTED TO GRADE, AS PER PLAN	
											2			611	99500	2	EACH	INLET, MISC.: I-3A	
											3			611	99574	3	EACH	MANHOLE, NO. 3	
											1			611	99654	1	EACH	MANHOLE ADJUSTED TO GRADE	
			2								1	1		611	99710	2	EACH	PRECAST REINFORCED CONCRETE OUTLET	
			800								550	250		SPECIAL	69098100	800	FT	MISC: DRAINAGE SYSTEM CLEANING, 36" AND UNDER	
																		<b>PAVEMENT</b>	
		146											341	251	01030	341	CY	PARTIAL DEPTH PAVEMENT REPAIR (442)	
		1,749	195										3,438	252	01001	3,438	SY	FULL DEPTH RIGID PAVEMENT REMOVAL AND FLEXIBLE REPLACEMENT, AS PER PLAN	
		10,497	10,134										20,631	252	01500	20,631	FT	FULL DEPTH PAVEMENT SAWING	
		34,989	33,345			6				15,208	2,907	12,307	68,334	254	01000	83,548	SY	PAVEMENT PLANING, ASPHALT CONCRETE (1.5" DEEP)	
		3,499	3,345							1,521	290	1,231	6,844	254	01600	8,365	SY	PATCHING PLANED SURFACE	
										1,402	930	472		301	56000	1,402	CY	ASPHALT CONCRETE BASE, PG64-22, (449)	
										1,144	749	395		304	20000	1,144	CY	AGGREGATE BASE	
		3,149	3,013							2,102	770	1,332	6,162	407	20000	8,264	GAL	NON-TRACKING TACK COAT	
		1,458	1,402							882	294	588	2,860	442	10000	3,742	CY	ASPHALT CONCRETE SURFACE COURSE, 12.5 MM, TYPE A (446)	
										299	208	91		442	10080	299	CY	ASPHALT CONCRETE INTERMEDIATE COURSE, 12.5 MM, TYPE A (446)	
											36.5	36.5		609	24510	73	FT	CURB, TYPE 4-C	
		28,565	31,308			73				19,140	6,117	13,023	59,873	872	10000	79,013	FT	VOID REDUCING ASPHALT MEMBRANE (VRAM)	

GENERAL SUMMARY

DESIGN AGENCY  
**TRANSYSTEMS**  
 1100 SUPERIOR AVE. E. STE 1000  
 CLEVELAND, OHIO 44114

DESIGNER  
**MSW**

REVIEWER  
**GHM 08/22/23**

PROJECT ID  
**110570**

SHEET TOTAL  
 P.055 | 208



**ITEM 614, LAW ENFORCEMENT OFFICER (WITH PATROL CAR)  
FOR ASSISTANCE DURING CONSTRUCTION OPERATIONS**

USE OF LAW ENFORCEMENT OFFICERS (LEOS) BY CONTRACTORS OTHER THAN THE USES SPECIFIED BELOW WILL NOT BE PERMITTED AT PROJECT COST. LEOS SHOULD NOT BE USED WHERE THE OMUTCD INTENDS THAT FLAGGERS BE USED.

IN ADDITION TO THE REQUIREMENTS OF C&MS 614 AND THE OMUTCD, A UNIFORMED LEO WITH AN OFFICIAL PATROL CAR (CAR WITH TOP-MOUNTED EMERGENCY FLASHING LIGHTS AND COMPLETE MARKINGS OF THE APPROPRIATE LAW ENFORCEMENT AGENCY) SHALL BE PROVIDED FOR THE FOLLOWING TRAFFIC CONTROL TASKS:

DURING THE ENTIRE ADVANCE PREPARATION AND CLOSURE SEQUENCE WHERE COMPLETE BLOCKAGE OF TRAFFIC IS REQUIRED.

DURING A TRAFFIC SIGNAL INSTALLATION WHEN IMPACTING THE NORMAL FUNCTION OF THE SIGNAL OR THE FLOW OF TRAFFIC, OR WHEN TRAFFIC NEEDS TO BE DIRECTED THROUGH AN ENERGIZED TRAFFIC SIGNAL CONTRARY TO THE SIGNAL DISPLAY (E.G., DIRECTING MOTORISTS THROUGH A RED LIGHT).

IN ADDITION TO THE REQUIREMENT OF C&MS 614 AND THE OMUTCD, A UNIFORMED LEO WITH AN OFFICIAL PATROL CAR (CAR WITH TOP-MOUNTED EMERGENCY FLASHING LIGHTS AND COMPLETE MARKINGS OF THE APPROPRIATE LAW ENFORCEMENT AGENCY) SHOULD BE PROVIDED FOR THE FOLLOWING TRAFFIC CONTROL TASKS AS APPROVED BY THE ENGINEER:

FOR LANE CLOSURES: DURING INITIAL SET-UP PERIODS, TEAR DOWN PERIODS, SUBSTANTIAL SHIFTS OF A CLOSURE POINT OR WHEN NEW LANE CLOSURE ARRANGEMENTS ARE INITIATED FOR LONG-TERM LANE CLOSURES/SHIFTS (FOR THE FIRST AND LAST DAY OF MAJOR CHANGES IN TRAFFIC CONTROL SETUP).

FOR OPERATIONS WITHOUT POSITIVE PROTECTION OCCURRING WITHIN 10 FEET OF AN OPEN TRAVELED LANE THAT MEET ALL OF THE FOLLOWING CRITERIA:

- ON A MULTI-LANE DIVIDED INTERSTATE, OTHER FREEWAY OR EXPRESSWAY; AND
- AN AUTHORIZED SPEED LIMIT OF 45 MPH OR GREATER THAT IS IN EFFECT AT THE TIME OF THE OPERATION; AND,
- AADT OF 50,000 (OR AADT OF 30,000 WITH 25% OR HIGHER PERCENT TRUCKS)

"WITHOUT POSITIVE PROTECTION" MEANS USE OF DRUMS, CONES, SHADOW VEHICLE, ETC, WITHOUT PROTECTION FROM PORTABLE BARRIER OR OTHER RIGID BARRIER ALONG THE WORK AREA. THIS PHRASE DOES NOT APPLY TO CASES WHERE POSITIVE PROTECTION IS REQUIRED. MOBILE OPERATIONS ARE REGARDED AS "WITHOUT POSITIVE PROTECTION". FOR WORK ZONES USING A COMBINATION OF BARRIER AND TEMPORARY TRAFFIC CONTROL DEVICES (CONES, DRUMS, ETC), THE DESIGNATION SHALL BE BASED UPON THE TYPE OF DEVICES USED IN THE AREA THAT WORKERS ARE LOCATED.

IF MULTIPLE ACTIVE LOCALIZED QUALIFYING WORK AREAS OCCUR WITHOUT POSITIVE PROTECTION, PER MAINLINE TRAFFIC DIRECTION, PROVIDE A UNIFORMED LEO AND OFFICIAL PATROL CAR IN ADVANCE OF:

- THE FIRST ACTIVE WORK AREA THAT DRIVERS WILL ENCOUNTER; OR
- THE ACTIVE WORK AREA Laterally CLOSEST TO THE OPEN TRAVELED LANE; OR
- OTHER LOCATION AS APPROVED BY THE ENGINEER.

THE UNIFORMED LEO AND OFFICIAL PATROL CAR MAY RELOCATE AMONG THE LISTED LOCATIONS AS APPROPRIATE AS THE OPERATIONS PROCEED IN THE LOCALIZED QUALIFYING WORK AREAS.

**ITEM 614, LAW ENFORCEMENT OFFICER (WITH PATROL CAR)  
FOR ASSISTANCE DURING CONSTRUCTION OPERATIONS (CONT.)**

IN GENERAL, LEOS SHOULD BE POSITIONED IN ADVANCE OF AND ON THE SAME SIDE AS THE LANE RESTRICTION (OR AT THE POINT OF ROAD CLOSURE), AND TO MANUALLY CONTROL TRAFFIC MOVEMENTS THROUGH SIGNALIZED INTERSECTIONS IN WORK ZONES.

LEOS SHOULD NOT FORGO THEIR TRAFFIC CONTROL RESPONSIBILITIES TO APPREHEND MOTORISTS FOR ROUTINE TRAFFIC VIOLATIONS. HOWEVER, IF A MOTORIST'S ACTIONS ARE CONSIDERED TO BE RECKLESS, THEN PURSUIT OF THE MOTORIST IS APPROPRIATE.

THE LEOS WORK AT THE DIRECTION OF THE CONTRACTOR. THE CONTRACTOR IS RESPONSIBLE FOR SECURING THE SERVICES OF THE LEOS WITH THE APPROPRIATE AGENCIES AND COMMUNICATING THE INTENTIONS OF THE PLANS WITH RESPECT TO DUTIES OF THE LEOS. THE ENGINEER SHALL HAVE FINAL CONTROL OVER THE LEOS' DUTIES AND PLACEMENT, AND WILL RESOLVE ANY ISSUES THAT MAY ARISE BETWEEN THE TWO PARTIES.

ENSURE PROVIDED LEOS HAVE BEEN TRAINED APPROPRIATE TO THE JOB DECISIONS THEY ARE REQUIRED TO MAKE WHILE ON THE PROJECT, IN ACCORDANCE WITH C&MS 614.03.

THE LEO SHALL REPORT IN TO THE CONTRACTOR PRIOR TO THE START OF THE SHIFT, IN ORDER TO RECEIVE INSTRUCTIONS REGARDING SPECIFIC WORK ASSIGNMENTS DURING HIS/HER SHIFT. THE LEO IS EXPECTED TO STAY AT THE PROJECT SITE FOR THE ENTIRE DURATION OF HIS/HER SHIFT. THE LEO SHALL REPORT TO THE CONTRACTOR AT THE END OF HIS/HER SHIFT. SHOULD IT BE NECESSARY TO LEAVE THE PROJECT SITE, THE LEO SHALL NOTIFY THE ENGINEER. THE CONTRACTOR SHALL PROVIDE THE LEO WITH A TWO-WAY COMMUNICATION DEVICE THAT SHALL BE RETURNED TO THE CONTRACTOR AT THE END OF HIS/HER SHIFT.

LEOS (WITH PATROL CAR) REQUIRED BY THE TRAFFIC MAINTENANCE TASKS ABOVE SHALL BE PAID FOR ON A UNIT PRICE (HOURLY) BASIS UNDER ITEM 614, LAW ENFORCEMENT OFFICER (WITH PATROL CAR) FOR ASSISTANCE. THE FOLLOWING ESTIMATED QUANTITIES HAVE BEEN CARRIED TO THE GENERAL SUMMARY.

ITEM 614, LAW ENFORCEMENT OFFICER WITH PATROL CAR FOR ASSISTANCE 500 HOURS

THE HOURS PAID SHALL INCLUDE ANY MINIMUM SHOW-UP TIME REQUIRED BY THE LAW ENFORCEMENT AGENCY INVOLVED.

ANY ADDITIONAL COSTS (ADMINISTRATIVE OR OTHERWISE) INCURRED BY THE CONTRACTOR TO OBTAIN THE SERVICES OF A LEO ARE INCLUDED WITH THE BID UNIT PRICE FOR ITEM 614, LAW ENFORCEMENT OFFICER WITH PATROL CAR FOR ASSISTANCE.

**FLOODLIGHTING**

FLOODLIGHTING OF THE WORK SITE FOR OPERATIONS CONDUCTED DURING NIGHTTIME PERIODS SHALL BE ACCOMPLISHED SO THAT THE LIGHTS DO NOT CAUSE GLARE TO THE DRIVERS ON THE ROADWAY. TO ENSURE THE ADEQUACY OF THE FLOODLIGHT PLACEMENT, THE CONTRACTOR AND THE ENGINEER SHALL DRIVE THROUGH THE WORK SITE EACH NIGHT WHEN THE LIGHTING IS IN PLACE AND OPERATIVE PRIOR TO COMMENCING ANY WORK. IF GLARE IS DETECTED, THE LIGHT PLACEMENT AND SHIELDING SHALL BE ADJUSTED TO THE SATISFACTION OF THE ENGINEER BEFORE WORK PROCEEDS.

PAYMENT FOR ALL LABOR, EQUIPMENT AND MATERIALS SHALL BE INCLUDED IN THE LUMP SUM CONTRACT PRICE FOR ITEM 614 MAINTAINING TRAFFIC.

**ITEM 614 - WORK ZONE MARKINGS**

THE CONTRACTOR SHALL PLACE WORK ZONE PAVEMENT MARKINGS UPON COMPLETION OF THE ASPHALT SURFACE COURSE PRIOR TO OPENING THE ROADWAY TO TRAFFIC.

THE FOLLOWING ESTIMATED QUANTITIES HAVE BEEN CARRIED TO THE GENERAL SUMMARY FOR USE AT LOCATIONS IDENTIFIED BY THE ENGINEER FOR WORK ZONE PAVEMENT MARKINGS PER THE REQUIREMENTS OF C&MS 614.11.

ITEM 614 WORK ZONE EDGE LINE 6", CLASS I, 807 PAINT	3.60 MILE
ITEM 614 WORK ZONE LANE LINE 6", CLASS I, 807 PAINT	1.67 MILE
ITEM 614 WORK ZONE CHANNELIZING LINE, 12", CLASS I, 807 PAINT	4,635 FT
ITEM 614 WORK ZONE DOTTED LINE, 6", CLASS I, 807 PAINT	2,011 FT
ITEM 614 WORK ZONE EDGE LINE 6", CLASS III, 642 PAINT	2.80 MILE
ITEM 614 WORK ZONE LANE LINE 6", CLASS III, 642 PAINT	0.05 MILE
ITEM 614 WORK ZONE CENTER LINE, CLASS III, 642 PAINT	2.66 MILE
ITEM 614 WORK ZONE CHANNELIZING LINE, 12", CLASS III, 642 PAINT	775 FT
ITEM 614 WORK ZONE STOP LINE, CLASS III, 642 PAINT	50 FT
ITEM 614 WORK ZONE ARROW, CLASS III, 642 PAINT	27 EACH



