

STATE OF OHIO  
 DEPARTMENT OF TRANSPORTATION  
**HAM-75-16.67 DB**  
 CITY OF SHARONVILLE AND  
 WEST CHESTER TOWNSHIP  
 HAMILTON AND BUTLER COUNTIES

**PROJECT DESCRIPTION**


IMPROVEMENTS INCLUDE THE RECONFIGURATION OF THE I-75 RAMP TO I-275 BY UTILIZING THE EXISTING SINGLE LANE EXIT FOR TRAFFIC TO GO WEST ON I-275 AND CREATING A SECOND EXIT FOR TRAFFIC TO GO EAST ON I-275. IMPROVEMENTS INCLUDE THE RECONSTRUCTION OF 0.35 MILES OF THE I-75 SOUTHBOUND RAMP TO I-275 WESTBOUND; THE RECONSTRUCTION OF 0.45 MILES OF THE I-75 SOUTHBOUND RAMP TO I-275 EASTBOUND; REPLACEMENT OF ALL OVERHEAD SIGNS AND RELOCATION OF AN EXISTING LIGHT TOWER INCLUDING CONCRETE MEDIAN BARRIER, DRAINAGE AND PAVEMENT MARKINGS.

**LIMITED ACCESS**

THIS IMPROVEMENT IS ESPECIALLY DESIGNED FOR THROUGH TRAFFIC AND HAS BEEN DECLARED A LIMITED ACCESS HIGHWAY OR FREEWAY BY ACTION OF THE DIRECTOR IN ACCORDANCE WITH THE PROVISIONS OF SECTION 5511.02 OF THE OHIO REVISED CODE.

**2016 SPECIFICATIONS**

THE STANDARD SPECIFICATIONS OF THE STATE OF OHIO, DEPARTMENT OF TRANSPORTATION, INCLUDING SUPPLEMENTAL SPECIFICATIONS LISTED IN THE PLANS AND CHANGES LISTED IN THE PROPOSAL SHALL GOVERN THIS IMPROVEMENT.

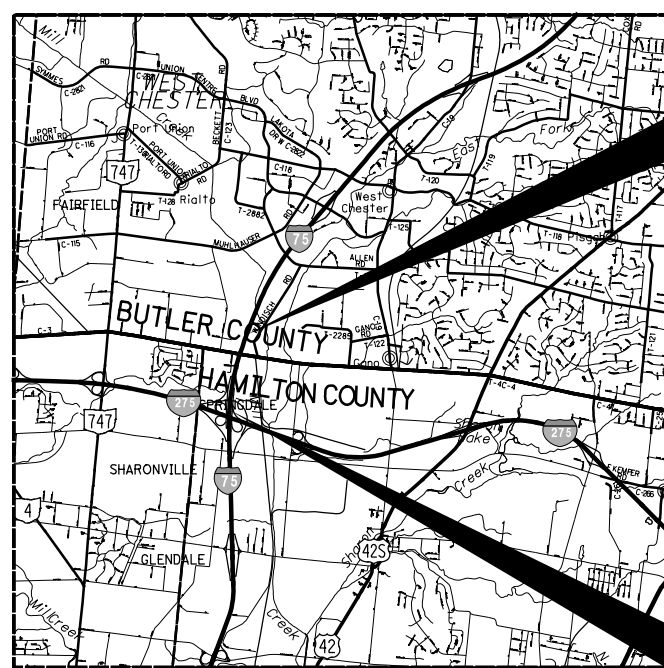

END PROJECT  
 STA. 35+98.00

BEGIN PROJECT  
 STA. 161+00.00

**INDEX OF SHEETS:**

TITLE SHEET	1
TRAFFIC CONTROL GENERAL NOTES	2
SIGN PLANS	3-7
ELEVATION VIEWS	8-10
SIGN DETAILS	11-12

AS-BUILT SHEET REVISIONS DATED 11/28/17:  
 1  
 3  
 9  
 10

**BUILDABLE UNIT 1  
 OVERHEAD SIGNS  
 AS-BUILTS  
 DATE: 11/28/17**

PORTION TO BE IMPROVED

INTERSTATE HIGHWAY	—————
FEDERAL ROUTES	—————
STATE ROUTES	—————
COUNTY & TOWNSHIP ROADS	—————
OTHER ROADS	—————

**DESIGN DESIGNATION**

SEE BU04

**UNDERGROUND UTILITIES**  
 CONTACT BOTH SERVICES TWO WORKING DAYS BEFORE YOU DIG.

**OHIO Utilities Protection SERVICE**  
 Call Before You Dig  
 1-800-362-2764  
 (Non-members must be called directly)

**OIL & GAS PRODUCERS UNDERGROUND PROTECTION SERVICE**  
 1-800-925-0988

PLAN PREPARED BY:  
**AECOM**  
 AKRON CLEVELAND COLUMBUS  
 564 WHITE POND DRIVE  
 AKRON, OHIO 44320-1100  
 (330) 836-9111

ENGINEERS SEAL:

SIGNED: *Judith M. Bennett*  
 DATE: 7/25/2017

STANDARD CONSTRUCTION DRAWINGS				SUPPLEMENTAL SPECIFICATIONS	SPECIAL PROVISIONS
TC-7.65	01/15/16			800	01/20/17
TC-12.30	01/20/17			992	4/18/14
TC-15.115	10/18/13				
TC-21.10	01/20/17				
TC-21.20	07/15/16				
TC-21.50	07/15/16				
TC-22.20	1/17/14				
TC-41.15	10/18/13				
TC-51.11	01/15/16				
TC-51.12	01/15/16				

NO.	REVISIONS	DATE
AB	AS-BUILT REVISION	11/28/17

BUILDABLE UNIT 1 - AS-BUILT PLANS - NOVEMBER 28, 2017

RAILROAD INVOLVEMENT

NONE

CONSTRUCTION PROJECT NO.

173015

PID NO.

104408

FEDERAL PROJECT NO.

E170(763)

HAM-75-16.67

1  
12

G:\Akron\DCS\Projects\TRN\60547096\_HAM751667\900-CAD-GIS\104408\_HAM-75-1667\Design\Traffic\Sheets\BU01\104408.ctb 11/28/2017 10:28:56 AM matt.phillips

**ITEM 630 - RIGID OVERHEAD SIGN SUPPORT FOUNDATION, AS PER PLAN**

IN ADDITION TO THE REQUIREMENTS OF 630.05, 4 - 3" X 138" ANCHOR BOLTS SHALL BE FURNISHED AND INSTALLED FOR THE RELOCATED TC-12.30, DESIGN 12 CANTILEVER SUPPORT AT STA. 178+82, LT OF  $\phi$  OF I-75.

**PROJECT BUILDABLE UNITS**

BUILDABLE UNITS (BUs) ARE PORTIONS OF THE PROJECT WHICH CAN BE DESIGNED, REVIEWED AND BUILT WITH ONLY LIMITED CONTROLS AND ASSUMPTIONS COMING FROM THE DESIGN OF OTHER PORTIONS OF THE PROJECT.

THIS PROJECT HAS BEEN BROKEN INTO FOUR (4) BUs AS FOLLOWS:

- BU01 - OVERHEAD SIGNS
- BU02 - MAINTENANCE OF TRAFFIC (MOT)
- BU03 - STORM WATER POLLUTION PREVENTION PLAN (SWPPP)
- BU04 - REMAINING WORK

**BUILDABLE UNIT 1 - AS-BUILT PLANS - NOVEMBER 28, 2017**

**HAM-75-16.67**

**TRAFFIC CONTROL GENERAL NOTES**

CALCULATED
TKI
CHECKED
JMB

G:\Akron\DCS\Projects\TRN\60547096\_HAM751667\900-CAD-GIS\104408\_HAM-75-1667\Design\Traffic\Sheets\BU04\104408\_TP001.dgn Design 11/28/2017 10:29:02 AM matt.philips


SIGN LEGEND

- ⊥ SIGN, SINGLE POST
- ⊥ SIGN, DOUBLE POST
- ┆ CANTILEVER SIGN SUPPORT
- ┆ TRUSS TYPE SIGN SUPPORT

- EXISTING SIGN
- EXISTING SIGN TO BE REMOVED
- PROPOSED SIGN

PAVEMENT MARKING LEGEND

- (EY) ITEM 644 - EDGE LINE, 6" (YELLOW)
- (EW) ITEM 644 - EDGE LINE, 6" (WHITE)
- (LL) ITEM 644 - LANE LINE, 6"
- (CH) ITEM 644 - CHANNELIZING LINE, 12"
- (CM) ITEM 644 - CHEVRON MARKING (WHITE)
- (DL) ITEM 644 - DOTTED LINE, 6" (WHITE)

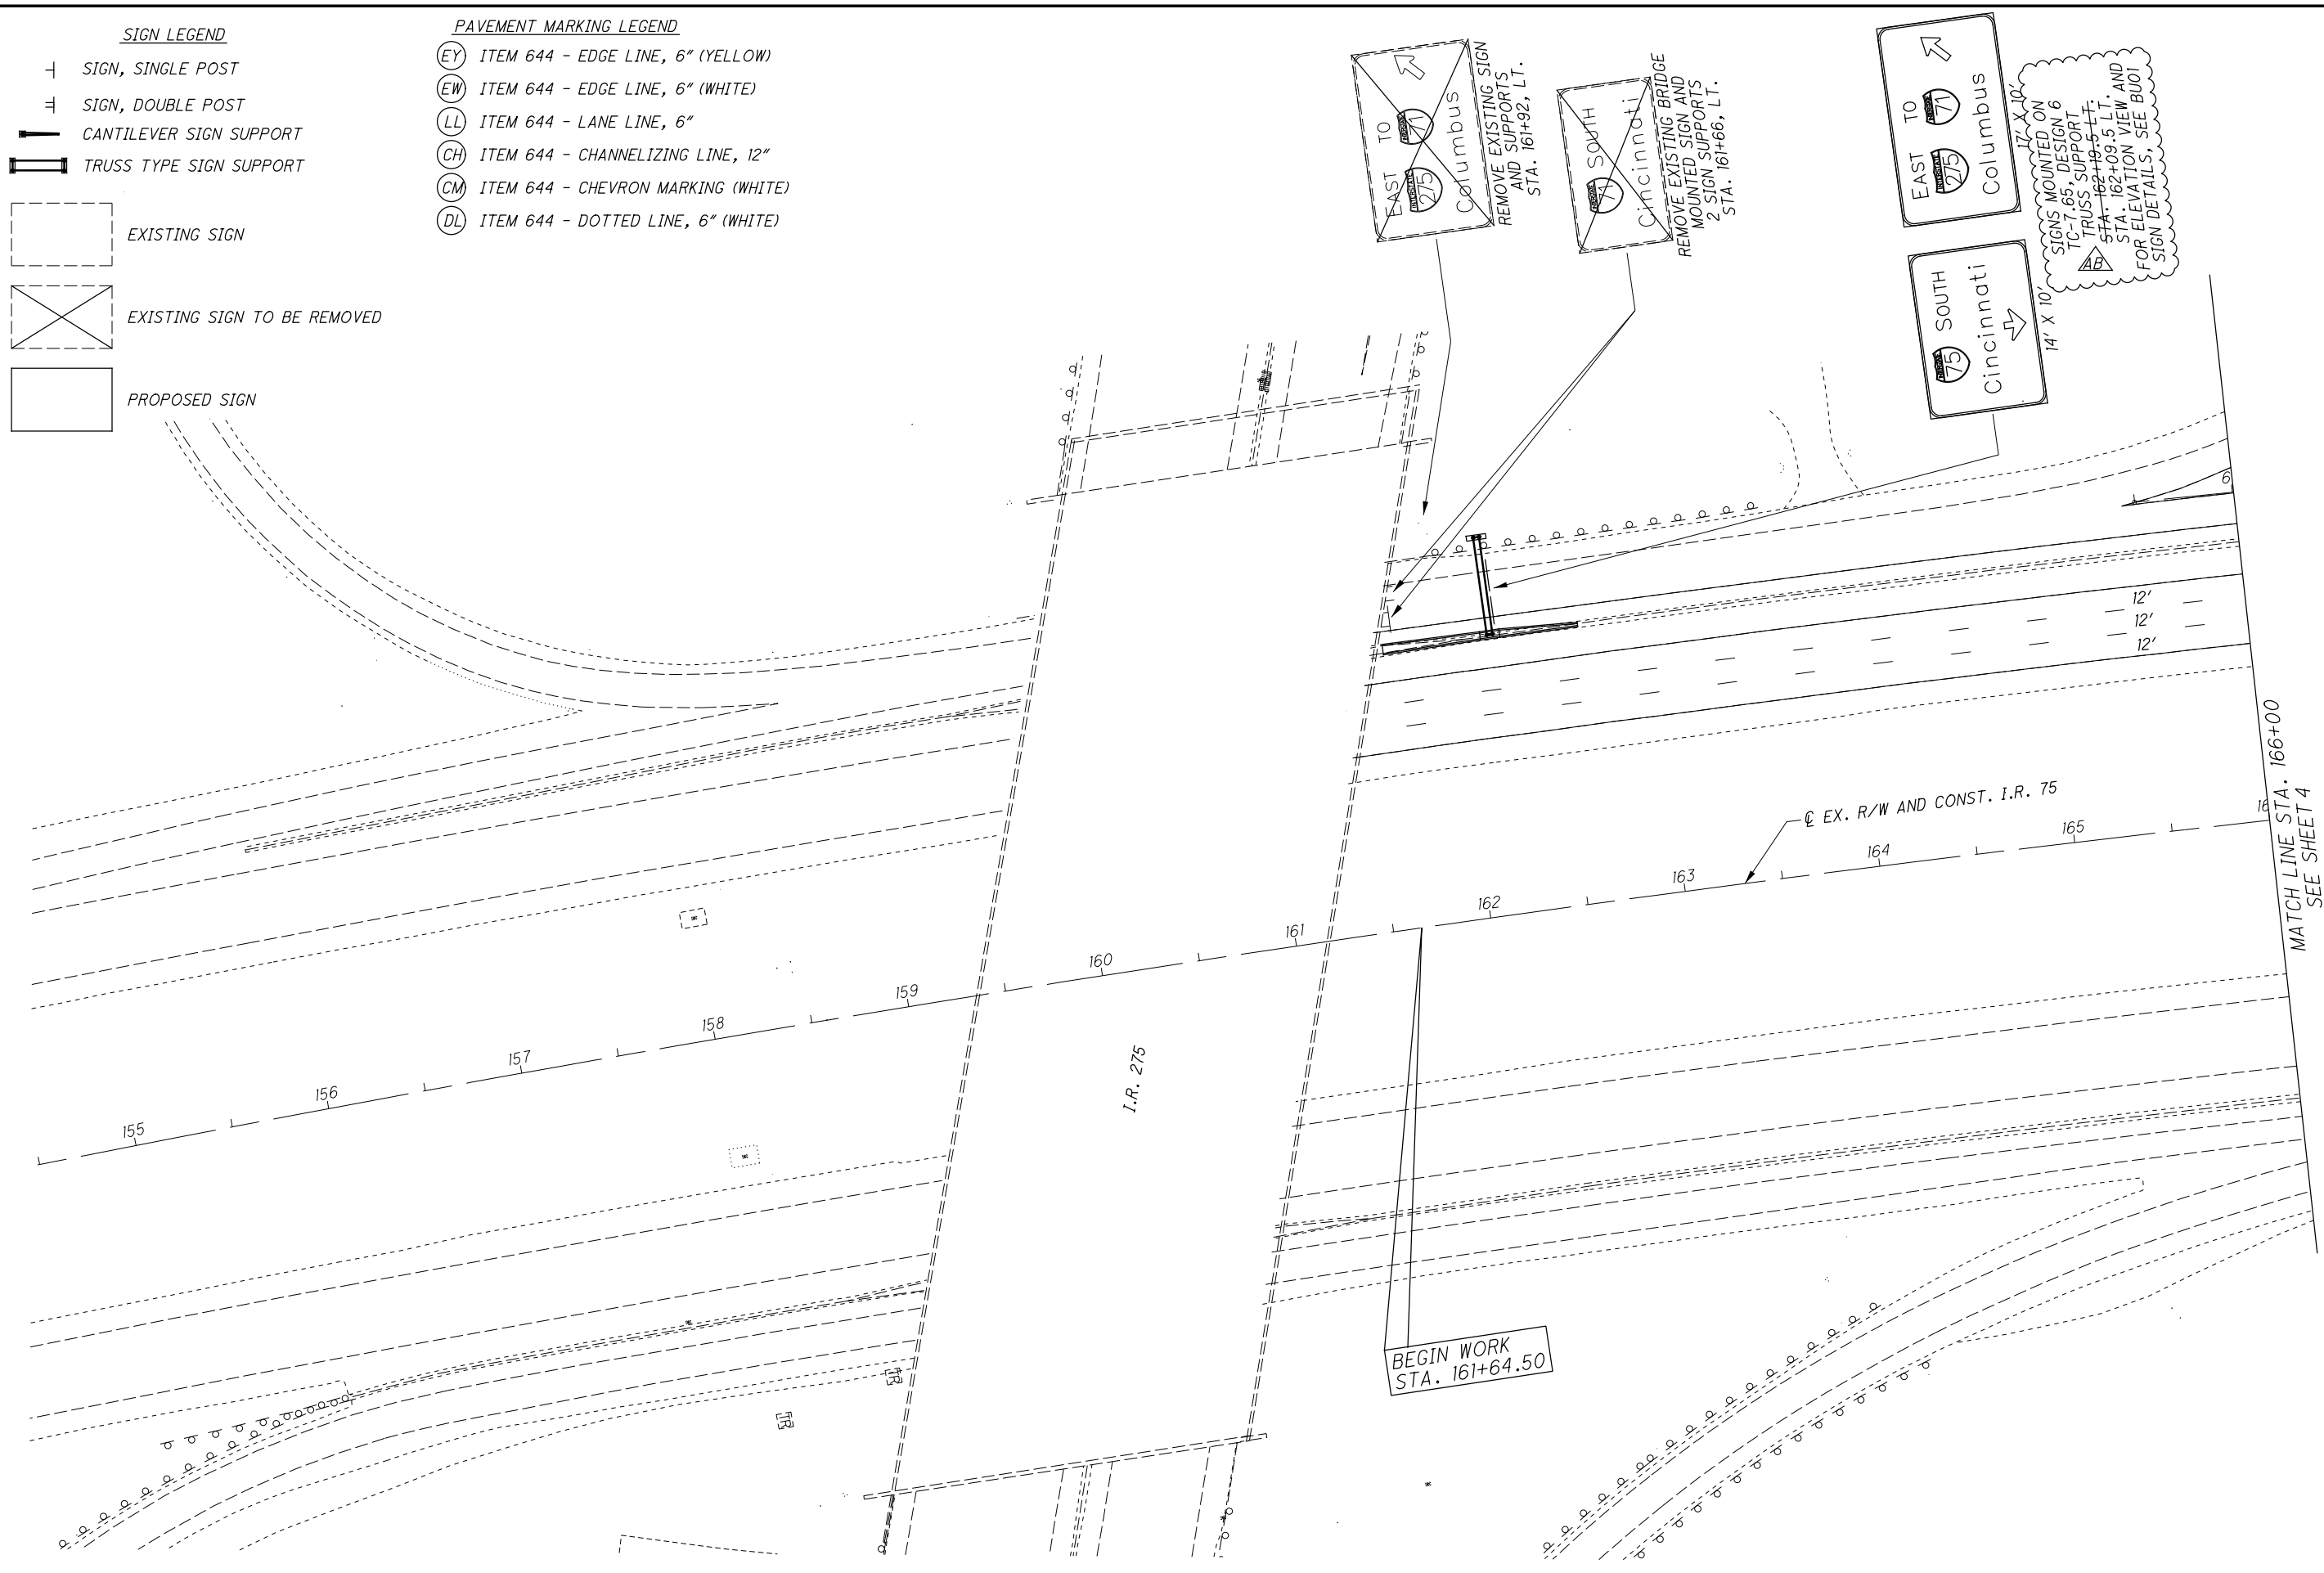

**BUILDABLE UNIT 1 - AS-BUILT PLANS - NOVEMBER 28, 2017**

**PAVEMENT MARKING AND SIGNING PLAN**

**HAM-75-16.67**

NO.	REVISIONS	DATE
AB	AS-BUILT REVISION	11/28/17

CALCULATED  
TKI  
CHECKED  
JMB

0 20 40 80  
HORIZONTAL SCALE IN FEET

G:\Akron\DCS\Projects\TRN\60547096\_HAM751667\900-CAD-GIS\104408\_HAM-75-1667\Design\Traffic\Sheets\BU04\104408\_TP002.dgn Design 11/28/2017 10:29:06 AM matt.philips


SIGN LEGEND

- ⊥ SIGN, SINGLE POST
- ⊥ SIGN, DOUBLE POST
- ┆ CANTILEVER SIGN SUPPORT
- ┆ TRUSS TYPE SIGN SUPPORT

- EXISTING SIGN
- EXISTING SIGN TO BE REMOVED
- PROPOSED SIGN

PAVEMENT MARKING LEGEND

- (EY) ITEM 644 - EDGE LINE, 6" (YELLOW)
- (EW) ITEM 644 - EDGE LINE, 6" (WHITE)
- (LL) ITEM 644 - LANE LINE, 6"
- (CH) ITEM 644 - CHANNELIZING LINE, 12"
- (CM) ITEM 644 - CHEVRON MARKING (WHITE)
- (DL) ITEM 644 - DOTTED LINE, 6" (WHITE)

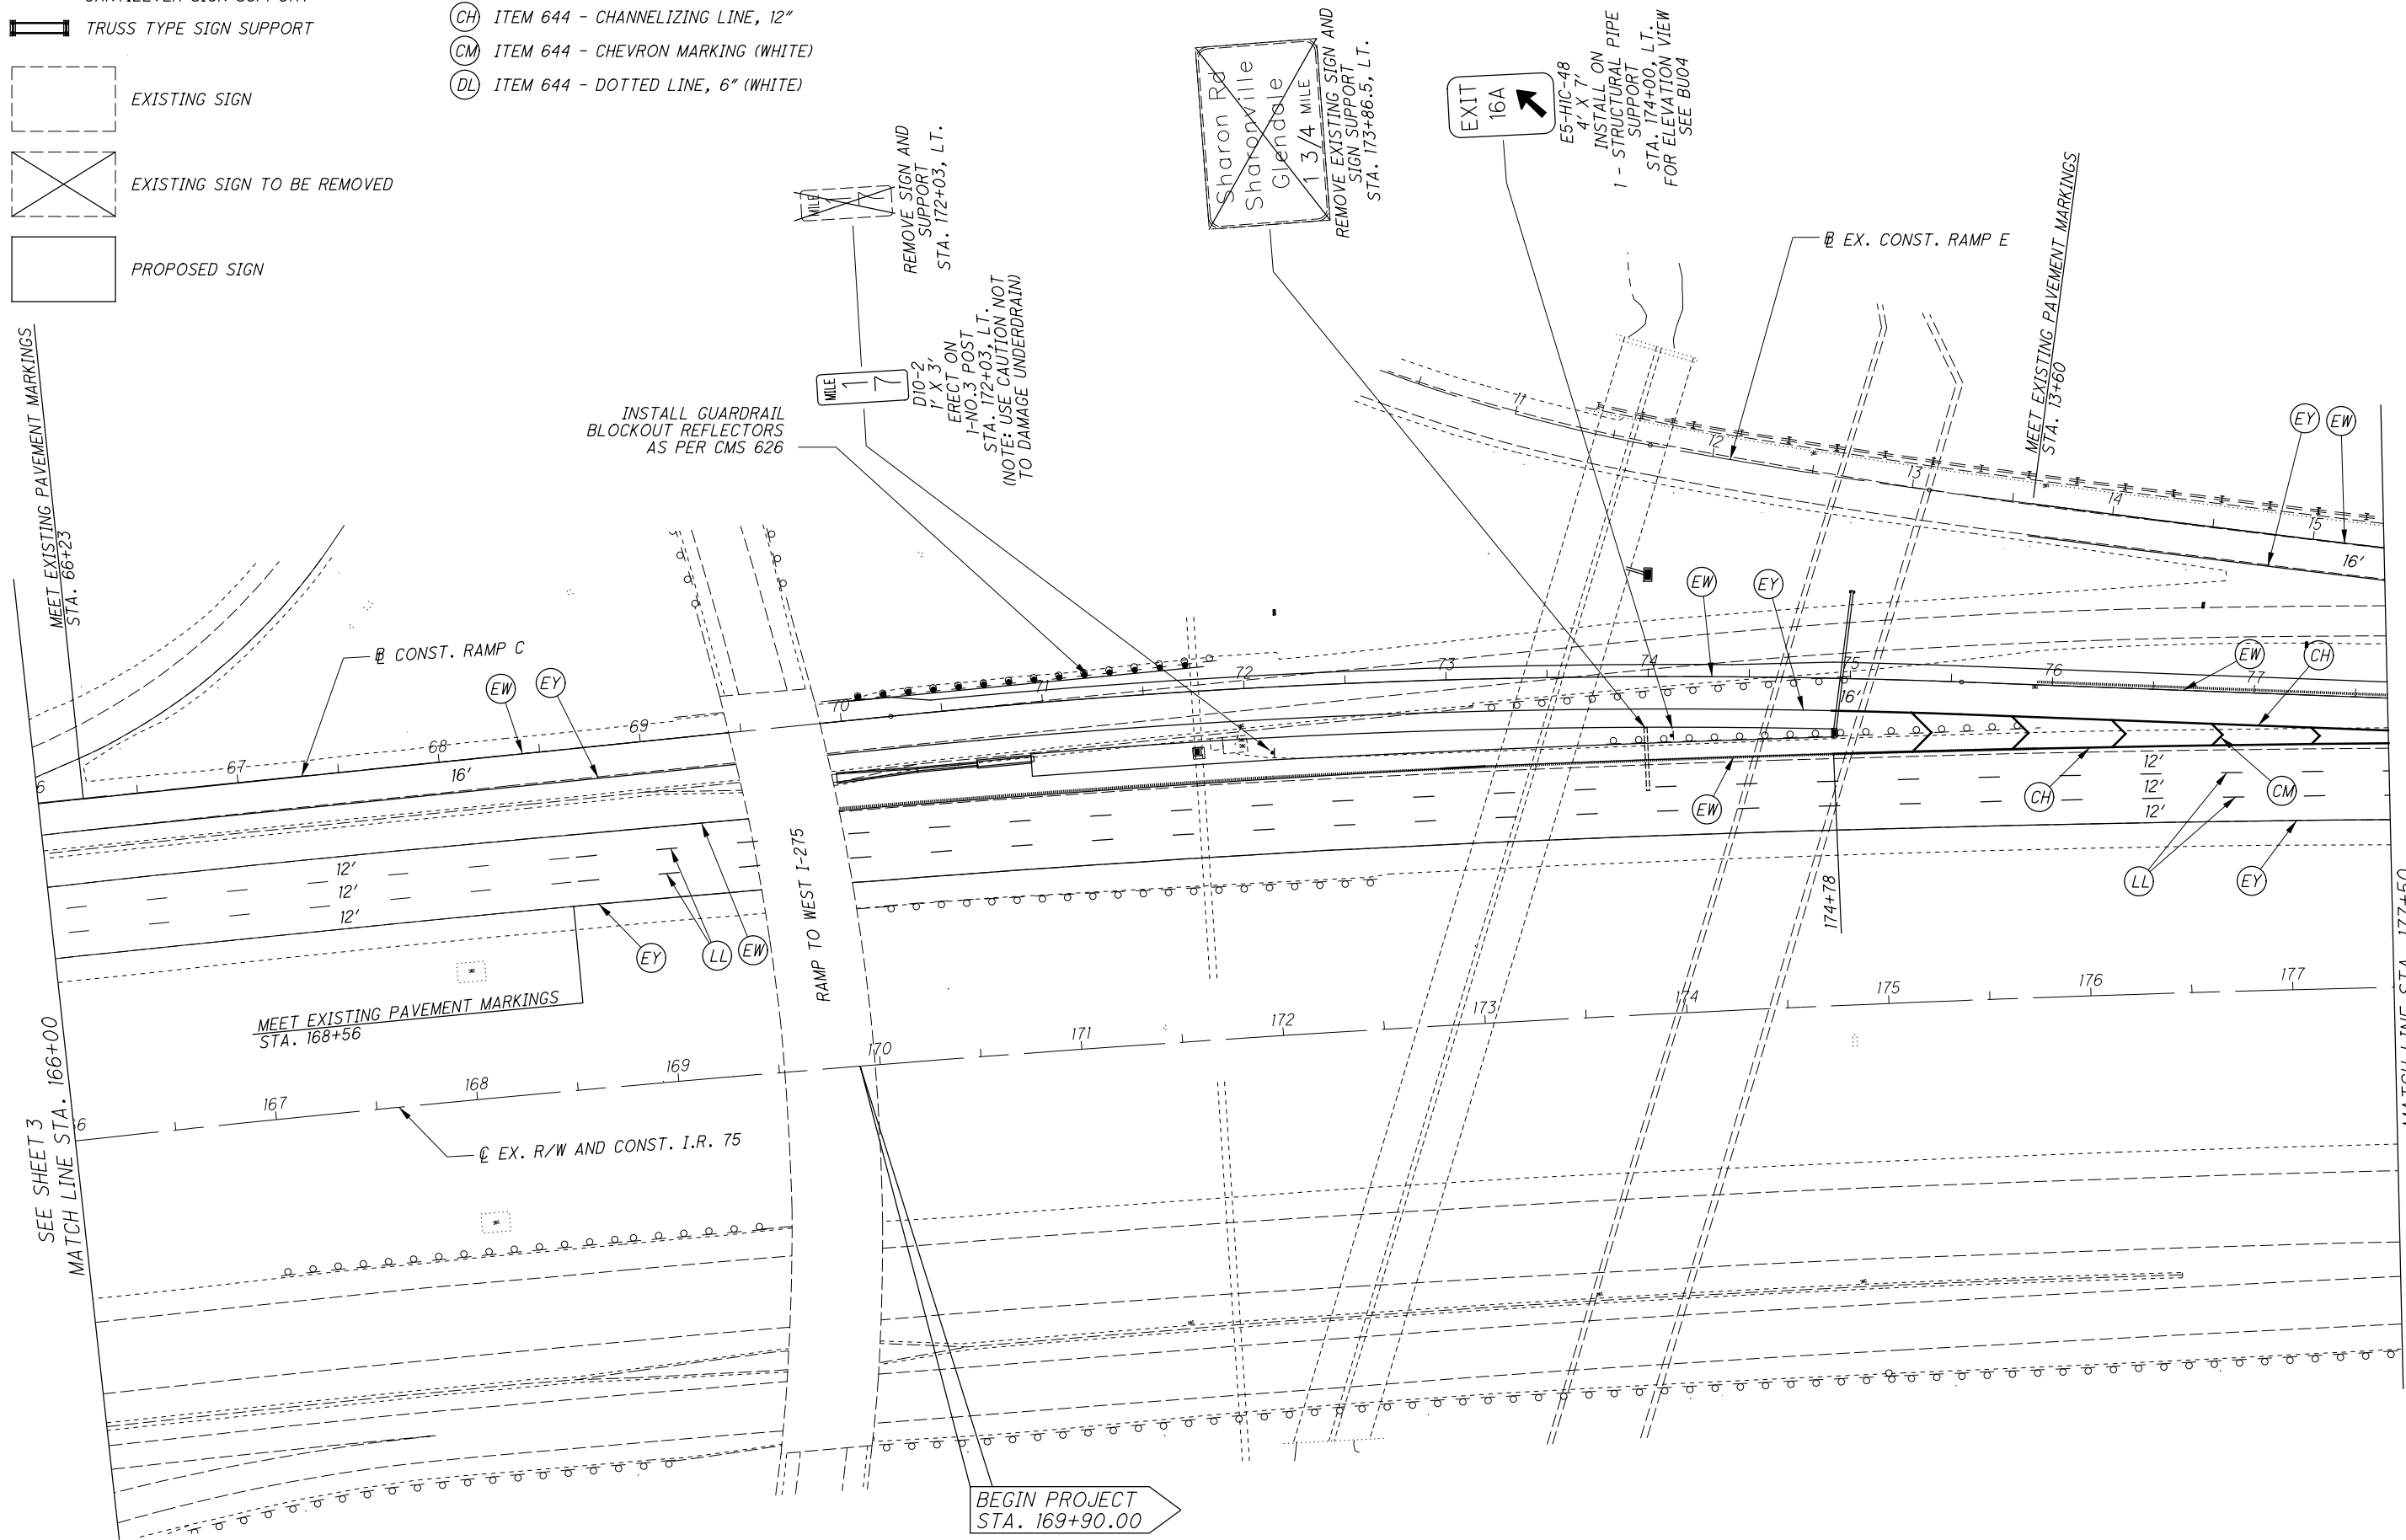

CALCULATED  
TKI  
CHECKED  
JMB

0 20 40 80  
HORIZONTAL SCALE IN FEET

**BUILDABLE UNIT 1 - AS-BUILT PLANS - NOVEMBER 28, 2017**


**PAVEMENT MARKING AND SIGNING PLAN**



G:\Akron\DCS\Projects\TRN\60547096\_HAM751667\900-CAD-GIS\104408\_HAM-75-1667\Design\Traffic\Sheets\BU04\104408\_TP003.dgn Design 11/28/2017 10:29:10 AM matt.philips


SIGN LEGEND

- ⊥ SIGN, SINGLE POST
- ⊥ SIGN, DOUBLE POST
- ┆ CANTILEVER SIGN SUPPORT
- ┆ TRUSS TYPE SIGN SUPPORT

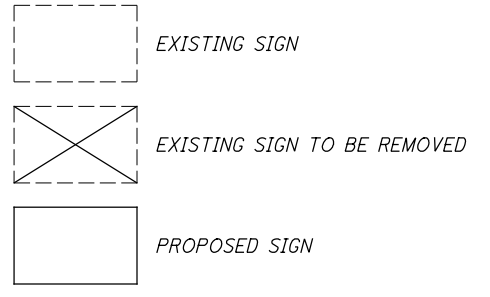

PAVEMENT MARKING LEGEND

- (EY) ITEM 644 - EDGE LINE, 6" (YELLOW)
- (EW) ITEM 644 - EDGE LINE, 6" (WHITE)
- (LL) ITEM 644 - LANE LINE, 6"
- (CH) ITEM 644 - CHANNELIZING LINE, 12"
- (CM) ITEM 644 - CHEVRON MARKING (WHITE)
- (DL) ITEM 644 - DOTTED LINE, 6" (WHITE)

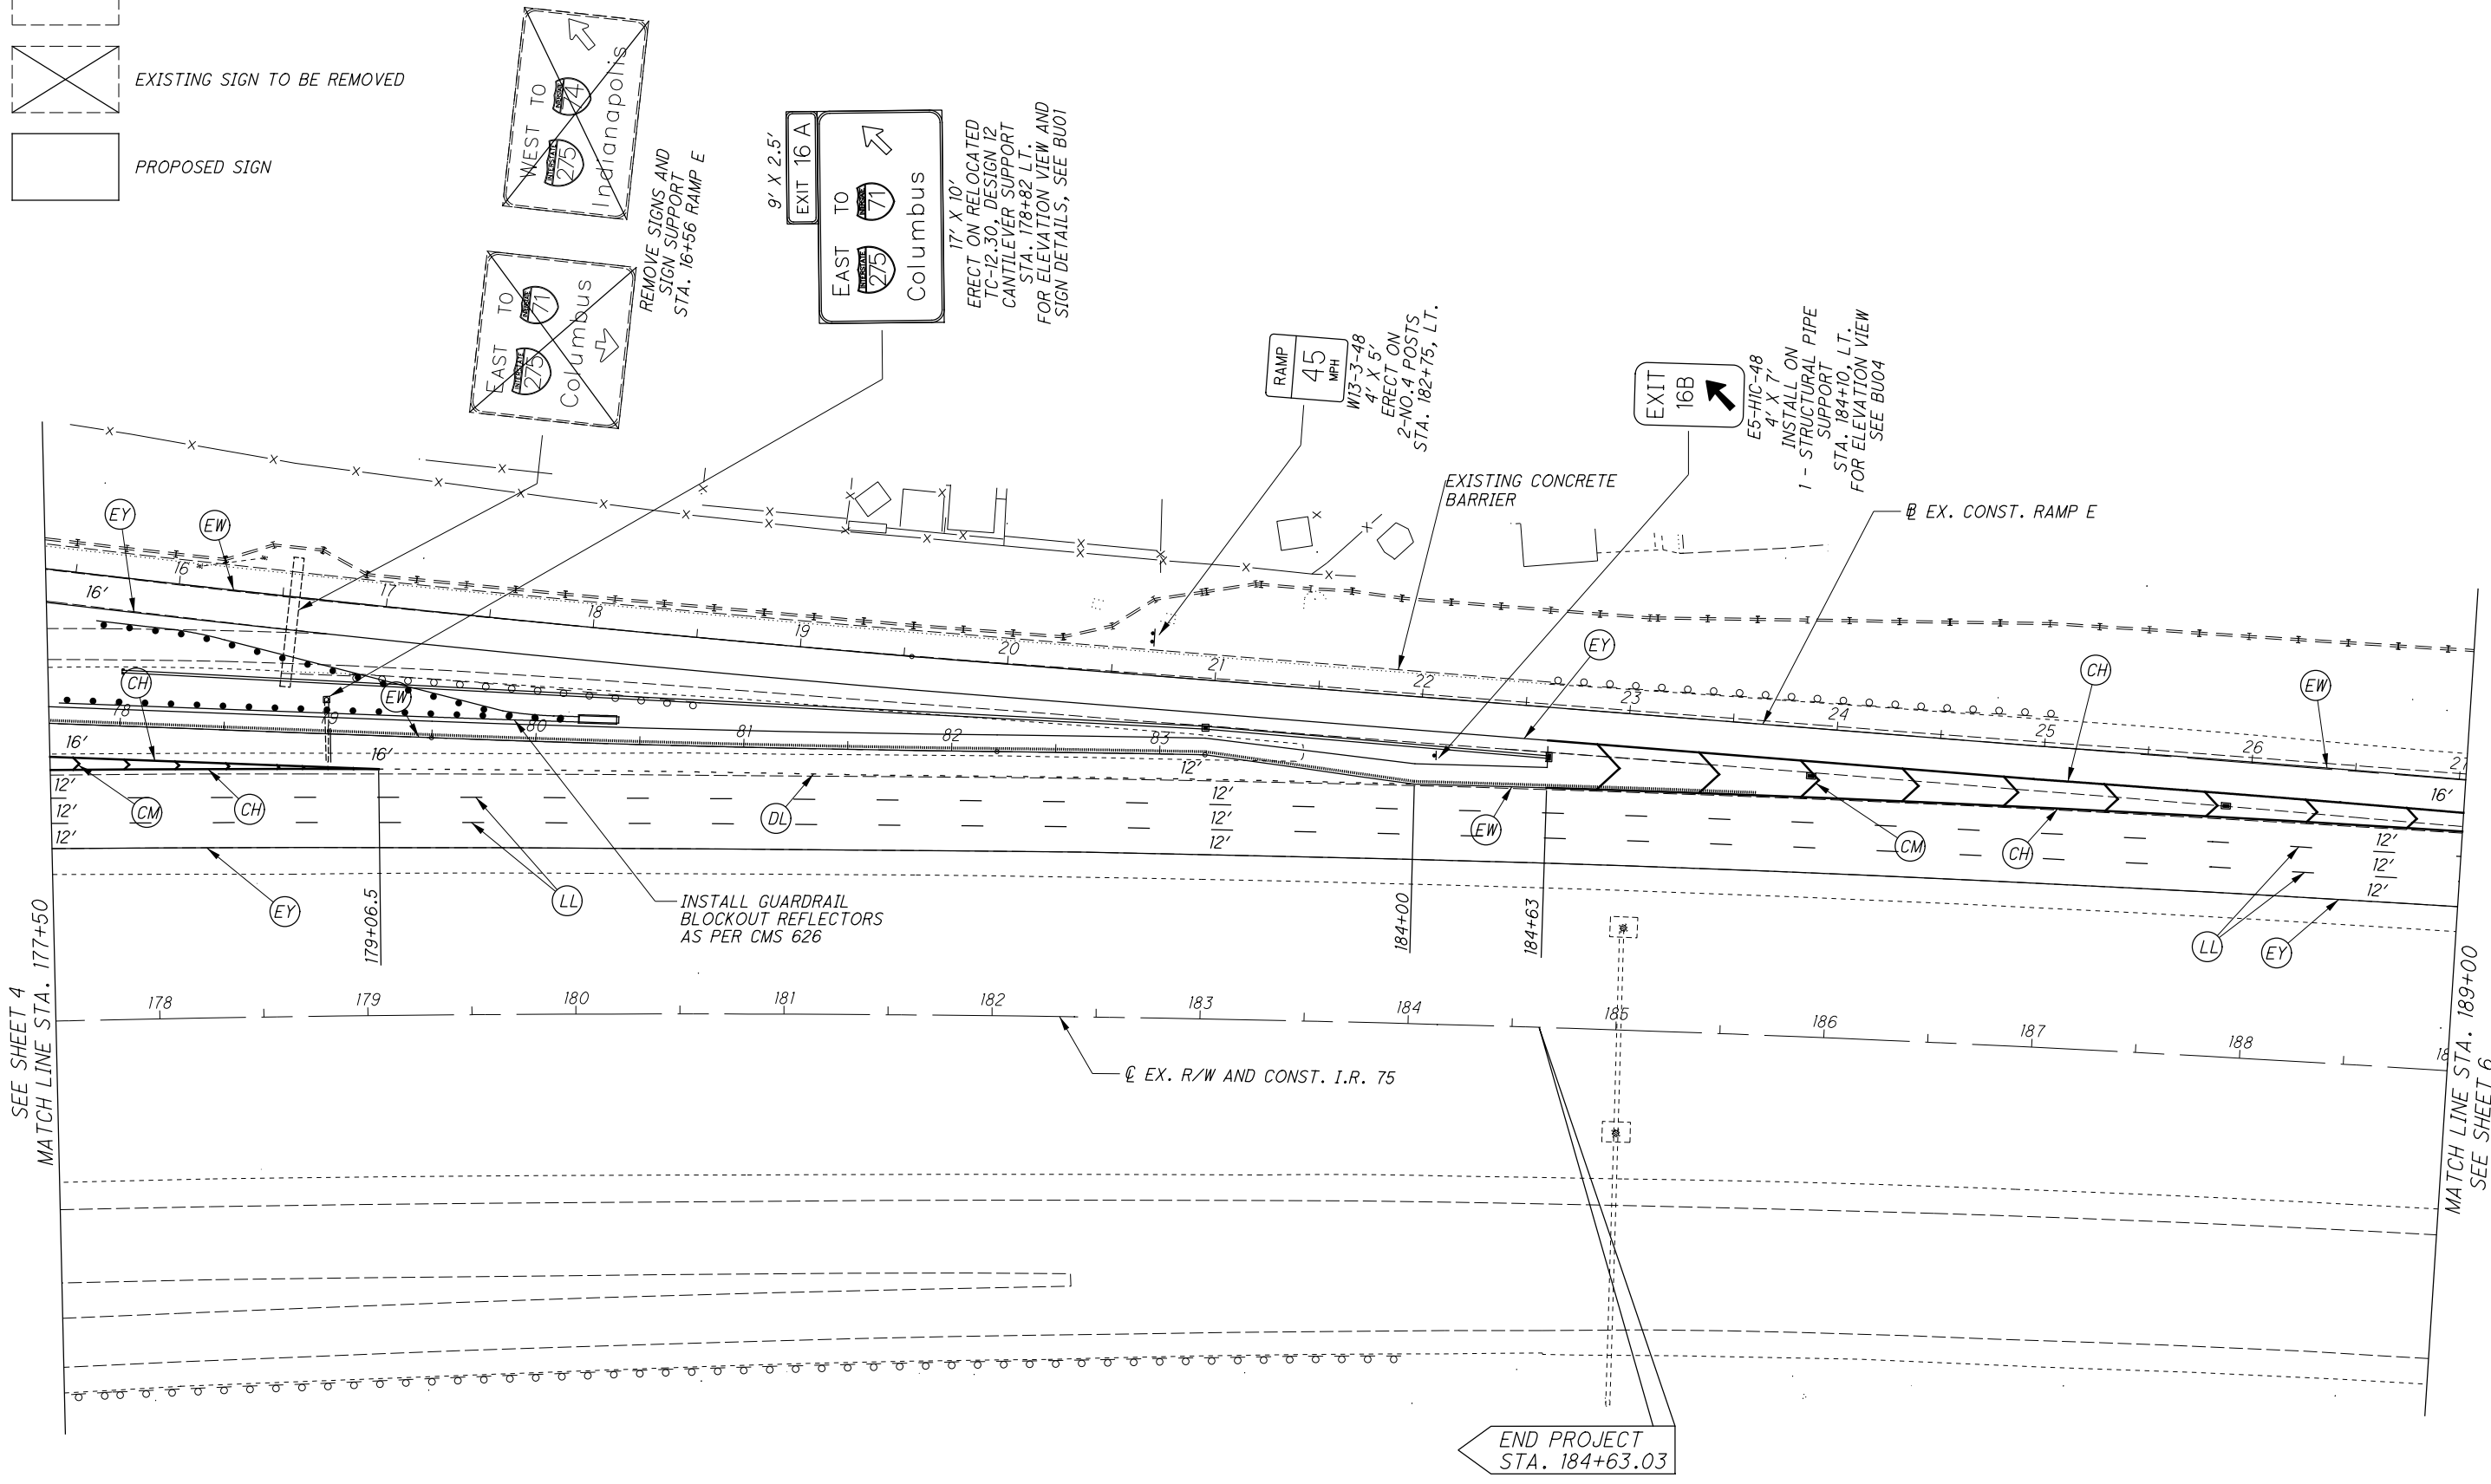

SEE SHEET 4 MATCH LINE STA. 177+50


MATCH LINE STA. 189+00 SEE SHEET 6

**BUILDABLE UNIT 1 - AS-BUILT PLANS - NOVEMBER 28, 2017**

**PAVEMENT MARKING AND SIGNING PLAN**

HAM-75-16.67


CALCULATED TKI CHECKED JMB

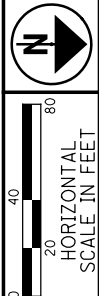

G:\Akron\DCS\Projects\TRN\60547096\_HAM751667\900-CAD-GIS\104408\_HAM-75-1667\Design\Traffic\Sheets\BU04\104408\_TP004.dgn Design 11/28/2017 10:29:13 AM matt.philips



**SIGN LEGEND**

- ⊥ SIGN, SINGLE POST
- ⊥ SIGN, DOUBLE POST
- ┌ CANTILEVER SIGN SUPPORT
- ┌ TRUSS TYPE SIGN SUPPORT

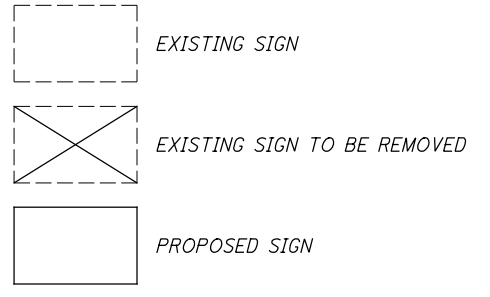

**PAVEMENT MARKING LEGEND**

- (EY) ITEM 644 - EDGE LINE, 6" (YELLOW)
- (EW) ITEM 644 - EDGE LINE, 6" (WHITE)
- (LL) ITEM 644 - LANE LINE, 6"
- (CH) ITEM 644 - CHANNELIZING LINE, 12"
- (CM) ITEM 644 - CHEVRON MARKING (WHITE)
- (DL) ITEM 644 - DOTTED LINE, 6" (WHITE)
- (DL1) ITEM 644 - DOTTED LINE 12" (WHITE)
- (RM) ITEM 644 - REMOVAL OF PAVEMENT MARKING

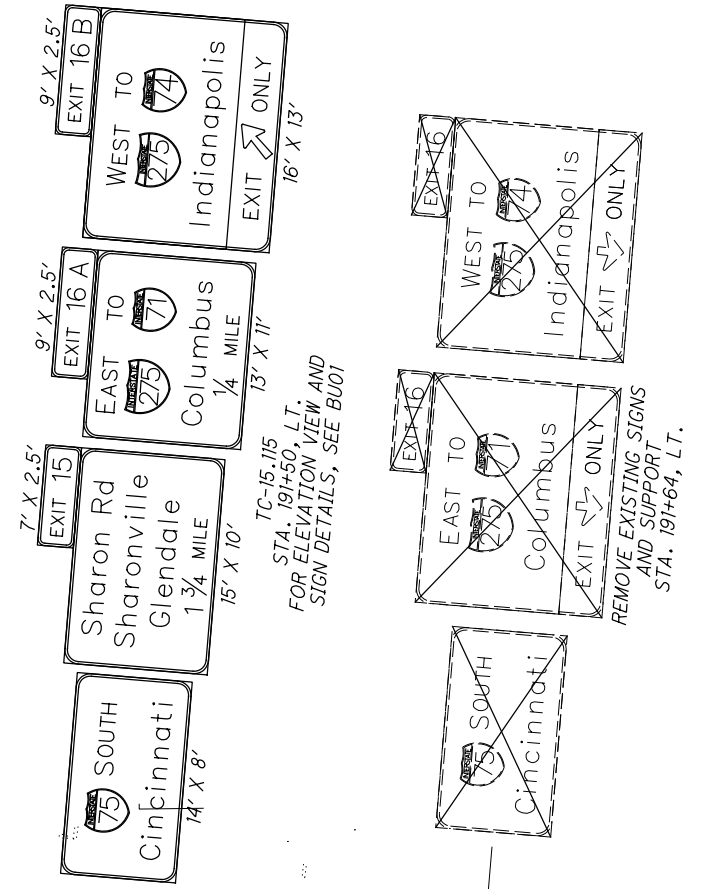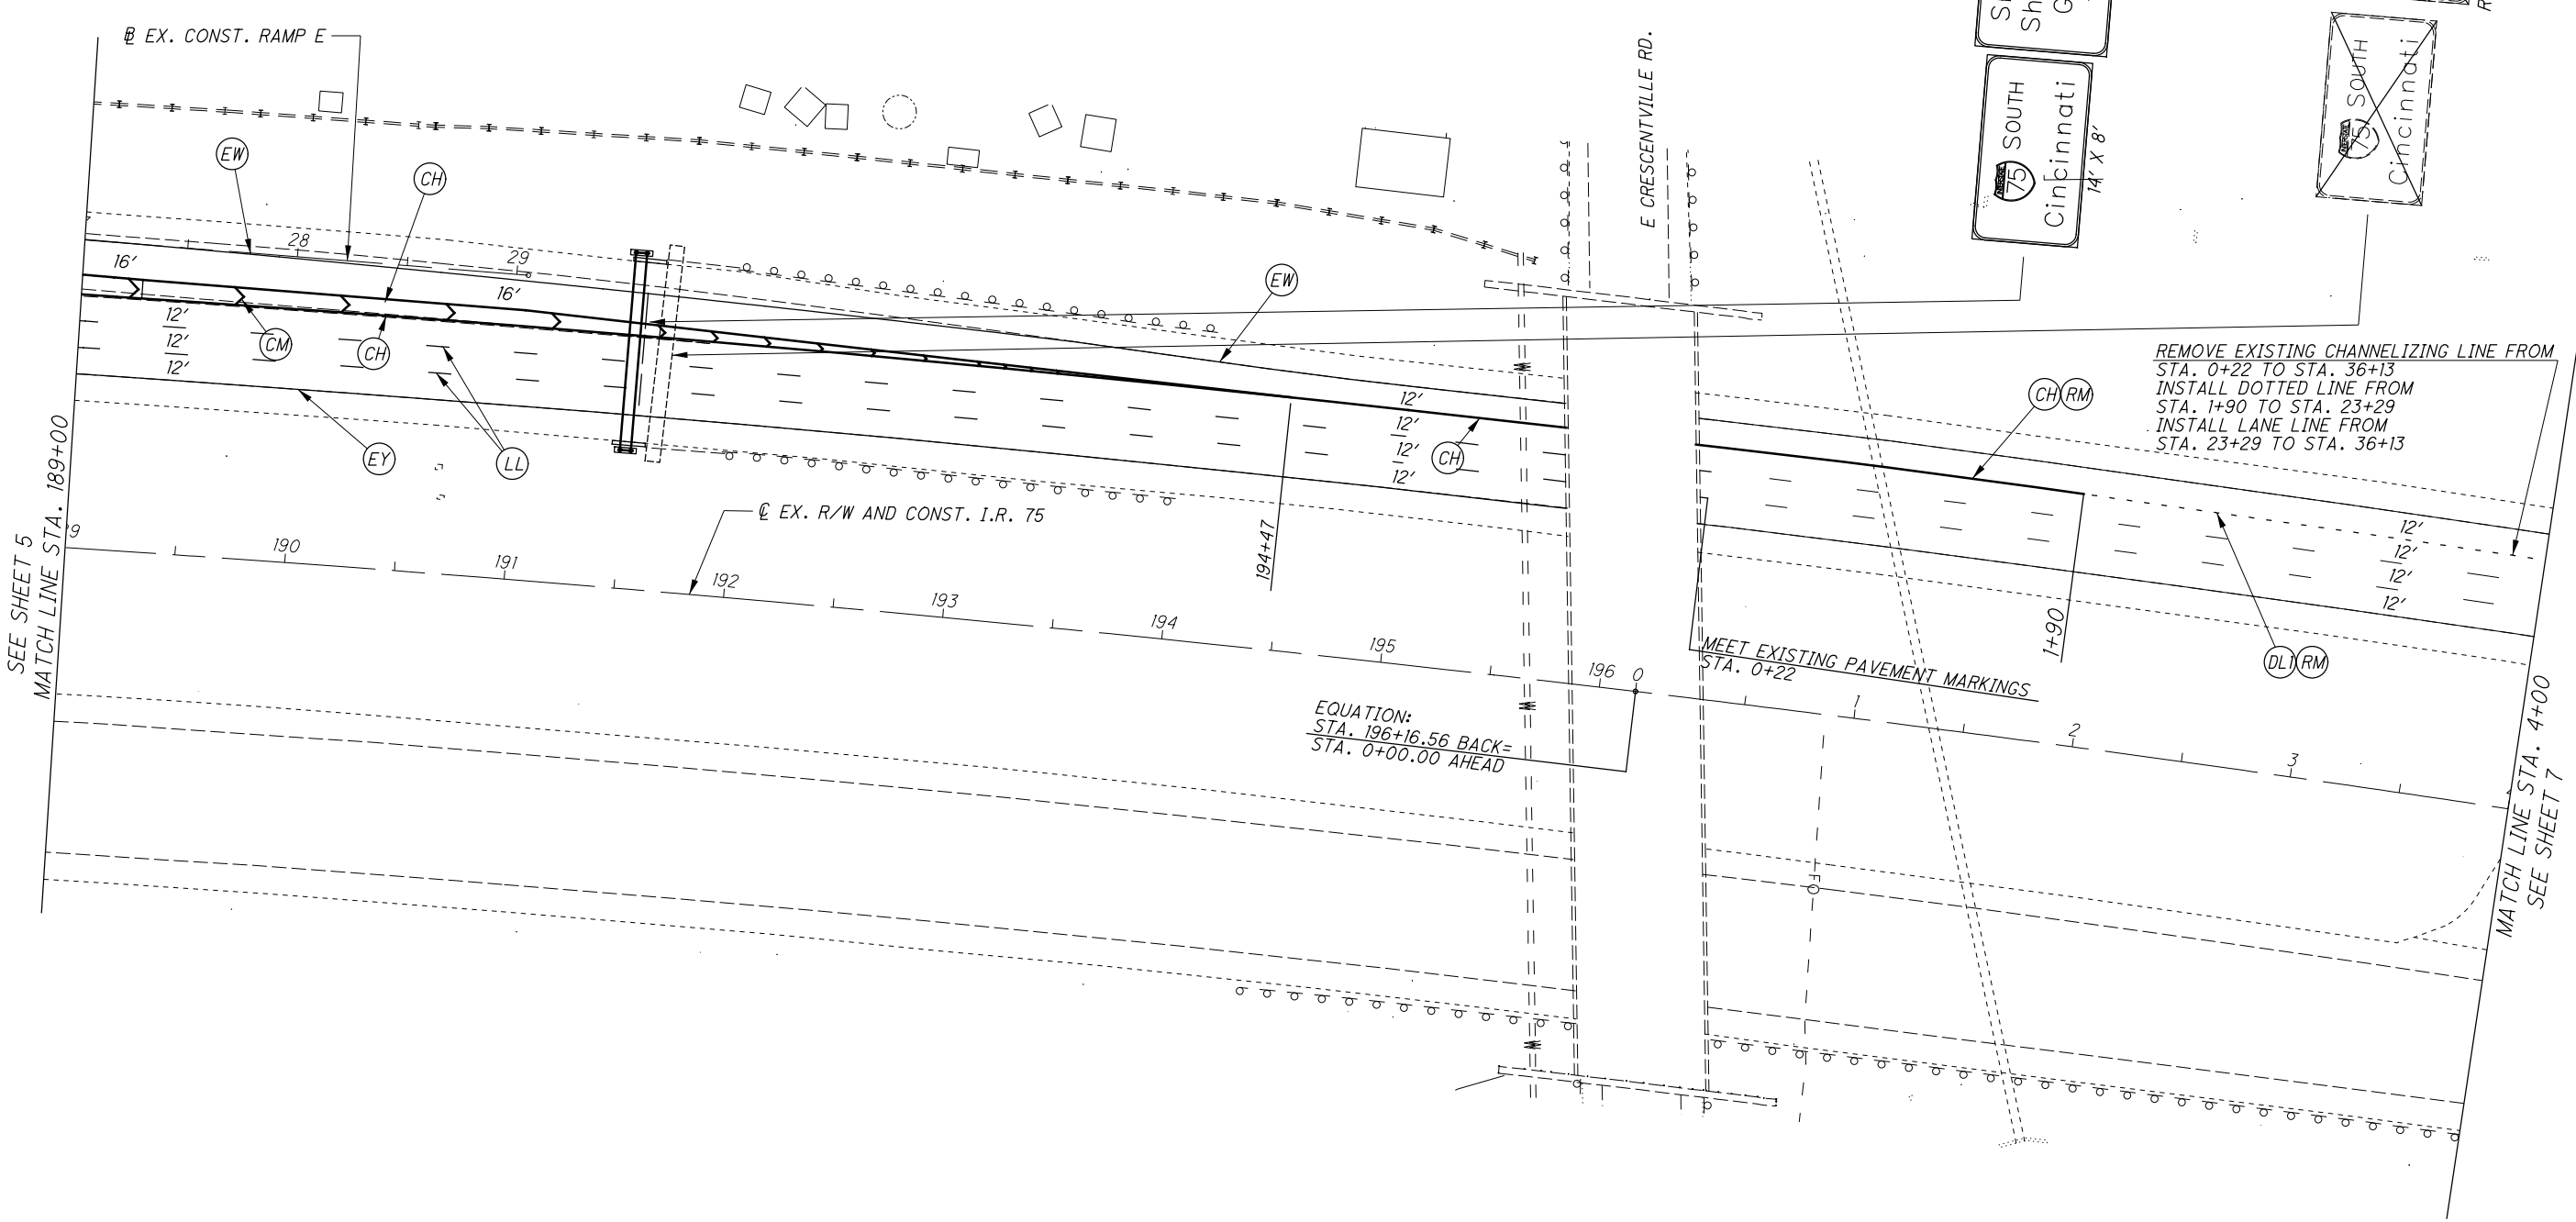

**BUILDABLE UNIT 1-AS-BUILT PLANS-NOVEMBER 28, 2017**

**HAM-75-16.67**

**PAVEMENT MARKING AND  
SIGNING PLAN**

CALCULATED  
TKI  
CHECKED  
JMB

0 40 80  
HORIZONTAL  
SCALE IN FEET


6  
12

**SIGN LEGEND**

- ⊥ SIGN, SINGLE POST
- ⊥ SIGN, DOUBLE POST
- ┆ CANTILEVER SIGN SUPPORT
- ┆ TRUSS TYPE SIGN SUPPORT



EXISTING SIGN

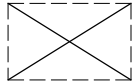


EXISTING SIGN TO BE REMOVED



PROPOSED SIGN

**PAVEMENT MARKING LEGEND**

- (EY) ITEM 644 - EDGE LINE, 6" (YELLOW)
- (EW) ITEM 644 - EDGE LINE, 6" (WHITE)
- (LL) ITEM 644 - LANE LINE, 6"
- (CH) ITEM 644 - CHANNELIZING LINE, 12"
- (CM) ITEM 644 - CHEVRON MARKING (WHITE)
- (DL) ITEM 644 - DOTTED LINE, 6" (WHITE)
- (DLI) ITEM 644 - DOTTED LINE, 12" (WHITE)
- (RM) ITEM 644 - REMOVAL OF PAVEMENT MARKING

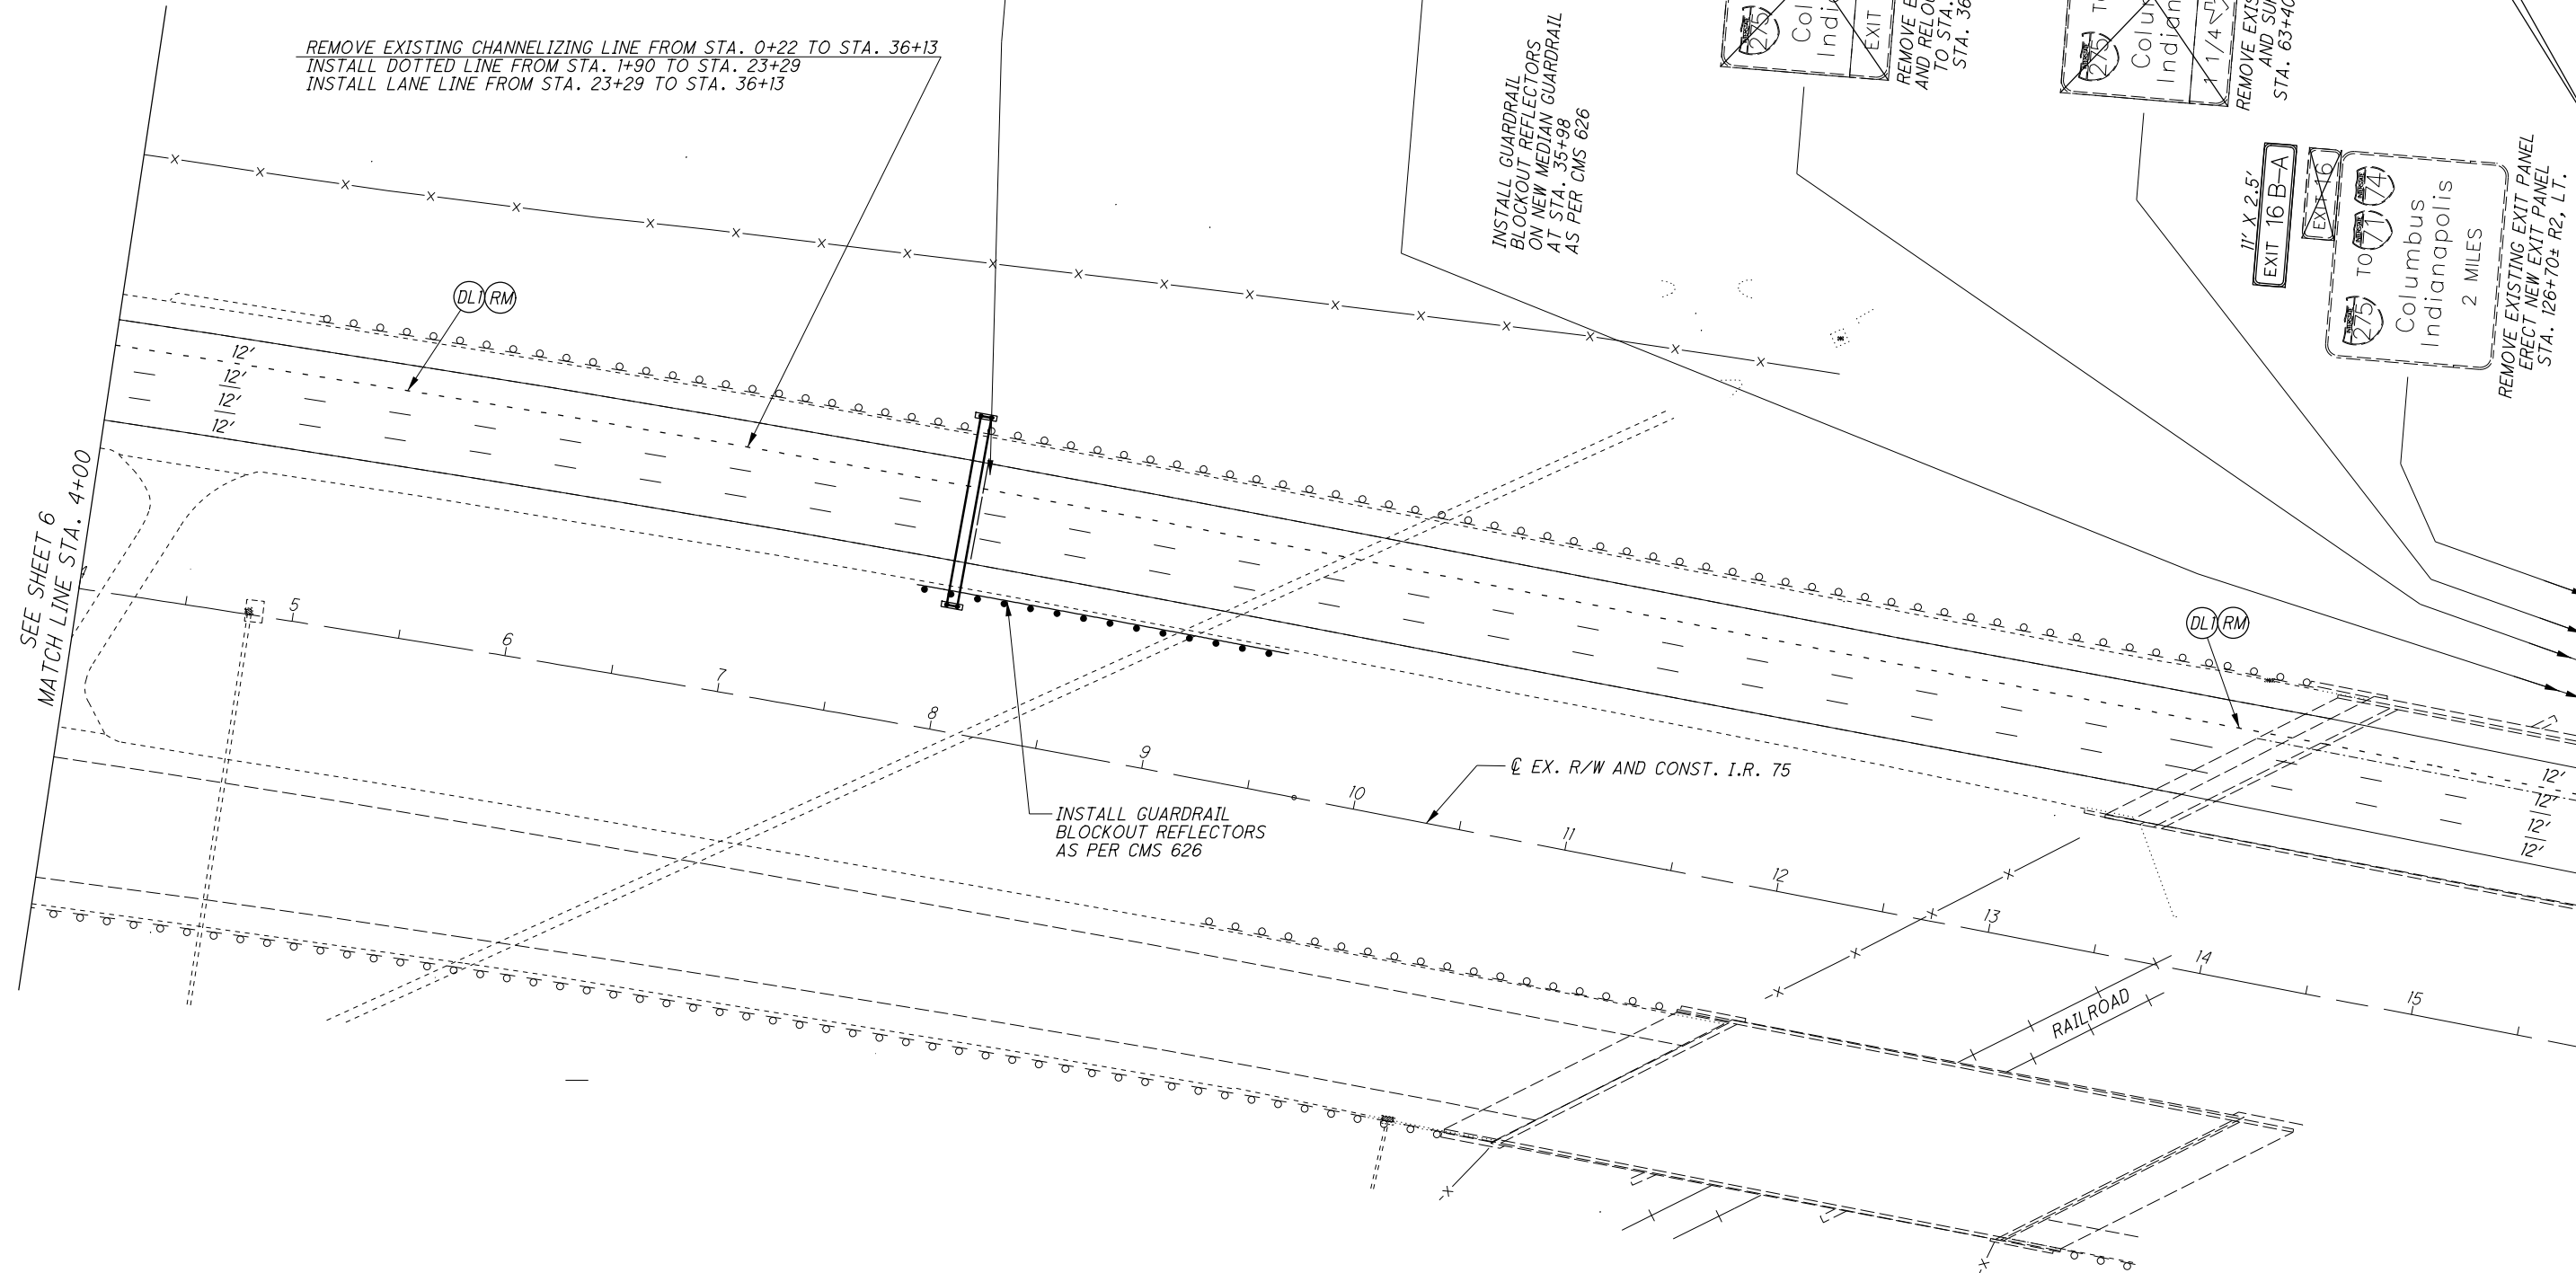


REMOVE EXISTING CHANNELIZING LINE FROM STA. 0+22 TO STA. 36+13  
 INSTALL DOTTED LINE FROM STA. 1+90 TO STA. 23+29  
 INSTALL LANE LINE FROM STA. 23+29 TO STA. 36+13


INSTALL GUARDRAIL  
 BLOCKOUT REFLECTORS  
 AS PER CMS 626

EX. R/W AND CONST. I.R. 75


RAILROAD

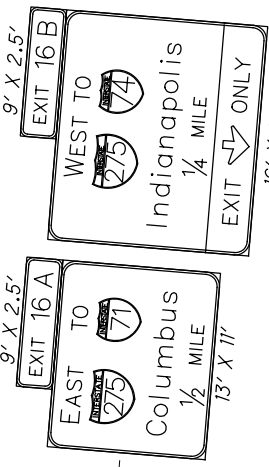


TC-7.65, DESIGN 8  
 STA. 8+00 R2, L.T.  
 FOR ELEVATION VIEW AND  
 SIGN DETAILS, SEE BU01

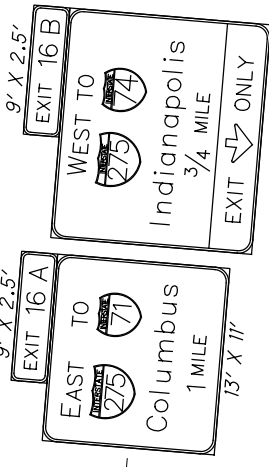


TC-7.65, DESIGN 8  
 STA. 35+98 R2, L.T.  
 FOR ELEVATION VIEW AND  
 SIGN DETAILS, SEE BU01

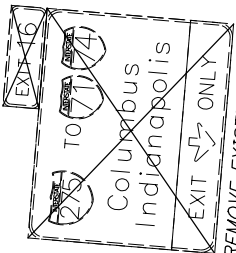

REMOVE EXISTING SIGNS  
 AND RELOCATE SUPPORT  
 TO STA. 178+82, L.T.  
 STA. 36+13 R2, L.T.

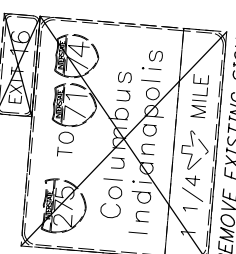

REMOVE EXISTING SIGNS  
 AND SUPPORT  
 STA. 63+40± R2, L.T.

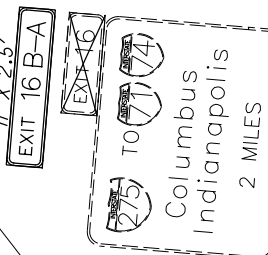

REMOVE EXISTING EXIT PANEL  
 ERECT NEW EXIT PANEL  
 STA. 126+70± R2, L.T.

BEGIN WORK  
 STA. 126+70±

**BUILDABLE UNIT 1 AS-BUILT PLANS - NOVEMBER 28, 2017**

**PAVEMENT MARKING AND SIGNING PLAN**


HAM-75-16.67

7  
12

CALCULATED  
TKI  
CHECKED  
JMB

HORIZONTAL SCALE IN FEET

G:\Akron\DCS\Projects\TRN\60547096\_HAM751667\900-CAD-GIS\104408\_HAM-75-1667\Design\Traffic\Sheets\BU0\104408\_TE001.dgn Design 11/28/2017 10:29:18 AM matt.philips

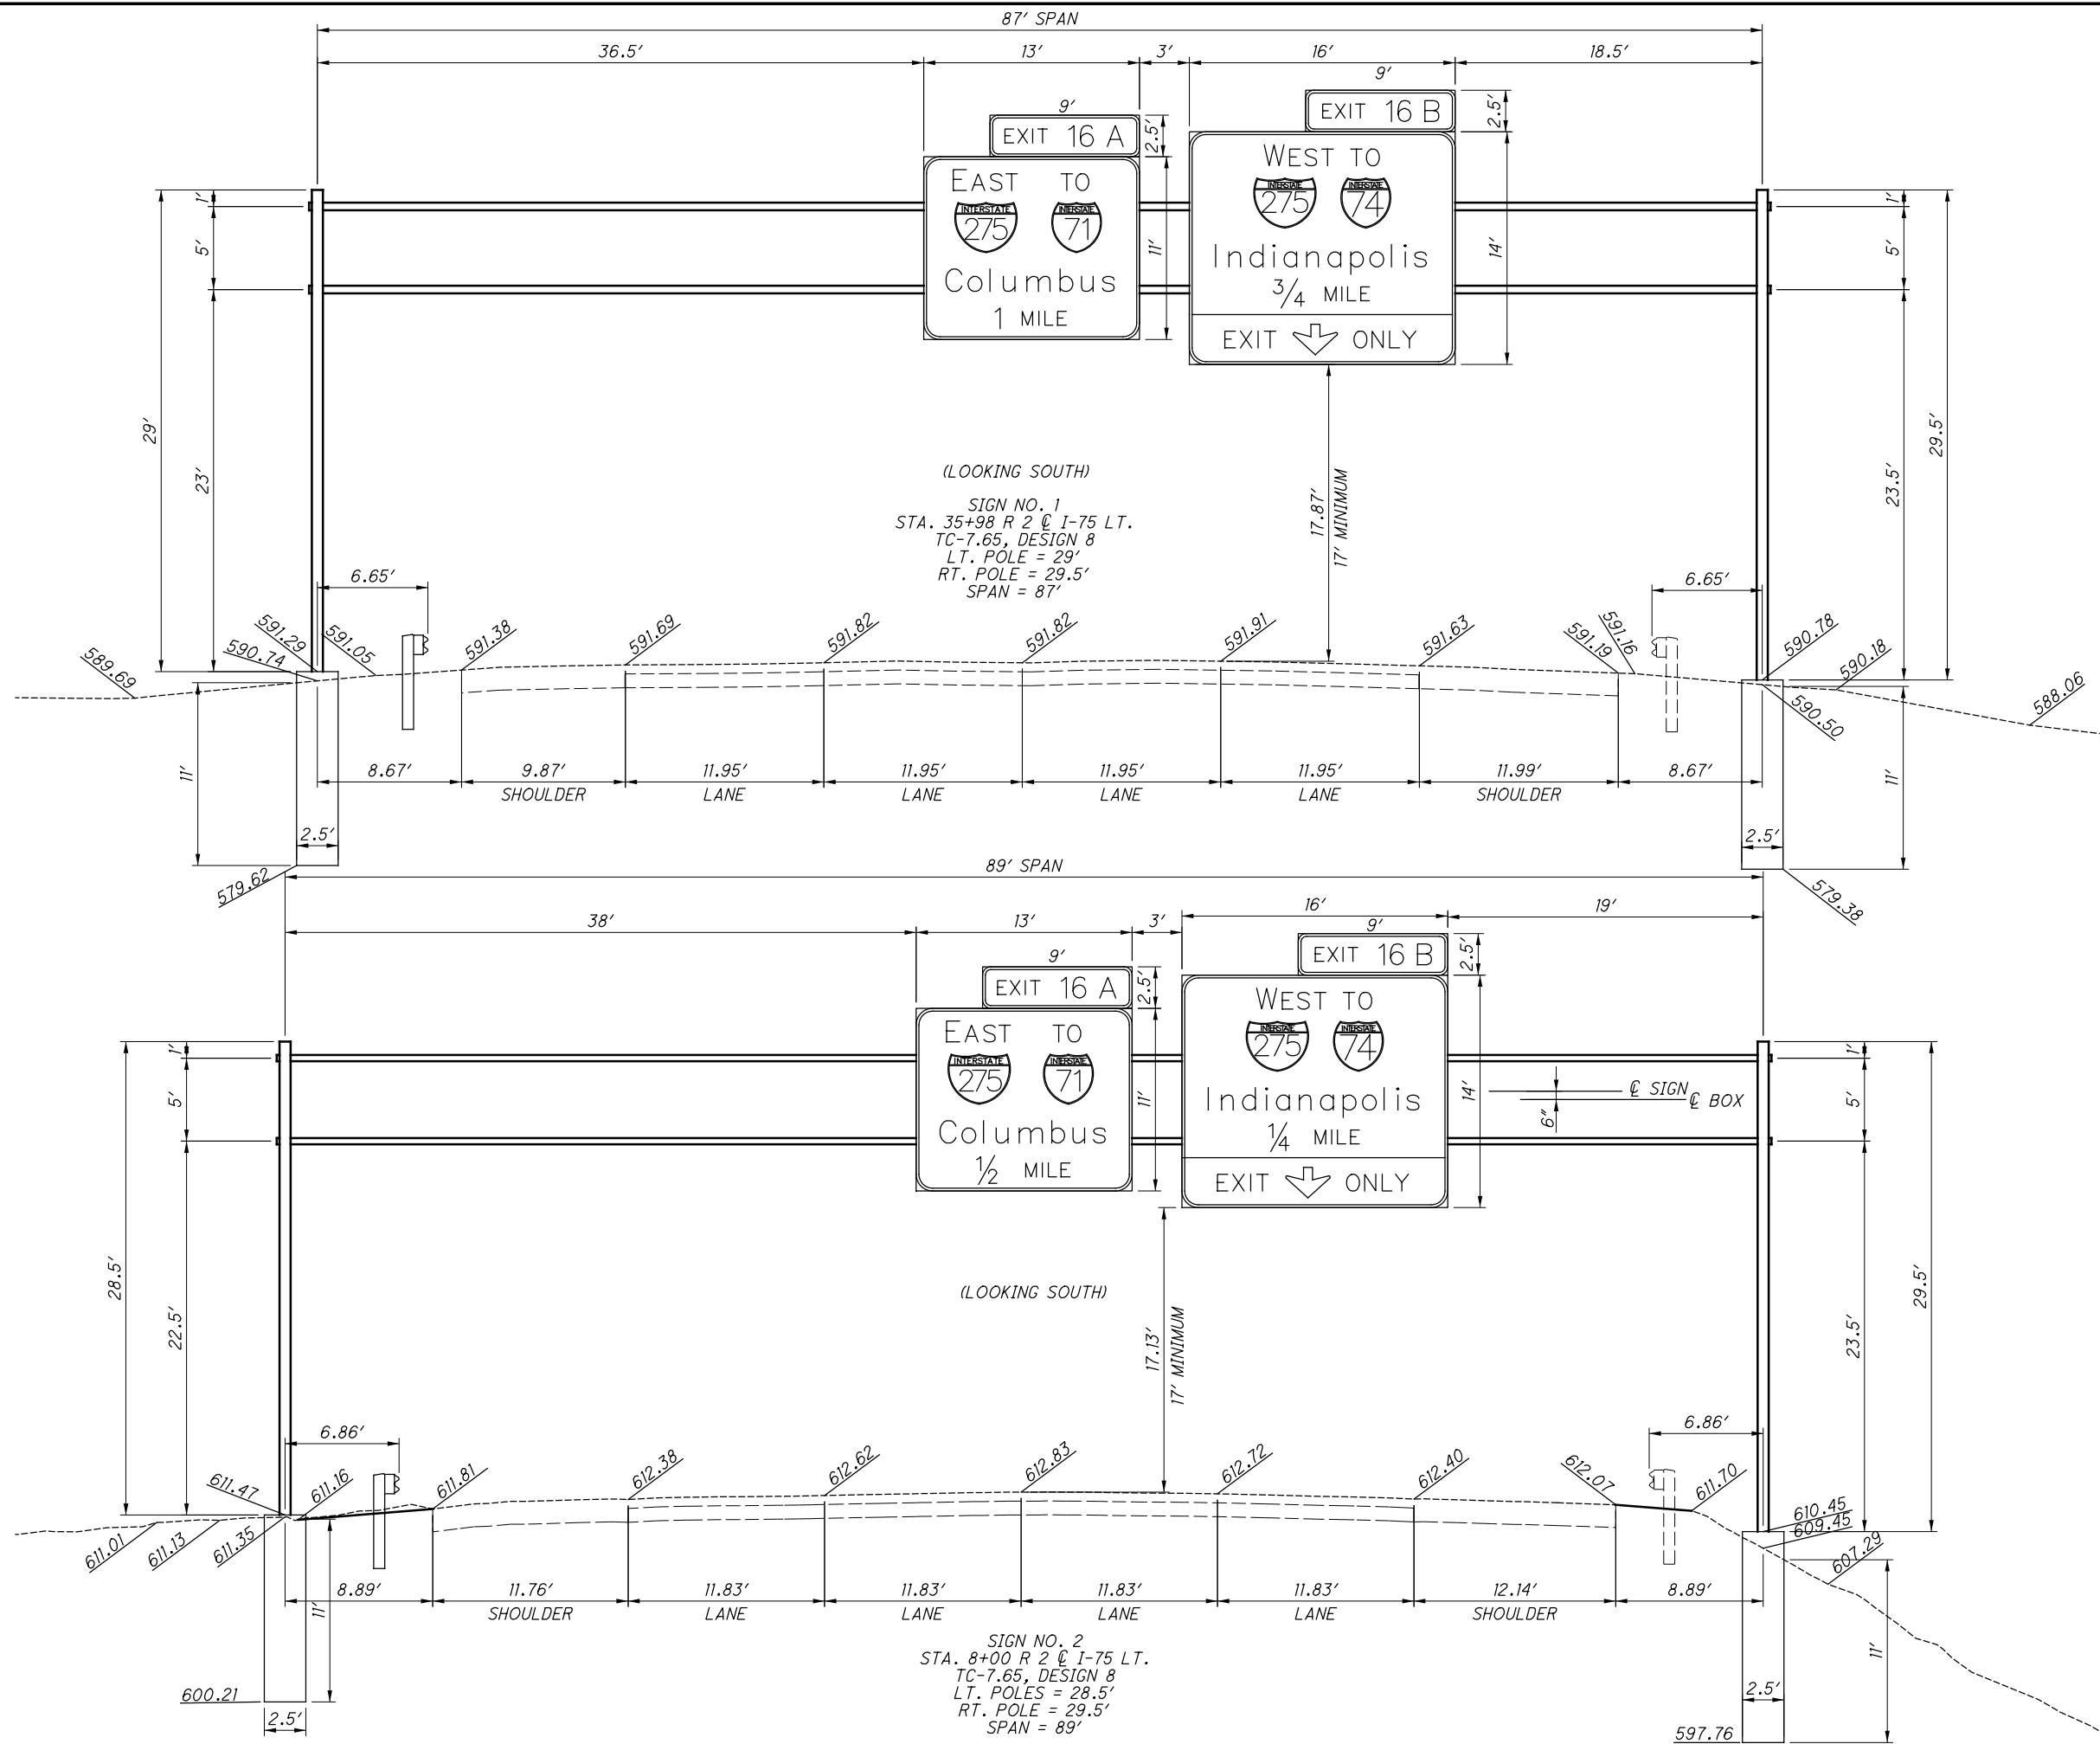

**BUILDABLE UNIT 1 - AS-BUILT PLANS - NOVEMBER 28, 2017**

**SIGN ELEVATION VIEWS**


**I-75**

CALCULATED
TKI
CHECKED
JMB

**HAM-75-16.67**

8  
12

G:\Akron\DCS\Projects\TRN\60547096\_HAM751667\900-CAD-GIS\104408\_HAM-75-1667\Design\Traffic\Sheets\BU01\104408\_TE002.dgn Design 11/28/2017 10:29:19 AM matt.philips

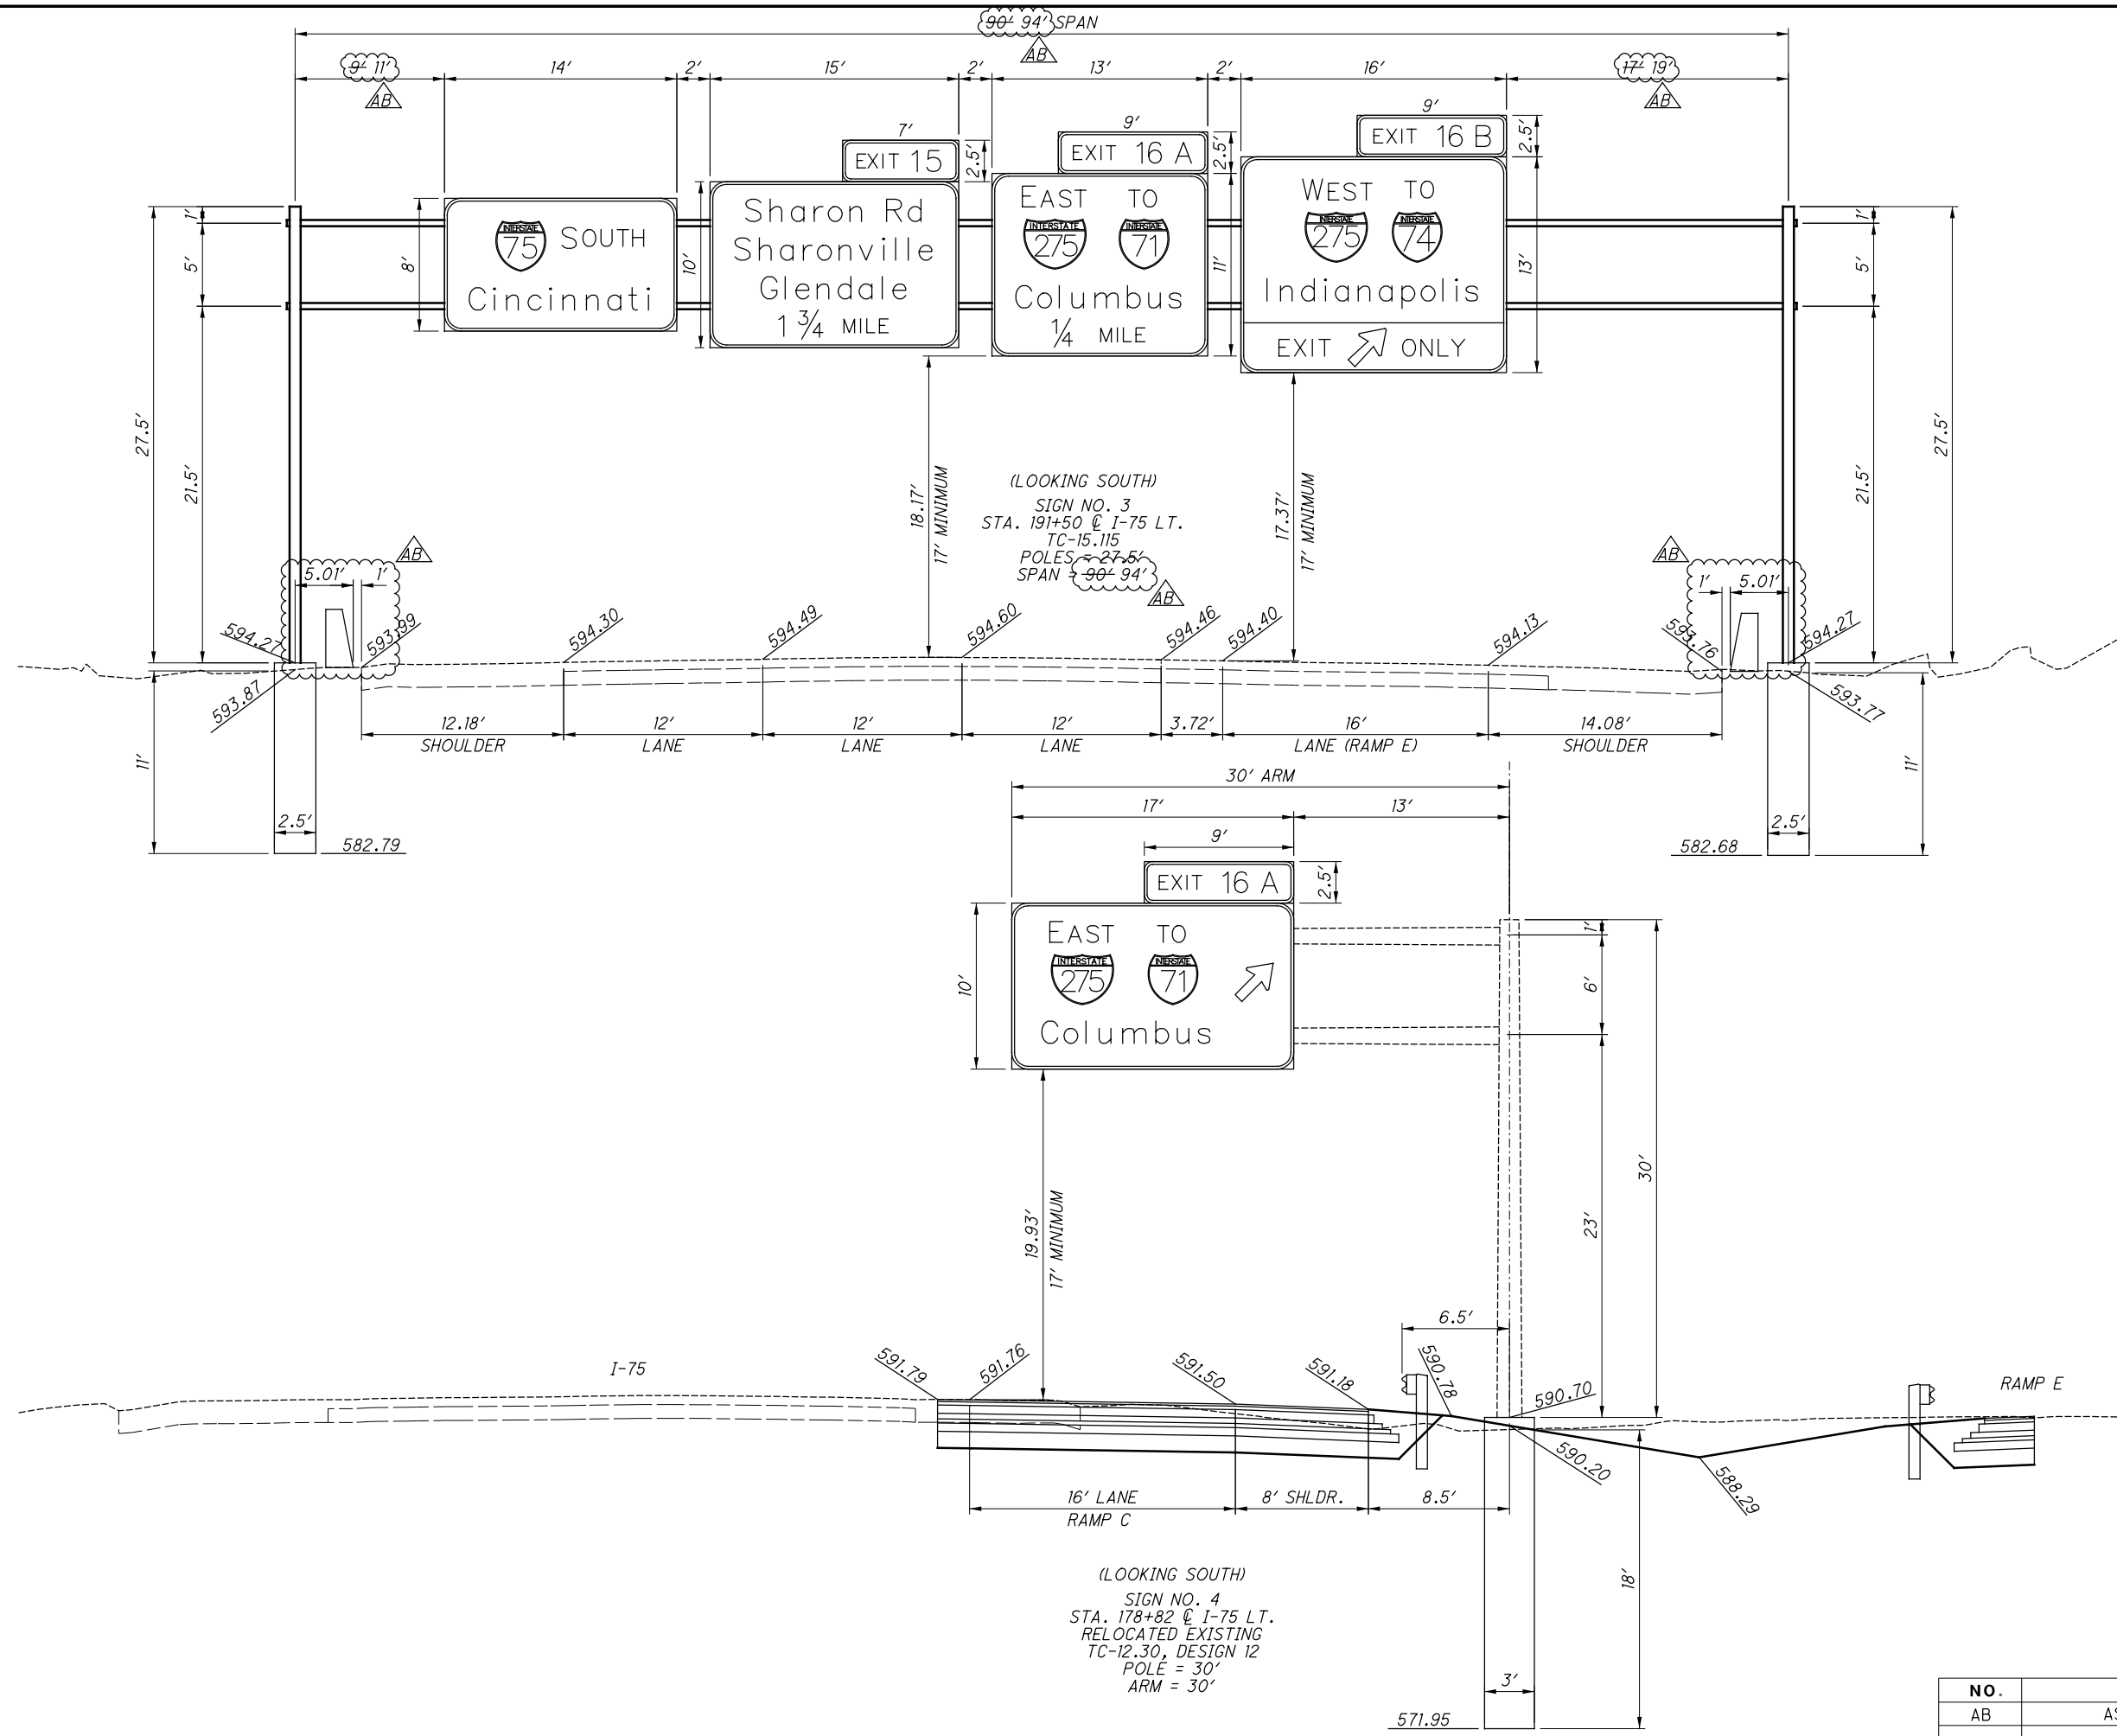

NO.	REVISIONS	DATE
AB	AS-BUILT REVISION	11/28/17

BUILDABLE UNIT 1-AS-BUILT PLANS-NOVEMBER 28, 2017

SIGN ELEVATION VIEWS


HAM-75-16.67

I-75

CALCULATED  
TKI  
CHECKED  
JMB

9  
12



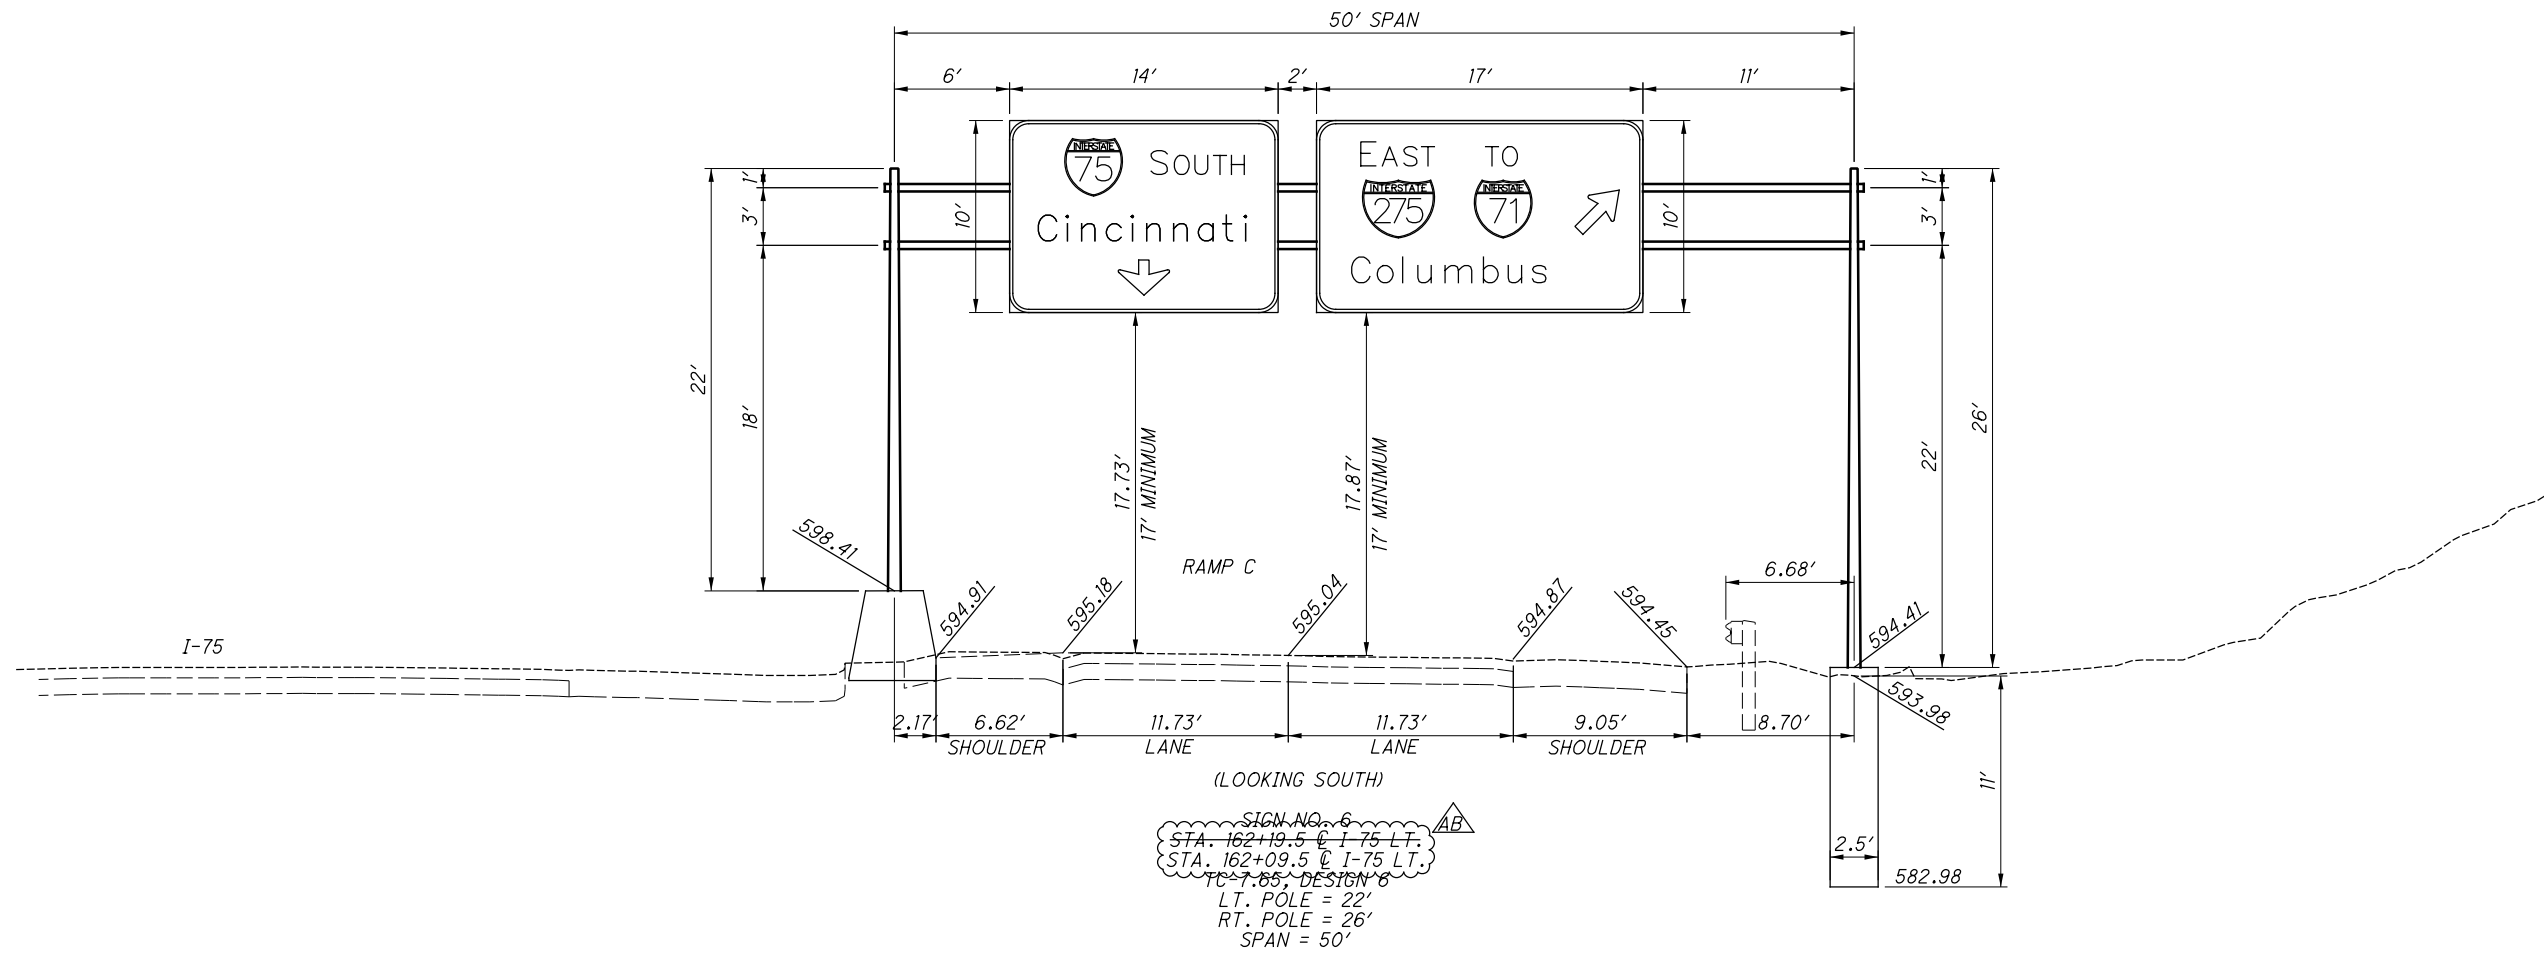

**BUILDABLE UNIT 1 - AS-BUILT PLANS - NOVEMBER 28, 2017**

**SIGN ELEVATION VIEWS**  
I-75


**HAM-75-16.67**

CALCULATED	TKI
	CHECKED
	JMB

NO.	REVISIONS	DATE
AB	AS-BUILT REVISION	11/28/17


10
12



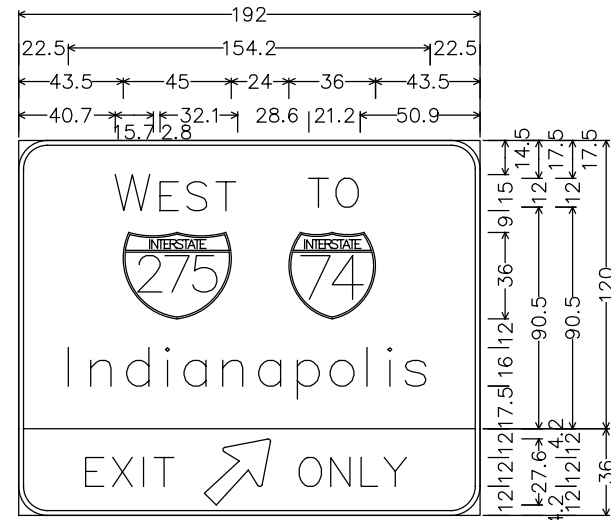


12.0" Radius, 2.0" Border, White on Green;  
 [WEST] E Mod; [TO] E Mod;  
 Interstate 275 M1-1; Interstate 74 M1-1;  
 [Indianapolis] E Mod;  
 12.0" Radius, 2.0" Border, Black on Yellow;  
 [EXIT] E; Arrow A-1 - 35.0" 45°; [ONLY] E;  
 Table of letter and object lefts.

W	E	S	T	T	O						
51.8	70.4	81.8	93.9	118.8	130.1						
43.5	112.5										
I	n	d	i	a	n	a	p	o	i	i	s
20.7	30.0	45.0	61.2	68.8	84.9	99.9	116.0	129.6	144.9	153.8	161.0
E	X	I	T	↗							
27.9	39.2	51.9	56.5	77.3							
O	N	L	Y								
116.8	129.8	142.5	152.1								

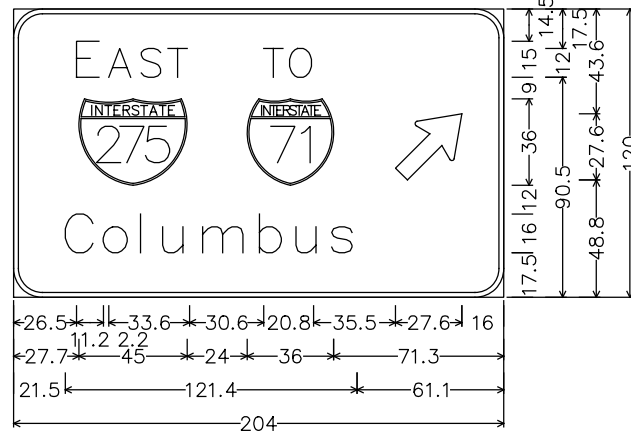


12.0" Radius, 2.0" Border, White on Green;  
 [E] E [AST] E;  
 [TO] E ;  
 [Columbus] E Mod;  
 Standard Arrow Custom 35.5" X 22.3" 45°;  
 Table of letter and object lefts.

E	A	S	T	T	O	↗	
26.2	39.6	53.1	64.2	104.1	114.8	158.9	
27.2	97.2						
C	o	l	u	m	b	u	s
21.5	37.3	52.8	62.0	78.6	102.2	117.5	132.4

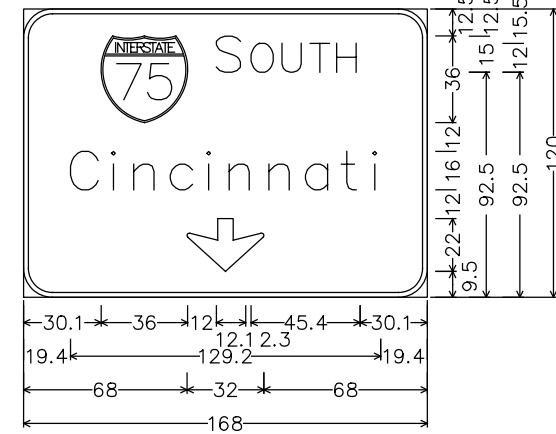


12.0" Radius, 2.0" Border, White on Green;  
 [SOUTH] E;  
 [Cincinnati] E Mod;  
 Down Arrow 22.0" 270°;  
 Table of letter and object lefts.

S	O	U	T	H					
37.6	85.6	100.0	112.9	124.6	135.7				
C	i	n	c	i	n	n	a	t	i
19.4	36.6	45.8	61.1	76.3	85.5	102.1	117.3	132.2	145.4
68.0									

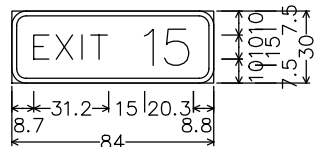


6.0" Radius, 2.0" Border, White on Green;  
 [EXIT] E;  
 [15] E ;  
 Table of letter and object lefts.

E	X	I	T
9.1	18.5	29.2	33.0
1	5		
55.3	63.6		

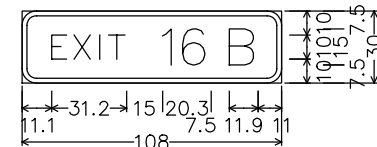


6.0" Radius, 2.0" Border, White on Green;  
 [EXIT] E; [16 B] E;  
 Table of letter and object lefts.

E	X	I	T
12.3	21.7	32.4	36.1
1	6	B	
58.5	66.8	86.3	

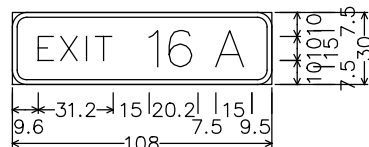

6.0" Radius, 2.0" Border, White on Green;  
 [EXIT] E; [16 A] E;  
 Table of letter and object lefts.

E	X	I	T
10.8	20.2	30.8	34.6
1	6	A	
57.0	65.3	84.7	

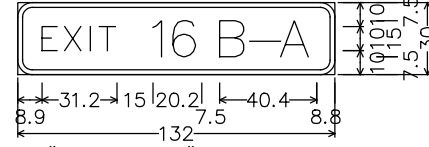

6.0" Radius, 2.0" Border, White on Green;  
 [EXIT] E; [16 B-A] E;  
 Table of letter and object lefts.

E	X	I	T	1	6
10.1	19.5	30.1	33.9	56.3	64.6
B	-	A			
84.0	99.9	109.4			

STATE OF OHIO  
DEPARTMENT OF TRANSPORTATION

# HAM-75-16.67 DB

CITY OF SHARONVILLE AND  
WEST CHESTER TOWNSHIP  
HAMILTON AND BUTLER COUNTIES

**PROJECT DESCRIPTION**


IMPROVEMENTS INCLUDE THE RECONFIGURATION OF THE I.R. 75 RAMP TO I.R. 275 BY UTILIZING THE EXISTING SINGLE LANE EXIT FOR TRAFFIC TO GO WEST ON I.R. 275 AND CREATING A SECOND EXIT FOR TRAFFIC TO GO EAST ON I.R. 275. IMPROVEMENTS INCLUDE THE RECONSTRUCTION OF 0.35 MILES OF THE I.R. 75 SOUTHBOUND RAMP TO I.R. 275 WESTBOUND; THE RECONSTRUCTION OF 0.45 MILES OF THE I.R. 75 SOUTHBOUND RAMP TO I.R. 275 EASTBOUND; REPLACEMENT OF ALL OVERHEAD SIGNS AND RELOCATION OF AN EXISTING LIGHT TOWER INCLUDING CONCRETE MEDIAN BARRIER, DRAINAGE AND PAVEMENT MARKINGS.

**LIMITED ACCESS**

THIS IMPROVEMENT IS ESPECIALLY DESIGNED FOR THROUGH TRAFFIC AND HAS BEEN DECLARED A LIMITED ACCESS HIGHWAY OR FREEWAY BY ACTION OF THE DIRECTOR IN ACCORDANCE WITH THE PROVISIONS OF SECTION 5511.02 OF THE OHIO REVISED CODE.

**2016 SPECIFICATIONS**

THE STANDARD SPECIFICATIONS OF THE STATE OF OHIO, DEPARTMENT OF TRANSPORTATION, INCLUDING SUPPLEMENTAL SPECIFICATIONS LISTED IN THE PLANS AND CHANGES LISTED IN THE PROPOSAL SHALL GOVERN THIS IMPROVEMENT.

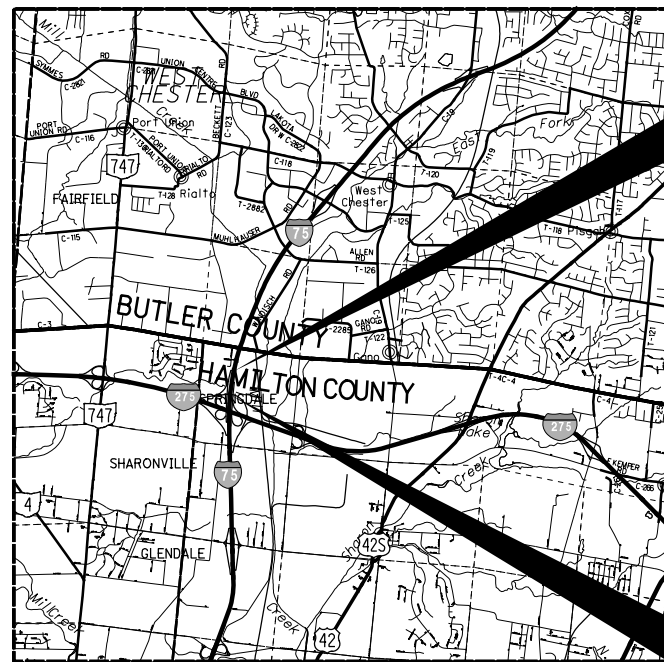

END PROJECT  
STA. 184+63.03

BEGIN PROJECT  
STA. 169+90.00

**INDEX OF SHEETS:**

TITLE SHEET	1
MOT GENERAL NOTES	2 - 3
MOT CUSTOM SIGN DETAILS	4 - 5
MOT TYPICAL SECTIONS	6 - 7
MOT DETOUR	8
MOT PLAN SHEETS	9 - 18

PORTION TO BE IMPROVED

INTERSTATE HIGHWAY	=====
FEDERAL ROUTES	=====
STATE ROUTES	=====
COUNTY & TOWNSHIP ROADS	=====
OTHER ROADS	-----

**DESIGN DESIGNATION**

SEE BU04

**BUILDABLE UNIT 2  
MAINTENANCE OF TRAFFIC  
AS-BUILTS (NO REVISIONS)  
DATE: 11/28/17**

**UNDERGROUND UTILITIES**

CONTACT BOTH SERVICES TWO WORKING DAYS  
BEFORE YOU DIG.

Call Before You Dig  
**1-800-362-2764**

(Non-members must be called directly)

OIL & GAS PRODUCERS  
UNDERGROUND PROTECTION SERVICE  
**1-800-925-0988**

PLAN PREPARED BY:

**AECOM**    AKRON CLEVELAND COLUMBUS  
564 WHITE POND DRIVE  
AKRON, OHIO 44320-1100  
(330) 836-9111

ENGINEERS SEAL:

ERIC JON  
THELLER  
80175

REGISTERED  
PROFESSIONAL ENGINEER

SIGNED: \_\_\_\_\_  
DATE: 8/17/2017

	STANDARD CONSTRUCTION DRAWINGS	SUPPLEMENTAL SPECIFICATIONS	SPECIAL PROVISIONS
MT-95.30 07/15/16		800 01/20/17	
MT-95.45 01/20/17		821 04/20/12	
MT-98.21 07/18/14		921 04/20/12	
MT-98.28 01/20/17			
MT-98.29 01/20/17			
MT-99.20 07/19/13			
MT-99.30 01/16/15			
MT-99.60 07/15/16			
MT-101.60 01/20/17			
MT-101.70 01/17/14			
MT-101.75 07/15/16			
MT-101.90 07/17/15			
MT-102.10 01/20/17			
MT-105.10 07/19/13			

**BUILDABLE UNIT 2-AS-BUILT PLANS-NOVEMBER 28, 2017**

FEDERAL PROJECT NO. <b>E170(763)</b>	PID NO. <b>104408</b>	CONSTRUCTION PROJECT NO. <b>173015</b>
RAILROAD INVOLVEMENT <b>NONE</b>		
<b>HAM-75-16.67</b>		
1 18		

G:\Akron\DCS\Projects\TRN\60547096\_HAM751667\900-CAD-GIS\104408\_HAM-75-1667\Design\MOT\Sheets\104408\_MT001.dgn\_Sheet 11/28/2017 10:16:08 AM matt.philips



**SEQUENCE OF OPERATION**

**PHASE 1**

DURING THE FIRST PHASE OF CONSTRUCTION, THE RAMP LANES GOING TO I-275 WILL BE REDUCED TO ONE LANE UNTIL ABOUT 79+00 WHERE EAST AND WEST WILL SPLIT DIRECTIONS. RAMP C WILL THEN SHIFT TO THE OUTSIDE SHOULDER AND THE LANE WIDTH WILL NARROW. AFTER CROSSING UNDER THE RAMP TO I-275 BRIDGE, RAMP C WILL SHIFT BACK TO THE EXISTING ALIGNMENT. MAINLINE I-75 SOUTHBOUND LANES WILL NARROW AND SHIFT TOWARDS THE MEDIAN WITHOUT ENCROACHING ON THE EXISTING SHOULDER FROM STA. 168+00 TO STA. 195+00. NORTHBOUND I-75 IS NOT AFFECTED BY ANY OF THIS WORK.

THE WORK BETWEEN THE MAINLINE AND THE RAMP WILL CONSIST OF INSTALLING FULL DEPTH PAVEMENT, SIGN FOUNDATIONS/SUPPORTS, A NEW OUTSIDE MAINLINE SHOULDER, A PART OF THE NEW RAMP C ALIGNMENT, AND PORTIONS OF STORM INLETS, STORM PIPES, UNDERDRAINS AND TRENCH DRAINS. THE STORM PIPE CROSSING UNDER THE EXISTING RAMP C SHALL BE INSTALLED DURING AND OVERNIGHT CLOSURE.

**PHASE 2**

DURING THE SECOND PHASE OF CONSTRUCTION, RAMP E SHALL REMAIN IN THE SAME LOCATION AS THE PREVIOUS PHASE. RAMP C WILL BE SHIFTED ONTO THE NEW PAVEMENT THAT WAS CONSTRUCTED IN PHASE 1. THE RAMP WILL SHIFT BACK TO THE EXISTING LOCATION AS IT CROSSES UNDER THE RAMP TO I-275 WEST BRIDGE. THE MAINLINE I-75 SOUTHBOUND LANES REMAIN IN THE SAME LOCATION AS THE PREVIOUS PHASE. I-75 NORTHBOUND IS STILL NOT AFFECTED DURING THIS PHASE.

THE WORK AREA IS LOCATED BETWEEN RAMPS C AND E. THIS WORK WILL INCLUDE FINISHING ALL OF THE NEW OUTSIDE SHOULDER OF RAMP C, REMOVAL OF OLD PAVEMENT, GRADING, AND ALL REMAINING DRAINAGE WORK.

OVERHEAD SIGN WORK SHALL BE PERFORMED DURING THIS PHASE. OVERLAYS AND COVERS MUST BE INSTALLED AS SHOWN IN THE PHASE 2 PLAN SHEETS UNTIL ALL NEW OVERHEAD SIGNS ARE INSTALLED.

**ITEM 614, MAINTAINING TRAFFIC (AT ALL TIMES)**

ALL EXISTING LANES OF TRAFFIC IN EACH DIRECTION SHALL BE MAINTAINED AT ALL TIMES, EXCEPT AS PERMITTED BY THE PERMITTED LANE CLOSURE TIMES NOTE, BY USE OF THE EXISTING PAVEMENT, THE COMPLETED PAVEMENT, AND ITEM 615 PAVEMENT FOR MAINTAINING TRAFFIC CLASS A.

**ITEM 614, MAINTAINING TRAFFIC (LANES OPEN DURING HOLIDAYS OR SPECIAL EVENTS)**

NO WORK SHALL BE PERFORMED AND ALL EXISTING LANES SHALL BE OPEN TO TRAFFIC DURING THE FOLLOWING DESIGNATED HOLIDAYS OR EVENTS:

CHRISTMAS	FOURTH OF JULY
NEW YEAR'S	LABOR DAY
MEMORIAL DAY	THANKSGIVING
EASTER	

THE PERIOD OF TIME THAT THE LANES ARE TO BE OPEN DEPENDS ON THE DAY OF THE WEEK ON WHICH THE HOLIDAY OR EVENT FALLS. THE FOLLOWING SCHEDULE SHALL BE USED TO DETERMINE THIS PERIOD:

DAY OF HOLIDAY OR EVENT	TIME ALL LANES MUST BE OPEN TO TRAFFIC
SUNDAY	12:00N FRIDAY THROUGH 6:00 AM MONDAY
MONDAY	12:00N FRIDAY THROUGH 6:00 AM TUESDAY
TUESDAY	12:00N MONDAY THROUGH 6:00 AM WEDNESDAY
WEDNESDAY	12:00N TUESDAY THROUGH 6:00 AM THURSDAY
THURSDAY	12:00N WEDNESDAY THROUGH 6:00 AM FRIDAY
THURSDAY (THANKSGIVING ONLY)	12:00N TUESDAY THROUGH 6:00 AM MONDAY
FRIDAY	12:00N THURSDAY THROUGH 6:00 AM MONDAY
SATURDAY	12:00N FRIDAY THROUGH 6:00 AM MONDAY

SHOULD THE CONTRACTOR FAIL TO MEET ANY OF THESE REQUIREMENTS, THE CONTRACTOR SHALL BE ASSESSED A DISINCENTIVE IN THE AMOUNT OF \$125 FOR EACH MINUTE THE ABOVE DESCRIBED LANE CLOSURE RESTRICTIONS ARE VIOLATED.

**ITEM 614, MAINTAINING TRAFFIC (LANE CLOSURE/REDUCTION REQUIRED)**

LENGTH AND DURATION OF LANE CLOSURES AND RESTRICTIONS SHALL BE AT THE APPROVAL OF THE ENGINEER. IT IS THE INTENT TO MINIMIZE THE IMPACT TO THE TRAVELING PUBLIC. LANE CLOSURES OR RESTRICTIONS OVER SEGMENTS OF THE PROJECT IN WHICH NO WORK IS ANTICIPATED WITHIN A REASONABLE TIME FRAME, AS DETERMINED BY THE ENGINEER, SHALL NOT BE PERMITTED. THE LEVEL OF UTILIZATION OF MAINTENANCE OF TRAFFIC DEVICES SHALL BE COMMENSURATE WITH THE WORK IN PROGRESS.

ALL WORK AND TRAFFIC CONTROL DEVICES SHALL BE IN ACCORDANCE WITH C&MS 614 AND OTHER APPLICABLE PORTIONS OF THE SPECIFICATIONS, AS WELL AS THE OHIO MANUAL OF UNIFORM TRAFFIC CONTROL DEVICES. PAYMENT FOR ALL LABOR, EQUIPMENT AND MATERIALS SHALL BE INCLUDED IN THE LUMP SUM CONTRACT PRICE FOR ITEM 614, SPECIAL - MAINTAINING TRAFFIC.

**PERMITTED LANE CLOSURE TIMES**

SHORT TERM LANE CLOSURES ARE THOSE WHICH ARE PERMITTED BY THE PERMITTED LANE CLOSURE NOTE. THESE TIMES SHALL NOT BE REVISED WITHOUT PRIOR APPROVAL FROM THE DISTRICT 8 WORK ZONE TRAFFIC ENGINEER. SHORT TERM LANE CLOSURES SHALL ONLY BE IMPLEMENTED WHEN WORK IS BEING CONTINUOUSLY PERFORMED IN THE LANE. THE CLOSURE SHALL BE REMOVED AS SOON AS POSSIBLE AFTER WORK HAS STOPPED. PERMITTED LANE CLOSURES SHALL ONLY BE ALLOWED DURING THE TIMES SPECIFIED IN THE LANE VALUE CONTRACT TABLE, SEE BELOW.

LANE VALUE CONTRACT TABLE			
DESCRIPTION OF CRITICAL LANE/RAMP TO BE MAINTAINED	RESTRICTED TIME PERIOD	TIME UNIT	DISINCENTIVE \$ PER TIME UNIT PER LANE
SB I-75: 3 LANES MAINTAINED, 1 LANE CLOSED; SEE NOTE 2	6 AM TO 8 PM	15 MINUTE PERIOD	\$1,875
SB I-75: 2 LANES MAINTAINED, 2 LANES CLOSED	6 AM TO 9 PM	15 MINUTE PERIOD	\$1,875
SB I-75: EXIT RAMP TO I-275; SEE NOTE 1	5 AM TO 11 PM	15 MINUTE PERIOD	\$1,875
SB I-75: SHORT DURATION CLOSING OF THE HIGHWAY	5 AM TO 12 AM	5 MINUTE PERIOD	\$1,200

1. THE SOUTHBOUND I-75 EXIT RAMP IS PERMITTED TO BE CLOSED IN ACCORDANCE WITH SECTION 13.3.4 A MAXIMUM OF 6 TIMES.

2. THE SOUTHBOUND I-75 EXIT RAMP IS PERMITTED TO BE MAINTAINED BY PROVIDING AN EXIT OPENING IN LIEU OF A DROP LANE CONFORMING TO THE 3 LANES MAINTAINED TIME PERIOD.

3. NO SHOULDER CLOSURE BETWEEN THE HOURS OF 6AM TO 9AM AND 3PM TO 7PM MONDAY THROUGH FRIDAY.

**TRENCH FOR WIDENING**

TRENCH EXCAVATION FOR BASE WIDENING SHALL BE ONLY ON ONE SIDE OF THE PAVEMENT AT A TIME. THE OPEN TRENCH SHALL BE ADEQUATELY MAINTAINED AND PROTECTED WITH DRUMS OR BARRICADES AT ALL TIMES. PLACEMENT OF PROPOSED SUBBASE AND BASE MATERIAL SHALL FOLLOW AS CLOSELY AS POSSIBLE BEHIND EXCAVATION OPERATIONS. THE LENGTH OF WIDENING TRENCH WHICH IS OPEN AT ANY ONE TIME SHALL BE HELD TO A MINIMUM AND SHALL AT ALL TIMES BE SUBJECT TO APPROVAL OF THE ENGINEER.

**OVERNIGHT TRENCH CLOSING**

THE BASE WIDENING SHALL BE COMPLETED TO A DEPTH OF NO MORE THAN 3 INCHES BELOW THE EXISTING PAVEMENT BY THE END OF EACH WORK DAY. NO TRENCH SHALL BE LEFT OPEN OVERNIGHT EXCEPT FOR A SHORT LENGTH (25 FEET OR LESS) OF A WORK SECTION AT THE END OF THE TRENCH. IN CASE WORK MUST BE SUSPENDED BECAUSE OF INCLEMENT WEATHER OR OTHER REASONS, THE TRENCH FOR THE UNCOMPLETED BASE WIDENING SHALL BE BACKFILLED AT THE DIRECTION OF THE ENGINEER.

**DUST CONTROL**

THE CONTRACTOR SHALL FURNISH AND APPLY WATER FOR DUST CONTROL AS DIRECTED BY THE ENGINEER. PAYMENT FOR ALL LABOR, EQUIPMENT, AND MATERIALS SHALL BE INCLUDED IN THE LUMP SUM CONTRACT PRICE FOR ITEM 614, SPECIAL - MAINTAINING TRAFFIC.

**FLOODLIGHTING**

FLOODLIGHTING OF THE WORK SITE FOR OPERATIONS CONDUCTED DURING NIGHTTIME PERIODS SHALL BE ACCOMPLISHED SO THAT THE LIGHTS DO NOT CAUSE GLARE TO THE DRIVERS ON THE ROADWAY. TO ENSURE THE ADEQUACY OF THE FLOODLIGHT PLACEMENT, THE CONTRACTOR AND THE ENGINEER SHALL DRIVE THROUGH THE WORK SITE EACH NIGHT WHEN THE LIGHTING IS IN PLACE AND OPERATIVE PRIOR TO COMMENCING ANY WORK. IF GLARE IS DETECTED, THE LIGHT PLACEMENT AND SHIELDING SHALL BE ADJUSTED TO THE SATISFACTION OF THE ENGINEER BEFORE WORK PROCEEDS.

PAYMENT FOR ALL LABOR, EQUIPMENT AND MATERIALS SHALL BE INCLUDED IN THE LUMP SUM CONTRACT PRICE FOR ITEM 614, SPECIAL - MAINTAINING TRAFFIC.

**ITEM 614, WORK ZONE IMPACT ATTENUATOR FOR 24" WIDE HAZARDS (BIDIRECTIONAL OR UNIDIRECTIONAL)**

THIS ITEM SHALL CONSIST OF FURNISHING AND INSTALLING A NON-GATING IMPACT ATTENUATOR. FURNISH AN IMPACT ATTENUATOR FROM THE OFFICE OF ROADWAY ENGINEERING'S APPROVED LIST FOR WORK ZONE IMPACT ATTENUATORS, FROM THE ROADWAY STANDARDS APPROVED PRODUCTS WEB PAGE.

INSTALLATION SHALL BE AT THE LOCATIONS SPECIFIED IN THE PLANS IN ACCORDANCE WITH THE MANUFACTURER'S SPECIFICATIONS.

THE CONTRACTOR SHALL REPAIR OR REPLACE A DAMAGED UNIT WITHIN 24 HOURS OF A DAMAGING IMPACT.

WHEN BIDIRECTIONAL DESIGNS ARE SPECIFIED, THE CONTRACTOR SHALL SUPPLY APPROPRIATE TRANSITIONS.

WHEN GATING IMPACT ATTENUATORS ARE DESIRED, THE CONTRACTOR SHALL SUBMIT DOCUMENTATION TO THE ENGINEER FOR ACCEPTANCE.

THE COST FOR THE ADDITIONAL BARRIER REQUIRED FOR A GATING IMPACT ATTENUATOR SHALL BE INCLUDED IN THE COST OF THE GATING IMPACT ATTENUATOR.

PAYMENT FOR THE ABOVE WORK SHALL BE INCLUDED IN LUMP SUM AND SHALL INCLUDE ALL LABOR, TOOLS, EQUIPMENT AND MATERIALS NECESSARY TO CONSTRUCT AND MAINTAIN A COMPLETE AND FUNCTIONAL IMPACT ATTENUATOR SYSTEM, INCLUDING ALL RELATED BACKUPS, TRANSITIONS, LEVELING PADS, HARDWARE AND GRADING, NOT SEPARATELY SPECIFIED, AS REQUIRED BY THE MANUFACTURER.

**ITEM 614, PORTABLE CHANGEABLE MESSAGE SIGNS, AS PER PLAN**

THE CONTRACTOR SHALL FURNISH, INSTALL, MAINTAIN AND REMOVE, WHEN NO LONGER NEEDED, TWO CHANGEABLE MESSAGE SIGNS. THE SIGN SHALL BE OF A TYPE SHOWN ON A LIST OF APPROVED PCMS UNITS AVAILABLE ON THE OFFICE OF MATERIALS MANAGEMENT WEB PAGE. THE LIST CONTAINS CLASS A AND B UNITS WITH MINIMUM LEGIBILITY DISTANCES OF 800 FEET AND 650 FEET, RESPECTIVELY.

EACH SIGN SHALL BE TRAILER-MOUNTED AND EQUIPPED WITH A FUNCTIONAL DIMMING MECHANISM, TO DIM THE SIGN DURING DARKNESS, AND A TAMPER AND VANDAL PROOF ENCLOSURE. EACH SIGN SHALL BE PROVIDED WITH APPROPRIATE TRAINING AND OPERATION INSTRUCTIONS TO ENABLE ON-SITE PERSONNEL TO OPERATE AND TROUBLESHOOT THE UNIT. THE SIGN SHALL ALSO BE CAPABLE OF BEING POWERED BY AN ELECTRICAL SERVICE DROP FROM A LOCAL UTILITY COMPANY. THE PCMS SHALL BE DELINEATED IN ACCORDANCE WITH C&MS 614.03.

THE PROBABLE PCMS LOCATIONS AND WORK LIMITS FOR THOSE LOCATIONS ARE SHOWN ON SHEET 3 OF THE PLANS. PLACEMENT, OPERATION, MAINTENANCE AND ALL ACTIVATION OF THE SIGNS BY THE CONTRACTOR SHALL BE AS DIRECTED BY THE ENGINEER. THE PCMS SHALL BE LOCATED IN A HIGHLY VISIBLE POSITION YET PROTECTED FROM TRAFFIC. THE CONTRACTOR SHALL, AT THE DIRECTION OF THE ENGINEER, RELOCATE THE PCMS TO IMPROVE VISIBILITY OR ACCOMMODATE CHANGED CONDITIONS. WHEN NOT IN USE, THE PCMS SHALL BE TURNED OFF. ADDITIONALLY, WHEN NOT IN USE FOR EXTENDED PERIODS OF TIME, THE PCMS SHALL BE TURNED AWAY FROM ALL TRAFFIC.

THE ENGINEER SHALL BE PROVIDED ACCESS TO EACH SIGN UNIT AND SHALL BE PROVIDED WITH APPROPRIATE TRAINING AND OPERATION INSTRUCTIONS TO ENABLE ODOT PERSONNEL TO OPERATE AND TROUBLESHOOT THE UNIT, AND TO REVISE SIGN MESSAGES, IF NECESSARY.

(THE CONTRACTOR SHALL IMPLEMENT A SYSTEM WHEREBY CHANGEABLE MESSAGES WILL BE IMPLEMENTED WITHIN \_\_\_\_\_ HOURS FOLLOWING TELEPHONE NOTIFICATION FROM THE PROJECT ENGINEER TO A DESIGNATED PHONE.)

ALL MESSAGES TO BE DISPLAYED ON THE SIGN WILL BE PROVIDED BY THE ENGINEER. A LIST OF ALL REQUIRED PRE-PROGRAMMED MESSAGES WILL BE GIVEN TO THE CONTRACTOR AT THE PROJECT PRECONSTRUCTION CONFERENCE. THE SIGN SHALL HAVE THE CAPABILITY TO STORE UP TO 99 MESSAGES. MESSAGE MEMORY OR PRE-PROGRAMMED DISPLAYS SHALL NOT BE LOST AS A RESULT OF POWER FAILURES TO THE ON-BOARD COMPUTER. THE SIGN LEGEND SHALL BE CAPABLE OF BEING CHANGED IN THE FIELD. THREE-LINE PRESENTATION FORMATS WITH UP TO SIX MESSAGE PHASES SHALL BE SUPPORTED. PCMS FORMAT SHALL PERMIT THE COMPLETE MESSAGE FOR EACH PHASE TO BE READ AT LEAST TWICE.

THE PCMS SHALL CONTAIN AN ACCURATE CLOCK AND PROGRAMMING LOGIC WHICH WILL ALLOW THE SIGN TO BE ACTIVATED, DEACTIVATED OR MESSAGES CHANGED AUTOMATICALLY AT DIFFERENT TIMES OF THE DAY FOR DIFFERENT DAYS OF THE WEEK.

THE CONTRACTOR SHALL BE RESPONSIBLE FOR 24-HOUR-PER-DAY OPERATION AND MAINTENANCE OF THESE SIGNS ON THE PROJECT FOR THE DURATION OF THE PHASES WHEN THE PLAN REQUIRES THEIR USE.

PAYMENT FOR THE ABOVE DESCRIBED ITEM SHALL BE LUMP SUM, ITEM 614, SPECIAL - MAINTAINING TRAFFIC. PAYMENT SHALL INCLUDE ALL LABOR, MATERIALS, EQUIPMENT, FUELS, LUBRICATING OILS, SOFTWARE, HARDWARE AND INCIDENTALS TO PERFORM THE ABOVE DESCRIBED WORK.

**ITEM 614 - WORK ZONE RAISED PAVEMENT MARKER, AS PER PLAN**

WORK ZONE RAISED PAVEMENT MARKERS, AS PER PLAN, AND THEIR INSTALLATION SHALL CONFORM TO C&MS 614 OR C&MS 621 AS SPECIFIED HEREIN.

- RAISED PAVEMENT MARKERS IN USE DURING THE SNOW-PLOWING SEASON SHALL CONFORM TO 621.
- RAISED PAVEMENT MARKERS IN USE DURING THE NON-SNOW-PLOW SEASON SHALL CONFORM TO EITHER 614 OR TO 621.

THE SNOW-PLOWING SEASON SHALL RUN FROM OCTOBER 15 THROUGH APRIL 1.

IF PROJECT DELAYS, NOT THE FAULT OF ODOT, CAUSE THE WORK TO EXTEND INTO THE SNOW-PLOWING SEASON, THE CONTRACTOR SHALL BE RESPONSIBLE FOR REPLACING WORK ZONE RAISED PAVEMENT MARKERS (WZRPMS) CONFORMING TO C&MS 614, WITH RAISED PAVEMENT MARKERS CONFORMING TO 621, AS DETERMINED BY THE ENGINEER, AT THE CONTRACTOR'S EXPENSE.

THIS ITEM SHALL INCLUDE PURCHASE, INSTALLATION AND REMOVAL OF ITEM 614 WORK ZONE RAISED PAVEMENT MARKER, AS PER PLAN, INCLUDING FILLING OF ANY DEPRESSIONS CREATED IN THE PAVEMENT AS PER C&MS 621.08.

RESURFACING OF THE TRANSITION AREAS SHALL BE PERFORMED AT THE TIME THAT THE SURFACE COURSE IS BEING APPLIED TO THE ENTIRE PROJECT. PRIOR TO APPLICATION OF THE SURFACE COURSE ON THE PROJECT, THE EXISTING PAVEMENT WITHIN THE TRANSITION AREA SHALL BE REMOVED TO A DEPTH NECESSARY TO REACH THE LEVEL OF THE INTERMEDIATE COURSE OF THE PAVEMENT, AS DETERMINED BY THE ENGINEER.

**DELINEATION OF PORTABLE AND PERMANENT BARRIER**

BARRIER REFLECTORS AND OBJECT MARKERS SHALL BE INSTALLED ON ALL PORTABLE BARRIER (PB) USED FOR TRAFFIC CONTROL AND ON PERMANENT CONCRETE BARRIER (INCLUDING BRIDGE PARAPETS) LOCATED WITHIN 5 FEET OF THE EDGE OF THE ADJACENT TRAVEL LANE.

BUILDABLE UNIT 2 - AS-BUILT PLANS - NOVEMBER 28, 2017

CALCULATED  
EJIT  
CHECKED  
RAM

MAINTENANCE OF TRAFFIC GENERAL NOTES

HAM-75-16.67

G:\Akron\DCS\Projects\TRN\60547096\_HAM751667\900-CAD-GIS\104408\_HAM-75-1667\Design\WOT\Sheets\104408\_MN001.dgn\_Sheet 11/28/2017 10:16:11 AM matt.philips



G:\Akron\DCS\Projects\TRN\60547096\_HAM751667\900-CAD-GIS\1044408\_HAM-75-1667\Design\WOT\Sheets\104408\_MN002.dgn Sheet 11/28/2017 10:16:12 AM matt.philips

BARRIER REFLECTORS SHALL CONFORM TO C&MS 626, EXCEPT THAT THE SPACING SHALL BE AS PER TRAFFIC SCD MT-101.70. OBJECT MARKERS AND THEIR INSTALLATION SHALL CONFORM TO C&MS 614.03 AND SCD MT-101.70. WHEN THE PB CONTAINS GLARE SCREEN, ONE SET OF THREE VERTICAL STRIPES OF SHEETING SHALL BE CONSIDERED EQUIVALENT TO AN OBJECT MARKER, ONE-WAY.

INCREASED BARRIER DELINEATION, AS SPECIFIED HEREIN, SHALL BE INSTALLED ON ALL PB AND CONCRETE PERMANENT BARRIER LOCATED WITHIN 5 FEET OF THE EDGE OF THE TRAVELED LANE ALONG TAPERS AND TRANSITION AREAS AND ALONG CURVES (OUTSIDE ONLY) WITH DEGREE OF CURVATURE GREATER THAN OR EQUAL TO 3 DEGREES.

THE INCREASED BARRIER DELINEATION SHALL CONSIST OF EITHER DELINEATION PANELS OR THE TRIPLE STACKING OF WORK ZONE BARRIER REFLECTORS.

DELINEATION PANELS SHALL CONSIST OF PANELS OF DELINEATION, APPROXIMATELY 34 INCHES LONG AND 6 INCHES WIDE AND SHALL BE "CRIMPED." PANELS SHALL BE INSTALLED AND SPACED PER TRAFFIC SCD MT-101.70.

TRIPLE-STACKED BARRIER REFLECTORS SHALL CONSIST OF ALIGNING THREE BARRIER REFLECTORS VERTICALLY, AT LOCATIONS WHERE A SINGLE BARRIER REFLECTOR WOULD BE OTHERWISE ATTACHED. THERE SHALL BE NO OPEN SPACE BETWEEN THE ADJACENT BARRIER REFLECTORS. THE TRIPLE-STACKED BARRIER REFLECTORS SHALL CONFORM TO C&MS 626, EXCEPT THAT THEY SHALL BE SPACED AND ALIGNED PER TRAFFIC SCD MT-101.70.

ALONG RUNS OF INCREASED BARRIER DELINEATION WHERE THIS ITEM IS PROVIDED, THE QUANTITY SHALL BE MEASURED AS THE ENTIRE LENGTH OF THE RUN OF INCREASED BARRIER DELINEATION, INCLUDING THE SPACES BETWEEN THE INDIVIDUAL DELINEATION PANELS OR STACKS OF BARRIER REFLECTORS.

**DELINEATION OF TEMPORARY AND PERMANENT GUARDRAIL**

BARRIER REFLECTORS SHALL BE INSTALLED ON ALL TEMPORARY GUARDRAIL USED FOR TRAFFIC CONTROL AND ON ALL PERMANENT GUARDRAIL LOCATED WITHIN 5 FEET OF THE EDGE OF THE ADJACENT TRAVEL LANE. BARRIER REFLECTORS SHALL CONFORM TO C&MS 626.

OBJECT MARKERS SHALL BE INSTALLED ON ALL TEMPORARY AND PERMANENT GUARDRAIL LOCATED WITHIN 5 FEET OF THE EDGE OF THE ADJACENT TRAVEL LANE. GUARDRAIL-MOUNTING OF OBJECT MARKERS SHALL BE MADE BY INSTALLING THE OBJECT MARKERS ON THE EXTENSION BLOCKS RATHER THAN DIRECTLY ONTO THE GUARDRAIL ITSELF. OBJECT MARKERS SHALL CONFORM TO C&MS 614.03 AND THE SPACING SHALL BE APPROXIMATELY 50 FEET.

**ITEM 614 - LAW ENFORCEMENT OFFICER (WITH PATROL CAR) FOR ASSISTANCE DURING CONSTRUCTION OPERATIONS**

USE OF LAW ENFORCEMENT OFFICERS (LEOS) BY CONTRACTORS OTHER THAN THE USES SPECIFIED BELOW WILL NOT BE PERMITTED AT PROJECT COST. LEOS SHOULD NOT BE USED WHERE THE OMUTCD INTENDS THAT FLAGGERS BE USED.

IN ADDITION TO THE REQUIREMENTS OF C&MS 614 AND THE OMUTCD, A UNIFORMED LEO WITH AN OFFICIAL PATROL CAR (CAR WITH TOP-MOUNTED EMERGENCY FLASHING LIGHTS AND COMPLETE MARKINGS OF THE APPROPRIATE LAW ENFORCEMENT AGENCY) SHALL BE PROVIDED FOR THE FOLLOWING TRAFFIC CONTROL TASKS:

- DURING THE ENTIRE ADVANCE PREPARATION AND CLOSURE SEQUENCE WHERE COMPLETE BLOCKAGE OF TRAFFIC IS REQUIRED

IN ADDITION TO THE REQUIREMENT OF C&MS 614 AND THE OMUTCD, A UNIFORMED LEO WITH AN OFFICIAL PATROL CAR (CAR WITH TOP-MOUNTED EMERGENCY FLASHING LIGHTS AND COMPLETE MARKINGS OF THE APPROPRIATE LAW ENFORCEMENT AGENCY) SHOULD BE PROVIDED FOR THE FOLLOWING TRAFFIC CONTROL TASKS AS APPROVED BY THE ENGINEER:

- FOR LANE CLOSURES: DURING INITIAL SET-UP PERIODS, TEAR DOWN PERIODS, SUBSTANTIAL SHIFTS OF A CLOSURE POINT OR WHEN NEW LANE CLOSURE ARRANGEMENTS ARE INITIATED FOR LONG-TERM LANE CLOSURES/SHIFTS (FOR THE FIRST AND LAST DAY OF MAJOR CHANGES IN TRAFFIC CONTROL SETUP)

IN GENERAL, LEOS SHOULD BE POSITIONED IN ADVANCE OF AND ON THE SAME SIDE AS THE LANE RESTRICTION OR AT THE POINT OF ROAD, AND TO MANUALLY CONTROL TRAFFIC MOVEMENTS THROUGH SIGNALIZED INTERSECTIONS IN WORK ZONES.

LEOS SHOULD NOT FORGO THEIR TRAFFIC CONTROL RESPONSIBILITIES TO APPREHEND MOTORISTS FOR ROUTINE TRAFFIC VIOLATIONS. HOWEVER, IF A MOTORIST'S ACTIONS ARE CONSIDERED TO BE RECKLESS, THEN PURSUIT OF THE MOTORIST IS APPROPRIATE.

LEOS SHOULD NOT FORGO THEIR TRAFFIC CONTROL RESPONSIBILITIES TO APPREHEND MOTORISTS FOR ROUTINE TRAFFIC VIOLATIONS. HOWEVER, IF A MOTORIST'S ACTIONS ARE CONSIDERED TO BE RECKLESS, THEN PURSUIT OF THE MOTORIST IS APPROPRIATE.

THE LEOS WORK AT THE DIRECTION OF THE CONTRACTOR. THE CONTRACTOR IS RESPONSIBLE FOR SECURING THE SERVICES OF THE LEOS WITH THE APPROPRIATE AGENCIES AND COMMUNICATING THE INTENTIONS OF THE PLANS WITH RESPECT TO DUTIES OF THE LEOS. THE ENGINEER SHALL HAVE FINAL CONTROL OVER THE LEOS' DUTIES AND PLACEMENT, AND WILL RESOLVE ANY ISSUES THAT MAY ARISE BETWEEN THE TWO PARTIES.

THE LEO SHALL REPORT IN TO THE CONTRACTOR PRIOR TO THE START OF THE SHIFT, IN ORDER TO RECEIVE INSTRUCTIONS REGARDING SPECIFIC WORK ASSIGNMENTS DURING HIS/HER SHIFT. THE LEO IS EXPECTED TO STAY AT THE PROJECT SITE FOR THE ENTIRE DURATION OF HIS/HER SHIFT. THE LEO SHALL REPORT TO THE CONTRACTOR AT THE END OF HIS/HER SHIFT. ONCE THE LEO HAS COMPLETED THE DUTIES DESCRIBED ABOVE AND STILL HAS TIME REMAINING ON HIS/HER SHIFT, THE LEO MAY BE ASKED TO PATROL THROUGH THE WORK ZONE (WITH FLASHING LIGHTS OFF) OR BE PLACED AT A LOCATION TO DETER MOTORISTS FROM SPEEDING. SHOULD IT BE NECESSARY TO LEAVE THE PROJECT SITE, THE LEO SHALL NOTIFY THE ENGINEER. THE CONTRACTOR SHALL PROVIDE THE LEO WITH A TWO-WAY COMMUNICATION DEVICE WHICH SHALL BE RETURNED TO THE CONTRACTOR AT THE END OF HIS/HER SHIFT.

**CONSTRUCTION NOTIFICATION**

THROUGHOUT THE DURATION OF THE PROJECT, THE CONTRACTOR SHALL NOTIFY THE PROJECT ENGINEER IN WRITING OF ALL TRAFFIC RESTRICTIONS AND UPCOMING MAINTENANCE OF TRAFFIC CHANGES. THE CONTRACTOR SHALL ENSURE THE WRITTEN NOTIFICATION IS SUBMITTED IN A TIMELY MANNER TO ALLOW THE PROJECT ENGINEER TO MEET THE REQUIRED TIME FRAMES SET FORTH IN THE TABLE BELOW TO INFORM THE OFFICE OF COMMUNICATIONS. THIS NOTIFICATION SHALL BE RECEIVED BY THE PROJECT ENGINEER PRIOR TO THE PHYSICAL SETUP OF ANY APPLICABLE SIGNS OR MESSAGE BOARDS.

INFORMATION SHOULD INCLUDE, BUT IS NOT LIMITED TO, ALL CONSTRUCTION ACTIVITIES THAT IMPACT OR INTERFERE WITH TRAFFIC AND SHALL LIST THE SPECIFIC LOCATION, TYPE OF WORK, ROAD STATUS, DATE AND TIME OF RESTRICTION, DURATION OF RESTRICTION, NUMBER OF LANES MAINTAINED, NUMBER OF LANES CLOSED, DETOUR ROUTES, IF APPLICABLE, AND ANY OTHER INFORMATION REQUESTED BY THE PROJECT ENGINEER.

NOTICE TO OFFICE OF COMMUNICATIONS TIME TABLE		
ITEM	DURATION OF CLOSURE	NOTICE DUE TO OFFICE OF COMMUNICATIONS
START OF CONSTRUCTION & RAMP & ROAD CLOSURES	>= 2 WEEKS	21 CALENDAR DAYS PRIOR TO CLOSURE
	> 12 HOURS & < 2 WEEKS	14 CALENDAR DAYS PRIOR TO CLOSURE
	< 12 HOURS	4 BUSINESS DAYS PRIOR TO CLOSURE
LANE CLOSURES & RESTRICTIONS	>= 2 WEEKS	14 CALENDAR DAYS PRIOR TO CLOSURE
	< 2 WEEKS	2 BUSINESS DAYS PRIOR TO CLOSURE
TRAFFIC PATTERN CHANGES	N/A	14 CALENDAR DAYS PRIOR TO CLOSURE

ANY UNFORESEEN CONDITIONS NOT SPECIFIED IN THE PLANS REQUIRING TRAFFIC RESTRICTIONS SHALL ALSO BE REPORTED TO THE PROJECT ENGINEER USING THE NOTICE TO OFFICE OF COMMUNICATIONS TIME TABLE.

**TRUCK MOUNTED ATTENUATOR**

WHEN THE CONTRACTOR IS SETTING/REMOVING A SHORT TERM WORK ZONE, A TRUCK MOUNTED ATTENUATOR (TMA) MUST TRAIL THE OPERATION, INCLUDING SETTING THE ADVANCE WARNING SIGNS OR TAKING THEM DOWN. THIS SAME TRUCK MUST HAVE A TYPE B FLASHING ARROW PANEL MOUNTED ON IT FACING THE REAR OF THE TRUCK. THE CONTRACTOR SHALL USE A TMA FOR ANY APPLICATION WHERE THE OMUTCD OR STANDARD CONSTRUCTION DRAWING USES THE PHRASE "OPTIONAL" OR "WHEN SPECIFIED IN THE PLAN".

THE TMA MUST BRING A VEHICLE WEIGHING 1800 TO 4500 LBS. AND TRAVELING AT 60 MPH TO A SAFE CONTROLLED STOP, PER NCHRP 350 CRITERIA. THE MANUFACTURER'S SPECIFICATION SHALL BE FOLLOWED CONCERNING THE SIZE OF THE TRUCK AND THE CONNECTIONS TO THE TMA.

**OVERNIGHT RAMP CLOSURE**

THE CONTRACTOR MAY CLOSE THE SOUTHBOUND I-75 EXIT RAMP TO EASTBOUND/WESTBOUND I-275 A MAXIMUM OF 6 TIMES FOR ANY TEMPORARY AND PROPOSED WORK. RESTRICT CLOSURES TO THE HOURS SHOWN IN THE LANE VALUE CONTRACT TABLE. PROVIDE NOTICE TO THE RAMP TRAFFIC AT LEAST 5 DAYS IN ADVANCE THROUGH THE USE OF A PORTABLE CHANGEABLE MESSAGE SIGN (PCMS). PROVIDE A LEO WITH PATROL CAR FOR EACH RAMP CLOSURE TO REMAIN PRESENT FOR THE DURATION OF THE CLOSURE.

WHEN CLOSING THIS RAMP USE A PCMS ROUTING TRAFFIC TO THE SHARON ROAD EXIT. PROVIDE A SECOND PCMS AT THAT LOCATION TO CONFIRM THE DETOUR AND TO PROVIDE THE INFORMATION NECESSARY TO RETURN MOTORISTS TO THEIR ORIGINAL DIRECTION OF TRAVEL.

**SHORT DURATION CLOSING OF THE HIGHWAY**

THE FOLLOWING NOTES SHALL APPLY FOR THE ERECTION/REMOVAL OF OVERHEAD SIGN TRUSSES.

1. FIVE CALENDAR DAYS PRIOR TO IMPLEMENTING THE SHORT DURATION CLOSING OF THE HIGHWAY THE CONTRACTOR SHALL PLACE A PORTABLE CHANGEABLE MESSAGE SIGN AT THE STRUCTURE IN THE DIRECTION THE ROAD IS TO BE CLOSED WITH THE MESSAGE:



2. CLOSURES WILL ONLY BE PERMITTED FOR REMOVAL AND ERECTION OF THE OVERHEAD SIGN TRUSSES AND WILL BE PERMITTED BETWEEN THE HOURS OF 12:00 MIDNIGHT AND 5:00 AM. THE MAXIMUM DURATION OF THE CLOSURE SHALL NOT EXCEED 15 MINUTES SUBJECT TO A DISINCENTIVE IN THE AMOUNT OF \$1200.00 FOR EACH 5 MINUTES OF ADDITIONAL CLOSURE TIME. TRAFFIC SHALL BE COMPLETELY CLEARED BEFORE THE NEXT CLOSING.

3. THE CONTRACTOR SHALL IMPLEMENT THE TRAFFIC CONTROL CONTAINED IN STANDARD CONSTRUCTION DRAWING MT-99.60.

4. THE CONTRACTOR SHALL FURNISH AND INSTALL TWO (2) WATCH FOR STOPPED TRAFFIC SIGNS (W3-H7-48) 1500 FEET UPSTREAM FROM THE ANTICIPATED BACKUP ON I-75. THE CONTRACTOR SHALL INSTALL ADDITIONAL WATCH FOR STOPPED TRAFFIC SIGNS EVERY 2000 FEET UPSTREAM FROM THE WATCH FOR STOPPED TRAFFIC SIGNS ON I-75 IF TRAFFIC BACKUPS REACH THE FIRST SET OF SIGNS. THE NEED FOR THESE SIGNS SHALL BE CONSTANTLY MONITORED BY THE CONTRACTOR. ALL WATCH FOR STOPPED TRAFFIC AND PREPARE TO STOP SIGNS SHALL BE EQUIPPED WITH TYPE B WARNING LIGHTS.

5. IN THE EVENT OF AN INCLEMENT WEATHER FORECAST (RAIN OR SNOW FORECAST AT 50% OR GREATER THE DAY THE EVENT WILL OCCUR IS DEFINED AS AN INCLEMENT FORECAST) THE CLOSURE SHALL NOT TAKE PLACE. THE ENGINEER WILL MAKE THE DETERMINATION BASED UPON THE WEATHER FORECAST PREDICTED BY THE NATIONAL WEATHER SERVICE.

**MAINTENANCE OF MAJOR GUIDE SIGNS**

THE DBT SHALL MAINTAIN THE SAME NUMBER OF GUIDE SIGNS AS CURRENTLY EXIST FOR EACH FREEWAY EXIT/ENTRANCE WHICH IS TO REMAIN OPEN DURING EACH PHASE OF CONSTRUCTION IN ORDER TO ALLOW MOTORISTS TO FIND THEIR DESTINATIONS SAFELY. ERECTION/DISMANTLING OF THE OVERHEAD SIGN SUPPORTS WHICH WILL BE AFFECTED BY THE PROPOSED CONSTRUCTION SHALL BE COMPLETED PRIOR TO THAT PHASE OF CONSTRUCTION. NO MORE THAN ONE SIGN FOR ANY EXIT OR ENTRANCE RAMP MAY BE REMOVED AT ANY TIME. IN INSTANCES WHERE THE COPY ON THE REPLACEMENT SIGN IS SUBSTANTIALLY DIFFERENT FROM THE COPY ON THE EXISTING SIGNS FOR A PARTICULAR EXIT OR ENTRANCE RAMP, ALL OF THE SIGNS IN THE SEQUENCE FOR THAT RAMP SHALL BE CHANGED WITHIN ONE CALENDAR DAY. IN SOME CASES IT SHALL BE NECESSARY TO SUPPLY AND INSTALL TEMPORARY SUPPORTS.

**ADDITIONAL DESCRIPTION OF REQUIRED WORK AND SPECIAL PROVISIONS**

THE DBT SHALL PROVIDE TEMPORARY PAVEMENT WEDGES AT ALL TIMES WHERE TRAFFIC IS REQUIRED TO TRAVEL FROM OR ONTO A PAVEMENT SURFACE OF A DIFFERENT ELEVATION. THE MINIMUM SLOPE OF THE TEMPORARY PAVEMENT WEDGE SHALL BE 3:1 ALONG LONGITUDINAL JOINTS AND 120:1 AT TRANSVERSE JOINTS. THESE WEDGES SHALL BE REMOVED PRIOR TO PLACING THE SPECIFIED PAVEMENT COURSE.

THE DBT SHALL RESURFACE ALL TRANSITION AREAS AT THE TIME THE SURFACE COURSE IS BEING APPLIED. IN PREPARATION FOR RESURFACING, THE EXISTING PAVEMENT SHALL BE REMOVED TO A DEPTH NECESSARY TO REACH THE LEVEL OF THE INTERMEDIATE COURSE OF THE PROPOSED PAVEMENT. THE RESURFACING OF ALL TRANSITION AREAS SHALL ALSO INCLUDE THE TANGENT AREA EXTENDING BEYOND THE PROPOSED WORK LIMITS. THE DBT SHALL ALSO RESURFACE ANY AREA WHERE STRIPING HAS BEEN REMOVED OR ALTERED TO PROVIDE A CLEAN SURFACE UPON COMPLETION OF THE PROJECT. SEE SECTION 14.3 FOR THE PROPOSED PAVEMENT MAKEUP.

THE DBT SHALL VERIFY THE EXISTING PAVEMENT COMPOSITION OF ANY SHOULDER OR GORE AREA USED TO MAINTAIN TRAFFIC. ANY EXISTING PAVEMENT COMPOSITION THAT DOES NOT MEET OR EXCEED THE REQUIREMENTS OF ITEM 615 PAVEMENT FOR MAINTAINING TRAFFIC CLASS A, SHALL BE REPLACED WITH ITEM 615 PAVEMENT FOR MAINTAINING TRAFFIC CLASS A.

**PAYMENT**

PAYMENT FOR ALL LABOR, MATERIALS, EQUIPMENT, AND INCIDENTALS TO COMPLETE ALL MAINTENANCE OF TRAFFIC ITEMS DESCRIBED IN SECTION 13 SHALL BE BID AS FOLLOWS:

ITEM 614E99000 SPECIAL - MAINTAINING TRAFFIC LUMP SUM

**PROJECT BUILDABLE UNITS**


BUILDABLE UNITS (BUS) ARE PORTIONS OF THE PROJECT WHICH CAN BE DESIGNED, REVIEWED AND BUILT WITH ONLY LIMITED CONTROLS AND ASSUMPTIONS COMING FROM THE DESIGN OF OTHER PORTIONS OF THE PROJECT.

THIS PROJECT HAS BEEN BROKEN INTO FOUR (4) BUS AS FOLLOWS:

- BU01 - OVERHEAD SIGNS
- BU02 - MAINTENANCE OF TRAFFIC (MOT)
- BU03 - STORM WATER POLLUTION PREVENTION PLAN (SWPPP)
- BU04 - REMAINING WORK

BUILDABLE UNIT 2 - AS-BUILT PLANS - NOVEMBER 28, 2017


CALCULATED	EJIT	MAINTENANCE OF TRAFFIC GENERAL NOTES
	CHECKED	
HAM-75-16.67		
3		
18		

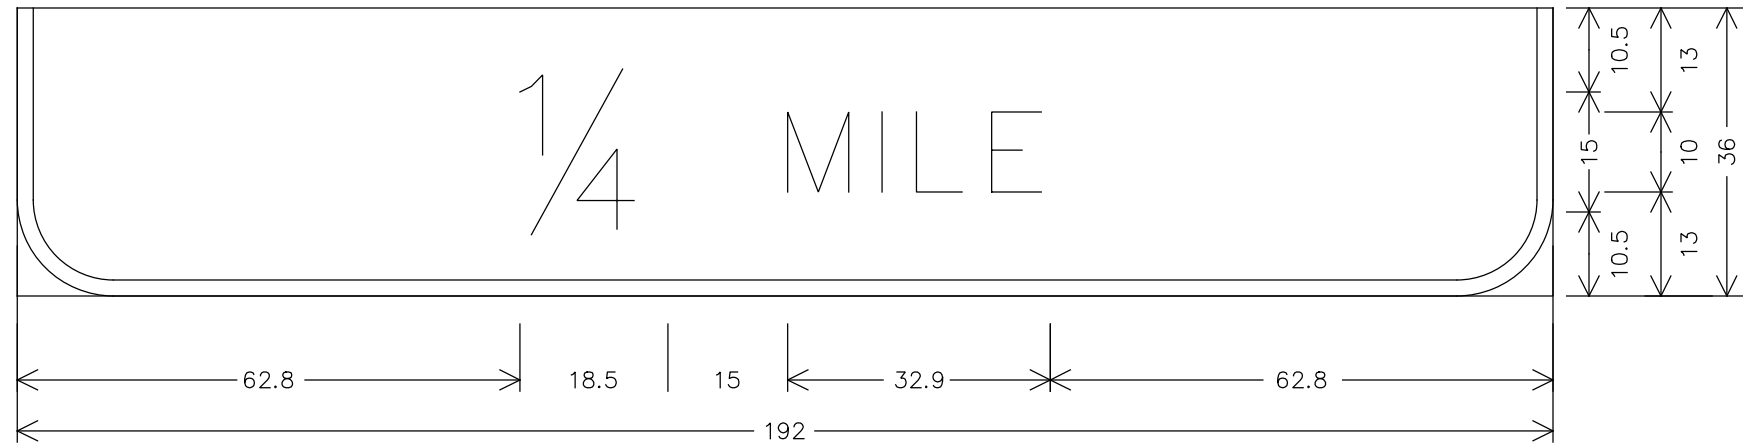

12.0" Radius, 2.0" Border, Black on Orange;  
 [1/4] E; [MILE] E;  
 Table of letter and object lefts.

1/4	M	I	L	E
62.8	96.3	108.1	112.4	121.8


OL01  
 SEE SHEET 17

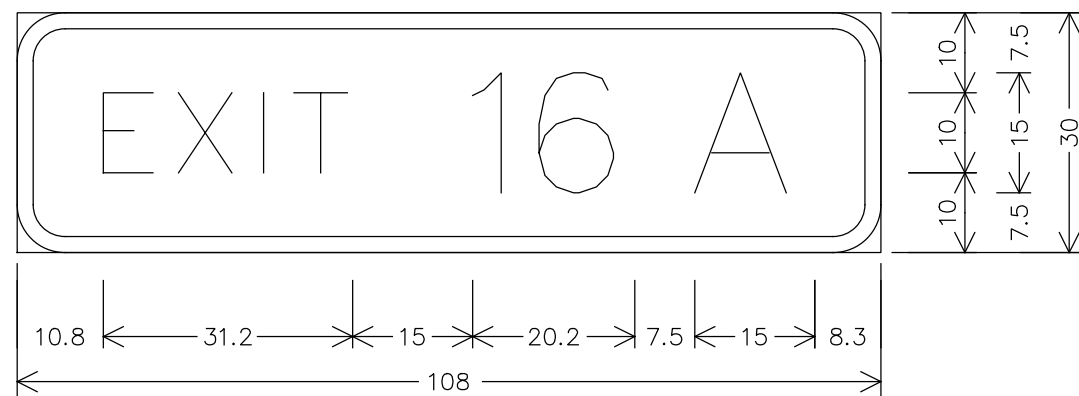

6.0" Radius, 2.0" Border, Black on Orange;  
 [EXIT] E; [16 A] E;  
 Table of letter and object lefts.

E	X	I	T
10.8	20.2	30.8	34.6
1	6	A	
57.0	65.3	84.7	


OL03  
 SEE SHEET 17

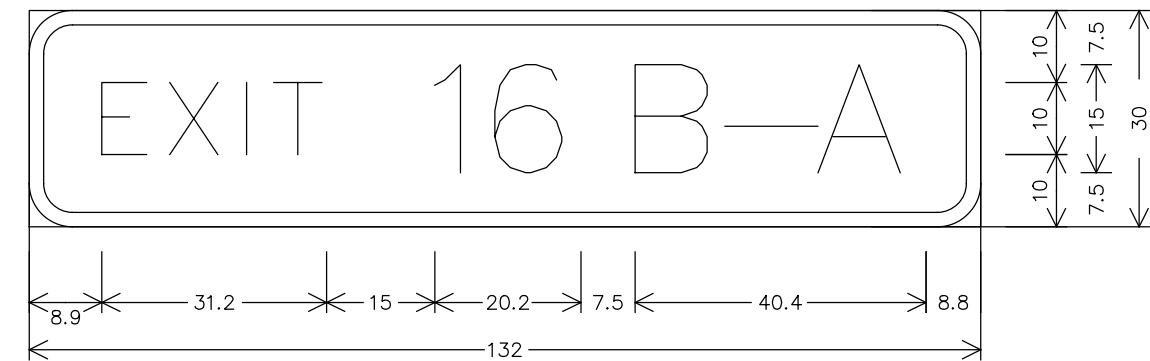

6.0" Radius, 2.0" Border, Black on Orange;  
 [EXIT] E; [16 B-A] E;  
 Table of letter and object lefts.

E	X	I	T	1	6
10.1	19.5	30.1	33.9	56.3	64.6
B	-	A			
84.0	99.9	109.4			

OL02  
 SEE SHEET 18

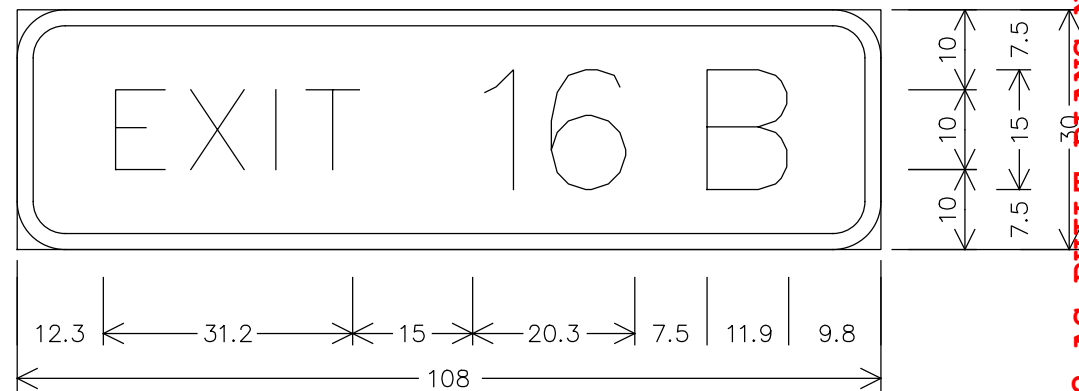


6.0" Radius, 2.0" Border, Black on Orange;  
 [EXIT] E; [16 B] E;  
 Table of letter and object lefts.

E	X	I	T
12.3	21.7	32.4	36.1
1	6	B	
58.5	66.8	86.3	

OL04  
 SEE SHEET 17

BUILDDABLE UNIT 2-AS-BUILT PLANS-NOVEMBER 28, 2017


G:\Akron\DCS\Projects\TRN\60547096\_HAM751667\900-CAD-GIS\104408\_HAM-75-1667\Design\MOT\Sheets\104408\_MM003.dgn Design 11/28/2017 10:16:19 AM matt.philips

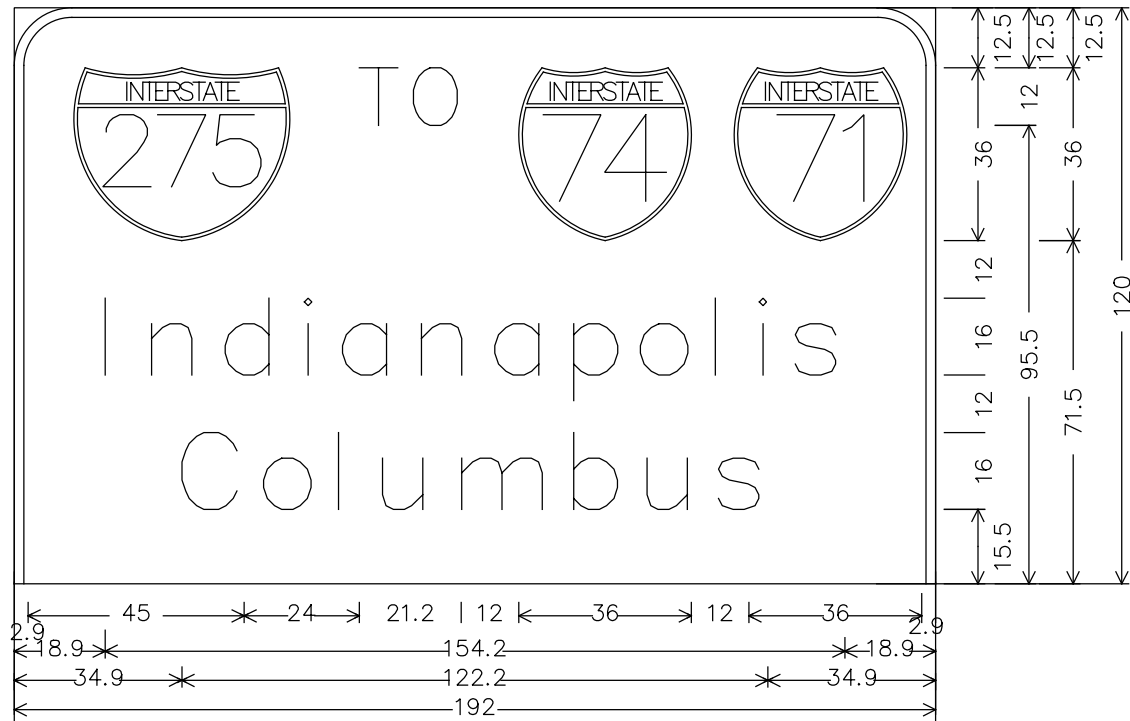

12.0" Radius, 2.0" Border, Black on Orange;  
 Interstate 275 M1-1; [TO] E; Interstate 74 M1-1;  
 Interstate 71 M1-1; [Indianapolis] E Mod;  
 [Columbus] E Mod;  
 Table of letter and object lefts.

275	T	O	74	71							
2.9	71.9	83.2	105.1	153.1							
I	n	d	i	a	n	a	p	o	l	i	s
18.9	28.6	43.9	60.5	68.4	84.8	100.2	116.6	130.5	146.1	155.2	162.8
C	o	l	u	m	b	u	s				
34.9	51.9	67.5	76.7	93.2	116.6	131.9	146.8				


OL05  
SEE SHEET 12

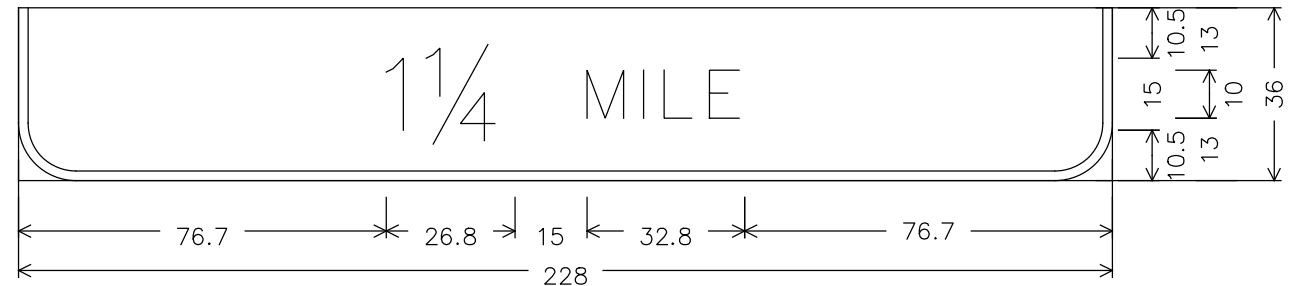

12.0" Radius, 2.0" Border, Black on Orange;  
 [1 1/4] E; [MILE] E;  
 Table of letter and object lefts.

1	1/4	M	I	L	E
76.7	85.0	118.5	130.3	134.6	144.0

OL06  
SEE SHEET 18

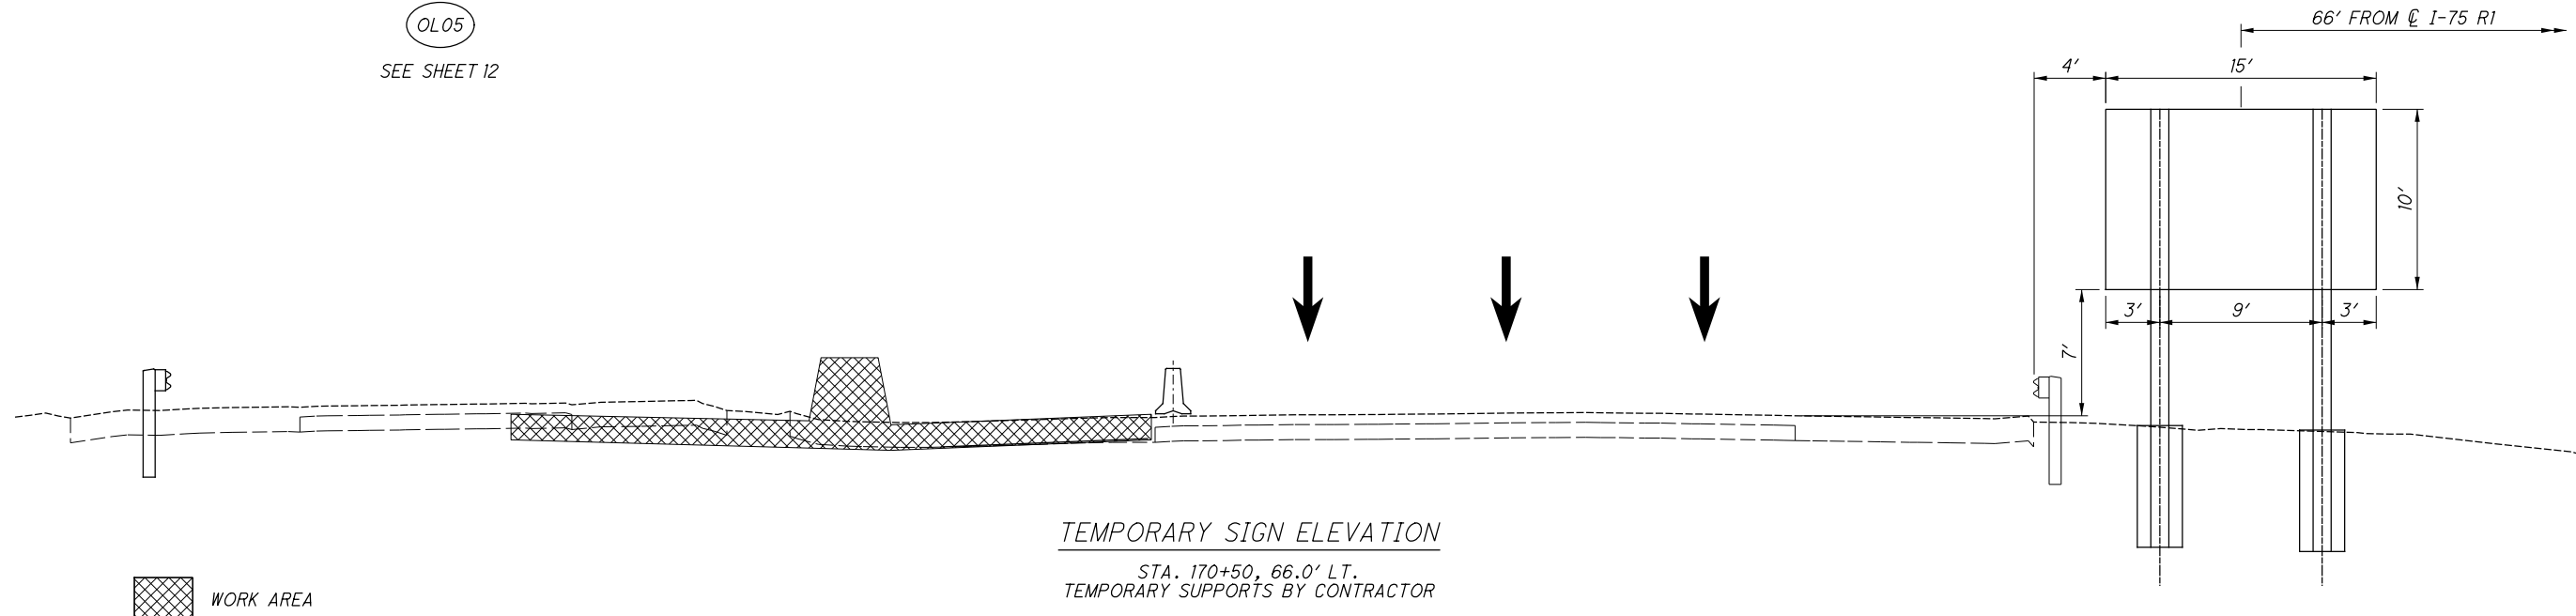

TEMPORARY SIGN ELEVATION  
 STA. 170+50, 66.0' LT.  
 TEMPORARY SUPPORTS BY CONTRACTOR

WORK AREA




BUILDABLE UNIT 2-AS-BUILT PLANS-NOVEMBER 28, 2017


MAINTENANCE OF TRAFFIC  
 CUSTOM SIGN DETAILS / SIGN ELEVATION

HAM-75-16.67


CALCULATED  
 EJT  
 CHECKED  
 RAM

G:\Akron\Projects\TRN\60547096\_HAM751667\900-CAD-GIS\104408\_HAM-75-1667\Design\MOT\Sheets\104408\_MY001.dgn\_Design 11/28/2017 10:16:25 AM matt.philips

-  WORK AREA
-  EDGE LINE
-  LANE LINE

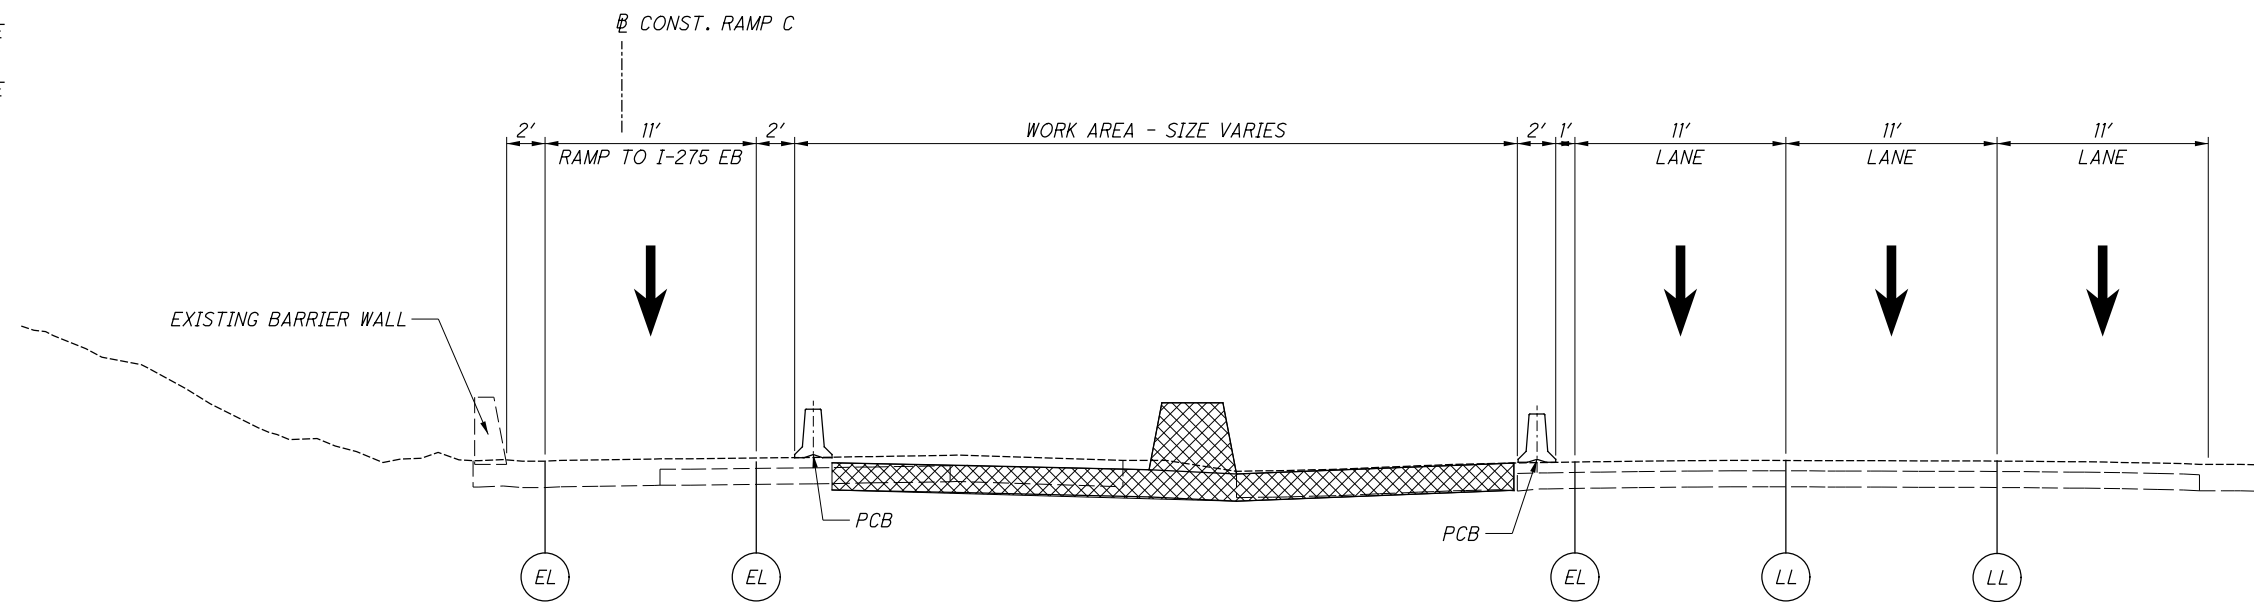

**TYPICAL SECTION - PHASE 1**  
 APPROXIMATE STATION LIMITS:  
 STA. 70+00 TO STA. 74+92

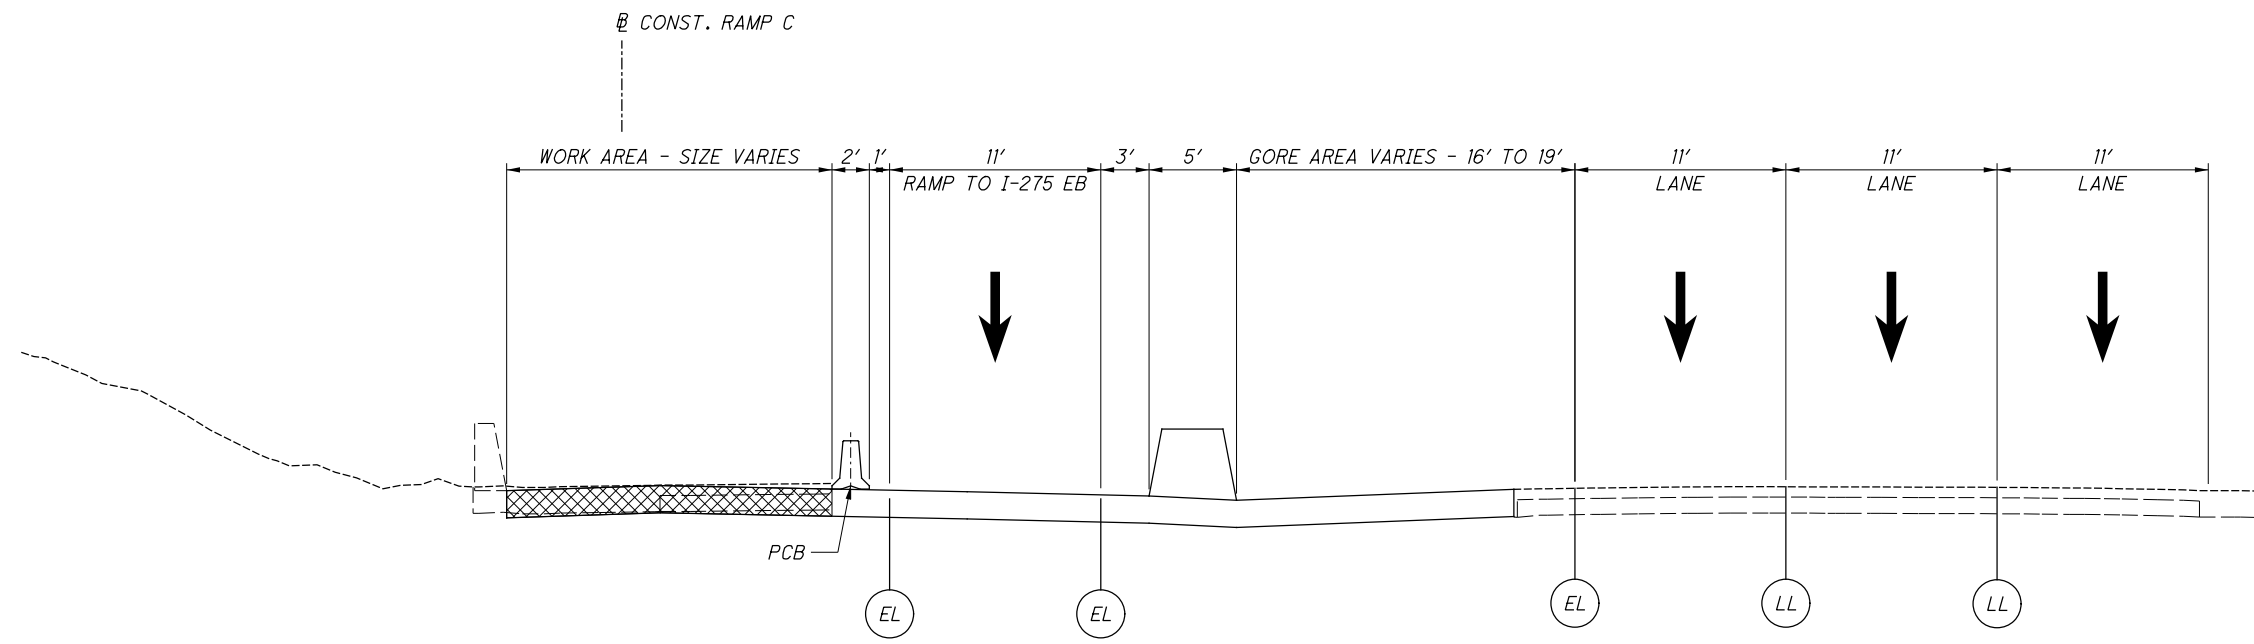

**TYPICAL SECTION - PHASE 2**  
 APPROXIMATE STATION LIMITS:  
 STA. 70+00 TO STA. 74+92

NOTE: PAVEMENT MARKINGS UNCHANGED ON SB I-75 MAINLINE FROM PHASE 1




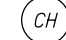
**BUILDABLE UNIT 2-AS-BUILT PLANS-NOVEMBER 28, 2017**


**MAINTENANCE OF TRAFFIC  
 TYPICAL SECTIONS**

**HAM-75-16.67**

CALCULATED
EJT
CHECKED
RAM


G:\Akron\DCS\Projects\TRN\60547096\_HAM751667\900-CAD-GIS\104408\_HAM-75-1667\Design\MOT\Sheets\104408\_MY002.dgn Design 11/28/2017 10:16:27 AM matt.philips

-  WORK AREA
-  EDGE LINE
-  LANE LINE
-  CHANNELIZING LINE

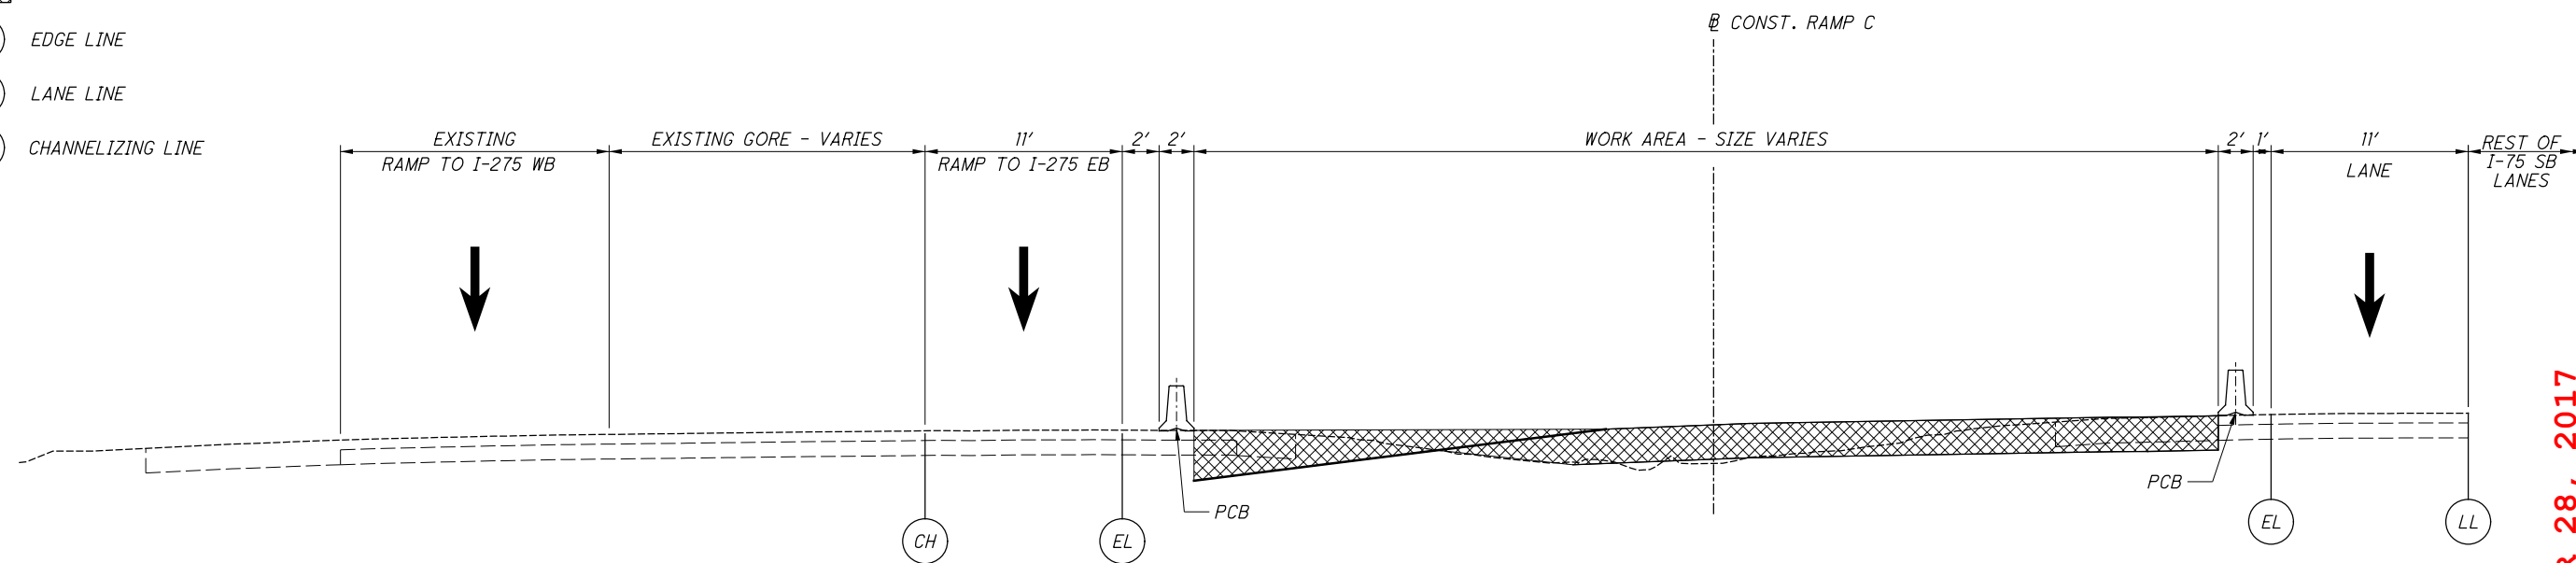

TYPICAL SECTION - PHASE 1

APPROXIMATE STATION LIMITS:  
STA. 74+92 TO STA. 82+00

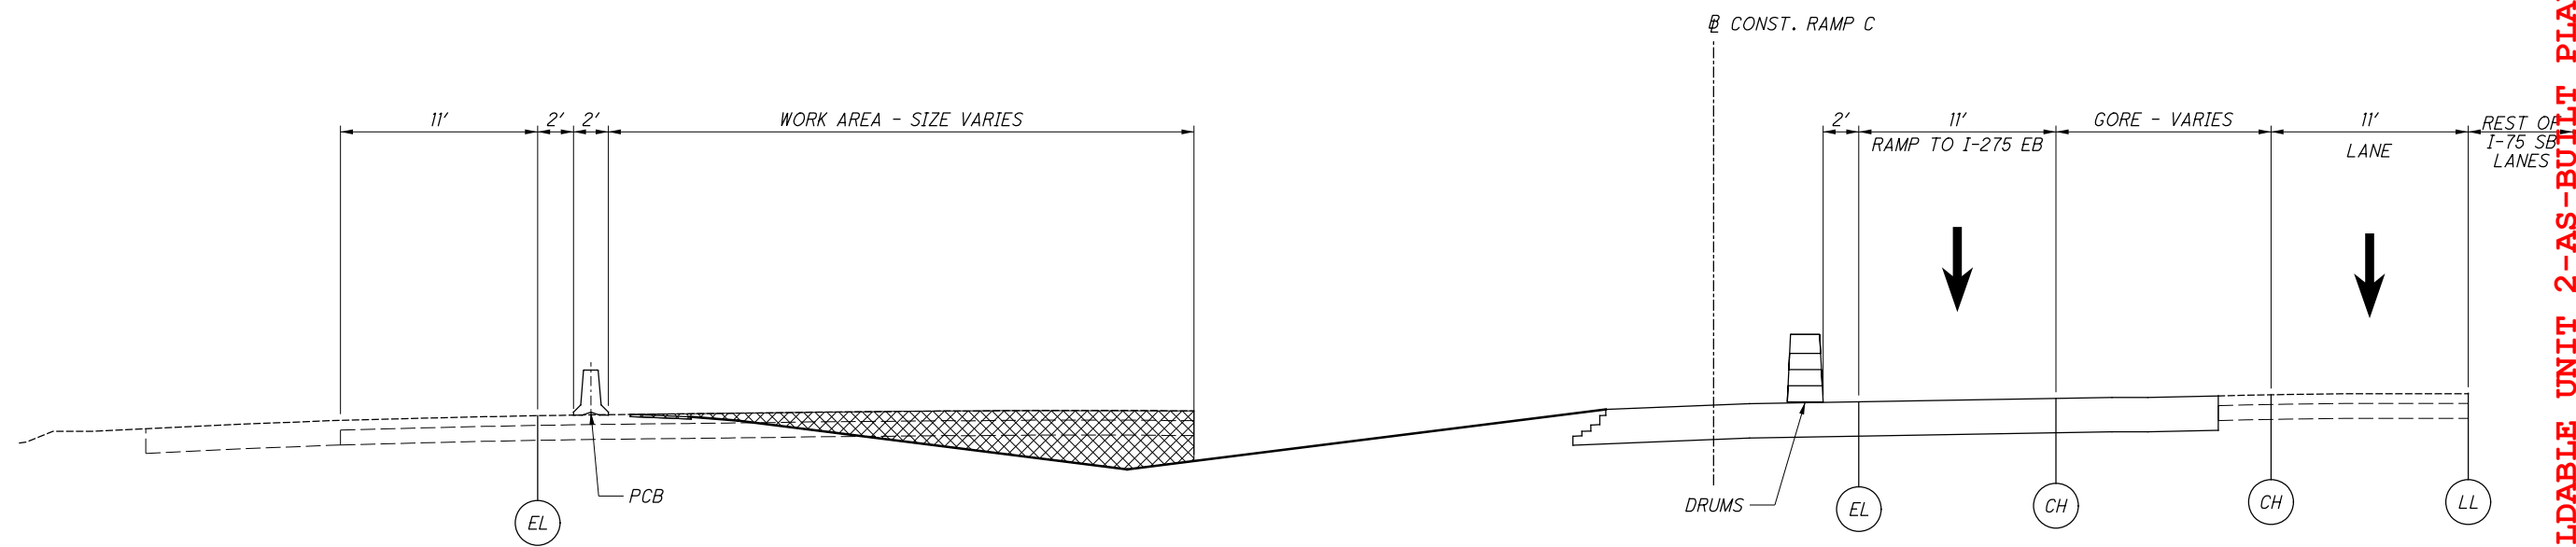

TYPICAL SECTION - PHASE 2

APPROXIMATE STATION LIMITS:  
STA. 74+92 TO STA. 82+00

NOTE: LANE LINES UNCHANGED ON SB I-75 MAINLINE FROM PHASE 1

BUILDABLE UNIT 2-AS-BUILT PLANS-NOVEMBER 28, 2017



MAINTENANCE OF TRAFFIC  
TYPICAL SECTIONS

CALCULATED
EJT
CHECKED
RAM

HAM-75-16.67



G:\Akron\DCS\Projects\TRN\60547096\_HAM751667\900-CAD-GIS\104408\_HAM-75-1667\Design\WOT\Sheets\104408\_MD001.dgn Sheet 11/28/2017 10:17:17 AM matt.philips

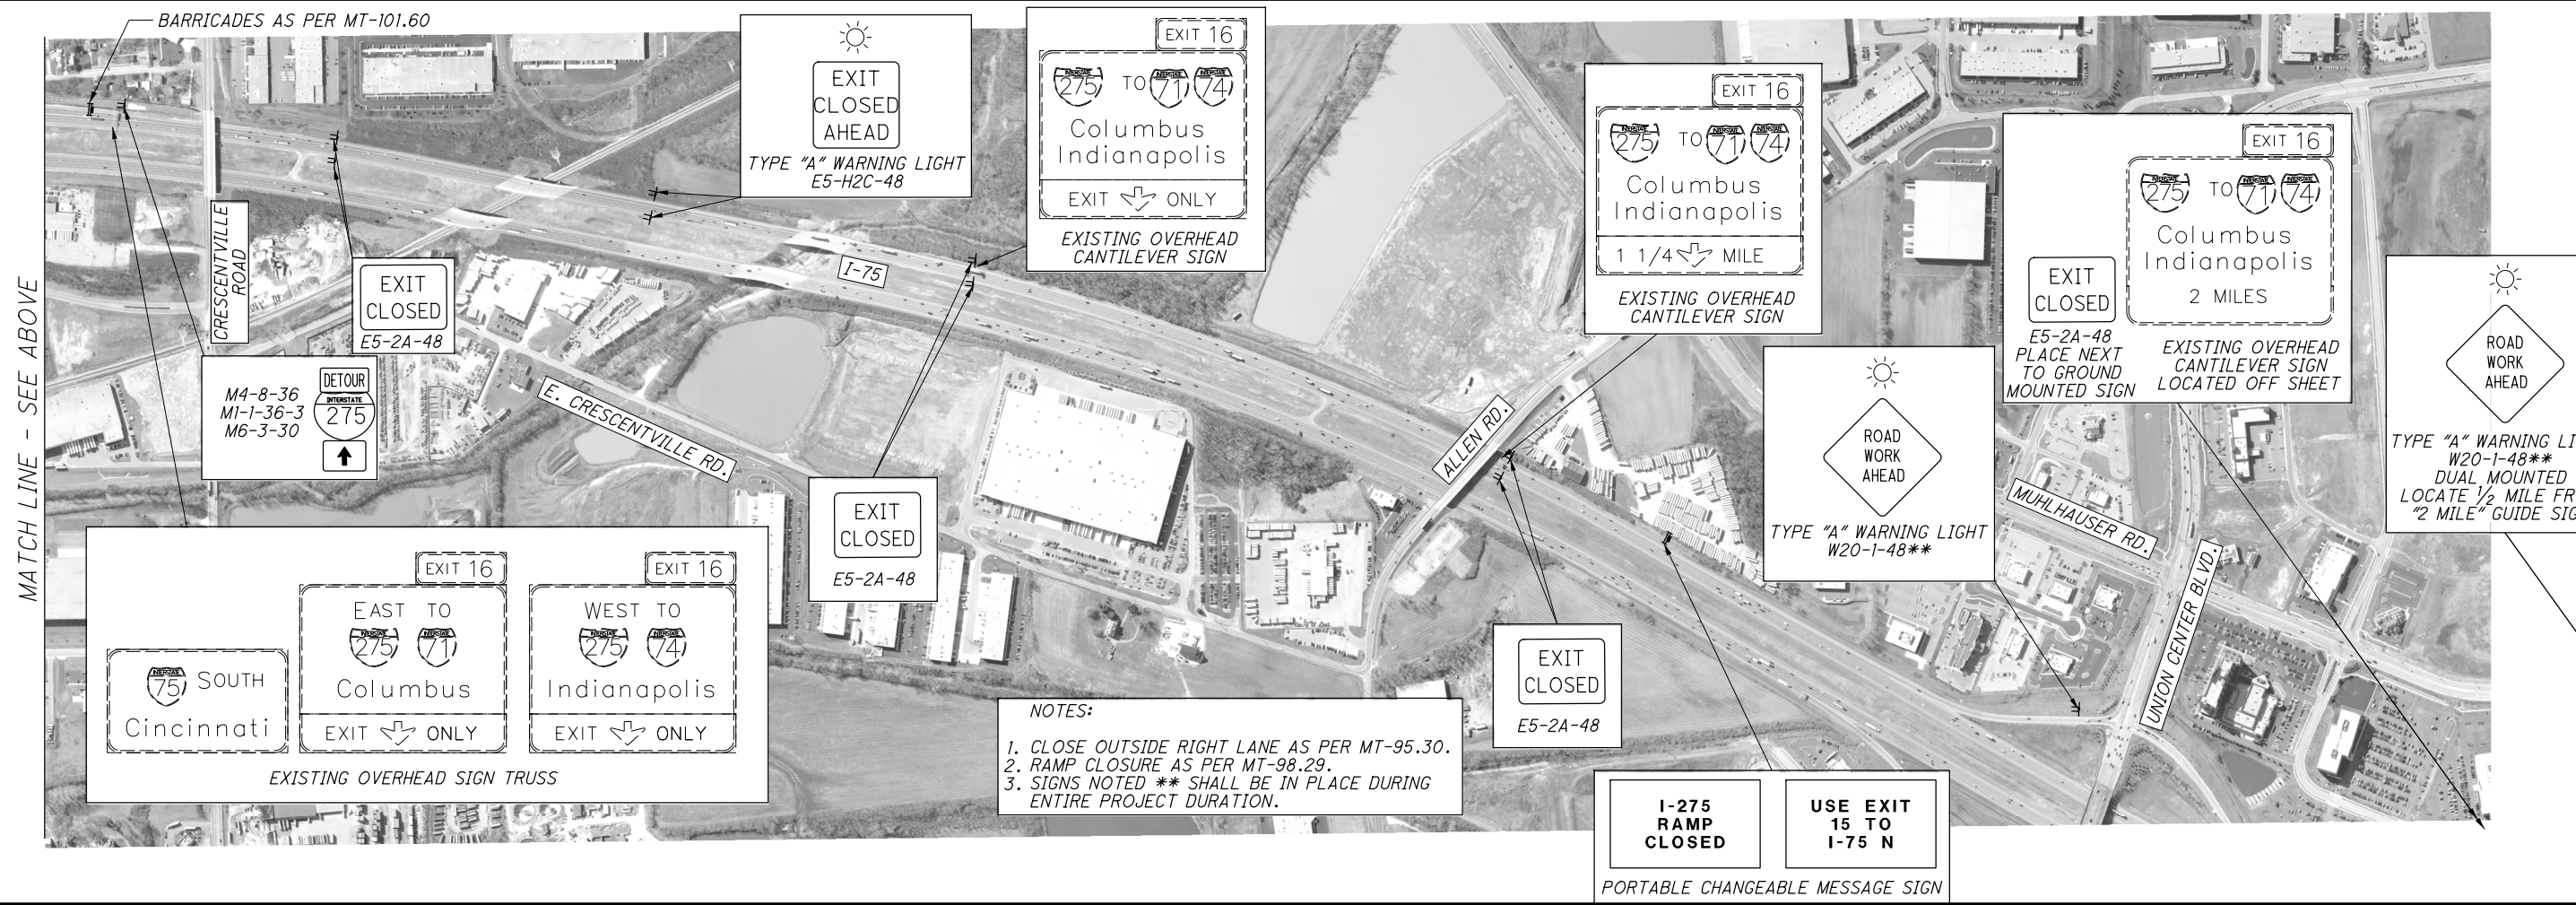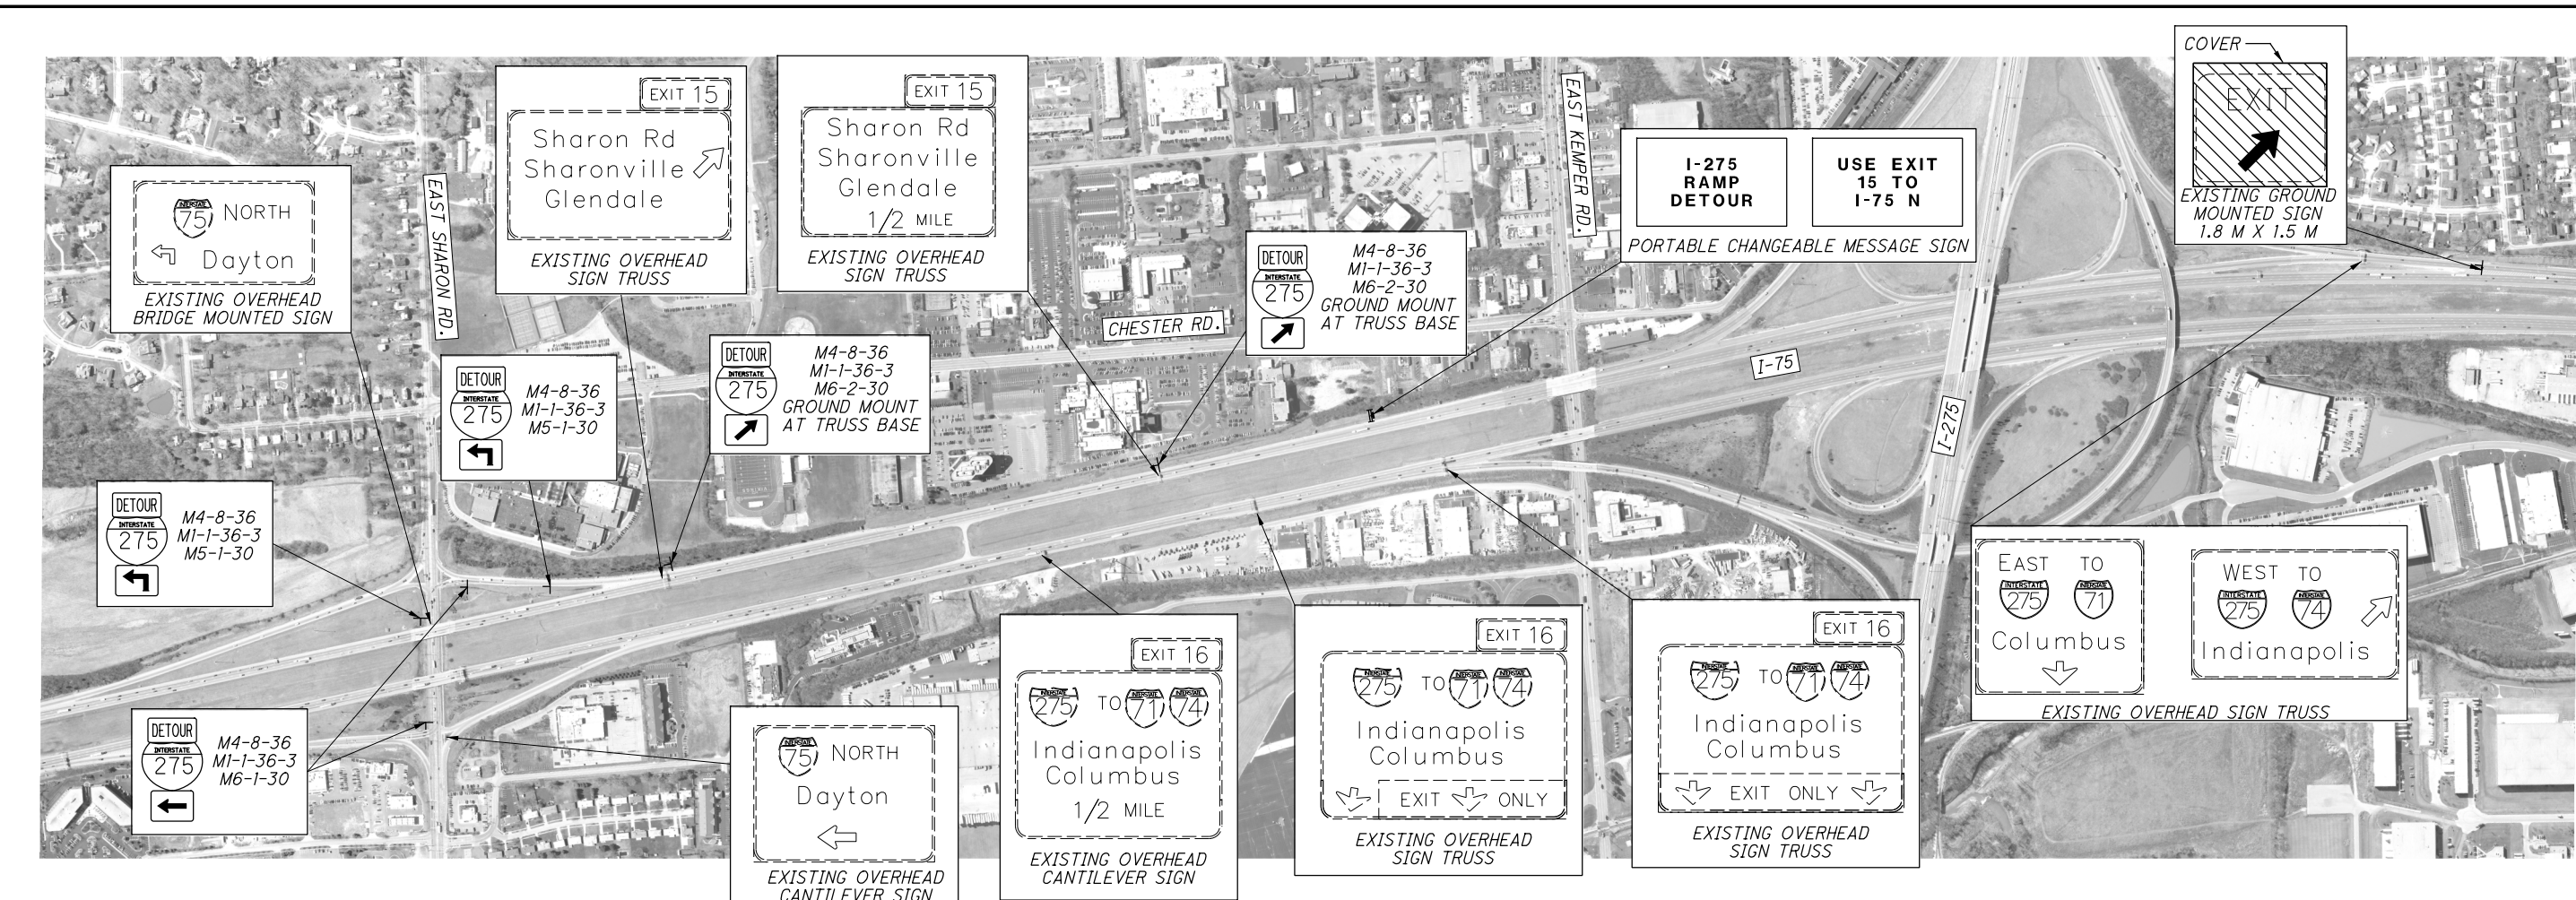

**NOTES:**

1. CLOSE OUTSIDE RIGHT LANE AS PER MT-95.30.
2. RAMP CLOSURE AS PER MT-98.29.
3. SIGNS NOTED \*\* SHALL BE IN PLACE DURING ENTIRE PROJECT DURATION.


BUILDABLE UNIT 2-AS-BUILT PLANS-NOVEMBER 2017 - SEE BELOW

MAINTENANCE OF TRAFFIC  
I-75 SB TO I-275 RAMP DETOUR

CALCULATED  
EJIT  
CHECKED  
RAM


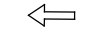
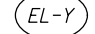
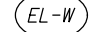
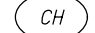

HAM-75-16.67



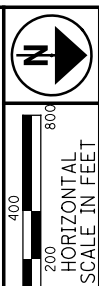



8  
18







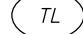




G:\Akron\DCS\Projects\TRN\60547096\_HAM751667\900-CAD-GIS\104408\_HAM-75-1667\Design\MOT\Sheets\104408\_MP001.dgn Design 11/28/2017 10:23:29 AM matt.philips


-  WORK AREA
-  TRAFFIC DIRECTION
-  EL-Y EDGE LINE - YELLOW, 6"
-  EL-W EDGE LINE - WHITE, 6"
-  CH CHANNELIZING LINE, 12"
-  PCB PORTABLE CONCRETE BARRIER, 32"

-  DRUMS
-  DL DOTTED LINE, 8"
-  TL TRANSVERSE LINE, 24"
-  LL LANE LINE
-  AU ATTENUATOR, UNIDIRECTIONAL
-  OLXX TEMPORARY OVERLAY

**LEGEND**

-  EXISTING SIGN
-  EXISTING SIGN TO BE REMOVED
-  PROPOSED SIGN

-  SIGN, SINGLE POST
-  SIGN, DOUBLE POST
-  CANTILEVER SIGN SUPPORT
-  TRUSS TYPE SIGN SUPPORT

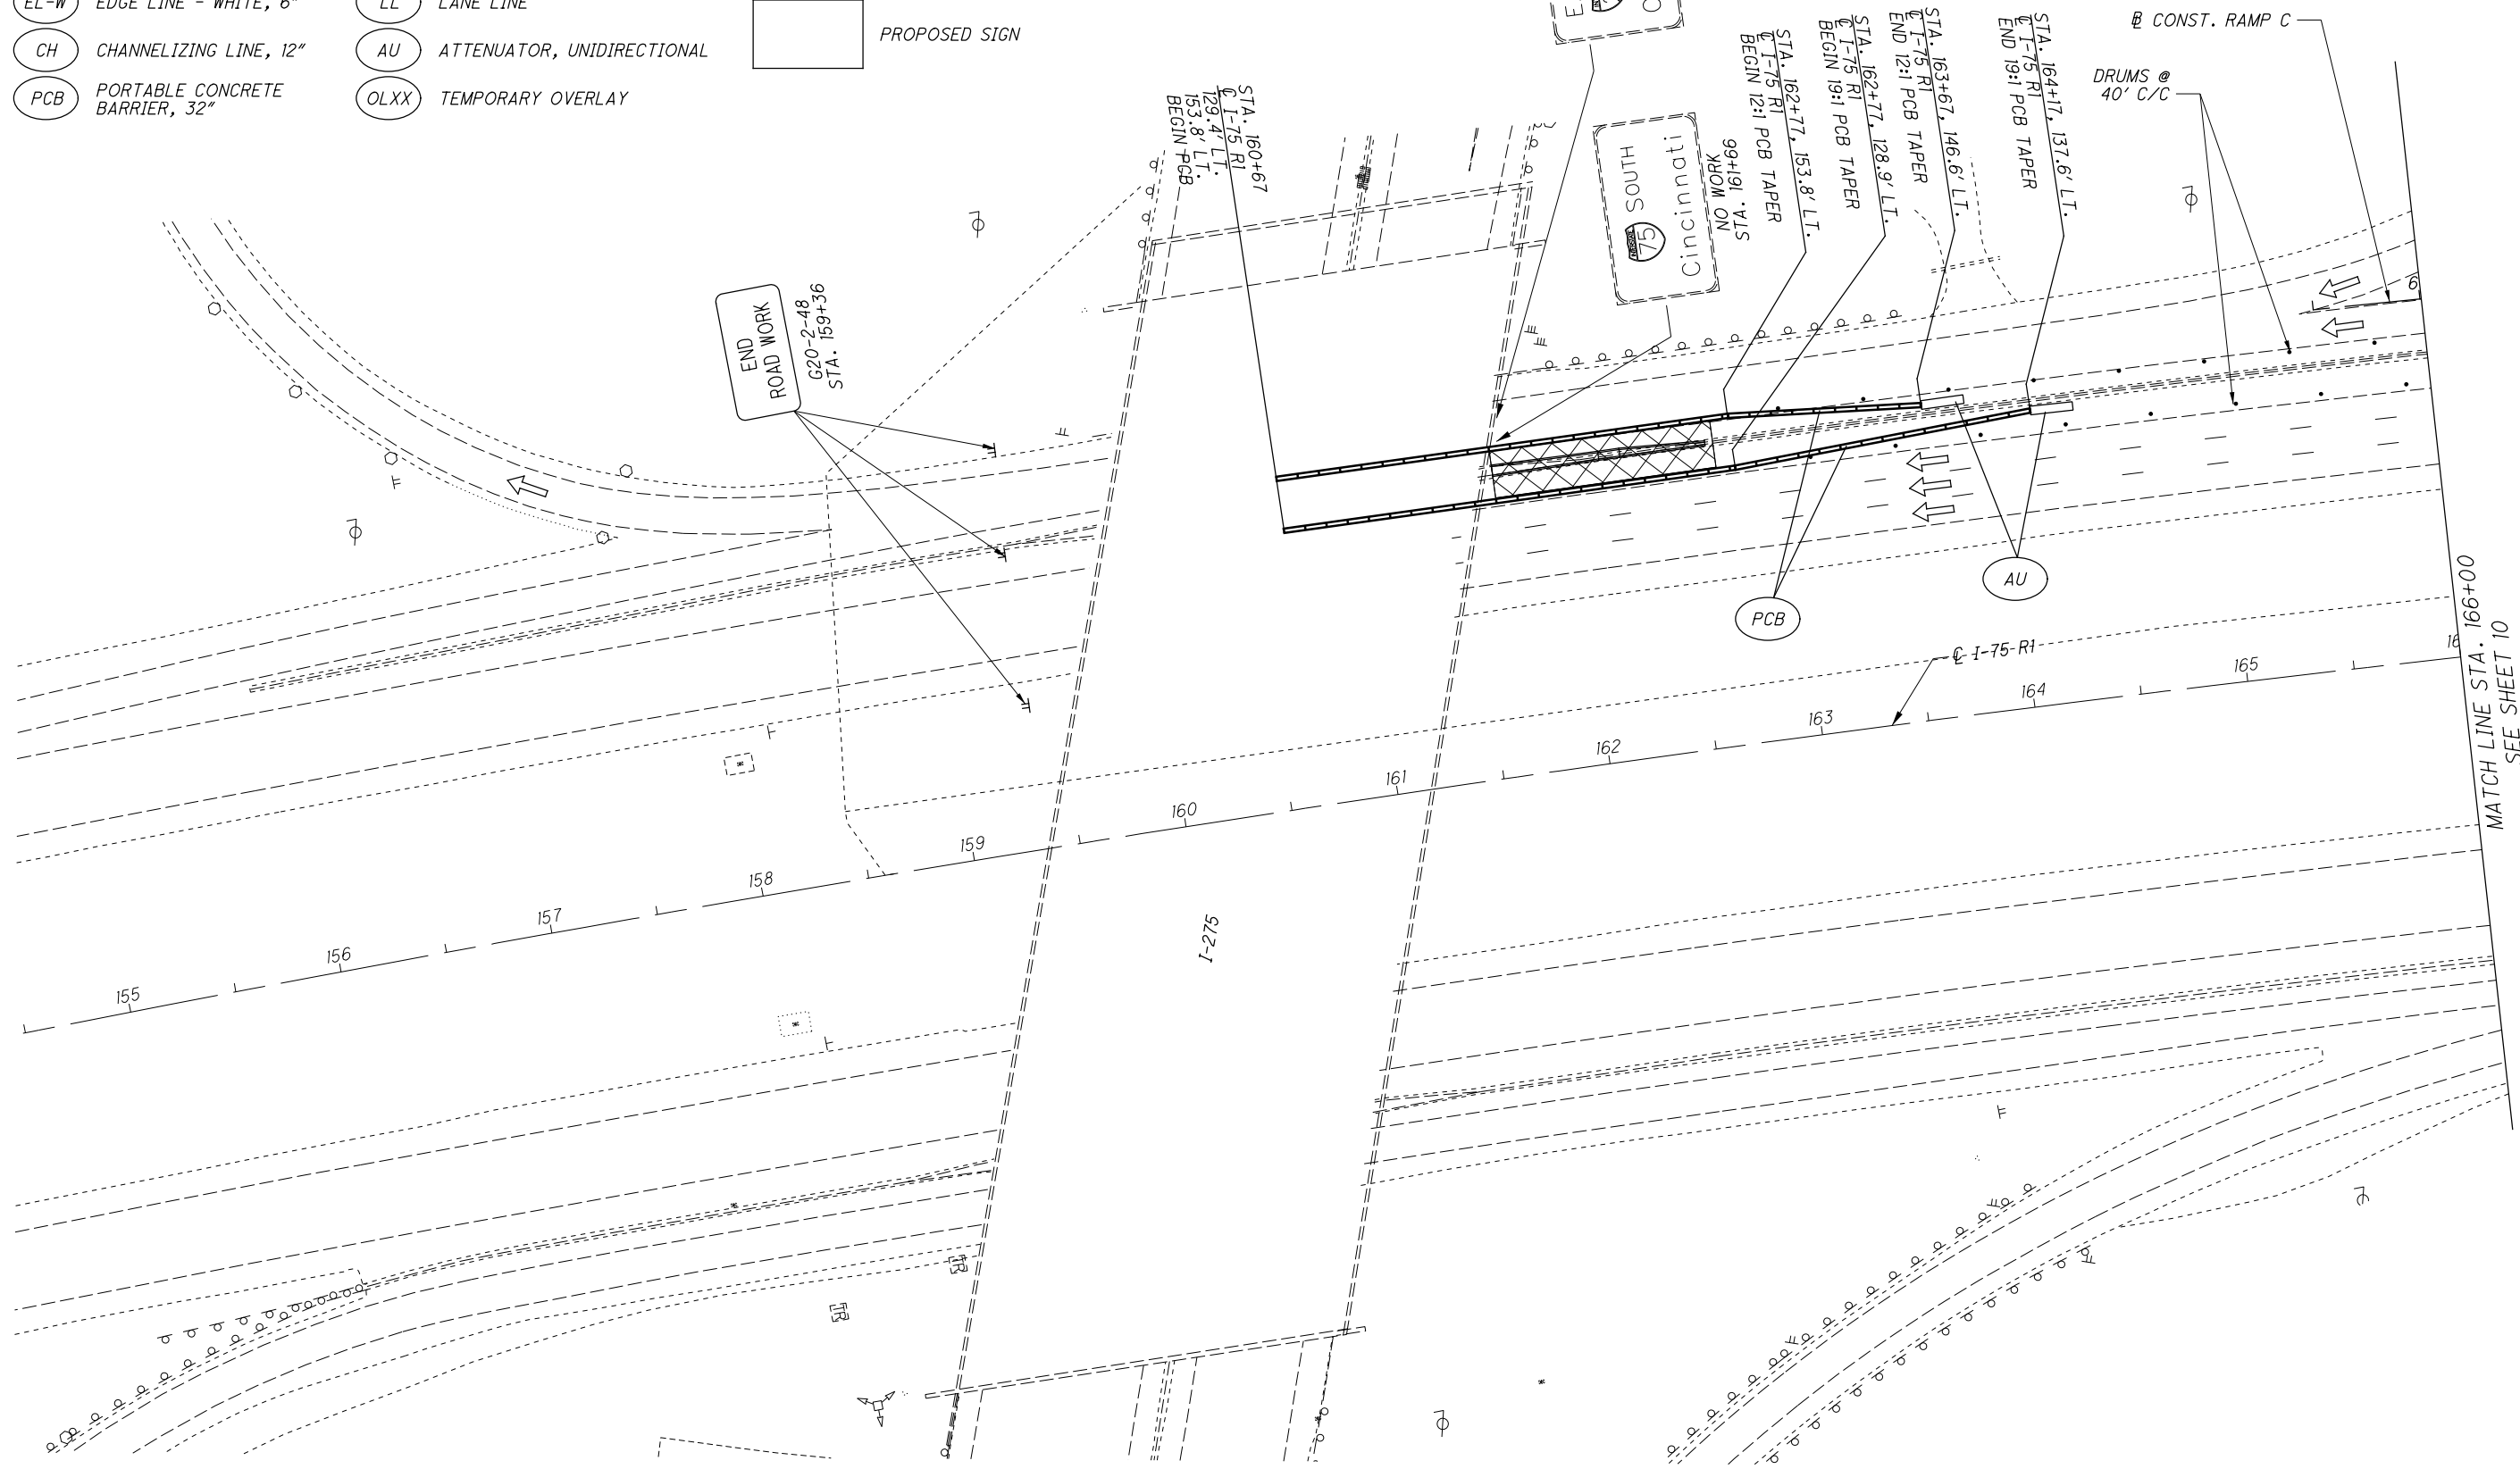

CALCULATED  
EJIT  
CHECKED  
RAM

0 20 40 80  
HORIZONTAL  
SCALE IN FEET




**BUILDABLE UNIT 2-AS-BUILT PLANS-NOVEMBER 28, 2017**

**MAINTENANCE OF TRAFFIC  
PLAN - PHASE 1**

**HAM-75-16.67**

NOTE: LEGEND LOCATED ON SHEET 9

G:\Akron\DCS\Projects\TRN\60547096\_HAM751667\900-CAD-GIS\104408\_HAM-75-1667\Design\MOT\Sheets\104408\_MP002.dgn Design 11/28/2017 10:23:33 AM matt.phillips

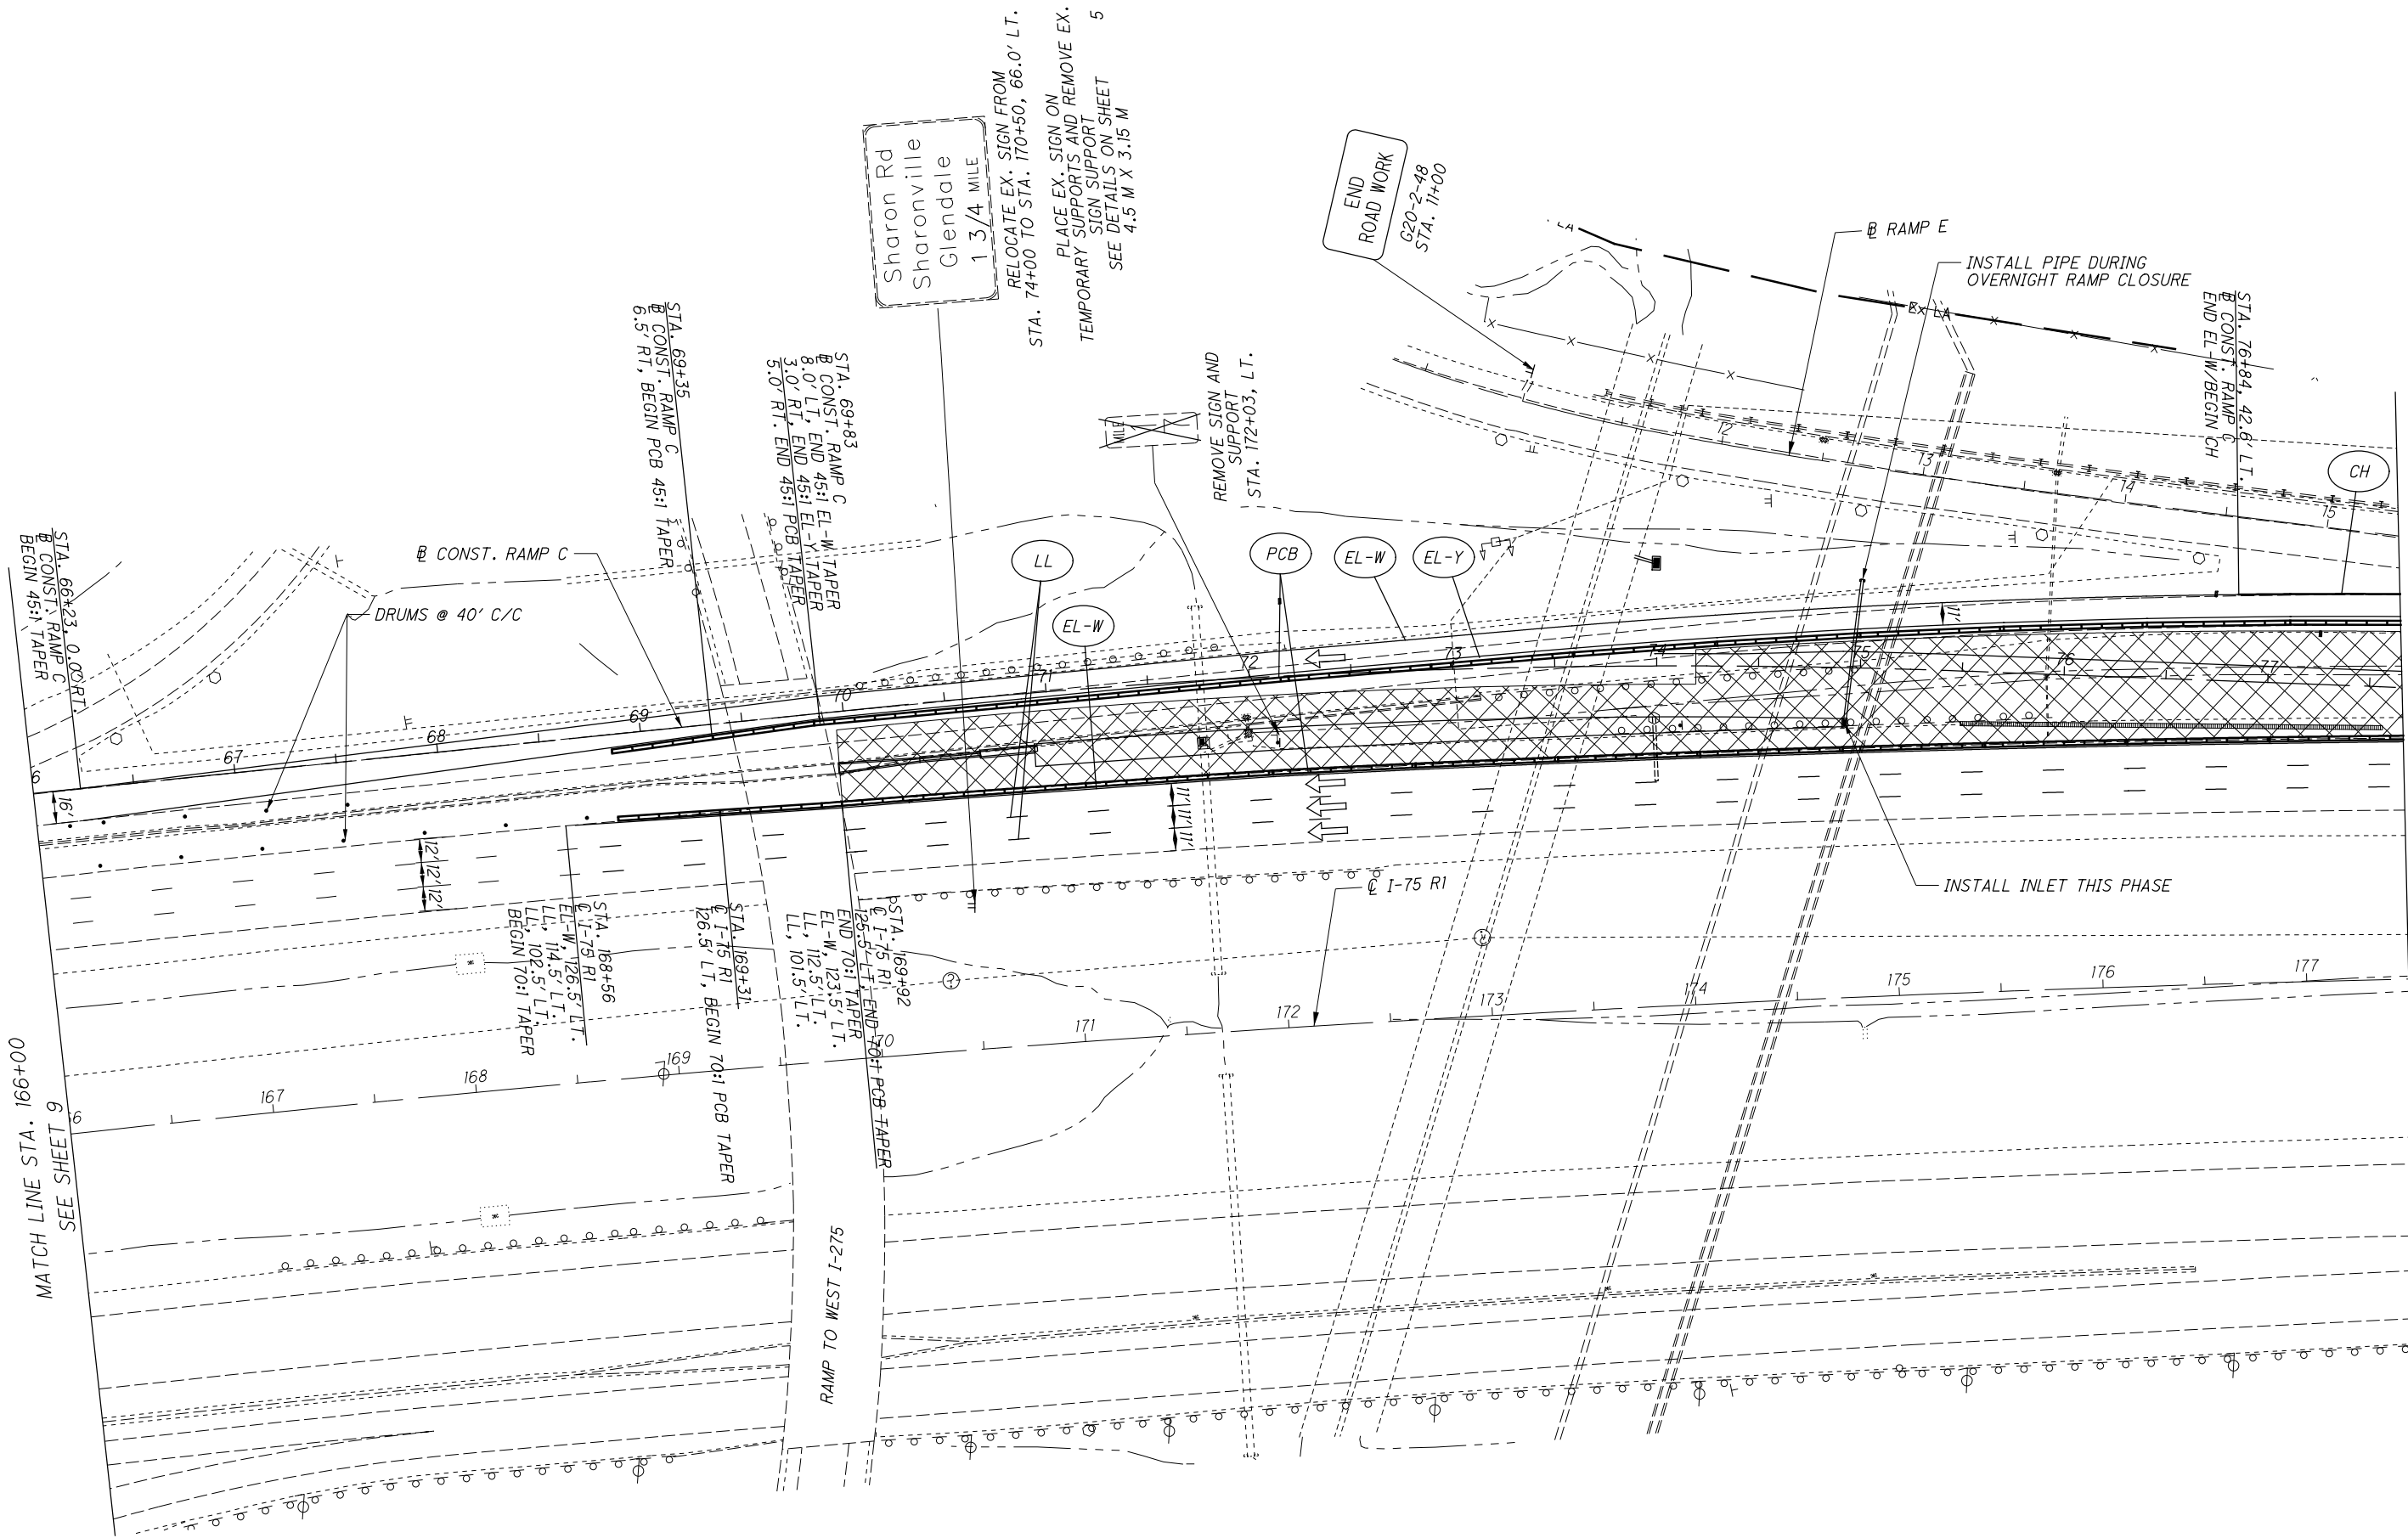

CALCULATED  
EJIT  
CHECKED  
RAM

0 20 40 80  
HORIZONTAL  
SCALE IN FEET

N

**BUILDABLE UNIT 2-AS-BUILT PLANS-NOVEMBER 28, 2017**

**MAINTENANCE OF TRAFFIC**

**PLAN - PHASE 1**


HAM-75-16.67

10  
18

NOTE: LEGEND LOCATED ON SHEET 9

C:\Akron\DCS\Projects\TRN\60547096\_HAM751667\900-CAD-GIS\104408\_HAM-75-1667\Design\MOT\Sheets\104408\_MP003.dgn Design 11/28/2017 10:23:36 AM matt.philips

MATCH LINE STA. 177+50  
SEE SHEET 10

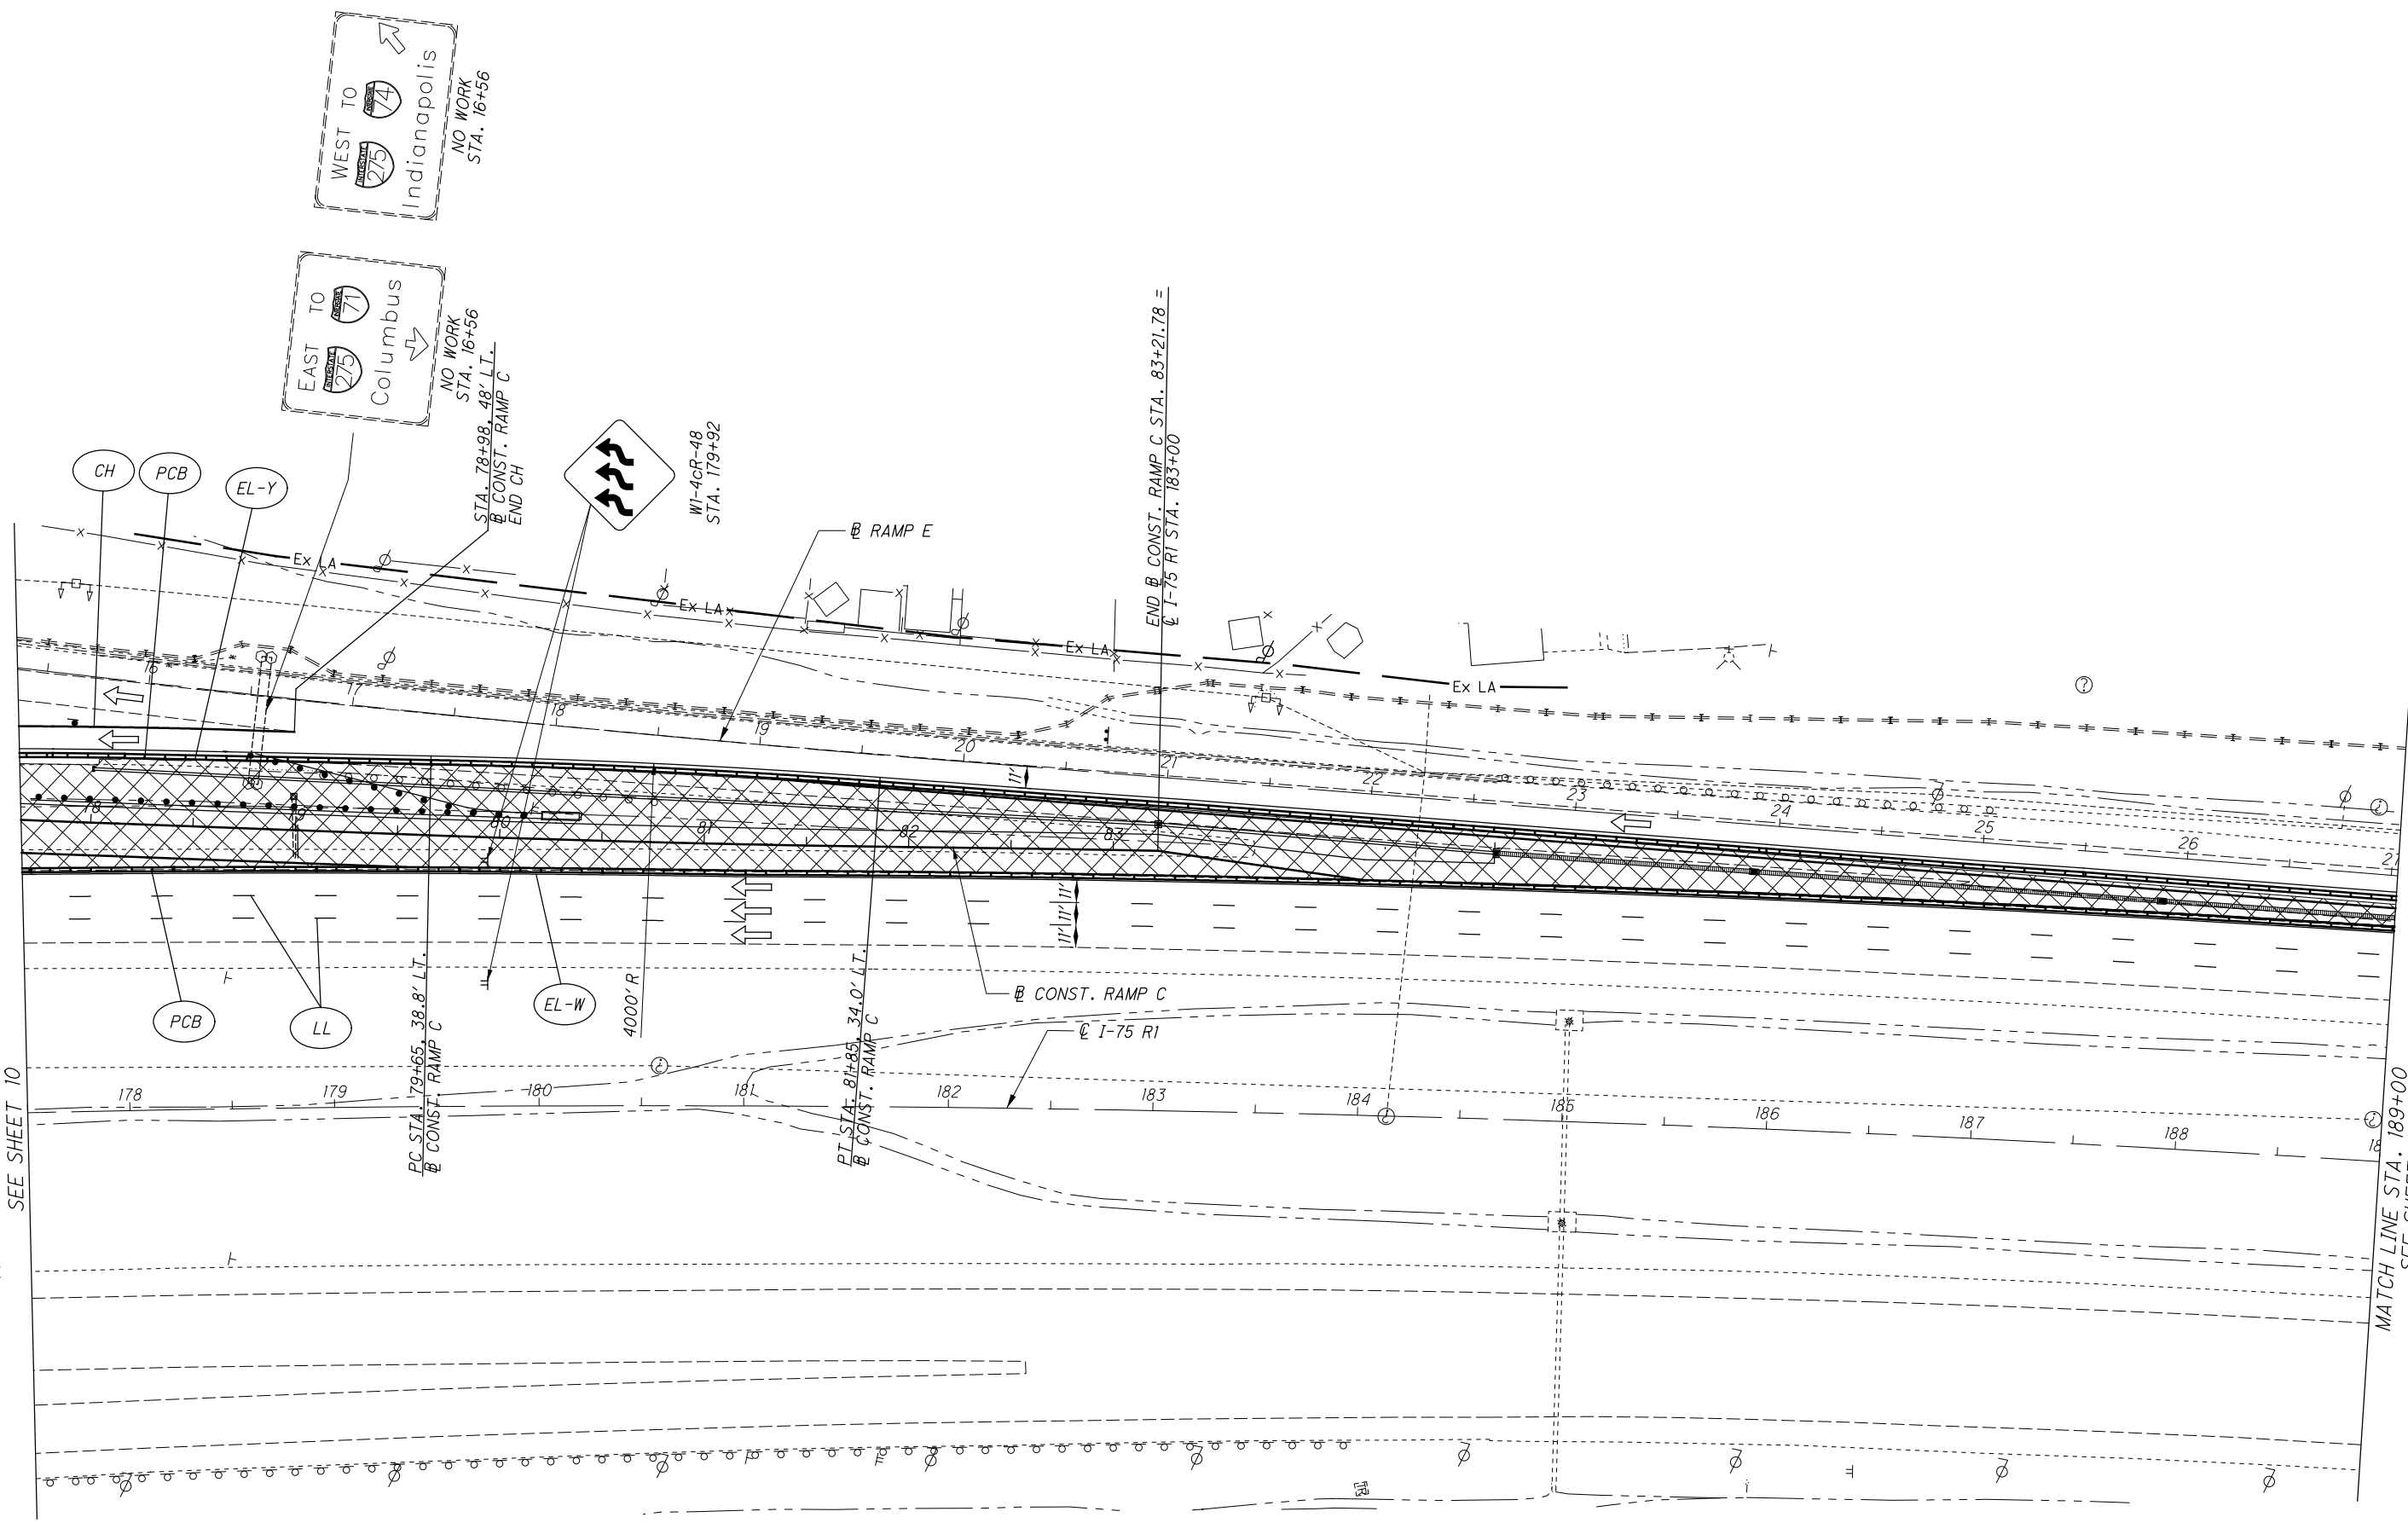

MATCH LINE STA. 189+00  
SEE SHEET 12

**BUILDABLE UNIT 2-AS-BUILT PLANS-NOVEMBER 28, 2017**

**HAM-75-16.67**


**MAINTENANCE OF TRAFFIC  
PLAN - PHASE 1**

CALCULATED
EJIT
CHECKED
RAM



11
18

NOTE: LEGEND LOCATED ON SHEET 9

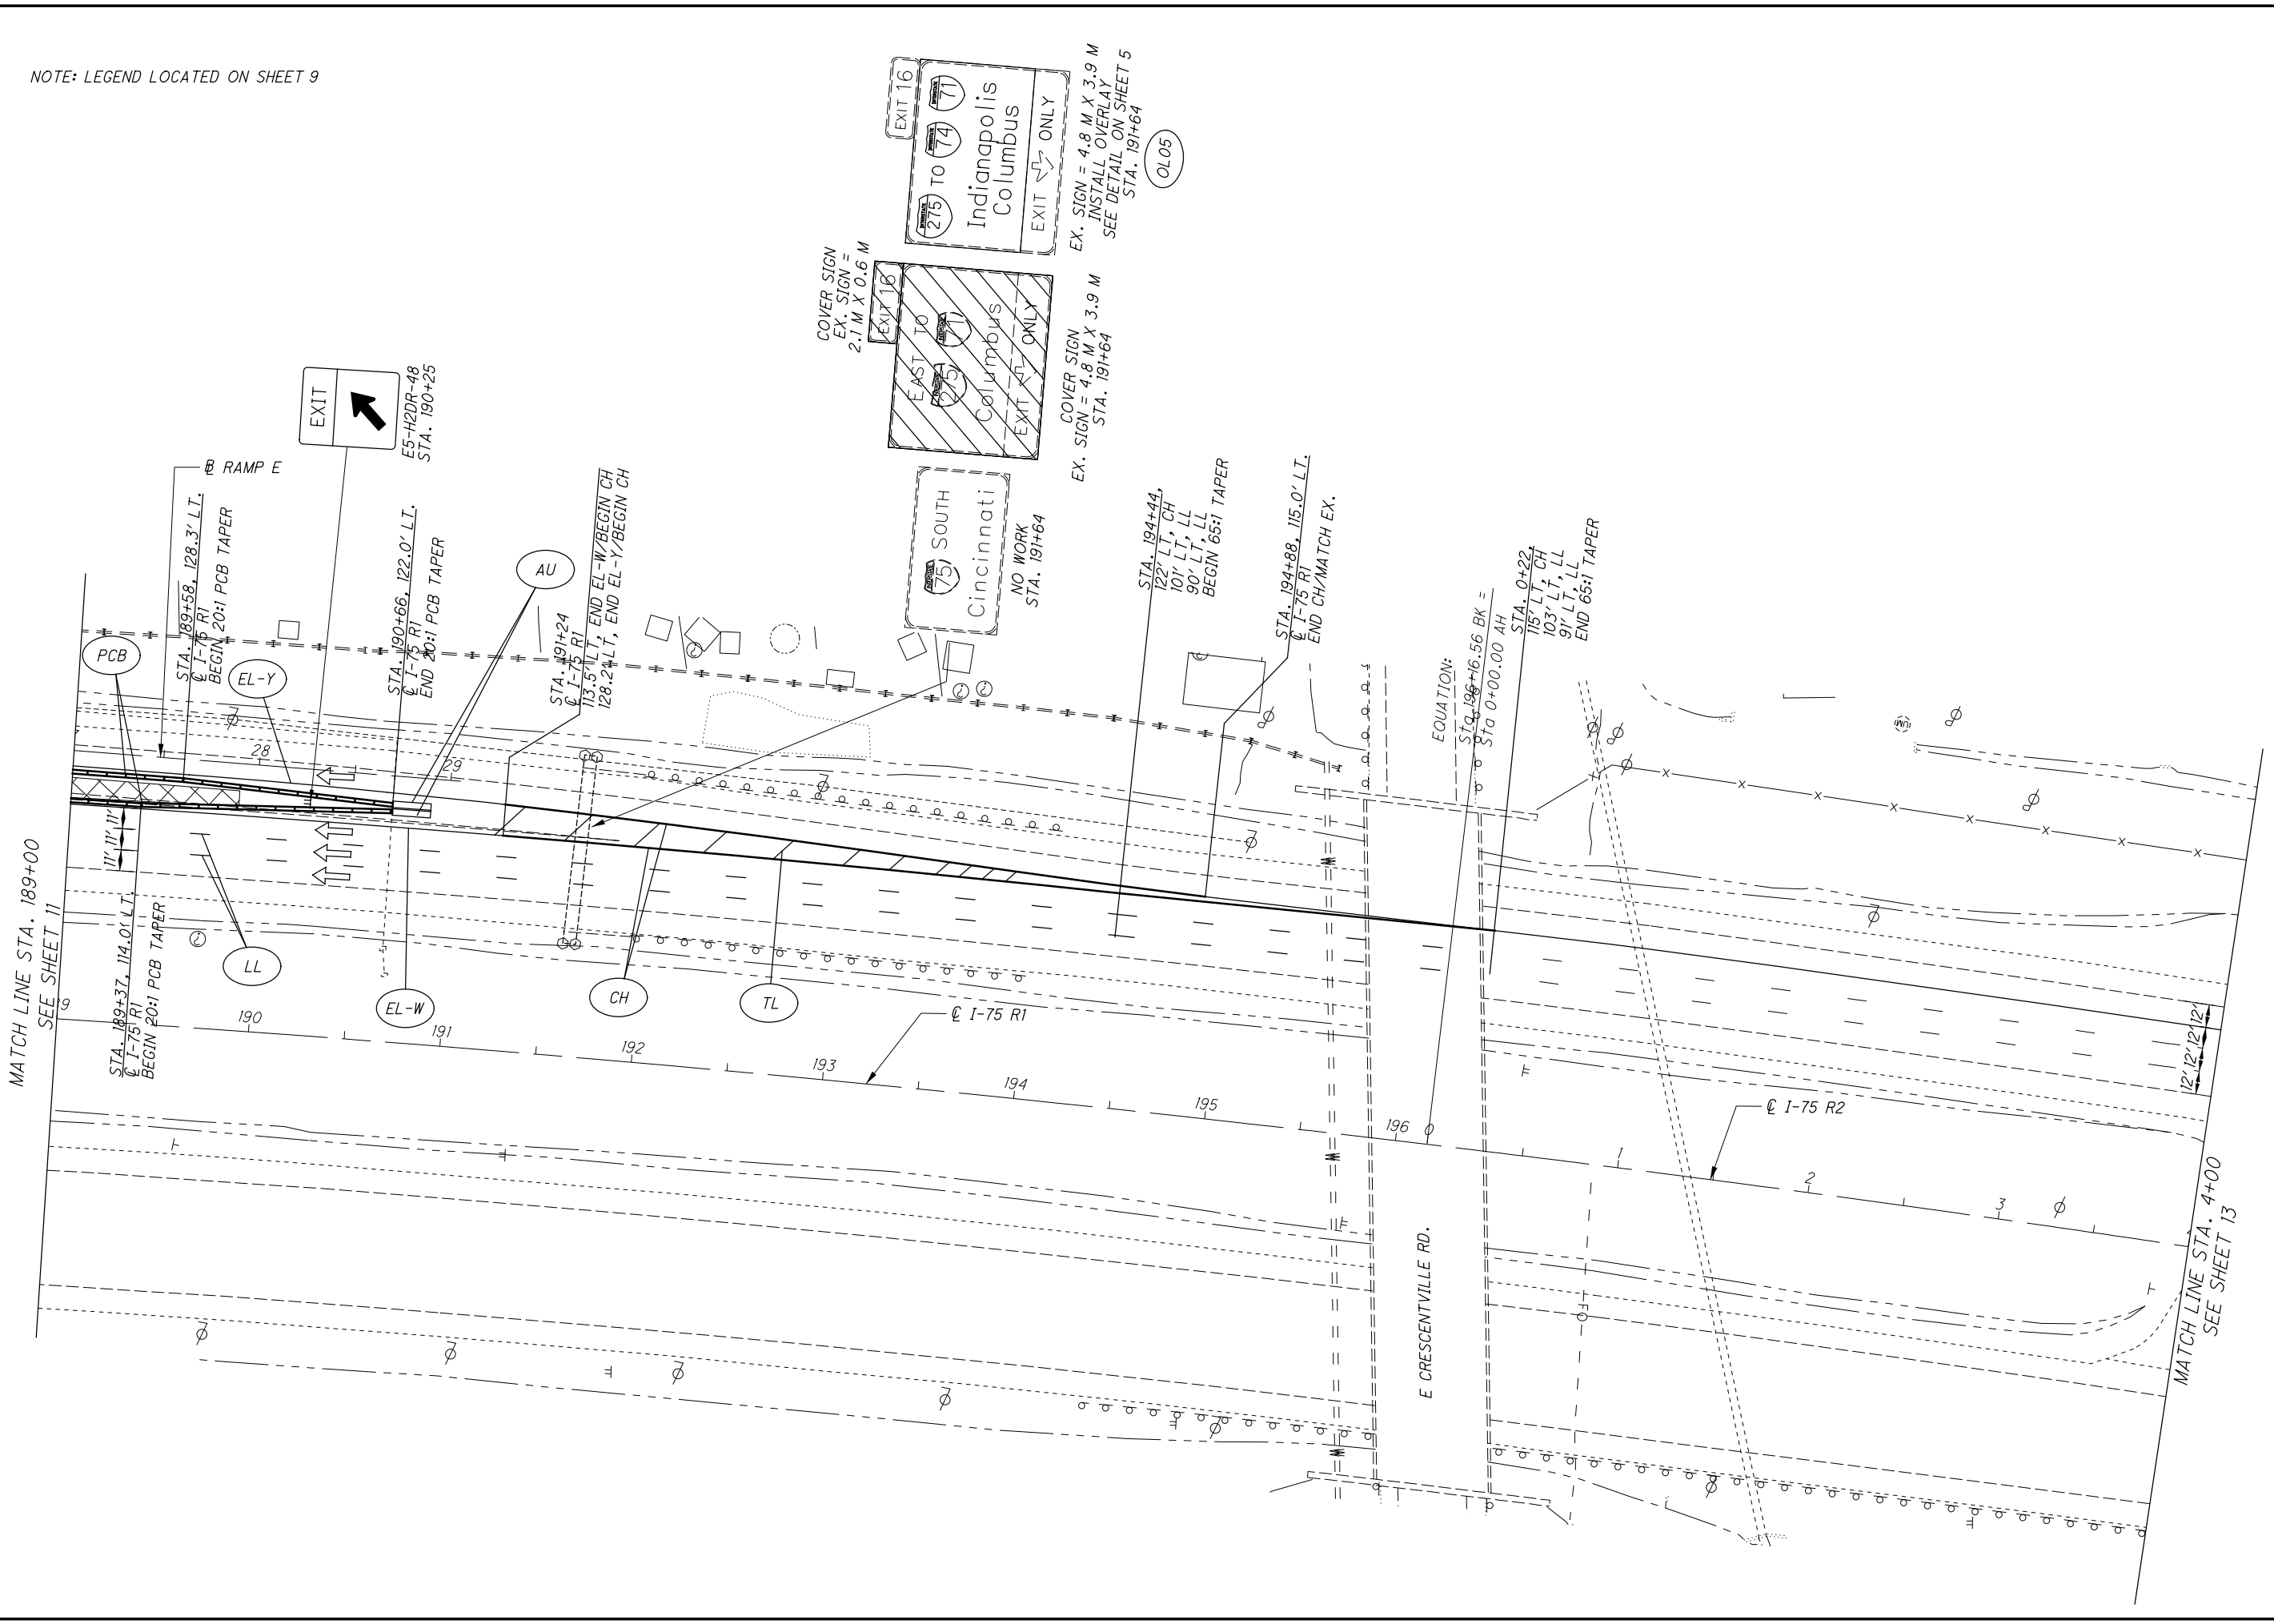

**BUILDABLE UNIT 2-AS-BUILT PLANS-NOVEMBER 28, 2017**

**HAM-75-16.67**


**MAINTENANCE OF TRAFFIC  
PLAN - PHASE 1**

CALCULATED
EJIT
CHECKED
RAM





NOTES:  
1. LEGEND LOCATED ON SHEET 9  
2. LEAD-IN "ROAD WORK AHEAD" SIGNS LOCATED ON SHEET 8

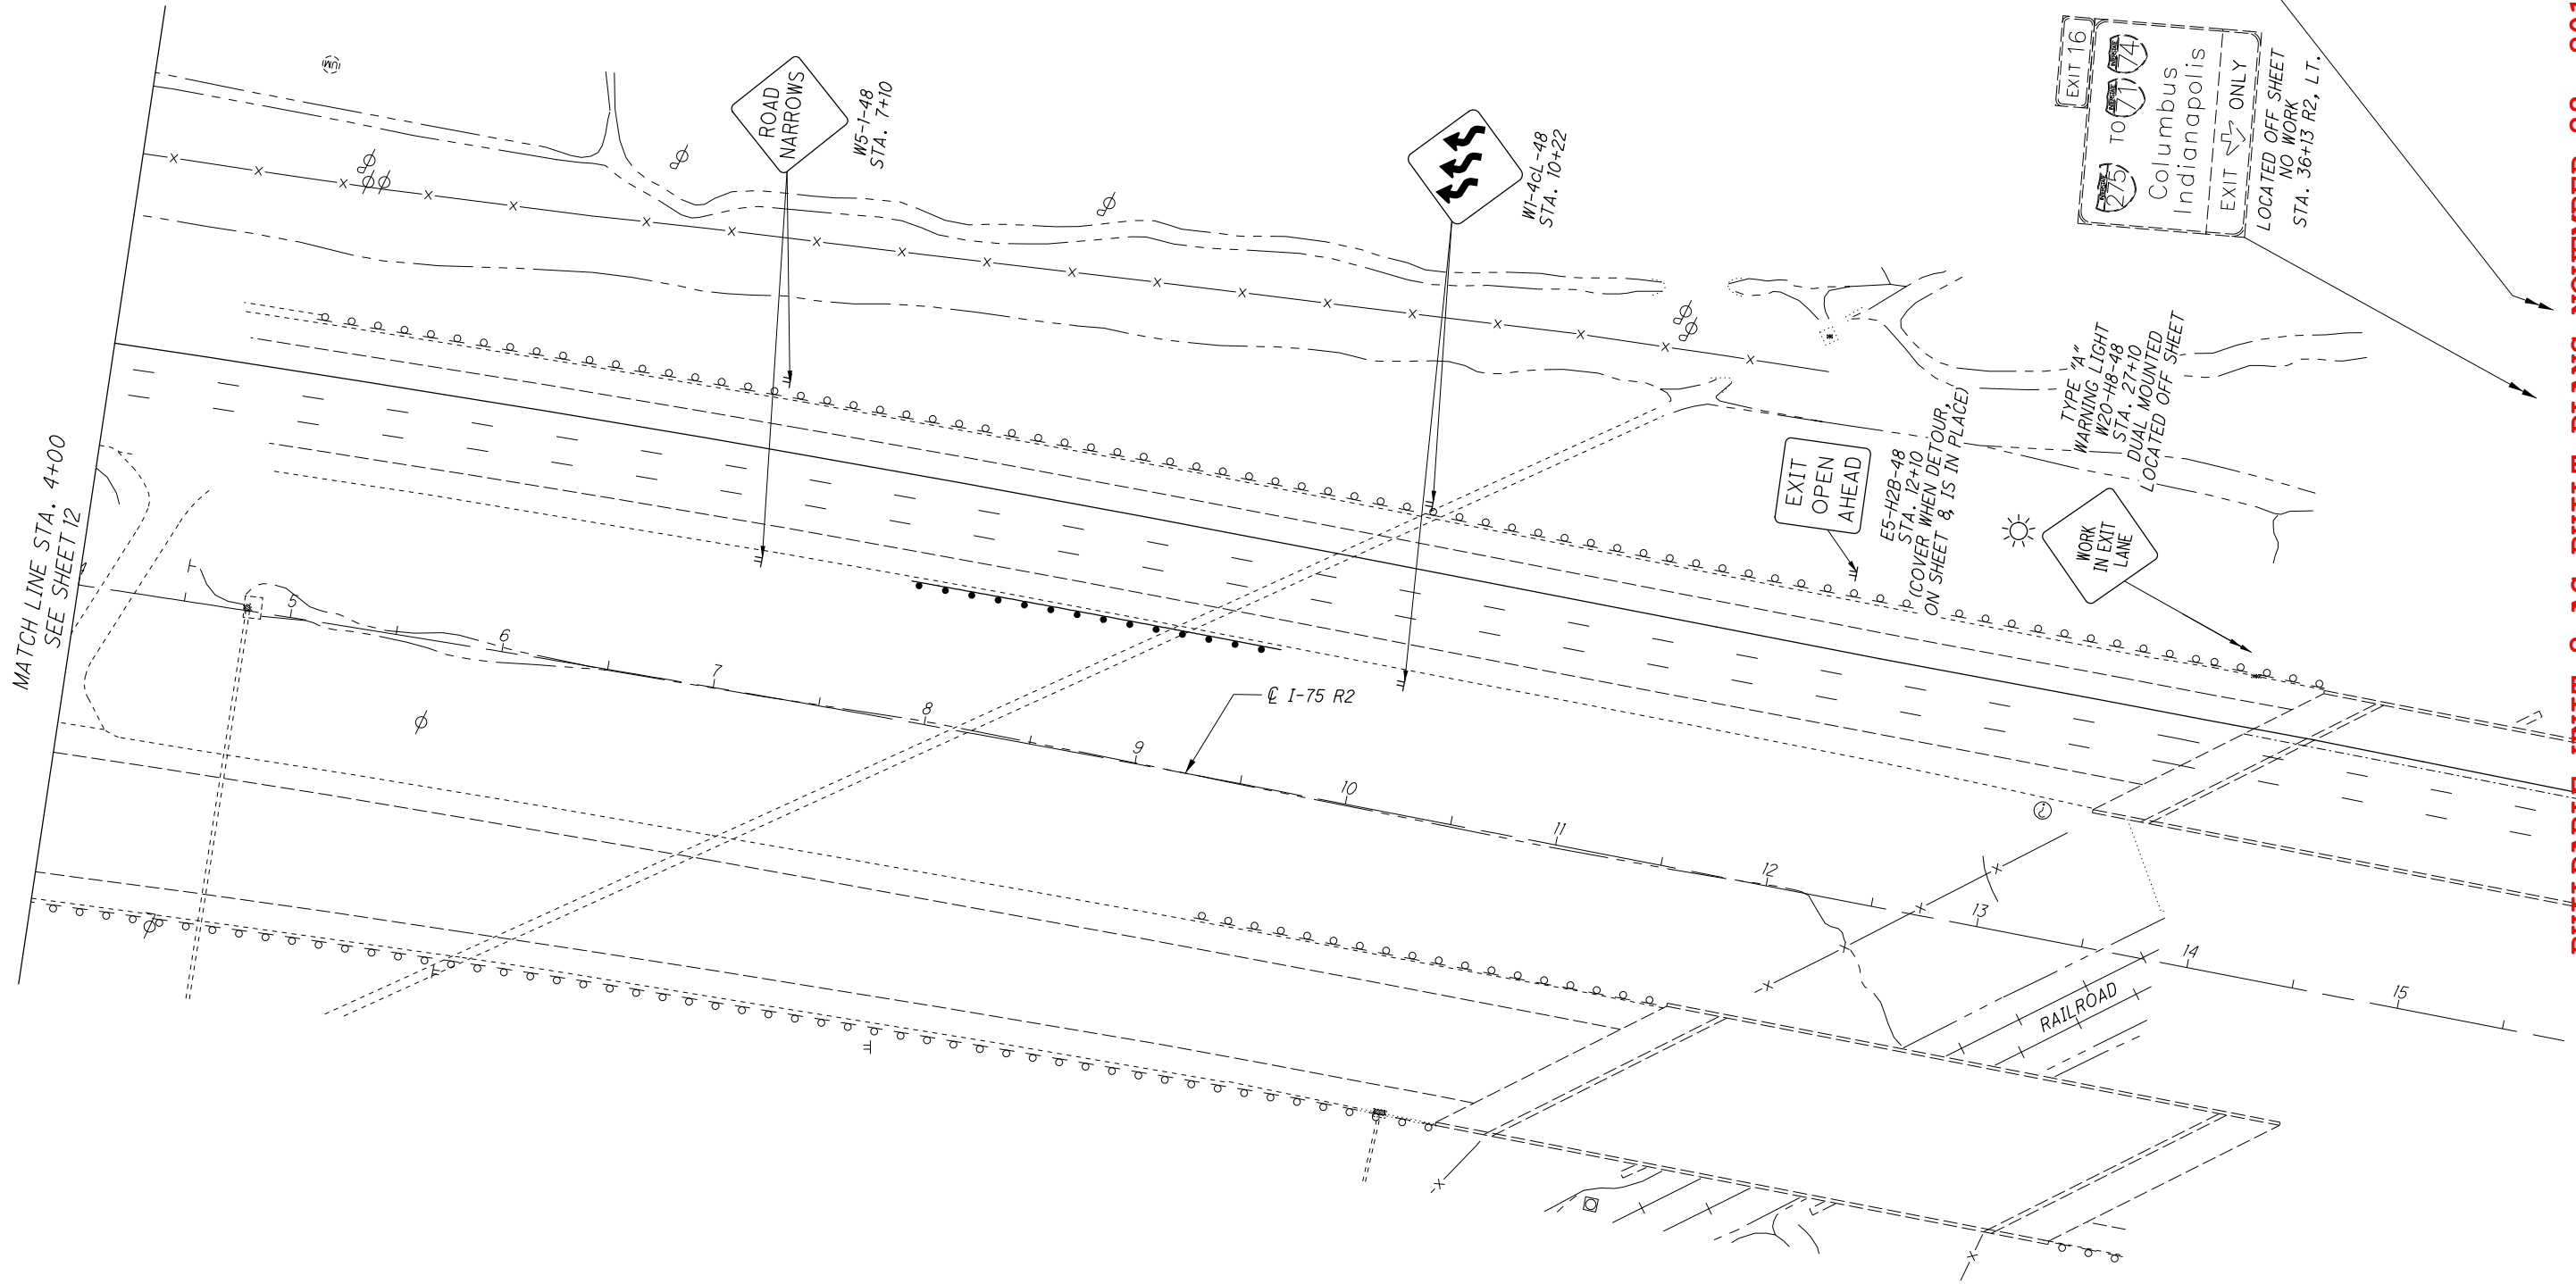

MATCH LINE STA. 4+00  
SEE SHEET 12

I-75 R2


RAILROAD

**BUILDABLE UNIT 2-AS-BUILT PLANS-NOVEMBER 28, 2017**

HAM-75-16.67


MAINTENANCE OF TRAFFIC  
PLAN - PHASE 1

CALCULATED  
EJIT  
CHECKED  
RAM

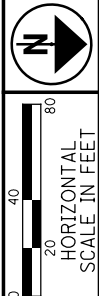

G:\Akron\DCS\Projects\TRN\60547096\_HAM751667\900-CAD-GIS\104408\_HAM-75-1667\Design\MOT\Sheets\104408\_MP201.dgn\_Design 11/28/2017 10:23:47 AM matt.philips

NOTE: LEGEND LOCATED ON SHEET 9

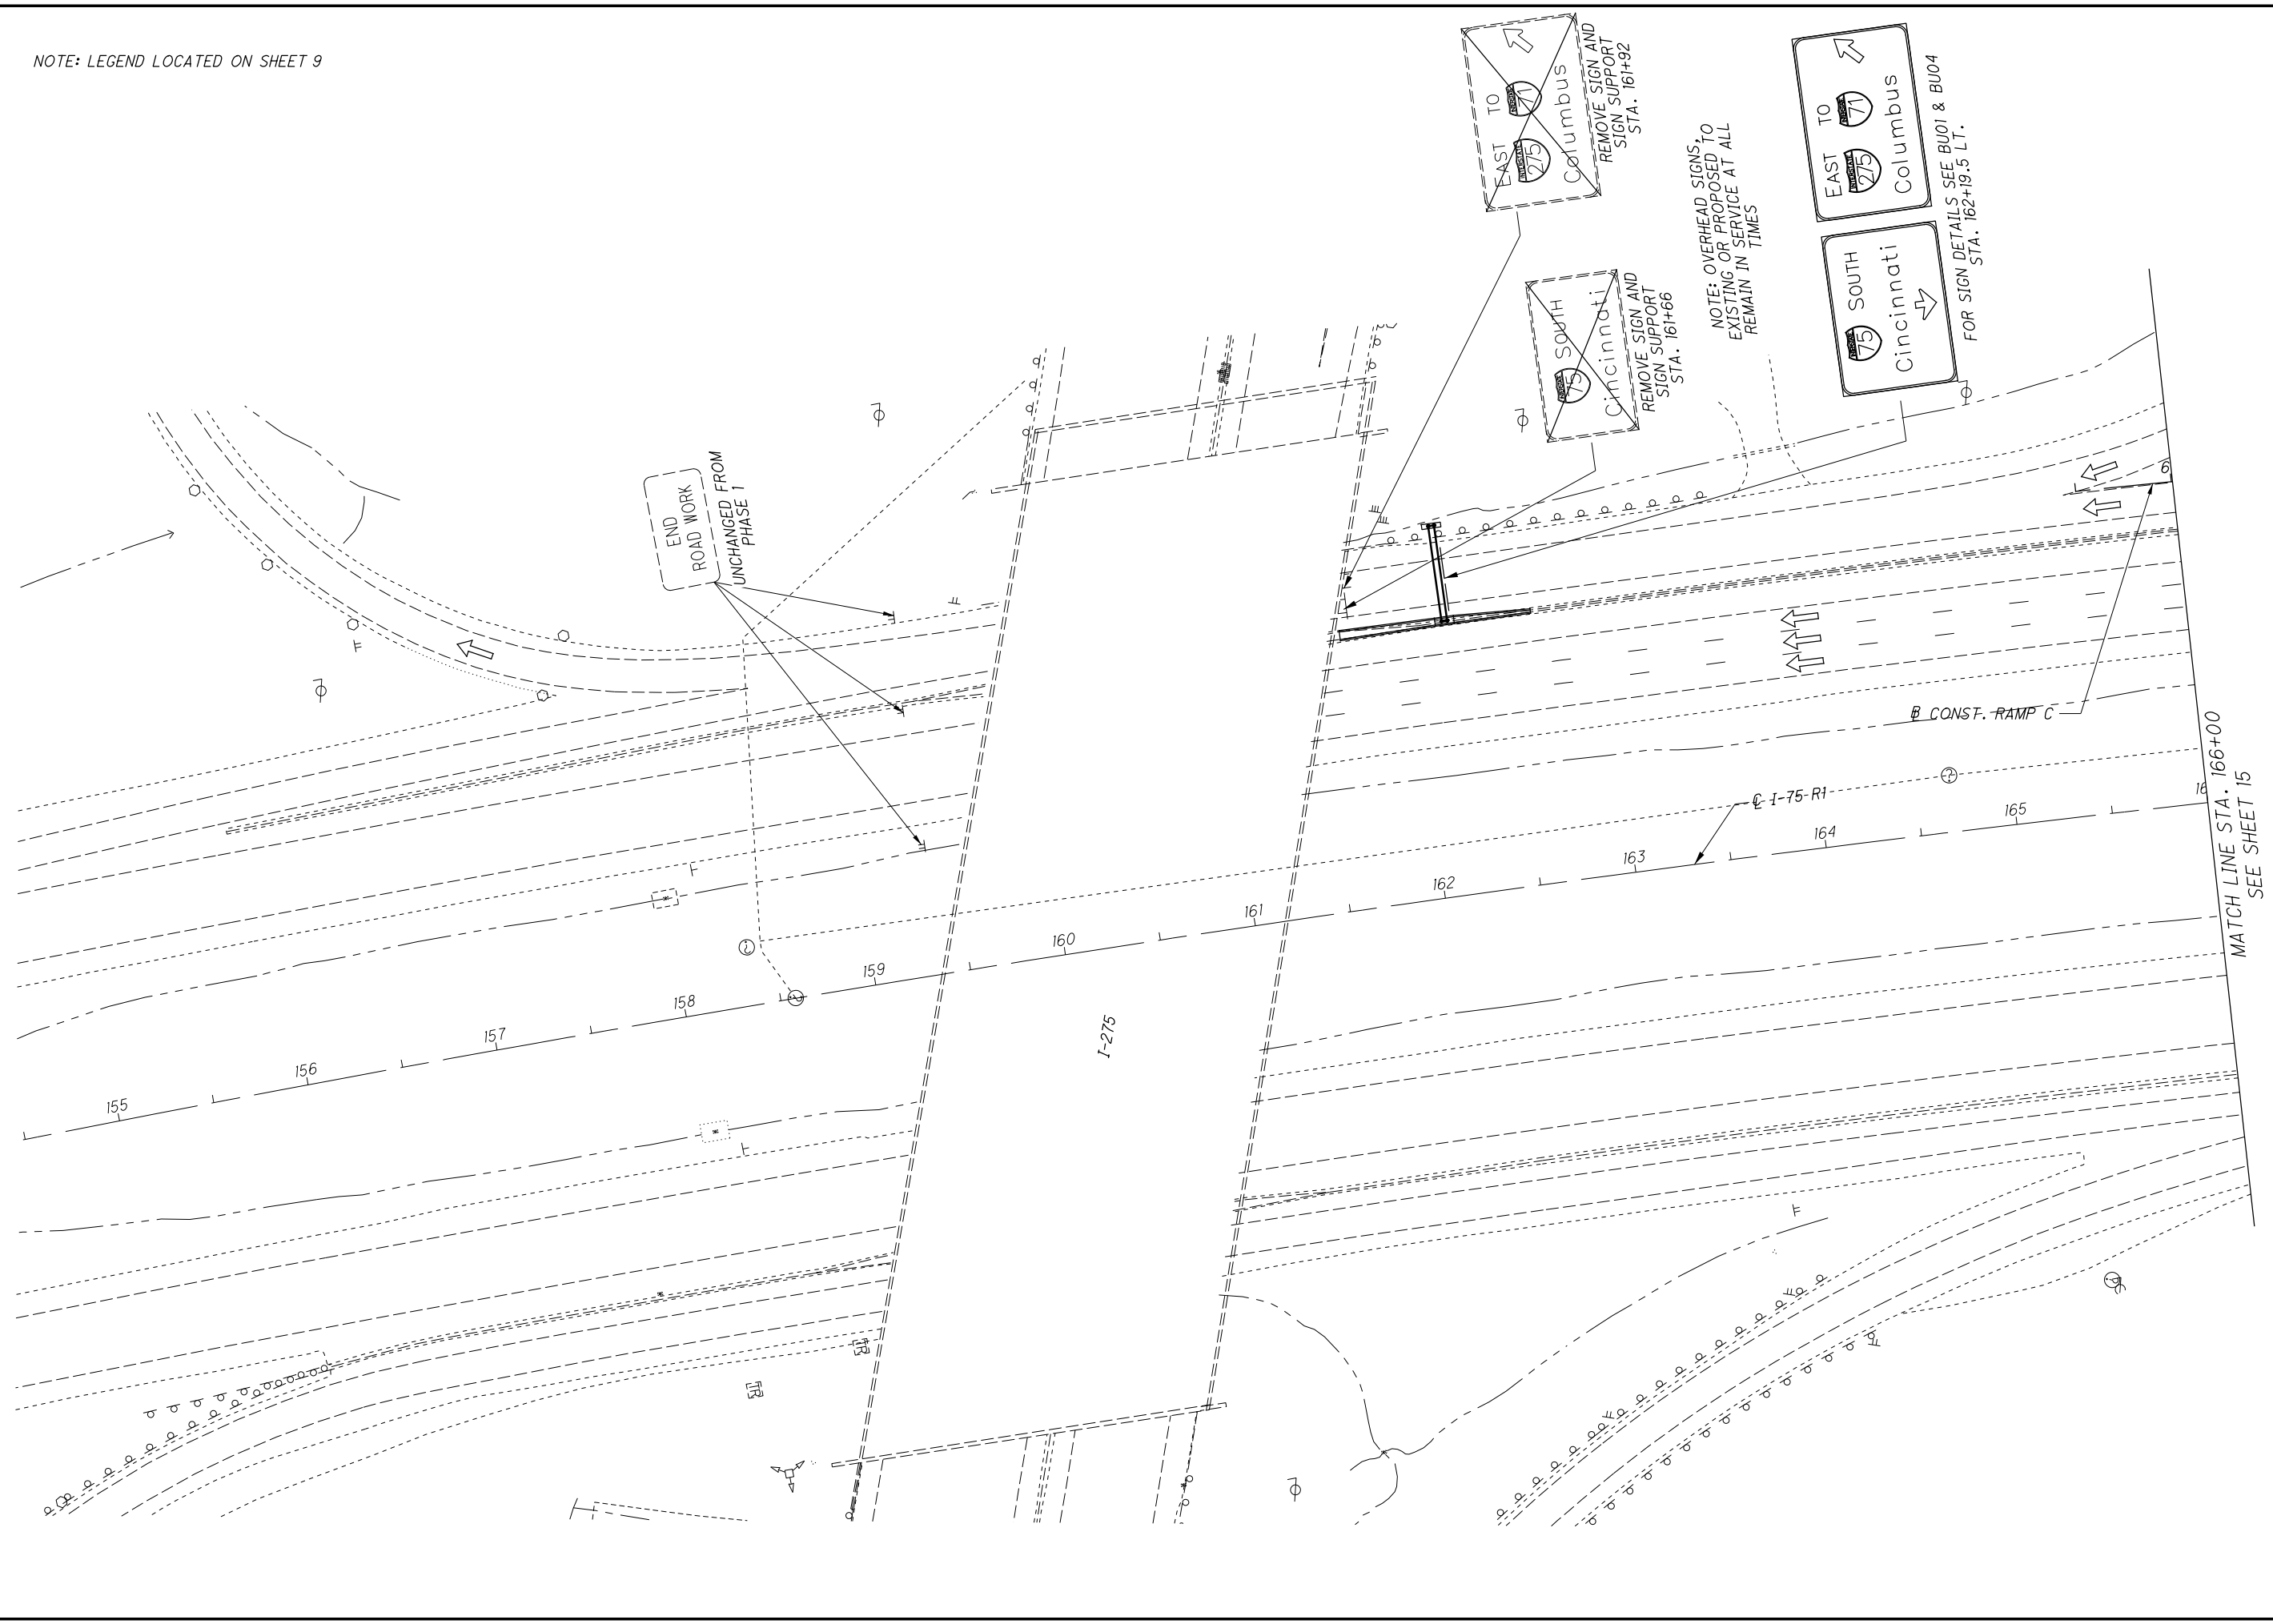

**BUILDABLE UNIT 2-AS-BUILT PLANS-NOVEMBER 28, 2017**

**MAINTENANCE OF TRAFFIC PLAN - PHASE 2**

**HAM-75-16.67**

CALCULATED
EJIT
CHECKED
RAM




14
18

NOTE: LEGEND LOCATED ON SHEET 9

NOTE: SB I-75 MAINLINE PAVEMENT MARKINGS ARE EXISTING FROM PREVIOUS PHASE.

G:\Akron\DCS\Projects\TRN\60547096\_HAM751667\900-CAD-GIS\104408\_HAM-75-1667\Design\MOT\Sheets\104408\_MP202.dgn Design 11/28/2017 10:23:50 AM matt.phillips

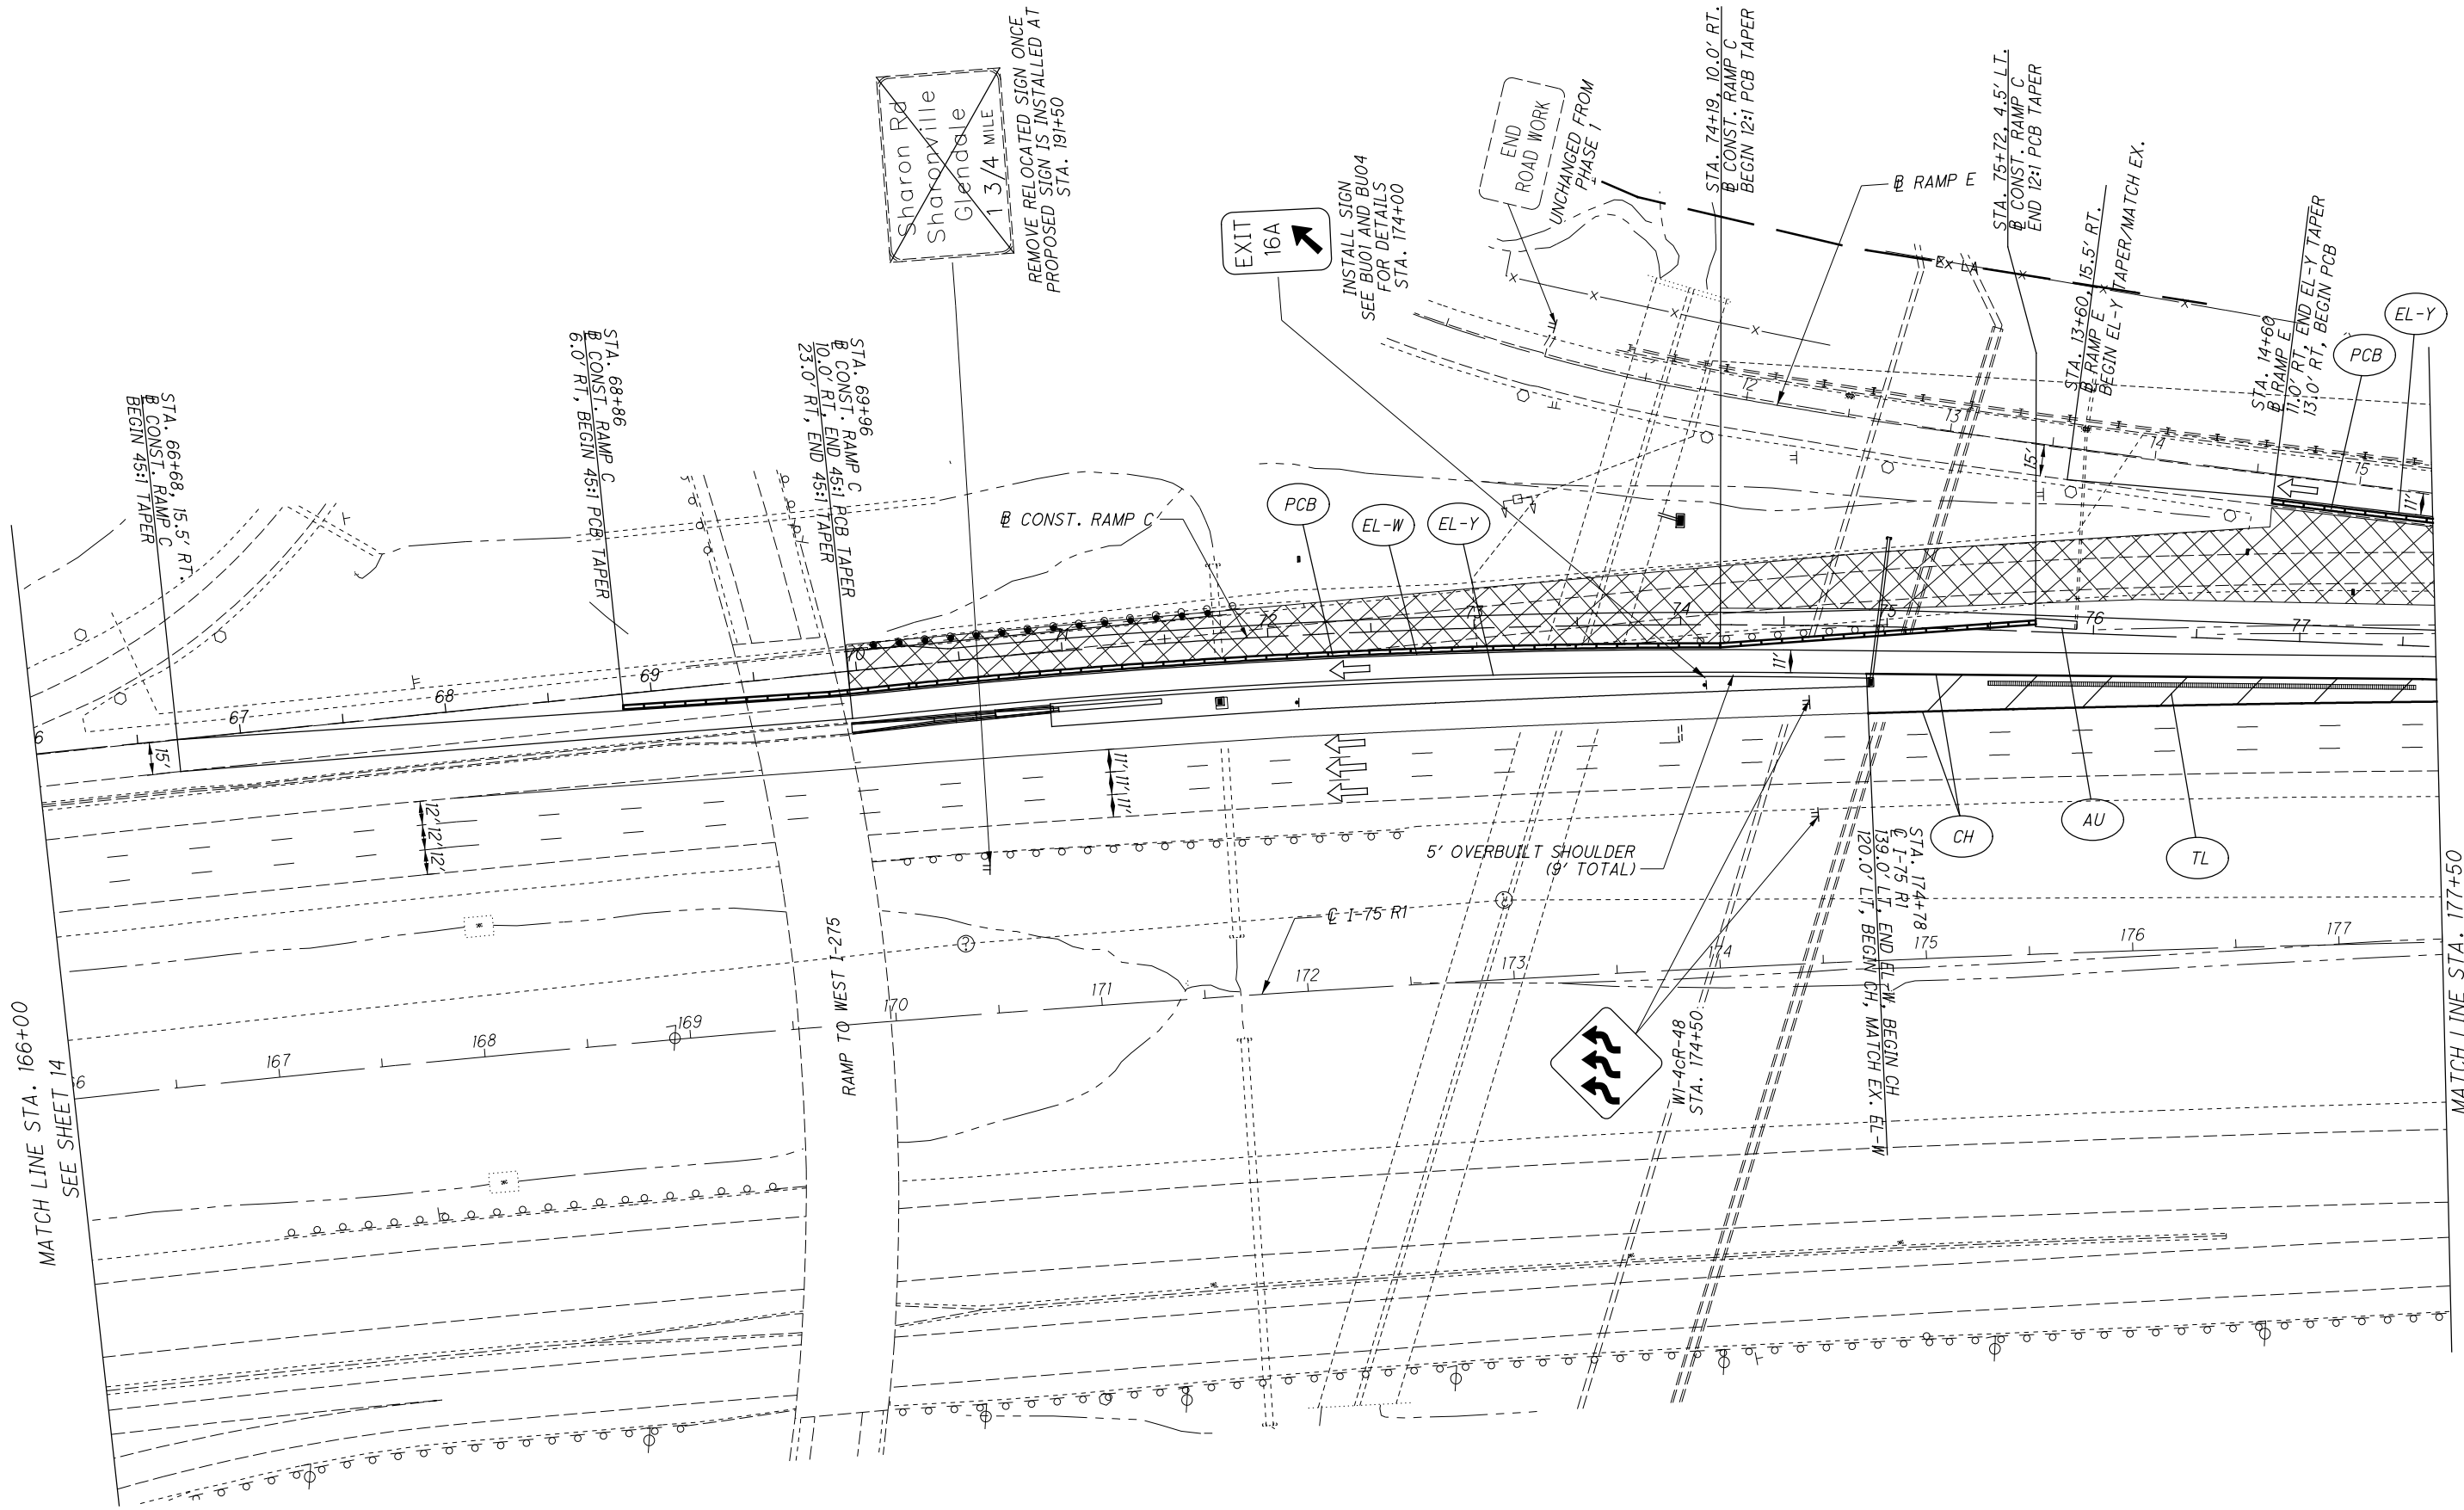

MATCH LINE STA. 166+00  
SEE SHEET 14

MATCH LINE STA. 177+50

CALCULATED  
EJT  
CHECKED  
RAM

0 20 40 80  
HORIZONTAL  
SCALE IN FEET

N

**BUILDABLE UNIT 2-AS-BUILT PLANS-NOVEMBER 28, 2017**

**MAINTENANCE OF TRAFFIC**

**PLAN - PHASE 2**

HAM-75-16.67

15  
18


NOTE: LEGEND LOCATED ON SHEET 9

NOTE: SB I-75 MAINLINE PAVEMENT MARKINGS ARE EXISTING FROM PREVIOUS PHASE.

C:\Akron\DCS\Projects\TRN\60547096\_HAM751667\900-CAD-GIS\104408\_HAM-75-1667\Design\MOT\Sheets\104408\_MP203.dgn Design 11/28/2017 10:23:54 AM matt.phillips

MATCH LINE STA. 177+50  
SEE SHEET 15

MATCH LINE STA. 189+00  
SEE SHEET 17

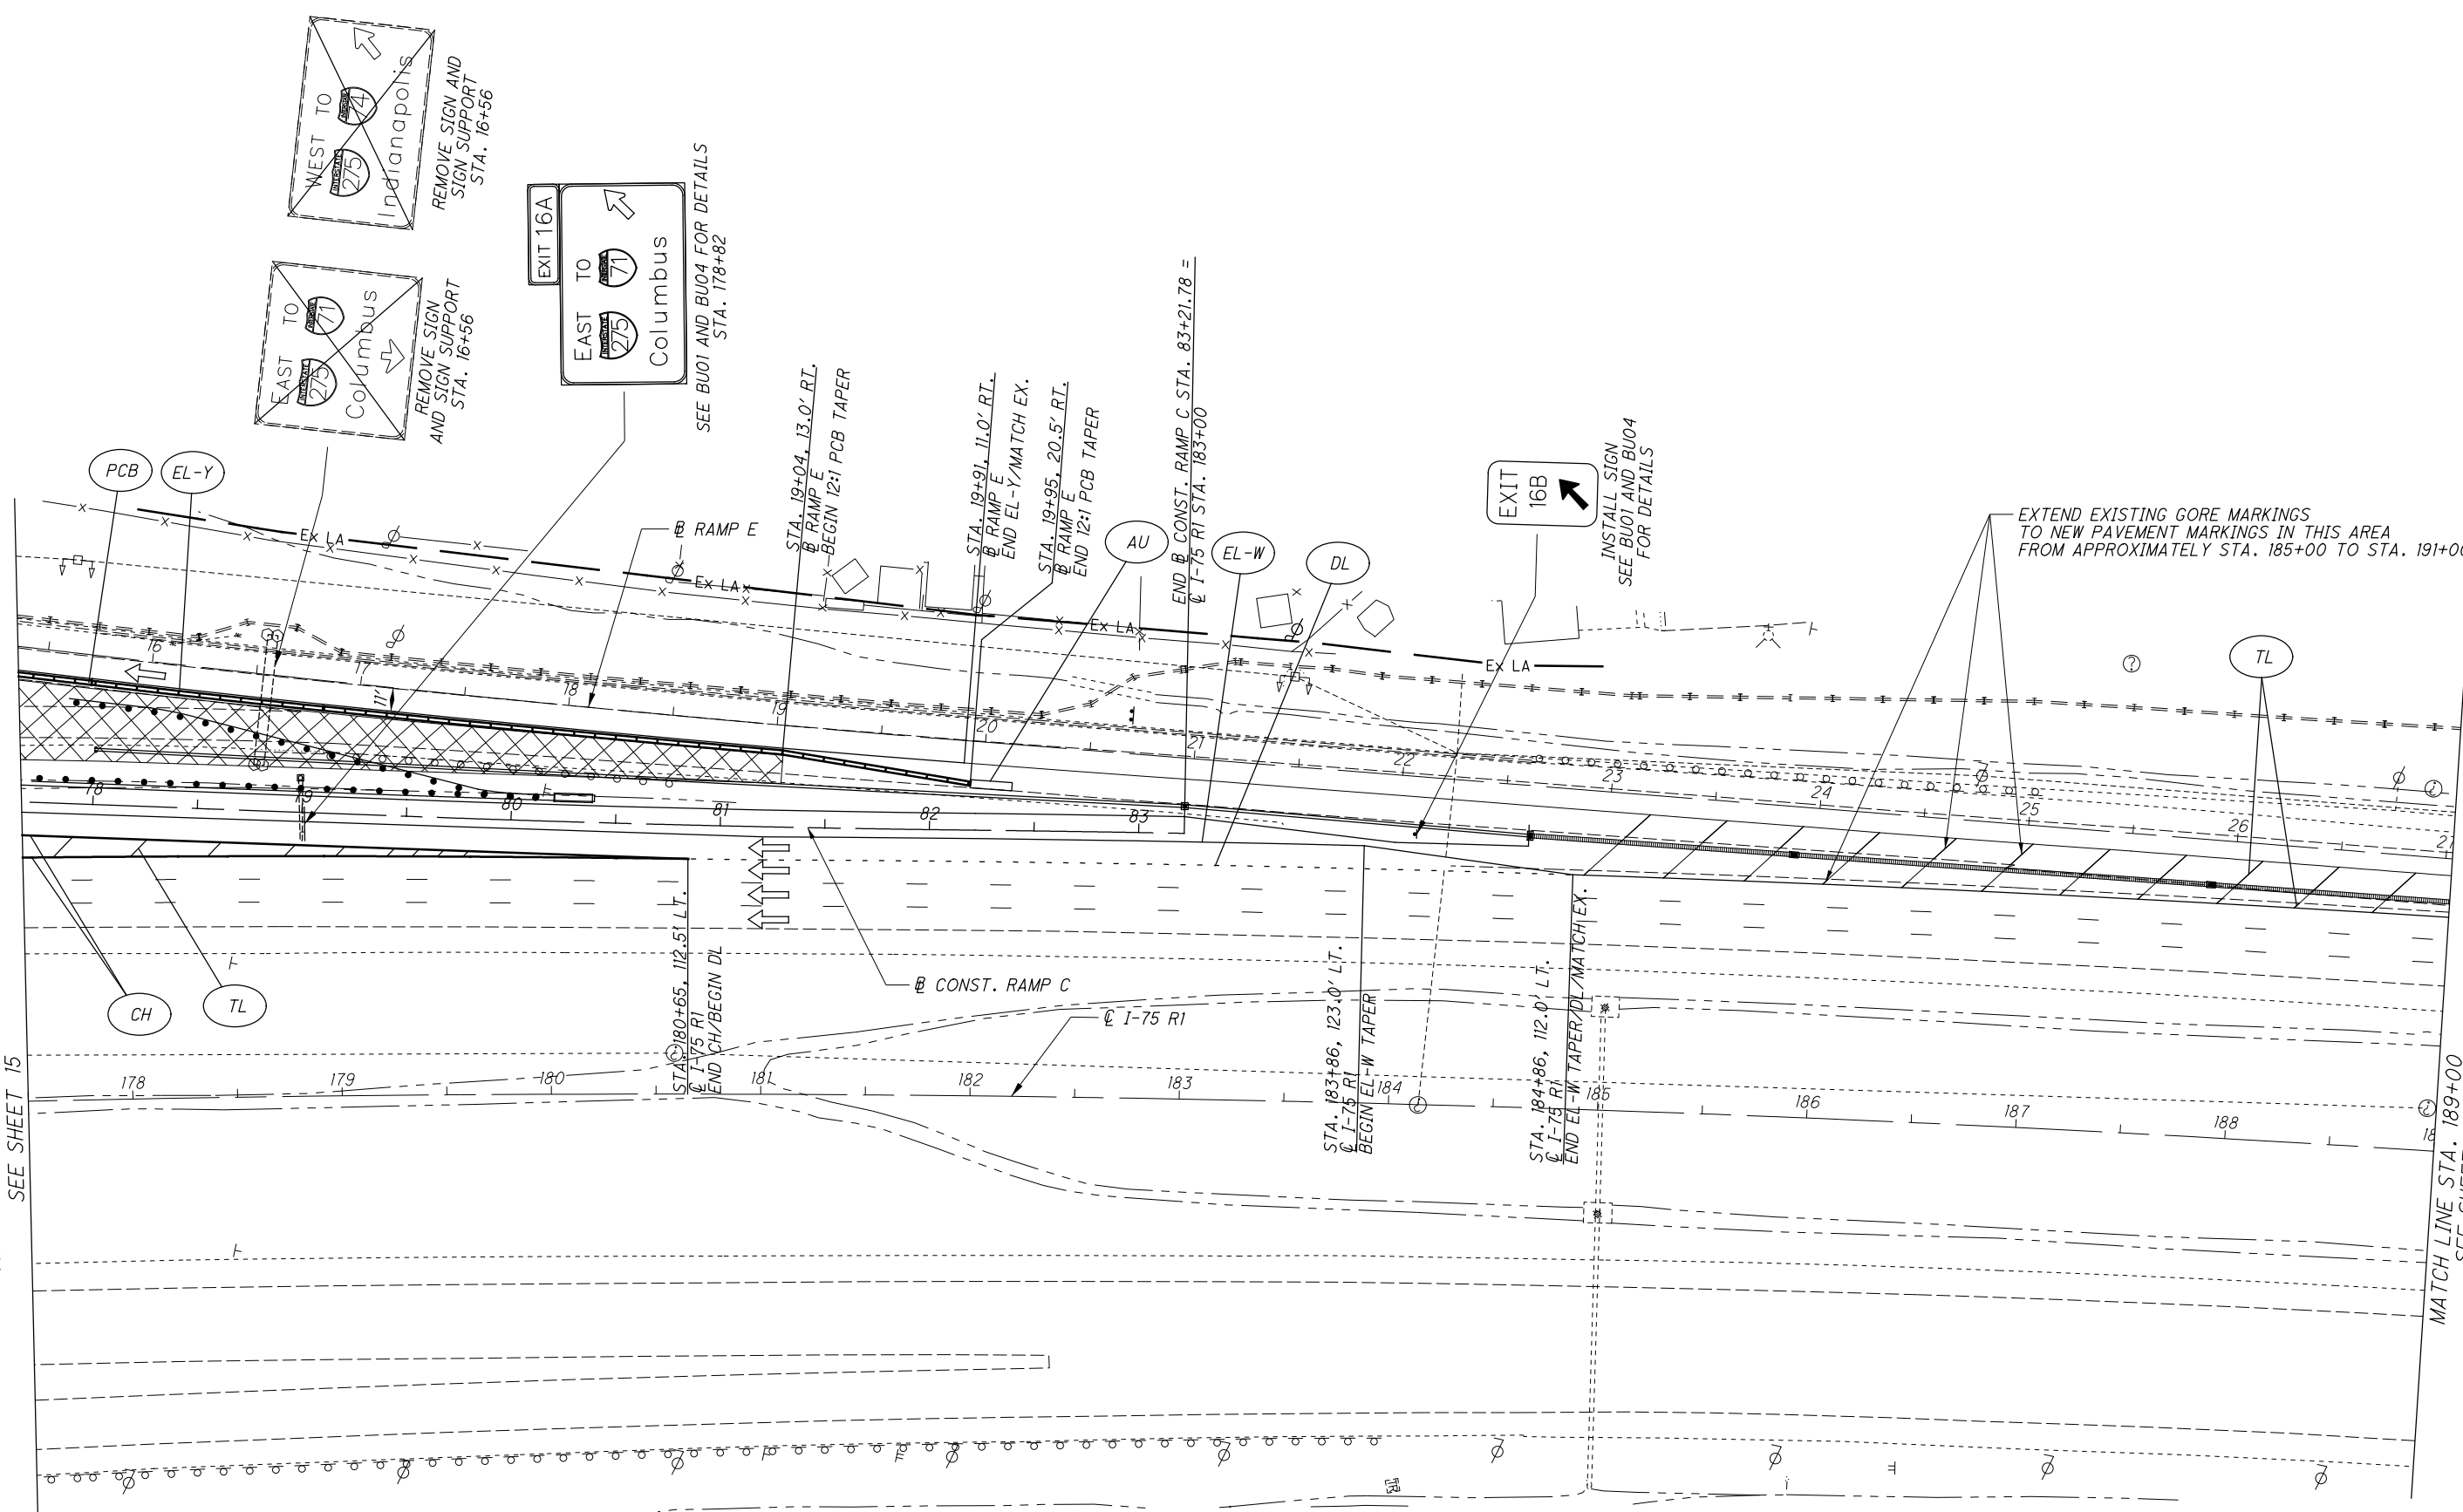

**BUILDABLE UNIT 2-AS-BUILT PLANS-NOVEMBER 28, 2017**

**HAM-75-16.67**

**MAINTENANCE OF TRAFFIC  
PLAN - PHASE 2**

CALCULATED
EJIT
CHECKED
RAM




16
18







NOTES:  
1. LEGEND LOCATED ON SHEET 9  
2. LEAD-IN "ROAD WORK AHEAD" SIGNS LOCATED ON SHEET 8

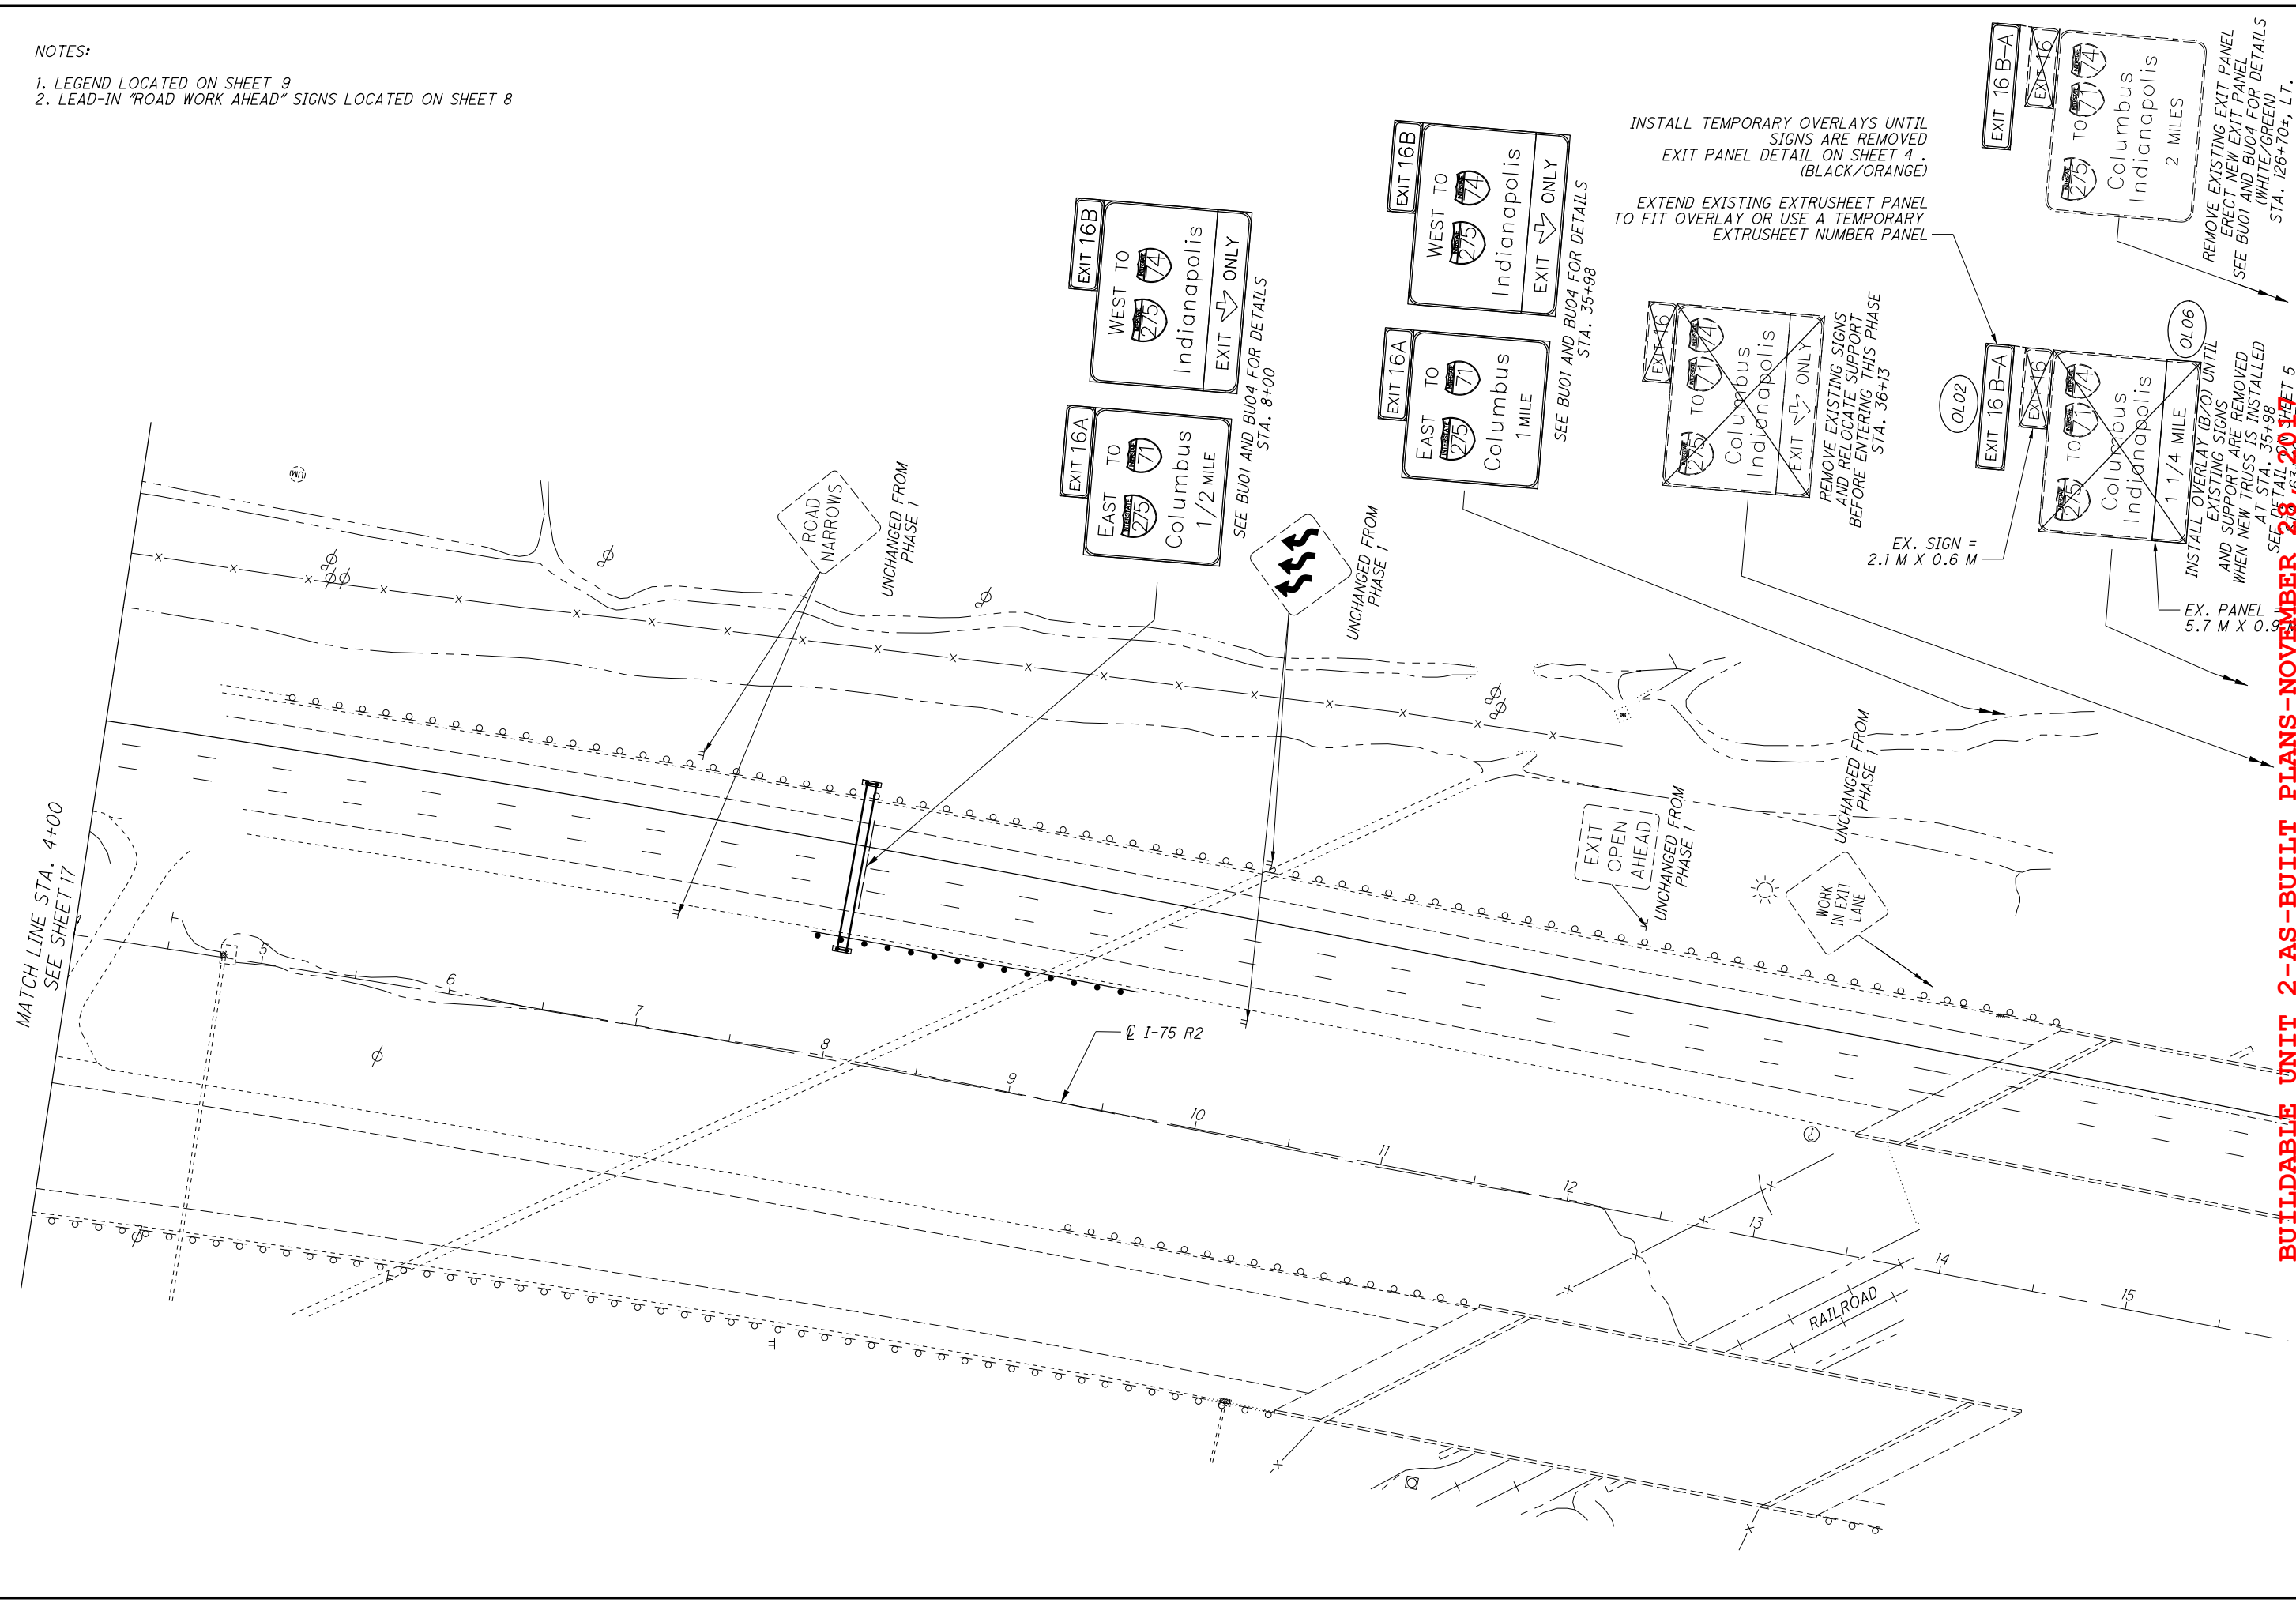

INSTALL TEMPORARY OVERLAYS UNTIL SIGNS ARE REMOVED  
EXIT PANEL DETAIL ON SHEET 4 .  
(BLACK/ORANGE)

EXTEND EXISTING EXTRUSHEET PANEL TO FIT OVERLAY OR USE A TEMPORARY EXTRUSHEET NUMBER PANEL

REMOVE EXISTING SIGNS AND RELOCATE SUPPORT BEFORE ENTERING THIS PHASE  
STA. 36+13

REMOVE EXISTING EXIT PANEL  
ERECT NEW EXIT PANEL  
SEE BU01 AND BU04 FOR DETAILS  
(WHITE/GREEN)  
STA. 126+70±, L.T.

INSTALL OVERLAY (B/O) UNTIL EXISTING SIGNS AND SUPPORT ARE REMOVED WHEN NEW TRUSS IS INSTALLED AT STA. 35+98  
SEE DETAIL 2017.11.16.163.407, L.T.

EX. SIGN = 2.1 M X 0.6 M

EX. PANEL = 5.7 M X 0.9 M

**BUILDABLE UNIT 2-AS-BUILT PLANS-NOVEMBER 28, 2017**

**HAM-75-16.67**

**MAINTENANCE OF TRAFFIC**

**PLAN - PHASE 2**

18  
18

CALCULATED  
EJIT  
CHECKED  
RAM

0 20 40 80  
HORIZONTAL  
SCALE IN FEET

N



G:\Akron\DCS\Projects\TRN\60547096\_HAM-75-1667\Design\CAD\900-CAD-GIS\104408\_HAM-75-1667\Design\Drawings\Sheets\104408\_DE002.dgn Design 11/28/2017 10:27:44 AM matt.phillips

**PROJECT DESCRIPTION**

IMPROVEMENTS INCLUDE THE RECONFIGURATION OF THE I.R. 75 RAMPS TO I.R. 275 BY UTILIZING THE EXISTING SINGLE LANE EXIT FOR TRAFFIC TO GO WEST ON I.R. 275 AND CREATING A SECOND EXIT FOR TRAFFIC TO GO EAST ON I.R. 275. IMPROVEMENTS INCLUDE THE RECONSTRUCTION OF 0.35 MILES OF THE I.R. 75 SOUTHBOUND RAMP TO I.R. 275 WESTBOUND; THE RECONSTRUCTION OF 0.45 MILES OF THE I.R. 75 SOUTHBOUND RAMP TO I.R. 275 EASTBOUND; REPLACEMENT OF ALL OVERHEAD SIGNS AND RELOCATION OF AN EXISTING LIGHT TOWER INCLUDING CONCRETE MEDIAN BARRIER, DRAINAGE AND PAVEMENT MARKINGS.

BU03 - ESTIMATED QUANTITIES			
ITEM	QUANTITY	UNIT	DESCRIPTION
659	230	CY	TOPSOIL NOT USED
670	2050	SY	SLOPE EROSION PROTECTION
832	100	FEET	FILTER FABRIC DITCH CHECK
832	200	FEET	INLET PROTECTION

**EARTH DISTURBED AREAS**

PROJECT EARTH DISTURBED AREA: 2.46 ACRES  
 ESTIMATED CONTRACTOR EARTH DISTURBED AREA: 0.00 ACRES  
 NOTICE OF INTENT EARTH DISTURBED AREA: 2.46 ACRES  
 IMPERVIOUS AREA PRE-CONSTRUCTION SITE: 3.86 ACRES  
 IMPERVIOUS AREA OF POST-CONSTRUCTION SITE: 3.79 ACRES  
 RUNOFF COEFFICIENT OF PRE-CONSTRUCTION SITE: 0.50-0.90  
 RUNOFF COEFFICIENT OF POST-CONSTRUCTION SITE: 0.70

**INTERMEDIATE RECEIVING WATERS:**

MILL CREEK

**SUBSEQUENT RECEIVING WATERS:**

OHIO RIVER

**IMPLEMENTATION SCHEDULE**

TEMPORARY EROSION CONTROL (BMPS) SHALL BE IMPLEMENTED PRIOR TO EARTH DISTURBING ACTIVITY AND MAINTAINED THROUGHOUT THE PROJECT DURATION UNTIL SITE HAS REACHED FINAL STABILIZATION.

**POST-CONSTRUCTION BMP OVERVIEW**

PROJECT EARTH DISTURBED AREA (EDA) 2.46 ACRES  
 IS THE PROJECT ROUTINE MAINTENANCE? NO  
 BMPs REQUIRED? YES  
 IS THE PROJECT REDEVELOPMENT? YES  
 DOES ENTIRE SITE DRAIN TO LARGE RIVER? NO  
 WATER QUALITY TREATMENT REQUIRED? YES  
 WATER QUANTITY TREATMENT REQUIRED? NO

PROJECT EDA INSIDE EXISTING R/W (Aix) 2.46 ACRES  
 NEW IMPERVIOUS AREA IN NEW PERMANENT R/W (Ain) 0.00 ACRES  
 TREATMENT PERCENTAGE (T%) 20%  
 TREATMENT REQUIREMENT 0.49 ACRES

PC-BMP SELECTED FOR USE: VEGETATED FILTER STRIPS

FILTER STRIP	ROUTE	BEGIN STATION	BEGIN LATITUDE (SEE NOTE)	BEGIN LONGITUDE (SEE NOTE)	END STATION	END LATITUDE (SEE NOTE)	END LONGITUDE (SEE NOTE)	SIDE	PAVEMENT WIDTH (FT)	FILTER STRIP WIDTH (FT)	FILTER STRIP SLOPE (z:1)	FILTER STRIP LENGTH (FT)	TRIBUTARY AREA IN ODOT R/W (ACRES)	FILTER STRIP AREA (SF)	ITEM 659 TOPSOIL VOLUME (CY)	ITEM 670 EROSION PROTECTION AREA (SY)
No. 1	RAMP C	72+25	N 39.293583	W 84.442053	73+75	N 39.293992	W 84.441983	LT	6	46 (MIN.)	8	150	0.18	7,068	87.3	785.3
No. 2	RAMP C	73+75	N 39.293992	W 84.441983	77+00	N 39.294871	W 84.441777	LT	31 (MAX.)	24 (MIN.)	5 (MAX.)	325	0.34	11,397	140.7	1,266.3
TOTAL TREATMENT CREDIT													0.52			

NOTE: LATITUDES AND LONGITUDES ARE AT THE EDGE OF SHOULDER.

CALCULATED  
MEP  
CHECKED  
CKJ

BUILDABLE UNIT 3-AS-BUILT PLANS-NOVEMBER 28, 2017

SWPPP GENERAL NOTES

HAM-75-16.67

NO.	REVISIONS	DATE
AB	AS-BUILT REVISION	11/28/17

2  
4






**LEGEND**

- D.C. FILTER FABRIC DITCH CHECK
- I.P. INLET PROTECTION
- NOT USED
- LIMITS OF ITEM 659 TOPSOIL AND ITEM 670 - SLOPE EROSION PROTECTION (EDGE OF SHOULDER TO INSIDE EDGE OF DITCH BOTTOM)

CALCULATED  
MEP  
CHECKED  
CKJ

G:\Akron\DCS\Projects\TRN\60547096\_HAM751667\900-CAD-GIS\104408\_HAM-75-1667\Design\Drainage\Sheets\104408\_DE001.dgn Design 11/28/2017 10:27:51AM matt.philips

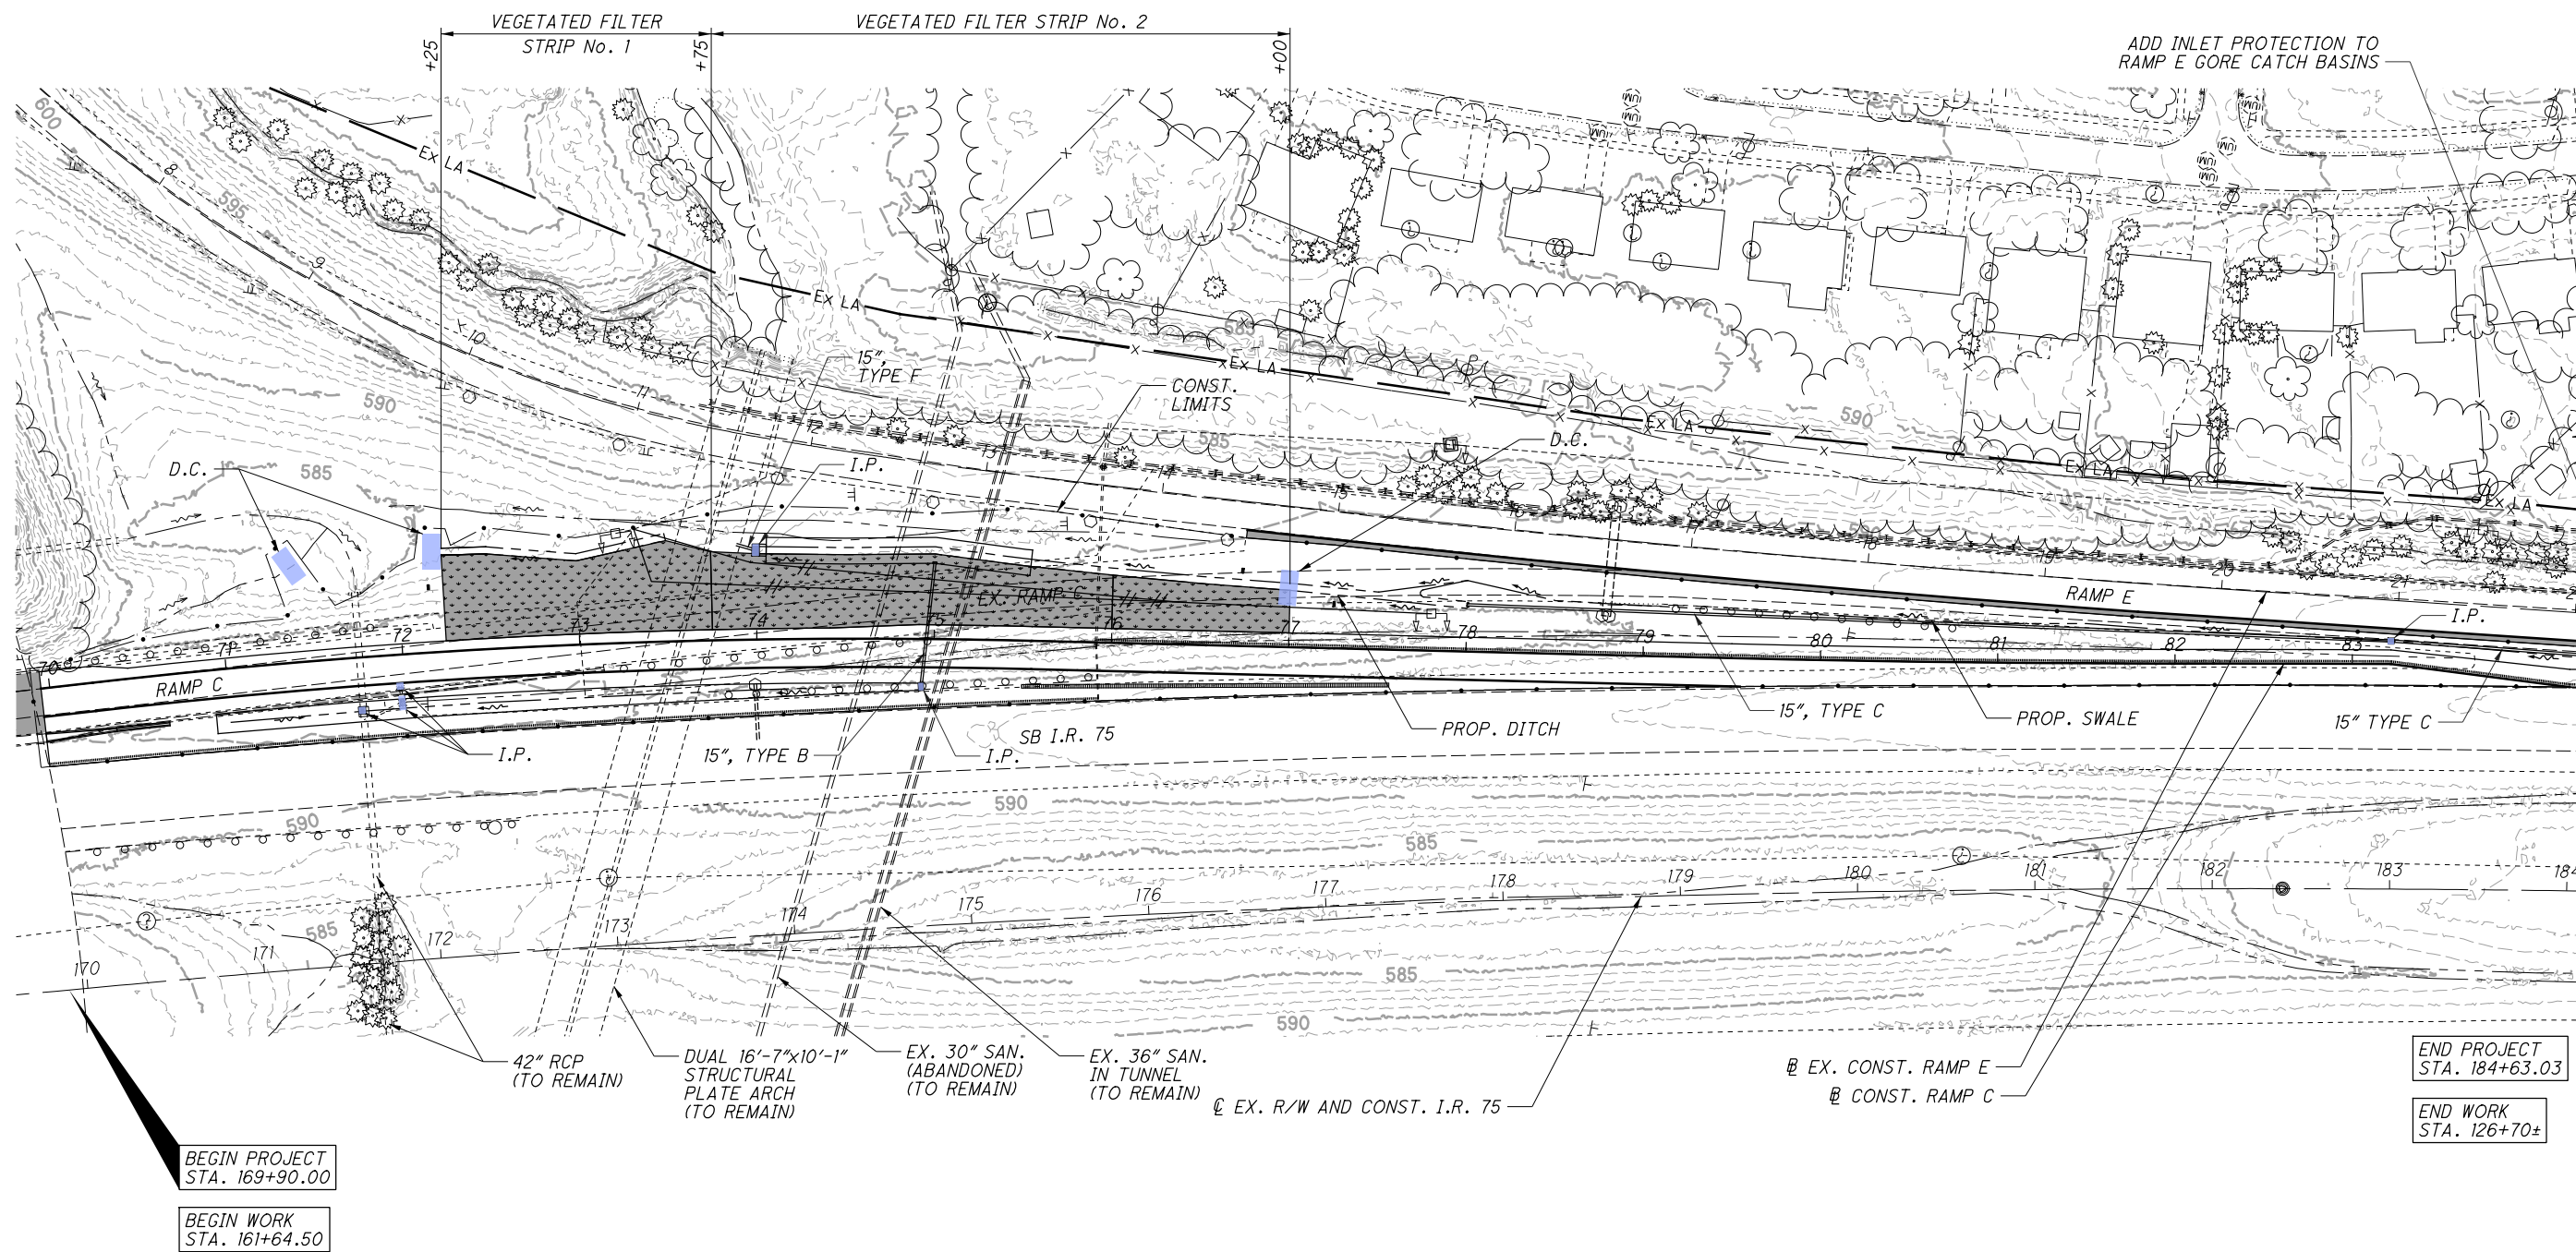

ADD INLET PROTECTION TO RAMP E GORE CATCH BASINS

BEGIN PROJECT STA. 169+90.00  
BEGIN WORK STA. 161+64.50

END PROJECT STA. 184+63.03  
END WORK STA. 126+70±

**BUILDABLE UNIT 3-AS-BUILT PLANS-NOVEMBER 28, 2017**


**HAM-75-16.67 STORM WATER POLLUTION PREVENTION PLAN**

NO.	REVISIONS	DATE
AB	AS-BUILT REVISION	11/28/17

STATE OF OHIO  
DEPARTMENT OF TRANSPORTATION

# HAM-75-16.67 DB

CITY OF SHARONVILLE AND  
WEST CHESTER TOWNSHIP  
HAMILTON AND BUTLER COUNTIES

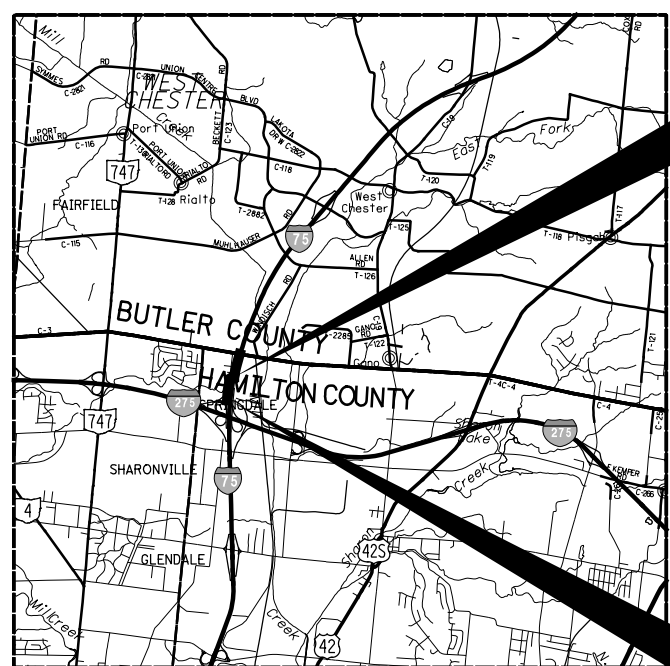

END PROJECT  
STA. 184+63.03

BEGIN PROJECT  
STA. 169+90.00

**PROJECT DESCRIPTION**

IMPROVEMENTS INCLUDE THE RECONFIGURATION OF THE I.R. 75 RAMP TO I.R. 275 BY UTILIZING THE EXISTING SINGLE LANE EXIT FOR TRAFFIC TO GO WEST ON I.R. 275 AND CREATING A SECOND EXIT FOR TRAFFIC TO GO EAST ON I.R. 275. IMPROVEMENTS INCLUDE THE RECONSTRUCTION OF 0.35 MILES OF THE I.R. 75 SOUTHBOUND RAMP TO I.R. 275 WESTBOUND; THE RECONSTRUCTION OF 0.45 MILES OF THE I.R. 75 SOUTHBOUND RAMP TO I.R. 275 EASTBOUND; REPLACEMENT OF ALL OVERHEAD SIGNS AND RELOCATION OF AN EXISTING LIGHT TOWER INCLUDING CONCRETE MEDIAN BARRIER, DRAINAGE AND PAVEMENT MARKINGS.

PROJECT EARTH DISTURBED AREA: 2.46 ACRES  
ESTIMATED CONTRACTOR EARTH DISTURBED AREA: 0.00 ACRES  
NOTICE OF INTENT EARTH DISTURBED AREA: 2.46 ACRES

**LIMITED ACCESS**

THIS IMPROVEMENT IS ESPECIALLY DESIGNED FOR THROUGH TRAFFIC AND HAS BEEN DECLARED A LIMITED ACCESS HIGHWAY OR FREEWAY BY ACTION OF THE DIRECTOR IN ACCORDANCE WITH THE PROVISIONS OF SECTION 5511.02 OF THE OHIO REVISED CODE.

**2016 SPECIFICATIONS**

THE STANDARD SPECIFICATIONS OF THE STATE OF OHIO, DEPARTMENT OF TRANSPORTATION, INCLUDING SUPPLEMENTAL SPECIFICATIONS LISTED IN THE PLANS AND CHANGES LISTED IN THE PROPOSAL SHALL GOVERN THIS IMPROVEMENT.

**INDEX OF SHEETS:**

TITLE SHEET	1
SCHEMATIC PLAN	2
PRIMARY PROJECT CONTROL	3
TYPICAL SECTIONS	4 - 6
GENERAL NOTES	7 - 8
PLANS AND PROFILES	9 - 16
CROSS SECTIONS - RAMP C	17 - 25
CROSS SECTIONS - I.R. 75	26 - 27
TERMINAL DETAILS	28 - 31
PAVEMENT ELEVATION TABLES	32
STORM SEWER PROFILE	33
LIGHTING	34 - 36
TRAFFIC CONTROL	37 - 43

AS-BUILT SHEET REVISIONS DATED 1/29/18:  
1, 4-6, 9, 11, 18-20, 35 AND 38-41

**BUILDABLE UNIT 04  
REMAINING WORK  
AS-BUILTS  
DATE: 1/29/18**

PORTION TO BE IMPROVED

INTERSTATE HIGHWAY	—————
FEDERAL ROUTES	—————
STATE ROUTES	—————
COUNTY & TOWNSHIP ROADS	—————
OTHER ROADS	—————

**DESIGN DESIGNATION** HAM-75-16.67

CURRENT ADT (2017)	81,120
DESIGN YEAR ADT (2037)	101,190
DESIGN HOURLY VOLUME (2037)	6,760
DIRECTIONAL DISTRIBUTION	55%
TRUCKS (24 HOUR B&C)	16%
DESIGN SPEED	70 MPH
LEGAL SPEED	65 MPH
DESIGN FUNCTIONAL CLASSIFICATION	01 URBAN INTERSTATE
NHS PROJECT	YES

**UNDERGROUND UTILITIES**  
CONTACT BOTH SERVICES TWO WORKING DAYS BEFORE YOU DIG.

**OHIO Utilities Protection SERVICE**  
Call Before You Dig  
1-800-362-2764  
(Non-members must be called directly)

**OIL & GAS PRODUCERS UNDERGROUND PROTECTION SERVICE**  
1-800-925-0988

ENGINEERS SEAL:

STATE OF OHIO  
REGISTERED PROFESSIONAL ENGINEER  
MATTHEW E. PHILIPS  
76821

SIGNED: *Matthew E. Philips*  
DATE: 8/17/2017

STANDARD CONSTRUCTION DRAWINGS								SUPPLEMENTAL SPECIFICATIONS	SPECIAL PROVISIONS			
BP-3.1	07/18/14	MGS-1.1	07/19/13	RM-4.3	07/18/14	TC-7.65	01/15/16	TC-52.20	07/15/16	800	01/20/17	
BP-5.1	07/19/13	MGS-2.1	07/19/13	RM-4.4	07/18/14	TC-12.30	01/20/17	TC-61.30	01/20/17	832	01/17/14	
BP-9.1	07/19/13	MGS-3.1	07/18/14	RM-4.5	07/18/14	TC-15.115	10/18/13	TC-65.10	01/17/14	839	07/17/15	
CB-1.1	01/15/16	MGS-4.2	07/19/13	RM-4.6	07/19/13	TC-21.10	01/20/17	TC-65.11	07/15/16	861	01/16/15	
CB-2.3	01/15/16	MGS-5.3	07/15/16			TC-21.20	07/15/16	TC-72.20	07/15/16	878	01/20/17	
CB-3.3	01/15/16			HL-10.31	07/17/15	TC-21.50	07/15/16			902	12/31/12	
CB-3.4	01/15/16			HL-20.11	01/20/17	TC-22.10	10/18/13			939	07/17/15	
DM-1.1	01/15/16			HL-20.21	01/20/17	TC-22.20	01/17/14			992	4/18/14	
DM-1.2	01/18/13			HL-20.24	01/15/16	TC-41.10	07/19/13					
HW-2.1	01/15/16			HL-30.11	01/20/17	TC-41.15	10/18/13					
				HL-30.21	01/17/14	TC-41.20	10/18/13					
				HL-30.22	01/17/14	TC-42.10	10/18/13					
				HL-50.11	01/16/15	TC-42.20	10/18/13					
				HL-60.21	01/16/15	TC-51.11	01/15/16					
						TC-51.12	01/15/16					
						TC-52.10	10/18/13					

PLAN PREPARED BY:

**AECOM**  
AKRON CLEVELAND COLUMBUS  
564 WHITE POND DRIVE  
AKRON, OHIO 44320-1100  
(330) 836-9111

NO.	REVISIONS	DATE
AB	AS-BUILT REVISION	1/29/18

FEDERAL PROJECT NO. **E170(763)**  
 CONSTRUCTION PROJECT NO. **173015**  
 PID NO. **104408**  
 RAILROAD INVOLVEMENT **NONE**  
**BUILDABLE UNIT 4-AS-BUILT PLANS-JANUARY 29, 2018**  
**HAM-75-16.67**

G:\Akron\DCS\Projects\TRN\60547096\_HAM751667\900-CAD-GIS\104408-Design\Roadway\Sheets\104408-GT001.dgn Design 1/23/2018 9:34:57 AM matt.philips




NOTES

\* SEE SHEET 3 FOR PRIMARY PROJECT CONTROL

CALCULATED  
MEP  
CHECKED  
JEM

0 200 400  
HORIZONTAL  
SCALE IN FEET

G:\AKron\DCS\Projects\TRN\60547096\_HAM751667\900-CAD-GIS\104408\_HAM-75-1667\Design\Roadway\Sheets\104408\_CB001.dgn Design 1/23/2018 9:35:09 AM matt.philips

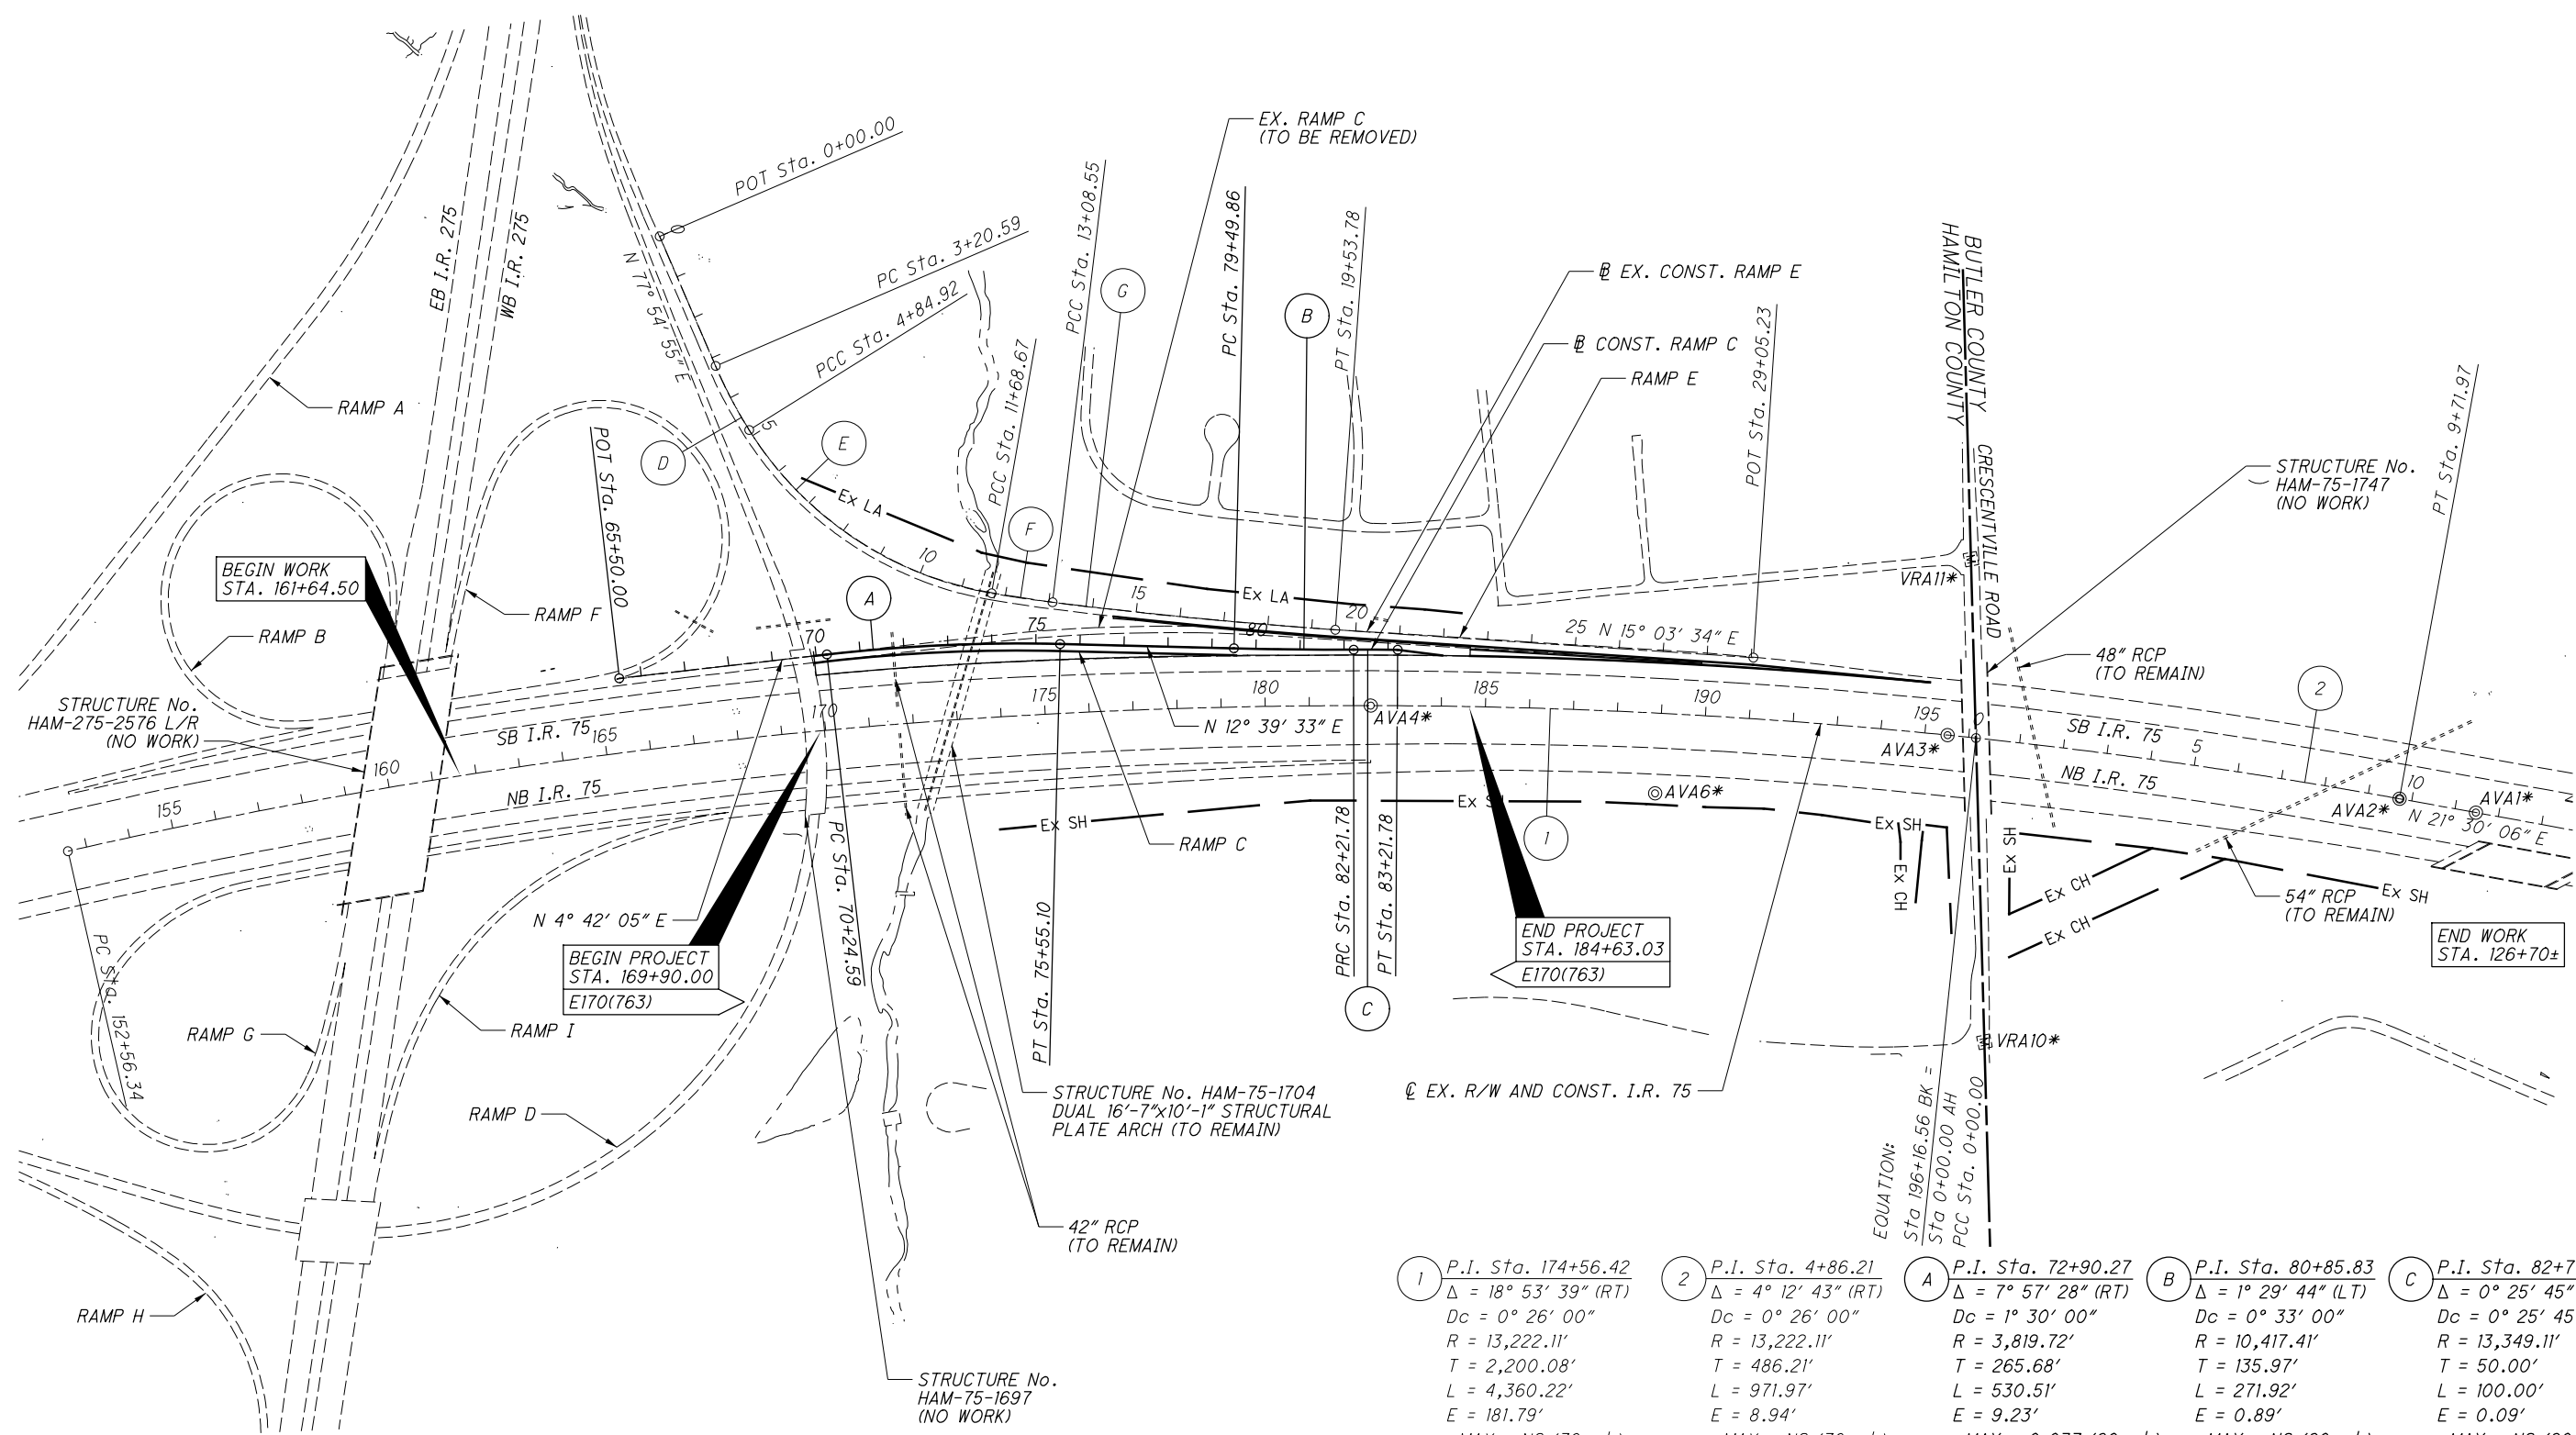

BEGIN WORK  
STA. 161+64.50

BEGIN PROJECT  
STA. 169+90.00  
E170(763)

END PROJECT  
STA. 184+63.03  
E170(763)

END WORK  
STA. 126+70±

<p>1 P.I. Sta. 174+56.42 Δ = 18° 53' 39" (RT) Dc = 0° 26' 00" R = 13,222.11' T = 2,200.08' L = 4,360.22' E = 181.79' eMAX = NC (70mph)</p>	<p>2 P.I. Sta. 4+86.21 Δ = 4° 12' 43" (RT) Dc = 0° 26' 00" R = 13,222.11' T = 486.21' L = 971.97' E = 8.94' eMAX = NC (70mph)</p>	<p>A P.I. Sta. 72+90.27 Δ = 7° 57' 28" (RT) Dc = 1° 30' 00" R = 3,819.72' T = 265.68' L = 530.51' E = 9.23' eMAX = 0.037 (60mph)</p>	<p>B P.I. Sta. 80+85.83 Δ = 1° 29' 44" (LT) Dc = 0° 33' 00" R = 10,417.41' T = 135.97' L = 271.92' E = 0.89' eMAX = NC (60mph)</p>	<p>C P.I. Sta. 82+71.78 Δ = 0° 25' 45" (RT) Dc = 0° 25' 45" R = 13,349.11' T = 50.00' L = 100.00' E = 0.09' eMAX = NC (60mph)</p>
<p>D P.I. Sta. 4+02.91 Δ = 8° 38' 20" (LT) Dc = 5° 15' 25" R = 1,089.89' T = 82.32' L = 164.33' E = 3.10'</p>	<p>E P.I. Sta. 8+48.43 Δ = 48° 07' 57" (LT) Dc = 7° 02' 22" R = 813.92' T = 363.51' L = 683.75' E = 77.49'</p>	<p>F P.I. Sta. 12+38.63 Δ = 3° 03' 32" (LT) Dc = 2° 11' 12" R = 2,620.12' T = 69.96' L = 139.88' E = 0.93'</p>	<p>G P.I. Sta. 16+31.23 Δ = 2° 54' 36" (LT) Dc = 0° 27' 04" R = 12,704.19' T = 322.68' L = 645.23' E = 4.10'</p>	

BUILDABLE UNIT 4-AS-BUILT PLANS--JANUARY 29, 2018

SCHEMATIC PLAN

HAM-75-16.67

PRIMARY PROJECT CONTROL INFORMATION - COMBINED SCALE FACTOR: 1.0000000000							
POINT NUMBER	GRID COORDINATES U.S. SURVEY FEET		STATION	OFFSET	REFERENCE ALIGNMENT	ELEVATION	DESCRIPTION
	NORTHING	EASTING					
AVA1	480455.7260	1419987.1850	11+48.05	-0.04	CENTERLINE EX. R/W AND CONST. I.R. 75	611.98	CENTERLINE MONUMENT
AVA2	480291.8820	1419922.6870	9+71.97	0.00	CENTERLINE EX. R/W AND CONST. I.R. 75	611.82	CENTERLINE MONUMENT
AVA3	479313.3550	1419580.7610	195+51.72	0.04	CENTERLINE EX. R/W AND CONST. I.R. 75	598.53	CENTERLINE MONUMENT
AVA4	478041.7760	1419259.5420	182+39.65	-0.03	CENTERLINE EX. R/W AND CONST. I.R. 75	590.98	CENTERLINE MONUMENT
AVA6	478636.1800	1419580.8990	188+94.91	182.27	CENTERLINE EX. R/W AND CONST. I.R. 75	594.50	CENTERLINE MONUMENT
VRA10	479259.6630	1420280.3290	0+96.92	683.76	CENTERLINE EX. R/W AND CONST. I.R. 75	590.09	MONUMENT BOX
VRA11	479443.4150	1419199.2310	195+64.05	-402.85	CENTERLINE EX. R/W AND CONST. I.R. 75	614.87	MONUMENT BOX


FOR PRIMARY PROJECT CONTROL LOCATIONS IN PLAN, SEE SHEET 2






G:\AKron\DCS\Projects\TRN\60547096\_HAM751667\900-CAD-GIS\104408\_HAM-75-1667\Design\Roadway\Sheets\104408\_GY001.dgn Sheet 1/23/2018 9:35:11 AM matt.philips

**EXISTING LEGEND:**

- (A) ASPHALT, 16.5"±
- (B) ASPHALT, 6.5"±
- (C) CONCRETE, 10"±
- (D) AGGREGATE BASE, 6"±
- (E) UNDERDRAIN, DEPTH VARIES

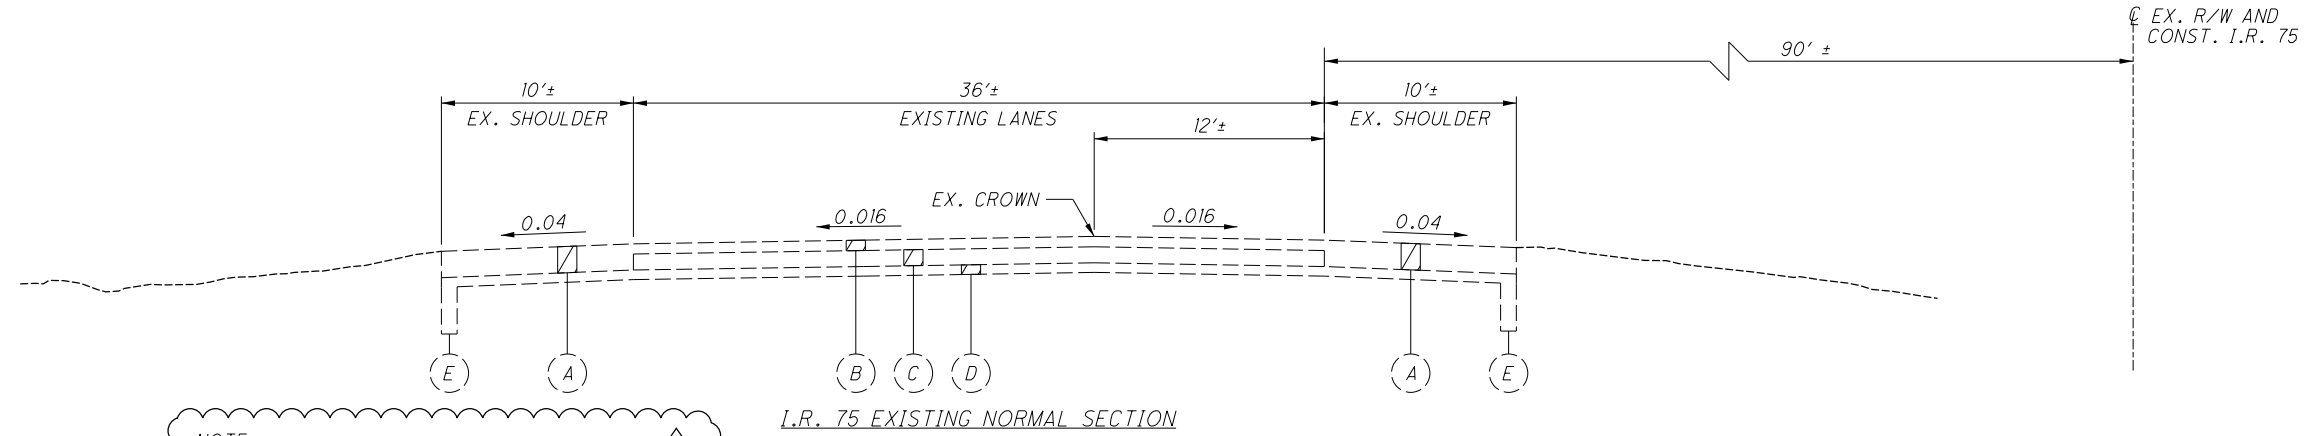

NOTE:  
SOUTHBOUND OUTSIDE SHOULDER BUILD-UP  
FROM STA. 177+75± TO STA. 183+50±  
CONSISTS OF 10"± ASPHALT OVER 10"± CONCRETE.

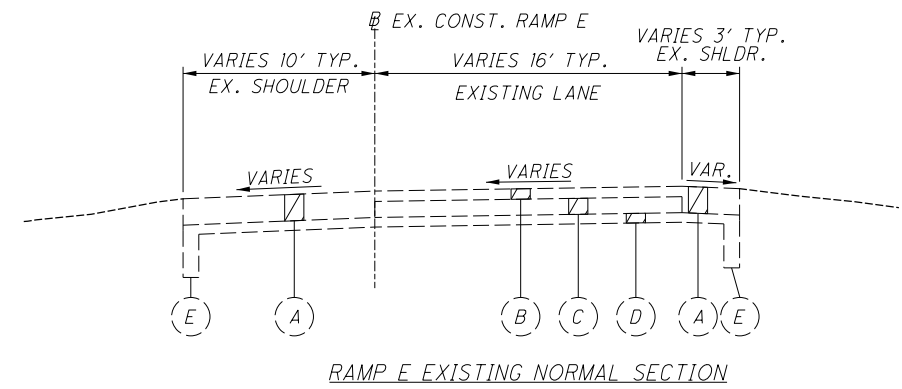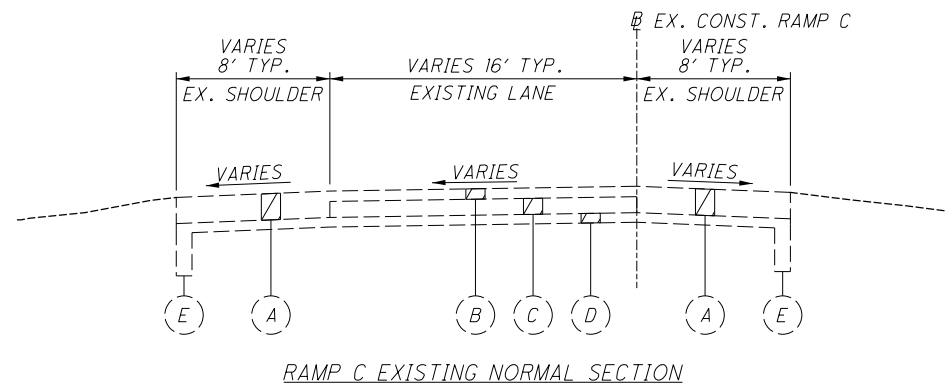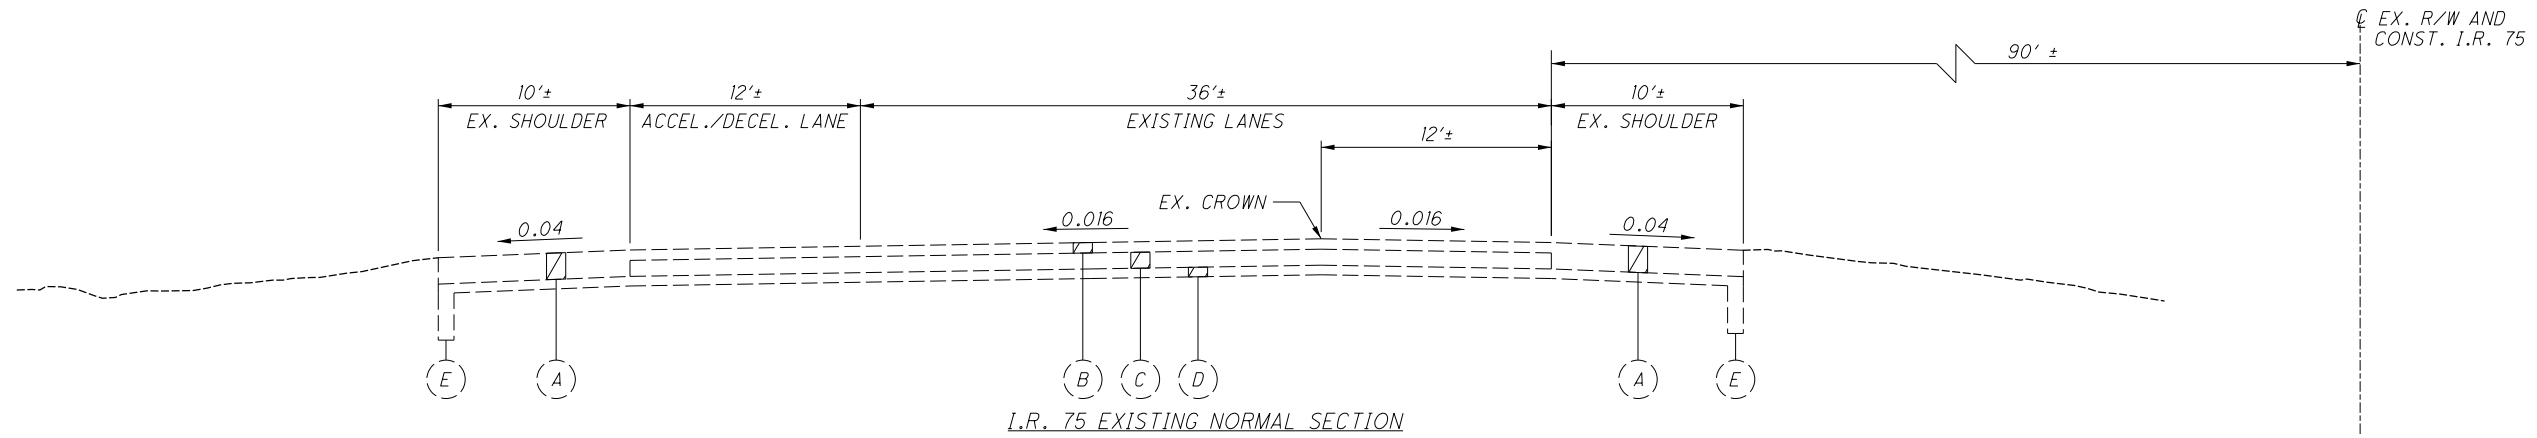

**BUILDABLE UNIT 4-AS-BUILT PLANS--JANUARY 29, 2018**

CALCULATED  
JEM  
CHECKED  
MAW

**EXISTING TYPICAL SECTIONS**

**HAM-75-16.67**

NO.	REVISIONS	DATE
AB	AS-BUILT REVISION	1/29/18

G:\Akron\DCS\Projects\TRN\60547096\_HAM751667\900-CAD-GIS\104408\_HAM-75-1667\Design\Roadway\Sheets\104408\_GY002.dgn Sheet 1/23/2018 9:35:13 AM matt.philips





**PROPOSED LEGEND**

- ① ITEM 204 - EXCAVATION OF SUBGRADE (T=12")
- ② ITEM 204 - GRANULAR MATERIAL, TYPE B, AS PER PLAN
- ③ ITEM 204 - GEOTEXTILE FABRIC, TYPE D
- ④ ITEM 254 - PAVEMENT PLANING, ASPHALT CONCRETE (T=1.5")
- ⑤ ITEM 302 - ASPHALT CONCRETE BASE (T=13")
- ⑥ ITEM 304 - AGGREGATE BASE (T=6")
- ⑦ ITEM 407 - TACK COAT
- ⑧ ITEM 442 - ASPHALT CONCRETE SURFACE COURSE, 12.5mm, TYPE A (446) (T=1.5")
- ⑨ ITEM 442 - ASPHALT CONCRETE INTERMEDIATE COURSE, 19mm, TYPE A (446) (T=2.5")
- ⑩ ITEM 605 - 6" SHALLOW PIPE UNDERDRAINS WITH GEOTEXTILE FABRIC, 707.31 (24" DEEP)
- ⑪ ITEM 659 - SEEDING AND MULCHING, CLASS 2
- ⑫ ITEM 861 - GEOGRID FOR SUBGRADE STABILIZATION
- ⑬ ITEM 252 - FULL DEPTH PAVEMENT SAWING (SAWCUT TO SOUND EDGE OF PAVEMENT; SEE PLAN FOR LOCATIONS)
- ⑭ ITEM 839 - TRENCH DRAIN WITH STANDARD GRATE (ACO TRAFFIKDRAIN)
- ⑮ ITEM 618 - RUMBLE STRIPS, ASPHALT CONCRETE (LIMITS PER SCD BP-9.1)
- ⑯ ITEM 204 - SUBGRADE COMPACTION AND PROOF ROLLING

**NOTES:**

FOR EXISTING PAVEMENT BUILD-UP, SEE SHEET 4

- (1) DO NOT PLACE GEOGRID OR GEOTEXTILE FABRIC OVER UNDERDRAIN.
- (2) VARIES FROM 9.57' AT STA. 69+95 TO 9.44' AT STA. 70+24.62  
VARIES FROM 9.44' AT STA. 70+24.62 TO 6' AT STA. 70+45  
VARIES FROM 6' AT STA. 74+41.41 TO 8' AT STA. 74+91.41
- (3) VARIES FROM 13.86' AT STA. 169+90.30 TO 10' AT STA. 170+85.51

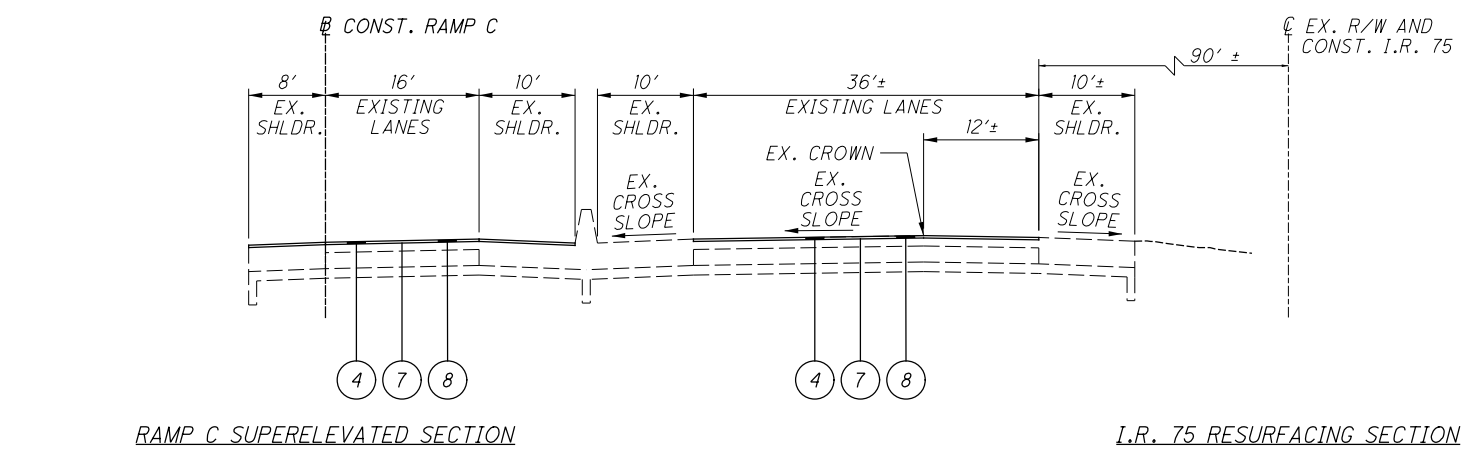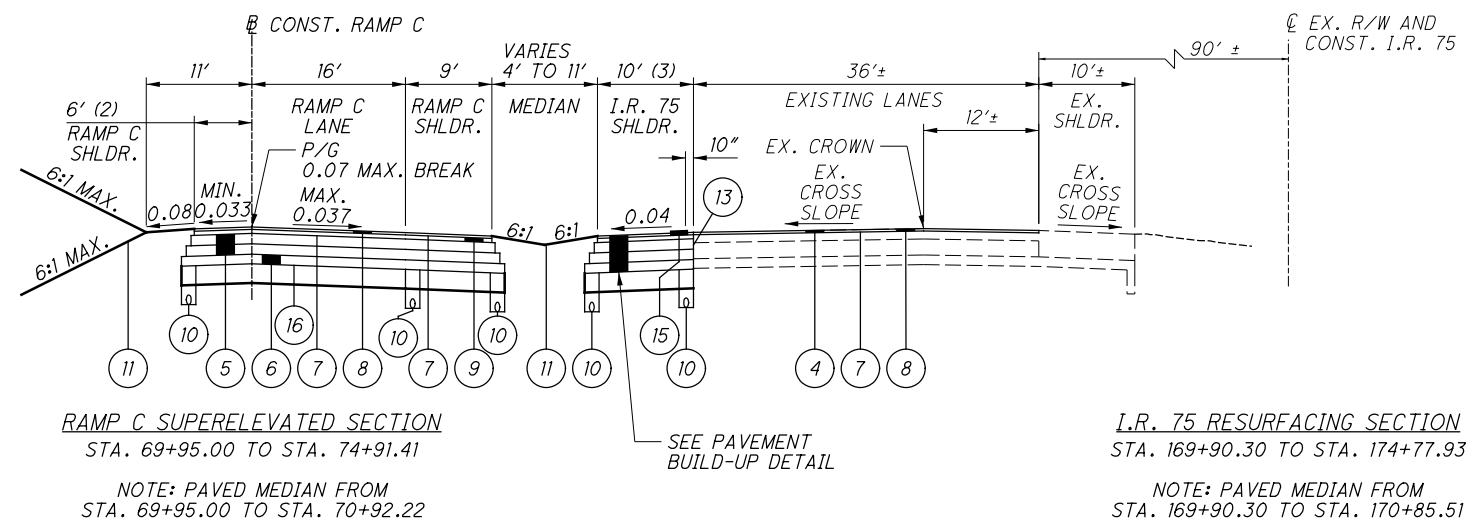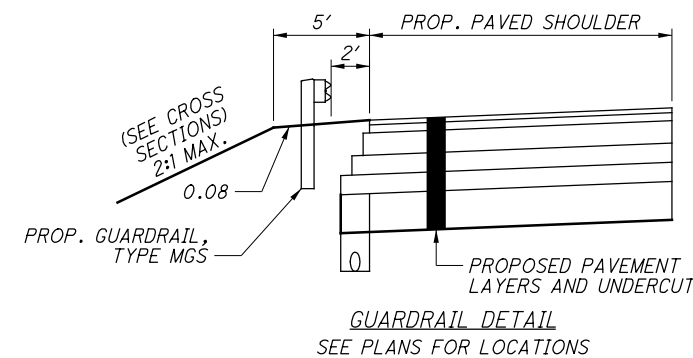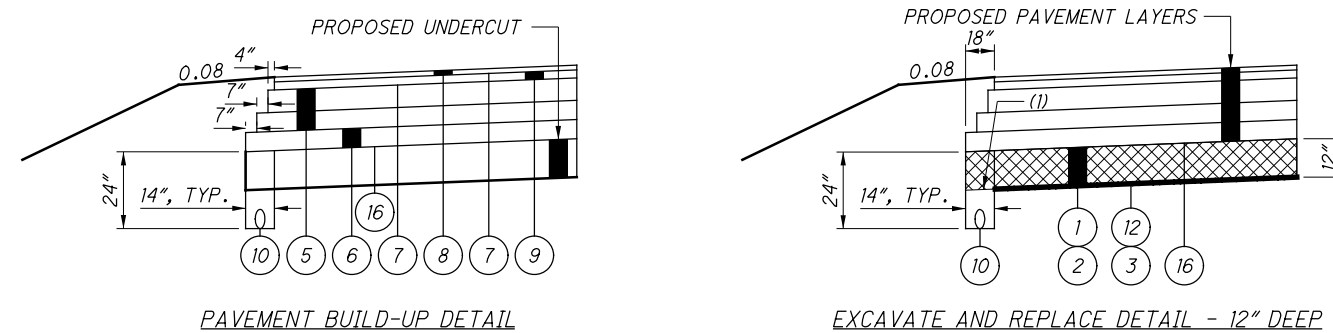


STA. 66+23.00 TO STA. 68+75.00 (LANE RESURFACING)  
 STA. 68+75.00 TO STA. 69+95.00 (LANE AND SHOULDERS CROSS SLOPE TRANSITION)  
 NOTE: SEE PAVEMENT ELEVATION TABLE FOR MORE INFORMATION.


NO.	REVISIONS	DATE
AB	AS-BUILT REVISION	1/29/18

**NOTES:**

- FOR PROPOSED LEGEND, SEE SHEET 5
- (1) VARIES FROM 4.44' AT STA. 14+50 TO 3' AT STA. 15+00.
  - (2) FOR TRENCH DRAIN LIMITS, SEE TERMINAL DETAILS.
  - (3) VARIES FROM 16' AT STA. 79+54.99 TO 12' AT STA. 82+21.78.  
12' FROM STA. 82+21.78 TO STA. 83+21.78.  
VARIES FROM 12' AT STA. 183+00 TO 0' AT STA. 184+00  
(REFERS TO EX. R/W AND CONST. I.R. 75).
  - (4) FOR GORE GEOMETRY, SEE TERMINAL DETAILS.

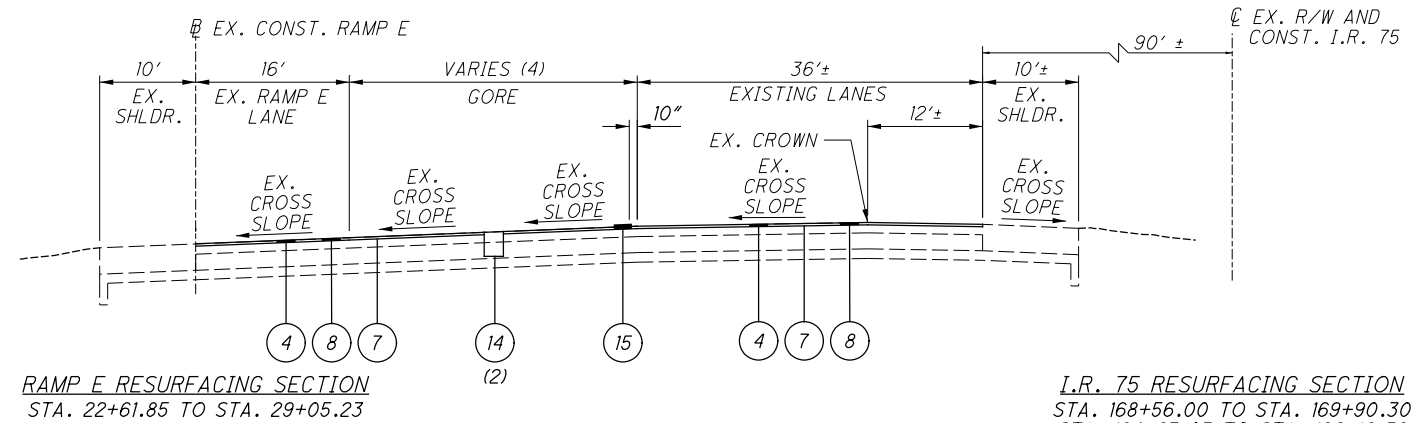


**I.R. 75 RESURFACING SECTION**  
 STA. 168+56.00 TO STA. 169+90.30  
 STA. 184+63.03 TO STA. 196+16.56  
 EQUATION: STA. 196+16.56 BK = STA. 0+00.00 AT  
 STA. 0+00.00 TO STA. 0+22.00

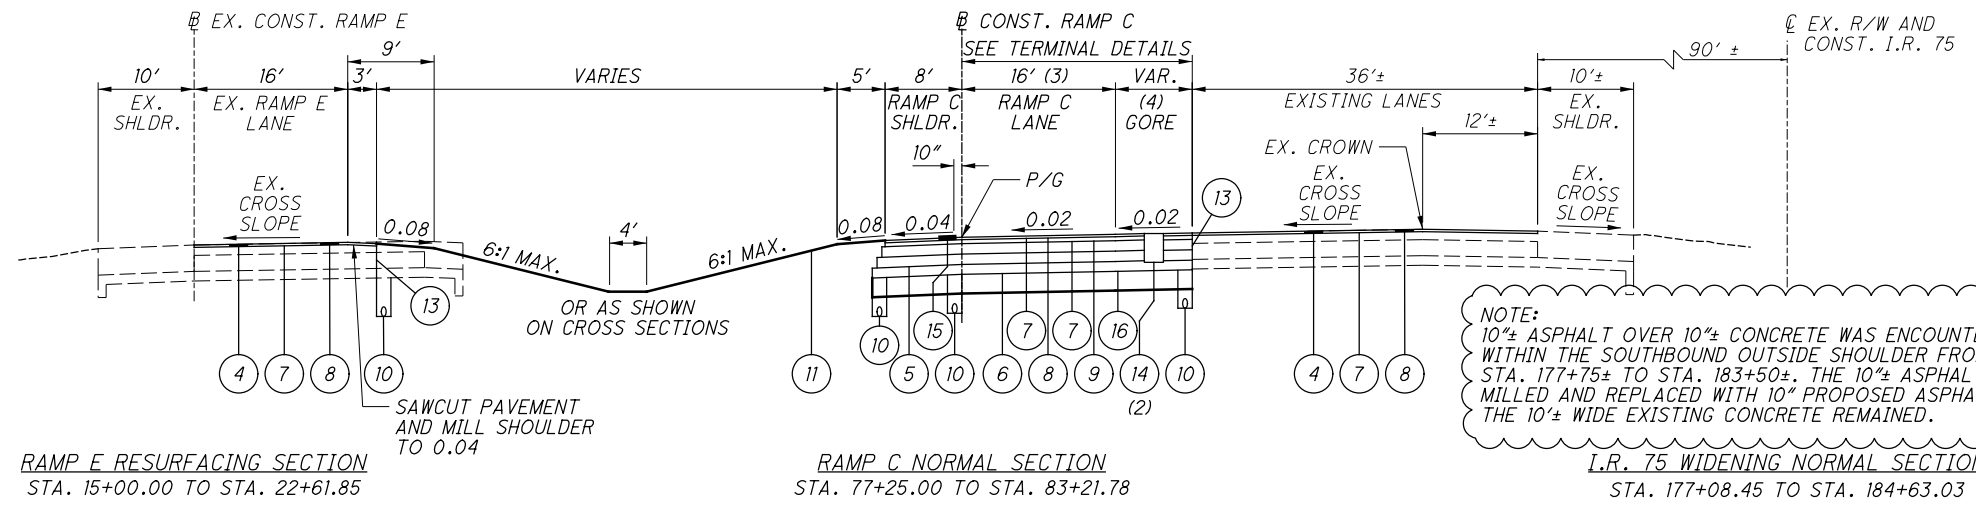

**I.R. 75 WIDENING NORMAL SECTION**  
STA. 177+08.45 TO STA. 184+63.03

**NOTE:**  
 10"± ASPHALT OVER 10"± CONCRETE WAS ENCOUNTERED WITHIN THE SOUTHBOUND OUTSIDE SHOULDER FROM STA. 177+75± TO STA. 183+50±. THE 10"± ASPHALT WAS MILLED AND REPLACED WITH 10" PROPOSED ASPHALT. THE 10"± WIDE EXISTING CONCRETE REMAINED.

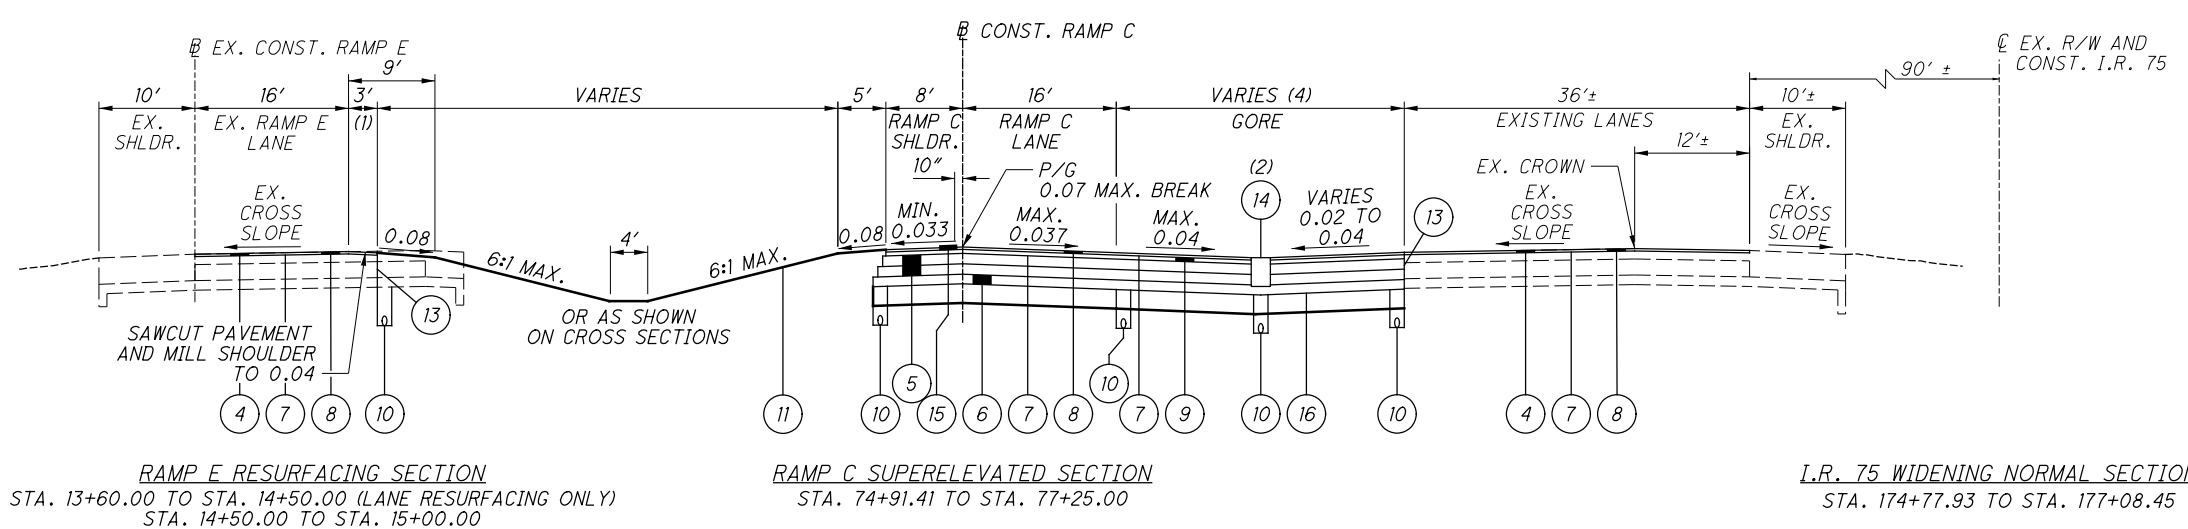

G:\AKron\DCS\Projects\TRN\60547096\_HAM751667\900-CAD-GIS\104408\_HAM-75-1667\Design\Roadway\Sheets\104408\_GY003.dgn Sheet 1/23/2018 9:35:14 AM matt.philips

NO.	REVISIONS	DATE
AB	AS-BUILT REVISION	1/29/18



**GENERAL**

**ROUNDING**

THE ROUNDING AT SLOPE BREAKPOINTS SHOWN ON THE TYPICAL SECTIONS APPLIES TO ALL CROSS-SECTIONS EVEN THOUGH OTHERWISE SHOWN.

**UTILITIES**

LISTED BELOW ARE ALL UTILITIES LOCATED WITHIN THE PROJECT CONSTRUCTION LIMITS TOGETHER WITH THEIR RESPECTIVE OWNERS:

CINCINNATI METROPOLITAN SEWER DISTRICT  
ATTN: WHITNEY DAVIS  
1600 GEST STREET  
CINCINNATI, OH 45204  
513-557-7019  
WHITNEY.DAVIS@CINCINNATI-OH.GOV

LEVEL 3 COMMUNICATIONS  
ATTN: TIM BOYKIN  
1025 ELDORADO BLVD.  
SUITE 43C-420  
BROOMFIELD, CO 80021  
720-888-7280  
TIM.BOYKIN@LEVEL3.COM  
RELO@LEVEL3.COM

DUKE ENERGY - ELECTRIC (DISTRIBUTION)  
ATTN: CRAIG HUTCHISON  
139 E. 4th ST., RM 467A  
CINCINNATI, OH 45202  
513-287-3852  
CRAIG.HUTCHISON@DUKE-ENERGY.COM

ODOT D8 TRAFFIC  
ATTN: JIM JUDD  
505 SOUTH SR741  
LEBANON, OH 45036  
513-933-6692  
JIM.JUDD@DOT.OHIO.GOV

DUKE ENERGY - ELECTRIC (TRANSMISSION)  
ATTN: TIM MEYER  
139 E. 4th ST., RM 552A  
CINCINNATI, OH 45202  
513-287-1266  
TIM.MEYER@DUKE-ENERGY.COM

CITY OF SHARONVILLE PUBLIC WORKS  
ATTN: JOSEPH KEMPE  
SHARONVILLE CITY HALL  
10900 READING RD., RM 160  
SHARONVILLE, OH 45241  
513-563-1177  
JKEMPE@CITYOFSHARONVILLE.COM

DUKE ENERGY - GAS  
ATTN: BRAD SEITER  
139 E. 4th ST., RM 460A  
CINCINNATI, OH 45202  
513-287-4415  
BRADLEY.SEITER@DUKE-ENERGY.COM

SOUTHWESTERN OHIO WATER COMPANY  
ATTN: MICHAEL C. FLAVIN, PE  
600 SHEPHERD AVE., SUITE 1  
CINCINNATI, OH 45215  
513-489-4844  
MIKE.FLAVIN@FUSE.NET

BUTLER COUNTY WATER AND SEWER  
ATTN: JAMES C. GROVE  
130 HIGH STREET  
HAMILTON, OH 45011  
513-785-5172 PHONE  
513-887-3777 FAX  
GROVEJC@BUTLERCOUNTYOHIO.ORG

VERIZON (MCI)  
ATTN: AL GUEST  
120 RAVINE STREET  
AKRON, OH 44303  
330-253-8267

THE LOCATION OF THE UNDERGROUND UTILITIES SHOWN ON THE PLANS ARE AS OBTAINED FROM THE OWNERS AS REQUIRED BY SECTION 153.64 O.R.C.

**ITS**

ITS FACILITIES AREN'T LISTED WITH OUPS, SO THE CONTRACTOR IS REQUIRED TO CONTACT ODOT CENTRAL OFFICE ITS LAB DIRECTLY SO THAT THE ODOT UTILITIES LOCATED WITHIN THIS PROJECT ARE MARKED. THE CONTRACTOR SHALL NOTIFY ODOT CENTRAL OFFICE ITS LAB AT THE CONTACT INFORMATION LISTED BELOW AND THE PROJECT ENGINEER, FOURTEEN (14) CALENDAR DAYS IN ADVANCE OF ANY WORK FOR MARKING OF ODOT OWNED UTILITIES.

CENTRAL OFFICE ITS LAB  
614-387-4113 - PHONE  
614-887-4134 - FAX  
CEN.ITS.LAB@DOT.STATE.OH.US - EMAIL

THE ABOVE REQUIREMENTS ARE IN ADDITION TO SECTION 105.07 AND 107.16 OF THE CONSTRUCTION AND MATERIAL SPECIFICATIONS AND THE UTILITY PROPOSAL NOTE.

THE CONTRACTOR SHALL NOTIFY OTHER UTILITIES THROUGH OUPS OR DIRECTLY A MINIMUM OF FORTY-EIGHT (48) HOURS IN ADVANCE OF WORK.

THE COST FOR THE ABOVE DESCRIBED WORK IS INCIDENTAL TO THE OVERALL BID PRICE OF THE PROJECT.

**SURVEYING PARAMETERS**

PRIMARY PROJECT CONTROL MONUMENTS GOVERN ALL POSITIONING ON ODOT PROJECTS. SEE SHEET 3 OF THE PLANS FOR A TABLE CONTAINING PROJECT CONTROL INFORMATION. USE THE FOLLOWING PROJECT CONTROL, VERTICAL POSITIONING, AND HORIZONTAL POSITIONING PARAMETERS FOR ALL SURVEYING:

**VERTICAL POSITIONING**

ORTHOMETRIC HEIGHT DATUM: NAVD88  
GEOID: GEOID12B

**HORIZONTAL POSITIONING**

REFERENCE FRAME: NAD83 (2011)  
ELLIPSOID: GRS80  
MAP PROJECTION: LAMBERT CONFORMAL CONIC  
COORDINATE SYSTEM: OHIO STATE PLANE, SOUTH ZONE  
COMBINED SCALE FACTOR: 1.00000000

ORIGIN OF COORDINATE SYSTEM: 0,0

USE THE POSITIONING METHODS AND MONUMENT TYPE USED IN THE ORIGINAL SURVEY TO RESTORE ALL MONUMENTS RELATED TO PRIMARY PROJECT CONTROL THAT ARE DAMAGED OR DESTROYED BY CONSTRUCTION ACTIVITIES. RESTORE THE DAMAGED OR DESTROYED MONUMENTS IN ACCORDANCE WITH CMS 623.

UNITS ARE IN U.S. SURVEY FEET.

**WORK LIMITS**

THE WORK LIMITS SHOWN ON THESE PLANS ARE FOR PHYSICAL CONSTRUCTION ONLY. PROVIDE THE INSTALLATION AND OPERATION OF ALL WORK ZONE TRAFFIC CONTROL AND WORK ZONE TRAFFIC CONTROL DEVICES REQUIRED BY THESE PLANS WHETHER INSIDE OR OUTSIDE THESE WORK LIMITS.

**CLEARING AND GRUBBING**

ALTHOUGH THERE ARE NO TREES OR STUMPS SPECIFICALLY MARKED FOR REMOVAL WITHIN THE LIMITS OF THE PROJECT, A LUMP SUM QUANTITY IS INCLUDED IN THE GENERAL SUMMARY FOR ITEM 201, CLEARING AND GRUBBING. ALL PROVISIONS AS SET FORTH IN THE SPECIFICATIONS UNDER THIS ITEM ARE INCLUDED IN THE LUMP SUM PRICE BID FOR ITEM 201, CLEARING AND GRUBBING.

**ITEM 204 - GRANULAR MATERIAL, TYPE B, AS PER PLAN**

THE TYPE B GRANULAR MATERIAL USED TO BACKFILL THE PAVEMENT UNDERCUT SHALL MEET THE REQUIREMENTS OF CMS 304 AND SHALL BE COMPRISED OF CRUSHED CARBONATE STONE. ALL OTHER ASPECTS OF ITEM 204 APPLY TO THIS WORK.

**PROJECT BUILDABLE UNITS**

BUILDABLE UNITS (BUs) ARE PORTIONS OF THE PROJECT WHICH CAN BE DESIGNED, REVIEWED AND BUILT WITH ONLY LIMITED CONTROLS AND ASSUMPTIONS COMING FROM THE DESIGN OF OTHER PORTIONS OF THE PROJECT.

THIS PROJECT HAS BEEN BROKEN INTO FOUR (4) BUs AS FOLLOWS:

- BU01 OVERHEAD SIGNS
- BU02 MAINTENANCE OF TRAFFIC (MOT)
- BU03 STORM WATER POLLUTION PREVENTION PLAN (SWPPP)
- BU04 REMAINING WORK

**ROADWAY**

**ITEM 606 - ANCHOR ASSEMBLY, MGS TYPE E**

THIS ITEM SHALL CONSIST OF FURNISHING AND INSTALLING ANY OF THE GUARDRAIL END TERMINALS FOR TYPE MGS GUARDRAIL AS LISTED ON ROADWAY ENGINEERING'S WEB PAGE UNDER ROADSIDE SAFETY DEVICES FOR APPROVED GUARDRAIL END TREATMENTS. INSTALLATION SHALL BE AT THE LOCATIONS SPECIFIED IN THE PLANS, IN ACCORDANCE WITH THE MANUFACTURER'S SPECIFICATIONS.

THE FACE OF THE TYPE E IMPACT HEAD SHALL BE COVERED WITH A SHEET OF TYPE G REFLECTIVE SHEETING, PER CMS 730.19.

REFER TO THE MANUFACTURER'S INSTRUCTIONS REGARDING THE INSTALLATION OF, AND THE GRADING AROUND THE FOUNDATION TUBES AND GROUND STRUT. THE TOP OF ANY FOUNDATION TUBE SHOULD BE LESS THAN 4 INCHES ABOVE THE GROUND. THE PLACEMENT OF THE FOUNDATION TUBES SHOULD BE AN APPROPRIATE DEPTH BELOW THE LEVEL LINE IN ORDER TO MAINTAIN THE FINISHED GUARDRAIL HEIGHT OF 31 INCHES FROM THE EDGE OF THE SHOULDER.

ON-SITE GRADING IS REQUIRED IF THE TOP OF THE FOUNDATION TUBES OR TOP OF THE GROUND STRUT DOES PROJECT MORE THAN 4 INCHES ABOVE THE GROUND LINE.

PAYMENT FOR THE ABOVE WORK SHALL BE MADE AT THE UNIT PRICE BID FOR ITEM 606, ANCHOR ASSEMBLY, MGS TYPE E, EACH, AND SHALL INCLUDE ALL LABOR, TOOLS, EQUIPMENT AND MATERIALS NECESSARY TO CONSTRUCT A COMPLETE AND FUNCTIONAL ANCHOR ASSEMBLY SYSTEM, INCLUDING ALL RELATED TRANSITIONS, REFLECTIVE SHEETING, HARDWARE, GRADING, EMBANKMENT AND EXCAVATION NOT SEPARATELY SPECIFIED, AS REQUIRED BY THE MANUFACTURER.

**ITEM 606 - IMPACT ATTENUATOR, TYPE 2 (UNIDIRECTIONAL)**

THIS ITEM SHALL CONSIST OF FURNISHING AND INSTALLING ANY OF THE TYPE 2 IMPACT ATTENUATORS AS LISTED ON THE OFFICE OF ROADWAY ENGINEERING'S WEB PAGE (REFER TO THE POSTED SHOP DRAWINGS FOR THE MOST CURRENT APPROVED PRODUCT MODELS). THE FACE OF THE IMPACT HEAD SHALL BE COVERED WITH TYPE G REFLECTIVE SHEETING, PER CMS 730.19.

PAYMENT FOR THE ABOVE WORK SHALL BE MADE AT THE UNIT PRICE BID FOR ITEM 606, IMPACT ATTENUATOR, TYPE 2 (UNIDIRECTIONAL), EACH, AND SHALL INCLUDE ALL LABOR, TOOLS, EQUIPMENT AND MATERIALS NECESSARY TO CONSTRUCT A COMPLETE AND FUNCTIONAL IMPACT ATTENUATOR SYSTEM, INCLUDING ALL RELATED BACKUPS/BACKSTOPS, TRANSITIONS, HARDWARE AND GRADING, NOT SEPARATELY SPECIFIED, AS REQUIRED BY THE MANUFACTURER. INSTALLATION SHALL BE AT THE LOCATIONS SPECIFIED IN THE PLANS, IN ACCORDANCE WITH THE MANUFACTURER'S SPECIFICATIONS.

**EROSION CONTROL**

**SEEDING AND MULCHING**

THE FOLLOWING QUANTITIES ARE PROVIDED TO PROMOTE GROWTH AND CARE OF PERMANENT SEEDING AREAS:

- 659, SOIL ANALYSIS TEST, EACH
- 659, SEEDING AND MULCHING, CLASS 2, SY
- 659, REPAIR SEEDING AND MULCHING, SY
- 659, INTER-SEEDING, SY
- 659, COMMERCIAL FERTILIZER, TON
- 659, LIME, SY
- 659, WATER, MGAL

SEEDING AND MULCHING SHALL BE APPLIED TO ALL AREAS OF EXPOSED SOIL BETWEEN THE RIGHT-OF-WAY LINES, AND WITHIN THE CONSTRUCTION LIMITS FOR AREAS OUTSIDE THE RIGHT-OF-WAY LINES COVERED BY WORK AGREEMENT OR SLOPE EASEMENT. QUANTITY CALCULATIONS FOR SEEDING AND MULCHING ARE BASED ON THESE LIMITS.

G:\Akron\DCS\Projects\TRN\60547096\_HAM751667\900-CAD-GIS\104408\_HAM-75-1667\Design\Roadway\Sheets\104408\_GN001.dgn Design 1/23/2018 9:35:16 AM matt.philips

BUILDABLE UNIT 4-AS-BUILT PLANS - JANUARY 29, 2018

HAM-75-16.67

GENERAL NOTES

CALCULATED  
MEP  
CHECKED  
JEM

**DRAINAGE**

**CROSSINGS AND CONNECTIONS TO EXISTING PIPES AND UTILITIES**

WHERE PLANS PROVIDE FOR A PROPOSED CONDUIT TO BE CONNECTED TO, OR CROSS OVER OR UNDER AN EXISTING SEWER OR UNDERGROUND UTILITY, THE CONTRACTOR SHALL LOCATE THE EXISTING PIPES OR UTILITIES BOTH AS TO LINE AND GRADE BEFORE STARTING TO LAY THE PROPOSED CONDUIT.

IF IT IS DETERMINED THAT THE ELEVATION OF THE EXISTING CONDUIT, OR EXISTING APPURTENANCE TO BE CONNECTED, DIFFERS FROM THE PLAN ELEVATION OR RESULTS IN A CHANGE IN THE PLAN CONDUIT SLOPE, THE ENGINEER SHALL BE NOTIFIED BEFORE STARTING CONSTRUCTION OF ANY PORTION OF THE PROPOSED CONDUIT WHICH WILL BE AFFECTED BY THE VARIANCE IN THE EXISTING ELEVATIONS.

IF IT IS DETERMINED THAT THE PROPOSED CONDUIT WILL INTERSECT AN EXISTING SEWER OR UNDERGROUND UTILITY IF CONSTRUCTED AS SHOWN ON THE PLAN, THE ENGINEER SHALL BE NOTIFIED BEFORE STARTING CONSTRUCTION OF ANY PORTION OF THE PROPOSED CONDUIT WHICH WOULD BE AFFECTED BY THE INTERFERENCE WITH AN EXISTING FACILITY.

PAYMENT FOR ALL THE OPERATIONS DESCRIBED ABOVE SHALL BE INCLUDED IN THE CONTRACT PRICE FOR THE PERTINENT 6" CONDUIT ITEM.

**REVIEW OF DRAINAGE FACILITIES**

BEFORE ANY WORK IS STARTED ON THE PROJECT AND AGAIN BEFORE FINAL ACCEPTANCE BY THE STATE, REPRESENTATIVES OF THE STATE AND THE CONTRACTOR, ALONG WITH LOCAL REPRESENTATIVES, SHALL MAKE AN INSPECTION OF ALL EXISTING SEWERS WHICH ARE TO REMAIN IN SERVICE AND WHICH MAY BE AFFECTED BY THE WORK. THE CONDITION OF THE EXISTING CONDUITS AND THEIR APPURTENANCE SHALL BE DETERMINED FROM FIELD OBSERVATIONS. RECORDS OF THE INSPECTION SHALL BE KEPT IN WRITING BY THE STATE.

ALL NEW CONDUITS, INLETS, CATCH BASINS, AND MANHOLES CONSTRUCTED AS A PART OF THE PROJECT SHALL BE FREE OF ALL FOREIGN MATTER AND IN A CLEAN CONDITION BEFORE THE PROJECT WILL BE ACCEPTED BY THE STATE.

ALL EXISTING SEWERS INSPECTED INITIALLY BY THE ABOVE MENTIONED PARTIES SHALL BE MAINTAINED AND LEFT IN A CONDITION REASONABLY COMPARABLE TO THAT DETERMINED BY THE ORIGINAL INSPECTION. ANY CHANGE IN THE CONDITION RESULTING FROM THE CONTRACTOR'S OPERATIONS SHALL BE CORRECTED BY THE CONTRACTOR TO THE SATISFACTION OF THE ENGINEER.

PAYMENT FOR ALL OPERATIONS DESCRIBED ABOVE SHALL BE INCLUDED IN THE CONTRACT PRICE FOR THE PERTINENT 6" CONDUIT ITEMS.

**EXISTING SUBSURFACE DRAINAGE**

PROVIDE UNOBSTRUCTED OUTLETS FOR ALL EXISTING UNDERDRAINS OR AGGREGATE DRAINS ENCOUNTERED DURING CONSTRUCTION.

PROVIDE AN OUTLET PER STANDARD CONSTRUCTION DRAWING DM-1.1 FOR ALL UNDERDRAINS THAT OUTLET TO A SLOPE. UNDERDRAINS THAT CAN BE CONNECTED TO THE NEW OR EXISTING UNDERDRAINS AT THE END OF THE PROJECT LIMITS AS WELL AS ALL NECESSARY BENDS OR BRANCHES REQUIRED FOR CONNECTION ARE INCLUDED IN THE BASIS OF PAYMENT FOR UNCLASSIFIED PIPE UNDERDRAINS.

THE FOLLOWING ITEMS HAVE BEEN INCLUDED IN THE GENERAL SUMMARY FOR THE WORK NOTED ABOVE:

- 601, TIED CONCRETE BLOCK MAT, TYPE 1, SY
- 605, AGGREGATE DRAINS, FT
- 611, 6" CONDUIT, TYPE F, FT
- 611, PRECAST REINFORCED CONCRETE OUTLET, EACH
- 605, 6" UNCLASSIFIED PIPE UNDERDRAINS, FT

**PAVEMENT**

**PART-WIDTH CONSTRUCTION**

BECAUSE OF THE NECESSITY TO BUILD THIS PROJECT UNDER TRAFFIC AND TO CONSTRUCT THE FULL PAVEMENT WIDTH IN STAGES, EXERCISE CARE TO PREVENT THE CONSTRUCTION OF A BUTT JOINT IN THE BASE COURSES. LAP LONGITUDINAL JOINTS AS SHOWN ON STANDARD CONSTRUCTION DRAWING BP-3.1.

**WATER QUALITY**

**POST CONSTRUCTION STORM WATER TREATMENT**

THIS PLAN UTILIZES STRUCTURAL BEST MANAGEMENT PRACTICES (BMP'S) FOR POST CONSTRUCTION STORM WATER TREATMENT. SEE BU03 (SWPPP) FOR MORE INFORMATION.

CALCULATED
MEP
CHECKED
JEM

**BUILDABLE UNIT 4-AS-BUILT PLANS--JANUARY 29, 2018**

**GENERAL NOTES**




 
**HAM-75-16.67**

8  
43

G:\AKron\DCS\Projects\TRN\60547096\_HAM751667\900-CAD-GIS\104408\_HAM-75-1667\Design\Roadway\Sheets\104408\_GN002.dgn Design 1/23/2018 9:35:17 AM matt.phillips

G:\Akron\DCS\Projects\TRN\60547096\_HAM751667\900-CAD-GIS\104408\_HAM-75-1667\Design\Roadway\Sheets\104408\_GPO01.dgn Design 1/23/2018 9:35:27 AM matt.phillips


**LEGEND**

-  PAVEMENT OR CONCRETE BARRIER TO BE REMOVED
-  RESURFACING FOLLOWING MOT
-  RESURFACING AND CROSS SLOPE TRANSITION
-  VEGETATED FILTER STRIP (SEE BU03 FOR MORE INFORMATION)

1 P.I. Sta. 174+56.42  
 $\Delta = 18^\circ 53' 39''$  (RT)  
 $D_c = 0^\circ 26' 00''$   
 $R = 13,222.11'$   
 $T = 2,200.08'$   
 $L = 4,360.22'$   
 $E = 181.79'$   
 $e_{MAX} = NC$  (70mph)

CALCULATED  
 JEM  
 CHECKED  
 MEP

0 20 40  
 HORIZONTAL  
 SCALE IN FEET

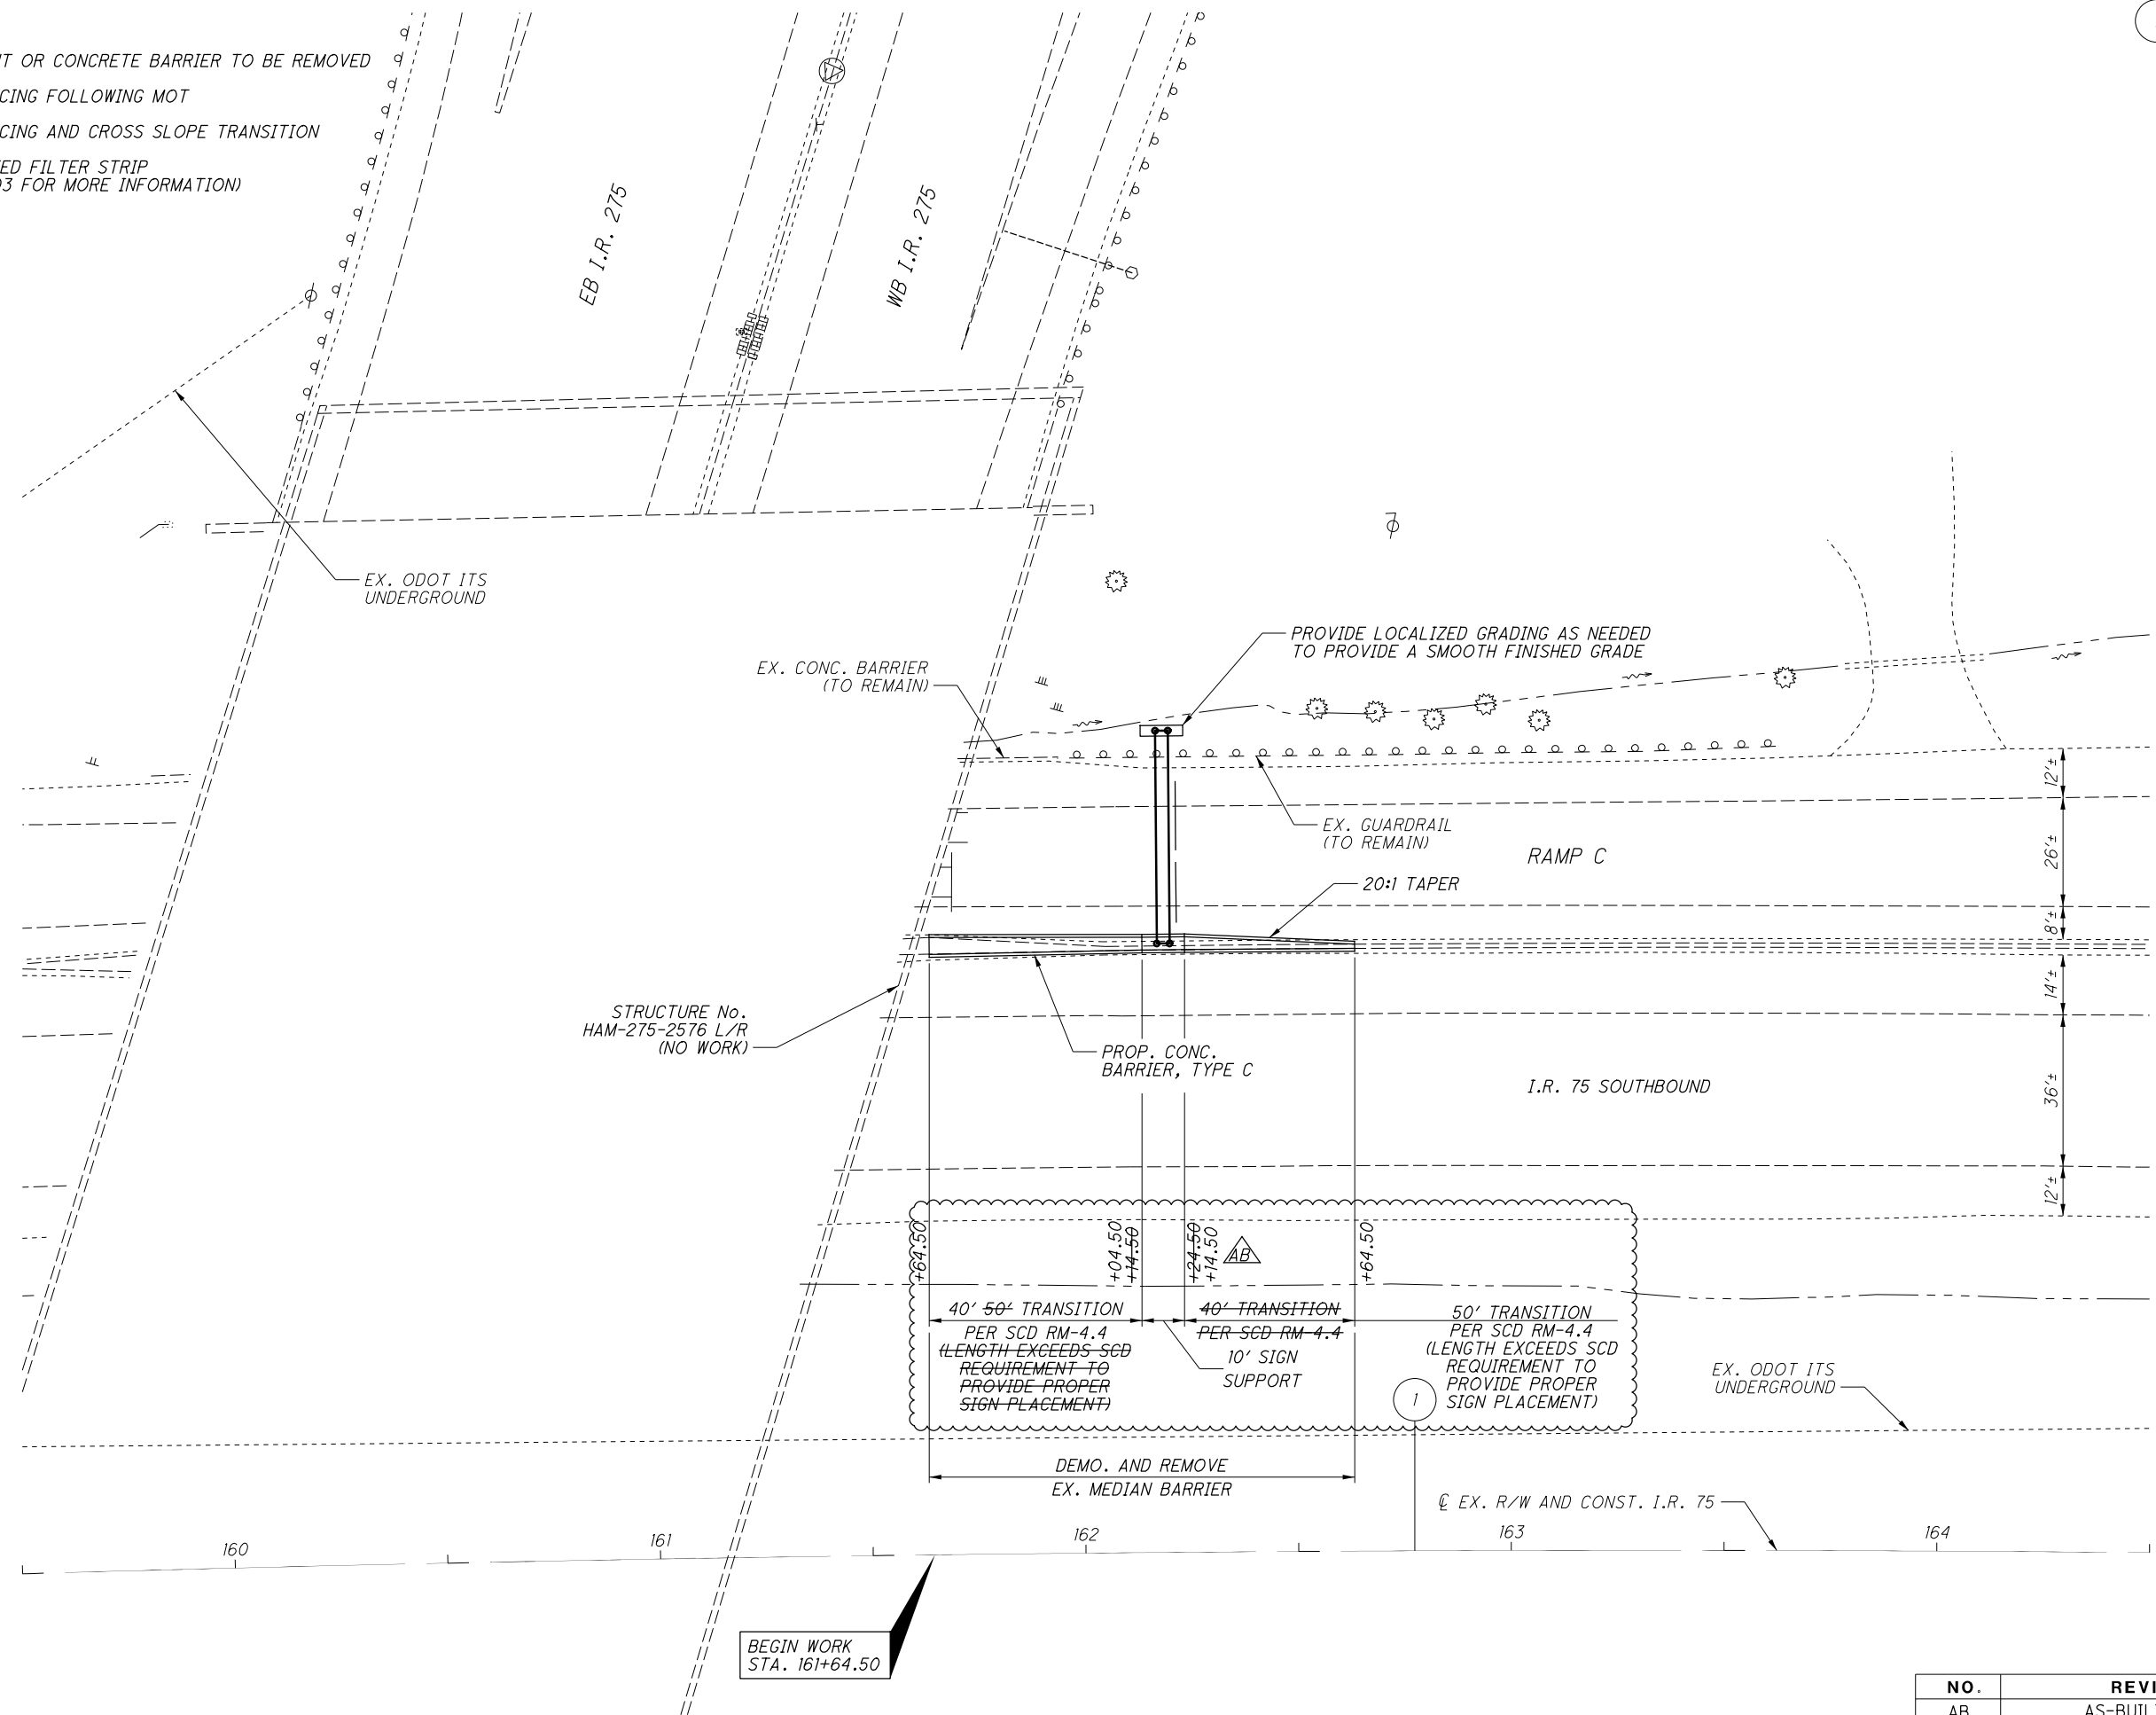

BEGIN WORK  
 STA. 161+64.50

**BUILDABLE UNIT 4-AS-BUILT PLANS--JANUARY 29, 2018**

**PLAN - I.R. 75**

**STA. 159+50.0 TO STA. 164+50.00**

**HAM-75-16.67**

NO.	REVISIONS	DATE
AB	AS-BUILT REVISION	1/29/18


9  
 43

CROSS REFERENCES


FOR PAVEMENT AND SHOULDER TAPERS, SEE SHEET 5  
 FOR LEGEND, SEE SHEET 9  
 FOR CROSS SECTIONS, SEE SHEET 17  
 FOR RAMP C PAVEMENT ELEVATION TABLE, SEE SHEET 32

NOTES

(A) INSTALL CURB, TYPE 4-C FROM STA. 70+06.47 TO STA. 70+24.62 PER SCD MGS-3.1.

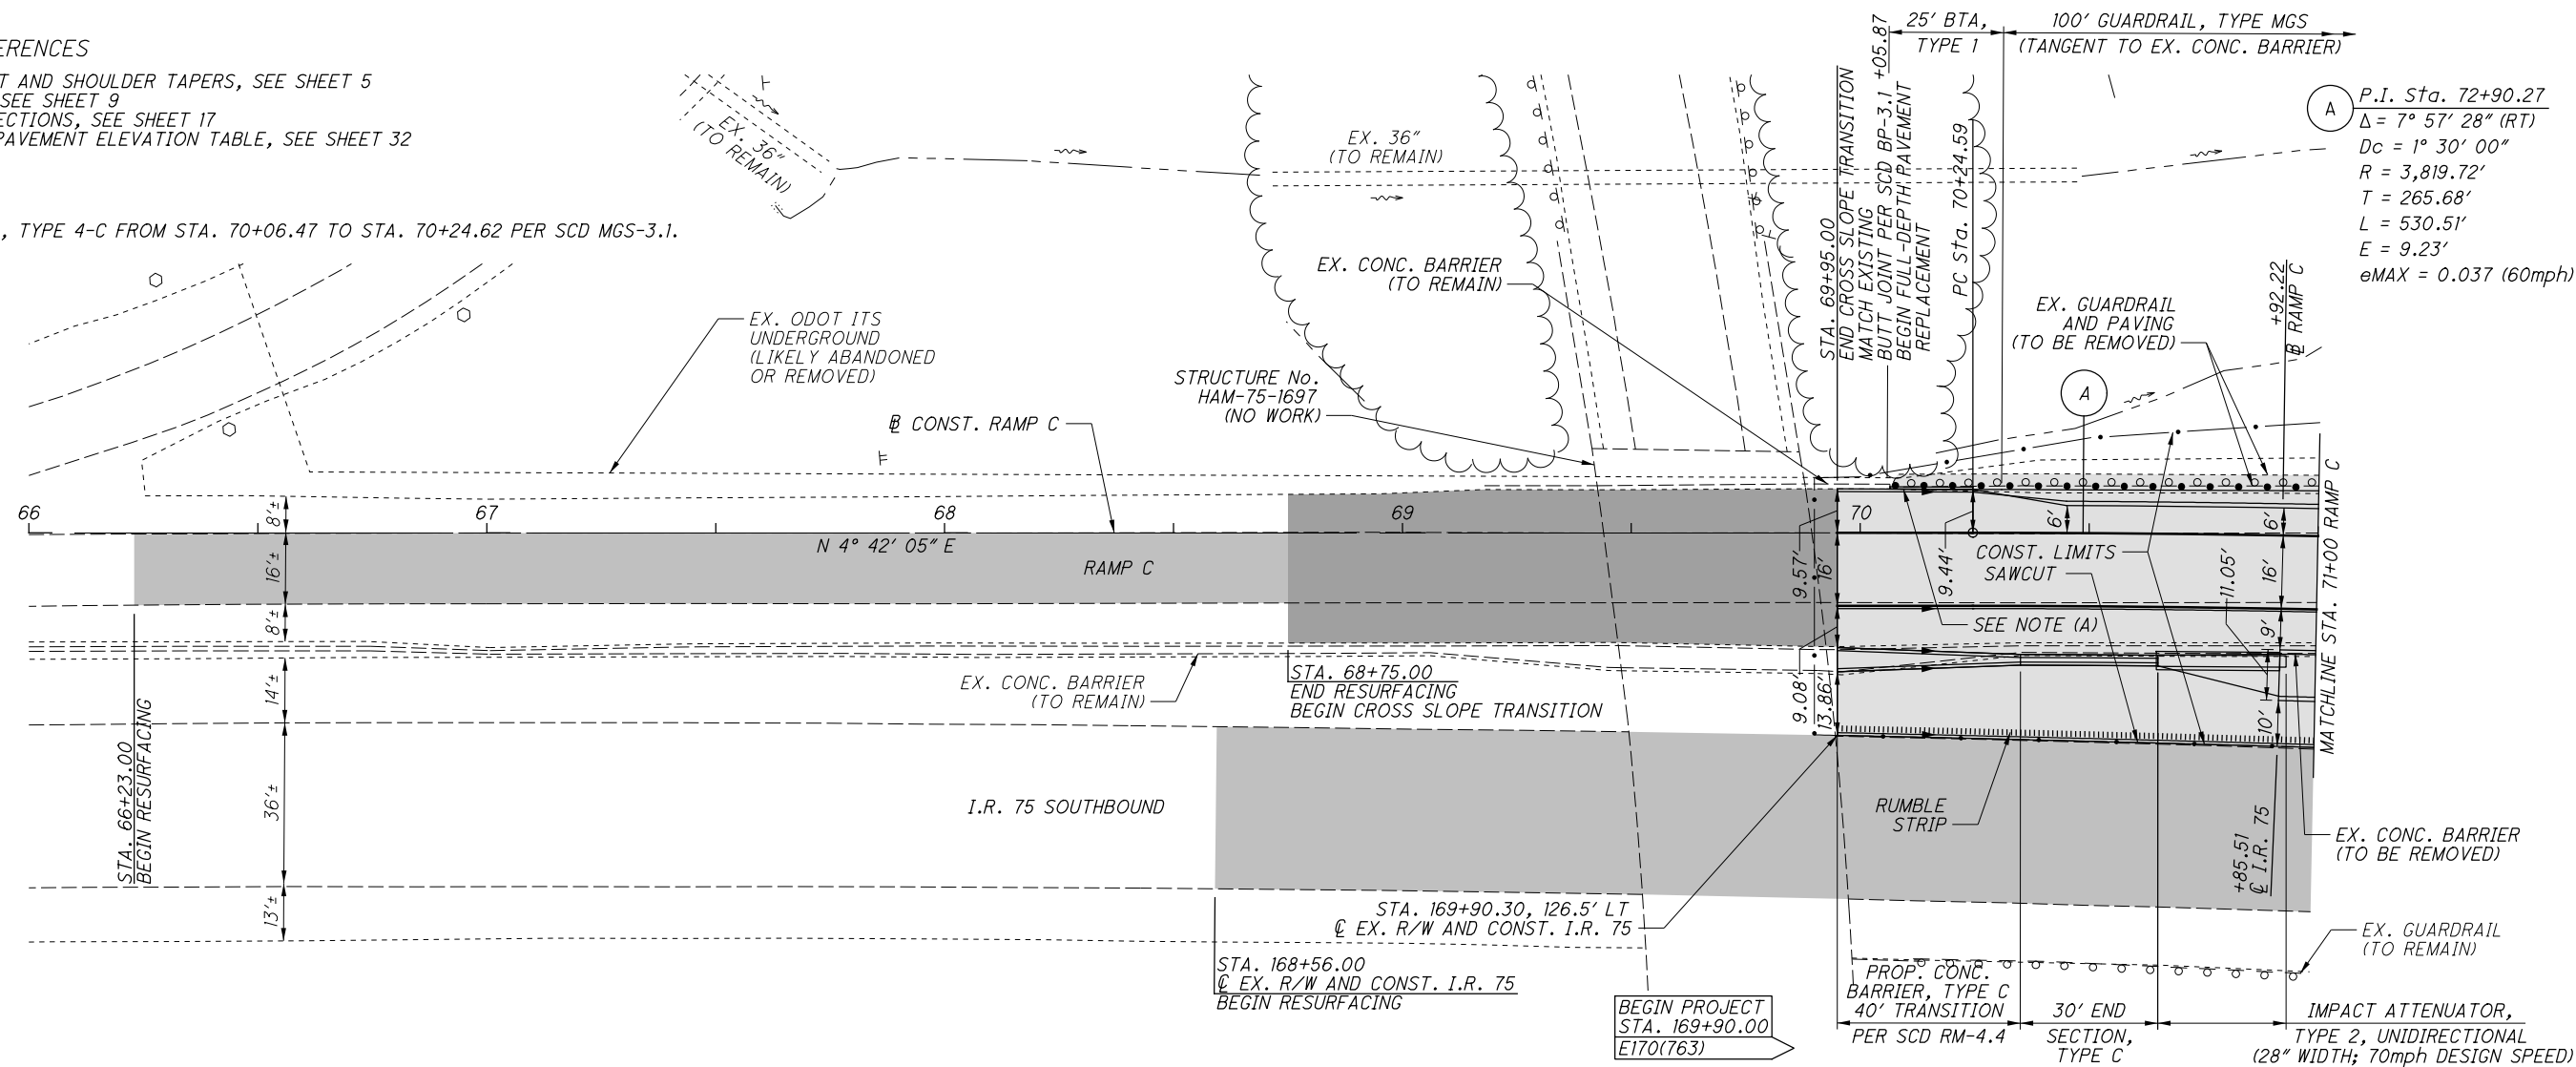

(A) P.I. Sta. 72+90.27  
 $\Delta = 7^\circ 57' 28''$  (RT)  
 $D_c = 1^\circ 30' 00''$   
 $R = 3,819.72'$   
 $T = 265.68'$   
 $L = 530.51'$   
 $E = 9.23'$   
 $e_{MAX} = 0.037$  (60mph)

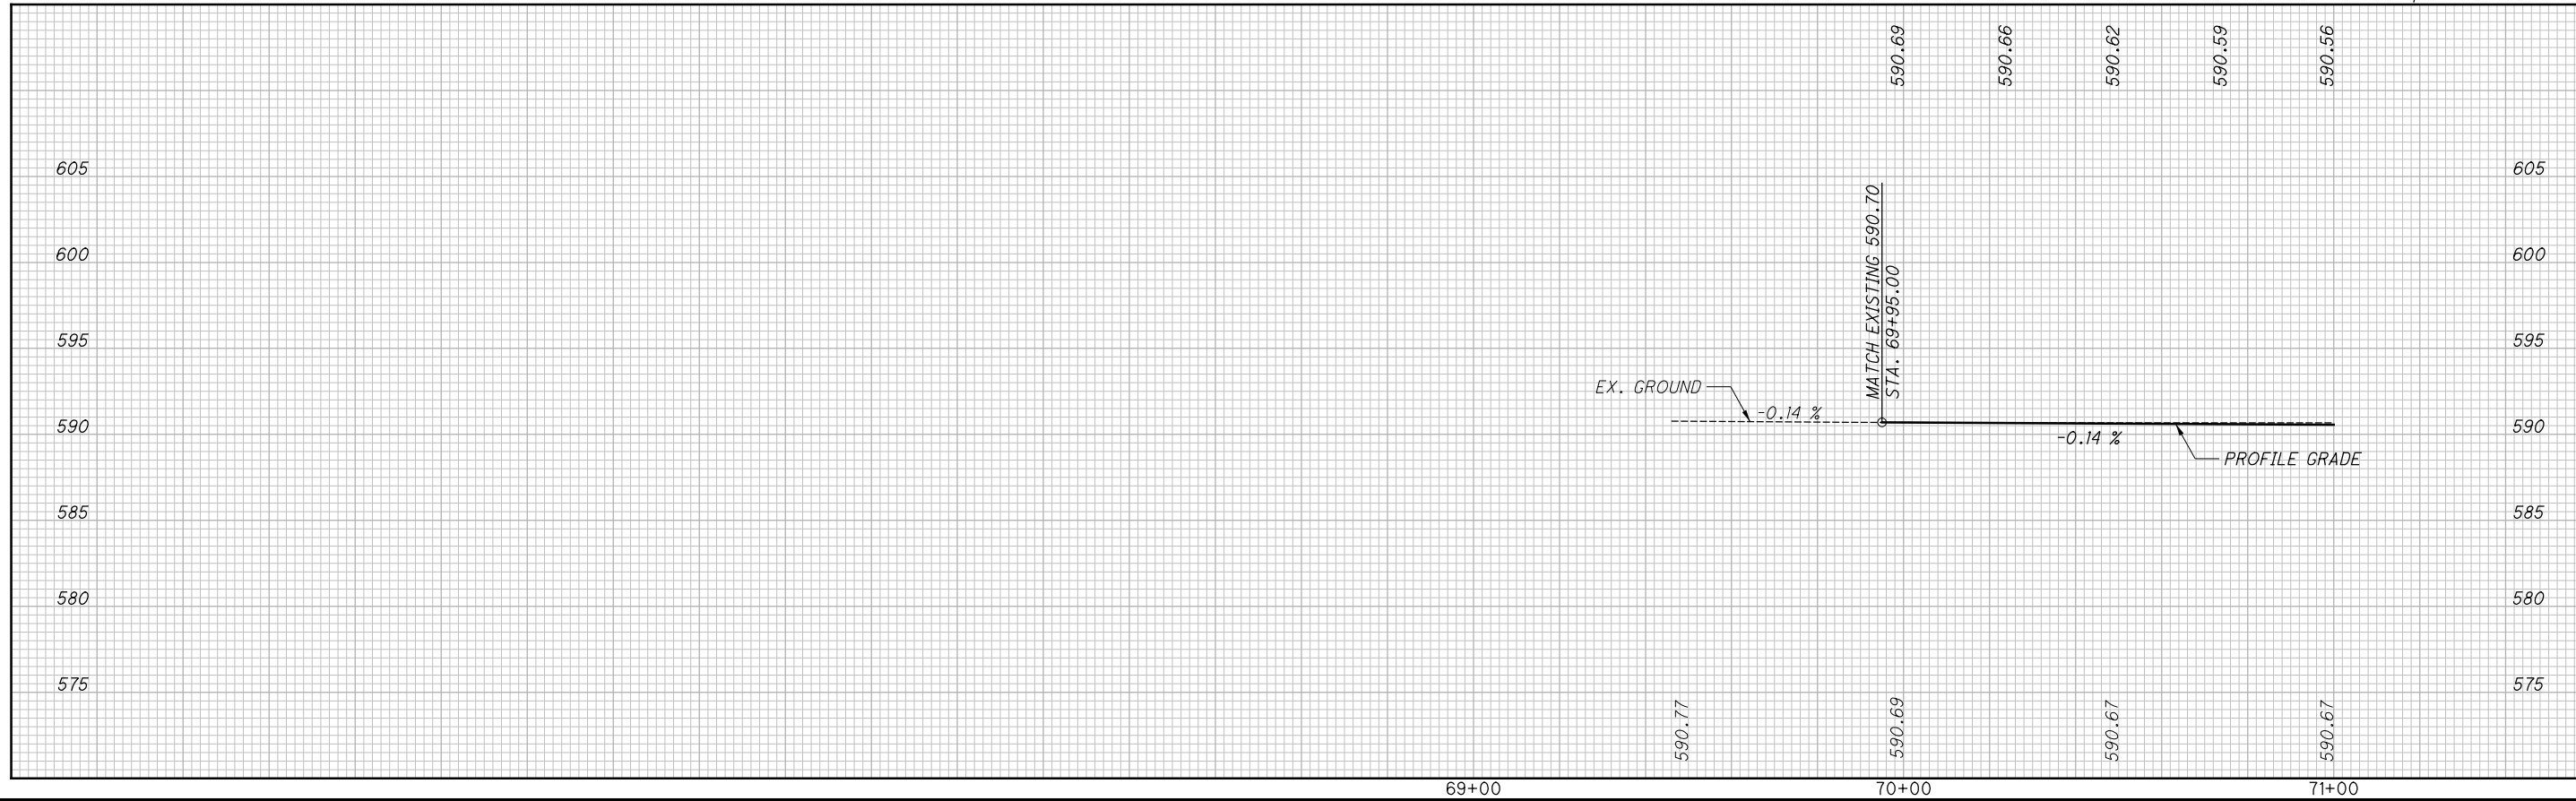

BUILDABLE UNIT 4-AS-BUILT PLANS-JANUARY 29, 2018  
 PLAN AND PROFILE - RAMP C  
 STA. 66+00.00 TO STA. 71+00.00  
 HAM-75-16.67  
 10/43

G:\AKron\DCS\Projects\TRN\60547096\_HAM751667\900-CAD-GIS\104408\_HAM-75-1667\Design\Roadway\Sheets\104408\_GPO02.dgn Design 1/23/2018 9:35:36 AM matt.philips




G:\AKron\Projects\TRN\60547096\_HAM751667\900-CAD-GIS\104408\_HAM-75-1667\Design\Roadway\Sheets\104408\_GPO03.dgn Design 1/23/2018 9:35:46 AM matt.philips

**CROSS REFERENCES**  
 FOR LEGEND, SEE SHEET 9  
 FOR CROSS SECTIONS, SEE SHEETS 17- 20  
 FOR TERMINAL DETAILS, SEE SHEET 28  
 FOR RAMP C PAVEMENT ELEVATION TABLE, SEE SHEET 32

**NOTES**  
 (A) STA. 72+16.8, 36.0' LT  
 $E = 586.0$   
 PRECAST REINFORCED CONCRETE OUTLET PER SCD DM-1.1  
 48"x48" TIED CONCRETE BLOCK MAT, TYPE 1


STRUCTURE No. HAM-75-1704  
 DUAL 16'-7"x10'-1" STRUCTURAL  
 PLATE ARCH (TO REMAIN)  
 NOTE: CONTRACTOR SHALL  
 MAINTAIN COVER OVER EX.  
 ARCHES AT ALL TIMES

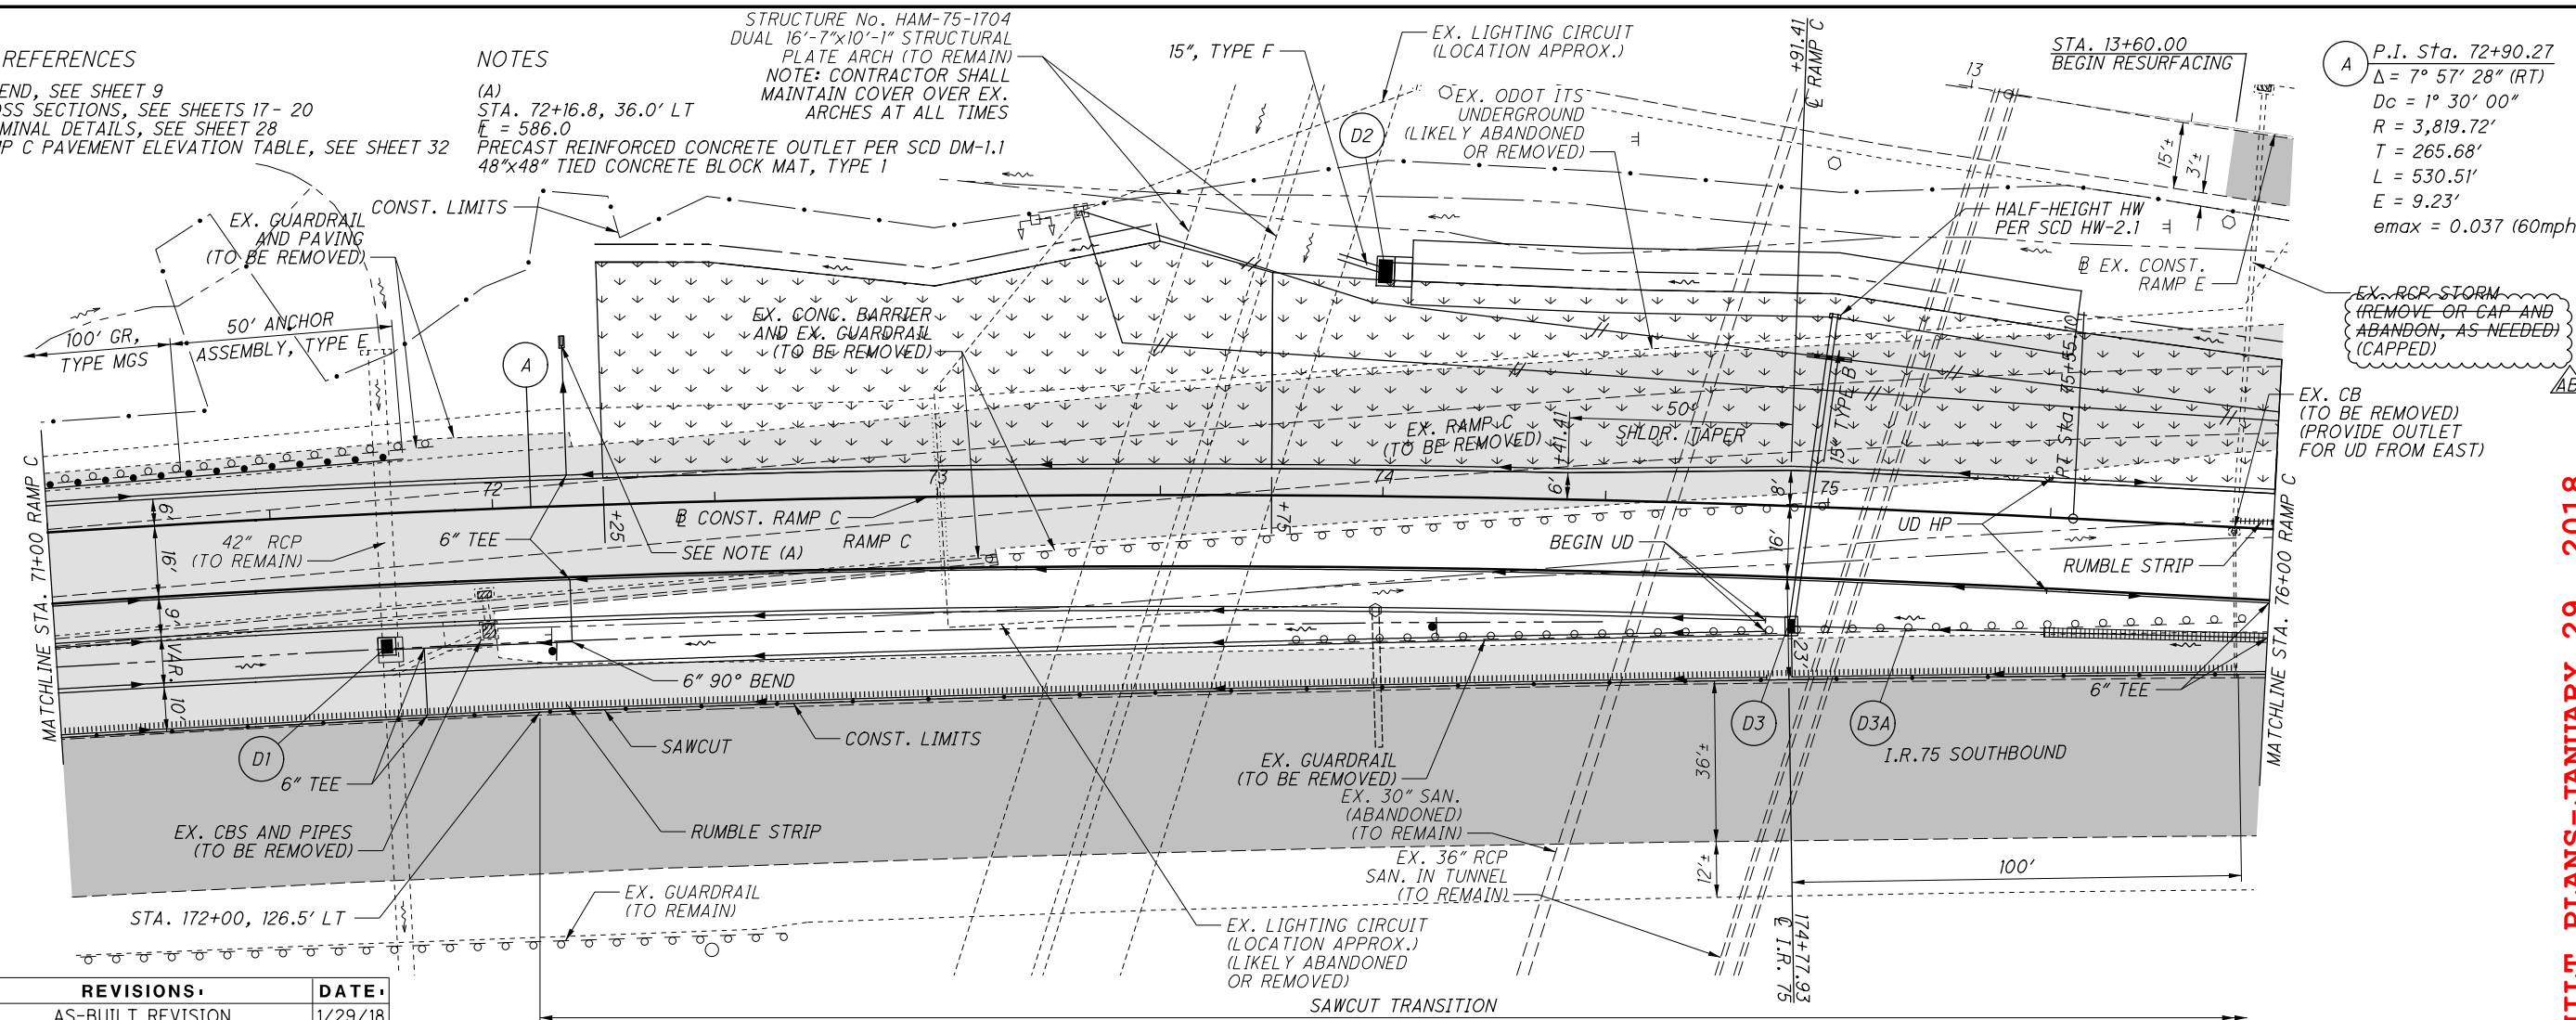

(A) P.I. Sta. 72+90.27  
 $\Delta = 7^\circ 57' 28''$  (RT)  
 $D_c = 1^\circ 30' 00''$   
 $R = 3,819.72'$   
 $T = 265.68'$   
 $L = 530.51'$   
 $E = 9.23'$   
 $e_{max} = 0.037$  (60mph)



NO.	REVISIONS	DATE
AB	AS-BUILT REVISION	1/29/18

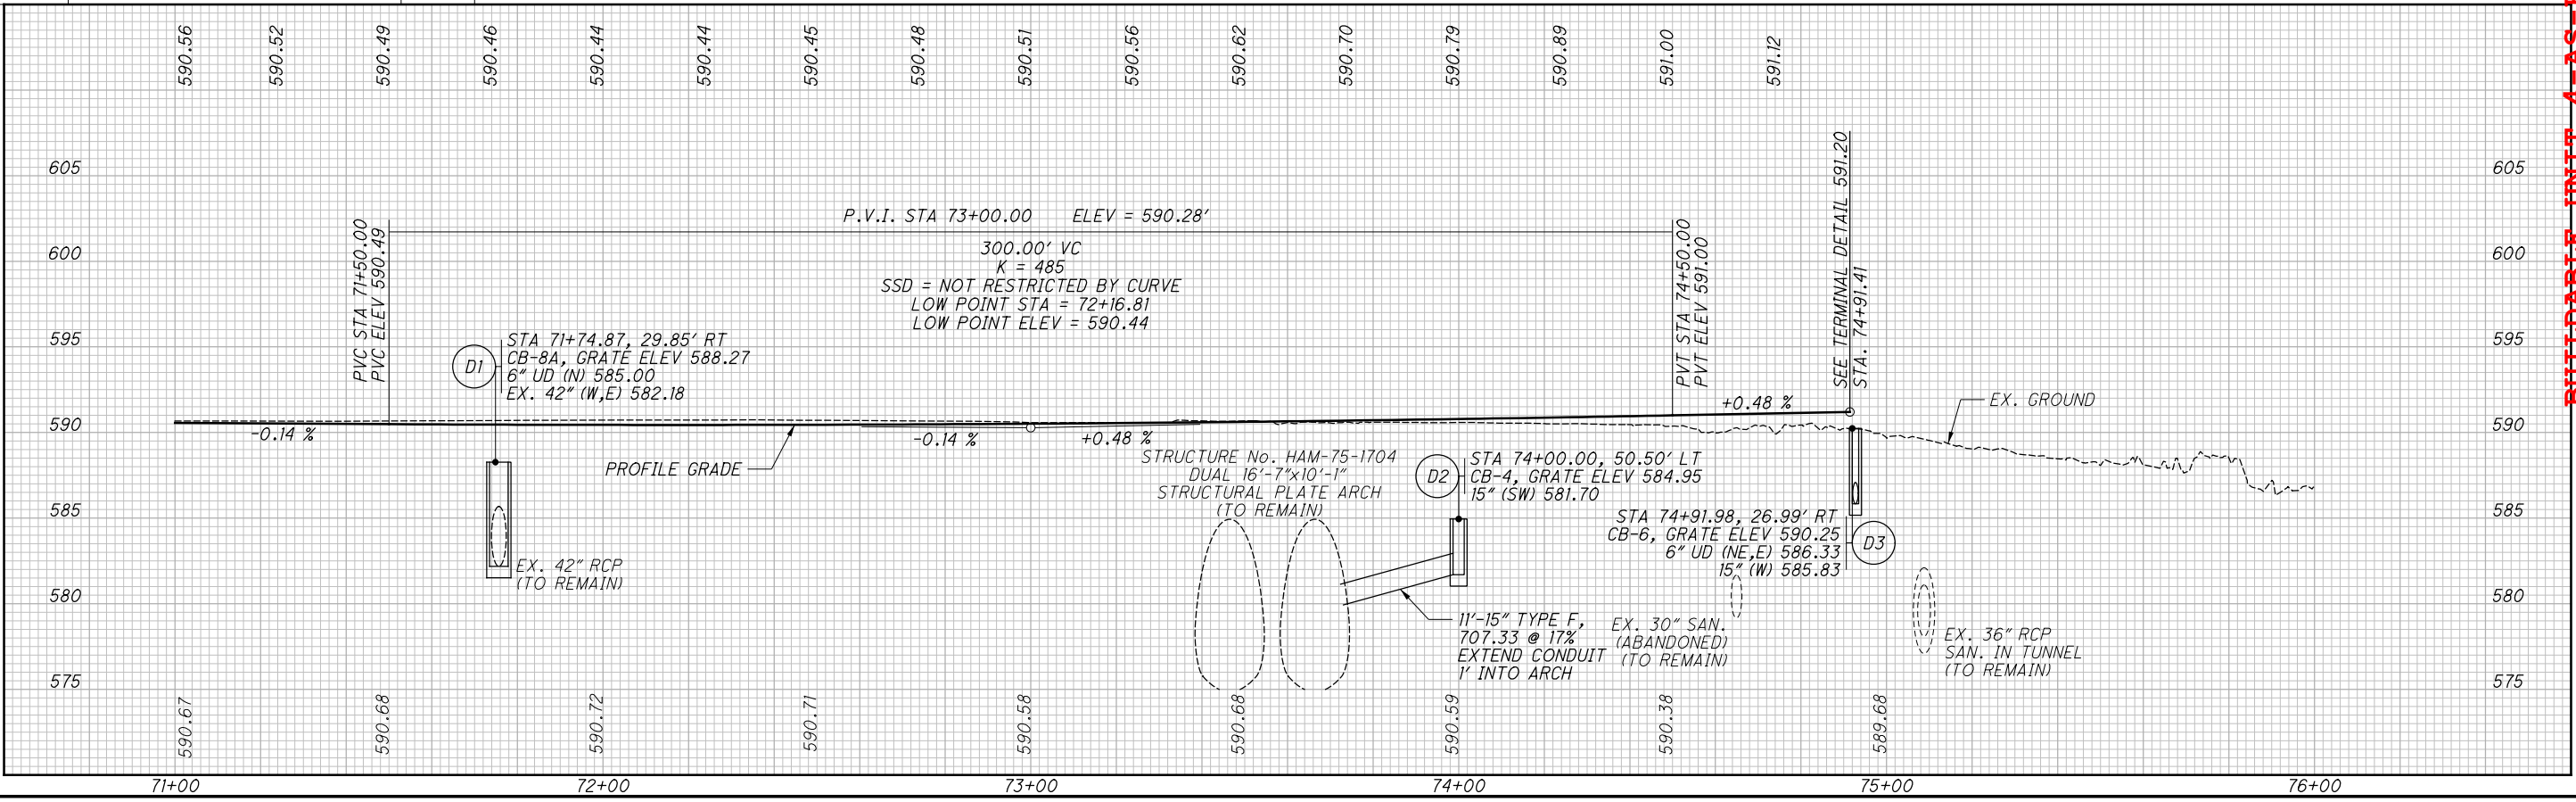

BUILDABLE UNIT 4-AS-BUILT PLANS-JANUARY 29, 2018

PLAN AND PROFILE - RAMP C  
 STA. 71+00.00 TO STA. 76+00.00

HAM-75-16.67




**CROSS REFERENCES**

FOR LEGEND, SEE SHEET 9  
 FOR CROSS SECTIONS, SEE SHEETS 23 - 27  
 FOR TERMINAL DETAILS, SEE SHEETS 29 - 30  
 FOR RAMP C AND E MEDIAN STORM SEWER PROFILE, SEE SHEET 33

**NOTES**

(A) RAMP C LANE WIDTH TRANSITIONS FROM 16' TO 12' THROUGH BASELINE CURVE B.

(B) CONTRACTOR SHALL USE CAUTION WHEN EXCAVATING NEAR EX. LIGHTING CONDUIT.

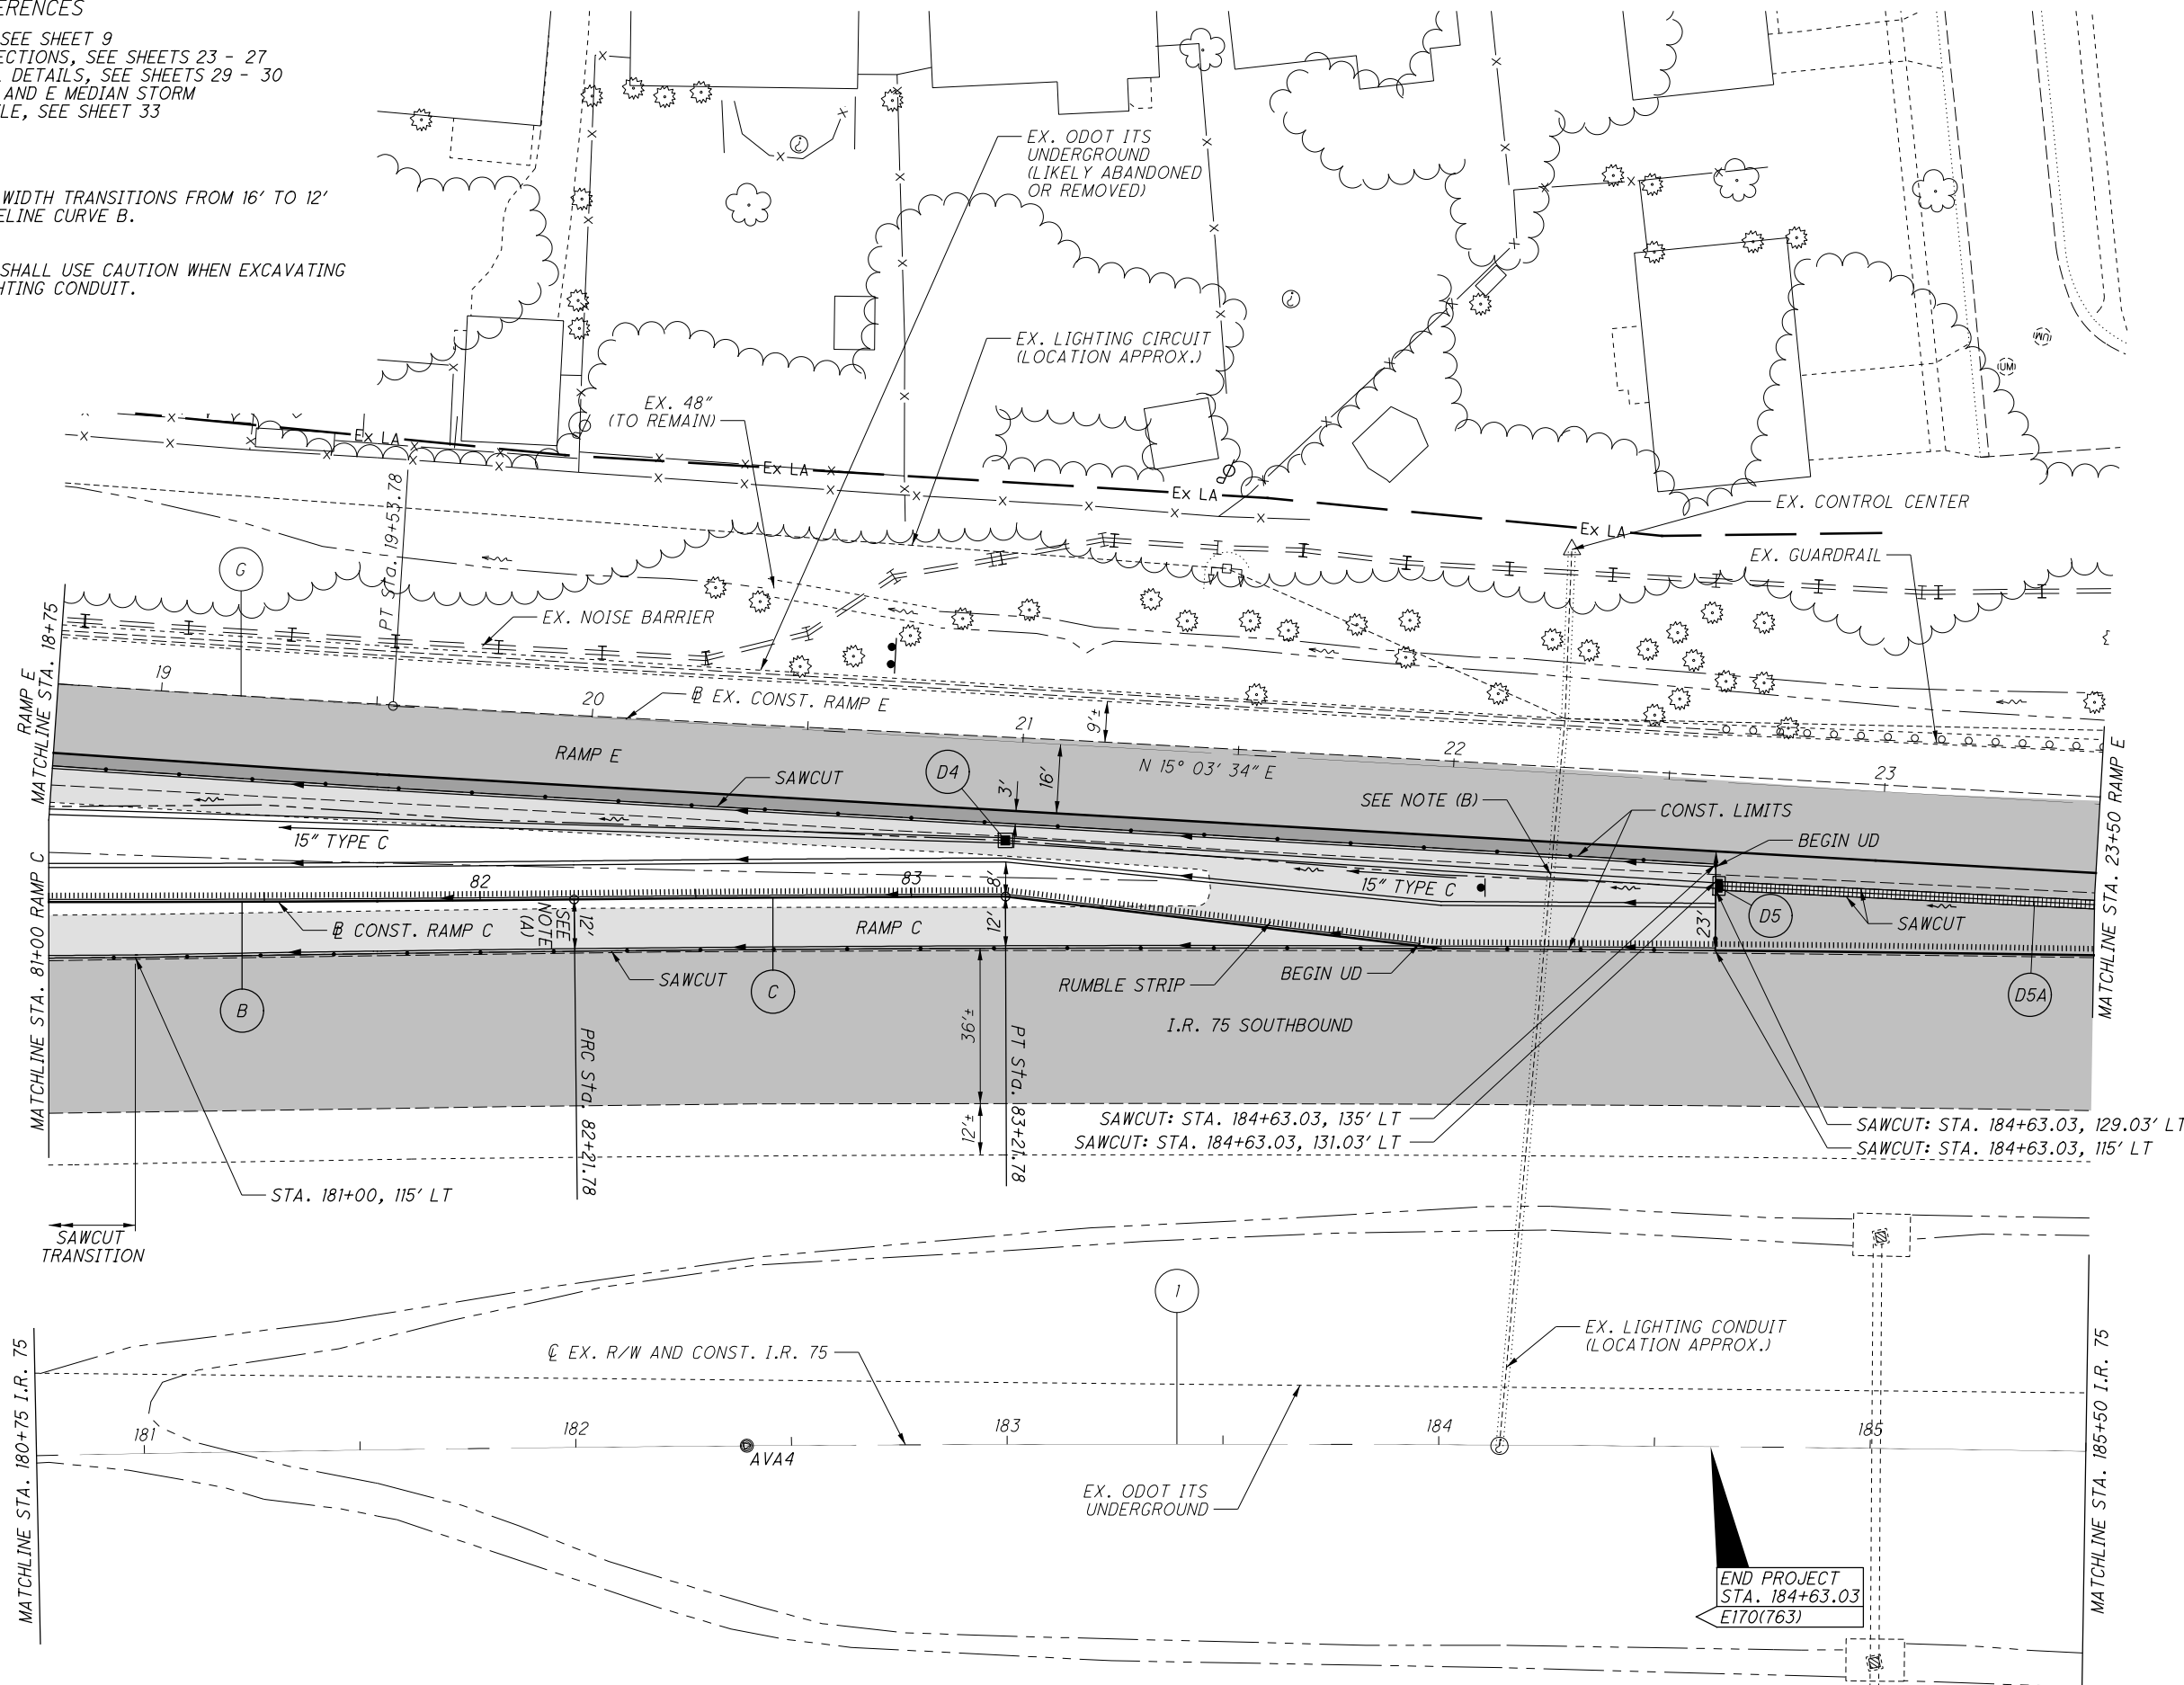

(B) P.I. Sta. 80+85.83  
 $\Delta = 1^{\circ} 29' 44'' (LT)$   
 $Dc = 0^{\circ} 33' 00''$   
 $R = 10,417.41'$   
 $T = 135.97'$   
 $L = 271.92'$   
 $E = 0.89'$   
 $e_{max} = NC (60mph)$

(C) P.I. Sta. 82+71.78  
 $\Delta = 0^{\circ} 25' 45'' (RT)$   
 $Dc = 0^{\circ} 25' 45''$   
 $R = 13,349.11'$   
 $T = 50.00'$   
 $L = 100.00'$   
 $E = 0.09'$   
 $e_{max} = NC (60mph)$

(G) P.I. Sta. 16+31.23  
 $\Delta = 2^{\circ} 54' 36'' (LT)$   
 $Dc = 0^{\circ} 27' 04''$   
 $R = 12,704.19'$   
 $T = 322.68'$   
 $L = 645.23'$   
 $E = 4.10'$   
 $e_{MAX} = NC (70mph)$

(I) P.I. Sta. 174+56.42  
 $\Delta = 18^{\circ} 53' 39'' (RT)$   
 $Dc = 0^{\circ} 26' 00''$   
 $R = 13,222.11'$   
 $T = 2,200.08'$   
 $L = 4,360.22'$   
 $E = 181.79'$   
 $e_{MAX} = NC (70mph)$



**BUILDABLE UNIT 4-AS-BUILT PLANS - JANUARY 29, 2018**

**PLAN - I.R. 75**

**STA. 180+75.00 TO STA. 185+50.00**

**HAM-75-16.67**

13  
43

G:\AKron\DCS\Projects\TRN\60547096\_HAM751667\900-CAD-GIS\104408\_HAM-75-1667\Design\Roadway\Sheets\104408\_GPO05.dgn Design 1/23/2018 9:36:05 AM matt.philips




CROSS REFERENCES  
 FOR LEGEND, SEE SHEET 9  
 FOR TERMINAL DETAILS, SEE SHEET 30

1 P.I. Sta. 174+56.42  
 $\Delta = 18^\circ 53' 39''$  (RT)  
 $Dc = 0^\circ 26' 00''$   
 $R = 13,222.11'$   
 $T = 2,200.08'$   
 $L = 4,360.22'$   
 $E = 181.79'$   
 $eMAX = NC$  (70mph)

CALCULATED  
 JEM  
 CHECKED  
 MEP

0 20 40  
 HORIZONTAL  
 SCALE IN FEET

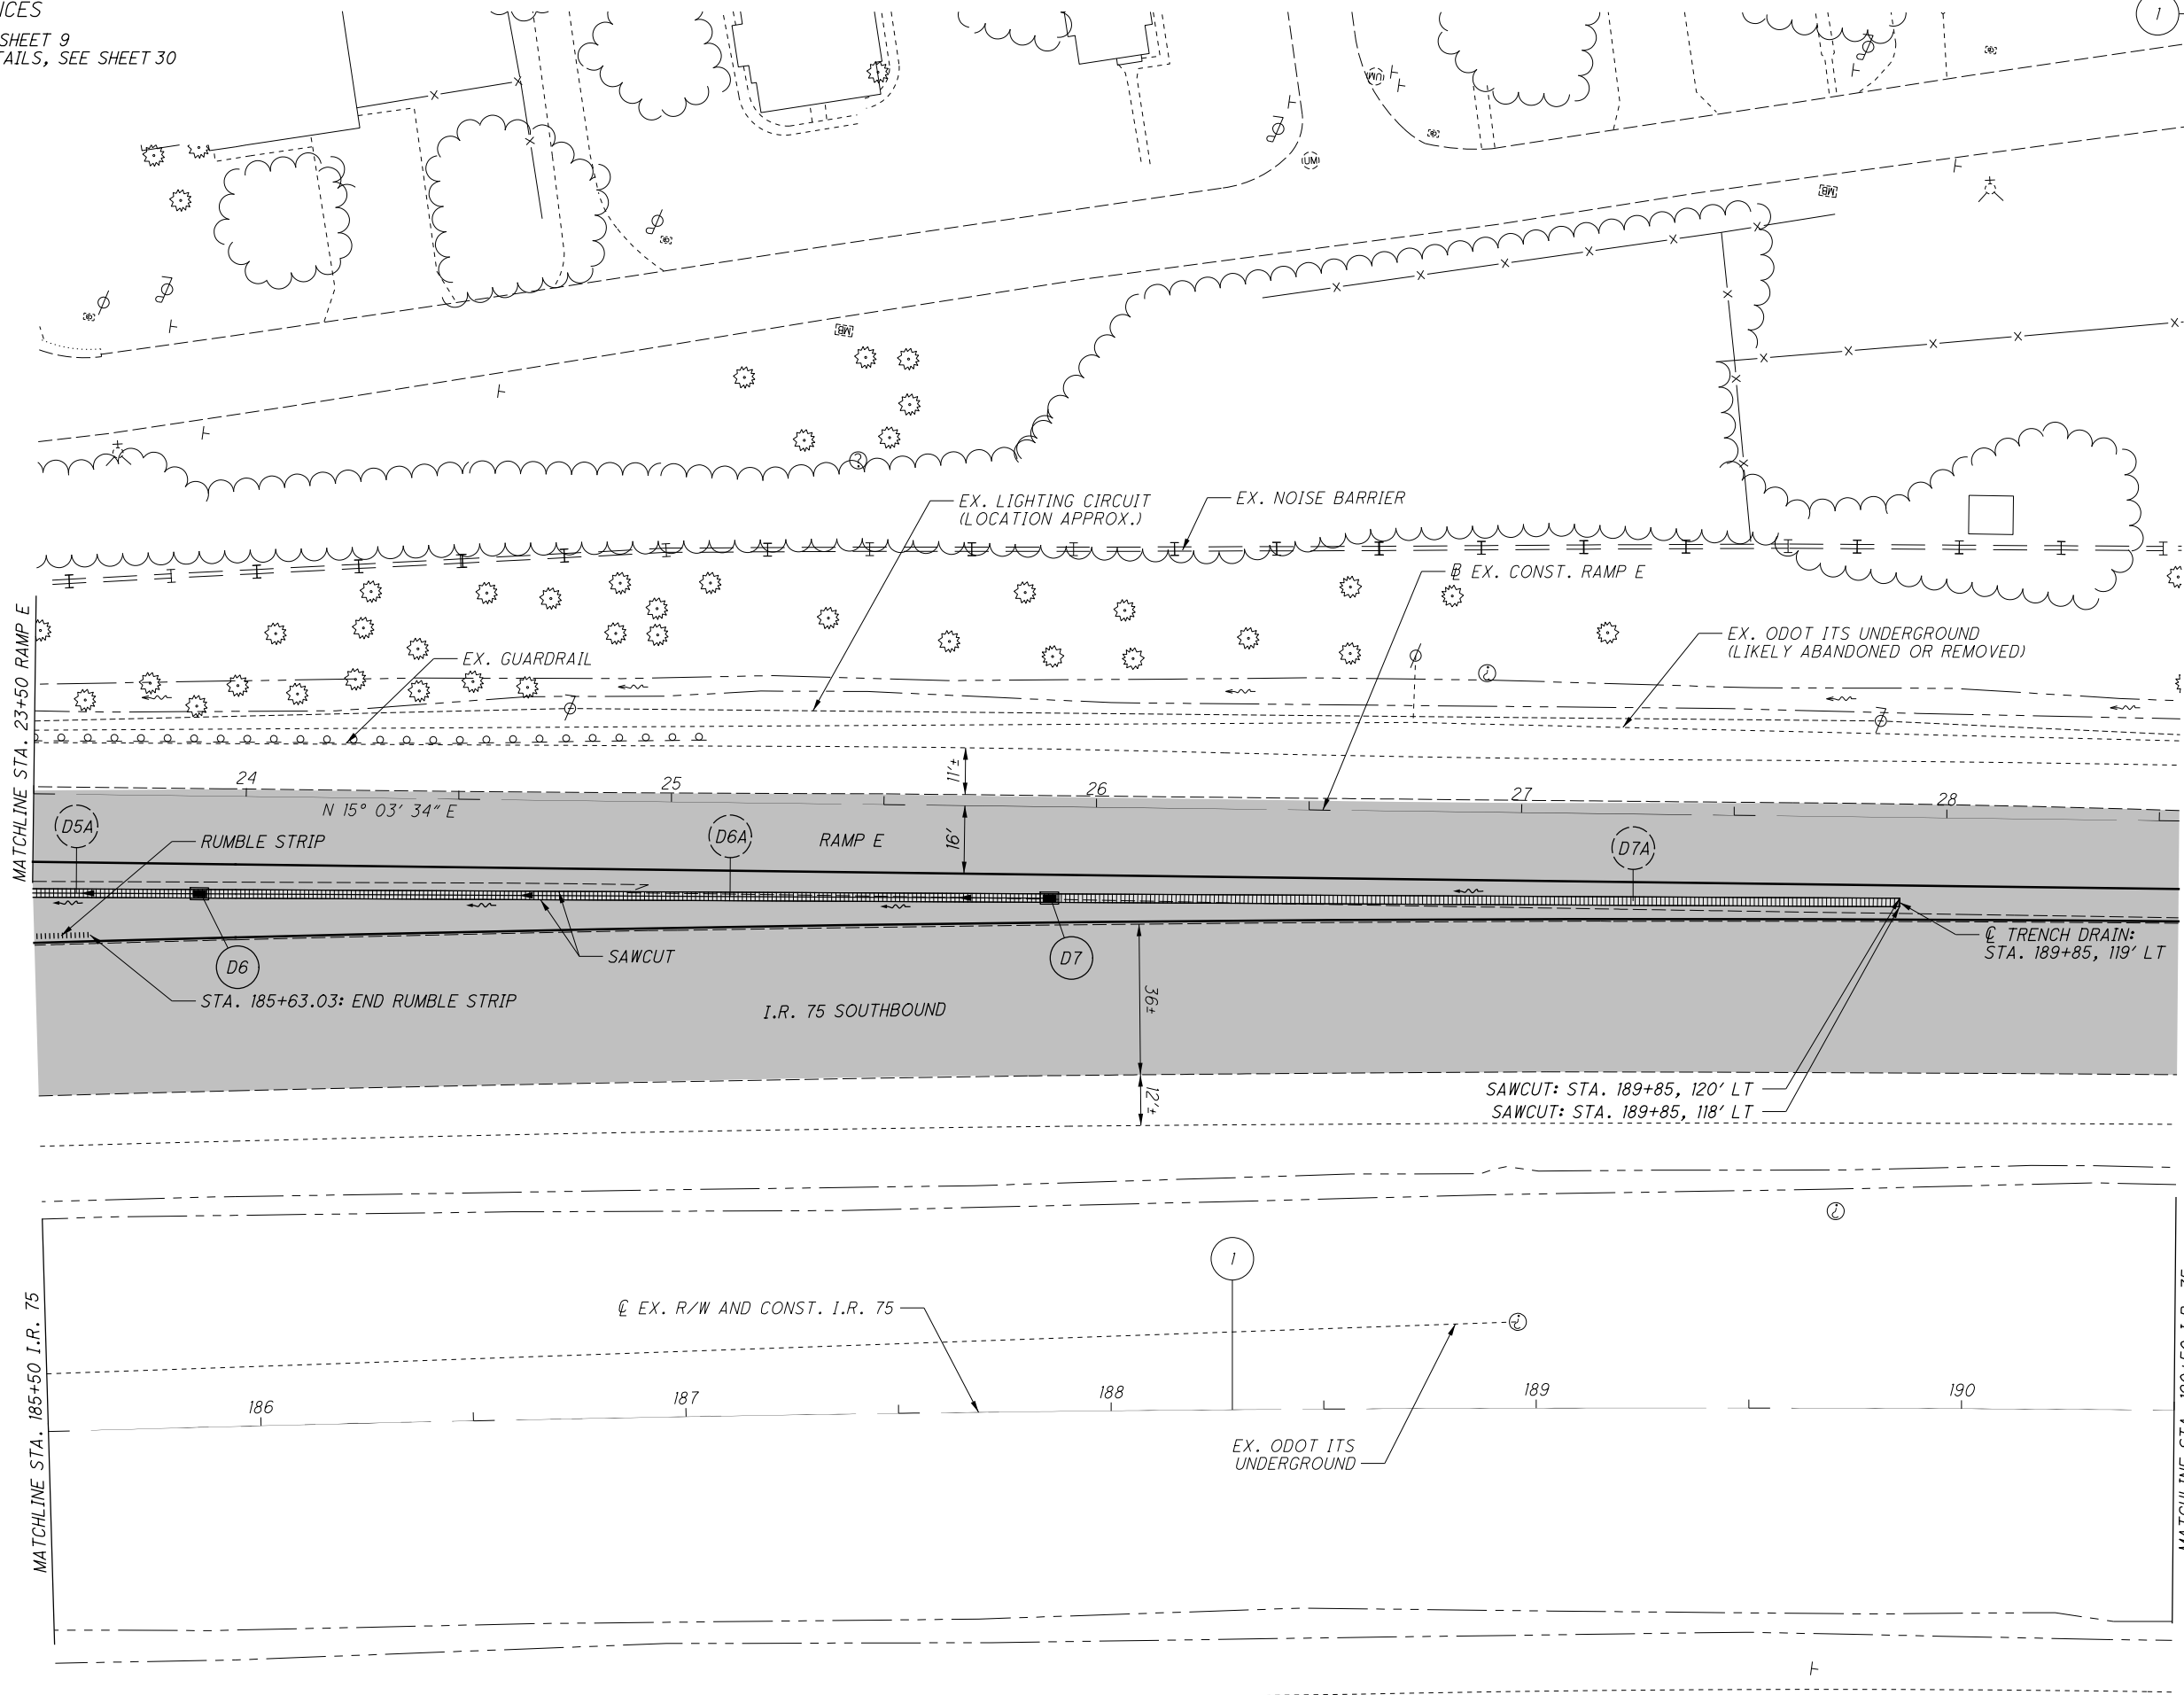

G:\Akron\DCS\Projects\TRN\60547096\_HAM751667\900-CAD-GIS\104408\_HAM-75-1667\Design\Roadway\Sheets\104408\_GPO06.dgn Design 1/23/2018 9:36:14 AM matt.phillips

BUILDABLE UNIT 4-AS-BUILT PLANS-JANUARY 29, 2018

PLAN - I.R. 75

STA. 185+50.0 TO STA. 190+50.00

HAM-75-16.67

14  
43




G:\AKron\DCS\Projects\TRN\60547096\_HAM751667\900-CAD-GIS\104408\_HAM-75-1667\Design\Roadway\Sheets\104408\_GPO07.dgn Design 1/23/2018 9:36:23 AM matt.philips

CROSS REFERENCES  
FOR LEGEND, SEE SHEET 9  
FOR TERMINAL DETAILS, SEE SHEET 31  
FOR "1/2 MILE" AND "1 MILE" TRUSS ROADSIDE BARRIER DETAILS,  
SEE SHEET 16

1 P.I. Sta. 174+56.42  
 $\Delta = 18^\circ 53' 39''$  (RT)  
Dc = 0° 26' 00"  
R = 13,222.11'  
T = 2,200.08'  
L = 4,360.22'  
E = 181.79'  
eMAX = NC (70mph)

CALCULATED	JEM	CHECKED	MEP
------------	-----	---------	-----

10  
20  
40  
HORIZONTAL  
SCALE IN FEET

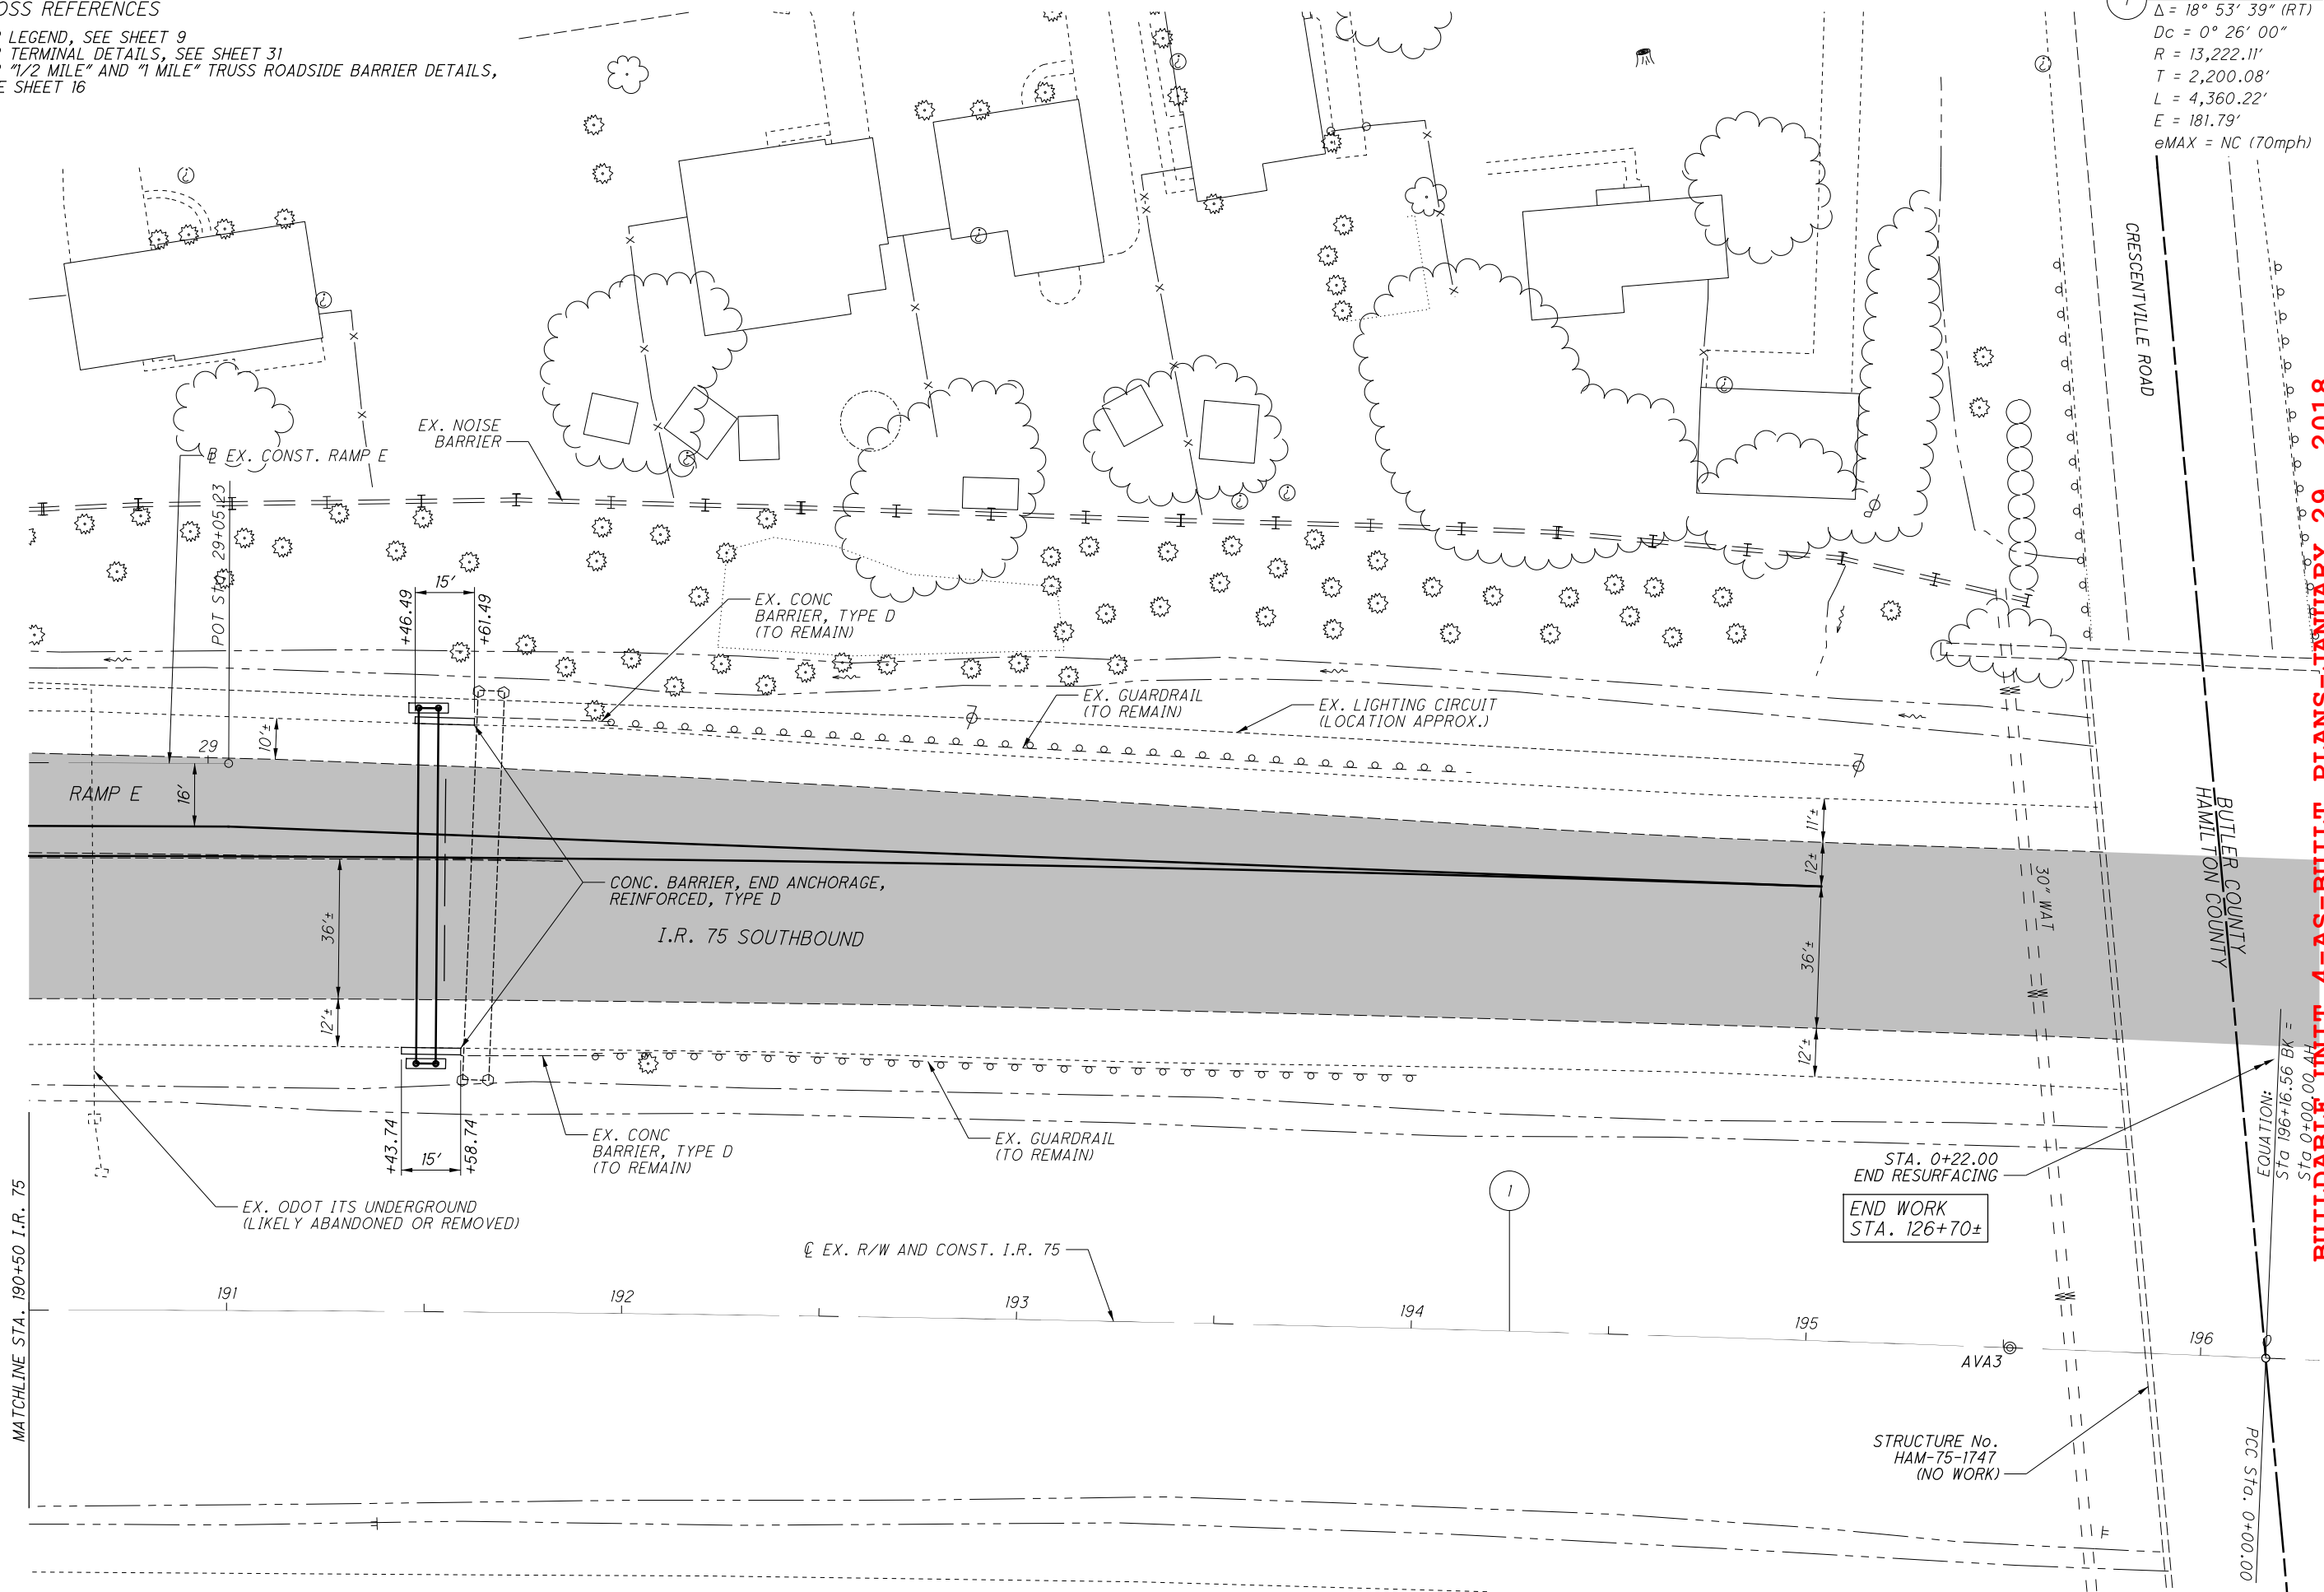

**BUILDABLE UNIT 4-AS-BUILT PLANS--JANUARY 29, 2018**

**PLAN - I.R. 75  
STA. 190+50.00 TO ENDING**

**HAM-75-16.67**


15  
43

CROSS REFERENCES

FOR LEGEND, SEE SHEET 9  
 FOR OVERHEAD SIGN SUPPORT DETAILS, SEE BU01

NOTES

ROADSIDE DESIGN FOR "1 MILE" TRUSS AT STA. 35+98 IS SIMILAR.

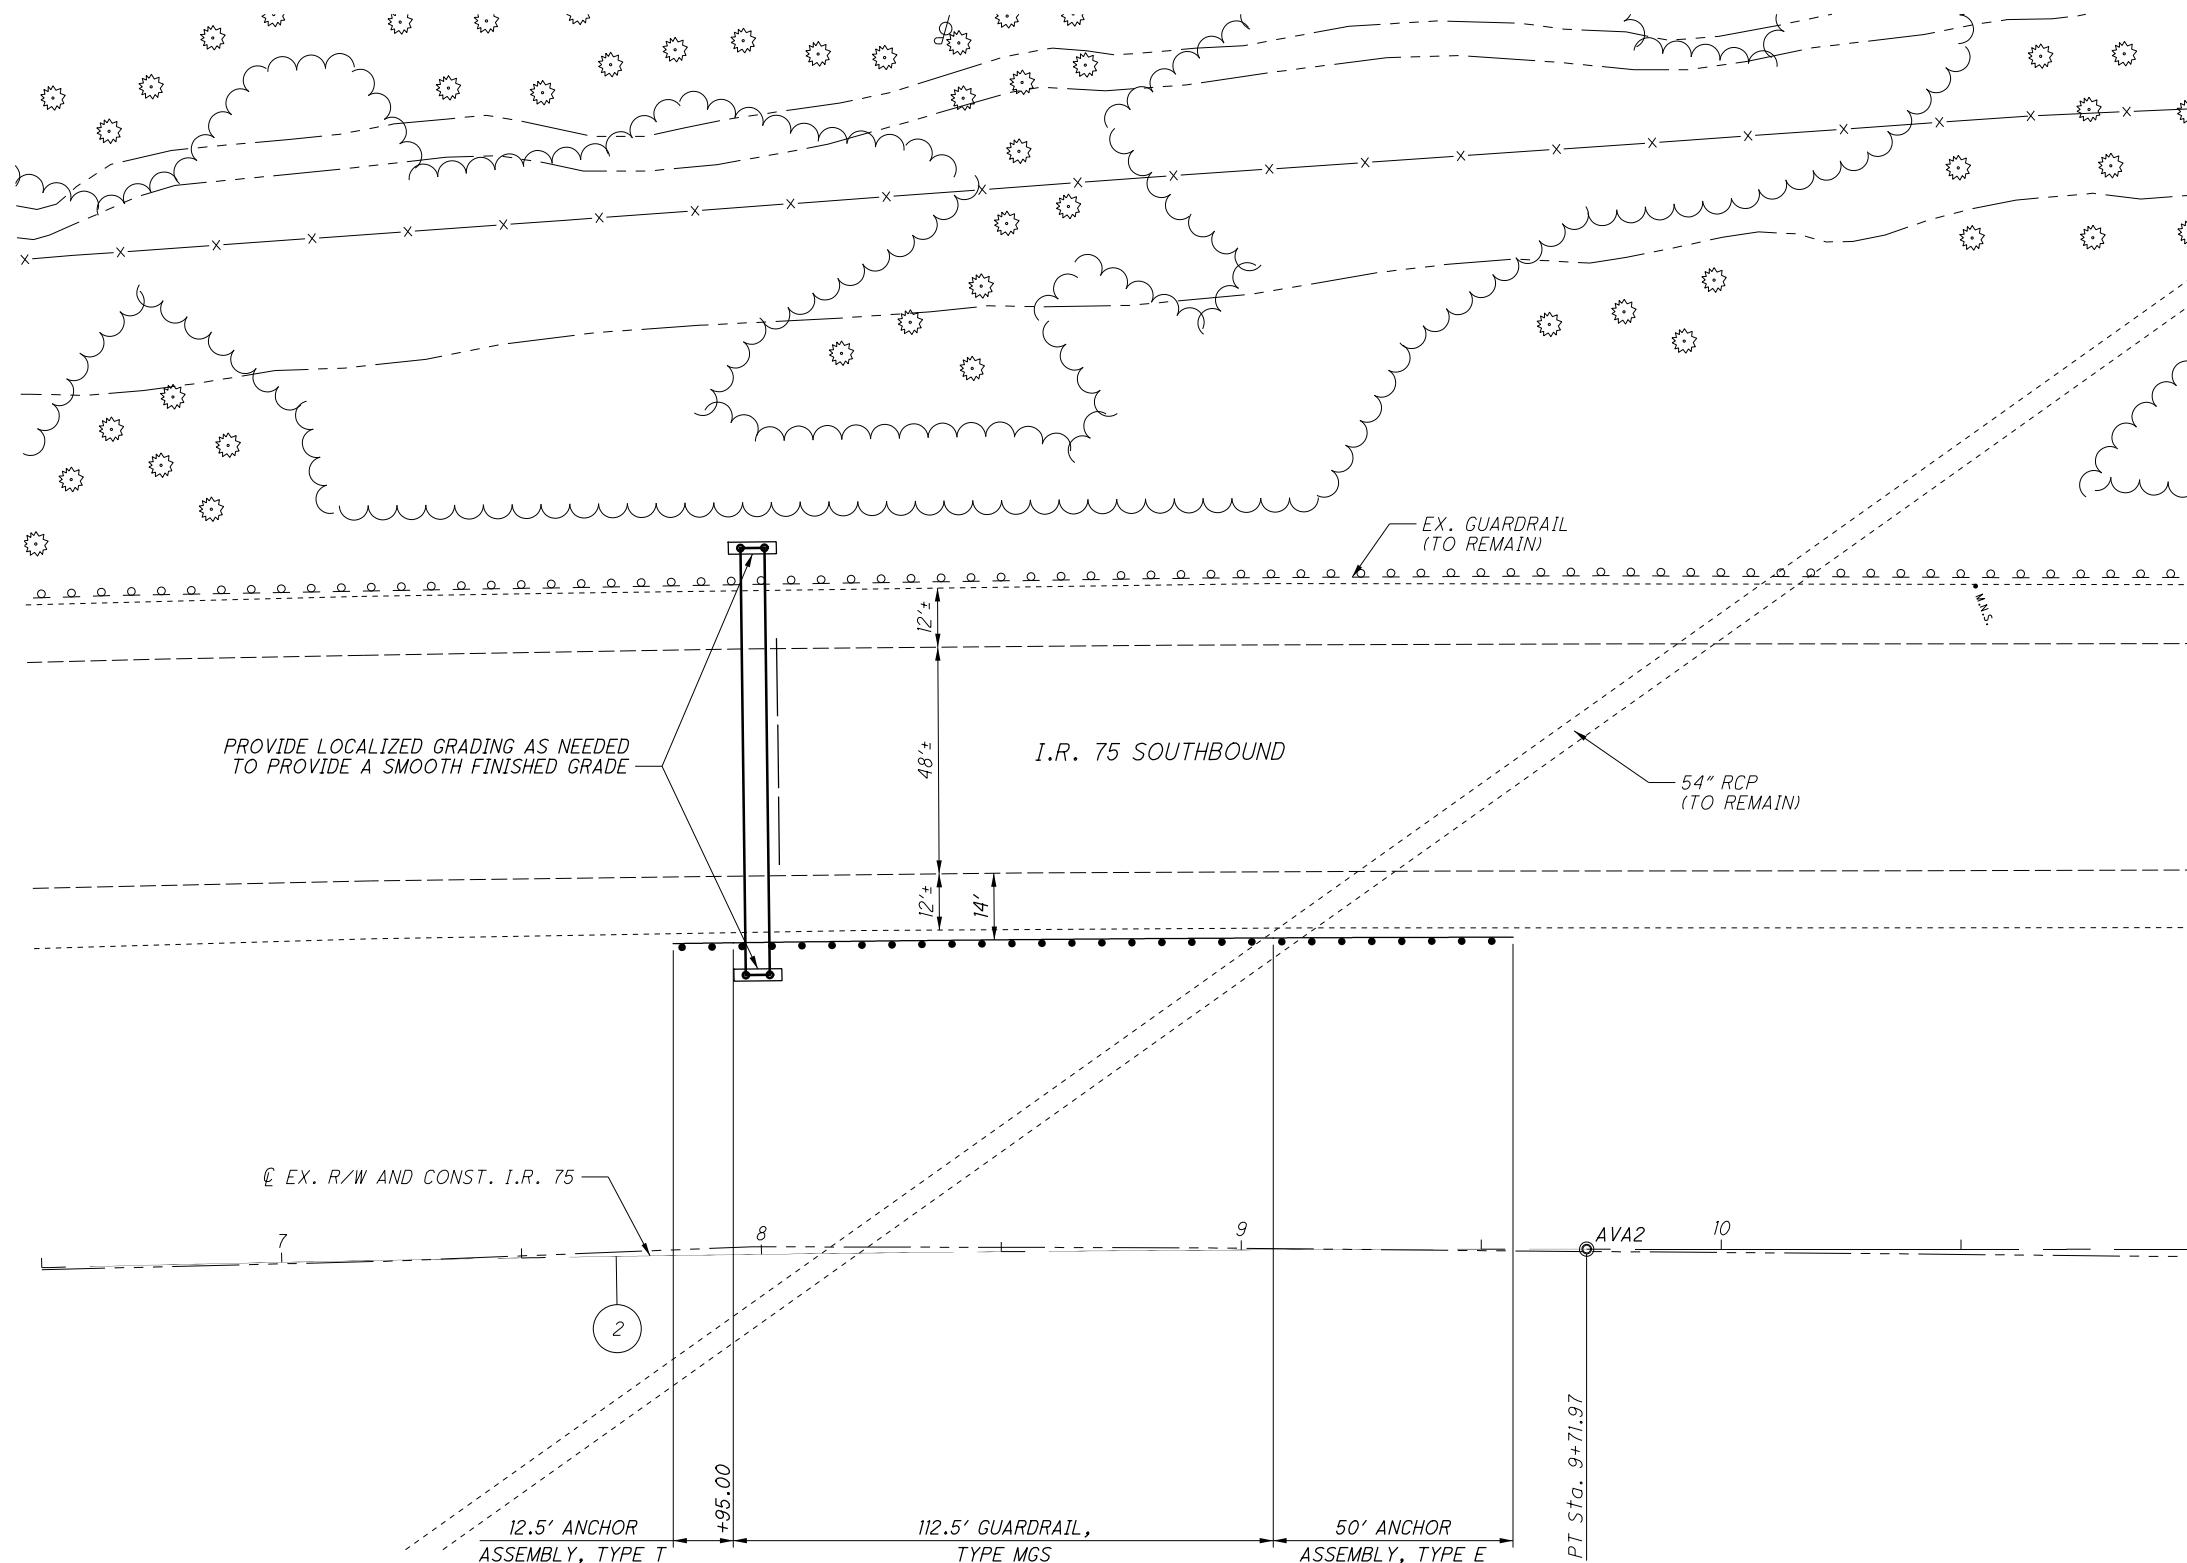

2 P.I. Sta. 4+86.21  
 $\Delta = 4^\circ 12' 43''$  (RT)  
 $D_c = 0^\circ 26' 00''$   
 $R = 13,222.11'$   
 $T = 486.21'$   
 $L = 971.97'$   
 $E = 8.94'$   
 $e_{MAX} = NC$  (70mph)

G:\AKron\DCS\Projects\TRN\60547096\_HAM751667\900-CAD-GIS\104408\_HAM-75-1667\Design\Roadway\Sheets\104408\_GPO08.dgn Design 1/23/2018 9:36:32 AM matt.philips

BUILDABLE UNIT 4-AS-BUILT PLANS--JANUARY 29, 2018

PLAN - I.R. 75

STA. 6+50.00 TO STA. 11+00.00


HAM-75-16.67

CALCULATED  
 MEP  
 CHECKED  
 JEM

0 20 40  
 HORIZONTAL  
 SCALE IN FEET

G:\AKron\DCS\Projects\TRN\60547096\_HAM751667\900-CAD-GIS\104408\_HAM-75-1667\Design\Roadway\Sheets\104408\_X5001.dgn Sheet 1/23/2018 9:36:34 AM matt.philips

SEEDING	
END WIDTH	SO. YDS.

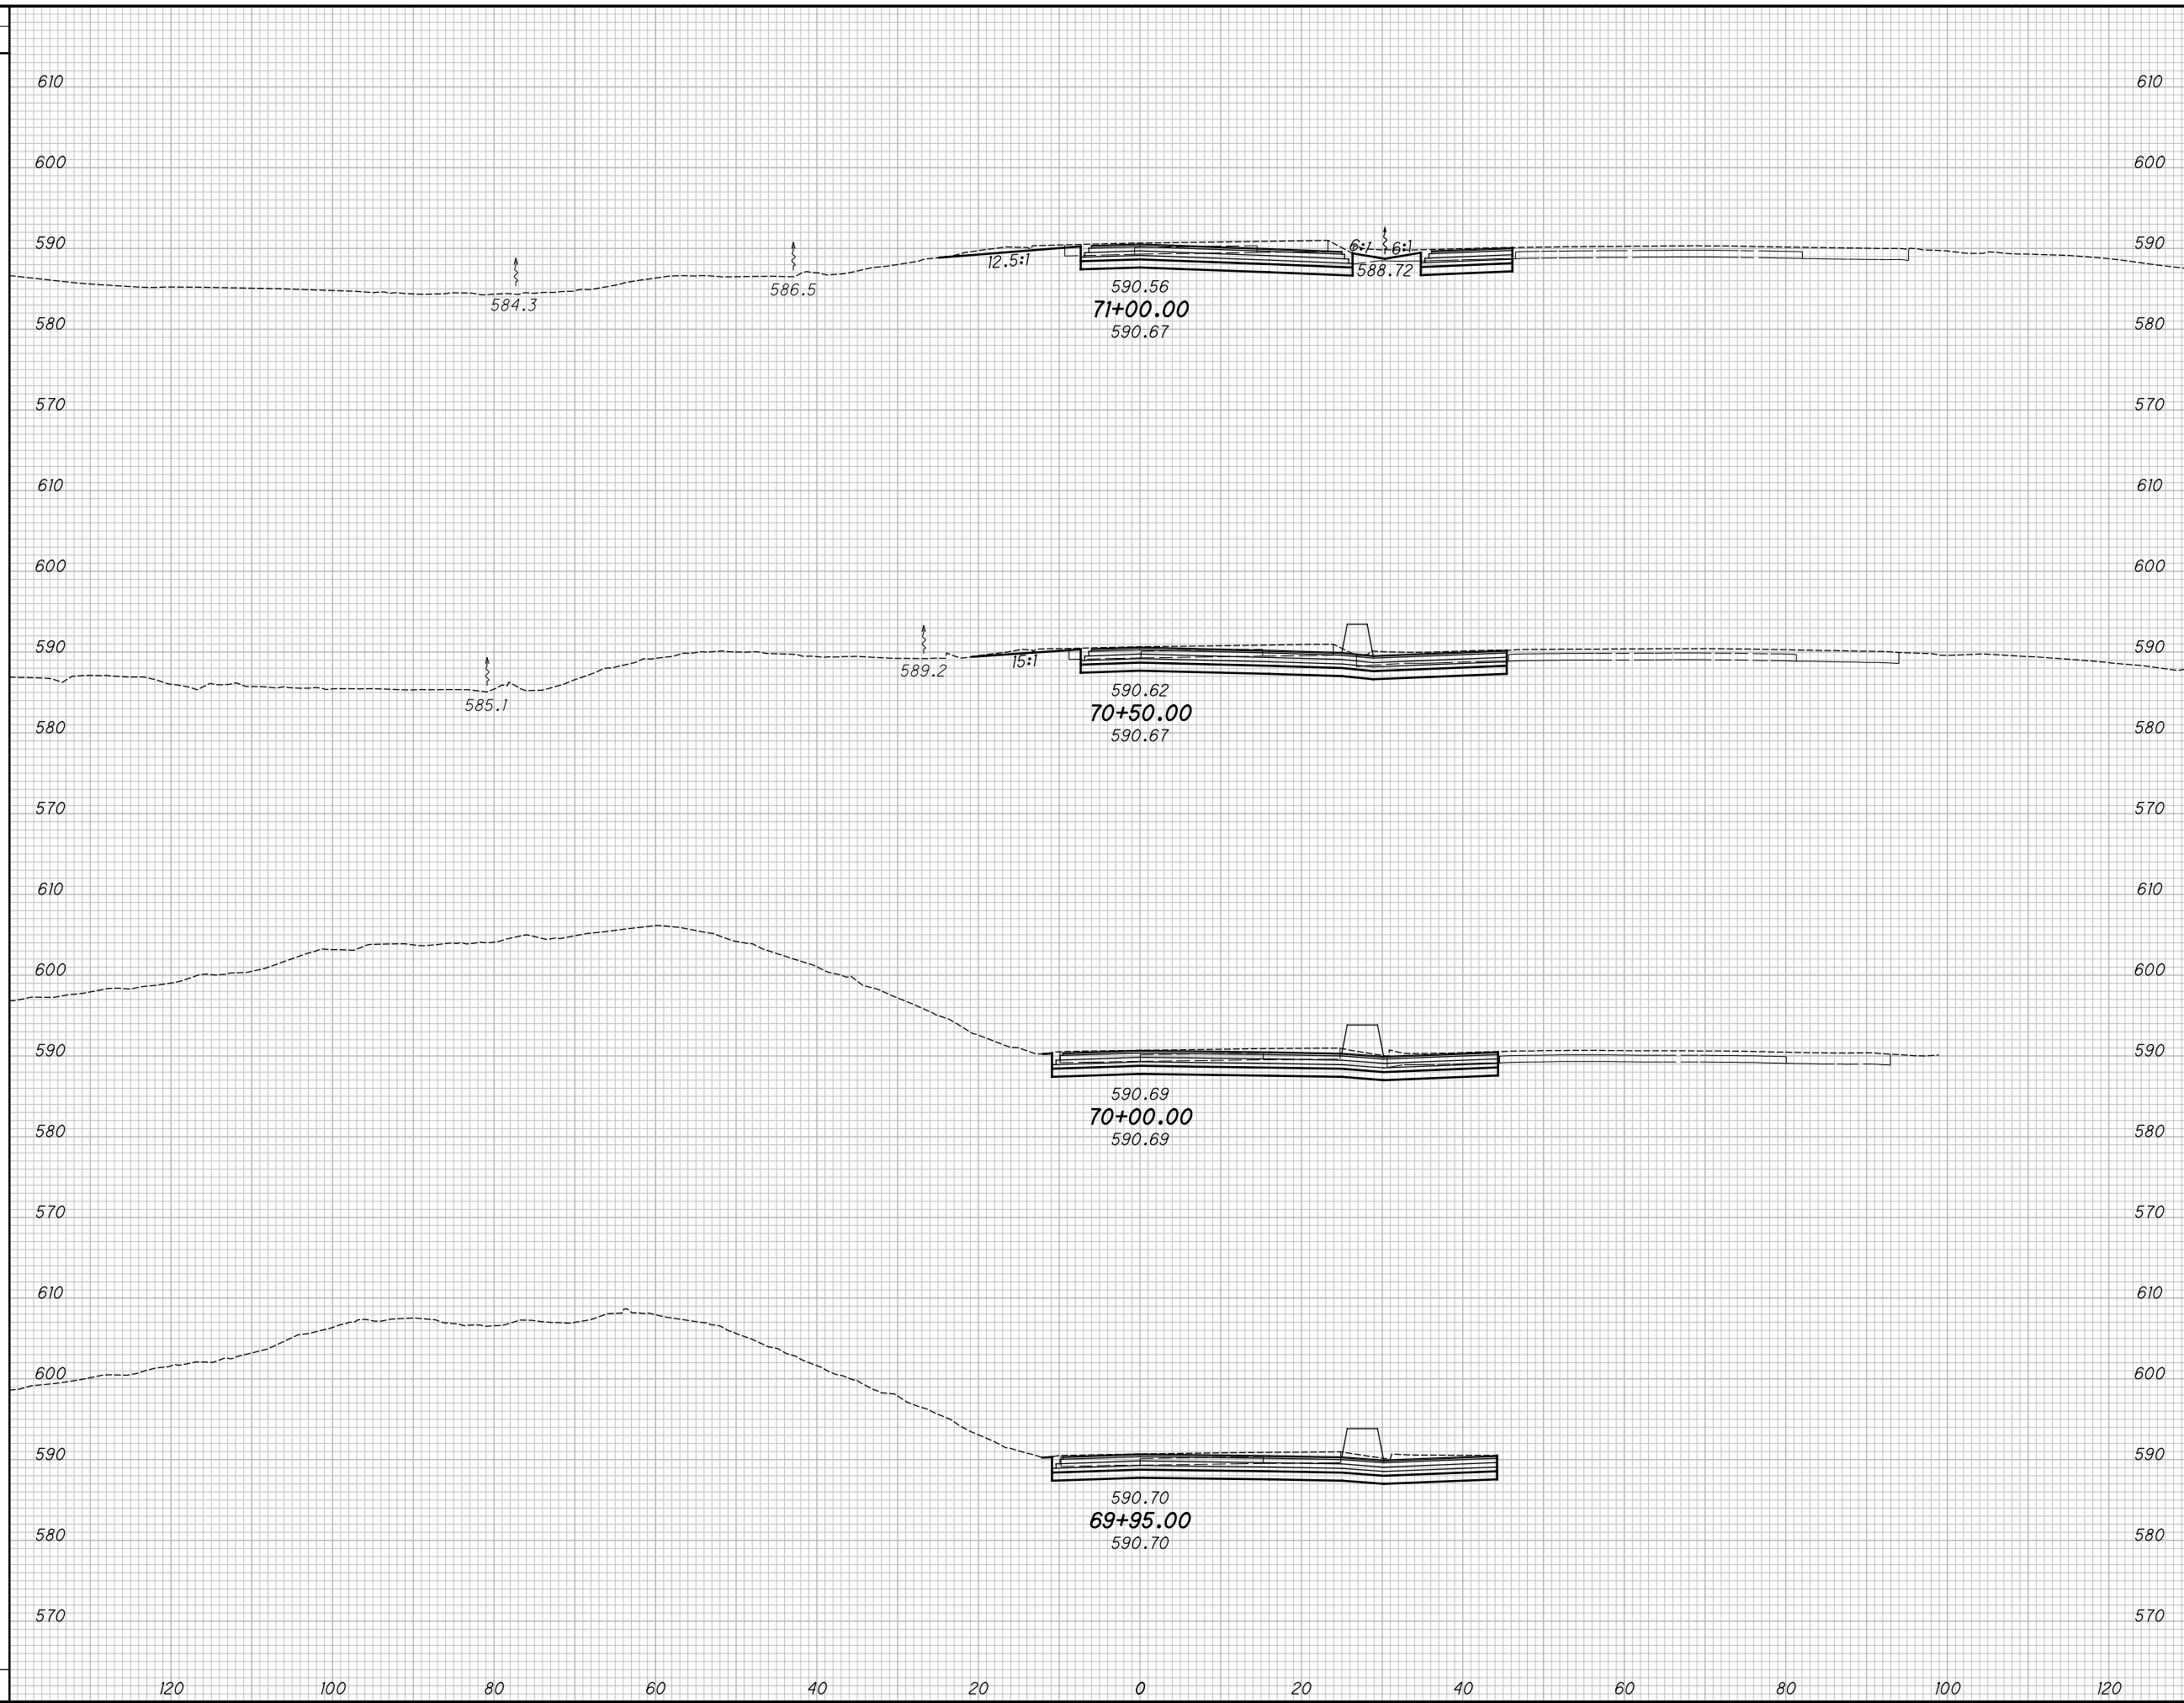

END CUT	AREA FILL	VOLUME		CALCULATED JEM	CHECKED MEP
		CUT	FILL		

**BUILDABLE UNIT 4-AS-BUILT PLANS--JANUARY 29, 2018**

**CROSS SECTIONS RAMP C**

**BEGINNING TO STA. 71+00.00**

**HAM-75-16.67**


17  
43

G:\Akron\DCS\Projects\TRN\60547096\_HAM751667\900-CAD-GIS\104408-CAD-GIS\104408-HAM-75-1667\Design\Roadway\Sheets\104408\_X500.dgn Sheet 1/23/2018 11:26:15 AM matt.philips

SEEDING	
END WIDTH	SO. YDS.

NO.	REVISIONS	DATE
AB	AS-BUILT REVISION	1/29/18

END AREA		VOLUME		CALCULATED JEM	CHECKED MEP
CUT	FILL	CUT	FILL		

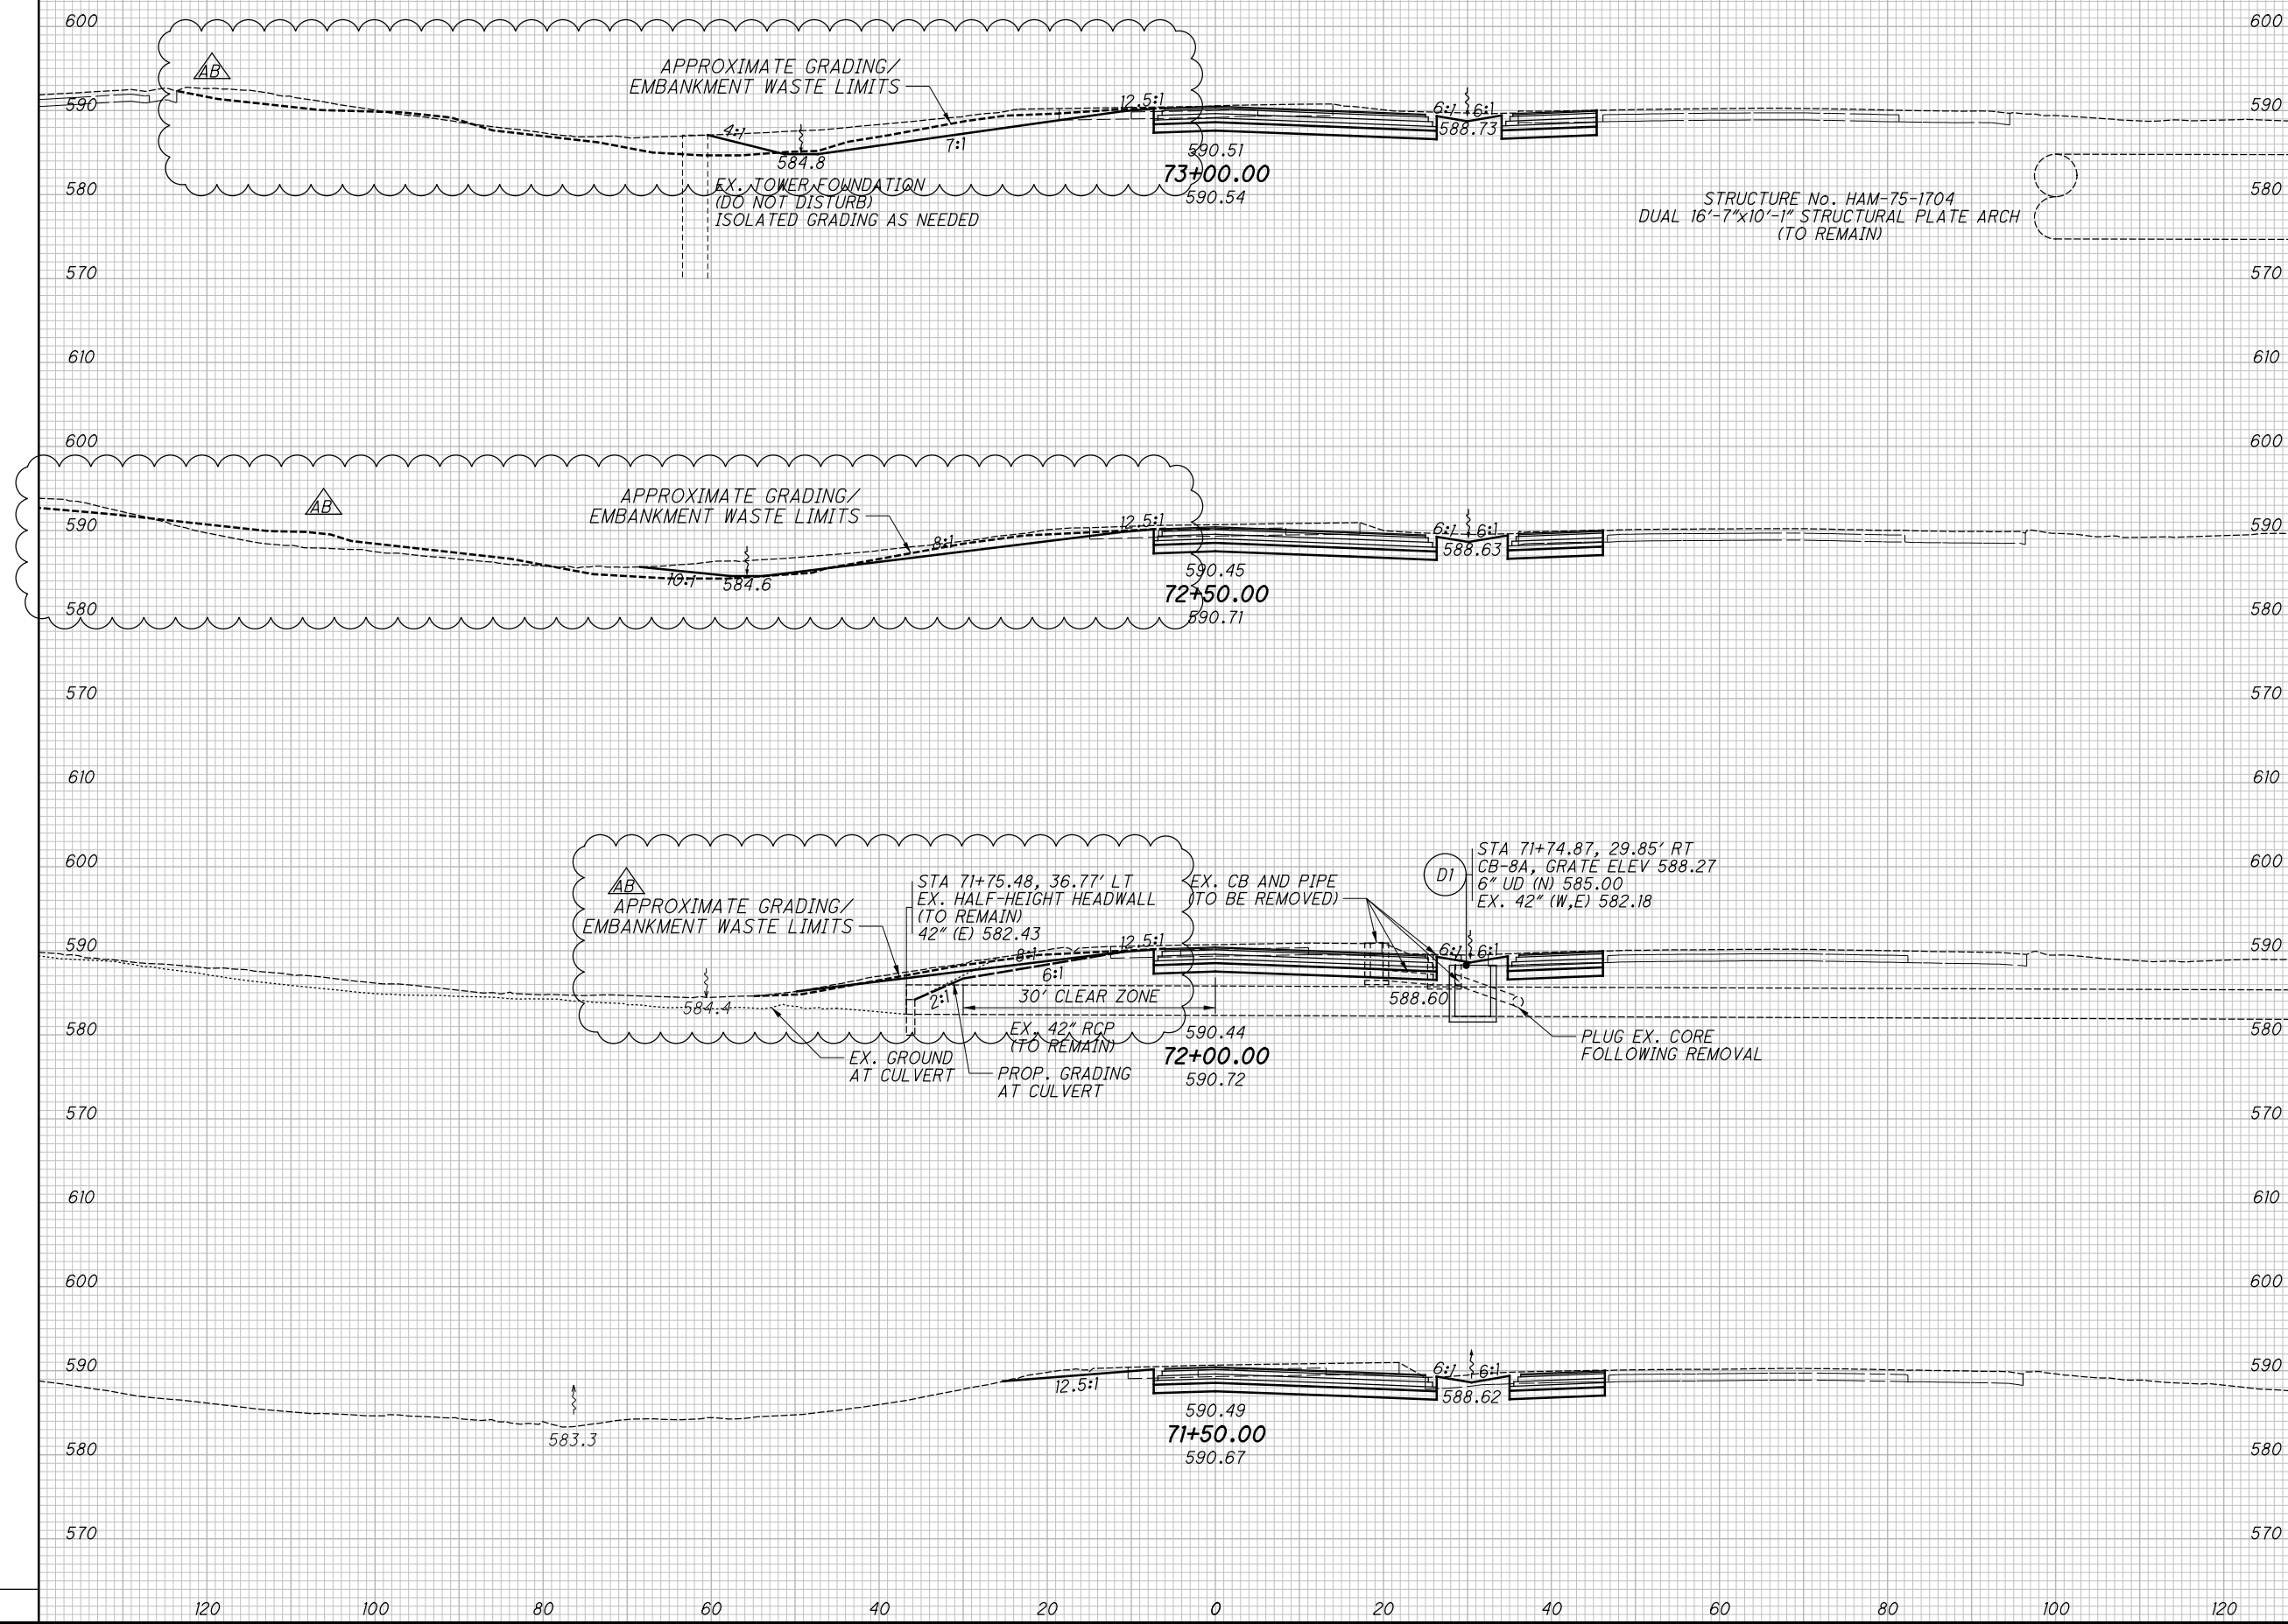

**BUILDABLE UNIT 4-AS-BUILT PLANS--JANUARY 29, 2018**

**CROSS SECTIONS RAMP C**

**STA. 71+50.00 TO STA. 73+00.00**

**HAM-75-16.67**




G:\Akron\DCS\Projects\TRN\60547096\_HAM751667\900-CAD-GIS\104408\_HAM-75-1667\Design\Roadway\Sheets\104408\_X500.dgn Sheet 1/23/2018 11:26:20 AM matt.philips

SEEDING

END WIDTH	SO. YDS.

END AREA		VOLUME		CALCULATED JEM	CHECKED MEP
CUT	FILL	CUT	FILL		

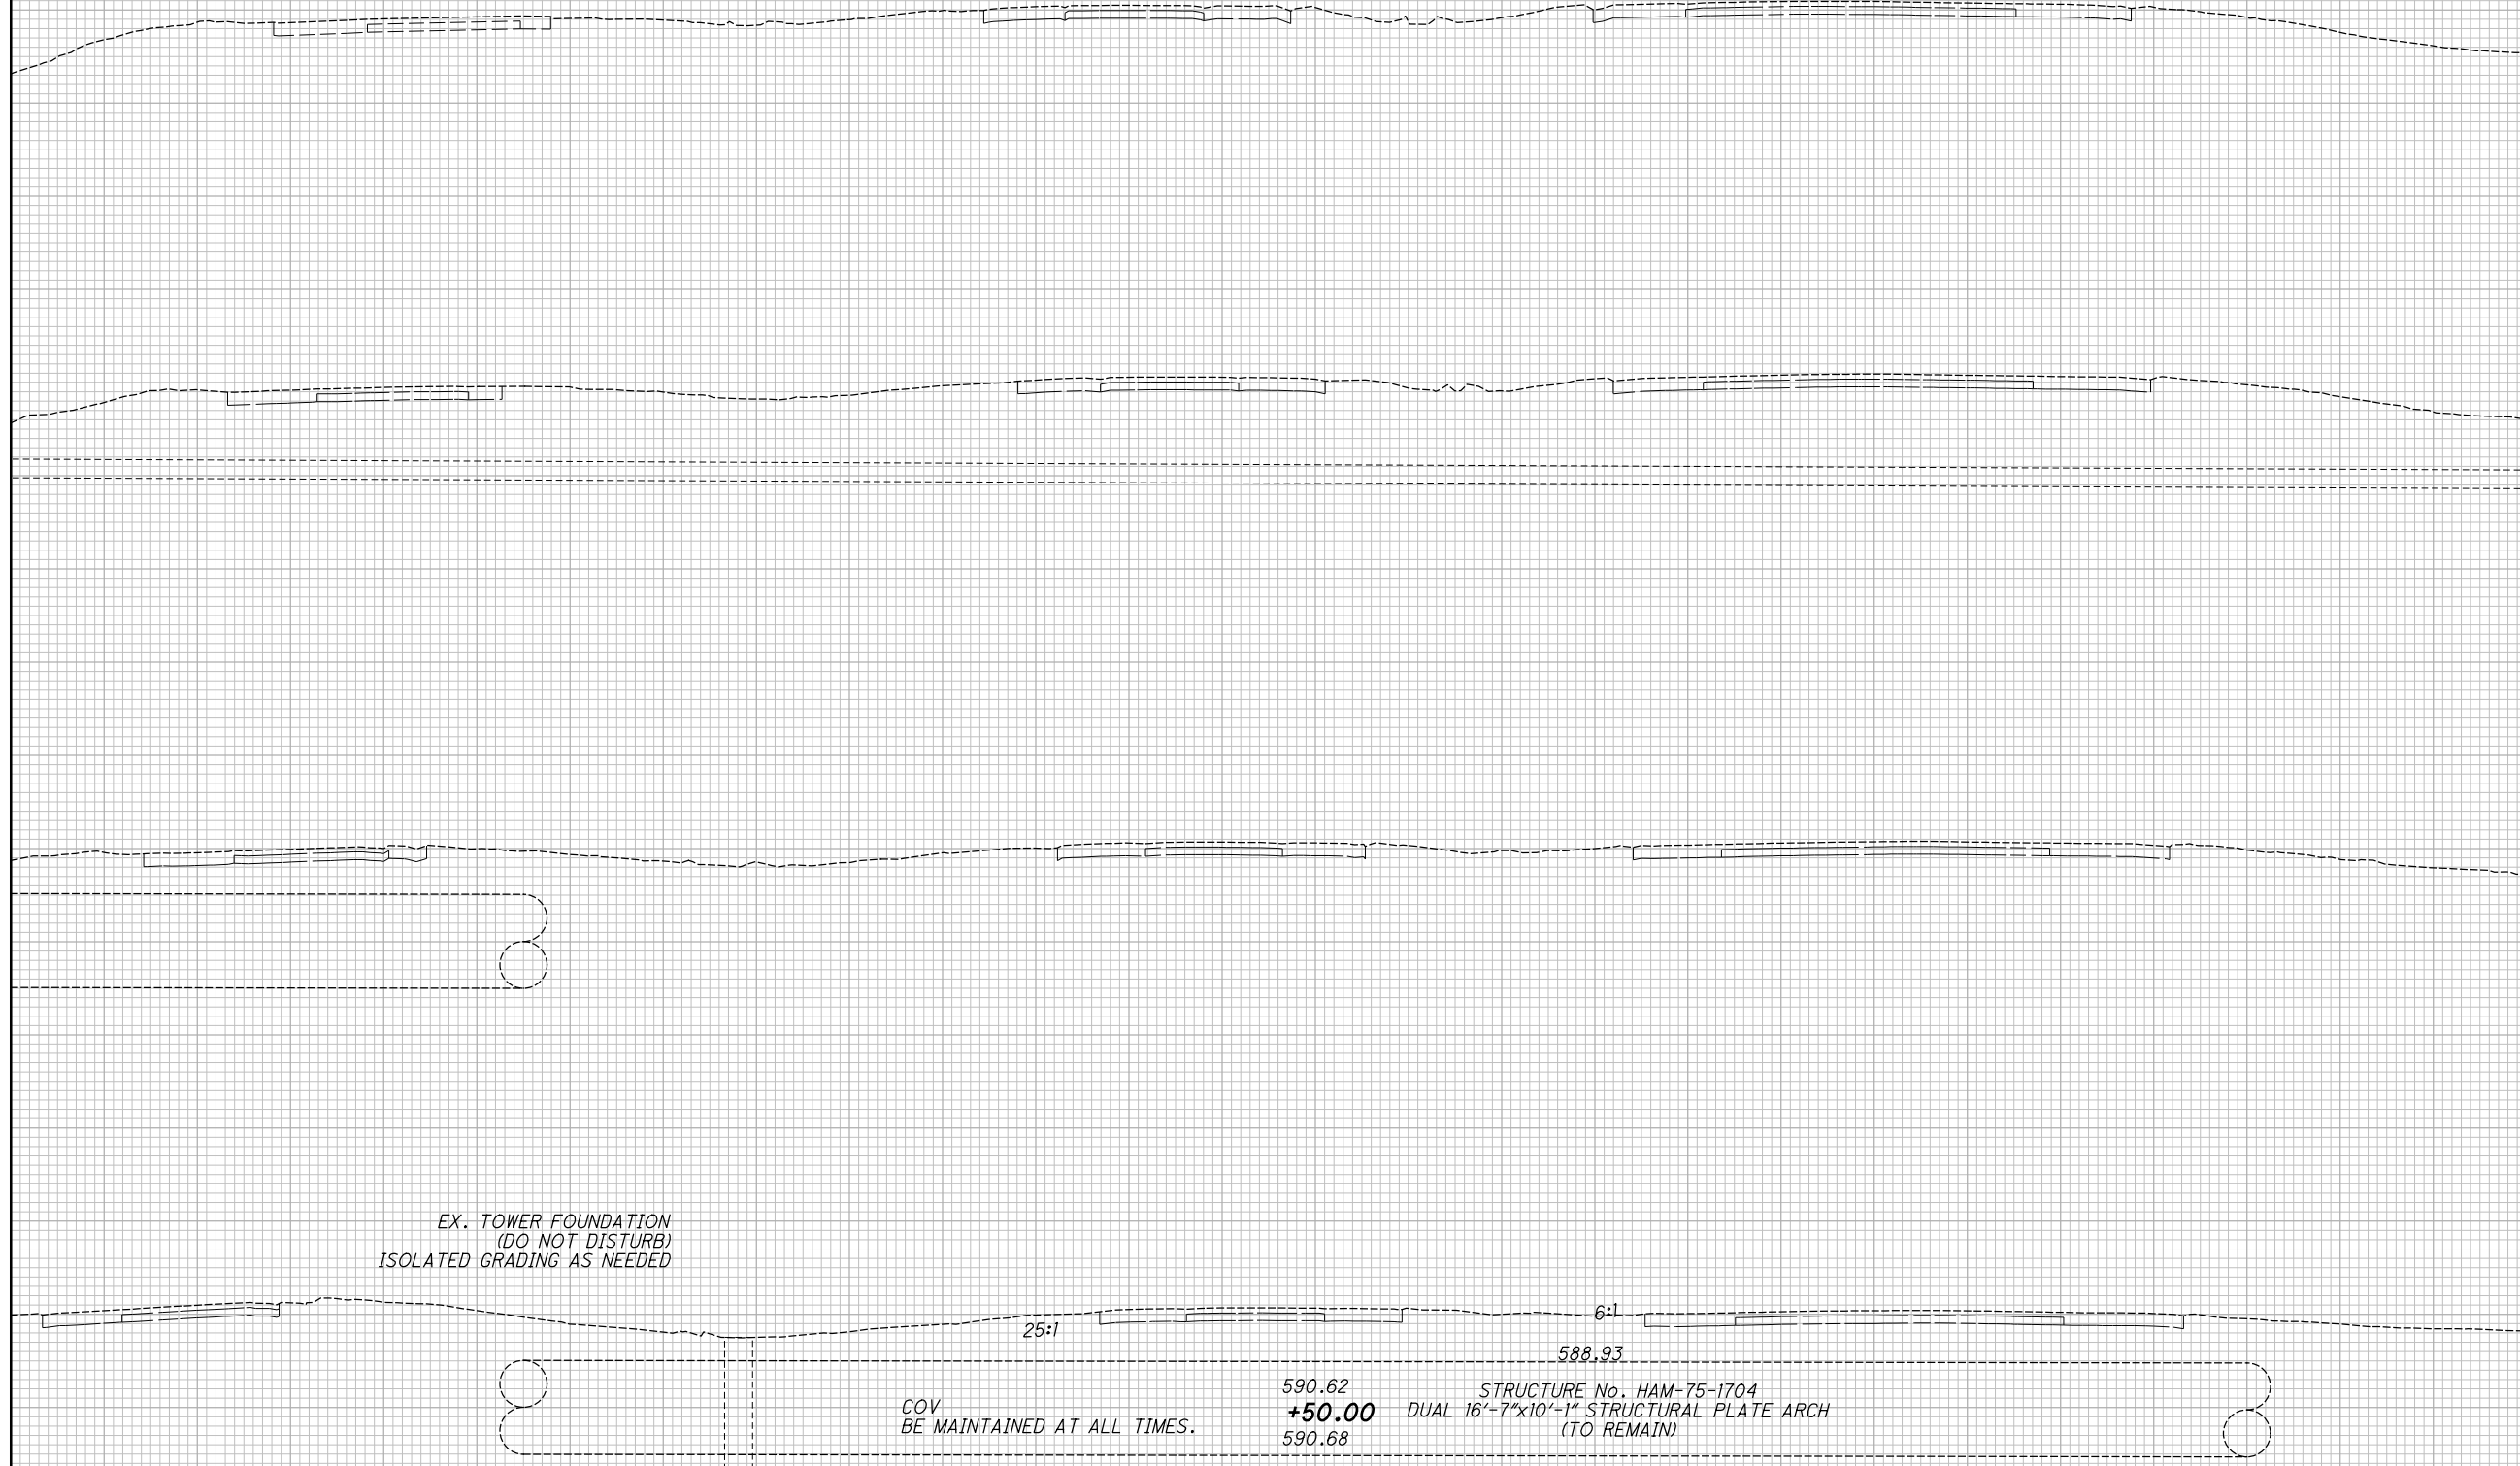

**BUILDABLE UNIT 4-AS-BUILT PLANS--JANUARY 29, 2018**

CA

HAM-75-16.67




G:\Akron\DCS\Projects\TRN\60547096\_HAM751667\900-CAD-GIS\104408\_HAM-75-1667\Design\Roadway\Sheets\104408\_X5001.dgn Sheet 1/23/2018 11:26:21AM matt.phillips

SEEDING	
END WIDTH	SO. YDS.

NO.	REVISIONS	DATE
AB	AS-BUILT REVISION	1/29/18

END AREA		VOLUME		CALCULATED	CHECKED	MEP
CUT	FILL	CUT	FILL			

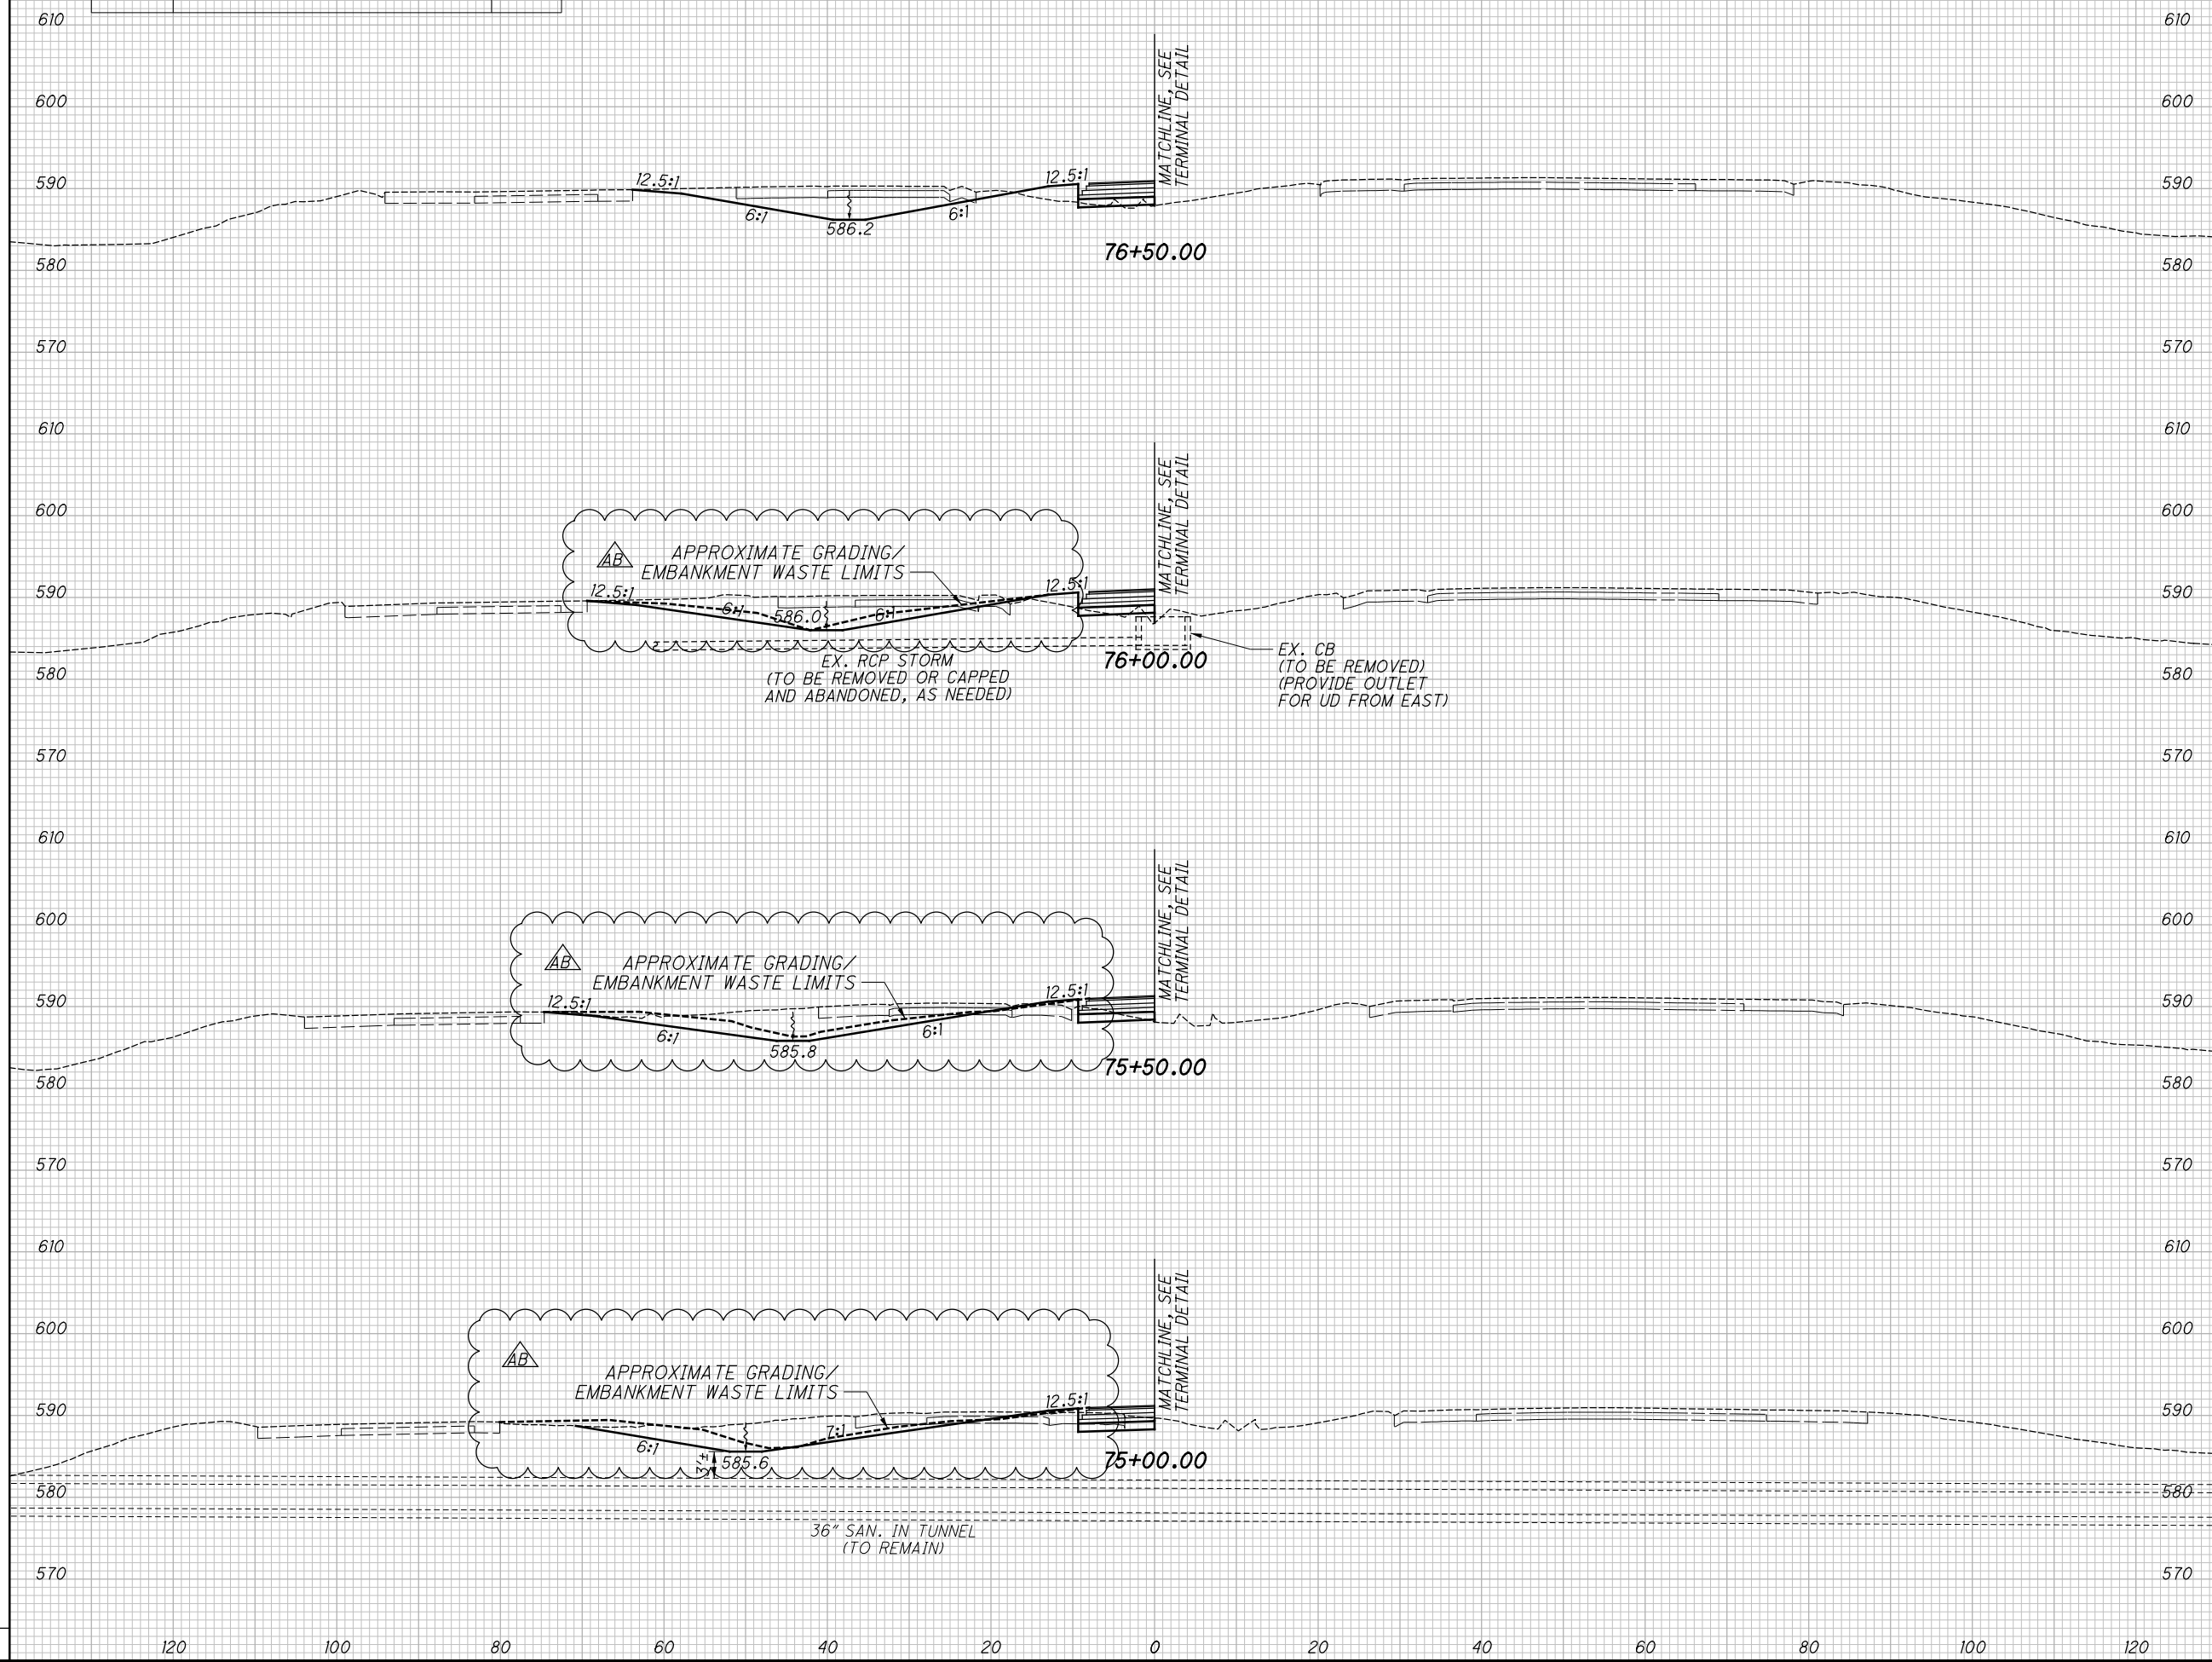


**BUILDABLE UNIT 4-AS-BUILT PLANS--JANUARY 29, 2018**  
**CROSS SECTIONS RAMP C**  
**STA. 75+00.00 TO STA. 76+50.00**

**HAM-75-16.67**

G:\Akron\DCS\Projects\TRN\60547096\_HAM751667\900-CAD-GIS\104408\_HAM-75-1667\Design\Roadway\Sheets\104408\_X5001.dgn Sheet 1/23/2018 9:36:38 AM matt.philips

SEEDING	
END WIDTH	SO. YDS.

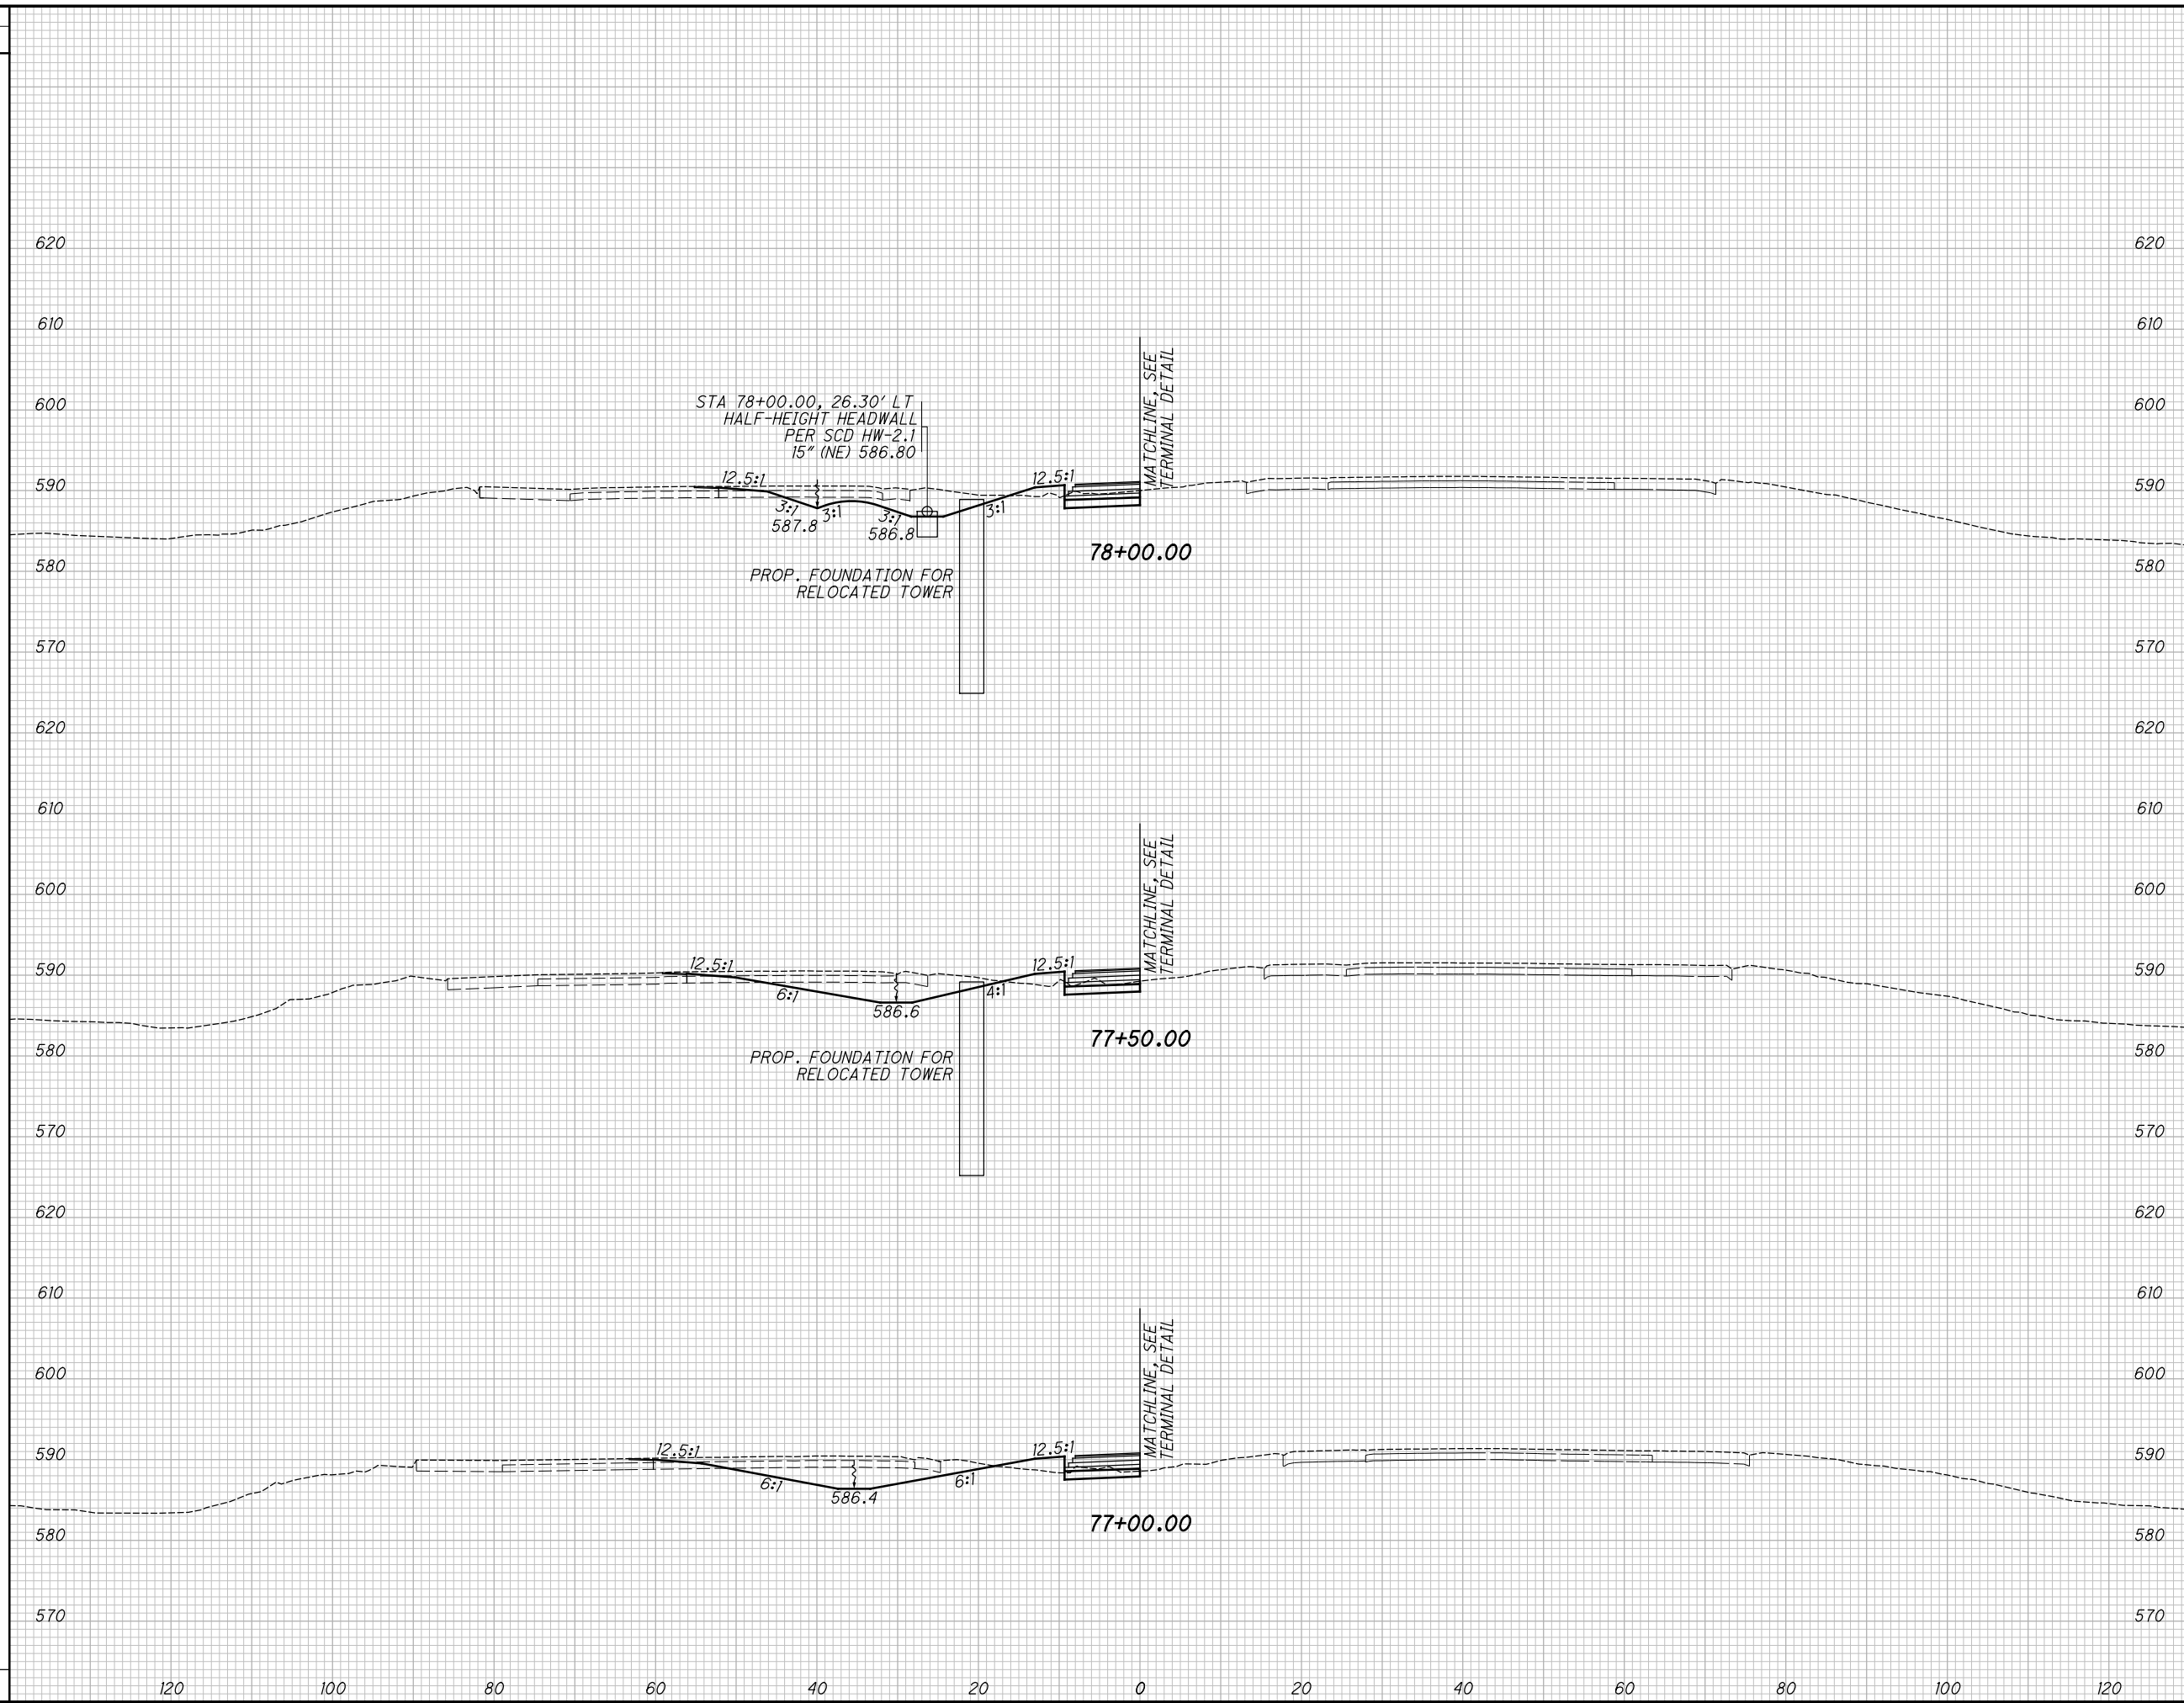


END AREA		VOLUME		CALCULATED JEM	CHECKED MEP
CUT	FILL	CUT	FILL		

**BUILDABLE UNIT 4-AS-BUILT PLANS--JANUARY 29, 2018**  
**CROSS SECTIONS RAMP C**  
**STA. 77+00.00 TO STA. 78+00.00**

**HAM-75-16.67**

G:\Akron\DCS\Projects\TRN\60547096\_HAM751667\900-CAD-GIS\104408\_HAM-75-1667\Design\Roadway\Sheets\104408\_X5001.dgn Sheet 1/23/2018 9:36:39 AM matt.philips

SEEDING	
END WIDTH	SO. YDS.

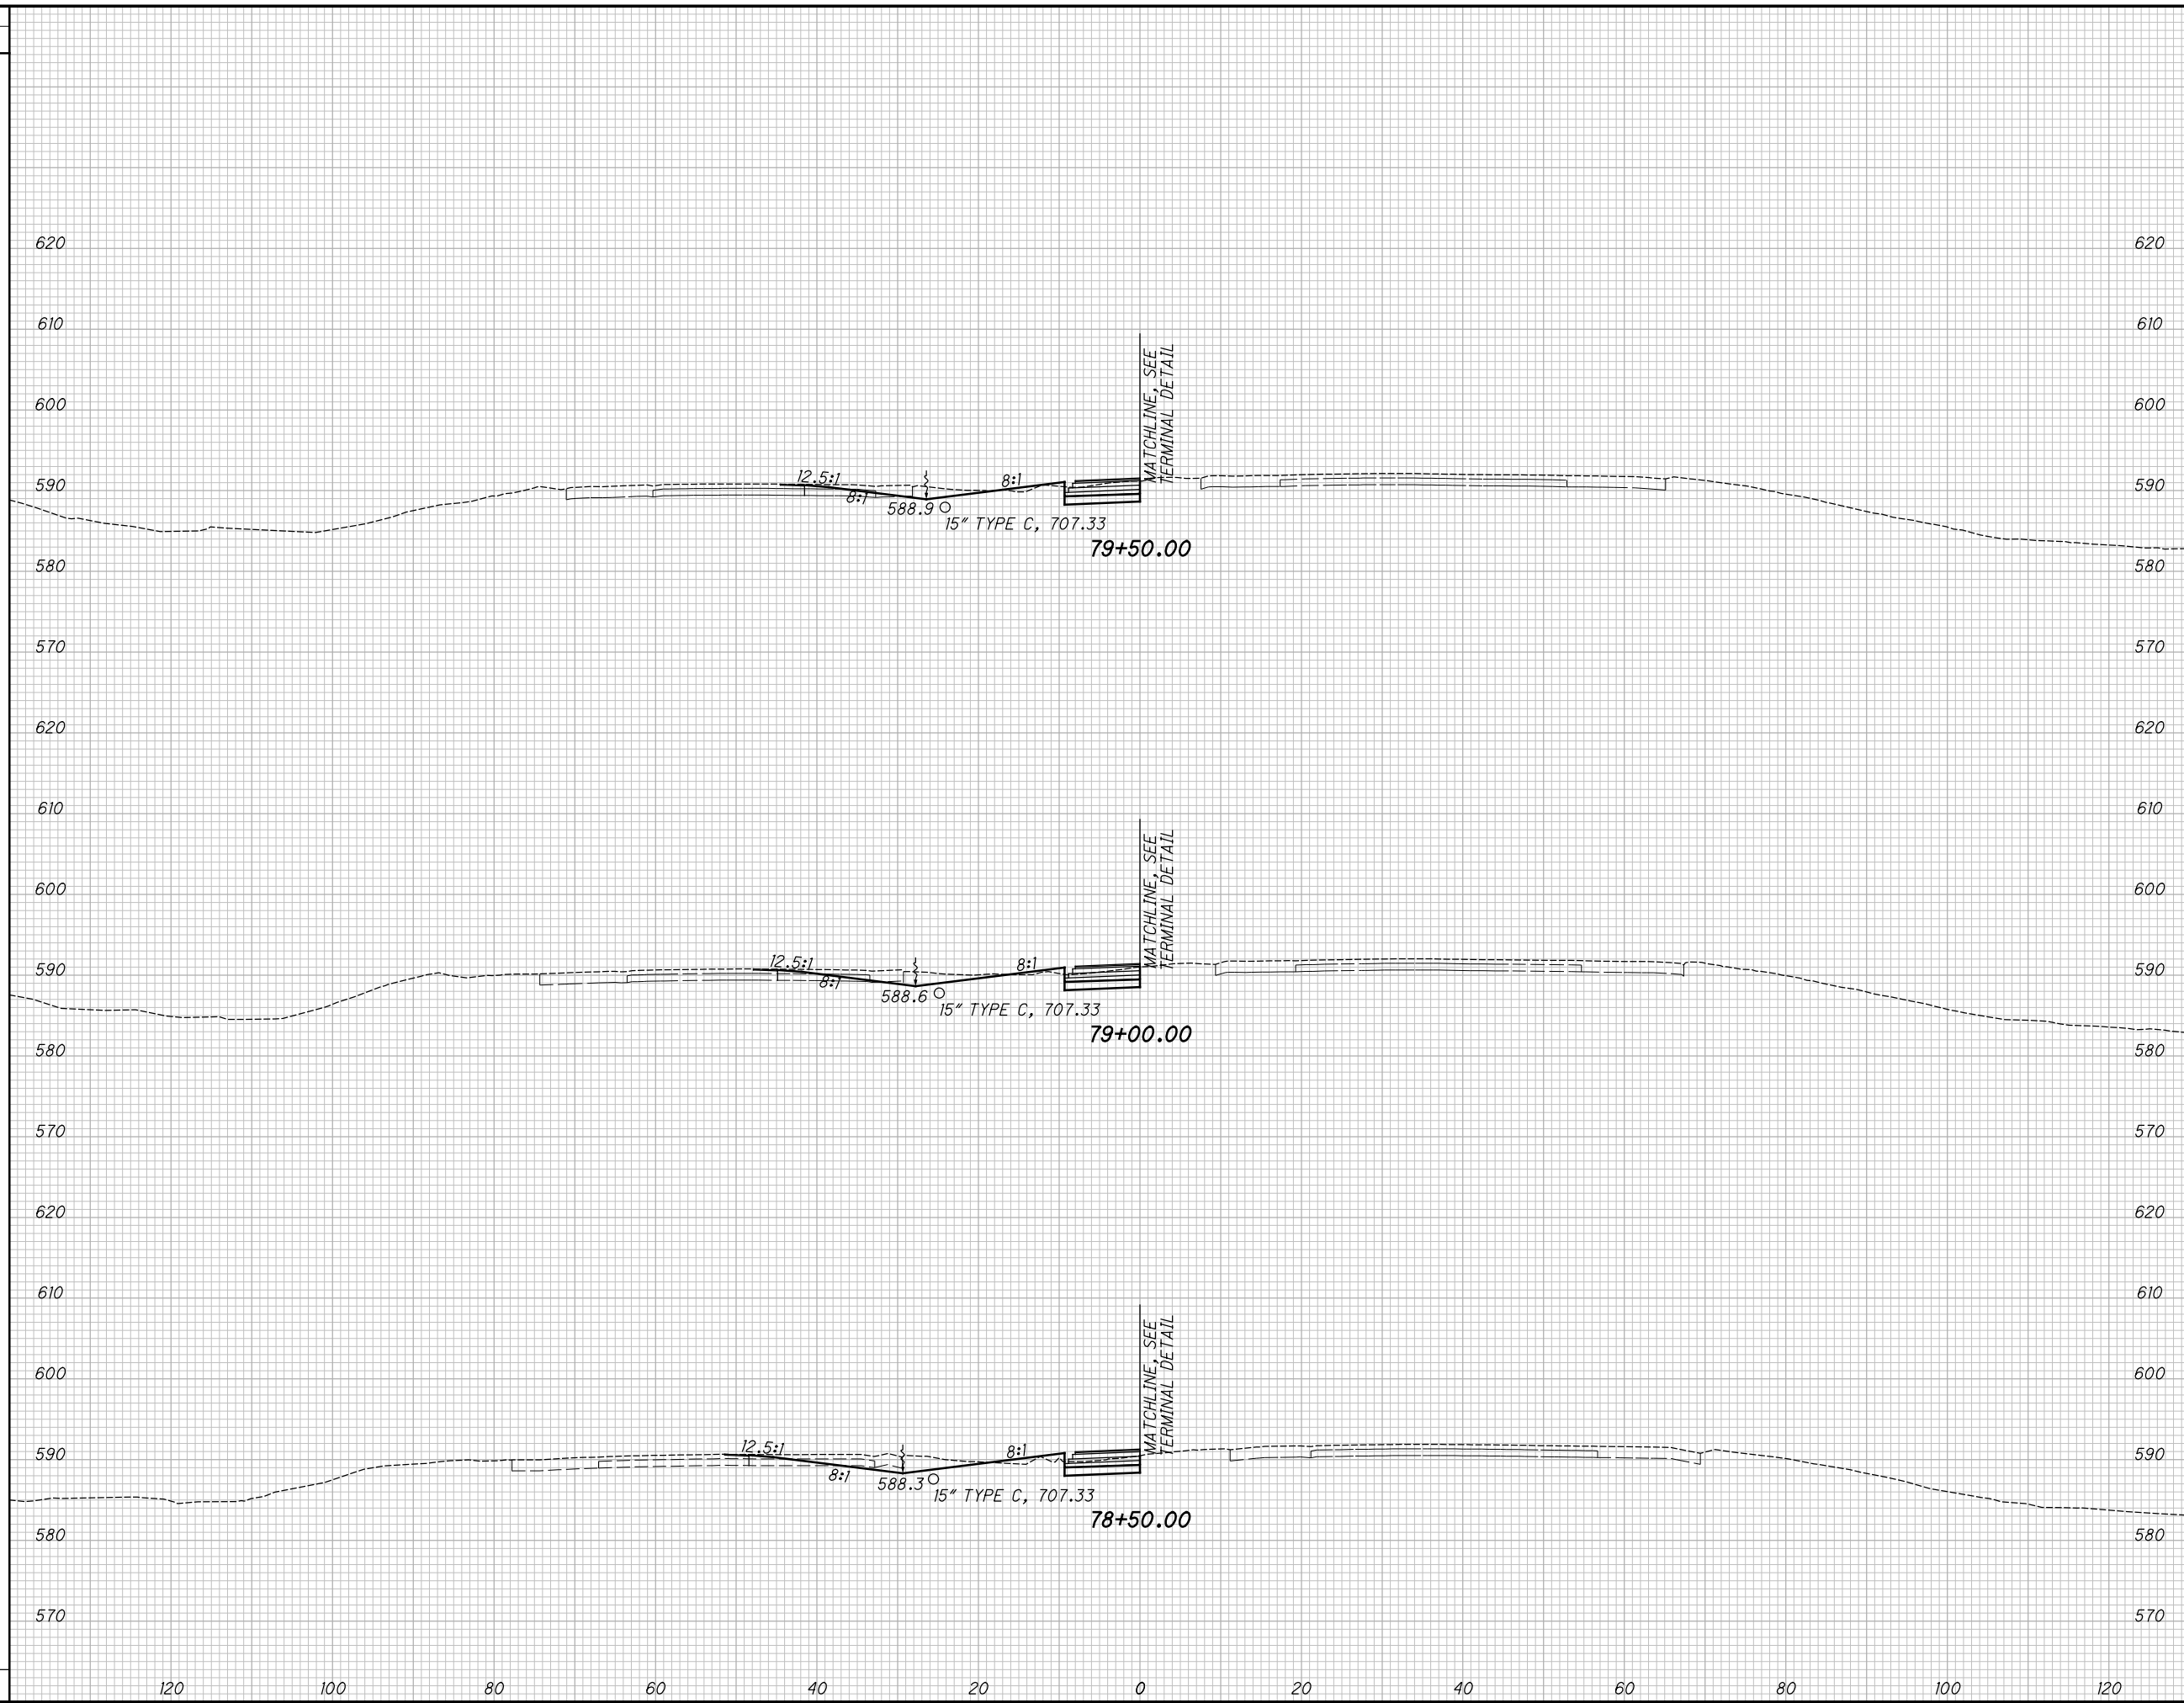

END AREA		VOLUME		CALCULATED JEM	CHECKED MEP
CUT	FILL	CUT	FILL		

**BUILDABLE UNIT 4-AS-BUILT PLANS--JANUARY 29, 2018**

**CROSS SECTIONS RAMP C**

**STA. 78+50.00 TO STA. 79+50.00**

**HAM-75-16.67**


22  
43



G:\AKron\DCS\Projects\TRN\60547096\_HAM751667\900-CAD-GIS\104408\_HAM-75-1667\Design\Roadway\Sheets\104408\_X5001.dgn Sheet 1/23/2018 9:36:40 AM matt.philips

SEEDING	
END WIDTH	SO. YDS.

END AREA		VOLUME		CALCULATED	
CUT	FILL	CUT	FILL	JEM	MEP

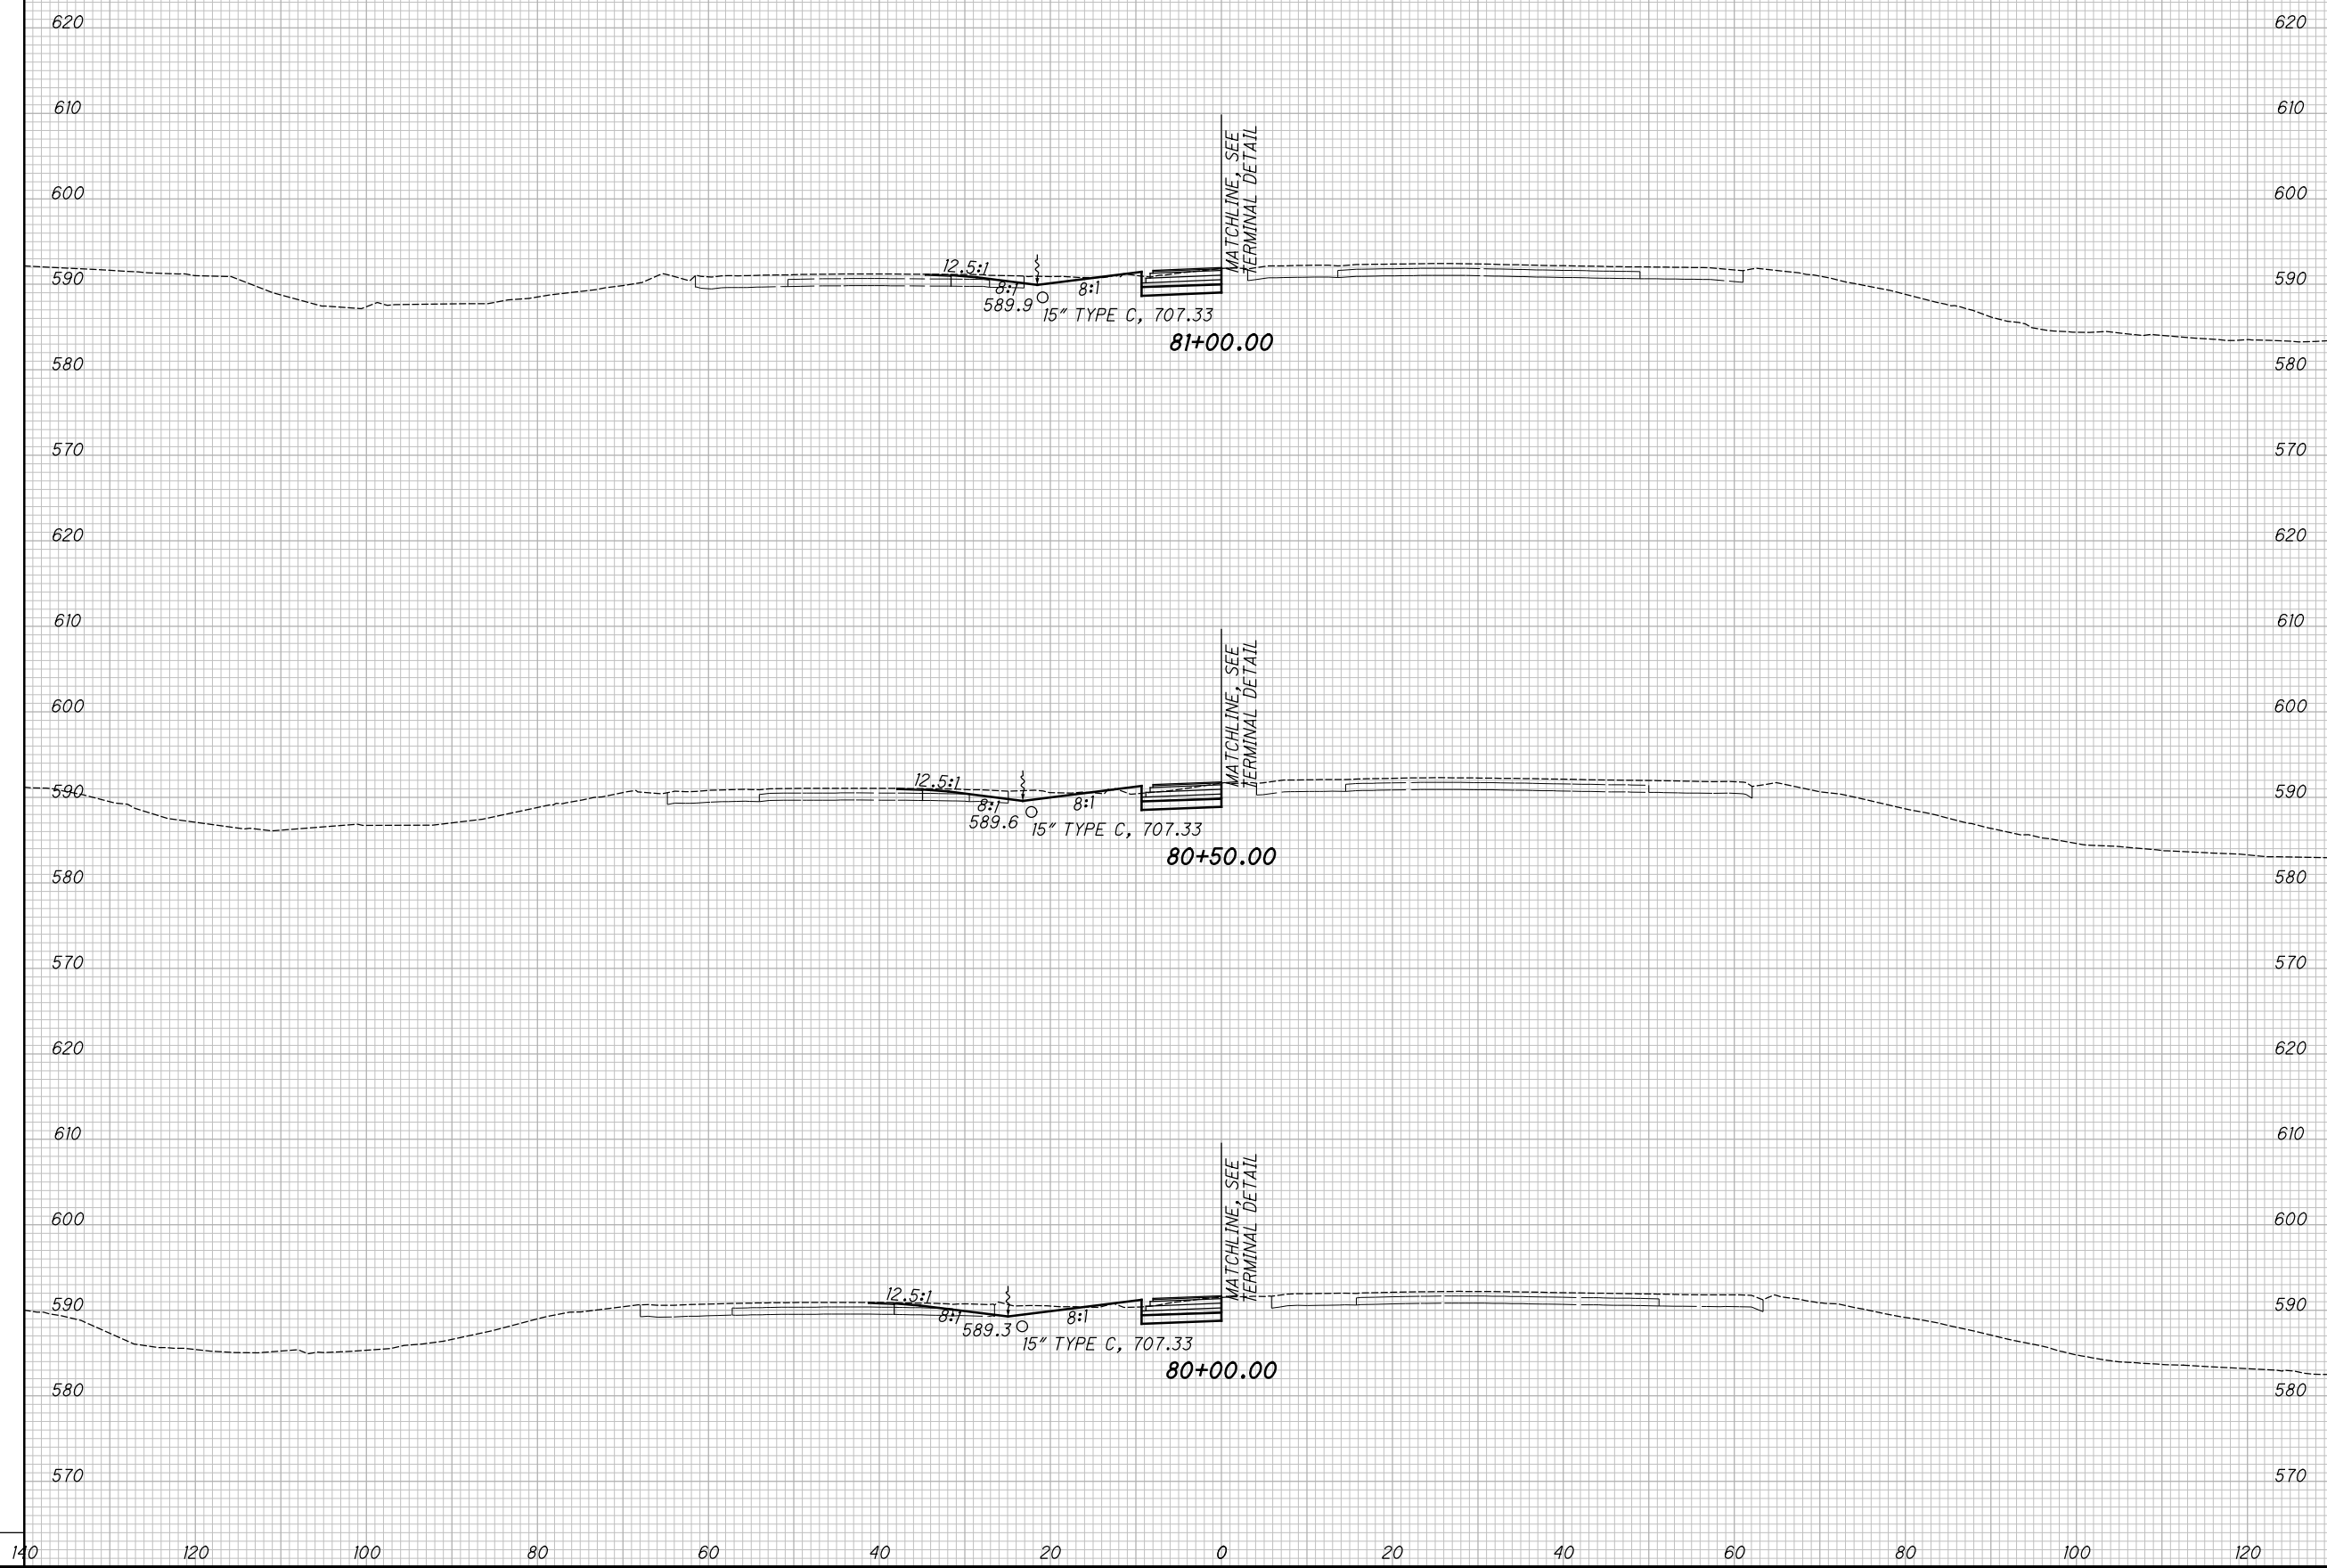


**BUILDABLE UNIT 4-AS-BUILT PLANS--JANUARY 29, 2018**  
**CROSS SECTIONS RAMP C**  
**STA. 80+00.00 TO STA. 81+00.00**

**HAM-75-16.67**

G:\Akron\DCS\Projects\TRN\60547096\_HAM751667\900-CAD-GIS\104408\_HAM-75-1667\Design\Roadway\Sheets\104408\_X5001.dgn Sheet 1/23/2018 9:36:41AM matr.phillips

SEEDING	
END WIDTH	SO. YDS.


END AREA		VOLUME		CALCULATED JEM	CHECKED MEP
CUT	FILL	CUT	FILL		

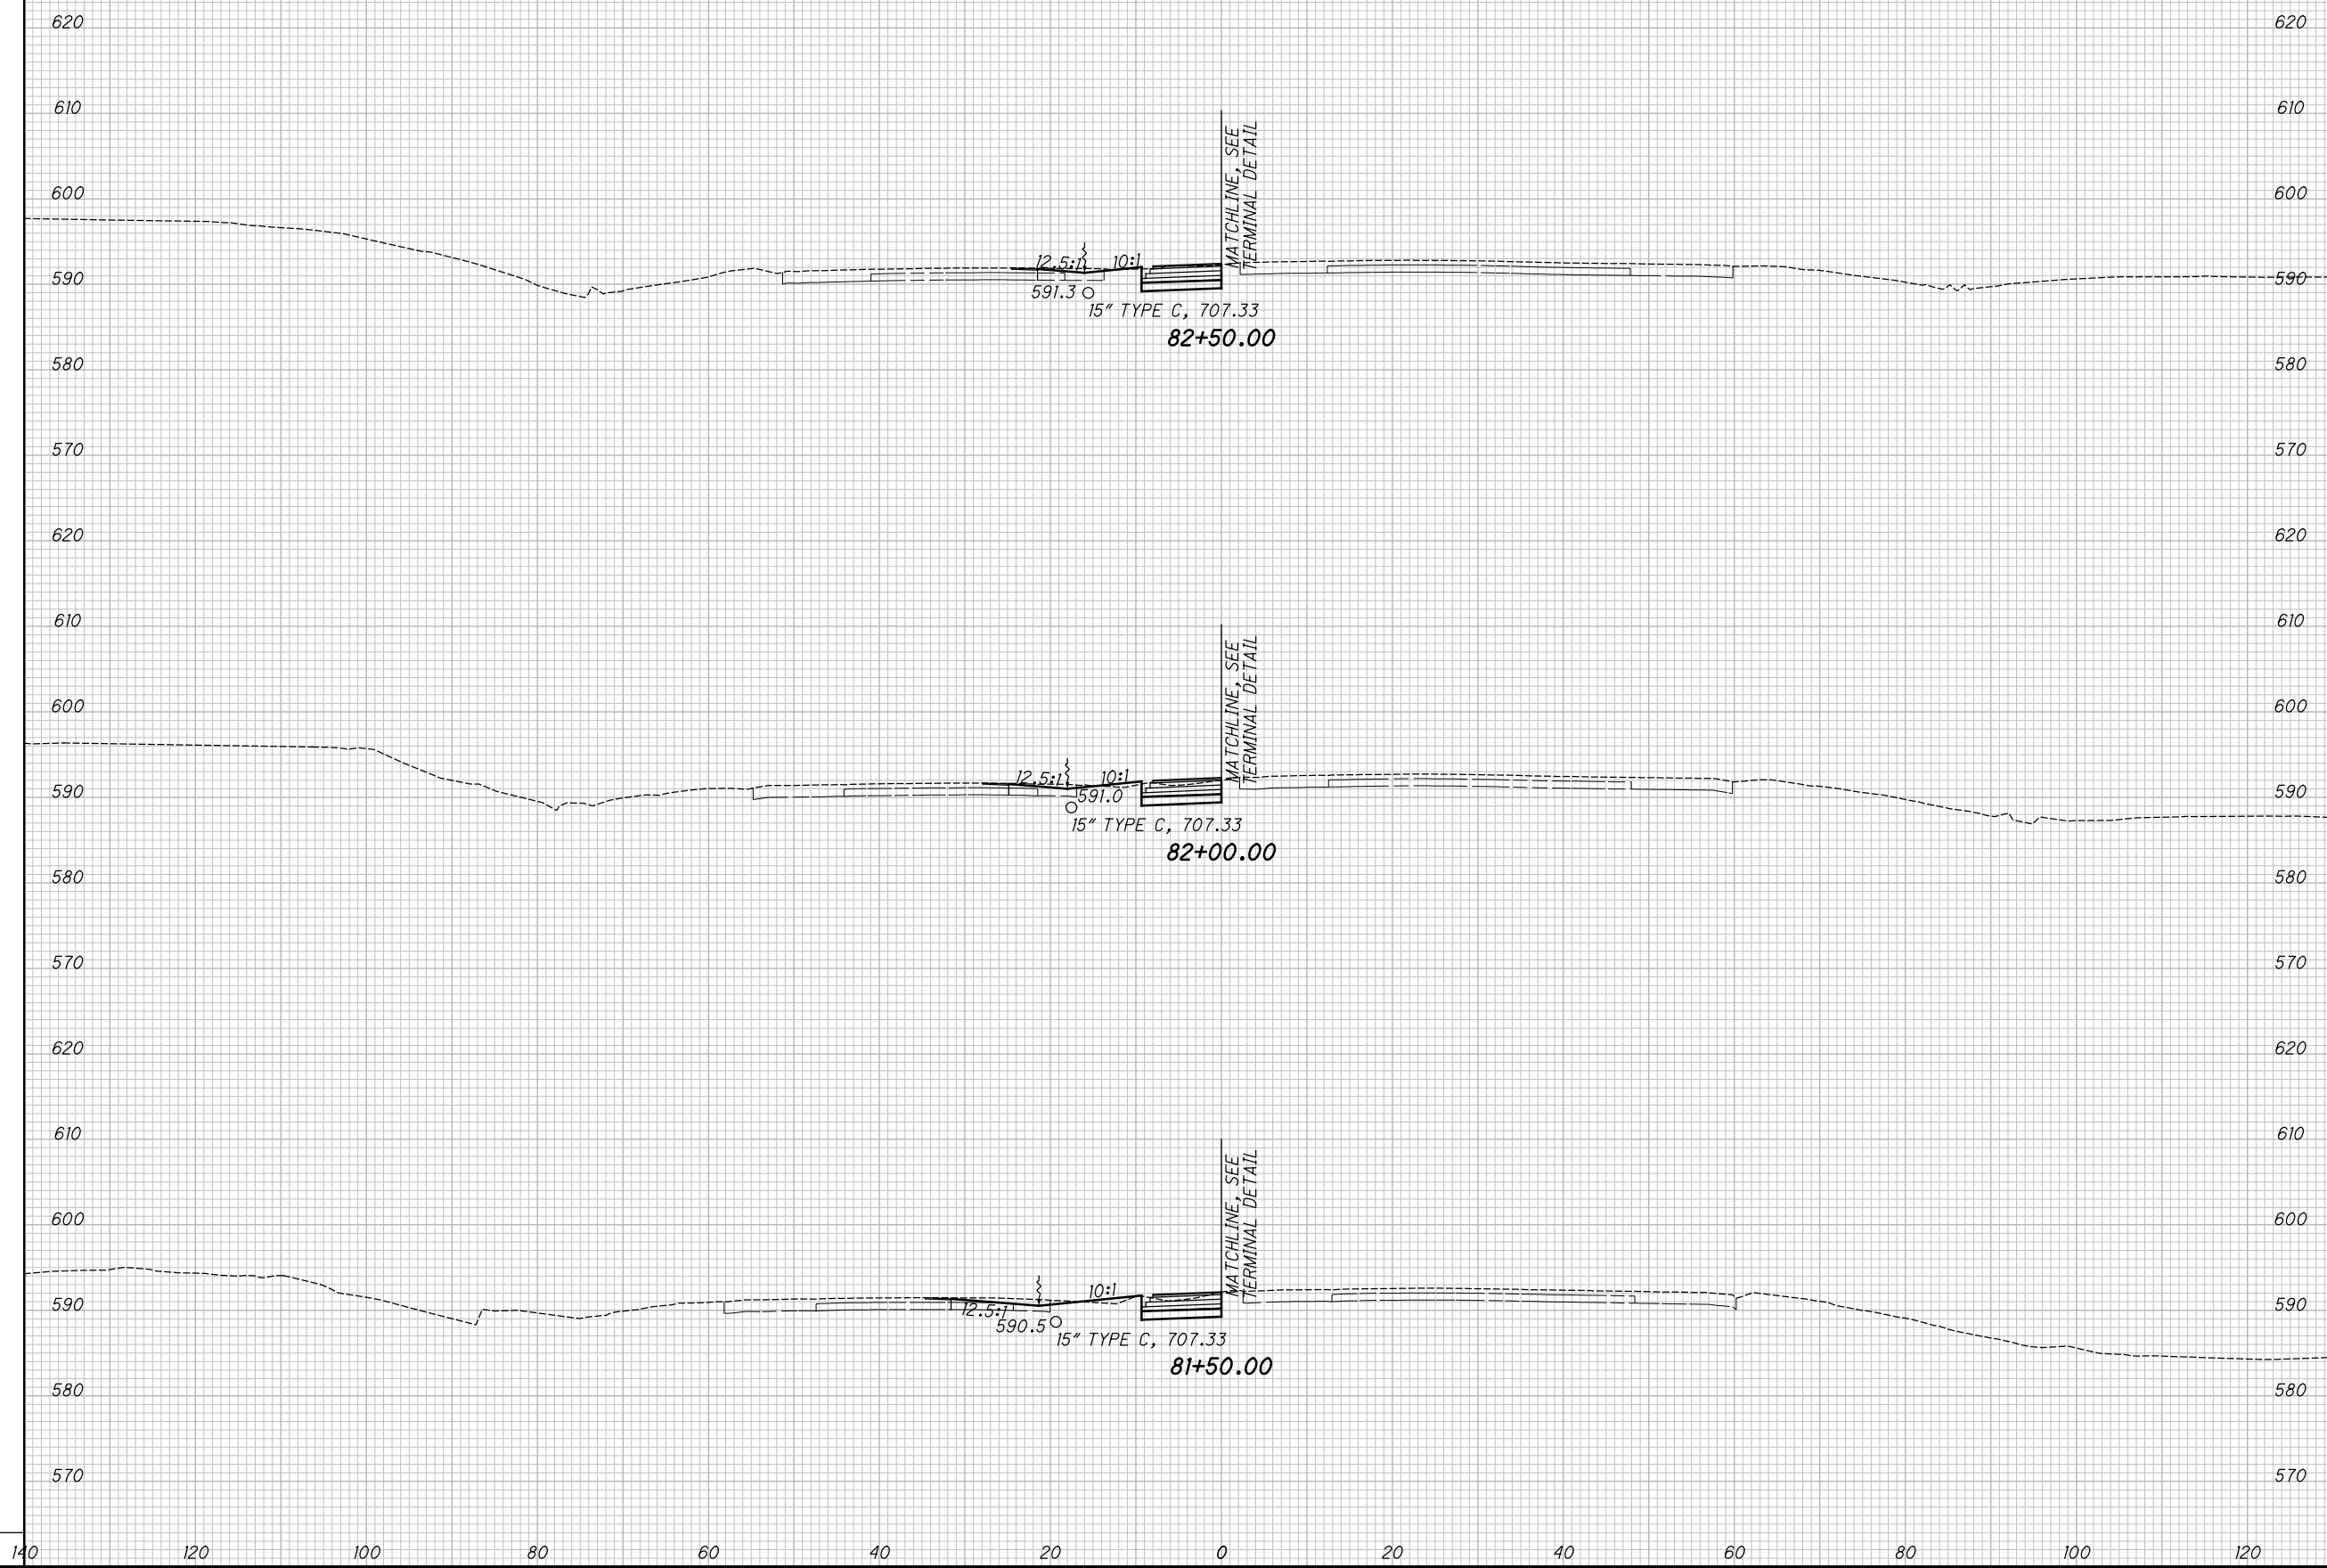

**BUILDABLE UNIT 4-AS-BUILT PLANS--JANUARY 29, 2018**  
**CROSS SECTIONS RAMP C**  
**STA. 81+50.00 TO STA. 82+50.00**

**HAM-75-16.67**

G:\Akron\DCS\Projects\TRN\60547096\_HAM751667\900-CAD-GIS\104408\_HAM-75-1667\Design\Roadway\Sheets\104408.X5001.dgn\_Sheet 1/23/2018 9:36:42 AM matt.philips

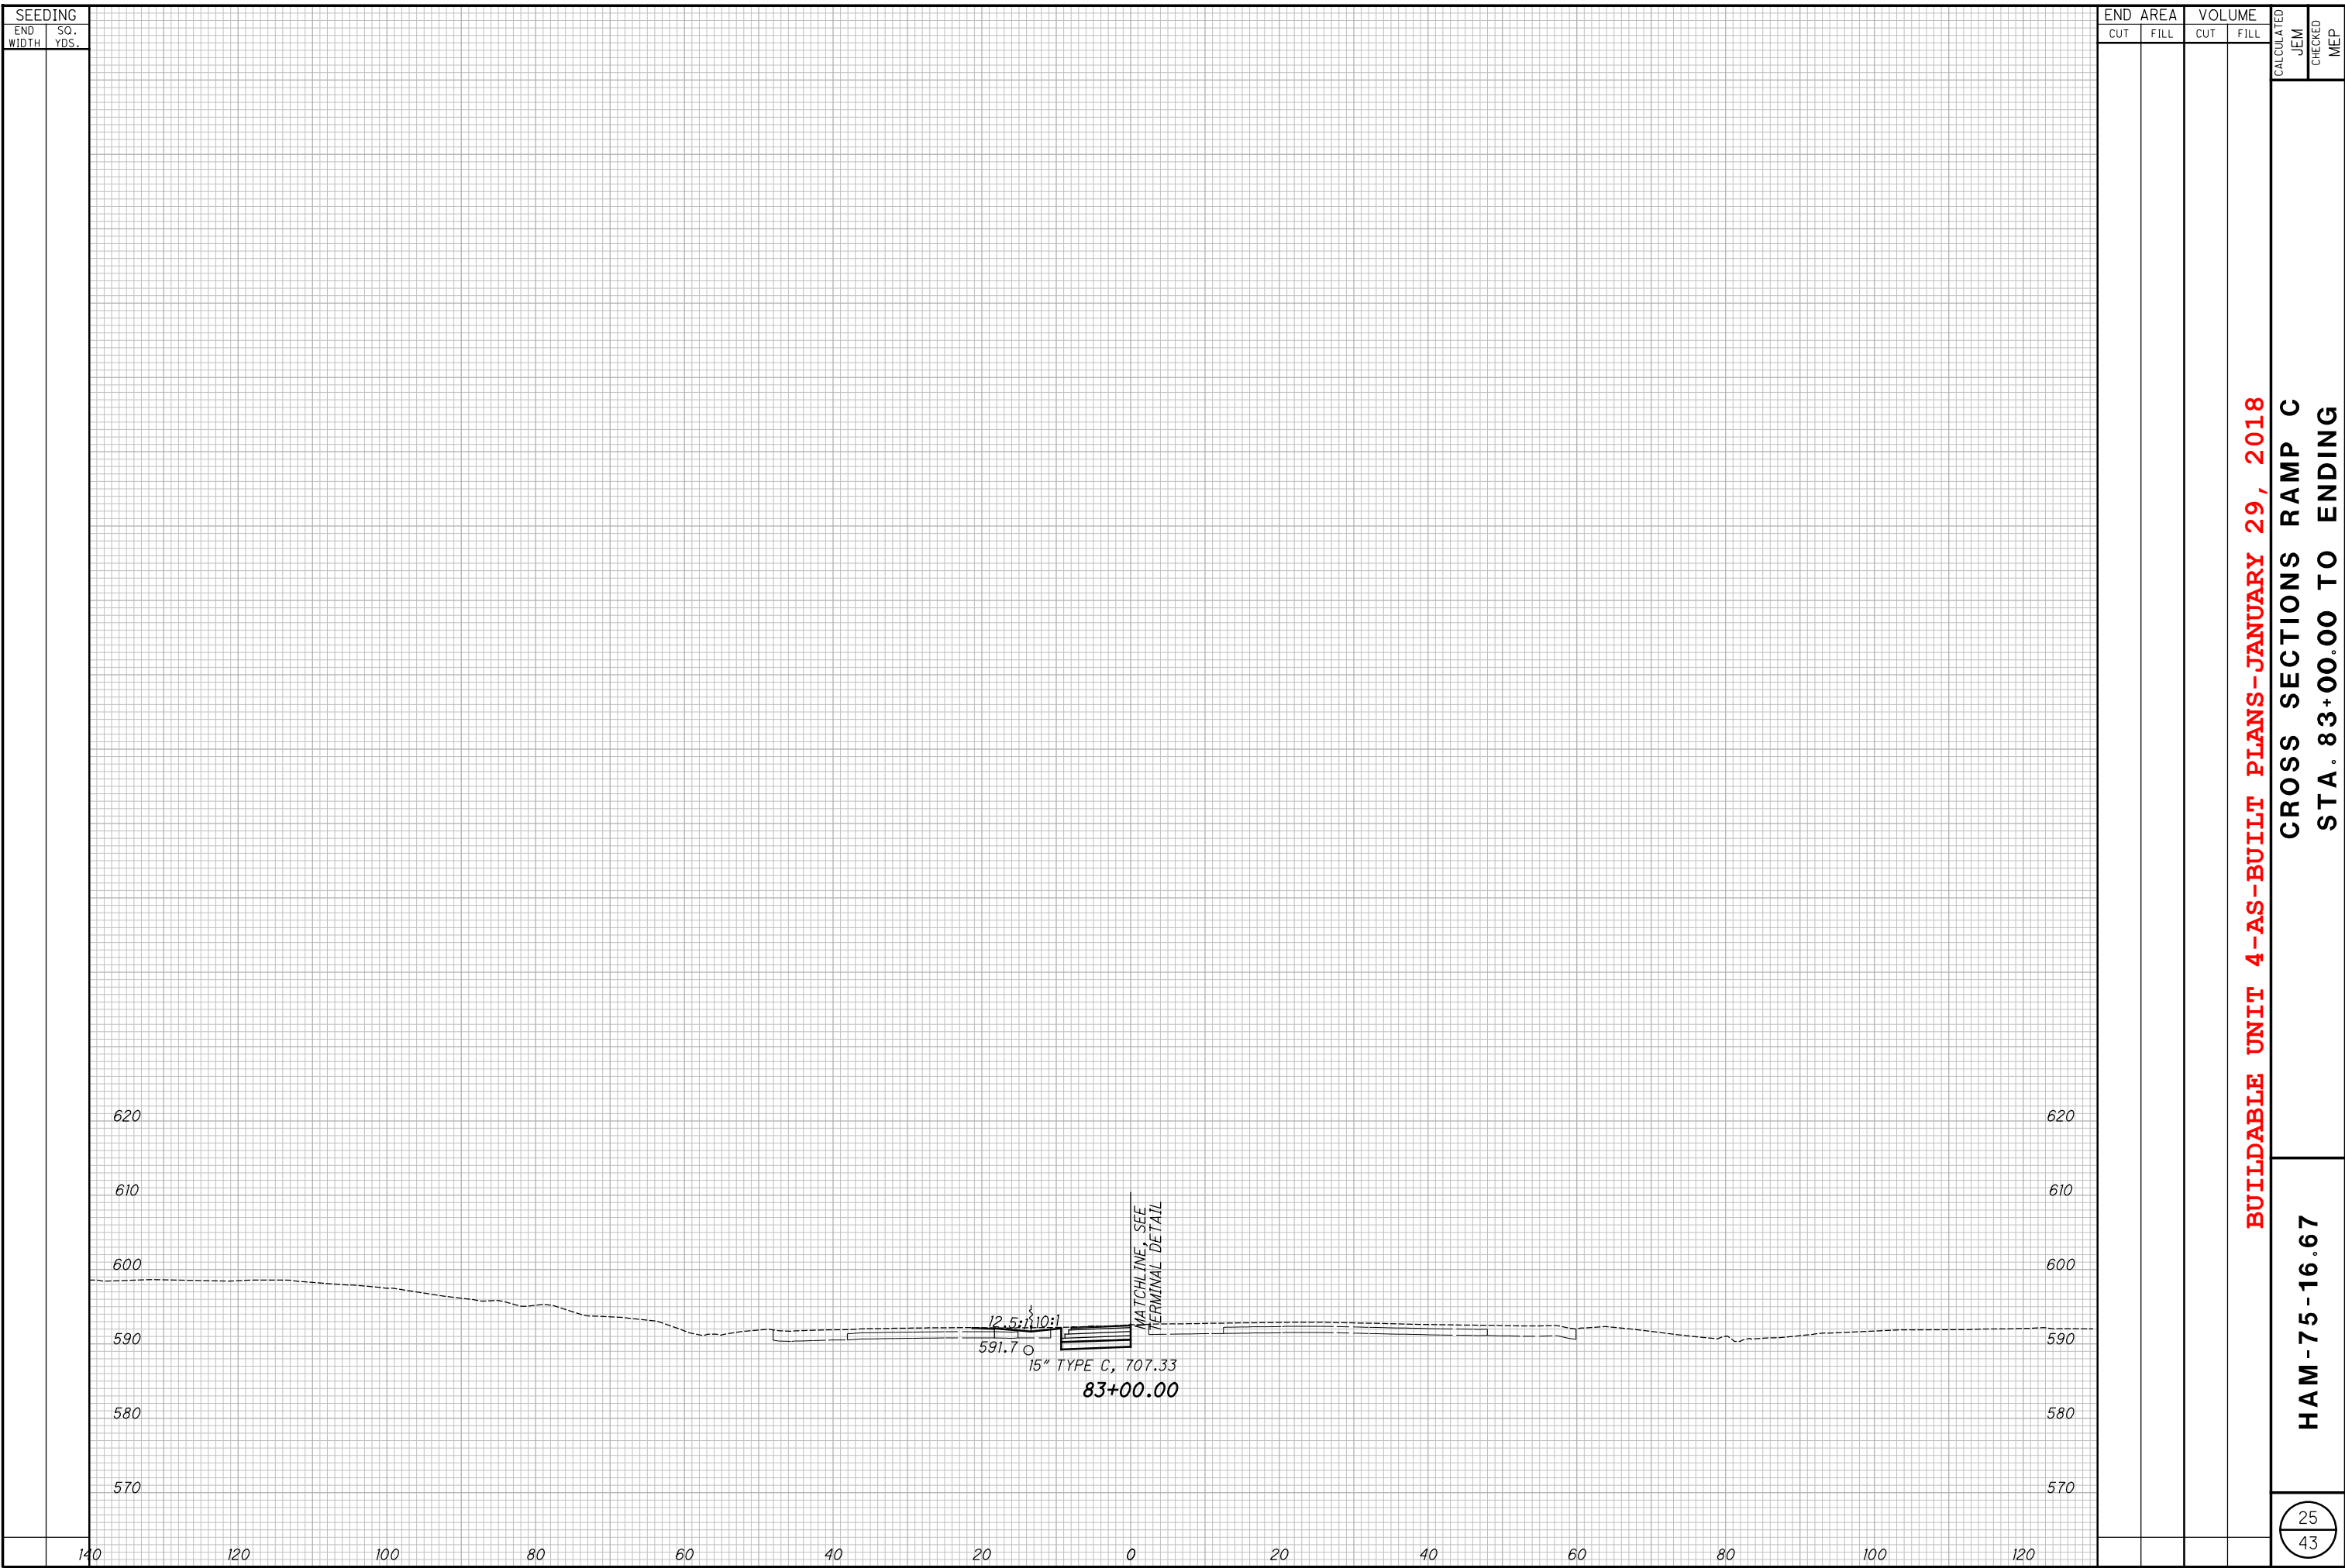

SEEDING	
END WIDTH	SO. YDS.

END AREA		VOLUME		CALCULATED JEM	CHECKED MEP
CUT	FILL	CUT	FILL		

**BUILDABLE UNIT 4-AS-BUILT PLANS--JANUARY 29, 2018**  
**CROSS SECTIONS RAMP C**  
**STA. 83+00.00 TO ENDING**


**HAM-75-16.67**

25  
43

G:\Akron\DCS\Projects\TRN\60547096\_HAM751667\900-CAD-GIS\104408-CAD-GIS\104408\_HAM-75-1667\Design\Roadway\Sheets\104408\_X5002.dgn Sheet 1/23/2018 9:36:44 AM matt.philips

SEEDING

END WIDTH	SO. YDS.

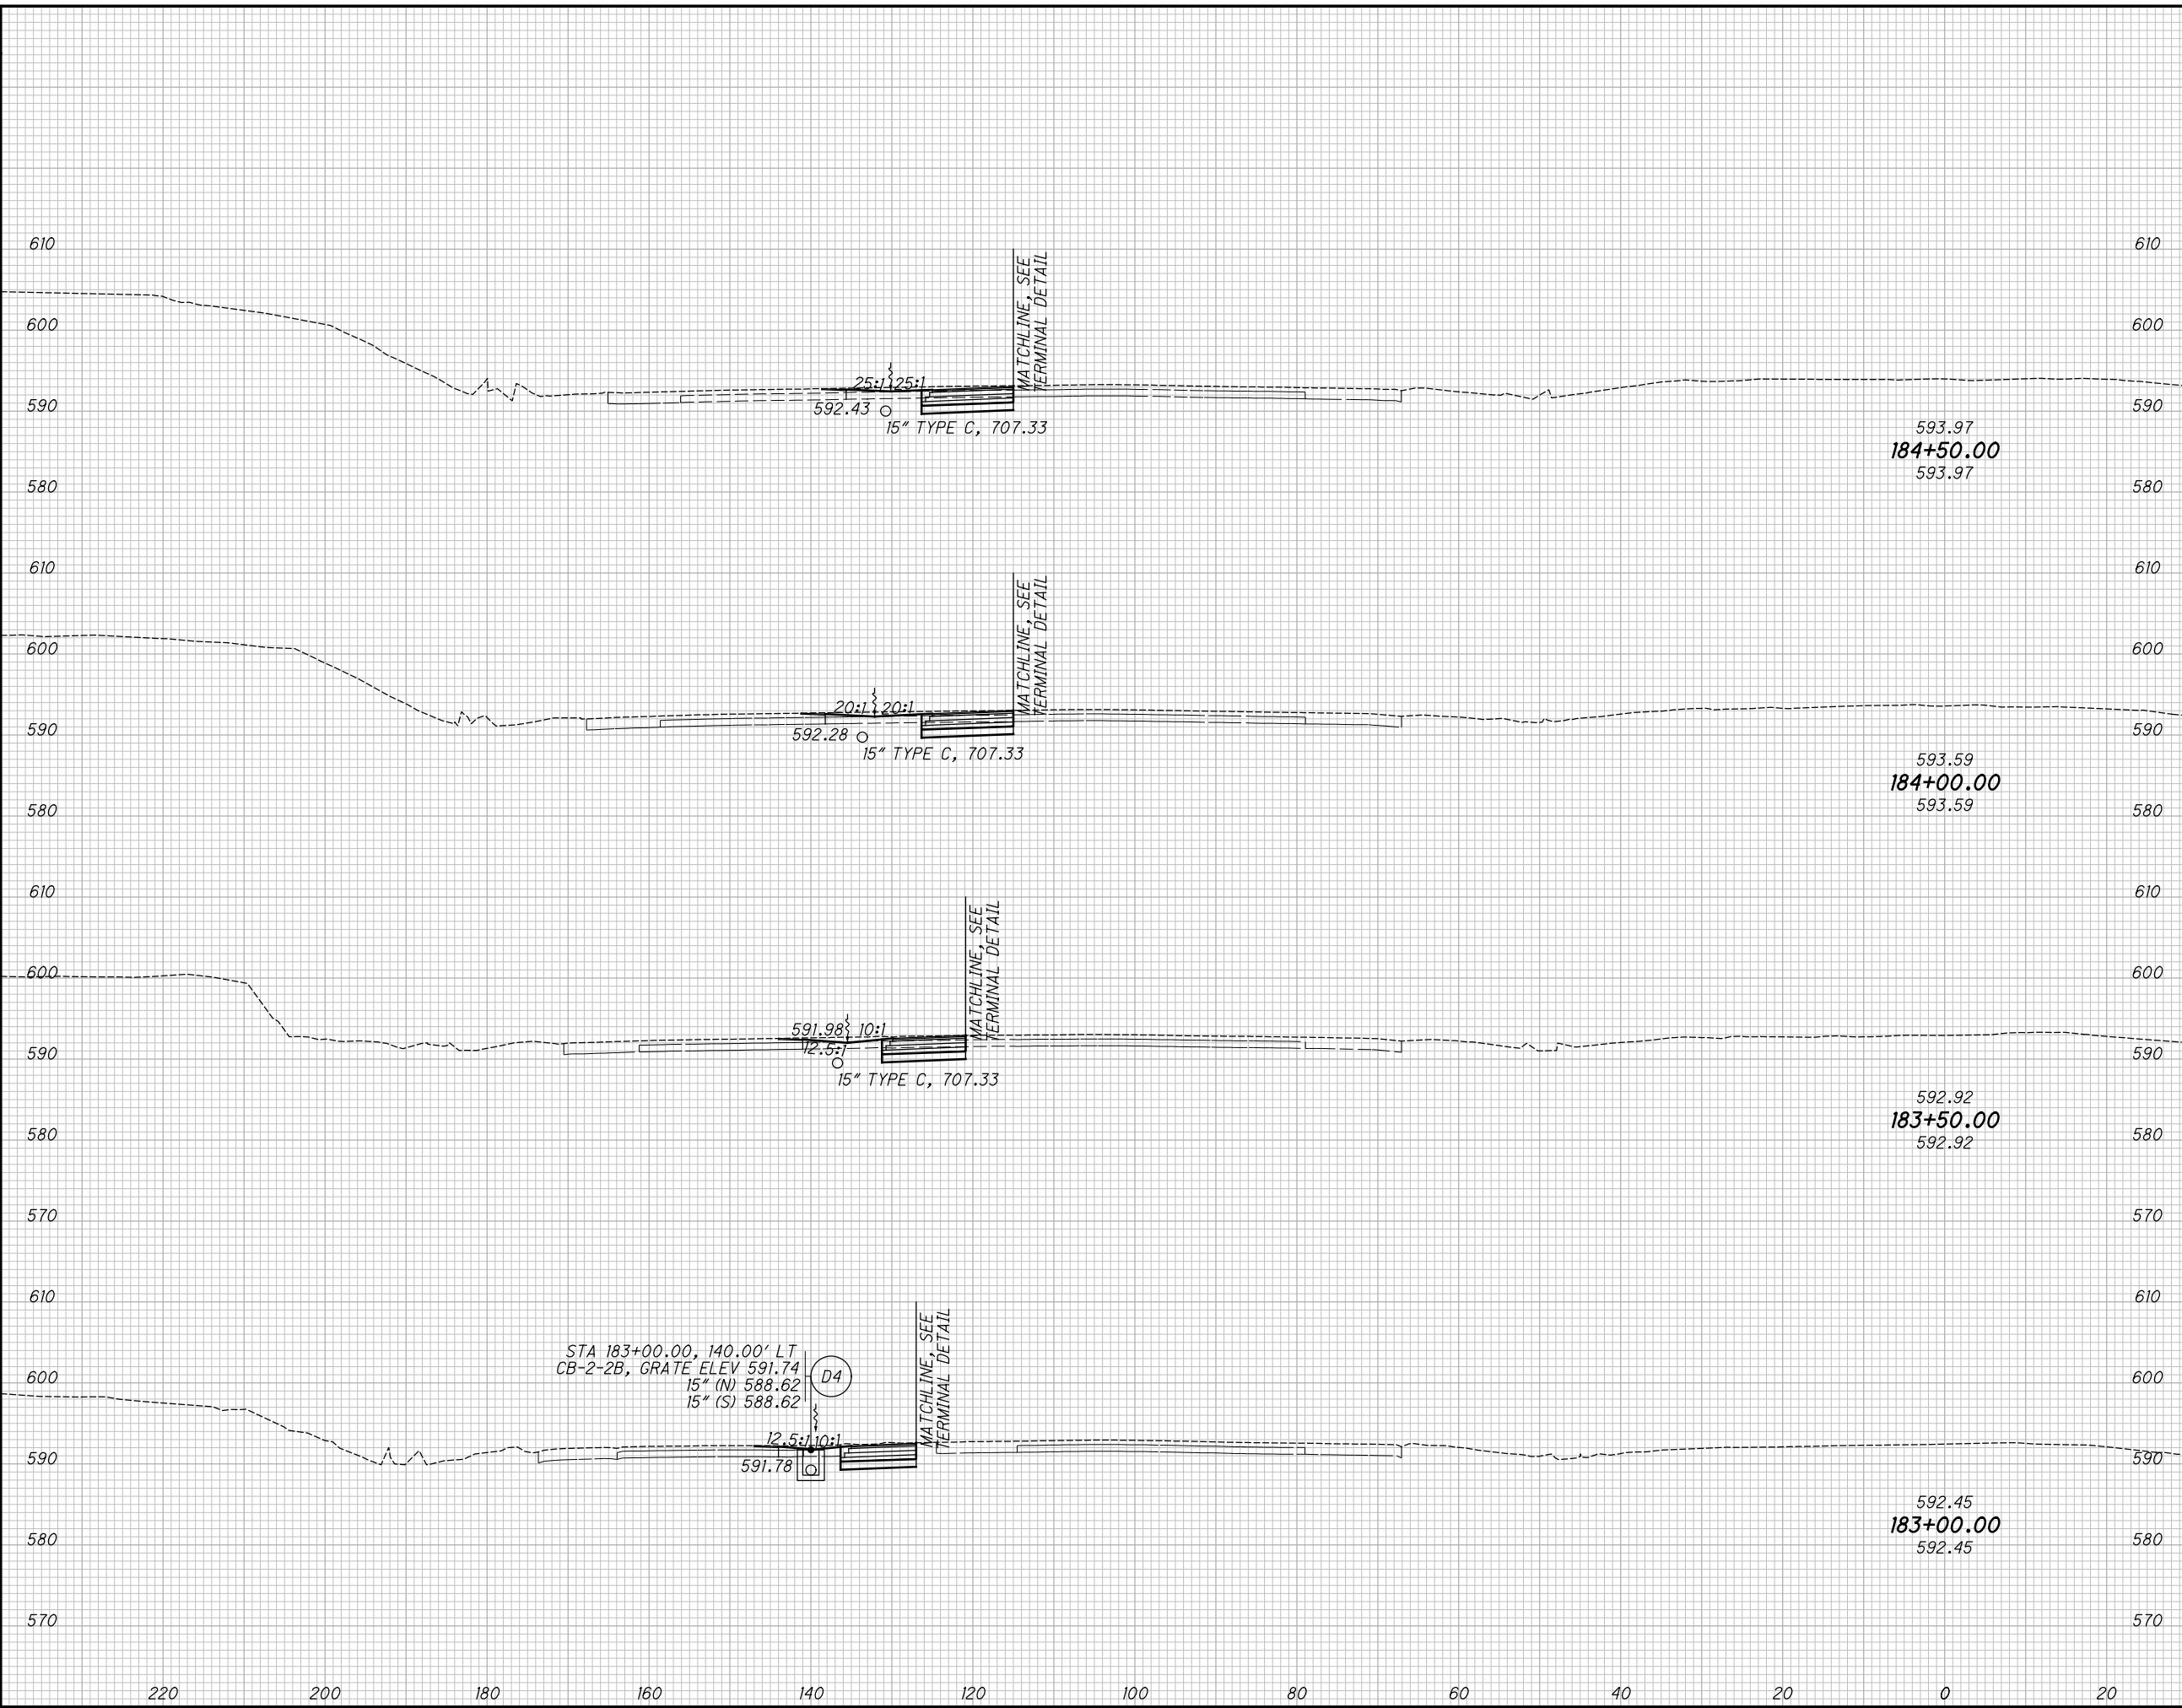

END AREA		VOLUME		CALCULATED JEM	CHECKED MEP
CUT	FILL	CUT	FILL		


**BUILDABLE UNIT 4-AS-BUILT PLANS-JANUARY 29, 2018**  
**CROSS SECTIONS I.R. 75**  
**BEGINNING TO STA. 184+50.00**

**HAM-75-16.67**



G:\AKron\DCS\Projects\TRN\60547096\_HAM751667\900-CAD-GIS\104408\_HAM-75-1667\Design\Roadway\Sheets\104408\_X5002.dgn Sheet 1/23/2018 9:36:45 AM matt.philips

SEEDING	
END WIDTH	SO. YDS.

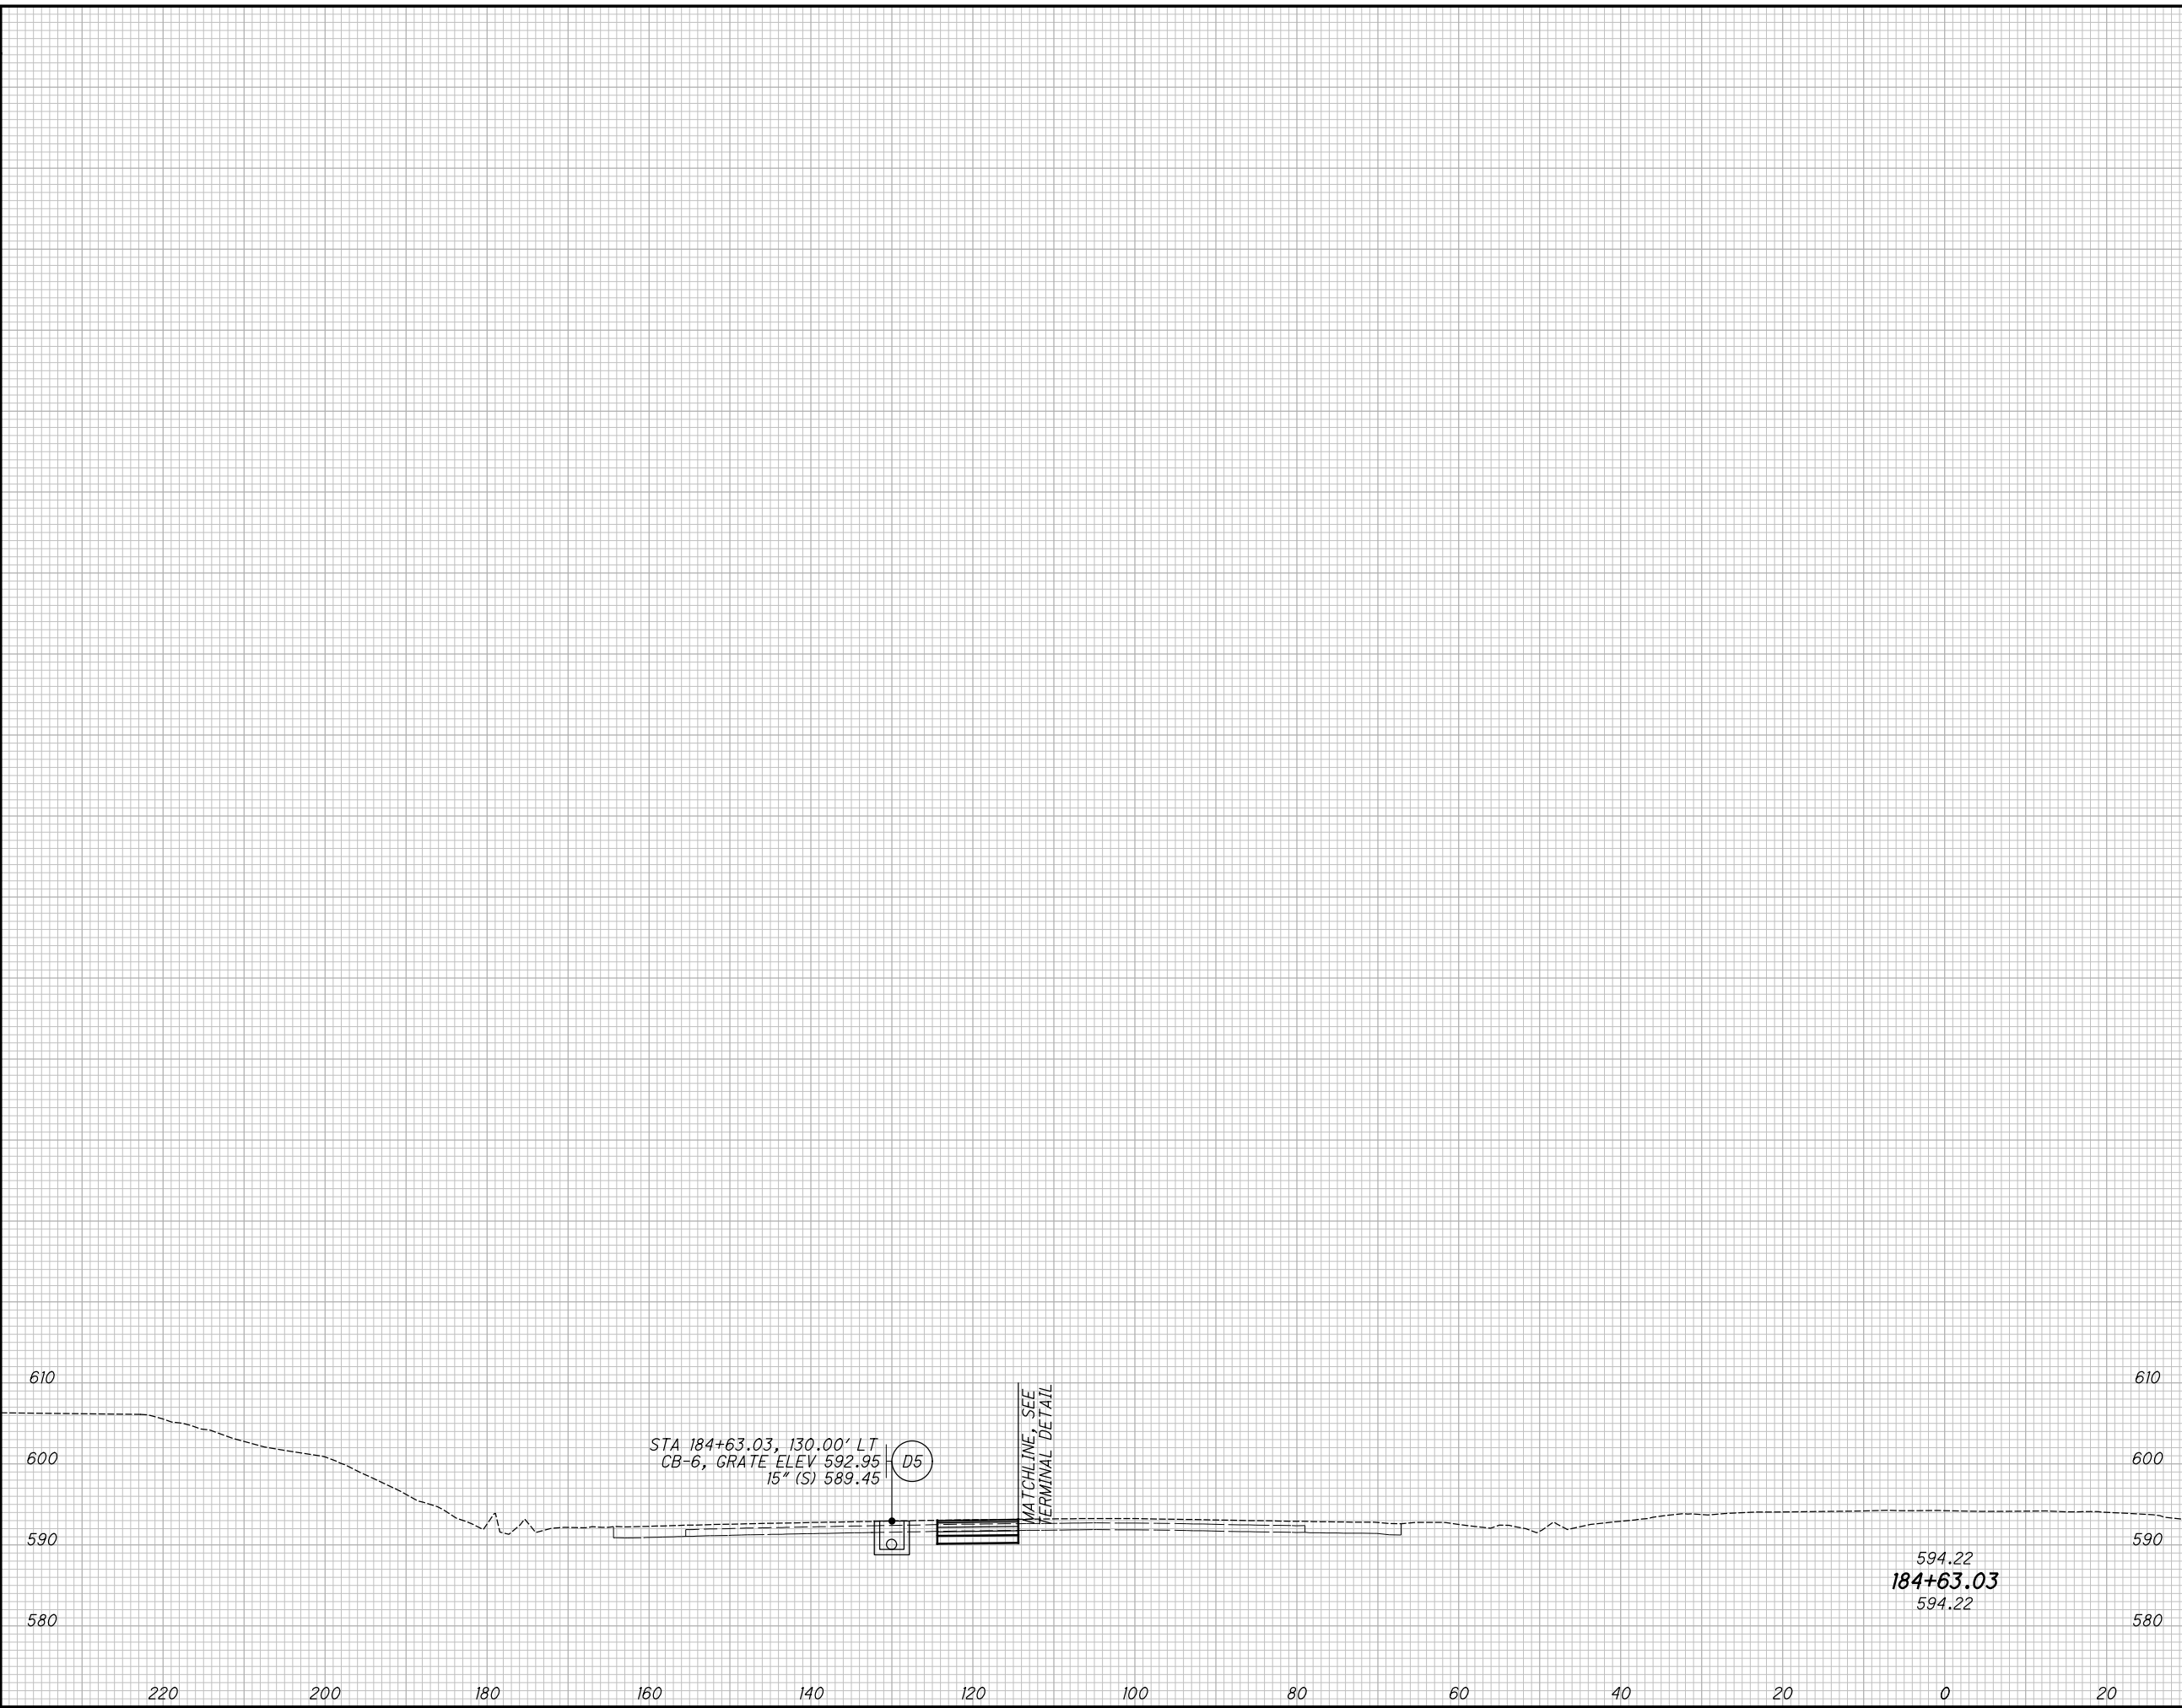

END AREA		VOLUME		CALCULATED JEM	CHECKED MEP
CUT	FILL	CUT	FILL		

**BUILDABLE UNIT 4-AS-BUILT PLANS--JANUARY 29, 2018**

**CROSS SECTIONS I.R. 75**

**STA. 184+63.03**

**HAM-75-16.67**

( 27 / 43 )



0 20 40  
HORIZONTAL SCALE IN FEET

CALCULATED  
MEP  
CHECKED  
JEM

BUILDABLE UNIT 4-AS-BUILT PLANS - JANUARY 29, 2018

RAMP C AND RAMP E  
TERMINAL DETAILS

HAM-75-16.67

28  
43

NOTES:  
ELEVATIONS ARE AT 25' INTERVALS, UNLESS OTHERWISE NOTED.  
RAMP STATIONING IS DENOTED WITH "\*" (+XX.XX\*).  
TRENCH DRAIN SHALL BE CONSTRUCTED WITHOUT CROSS SLOPE CREATING EQUIVALENT PAVEMENT ELEVATIONS AT THE SIDES.  
SAWCUT OFFSET FROM  $\bar{C}$  EX. R/W AND CONST. I.R. 75 VARIES. SEE PLAN SHEETS FOR DETAILS.  
MINIMAL SHOULDERS ELEVATIONS HAVE BEEN LABELLED FOR CLARITY.


(A):  
FROM PHYSICAL NOSE, TRANSITION 9' SHOULDER CROSS SLOPE -3.70% TO -4.00% OVER 10'.  
FOR CONTINUATION OF RAMP C DETAILS SOUTH OF PHYSICAL NOSE, SEE SHEET 32

LEGEND:

EXISTING ELEVATION - XXX.XX  
PROPOSED ELEVATION - XXX.XX

CURVE DATA  
 $\bar{C}$  EX. CONST. RAMP E  
P.I. Sta. 12+38.63\*  
 $\Delta = 3^\circ 03' 32''$  (LT)  
Dc = 2° 11' 12"  
R = 2,620.12'  
T = 69.96'  
L = 139.88'  
E = 0.93'

CURVE DATA  
 $\bar{C}$  EX. CONST. RAMP E  
P.I. Sta. 16+31.23\*  
 $\Delta = 2^\circ 54' 36''$  (LT)  
Dc = 0° 27' 04"  
R = 12,704.19'  
T = 322.68'  
L = 645.23'  
E = 4.10'  
eMAX = NC (60mph)

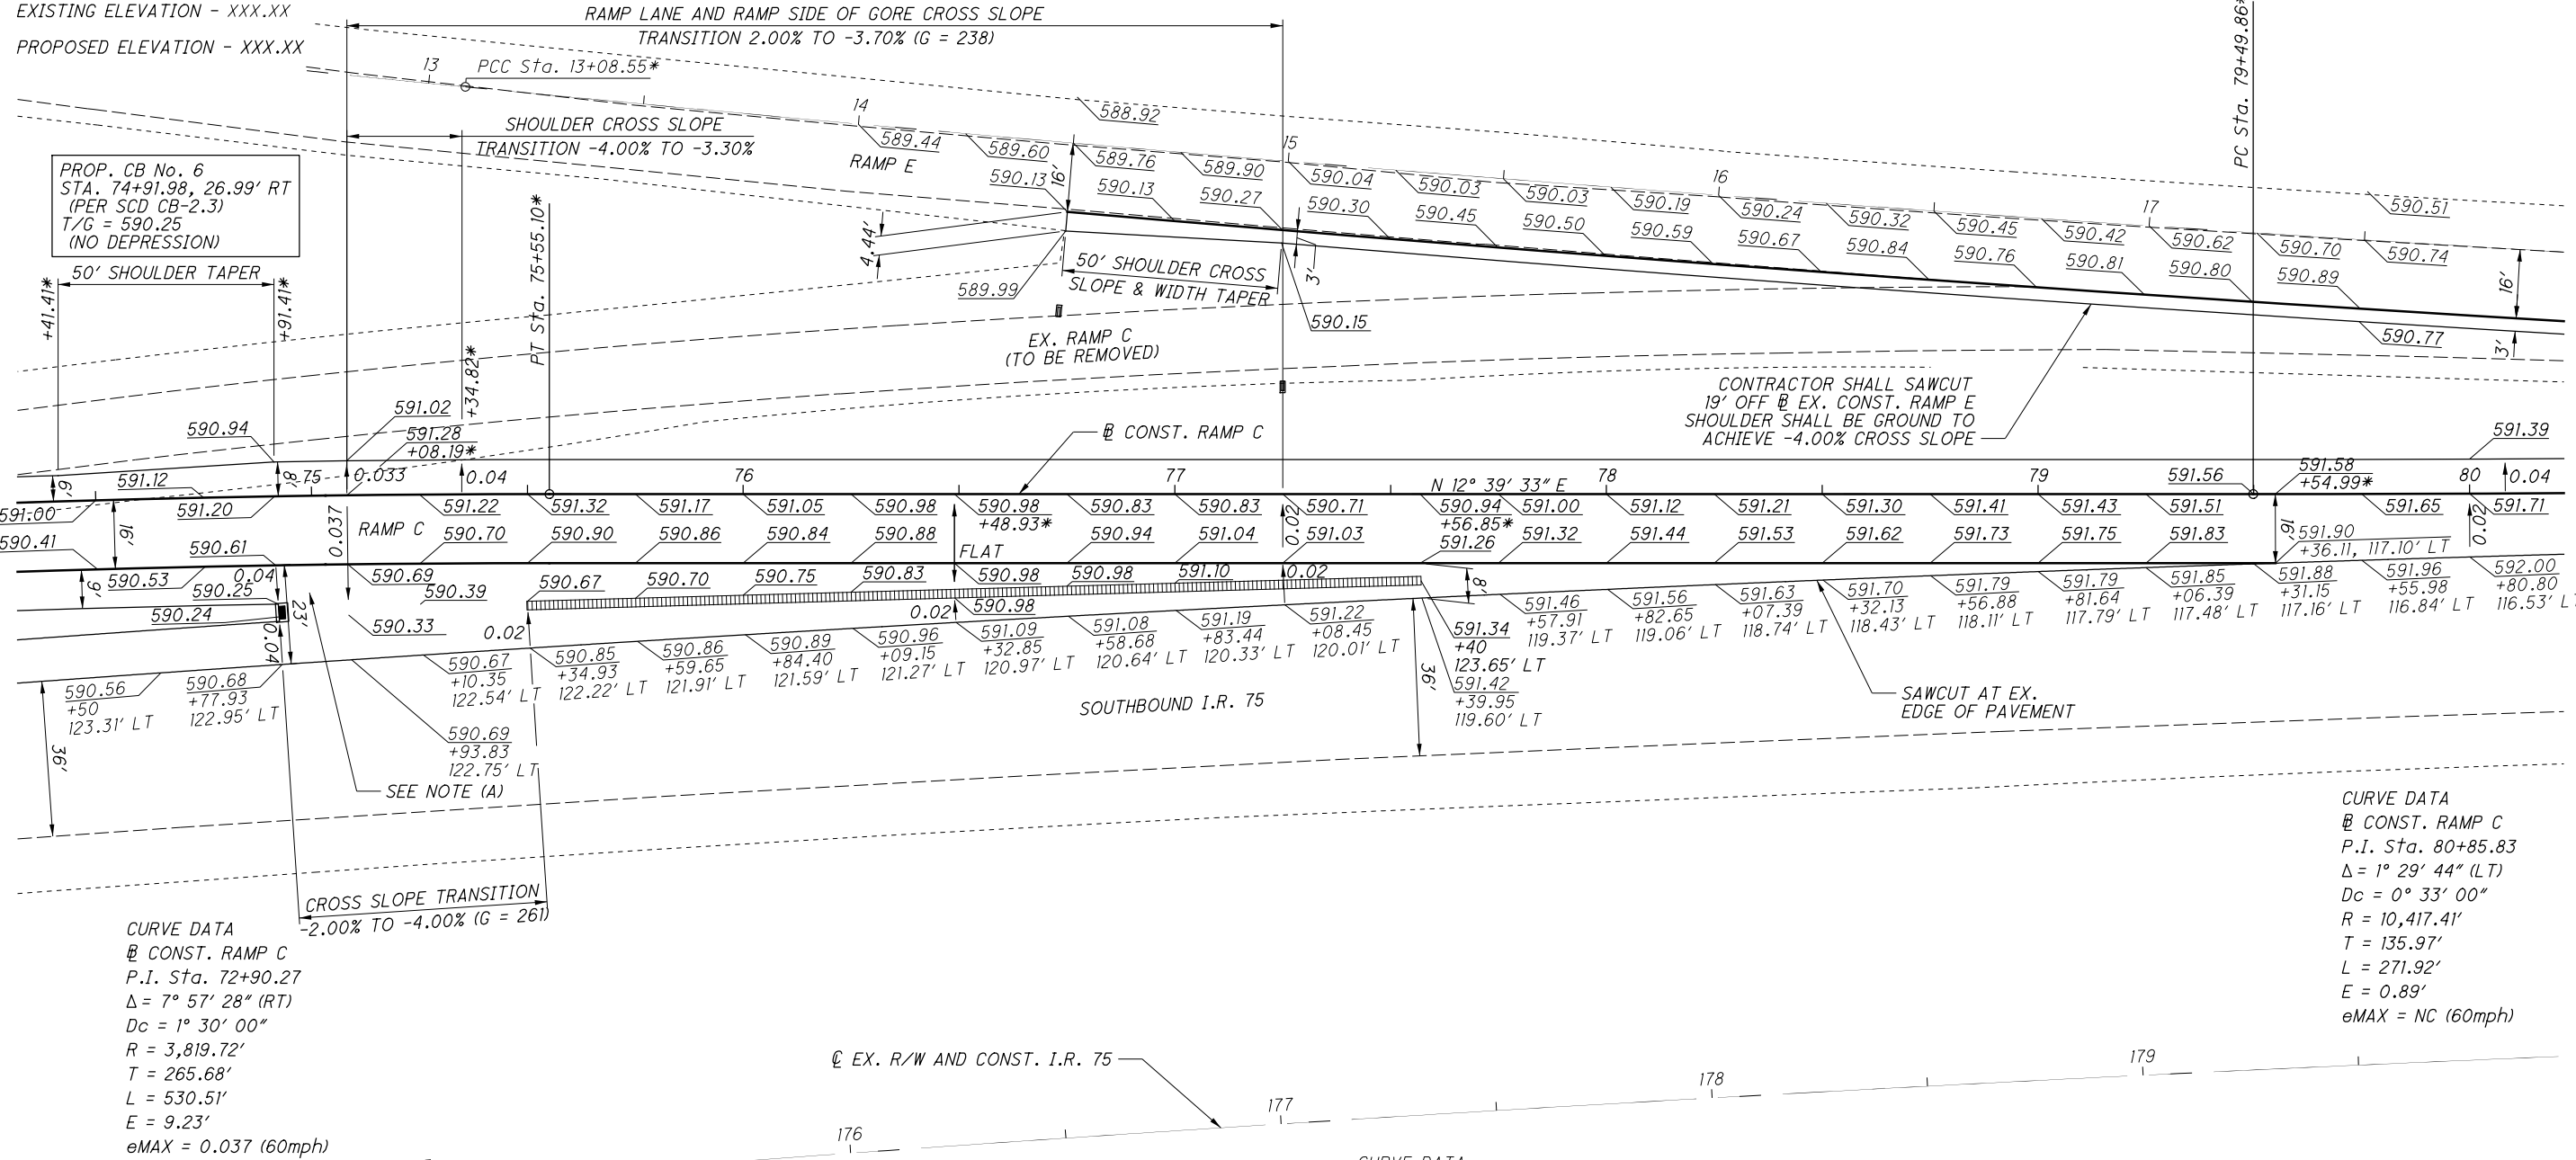

PROP. CB No. 6  
STA. 74+91.98, 26.99' RT  
(PER SCD CB-2.3)  
T/G = 590.25  
(NO DEPRESSION)

CONTRACTOR SHALL SAWCUT  
19' OFF  $\bar{C}$  EX. CONST. RAMP E  
SHOULDER SHALL BE GROUND TO  
ACHIEVE -4.00% CROSS SLOPE

SAWCUT AT EX.  
EDGE OF PAVEMENT

CURVE DATA  
 $\bar{C}$  CONST. RAMP C  
P.I. Sta. 72+90.27  
 $\Delta = 7^\circ 57' 28''$  (RT)  
Dc = 1° 30' 00"  
R = 3,819.72'  
T = 265.68'  
L = 530.51'  
E = 9.23'  
eMAX = 0.037 (60mph)

CURVE DATA  
 $\bar{C}$  CONST. RAMP C  
P.I. Sta. 80+85.83  
 $\Delta = 1^\circ 29' 44''$  (LT)  
Dc = 0° 33' 00"  
R = 10,417.41'  
T = 135.97'  
L = 271.92'  
E = 0.89'  
eMAX = NC (60mph)

CURVE DATA  
 $\bar{C}$  EX. R/W AND CONST. I.R. 75  
P.I. Sta. 174+56.42  
 $\Delta = 18^\circ 53' 39''$  (RT)  
Dc = 0° 26' 00"  
R = 13,222.11'  
T = 2,200.08'  
L = 4,360.22'  
E = 181.79'  
eMAX = NC (70mph)

G:\AKron\DCS\Projects\TRN\60547096\_HAM751667\900-CAD-GIS\104408\_HAM-75-1667\Design\Roadway\Sheets\104408\_G1001.dgn Sheet 1/23/2018 9:36:53 AM matt.philips

NOTES:

ELEVATIONS ARE AT 25' INTERVALS, UNLESS OTHERWISE NOTED.

RAMP STATIONING IS DENOTED WITH "\*" (+XX.XX\*).

TRENCH DRAIN SHALL BE CONSTRUCTED TO MATCH THE EXISTING CROSS SLOPE.

SAWCUT OFFSET FROM  $\varnothing$  EX. R/W AND CONST. I.R. 75 VARIES. SEE PLAN SHEETS FOR DETAILS.

MINIMAL SHOULDERS ELEVATIONS HAVE BEEN LABELLED FOR CLARITY.

LEGEND:


EXISTING ELEVATION - XXX.XX

PROPOSED ELEVATION - XXX.XX

CURVE DATA  
 $\varnothing$  EX. CONST. RAMP E  
 P.I. Sta. 16+31.23\*  
 $\Delta = 2^\circ 54' 36''$  (LT)  
 $D_c = 0^\circ 27' 04''$   
 $R = 12,704.19'$   
 $T = 322.68'$   
 $L = 645.23'$   
 $E = 4.10'$   
 $e_{MAX} = NC$  (60mph)

CURVE DATA  
 $\varnothing$  CONST. RAMP C  
 P.I. Sta. 80+85.83  
 $\Delta = 1^\circ 29' 44''$  (LT)  
 $D_c = 0^\circ 33' 00''$   
 $R = 10,417.41'$   
 $T = 135.97'$   
 $L = 271.92'$   
 $E = 0.89'$   
 $e_{MAX} = NC$  (60mph)

CURVE DATA  
 $\varnothing$  CONST. RAMP C  
 P.I. Sta. 82+71.78  
 $\Delta = 0^\circ 25' 45''$  (RT)  
 $D_c = 0^\circ 25' 45''$   
 $R = 13,349.11'$   
 $T = 50.00'$   
 $L = 100.00'$   
 $E = 0.09'$   
 $e_{MAX} = NC$  (60mph)

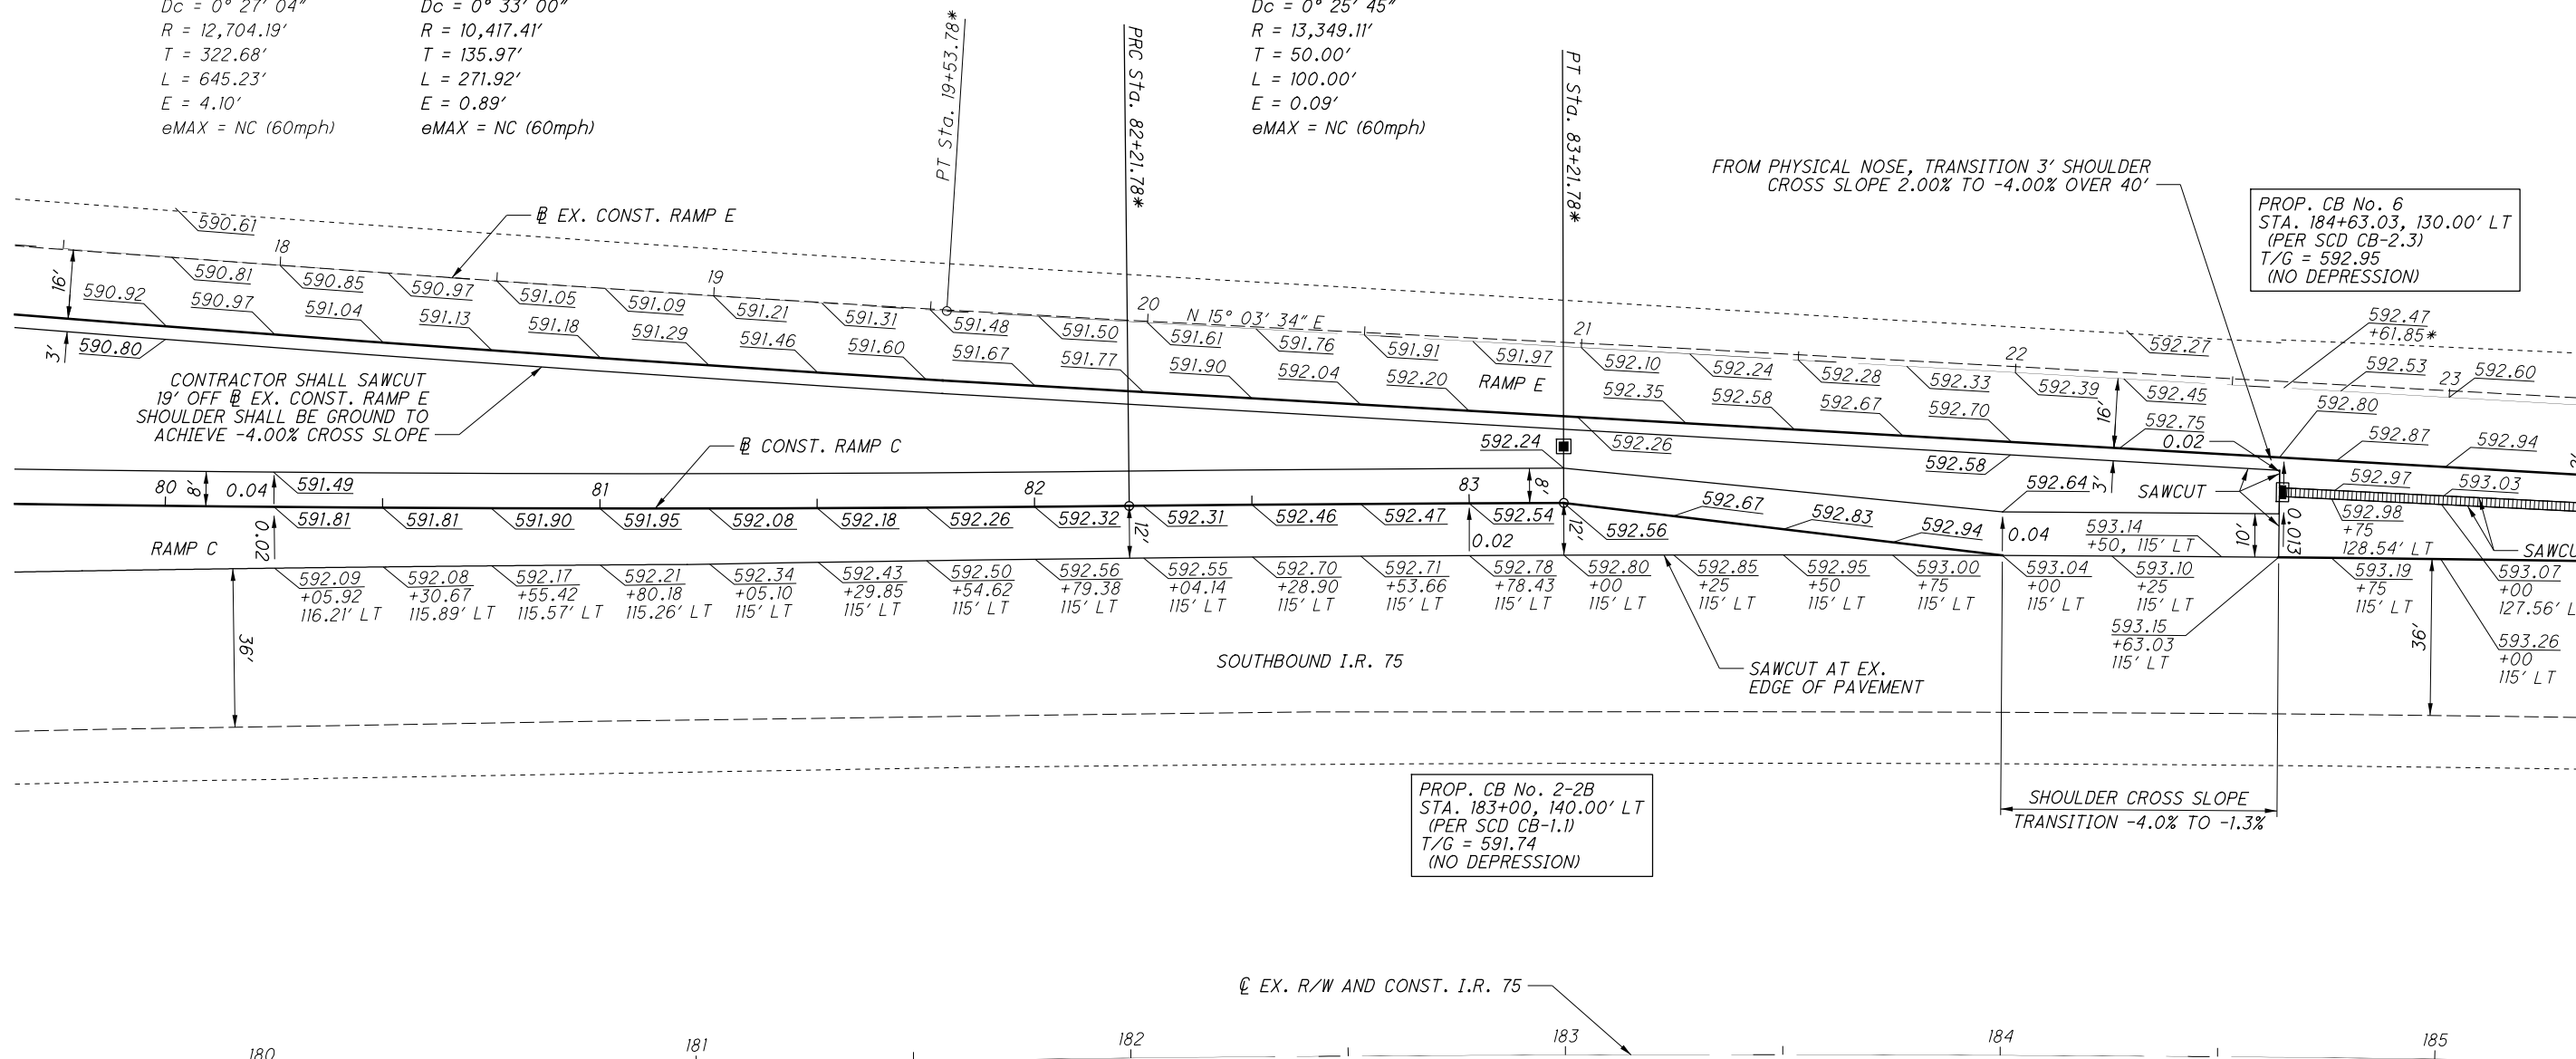

PROP. CB No. 2-2B  
 STA. 183+00, 140.00' LT  
 (PER SCD CB-1.1)  
 $T/G = 591.74$   
 (NO DEPRESSION)

PROP. CB No. 6  
 STA. 184+63.03, 130.00' LT  
 (PER SCD CB-2.3)  
 $T/G = 592.95$   
 (NO DEPRESSION)

CURVE DATA  
 $\varnothing$  EX. R/W AND CONST. I.R. 75  
 P.I. Sta. 174+56.42  
 $\Delta = 18^\circ 53' 39''$  (RT)  
 $D_c = 0^\circ 26' 00''$   
 $R = 13,222.11'$   
 $T = 2,200.08'$   
 $L = 4,360.22'$   
 $E = 181.79'$   
 $e_{MAX} = NC$  (70mph)



BUILDABLE UNIT 4-AS-BUILT PLANS - JANUARY 29, 2018

RAMP C AND RAMP E  
 TERMINAL DETAILS

HAM-75-16.67

G:\AKron\Projects\TRN\60547096\_HAM751667\900-CAD-GIS\104408\_HAM-75-1667\Design\Roadway\Sheets\104408\_G1002.dgn Sheet 1/23/2018 9:37:02 AM matt.philips

NOTES:

ELEVATIONS ARE AT 25' INTERVALS, UNLESS OTHERWISE NOTED.

RAMP STATIONING IS DENOTED WITH "\*" (+XX.XX\*).

TRENCH DRAIN SHALL BE CONSTRUCTED TO MATCH THE EXISTING CROSS SLOPE.

MINIMAL SHOULDERS ELEVATIONS HAVE BEEN LABELLED FOR CLARITY.



LEGEND:

EXISTING ELEVATION - XXX.XX

PROPOSED ELEVATION - XXX.XX

CALCULATED  
MEP  
CHECKED  
JEM

G:\AKron\DCS\Projects\TRN\60547096\_HAM751667\900-CAD-GIS\104408\_HAM-75-1667\Design\Roadway\Sheets\104408\_G1003.dgn\_Sheet 1/23/2018 9:37:10 AM matt.philips

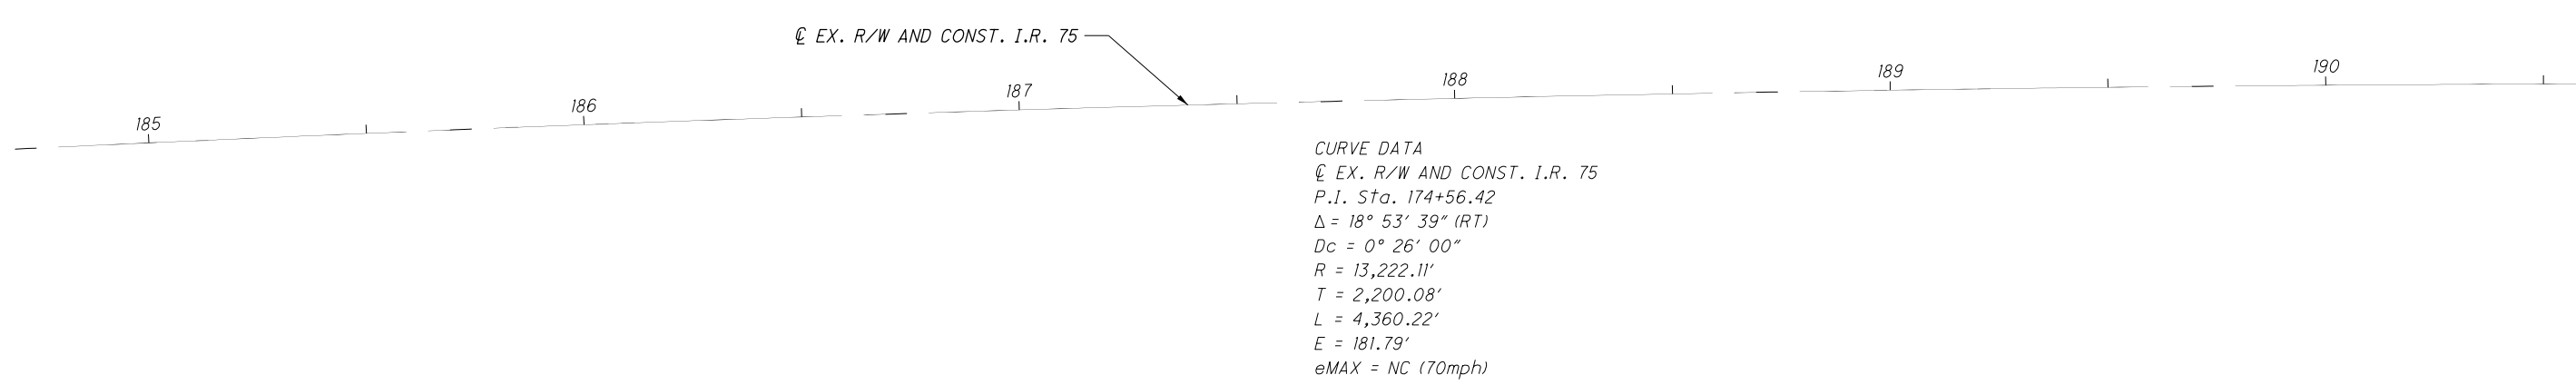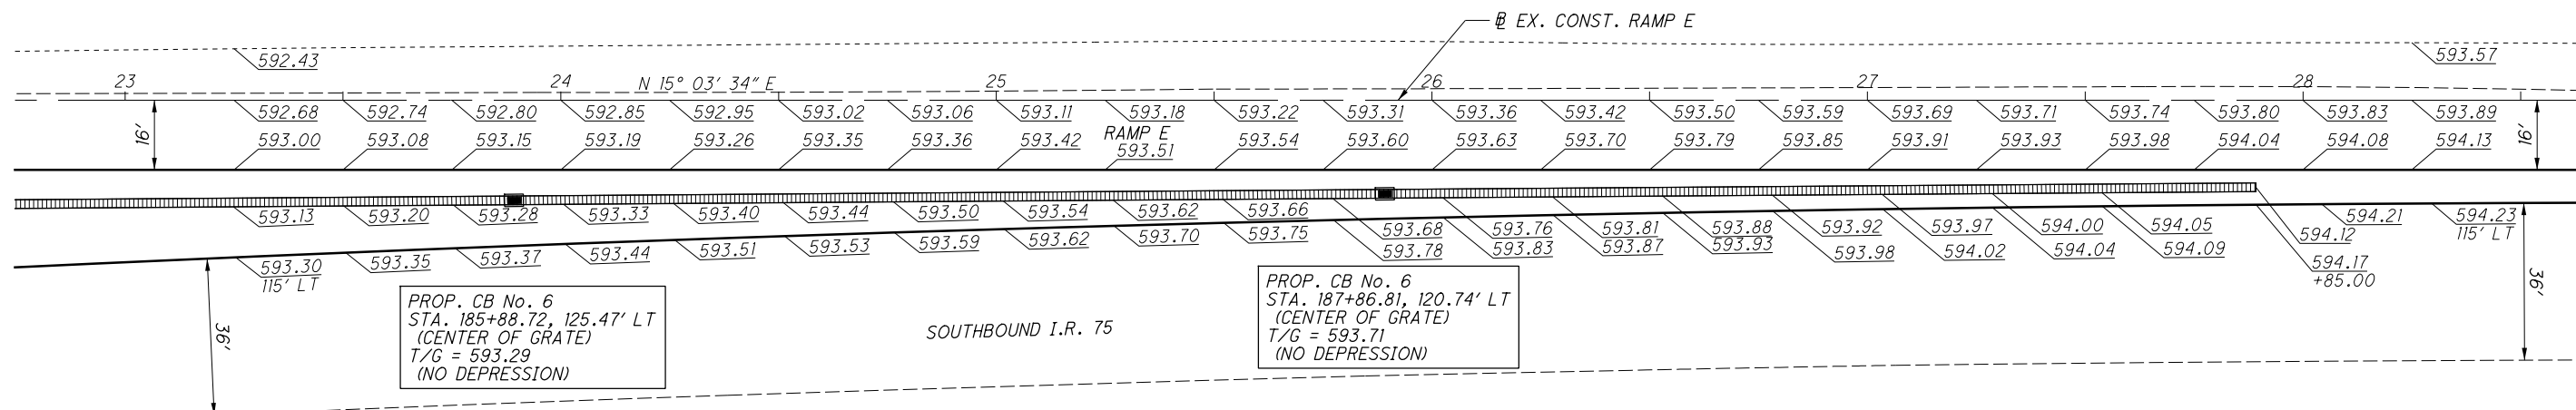

BUILDABLE UNIT 4-AS-BUILT PLANS--JANUARY 29, 2018


RAMP C  
TERMINAL DETAIL

HAM-75-16.67



G:\Akron\Projects\TRN\60547096\_HAM751667\900-CAD-GIS\104408\_HAM-75-1667\Design\Roadway\Sheets\104408\_G1004.dgn Sheet 1/23/2018 9:37:19 AM matt.philips

NOTES:  
 ELEVATIONS ARE AT 25' INTERVALS, UNLESS OTHERWISE NOTED.  
 RAMP STATIONING IS DENOTED WITH "\*" (+XX.XX\*).  
 TRENCH DRAIN SHALL BE CONSTRUCTED TO MATCH THE EXISTING CROSS SLOPE.  
 MINIMAL SHOULDERS ELEVATIONS HAVE BEEN LABELLED FOR CLARITY.  
 LEGEND:  
 EXISTING ELEVATION - XXX.XX  
 PROPOSED ELEVATION - XXX.XX

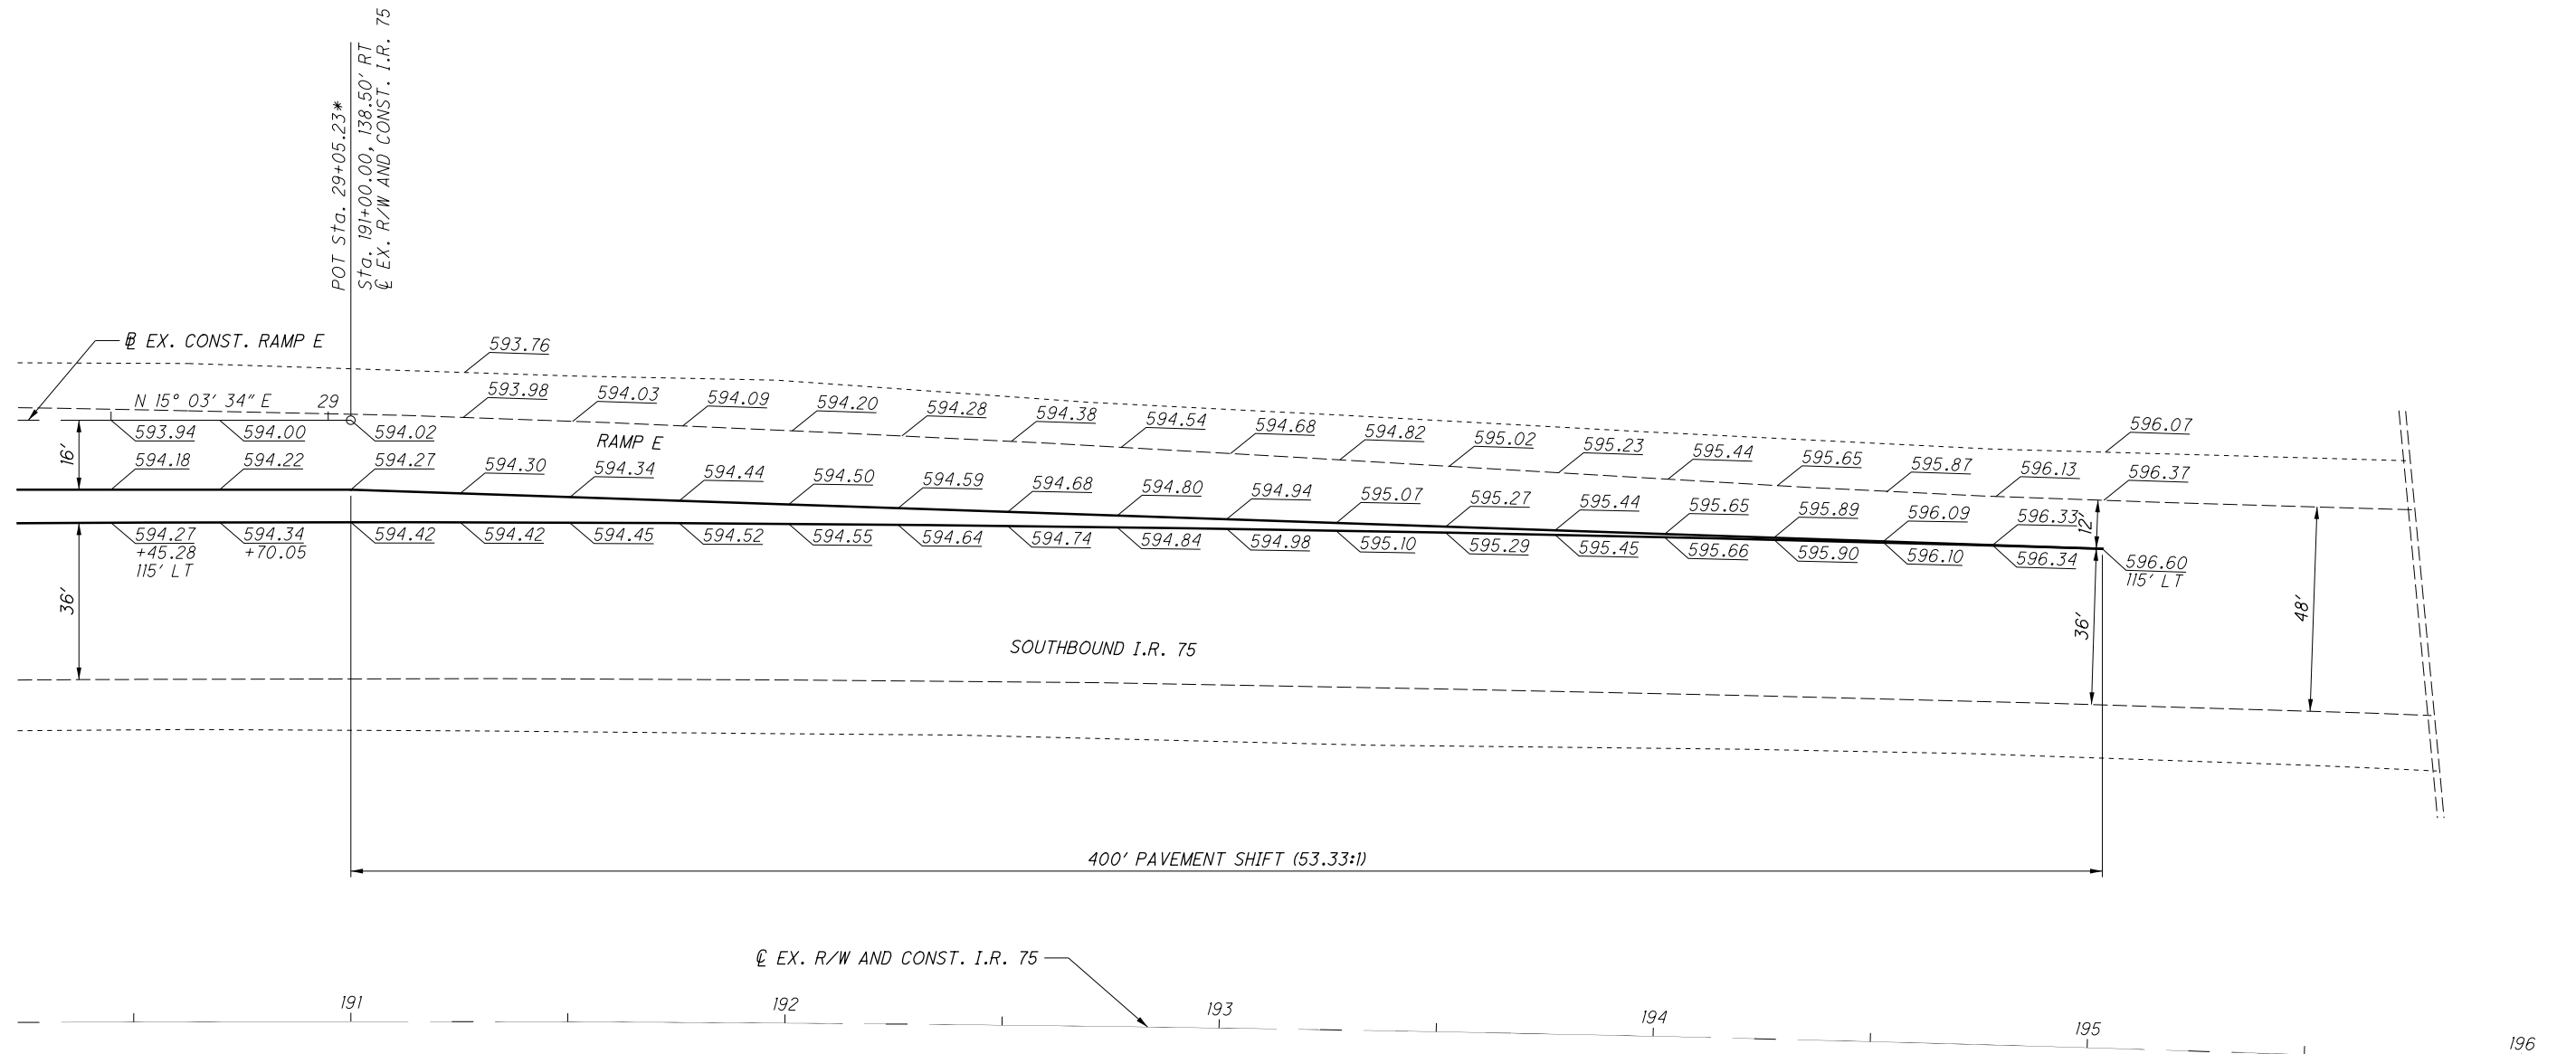

CURVE DATA  
 EX. R/W AND CONST. I.R. 75  
 P.I. Sta. 174+56.42  
 $\Delta = 18^\circ 53' 39''$  (RT)  
 $Dc = 0^\circ 26' 00''$   
 $R = 13,222.11'$   
 $T = 2,200.08'$   
 $L = 4,360.22'$   
 $E = 181.79'$   
 $eMAX = NC$  (70mph)

BUILDABLE UNIT 4-AS-BUILT PLANS--JANUARY 29, 2018

HAM-75-16.67

RAMP C

TERMINAL DETAIL

CALCULATED  
 MEP  
 CHECKED  
 JEM

0 20 40  
 HORIZONTAL  
 SCALE IN FEET

G:\Akron\DCS\Projects\TRN\60547096\_HAM751667\CAD\900-CAD-GIS\104408\_HAM-75-1667\Design\Roadway\Sheets\104408\_GE001.dgn Design 1/23/2018 9:37:21 AM matt.philips

RAMP C - PAVEMENT ELEVATION TABLE

SHOULDER					RAMP C			PAVEMENT					SHOULDER					CURVE DATA	REMARKS		
PROPOSED SHOULDER WIDTH	PROPOSED EDGE OF SHOULDER ELEVATION	EXISTING CROSS SLOPE	EXISTING EDGE OF SHOULDER ELEVATION	EXISTING MINUS PROPOSED PAVEMENT ELEVATION	PROPOSED SHOULDER CROSS-SLOPE	BASILINE STATION	PROFILE GRADE ELEVATION	LONGITUDINAL SLOPE	PROPOSED PAVEMENT WIDTH	PROPOSED EDGE OF PAVEMENT ELEVATION	EXISTING CROSS SLOPE	EXISTING EDGE OF PAVEMENT ELEVATION	EXISTING MINUS PROPOSED PAVEMENT ELEVATION	PROPOSED PAVEMENT CROSS-SLOPE	PROPOSED SHOULDER CROSS-SLOPE	PROPOSED EDGE OF SHOULDER ELEVATION	EXISTING CROSS SLOPE			EXISTING EDGE OF SHOULDER ELEVATION	EXISTING MINUS PROPOSED PAVEMENT ELEVATION
8.04	592.62	-1.87%	592.62		-1.87%	66+50.00	592.77		15.65	592.72	-0.32%	592.72		-0.32%	-3.33%	592.45	-3.33%	592.45		8.12	
7.63	592.37	-2.10%	592.37		-2.10%	66+75.00	592.53	-0.96%	15.54	592.70	1.09%	592.70		1.09%	-4.26%	592.35	-4.26%	592.35		8.21	
7.53	592.22	-2.79%	592.22		-2.79%	66+85.00	592.43	-1.00%	15.50	592.41	-0.13%	592.41		-0.13%	-1.71%	592.27	-1.71%	592.27		8.20	BEGIN RESURFACING
7.53	592.09	-3.19%	592.09		-3.19%	67+00.00	592.33	-0.67%	15.45	592.61	1.81%	592.61		1.81%	-4.53%	592.24	-4.53%	592.24		8.17	
7.36	591.89	-3.53%	591.89		-3.53%	67+25.00	592.15	-0.72%	15.36	592.46	2.02%	592.46		2.02%	0.24%	592.48	0.24%	592.48		8.18	
7.65	591.60	-4.71%	591.60		-4.71%	67+50.00	591.96	-0.76%	15.32	592.31	2.28%	592.31		2.28%	2.31%	592.50	2.31%	592.50		8.23	
7.78	591.42	-4.63%	591.42		-4.63%	67+75.00	591.78	-0.72%	15.30	592.10	2.09%	592.10		2.09%	2.28%	592.29	2.28%	592.29		8.33	
8.03	591.11	-6.10%	591.11		-6.10%	68+00.00	591.60	-0.72%	15.30	591.90	1.96%	591.90		1.96%	2.27%	592.09	2.27%	592.09		8.38	
8.30	591.11	-3.86%	591.11		-3.86%	68+25.00	591.43	-0.68%	15.16	591.73	1.98%	591.73		1.98%	1.87%	591.89	1.87%	591.89		8.55	
8.30	591.01	-3.25%	591.01	0.00	-3.25%	68+50.00	591.28	-0.60%	15.15	591.57	1.91%	591.57	0.00	1.91%	1.51%	591.70	1.51%	591.70	0.00	8.60	
8.31	590.88	-3.13%	590.89	0.01	-3.26%	68+75.00	591.15	-0.52%	15.17	591.43	1.85%	591.43	0.00	1.85%	0.96%	591.51	1.40%	591.55	0.04	8.57	BEGIN CROSS SLOPE TRANSITION
8.37	590.75	-2.87%	590.78	0.03	-3.26%	69+00.00	591.02	-0.52%	15.17	591.21	1.71%	591.28	0.07	1.23%	0.41%	591.24	1.31%	591.39	0.15	8.38	
9.36	590.57	-2.03%	590.69	0.12	-3.27%	69+25.00	590.88	-0.56%	15.16	590.97	1.58%	591.12	0.15	0.61%	-0.14%	590.96	1.17%	591.22	0.26	8.56	
9.42	590.51	-2.08%	590.62	0.11	-3.27%	69+50.00	590.82	-0.26%	15.17	590.82	1.15%	590.99	0.17	0.00%	-0.69%	590.75	1.13%	591.09	0.34	8.88	
9.54	590.44	-2.22%	590.54	0.10	-3.28%	69+75.00	590.75	-0.26%	15.16	590.66	1.18%	590.93	0.27	-0.62%	-1.24%	590.54	1.17%	591.04	0.50	9.41	
9.56	590.39	-1.57%	590.55	0.16	-3.28%	69+95.00	590.70	-0.26%	16.00	590.52	1.31%	590.91	0.39	-1.11%	-1.69%	590.37	0.44%	590.95	0.58	9.08	END RESURFACING - BEGIN FULL-DEPTH
9.54	590.38				-3.28%	70+00.00	590.69	-0.14%	16.00	590.50				-1.24%	-1.80%	590.33				9.00	
9.44	590.35				-3.29%	70+24.59	590.66	-0.14%	16.00	590.36				-1.84%	-2.34%	590.15				9.00	P.C.
9.44	590.35				-3.29%	70+24.62	590.66	-0.14%	16.00	590.36				-1.84%	-2.34%	590.15				9.00	
6.00	590.43				-3.29%	70+45.00	590.63	-0.14%	16.00	590.26				-2.34%	-2.79%	590.01				9.00	
6.00	590.43				-3.29%	70+50.00	590.62	-0.14%	16.00	590.23				-2.47%	-2.90%	589.97				9.00	
6.00	590.39				-3.30%	70+75.00	590.59	-0.14%	16.00	590.10				-3.08%	-3.45%	589.79				9.00	
6.00	590.36				-3.30%	71+00.00	590.56	-0.14%	16.00	589.96				-3.70%	-4.00%	589.60				9.00	FULL SUPERELEVATION
6.00	590.32				-3.30%	71+25.00	590.52	-0.14%	16.00	589.93				-3.70%	-4.00%	589.57				9.00	
6.00	590.29				-3.30%	71+50.00	590.49	-0.14%	16.00	589.89				-3.70%	-4.00%	589.53				9.00	
6.00	590.26				-3.30%	71+75.00	590.46	-0.11%	16.00	589.87				-3.70%	-4.00%	589.51				9.00	
6.00	590.25				-3.30%	72+00.00	590.44	-0.06%	16.00	589.85				-3.70%	-4.00%	589.49				9.00	
6.00	590.24				-3.30%	72+25.00	590.44	-0.01%	16.00	589.85				-3.70%	-4.00%	589.49				9.00	
6.00	590.25				-3.30%	72+50.00	590.45	0.04%	16.00	589.86				-3.70%	-4.00%	589.50				9.00	
6.00	590.28				-3.30%	72+75.00	590.48	0.09%	16.00	589.88				-3.70%	-4.00%	589.52				9.00	
6.00	590.31				-3.30%	73+00.00	590.51	0.15%	16.00	589.92				-3.70%	-4.00%	589.56				9.00	
6.00	590.36				-3.30%	73+25.00	590.56	0.20%	16.00	589.97				-3.70%	-4.00%	589.61				9.00	
6.00	590.43				-3.30%	73+50.00	590.62	0.25%	16.00	590.03				-3.70%	-4.00%	589.67				9.00	
6.00	590.50				-3.30%	73+75.00	590.70	0.30%	16.00	590.11				-3.70%	-4.00%	589.75				9.00	
6.00	590.59				-3.30%	74+00.00	590.79	0.35%	16.00	590.19				-3.70%	-4.00%	589.83				9.00	
6.00	590.69				-3.30%	74+25.00	590.89	0.40%	16.00	590.30				-3.70%	-4.00%	589.94				9.00	
6.00	590.76				-3.30%	74+41.41	590.96	0.45%	16.00	590.37				-3.70%	-4.00%	590.01				9.00	
6.34	590.79				-3.30%	74+50.00	591.00	0.47%	16.00	590.41				-3.70%	-4.00%	590.05				9.00	
7.34	590.88				-3.30%	74+75.00	591.12	0.48%	16.00	590.53				-3.70%	-4.00%	590.17				9.00	
8.00	590.94				-3.30%	74+91.41	591.20	0.48%	16.00	590.61				-3.70%	-4.00%	590.25				9.00	
SEE TERMINAL DETAIL FOR CONTINUATION																					

P.I. STA. 72+90.27  
Dc = 1° 30' 00"

G = 253:1

BUILDABLE UNIT 4-AS-BUILT PLANS - JANUARY 29, 2018



CALCULATED  
MEP  
CHECKED  
JEM

PAVEMENT ELEVATION TABLE

HAM-75-16.67

CROSS REFERENCES  
FOR PLAN VIEW, SEE SHEETS 12 - 13

G:\Akron\DCS\Projects\TRN\60547096\_HAM751667\900-CAD-GIS\104408\_HAM-75-1667\Design\Roadway\Sheets\104408\_DF001.dgn Design 1/23/2018 9:37:22 AM matt.phillips

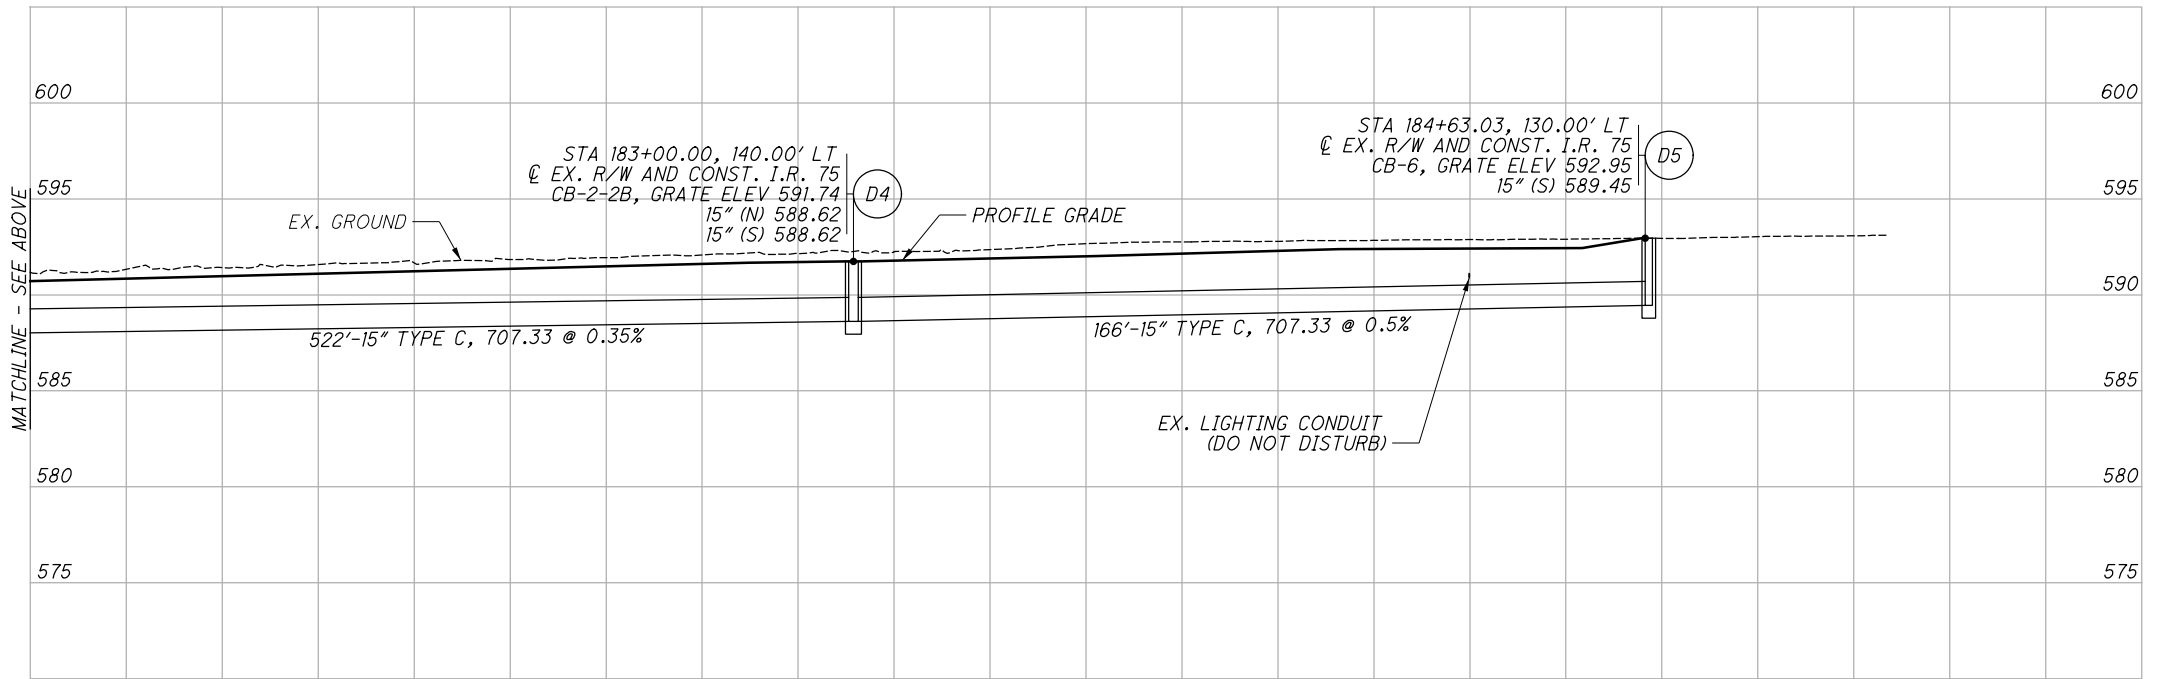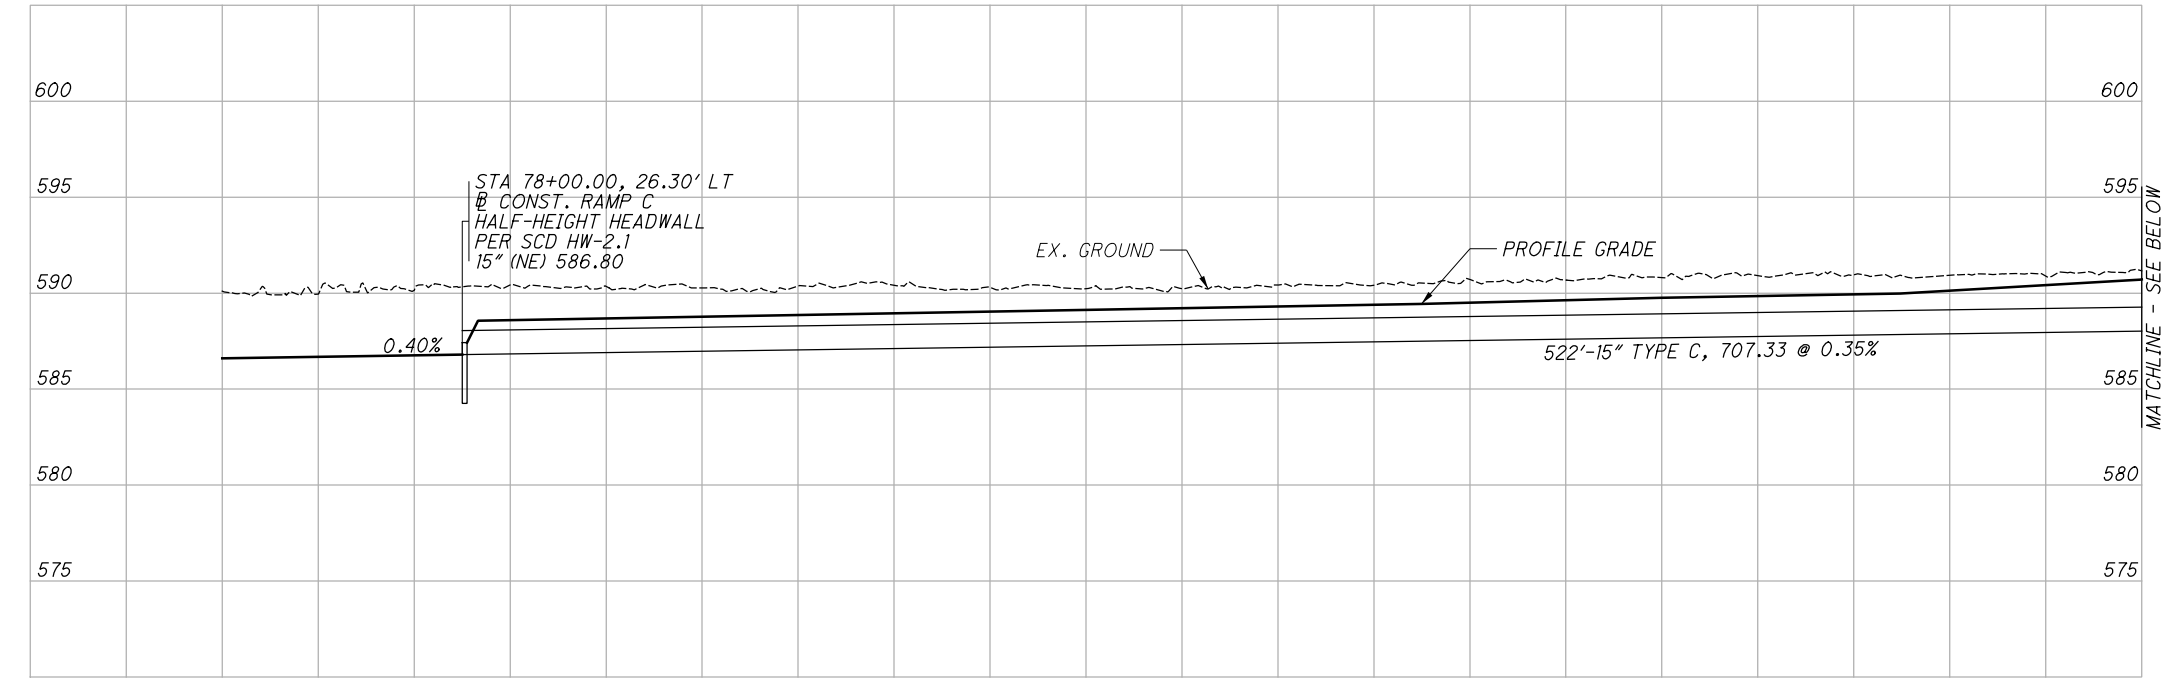


BUILDABLE UNIT 4-AS-BUILT PLANS--JANUARY 29, 2018

STORM SEWER PROFILE  
RAMPS C AND E MEDIAN

HAM-75-16.67

CALCULATED  
MEP  
CHECKED  
JEM

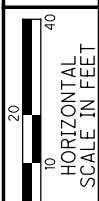

33  
43

**LIGHTING**

**625, LIGHT TOWER, INSTALLATION ONLY, AS PER PLAN**

THIS ITEM OF WORK SHALL CONSIST OF INSTALLING AN EXISTING LIGHT TOWER REMOVED AND SALVAGED FROM A PREVIOUS LOCATION ON THE PROJECT SITE.

WHERE THE TOWER WILL BE INSTALLED ON A NEW FOUNDATION, NEW ANCHOR BOLTS SHALL BE FURNISHED.

THE TOWER AND LOWERING MECHANISM SHALL BE CLEANED AND LUBRICATED.

ANY REPAIRS AND ADJUSTMENTS NECESSARY TO RETURN THE TOWER AND MECHANISM TO GOOD OPERATING CONDITION SHALL BE MADE.

**625, LUMINAIRE, INSTALLATION ONLY, AS PER PLAN**

THIS ITEM OF WORK SHALL CONSIST OF INSTALLING AN EXISTING LUMINAIRE REMOVED AND SALVAGED FROM A PREVIOUS LOCATION ON THE PROJECT.

THE LUMINAIRE SHALL BE CLEANED, ADJUSTMENTS TO THE OPTICAL COMPONENTS MADE TO ENSURE THAT THE SPECIFIED DISTRIBUTION IS BEING PRODUCED.

**HIGH VOLTAGE TEST WAIVED**

THE HIGH VOLTAGE TEST SHALL NOT BE PERFORMED ON THE CIRCUITS CONSTRUCTED BY THIS PROJECT, SINCE THE TEST COULD DAMAGE THE PORTION OF THE COMPLETED CIRCUIT WHICH HAS BEEN IN SERVICE PRIOR TO THIS PROJECT.

G:\AKron\DCS\Projects\TRN\60547096\_HAM751667\900-CAD-GIS\104408\_HAM-75-1667\Design\Lighting\Sheets\104408\_LN001.dgn Sheet 1/23/2018 9:37:23 AM matt.philips

CALCULATED	CX
	CHECKED
MAW	
<b>BUILDABLE UNIT 4-AS-BUILT PLANS--JANUARY 29, 2018</b>	
<b>HAM-75-16.67</b>	<b>LIGHTING GENERAL NOTES</b>
34	43




G:\Akron\DCS\Projects\TRN\60547096\_HAM751667\900-CAD-GIS\104408\_HAM-75-1667\Design\Lighting\Sheets\104408\_LP001.dgn Design 1/23/2018 9:37:31 AM matt.philips



BUILDABLE UNIT 4-AS-BUILT PLANS - JANUARY 29, 2018


RAMP C LIGHTING PLAN

HAM-75-16.67

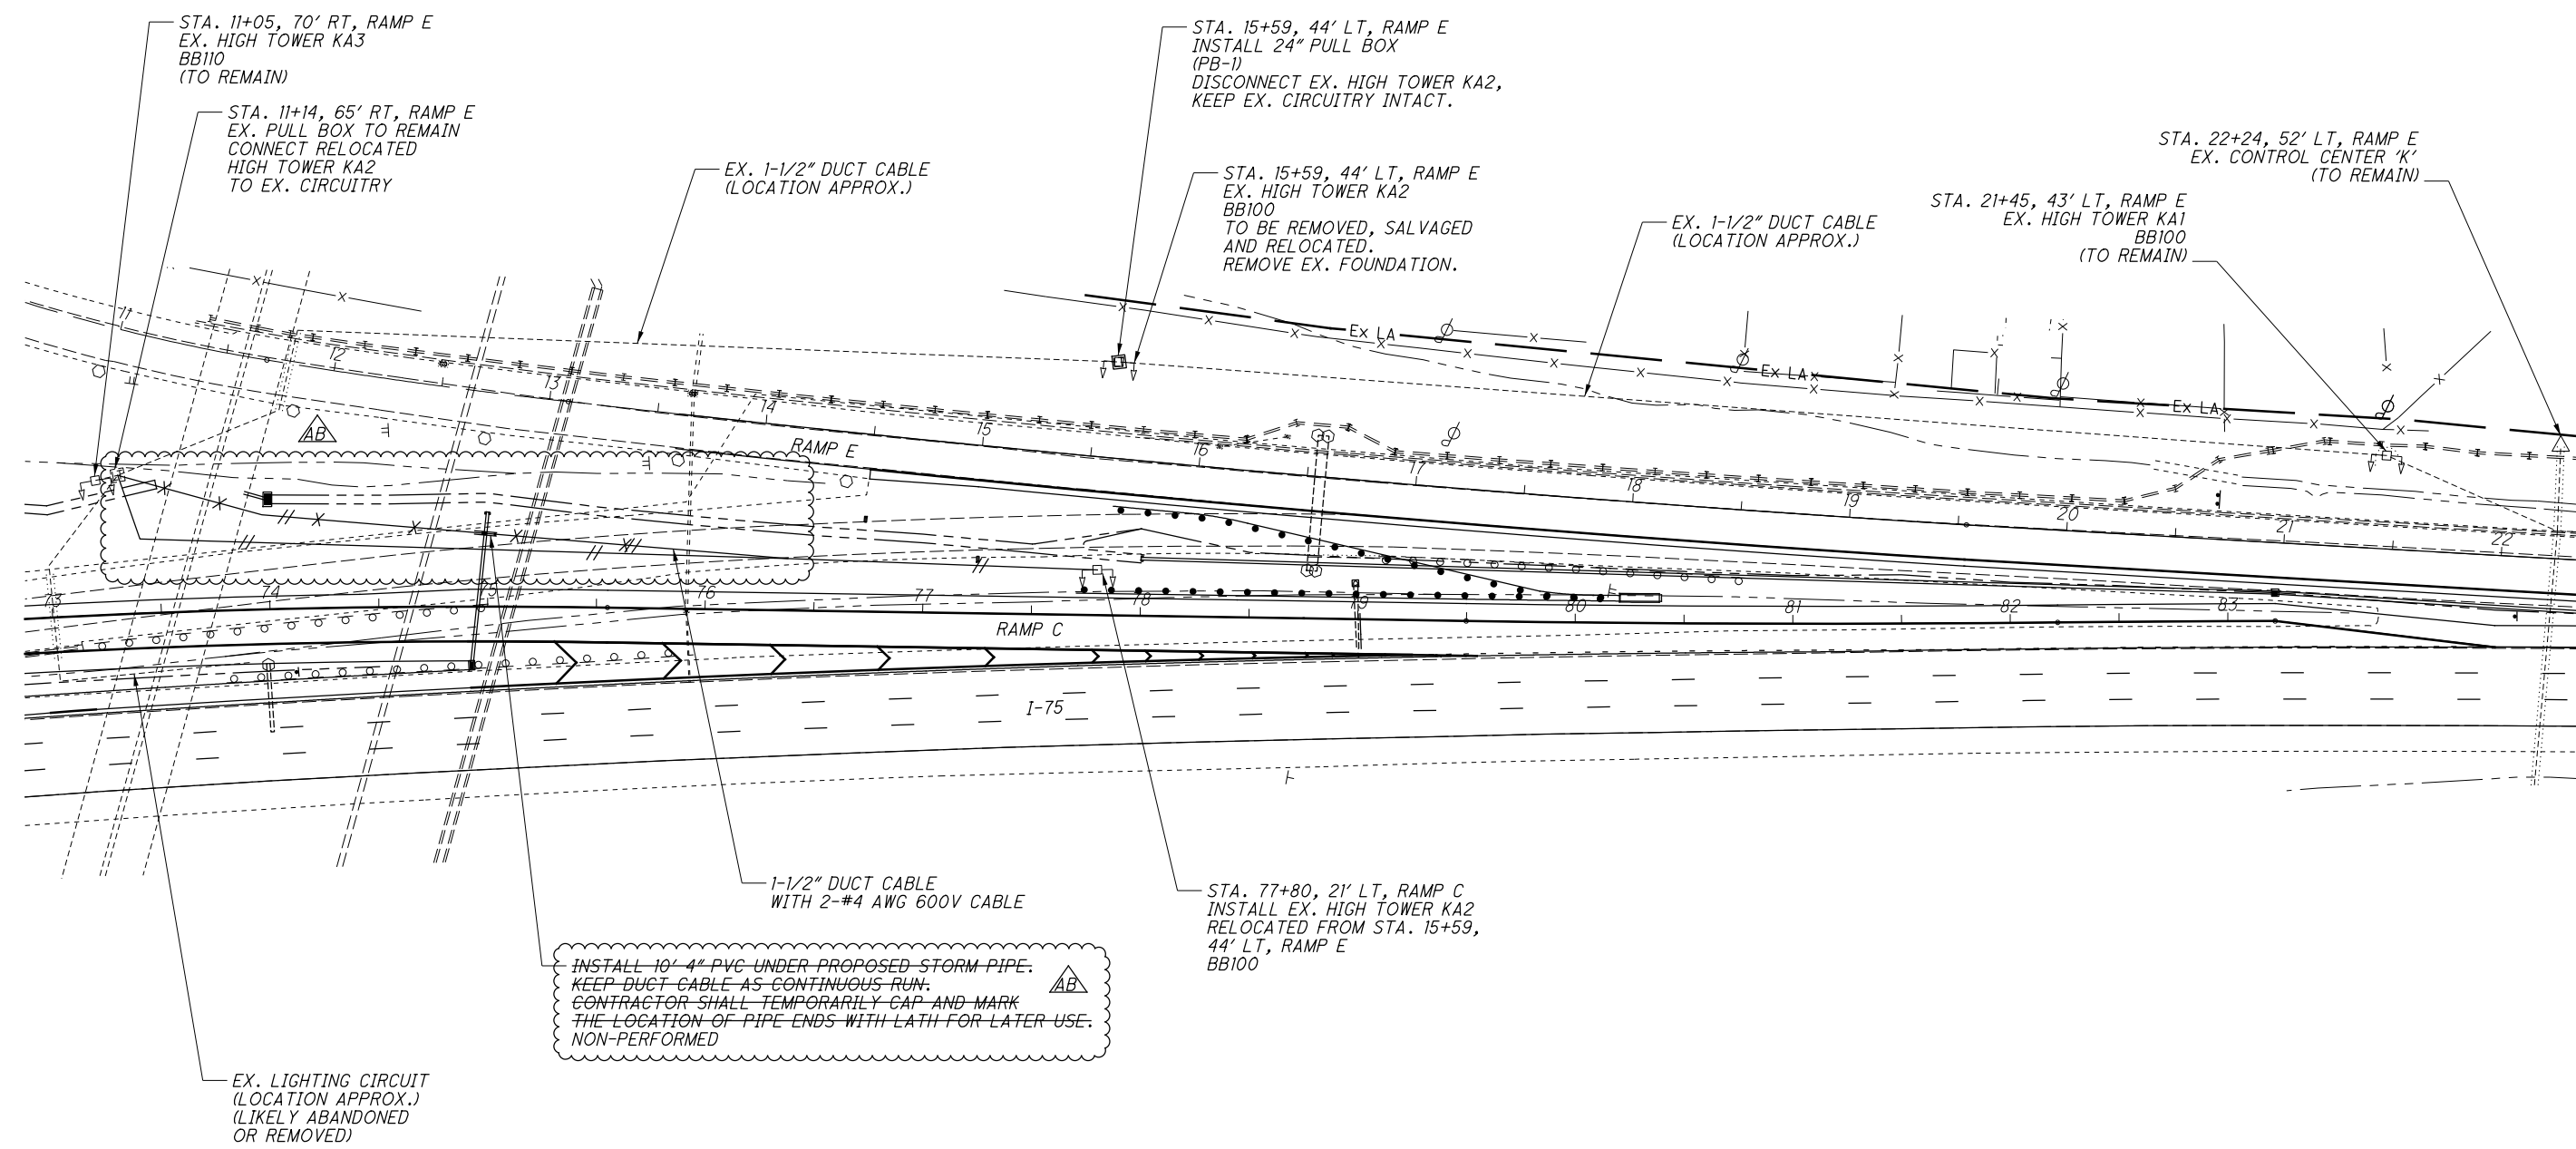

INSTALL 10' 4" PVC UNDER PROPOSED STORM PIPE. KEEP DUCT CABLE AS CONTINUOUS RUN. CONTRACTOR SHALL TEMPORARILY CAP AND MARK THE LOCATION OF PIPE ENDS WITH LATH FOR LATER USE. NON-PERFORMED


LIGHTING CIRCUIT DIAGRAM (NOT TO SCALE)

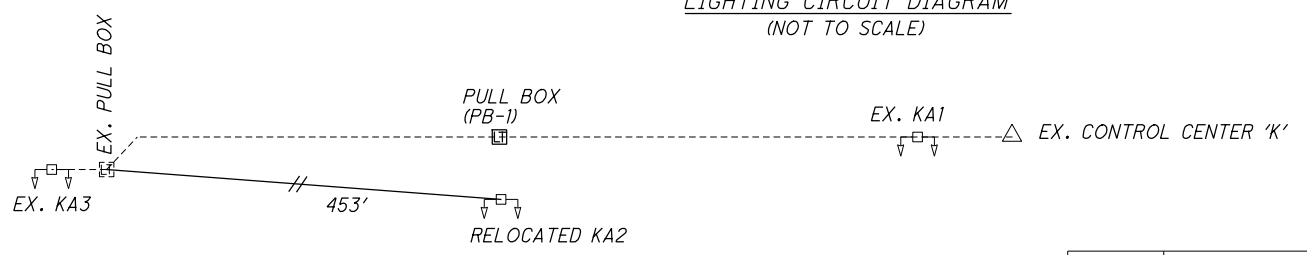

LEGEND

- EX LIGHT TOWER (ASYMMETRICAL) WITH 2-1000W
- PULL BOX
- EX POWER SERVICE, 480 V, 2-WIRE

NO.	REVISIONS	DATE
AB	AS-BUILT REVISION	1/29/18

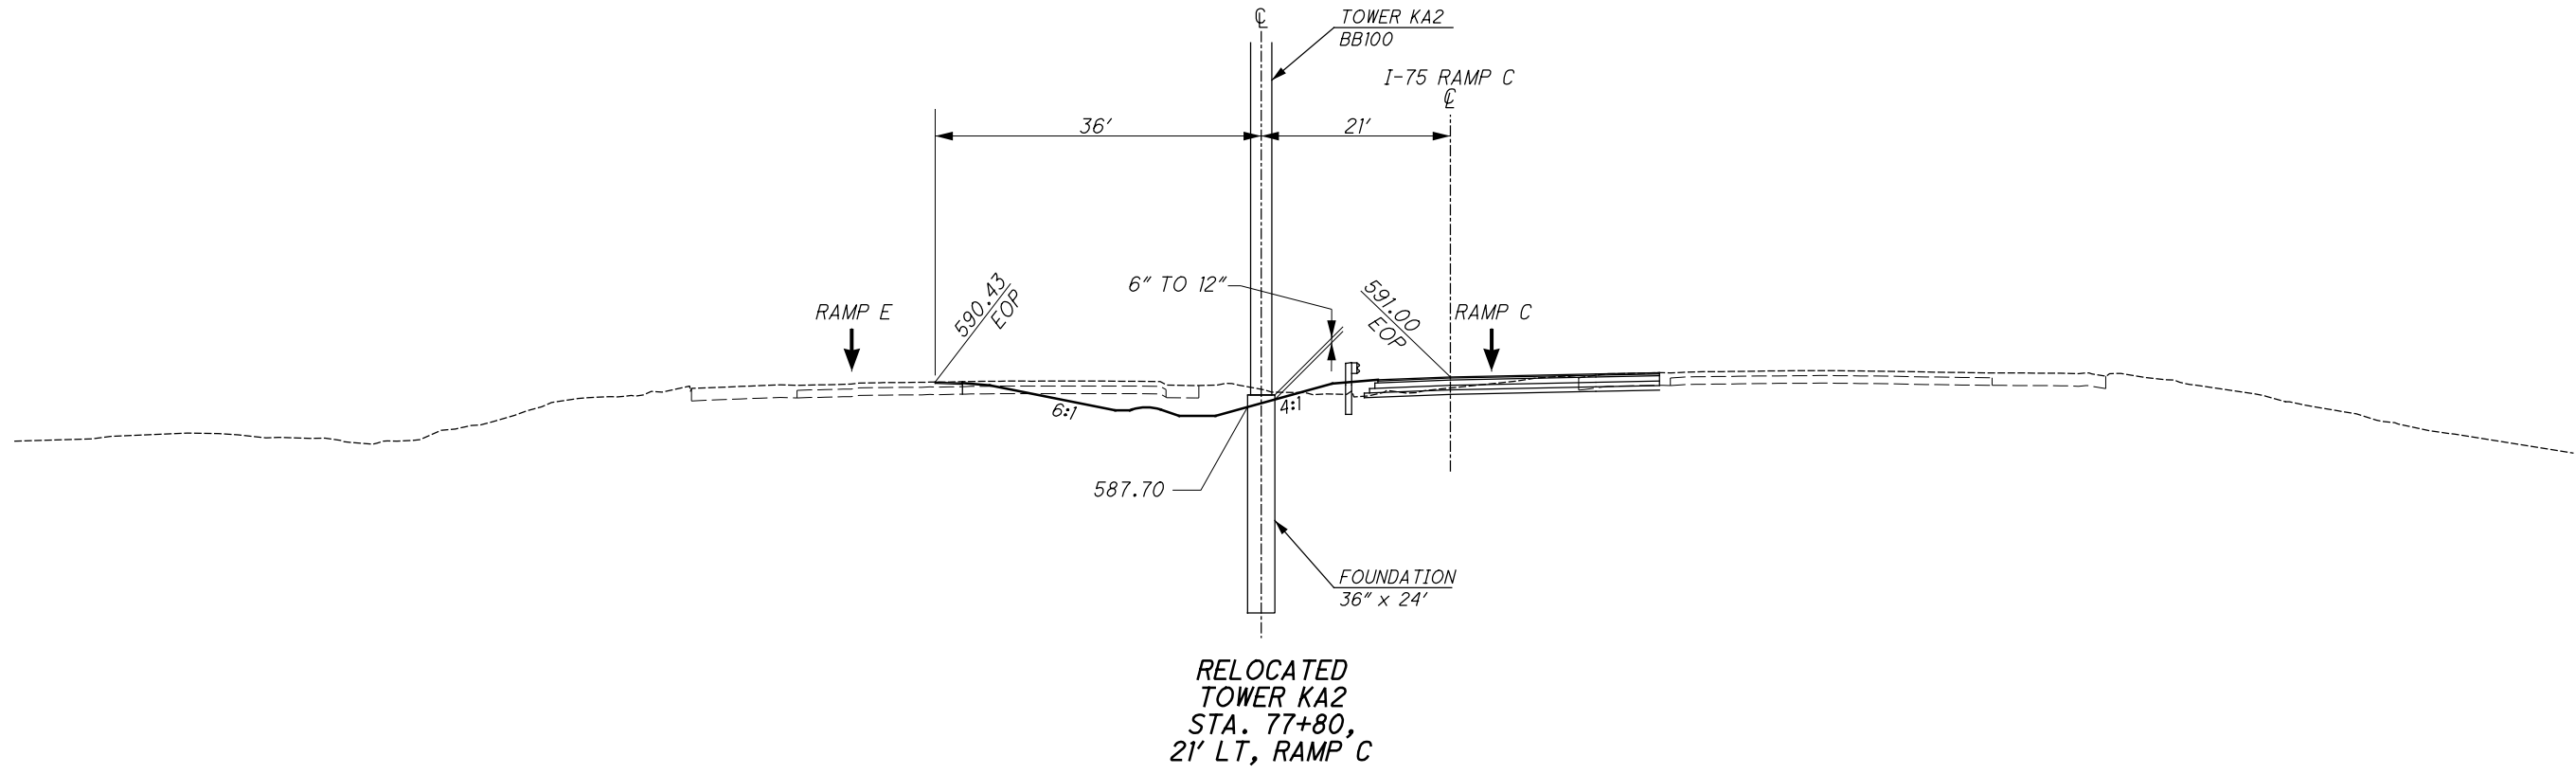

**BUILDABLE UNIT 4-AS-BUILT PLANS--JANUARY 29, 2018**

**HAM-75-16.67**

**I-75 RAMP C  
LIGHTING TOWER ELEVATIONS**

CALCULATED  
CX  
CHECKED  
MAW

0 5 10 20  
HORIZONTAL  
SCALE IN FEET

36  
43




G:\Akron\DCS\Projects\TRN\60547096\_HAM751667\900-CAD-GIS\104408\_HAM-75-1667\Design\Traffic\Sheets\BU04\104408\_TP001.dgn Design 1/23/2018 9:37:37 AM matt.philips

SIGN LEGEND

- ⊥ SIGN, SINGLE POST
- ⊥ SIGN, DOUBLE POST
- ┆ CANTILEVER SIGN SUPPORT
- ┆ TRUSS TYPE SIGN SUPPORT
- ▭ EXISTING SIGN
- ▭ EXISTING SIGN TO BE REMOVED
- ▭ PROPOSED SIGN

PAVEMENT MARKING LEGEND

- (EY) ITEM 644 - EDGE LINE, 6" (YELLOW)
- (EW) ITEM 644 - EDGE LINE, 6" (WHITE)
- (LL) ITEM 644 - LANE LINE, 6"
- (CH) ITEM 644 - CHANNELIZING LINE, 12"
- (CM) ITEM 644 - CHEVRON MARKING (WHITE)
- (DL) ITEM 644 - DOTTED LINE, 6" (WHITE)

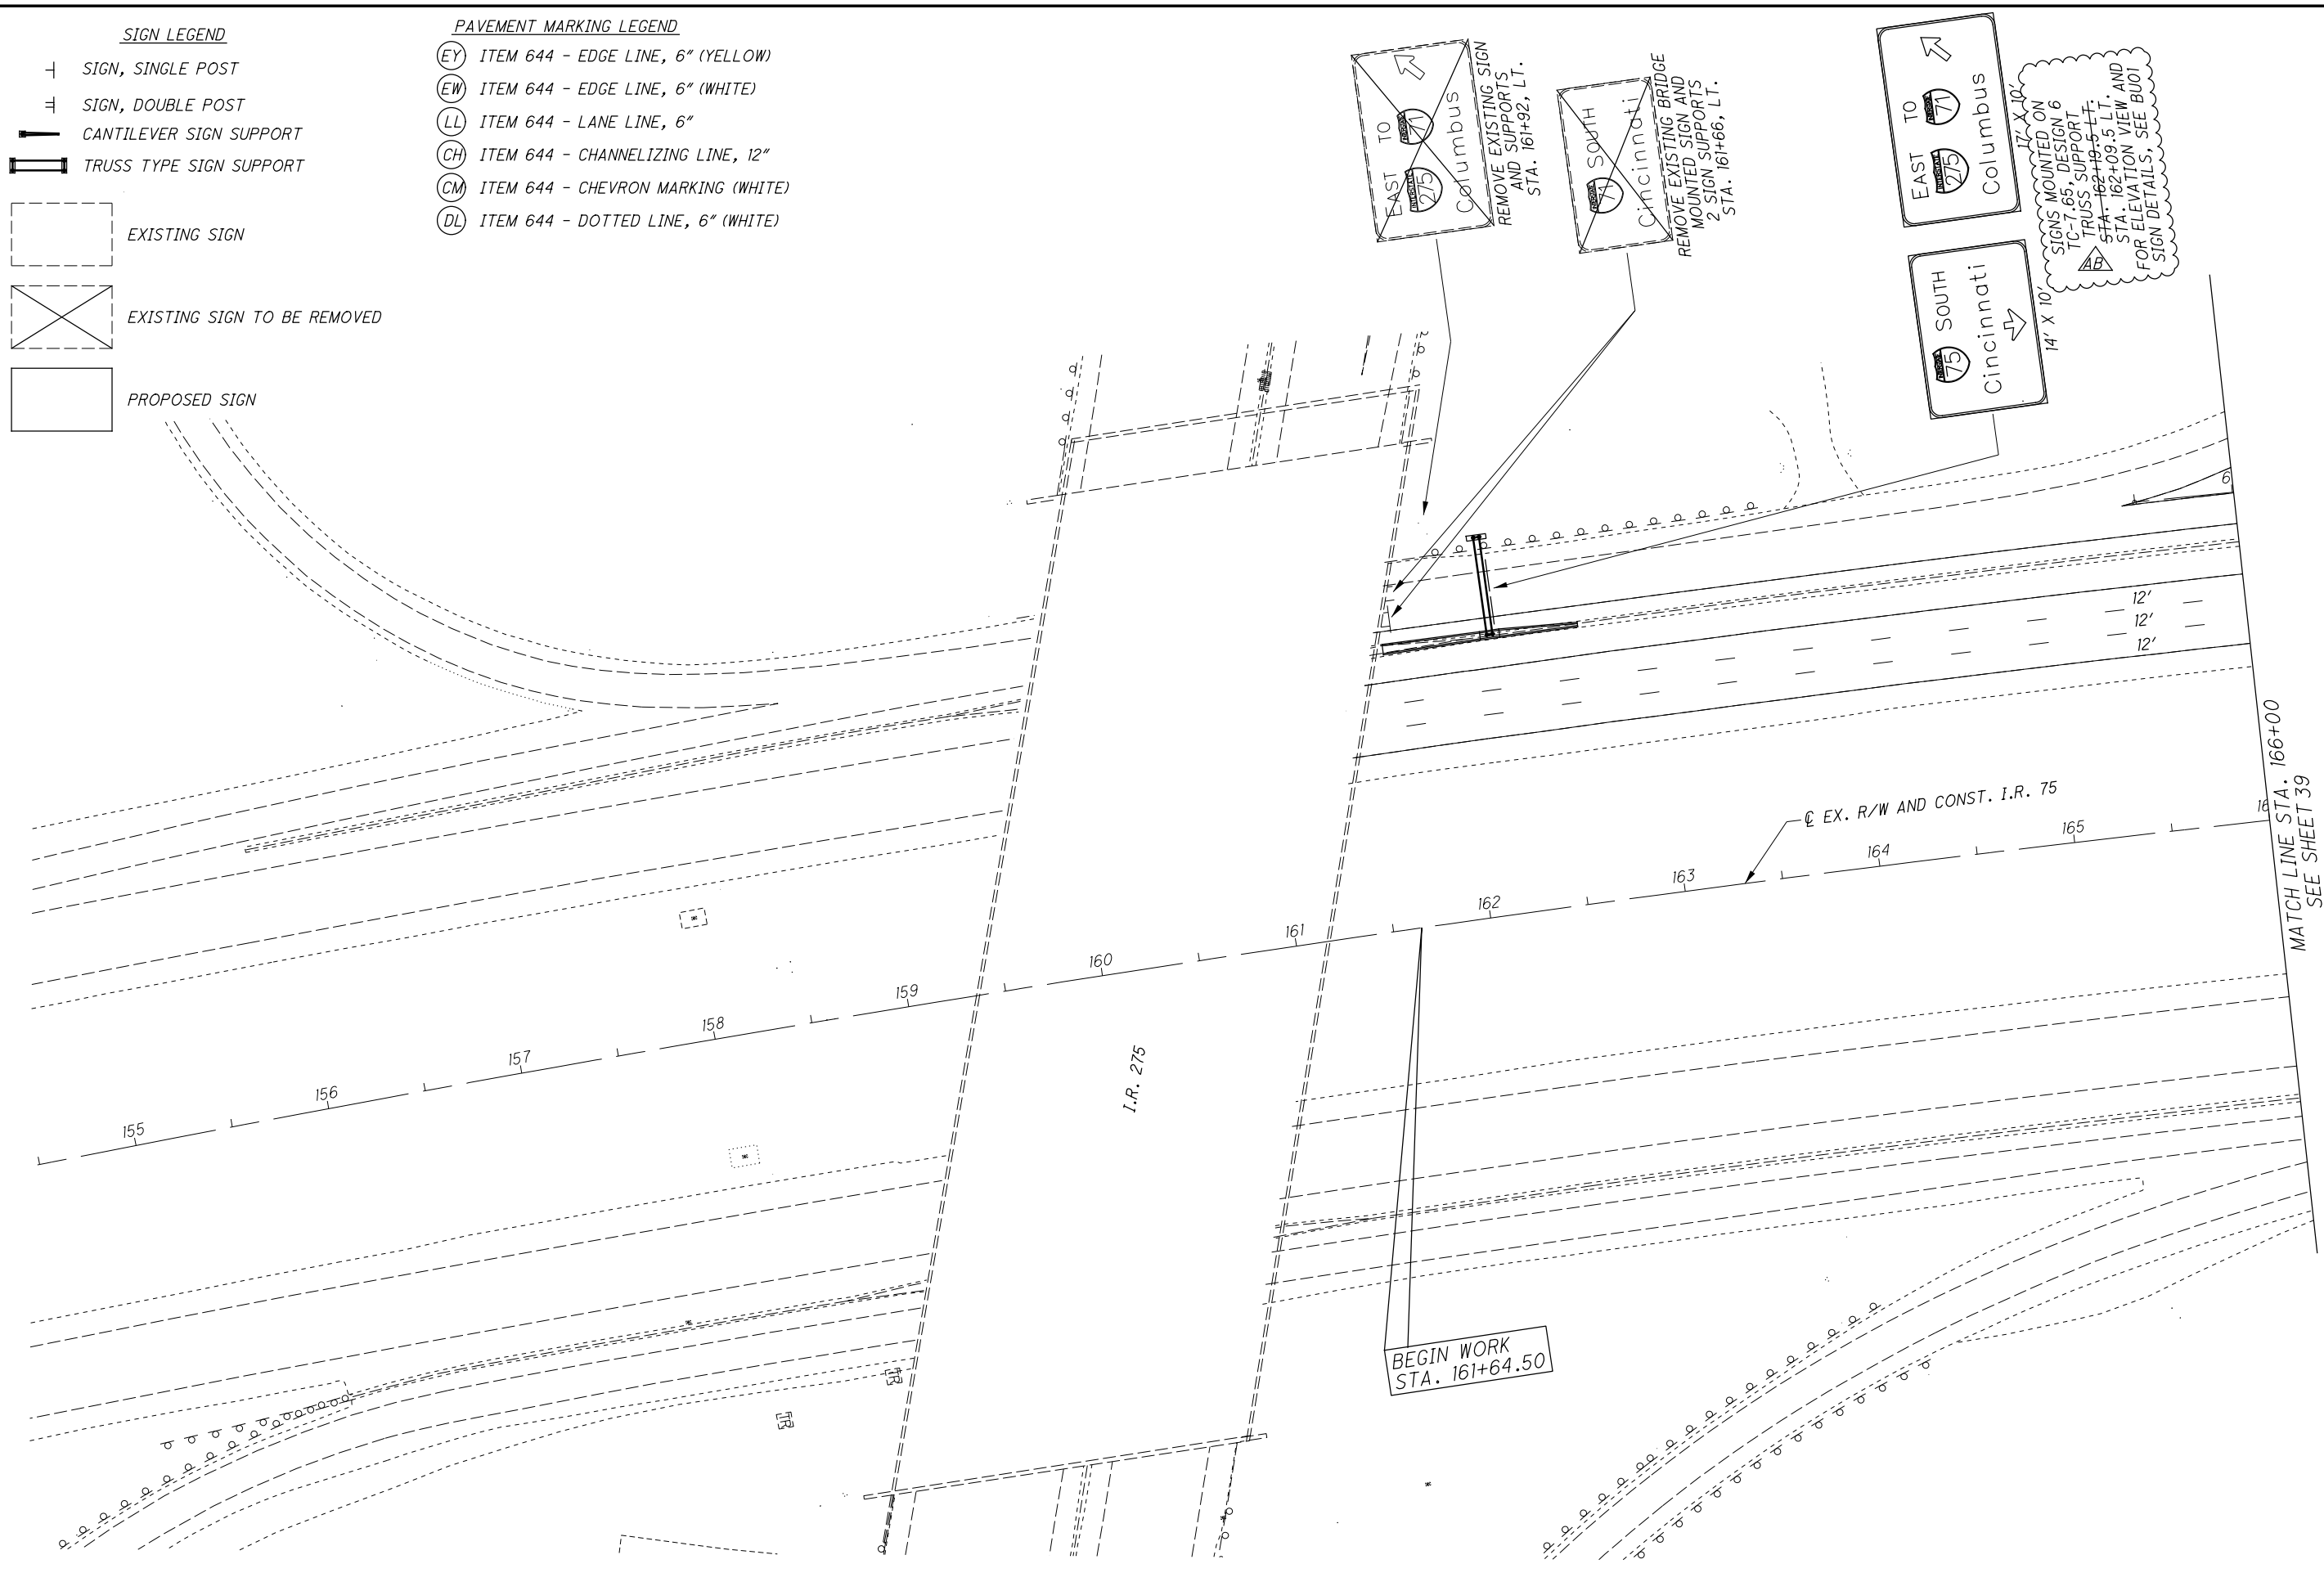

**BUILDABLE UNIT 4-AS-BUILT PLANS--JANUARY 29, 2018**

**PAVEMENT MARKING AND SIGNING PLAN**

HAM-75-16.67

CALCULATED TKI  
CHECKED JMB

0 20 40 80  
HORIZONTAL SCALE IN FEET


N

NO.	REVISIONS	DATE
AB	AS-BUILT REVISION	1/29/18

38  
43



G:\Akron\DCS\Projects\TRN\60547096\_HAM751667\900-CAD-GIS\104408\_HAM-75-1667\Design\Traffic\Sheets\BU04\104408\_IP002.dgn Design 1/23/2018 9:37:40 AM matt.philips

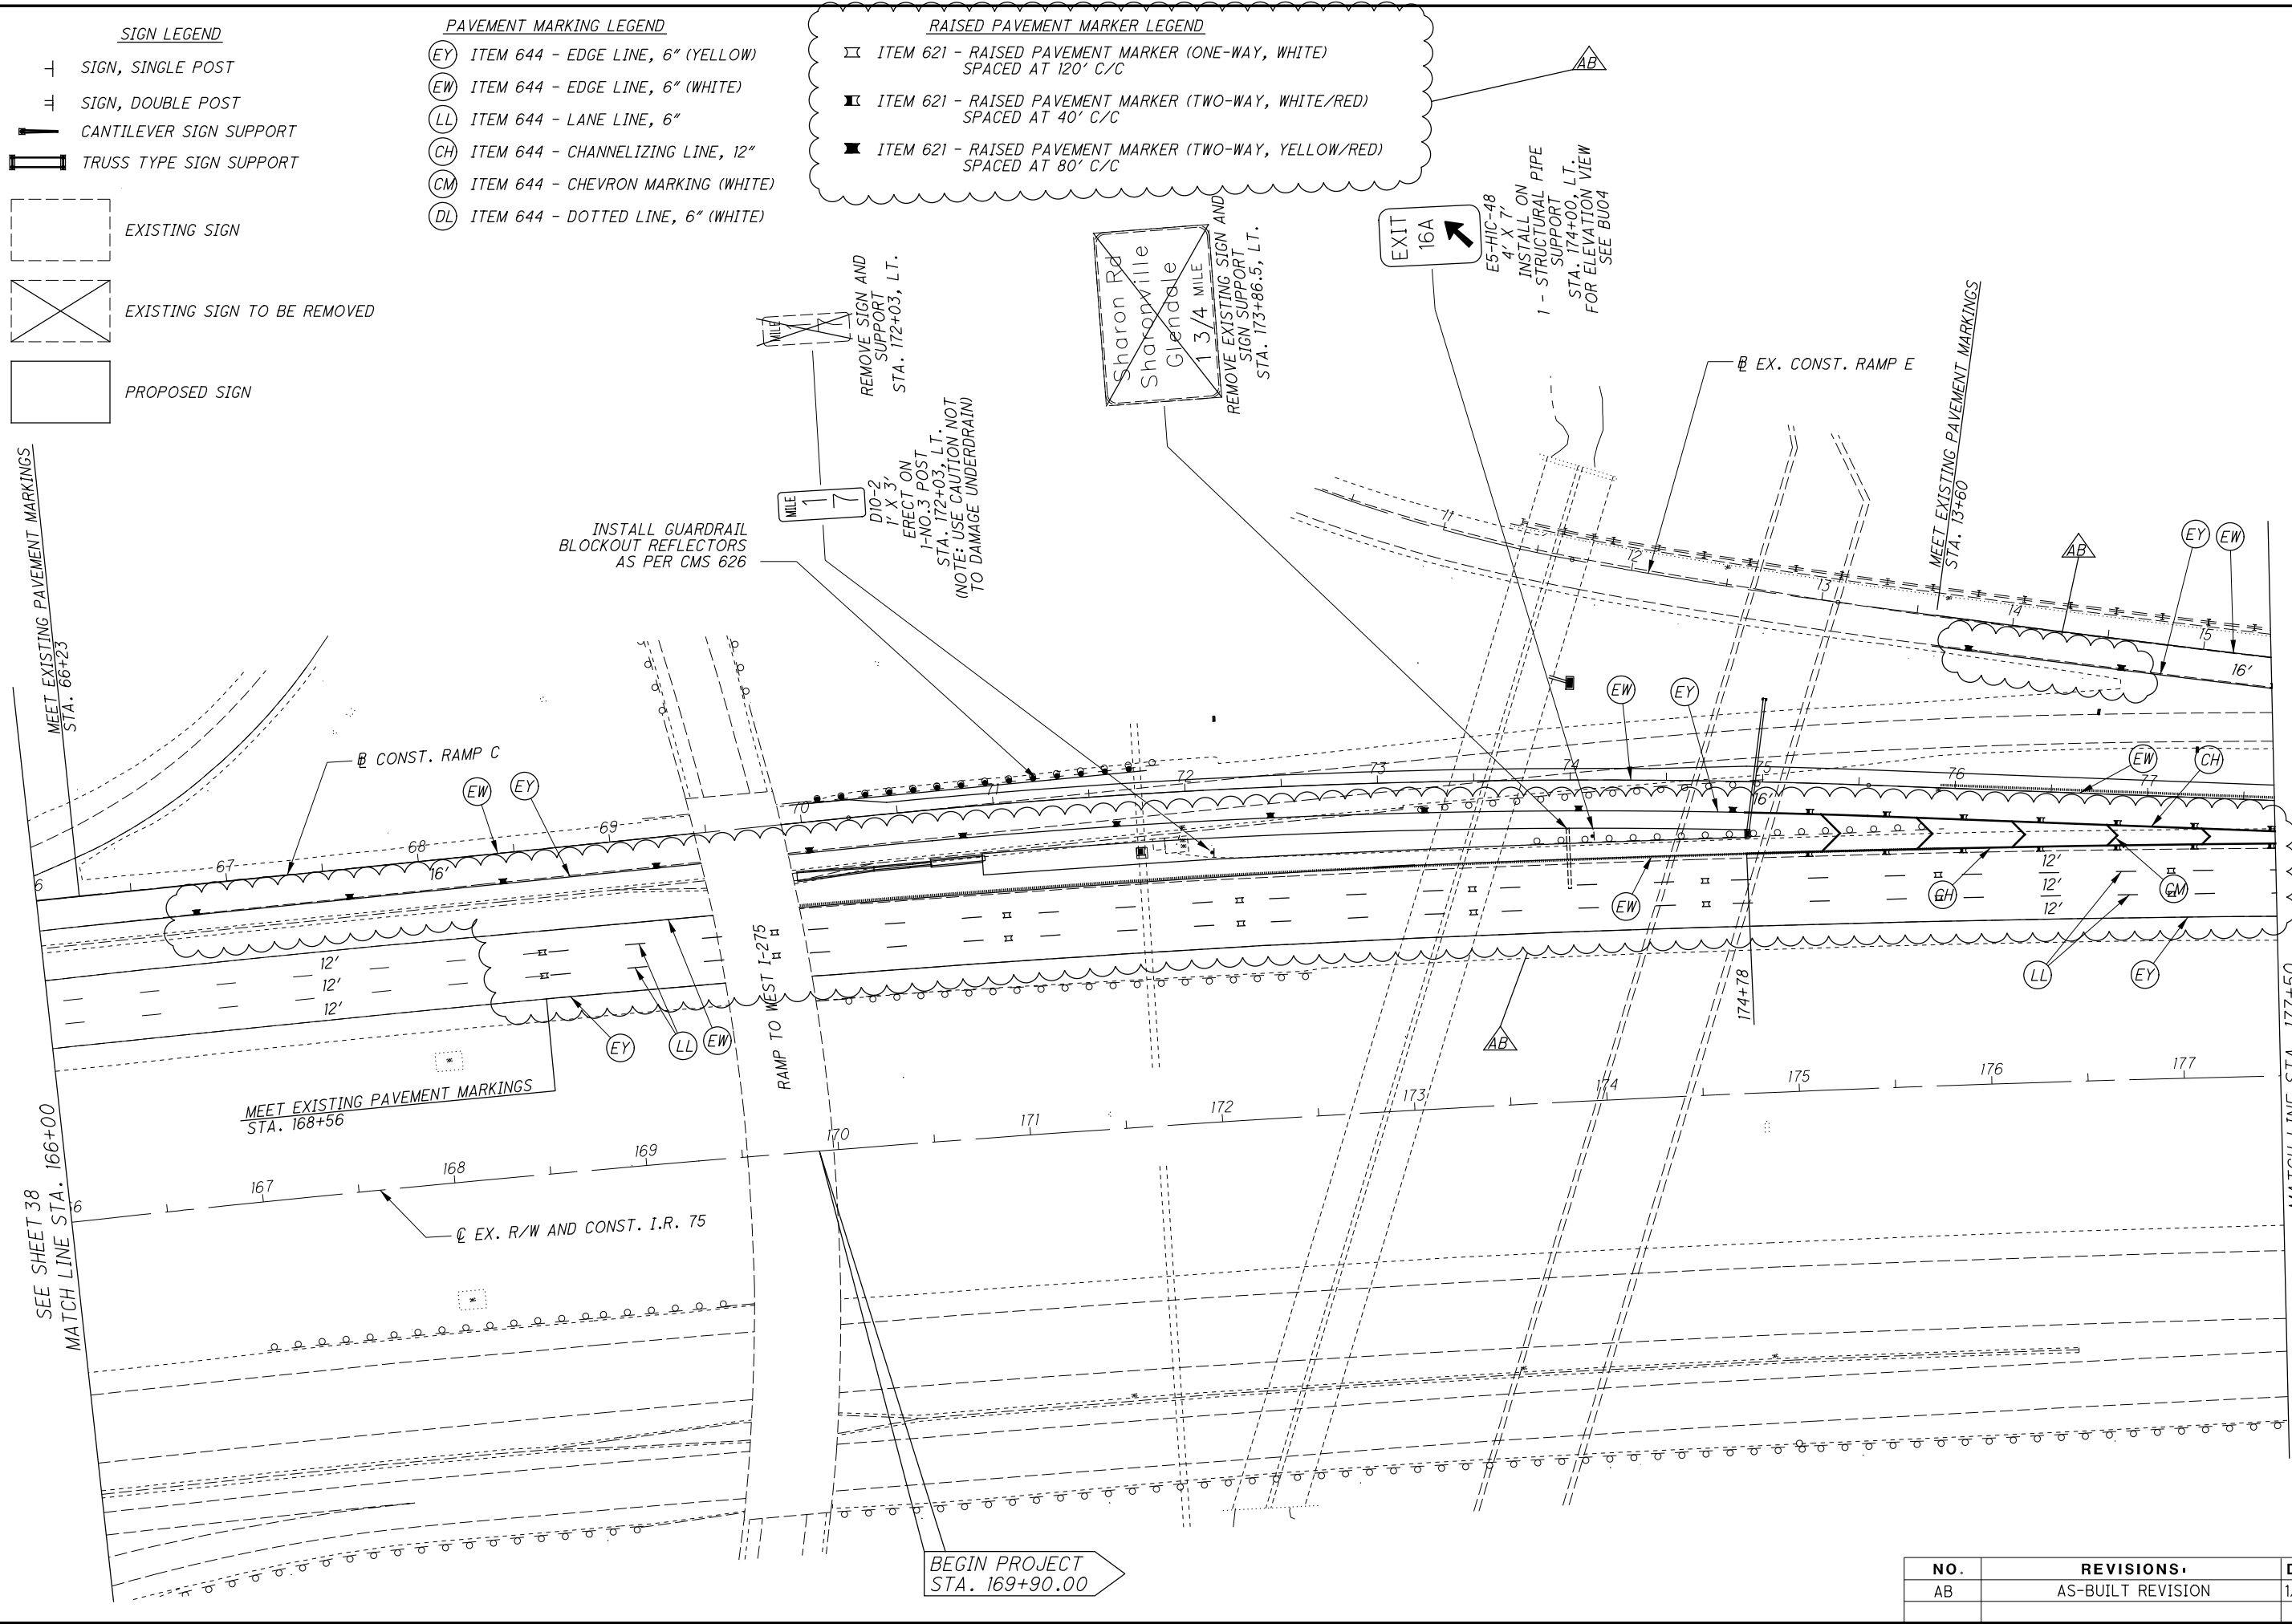

**SIGN LEGEND**

- ⊥ SIGN, SINGLE POST
- ⊥ SIGN, DOUBLE POST
- ┌ CANTILEVER SIGN SUPPORT
- ┌ TRUSS TYPE SIGN SUPPORT
- ▭ EXISTING SIGN
- ▭ EXISTING SIGN TO BE REMOVED
- ▭ PROPOSED SIGN

**PAVEMENT MARKING LEGEND**

- (EY) ITEM 644 - EDGE LINE, 6" (YELLOW)
- (EW) ITEM 644 - EDGE LINE, 6" (WHITE)
- (LL) ITEM 644 - LANE LINE, 6"
- (CH) ITEM 644 - CHANNELIZING LINE, 12"
- (CM) ITEM 644 - CHEVRON MARKING (WHITE)
- (DL) ITEM 644 - DOTTED LINE, 6" (WHITE)

**RAISED PAVEMENT MARKER LEGEND**

- ▣ ITEM 621 - RAISED PAVEMENT MARKER (ONE-WAY, WHITE) SPACED AT 120' C/C
- ▣ ITEM 621 - RAISED PAVEMENT MARKER (TWO-WAY, WHITE/RED) SPACED AT 40' C/C
- ▣ ITEM 621 - RAISED PAVEMENT MARKER (TWO-WAY, YELLOW/RED) SPACED AT 80' C/C

CALCULATED  
TKI  
CHECKED  
JMB

0 20 40 80  
HORIZONTAL SCALE IN FEET

39  
43

**BUILDABLE UNIT 4-AS-BUILT PLANS-JANUARY 29, 2018**

**PAVEMENT MARKING AND SIGNING PLAN**

HAM-75-16.67

NO.	REVISIONS	DATE
AB	AS-BUILT REVISION	1/29/18

BEGIN PROJECT STA. 169+90.00

G:\Akron\DCS\Projects\TRN\60547096\_HAM751667\900-CAD-GIS\104408\_HAM-75-1667\Design\Traffic\Sheets\BU04\104408\_TP003.dgn Design 1/23/2018 9:37:42 AM matt.philips

**SIGN LEGEND**

- ⊥ SIGN, SINGLE POST
- ⊥ SIGN, DOUBLE POST
- ┌ CANTILEVER SIGN SUPPORT
- ┌ TRUSS TYPE SIGN SUPPORT


- EXISTING SIGN
- EXISTING SIGN TO BE REMOVED
- PROPOSED SIGN

**PAVEMENT MARKING LEGEND**

- (EY) ITEM 644 - EDGE LINE, 6" (YELLOW)
- (EW) ITEM 644 - EDGE LINE, 6" (WHITE)
- (LL) ITEM 644 - LANE LINE, 6"
- (CH) ITEM 644 - CHANNELIZING LINE, 12"
- (CM) ITEM 644 - CHEVRON MARKING (WHITE)
- (DL) ITEM 644 - DOTTED LINE, 6" (WHITE)

**RAISED PAVEMENT MARKER LEGEND**

- ▣ ITEM 621 - RAISED PAVEMENT MARKER (ONE-WAY, WHITE) SPACED AT 120' C/C
- ▣ ITEM 621 - RAISED PAVEMENT MARKER (TWO-WAY, WHITE/RED) SPACED AT 40' C/C
- ▣ ITEM 621 - RAISED PAVEMENT MARKER (TWO-WAY, YELLOW/RED) SPACED AT 80' C/C

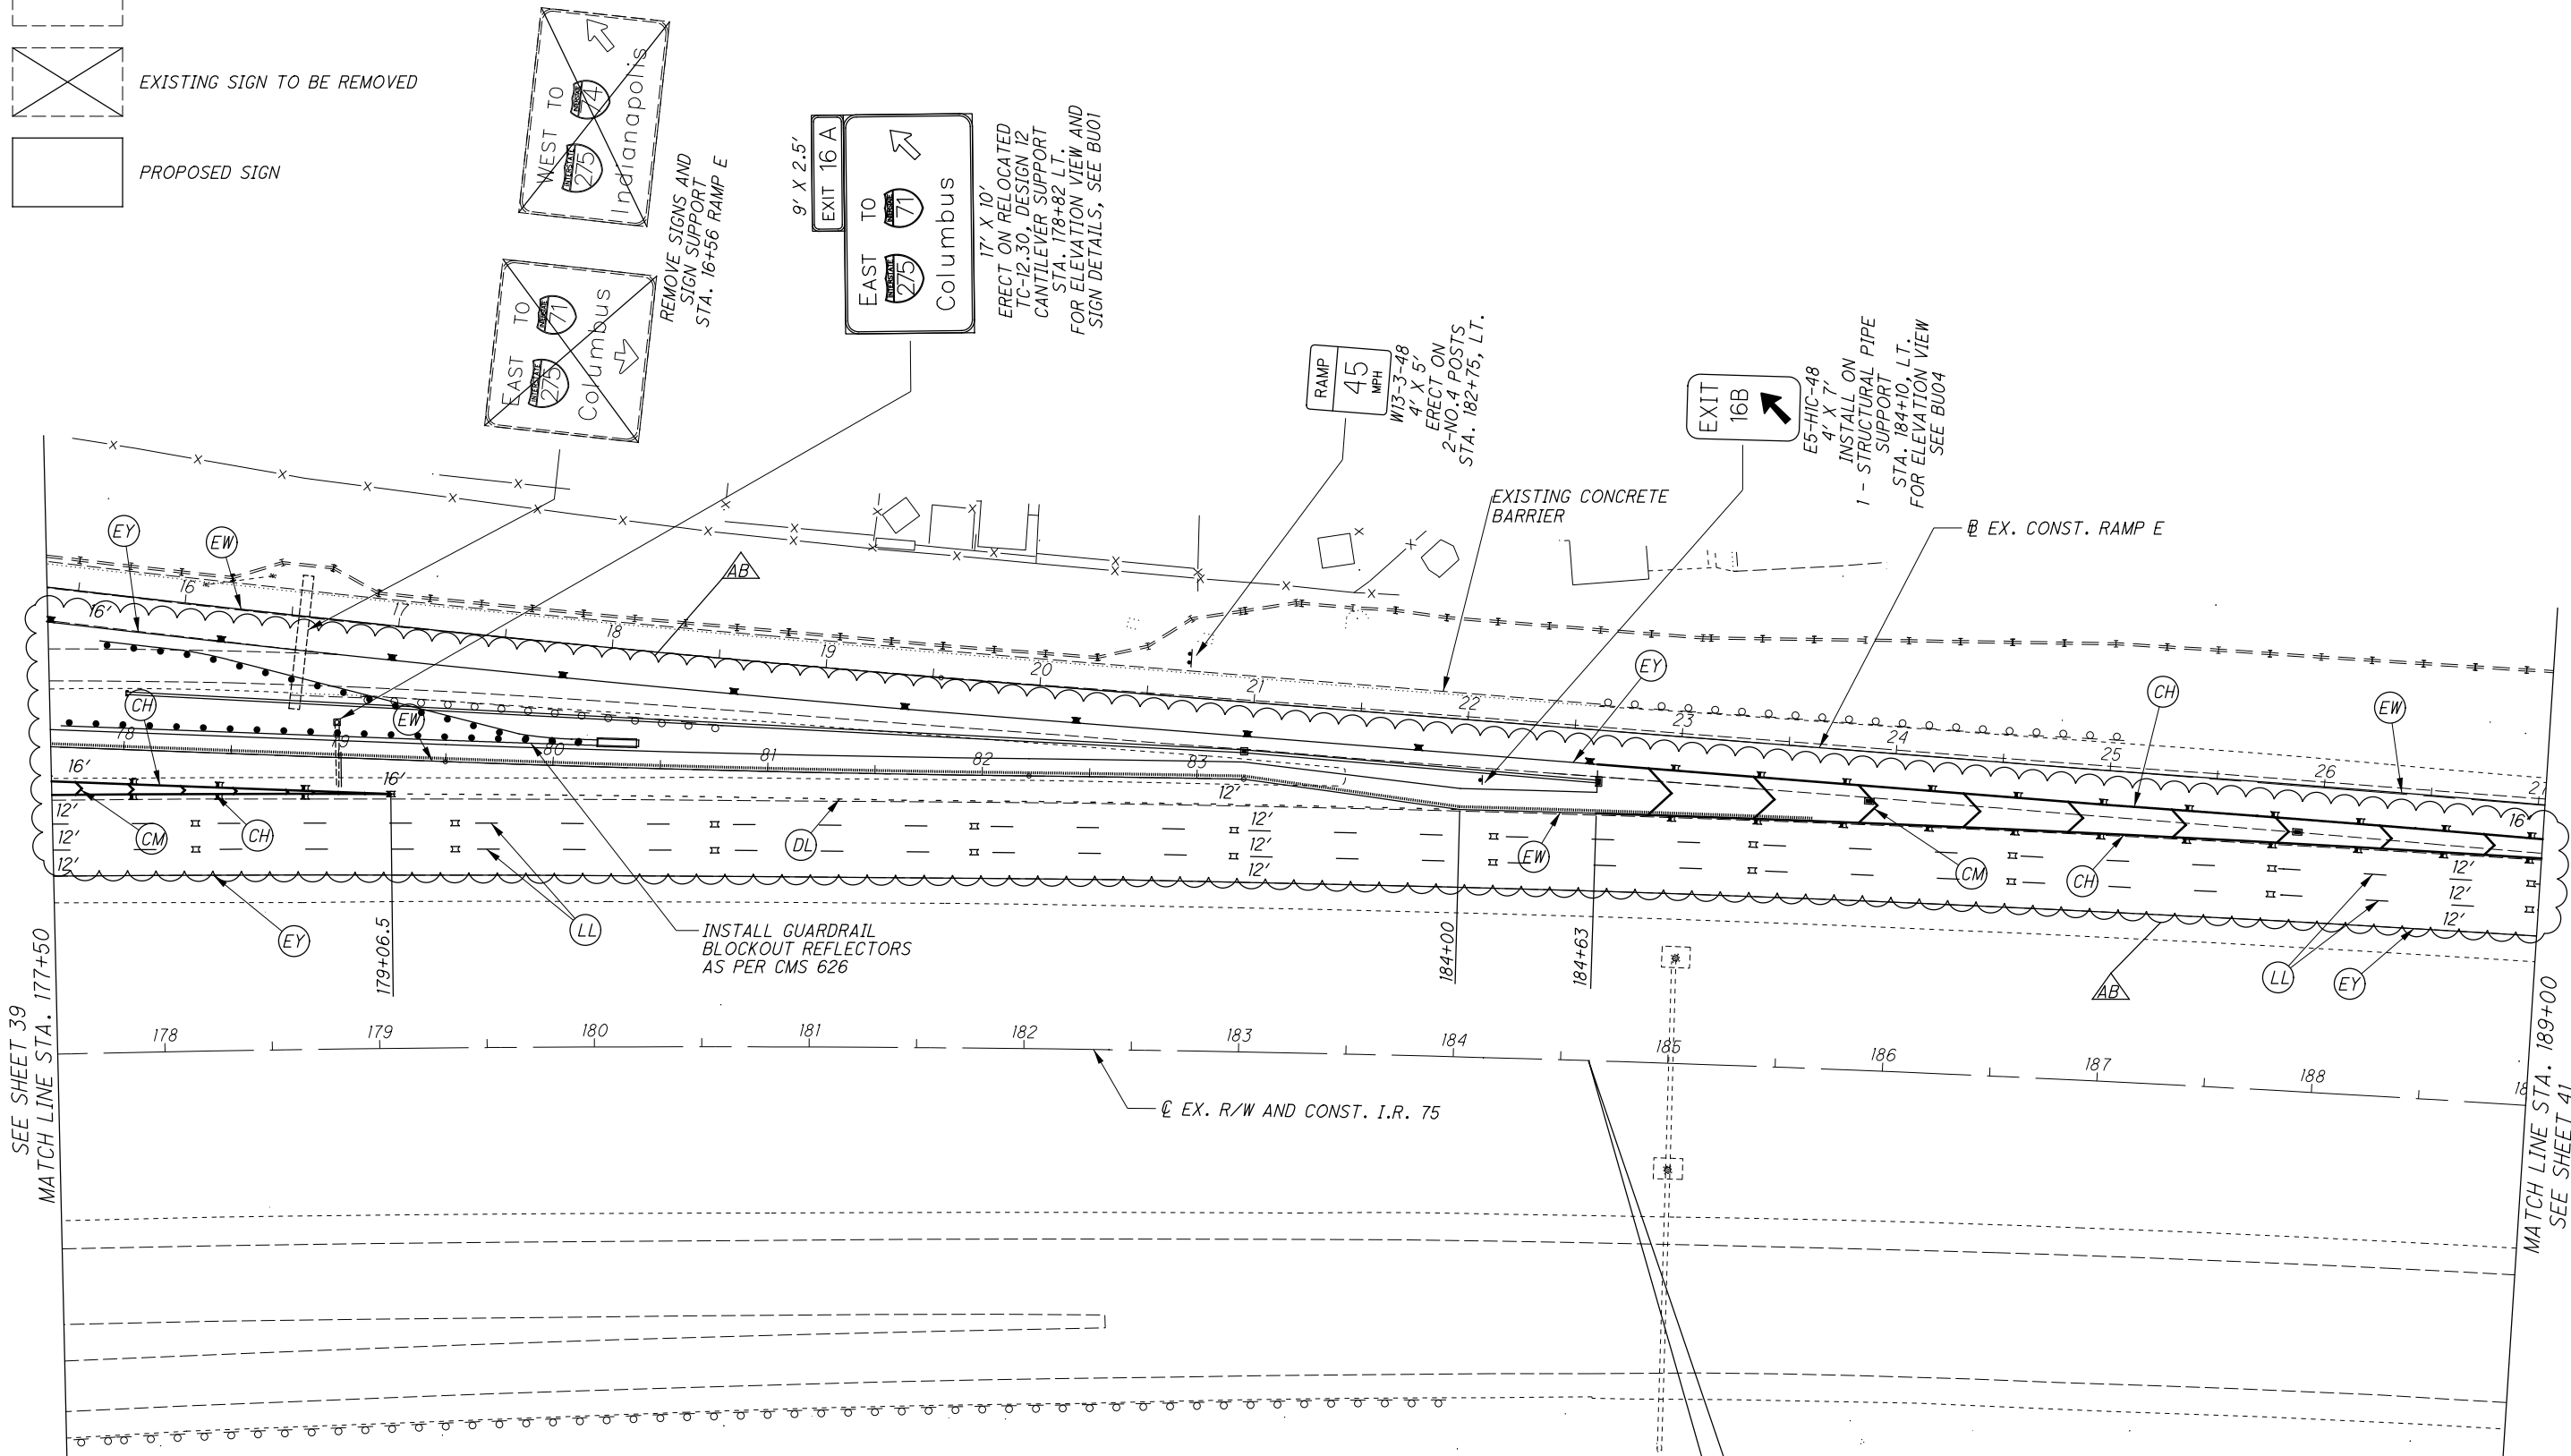

**BUILDABLE UNIT 4-AS-BUILT PLANS-JANUARY 29, 2018**

**PAVEMENT MARKING AND SIGNING PLAN**

**HAM-75-16.67**

CALCULATED: TKI  
CHECKED: JMB

0 20 40 80  
HORIZONTAL SCALE IN FEET

NO.	REVISIONS	DATE
AB	AS-BUILT REVISION	1/29/18

40  
43

END PROJECT  
STA. 184+63.03

G:\Akron\DCS\Projects\TRN\60547096\_HAM751667\900-CAD-GIS\104408\_HAM-75-1667\Design\Traffic\Sheets\BU04\104408\_TP004.dgn Design 1/23/2018 9:37:45 AM matt.philips

**SIGN LEGEND**



- ⊥ SIGN, SINGLE POST
- ⊥ SIGN, DOUBLE POST
- ┌ CANTILEVER SIGN SUPPORT
- ┌ TRUSS TYPE SIGN SUPPORT
- ▭ EXISTING SIGN
- ▭ EXISTING SIGN TO BE REMOVED
- ▭ PROPOSED SIGN

**PAVEMENT MARKING LEGEND**

- (EY) ITEM 644 - EDGE LINE, 6" (YELLOW)
- (EW) ITEM 644 - EDGE LINE, 6" (WHITE)
- (LL) ITEM 644 - LANE LINE, 6"
- (CH) ITEM 644 - CHANNELIZING LINE, 12"
- (CM) ITEM 644 - CHEVRON MARKING (WHITE)
- (DL) ITEM 644 - DOTTED LINE, 6" (WHITE)
- (DL) ITEM 644 - DOTTED LINE 12" (WHITE)
- (RM) ITEM 644 - REMOVAL OF PAVEMENT MARKING

**RAISED PAVEMENT MARKER LEGEND**

- ▣ ITEM 621 - RAISED PAVEMENT MARKER (ONE-WAY, WHITE) SPACED AT 120' C/C
- ▣ ITEM 621 - RAISED PAVEMENT MARKER (TWO-WAY, WHITE/RED) SPACED AT 40' C/C
- ▣ ITEM 621 - RAISED PAVEMENT MARKER (TWO-WAY, YELLOW/RED) SPACED AT 80' C/C

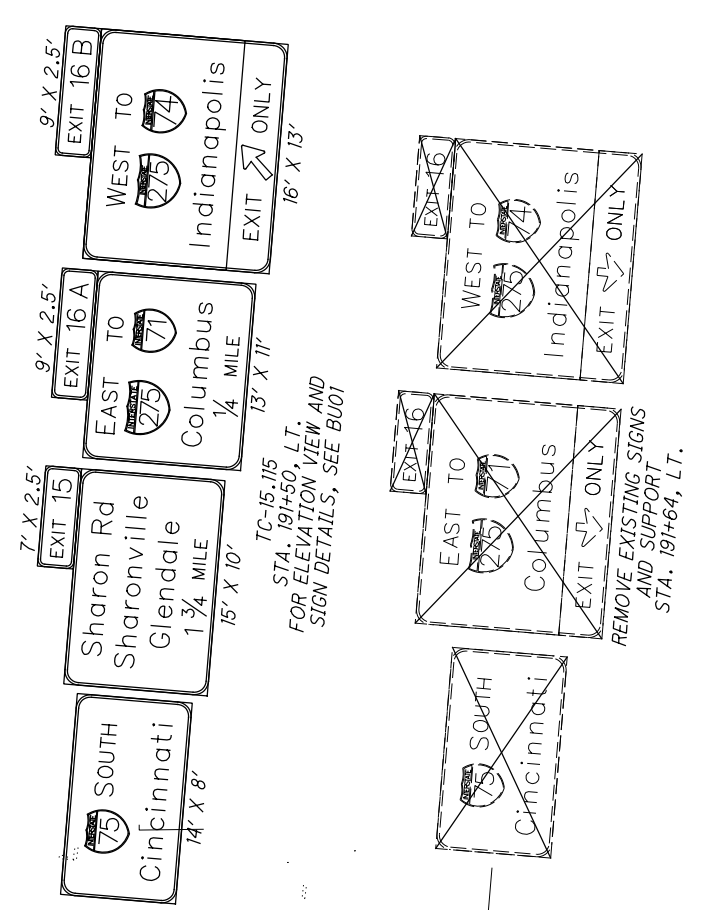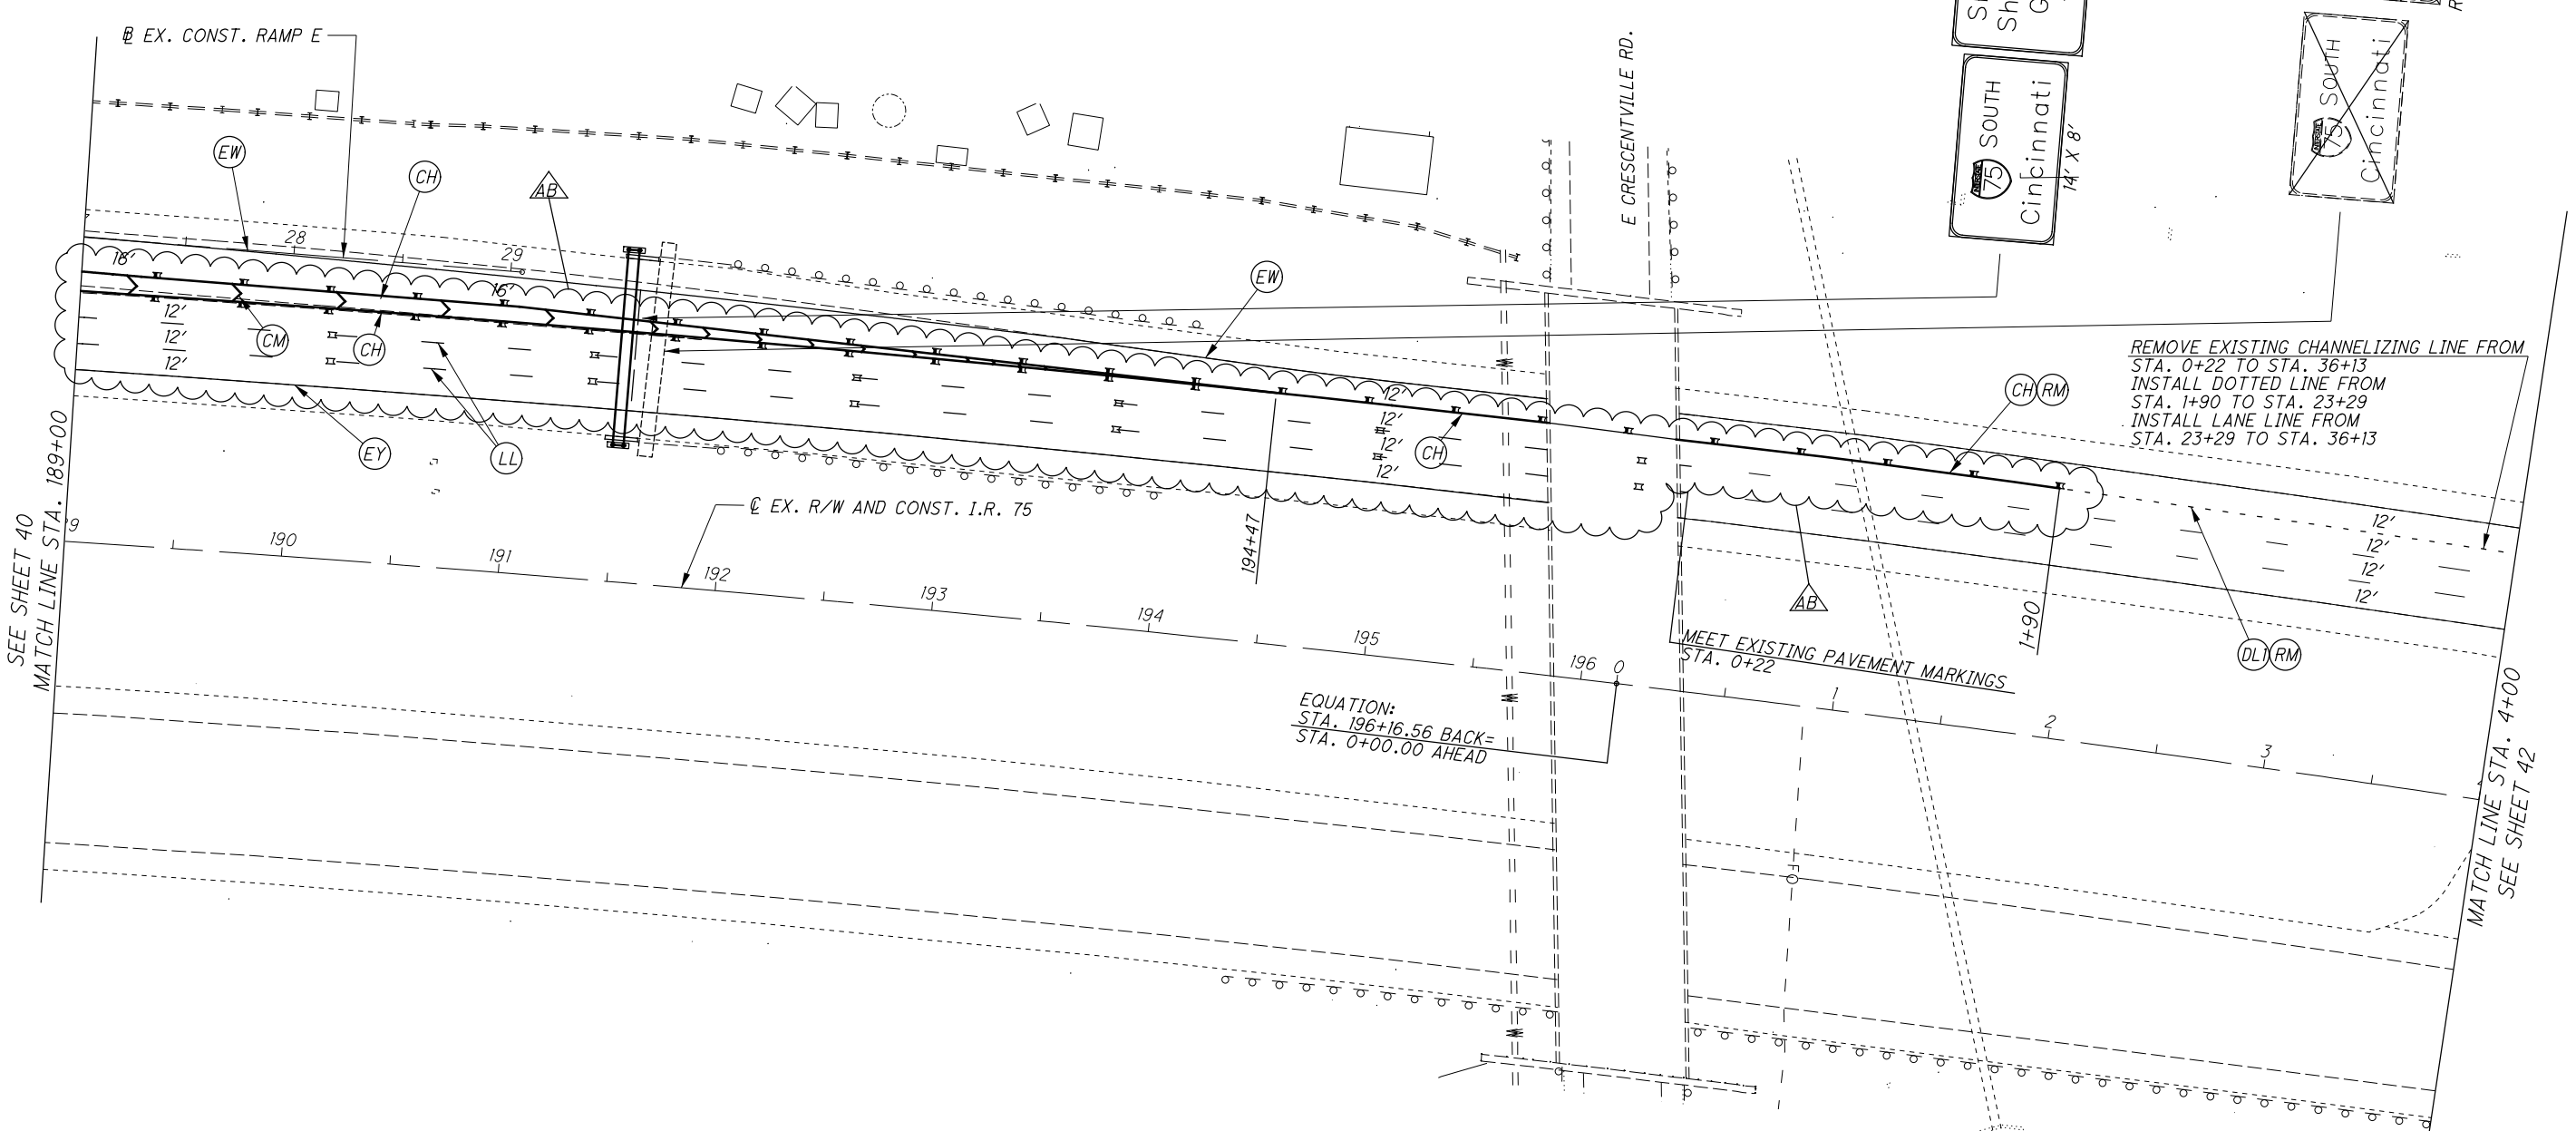

**BUILDABLE UNIT 4-AS-BUILT PLANS-JANUARY 29, 2018**

**PAVEMENT MARKING AND SIGNING PLAN**

**HAM-75-16.67**

NO. REVISIONS DATE

AB AS-BUILT REVISION 1/29/18

41  
43

CALCULATED TKI CHECKED JMB

0 20 40 80  
HORIZONTAL SCALE IN FEET







