


c:\pwworking\hmm\external\ty61470\dms72726\87268TP004.dgn 10/24/2014 4:12:33 PM TYN61470

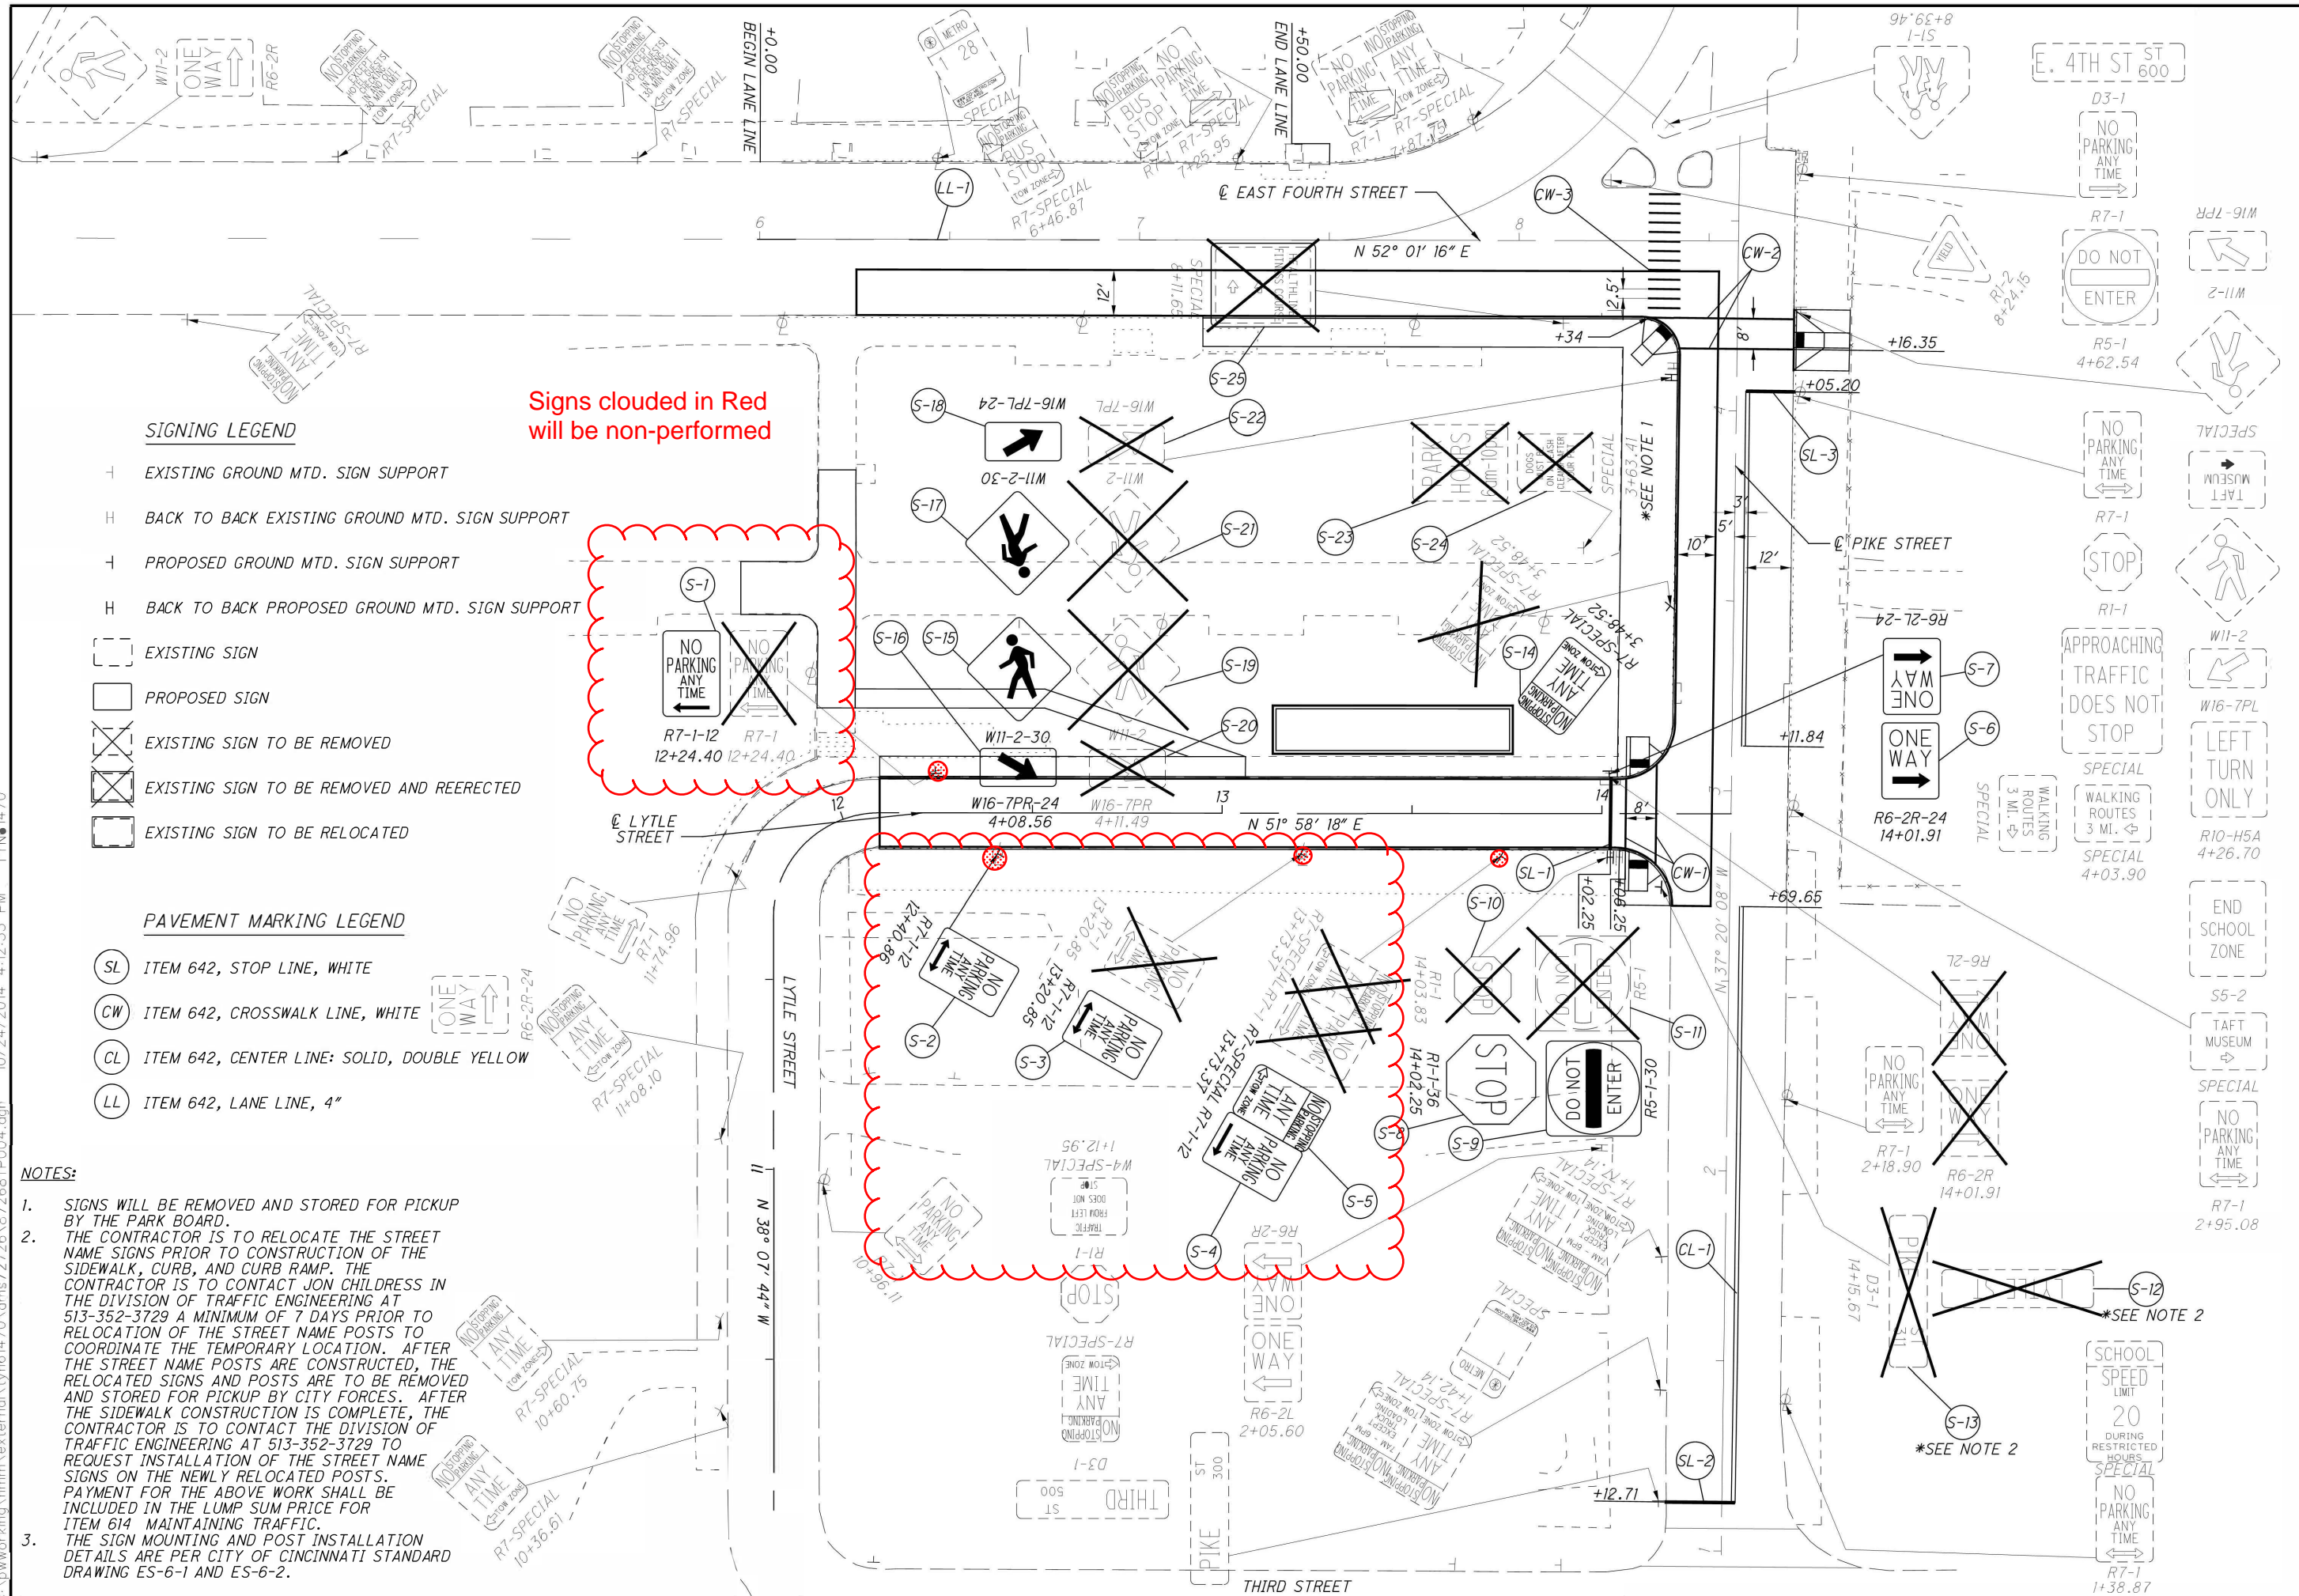

Signs clouded in Red will be non-performed

CALCULATED
RDL
CHECKED
CWP