

The Great Lakes Construction Co.

TRANSMITTAL
No. 181

925 Laidlaw Ave.
Cincinnati, Ohio 45237

PROJECT: ODOT 150085 HAM 71-1.34 **DATE:** December 18, 2017

TO: ODOT District 8 **REF:** Dry Standpipe As-Build Drawings
505 South SR 741 Dry Stand Pipe O&M
Lebanon, OH 45036 Line Item: #118.00 & #119.00

ATTN: Marvin Lennon

WE ARE SENDING		SUBMITTED FOR:		ACTION TAKEN:	
<input type="checkbox"/>	Shop Drawings	<input type="checkbox"/>	Approval	<input type="checkbox"/>	Approved as Submitted
<input type="checkbox"/>	Letter	<input checked="" type="checkbox"/>	Your Use	<input type="checkbox"/>	Approved as Needed
<input type="checkbox"/>	Prints	<input type="checkbox"/>	As Requested	<input type="checkbox"/>	Returned after Loan
<input type="checkbox"/>	Change Order	<input type="checkbox"/>	Review and Comment	<input type="checkbox"/>	Resubmit
<input type="checkbox"/>	Plans	<input type="checkbox"/>		<input checked="" type="checkbox"/>	Submit
<input type="checkbox"/>	Samples	SENT VIA:		<input type="checkbox"/>	Returned
<input type="checkbox"/>	Specifications	<input checked="" type="checkbox"/>	Attached	<input type="checkbox"/>	Returned for Correction
<input checked="" type="checkbox"/>	Other: LV Transformer O&M	<input type="checkbox"/>	Separate Cover:	<input type="checkbox"/>	Due Date:

<u>SUBMITTAL</u>	<u>COPIES</u>	<u>DATE</u>	<u>DESCRIPTION</u>
TR85.15-181	1 pdf	12/18/2017	Dry Standpipe As-build Drawings, per sheet 111/555, Section 638.0111, Dry Standpipe O&M, per sheet 114/555, Section 638.0305


REMARKS

CC: Joe Smithson, ODOT D8

Signed:



Jacob D. Elmore.

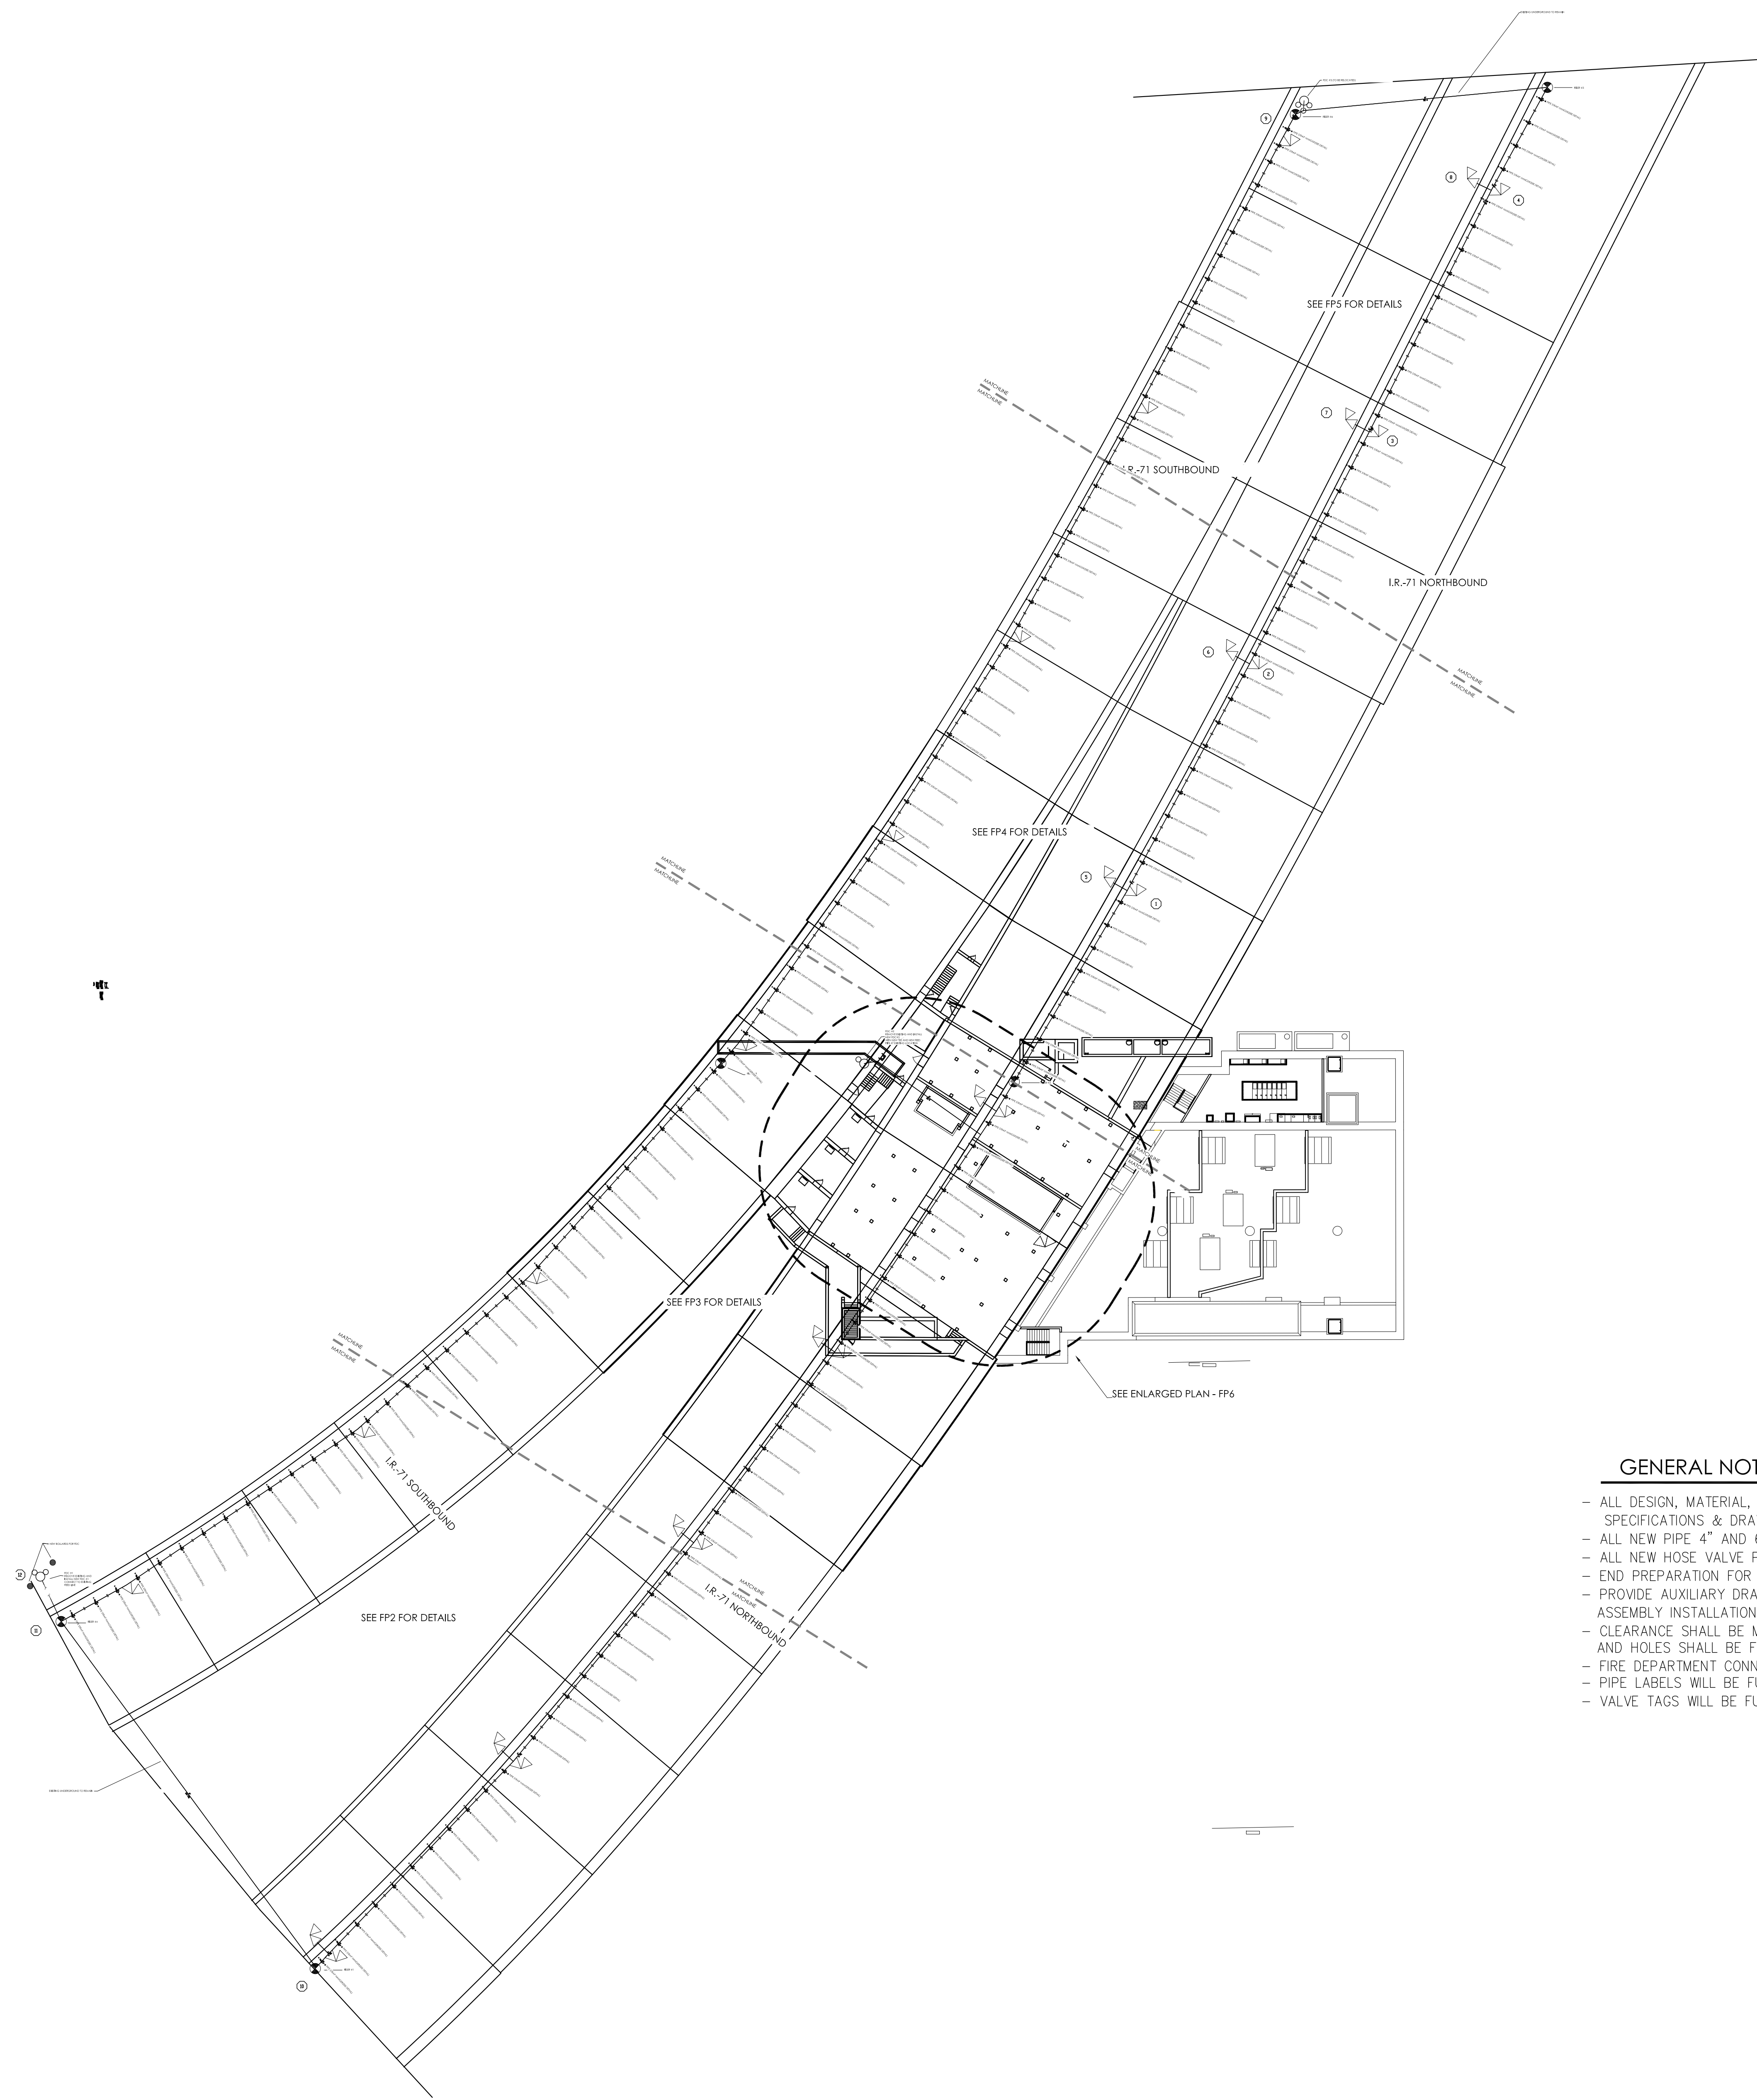

PLAN VIEW OF DRY STANDPIPE
SCALE: 1" = 30'-0"

GENERAL NOTES

- ALL DESIGN, MATERIAL, & INSTALLATION SHALL BE IN ACCORDANCE WITH NFPA 14 DESIGN SPECIFICATIONS & DRAWINGS, STATE AND LOCAL BUILDING/FIRE CODES, LOCAL FIRE DEPT AND OWNER'S REP.
- ALL NEW PIPE 4" AND 6" TO BE DUCTILE IRON
- ALL NEW HOSE VALVE PIPING TO BE GALVANIZED.
- END PREPARATION FOR ALL PIPE SHALL BE GROOVED WITH GROOVED FITTINGS
- PROVIDE AUXILIARY DRAINS AT ALL TRAPPED PIPING CONTAINING MORE THAN 5 GALLONS OF TRAPPED WATER - DRAIN ASSEMBLY INSTALLATION, DESIGN, AS INDICATED
- CLEARANCE SHALL BE MAINTAINED AROUND ALL PIPES WHERE PENETRATIONS ARE MADE IN FIRE RATED WALLS OR FLOORS AND HOLES SHALL BE FILLED WITH FIRESTOP MATERIAL
- FIRE DEPARTMENT CONNECTION THREAD TYPE SHALL BE PER RESPONDING AGENCY REQUIREMENTS
- PIPE LABELS WILL BE FURNISHED AND INSTALLED PER SPECIFICATIONS.
- VALVE TAGS WILL BE FURNISHED AND INSTALLED PER SPECIFICATIONS.

AS-BUILT
06-15-17


STATE OF OHIO CERTIFIED
COMPANY: DALMATIAN FIRE, INC. #53-83-1006
DESIGNER: ROBERT TAKSY #3073
Robert Taksy
#3073

LYTLE TUNNEL 1-71 CINCINNATI OHIO	TITLE: DRY STANDPIPE PLAN VIEW OF STANDPIPE		SPRINKLERS	QTY	DESIGN DATA		TRADE	COMPANY NAME	SIGNATURE	DATE
	OCCUPANCY:	SO. FT.			DENSITY:	GPM /				
DALMATIAN FIRE, INC. 4700 DUKE BLVD, SUITE 160 WASSON, OHIO 45040 (513) 388-4500 FAX (513) 388-2880		DATE: 6.16.2016	DRAWN BY: Z. CRIFE	TOTAL SPRINKLERS THIS SHEET: 0		FLOW TEST:	PSI STATIC	ELECTRICAL		
		CONTRACT No: 2585*	CHECKED BY: B. TANSY			PSI RESIDUAL	PSI FLOWING	PLUMBING		
		SCALE: 1" = 30'-0"	FILE NAME:					HVAC		

SHEET No. 1
FP1 OF 9



EXISTING UNDERGROUND TO REMAIN

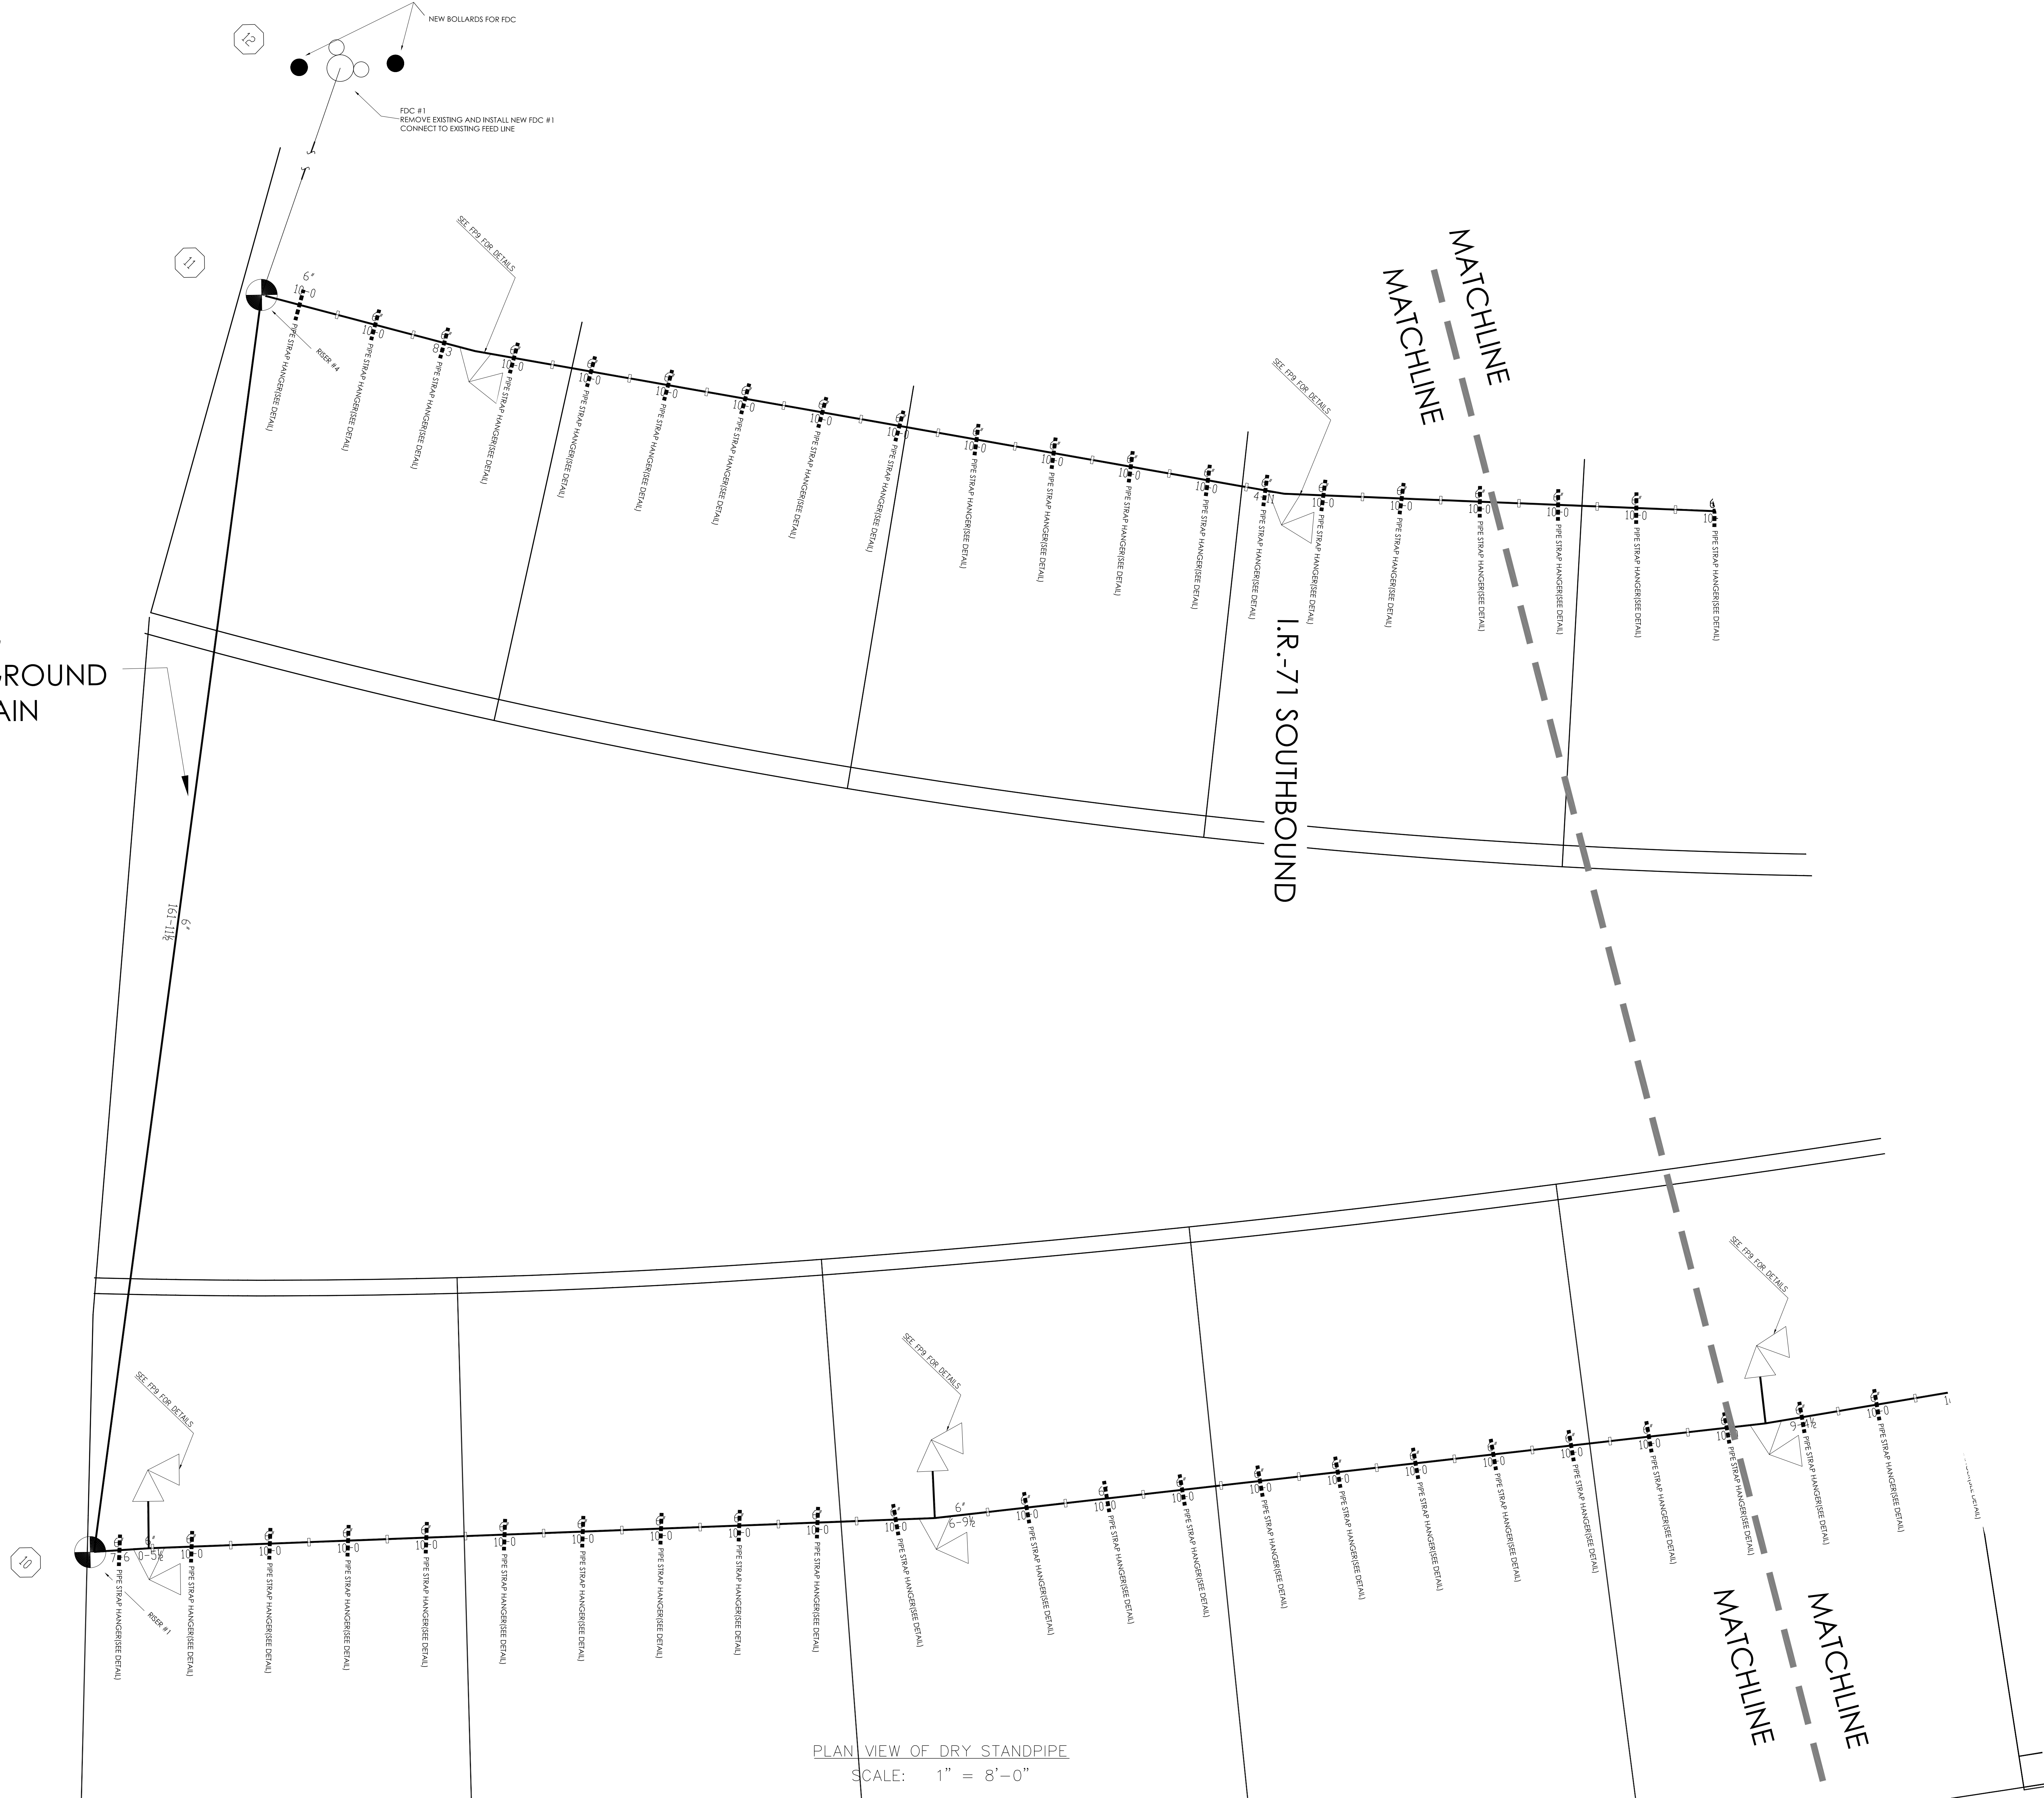

PLAN VIEW OF DRY STANDPIPE
SCALE: 1" = 8'-0"

LYTLE TUNNEL 1-71 CINCINNATI OHIO		DRY STANDPIPE PLAN VIEW DATE: 6.16.2016 DRAWN BY: Z. CRUPE		COMPANY NAME DALMATIAN FIRE, INC.		SIGNATURE		DATE		
DALMATIAN FIRE, INC. 4700 DUKE BLVD, SUITE 160 MASON, OHIO 45040 (513) 388-4500 FAX (513) 388-2880		CONTRACT No.: 2585* CHECKED BY: R. TANSY FILE NAME:		TRADE SPRINKLER PLUMBING ELECTRICAL HVAC		DESIGN DATA OCCUPANCY: / SO. FT. / DENSITY: GPM / GPM HOSE ALLOWANCE: / FLOW TEST: PSI STATIC / PSI RESIDUAL PSI FLOWING		TOTAL SPRINKLERS THIS SHEET: 0		DATE
SHEET No.: FP2 OF 9		TITLE:		SPRINKLERS		QTY		DESIGN DATA		DATE

AS-BUILT
06-15-17





PLAN VIEW OF DRY STANDPIPE
SCALE: 1" = 8'-0"


LYTLE TUNNEL 1-71 CINCINNATI, OHIO		DRY STANDPIPE PLAN VIEW		SPRINKLERS		QTY DESIGN DATA		TRADE		COMPANY NAME		SIGNATURE		DATE	
SCALE:		DATE: 6.16.2016		DRAWN BY: Z. CRIFE		OCCUPANCY:		SPRINKLER		DALMATIAN FIRE, INC.					
CONTRACT No.: 2585*		CHECKED BY: R. TANSY		FILE NAME:		HOSE ALLOWANCE:		PLUMBING							
CONTRACT W/TH:						SO. FT. / GPM		ELECTRICAL							
						FLOW TEST:		HVAC							
						PSI STATIC / GPM FLOWING									
						TOTAL SPRINKLERS THIS SHEET									
						0									








AS-BUILT
06-15-17

SHEET No.:
FP4 OF 9

DALMATIAN FIRE, INC.
4700 DUKE BLVD., SUITE 100
MASON, OHIO 45040
(513) 388-4580 FAX (513) 388-2880

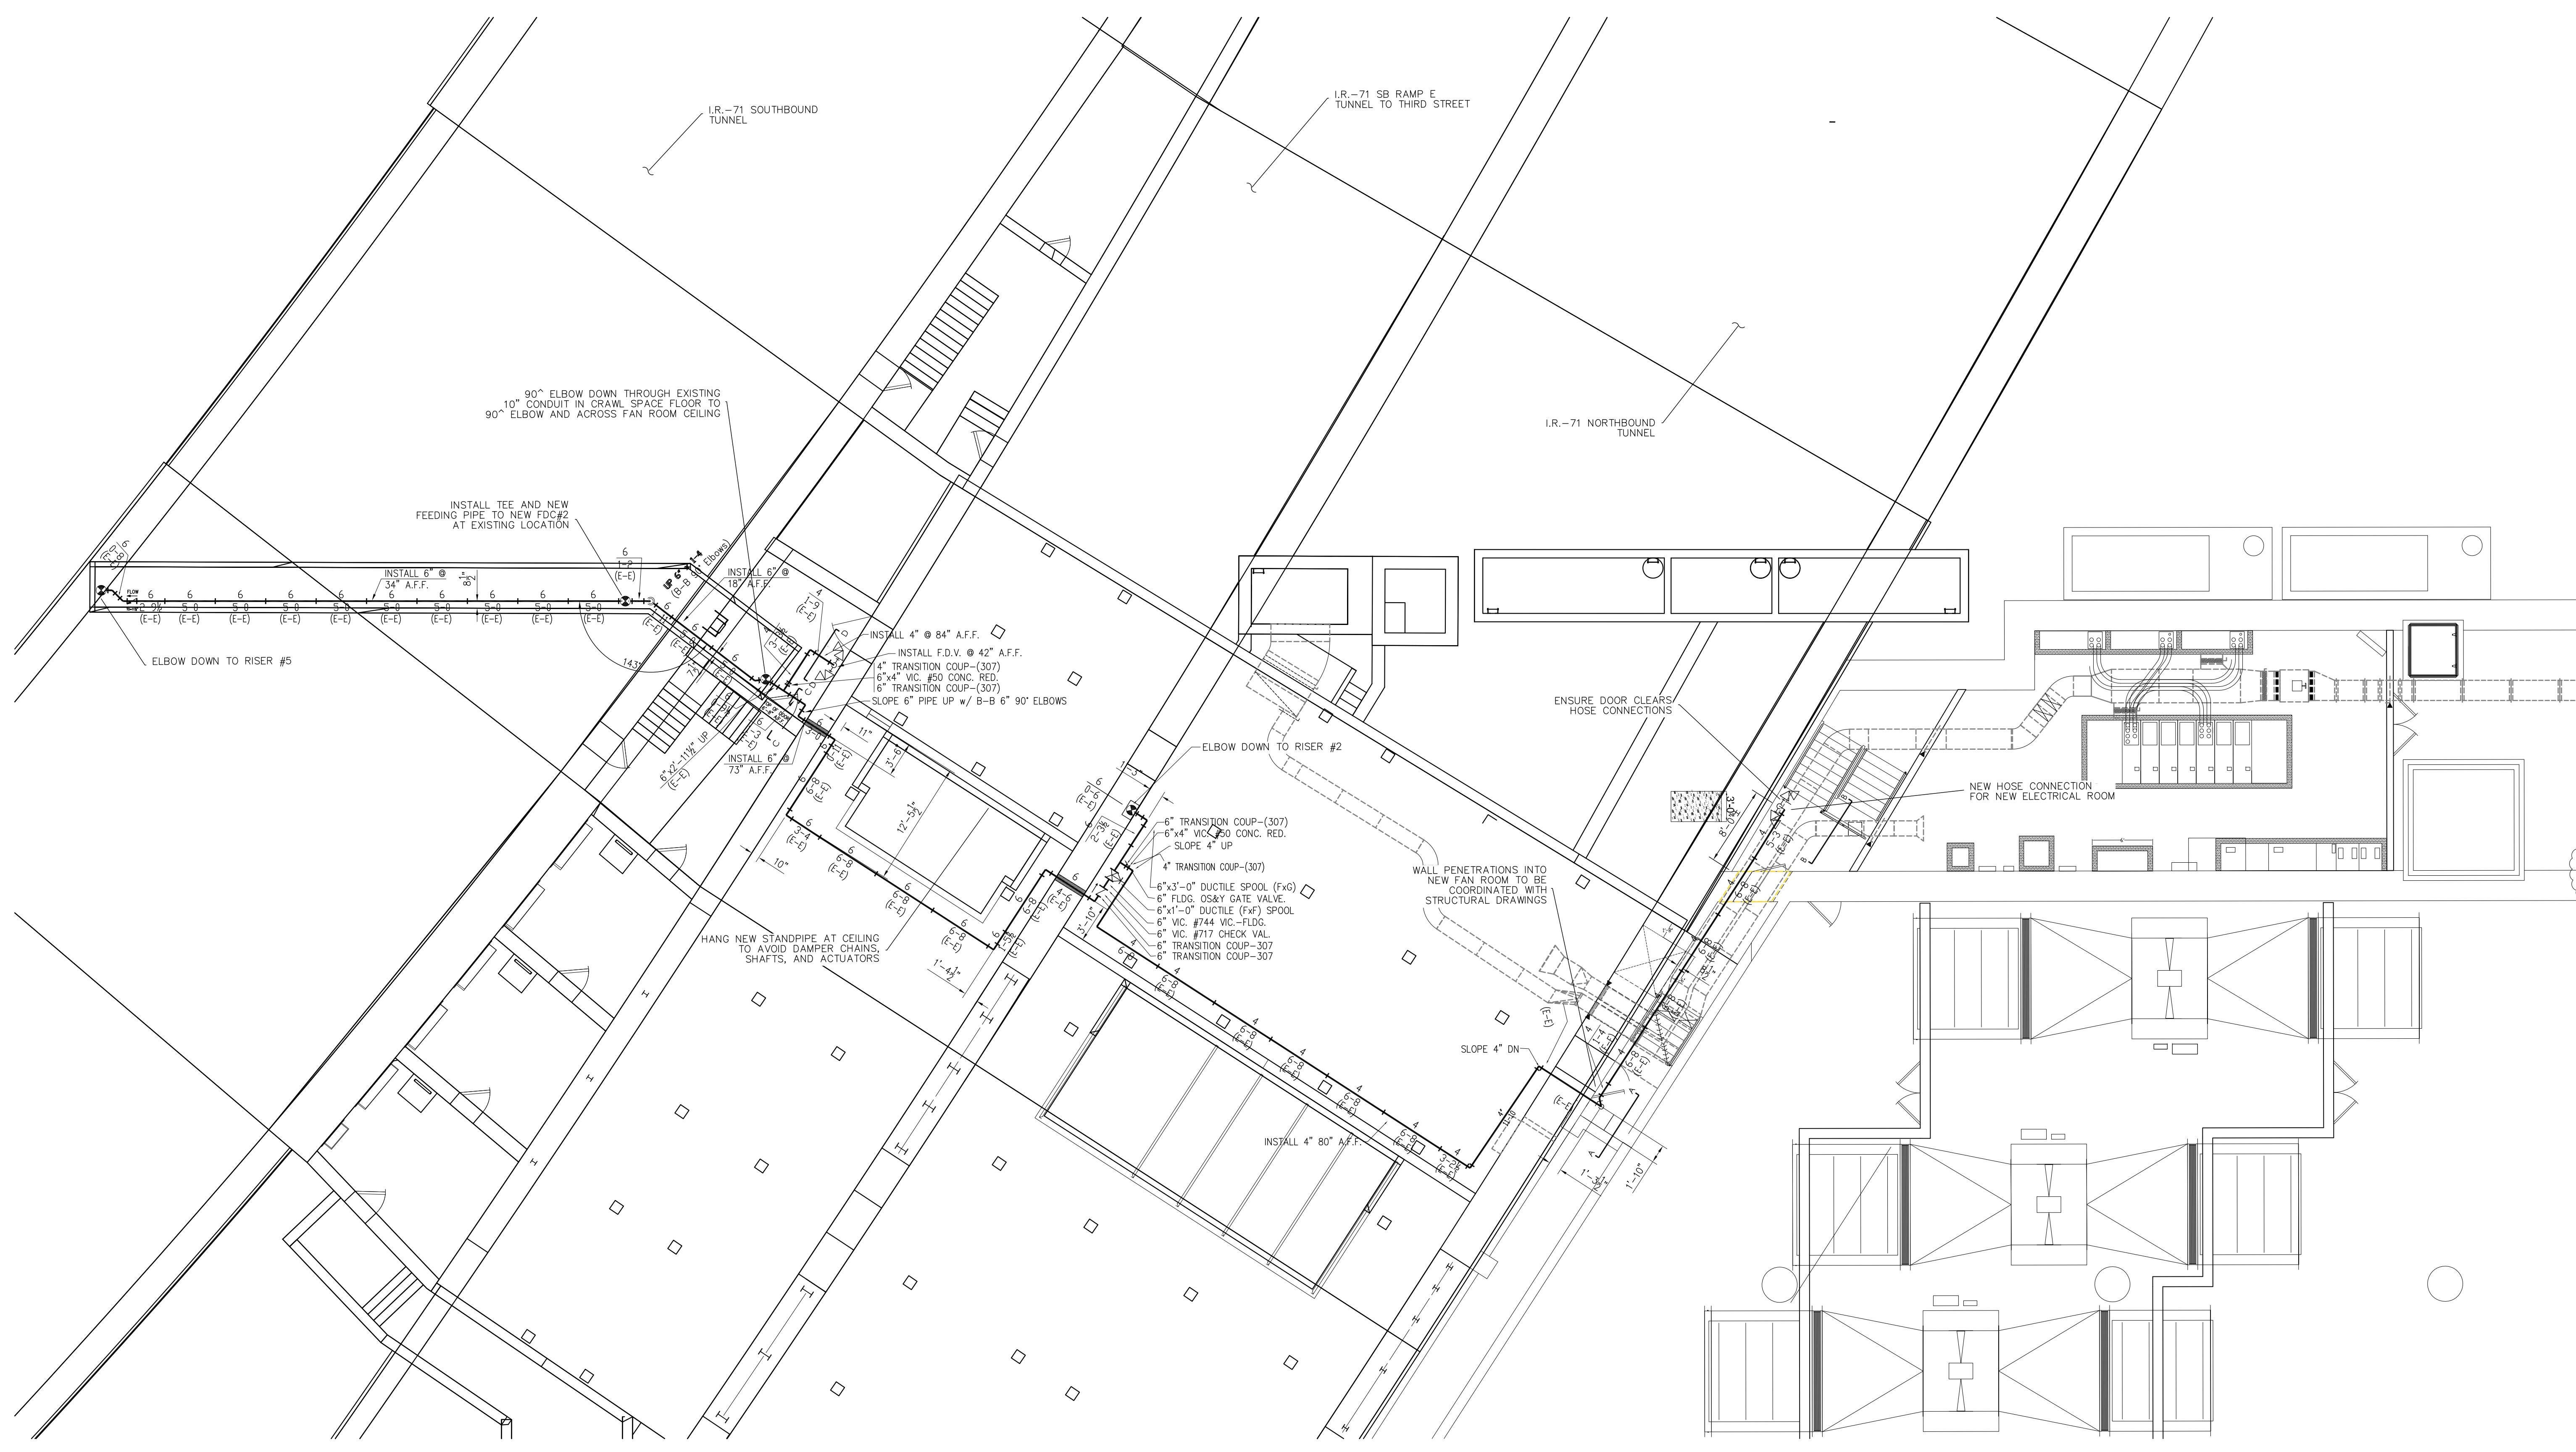


NEW WORK PLAN - FAN ROOM DRY STANDPIPE
 SCALE: 1/8" = 1'-0"

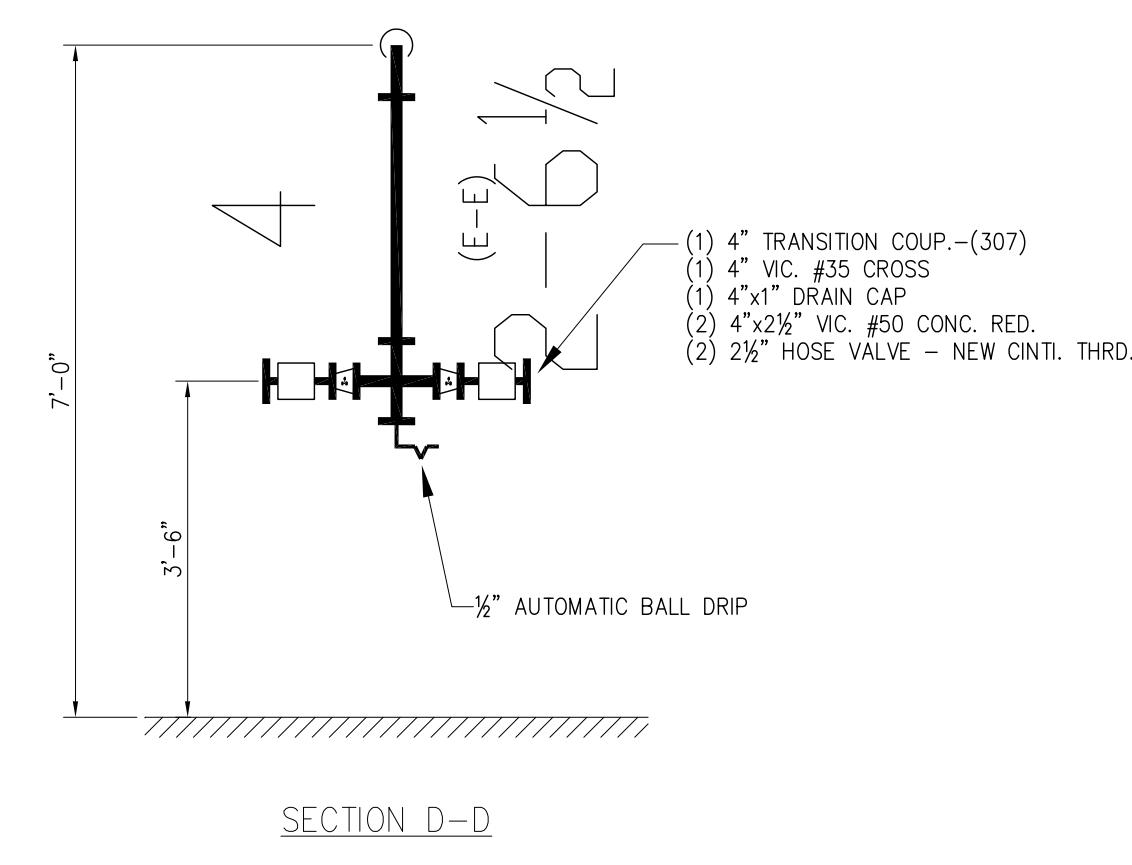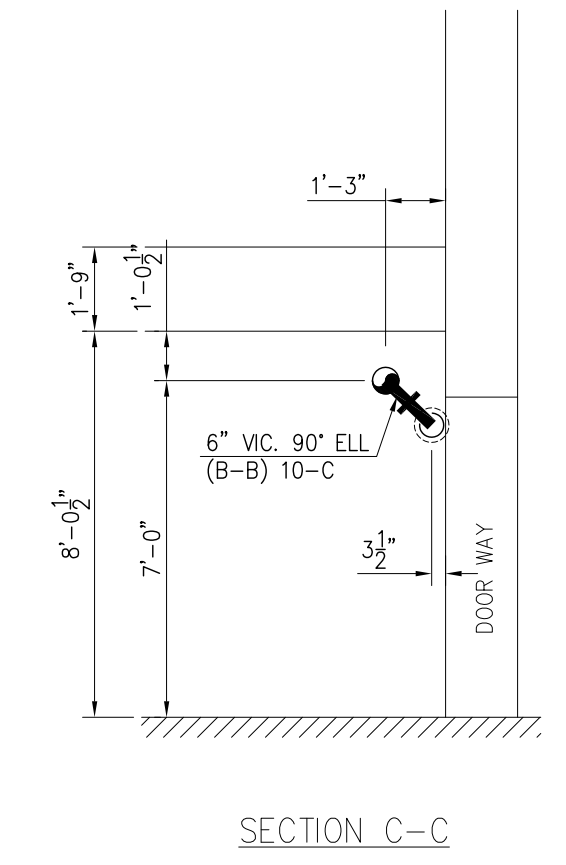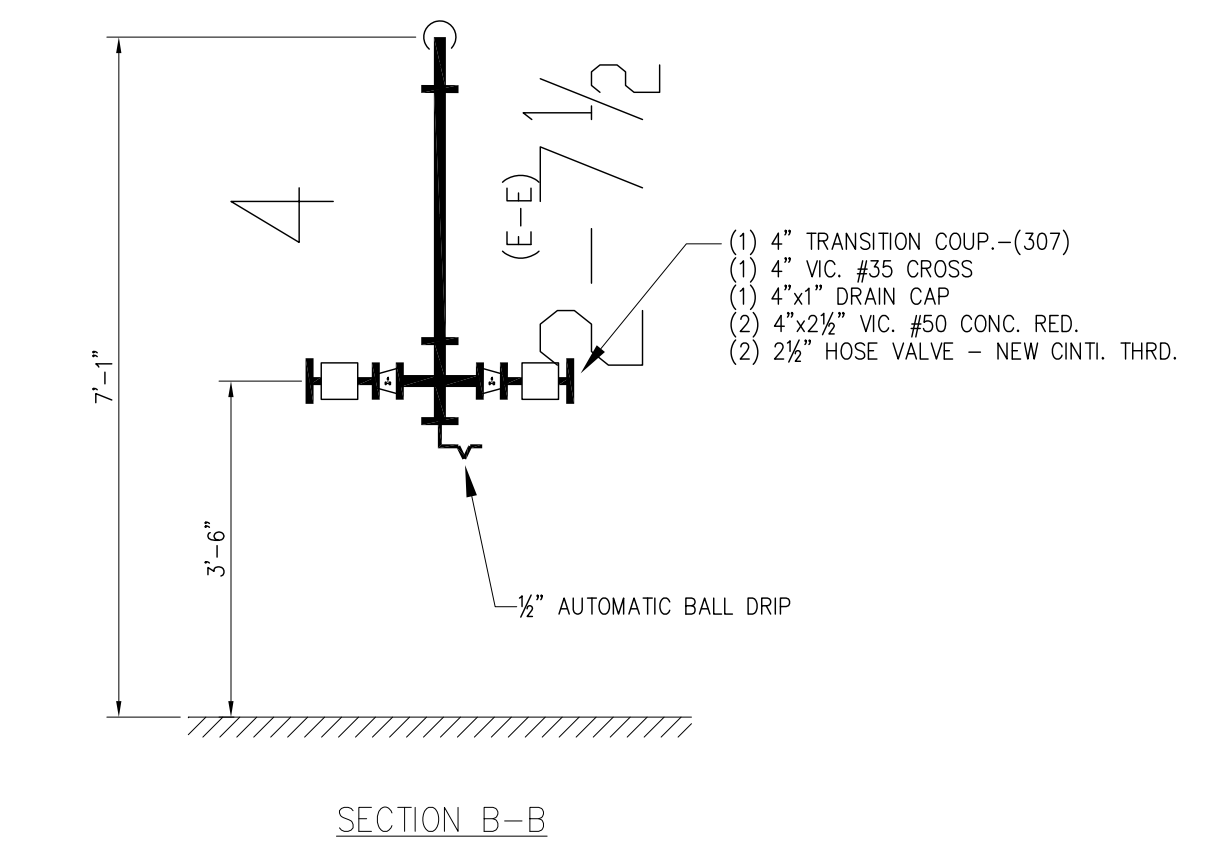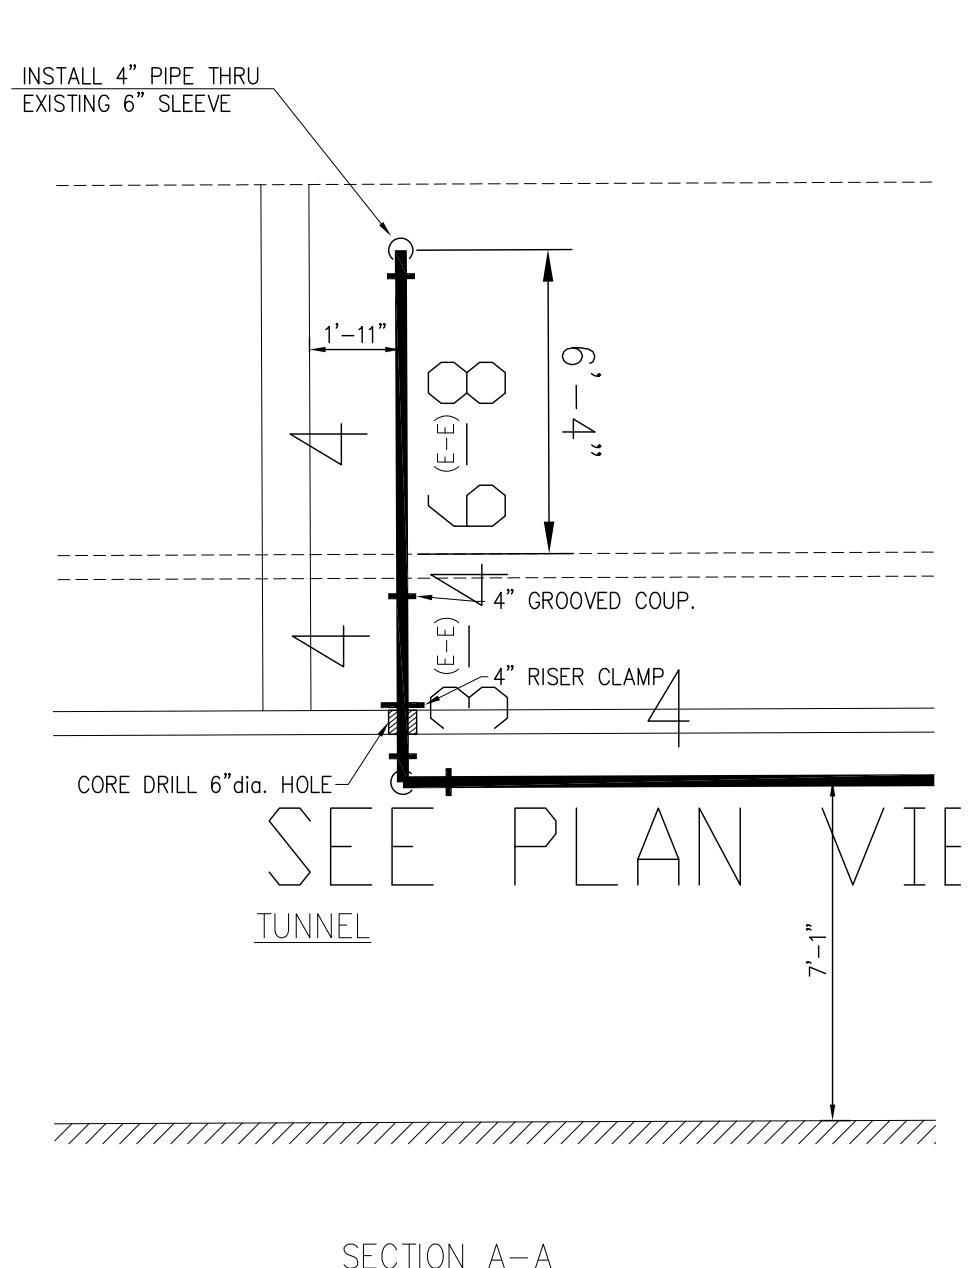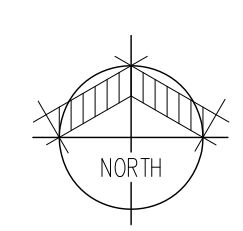


AS-BUILT
06-15-17

STATE OF OHIO CERTIFIED
 COMPANY: DALMATIAN FIRE, INC. #53-83-1006
 DESIGNER: ROBERT TANSY #3073

LYTLE TUNNEL 1-71 CINCINNATI	DRY STANDPIPE FAN ROOM DETAIL FABRICATION PLAN	DATE: 9.28.2016	DRAWN BY: C. BARRETT	FILE NAME:	DATE
	SCALE: NONE	CHECKED BY: R. TANSY	CONTRACT No.: 2585*	CONTRACT WITH: LAKE ERIE CONSTRUCTION	SIGNATURE
OHIO DALMATIAN FIRE, INC. 4700 DUKE BLVD., SUITE 100 WASSON, OHIO 45040 (513) 388-4500 FAX (513) 398-2880	TRADE: SPRINKLER PIPING	COMPANY NAME: DALMATIAN FIRE, INC.	TRADE: ELECTRICAL HVAC	COMPANY NAME: DALMATIAN FIRE, INC.	SIGNATURE
	QTY DESIGN DATA: OCCUPANCY: SO. FT. GPM / HOSE ALLOWANCE: GPM	SPRINKLERS	DESIGNER: ROBERT TANSY #3073	DESIGNER: ROBERT TANSY #3073	DESIGNER: ROBERT TANSY #3073
0	TOTAL SPRINKLERS THIS SHEET	DATE: 9.28.2016	DATE: 9.28.2016	DATE: 9.28.2016	DATE

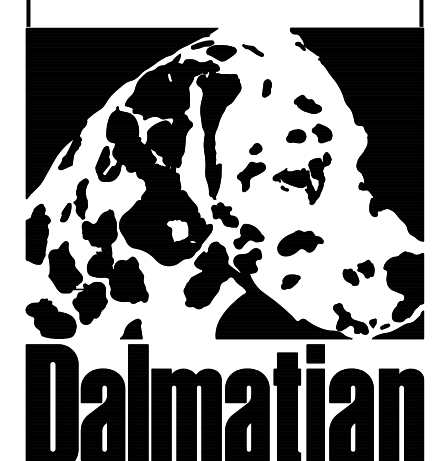


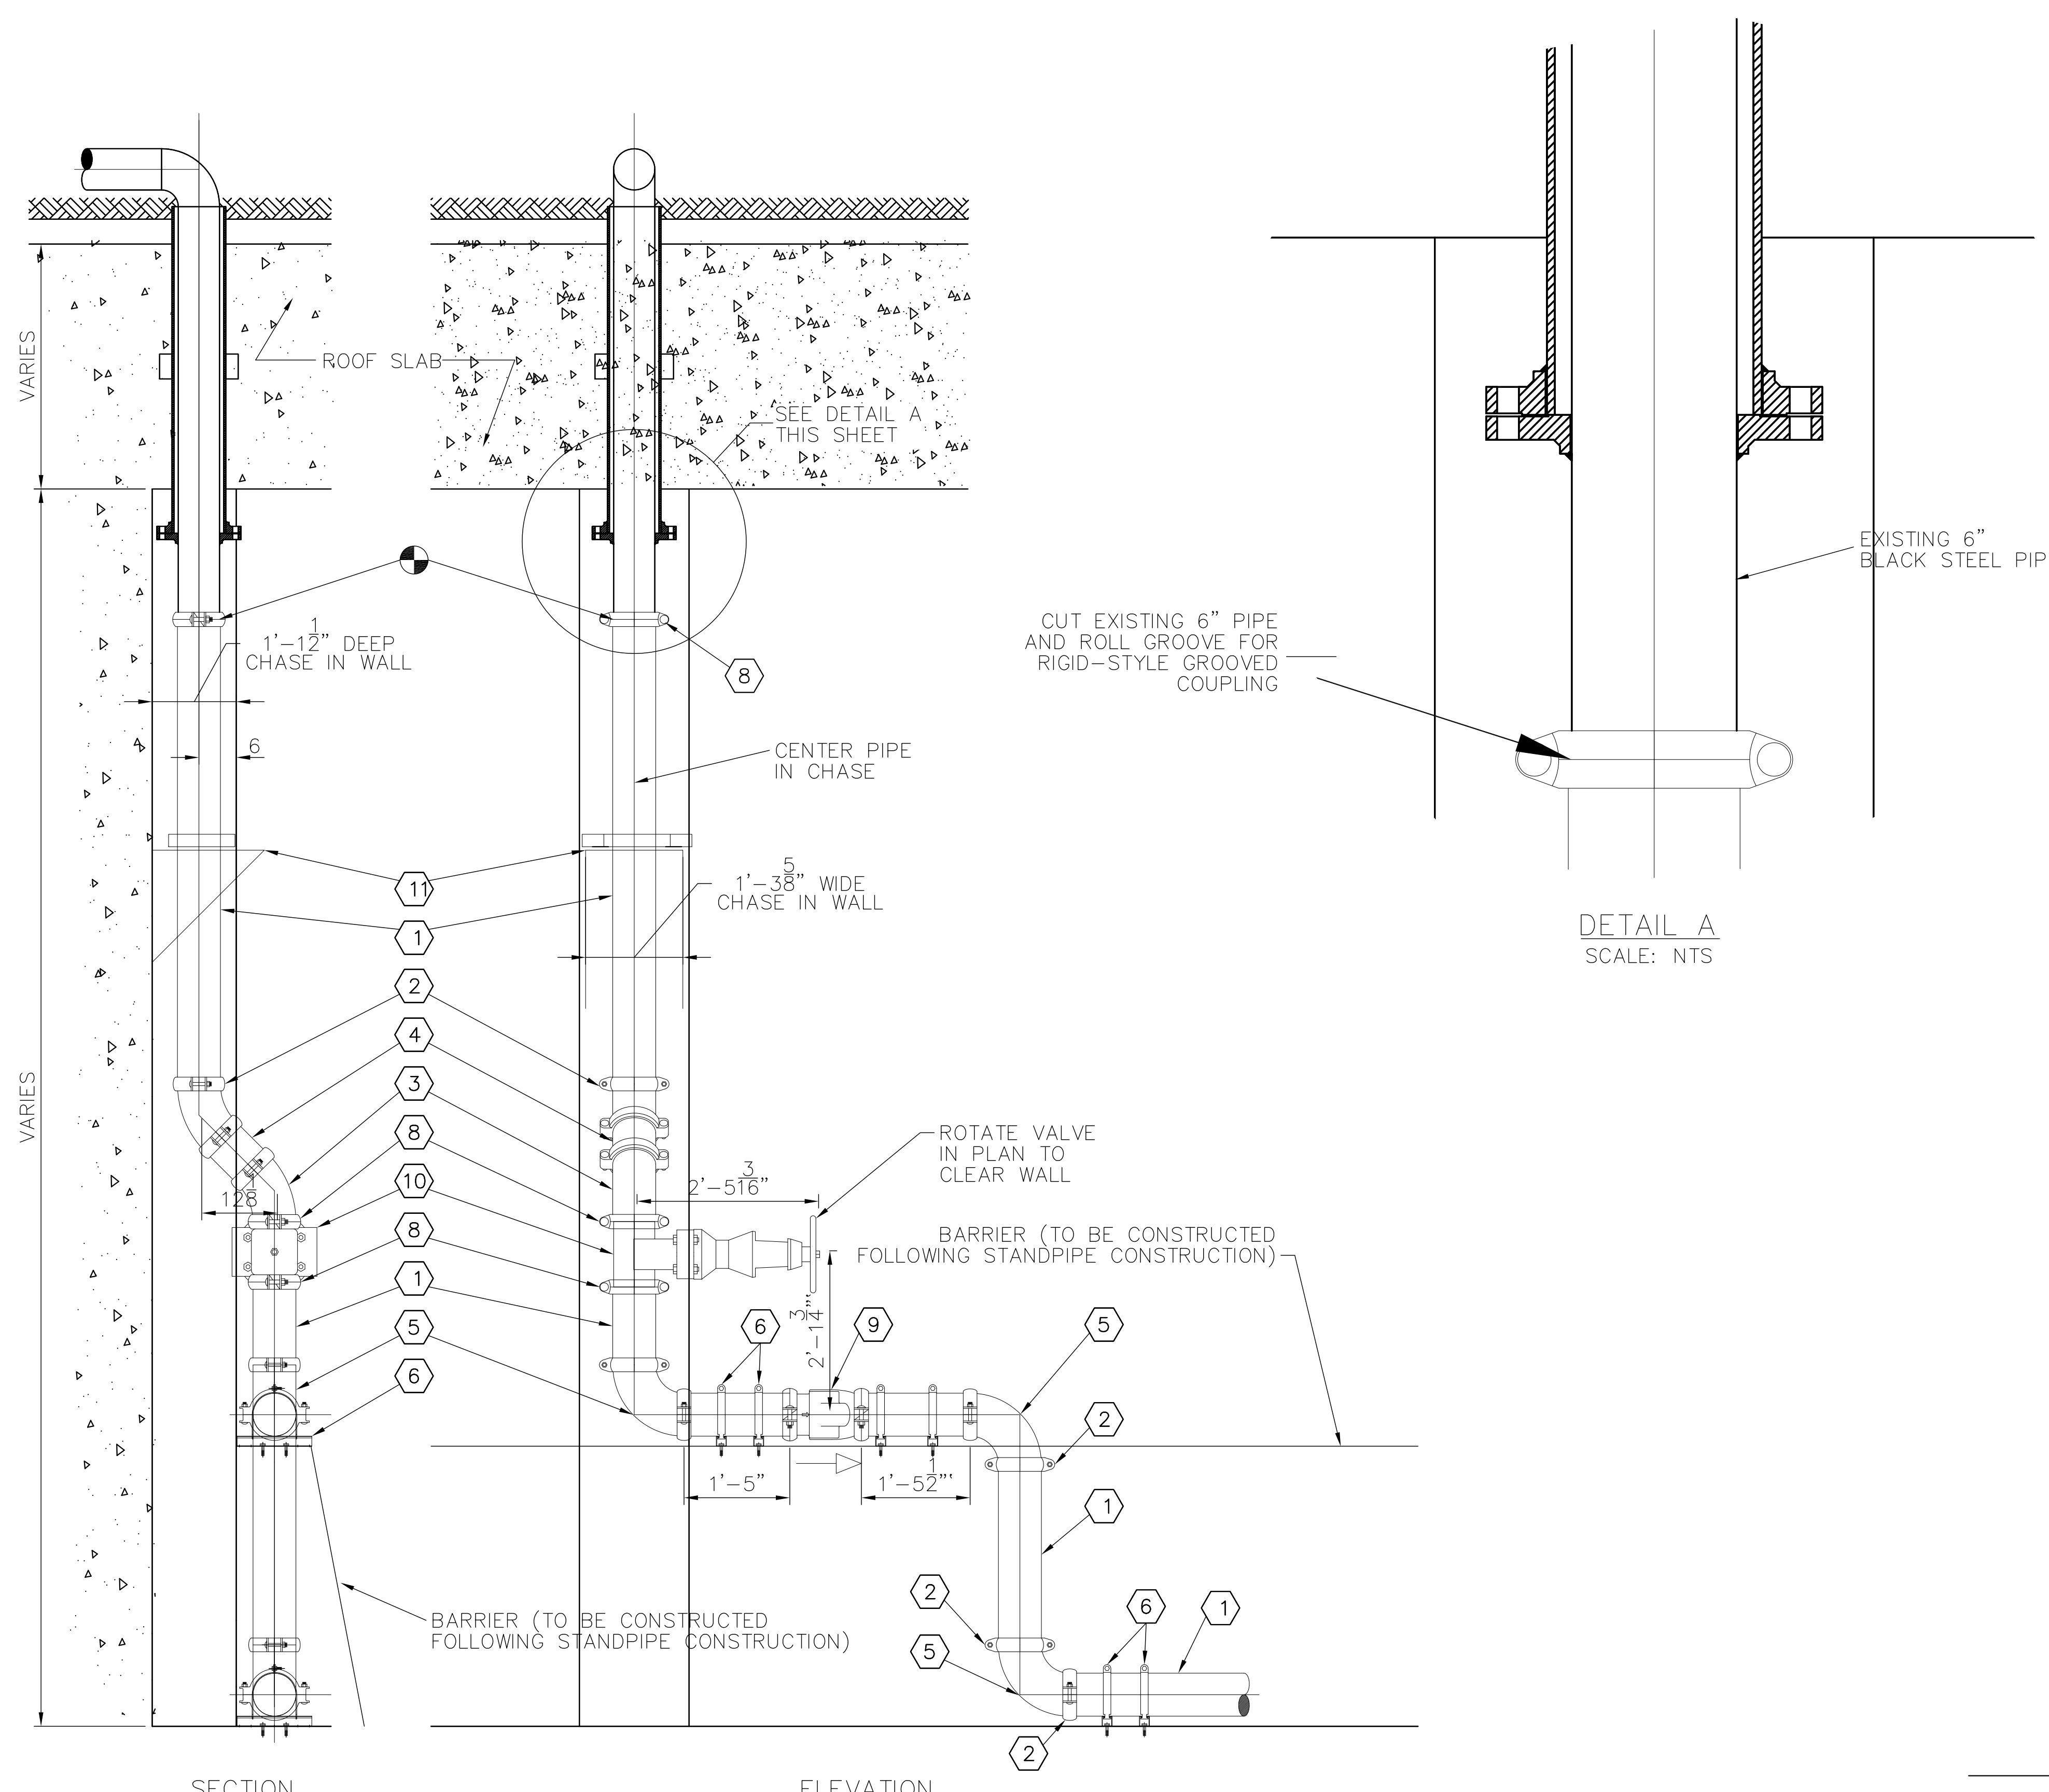


END RISER (RISERS #1, 3) (#4, 6 OPPOSITE HAND)
SCALE: NTS

- KEYNOTE LEGEND:**
- ① NEW 6" AWWA D.I. PIPE WITH GROOVED ENDS
 - ② NEW 6" AWWA D.I. GROOVED COUPLING
 - ③ NEW 6" AWWA D.I. GROOVED 45° ELBOW
 - ④ NEW 6" AWWA D.I. GROOVED NIPPLE
 - ⑤ NEW 6" AWWA D.I. GROOVED 90° ELBOW
 - ⑥ NEW 1 1/2" x 1 1/2" 12 GA. STEEL CHANNEL STRUT WITH 10 GA. STEEL PIPE STRAP FOR 6 3/4" O.D. TUBING AND ANCHOR BOLTS TO FLOOR
 - ⑧ NEW 6" AWWA D.I. TO 6" NPS GROOVED TRANSITION COUPLING
 - ⑨ NEW 6" UL/FM CHECK VALVE
 - ⑩ NEW 6" UL/FM OS&Y VALVE
 - ⑪ NEW BRACKET TO SUPPORT RISER CLAMP, WITH RISER CLAMP


DETAIL A
SCALE: NTS

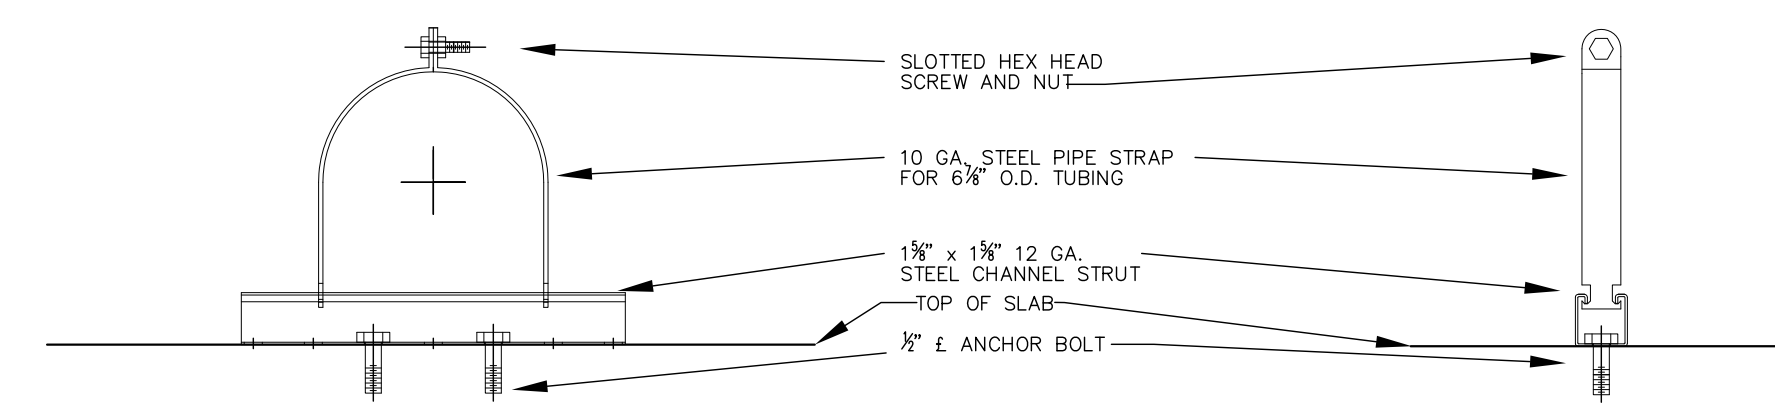

PIPE SUPPORT
SCALE: NTS

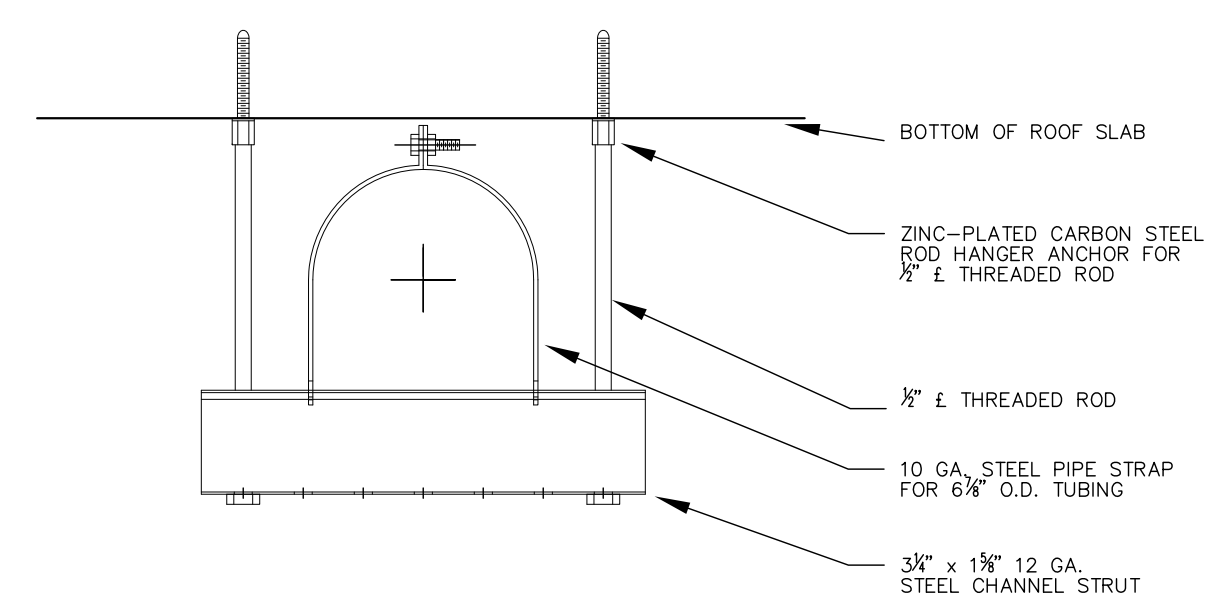


PIPE STRAP HANGER DETAIL
SCALE: NTS

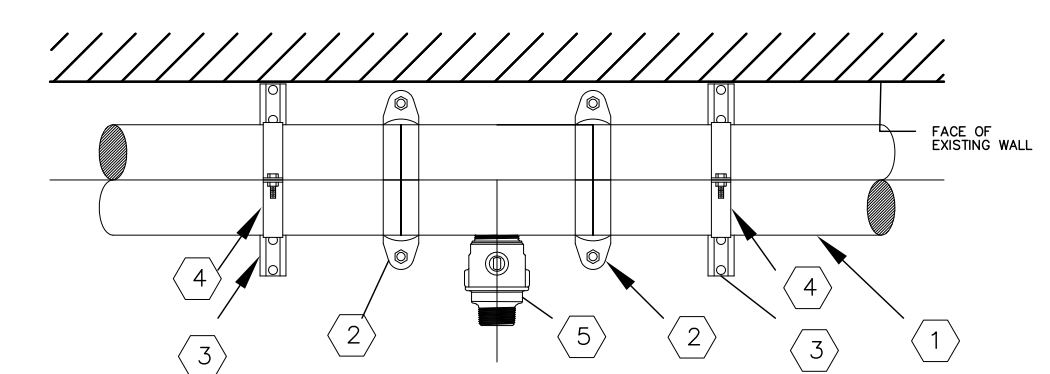


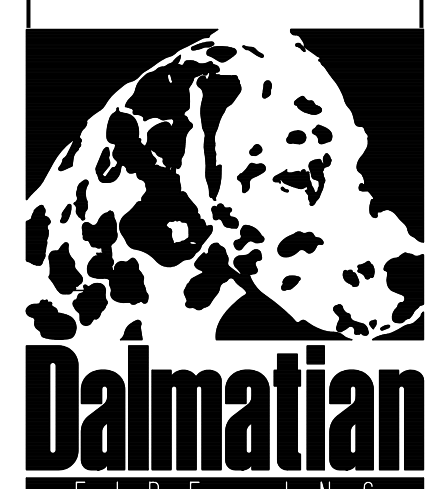
SECTION



- KEYNOTE LEGEND:**
- ① NEW 6" AWWA D.I. PIPE WITH GROOVED ENDS
 - ② NEW 6" AWWA D.I. GROOVED COUPLING
 - ③ NEW 1 1/2" x 1 1/2" 12 GA. STEEL CHANNEL STRUT
 - ④ NEW 10 GA. STEEL PIPE STRAP FOR 6 3/4" O.D. TUBING
 - ⑤ NEW 2" STANDARD AWWA CORPORATION STOP INLET THREAD, 2" MALE NPT OUTLET BALL CORPORATION STOP TAPPED INTO D.I. PIPE

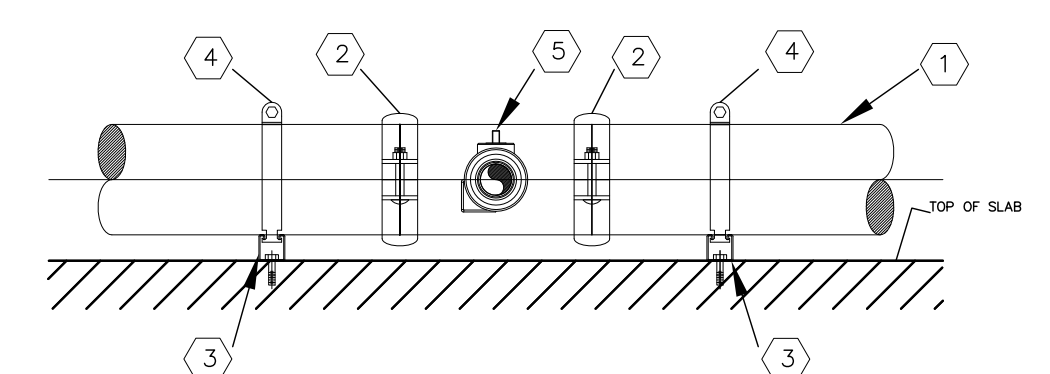

ELEVATION
SCALE: NTS

DRY STANDPIPE DETAIL

DATE	
SIGNATURE	
COMPANY NAME	DALMATIAN FIRE, INC.
TRADE	SPRINKLER PIPING / ELECTRICAL / HVAC
DESIGN DATA	OCCUPANCY: / SO. FT. / GPM / HOSE ALLOWANCE: / FLOW TEST: PSI STATIC / PSI RESIDUAL / GPM FLOWING
QTY	0
SPRINKLERS	TOTAL SPRINKLERS THIS SHEET
TITLE	DRY STANDPIPE END RISERS
DATE	6.16.2016
DRAWN BY	Z. CRIFE
CHECKED BY	R. TANSY
FILE NAME	
CONTRACT No.	2585*
CONTRACT WITH	
LYTLE TUNNEL	OHIO
CINCINNATI	DALMATIAN FIRE, INC.
	4700 DUKE BLVD., SUITE 180 WASSON, OHIO 45040 (513) 388-4580 FAX (513) 388-2880
SHEET No. 1	F7 OF 9
AS-BUILT 06-15-17	
STATE OF OHIO CERTIFIED COMPANY: DALMATIAN FIRE, INC. #53-83-1006 DESIGNER: ROBERT TANSY #3073  #3073	
	

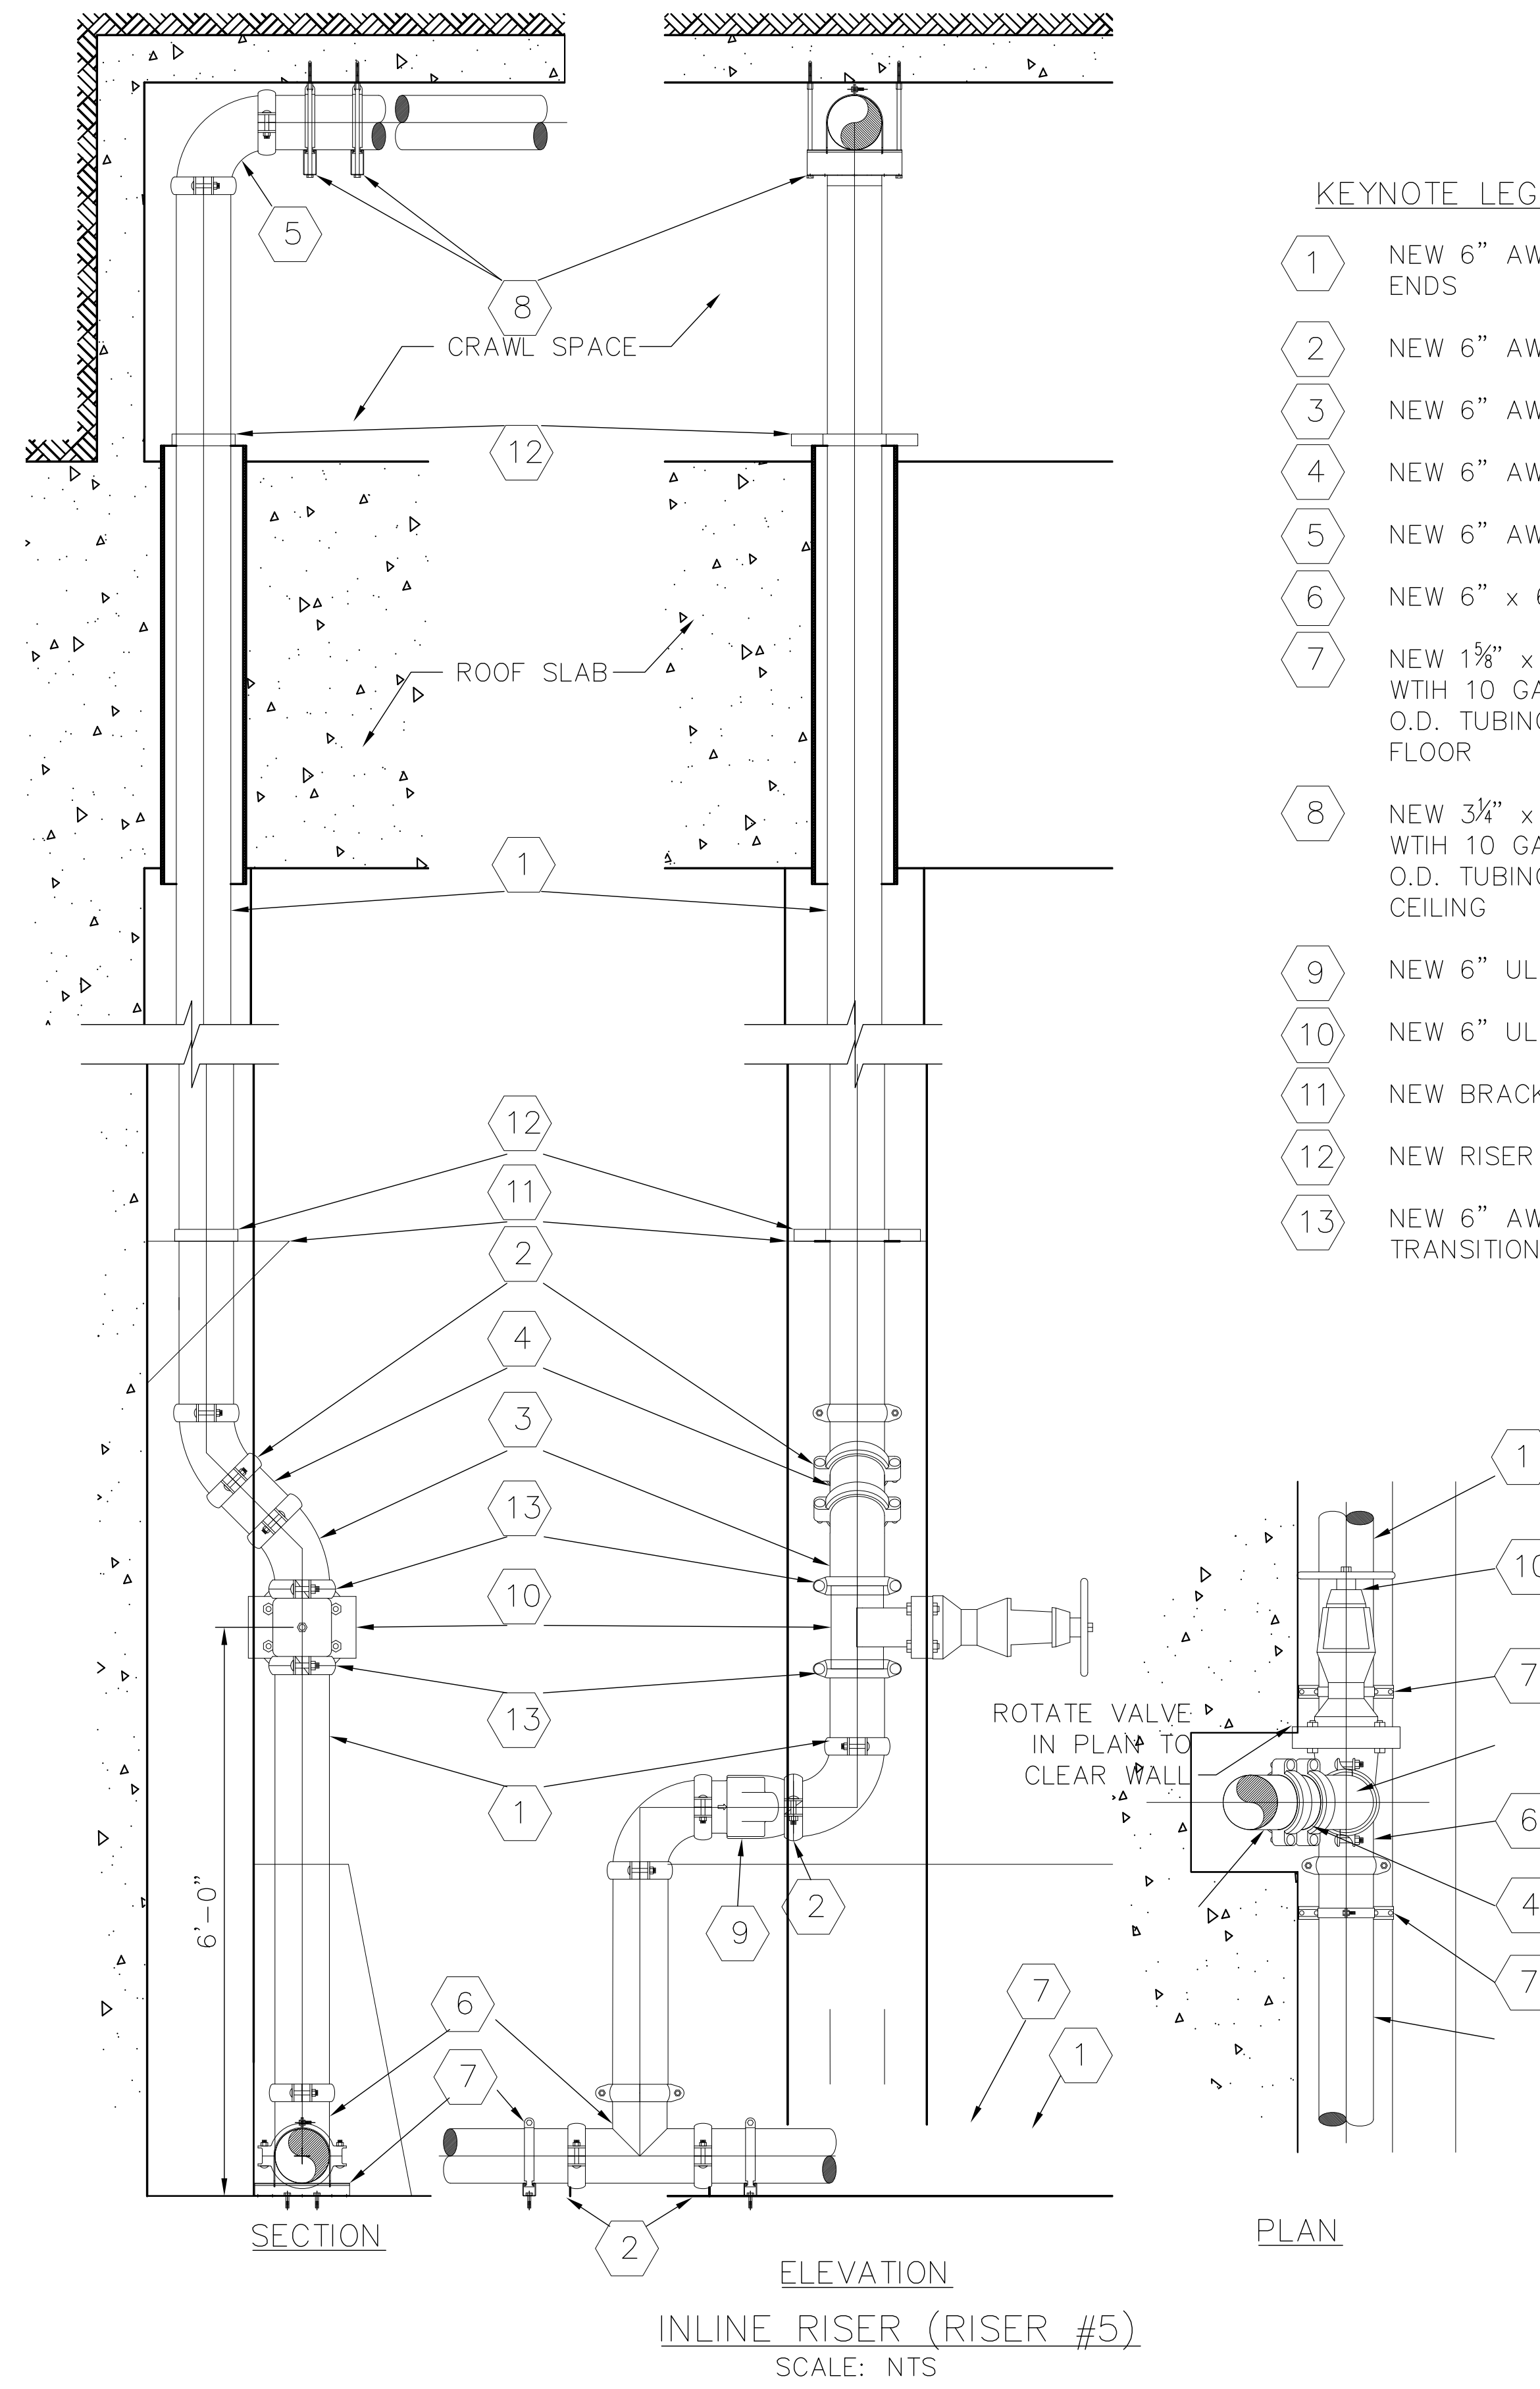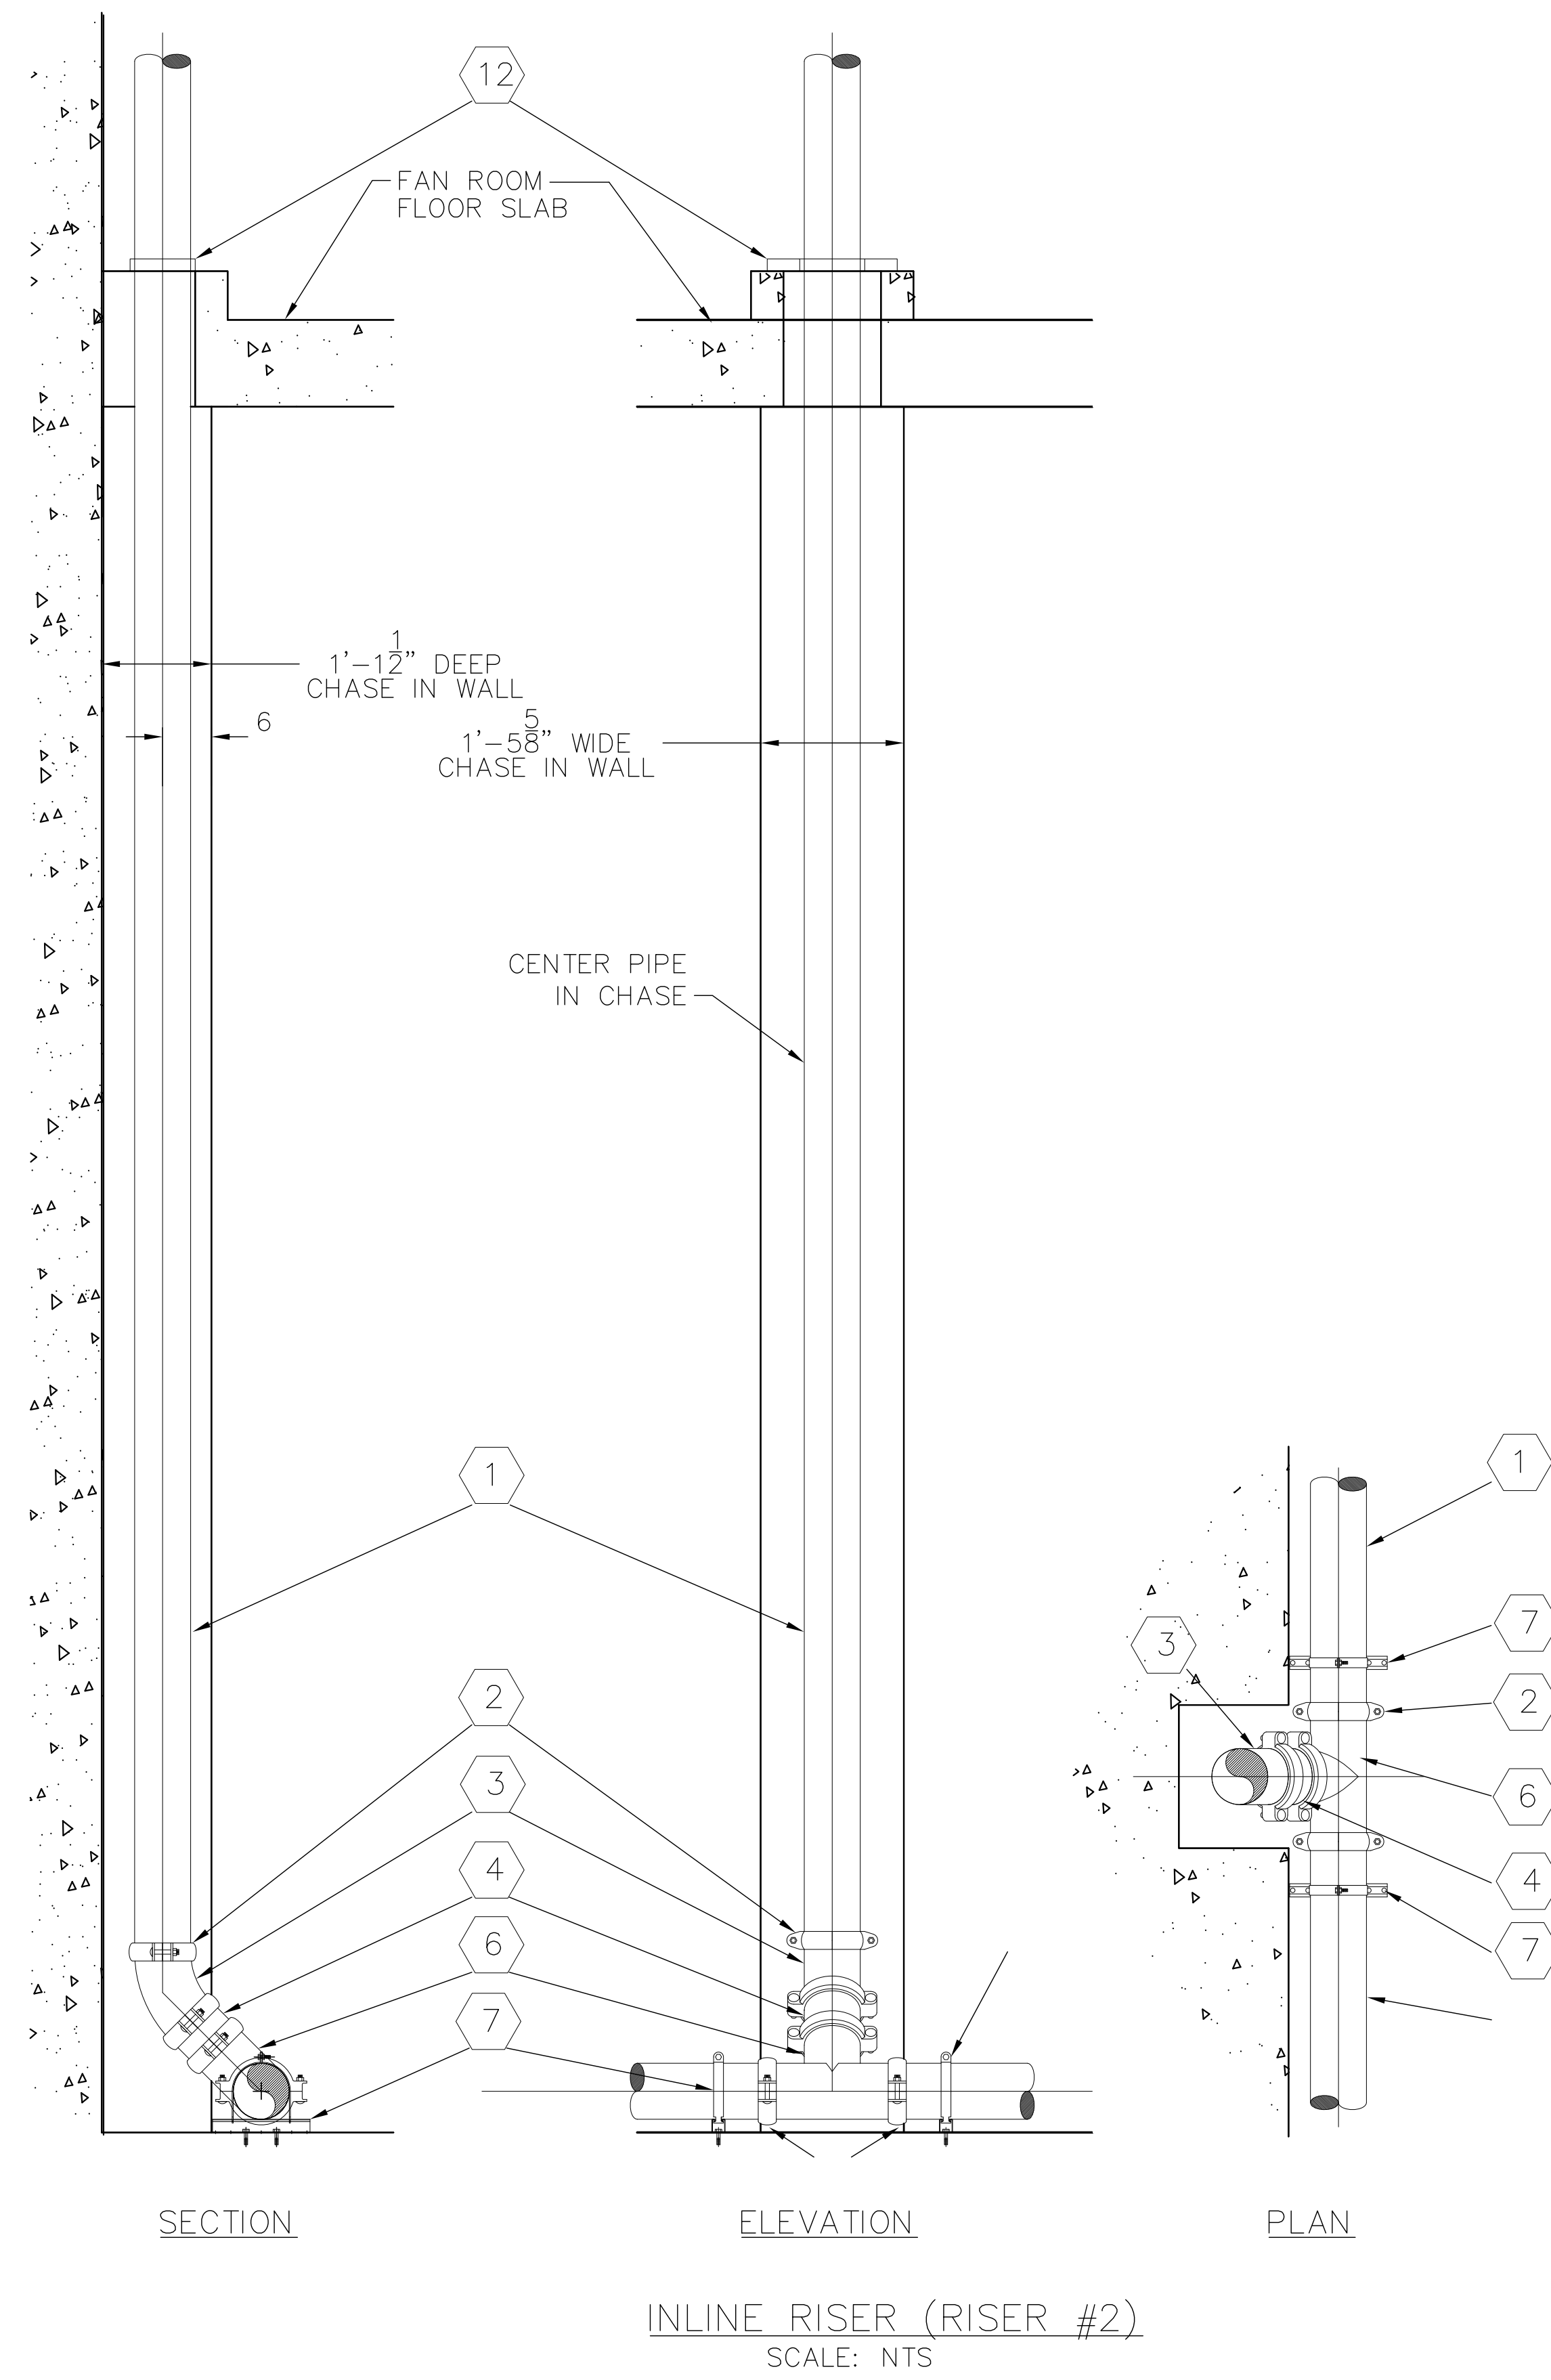

KEYNOTE LEGEND:

- 1 NEW 6" AWWA D.I. PIPE WITH GROOVED ENDS
- 2 NEW 6" AWWA D.I. GROOVED COUPLING
- 3 NEW 6" AWWA D.I. GROOVED 45° ELBOW
- 4 NEW 6" AWWA D.I. GROOVED NIPPLE
- 5 NEW 6" AWWA D.I. GROOVED 90° ELBOW
- 6 NEW 6" x 6" AWWA D.I. GROOVED TEE
- 7 NEW 1 1/2" x 1 1/2" STEEL CHANNEL STRUT WITH 10 GA. STEEL PIPE STRAP FOR 6 1/8" O.D. TUBING AND ANCHOR BOLTS TO FLOOR
- 8 NEW 3/4" x 1 1/2" STEEL CHANNEL STRUT WITH 10 GA. STEEL PIPE STRAP FOR 6 1/8" O.D. TUBING AND ANCHOR RODS TO CEILING
- 9 NEW 6" UL/FM CHECK VALVE
- 10 NEW 6" UL/FM OS&Y VALVE
- 11 NEW BRACKET TO SUPPORT RISER CLAMP
- 12 NEW RISER CLAMP
- 13 NEW 6" AWWA D.I. TO 6" NPS GROOVED TRANSITION COUPLING

SPRINKLERS		DESIGN DATA		COMPANY NAME		SIGNATURE		DATE	
QTY	0	OCCUPANCY:		TRADE	DALMATIAN FIRE, INC.				
		DENSITY:	GPM / SQ. FT.	SPRINKLER					
		HOSE ALLOWANCE:	GPM	PIPING					
				PLUMBING					
				ELECTRICAL					
				HVAC					
		FLOW TEST:	PSI STATIC						
			PSI RESIDUAL						
			GPM FLOWING						
TOTAL SPRINKLERS THIS SHEET									

TITLE:	DRY STANDPIPE DETAILS INLINE RISER DETAIL
DATE:	6.16.2016
CHECKED BY:	R. TANSY
CONTRACT No.:	2585*
CONTRACT WITH:	
DRAWN BY:	Z. CRIFE
FILE NAME:	


LYTLE TUNNEL
CINCINNATI
OHIO
DALMATIAN FIRE, INC.
4700 DUKE BLVD., SUITE 160
WASSON, OHIO 45040
(513) 388-4580 FAX (513) 388-2880

SHEET No. 1
FP8 OF 9


AS-BUILT
06-15-17

STATE OF OHIO CERTIFIED
COMPANY: DALMATIAN FIRE, INC. #53-83-1006
DESIGNER: ROBERT TANSY #3073

#3073

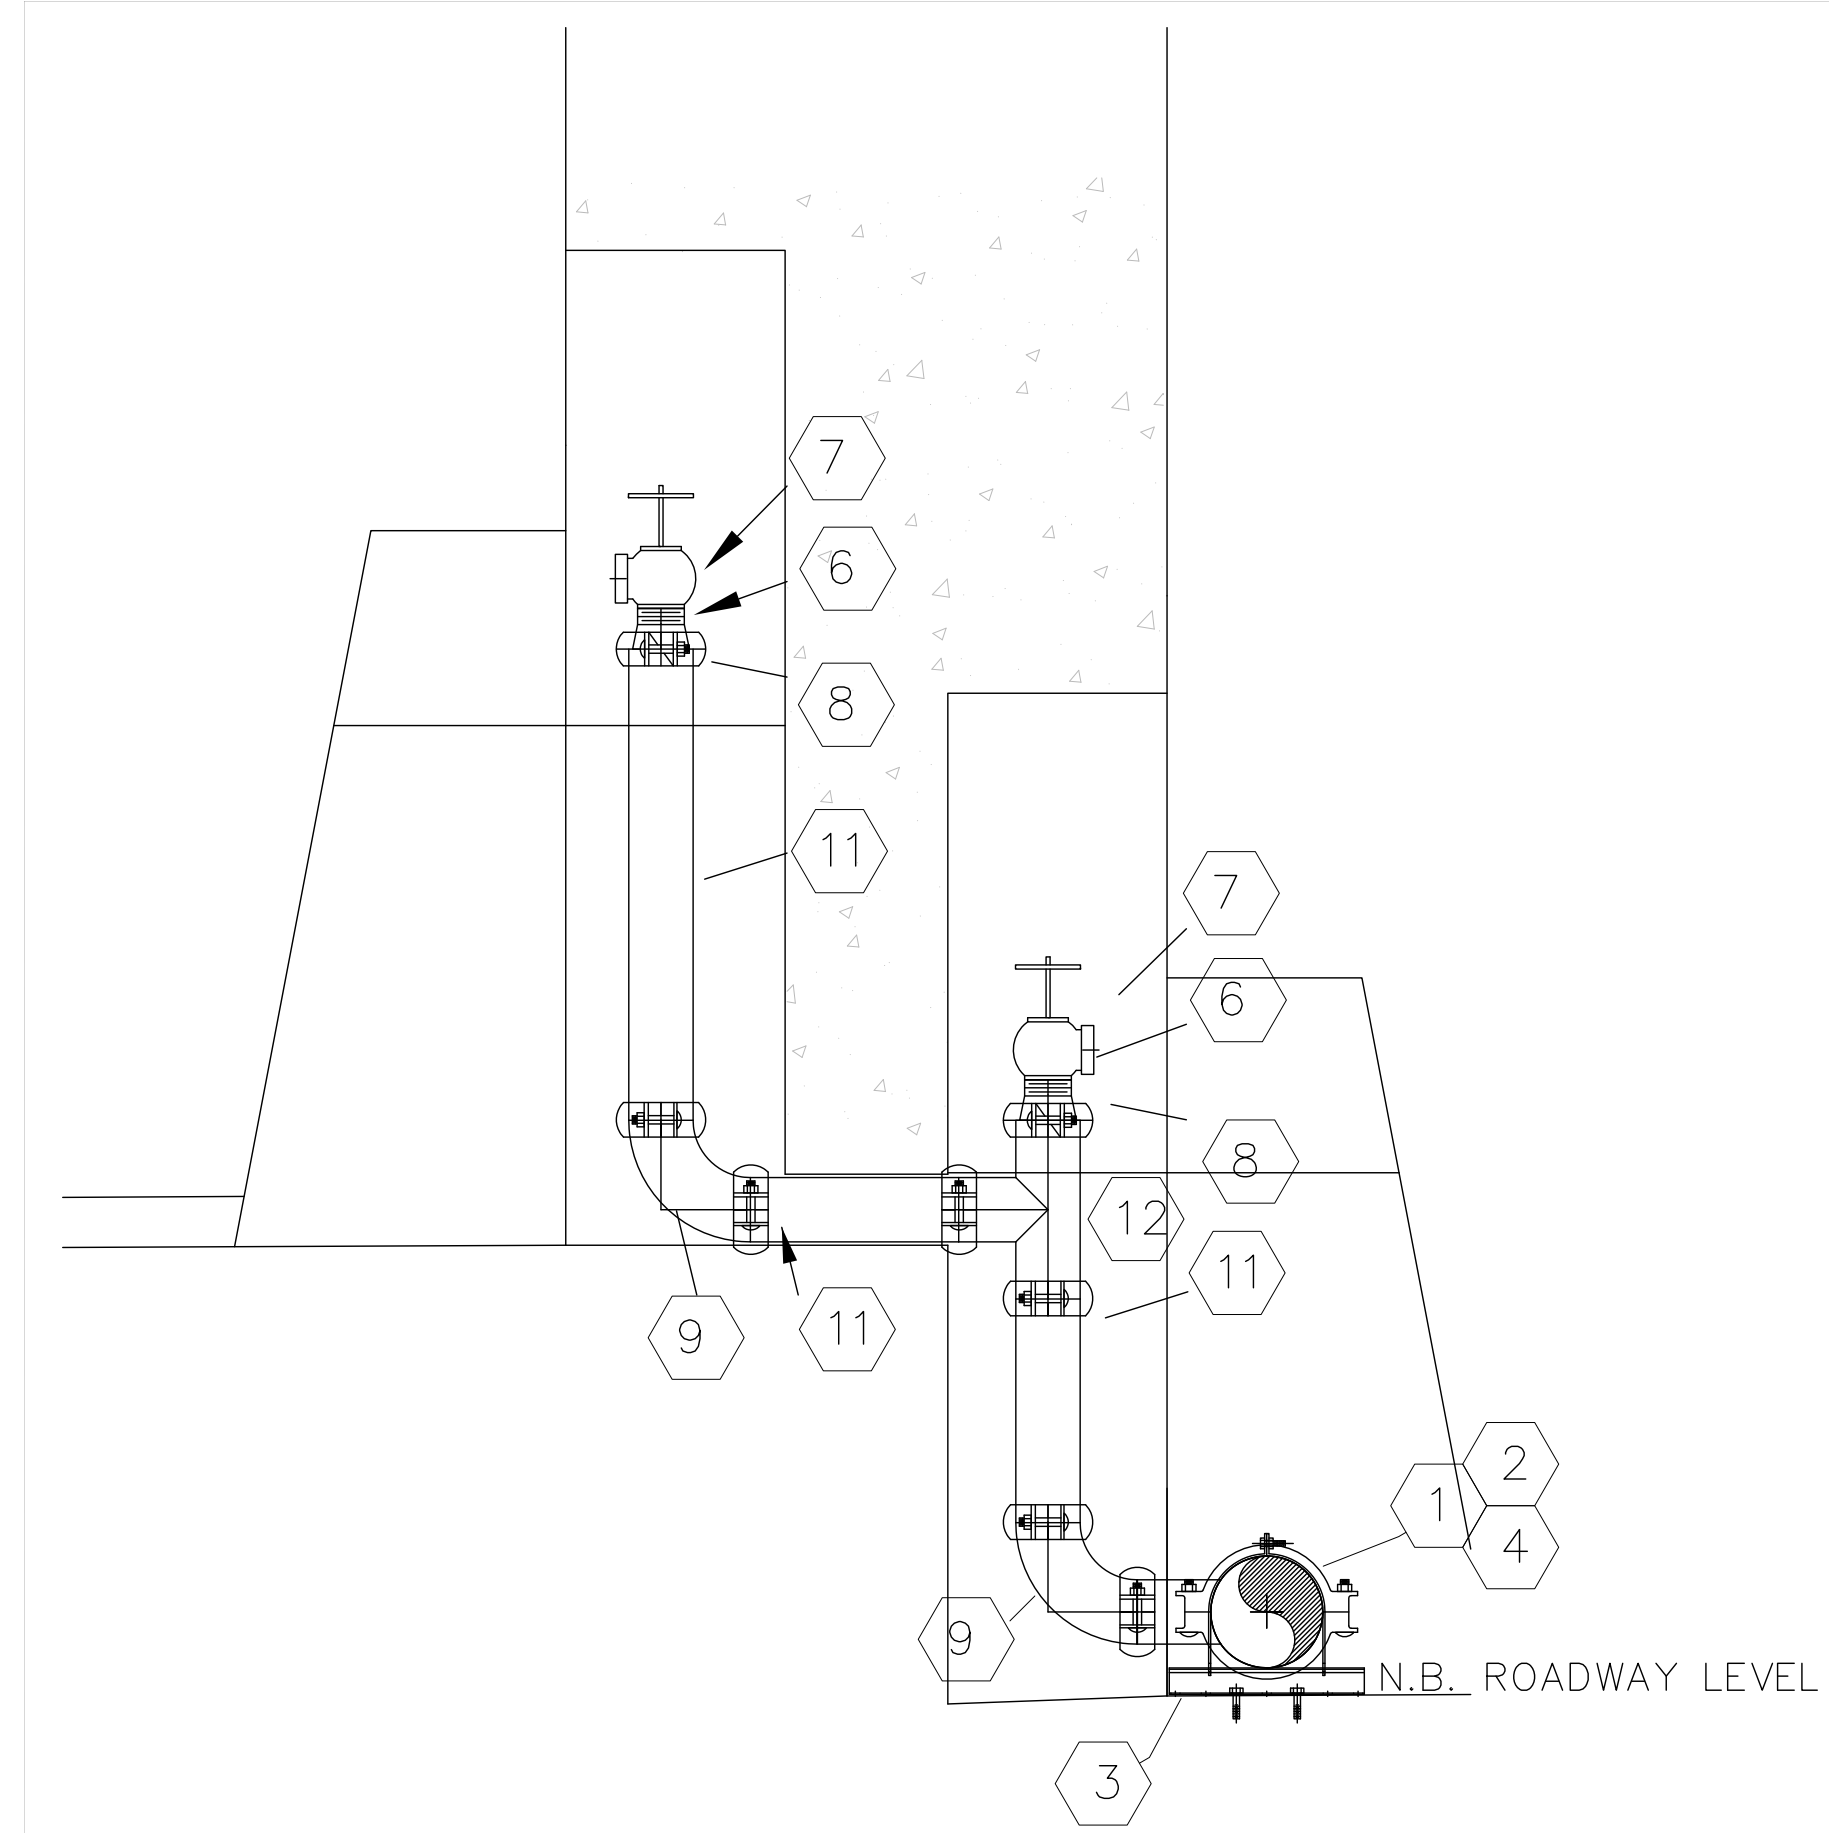


TYPICAL HOSE CONNECTION (NORTHBOUND/RAMP E)
EXCEPT HC9/HC18
SCALE: NTS

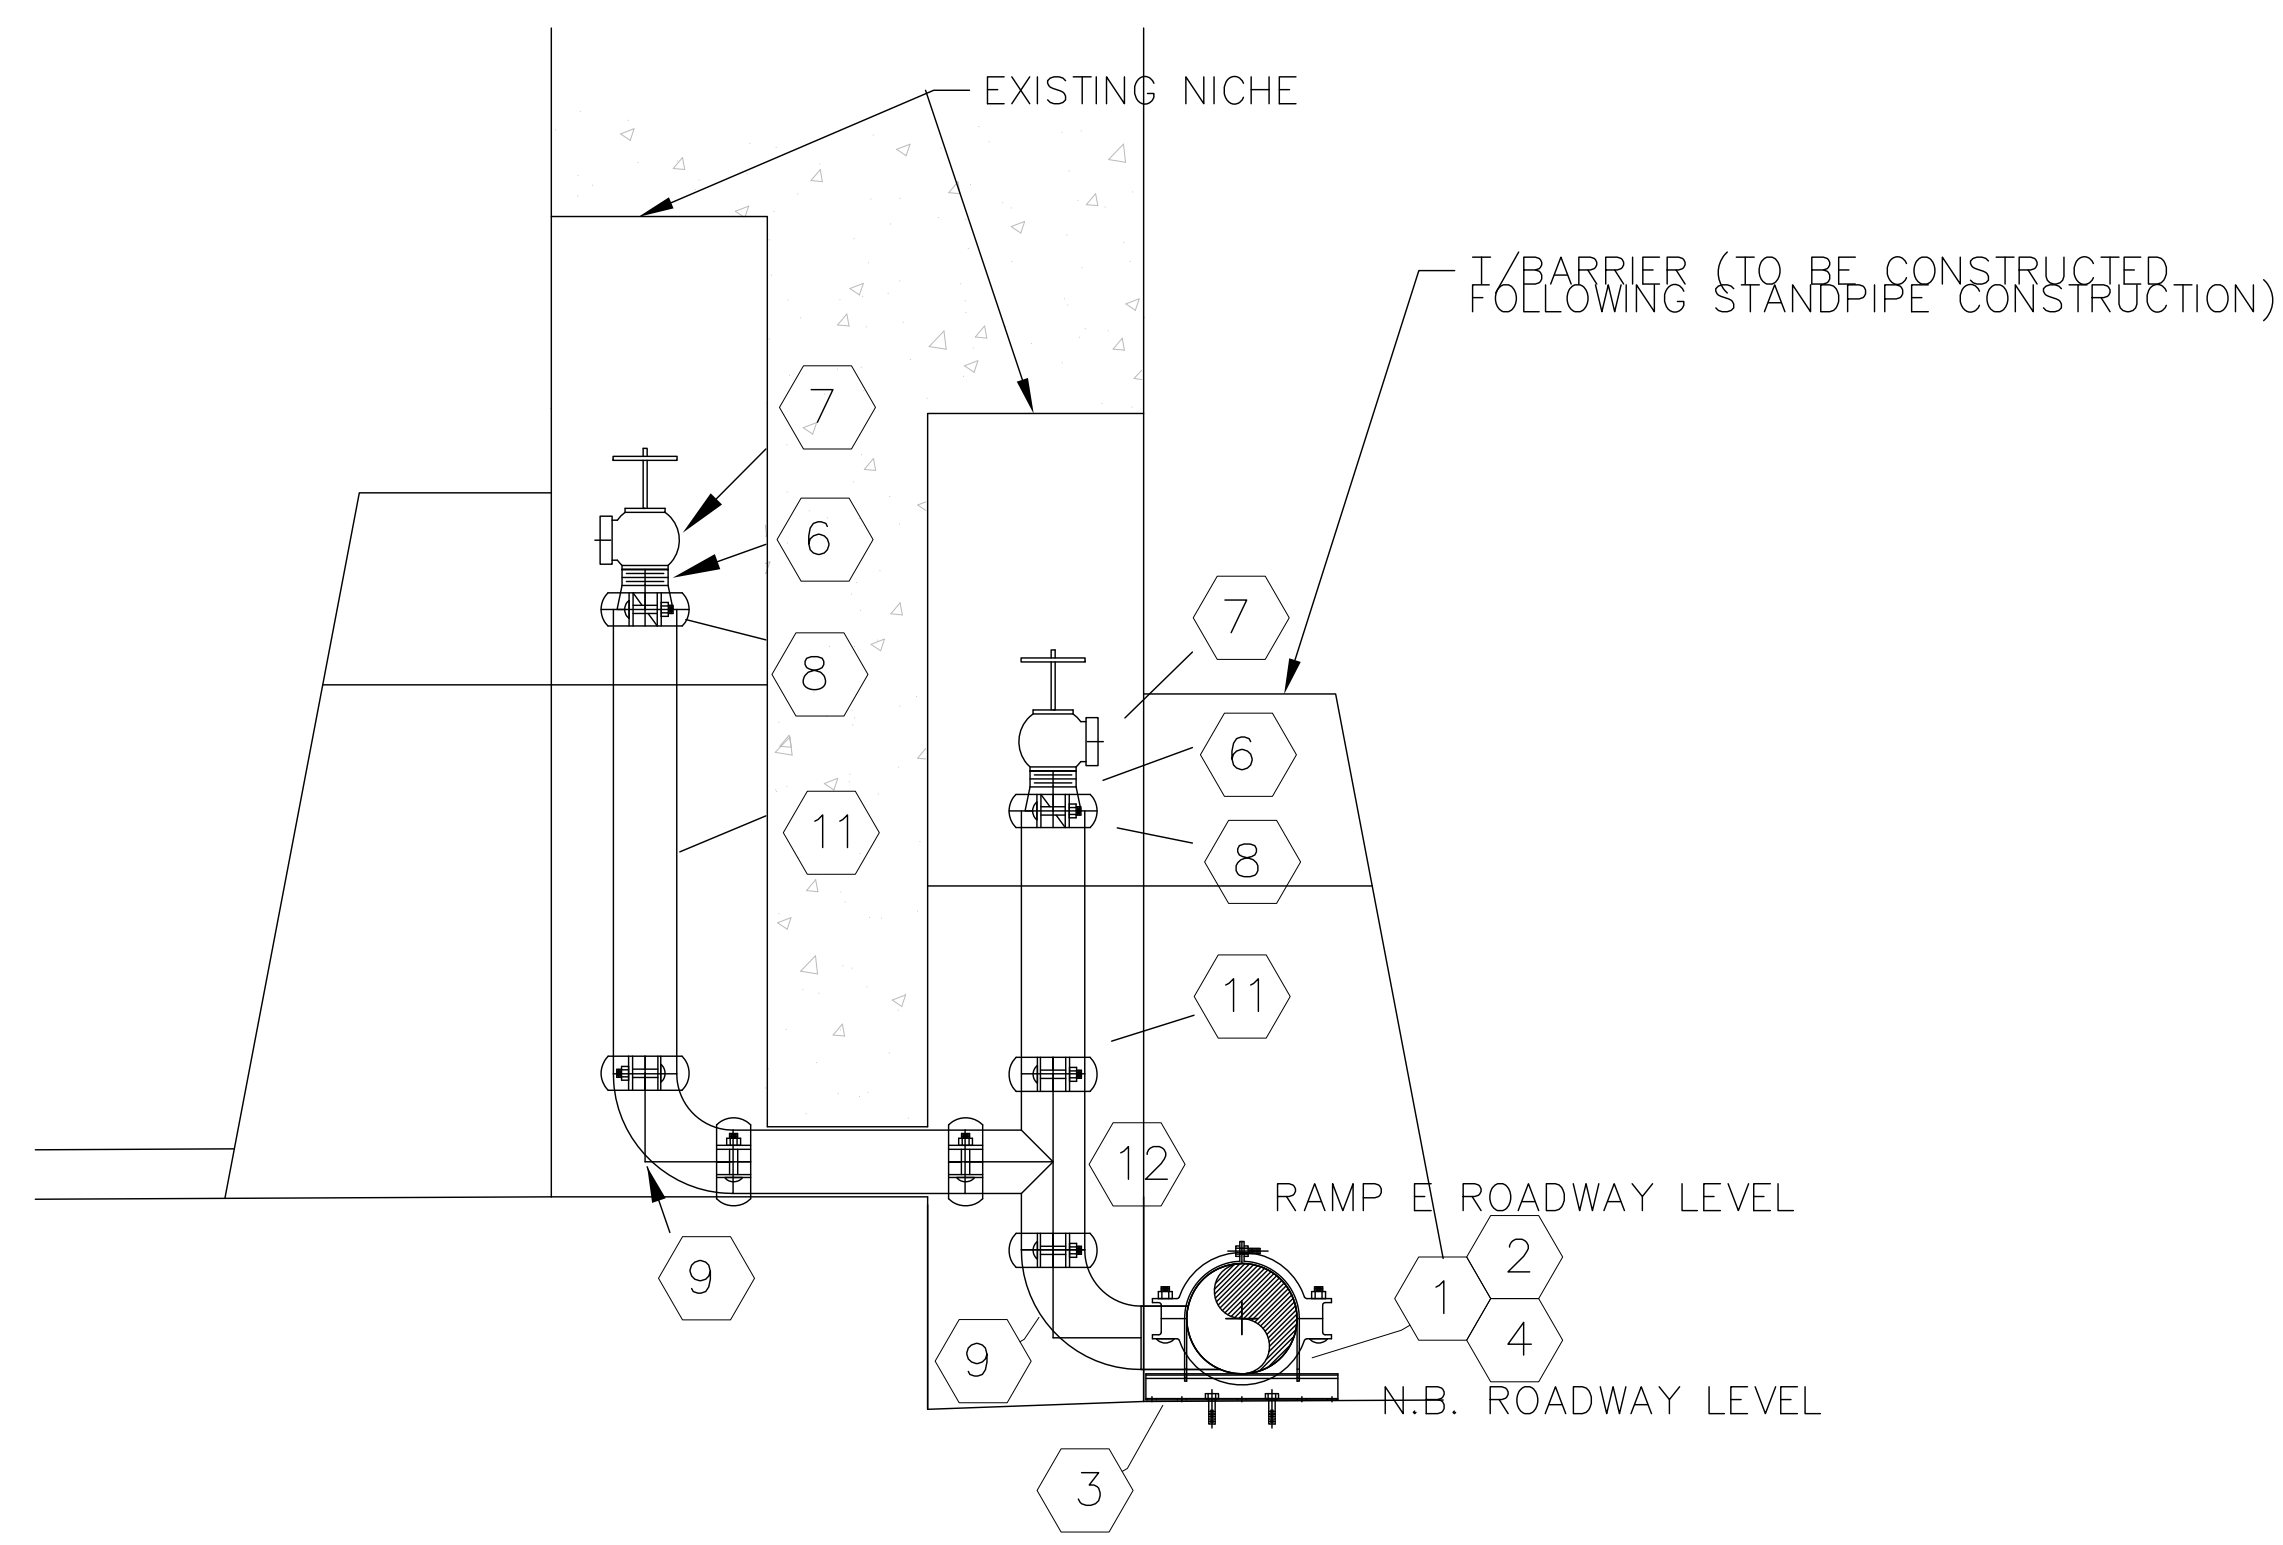


HOSE CONNECTION HC9/HC18 (NORTHBOUND/RAMP E)
SCALE: NTS

KEYNOTE LEGEND:

- 1 NEW 6" AWWA D.I. PIPE WITH GROOVED ENDS
- 2 NEW 6" AWWA D.I. GROOVED COUPLING
- 3 NEW 1 1/8" x 1 STRUT WITH 10 GA. STEEL PIPE STRAP FOR 6 3/8" O.D. TUBING AND ANCHOR BOLTS TO FLOOR
- 4 NEW 6" x 3" AWWA D.I. REDUCING TEE
- 5 NEW 3" AWWA D.I. TO 3" NPS GROOVED TRANSITION COUPLING
- 6 NEW THREADED REDUCER 3" NPS GROOVED x 2 1/2" MALE NPT
- 7 NEW 2 1/2" ANGLE HOSE VALVE, 2 NPT x 2 1/2" MALE CITY OF CINCINNATI NEW HOSE THREAD FITTED WITH CAP AND CHAIN (CAP AND CHAIN NOT SHOWN)
- 8 NEW 3" GALVANIZED GROOVED COUPLING
- 9 NEW 3" GALVANIZED GROOVED 90° ELBOW
- 10 NEW 3" GALVANIZED GROOVED 45° ELBOW
- 11 NEW 3" GALVANIZED PIPE WITH 1/2" FEMALE GROOVED ENDS
- 12 NEW 3" GALVANIZED GROOVED TEE

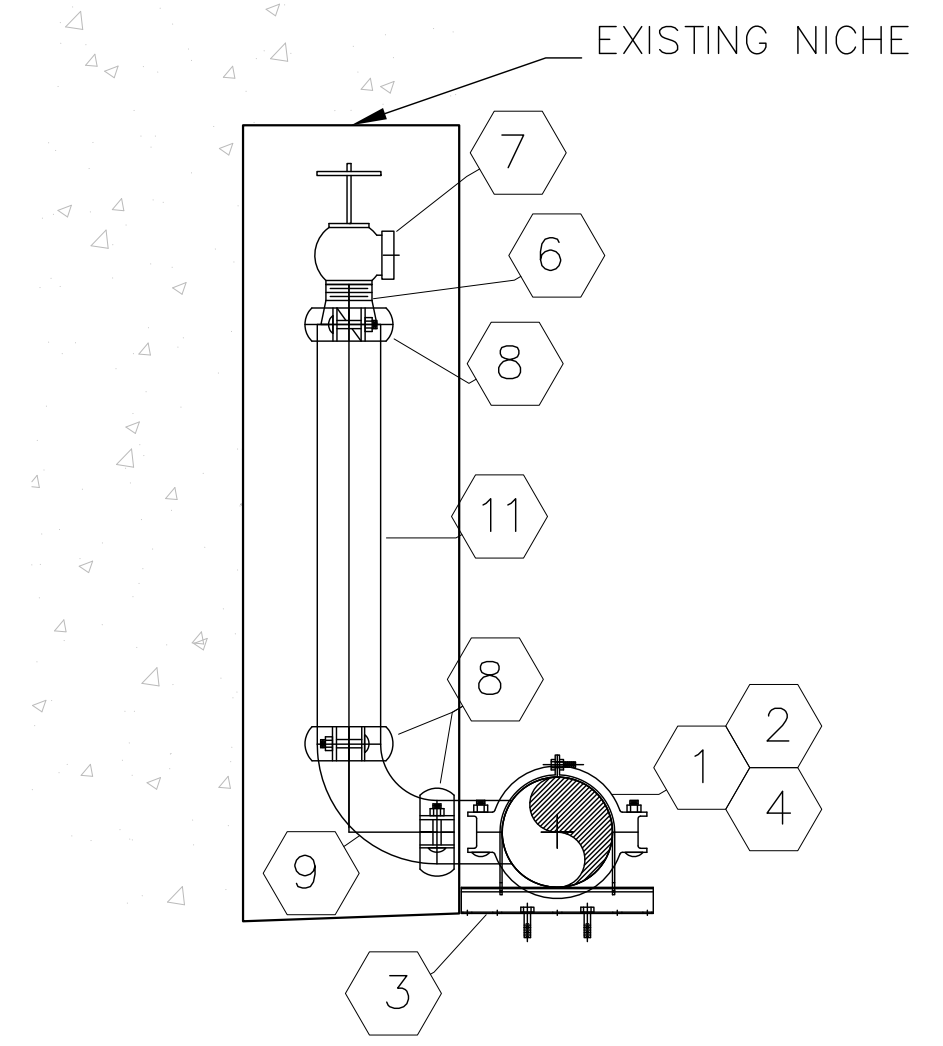


TYPICAL HOSE CONNECTION (SOUTHBOUND)
SCALE: NTS

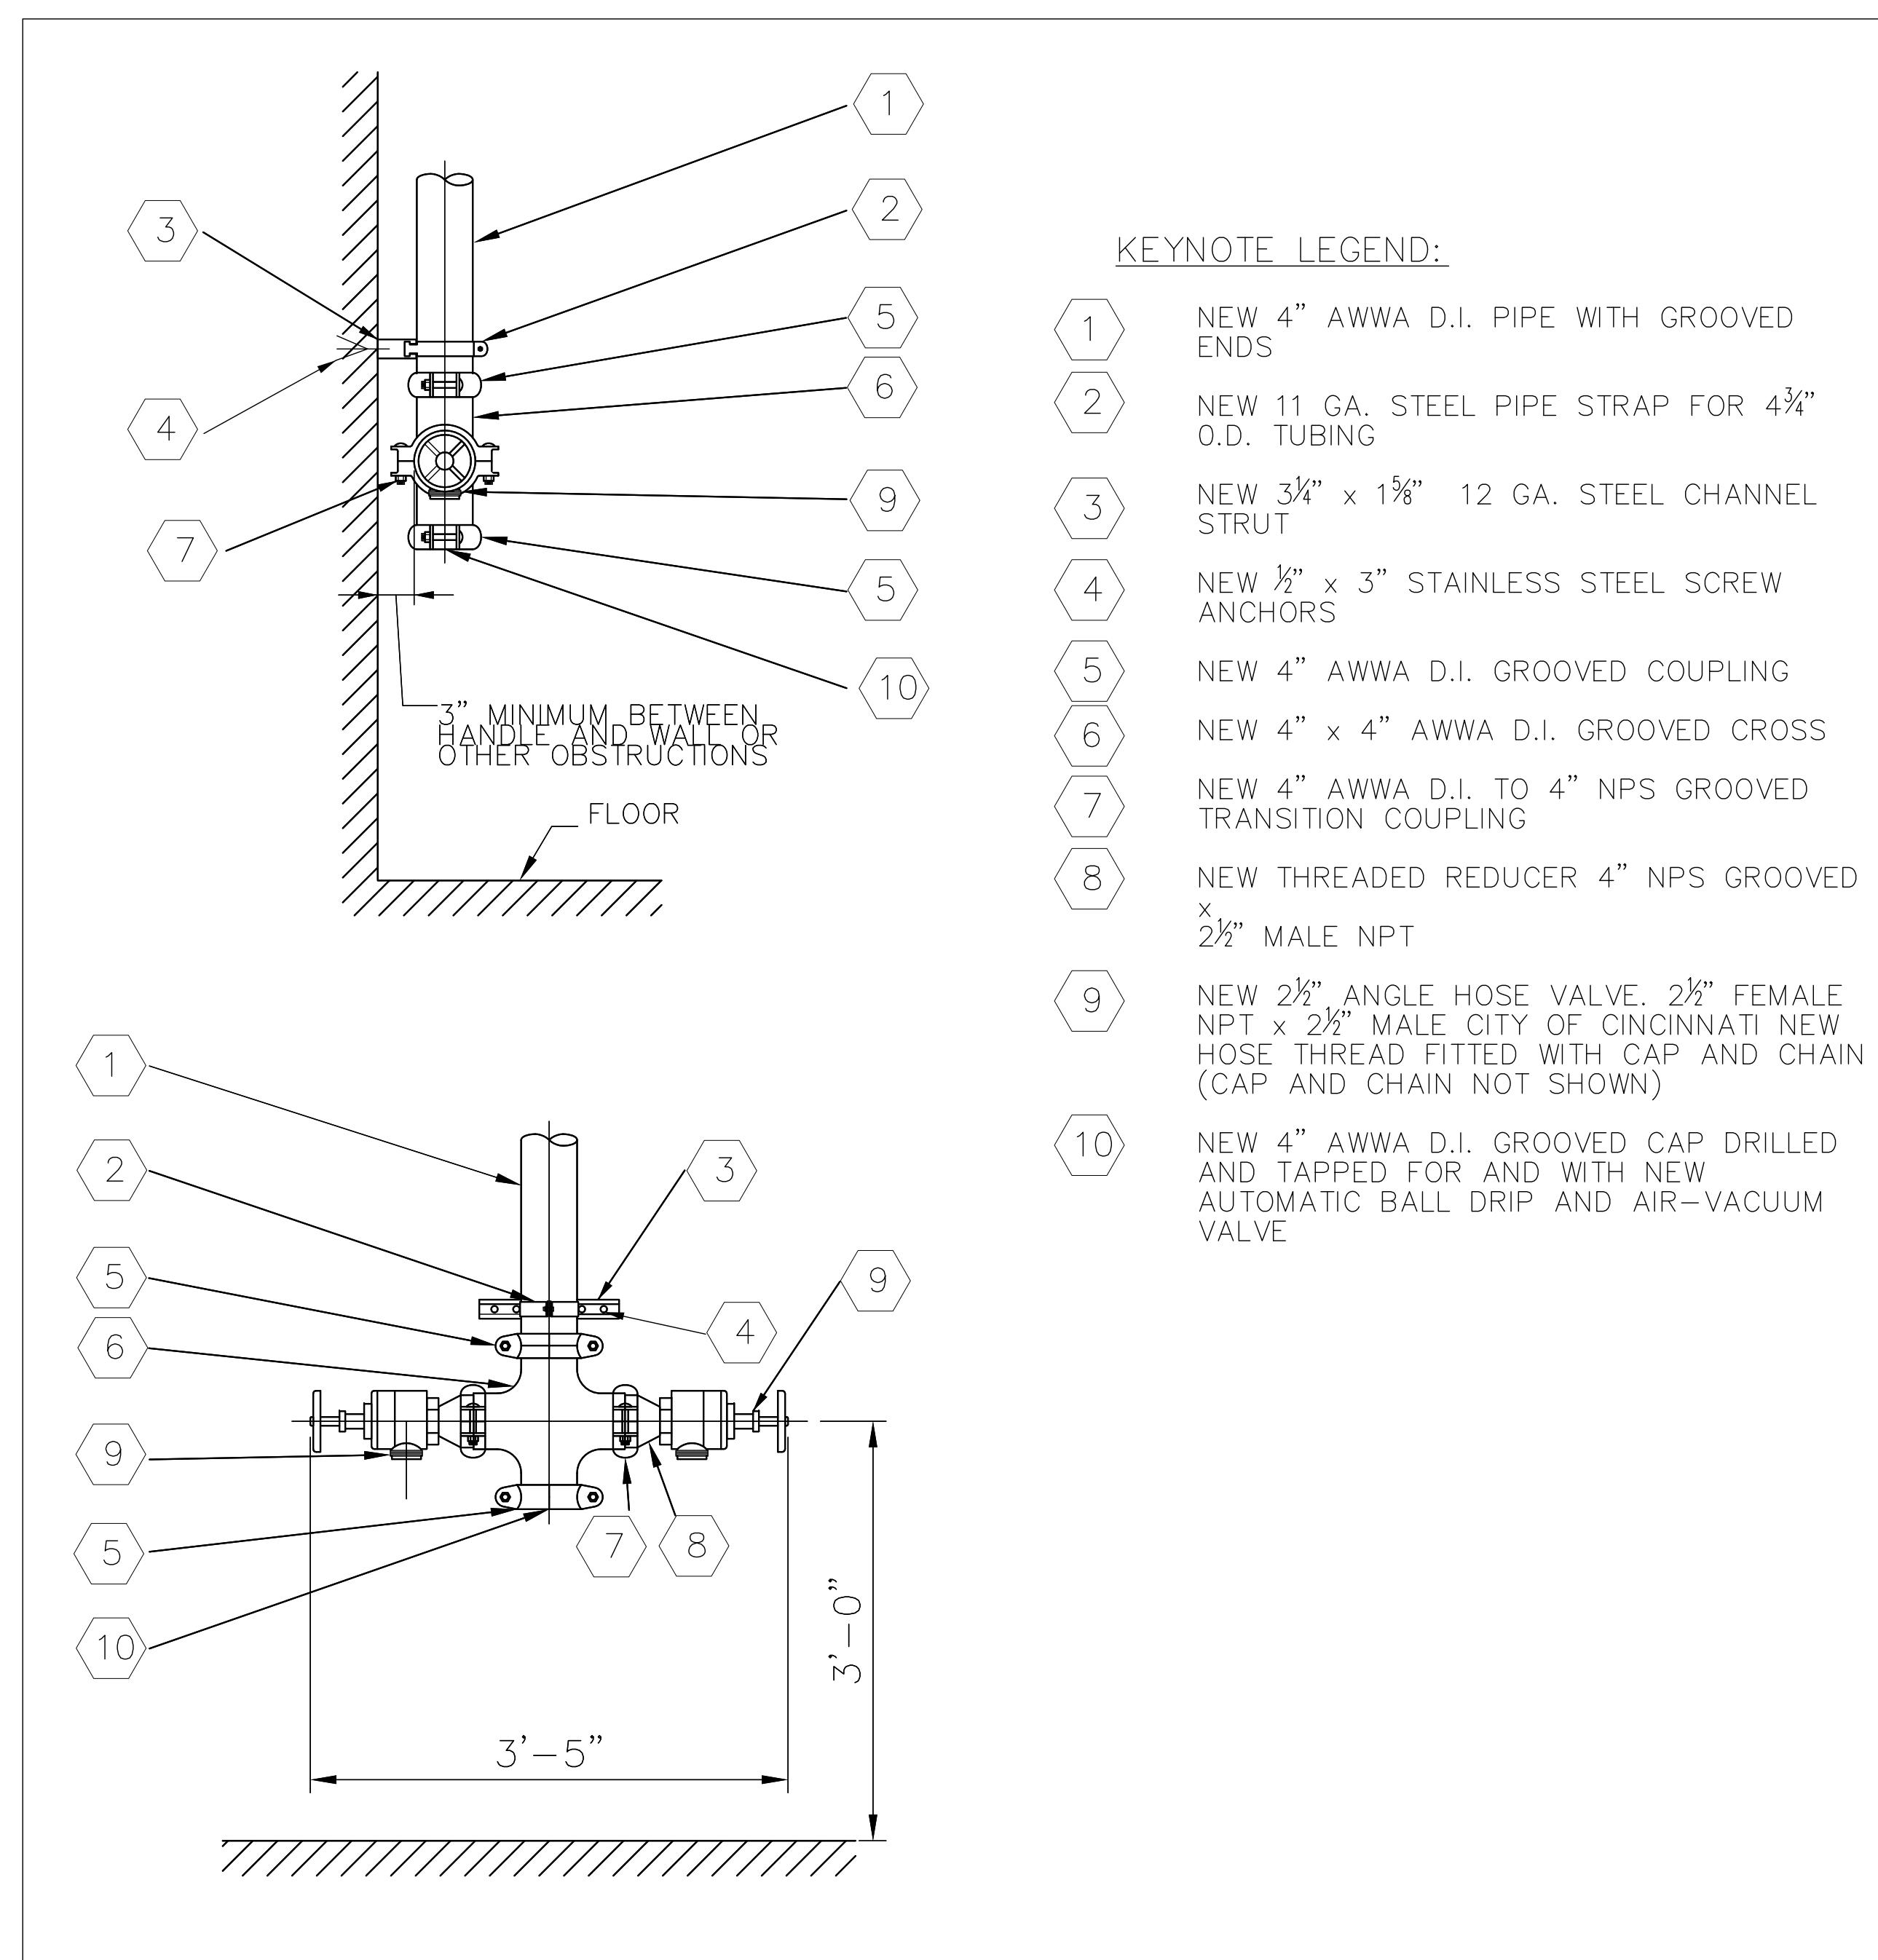

KEYNOTE LEGEND:

- 1 NEW 4" AWWA D.I. PIPE WITH GROOVED ENDS
- 2 NEW 11 GA. STEEL PIPE STRAP FOR 4 1/2" O.D. TUBING
- 3 NEW 3 1/2" x 1 1/8" 12 GA. STEEL CHANNEL STRUT
- 4 NEW 1/2" x 3" STAINLESS STEEL SCREW ANCHORS
- 5 NEW 4" AWWA D.I. GROOVED COUPLING
- 6 NEW 4" x 4" AWWA D.I. GROOVED CROSS
- 7 NEW 4" AWWA D.I. TO 4" NPS GROOVED TRANSITION COUPLING
- 8 NEW THREADED REDUCER 4" NPS GROOVED x 2 1/2" MALE NPT
- 9 NEW 2 1/2" ANGLE HOSE VALVE, 2 1/2" FEMALE NPT x 2 1/2" MALE CITY OF CINCINNATI NEW HOSE THREAD FITTED WITH CAP AND CHAIN (CAP AND CHAIN NOT SHOWN)
- 10 NEW 4" AWWA D.I. GROOVED CAP DRILLED AND TAPPED FOR AND WITH NEW AUTOMATIC BALL DRIP AND AIR-VACUUM VALVE

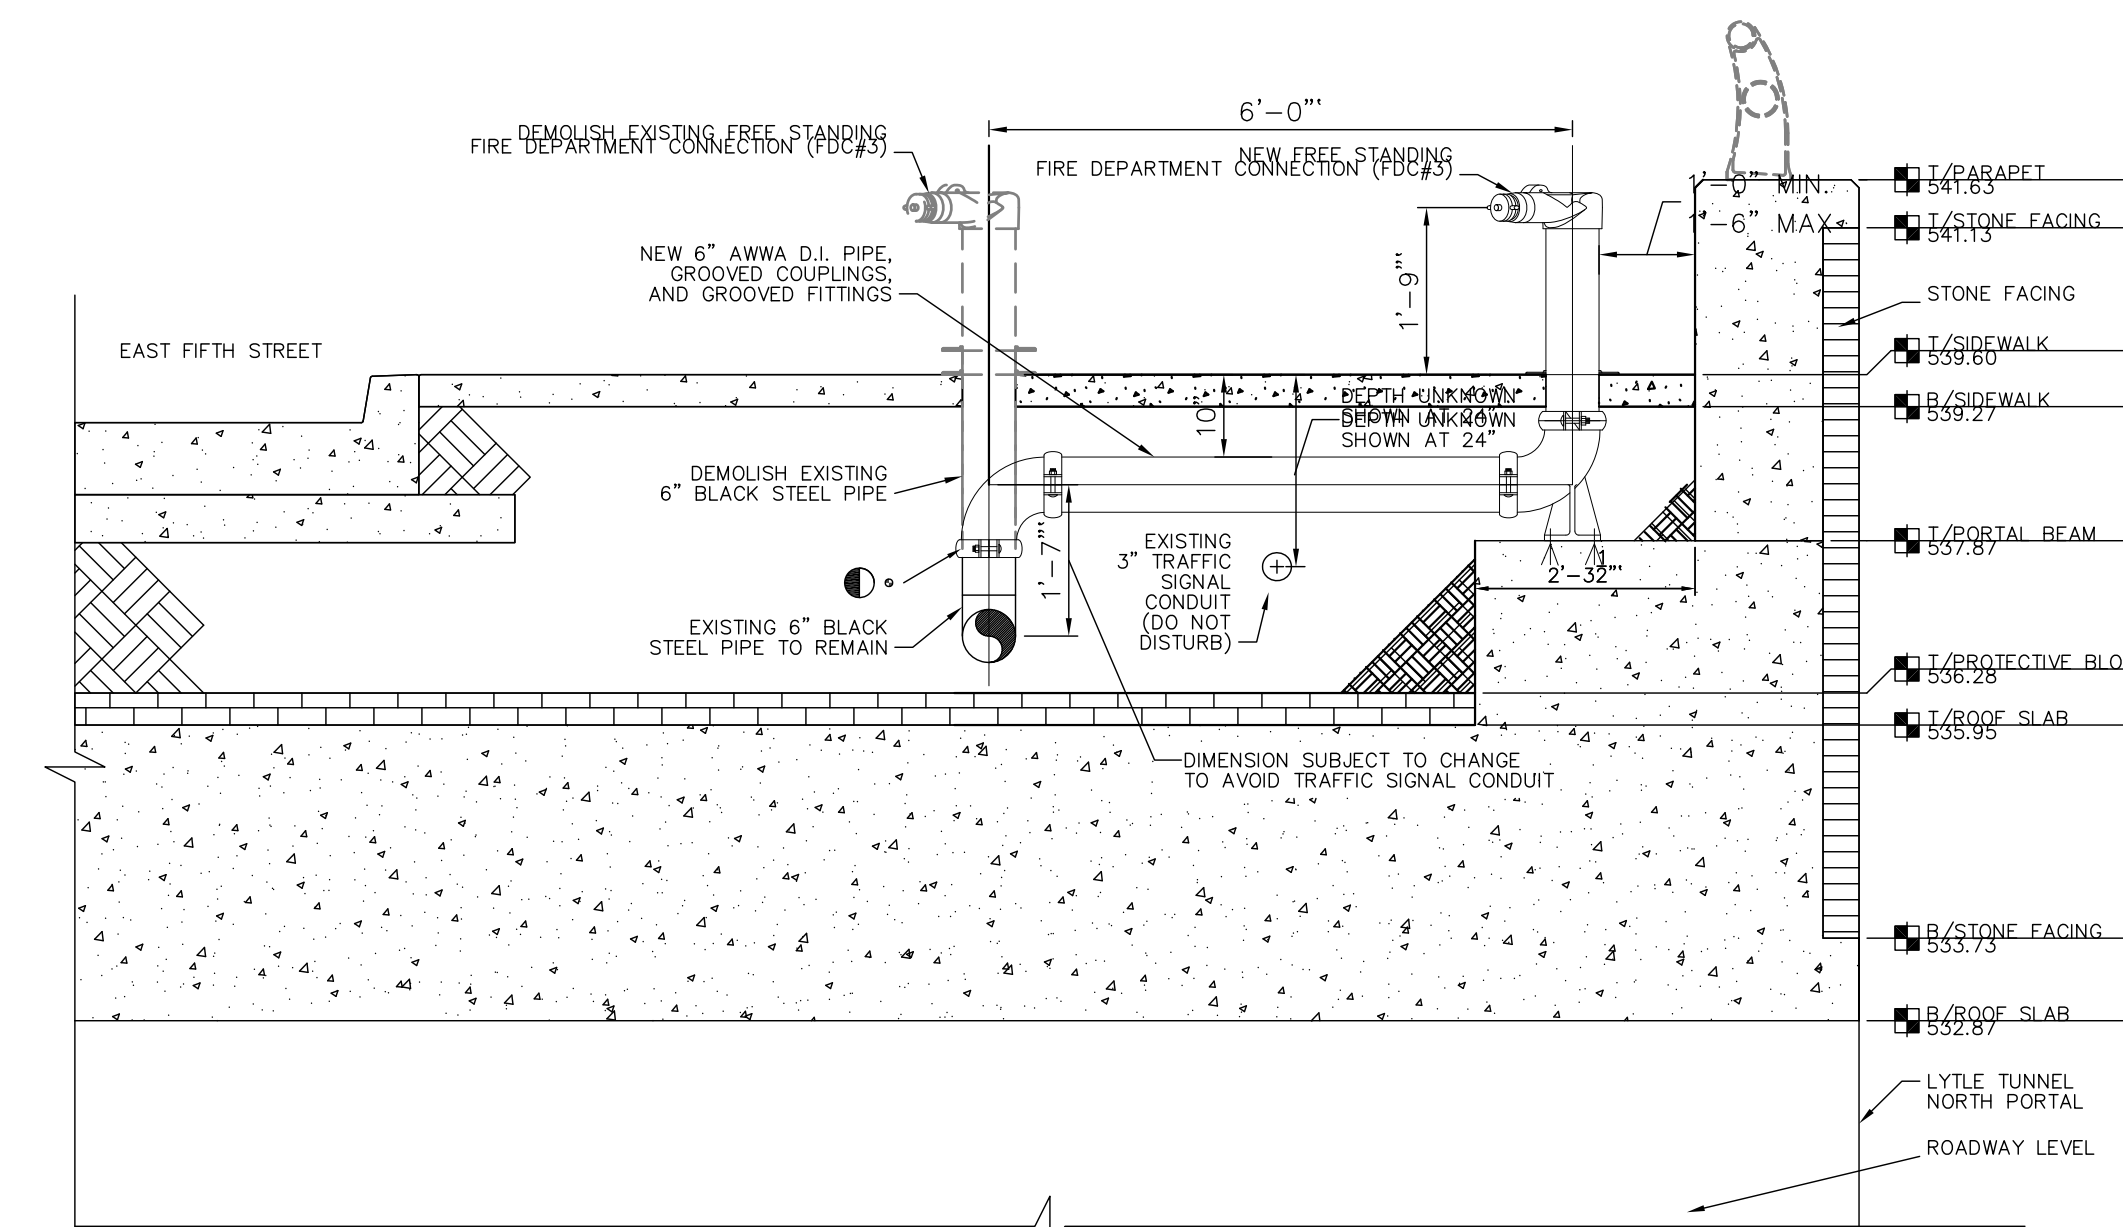

RELOCATION OF FDC #3
SCALE: NTS

AS-BUILT
06-15-17

STATE OF OHIO CERTIFIED
COMPANY: DALMATIAN FIRE, INC. #53-83-1006
DESIGNER: ROBERT TANSY #3073

Robert Tansy
#3073

DATE		SIGNATURE		COMPANY NAME		TRADE		DESIGN DATA		SPRINKLERS		FILE NAME	
				DALMATIAN FIRE, INC.	SPRINKLER PIPING	OCCUPANCY: / SO. FT. / GPM	0	DATE: 6.16.2016	DRAWN BY: Z. CRUPE	TOTAL SPRINKLERS THIS SHEET		0	FILE NAME:
					ELECTRICAL	HOSE ALLOWANCE: / GPM		CHECKED BY: R. TANSY					
					HVAC	FLOW TEST: / PSI STATIC / GPM FLOWING		CONTRACT No: 2585*					
								CONTRACT W/TH:					

LYTLE TUNNEL
OHIO
DALMATIAN FIRE, INC.
CINCINNATI
4700 DUKE BLVD., SUITE 100
MASON, OHIO 45040
(513) 388-4580 FAX (513) 388-2880

CONTRACTOR'S MATERIAL AND TEST CERTIFICATE FOR ABOVEGROUND PIPING

Standpipe System NFPA 14

PROCEDURE

Upon completion of work, inspection and tests shall be made by the contractor's representative and witnessed by an owner's representative. All defects shall be corrected and the system left in service before the contractor's personnel finally leave the job.

A certificate shall be filled out and signed by both representatives. Copies shall be prepared for approving authorities, owners, and contractor. It is understood that the owner's representative's signature in no way prejudices any claim against the contractor for faulty material, poor workmanship, or failure to comply with the approving authority's requirements or local ordinances.

Property name LITTLE TUNNEL	Date 7-13-17
------------------------------------	---------------------

Property address _____

Plans	Accepted by approving authorities (names) CINCINNATI FIRE DEPARTMENT	
	Address _____	
	Installation conforms to accepted plans?	<input checked="" type="checkbox"/> Yes <input type="checkbox"/> No
	Equipment used is approved or listed? If no, explain deviations. _____	<input checked="" type="checkbox"/> Yes <input type="checkbox"/> No

Type of System	Automatic dry	<input type="checkbox"/> Yes
	Automatic wet	<input type="checkbox"/> Yes
	Semiautomatic dry	<input type="checkbox"/> Yes
	Manual dry	<input checked="" type="checkbox"/> Yes
	Manual wet	<input type="checkbox"/> Yes
	Combination standpipe/sprinkler If other, explain. _____	<input type="checkbox"/> Yes

Water Supply Data Used for Design and As Shown on Plans	Fire pump data	
	Manufacturer _____ Model _____	
	Type: <input type="checkbox"/> Electric <input type="checkbox"/> Diesel <input checked="" type="checkbox"/> Other (explain) FIRE TRUCK	
	Rated, gpm 1000 Rated, psi 150 Shutoff, psi _____	

Water Supply Source Capacity, Gallons	<input type="checkbox"/> Public waterworks system <input type="checkbox"/> Storage tank <input type="checkbox"/> Gravity tank <input type="checkbox"/> Open reservoir <input checked="" type="checkbox"/> Other (explain) PUBLIC HYDRANTS AND FIRE TRUCK
--	--

If Public Waterworks System:	Static, psi _____ Residual, psi _____ Flow, gpm _____
-------------------------------------	---

Have Copies of the Following Been Left on the Premises?	<input checked="" type="checkbox"/> System components instructions <input type="checkbox"/> Care and maintenance of system <input type="checkbox"/> NFPA 25 <input type="checkbox"/> Copy of accepted plans <input type="checkbox"/> Hydraulic data/calculations
--	---

Supplies Building(s)	Main waterflow shutoff location N/A
	Number of standpipe risers 27 HOSE VALVES IN TUNNEL
	Do all standpipe risers have base of riser shutoff valves? <input checked="" type="checkbox"/> Yes <input type="checkbox"/> No

Valve Supervision	<input checked="" type="checkbox"/> Locked open <input type="checkbox"/> Sealed and tagged <input type="checkbox"/> Tamperproof switch <input type="checkbox"/> Other If other, explain. _____
--------------------------	---

Pipe and Fittings	Type of pipe DUCTILE IRON
	Type of fittings " "

Hose Threads	Hose threads have been verified for compliance with local fire department <input checked="" type="checkbox"/> Yes <input type="checkbox"/> No
---------------------	---

Backflow Preventor	<input type="checkbox"/> Double check assembly Size _____ Make and model _____ <input type="checkbox"/> Reduced-pressure device
---------------------------	--

FIGURE 11.1.3(a) Sample Contractor's Material and Test Certificate for Aboveground Piping.

J

CONTROL VALVE DEVICE

Type	Size	Make	Model
N/A			

Time to trip through remote hose valve _____ Min _____ Sec Water pressure _____ Air pressure _____
 Time water reached remote hose valve outlet N/A Min _____ Sec Trip point air pressure _____ psi
 Alarm operated properly? Yes No If no, explain. _____

Time water reached remote hose valve outlet _____ Min _____ Sec
 Hydraulic activation Yes
 Electric activation Yes
 Pneumatic activation Yes
 Make and model of activation device _____
 Each activation device tested? Yes No If no, explain. N/A

Each activation device operated properly? Yes No If no, explain. _____

PRESSURE-REGULATING DEVICE AT HOSE VALVES

Location & Floor	Model	Nonflowing (psi)		Flowing (psi)		gpm
		Inlet	Outlet	Inlet	Outlet	
Tonnell South Bound	2 1/2" Hose	Outlet #1	P1010	P1010	10 PSI	292
	Valve	Outlet #2		P1010	10 PSI	292

All hose valves on system operated properly? Yes No If no, explain. _____

FIGURE 11.1.3(a) Continued


Test Description	<p><i>Hydrostatic:</i> Hydrostatic tests shall be made at not less than 200 psi (13.6 bar) for 2 hours or 50 psi (3.4 bar) above static pressure in excess of 150 psi (10.2 bar) for 2 hours. Differential dry pipe valve clappers shall be left open during test to prevent damage. All aboveground piping leakage shall be stopped.</p> <p><i>Pneumatic:</i> Establish 40 psi (2.7 bar) air pressure and measure drop, which shall not exceed 1½ psi (0.1 bar) in 24 hours. Test pressure tanks at normal water level and air pressure and measure air pressure drop, which shall not exceed 1½ psi (0.1 bar) in 24 hours.</p>		
Tests	All piping hydrostatically tested at <u>200</u> psi (___ bar) for <u>2</u> hrs Dry piping pneumatically tested? <input type="checkbox"/> Yes <input type="checkbox"/> No Equipment operates properly? <input type="checkbox"/> Yes <input type="checkbox"/> No		If no, state reason.
	Do you certify as the standpipe contractor that additives and corrosive chemicals, sodium silicate, or derivatives of sodium silicate, brine, or other corrosive chemicals were not used for testing systems or stopping leaks? <input type="checkbox"/> Yes <input type="checkbox"/> No		
	Drain test	Reading of gauge located near water supply test connection _____ psi (___ bar)	Residual pressure with valve in test connection open wide _____ psi (___ bar)
	Underground mains and lead-in connections to system risers flushed before connection made to standpipe piping. Verified by copy of the U form no. 85b? <input type="checkbox"/> Yes <input type="checkbox"/> No <input type="checkbox"/> Other (explain) _____ Flushed by installer of underground standpipe piping? <input type="checkbox"/> Yes <input type="checkbox"/> No _____		
Blank Testing	Number used <u>0</u>	Locations _____	Number removed _____
Welding	Welded piping <input type="checkbox"/> Yes <input checked="" type="checkbox"/> No		
	If yes ...		
	Do you certify as the standpipe contractor that welding procedures comply with the requirements of at least AWS D10.9, Level AR-3? <input type="checkbox"/> Yes <input type="checkbox"/> No		
	Do you certify that the welding was performed by welders qualified in compliance with the requirements of at least AWS D10.9, Level AR-3? <input type="checkbox"/> Yes <input type="checkbox"/> No		
Do you certify that welding was carried out in compliance with a documented quality control procedure to ensure that all discs are retrieved, that openings in piping are smooth, that slag and other welding residue are removed, and that the internal diameters of piping are not penetrated? <input type="checkbox"/> Yes <input type="checkbox"/> No			
Cutouts (Discs)	Do you certify that you have a control feature to ensure that all cutouts (discs) are retrieved? <u>N/A</u> <input type="checkbox"/> Yes <input type="checkbox"/> No		
Hydraulic Data Nameplate	Nameplate provided? <input type="checkbox"/> Yes <input type="checkbox"/> No <input type="checkbox"/> If no, explain. <u>N/A</u>		
Remarks	Date left in service with all control valves open: _____		
Name of Sprinkler/Standpipe Contractor	Name of contractor <u>DALMATIAN FIRE Inc.</u> Address <u>4700 DOKE DRIVE</u> State license number (if applicable) <u>53-83-1006</u>		
System Operating Test Witnessed by	Property owner _____ Title _____ Date _____ Sprinkler/standpipe contractor _____ Title _____ Date _____ Approving authorities _____ Title _____ Date _____		
Additional Explanation and Notes	<p style="font-size: 1.2em;">THIS TEST WAS PERFORMED WITH THE USE OF A CINCINNATI FIRE TRUCK.</p>		

FIGURE 11.1.3(a) Continued

MIKE THOMAS 54.89.0608

JAKE ELMORE TGLCC

OPERATION OF FDC #1 ACTIVATES ALL HOSE VALVES EXCLUDING HC2F

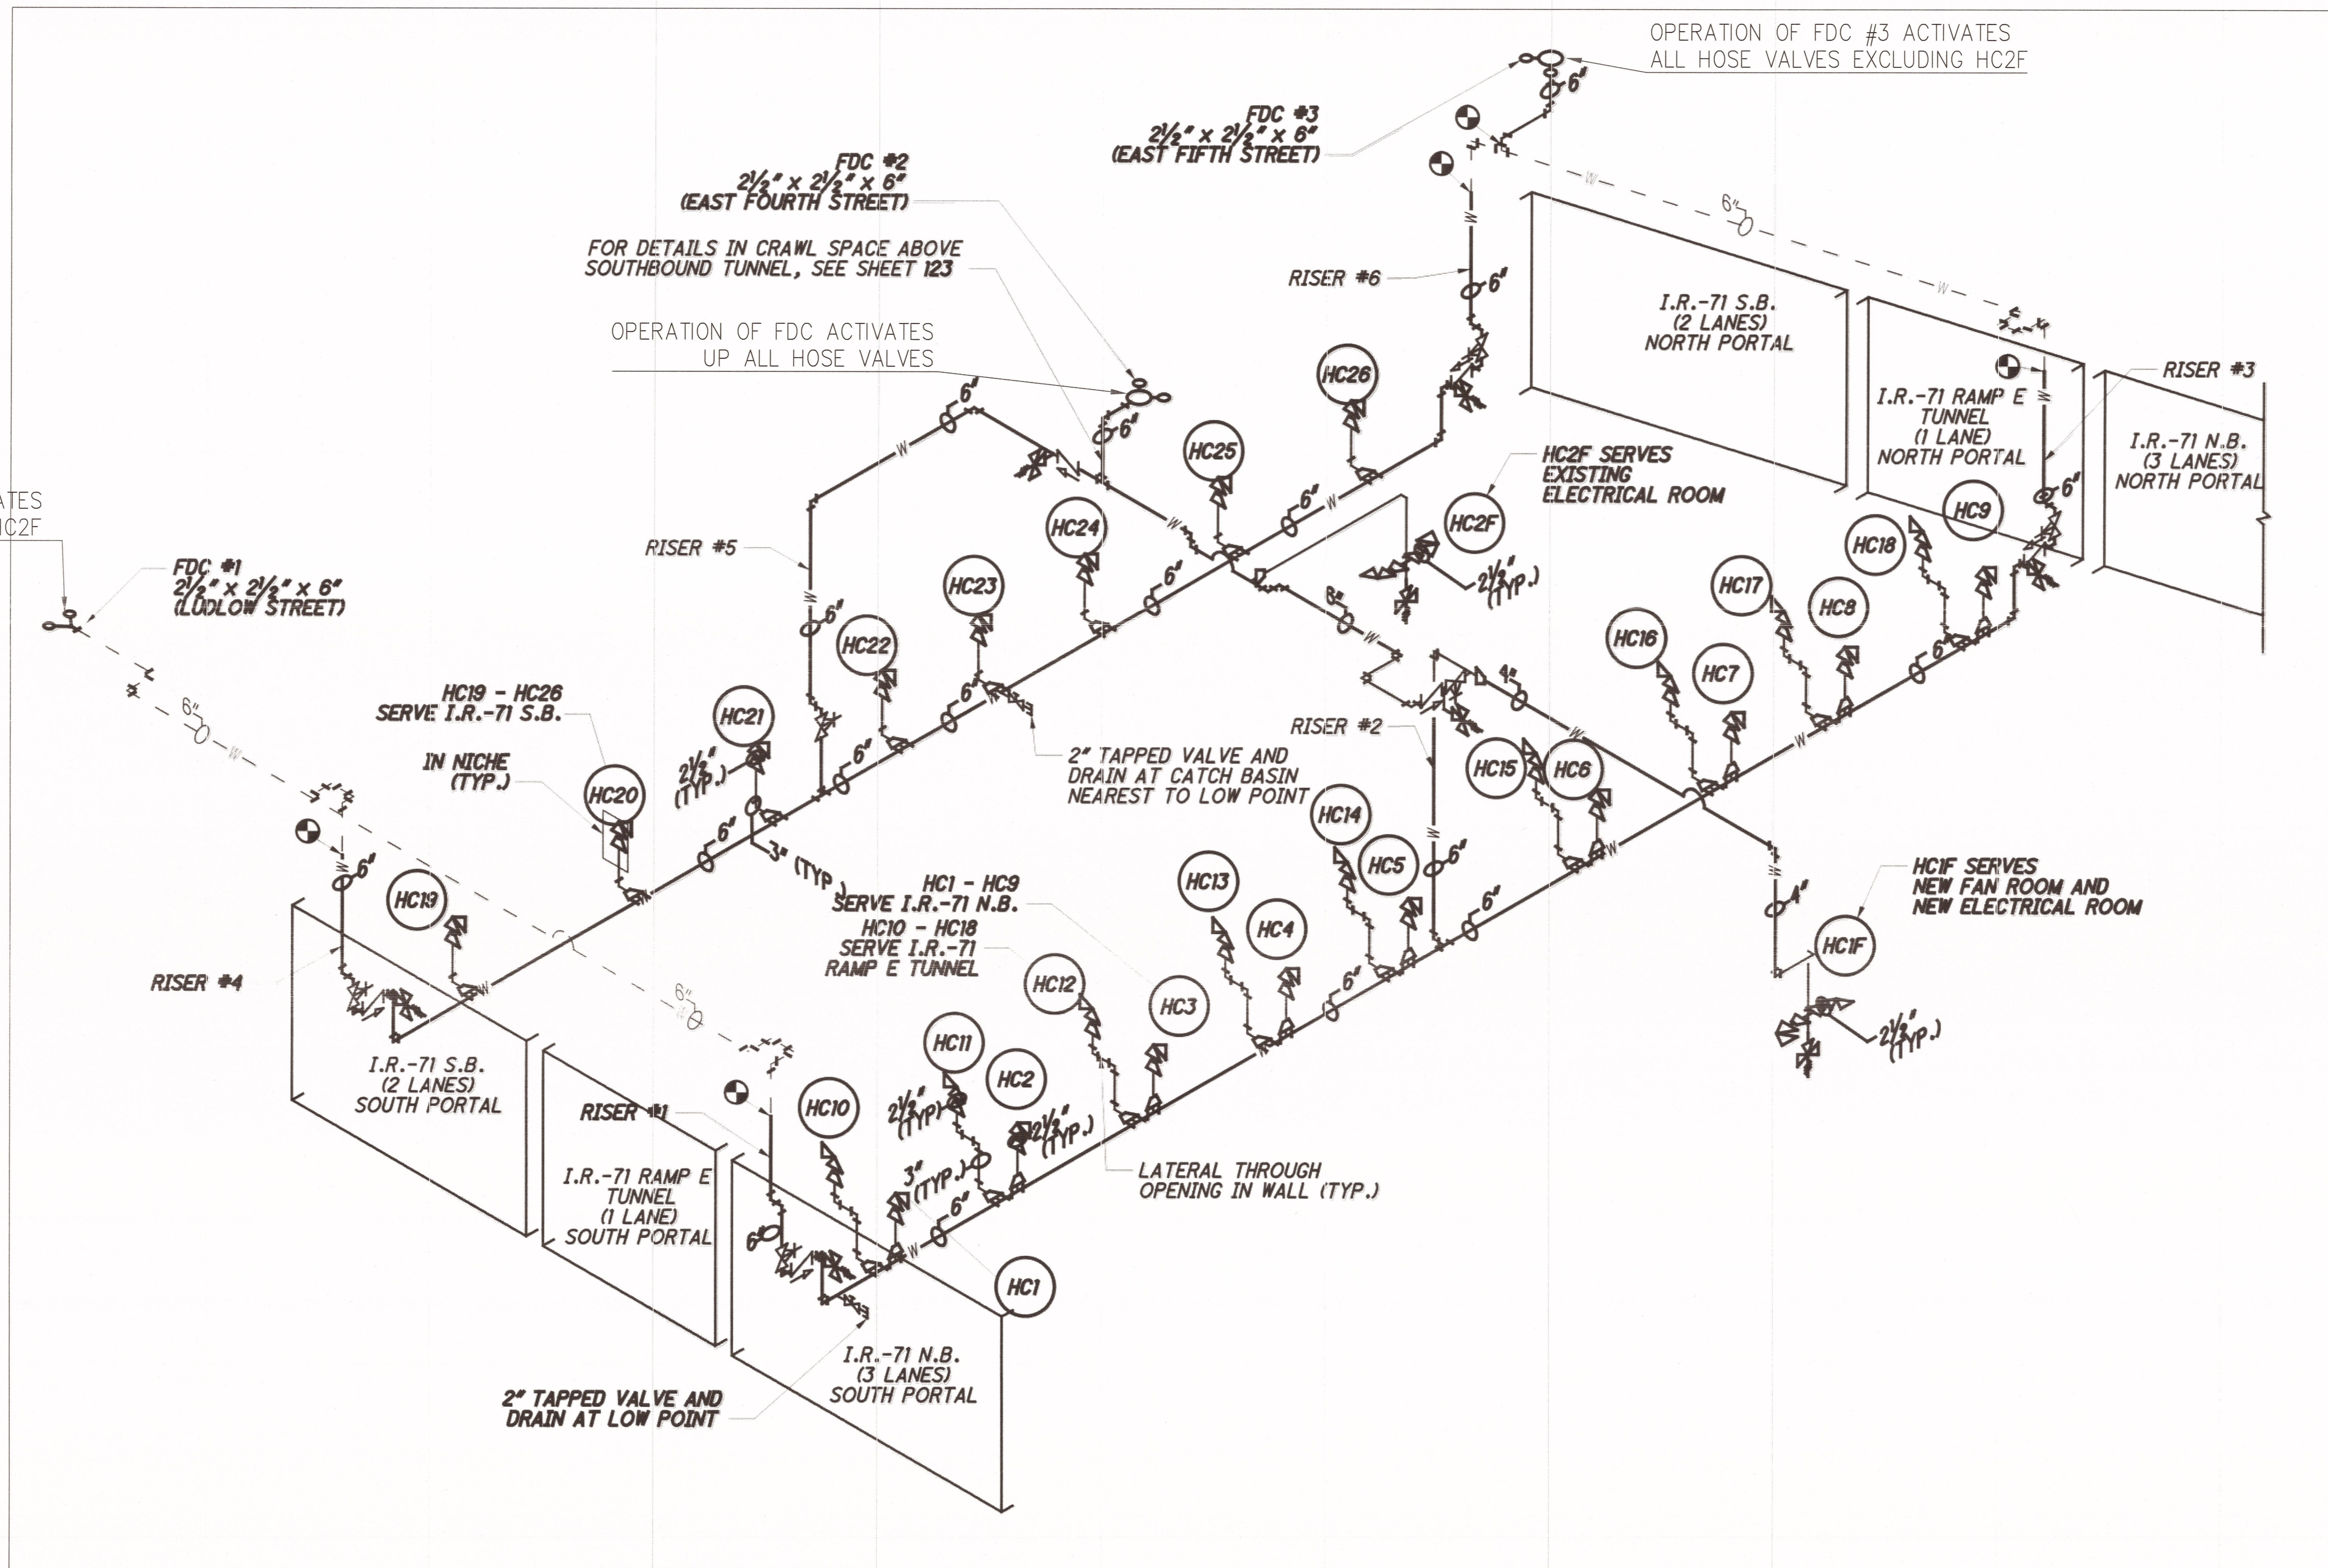


SCHEMATIC VIEW OF SYSTEM
NOT TO SCALE

DATE		SIGNATURE	
COMPANY NAME		DALMATIAN FIRE, INC.	
TRADE		SPRINKLER PIPING PLUMBING ELECTRICAL HVAC	
QTY DESIGN DATA		SQ. FT. GPM HOSE ALLOWANCE	
SPRINKLERS		TOTAL SPRINKLERS THIS SHEET	
TITLE		SCHEMATIC DETAIL HOSE OPERATION	
DATE		6.16.2016	
DRAWN BY		Z. CRUPE	
CHECKED BY		R. TANSY	
CONTRACT NO.		2585*	
CONTRACT WTR.			
CINCINNATI		OHIO	
LYTLE TUNNEL I-71		DALMATIAN FIRE, INC.	
		4700 DUKE BLVD, SUITE 160 MASON, OHIO 45040 (513) 398 4500 FAX (513) 398 2880	
SHEET No.:		FP10 OF 10	

AS-BUILT
10-12-17

STATE OF OHIO CERTIFIED
COMPANY: DALMATIAN FIRE, INC. #53-83-1006
DESIGNER: ROBERT TANSY #3073
Robert Tansy
#3073

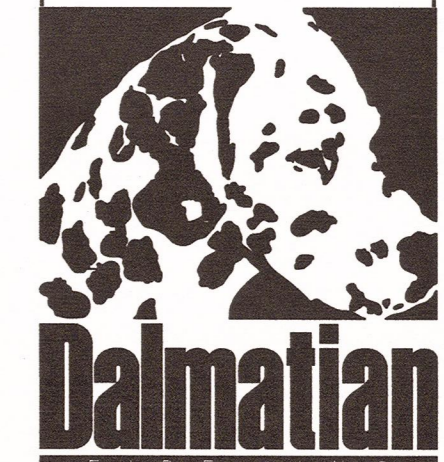



Cincinnati, Indianapolis, Louisville, Columbus

Project: Lytle Tunnel

Maintenance and Operation of the Fire Protection System

The attached copy of NFPA-25 offers a detailed list for Inspection, Testing and Maintenance of Standpipe Systems.

The standpipe system installed at this facility is a Manual Dry Standpipe system which has less maintenance items than what's shown in the NFPA-25 manual.

The items that need to be inspected and maintained are as follows:

1. Drain all low point drains at least Semi-annually and Annually.
2. Operate all control valves by closing and opening.
3. The control valve stems should be greased to prevent corrosion.
4. Visually inspect all fire hose valves annually to see that the caps are still in place.
5. Visually inspect all three Fire Department connections to see that the caps are in place.

PROTECTING PEOPLE, PROPERTY AND DREAMS

4700 DUKE DRIVE, SUITE 160 | MASON, OHIO 45040 | 513.398.4500 | DALMATIANFIRE.NET



Chapter 6 Standpipe and Hose Systems

6.1 General.

This chapter shall provide the minimum requirements for the routine inspection, testing, and maintenance of standpipe and hose systems. Table 6.1 shall be used to determine the minimum required frequencies for inspection, testing, and maintenance.

Table 6.1 Summary of Standpipe and Hose Systems Inspection, Testing, and Main

Item	Frequency	Reference
Inspection		
Control valves	Weekly/monthly	Table 13.1
Pressure regulating devices	Quarterly	Table 13.1
Piping	Annually	6.2.1
Hose connections	Annually	Table 13.1
Cabinet	Annually	NFPA 1962, <i>Standard for and Use of Fire Hose, Cc and the Service Testing c</i>
Hose	Annually	NFPA 1962
Hose storage device	Annually	NFPA 1962
Hose nozzle	Annually and after each use	NFPA 1962
Test		
Waterflow devices	Quarterly/semiannually	Table 13.1
Valve supervisory devices	Semiannually	Table 13.1

Table 6.1 Summary of Standpipe and Hose Systems Inspection, Testing, and Main

Item	Frequency	Reference
Supervisory signal devices (except valve supervisory switches)	Semiannually	Table 13.1
Hose storage device	Annually	NFPA 1962
Hose	5 years/3 years	NFPA 1962
Pressure control valve	5 years	Table 13.1
Pressure reducing valve	5 years	Table 13.1
Hydrostatic test	5 years	6.3.2
Flow test	5 years	6.3.1
Main drain test	Annually	Table 13.1
Maintenance		
Hose connections	Annually	Table 6.2.2
Valves (all types)	Annually/as needed	Table 13.1

6.1.1 Valves and Connections. Valves and fire department connections shall be inspected, tested, and maintained in accordance with Chapter 13.

6.1.2 Impairments. Where the inspection, testing, and maintenance of standpipe and hose systems results or involves a system that is out of service, the procedures outlined in Chapter 15 shall be followed.

6.2 Inspection.

6.2.1 Components of standpipe and hose systems shall be visually inspected annually or as specified in Table 6.1.

6.2.2 Table 6.2.2 shall be used for the inspection, testing, and maintenance of all classes of standpipe and hose systems.

Table 6.2.2 Standpipe and Hose Systems

Component/Checkpoint	Corrective Action
Hose Connections	
Cap missing	Replace
Fire hose connection damaged	Repair
Valve handles missing	Replace
Cap gaskets missing or deteriorated	Replace
Valve leaking	Close or repair
Visible obstructions	Remove
Restricting device missing	Replace
Manual, semiautomatic, or dry standpipe — valve does not operate smoothly	Lubricate or repair

Table 6.2.2 Standpipe and Hose Systems

Component/Checkpoint	Corrective Action
Damaged piping	Repair
Control valves damaged	Repair or replace
Missing or damaged pipe support device	Repair or replace
Damaged supervisory devices	Repair or replace
Hose	
Inspect	Remove and inspect the hose, including gaskets, and rerack rereel at intervals in accordance with NFPA 1962, <i>Standard for the Care, Use, and Service Testing of Fire Hose Including Couplings and Nozzles</i>
Mildew, cuts, abrasions, and deterioration evident	Replace with listed lined, jacketed hose
Coupling damaged	Replace or repair
Gaskets missing or deteriorated	Replace
Incompatible threads on coupling	Replace or provide thread adapter
Hose not connected to hose rack nipple or valve	Connect
Hose test outdated	Retest or replace in accordance with NFPA 1962
Hose Nozzle	
Hose nozzle missing	Replace with listed nozzle
Gasket missing or deteriorated	Replace
Obstructions	Remove
Nozzle does not operate smoothly	Repair or replace
Hose Storage Device	
Difficult to operate	Repair or replace
Damaged	Repair or replace
Obstruction	Remove
Hose improperly racked or rolled	Remove
Nozzle clip in place and nozzle correctly contained?	Replace if necessary
If enclosed in cabinet, will hose rack swing out at least 90 degrees?	Repair or remove any obstructions
Cabinet	
Check overall condition for corroded or damaged parts	Repair or replace parts; replace entire cabinet if necessary
Difficult to open	Repair
Cabinet door will not open fully	Repair or move obstructions
Door glazing cracked or broken	Replace
If cabinet is break-glass type, is lock functioning properly?	Repair or replace
Glass break device missing or not attached	Replace or attach
Not properly identified as containing fire equipment	Provide identification
Visible obstructions	Remove
All valves, hose, nozzles, fire extinguisher, etc., easily accessible	Remove any material not related

6.2.3 Checkpoints and corrective actions outlined in Table 6.2.2 shall be followed to determine that components are free of corrosion, foreign material, physical damage, tampering, or other conditions that adversely affect system operation.

6.3 Testing.

Where water damage is a possibility, an air test shall be conducted on the system at 25 psi (1.7 bar) prior to introducing water to the system.

6.3.1 Flow Tests.

6.3.1.1* A flow test shall be conducted every 5 years at the hydraulically most remote hose connections of each zone of an automatic standpipe system to verify the water supply still provides the design pressure at the required flow.

6.3.1.2 Where a flow test of the hydraulically most remote outlet(s) is not practical, the authority having jurisdiction shall be consulted for the appropriate location for the test.

6.3.1.3 All systems shall be flow tested and pressure tested at the requirements for the design criteria in effect at the time of the installation.

6.3.1.3.1 The actual test method(s) and performance criteria shall be discussed in advance with the authority having jurisdiction.

6.3.1.4 Standpipes, sprinkler connections to standpipes, or hose stations equipped with pressure reducing valves or pressure regulating valves shall have these valves inspected, tested, and maintained in accordance with the requirements of Chapter 13.

6.3.1.5 A main drain test shall be performed on all standpipe systems with automatic water supplies in accordance with the requirements of Chapter 13.

6.3.1.5.1 The test shall be performed at the low point drain for each standpipe or the main drain test connection where the supply main enters the building (when provided).

6.3.1.5.2 Pressure gauges shall be provided for the test and shall be maintained in accordance with 5.3.2.

6.3.2 Hydrostatic Tests.

6.3.2.1 Hydrostatic tests of not less than 200 psi (13.8 bar) pressure for 2 hours, or at 50 psi (3.4 bar) in excess of the maximum pressure, where maximum pressure is in excess of 150 psi (10.3 bar), shall be conducted every 5 years on manual standpipe systems and automatic-dry standpipe systems, including piping in the fire department connection.

6.3.2.2* Hydrostatic tests shall be conducted in accordance with 6.3.2.1 on any system that has been modified or repaired.

6.3.2.2.1 Manual wet standpipes that are part of a combined sprinkler/standpipe system shall not be required to be tested in accordance with 6.3.2.1.

6.3.2.3 The hydrostatic test pressure shall be measured at the low elevation point of the individual system or zone being tested. The inside standpipe piping shall show no leakage.

6.3.3 Alarm Devices. Where provided, waterflow alarm and supervisory devices shall be tested in accordance with 13.2.6 and 13.3.3.5.

6.3.3.1 Where freezing conditions necessitate a delay in testing, tests shall be performed as soon as weather allows.

6.4 Maintenance.

Maintenance and repairs shall be in accordance with 6.2.3 and Table 6.2.2.

6.4.1 Equipment that does not pass the inspection or testing requirements shall be repaired and tested again or replaced.

6.5 Component Action Requirements.

6.5.1 Whenever a component in a standpipe and hose system is adjusted, repaired, reconditioned or replaced, the action required in Table 6.5.1, Summary of Component Replacement Action Requirements, shall be performed.

Table 6.5.1 Summary of Component Replacement Action Requirements

Component	Adjust	Repair	Replace	Required Action
Water Delivery Components				
Control valves	X	X	X	See Chapter 13
Hose valve pressure regulating devices	X	X	X	See Chapter 13
System pressure regulating devices	X	X	X	See Chapter 13
Piping	X	X	X	Hydrostatic test in conformance with NFPA 14, <i>Standard for the Installation, Maintenance and Testing of Standpipe and Hose Systems</i>
Fire hose			X	
Hose valve	X	X	X	See Chapter 13
Fire department connections	X	X	X	See Chapter 13
Backflow prevention device	X	X	X	See Chapter 13
Valves				See Chapter 13
Fire pump				See Chapter 8
Alarm and Supervisory Components				
Vane-type waterflow	X	X		Operational test using inspection connection
Vane-type waterflow			X	Operational test using inspection connection
Pressure switch-type waterflow	X	X	X	Operational test using inspection connection
Water motor gong	X	X	X	Operational test using inspection connection

Table 6.5.1 Summary of Component Replacement Action Requirements

Component	Adjust	Repair	Replace	Required Action
Valve supervisory device	X	X	X	Operational test for receipt c and verification of conforma NFPA 14 and/or NFPA 72, 1 Fire Alarm Code
Status-Indicating Components				
Gauges			X	Verify at 0 psi and system w pressure
System Housing and Protection Components				
Cabinet	X	X	X	Verify compliance with NFF
Hose storage rack	X	X	X	Verify compliance with NFF
Testing and Maintenance Components				
Drain riser	X	X	X	Check for leaks while flowir connection above the repair
Auxiliary drains	X	X	X	Check for leaks at system w pressure
Main drain	X	X	X	Check for leaks and residual during main drain test
Structural Components				
Hanger/seismic bracing	X	X	X	Verify conformance with NF
Pipe stands	X	X	X	Verify conformance with NF
Informational Components				
Identification signs	X	X	X	Verify conformance with NF
Hydraulic placards	X	X	X	Verify conformance with NF

6.5.1.1 Where the original installation standard is different from the cited standard, the use of the appropriate installing standard shall be permitted.

6.5.1.2 A main drain test shall be required if the control valve or other upstream valve was operated in accordance with 13.3.3.4.

6.5.1.3 These actions shall not require a design review, which is outside the scope of this standard.